


See Dwg No 779-881-2 sta 10+89



See Dwg No 779-881-6 sta 19+04

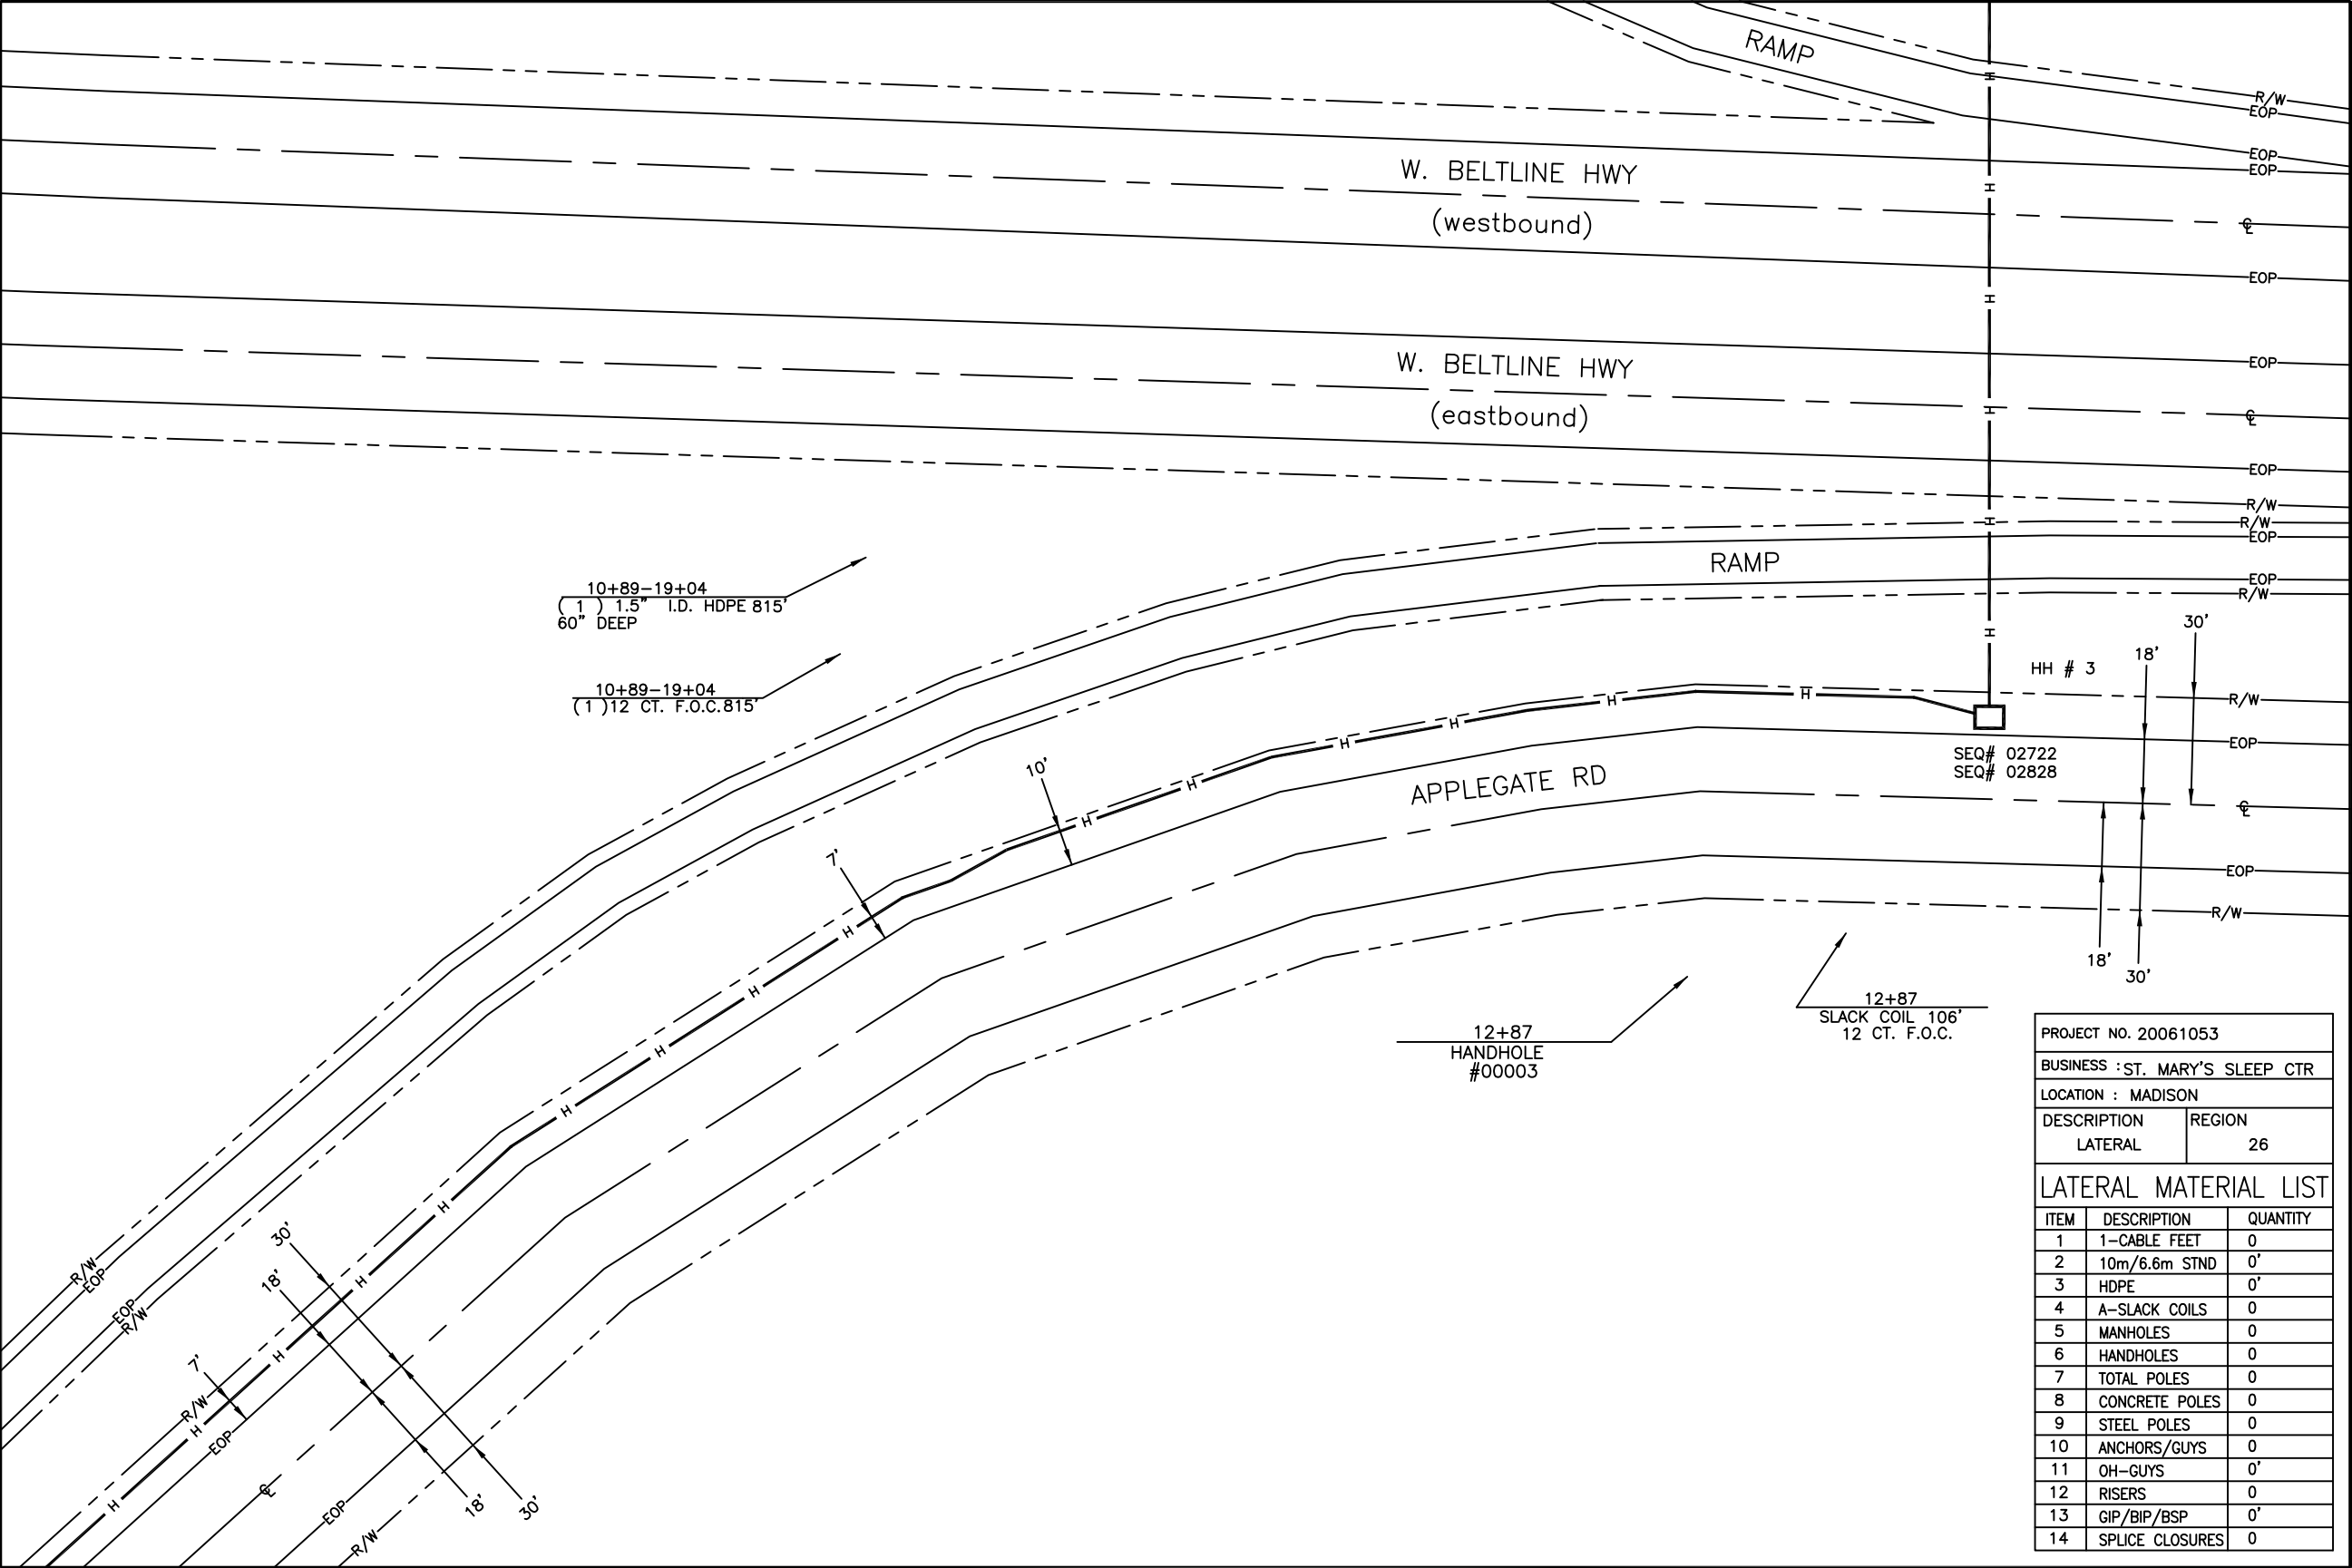

PROJECT NO. 20061053	
PROJECT CITY - MADISON, WI	
FILENAME 779-881-4	FULL FILENAME 779-881-4.dwg
DATE 3-28-06	DESCRIPTION GRID
DWG. NO. 779-881-4	DRAWN BY CTS
SCALE 1"=50'	REGION 26

REVISIONS			
REV.	DESCRIPTION	INITIALS	DATE
0	AB-REDLINES	MBTSI	6-28-06

MATERIAL LIST		
ITEM	DESCRIPTION	QUANTITY
1	1-CABLE FEET	0
2	10m/6.6m STND	0'
3	HDPE	0'/0'
4	A-SLACK COILS	0
5	MANHOLES	0
6	HANDHOLES	0
7	TOTAL POLES	0
8	CONCRETE POLES	0
9	STEEL POLES	0
10	ANCHORS/GUYS	0
11	OH-GUYS	0'
12	RISERS	0
13	GIP/BIP/BSP	0'
14	SPLICE CLOSURES	0

SIGNATURE CYCLE	
OSP ENG:	
SIGNATURE:	
OSP MNGR:	
SIGNATURE:	
CAD SUP:	
SIGNATURE:	
CONST SUP:	
SIGNATURE:	

CENTURYTEL		
779-881-1	779-881-2	780-881-1
779-881-3	779-881-4	780-881-3
779-881-5	779-881-6	780-881-6
DISCLAIMER		

EXCEPT AS MAY BE OTHERWISE PROVIDED BY CONTRACT, THESE DRAWINGS AND SPECIFICATIONS SHALL REMAIN THE PROPERTY OF CENTURYTEL SOLUTIONS BEING ISSUED IN STRICT CONFIDENCE AND SHALL NOT BE REPRODUCED, COPIED, OR USED FOR ANY PURPOSE, WITHOUT SPECIFIC WRITTEN PERMISSION.