


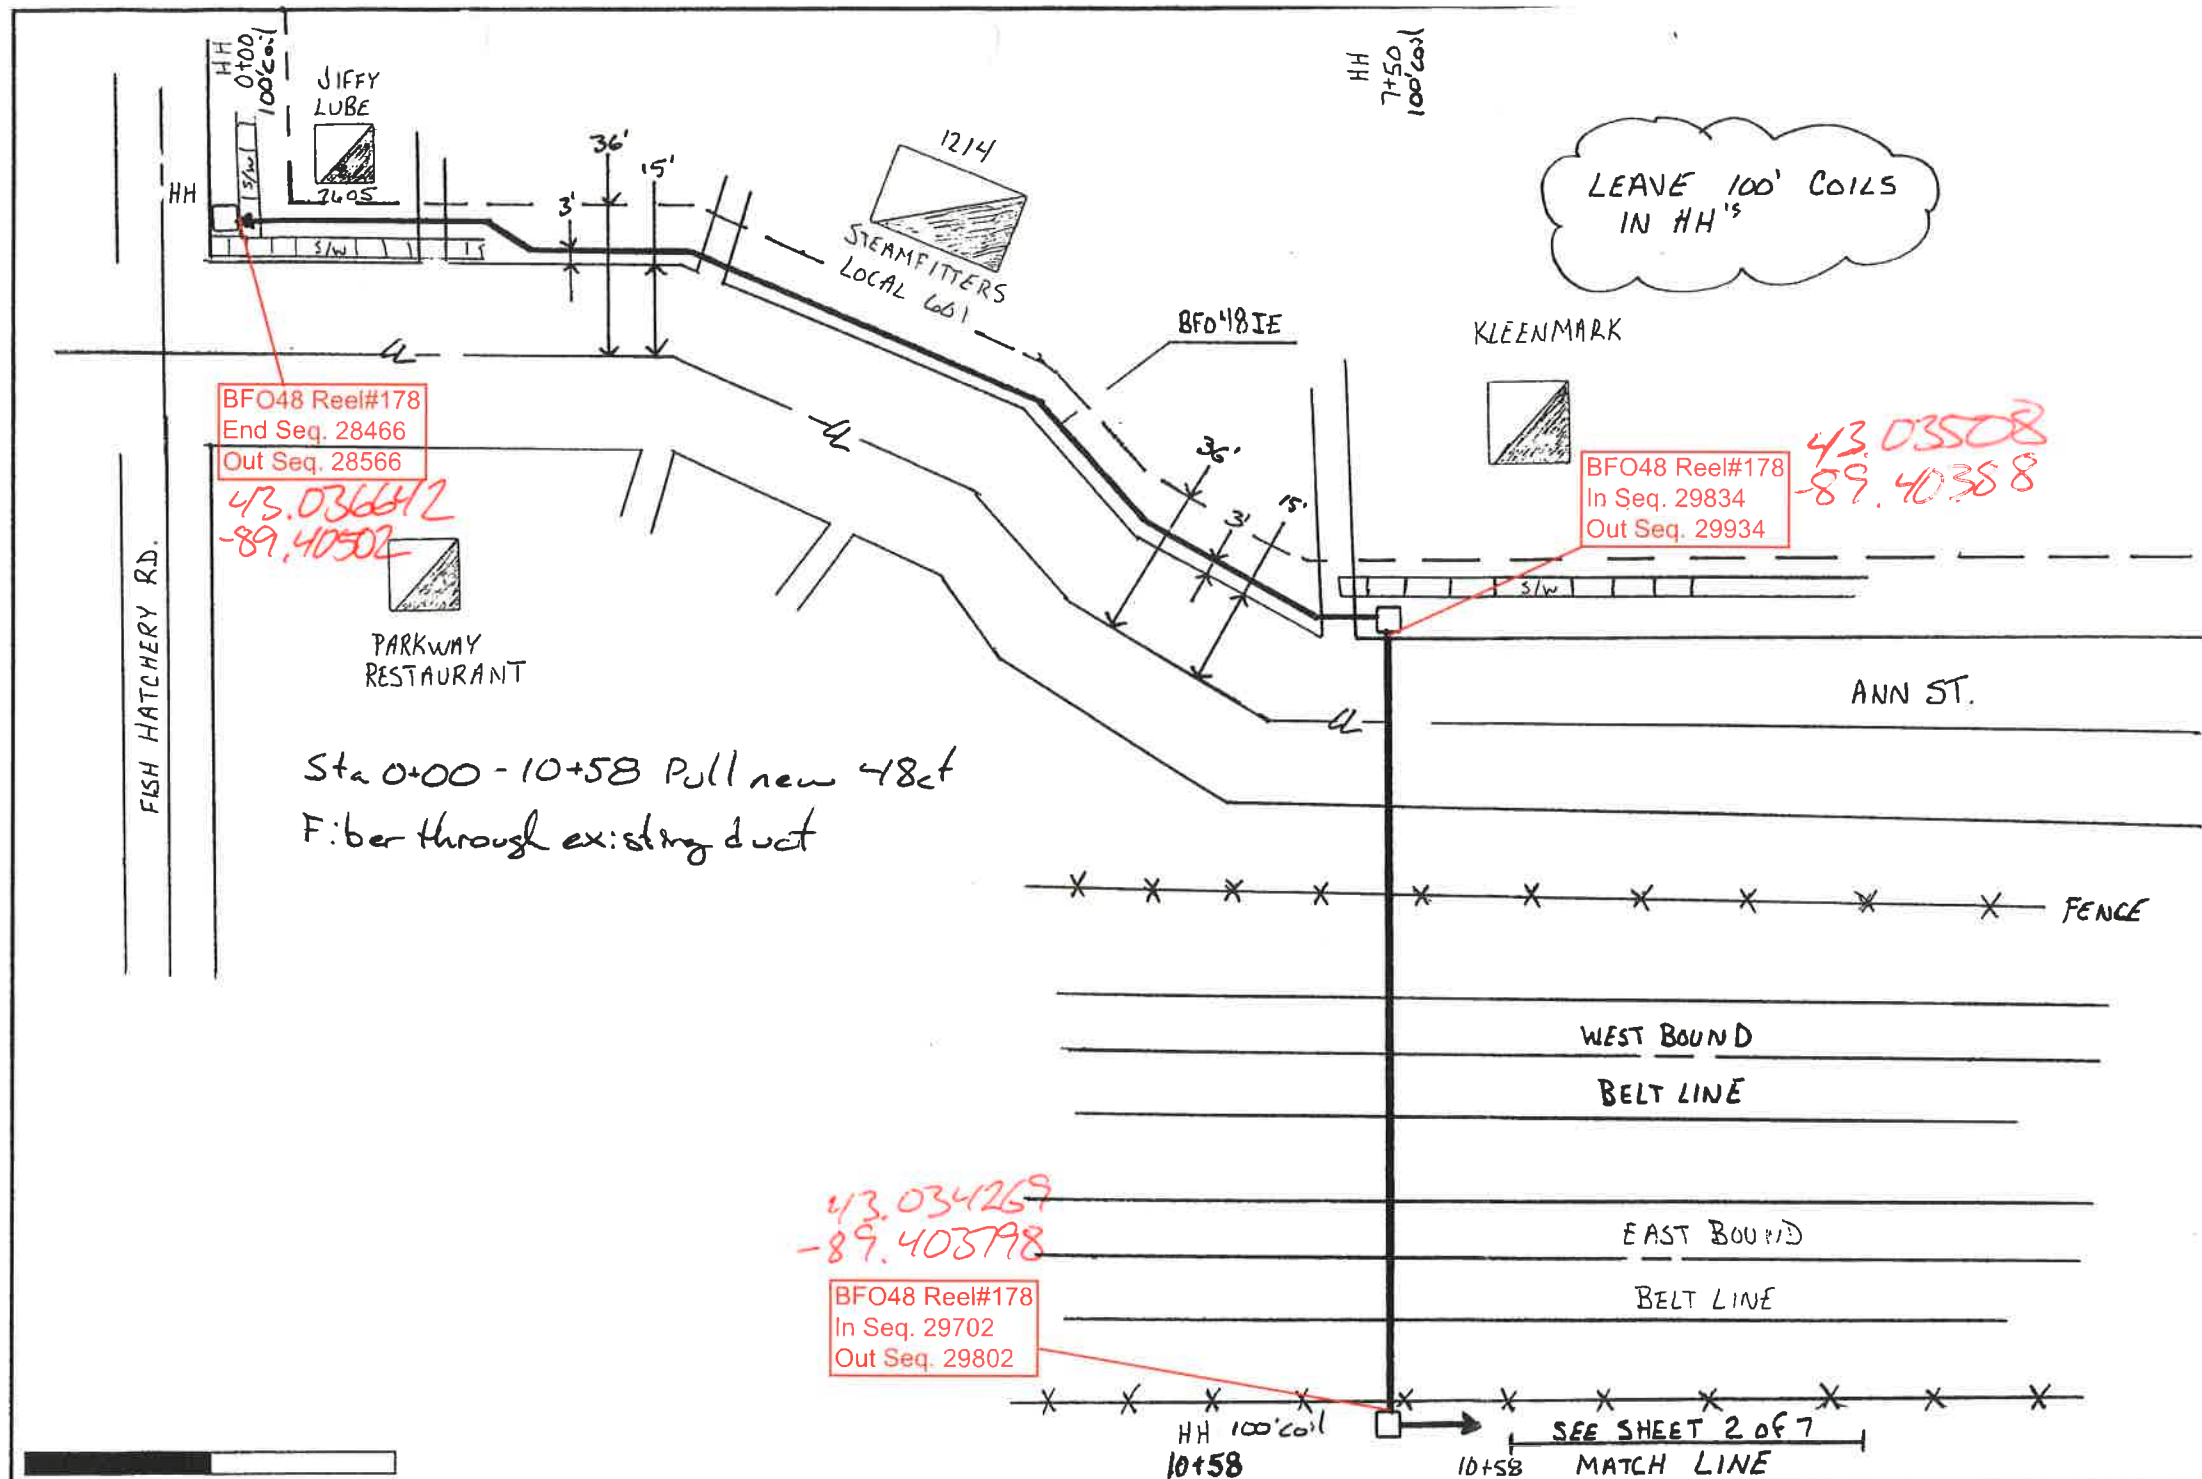

Assembly Units	Quantity	As-built	Assembly Units	Quantity	As-built	Assembly Units	Quantity	As-built
BFO48IE	1358	1336' ✓						
WHBFO	1	1 ✓						
HO-1	4	4 ✓						
BM2C	1	1 ✓						
BM2(5/8X8)	1	1 ✓						
WBHF		3						


 CenturyLink
 1151 CenturyTel Dr Bldg A
 Wentzville, MO 63385
 Main Office No: 636-887-4747
 Network Ops Cntr: 800 604-6688
 Main Fax No: 636-887-4960

TITLE: PLACE FACILITIES TO MERITER BLDG.
 DRAWING DESCRIPTION: EXTEND 48 FIBER TO 2LSD NOVATION PKWY
 NOTICE: INFORMATION ON THIS DOCUMENT IS PROPRIETARY AND SHALL NOT BE USED, COPIED, REPRODUCED OR DISCLOSED IN WHOLE OR IN PART WITHOUT WRITTEN CONSENT OF LIGHTCORE

Revisions		
No.	Description	Date
1.		
2.		
3.		
4.		
5.		

DATE: 6/2011	PJNO: E.255771
SCALE: NTS	City / State: MADISON, WI
DRAWN BY: TO	SHEET: 2 OF 8
CHECKED BY: DB	DRAWING: 1
APPROVED BY:	