


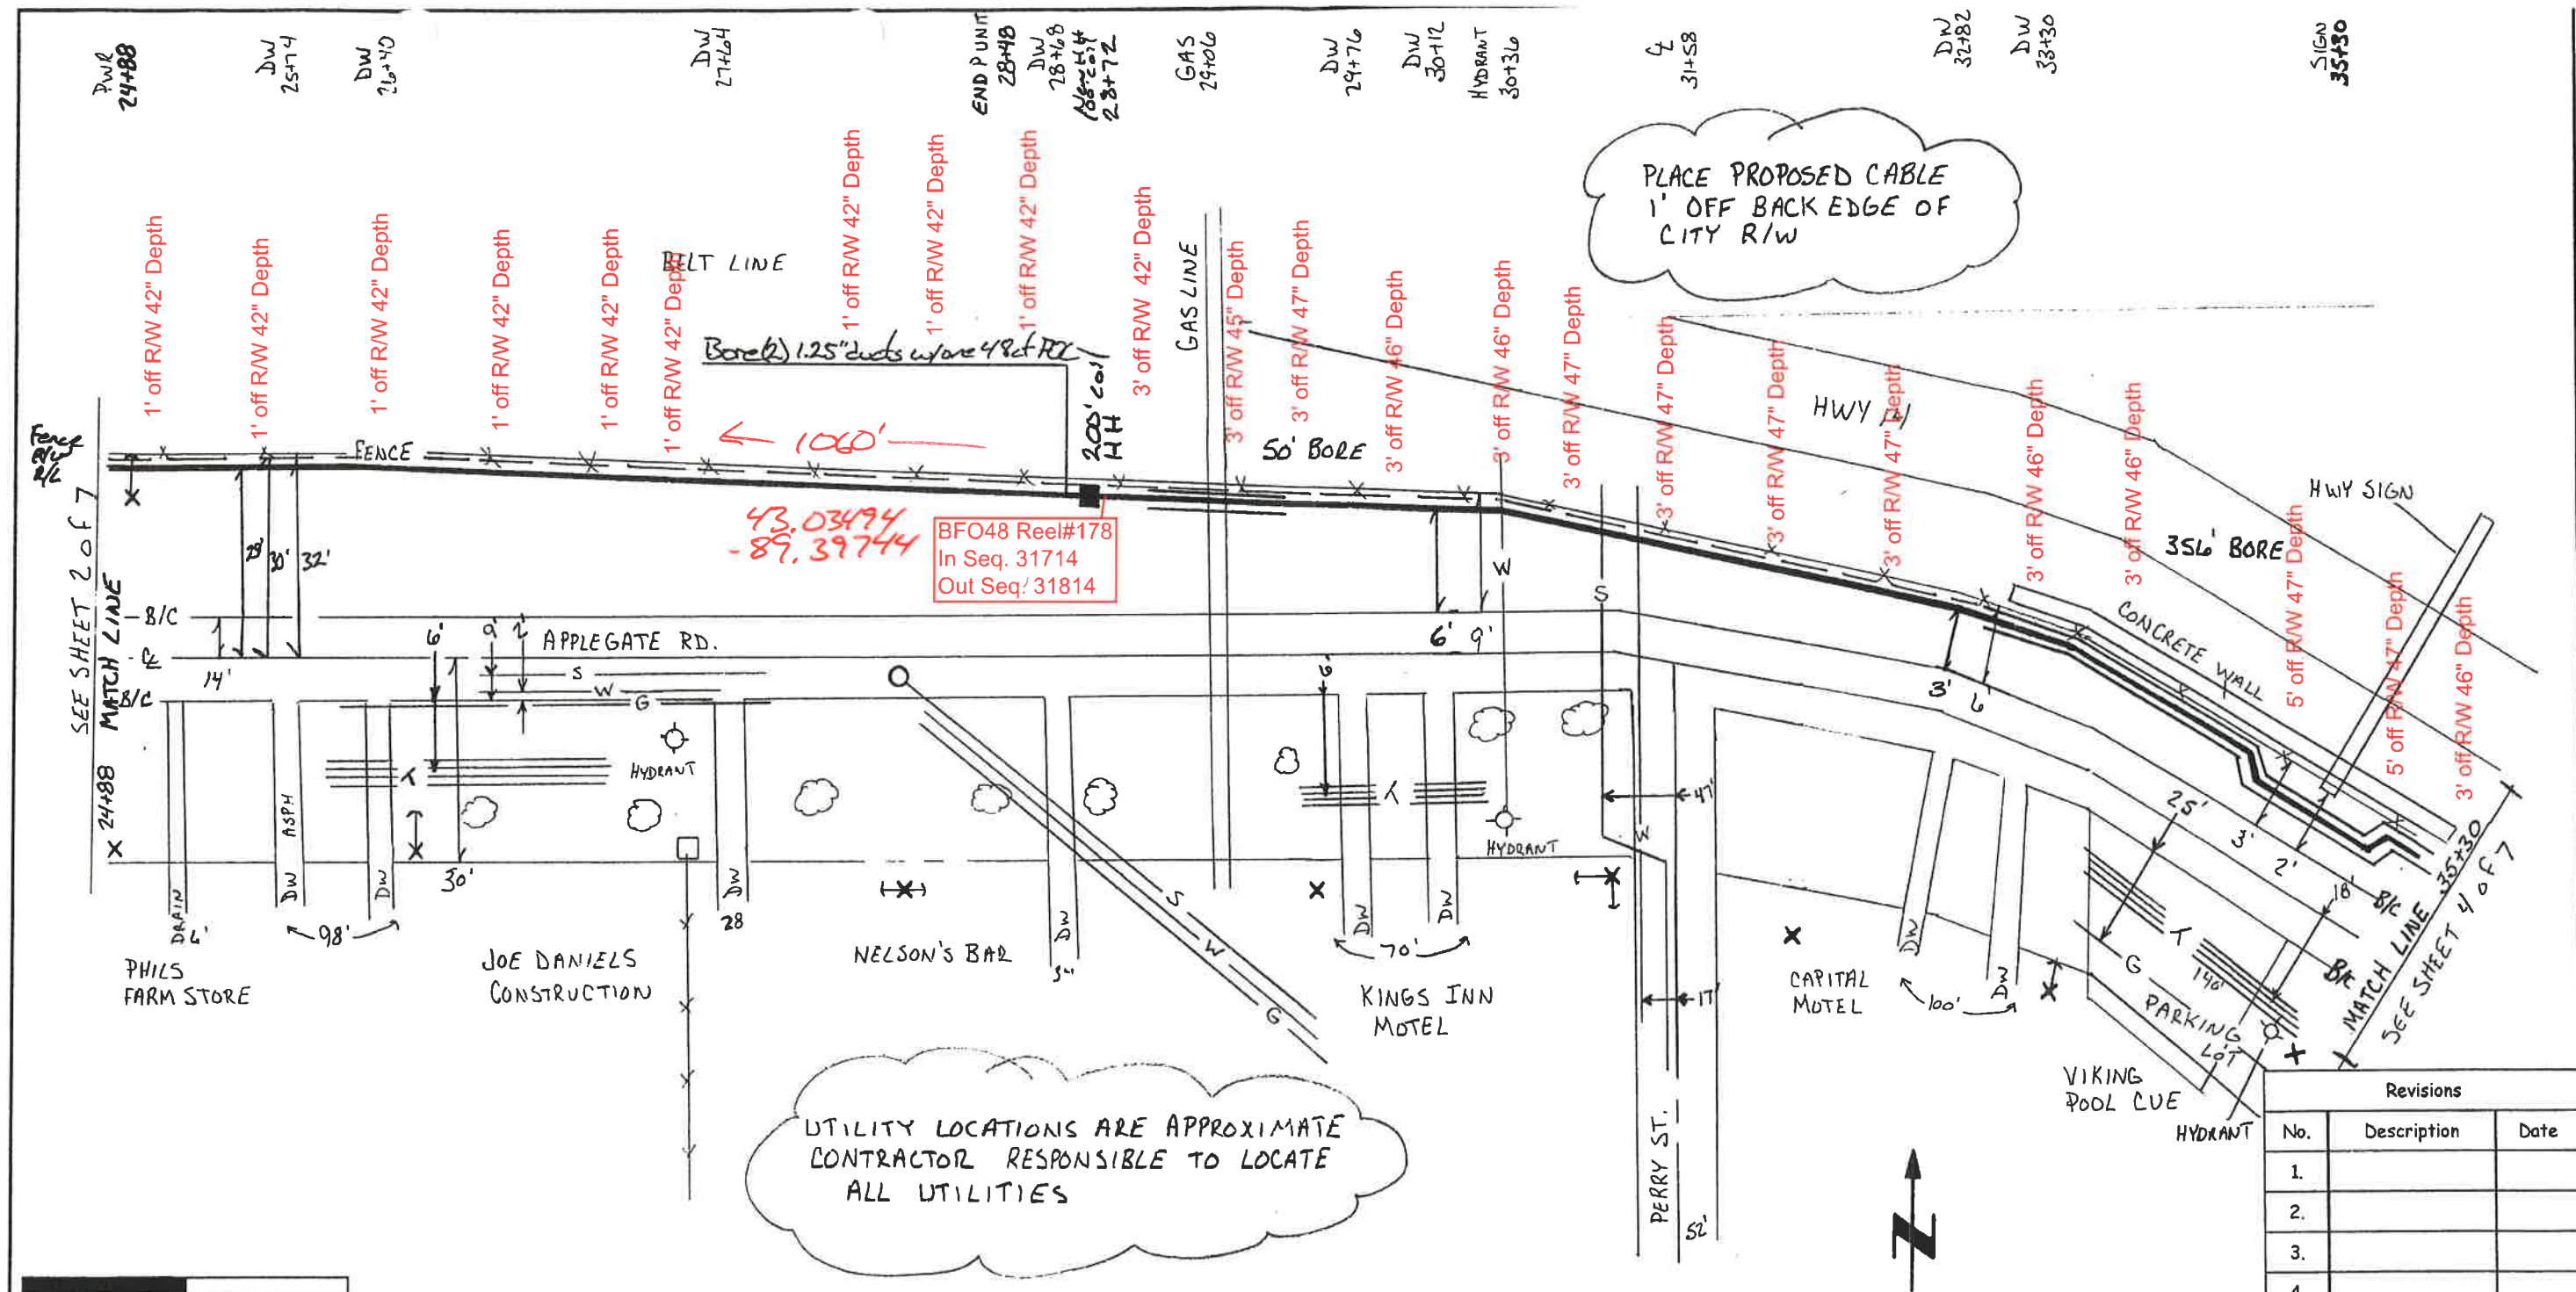

Assembly Units	Quantity	As-built	Assembly Units	Quantity	As-built	Assembly Units	Quantity	As-built
BM60 (1.25) 2 PD	1042	1042' 1060'						
BFO48 IE	1242	1160' ✓						
BHF (30M) 8K6 ST	1	1 ✓						
BM53P (8)	1	1 ✓						

CenturyLink
 1151 CenturyTel Dr Bldg A
 Wentzville, MO 63385
 Main Office No: 636-887-4747
 Network Ops Cntr: 800 604-6688
 Main Fax No: 636-887-4960

TITLE:
 PLACE FACILITIES TO MERITER BLDG
 DRAWING DESCRIPTION:
 EXTEND 48 FIBER TO 2650 NOVATION PKWY

NOTICE
 INFORMATION ON THIS DOCUMENT IS PROPRIETARY AND SHALL NOT BE USED, COPIED, REPRODUCED
 OR DISCLOSED IN WHOLE OR IN PART WITHOUT WRITTEN CONSENT OF LIGHTCORE

Revisions		
No.	Description	Date
1.		
2.		
3.		
4.		
5.		

DATE:	PJNO:
6/2011	E.255771
SCALE:	City / State:
NTS	MADISON, WI
DRAWN BY:	
TO	SHEET: 4 OF 8
CHECKED BY:	DRAWING:
APPROVED BY:	3