


MATCHLINE STA. 3+39 E SHEET 2

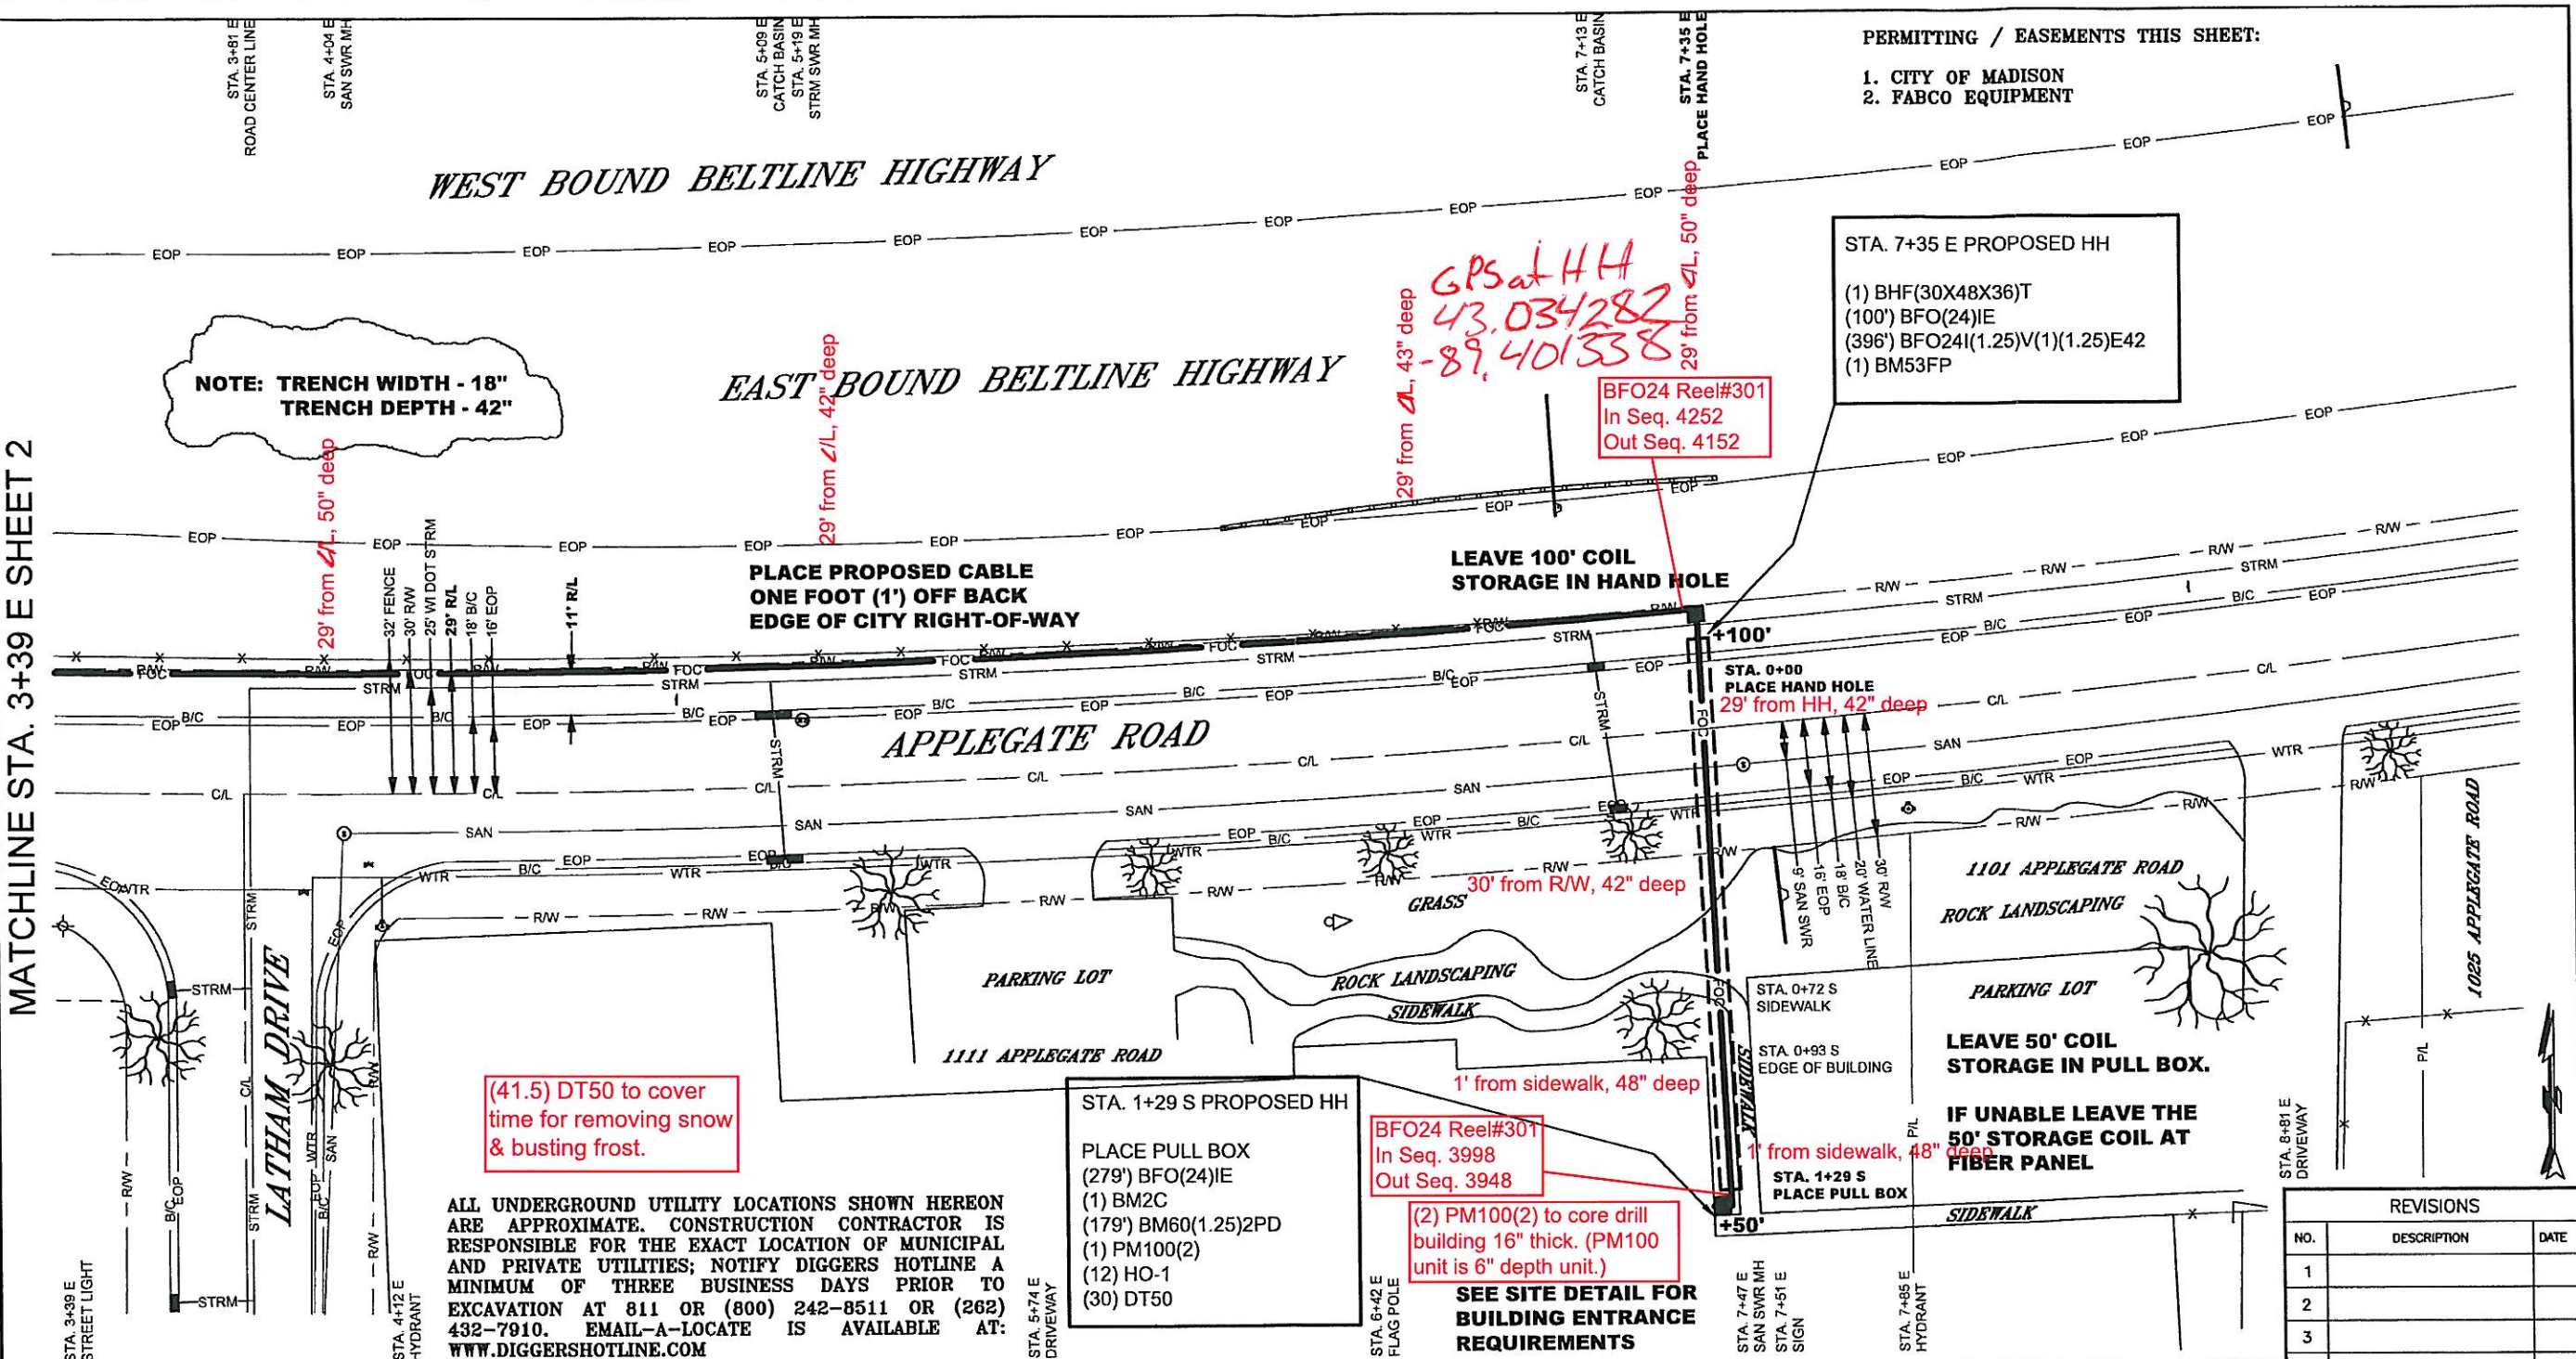

ASSEMBLY UNITS	QTY	AS BUILT	ASSEMBLY UNITS	QTY	AS BUILT	ASSEMBLY UNITS	QTY	AS BUILT
BHF(30X48X36)T	1	1	DT50	30	71.5			
HO-1	12	4	HBFO(24)		1			
BFO24I(1.25)V(1)(1.25)E42	0							
BM53FP	1	1						
BFO24IE	795	806	1214					
BM60(1.25)2PD	545	545	860					
PM100(2)	1	2						
BM2C	1	1						

14567 N. Outer Forty Rd Suite 500
Chesterfield Missouri, 63017
Main Office No.: 314-880-1000
Network Ops Cntr.: 800-604-6688
Main Fax No.: 314-880-1999

TITLE
PLACE FACILITIES TO FABCO EQUIPMENT
DRAWING DESCRIPTION
EXTEND FIBER TO 1111 APPLGATE ROAD MADISON, WISCONSIN

*****NOTICE*****
INFORMATION ON THIS DOCUMENT IS PROPRIETARY AND SHALL NOT BE USED, COPIED,
REPRODUCED OR DISCLOSED IN WHOLE OR IN PART WITHOUT WRITTEN CONSENT OF LIGHTCORE

NO.	DESCRIPTION	DATE
1		
2		
3		
4		
5		
6		

DATE
12/2010
SCALE
NTS
DRAWN BY
K.WHITING
CHECKED BY
APPROVED BY:

PJ NO.
E.229228
CNTY:DANE
STATE:WISCONSIN
SHEET 3 OF 7
DRAWING NO.
2