



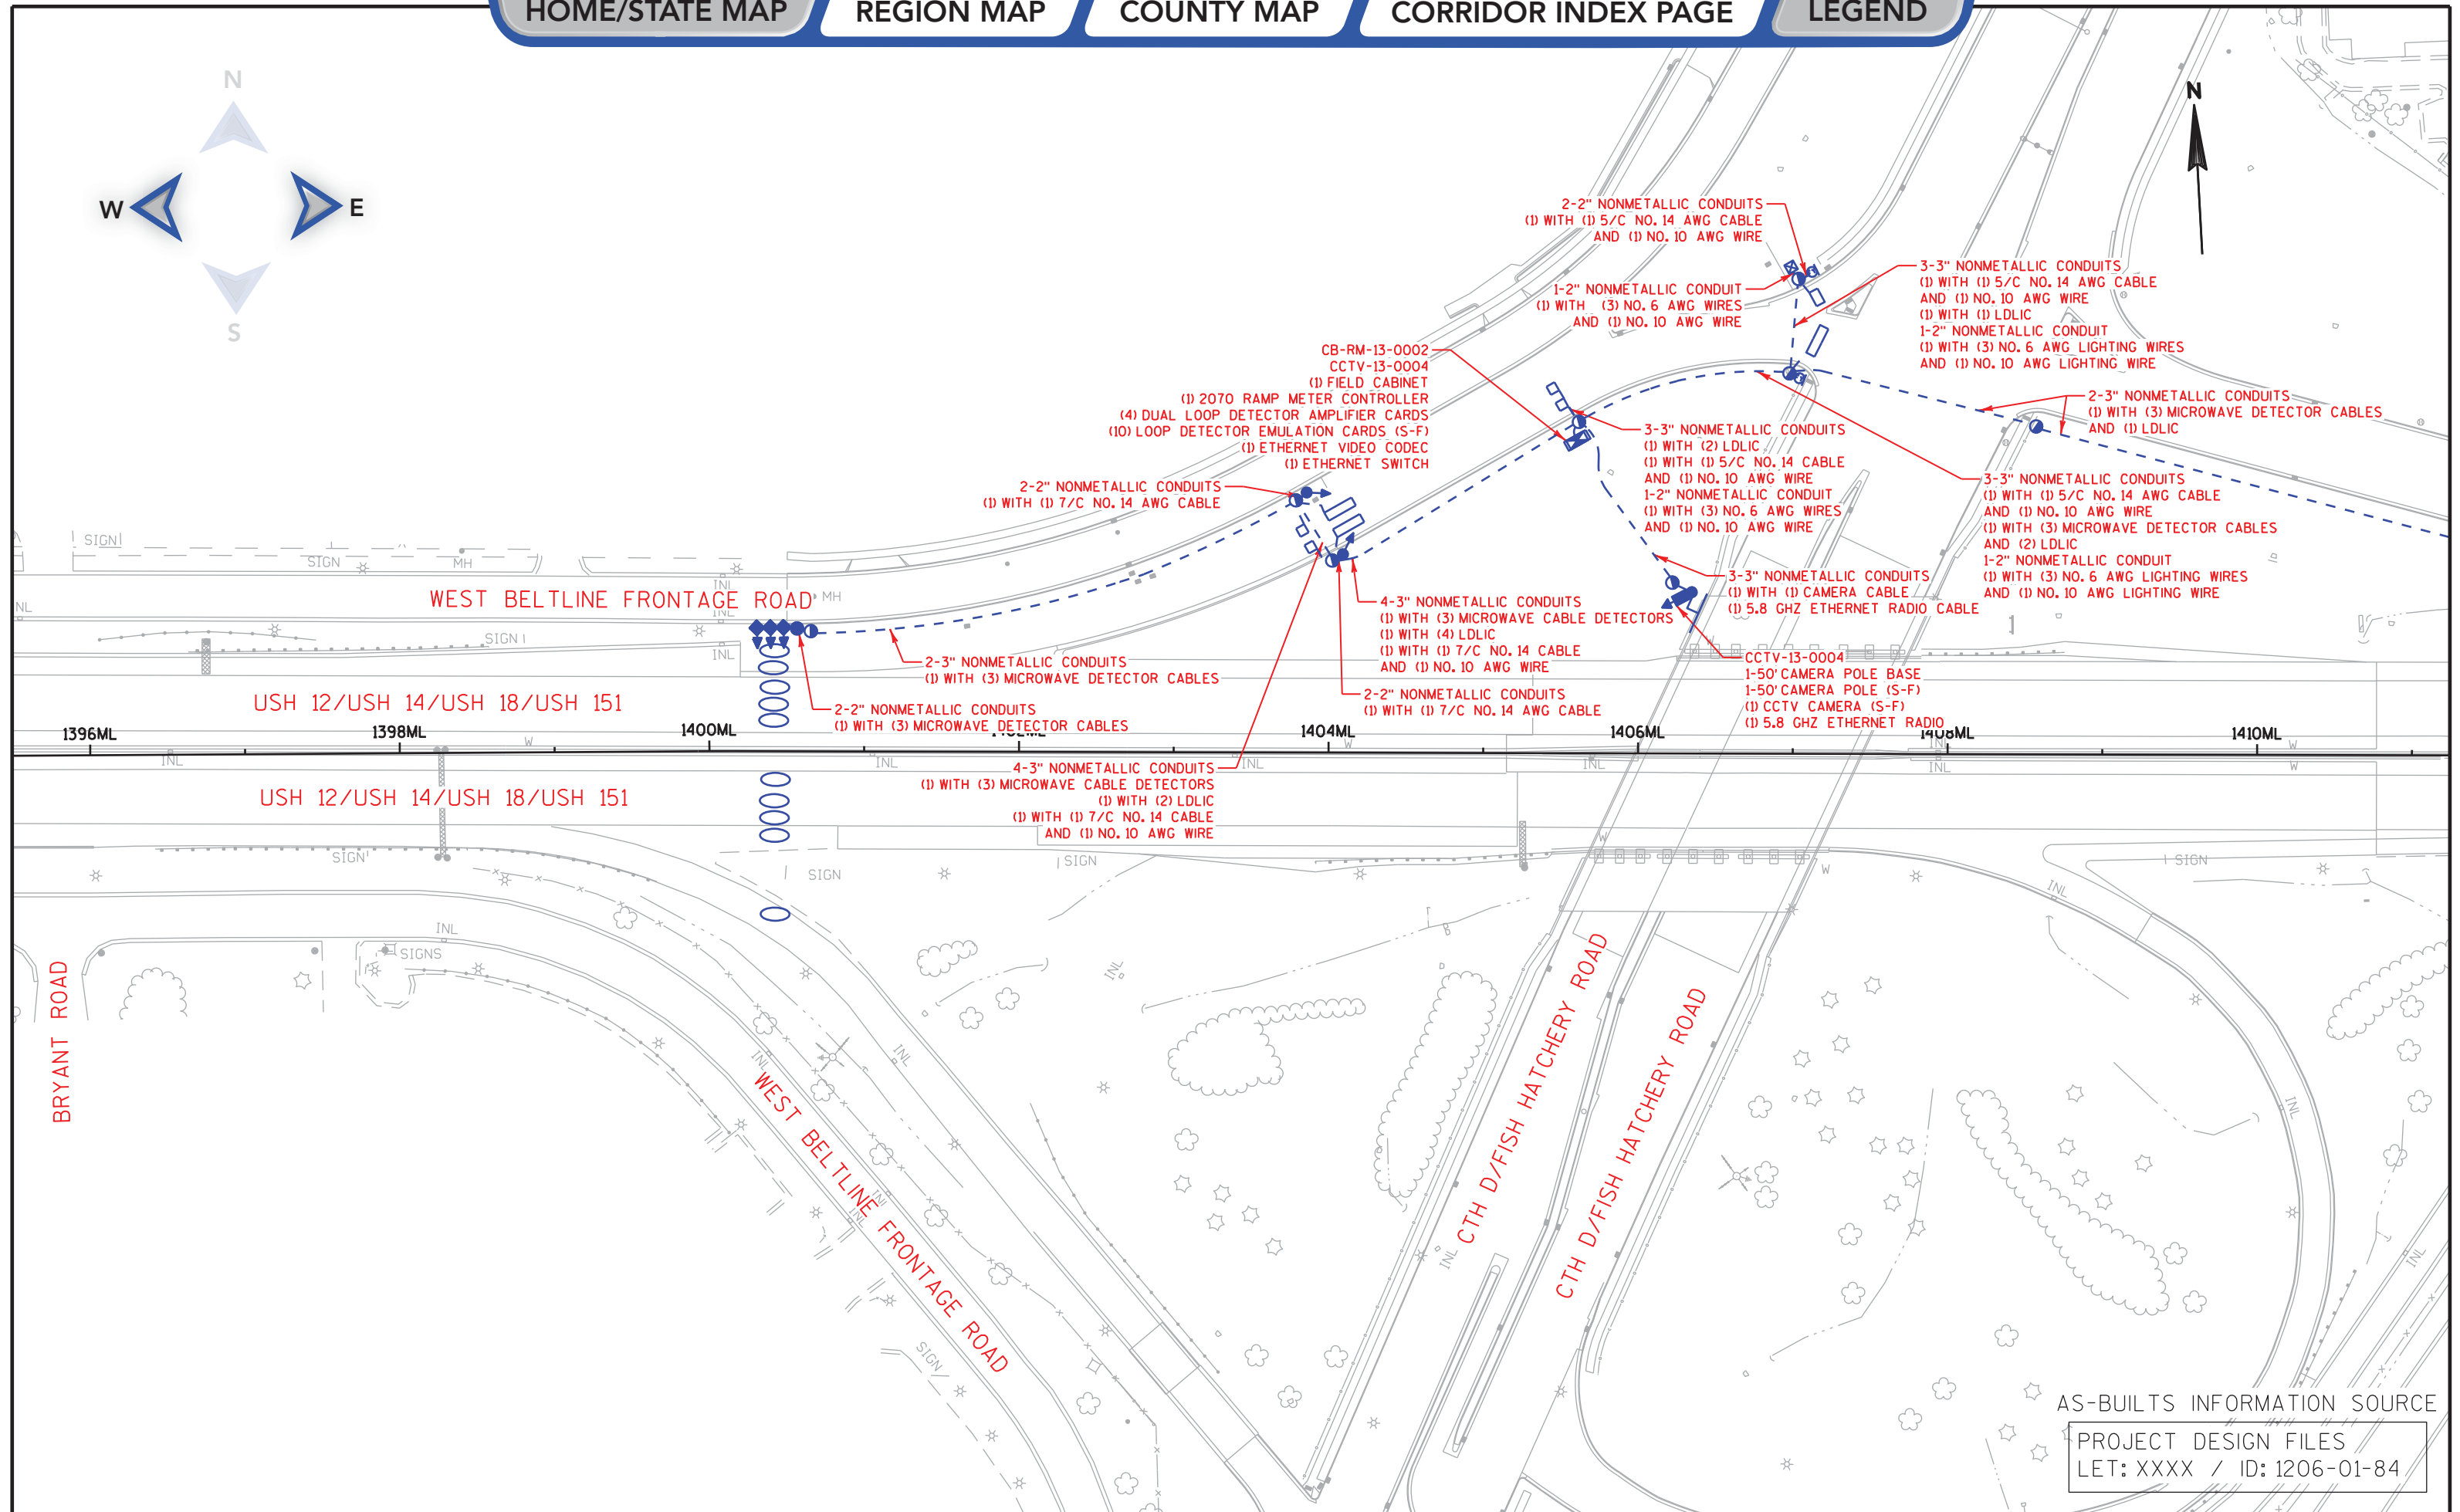



AS-BUILTS INFORMATION SOURCE
PROJECT DESIGN FILES
LET: XXXX / ID: 1206-01-84

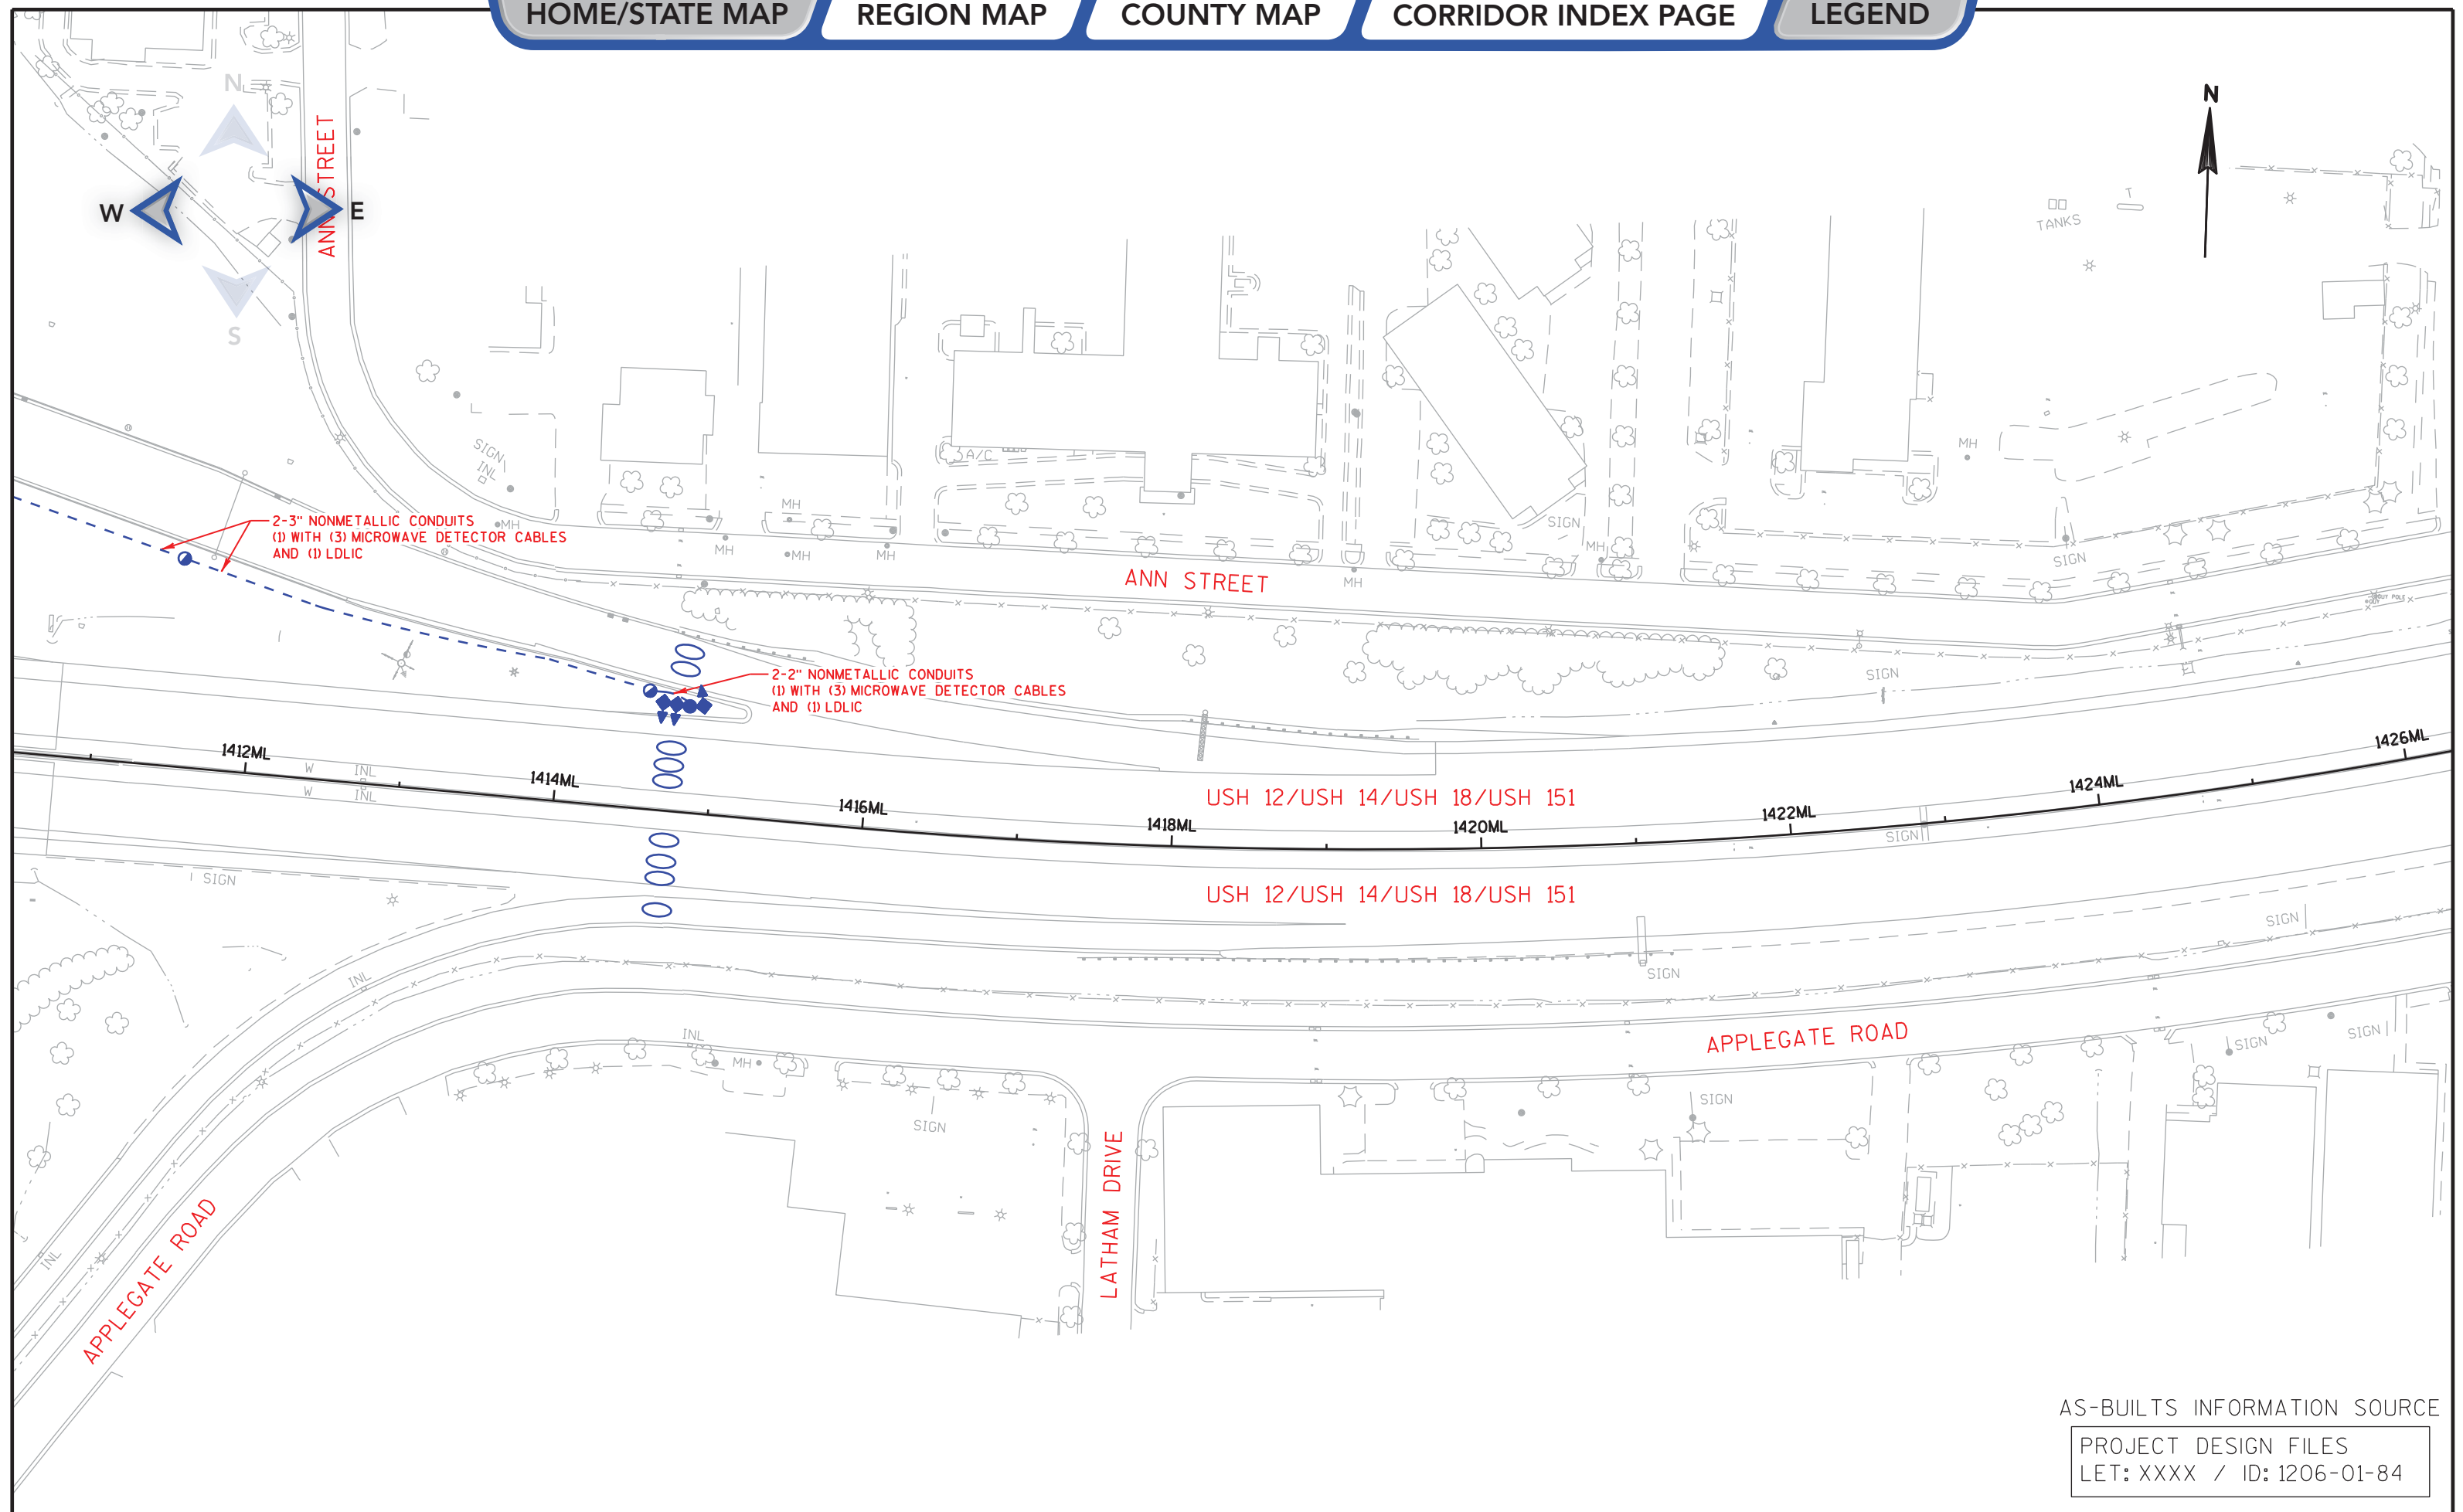


AS-BUILTS INFORMATION SOURCE

PROJECT DESIGN FILES
LET: XXXX / ID: 1206-01-84

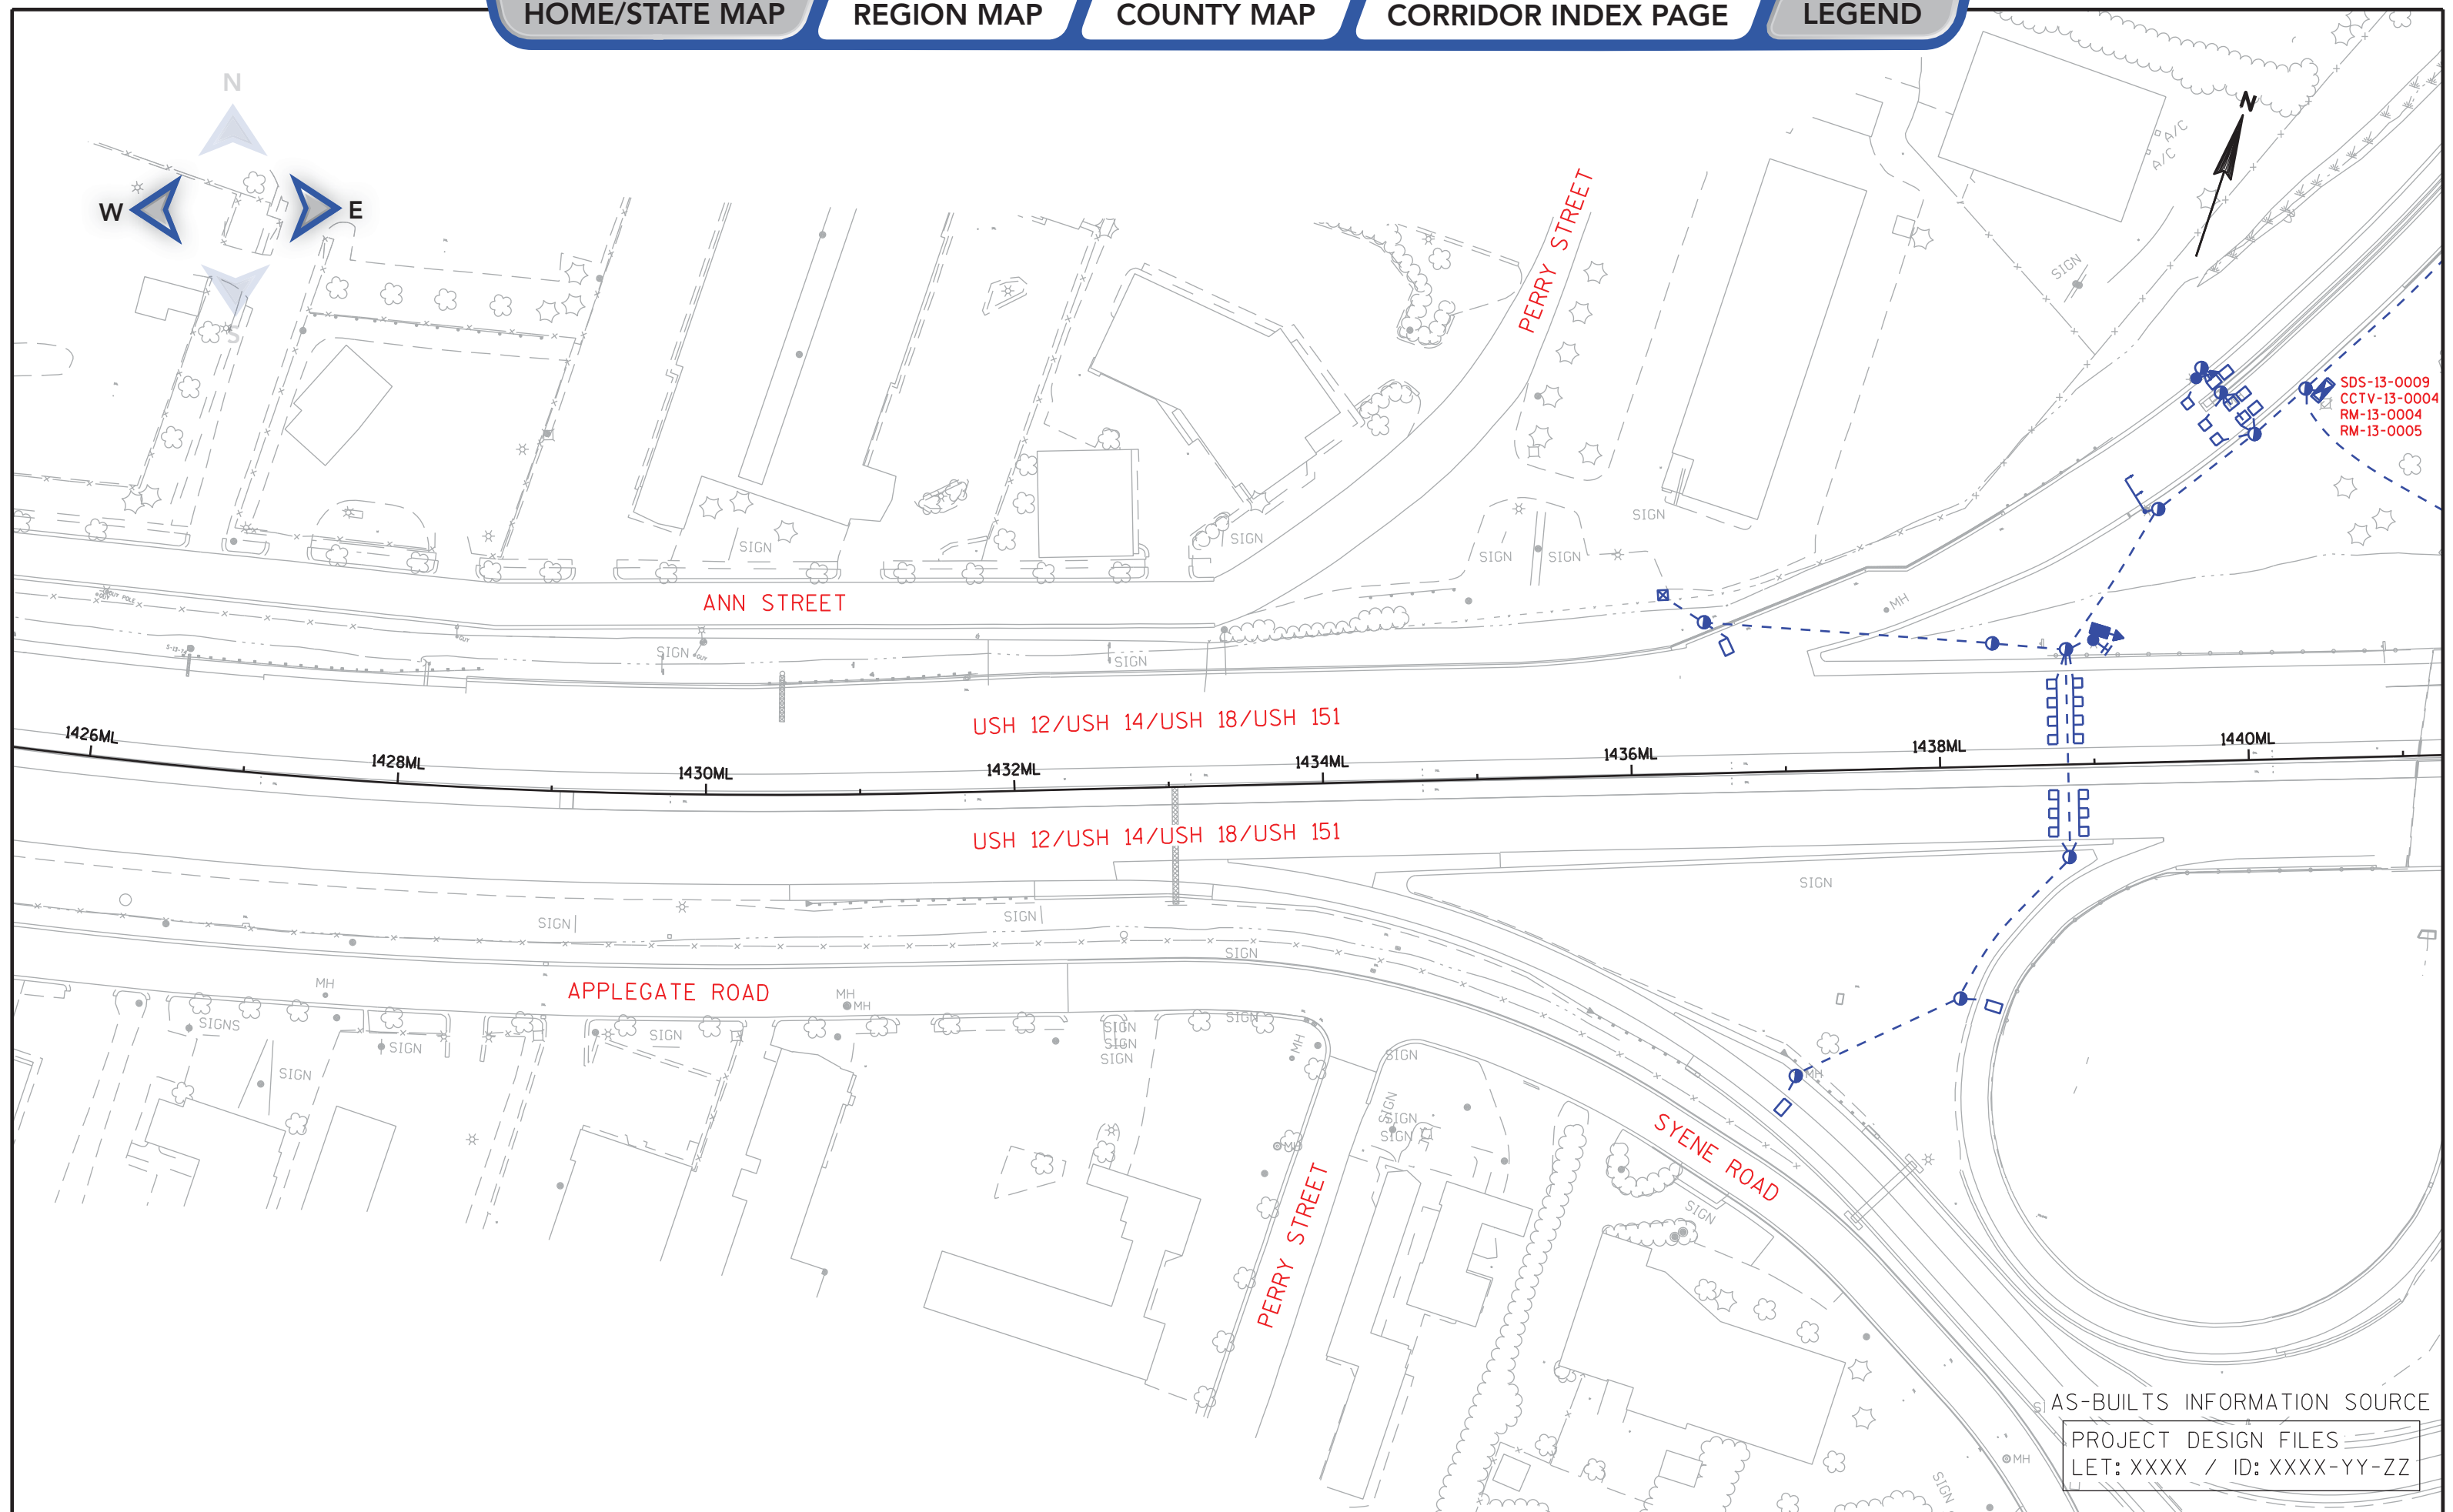


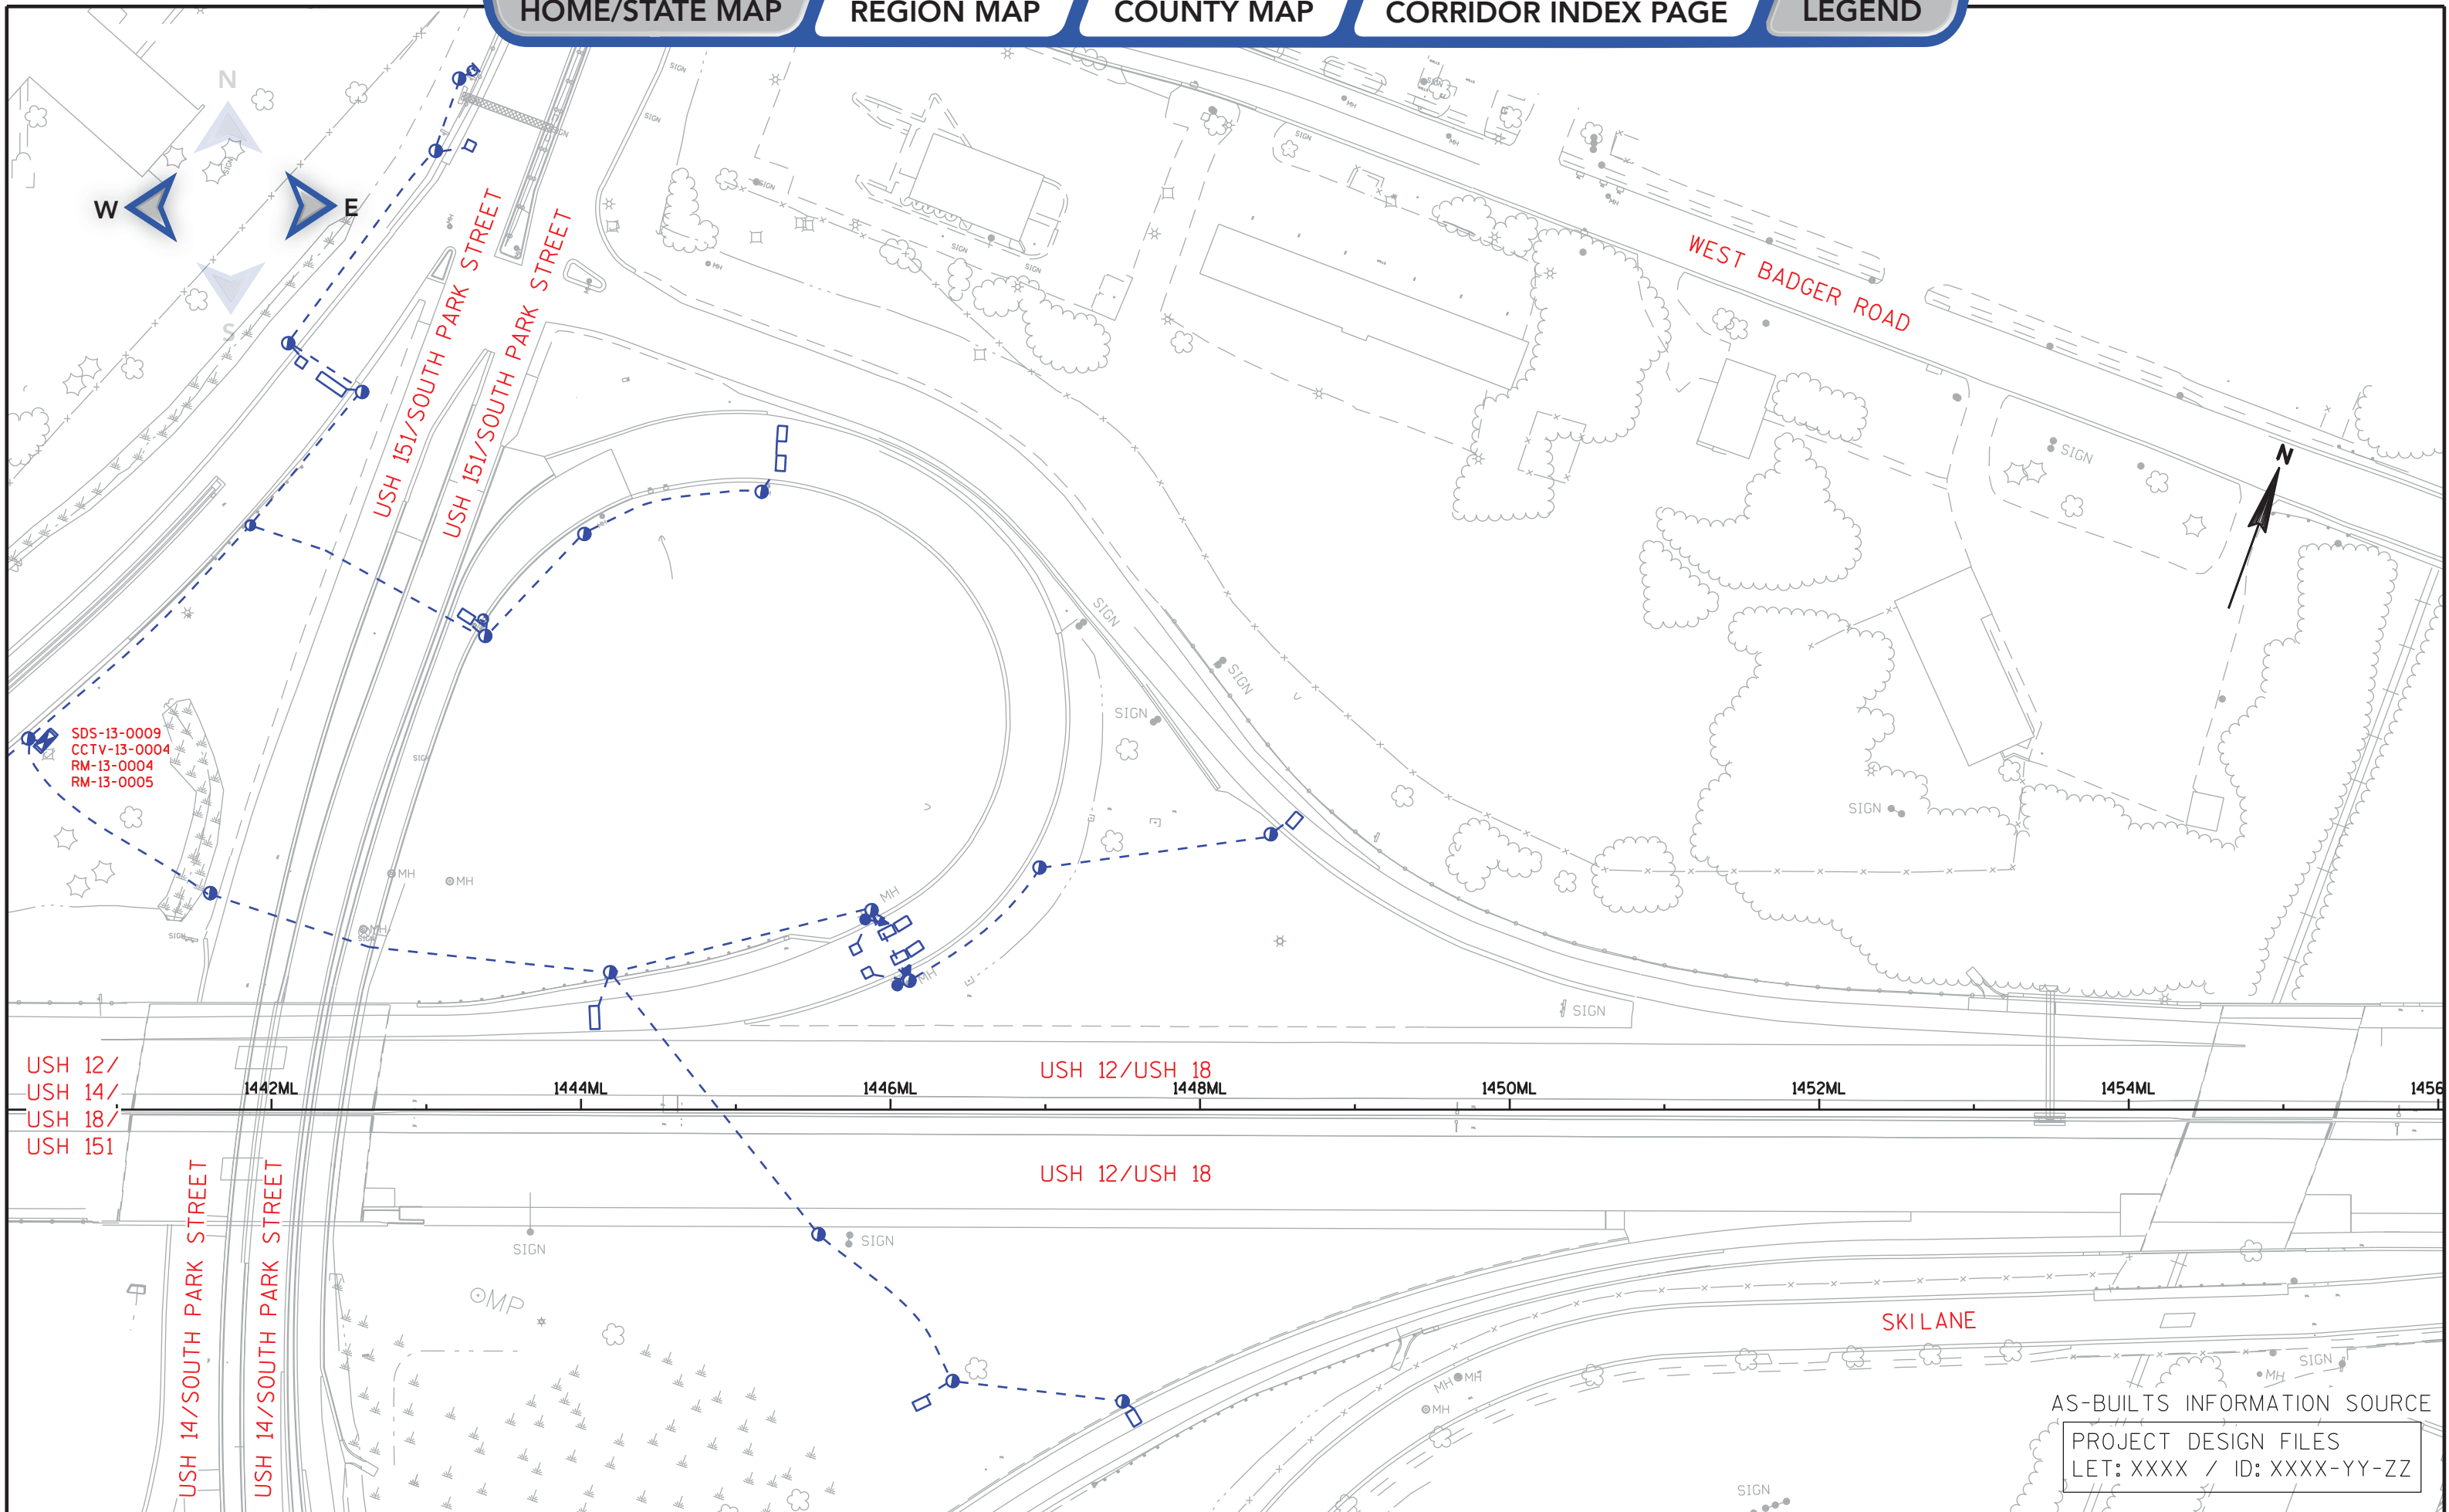


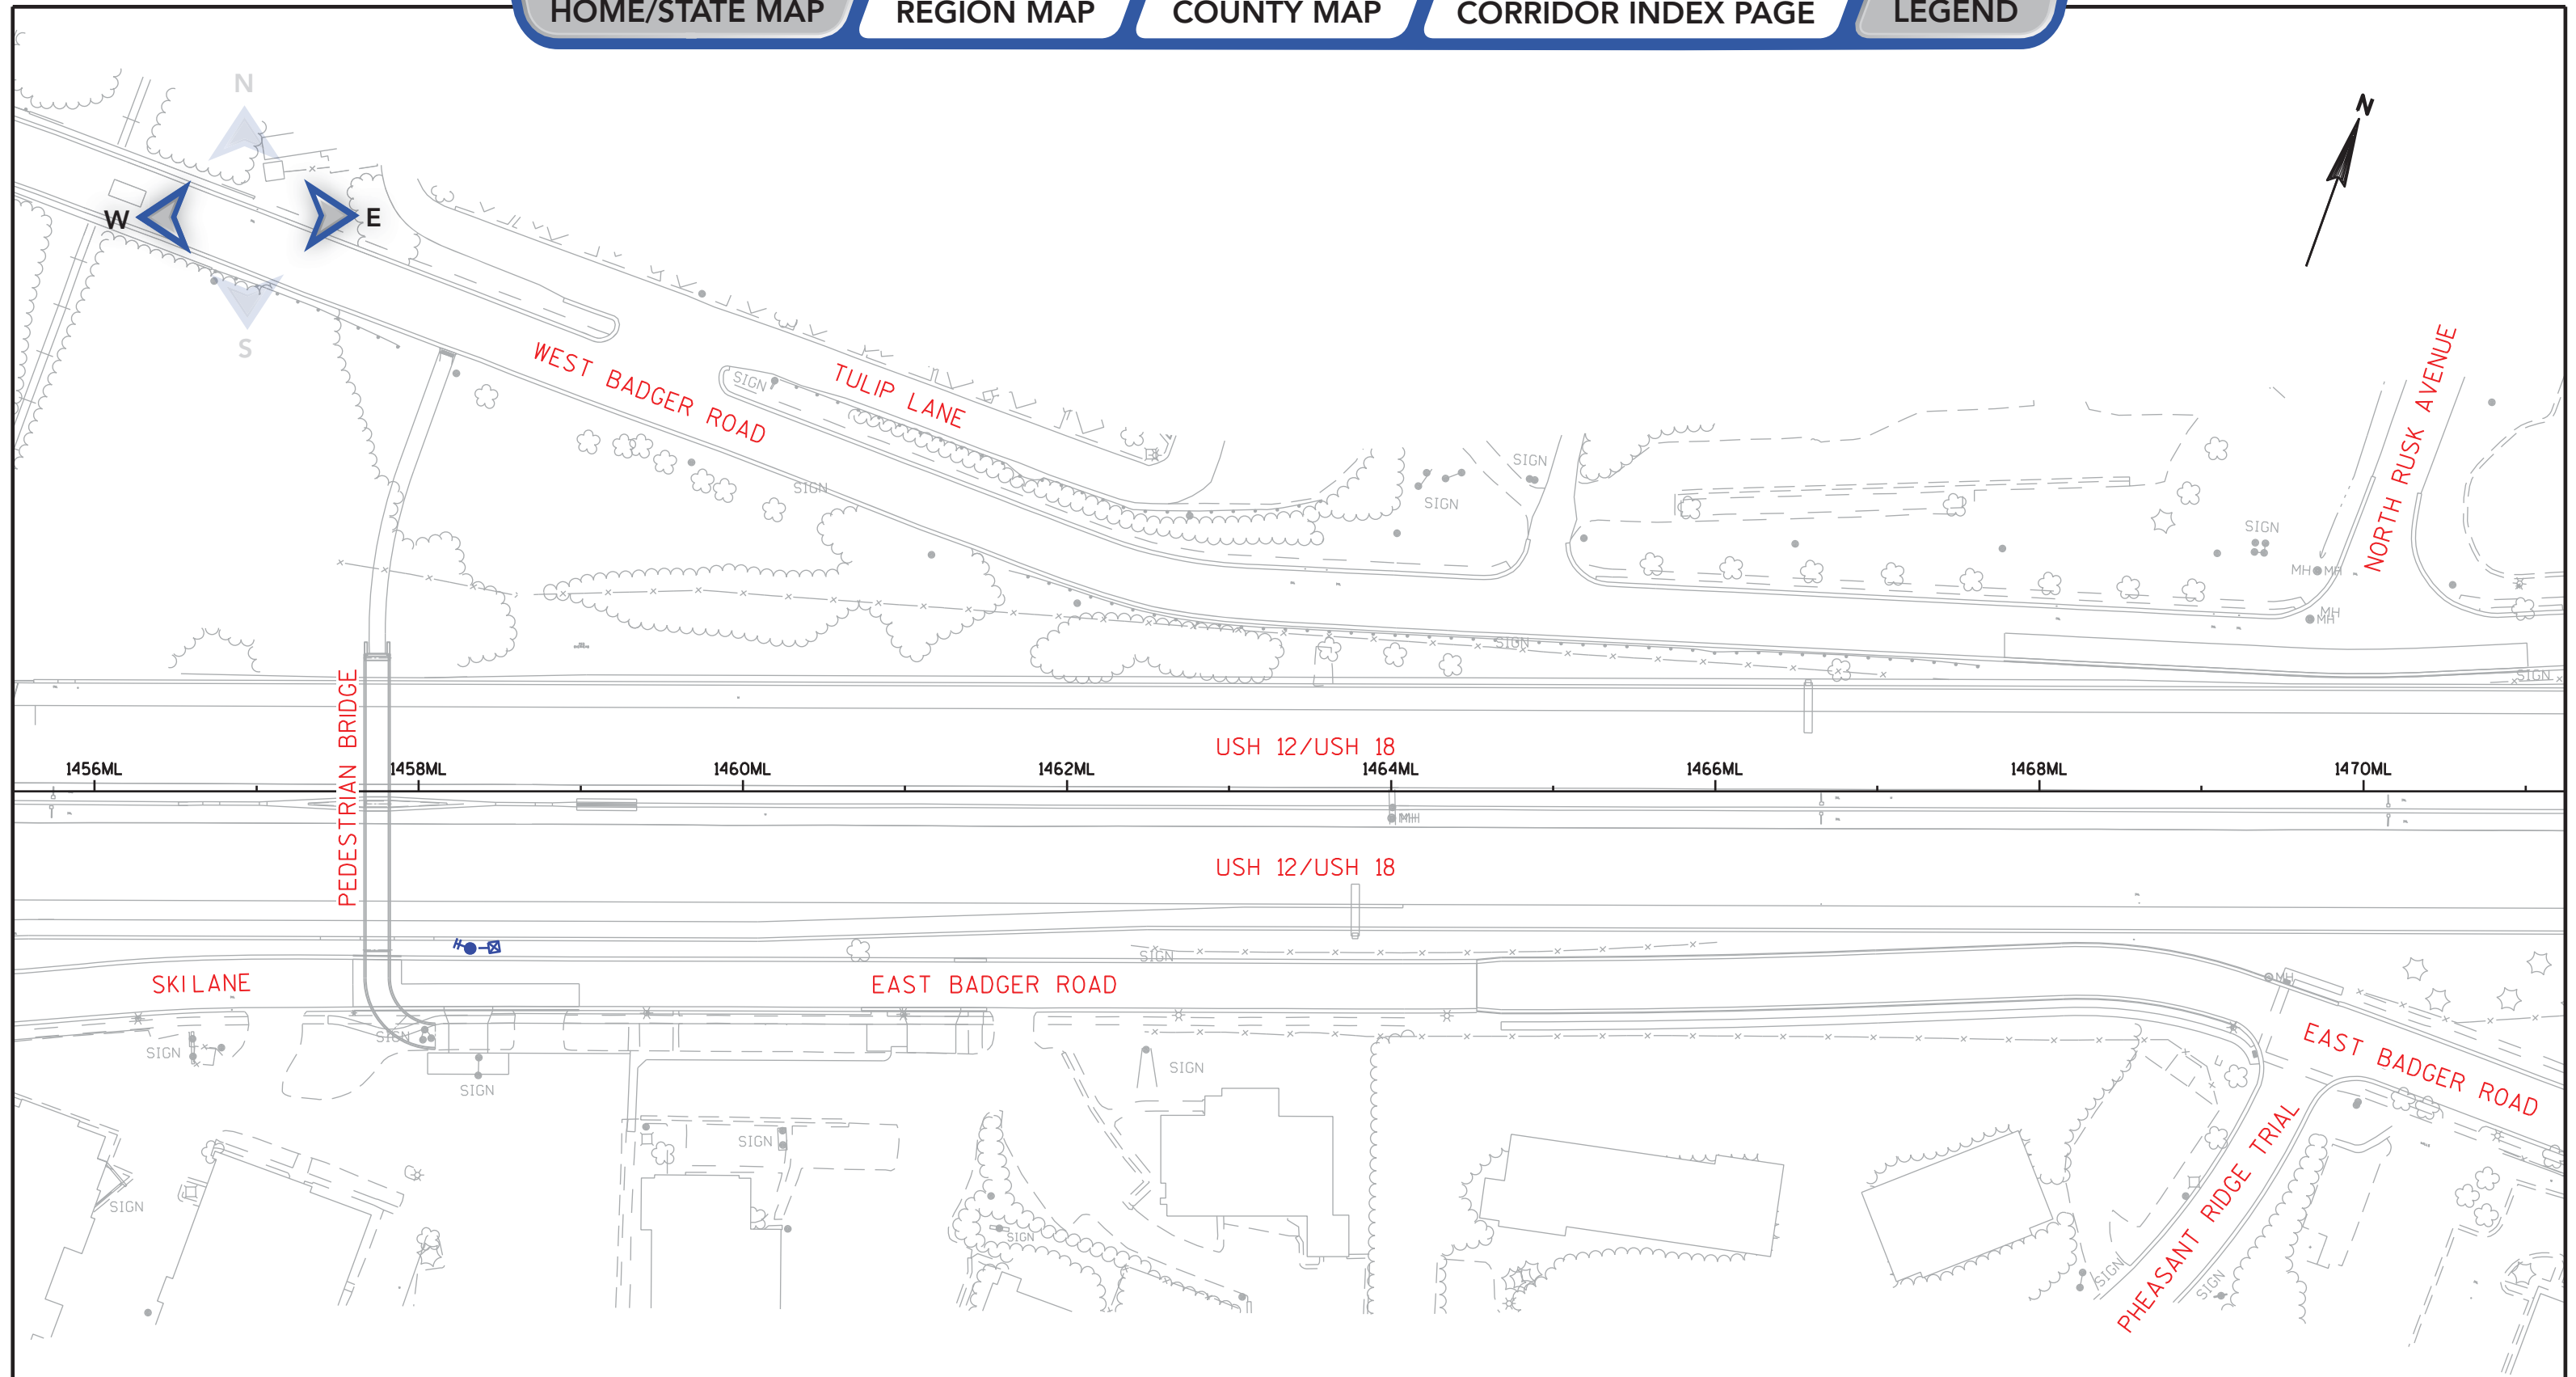

AS-BUILTS INFORMATION SOURCE


PROJECT DESIGN FILES
LET: XXXX / ID: XXXX-YY-ZZ

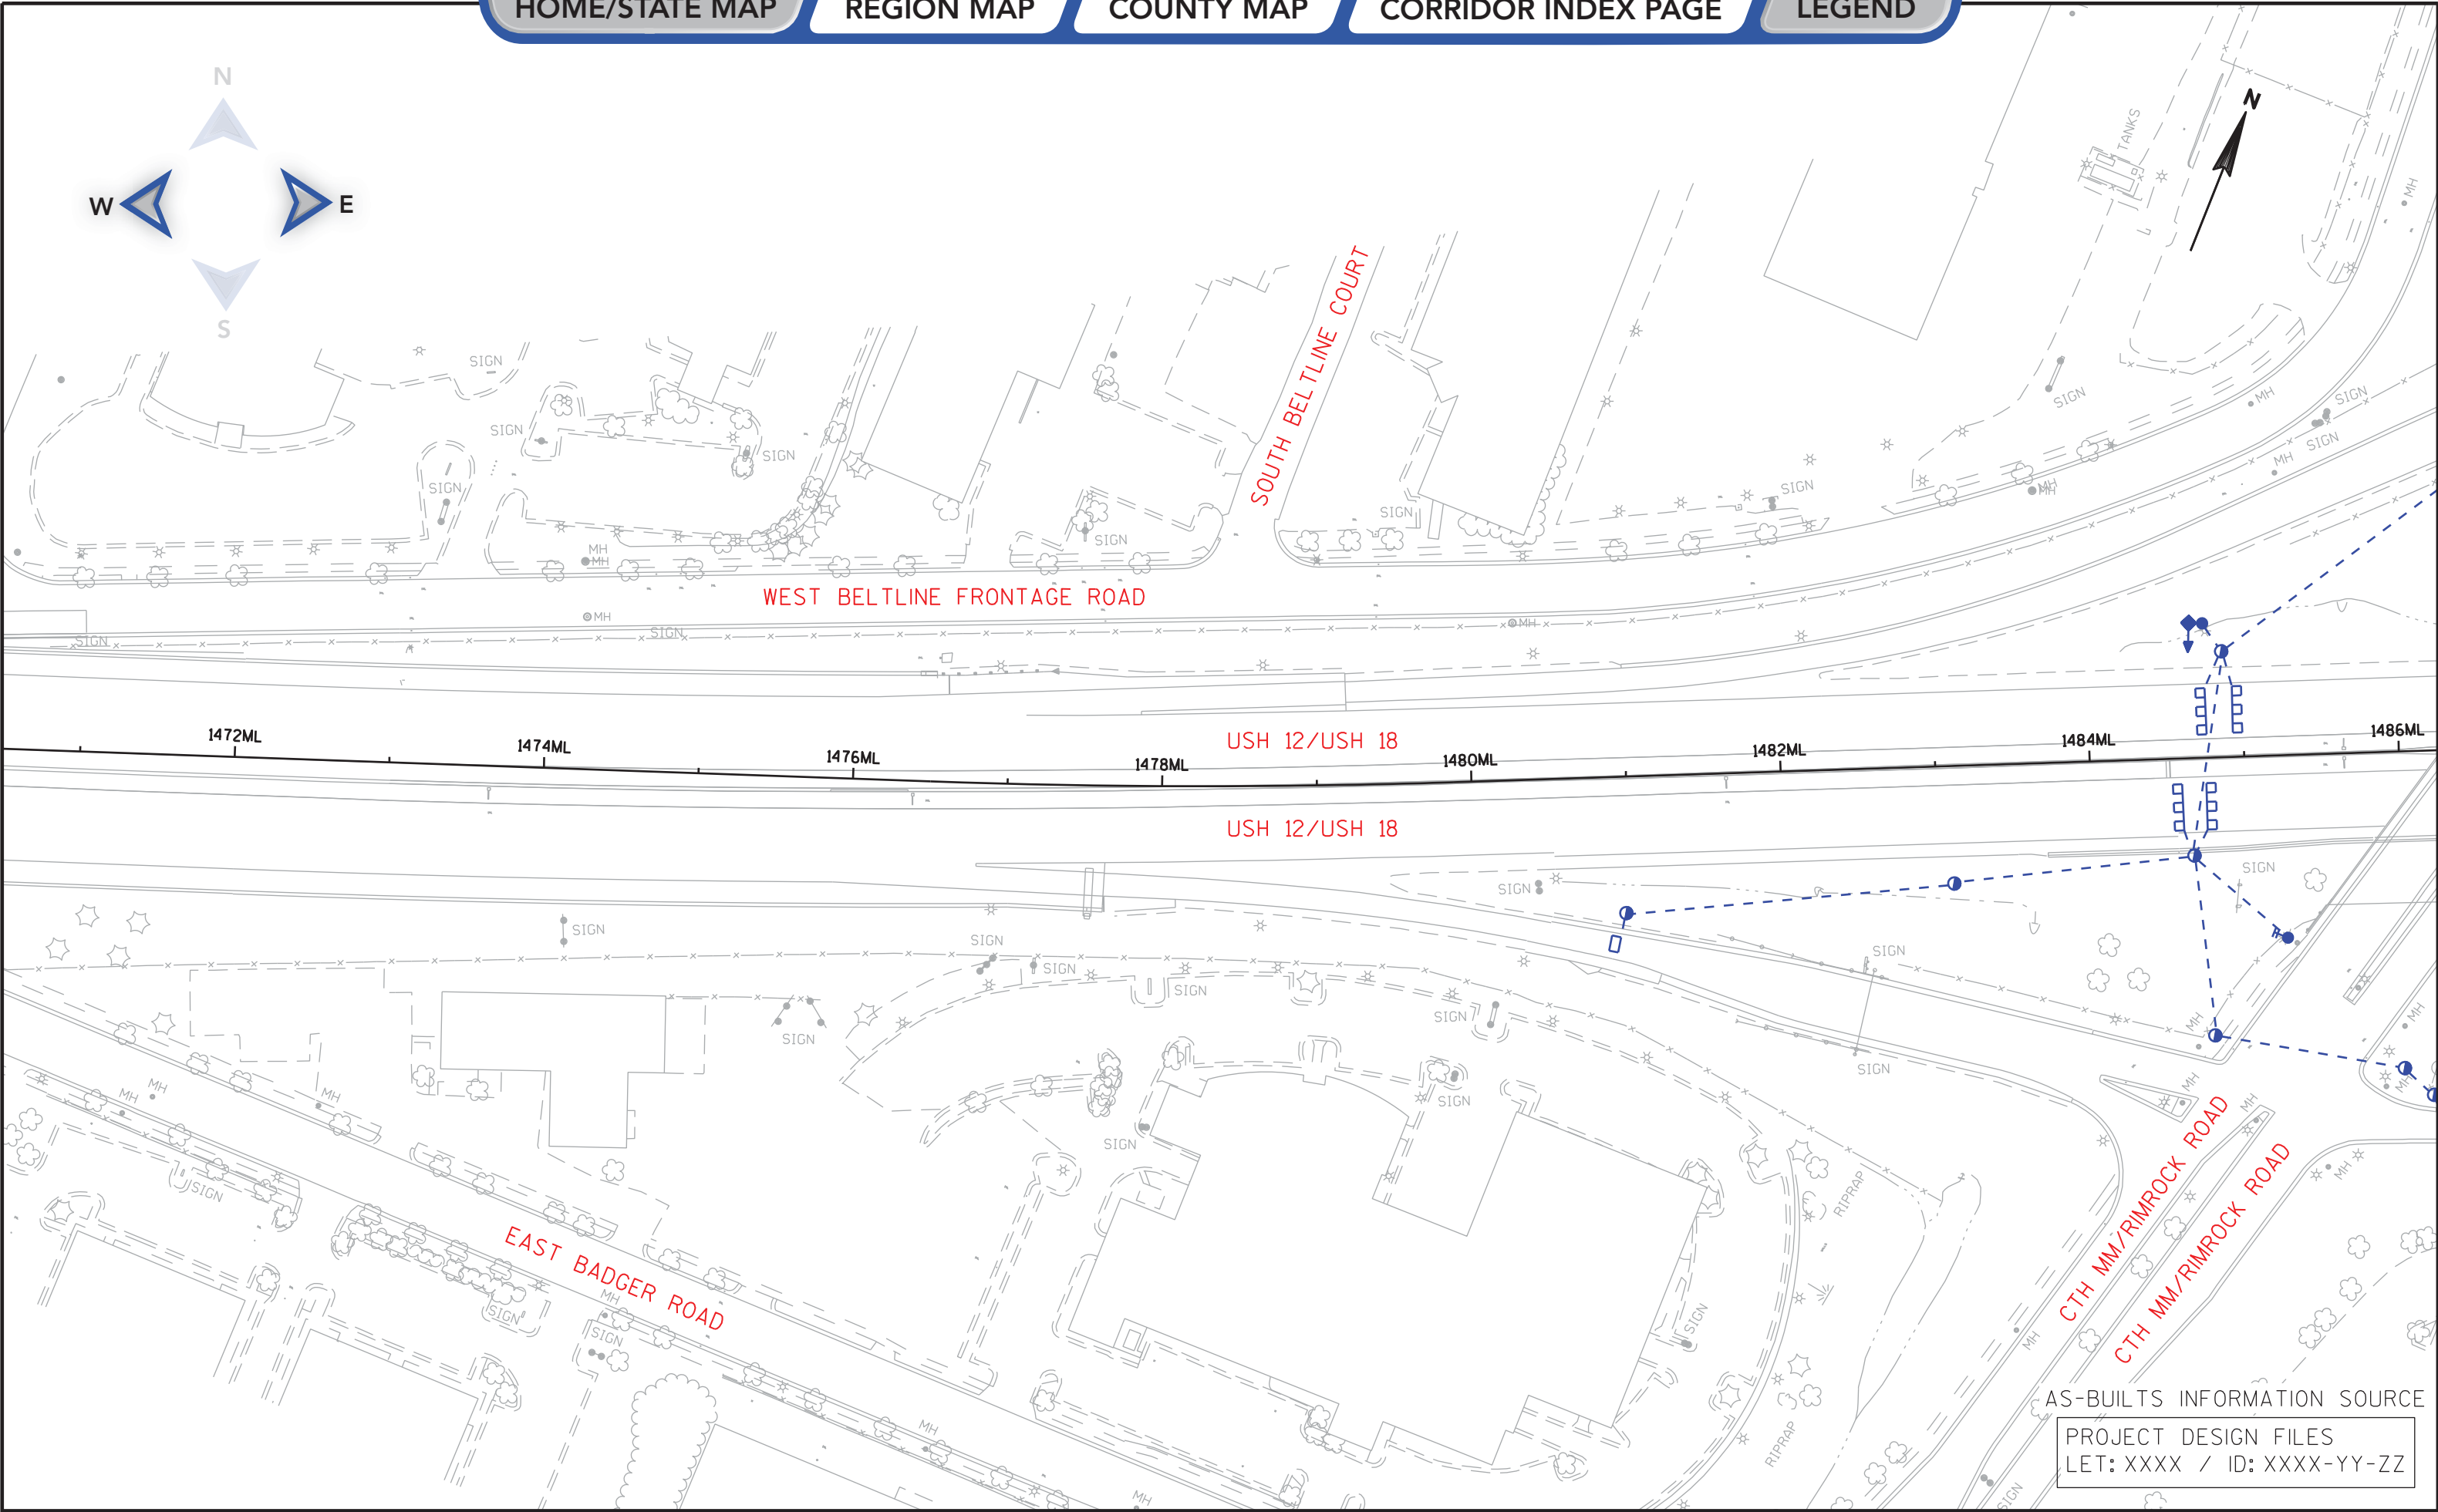

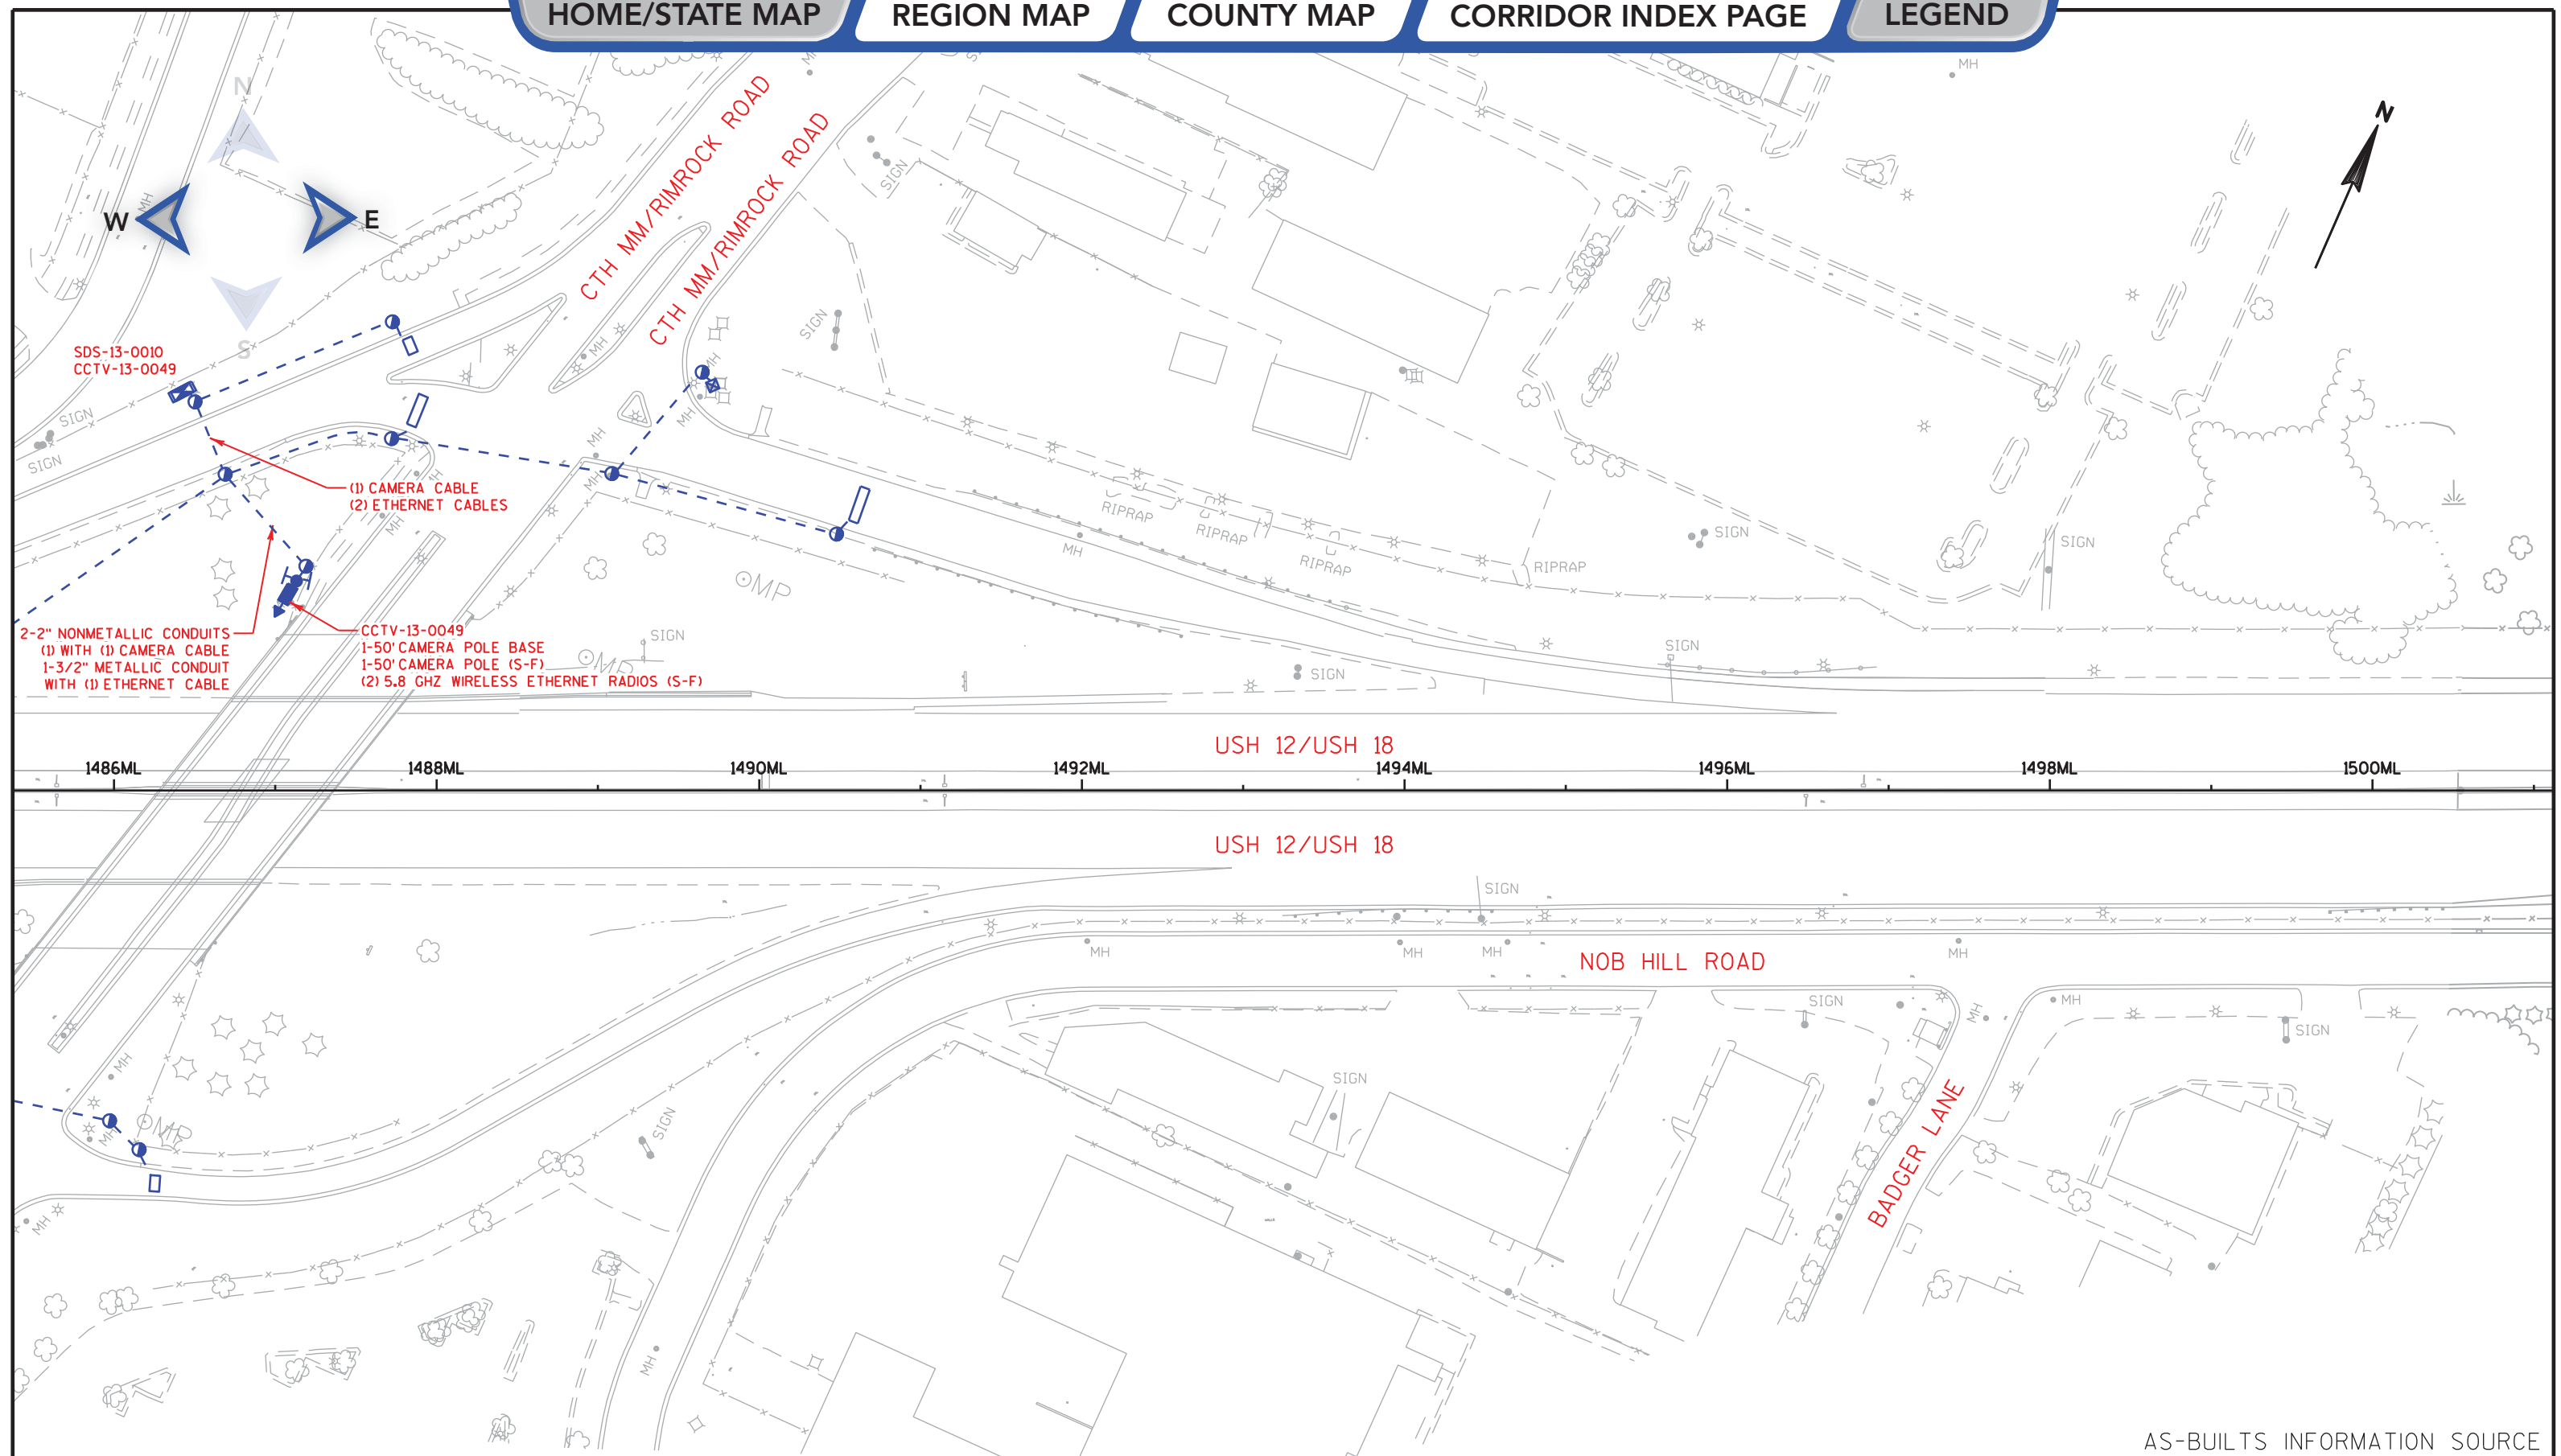


AS-BUILTS INFORMATION SOURCE

PROJECT DESIGN FILES
LET: XXXX / ID: 0081-07-02
LET: XXXX / ID: XXXX-YY-ZZ


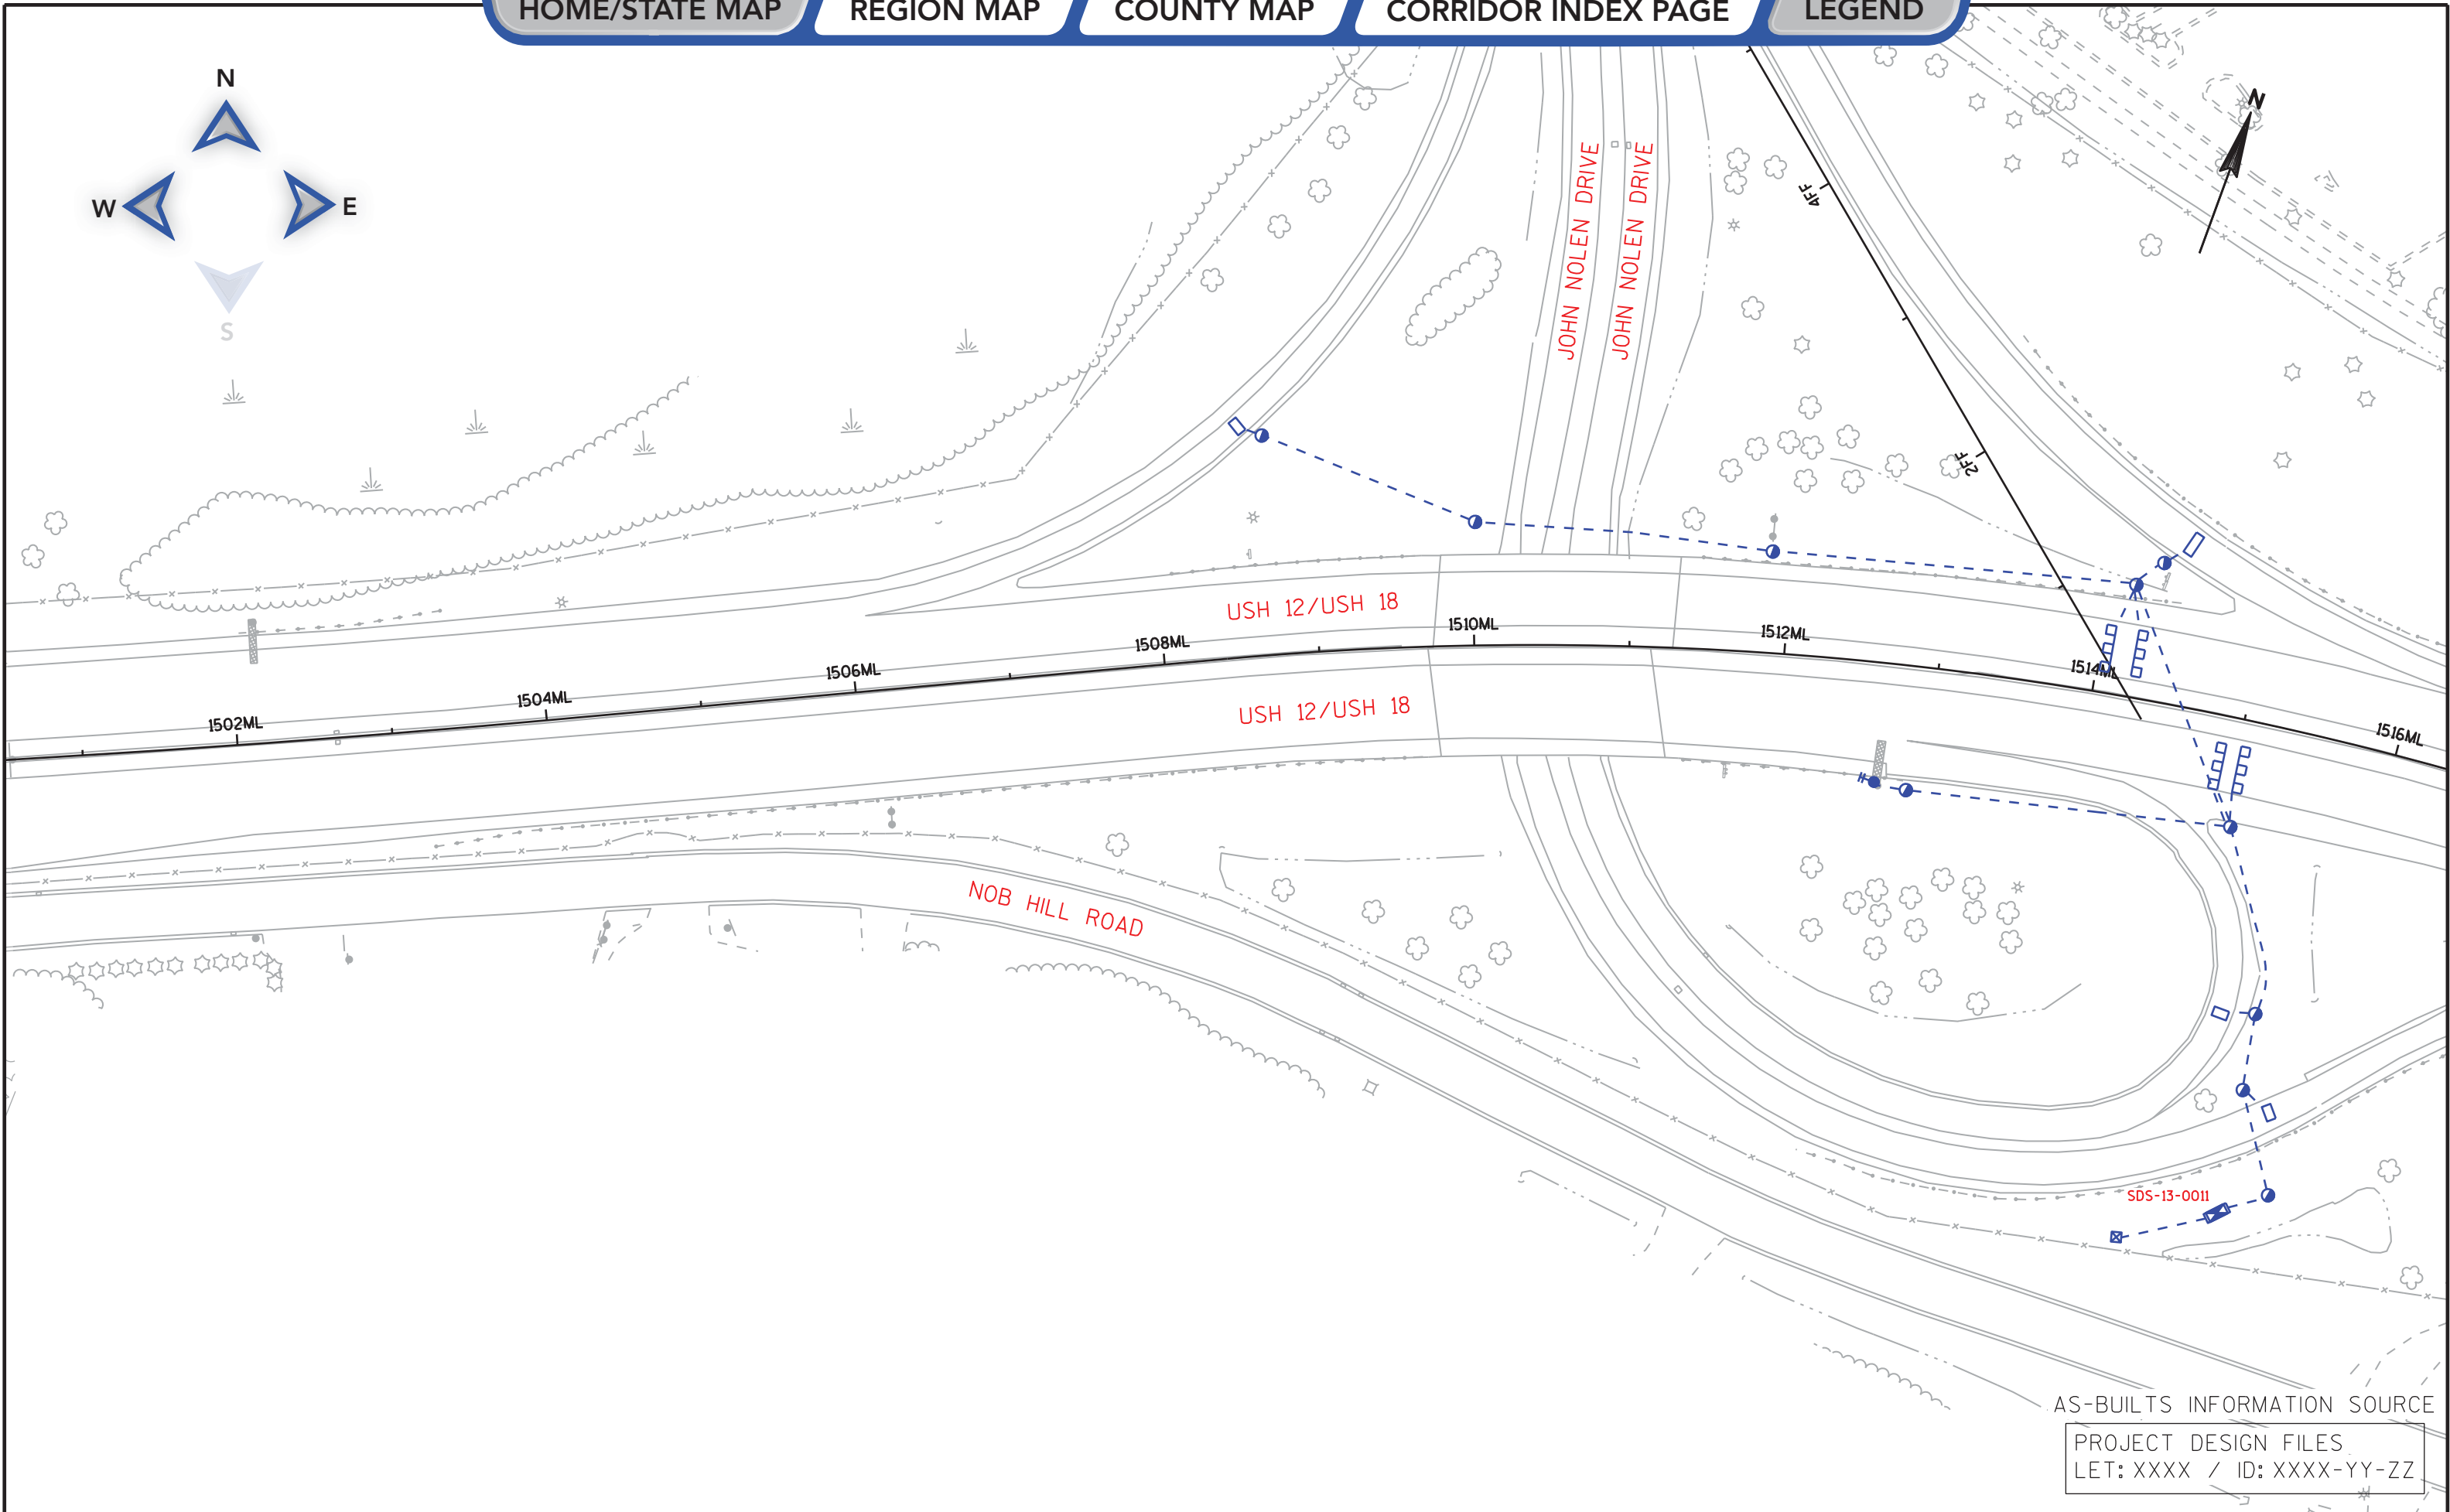


AS-BUILTS INFORMATION SOURCE
PROJECT DESIGN FILES
LET: XXXX / ID: XXXX-YY-ZZ

FIBER RUN CONTINUES NORTHWEST
ALONG RAILROAD TRACKS

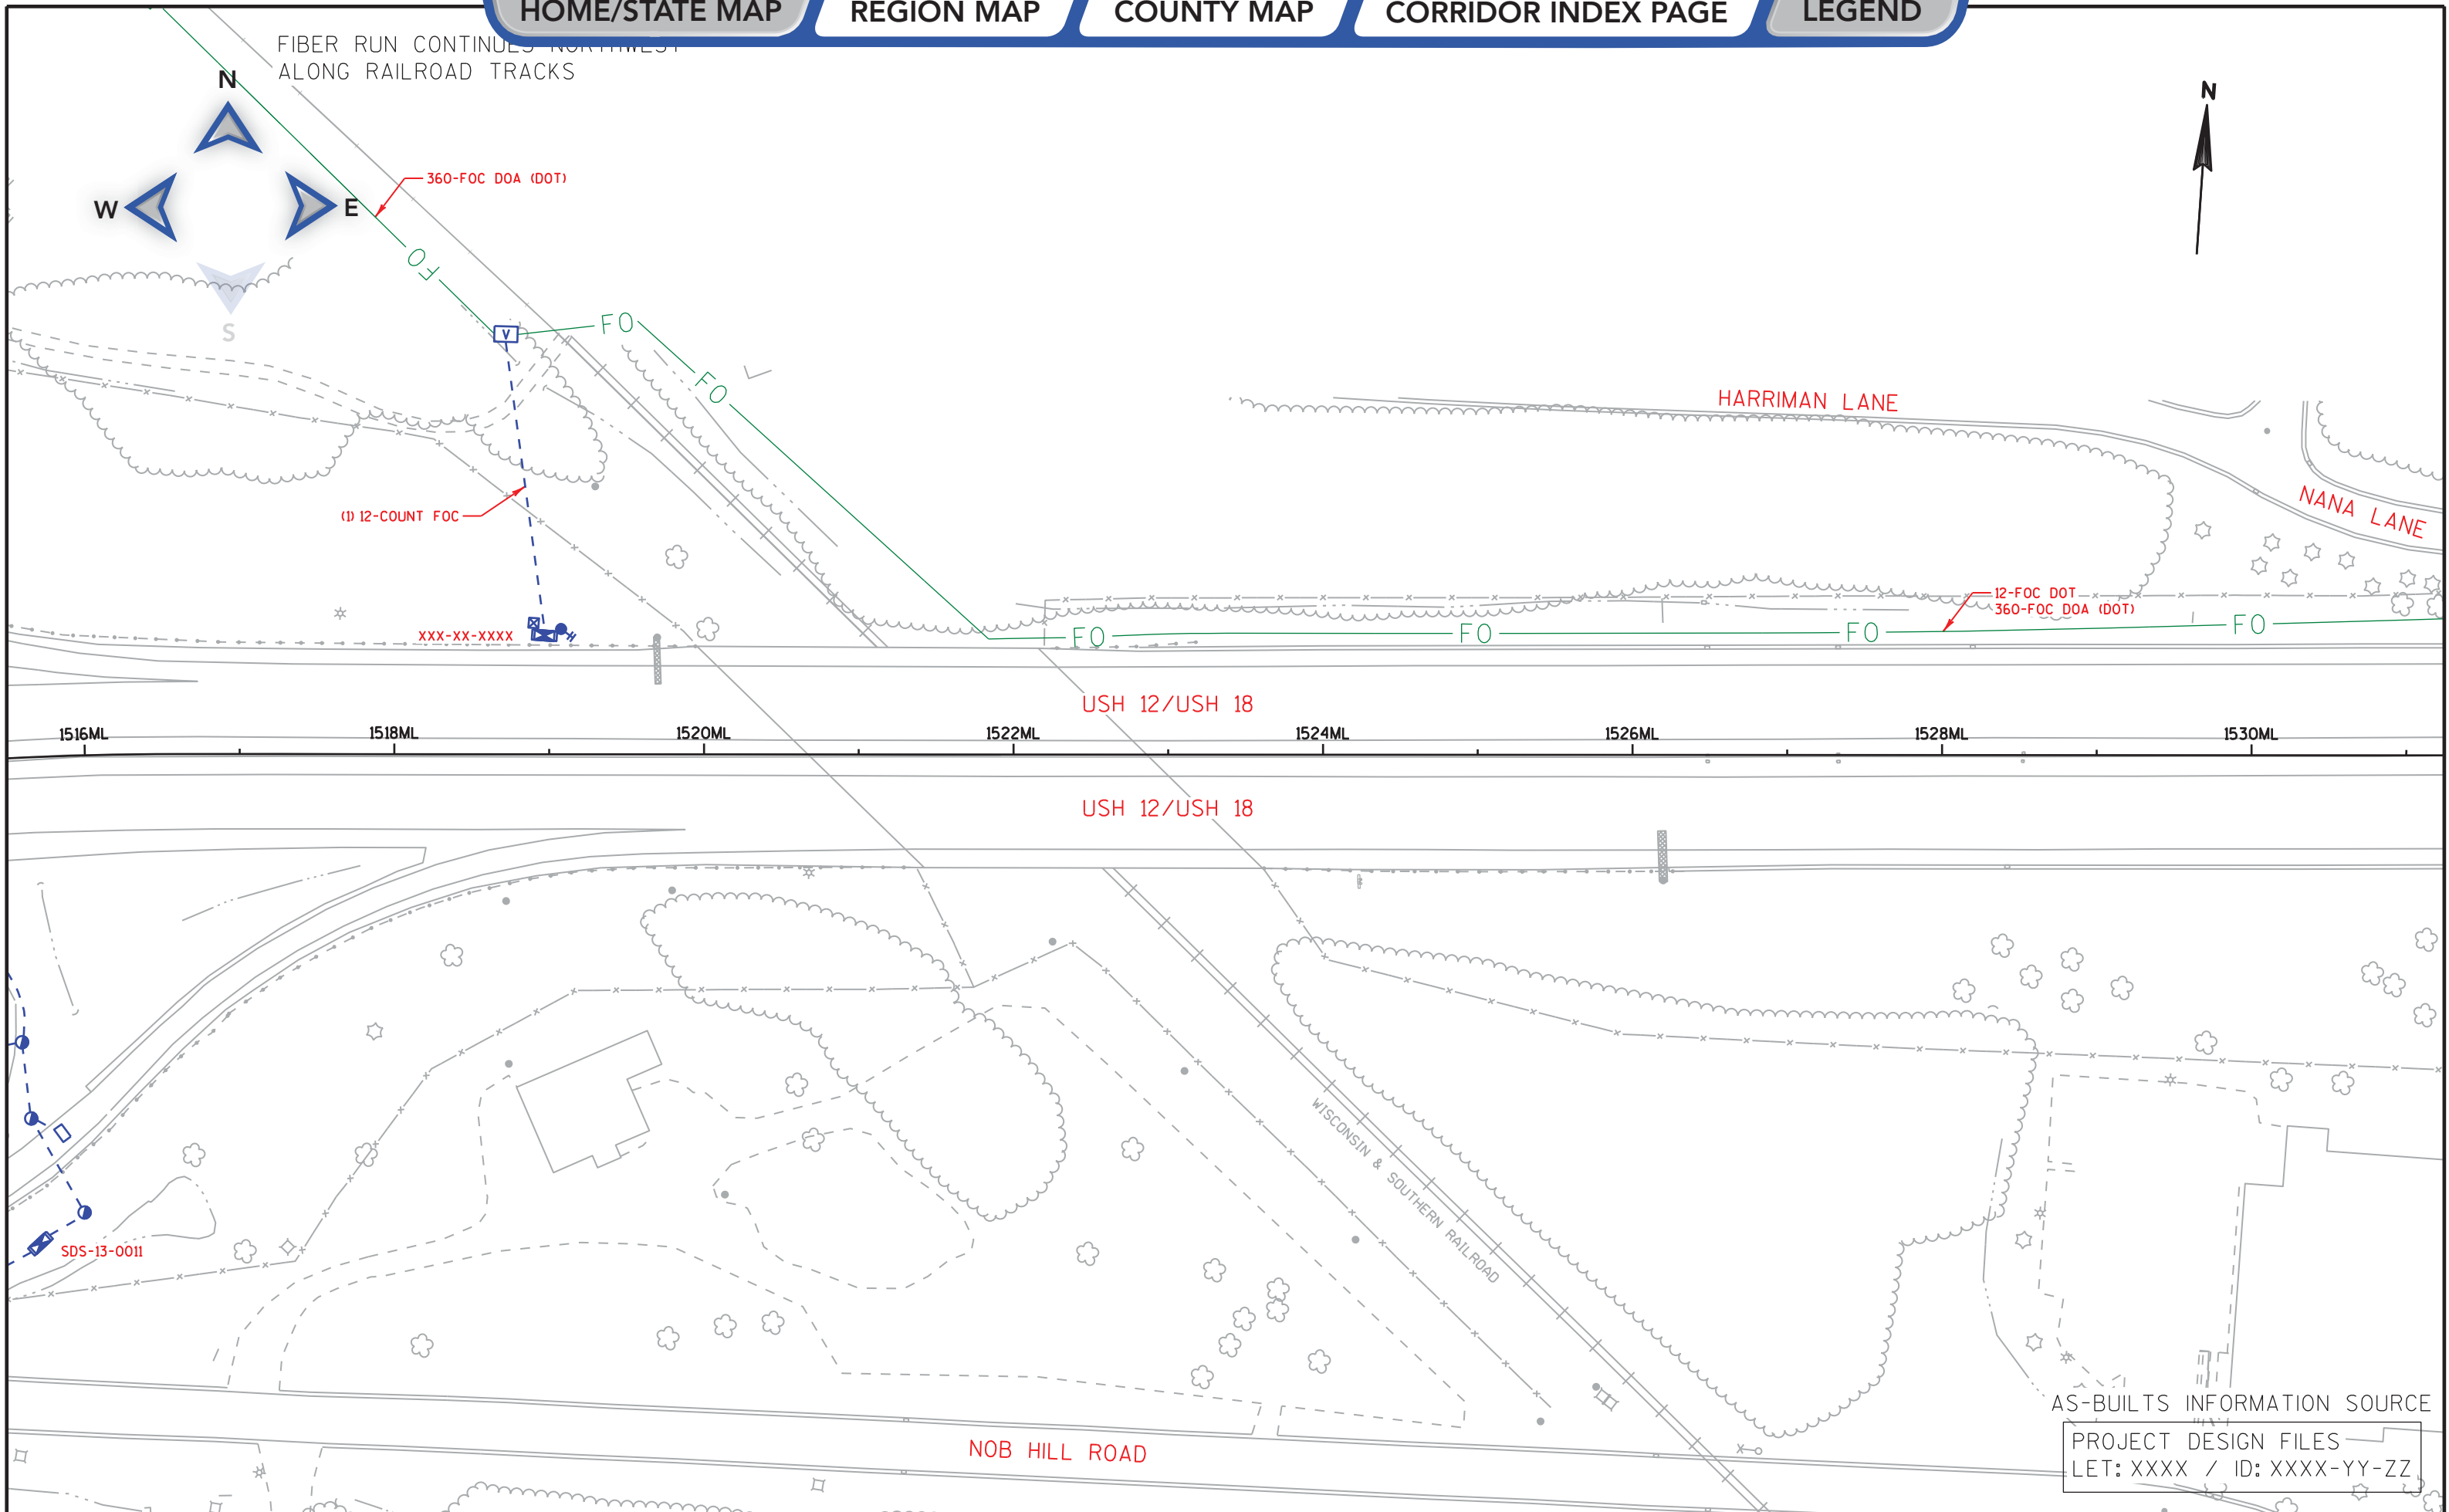




AS-BUILTS INFORMATION SOURCE
PROJECT DESIGN FILES
LET: XXXX / ID: XXXX-YY-ZZ

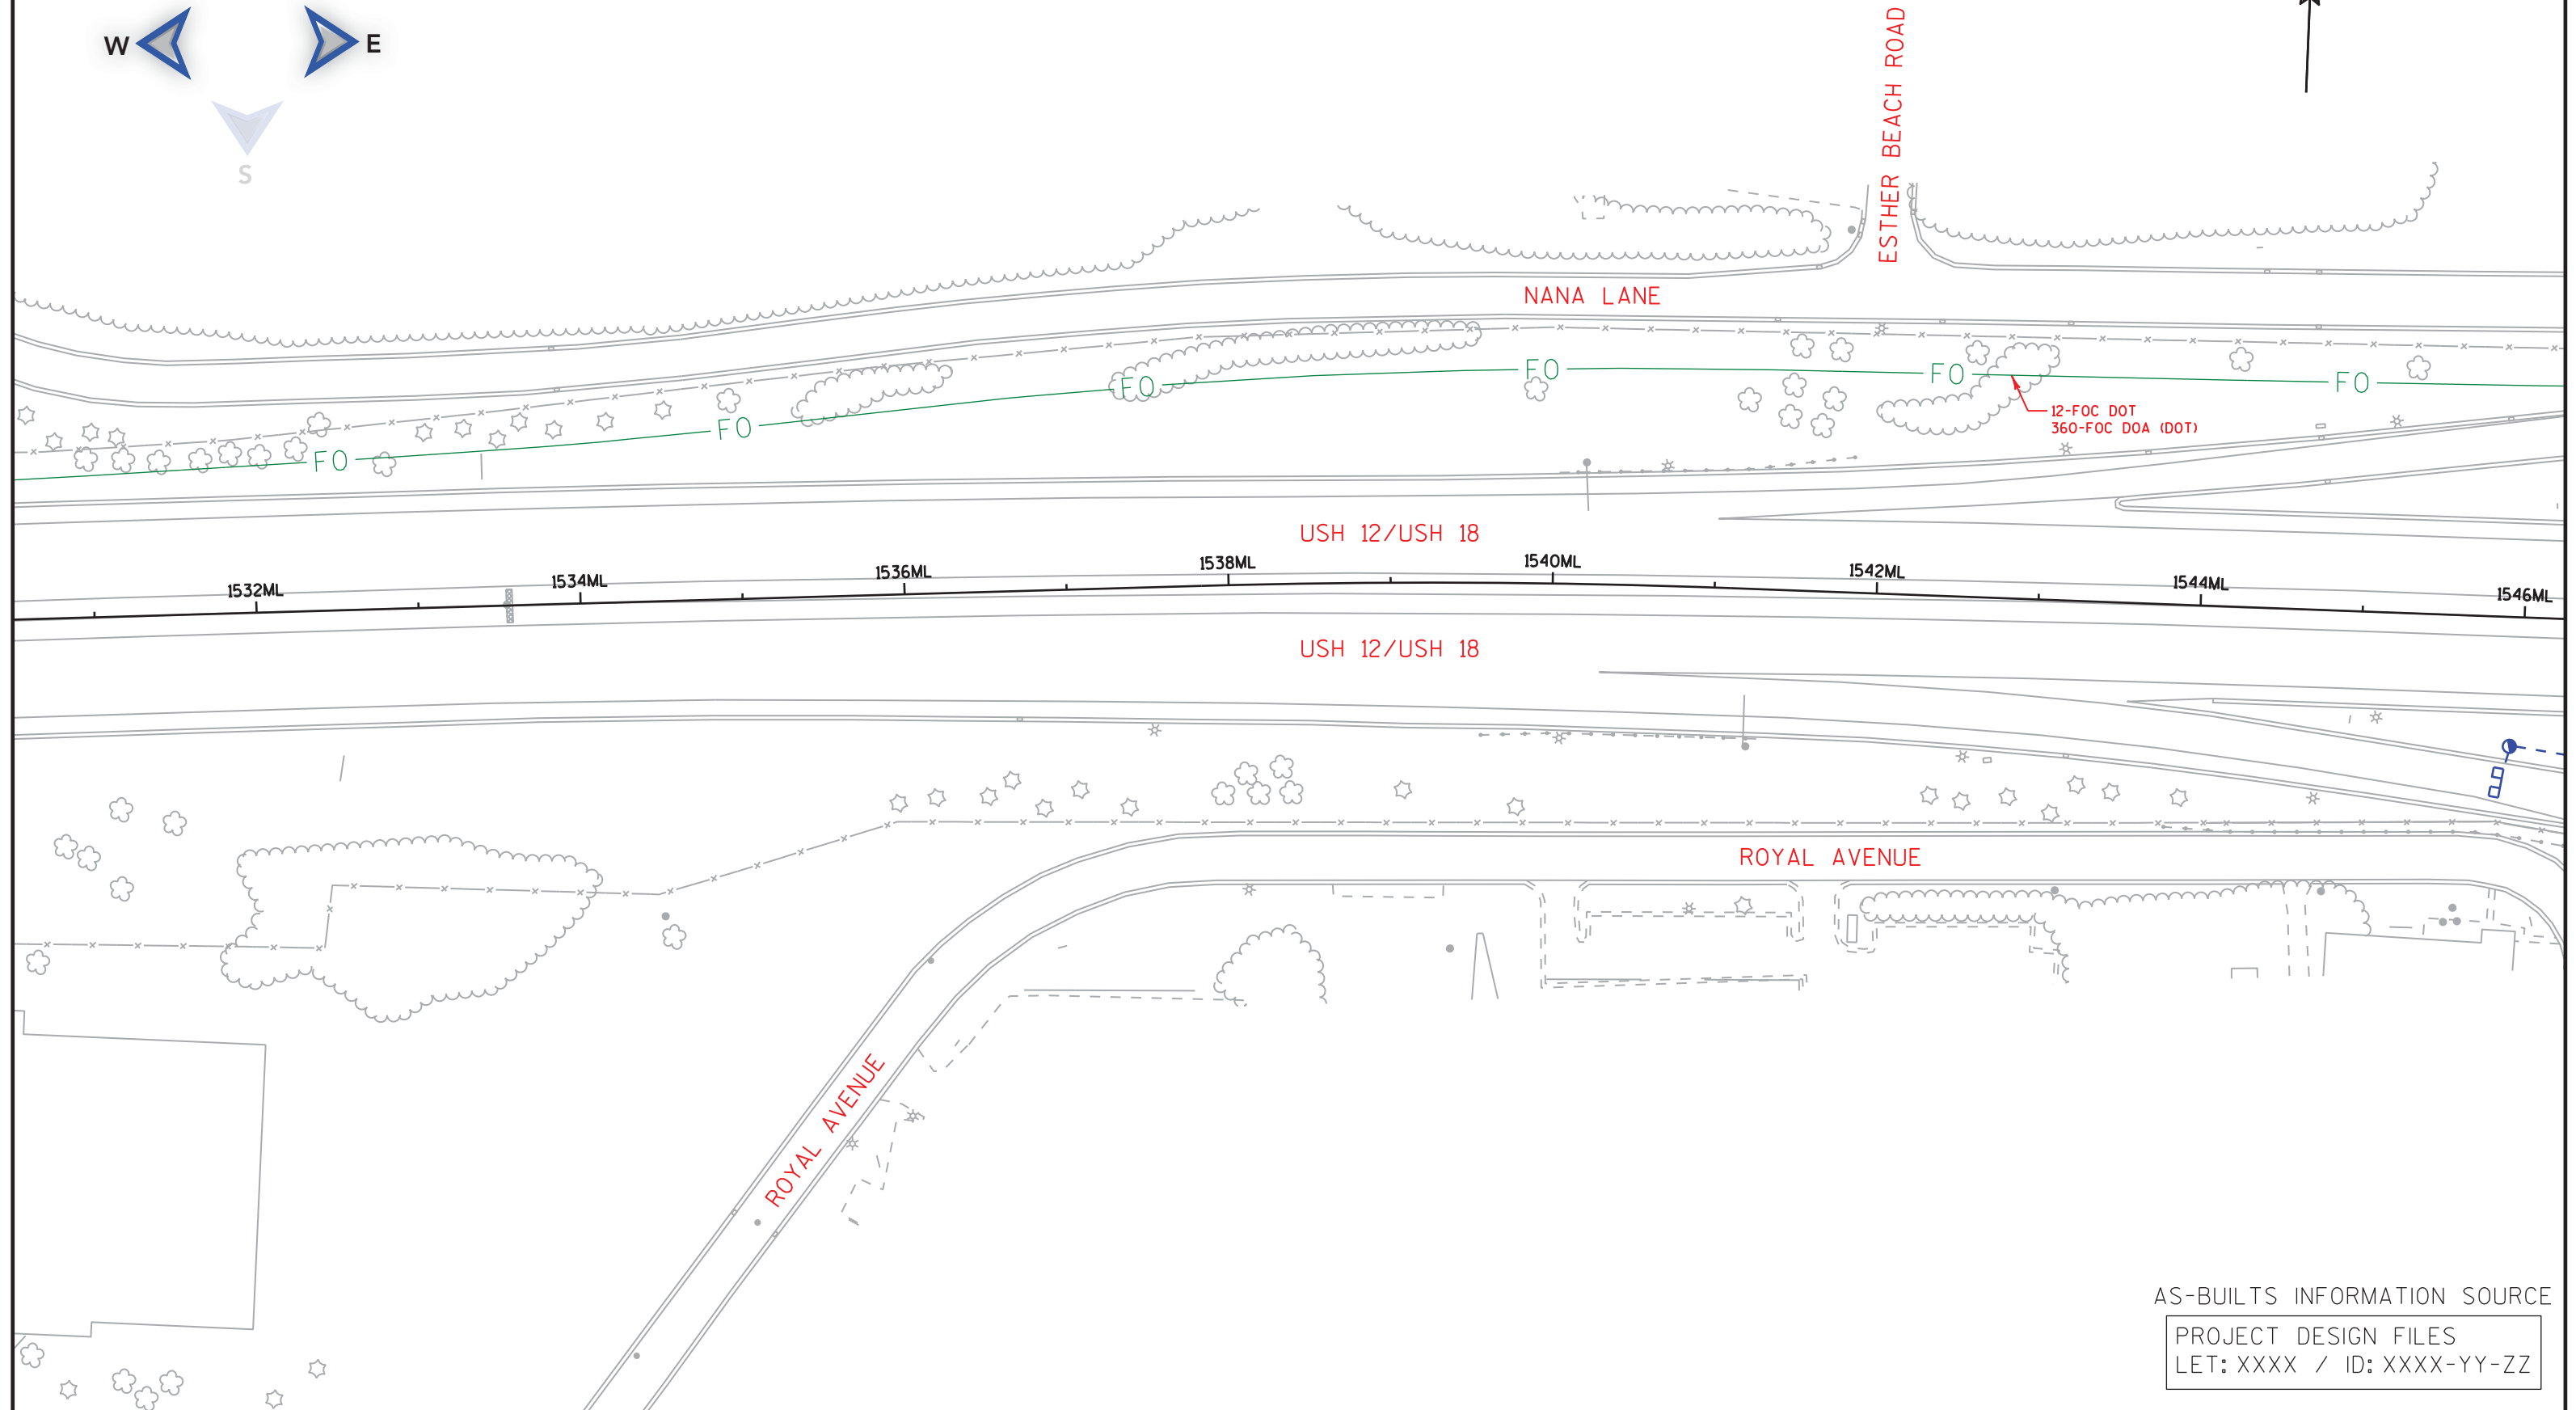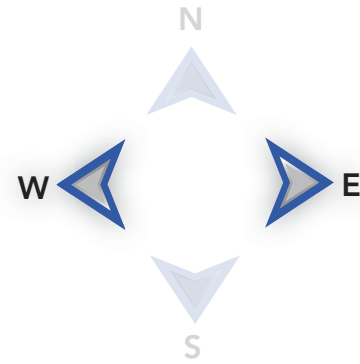

AS-BUILTS INFORMATION SOURCE



PROJECT DESIGN FILES
LET: XXXX / ID: XXXX-YY-ZZ

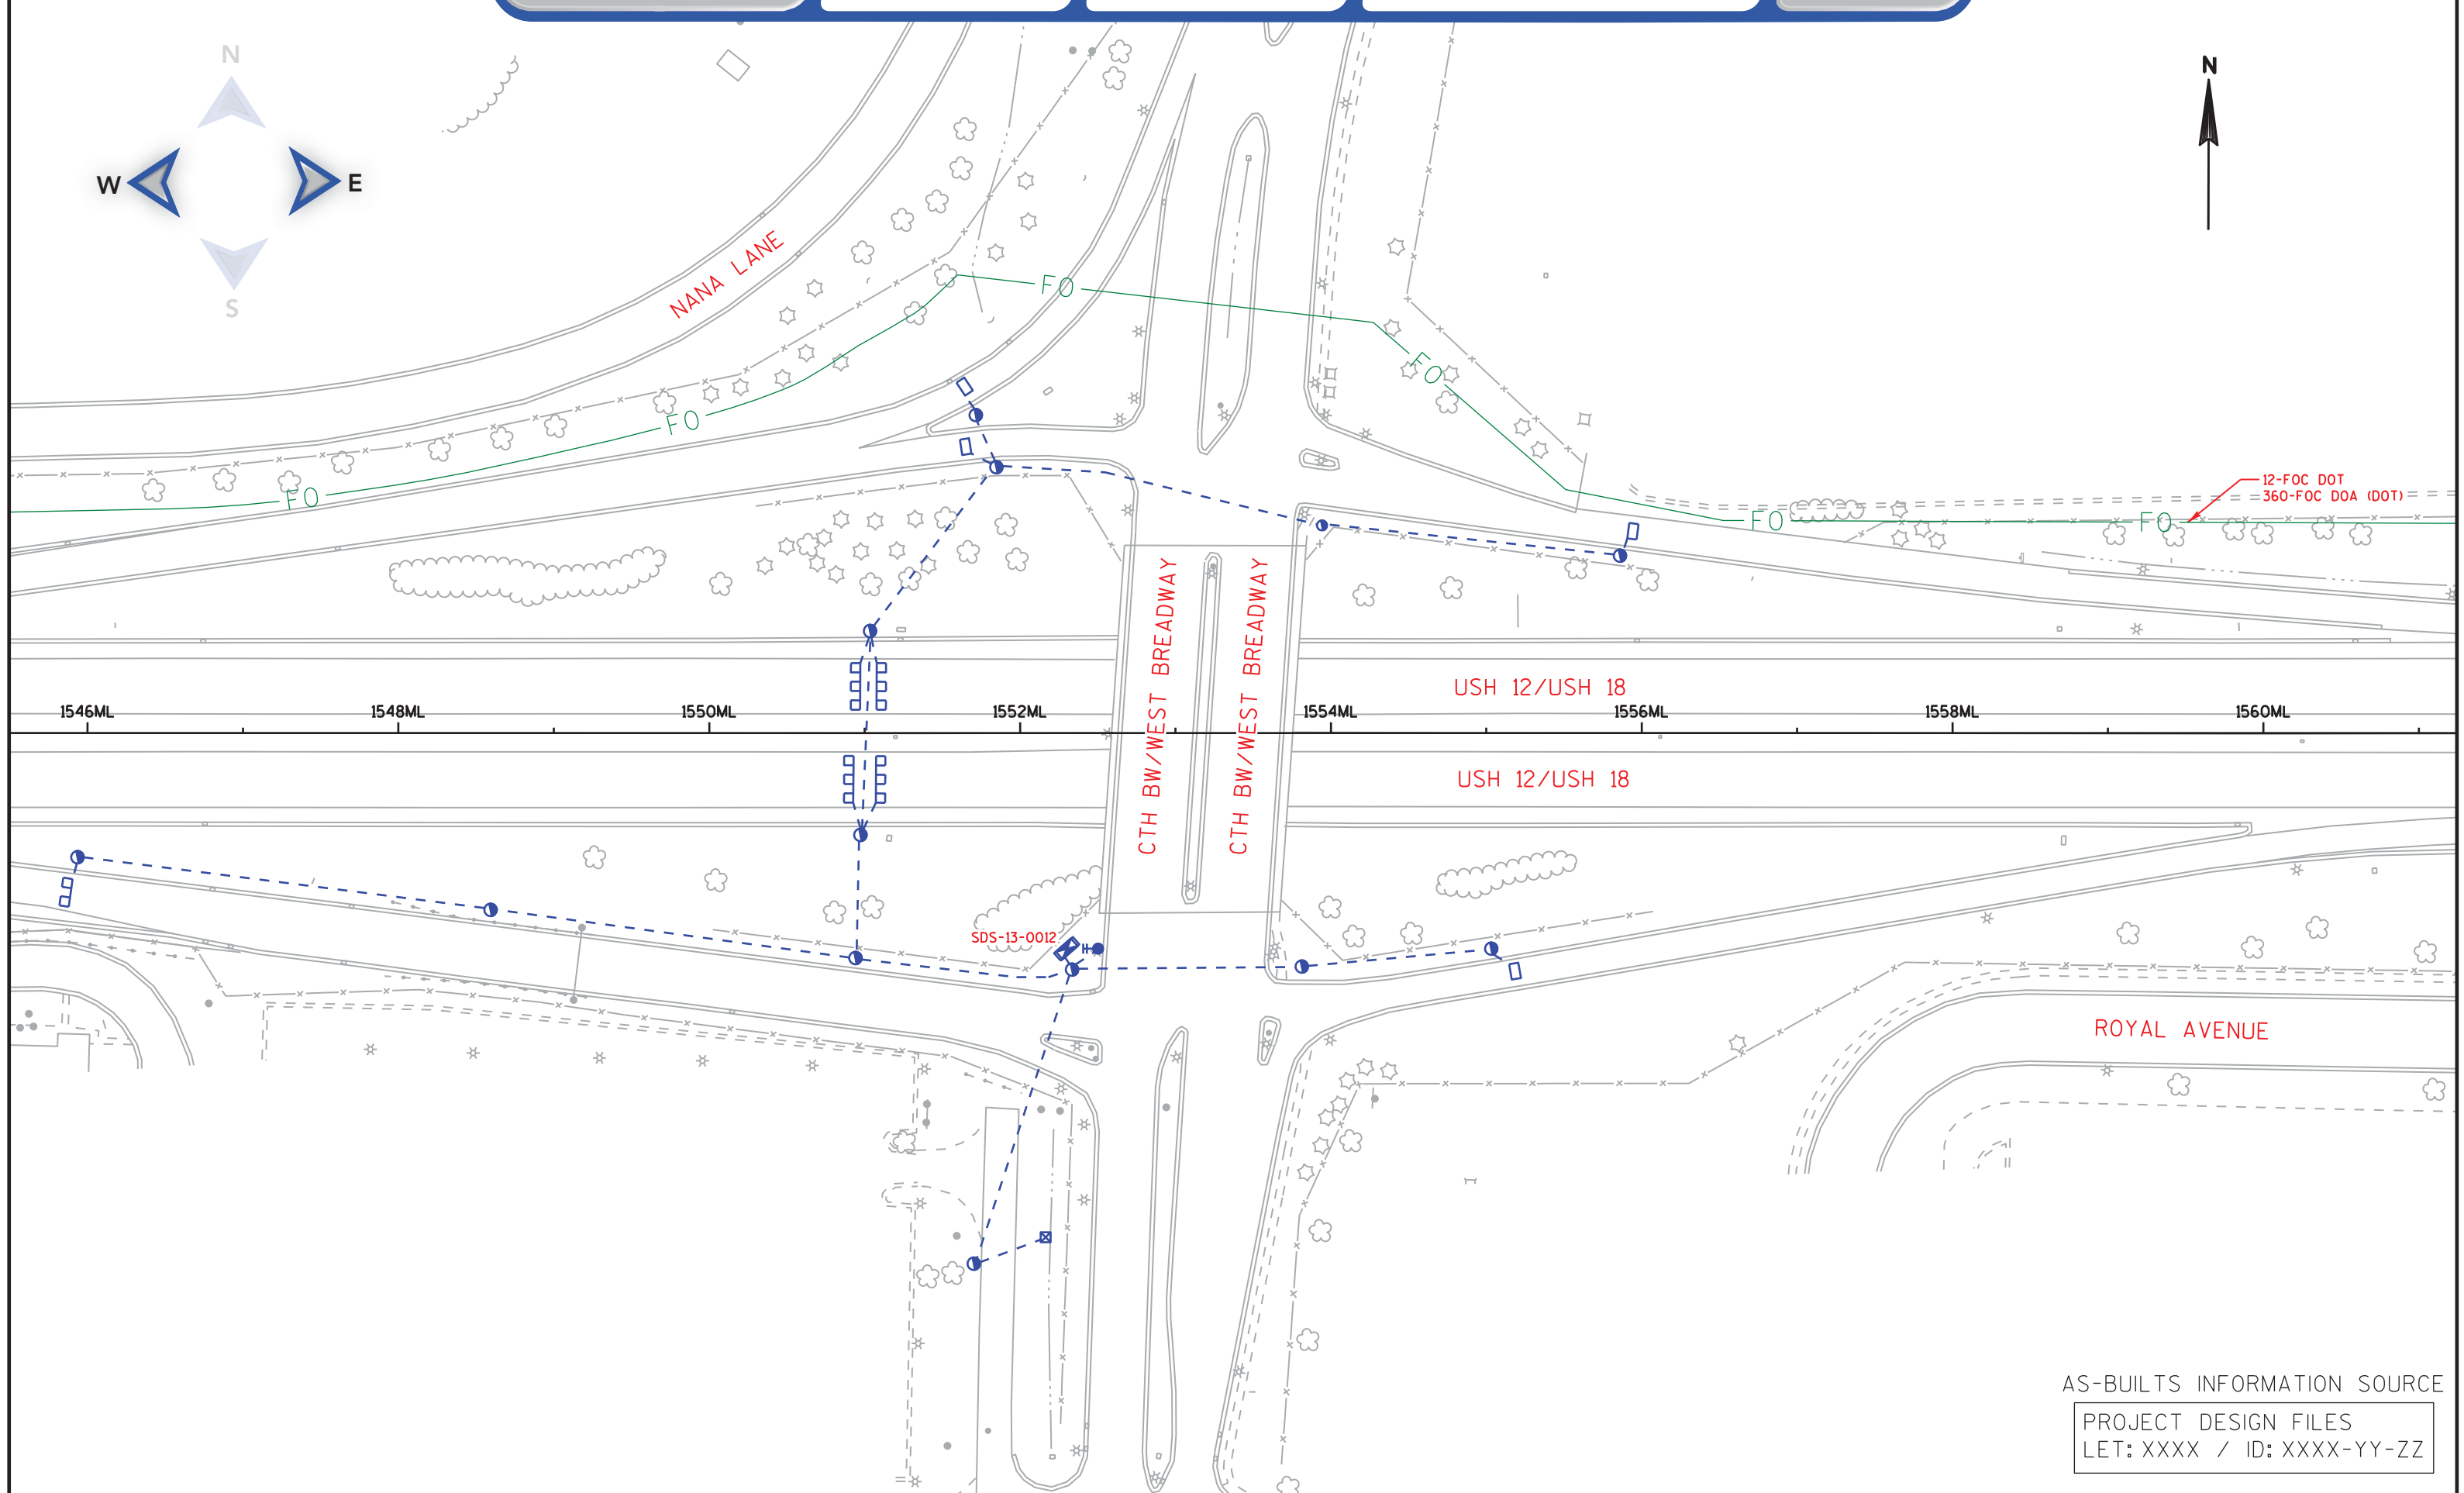

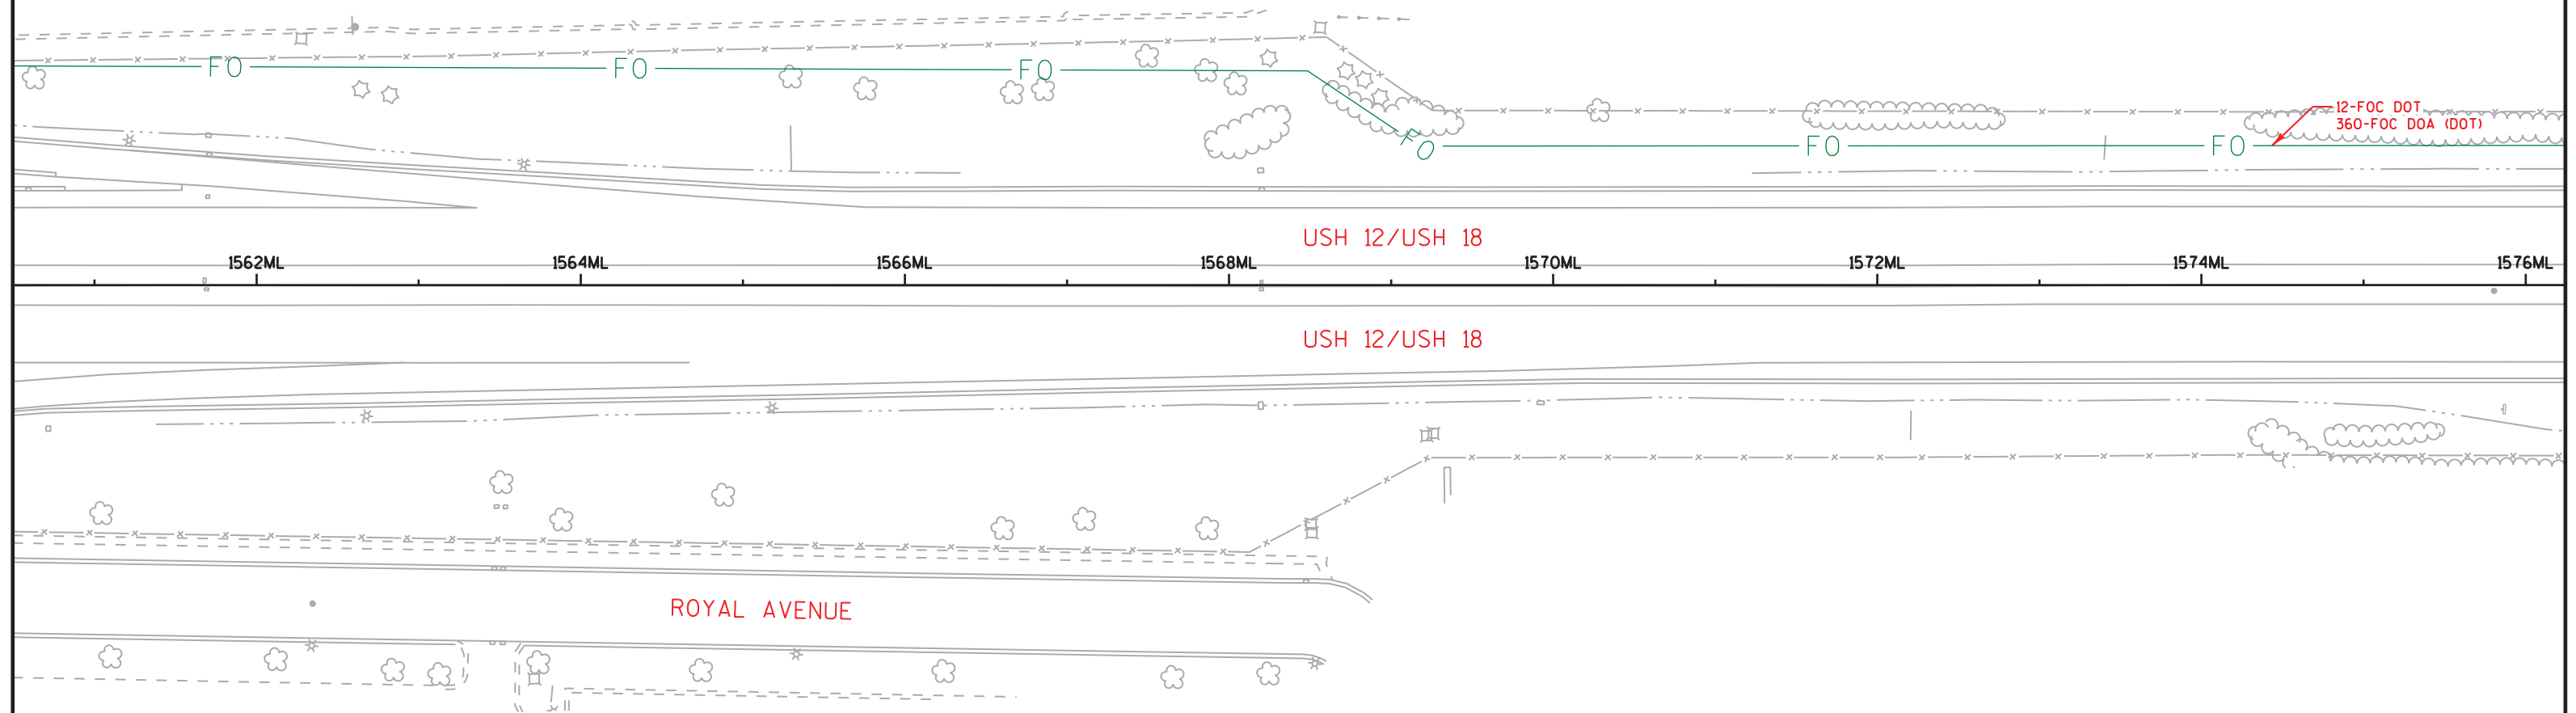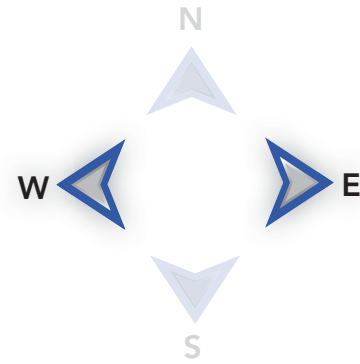



AS-BUILTS INFORMATION SOURCE

PROJECT DESIGN FILES
LET: XXXX / ID: XXXX-YY-ZZ

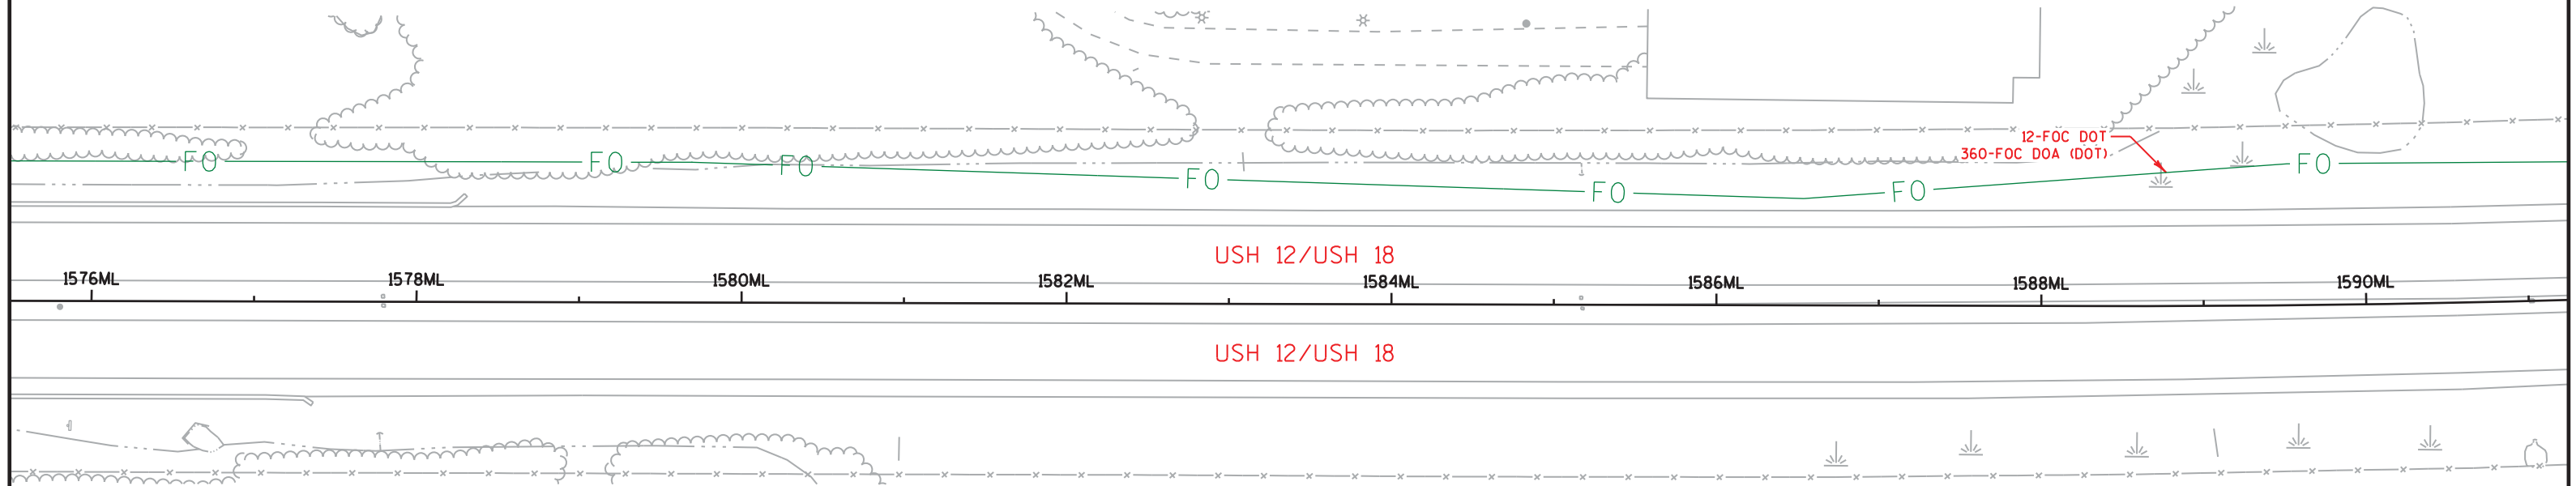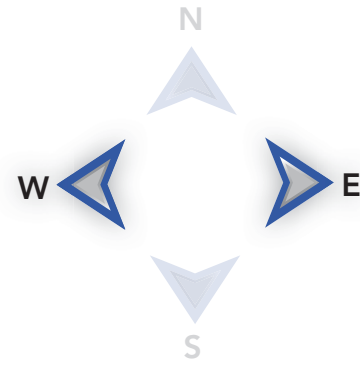



AS-BUILTS INFORMATION SOURCE

PROJECT DESIGN FILES
LET: XXXX / ID: XXXX-YY-ZZ

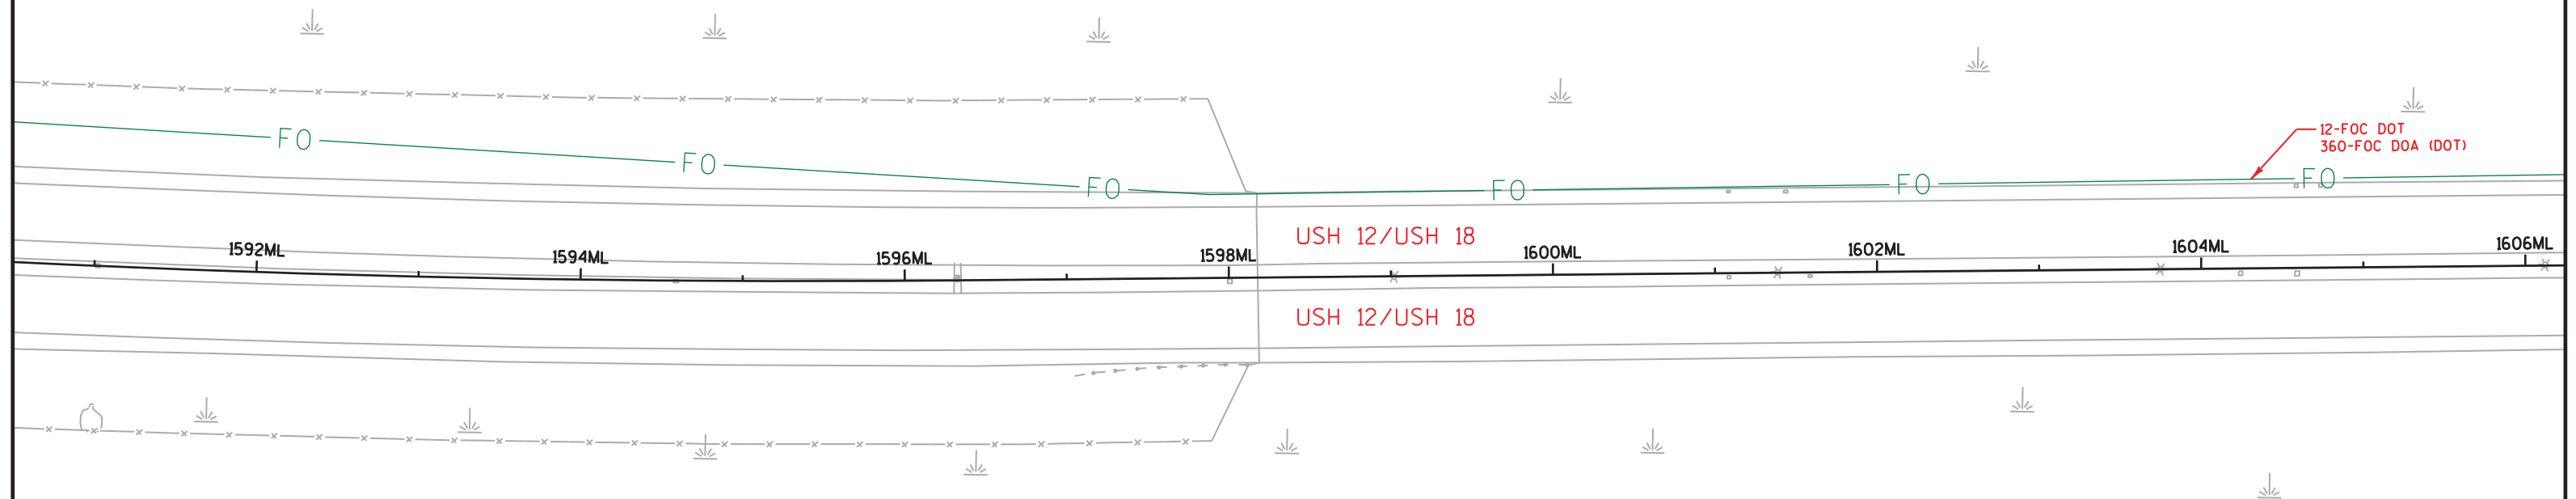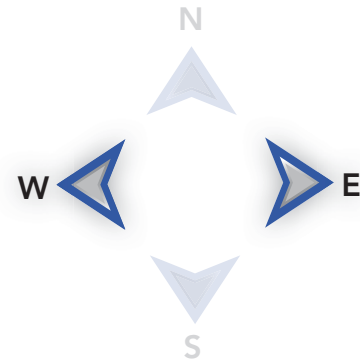


AS-BUILTS INFORMATION SOURCE

PROJECT DESIGN FILES
LET: XXXX / ID: XXXX-YY-ZZ

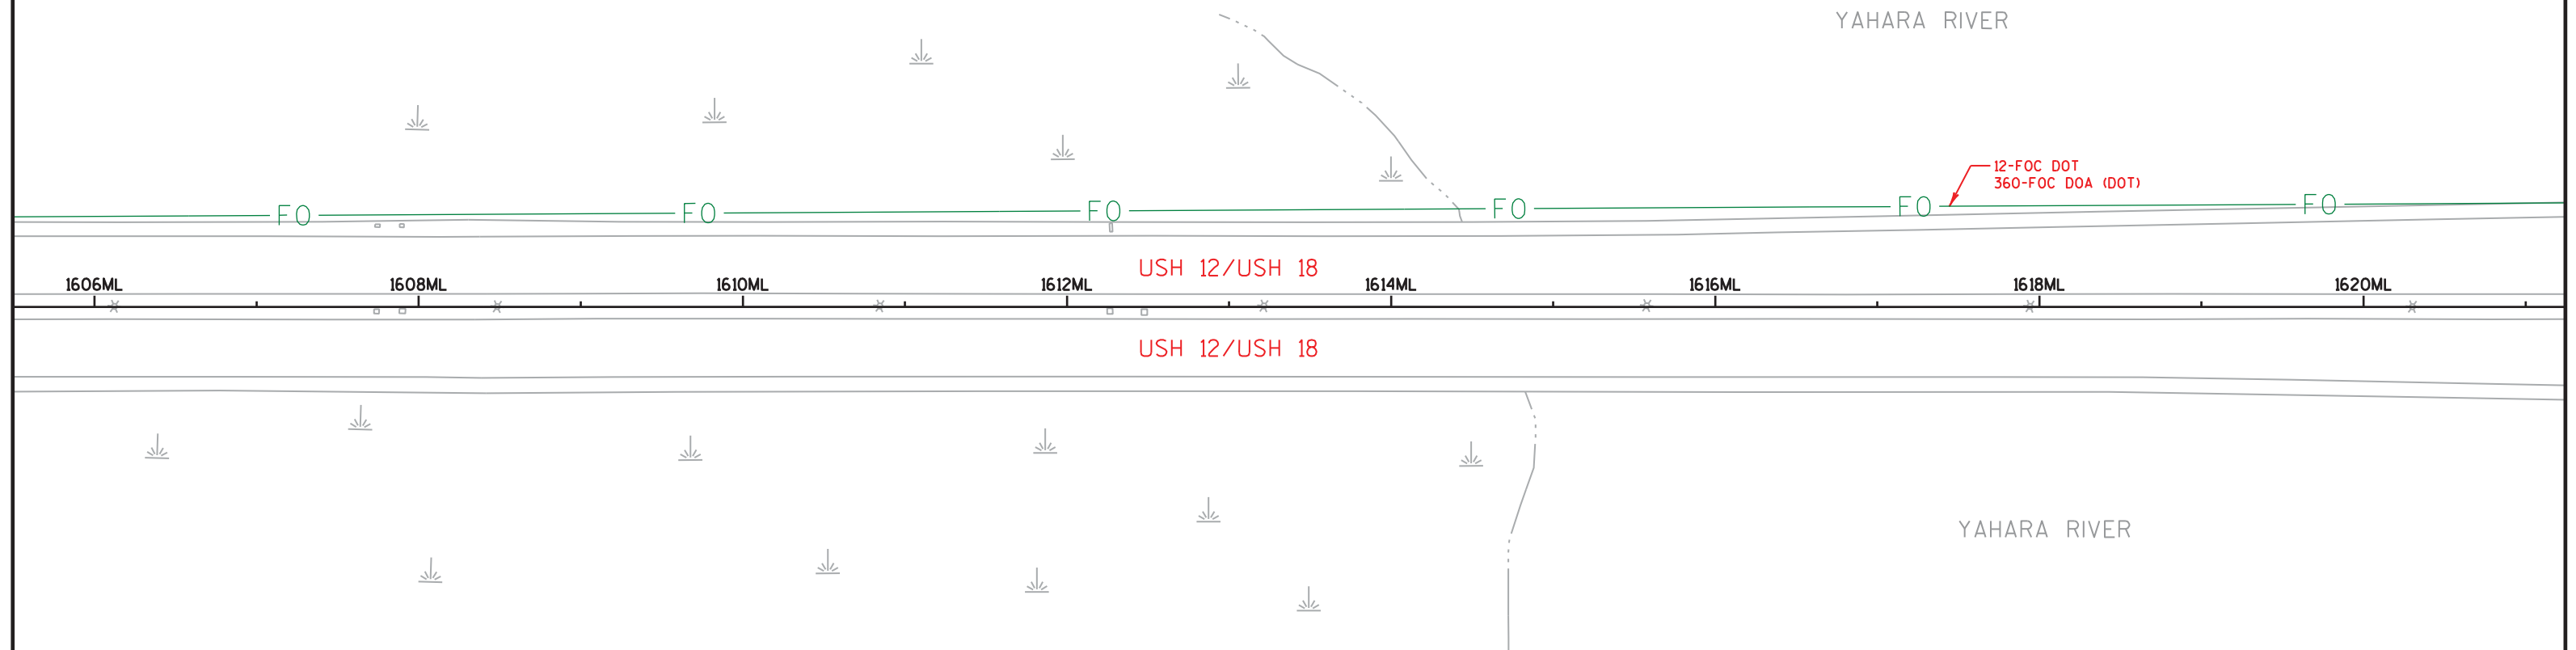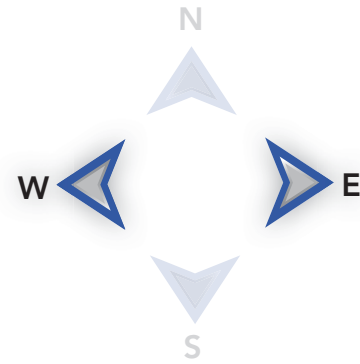


AS-BUILTS INFORMATION SOURCE


PROJECT DESIGN FILES
LET: XXXX / ID: XXXX-YY-ZZ

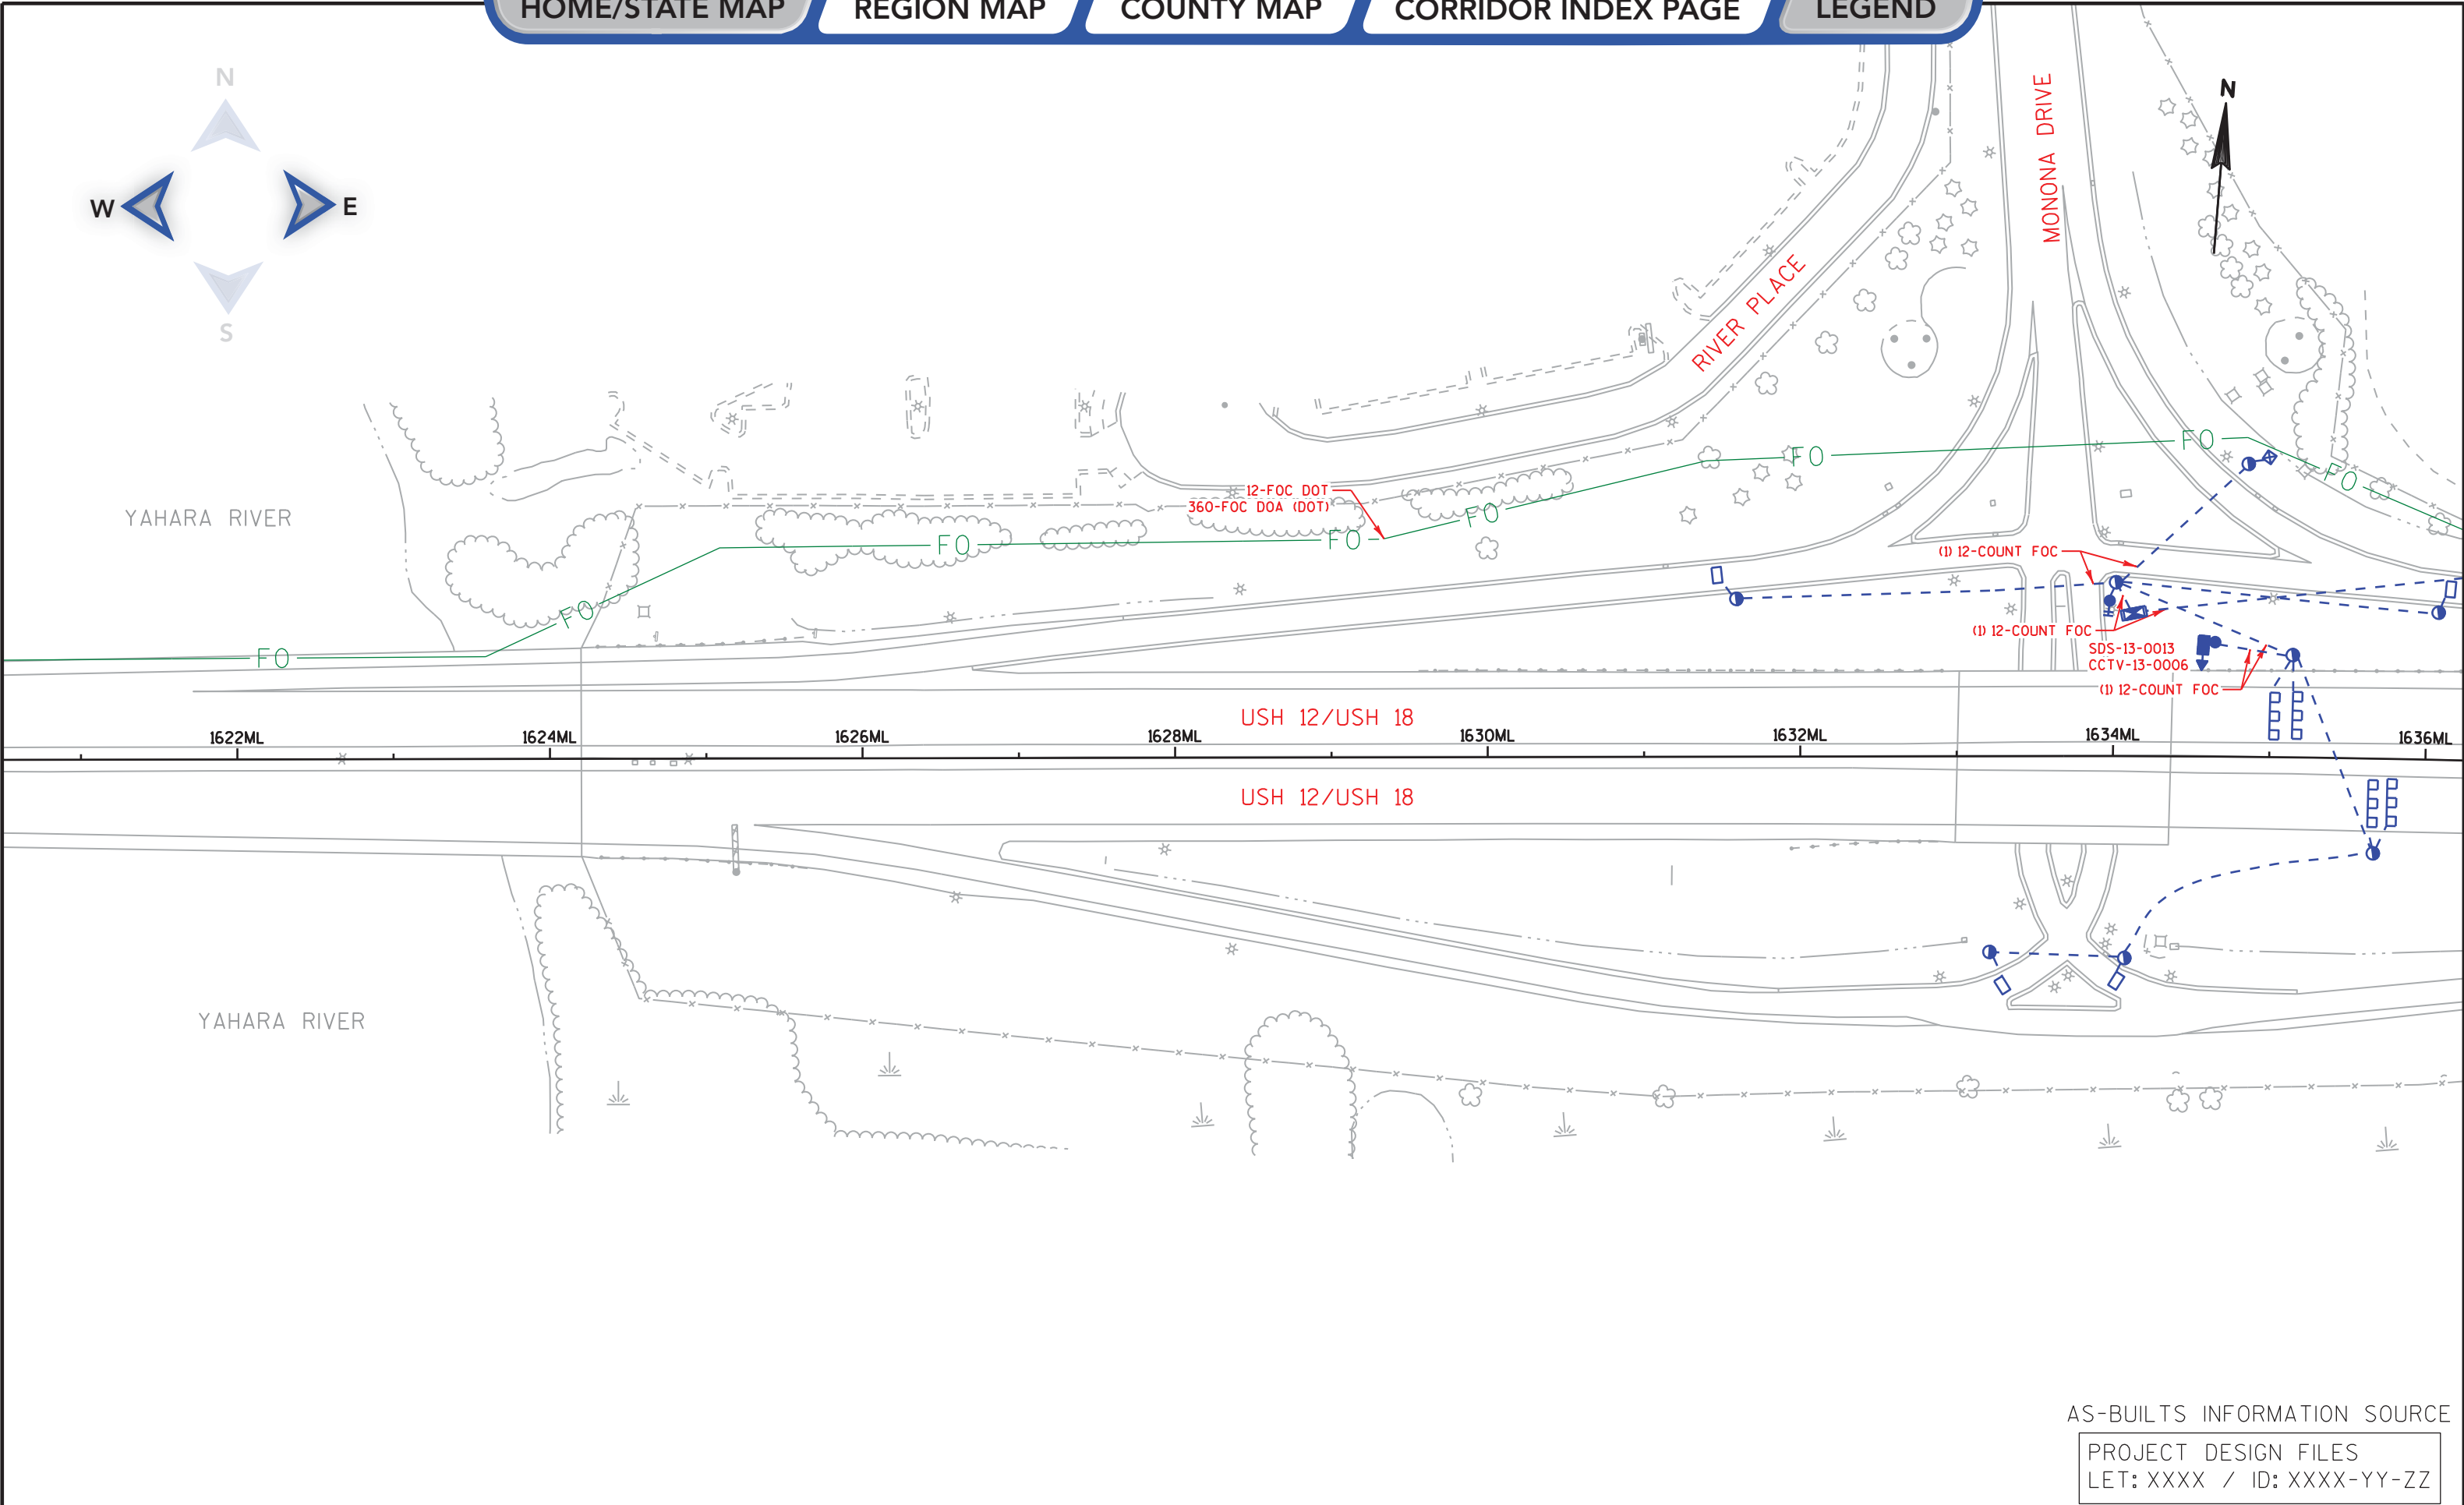


AS-BUILTS INFORMATION SOURCE
PROJECT DESIGN FILES
LET: XXXX / ID: XXXX-YY-ZZ

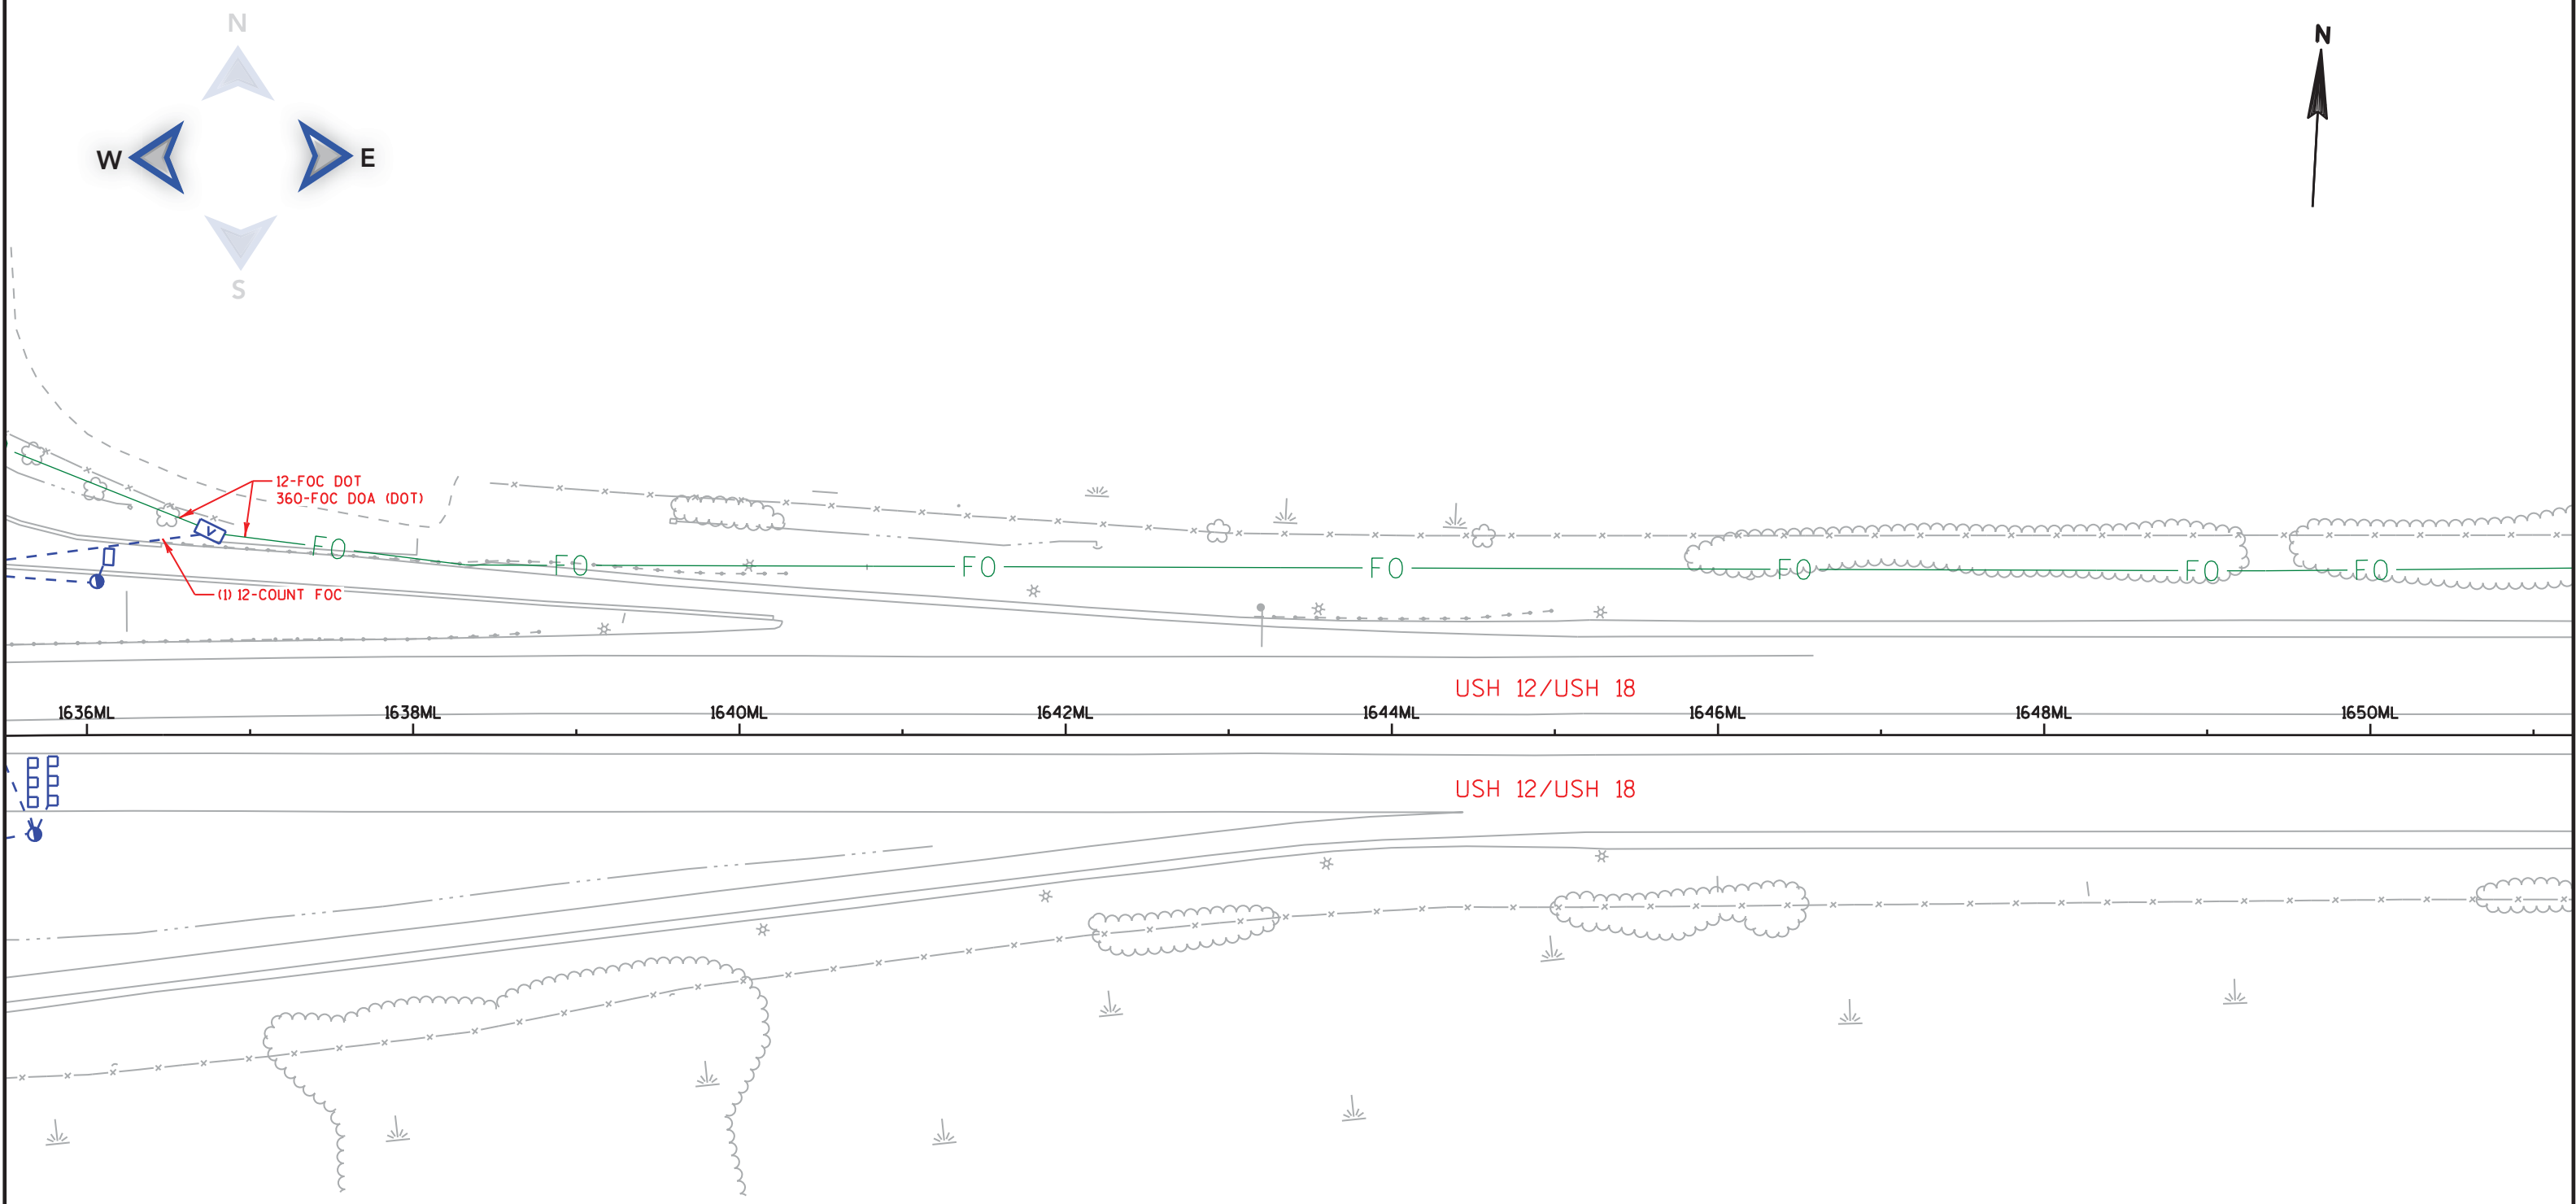


AS-BUILTS INFORMATION SOURCE
PROJECT DESIGN FILES
LET: XXXX / ID: XXXX-YY-ZZ

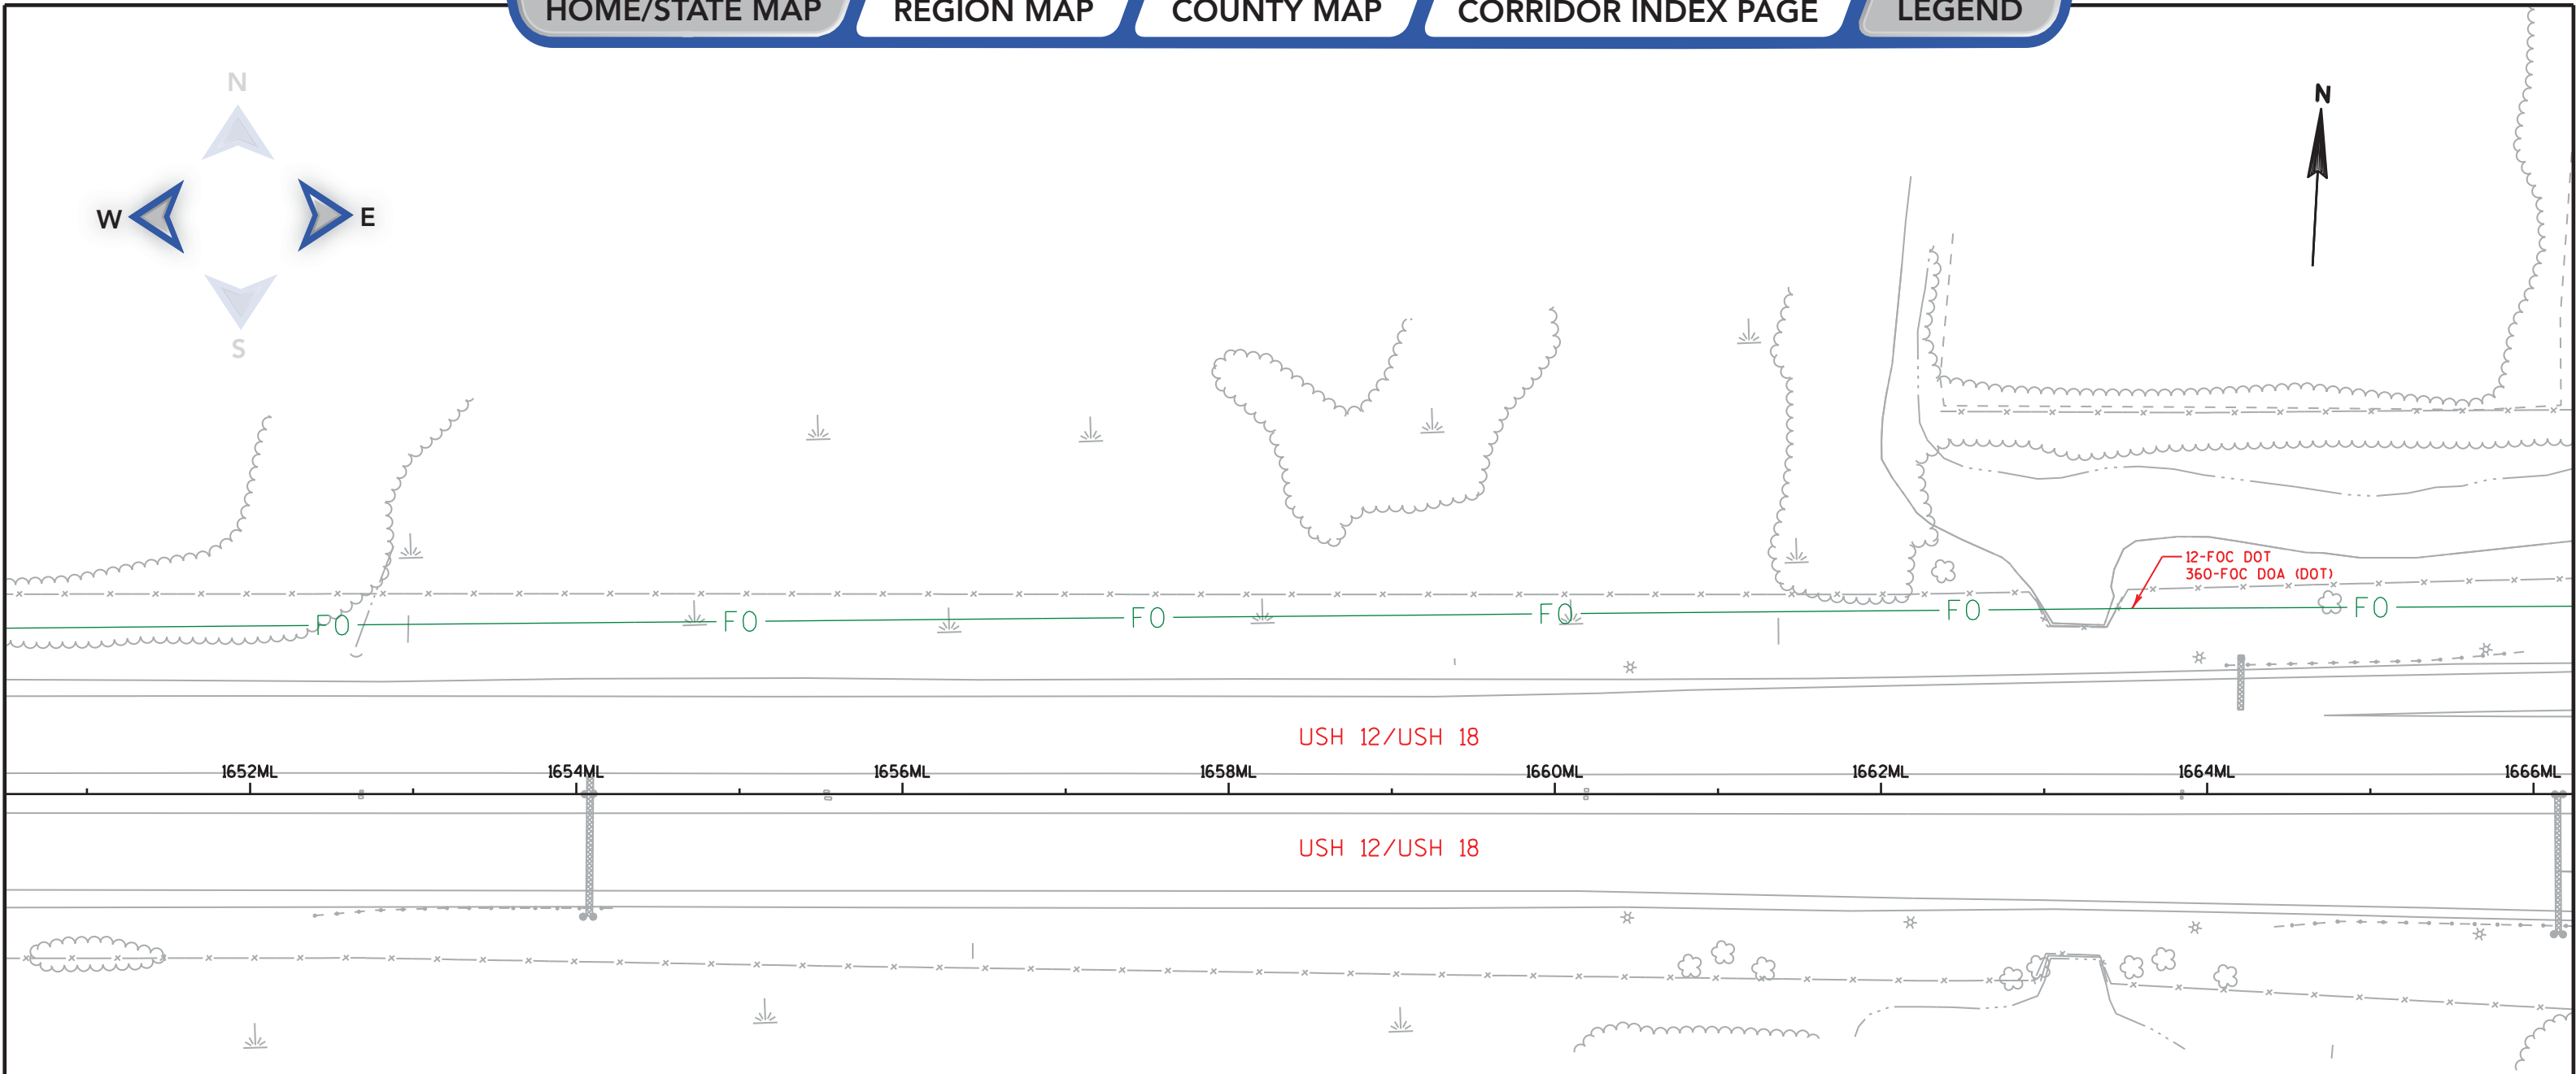


AS-BUILTS INFORMATION SOURCE
PROJECT DESIGN FILES
LET: XXXX / ID: XXXX-YY-ZZ

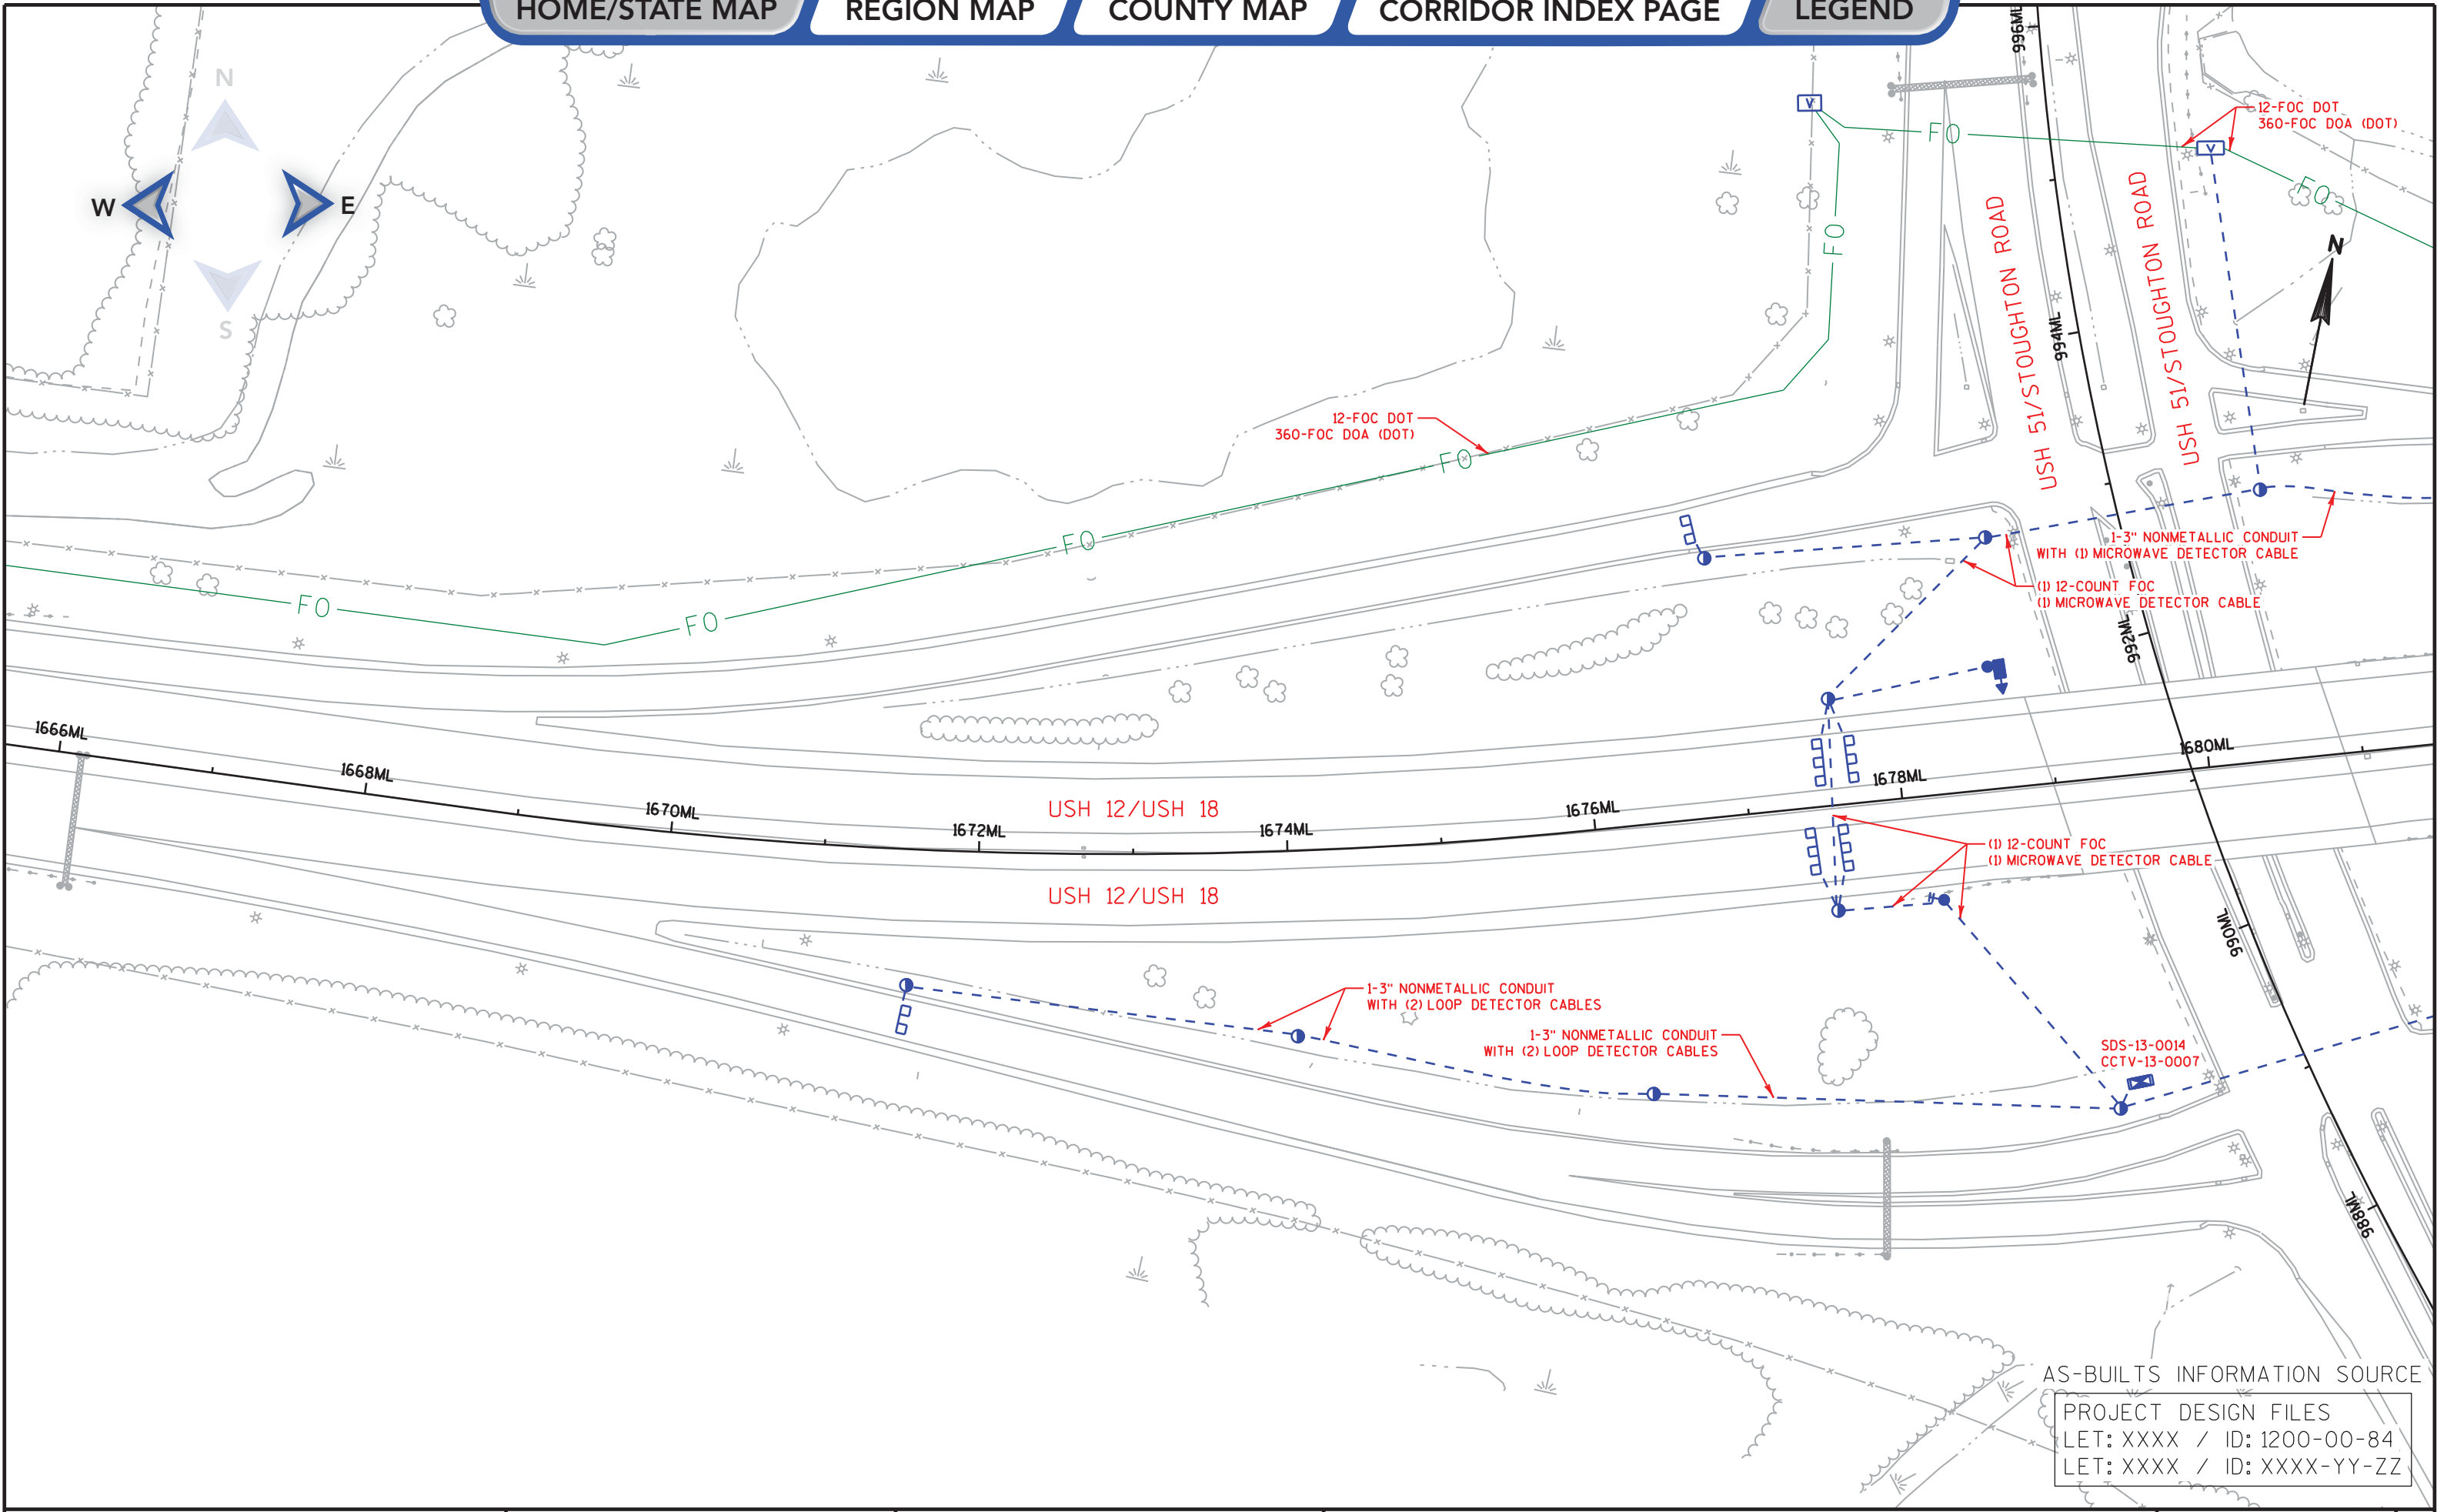


AS-BUILTS INFORMATION SOURCE
PROJECT DESIGN FILES
LET: XXXX / ID: 1200-00-84
LET: XXXX / ID: XXXX-YY-ZZ

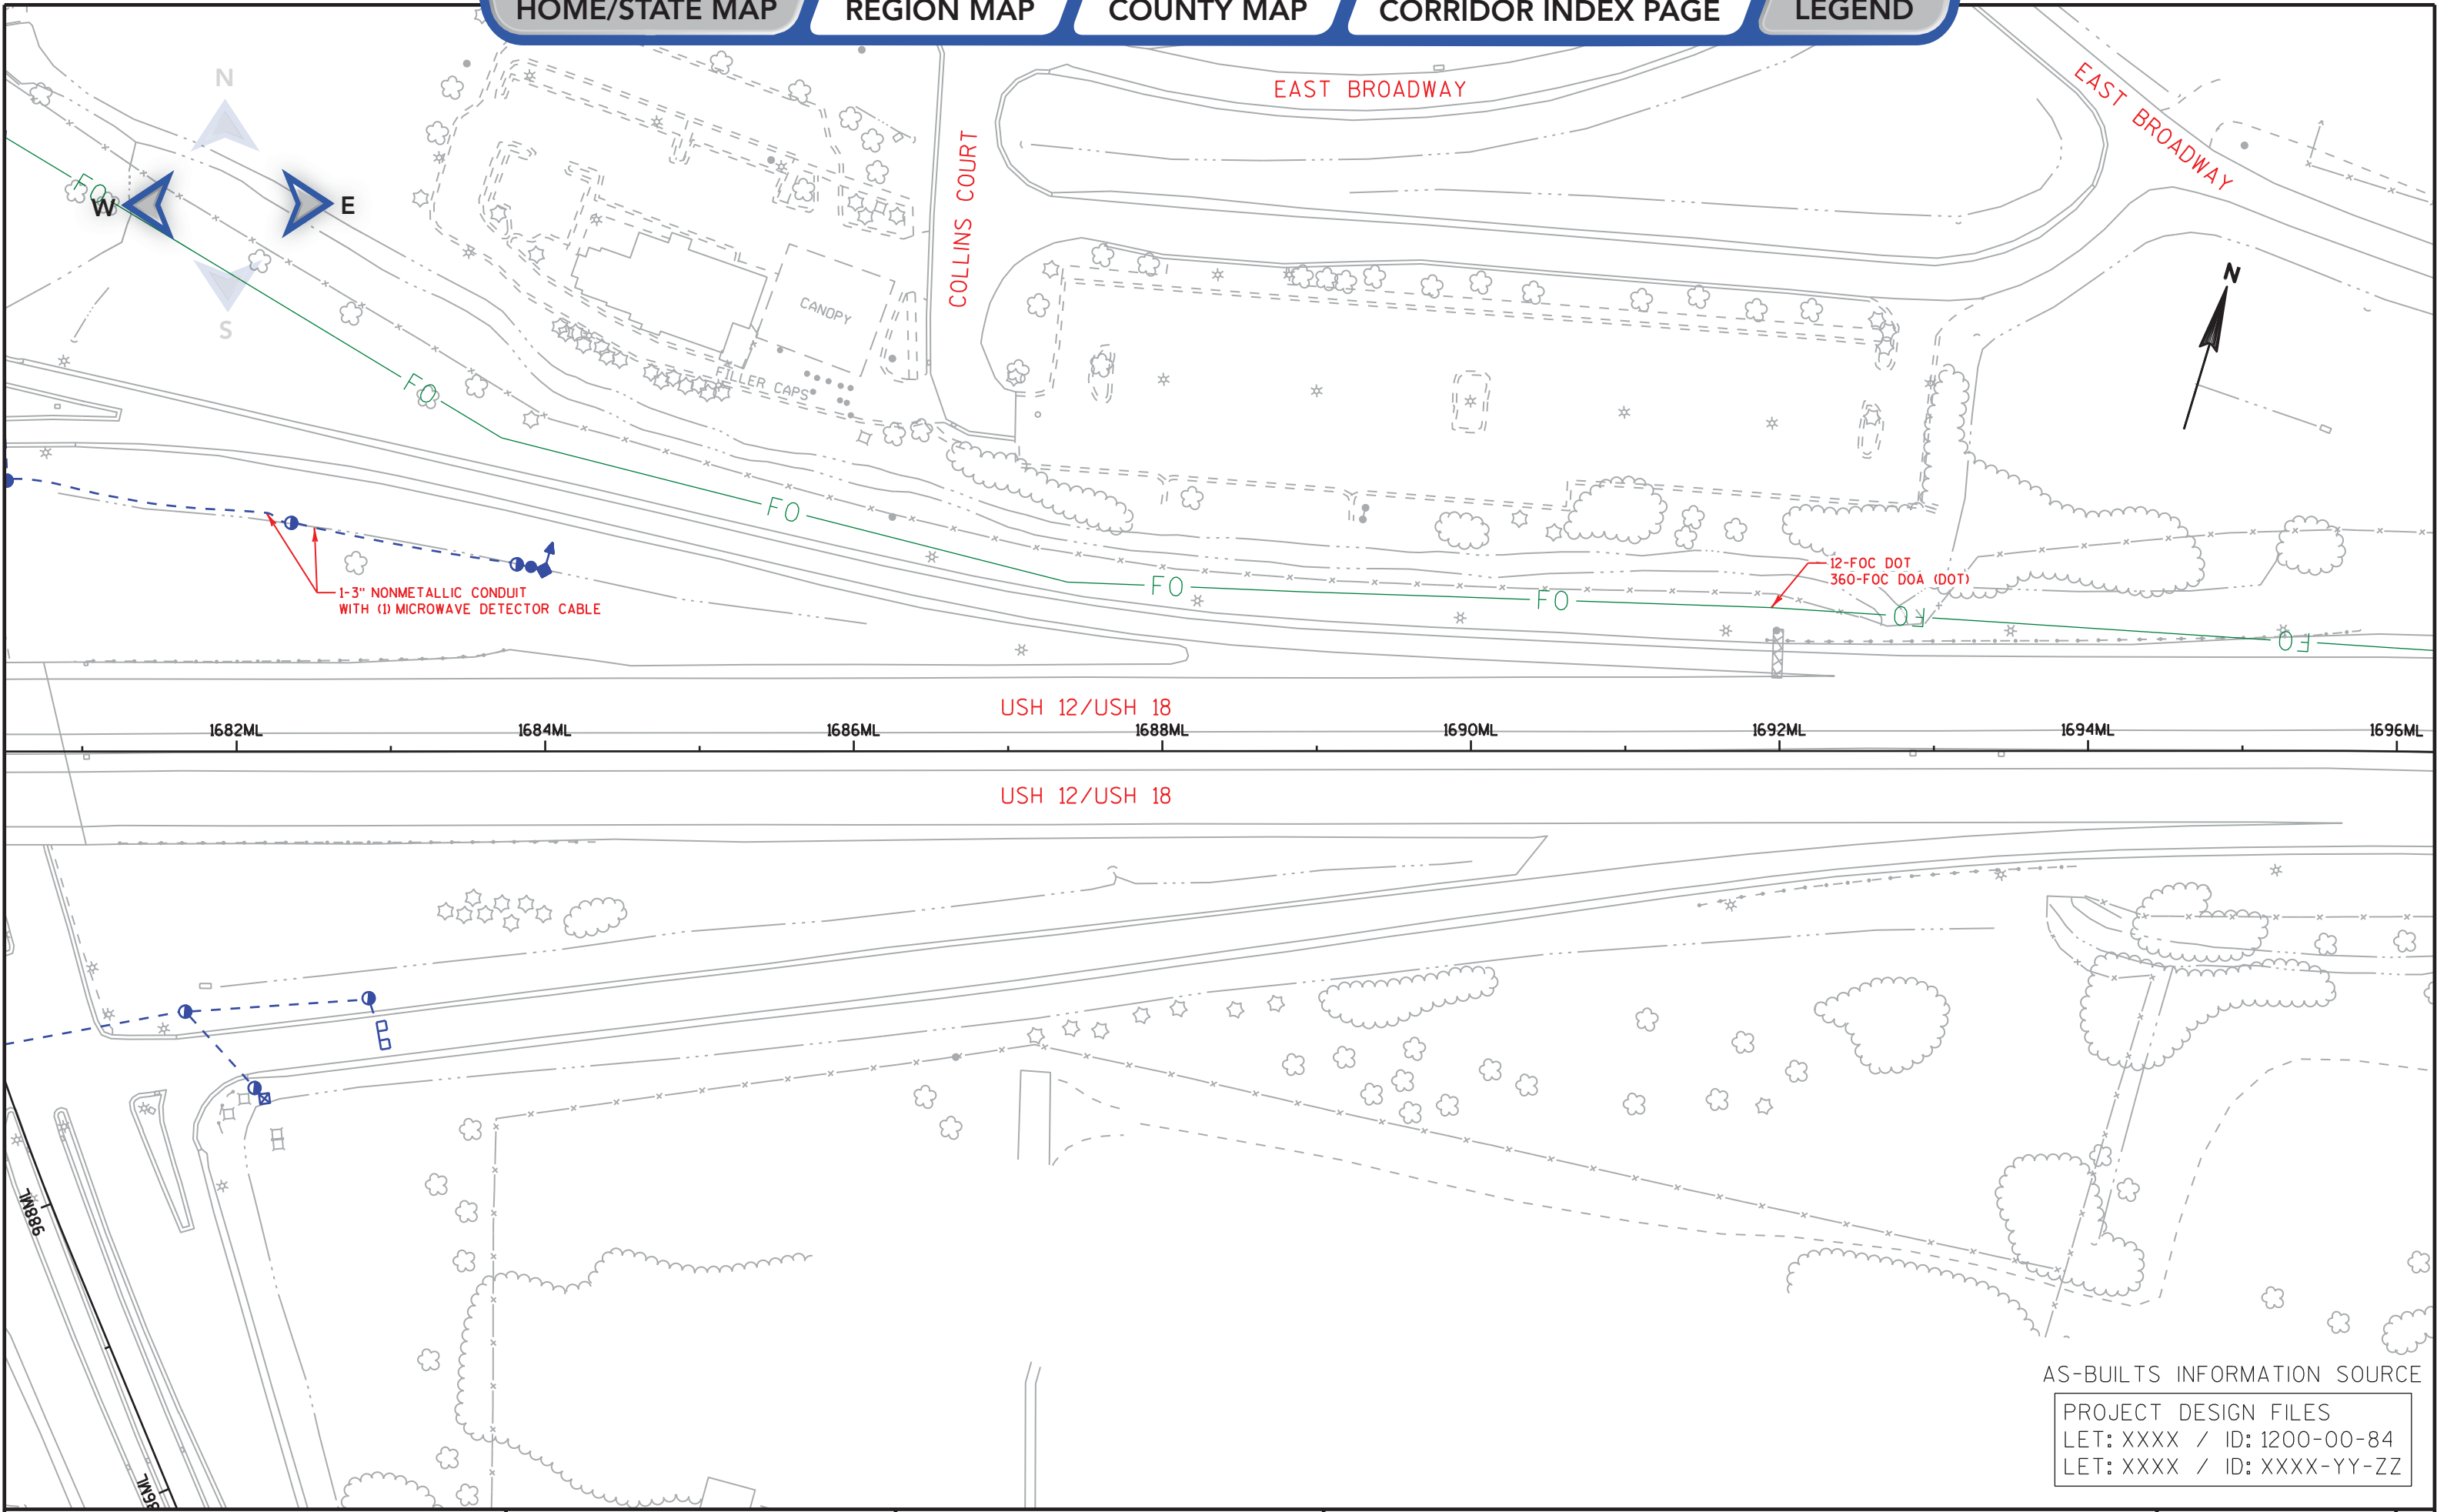

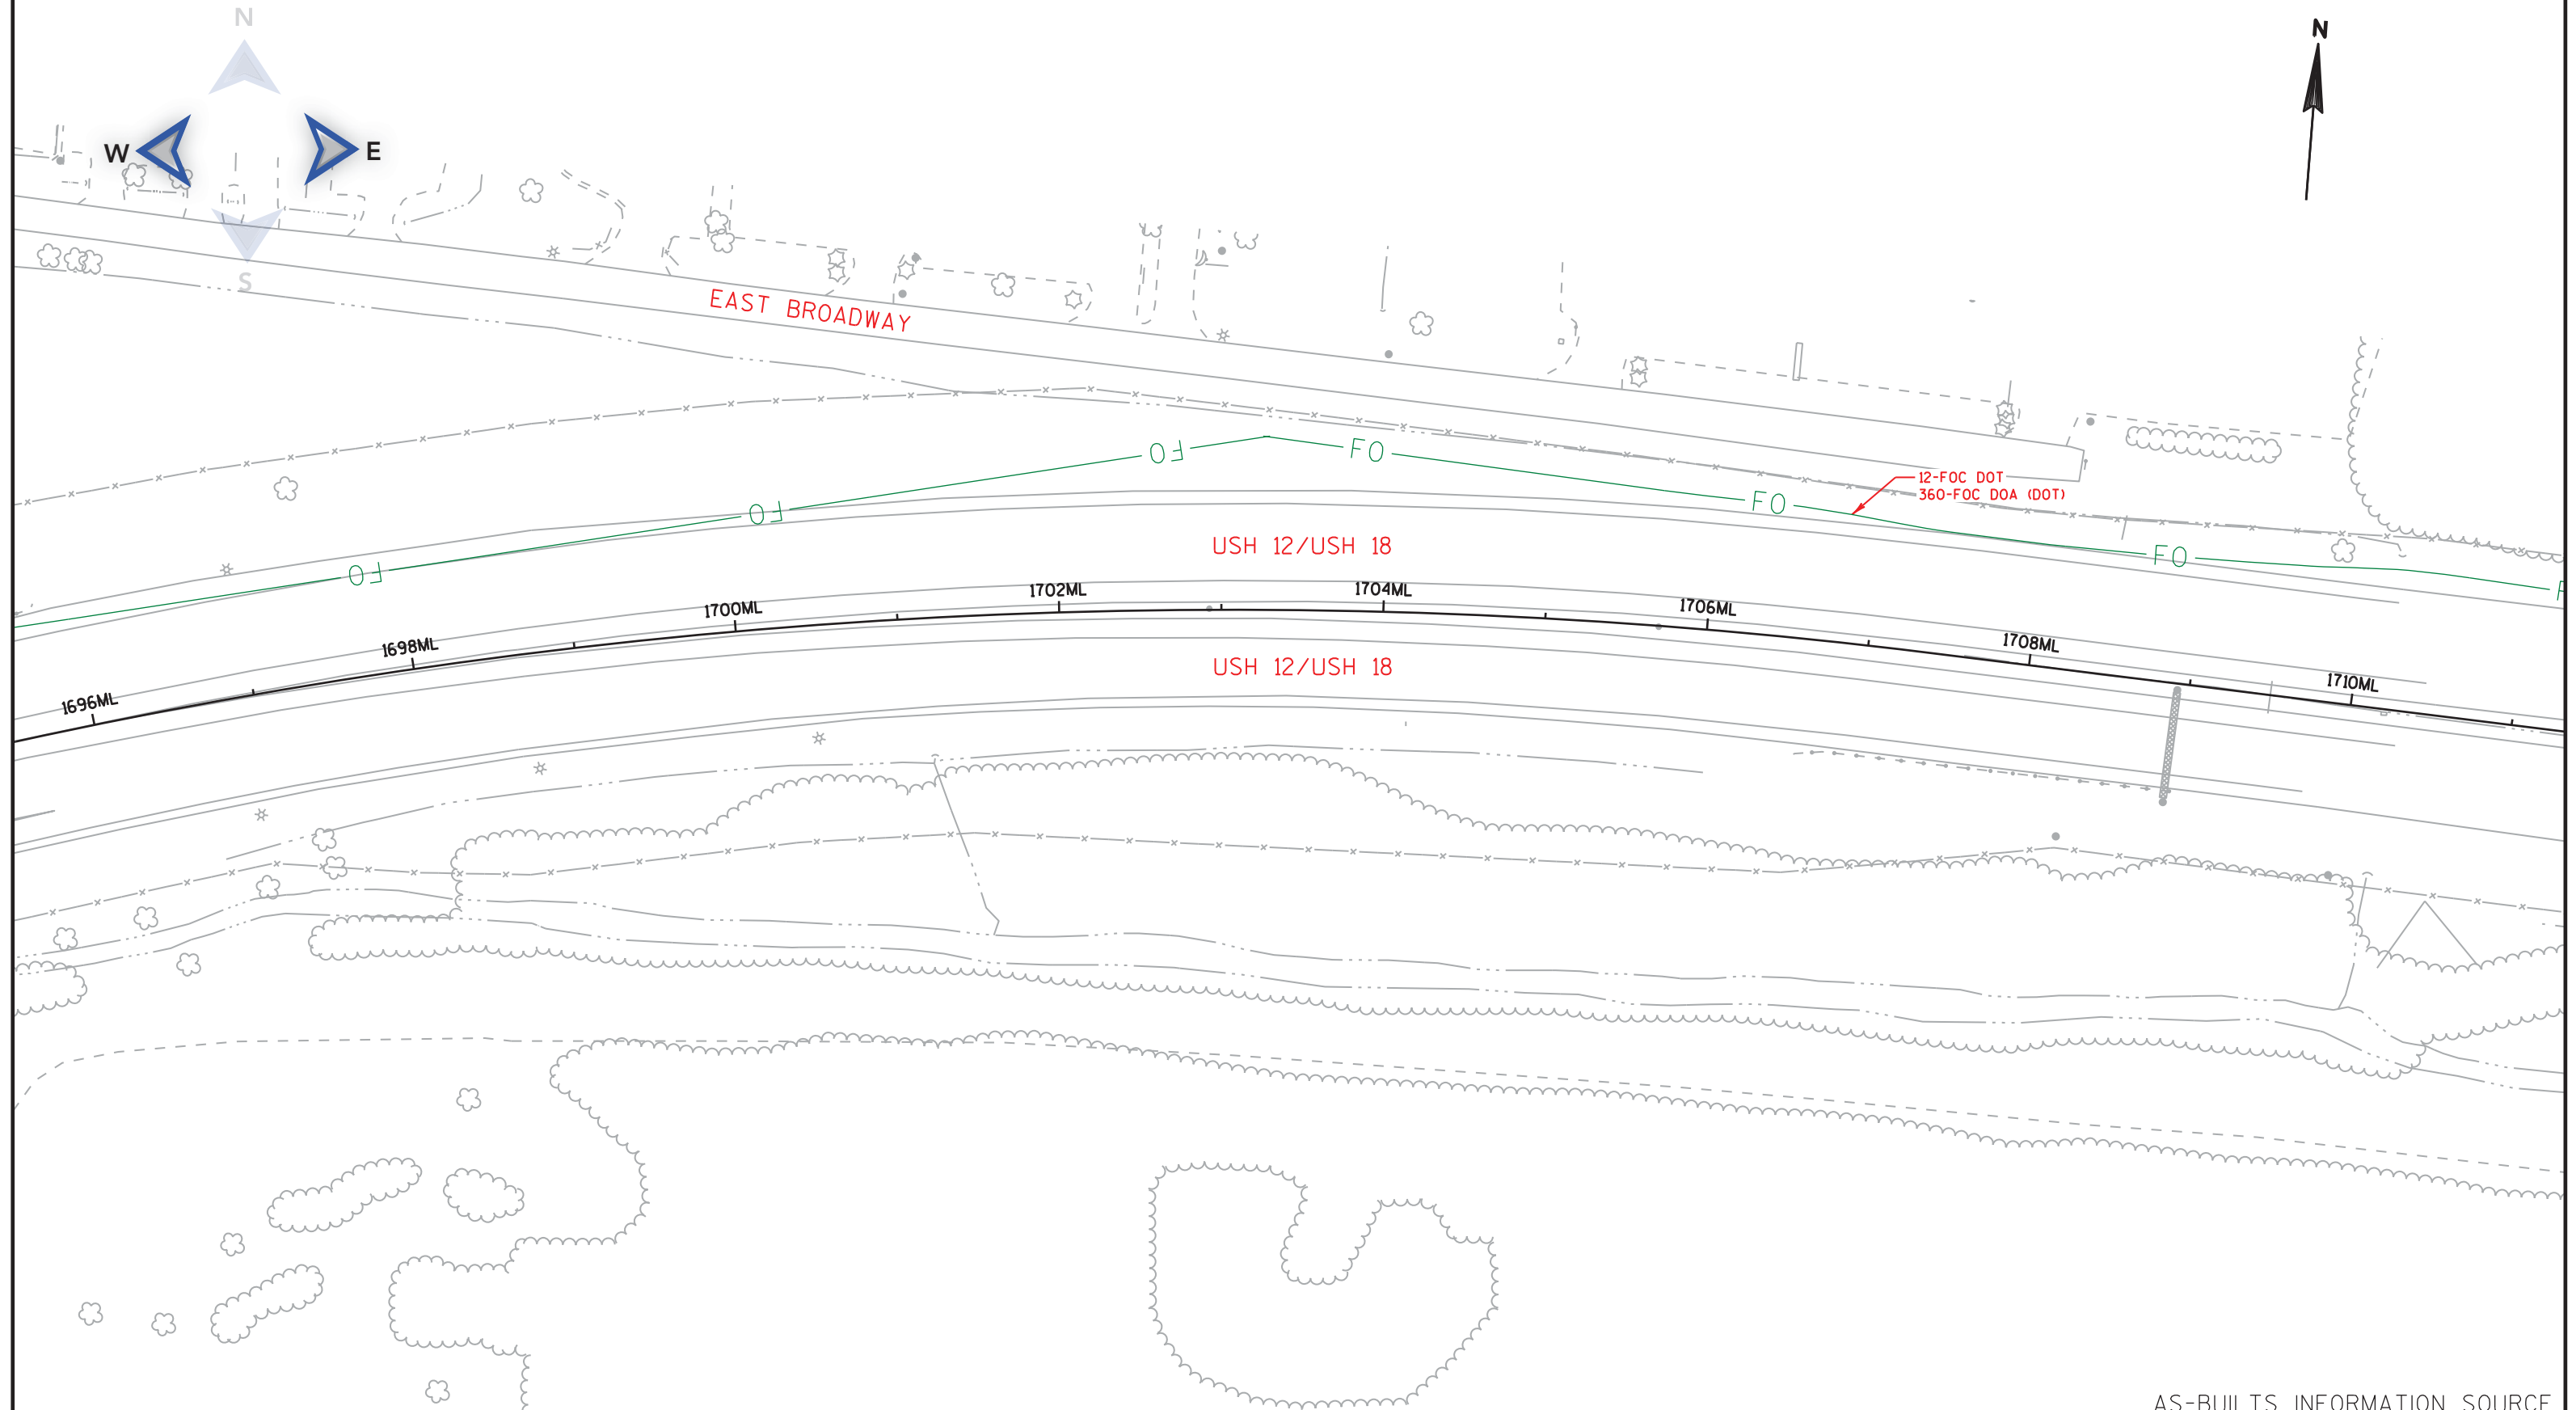


AS-BUILTS INFORMATION SOURCE

PROJECT DESIGN FILES
LET: XXXX / ID: XXXX-YY-ZZ

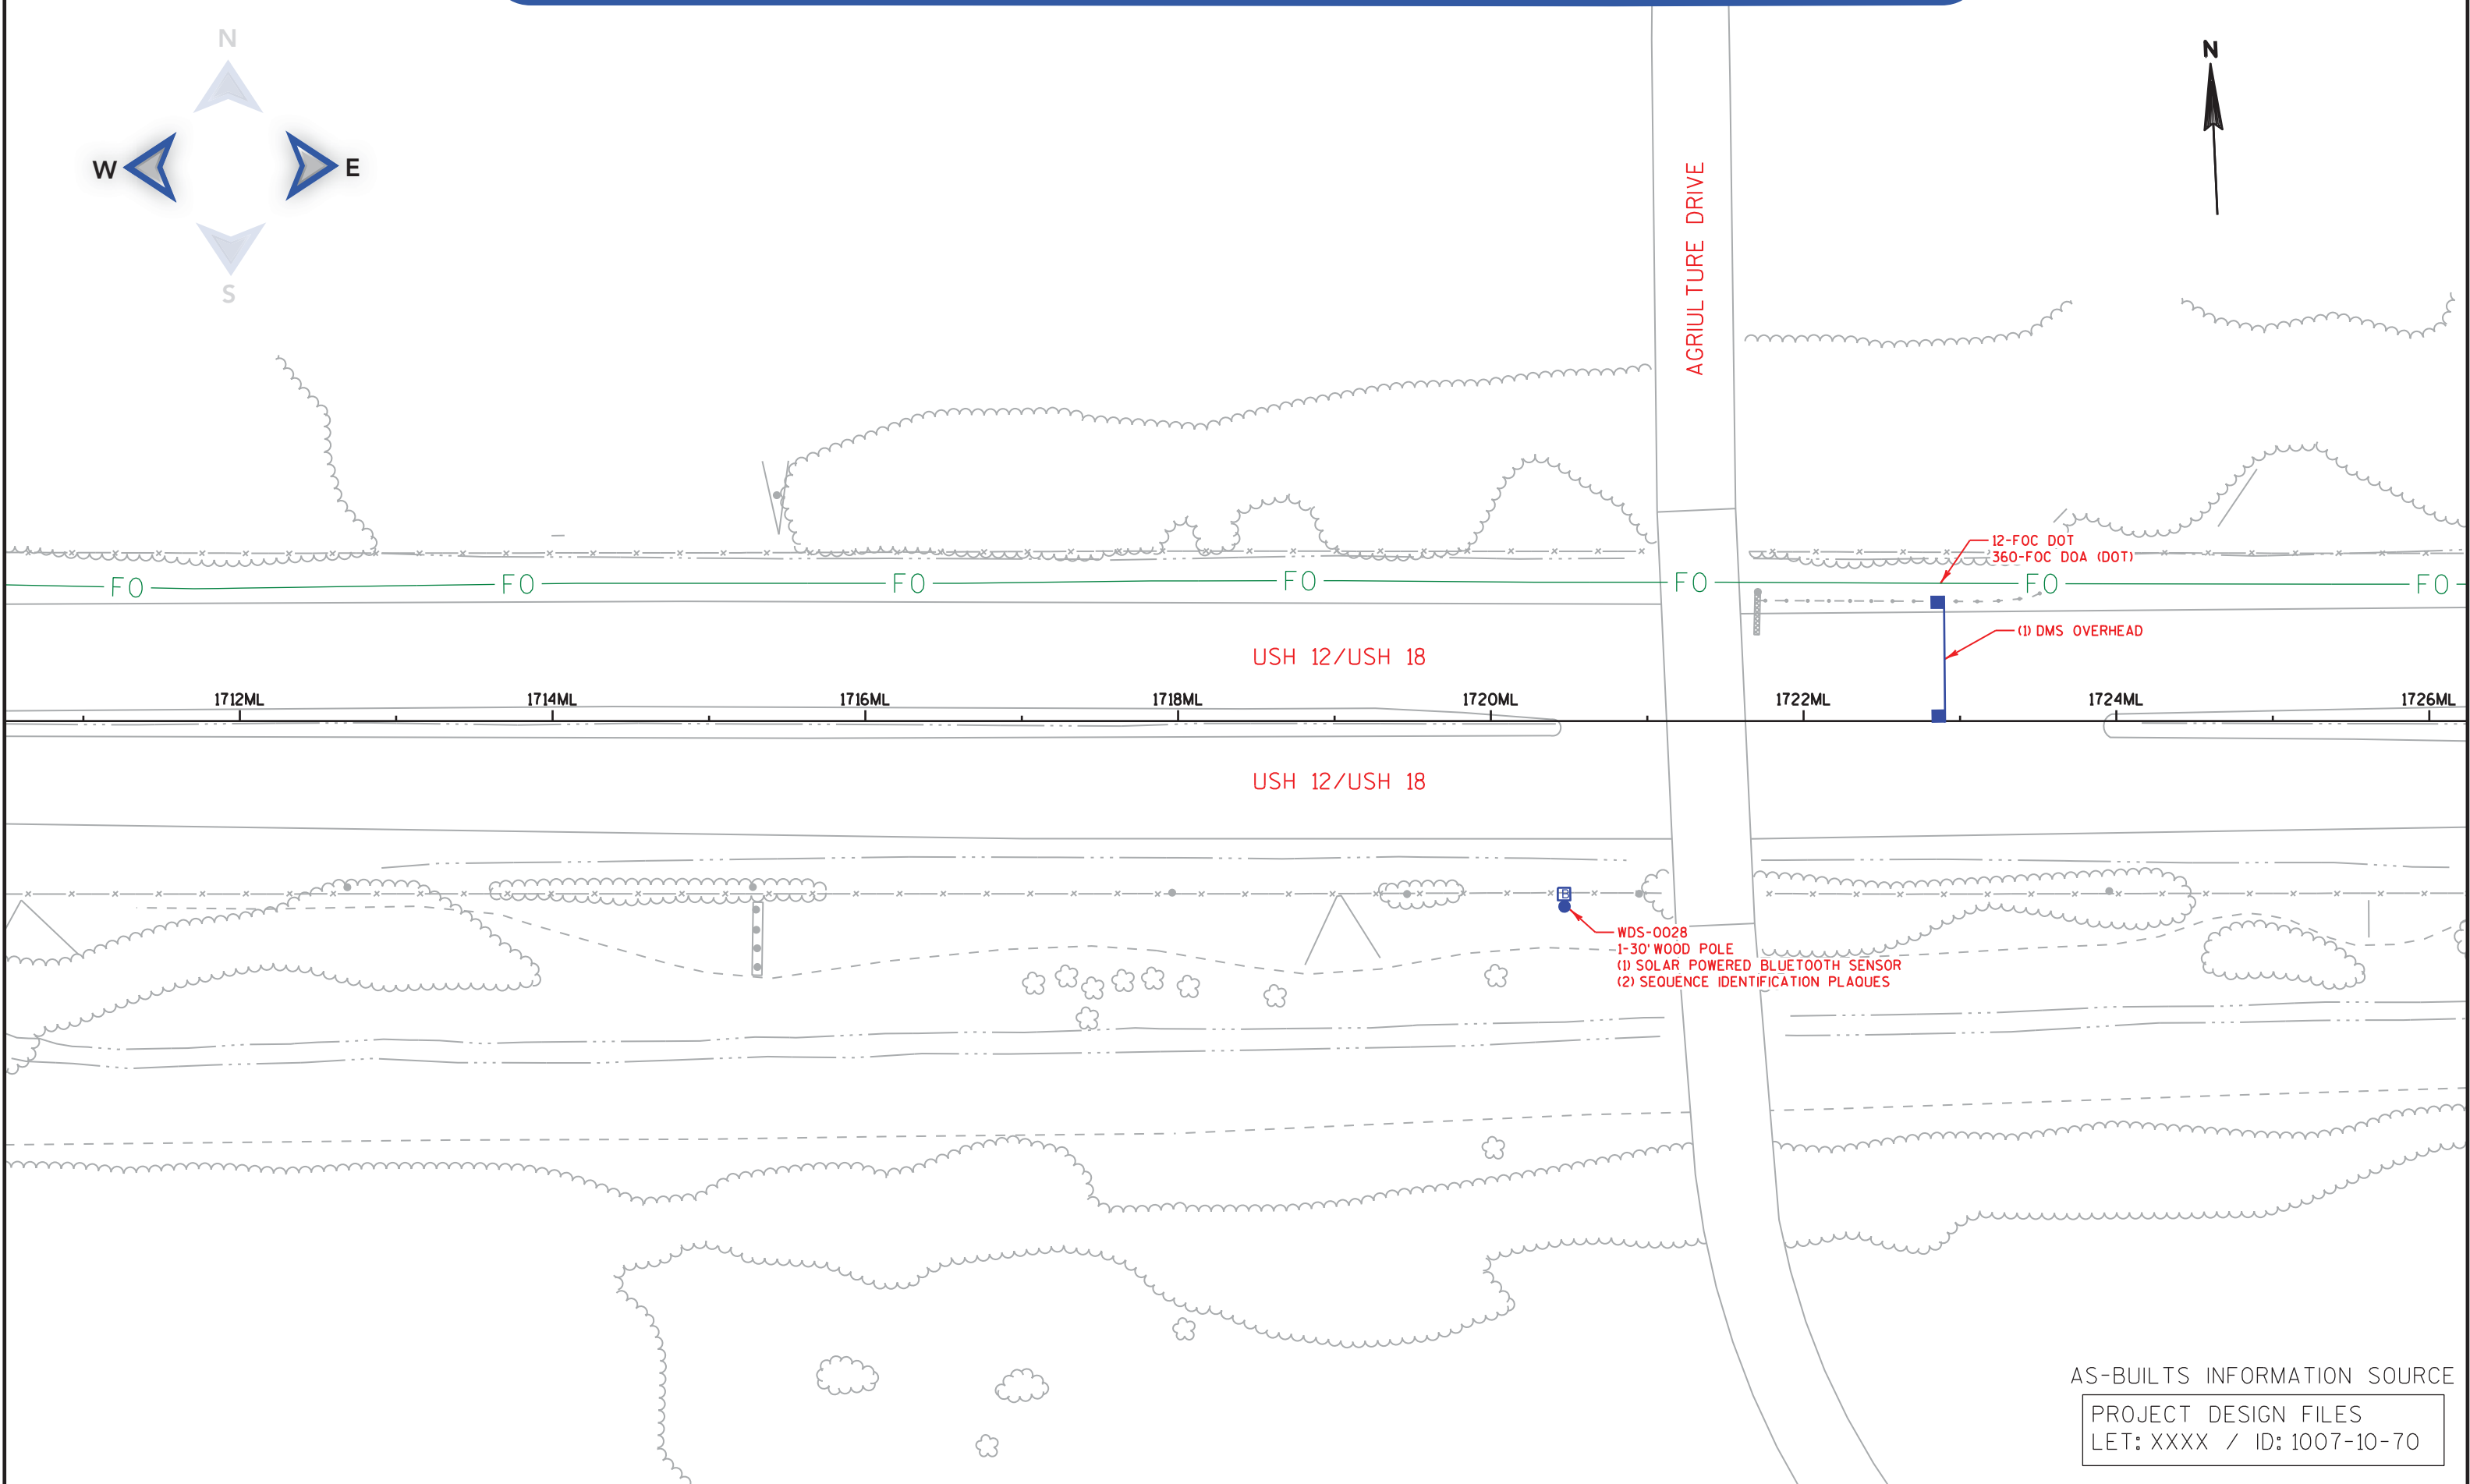


AS-BUILTS INFORMATION SOURCE


PROJECT DESIGN FILES
LET: XXXX / ID: 1007-10-70

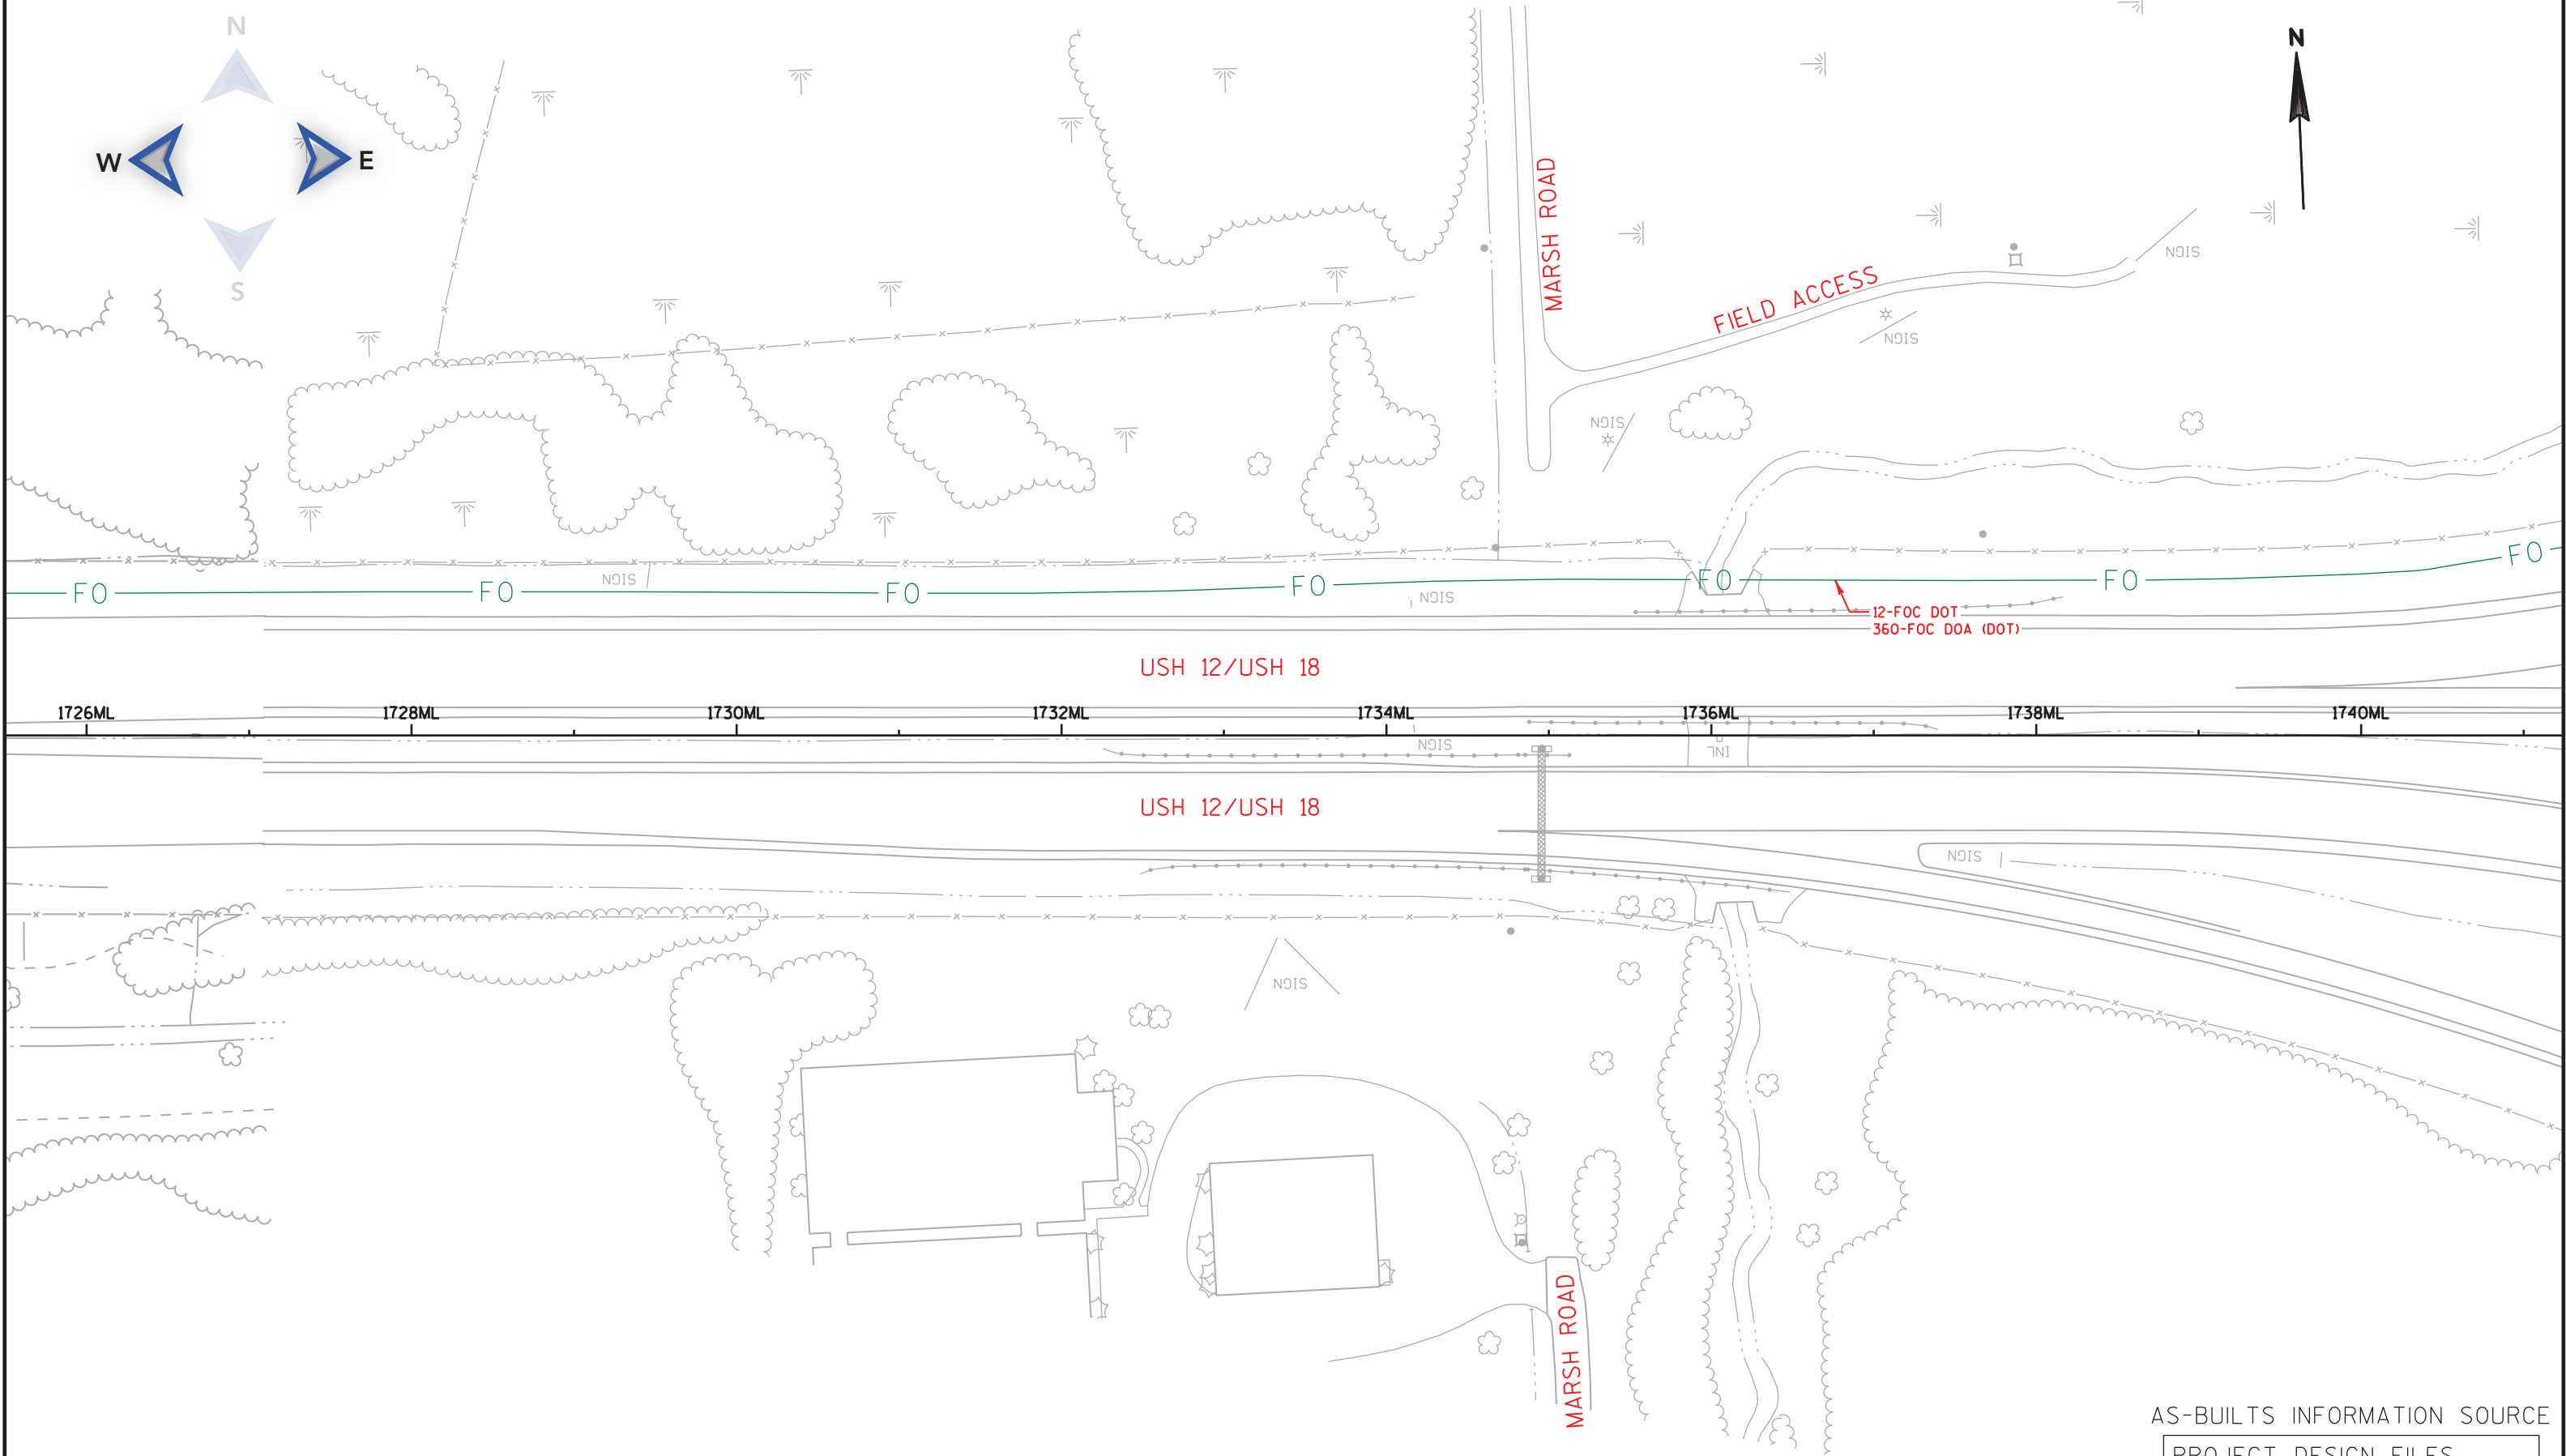


AS-BUILTS INFORMATION SOURCE
PROJECT DESIGN FILES
LET: XXXX / ID: XXXX-YY-ZZ

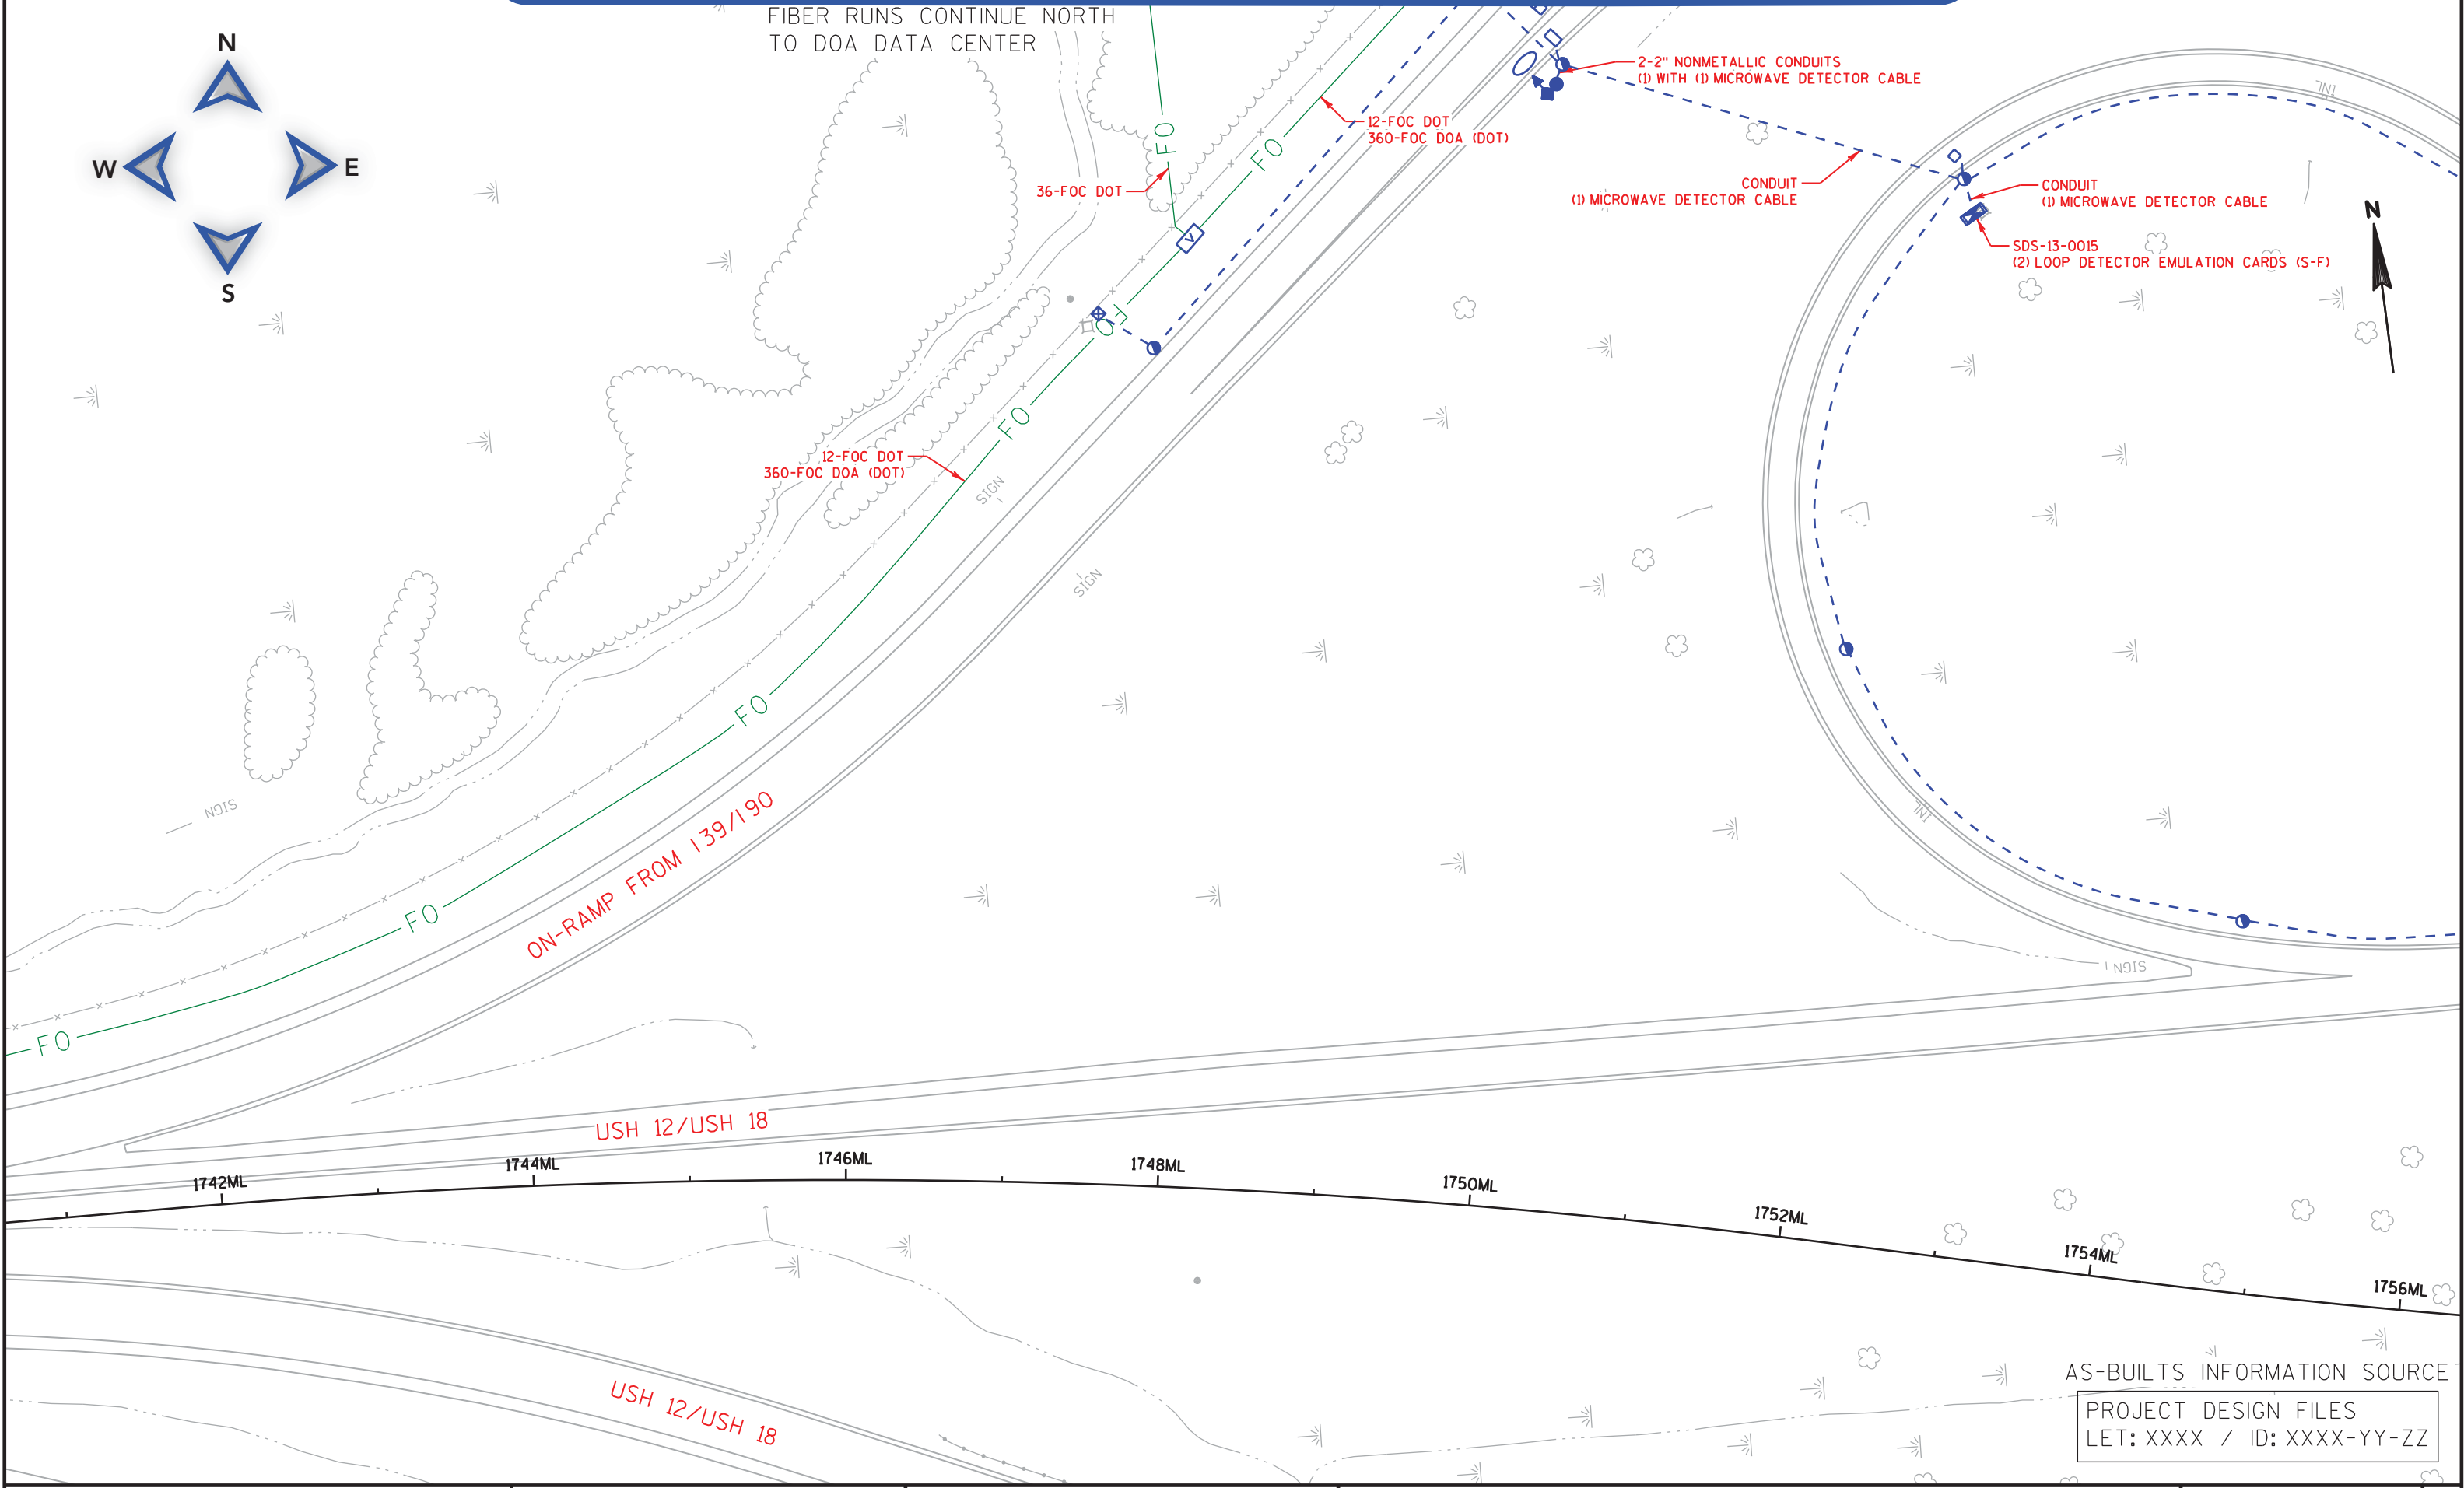

AS-BUILTS INFORMATION SOURCE
PROJECT DESIGN FILES
LET: XXXX / ID: XXXX-YY-ZZ

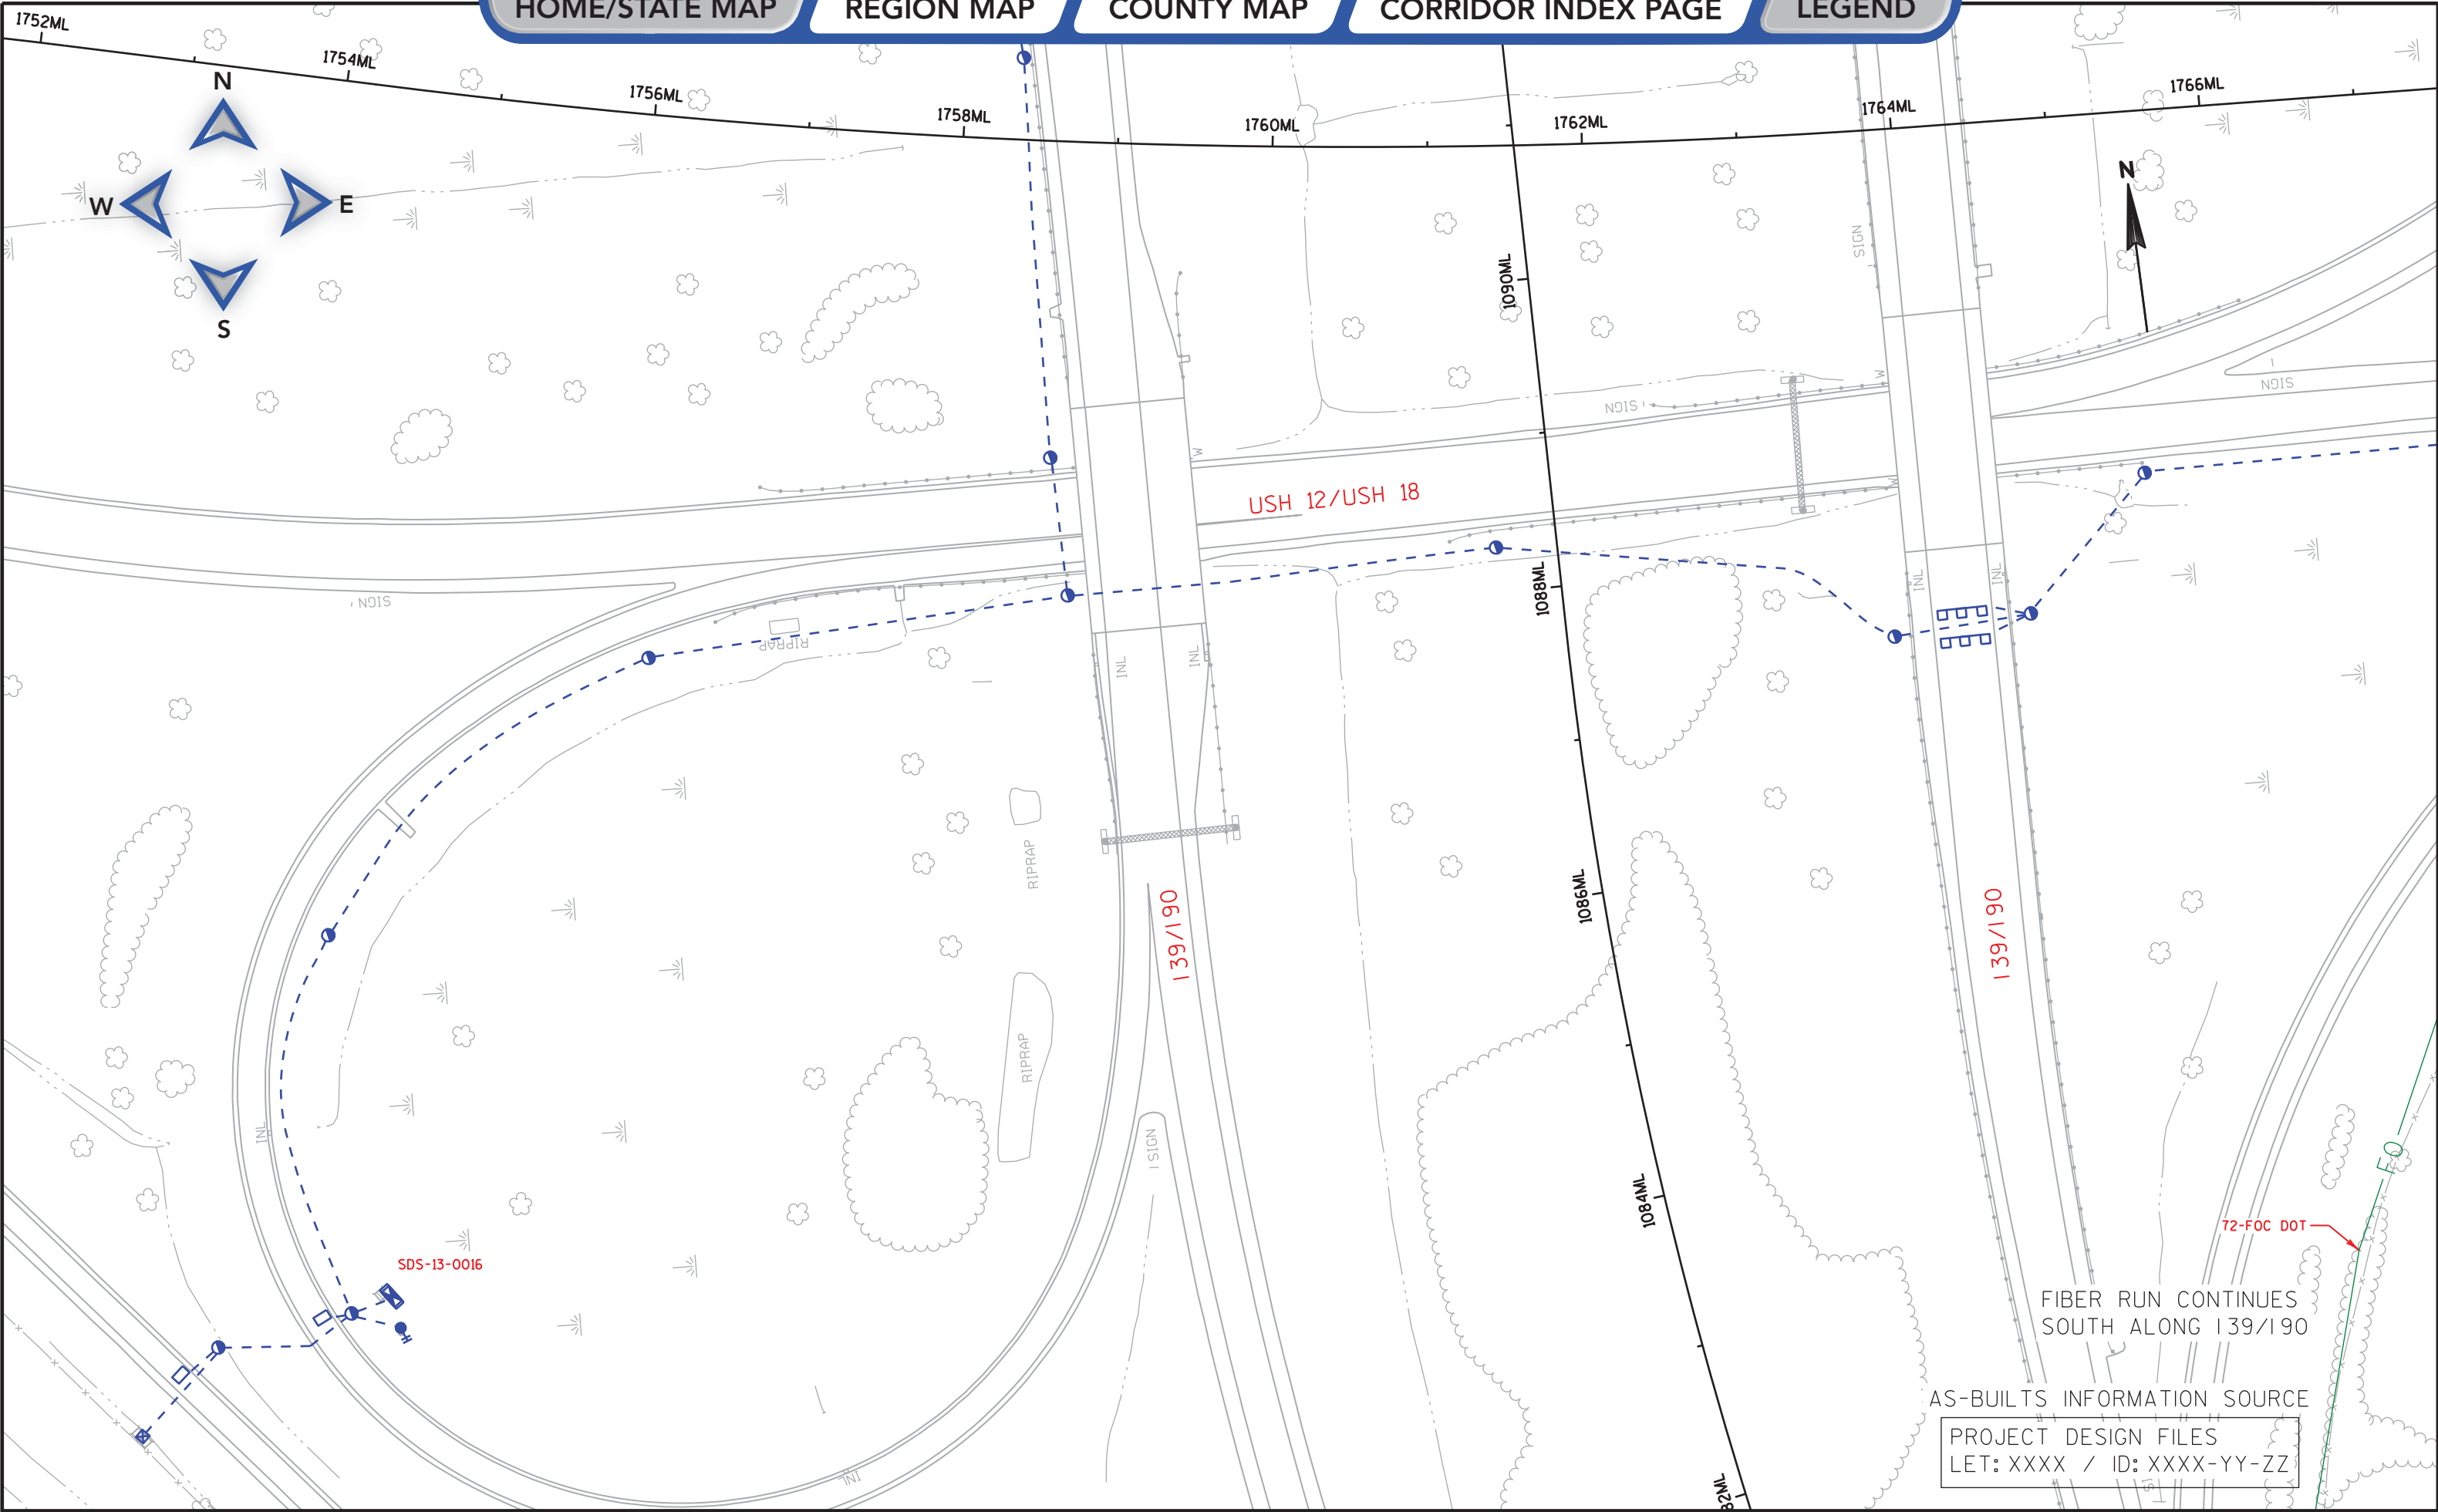

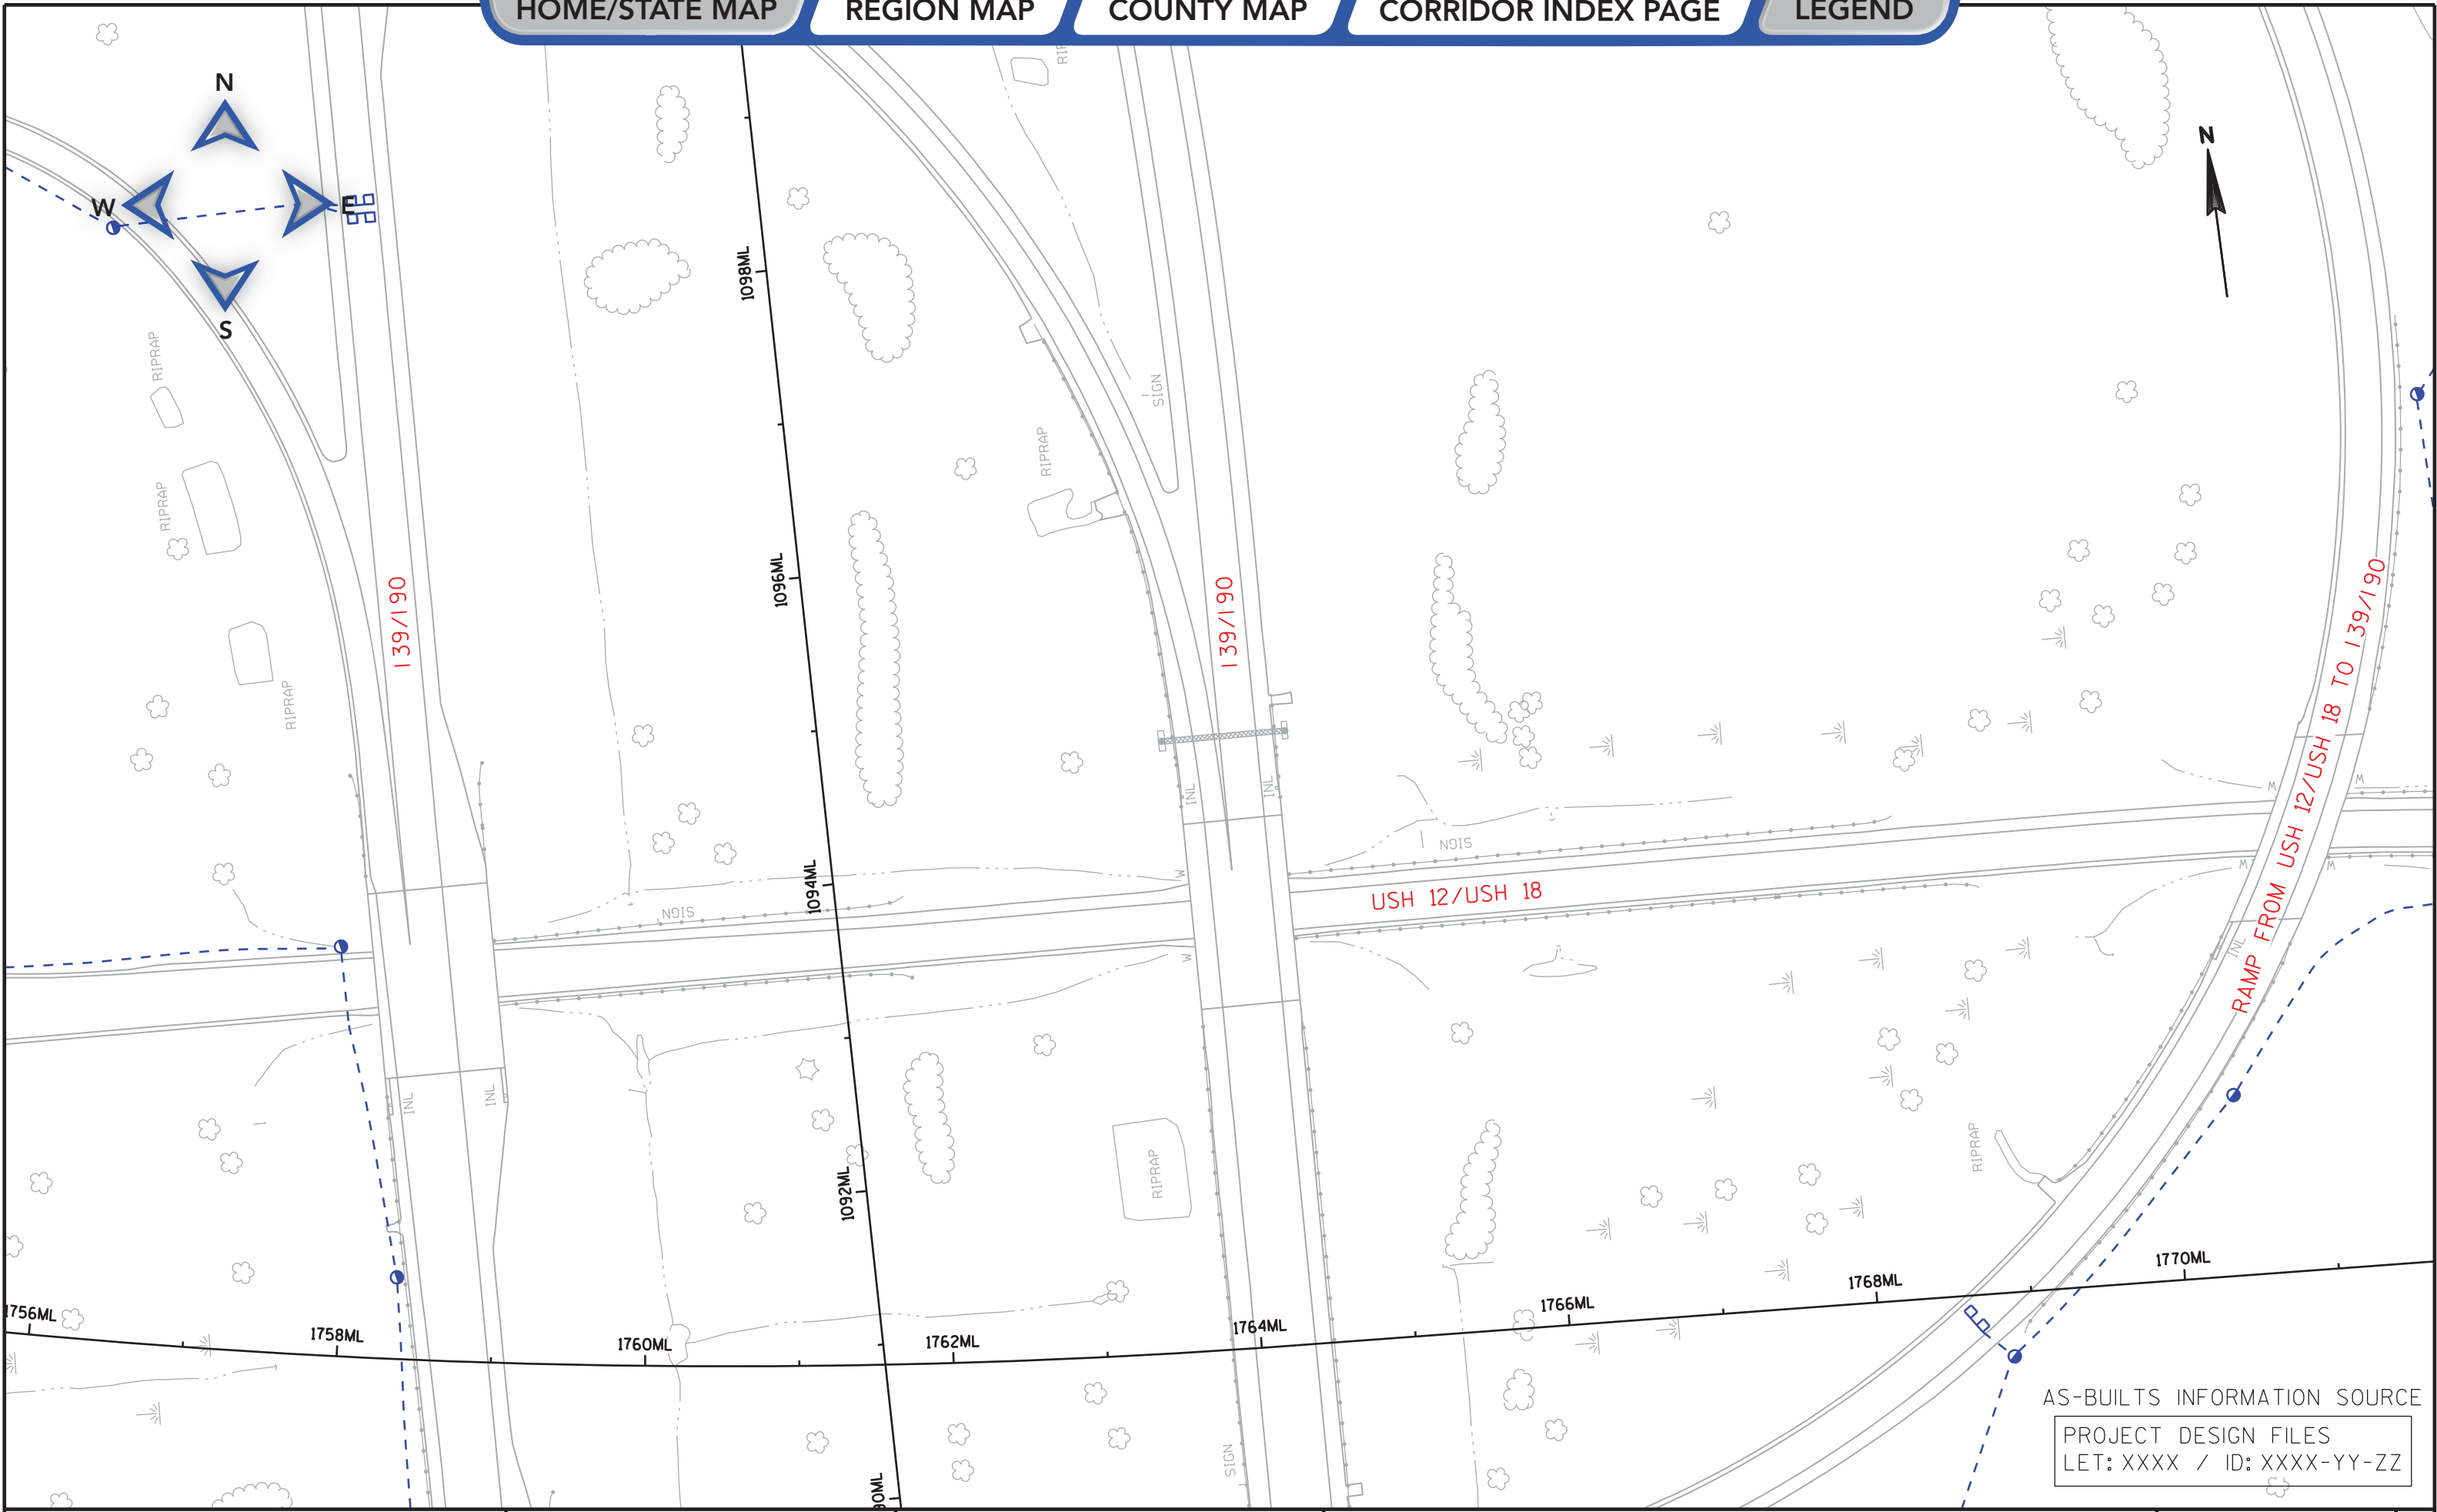

AS-BUILTS INFORMATION SOURCE
PROJECT DESIGN FILES
LET: XXXX / ID: XXXX-YY-ZZ