MAD MAR 2017

ORDER OF SHEETS

Section No. 1 Section No. 2 Typical Sections and Details

Estimate of Quantities Miscellaneous Quantities Right of Way Plat Plan and Profile

Computer Earthwork Data

Cross Sections

TOTAL SHEETS = 192

STATE OF WISCONSIN DEPARTMENT OF TRANSPORTATION

PLAN OF PROPOSED IMPROVEMENT

STATE PROJECT PROJECT CONTRACT WISC 2017094 1690-05-71

FEDERAL PROJECT

GLARUS - VERONA NEW

STH 92 TO CTH D

STH 69 DANE COUNTY

> STATE PROJECT NUMBER 1690-05-71

AS-BUILT PLAN

SUPERVISOR: Bill Strobel PROJECT LEADER: Derrick Ballweg PROJECT MANAGER: Mahesh Shrestha PRIME CONTRACTOR: H. James & Sons, Inc. WORK STARTED: 5/22/17 WORK COMPLETED: 8/30/17




DESIGN DESIGNATION

A.A.D.T. 2016 = 5200 A.A.D.T. 2036 = 7900 D.H.V. D.D. = 60/40 = 5.5% DESIGN SPEED = 35 MPH **ESALS** = 920,000

Subcontractor List: Augelli Concrete & Excavating, LLC Guide Lines Pavement Marking, LLC Hard Rock Sawing & Drilling Specialist Co. **Lunda Construction Company** Payne and Dolan, Inc. SJK Engineering, LLC T-N-T Tree Service, LLC Traffic Control & Protection West-Land Restoration, Inc. Yahara Materials, Inc.

CONVENTIONAL SYMBOLS

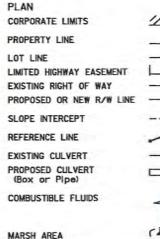

WOODED OR SHRUB AREA

11111111 TELEPHONE WATER UTILITY PEDESTAL

PROFILE GRADE LINE ORIGINAL GROUND MARSH OR ROCK PROFILE (To be noted as such) SPECIAL DITCH GRADE ELEVATION CULVERT (Profile View) UTILITIES ELECTRIC FIBER OPTIC GAS SANITARY SEWER STORM SEWER

POWER POLE

TELEPHONE POLE

X

Ġ

END PROJECT 1690-05-71 STA. 28+50.00 FEDERAL AVE. D 3RD AVE. DR. LAKE BELLE VIEW BROSS CIR. ENTERPRISE SERV-US ST. SUGAR RIVER 69 W. MAIN ST. E. MAIN ST. 92 W. PEARL ST. E. PEARL ST. 1/8 MILE

TOTAL NET LENGTH OF CENTERLINE = 0.320 MI (URBAN)

HORIZONTAL POSITIONS SHOWN ON THIS PLAN ARE WISCONSIN COUNTY COORDINATES, DANE COUNTY, NADB3 (2011), IN U.S. SURVEY FEET.
VALUES ARE GRID COORDINATES, GRID BEARINGS, AND GRID DISTANCES.
GRID DISTANCES MAY BE USED AS GROUND DISTANCES.

B-13-337

142,67

EXCEPTION TO NET

STA. 10+17.94

X=781,199,50

CENTERLINE LENGTH

BEGIN PROJECT 1690-05-71

ORIGINAL PLANS PREPARED BY SCONSIA ACQUELYN M. MESSER 41278 DELAFIELD, STATE OF WISCONSIN DEPARTMENT OF TRANSPORTATION PREPARED BY Surveyor GRAEF Designer MAHESH SHRESTHA Project Manager Regional Examiner BILL STROBEL Regional Supervisor. Alle

FILE NAME : L:\JOBS2014\20145023\CAD\TRANSPORTATION\DWG\SHEETSPLAN\OLD\010101_TI.DWG 2014-5023 - 010101_TI - TITLE SHEET 1 IN EQ 0.5 MI

GENERAL NOTES

NO TREES OR SHRUBS ARE TO BE REMOVED UNLESS INDICATED FOR REMOVAL BY THE ENGINEER.

THE EXACT LOCATION OF PRIVATE ENTRANCES IS TO BE DETERMINED IN THE FIELD BY THE ENGINEER.

ALL HOLES OR OPENINGS BELOW SUBGRADE RESULTING FROM THE ABANDONMENT OR REMOVAL OF EXISTING STRUCTURES OR FROM GRUBBING OF TREES
OR STUMPS SHALL BE BACKFILLED WITH GRANULAR BACKFILL. BACKFILL GRANULAR MATERIAL IS INCIDENTAL TO THE REMOVAL ITEM.

ALL RADIUS DIMENSIONS FOR CURB & GUTTER ARE GIVEN TO THE FLANGE. ALL ELEVATIONS ALONG CURB & GUTTER ARE GIVEN TO THE FLANGE. OFFSETS NOTED ARE TO THE FLANGE OR EDGE OF LANE IF NO CURB, UNLESS

THE LOCATIONS OF EXISTING AND PROPOSED UTILITY INSTALLATIONS AS SHOWN ON THE PLANS ARE APPROXIMATE. THERE MAY BE OTHER UTILITY INSTALLATIONS WITHIN THE PROJECT AREA THAT ARE NOT SHOWN.

HMA PAVEMENT WHERE INDICATED ON THE PLANS, SHALL CONSIST OF LAYERS AS FOLLOWS, UNLESS OTHERWISE NOTED ON THE PLANS OR

5.0" DEPTH 3.0" OF HMA PAVEMENT 3 LT 58-28 S, AS THE LOWER LAYER

2.0" OF HMA PAVEMENT 4 LT 58-28 S, AS THE UPPER LAYER

2.0" OF HMA PAVEMENT *LT 58-28 S. AS THE LOWER LAYER 4.0" DEPTH

2.0" OF HMA PAVEMENT 4 LT 58-28 S. AS THE UPPER LAYER

HMA PAVEMENT WEIGHT CALCULATIONS ARE BASED ON 112 LB/SY/IN.

HMA PAVING JOINTS ON THE PROJECT SHALL BE A VERTICAL LONGITUDINAL JOINTS IN PLACE OF THE NOTCHED WEDGE LONGITUDINAL JOINTS. CONTRACTOR SHALL REFER TO THE LONGITUDINAL JOINT SECTION OF THE STANDARD SPECIFICATION.

THE CONTRACTOR'S PAVING OPERATIONS SHALL BE CONSISTENT WITH THE PLAN TYPICAL SECTIONS AND CONSTRUCTED TO PREVENT HMA LONGITUDINAL JOINTS FROM BEING LOCATED WITHIN A DRIVING, TURNING, BIKE OR PARKING LANE.

SILT FENCE SHALL BE INSTALLED IN THE LOCATIONS SHOWN ON THE PLANS, OR AS DIRECTED BY THE ENGINEER.

ASPHALT AND CONCRETE DRIVEWAYS SHALL BE SAWCUT AT THE MATCH LINE AS SHOWN ON THE PLANS OR AS DIRECTED BY THE ENGINEER.

THE CONTRACTOR SHALL NOTIFY DIGGERS HOTLINE AND AFFECTED UTILITIES PIROR TO THE START OF WORK. ANY LOCAL MUNICIPAL UTILITY WHICH IS NOT A MEMBER OF THE DIGGERS HOTLINE MUST BE CONTACTED SEPARATELY.

INLET PROTECTION IS REQUIRED AT ALL INLETS AS PER DETAIL OR AS DIRECTED

REMOVAL OF EROSION CONTROL DEVICES IS INCLUDED IN THE COST OF THEIR

SIGNS IN CONFLICT WITH TRAFFIC CONTROL "IN USE" SHALL BE COVERED AS DIRECTED BY THE ENGINEER AND PAID FOR UNDER THE ITEM TRAFFIC CONTROL

TRAFFIC CONTROL DEVICES SHALL BE ADJUSTED TO FIT FIELD CONDITIONS AS

RE-TOPSOIL OF GRADED AREAS, AS DESIGNATED BY THE ENGINEER, IMMEDIATELY AFTER GRADING IS COMPLETED WITHIN THOSE AREAS. SOD, FERTILIZE, AND MULCH TOP-SOILED AREAS, AS DESIGNATED BY THE ENGINEER, WITHIN FIVE (5) CALENDAR DAYS AFTER PLACEMENT OF TOPSOIL. IF GRADED AREAS ARE LEFT EXPOSED FOR MORE THAN (14) CALENDAR DAYS, SEED THOSE AREAS WITH TEMPORARY SEED.

STOCKPILE EXCESS MATERIAL OR SPOILS ON UPLAND AREAS AWAY FROM WETLANDS, FLOODPLAINS AND WATERWAYS. STOCKPILED SOIL SHALL BE PROTECTED AGAINST EROSION. IF STOCKPILED MATERIAL IS LEFT FOR MORE THAN FOURTEEN (14) CALENDAR DAYS, SEED THE STOCKPILE WITH TEMPORARY SEED.

EROSION CONTROL BMP'S ARE AT SUGGESTED LOCATIONS. THE ACTUAL LOCATIONS WILL BE DETERMINED BY THE CONTRACTOR'S ECIP AND BY THE ENGINEER. EROSION CONTROL BMP'S SHALL BE MAINTAINED UNTIL PERMANENT VEGETATION IS ESTABLISHED OR UNTIL THE ENGINEER DETERMINES THAT THE BMP IS NO LONGER

DISTANCE BEHIND CURB TO UTILITY POLES MAY REQUIRE CONCRETE CURB AND GUTTER TO BE HAND FORMED RATHER THAN SLIP FORMED. THIS WILL BE INCIDENTAL TO THE ITEM.

STANDARD ABBREVIATIONS

APRON END WALL AGG BAD BM C&G C/L CONC AGGREGATE BASE AGGREGATE DENSE CURB AND GUTTER
CENTER OR CONSTRUCTION LINE CONCRETE CP CPCM CULVERT PIPE CULVERT PIPE CORRUGATED METAL CULVERT PIPE REINFORCED CONCRETE CPRC CPRCHE CULVERT PIPE REINFORCED CONCRETE HORIZONTAL ELLIPTICAL CSCP CORRUGATED STEEL CULVERT PIPE

DEGREE OF CURVE ∆ DISCH DELTA DISCHARGE FIELD ENTRANCE

HORIZONTAL ELLIPTICAL REINFORCED CONCRETE PIPE HOT MIX ASPHALT HERCP HMA

CORRUGATED STEEL PIPE ARCH

CONCRETE SURFACE DRAIN

INV LENGTH OF CURVE L LHF LT LEFT HAND FORWARD LEFT

MIN M/L MINIMUM MATCHLINE NB NC NTS NORTHBOLIND NORMAL CROWN NOT TO SCALE PAVT PAVEMENT PB PC PCC PULL BOX

CSPA CSD

POINT-OF-CURVE POINT OF COMPOUND CURVE PE PI PLE PT PVC PRIVATE ENTRANCE POINT OF INTERSECTION PERMANENT LIMITED EASEMENT POINT OF TANGENT POINT OF VERTICAL CURVE

PVI PVT POINT OF VERTICAL INTERSECTION POINT OF VERTICAL TANGENT R R/L RADIUS OF CURVE

REFERENCE LINE R/W RIGHT OF WAY RAD RADIUS REVERSE CROWN RC RCAEW

APRON ENDWALL FOR CULVERT PIPE REINFORCED CONCRETE REINFORCED CONCRETE HORIZONTAL ELLIPTICAL STORM SEWER
REINFORCED CONCRETE PIPE - STORM SEWER

RCPSS REOD REQUIRED

RIGHT HAND FORWARD RHF RO RT SALV SB SDD SE SF STA RUN OFF LENGTH RIGHT SALVAGED SIGNAL BASE

STANDARD DETAIL DRAWING SUPER ELEVATION

SQUARE FOOT STATION SQUARE YARD SY TANGENT LENGTH ŤC

TEMPORARY LIMITED EASEMENT

VILLAGE CONTACT VILLAGE OF BELLEVILLE WISCONSIN DEPT OF TRANSPORTATION, SW REGION TIM FRANCOIS MAHESH SHRESTHA 20 RIVER ST. 2101 WRIGHT STREET BELLEVILLE, WI 53508 MADISON, WI 53704 (608) 424-3666 (608) 245-2674 (608) 395-5183 (MOBILE)

DEPT. OF NATURAL RESOURCES

TFRANCOIS@VILLAGEOFBELLEVILLE.COM

WISCONSIN DEPT. OF NATURAL RESOURCES ERIC HEGGELUND 3911 FISH HATCHERY ROAD FITCHBURG, WI 53711 (608) 275-3301 FRIC.HEGGEL UNDOWISCONSIN.GOV

DESIGN CONTACT

UTILITIES

SECTION 2 ORDER OF SHEETS

GENERAL NOTES

REMOVAL PLAN PLAN DETAILS

PAVEMENT GRADES

EROSION CONTROL

STORM SEWER PLAN

PERMANENT SIGNING

PAVEMENT MARKING

ALIGNMENT PLAN

TRAFFIC CONTROL/DETOUR

PROJECT OVERVIEW TYPICAL SECTIONS

CONSTRUCTION DETAILS

COMMUNICATION LINE CHARTER COMMUNICATIONS MARK GAUGER 2701 DANIELS ST. MADISON, WI 53718 (608) 575-6415 (MOBILE) MARK.GAUGER@CHARTER.COM

COMMUNICATION LINE FRONTIER COMMUNICATIONS OF WILLC. 100 COMMUNICATIONS DRIVE SUN PRAIRIE, WI 53590 (608) 837-1410 (262) 325-7048 (MOBILE) EDWARD.O.STIEBER@FTR.COM

ELECTRICITY ALLIANT ENERGY RICK MARTINGILIO 2147 COUNTY HWY PB VERONA. WI 53593 RICKAMARTINGILIO@ALLIANTENERGY.COM

WE ENERGIES ADAM MARING N3025 14TH AVENUE MONROE, WI 53566 (608) 328-5679 (608) 426-1715 ADAM.MARING@WE-ENERGIES.COM

WATER/SANITARY SEWER VILLAGE OF BELLEVILLE TIM FRANCOIS 20 RIVER STREET BELLEVILLE, WI 53508 (608) 424-3666 (608) 395-5183 (MOBILE) TFRANCOIS@VILLAGEOFBELLEVILLE.COM

WISDOT CONTACT

MAHESH.SHRESTHA@DOT.WI.GOV

GRAEF MARY BETH PETTIT 125 S. 84TH STREET, SUITE 401 MILWAUKEE, WI 53214 (414) 266-9175 MARYBETH.PETTIT@GRAEF-USA.COM



PLOT SCALE :

www.DiggersHotline.com

PROJECT NO:1690-05-71

HWY:STH 69


COUNTY: DANE

GENERAL NOTES


PLOT BY: MESSER. JACKIE

SHEET

Ε

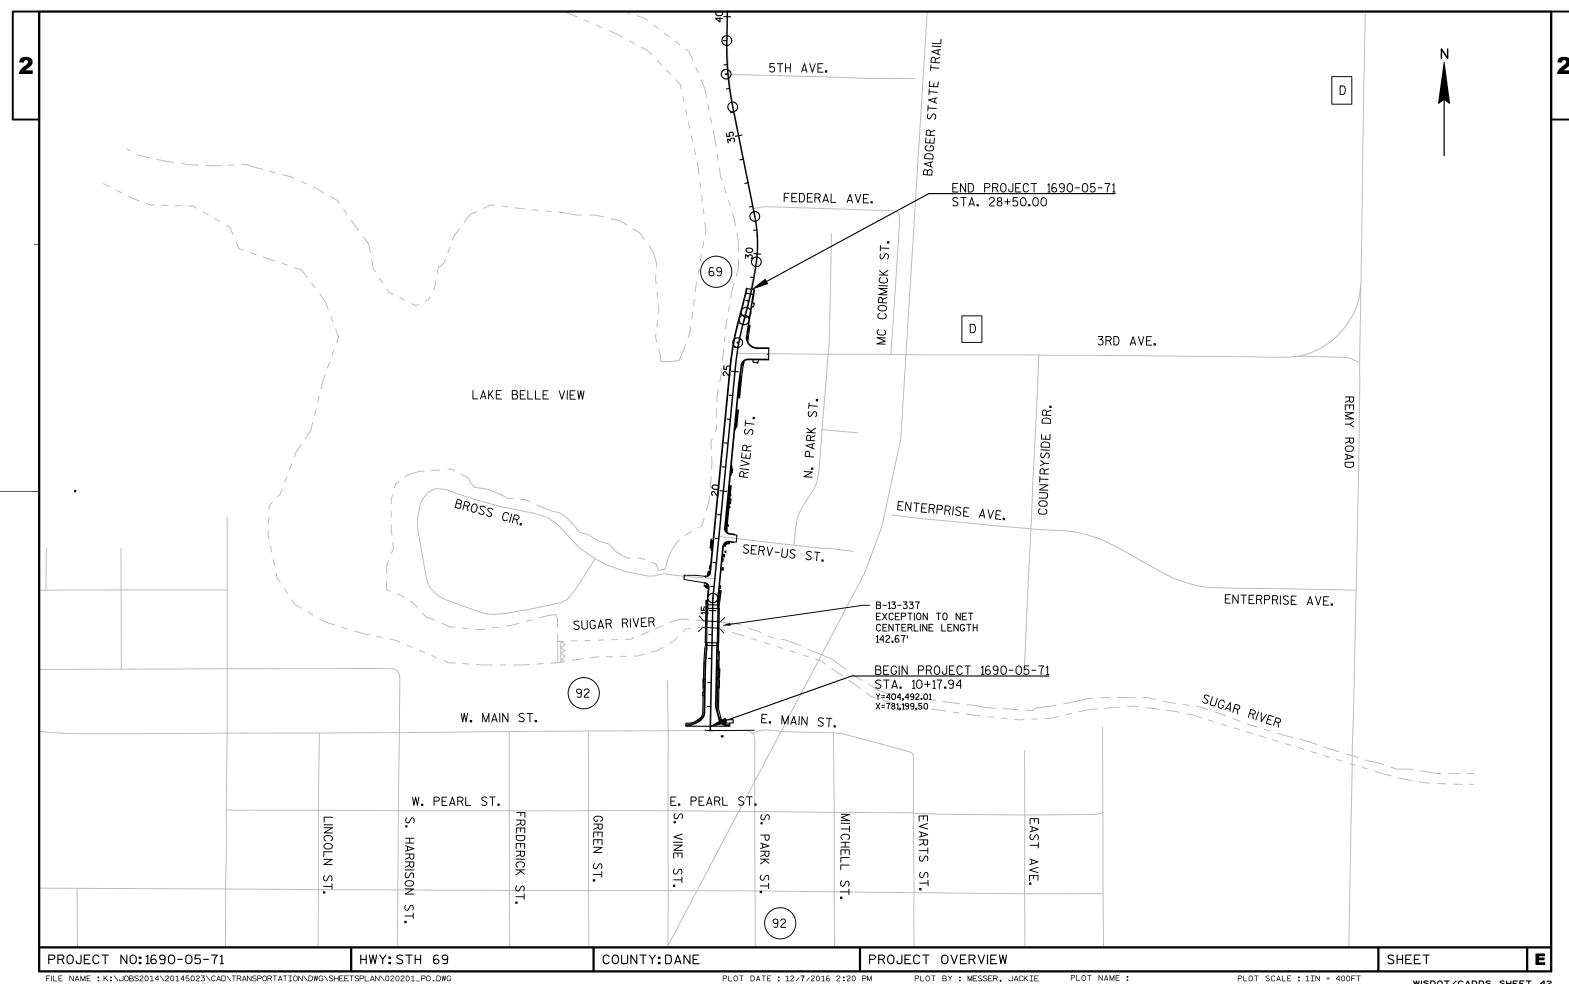



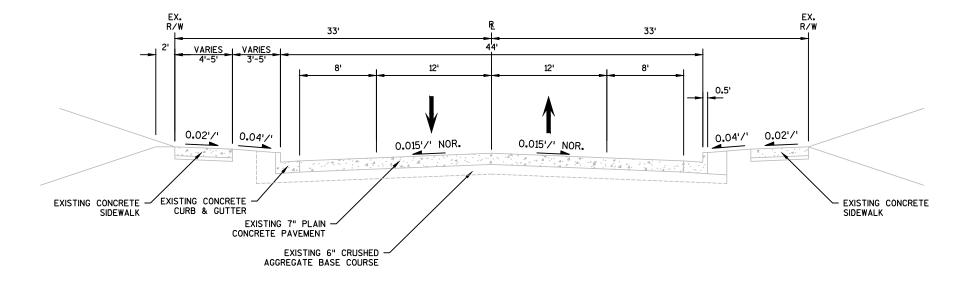

EXISTING TYPICAL SECTION STH 69

STA 10+17.94 TO STA 18+10.00

EX.
R/W

33'

VARIES

44'

12'

12'

8'

0.04'/'

0.04'/'

0.02'/'

EXISTING CONCRETE
CURB & GUTTER

EXISTING 7" PLAIN
CONCRETE PAVEMENT


EXISTING 6" CRUSHED
AGGREGATE BASE COURSE

EXISTING TYPICAL SECTION STH 69

STA 18+10.00 TO STA 24+75.00


PROJECT NO:1690-05-71 HWY:STH 69 COUNTY:DANE EXISTING TYPICAL SECTIONS SHEET **E**

2

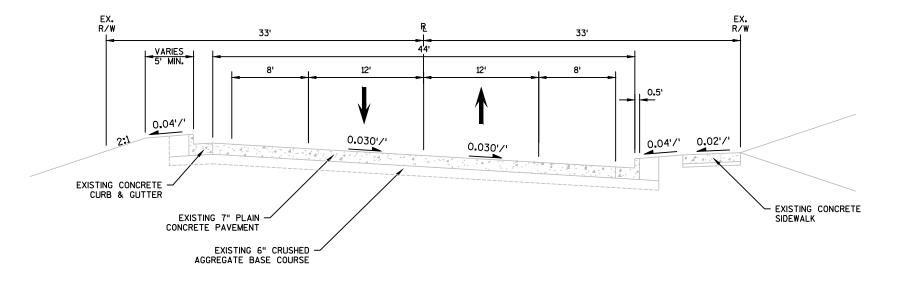

EXISTING TYPICAL SECTION STH 69


STA 24+75 TO STA 26+50

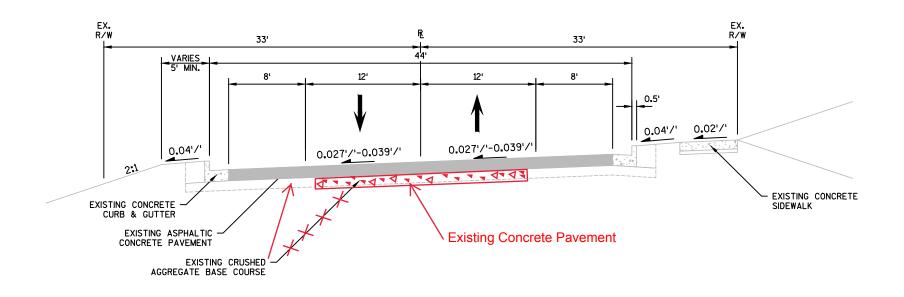

EXISTING TYPICAL SECTION STH 69

STA 26+50 TO STA 28+50

PROJECT NO:1690-05-71 HWY:STH 69 COUNTY:DANE EXISTING TYPICAL SECTIONS SHEET **E**

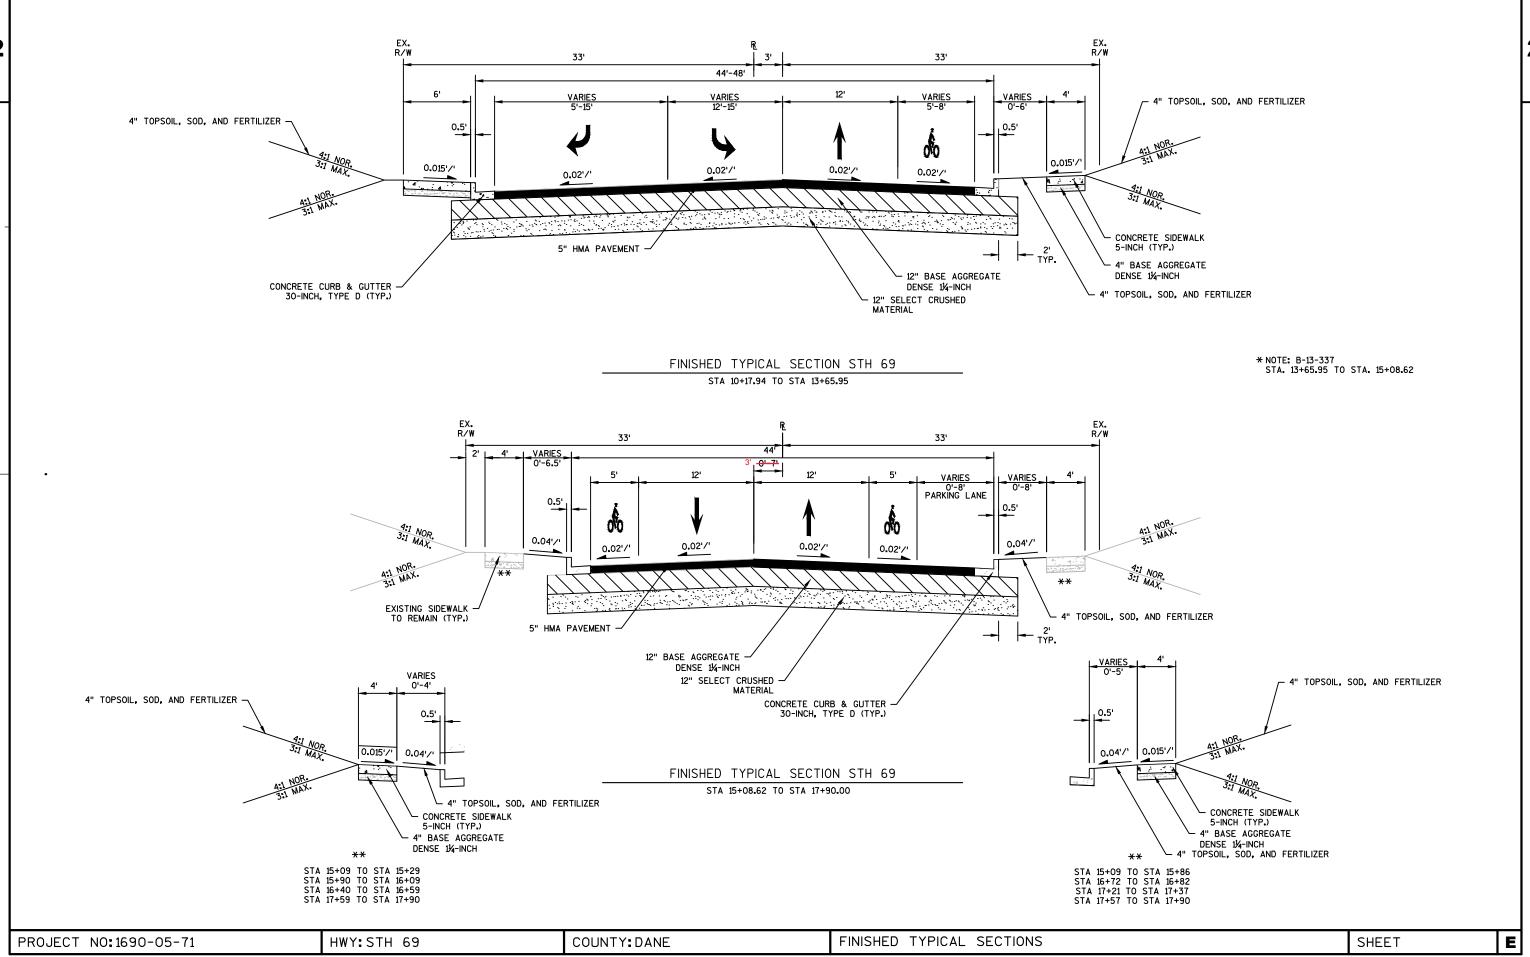


FILE NAME : K:\JOBS2014\20145023\CAD\TRANSPORTATION\DWG\SHEETSPLAN\020302_TS.DWG


PLOT DATE: 12/7/2016 2:21 PM

PLOT BY : MESSER, JACKIE

PLOT SCALE : 1 IN:10 FT



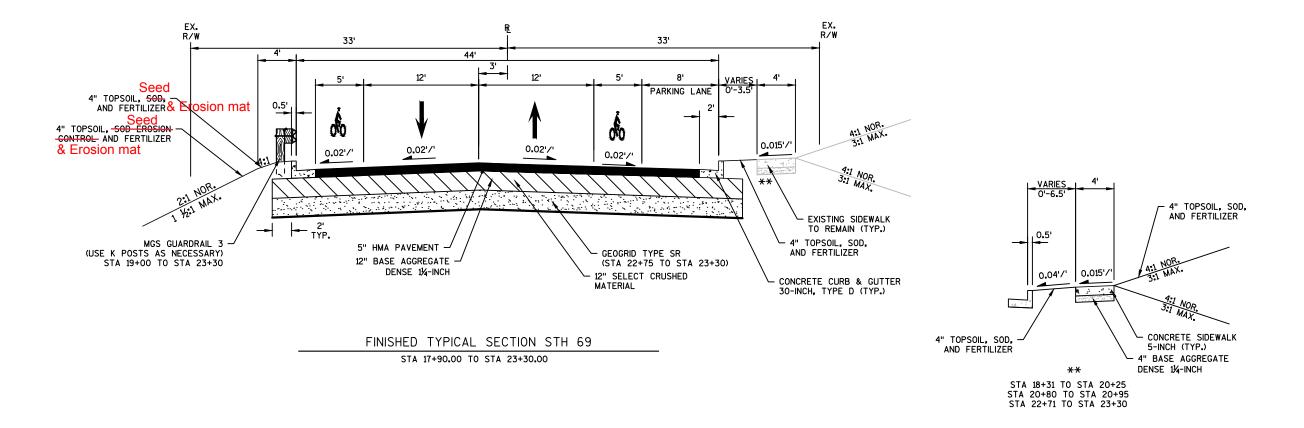

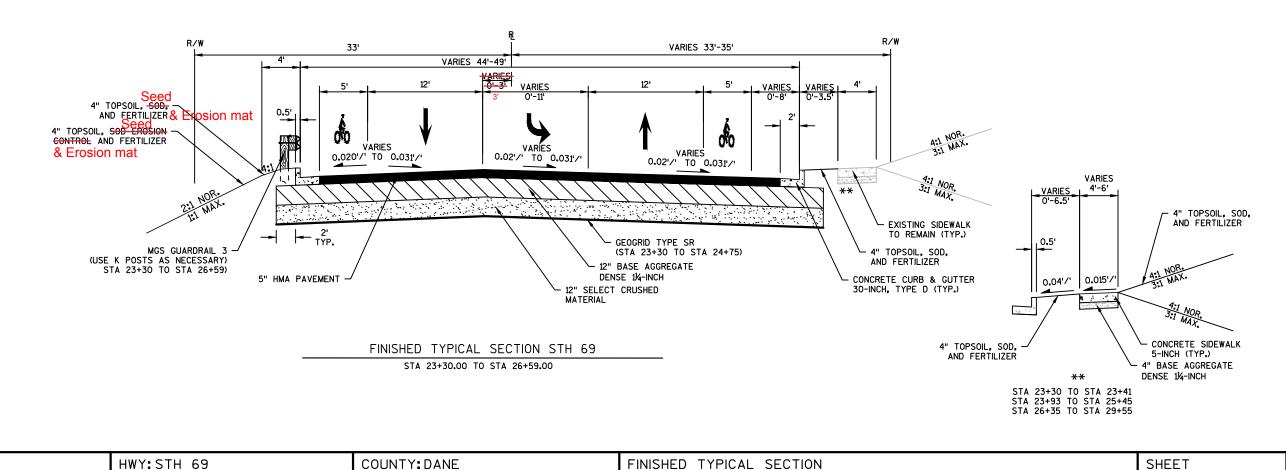


FILE NAME: K:\JOBS2014\20145023\CAD\TRANSPORTATION\DWG\SHEETSPLAN\020302_TS.DWG PLOT DATE: 12/21/2016 12:20 PM PLOT BY: MESSER, JACKIE PLOT NAME: PLOT SCALE: 1 IN:10 FT


PROJECT NO:1690-05-71


IN:10 FT WISDOT/CADDS SHEET 42

Ε




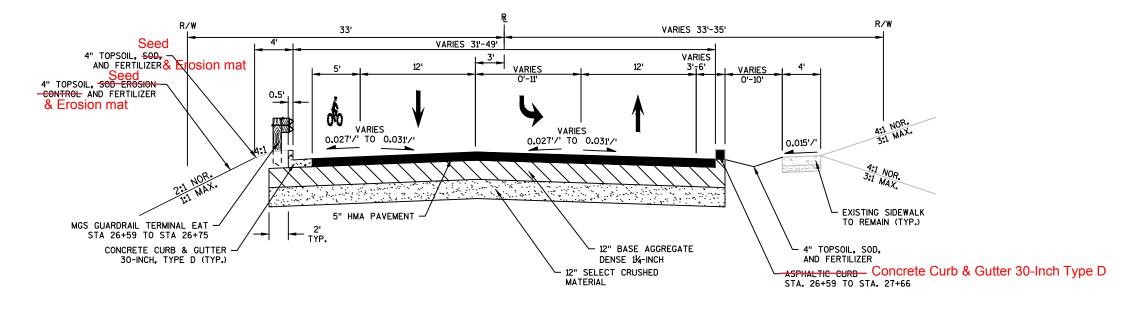

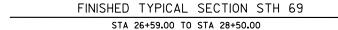


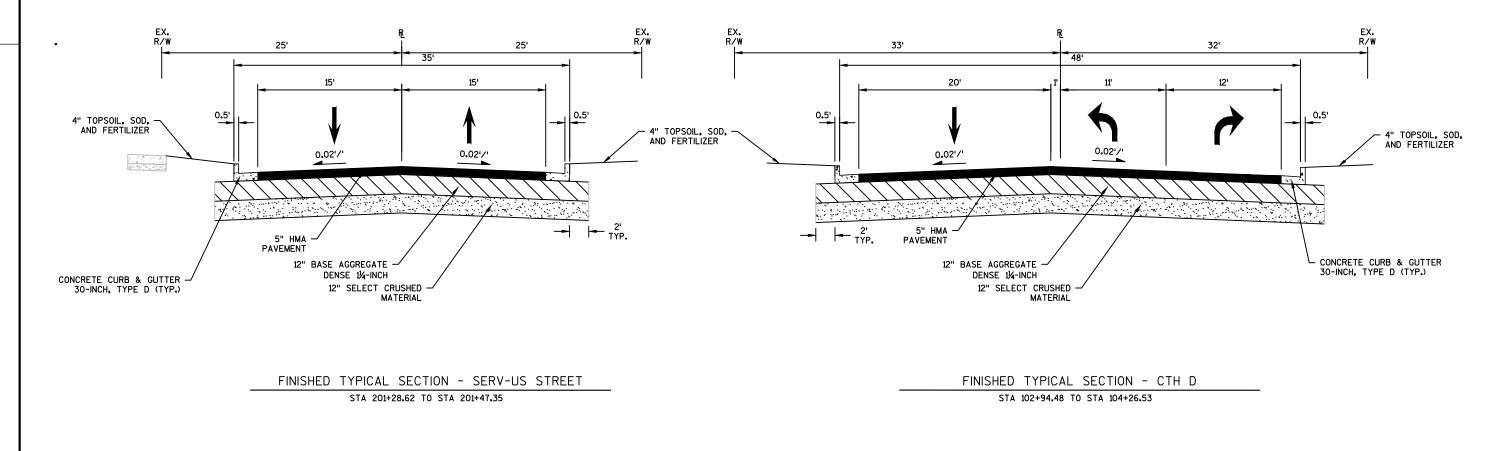


PROJECT NO:1690-05-71 COUNTY: DANE SHEET Ε HWY: STH 69 PLAN: FINISHED TYPICAL SECTION PLOT SCALE : 1 IN:10 FT

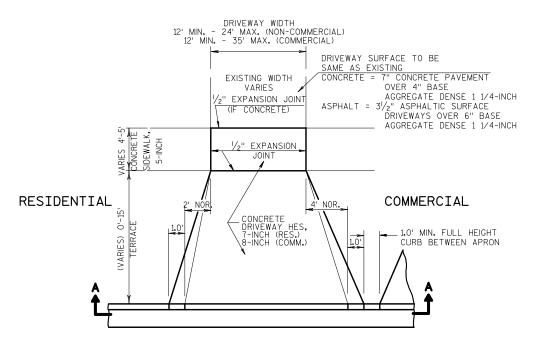


PLAN

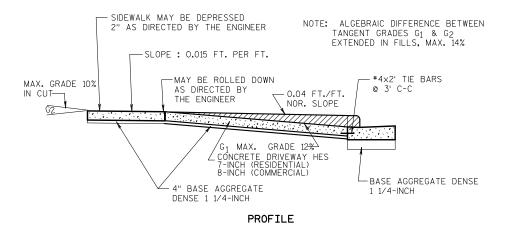


CONCRETE-FLARED DRIVEWAY DETAIL (WITH TERRACE)

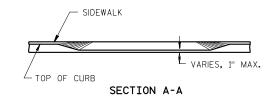

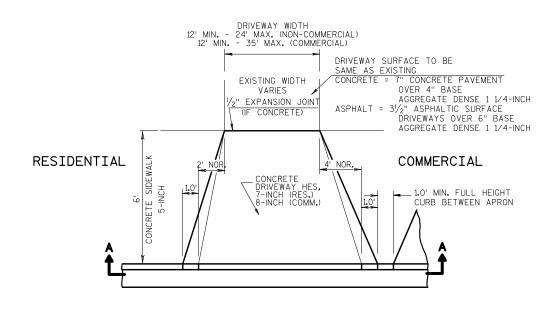

PLAN

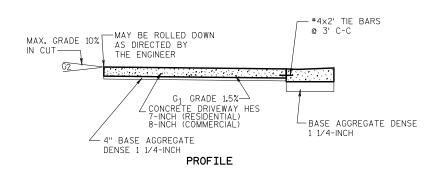

CONCRETE-FLARED DRIVEWAY DETAIL (NO TERRACE)

PROJECT NO:1690-05-71 HWY:STH 69 COUNTY: DANE FILE NAME : K:\JOBS2014\20145023\CAD\TRANSPORTATION\DWG\SHEETSPLAN\021001_CD.DWG PLOT DATE: 12/7/2016 2:21 PM PLOT BY : MESSER, JACKIE

CONSTRUCTION DETAILS

PLOT NAME :

SHEET

PLOT SCALE : 1 IN:200 FT

WISDOT/CADDS SHEET 42

E

UNDERDRAIN OUTFALL AT INLET


NOTES:

1. PROVIDE TWO 6" DIA. OPENINGS FOR UNDERDRAIN PIPE A MINIMUM OF 38" BELOW THE RIM ELEVATION.

2. SEE DRAINAGE TABLE AND MISCELLANEOUS QUANTITIES FOR PIPE UNDERDRAIN LOCATIONS.

3. PIPE UNDERDRAIN ONLY REQUIRED ON HIGH SIDE OF INLET IN SLOPED CONDITION.


4. PIPE UNDERDRAIN REQUIRED ON BOTH SIDES OF INLET IN SAG CONDITION.

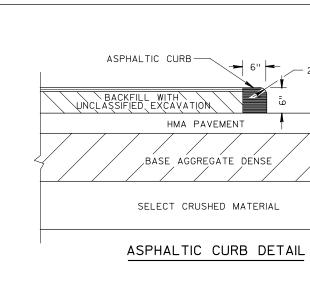

PROPOSED PAVEMENT RECONSTRUCTION - REFER TO TYPICAL SECTIONS FOR PAVEMENT DEPTH - SAWCUT EXISTING PAVEMENT 3" MIN. DEPTH REMOVE MATERIAL UNDER ITEM 'REMOVING ASPHALTIC SURFACE, BUTT JOINTS' PAVEMENT MATERIAL TYPE AS NOTED PER LOCATION. EXISTING PAVEMENT NOTE: CONTRACTOR TO PROVIDE A 10' WIDE TEMPORARY ASPHALTIC WEDGE ADJACENT TO MILLED BUTT JOINTS AT ALL STREETS WHERE TRAFFIC IS TO BE MAINTAINED DURING CONSTRUCTION. SURFACE TO REMAIN (VARIABLE DEPTH)

SAWCUT AND THE TEMPORARY ASPHALTIC WEDGE WILL BE CONSIDERED INCIDENTAL TO THE ITEM "REMOVING ASPHALTIC SURFACE, BUTT JOINTS."

BUTT JOINT DETAIL

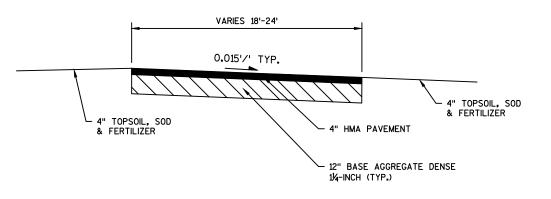

FINISHED TYPICAL SECTION - BROSS CIRCLE SEE PLAN DETAILS FOR ROADWAY DIMENSIONS (FACING EAST)

PROJECT NO:1690-05-71

HWY:STH 69

COUNTY: DANE

CONSTRUCTION DETAILS

PLOT NAME :

SHEET

E


FILE NAME : K:\JOBS2014\20145023\CAD\TRANSPORTATION\DWG\SHEETSPLAN\021001_CD.DWG LAYOUT NAME - 021001_CD - 021002_CD

PLOT DATE: 12/7/2016 2:21 PM

PLOT BY : MESSER, JACKIE

0.020'/'

2

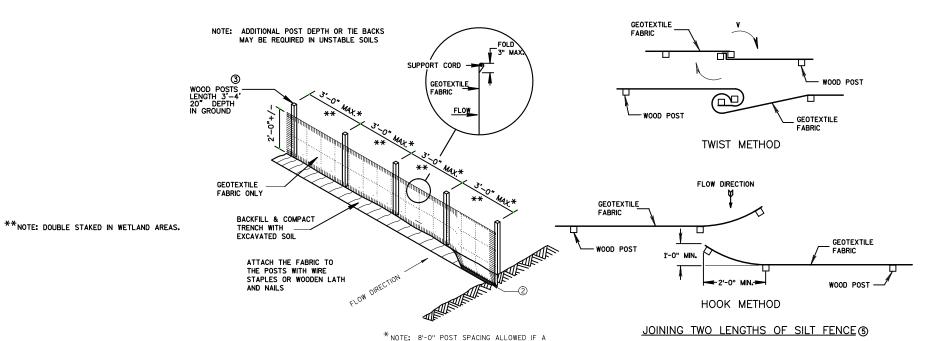

TIEBACK BETWEEN FENCE GEOTEXTILE FABRIC POST AND ANCHOR FLOW DIRECTION (2) SILT__ FENCE FLOW DIRECTION --KUNNYANYANYA BUNK NXXXXXX **EXCESS** ANCHOR STAKE MIN. 18" LONG

SILT FENCE TIE BACK

(WHEN ADDITIONAL SUPPORT REQUIRED)

GENERAL NOTES:


- ① HORIZONTAL BRACE REQUIRED WITH 2" X 4" WOODEN FRAME OR EQUIVALENT AT TOP OF POSTS.
- (2) TRENCH SHALL BE A MINIMUM OF 4" WIDE & 6" DEEP TO BURY AND ANCHOR THE GEOTEXTILE FABRIC. FOLD MATERIAL TO FIT TRENCH AND BACKFILL & COMPACT TRENCH WITH EXCAVATED SOIL.
- 3 WOOD POSTS SHALL BE A MINIMUM SIZE OF 1 1/8 " X 1 1/8 " OF OAK OR HICKORY.
- 4 SILT FENCE TO EXTEND ACROSS THE TOP OF THE PIPE.
- (5) CONSTRUCT SILT FENCE FROM A CONTINUOUS ROLL IF POSSIBLE BY CUTTING LENGTHS TO AVOID JOINTS. IF A JOINT IS NECESSARY USE ONE OF THE FOLLOWING TWO METHODS; A) OVERLAP THE END POSTS AND TWIST, OR ROTATE, AT LEAST 180 DEGREES, B) HOOK THE END OF EACH SILT FENCE LENGTH.

FENCE SPECIAL DETAIL (ALSO REQUIRED AROUND STOCKPILES) N.T.S.

TRENCH DETAIL


WOVEN GEOTEXTILE FABRIC IS USED.

PROJECT NO:1690-05-71 COUNTY: DANE CONSTRUCTION DETAILS E HWY:STH 69 SHEET PLOT NAME :

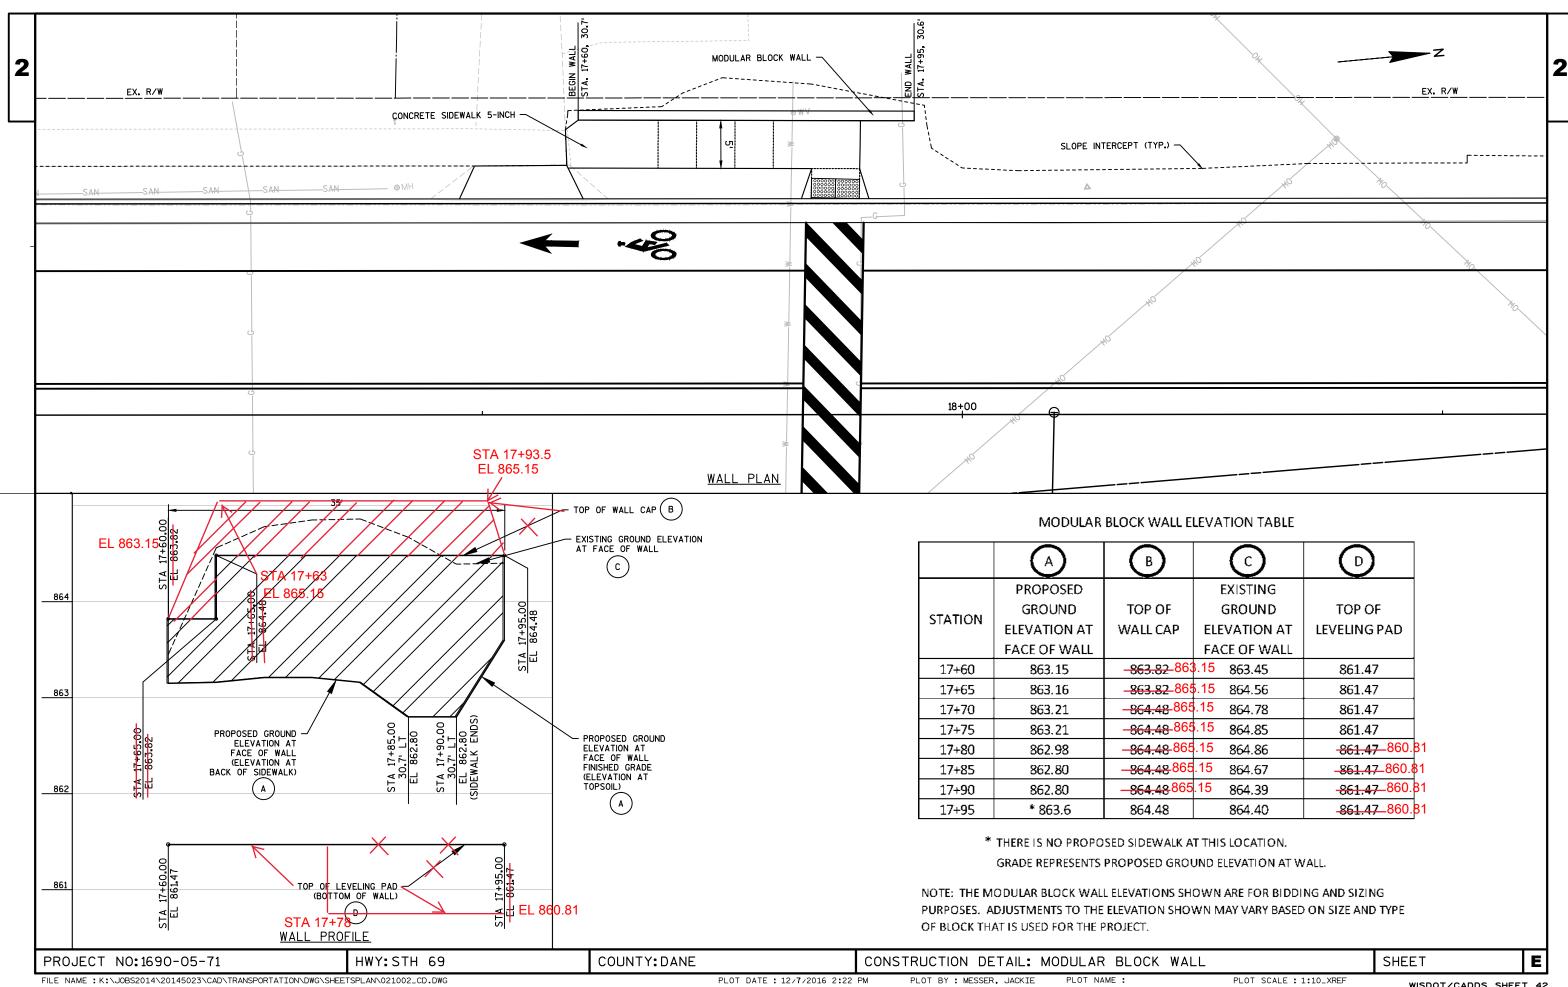

2

2

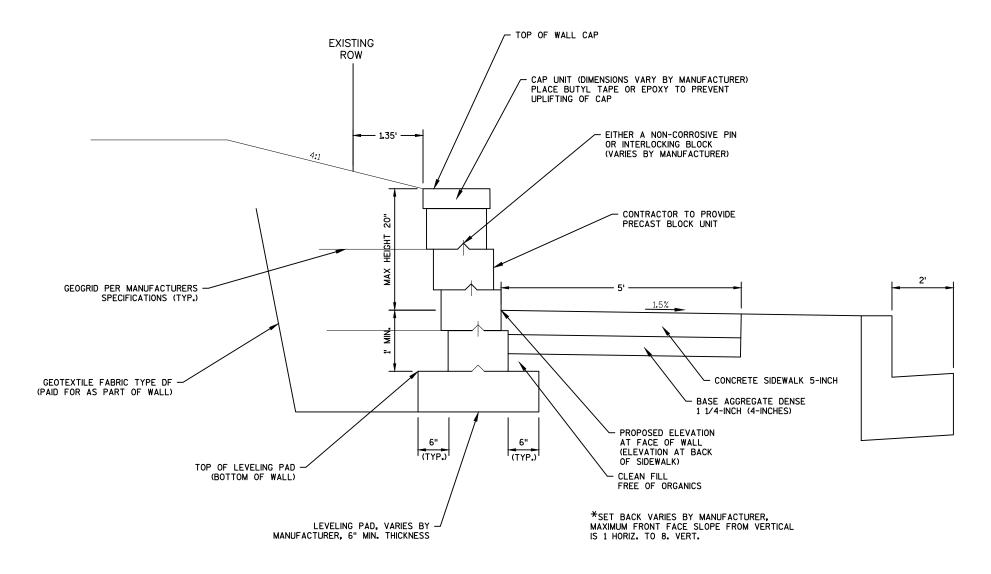


TYPICAL RETAINING WALL SECTION — REINFORCED MODULAR BLOCK WALL N.T.S.

PROJECT NO:1690-05-71 HWY:STH 69 COUNTY:DANE CONSTRUCTION DETAIL: MODULAR BLOCK WALL

SHEET

PLOT BY: MESSER, JACKIE


E

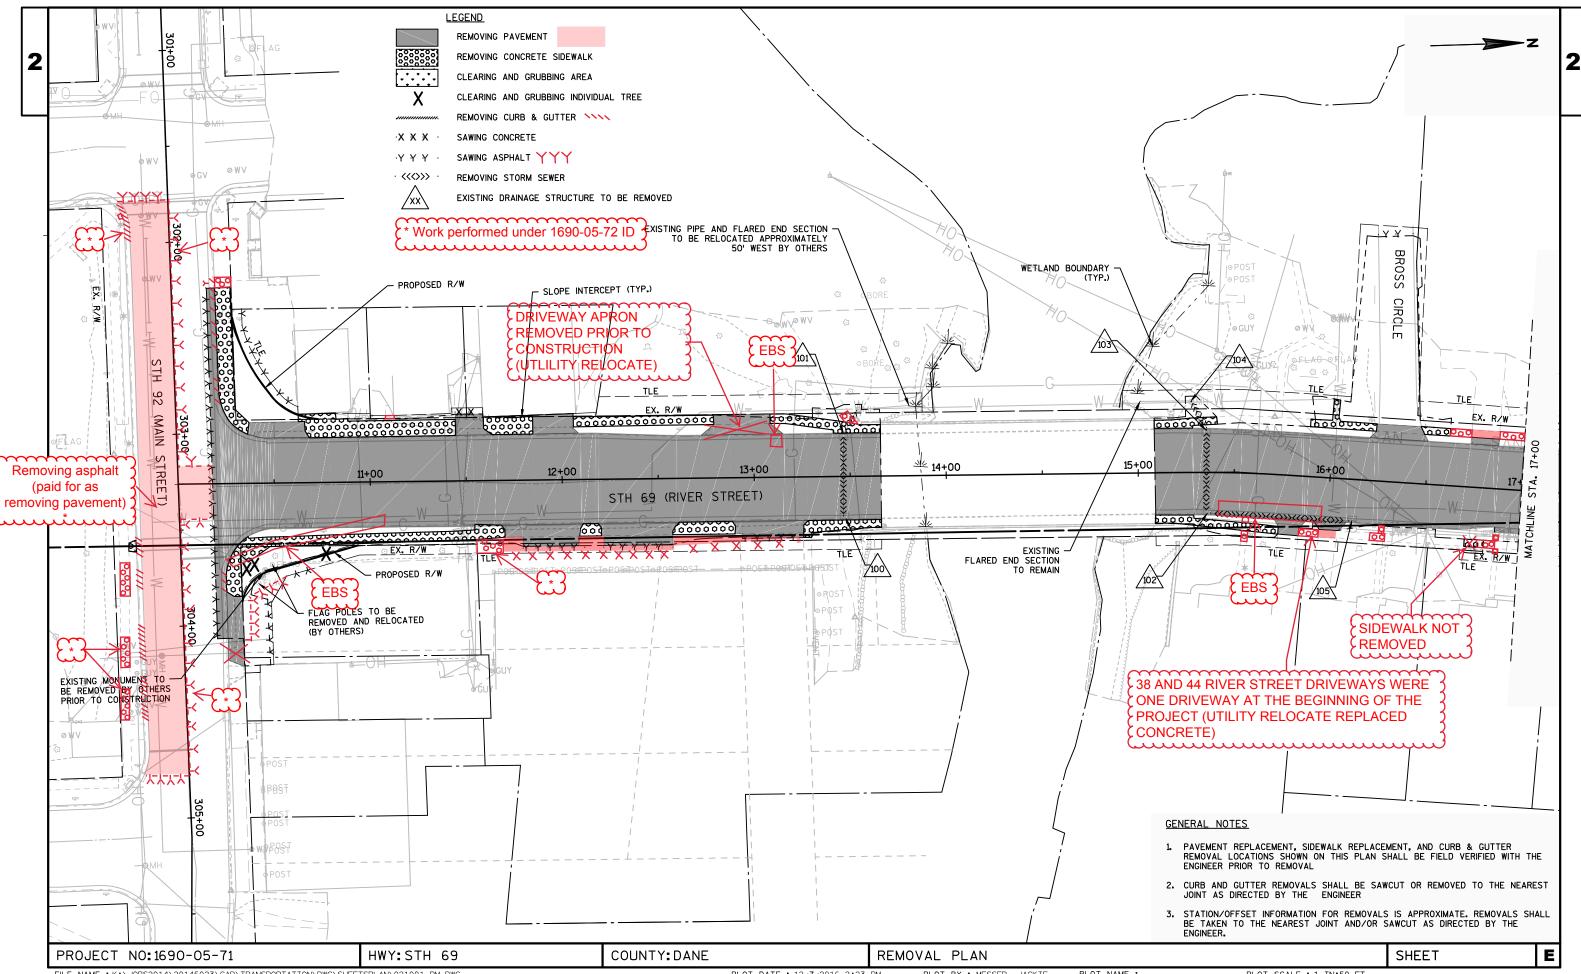



FILE NAME : K:\JOBS2014\20145023\CAD\TRANSPORTATION\DWG\SHEETSPLAN\021001_RM.DWG LAYOUT NAME - 021001_RM - 022501_SS

PLOT DATE: 12/7/2016 2:23 PM

PLOT BY : MESSER, JACKIE PLOT NAME : PLOT SCALE : 1 IN:50 FT

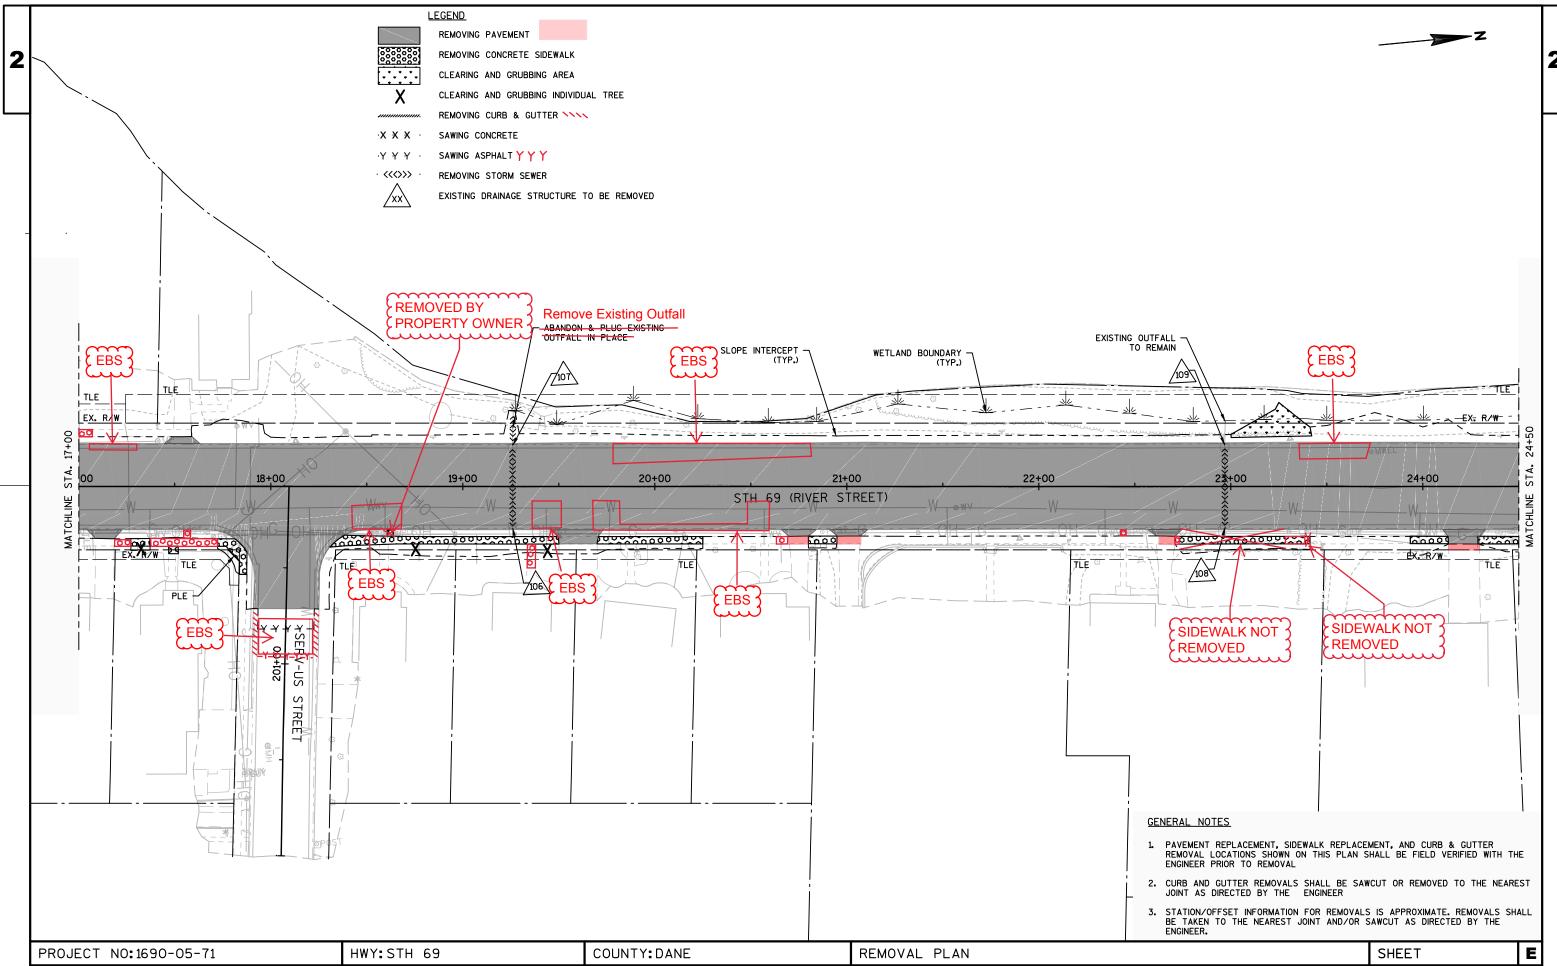


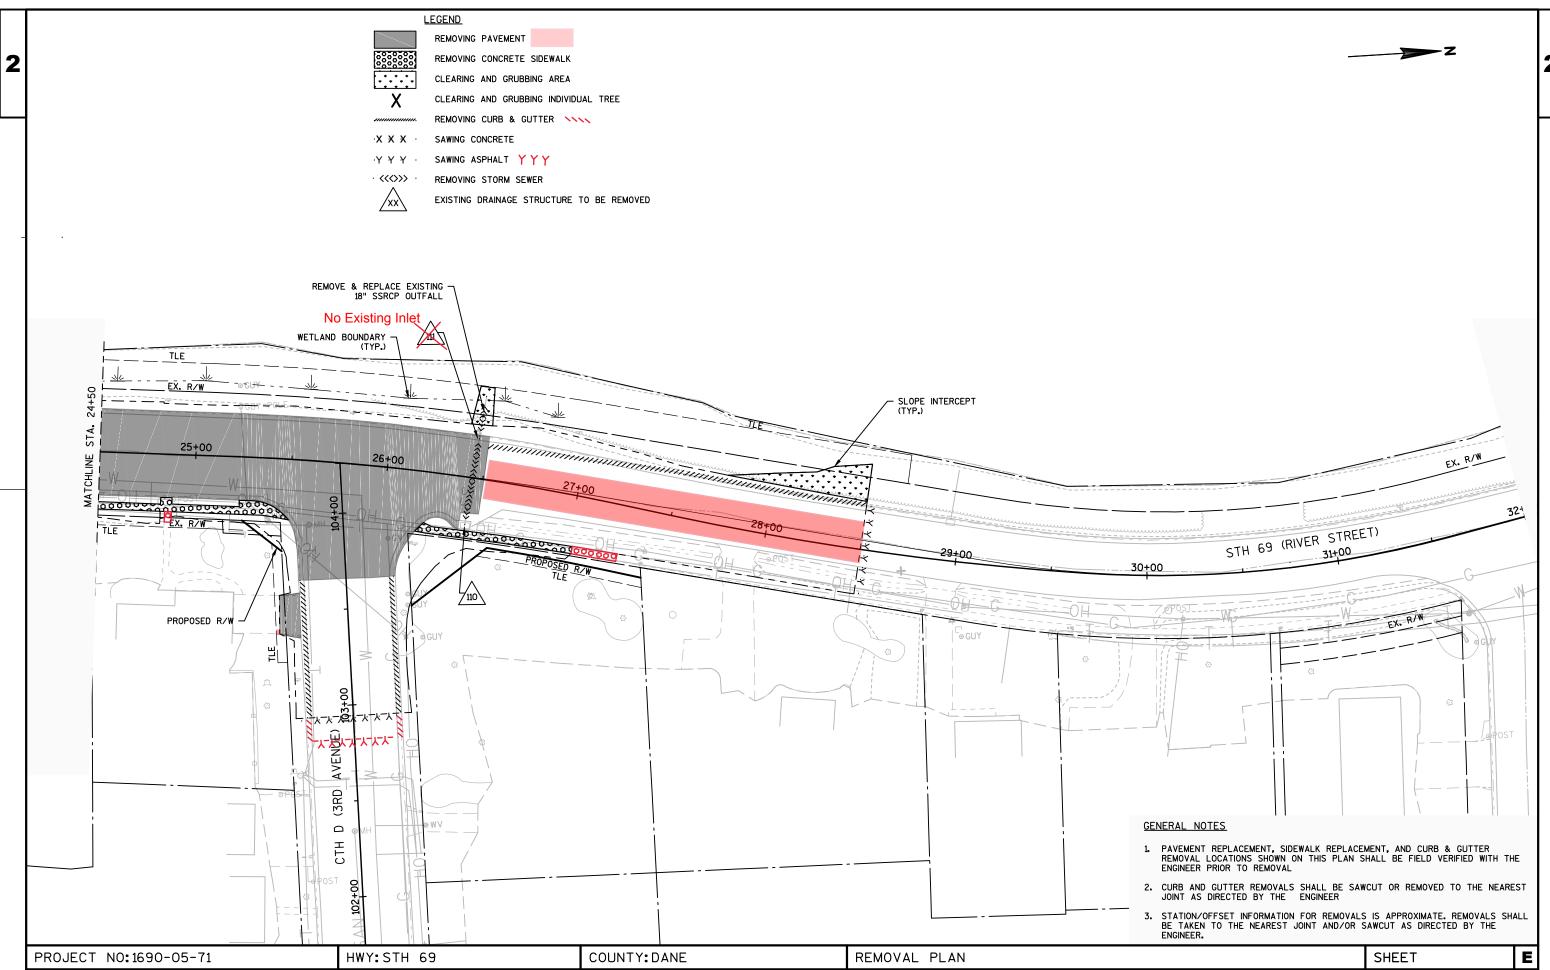


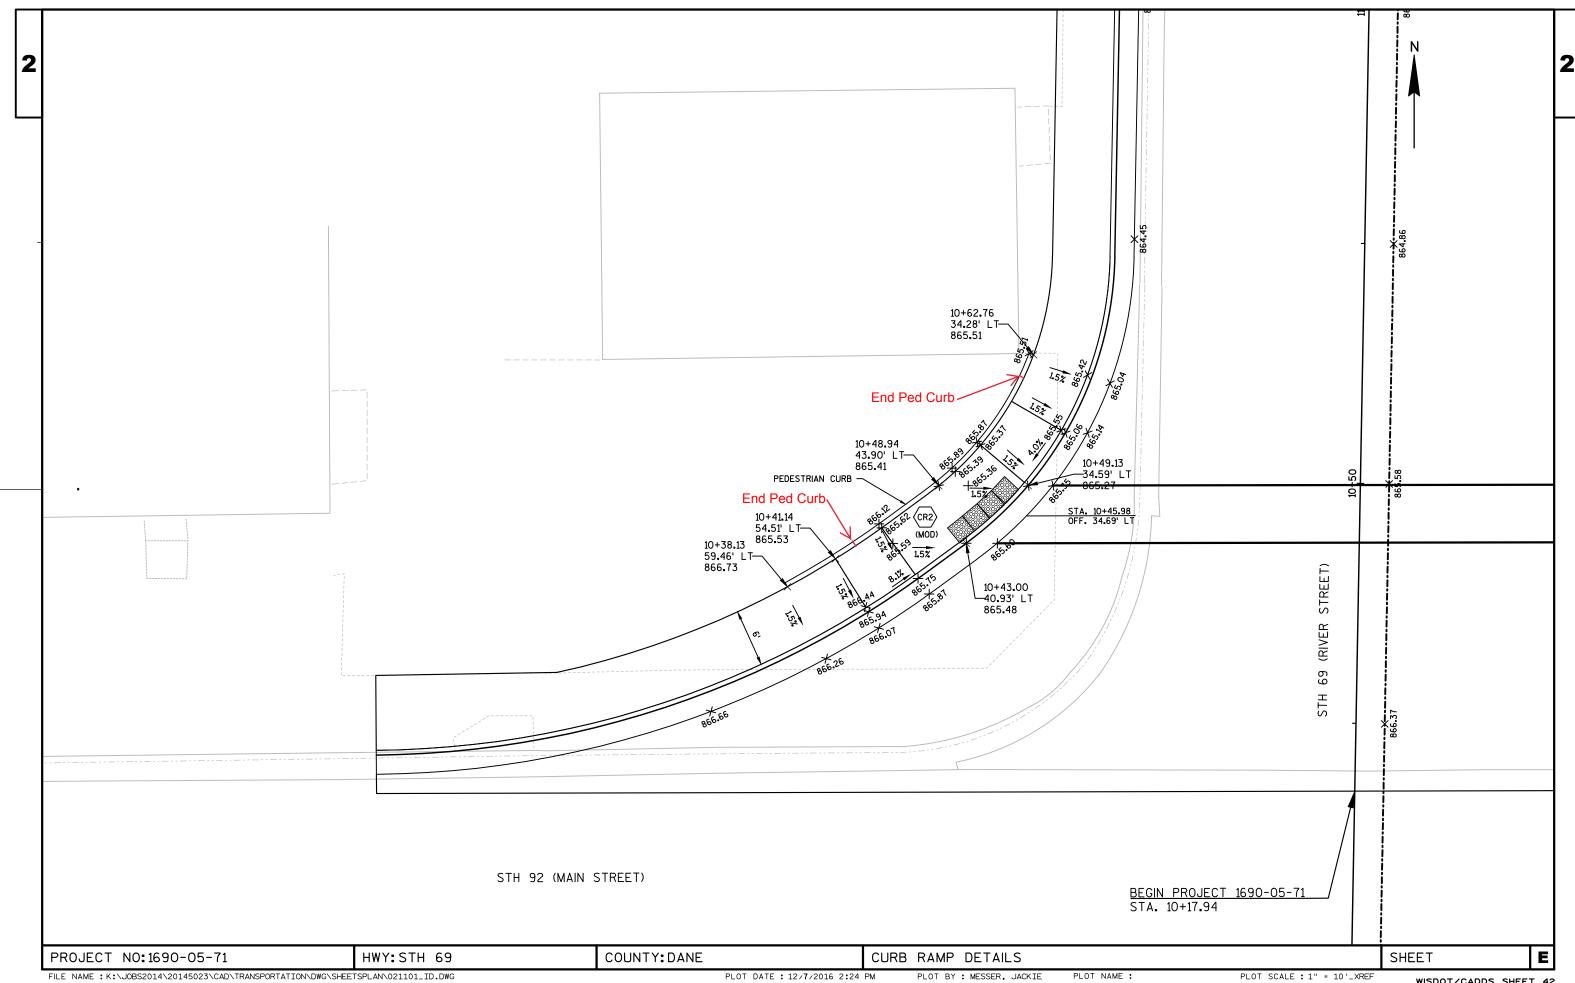



FILE NAME : K:\JOBS2014\20145023\CAD\TRANSPORTATION\DWG\SHEETSPLAN\021101_ID.DWG


PLOT SCALE : 1" = 10'_XREF

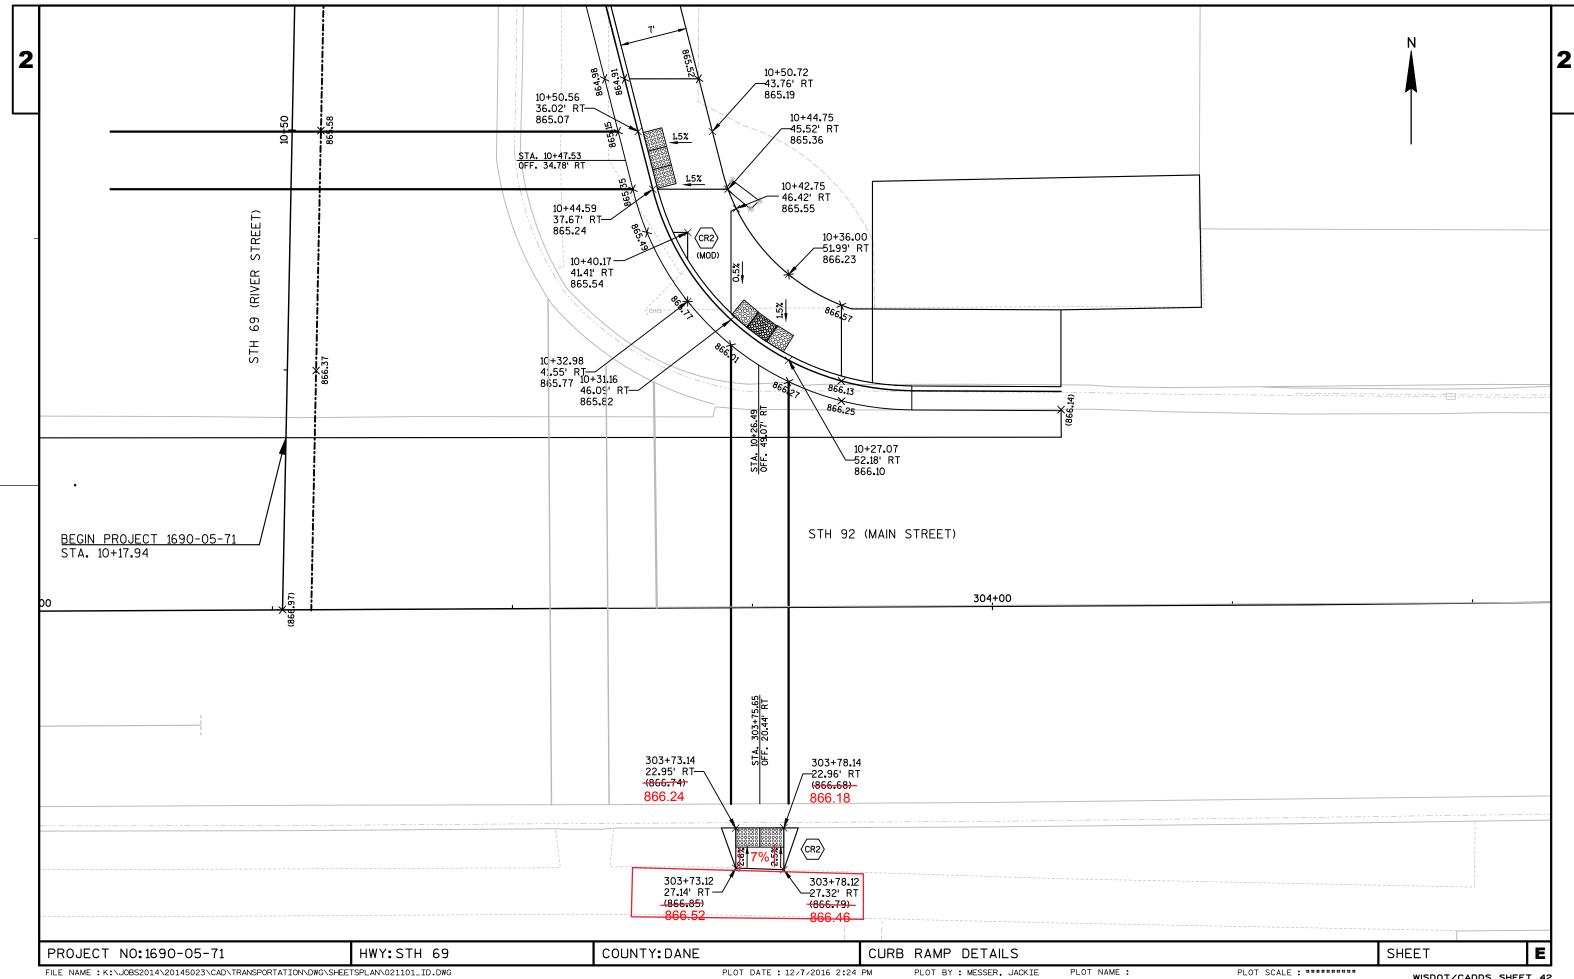


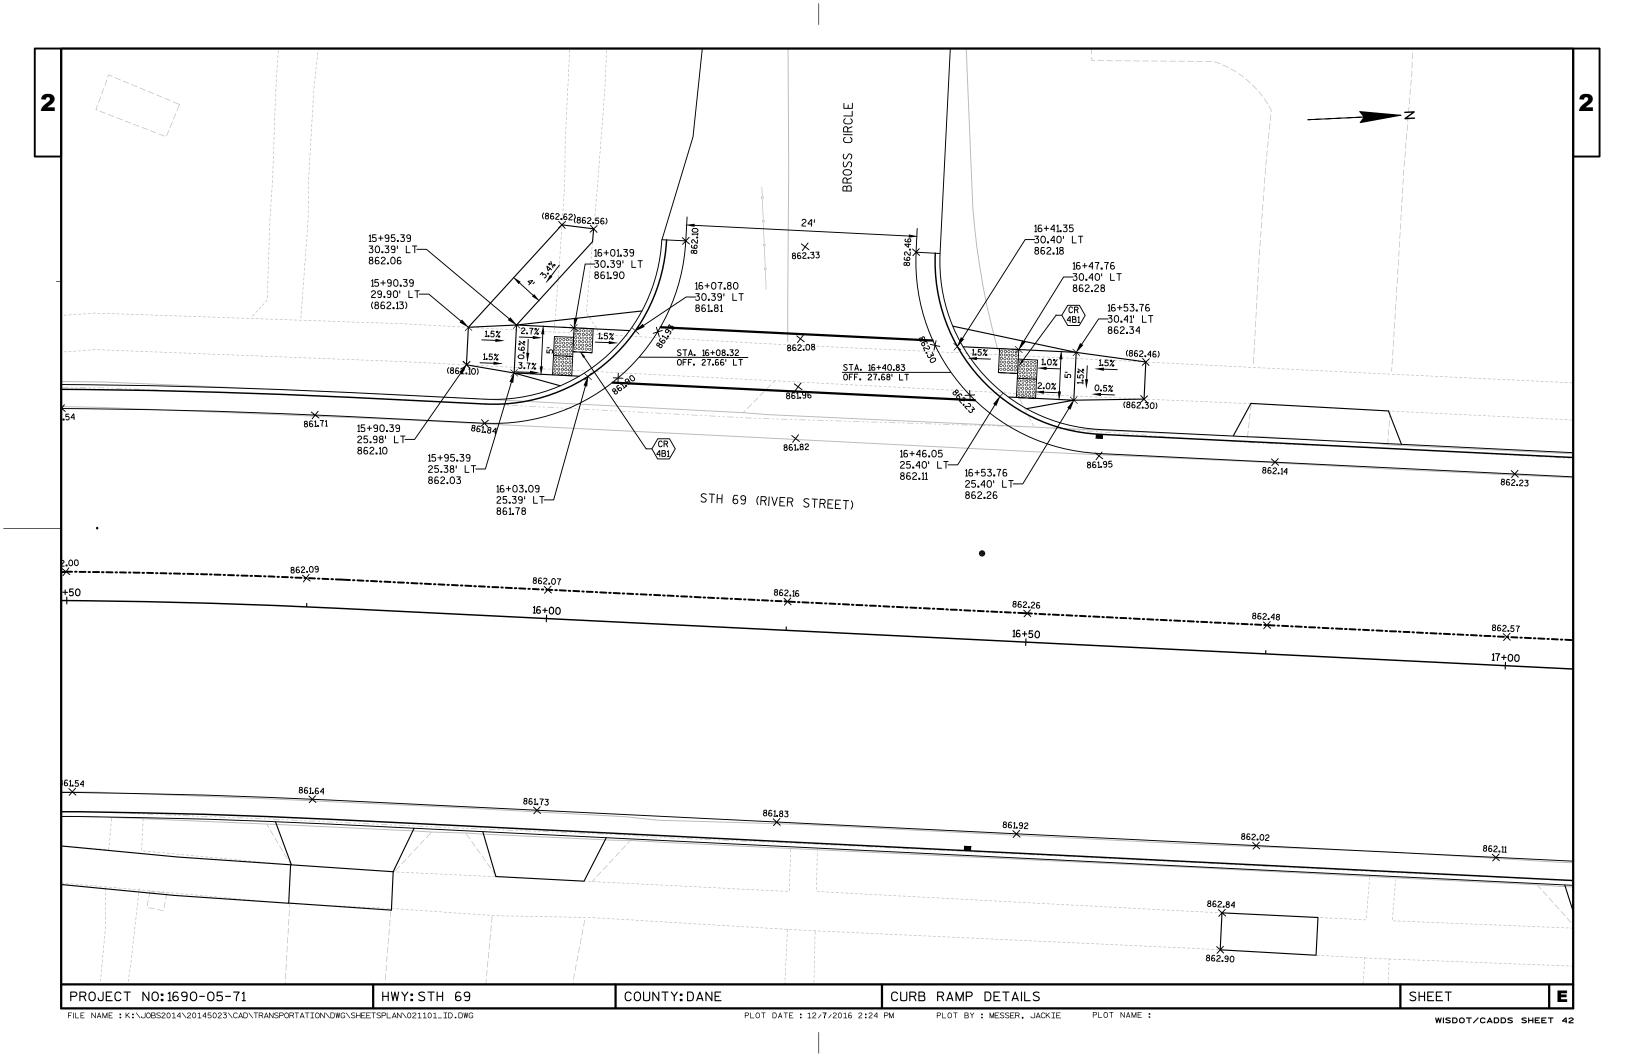


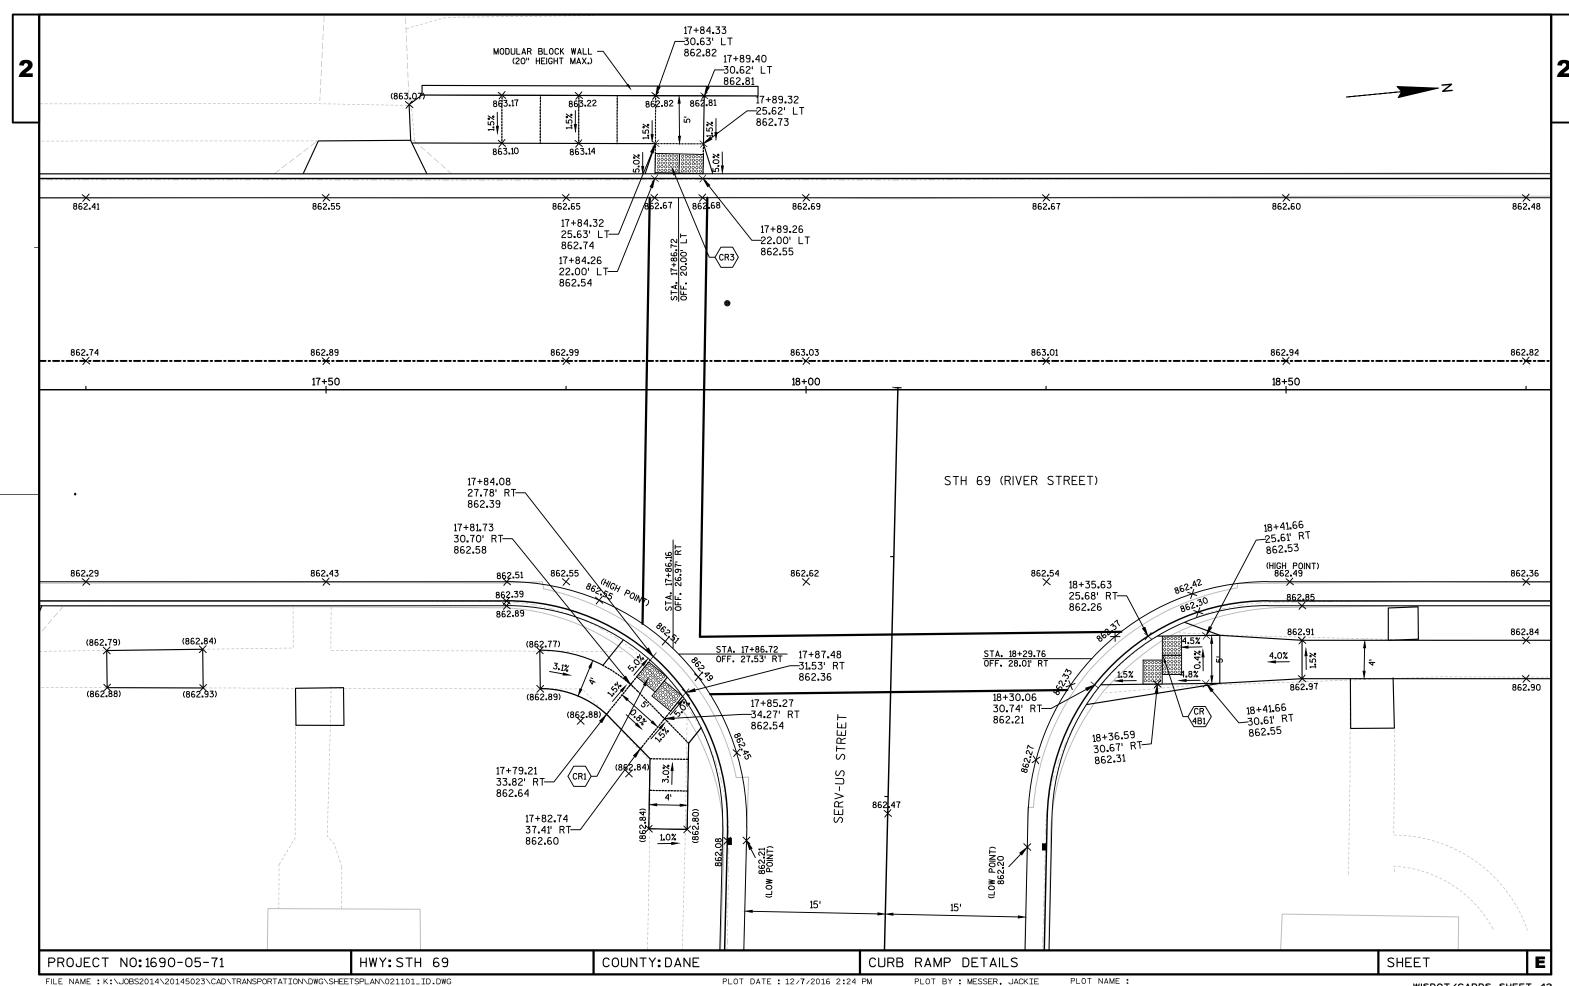


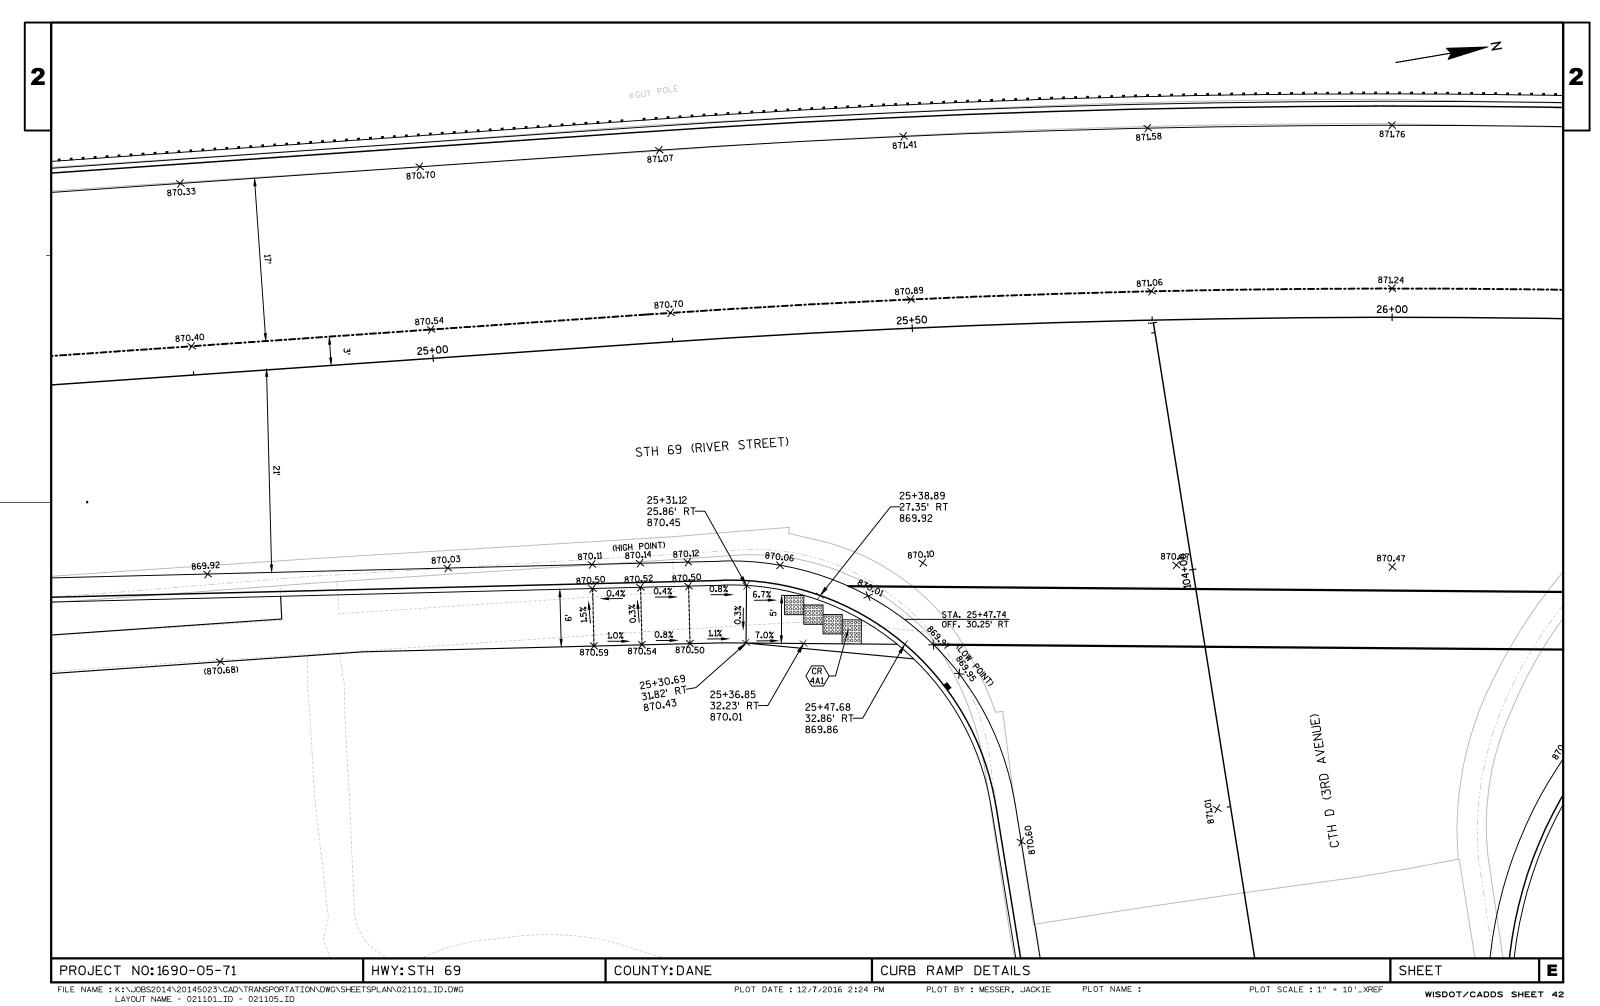


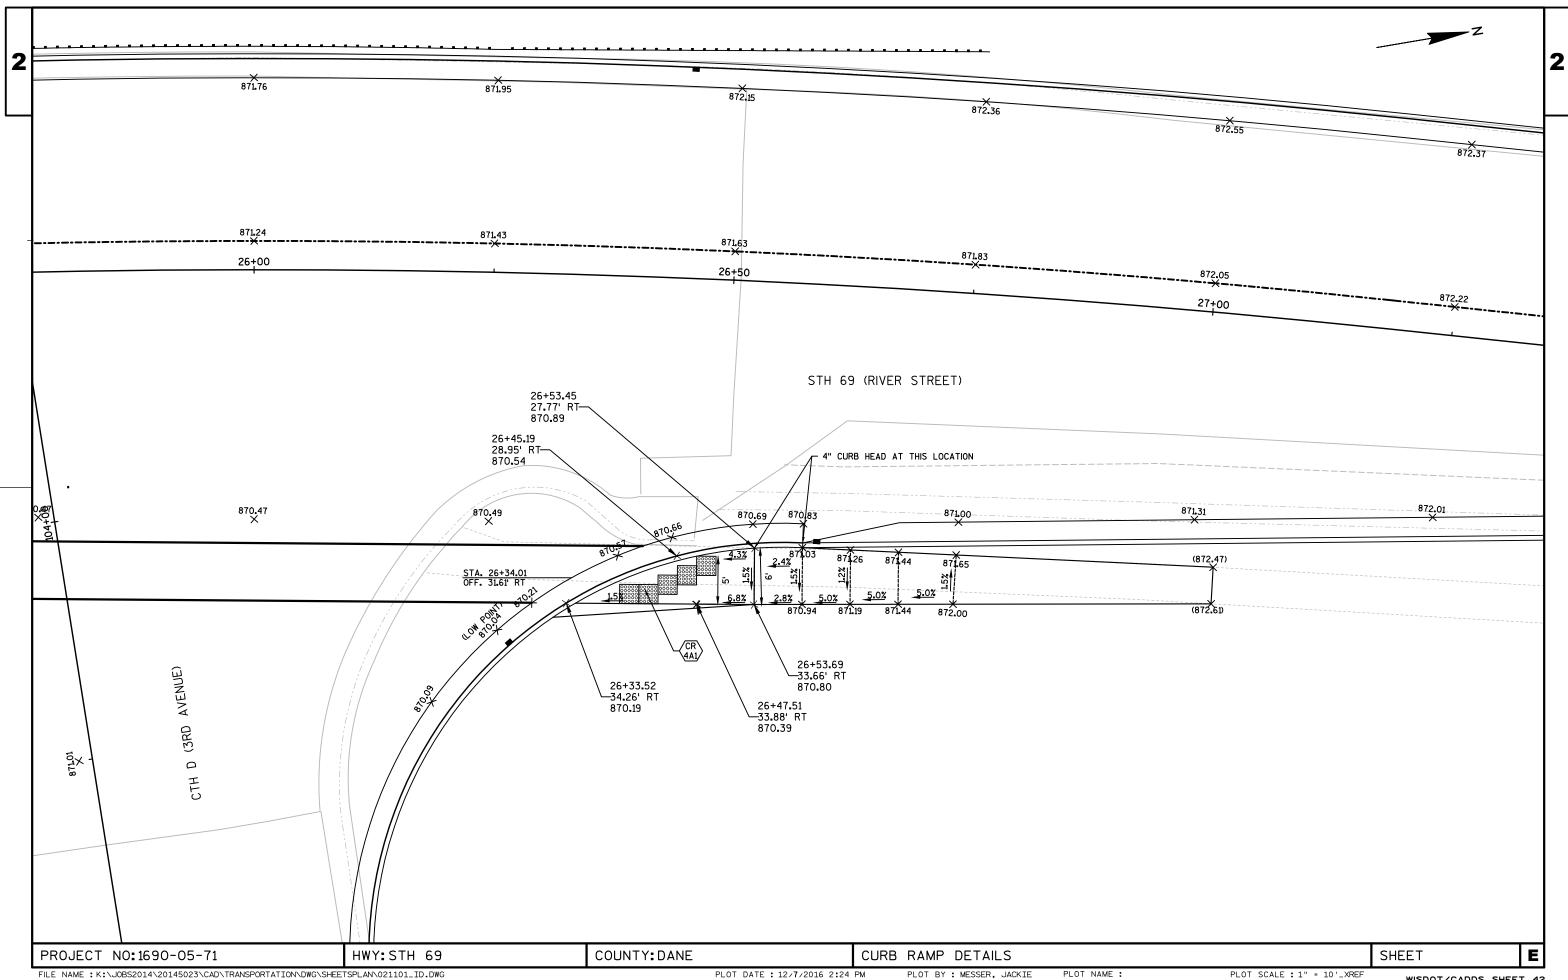


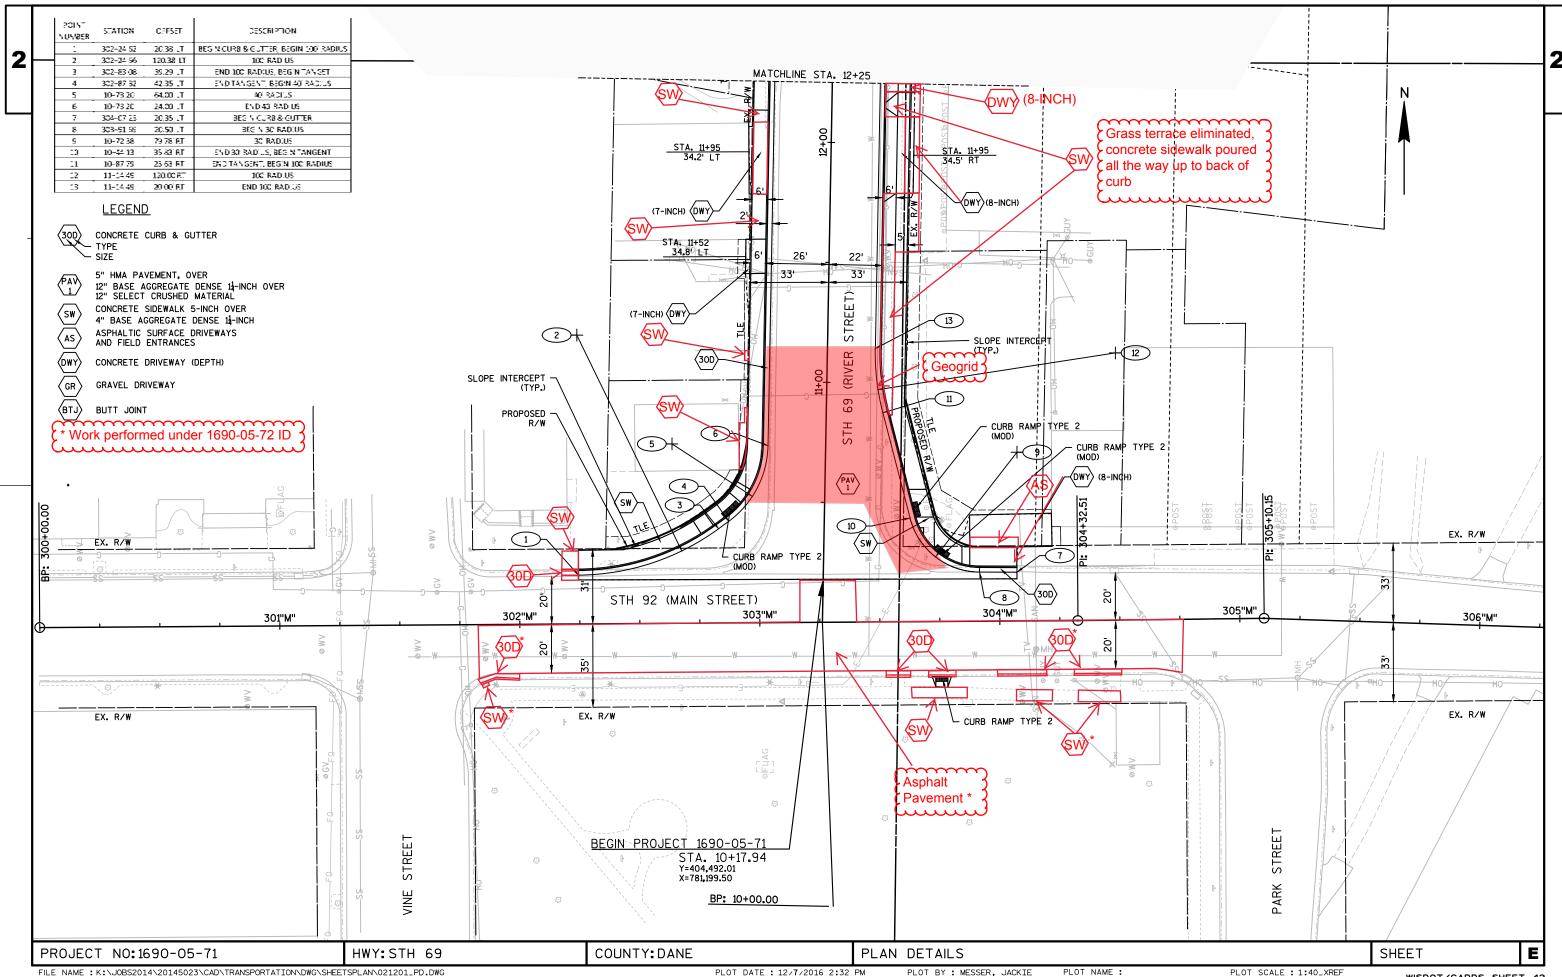

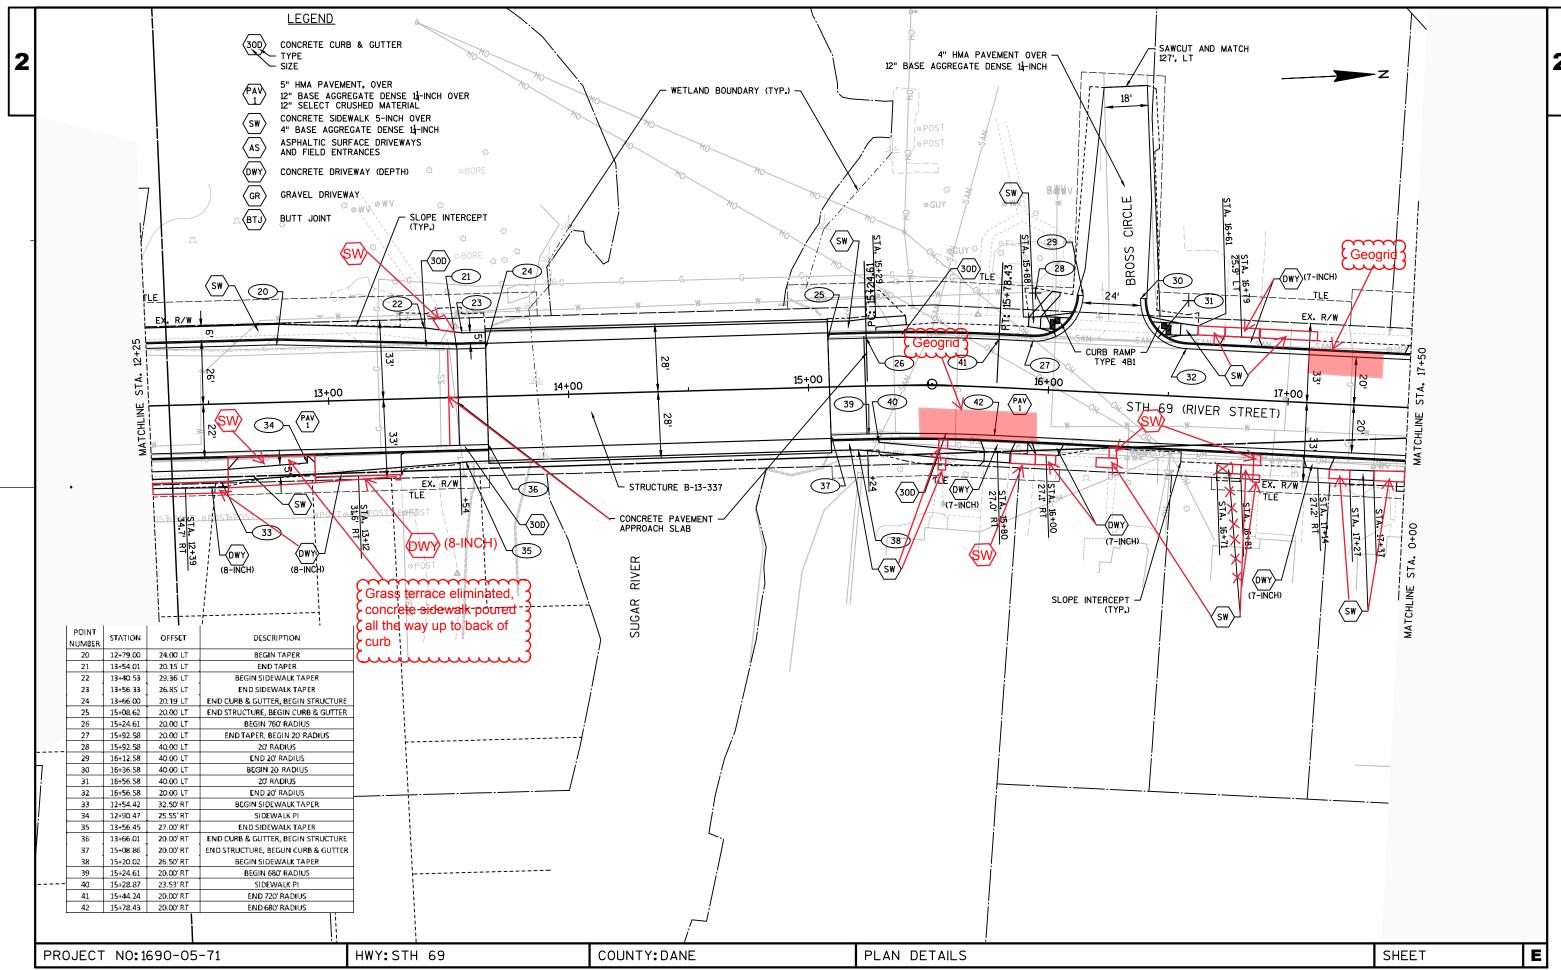

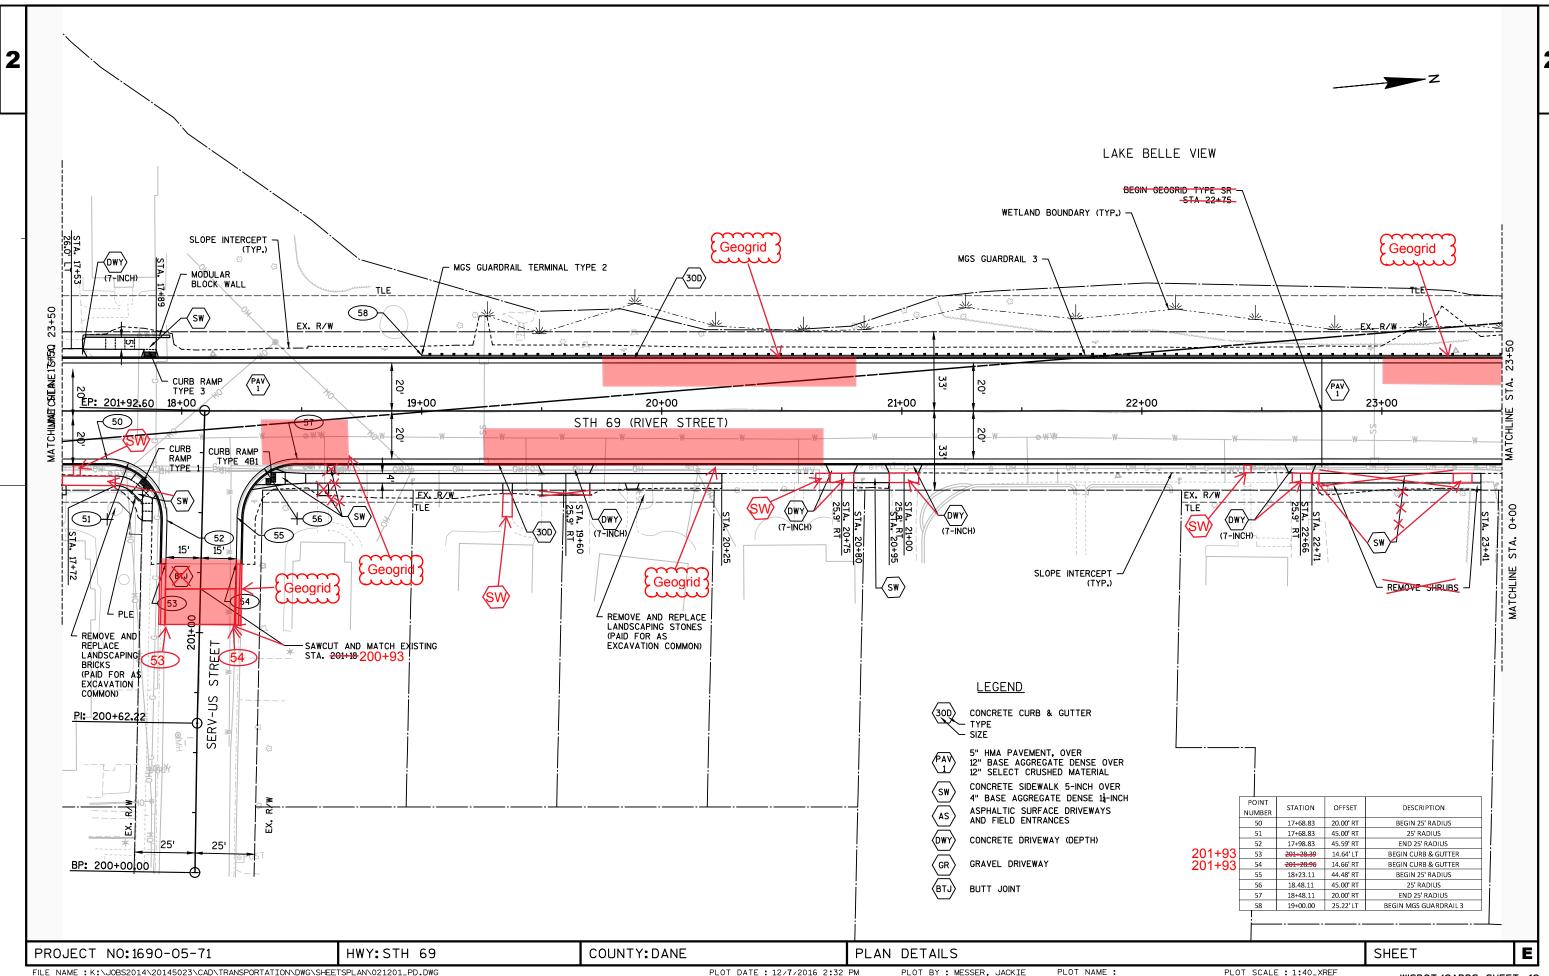


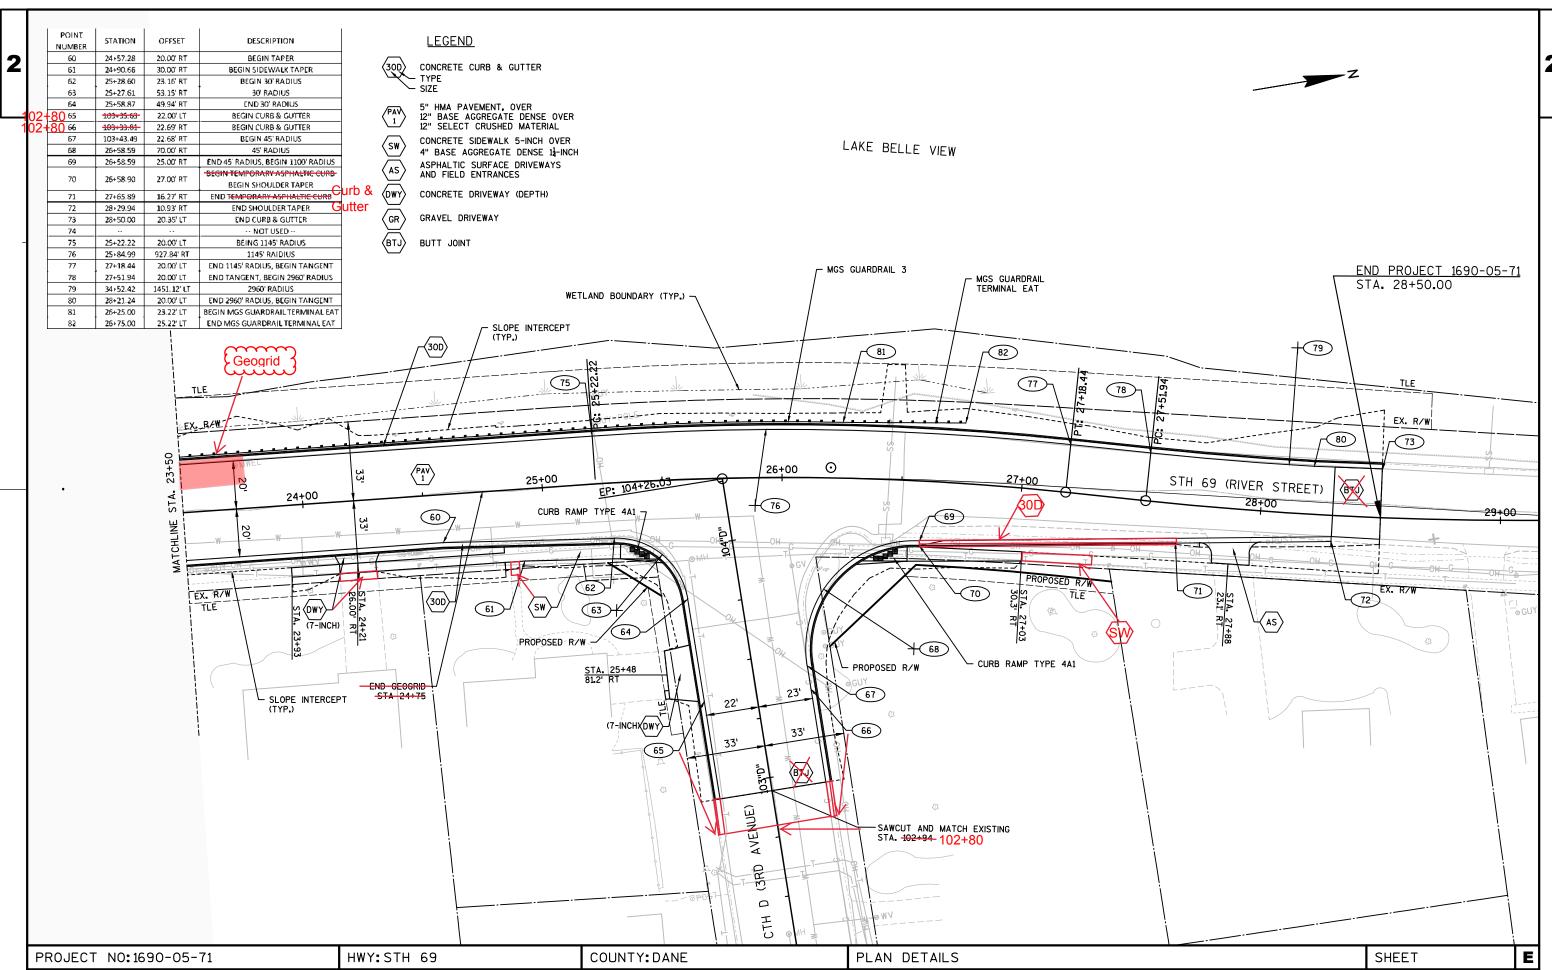


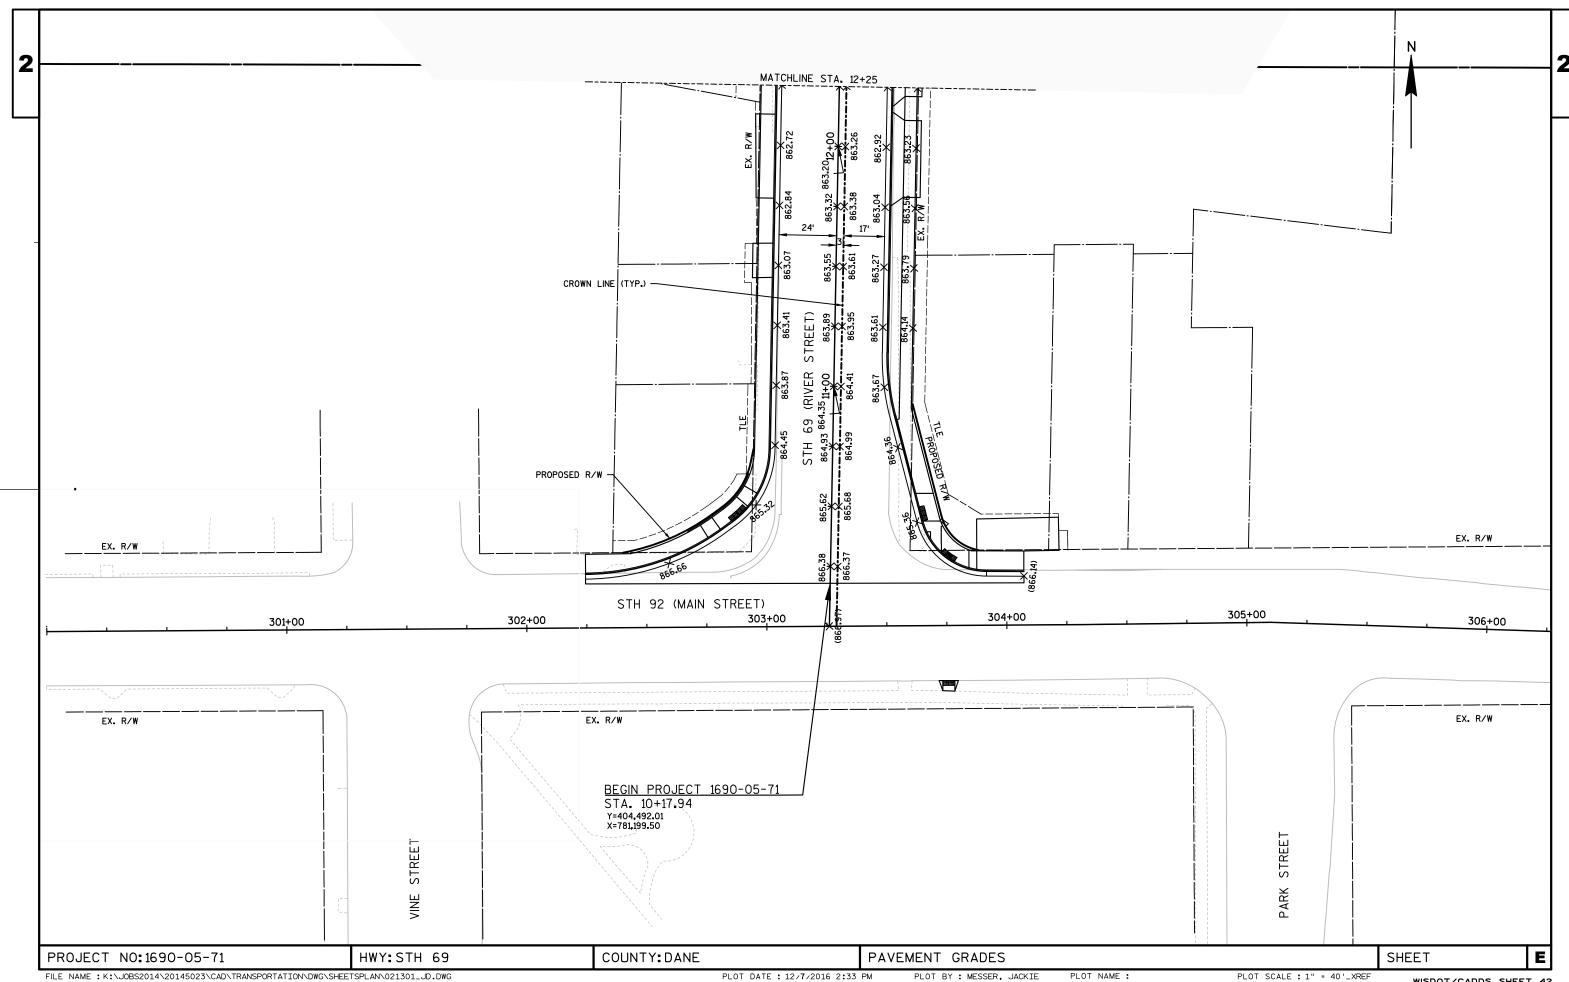



FILE NAME : K:\JOBS2014\20145023\CAD\TRANSPORTATION\DWG\SHEETSPLAN\021301_JD.DWG


PLOT SCALE : 1" = 40'_XREF

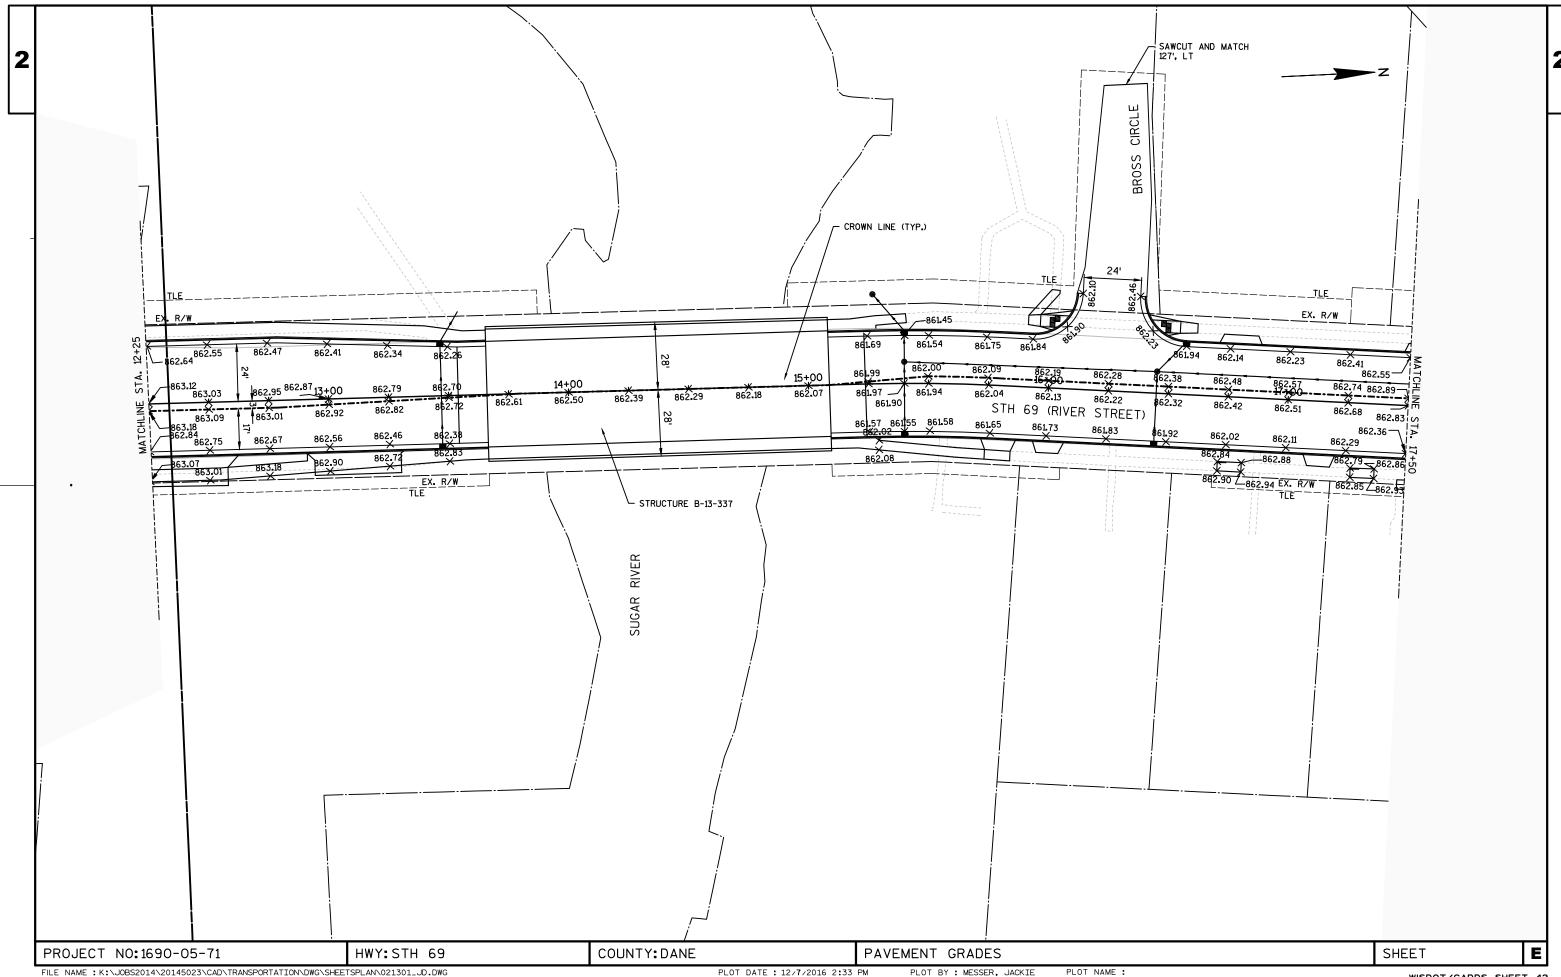

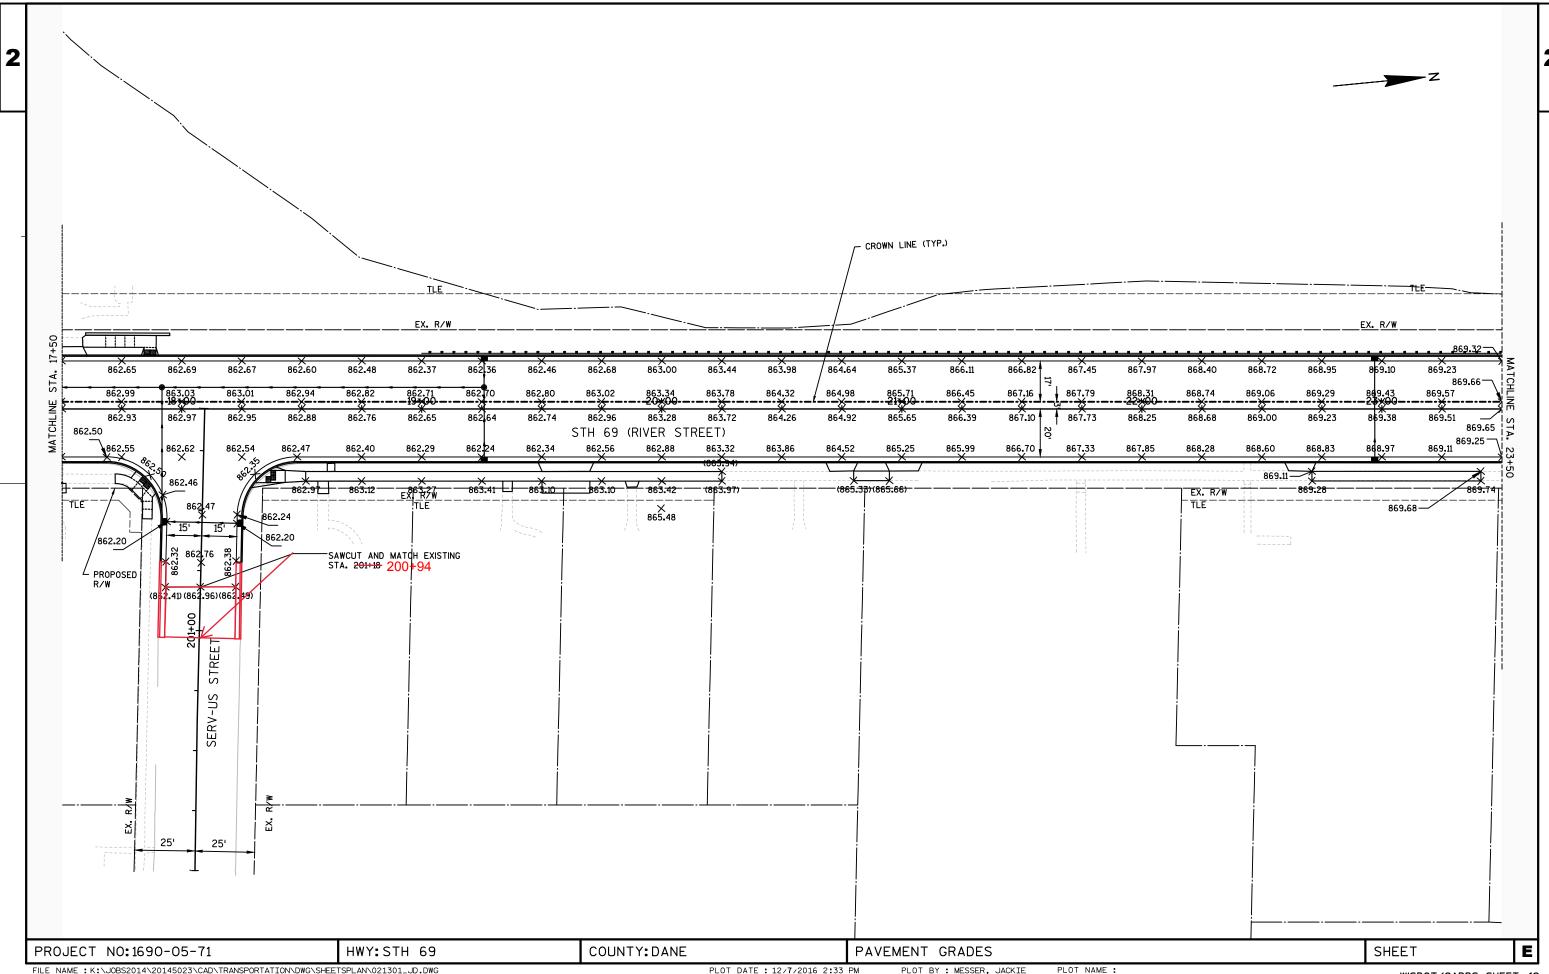

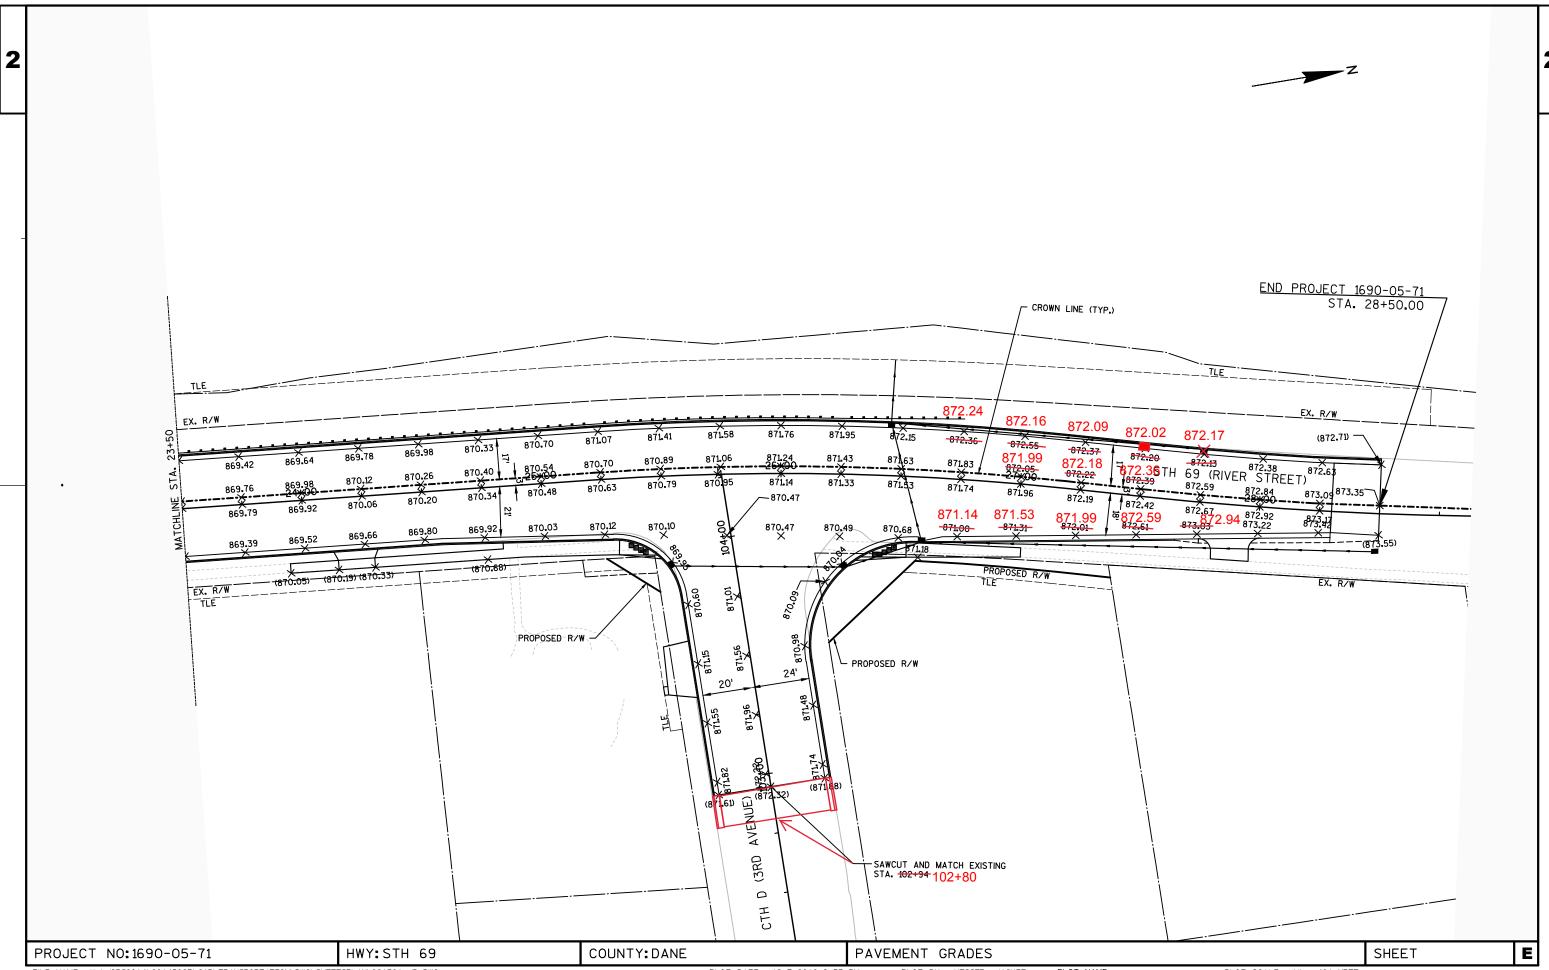

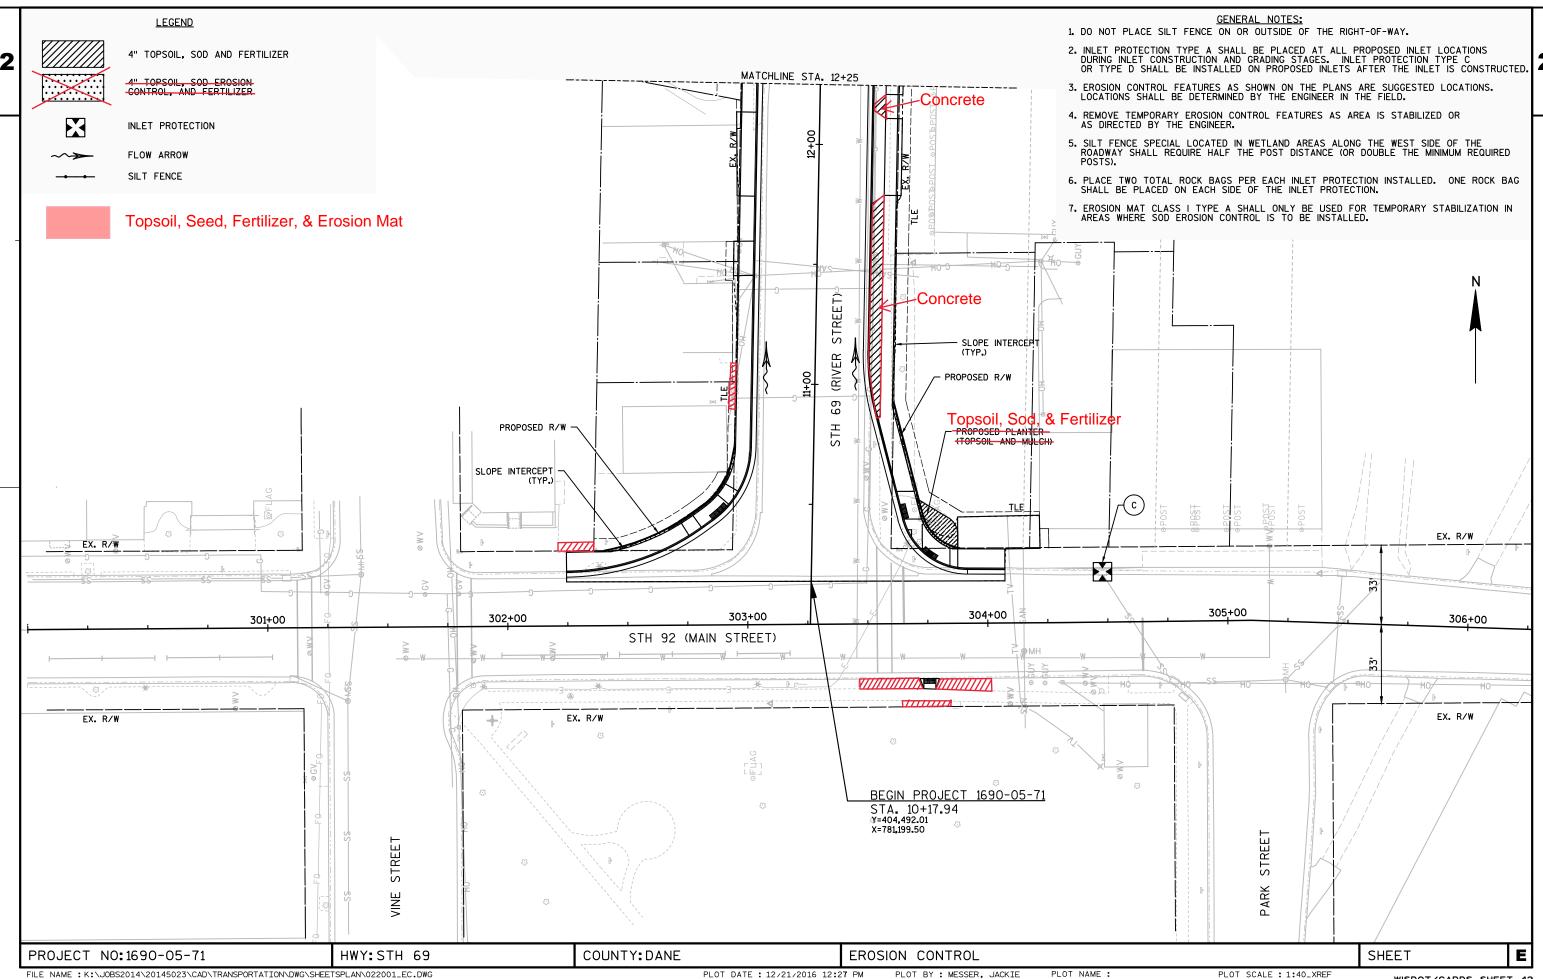


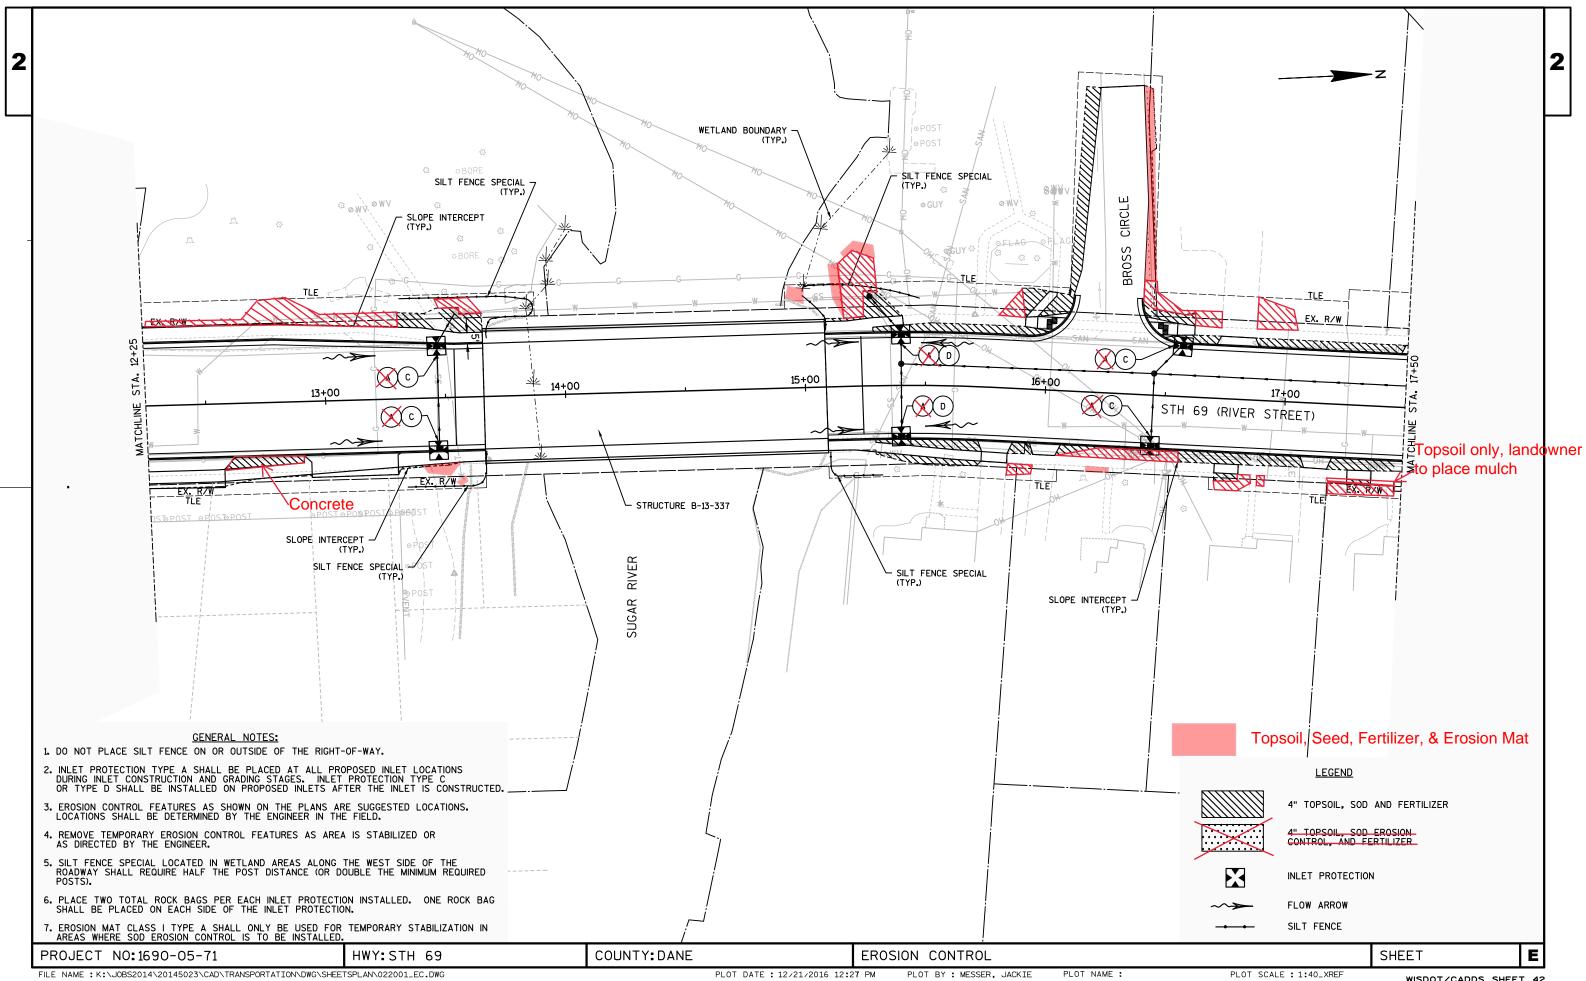

FILE NAME : K:\JOBS2014\20145023\CAD\TRANSPORTATION\DWG\SHEETSPLAN\022001_EC.DWG


PLOT NAME :


PLOT SCALE: 1:40_XREF

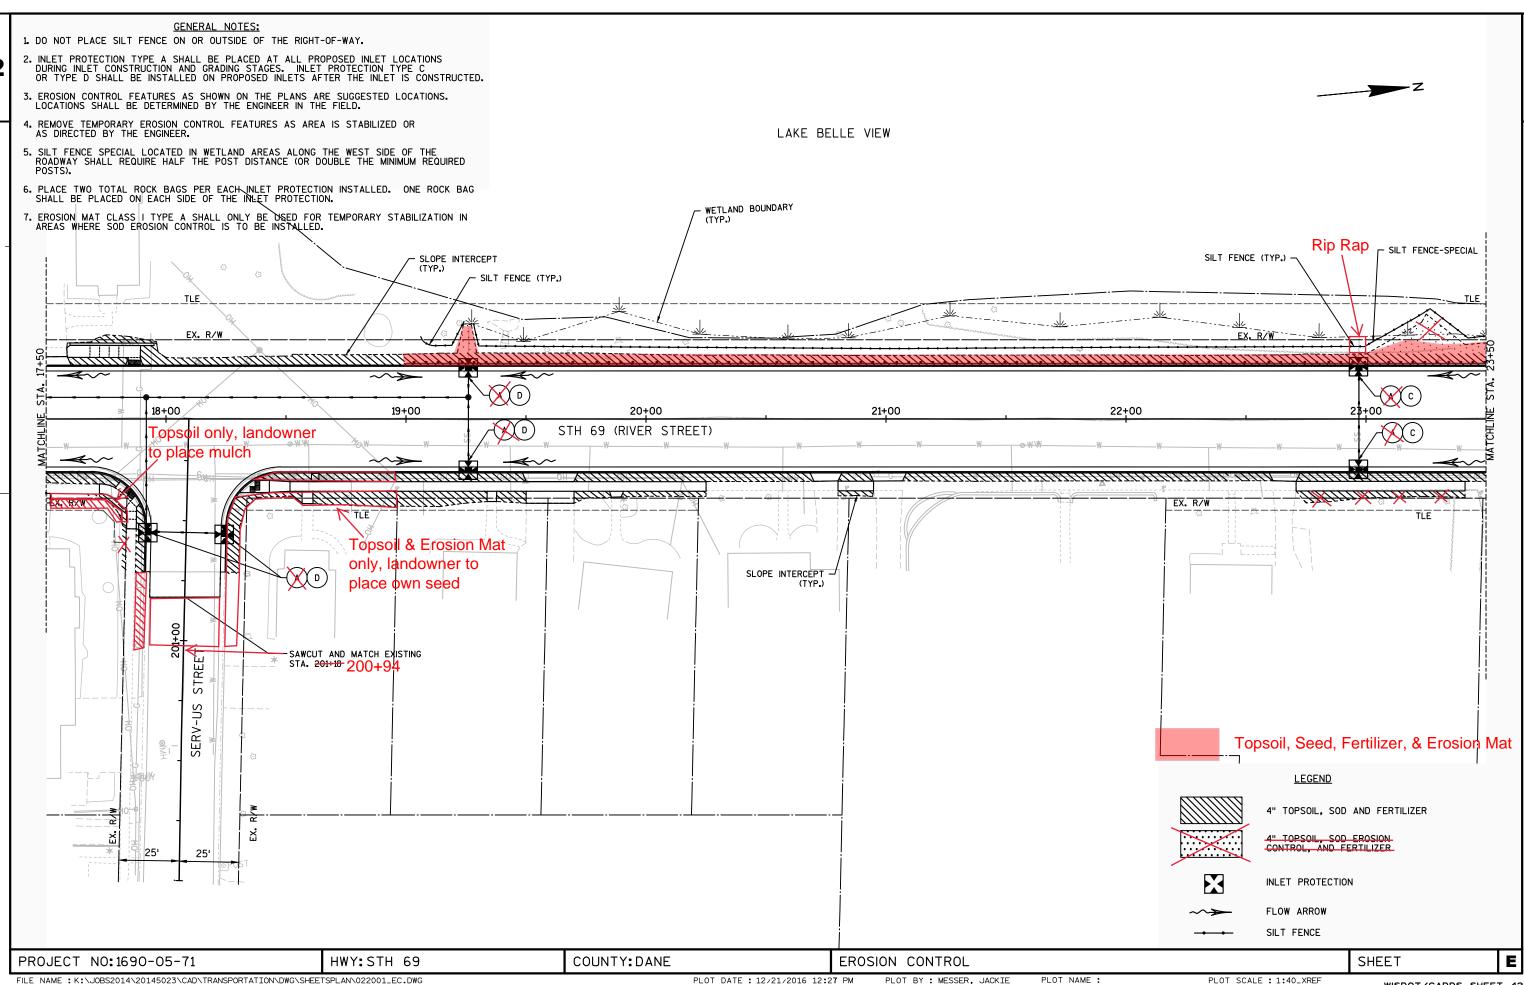



- 2. INLET PROTECTION TYPE A SHALL BE PLACED AT ALL PROPOSED INLET LOCATIONS DURING INLET CONSTRUCTION AND GRADING STAGES. INLET PROTECTION TYPE C OR TYPE D SHALL BE INSTALLED ON PROPOSED INLETS AFTER THE INLET IS CONSTRUCTED.
- 3. EROSION CONTROL FEATURES AS SHOWN ON THE PLANS ARE SUGGESTED LOCATIONS. LOCATIONS SHALL BE DETERMINED BY THE ENGINEER IN THE FIELD.
- 4. REMOVE TEMPORARY EROSION CONTROL FEATURES AS AREA IS STABILIZED OR AS DIRECTED BY THE ENGINEER.
- 5. SILT FENCE SPECIAL LOCATED IN WETLAND AREAS ALONG THE WEST SIDE OF THE ROADWAY SHALL REQUIRE HALF THE POST DISTANCE (OR DOUBLE THE MINIMUM REQUIRED
- 6. PLACE TWO TOTAL ROCK BAGS PER EACH INLET PROTECTION INSTALLED. ONE ROCK BAG SHALL BE PLACED ON EACH SIDE OF THE INLET PROTECTION.
- 7. EROSION MAT CLASS I TYPE A SHALL ONLY BE USED FOR TEMPORARY STABILIZATION IN AREAS WHERE SOD EROSION CONTROL IS TO BE INSTALLED.



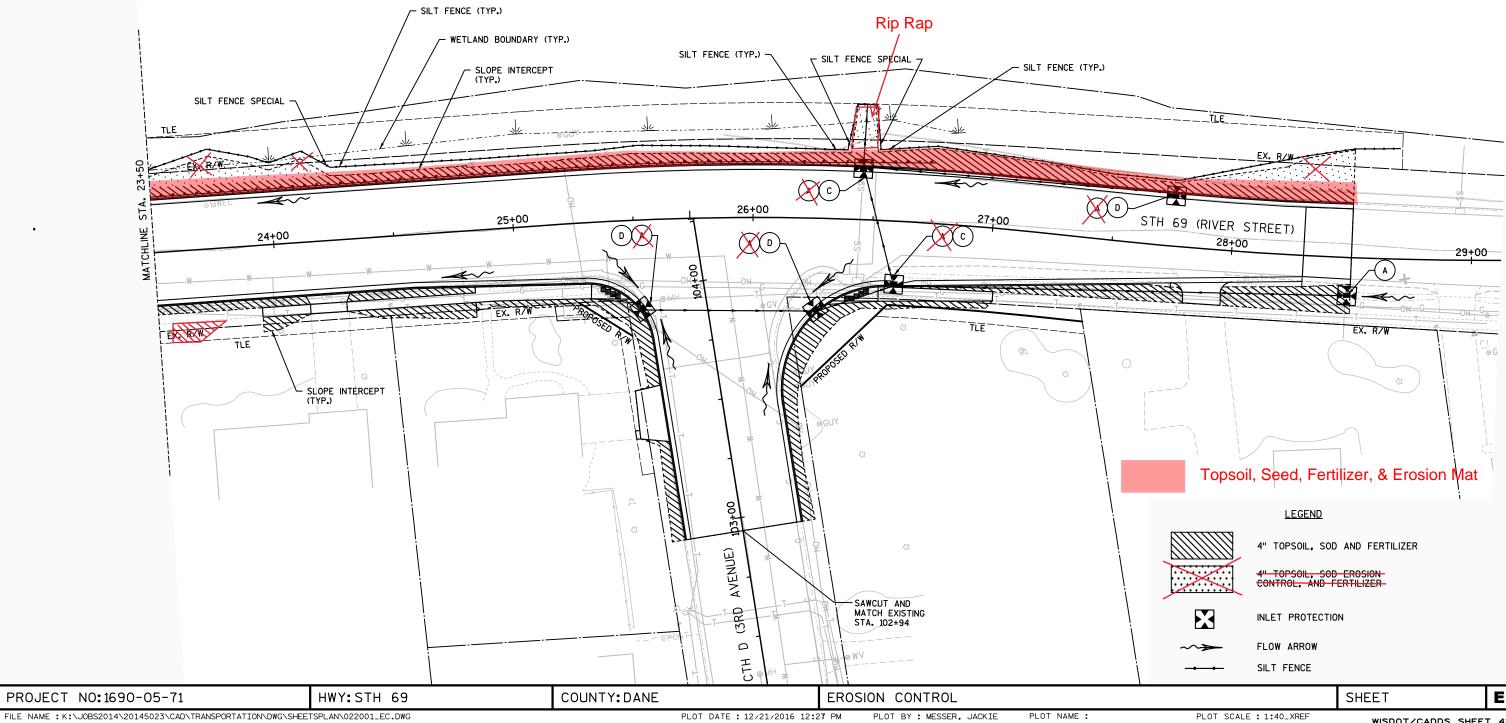

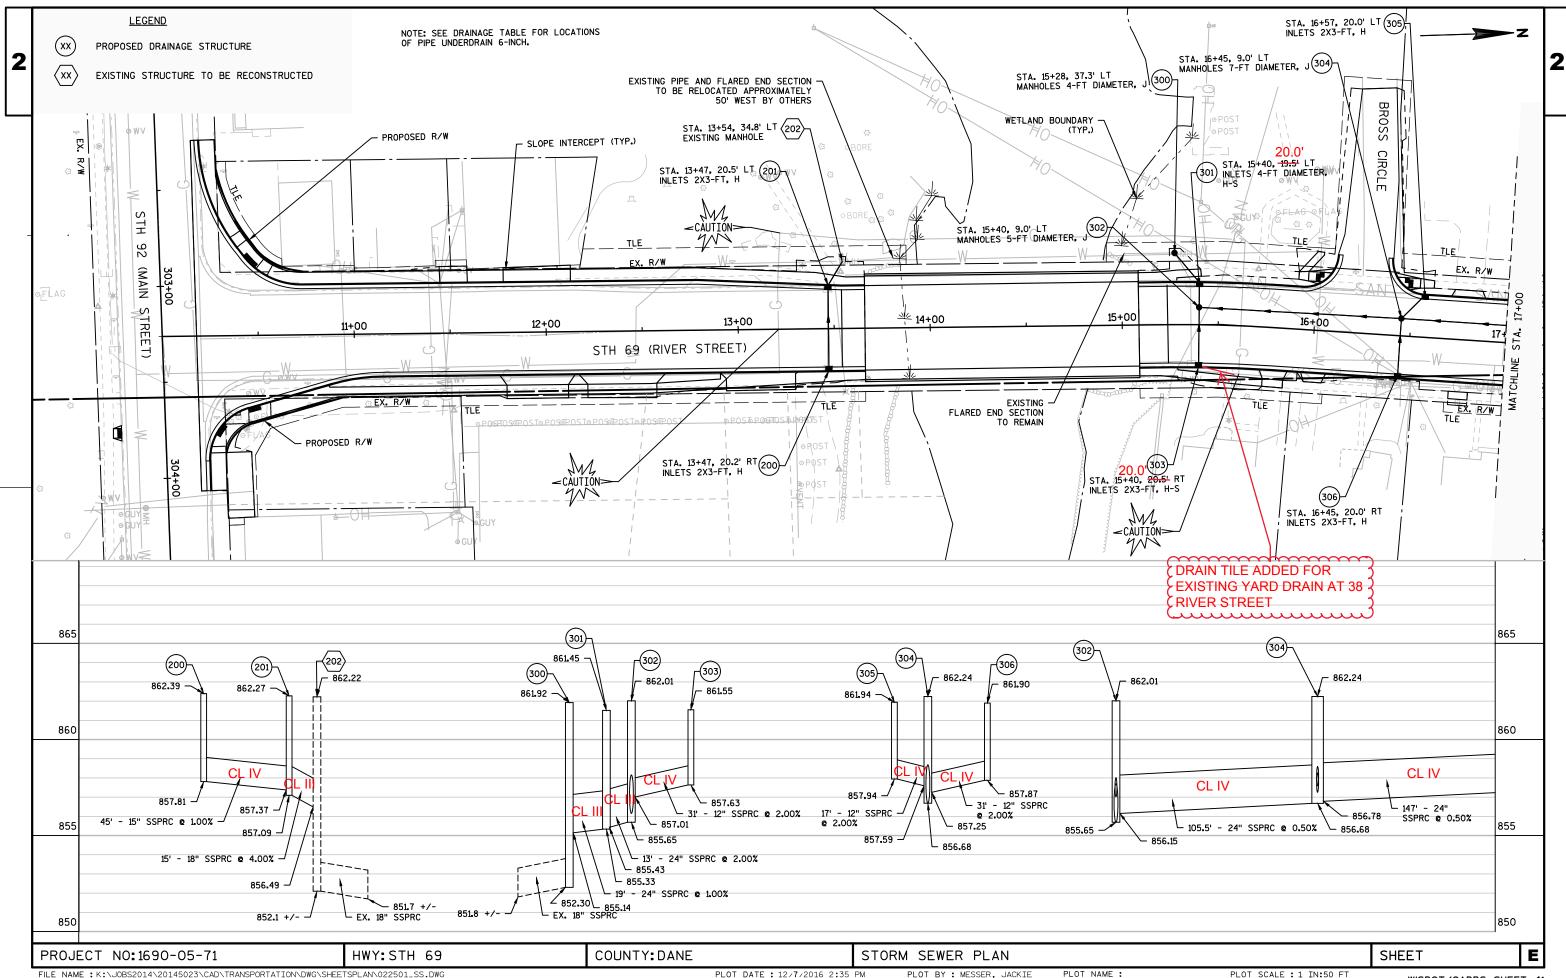

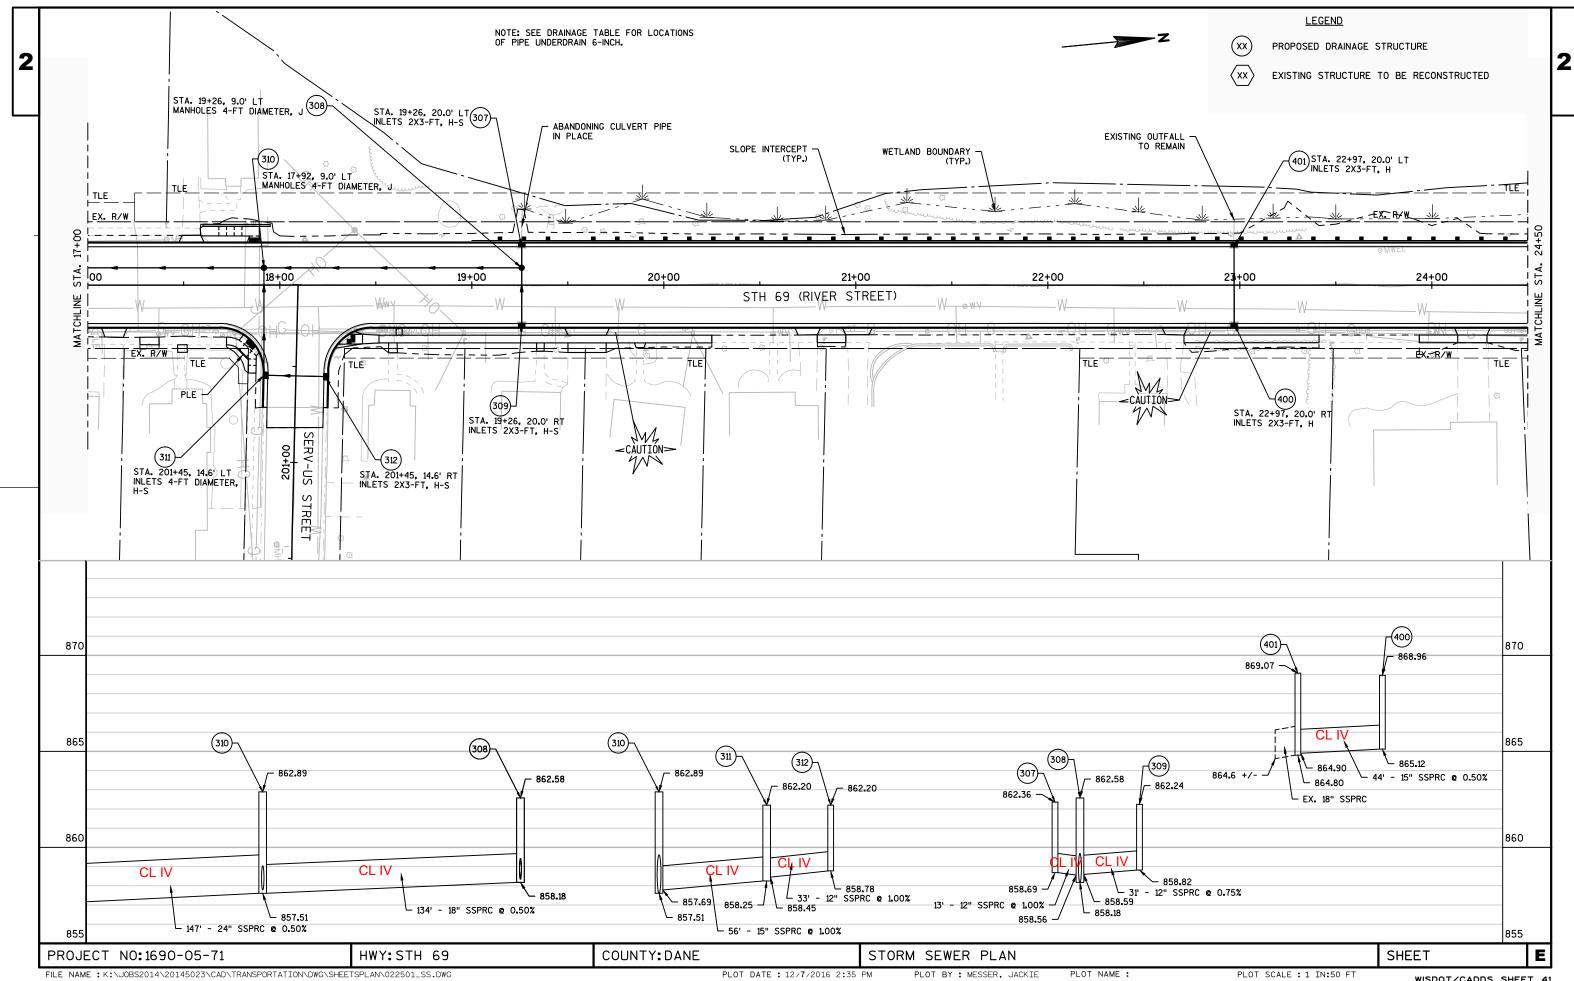

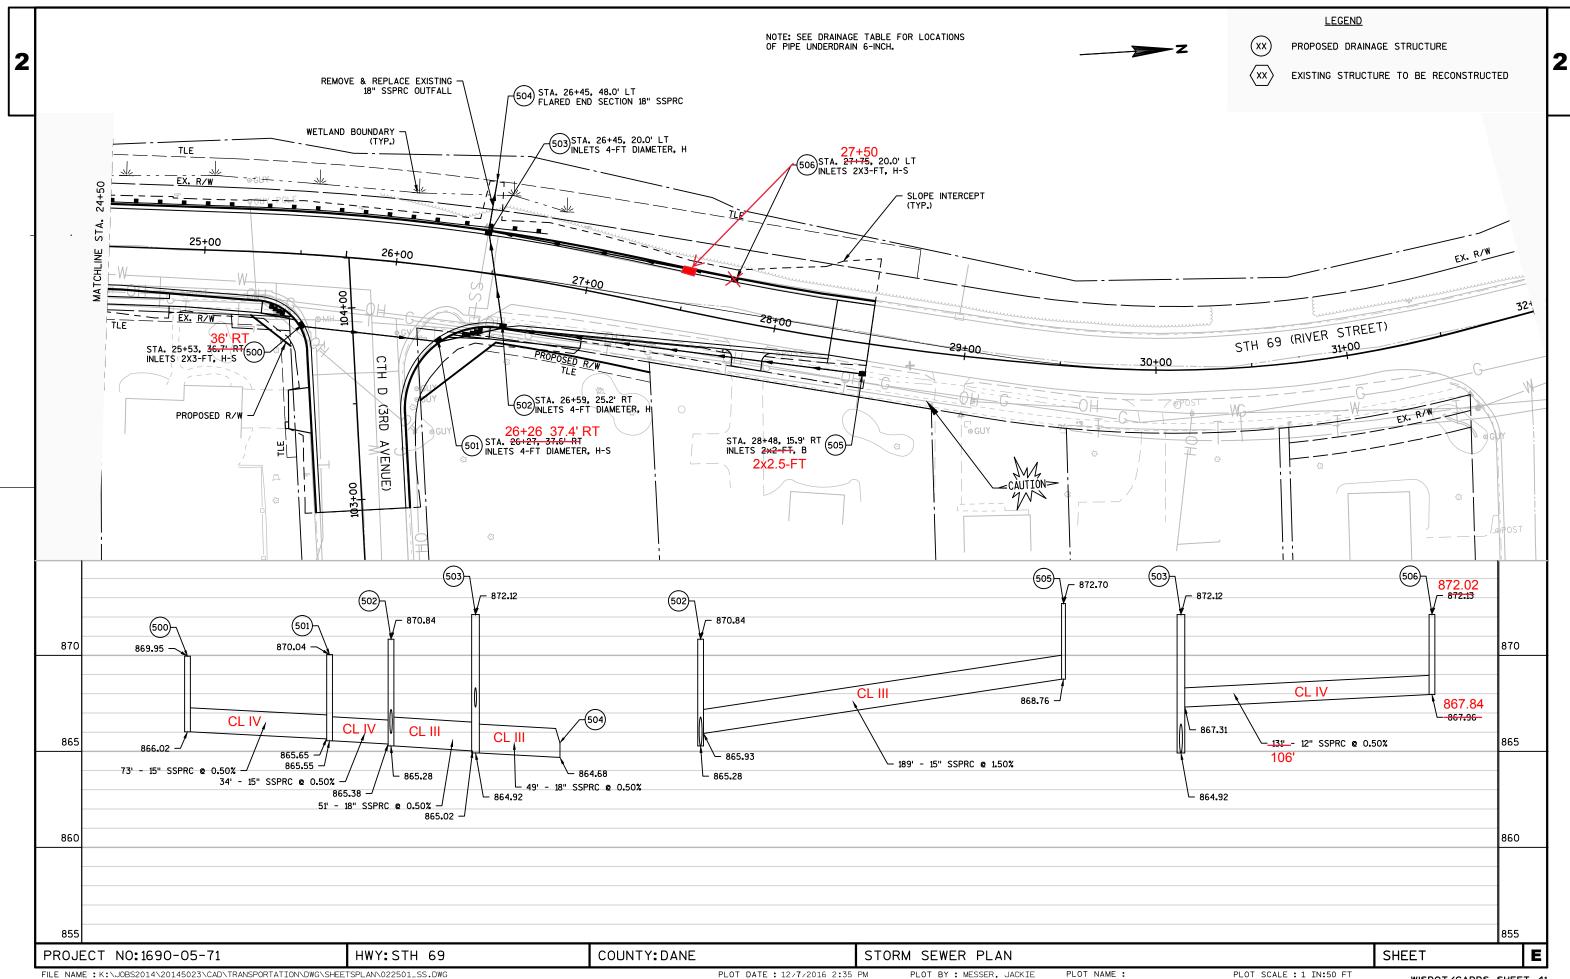


DRAINAGE TABLE


					INLET/CB	MH					DIS	CHARGE PIPE				
STRUCT.			C-C	TO	TYPE &	TYPE &	RIM/GRATE	DEPTH	SIZE	INLET	DISCH.	LENGTH	SLOPE	PIPE		
NO.	STATION	OFFSET	(FT)	STRUCT.	COVER	COVER	ELEV.	(FT)	(IN)	ELEV.	ELEV.	(FT)	(%)	CLASS	REMARKS	JOIN TIES
200	13+47.00	20.2' RT	45	201	INL 2X3 H		862.39	4.58	15	857.81	857.36	45.00	1.00	IV —III	50' OF PIPE UNDERDRAIN 6-INCH SHALL BE CONNECTED TO HIGH SIDE OF INLET.	·····
201	13+47.00	20.5' LT	15	202	INL 2X3 H		862.27	5.18	18	857.09	856.49	15.00	4.00	III	50' OF PIPE UNDERDRAIN 6-INCH SHALL BE CONNECTED TO HIGH SIDE OF INLET. CONNECT TO EXISTING STORM SEWER MANHOLE 202. (NOTE: EXISTING PIPE AT MANHOLE 202 IS TO BE RELOCATED APPROXIMATELY 50 WEST BY OTHERS PRIOR TO CONSTRUCTION. VERIFY CHANGES TO MANHOLE	
307	19+26.00	20.0' LT	13	308	INL 2X3 H-S		862.36	3.67	12	858.69	858.56	13.00	1.00	IV	50' OF PIPE UNDERDRAIN 6-INCH SHALL BE CONNECTED ON BOTH SIDES OF INLET IN SAG CONDITION.	F
															50' OF PIPE UNDERDRAIN 6-INCH SHALL BE CONNECTED ON BOTH SIDES OF	F
309	19+26.00	20.0' RT	31	308	INL 2X3 H-S		862.24	3.42	12	858.82	858.59	31.00	0.75	IV	INLET IN SAG CONDITION.	
308	19+26.00	9.0' LT	134	310		4FT J	862.58	4.40	18	858.18	857.51	134.00	0.50	- III - \	/	
312	201+45.00	14.6' RT	33	311	INL 2X3 H-S		862.20	3.42	12	858.78	858.45	33.00	1.00	IV	50' OF PIPE UNDERDRAIN 6-INCH SHALL BE CONNECTED ON BOTH SIDES OF INLET IN SAG CONDITION.	F
														IV	50' OF PIPE UNDERDRAIN 6-INCH SHALL BE CONNECTED ON BOTH SIDES OF	F
	201+45.00 17+92.00		56 147	310 304	INL 4FT H-S	7	862.20	3.95	15 24	858.25 857.51	857.69 856.78	56.00	1.00		INLET IN SAG CONDITION.	
310	17+92.00	9.0' LT	147	304		4FT J	862.89	5.38	24	837.31	836.78	147.00	0.50			
															50' OF PIPE UNDERDRAIN 6-INCH SHALL BE CONNECTED ON BOTH SIDES OF	F
305	16+57.00	20.0' LT 20.0' RT	17 31	304	INL 2X3 H		861.94	4.00	12	857.94	857.60	17.00	2.00	IV TV	INLET IN SAG CONDITION.	
306 304	16+45.00 16+45.00	9.0' LT	3 I 106	304 302	INL 2X3 H	7FT J	861.90 862.24	4.03 5.56	12 24	857.87 856.68	857.25 856.15	31.00 105.50	2.00 0.50		<i>t</i>	
004	10.40.00	J.U LI	100			,,,,,,,,,,,,,,,,,,,,,,,,,,,,,,,,,,,,,,	002.24	3.30		000.00	000110	100.00	0.00			
303	15+40.00	20' - 20.5 ' RT	31	302	INL 2X3 H-S		861.55	3.92	12	857.63	857.01	31.00	2.00	IV	50' OF PIPE UNDERDRAIN 6-INCH SHALL BE CONNECTED ON BOTH SIDES OF	F
302	15+40.00	9.0' LT	13	301		5FT J	862.01	6.36	24	855.65	855.39	13.00	2.00	III		
301	15+40.00	20' _ 19.5' LT	19	300	INL 4FT H-S		861.45	6.12	24	855.33	855.14	19.00	1.00	III	50' OF PIPE UNDERDRAIN 6-INCH SHALL BE CONNECTED ON BOTH SIDES OF INLET IN SAG CONDITION.	F
300	15+28.00	37.3' LT				4FT J	861.92	9.62		852.30					CONNECT TO EXISTING STORM SEWER OUTFALL PIPE INTO SUGAR RIVER, 18" S I.E. 852.3 +/	
400	22+97.00	20.0' RT	44	401	INL 2X3 H		868.96	3.84	15	865.12	864.90	44.00	0.50	IV -:::-	50' OF PIPE UNDERDRAIN 6-INCH SHALL BE CONNECTED TO HIGH SIDE OF INLET.	
401	22+97.00	20.0' LT			INL 2X3 H		869.07	4.27		864.80					50' OF PIPE UNDERDRAIN 6-INCH SHALL BE CONNECTED TO HIGH SIDE OF INLET. CONNECT TO EXISTING STORM SEWER OUTFALL PIPE INTO LAKE BELLE VIEW, 18" W I.E. 864.8 +/	
		36'												IV	50' OF PIPE UNDERDRAIN 6-INCH SHALL BE CONNECTED ON BOTH SIDES OF	
500	25+53.00 26+26		73	501	INL 2X3 H-S		869.95	3.93	15	866.02	865.66	73.00	0.50		INLET IN SAG CONDITION.	X
501	20+20 -26+27-00	37.4'	34	502	INL 4FT H-S		870.04	4.49	15	865.55	865.38	34.00	0.50	V	50' OF PIPE UNDERDRAIN 6-INCH SHALL BE CONNECTED ON BOTH SIDES OF	
505	28+48.00		189	502	INL 2X2 B		872.70	3.94	15	868.76	865.93	189.00	1.50	III		Х
502	26+59.00	25.2' RT	51	503	INL 4FT H		870.84	5.56	18	865.28	865.03	51.00	0.50	III	50' OF PIPE UNDERDRAIN 6-INCH SHALL BE CONNECTED TO HIGH SIDE OF INLET.	
506	27+50 27+75.00	20.0' LT	31	503	INL 2X3 H-S		872.02 872.13	4.17	12	867.84 -867.96	867.31	105.75' 130.75	0.50	IV	50' OF PIPE UNDERDRAIN 6-INCH SHALL BE CONNECTED ON BOTH SIDES OF INLET IN SAG CONDITION.	F
503	26+45.00	20.0' LT	49	504	INL 4FT H		872.12	7.20	18	864.92	864.68	49.00	0.50	III	50' OF PIPE UNDERDRAIN 6-INCH SHALL BE CONNECTED TO HIGH SIDE OF INLET. APRON ENDWALL REQUIRED AT STRUCTURE 504. DISCHARGE INVER'SHOWN IS TO END OF FLARED END SECTION.	


- NOTES: 1. STATIONS AND OFFSETS TO MANHOLES AND INLETS 2X2 ARE GIVEN TO THE CENTER OF STRUCTURE.
 - 2. STATIONS AND OFFSETS TO INLETS IN CURB ARE GIVEN TO FLANGE LINE OF CURB.
 - 3. STATIONS, OFFSETS AND ELEVATIONS OF ENDWALLS ARE GIVEN TO THE END OF THE ENDWALL.
 - 4. MANHOLE AND INLETS 2X2 RIM/GRATE ELEVATIONS ARE GIVEN TO THE CENTER OF STRUCTURE.
 - 5. CURB INLET RIM/GRATE ELEVATIONS ARE GIVEN TO FLANGE LINE.
 - 6. DEPTH OF MANHOLES AND INLETS ARE MEASURED FROM THE LOWEST INVERT OF THE STRUCTURE TO THE RIM/GRATE ELEVATION.
 - 7. PIPE LENGTHS FOR STRUCTURES ARE SHOWN FROM CENTER OF STRUCTURE TO CENTER OF STRUCTURE.
 - 8. CONTRACTOR SHALL VERIFY DEPTH AND ELEVATIONS OF ALL EXISTING STORM SEWER STRUCTURES BEFORE BEGINNING WORK AND SHALL REPORT ANY DISCREPANCIES TO ENGINEER PRIOR TO BEGINNING WORK.


PROJECT NO:1690-05-71 STORM SEWER DRAINAGE TABLE HWY:STH 69 COUNTY: DANE SHEET


E

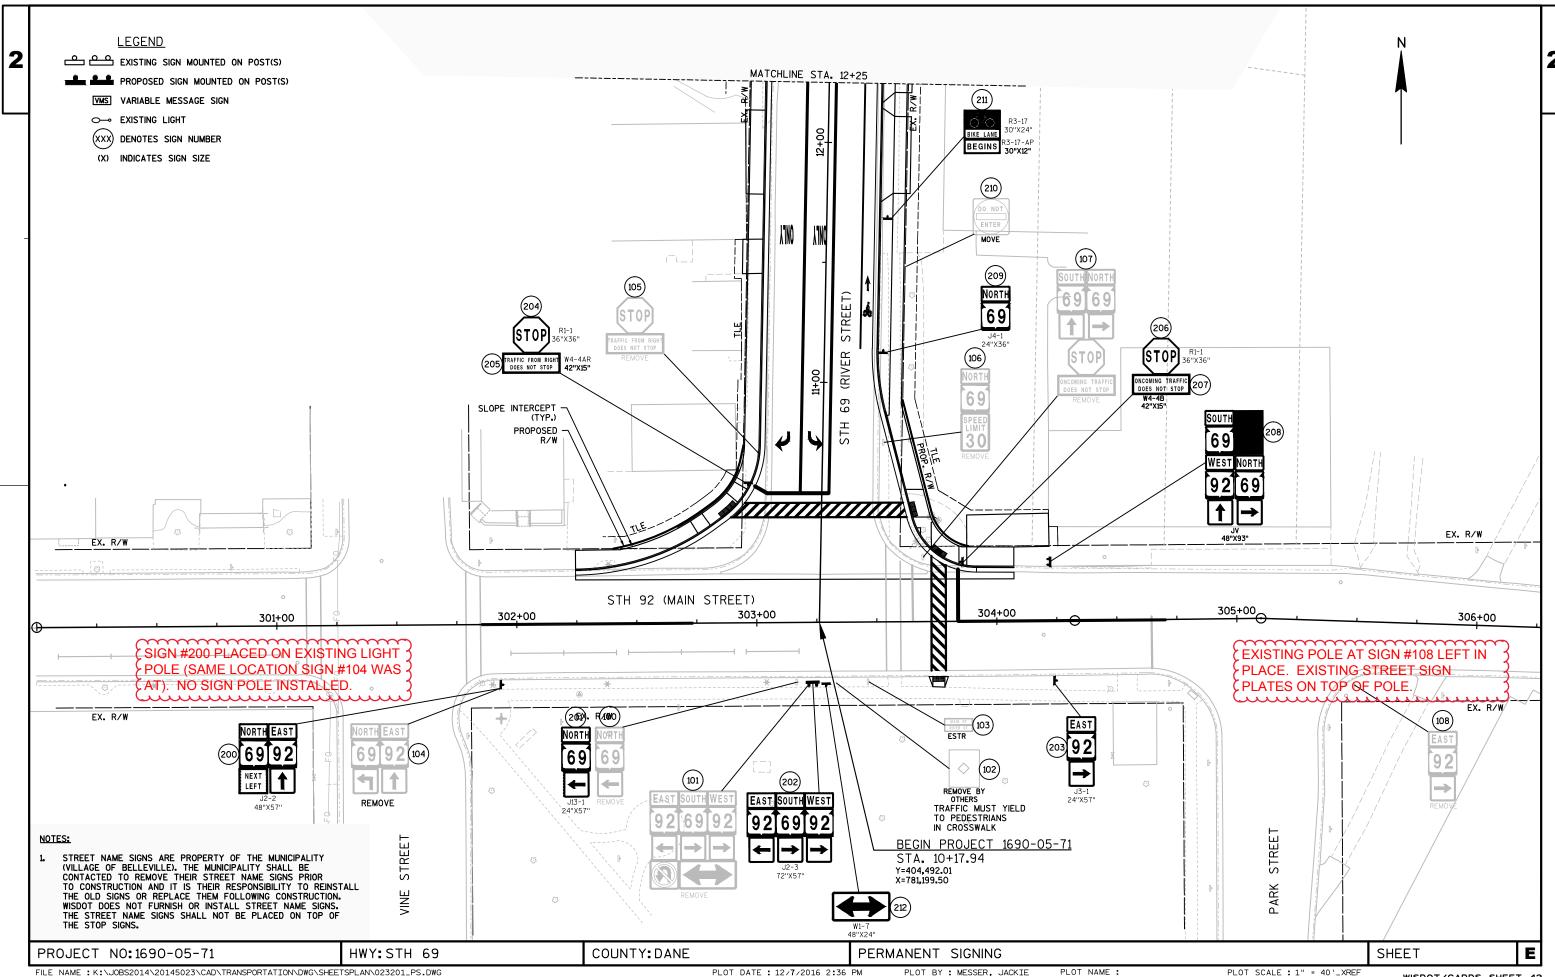


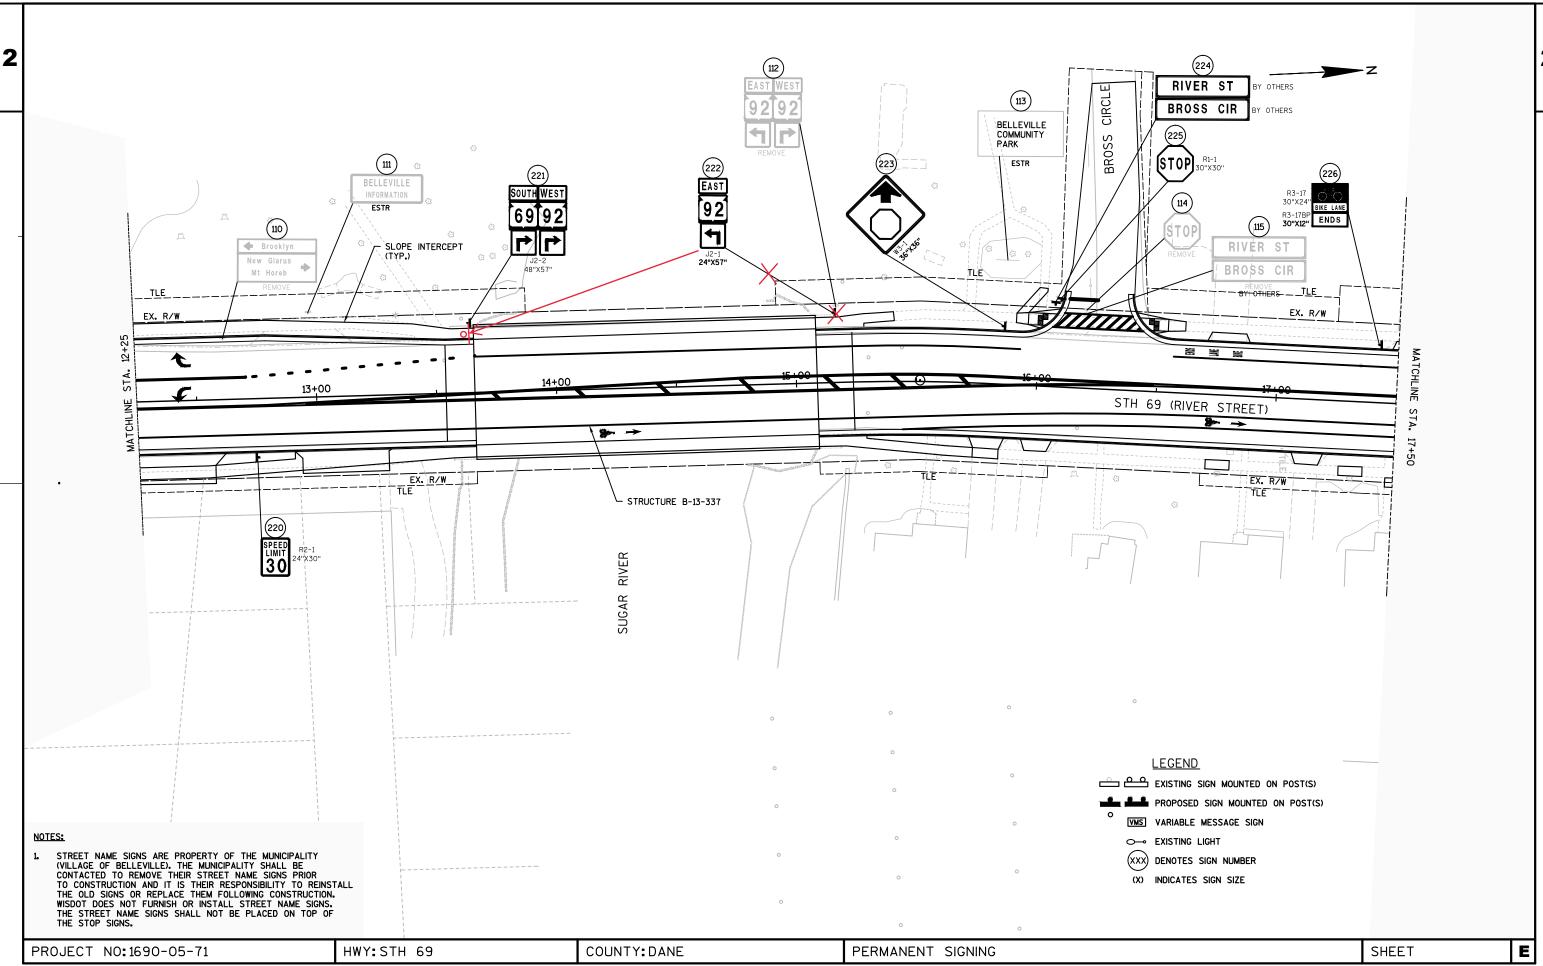


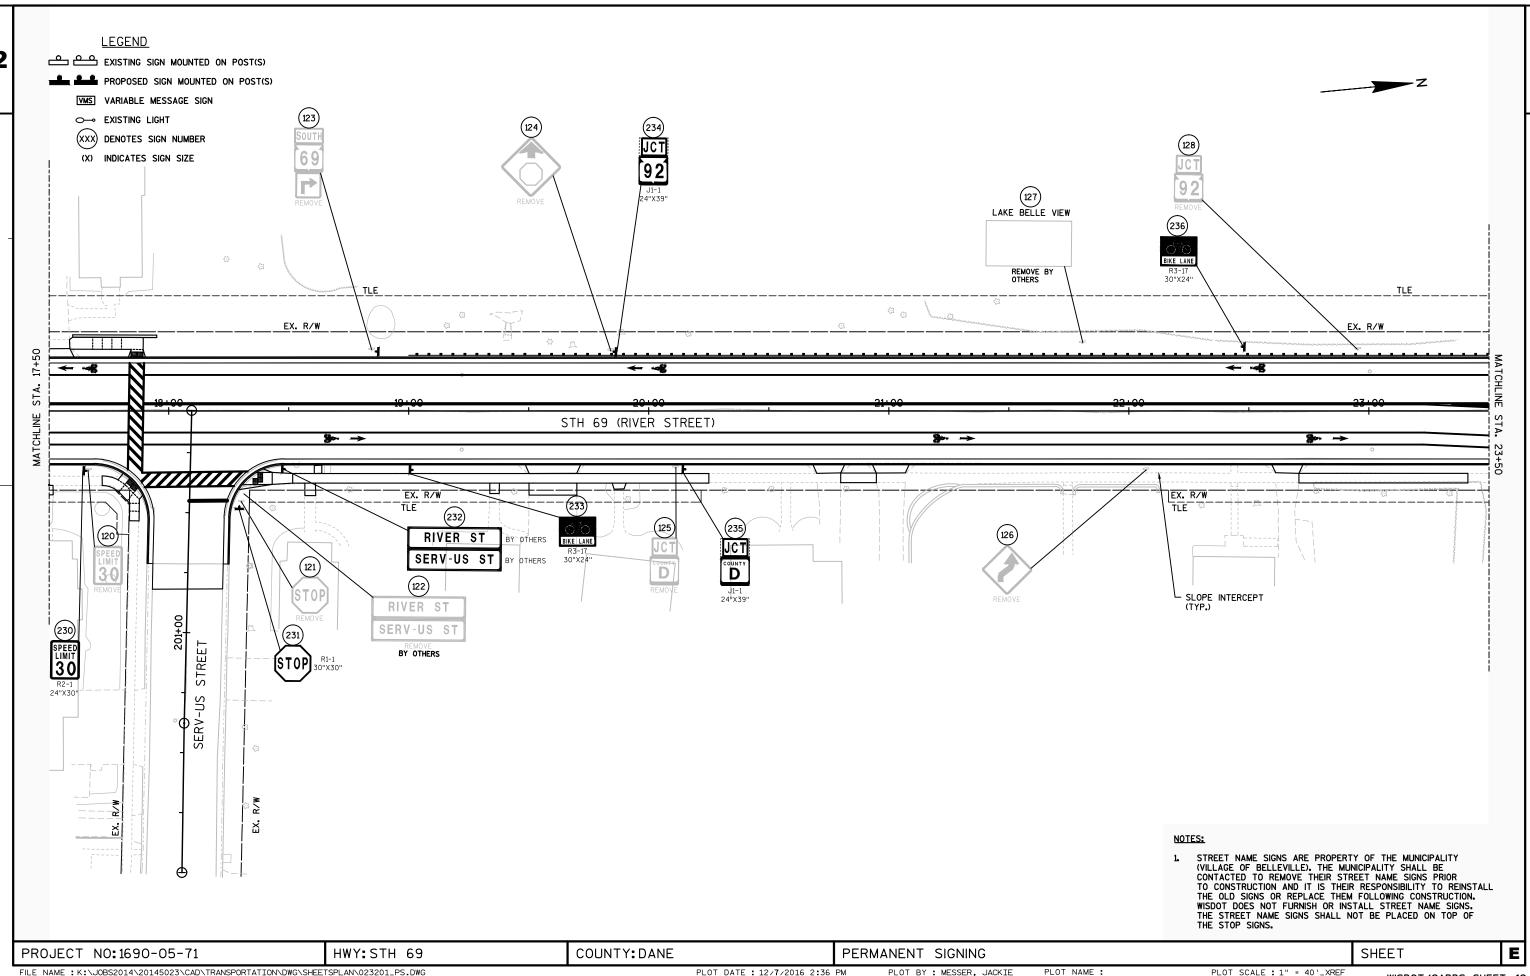


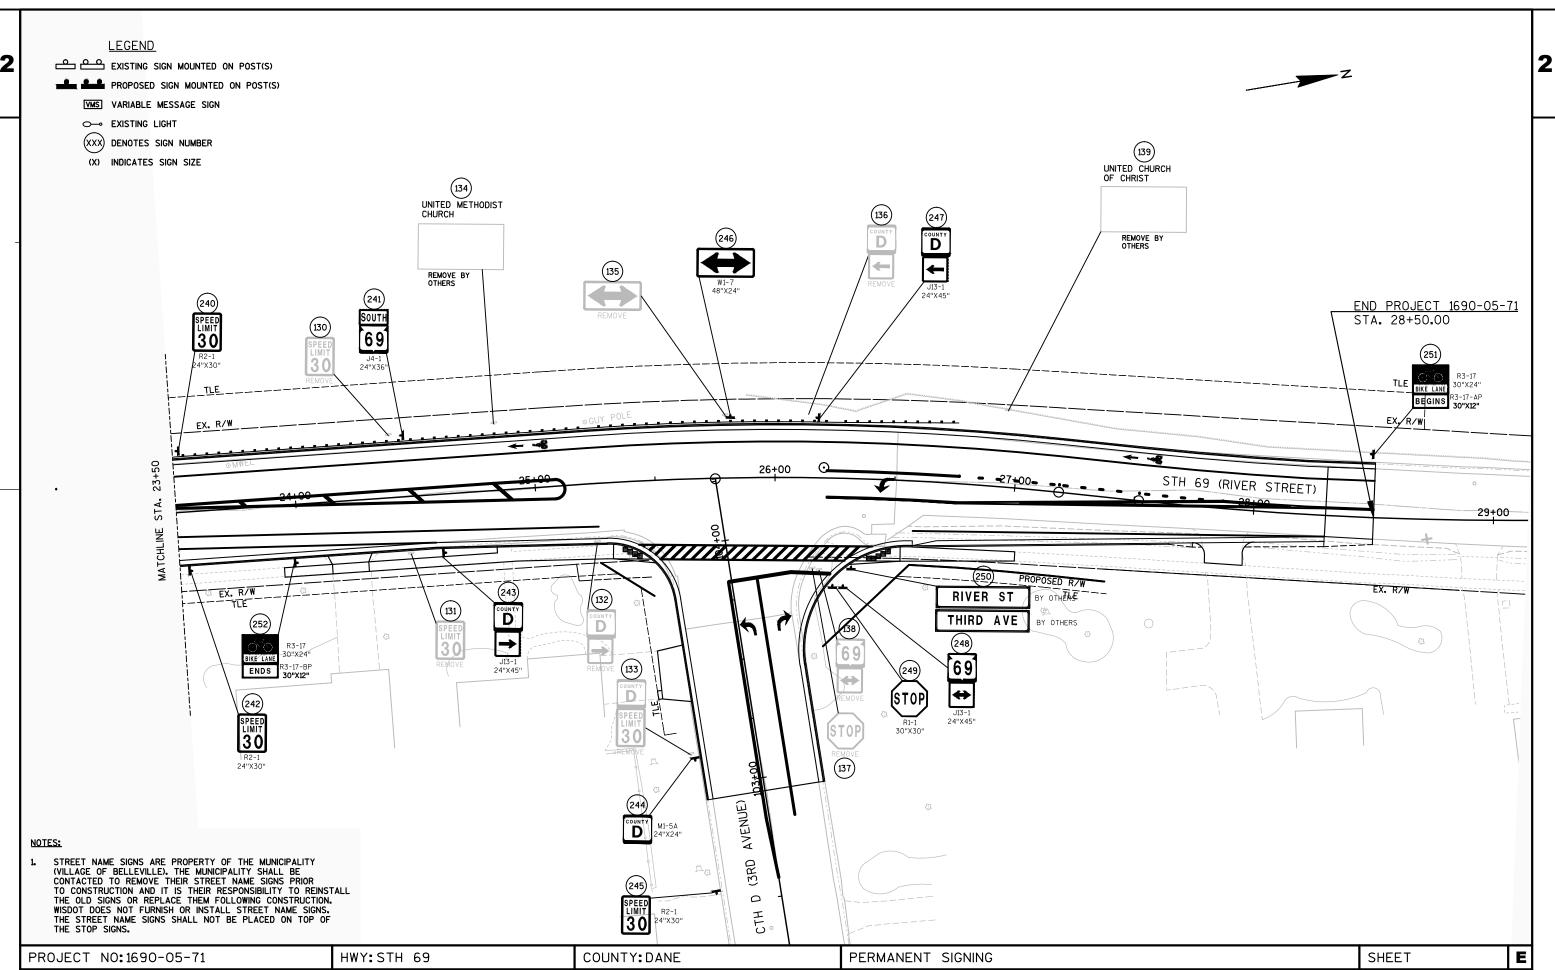


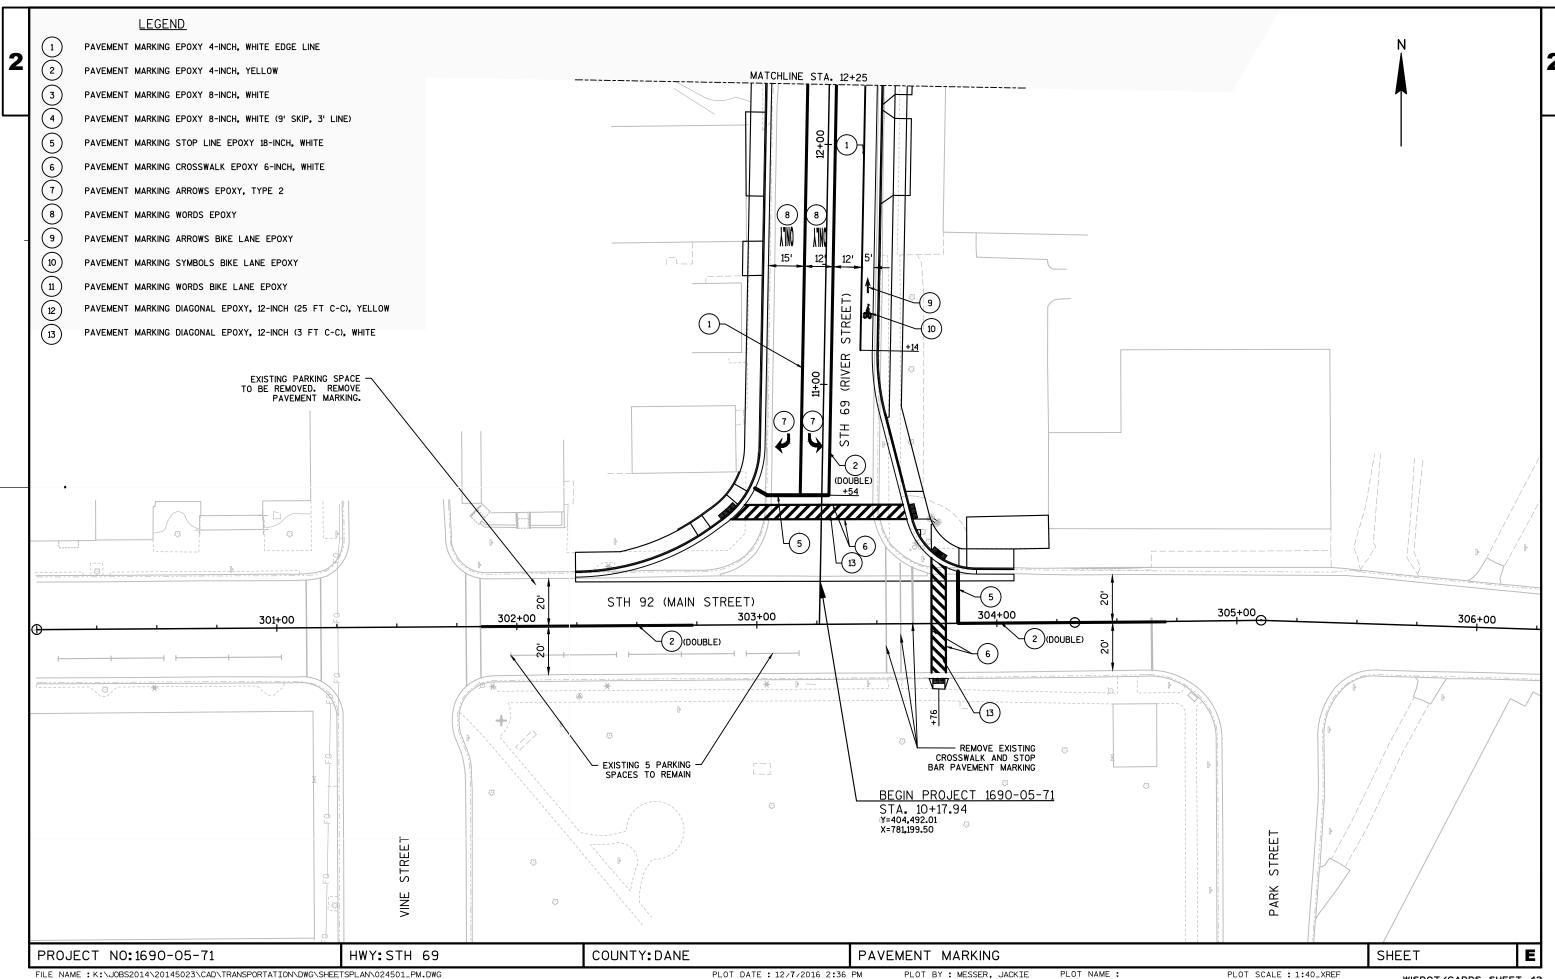

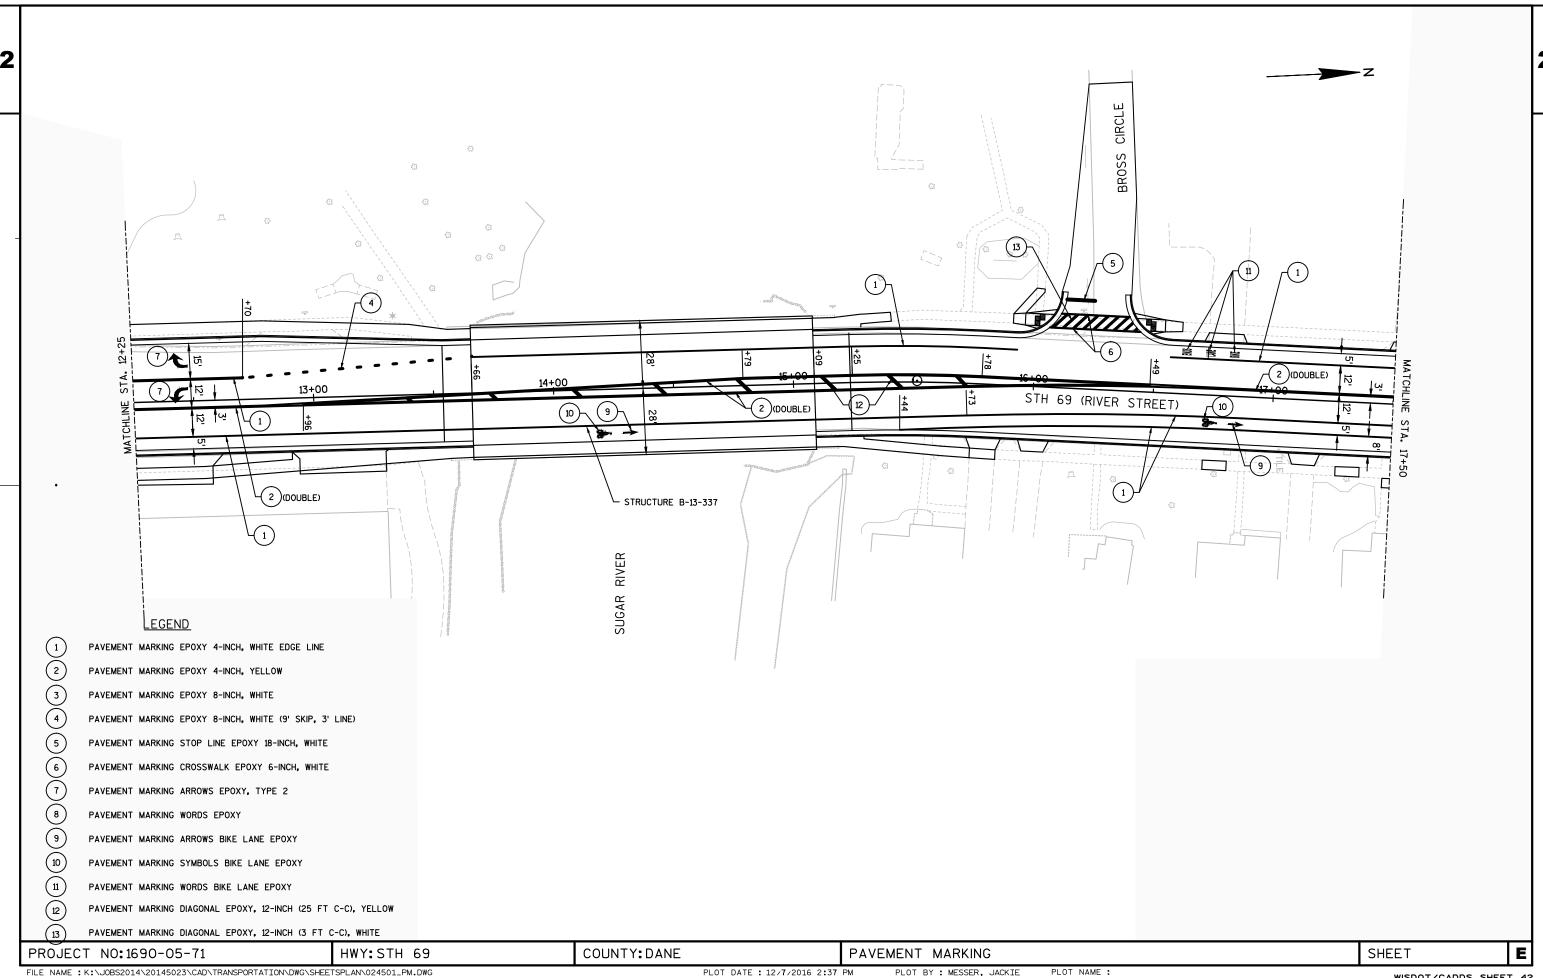

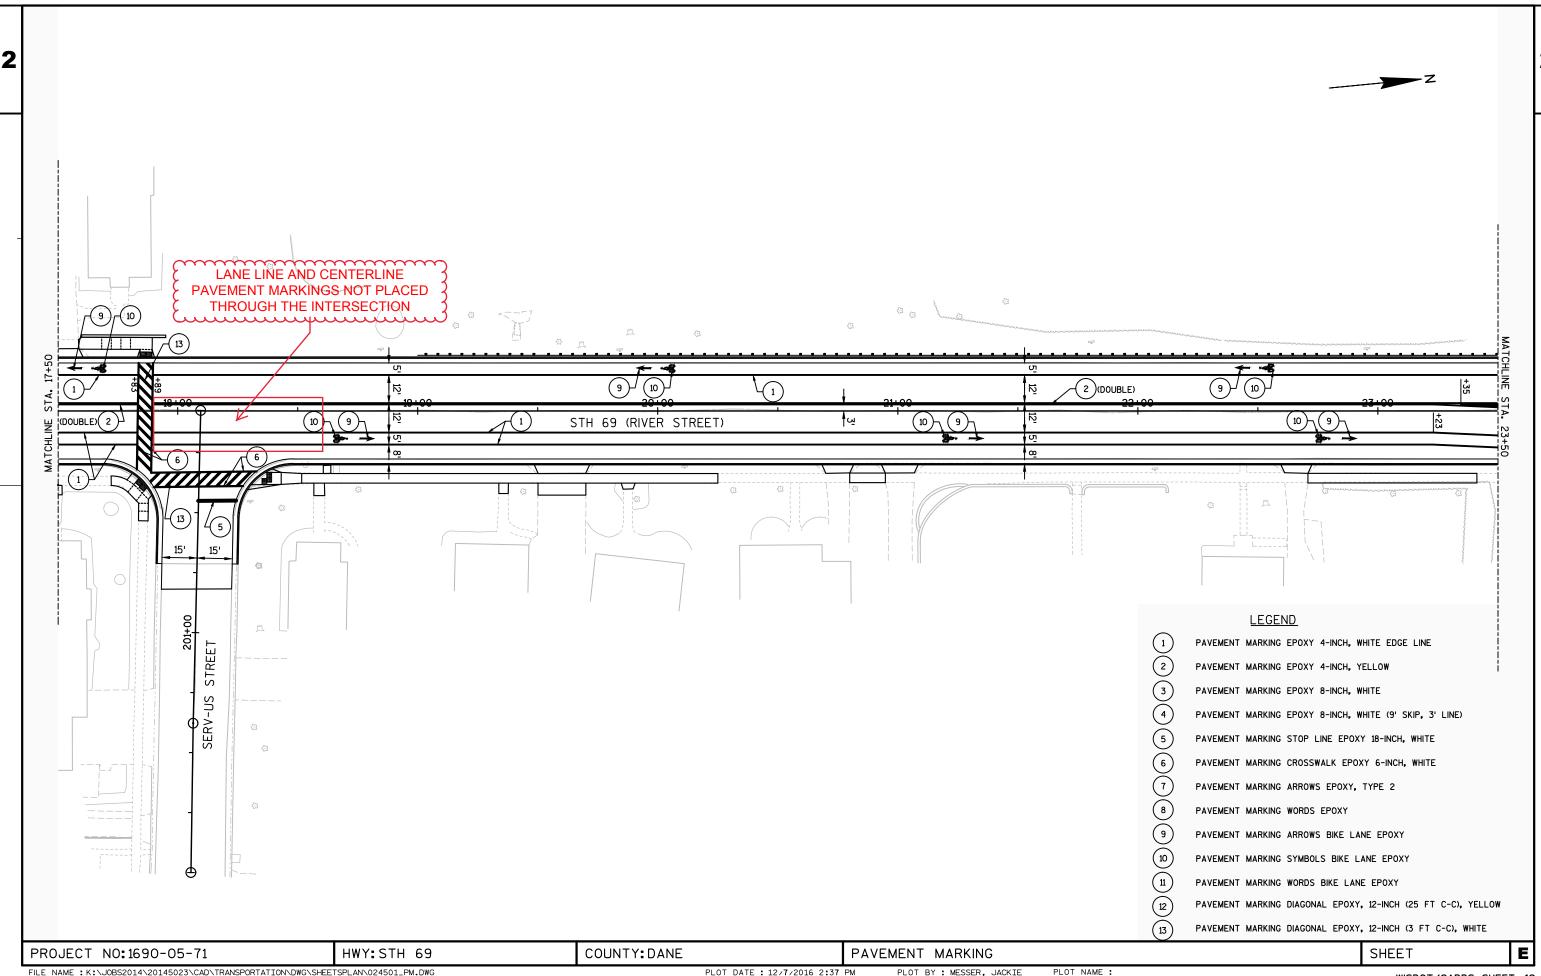

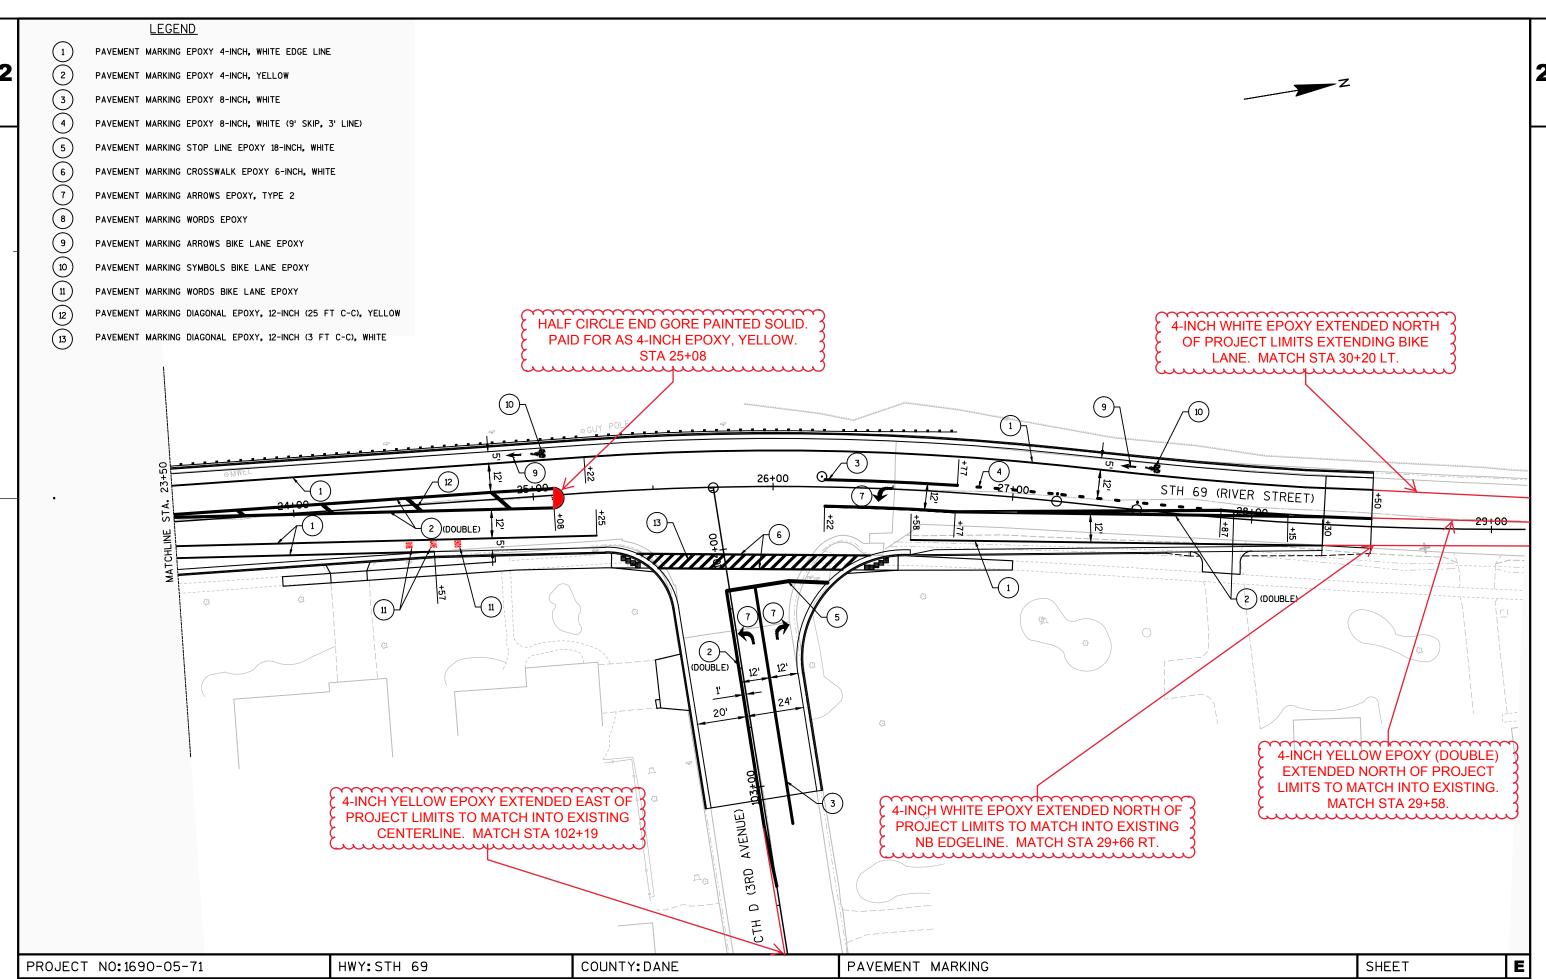

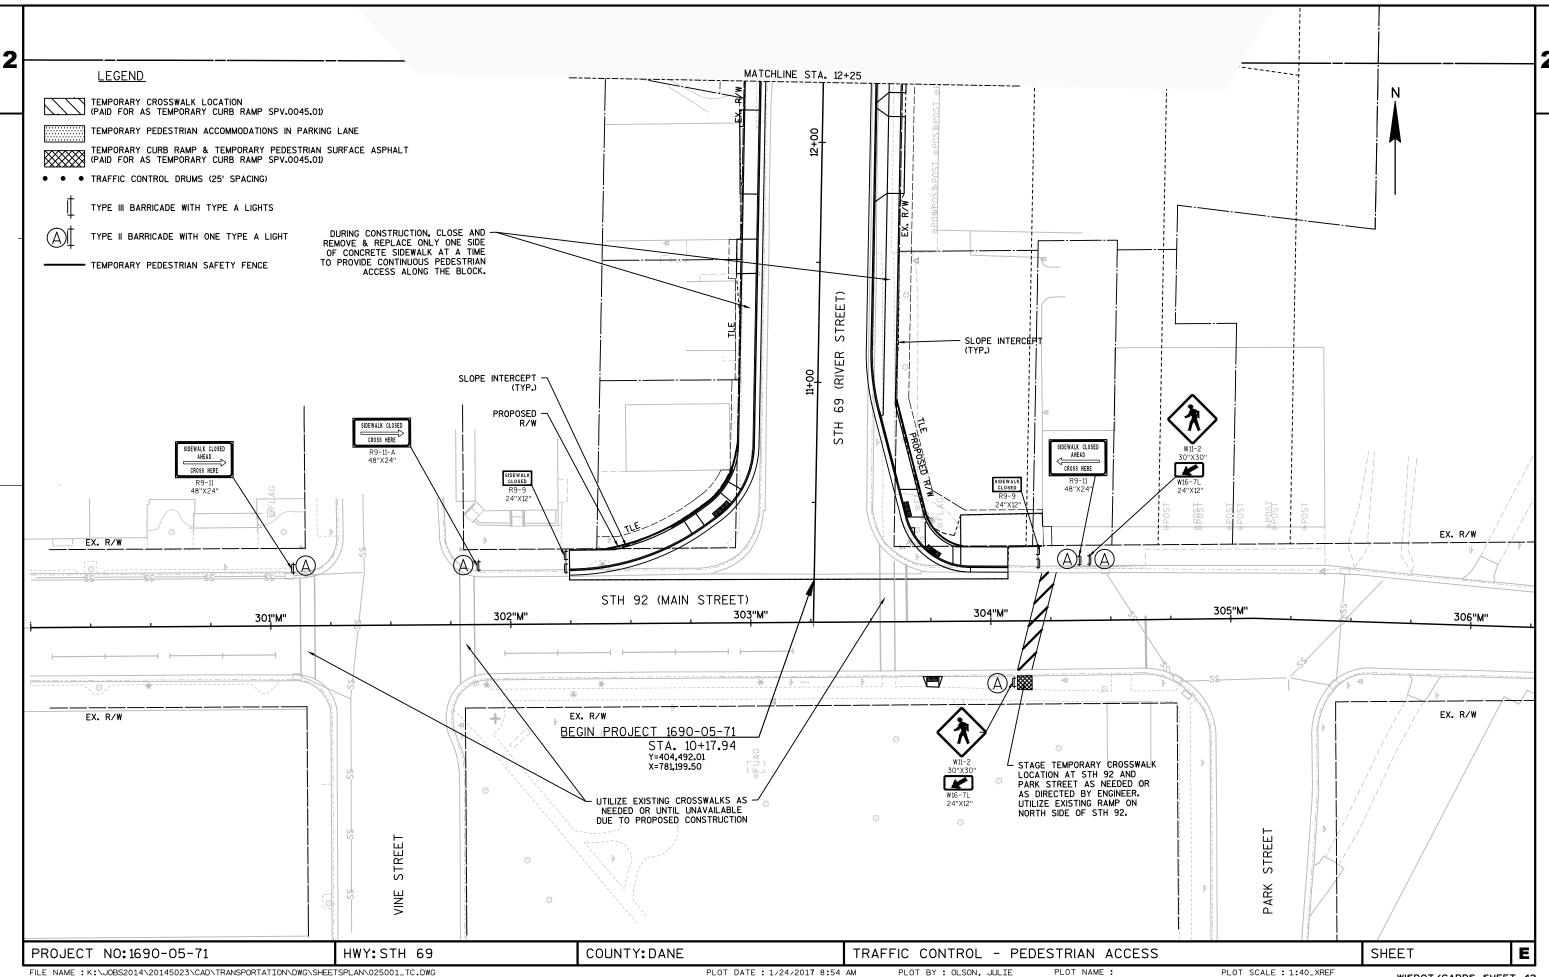


FILE NAME : K:\JOBS2014\20145023\CAD\TRANSPORTATION\DWG\SHEETSPLAN\025001_TC.DWG


PLOT DATE: 1/24/2017 8:54 AM

PLOT BY : OLSON, JULIE

PLOT SCALE : 1:40_XREF

WISDOT/CADDS SHEET 42

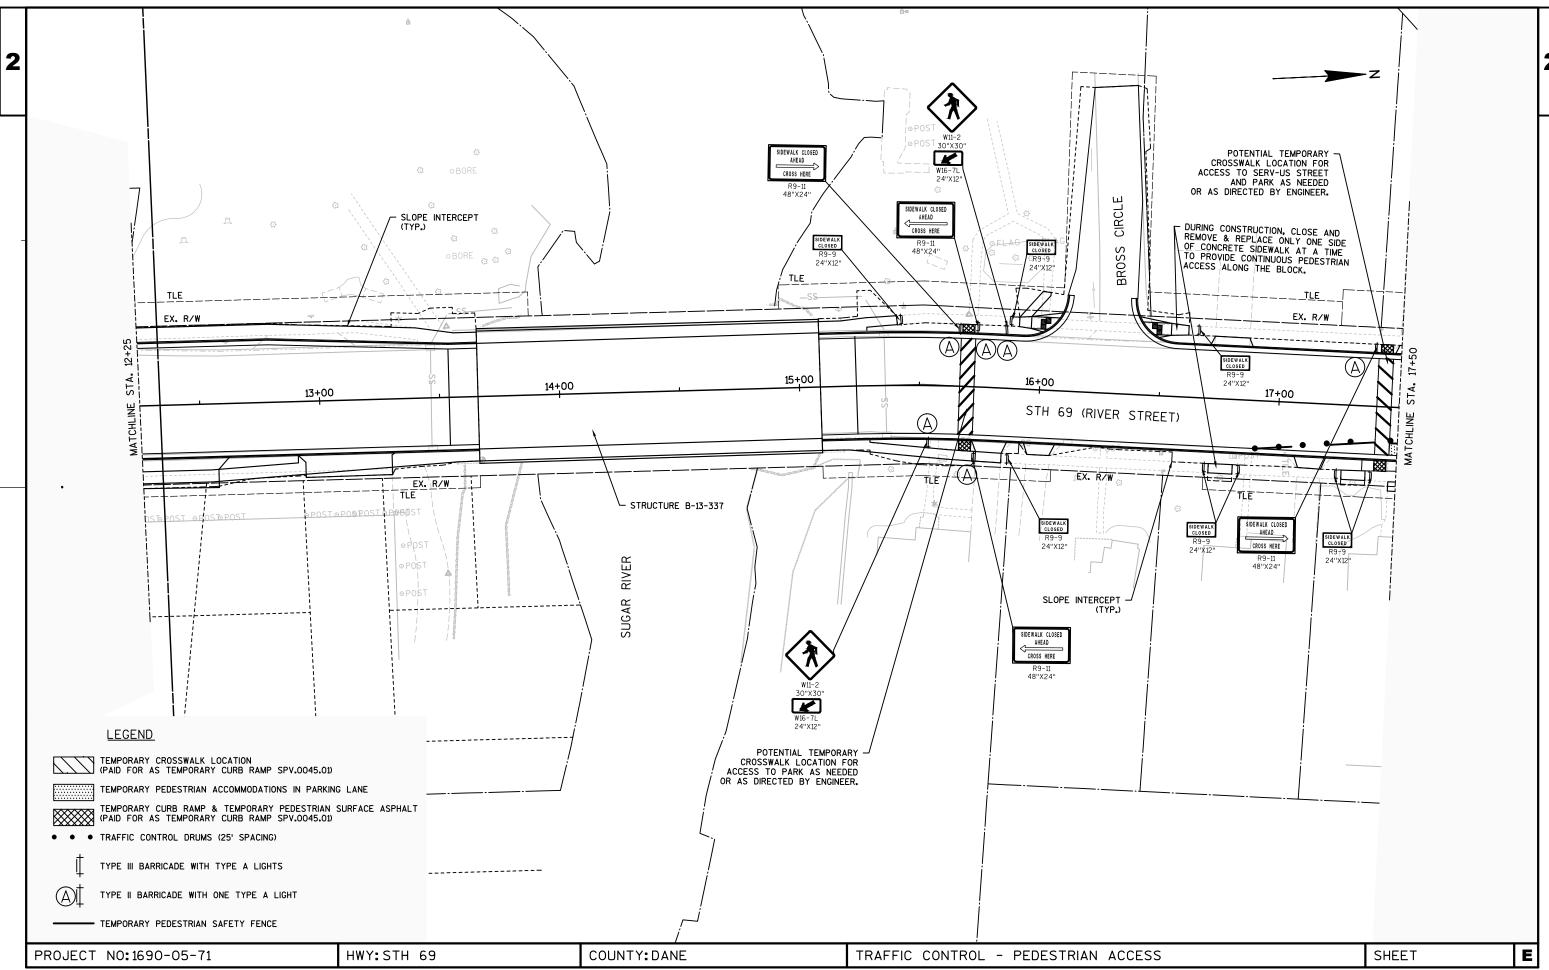

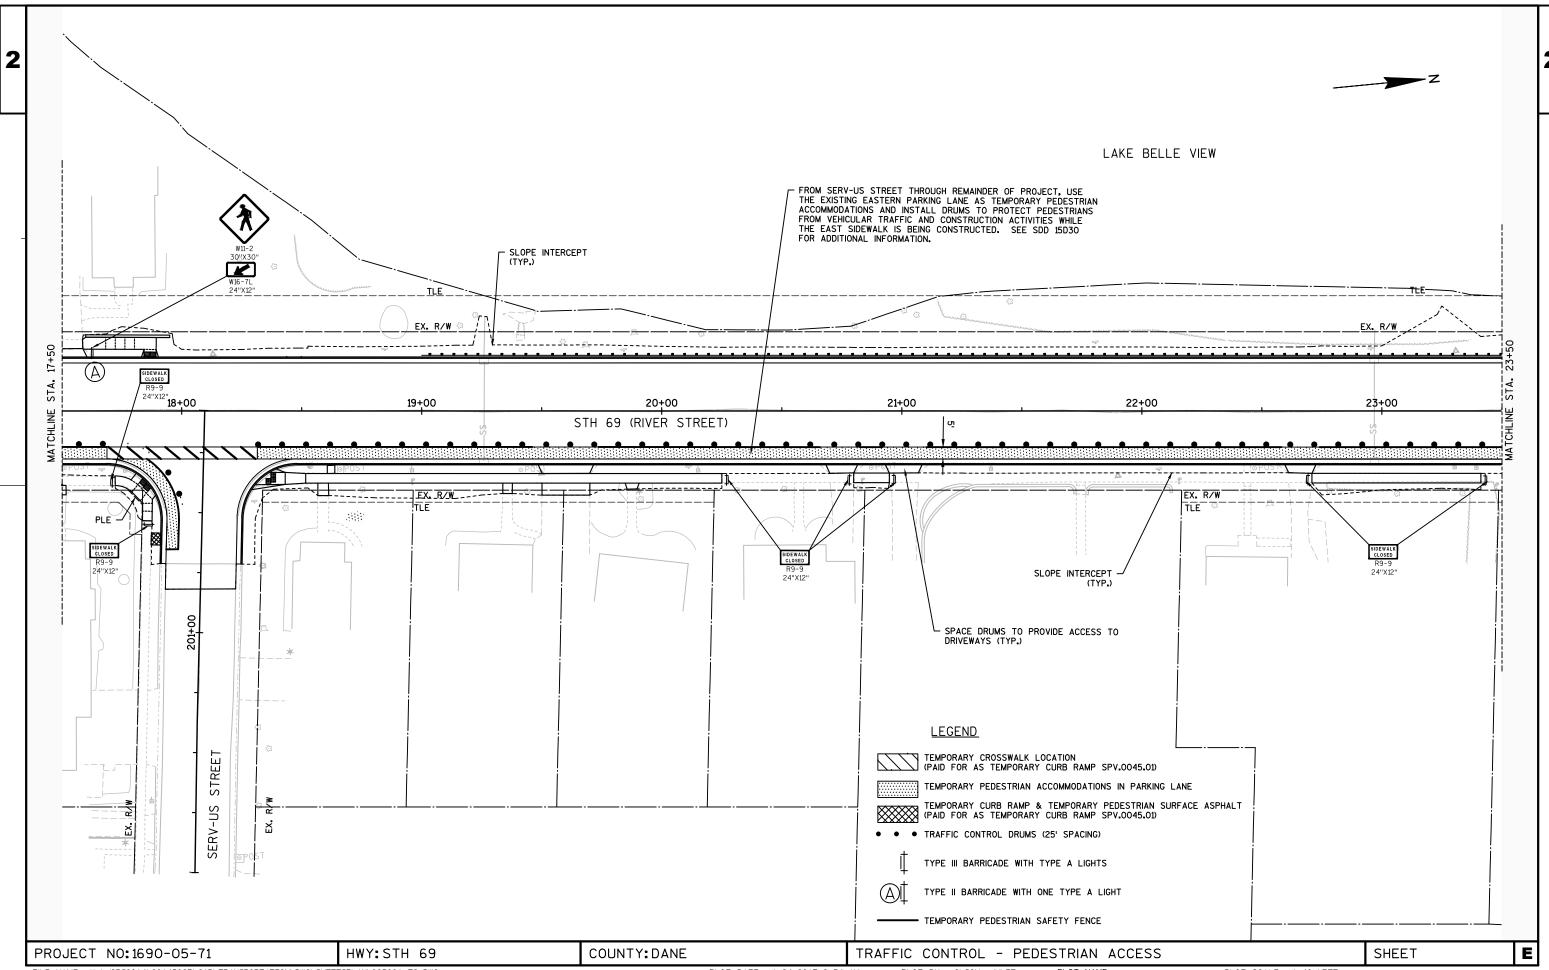

FILE NAME : K:\JOBS2014\20145023\CAD\TRANSPORTATION\DWG\SHEETSPLAN\025001_TC.DWG


PLOT DATE: 1/24/2017 8:54 AM


PLOT BY : OLSON, JULIE

PLOT NAME :


PLOT SCALE : 1:40_XREF


WISDOT/CADDS SHEET 42

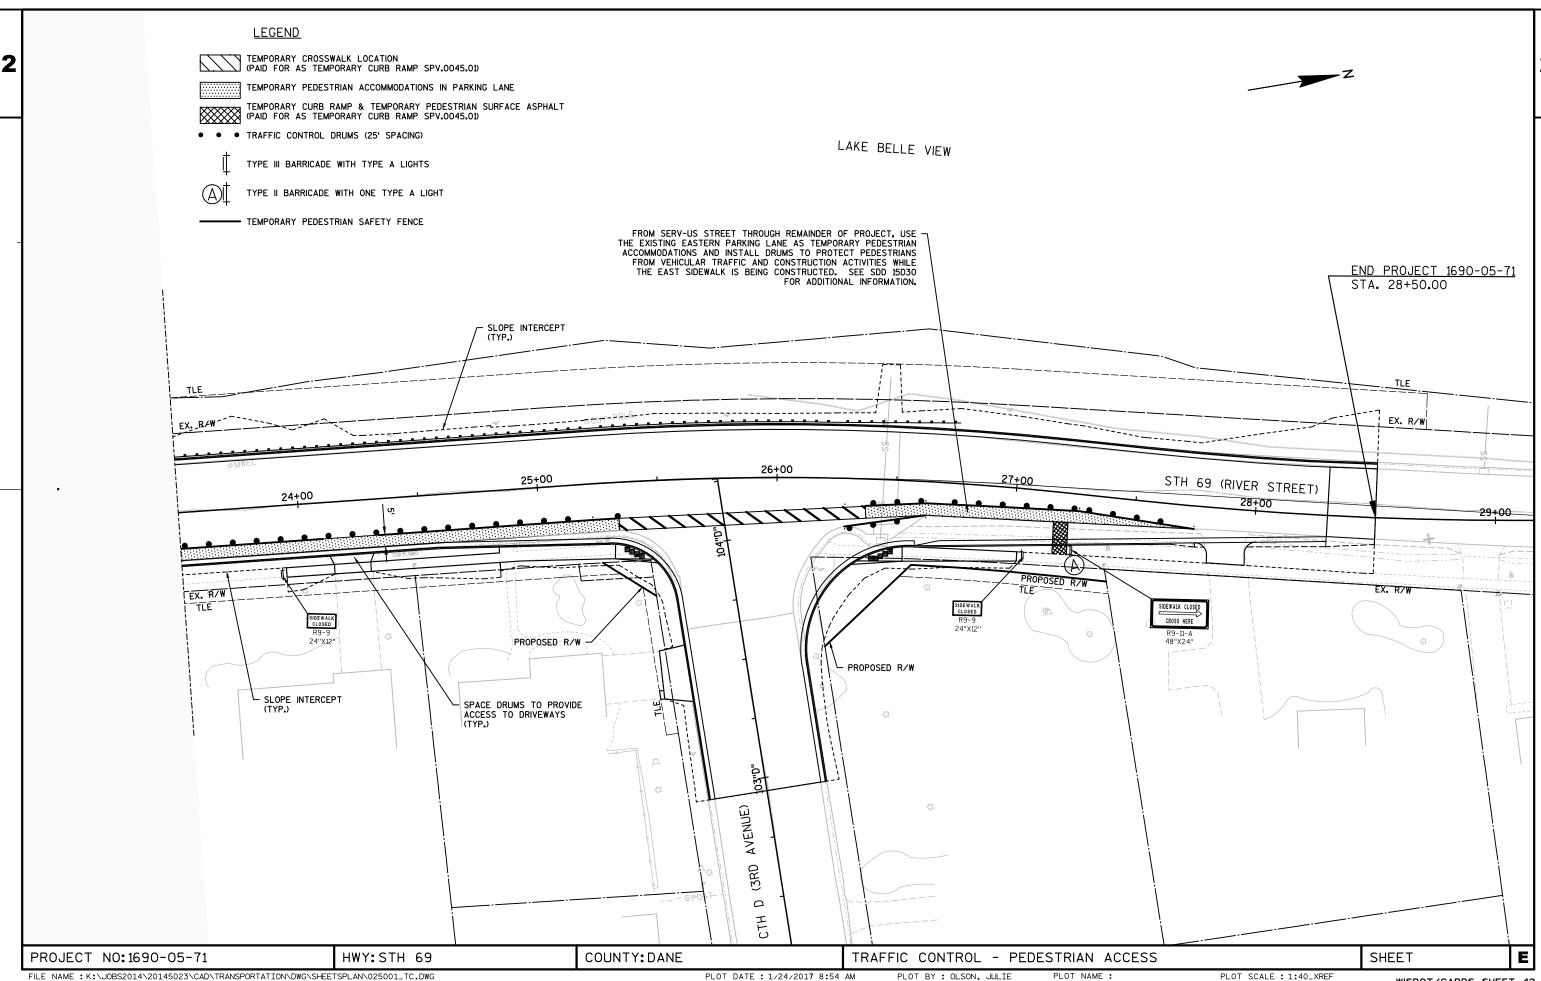


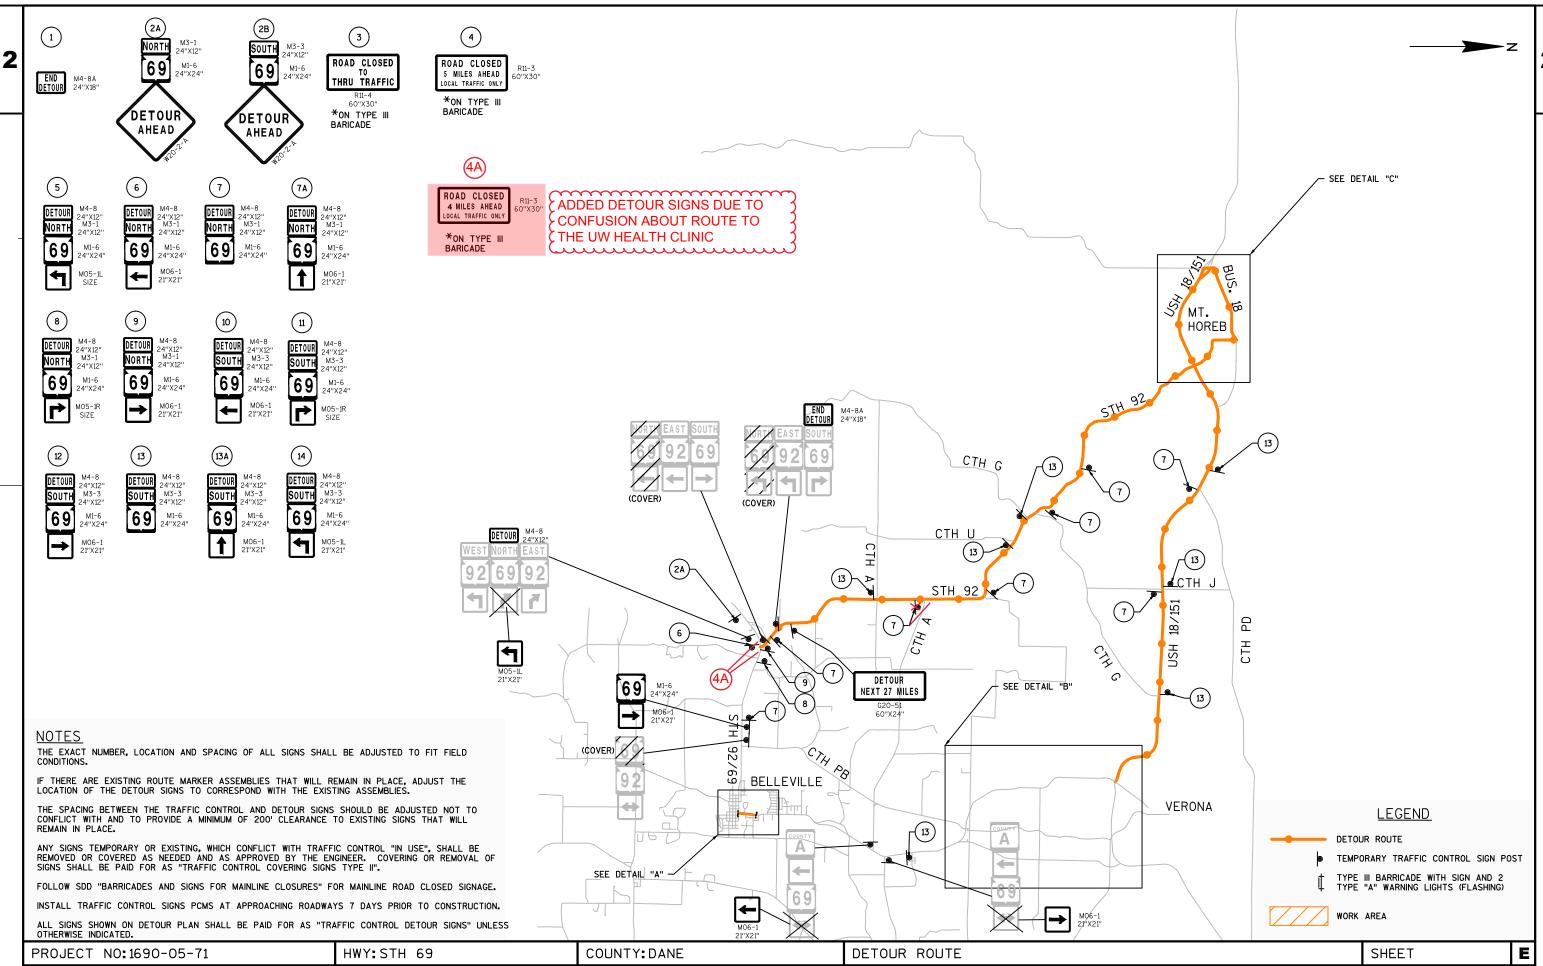



PLOT BY : MESSER, JACKIE

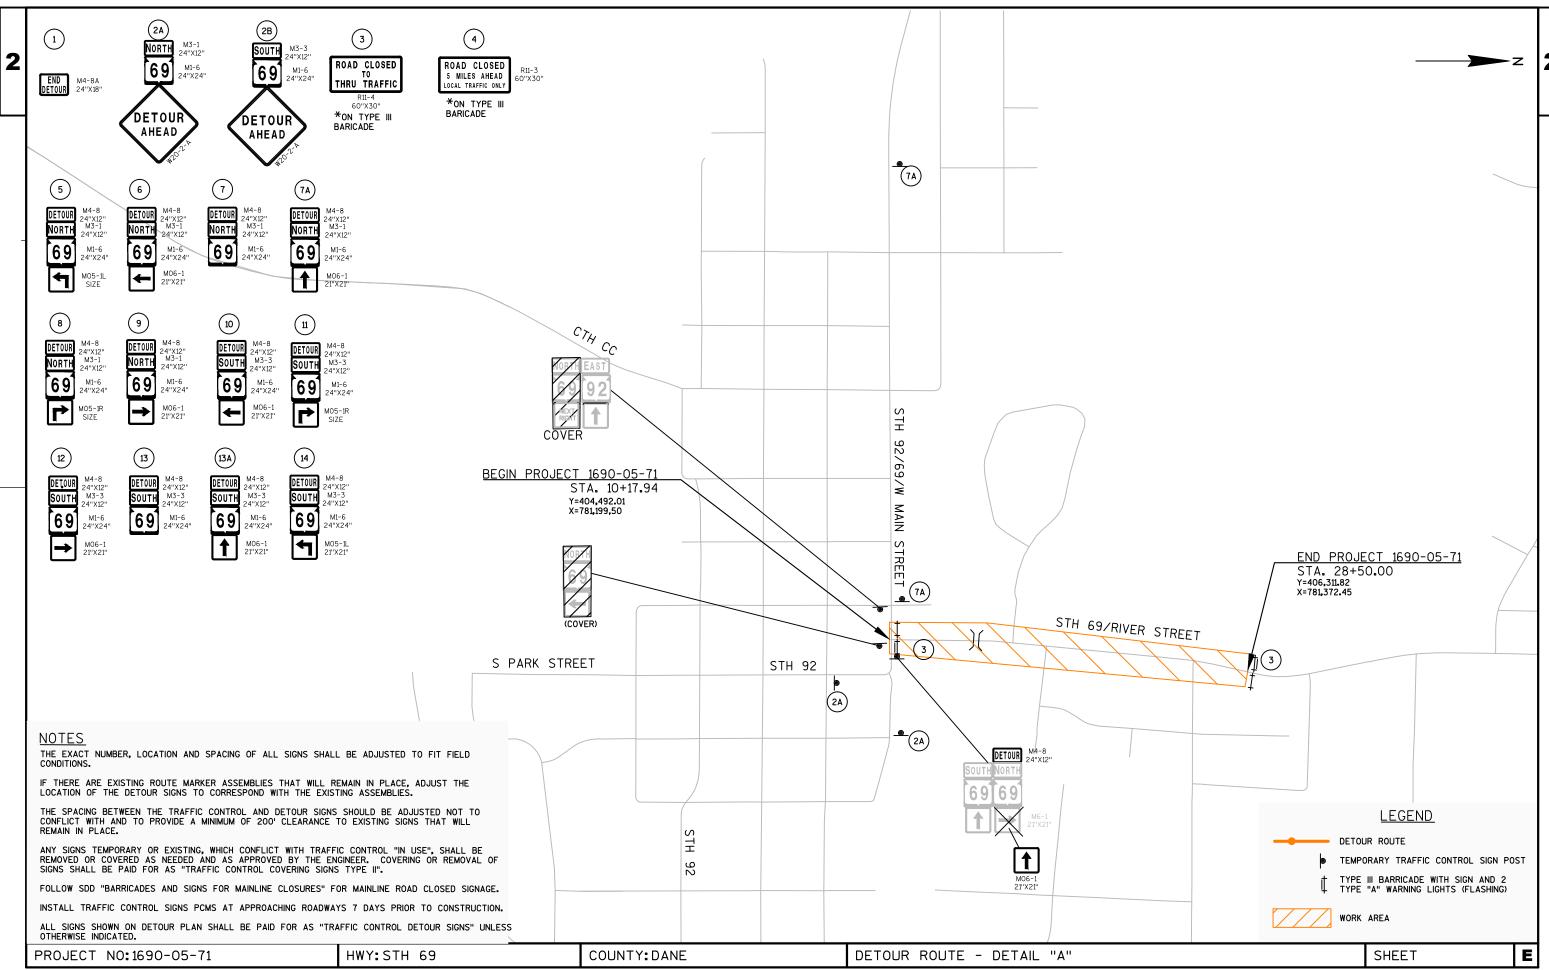

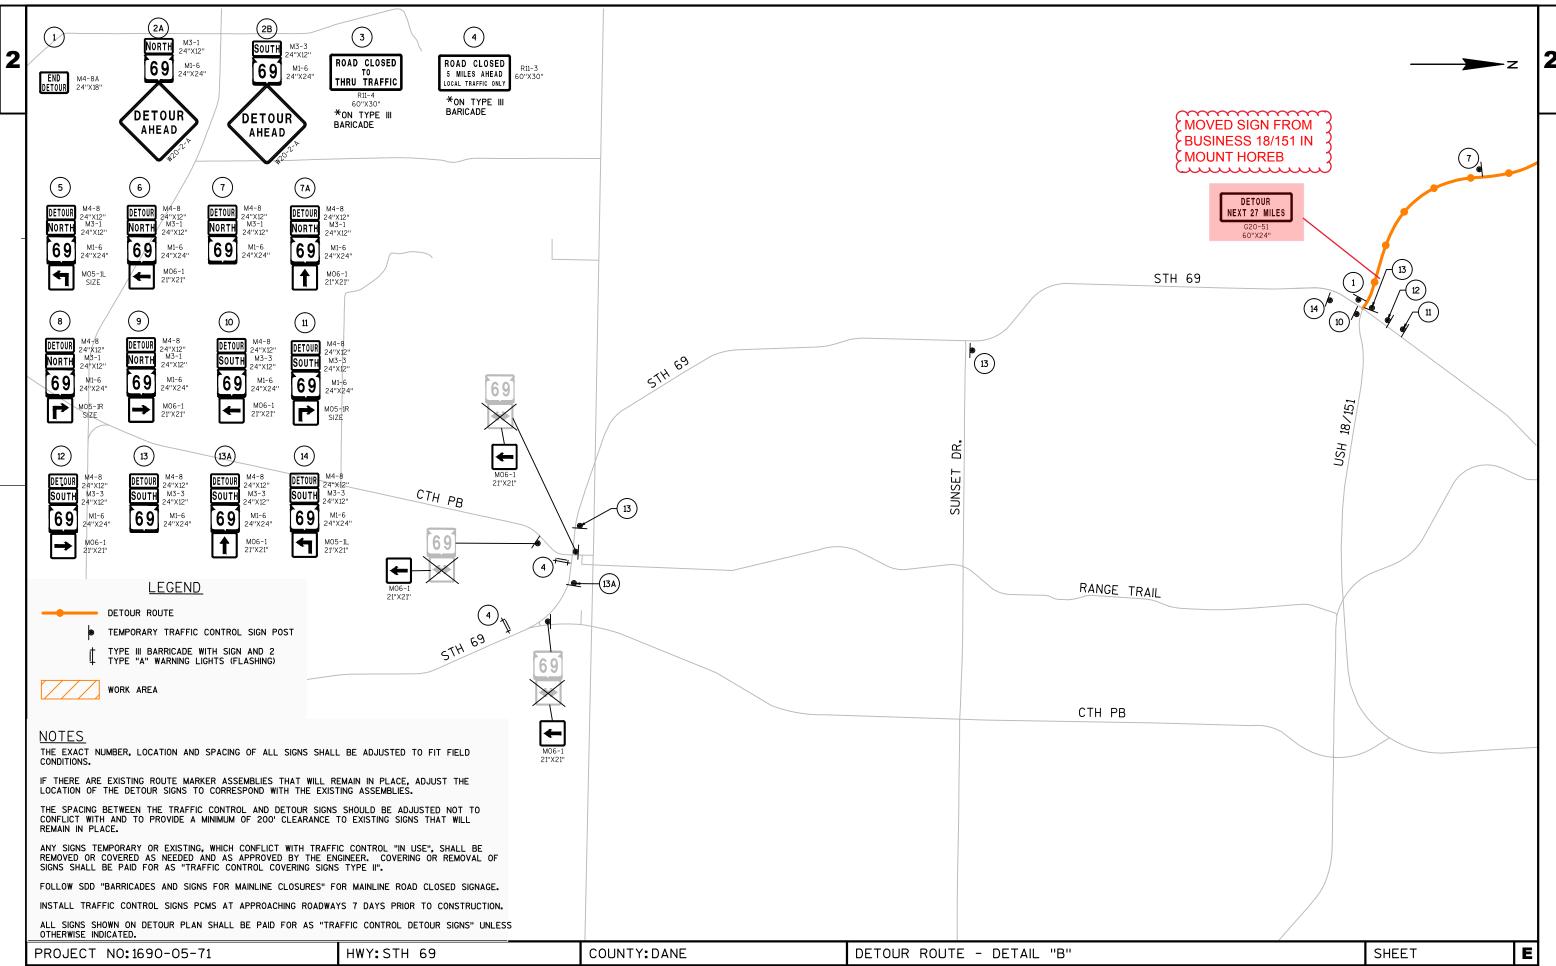

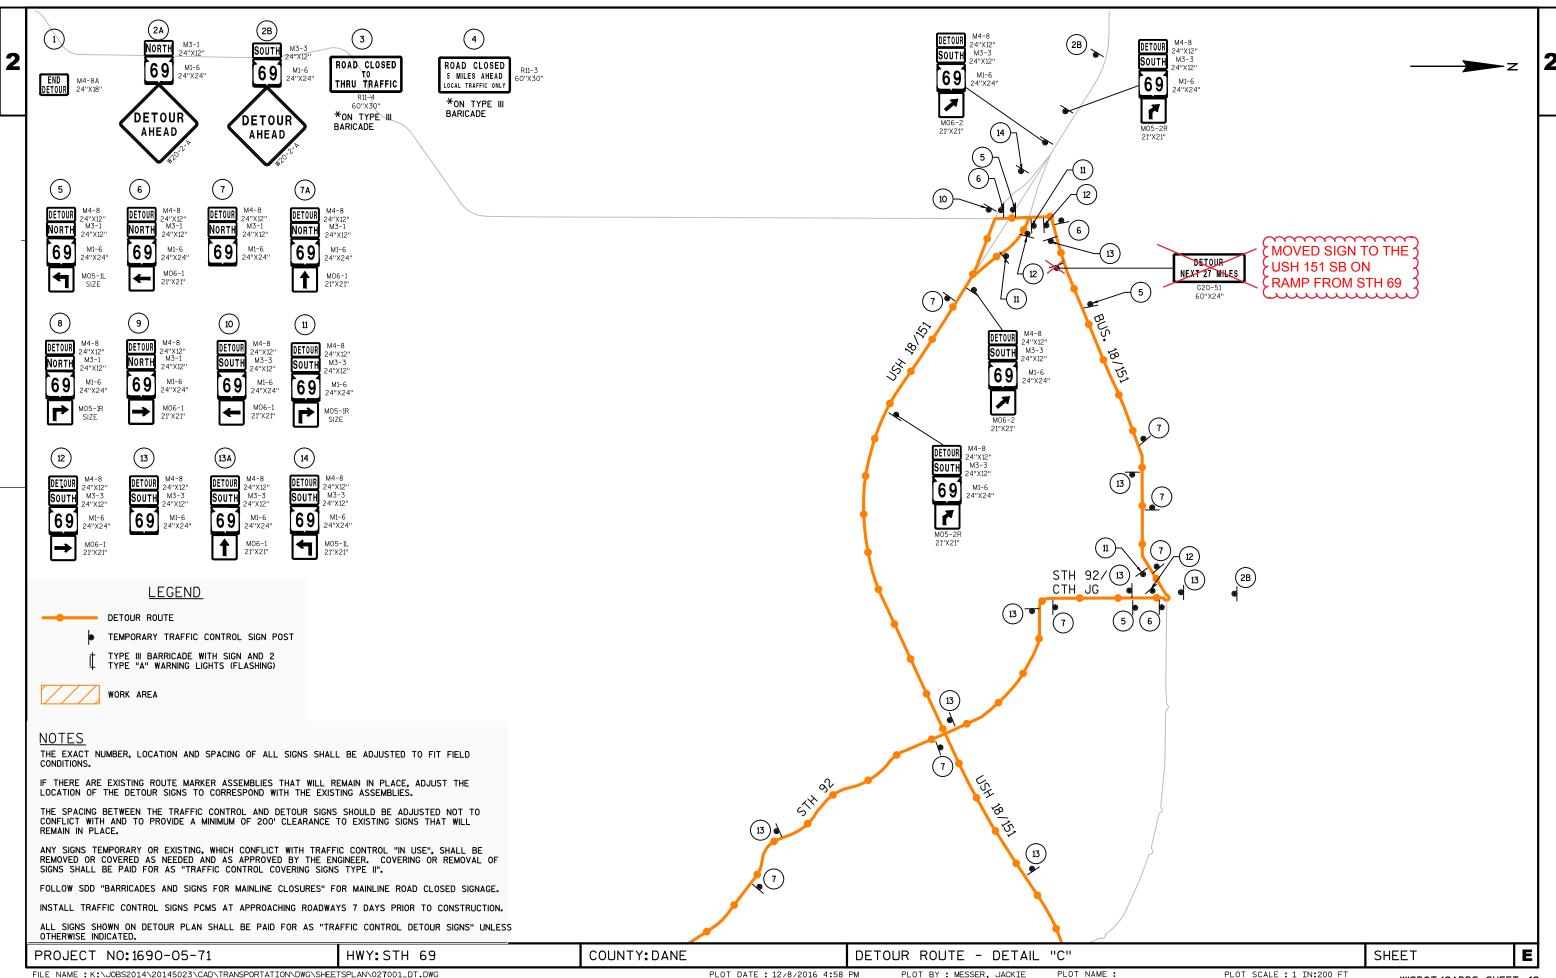

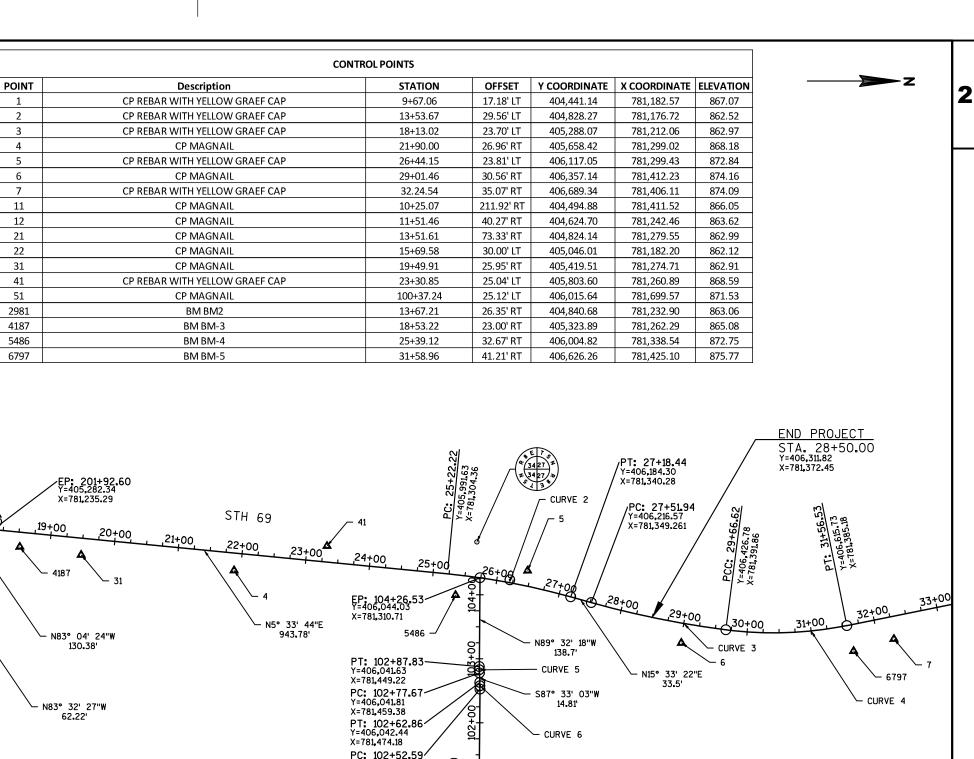

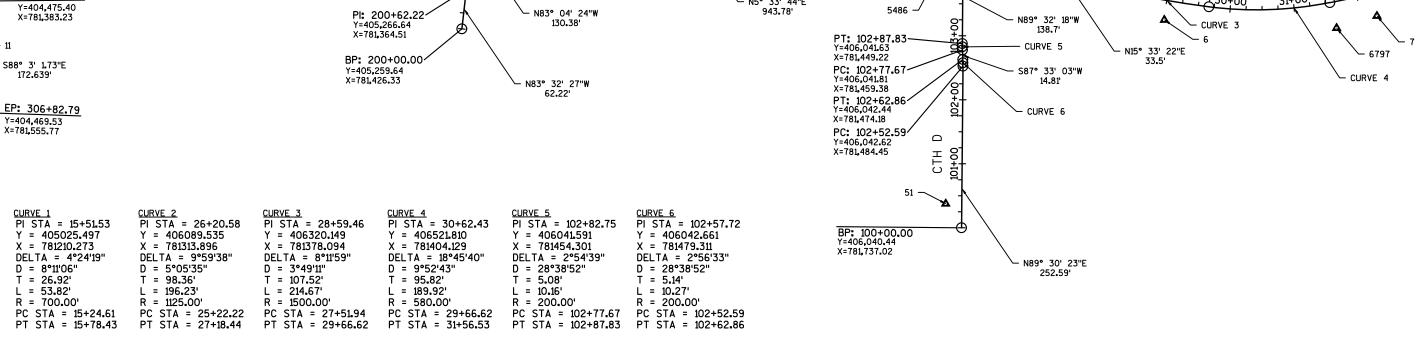

FILE NAME: K:\JOBS2014\20145023\CAD\TRANSPORTATION\DWG\SHEETSPLAN\027201_AD.DWG

BP: 300+00.00

Y=404.472.43

S89° 42' 40"E

432.511

11+00

PROJECT NO:1690-05-71

S89° 25' 6-37"F

77.635'

Pl: 304+32.51

PI: 305+10.15

Y=404,474.612

X=781,305,601

12+00

BEGIN PROJECT STA. 10+17.94 Y=404,492.01 X=781,199.50

13+00

N1° 09' 26"E

524.61

14+00

- 2981

15+00

HWY:STH 69

CURVE 1

17+00

ST

SERV-US

\$201+00

301+00

306+00

PLOT DATE: 12/7/2016 2:38 PM

COUNTY: DANE

2

3

4

5

6

7

11

12

21

22

31

41

51

PLOT BY : MESSER, JACKIE PLOT NAME :

ALIGNMENT PLAN

PLOT SCALE: 1" = 150'_XREF

SHEET

E

18-Inch

601.0411

0390

Concrete Curb & Gutter 30-Inch Type D

Estimate Of Quantities By Plan Sets

Page 1

					1690-05-71
Line	Item	Item Description	Unit	Total	Qty
0010		·	STA	2.000	2.000
	201.0105	Clearing			
0020	201.0120	Crubbing	ID STA	120.000	120.000
0030	201.0205	Grubbing	STA	2.000	2.000
0040	201.0220	Grubbing Removing Revenent	ID ev	120.000	120.000
0050	204.0100	Removing Pavement	SY	8,466.000	8,466.000
0060	204.0115	Removing Asphaltic Surface Butt Joints	SY	198.000	198.000
0070	204.0150	Removing Curb & Gutter	LF	342.000	342.000
0800	204.0155	Removing Concrete Sidewalk	SY	718.000	718.000
0090	204.0210	Removing Manholes	EACH	1.000	1.000
0100	204.0220	Removing Inlets	EACH	11.000	11.000
0110	204.0245	Removing Storm Sewer (size) 01. 12-Inch	LF	72.000	72.000
0120	204.0245	Removing Storm Sewer (size) 02. 15-Inch	LF	160.000	160.000
0130	204.0245	Removing Storm Sewer (size) 03. 18-Inch	LF	113.000	113.000
0140	204.0270	Abandoning Culvert Pipes	EACH	1.000	1.000
0150	205.0100	Excavation Common	CY	13,093.000	13,093.000
0160	213.0100	Finishing Roadway (project) 01. 1690-05-71	EACH	1.000	1.000
0170	305.0120	Base Aggregate Dense 1 1/4-Inch	TON	7,434.000	7,434.000
0180	312.0110	Select Crushed Material	TON	6,978.000	6,978.000
0190	415.0410	Concrete Pavement Approach Slab	SY	120.000	120.000
0200	416.0170	Concrete Driveway 7-Inch	SY	135.000	135.000
0210	416.0180	Concrete Driveway 8-Inch	SY	125.000	125.000
0220	440.4410	Incentive IRI Ride	DOL	640.000	640.000
0230	455.0605	Tack Coat	GAL	1,809.000	1,809.000
0240	460.2000	Incentive Density HMA Pavement	DOL	1,650.000	1,650.000
0240	460.4110.S	Reheating HMA Pavement Longitudinal Joints	LF	3,701.000	3,701.000
0260	460.5223	HMA Pavement 3 LT 58-28 S	TON	1,462.000	1,462.000
0200	460.5224	HMA Pavement 4 LT 58-28 S	TON	1,026.000	1,026.000
0280	465.0120	Asphaltic Surface Driveways and Field Entrances	TON	20.000	20.000
0290	465.0310	Asphaltic Curb	LF	107.000	107.000
0300	502.3200	Protective Surface Treatment	SY	698.000	698.000
0310	509.0301	Preparation Decks Type 1	SY	200.000	200.000
0320	509.0302	Preparation Decks Type 2	SY	103.000	103.000
0330	509.0500	Cleaning Decks	SY	698.000	698.000
0340	509.1200	Curb Repair	LF	10.000	10.000
0350	509.1500	Concrete Surface Repair	SF	19.000	19.000
0360	509.2000	Full-Depth Deck Repair	SY	1.000	1.000
0370	509.2500	Concrete Masonry Overlay Decks	CY	69.000	69.000
0380	522.1018	Apron Endwalls for Culvert Pipe Reinforced Concrete	EACH	1.000	1.000

3,412.000

3,412.000

Estimate Of Quantities By Plan Sets

Page 2

					1690-05-71	
Line	Item	Item Description	Unit	Total	Qty	
		·				
0400	601.0600	Concrete Curb Pedestrian	LF	36.000	36.000	
0410	602.0410	Concrete Sidewalk 5-Inch	SF	6,459.000	6,459.000	
0420	602.0505	Curb Ramp Detectable Warning Field Yellow	SF	147.000	147.000	
0430	608.0315	Storm Sewer Pipe Reinforced Concrete Class III 15- Inch	LF	441.000	441.000	
0440	608.0318	Storm Sewer Pipe Reinforced Concrete Class III 18- Inch	LF	249.000	249.000	
0450	608.0324	Storm Sewer Pipe Reinforced Concrete Class III 24- Inch	LF	285.000	285.000	
0460	608.0412	Storm Sewer Pipe Reinforced Concrete Class IV 12-Inch	LF	287.000	287.000	
0470	611.0420	Reconstructing Manholes	EACH	1.000	1.000	
0480	611.0530	Manhole Covers Type J	EACH	5.000	5.000	
0490	611.0606	Inlet Covers Type B	EACH	1.000	1.000	
0500	611.0624	Inlet Covers Type H	EACH	8.000	8.000	
0510	611.0639	Inlet Covers Type H-S	EACH	9.000	9.000	
0520	611.2004	Manholes 4-FT Diameter	EACH	3.000	3.000	
0530	611.2005	Manholes 5-FT Diameter	EACH	1.000	1.000	
0540	611.2007	Manholes 7-FT Diameter	EACH	1.000	1.000	
0550	611.3004	Inlets 4-FT Diameter	EACH	5.000	5.000	
0560	611.3220	Inlets 2x2-FT	EACH	1.000	1.000	
0570	611.3230	Inlets 2x3-FT	EACH	12.000	12.000	
0580	612.0106	Pipe Underdrain 6-Inch	LF	1,300.000	1,300.000	
0590	614.2300	MGS Guardrail 3	LF	728.000	728.000	
0600	614.2610	MGS Guardrail Terminal EAT	EACH	1.000	1.000	
0610	614.2620	MGS Guardrail Terminal Type 2	EACH	1.000	1.000	
0620	619.1000	Mobilization	EACH	0.900	0.900	
0630	624.0100	Water	MGAL	74.000	74.000	
0640	625.0100	Topsoil	SY	1,929.000	1,929.000	
0650	627.0200	Mulching	SY	22.000	22.000	
0660	628.1504	Silt Fence	LF	839.000	839.000	
0670	628.1520	Silt Fence Maintenance	LF	1,256.000	1,256.000	
0680	628.1905	Mobilizations Erosion Control	EACH	10.000	10.000	
0690	628.1910	Mobilizations Emergency Erosion Control	EACH	5.000	5.000	
0700	628.2006	Erosion Mat Urban Class I Type A	SY	260.000	260.000	
0710	628.7005	Inlet Protection Type A	EACH	18.000	18.000	
0720	628.7015	Inlet Protection Type C	EACH	9.000	9.000	
0730	628.7020	Inlet Protection Type D	EACH	9.000	9.000	
0740	628.7570	Rock Bags	EACH	72.000	72.000	
0750	629.0210	Fertilizer Type B	CWT	1.200	1.200	
0770	631.0300	Sod Water	MGAL	129.000	129.000	

Page

3

1030

1040

1050

1060

1070

1080

1090

1100

1110

1130

1140

1150

1160

1170

1180

1190

646.0106

646.0126

646.0600

647.0166

647.0206

650.6500

Pavement Marking Epoxy 4-Inch

Pavement Marking Epoxy 8-Inch

Pavement Marking Arrows Epoxy Type 2

Pavement Marking Arrows Bike Lane Epoxy

Removing Pavement Markings

Estimate Of Quantities By Plan Sets

1690-05-71 **Item Description** Unit Total Line Item Qty 0780 631.1000 Sod Lawn SY 1,648.000 1,648.000 SY 0790 631.1100 Sod Erosion Control 259.000 259.000 0800 634.0814 Posts Tubular Steel 2x2-Inch X 14-FT **EACH** 13.000 13.000 0810 634.0816 Posts Tubular Steel 2x2-Inch X 16-FT **EACH** 19.000 19.000 **EACH** 1.000 0820 634.0818 Posts Tubular Steel 2x2-Inch X 18-FT 1.000 SF 0830 271.000 271.000 637.2210 Signs Type II Reflective H SF 0840 637.2230 Signs Type II Reflective F 31.000 31.000 0850 638.2102 Moving Signs Type II **EACH** 1.000 1.000 0860 638.2602 Removing Signs Type II **EACH** 24.000 24.000 0870 638.3000 Removing Small Sign Supports **EACH** 27.000 27.000 Moving Small Sign Supports **EACH** 0880 638.4000 1.000 1.000 0890 642.5201 Field Office Type C **EACH** 1.000 1.000 **EACH** 1.000 0900 643.0100 Traffic Control (project) 01. 1690-05-71 1.000 DAY 0920 643.0300 Traffic Control Drums 1,526.000 1,526.000 0930 643.0420 Traffic Control Barricades Type III DAY 3,706.000 3,706.000 0940 Traffic Control Warning Lights Type A DAY 5,995.000 5,995.000 643.0705 0950 643.0900 Traffic Control Signs DAY 4,033.000 4,033.000 **EACH** 0960 643.0920 Traffic Control Covering Signs Type II 13.000 13.000 0970 643.1050 Traffic Control Signs PCMS DAY 327.000 327.000 0980 643.2000 Traffic Control Detour (project) 01. 1690-05-71 **EACH** 1.000 1.000 0990 643.3000 Traffic Control Detour Signs DAY 51,993.000 51,993.000 1000 Temporary Pedestrian Surface Asphalt SF 210.000 210.000 644.1410.S LF 644.1616.S Temporary Pedestrian Safety Fence 875.000 1010 875.000 SY 1020 645.0220 Geogrid Type SR 1,089.000 1,089.000

9,436.000

380.000

144.000

7.000

11.000

1.000

647.0306 Pavement Marking Symbols Bike Lane Epoxy **EACH** 11.000 11.000 647.0356 Pavement Marking Words Epoxy **EACH** 2.000 2.000 647.0406 Pavement Marking Words Bike Lane Epoxy **EACH** 6.000 6.000 LF 647.0566 Pavement Marking Stop Line Epoxy 18-Inch 122.000 122.000 LF Pavement Marking Diagonal Epoxy 12-Inch 716.000 716.000 647.0726 LF 647.0766 Pavement Marking Crosswalk Epoxy 6-Inch 638.000 638.000 **EACH** 650.4000 Construction Staking Storm Sewer 23.000 23.000 650.4500 Construction Staking Subgrade LF 1,689.000 1,689.000 LF 650.5000 Construction Staking Base 1,689.000 1,689.000 650.5500 Construction Staking Curb Gutter and Curb & Gutter 3,448.000 3,448.000

Construction Staking Structure Layout (structure) 01. B- LS

LF

LF

LF

EACH

EACH

9,436.000

380.000

144.000

7.000

11.000

1.000

Estimate Of Quantities By Plan Sets

Page 4

1690-05-71	
------------	--

Line	Item	Item Description	Unit	Total	Qty
		13-337			
1200	650.7000	Construction Staking Concrete Pavement	LF	27.000	27.000
1210	650.9910	Construction Staking Supplemental Control (project) 01. 1690-05-71	LS	1.000	1.000
1220	650.9920	Construction Staking Slope Stakes	LF	1,689.000	1,689.000
1230	690.0150	Sawing Asphalt	LF	541.000	541.000
1240	690.0250	Sawing Concrete	LF	14.000	14.000
1250	715.0415	Incentive Strength Concrete Pavement	DOL	500.000	500.000
1260	ASP.1T0A	On-the-Job Training Apprentice at \$5.00/HR	HRS	500.000	500.000
1270	ASP.1T0G	On-the-Job Training Graduate at \$5.00/HR	HRS	350.000	350.000
1280	SPV.0045	Special 01. Temporary Curb Ramp	DAY	175.000	175.000
1570	SPV.0060	Special 29. Construction Staking Curb Ramp	EACH	11.000	11.000
1640	SPV.0090	Special 07. Silt Fence Special	LF	417.000	417.000
1670	SPV.0165	Special 02. Wall Modular Block Gravity LRFD	SF	102.000	102.000

	_	STREET STH 69 STH 69	STATION				CAT 10	CAT 10	CAT 10	CAT	10		
		STH 69	CIVITON	TΛ	STATION	OFFSET	201.0105 CLEARING STA	201.0120 CLEARING ID	201.0205 GRUBBING STA	201. GRUB T	0220		
			10+17	-	17+00	RT	-	16	-		6		
		שם חוכ	17+00	-	24+50	LT	1	104	1	10			
		STH 69	24+50	-	28+50	LT	1	-	1				
	_				PROJ	ECT TOTALS	2	120	2	12	20		
									REMOVING ASP	PHALTI	C SURFACE E	BUTT JOINTS	
	REMOVING F	PAVEMENT											
			CAT ·	10									CAT 10 204.0115
			204.0					STREET	FROM		TO STA	LOCATION	\$Y
STREET	FROM STA	TO STA	SY		_			STH 69	23+50	-	28+50	LT & RT	65
STH 69		- 17+00	3,17		_		SE	ERV-US STREET	201+18	-	201+72	LT & RT	34
STH 69		- 24+50	3,76					CTH D	102+94	-	104+01	LT & RT	99
STH 69		- 28+50	1,25										
SERV-US STREET CTH D	100.01	- 201+72 - 104+01	253 26				PRO	OJECT TOTAL					198
PROJECT TOTAL			8,46		_								
									REMO	VING (CONCRETE SI	DEWALK	
	REMOVING CUR	B & GUTTER	CAT -	10									CAT 10 204.0155
			204.0					STREET	FROM STA		T0 S		
STREET	FROM STA	TO STA	LF		_			STH 69 STH 69	10+17 17+00	-			RT 482 151
STH 69		- 17+00			_			STH 69	24+50	-			85
STH 69 STH 69	04.50	- 24+50 - 28+50	342			l	SER	RV-US STREET	201+18	-	201+	72	0
PROJECT TOTAL	24.00	20.00	342		_			CTH D	102+94	-	104+	01	0
			042				PROJ	JECT TOTAL					718
DJECT NO: 1690-05-71	HWY: S	STH 69	l c	OUNT	Y: DANE		MISCE	ELLANEOUS QUA	ANTITIES				SHEET:

									REMOVIN	G INLETS			
							STRE	EET	STATION	OFFSI	ĒΤ	CAT 10 204.0220 EACH	
	REMOVING I	MANHOLES		CAT 10			STH STH STH	69 69 69	13+48 13+47 15+36	22.0' 22.5' 21.3'	RT LT RT	1 1 1	
STREET	STATION	0FFSET		204.0210 EACH			STH STH	69	15+35 16+13	21.9'	LT RT	1	
STH 69 PROJECT TOTAL	15+28	37.1'	LT	1			STH STH STH	69	19+26 19+26 22+97	21.5' 21.5' 21.3'	RT LT RT	1 1 1	
							STH STH	69 69	22+97 26+44	21.6' 26.0'	LT RT	1 1	
							PROJECT TO		26+44	20.9'	LT	11	
				REMOV	/ING STORM	SEWER (SIZE)							
						CAT 10 204.0245.01 (12-INCH)	CAT 10 204.0245.02 (15-INCH)	CAT 10 204.0245.03 (18-INCH)	3				
			STREET STH 69	STATION 13+47	LOCATION LT & RT	LF 	LF 56	LF 	_				
		S	STH 69 STH 69	15+40 15+35	LT & RT LT		44 16						
		S	STH 69	15+40-16+13	RT	72							
			STH 69 STH 69	19+26 22+95	LT & RT LT & RT		 44	44 					
			STH 69	26+45	LT & RT			69					
		P	ROJECT TO	OTAL		72	160	113	_				
A	BANDONING CULVER	T PIPES						FINI	SHING ROAD	WAY (1690-0	5-71)		
			CAT 10								AT 10		
STREET	STATION L		04.0270 EACH					STR	EET		3.0100 EACH		
STH 69	19+26	LT	1	=			_	PROJECT 1	600 05 71		1		
PROJECT T	OTAL		1	=				PROJECT I	090-03-71		ı		
							_				1		

EARTHWORK SUMMARY

Division	From/To Station	Location	Common Excavation (1)		Salvaged/ Unusable Pavement Material (4)	Available Material (5)	Unexpanded Fill	Expanded Fill (13)	Mass Ordinate +/- (14)	Waste	Borrow (15)	Comment:
			Cut (2)	EBS Excavation (3)				Factor 1.11				
CATEGORY 10 (PRIORITY 1)												
•	10+17 to 28+50	Mainline	8934	0	1581	7353	162	179	7174	7174	-	
	6+38 to 9+50	Mainline	697	0	87	611	38			569	-	
STH 69	16+50 to 23+50	Parking Lane	363	0	88	275	0	0	275	275	-	
BROSS CIRCLE	16+26	Driveway	122	0	0	122	0	0	122	122	-	
* UNDISTRIBUTED		Project	0	2977	0	0	0	0	0		-	
PROJECT TOTAL			Total Common Exc	13093	1755	8361	200	221	8139	8139	-	

- 1) Common Excavation is the sum of the Cut and EBS Excavation columns. Item number 205.0100
- 2) Salvaged/Unsuable Pavement Material is included in Cut.
- 3) EBS Excavation
- 4) Salvaged/Unusable Pavement Material
- 5) Available Material = Cut Salvaged/Unusuable Pavement Material
- 13) Expanded Fill. Factor = 1.11

Depending on selections:

Expanded Fill = (Unexpanded Fill - Rock* Rock Factor - Reduced Marsh - Reduced EBS) * Fill Factor

Or Expanded Fill = (Unexpanded Fill - Rock* Rock Factor - Reduced EBS) * Fill Factor
Or Expanded Fill = (Unexpanded Fill - Rock* Rock Factor - Reduced Marsh) * Fill Factor

Expanded Fill = (Onexpanded Fill - Rock Rock Factor - Reduced Marsh) Fill Factor

- 14) The Mass Ordinate + or Qty calculated for the Division. Plus quantity indicates an excess of material within the Division. Minus indicates a shortage of material within the Division.
- 15) Borrow Excavation: Borrow shall not contain organics. See Specifications for additional information.
- * Undistributed EBS is calculated as 10% of pavement area with a depth of 1-ft.

PROJECT NO: 1690-05-71	HWY: STH 69	COUNTY: DANE	MISCELLANEOUS QUANTITIES	SHEET:	Е
------------------------	-------------	--------------	--------------------------	--------	---

FILE NAME : ______ PLOT DATE : _____ PLOT BY : _____ PLOT NAME : _____ PLOT SCALE : 1:1

							305.0120			
	STREET	FROM		то	LOCATION	OFFSET	TON	CATEGORY		
	STH 69	10+18	-	12+25	MAINLINE	LT & RT	1,112	10		
	STH 69	12+25	-	17+50	MAINLINE	LT & RT	1,362	10		
	STH 69	17+50	-	23+50	MAINLINE	LT & RT	1,944	10		
	STH 69	23+50	-	28+50	MAINLINE	LT & RT	1,798	10		
	SERV-US STREET	201+18	-	201+72	SIDE STREET	LT & RT	176	10		
	CTH D	102+94	-	104+01	SIDE STREET	LT & RT	500	10		
	UNDISTRIBUTED				DRIVEWAYS	LT & RT	30	10		
	STH 69	12+25	-	17+50	PARKING LANE	RT	28	10		
	STH 69	17+50	-	23+50	PARKING LANE	RT	254	10		
	BROSS CIRCLE		-		RADIUS RETURN	LT	78	10		
	BROSS CIRCLE		-		DRIVEWAY	LT	152	10		
	PROJECT TOTAL						7,434			
				SELECT	T CRUSHED MATERIAL					
				JEEU I	I GROOTED MATERIAL		312.0110			
	STREET	FROM		T0	LOCATION	OFFSET	TON	CATEGORY		
	STH 69	10+18		12+25	MAINLINE	LT & RT	1,012	10		
	STH 69	12+25	-	17+50	MAINLINE	LT & RT	1,282	10		
	STH 69	17+50	-	23+50	MAINLINE	LT & RT	1,898	10		
	STH 69	23+50	-	28+50	MAINLINE	LT & RT	1,764	10		
	SERV-US STREET	201+18	-	201+72	SIDE STREET	LT & RT	176	10		
	CTH D	102+94	-	104+01	SIDE STREET	LT & RT	492	10		
	STH 69	12+25	-	17+50	PARKING LANE	RT	28	10		
	STH 69	17+50	-	23+50	PARKING LANE	RT	254	10		
	BROSS CIRCLE		-		RADIUS RETURN		72	10		
	BROSS CIRCLE		-		DRIVEWAY	LT	0	10		
	PROJECT TOTAL						6,978		_	
							CONC	DETE DETVEWAY	7 TNCU	
	CONCRETE PAVEMENT APPROA	CH SLAB					CONC	RETE DRIVEWAY	I - INUN	CAT 10
	CONTRACT INTEREST ATTRON									416.0170
			CAT 10			STREET	FROM	STATION	TO STATION	SY
			415.0410	1	-	STH 69)+17	12+25	31
STREET	FROM STA T	O STA	SY			STH 69		2+25	17+50	29
						STH 69		′+50	23+50	35
STH 69		13+66	53			STH 69		3+50	28+50	13
STH 69	15+08 - 1	15+93	67			SERV-US STREET		1+18	201+72	-
PROJECT TOTAL			120			CTH D		2+94	104+01	27
11100201 101712										

MISCELLANEOUS QUANTITIES

Е

SHEET:

COUNTY: DANE PLOT DATE : ___ PLOT NAME : _____ PLOT SCALE: 1:1

HWY: STH 69

PROJECT NO: 1690-05-71

3

CONCRETE DRIVEWAY 8-INCH

			CAT 10
			416.0180
STREET	FROM STATION	TO STATION	SY
STH 69	10+17	12+25	55
STH 69	12+25	17+50	70
STH 69	17+50	23+50	-
STH 69	23+50	28+50	-
SERV-US STREET	201+18	201+72	-
CTH D	102+94	104+01	-
PROJECT TOTAL			125

REHEATING HMA PAVEMENT LONGITUDINAL JOINTS

				CAT 10
				460.4110.S
STREET	FROM STATION		TO STATION	LF
STH 69	10+18	-	28+50	3379
SERV-US STREET	201+18	-	201+72	108
CTH D	102+94	-	104+01	214
PROJECT TOTAL				3701

ASPHALTIC PAVEMENT

					455.0605	460.5223	460.5224	465.0120	
					TACK COAT	HMA	HMA	ASPHALTIC SURFACE	
						PAVEMENT	PAVEMENT	DRIVEWAYS AND	
						3 LT 58-28 S	4 LT 58-28 S	FIELD ENTRANCES	
STREET	FROM		T0	LOCATION	GAL	TON	TON	TON	CATEGORY
STH 69	10+18	-	12+25	MAINLINE	253	212	142	12	10
STH 69	12+25	-	17+50	MAINLINE	316	265	177	4	10
STH 69	17+50	-	23+50	MAINLINE	457	384	256	0	10
STH 69	23+50	-	28+50	MAINLINE	453	380	253	4	10
SERV-US STREET	201+18	-	201+72	SIDE STREET	41	35	23	0	10
CTH D	102+94	-	104+01	SIDE STREET	122	103	68	0	10
STH 69	12+25	-	17+50	PARKING LANE	8	7	5	0	10
STH 69	17+50	-	23+50	PARKING LANE	76	64	43	0	10
BROSS CIRCLE		-		RADIUS RETURN	14	12	8	0	10
BROSS CIRCLE		-		DRIVEWAY	69	0	51	0	10
OJECT TOTALS					1809	1462	1026	20	

PROJECT NO: 1690-05-71	HWY: STH 69	COUNTY: DANE	MISCELLANEOUS QUANTITIES	SHEET:	E
------------------------	-------------	--------------	--------------------------	--------	---

FILE NAME : _____ PLOT BY : ____ PLOT NAME : ____ PLOT SCALE : 1:1

CONCRETE CURB & GUTTER 30-INCH TYPE D

PLOT SCALE : 1:1

			ASPHALTIC	CURB		0.7 40	<u> </u>	STREET	FROM STA	TION	TO STATION	OFFSET	CAT 10 601.0411 LF
	STREET	FROM STA	TION T	O STATION	OFFSET	CAT 10 465.0310 LF		STH 69 STH 69 STH 69	10+1 12+2 17+5	5 -	12+25 17+50 23+50	LT & R' LT & R' LT & R'	T 763
	STH 69	26+59	9 -	27+66	RT	107		STH 69	23+5		28+50	LT & R	
	PROJECT TOTAL					107		SERV-US STREET CTH D	201+1		201+72	LT & R	
	PROJECT TOTAL					107			102+9	-	104+01	LT & R	
							PR	OJECT TOTAL					3,412
									CON	CRETE SIDE	WALK 5-INCH		
		CON	CRETE CURB P	EDESTRIAN									CAT 10
						CAT 10							602.0410
						601.0411		STREET	FROM STA		O STA	OFFSET	SF
	STREET	FROM STA	ATION	TO STATION	OFFSET	LF		STH 69 STH 69	10+17 12+25		2+25 7+50	LT & RT LT & RT	2,138 1,973
	STH 69	10+3		10+63	LT	36		STH 69	17+50	- 2	3+50	LT & RT	1,368
	PROJECT TOTAL					36		STH 69 OJECT TOTAL	23+50	- 2	8+50	RT	980 6,459
	CURB RAMP DE	TECTABLE WARNING	FIELD YELLO	w	T								
				CAT 10				s	TORM SEWER F	PIPE			
	STREET	FROM STA	OFFSET	602.0505 SF				CAT 10		CAT 10	CA	NT 10	CAT 10
	STH 92	303+75	LT	13				608.0315		508.0318		3.0324	608.0412
	STH 92	303+75	RT	10				STORM SEWER PIF		M SEWER PIF		SEWER PIPE	STORM SEWER PIP
	STH 69	10+46	LT	16				REINFORCED CONCR		RCED CONCR		ED CONCRETE	
	STH 69	10+46	RT	12		FROM	ТО	CLASS III 15-IN		III 18-IN		II 24-INCH	CLASS IV 12-INC
	STH 69	16+10	LT	13	STRE		STATION	LF		LF		LF	LF
	STH 69	16+41	LT	13	<u> </u>								
	STH 69	17+87	LT	10	STH			45		15		193	79 77
	STH 69	17+87	RT	10	STH STH		T1 11	100 296		134 100		92	77 131
	STH 69 STH 69	18+30 25+47	RT RT	13 17	PROJECT		20.00	441		249		285	287
	STH 69	26+35	RT	20	'"00501	IVIAL		771		27 3	•		201
			OJECT TOTAL	147									
DD() !!	ECT NO: 1690-05-71		HWY: STH 69			NTY: DANE		MISCELLANEOUS Q	LIANITITIES				SHEET:
≺ v J. II	I N I I MU-U5-/ 1		LIVVY SIH NY		I (.(.)[]	INI Y LIAINE		TIVIDSCELLANEOUS ()	UANILLES				LODEEL

STORM SEWER STRUCTURES

3	STREET	STRUCTURE NO.	STATION	OFFSET	CAT 10 522.1018 APRON ENDWALLS FOR CULVERT PIPE REINFORCED CONCRETE 18-INCH LF	CAT 10 611.0420 RECONSTRUCTING MANHOLES	CAT 10 611.0530 MANHOLE COVERS TYPE J EACH	CAT 10 611.0606 INLET COVERS TYPE B	CAT 10 611.0624 INLET COVERS TYPE H	CAT 10 611.0639 INLET COVERS TYPE H-S	CAT 10 611.2004 MANHOLES 4-FT DIAMETER EACH	CAT 10 611.2005 MANHOLES 5-FT DIAMETER EACH	CAT 10 611.2007 MANHOLES 7-FT DIAMETER EACH	CAT 10 611.3004 INLETS 4-FT DIAMETER EACH	CAT 10 611.3220 INLETS 2X2-FT EACH	CAT 10 611.3230 INLETS 2X3-FT EACH	Ī
=	STH 69	200	13+47	20.2' RT			LAUII		1			LAOII	LAOII	LAOII		1	=
	STH 69	201	13+47	20.5' LT					1							1	ı
-	STH 69	202	13+54	34.8' LT		1											ł
-	STH 69	300	15+28	37.3' LT		· ·	1	••		••	1						-
	STH 69	301	15+40	19.5' LT			••			1	·			1			1
	STH 69	302	15+40	9.0' LT			1					1					ı
	STH 69	303	15+40	20.5' RT						1						1	1
	STH 69	304	16+45	9.0' LT			1						1				1
	STH 69	305	16+57	20.0' LT					1							1	1
	STH 69	306	16+45	20.0' RT					1							1	1
-	STH 69	307	19+26	20.0' LT						1						1	1
	STH 69	308	19+26	9.0' LT			1				1						1
	STH 69	309	19+26	20.0' RT						1						1	1
	STH 69	310	17+92	9.0 ' LT			1				1						1
	SERV-US	311	201+45	14.6' LT						1				1			1
Ι.	SERV-US	312	201+45	14.6' RT						1						1	╝
	STH 69	400	22+97	20.0' RT					1							1	1
۱.	STH 69	401	22+97	20.0' LT					1							1	_
	STH 69	500	25+53	36.7' RT						1						1	1
	STH 69	501	26+27	37.6' RT						1				1			1
	STH 69	502	26+59	25.2' RT					1					1			1
	STH 69	503	26+45	20.0' LT					1					1			1
	STH 69	507	26+45	48' LT	1												1
	STH 69	505	28+48	15.9' RT				1							1		1
-	STH 69	506	27+75	20.0' LT						1						1	-
	PROJECT TOTAL	=			1	1	5	1	8	9	3	1	1	5	1	12	1

5-INCH
5-INCH

				CAT 10 612.010
STREET	FROM STATION		TO STATION	LF
STH 69	10+17	-	17+00	400
STH 69	17+00	-	24+50	300
STH 69	24+50	-	28+50	200
SERV-US STREET	201+18	-	201+72	200
CTH D	102+94	-	104+01	200

MGS GUARDRAIL *

			CAT 10	CAT 10	CAT 10
STREET	STATION	OFFSET	MGS GUARDRAIL 3 614.2300 LF	MGS GUARDRAIL TERMINAL EAT 614.2610 EACH	MGS GUARDRAIL TERMINAL TYPE 2 614.2620 EACH
-					
STH 69	19+00 TO 26+50	LT	728	1	1
	PROJ	ECT TOTAL	728	1	1

* NOTE: MGS GUARDRAIL WITH TYPE K POSTS MAY BE USED AS NECESSARY DUE TO SLOPES BEHIND GUARDRAIL.

PROJECT NO: 1690-05-71 HWY: STH 69 COUNTY: DANE MISCELLANEOUS QUANTITIES SHEET: **E**

FILE NAME : ______ PLOT DATE : _____ PLOT BY : _____ PLOT NAME : _____ PLOT SCALE : 1:1

								WAT	TER		
		MOBILIZATION								624.0100	
							STREET	FROM	T0	MGAL	CATEGORY
			* CAT 10				STH 69	10+17	12+25	11.1	10
			619.1000				STH 69	10+17 12+25	12+25 17+50	13.6	10
	l	LOCATION	EACH	<u></u>			STH 69	17+50	23+50	19.4	10
	PROJEC	CT 1690-05-71	0.9				STH 69	23+50	28+50	18.0	10
						e	ERV-US STREET	201+18	201+72	1.8	10
		PROJECT TOTA	L 0.9			3	CTH D	102+94	104+01	5.0	10
	* MODILIZATI	ON - COMPINATION O	E DDO JECT TD								
		ON = COMBINATION O					STH 69	12+25	17+50	0.3	10
		ND 1690-05-72. AD		70			STH 69	17+50	23+50	2.5	10
	QUANITIY OF	MOBILIZATION IN PR	OJECI 1690-05-	72.			BROSS CIRCLE	RADIUS RETURN		0.8	10
							BROSS CIRCLE	DRIVEWAY		1.5	10
									PROJECT TOTAL	74	
		TOPSOIL							OUTNO		
				CAT 10				MUL	CHING		
				605 0400						CAT 10	
	ATREET		TO 074770U	625.0100						CAT 10	
=	STREET	FROM STATION	TO STATION	SY						627.0200)
	STH 69	10+17 -	12+25	69			STRE	ET FROM STA	TION TO STA	ATION SY	
	STH 69	12+25 -	17+50	304			STH				_
	STH 69	17+50 -	23+50	747			UNDISTRI		12	2	
	STH 69	23+50 -	28+50	634					T TOTAL	22	=
_	UNDISTRIBUTED			175				PRUJEU	I IUIAL	22	
		PROJECT TOTAL		1929							
		SILT FENCE	<u> </u>								
			CAT 10	CAT 10	CAT 10			EROSION CONTROL	MOBILIZATIONS		
			628.1504	628.1520	SPV.0090.07					000 4040	
				SILT FENCE	SILT FENCE			•••	628.1905	628.1910	
			SILT FENCE	MAINTENANCE	SPECIAL				BILIZATIONS	MOBILIZATIO	
STREET	FROM STATION	TO STATION	LF	LF	LF			ERO	SION CONTROL	EMERGENCY	
STH 69	10+17	- 12+25	0	0	0					EROSION CONT	ROL
STH 69	12+25	- 17+50	0	230	230		LOCATION		EACH	EACH	
STH 69	17+50	- 23+50	404	464	60		PROJECT 1690-		10	5	
STH 69	23+50	- 28+50	435	562	127		PR	OJECT TOTAL	10	5	
SERV-US STREET		- 201+72	0	0	0						
CTH D	102+94	- 201+72 - 104+01	0	0	0						
OIN D	PROJECT T		839	1,256	417						
PROJECT NO: 1690-		HWY: STH 69		COUNTY: I		I	ELLANEOUS QUANTIT			SHE	

CAT 10

628.2006 EROSION MAT URBAN CLASS I TYPE A

STREET FROM STATION TO STATION SY
UNDISTRIBUTED 260
PROJECT TOTAL 260

* NOTE: UNDISTRIBUTED QUANTITY FOR EROSION MAT SHALL ONLY BE USED FOR TEMPORARY STABILIZATION IN AREAS WHERE SOD EROSION CONTROL IS TO BE INSTALLED.

	II	NLET	PROTECTION			
				CAT 10	CAT 10	CAT 10
				628.7005 INLET	628.7015 INLET	628.7020 INLET
				PROTECTION	PROTECTION	PROTECTION
				TYPE A	TYPE C	TYPE D
STREET	FROM STATION		TO STATION	EACH	EACH	EACH
STH 69	10+17	-	12+25	0	1	0
STH 69	12+25	-	17+50	6	4	2
STH 69	17+50	-	23+50	4	2	2
STH 69	23+50	-	28+50	6	2	3
SERV-US STREET	201+18	-	201+72	2	0	2
CTH D	102+94	-	104+01	0	0	0
	PROJECT TO	TAL		18	9	9

CAT 10 628.7570 STREET FROM STATION TO STATION **EACH** STH 69 10+17 12+25 2 STH 69 12+25 17+50 24 STH 69 17+50 23+50 16 STH 69 23+50 28+50 22 SERV-US STREET 201+18 201+72 8 CTH D 102+94 104+01 PROJECT TOTAL 72

ROCK BAGS

				CAT 10
				629.0210
STREET	FROM		T0	CWT
STH 69	10+17	-	12+25	0.0
STH 69	12+25	-	17+50	0.2
STH 69	17+50	-	23+50	0.5
STH 69	23+50	-	28+50	0.4
UNDISTRIBUTED				0.1
	P	ROJE	CT TOTAL	1.2

FERTILIZER TYPE B

		SOD QUANTITIES			
			CAT 10 631.0300 SOD WATER	CAT 10 631.1000 SOD LAWN	CAT 10 631.1100 SOD EROSION CONTROL
STREET	FROM	T0	MGAL	SY	SY
STH 69	10+17	12+25	3	49	0
STH 69	12+25	17+50	20	254	50
STH 69	17+50	23+50	50	644	103
STH 69	23+50	28+50	43	551	83
UNDISTRIBUTED	UNDISTRIBUTED		12	150	24
		PROJECT TOTAL	129	1,648	259

PROJECT NO: 1690-05-71	HWY: STH 69	COUNTY: DANE	MISCELLANEOUS QUAN	NTITIES		SHEET:	E]
FILE NAME :		DI OT DATE :	PLOT RV ·	DI OT NAME :	DLOT SCALE : 1:1			_

TYPE II SIGNS

									TYPI	E II SIGNS							
sı	GN							T 2)	34.0814 POSTS UBULAR STEEL (2-INCH 14-FT	634.0816 POSTS TUBULAR STEEL 2X2-INCH X 16-FT	634.0818 POSTS TUBULAR STEEL 2X2-INCH X 18-FT	637.2210 SIGNS Type II Reflective H	637.2230 SIGNS Type II Reflective F	638.2102 MOVING SIGNS TYPE II	638.4000 MOVING SMALL SIGN SUPPORTS		ALL SIGNS CATEGORY 0010 UNLESS OTHERWISE NOTED
NO	ο.	LOCATION	STATION	OFFSET	SIGN CODE	MESSAGE	SIZE	E	EACH	EACH	EACH	SF	SF	EACH	EACH	REMARKS	
20	00	STH 92	301+93	25' RT	J2-2	NORTH, STH 69, NEXT LEFT EAST, STH 92, AHEAD ARROW	48 X	57	-	+	-	19.0	1.9	-	-		
$3 _{\frac{20}{20}}$	01	STH 92	303+17	25' RT	J13-1	NORTH, STH 69, LEFT ARROW	24 X	57	-	1	-	9.5	-	-	-		
20	02	STH 92	303+23	25' RT	J2-3	EAST, STH 92, LEFT ARROW SOUTH, STH 69, RIGHT ARROW WEST, STH 92, RIGHT ARROW	72 X	57	-	-	-	28.5	-	-	-		
20		STH 92	304+23	25' RT	J3-1	EAST, STH 92, RIGHT ARROW	24 X		-	1	-	9.5	-	-	-		
20		STH 69	10+58	31' LT	R1-1	STOP	36 X		-	1	-	7.5	-	-	-	0.445 0005 40 004	
20		STH 69 STH 92	10+58	31' LT 60' RT	R11-54-F	TRAFFIC FROM RIGHT DOES NOT STOP STOP	36 X		-		-	4.4	-	-	-	SAME POST AS 204	
20		STH 92	10+26 10+26	60' RT	R1 - 1 W4 - 4B	ONCOMING TRAFFIC DOES NOT STOP			-	1 	-	9.0	4.4	-	<u>-</u>	SAME POST AS 206	
20		STH 69	304+22	25' LT	JV3-3	SOUTH, STH 69, WEST, STH 92, AHEAD ARROW	48 X		-	<u>-</u>	1	31.0	-	-	-	SAME FOST AS 200	
20	09	STH 69	11+12	25' RT	J4-1	(BLANK), NORTH STH 69, RIGHT NORTH, STH 69	24 X	36	-	1	-	6.0	-	-	-		
21		STH 69	11+49	34' RT		DO NOT ENTER	-		-	-	-	-	-	1.0	1.0		
21	11	STH 69	11+68	25' RT	R3-17, R3-17-AP	BIKE LANE, BEGINS	30 X	36	-	1	-	7.5	-	-	-		
21	12	STH 69	303+29	25' RT	W1-7	DOUBLE ARROW	48 X		1	-	-	=	8.0	-	-		
22	20	STH 69	12+74	25' RT	R2-1	SPEED LIMIT 30 MPH	24 X	30	1	-	-	5.0	-	-	-		
22	21	STH 69	13+65	30' LT	J2-2	SOUTH, STH 69, AHEAD RIGHT ARROW WEST, STH 92, AHEAD RIGHT ARROW	48 X	57	-	1	-	19.0	-	-	-		
22	22	STH 69	15+16	29' LT	J2-1	EAST, STH 92, AHEAD LEFT ARROW	24 X	57	-	1	-	9.5	-	-	-		
		STH 69	15+85	24' LT	W3 - 1	STOP AHEAD	36 X	36	-	1	-	-	9.0	-	-		
22		STH 69	16+07	35' LT	- D4 4	RIVER ST, BROSS CIR	- v		-	-	-	-	-	-	-	TO BE INSTALLED BY OTHERS	
22		STH 69	16+09 17+43	37' LT 25' LT	R1-1 R3-17, R3-17-BP	STOP BIKE LANE, ENDS	30 X		<u>1</u>	<u>-</u> 1	-	5.2 7.5	-	-	-	TWO SIGNS ON SAME POST	
23		STH 69	17+64	25' RT	R2-1	SPEED LIMIT 30	24 X		1	<u> </u>	_	5.0	-	_	_	THE STATE OF STATE 1991	
23		STH 69	18+29	41' RT	R1 - 1	STOP	30 X		1	-	-	5.2	-	-	-		
23		STH 69	18+47	24' RT	•	RIVER ST, SERV-US ST	•		-	-	-	-	-	-	-	TO BE INSTALLED BY OTHERS	
23	33	STH 69	19+00	25' RT	R3-17	BIKE LANE	30 X	24	1	-	-	5.0	-	-	-		
23	34	STH 69	19+85	25' LT	J1-1	JCT, STH 92	24 X	39	-	1	-	6.5	-	-	-		
23		STH 69	20+14	25' RT	J1-1	JCT, CTH D	24 X		-	1	-	6.5	-	-	-		
23	36	STH 69	20+48	27' LT	R3-17	BIKE LANE	30 X	24	1	-	-	5.0	-	-	-		
24	40	STH 69	23+52	26' LT	R2-1	SPEED LIMIT 30	24 X	30	1	-	-	5.0	-	-	-		
24	41	STH 69	24+47	25' LT	J4 - 1	SOUTH, STH 69	24 X	36	ē	1	-	6.0	-	-	-		
24	42	STH 69	23+55	25' RT	R2-1	SPEED LIMIT 30	24 X	30	1	-	-	5.0	-	-	-		
24	43	STH 69	24+61	24' RT	J13-1	CTH D, RIGHT ARROW	24 X	45	-	1	-	7.5	-	-	-		
24		CTH D	103+13	27' LT	M1-5A	CTH D	24 X	24	1	-	-	4.0	-	-	-		
24		CTH D	102+57	27' LT	R2-1	SPEED LIMIT 30 MPH	24 X		1	-	-	5.0	-	-	-		
24		STH 69	25+82	25' LT	W1-7	DOUBLE ARROW	48 X		1		-	<u>-</u>	8.0	-	-		
24	47	STH 69	26+18	25' LT	J13-1	CTH D, LEFT ARROW	24 X	45	-	1	-	7.5	-	-	-		
24	48	STH 69	26+29	45' RT	J13-1	STH 69, DOUBLE ARROW	24 X	45	-	1	-	7.5	-	-	-		
24	49	STH 69	26+24	45' RT	R1 - 1	STOP	30 X	30	1	-	-	5.2	-	-	-		
25		STH 69	26+33	37' RT	-	RIVER ST, THIRD AVE		-	-	-	-	-	-	=	-	TO BE INSTALLED BY OTHERS	
25		STH 69	28+48	26' RT	R3-17, R3-17-AP	BIKE LANE, BEGINS	30 X		-	1	-	7.5	-	-	-	TWO SIGNS ON SAME POST	
25	52	STH 69	23+99	24' RT	R3-17, R3-17-BP	BIKE LANE, ENDS PROJECT TOTAL	30 X	36	13	1 19	1	271	31	1	1	TWO SIGNS ON SAME POST	
-																	
PR	OJEC.	T NO: 1690	-05-71		HWY: ST	TH 69 CO	:YTNUC	DANE			MISCELLAN	NEOUS QUAN	TITIES			SHEE	T: E

FILE NAME :_____ PLOT DATE :____ PLOT BY :____ PLOT NAME :____ PLOT SCALE : 1:1

Е

SHEET:

CAT 10

CAT 10

638.2602 REMOVING SIGNS TYPE II

638.3000 REMOVING SMALL SIGN SUPPORTS

EMOVAL NO.	LOCATION	MESSAGE	STATION	OFFSET	EACH	EACH	REMARKS
100	STH 92	NORTH, STH 69, ARROW	303+17	25' RT	1	1	
		EAST, STH 92, ARROW,					
		SOUTH, STH 69, ARROW,					
		WEST, STH 92, ARROW,					
101	STH 92	NO U-TURN, DOUBLE ARROW	303+23	25' RT	1	2	
		TRAFFIC MUST YIELD TO					
102	STH 92	PEDESTRIANS IN CROSSWALK	303+33	25' RT			EXISTING SIGN TO REMAIN
103	STH 92	STREET NAME SIGNS	303+46	25' RT			EXISTING SIGN TO REMAIN
		NORTH, STH 69, ARROW					
104	STH 92	EAST, STH 92, ARROW	301+94	25' RT	1	2	
		STOP, TRAFFIC FROM RIGHT					
105	STH 69	DOES NOT STOP	10+70	27' LT	1	1	
		NORTH, STH 69, SPEED					
106	STH 69	LIMIT	10+75	26' RT	1	1	
		STOP, ONCOMING TRAFFIC					
107	STH 69	DOES NOT STOP	10+28	43' RT	1	1	
		BROOKLYN, NEW GLARUS, MT					
110	STH 69	HOREB	12+62	26' LT	1	2	
111	STH 69	BELLEVILLE INFORMATION	12+98	36' LT			EXISTING SIGN TO REMAIN
		EAST, STH 92, ARROW,					
112	STH 69	WEST, STH 92, ARROW	15+17	32' LT	1	1	
440			4=.00				
113	STH 69	BELLEVILLE COMMUNITY PARK	15+86	52' LT			EXISTING SIGN TO REMAIN
114	STH 69	STOP	16+19	33' LT	1	1	CTON TO BE DEMOVED BY OTHER
115	STH 69	STREET NAME SIGNS	16+20	31' LT			SIGN TO BE REMOVED BY OTHER
120	STH 69	SPEED LIMIT	17+66	25' RT	1	1	
121	STH 69	STOP	201+55	22' RT	1	1	0.000 TO DE DEMOVED DV 0.000
122	STH 69	STREET NAME SIGNS	201+58	23' RT			SIGN TO BE REMOVED BY OTHER
123	STH 69	SOUTH, STH 69, ARROW	18+85	26' LT	1	1	
124	STH 69	STOP AHEAD	19+84	25' LT	1	1	
125	STH 69	JCT, CTH D	20+11	25' RT	1	1	
126	STH 69	CURVE AHEAD	22+07	25' RT	1	1	EVICTING OTON TO DEMAIN
127	STH 69	LAKE BELLE VIEW	21+81	29' LT			EXISTING SIGN TO REMAIN
128	STH 69	JCT, STH 92	22+95	26' LT	1		
130	STH 69	SPEED LIMIT	24+40	27' LT	1	1	
131	STH 69	SPEED LIMIT	24+47	24' RT	1	1	
132	STH 69	CTH D, ARROW	25+24	24' RT	1	1	
133	CTH D	CTH D, SPEED LIMIT	103+14	28' LT	1	1	
134	STH 69	UNITED METHODIST CHURCH	24+85	28' LT			EXISTING SIGN TO REMAIN
135	STH 69	DOUBLE ARROW	25+80	26' LT	1	1	
136	STH 69	CTH D, ARROW	26+14	26' LT	1	1	
137	STH 69	STOP	103+83	34' RT	1	1	
138	STH 69	STH 69, DOUBLE ARROW	103+82	37' RT	1	1	
139	STH 69	UNITED CHURCH OF CHRIST	26+95	32' LT			EXISTING SIGN TO REMAIN

PLOT DATE : ___ PLOT NAME : _____ PLOT SCALE: 1:1

COUNTY: DANE

HWY: STH 69

PROJECT NO: 1690-05-71

PROJECT TOTALS

24

MISCELLANEOUS QUANTITIES

27

FIELD OFFICE TYPE C

643.2000 643.3000 TRAFFIC CONTROL TRAFFIC CONTROL DETOUR DETOUR SIGNS

PROJECT	LOCATION	DAYS	EACH	EACH	DAYS
1690-05-71	DETOUR ROUTE	109	1	477	51993
	PROJECT TOTAL		1		51.993

TRAFFIC CONTROL DETOUR

TRAFFIC CONTROL

			643.0100.01 TRAFFIC CONTROL (1690-05-71)	643.0300 TRAFFIC CONTROL DRUMS *		643.0420 TRAFFIC CONTROL BARRICADES TYPE III		643.0705 TRAFFIC CONTROL WARNING LIGHTS TYPE A		643.0900 Traffic Control Signs		643.0920 TRAFFIC CONTROL COVERING SIGNS TYPE II	643.1050 Traffic Control Signs PCMS	
CATEGORY	STREET	DAYS	EACH	DRUM	DAYS	EACH	DAYS	EACH	DAYS	EACH	DAYS	EACH	EACH	DAYS
10	STH 69	109	1	42	1,526	34	3706	55	5,995	37	4,033	13	3	327
	PROJECT TOTAL	109	1		1,526		3,706		5,995		4,033	13		327

^{*} TRAFFIC CONTROL DRUMS USED FOR TEMPORARY PEDESTRIAN ACCESS ASSUMES 1/3 OF TOTAL CONSTRUCTION TIME (35 DAYS)

TEMPORARY PEDESTRIAN SURFACE ASPHALT

			CAT 10 644.1410.5
STREET	STATION	OFFSET	SF
STH 69	304"M"	22' RT	34
STH 69	15+70	24' LT	17
STH 69	15+70	25' RT	21
STH 69	17+44	24' LT	17
STH 69	17+43	25' RT	21
STH 69	27+20	18' RT	81
SERV-US ST	201+39	19' LT	19
OJECT TOTAL			210

TEMPORARY PEDESTRIAN SAFETY FENCE

CAT 10

				644.1616.S
STREET	FROM STA		TO STA	LF
STH 69	10+17	-	12+25	0
STH 69	12+25	-	17+50	37
STH 69	17+50		23+50	506
STH 69	23+50	-	28+50	332
PROJECT TOTAL				875

PROJECT NO: 1690-05-71 HWY: STH 69 COUNTY: DANE MISCELLANEOUS QUANTITIES SHEET: **E**

FILE NAME : ______ PLOT DATE : _____ PLOT BY : _____ PLOT NAME : _____ PLOT SCALE

REMOVING PAVEMENT MARKING

GEOGRID TYPE SR

CAT 10 645.0220

STREET	FROM		T0	LOCATION	SY
STH 69	17+50	-	23+50	MAINLINE	408
STH 69	23+50	-	28+50	MAINLINE	681
PROJECT TOTAL					1,089

CAT 10 646.0600 REMOVING PAVEMENT MARKING

STREET

LF

STH 92	144
PROJECT TOTAL	144

PAVEMENT MARKING

				l	T 10 .0106 EPOXY 4-INCH YELLOW	CAT 10 646.0126 EPOXY 8-INCH WHITE	CAT 10 647.0166 ARROWS EPOXY TYPE 2	CAT 10 647.0206 ARROWS BIKE LANE EPOXY	CAT 10 647.0306 SYMBOLS BIKE LANE EPOXY	CAT 10 647.0356 WORDS EPOXY	CAT 10 647.0406 WORDS BIKE LANE EPOXY	CAT 10 647.0566 STOP LINE EPOXY 18- INCH	CAT 10 647.0726 DIAGONAL EPOXY 12- INCH YELLOW	CAT 30 647.0726 DIAGONAL EPOXY 12- INCH WHITE	CAT 10 647.0766 CROSSWALK EPOXY 6- INCH
STREET	FROM STATION	TO STATION	LOCATION	LF	LF	LF	EACH	EACH	EACH	EACH	EACH	LF	LF	LF	LF
CATEGORY 10															
STH 69	10+17 -	12+25	MAINLINE	109	690	170	2	1 1	1	2		53			231
STH 69	12+25 -		MAINLINE	1,051	1,758	83	2	2	2		3		45		
STH 69	17+50 -		MAINLINE	1,215	1,241			6	6			16			171
STH 69	23+50 -		MAINLINE	1,312	1,395	128	3	2	2		3	42	25		169
STH 69	10+17 -		PARKING LANE												
STH 69	12+25 -	17+50	PARKING LANE/BROSS CIRCLE	98								12			66
STH 69	17+50 -	23+50	PARKING LANE	567											
STH 69	23+50 -	28+50	PARKING LANE												
SUBTOTA	AL			4,352	5,084	380	7	11	11	2	6	122	70	0	638
CATEGORY 10 TOTA	AL .			9,	436	380	7	11	11	2	6	122	70	0	638
CATEGORY 30			l												
STH 69	<u> 10+17 -</u>	28+50	CROSSWALKS											646	
SUBTOTA	AL .			0	0	0	0	0	0	0	0	0	0	646	0
CATEGORY 30 TOTA	AL				0	0	0	0	0	0	0	0	0	646	0
PROJECT TOTA	AL		1	9,	436	380	7	11	11	2	6	122	70	646	638

PROJECT NO: 1690-05-71	HWY: STH 69	COUNTY: DANE	MISCELLANEOUS QUANTITIE	S		SHEET:	Е
FILE NAME :		PLOT DATE :	PLOT BY :	PLOT NAME :	PLOT SCALE : 1:1		

CONSTRUCTION STAKING

ITEM	QUANTITY	UNIT	DESCRIPTION	CATEGORY
650.4000	23	EACH	CONSTRUCTION STAKING STORM SEWER	0010
650.4500	1,689	LF	CONSTRUCTION STAKING SUBGRADE	0010
650.5000	1,689	LF	CONSTRUCTION STAKING BASE	0010
650.5500	3,448	LF	CONSTRUCTION STAKING CURB GUTTER AND CURB & GUTTER	0010
650.6500	1	LS	CONSTRUCTION STAKING STRUCTURE LAYOUT (B-13-337)	0020
650.7000	27	LF	CONSTRUCTION STAKING CONCRETE PAVEMENT	0010
650.9910	1	LS	CONSTRUCTION STAKING SUPPLEMENTAL CONTROL (ID 1690-05-71)	0010
650.9920	0	LF	CONSTRUCTION STAKING SLOPE STAKES	0010
SPV.0060.29	11	EACH	CONSTRUCTION STAKING CURB RAMP	0010

	SAW	ING ASI	PHALT	
				CAT 10
				690.0150
STREET	STATION		TO STATION	LF
STH 69	10+17	-	17+00	398
STH 69	17+00	-	24+50	47
STH 69	24+50	-	28+50	96
			PROJECT TOTAL	541

SAWING CONCRETE

				CAT 10
				690.0250
STREET	STATION		0	LF
STH 69	10+17	-	17+00	14
STH 69	17+00	-	24+50	
STH 69	24+50	-	28+50	
	_		PROJECT TOTAL	14

TEMPORARY CURB RAMP

SPV.0045.01

PROJECT	*DAYS	EACH	DAYS
1690-05-71	35	5	175
PROJECT TOTAL			175

* ASSUMES CROSSWALKS WILL BE IN PLACE 1/3 OF TOTAL CONSTRUCTION TIME.

WALL MODULAR BLOCK GRAVITY LRFD

SPV.0165.02

 SIREEI	FROM	10	SF
STH 69	17+60	17+95	102
	-	TOTAL	102

PROJECT NO: 1690-05-71 HWY: STH 69 COUNTY: DANE MISCELLANEOUS QUANTITIES SHEET: **E**

LE NAME : _____ PLOT DATE : ____ PLOT BY : ____ PLOT NAME : ____ PLOT SCALE

STATE OF WISCONSIN DEPARTMENT OF TRANSPORTATION | AsBuilt Plan may not be final records. TRANSPORTATION PROJECT PLAT TITLE SHEET

1690-05-21

NEW GLARUS - VERONA STH 92 TO CTH D

> **STH 69** DANE COUNTY

CONVENTIONAL SYMBOLS

SECTION LINE CORNER OLIARTER LINE NOTATION FOR COMBUSTABLE CAUTION SIXTEENTH LINE NOTATION FOR NEW REFERENCE LINE FLUIDS NEW R/W LINE EXISTING R/W LINE NOTATION FOR HIGH VOLTAGE PROPERTY LINE LOT, TIE & OTHER MINOR LINES CORPORATE LIMITS 111111111 FLECTRIC POLE UNDERGROUND FACILITY (COMMUNICATIONS, ELECTRIC, ETC) TELEPHONE POLE PEDESTAL (LABEL TYPE) FEE ACQUISITION AREA (HATCHING VARIES BY OWNER) (TV. TEL. ELEC. ETC.) TEMPORARY LIMITED EASEMENT AREA ACCESS CONTROLLED BY ACQUISITION EASEMENT AREA (HIGHWAY, NO ACCESS (BY STATUTORY AUTHORITY) PERMANENT LIMITED, OR ACCESS RESTRICTED (BY PREVIOUS RESTRICTED DEVELOPMENT) PROJECT OR CONTROL)

NATIONAL GEODETIC SURVEY MONUMENT SIXTEENTH CORNER MONUMENT

LENGTH OF CURVE

DIRECTION AHEAD

TANGENT

PARCEL NUMBER

R/W MONUMENT

FOUND IRON PIN

WATER, ETC.)

R/W POINT

VALVE (GAS.

COMPENSABLE

SIGN

NON-MONUMENTED O

OFF-PREMISE 41-25 SIGN

SIGN


NON-COMPENSABLE

Ь


(25) UTILITY NUMBER

CONVENTIONAL ABBREVIATIONS

ACCESS RIGHTS	AR	POINT OF COMPOUND CURVE	
ACRES	AC	POINT OF INTERSECTION	ΡI
AHEAD	AH	PROPERTY LINE	PL
ALUMINUM	ALUM	RECORDED AS	(100')
AND OTHERS	ET AL	REFERENCE LINE	R/L
BACK	BK	REMAINING	REM
BLOCK	BLK	RIGHT	RT
CENTERLINE	C/L	RIGHT OF WAY	R/W
CERTIFIED SURVEY MAP	CSM	SECTION	SEC
CONCRETE	CONC	SEPTIC VENT	SEPV
COUNTY	CO	SQUARE FEET	SF
COUNTY TRUNK HIGHWAY	CTH	STATE TRUNK HIGHWAY	STH
DISTANCE	DIST	STATION	STA
CORNER	COR	SUBDIVISION	SUBD
DOCUMENT NUMBER	DOC	TANGENT	TAN
EASEMENT	EASE	TELEPHONE PEDESTAL	TP
EXISTING	EX	TEMPORARY LIMITED	TLE
GAS VALVE	GV	EASEMENT	
GRID NORTH	GN	TRANSPORTATION PROJECT	TPP
HIGHWAY EASEMENT	HE	PLAT	
IDENTIFICATION	ID	UNITED STATES HIGHWAY	USH
LAND CONTRACT	LC	VOLUME	V
LEFT	LT		
MONUMENT	MON	CURVE DATA	
NATIONAL GEODETIC SURVEY	NGS	CONVE DATA	
NUMBER	NO	LONG CHORD	LC
OUTLOT	OL	LONG CHORD BEARING	
PAGE	P	RADIUS	R
POINT OF TANGENCY	PT	DEGREE OF CURVE	D
PERMANENT I TMTTED	PLF	CENTRAL ANGLE OR DELTA	Δ

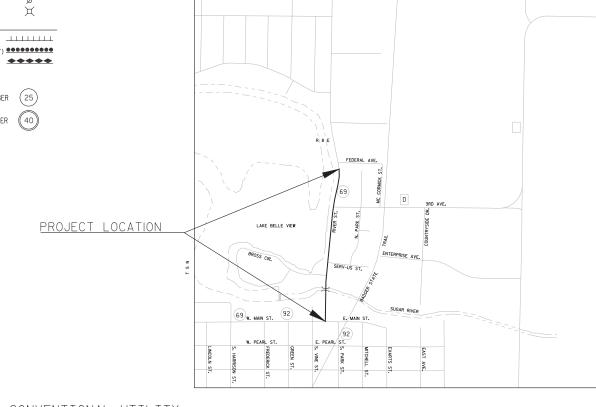

CONVENTIONAL UTILITY SYMBOLS

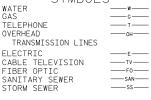

LAYOUT 0.25 MI. The most current Right of Way information should be viewed in DOTView using the Real Estate Project ID. The Plat information contained in this

> THE NOTES, CONVENTIONAL SIGNS, AND ABBREVIATIONS ARE ASSOCIATED WITH EACH TRANSPORTATION PROJECT PLAT FOR PROJECT 1690-05-21

POSITIONS SHOWN ON THIS PLAT ARE WISCONSIN COUNTY COORDINATES, DANE COUNTY, NAD83 (2011), IN U.S. SURVEY FEET. VALUES SHOWN ARE GRID COORDINATES, GRID BEARINGS, AND GRID DISTANCES. GRID DISTANCES MAY BE USED AS GROUND DISTANCES.

RIGHT-OF-WAY MONUMENTS ARE TYPE 2 MONUMENTS (TYPICALLY $\frac{3}{4}$ " X 24" REBARS) AND WILL BE PLACED PRIOR TO THE COMPLETION OF THE PROJECT.

ALL RIGHT-OF-WAY LINES DEPICTED IN THE NON-ACQUISITION AREAS ARE INTENDED TO RE-ESTABLISH EXISTING RIGHT-OF-WAY LINES AS DETERMINED FROM PREVIOUS PROJECTS, OTHER RECORDED DOCUMENTS, OR FROM CENTERLINE OF EXISTING PAVEMENTS.

RIGHT-OF-WAY BOUNDARIES ARE DEFINED WITH COURSES OF THE PERIMETER OF THE HIGHWAY LANDS REFERENCED TO THE U.S. PUBLIC LAND SURVEY SYSTEM OR OTHER

DIMENSIONING FOR THE NEW RIGHT-OF-WAY IS MEASURED ALONG AND PERPENDICULAR TO THE NEW REFERENCE LINES.

A TEMPORARY LIMITED EASEMENT (TLE) IS A RIGHT FOR CONSTRUCTION PURPOSES, AS DEFINED HEREIN, INCLUDING THE RIGHT TO OPERATE NECESSARY EQUIPMENT THEREON, THE RIGHT OF INCRESS AND EGRESS, AS LONG AS REQUIRED FOR SUCH PUBLIC PURPOSE, INCLUDING THE RIGHT TO PRESERVE, PROTECT, REMOVE, OR PLANT THEREON ANY VEGETATION THAT THE HIGHWAY AUTHORITIES MAY DEEM DESIRABLE. ALL (TLES) ON THIS PLAT EXPIRE AT THE COMPLETION OF THE CONSTRUCTION PROJECT FOR WHICH THIS INSTRUMENT IS GIVEN.

A PERMANENT LIMITED EASEMENT (PLE) IS A RIGHT FOR CONSTRUCTION AND MAINTENANCE PURPOSES, AS DEFINED HEREIN, INCLUDING THE RIGHT TO OPERATE NECESSARY EQUIPMENT THEREON AND THE RIGHT OF INGRESS AND EGRESS, AS LONG AS REQUIRED FOR SUCH PUBLIC PURPOSE, INCLUDING THE RIGHT TO PRESERVE, PROTECT, REMOVE, OR PLANT THEREON ANY VEGETATION THAT THE HIGHWAY AUTHORITIES MAY DEEM DESIRABLE, BUT WITHOUT PREJUDICE TO THE OWNER'S RIGHTS TO MAKE OR CONSTRUCT IMPROVEMENTS ON SAID LANDS OR TO FLATTEN THE SLOPES, PROVIDING SAID ACTIVITIES WILL NOT IMPAIR OR OTHERWISE ADVERSELY AFFECT THE HIGHWAY FACILITIES.

AN EASEMENT FOR HIGHWAY PURPOSES (HE), AS LONG AS SO USED, INCLUDING THE RIGHT TO PRESERVE, PROTECT, REMOVE, OR PLANT THEREON ANY VEGETATION THAT THE HIGHWAY AUTHORITIES MAY DEEM DESIRABLE.

PROPERTY LINES SHOWN ON THIS PLAT ARE DRAWN FROM DATA DERIVED FROM MAPS AND DOCUMENTS OF PUBLIC RECORD AND/OR EXISTING OCCUPATIONAL LINES. THIS PLAT MAY NOT BE A TRUE REPRESENTATION OF EXISTING PROPERTY EXCLUDING RIGHT-OF-WAY, AND SHOULD NOT BE USED AS A SUBSTITUTE FOR AN ACCURATE FIELD SURVEY.

FOR THE LATEST ACCESS/DRIVEWAY INFORMATION, CONTACT THE PLANNING UNIT OF THE WISCONSIN DEPARTMENT OF TRANSPORTATION OFFICE IN MADISON.

PARCEL IDENTIFICATION NUMBERS MAY NOT POINT TO ALL AREAS OF ACQUISITION, AS NOTED ON THE SCHEDULE OF LANDS & INTERESTS REQUIRED.

EXISTING HIGHWAY RIGHT-OF-WAY SHOWN HEREIN IS BASED ON THE FOLLOWING

EXISTING HIGHWAY RIGHT OF WAY FOR STH 69 ESTABLISHED FROM PREVIOUS PROJECT AND SURVEYS: RIGHT OF WAY PLAT FROM FEDERAL AID PROJECT NO. 379B, RIGHT OF WAY PROJECT NO. 5606-00-24 DATED AUG. 8TH, 2008, THE ORIGINAL PLAT OF BELLEVILLE, CSM NO. 8526, CSM NO. 4123, PLAT OF SURVEY 93-0764, PLAT OF SURVEY 94-0441, PLAT OF SURVEY 2014-00782 AND BLAZER

EXISTING HIGHWAY RIGHT OF WAY FOR EAST MAIN STREET ESTABLISHED FROM RIGHT OF WAY PROJECT NO. 5606-00-24 DATED AUG. 8TH, 2008 AND THE ORIGINAL PLAT OF BELLEVILLE.

EXISTING HIGHWAY RIGHT OF WAY FOR SERV-US STREET ESTABLISHED FROM PREVIOUS PROJECT AND SURVEYS: RIGHT OF WAY PLAT FROM FEDERAL AID PROJECT NO. 379B AND THE ORIGINAL PLAT OF BELLEVILLE, PLAT OF SURVEY 93-0764. EXISTING HIGHWAY RIGHT OF WAY FOR CTH D ESTABLISHED FROM PREVIOUS PROJECT AND SURVEYS: RIGHT OF WAY PLAT FROM FEDERAL AID PROJECT NO. 379B, RIGHT OF WAY PROJECT NO. 5606-00-24 DATED AUG. 8TH, 2008, CSM NO. 8526 AND BLAZER SUBDIVISION.

> RESERVED FOR REGISTER OF DEEDS PROJECT NUMBER 1690-05-21 - 4.01 SHEET 2 OF 2 AMENDMENT NO:

PERMANENT LIMITED

POINT OF BEGINNING

POINT OF CURVATURE

FASEMENT

TRANSPORTATION
THAT PART OF LOT 1
ALL IN SECTION 34, T PROJECT
OF BLOCK 2
1 5 N, R 8 F T PLAT N
23, LOT 3
8 E, VILLAGE NO: 1690-05-21 - 4.01 BLOCK 22 AND BLOCK 28 II BELLEVILLE, DANE COUNTY, \equiv WISCONSIN PLAT 유 BELLEVILLE.


RELOCATION ORDER STH 69 NEW GLARUS - VERONA (STH 69 TO CTH D)


HEREBY ORDERS THAT: TO EFFECT THIS CHANGE, OPERLY ESTABLISH, LAY OUT, WIDEN, ENLARGE, EXTEND, CONSTRUCT, RECONSTRUCT, IMPROVE, OR MAINTAIN OF WISCONSIN DEPARTMENT OF TRANSPORTATION DEEMS IT NECESSARY TO RELOCATE OR CHANGE AID HIGH IN LANDS FOR THE ABOVE PROJECT. DEP,

PORTION OF THE HIGHWAY DESIGNATED ABOVE, THE Y AND ACQUIRE CERTAIN LANDS AND INTERESTS OR

THIS IS A COPY, ORIGINAL DOCUMENT IS FILED AT THE COUNTY REGISTER OF DEEDS

유 $\overline{\sim}$

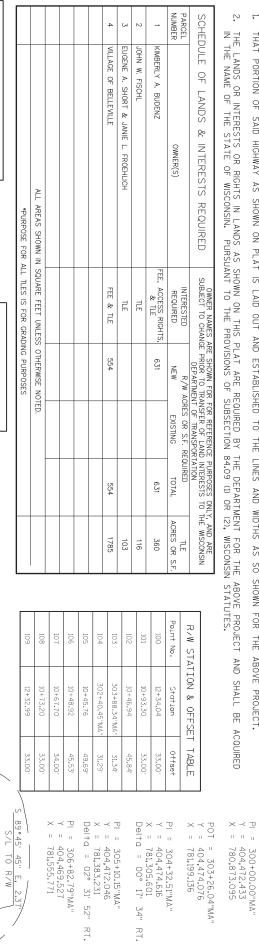

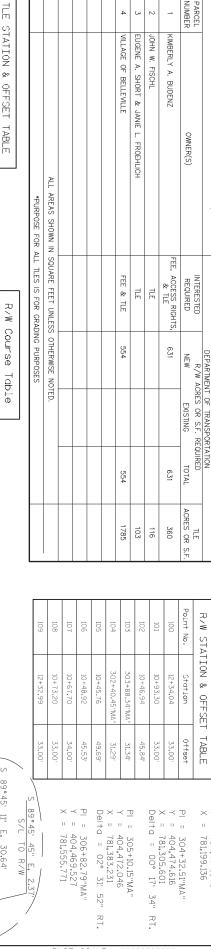

PLOT NAME : PLOT SCALE : *********

VILLAGE 9°41' 31" W, 86.39' R/L TO R/W VINE STREET 01°09' 26" E, 31. R/L TO R/W 9 SECTION LINE 89°41' 48" W 29.81' — W PARK STREET 4 BELLEVILLE 4) TLE -2 2 INTERESTS 02"E REQUIRED PI: 306+82.79"MA" PLOT DATE : PLOT DATE: 1/13/2016 11:16 AM

PI: 300+00.00"MA"

360

ORIGINAL S VINE

304+32.51"MA"

ORIGINAL

º STREET

5

≤

PLAT BELLEVILLE

LOT 2

N1° 09' 26"E

PLAT BELLEVILLE

SW-SE

P.L.

4 1,711 SF T 3 LOT :

PLOT BY : CLARK, CLYDE J

(4)

FOR ADDITIONAL INFORMATION RECORDED AS SHEET 2 OF 2. IT-OF-WAY SHOWN HEREI S OF REFERENCE: EXISTI H 69 ESTABLISHED FRON AID PROJECT NO. 379B, -24 DATED AUG. 8TH, 2 VEWAY INFORMATION, CONTACT NSIN DEPARTMENT OF ADISON. E WISCONSIN COUNTY 33/2011 IN US SURVEY FEET. TES, GRID BEARINGS AND MAY BE USED AS GROUND TO EIN IS BASED TING HIGHWAY OM RIGHT OF B, RIGHT OF W 2008 AND TH SHEET WAY WAY THE 89°42' 31" E, 31.85' S/L TO R/L GR@EF THIS PLAT AND REL
THE WISCONSIN DEPA
SW REGION - MADISO SCALE,

Schlogel [


OCATION SKETCH NOT TO SCALE

4

FILE NAME : C:\USERS\DOTC4C\DESKTOP\16900521\040401_RP.DWG APPRAISAL PLAT DATE : 12/21/2015

1690-05-21

4.01

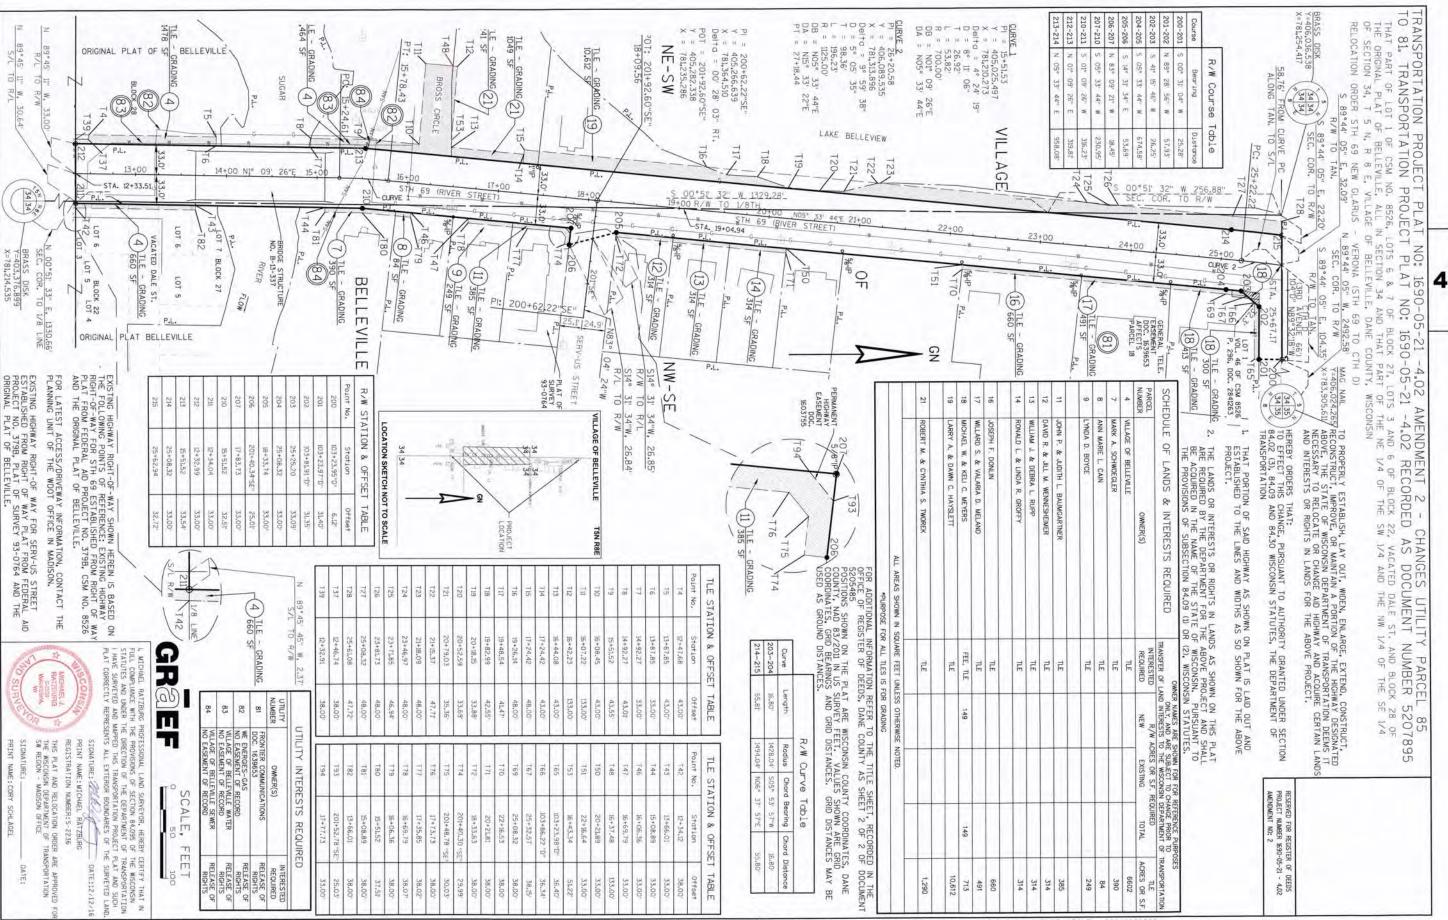

1690-05 2

TRANSPORTATION PROJECT PLAT NO: 1690 THAT PART OF LOT 2 OF BLAZER SUBDIVISION NORTH OF THE SW 1/4 OF THE NE 1/4 OF SECTION 34, T 5 WISCONSIN PARK : STREET 8 8 E, 1 - 4.03 ET ADDITION. VILLAGE OF ALL IN SECTION 34 BELLEVILLE, DANE COUNTY, PART

RELOCATION ORDER NEW GLARUS VERONA $\frac{1}{0}$

 \bigcirc

유표

THIS IS A COPY, ORIGINAL DOCUMEN' IS FILED AT THE COUNTY REGISTER OF DEEDS


TO PROPERLY ESTABLISH, LAY OUT, WIDEN, ENLARGE, EXTEND, CONSTRUCT, RECONSTRUCT, IMPROVE, OR STATE OF WISCONSIN DEPARTMENT OF TRANSPORTATION DEEMS IT NECESSARY TO RELOCATE OR CHANGE RIGHTS IN LANDS FOR THE ABOVE PROJECT. MAINTAIN AID HIGHW THE HIGHWAY DESIGNATED ABOVE, IRE CERTAIN LANDS AND INTERESTS


HEREBY ORDERS THAT: TO EFFECT THIS CHANGE, PURSUANT AND DEF 유

THAT PORTION OF SAID HIGHWAY AS SHOWN ON PLAT IS LAID OUT AND ESTABLISHED TO AND WIDTHS AS SO

THE LANDS OR INTERESTS OR RIGHTS IN LANDS AS SHOWN ON THIS IN THE NAME OF THE STATE OF WISCONSIN. PURSUANT TO THE PR

ARE REQUIRED BY US OF SUBSECTION AND SHALL BΕ

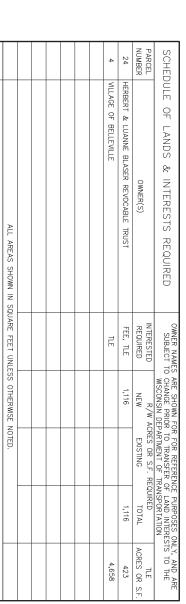

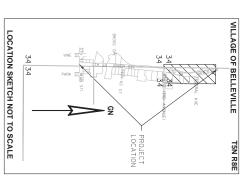

STH 69 (RIVER STREET)

70.21	35.82	51.08	†ion	OFFSET	SCALE		- PROJECT LOCATION	T5N R8E
52.39'	49.38'	47.72'	Offset	TABLE	11	2552 741	R = 19. R = 112 DB = N DA = N PC = 2	CURVE PI = 2 Y = 40 X = 78 Del+a D = 50 T = 98
					32	102+82.75"D" 406,041.591 781,454.301 = 2° 54' 39" 28° 38' 52" 5.08' 10,16' 200.00' \$87° 33' 03"Y	96.23' 125.00' N05° 33' 44"E N15° 33' 22"E 25+22.22	26+20.58 26+20.58 406,089.535 781,313.896 = 9° 59' 38'' 5° 05' 35'' 98.36'

66'

VILLAGE

CURVE 4

CSM 4123 DOC. 1784284 V-17, P-184

TION &

LAKE BELLEVILLE


'' 41" E, 25.40' I. TO R/W

SW-NE

< ₹	· · · m =
CURVE 6 PI = 102+57,72"D" Y = 406,042.661 X = 781,479.311 Del+d = 2° 56' 33" D = 28° 38' 52" T = 10.27' R = 200.00' DB = N89° 30' 23"W DA = \$87° 33' 03'W	CURVE 3 PI = 28+59.46 Y = 406,320,149 X = 781,378.094 Delta = 8° 11' 59" D = 3° 49' 11" T = 107.52' L = 214.67' R = 1500.00' DB = N15° 33' 22"E DA = N07° 21' 23"E
PI = 100+00 Y = 406,04 X = 781,733 PI = 104+26 Y = 406,04 X = 781,310	CURVE 4 PI = 30+62. Y = 406,521 X = 781,404 Del+a = 18° D = 9° 52' T = 95.82' L = 189,92' R = 580,00' DB = N07° DA = N11° 2

R/W STA	R/W STATION & OFFSET	1 .
Point No.	Station	Offset
301	28+70.21	28,65
302	27+39.82	29.90
303	27+41.19	35.00
304	27+18.45	35.00
305	26+57,60	35.01
306	103+50.07"D"	34.62
307	103+23.95"D"	6,12'
308	25+62.94	32.72
309	26+96,18	34.39
310	28+70,21	37.39

	R/W Cu	R/W Curve Table	
g+h	Radius	Radius Chord Bearing Chord Distance	Chord Distance
96'	1093.93'	1093.93' S13° 59' 41"W	58,95'
.19'	1494.04'	1494.04' N10° 19' 59''E	137.15'

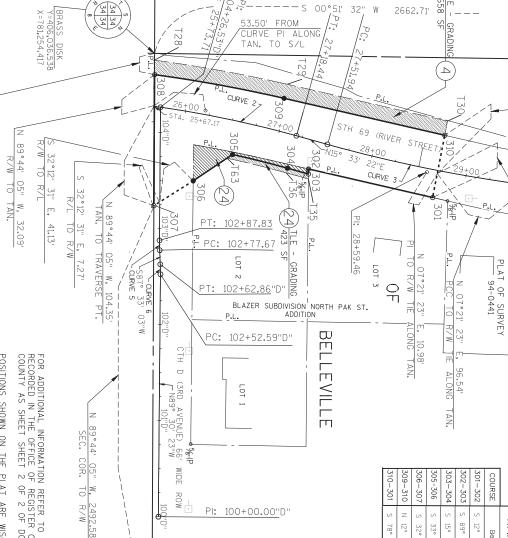

		₹	0	일	S O	7	R/W Course Table
COURSE		Be	Bearing	Ď			Distance
301-302	S	S 12° 57' 50"	57:	50"	W		132.66'
302-303	S	.68	28	28' 56"	ш		5,28'
303-304	S	15°	331	15° 33' 22" W	W		22.74'
305-306	S	33°	53	33° 53' 41''	Е		49,35'
306-307	S		32° 12' 31"	31"	Е		48.40'
309-310	z	N 12° 57' 50"	57:	50"	т		171.82'
310-301	S	78°	57	S 78° 57' 41" E	т	\vdash	66.04'

	-301	-310	-307	-306	-304	-303	-302 S 12° 57' 50" W
	S	z		S	S	S	S
	78°	12°	320	33°	15°	S 89°	12°
	57	57:	12	53	33	28	57:
	S 78° 57' 41" E	N 12° 57' 50" E	S 32° 12' 31" E	S 33° 53' 41" E	15° 33' 22" W	28' 56"	50"
	ш	т	т	т	W	Е	W
	66.04'	171.82'	48.40'	49,35'	22,74"	5,28'	132.66'
7	30		1				

34 35	5)		
	MAG NAIL Y=406,024,265 X=783,905,611		
	L 24.265 05,611		

POSITIONS SHOWN ON THE PLAT ARE WISCONSIN COUNTY COORDINATES, DANE COUNTY, NAD 83/2011 IN US SURVEY FEET. VALUES SHOWN ARE GRID COORDINATES, GRID BEARINGS AND GRID DISTANCES. GRID DISTANCES MAY BE USED AS GROUND DISTANCES. R ADDITIONAL INFORMATION REFER TO THE TITLE SHEET, SORDED IN THE OFFICE OF REGISTER OF DEEDS, IN DANE JUTY AS SHEET SHEET 2 OF 2 OF DOCUMENT 5205485.

TING HIGHWAY RIGHT-OF-WAY SHO FOLLOWING POINTS OF REFERELY T-OF-WAY FOR STH 69 ESTABLY T FROM FEDERAL AID PROJECT N DIVISION AND CSM NO. 4123. SHOWN HEREN IS BASED ON RENCE: EXISTING HIGHWAY BLISHED FROM RIGHT OF WAY T NO. 379B, BLAZER

FOR LATEST ACCESS/DRIVEWAY INFORMATION, CONTACT PLANNING UNIT OF THE WDOT OFFICE IN MADISON. ΞH

4



SURVEYED AND MAPPED THIS T	TES AND UNDER THE DIRECTION OF THE DEPARTMENT OF TRANSF	COMPLIANCE WITH THE PROVISIONS OF SECTION 84.095 OF THE WIS	HAEL RATZBURG PROFESSIONAL LAND SURVEYOR, HEREBY CERTIFY	
SURVEYED AND MAPPED THIS TRANSPORTATION PROJECT PLAT A	OF THE DEPARTMENT OF TRANS	S OF SECTION 84.095 OF THE W	LAND SURVEYOR, HEREBY CERTIF	SCALE, FEET

THIS PLAT AND RELOC THE WISCONSIN DEPAR SW REGION - MADISON SIGNATURE: Schlogel

23"E 17"W

21

PLOT BY : CLARK, CLYDE J

PLOT NAME : PLOT SCALE : *********

DATE: OCT. 2, 2015


TRANSPORTATION PROJECT PLAT NO: 1690-05-21 - 4.04 RELOCATION ORDER STH 69, VILLAGE OF BELLEVILLE, STH 92 TO CTH D


R/W MONUMENT POINT NUMBER AND COORDINATE TABLE


R/W MON	UMENT POINT NUMBER AND) COORDINATE TABLE
POINT	Y	Х
100	404,707.401	781,236.855
101	404,566.690	781,234.013
102	404,520.075	781,245.919
103	404,505.726	781,261.268
104	404,504.933	781,113.385
105	404,520.828	781,150.377
106	404,523.907	781,154.599
107	404,542.445	781,166.510
108	404,547.923	781,167.620
109	404,707.685	781,170.847
200	406,035.804	781,413.057
201	406,010.520	781,412.828
202	406,011.044	781,354.897
203	405,991.313	781,337.586
204	405,974.608	781,335.860
205	405,303.205	781,270.474
206	405,248.538	781,306.366
207	405,251.826	781,278.977


R/W MON	IUMENT POINT NUMBER AN	D COORDINATE TABLE
POINT	Y	X
208	405,250.518	781,278.827
209	405,241.231	781,264.439
210	405,023.562	781,243.241
211	404,707.401	781,236.855
212	404,707.685	781,170.847
213	405,027.433	781,177.305
214	405,981.005	781,270.171
215	406,036.435	781,276.616
301	406,326.151	781,404.576
302	406,196.871	781,374.816
303	406,196.824	781,380.094
304	406,174.919	781,373.996
305	406,117.717	781,359.740
306 406,076.754		781,387.260
307 406,035.804		781,413.057
308	406,036.435	781,276.616
309	406,171.356	781,301.216
310 406,338.795		781,339.761

POSITIONS SHOWN ON THIS PLAT ARE WISCONSIN COUNTY COORDINATES, DANE COUNTY, NAD83/2011 IN US SURVEY FEET. VALUES SHOWN ARE GRID COORDINATES, GRID BEARINGS AND GRID DISTANCES, GRID DISTANCES MAY BE USED AS GROUND DISTANCES.

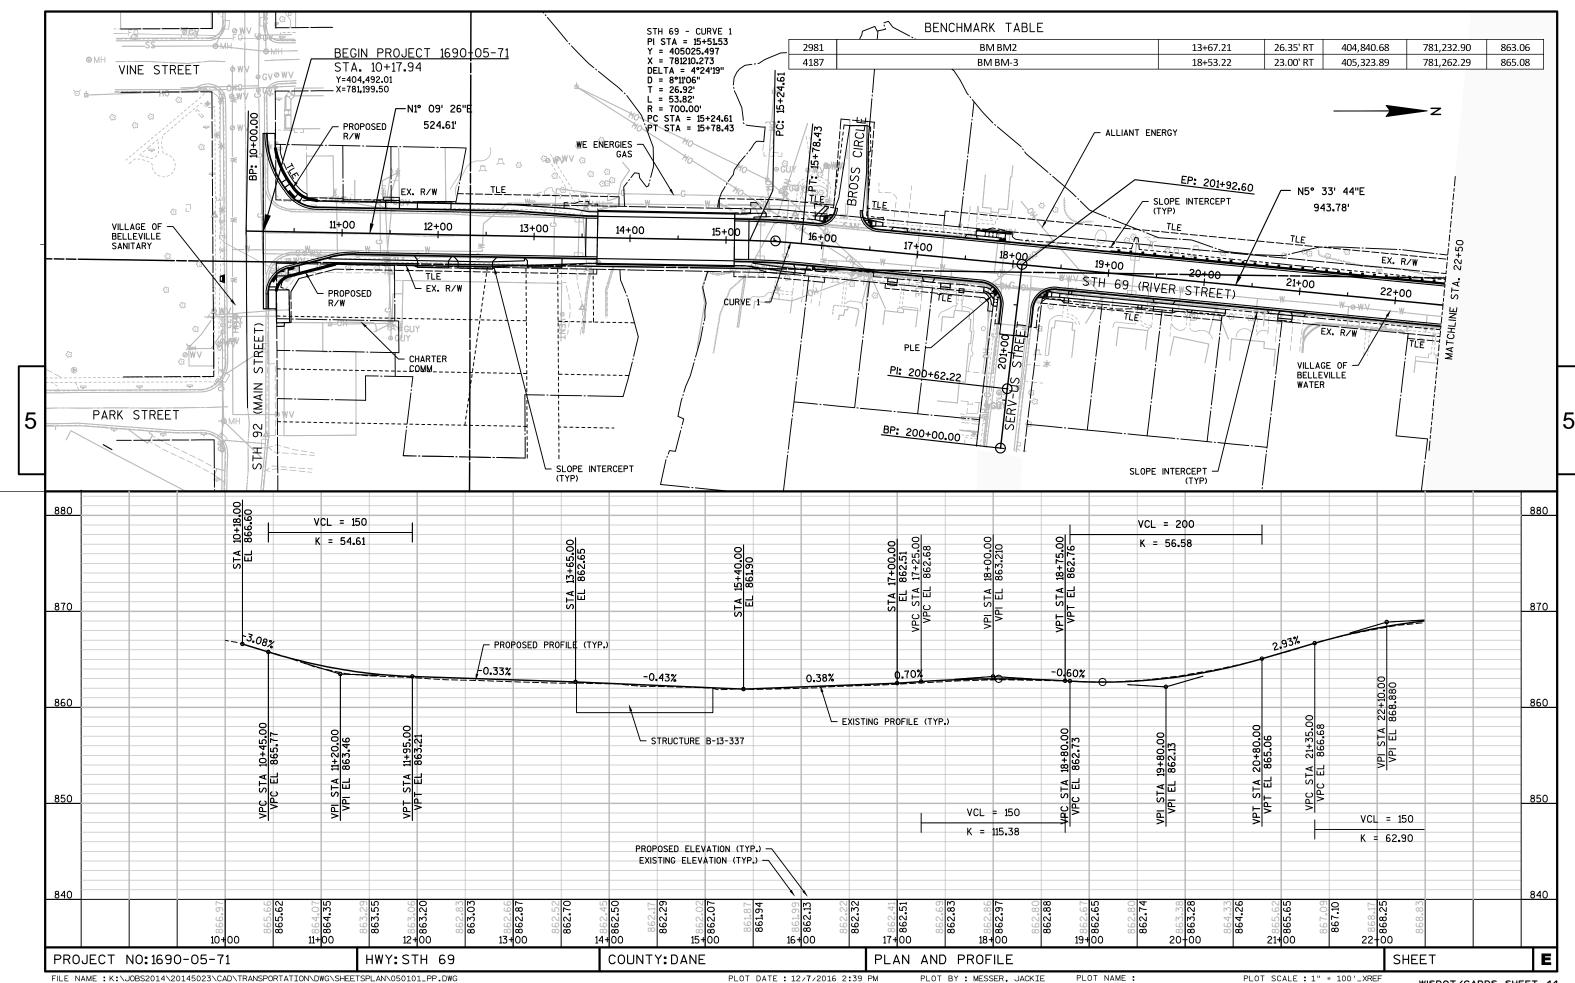

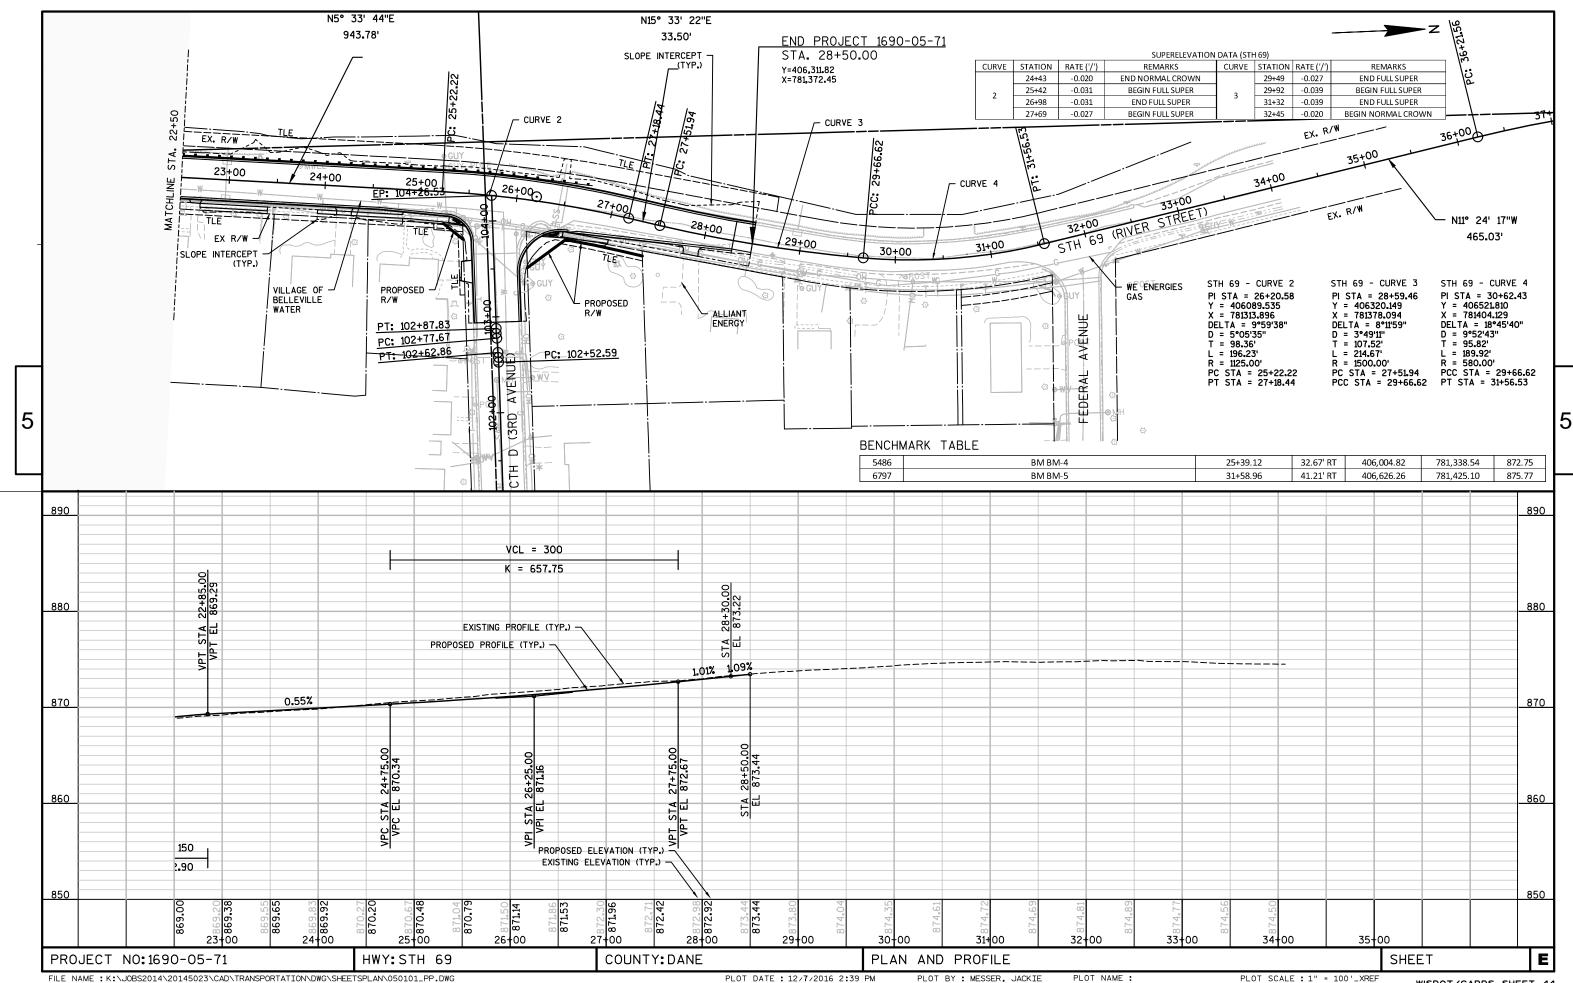

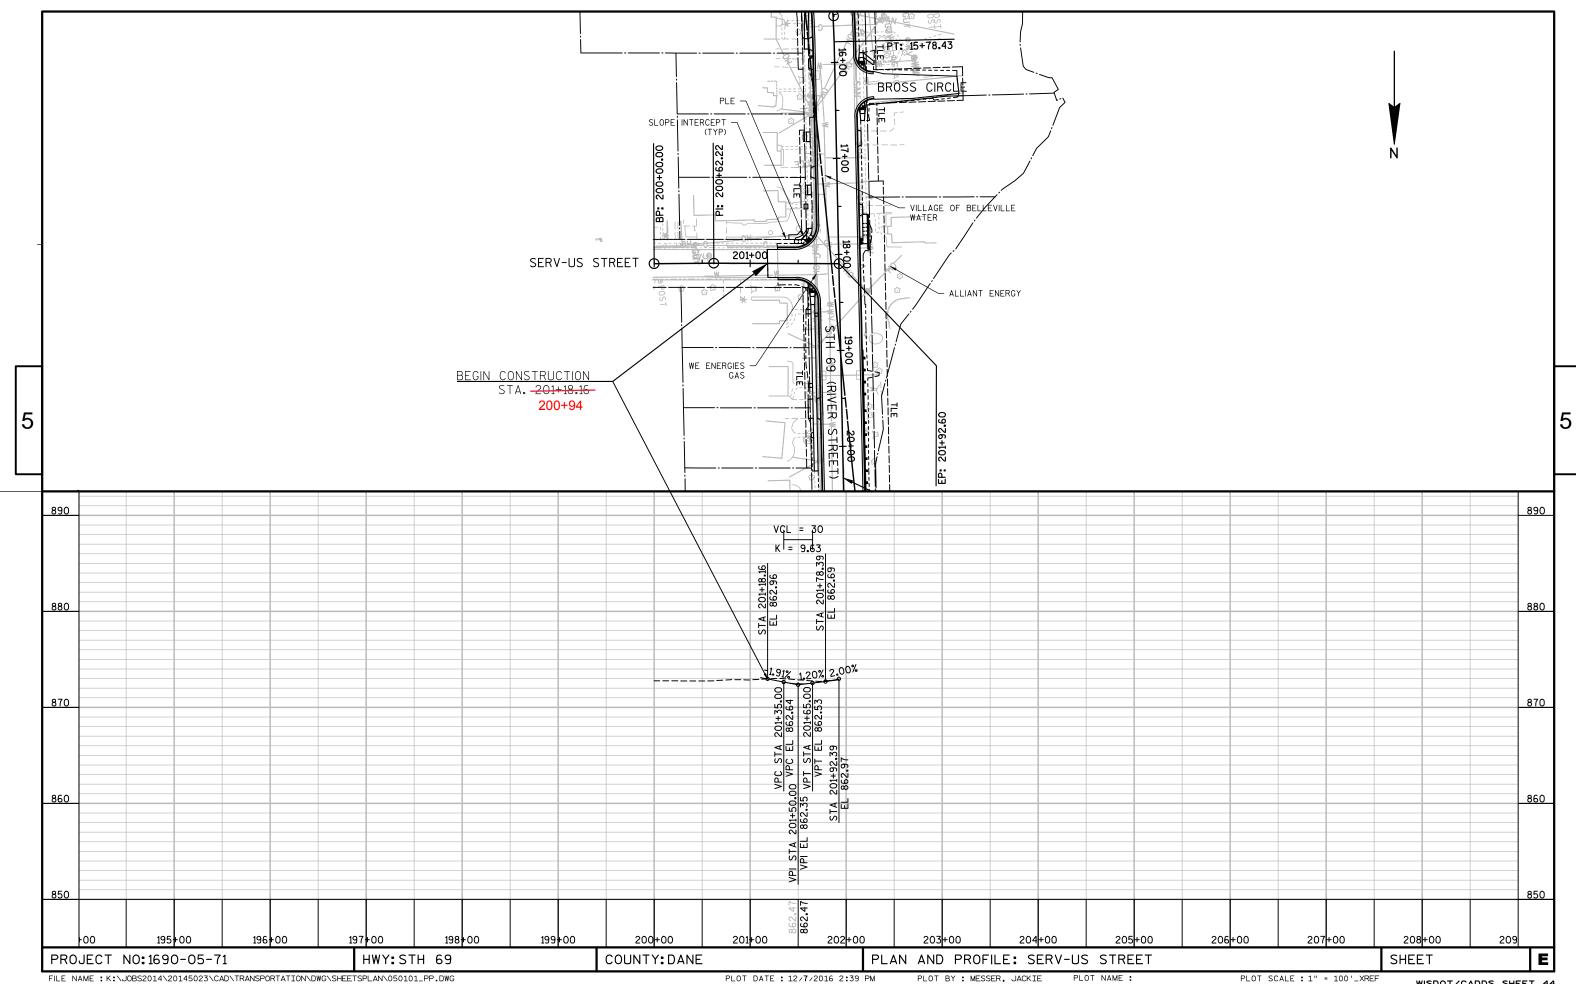


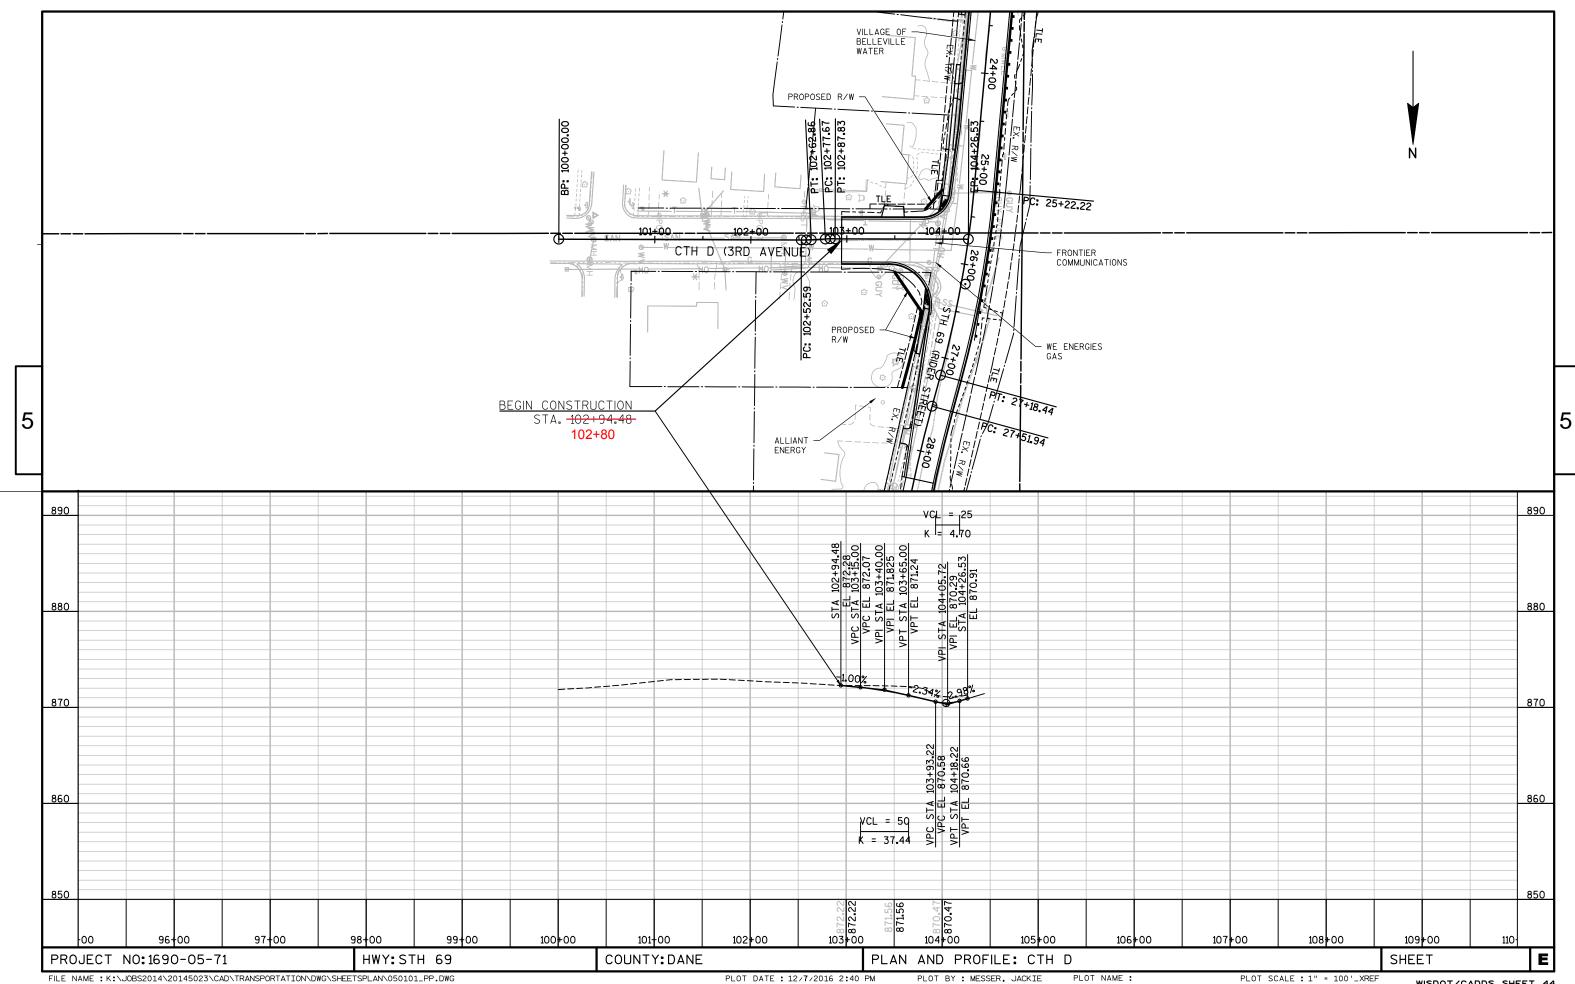


Standard Detail Drawing List

08A05-19A 08A05-19B 08A05-19D 08B09-01 08C06-01 08C07-01 08D01-19	INLET COVERS TYPE A, H, A-S, H-S & Z INLET COVERS TYPE B, B-A, C, MS, MS-A, & WM INLET COVER TYPE BW, MANHOLE COVERS, TYPE K, J, J-S, L & M MANHOLES 3-FT, 4-FT, 5-FT, 6-FT, 7-FT AND 8-FT DIAMETER INLETS 3-FT AND 4-FT DIAMETER INLETS 2X2-FT, 2X2.5-FT, 2X3-FT AND 2.5X3-FT CONCRETE CURB, CONCRETE CURB AND GUTTER AND TIES
08D05-17A	CURB RAMPS TYPES 1 AND 1-A
08D05-17B	CURB RAMPS TYPES 2 AND 3
08D05-17C 08D05-17D	CURB RAMPS TYPES 4A AND 4A1
08D05-17D	CURB RAMPS TYPE 4B AND 4B1
08D05-17E	CURB RAMPS TYPES 5, 6, 7A, 7B & 8
08E09-06	SILT FENCE
08E10-02	INLET PROTECTION TYPE A, B, C AND D
08F01-11 09A01-13B	APRON ENDWALLS FOR CULVERT PIPE AT-GRADE SIDE ROAD INTERSECTION, TYPE "A1" & "A2"
13B02-08A	
14B42-04A	CONCRETE PAVEMENT APPROACH SLAB MIDWEST GUARDRAIL SYSTEM (MGS) GUARDRAIL
14B42-04B	MIDWEST GUARDRAIL SYSTEM (MGS) GUARDRAIL
14B42-04C	MIDWEST GUARDRAIL SYSTEM (MGS) GUARDRAIL
14B44-02A	MIDWEST GUARDRAIL SYSTEM ENERGY ABSORBING TERMINAL (MGS)
14B44-02B	MIDWEST GUARDRAIL SYSTEM ENERGY ABSORBING TERMINAL (MGS)
14B44-02C	MIDWEST GUARDRAIL SYSTEM ENERGY ABSORBING TERMINAL (MGS)
14B47-02A	MIDWEST GUARDRAIL SYSTEM (MGS) TYPE 2 TERMINAL
14B47-02B	MIDWEST GUARDRAIL SYSTEM (MGS) TYPE 2 TERMINAL
14B47-02C	MIDWEST GUARDRAIL SYSTEM (MGS) TYPE 2 TERMINAL
15C02-06A	BARRICADES AND SIGNS FOR MAINLINE CLOSURES
15C02-06B	BARRICADES AND SIGNS FOR MAINLINE CLOSURES
15C02-06C	DETOUR SIGNING FOR MAINLINE CLOSURES
15003-03	BARRI CADES AND SIGNS FOR SIDEROAD CLOSURES
15005-03	TRAFFIC CONTROL, ADVANCE WARNING SIGNS 40 M.P.H. OR LESS
15C07-13A 15C07-13B	PAVEMENT MARKING SYMBOLS
15C07-13B 15C07-13C	PAVEMENT MARKING WORDS PAVEMENT MARKING ARROWS
15C07-13C 15C08-16A	PAVEMENT MARKING (MAINLINE)
15C08-16A	PAVEMENT MARKING (MAINEINE) PAVEMENT MARKING (INTERSECTIONS)
15C08-16E	PAVEMENT MARKING (INTERSECTIONS) PAVEMENT MARKING (LEFT TURN LANE)
15C18-03	MEDIAN ISLAND MARKING
	BI CYCLE LANE MARKING
15C29-04A 15C29-04B	PAVEMENT MARKING FOR SHARED LANE 35 MPH OR LESS
15C33-02	STOP LINE AND CROSSWALK PAVEMENT MARKING
15D12-06A	TRAFFIC CONTROL, LANE CLOSURE
15D21-04	TRAFFIC CONTROL, INTERSECTION WITHIN SINGLE LANE CLOSURE
15D30-03A	TRAFFIC CONTROL, PEDESTRIAN ACCOMMODATION TRAFFIC CONTROL, TEMPORARY ADA COMPLIANT PEDESTRIAN ACCOMMODATION
15D30-03C	TRAFFIC CONTROL, PEDESTRIAN ACCOMMODATION

6

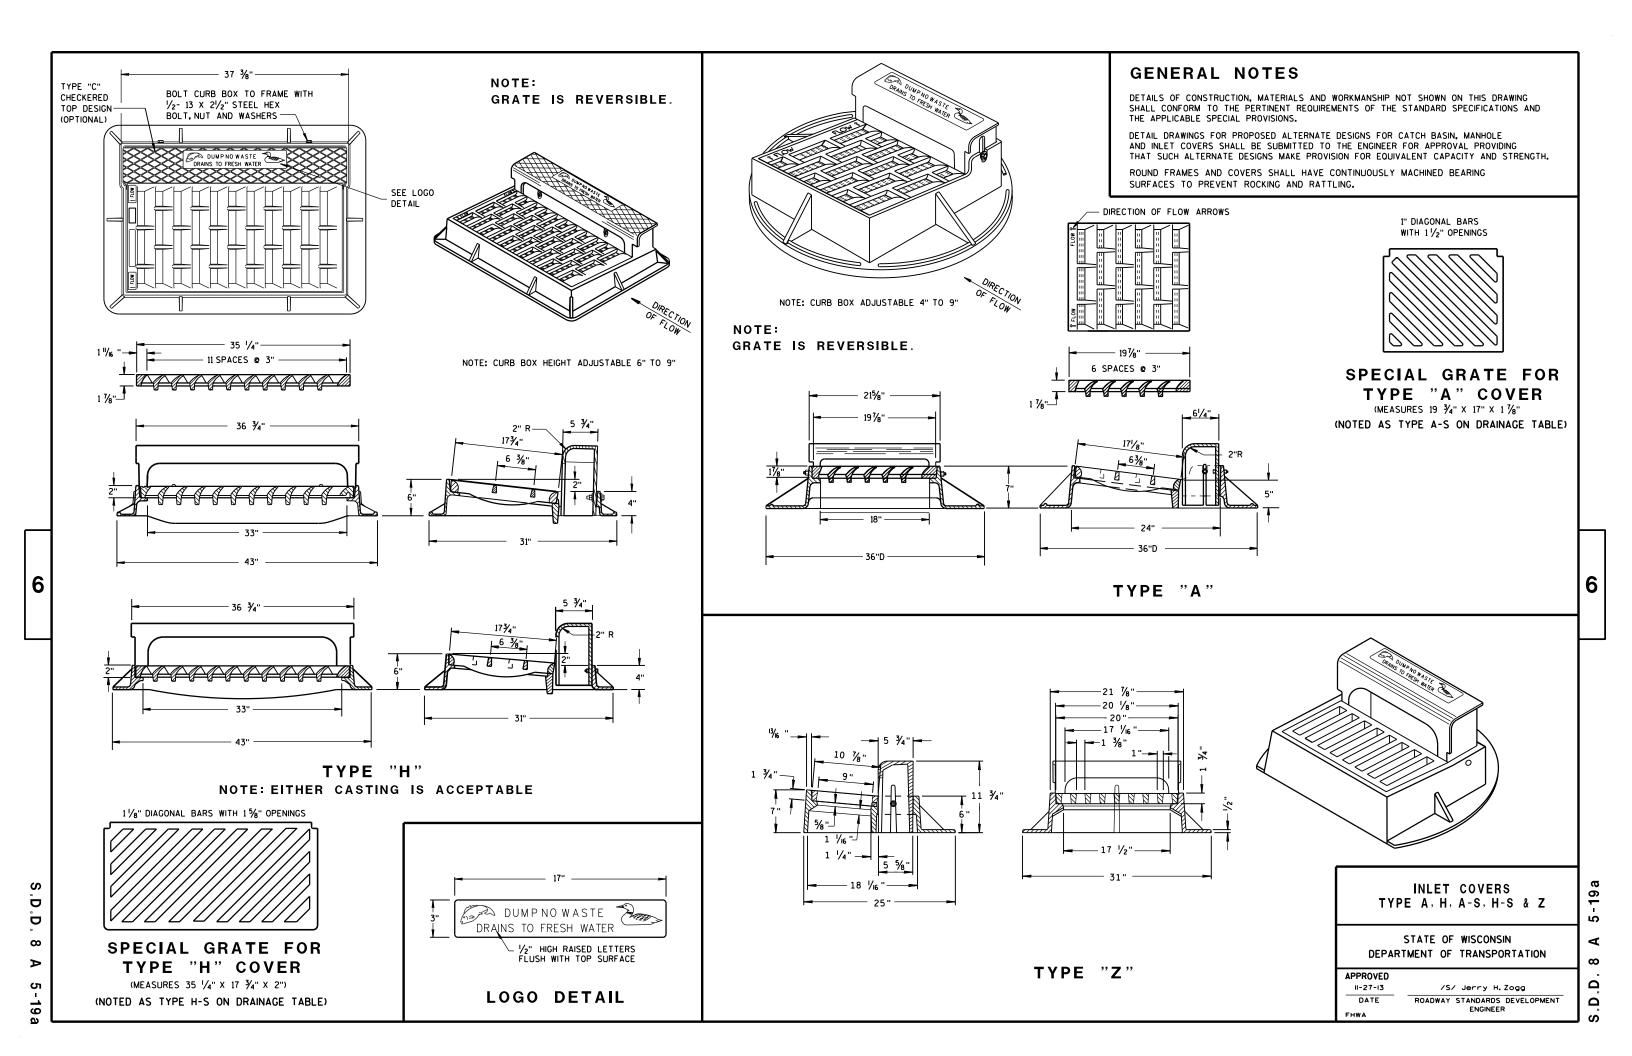

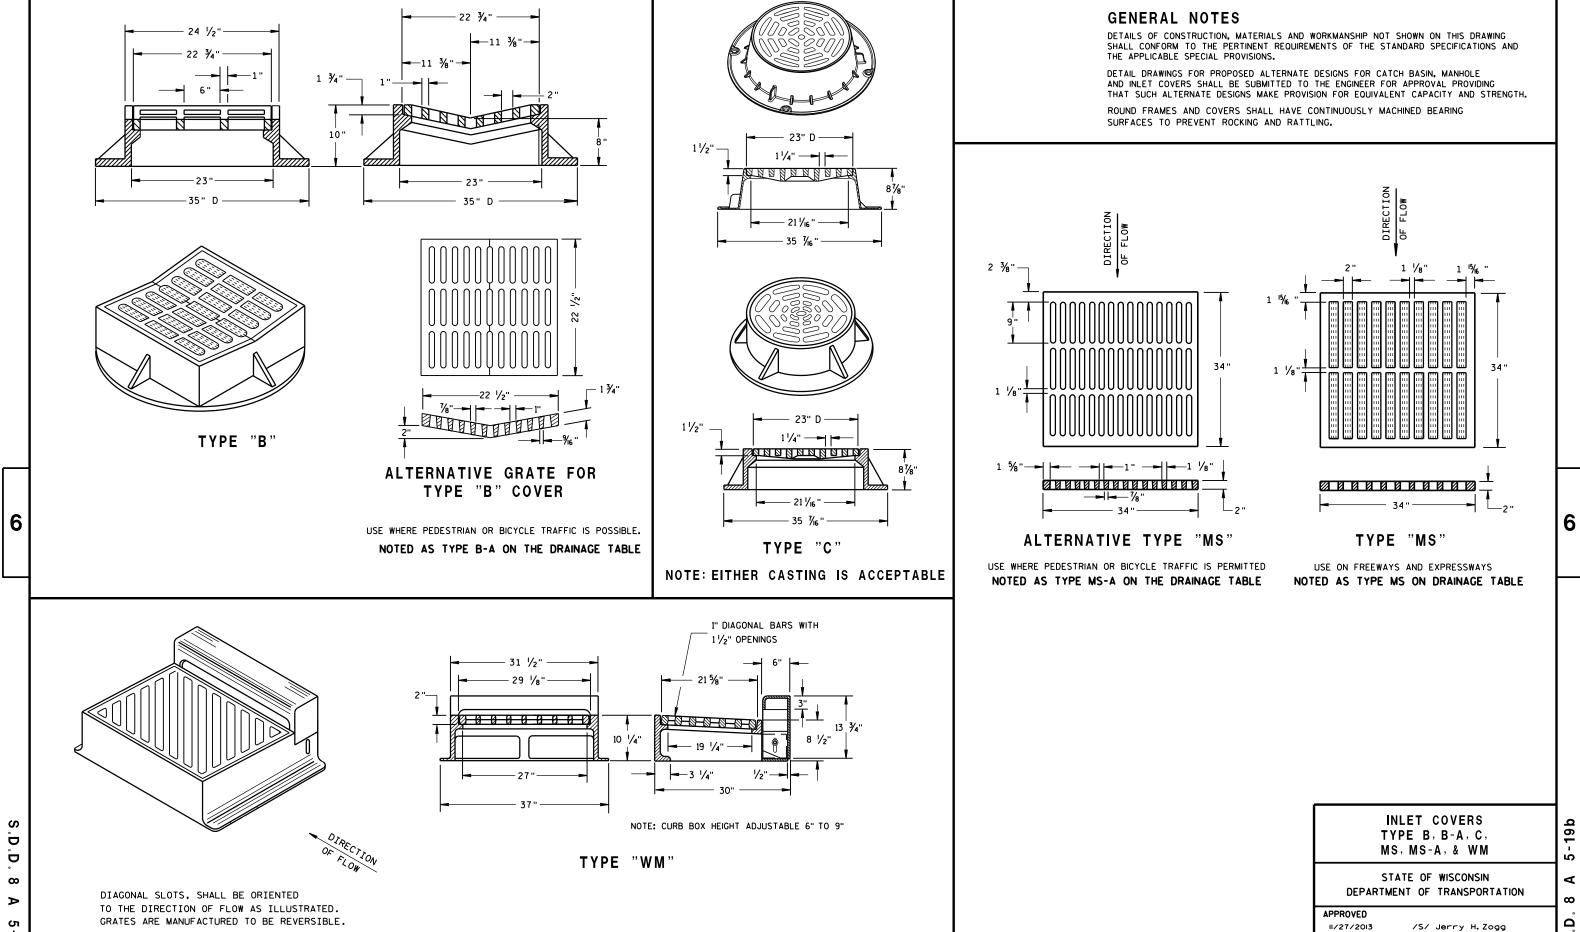


6

Ω

DATE

FHWA

ROADWAY STANDARDS DEVELOPMENT ENGINEER

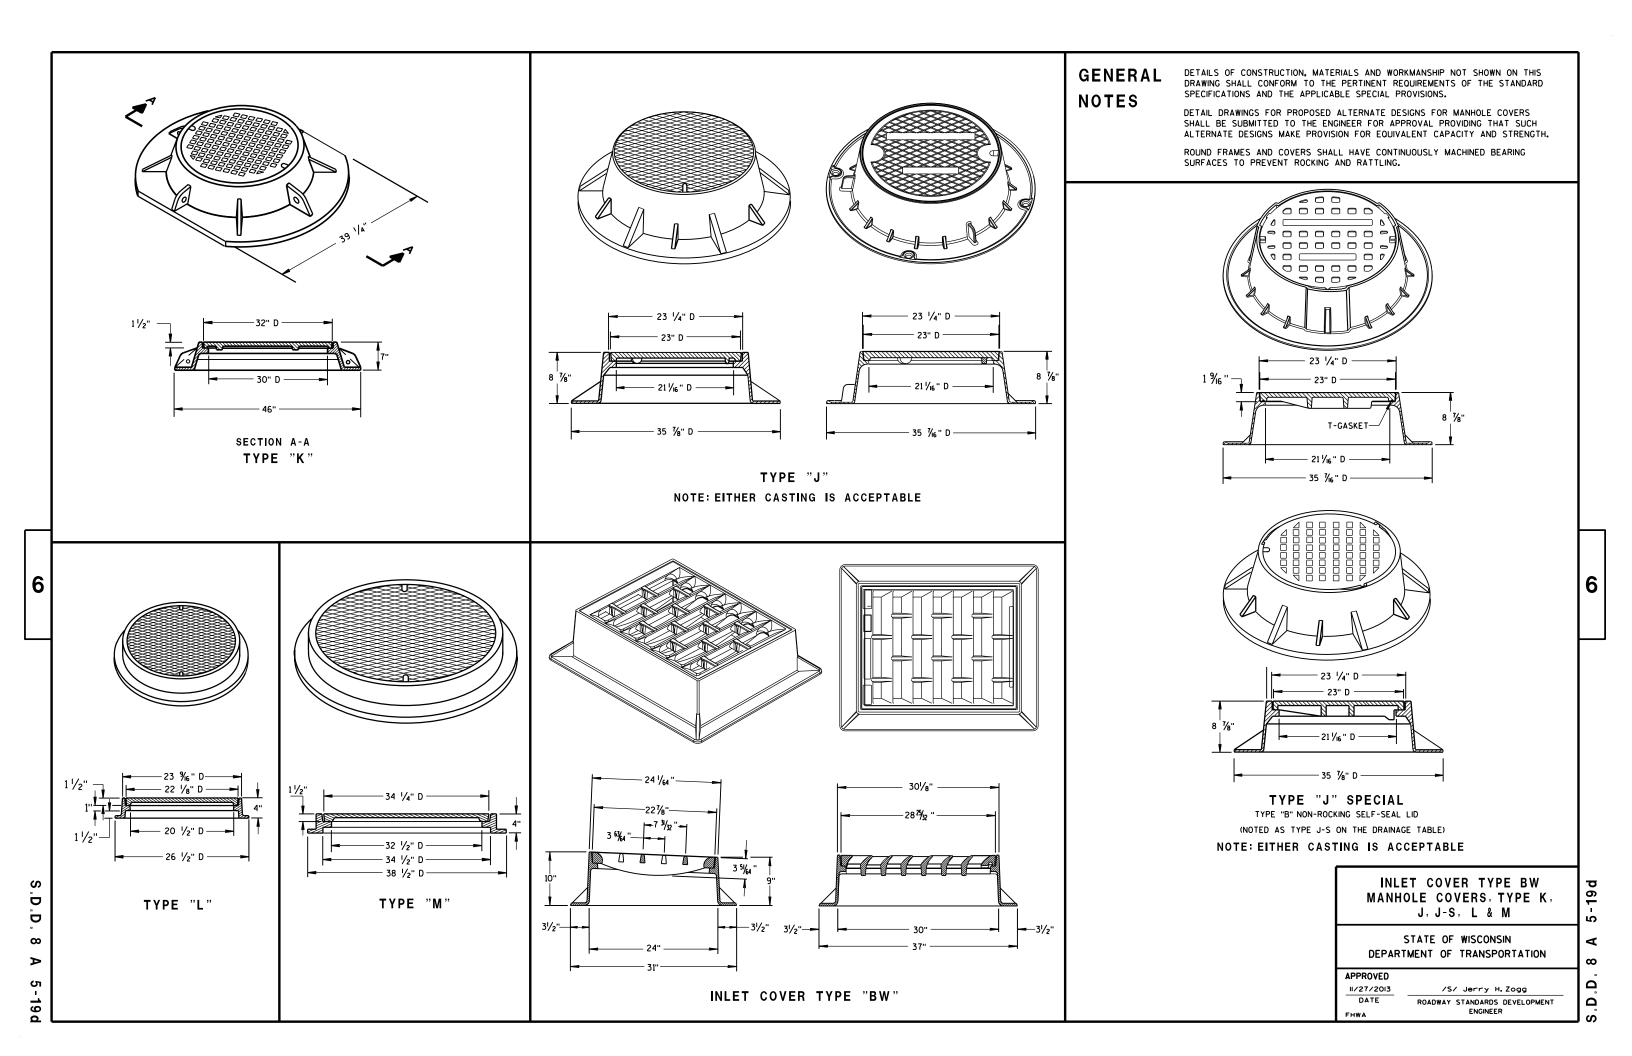



 ∞

Ω

Ω




SEE DETAIL "B"


S




 \Box

ထ

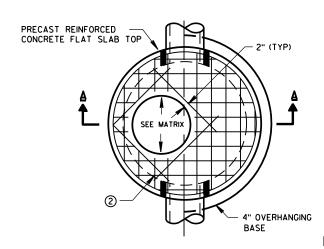

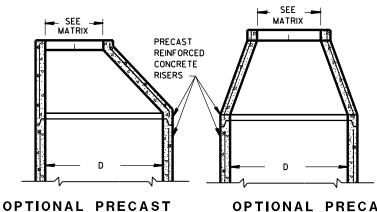

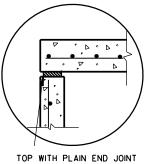

JOINTS TO BE SEALED WITH

PLAN VIEW CIRCULAR OPENING

SEE

MORTAR -

MATRIX

• 4° • •

- PRECAST REINFORCED

CONCRETE FLAT SLAB TOP

1/2" CEMENT

- MORTAR

BEVEL 45°

2 COURSES 으는

12'. EPT

6" BLOCK

4" MIN

PLASTER COAT


REINFORCED CONCRETE **ECCENTRIC TOP**

PRECAST

WALL

OPTIONAL PRECAST REINFORCED CONCRETE CONCENTRIC TOP


A BUTYL RUBBER SEAL PER SEALANT MANUFACTURERS TOP WITH TONGUE AND GROOVE JOINT RECOMMENDATIONS

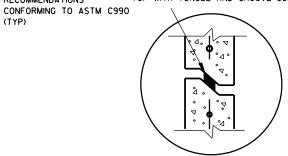




RISER WITH TONGUE AND GROOVE JOINT

DETAIL "B"

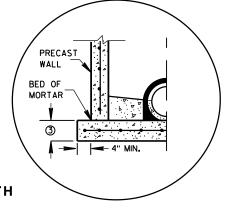



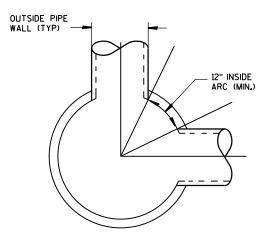

DETAIL "C"

CONCRETE WITH MONOLITHIC BASE

(I)·

CONCRETE

②-

SEE DETAIL "A"

(MIN. SLOPE 1 IN./FT.)

PRECAST REINFORCED CONCRETE BLOCK WITH CAST-IN-PLACE OR PRECAST REINFORCED **CONCRETE BASE 2**

SPLIT PIPE OR FORM CONCRETE TO FIT

DETAIL "A"

MANHOLES 3-FT, 4-FT, 5-FT, 6-FT, 7-FT AND 8-FT DIAMETER

GENERAL NOTES

DETAILS OF CONSTRUCTION, MATERIALS AND WORKMANSHIP NOT SHOWN ON THIS DRAWING SHALL CONFORM TO THE PERTINENT REQUIREMENTS OF THE STANDARD SPECIFICATIONS AND THE APPLICABLE SPECIAL PROVISIONS.

UNLESS OTHERWISE AUTHORIZED IN WRITING BY THE ENGINEER, THE CONTRACTOR SHALL NOT ORDER AND DELIVER PRECAST MANHOLE UNITS REQUIRED FOR THE PROJECT UNTIL A LIST OF SIZES IS FURNISHED BY

DETAILED DRAWINGS FOR PROPOSED ALTERNATE DESIGNS FOR UNDERGROUND DRAINAGE STRUCTURES SHALL BE SUBMITTED TO THE ENGINEER FOR APPROVAL PROVIDING THAT SUCH ALTERNATE DESIGNS MAKE PROVISION FOR EQUIVALENT CAPACITY AND STRENGTH.

ALL DRAINAGE STRUCTURES ARE DESIGNATED ON THE PLANS AS "MANHOLES 3X3-L". "CATCH BASINS 4-B". "INLETS 2X3-H", ETC. THE FIRST NUMBERS DESIGNATE THE SIZE OF THE STRUCTURE, AND THE FOLLOWING LETTER DESIGNATES THE TYPE OF COVER TO BE USED TO COMPRISE THE COMPLETE UNIT.

BASES SHALL BE PLACED ON A BED OF MATERIAL AT LEAST 6 INCHES IN DEPTH, WHICH MEETS THE REQUIREMENTS OF GRANULAR BACKFILL. THIS BEDDING SHALL BE COMPACTED AND PROVIDE UNIFORM SUPPORT FOR THE ENTIRE AREA OF THE BASE.

PRECAST REINFORCED CONE TOPS (ECCENTRIC OR CONCENTRIC) OR PRECAST REINFORCED FLAT SLAB TOPS MAY BE USED ON CONCRETE BLOCK STRUCTURES. THE CONE TOPS SHALL BE INSTALLED ON A BED OF MORTAR.

ECCENTRIC CONE TOPS MAY BE USED ON ALL STRUCTURES, AND CONCENTRIC CONE TOPS SHALL BE USED ONLY ON STRUCTURES 5 FEET OR LESS IN DEPTH, UNLESS OTHERWISE DIRECTED BY THE ENGINEER.

STEPS MEETING AASHTO M199 AND THE FOLLOWING REQUIREMENTS SHALL BE INSTALLED IN ALL STRUCTURES OVER 5 FEET IN DEPTH: 16 INCH C-C MAXIMUM SPACING: PROJECT A MINIMUM CLEAR DISTANCE OF 4 INCHES FROM THE WALL AT THE POINT OF EMBEDMENT; MINIMUM LENGTH OF 10 INCHES; MINIMUM WALL EMBEDMENT OF 3 INCHES. FERROUS METAL STEPS NOT PAINTED OR TREATED TO RESIST CORROSION SHALL HAVE A MINIMUM CROSS SECTIONAL DIMENSION OF 1 INCH.

STEPS OF APPROVED POLYPROPYLENE PLASTIC COATED REINFORCEMENT BAR ARE ACCEPTABLE. REINFORCING BAR MUST BE A MINIMUM OF 1/2" AND MEET THE REQUIREMENTS OF ASTM A615.

CERTIFICATION SHALL BE PROVIDED THAT INSTALLED STEPS WHEN TESTED IN ACCORDANCE WITH SECTION 10 OF AASHTO T280 CAN WITHSTAND A VERTICAL LOAD OF 800 LBS. AND A HORIZONTAL LOAD OF 400 LBS.

ALL BAR STEEL REINFORCEMENT SHALL BE EMBEDDED 2 INCHES CLEAR UNLESS OTHERWISE SHOWN OR NOTED.

CONCRETE BLOCK WILL NOT BE PERMITED FOR STRUCTURES GREATER THAN 4 FEET IN DIAMETER.

PRECAST REINFORCED RISERS SHALL HAVE A TONGUE AND GROOVE JOINT WITH TONGUE UP OR DOWN.

ALL PRECAST MANHOLE UNITS SHALL CONFORM TO THE PERTINENT REQUIREMENTS OF AASHTO DESIGNATION M 199.

4" OVERHANGING BASES ARE REQUIRED FOR ALL CONCRETE BLOCK INSTALLATIONS. 4" OVERHANG IS REQUIRED WHEN SEPARATE PRECAST BASE IS PROVIDED. OVERHANG IS NOT REQUIRED ON PRECAST STRUCTURES WITH AN INTEGRAL OR MONOLITHIC BASE.

FOR ADDITIONAL CONFIGURATIONS, MAINTAIN A MINIMUM OF 12 INCHES AS MEASURED FROM THE INSIDE OF THE STRUCTURE WALL BETWEEN THE OUTSIDE PIPE WALLS OF ADJACENT PIPES. SEE DETAIL "C".

- MINIMUM WALL THICKNESS SHALL BE 4 INCHES FOR 3-FT. 5 INCHES FOR 4-FT. 6 INCHES FOR 5-FT. 7 INCHES FOR 6-FT, 8 INCHES FOR 7-FT AND 9 INCHES FOR 8-FT DIAMETER PRECAST MANHOLES.
- (2) FOR PRECAST MANHOLES PROVIDE REINFORCING STEEL IN ACCORDANCE TO AASHTO M199.
- (3) PRECAST FLAT SLAB TOPS AND BASES WITH A DIAMETER OF 48" AND LESS SHALL HAVE A MINIMUM THICKNESS OF 6". PRECAST FLAT SLAB TOPS AND BASES WITH A DIAMETER LARGER THAN 48" SHALL HAVE A MINIMUM THICKNESS

MANHOLE COVER OPENING MATRIX

MANHOLE COVER TYPE	С	ALL J'S	К	L	M
OPENING SIZE (FT)					
2 DIA.	х	х		х	
3 DIA.			×		Х

PIPE MATRIX

MANHOLE	MAXIMUM INSIDE PIPE DIAMETER FOR TWO PIPES					
SIZE	180° SEPARATION (IN)	90° SEPARATION (IN)				
3-FT	15	12				
4-FT	24	18				
5-FT	36	24				
6-FT	42	36				
7-FT	48	36				
8-FT	60	42				

MANHOLES 3-FT, 4-FT, 5-FT, 6-FT, 7-FT AND 8-FT DIAMETER

> STATE OF WISCONSIN DEPARTMENT OF TRANSPORTATION

APPROVED	
6/5/2012	/S/ Jerry H.Zogg
DATE	ROADWAY STANDARDS DEVELOPMENT
FHWA	ENGINEER

SEE MATRIX

DISCHARGE PIPE

SECTION A-A

MORTAR

8 (1)

PRECAST REINFORCED

MONOLITHIC BASE

CONCRETE WITH

SEE DETAIL "A"

1/2" CEMENT

CONCRETE

(MIN. SLOPE 1 IN. /FT.)

CONTRACTOR TO PROVIDE DRAWING(S) STAMPED BY A PROFESSIONAL ENGINEER

FOR STEEL REINFORCING DESIGN

CONCRETE BLOCK


OR PRECAST REINFORCED

CONCRETE BASE 2

WITH CAST-IN-PLACE

FOR CAST-IN-PLACE STRUCTURES


PLASTER COAT

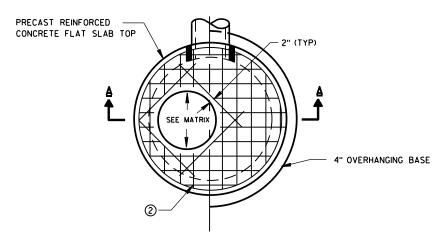

PLAN VIEW CIRCULAR OPENING

JOINTS TO BE SEALED WITH A BUTYL RUBBER SEAL PER SEALANT MANUFACTURERS RECOMMENDATIONS CONFORMING TO ASTM C990 (TYP) PRECAST DISCHARGE WALL TOP WITH PLAIN END JOINT



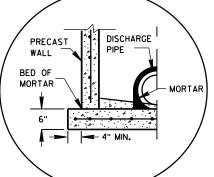

SEPARATE PRECAST REINFORCED

CONCRETE BASE OPTION



TOP WITH TONGUE AND GROOVE JOINT

RISER WITH TONGUE AND GROOVE JOINT

CIRCULAR INLETS W/ FLAT TOP

DETAIL "A"

DETAIL "B"

INLETS 3-FT AND 4-FT DIAMETER

GENERAL NOTES

DETAILS OF CONSTRUCTION, MATERIALS AND WORKMANSHIP NOT SHOWN ON THIS DRAWING SHALL CONFORM TO THE PERTINENT REQUIREMENTS OF THE STANDARD SPECIFICATIONS AND THE APPLICABLE SPECIAL PROVISIONS.

UNLESS OTHERWISE AUTHORIZED IN WRITING BY THE ENGINEER, THE CONTRACTOR SHALL NOT ORDER AND DELIVER PRECAST INLET UNITS REQUIRED FOR THE PROJECT UNTIL A LIST OF SIZES IS FURNISHED BY THE ENGINEER.

DETAILED DRAWINGS FOR PROPOSED ALTERNATE DESIGNS FOR UNDERGROUND DRAINAGE STRUCTURES SHALL BE SUBMITTED TO THE ENGINEER FOR APPROVAL PROVIDING THAT SUCH ALTERNATE DESIGNS MAKE PROVISION FOR EQUIVALENT CAPACITY AND

ALL DRAINAGE STRUCTURES ARE DESIGNATED ON THE PLANS AS "MANHOLES 3X3-L", "CATCH BASINS 4-B", "INLETS 2X3-H", ETC. THE FIRST NUMBERS DESIGNATE THE SIZE OF THE STRUCTURE, AND THE FOLLOWING LETTER DESIGNATES THE TYPE OF COVER TO BE USED TO COMPRISE THE COMPLETE UNIT.

BASES SHALL BE PLACED ON A BED OF MATERIAL AT LEAST 6 INCHES IN DEPTH, WHICH MEETS THE REQUIREMENTS OF GRANULAR BACKFILL. THIS BEDDING SHALL BE COMPACTED AND PROVIDE UNIFORM SUPPORT FOR THE ENTIRE AREA OF THE BASE.

ALL BAR STEEL REINFORCEMENT SHALL BE EMBEDDED 2 INCHES CLEAR UNLESS OTHERWISE SHOWN OR NOTED.

ALL PRECAST INLET UNITS SHALL CONFORM TO THE PERTINENT REQUIREMENTS OF AASHTO DESIGNATION M199.

PRECAST REINFORCED RISERS SHALL HAVE A TONGUE AND GROOVE JOINT WITH TONGUE UP OR DOWN.


4" OVERHANGING BASES ARE REQUIRED FOR ALL CONCRETE BLOCK INSTALLATIONS. 4" OVERHANG IS REQUIRED WHEN SEPARATE PRECAST BASE IS PROVIDED. OVERHANG IS NOT REQUIRED ON PRECAST STRUCTURES WITH AN INTEGRAL OR MONOLITHIC BASE.

FOR ADDITIONAL CONFIGURATIONS, MAINTAIN A MINIMUM OF 12 INCHES AS MEASURED FROM THE INSIDE OF THE STRUCTURE WALL BETWEEN THE OUTSIDE PIPE WALLS OF ADJACENT PIPES. SEE DETAIL "C".

- (1) MINIMUM WALL THICKNESS SHALL BE 4-IN FOR 3-FT DIAMETER AND 5-IN FOR 4-FT DIAMETER PRECAST INLETS.
- (2) FOR PRECAST CATCH BASINS PROVIDE REINFORCING STEEL IN ACCORDANCE TO AASHTO M199.

INLET COVER OPENING MATRIX

	INLET COVER TYPE	ALL A'S	ALL B'S	BW	С	F	ALL H'S	S	T	٧	WM	Z
INLET SIZE	OPENING SIZE (FT)											
3-FT	2 DIA.				×							х
	2X2	х	х					х		х		
4-FT	2 DIA.				х							х
	2X2	х	x					х		х		
	2X2.5			Х				х	х	Х	Х	
	2X3						х					
	2.5X3					Х						

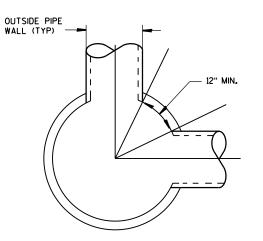

DETAIL "C"

PIPE MATRIX

INLET	MAXIMUM INSIDE P FOR TWO	
SIZE	180° SEPARATION (IN)	90° SEPARATION (IN)
3-FT	15	12
4-FT	24	18

INLETS 3-FT AND 4-FT DIAMETER


STATE OF WISCONSIN DEPARTMENT OF TRANSPORTATION

APPROVED

6/5/2012 /S/ Jerry H. Zogg DATE ROADWAY STANDARDS DEVELOPMENT ENGINEER FHW4

Ö ∞ C

ထ ω Δ Ω

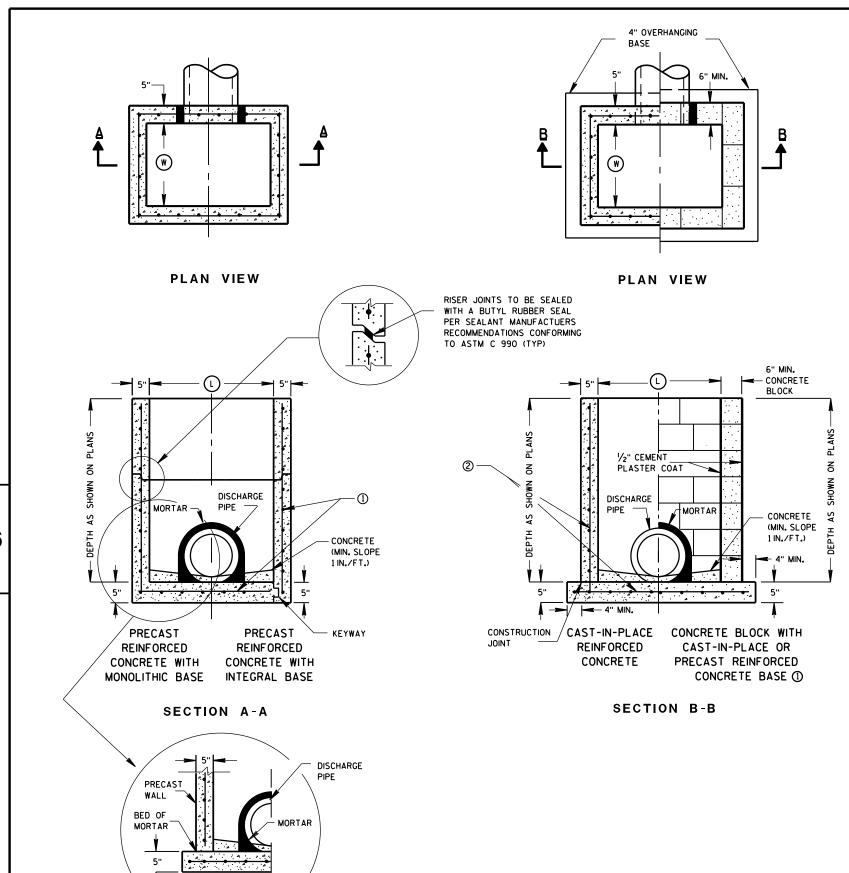

GENERAL NOTES

DETAILS OF CONSTRUCTION, MATERIALS AND WORKMANSHIP NOT SHOWN ON THIS DRAWING SHALL CONFORM TO THE PERTINENT REQUIREMENTS OF THE STANDARD SPECIFICATIONS AND THE APPLICABLE SPECIAL PROVISIONS.

UNLESS OTHERWISE AUTHORIZED IN WRITING BY THE ENGINEER, THE CONTRACTOR SHALL NOT ORDER AND DELIVER PRECAST INLET UNITS REQUIRED FOR THE PROJECT UNTIL A LIST OF SIZES IS FURNISHED BY THE ENGINEER.

DETAILED DRAWINGS FOR PROPOSED ALTERNATE DESIGNS FOR UNDERGROUND DRAINAGE STRUCTURES SHALL BE SUBMITTED TO THE ENGINEER FOR APPROVAL PROVIDING THAT SUCH ALTERNATE DESIGNS MAKE PROVISION FOR EQUIVALENT CAPACITY AND STRENGTH.

ALL PRECAST INLET UNITS SHALL CONFORM TO THE PERTINENT REQUIREMENTS OF ASTM C 913.

ALL DRAINAGE STRUCTURES ARE DESIGNATED ON THE PLANS AS "MANHOLES 3X3-L", "CATCH BASINS 4-B", "INLETS 2X3-H", ETC. THE FIRST NUMBERS DESIGNATES THE SIZE OF THE STRUCTURE, AND THE FOLLOWING LETTER DESIGNATES THE TYPE OF COVER TO BE USED TO COMPRISE THE COMPLETE UNIT.

BASES SHALL BE PLACED ON A BED OF MATERIAL AT LEAST 6 INCHES IN DEPTH, WHICH MEETS THE REQUIREMENTS OF GRANULAR BACKFILL. THIS BEDDING SHALL BE COMPACTED AND PROVIDE UNIFORM SUPPORT FOR THE ENTIRE AREA OF THE BASE.

ALL BAR STEEL REINFORCEMENT SHALL BE EMBEDDED 2 INCHES CLEAR UNLESS OTHERWISE SHOWN OR NOTED.

PRECAST REINFORCED RISERS SHALL HAVE A TONGUE AND GROOVE JOINT WITH TONGUE UP OR DOWN.

- 4" OVERHANGING BASES ARE REQUIRED FOR CAST-IN-PLACE REINFORCED CONCRETE AND CONCRETE BLOCK INSTALLATIONS.
- 4" OVERHANG IS REQUIRED WHEN SEPARATE PRECAST BASE IS PROVIDED.
- OVERHANG IS NOT REQUIRED ON PRECAST STRUCTURES WITH AN INTEGRAL OR MONOLITHIC BASE.

MAXIMUM INSIDE PIPE DIAMETER DETERMINED BY 3 INCH CLEARANCE ON EACH SIDE OF THE OUTSIDE WALL OF THE PIPE. SEE DETAIL "A". ASSUMES PIPE ENTERS PERPENDICULAR TO THE STRUCTURE.


- 1) FOR PRECAST INLETS PROVIDE REINFORCING STEEL IN ACCORDANCE TO ASTM C 913.
- (2) CONTRACTOR TO PROVIDE DRAWING(S) STAMPED BY A PROFESSIONAL ENGINEER FOR STEEL REINFORCING DESIGN FOR CAST-IN-PLACE STRUCTURES.

INLET COVER MATRIX

INLET SIZE		INLET COVER TYPE	ALL A'S	ALL B'S	BW	F	ALL H'S	s	т	v	WM
·	WIDTH (V) (FT)	LENGTH (L) (FT)									
2X2-FT	2	2	Х	х				Х		х	
2X2.5-FT	2	2.5			Х			Х	Х	Х	Х
2X3-FT	2	3					Х				
2.5X3-FT	2.5	3				Х					

PIPE MATRIX

	MAXIMUM INSIDE PIPE DIAMETER						
INLET SIZE	WIDTH (IN)	LENGTH (IN)					
2X2-FT	12	12					
2X2.5-FT	12	18					
2X3-FT	12	24					
2.5X3-FT	18	24					

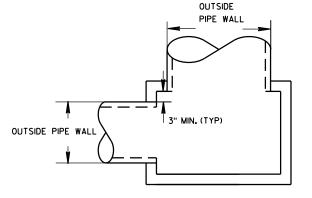

DETAIL "A"

INLETS 2X2-FT, 2X2.5-FT, 2X3-FT AND 2.5X3-FT

STATE OF WISCONSIN DEPARTMENT OF TRANSPORTATION

APPROVED 6/5/2012 DATE

FHWA


/S/ Jerry H. Zogg ROADWAY STANDARDS DEVELOPMENT


ENGINEER


INLETS 2X2-FT, 2X2.5-FT, 2X3-FT AND 2.5X3-FT


SEPARATE PRECAST REINFORCED


CONCRETE BASE OPTION

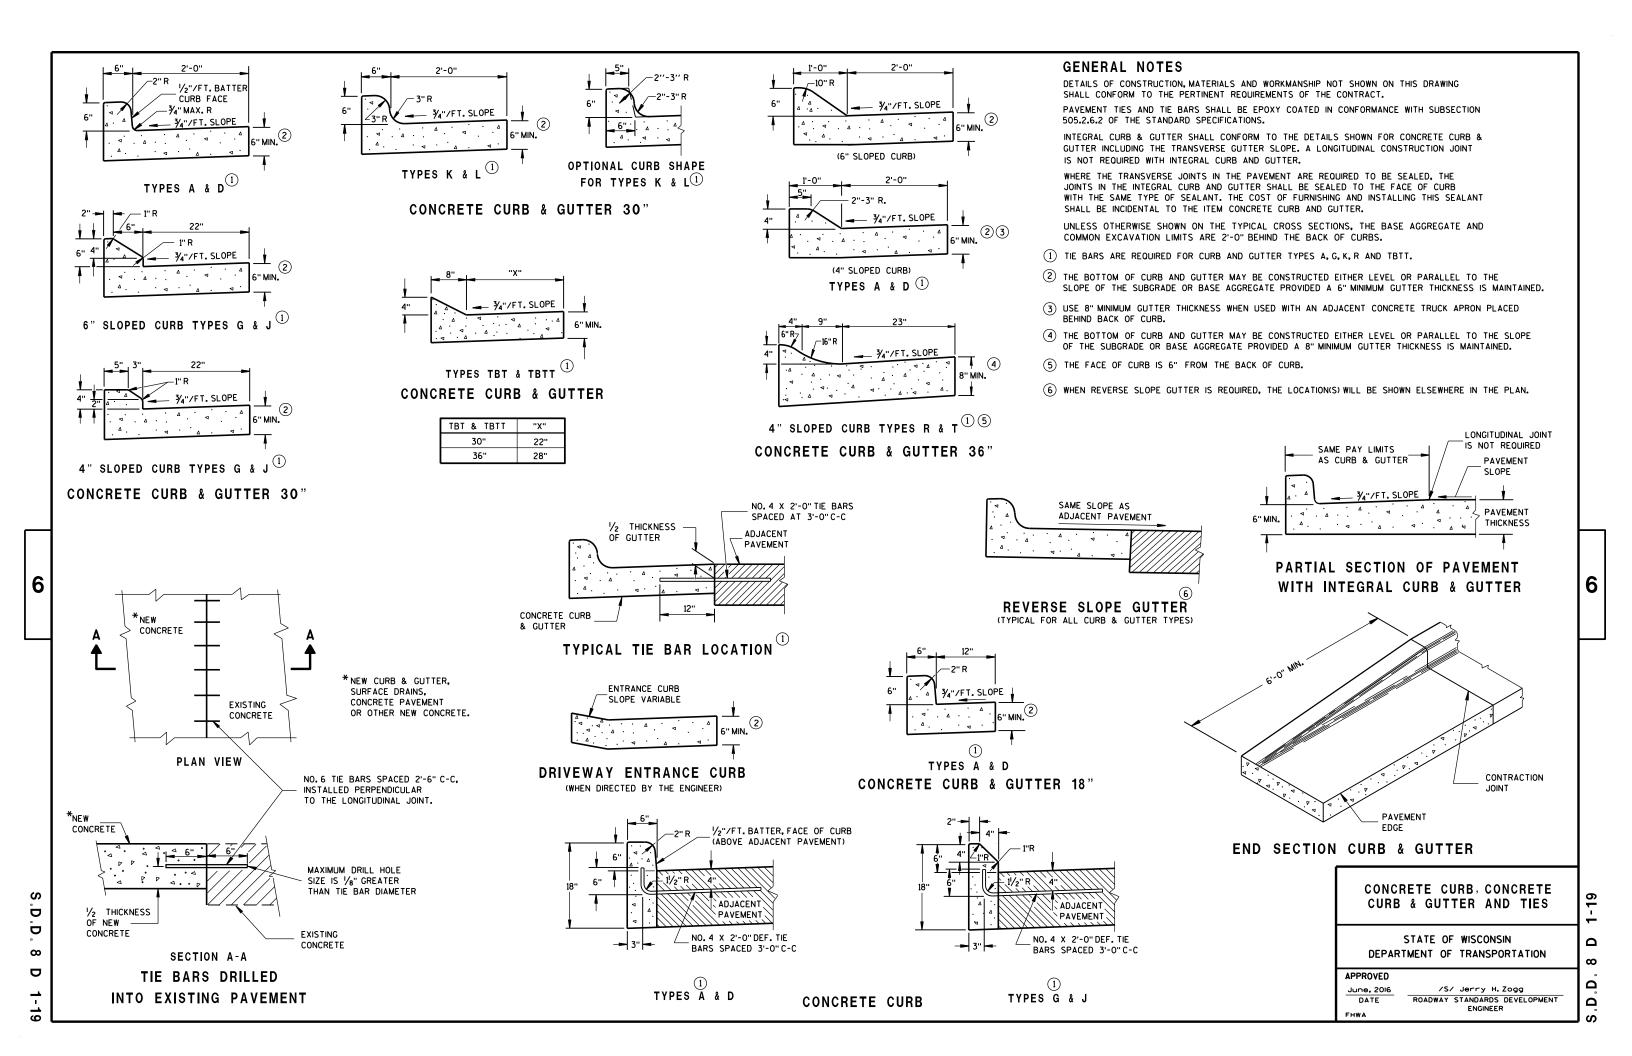

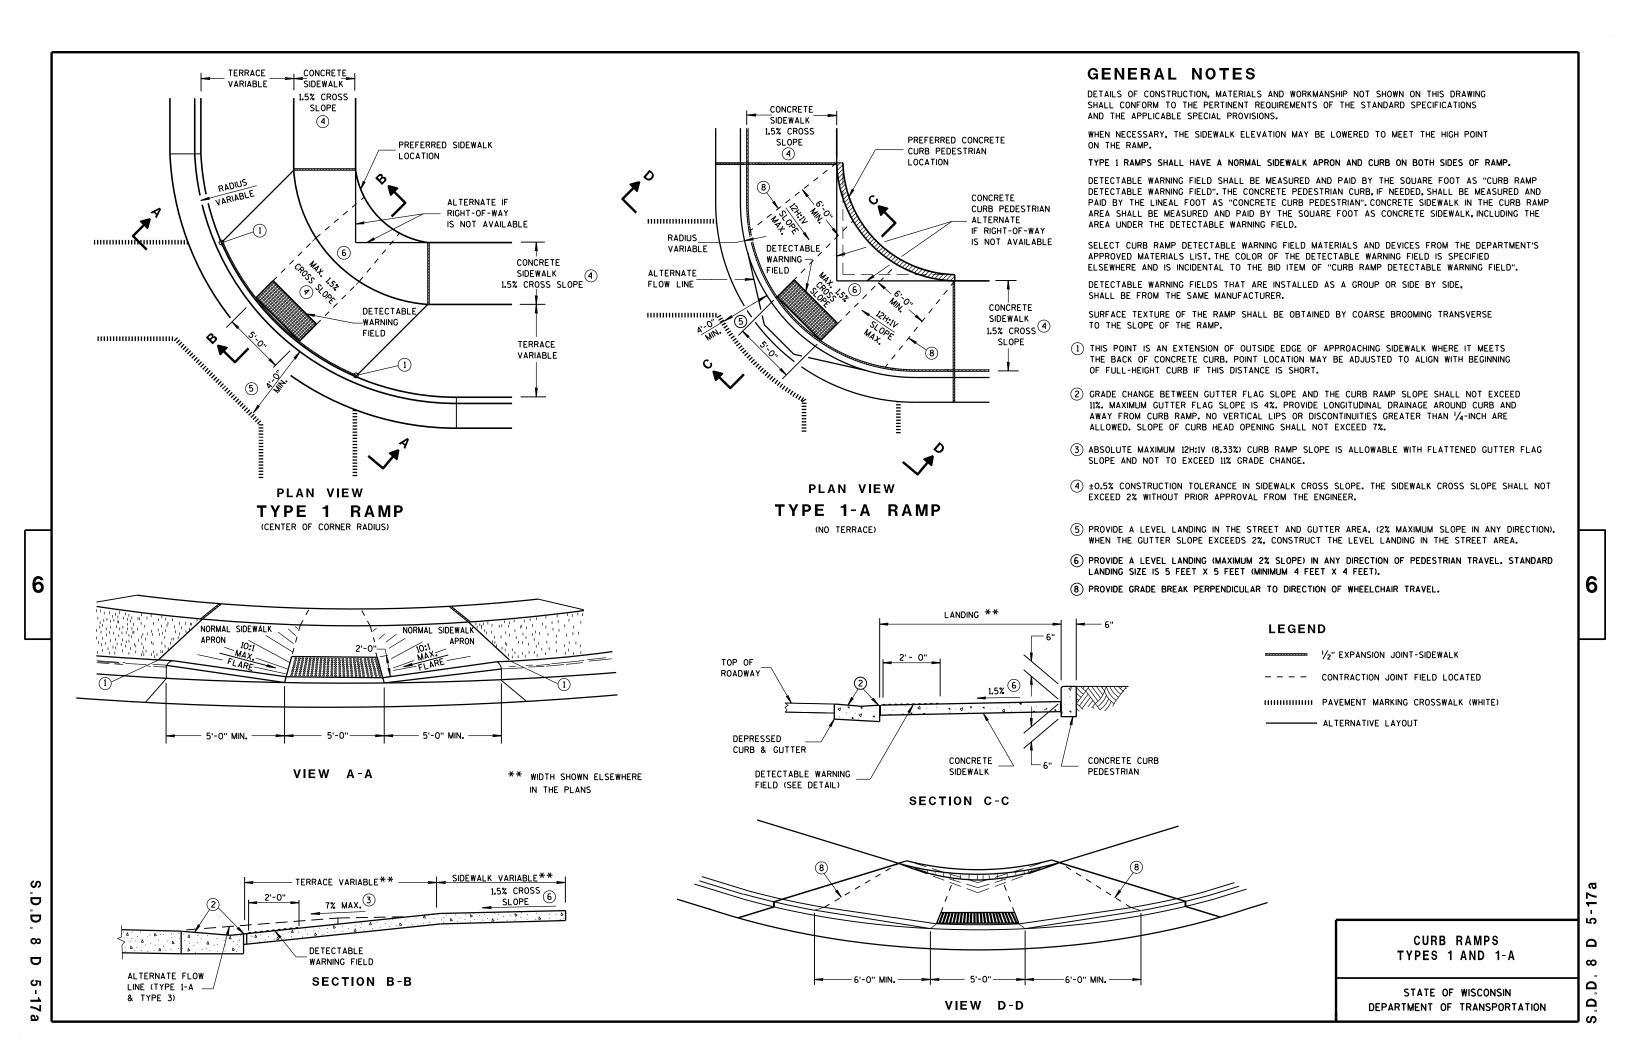

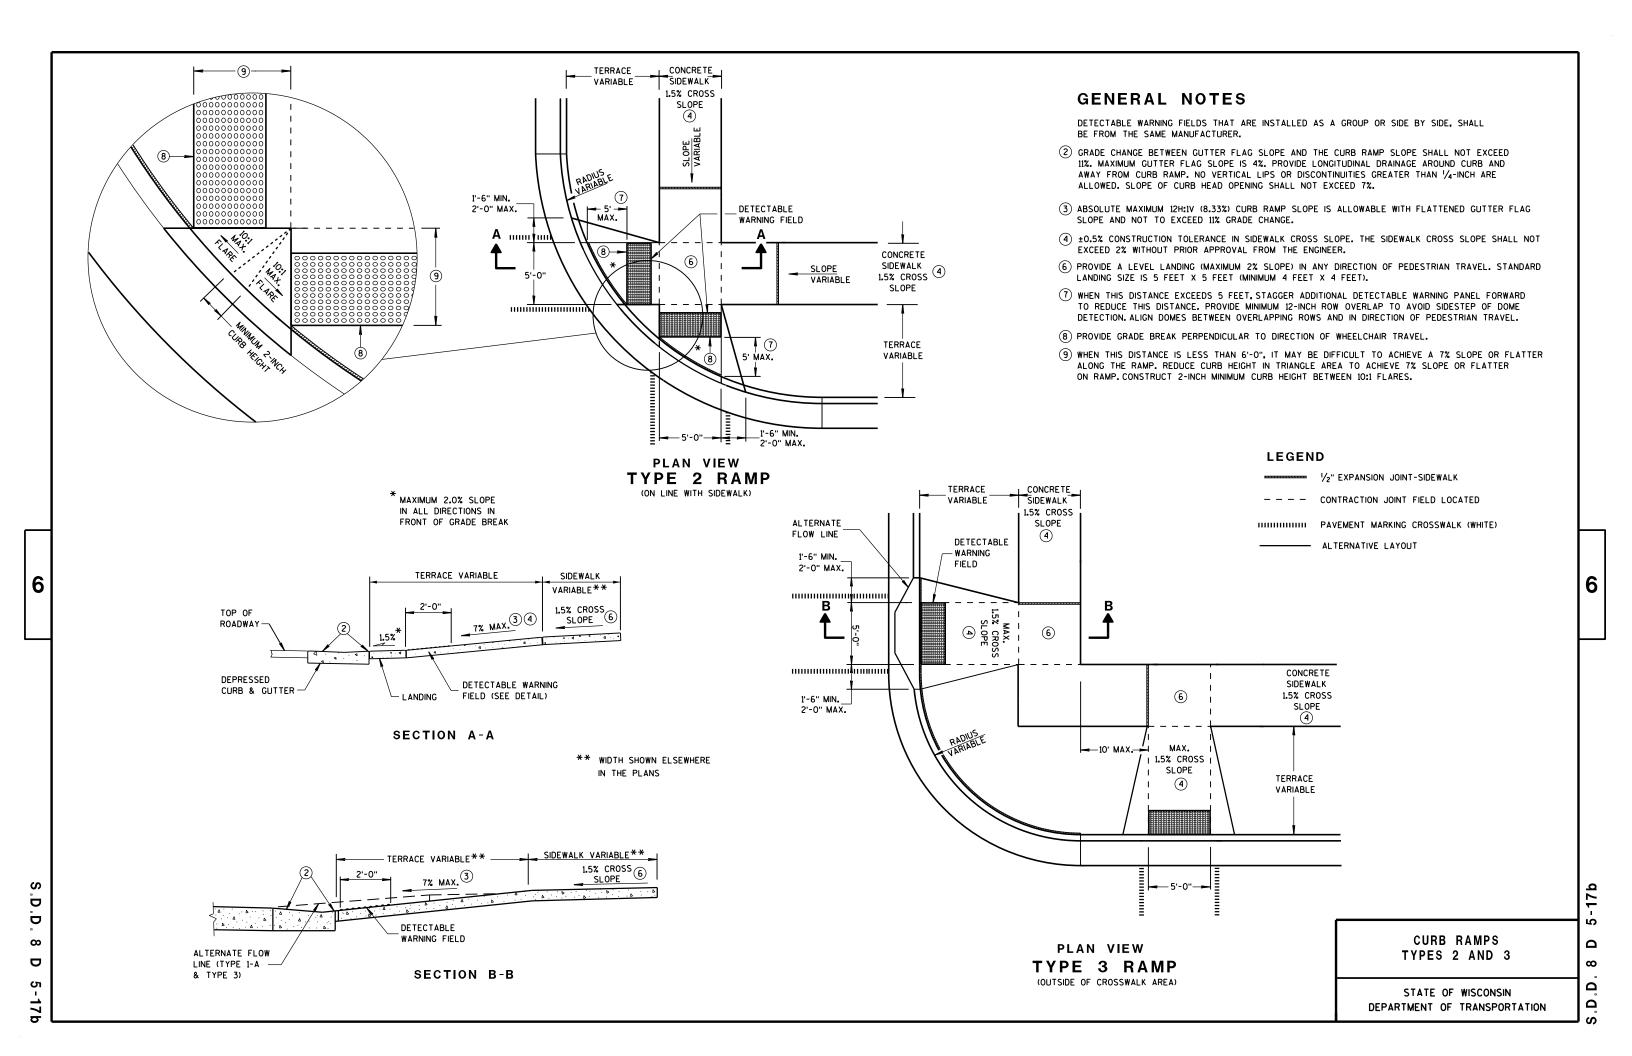

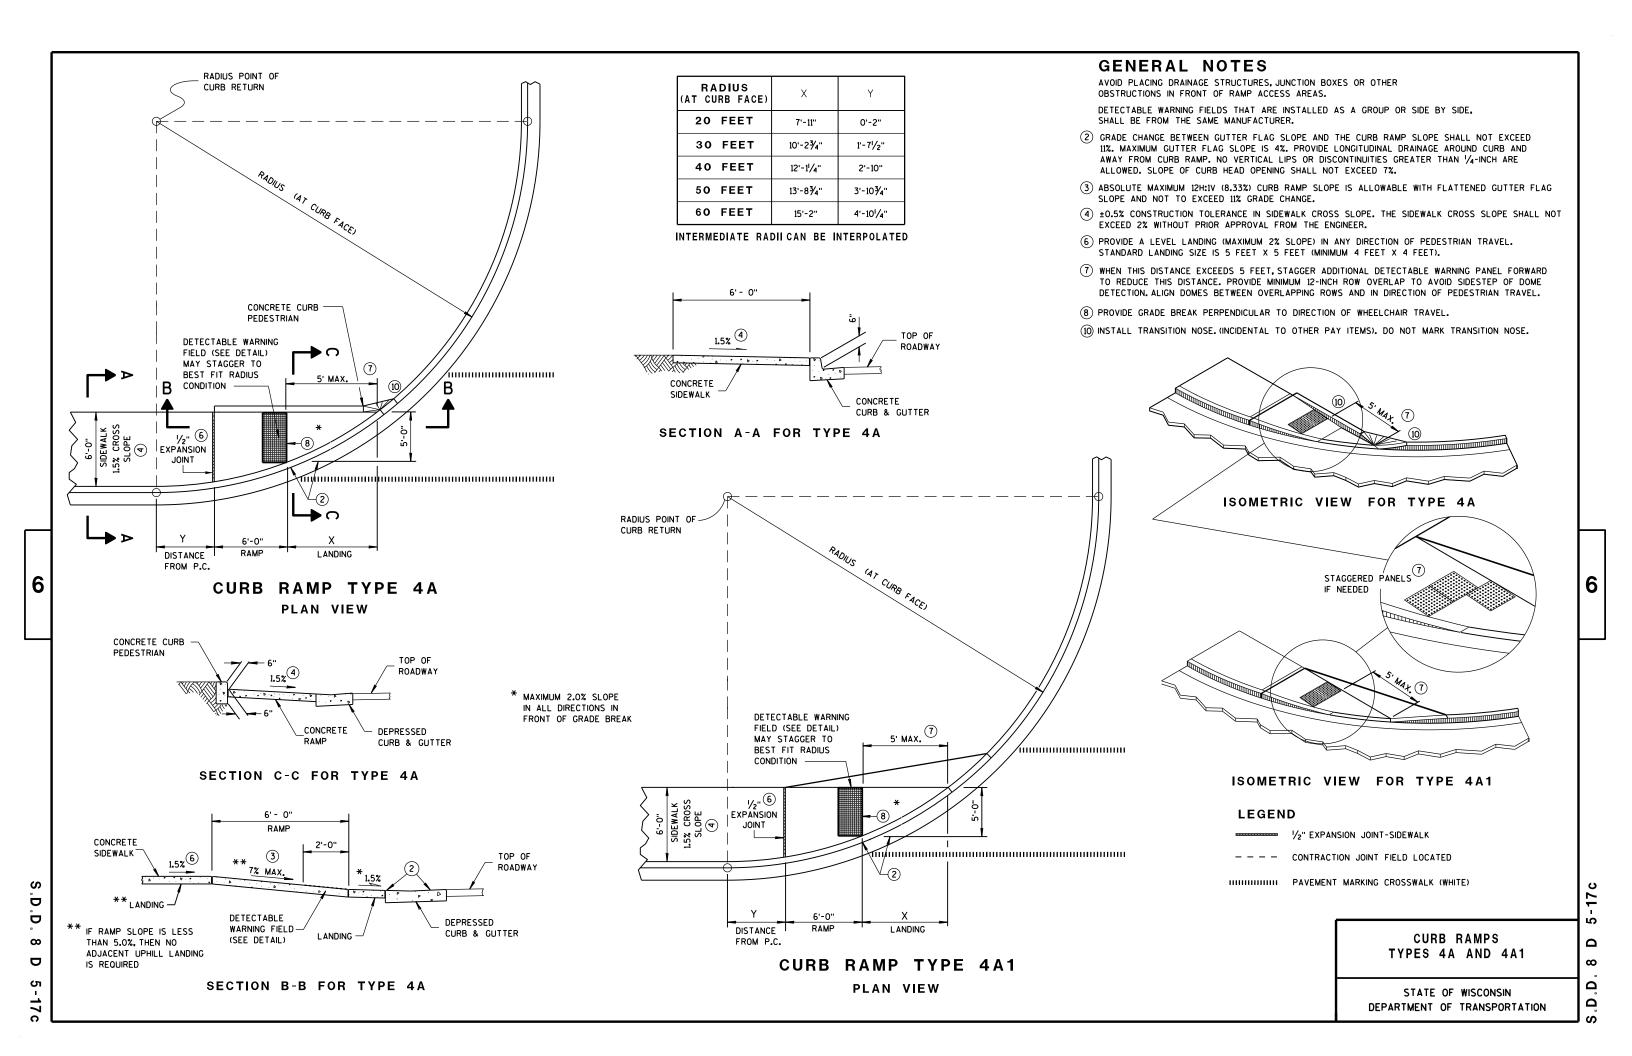

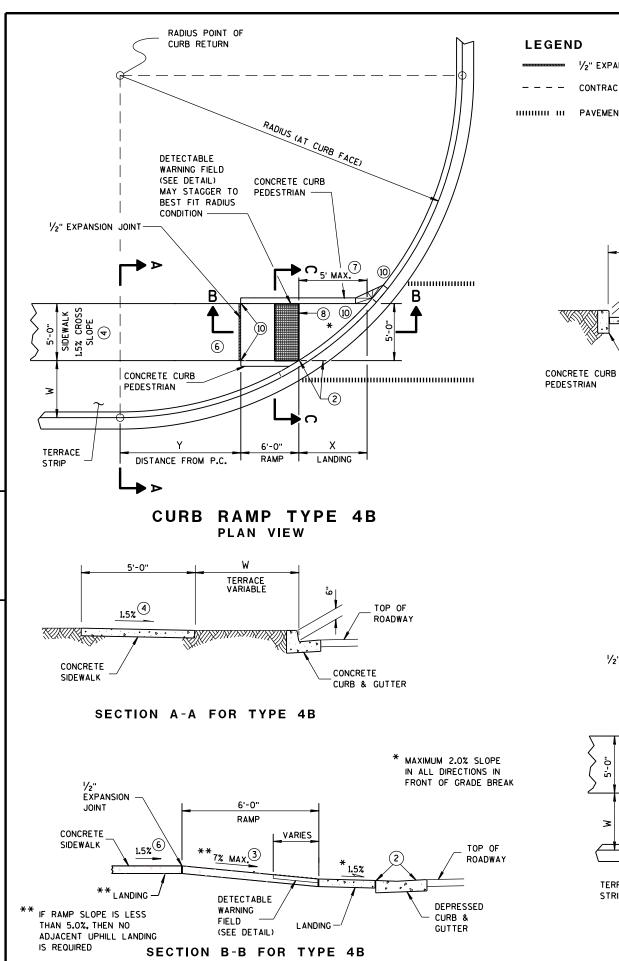

6

D

 ∞

D

LEGEND

¹/₂" EXPANSION JOINT-SIDEWALK

CONTRACTION JOINT FIELD LOCATED

5'-0" RAMP

VARIES

0 TO 6"

1.5%

SECTION C-C FOR TYPE 4B

HIHHHH HI PAVEMENT MARKING CROSSWALK (WHITE)


RADIUS	W = 3' - 0"		W = 4' - Ø"		W = 5' - Ø"		W = 6' - Ø"		W = 7' - 0"	
(AT CURB FACE)	X	Y	X	Y	X	Y	X	Υ	X	Υ
20 FEET	5'-9¾"	3'-61/2"	4'-11'/2"	5'-1¾"	4'-3'/4"	6'-51/2"	3'-8¾"	7'-6¾"	3'-3"	8'-6'/4"
30 FEET	7'-91/4"	5'-101/2"	6'-91/2"	7'-11'/4"	6'-0'/4"	9'-8"	5'-5"	11'-1¾''	4'-10¾"	12'-5¾"
40 FEET	9'-4"	7'-10"	8'-2¾"	10'-3"	7'-4¾"	12'-3¾"	6'-81/2"	14'-1'/4"	6'-1¾"	15'-81/2"
50 FEET	10'-8"	9'-61/2"	9'-51/2"	12'-3'/4"	8'-61/2"	14'-71/2"	7'-9¾"	16'-8'/4"	7'-21/2"	18'-6'/4"
60 FEET	11'-10'/4"	11'-0¾''	10'-61/2"	14'-1'/4"	9'-61/2"	16'-81/2"	8'-9'/4"	18'-11¾"	8'-11/2"	21'-0'/2"

GENERAL NOTES

INTERMEDIATE RADII CAN BE INTERPOLATED

AVOID PLACING DRAINAGE STRUCTURES, JUNCTION BOXES OR OTHER OBSTRUCTIONS IN FRONT OF RAMP ACCESS AREAS. DETECTABLE WARNING FIELDS THAT ARE INSTALLED AS A GROUP OR SIDE BY SIDE, SHALL BE FROM THE SAME MANUFACTURER.

- 2 GRADE CHANGE BETWEEN GUTTER FLAG SLOPE AND THE CURB RAMP SLOPE SHALL NOT EXCEED 11%. MAXIMUM GUTTER FLAG SLOPE IS 4%. PROVIDE LONGITUDINAL DRAINAGE AROUND CURB AND AWAY FROM CURB RAMP. NO VERTICAL LIPS OR DISCONTINUITIES GREATER THAN 1/4-INCH ARE ALLOWED. SLOPE OF CURB HEAD OPENING SHALL NOT EXCEED 7%.
- (3) ABSOLUTE MAXIMUM 12H:1V (8.33%) CURB RAMP SLOPE IS ALLOWABLE WITH FLATTENED GUTTER FLAG SLOPE AND NOT TO EXCEED 11% GRADE CHANGE.
- (4) ±0.5% CONSTRUCTION TOLERANCE IN SIDEWALK CROSS SLOPE. THE SIDEWALK CROSS SLOPE SHALL NOT EXCEED 2% WITHOUT PRIOR APPROVAL FROM THE ENGINEER.
- 6 PROVIDE A LEVEL LANDING (MAXIMUM 2% SLOPE) IN ANY DIRECTION OF PEDESTRIAN TRAVEL. STANDARD LANDING SIZE IS 5 FEET X 5 FEET (MINIMUM 4 FEET X 4 FEET).
- (7) WHEN THIS DISTANCE EXCEEDS 5 FEET, STAGGER ADDITIONAL DETECTABLE WARNING PANEL FORWARD TO REDUCE THIS DISTANCE. PROVIDE MINIMUM 12-INCH ROW OVERLAP TO AVOID SIDESTEP OF DOME DETECTION. ALIGN DOMES BETWEEN OVERLAPPING ROWS AND IN DIRECTION OF PEDESTRIAN TRAVEL.
- (8) PROVIDE GRADE BREAK PERPENDICULAR TO DIRECTION OF WHEELCHAIR TRAVEL.
- (10) INSTALL TRANSITION NOSE. (INCIDENTAL TO OTHER PAY ITEMS). DO NOT MARK TRANSITION NOSE.

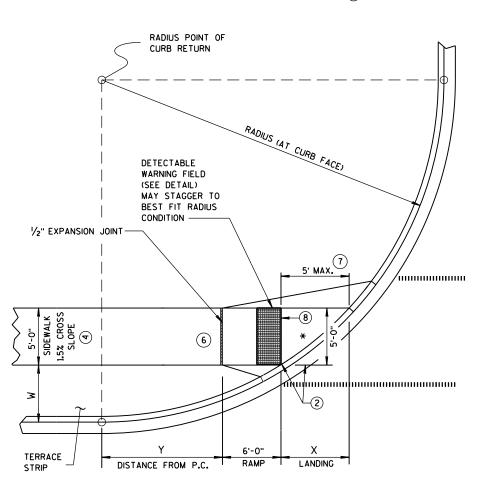

TERRACE STRIP


VARIES O TO W

CONCRETE CURB & GUTTER

TOP OF

ROADWAY

CURB RAMP TYPE 4B1 **PLAN VIEW**

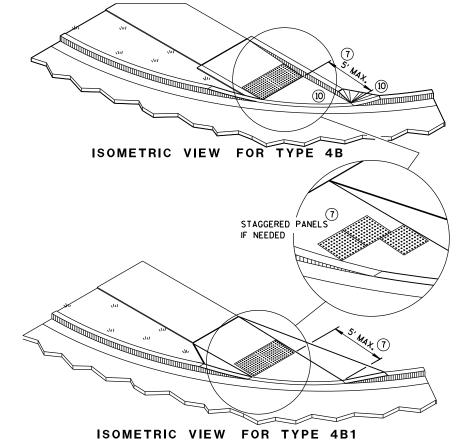


CURB RAMPS TYPE 4B AND 4B1

STATE OF WISCONSIN DEPARTMENT OF TRANSPORTATION

2 Ω ∞ Ω

Ω

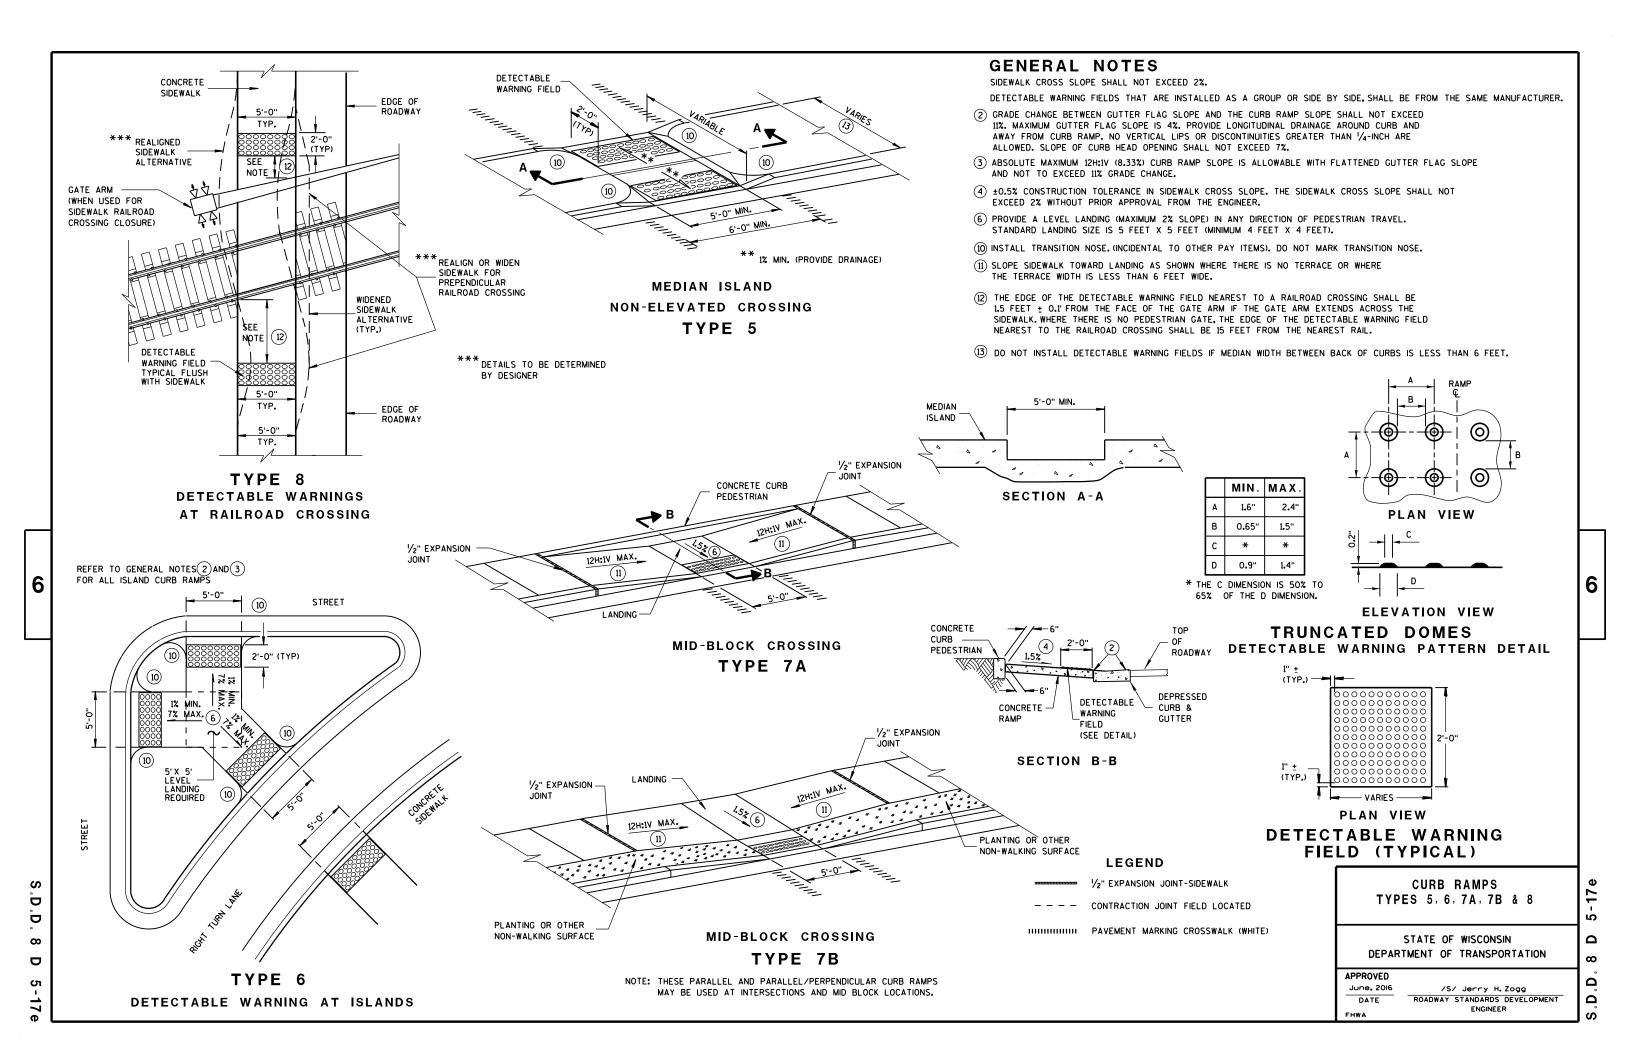


TYPICAL APPLICATION OF SILT FENCE


6

b


Ō

Ш

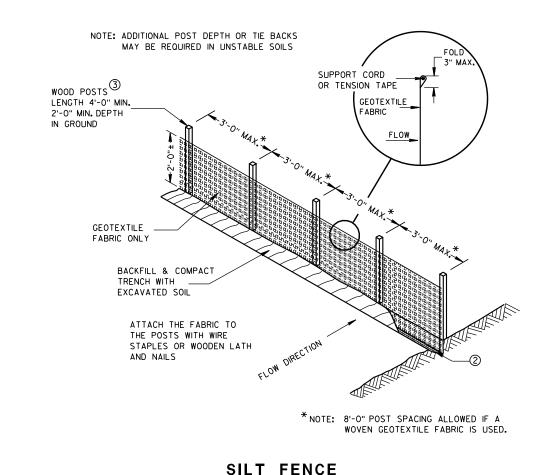

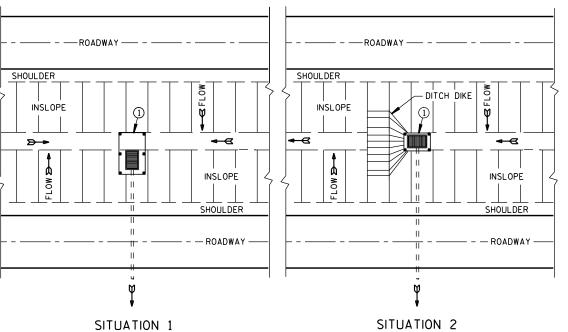


PLAN VIEW SILT FENCE AT MEDIAN SURFACE DRAINS

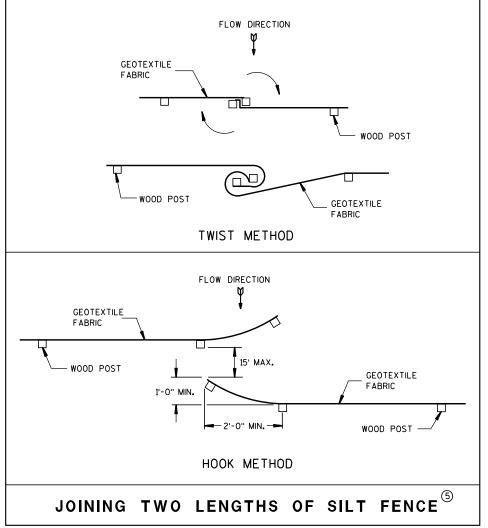


GENERAL NOTES

DETAILS OF CONSTRUCTION NOT SHOWN ON THIS DRAWING SHALL CONFORM TO THE PERTINENT REQUIREMENTS OF THE STANDARD SPECIFICATIONS AND APPLICABLE SPECIAL PROVISIONS.

- ① HORIZONTAL BRACE REQUIRED WITH 2" X 4" WOODEN FRAME OR EQUIVALENT AT TOP OF POSTS.
- 2 FOR MANUAL INSTALLATIONS THE TRENCH SHALL BE A MINIMUM OF 4" WIDE & 6" DEEP TO BURY AND ANCHOR THE GEOTEXTILE FABRIC. FOLD MATERIAL TO FIT TRENCH AND BACKFILL & COMPACT TRENCH WITH EXCAVATED SOIL.
- 3 WOOD POSTS SHALL BE A MINIMUM SIZE OF 11/8" X 11/8" OF OAK OR HICKORY.
- 4) SILT FENCE TO EXTEND ACROSS THE TOP OF THE PIPE.
- (5) CONSTRUCT SILT FENCE FROM A CONTINUOUS ROLL IF POSSIBLE BY CUTTING LENGTHS TO AVOID JOINTS. IF A JOINT IS NECESSARY USE ONE OF THE FOLLOWING TWO METHODS; A) OVERLAP THE END POSTS AND TWIST, OR ROTATE, AT LEAST 180 DEGREES, B) HOOK THE END OF EACH SILT FENCE LENGTH.

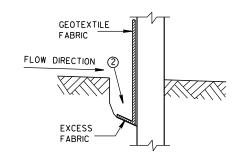


TRENCH DETAIL

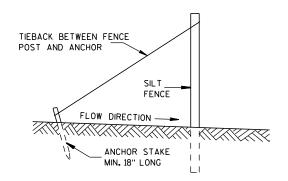


SILT FENCE TIE BACK


(WHEN REQUIRED BY THE ENGINEER)

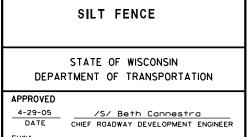

6

တ ∞ Ω

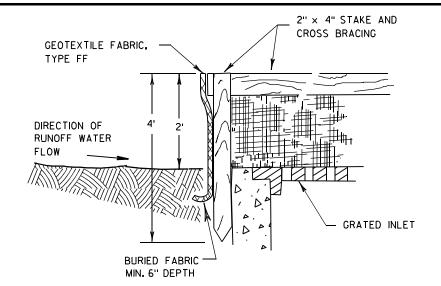

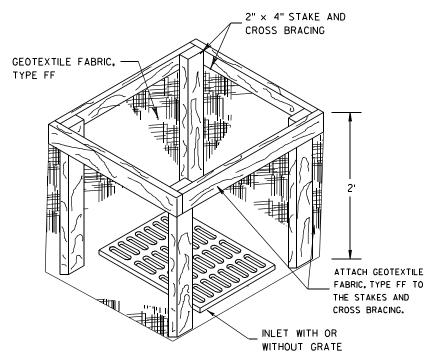

INLET PROTECTION, TYPE A


GENERAL NOTES

INLET PROTECTION DEVICES SHALL BE MAINTAINED OR REPLACED AT THE DIRECTION OF THE ENGINEER.

MANUFACTURED ALTERNATIVES APPROVED AND LISTED ON THE DEPARTMENT'S EROSION CONTROL PRODUCT ACCEPTABILITY LIST MAY BE

WHEN REMOVING OR MAINTAINING INLET PROTECTION, CARE SHALL BE TAKEN SO THAT THE SEDIMENT TRAPPED ON THE GEOTEXTILE FABRIC DOES NOT FALL INTO THE INLET. ANY MATERIAL FALLING INTO THE INLET SHALL BE REMOVED IMMEDIATELY.

- 1) FINISHED SIZE, INCLUDING FLAP POCKETS WHERE REQUIRED, SHALL EXTEND A MINIMUM OF 10" AROUND THE PERIMETER TO FACILITATE MAINTENANCE OR REMOVAL.
- (2) FOR INLET PROTECTION, TYPE C (WITH CURB BOX), AN ADDITIONAL 18" OF FABRIC IS WRAPPED AROUND THE WOOD AND SECURED WITH STAPLES. THE WOOD SHALL NOT BLOCK THE ENTIRE HEIGHT OF THE CURB BOX OPENING.
- (3) FLAP POCKETS SHALL BE LARGE ENOUGH TO ACCEPT WOOD 2X4.

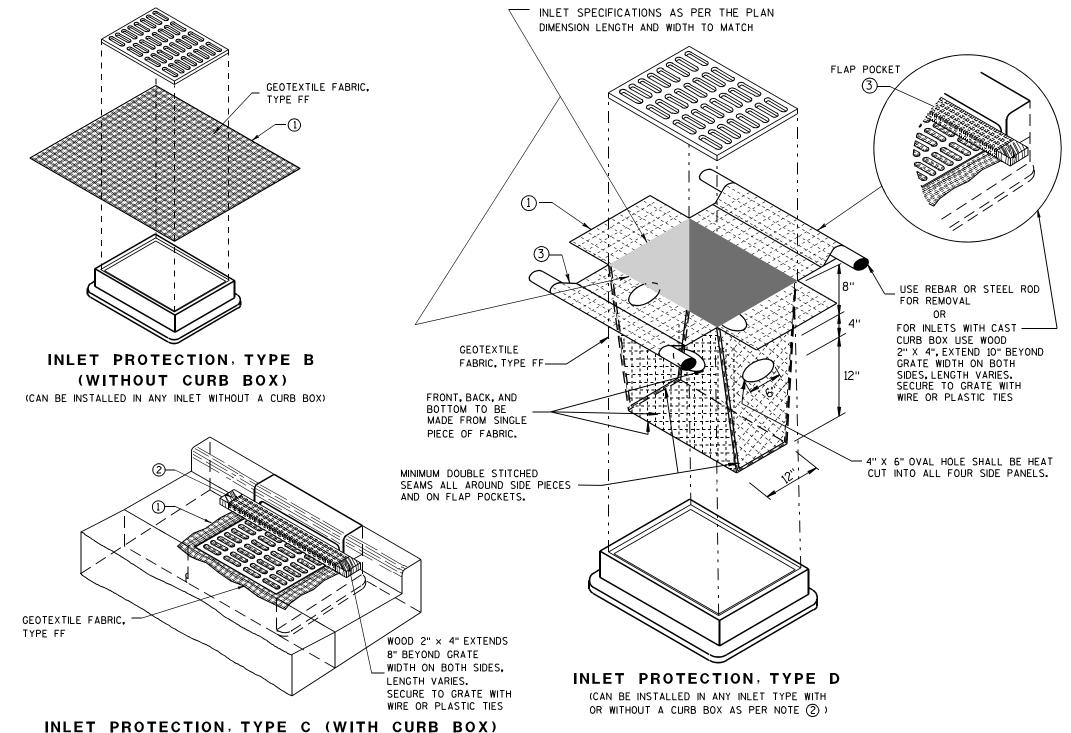

INSTALLATION NOTES

TYPE B & C

TRIM EXCESS FABRIC IN THE FLOW LINE TO WITHIN 3" OF THE GRATE.

THE CONTRACTOR SHALL DEMONSTRATE A METHOD OF MAINTENANCE, USING A SEWN FLAP, HAND HOLDS OR OTHER METHOD TO PREVENT ACCUMULATED SEDIMENT FROM ENTERING THE INLET.

TYPE D

DO NOT INSTALL INLET PROTECTION TYPE D IN INLETS SHALLOWER THAN 30", MEASURED FROM THE BOTTOM OF THE INLET TO THE TOP OF THE GRATE.

TRIM EXCESS FABRIC IN THE FLOW LINE TO WITHIN 3" OF THE GRATE.

THE INSTALLED BAG SHALL HAVE A MINIMUM SIDE CLEARANCE, BETWEEN THE INLET WALLS AND THE BAG, MEASURED AT THE BOTTOM OF THE OVERFLOW HOLES, OF 3". WHERE NECESSARY THE CONTRACTOR SHALL CINCH THE BAG, USING PLASTIC ZIP TIES, TO ACHIEVE THE 3" CLEARANCE, THE TIES SHALL BE PLACED AT A MAXIMUM OF 4" FROM THE BOTTOM OF THE BAG.

INLET PROTECTION TYPE A, B, C, AND D

6

0

ш

 ∞

STATE OF WISCONSIN DEPARTMENT OF TRANSPORTATION

APPROVED

10/16/02 /S/ Beth Cannestra

CHIEF ROADWAY DEVELOPMENT ENGINEER

 ∞

Δ

S
0,
Ö
D
∞
П
-
⇉

6

METAL APRON ENDWALLS											
PIPE	MIN. THICK.		DIMENSIONS (Inches)							APPROX.	
DIA.	(Inches)		Α	В	Н	L	L ₁	L ₂	W	SLOPE	BODY
(IN.)	STEEL	ALUM.	(±]")	(MAX.)	(±]")	(±1½")	1	1	(±2")	JLUFE	
12	.064	.060	6	6	6	21	12	171/2	24	21/2+o 1	1Pc.
15	.064	.060	7	8	6	26	14	213/4	30	21/2+o 1	1Pc.
18	.064	.060	8	10	6	31	15	28 ¹ / ₄	36	21/2+o 1	1Pc.
21	.064	.060	9	12	6	36	18	295/8	42	21/2+o 1	1Pc.
24	.064	.075	10	13	6	41	18	371/4	48	21/2+o 1	1Pc.
30	.079	.075	12	16	8	51	18	52 ¹ / ₄	60	21/2+0 1	1Pc.
36	.079	.105	14	19	9	60	24	59¾	72	21/2+o 1	2 Pc.
42	.109	.105	16	22	11	69	24	75%	84	21/2 to 1	2 Pc.
48	.109	.105	18	27	12	78	24	81	90	2 ¹ / ₄ +o 1	3 Pc.
54	.109	.105	18	30	12	84	30	851/2	102	21/4+0 1	3 Pc.
60	.109×	.105×	18	33	12	87	-	-	114	2 to 1	3 Pc.
66	.109×	.105×	18	36	12	87	1	l	120	2 to 1	3 Pc.
72	.109×	.105×	18	39	12	87	1	ı	126	2 to 1	3 Pc.
78	.109×	.105×	18	42	12	87	_	-	132	1½+o 1	3 Pc.
84	.109×	.105×	18	45	12	87		-	138	1½+o 1	3 Pc.
90	.109×	.105×	18	37	12	87		-	144	1½+o 1	3 Pc.
96	.109×	.105×	18	35	12	87	_	_	150	11/2+0 1	3 Pc.


* EXCEPT CENTER PANEL


SEE GENERAL NOTES


	REINFORCED CONCRETE APRON ENDWALLS								
PIPE		APPROX.							
DIA.	T	A	В	С	D	E	G	SLOPE	
12	2	4	24	48 1/8	721/8	24	2	3 to 1	
15	21/4	6	27	46	73	30	21/4	3 to 1	
18	$2\frac{1}{2}$	9	27	46	73	36	21/2	3 to 1	
21	23/4	9	36	371/2	731/2	42	23/4	3 to 1	
24	3	91/2	431/2	30	731/2	48	3	3 to 1	
27	31/4		491/2	24	731/2	54	31/4	3 to 1	
30	$3\frac{1}{2}$	12	54	193⁄4	731/2	60	31/2	3 to 1	
36	4	15	63	34¾	97¾	72	4	3 to 1	
42	$4\frac{1}{2}$	21	63	35	98	78	41/2	3 to 1	
48	5	24	72	26	98	84	5	3 to 1	
54	51/2	27	65	331/4-35	* 98 ¹ /4- 100	90	51/2	2% to 1	
60	6	* ** 30-35	60	39	99	96	5	2 to 1	
66	61/2		* ** 72-78	* ** 21-27	99	102	51/2	2 to 1	
72	7	* ** 24-36	78	21	99	108	6	2 to 1	
78	71/2	* ** 24-36	78	21	99	114	61/2	2 to 1	
84	8	36	901/2	21	1111/2	120	61/2	1½+o 1	
90	81/2	41	871/2	24	1111/2	132	61/2	11/2+0 1	

THREADED 76" DIA. ROD AROUND CULVERT & THROUGH CONNECTOR LUG TANK TYPE CONNECTOR LUG OR ALTERNATE CONNECTOR STRAP (SEE DETAIL) MEASURED LENGTH OF CULVERT TYPE 1 FOR 12" THRU 24" CORR. PIPE

END SECTION CONNECTOR STRAP

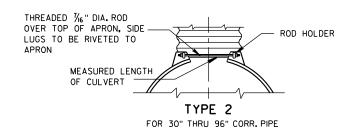

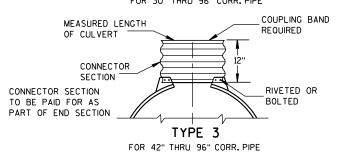

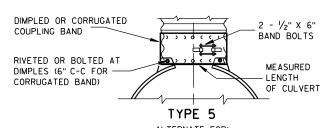

ALTERNATE FOR: ALL SIZES CORRUGATED CIRCULAR PIPE

NOTE: DIMPLED BAND FITS OVER OUTSIDE OF ENDWALL. AND CORRUGATED BAND FITS INSIDE ENDWALL. DIMPLED BAND MAY BE USED WITH HELICALLY CORRUGATED PIPE.

> FOR CIRCUMFERENTIALLY CORRUGATED PIPE USE ENDWALL CONNECTION DETAILS 1, 2, 3 OR 5


FOR HELICALLY CORRUGATED PIPE USE ENDWALL CONNECTION DETAILS 1, 2 OR 5.


FOR HELICALLY CORRUGATED PIPES WITH TWO CIRCUMFERENTIAL CORRUGATIONS AT EACH END USE ENDWALL CONNECTION DETAILS 1, 2 OR 3.

CONNECTION DETAILS


1" WIDE, 12 GA. (0.109" THICK) GALVANIZED STRAP WITH STANDARD 6" X 1/2" BAND BOLT AND NUT ALTERNATE FOR TYPE 1 CONNECTION

*MINIMUM **MAXIMUM

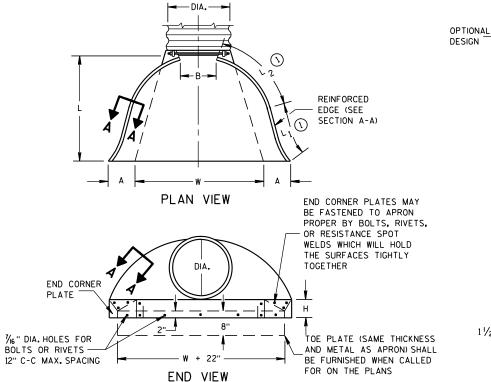


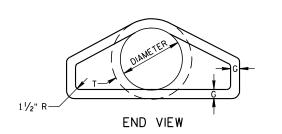


PLAN

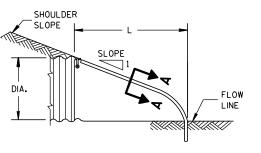

SIDE ELEVATION METAL ENDWALLS

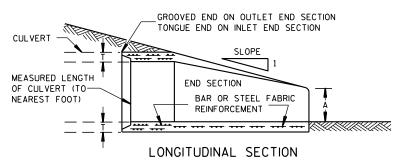

CONCRETE ENDWALLS

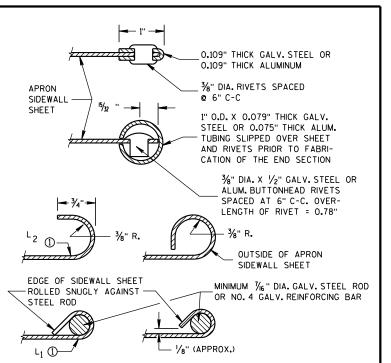

SECTION A-A

GENERAL NOTES

DETAILS OF CONSTRUCTION, MATERIALS AND WORKMANSHIP NOT SHOWN ON THIS DRAWING SHALL CONFORM TO THE PERTINENT REQUIREMENTS OF THE STANDARD SPECIFICATIONS AND THE APPLICABLE SPECIAL PROVISIONS.

CONCRETE CULVERT ENDWALLS MAY NOT BE USED WITH GALVANIZED STEEL OR ALUMINUM CULVERT PIPE OR VISE VERSA, GALVANIZED STEEL OR ALUMINUM ENDWALLS SHALL NORMALLY BE INSTALLED ON CULVERT PIPE OF THE SAME METAL.

ALL THREE PIECE STEEL APRON ENDWALLS FOR 60" DIAMETER PIPE AND LARGER SHALL HAVE 0.109" SIDES AND 0.138" CENTER PANELS. ALL THREE PIECE ALUMINUM APRON ENDWALLS FOR 60" DIAMETER PIPE AND LARGER SHALL HAVE 0.105" SIDES AND 0.134" CENTER PANELS. THE WIDTH OF CENTER PANELS SHALL BE GREATER THAN 20 PERCENT OF THE PIPE

LAP SEAMS SHALL BE TIGHTLY JOINED BY GALVANIZED RIVETS OR BOLTS FOR STEEL UNITS AND ALUMINUM RIVETS AND BOLTS FOR ALUMINUM UNITS. FOR THE 60" THROUGH 96" DIAMETER APRON ENDWALL SIZES. THE REINFORCED EDGES AND CENTER PANEL SEAMS SHALL BE FURTHER REINFORCED WITH GALVANIZED STEEL OR ALUMINUM STIFFENER ANGLES. THE ANGLES SHALL BE ATTACHED BY GALVANIZED NUTS AND BOLTS FOR STEEL UNITS AND ALUMINUM NUTS AND BOLTS FOR ALUMINUM UNITS.


WHERE TWO OR MORE PIPES WITH APRON ENDWALLS ARE LAID ADJACENT TO EACH OTHER, THEY SHALL BE SEPARATED BY A DISTANCE SUFFICIENT TO PROVIDE A MINIMUM CLEARANCE OF 6 INCHES BETWEEN APRON ENDWALLS.


(1) FOR PIPE SIZES UP TO 60" DIAMETER, A 180° ROLLED EDGE MAY BE USED INSTEAD OF STEEL ROD REINFORCEMENT. SEE SECTION A-A.




STATE OF WISCONSIN DEPARTMENT OF TRANSPORTATION

11/30/94 /S/ Rory L. Rhinesmith CHIEF ROADWAY DEVELOPMENT ENGINEER

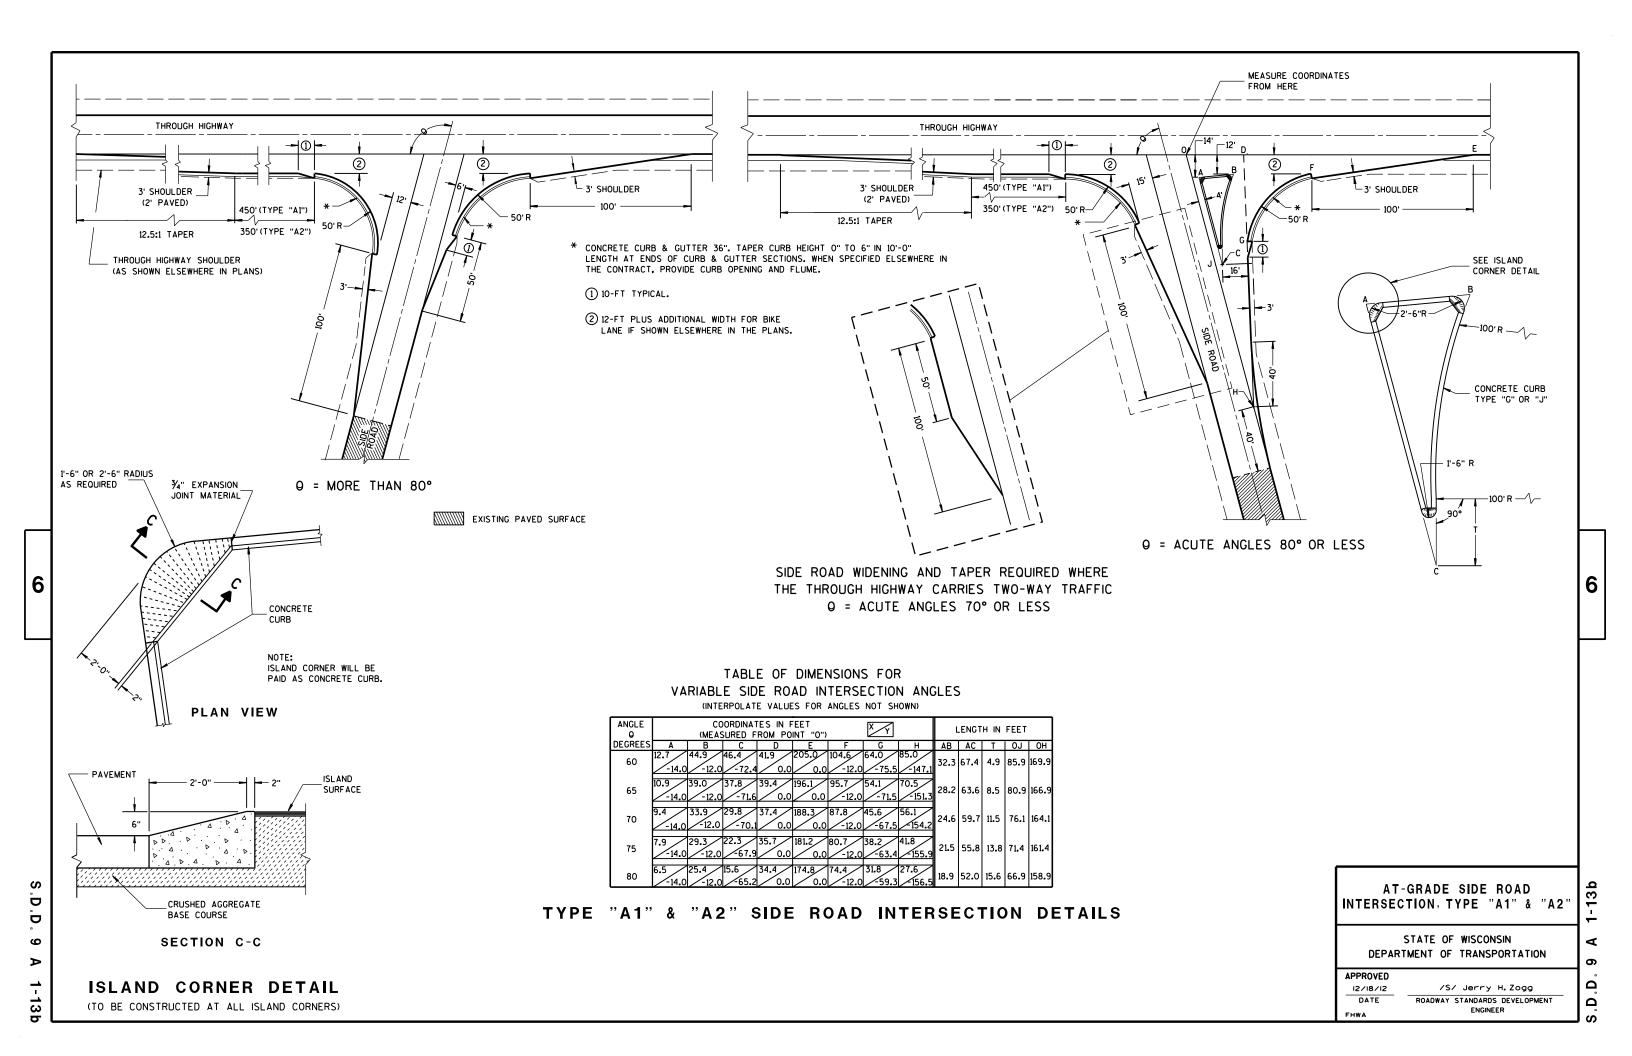

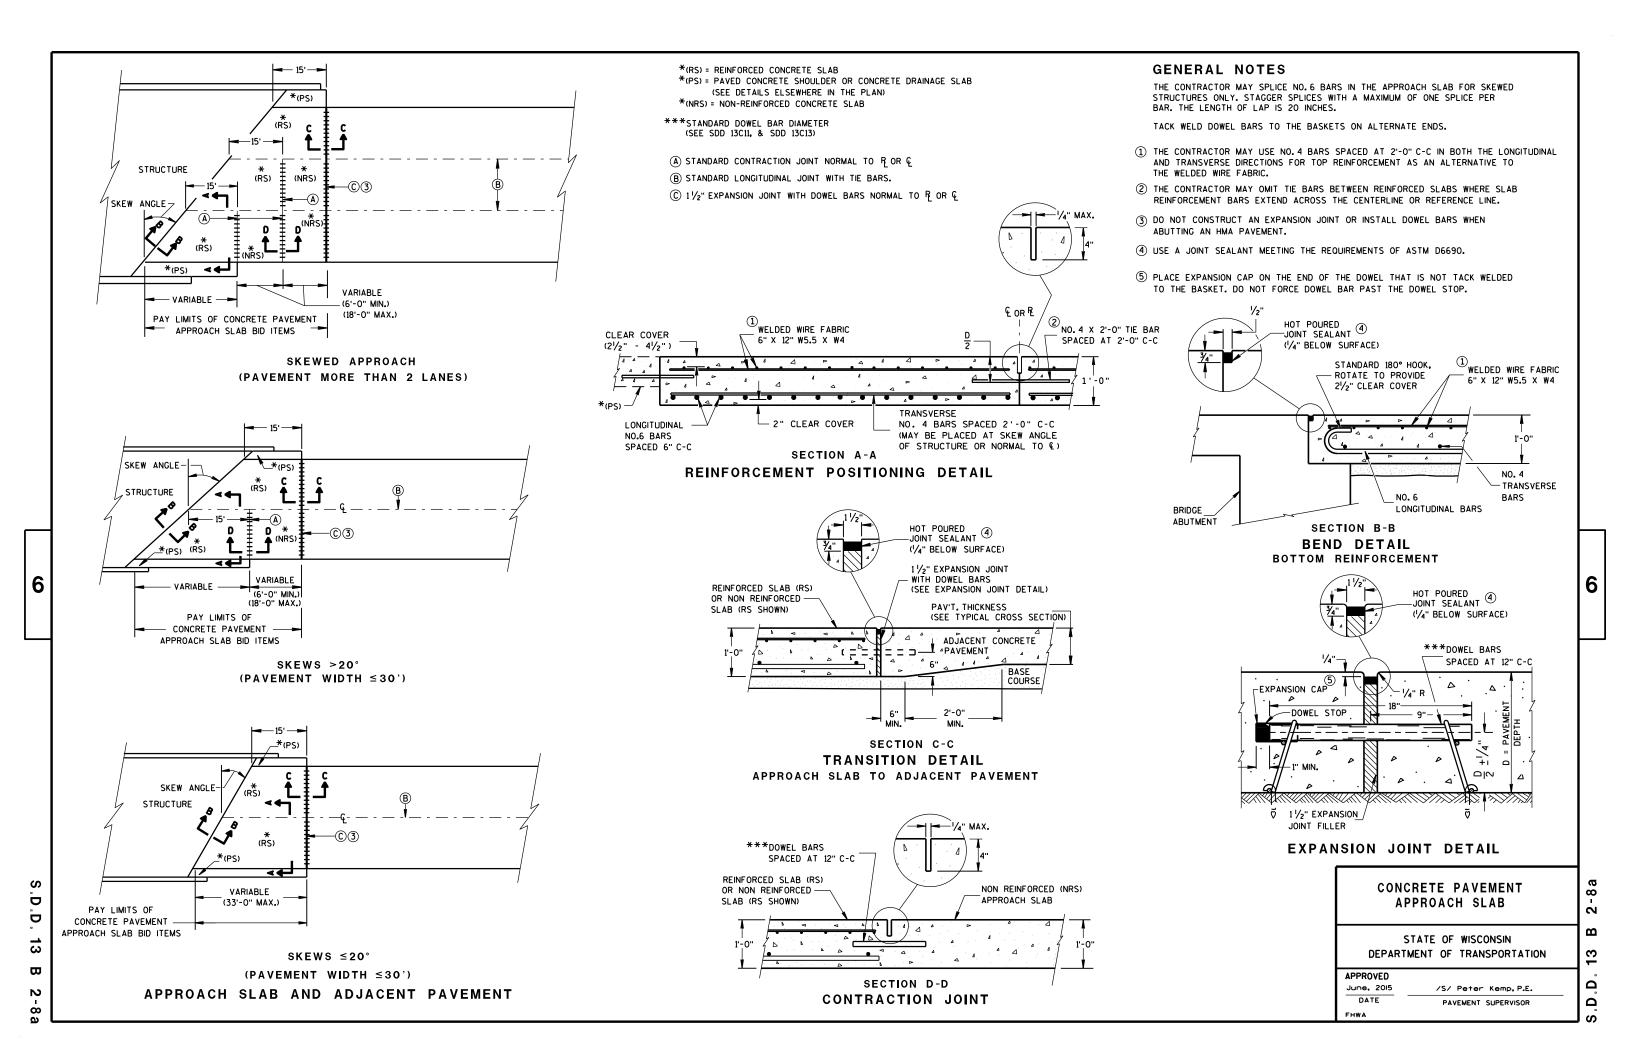


- 2 USE WOOD OR APPROVED PLASTIC BLOCKOUTS. WOOD BLOCKOUTS MAY BE CONSTRUCTED OUT OF TWO OR MORE WOOD BLOCKOUTS. SEE ALTERNATE WOOD BLOCKOUT DETAIL. DIMENSIONS OF APPROVED PLASTIC BLOCKOUTS MAY VARY.
- (3) IF ROCK IS ENCOUNTERED DURING EXCAVATION, PROVIDE A HOLE 12 INCHES IN DIAMETER EXTENDING 20 INCHES DEEP INTO THE ROCK. PLACE APPROXIMATELY 2½ INCHES OF GRANULAR MATERIAL IN THE BOTTOM OF THE HOLE. CUT THE POSTS THE TO LENGTH AMD INSTALL. BACKFILL WITH EXCAVATED MATERIAL AND COMPACT. BACKFILL IS TO BE FREE OF LARGE ROCKS.
- (4) WHEN THE DISTANCE FROM BACK OF POST TO SHOULDER HINGE POINT IS LESS THAN 2 FEET INSTALL LONGER POST AT HALF POST SPACING (K).
- (5) FOR NEW MGS INSTALLATION TOP OF W-BEAM RAIL TOLERANCE IS ± 1". FOR EXISTING MGS INSTALLATION TOP OF W-BEAM IS BETWEEN 273/4" TO 32".
- (6) WHEN USING STEEL POST AND WOOD BLOCKOUTS INSTALL FOUR 16D GALVANIZED NAILS. INSTALL NAILS AT THE BACK CORNERS OF THE BLOCK AND BEND THE NAILS OVER THE FLANGE OF THE STEEL POST.

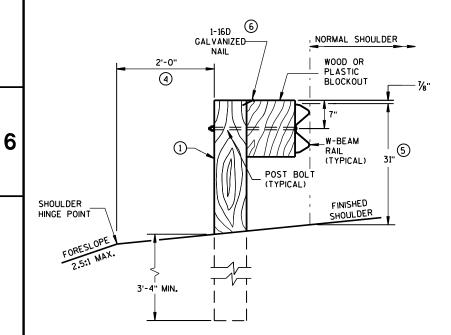


END VIEW


LOCATED ALONG A ROADWAY SHOULDER STANDARD INSTALLATION

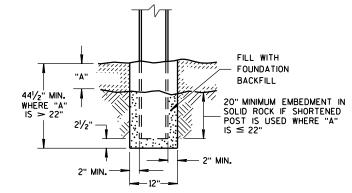


SETTING STEEL OR WOOD POST IN ROCK $^{\scriptsize{\textcircled{3}}}$

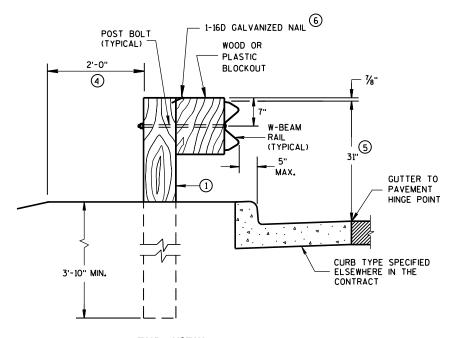


END VIEW
LOCATED ALONG A CURBED ROADWAY

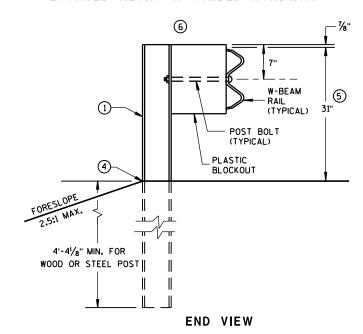


MGS LONGER POST AT HALFPOST SPACING W BEAM (K)

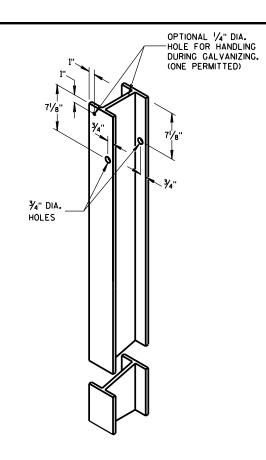


STEEL POST & HOLE PUNCHING DETAIL (w6X9)

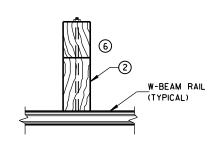


PLAN VIEW
WOOD POST,
BLOCKOUT & BEAM

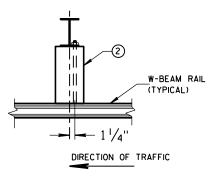

PLAN VIEW
STEEL POST,
PLASTIC BLOCKOUT & BEAM

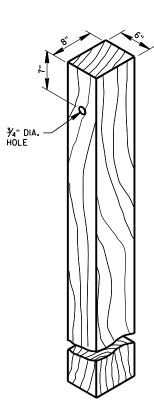

WOOD POST (6" X 8") NOMINAL $^{\scriptsize \textcircled{1}}$

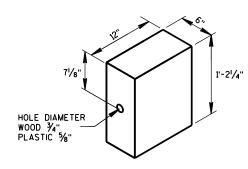

WOOD OR PLASTIC BLOCKOUT

MIDWEST GUARDRAIL SYSTEM (MGS) GUARDRAIL


STATE OF WISCONSIN
DEPARTMENT OF TRANSPORTATION

S.D.D. 14 B 42-4

D.D. 14


2-4

6

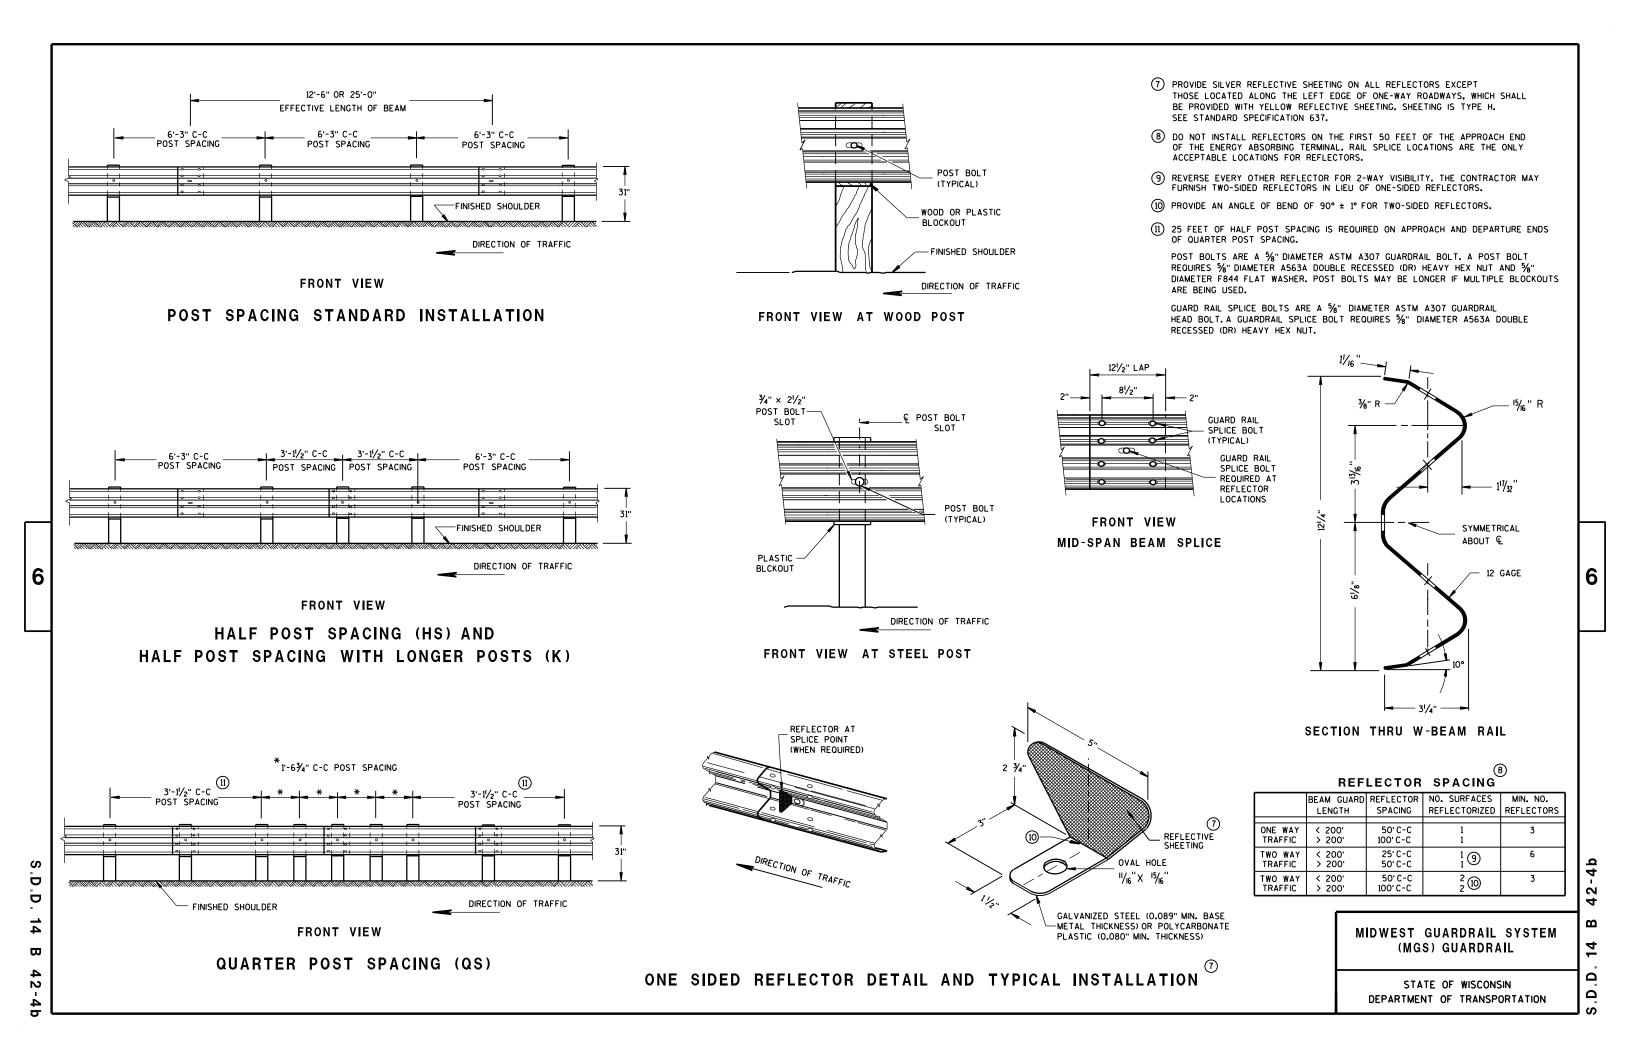

DETAIL FOR 16" BLOCKOUT DEPTH

IT IS ACCEPTABLE TO USE BLOCKOUTS UP TO 16" DEEP TO INCREASE THE POST OFFSET TO AVOID UNDERGROUND OBSTACLES. THERE IS NO LIMIT TO THE NUMBER OF POSTS THAT CAN HAVE ADDITIONAL BLOCKOUTS UP TO 16" DEEP.

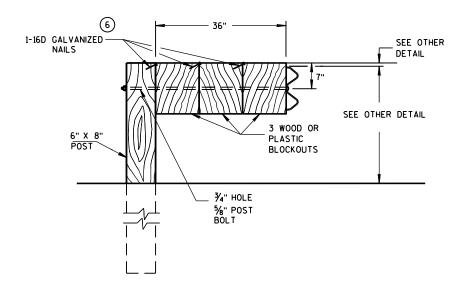


DETAIL FOR 36" BLOCKOUT DEPTH

NOTES: UNDER SPECIAL CIRCUMSTANCES, SUCH AS AVOIDING OBSTACLES THAT ARE NOT RELOCATED, IT IS ACCEPTABLE TO INSTALL ADDITIONAL BLOCKOUTS TO OBTAIN UP TO 36" DEPTH FOR ONE OR TWO POSTS IN A SECTION OF GUARDRAIL.


> DO NOT USE 16" OR 36" BLOCKOUTS IF IT CAUSES THE POST TO BE DRIVEN BEYOND SHOULDER HINGE POINT OR CAUSES A FIXED OBJECT TO BE WITHIN THE DEFLECTION DISTANCE OF THE BARRIER.

NOTE: 1. ALL FILLETS SHALL HAVE A MINIMUM RADIUS OF 1/16". 2. IF THE BOLT EXTENDS MORE THAN 1/4" FROM THE NUT THE BOLT SHOULD BE TRIMMED BACK.

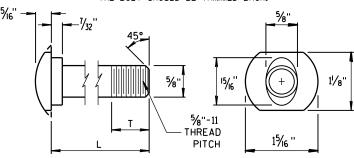


POST BOLT TABLE


)

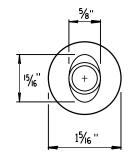

ALTERNATE BOLT HEAD

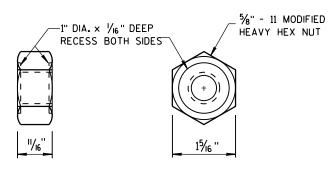


POST BOLT, SPLICE BOLT AND RECESS NUT

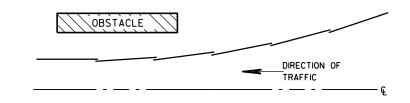



PLAN VIEW

BEAM LAPPING DETAIL

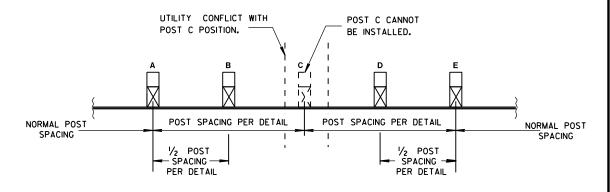

POST DRIVING FOR CONTINUOUS UNDERGROUND OBSTRUCTION

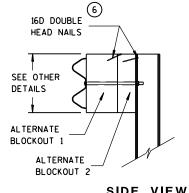

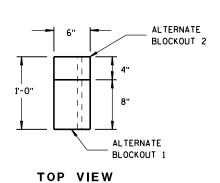

6

2

 $\mathbf{\omega}$

SIDE VIEW

ALTERNATE WOOD **BLOCKOUT DETAIL**

MIDWEST GUARDRAIL SYSTEM (MGS) GUARDRAIL


STATE OF WISCONSIN DEPARTMENT OF TRANSPORTATION

APPROVED

/S/ Jerry H. Zogg ROADWAY STANDARDS DEVELOPMENT ENGINEER

S b Ö ₩ 2

6

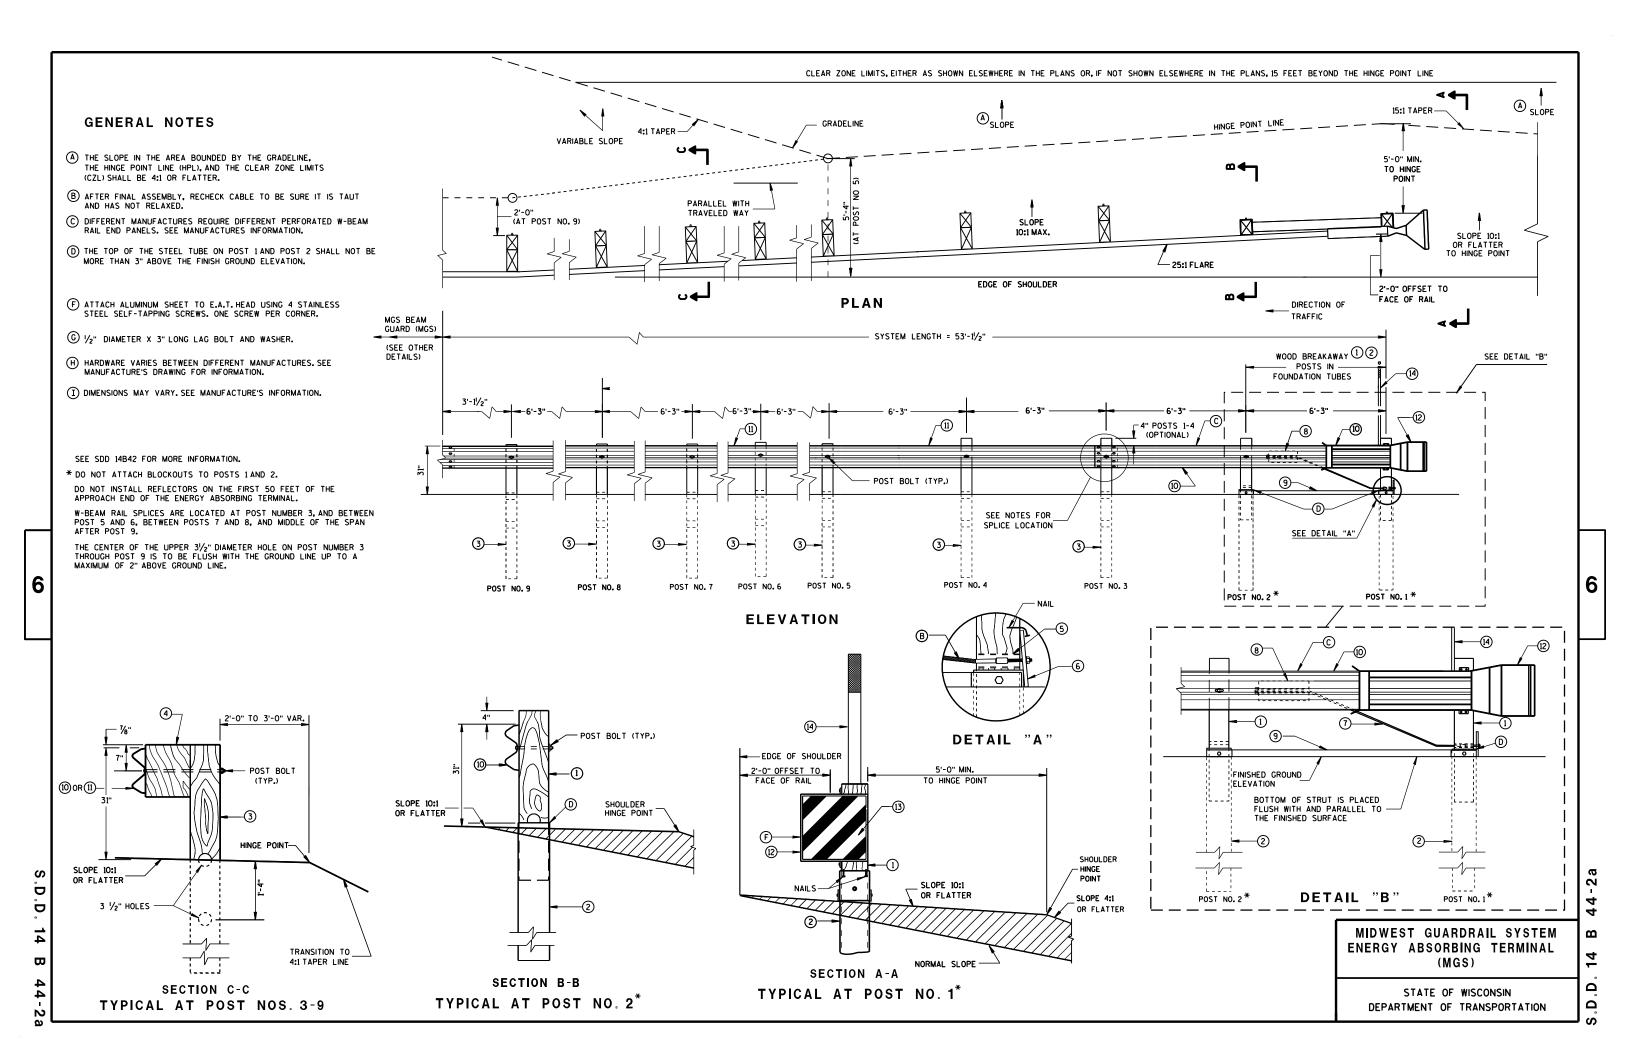

6

S.D.D.


₩



PLAN VIEW

BILL OF MATERIALS


	PART NO.	DESCRIPTION MATERIALS PROVIDED BY MGS EAT MANUFACTURER. SEE MANUFACTURER'S DETAILS FOR MORE INFORMATION.					
Ī	1	WOOD BREAKAWAY POST					
	2	6" X 8" X 0.188", 6'-0" LONG FOUNDATION TUBE AT POSTS 1 AND 2					
	3	WOOD CRT					
	4	WOOD BLOCKOUT					
	(5)	PIPE SLEEVE					
Ī	6	BEARING PLATE					
	7	BCT CABLE ASSEMBLY					
	8	ANCHOR CABLE BOX					
	9	GROUND STRUT					
	(5)	PERFORATED W-BEAM RAIL END PANEL, 12'-6" LONG.					
	(1)	STANDARD W-BEAM RAIL.MULTIPLE SECTIONS REQUIRED. SECTIONS VARY IN LENGTH.					
	(12)	END SECTION EAT					
	(13)	0.040" ALUMINUM SHEET WITH REFLECTIVE SHEETING TYPE F PER SECTION 637 OF THE STANDARD SPECIFICATIONS					
	(14)	EAT MARKER POST - YELLOW (SEE APPROVED PRODUCTS LIST)					

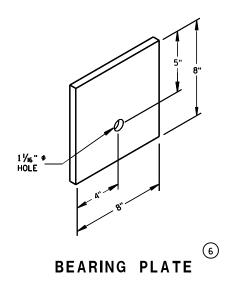



MIDWEST GUARDRAIL SYSTEM ENERGY ABSORBING TERMINAL (MGS)


STATE OF WISCONSIN DEPARTMENT OF TRANSPORTATION


44-2b $\mathbf{\omega}$ 14 ٠٠ ت

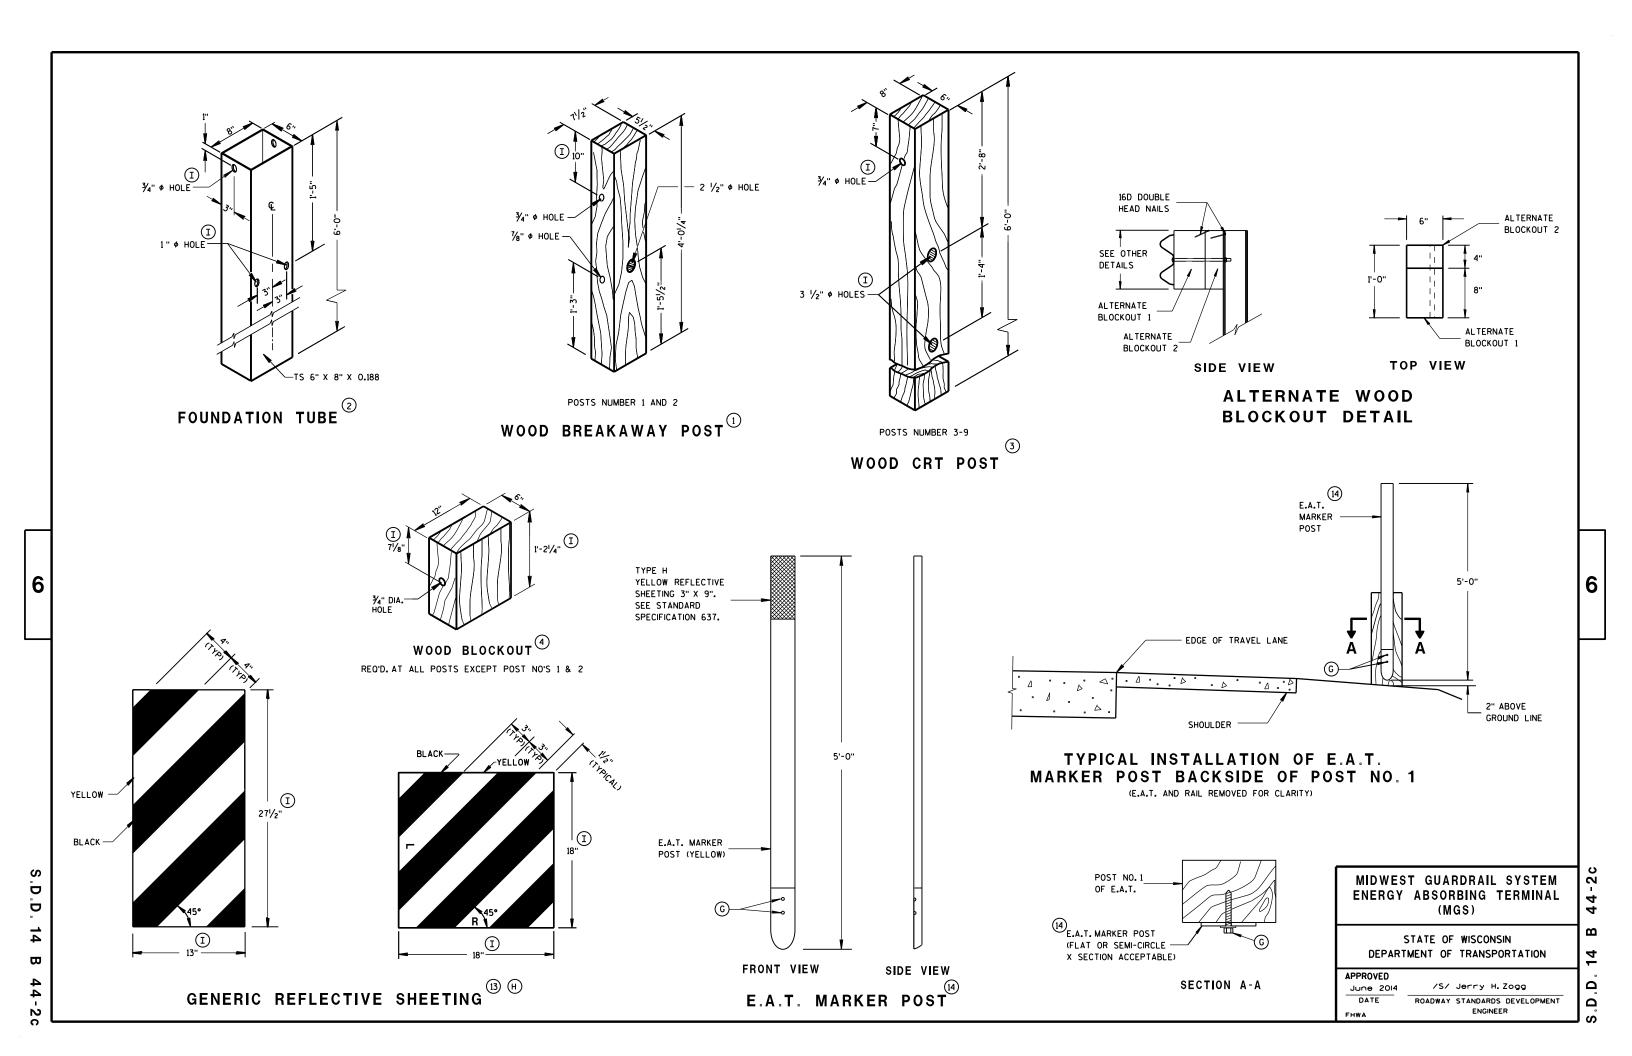

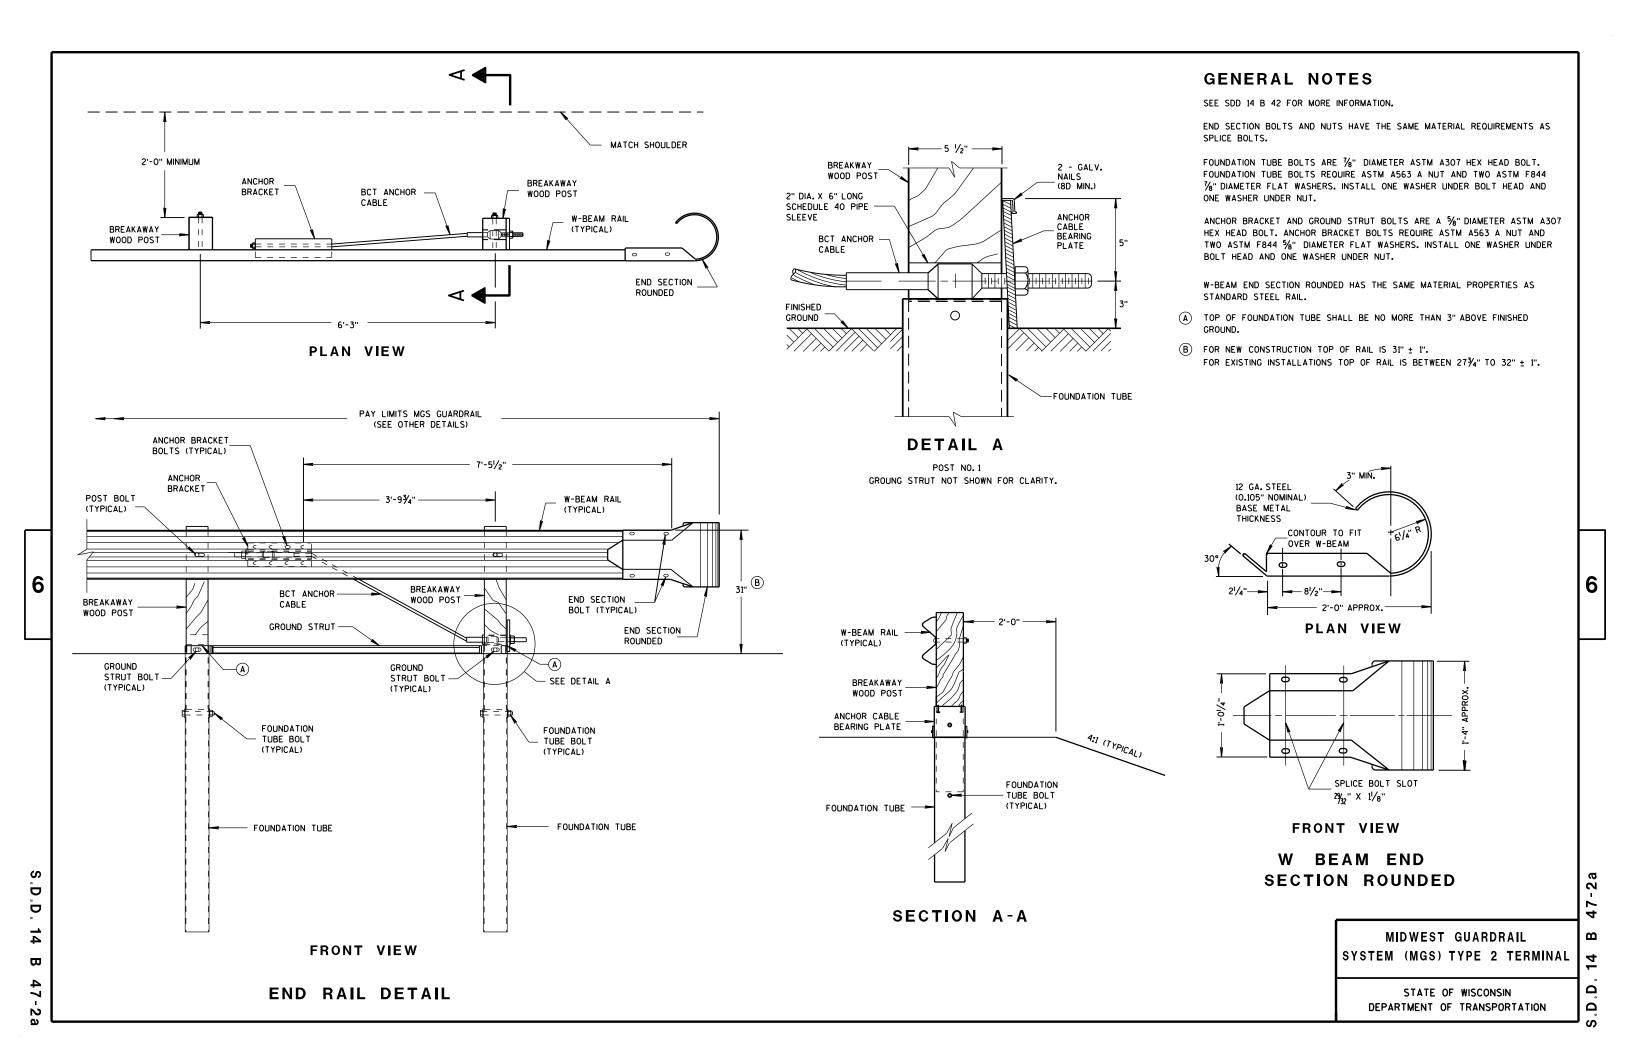


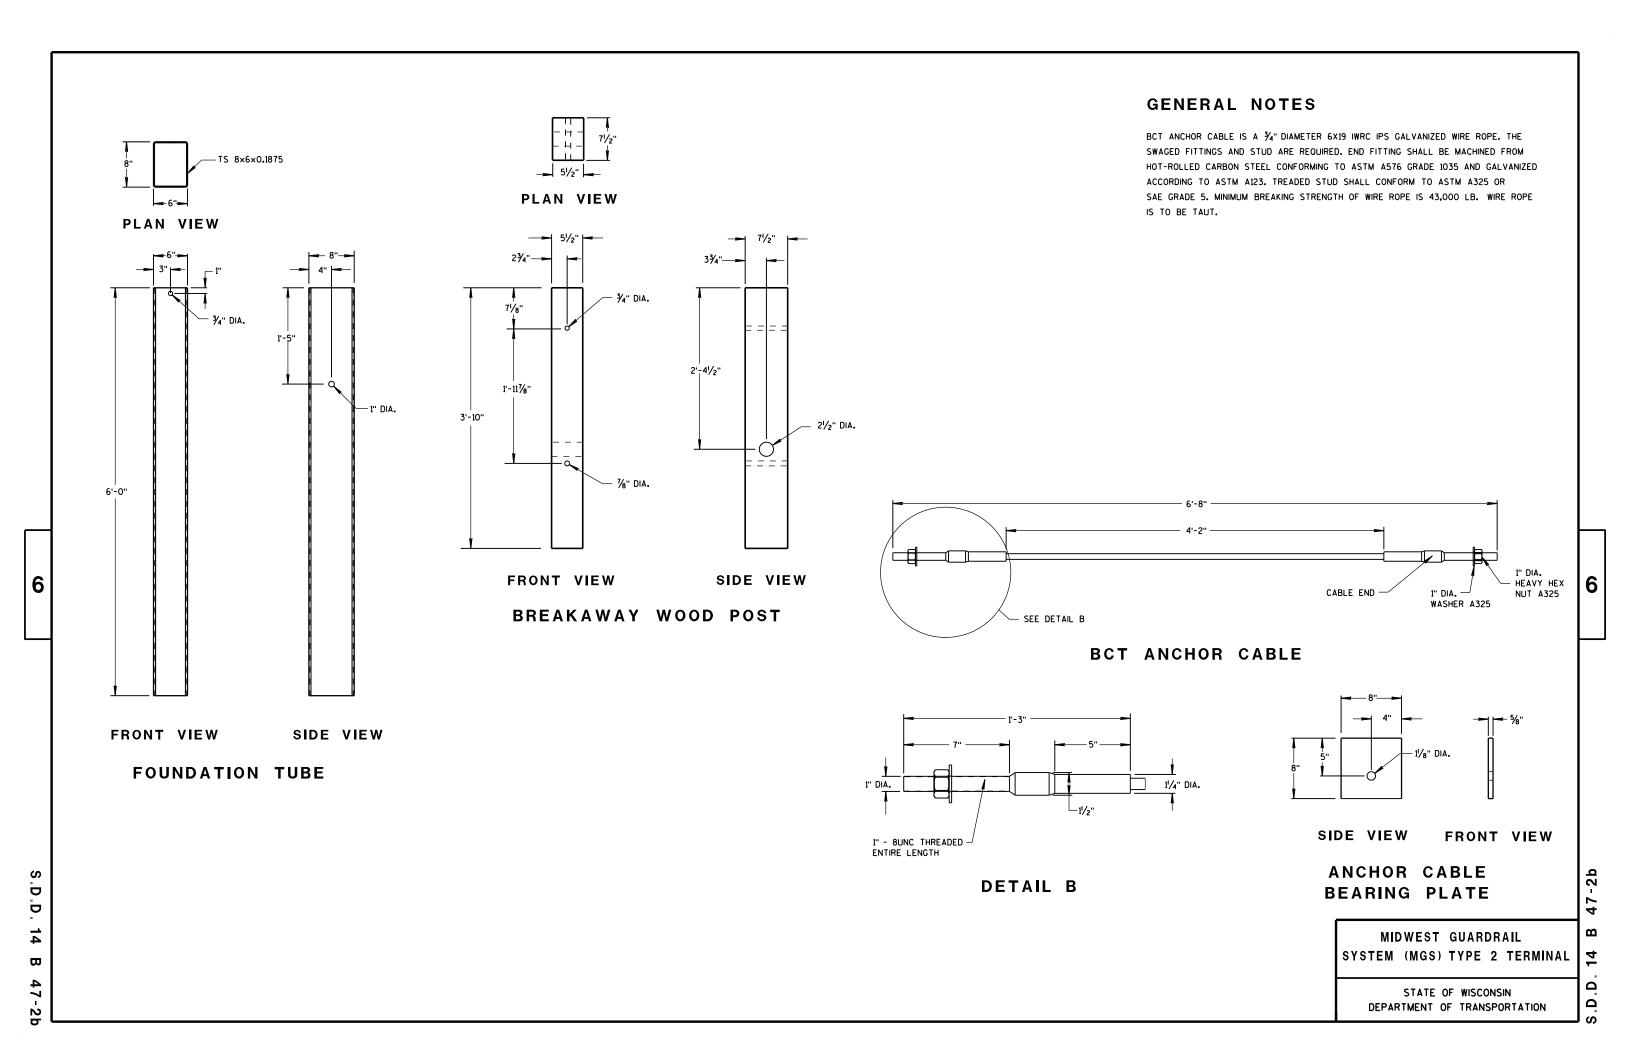

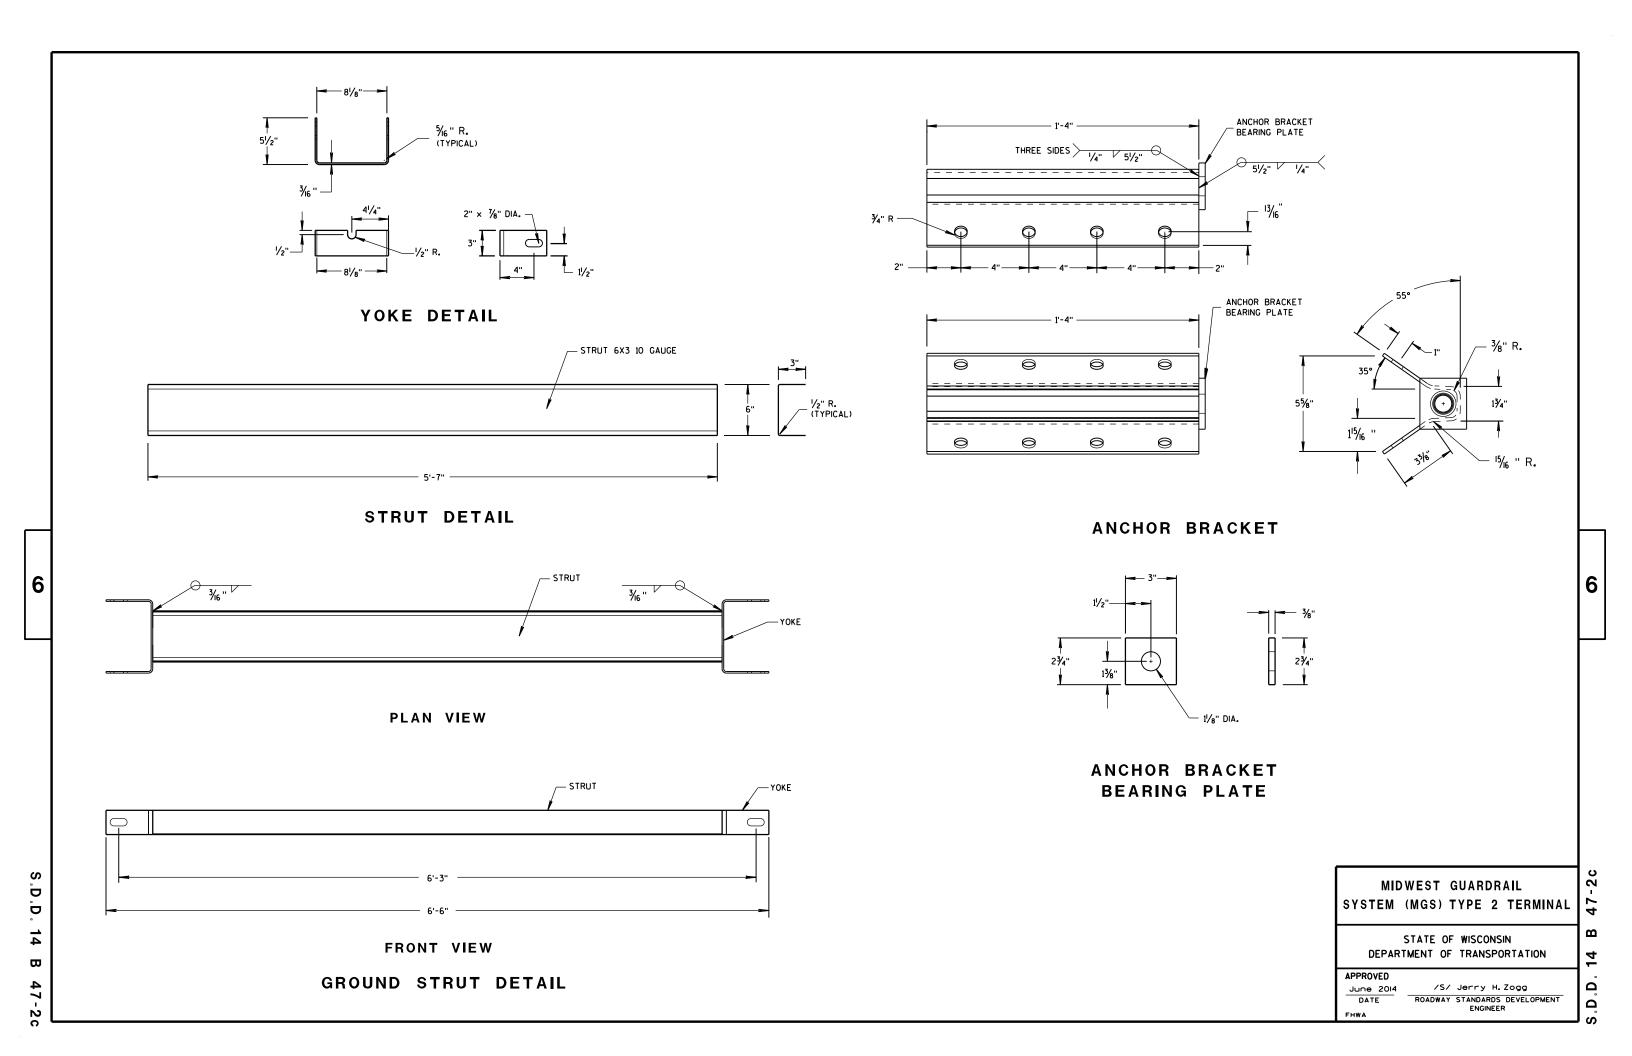

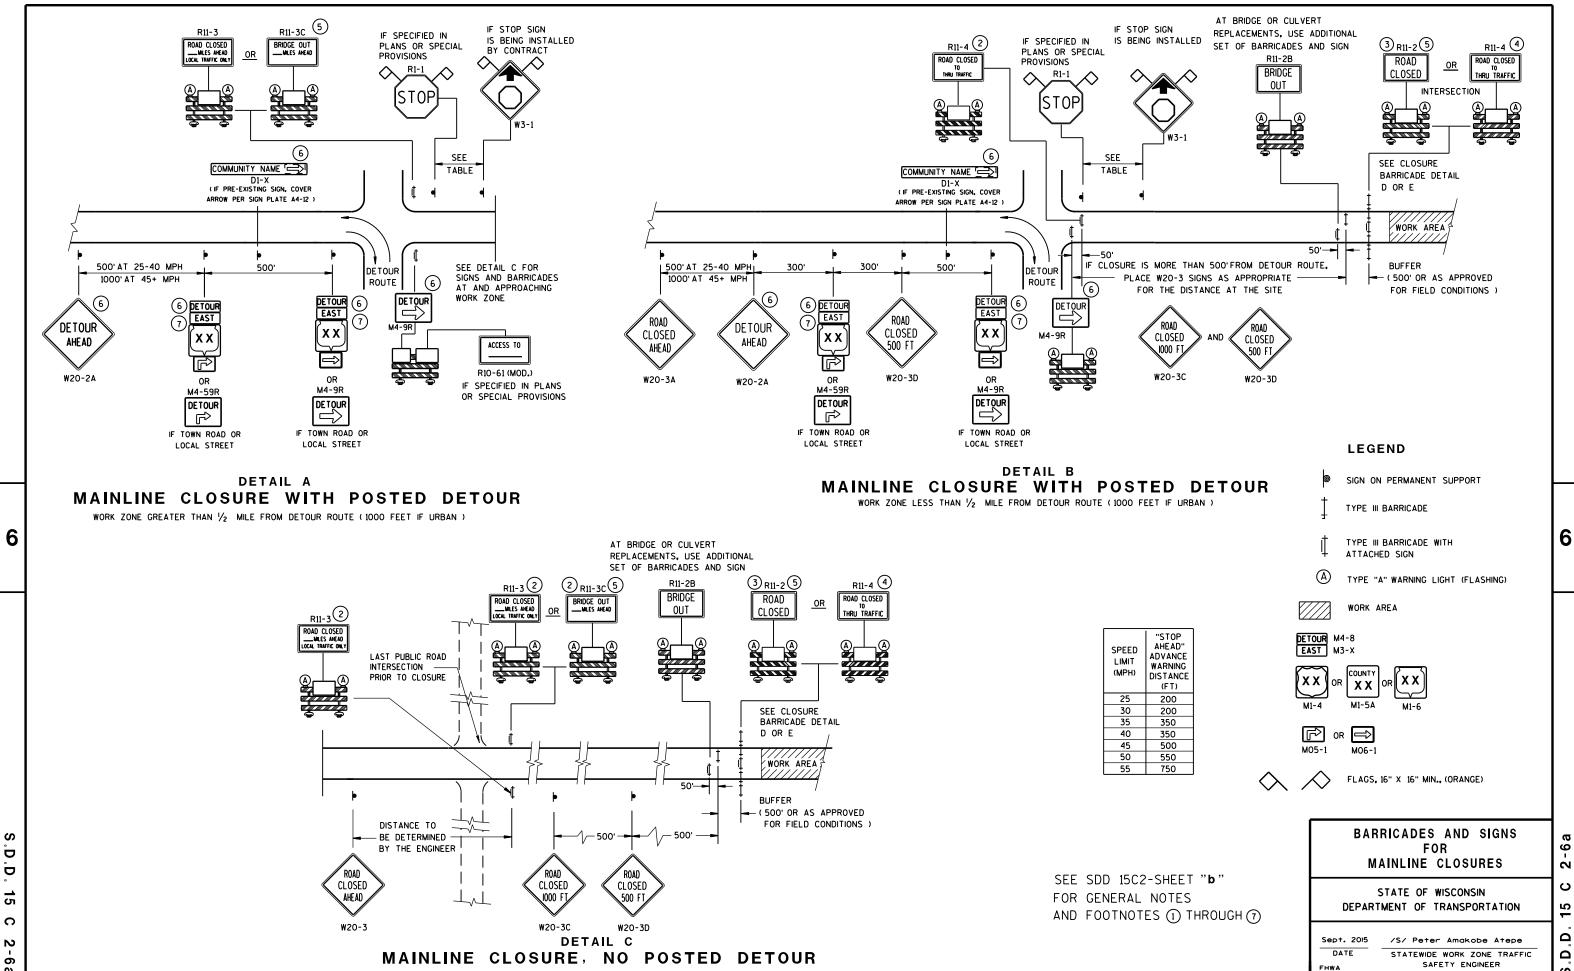

APPROACH VIEW

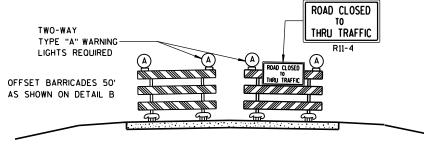

DETAIL E LANE CLOSURE BARRICADE DETAIL APPROACH VIEW

SEE SDD 15C2-SHEET "a" FOR LEGEND

GENERAL NOTES

THE EXACT NUMBER, LOCATION, AND SPACING OF ALL SIGNS AND BARRICADES SHALL BE ADJUSTED TO FIT FIELD CONDITIONS AS APPROVED BY THE ENGINEER.

ANY SIGNS TEMPORARY OR EXISTING, WHICH CONFLICT WITH TRAFFIC CONTROL "IN USE" SHALL BE REMOVED OR COVERED AS NEEDED AND AS APPROVED BY THE ENGINEER.

THE SPACING BETWEEN TRAFFIC CONTROL SIGNS SHOULD BE ADJUSTED TO NOT CONFLICT WITH AND SHOULD PROVIDE A DESIRABLE MINIMUM OF 200 FEET CLEARANCE TO EXISTING SIGNS THAT WILL REMAIN IN PLACE.

BARRICADES THAT MUST BE MOVED FOR A WORK OPERATION SHALL BE IMMEDIATELY RE-ESTABLISHED UPON COMPLETION OF THE OPERATION OR, FOR CONTINUING OPERATIONS, AT THE END OF EACH WORKING DAY.

SIGNS THAT WILL BE IN PLACE LESS THAN 7 CONTINUOUS DAYS AND NIGHTS MAY BE MOUNTED ON PORTABLE SUPPORTS.

ALL TYPE III BARRICADES SHALL HAVE RAILS REFLECTORIZED ON BOTH FACES. STRIPES SHALL BE PROPERLY SLOPED DOWN TOWARD THE TRAFFIC SIDE OR AS SHOWN IN THE ROAD CLOSURE BARRICADE DETAIL D FOR FULL ROAD CLOSURES.

TYPE "A" LOW-INTENSITY FLASHING WARNING LIGHTS SHALL BE VISIBLE ON BOTH SIDES OF THE

THE R11-2, R11-3, M4-9, R11-4 AND R10-61 SIGNS PLACED ON BARRICADES SHALL COVER NO MORE THAN THE TOP RAIL. THE SIGNS SHALL NOT COVER ANY PORTION OF THE MIDDLE OR BOTTOM RAILS.

"WO AND "MO" SIGNS ARE THE SAME AS "W" AND "M" SIGNS EXCEPT THE BACKGROUND IS ORANGE.

ALL SIGNS SHALL BE 48" X 48" UNLESS OTHERWISE NOTED BELOW:

R1-1 SHALL BE 36" X 36".

R11-2 SHALL BE 48" X 30". R11-3, R11-4 AND R10-61 SHALL BE 60" X 30". M4-9 SHALL BE 30" X 24". M3-X SHALL BE 24" X 12". (36" X 18" IF NEEDED TO MATCH EXISTING SIGNS.) M4-8 SHALL BE 24" X 12". (30" X 15" IF NEEDED TO MATCH EXISTING SIGNS.) M1-4, M1-5A, AND M1-6 SHALL BE 24" X 24". (36" X 36" IF NEEDED TO MATCH EXISTING SIGNS.) MO5-1 AND MO6-1 SHALL BE 21" X 21". (30" X 30" IF NEEDED TO MATCH EXISTING SIGNS.) D1-X SHALL BE AS SHOWN ON SPECIFIC PROJECT SIGNING DETAIL SHEETS.

- (1) TWO WARNING LIGHTS SHALL BE PROVIDED ON THE CENTER BARRICADE AND A MINIMUM OF ONE WARNING LIGHT SHALL BE PROVIDED ON EACH OF THE OTHER BARRICADES WITHIN THE ROADWAY LIMITS. SPACING OF THE WARNING LIGHTS SHALL BE UNIFORM TO THE EDGE OF ROADWAY AS SHOWN (APPROX. 8-FOOT
- THESE SIGNS AND BARRICADES ARE NOT REQUIRED IF ROAD CLOSURE BEGINS AT INTERSECTION.
- FOR ROAD CLOSURE WITHOUT LOCAL ACCESS TO PROJECT, SEE ROAD CLOSURE BARRICADE DETAIL D.
- FOR ROAD CLOSURE WITH LOCAL ACCESS TO PROJECT, SEE LANE CLOSURE BARRICADE DETAIL E.
- FOR BRIDGE OR CULVERT REPLACEMENTS, SUBSTITUTE "BRIDGE OUT" INSTEAD OF "ROAD CLOSED" ON R11-2 AND R11-3 SIGNS.
- INSTALL DETOUR AND COMMUNITY GUIDE SIGNS AND ARROWS ONLY IF SPECIFIED IN THE CONTRACT. IF THERE ARE EXISTING ROUTE MARKER ASSEMBLIES THAT WILL REMAIN IN PLACE, ADJUST THE LOCATION OF THE DETOUR ROUTE SIGNS TO CORRESPOND WITH THE EXISTING ASSEMBLIES. MODIFY EXISTING SIGNS WHERE POSSIBLE. SEE SPECIFIC PROJECT DETOUR SIGNING DETAIL SHEETS. IF DETOUR SIGNS ARE BEING INSTALLED BY OTHERS. PLACE THE CONTRACTED TRAFFIC CONTROL SIGNS TO ALLOW FOR PLACEMENT OF ALL WARNING, DETOUR AND GUIDE SIGNS AS SHOWN.
- "EAST" CARDINAL DIRECTION MARKERS AND RIGHT TURN ARROWS ARE SHOWN. USE OTHER CARDINAL DIRECTIONS AND ARROWS AS APPROPRIATE.

BARRICADES AND SIGNS FOR MAINLINE CLOSURES


2


2

Ω

STATE OF WISCONSIN DEPARTMENT OF TRANSPORTATION

/S/ Peter Amakobe Atepe STATEWIDE WORK ZONE TRAFFIC SAFETY ENGINEER

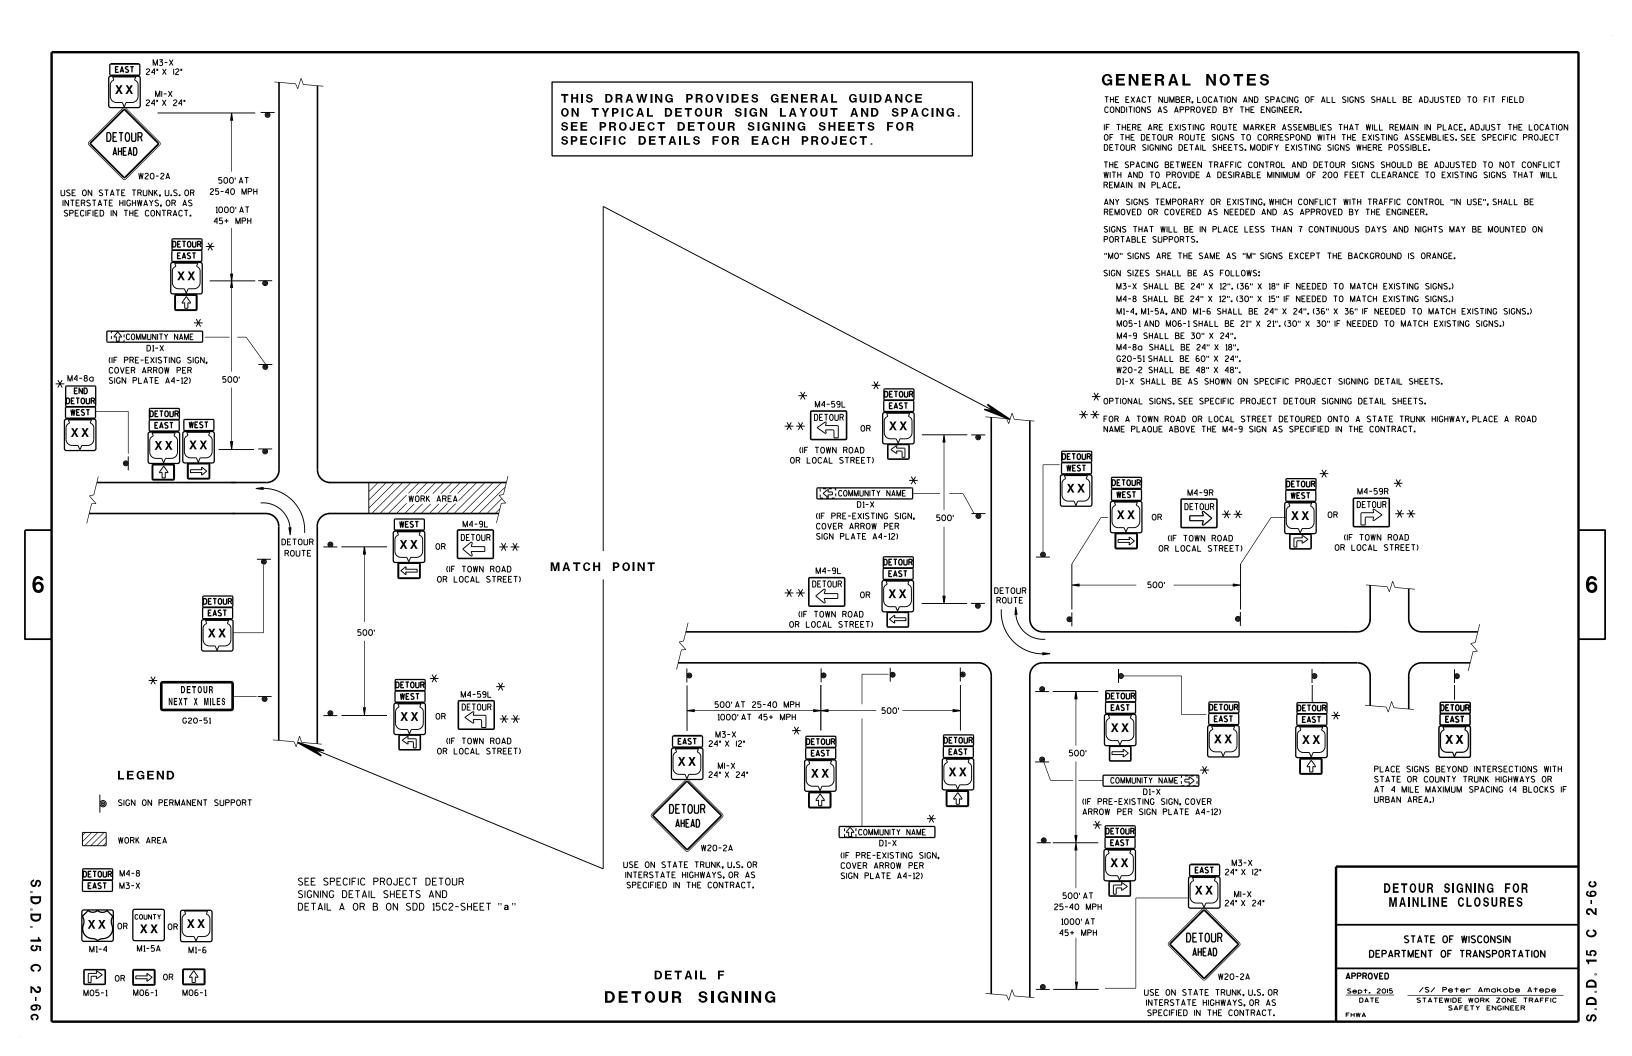

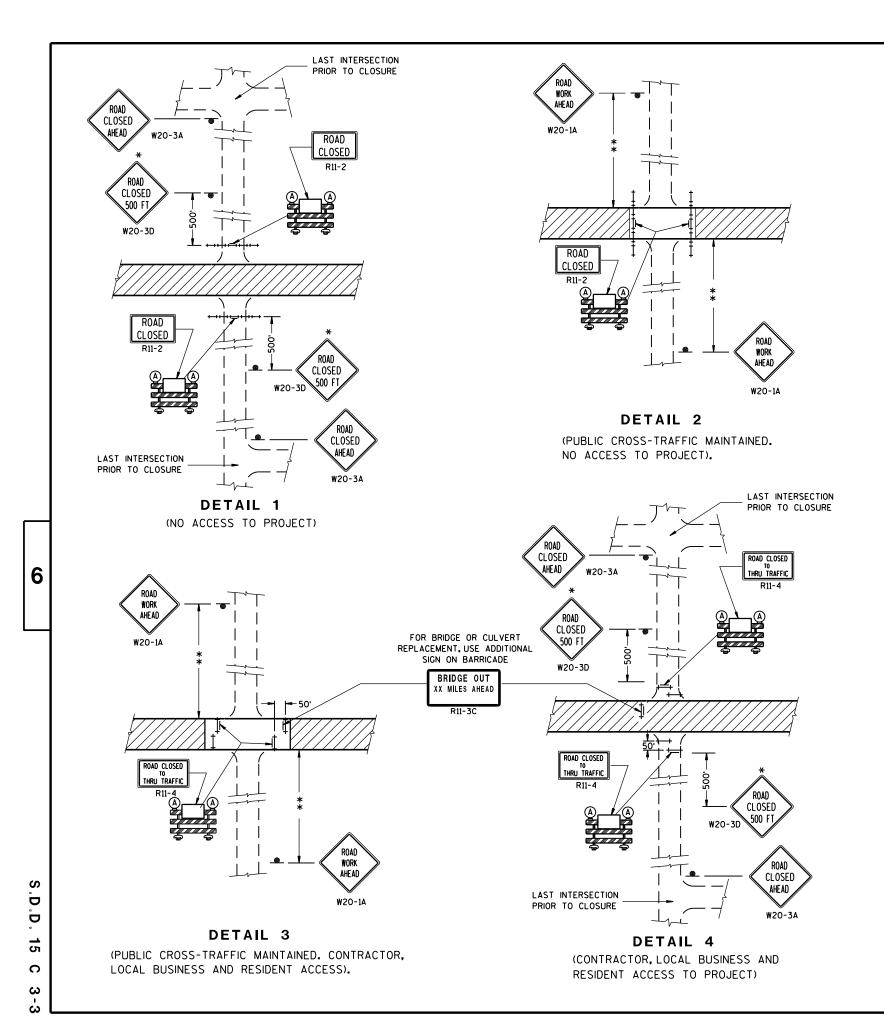

THE EXACT NUMBER, LOCATION, AND SPACING OF ALL SIGNS AND BARRICADES SHALL BE ADJUSTED TO FIT FIELD CONDITIONS AS APPROVED BY THE ENGINEER.

ANY SIGNS TEMPORARY OR EXISTING, WHICH CONFLICT WITH TRAFFIC CONTROL "IN USE" SHALL BE REMOVED OR COVERED AS NEEDED AND AS APPROVED BY THE ENGINEER.

THE SPACING BETWEEN TRAFFIC CONTROL SIGNS SHOULD BE ADJUSTED TO NOT CONFLICT WITH AND SHOULD PROVIDE A DESIRABLE MINIMUM OF 200 FEET CLEARANCE TO EXISTING SIGNS THAT WILL REMAIN IN PLACE.

IF A "STOP" SIGN MUST BE REMOVED FOR A WORK OPERATION, A TEMPORARY "STOP" SIGN SHALL BE PLACED PRIOR TO THE SIGN REMOVAL, OR A FLAGGER SHALL BE PROVIDED UNTIL THE SIGN IS RE-ESTABLISHED.

BARRICADES THAT MUST BE MOVED FOR A WORK OPERATION SHALL BE IMMEDIATELY RE-ESTABLISHED UPON COMPLETION OF THE OPERATION OR, FOR CONTINUING OPERATIONS, AT THE END OF EACH WORKING DAY.

SIGNS THAT WILL BE IN PLACE LESS THAN 7 CONTINUOUS DAYS AND NIGHTS MAY BE MOUNTED ON PORTABLE SUPPORTS.

ALL TYPE III BARRICADES SHALL HAVE RAILS REFLECTORIZED ON BOTH FACES. STRIPES SHALL BE PROPERLY SLOPED DOWN TOWARD THE TRAFFIC SIDE OR AS SHOWN IN THE ROAD CLOSURE BARRICADE DETAIL D FOR FULL ROAD CLOSURES.

TYPE "A" LOW-INTENSITY FLASHING WARNING LIGHTS SHALL BE VISIBLE ON BOTH SIDES OF THE BARRICADE.

THE R11-2, R11-3 AND R11-4 SIGNS PLACED ON BARRICADES SHALL COVER NO MORE THAN THE TOP RAIL. THE SIGNS SHALL NOT COVER ANY PORTION OF THE MIDDLE OR BOTTOM RAILS.

ALL SIGNS SHALL BE 48" X 48" UNLESS OTHERWISE NOTED BELOW:
RI1-2 SHALL BE 48" X 30".
RI1-4 AND RI1-3 SHALL BE 60" X 30".

*OMIT THE "ROAD CLOSED 500 FT." SIGN IF THE LAST INTERSECTION IS 500 FT. OR LESS FROM THE WORK ZONE.

**500' MAX. OR AT LAST INTERSECTION WHICHEVER IS CLOSER.

LEGEND

SIGN ON PERMANENT SUPPORT

TYPE III BARRICADE

TYPE III BARRICADE WITH
ATTACHED SIGN

(A) TYPE "A" WARNING LIGHT (FLASHING)

//// w

WORK AREA

BARRICADES AND SIGNS FOR SIDEROAD CLOSURES

STATE OF WISCONSIN
DEPARTMENT OF TRANSPORTATION

APPROVED

Sept. 2015

DATE
STATEWIDE WORK ZONE TRAFFIC
SAFETY ENGINEER

.D.D. 15 C

က

6

6

S

D

D

15

C

THE EXACT NUMBER, LOCATION, AND SPACING OF ALL SIGNS AND DEVICES SHALL BE ADJUSTED TO FIT FIELD CONDITIONS.


THE SPACING BETWEEN TRAFFIC CONTROL SIGNS SHOULD BE ADJUSTED TO NOT CONFLICT WITH AND SHOULD PROVIDE A DESIRABLE MINIMUM OF 200 FEET CLEARANCE TO EXISTING SIGNS THAT WILL REMAIN IN PLACE.

ALL SIGNS ARE 48"×48" UNLESS OTHERWISE NOTED. IF NECESSARY DUE TO SPACE CONSTRAINTS, 36"×36" SIGNS MAY BE USED INSTEAD OF 48"×48" SIGNS.

SIGNS THAT WILL BE IN PLACE LESS THAN 7 CONTINUOUS DAYS AND NIGHTS MAY BE MOUNTED ON PORTABLE SUPPORTS.

IF A "STOP" SIGN MUST BE REMOVED FOR A WORK OPERATION, A TEMPORARY "STOP" SIGN SHALL BE PLACED PRIOR TO THE SIGN REMOVAL, OR A FLAGGER SHALL BE PROVIDED UNTIL THE SIGN IS RE-ESTABLISHED.

★ THE THIRD W20-1 SIGN IS REQUIRED ONLY IF THERE IS AN INTERSECTION BETWEEN THE "ROAD WORK 500 FT" SIGN AND THE WORK ZONE. ADJUST THE PLACEMENT OF THIS SIGN BASED ON INTERSECTION LOCATION AND OTHER FIELD CONDITIONS.

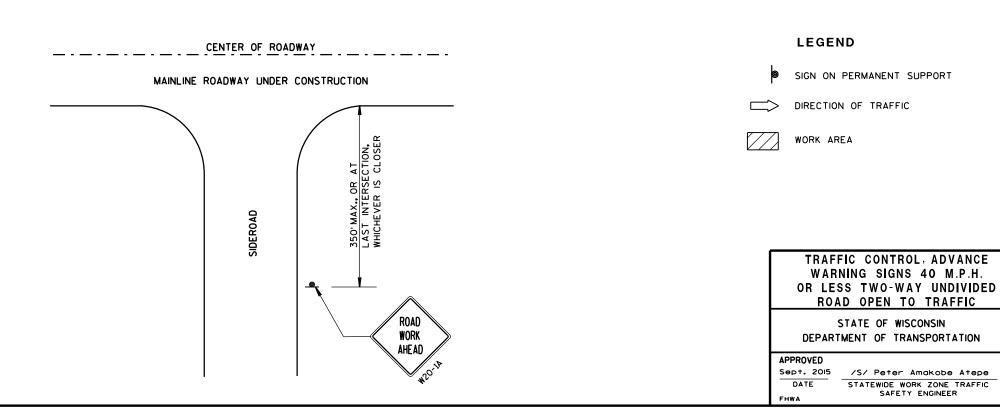



6

5-


Ω

DETAILS OF INSTALLATION, MATERIALS AND WORKMANSHIP NOT SHOWN ON THIS DRAWING SHALL CONFORM TO THE PERTINENT REQUIREMENTS OF THE STANDARD SPECIFICATIONS AND APPLICABLE SPECIAL PROVISIONS.

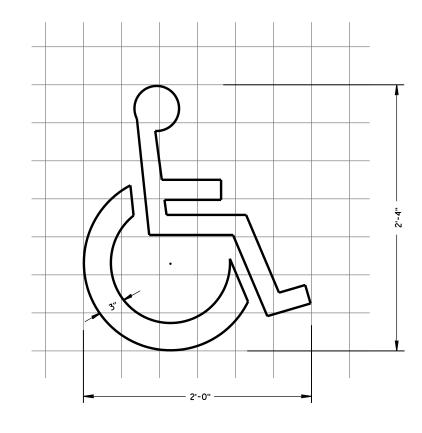

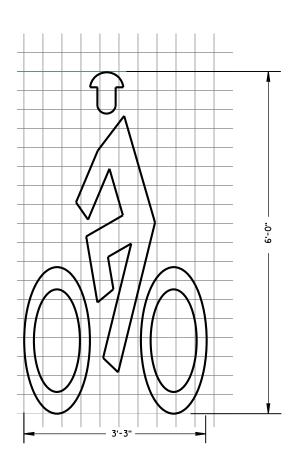

BIKE CROSSING SYMBOL

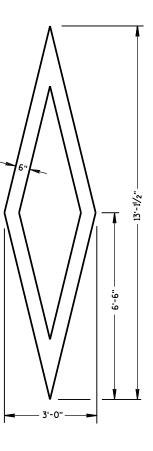

PREFERENTIAL LANE SYMBOL

FHWA

PAVEMENT MARKING SYMBOLS

6

15

۵

STATE OF WISCONSIN
DEPARTMENT OF TRANSPORTATION


APPROVED


4/18/16
DATE


STATE SIGNING AND MARKING ENGINEER


S.D.D. 15 C 7-13a


6

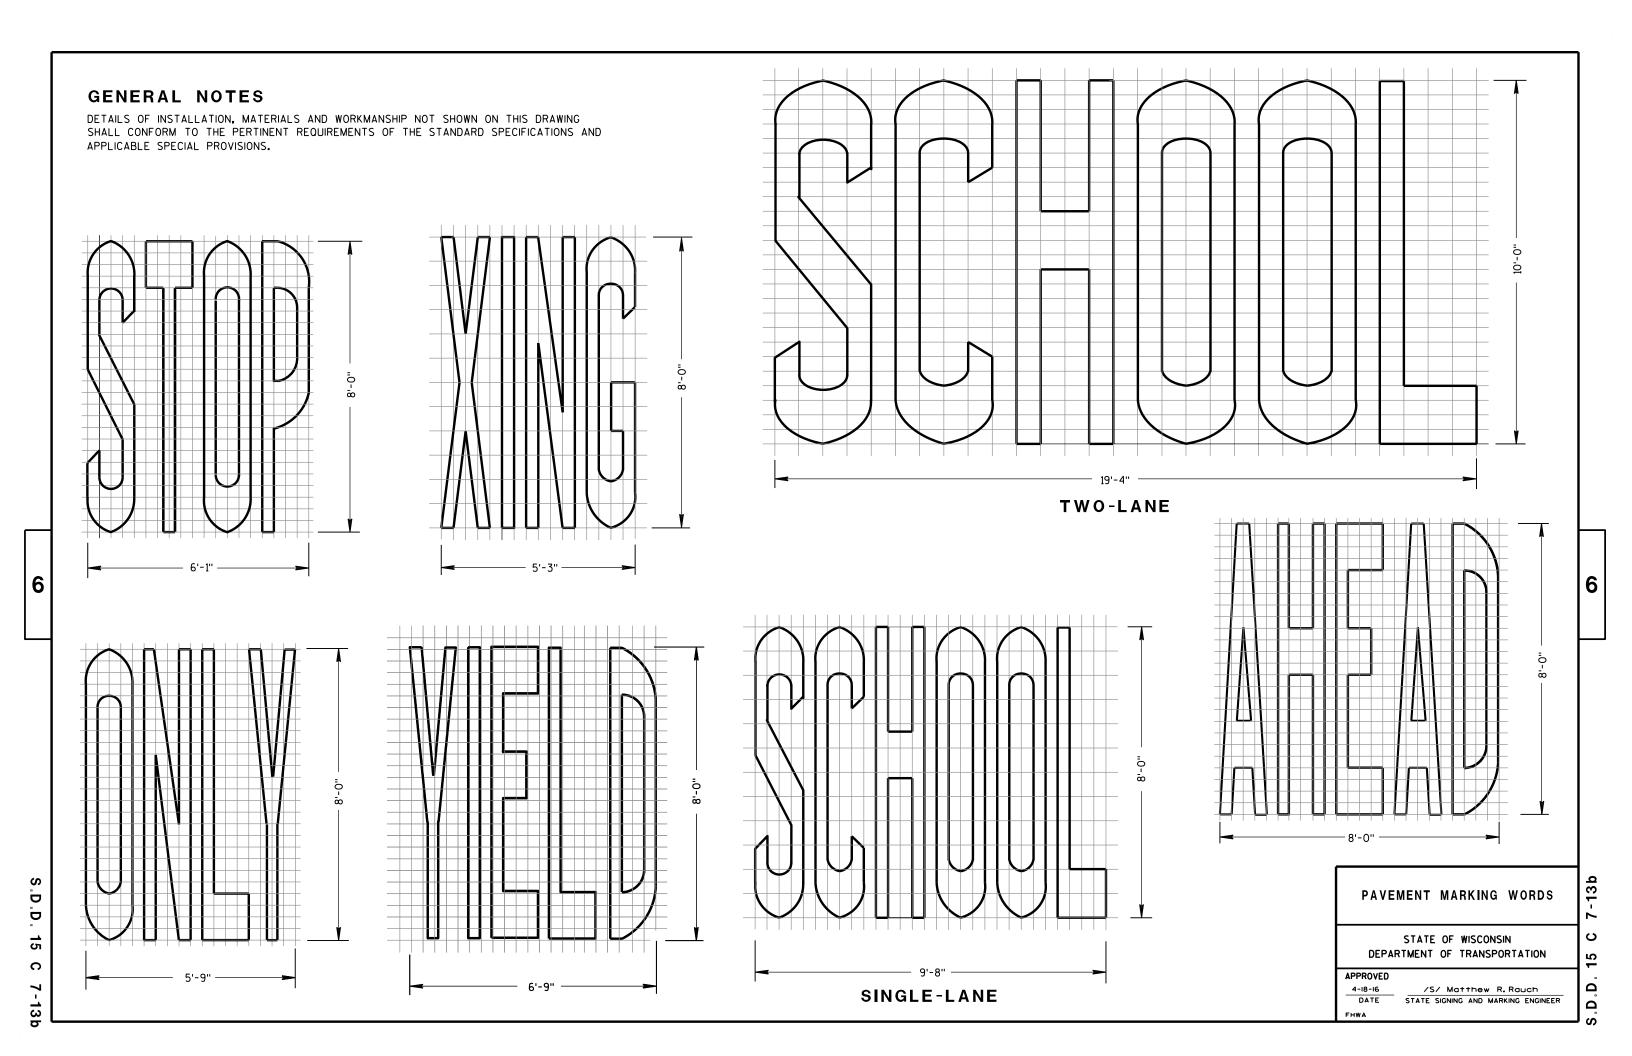


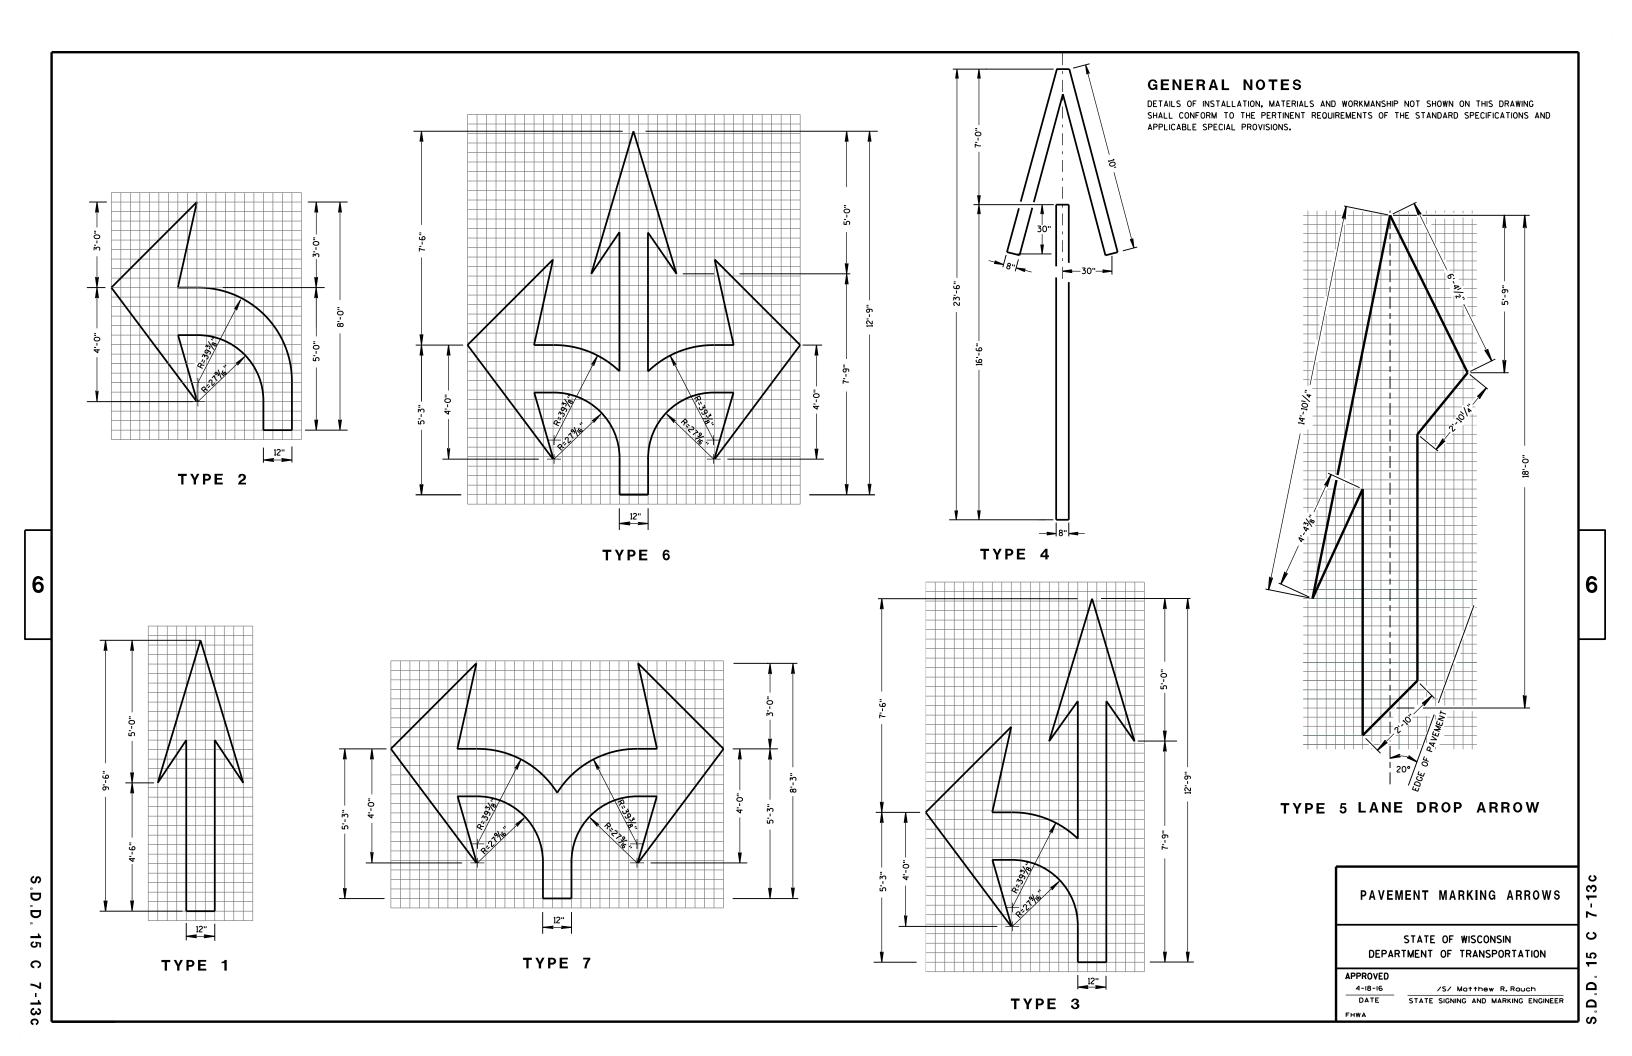


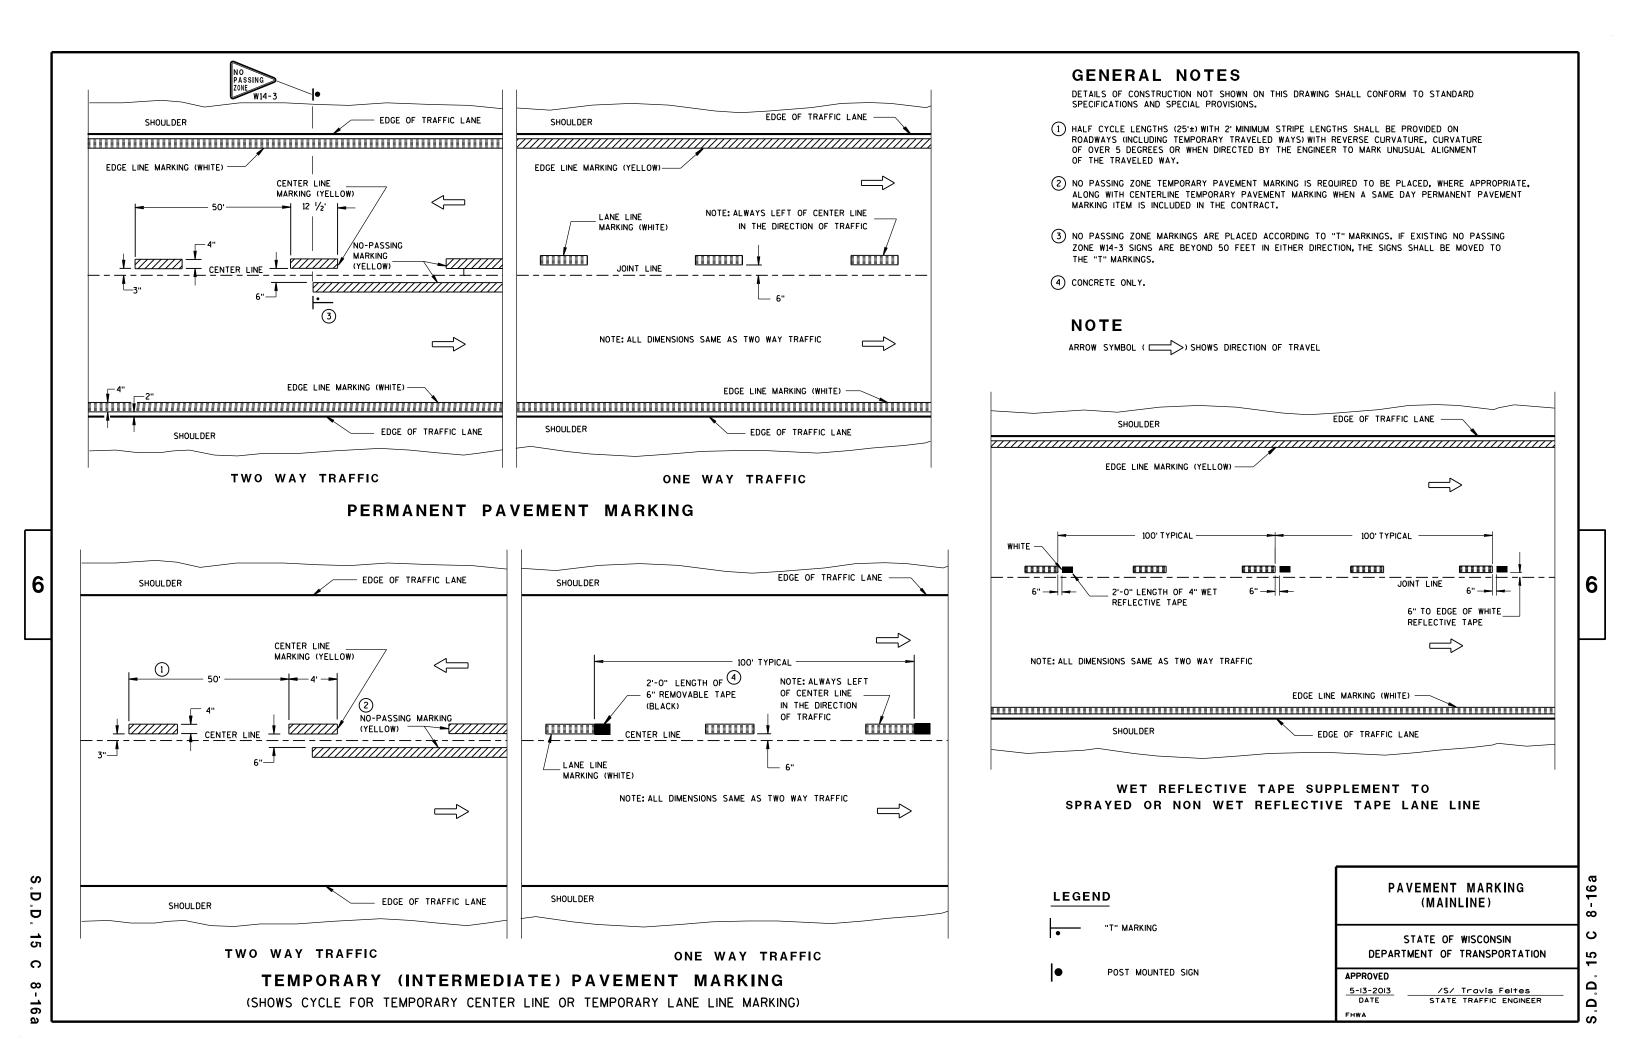


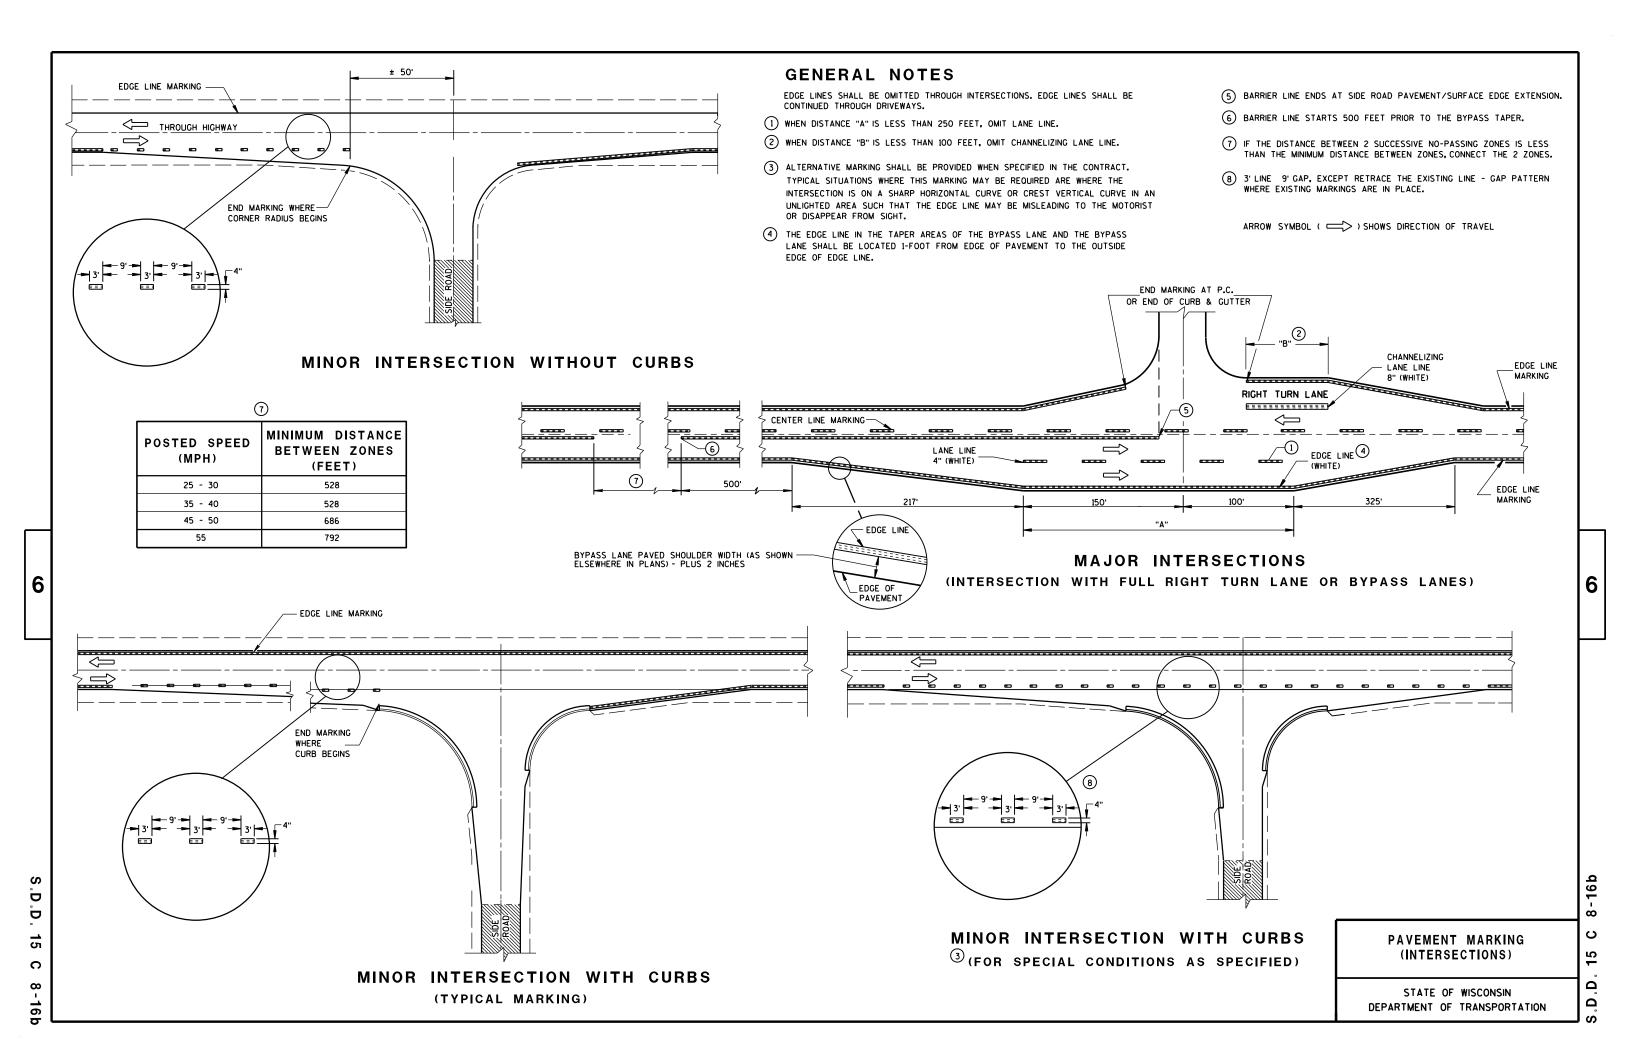


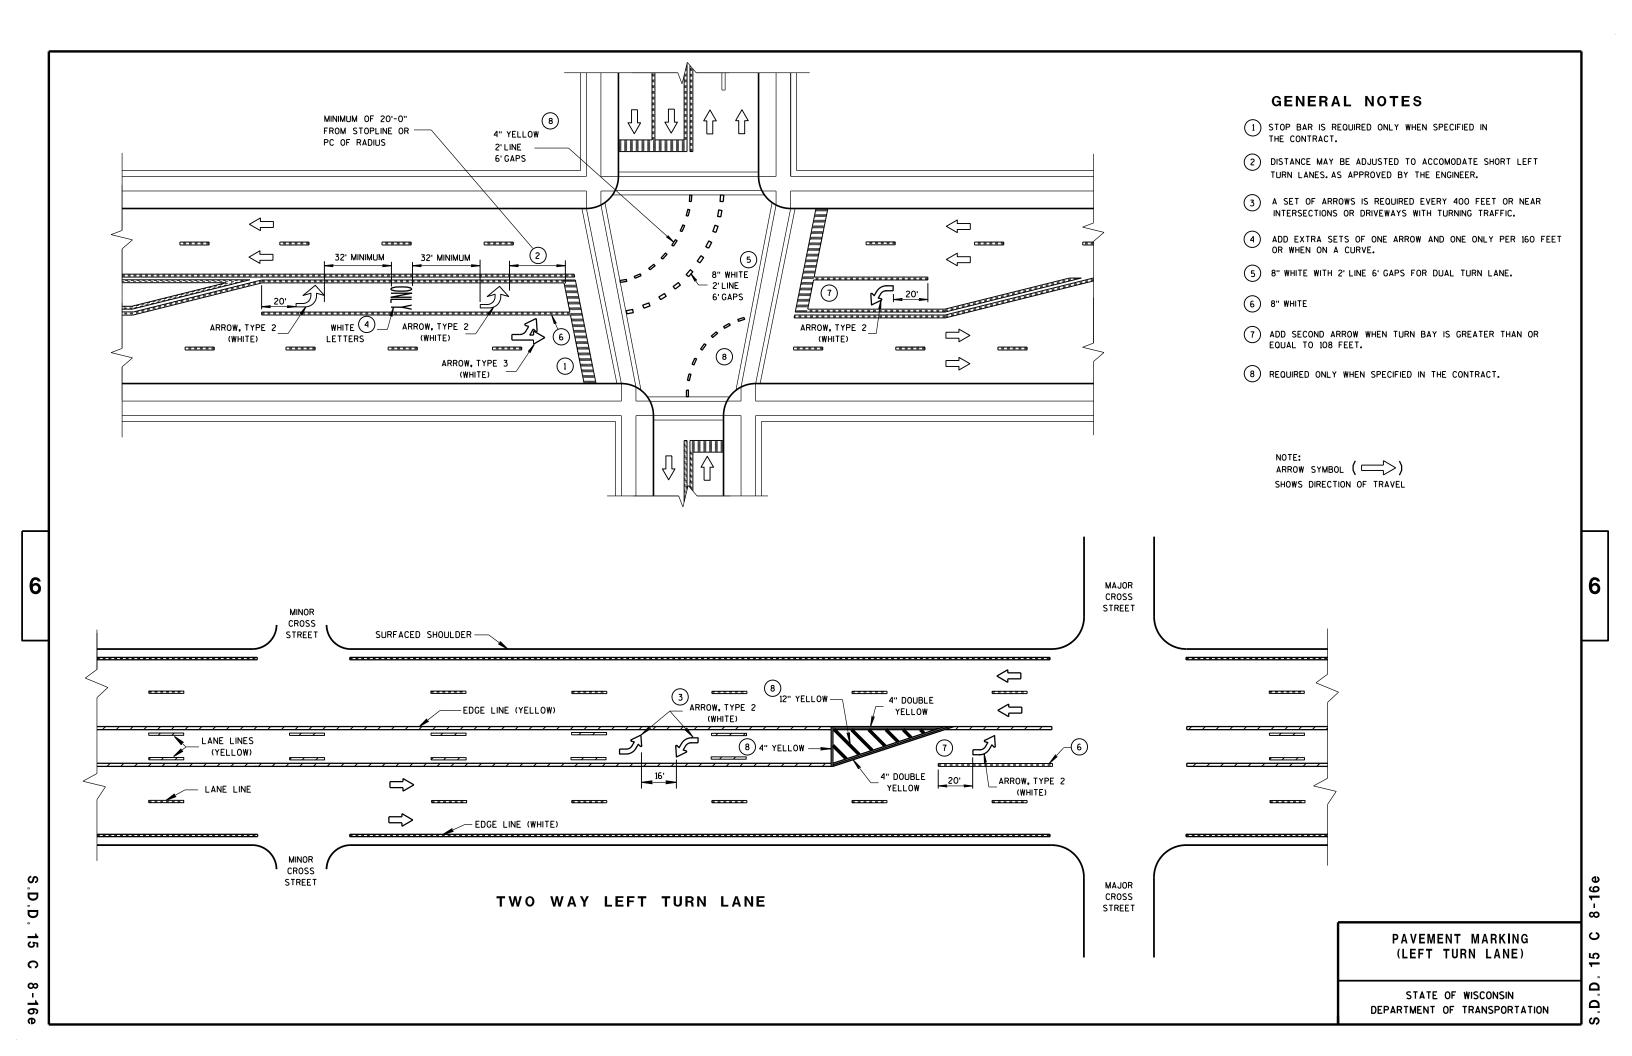

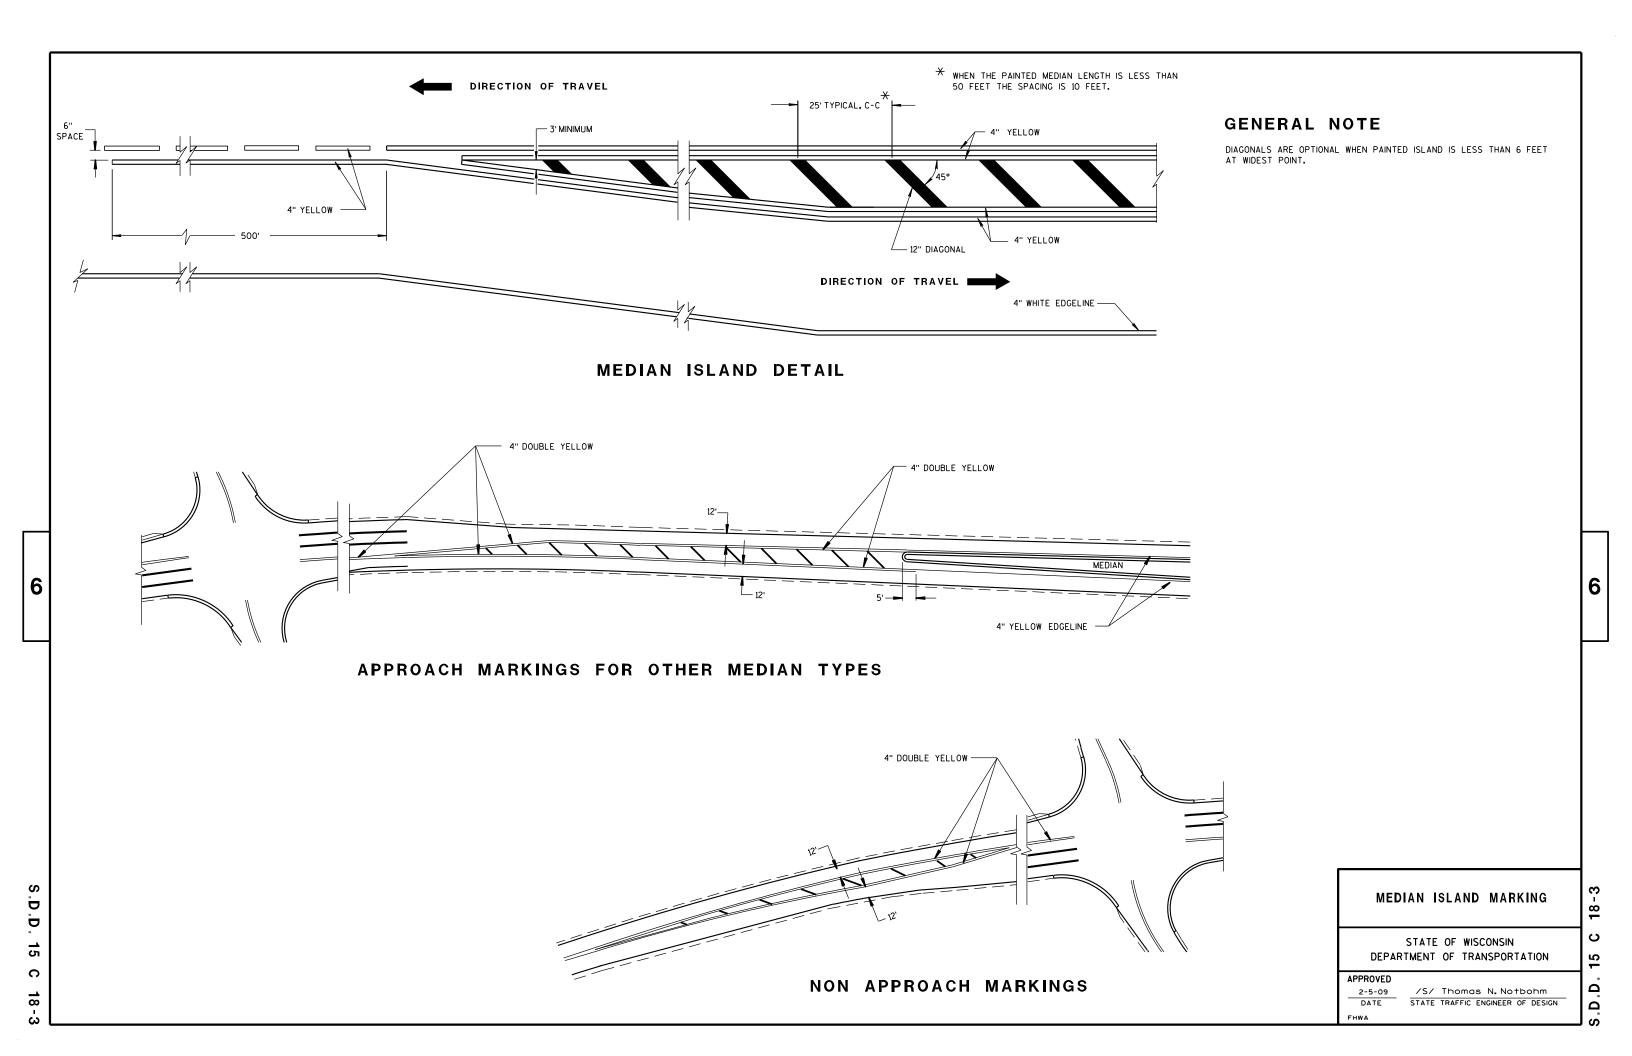

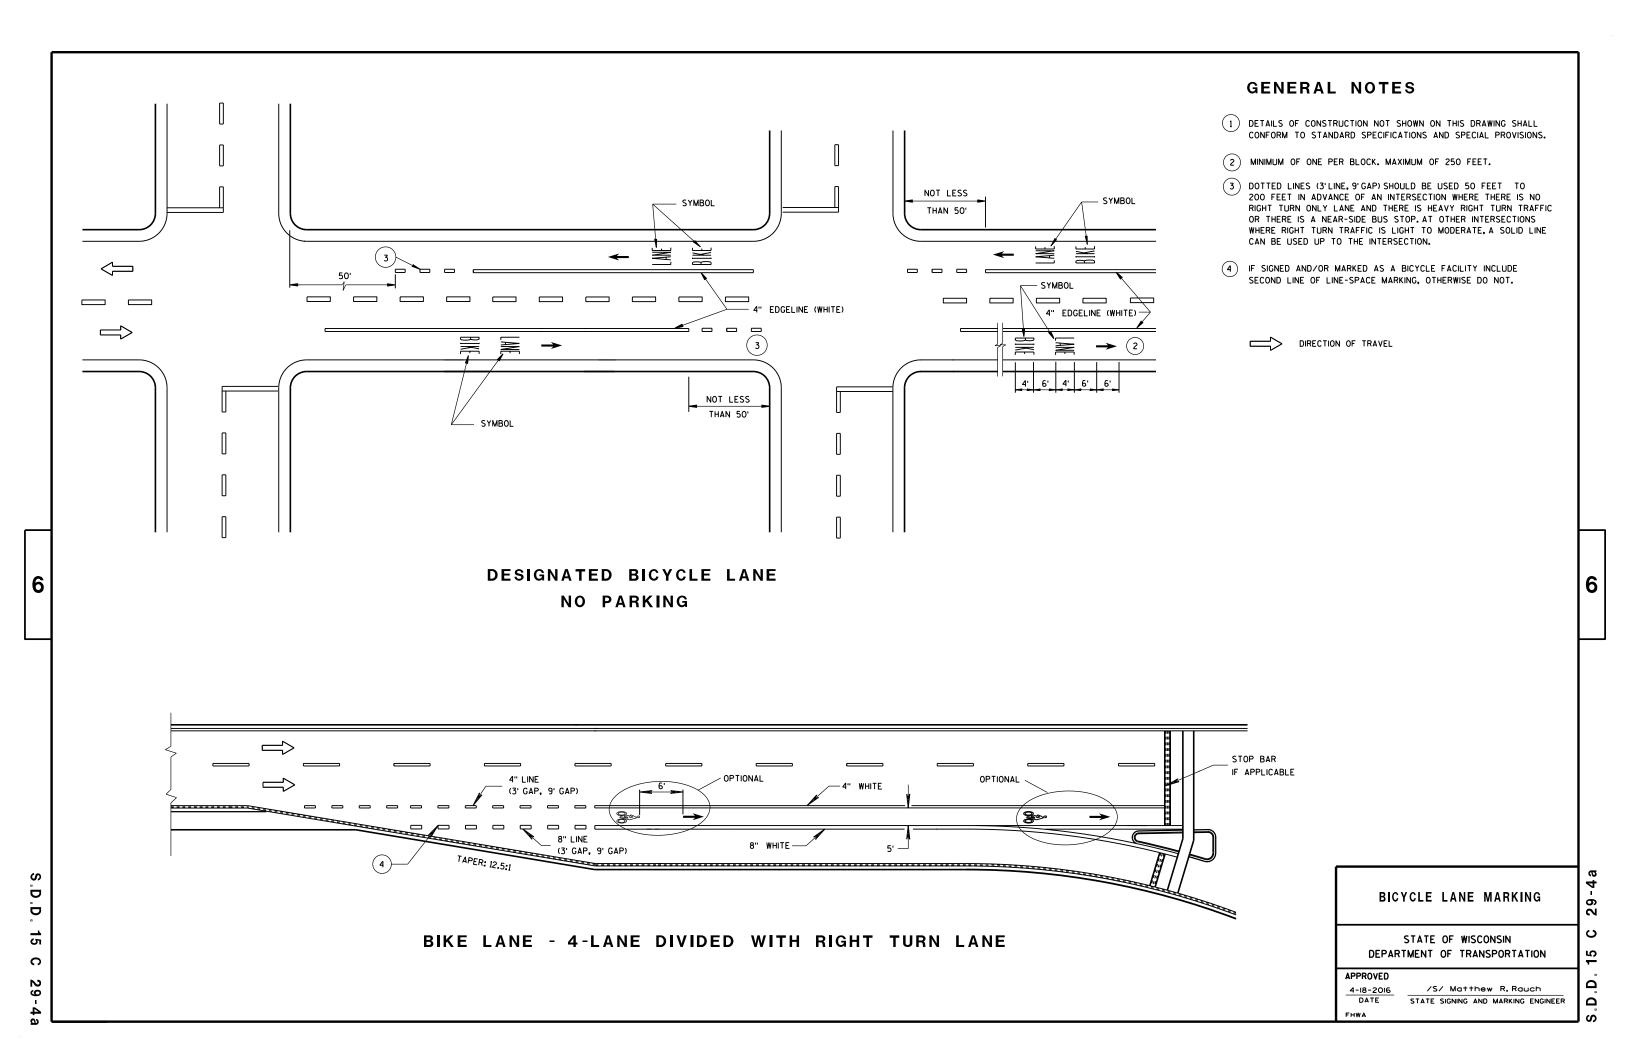

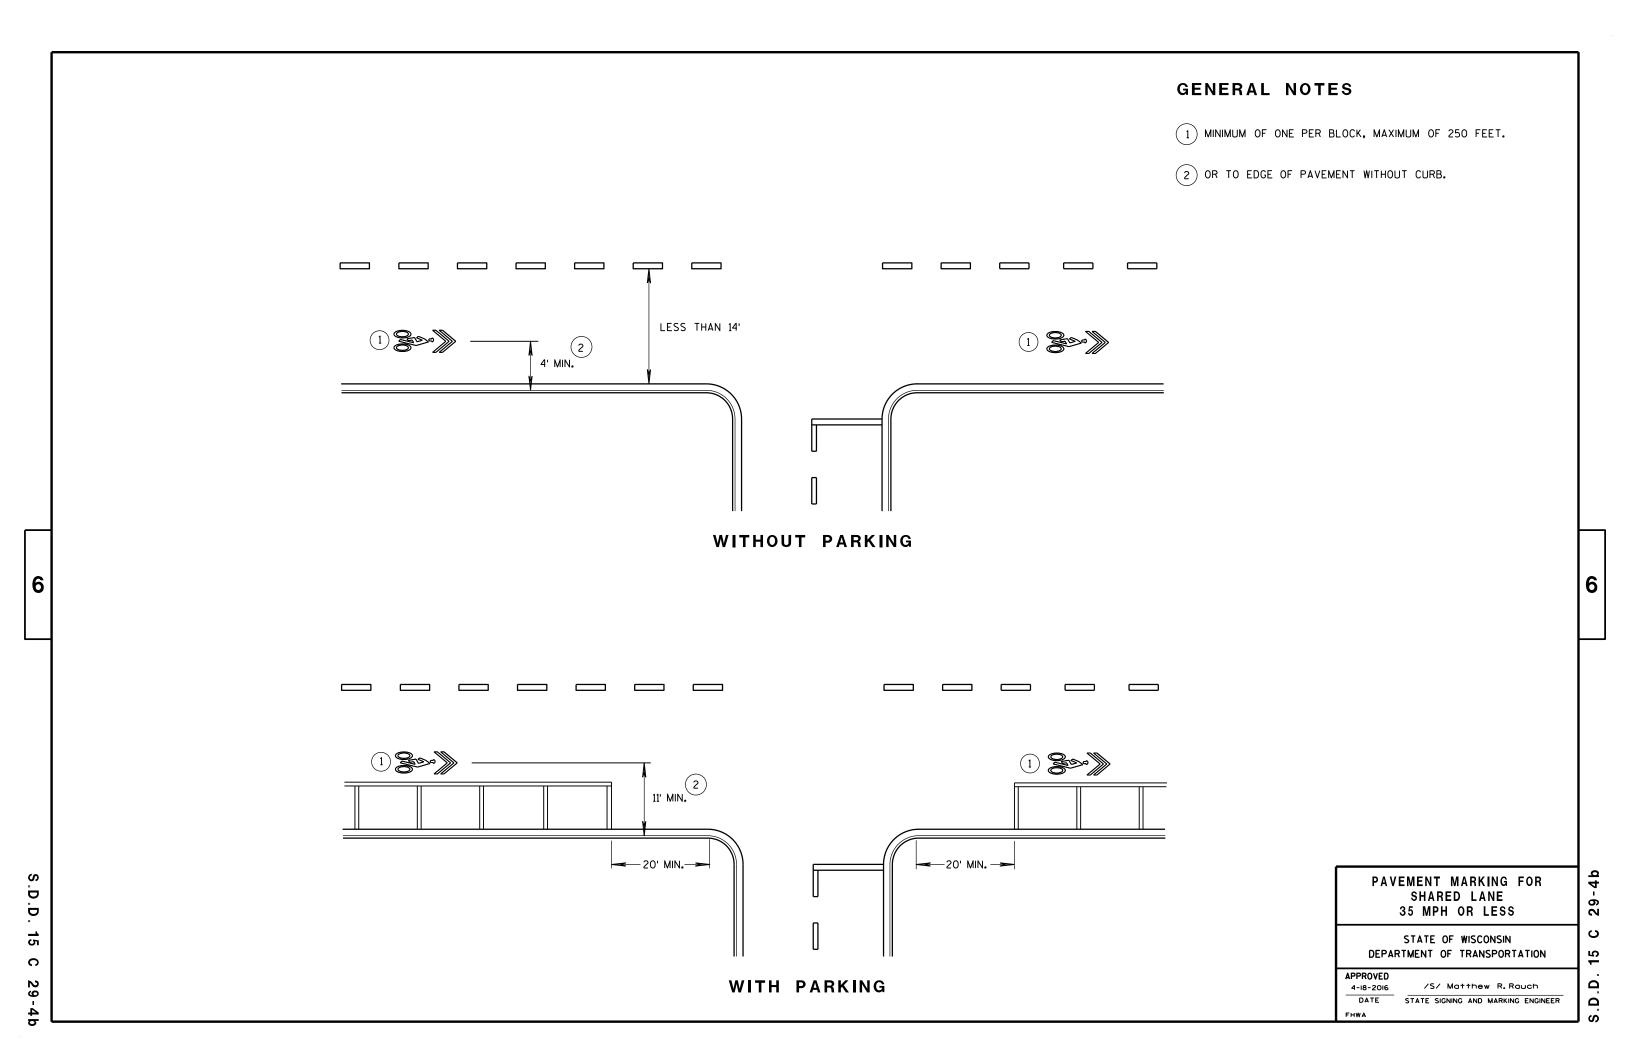

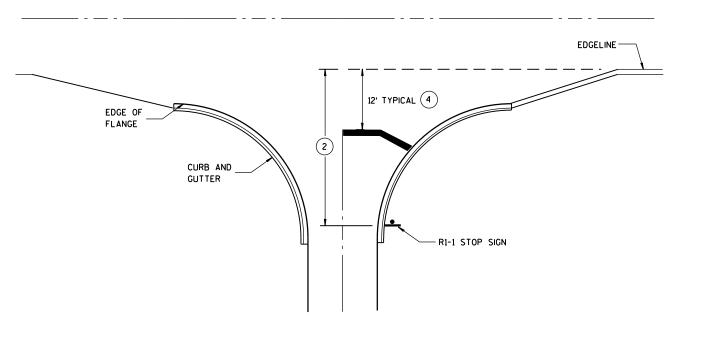

8" CHANNELIZATION WHITE


FLANGELINE (EXTENSION)

4" WHITE EDGELINE


R1-1 STOP SIGN

TYPICAL STOP LINE PAVEMENT MARKING WITH CURB AND GUTTER

TYPICAL STOP LINE PAVEMENT MARKING FOR SIDEROADS WITH RIGHT TURN LANE

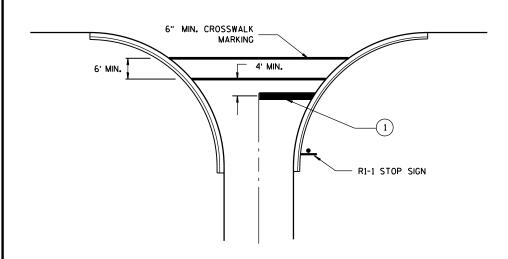

TYPICAL STOP LINE PAVEMENT MARKING FOR SIDEROADS WITH CROSSWALK MARKING

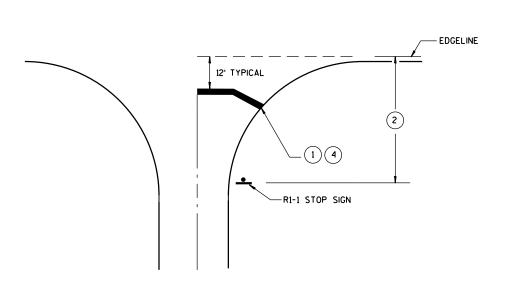

TYPICAL STOP LINE PAVEMENT MARKING WITHOUT CURB AND GUTTER

GENERAL NOTES

- 1 18-INCH STOP LINES MAY BE DELETED OR ADDED BY THE PROJECT ENGINEER BASED ON VISIBILITY AND SIGHT LINES.
- 2 IF STOP SIGN IS LESS THAN OR EQUAL TO 40 FEET FROM THE EDGELINE THAN NO STOP LINE IS REQUIRED.
- 3 IF STOP SIGN IS LESS THAN OR EQUAL TO 30 FEET FROM THE FLANGELINE EXTENSION THAN NO STOP LINE IS REQUIRED.
- MOVE CLOSER TO EDGE OF TRAVEL LANE AS NEEDED FOR VISIBILITY AND SIGHT LINES. (NO CLOSER THAN 4 FEET).

STOP LINE AND CROSSWALK PAVEMENT MARKING

STATE OF WISCONSIN
DEPARTMENT OF TRANSPORTATION

APPROVED	
4-18-2016	/S/ Matthew R. Rauch
DATE	STATE SIGNING AND MARKING ENGINEER

.D. 15 C 33-

D

6


3. D. D.


က

15

6

GENERAL NOTES LEGEND THE EXACT NUMBER, LOCATION, AND SPACING OF ALL SIGNS AND DEVICES SHALL BE REMOVE PAVEMENT MARKINGS IF LANE CLOSURE IS TO BE IN PLACE FOR LONGER THAN ADJUSTED TO FIT FIELD CONDITIONS AS APPROVED BY THE ENGINEER. 4 OR MORE DAYS AND NIGHTS. TYPE III BARRICADE WITH ATTACHED SIGN THE SPACING BETWEEN SIGNS SHOULD BE ADJUSTED TO NOT CONFLICT WITH AND TO PROVIDE A MINIMUM OF 200 FEET, (500 FEET DESIREABLE) DISTANCE TO EXISTING WARNING LIGHTS ARE NOT REQUIRED IF THE LANE CLOSURE IS A DAYTIME ONLY OPERATION. SIGN ON PERMENENT SUPPORT IF THE HORIZONTAL ALIGNMENT IS SUCH THAT A CURVE MAY REQUIRE ADDITIONAL TRAFFIC CONTROL DRUM WITH TYPE "C" STEADY BURN LIGHT THIS LANE CLOSURE IS TYPICAL FOR CLOSING RIGHT LANE - REVERSE FOR CLOSING DELINEATION. THE DEVICE SPACING MAY BE DECREASED TO 50 FEET. LEFT LANE. TRAFFIC CONTROL DRUM ALL SIGNS ARE 48"x48" UNLESS OTHERWISE NOTED. ADJUSTMENTS IN BUFFER SPACE NEED TO BE INCORPORATED WHEN THE LANE CLOSURE OCCURS NEAR AN INTERCHANGE EXIT OR ENTRANCE RAMP. THE LANE CLOSURE MUST FLASHING ARROW BOARD "WO" IS THE SAME AS "W" EXCEPT THE BACKGROUND IS ORANGE. MUST TAKE PLACE FAR ENOUGH IN ADVANCE OF AN EXIT OR ENTRANCE RAMP TO STILL ALLOW FOR ADEQUATE BUFFER SPACE. THE MINIMUM LENGTH OF THE BUFFER SPACE BEFORE AN EXIT RAMP SHOULD BE 1/2 THE LENGTH OF THE TRANSITION AREA. ANY SIGNS TEMPORARY OR EXISTING, WHICH CONFLICT WITH TRAFFIC CONTROL "IN USE" TYPE "A" WARNING LIGHT (FLASHING) THE ENTRANCE RAMP SHOULD BE FOLLOWED BY THE ORIGINAL BUFFER SPACE LENGTH OF 800 FEET DESIRABLE PRIOR TO ANOTHER TRAFFIC CONTROL CHANGE SUCH AS A SHALL BE REMOVED OR COVERED AS NEEDED AND AS APPROVED BY THE ENGINEER. NO WARNING LIGHTS SHALL BE WORKING ON "COVERED" OR "DOWNED" SIGNS. * X -X REMOVING PAVEMENT MARKING CROSSOVER MANEUVER. CONSIDER GEOMETRICS WHEN LOCATING SIGNS AND ARROW BOARD SO THE DRIVER HAS * THE LEFT REVERSE CURVE SIGN (WO1-4L) IS ONLY REQUIRED WHEN THIS DETAIL IS A CLEAR VIEW OF THE ARROW BOARD AND LANE CLOSURE DRUMS FOR A MINIMUM USED IN COMBINATION WITH "SINGLE LANE CROSSOVER" DETAIL. DIRECTION OF TRAFFIC 1500 FEET IN FRONT OF DRUMS. FOR A LANE CLOSURE THAT IS IN PLACE LESS THAN 7 CONTINUOUS DAYS AND NIGHTS. THE ADVANCED WARNING SIGNS MAY BE MOUNTED ON PORTABLE SUPPORTS. 6 6 WORK CLOSED CLOSED I MILE 1500 F XX м.Р.н 36"×36" IF NEEDED. USE ONLY TYPE III BARRICADE IF DESIGN SPEED IS TEMPORARY PAVEMENT MARKING, REMOVABLE TAPE SPACED EVERY 1/4 MILE. 10 MPH BELOW 4-INCH EDGELINE (WHITE ON RIGHT, YELLOW ON LEFT) POSTED SPEED. 100' \Rightarrow \Rightarrow \Longrightarrow WORK AREA 50' TYP. L/2 500' MIN. - 800' DESIRABLE 575 L. TAPER 500 50 MPH - 600' 55 MPH - 660' 2600' 1600' 1000' 60 MPH - 720' TRAFFIC CONTROL, 9 65 MPH - 780' D 70 MPH - 840' LANE CLOSURE 5 DRUMS SPACED @ 10' INTERVALS AS 2 Ö NEEDED IN FRONT OF ARROW BOARD 15 Δ STATE OF WISCONSIN ADVANCED WARNING AREA TRANSITION AREA BUFFER SPACE DEPARTMENT OF TRANSPORTATION D **APPROVED** /S/ Peter Amakobe Atepe 2 March 2016 STATEWIDE WORK ZONE TRAFFIC SAFETY ENGINEER Ω 6 FHWA

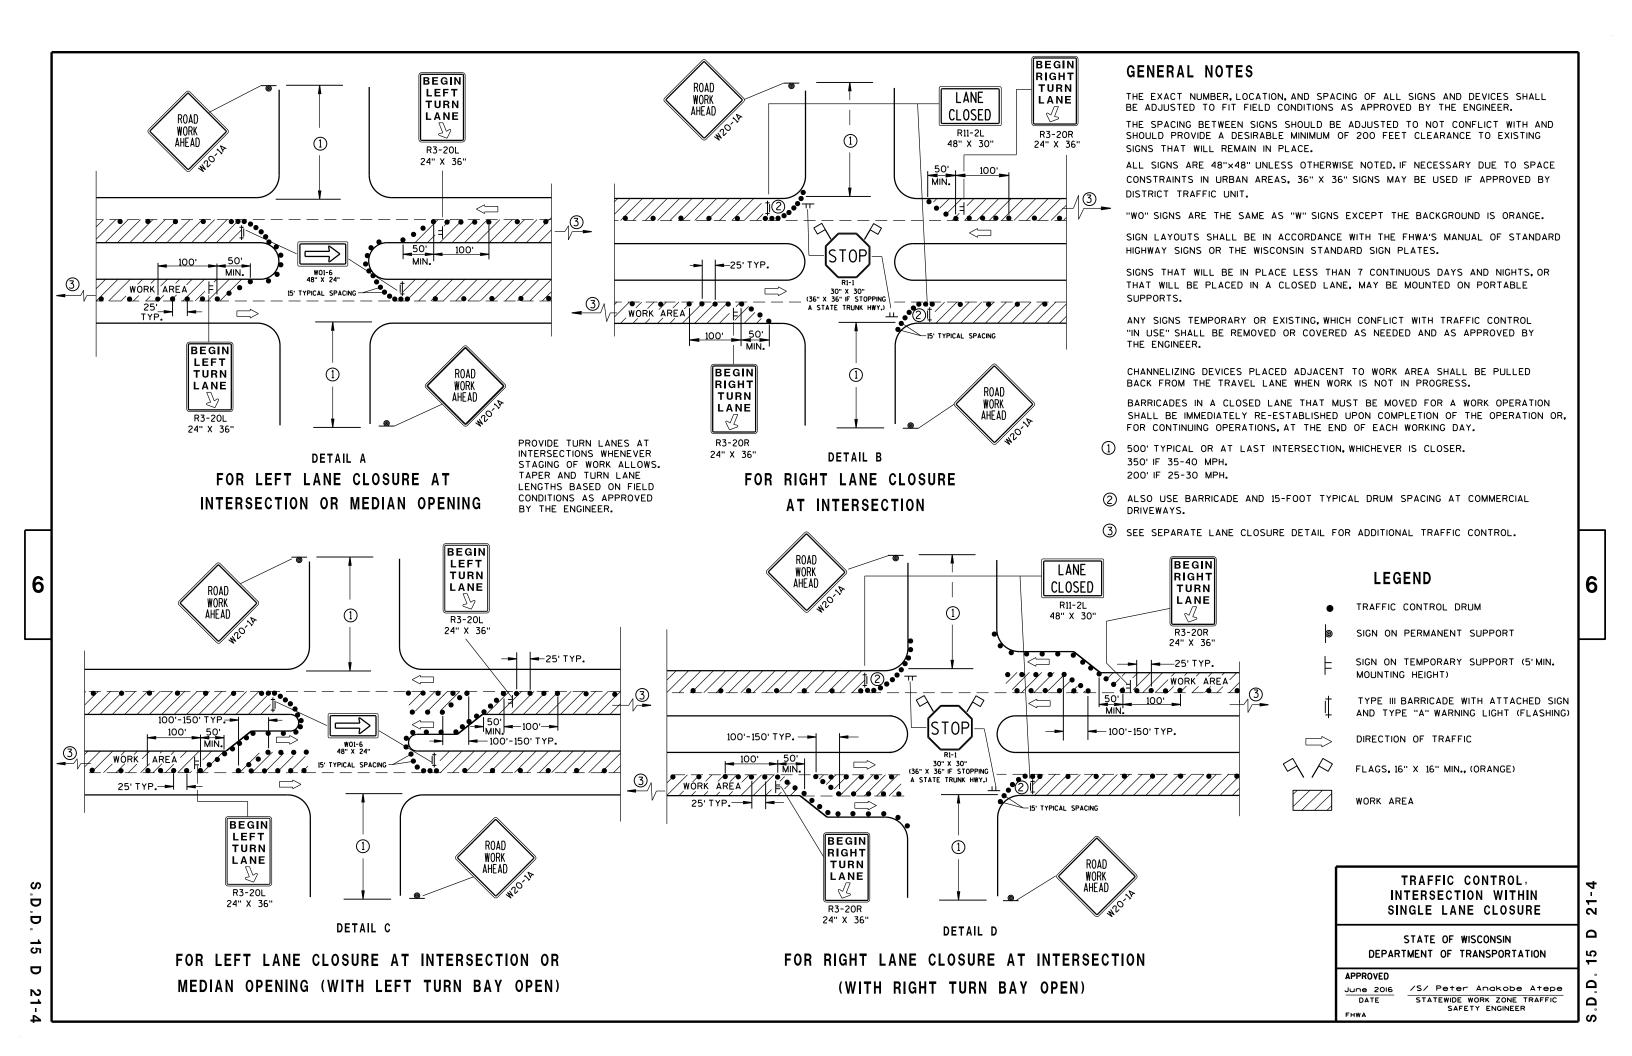

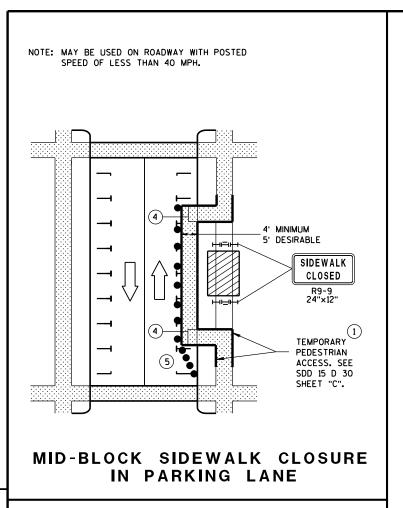

NOTE: LAYOUT SAME AS ABOVE. 6 4' MINIMUM 5' DESIRABLE SIDEWALK CLOSED RQ-Q TEMPORARY PEDESTRIAN ACCESS. SEE SDD 15 D 30 SHEET "C". SIDEWALK DIVERSION


D

D


15

D

0

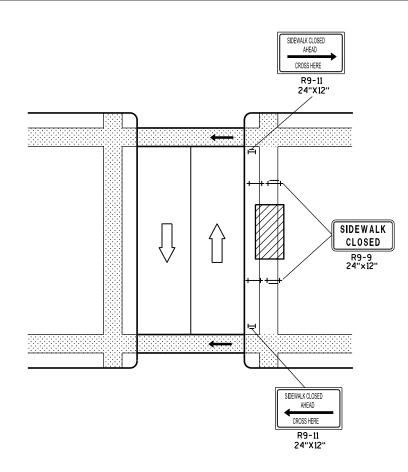

MID-BLOCK SIDEWALK CLOSURE

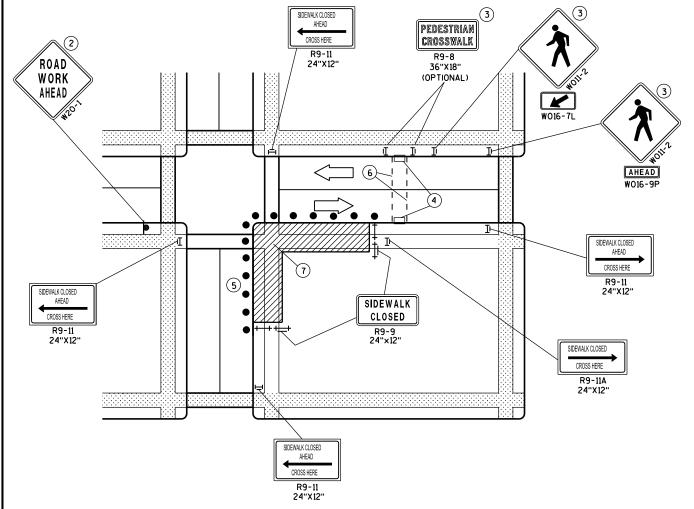

CORNER SIDEWALK CLOSURE WITH TEMPORARY CROSSWALK

GENERAL NOTES

WHEN CLOSING OR RELOCATING CROSSWALKS OR SIDEWALKS, PROVIDE DETECABLE TEMPORARY FACILITIES AND INCLUDE ACCESSIBILITY FEATURES CONSISTENT WITH EXISTING PEDESTRIAN FACILITIES.

TEMPORARY TRAFFIC CONTROL DEVICES FOR PEDESTRIANS ARE SHOWN. OTHER DEVICES MAY BE NECESSARY TO CONTROL VEHICULAR TRAFFIC. STAGE WORK, AS NECESSARY, TO PROVIDE A TEMPORARY PEDESTRIAN ACCESS ROUTE AT ALL TIMES. FOR ROADWAYS WITH NO AVAILABLE DETOURS, MAINTAIN ONE OPEN SIDEWALK AT ALL TIMES.

"WO" SIGN IS THE SAME AS "W" SIGN EXCEPT THE BACKGROUND IS ORANGE.

FOR NIGHTTIME CLOSURE USE TYPE "A" FLASHING WARNING LIGHTS ON BARRICADES, SUPPORTING SIGNS AND CLOSING SIDEWALK. USE TYPE "C" STEADY BURN LIGHTS ON CHANNELIZING DEVICES SEPARATING THE WORK AREA FROM VEHICULAR TRAFFIC.

PEDESTRIAN TRAFFIC SIGNAL DISPLAY CONTROLLING CLOSED CROSSWALK SHALL BE COVERED OR DEACTIVATED.

POST MOUNTED SIGNS LOCATED ADJACENT TO A SIDEWALK SHALL HAVE A 7 FOOT MINIMUM CLEARANCE FROM THE BOTTOM OF THE SIGN TO THE SIDEWALK SURFACE.

ALTERNATE SIDEWALK WORK BETWEEN LEFT AND RIGHT SIDE OF ROADWAY TO MAINTAIN PEDESTRIAN ACCESS.

- 1) IF SIDEWALK CLOSURE AFFECTS AN ACCESSIBLE AND DETECTABLE FACILITY, MAINTAIN ACCESSIBILITY AND DETECTABILITY ALONG THE ALTERNATE PEDESTRIAN ROUTE.
- 2) "ROAD WORK AHEAD" SIGNS ARE NOT REQUIRED IF THE SIDEWALK CLOSURE OCCURS WITHIN A LARGER WORK ZONE WHERE ADVANCE WARNING SIGNS ARE ALREADY PRESENT, OR IF THE WORK AREA AND EQUIPMENT ARE MORE THAN 2 FEET BEHIND THE CURB.
- (3) IF TEMPORARY PEDESTRIAN CROSSWALK IS NOT PROVIDED, OMIT R9-8 AND WO11-2 SIGN ASSEMBLIES. IF PROVIDED INCLUDE ON BOTH SIDES OF THE CROSSWALK.
- (4) TEMPORARY CURB RAMPS. SEE SDD 15 D 30 SHEET "B".
- (5) DRUMS OR BARRICADES AT 25 FOOT SPACING. STREET PARKING SHALL BE PROHIBITED FOR AT LEAST 50 FEET IN ADVANCE OF THE MID-BLOCK CROSSWALK.
- (6) TEMPORARY PAVEMENT MARKING FOR CROSSWALK LINES.
- (7) LIMIT WORK TO ONE QUADRANT AT A TIME TO MINIMIZE PEDESTRIAN

LEGEND

SIGN ON PERMANENT

SUPPORT UNDER PEDESTRIAN

TRAFFIC

TRAFFIC TRAFFIC CONTOL DRUM

DIRECTION OF

WORK AREA

PEDESTRIAN CHANNELIZATION DEVICE

TYPE II BARRICADE WITH/WITHOUT SIGN (ALL WITH ONE WARNING LIGHT, TYPE A. LOW-INTENSITY FLASHING)

TYPE III BARRICADE WITH/WITHOUT SIGN (ALL WITH ONE WARNING LIGHT, TYPE A, LOW-INTENSITY FLASHING)

TRAFFIC CONTROL, PEDESTRIAN ACCOMMODATION

STATE OF WISCONSIN DEPARTMENT OF TRANSPORTATION က 0 က Ω Ω Ω PARALLEL TO CURB

0

GENERAL NOTES

NOTIFY THE BUS COMPANY 7 DAYS IN ADVANCE OF THE BUS STOP RELOCATION.
ALTERNATE SIDEWALK WORK BETWEEN LEFT AND RIGHT SIDE OF ROADWAY
TO MAINTAIN PEDESTRIAN ACCESS.

- (1) CURB RAMPS SHALL BE 48" MIN. WIDTH WITH A FIRM, STABLE AND SLIP RESISTANT SURFACE. INSTALL CONTRASTING DETECTABLE WARNING FIELD AT PEDESTRIAN STREET CROSSINGS. REFER TO SDD 8D5 SHEET "E".
- (2) PROTECTIVE EDGING WITH A 2" MIN. HEIGHT SHALL BE INSTALLED WHEN A CURB RAMP OR LANDING PLATFORM HAS A VERTICAL DROP OF 6" OR GREATER OR HAS A SIDE APRON SLOPE STEEPER THAN 1:3 (33%). PROTECTIVE EDGING SHOULD BE CONSIDERED WHEN CURB RAMPS OR LANDING PLATFORMS HAVE A VERTICAL DROP OF 3" OR MORE.
- (3) DETECTABLE EDGING WITH 6" MIN. HEIGHT AND CONTRASTING COLOR SHALL BE INSTALLED ON ALL CURB RAMP LANDINGS WHERE THE WALKWAY CHANGES DIRECTION (TURNS).
- (4) CURB RAMPS AND LANDINGS SHALL HAVE A 1:50 (2%) MAX. CROSS-SLOPE.
- 5 CLEAR SPACE OF 48"X48" MIN. SHALL BE PROVIDED ABOVE AND BELOW THE CURB RAMP.
- (6) THE CURB RAMP WALKWAY EDGE SHALL BE MARKED WITH A YELLOW COLOR, 4" WIDE MARKING, UNLESS A CONTRASTING DETECTABLE WARNING FIELD IS PROVIDED.
- 7 DO NOT RESTRICT WATER FLOW IN THE GUTTER SYSTEM.
- (8) LATERAL JOINTS OR GAPS BETWEEN SURFACES SHALL BE LESS THAN 1/2" WIDTH.
- (9) CHANGES BETWEEN SURFACE HEIGHTS SHALL NOT EXCEED 1/2". LATERAL EDGES SHALL BE VERTICAL UP TO 1/4" HIGH, AND BEVELED AT 1:2 BETWEEN 1/4" AND 1/2".
- 5' WIDE MIN. WITH PEDSETRIAN SAFETY FENCE, 10' WIDE MIN. WITHOUT PEDESTRIAN SAFETY FENCE.


APPROVED


June 2016

/S/ Peter Amakobe Atepe STATEWIDE WORK ZONE TRAFFIC

SAFETY ENGINEER

Ω

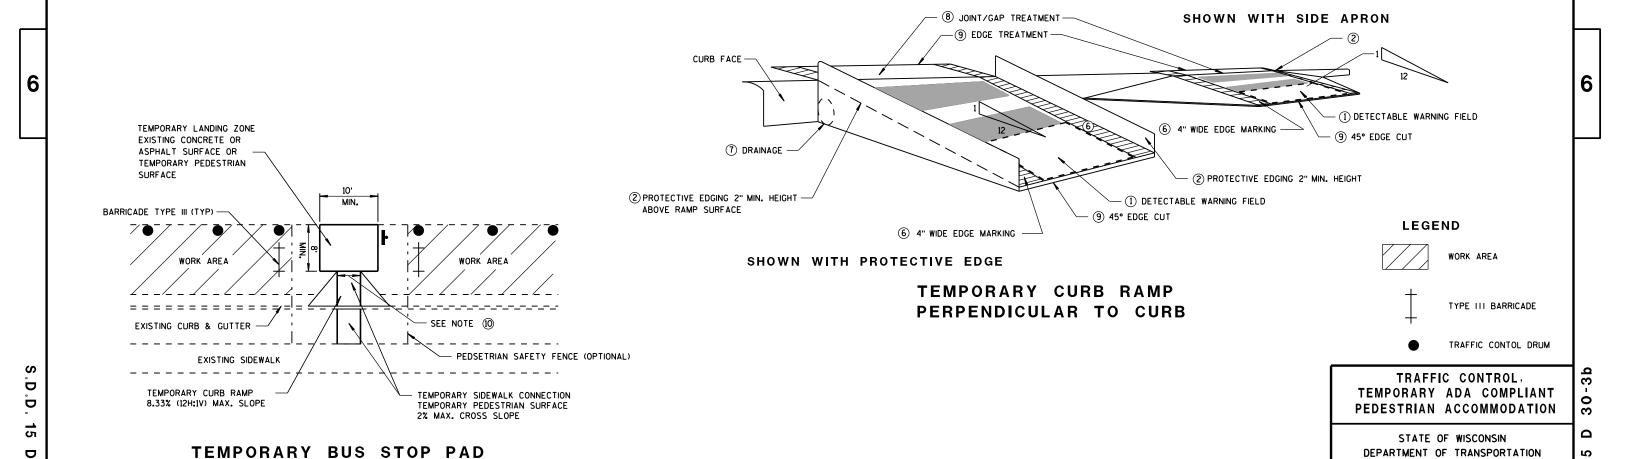


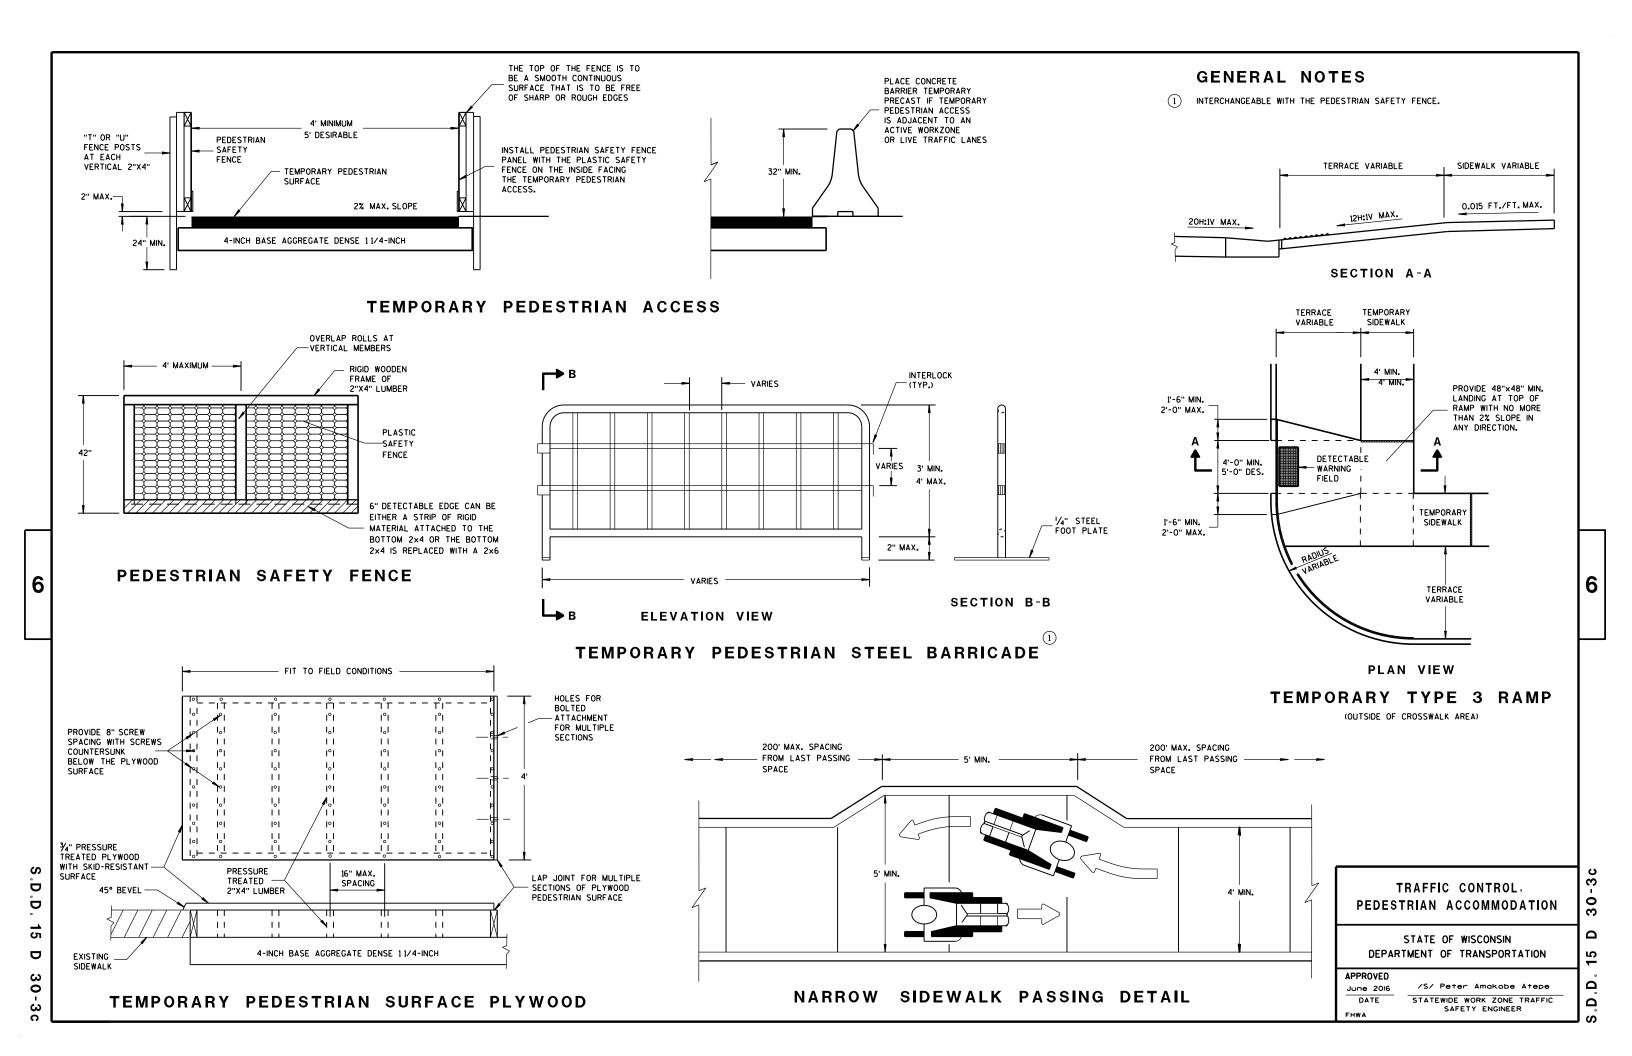

NOTES

1. Signs are Type II - Type H Reflective - reference WIS DOT Standard

areater than 48 inches (both vertical and horizontal) shall have one horizontal splice between the arrows and route shields. Vertical splices shall not be used on route assemblies with a horizontal dimension of 144 inches or less. The contractor shall not use more than one vertical joint per sign and the joint shall be between route shields.

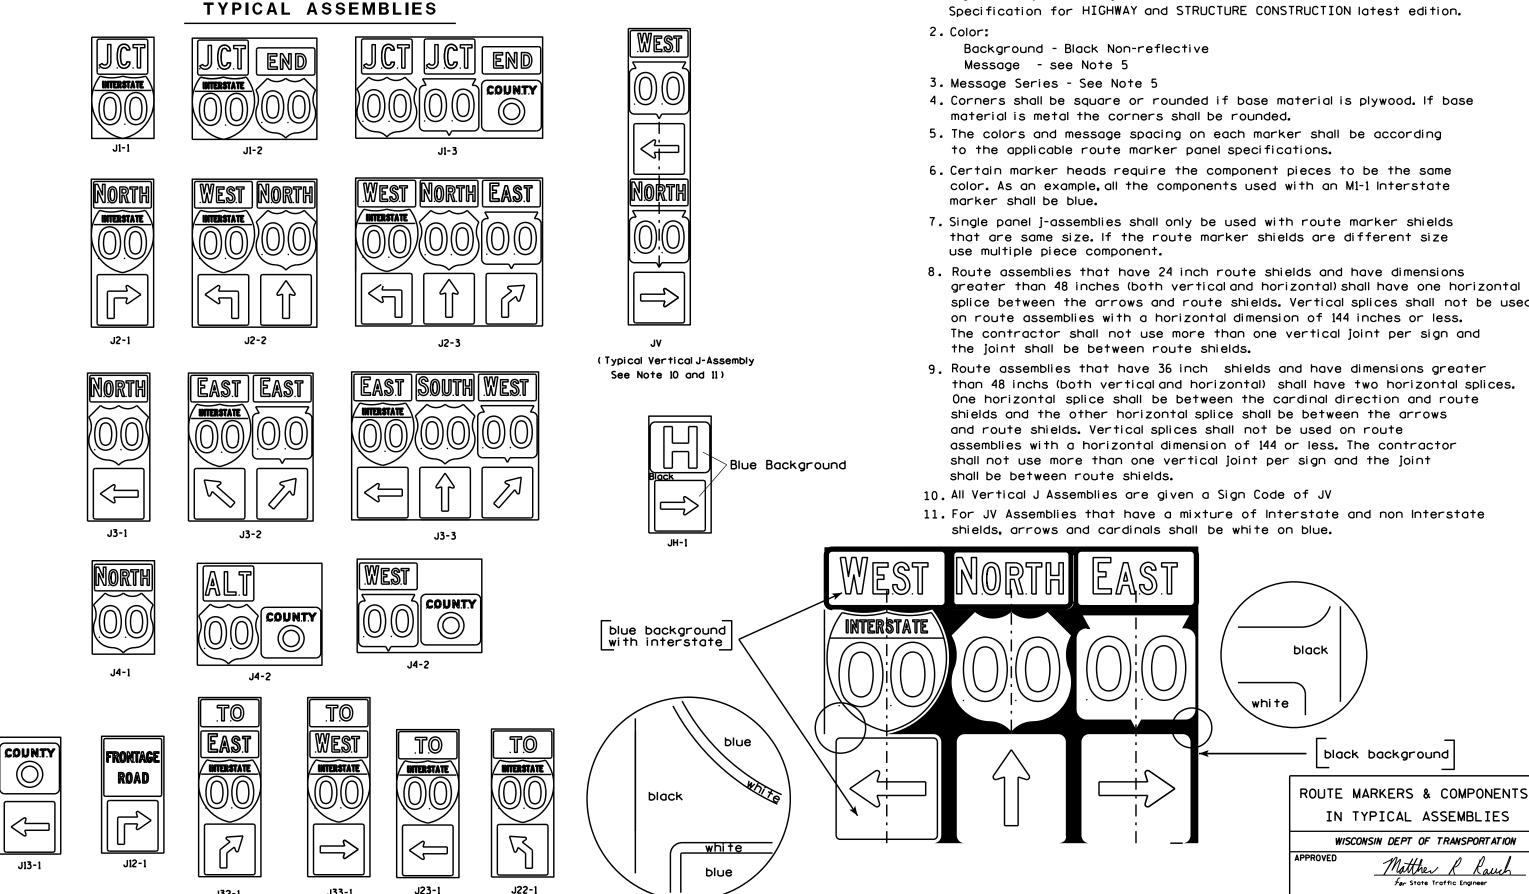

PROJECT NO:

J32-1

J23-1

J33-1

PLOT BY: mscsja

PLATE NO. __A2-15.8


DATE 2/06/14

SHEET NO:


URBAN ARFA

2' Min - 4' Max (See Note 6) 7'-3"(士) ** Curb Flowline. White Edgeline Location

RURAL AREA (See Note 2)

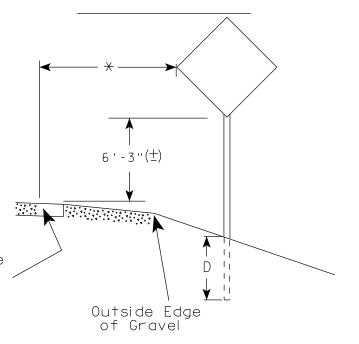

2' Min - 4' Max (See Note 6)

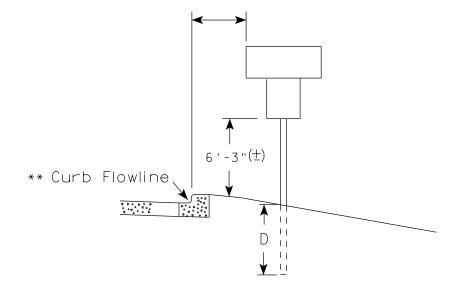

5'-3"(生) A POLICE AND A POL D^{-1} Outside Edae of Gravel

White Edgeline Location

** The existence of curb and gutter does not in itself mandate the vertical clearance illustrated. That height is typically measured where

there is sidewalk adjacent to the roadway or parking is permitted. In the absence of sidewalk vertical clearance is measured from the top of the curb. Offset of signs is measured from the flow line.

HWY:

* 6 feet from edge of a paved shoulder or 12 feet from the edge of pavement (edge line location) or 2 feet from outside edge of gravel, whichever is greater unless directed by project engineer.

PLOT BY : mscj9h

GENERAL NOTES

- 1. Signs wider than 4 feet or 20 sq.ft or larger, shall be mounted on multiple posts. Refer to plate A4-4.
- 2. If signs are mounted on barrier wall, see A4-10 sign plate.
- 3. For expressways and freeways, mounting height is $7'-3''(\pm)$ or 6'-3" (±) depending upon existence of a sub-sign.
- 4. Minimum mounting height for J assemblies (A2-1S) is $7'-3''(\pm)$ or $6'-3''(\pm)$ per urban or rural detail respectively.
- 5. Minimum mounting height for signs mounted on traffic signal poles is $5' - 3'' (\pm)$.
- 6. Offset distance shall be consistent with existing signs or consistent throughout length of project.
- 7. The (+) tolerance for mounting height is 3 inches.
- 8. Folding signs shall be mounted at a height of 5'-3'' (\pm) or as directd by the Engineer.
- 9. The Double Arrow sign (W12-1) shall be mounted at a height of 2'-3" (\pm) . The Chevron sign (W1-8), Roundabout Chevron panel (R6-4B), Enhanced Reference Markers, Clearance Markers (W5-52), Mile Markers (D10 series), In Road Object Markers (W5-54) & End of Road Markers (W5-56) shall be mounted at a height of 4'-3'' (\pm).

POST EMBEDMENT DEPTH

Area of Sign	
Installation	D
(Sq. Ft.)	(Min)
20 or Less	4'
Greater than 20	5'

TYPICAL INSTALLATION OF PERMANENT TYPE II SIGNS ON SINGLE POSTS

WISCONSIN DEPT OF TRANSPORTATION

APPROVED

for State Traffic Engineer

DATE 7/23/15

SHEET NO:

FILE NAME : C:\CAEfiles\Projects\tr_stdplate\A43.DGN

PROJECT NO:

COUNTY:


PLOT DATE: 23-JUL-2015 15:21

PLOT NAME :

PLOT SCALE: 99.237937:1.000000

WISDOT/CADDS SHEET 42


PLATE NO. <u>A4-3.20</u>

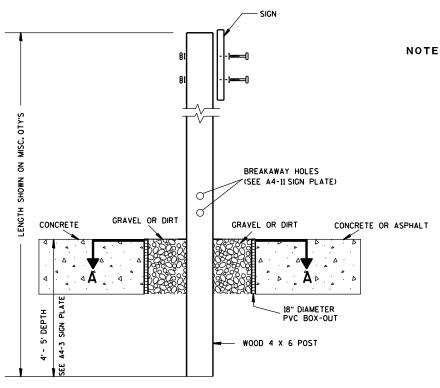

NOTES: 1. ALL MATERIAL TO BE APPROVED

BY ENGINEER PRIOR TO INSTALLATION

- 2. SEE SIGN PLATE A4-8 FOR SIGN HARDWARE REQUIREMENTS
- 3. 18 INCH X 18 INCH SQUARE BOX-OUTS MAY BE USED FOR INSTALLATIONS IN EXISTING CONCRETE OR ASPHALT LOCATIONS.

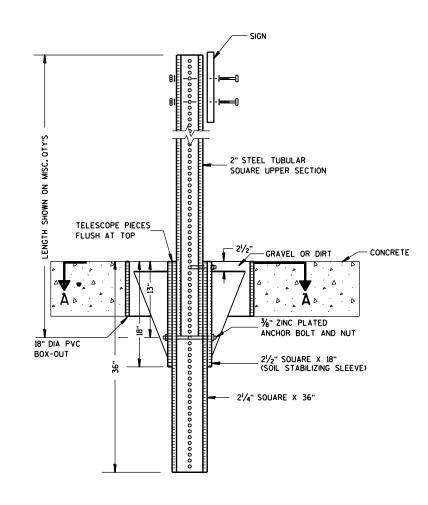


ELEVATION VIEW

DETAIL OF STEEL 2 X 2 SIGN POST IN BOX-OUT

ELEVATION VIEW

DETAIL OF WOOD 4 X 6 SIGN POST IN BOX-OUT

HWY:

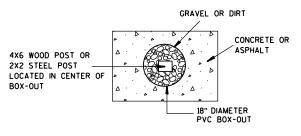

PLAN VIEW

COUNTY:

FOR NEW CONCRETE/ASPHALT INSTALLATIONS

SIGN POST BOX-OUTS A4-3B

WISCONSIN DEPT OF TRANSPORTATION

For State Traffic Engineer

DATE 1/27/14 PLATE NO. A4-3B.1

SHEET NO:

FILE NAME : C:\CAEFiles\Projects\tr_stdplate\A43B.DGN

PROJECT NO:

PLOT DATE: 27-JAN-2014 09:48

PLOT NAME :

PLOT BY: mscsja


PLOT SCALE : 13.659812:1.000000

APPROVED

- 1. For 3 or 4 post installations, individual post spacing shall be greater than 3'-6".
- 2. See tables below for required number of posts.
- 3. For expressways and freeways. mounting height is 7'-3'' (±) or 6'-3'' (±) depending upon existence of sub-sign.
- 4. The (±) tolerance for mounting height is 3 inches.
- 5. Minimum mounting height for J assemblies (A2-1S) is 7'-3'' (±) or 6'-3'' (±) per urban or rural detail respectively.
- 6. Offset distance shall be consistent with existing signs or consistent throughout length of project.
- 7. Folding signs shall be mounted at a height of 5'-3" (±) or as directed by the engineer.
- 8. The Double Arrow sign (W12-1) shall be mounted at a height of 2'-3" (±). The Chevron sign (W1-8). Roundabout Chevron panel (R6-4B), Clearance Markers (W5-52), Mile Markers (D10 series), In Road Object Markers (W5-54) & End of Road Markers (W5-56) shall be mounted at a height of 4"-3" (±).
- * 6 feet from edge of a paved shoulder or 12 feet from the edge of pavement (edge line location) or 2 feet from outside edge of gravel, whichever is greater unless directed by project engineer.
- ** The existence of curb and gutter does not in itself mandate the vertical clearance illustrated. That height is typically measured where there is sidewalk adjacent to the roadway or parking is permitted. In the absence of sidewalk vertical clearance is measured from the top of the curb. Offset of signs is measured from the flow line.
- *** See A4-3 sign plate for signs 4' or less in width and less than 20 S.F. in area.

URBAN AREA RURAL AREA (See Note 3) 2'Min - 4'Max (See Note 6) ₩E# FF# 6'-3"(±) 6'-3"(±) 7'-3"(±) ** Curb ****\ Flowline D **7000** White Edgeline D 11 White Edgeline, Location Outside Edae Location

2' Min - 4' Max (See Note 6) 6 ' - 3 "(±) Curb Flowline. -11

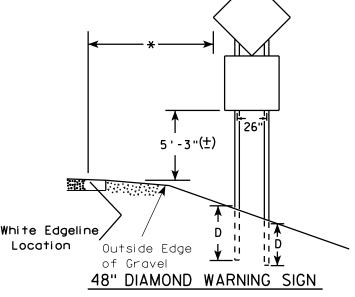

COUNTY:

Outside Edge

of Gravel

SIGN SHAPE OTHER THAN DIAMOND (TWO POSTS REQUIRED) Ε Greater than 48" 12" Less than 60" L/5 60" to 120"

48" DIAMOND WARNING SIGN

HWY:

SIGN SHAPE OTHER THAN (THREE POSTS REQUIR	
L	E
Greater than 120" less than 168"	12"

SIGN SHAPE OTHER THAN (FOUR POSTS REQUIRE	
L	E
168" and greater	12"

POST EMBEDMENT DEPTH

of Gravel

Area of Sign	
Installation	D
(Sq. Ft.)	(Min)
20 or Less	4'
Greater than 20	5'

TYPICAL INSTALLATION OF TYPE II SIGNS ON MULTIPLE POSTS

WISCONSIN DEPT OF TRANSPORTATION

APPROVED Matther For State Traffic Engineer

DATE 7/23/15

PLATE NO. 44-4.14 SHEET NO:

FILE NAME : C:\CAEfiles\Projects\tr_stdplate\A44.DGN

* * *


PROJECT NO:

PLOT DATE: 23-JUL-2015 15:23

PLOT NAME :

PLOT BY: mscj9h

PLOT SCALE: 107.021305:1.000000

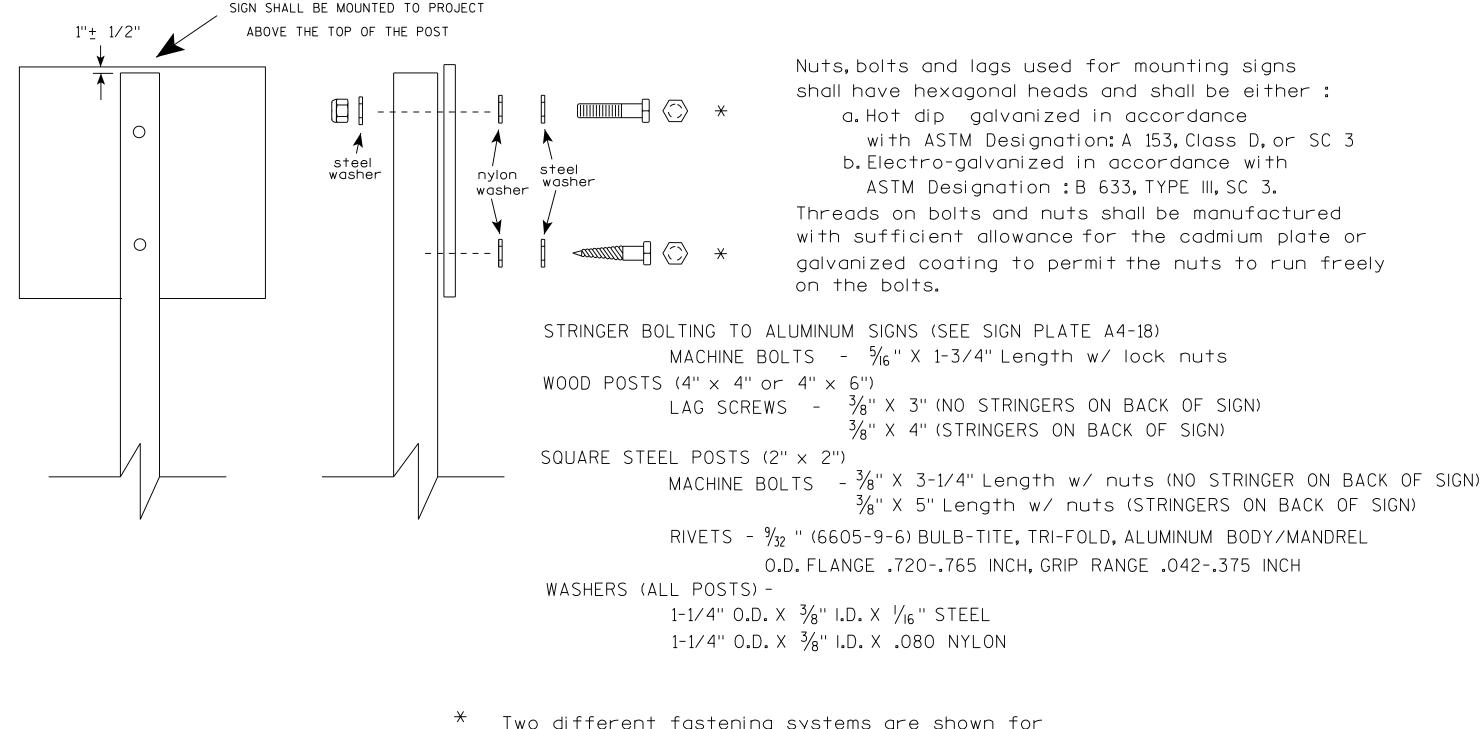

Two different fastening systems are shown for illustration purposes. On any individual sign, either one or the other system shall be used. Actual number of fasteners per sign varies with the sign area, but normally there are two. For a single post installation, all signs greater than 9 sq. ft. require the use of 3 fasteners.

ATTACHMENT OF SIGNS
TO POSTS

WISCONSIN DEPT OF TRANSPORTATION

APPROVED

Nather R Raw
For State Traffic Engineer

DATE <u>8/11/16</u>

PLATE NO. <u>44-8.8</u>

PROJECT NO:


FILE NAME : C:\CAFfiles\Projects\tr strolgte\A48 DCN

PLOT DATE . 11-416-2016 11:35

PINT RY * \$\$ nintuser \$\$

SHEET NO:

LI NO:

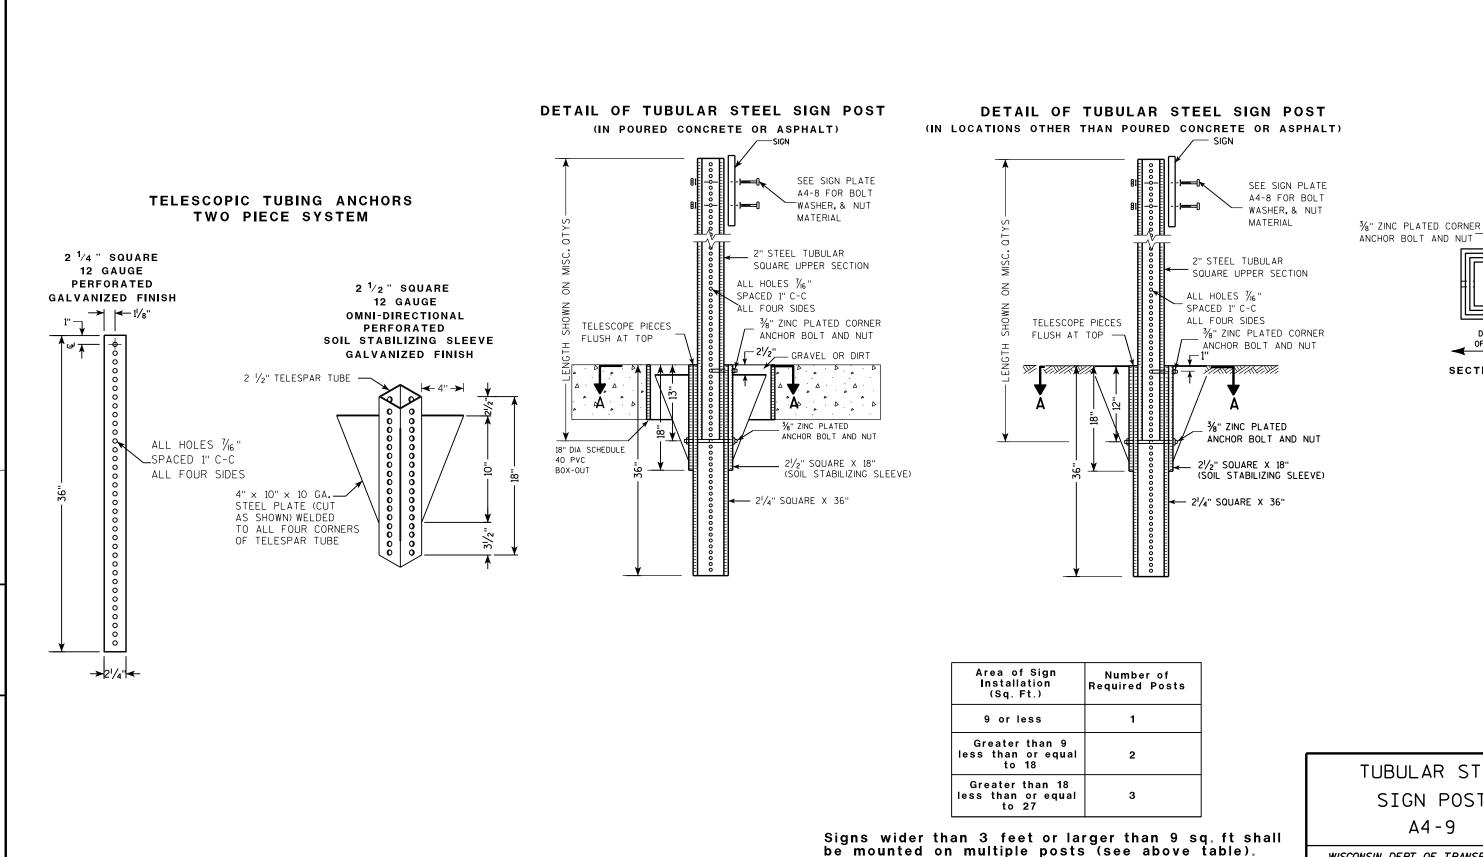

TUBULAR STEEL SIGN POST A4-9

WISCONSIN DEPT OF TRANSPORTATION

For State Traffic Engineer DATE 2/05/15 PLATE NO. <u>A4-9.9</u>

SHEET NO:

FILE NAME : C:\CAEFiles\Projects\tr_stdplate\A49.DGN

HWY:

PROJECT NO:

PLOT DATE: 05-FEB-2015 17:09


COUNTY:

PLOT NAME :

PLOT BY: mscsja

PLOT SCALE: 13.659812:1.000000

SECTION A-A

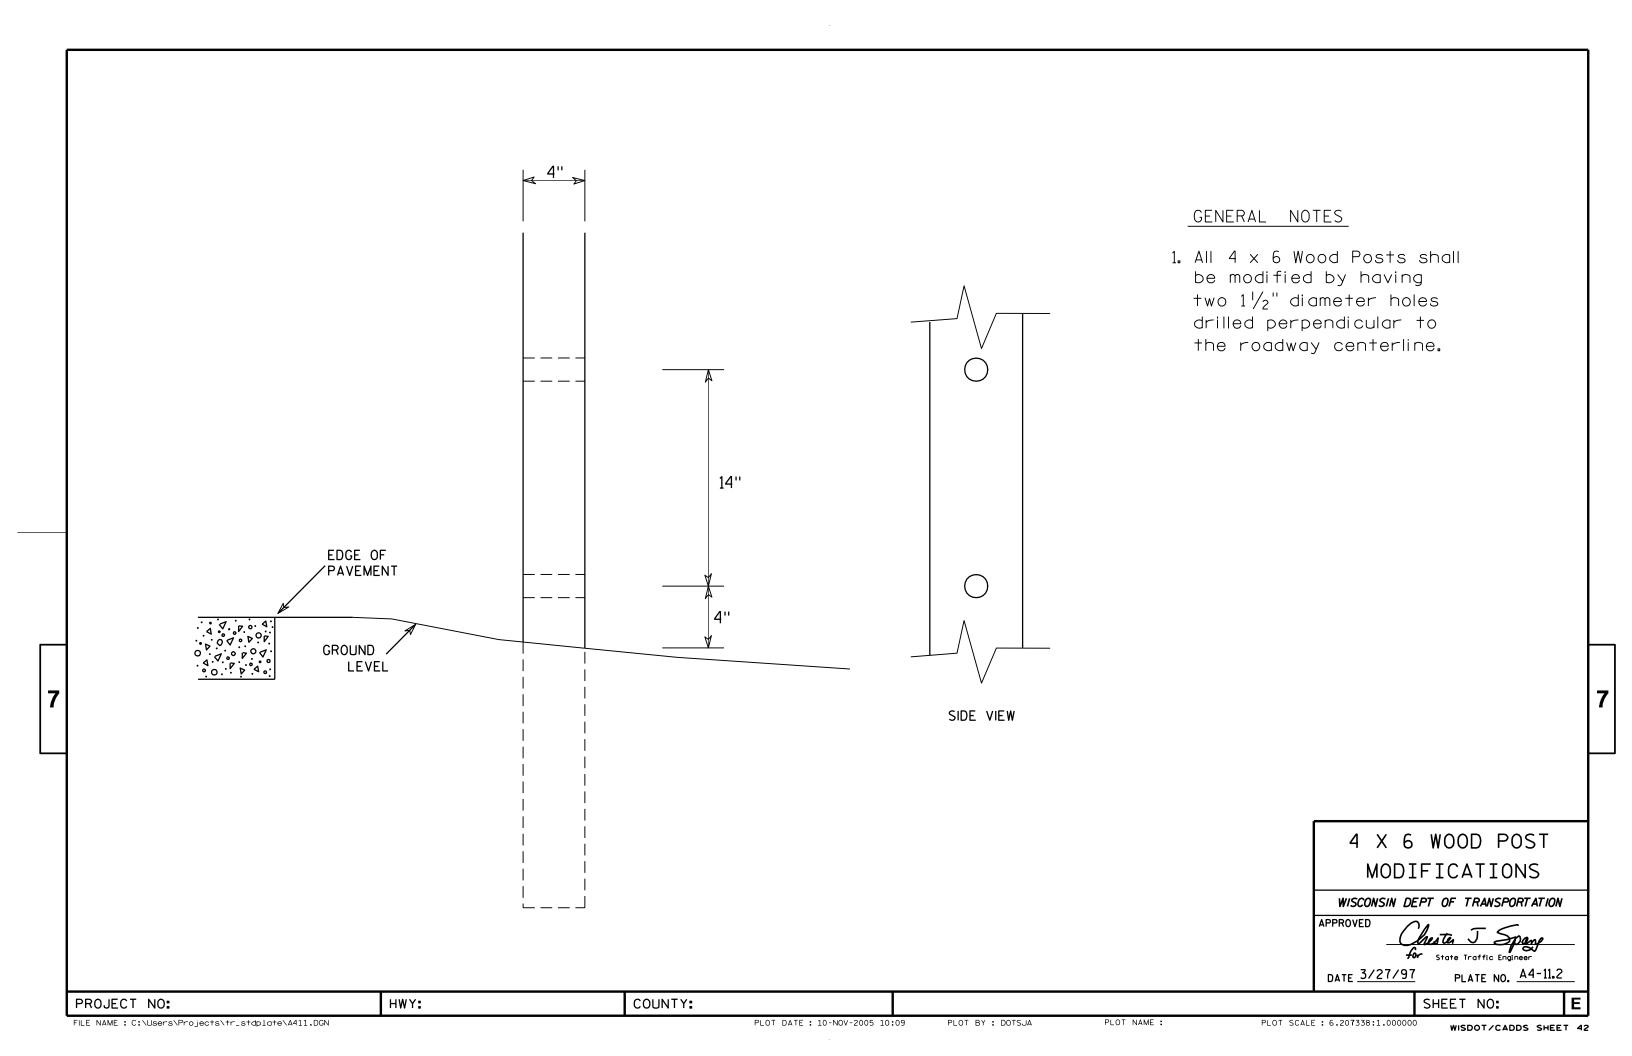

NOTES

- Sign is Type II see Note 7 reference WIS DOT Standard Specification for HIGHWAY and STRUCTURE CONSTRUCTION latest edition.
- 2. Color:


Background - White & Black - See Note 7 Message - Black


- 3. Message Series see Note 5
- 4. Corners may be square or rounded when base material is plywood but borders shall be rounded as shown. When base material is metal, the corners and borders shall be rounded.
- 5. Message Series E for 1 letter.


 Message Series D for 2 letters unless
 message is too big then Series C.

 Message Series C for 3 letters unless
 message is too big then Series B.
- 6. Substitute appropriate letters & optically center to achieve proper balance.
- 7. Permanent Signs

Background - Type H Reflective Detour or temporary Signs Background - Reflective

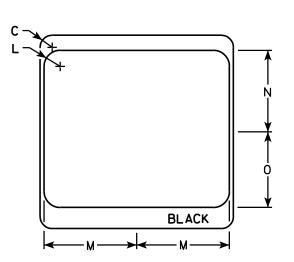

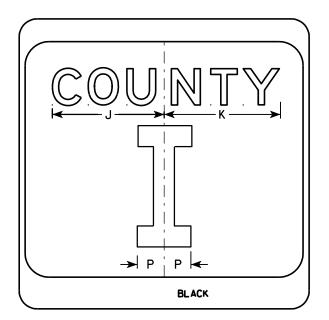

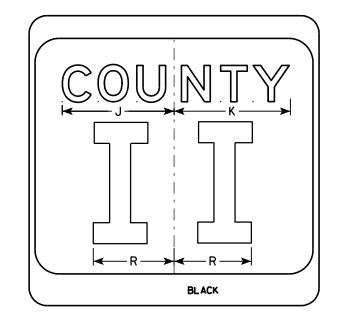

С	D E	F	G	Н	I		V						_	_	_								Aren
					_		N.	L	M	N	0	P	Q	R	S	T	U	٧	W	_ X	Y	Z	Area sq. ft.
1 1/2		10	3	5 1/8	4 1/8	9 1/4	9 %	2	11 1/2	10 1/8	9 3/8	2 1/4		6 %									4.0
2 1/4		16	4	7 5/8	5 %	12 1/4	12 1/8	3	17 1/8	15 1/4	14	3 3/8		10									9.0
2 1/4		16	4	7 %	5 %	12 1/4	12 1/8	3	17 1/8	15 1/4	14	3 %		10									9.0
2 1/4		16	4	7 %	5 %	12 1/4	12 1/8	3	17 1/8	15 1/4	14	3 3/8		10									9.0
			Гыу	N.V.					COLIN	TV.													
4	2 1/4	2 1/4	2 1/4 16 2 1/4 16	2 1/4 16 4 2 1/4 16 4 2 1/4 16 4	2 1/4 16 4 7 5/8 2 1/4 16 4 7 5/8	2 1/4 16 4 7 5/8 5 5/8 2 1/4 16 4 7 5/8 5 5/8 2 1/4 16 4 7 5/8 5 5/8 2 1/4 16 4 7 5/8 5 5/8	2 1/4 16 4 7 5/8 5 5/8 12 1/4 2 1/4 16 4 7 5/8 5 5/8 12 1/4 2 1/4 16 4 7 5/8 5 5/8 12 1/4 2 1/4 16 4 7 5/8 5 5/8 12 1/4	2 1/4 16 4 7 5/8 5 5/8 12 1/4 12 3/8 2 1/4 16 4 7 5/8 5 5/8 12 1/4 12 3/8 2 1/4 16 4 7 5/8 5 5/8 12 1/4 12 3/8 2 1/4 16 4 7 5/8 5 5/8 12 1/4 12 3/8	2 1/4 16 4 7 5/8 5 5/8 12 1/4 12 3/8 3 2 1/4 16 4 7 5/8 5 5/8 12 1/4 12 3/8 3 2 1/4 16 4 7 5/8 5 5/8 12 1/4 12 3/8 3 2 1/4 16 4 7 5/8 5 5/8 12 1/4 12 3/8 3	2 1/4 16 4 7 5/8 5 5/8 12 1/4 12 7/8 3 17 1/8 2 1/4 16 4 7 5/8 5 5/8 12 1/4 12 7/8 3 17 1/8 2 1/4 16 4 7 5/8 5 5/8 12 1/4 12 7/8 3 17 1/8 2 1/4 16 4 7 5/8 5 5/8 12 1/4 12 7/8 3 17 1/8	2 1/4 16 4 7 5/8 5 5/8 CTH MARKER
M1-5A FOR ASSEMBLIES

WISCONSIN DEPT OF TRANSPORTATION

APPROVED

Forstate Traffic Engineer

DATE 9/27/11 PLATE NO. M1-5A.8

SHEET NO:

FILE NAME : C:\Users\PROJECTS\tr_stdplate\M15A.DGN

BLACK

M1-5A

PLOT DATE: 29-SEP-2011 11:25

PLOT NAME :

PLOT BY: mscsja

PLOT SCALE: 5.959043:1.000000

WISDOT/CADDS SHEET 42

NOTES

- 1. Sign is Type II See Note 6 reference WIS DOT Standard Specification for HIGHWAY and STRUCTURE CONSTRUCTION latest edition.
- 2. Color:

Background - White & Black - See Note 6 Message - Black

- 3. Message Series See note 5
- 4. Corners may be square or rounded when base material is plywood but borders shall be rounded as shown. When base material is metal, the corners and borders shall be rounded.
- 5. Substitute appropriate Series numerals and adjust spacing as per plate A10-1.
- 6. Permanent Signs
 Background Type H Reflective
 Detour or temporary Signs
 Background Reflective

	G
	BLACK
✓ M1 -	

HWY:

Metric equivalent for this sign is:

╛	SIZE					
	1					
	2	600	mm	Χ	600	mm
	3	900	mm	Χ	900	mm
	4	900	mm	Χ	900	mm
	5	900	mm	Χ	900	mm

PROJECT NO:

Area sq. ft. Area m2 Α С 0 2 1 1/2 6 1/2 10 1/4 2 1/2 8 7/8 11 1/2 1 1/8 11 1/4 21 1/8 24 5 1/2 4.0 .36 3 36 2 1/4 9 1/4 15 3/8 5 3/8 12 5/8 17 1/8 1 1/2 2 3/8 | 16 1/8 | 33 9.0 18 .81 4 9 1/4 15 3/8 5 3/8 12 5/8 17 1/8 1 1/2 2 3/8 2 1/4 36 16 % 33 9.0 .81 5 8 3/4 9 1/4 15 3/8 5 3/8 12 5/8 17 1/8 1 1/2 2 3/8 36 2 1/4 16 % 9.0

COUNTY:

STATE ROUTE MARKER M1-6 FOR ASSEMBLIES

WISCONSIN DEPT OF TRANSPORTATION

APPROVED

Thestin J Spang

for State Traffic Engineer

DATE 3/20/02 PLATE NO. M1-6.9

SHEET NO:


FILE NAME : C:\Users\Projects\tr_stdplate\M16.DGN


PLOT DATE: 13-OCT-2005 14:55


PLOT BY : DITJPH

PLOT NAME :


PLOT SCALE: 6.715871:1.000000

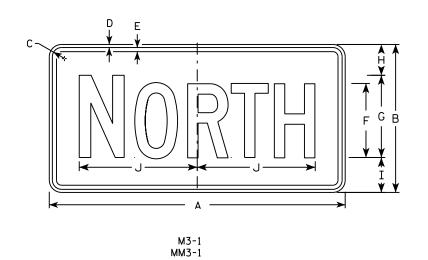


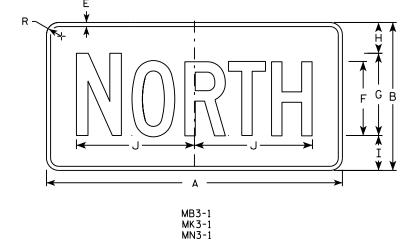


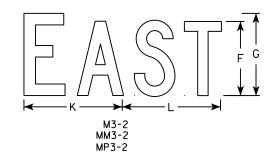


MP3-1

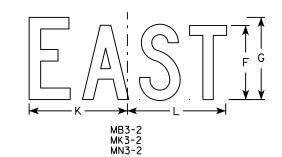


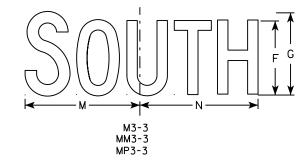

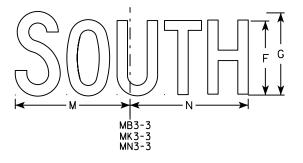

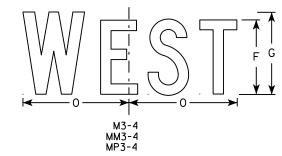

HWY:

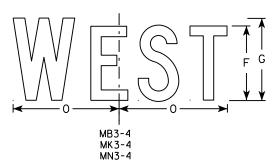

NOTES

- 1. All Signs Type II Type H
- 2. Color:

Background - See note 5 Message - See note 5

- 3. Message Series C
- 4. Corners may be square or rounded when base material is plywood but borders shall be rounded as shown. When base material is metal, the corners and borders shall be rounded.

5. M3-1 thru M3-4 Background - White Message - Black

MB3-1 thru MB3-4 Background - Blue

Message - White

MK3-1 thru MK3-4 Background - Green

Message - White

MM3-1 thru MM3-4 Background - White

Message - Green

MN3-1 thru MN3-4 Background - Brown

Message - White

MP3-1 thru MP3-4 Background - White

Message - Blue

6. Note the first letter of each direction is larger than the remainder of the message.

SIZE	Α	В	С	D	E	F	G	Н	I	J	K	L	М	N	0	Р	0	R	S	T	U	٧	W	Х	Υ	Z	Area sq. ft.
1 1																											
2	24	12	1 1/8	3/8	3/8	6	7	2 1/4	2 3/4	10 1/4	7 1/8	8 3/8	10 1/4	9 3/4	8 3/4			1 1/2									2.00
3	36	18	1 1/8	3/8	1/2	9	10	3 3/4	4 1/4	14 3/8	12	12 1/8	14	14 1/8	13			1 1/2									4.5
4	36	18	1 1/8	3/8	1/2	9	10	3 3/4	4 1/4	14 3/8	12	12 1/8	14	14 1/8	13			1 1/2									4.5
5	36	18	1 1/8	3/8	1/2	9	10	3 3/4	4 1/4	14 3/8	12	12 1/8	14	14 1/8	13			1 1/2									4.5

COUNTY:

STANDARD SIGNS M3-1 thur M3-4 SERIES

WISCONSIN DEPT OF TRANSPORTATION

APPROVED

PROVED Matthe & Rame

DATE 10/15/15 PLATE NO. M3-1.14

SHEET NO:

Ε

PROJECT NO:

FILE NAME · C·\CAFfiles\Projects\tr stdplote\M31 DGN

PLOT DATE . 01-DEC-2015 17:54

PLOT RY . \$\$ plotuser \$\$ PLOT NAMF :

PLOT SCALE . 11 675051.1 000000

NOTES

- 1. Sign is Type II Type F Reflective reference WIS DOT Standard Specification for HIGHWAY and STRUCTURE CONSTRUCTION latest edition.
- 2. Color:

Background - Orange Message - Black

- 3. Message Series B
- 4. Corners may be square or rounded when base material is plywood but borders shall be rounded as shown. When base material is metal, the corners and borders shall be rounded.

$C \xrightarrow{D} E \\ \downarrow \\ \downarrow \\ \uparrow$	★ G	
	F - * G *	

С E F G H I J S Х Z D 0 10 10 1/4 1 1/8 3/8 3/8 24 2.0 3 36 1 1/8 3/8 1/2 4 1/2 14 5/8 14 1/2 4.5 4 5

COUNTY:

STANDARD SIGN M4-8

WISCONSIN DEPT OF TRANSPORTATION

APPROVED

DATE 11/10/10 PLATE NO. M4-8.2

SHEET NO:

PLOT DATE: 10-NOV-2010 13:18

PLOT NAME :

PLOT BY : ditjph

PLOT SCALE: 4.767233:1.000000

WISDOT/CADDS SHEET 42

PROJECT NO:

HWY:

1. Sign is Type II - Type F Reflective - reference WIS DOT Standard Specification for HIGHWAY and STRUCTURE CONSTRUCTION latest edition.

2. Color:

Background - Orange Message - Black

- 3. Message Series B
- 4. Corners may be square or rounded when base material is plywood but borders shall be rounded as shown. When base material is metal, the corners and borders shall be rounded.

 $D \longrightarrow$ Н M4-8A

SIZE	Α	В	С	D	E	F	G	Н	I	J	K	L	М	N	0	Р	٥	R	S	Т	U	٧	w	Х	Y	Z	Area sq. ft.
1																											
2	24	18	1 1/8	3/8	1/2	6	2	2	4 3/4	9 3/4																	3.0
3	30	24	1 1/8	3/8	1/2	8	2 1/2	3	6 3/4	13																	5.0
4																											
5	·																										

COUNTY:

STANDARD SIGN M4-8A

WISCONSIN DEPT OF TRANSPORTATION

APPROVED

Matther For State Traffic Engineer

PLATE NO. M4-8A.2 DATE 3/9/11

SHEET NO:

FILE NAME : C:\Users\PROJECTS\tr_stdplate\M48A.DGN

HWY:

PROJECT NO:


PLOT DATE: 09-MAR-2011 10:29


PLOT BY: mscj9h

PLOT NAME :

PLOT SCALE: 3.972696:1.000000

WISDOT/CADDS SHEET 42

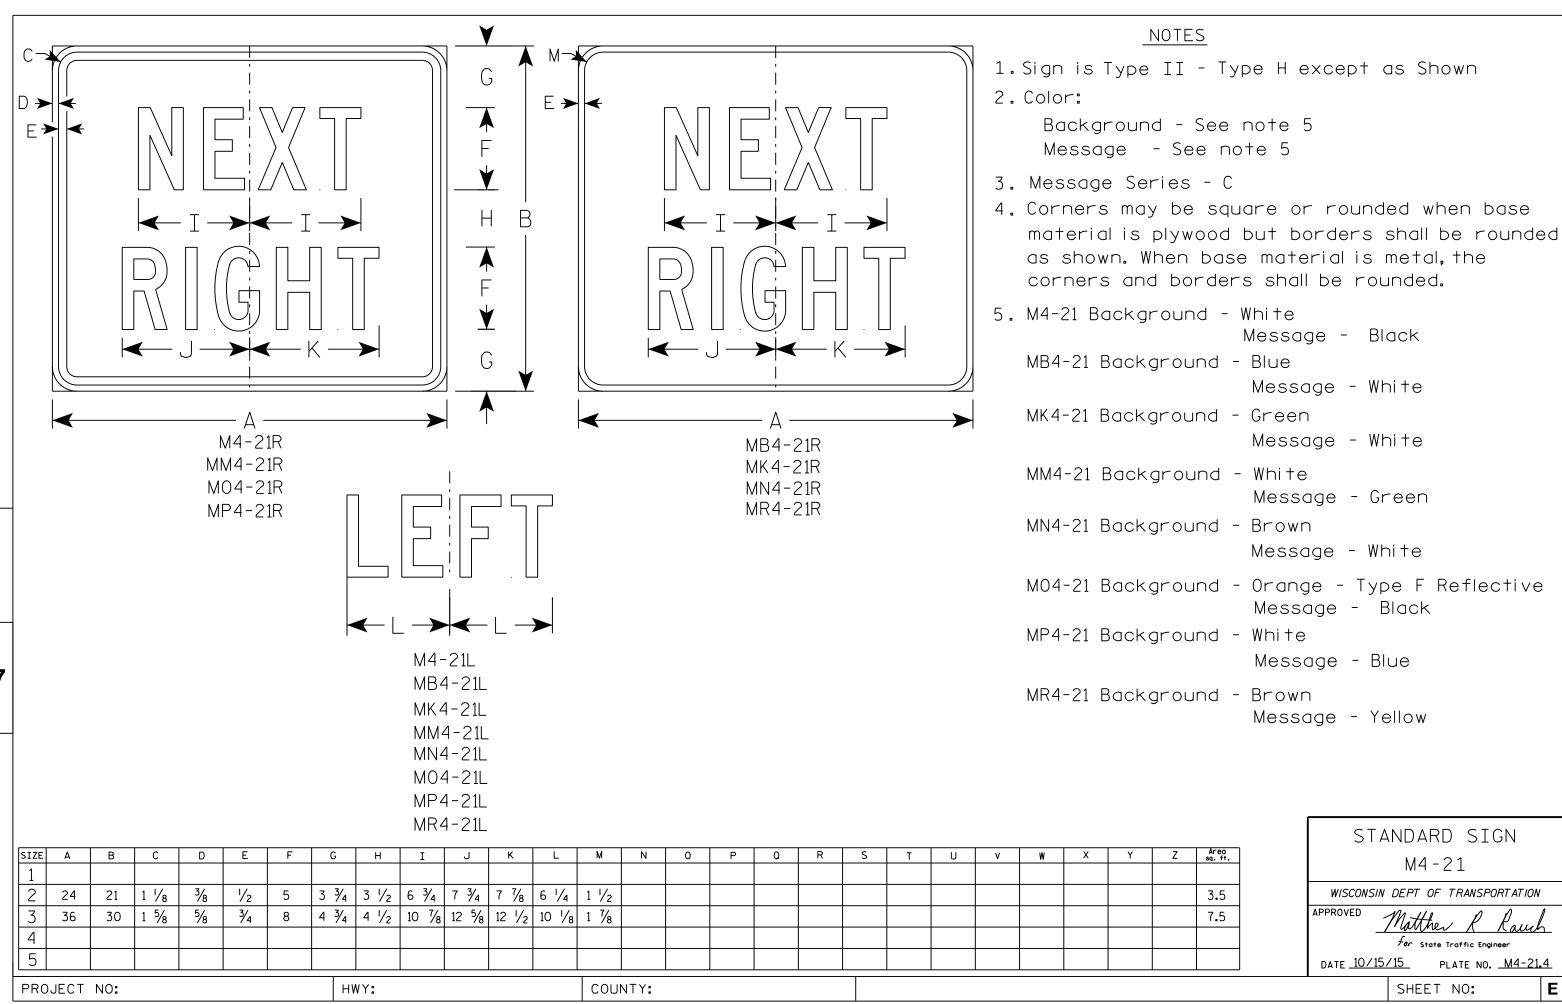

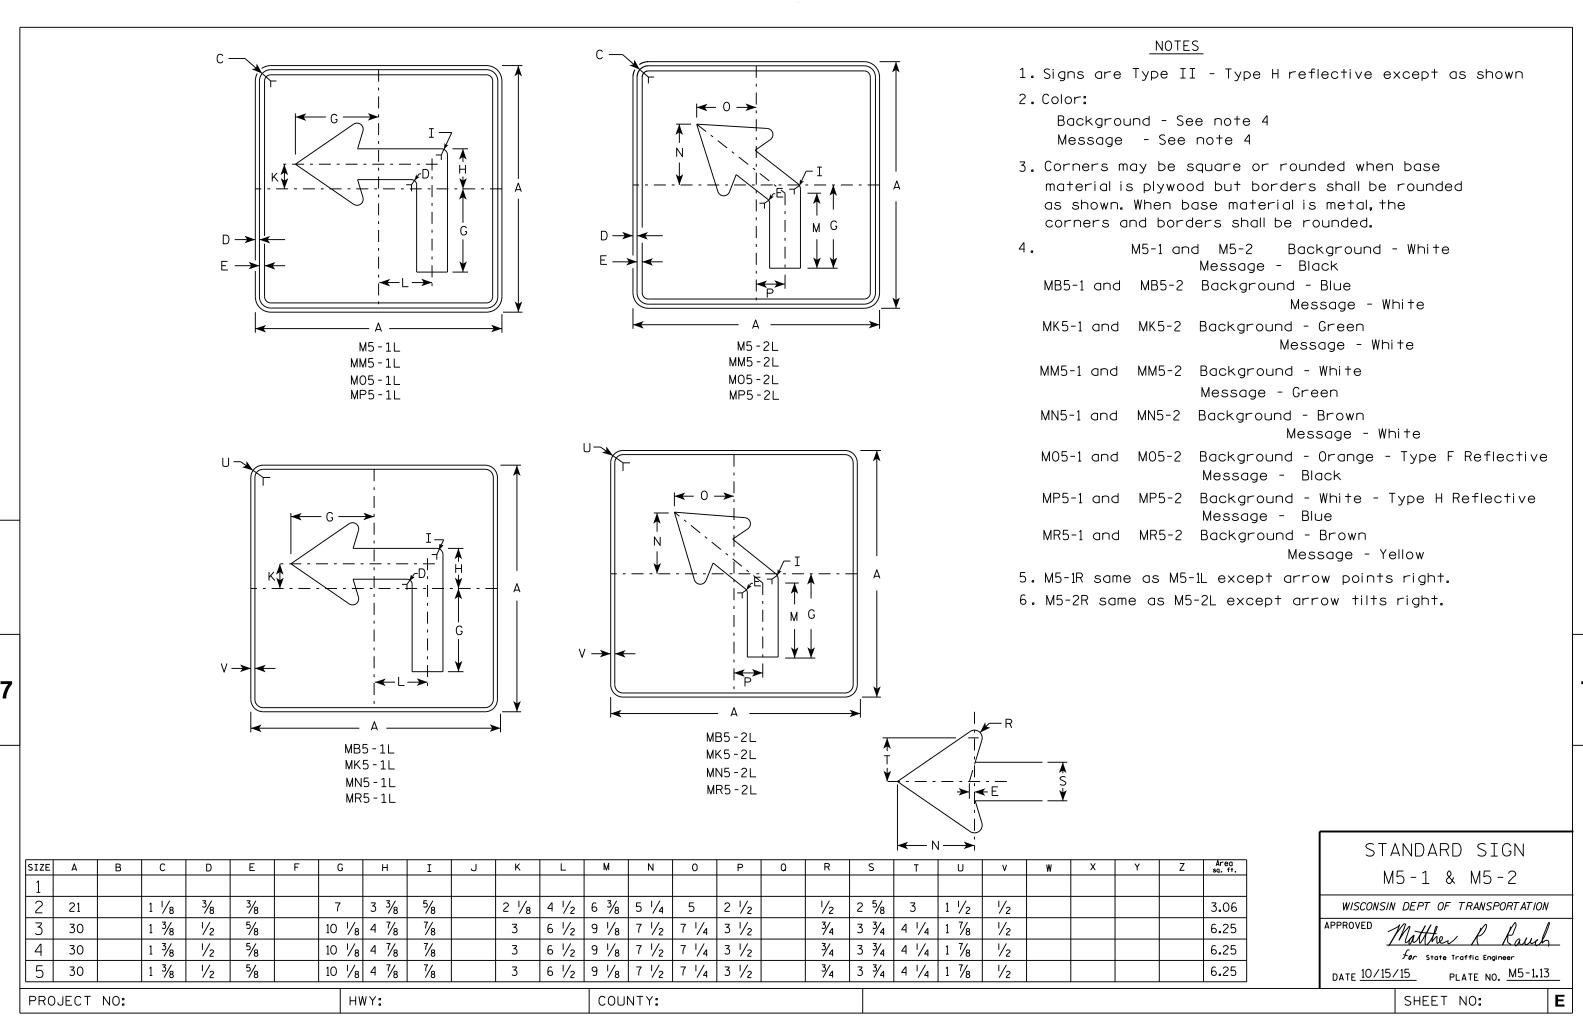



FILE NAME . C.\CAFfiles\Projects\tr stdnlate\M51 DCN


PLOT DATE . 01-DEC-2015 18.07

PINT RY . \$\$ DIOTUSET \$\$ PINT NAMF :

PLOT SCALE . 11 675051.1 000000

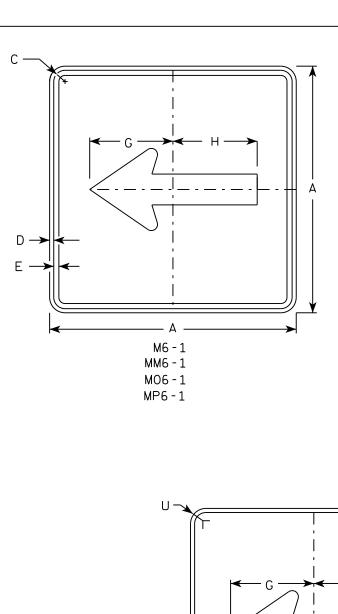


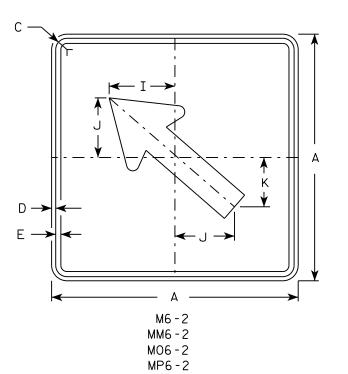

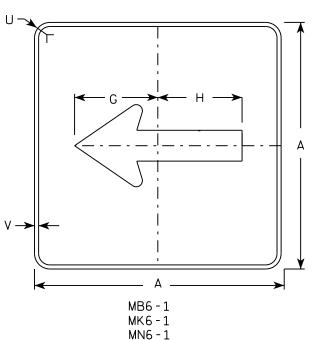

MR6-1

HWY:

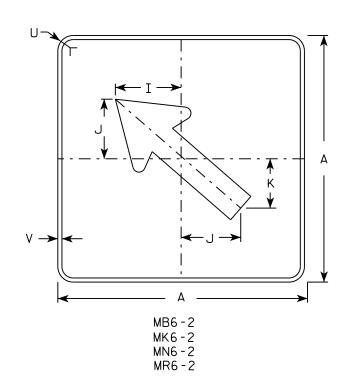

NOTES

- 1. Signs are Type II Type H except as Shown
- 2. Color:

Background - See note 4 Message - See note 4

- 3. Corners may be square or rounded when base material is plywood but borders shall be rounded as shown. When base material is metal, the corners and borders shall be rounded.
- 4. M6-1 and M6-2 Background White

Message - Black

MB6-1 and MB6-2 Background - Blue

Message - White

MK6-1 and MK6-2 Background - Green

Message - White

MM6-1 and MM6-2 Background - White

Message - Green

MN6-1 and MN6-2 Background - Brown

Message - White

M06-1 and M06-2 Background - Orange - Type F Reflective


Message - Black

MP6-1 and MP6-2 Background - White

Message - Blue

MR6-1 and MR6-2 Background - Brown

Message - Yellow

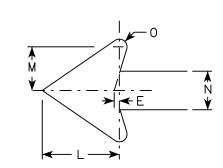

SIZ	E /	Α	В	С	D	E	F	G	Н	I	J	К	L	М	N	0	Р	0	R	S	T	U	V	W	X	Y	Z	Area sq. ft.
1																												
2	2	21		1 1/8	3/8	3/8		7 1/2	7 1/8	5 %	5	4 1/4	5 1/4	3	2 5/8	1/2						1 1/2	1/2					3.06
3	3	30		1 3/8	1/2	5/8		10 3/4	10 1/4	8	7 1/4	6	7 1/2	4 1/4	3 3/4	3/4						1 %	1/2					6.25
4	3	30		1 3/8	1/2	5/8		10 3/4	10 1/4	8	7 1/4	6	7 1/2	4 1/4	3 3/4	3/4						1 1/8	1/2					6.25
5	3	30		1 3/8	1/2	5/8		10 3/4	10 1/4	8	7 1/4	6	7 1/2	4 1/4	3 3/4	3/4						1 1/8	1/2					6.25

COUNTY:

STANDARD SIGN M6-1 & M6-2 SERIES

WISCONSIN DEPT OF TRANSPORTATION

SHEET NO:

APPROVED

DATE 10/15/15

PLATE NO. M6-1.15 Ε

FILE NAME . C.\CAFfiles\Projects\tr stdolate\M61 DCN

PROJECT NO:

PLOT DATE . 01-DEC-2015 17:57

PLOT RY . \$\$ plotuser \$\$ PLOT NAME :


PLOT SCALE . 11 675051.1 000000

NOTES 1. Sign is Type II - Type H Reflective - reference WIS DOT Standard Specification for HIGHWAY and STRUCTURE CONSTRUCTION latest edition. 2. Color: Background - Red Message - White 3. Message Series - C R1-1 SIZE A STANDARD SIGN 30 5/8 10 12 1/2 45° 12 3/4 5.18 2S 30 5/8 12 1/2 45° 12 3/4 10 5.18 R1-1 2M 36 3/4 12 15 45° 15 % 7.46 3/4 15 3/8 12 45° 36 15 7.46 WISCONSIN DEPT OF TRANSPORTATION 45° 20 1/2 48 16 20 13.25 APPROVED Matthew & Kauch 5 48 16 20 45° 20 1/2 13.25 3/8 7 3/4 45° 7 3/4 1.86 18 6 For State Traffic Engineer 12 1/4 4 45° 5 1/8 0.78 DATE <u>11/12/15</u> PLATE NO. _____R1-1.13 COUNTY: SHEET NO: PROJECT NO: HWY: PLOT SCALE • 4 378143•1 000000

FILE NAME · C·\CAFfiles\Projects\tr stdplote\R11 DGN

PLOT DATE . 01-DEC-2015 18:07

PINT RY . \$\$ plotuser \$\$ PINT NAMF :

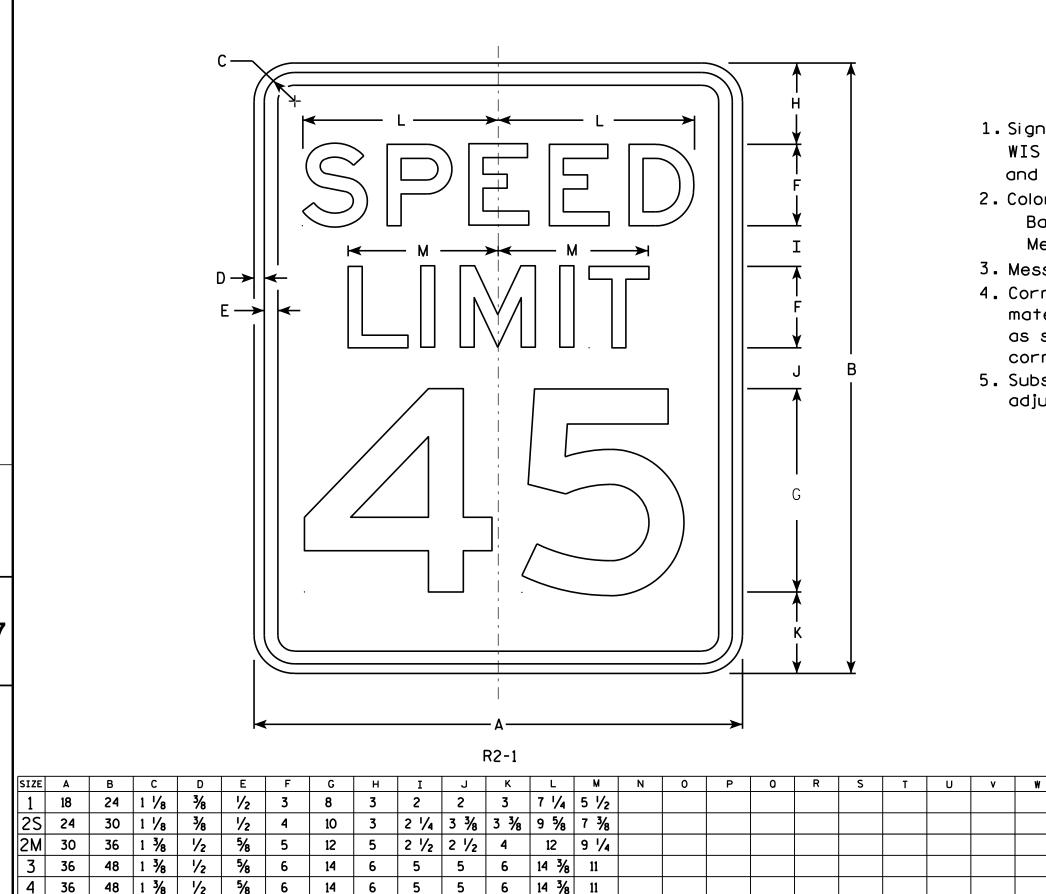

4 1/2 6 3/4 6 3/4 19 1/4 14 5/8

COUNTY:

20

HWY:

6

NOTES

- 1. Sign is Type II Type H Reflective reference WIS DOT Standard Specification for HIGHWAY and STRUCTURE CONSTRUCTION latest edition.
- 2. Color:

Background - White Message - Black

- 3. Message Series E
- 4. Corners may be square or rounded when base material is plywood but borders shall be rounded as shown. When base material is metal. the corners and borders shall be rounded.
- 5. Substitute appropriate numerals and optically adjust spacing to achieve proper balance.

3.0

5.0

7.5

12.0

12.0

20.0

STANDARD SIGN R2-1 WISCONSIN DEPT OF TRANSPORTATION APPROVED Matther R Raus For State Traffic Engineer DATE <u>5/26/1</u>0 PLATE NO. R2-1.13

SHEET NO:

FILE NAME : C:\Users\PROJECTS\tr_stdplate\R21.DGN

2 1/4

5

48

PROJECT NO:


60

PLOT DATE: 28-MAY-2010 08:32

PLOT BY : ditjph

PLOT NAME :


PLOT SCALE: 4.717577:1.000000

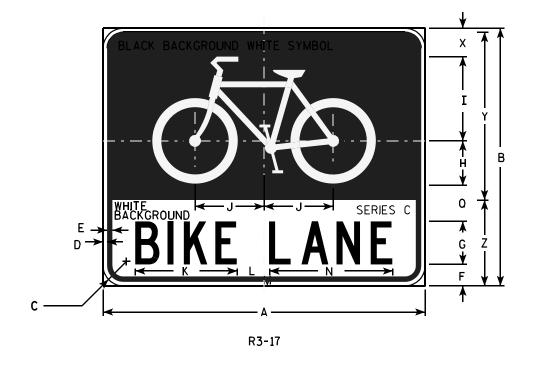


- 1. Sign is Type II Type H Reflective reference WIS DOT Standard Specification for HIGHWAY and STRUCTURE CONSTRUCTION latest edition.
- 2. Color:

Background - AS SHOWN Message - BLACK

- 3. Message Series C or as noted on the Signs.
- 4. Corners may be square or rounded when base material is plywood but borders shall be rounded as shown. When base material is metal, the corners and borders shall be rounded.

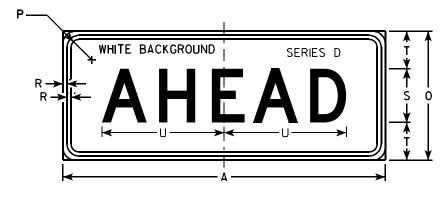

R3-17ap

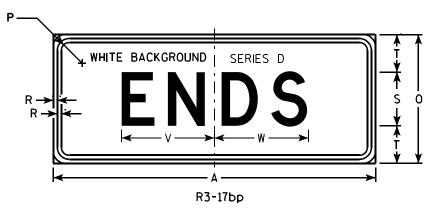

																											R3-17	R3-17ap	R3-17bp
SIZE	Α	В	С	D	E	F	G	Н	I	J	K	L	M	N	0	Р	0	R	S	Т	U	٧	₩	Х	Y	Z	Area sq. ft.	Areg sq. it.	Area sq. ft.
1																													
2S	30	24	1 1/8	3/8	1/2	2	4	4 1/8	7 1/8	6 3/8	9 1/2	2 %	7/8	13	12	1 1/8	3 %	3/8	5	3 1/2	11 3/8	8 %	8 3/4	2 3/8	15 %	8	5.0	2.5	2.5
2M	30	24	1 1/8	3/8	1/2	2	4	4 1/8	7 1/8	6 3/8	9 1/2	2 %	7/8	13	12	1 1/8	3 %	3/8	5	3 1/2	11 3/8	8 %	8 3/4	2 3/8	15 5/8	8	5.0	2.5	2.5
3																													
4																													
5																													
		•				•	•		•	•	•	•	•			•	•	•		•		•	•	•	•	•	•		

STANDARD SIGN R3-17 & R3-17a&bp

WISCONSIN DEPT OF TRANSPORTATION

APPROVED

Matthew R R

For State Traffic Engineer

DATE 4/12/2011 PLATE NO. R3-17.2


SHEET NO:

PROJECT NO:

- 1. Sign is Type II Type H Reflective reference WIS DOT Standard Specification for HIGHWAY and STRUCTURE CONSTRUCTION latest edition.
- 2. Color:

Background - White Message - Black

- 3. Message Series C
- 4. Corners may be square or rounded when base material is plywood but borders shall be rounded as shown. When base material is metal, the corners and borders shall be rounded.
- 5. Use Size 2 for Sidewalks. Use Size 3 for Paths and Trails.

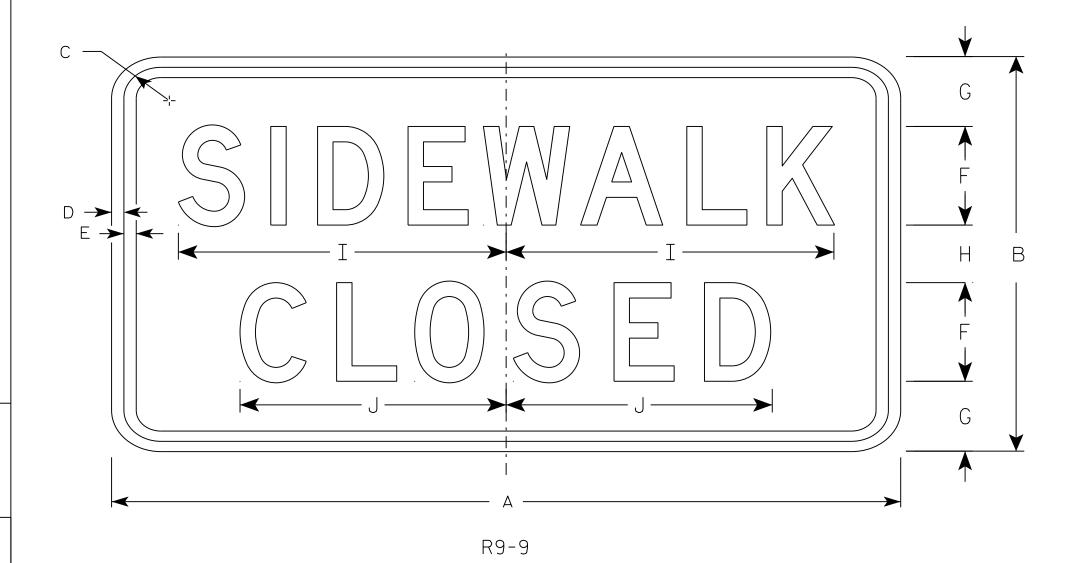

SIZE A 2S 24 1 3/4 1/2 2 1/8 1 3/4 10 1/2 12 3 8 1/8 2.0 24 1 3/4 1/2 2 1/8 1 3/4 8 1/8 12 10 2.0 1 3/4 3 1/2 30 18 1/2 1/2 3 | 12 1/2 | 10 1/4 3.75

COUNTY:

STANDARD SIGN R9-9

WISCONSIN DEPT OF TRANSPORTATION

APPROVED M__//

Manher R Ray

DATE <u>8/11/16</u>

SHEET NO: R9-9.6

| PINT NATE * 11-AIR-2016 11:33 PINT RY * \$\$ DIOTUSER \$\$ PINT NAME: PINT SCALE * 2 918761*1 000000


HWY:

PROJECT NO:

- 1. Sign is Type II Type H Reflective
- 2. Color:

Background - White Message - Black

- 3. Message Series C except Size 1 is Series D
- 4. Corners may be square or rounded when base material is plywood but borders shall be rounded as shown. When base material is metal, the corners and borders shall be rounded.
- 5. Use Size 2 for Sidewalks. Use Size 3 for Paths and Trails.

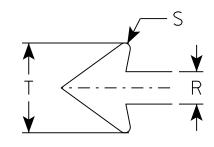

R9-11

SIZE	Α	В	С	D	E	F	G	Н	I	J	K	L	М	N	0	Р	O	R	S	Т	U	V	W	Х	Υ	Z	Area sq. ft.
1																											
25	24	12	1 1/8	3/8	3/8	1 1/2	1 1/2	1 1/2	9 3/4	5/8	1 1/2	7 %	3 1/2	9 1/4	6 %	5 1/8		1	1/8	2 3/4							2.0
2M	24	12	1 1/8	3/8	3/8	1 1/2	1 1/2	1 1/2	9 3/4	5/8	1 1/2	7 %	3 1/2	9 1/4	6 %	5 1/8		1	1/8	2 3/4							2.0
3	30	15	1 1/8	3/8	1/2	2	1 1/2	1 1/2	13	3/4	2	10 1/4	4 5/8	12 3/8	8 1/8	6 1/8		1 1/4	1/4	3 %							3.125
4																											
5																											

COUNTY:

STANDARD SIGN R9-11

WISCONSIN DEPT OF TRANSPORTATION

APPROVED

DATE 11/29/16

PLATE NO. R9-11.3

SHEET NO:

HWY:


PROJECT NO:

 $D \rightarrow$

- 1. Sign is Type II Type H Reflective
- 2. Color:

Background - White Message - Black

- 3. Message Series C
- 4. Corners may be square or rounded when base material is plywood but borders shall be rounded as shown. When base material is metal, the corners and borders shall be rounded.
- 5. Use Size 2 for Sidewalks. Use Size 3 for paths and Trails.

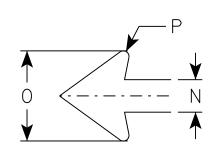

C
SIDE WALK CLOSED F F F F F F F F F F F F F F F F F F F
←
R9-11A

SIZE	Α	В	С	D	E	F	G	Н	I	J	K	L	М	N	0	Р	0	R	S	T	U	V	W	Х	Y	Z	Area sq. ft.
1 1																											
2S	24	12	1 1/8	3/8	3/8	2	10 1/4	5/8	1 1/2	8 1/4	9 1/4	7	5 %	1	2 3/4	1/8											2.0
2M	24	12	1 1/8	3/8	3/8	2	10 1/4	5/8	1 1/2	8 1/4	9 1/4	7	5 %	1	2 3/4	1/8											2.0
3	30	15	1 1/8	3/8	1/2	2	13	3/4	2	10 1/4	12 3/8	8 1/8	6 %	1 1/4	3 %	1/4											3.125
4																											
5																											

COUNTY:

STANDARD SIGN R9-11A

WISCONSIN DEPT OF TRANSPORTATION

APPROVED

For Sta

PLATE NO. <u>R9-11A.3</u>

SHEET NO:

FILE NAME : C:\CAEfiles\Projects\tr_stdplate\R911A.DGN

HWY:

PROJECT NO:

PLOT DATE: 01-DEC-2016 11:44

PLOT BY: \$\$...plotuser...\$\$ PLOT NAME:

PLOT SCALE : 5.904805:1.000000


WISDOT/CADDS SHEET 42

| "

- 1. Sign is Type II Type H Reflective
- 2. Color:

Background - White Message - Black

- 3. Message Series C
- 4. Corners may be square or rounded when base material is plywood but borders shall be rounded as shown. When base material is metal, the corners and borders shall be rounded.
- 5. Substitute appropriate numerals to nearest quarter mile and optically adjust spacing to achieve proper balance.

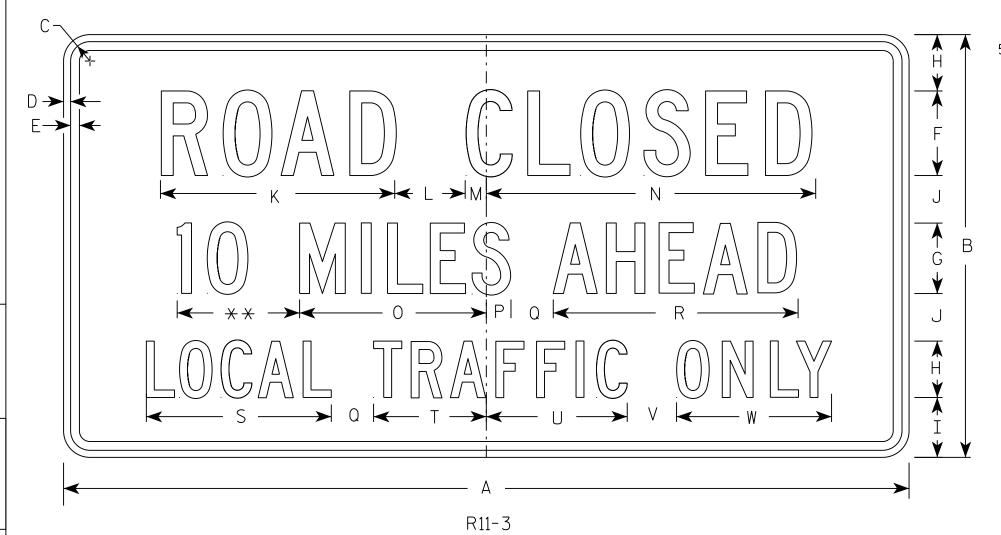

** See Note 5

Α	В	С	D	Е	F	G	Н	Ι	7	К	L	М	N	0	Р	Q	R	S	Т	C	٧	W	X	Y	Z	Area sq. ft.
36	18	1 3/8	1/2	5/8	4	3	2 1/2	2	2	11 1/8	3	1 1/8	15 1/4	8	1 1/2	2	10 3/4	8 %	4 3/4	6 ½	2	6 3/4				4.5
60	30	1 3/8	1/2	5/8	6	5	4	4 1/4	3	16 %	5	1 1/2	23	13 1/4	1 3/4	3	17 3/8	13 1/8	8	10	3 ½	11				12.5
60	30	1 3/8	1/2	5/8	6	5	4	4 1/4	3 %	16 5/8	5	1 1/2	23	13 1/4	1 3/4	3	17 3/8	13 1/8	8	10	3 ½	11				12.5
	60	60 30	60 30 1 3/8	60 30 1 3/8 1/2	60 30 1 3/8 1/2 5/8	60 30 1 3/8 1/2 5/8 6	60 30 1 3/8 1/2 5/8 6 5	60 30 1 3/8 1/2 5/8 6 5 4	60 30 1 3/8 1/2 5/8 6 5 4 4 1/4	36 18 1 3/8 1/2 5/8 4 3 2 1/2 2 2 60 30 1 3/8 1/2 5/8 6 5 4 4 1/4 3 3/8	36 18 1 3/8 1/2 5/8 4 3 2 1/2 2 2 11 1/8 60 30 1 3/8 1/2 5/8 6 5 4 4 1/4 3 3/8 16 5/8	36 18 1 3/8 1/2 5/8 4 3 2 1/2 2 2 11 1/8 3 60 30 1 3/8 1/2 5/8 6 5 4 4 1/4 3 3/8 16 5/8 5	36 18 1 3/8 1/2 5/8 4 3 2 1/2 2 2 11 1/8 3 1 1/8 60 30 1 3/8 1/2 5/8 6 5 4 4 1/4 3 3/8 16 5/8 5 1 1/2	36 18 1 3/8 1/2 5/8 4 3 2 1/2 2 2 11 1/8 3 1 1/8 15 1/4 60 30 1 3/8 1/2 5/8 6 5 4 4 1/4 3 3/8 16 5/8 5 1 1/2 23	36 18 1 3/8 1/2 5/8 4 3 2 1/2 2 2 11 1/8 3 1 1/8 15 1/4 8 60 30 1 3/8 1/2 5/8 6 5 4 4 1/4 3 3/8 16 5/8 5 1 1/2 23 13 1/4	36 18 1 3/8 1/2 5/8 4 3 2 1/2 2 2 11 1/8 3 1 1/8 15 1/4 8 1 1/2 60 30 1 3/8 1/2 5/8 6 5 4 4 1/4 3 3/8 16 5/8 5 1 1/2 23 13 1/4 1 3/4	36 18 1 3/8 1/2 5/8 4 3 COUNTY:

STANDARD SIGN R11-3

WISCONSIN DEPT OF TRANSPORTATION

APPROVED

Matther R DATE 7/28/16 PLATE NO. R11-3.7

> Ε SHEET NO:

FILE NAME + C+\CAFfiles\Projects\tr stdolote\R113 DGN

PROJECT NO:

HWY:

PLOT DATE . 28-. III -2016 16.25


PINT RY . \$\$ plotuser \$\$ PINT NAME :

PLOT SCALE . 6 810445.1 000000

- 1. Sign is Type II Type H Reflective reference WIS DOT Standard Specification for HIGHWAY and STRUCTURE CONSTRUCTION latest edition.
- 2. Color:

Background - White Message - Black

- 3. Message Series C
- 4. Corners may be square or rounded when base material is plywood but borders shall be rounded as shown. When base material is metal, the corners and borders shall be rounded.

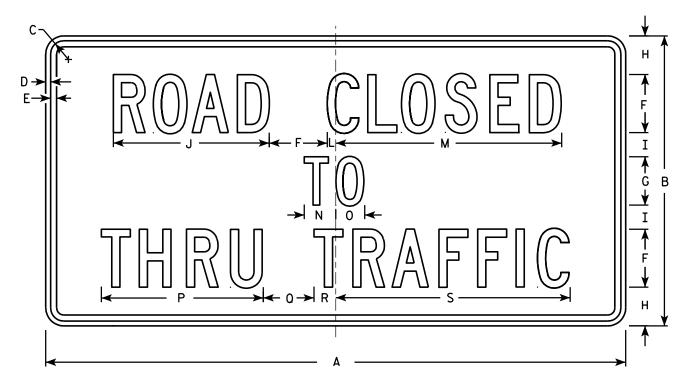

R11-4

SIZE	Α	В	С	D	E	F	G	Н	I	J	K	L	М	N	0	Р	0	R	S	Т	U	V	W	X	Y	Z	Areg sq. ft.
1																											
2S	60	30	1 3/8	1/2	5/8	6	5	4	2 1/2	16 1/8		7 ⁄8	23 3/8	3 1/4	3	16 3/4	5 1/4	2 1/4	24 1/4								12.5
2M	60	30	1 3/8	1/2	5/8	6	5	4	2 1/2	16 1/8		7∕8	23 3/8	3 1/4	3	16 3/4	5 1/4	2 1/4	24 1/4								12.5
3																											
4																											
5																											
PRO	JECT	NO:					Н\	WY:					COU	NTY:													

STANDARD SIGN R11 - 4

WISCONSIN DEPT OF TRANSPORTATION

DATE 4/1/11 PLATE NO. R11-4.3

SHEET NO:


FILE NAME : C:\Users\PROJECTS\tr_stdplate\R114.DGN

PLOT DATE : 01-APR-2011 14:11

PLOT BY: mscj9h

PLOT NAME :


PLOT SCALE: 9.931739:1.000000

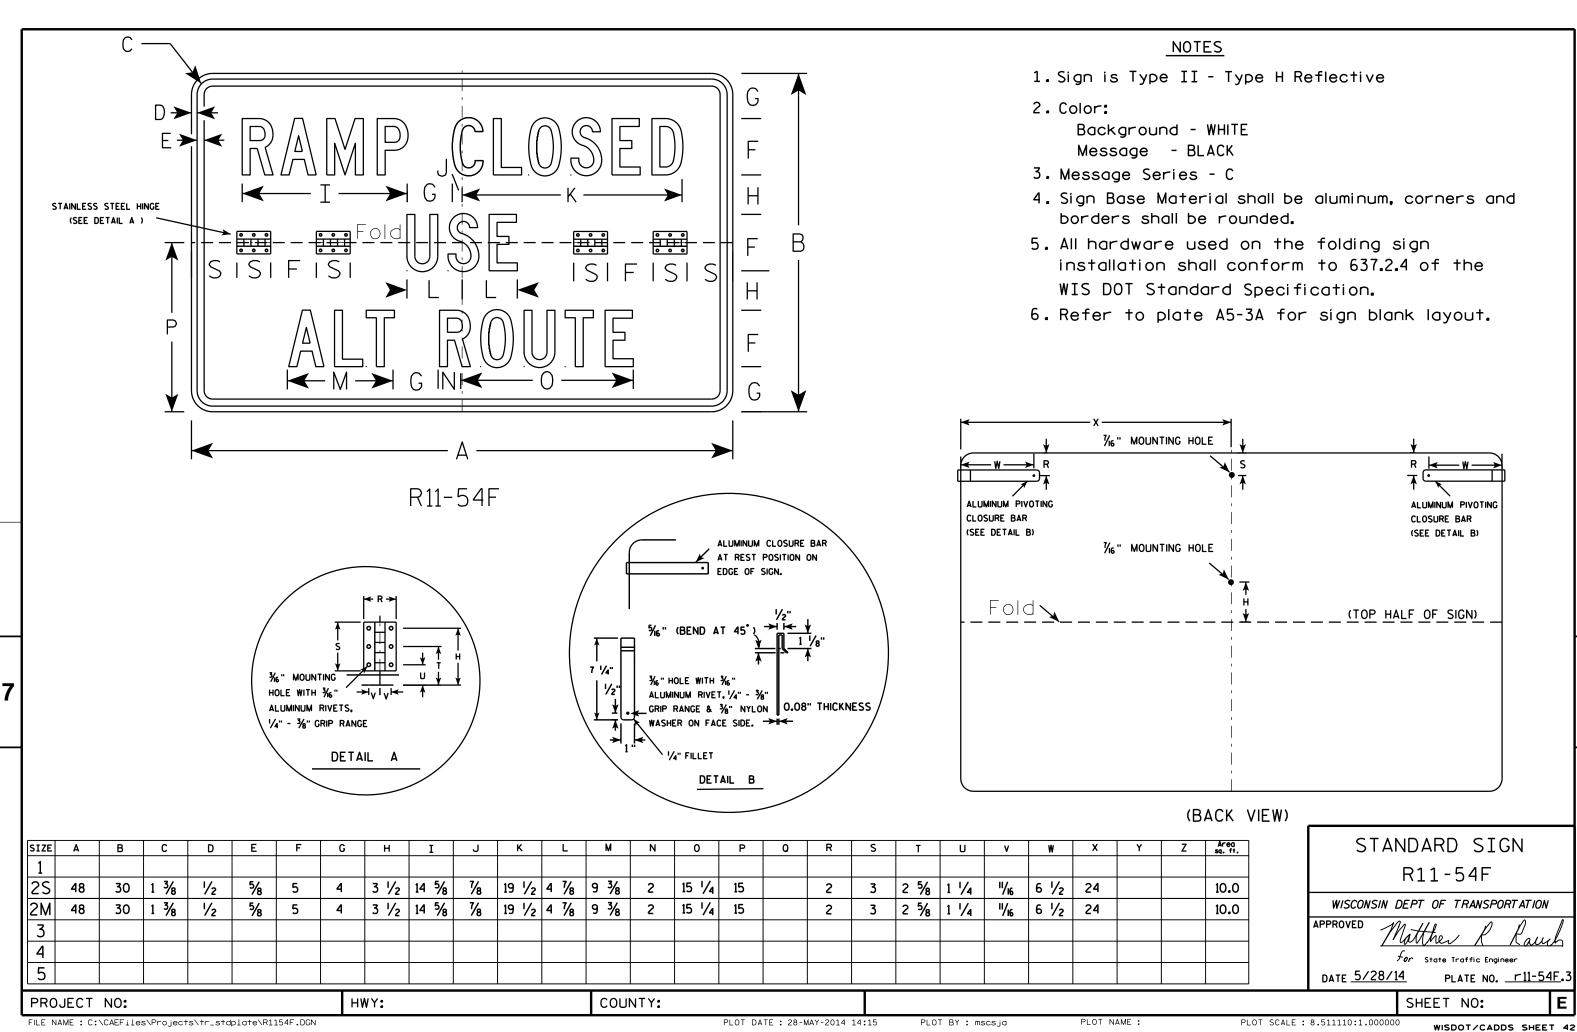

- 1. Sign is Type II Type F Reflective reference WIS DOT Standard Specification for HIGHWAY and STRUCTURE CONSTRUCTION latest edition.
- 2. Color:

Background - Yellow Message - Black

3. Corners may be square or rounded when base material is plywood but borders shall be rounded as shown. When base material is metal, the corners and borders shall be rounded.

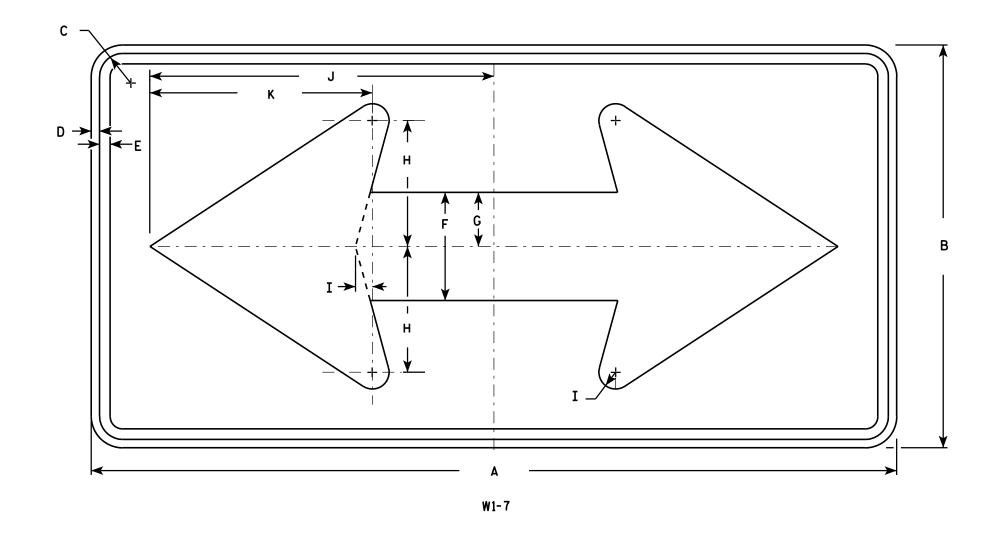

SIZE	Α	В	С	D	E	F	G	Н	I	J	K	L	М	N	0	Р	0	R	S	T	U	٧	W	X	Y	Z	Area sq. ft.
1	36	18	1 1/8	3⁄8	1/2	5	2 1/2	5 ¾	₹4	15 %	10 1/8																4.5
2S	48	24	1 3/8	1/2	5/8	6 1/2	3 1/4	7 1/2	1	20 1/2	13 1/4																8.0
2M	48	24	1 3/8	1/2	5/8	6 1/2	3 1/4	7 1/2	1	20 1/2	13 1/4																8.0
3	60	30	1 3/8	1/2	5/8	8	4	9 1/4	1 1/4	25 %	16 1/4																12.5
4	60	30	1 3/8	1/2	5/8	8	4	9 1/4	1 1/4	25 ¾	16 1/4																12.5
5	96	48	2 1/4	3/4	1	13	6 1/2	15	2	41	26 1/2										·						32.0

COUNTY:

STANDARD SIGN W1-7

WISCONSIN DEPT OF TRANSPORTATION

APPROVED

Matthew R Raw

For State Traffic Engineer

DATE 6/7/10 PLATE NO. W1-7.7

SHEET NO:

FILE NAME : C:\Users\PROJECTS\tr_stdplate\W17.DCN

PROJECT NO:


HWY:

PLOT DATE: 07-JUN-2010 12:35

PLOT BY : ditjph

PLOT NAME :

PLOT SCALE: 5.720679:1.000000

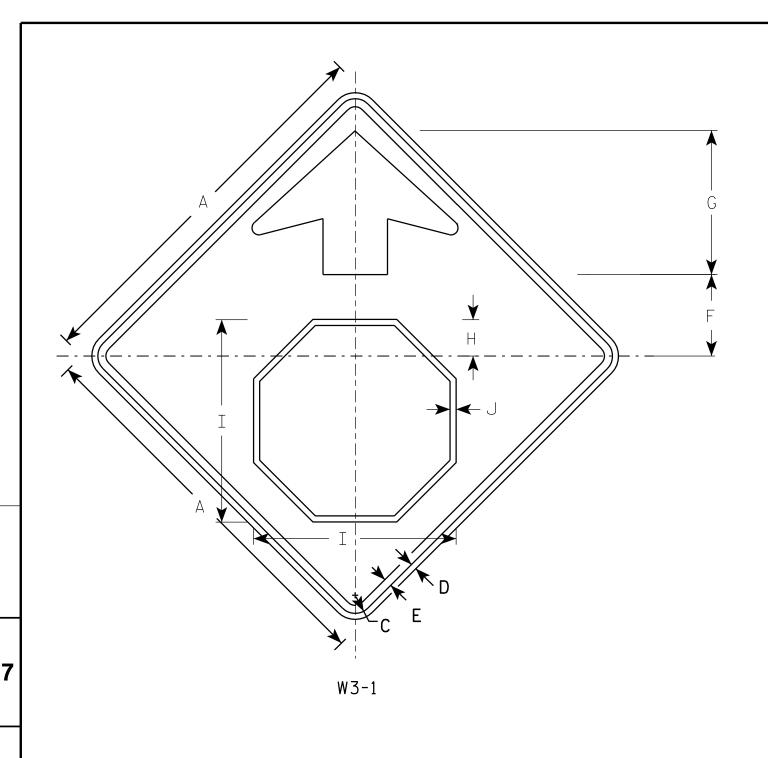


- 1. All Signs Type II Type F Reflective reference WIS DOT Standard Specification for HIGHWAY and STRUCTURE CONSTRUCTION latest edition.
- 2. Color:

Background - YELLOW

Arrow & Border - BLACK

Stop Symbol - WHITE BORDER ON RED BACKGROUND

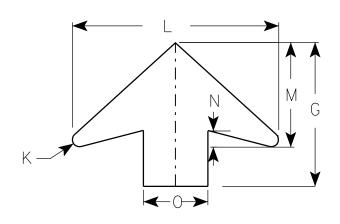

ARROW	DFTAII
$\neg \cdots $	

SIZE	Α	В	С	D	E	F	G	Н	I	J	K	L	М	N	0	Р	0	R	S	T	U	٧	W	X	Y	Z	Areo sq. ft.
1	30		1 3/8	1/2	5/8	6 1/4	11 1/4	2 1/8	15 ¾	1/2	1/2	16	8	1 1/4	5												6.25
2S	36		1 1/8	5/8	3/4	7 1/2	13 1/2	3 1/2	19	5/8	5/8	19 1/4	9 3/4	1 %	6												9.0
2M	36		1 1/8	5/8	3/4	7 1/2	13 1/2	3 1/2	19	5/8	5/8	19 1/4	9 3/4	1 %	6												9.0
3	36		1 5/8	5/8	3/4	7 1/2	13 1/2	3 1/2	19	5/8	5/8	19 1/4	9 3/4	1 %	6												9.0
4	48		2 1/4	3/4	1	10	17 1/8	4 1/2	25 1/8	3/4	7 ⁄8	25 %	13	2	8												16.0
5	48		2 1/4	3/4	1	10	17 1/8	4 1/2	25 1/8	₹4	7 /8	25 %	13	2	8												16.0

STANDARD SIGN W3-1

WISCONSIN DEPT OF TRANSPORTATION

APPROVED Matthew R

For State Traffic Engineer

DATE 6/7/10 PLATE NO. W3-1.12

SHEET NO:

PROJECT NO:

- 1. Sign is Type II Type F Reflective reference WIS DOT Standard Specification for HIGHWAY and STRUCTURE CONSTRUCTION latest edition.
- 2. Color:

Background - Yellow Message - Black

- 3. Message Series B
- 4. Corners may be square or rounded when base material is plywood but borders shall be rounded as shown. When base material is metal, the corners and borders shall be rounded.

C	
	G
	F
	<u>₩</u> H B
	F
$\begin{array}{c ccccccccccccccccccccccccccccccccccc$	G
	
A	

W4-4B

SIZE	A	В	С	D	E	F	G	Н	I	J	К	L	M	N	0	Р	0	R	S	Т	U	v	w	x	Y	Z	Area sq. 11.
1																											
25	30	12	1 1/8	3/8	1/2	3	2 1/4	1 1/2	12 3/8	5/8	1 1/2	10 3/8	6 1/4	2 1/4	2 1/4	6 1/4											2.5
2M	30	12	1 1/8	3/8	1/2	3	2 1/4	1 1/2	12 3/8	5/8	1 1/2	10 3/8	6 1/4	2 1/4	2 1/4	6 1/4											2.5
3	42	15	1 1/8	3/8	1/2	4	2 5/8	1 3/4	16 %	5/8	2 3/8	13 %	8 3/8	3	3 1/8	8 3/8											4.17
4	48	18	1 1/8	3/8	1/2	5	3	2	21	5/8	3 1/8	17 1/4	10 1/2	3 %	3 1/8	10 3/8											6.0
5																											

COUNTY:

STANDARD SIGN W4-4B

WISCONSIN DEPT OF TRANSPORTATION

APPROVED For State Traffic Engineer


DATE 03/12/13 PLATE NO. W4-4B.2

SHEET NO:

PROJECT NO:

HWY:

PLOT NAME :

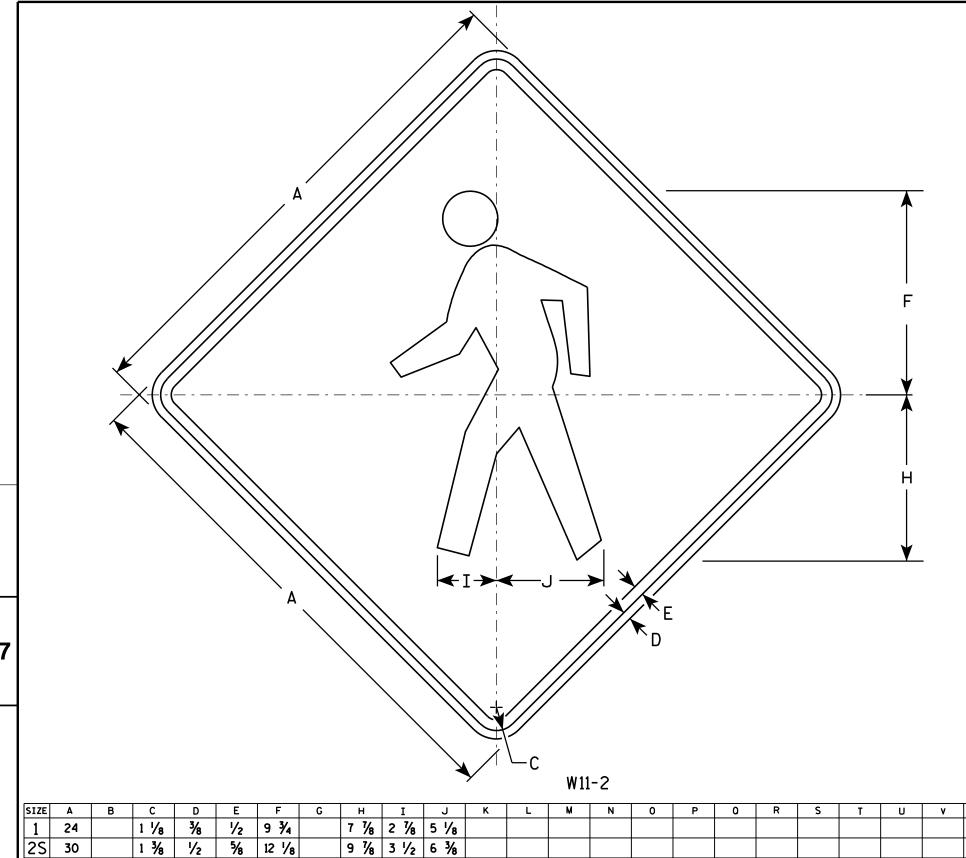

<u>NOTES</u>

- 1. Sign is Type II Type F Reflective reference WIS DOT Standard Specification for HIGHWAY and STRUCTURE CONSTRUCTION latest edition.
- 2. Color:

Background - Yellow Message - Black

3. Corners may be square or rounded when base material is plywood but borders shall be rounded as shown. When base material is metal, the corners and borders shall be rounded.

STANDARD SIGN W11-2

WISCONSIN DEPT OF TRANSPORTATION

APPROVED

4.0

6.25

9.0

9.0

16.0

PLOT NAME :

For State Traffic Engineer

DATE 6/7/10

PLATE NO. W11-2.7

SHEET NO:

FILE NAME : C:\Users\PROJECTS\tr_stdplate\W112.DGN

1 1/8

1 %

2 1/4 3/4

2M

3

4 48

5

PROJECT NO:

5/8

5/8

3/4

14 1/2

3/4 14 1/2

1 19 3/8

11 1/8 4 1/4 7 5/8

11 1/8 4 1/4 7 5/8

15 3/4 5 5/8 10 1/4

HWY:

PLOT DATE : 07-JUN-2010 13:29

COUNTY:

PLOT BY : ditjph

PLOT SCALE : 5.700818:1.000000

- 1. Sign is Type II Type F Reflective reference WIS DOT Standard Specification for HIGHWAY and STRUCTURE CONSTRUCTION latest edition.
- 2. Color:

Background - Yellow Message - Black

- 3. Corners may be square or rounded when base material is plywood but borders shall be rounded as shown. When base material is metal, the corners and borders shall be rounded.
- 4. W16-7R is the same as W16-L except the arrow is reversed along the vertical centerline.

E	
C H G	
	B B
H → A	—
W16-7L	

SIZE	Α	В	С	D	E	F	G	Н	I	7	K	L	М	N	0	Р	0	R	S	T	٦	٧	₩	Х	Y	Z	Area sq. ft.
1																											
25	24	12	3/8	3/8	1 1/8	3	30°	5 ¾	4	1/2	7																2.0
2M	30	18	3/8	1/2	1 1/8	4 1/2	30°	8 1/2	6	5/8	10 1/4																3.75
3	30	18	3/8	1/2	1 1/8	4 1/2	30°	8 1/2	6	5/8	10 1/4																3.75
4																											8
5																											8

COUNTY:

STANDARD SIGN W16-7

WISCONSIN DEPT OF TRANSPORTATION

APPROVED Matthew & Ray

For State Traffic Engineer

DATE 11/02/10 PLATE NO. W16-7.5

SHEET NO:

FILE NAME : C:\Users\PROJECTS\tr_stdplate\W167.DGN

HWY:


PROJECT NO:

PLOT DATE: 02-NOV-2010 09:34


PLOT BY : dotsja


PLOT NAME :


PLOT SCALE: 3.972696:1.000000

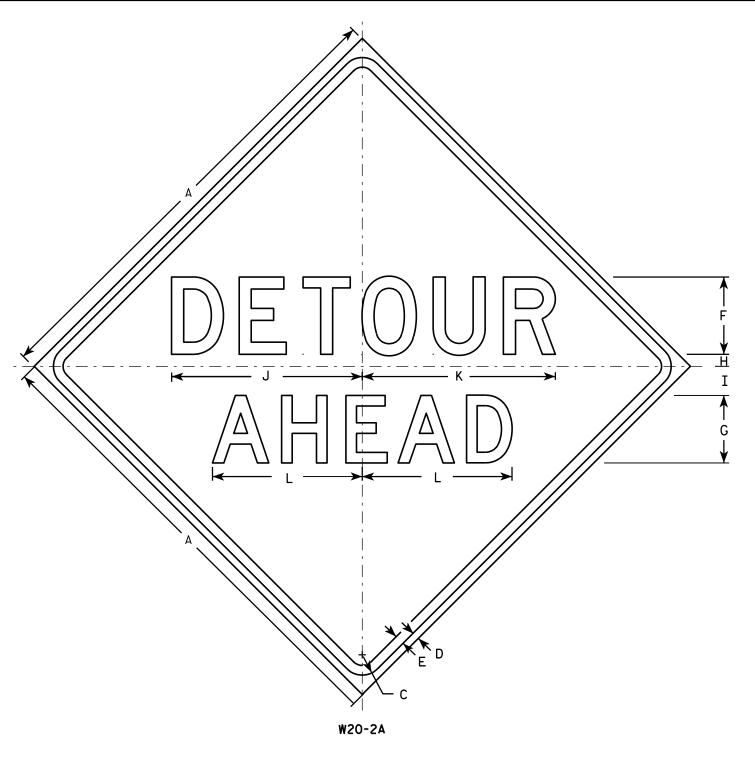



HWY:

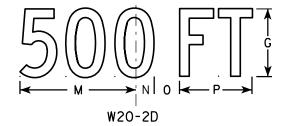

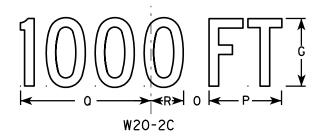

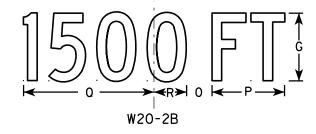

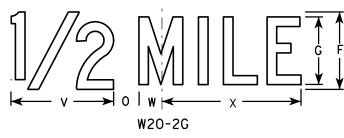

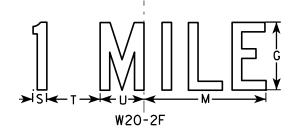

<u>NOTES</u>

- Sign is Type II Type F Reflective reference WIS DOT Standard Specification for HIGHWAY and STRUCTURE CONSTRUCTION latest edition.
- 2. Color:

Background - Orange Message - Black

- 3. Message Series See note 5
- 4. Corners may be square or rounded when base material is plywood but borders shall be rounded as shown. When base material is metal, the corners and borders shall be rounded.
- 5. Line 1 is Series D.
 Line 2 is Series D for AHEAD and
 Series C for all other distances.

SIZE	Α		В	С	D	E	F	G	Н	I	J	K	L	М	N	0	Р	0	R	S	T	U	٧	W	X	Y	Z	Area sq. ft.
1	36	6		1 5/8	5/8	3/4	6	5	1	2 1/4	14 3/4	15	11 5/8	9	1 3/8	1 1/8	5 %	10 1/8	2 1/2	1 1/8	4 1/2	3 1/2	8	1 3/4	10 3/4			9.0
2S	48	8		2 1/4	3/4	1	8	7	1 1/4	3	19 3/4	20	15 1/2	12	1 1/8	2 %	7 1/2	13 1/2	3 3/8	1 1/2	6	4 %	10 %	2 3/8	14 3/8			16.0
2M	48	8		2 1/4	3/4	1	8	7	1 1/4	3	19 3/4	20	15 1/2	12	1 1/8	2 %	7 1/2	13 1/2	3 %	1 1/2	6	4 %	10 %	2 3/8	14 3/8			16.0
3	48	8		2 1/4	¾	1	8	7	1 1/4	3	19 ¾	20	15 1/2	12	1 %	2 %	7 1/2	13 1/2	3 %	1 1/2	6	4 %	10 %	2 3/8	14 3/8			16.0
4	48	8		2 1/4	3∕4	1	8	7	1 1/4	3	19 3/4	20	15 1/2	12	1 %	2 %	7 1/2	13 1/2	3 %	1 1/2	6	4 %	10 %	2 3/8	14 3/8			16.0
5	48	8		2 1/4	₹4	1	8	7	1 1/4	3	19 ¾	20	15 1/2	12	1 %	2 %	7 1/2	13 1/2	3 3/8	1 1/2	6	4 %	10 %	2 3/8	14 3/8			16.0

COUNTY:

STANDARD SIGN W20-2A,B,C,D,F & G


WISCONSIN DEPT OF TRANSPORTATION

DATE 3/18/11 PLATE NO. W20-2.6

SHEET NO:

PROJECT NO:

PLOT NAME :

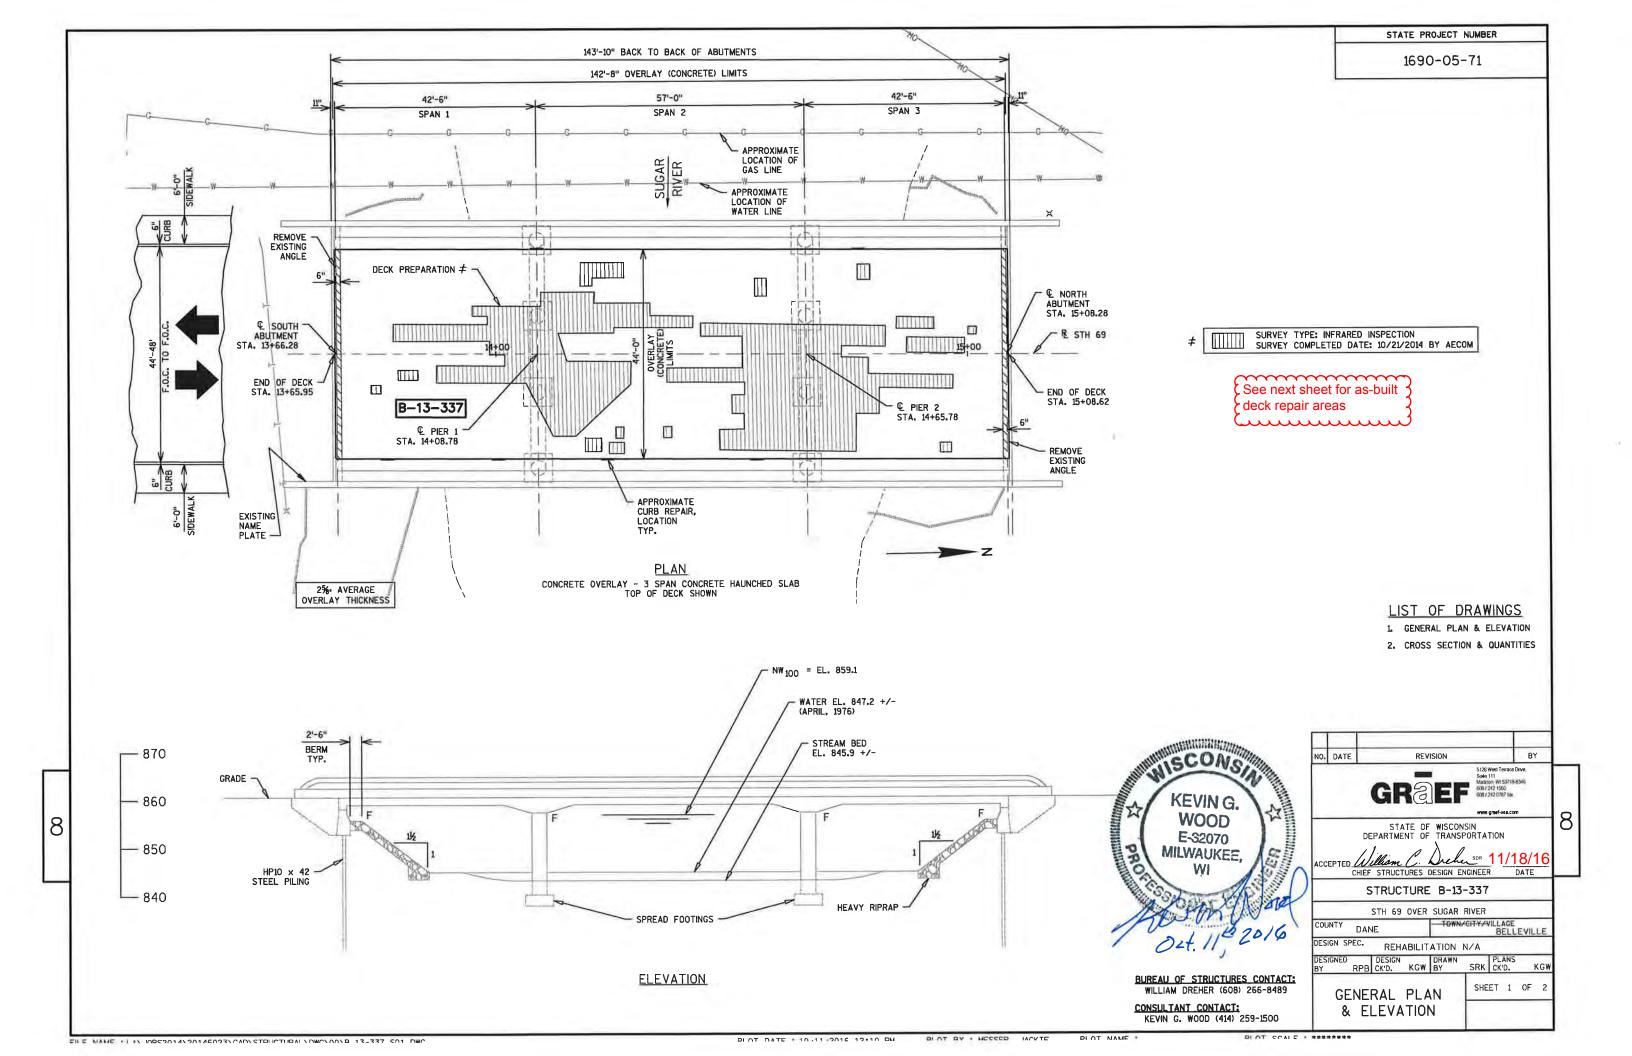



PREPARATION DECKS TYPE 1 —————

1	4.0 SF	0.4 SY	9	7.5 SF	0.8 SY
2	13.9 SF	1.5 SY	10	7.2 SF	0.8 SY
3	6.8 SF	0.8 SY	11	38.3 SF	4.3 SY
4	8.7 SF	1.0 SY	12	12.8 SF	1.4 SY
5	21.2 SF	2.4 SY	13	15.6 SF	1.7 SY
6	2.1 SF	0.2 SY	14	881.4 SF	97.9 SY
7	21.7 SF	2.4 SY	15	889.0 SF	98.8 SY
8	9.6 SF	1.1 SY		TOTAL	215.4 SY

PREPARATION DECKS TYPE 2 -----

1	0.4 SF	0.1 SY
2	1.3 SF	0.1 SY
3	2.1 SF	0.2 SY
4	1.0 SF	0.1 SY
5	1.8 SF	0.2 SY
6	0.5 SF	0.1 SY
7	0.6 SF	0.1 SY
8	0.6 SF	0.1 SY

9	3.8 SF	0.4 SY
10	0.7 SF	0.1 SY
11	1.0 SF	0.1 SY
12	2.5 SF	0.3 SY
13	9.8 SF	1.1 SY
14	1.4 SF	0.2 SY
15	17.0 SF	1.9 SY
16	0.9 SF	0.1 SY

17	106.7 SF	11.9 SY
18	2.9 SF	0.3 SY
19	3.1 SF	0.3 SY
20	1.6 SF	0.2 SY
21	73.2 SF	8.1 SY
22	2.1 SF	0.2 SY
23	23.6 SF	2.6 SY
24	4.6 SF	0.5 SY

25	7.4 SF	0.8 SY
26	9.1 SF	1.0 SY
27	0.8 SF	0.1 SY
28	4.1 SF	0.5 SY
29	2.1 SF	0.2 SY
30	1.4 SF	0.2 SY
31	128.4 SF	14.3 SY
32	1.6 SF	0.2 SY
32	1.6 SF	0.2 SY

	TOTALS	51.4 SY
40	1.4 SF	0.2 SY
39	13.3 SF	1.5 SY
38	1.0 SF	0.1 SY
37	13.6 SF	1.5 SY
36	2.3 SF	0.3 SY
35	3.3 SF	0.4 SY
34	2.4 SF	0.3 SY
33	4.8 SF	0.5 SY

BENCH MARK

BM*2 - ALUMINUM DISC IN THE SIDEWALK AT THE SOUTHEAST CORNER OF THE BRIDGE WITH ELEVATION 863.06

TOTAL ESTIMATED QUANTITIES

ITEM NO.	BIDITEMS	UNIT	S. A BUT	N. A BUT	PIER 1	PIER 2	SUPER	TOTAL
502.3200	PROTECTIVE SURFACE TREATMENT	SY	-	-	-	-	698	698
509.0301	PREPARATION DECKS TYPE 1	SY	-	-	-	-	200	200
509.0302	PREPARATION DECKS TYPE 2	SY	-	-	-	-	103	103
509.0500	CLEANING DECKS	SY	-	-	-	-	698	698
509.1200	CURB REPAIR	LF	-	-	-	-	10	10
509.1500	CONCRETE SURFA CE REPAIR	SF	-	2	17	-	-	19
509.2000	FULL-DEPTH DECK REPAIR	SY	-	-	-	-	1	1
509.2500	CONCRETE MASONRY OVERLAY DECKS	CY	-	-	-	-	69	69
	NON-BID ITEMS					<u> </u>		

1/2" MIN. OR TO

-INCORPORATE EXISTING REINFORCING

-SAWCUI

DESIGN DATA

LIVE LOAD: DESIGN LOADING: HS-20

INVENTORY RATING: HS-23

OPERATING RATING: HS-39

WISCONSIN STANDARD PERMIT VEHICLE (WIS-SPV) = 250 KIPS

MATERIAL PROPERTIES:

CONCRETE MASONRY OVERLAY DECKSf'c = 4,000 P.S.I.

TRAFFIC DATA

STH 69

A.D.T. = 6,200 (2016) A.D.T. = 7,900 (2036) RDS = 35 MPH

EXISTING ANGLE TO BE REMOVED. TOP OF OVERLAY -REMOVAL TO BE PAID FOR UNDER "PREPARATION DECKS TYPE 1" AND PREPARATION DECKS TYPE 2." END OF DECK REMOVE EXISTING CONCRETE. REPAIR TO BE FILLED WITH "CONCRETE MASONRY OVERLAY DECKS"

CURB REPAIR DETAIL

PROVIDE 2"

CURB REPAIR

SECTION AT END OF SLAB

GENERAL NOTES

DRAWINGS SHALL NOT BE SCALED.

BAR STEEL REINFORCEMENT SHALL BE EMBEDDED 2 INCHES CLEAR UNLESS OTHERWISE SHOWN OR NOTED.

STATE PROJECT NUMBER

1690-05-71

BY

DIMENSIONS SHOWN ARE BASED ON THE ORIGINAL STRUCTURE PLANS.

USE EXISTING BAR STEEL REINFORCEMENT WHERE SHOWN AND EXTEND 24 BAR DIAMETERS INTO

BEVEL ALL EXPOSED EDGES OF CONCRETE 3/4" UNLESS OTHERWISE NOTED.

A MINIMUM OF 1" OF CONCRETE SHALL BE REMOVED FROM THE ENTIRE BRIDGE DECK UNDER THE BID ITEM "CLEANING DECKS". ORIGINAL PLANS INDICATE A $2\frac{1}{2}$ -INCH TOP OF CONCRETE COVER.

THE EXISTING STRUCTURE, B-13-337, IS A 3-SPAN CONCRETE HAUNCHED SLAB BRIDGE WITH AN OVERALL WIDTH OF 56'-O" AND AN OVERALL LENGTH OF 143'-10". THE ENTIRE DECK SURFACE IS TO BE PREPARED FOR A NEW CONCRETE OVERLAY.

ANY EXCAVATION REQUIRED TO COMPLETE THE OVERLAY OR THE PAVING BLOCK AT ABUTMENTS TO BE CONSIDERED INCIDENTAL TO THE BID ITEM "CONCRETE MASONRY OVERLAY DECKS".

ALL CONCRETE REMOVAL NOT COVERED WITH A CONCRETE OVERLAY SHALL BE DEFINED

PROTECTIVE SURFACE TREATMENT SHALL BE APPLIED TO THE ENTIRE TOP SURFACE OF THE NEW CONCRETE OVERLAY.

CLEAN AND FILL EXISTING LONGITUDINAL AND TRANSVERSE CRACKS WITH PENETRATING EPOXY AS DIRECTED BY THE FIELD ENGINEER.

"PREPARATION DECKS TYPE I", "PREPARATION DECKS TYPE 2", AND "FULL-DEPTH DECK REPAIR" AREAS ARE BASED ON THE PLANS AND AS DETERMINED BY THE ENGINEER. DECK PREPARATION AND FULL-DEPTH DECK REPAIRS SHALL BE FILLED WITH "CONCRETE MASONRY OVERLAY DECKS."


PROFILE GRADE LINE SHALL BE DETERMINED IN THE FIELD BASED ON A MINIMUM OVERLAY THICKNESS OF 1½" PLACED ABOVE THE DECK SURFACE AFTER SURFACE PREPARATION. EXPECTED AVERAGE OVERLAY THICKNESS IS 2½". IF EXPECTED AVERAGE OVERLAY THICKNESS IS EXCEEDED BY MORE THAN ½", CONTACT THE STRUCTURES DESIGN SECTION.

"CONCRETE SURFACE REPAIR" AND "CURB REPAIR" AS DIRECTED BY THE FIELD ENGINEER-QUANTITIES SHOWN ON THE PLANS ARE APPROXIMATE.

AT "CURB REPAIR" EXPOSE EXISTING REINFORCEMENT A MINIMUM OF 11/2" CLEAR.

NOT MORE THAN 1/3 OF THE TOP BAR STEEL SHALL BE EXPOSED IN THE NEGATIVE MOMENT

AREA IF THE BAR ENDS ARE NOT ANCHORED. IF MORE THAN 1/3 OF THE STEEL IS EXPOSED, EITHER THE CENTERS OF ADJACENT SPANS MUST BE SHORED OR ONLY LONGITUDINALLY OVERLAY 1/3 OF THE BRIDGE AT A TIME.

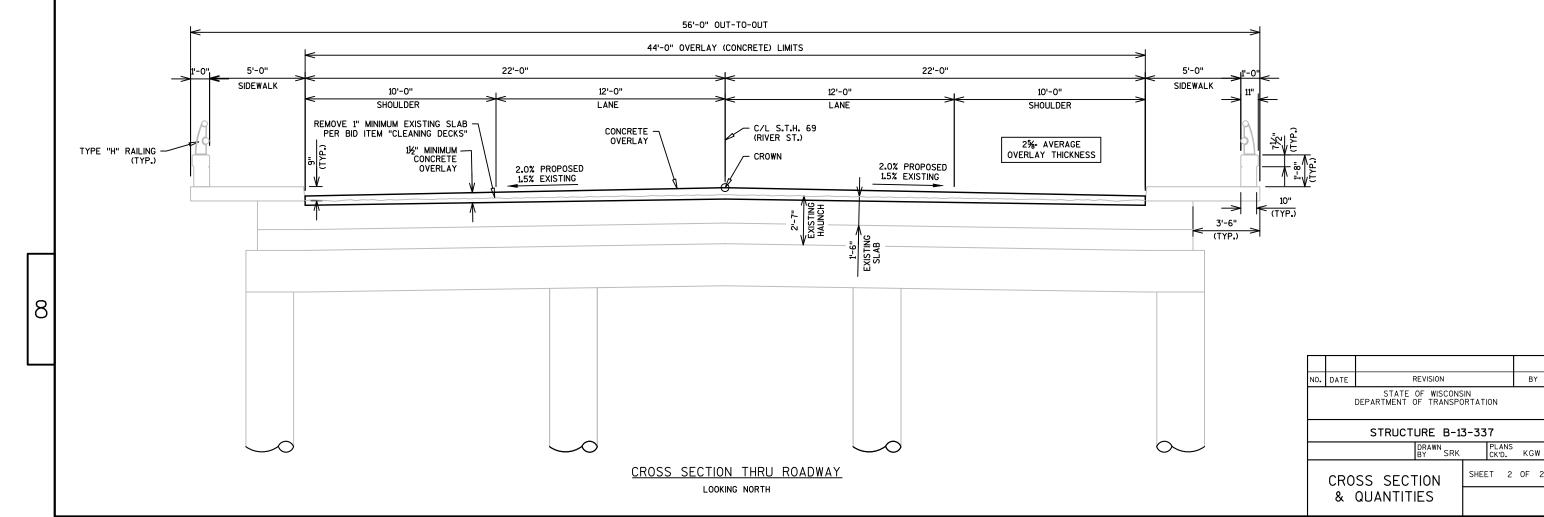

9

		AREA (SF)			Incremental Vo	l (CY) (Unadjusted)		Cumulative V	ol (CY)	
STATION	Distance	Cut	Salvaged/Unusable Pavement Material	Fill	Cut Note 1	Salvaged/Unusable Pavement Material Note 2	Fill Note 3	Cut 1.00 Note 1	Expanded Fill 1.11	Mass Ordinate
10+19		389	107	0	0	0	0	0	0	0
10+50	31	210	31	0	343	79	0	343	0	264
11+00	50	123	25	6	308	51	6	652	6	515
11+50	50	118	33	0	224	53	6	875	13	679
12+00	50	130	40	0	229	68	0	1105	13	841
12+50	50	123	32	0	234	67	0	1339	13	1008
13+00	50	122	38	0	226	65	0	1565	13	1170
13+50	50	118	23	0	222	57	0	1787	13	1335
13+66	16	123	23	18	71	14	5	1859	19	1387
					STRUCTURE B	3-13-337				
15+09		114	23	25	0	0	0	1859	19	1387
15+50	41	124	23	1	181	35	20	2039	41	1510
15+80	30	161	30	1	158	29	1	2198	42	1638
16+00	20	164	27	0	121	21	0	2318	42	1737
16+26	26	99	29	0	126	27	0	2445	42	1836
16+50	24	158	20	0	114	22	0	2559	42	1928
16+79	29	214	23	0	200	23	0	2758	42	2105
17+00	21	208	20	1	164	17	0	2923	43	2252
17+14	14	180	24	1	101	11	0	3023	43	2341
17+32	18	153	20	1	111	15	1	3135	44	2437
17+50	18	111	23	2	88	14	1	3223	45	2509
17+75	25	116	21	1	105	21	1	3328	46	2593
17+87	12	150	25	0	59	10	0	3387	46	2641
18+00	13	210	46	0	87	17	0	3474	47	2711
18+50	50	101	20	0	288	60	1	3762	47	2938
19+00	50	113	20	0	198	37	0	3960	47	3099
19+50	50	111	26	1	207	42	1	4167	49	3262
19+60	10	110	26	2	41	10	1	4208	49	3293
20+00	40	111	20	1	164	34	2	4371	51	3421
20+50	50	103	20	1	198	37	1	4569	53	3581
20+75	25	97	23	0	93	20	0	4662	53	3653
21+00	25	96	23	2	90	22	1	4751	55	3720
21+50	50	111	20	1	192	40	3	4943	58	3868
22+00	50	101	20	0	196	37	1	5139	59	4026
22+50	50	96	20	1	182	37	1	5322	60	4171
22+66	16	93	23	1	56	13	0	5377	61	4213
23+00	34	101	20	1	122	27	1	5499	62	4307
23+50	50	109	23	6	195	40	6	5694	69	4455
24+00	50	117	23	4	209	43	9	5903	79	4610
24+21	21	142	29	1	101	20	2	6004	81	4688
24+50	29	171	23	0	168	28	1	6172	82	4827
25+00	50	185	23	0	329	43	0	6501	82	5113
25+50	50	233	28	0	388	48	0	6889	82	5453
26+00	50	444	87	0	628	106	0	7516	83	5974
26+50	50	150	22	27	550	101	25	8067	111	6395
27+00	50	133	0	4	262	21	28	8329	142	6605
27+50	50	120	0	3	234	0	6	8563	149	6833
27+89	39	102	0	0	160	0	2	8723	151	6991
28+00	11	97	0	2	41	0	1	8763	152	7031
28+29	29	90	0	15	100	0	9	8864	162	7121
28+50	21	91	0	26	70	0	16	8934	179	7174
			-		. •	-				
			C	Column totals	8934	1581	162			

PROJECT NO: 1690-05-71 HWY: STH 69 COUNTY: DANE EARTHWORK SHEET: **E**

FILE NAME : _____ PLOT BY : ____ PLOT NAME : ____ PLOT SCALE : 1:1

ام

STH 69 CATEGORY 10- BROSS CIRCLE AND EASTBOUND PARKING LANE


		AREA (SF)			Incremental Vo	l (CY) (Unadjusted)					Cumulative V	ol (CY)	
STATION	Distance	Cut	Salvaged/Unusable Pavement Material	Fill	Cut Note 1	Salvaged/Unusable Pavement Material Note 2	Fill Note 3	Marsh Exc	Rock Exc	EBS	Cut 1.00 Note 1	Expanded Fill 1.11	Mass Ordinate
16+50	0	15	4	0	0	0	0	0	0	0	0	0	0
16+79	29	15	4	0	16	4	0	0	0	0	16	0	12
17+00	21	15	4	0	11	3	0	0	0	0	27	0	20
17+14	14	15	4	0	8	2	0	0	0	0	34	0	26
17+32	18	15	4	0	10	2	0	0	0	0	44	0	33
17+50	18	15	4	0	10	2	0	0	0	0	54	0	41
17+75	25	15	4	0	13	3	0	0	0	0	67	0	51
17+87	12	15	4	0	6	2	0	0	0	0	74	0	56
18+00	13	15	4	0	7	2	0	0	0	0	81	0	61
18+50	50	15	4	0	27	6	0	0	0	0	107	0	81
19+00	50	15	4	0	27	6	0	0	0	0	134	0	102
19+50	50	15	4	0	27	6	0	0	0	0	161	0	122
19+60	10	15	4	0	5	1	0	0	0	0	166	0	126
20+00	40	15	4	0	21	5	0	0	0	0	188	0	143
20+50	50	15	4	0	27	6	0	0	0	0	215	0	163
20+75	25	15	4	0	13	3	0	0	0	0	228	0	173
21+00	25	15	4	0	13	3	0	0	0	0	242	0	183
21+50	50	15	4	0	27	6	0	0	0	0	269	0	204
22+00	50	15	4	0	27	6	0	0	0	0	295	0	224
22+50	50	15	4	0	27	6	0	0	0	0	322	0	244
22+66	16	15	4	0	9	2	0	0	0	0	331	0	251
23+00	34	15	4	0	18	4	0	0	0	0	349	0	265
23+50	50	0	0	0	13	3	0	0	0	0	363	0	275
			Co	olumn totals	363	88	0	0	0	0			


9


PROJECT NO: 1690-05-71 HWY: STH 69 COUNTY: DANE EARTHWORK SHEET: **E**


FILE NAME : ______ PLOT BY : _____ PLOT NAME : _____ PLOT SCALE : 1:1


	AREA (SF)			incremental vo	l (CY) (Unadjusted)		Cumulative V	OI (CY)	
Distance	Cut	Salvaged/Unusable Pavement Material	Fill	Cut Note 1	Salvaged/Unusable Pavement Material Note 2	Fill Note 3	Cut 1.00 Note 1	Expanded Fill 1.11	Mass Ordinate
	0	26	0	i				0	0
6			4						8
			24						108
									235
									459
8	446	26	0	118	8	0	697	42	569
		C	olumn totals	697	87	38			
			olumin totais	077	67	30			
	6 25 25 25 25	Distance 0 6 132 25 166 25 203 25 350	Distance Pavement Material 0 26 6 132 26 25 166 26 25 203 26 25 350 26 8 446 26	Distance Pavement Material 0 26 0 6 132 26 4 25 166 26 24 25 203 26 14 25 350 26 1 8 446 26 0	Distance Pavement Material Note 1 0 26 0 0 6 132 26 4 15 25 166 26 24 138 25 203 26 14 171 25 350 26 1 256	Distance Pavement Material Note 1 Pavement Material Note 2 0 26 0 0 0 6 132 26 4 15 6 25 166 26 24 138 24 25 203 26 14 171 24 25 350 26 1 256 24 8 446 26 0 118 8	Distance Pavement Material Note 1 Note 2 Note 3 0 26 0 0 0 0 6 132 26 4 15 6 0 25 166 26 24 138 24 13 25 203 26 14 171 24 18 25 350 26 1 256 24 7 8 446 26 0 118 8 0	Distance Pavement Material Pavement Material Note 1 Note 2 Note 3 Note 1 0 26 0 0 0 0 0 0 6 132 26 4 15 6 0 15 25 166 26 24 138 24 13 153 25 203 26 14 171 24 18 324 25 350 26 1 256 24 7 580 8 446 26 0 118 8 0 697	Distance Pavement Material Note 1 Note 2 Note 3 Note 1 0 26 0 0 0 0 0 0 6 132 26 4 15 6 0 15 0 25 166 26 24 138 24 13 153 15 25 203 26 14 171 24 18 324 34 25 350 26 1 256 24 7 580 42 8 446 26 0 118 8 0 697 42

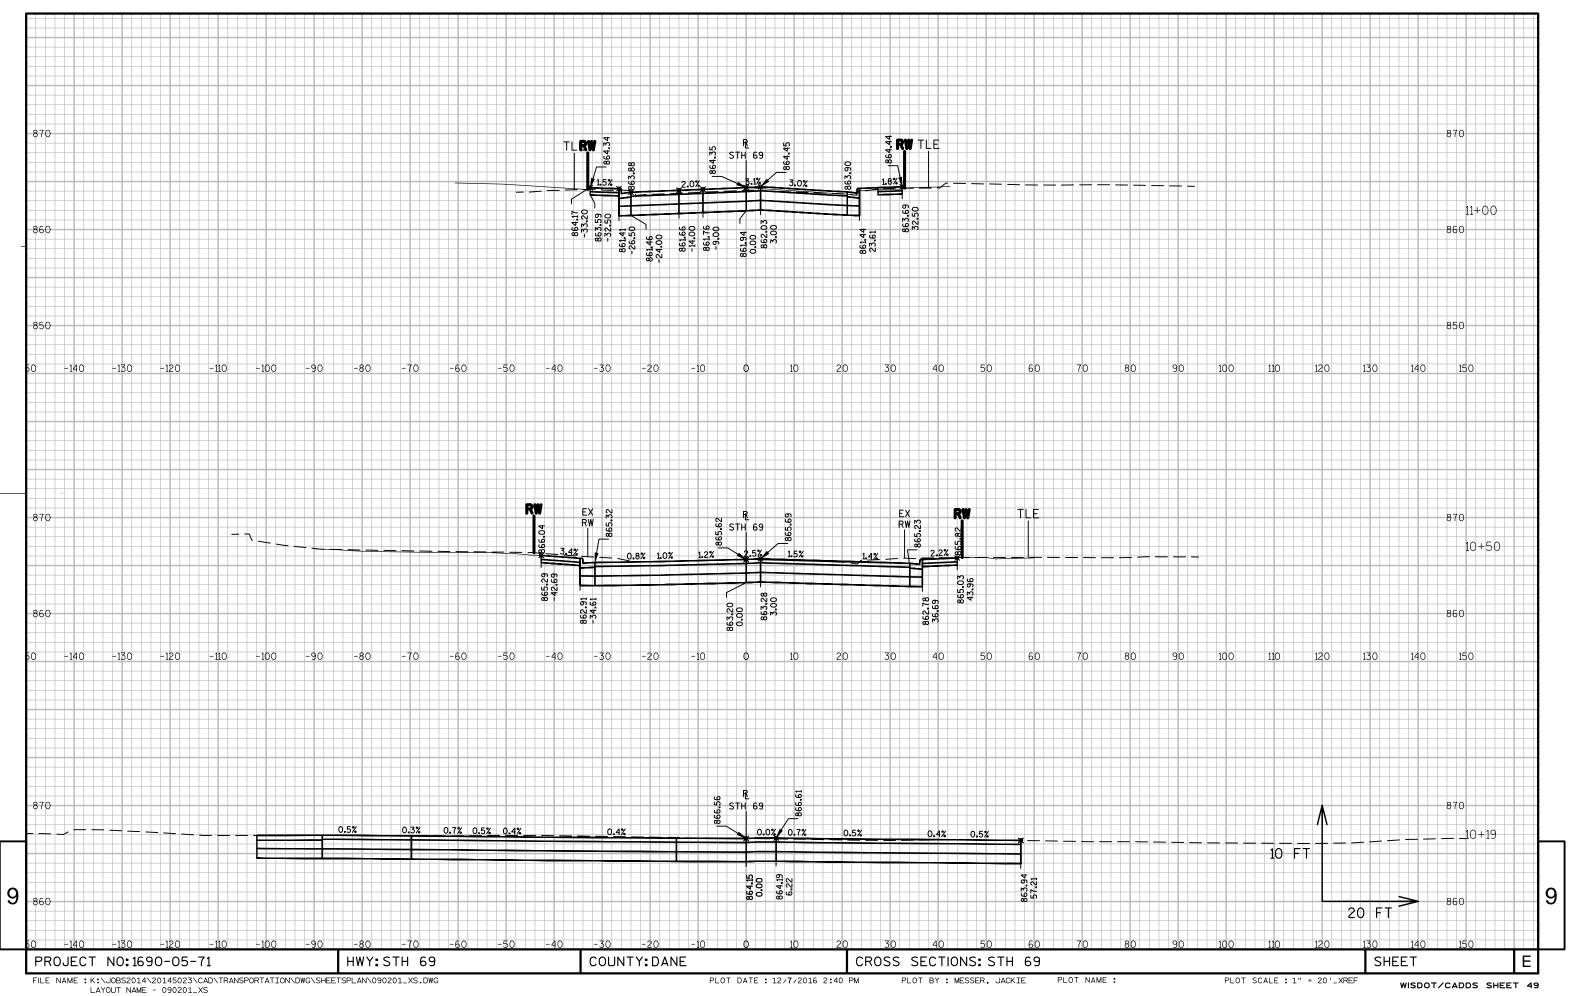


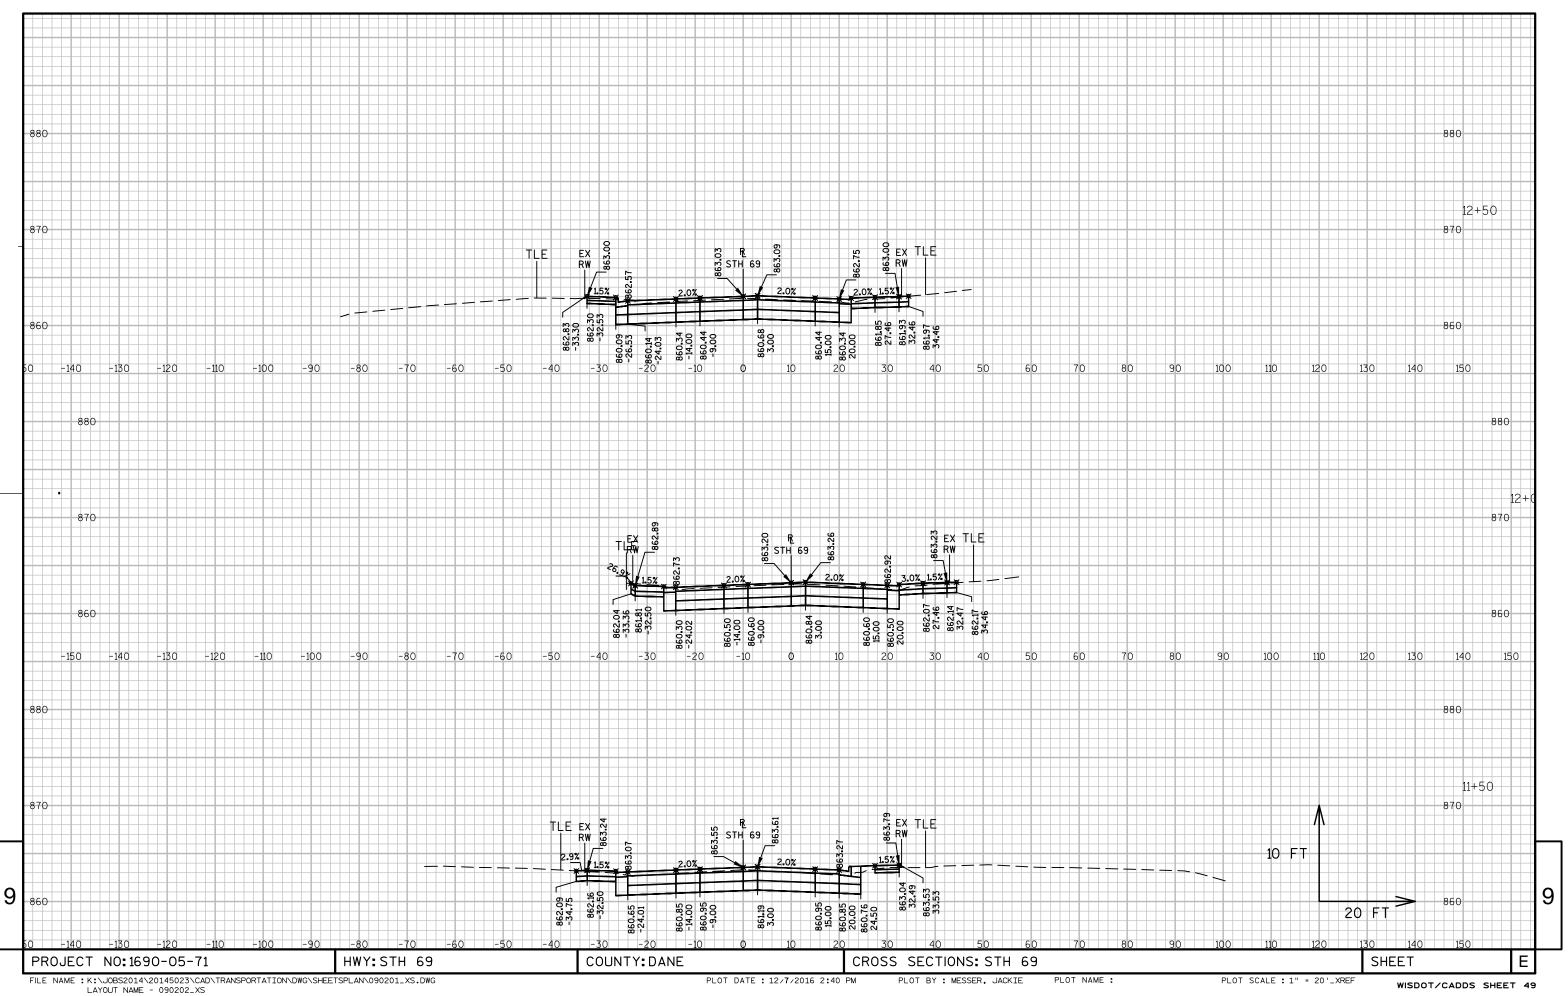


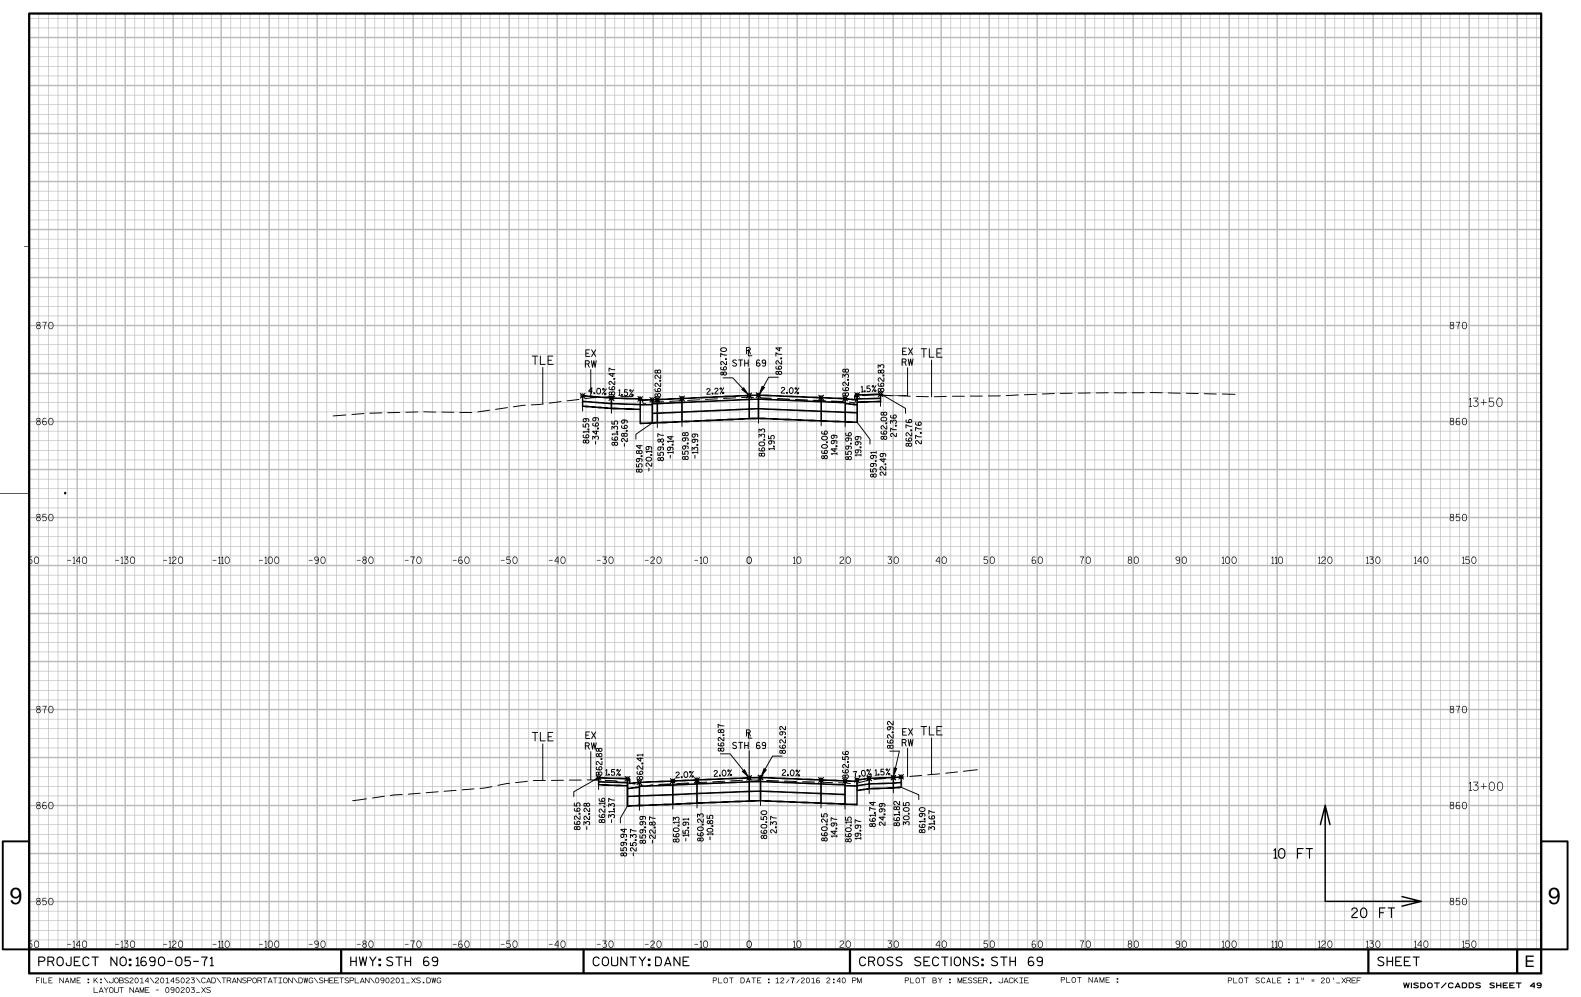


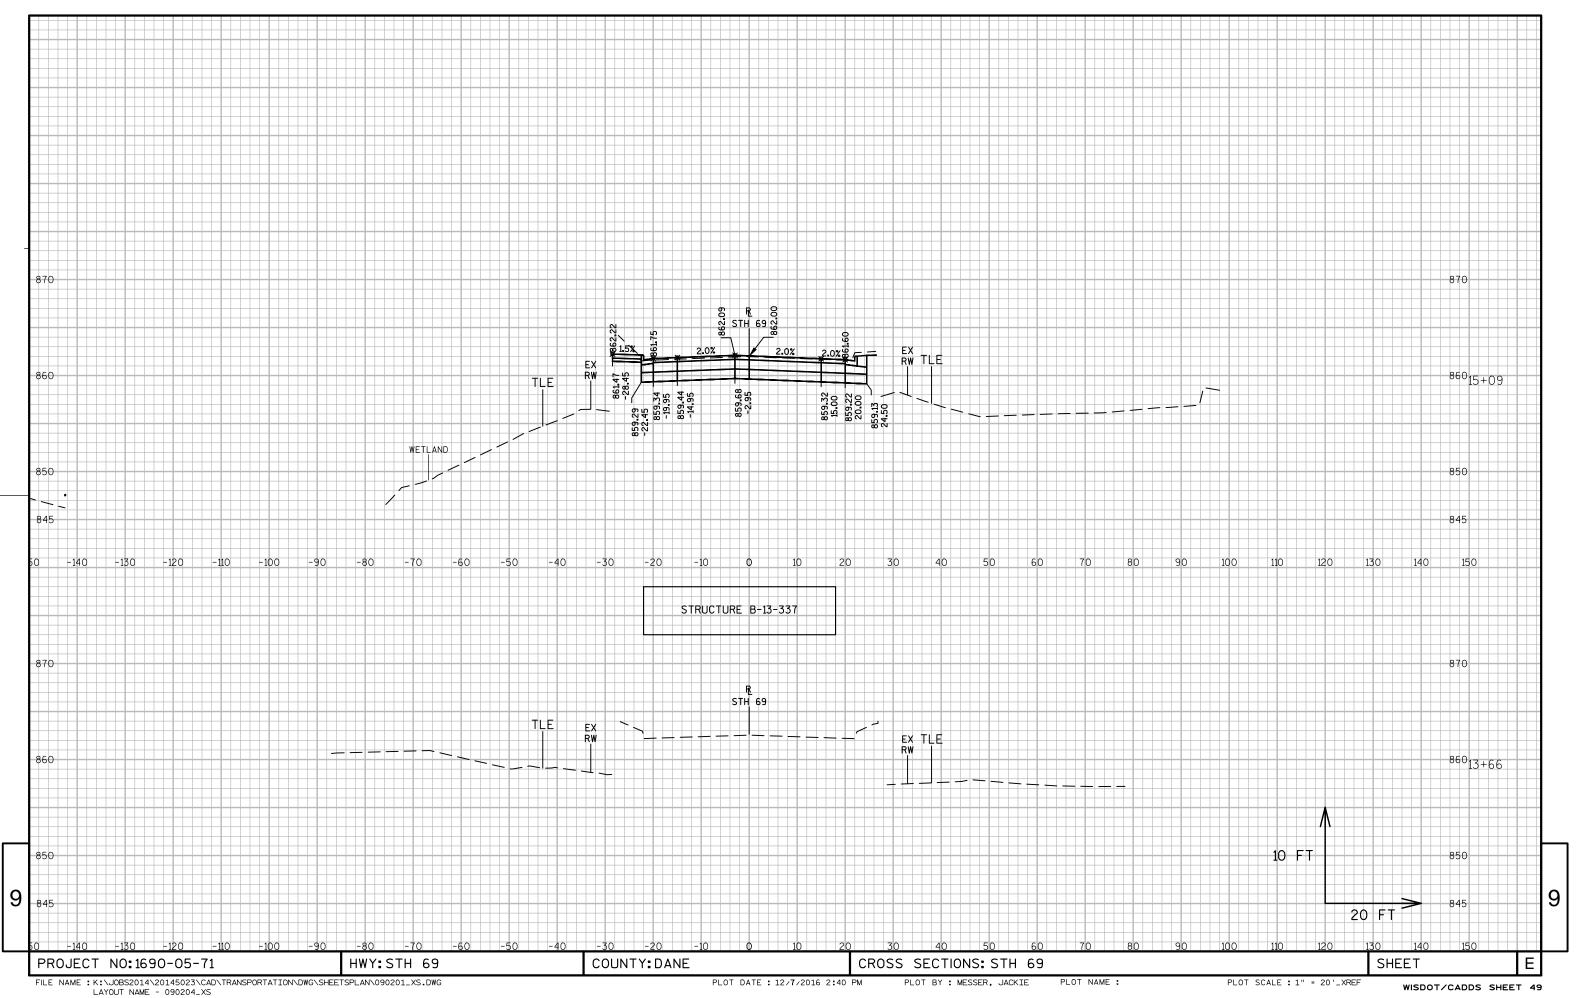


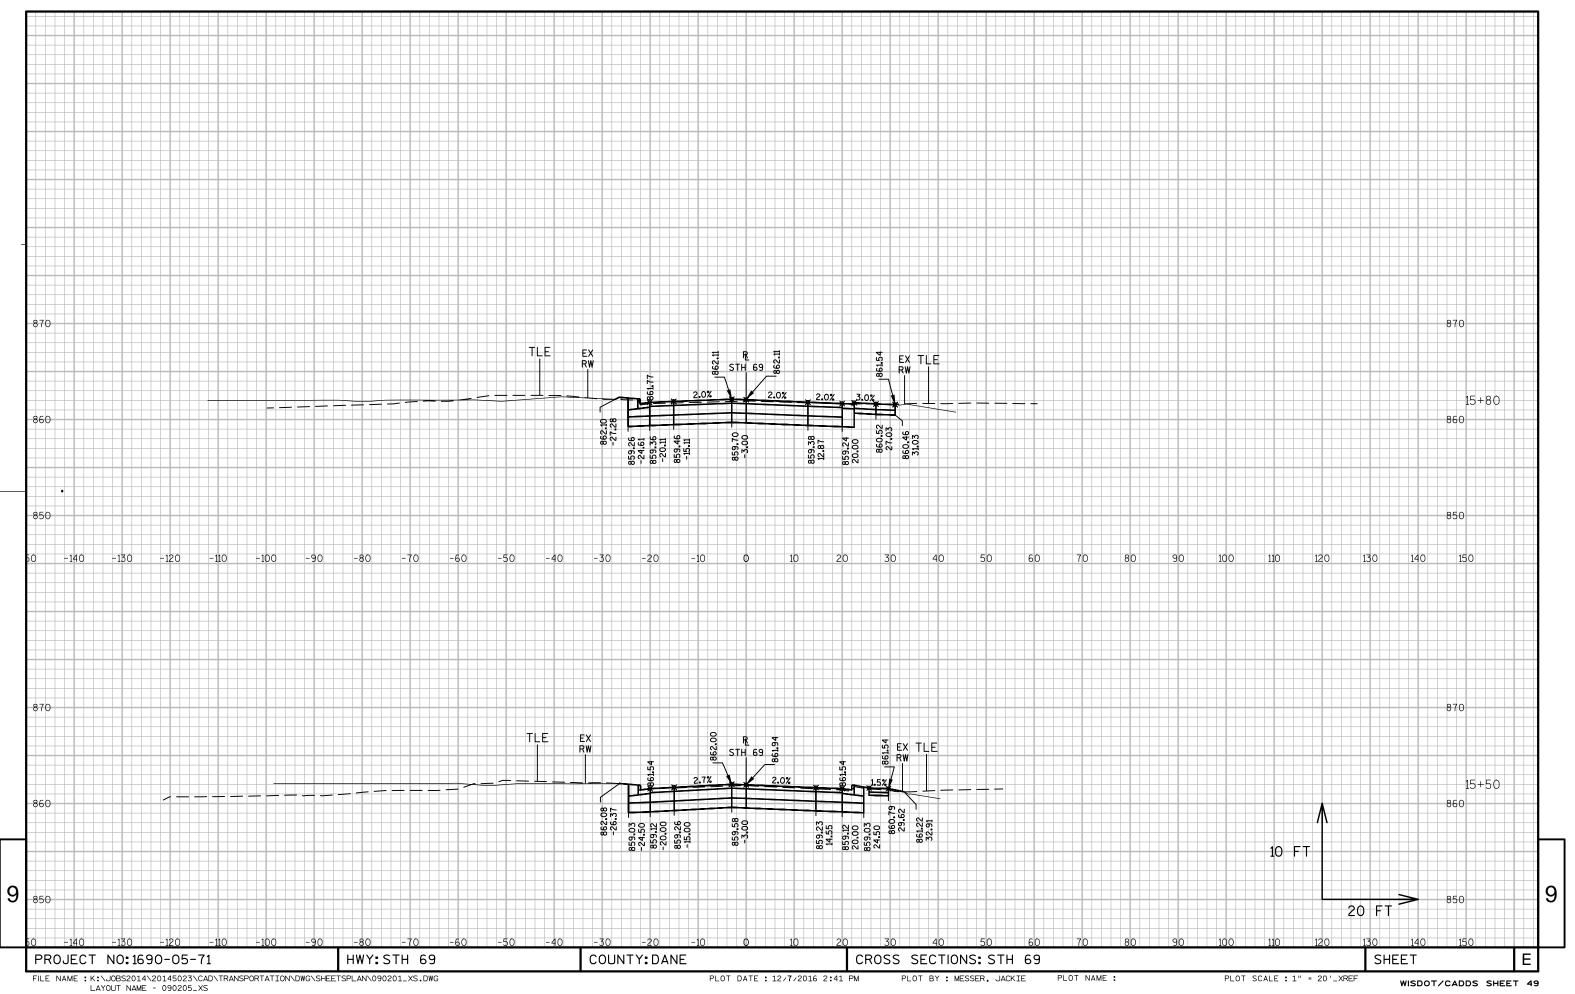


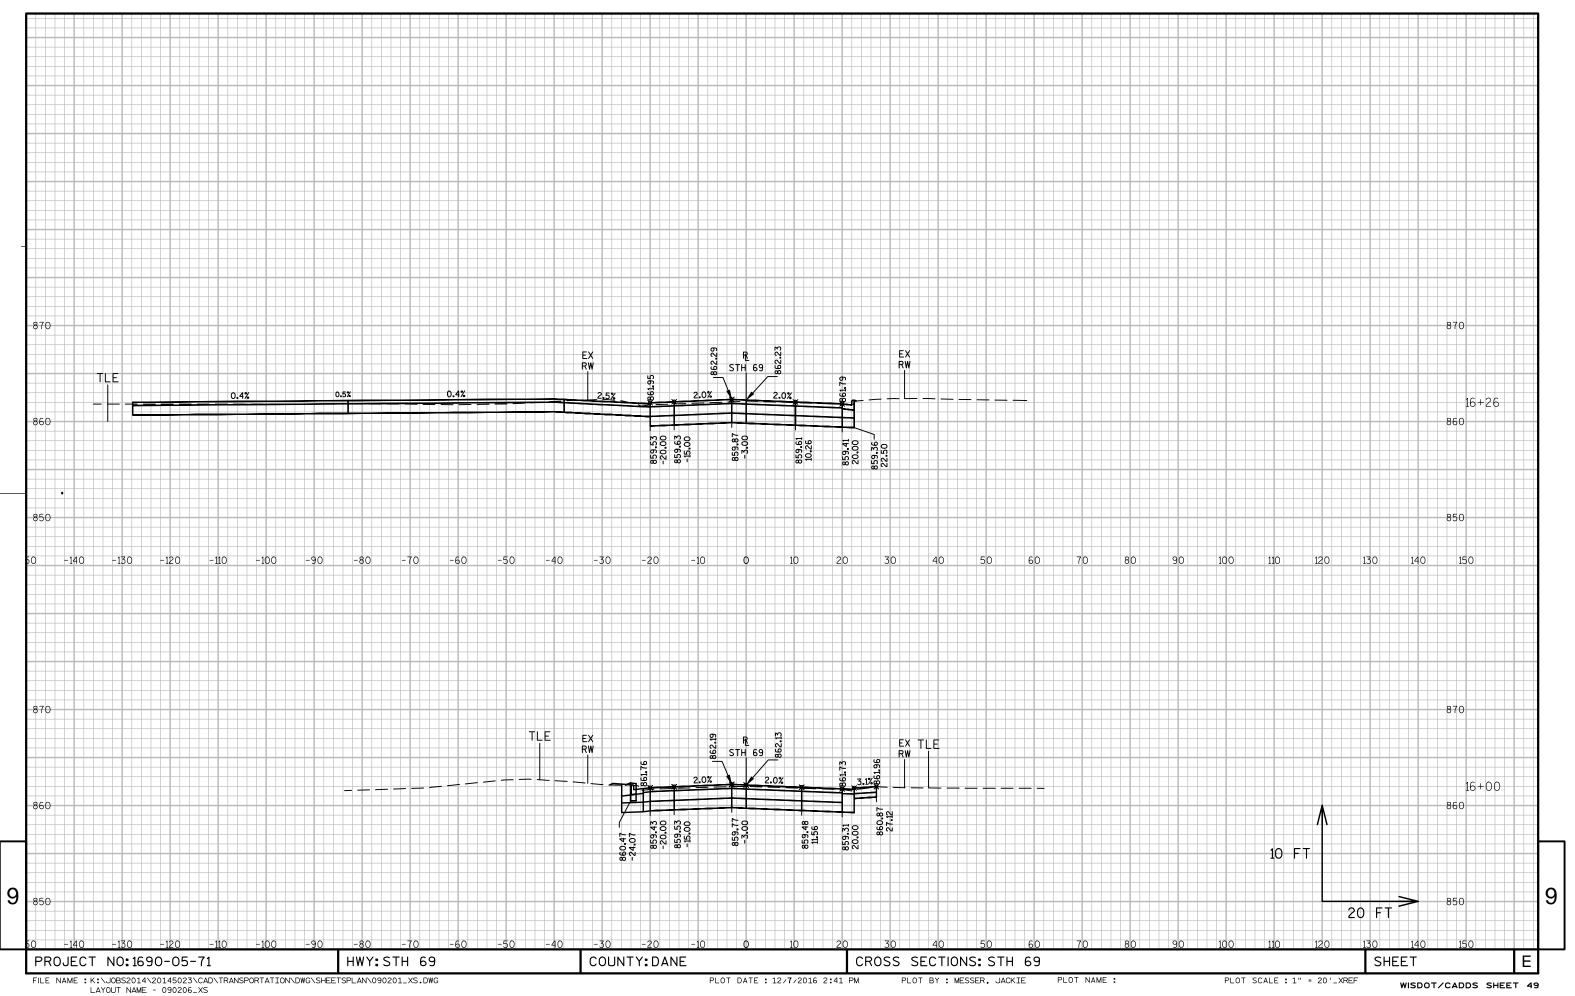


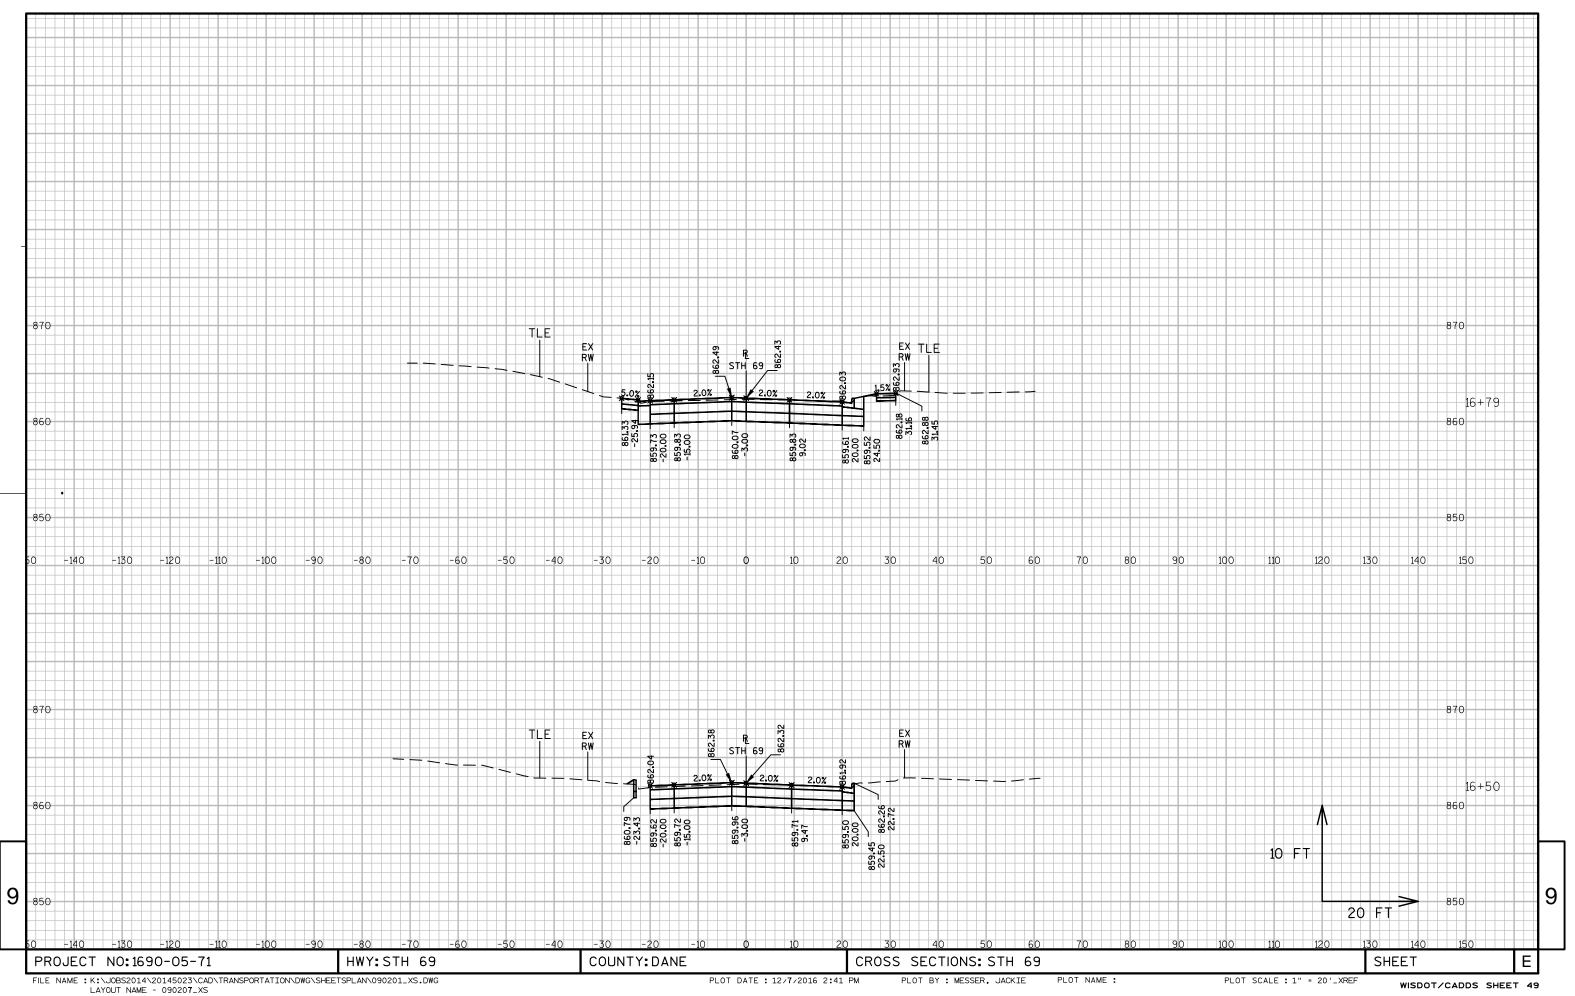


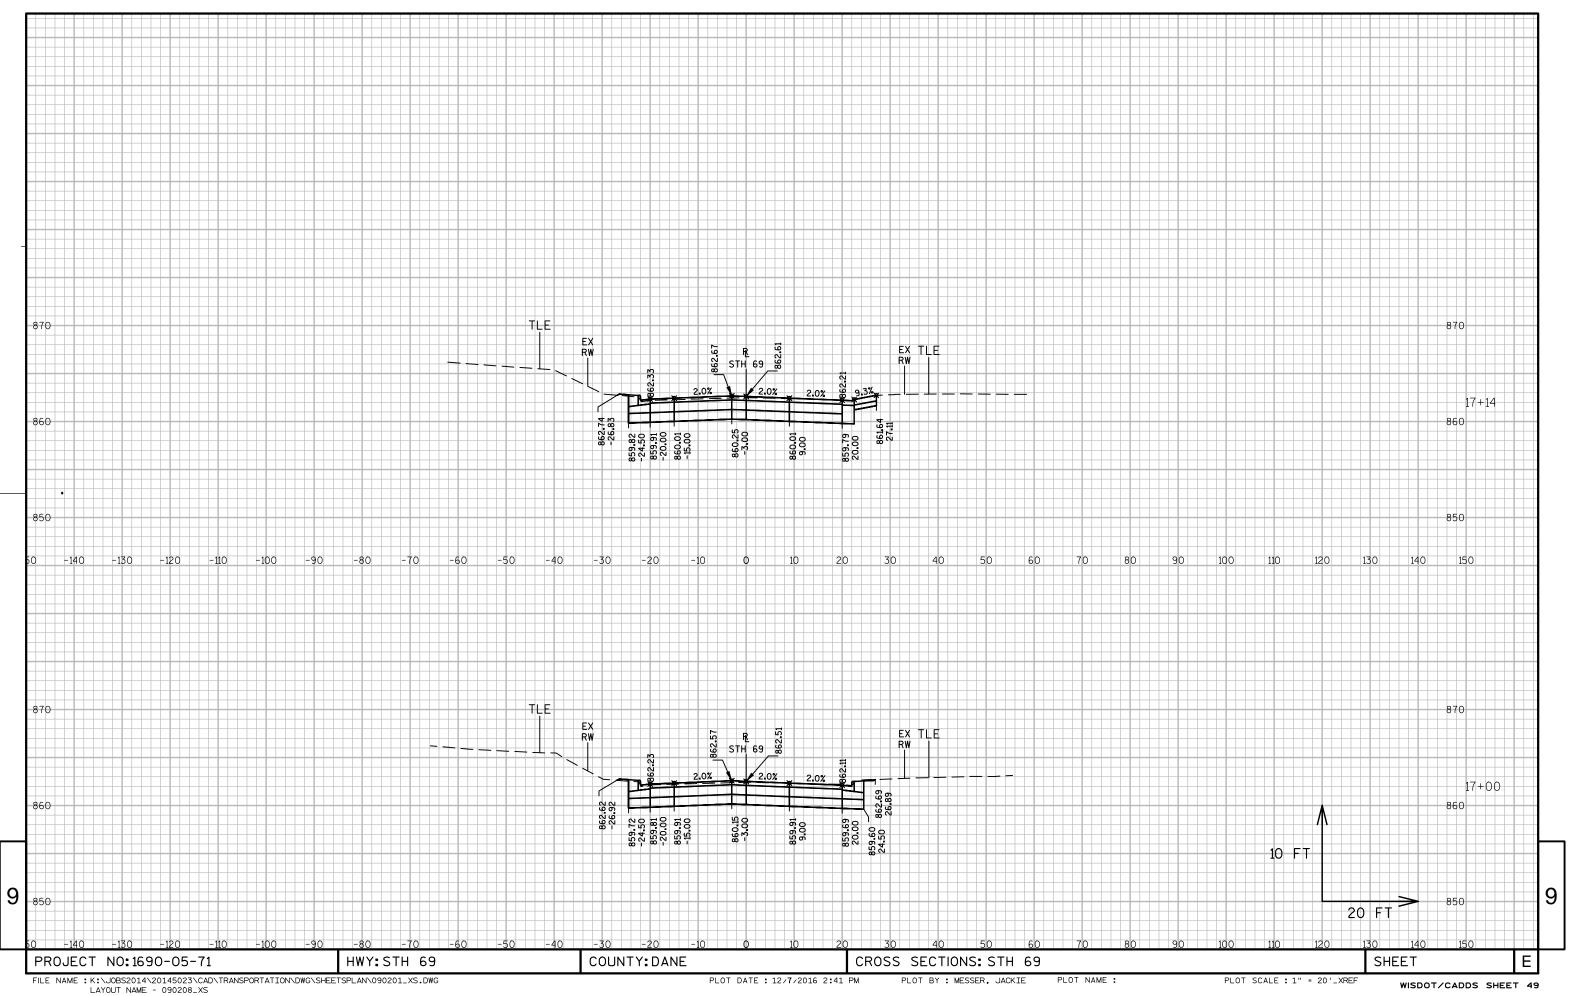


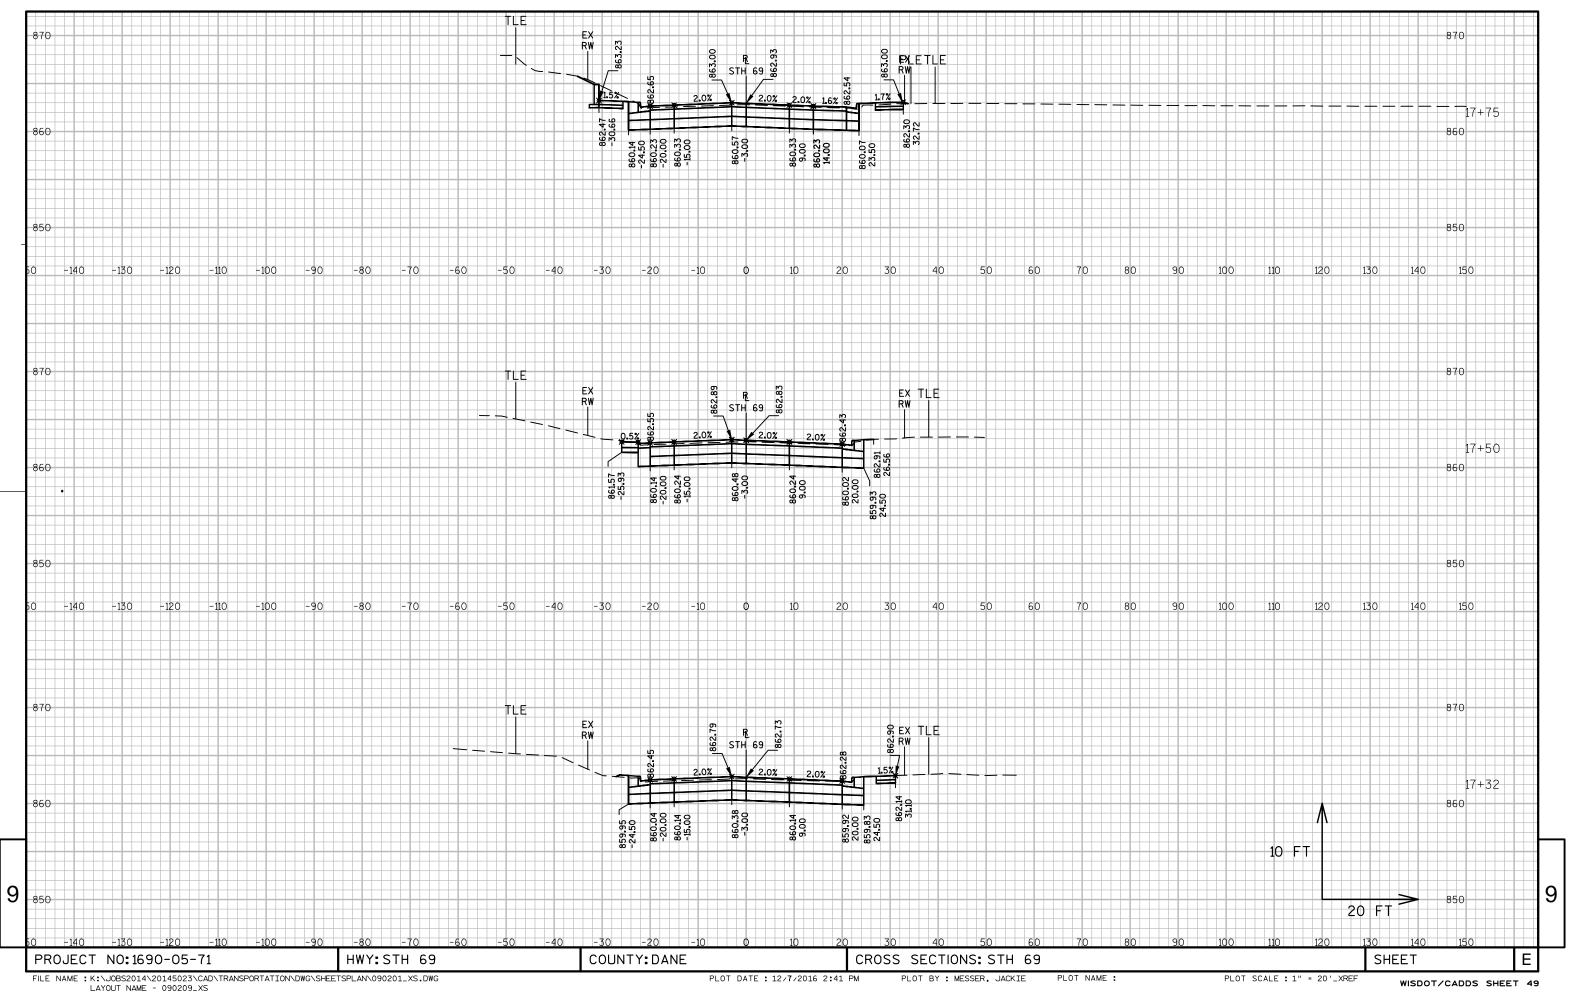


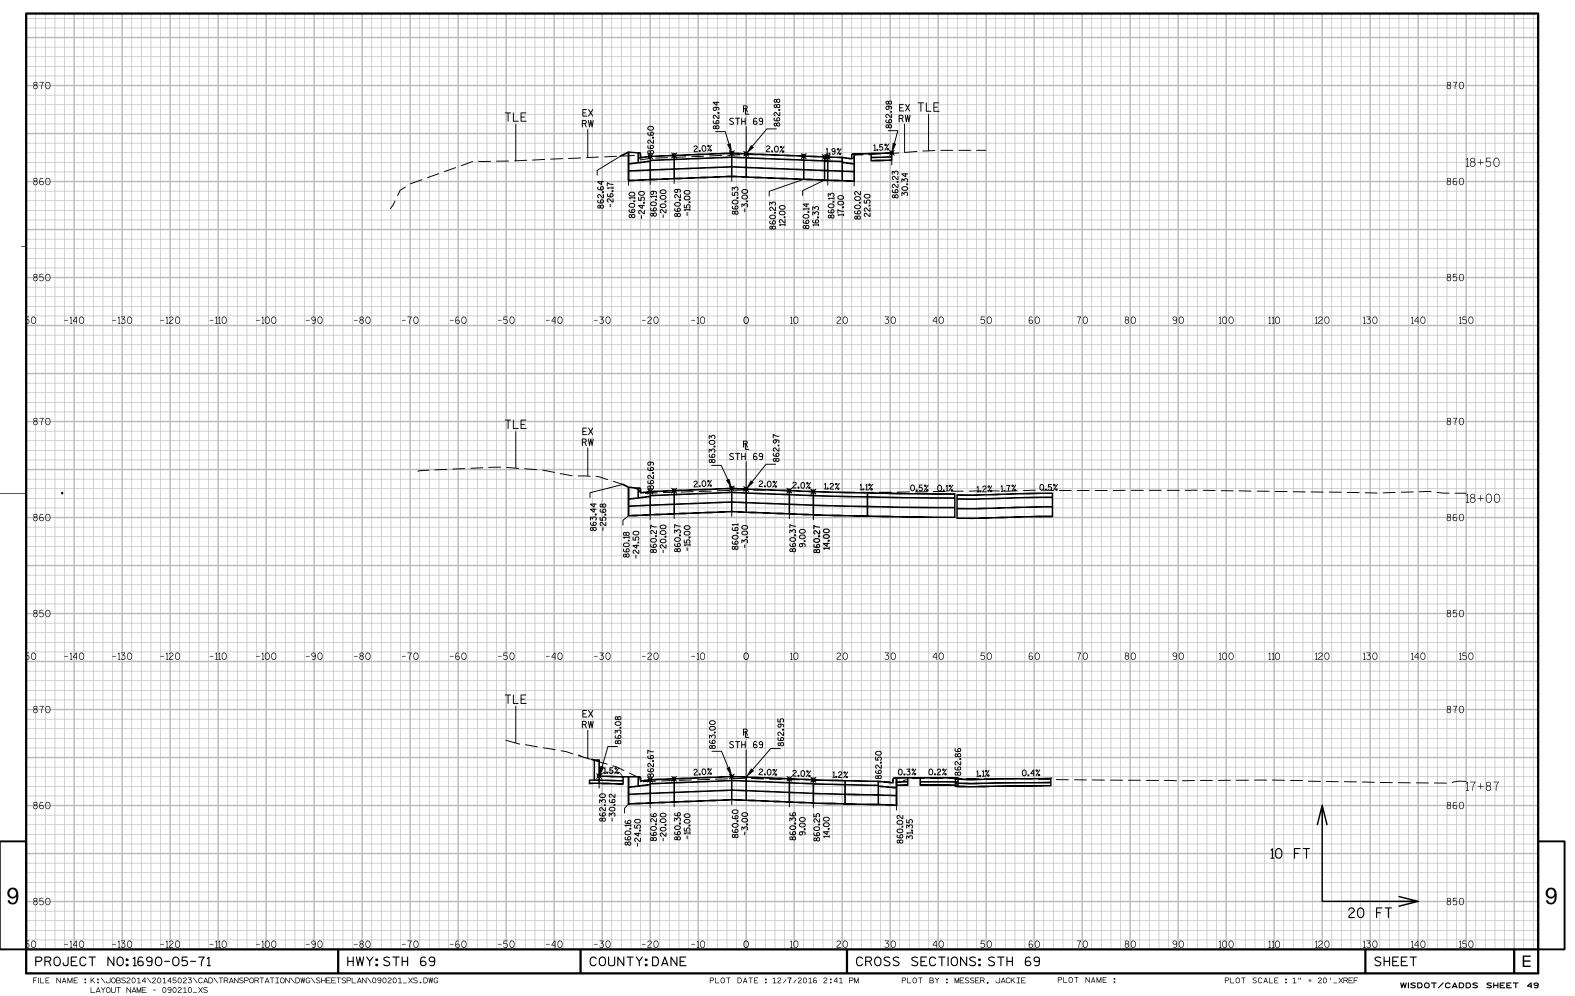


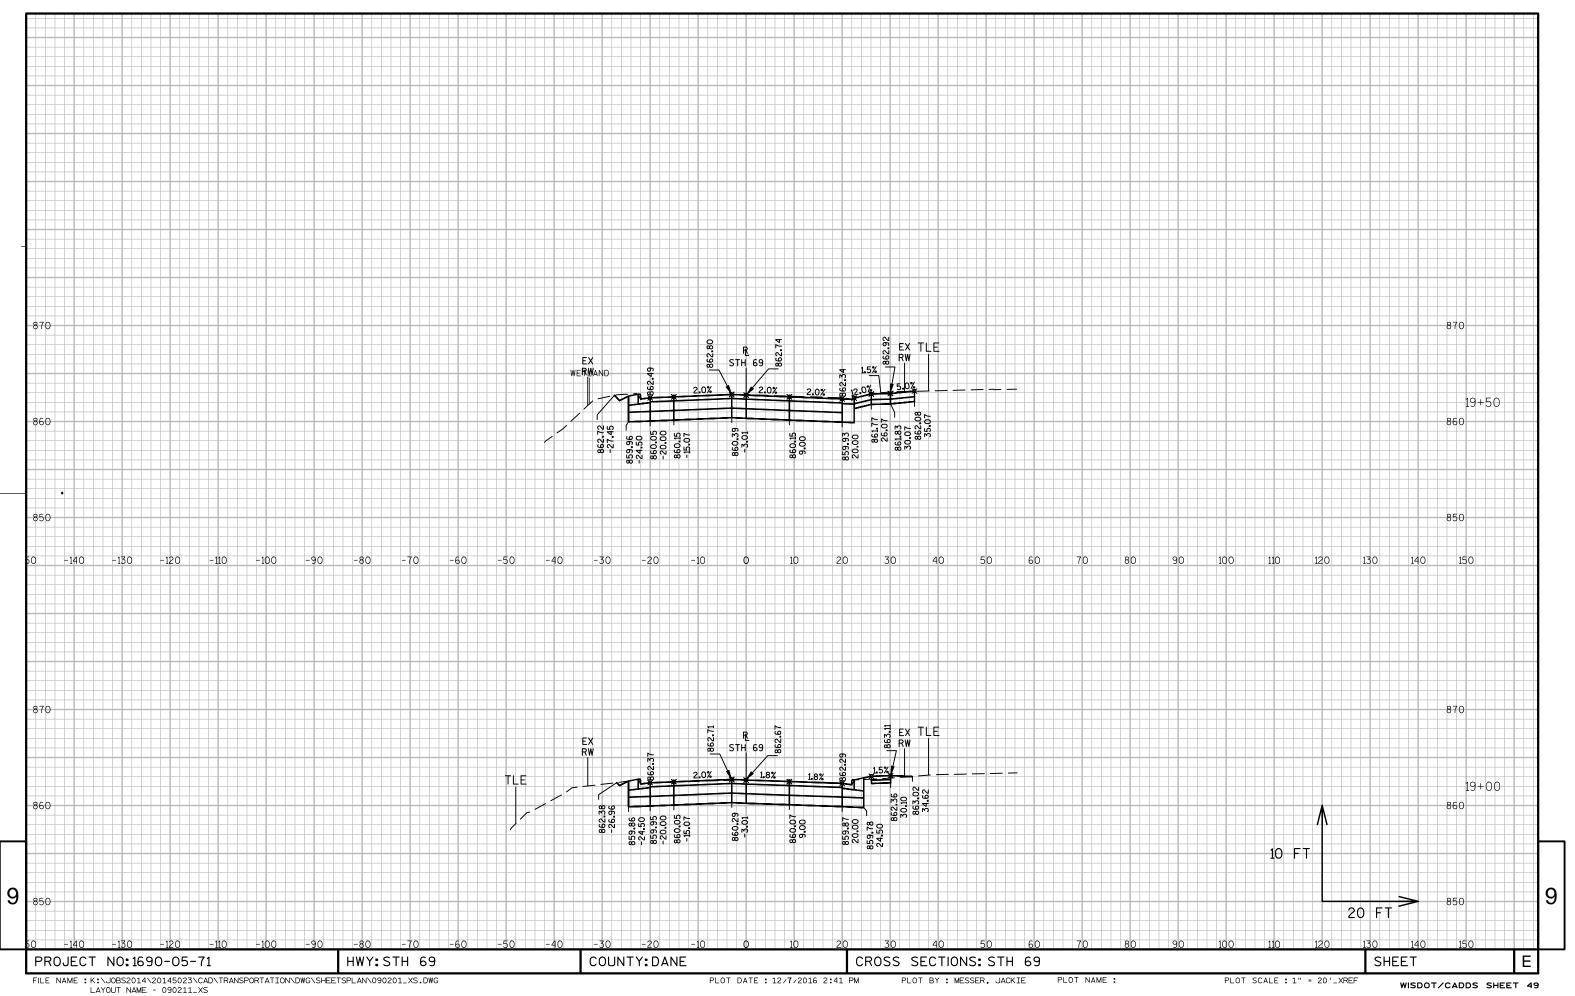


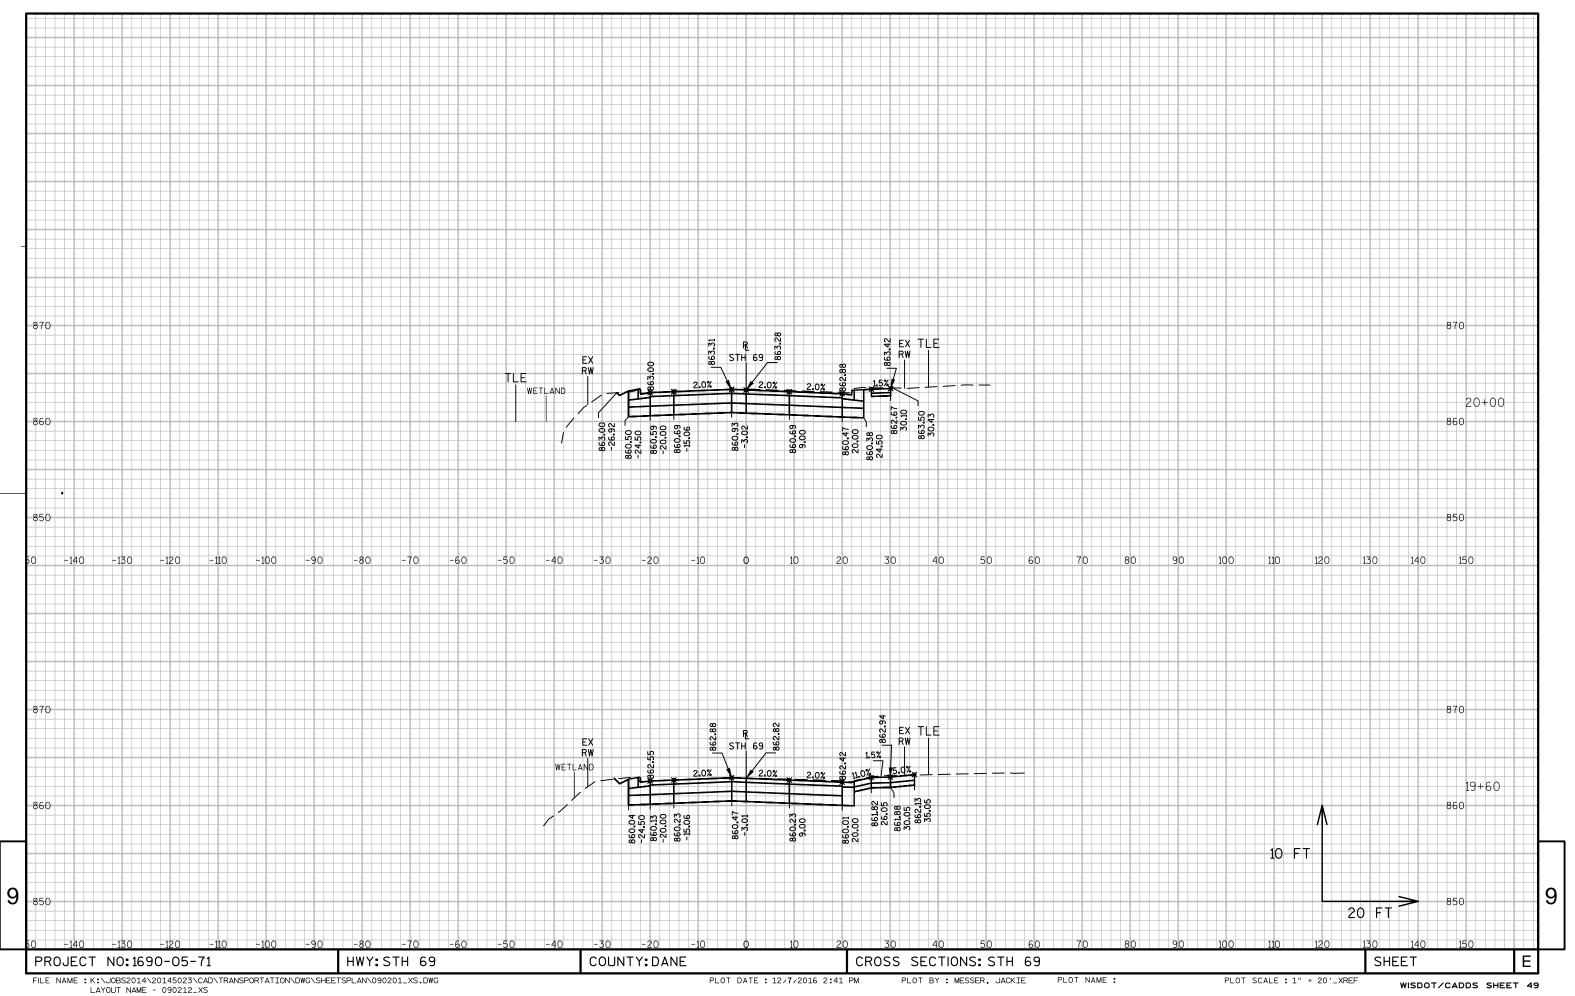


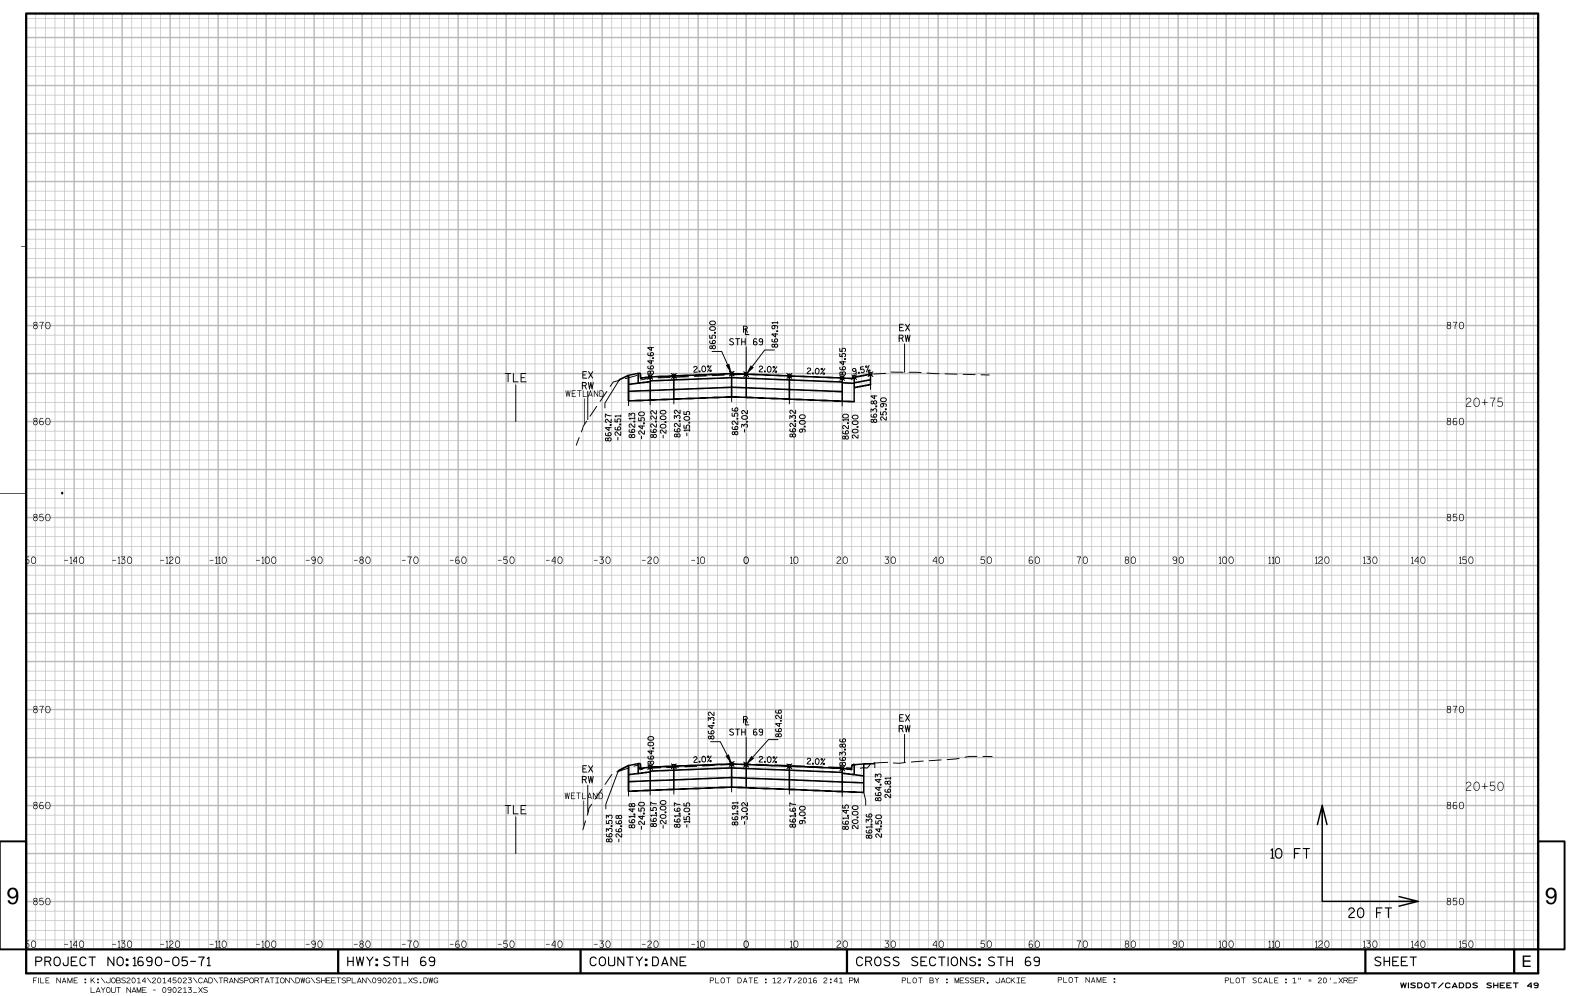


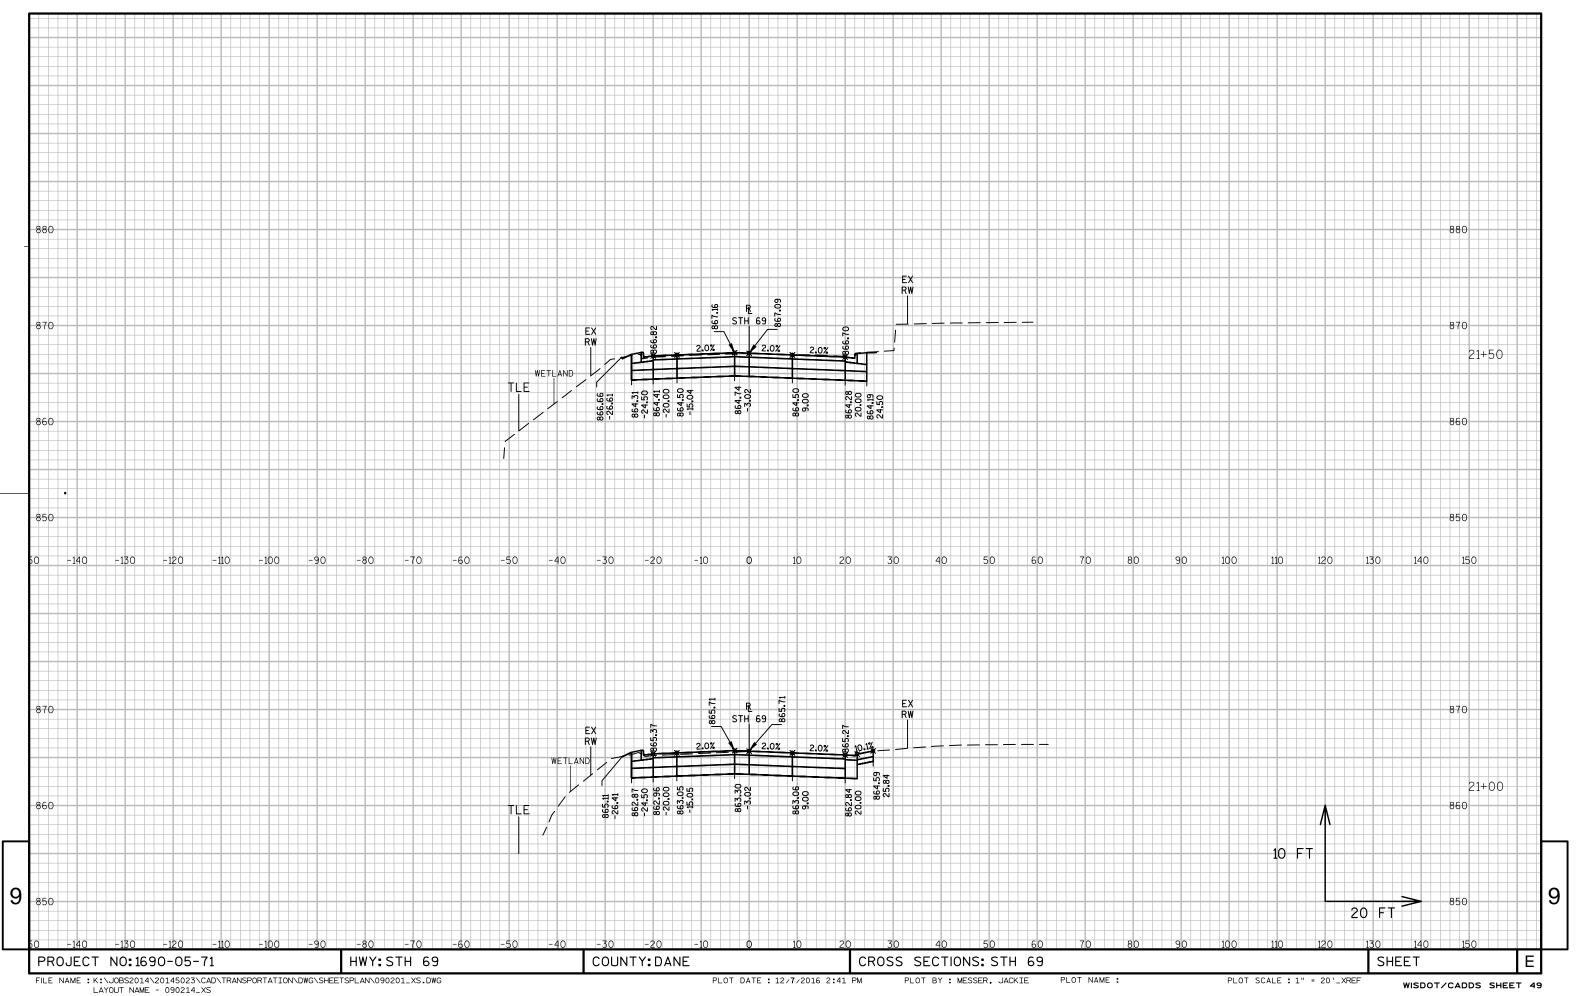


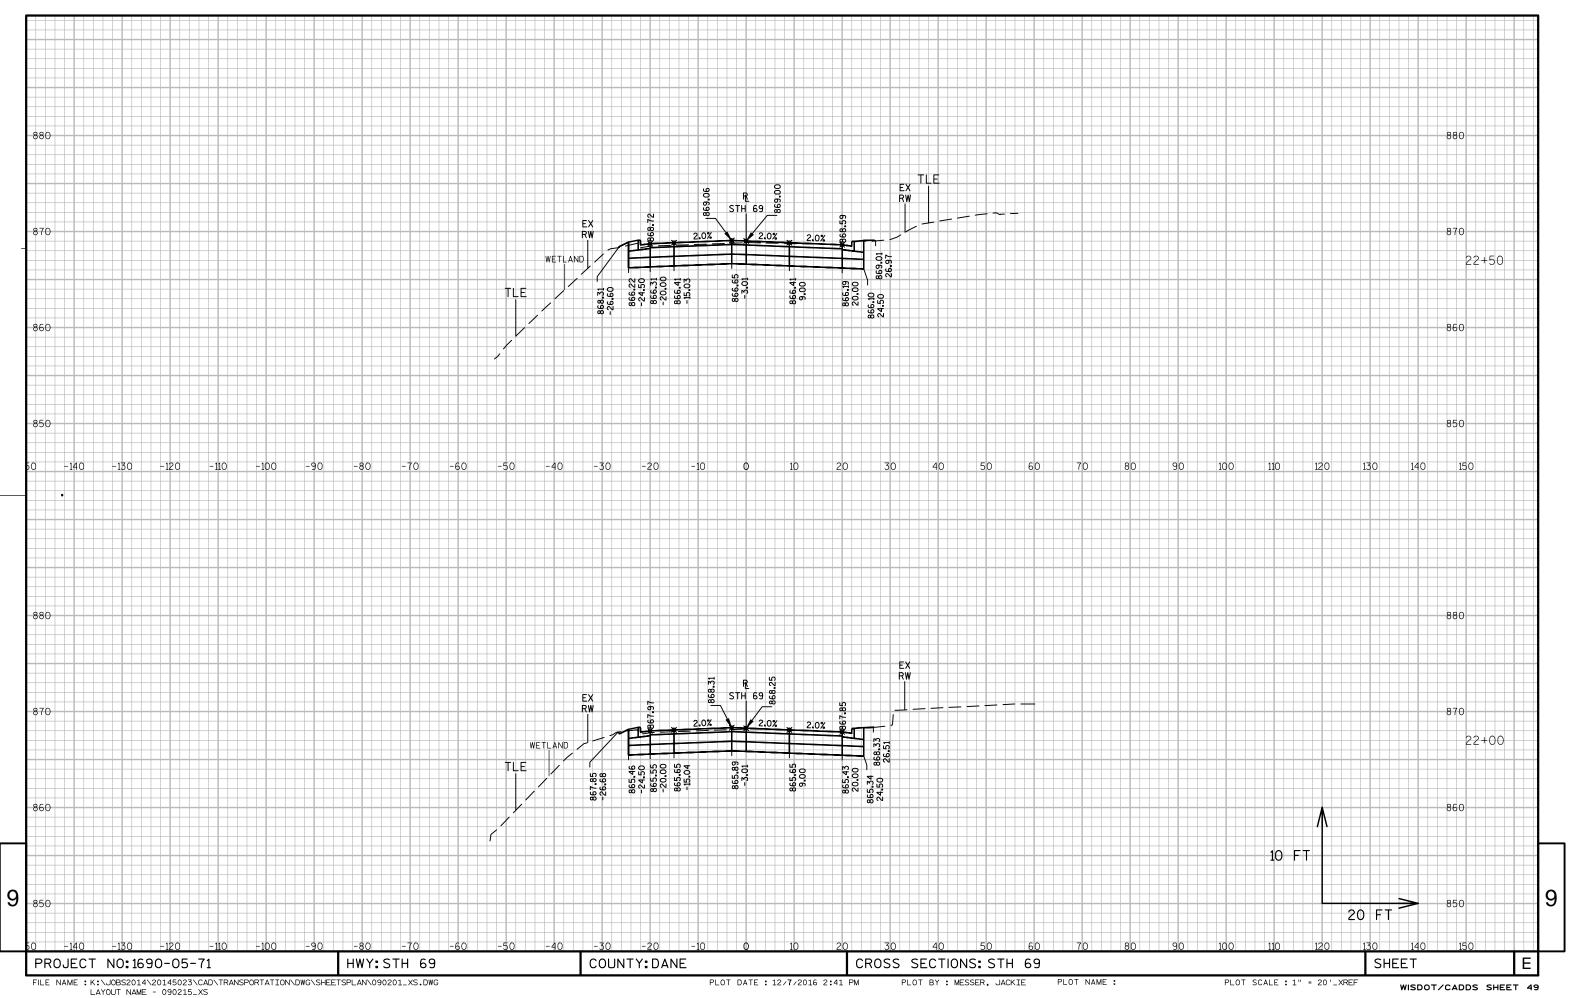


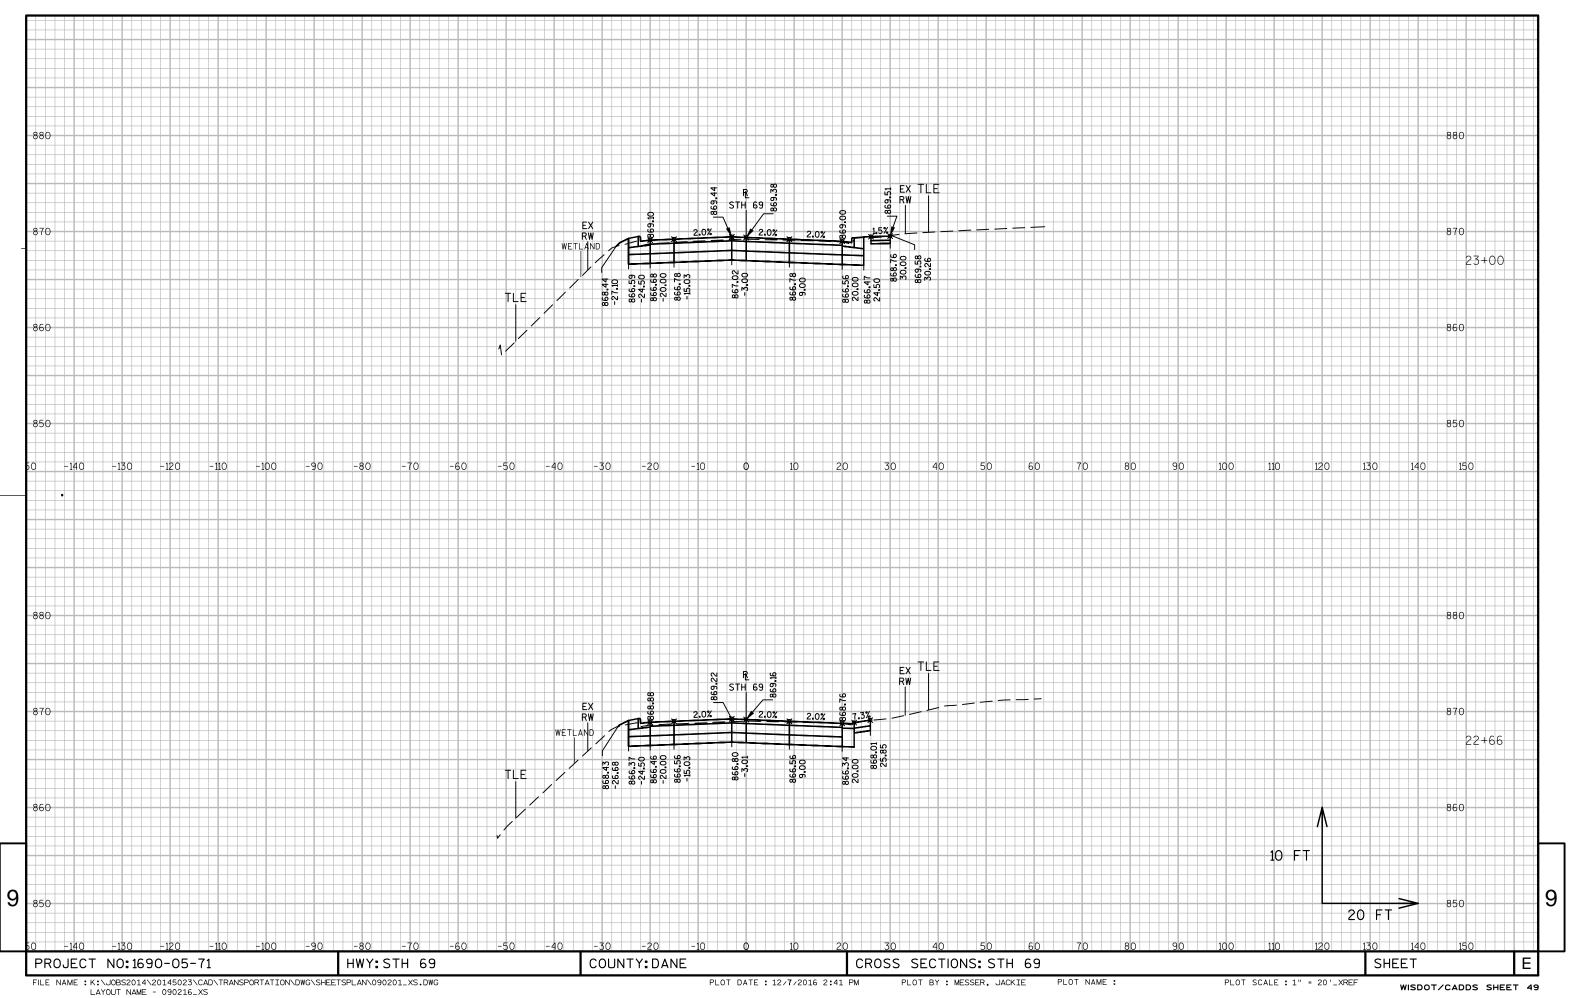


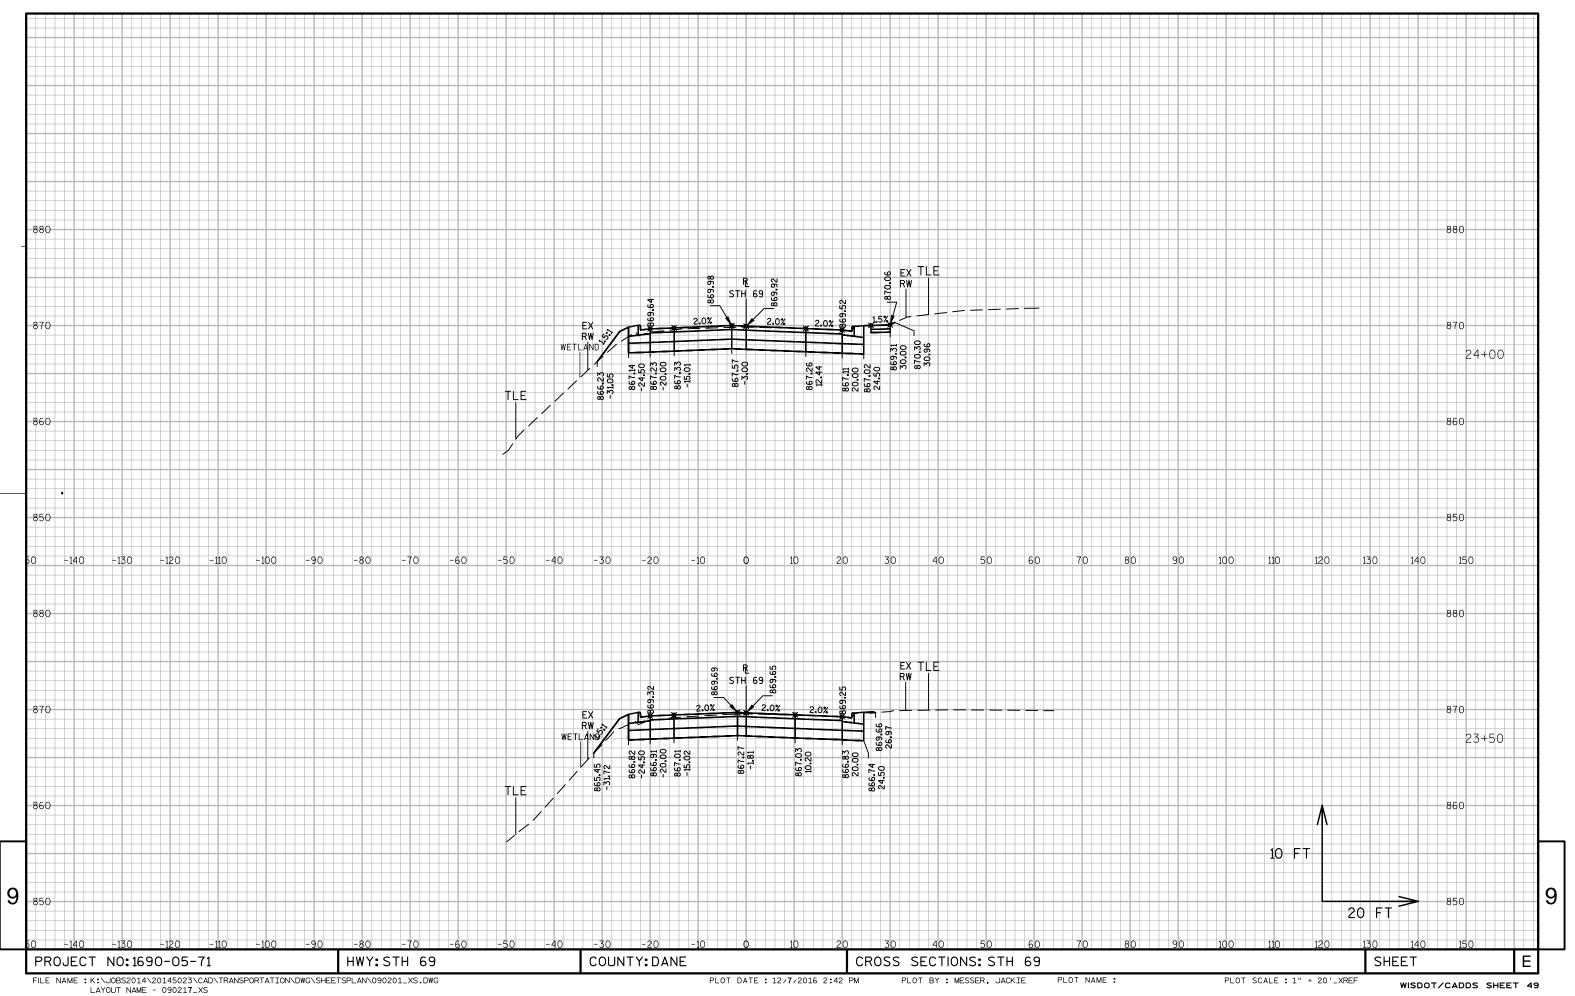


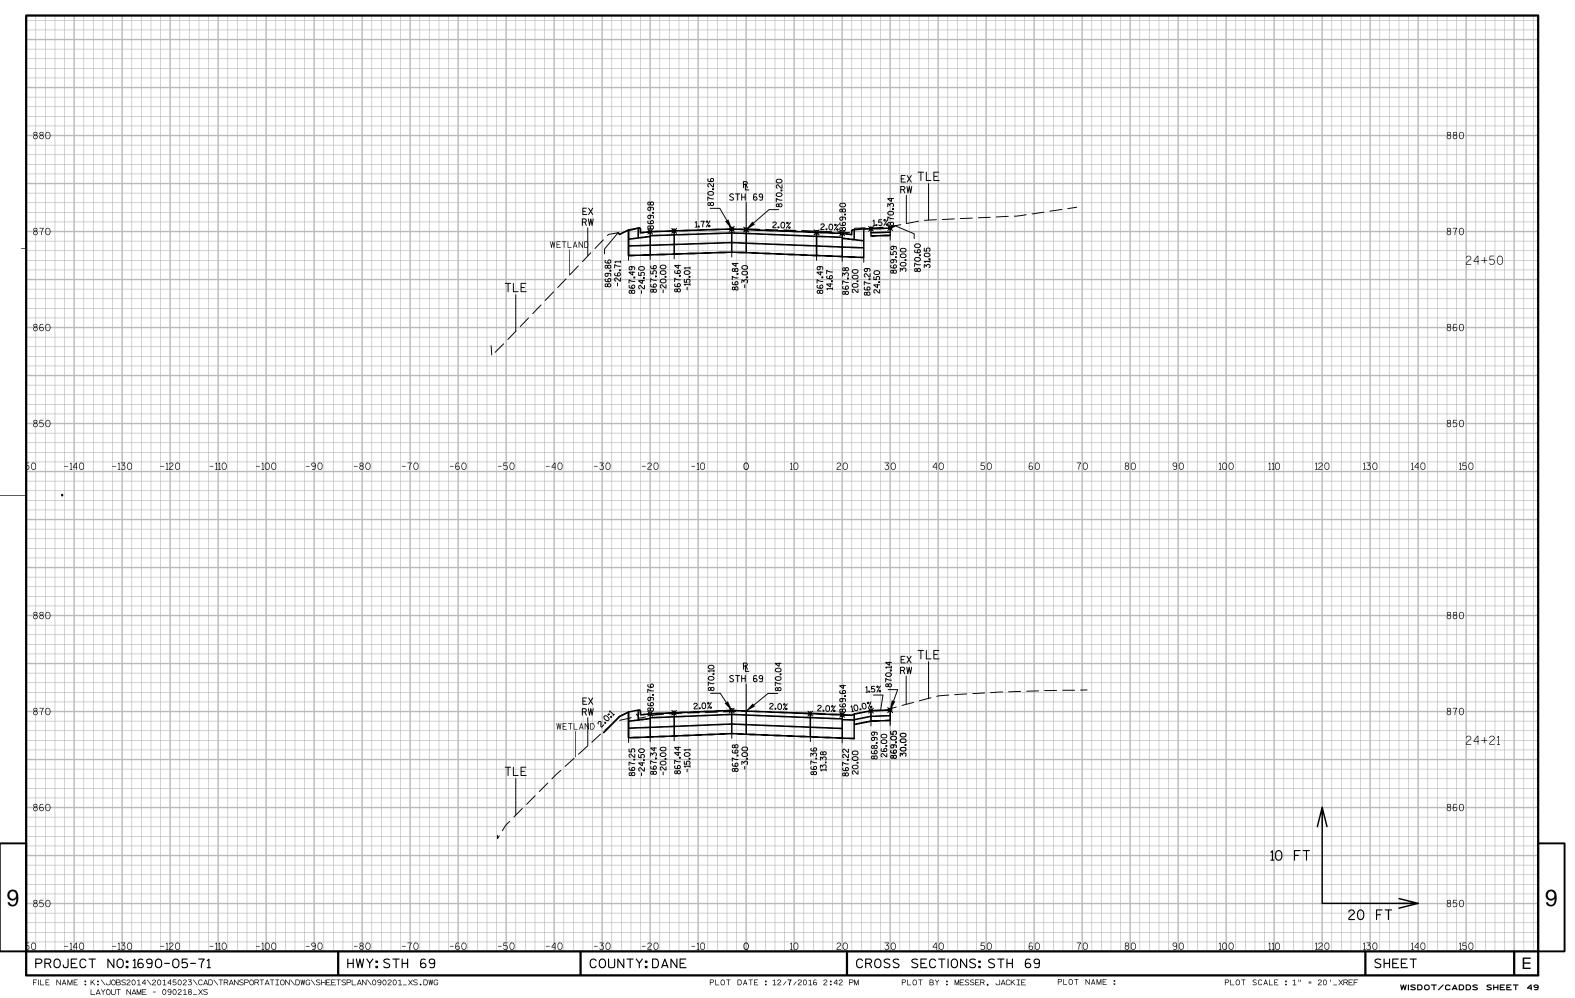


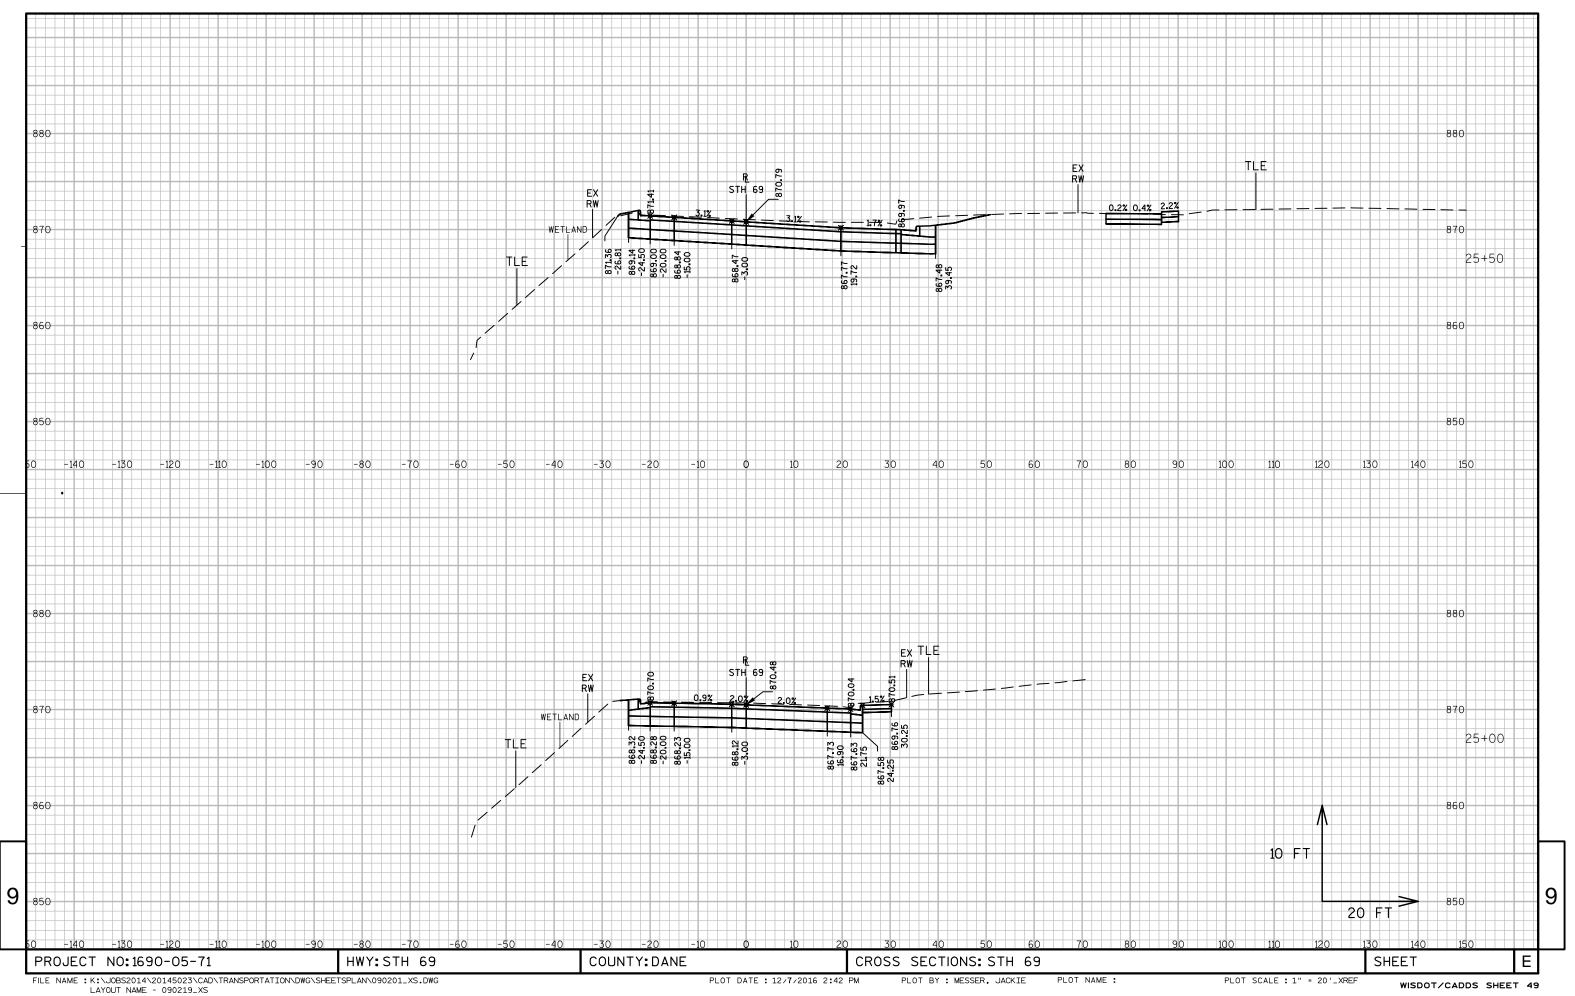


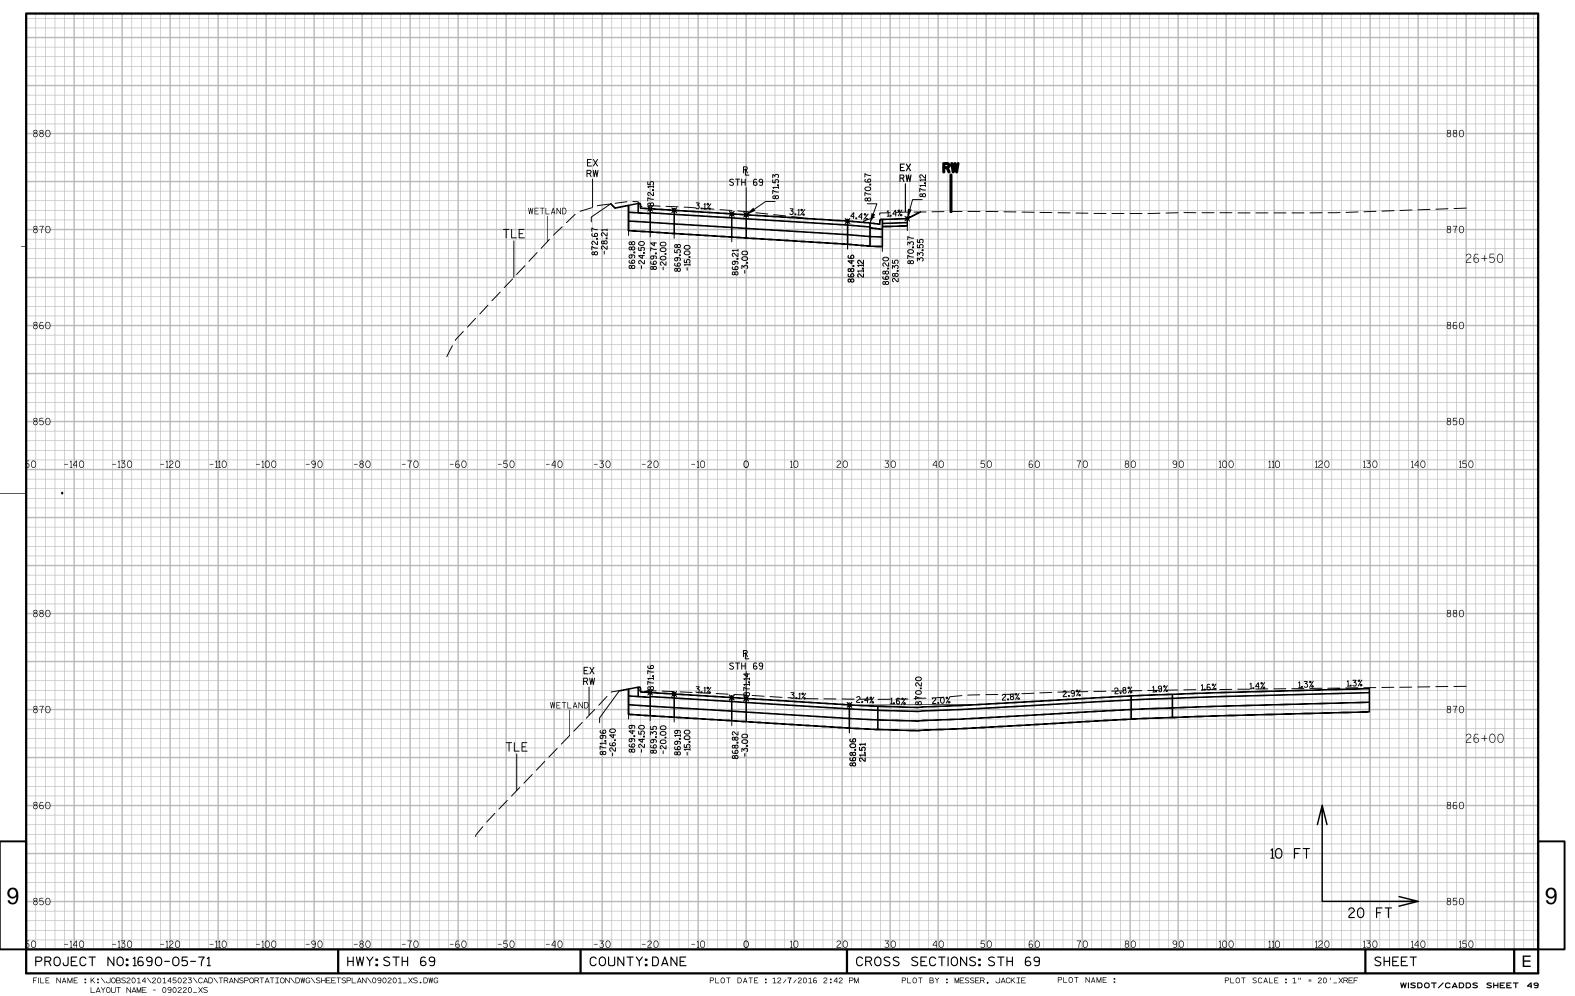


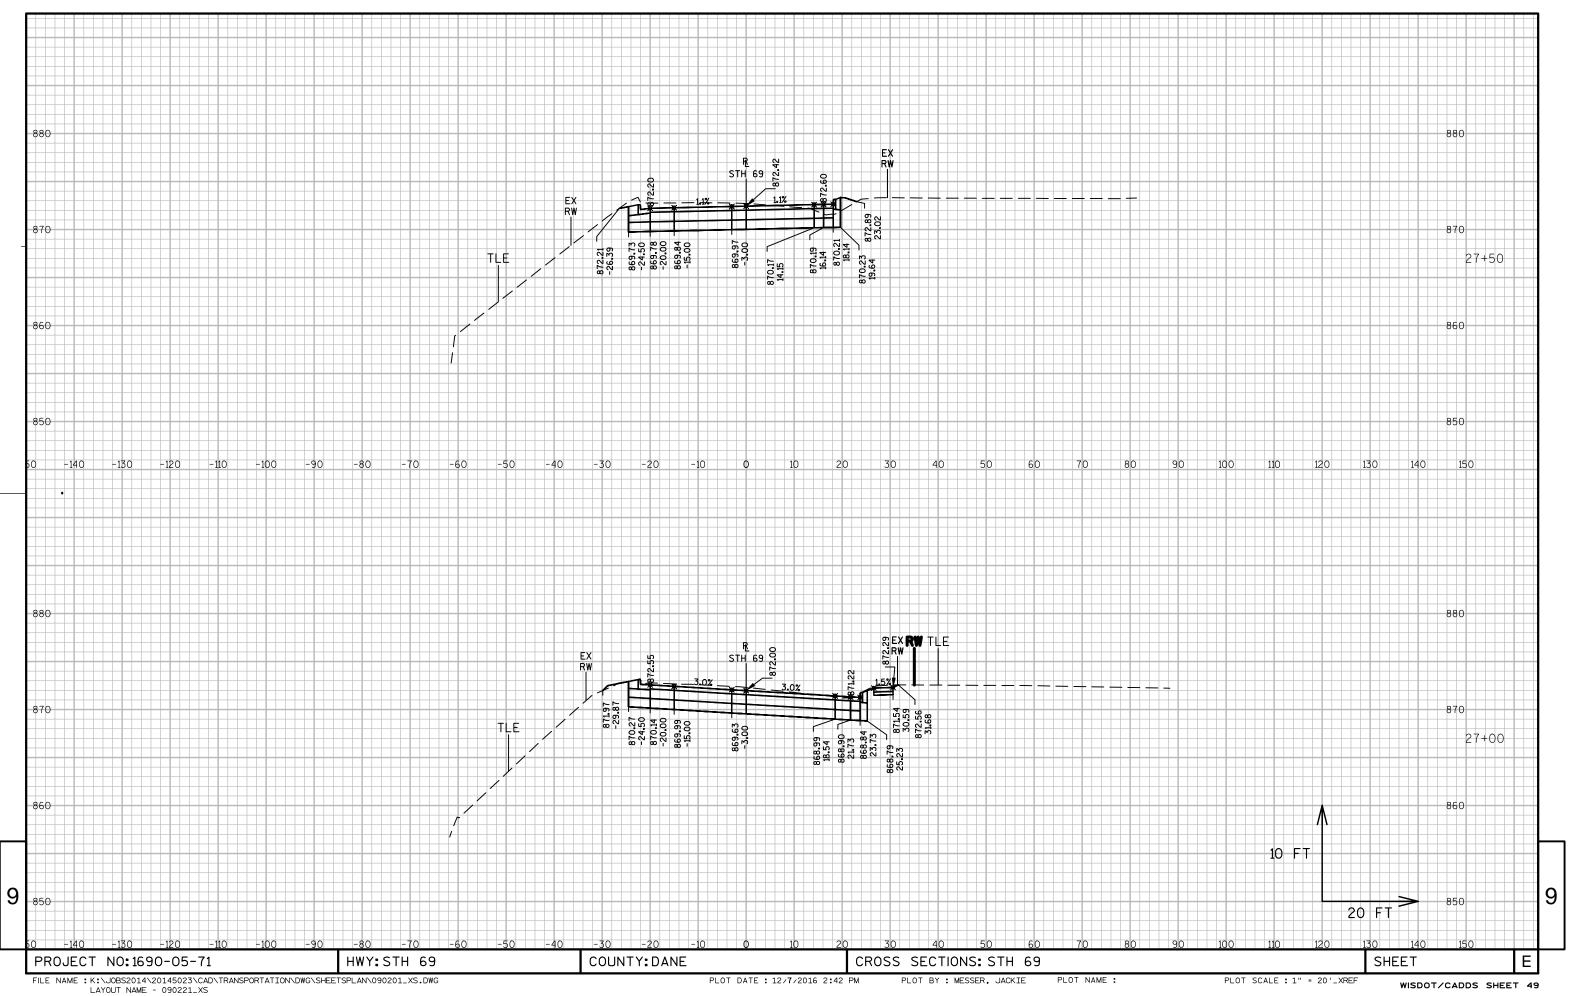


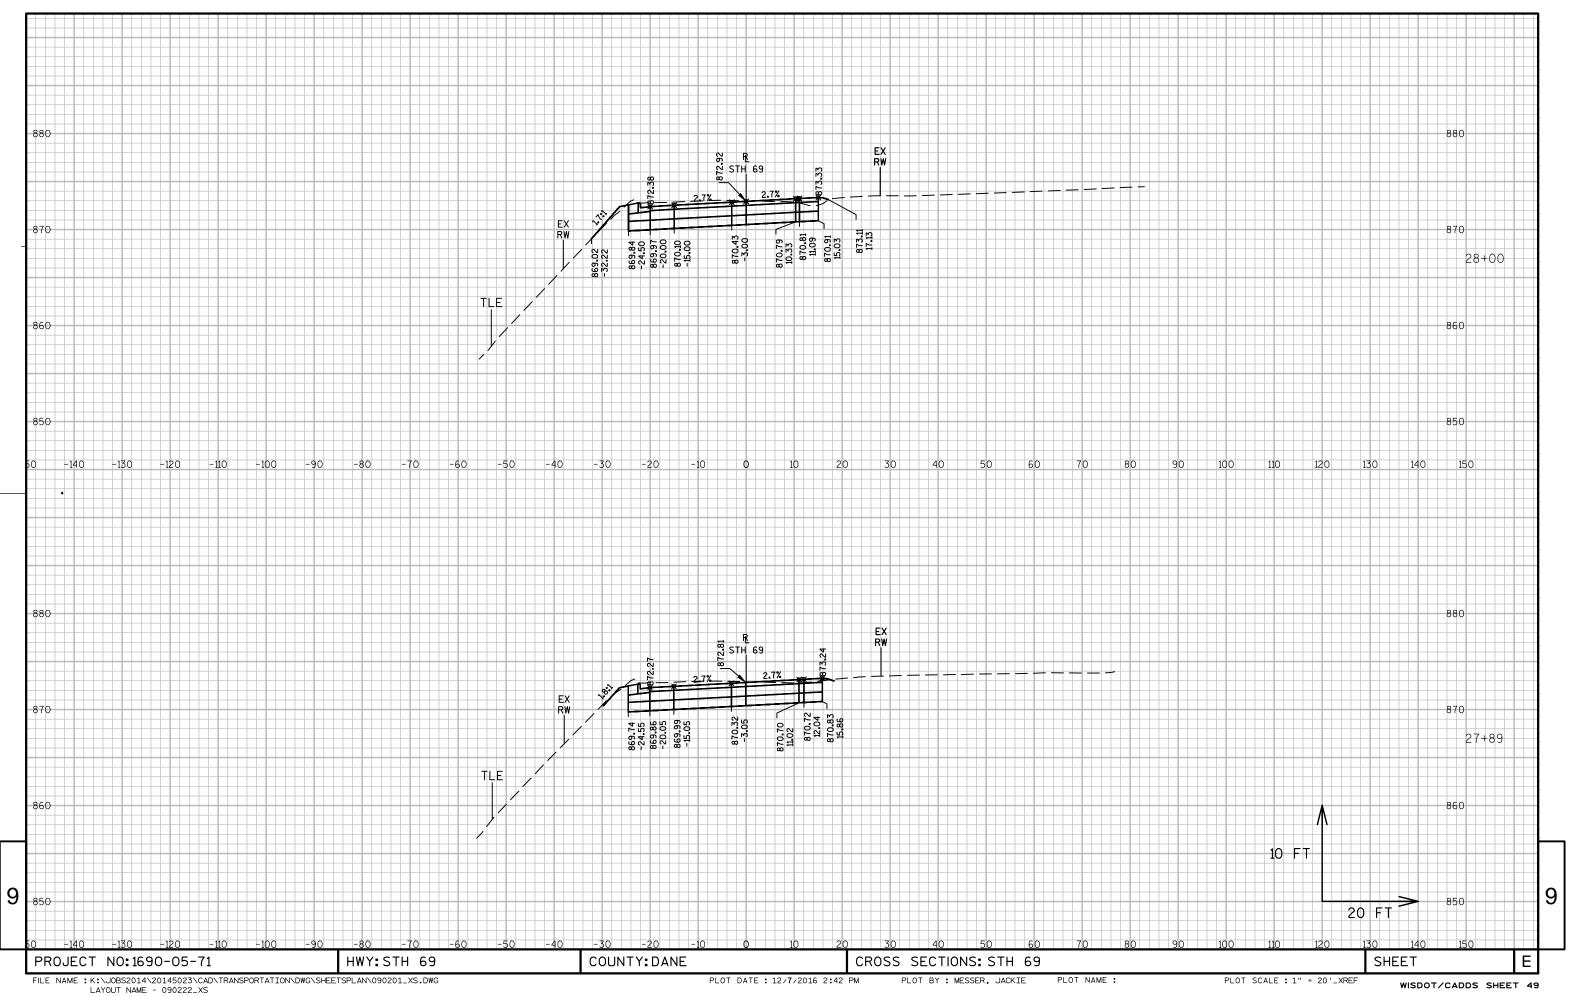


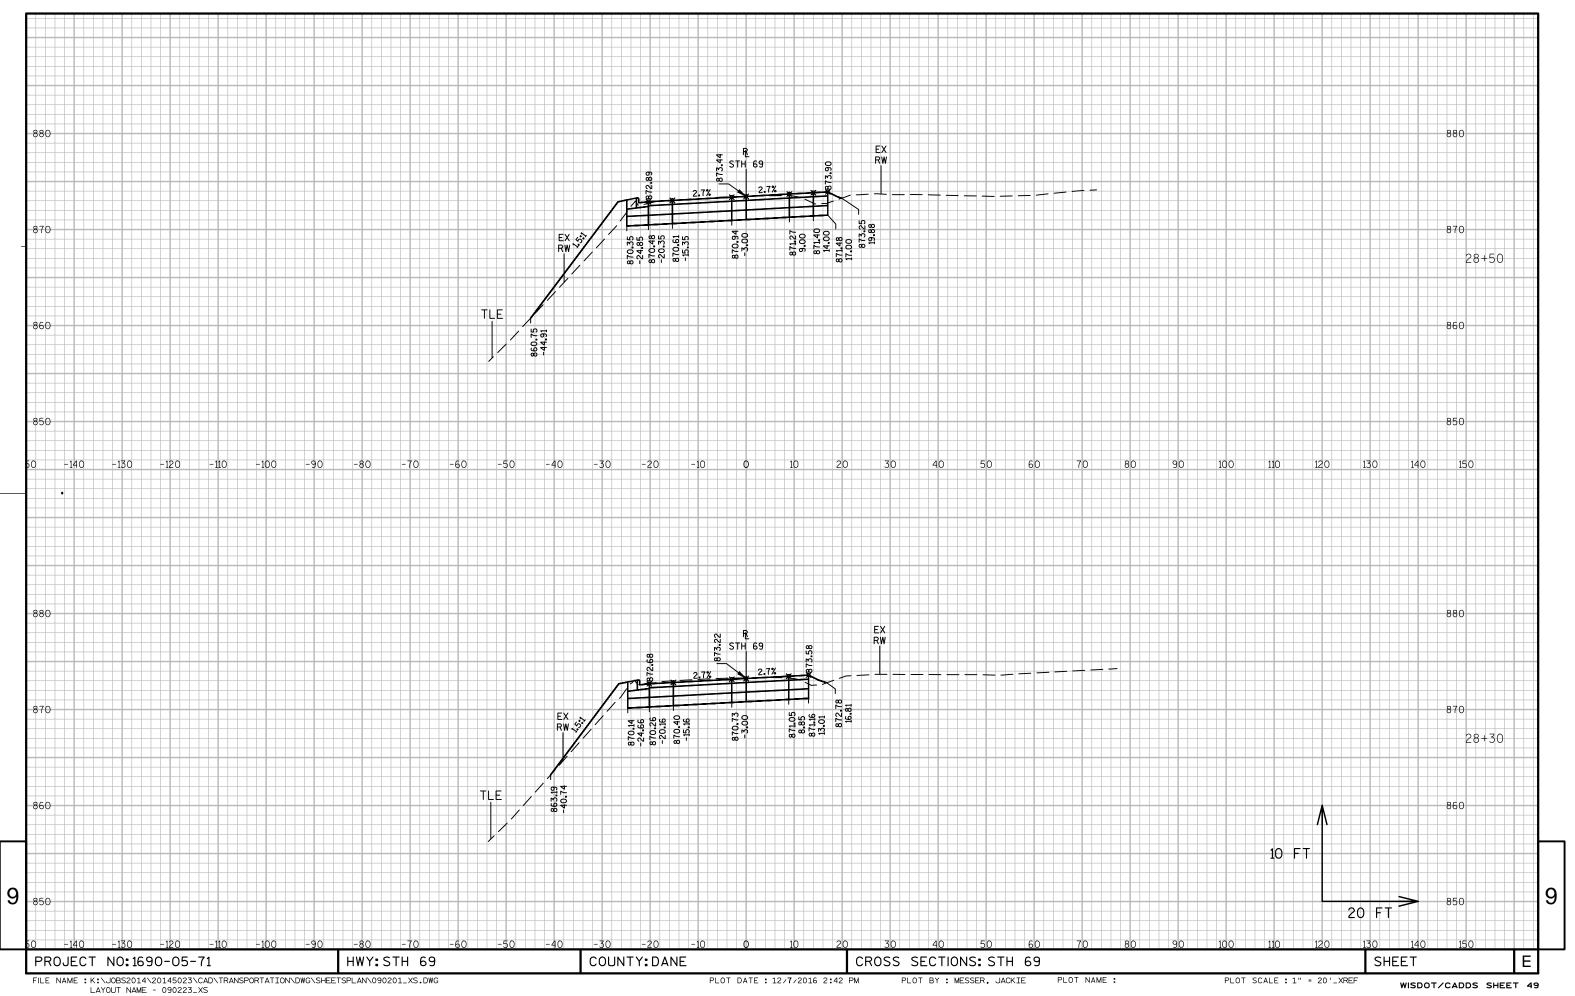


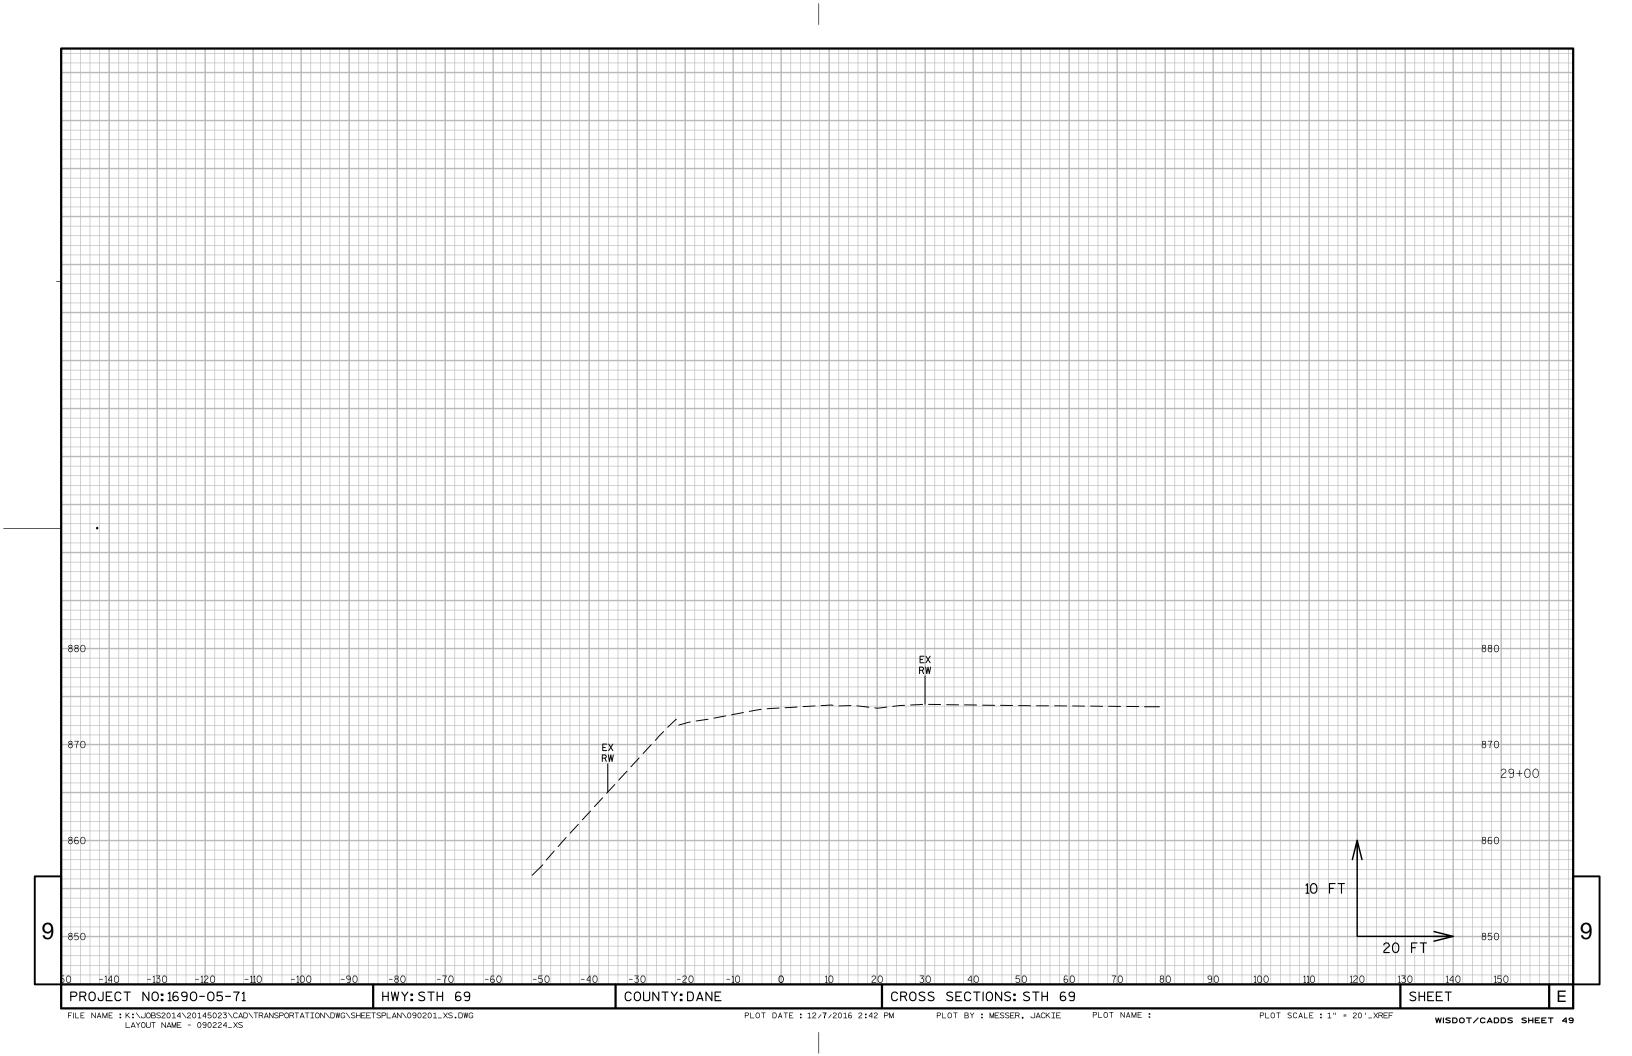

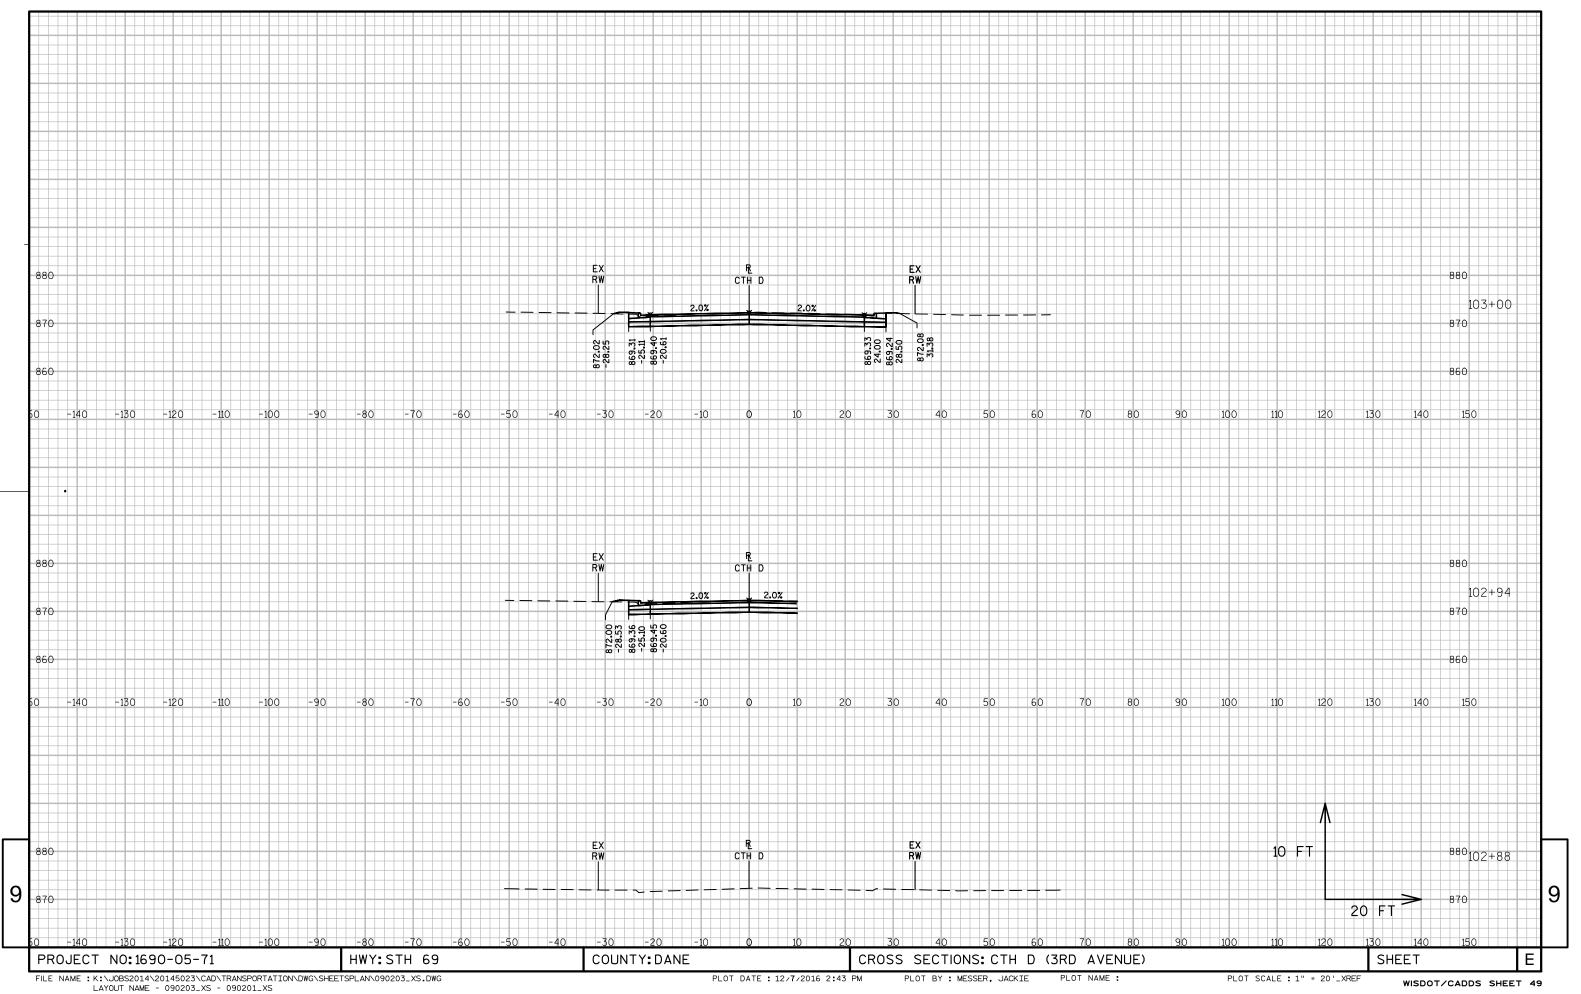

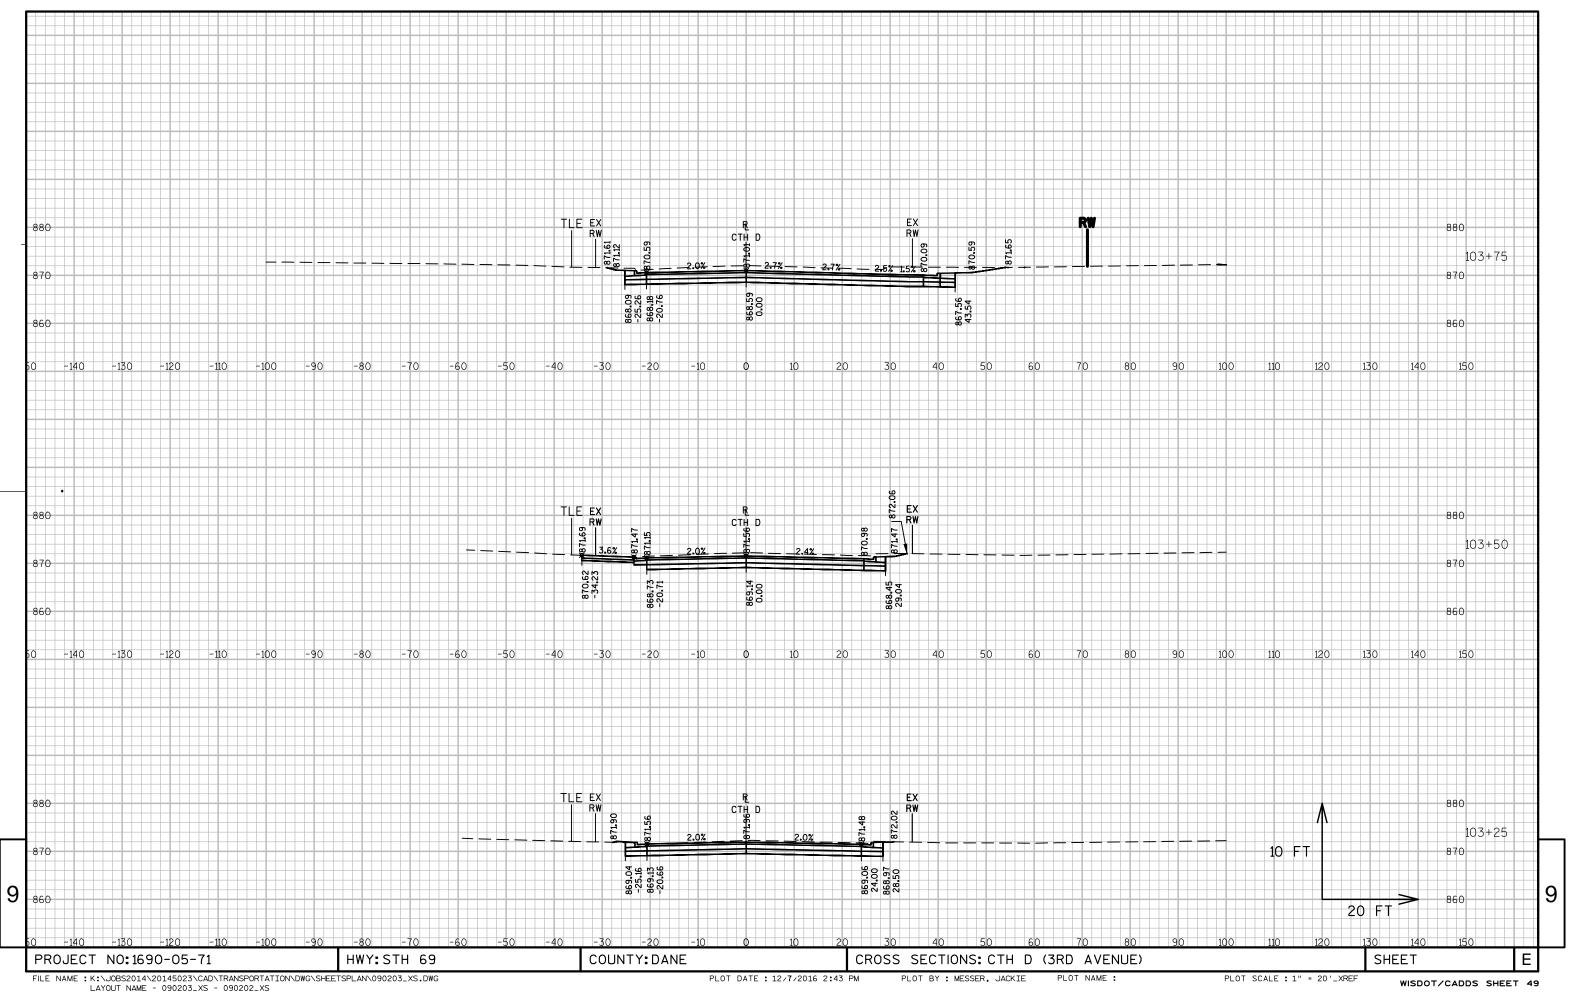

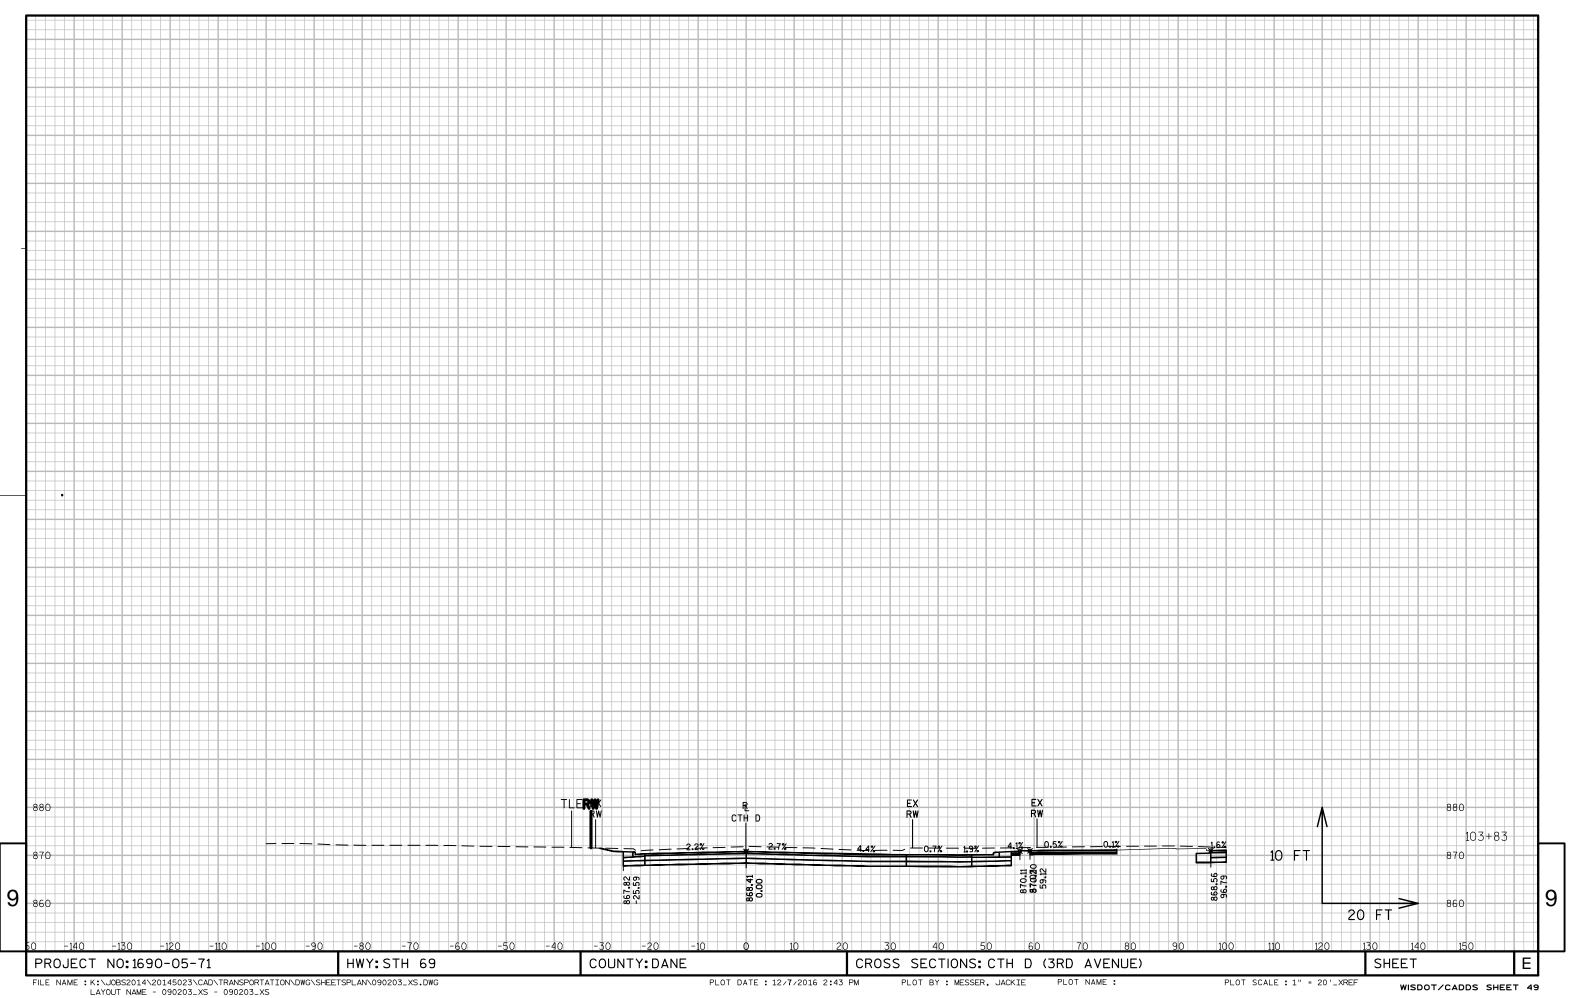

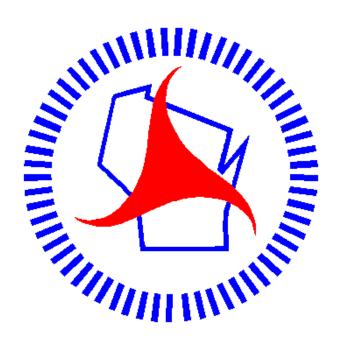

Wisconsin Department of Transportation

Dedicated people creating transportation solutions through innovation and exceptional service.

http://www.dot.wisconsin.gov