

DNR/DOT PROJECT REVIEW

State of Wisconsin – Department of Natural Resources (DNR) and Department of Transportation (WisDOT)
DTNR0002 8/2017

DNR Internet: http://dnr.wi.gov/	WisDOT Internet: http://wisconsindot.gov/
ANDY BARTA DNR SOUTH CENTRAL REGION HEADQUARTERS 3911 FISH HATCHERY ROAD FITCHBURG, WI 53711	Wisconsin Department of Transportation Division of Transportation Systems Development 3550 Mormon Coulee Road La Crosse, WI 54601

Inform WisDOT Regional Environmental Coordinator, if more than 45 days is needed.

Design Project ID 5680-04-30	Project Highway STH 60	Review Submittal Date (m/d/yy) 5/1/18
Construction Project ID 5680-04-60	Estimated Project Cost (range) \$3,750,000.00 to \$4,250,000.00	Construction Year (yyyy) 2020
Project Name Spring Green - Sauk City	Project Limits USH 14 to Fox Road	
County Sauk	Project on Tribal Land ☐ Yes ☒ No	
Contact Name Nathaniel Schumaker	Contact (Area Code) Phone Number (608) 386-1334	
Section/Township/Range S02, T08N, R04E		

Type of Review Requested ☒ Initial Review ☐ Final Concurrence ☐ Scope Change ☐ Other:	Document Type ☐ Environmental Assessment (EA) ☐ Environmental Report (ER) ☐ Programmatic Categorical Exclusion (PCE) ☒ Categorical Exclusion Checklist (CEC)
WisDOT Project Classification ☐ Bridge Rehabilitation, FDM 3-5-2 ☐ Bridge Replacement, FDM 3-5-2 ☐ Expansion, FDM 3-5-2 ☐ Pavement Replacement, FDM 3-5-2 ☐ Preventive Maintenance, FDM 3-1-5 ☐ SHRM (State Hwy Rehab/Maint), Maintenance Manual 13.08 ☐ Recondition, FDM 3-5-2 ☐ Reconstruction, FDM 3-5-2 ☒ Resurface, FDM 3-5-2 ☐ Safety (HSIP), PMM 4-1-10 ☐ Other:	Work Involved ☒ Beam Guard Replacement ☒ Borrow and/or Waste Site Required ☐ Channel Change/Stream Relocation ☐ Clearing and Grubbing ☐ Culvert Replacement or Extensions ☐ Dredging ☐ Grading ☒ Fill Outside Toe of Slope ☐ Intersection Improvement ☐ Right of Way Acquisition ☒ Shoulder Work ☐ Storm Sewer ☐ Other:

Storm Water Management (check all that apply)

- ☐ Trans 401 post construction requirements
☐ NPDES MS4/Urbanized Area
☐ TMDL Implementation Area

For more information, please see the back of this form.

Project Description and Reason for Project:

(include project location map with limits and necessary attachments; attach additional sheets if needed)

The purpose of this project is to preserve and improve the existing pavement with a two inch mill and HMA overlay. This may be upgraded to a mill and relay operation depending on the pavement structure information determined by the boring operation performed in April of 2018. Either operation is proposed to maintain the existing roadway width of 32 feet as shown in the attached typical sections. In addition to the pavement improvement, guardrail terminals are to be upgraded as needed. A relatively low quantity of borrow will be required for the necessary grading work for the new MGS energy absorbing terminals. There is no proposed culvert work at this time because that endeavour has been assigned to Sauk County maintenance personnel. Lastly, there is no currently scoped structure work.

Attachments:

#1 - Project Location Map

#2 - Typical Sections

#3 - Plan Details

#4 - 1957 Asbuilt

Attachment #1

Wisconsin Department of Transportation

State Project I.D. 5680-04-30/60

Spring Green – Sauk City

USH 14 to Fox Road


STH 60, Sauk County

Project Location Map




2

2

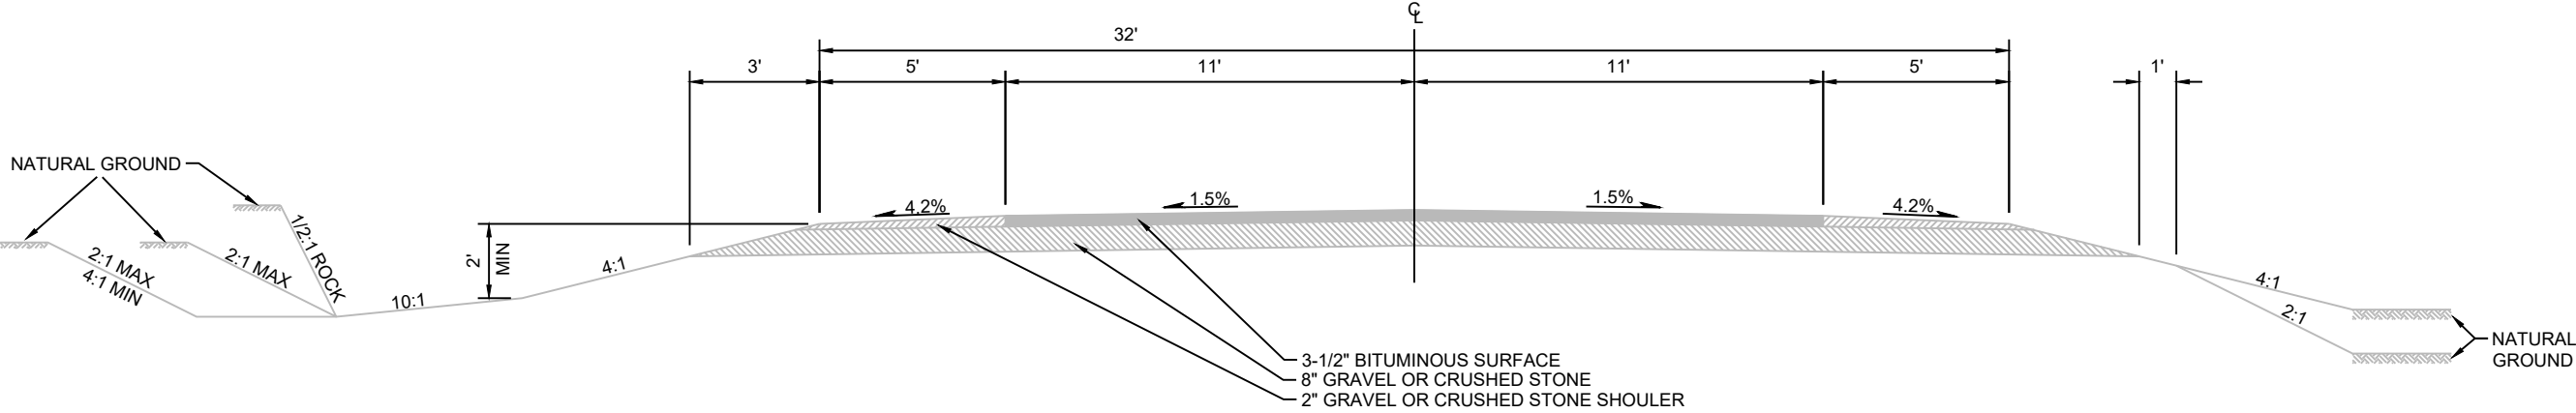


STANDARD 1/2 SECTION IN CUT STANDARD 1/2 SECTION IN FILL

STH 60 EXISTING TYPICAL SECTION
STA. 0+93 TO STA. 541+00

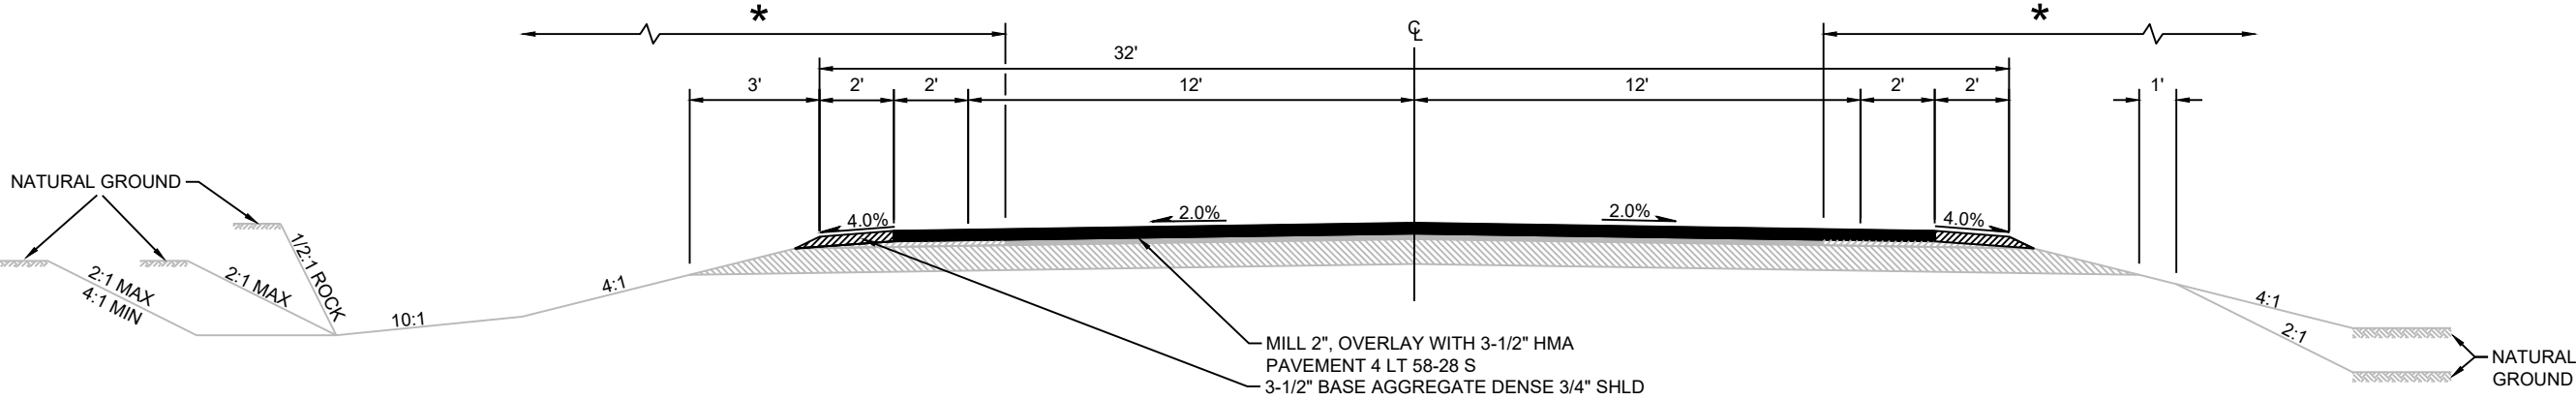

STANDARD 1/2 SECTION IN CUT STANDARD 1/2 SECTION IN FILL

STH 60 PROPOSED TYPICAL SECTION
STA. 0+93 TO STA. 541+00

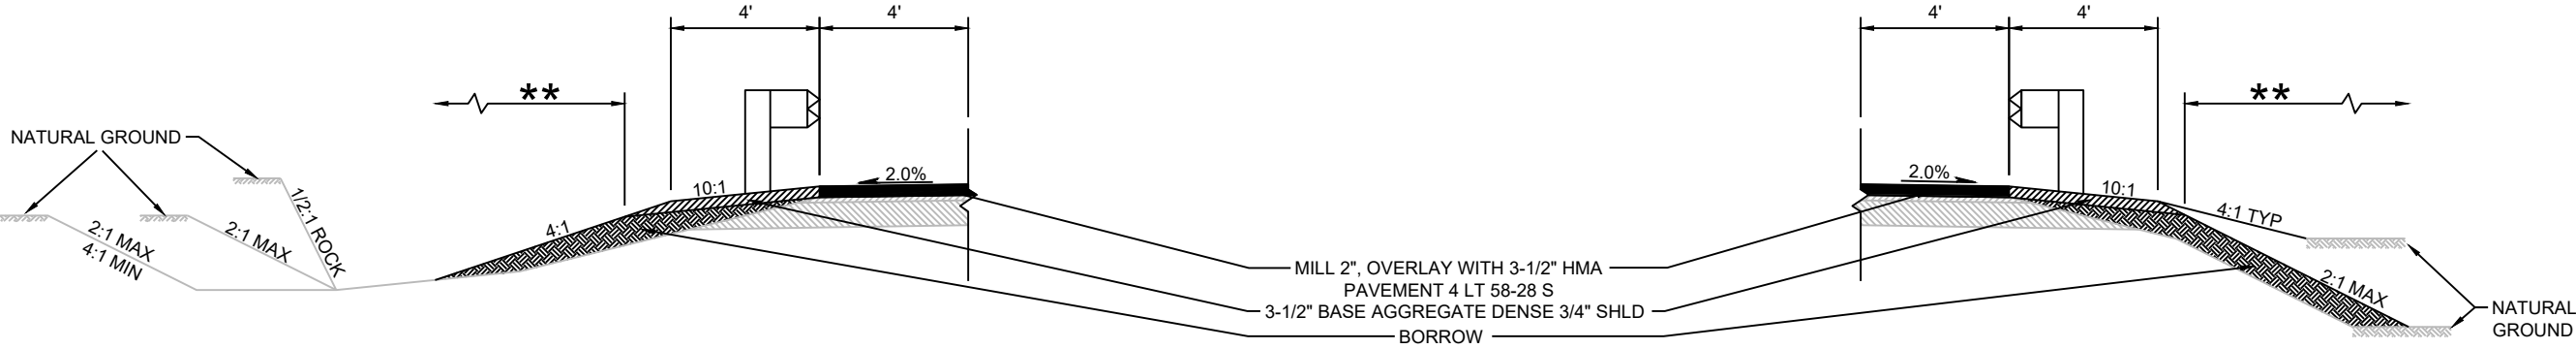

STH 60 PROPOSED GUARDRAIL TYPICAL SECTIONS

* LIMITS OF SHAPING SHOULDERS & PREPARING FOUNDATION FOR ASPHALTIC SHOULDERS

** LIMITS OF TOPSOIL, EMAT AND SEEDING

Attachment #3
Typical Sections



PROJECT NO: 5680-04-60	HWY: STH 60	COUNTY: SAUK	PLAN DETAILS	SHEET	E
------------------------	-------------	--------------	--------------	-------	---



PROJECT NO: 5680-04-60	HWY: STH 60	COUNTY: SAUK	PLAN DETAILS	SHEET	E
------------------------	-------------	--------------	--------------	-------	---

2



2



PROJECT NO: 5680-04-60	HWY: STH 60	COUNTY: SAUK	PLAN DETAILS	SHEET	E
------------------------	-------------	--------------	--------------	-------	---




PROJECT NO: 5680-04-60	HWY: STH 60	COUNTY: SAUK	PLAN DETAILS	SHEET	E
------------------------	-------------	--------------	--------------	-------	---




2

2

PROJECT NO: 5680-04-60	HWY: STH 60	COUNTY: SAUK	PLAN DETAILS	SHEET	E
------------------------	-------------	--------------	--------------	-------	---

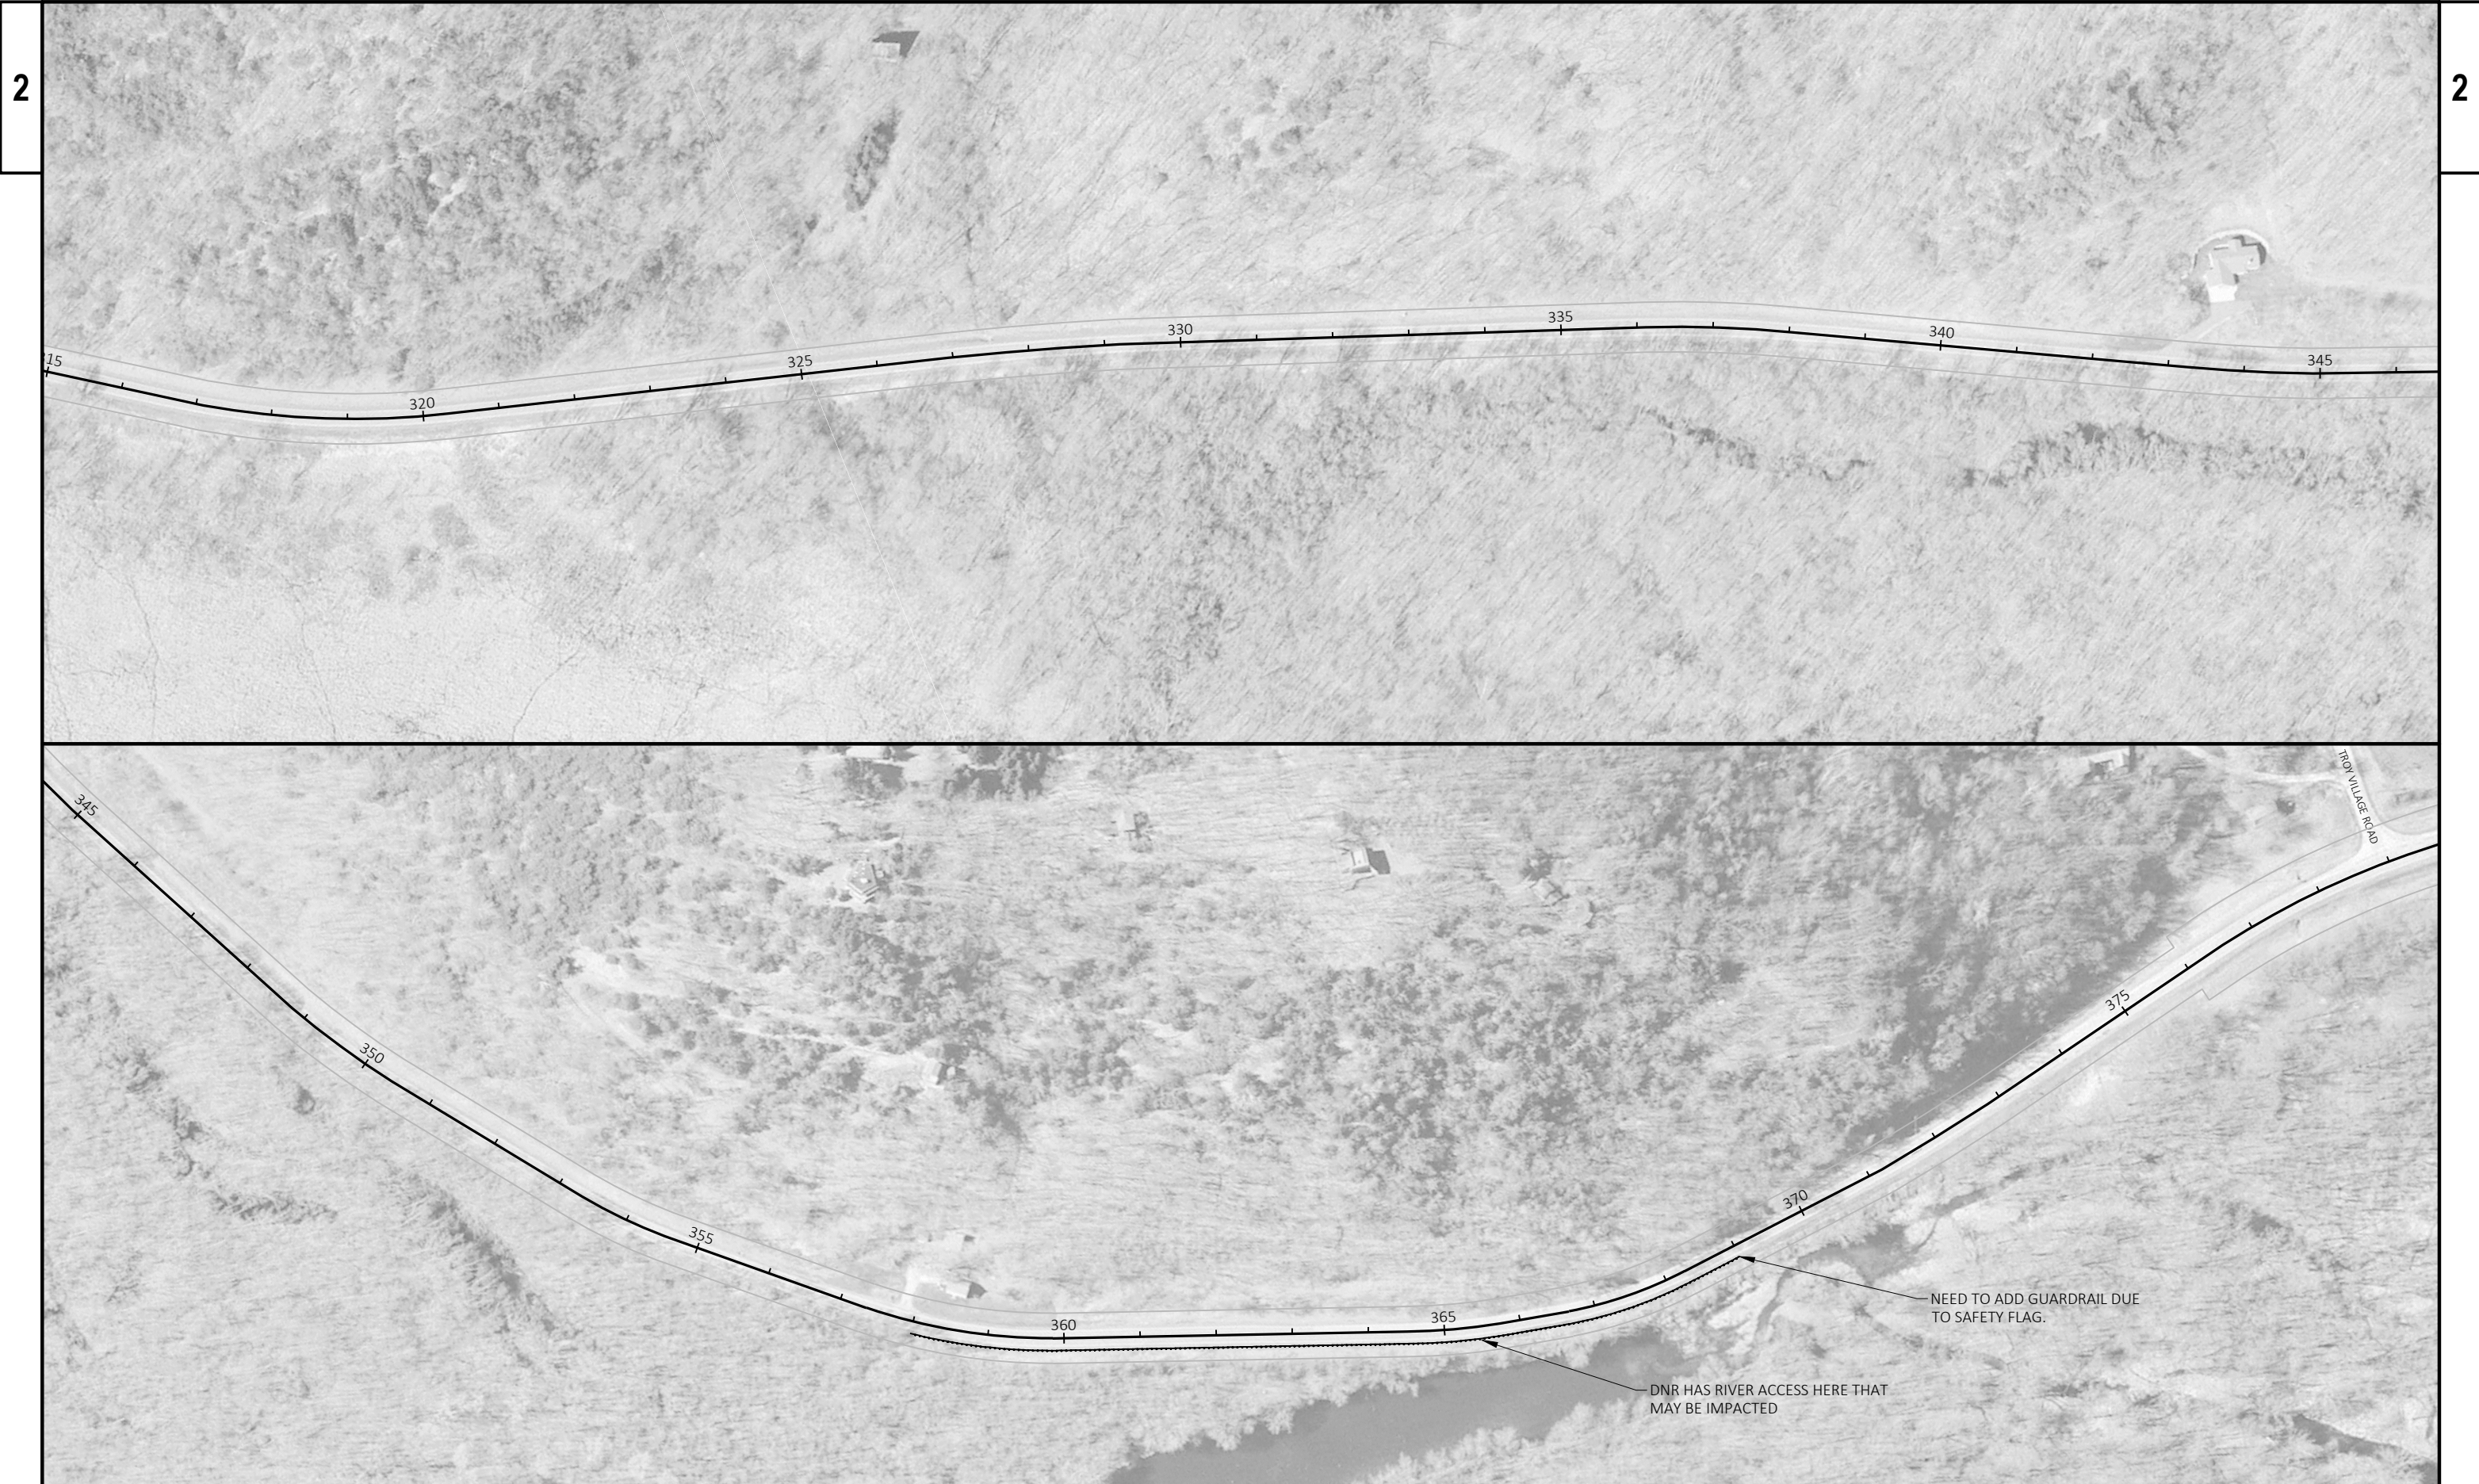

PROJECT NO: 5680-04-60	HWY: STH 60	COUNTY: SAUK	PLAN DETAILS	SHEET	E
------------------------	-------------	--------------	--------------	-------	---

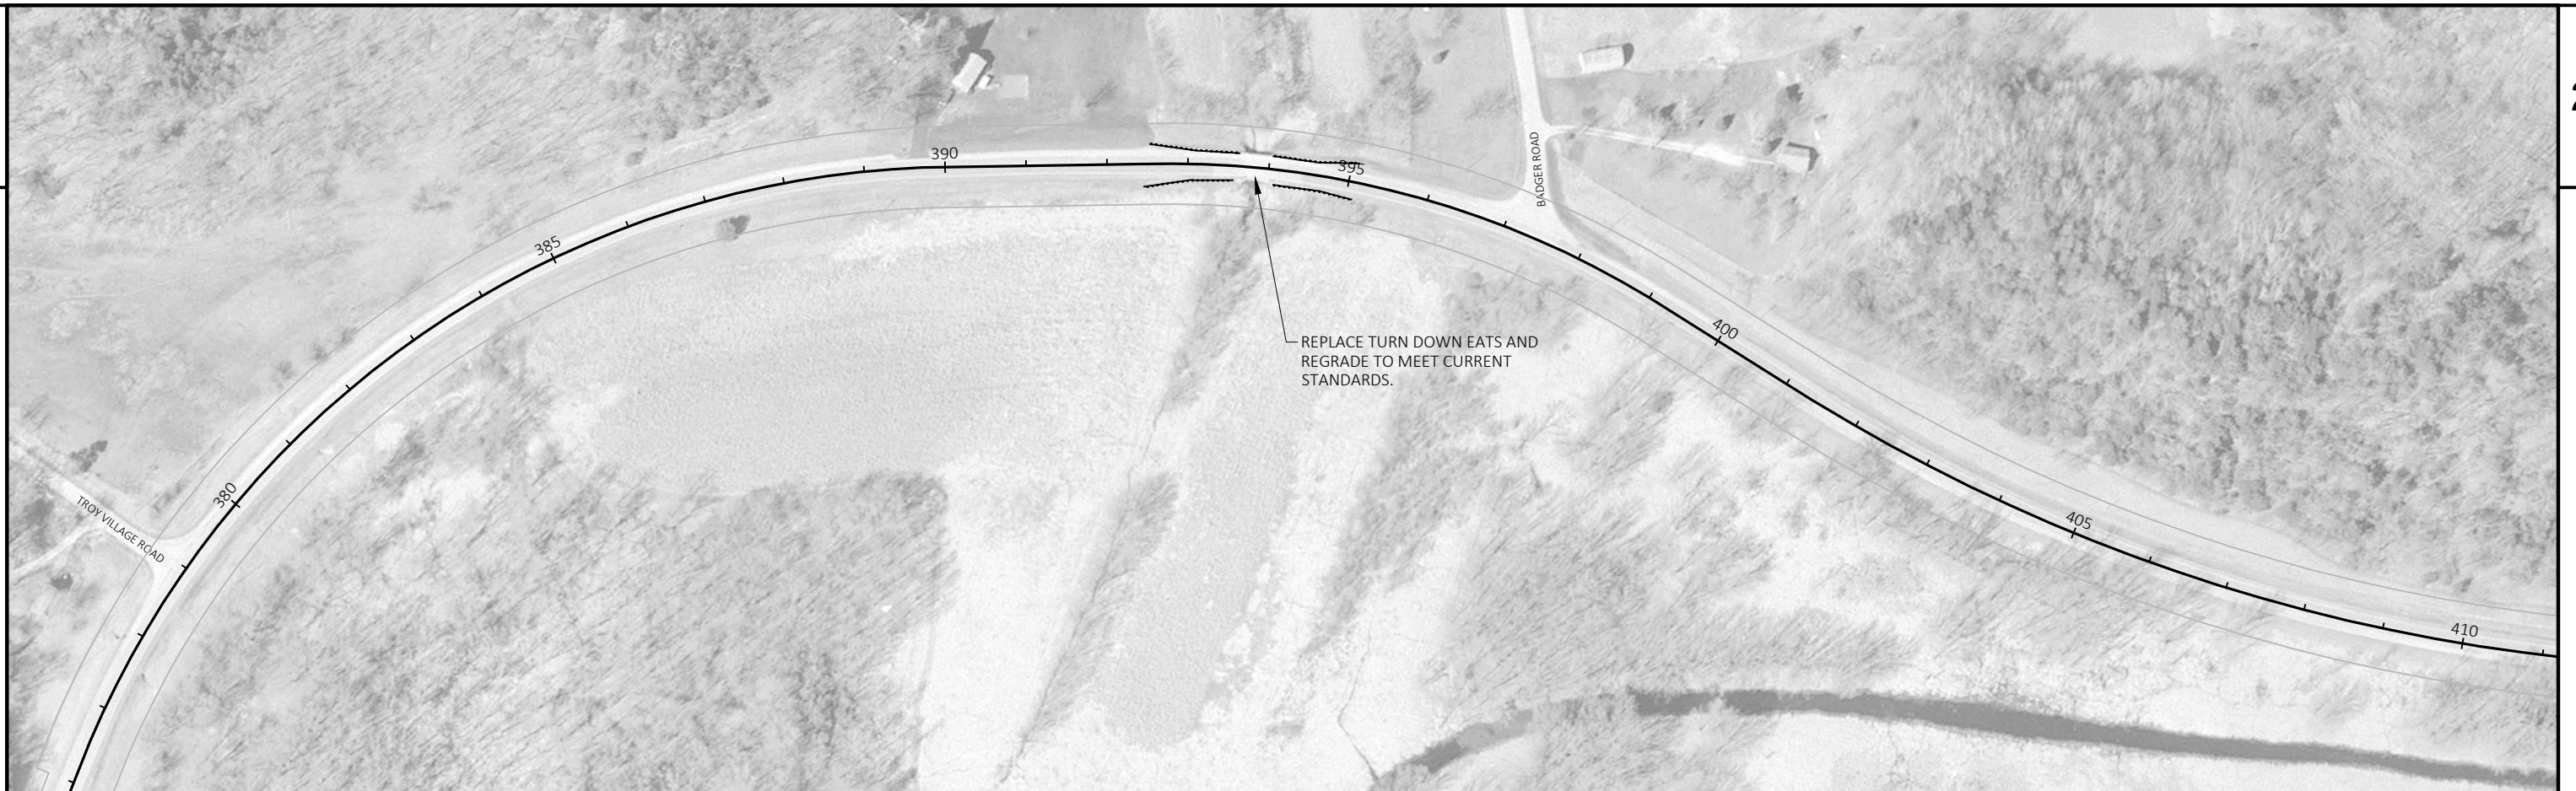

PROJECT NO: 5680-04-60

HWY: STH 60

COUNTY: SAUK


PLAN DETAILS

SHEET

E




PROJECT NO: 5680-04-60	HWY: STH 60	COUNTY: SAUK	PLAN DETAILS	SHEET	E
------------------------	-------------	--------------	--------------	-------	---

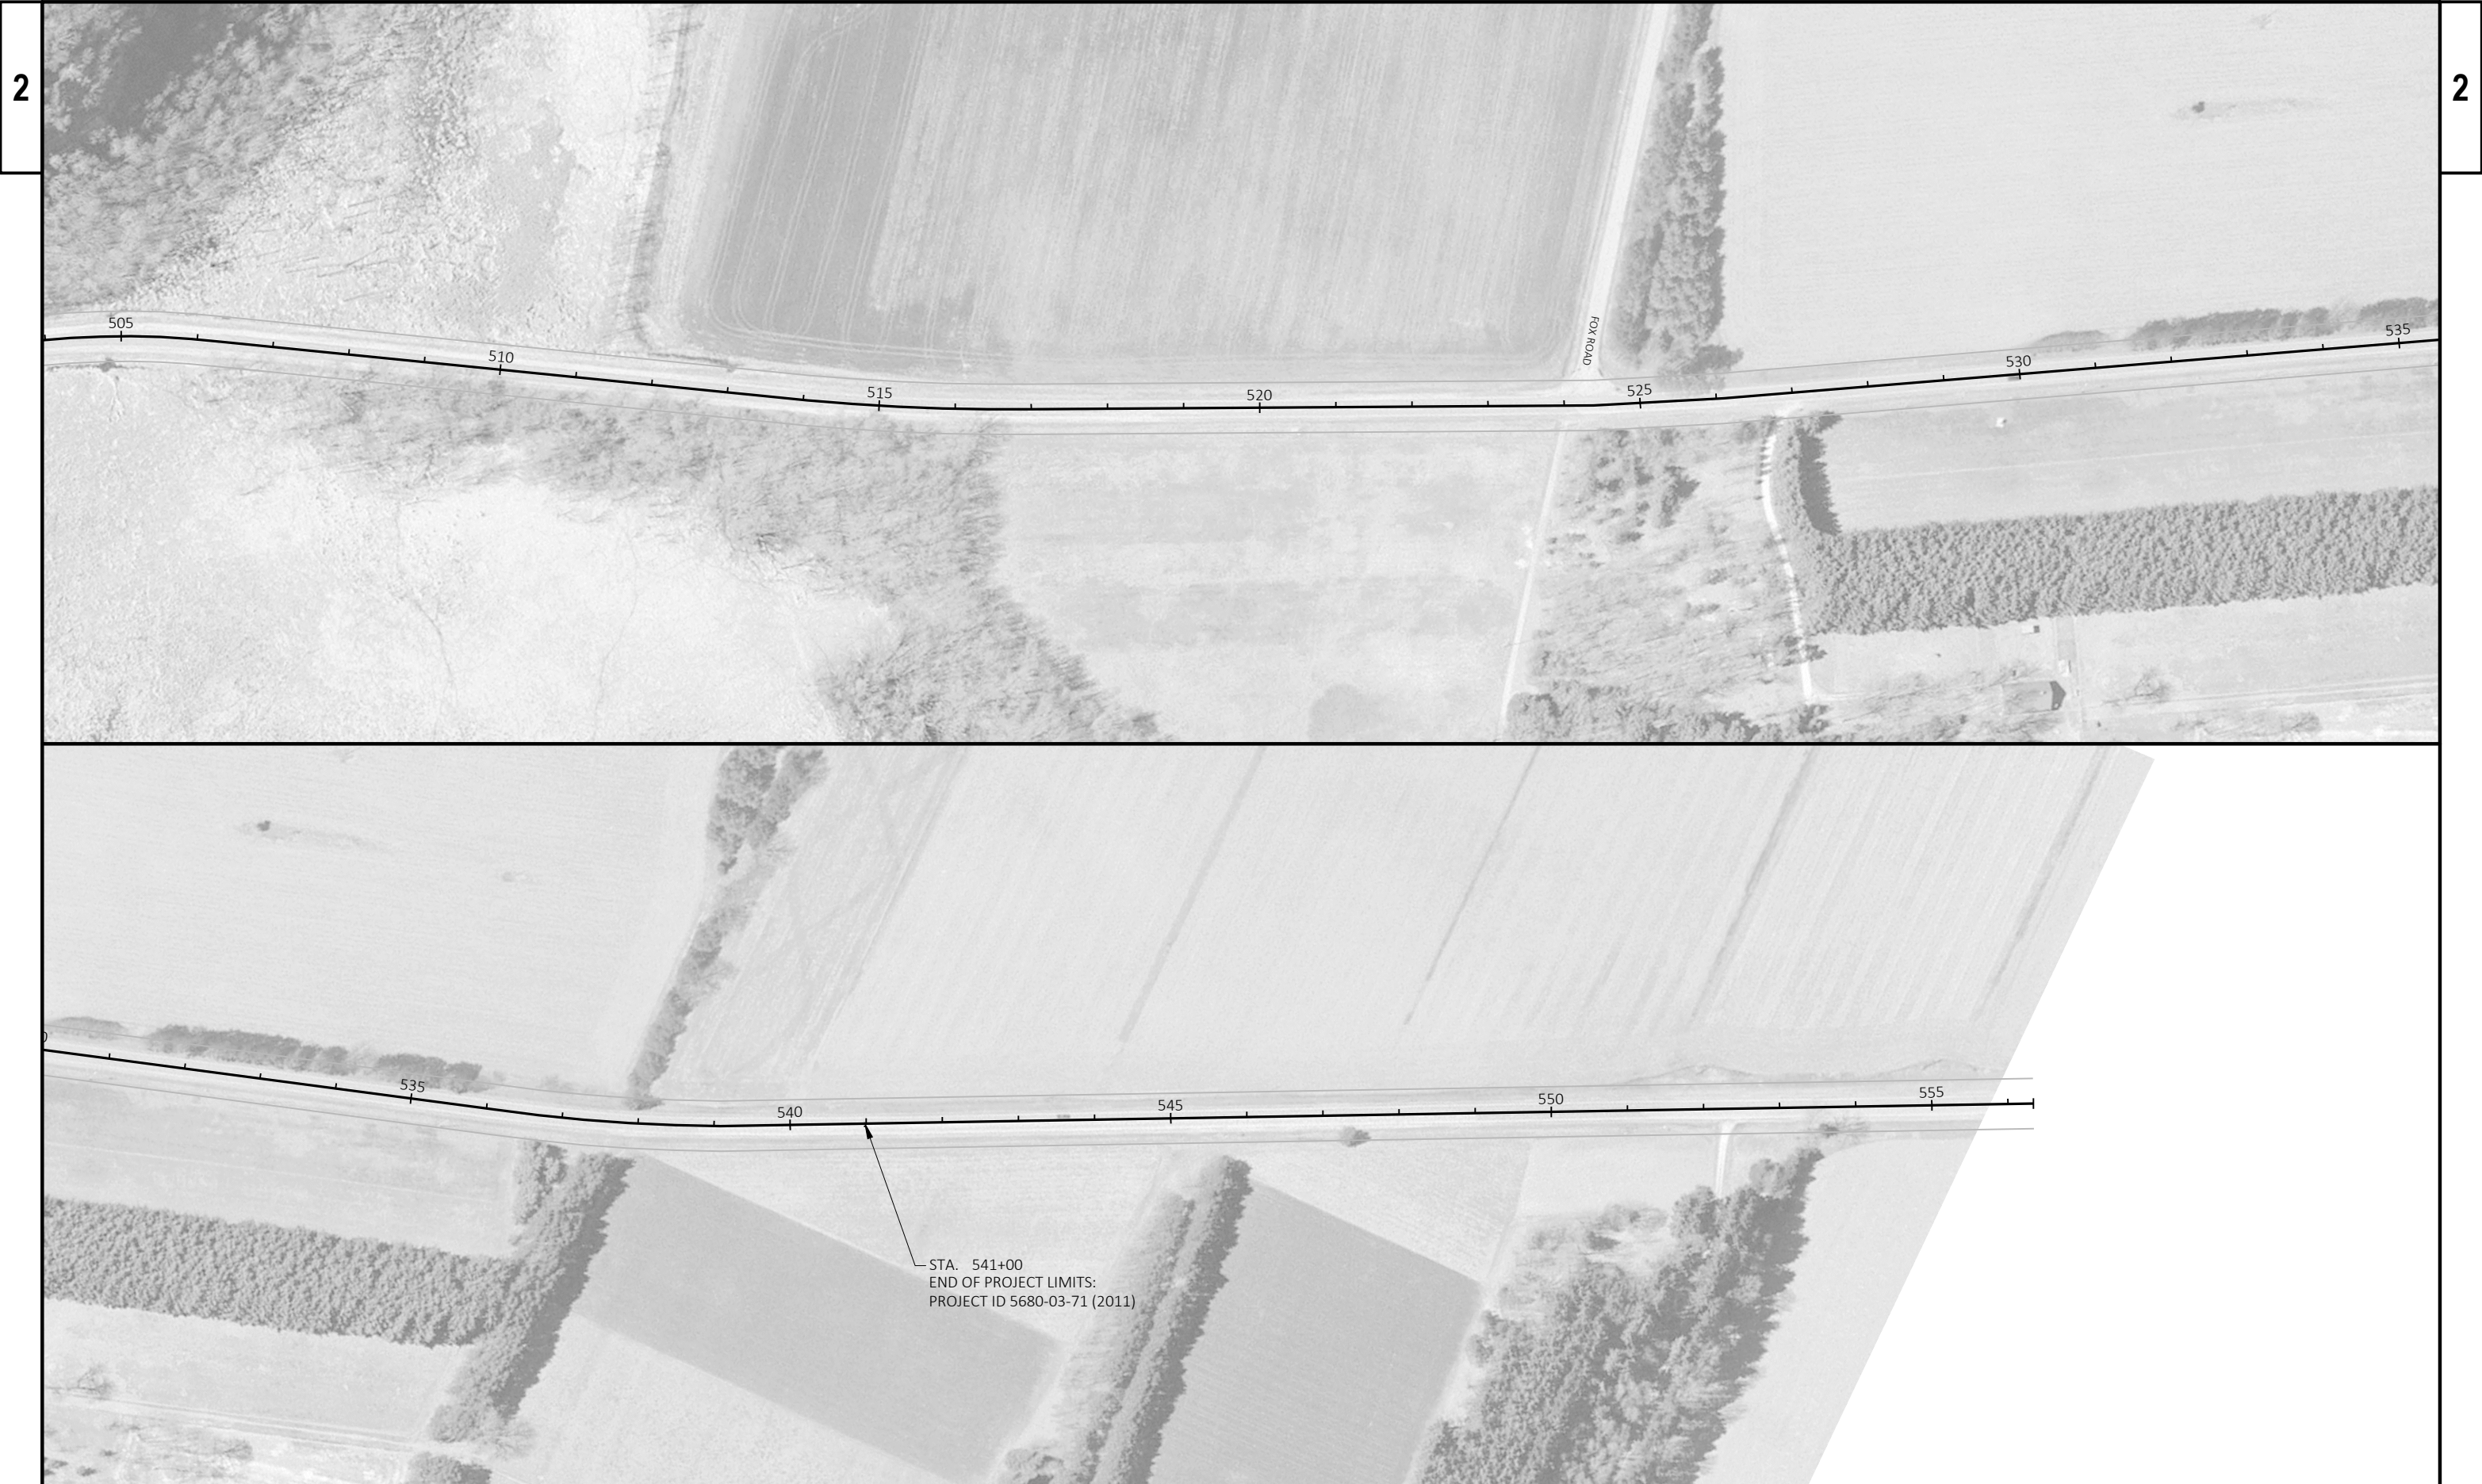

INDEX OF SHEETS

SHEET NO. 1 TITLE
 SHEET NO. 2-2.2 TYPICAL CROSS SECTIONS
 SHEET NO. 3-3.1 ESTIMATE OF QUANTITIES
 SHEET NO. 3A MISCELLANEOUS QUANTITIES
 SHEET NO. 4.0-4.2 RIGHT OF WAY PLAT
 SHEET NO. 5-15 PLAN AND PROFILE STA. 235+00 TO STA. 626+00
 SHEET NO. 16-28 STANDARD DETAILS
 SHEET NO. 29-32 DRAINAGE STRUCTURES
 SHEET NO. 33-86 CROSS SECTIONS

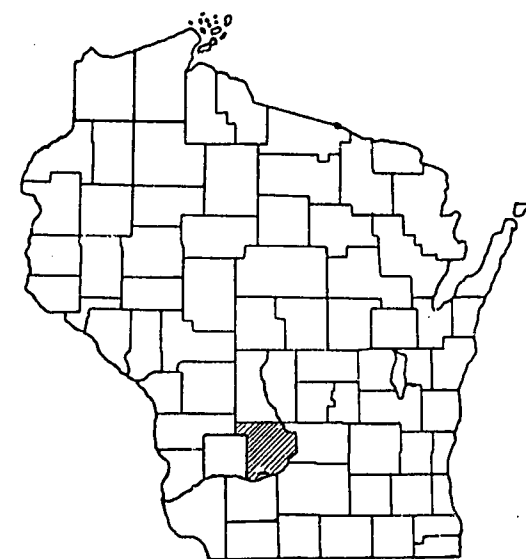

Attachment #4
 Asbuilt


STATE OF WISCONSIN STATE HIGHWAY COMMISSION OF WISCONSIN

PLAN AND PROFILE OF PROPOSED U. S. H. 14 - U. S. H. 12 ROAD S. T. H. 60 SAUK COUNTY PROJECT S 0213(I)

COUNTY AND HIGHWAY	ROUTE AND SECTION	CLASS AND AGREEMENT		FEDERAL DIVISION OFFICE	SHEET NUMBER	TOTAL SHEETS
56.2	213.0	STATE	FEDERAL	WIS. 4	1	86

R1- 11/1/57

SCALES { PLAN 1 IN. = 100 FT.
 PROFILE HOR. 1 IN. = 100 FT. VERT. 1 IN. = 10 FT.
 CROSS SECTIONS HOR. 1 IN. = 5 FT. VERT. 1 IN. = 5 FT.

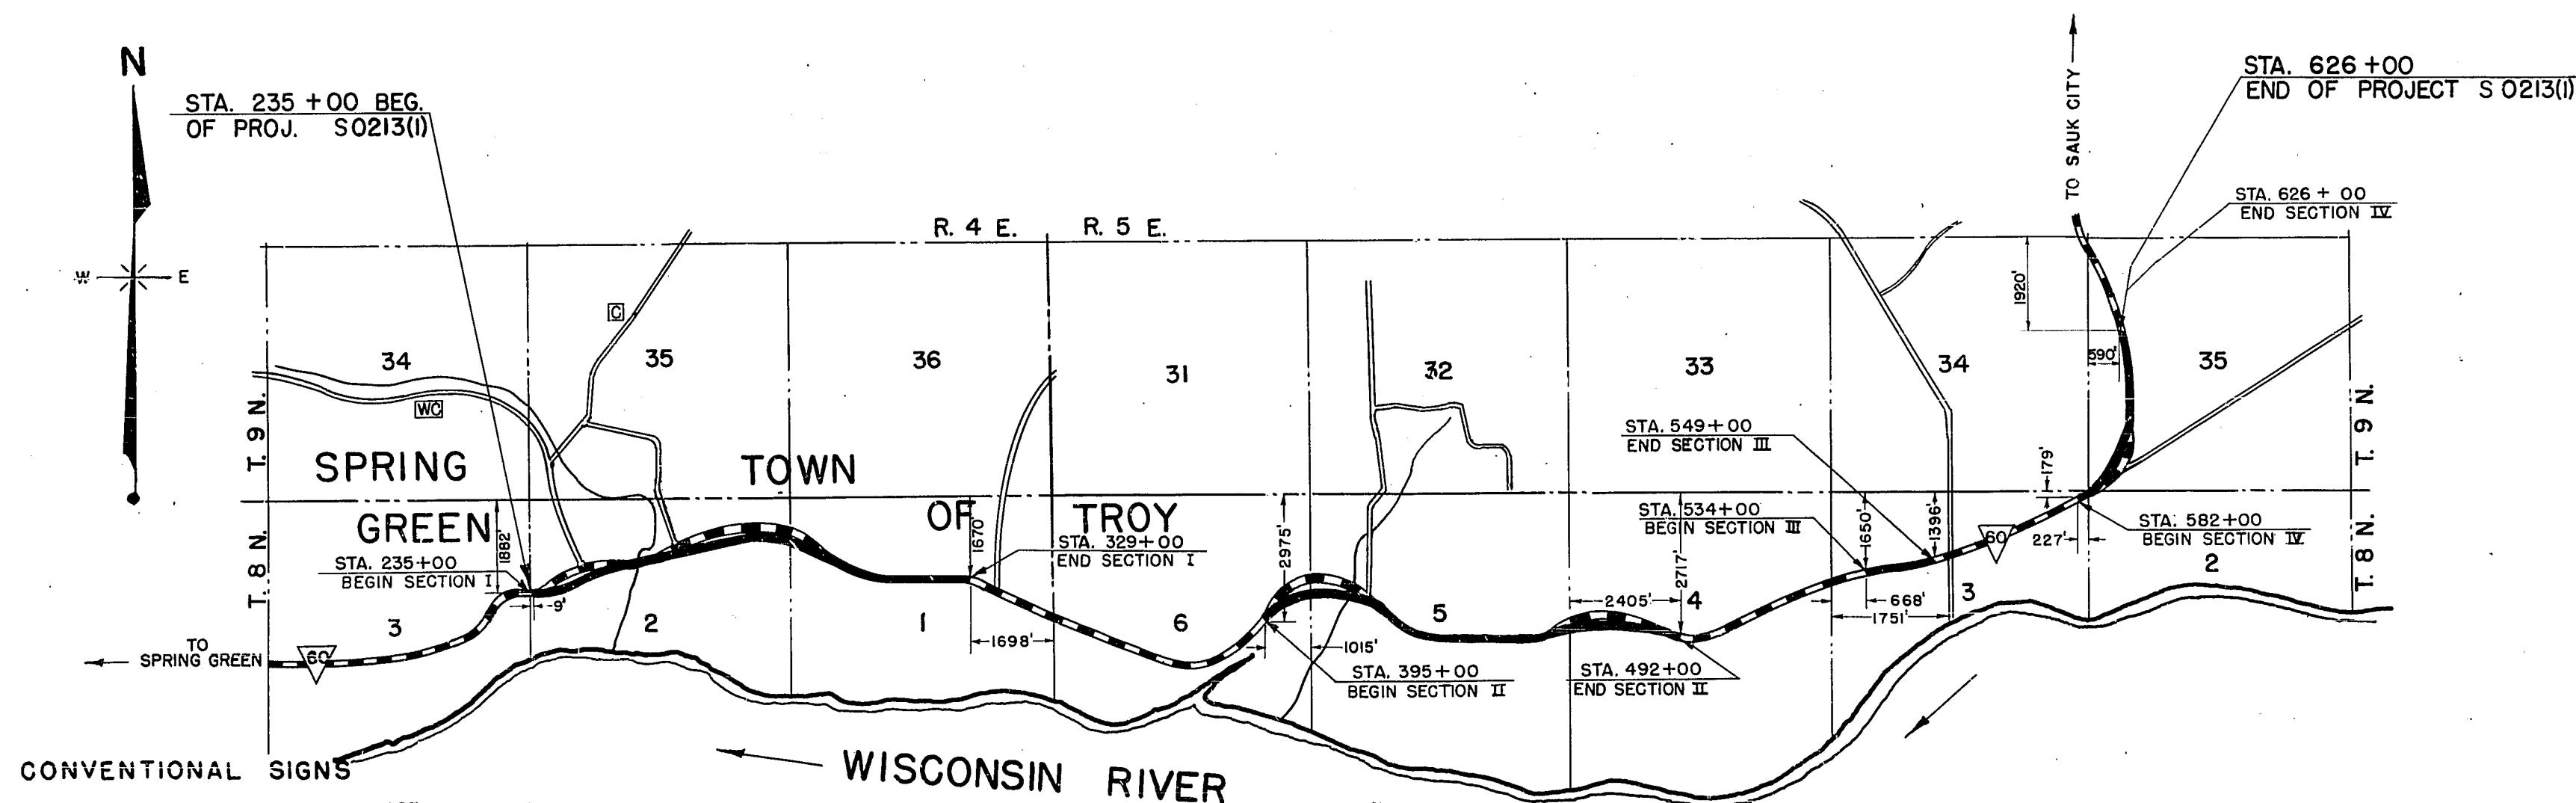

CONVENTIONAL SIGNS

STATE LINE.....
 COUNTY LINE.....
 TOWNSHIP OR RANGE LINE.....
 SECTION LINE.....
 NEW RIGHT OF WAY LINE.....
 PRESENT RIGHT OF WAY LINE.....
 WIRE FENCE {WOVEN.....
 BARBED.....
 LOT LINE.....
 CORPORATE OR CITY LIMITS.....
 PROPERTY LINE.....
 TRAVELED WAY OR P.E.....
 RAILROADS.....
 BASE OR SURVEY LINE.....

CULVERTS IN PLACE.....
 CULVERTS REQUIRED.....
 DROP INLET.....
 POWER POLE.....
 TELEPHONE OR TELEGRAPH POLE.....
 RIGHT OF WAY MARKERS.....
 REFERENCE STAKE FOR HUBS ONLY.....
 MARSH.....
 HEDGE.....
 TREES.....
 GROUND ELEVATION.....
 GRADE ELEVATION.....

LAYOUT

SCALE 0 1/4 1/2 1.0 MILE

TOTAL NET LENGTH OF CENTERLINE = 4.735 MI.
 SECTION I = 1.780 MI.
 SECTION II = 1.837 MI.
 SECTION III = 0.284 MI.
 SECTION IV = 0.834 MI.

FENNER-BREY ENGINEERING CORP.
 MANITOWOC & BEAVER DAM

BY *L. E. Fenner*
 SIGNATURE

STATE HIGHWAY
 COMMISSION OF WISCONSIN
 MADISON, WISCONSIN






CORRECT:
 DATE 3/12/56 *J. J. Jones*
 DISTRICT ENGINEER

RECOMMENDED FOR APPROVAL:
 DATE 3/15/56 *J. J. Pitt*
 ENGINEER OF DESIGN

APPROVED:
 DATE 3/15/56 *E. G. Rostum*
 STATE HIGHWAY ENGINEER


DEPARTMENT OF COMMERCE
 BUREAU OF PUBLIC ROADS

APPROVED: _____ DATE _____
 DISTRICT ENGINEER

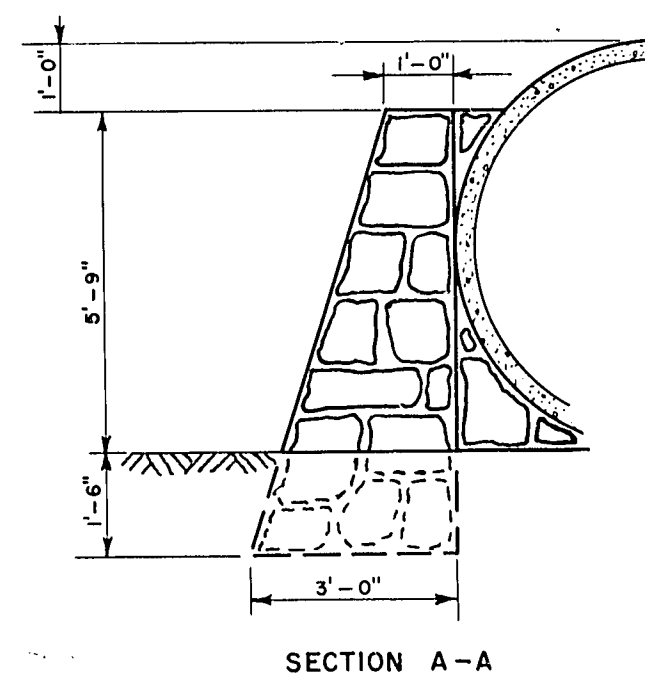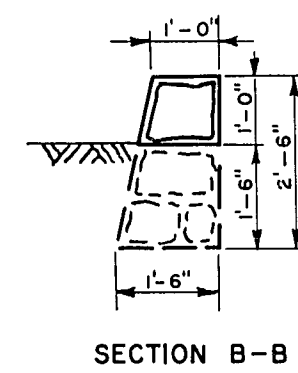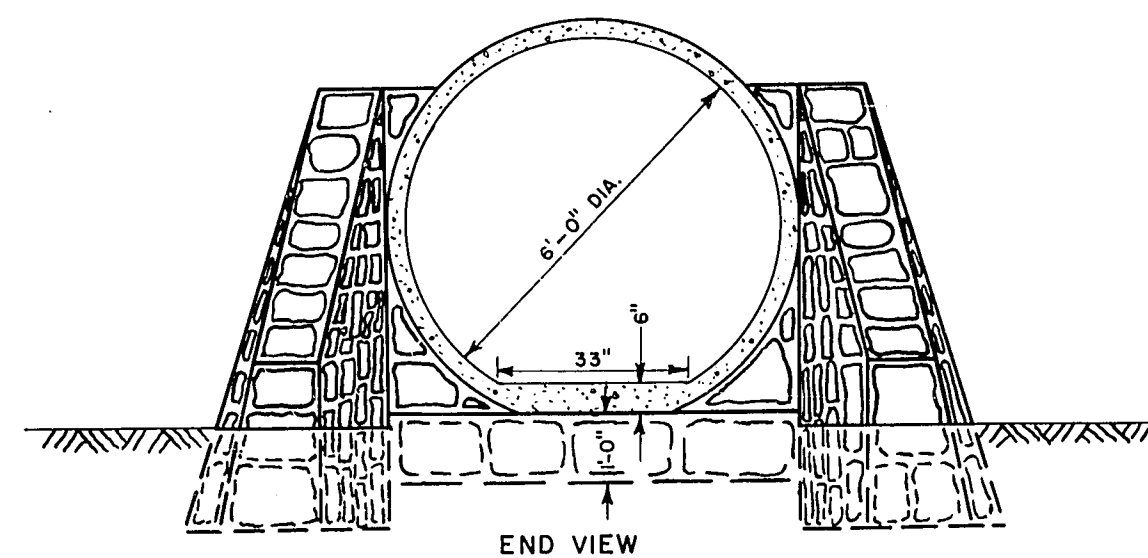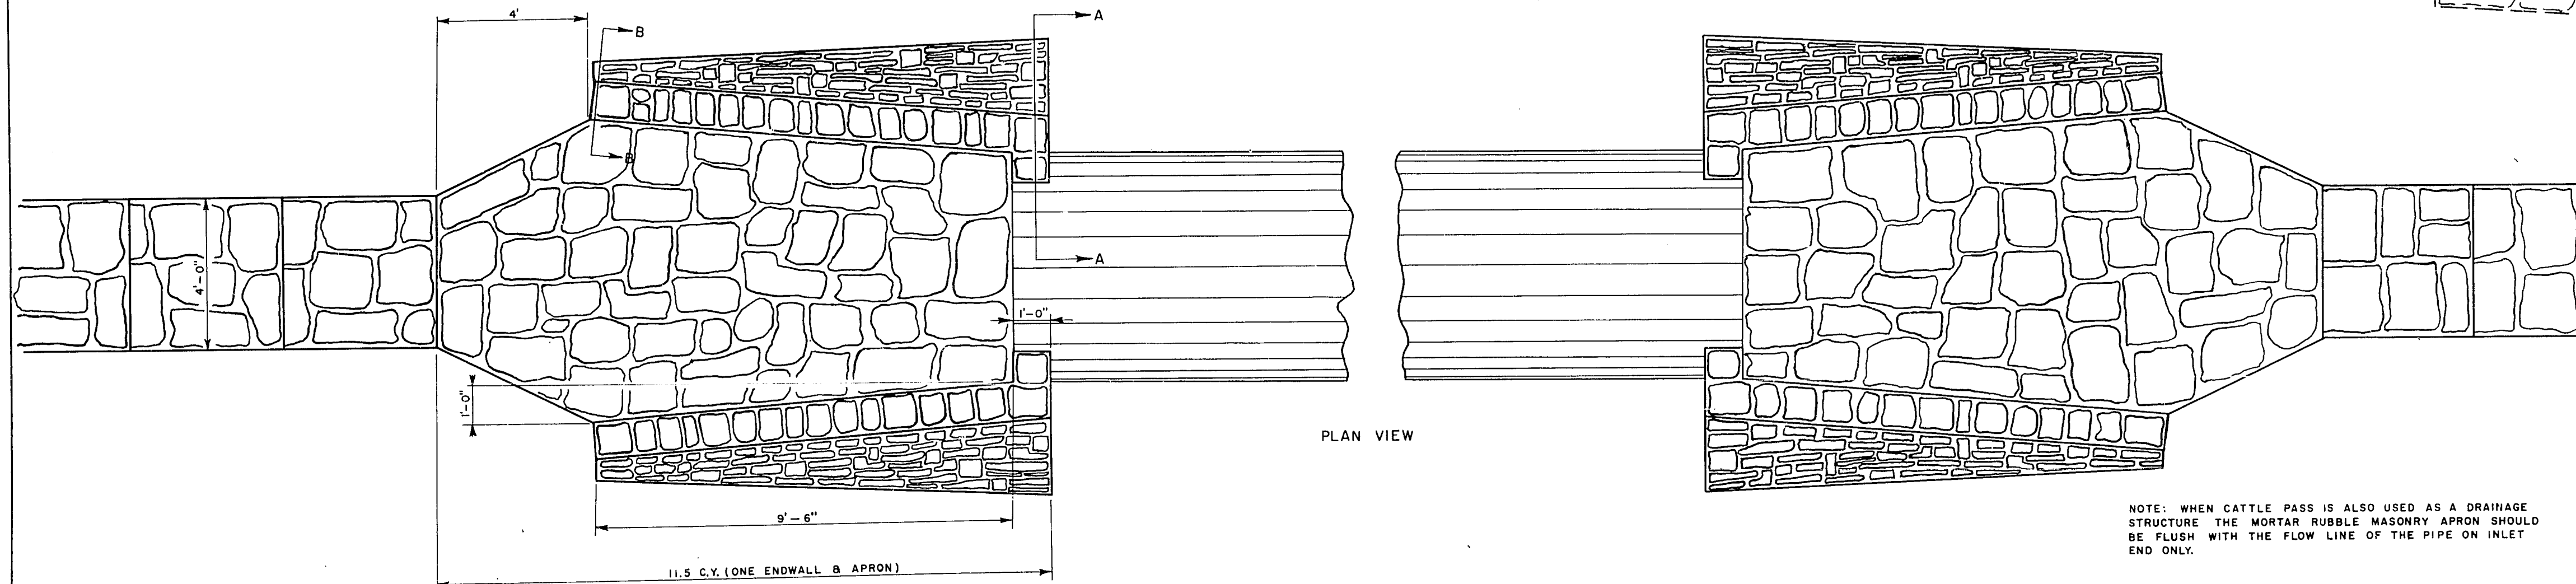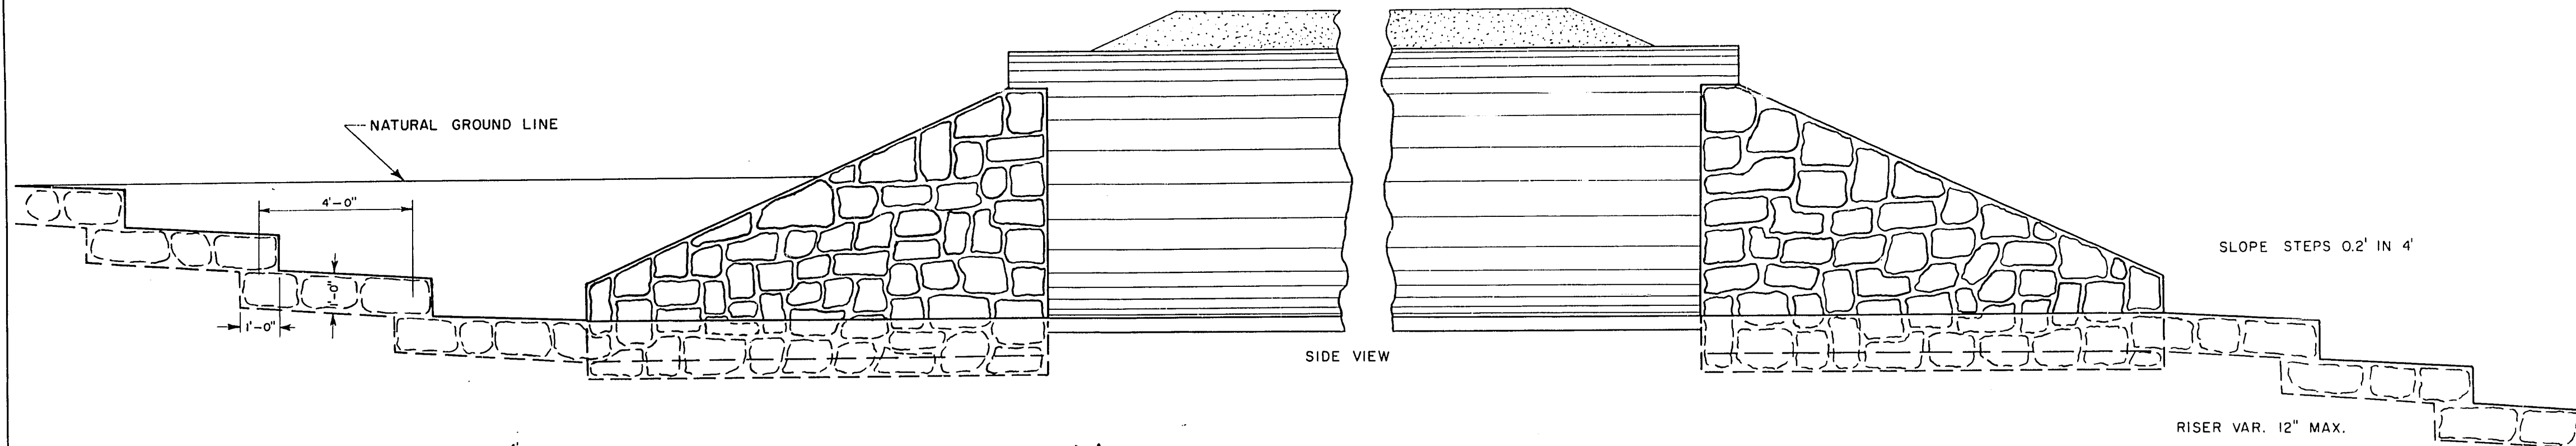


DETAIL OF
MORTAR RUBBLE MASONRY END WALLS
AND CATTLE WALKS
FOR
CATTLE PASSES


DO NOT SCALE

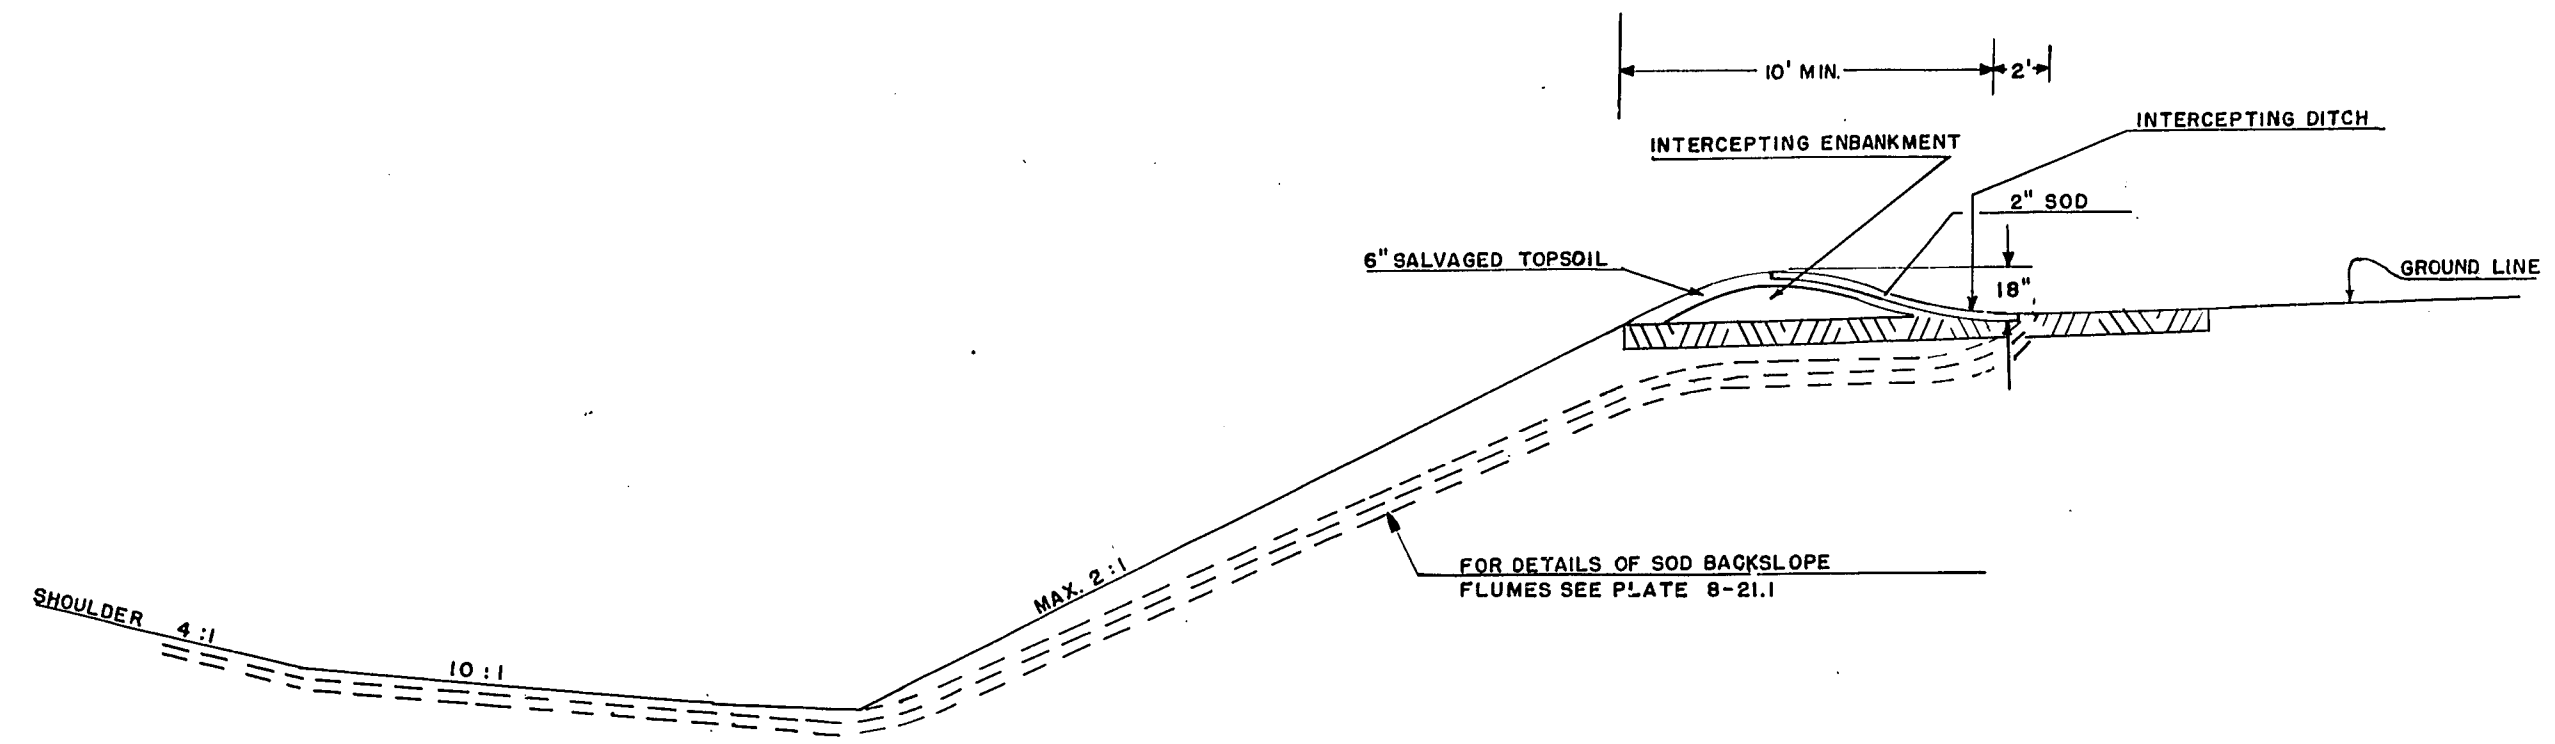

DETAIL OF INTERCEPTING ENBANKMENT

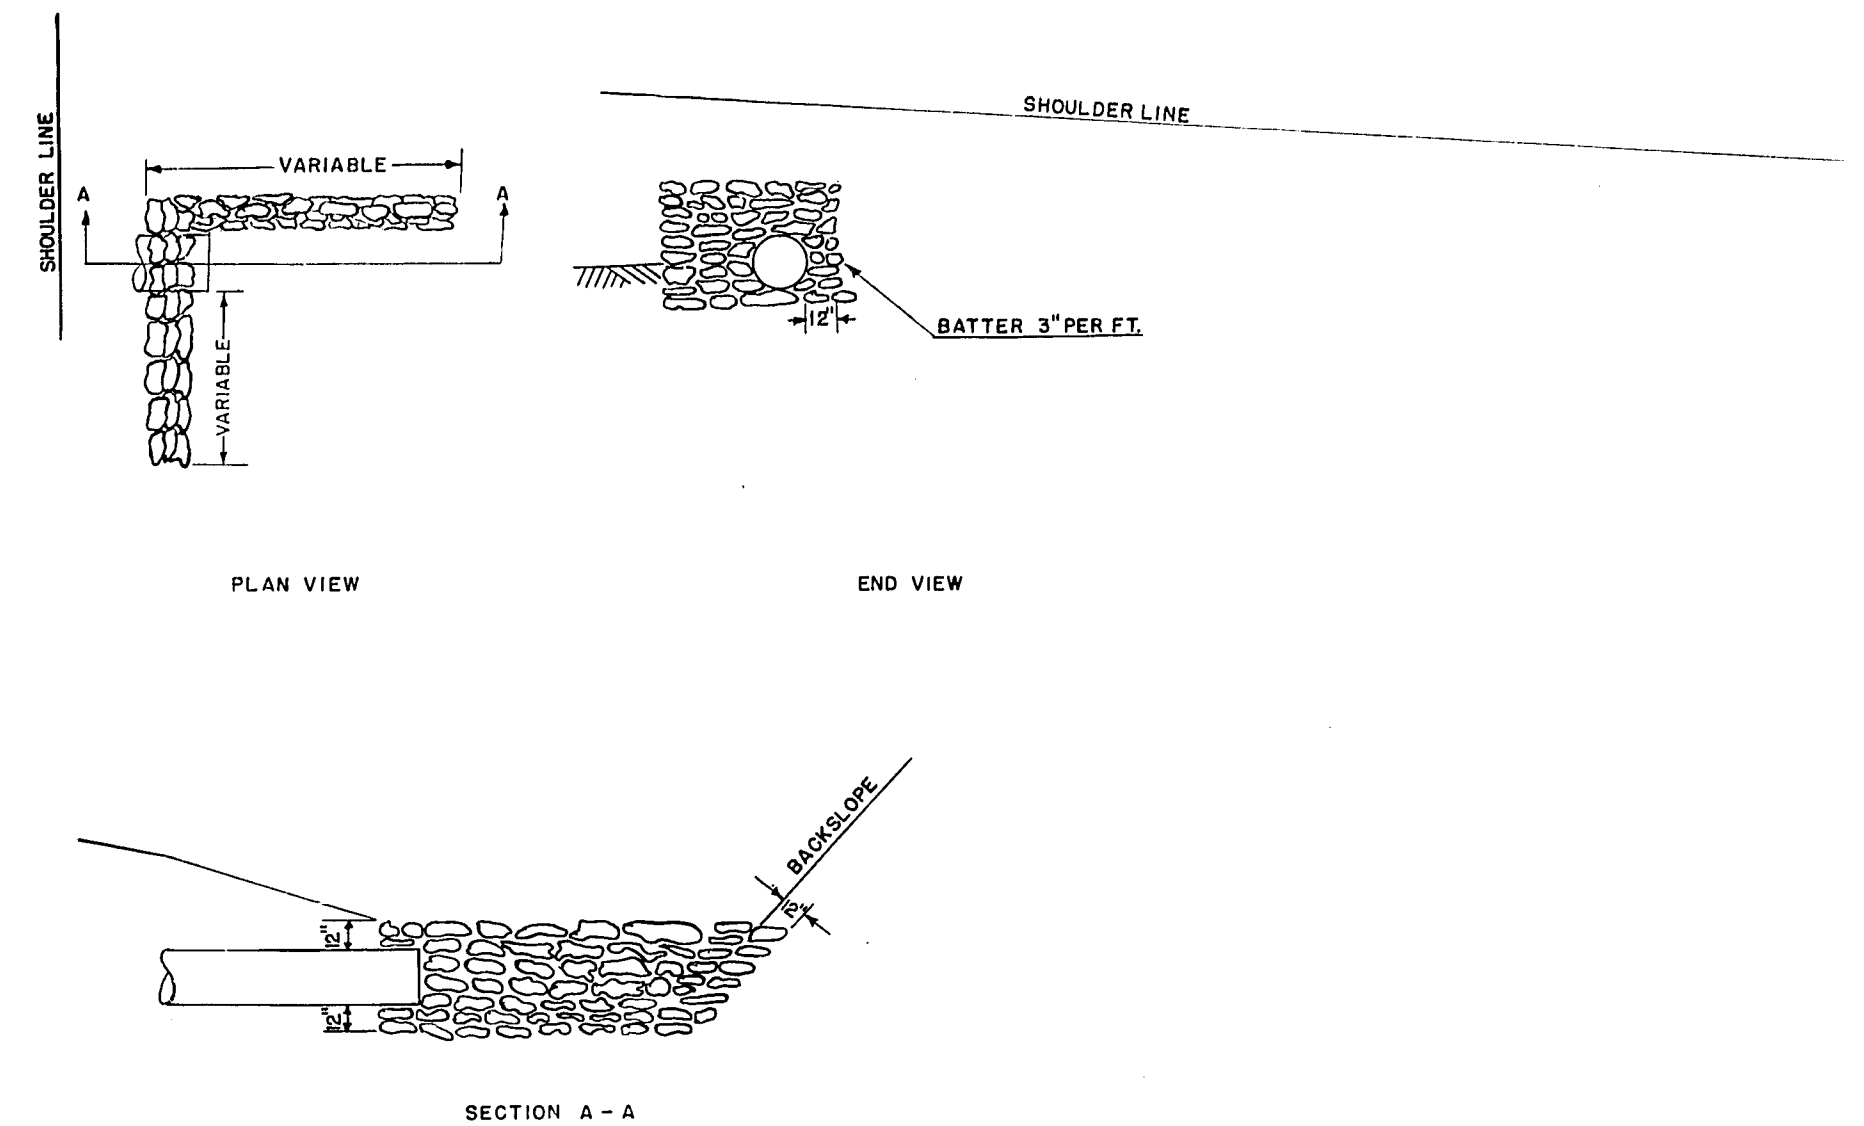

DETAIL OF BREAKER WALL

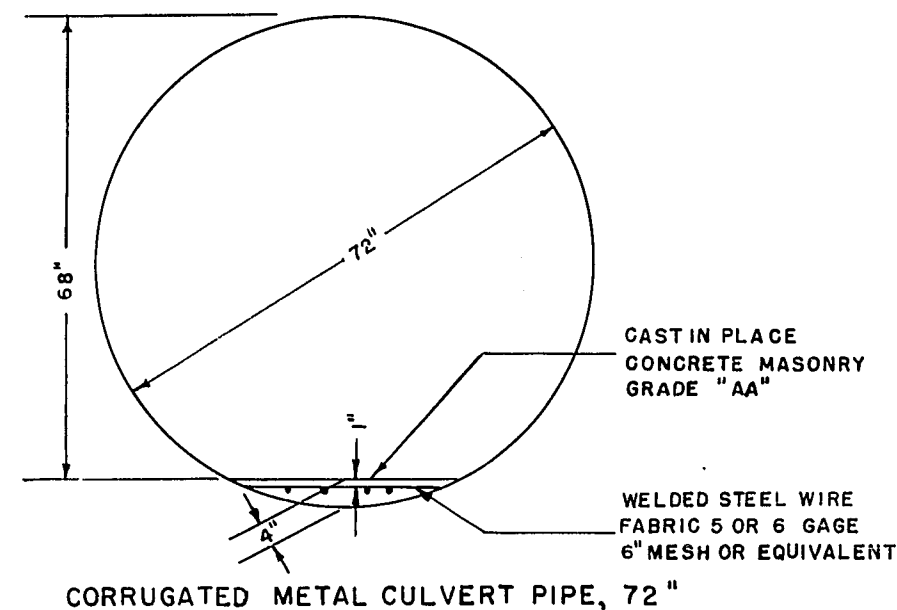

CORRUGATED METAL CULVERT PIPE, 72"

DETAILS OF CONSTRUCTION NOT SHOWN ON THIS DRAWING SHALL CONFORM TO THE PERTINENT REQUIREMENTS OF THE STANDARD SPECIFICATIONS, SECTIONS 2411 & 4116, AND THE APPLICABLE SPECIAL PROVISIONS.

CONCRETE MASONRY AND WIRE FABRIC TO BE INCLUDED IN THE BID PRICE FOR CULVERT PIPE.

DETAIL OF WALKWAY FOR 72" C.M. CULVERT PIPE

TYPICAL CROSS SECTION
FOR

MISCELLANEOUS DETAILS


DO NOT SCALE

DETAIL SUMMARY SHEET OF MISCELLANEOUS QUANTITIES

PROJECT: S0213(1) SHEET NUMBER: 3A TOTAL SHEETS: 86


CLEARING				GRUBBING				FINISHING ROADWAY				MARKER POSTS				STEEL PLATE BEAM				INTERCEPTING				PIPE CULVERTS													
SEC. NO.	STATION		STA.	SEC. NO.	STATION		STA.	SEC. NO.	STATION		STA.	SHOULDER DELINEATION			GUARD CLASS "B"			EMBANKMENT																			
I	235+00 - 242+00		7	I	235+00 - 242+00		7	I	235+00 - 329+00		93.6	SEC. NO.	STATION		SIDE	NO.	SEC. NO.	STATION		SIDE	L.F.	SEC. NO.	STATION		SIDE	L.F.	I	236+00		24	60	C.P.	✓	2.0	2		
"	243+00 - 246+00		3	"	243+00 - 246+00		3	"	245A+20 - 249A+00		3.8	"	239+50 - 247+50		R	6	I	264+38.5 - 264+80		R&L	83	II	410+00 - 415+00		L	500	"	241+00		36	80	C.P.	✓	3.4	2		
"	247+00 - 250+00		3	"	247+00 - 250+00		3	"	267A+00 - 269A+00		2.0	"	240+50 - 244+50		L	9	I	265+20 - 265+61.5		R&L	83	II	424+00 - 440+00		L	1600	"	246+40		48	72	C.P.	✓	5.6	2		
"	263+00 - 266+00		3	"				"				"	250+00 - 253+00		R	7	"					"					"	273+50		36	78	C.P.	✓	3.4	2		
"	296+00 - 302+00		6	"	296+00 - 302+00		6	II	395+00 - 492+00		96.8	"	259+50 - 265+75		R	7	II	419+09.5 - 419+51		R&L	83	"					"	283+39		72	50	C.P.	✓	*27.9	2		
"	317+00 - 319+00		2	"	317+00 - 319+00		2	"	423A+20 - 426A+00		2.8	"	259+50 - 265+75		L	7	II	419+81 - 420+22.5		R&L	83	"					"	291+50		30"	76	C.P.	✓	2.6	2		
II	395+00 - 401+00		6	II	395+00 - 399+00		4	III	534+00 - 549+00		16.0	"	267A S.R.			4	"					"					"	304+28		72	50	C.P.	✓	*27.9	2		
"	411+00 - 415+00		4	"	411+00 - 415+00		4	"				"	268+50 - 276+50		R	9	"					"					"	309+40		30"	78	C.P.	✓	2.6	2		
"	425+00 - 428+00		3	"	425+00 - 428+00		3	IV	582+00 - 626+00		44.0	"	290+50 - 296+00		R	6	"					"					"	318+66		72	48	C.P.	✓	*26.4	2		
"	430+00 - 433+00		3	"	430+00 - 433+00		3	"	592A+00 - 594A+00		2.0	"	308+00 - 312+00		R	9	"					"					"	323+32		65"X40"	60	CMPA	✓	5.0	2		
"	435+00 - 440+00		5	"				SALVAGED TOPSOIL				II	395+00 - 402+00		R	8	"					SEC. NO.	STATION		LOC.	S.Y.	"	4 P.E.S.		18"	120	C.P.	✓	1.60			
"	445+00 - 446+00		1	"	445+00 - 446+00		1					"				"	401+00 - 403+00		L	5	"					II	410+00 - 415+00		INT. EMB.	580	"						
"	448+00 - 473+00		25	"	448+00 - 473+00		25					"				"	414+50 - 418+00		R	8	"					II	410+00		FLUME	120	"						
"	482+00 - 485+00		3	"	482+00 - 485+00		3					"				"	426+00 - 428+00		R	5	"					II	415+00		FLUME	100	"						
IV	591+00 - 593+00		2	IV	591+00 - 593+00		2	SEC. NO.	STATION		S.Y.	"	423A S.R.			4	"					II	424+00 - 440+00		INT. EMB.	1900	"										
"	596+00 - 598+00		2	"	596+00 - 598+00		2	"	235+00 - 239+00		356	"	440+50 - 458+50		R	19	"					II	426+00		FLUME	100	"										
I	259+00 - 260+00		105	I	259+00 - 260+00		105	"	245A+75 - 249A+00		542	"	442+50 - 454+00		L	12	"					II	435+00		FLUME	100	II	401+00		24	84	C.P.	✓	2.0	2		
"	267A+25		SR.	21	"	267A+25		SR.	21	"	245+00 - 259+50		9987	"	462+00 - 469+00		R	8	"			"					"	407+00		36	68	C.P.	✓	3.4	2		
"	281+79			24	"	281+79			24	"	265+00 - 291+00		13385	"	463+00 - 473+00		L	11	"			"					"	435+00		36	68	C.P.	✓	3.4	2		
"	290+53			24	"	290+53			24	"	267A+00 - 269A+00		267	"							"					"	445+00		36	60	C.P.	✓	3.4	2			
"	306+53			30	"					"	294+00 - 319+00		8333	IV	592A S.R.			4	"			"					"	451+00		36	58	C.P.	✓	3.4	2		
"	310+41			24	"					"				"	590 S.R.		R	4	"			"					"	465+00		36	56	C.P.	✓	3.4	2		
II	418+00 - 420+00		60	II	418+00 - 420+00		60	"	359+00 - 401+00		666	"					"					"					"	471+00		58"X36"	56	CMPA	✓	4.2	2		
"				"				"	403+00 - 406+00		466	"					"					"					"	477+00		43"X27"	56	CMPA	✓	3.4	2		
"				"				"	409+00 - 416+00		3966	"					"					"					"	483+10		43"X27"	20	CMPA	✓	3.4	2		
"				"				"	423A+20 - 426A+00		406	"					"					"					"	486+97		43"X27"	20	CMPA	✓	3.4	2		
IV	588+04		28	IV	588+04		28	"	420+00 - 443+00		8944	"					"					"					"	3 P.E.S.		18"	90	C.P.	✓	9.0			
"	619+07		36	"				"	454+00 - 463+00		1000	"					"					"					"	403+50		72	58	C.P.	✓	*27.9	2		
"	619+72		12	"	619+72		12	"	477+00 - 482+00		722	"					"					"					"	474+50		43"X27"	56	CMPA	✓	3.4	2		
"	625+56		21	"	625+56		21	"				"					"					"					"	424+40		24	68	C.P.	✓	2.0	2		
OBLITERATING OLD ROAD				IV	586+00 - 589+00		220	"	592A+00 - 594A+00		443	"					"					"					III	535+26		36"X22"	108	CMPA	✓	4.8	2		
				"				"	591+00 - 598+00		777	"					"							"					"	543+41		43"X27"	108	CMPA	✓	6.0	2
				"				"	612+00 - 626+00		3110	"					"							"					"								
				"				"				"				"					"					"											

COUNTY AND HIGHWAY	ROUTE AND SECTION	CLASS AND AGREEMENT		FEDERAL DIVISION OFFICE	SHEET NUMBER	TOTAL SHEETS
		STATE	FEDERAL			
56.2	213.0	21.1		WIS. 5N	4	86

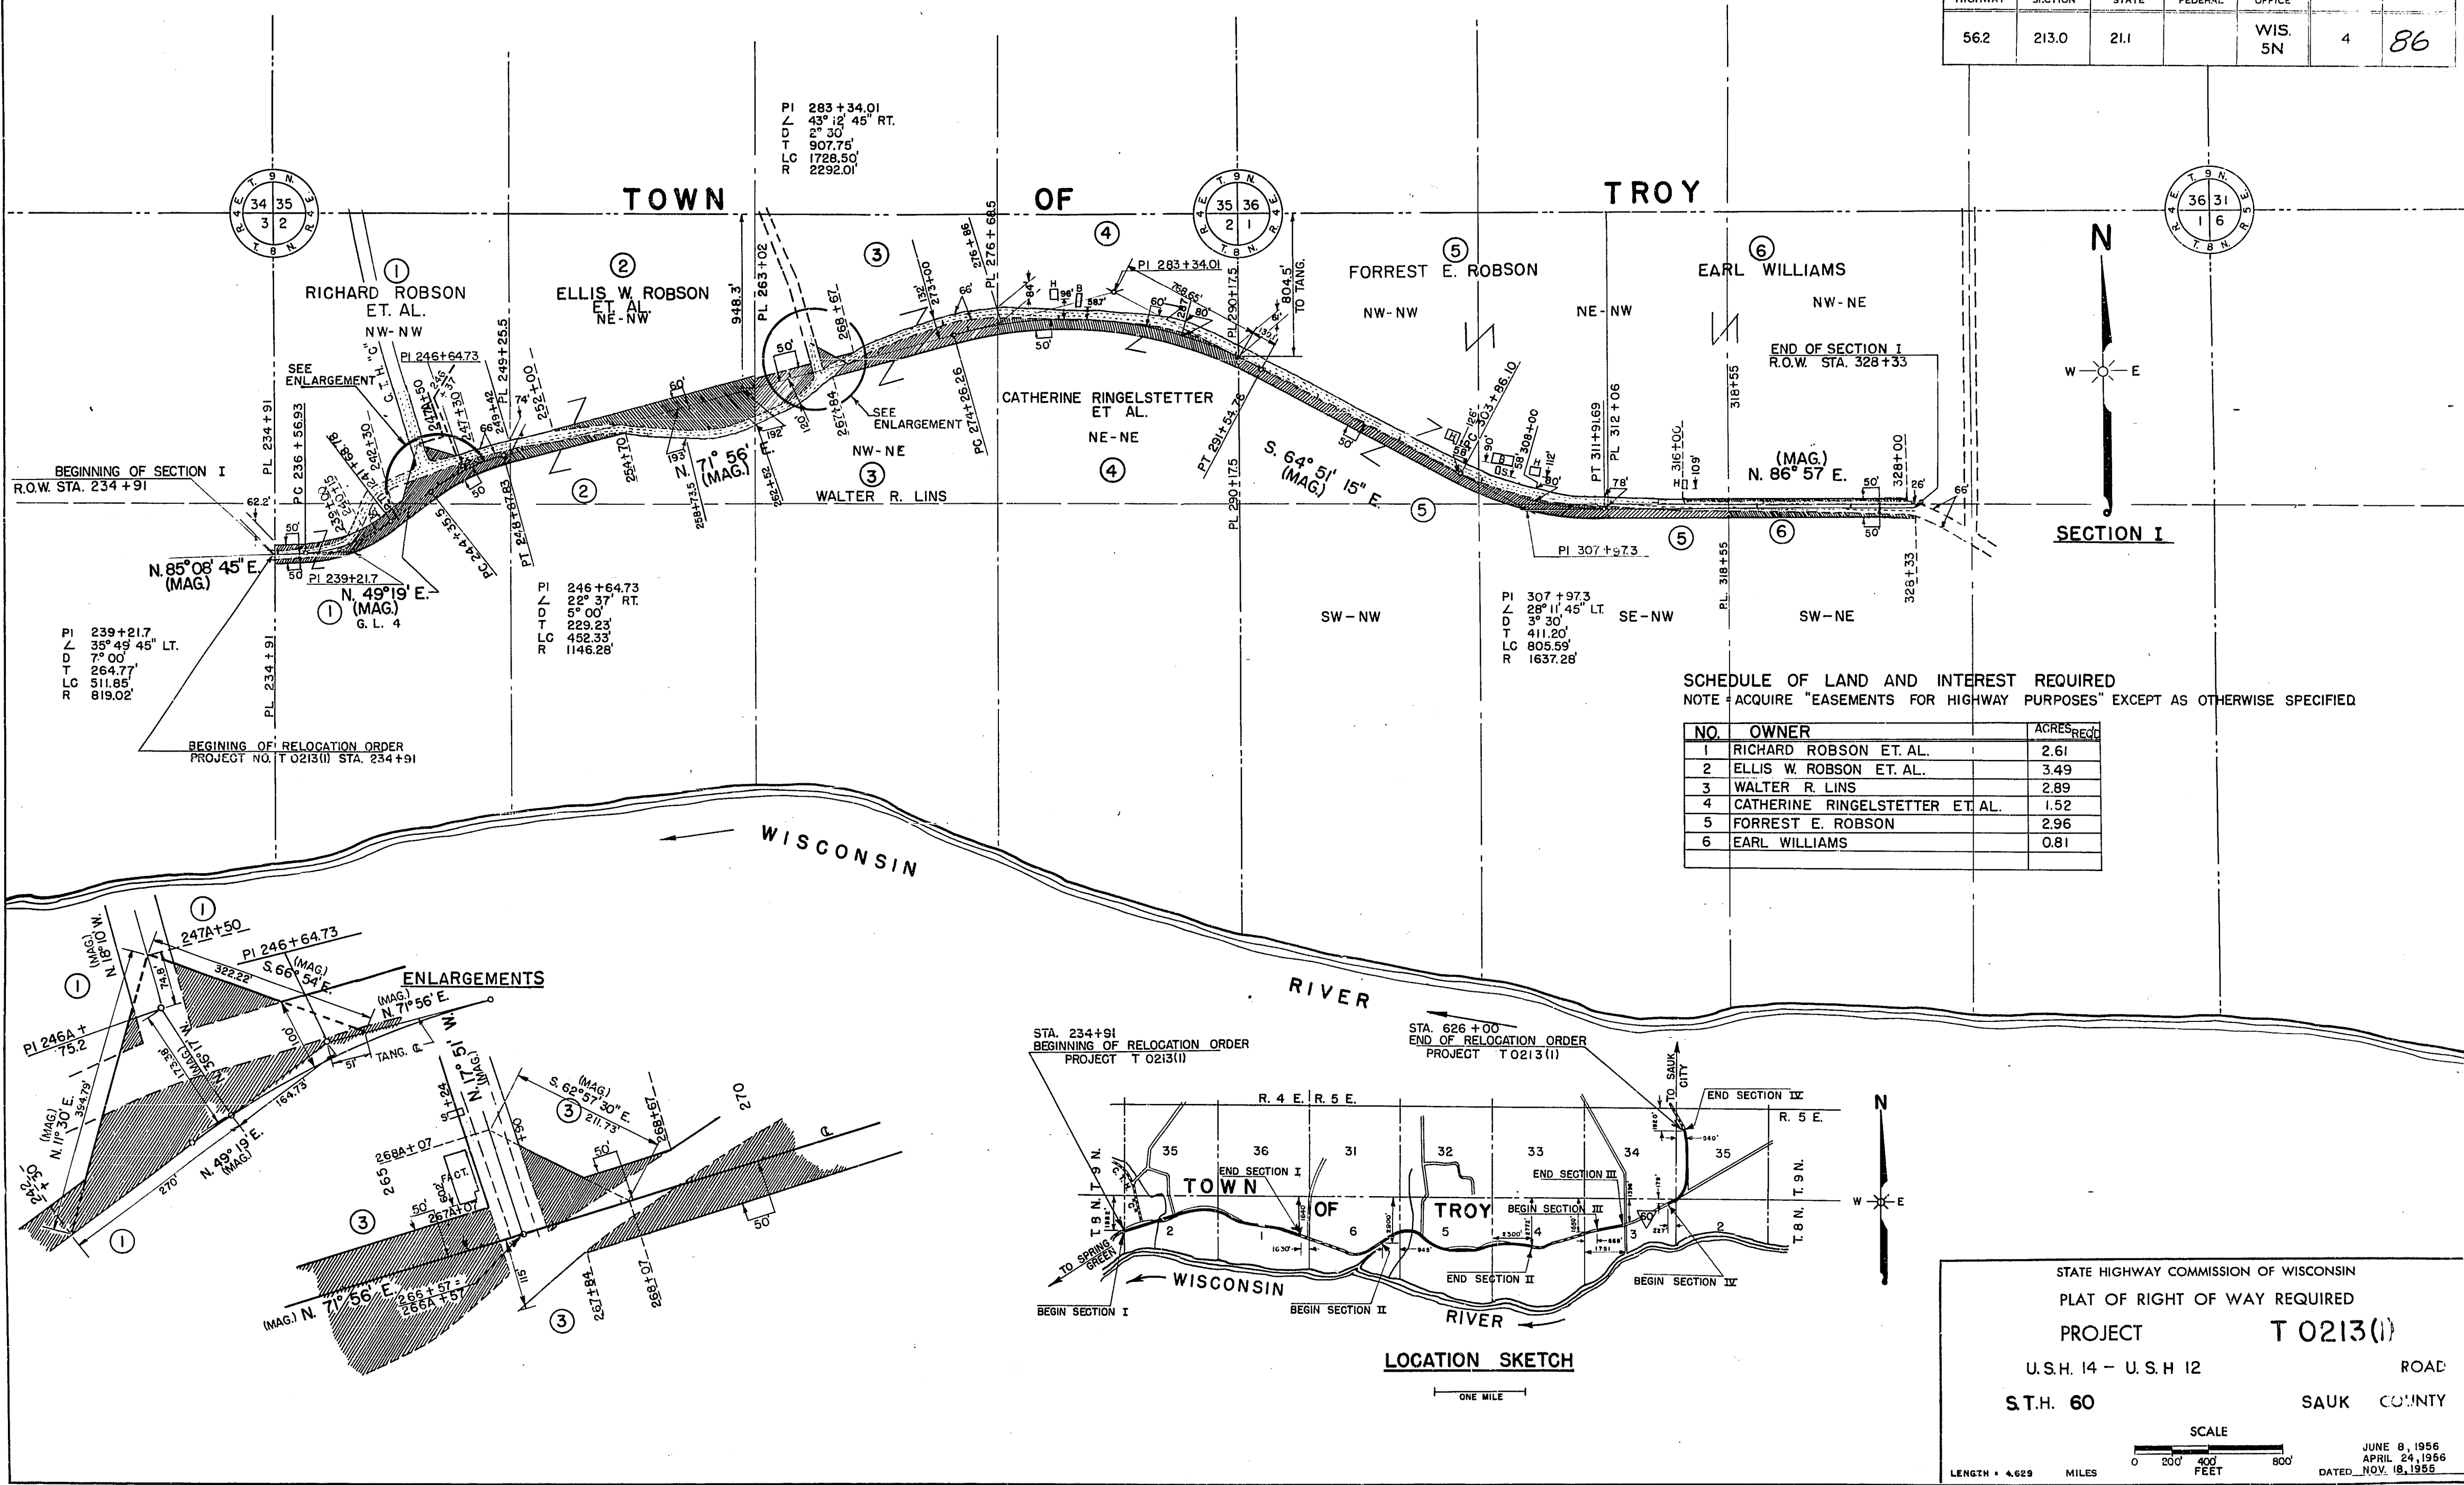

SCHEDULE OF LAND AND INTEREST REQUIRED
NOTE - ACQUIRE "EASEMENTS FOR HIGHWAY PURPOSES" EXCEPT AS OTHERWISE SPECIFIED

NO.	OWNER	ACRES
1	RICHARD ROBSON ET. AL.	2.61
2	ELLIS W. ROBSON ET. AL.	3.49
3	WALTER R. LINS	2.89
4	CATHERINE RINGELSTETTER ET. AL.	1.52
5	FORREST E. ROBSON	2.96
6	EARL WILLIAMS	0.81

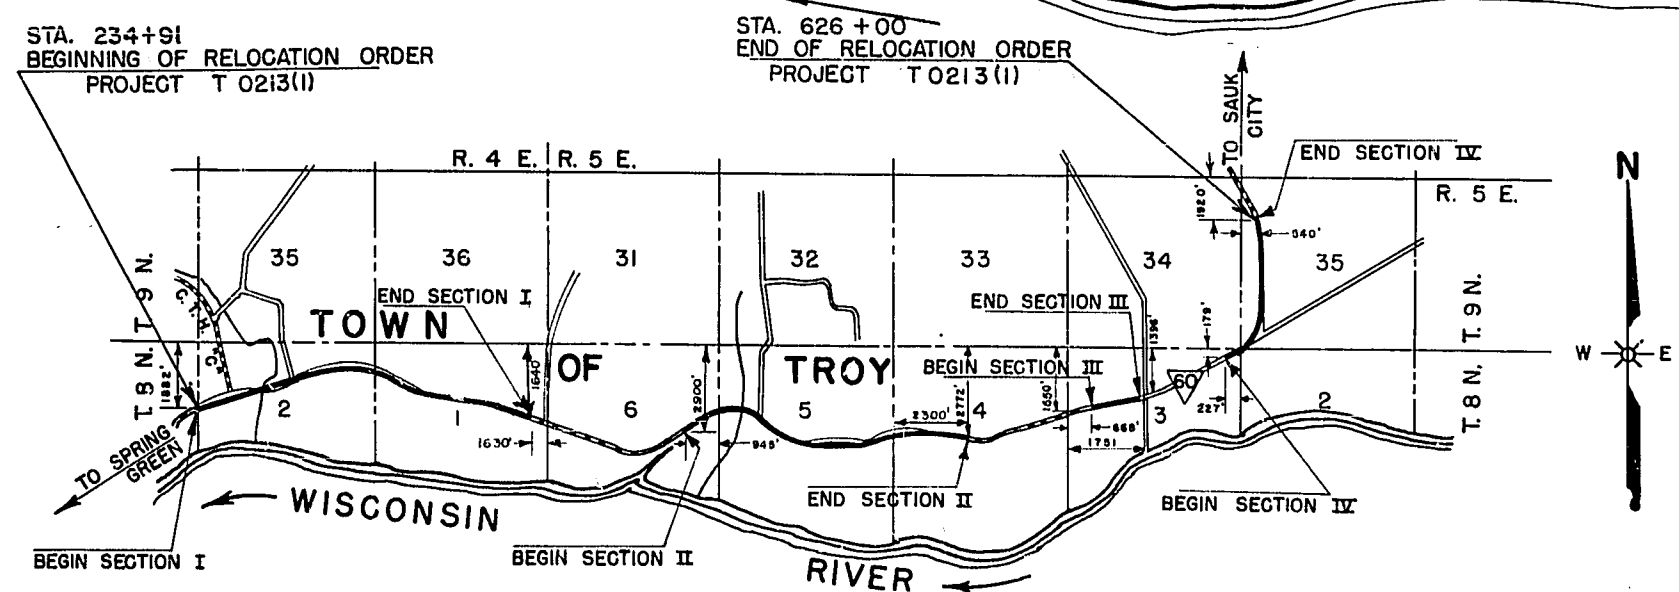


STATE HIGHWAY COMMISSION OF WISCONSIN
PLAT OF RIGHT OF WAY REQUIRED
PROJECT T 0213(1)
U.S.H. 14 - U.S.H. 12 ROAD
S.T.H. 60 SAUK COUNTY

SCALE
0 200 400 800 FEET
LENGTH - 4.629 MILES

JUNE 8, 1956
APRIL 24, 1956
DATED NOV. 18, 1955

COUNTY AND HIGHWAY	ROUTE AND SECTION	CLASS AND AGREEMENT		FEDERAL DIVISION OFFICE	SHEET NUMBER	TOTAL SHEETS
		STATE	FEDERAL			
56.2	213.0	21.1		WIS. 5N	41	86

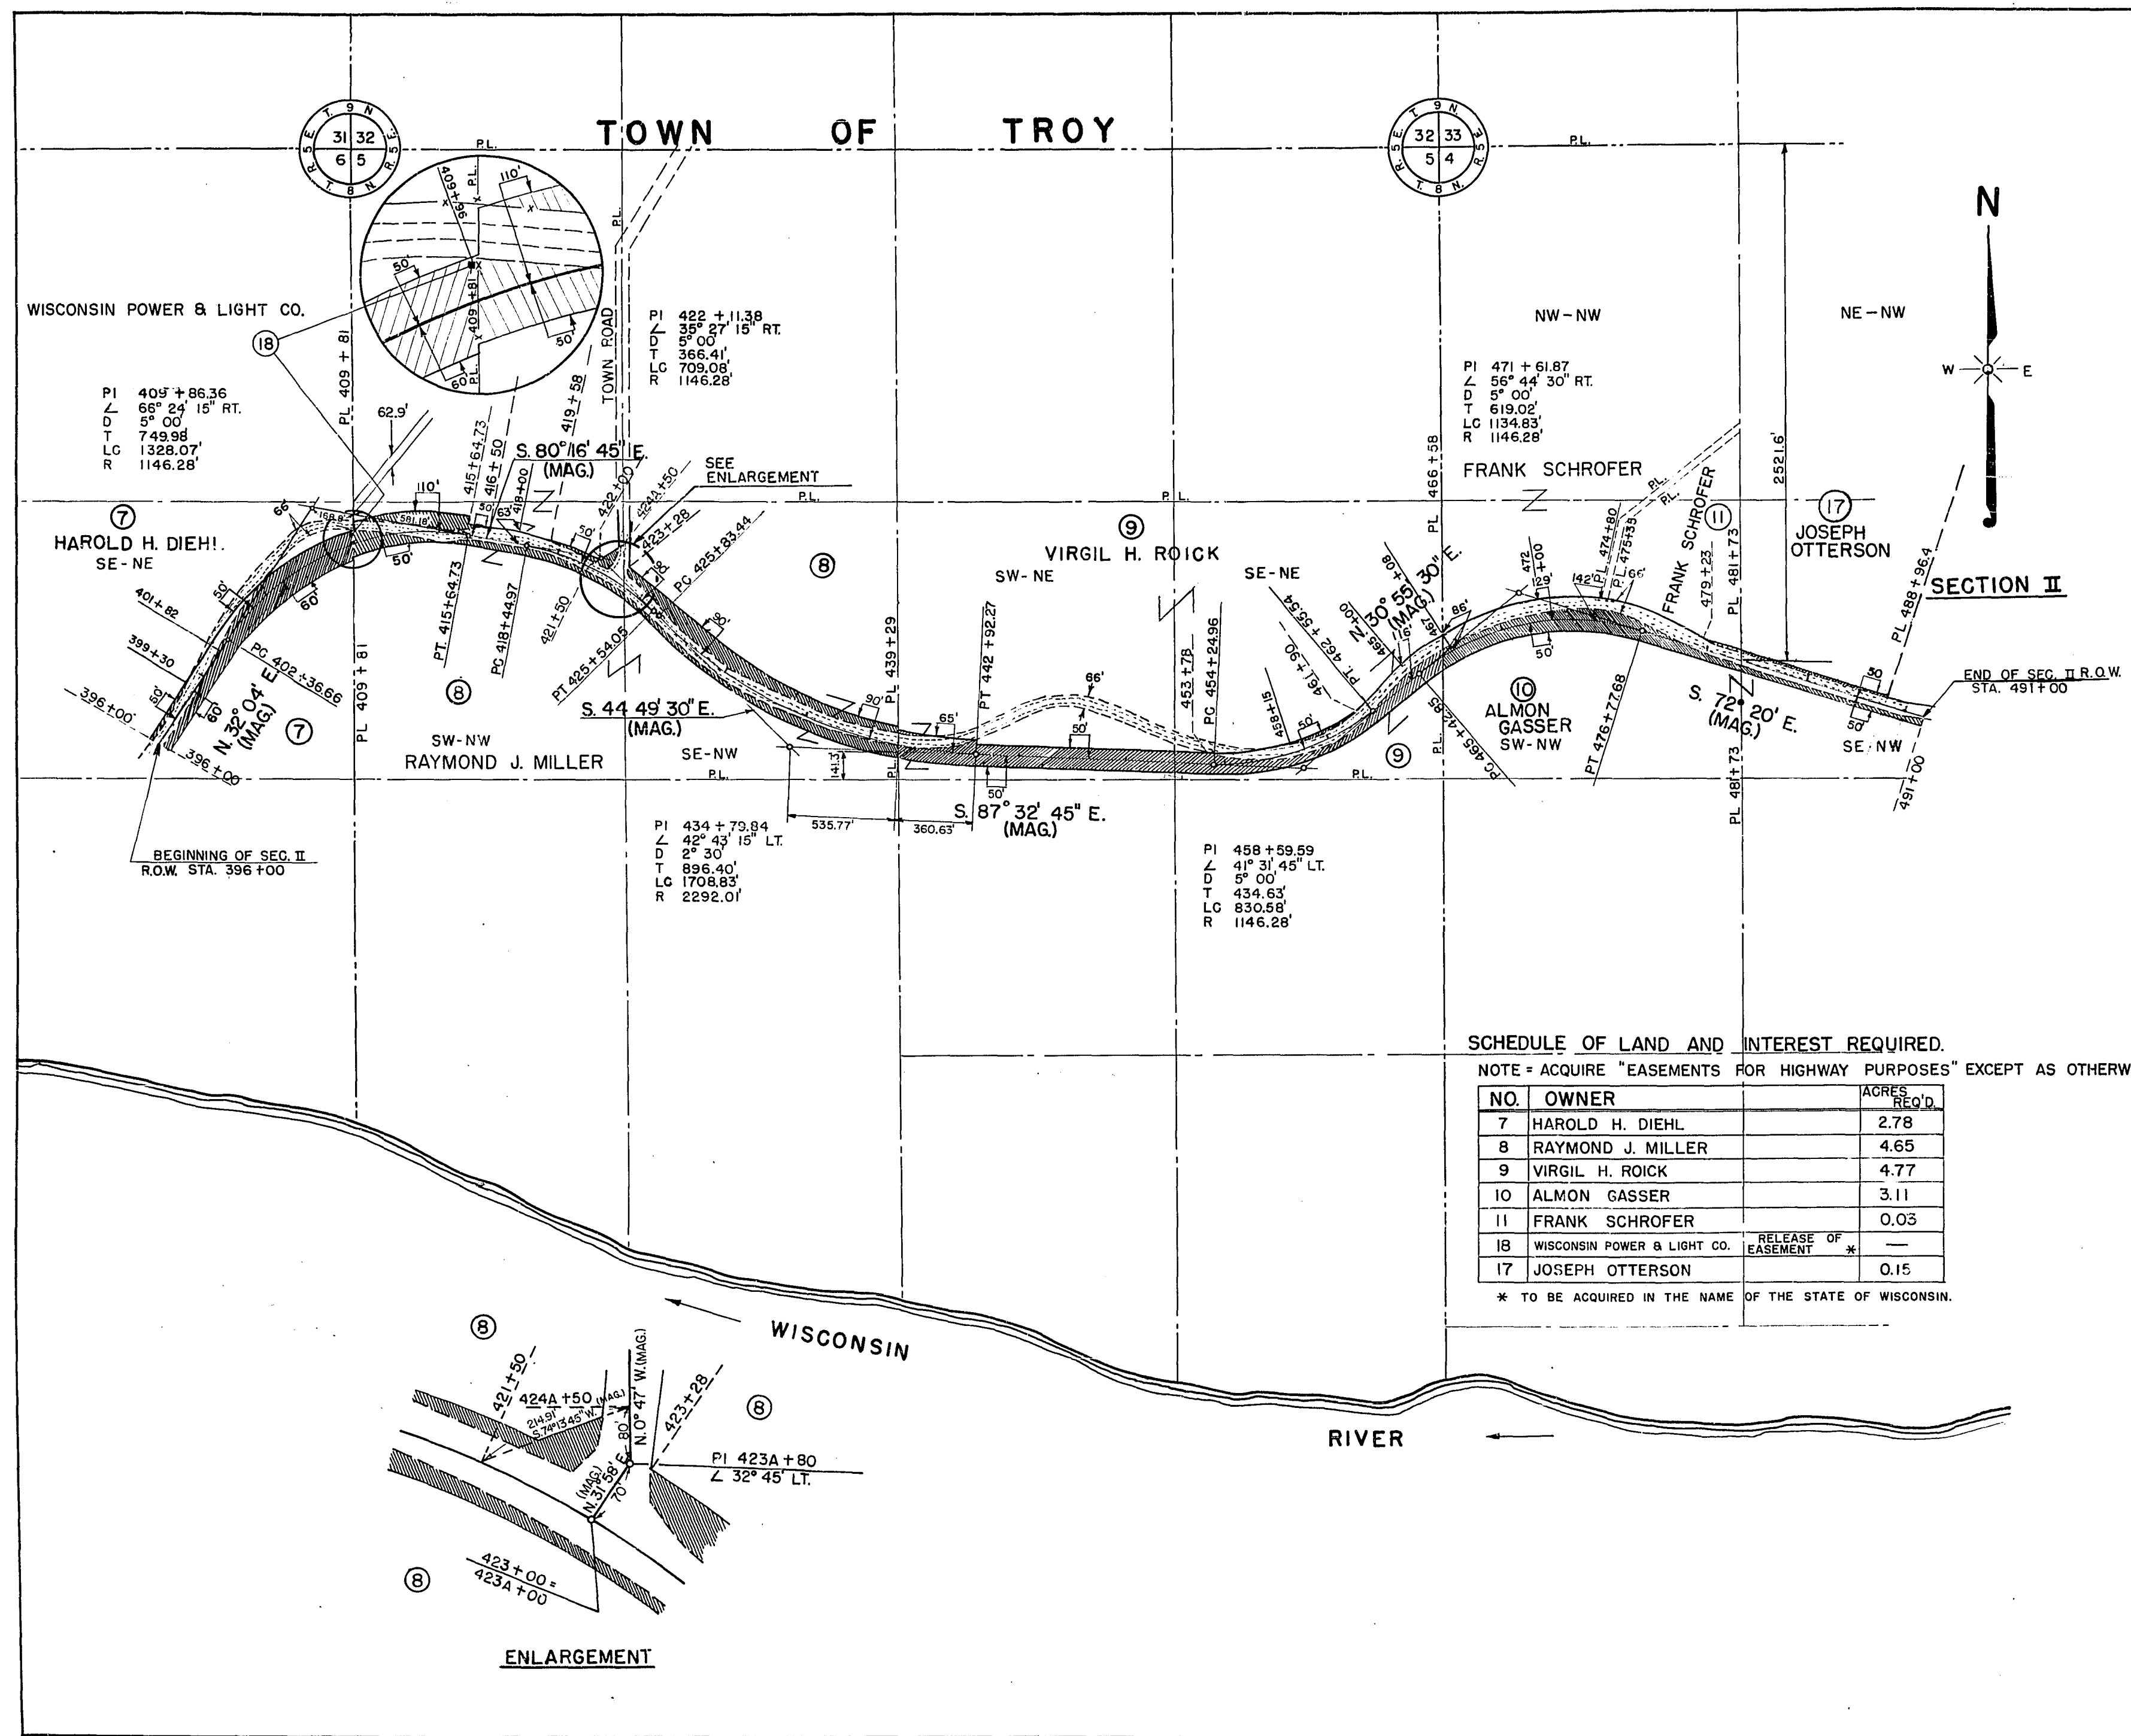


SCHEDULE OF LAND AND INTEREST REQUIRED.

NOTE = ACQUIRE "EASEMENTS FOR HIGHWAY PURPOSES" EXCEPT AS OTHERWISE SPECIFIED.

NO.	OWNER	ACRES REQ'D.
7	HAROLD H. DIEHL	2.78
8	RAYMOND J. MILLER	4.65
9	VIRGIL H. ROICK	4.77
10	ALMON GASSER	3.11
11	FRANK SCHROFER	0.03
18	WISCONSIN POWER & LIGHT CO.	RELEASE OF EASEMENT *
17	JOSEPH OTTERSON	0.15

* TO BE ACQUIRED IN THE NAME OF THE STATE OF WISCONSIN.



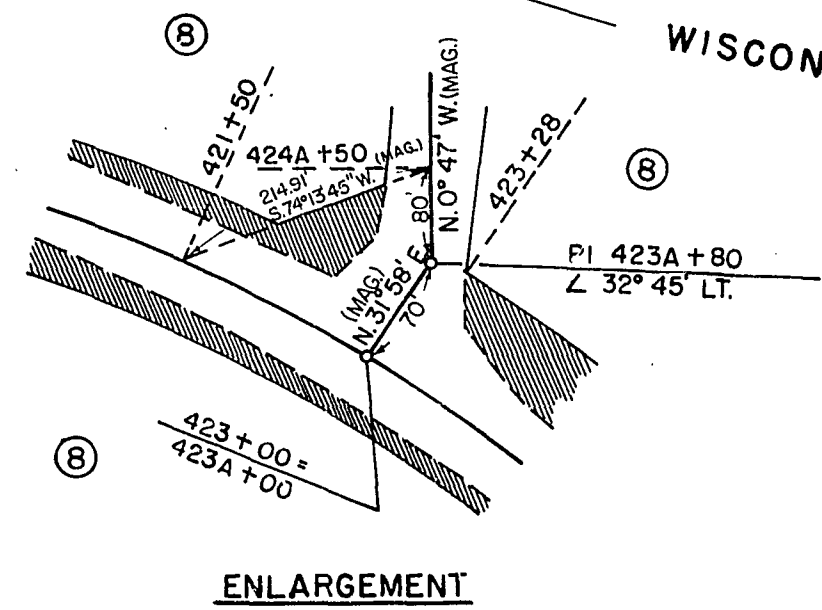


STATE HIGHWAY COMMISSION OF WISCONSIN
PLAT OF RIGHT OF WAY REQUIRED
PROJECT T 0213(1)
U. S. H. 14 - U. S. H. 12 ROAD
S.T.H. 60 SAUK COUNTY

SCALE
0 200' 400' 800'
LENGTH 4.629 MILES

JUNE 8, 1956
APRIL 24, 1956
DATED NOV. 18, 1955

COUNTY AND HIGHWAY	ROUTE AND SECTION	CLASS AND AGREEMENT		FEDERAL DIVISION OFFICE	SHEET NUMBER	TOTAL SHEETS
		STATE	FEDERAL			
56.2	213.0	21.1		WIS. 5N	4.2	86

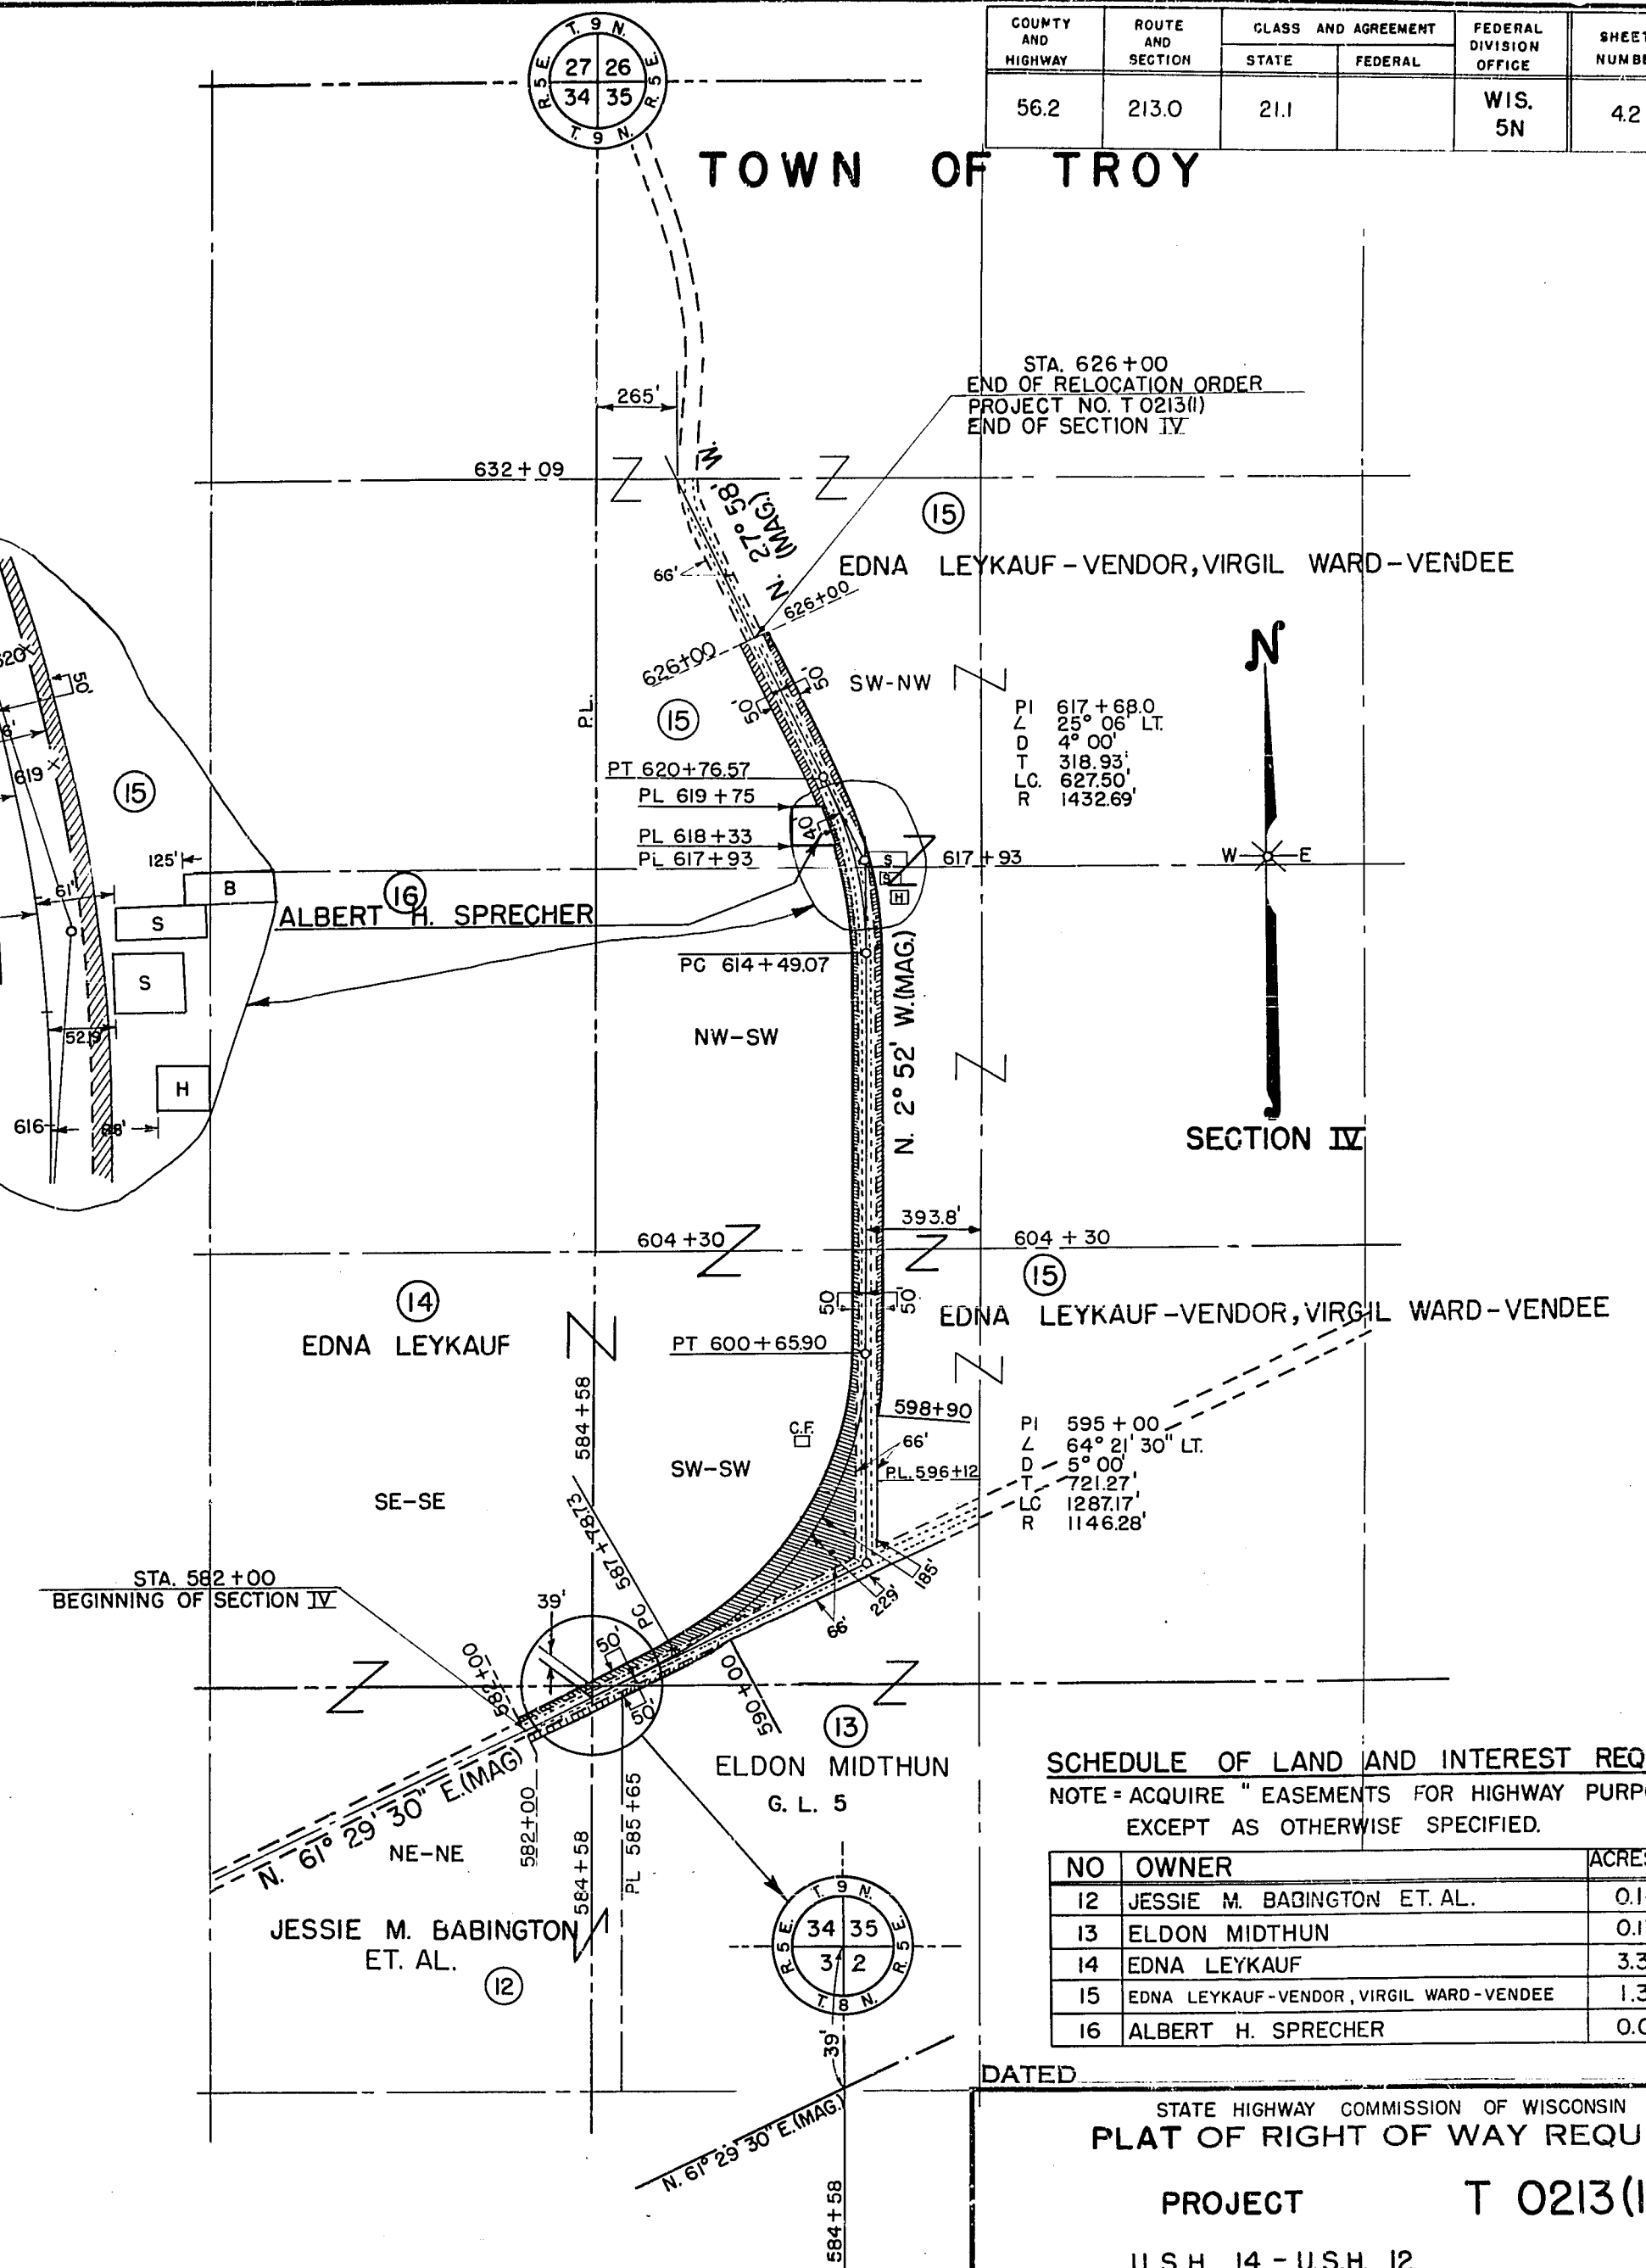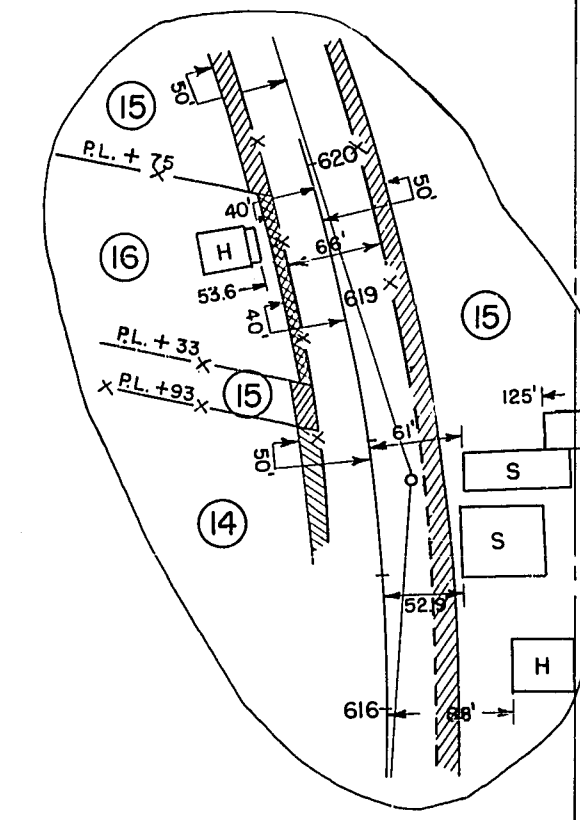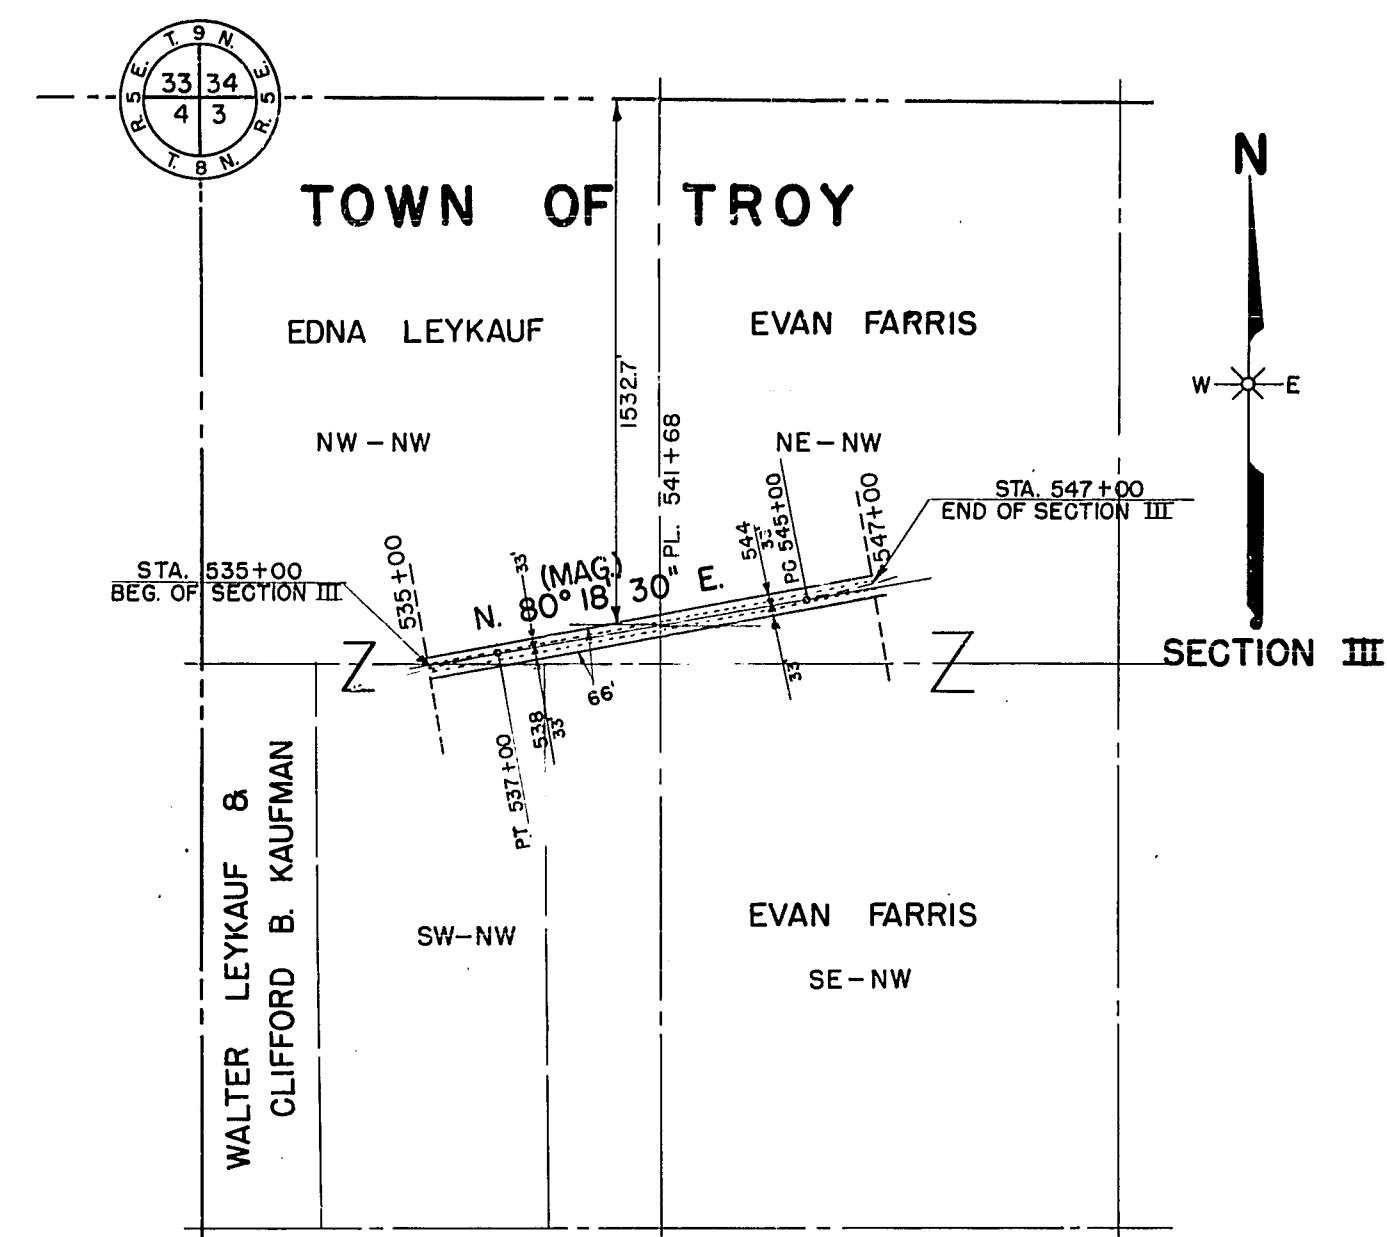

SCHEDULE OF LAND AND INTEREST REQUIRED.
NOTE - ACQUIRE "EASEMENTS FOR HIGHWAY PURPOSES" EXCEPT AS OTHERWISE SPECIFIED.

NO	OWNER	ACRES
12	JESSIE M. BABINGTON ET. AL.	0.14
13	ELDON MIDTHUN	0.17
14	EDNA LEYKAUF	3.30
15	EDNA LEYKAUF - VENDOR, VIRGIL WARD - VENDEE	1.38
16	ALBERT H. SPRECHER	0.04

DATED _____

STATE HIGHWAY COMMISSION OF WISCONSIN
PLAT OF RIGHT OF WAY REQUIRED

PROJECT T 0213(1)

U.S.H. 14 - U.S.H. 12

S. T. H. 60 SAUK COUNTY

SCALE
0' 200' 400' 800'
LENGTH 4.629 MILES


JUNE 8, 1956
APRIL 24, 1956
NOV. 18, 1955

Map Details:

- North Arrow:** Points North (N) is towards the top-left.
- Scale:** 1" = 100'.
- Property Owners:**
 - RICHARD ROBSON ET. AL. (Top Left and Bottom Center)
 - ELLIS W. ROBSON ET. AL. (Top Right and Middle Right)
- Key Features and Stationing:**
 - BLUFF:** Located on the left side, with a top elevation of 819.02'.
 - SLOUGH:** Located at the bottom left.
 - BLUSH:** Located on the right side.
 - EXISTING R.O.W. LINE:** Right-of-Way line on the right.
 - CULV.:** Culvert structure on the right.
 - STATIONING:** 239+00 to 248+00.
- Curves and Grades:**
 - CONST. 12° CURVE:** A constant grade curve.
 - CONST. 12° CURVE:** A constant grade curve.
- Other Data:**
 - PI. 239+21.7:** Point of Intersection.
 - PI. 246+64.73:** Point of Intersection.
 - PI. 248+00:** Point of Intersection.
 - PI. 248+00:** Point of Intersection.
 - PI. 248+00:** Point of Intersection.



UNC. EX. = UNCLASSIFIED EXCAVATION
F. = FILL
SHRINKAGE = 25% TO 35%

CP = CULVERT PIPE
C.M.P.A. = CORRUGATED METAL PIPE ARCH
L.H.F. = LEFT HAND FORWARD
R.H.F. = RIGHT HAND FORWARD

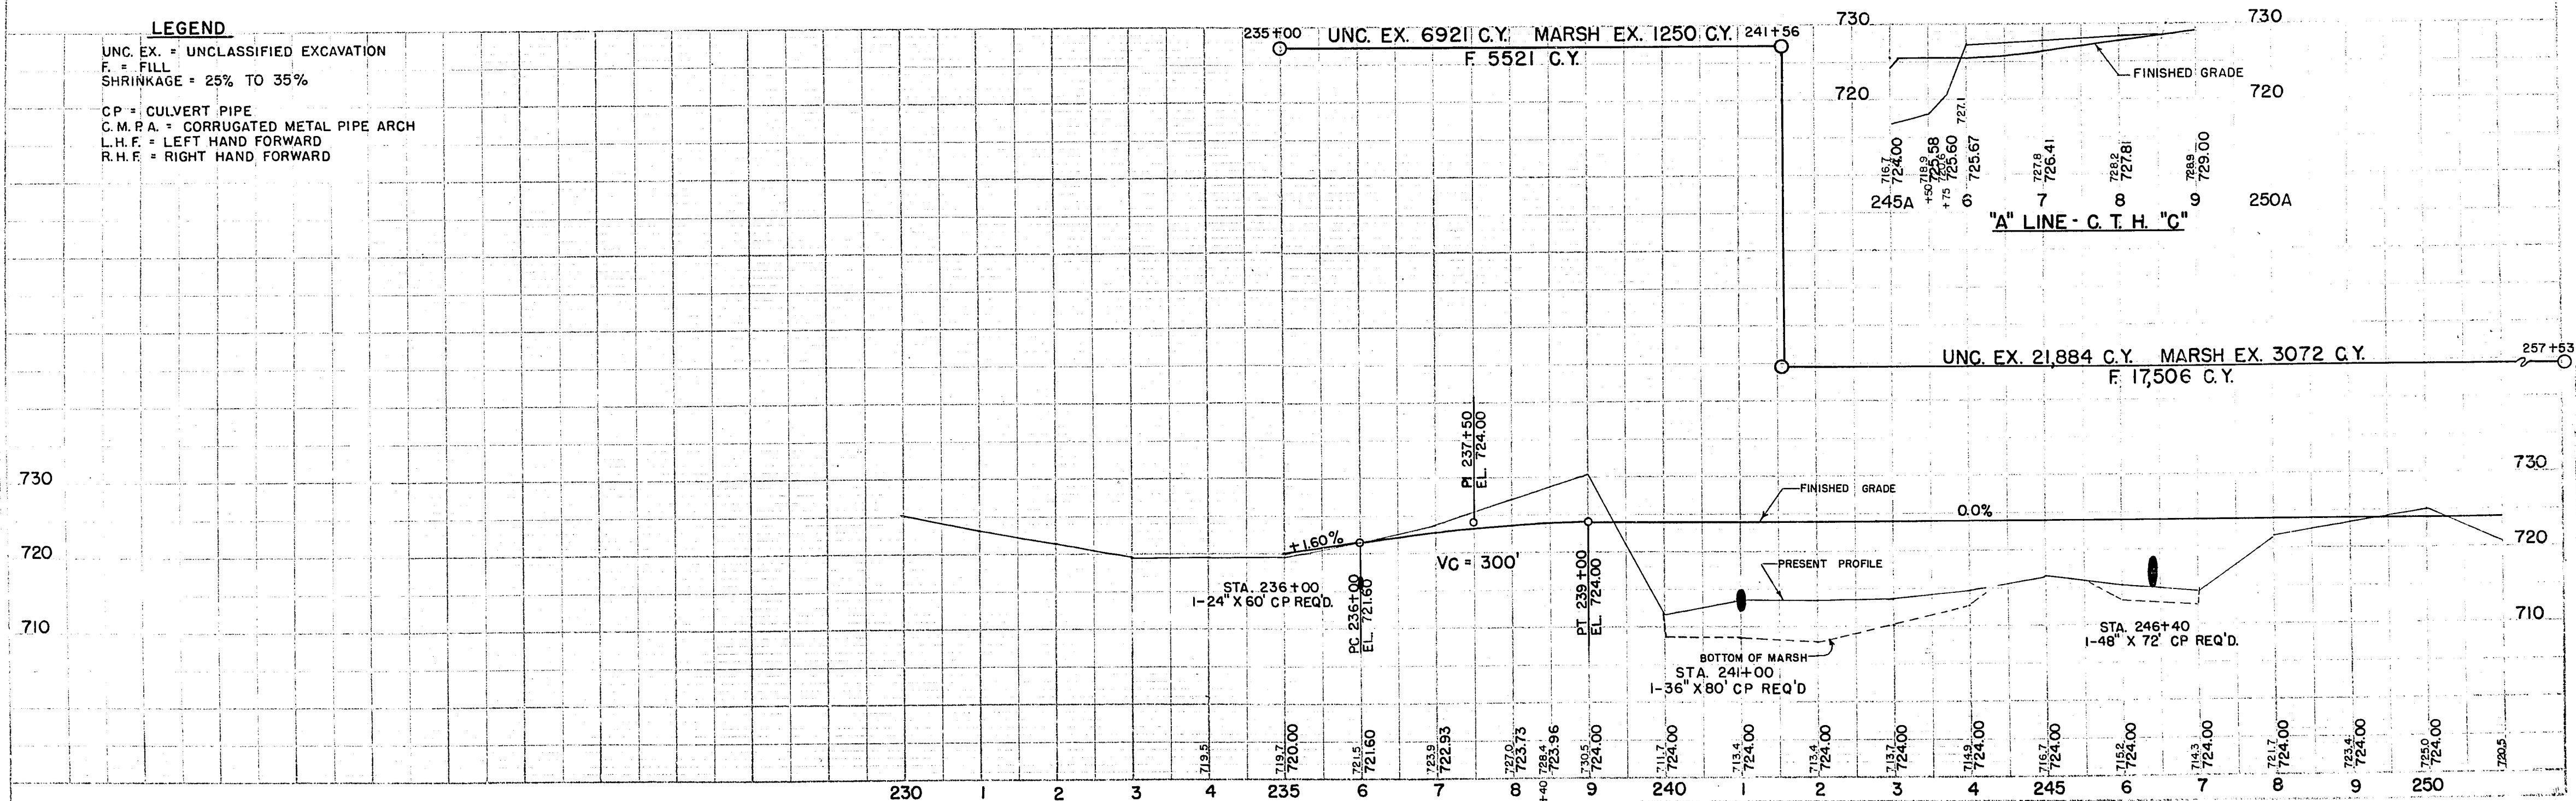

BENCH MARKS			
NO.	STATION	DESCRIPTION	ELEV.
72	262 +30	SPIKE - 24" ELM - 250' RT.	717.44
73	279 +90	SPIKE - 40' COTTONWOOD - 70' LT.	725.78

SO213(1) 6 86

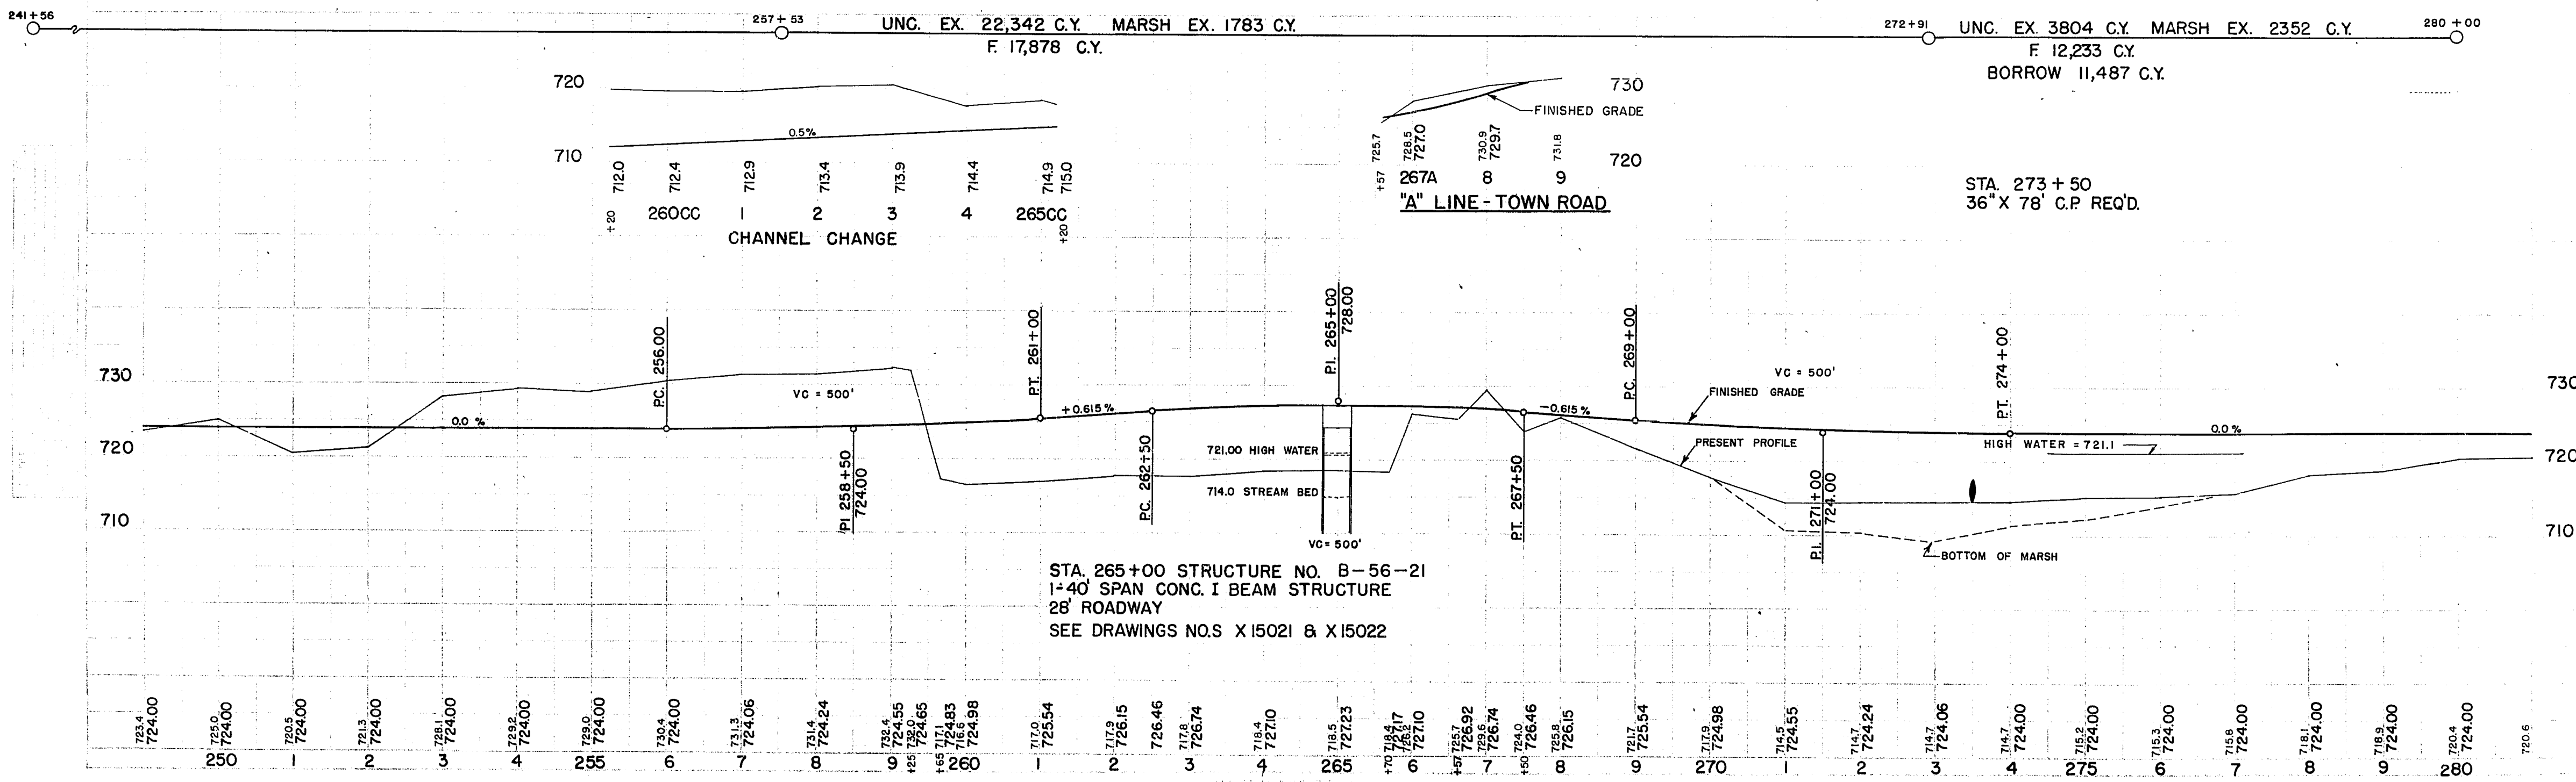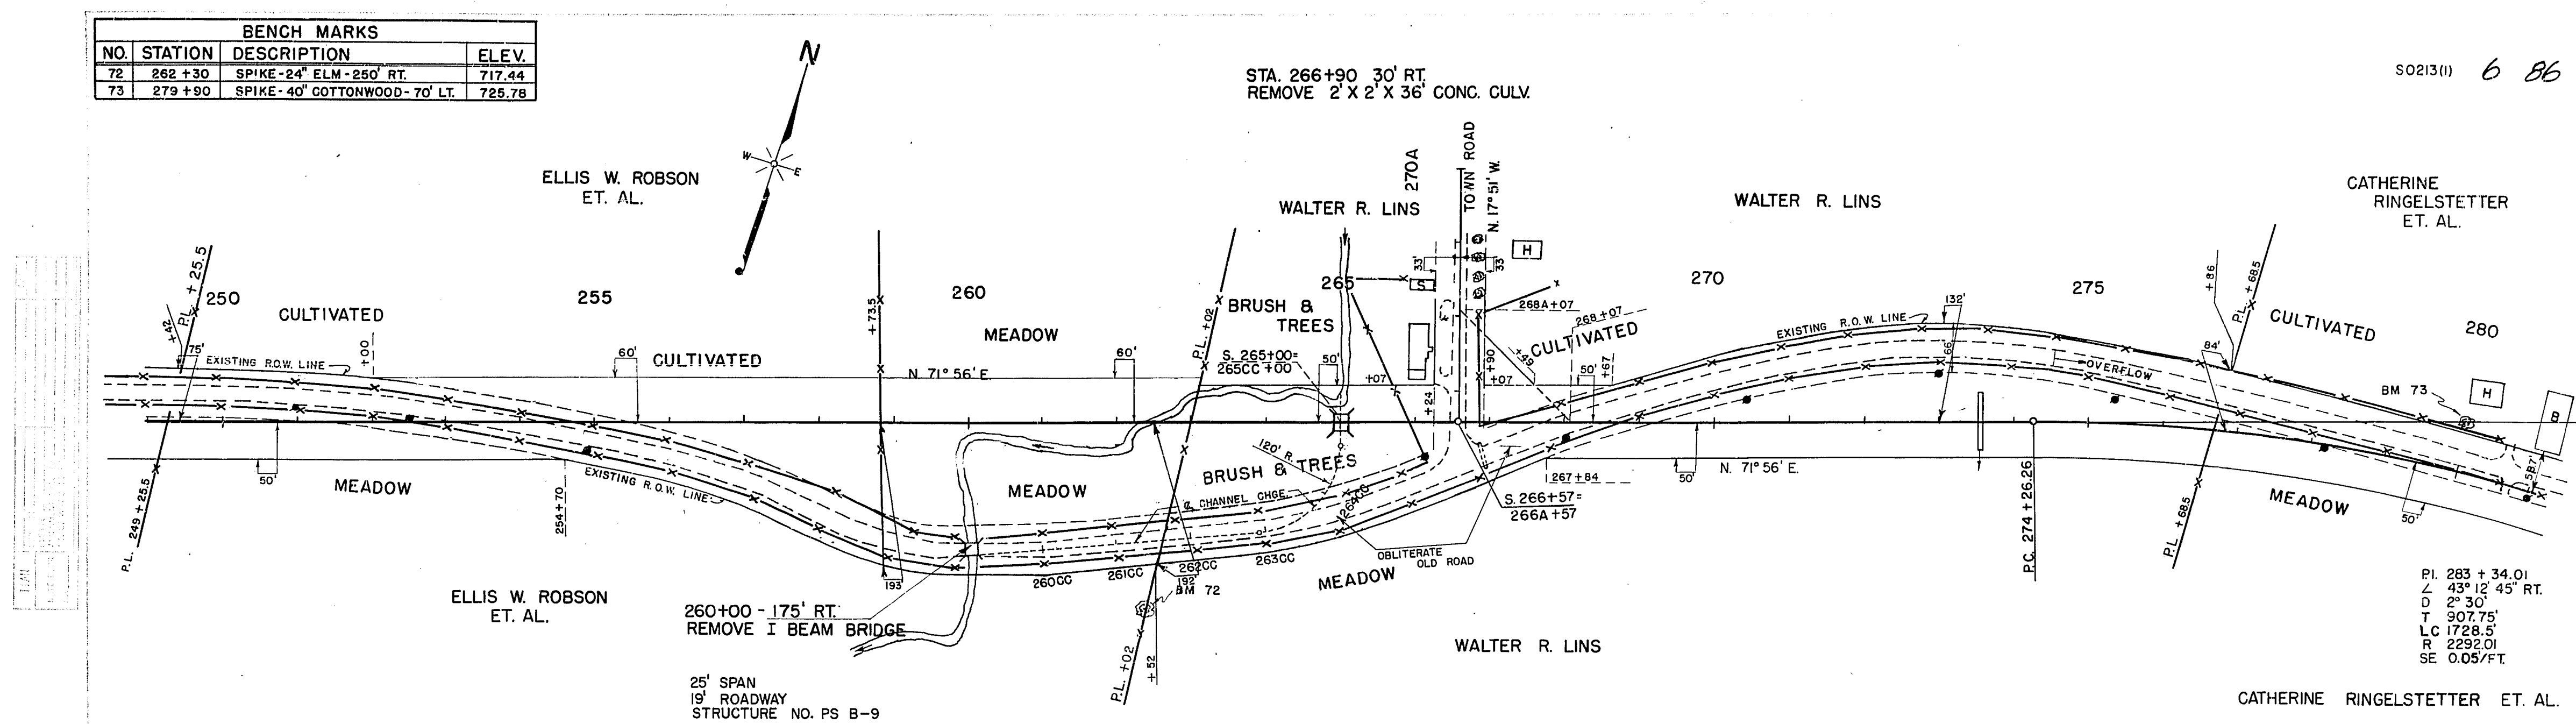

BENCH MARKS			
NO.	STATION	DESCRIPTION	ELEV.
75	312 + 83	SPIKE - 18" B. ELDER - 74' LT.	720.84
76	333 + 40*	SPIKE - PP - 45' LT.	726.67

* TRAVERSE STATION

P.I. 307 + 97.3
L 28° 11' 45" LT.
D. 3° 30'
T. 411.20'
L.C. 805.59'
R. 1637.28'
SE 0.07'/FT.

FORREST E. ROBSON

STA. 318 + 66 12' RT.
REMOVE 24" X 34' C.G.S.M.C.P.

STA. 323 + 32 8' RT.
REMOVE 8' X 45' CONC. CULV.



EARL WILLIAMS

EARL WILLIAMS

STA. 329 + 00
END OF SECTION I

TOWN ROAD

TEMPORARY APPROACH

BM 76

CULTIVATED

CULTIVATED

325

320

315

310

EXISTING R/W

N. 86° 57' E.

EXISTING R/W

MEADOW

MEADOW

FORREST E. ROBSON

EARL WILLIAMS

UNC. EX. 2978 C.Y.
F 10248 C.Y.
BORROW 9832 C.Y.

STA. 318 + 66
1- 72" X 48' CULV. PIPE REQ'D.
DITCH FOR DISCHARGE

STA. 323 + 32
1- 65" X 40" X 60' C.M.P.A. REQ'D.

FINISHED GRADE

0.0 %


0.0 %

730
720
710


730
720
710

715.9 724.00 310
716.8 724.00 1
717.5 724.00 2
717.7 724.00 3
719.0 724.00 4
720.0 724.00 5
721.1 724.00 6
721.4 724.00 7
721.7 724.00 8
721.8 724.00 9
721.7 724.00 320
721.6 724.00 1
722.1 724.00 2
722.6 724.00 3
722.2 724.00 4
721.8 724.00 5
721.7 724.00 6
721.9 724.00 7
722.7 724.00 8
722.9 724.00 9
723.50 723.30 330

PLAN	DATE	BY	NO.
REVIEWED			
APPROVED			
BY			
DATE			

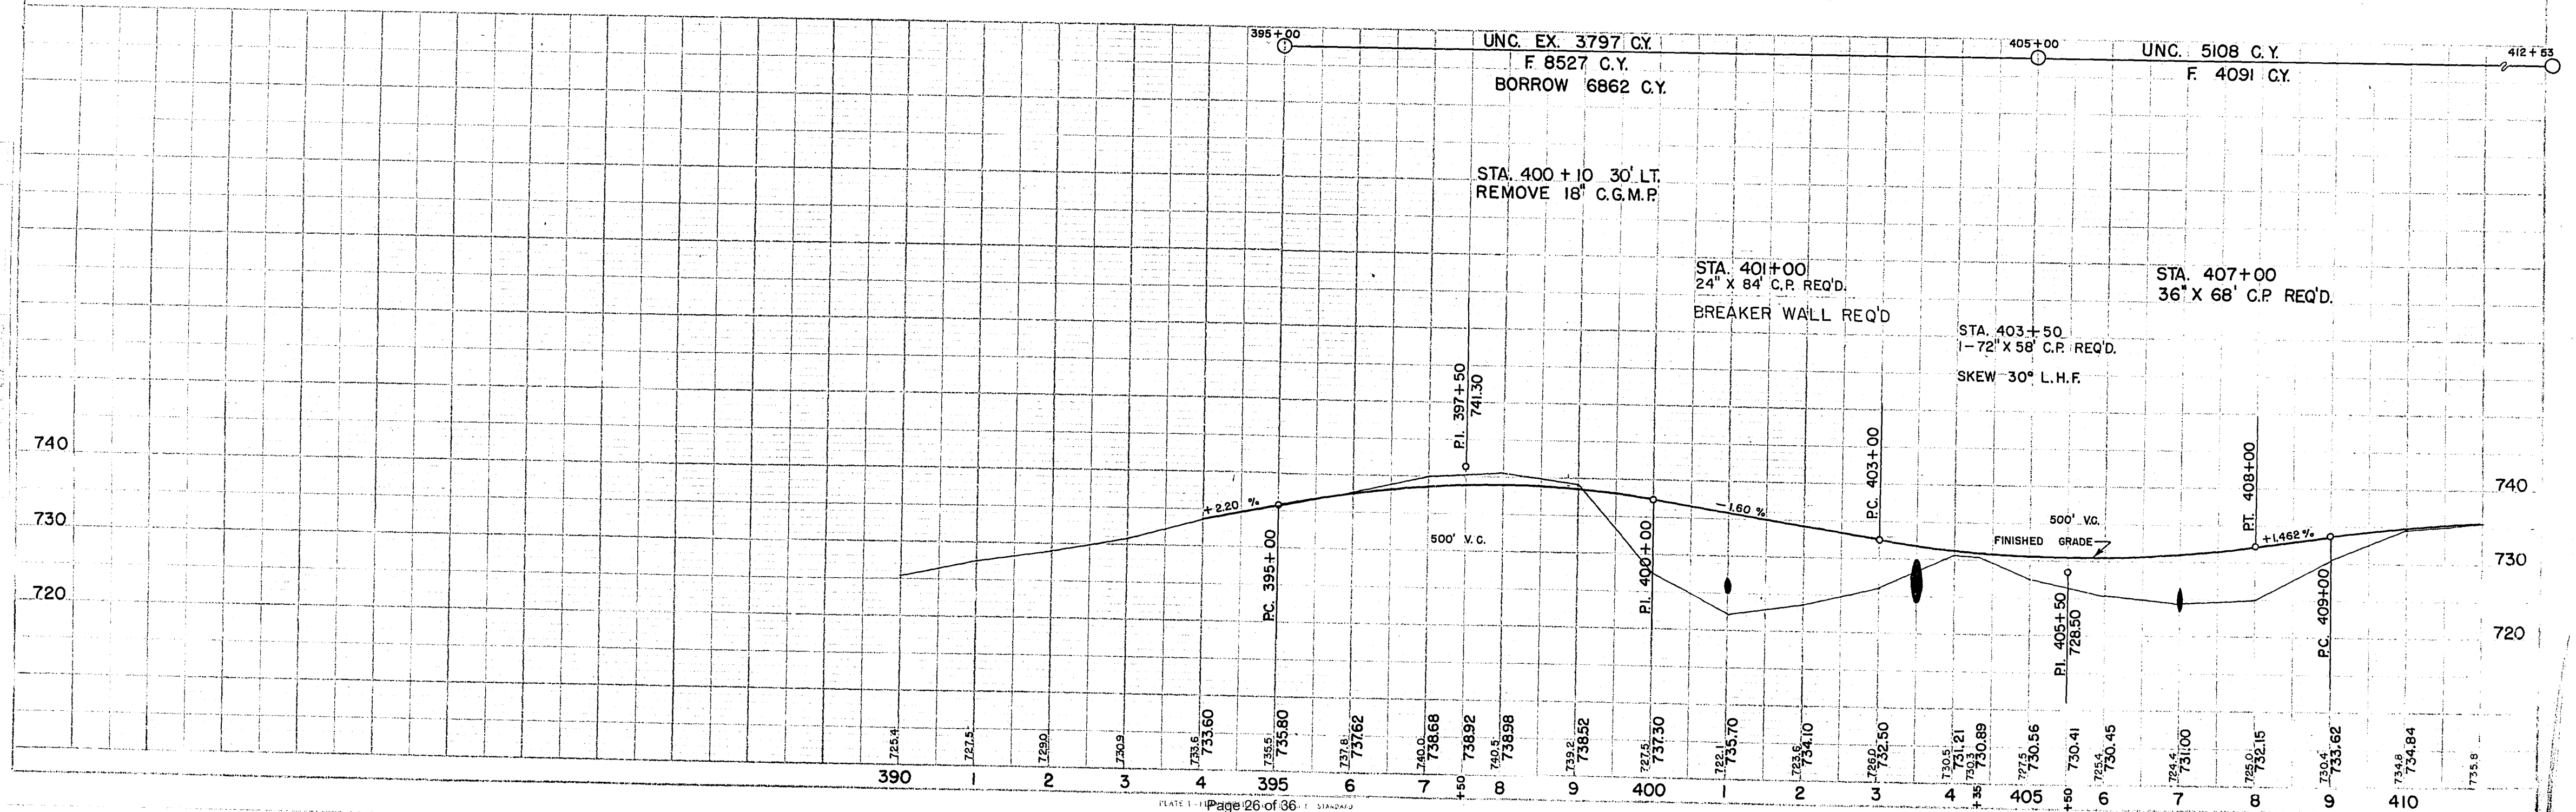



BENCH MARKS			
NO.	STATION	DESCRIPTION	ELEV.
82	423A+90	U.S. BM - 25' RT.	736.44
83	431+95	SPIKE - 10' ELM - 40' RT.	721.81

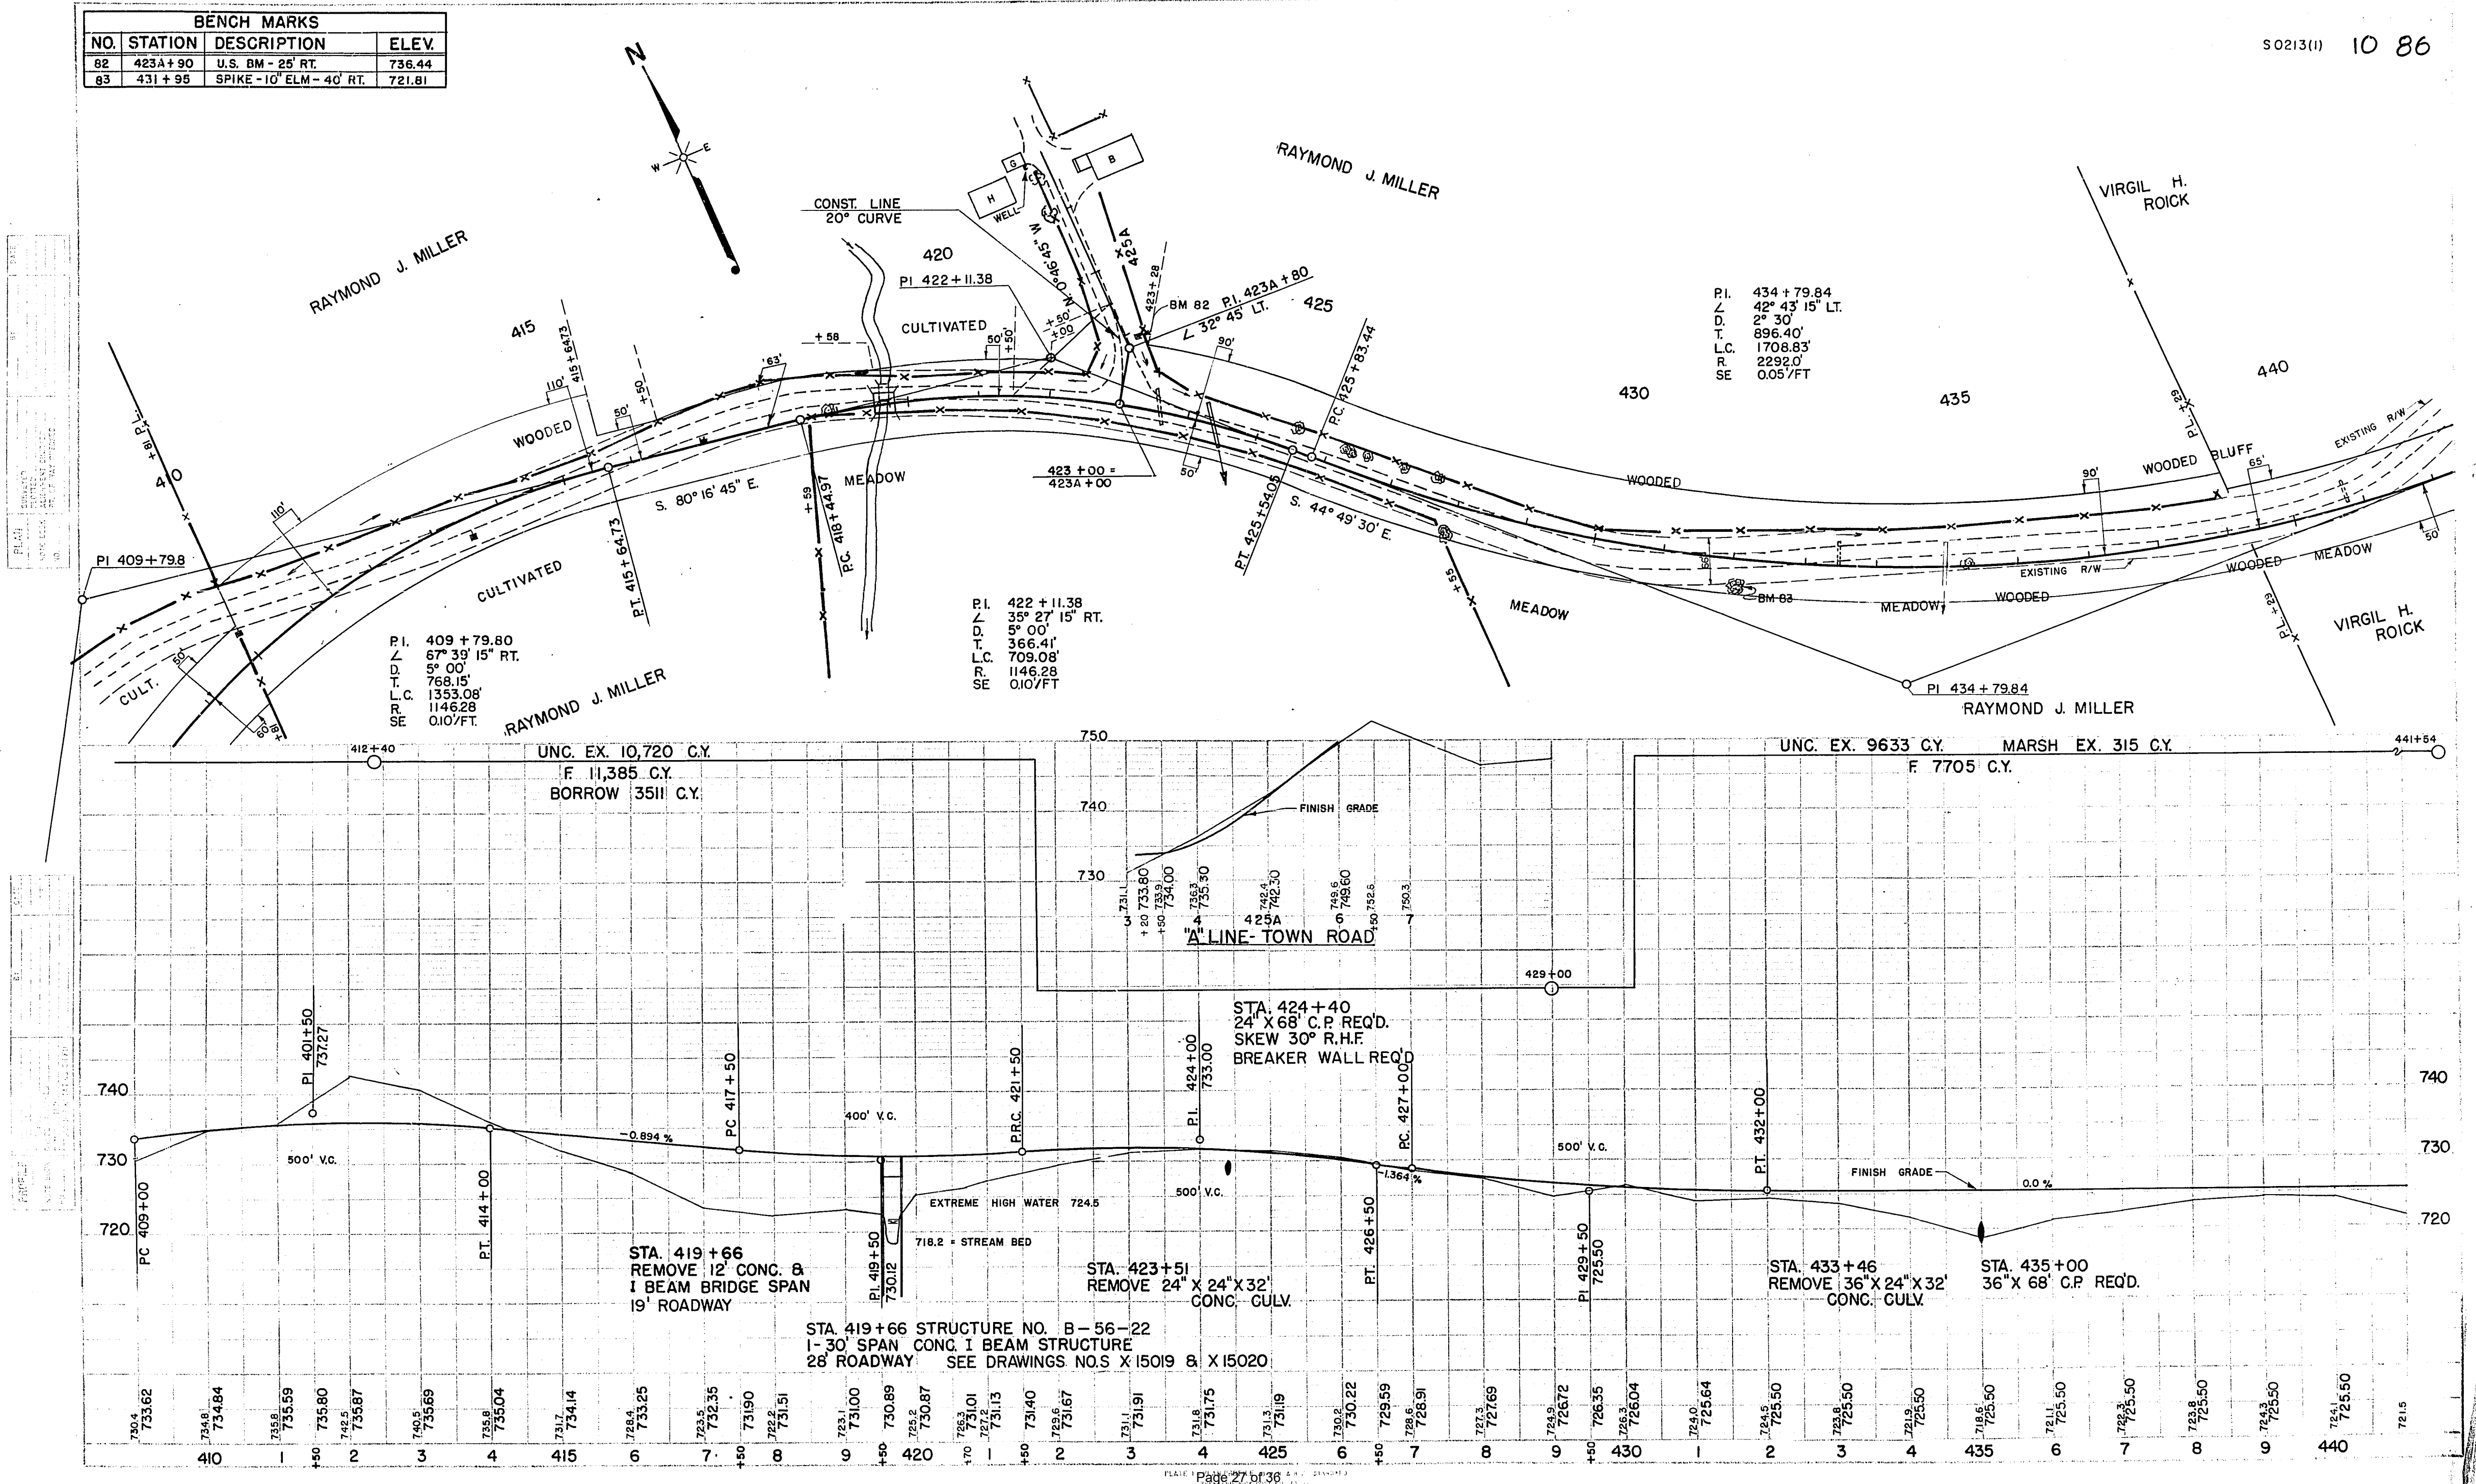

BENCH MARKS			
NO.	STATION	DESCRIPTION	ELEV.
84	445+40	SPIKE - 16" ELM - 150' LT.	723.39
85	456+42	SPIKE - 12" ELM - 4' LT.	722.04
86	467+88	SPIKE - 36" ELM - ON G.	723.29

S 0213(1) 11 86

DATE: 11/11/86
 DRAWN BY: J. H. ROICK
 CHECKED BY: J. H. ROICK
 APPROVED BY: J. H. ROICK
 PLAN: 11/11/86

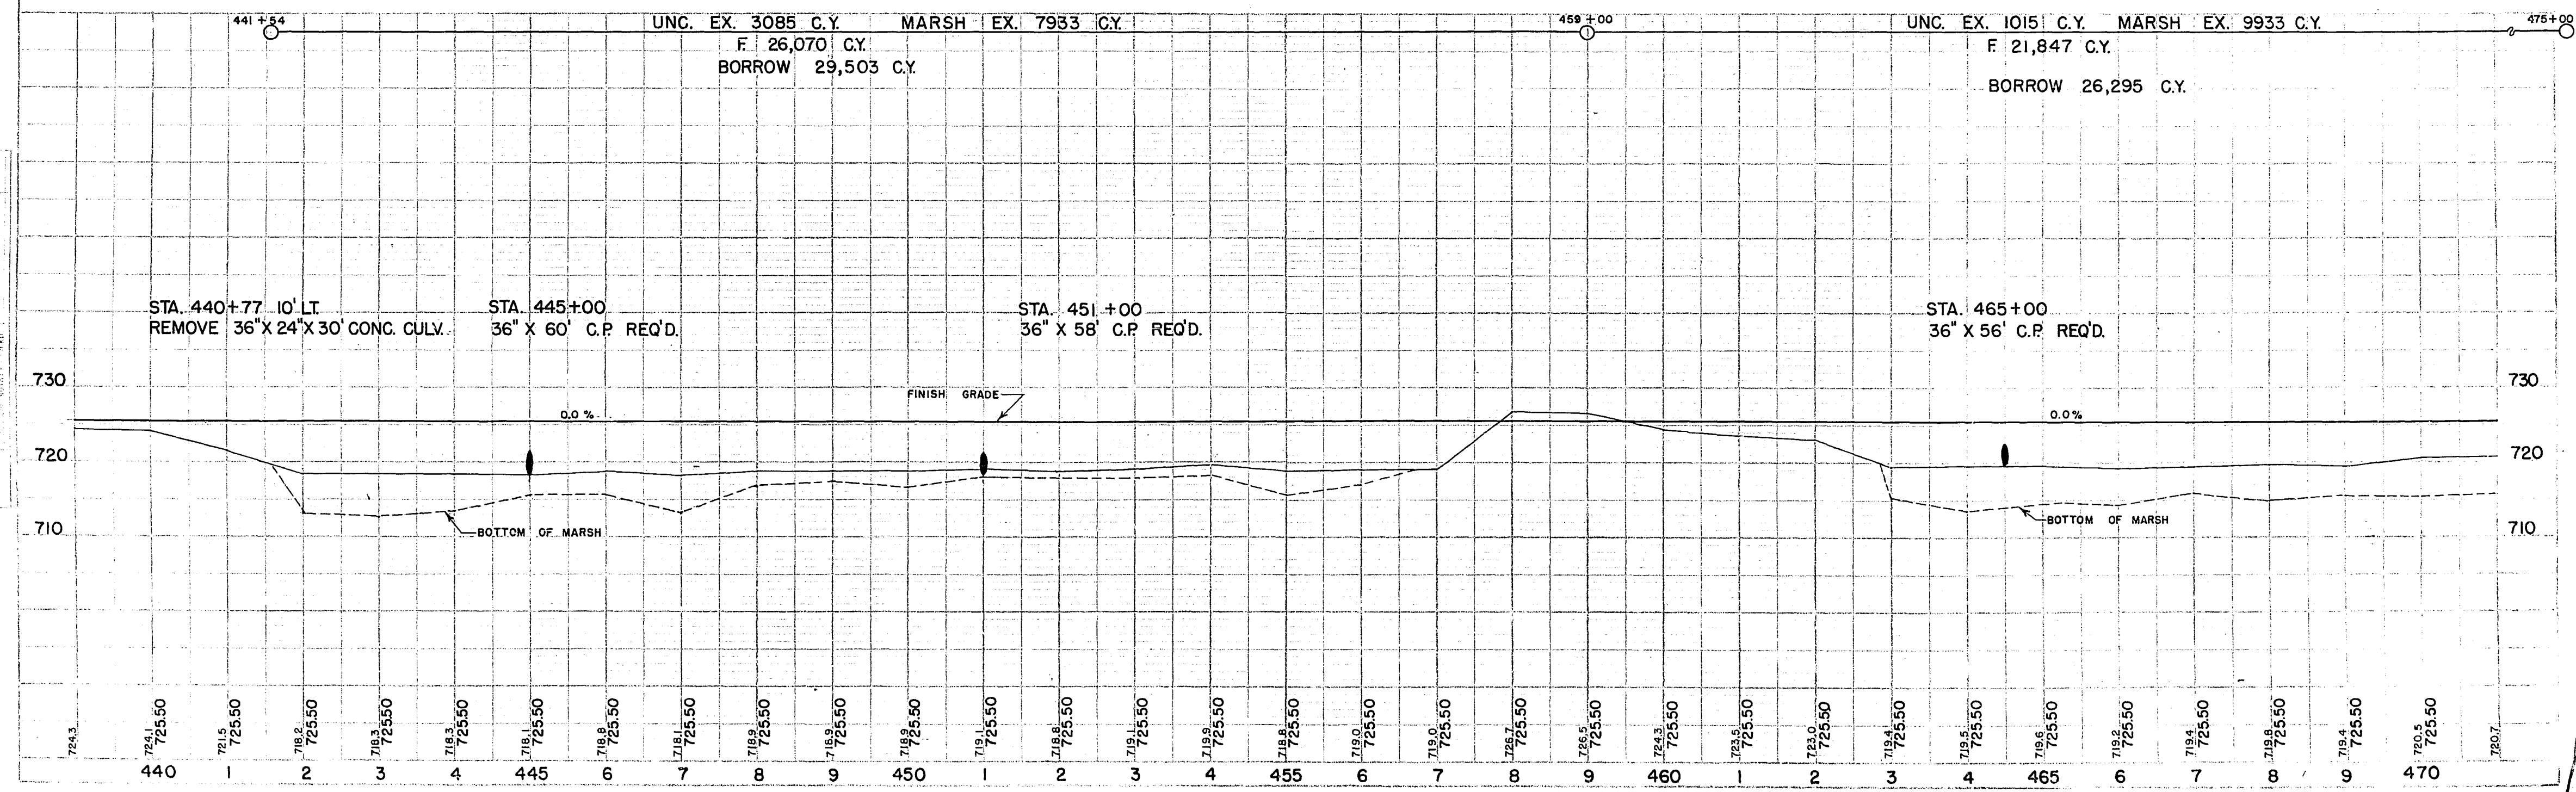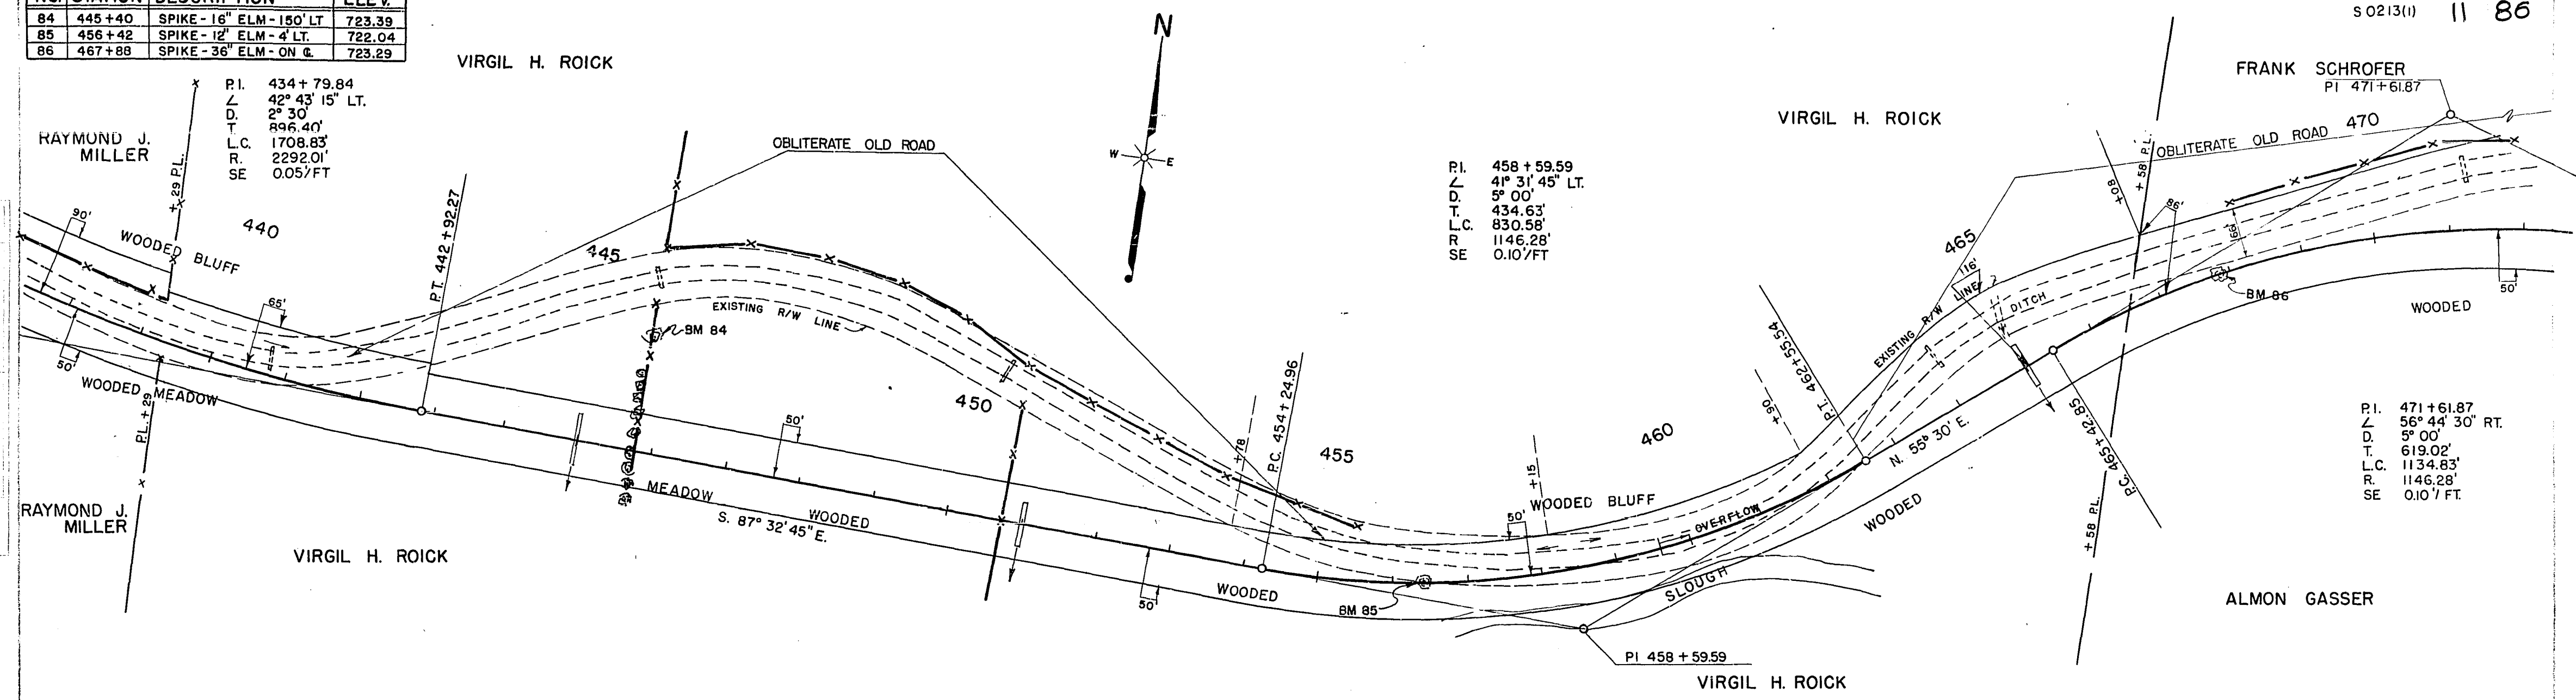

BENCH MARKS			
NO.	STATION	DESCRIPTION	ELEV.
87	478 + 87	SPIKE - 24" MPL. - 70' RT.	722.76
88	492 + 70	SPIKE - 24" ELM - 10' LT.	721.44

PI. 471+61.87
L 56° 44' 30" RT.
D. 5° 00'
T. 619.02'
L.C. 1134.83'
R. 1146.28
SE 0.10'/FT

FRANK SCHROFER

AARON ROGERS

JOSEPH OTTERSON

DANIEL R. OTT

ALMON GASSER

OBLITERATE OLD ROAD

PI. 471+61.87

475

480

485

490

STA. 492+00
END OF SECTION II

BM 88

470

PI. 471+61.87

EXISTING R/W LINE

OVERFLOW

EXISTING R/W LINE

PT. 476+77.68

BM 87

MEADOW

MEADOW

WOODED

WOODED

MEADOW

MEADOW

UNC. EX. 2381 C.Y. MARSH EX. 1159 C.Y.
F. 6025 C.Y.
BORROW 5150 C.Y.

STA. 486+97
48" X 24" X 32' CONC. CULV. IN PLACE
EXTEND RT. WITH 43" X 27" X 20' C.M.P.A.

STA. 477+00
1-43" X 27" X 56' C.M.P.A. REQ'D.
DITCH FOR DISCHARGE

STA. 471+00
1-58" X 36" X 56' C.M.P.A. REQ'D.

STA. 474+50
1-43" X 27" X 56' C.M.P.A. REQ'D.
DITCH FOR DISCHARGE

STA. 483+10
48" X 24" X 32' CONC. CULV. IN PLACE
EXTEND 20' RT. WITH 43" X 27" X 20' C.M.P.A.

FINISH GRADE

0.0 %

0.0 %

BOTTOM OF MARSH

BOTTOM OF MARSH



720

720

710


710

BENCH MARKS			
NO.	STATION	DESCRIPTION	ELEV.
91	534 + 70	SPIKE - TIE TREE - 40' LT.	727.28
92	545 + 25	SPIKE - 36" OAK - 75' RT.	728.43

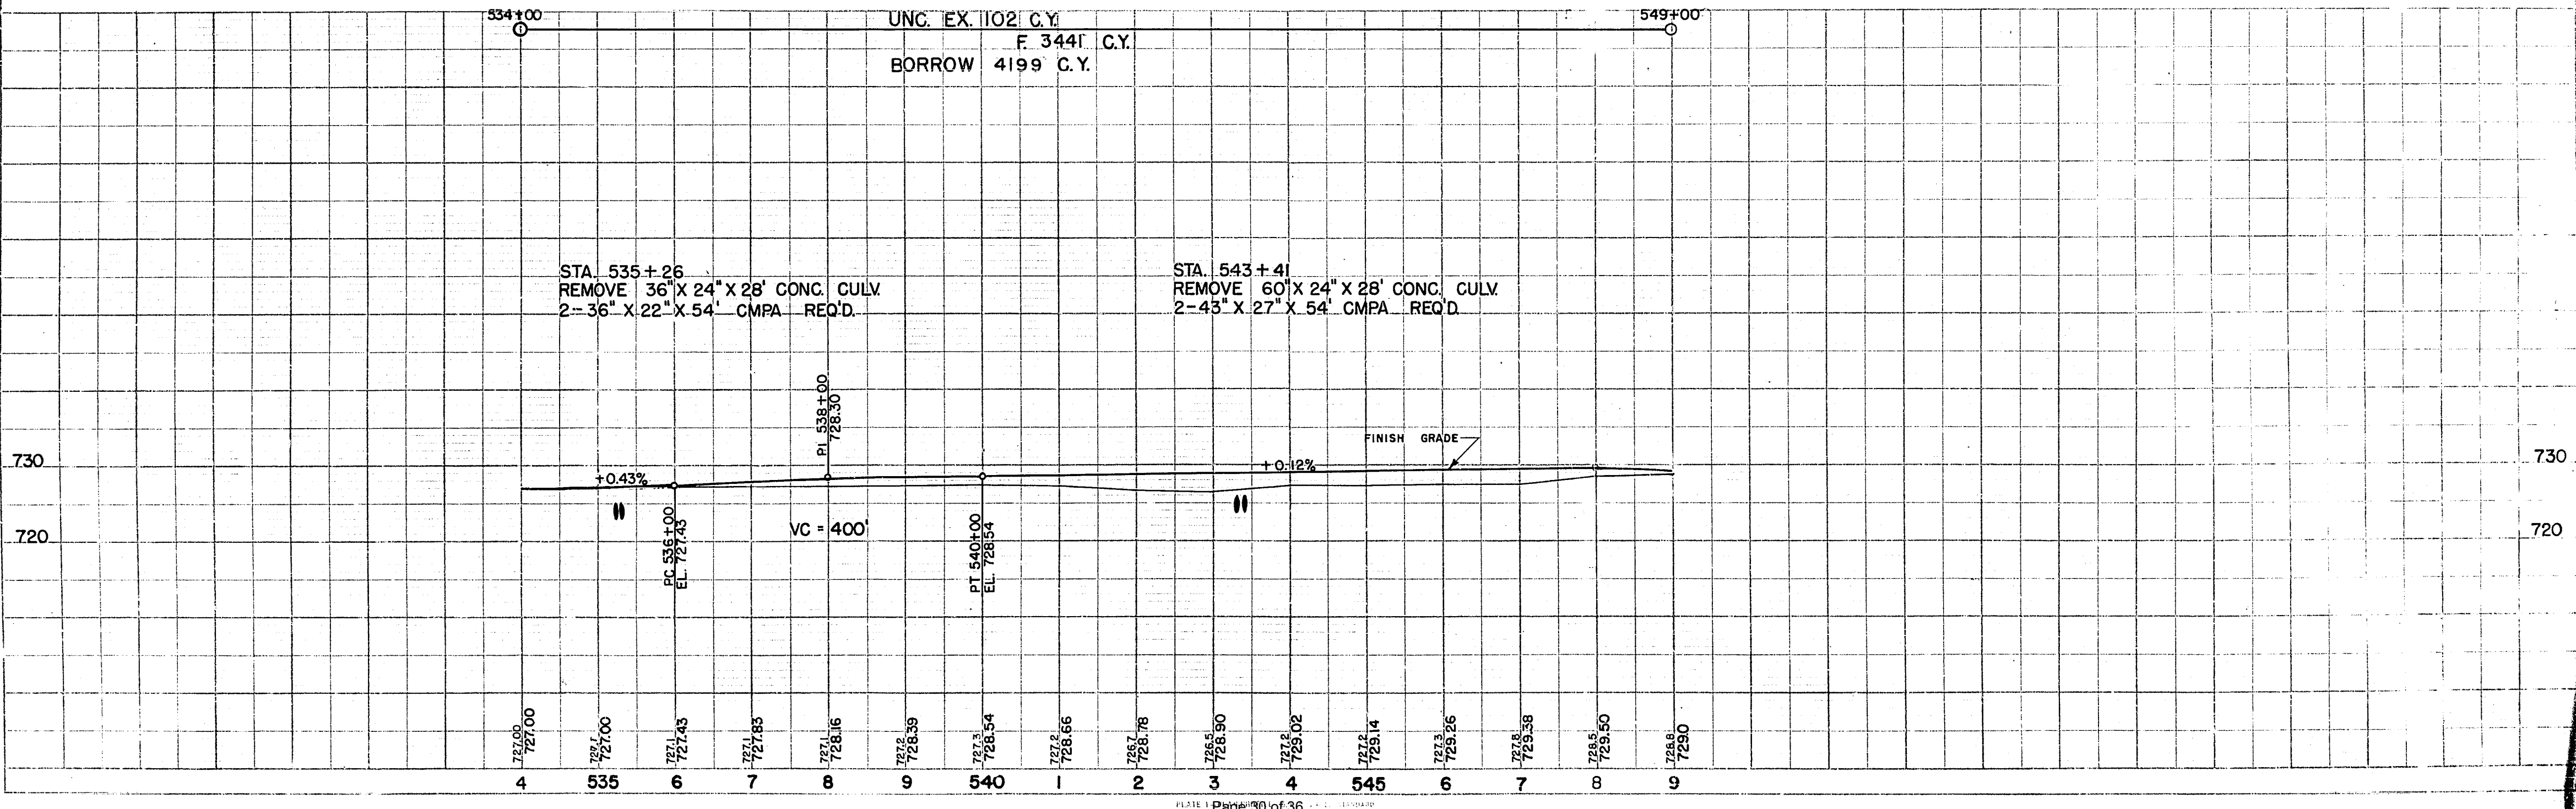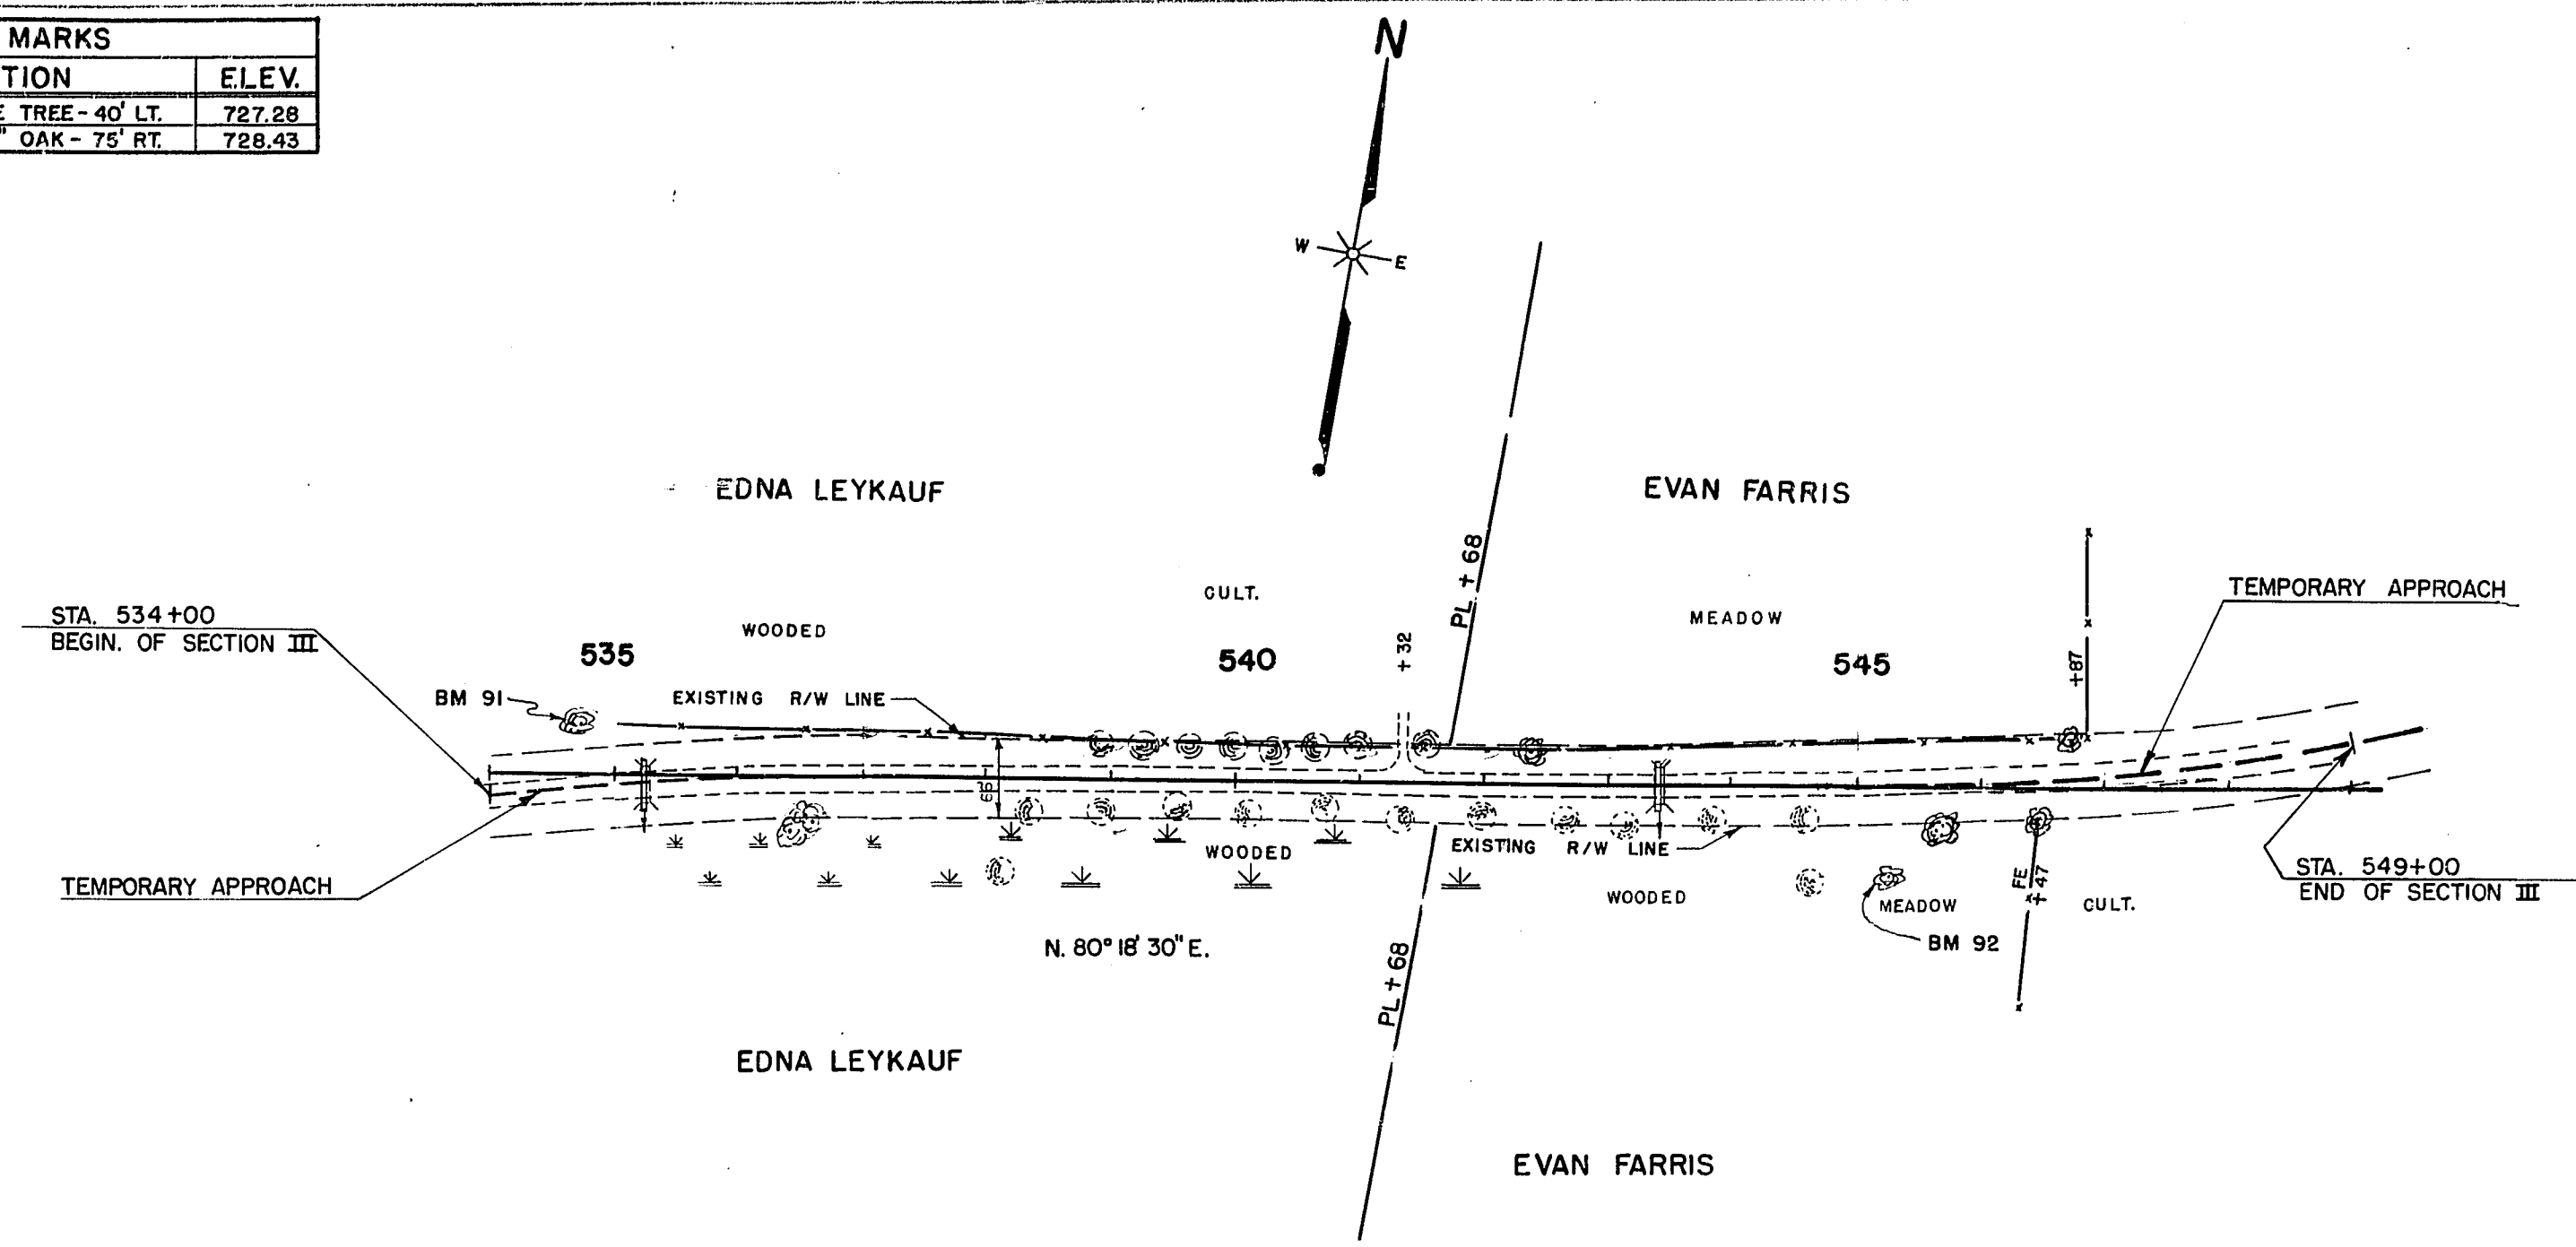


PLAN
 DATE
 BY
 CHECKED
 ALIGNED CHECKED
 NOTE BOOK
 NO. OF PAGES CHECKED
 N.B.

PROFILE
 DATE
 BY
 CHECKED
 NOTE BOOK
 NO. OF PAGES CHECKED
 N.B.

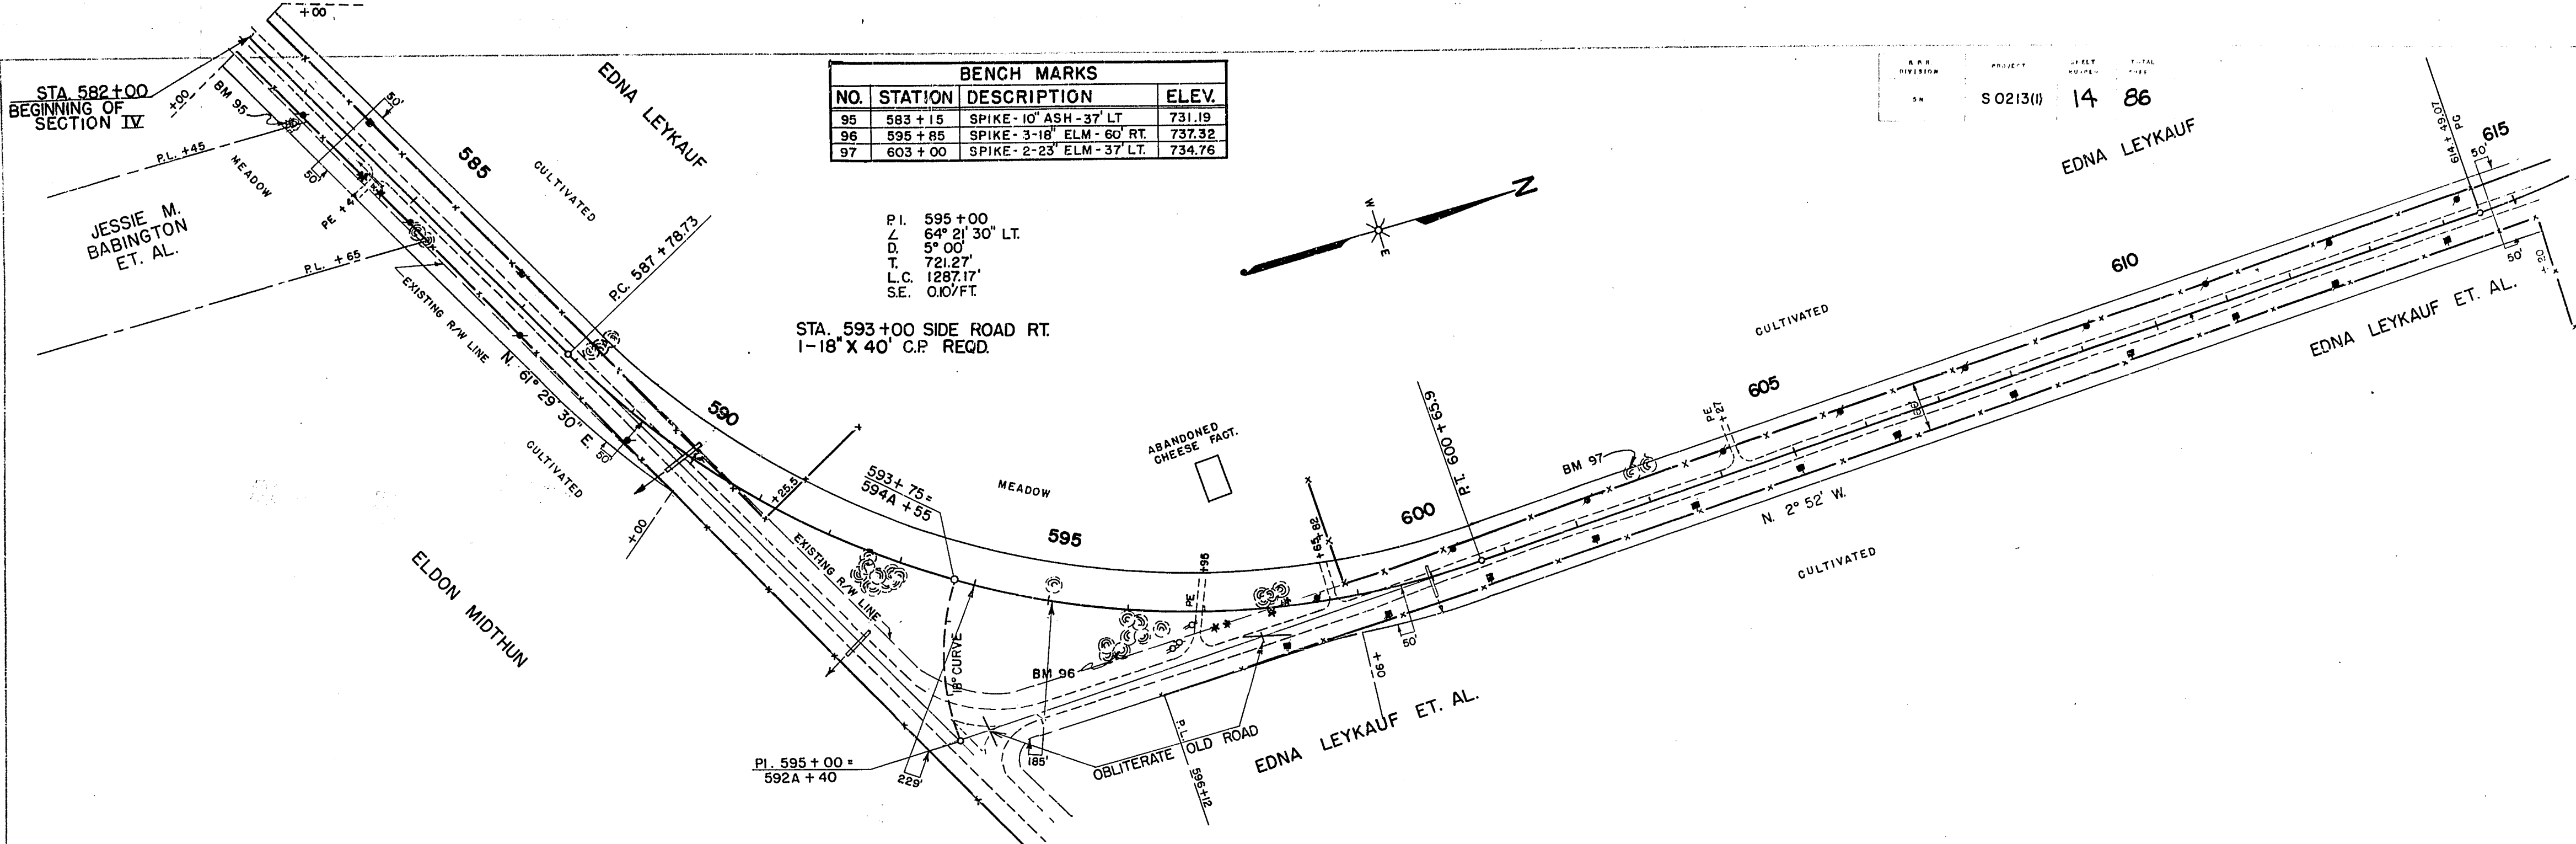




BENCH MARKS			
NO.	STATION	DESCRIPTION	ELEV.
95	583 + 15	SPIKE - 10" ASH - 37' LT	731.19
96	595 + 85	SPIKE - 3-18" ELM - 60' RT	737.32
97	603 + 00	SPIKE - 2-23" ELM - 37' LT	734.76

P.I. 595 + 00
 L 64° 21' 30" LT.
 D 5° 00'
 T 721.27'
 L.C. 1287.17'
 S.E. 0.10/FT.

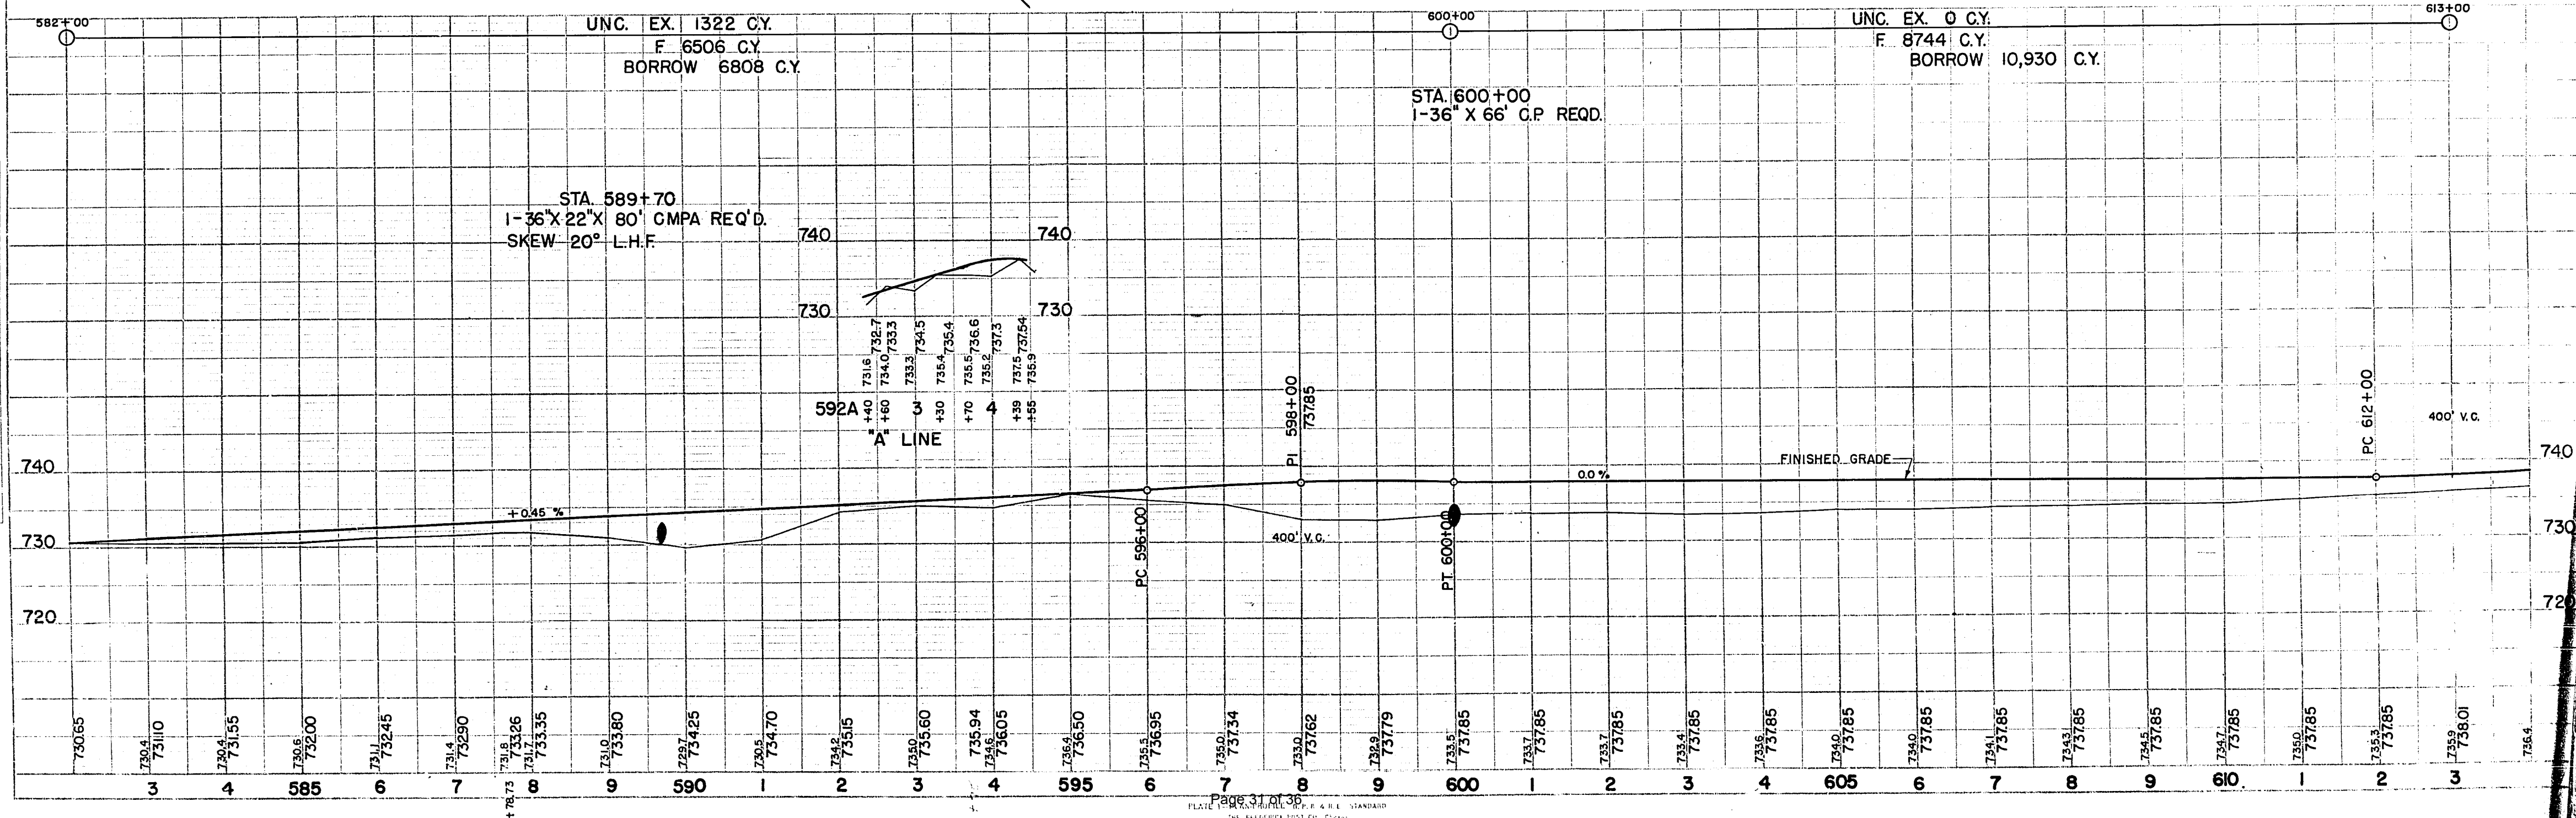

BENCH MARKS			
NO.	STATION	DESCRIPTION	ELEV.
98	616+00	SPIKE-30" ELM-80' RT.	738.52
99	625+56	SPIKE-3-7" GRAB APPLE-22' RT.	754.07


PI. 617+68
 Z. 25° 06' LT.
 D. 4° 00'
 T. 318.93'
 L.C. 627.50'
 S.E. 0.08/FT

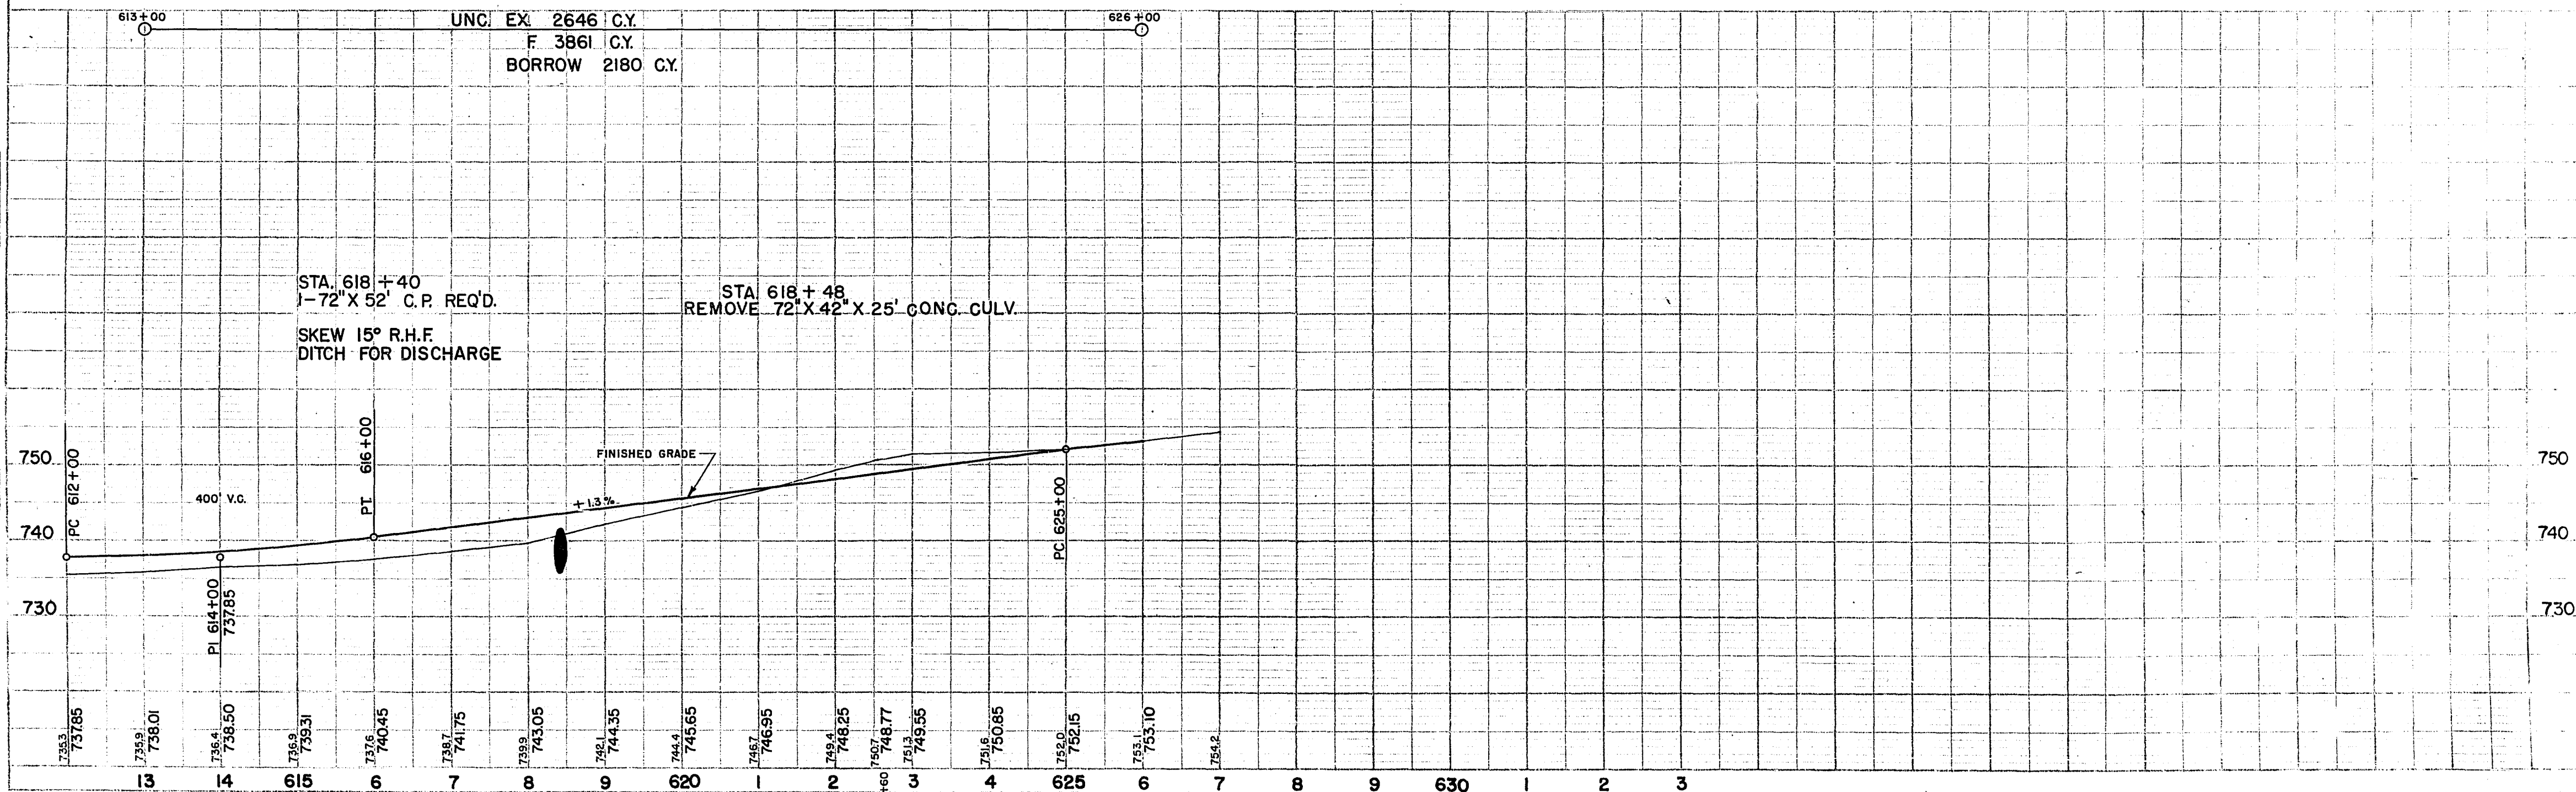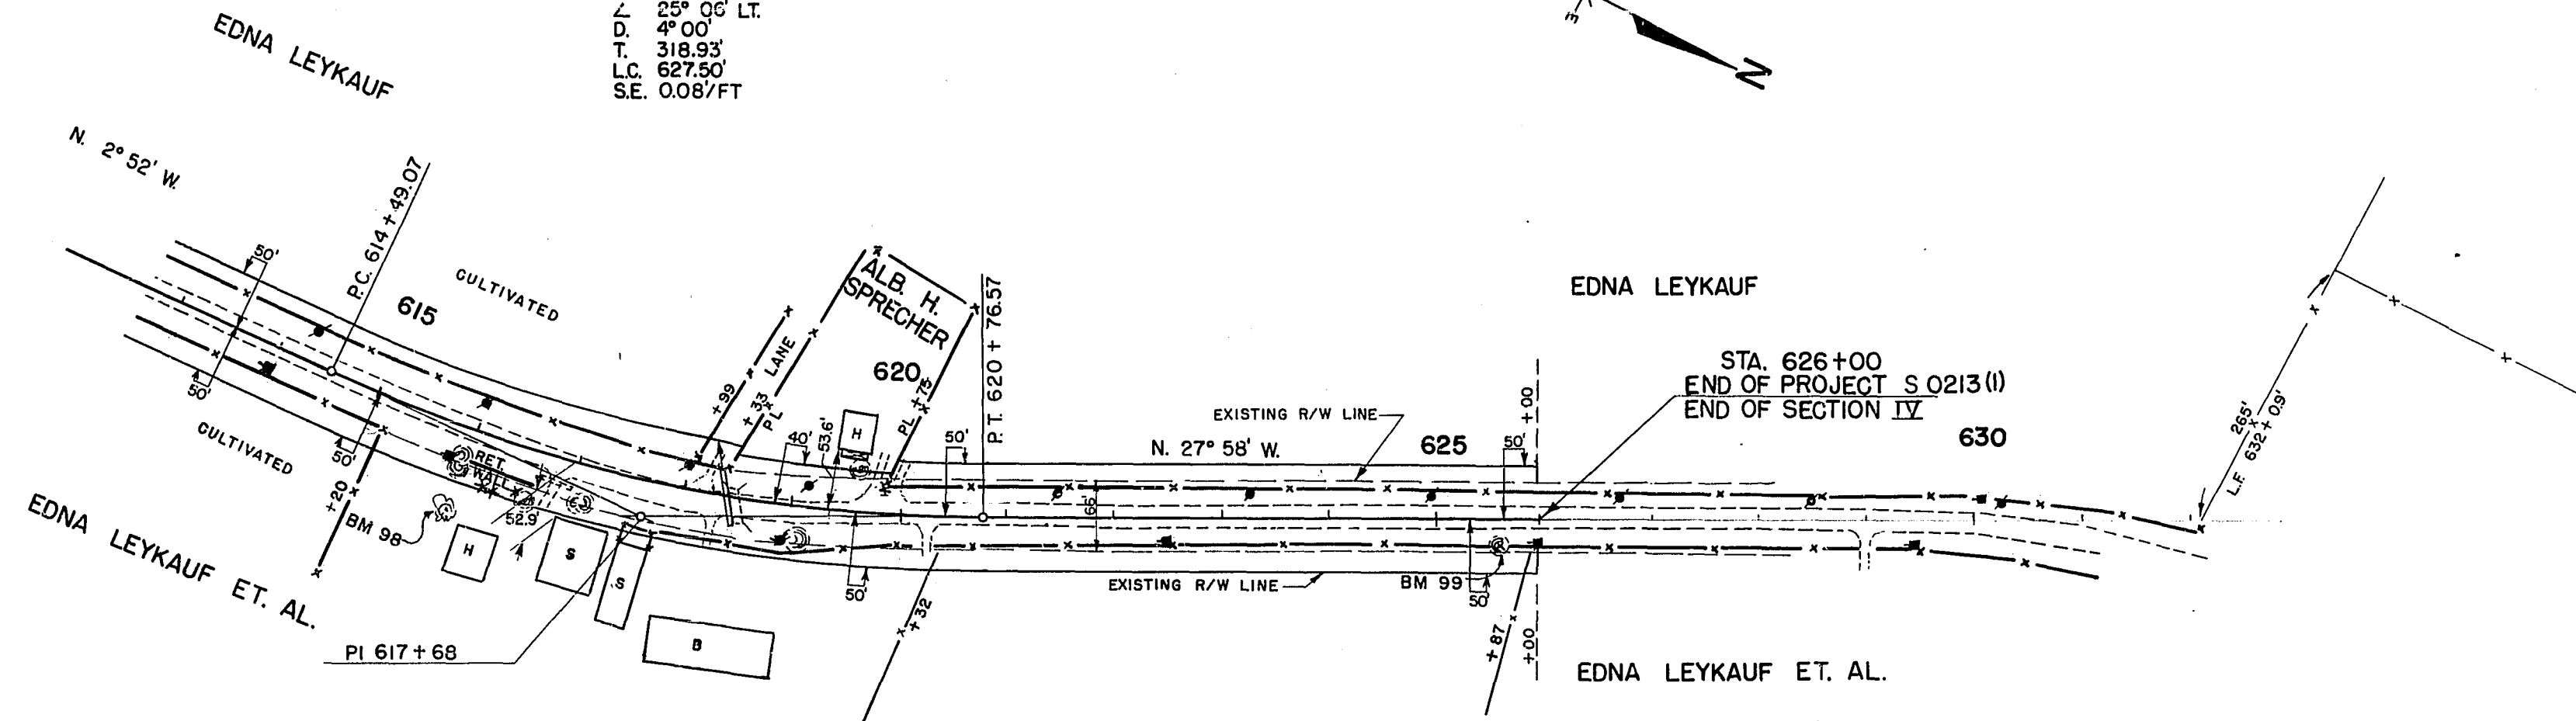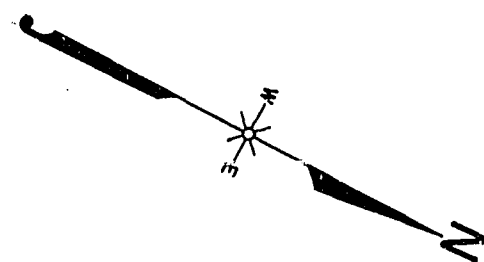

COUNTY & HIGHWAY	ROUTE & SECTION	CLASS & ASSIGNMENT	STATE	FEDERAL	R.P.D. DIVISION	PROJECT	SHEET NUMBER	SHEET TOTAL
56.2	213.0	21.1			4	S0213(1)	29	86

BILL OF BARS

NO. REQD.	MARK	SIZE	LENGTH	SPACING	LOCATION
148	S1	.5	29'-0"	6 1/2" O.C.	TRANSVERSE IN FLOOR
58	S2	5	21'-0"	SHOWN	LONGITUDINAL IN FLOOR
20	S3	5	22'-0"	SHOWN	LONGITUDINAL IN CURBS & FLOOR
56	S4	5	4'-0"	1'-6" O.C.	TRANSVERSE IN CURB
36	S5	6	4'-0"	4 1/2" O.C.	TRANSVERSE - PAVING SUPPORT AT ABUTMENT

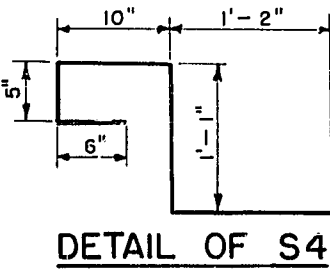

GENERAL NOTES

DRAWINGS SHALL NOT BE SCALED

ALL CONCRETE MASONRY SHALL BE GRADE "AA"

BEVEL ALL EXPOSED EDGES OF CONCRETE 1" UNLESS OTHERWISE SPECIFIED.

BAR STEEL REINFORCEMENT DIMENSIONS APPLY ALONG Δ OF BAR.

BAR STEEL REINFORCEMENT IN FLOOR SHALL BE CUT OFF AT FLOOR DRAINS.

UNLESS OTHERWISE SPECIFIED, ALL SHOP CONNECTIONS SHALL BE 3/4" ϕ RIVETS

AND ALL FIELD CONNECTIONS SHALL BE 3/4" ϕ RIVETS OR 3/4" ϕ RIBBED BOLTS. SEE SPECIFICATIONS.

PILES SHALL BE TREATED TIMBER PILING 50'-0" LONG AND SHALL BE DRIVEN TO A MINIMUM BEARING VALUE OF 20 TONS PER PILE.

THE 3" X 10" BULKHEAD PLANK IN THE BODY OF THE ABUTMENTS MAY BE SPLICED. SPLICES MUST BE AT Δ OF PILES AND MUST BE STAGGERED IN ADJACENT PLANKS.

THE FRONT FACES OF THE ABUTMENTS SHALL BE RIPRAPPED AS SHOWN IN SECTION SI-SI WITHIN THE LIMITS OF THE ENDS OF THE WINGS. AFTER THE FILL IS IN PLACE, THE SLOPE OF THE FILL AROUND THE ENDS OF THE WINGS SHALL BE RIPRAPPED TO A MINIMUM THICKNESS OF 1'-0" AS DIRECTED BY THE ENGINEER.

CONTRACTOR SHALL MAKE PROVISION FOR 1/2" THICKENING OF FLOOR SLAB FOR D.L. DEFLECTION.

BEAMS SHALL BE DETAILED BY FABRICATOR WITH NATURAL CAMBER UP

TREATED LUMBER & TIMBER

NOMINAL SIZE	NO. OF PIECES	LENGTH	SURFACE	GRADE	LOCATION
3" X 6"	4	10'-0"	NONE	1200**f J & P	WING CLEAT
	4	11'-6"	NONE	1200**f J & P	" "
	4	13'-6"	"	1200**f J & P	" "
	4	13'-0"	NONE	1200**f J & P	BODY CLEAT
	4	3'-0"	NONE	1200**f B & P	" "
6" X 6"	14	8'-6"	NONE	1200**f B & P	" "
3" X 10"	8	5'-0"	NONE	1200**f J & P	BODY BACKING
	4	2'-6"	NONE	1200**f J & P	WING BACKING
	4	5'-0"	NONE	" "	" "
	4	7'-6"	NONE	" "	" "
	4	10'-0"	NONE	" "	" "
	48	12'-6"	NONE	" "	" "
	4	15'-3"	NONE	" "	BODY BACKING
26	35'-6"	NONE	" "	" "	" "
3" X 12"	4	5'-0"	NONE	" "	BODY BACKING
12" X 12"	2	28'-0"	S 4 S	1600**f B & S	ABUTMENT CAP

TOTAL ESTIMATED QUANTITIES

BID ITEMS	UNIT	QUANTITY
EXCAVATION FOR STRUCTURES	C.Y.	57
CONCRETE MASONRY	C.Y.	32.4
BAR STEEL REINFORCEMENT	L.B.	6,645
STRUCTURAL CARBON STEEL	L.B.	25,985
SHEET ZINC	L.B.	34
TREATED LUMBER & TIMBER	MBM	5.62
UNTREATED TIMBER TEST PILING(10SS)L.S.		1
TREATED TIMBER PILING DELIVERED	L.F.	1300'
TREATED TIMBER PILING DRIVEN	L.F.	1045
BEAM TYPE BRIDGE RAIL	L.F.	84.5
FLOOR DRAINS	EACH	4
RIPRAP	C.Y.	57
REMOVING OLD BRIDGE	LUMP SUM	1


** DRIVE AT LOCATION OF WEST ABUT.

LIST OF DRAWINGS


- LAYOUT-RAILING & DRAIN DETAILS, ETC. — X15021
- ABUTMENTS — X15022

* NOTE: THE DESIGN OF THIS STRUCTURE IS IN ACCORDANCE WITH THE REQUIREMENTS OF THE "STANDARD SPECIFICATIONS FOR HIGHWAY BRIDGES A.A.S.H.O. EDITION OF 1953."


REVISED	STATE HIGHWAY COMMISSION OF WISCONSIN
	LAYOUT-RAILING & DRAIN DETAILS, ETC.
	CO. SAUK TOWN TROY STA. 265+00.00
	SECTION 2 TOWN 8 N. RANGE 4 E.
	DATE 7-18-55 DRWN BY PENNER CKD SPEC 1951# LOAD H20
	CORRECT <i>H. B. Schult</i> ENGINEER OF BRIDGES
	APPROVED <i>E. C. Restina</i> STATE HIGHWAY ENGINEER
	STRUCTURE B-56-21 SHEET 1 OF 2

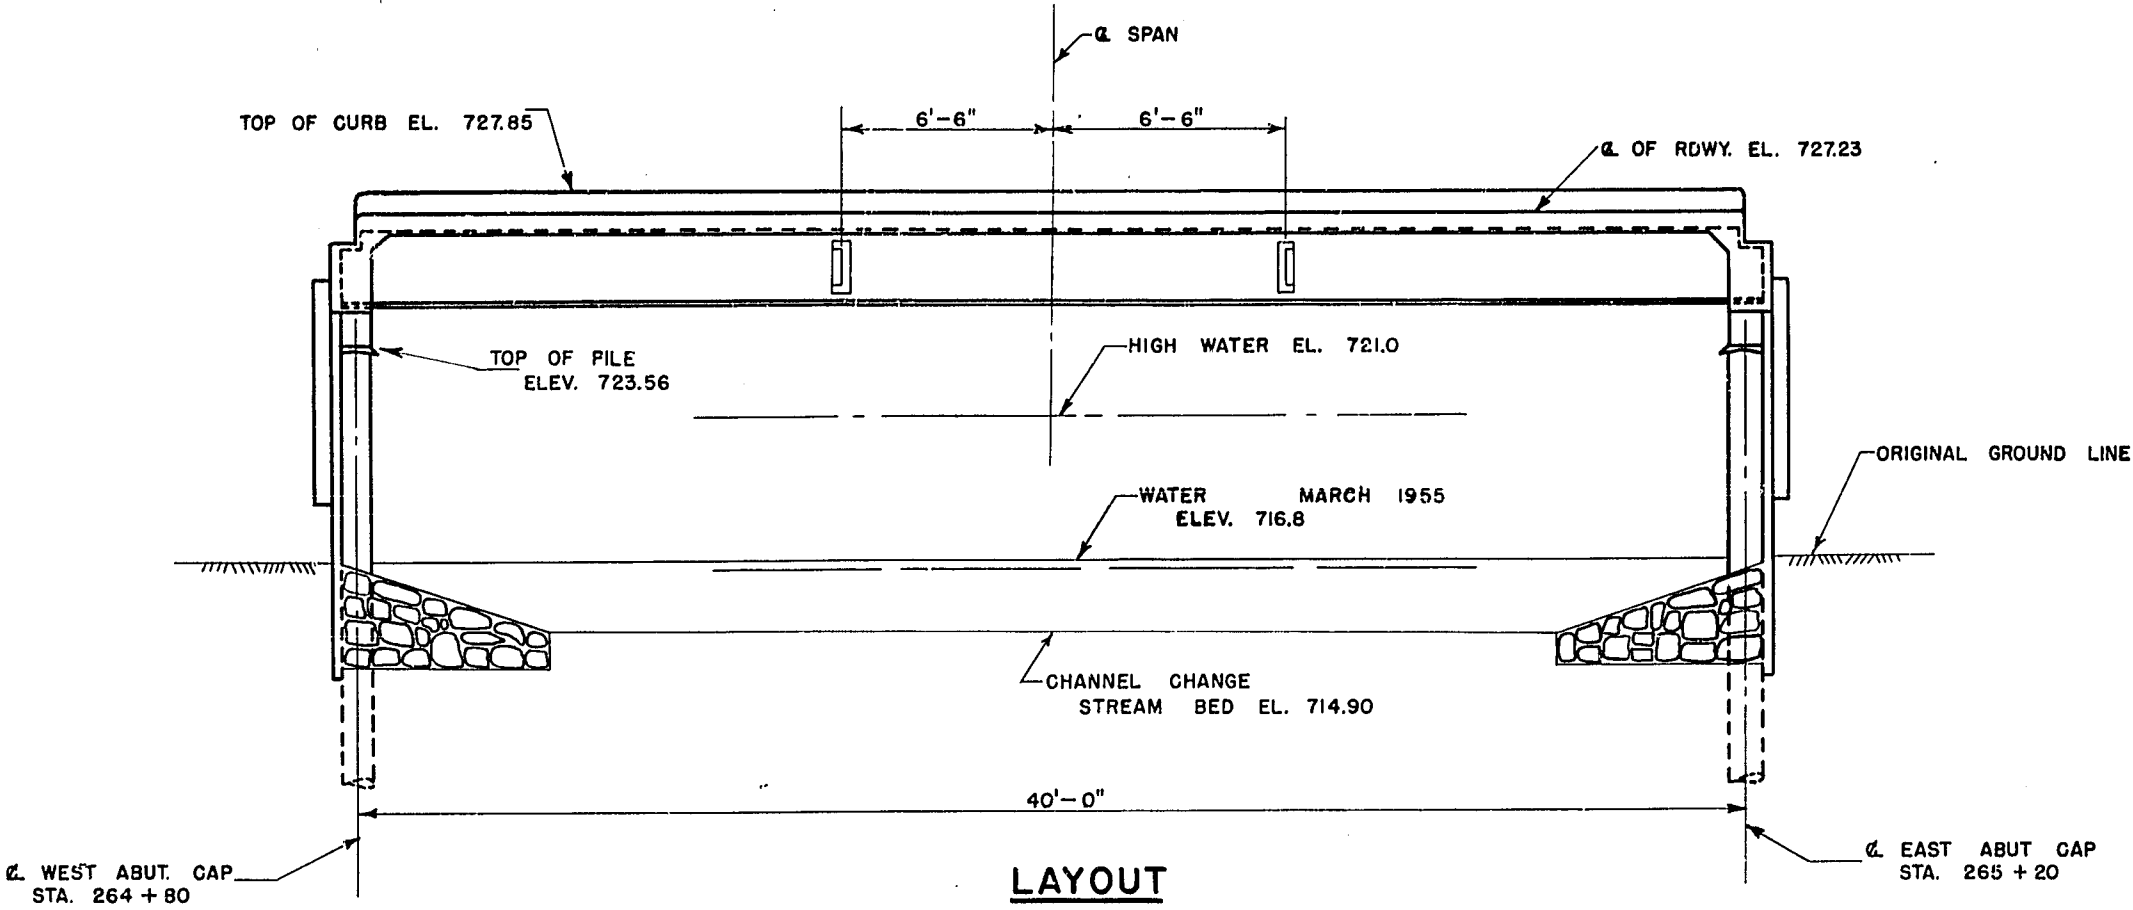

LAYOUT

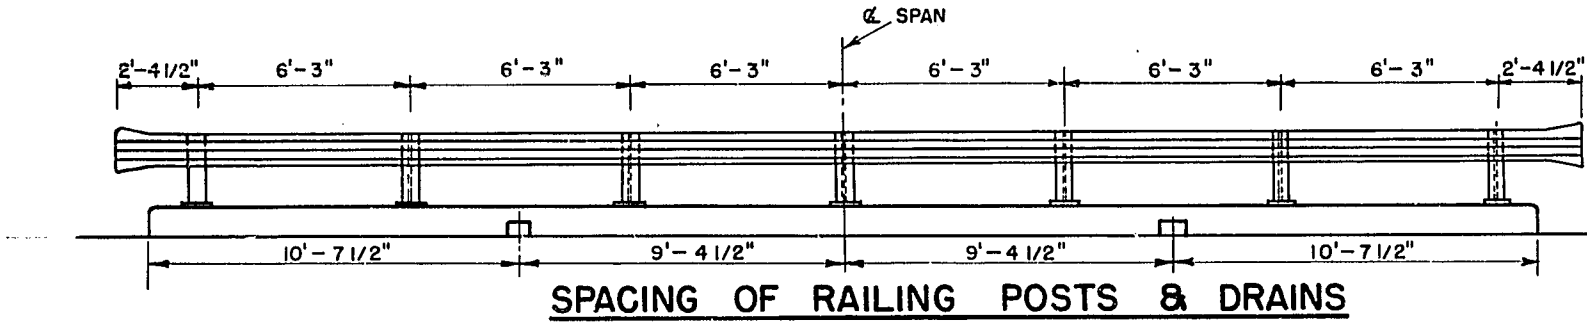

SPACING OF RAILING POSTS & DRAINS

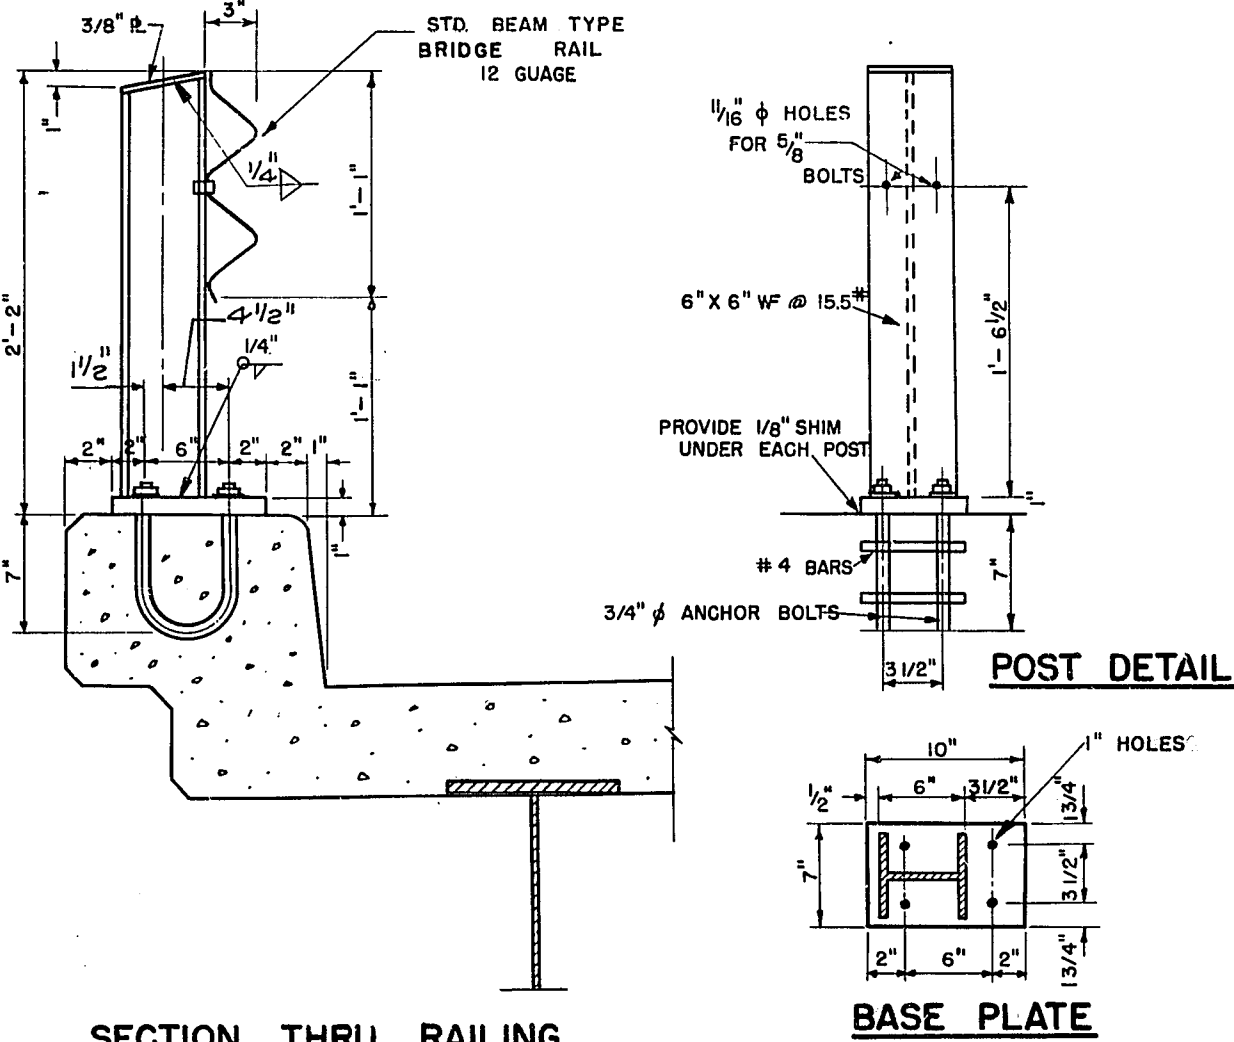


SECTION THRU RAILING


POST DETAIL

BASE PLATE


RAILING DETAILS

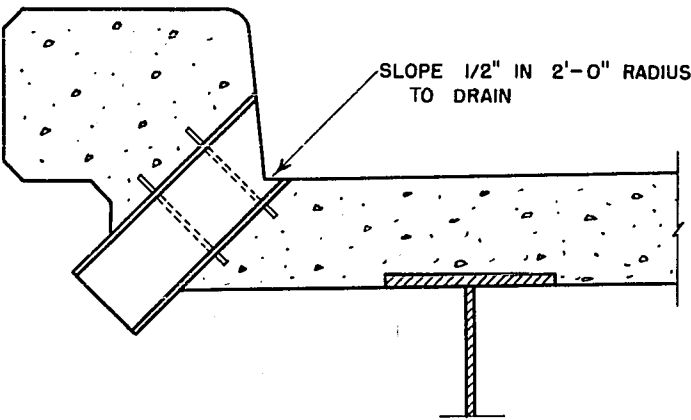


SECTION THRU DRAIN

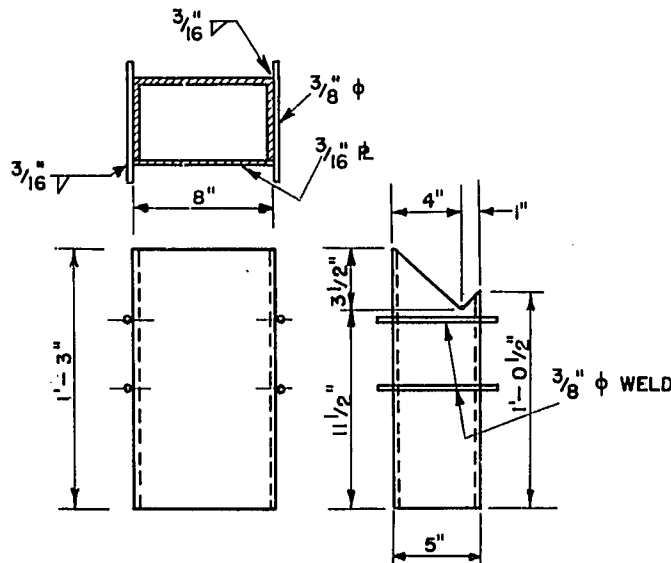

DRAIN DETAILS


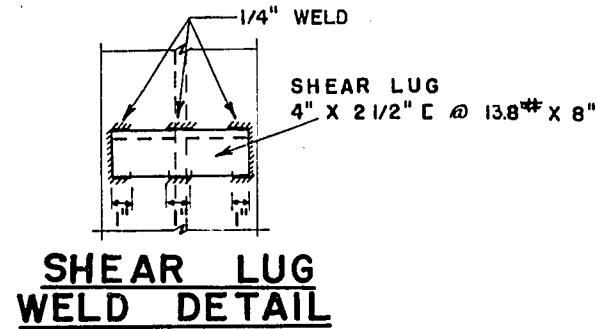


SHEAR LUG WELD DETAIL

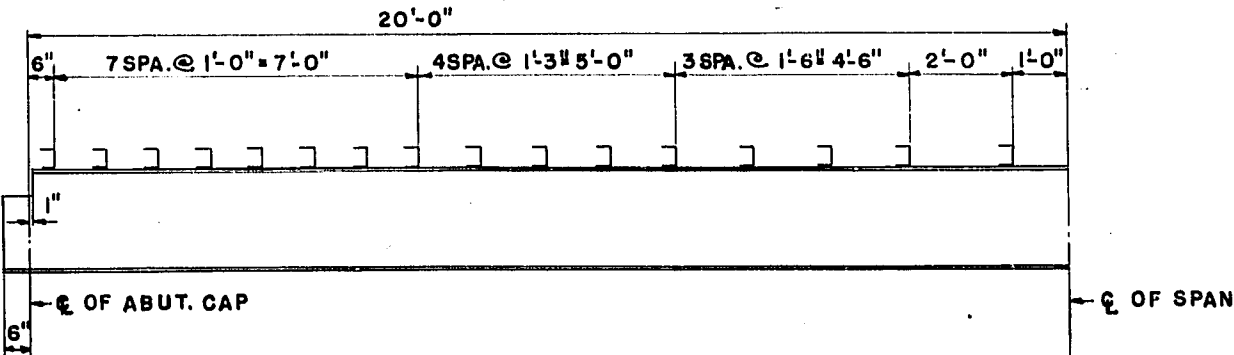

SHEAR LUG SPACING

D.P. DIVISION	PROJECT	SHEET NUMBER	TOTAL SHEETS
4	S 0213(1)	30	86

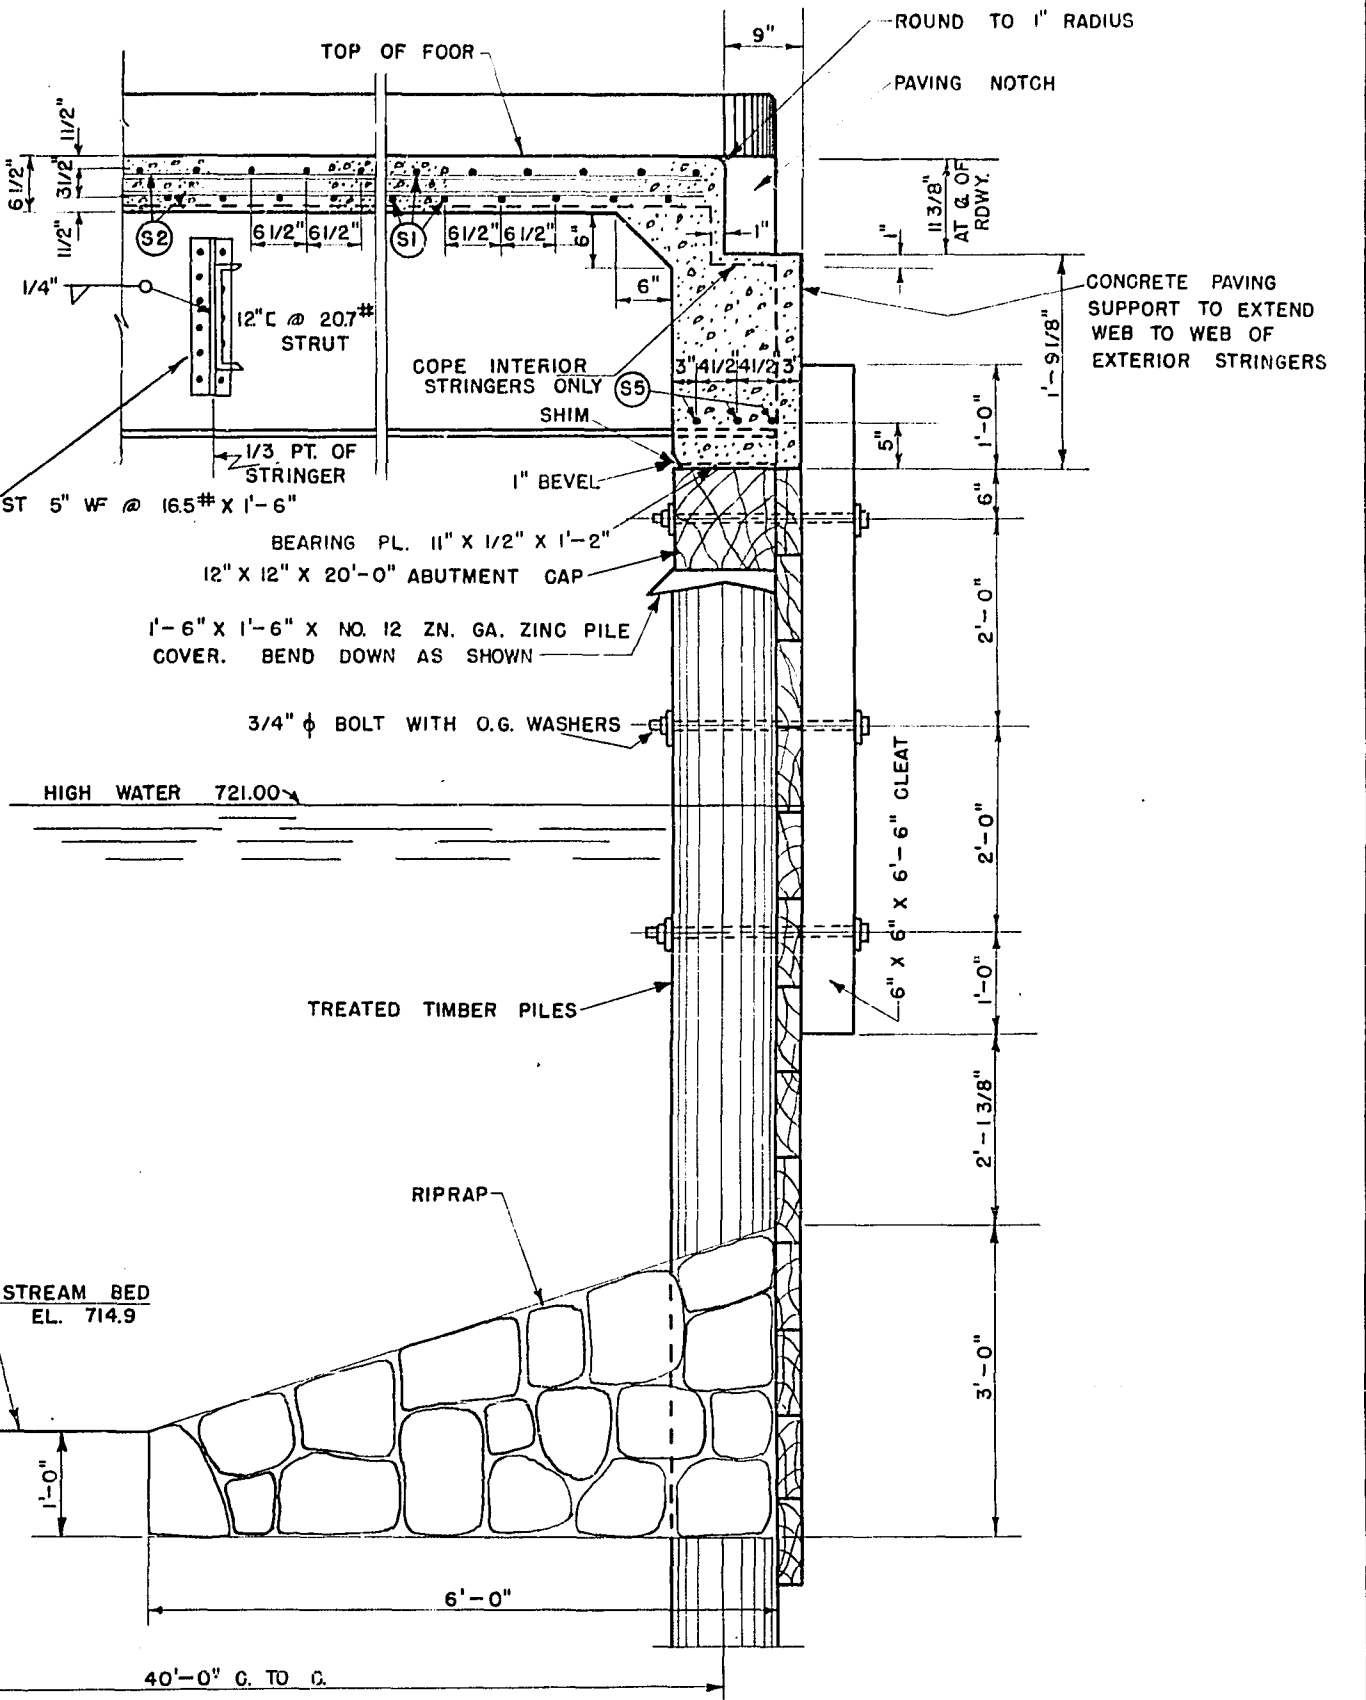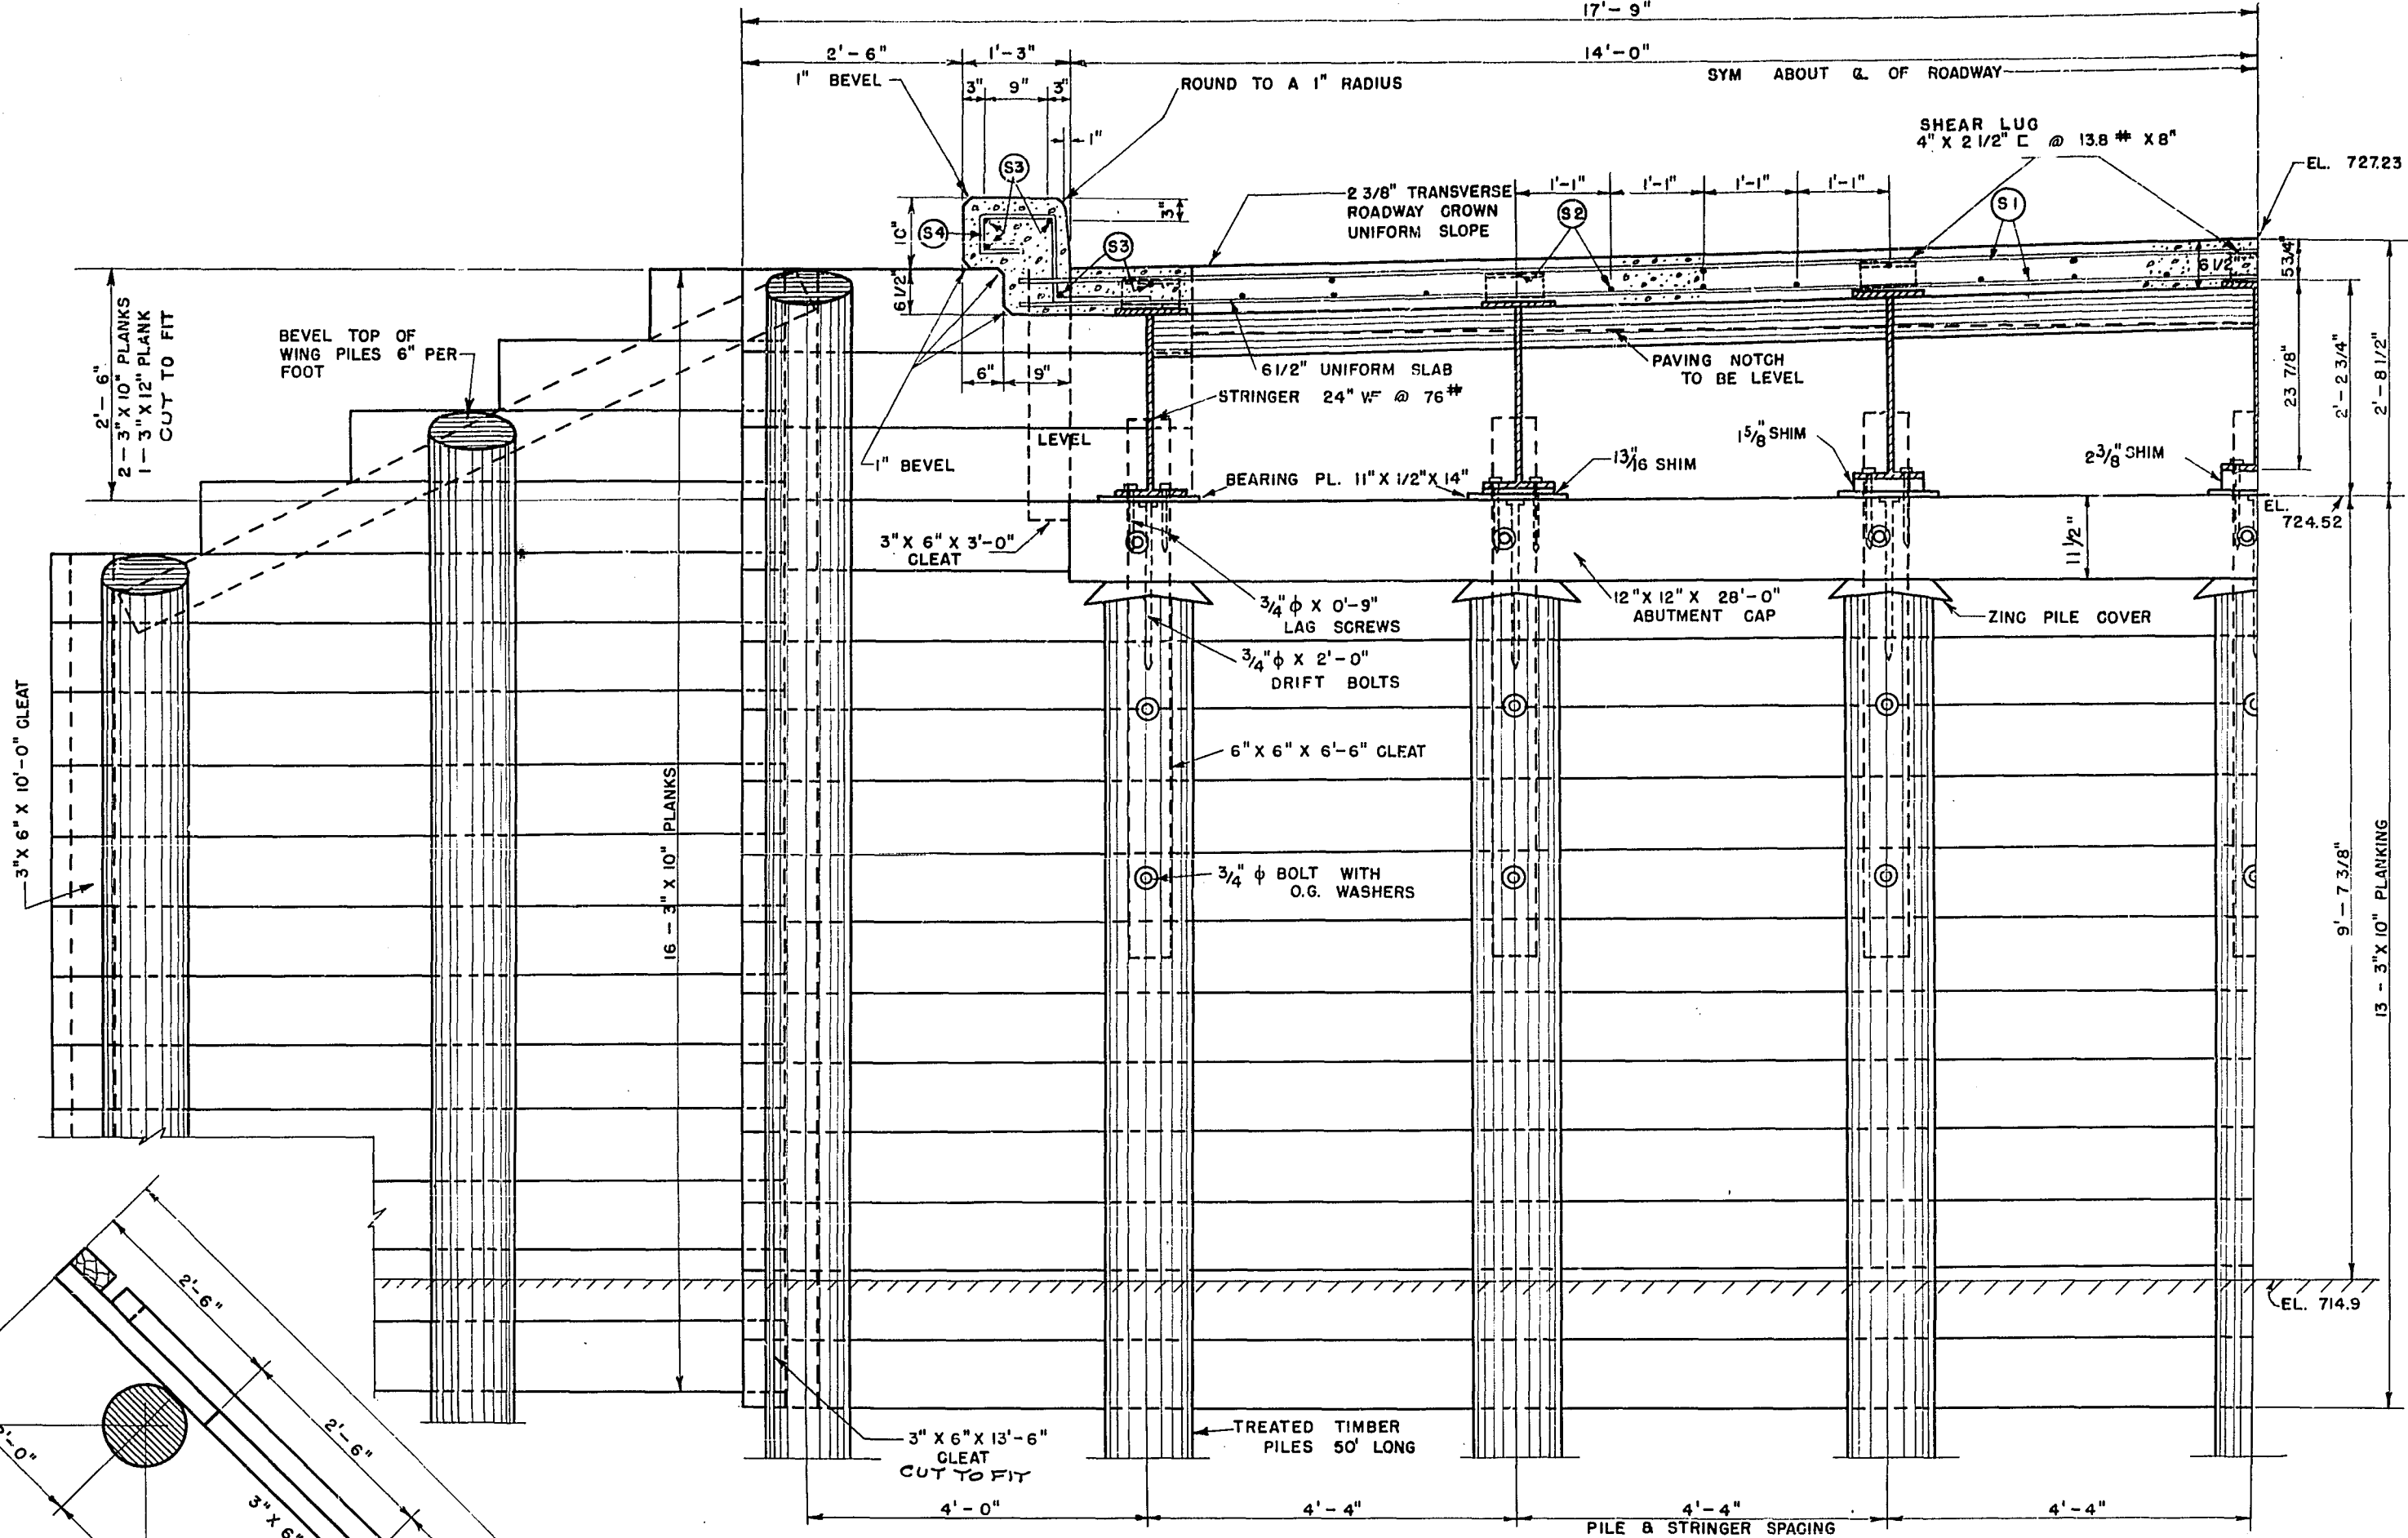


REVISED	STATE HIGHWAY COMMISSION OF WISCONSIN
	ABUTMENTS
DATE 7-18-55	DRWN BY PENNIE GREYCKD
STRUCTURE B-56-21	SHEET 2 OF 2

COUNTY & HIGHWAY	ROUTE & SECTION	CLASS & ACMT	FEDERAL	R. P. R. DIVISION	PROJECT	SHEET NUMBER	TOTAL SHEETS
56.2	213.0	21.1		4	S 0213 (1)	31	86

BILL OF BARS


NO. REQD.	MAK	SIZE	LENGTH	SPACING	LOCATION
188	S1	4	29'-0"	3 3/4"	TRANSVERSE (TOP & BOTTOM) FLOOR
20	S2	4	29'-0"	SHOWN	LONGITUDINAL (BOTTOM) FLOOR
29	S3	4	29'-0"	1'-0"	LONGITUDINAL (TOP) FLOOR
40	S4	4	4'-0"	1'-6"	TRANSVERSE IN CURB
8	S5	6	30'-6"	SHOWN	LONGITUDINAL IN CURB
30	S6	6	4'-10"	4 1/4"	PAVING SUPPORT

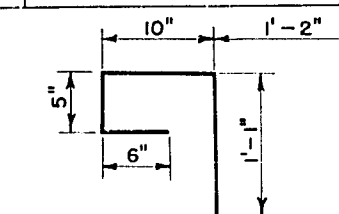

DETAIL OF S4

GENERAL NOTES

DRAWINGS SHALL NOT BE SCALED.
ALL CONCRETE MASONRY SHALL BE GRADE "AA".
BEVEL ALL EXPOSED EDGES OF CONCRETE 1" UNLESS OTHERWISE SPECIFIED.
BAR STEEL REINFORCEMENT DIMENSIONS APPLY ALONG ϕ OF BAR.
BAR STEEL REINFORCEMENT IN FLOOR SHALL BE CUT OFF AT FLOOR DRAINS.
UNLESS OTHERWISE SPECIFIED, ALL SHOP CONNECTIONS SHALL BE 3/4" ϕ RIVETS AND ALL FIELD CONNECTIONS SHALL BE 3/4" ϕ RIVETS OR 3/4" ϕ RIBBED BOLTS. SEE SPECIFICATIONS.
PILES SHALL BE TREATED TIMBER PILING 50'-0" LONG AND SHALL BE DRIVEN TO A MINIMUM BEARING VALUE OF 20 TONS PER PILE.
THE 3" X 10" BULKHEAD PLANK IN THE BODY OF THE ABUTMENTS MAY BE SPLICED. SPLICES MUST BE AT ϕ OF PILES AND MUST BE STAGGERED IN ADJACENT PLANKS.
THE FRONT FACES OF THE ABUTMENTS SHALL BE RIPRAPPED AS SHOWN IN SECTION S1-S1 WITHIN THE LIMITS OF THE ENDS OF THE WINGS. AFTER THE FILL IS IN PLACE, THE SLOPE OF THE FILL AROUND THE ENDS OF THE WINGS SHALL BE RIPRAPPED TO A MINIMUM THICKNESS OF 1'-0" AS DIRECTED BY THE ENGINEER.

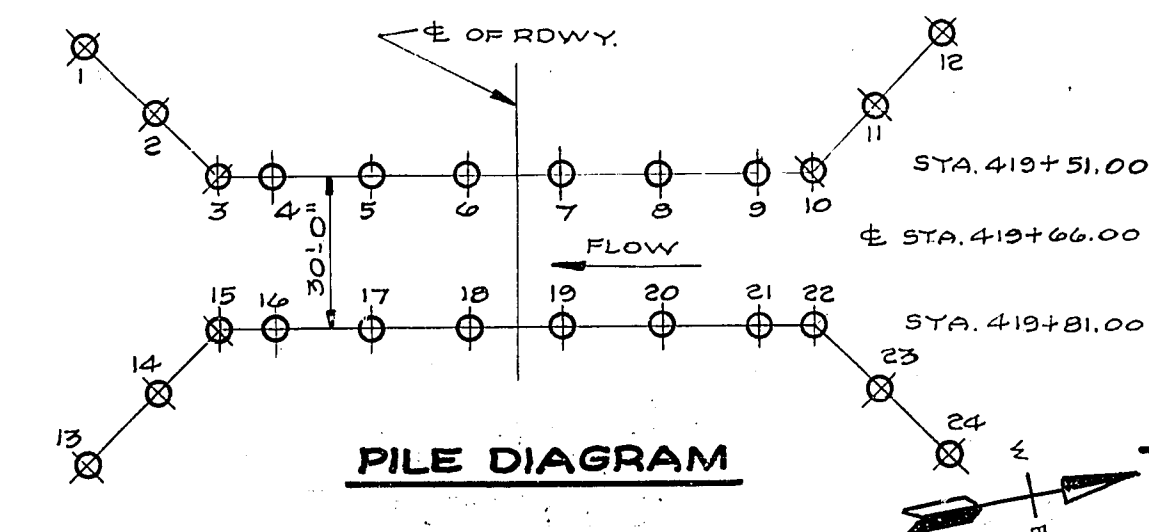

PILE DIAGRAM

LIST OF DRAWINGS

- 1- LAYOUT-RAILING & DRAIN DETAILS, ETC. X15019
- 2- ABUTMENTS X15020

* NOTE: THE DESIGN OF THIS STRUCTURE IS IN ACCORDANCE WITH THE REQUIREMENTS OF THE "STANDARD SPECIFICATIONS FOR HIGHWAY BRIDGES A.A.S.H.O. EDITION OF 1953."

REVISED	STATE HIGHWAY COMMISSION OF WISCONSIN
	LAYOUT-RAILING & DRAIN DETAILS, ETC.
	CO. SAUK TOWN TROY STA. 419+66.00
	SECTION 5 TOWN 8 N. RANGE 5 E.
	DATE 7-14-55 DRAWN BY J. B. SCHULTZ CHECKED BY E. C. ROETTER
	CORRECTED BY J. B. SCHULTZ ENGINEER OF BRIDGES
	APPROVED BY E. C. ROETTER STATE HIGHWAY ENGINEER
	STRUCTURE B-56-22 SHEET 1 OF 2

TREATED LUMBER & TIMBER


NOMINAL SIZE	NO. OF PIECES	LENGTH	SURFACE	GRADE	LOCATION
3" X 6"	2	7'-6"	NONE	1200# J & P	WING CLEAT
	2	10'-0"	NONE	1200# J & P	WING CLEAT
	2	10'-9"	"	"	"
	4	11'-6"	NONE	"	"
	2	13'-0"	"	"	"
	4	3'-0"	NONE	"	BODY CLEAT
6" X 6"	12	6'-0"	NONE	1200# J & P	"
	4	5'-0"	NONE	1200# J & P	BODY BACKING
	4	2'-6"	NONE	"	WING BACKING
	4	5'-0"	NONE	"	"
	4	7'-6"	"	"	"
	4	10'-0"	"	1200# J & P	"
3" X 10"	42	12'-6"	"	"	"
	18	35'-0"	"	"	BODY BACKING
	* 2	11'-1 1/2"	"	"	"
	* 2	29'-0 3/8"	"	"	"
	8	5'-0"	NONE	1200# J & P	BODY BACKING
	* 2	21'-4 1/8"	"	"	"
12" X 12"	* 2	28'-2"	S2E	1600# B & S	ABUTMENT CAP

* SEE DETAILS


TOTAL ESTIMATED QUANTITIES

BID ITEMS	UNIT	QUANTITY
EXACATION FOR STRUCTURES	C.Y.	86
CONCRETE MASONRY	C.Y.	28.8
BAR STEEL REINFORCEMENT	LB.	5,284
STRUCTURAL CARBON STEEL	LB.	15,898
SHEET ZINC	LB.	29
TREATED LUMBER & TIMBER	MBM	4.75
* UNTREATED TIMBER TEST PILING (1855) L.S.		1
TREATED TIMBER PILING DELIVERED	L.F.	1200
TREATED TIMBER PILING DRIVEN	L.F.	968
BEAM TYPE BRIDGE RAIL	L.F.	65
FLOOR DRAINS	EACH	3
RIP RAP	C.Y.	57


* DRIVE AT LOCATION OF WEST ABUT.

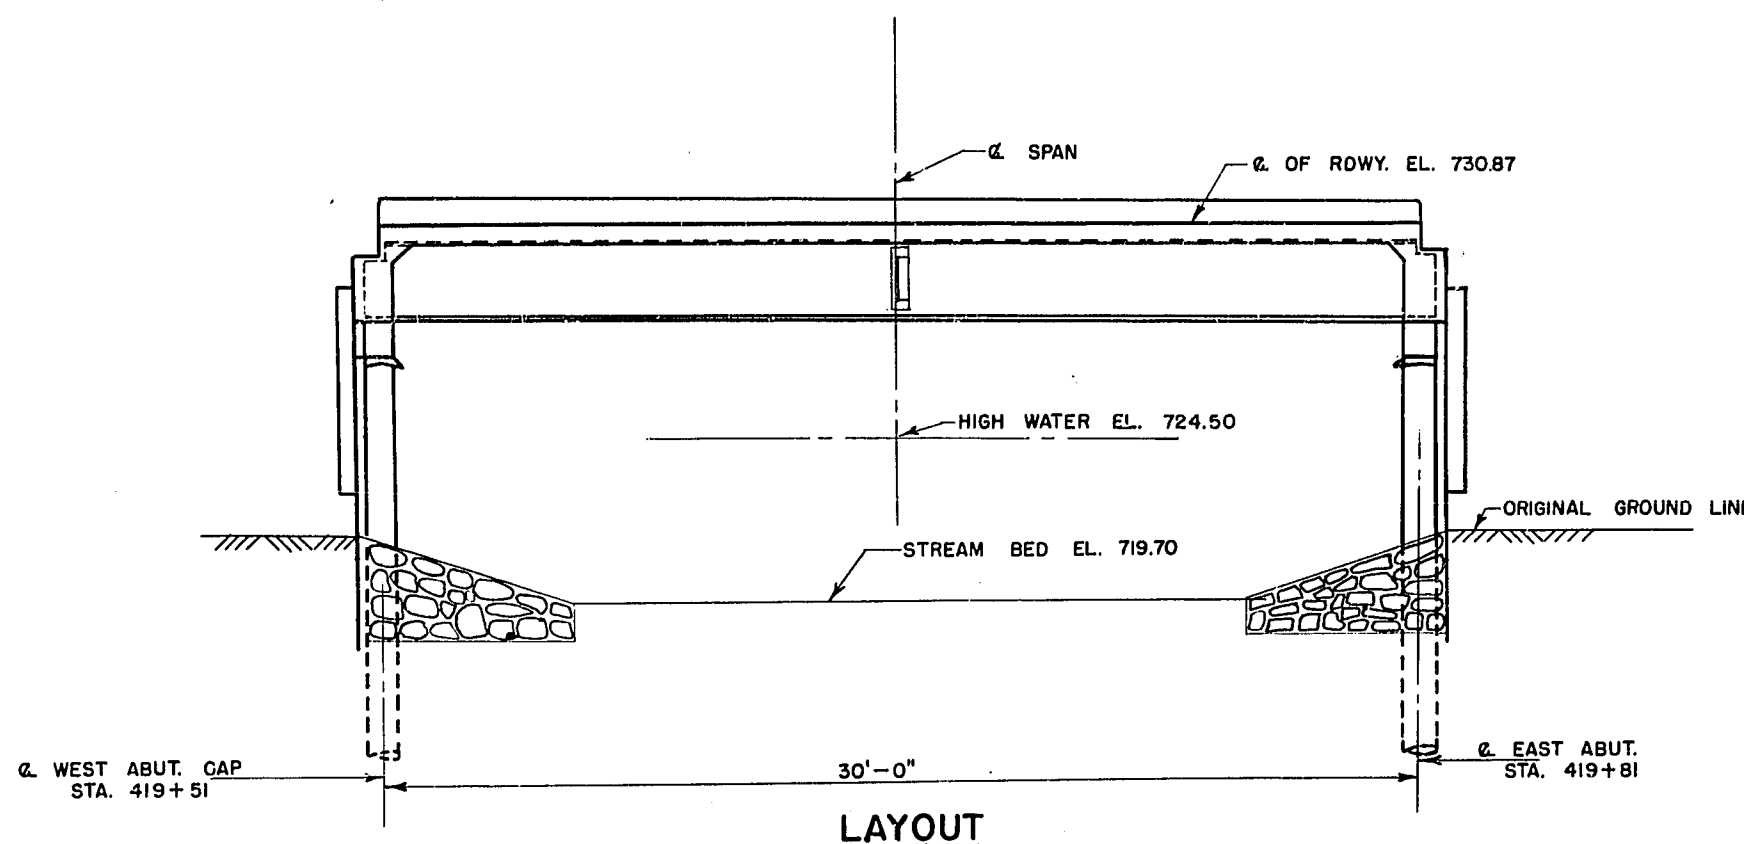

LAYOUT

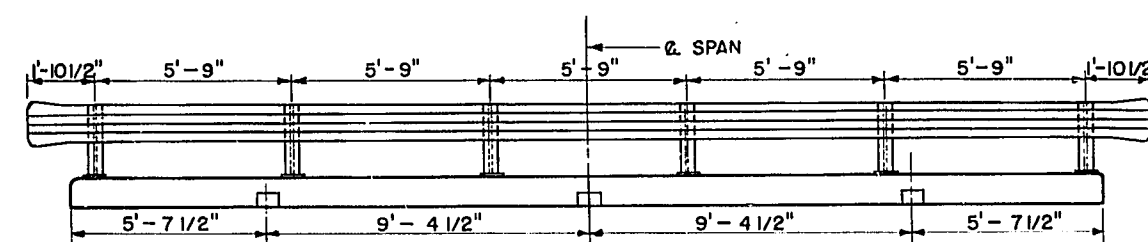


SPACING OF RAILING POSTS & DRAINS

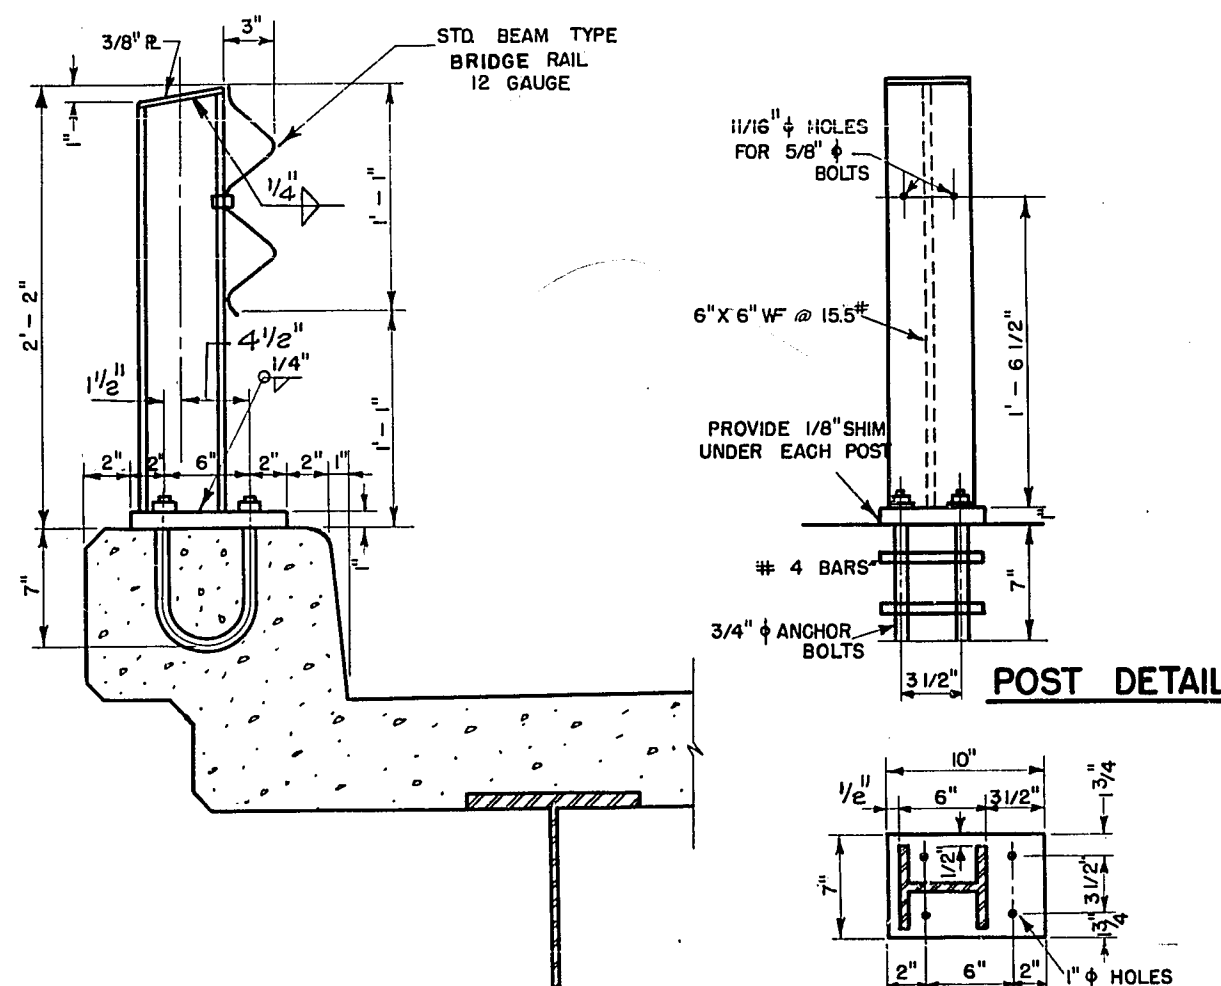


SECTION THRU RAILING


POST DETAIL

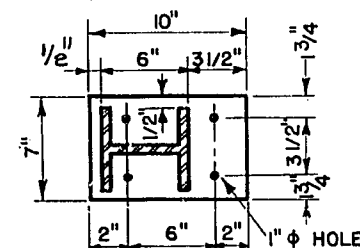


BASE PLATE

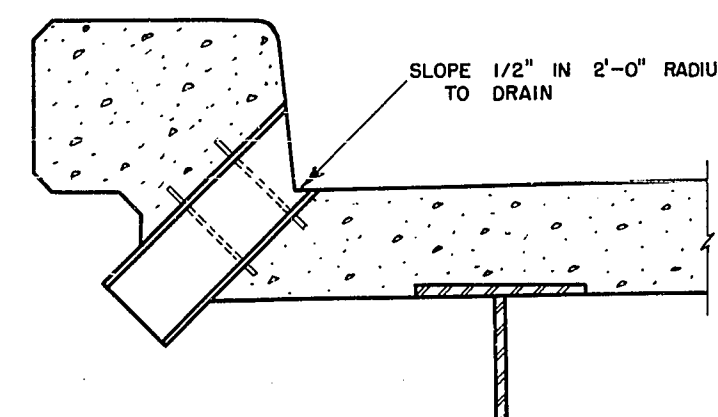

SECTION THRU DRAIN

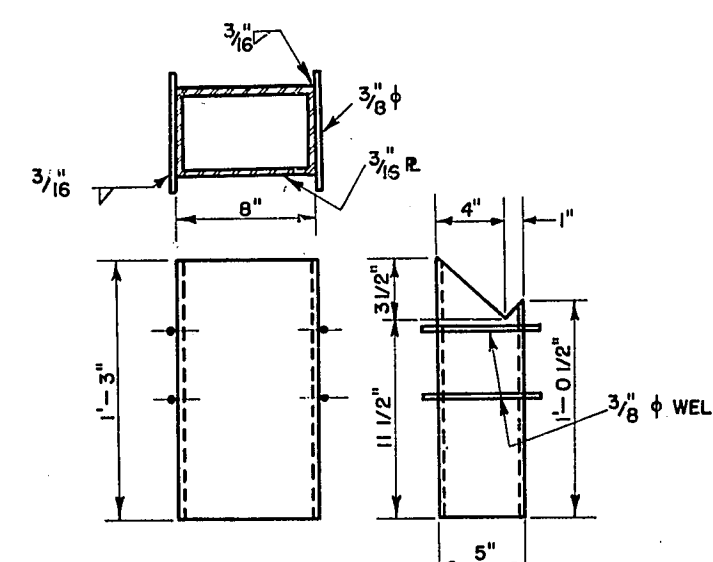


DRAIN DETAILS

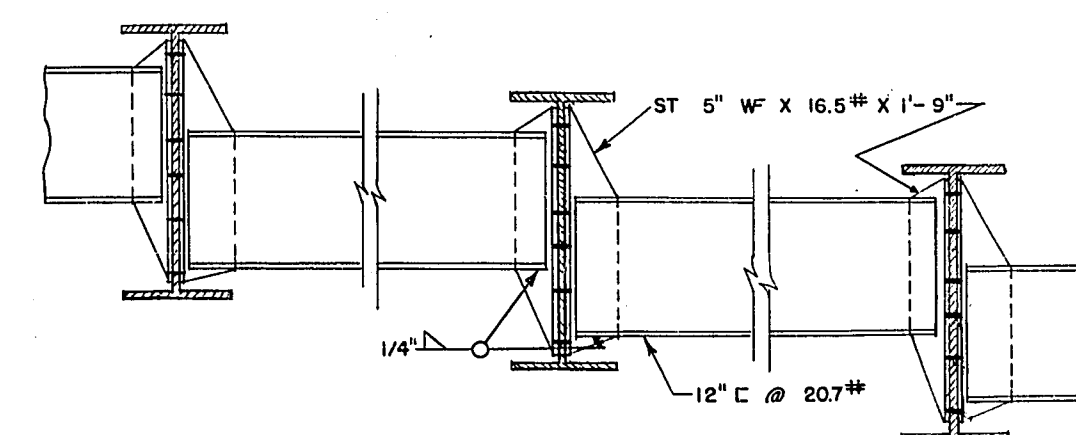

DIAPHRAGM CONNECTION DETAIL

NOTE: - CONTRACTOR SHALL MAKE PROVISION FOR 1/4" THICKENING OF FLOOR SLAB FOR D.L. DEFLECTION. BEAMS SHALL BE DETAILED BY FABRICATOR WITH NATURAL CAMBER UP.

D.P.R. DIVISION	PROJECT	SHEET NUMBER	TOTAL SHEETS
4	S 0213(I)	32	86

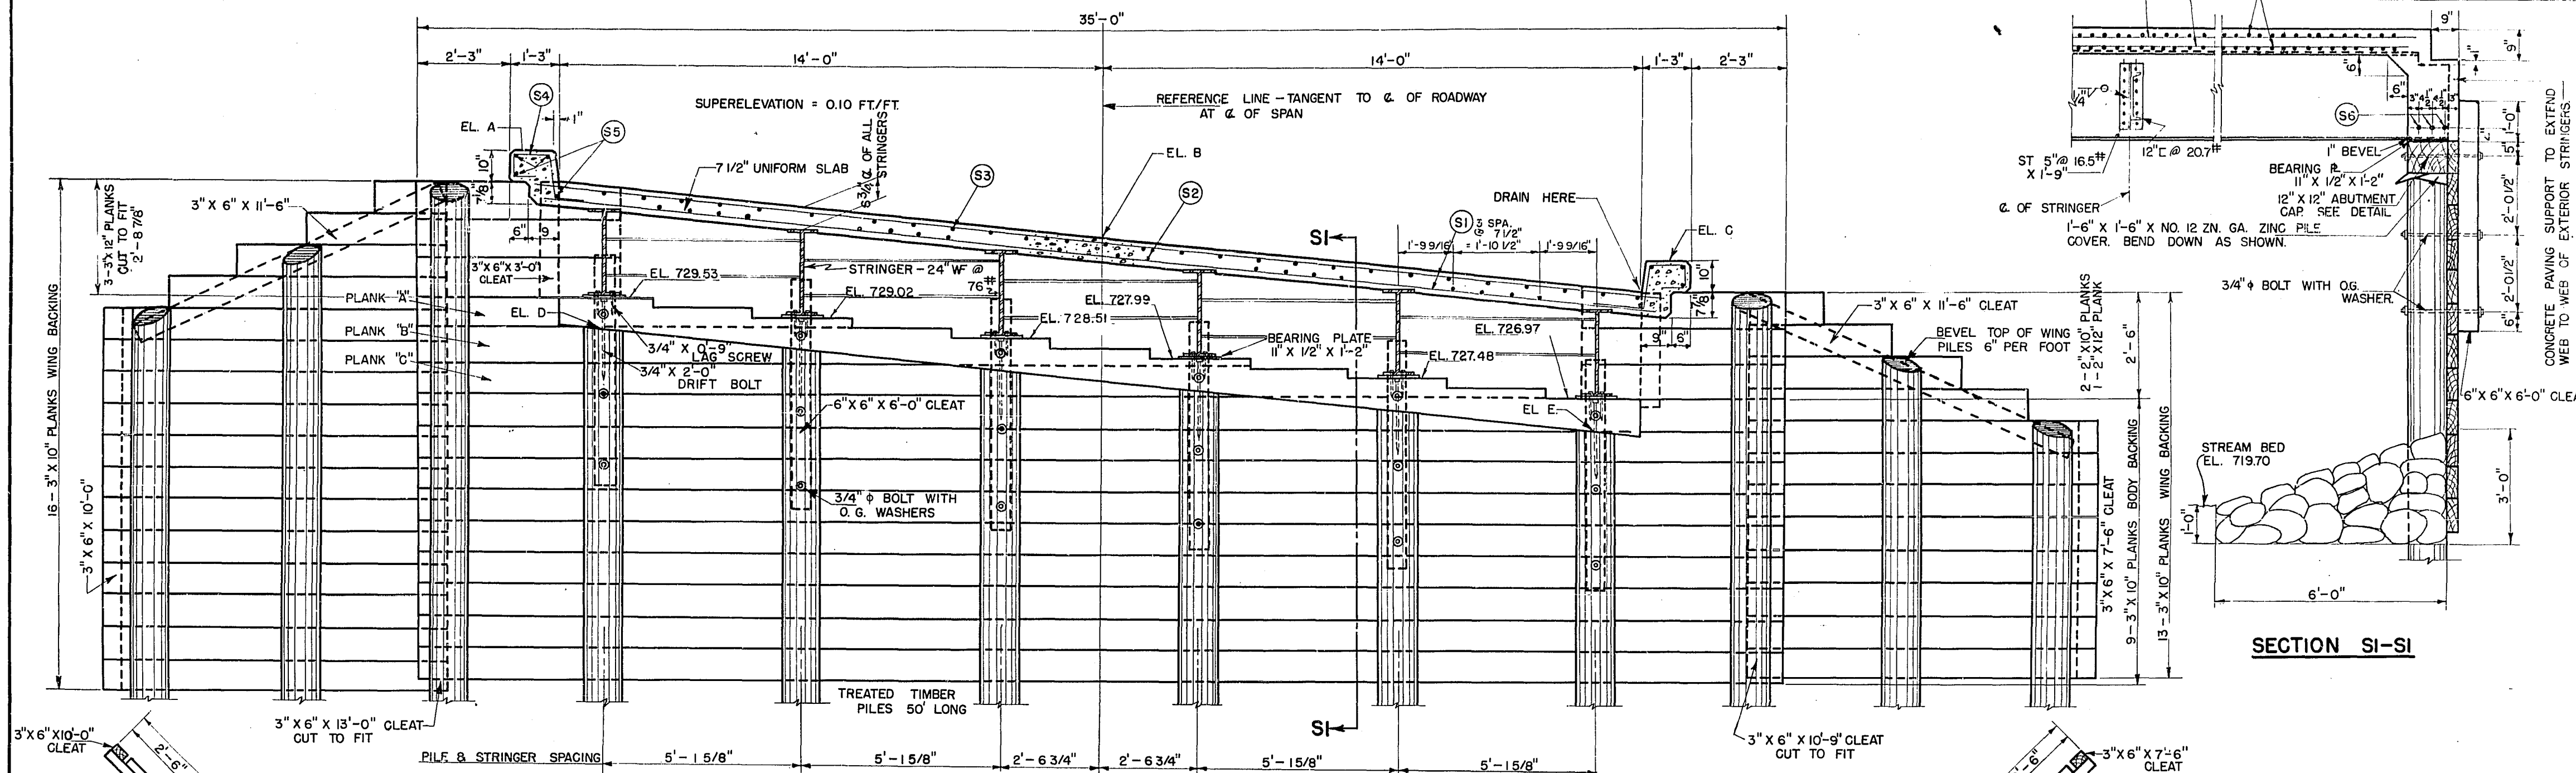


SECTION SI-SI


FRONT ELEVATION

TABLE OF ELEVATIONS


UNIT	ELEVATION				
	A	B	C	D	E
NBS ABUT.	733.10	730.87	730.30	728.70	726.15

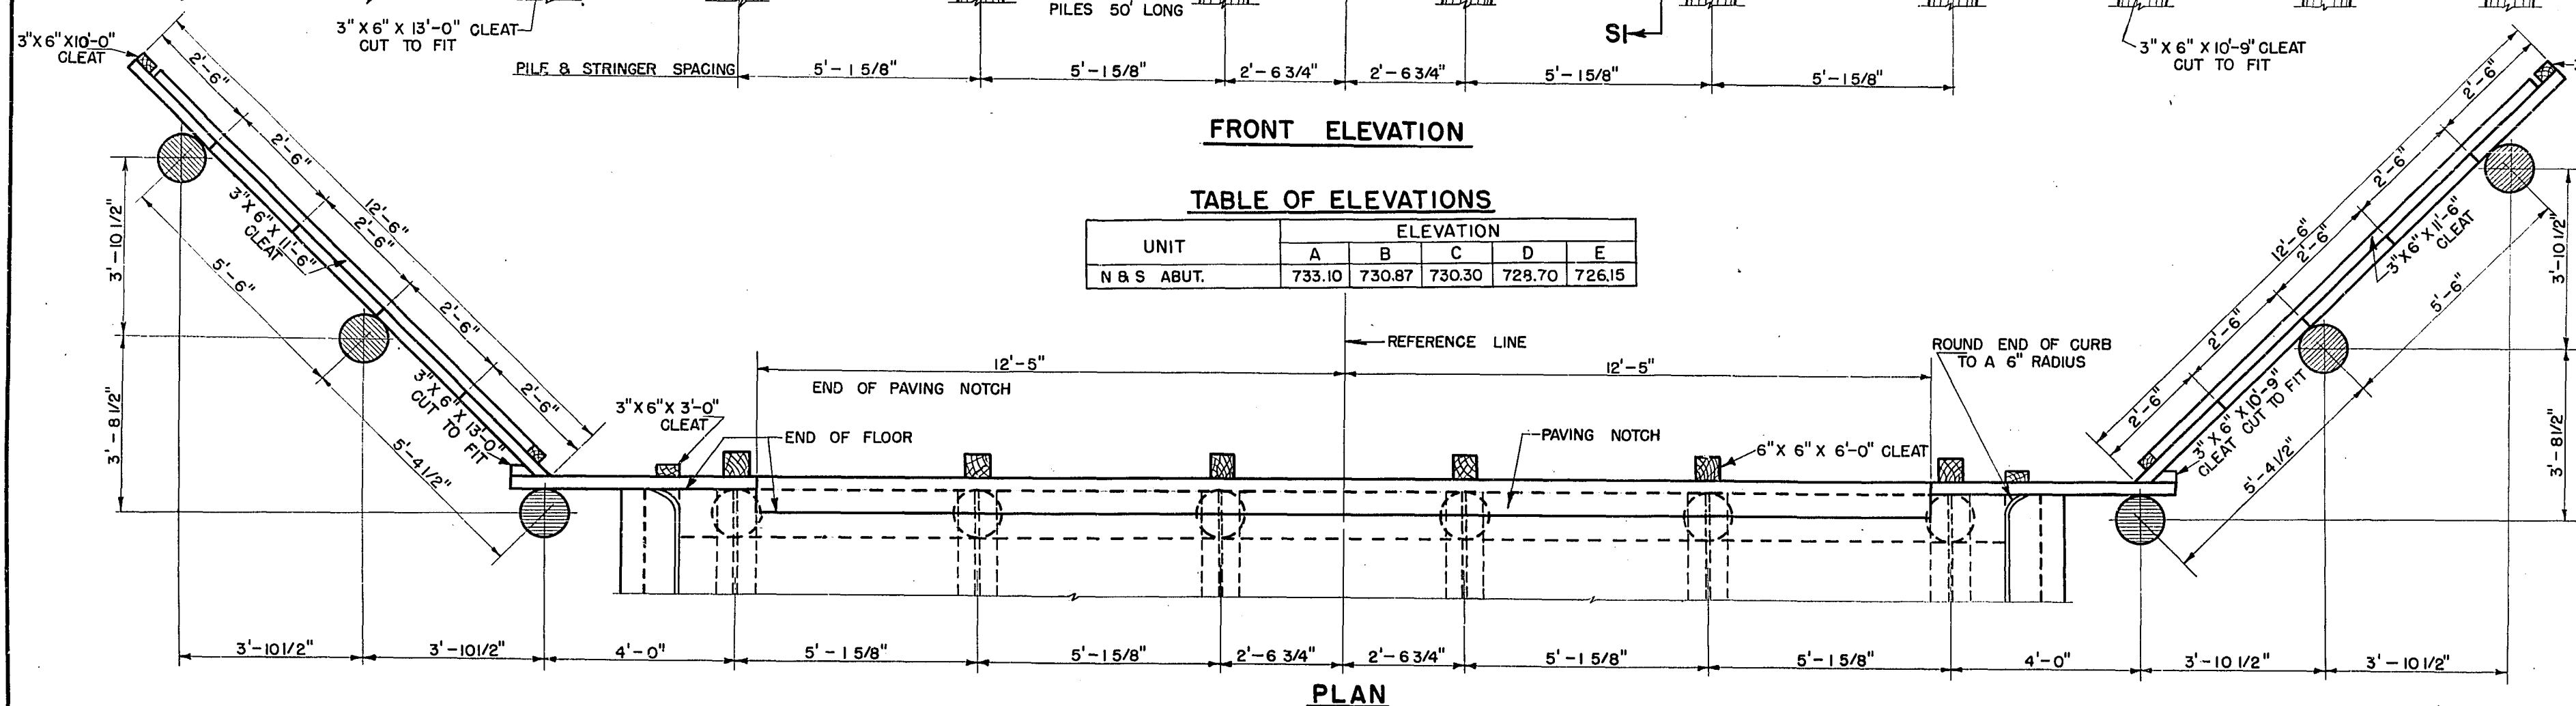


PLAN

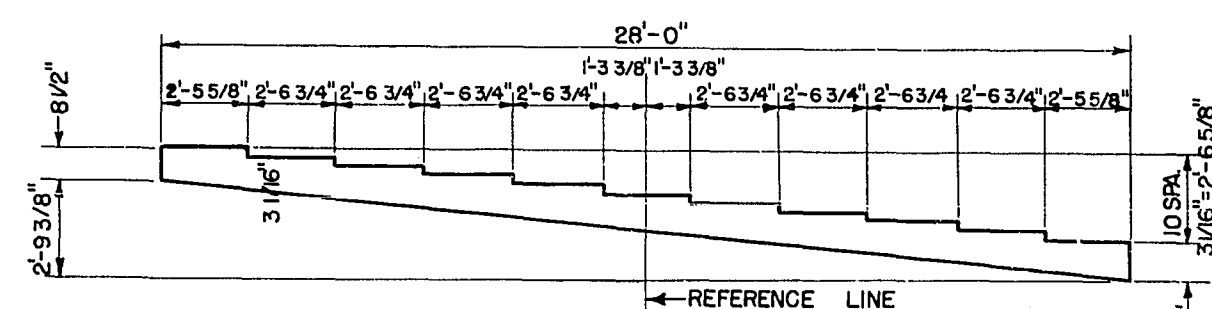


DETAILS OF ABUTMENT CAP

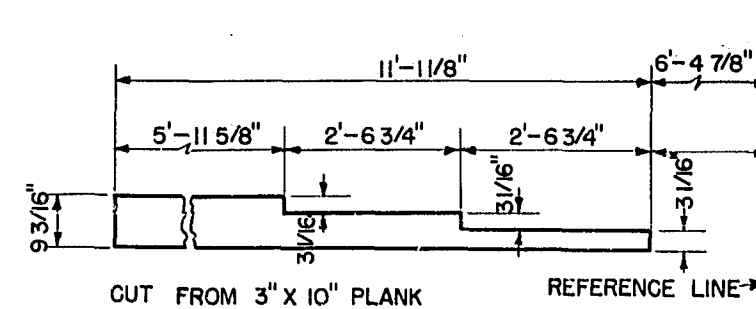

DETAILS OF PLANK "A"

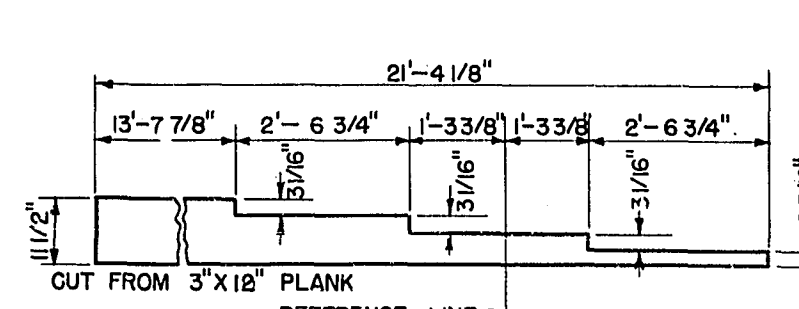

DETAILS OF PLANK "B"

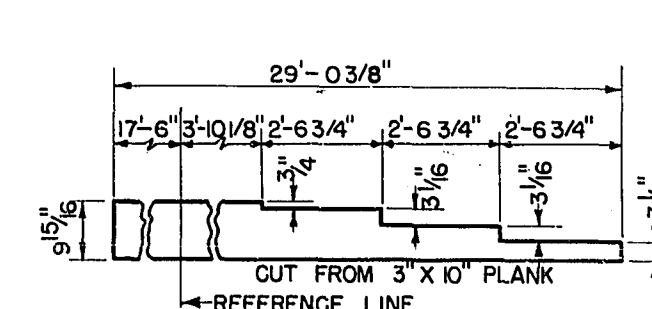

DETAILS OF PLANK "C"

REVISED	STATE	HIGHWAY	COMMISSION	OF WISCONSIN
		ABUTMENTS FENNER		
	DATE 7-14-80	DRAWN BY REYCKD.	SPEC. 1981	LOAD H20
STRUCTURE B-56-22			SHEET 2 OF 2	