


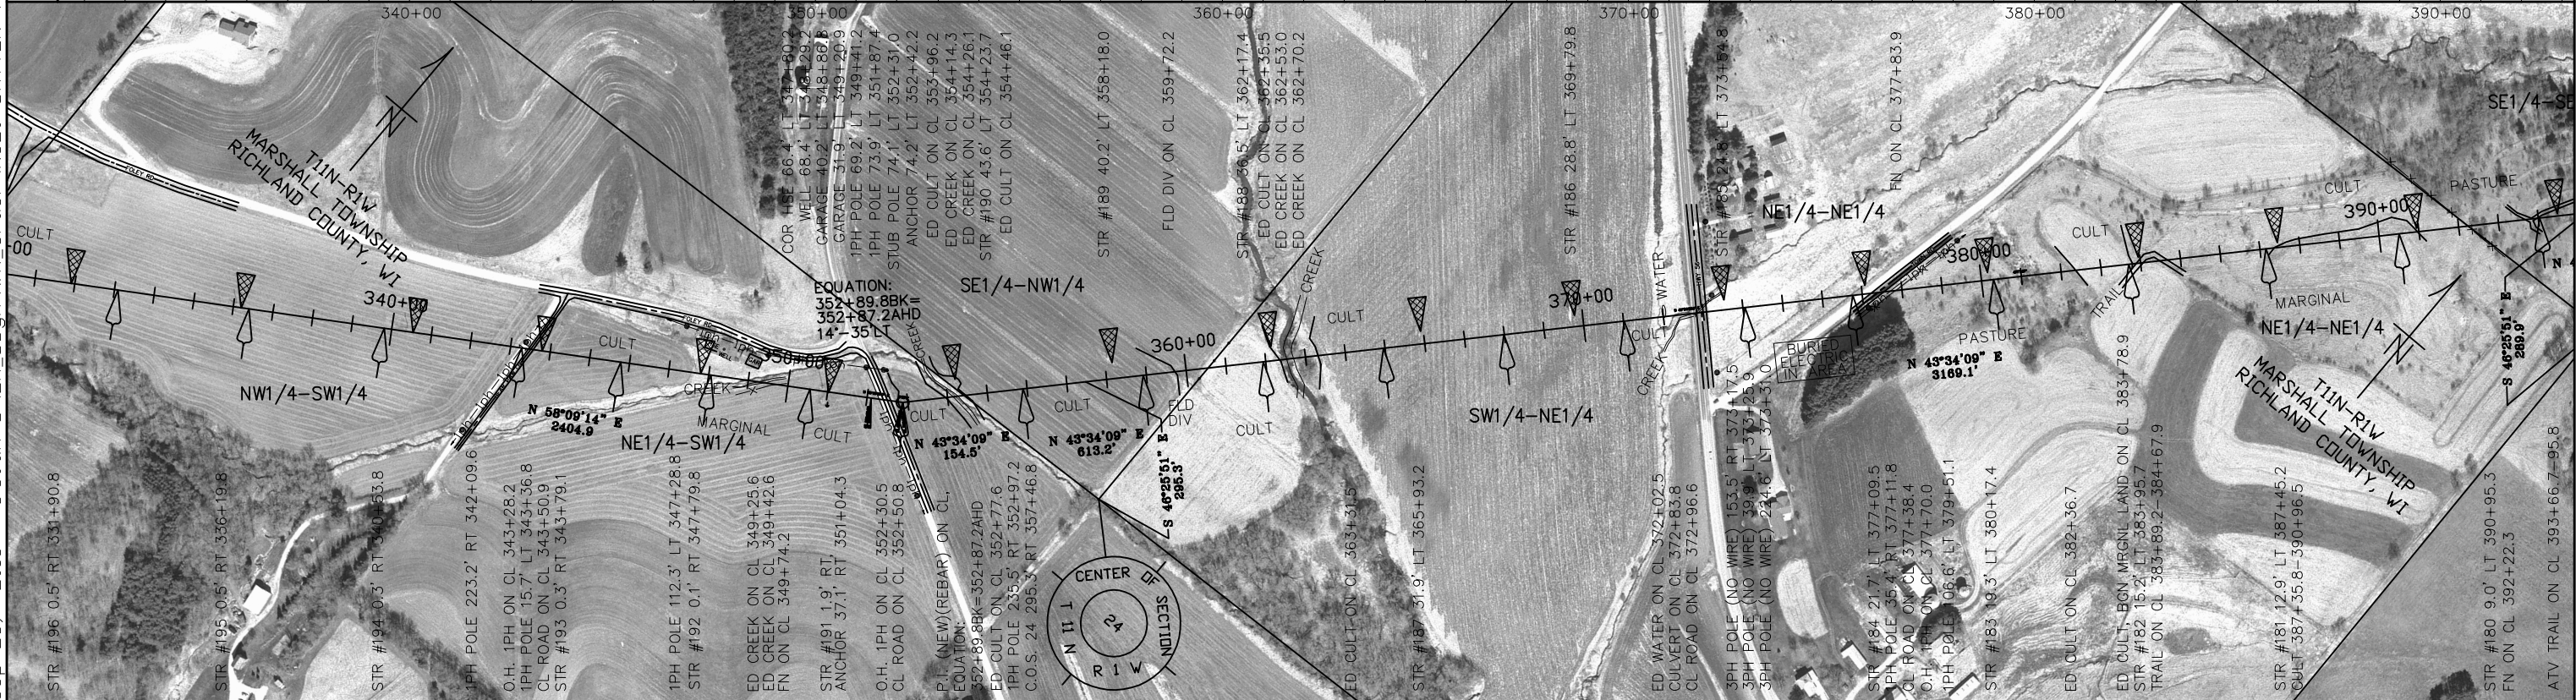

STRUCTURE LEGEND  NEW STRUCTURE  EXISTING STRUCTURE  STRUCTURE TO BE MOVED OR REMOVED		PROFILE LEGEND  EXISTING STRUCTURE LOCATION  10' RIGHT CENTERLINE  10' LEFT		DRAWN UEI DESIGNED UEI		PLOT SCALE 1"=40'V 1"=400'H WORK ORDER W7597		 DAIRYLAND POWER COOPERATIVE LA CROSSE, WISCONSIN		DRAWING STATUS AS BUILT DATE <u>2-14-13</u> SUPERSEDES <u>9-5-06</u>		N-329 69 kV TRANSMISSION LINE DAYTON TO ROCKBRIDGE TAP		LINE REVISION NUMBER <u>0</u>		SHEET 9 OF 46 b/P-495 AutoCAD	
---	--	---	--	---	--	---	--	--	--	---	--	---	--	---	--	--	--