



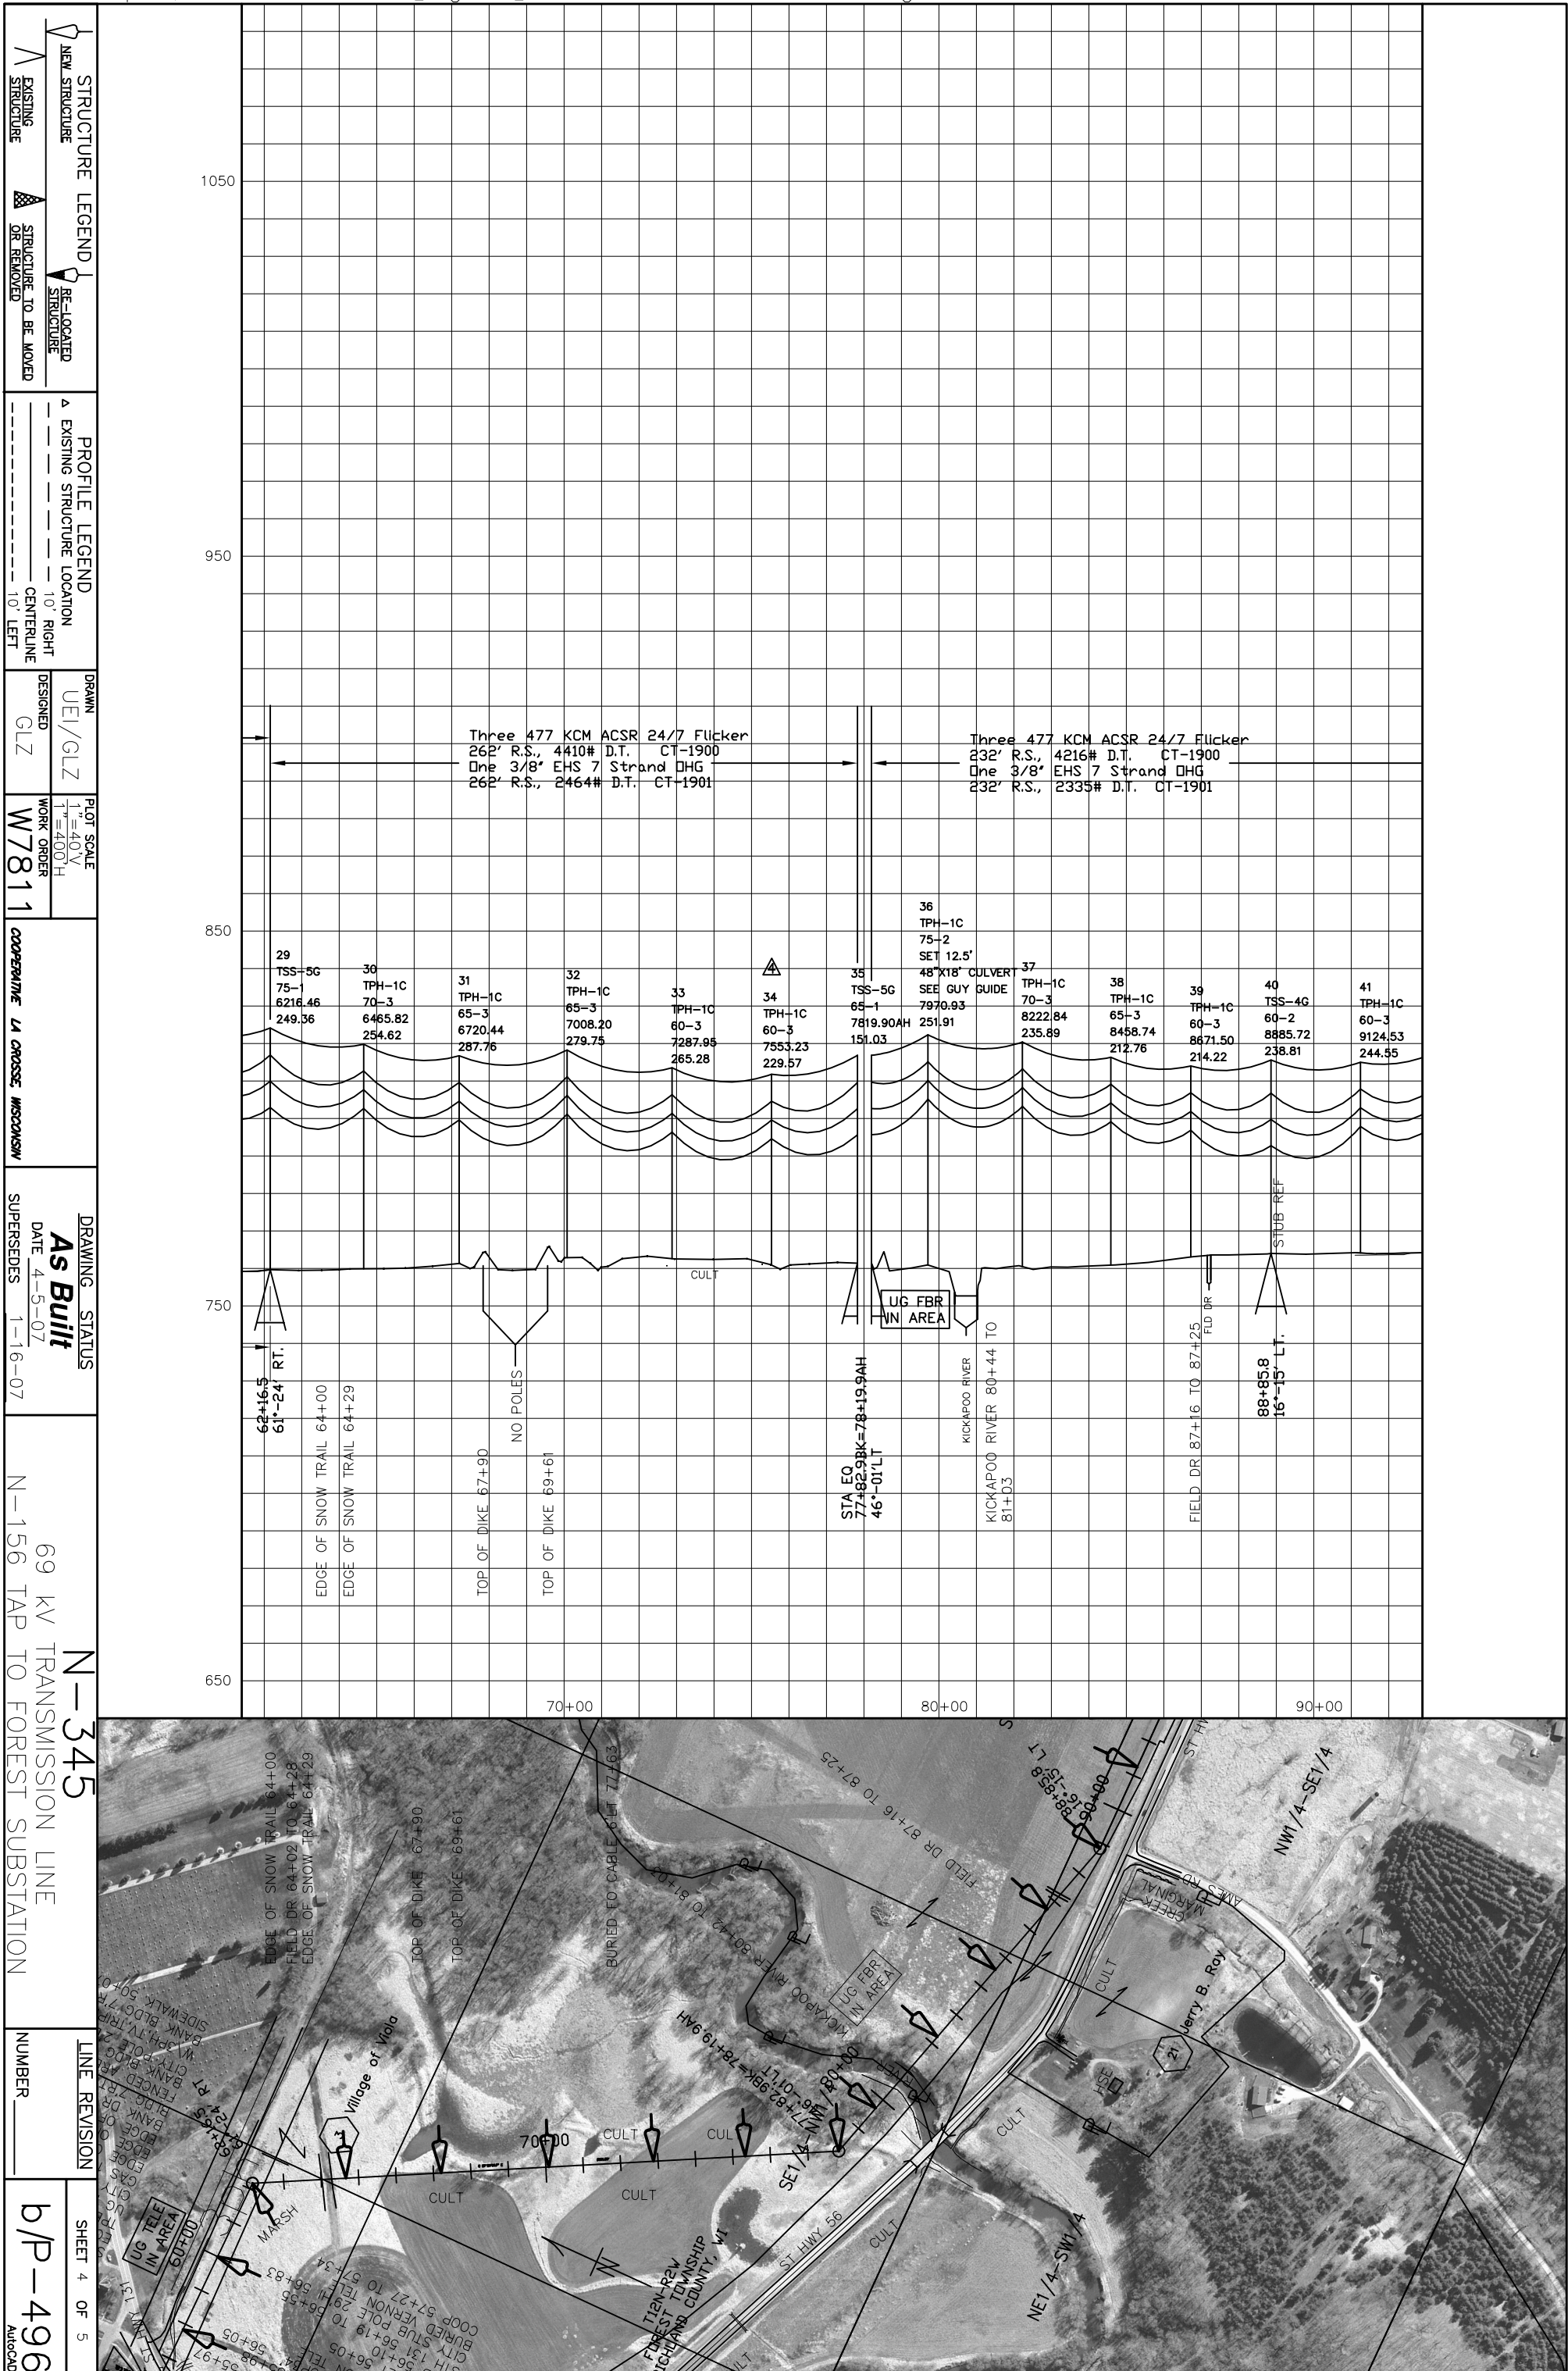

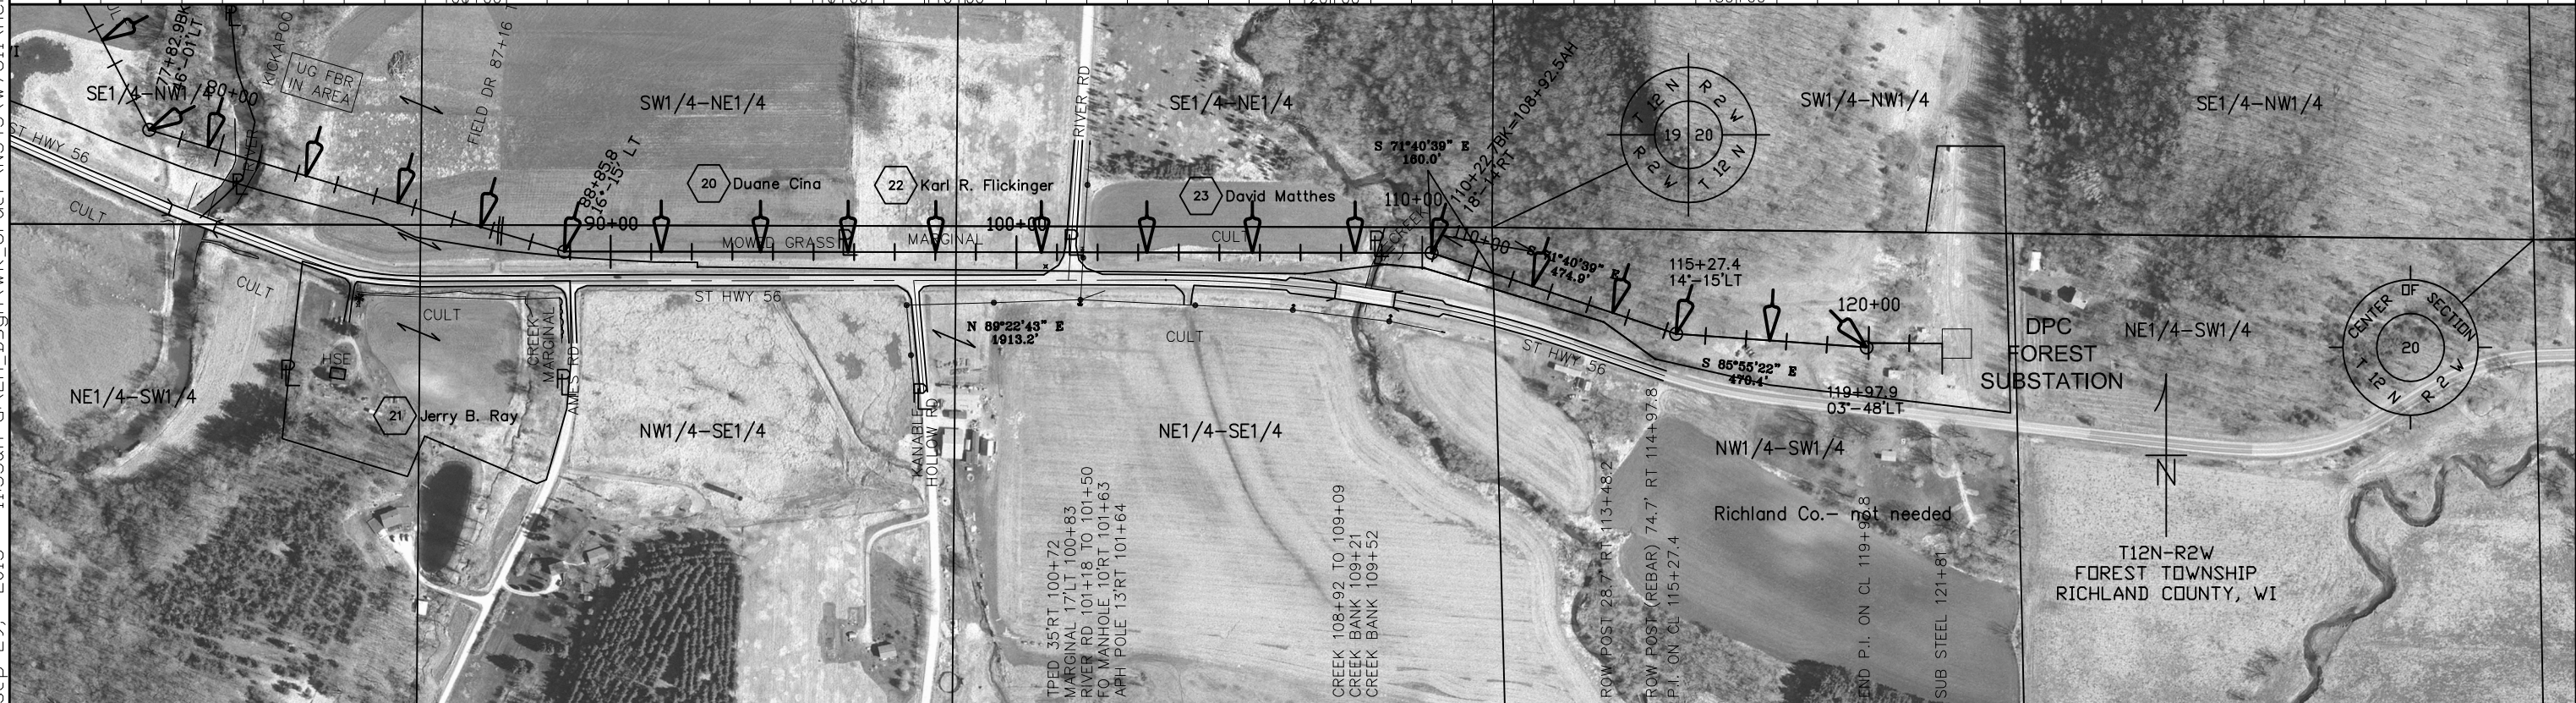

STRUCTURE LEGEND  NEW STRUCTURE  EXISTING STRUCTURE  STRUCTURE TO BE MOVED OR REMOVED		PROFILE LEGEND  EXISTING STRUCTURE LOCATION ----- 10' RIGHT ----- CENTERLINE ----- 10' LEFT		DRAWN UEI/GLZ DESIGNED GLZ	PLOT SCALE 1"=40'V 1"=400'H WORK ORDER W7811	DRAWING STATUS As Built DATE 6-27-07 SUPERSEDES 4-5-07 COOPERATIVE LA CROSSE, WISCONSIN	N-345 69 kV TRANSMISSION LINE N-156 TAP TO FOREST SUBSTATION	LINE REVISION NUMBER _____	SHEET 5 OF 5 b/P-496 AutoCAD
---	--	--	--	---	--	---	---	--------------------------------------	---