


INDEX OF SHEETS

Sheet No. 1	Title
Sheet No. 2.1-2.4	Typical Sections and Details
Sheet No. 3.1	Estimate of Quantities
Sheet No. -	Miscellaneous Quantities
Sheet No. -	Right of Way Plat
Sheet No. -	Plan and Profile
Sheet No. 6.1-6.3	Standard Detail Drawings
Sheet No. -	Sign Plates
Sheet No. -	Structure Plans
Sheet No. -	Computer Earthwork Data
Sheet No. -	Cross Sections

TOTAL SHEETS = 9

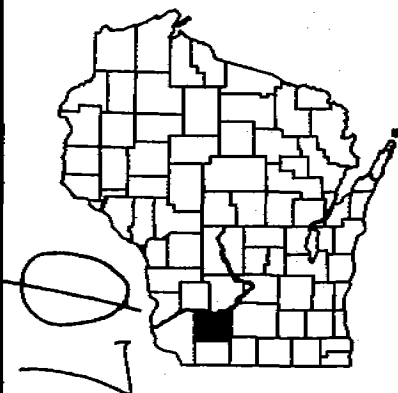

DESIGN DESIGNATION

A.D.T. (1996)	=	900
A.D.T.	=	
D.H.V.	=	
D.	=	
T.	=	
DESIGN SPEED	=	
ESALS	=	

CONVENTIONAL SIGNS

PLAN	PROFILE
CORPORATE LIMITS	GRADE LINE
PROPERTY LINE	ORIGINAL GROUND
LOT LINE	MARSH OR ROCK PROFILE
LIMITED HIGHWAY EASEMENT	SPECIAL DITCH
EXISTING RIGHT OF WAY	PROFILE EXISTING TRAVELWAY
NEW RIGHT OF WAY	GRADE ELEVATION
SLOPE INTERCEPT	CULVERT
DRAIN TILE	EROSION CONTROL DEVICES
REFERENCE LINE	SILT FENCE
CULVERT IN PLACE	INTERCEPTING EMBANKMENT
CULVERT REQUIRED (Profile)	EROSION BALES
DRIVEWAY / CULVERT - PROPOSED	EROSION MAT
UNDERGROUND FACILITY (GAS, TELEPHONE, ELECTRIC, ETC.)	DITCH DIKE
PEDESTAL (TELEPHONE, ELECTRIC, ETC.)	INLET / DISCHARGE APRONS, FLUMES, ETC.
TELEPHONE POLE	
POWER POLE	
COMBUSTIBLE FLUIDS	

STATE OF WISCONSIN DEPARTMENT OF TRANSPORTATION PLAN OF PROPOSED IMPROVEMENT


S.T.H. 23 - S.T.H. 133 ROAD

S.T.H. 130
IOWA COUNTY

AS BUILT CONSTRUCTION PLAN

WORK TYPE PAVEMENT REHABILITATION
CONTRACTOR MATHY CONST. CO.
PROJECT MANAGER TADD OVENS
WORK START-COMPLETED WORK STARTED 9-7-99
WORK SUSPENDED 11-15-99
WORK RESUMED 4-26-00
WORK COMPLETED 5-16-00

STATE PROJECT NUMBER
5770-00-60

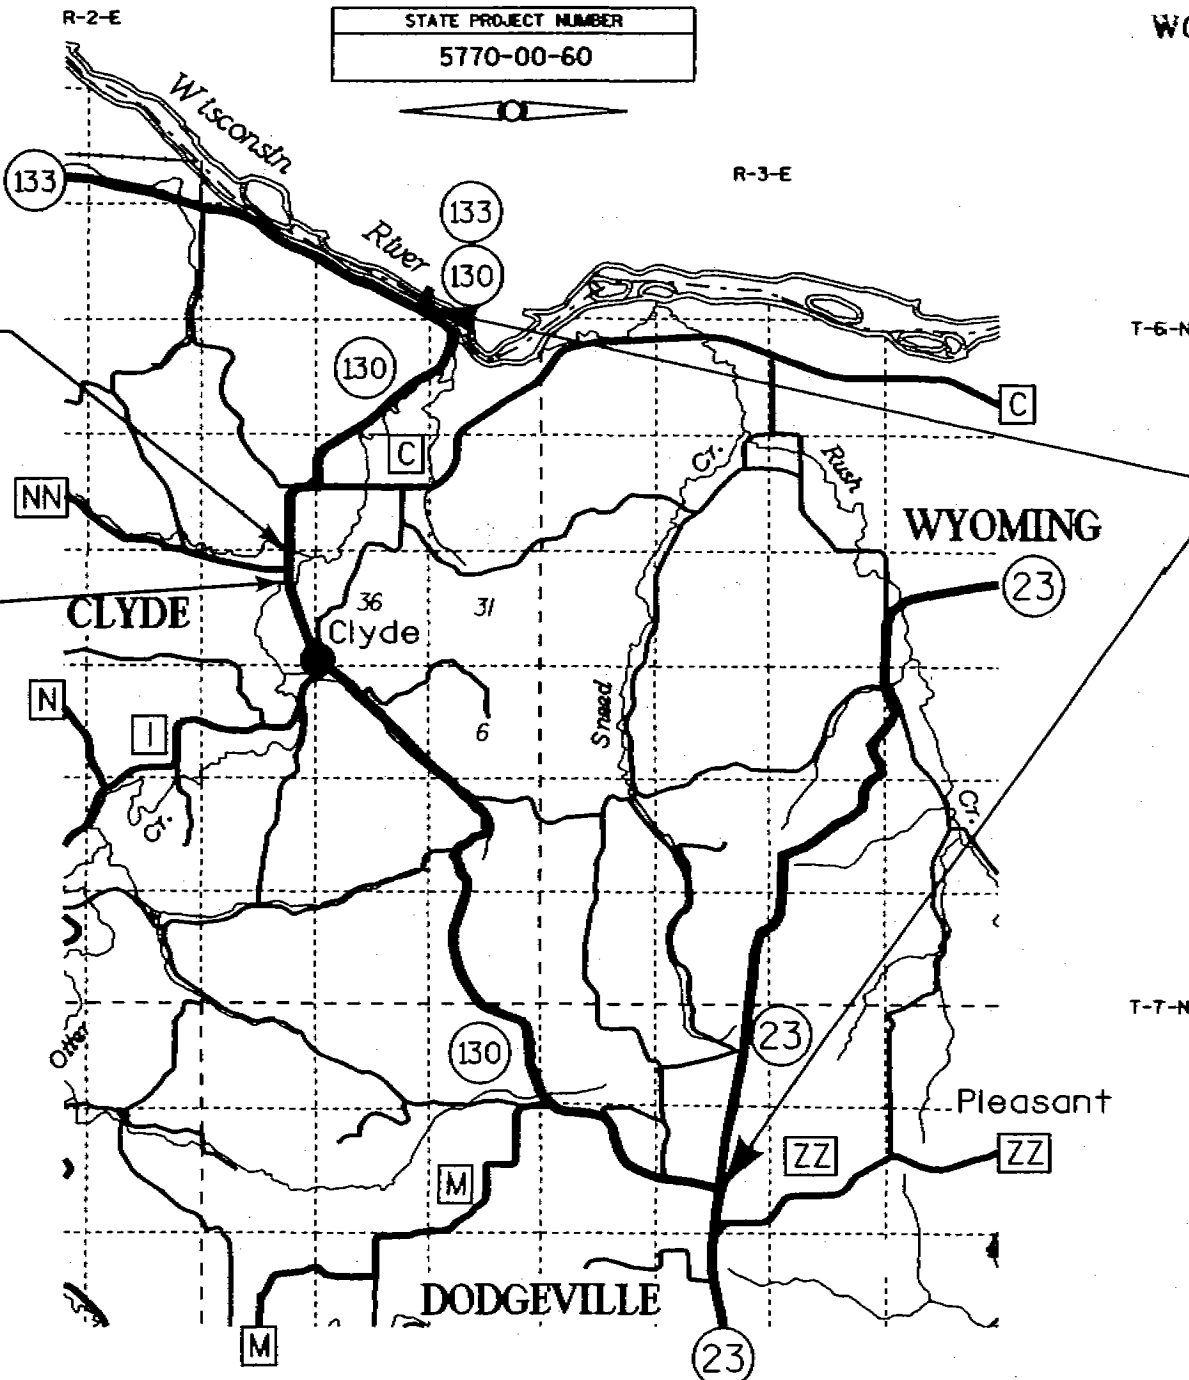

EXCEPTION TO NET CENTERLINE LENGTH
LOG Km 12.806 - LOG Km 12.813
STRUCTURE B-25-934


EXCEPTION TO NET CENTERLINE LENGTH
LOG Km 12.340 - LOG Km 12.380
STRUCTURE B-25-933

PROJECT LOCATION
5770-00-60

LAYOUT
SCALE 0 1 Km

TOTAL NET LENGTH OF CENTERLINE = 17.670 Km

ORIGINAL PLANS PREPARED BY

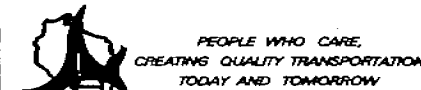

WISDOT DISTRICT 1 STAFF

STATE OF WISCONSIN
DEPARTMENT OF TRANSPORTATION

PREPARED BY	
Surveyor	
Designer	J. STEINER
District Examiner	
District Supervisor	D. HUNTLEY
Proj. Dev. Engineer	L. BARTHA
C.D. Examiner	J. GOODMAN

APPROVED FOR DISTRICT OFFICE
DATE 12/17/99 D. A. Huntley
(Signature)

AUTHORIZED FOR CENTRAL OFFICE MAINTENANCE
DATE 2/16/00 Thomas Kapla
(Signature)