

INDEX OF SHEETS

Sheet No. 1	Title
Sheet No. 2-2.5	Typical Sections and Details
Sheet No. 3-3.1	Estimate of Quantities
Sheet No. 3A	Miscellaneous Quantities
Sheet No. -	Right of Way Plat
Sheet No. -	Plan and Profile
Sheet No. 4-4.8	Standard Detail Drawings
Sheet No. -	Sign Plates
Sheet No. 8-8.10	Structure Plans
Sheet No. -	Computer Earthwork Data
Sheet No. -	Cross Sections

TOTAL SHEETS = 30

STH 23-WISCONSIN RIVER ROAD
(B-25-934)

S.T.H. 130

STATE PROJECT NUMBER
5770-00-79



STATE OF WISCONSIN DEPARTMENT OF TRANSPORTATION

PLAN OF PROPOSED IMPROVEMENT STRUCTURE MAINTENANCE REPAIRS

BRIDGE DECK, OVERLAY, AND APPROACH REPLACEMENT

IOWA COUNTY

FIFTH STREET, VILLAGE OF HOLLANDALE
(B-25-935)

S.T.H. 191

STATE PROJECT NUMBER
5953-01-71

AS BUILT PLAN

Work Type: Structure Maintenance repair,
Concrete Overlay, B-25-935
Structure Maintenance repair,
Concrete Flat Slab Superstructure
B-25-934

Contractor: Ed Kraemer & Sons, Inc.
Project Engineer: S. Mokhtari
Year Constructed: May 29, 1990 -
October 15, 1990

S.T.H. 130

Design Designation
A.D.T.(1990) = 840
A.D.T.(2000) = 900
A.D.T.(2010) = 950
D.H.V. = 143
D. = 60/40
T. = 8%

S.T.H. 191

Design Designation
A.D.T.(1990) = 880
A.D.T.(2000) = 920
A.D.T.(2010) = 970
D.H.V. = 148
D. = 60/40
T. = 6.8%

END PROJECT 5770-00-79
AT STA. 200+75.64


STRUCTURE B-25-934

BEGIN PROJECT 5770-00-79
AT STA. 199+50.00
Y = 412,900
X = 1,942,200

CONVENTIONAL SIGNS

COUNTY LINE
CORPORATE LIMITS
PROPERTY LINE
LOT LINE
LIMITED HIGHWAY EASEMENT
EXISTING RIGHT OF WAY
NEW RIGHT OF WAY
REFERENCE LINE
SLOPE INTERCEPT
ORIGINAL GROUND
MARSH OR ROCK PROFILE
CULVERT IN PLACE
CULVERT REQUIRED
CULVERT REQUIRED (Profile)

COMBUSTIBLE FLUIDS
(UNDER PRESSURE)
UNDERGROUND UTILITIES
GAS
ELECTRIC
TELEPHONE
SERVICE PEDESTAL
CABLE MARKER
POWER POLE
TELEPHONE POLE
RAILROADS
MARSH
WOODED AREA

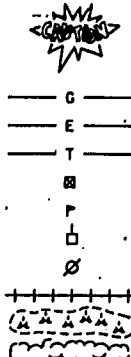


END PROJECT 5953-01-71
AT STA. 201+00.00
STRUCTURE B-25-935

BEGIN PROJECT 5953-01-71
AT STA. 199+50.00
Y = 320,800
X = 2,016,500

LAYOUT
SCALE 0 2 MI.

Total Net Length of Centerline = 0.024 MI. PROJ. 5770-00-79
0.028 MI PROJ. 5953-01-71

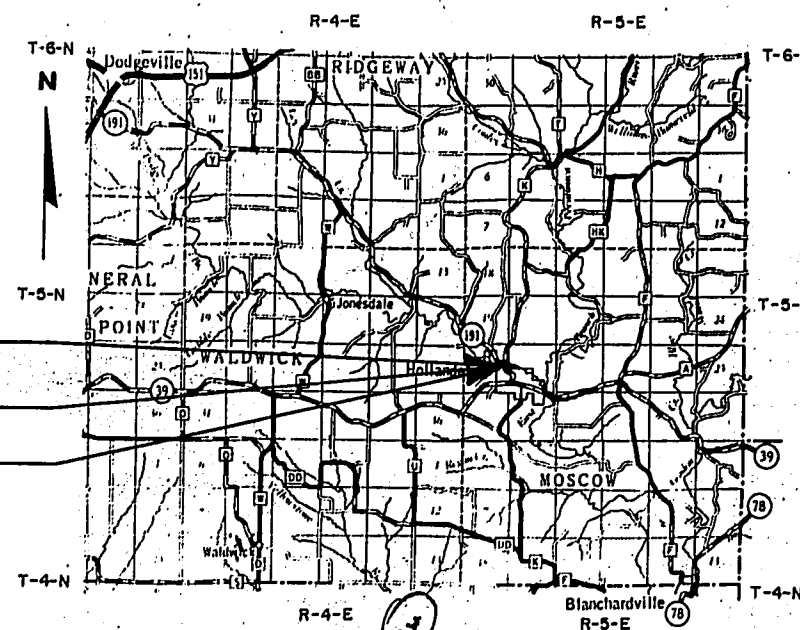

ORIGINAL PLANS PREPARED
BY
WESTBROOK ASSOCIATED ENGINEERS INC.
SPRING GREEN, WI. 53588



CONSULTING ENGINEERS
DATE

STATE OF WISCONSIN
DEPARTMENT OF TRANSPORTATION

Surveyor D.O.T. District Checker J.G.N.
Designer J.G.N. C.O. Checker P.L.
District Supervisor D.A.N. C.O. Coordinator

APPROVED:
DATE: 1-9-90
APPROVED:
DATE: 3/6/90
DISTRICT TRANSPORTATION DIRECTOR
STATE MAINTENANCE ENGINEER FOR HWY