



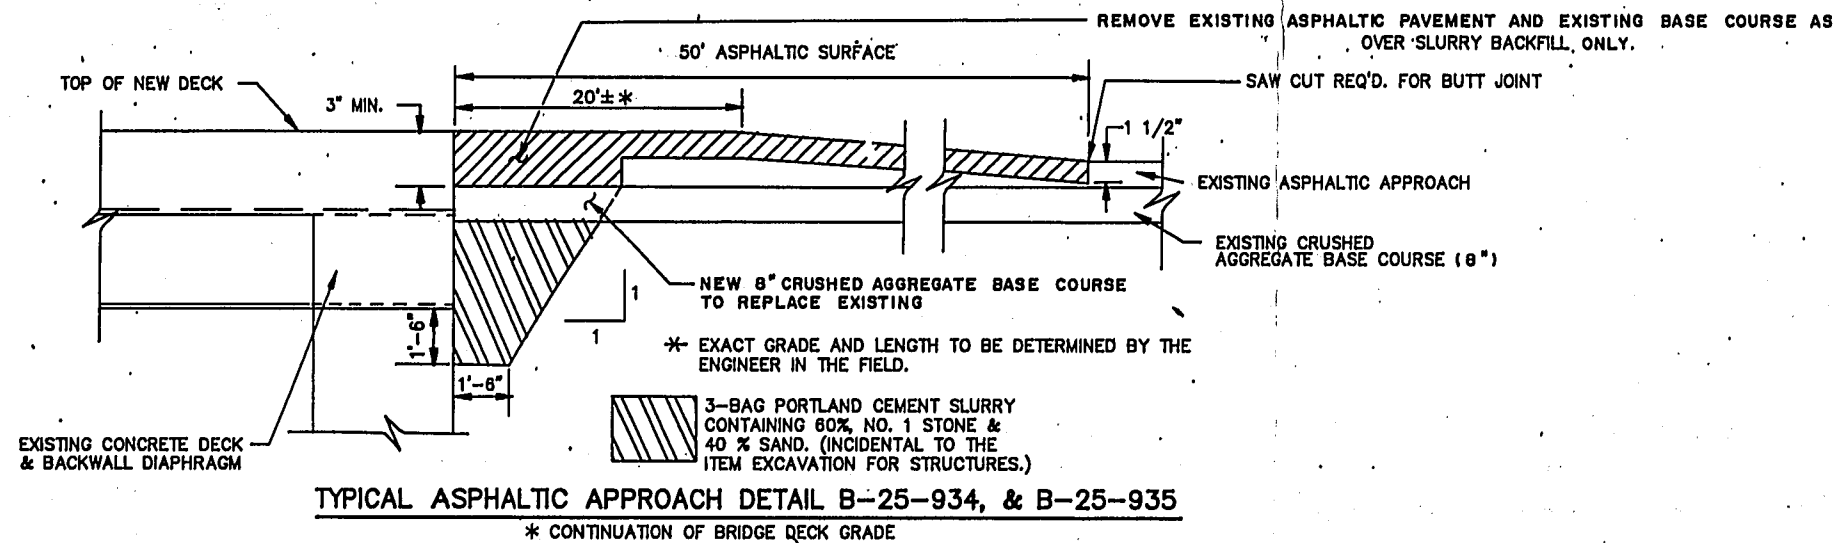

THE LOCATIONS OF EXISTING AND PROPOSED UTILITY INSTALLATIONS AS SHOWN ON THE PLANS ARE APPROXIMATE. THERE MAY BE OTHER UTILITY INSTALLATIONS WITHIN THE PROJECT AREA THAT ARE NOT SHOWN.

STANDARD DETAIL DRAWINGS

15C2-2	BARRICADES AND TRAFFIC CONTROL FOR ROAD CLOSURES
15C8-3	PAVEMENT MARKING
14B2-8a,b, & c	CLASS "A" STEEL PLATE BEAM GUARD & SPECIAL ANCHORAGES
15C8-2	TRAFFIC CONTROL DEVICES FOR TWO LANE BRIDGES
14B7-8a	TEMPORARY PRECAST CONCRETE BARRIER
14B7-8b	PRECAST CONCRETE BARRIER END SECTION AND PORTABLE CRASH CUSHION
12A3-4	NAME PLATE - STRUCTURES

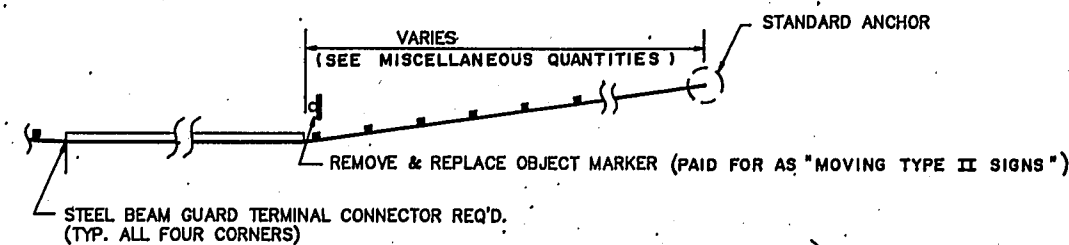


STEEL PLATE BEAM DETAILS

FOR STRUCTURES B-25-934 & B-25-935

UTILITIES

WISCONSIN POWER & LIGHT CO. 215 HIGH STREET MINERAL POINT, WI 53565 ATTN: LARRY DOLPHIN PH. 1-800-533-4220	GTE TELEPHONE 301 WEST DIVISION ST. DODGEVILLE, WI 53533 ATTN: DICK MUNSON PH. 608-935-2387
WISCONSIN POWER & LIGHT CO. P.O. BOX 99 SPRING GREEN, WI 53588 ATTN: DENNIS LOBENSTEIN PH. 608-588-2592	DIGGER'S HOTLINE 1-800-242-8511 S.T.H. 130 FILE NO. 995914 S.T.H. 191 FILE NO. 995915

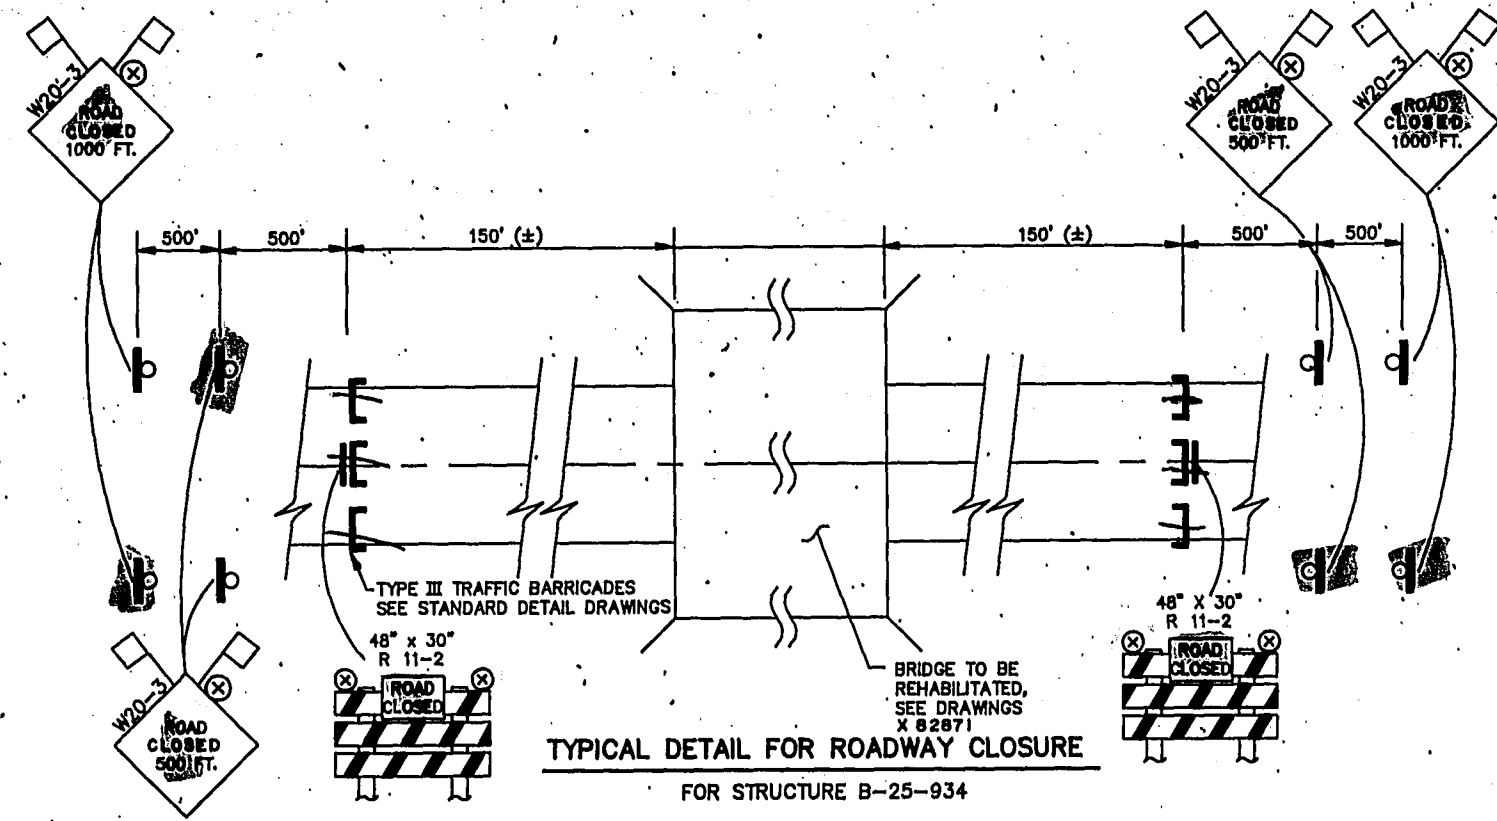

TYPICAL DETAIL FOR ROADWAY CLOSURE
FOR STRUCTURE B-25-934

LEGEND

-  TYPE III BARRICADE WITH ATTACHED SIGN / WITHOUT SIGN
-  FLASHING LIGHT (TYPE "A" LOW INTENSITY)
-  18" X 18" (MIN.) ORANGE FLAGS ATTACHED TO SIGN
-  WOOD POST WITH ATTACHED SIGN

GENERAL TRAFFIC CONTROL NOTES

ALL EXISTING TRAFFIC SIGNS THAT CONFLICT WITH THE NEW WORK SHALL BE COVERED.

SIGN LOCATIONS ARE APPROXIMATE ONLY. EXACT LOCATION TO BE DETERMINED IN THE FIELD.

TRAFFIC CONTROL SIGNING, TEMPORARY PAVEMENT MARKING, & CHANNELIZATION DEVICES SHALL BE ADJUSTED AS REQUIRED FOR STAGE I CONSTRUCTION.

BARRICADES SHALL BE EQUIPPED WITH TYPE "A" (LOW-INTENSITY FLASHING) LIGHTS.

ALL SIGNS ARE 48" X 48" UNLESS OTHERWISE NOTED.

PROJECT DESIGNATION	SHEET NO.
5770-00-79	2.3
TRAFFIC CONTROL & DETOUR ROUTE	
S.T.H. 130	IOWA CO.

NOTE: USE STANDARD DETAIL DRAWING
"BARRICADES AND TRAFFIC CONTROL FOR
ROAD CLOSURES"

PROJECT LOCATION
B-25-934

R-11-3 60" X 30"
ROAD CLOSED
8 MI. AHEAD
LOCAL TRAFFIC ONLY

R-11-3 (60" X 30")
6 MILES

R-11-3 (60" X 30")
1 MILE

R 11-3 60" X 30"
ROAD CLOSED
1 MI. AHEAD
LOCAL TRAFFIC ONLY

DETOUR
AHEAD

DETOUR
1500 FT.

NOTES: SIGN SPACING MAY BE ADJUSTED IN THE FIELD AS DIRECTED
BY THE ENGINEER.

ALL SIGNS ARE 48" X 48" UNLESS OTHERWISE NOTED

BARRICADE STRIPES TO SLOPE DOWNWARD IN DIRECTION OF
TRAFFIC FLOW.

EXISTING SIGNS THAT CONFLICT WITH THE TRAFFIC CONTROL OR
CONSTRUCTION SHALL BE COVERED OR REMOVED. THESE SIGNS
SHALL BE UNCOVERED OR RESET WHEN THE PROJECT IS
COMPLETED. TO BE PAID FOR UNDER ITEM: "MOVING SIGNS, TYPE II"

LEGEND

⊣ WOOD POST WITH ATTACHED SIGN

⊗ FLASHING LIGHT (TYPE "A")


--- DETOUR ROUTE (TO BE SIGNED BY WIS. D.O.T.)

] TYPE III BARRICADE WITH ATTACHED SIGN AND TWO
TYPE 'A' WARNING LIGHTS

18
30
30
78

NOTES

1. Sign is Type II Reflective - reference WIS D.O.T. Standard Specification for ROAD and BRIDGE CONSTRUCTION latest edition.
2. Color:
Background - Orange
Message - Black
3. Message Series - See note 5
4. Corners may be square or rounded when base material is plywood but borders shall be rounded as shown. When base material is metal, the corners and borders shall be rounded.
5. The top line is series E, the numerals are series C, and the bottom line is series D.
6. Substitute appropriate numerals as shown in the plan.

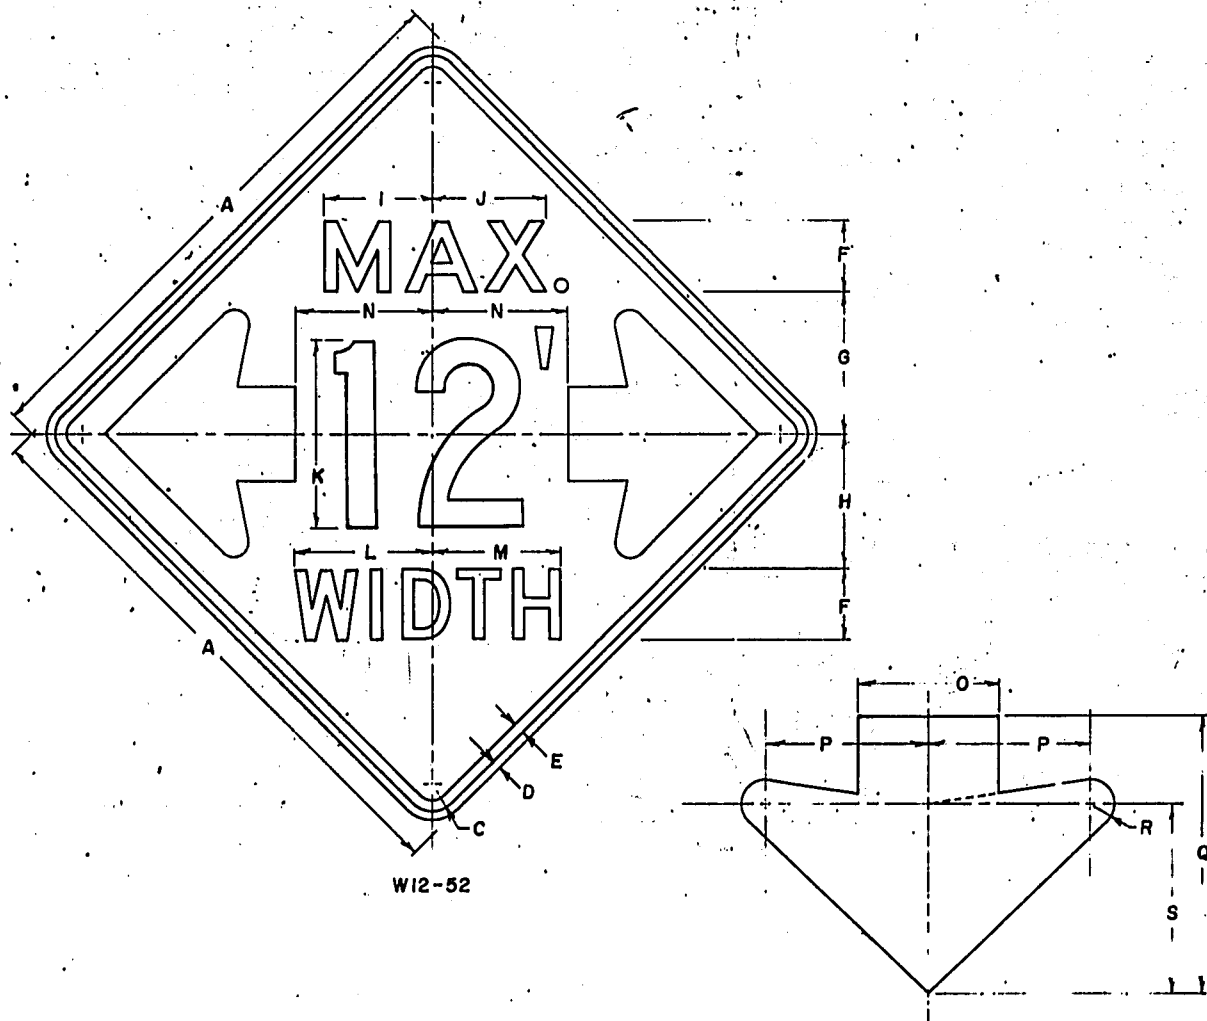

W12-52

RV	CK	RA	RA







SIZE	CODE SIZE	A	B	C	D	E	F	G	H	I	J	K	L	M	N	O	P	Q	R	S	T	U	V	W	X	Y	Z	Bid Area Sq. Ft.
Minimum	1																											
Standard	2	48		2 1/4	3/4	1	6	12	11 3/8	9 1/4	9 5/8	16	11 3/4	10 7/8	11 1/2	8	9 3/16	15 5/8	1 5/16	10 5/8								16.0
Oversize	3																											
Exp-way	4																											
Freeway	5																											
Bicycle	6																											
Snowmobile	7																											
		AA	BB	CC	DD	EE	FF	GG	HH	II	JJ	KK	LL	MM	NN	OO	PP	QQ	RR	SS	TT	UU	VV	WW	XX	YY	ZZ	
Minimum	1																											
Standard	2																											
Oversize	3																											
Exp-way	4																											
Freeway	5																											
Bicycle	6																											
Snowmobile	7																											

Date Drawn - 1-22-82 odw	Date Redrawn -
Date Revised -	
STANDARD SIGN W12-52	
WISCONSIN DEPT OF TRANSPORTATION	
APPROVED	
DATE 2-22-82	PLATE NO W12-82.1

ORIGINAL

NOTES

1. Sign is Type II - Reflective - reference WIS DOT Standard Specification for ROAD and BRIDGE CONSTRUCTION latest edition.
2. Color:
Background - Orange
Message - Black
3. Message Series "C".
4. These plaques are for changing the distance shown on signs W20-1 thru W20-7. They may be mounted on the face of the sign to be changed so as to cover the distance previously shown.
5. W20-50E covers other distances (specify).

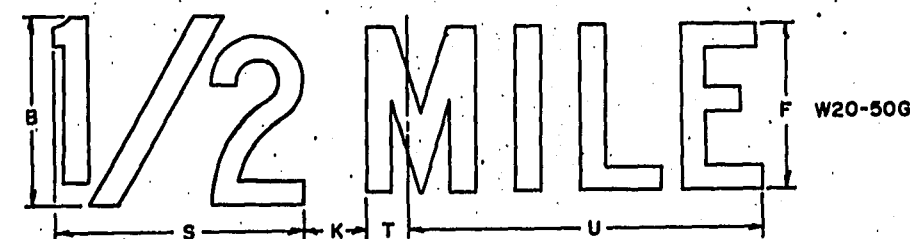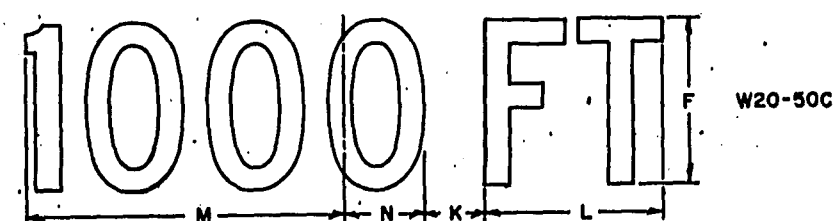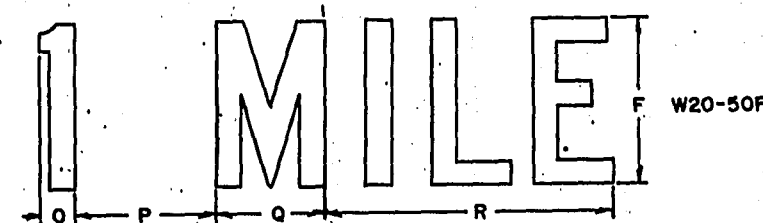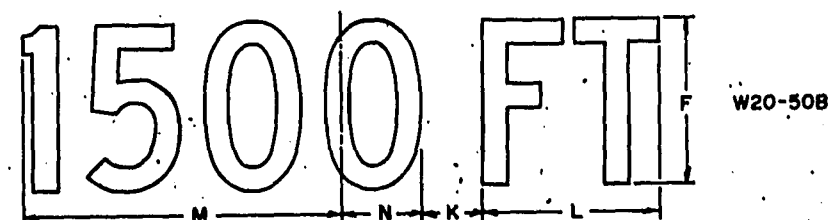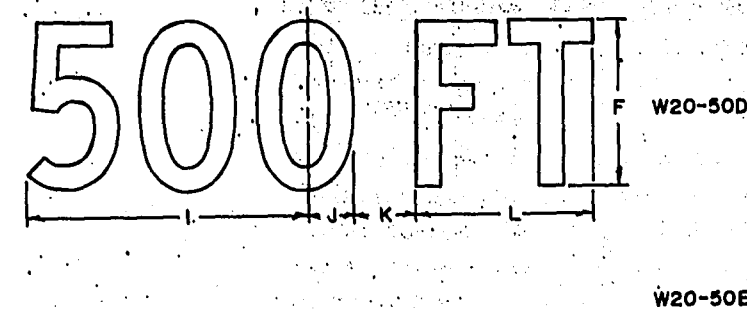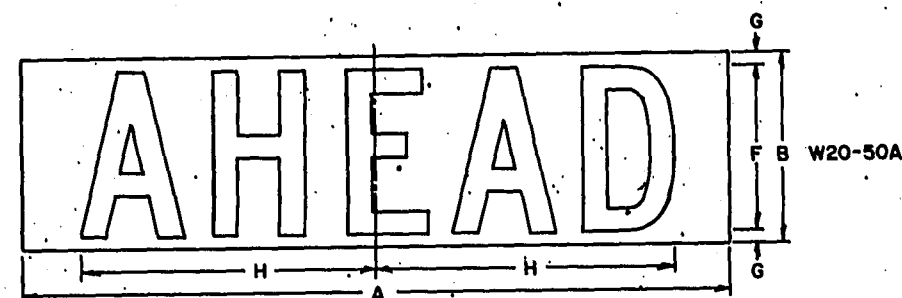

SIZE	CODE SIZE	A	B	C	D	E	F	G	H	I	J	K	L	M	N	O	P	Q	R	S	T	U	V	W	X	Y	Z	Bid Area Sq. Ft.
Minimum	1																											
Standard	2	30	8				7	1/2	12 5/8	12	1 7/8	2 5/8	7 1/2	13 1/2	3 3/8	1 7/8	6	4 9/16	12 3/16	10 5/8	1 3/4	15						1.67
Oversize	3	30	8				7	1/2	12 5/8	12	1 7/8	2 5/8	7 1/2	13 1/2	3 3/8	1 7/8	6	4 9/16	12 3/16	10 5/8	1 3/4	15						1.67
Exp-way	4	30	8				7	1/2	12 5/8	12	1 7/8	2 5/8	7 1/2	13 1/2	3 3/8	1 7/8	6	4 9/16	12 3/16	10 5/8	1 3/4	15						1.67
Freeway	5	30	8				7	1/2	12 5/8	12	1 7/8	2 5/8	7 1/2	13 1/2	3 3/8	1 7/8	6	4 9/16	12 3/16	10 5/8	1 3/4	15						1.67
Bicycle	6																											
Snowmobile	7																											
		AA	BB	CC	DD	EE	FF	GG	HH	II	JJ	KK	LL	MM	NN	OO	PP	QQ	RR	SS	TT	UU	VV	WW	XX	YY	ZZ	
Minimum	1																											
Standard	2																											
Oversize	3																											
Exp-way	4																											
Freeway	5																											
Bicycle	6																											
Snowmobile	7																											

Date Drawn - 8-24-84 Date Redrawn - 4-22-83

Date Revised -

SUPPLEMENTARY MESSAGES
W20-50A,B,C,D,E,F&G

WISCONSIN DEPT OF TRANSPORTATION

APPROVED
DATE 5-5-87
Chief Traffic Engineer
PLATE NO. W20-50.3