



BENCH MARK

B.M. NO.	STATION	OFFSET	DESCRIPTION	ELEV.
304	99+39.71	11.94' RT	CHISELED SQUARE ON SE CORNER OF STRUCT.	715.64
305	108+09.18	24.39' RT	CHISELED 'X' ON PIPE	711.09

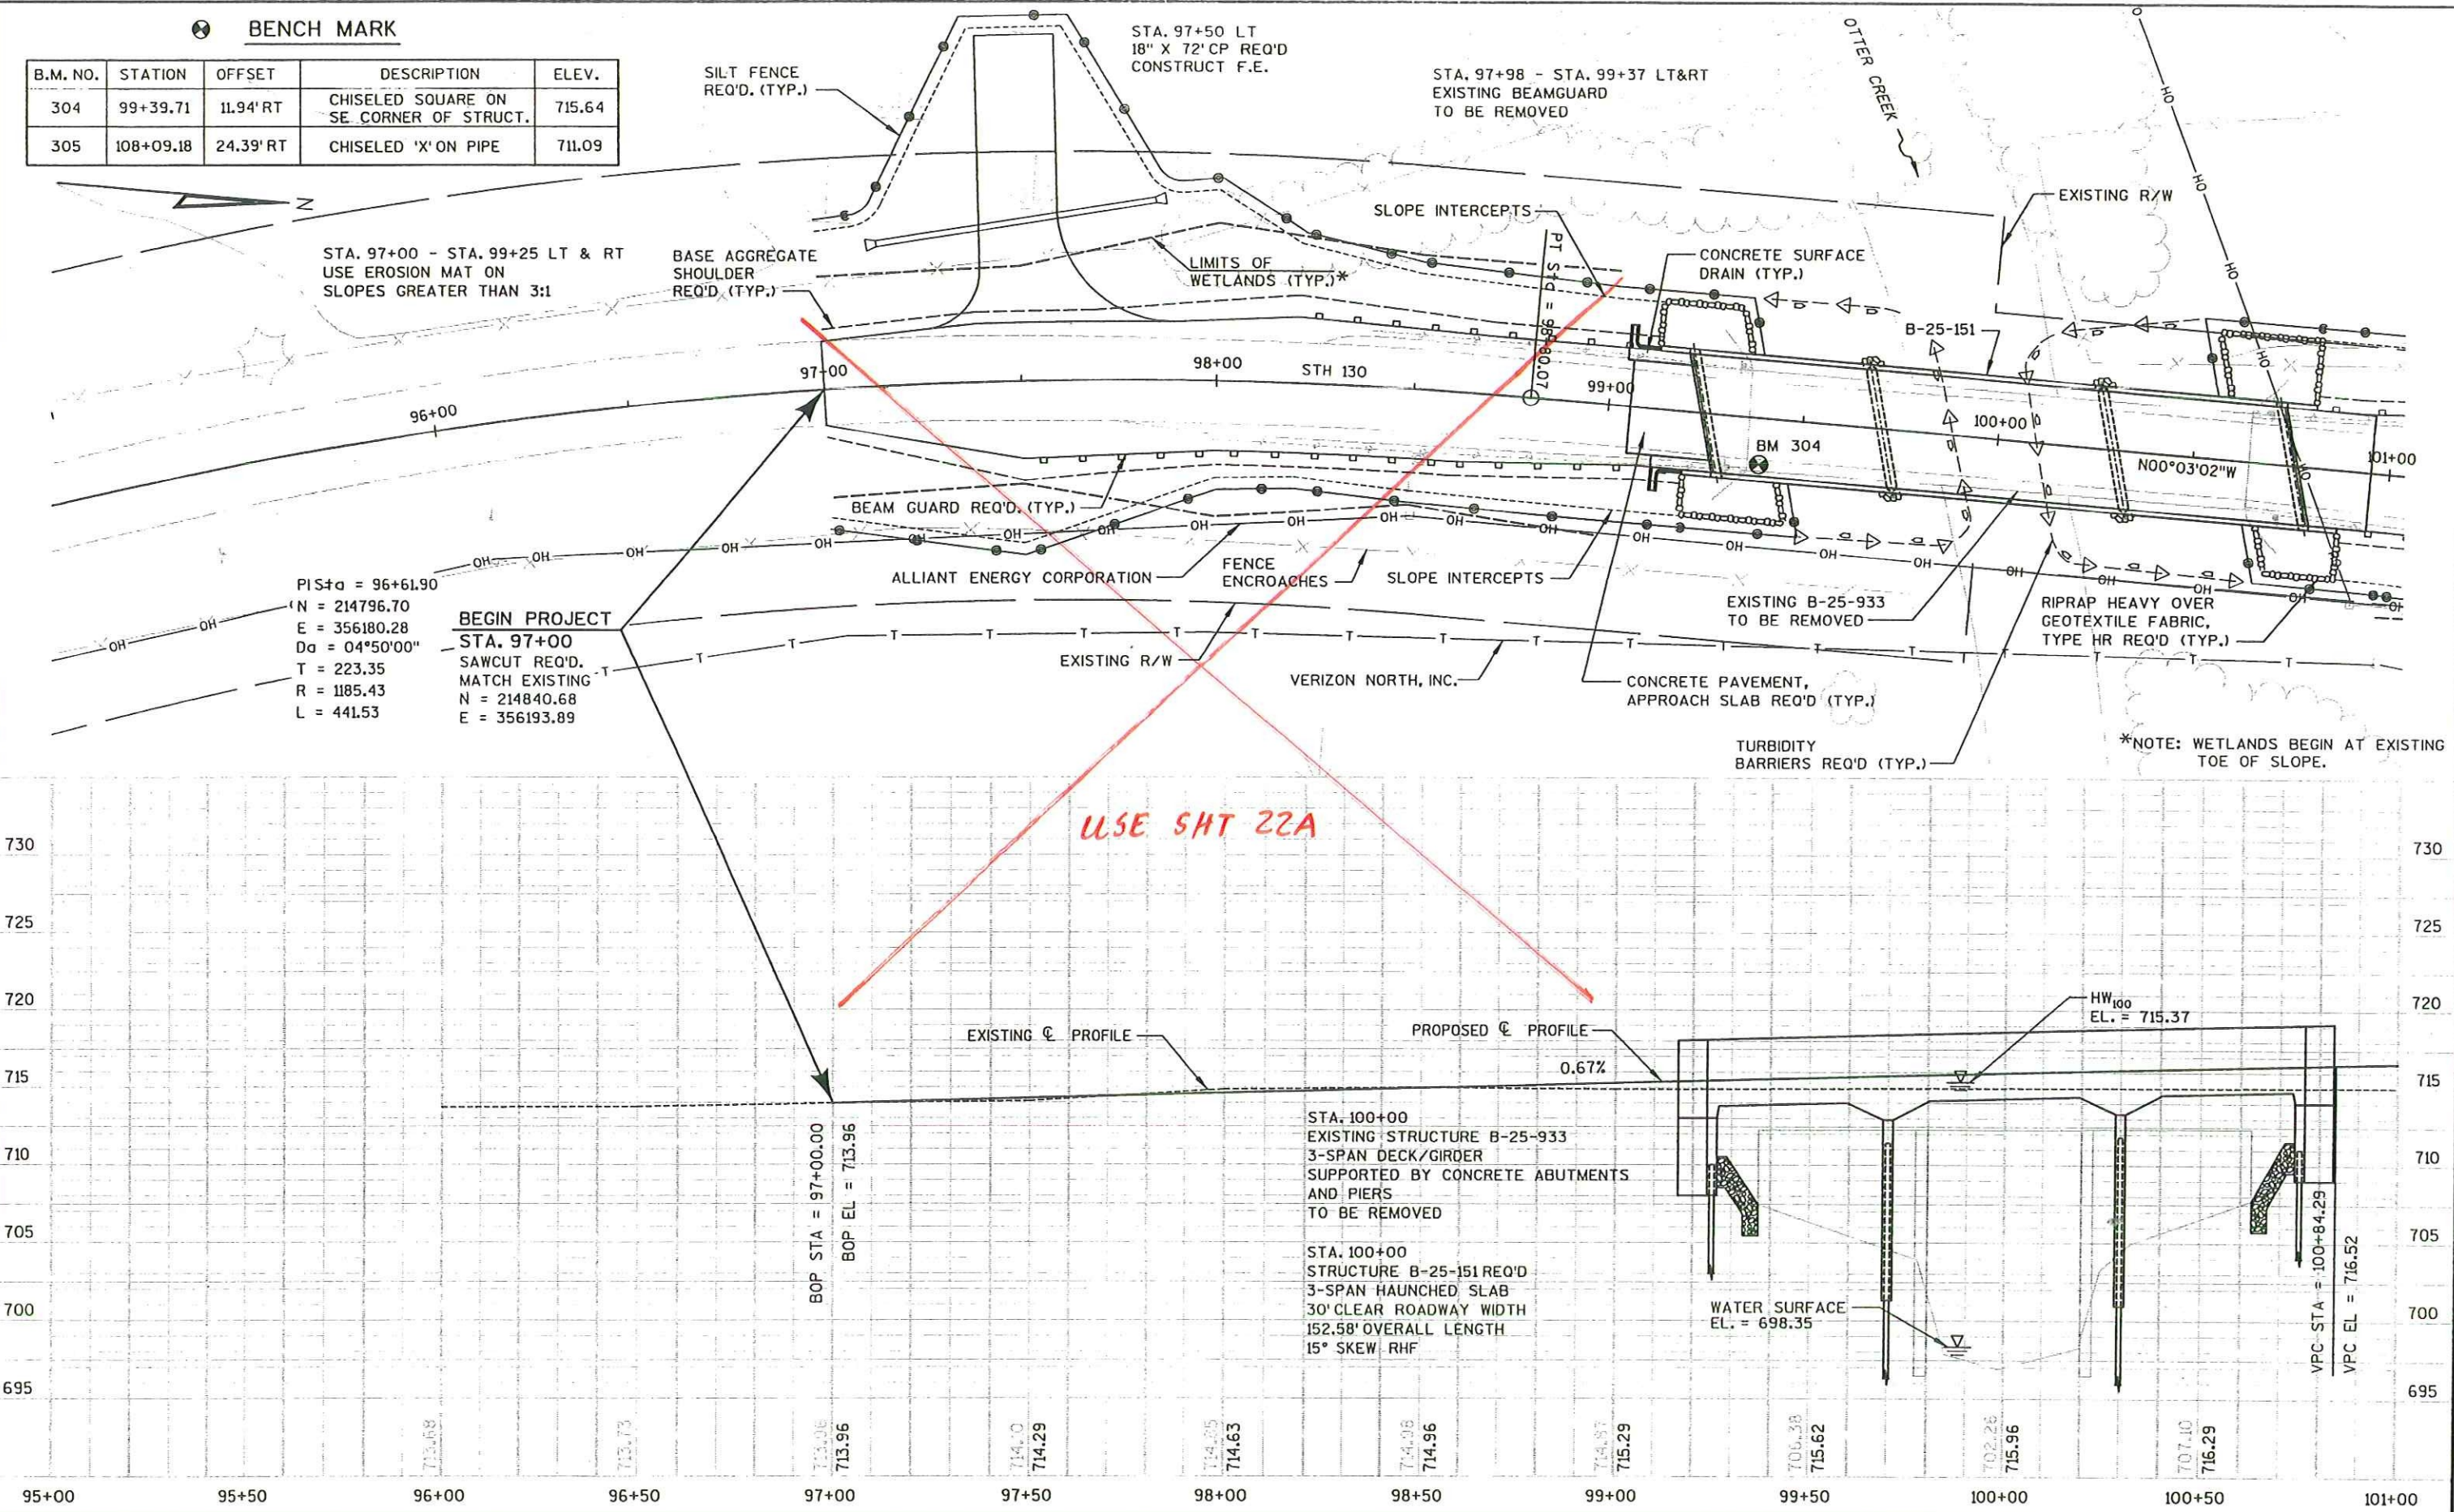


5

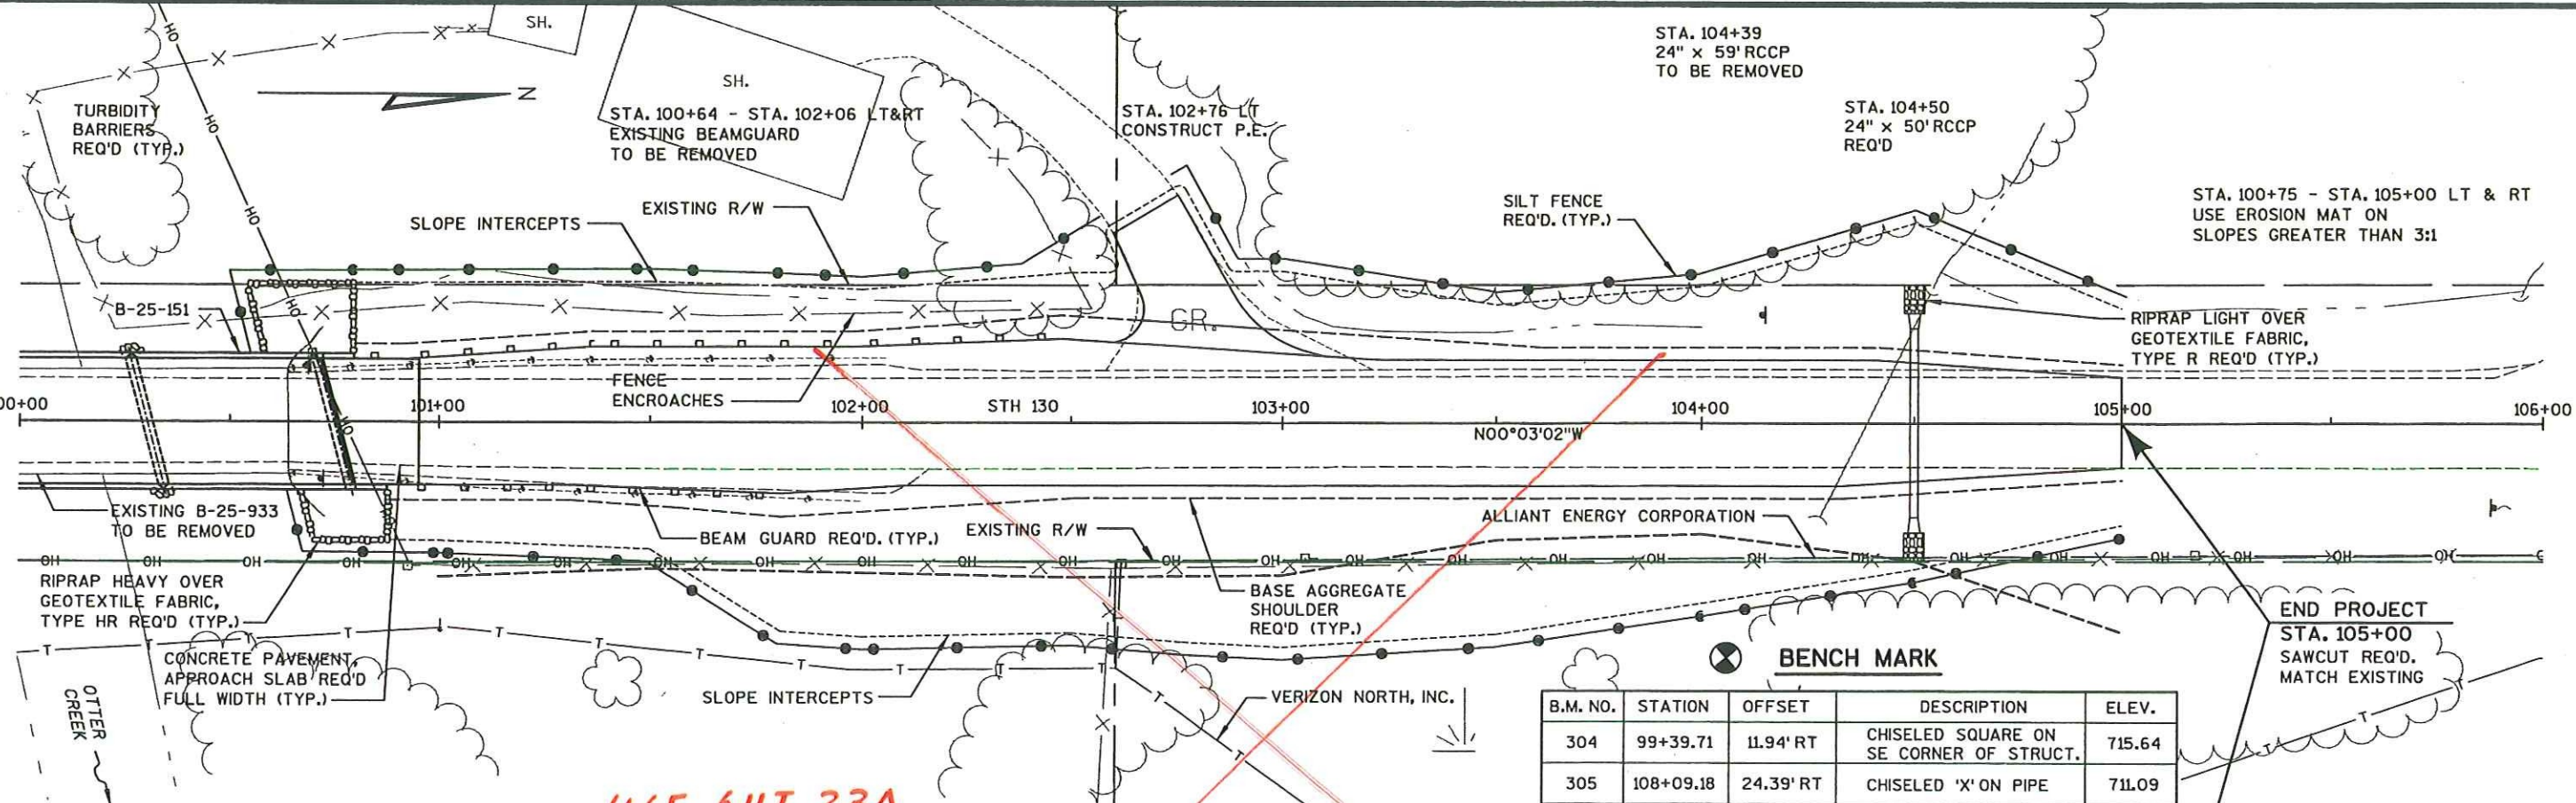

USE SHT 23A

B.M. NO.	STATION	OFFSET	DESCRIPTION	ELEV.
304	99+39.71	11.94' RT	CHISELED SQUARE ON SE CORNER OF STRUCT.	715.64
305	108+09.18	24.39' RT	CHISELED 'X' ON PIPE	711.09

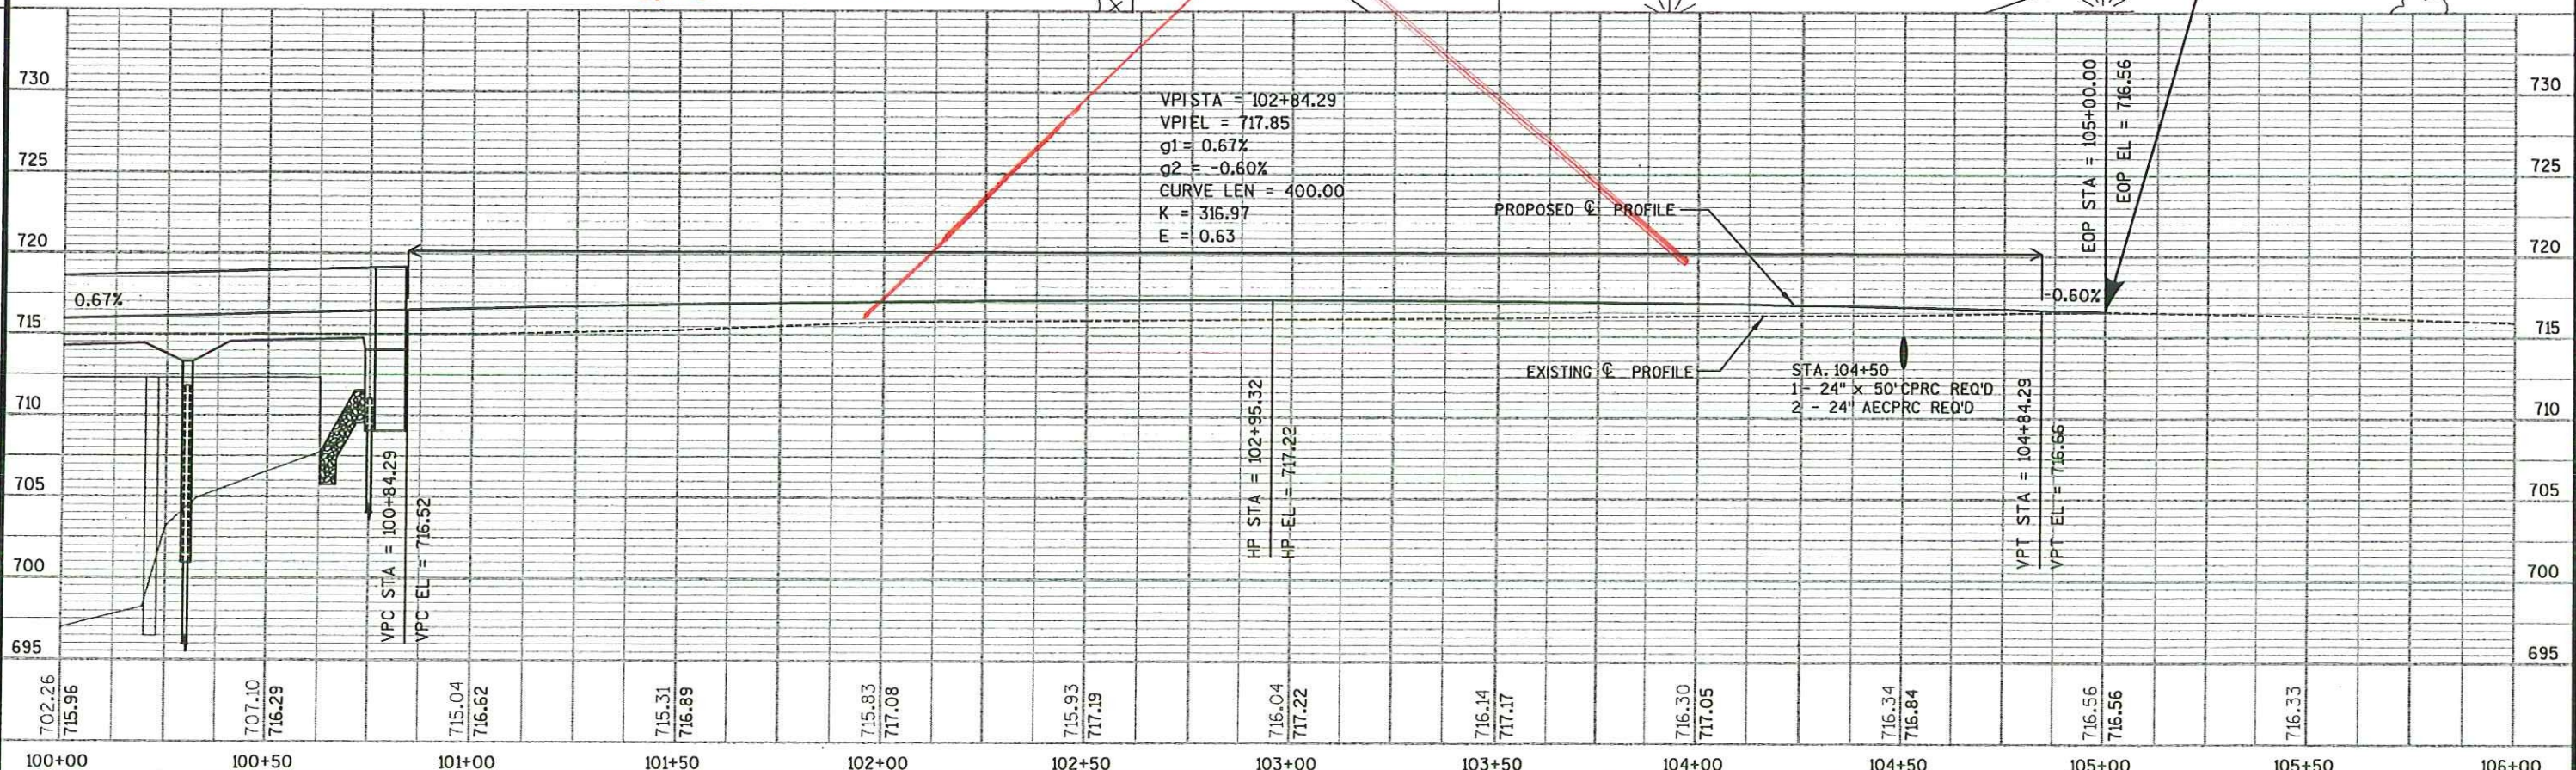

5

