


PROJECT : 5770-00-75 COUNTY : IOWA DATE : DESIGN I.D. 6770-00-05

INDEX OF SHEETS

Sheet No. 1	Title
Sheet No. 2.1-2.5	Typical Sections and Details
Sheet No. 3.1	Estimate of Quantities
Sheet No. 3A	Miscellaneous Quantities
Sheet No. 1	Right of Way Plat
Sheet No. 1	Plan and Profile
Sheet No. 6.1-6.6	Standard Detail Drawings
Sheet No. 1	Sign Plates
Sheet No. 1	Structure Plans
Sheet No. 1	Computer Earthwork Data
Sheet No. 1	Cross Sections

TOTAL SHEETS = 14

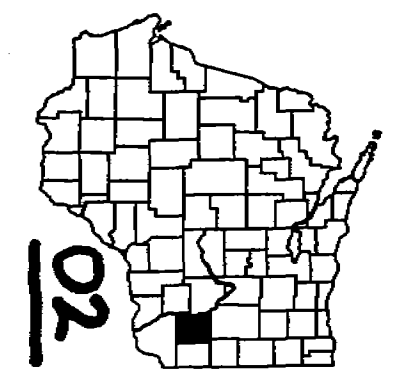

DESIGN DESIGNATION

A.D.T. 1996	=	900
A.D.T.	=	
D.H.V.	=	
D.	=	
T.	=	
DESIGN SPEED	=	
ESALS	=	

CONVENTIONAL SYMBOLS

PLAN	PROFILE
CORPORATE LIMITS	GRADE LINE
PROPERTY LINE	ORIGINAL GROUND
LOT LINE	MARSH OR ROCK PROFILE
LIMITED HIGHWAY EASEMENT	SPECIAL DITCH
EXISTING RIGHT OF WAY	PROFILE EXISTING TRAVELWAY
NEW RIGHT OF WAY	GRADE ELEVATION
SLOPE INTERCEPT	CULVERT
REFERENCE LINE	UTILITIES
CULVERT IN PLACE	GAS
CULVERT REQUIRED (Profile)	ELECTRIC
DRIVEWAY / CULVERT - PROPOSED	TELEPHONE OR TELEGRAPH
COMBUSTIBLE FLUIDS	FIBER OPTIC
MARSH AREA	SERVICE PEDESTAL
WOODED OR SHRUB AREA	POWER POLE
	TELEPHONE POLE
	SANITARY SEWER
	STORM SEWER
	WATER

STATE OF WISCONSIN
DEPARTMENT OF TRANSPORTATION
PLAN OF PROPOSED IMPROVEMENT
S.T.H. 23 - S.T.H. 133 ROAD

(SPRING VALLEY ROAD - LIMMEX ROAD)

S.T.H. 130

AS BUILT CONSTRUCTION PLAN

IOWA COUNTY


WORK TYPE STEEL PLATE BEAM GUARD

STATE PROJECT NUMBER
5770-00-75


CONTRACTOR TIMERLINE CONTRACTORS, INC.

PROJECT MANAGER LEE SCHRANK

WORK START-COMPLETED 7/30/01 - 8/29/01

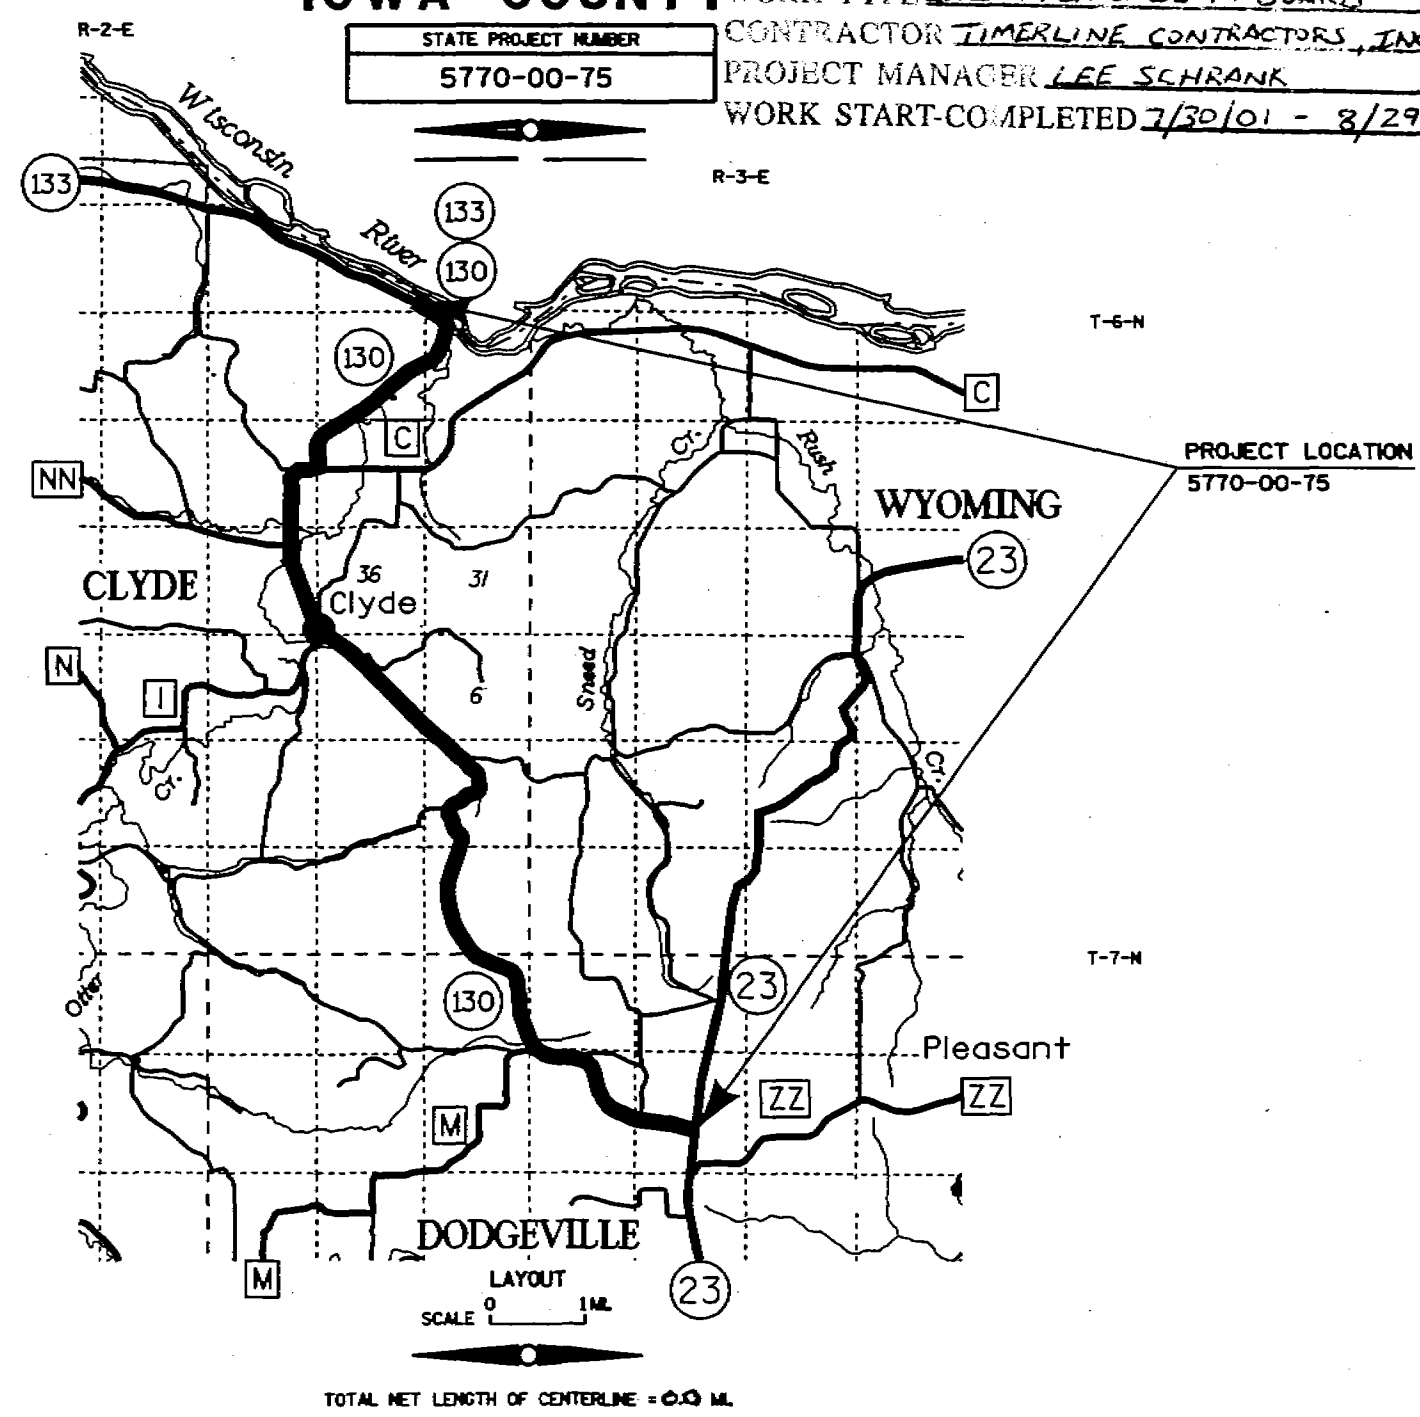

ORIGINAL PLANS PREPARED BY

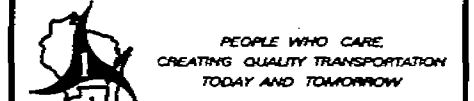

WISDOT DISTRICT 1 STAFF

STATE OF WISCONSIN
DEPARTMENT OF TRANSPORTATION

PREPARED BY	
Surveyor	
Designer	TADO OWENS
District Engineer	JOHN STENER
District Supervisor	WILLIAM MC NARY
Proj. Dev. Engineer	
C.O. Engineer	T.T. BAYLEY

APPROVED FOR DISTRICT OFFICE
DATE: 12/20/00 [Signature]
(Signature)

AUTHORIZED FOR CENTRAL OFFICE DESIGN
DATE: 4/5/01 [Signature]
(Signature)