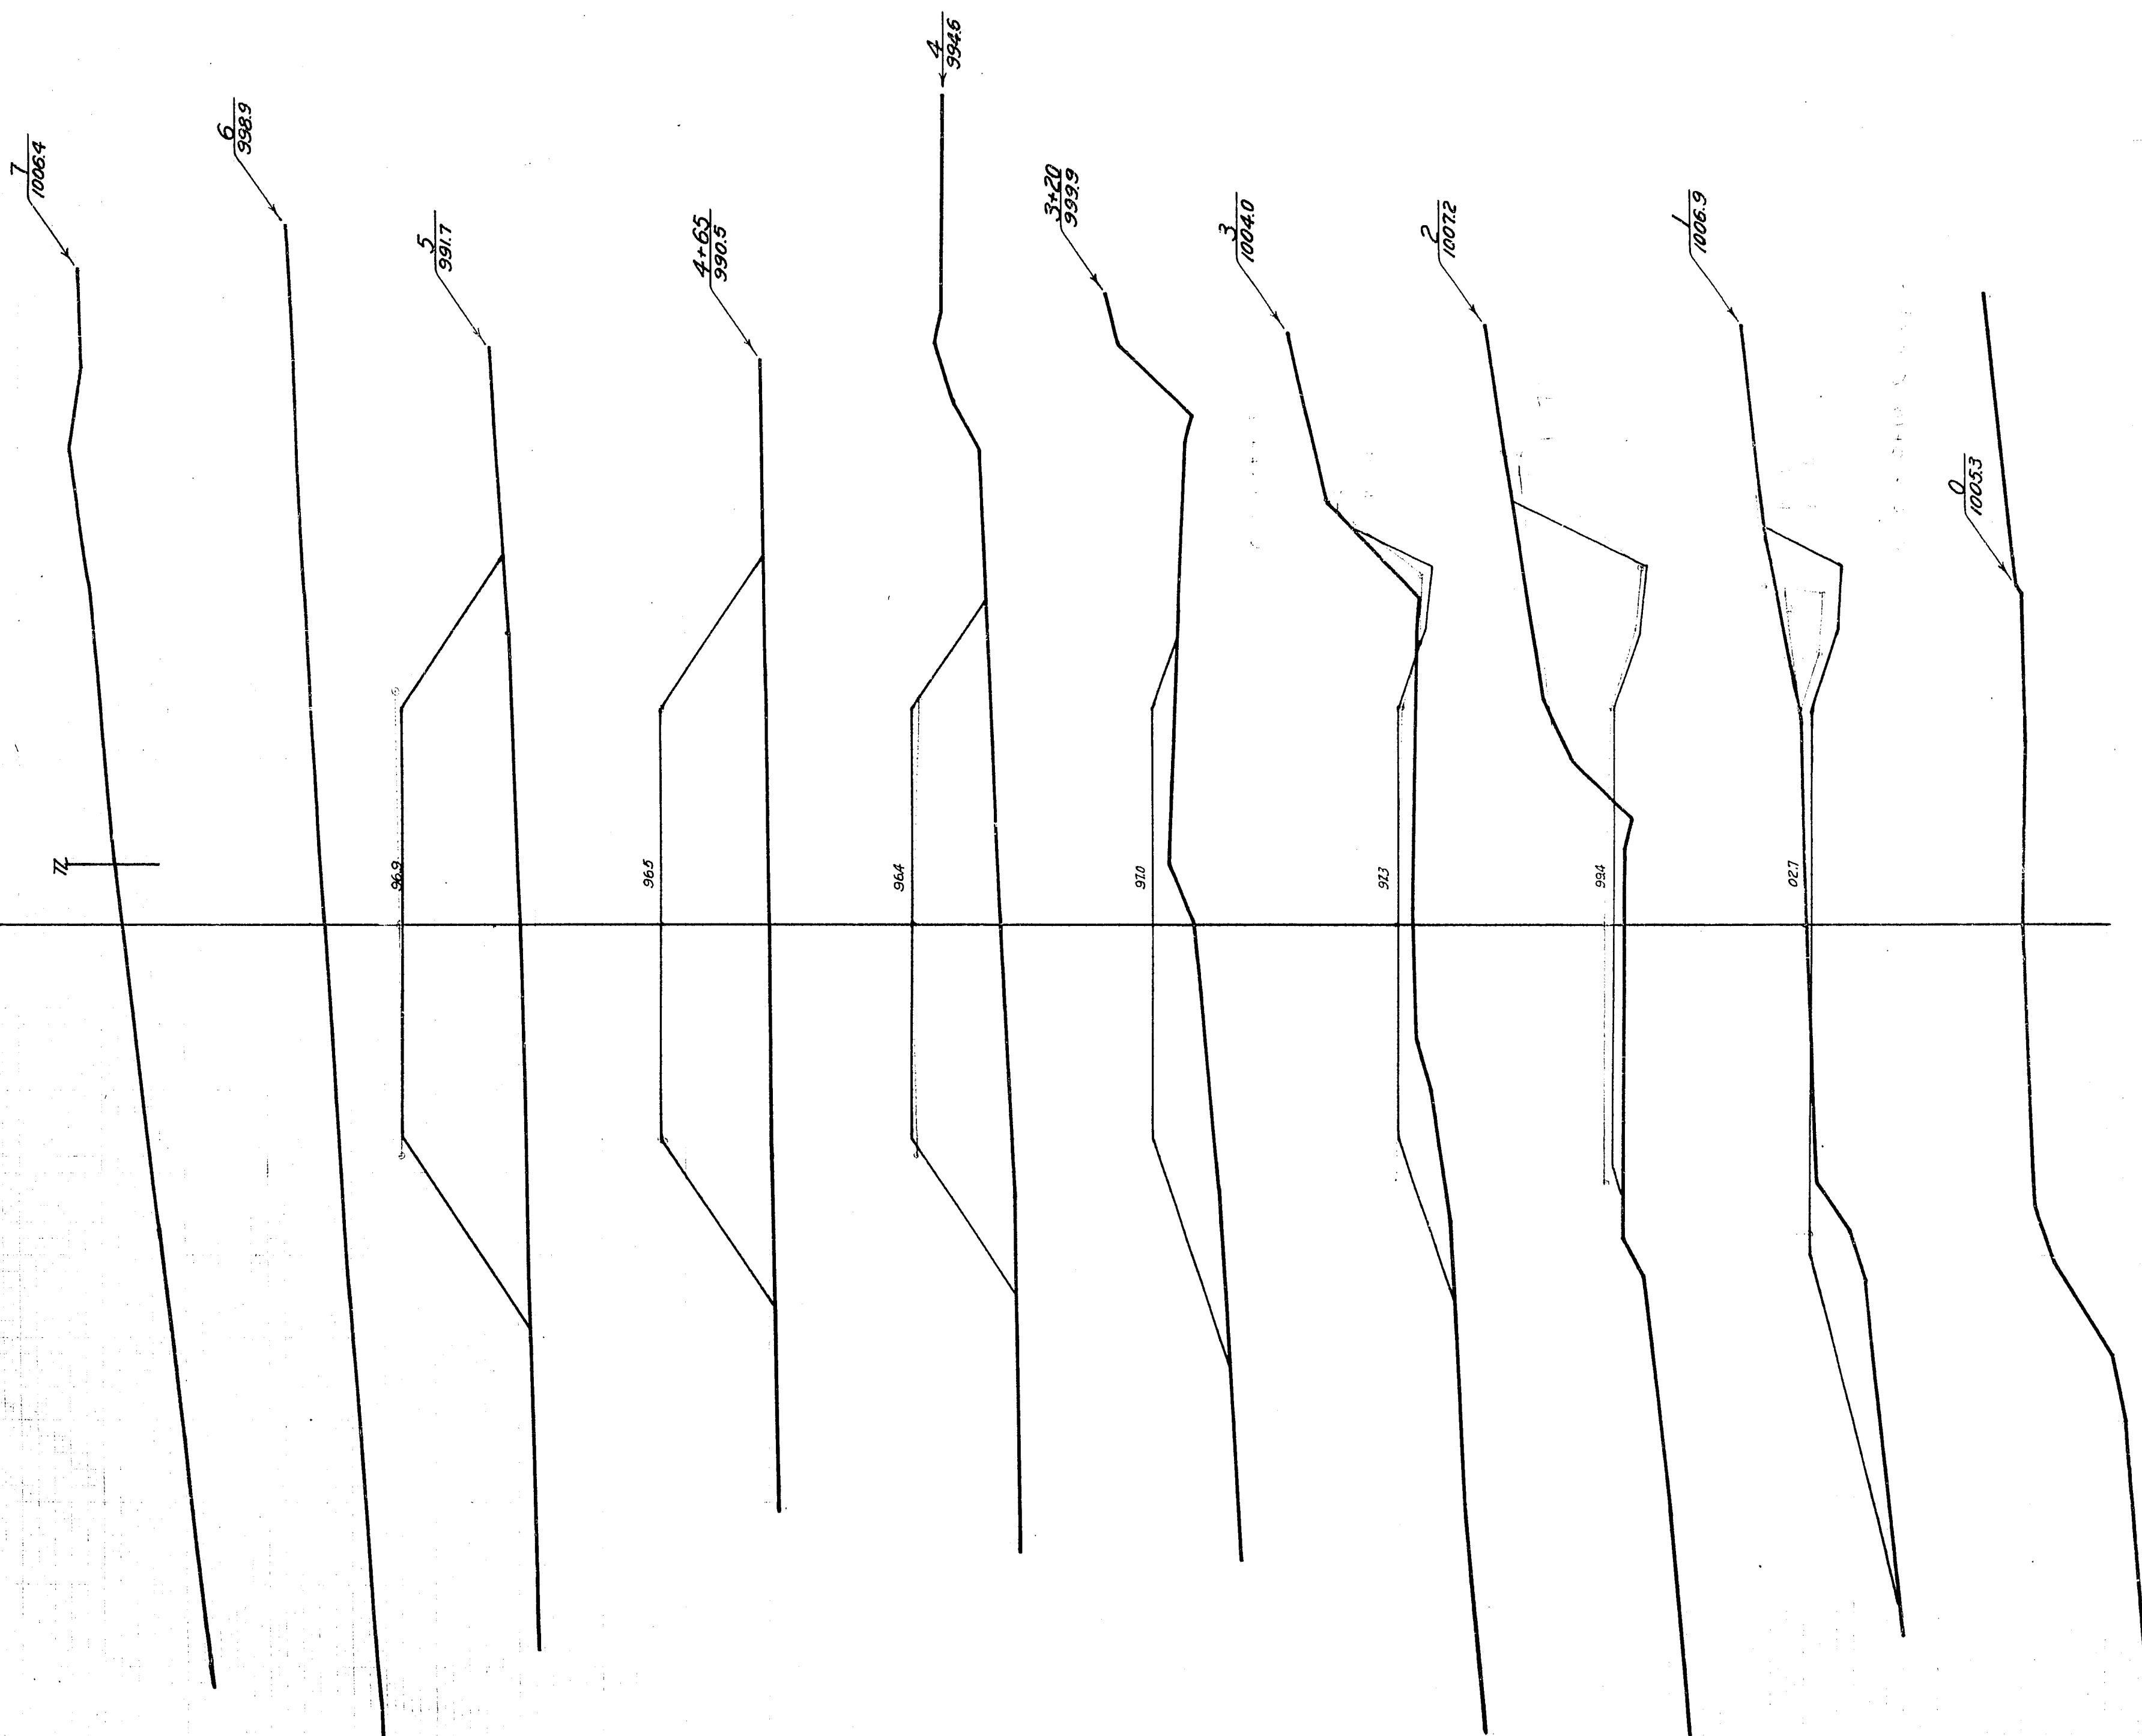
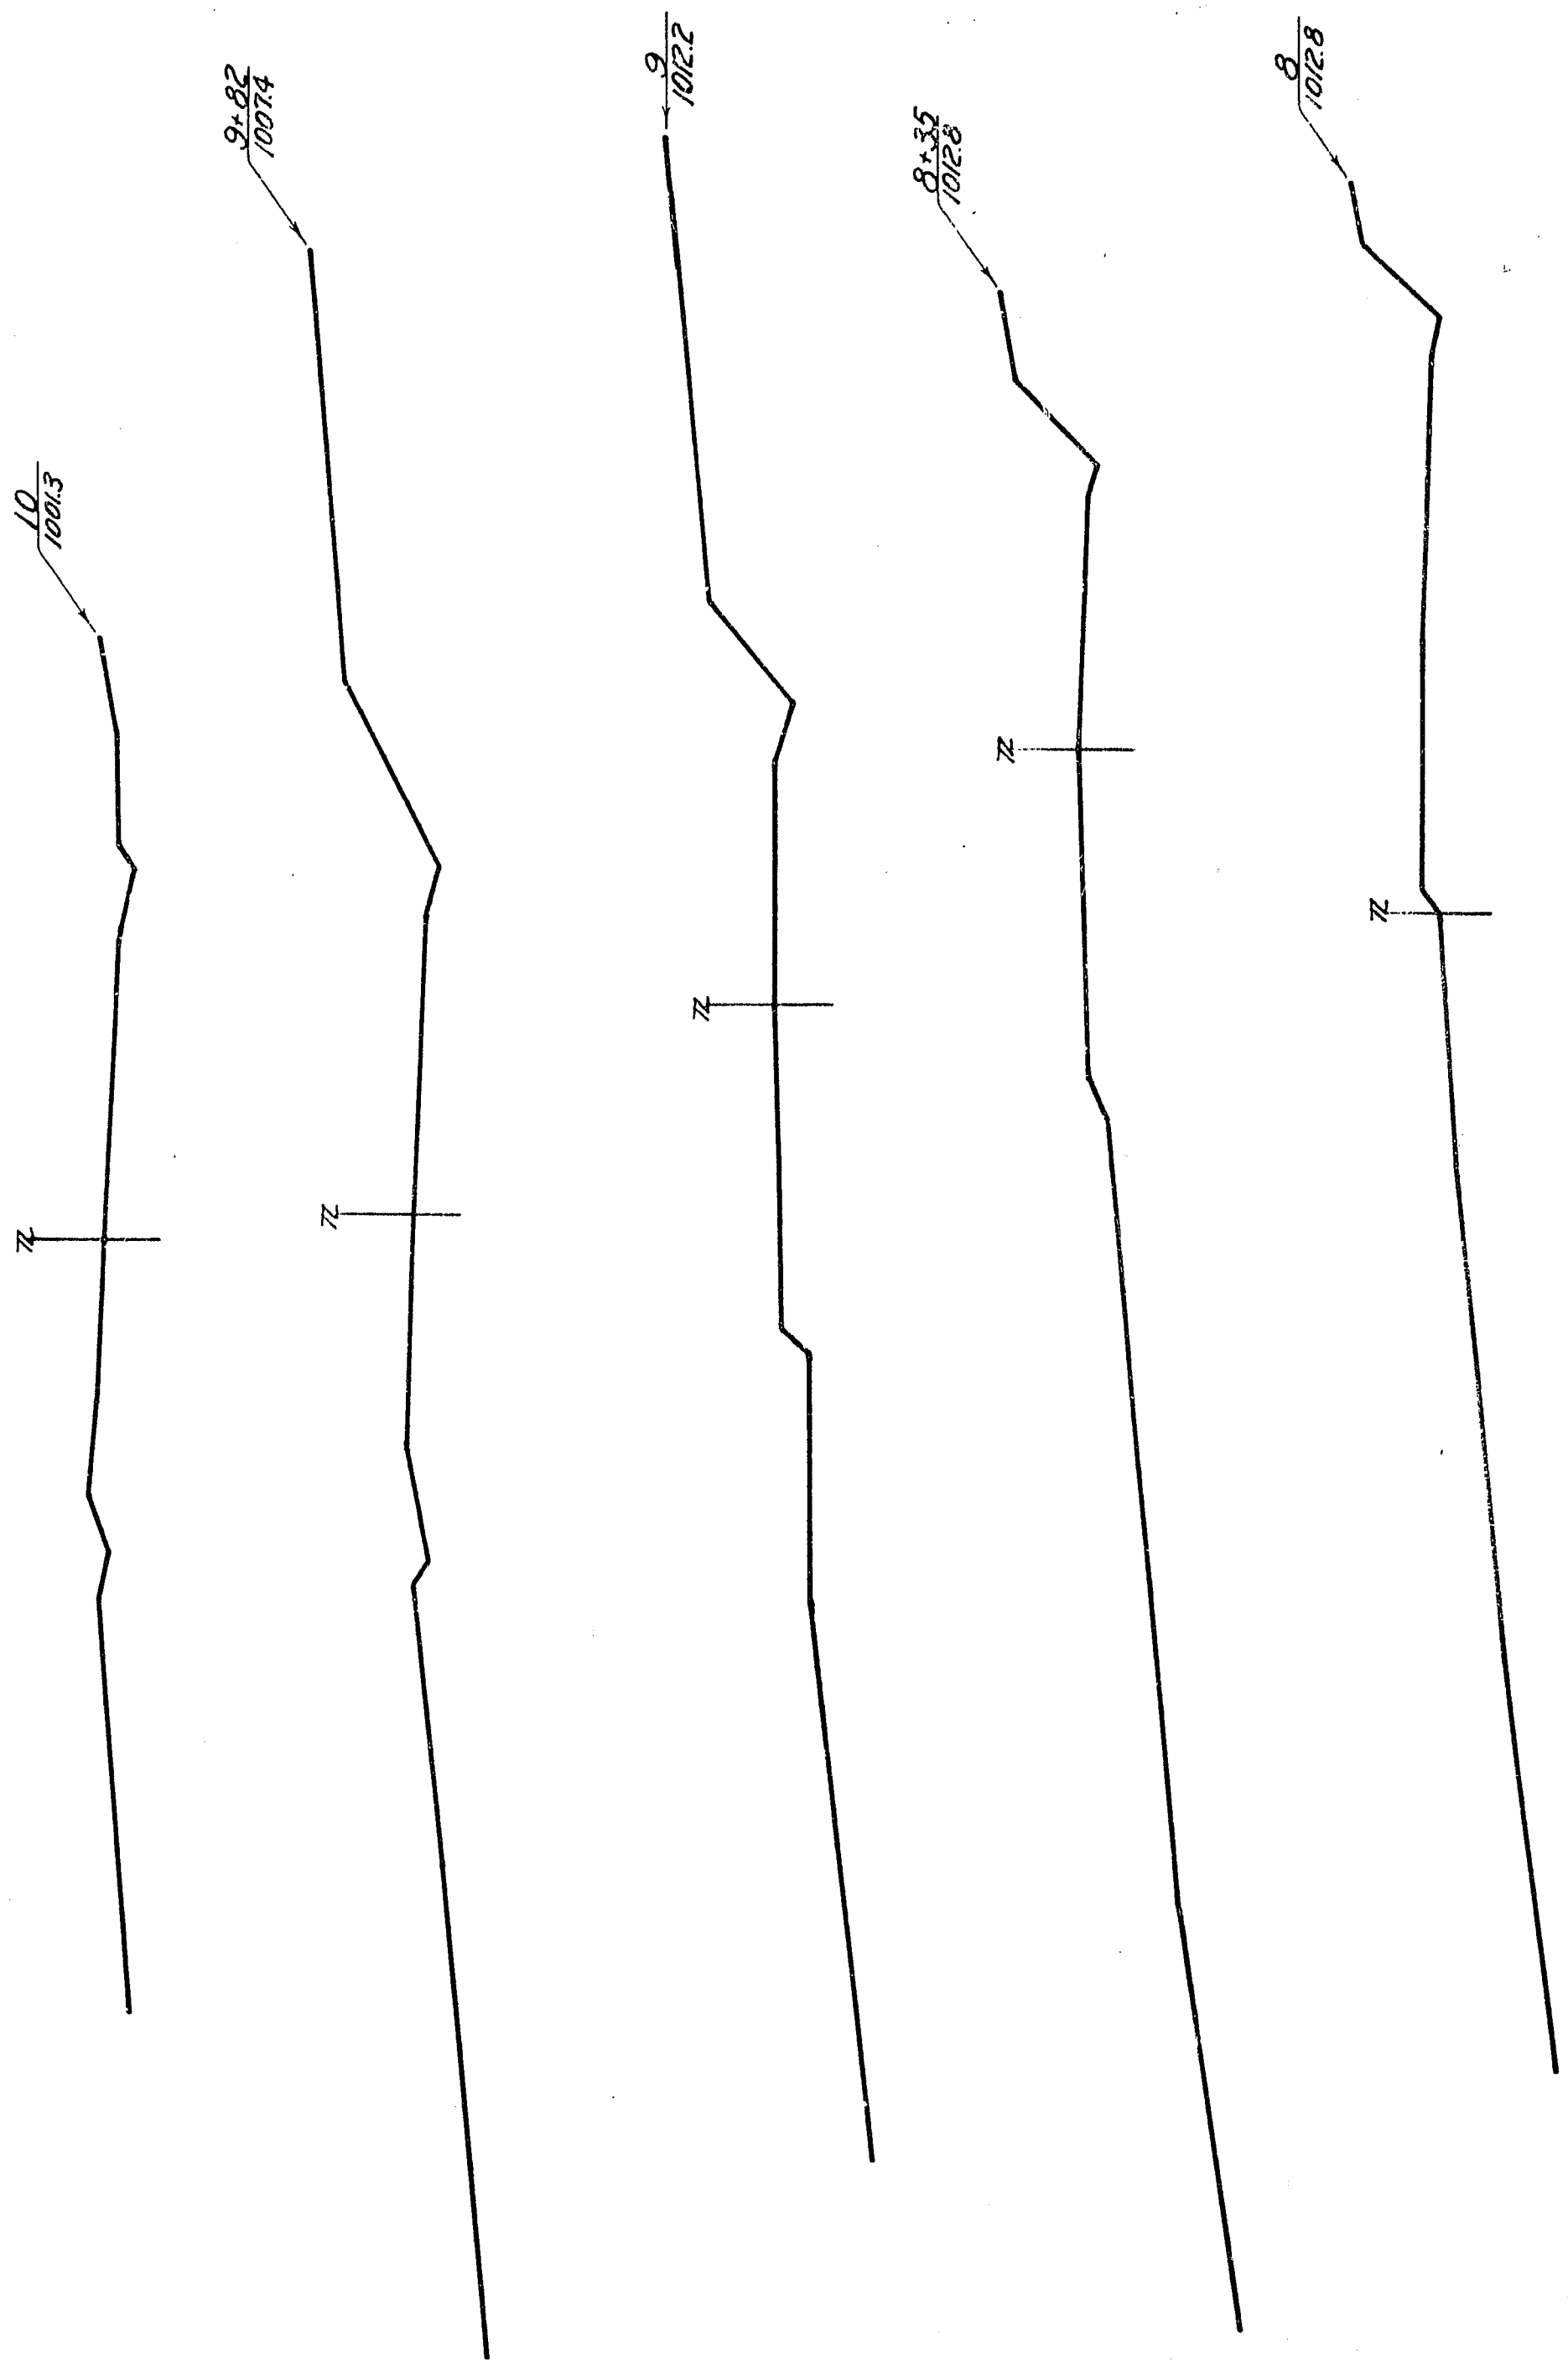
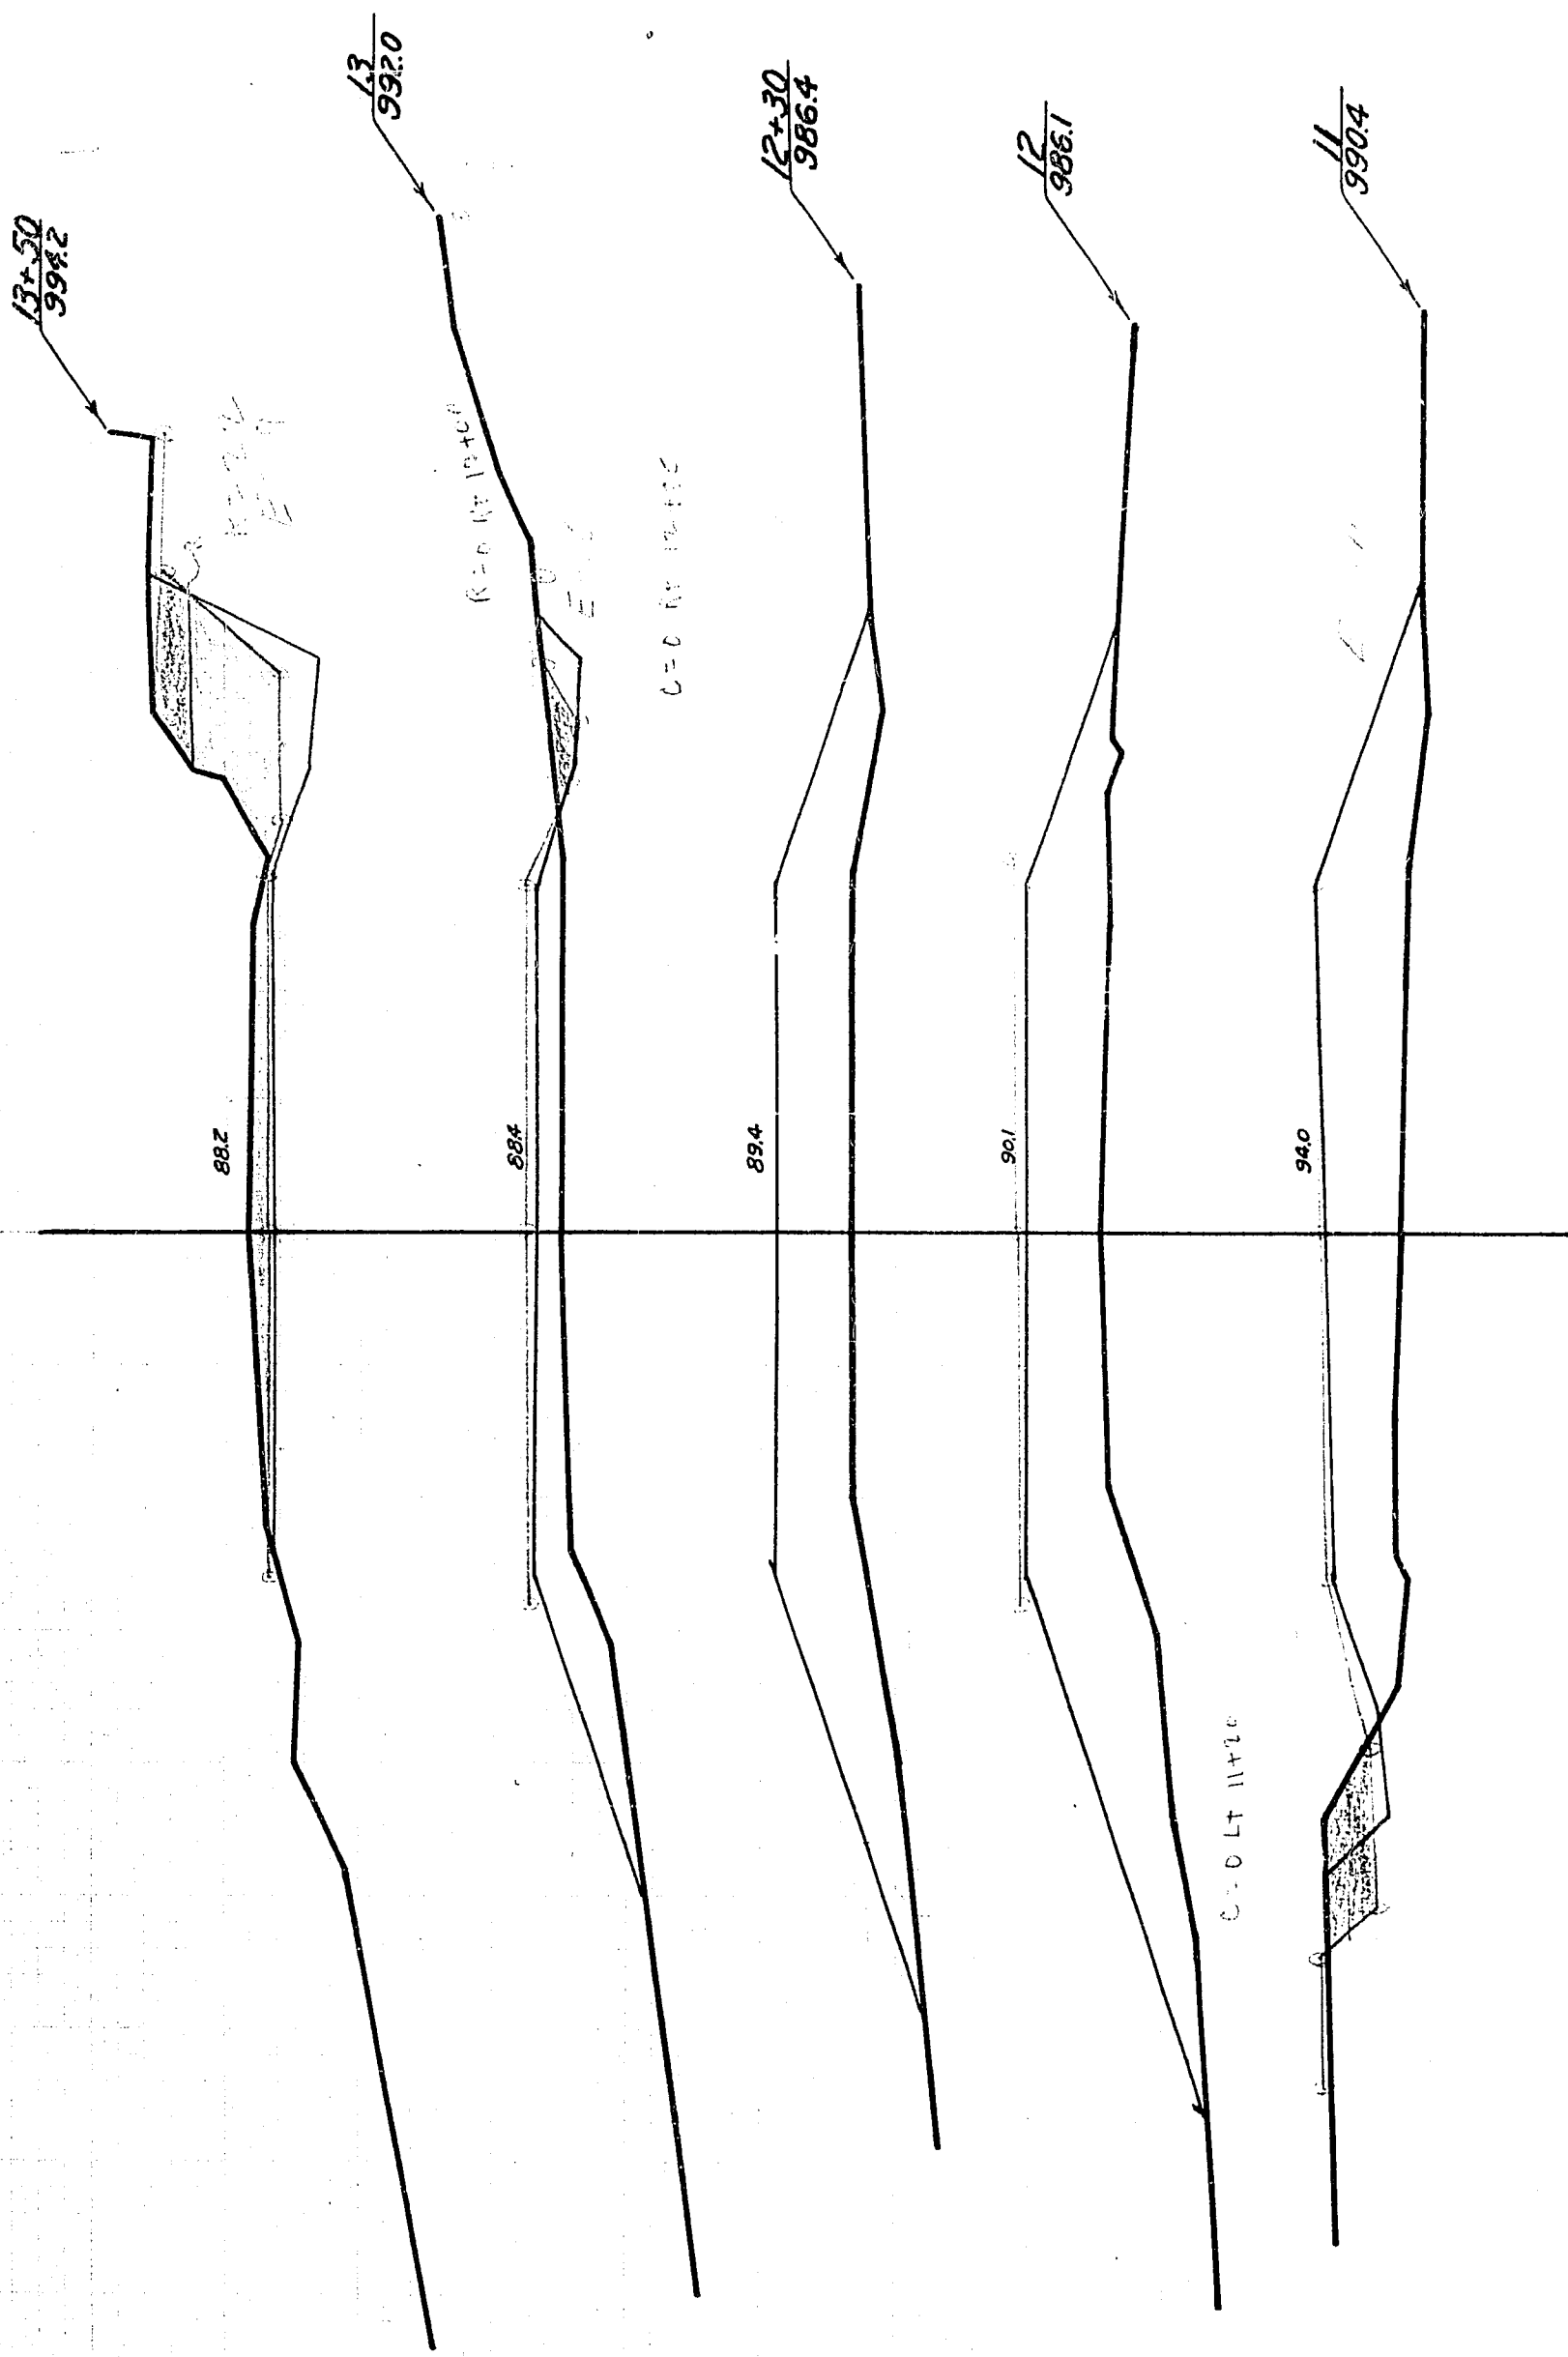


[illegible]

[illegible]

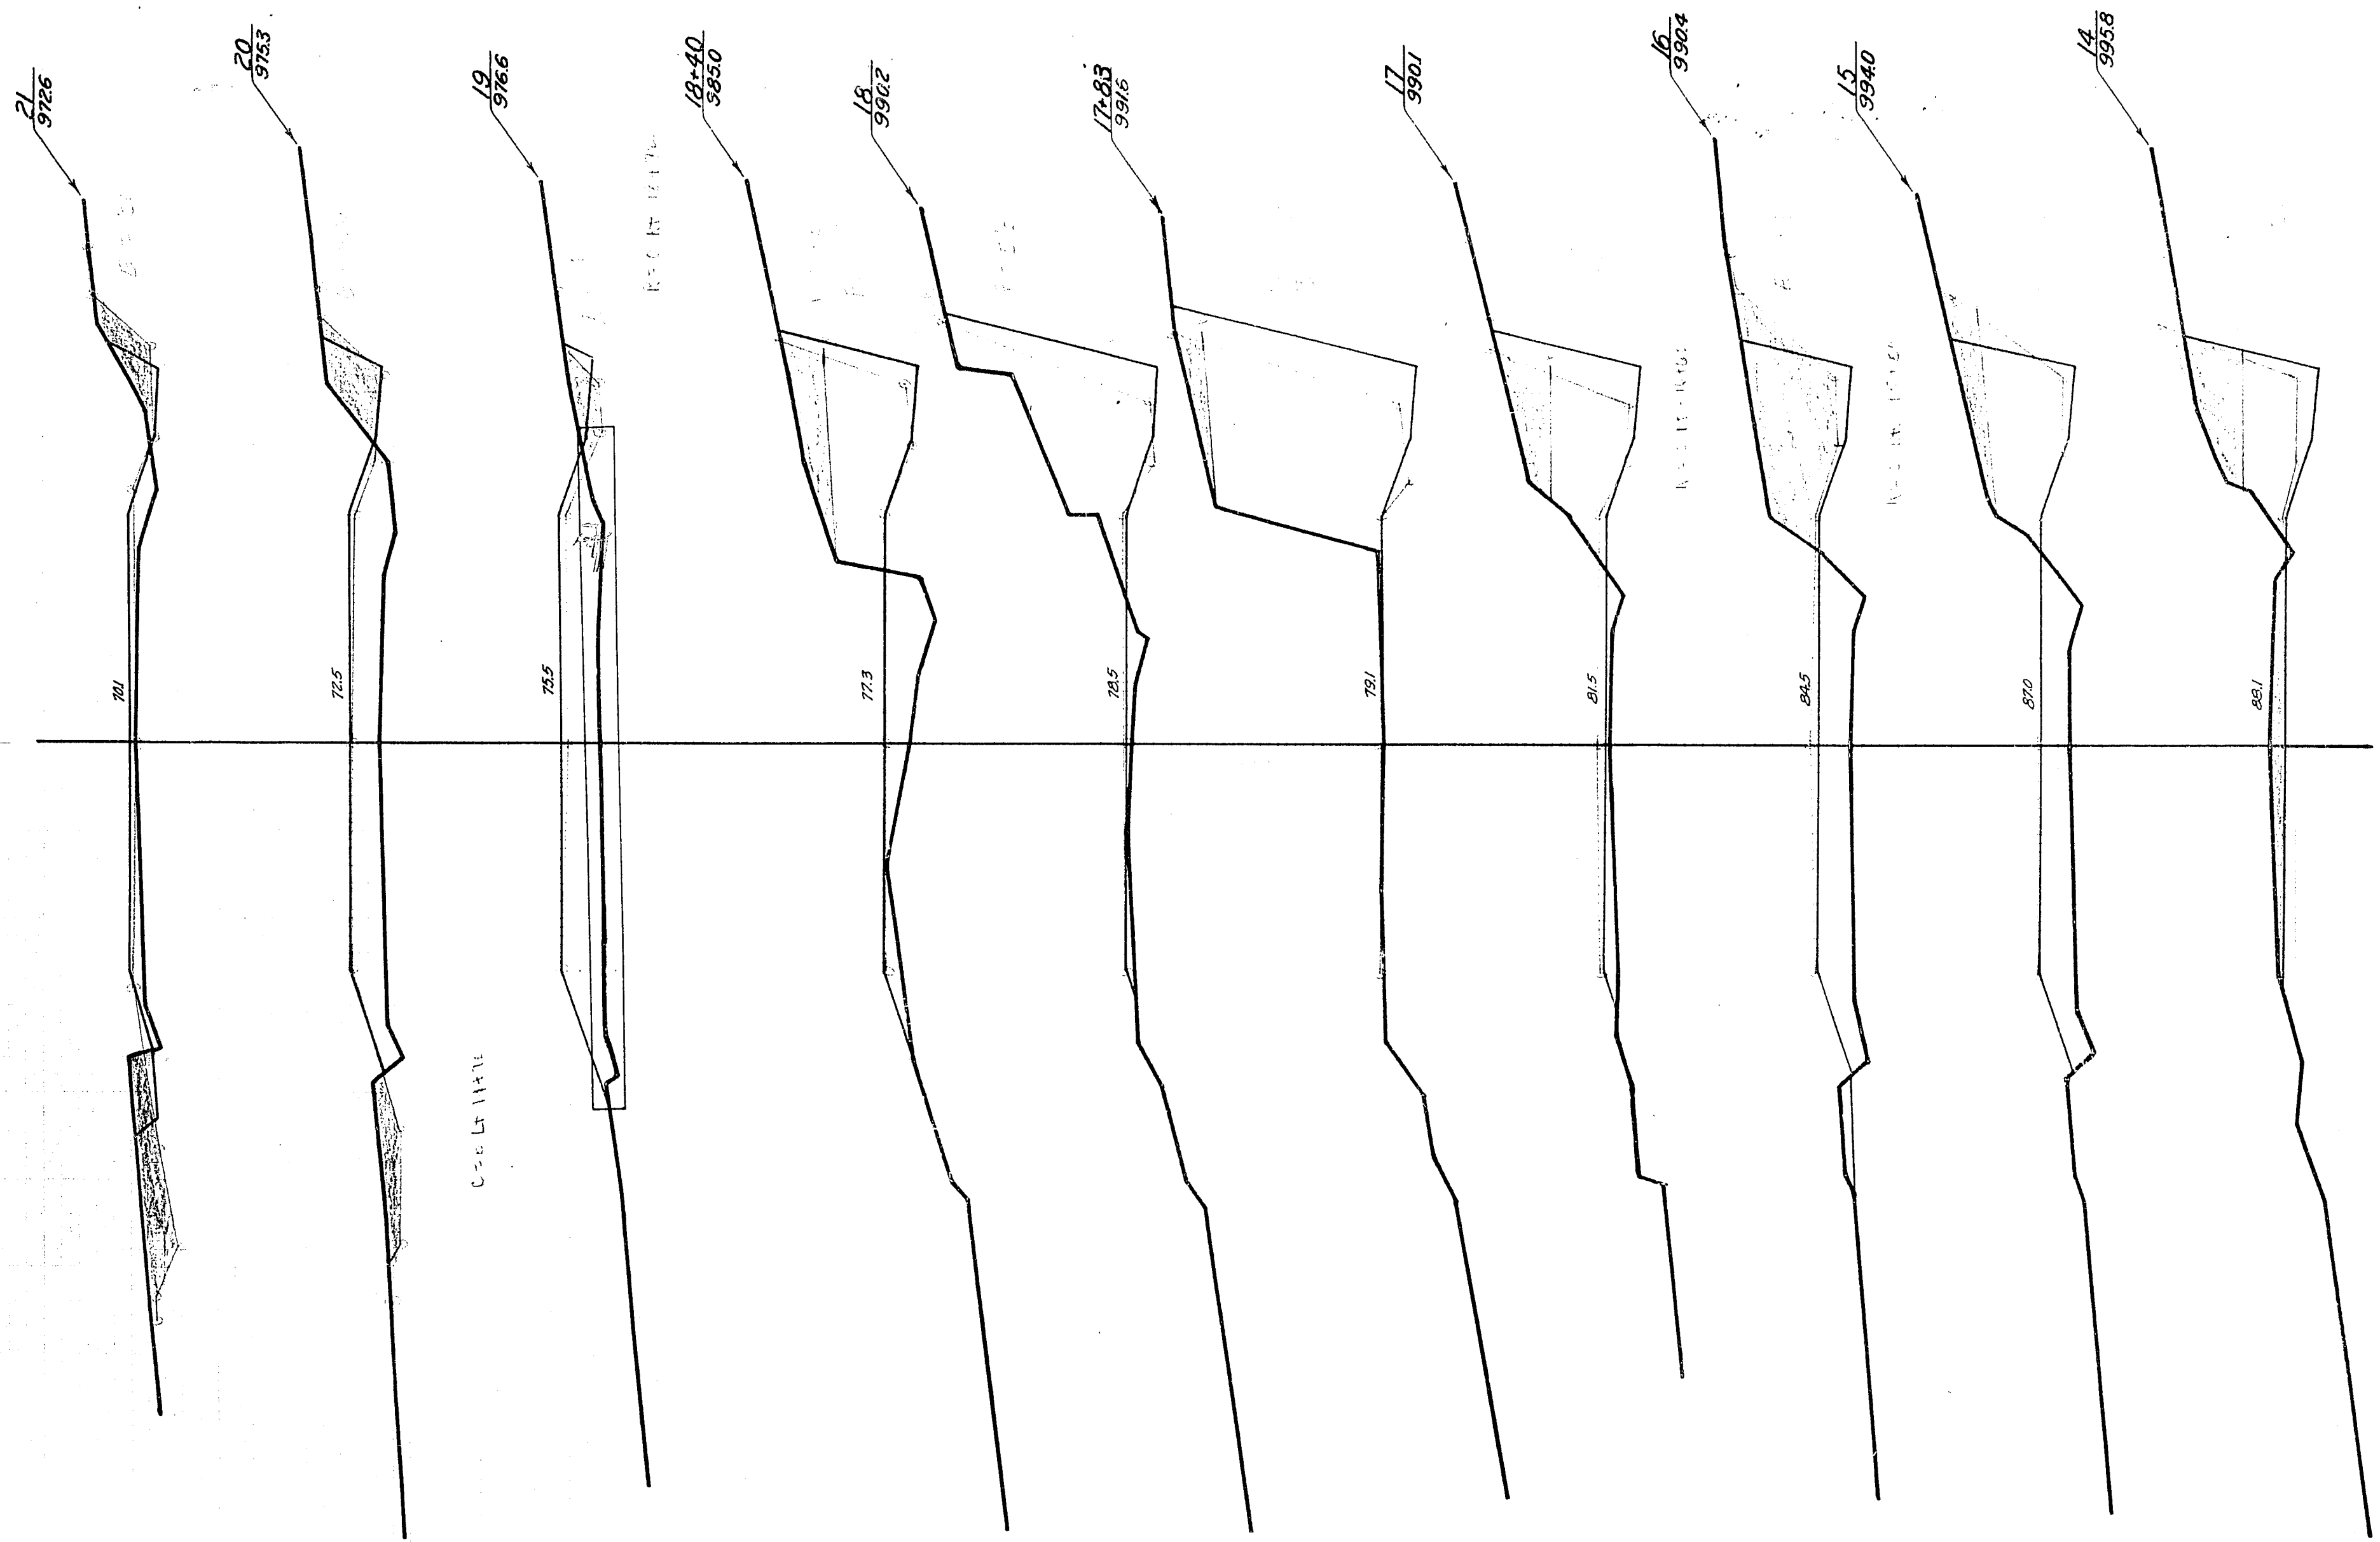
FED. ROAD DIST. NO.	STATE	STATION	SHEET NO.	TOTAL SHEETS
4	WISC.	9400	38	111
DIVISION JOB NO. 9400				

STATION	END AREA			YARDAGE				
	CUT			DISTANCE	CUT			TOTAL FILL
	EARTH	ROCK	FILL		EARTH	L. ROCK	S. ROCK	
10 67	22		57	32				19 98
11	8		105	40			6	
12 40	0			100			0	463
12	0		145	30			0	150
13 30	0		124	70			9	219
13 50	7	45		50			59	41
14 50	59	0						
TOTAL							93	971

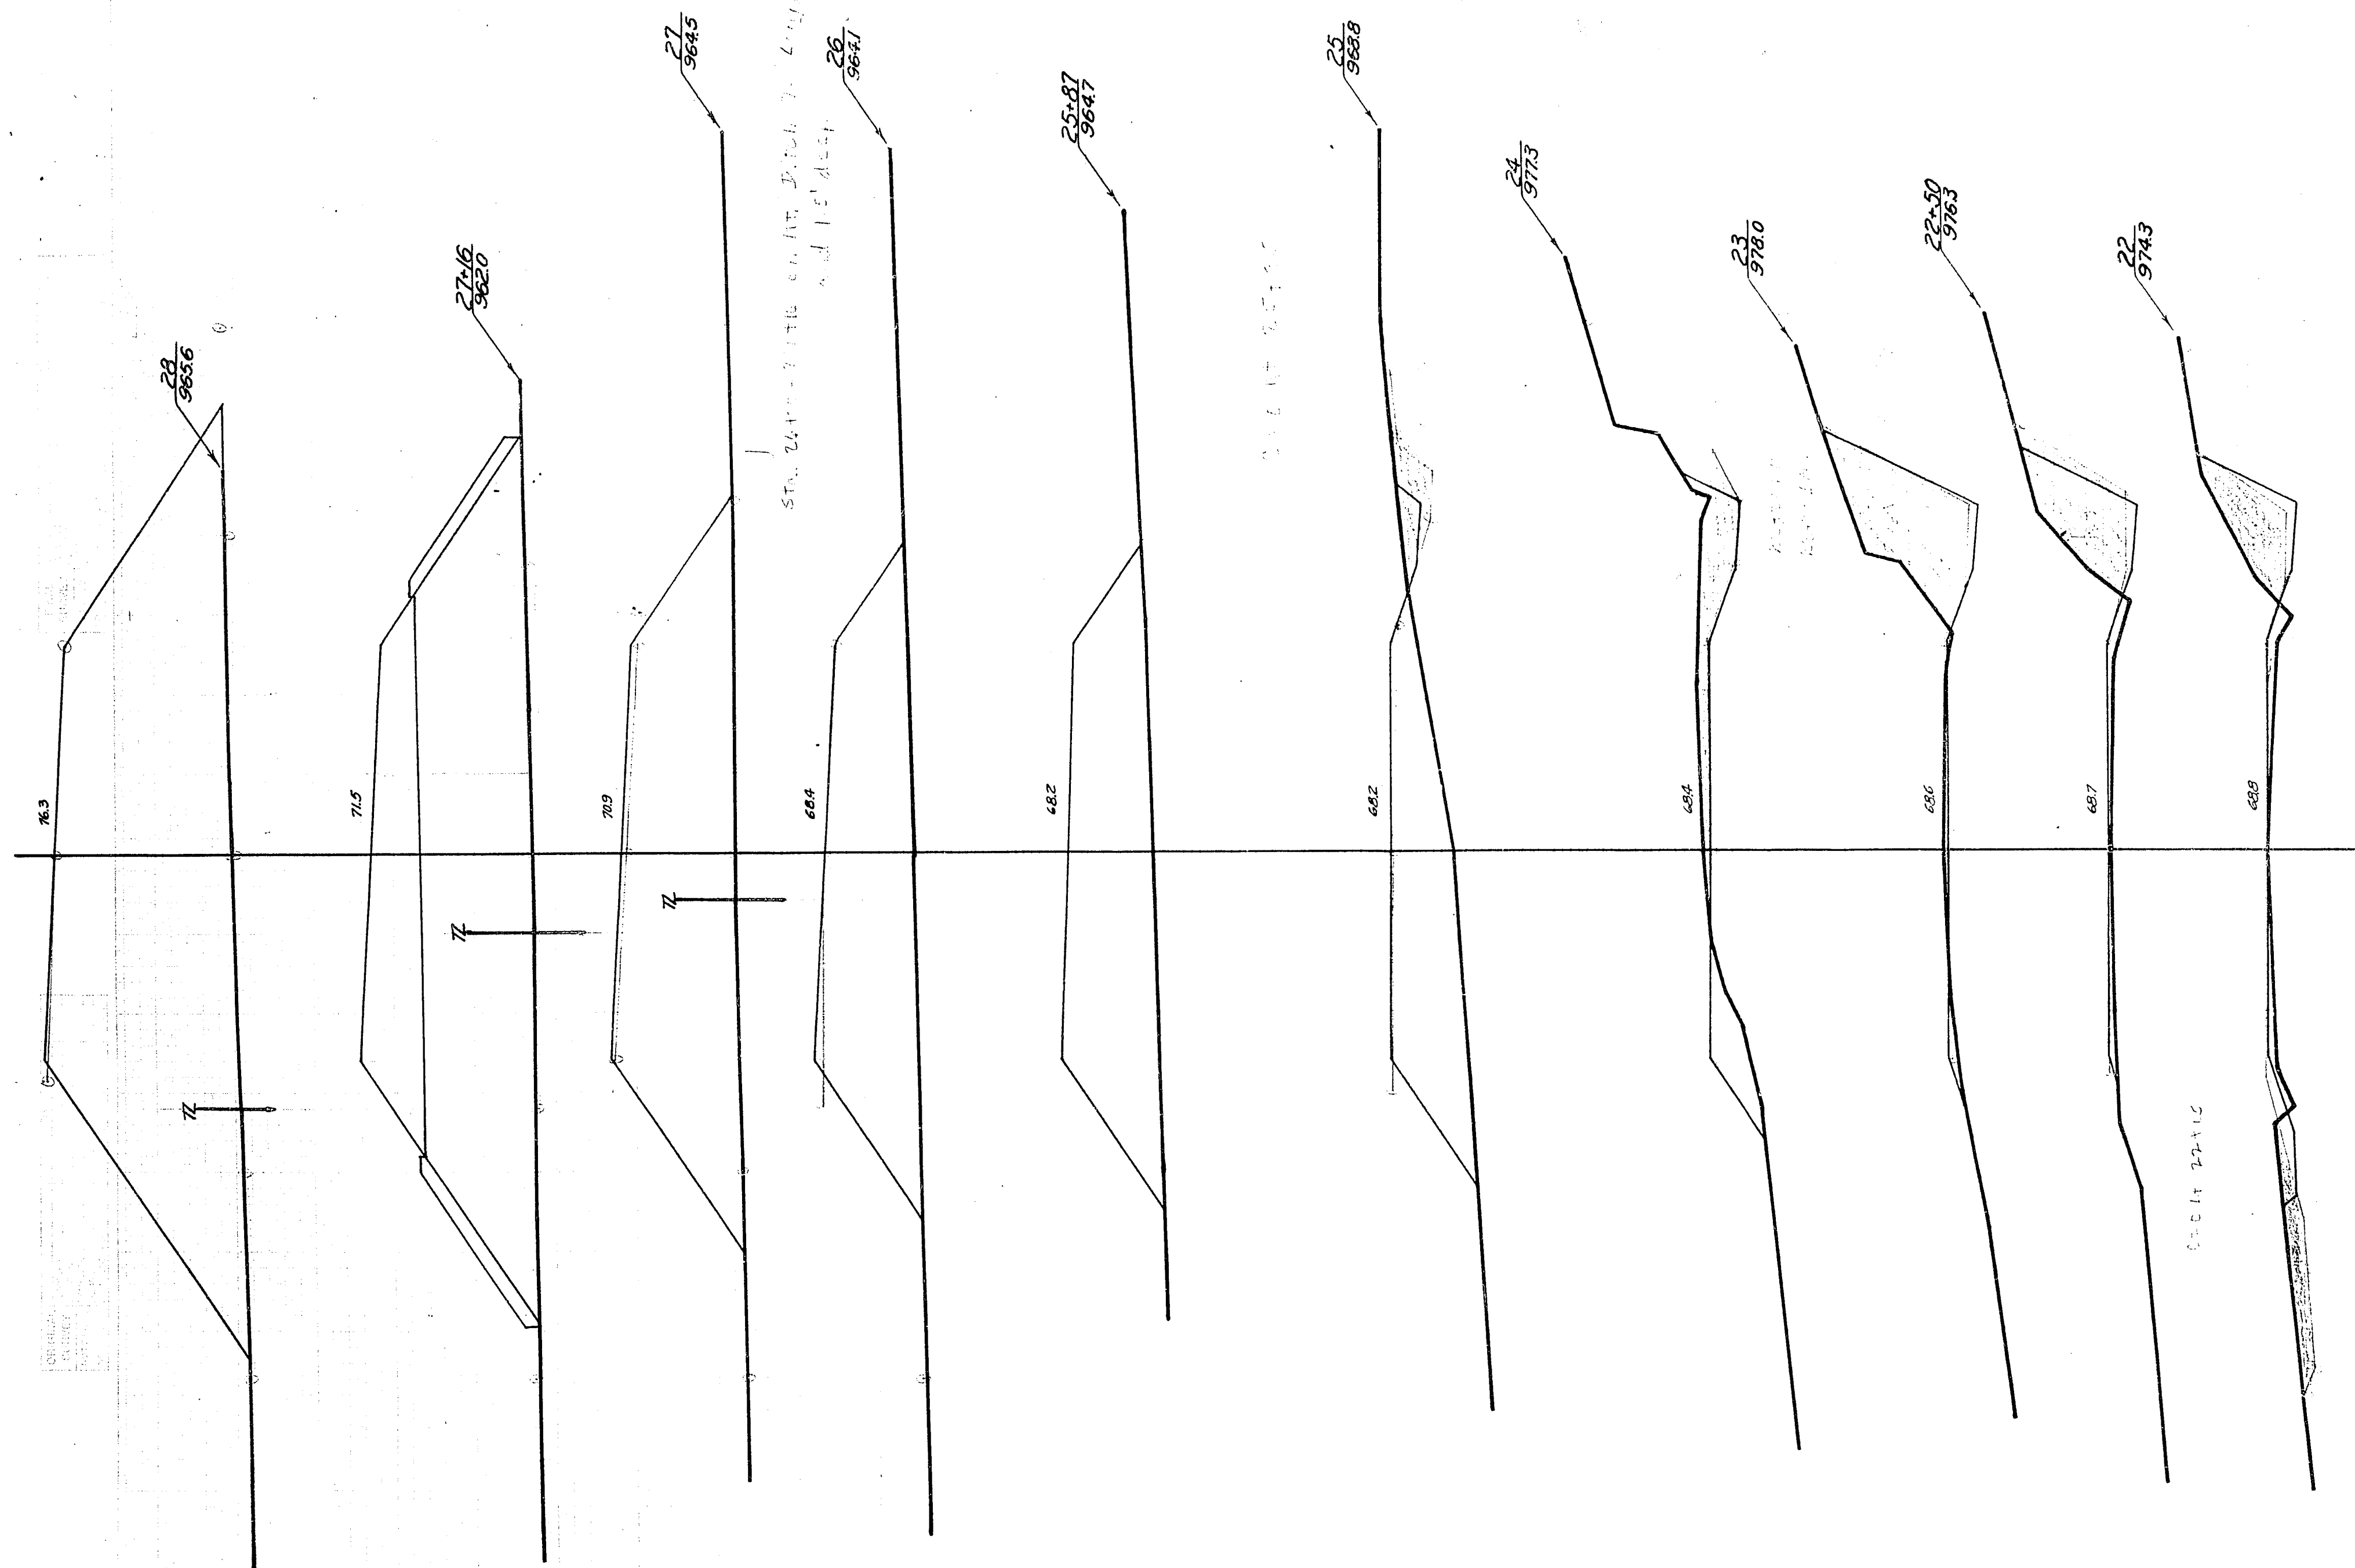


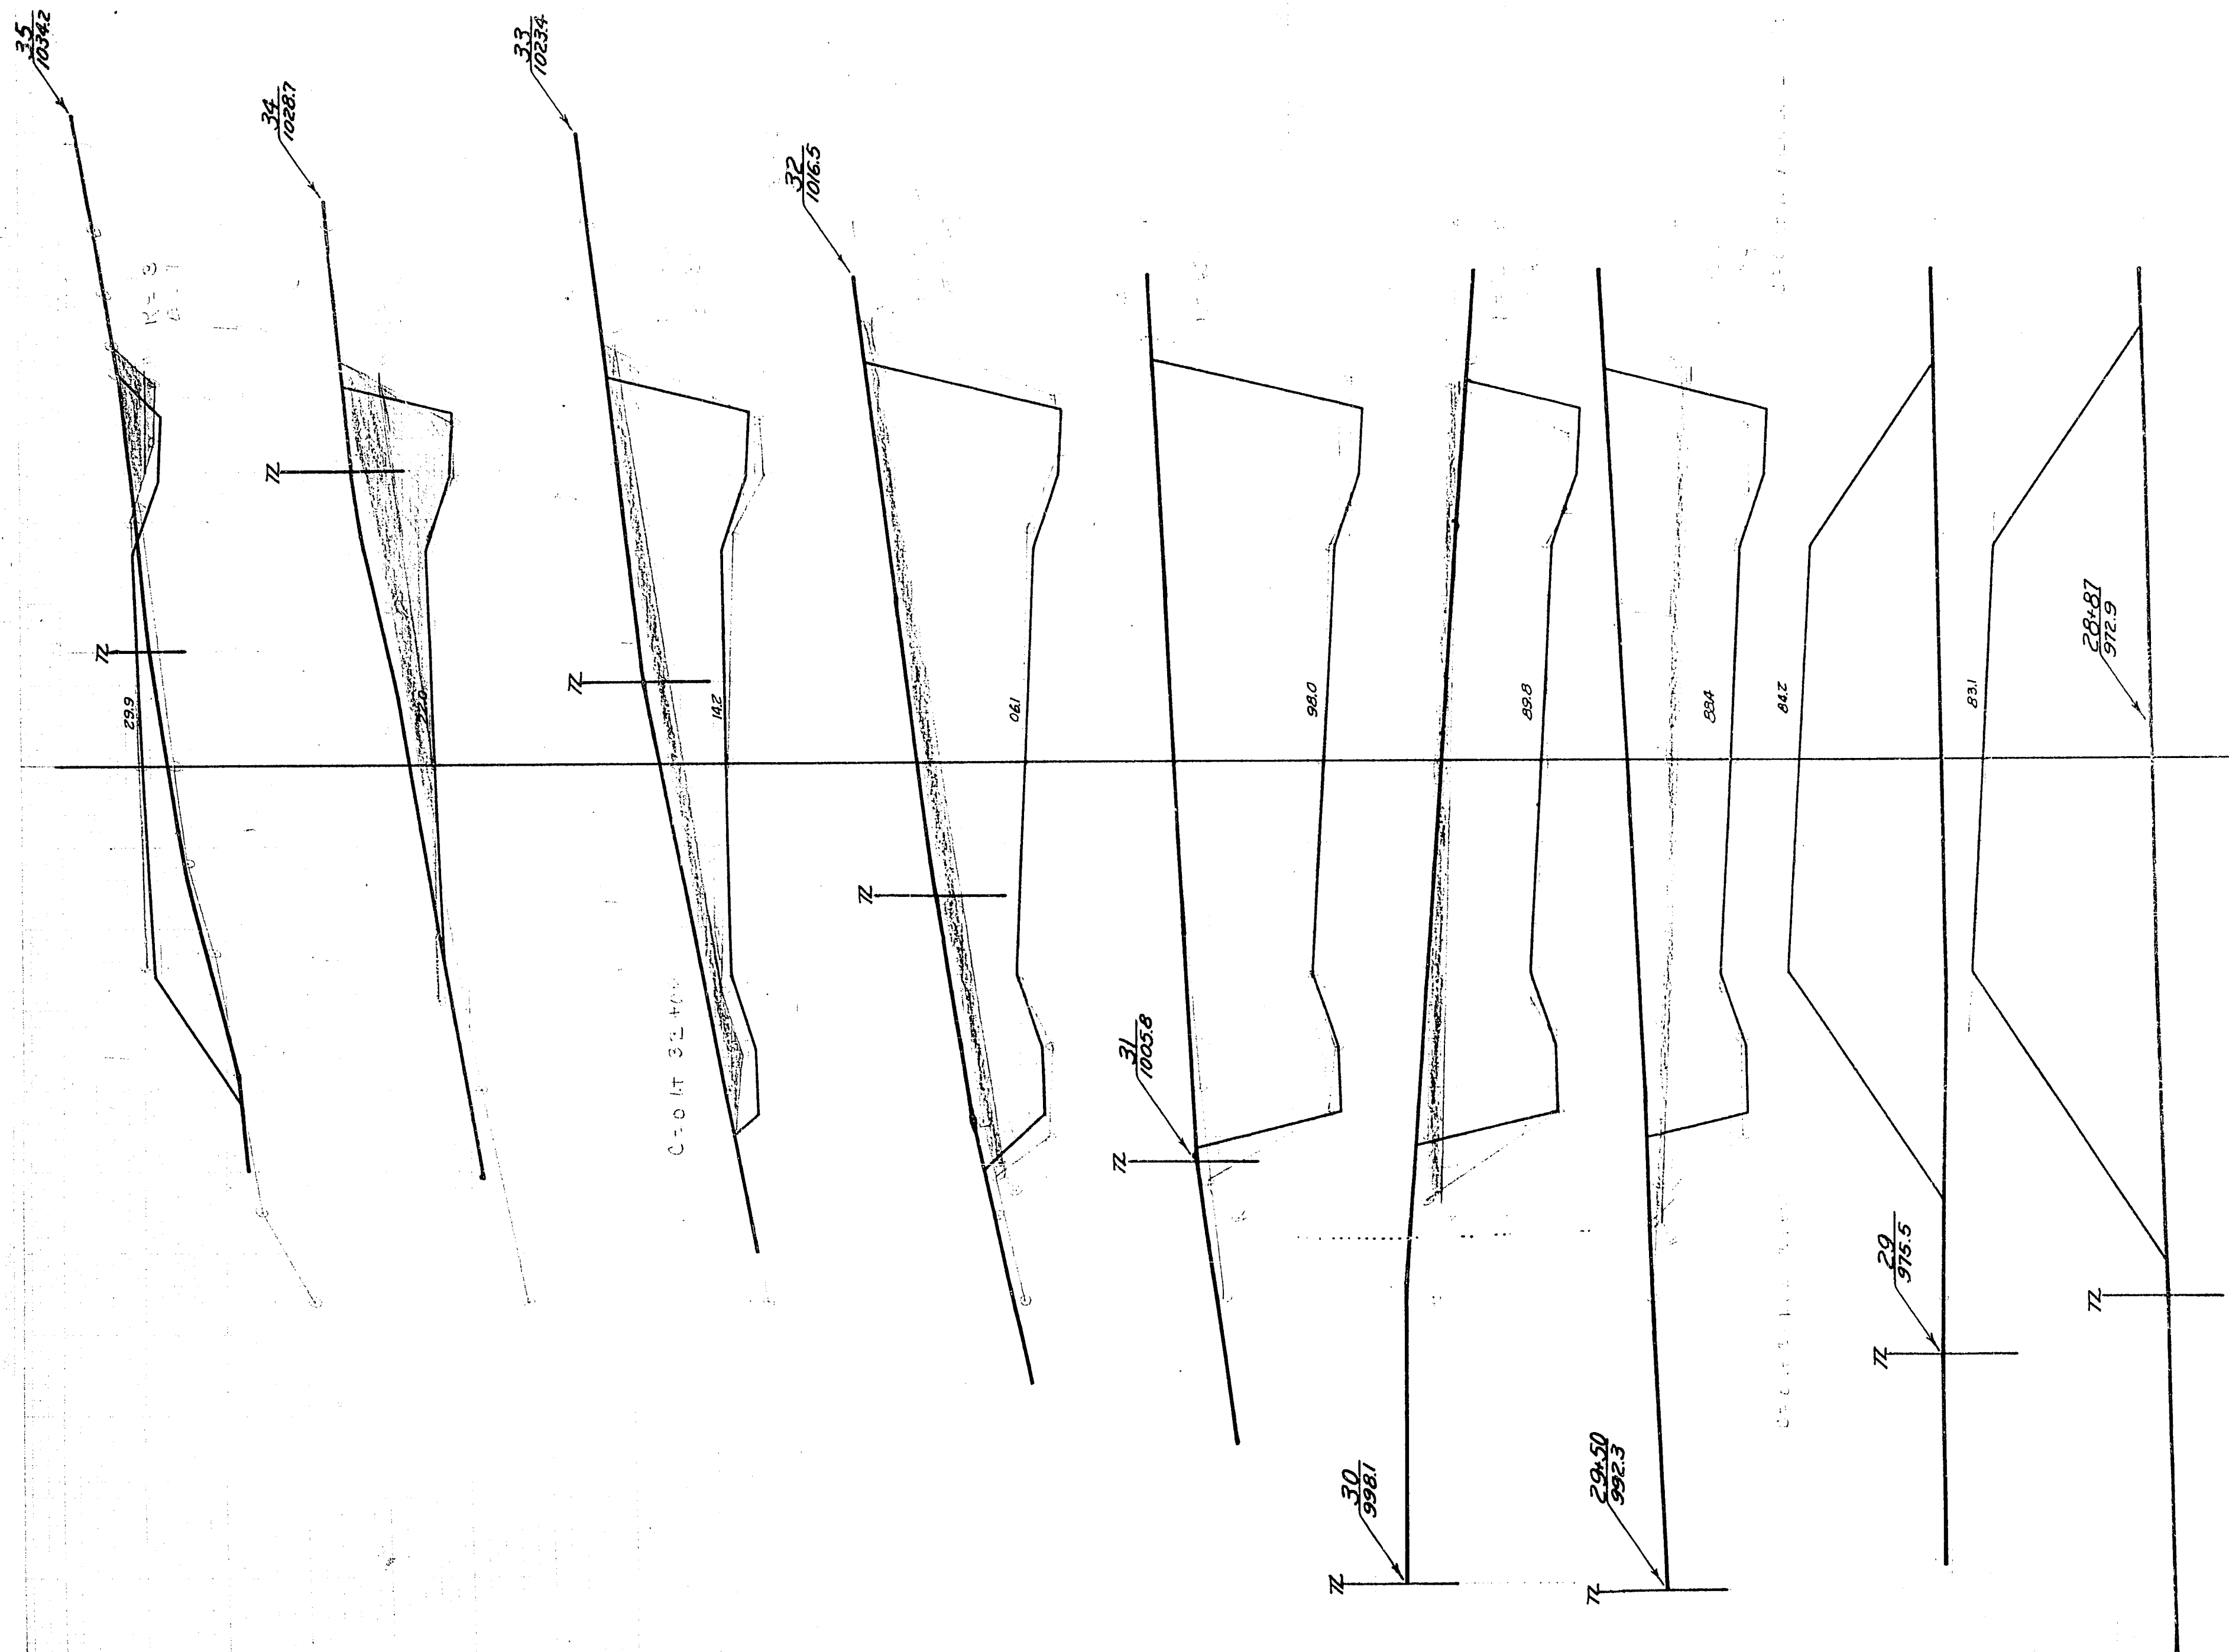
FED. ROAD DIST. NO.	STATE	STATE AID PROJ. NO.	SHEET NO.	TOTAL SHEETS
4	WISC.	9408	39	111
DIVISION JOB NO. 9408				

STATION	END AREA			YARDAGE				
	CUT			DISTANCE	CUT			
	EARTH	ROCK	FILL		EARTH	L. ROCK	S. ROCK	TOTAL FILL
13	59	0		50			115	0
14	66	1		100			217	96
15	51	51					191	198
16	52	56		100			211	130
17	62	14		83			294	22
+ 83	129	1		17			63	4
18	73	8		40			104	31
+ 40	66	34		60			80	119
19	5	72		100			30	256
20	11	66		100			41	163
21	11	22						
TOTAL							1346	1019



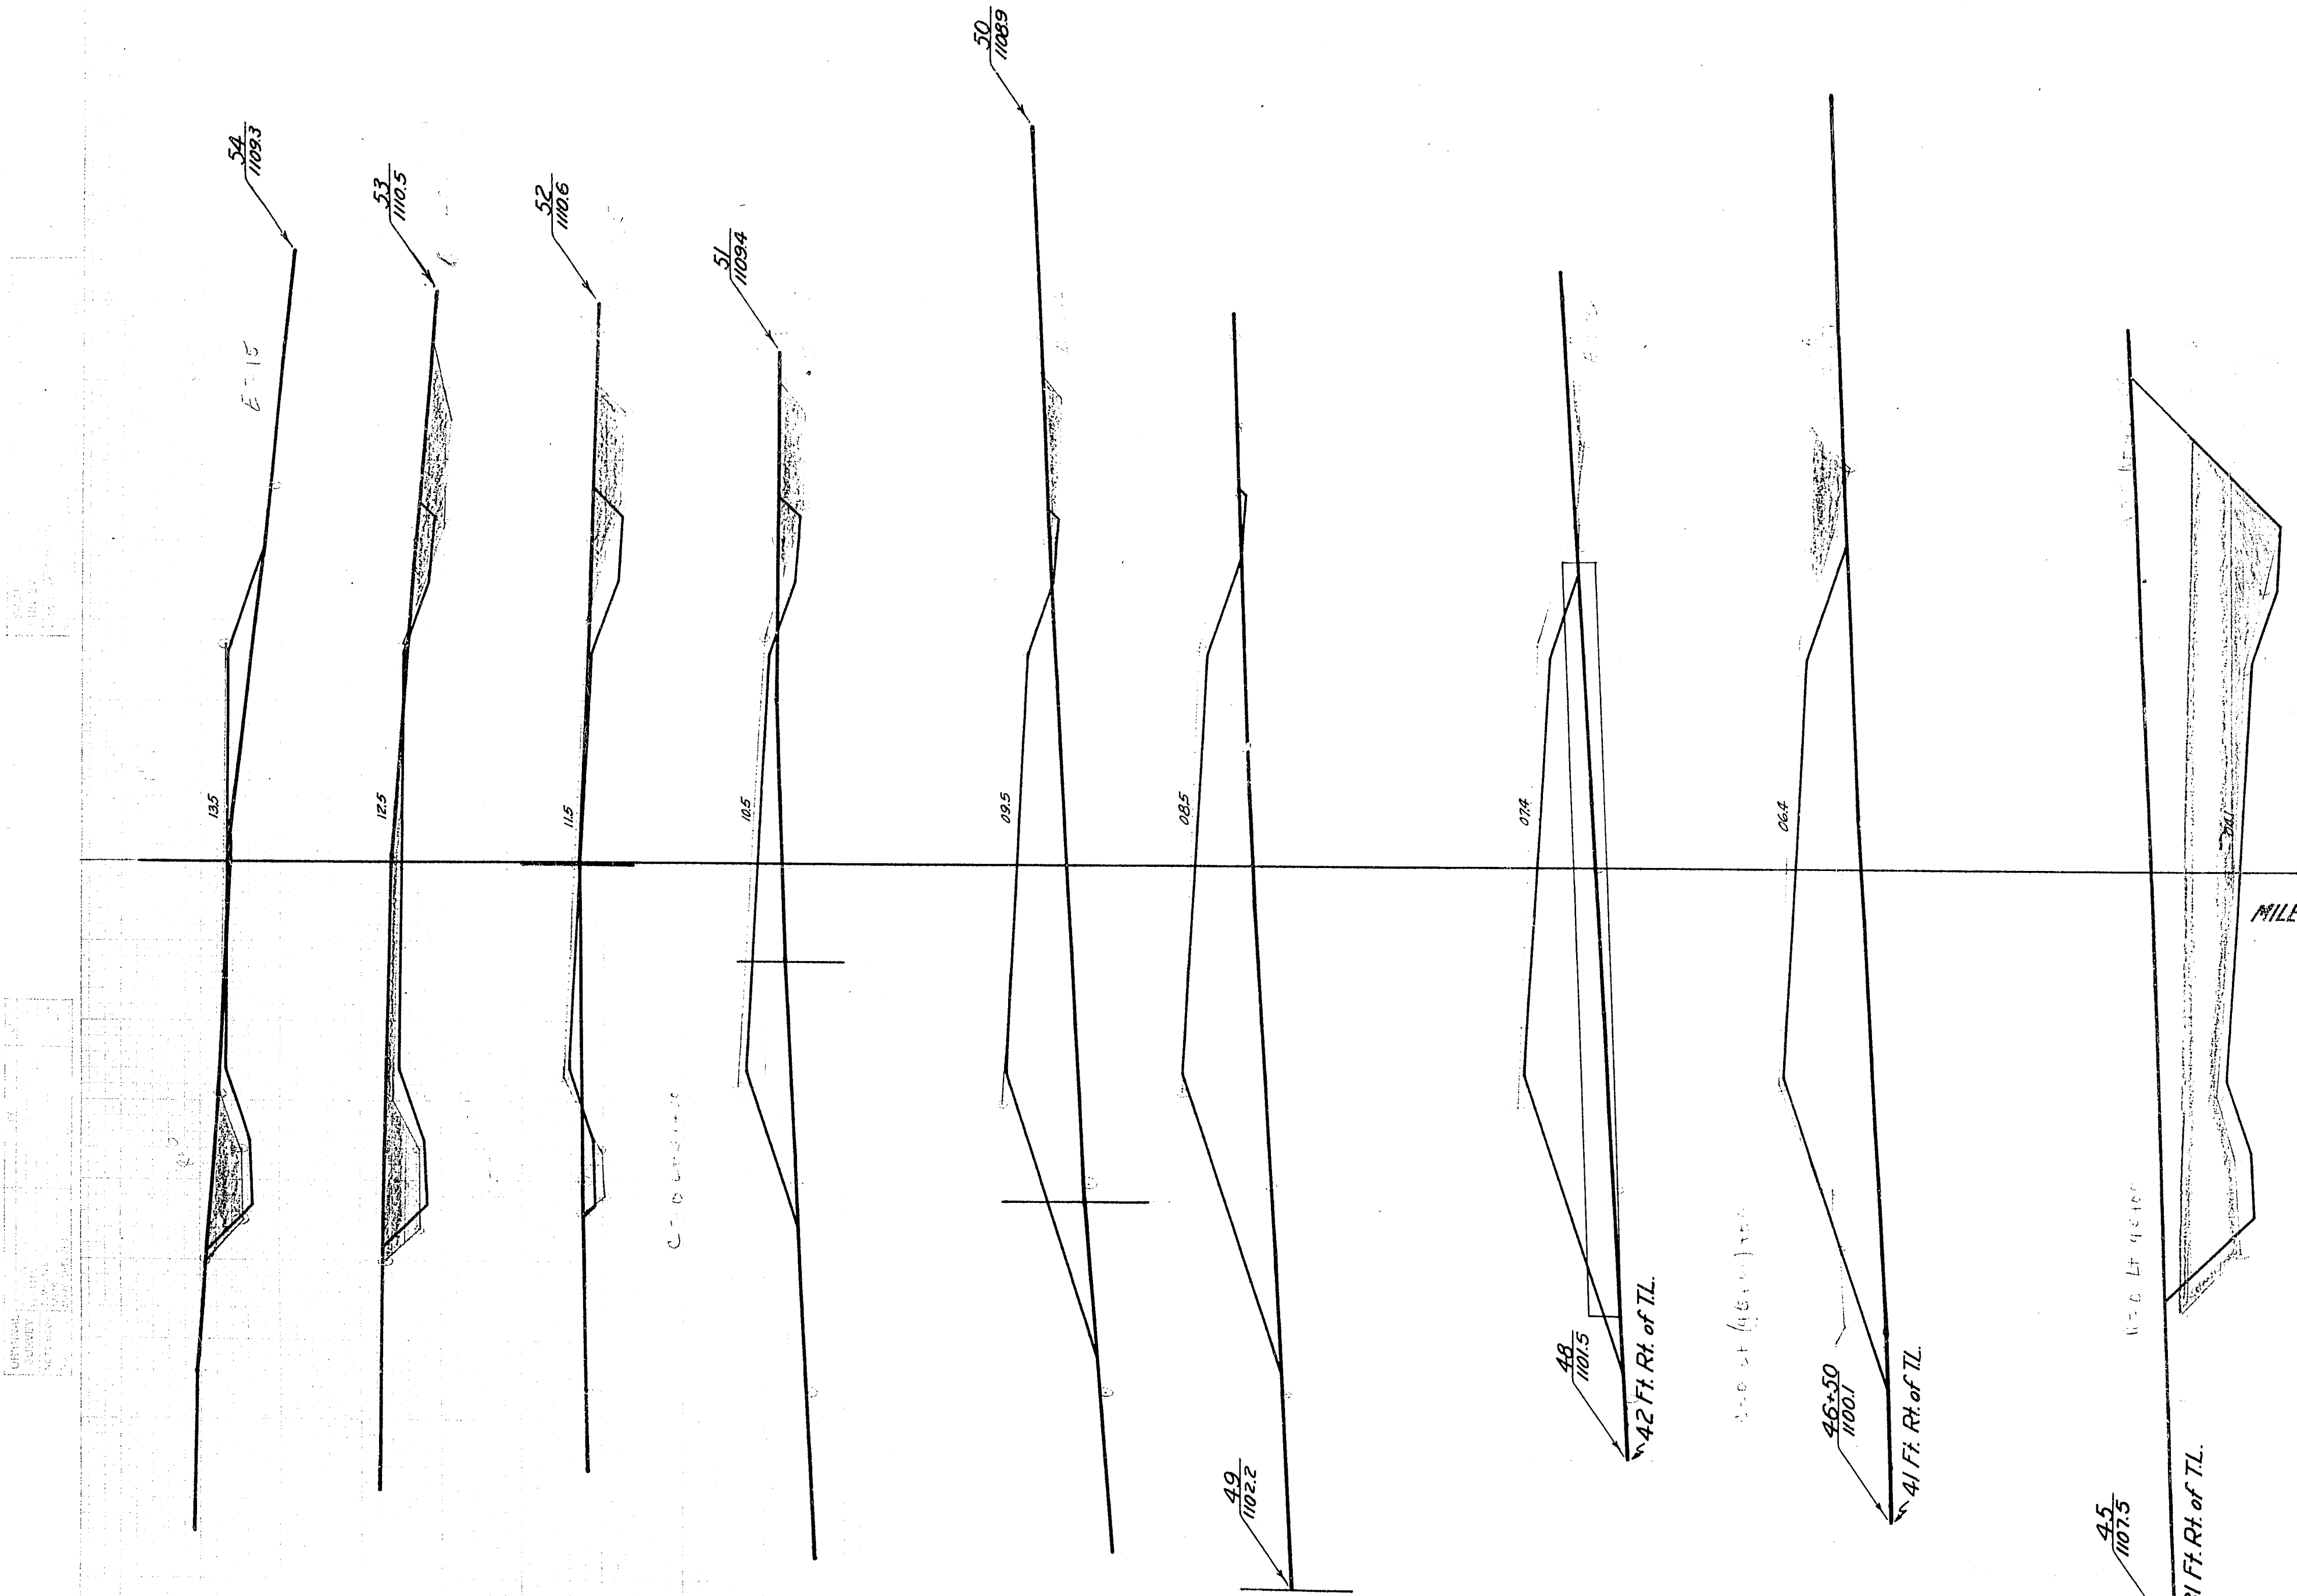
FED. ROAD DIST. NO.	STATE	STATE AID PROJ. NO.	SHEET NO.	TOTAL SHEETS
4	WISC.	9408	40	III
DIVISION		JOB NO. 9408		

[illegible]

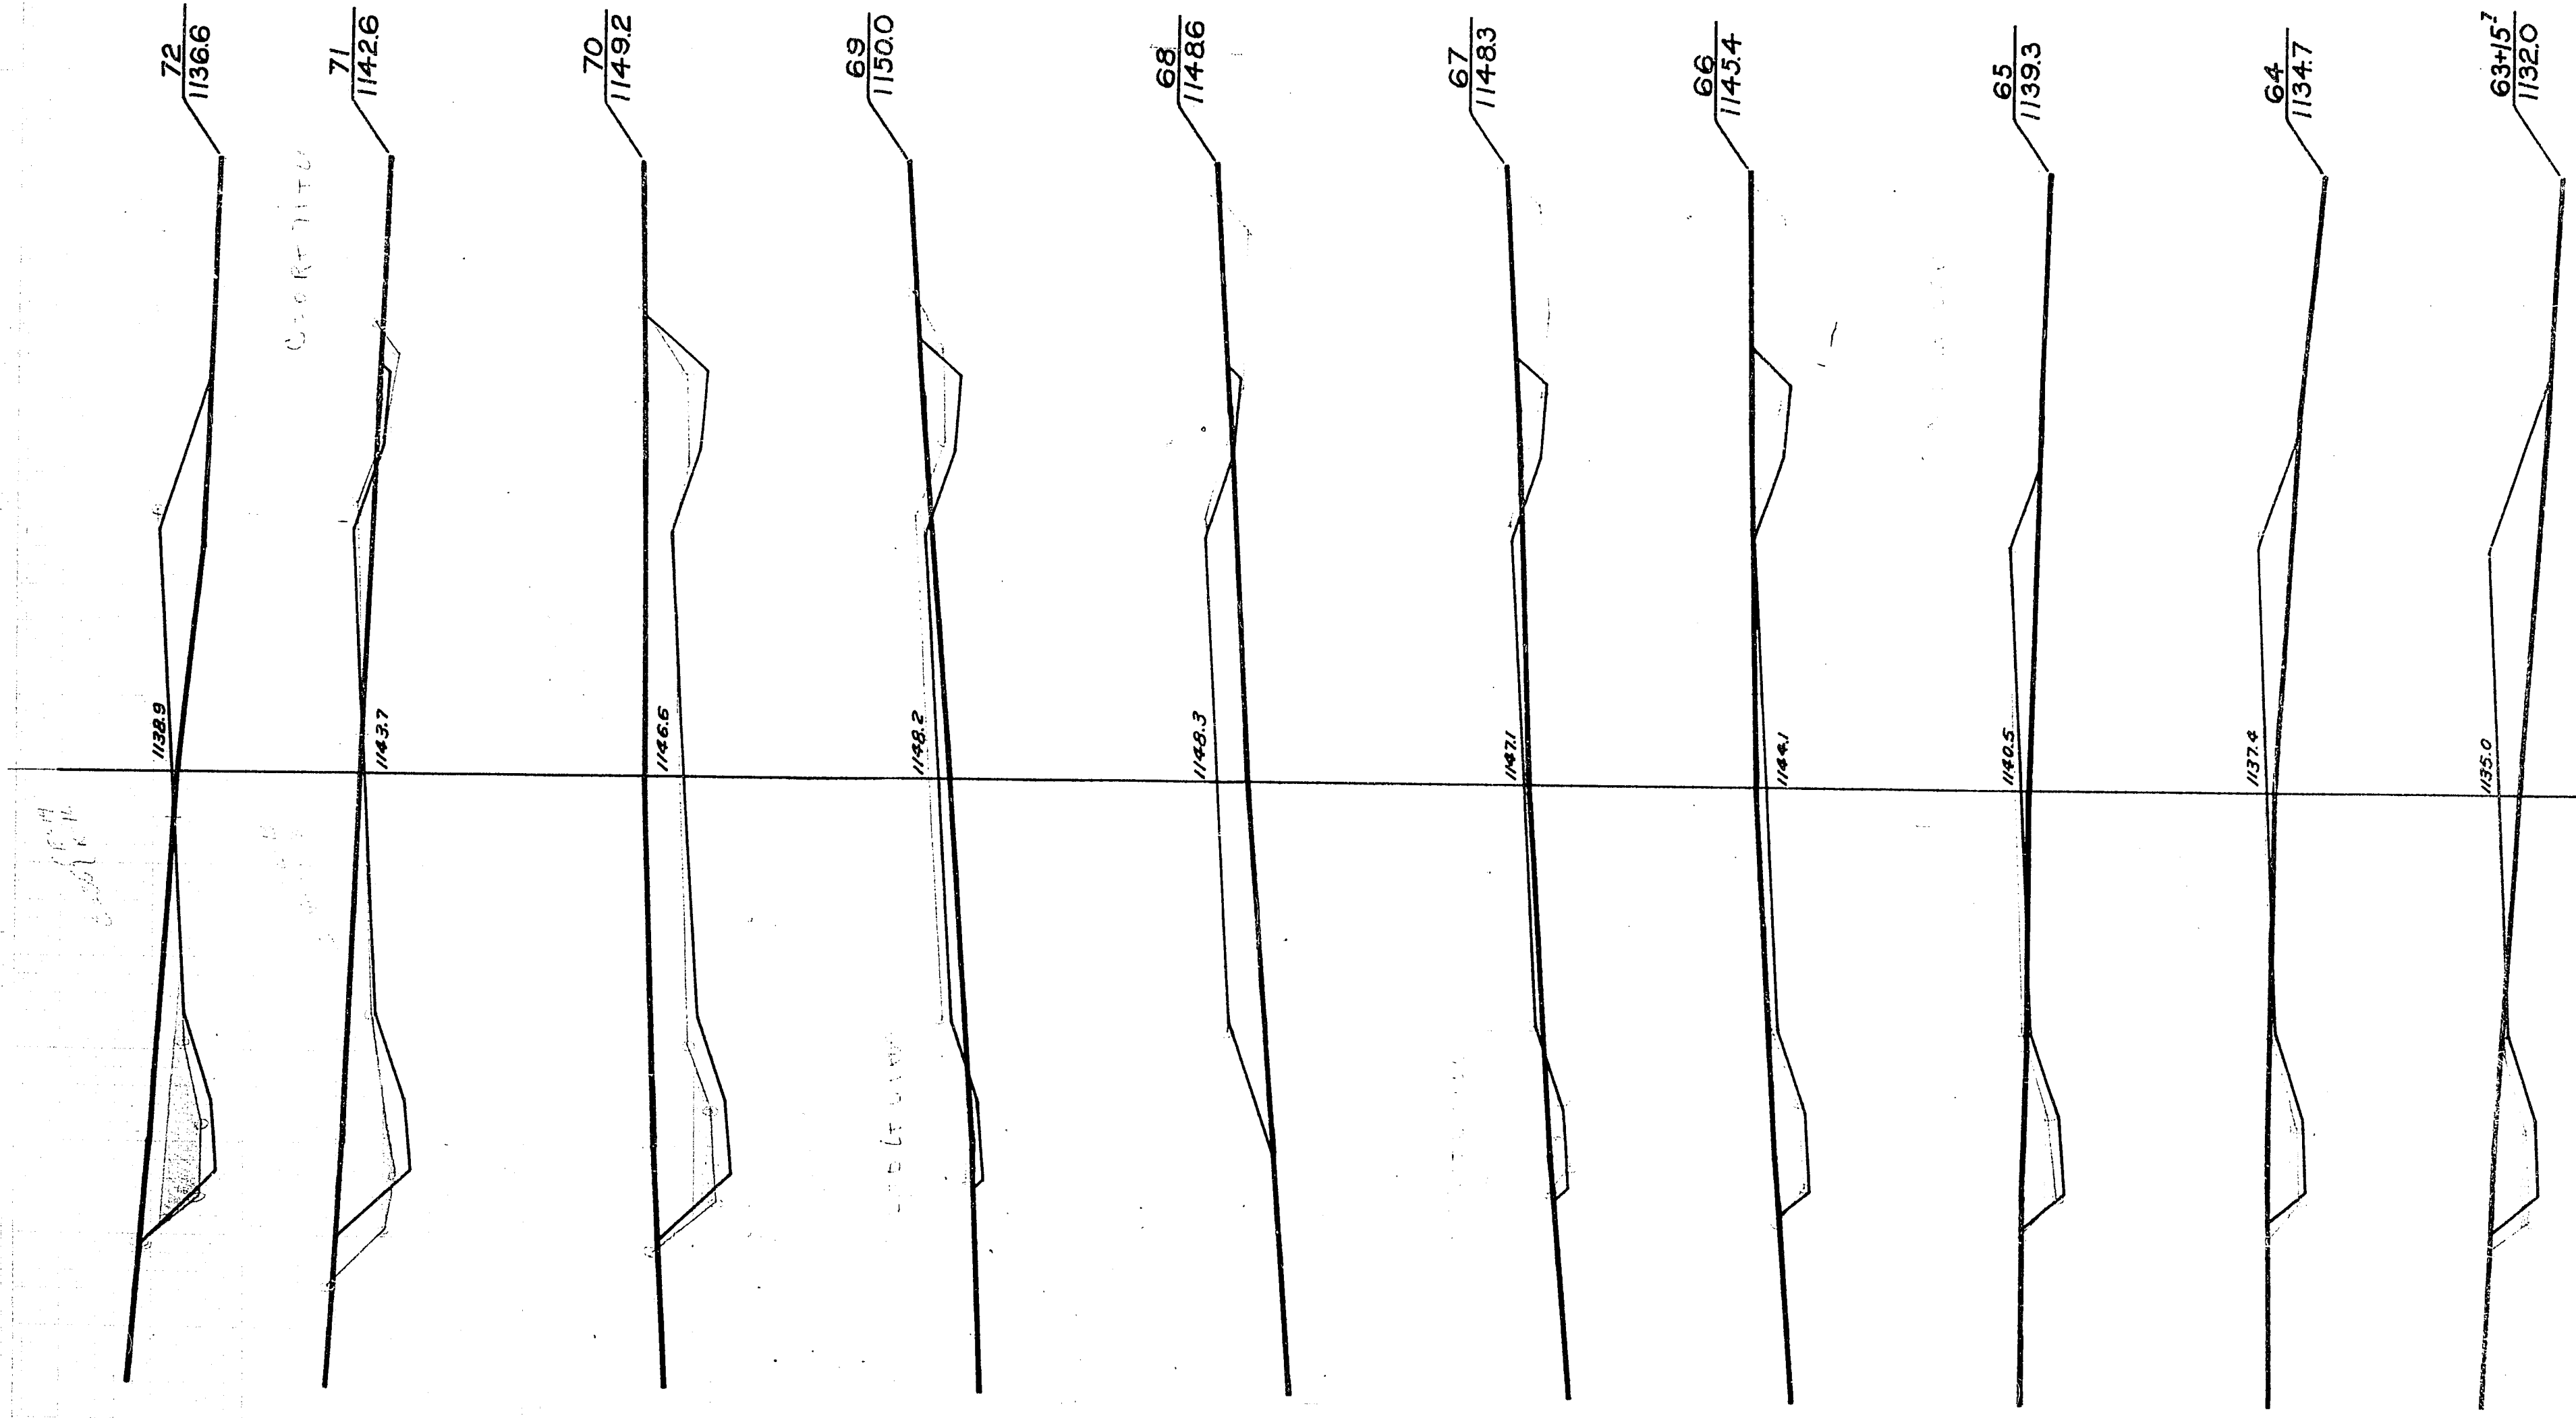
[illegible]

[illegible]

STATION	END AREA			DISTANCE	YARDAGE					
	CUT		FILL		CUT				TOTAL FILL	
	EARTH	ROCK			EARTH	L. ROCK	S. ROCK	TOTAL		
44	295		0	105 ⁶					1198	0
45	318		0							0
46			0						413	
47	0			99 ³					185	
48	0		168					0		
49	0		146					0	578	
50	1		149	105 ⁶				2	578	
51	3		120	102 ⁹				7	513	
52								12	196	
53					14,528			130,36		
54	7		52	100 ²				7	126	
55	19		6					48	107	
56	42		0					113	11	
57				100				120	28	
58	23		15							
TOTAL.								1920	2322	

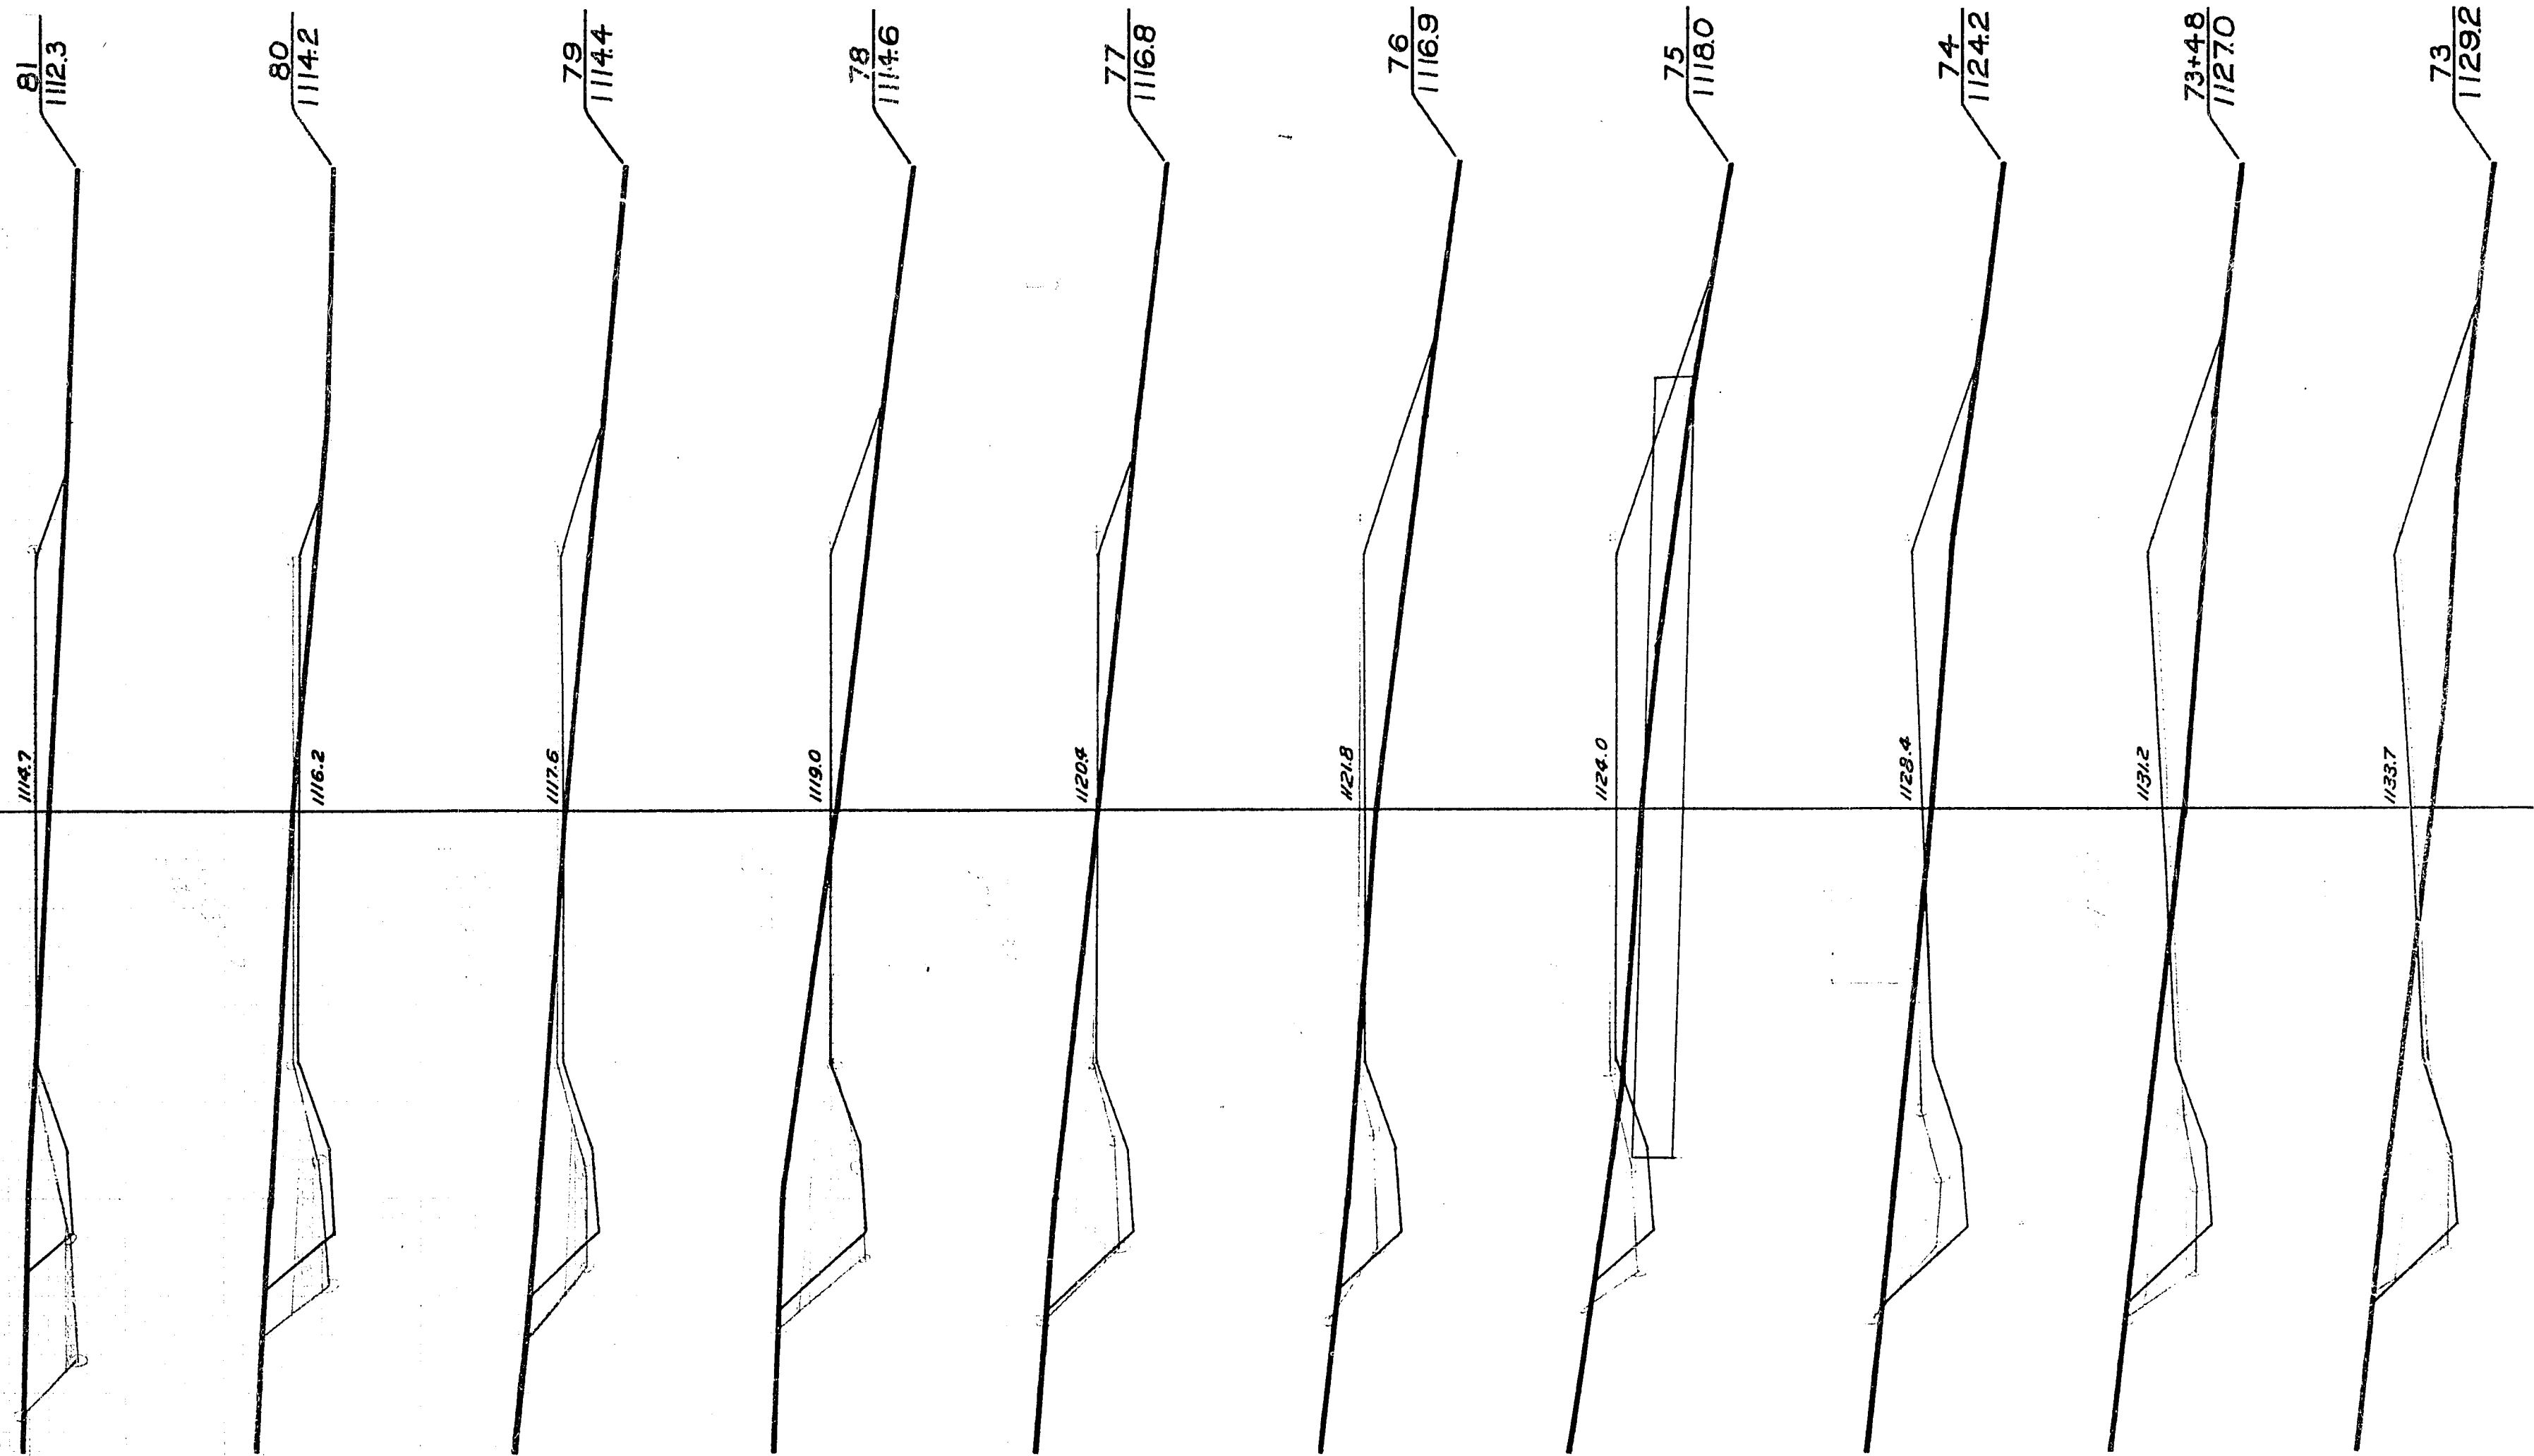


[illegible]

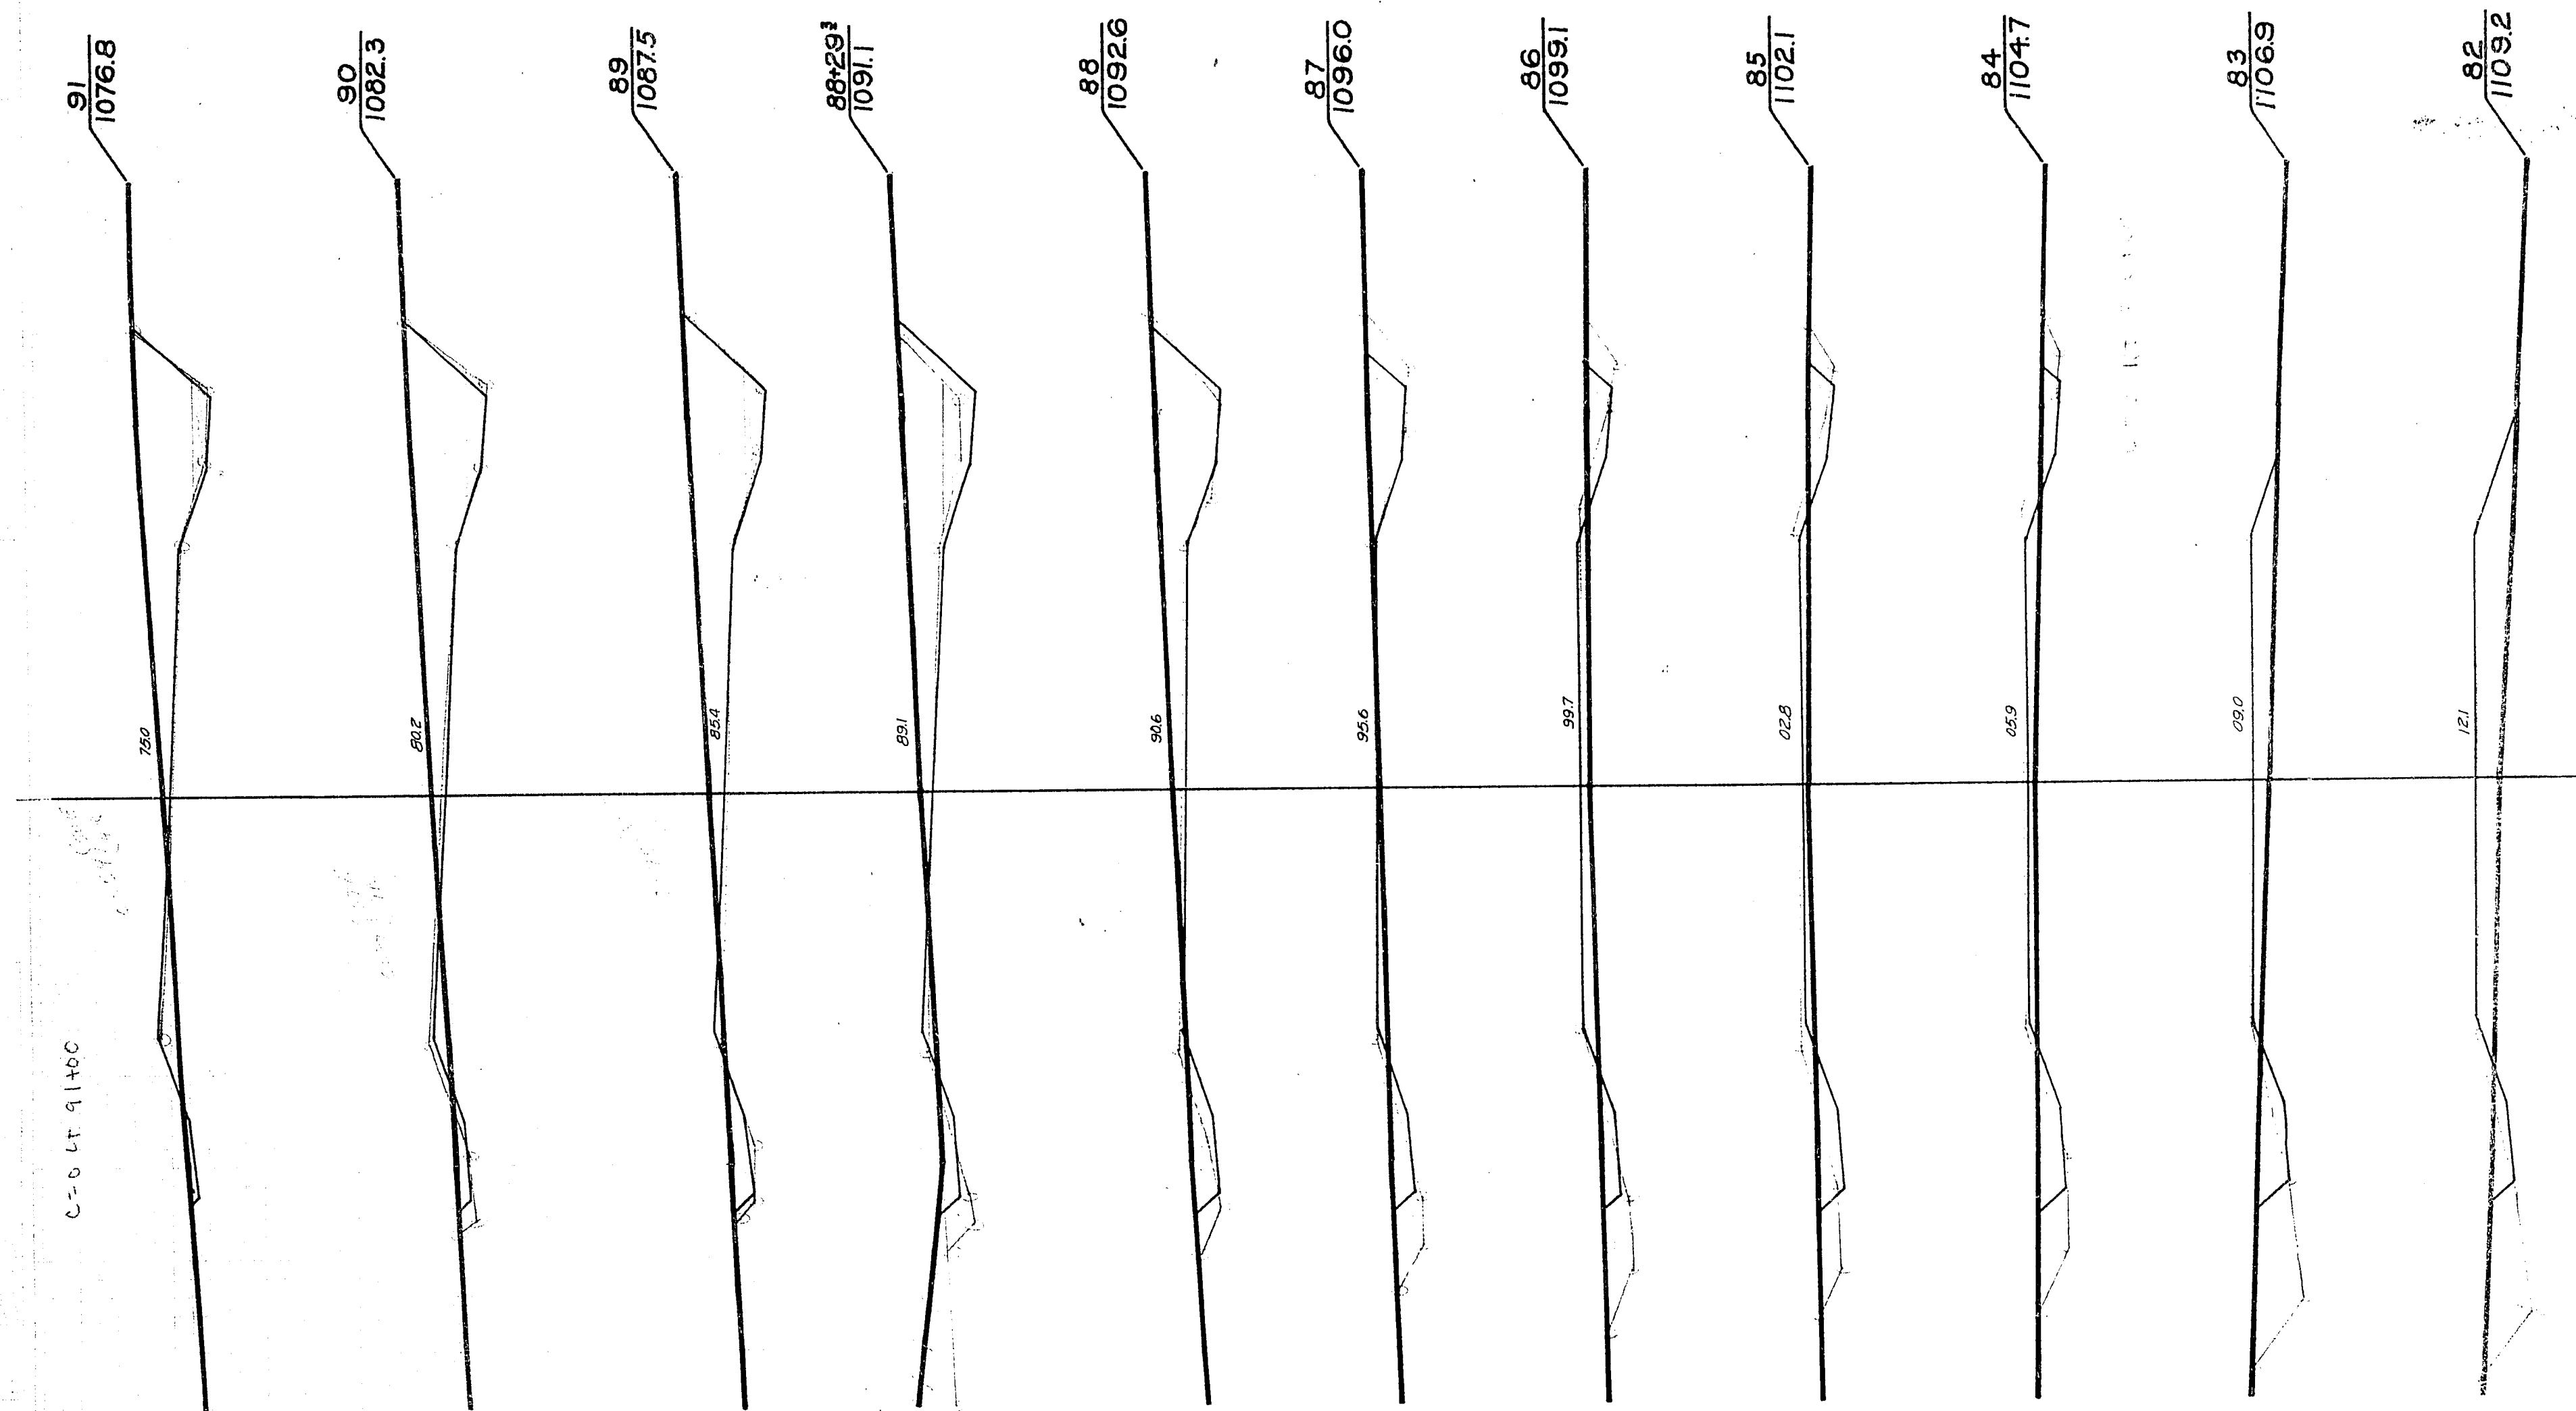


STATION	END AREA			YARDAGE				
	CUT			DISTANCE	CUT			
	EARTH	ROCK	FILL		EARTH	L. ROCK	S. ROCK	TOTAL FILL
63	16		47					
+15.7	19		42	15.7				9
64	22		16	84.3				65
65	17		16	100				72
66	39		0	100				104
67	14		12	100				98
68	3		52	100				31
69	16		16	100				35
+25			0	25				7
70	120		0	100				252
+50			0	100				7
71	46		7	100				307
72	39		27					157
TOTAL								550

FED. ROAD DIST. NO.	STATE	State AID PROJ. NO.	SHEET NO.	TOTAL SHEETS
4	WISC.	9408	46	111
DIVISION		JOB NO. 9408		

[illegible]

FED. ROAD DIST. NO.	STATE	STATE AID PROJ. NO.	SHEET NO.	TOTAL SHEETS
4	WISC.	9408	47	111
DIVISION JOB NO. 9408				

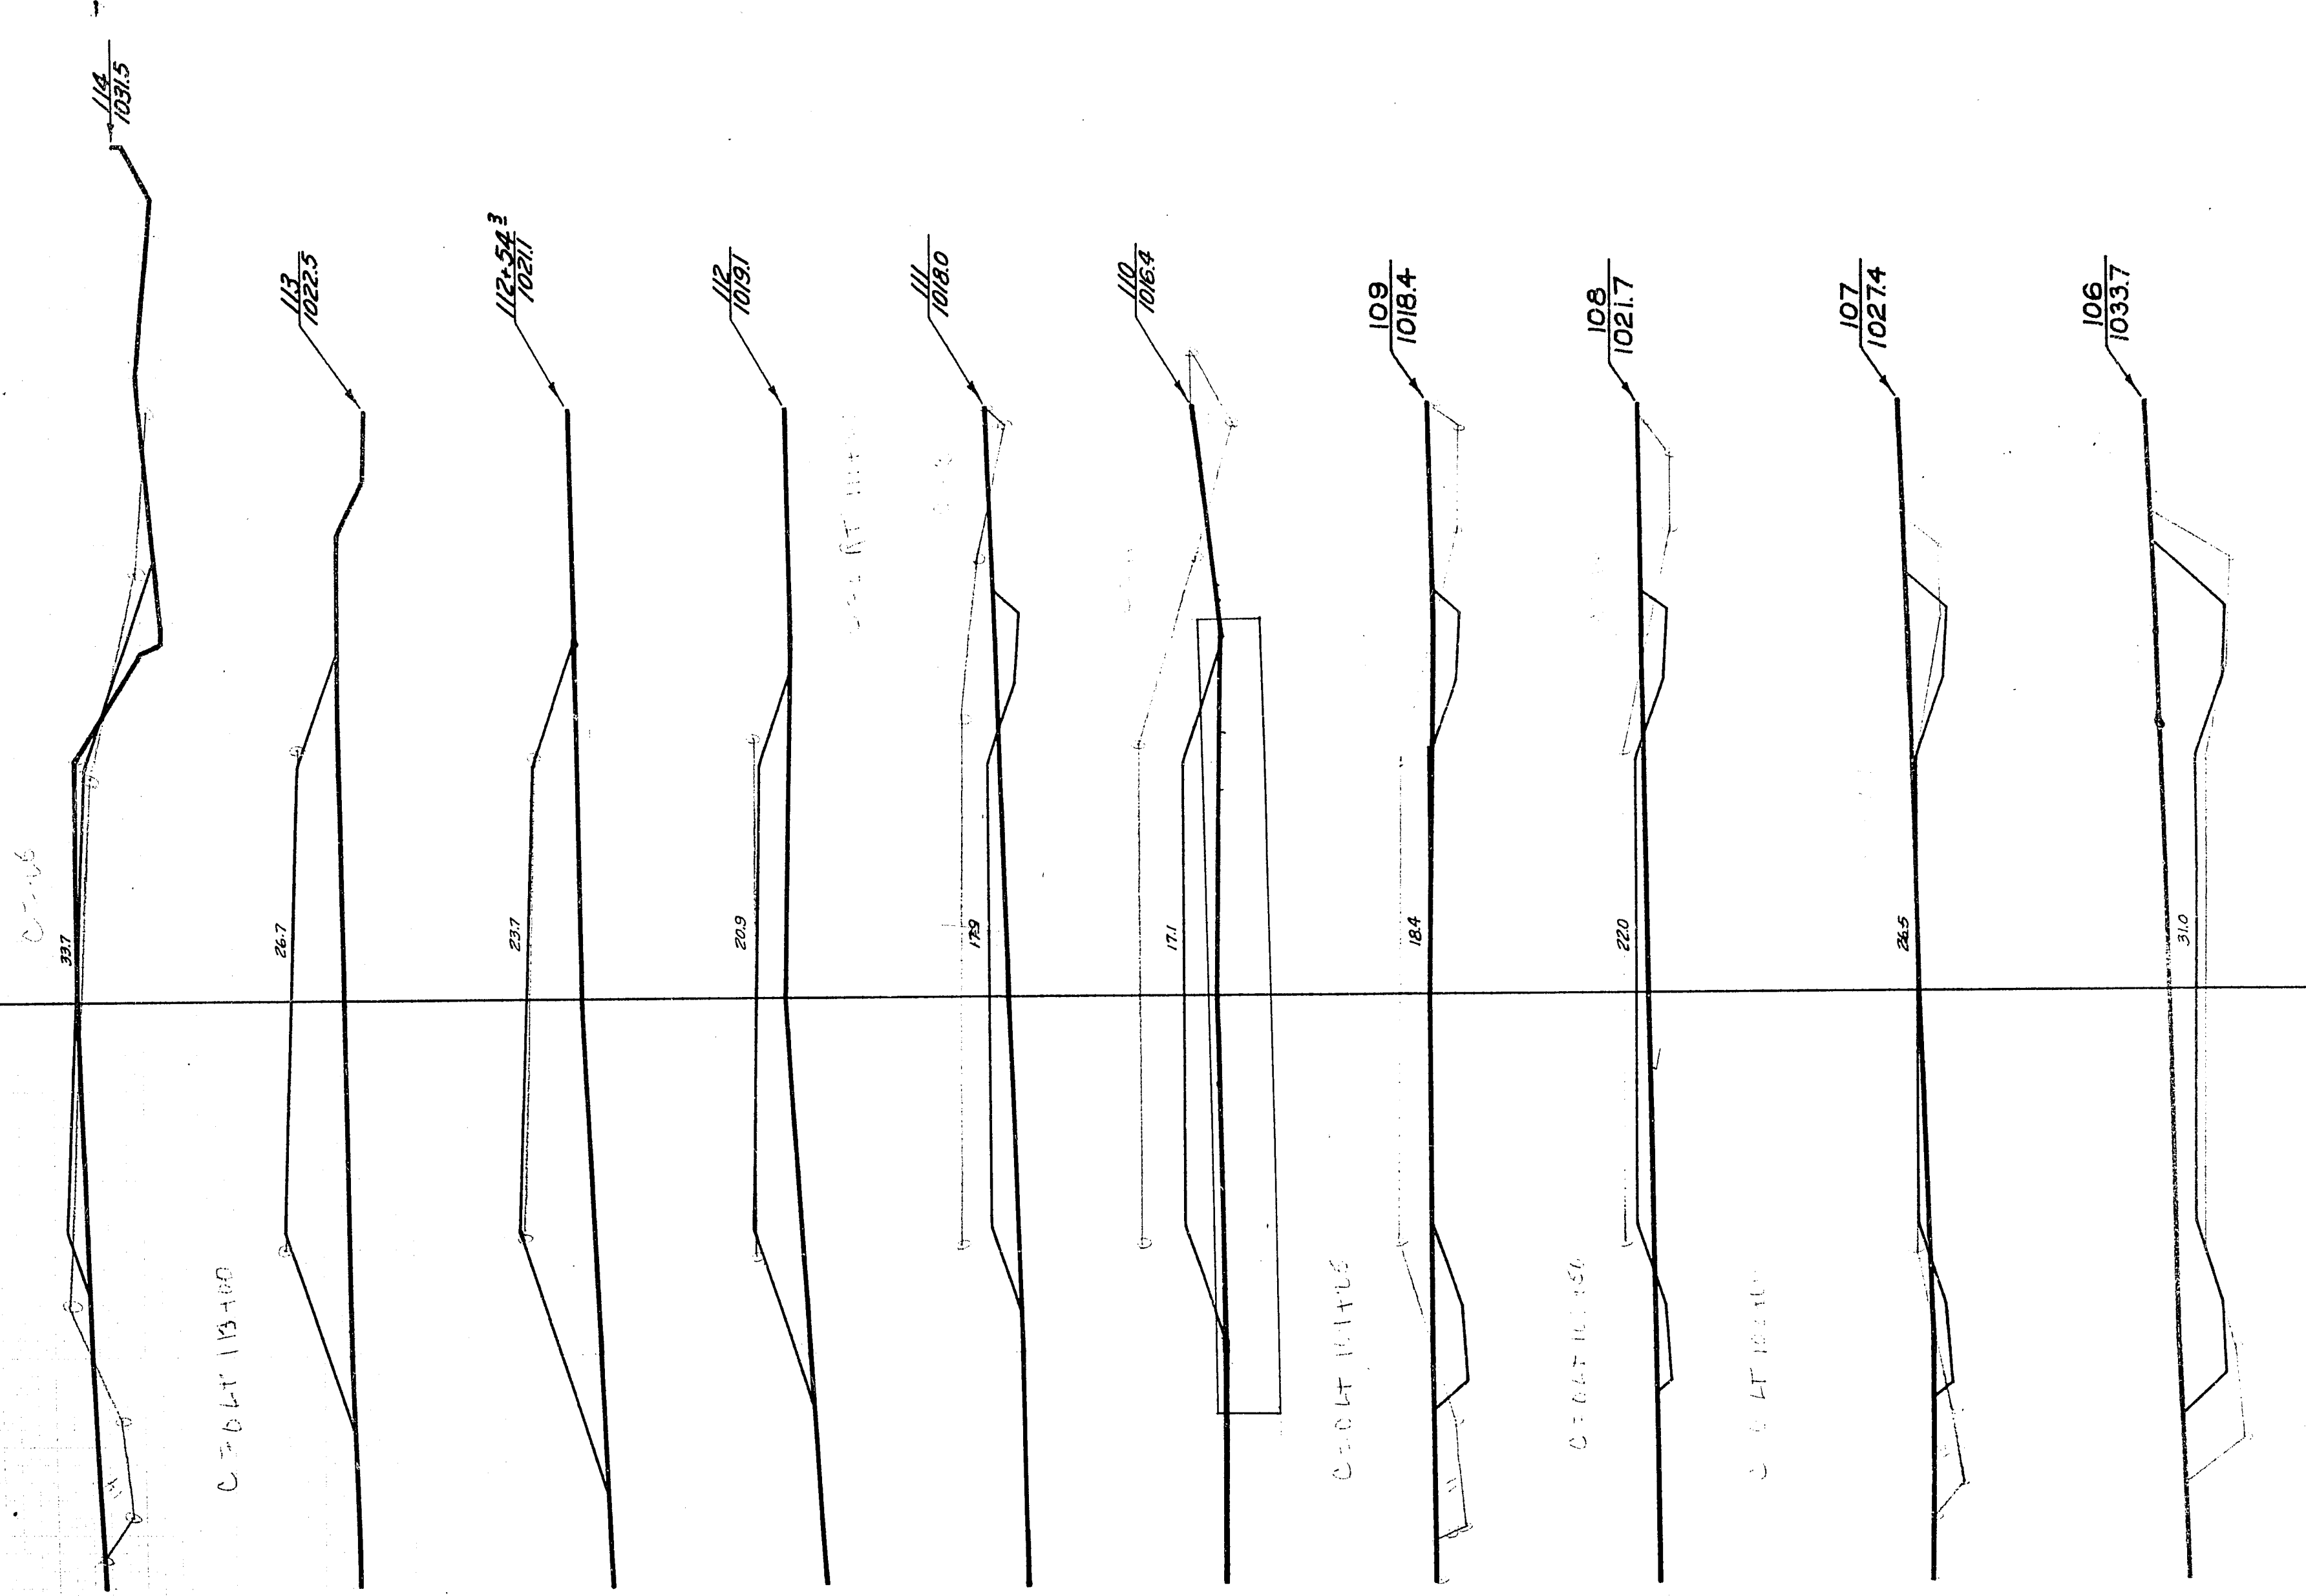
[illegible]

FED. ROAD DIST. NO.	STATE	STATE AID PROJ. NO.	SHEET NO.	TOTAL SHEETS
4	WISC.	9408	49	111

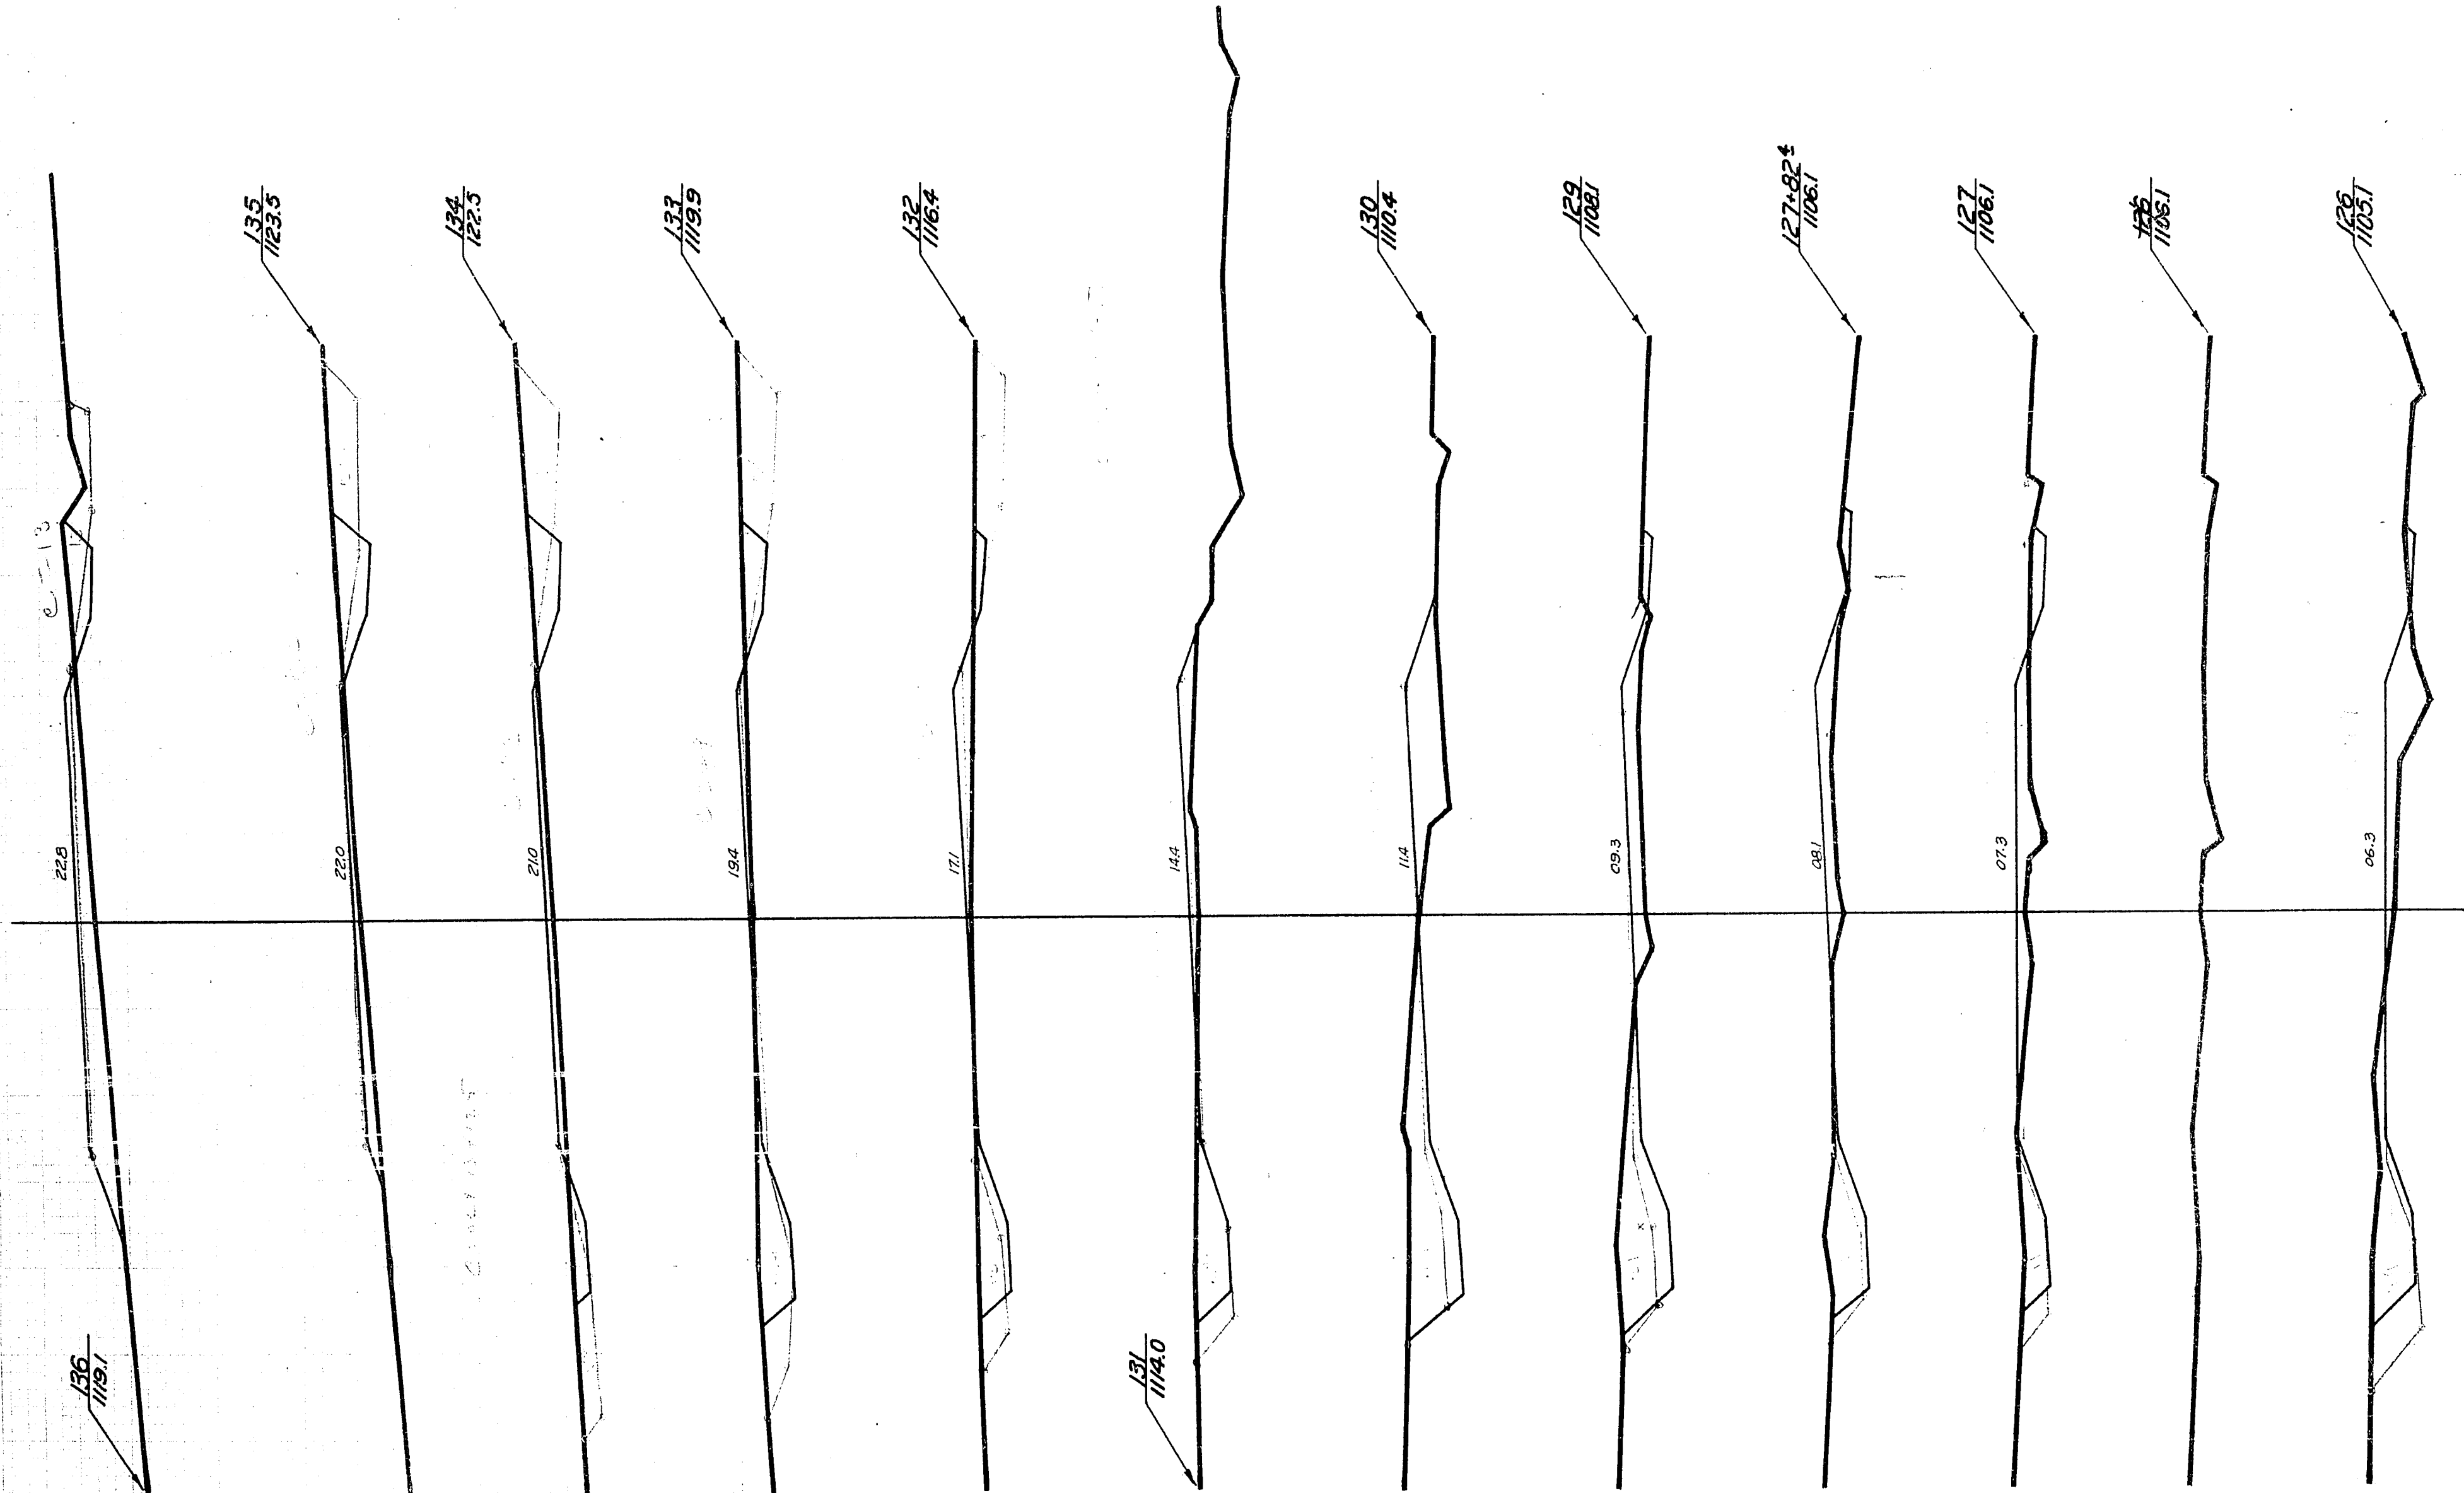
DIVISION JOB NO. 9408

[illegible]

STATION	END AREA			DISTANCE	YARDAGE				
	CUT		FILL		CUT			TOTAL FILL	
	EARTH	ROCK			EARTH	L. ROCK	S. ROCK		TOTAL
105	248		0					633	0
106	94		0					215	11
107	22		6					65	44
108	13		18					67	33
109	23		0					43	122
110	0		66					15	187
111	8		35					15	187
112	0		66					0	193
+ 54 ³	0		125	54 ³				0	196
113	0		107	45 ¹				7	230
114	4		17						
TOTAL								1260	1203



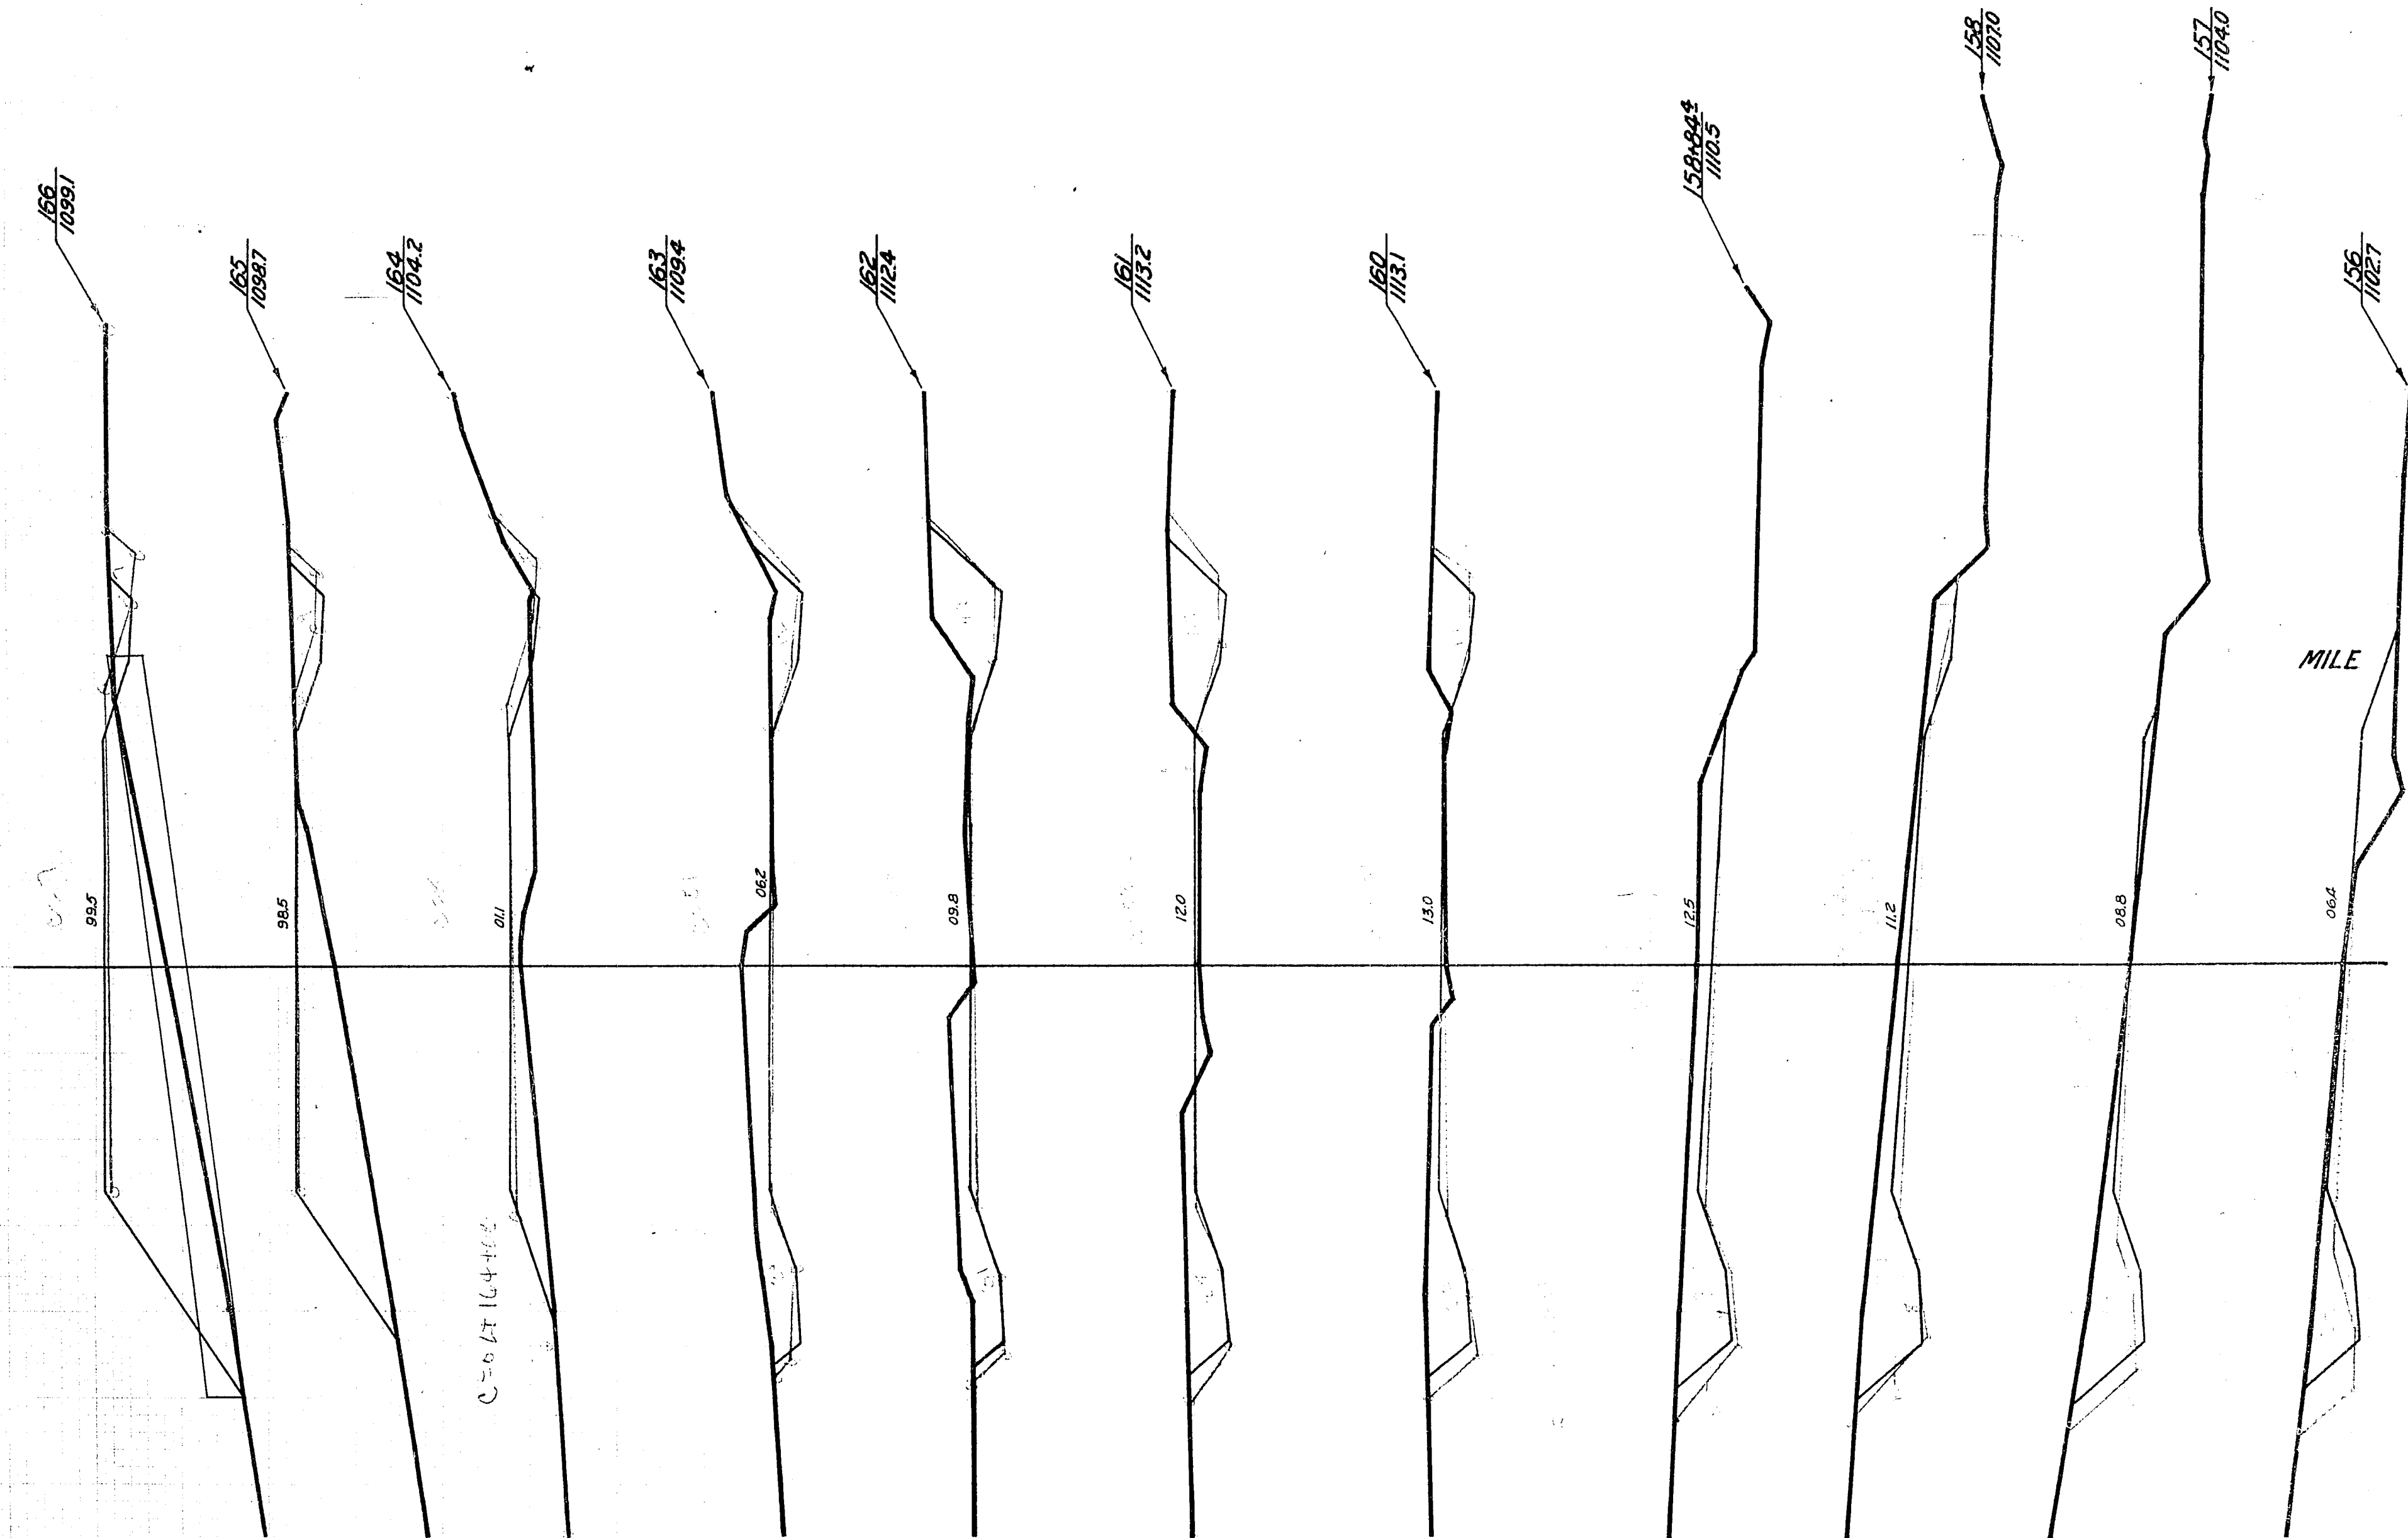
ORIGINAL
SURVEY
SECTION

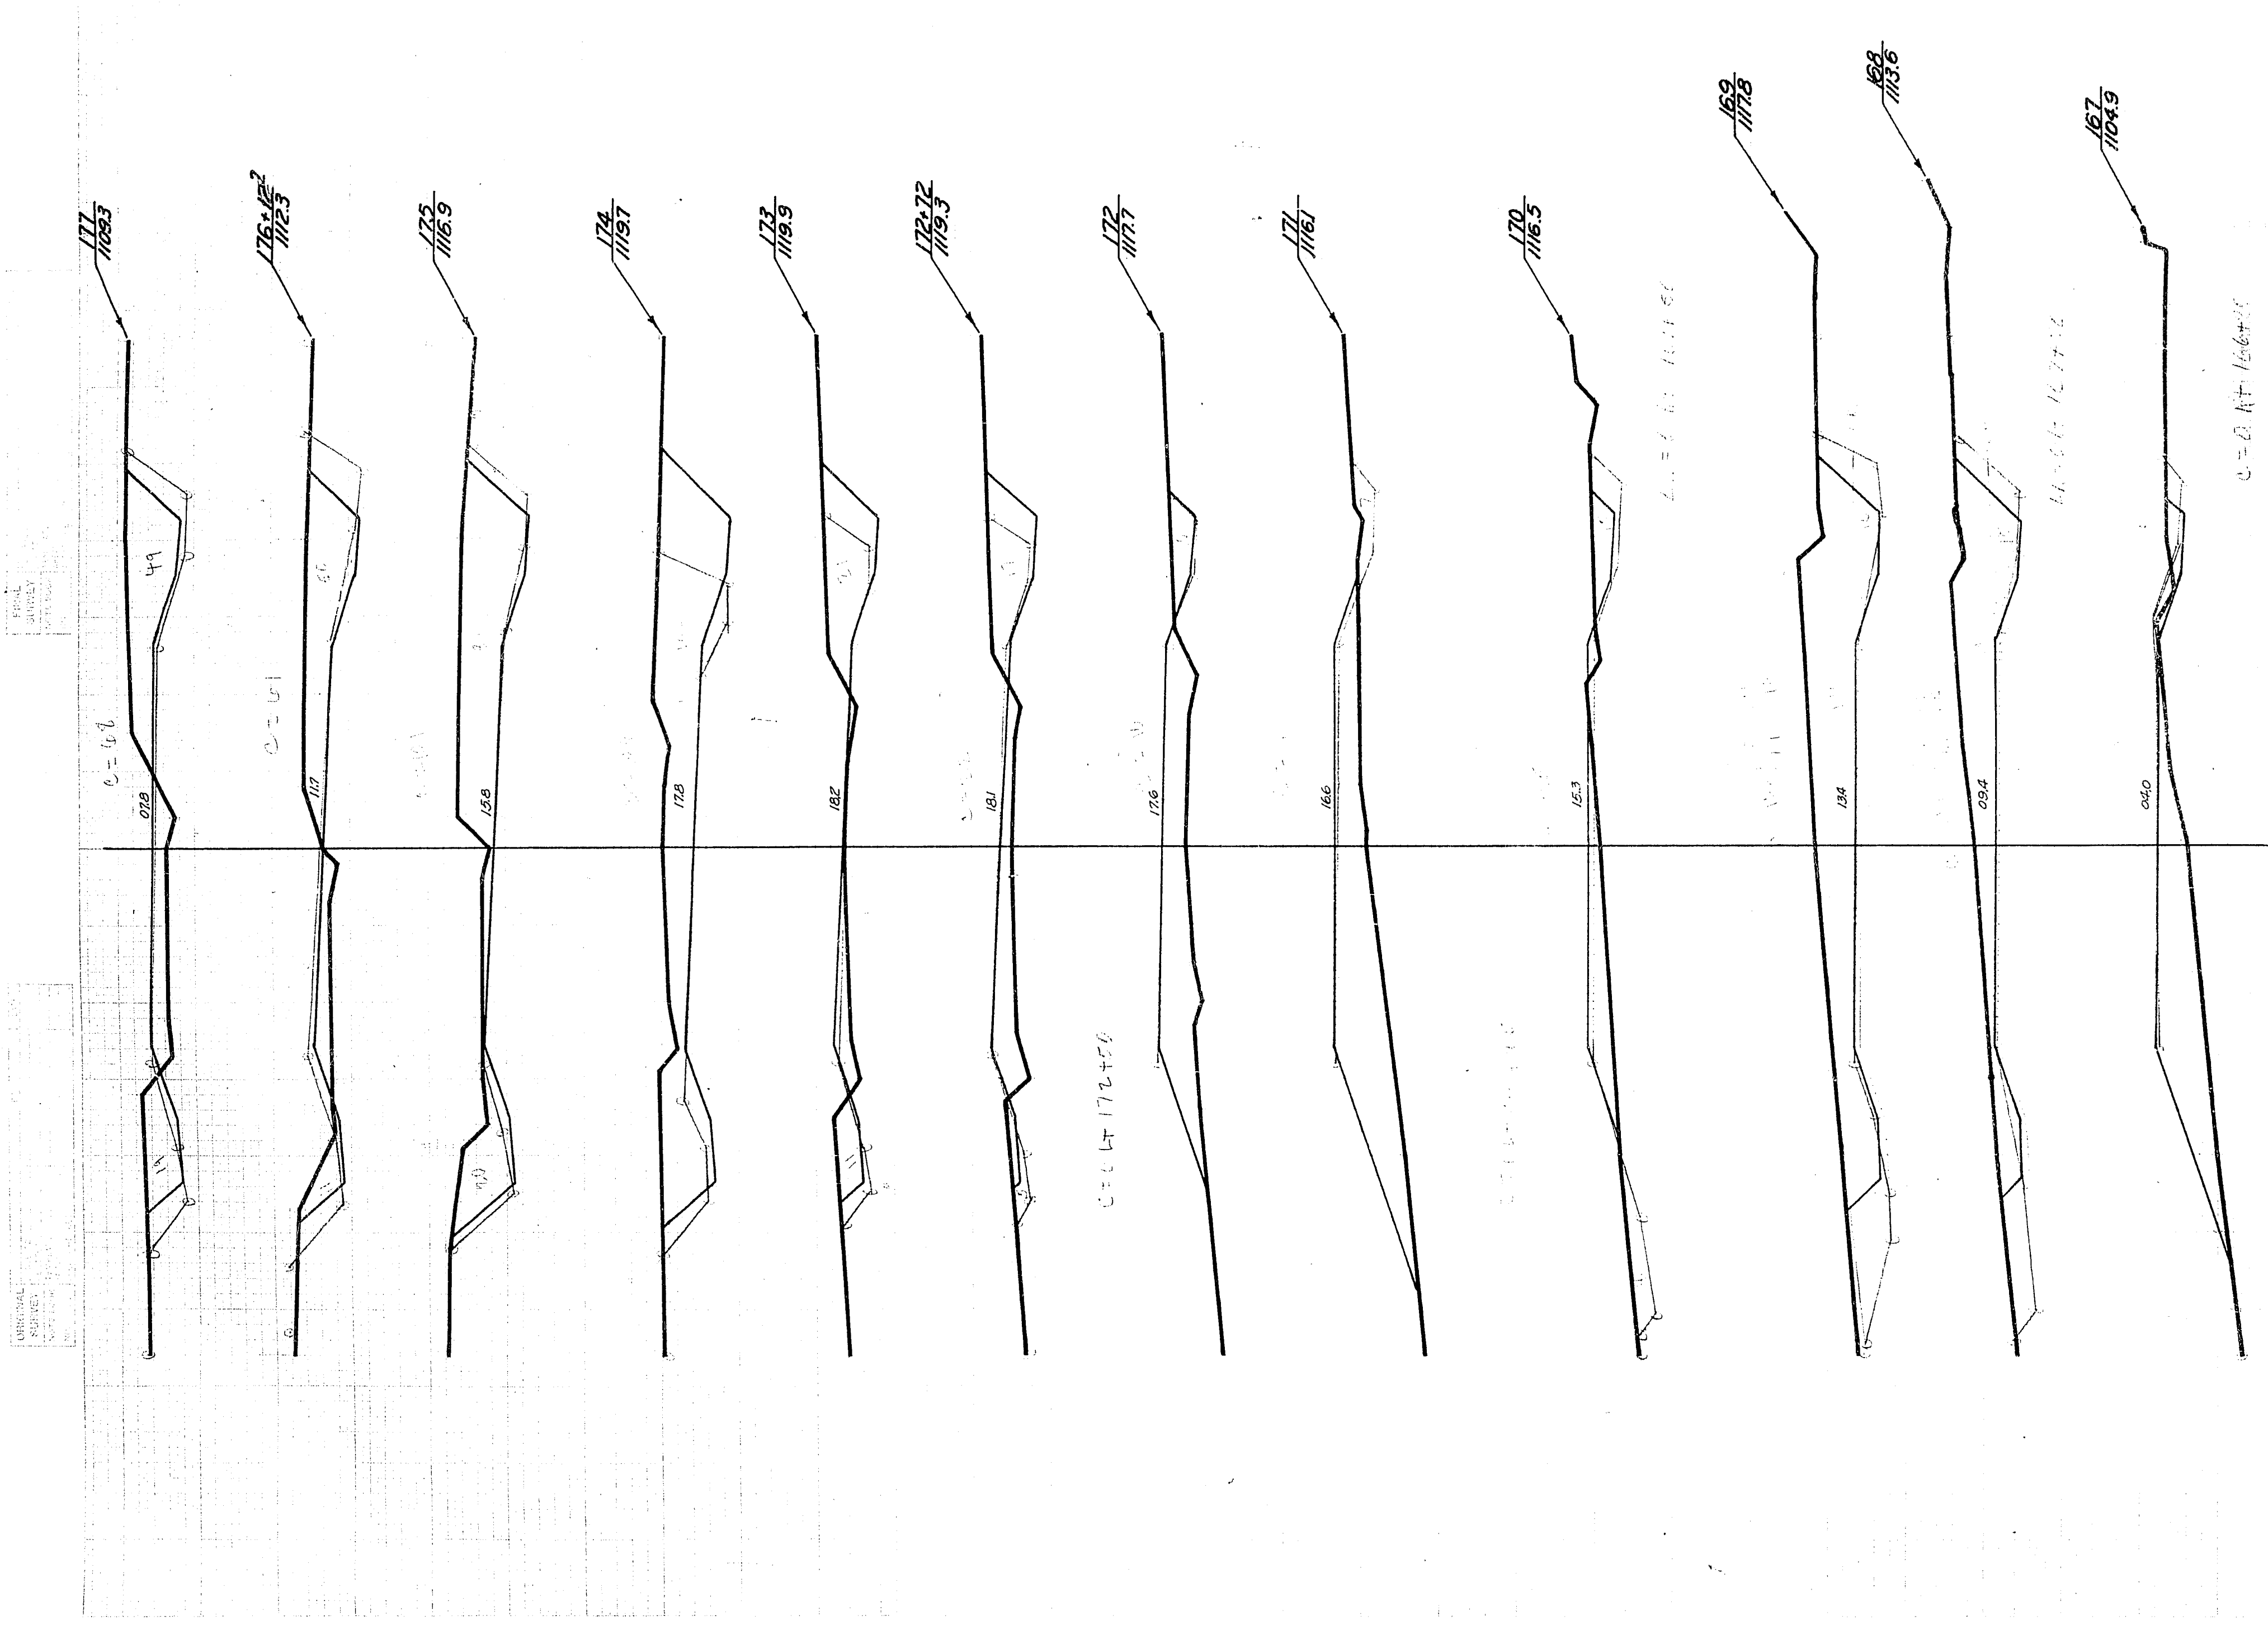
[illegible]

[illegible]

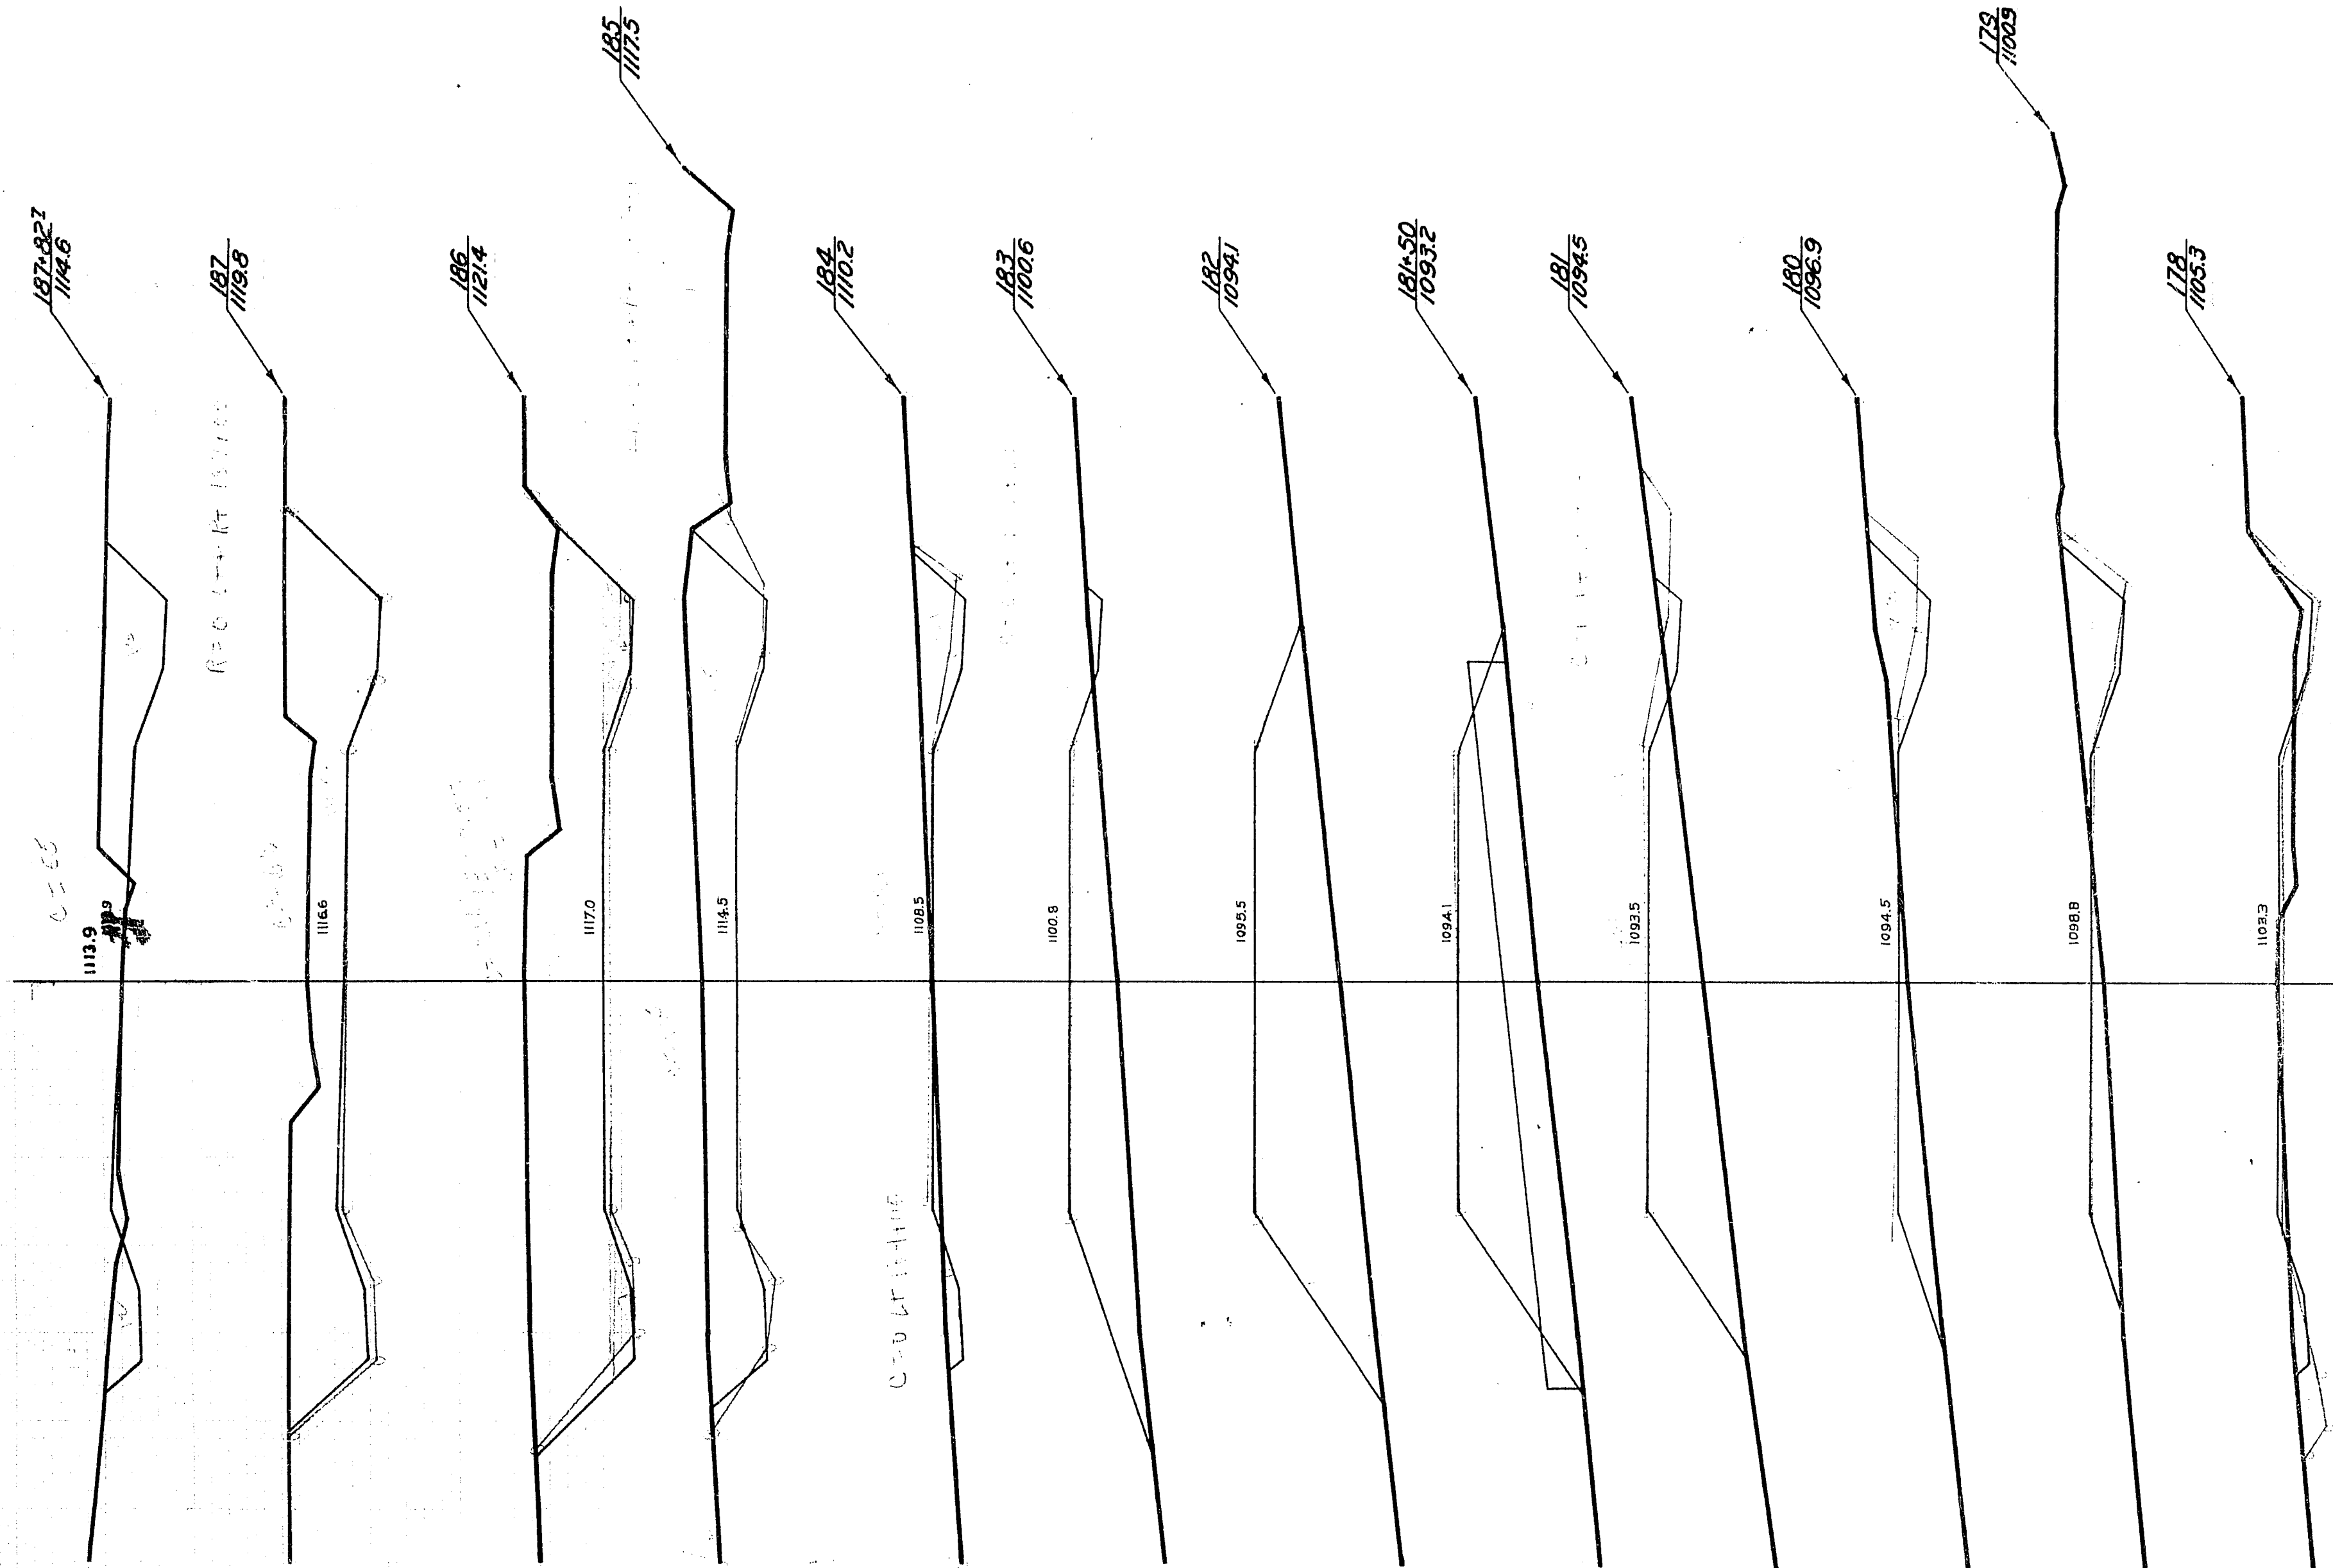
[illegible]

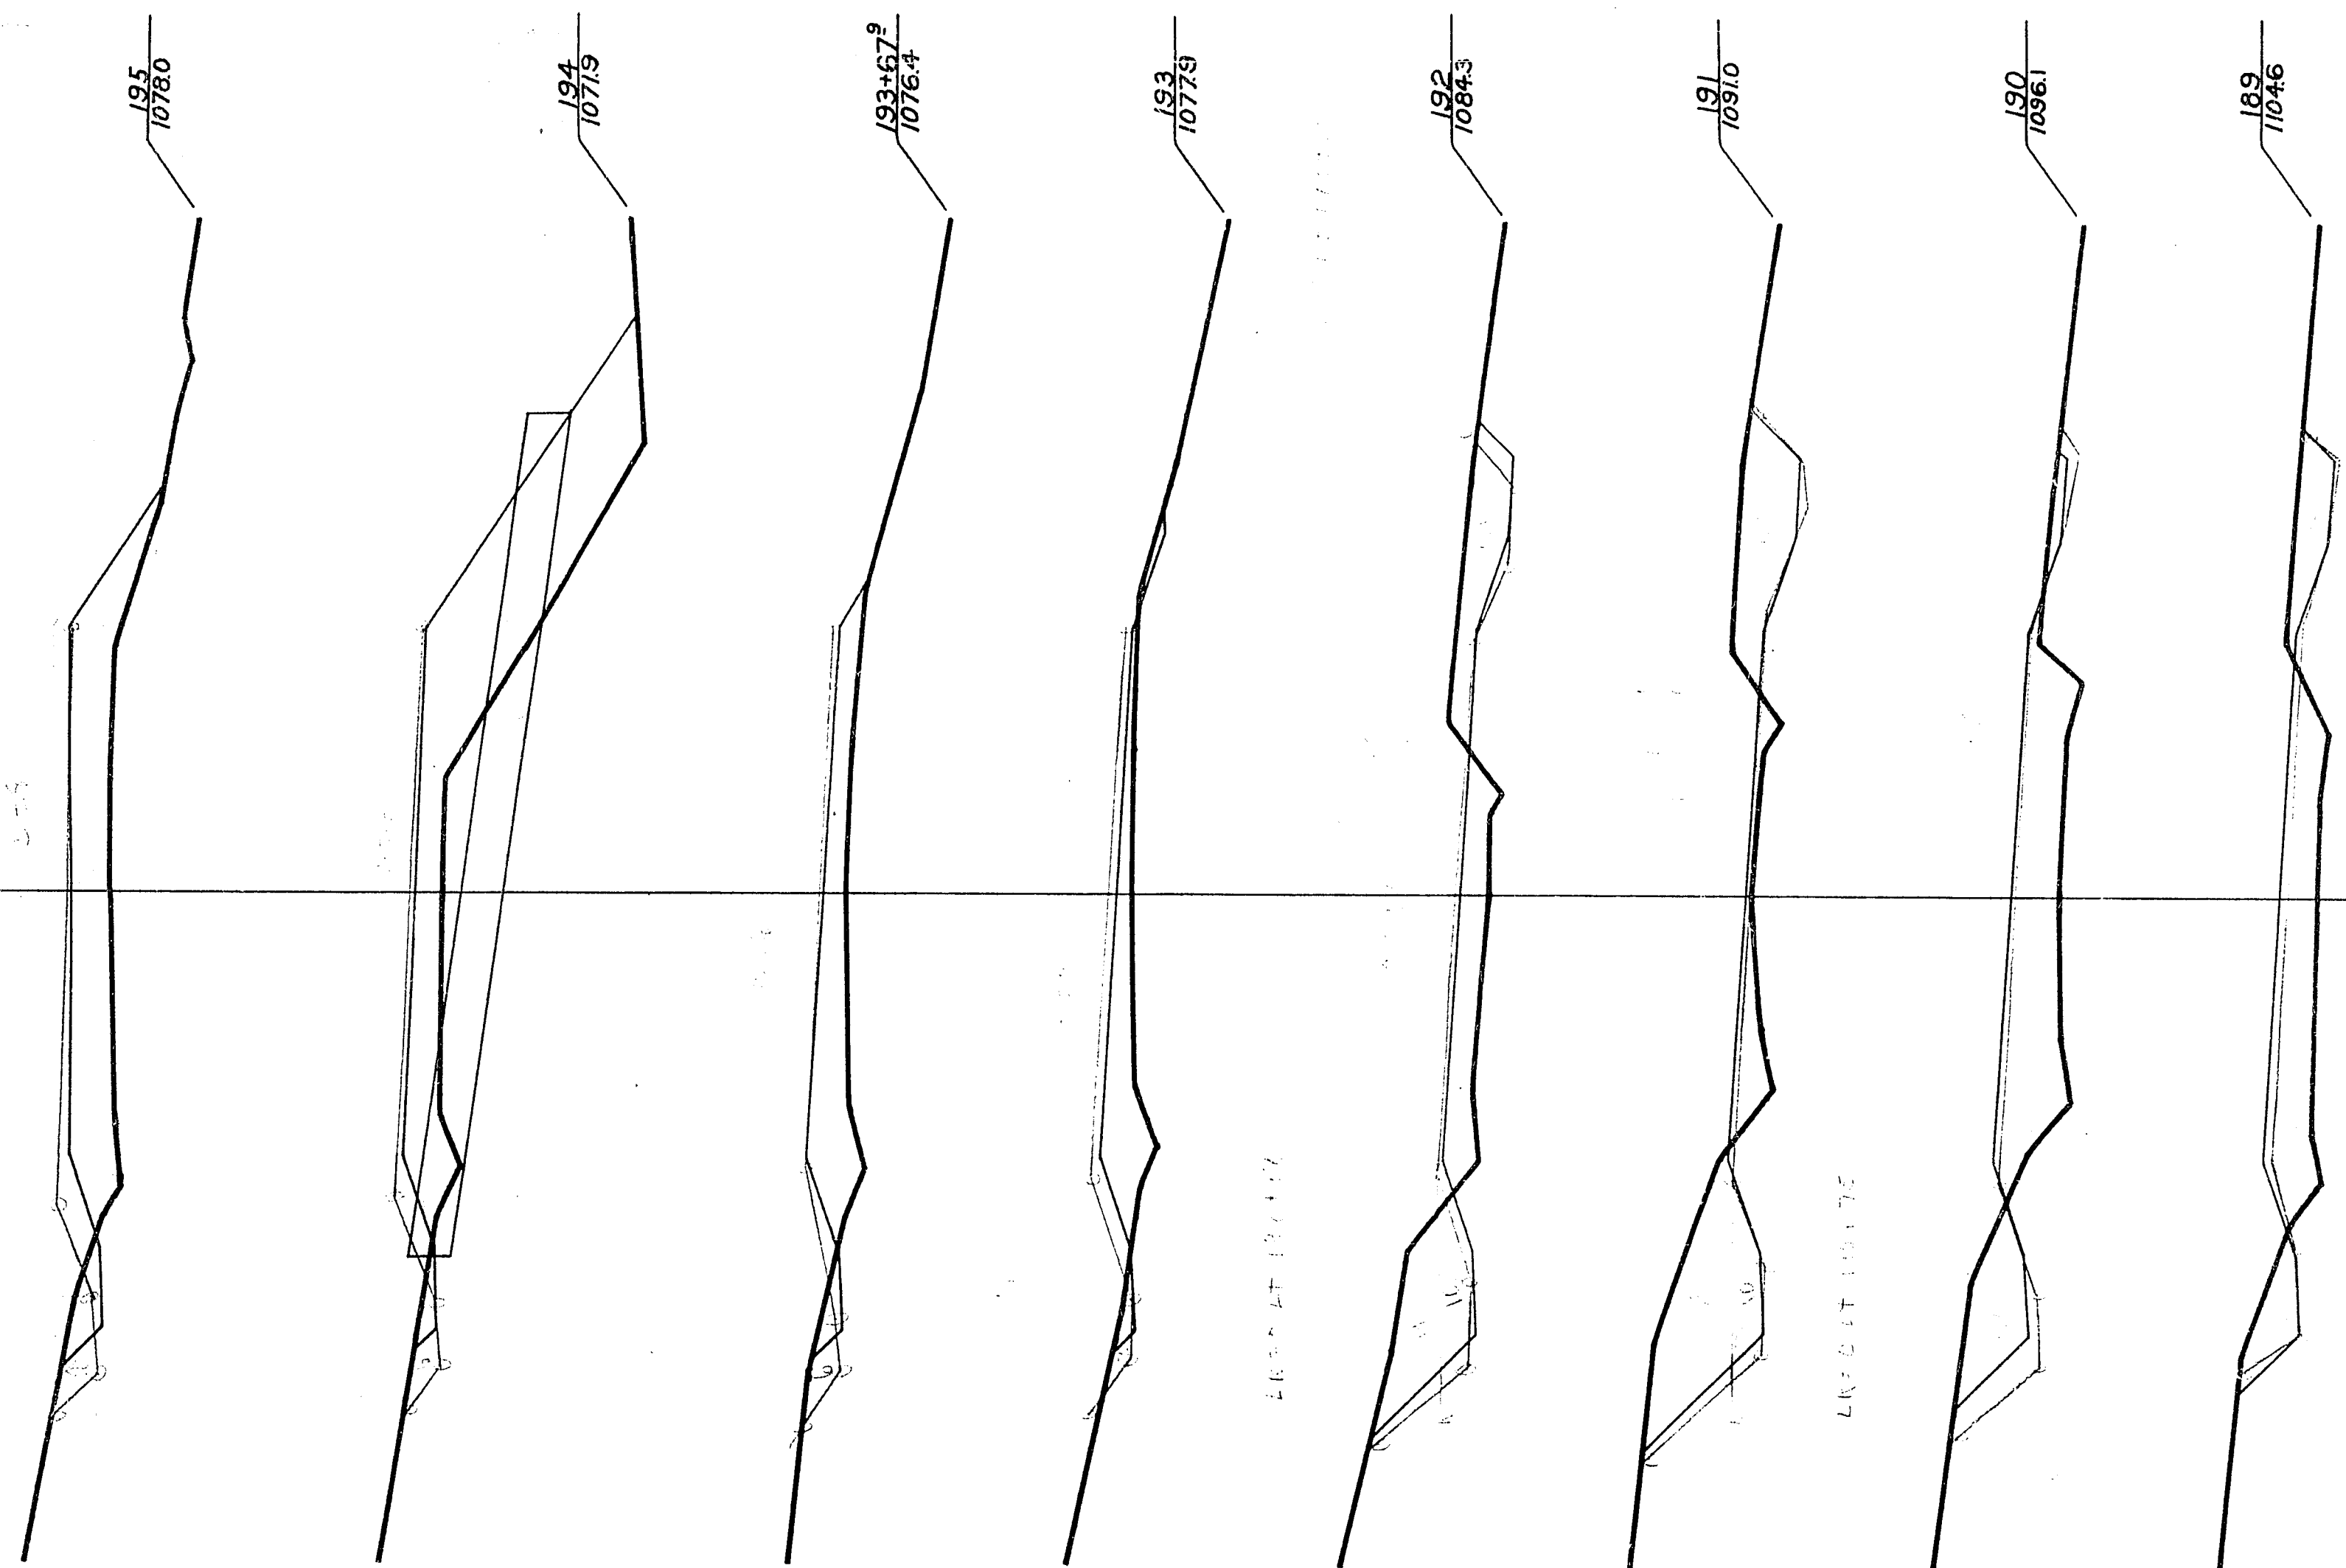
FED. ROAD DIST. NO.	STATE	STATE AID PROJ. NO.	SHEET NO.	TOTAL SHEETS
4	WISC.	9408	55	111
DIVISION		JOB NO. 9408		

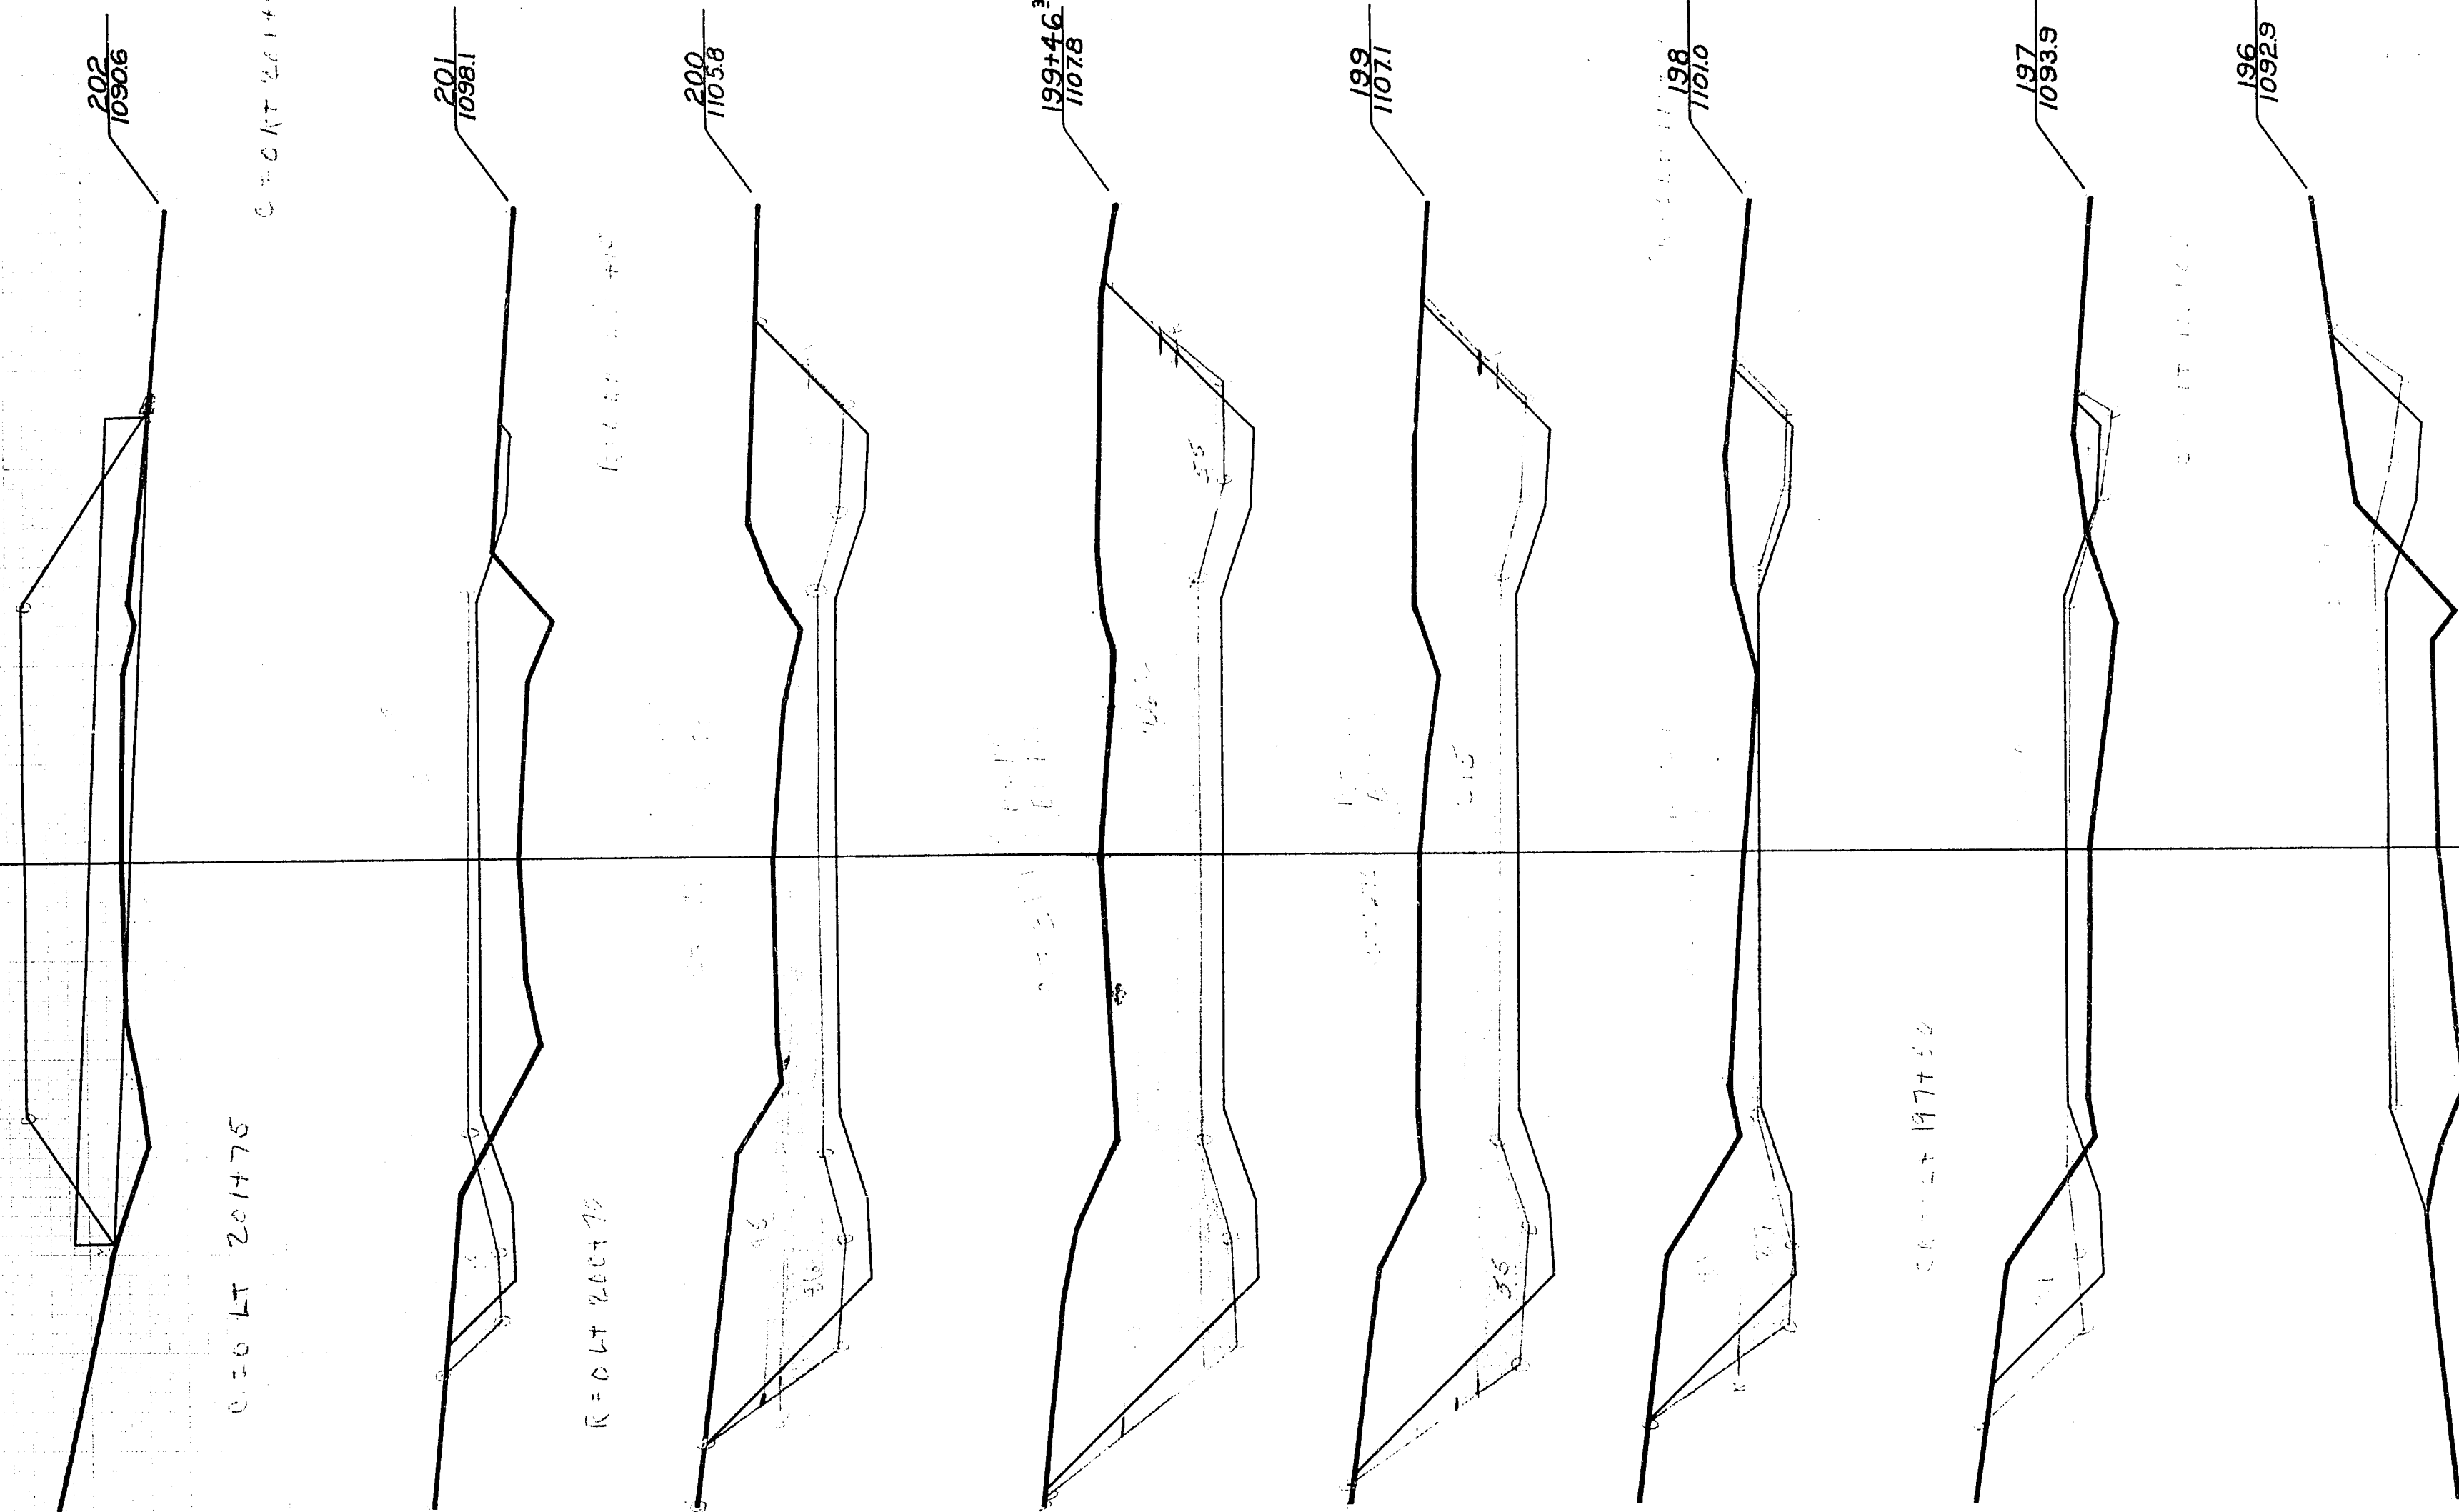
[illegible]



FED. ROAD DIST. NO.	STATE	STATE AID PROJ. NO.	SHEET NO.	TOTAL SHEETS
4	WISC.	9408	57	111
DIVISION JOB NO.			9408	

[illegible]

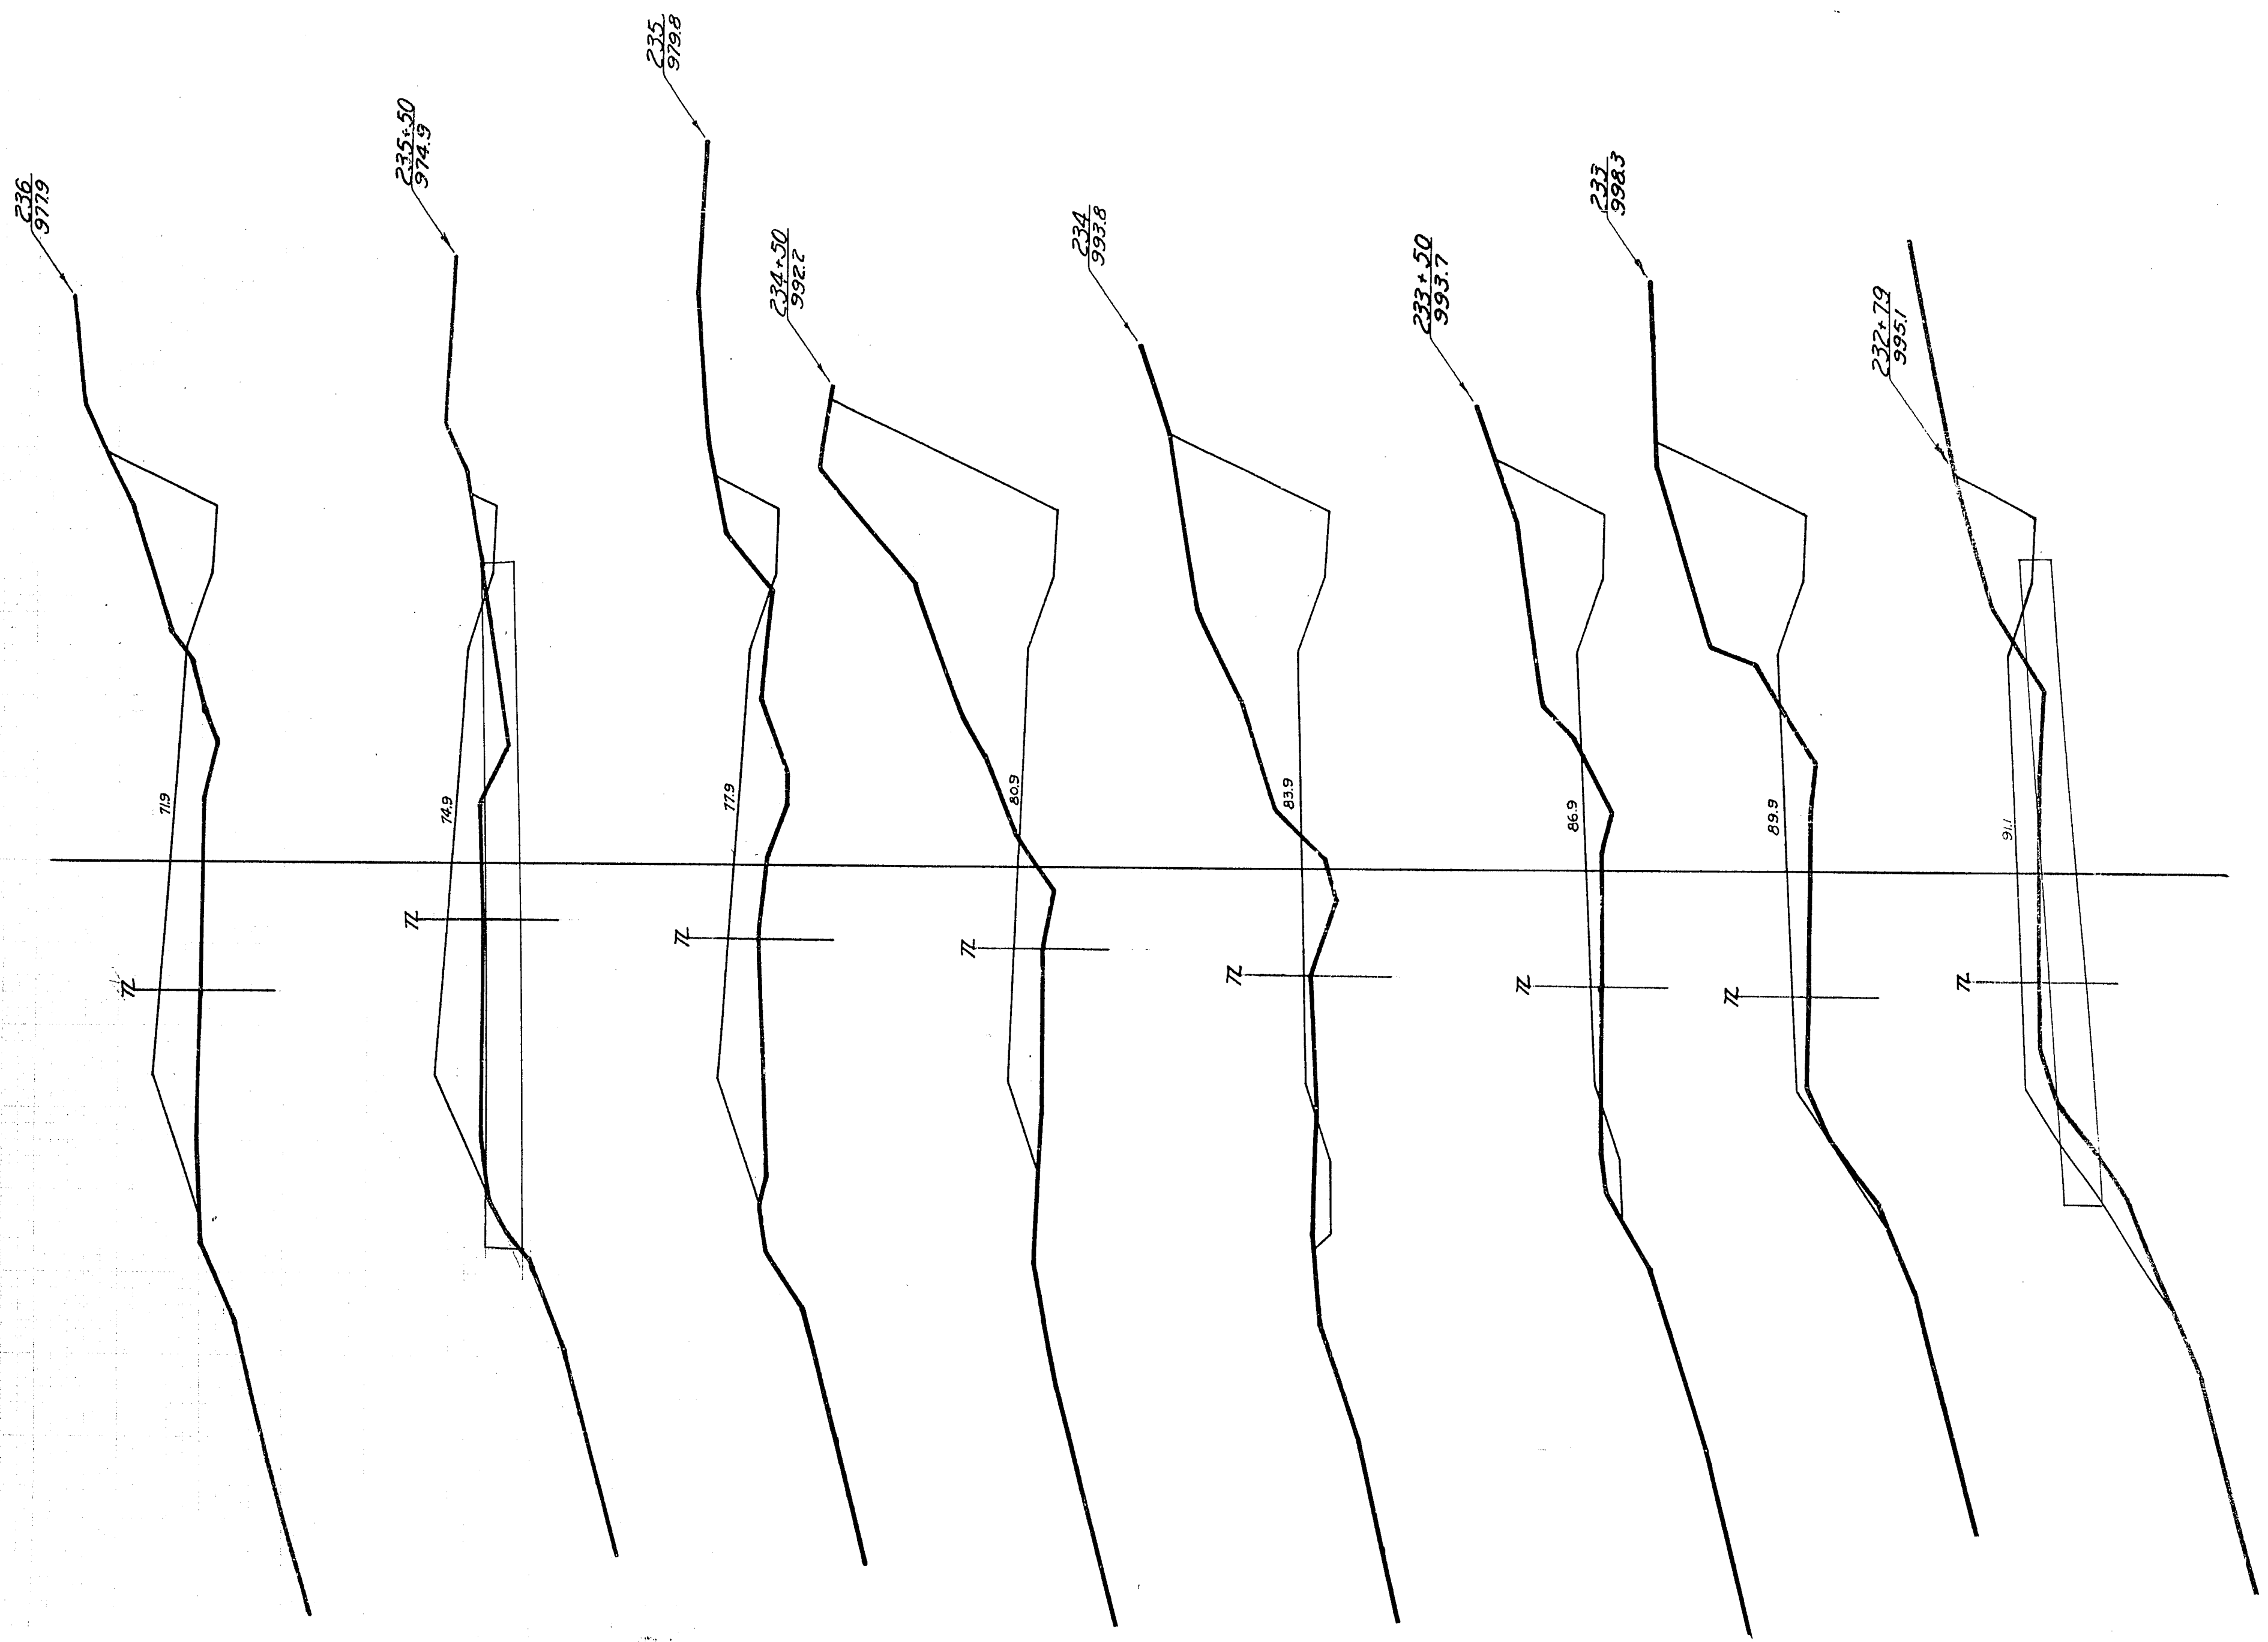
[illegible]

[illegible]

FED. ROAD DIST. NO.	STATE	STATE AID PROJ. NO.	SHEET NO.	TOTAL SHEETS
4	WISC.	9408	62	111
DIVISION		JOB NO. 9408		

[illegible]

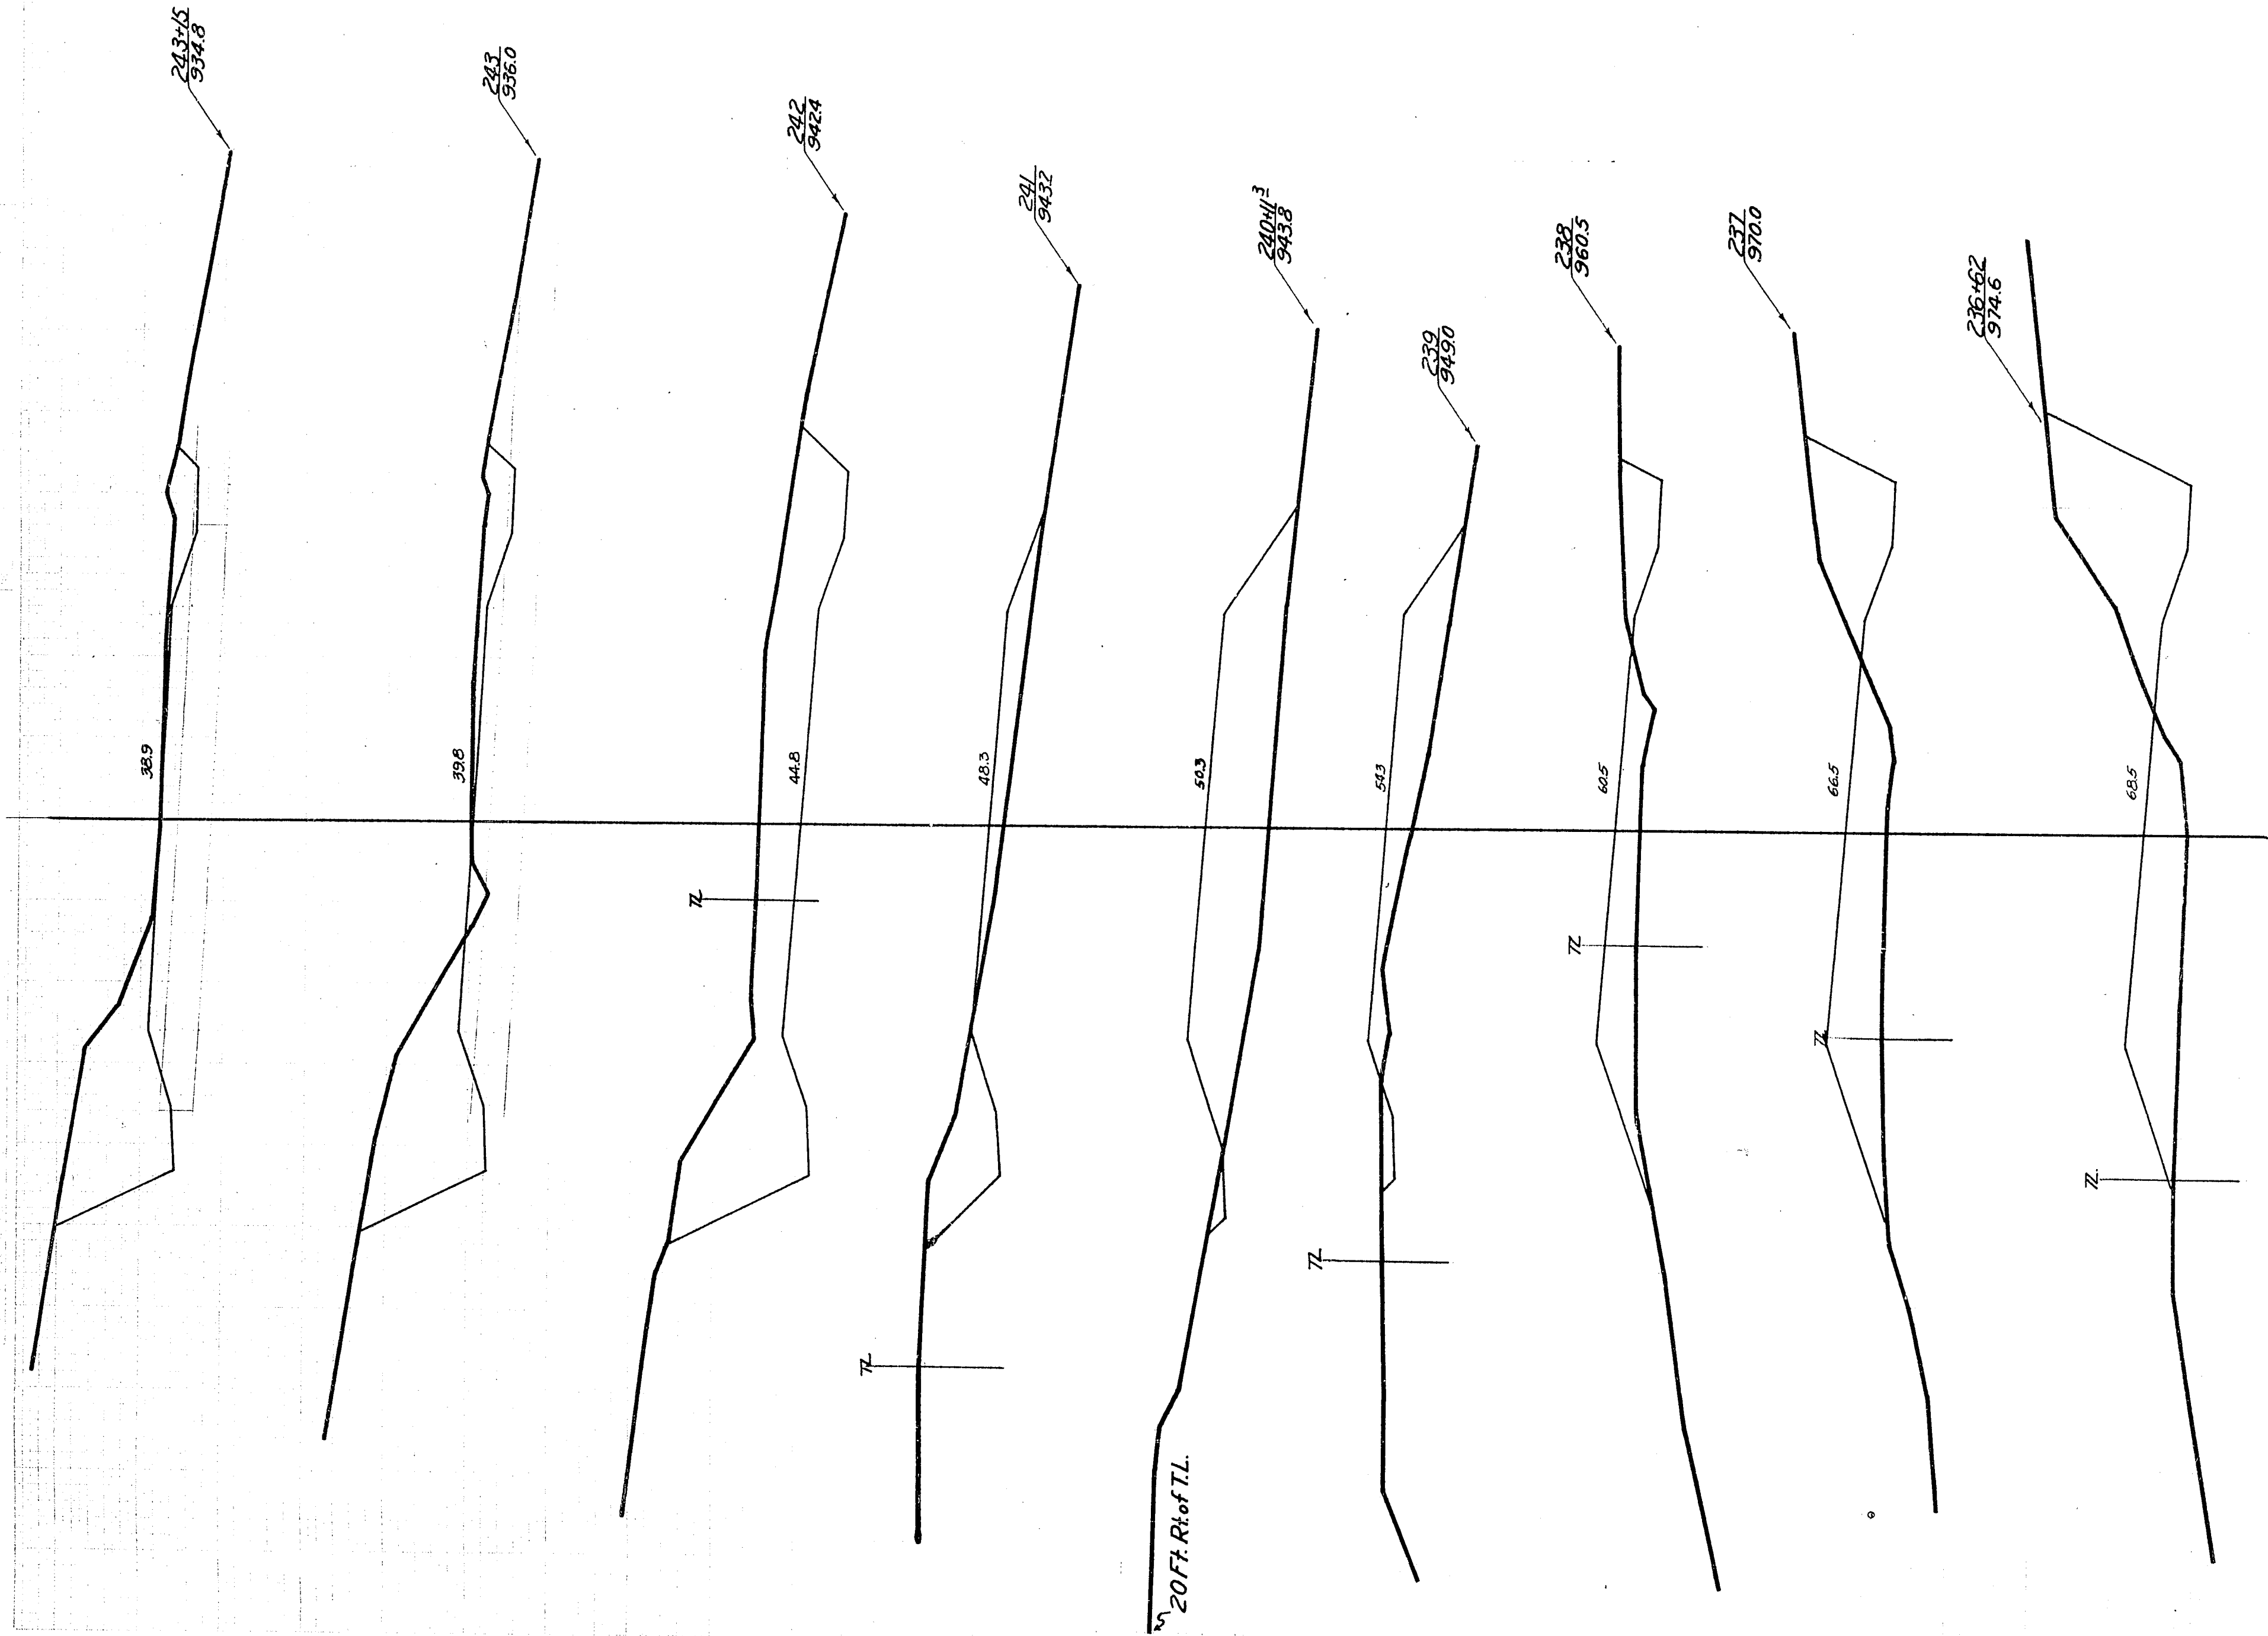
FED. ROAD DIST. NO.	STATE	STATE AID PROJ. NO.	SHEET NO.	TOTAL SHEETS
4	WISC.	9408	164	111
DIVISION JOB NO. 9408				

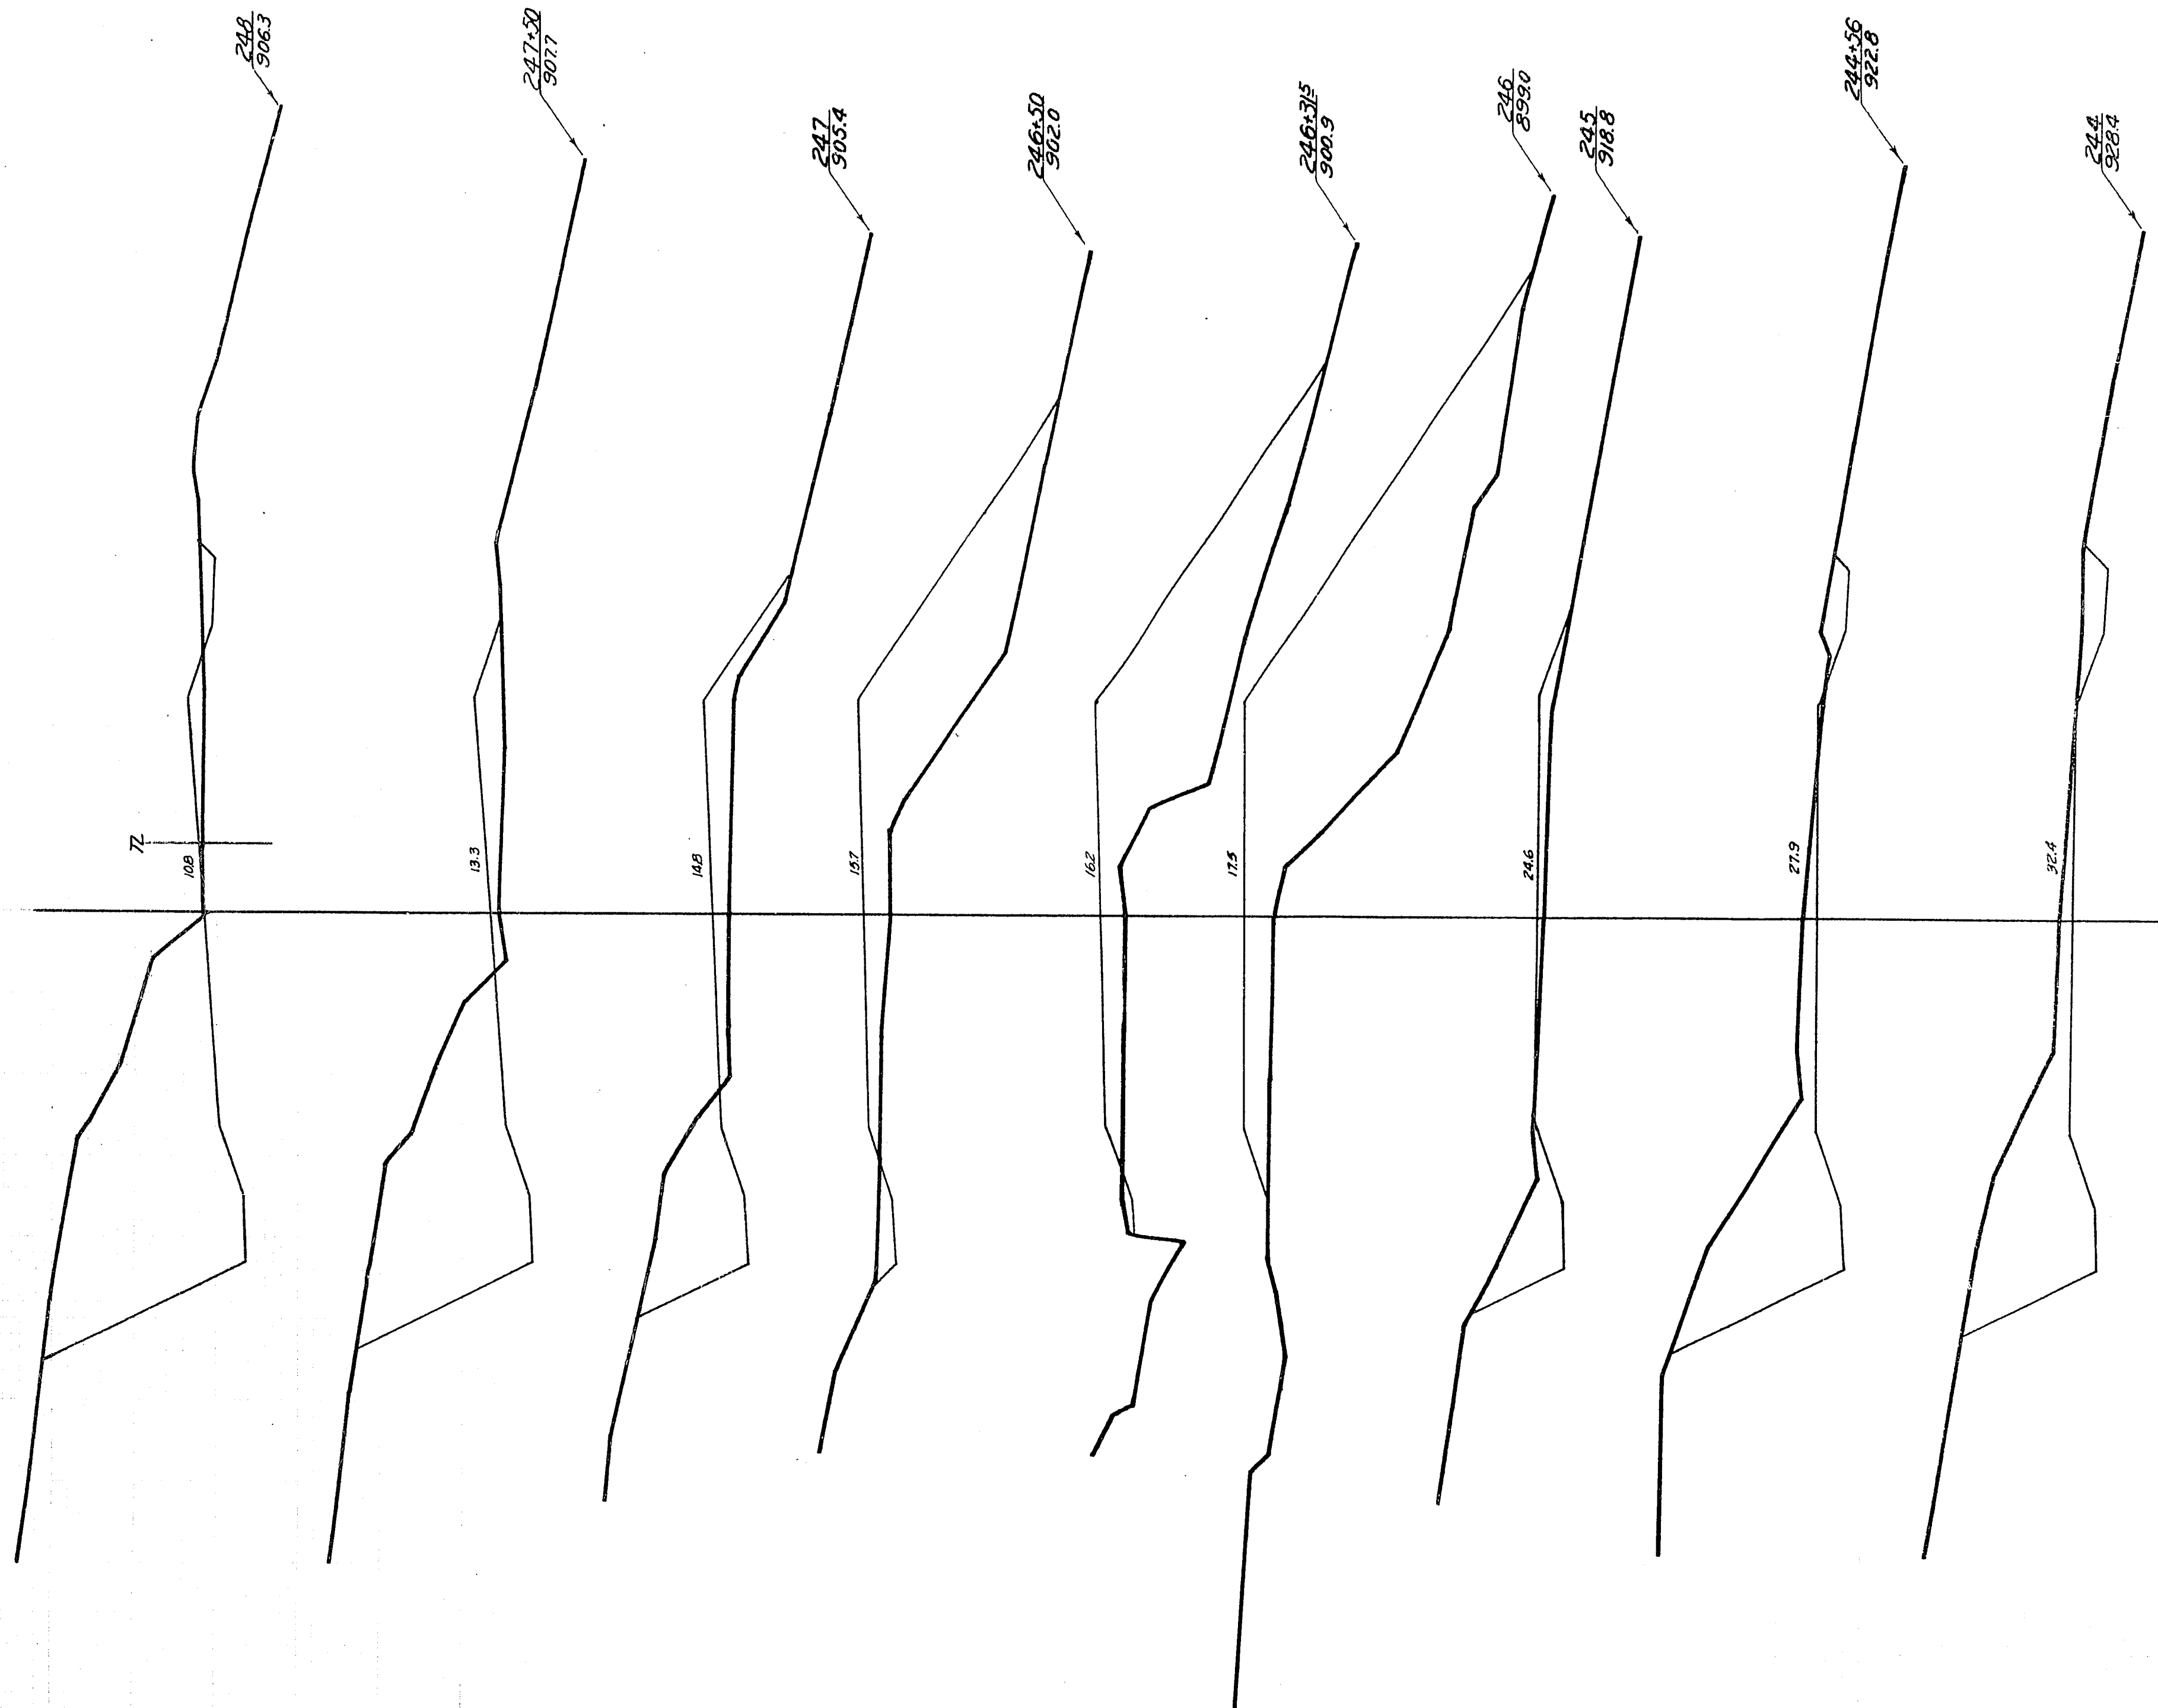


STATION	END AREA			YARDAGE				
	CUT			DISTANCE	CUT			
	EARTH	ROCK	FILL		EARTH	L. ROCK	S. ROCK	TOTAL
232+50	0		132					
+79	25		59	30				15 106
233	75		30	20				37 33
+50	59		16	50 ¹				124 43
234	121		15	50				167 30
+50	152		31	50				252 43
235	14		68	50				154 93
+50	5		70	51 ¹				19 130
236	35		62	50				37 122
TOTAL								805 600

FED. ROAD DIST. NO.	STATE	STATE AID PROJ. NO.	SHEET NO.	TOTAL SHEETS
4	WISC.	9408	65	111

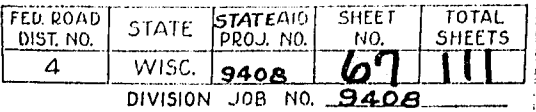
DIVISION JOB NO. 9408

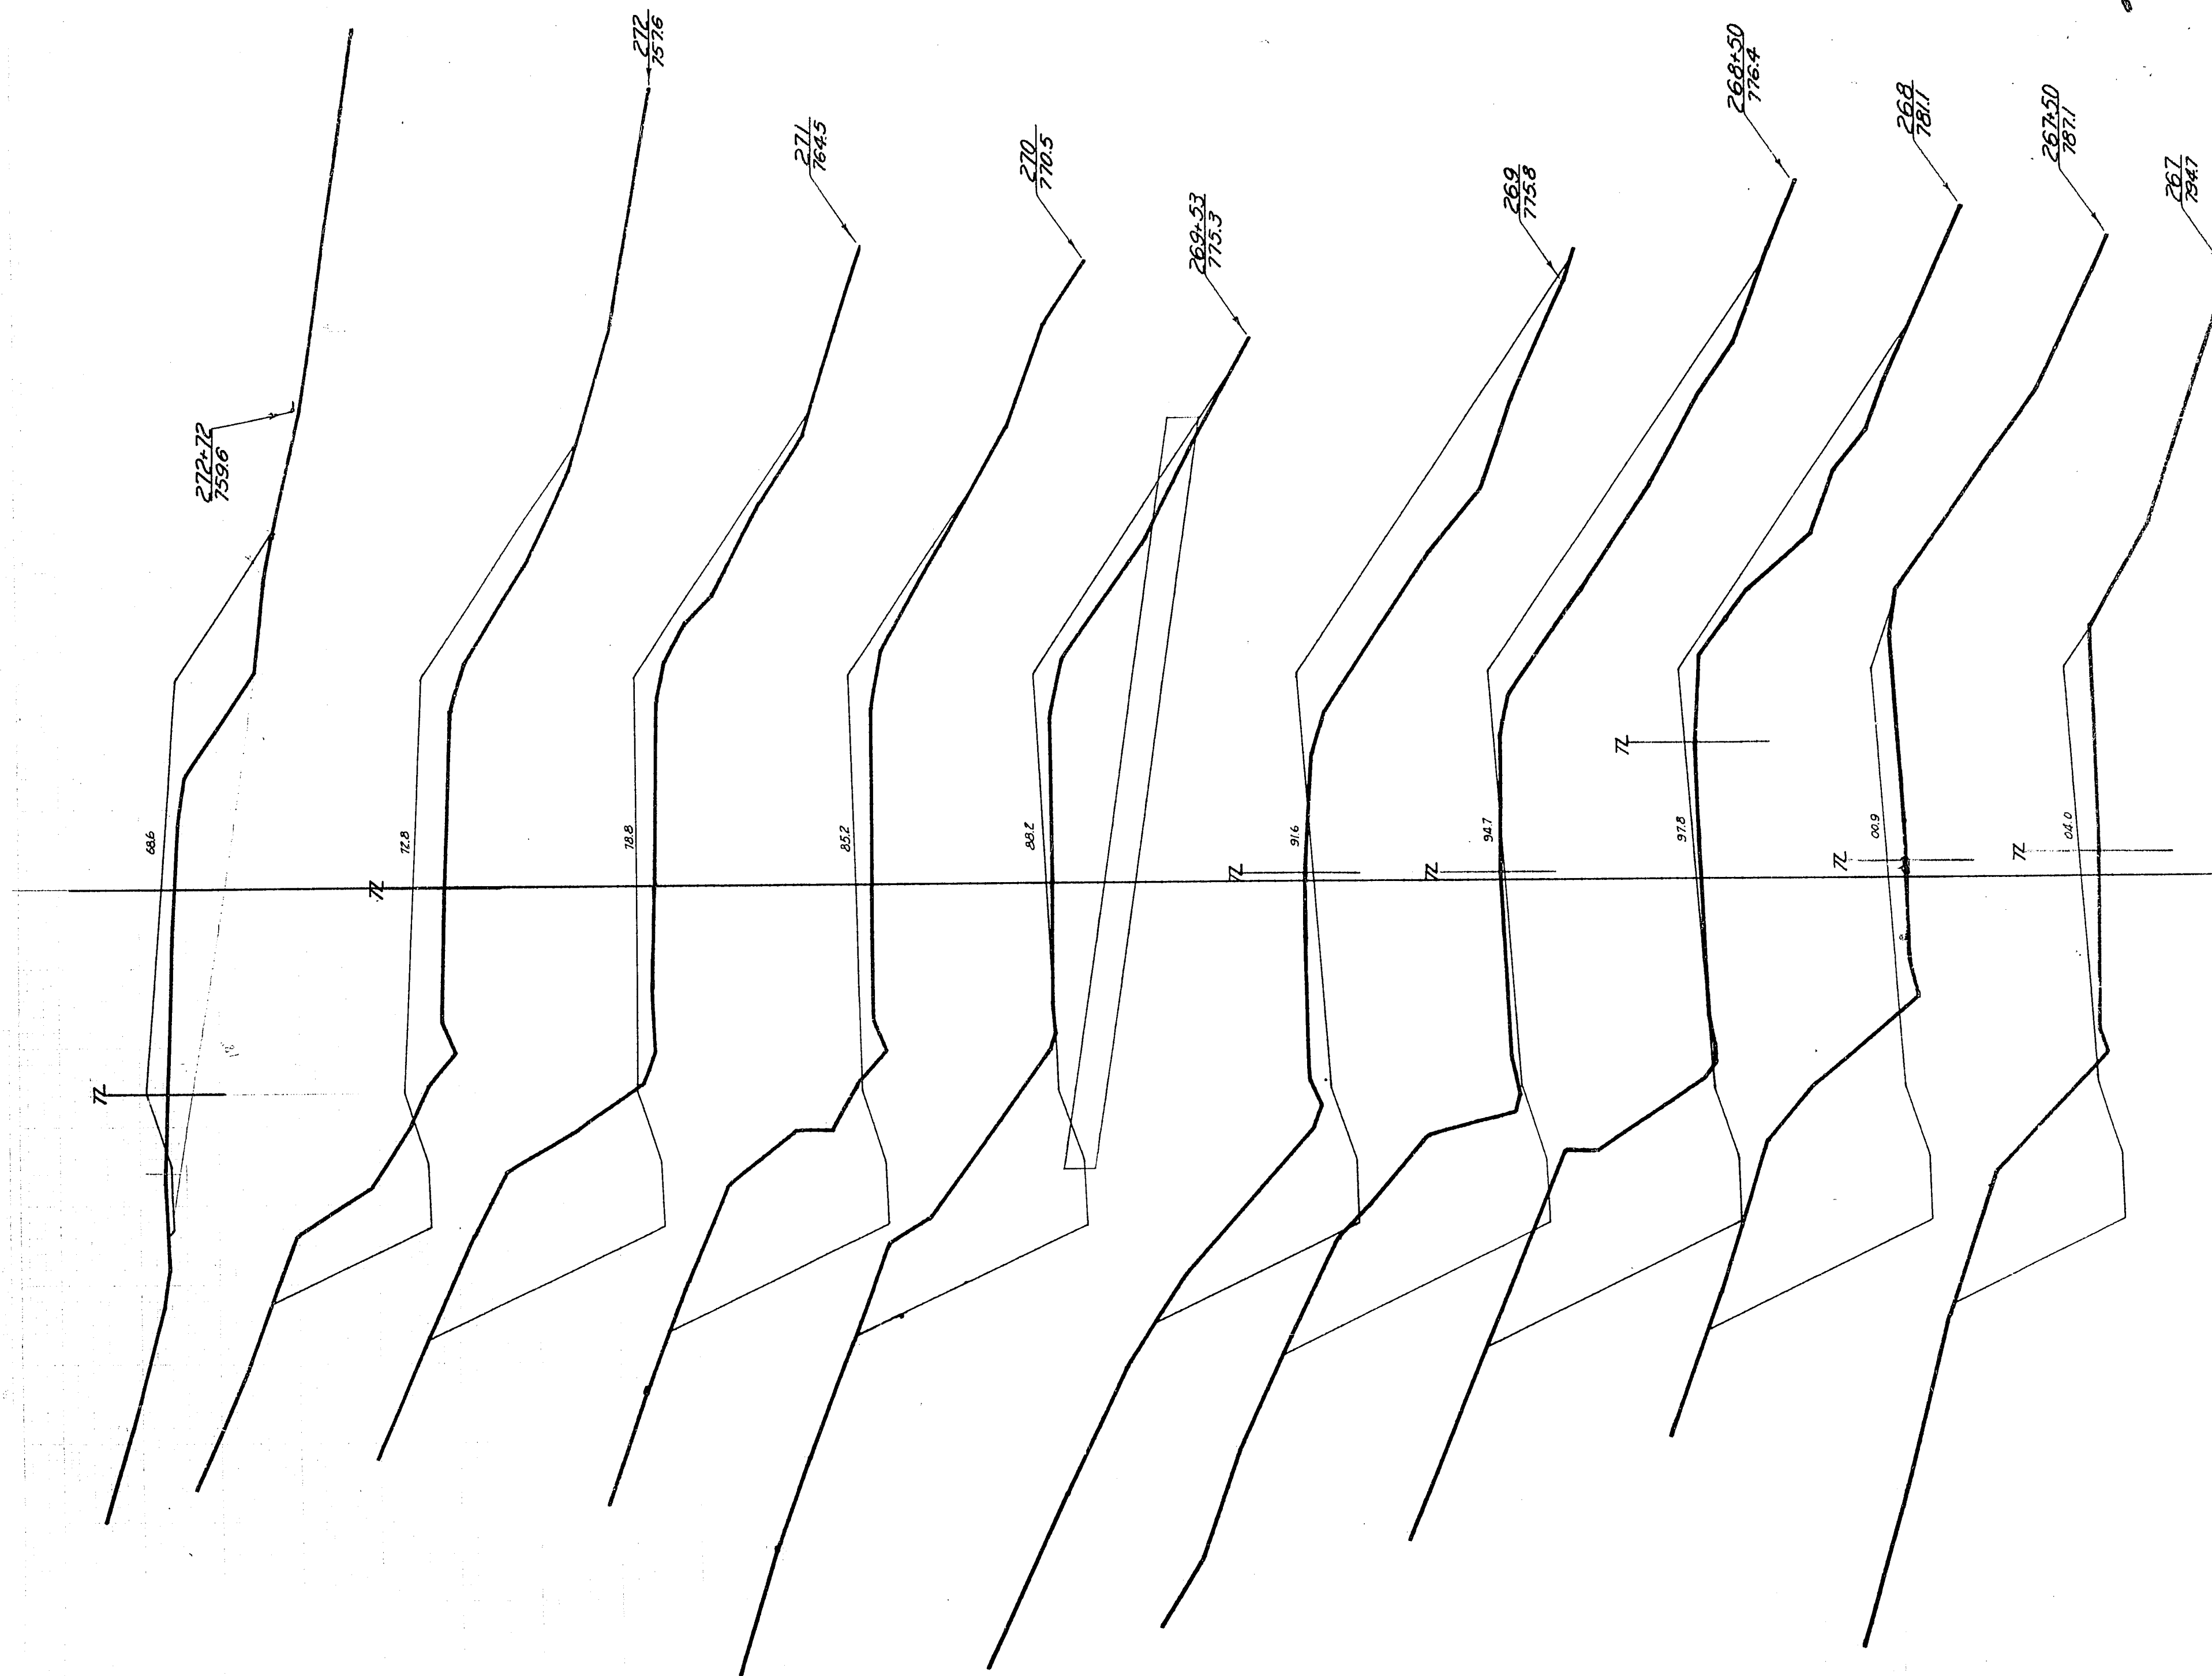
[illegible]

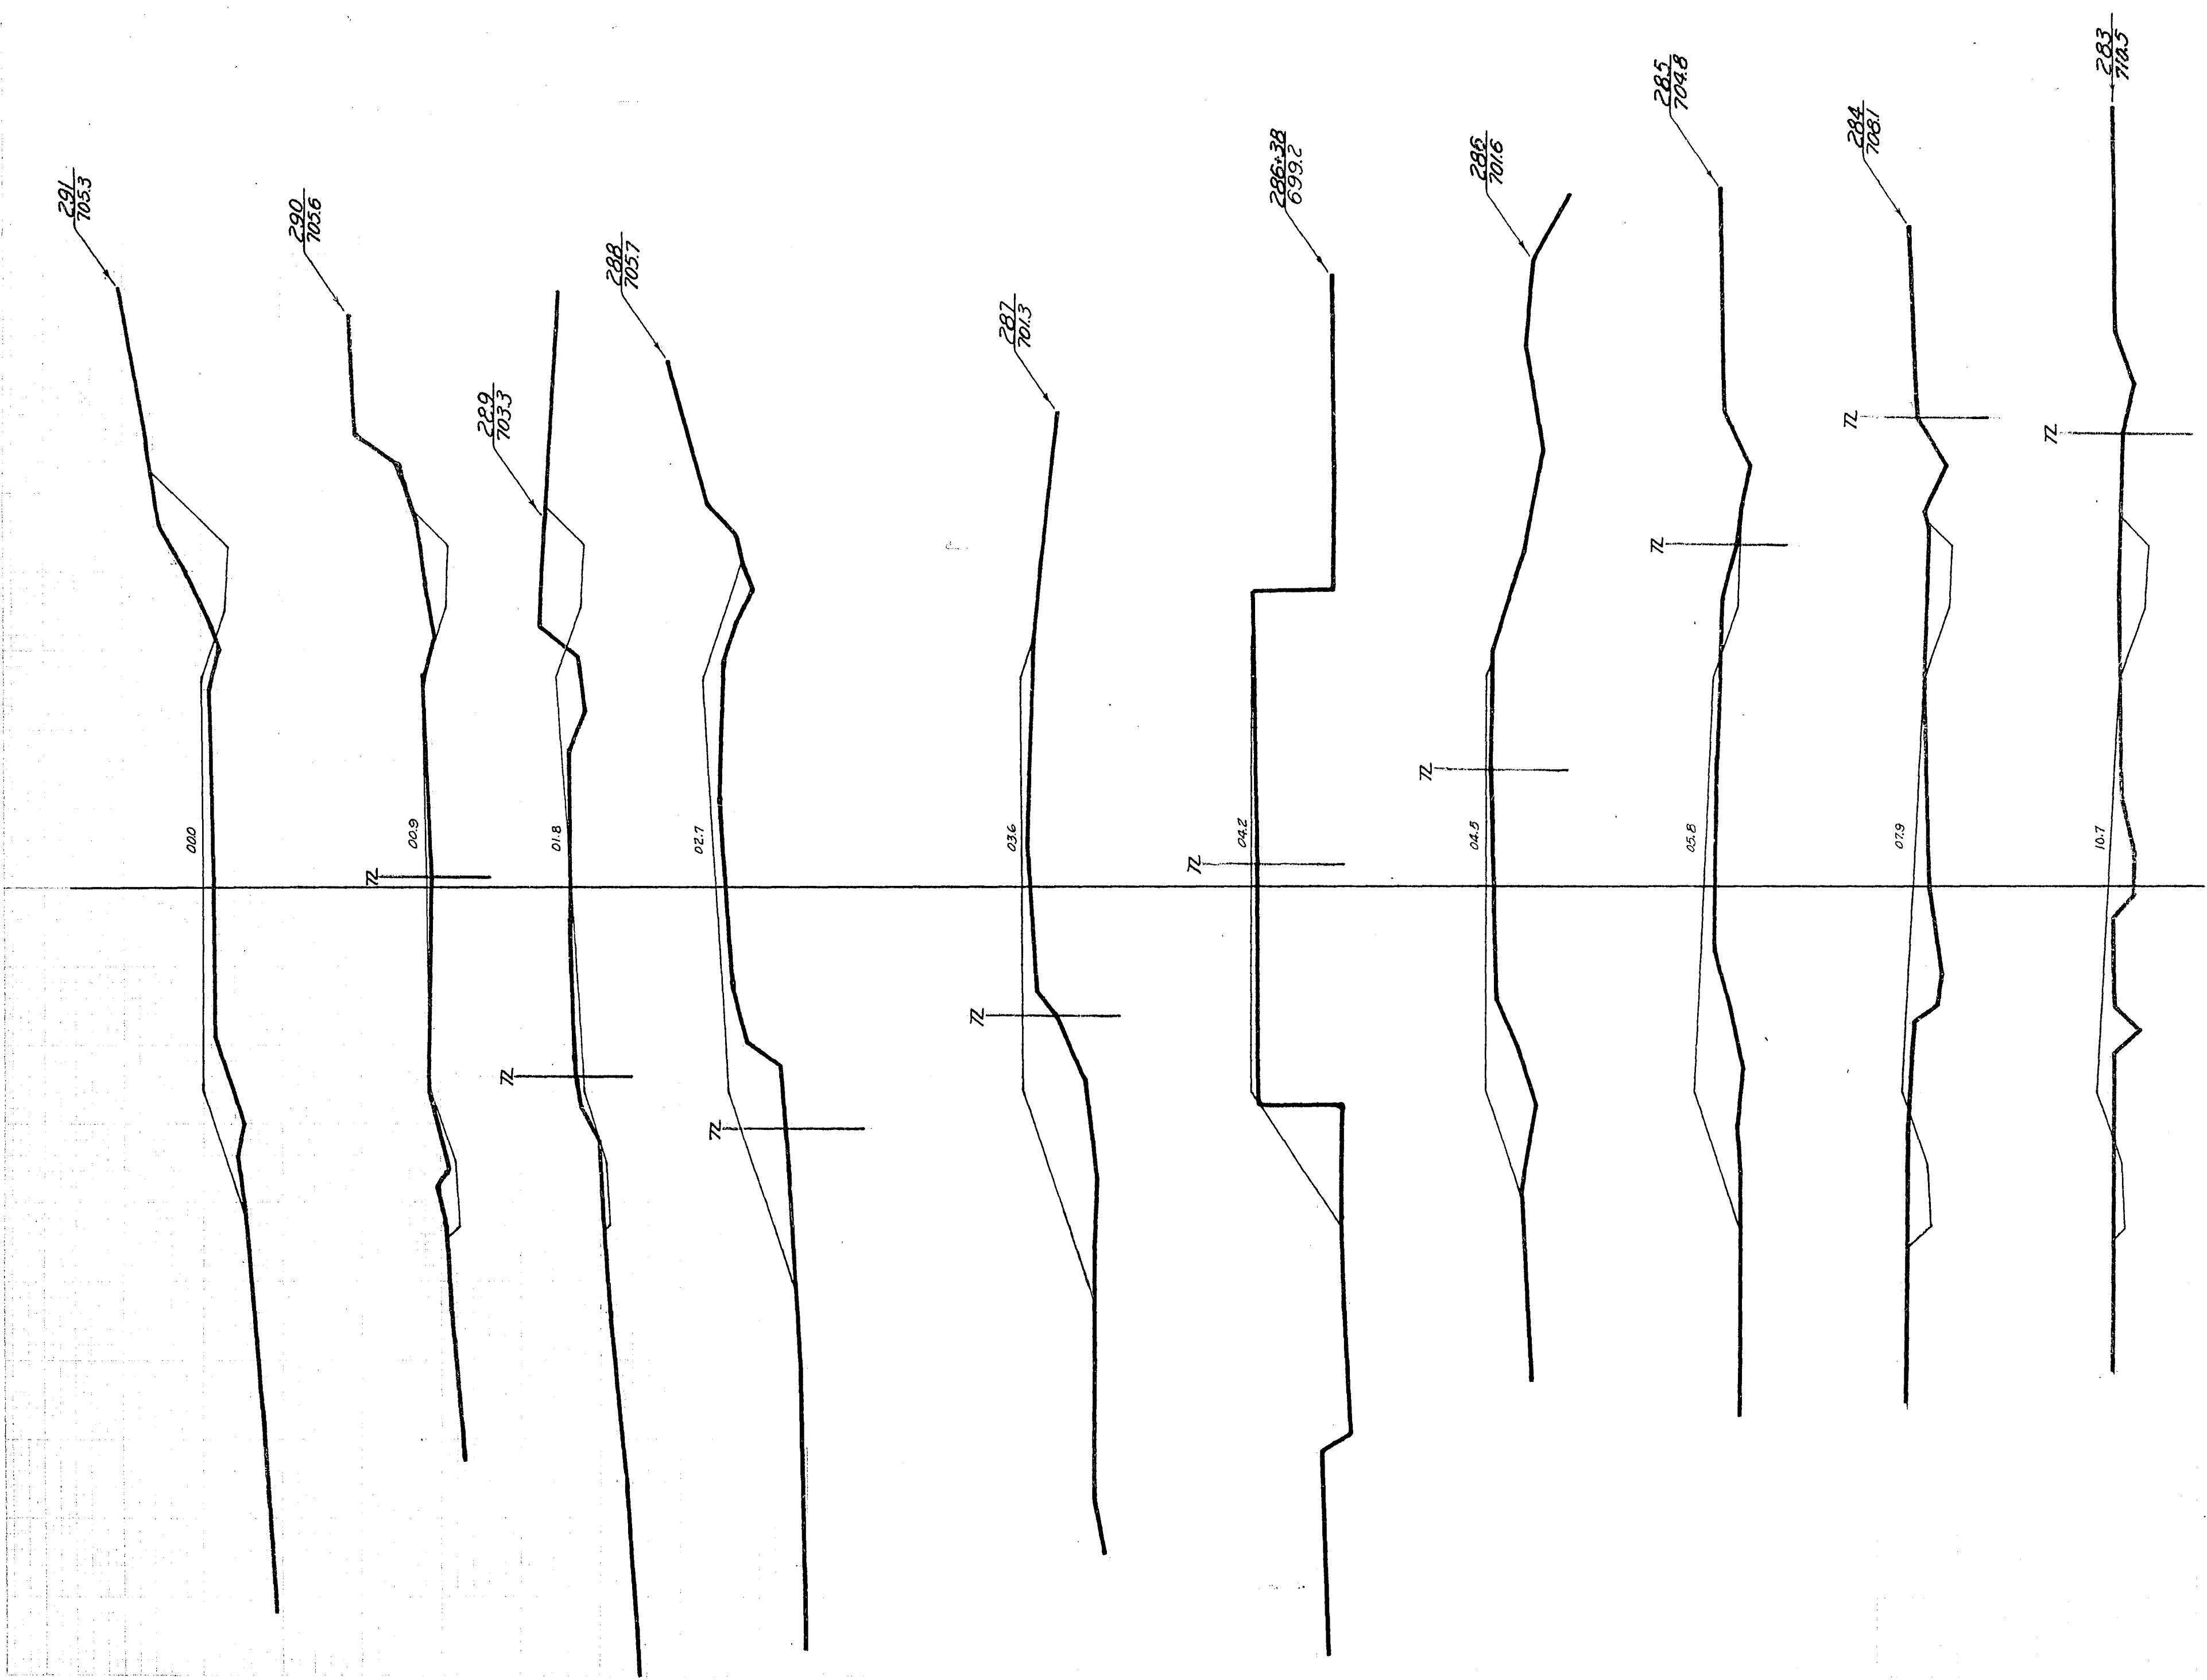


FED. ROAD DIST. NO.	STATE	STATE AID PROJ. NO.	SHEET NO.	TOTAL SHEETS
4	WISC.	9408	66	11

DIVISION JOB NO. 9408

[illegible]

[illegible]



FED. ROAD DIST. NO.	STATE	STATE AID PROJ. NO.	SHEET NO.	TOTAL SHEETS
4	WISC.	9408	72	111
DIVISION JOB NO. 9408				

STATION	END AREA			DISTANCE	YARDAGE			
	EARTH	ROCK	FILL		EARTH	L. ROCK	S. ROCK	TOTAL
282	31		26					
283	15		23	100 ²				85 91
284	18		22	100				61 83
285	5		40	100 ³				43 115
286	0		27	101 ²				9 126
287	0		56	101 ⁶				0 156
288	0		55	101 ⁵				0 207
289	0		20	20				0
290	24		10	80				35 120
291	14		1	100 ⁶				70 20
292	21		27	100				65 52
TOTAL								365 970

FED. ROAD DIST. NO.	STATE	AID PROJ. NO.	SHEET NO.	TOTAL SHEETS
4	WISC.		7	

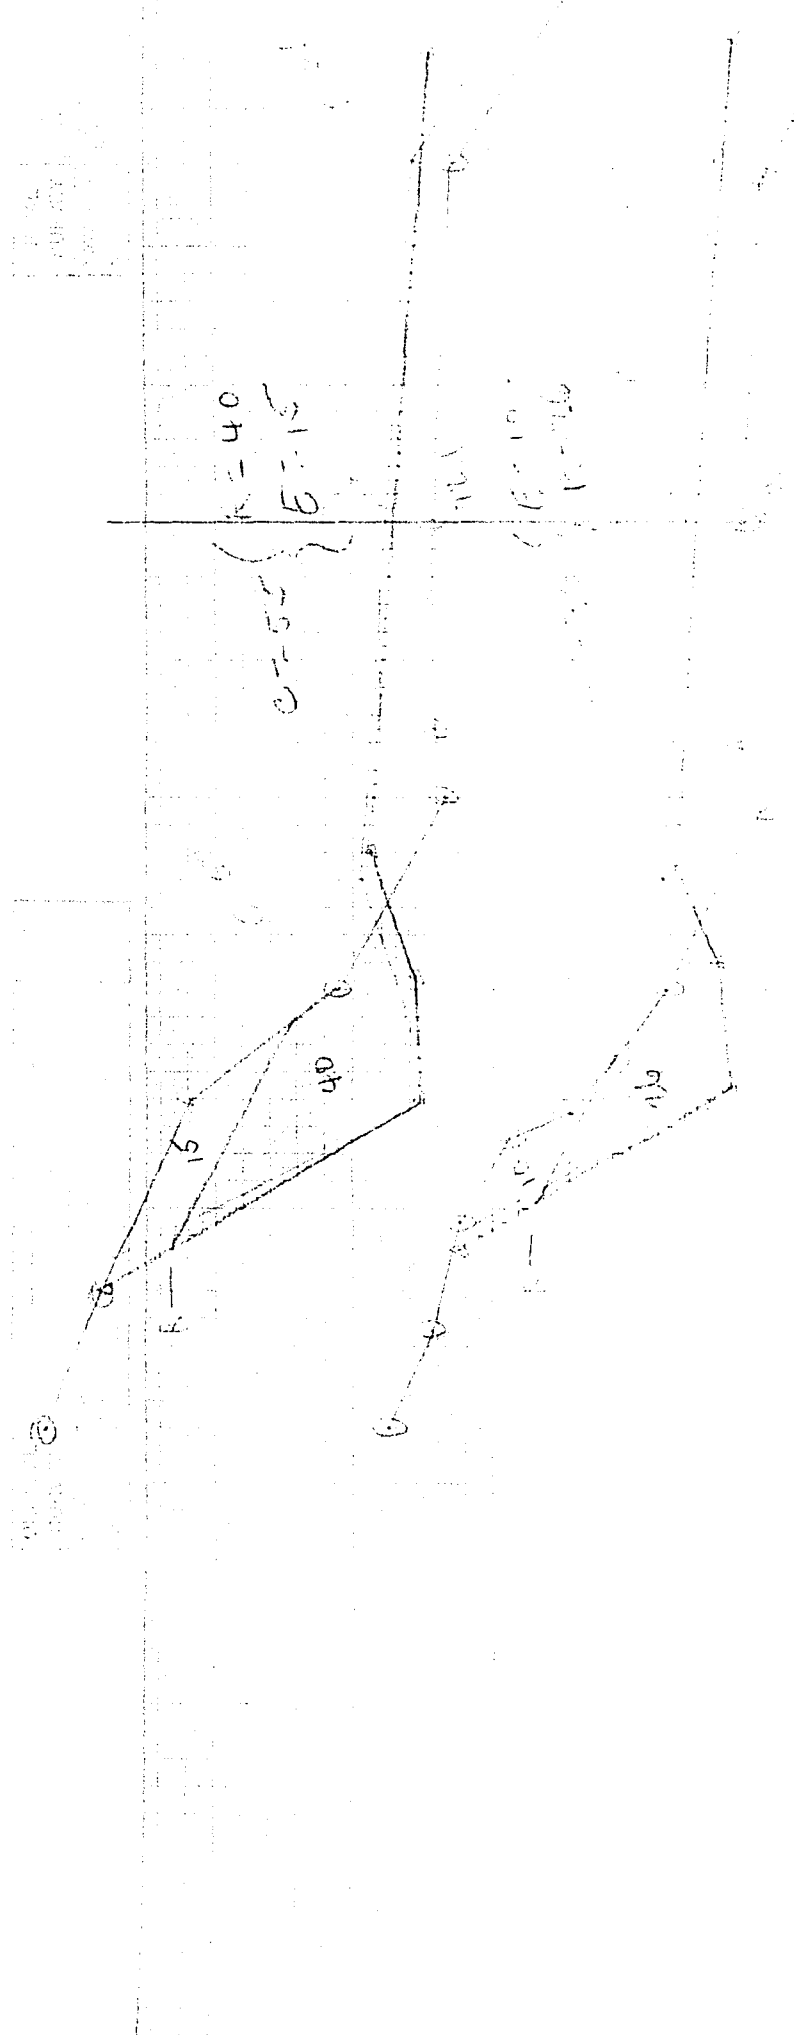
DIVISION JOB NO.

[illegible]

[illegible]

FED. ROAD DIST. NO.	STATE	AID PROJ. NO.	SHEET NO.	TOTAL SHEETS
4	WISC.		217	

DIVISION JOB NO. ...

[illegible][illegible][illegible][illegible]

FED. ROAD DIST. NO.	STATE	AID PROJ. NO.	SHEET NO.	TOTAL SHEETS
4	WISC.		11	

DIVISION JOB NO. 47

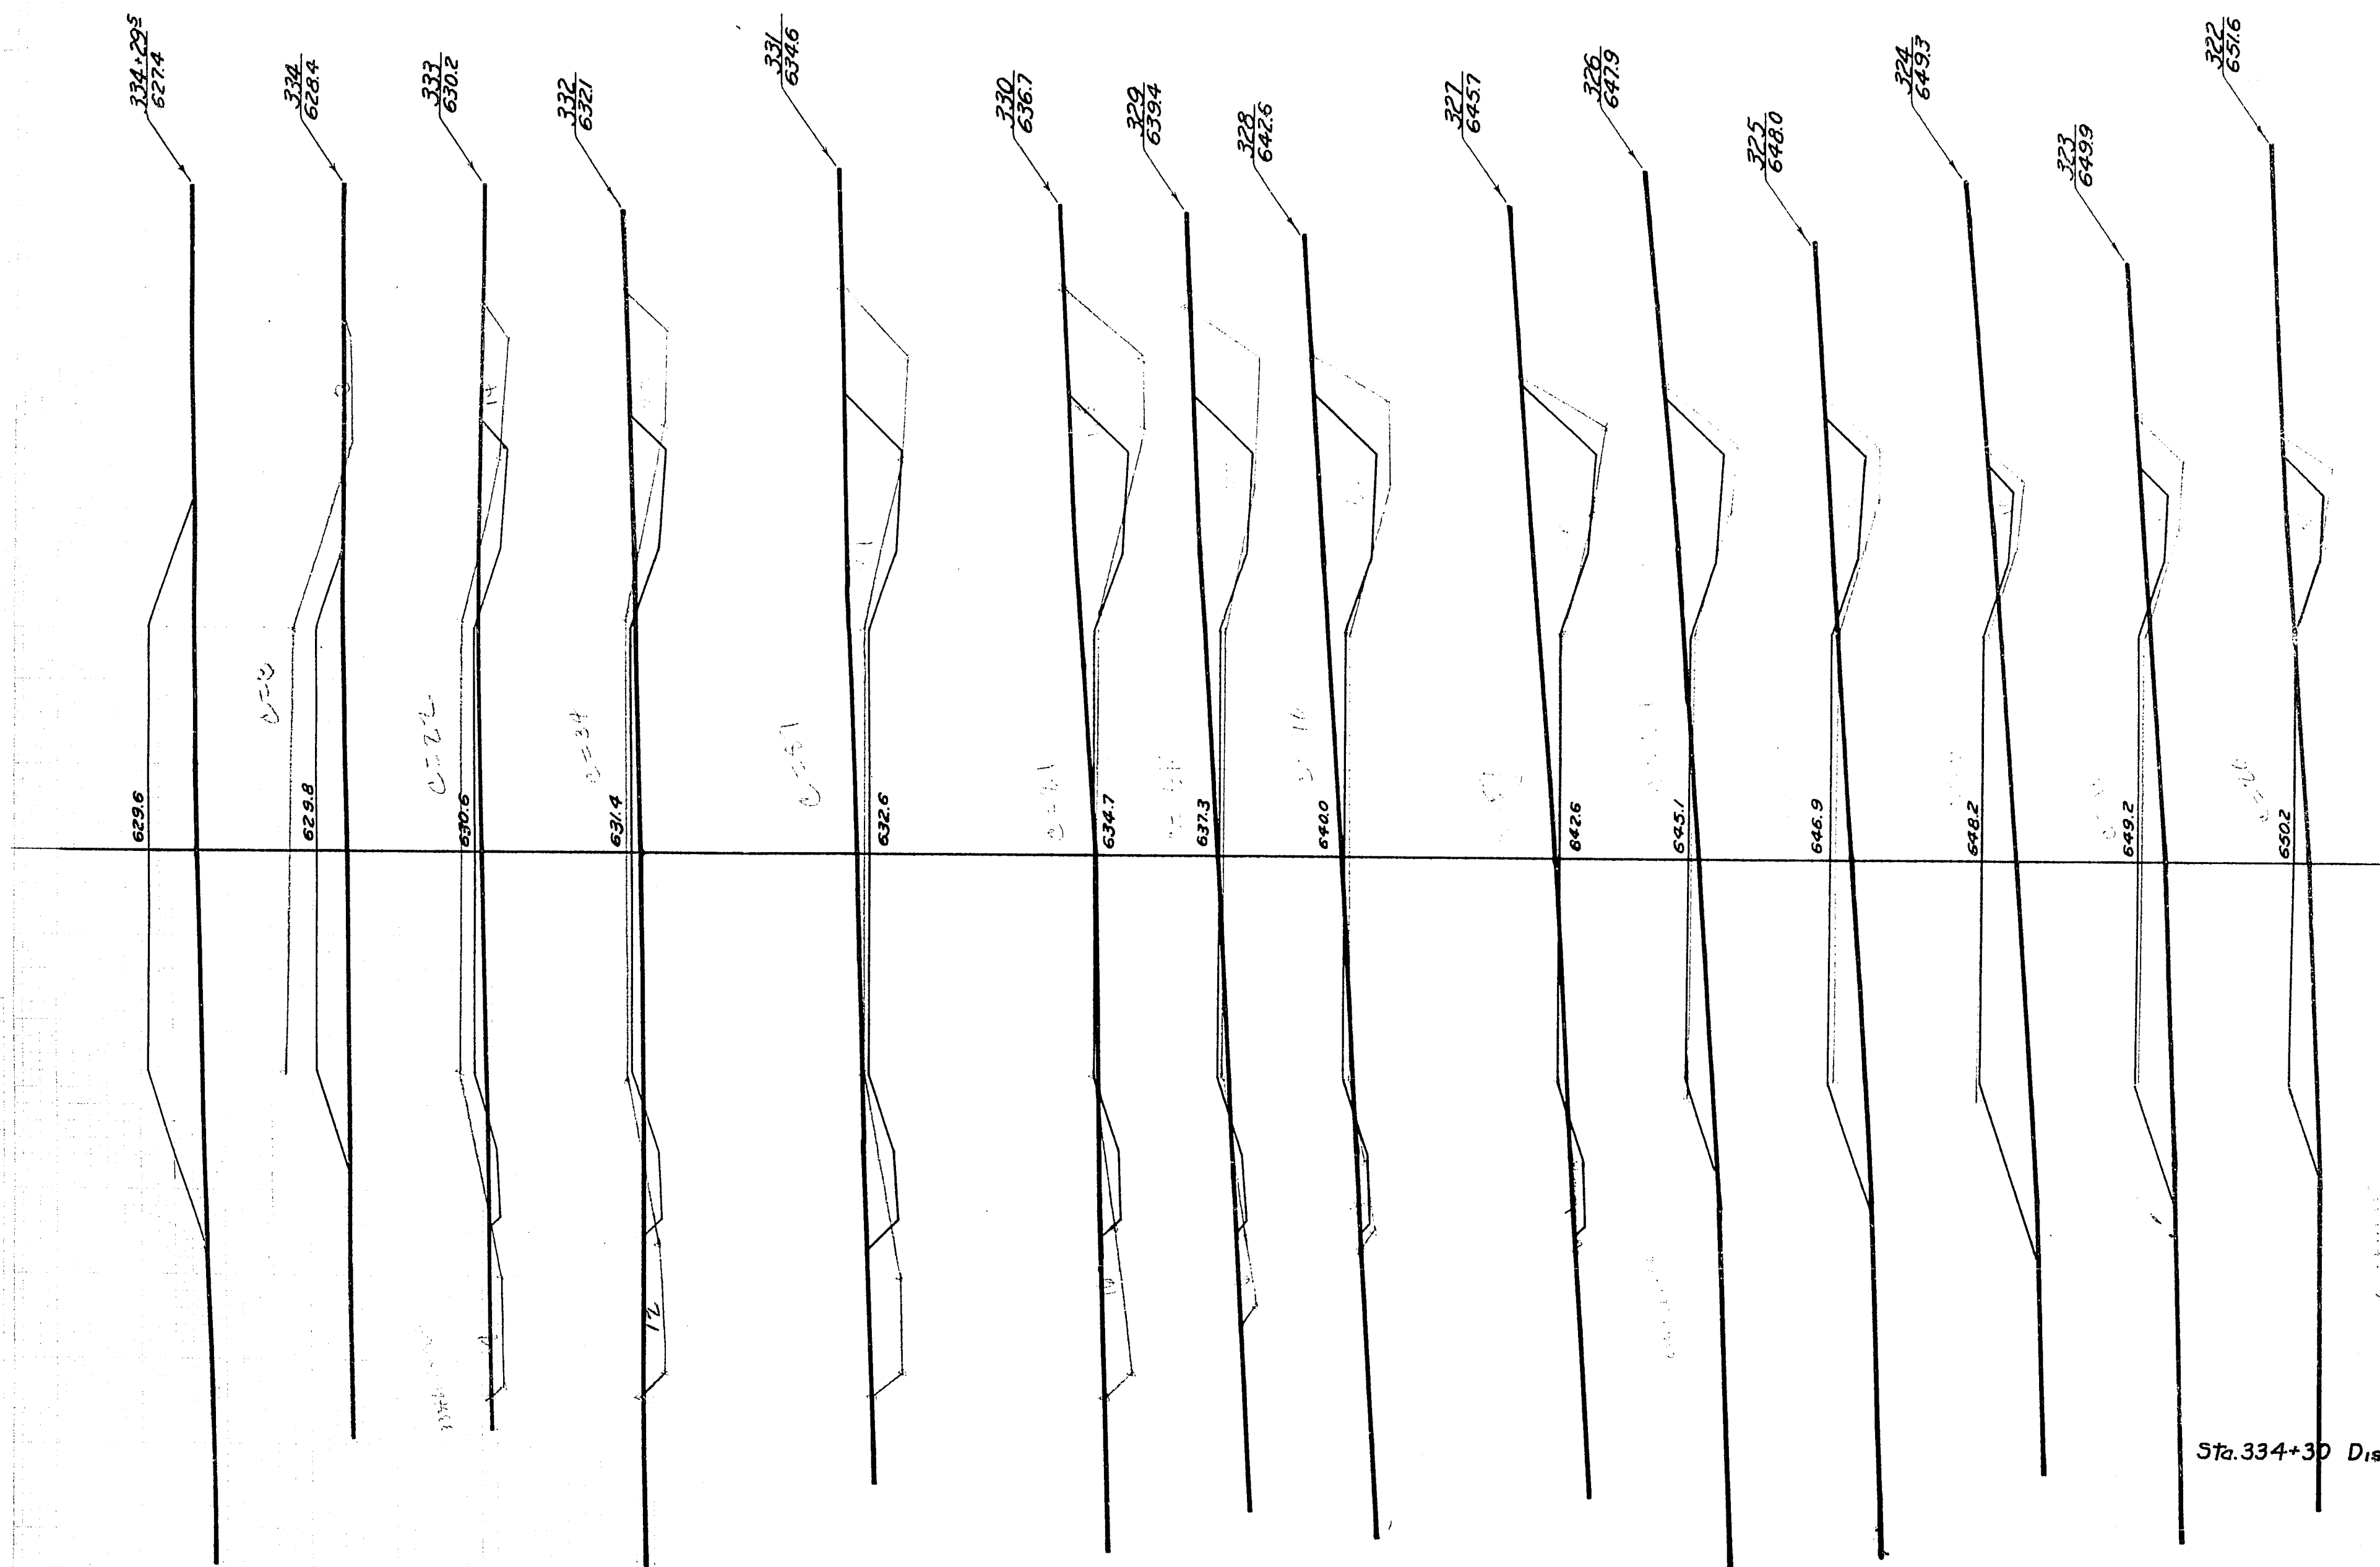
[illegible]

[illegible]

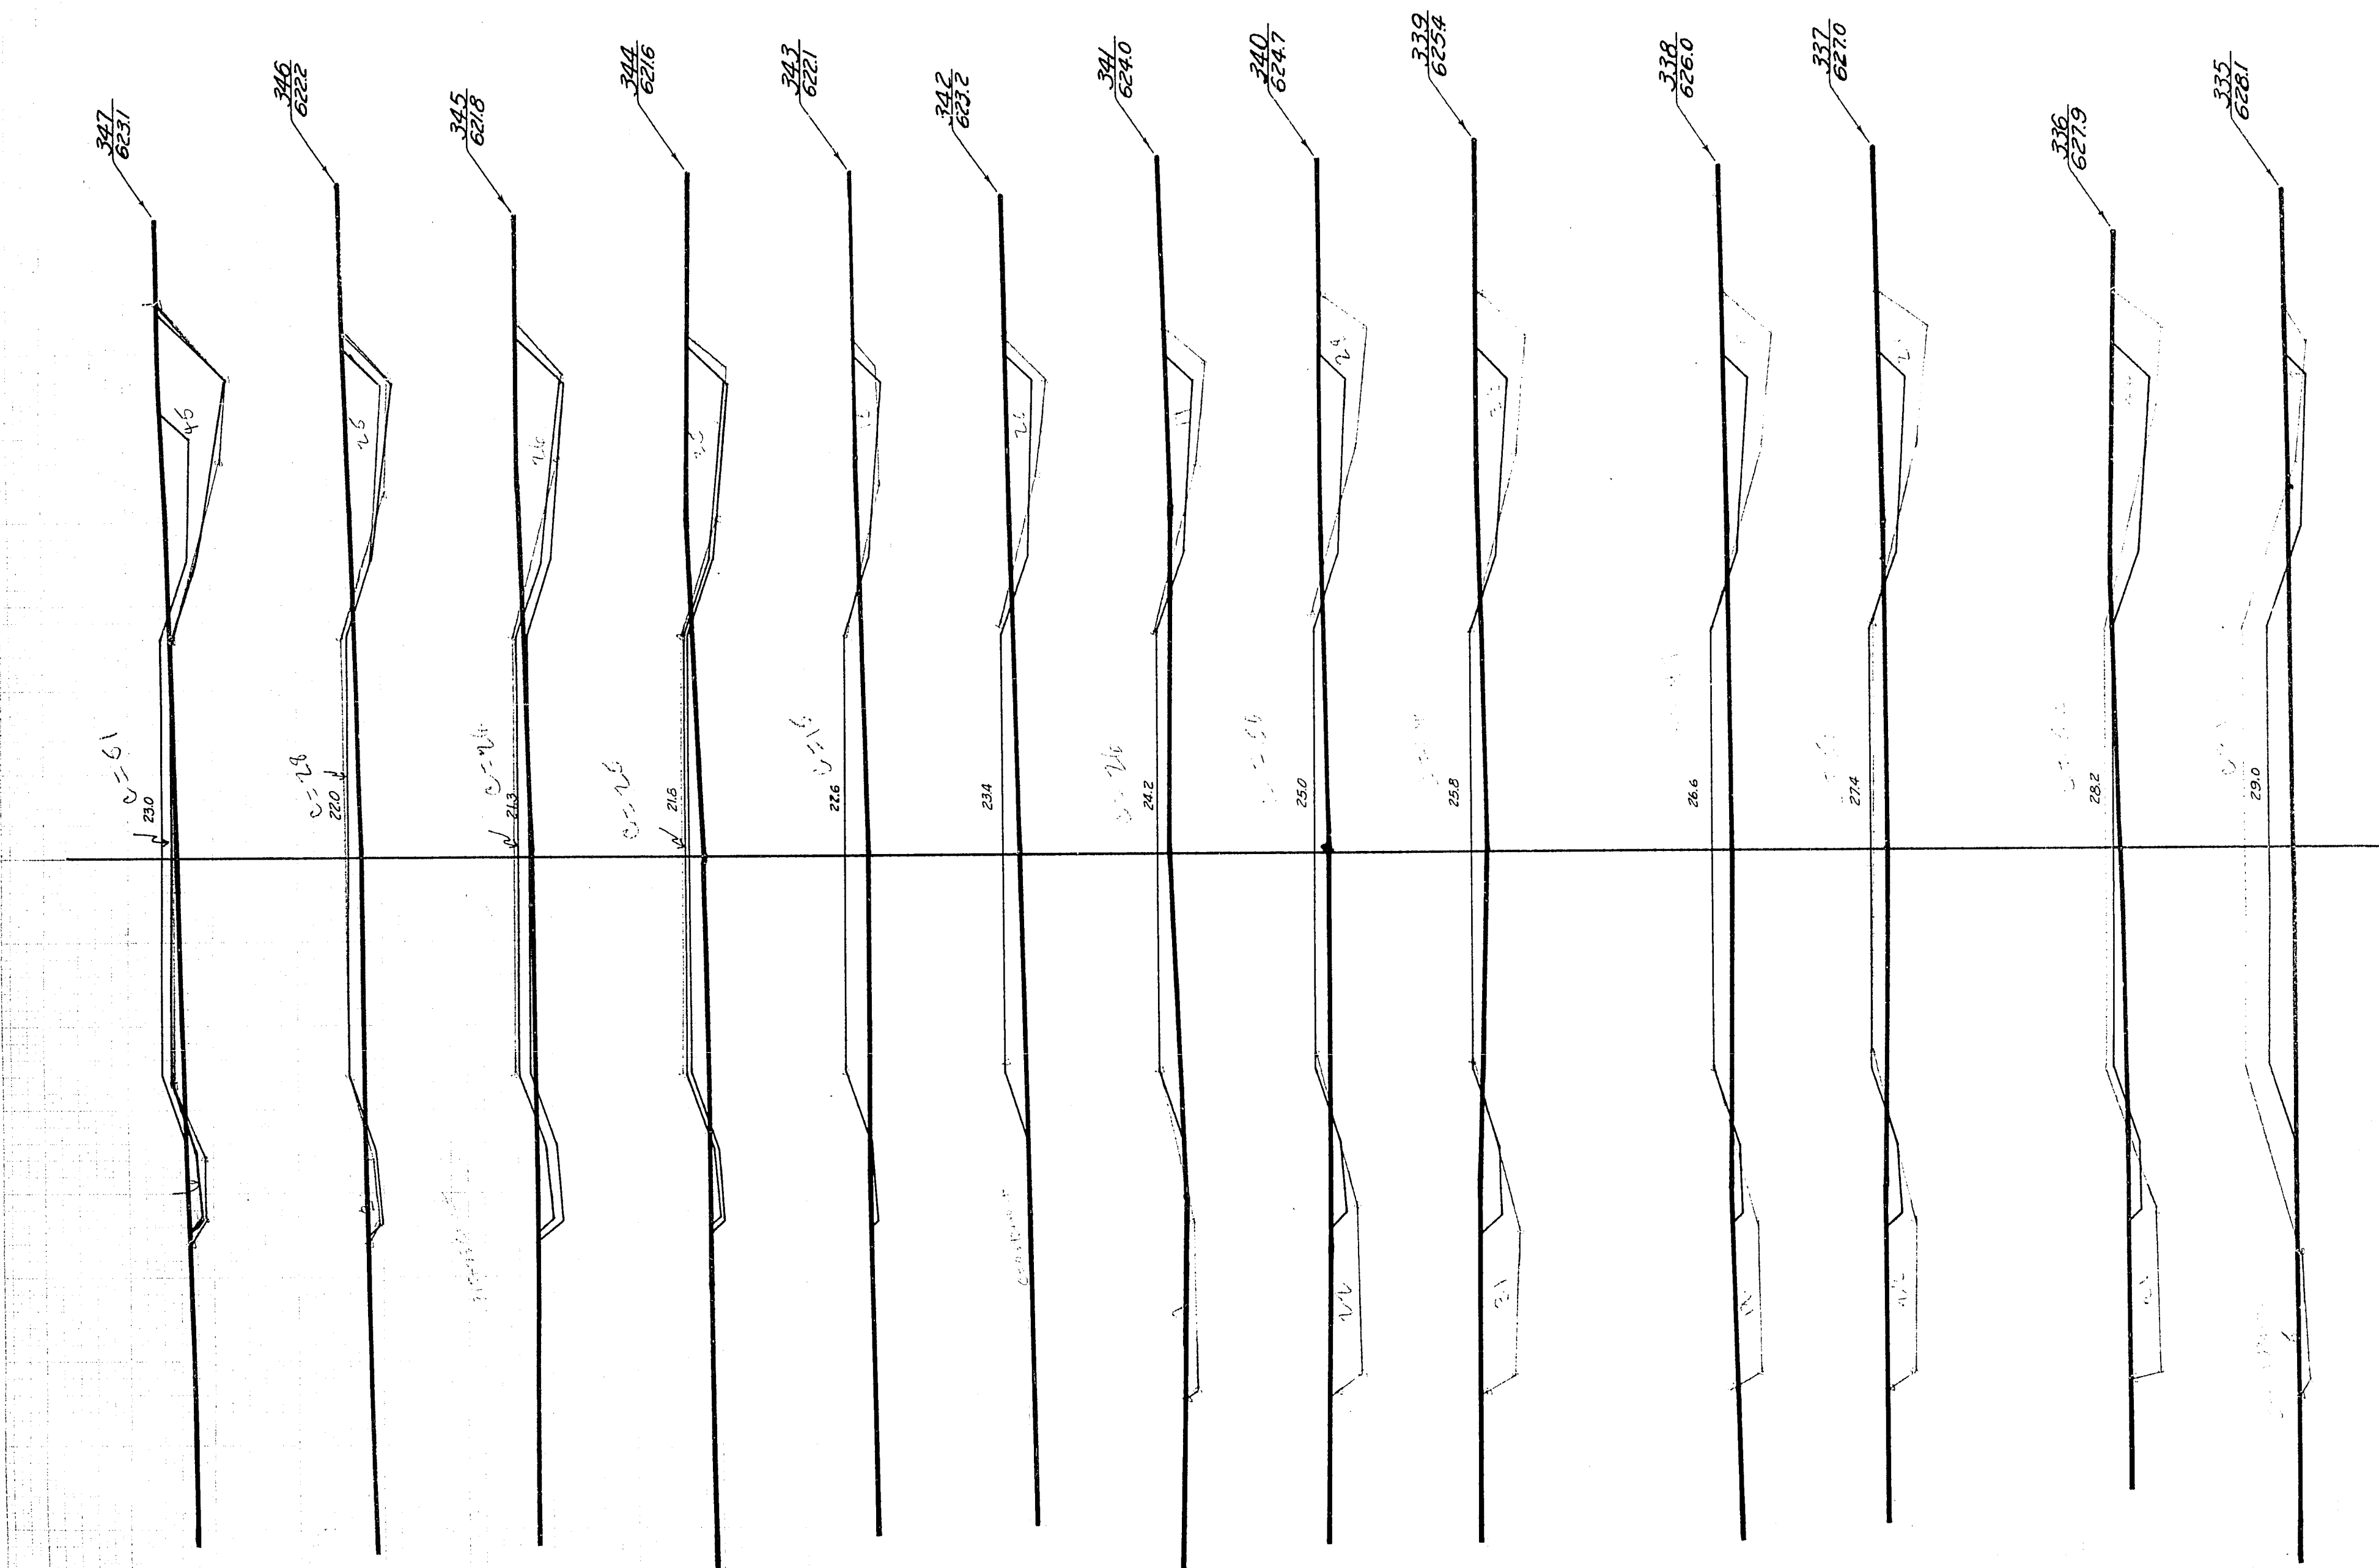
[illegible]

FED. ROAD DIST. NO.	STATE	State AID PROJ. NO.	SHEET NO.	TOTAL SHEETS
4	WISC.	9408	716	111

DIVISION JOB NO. 9408

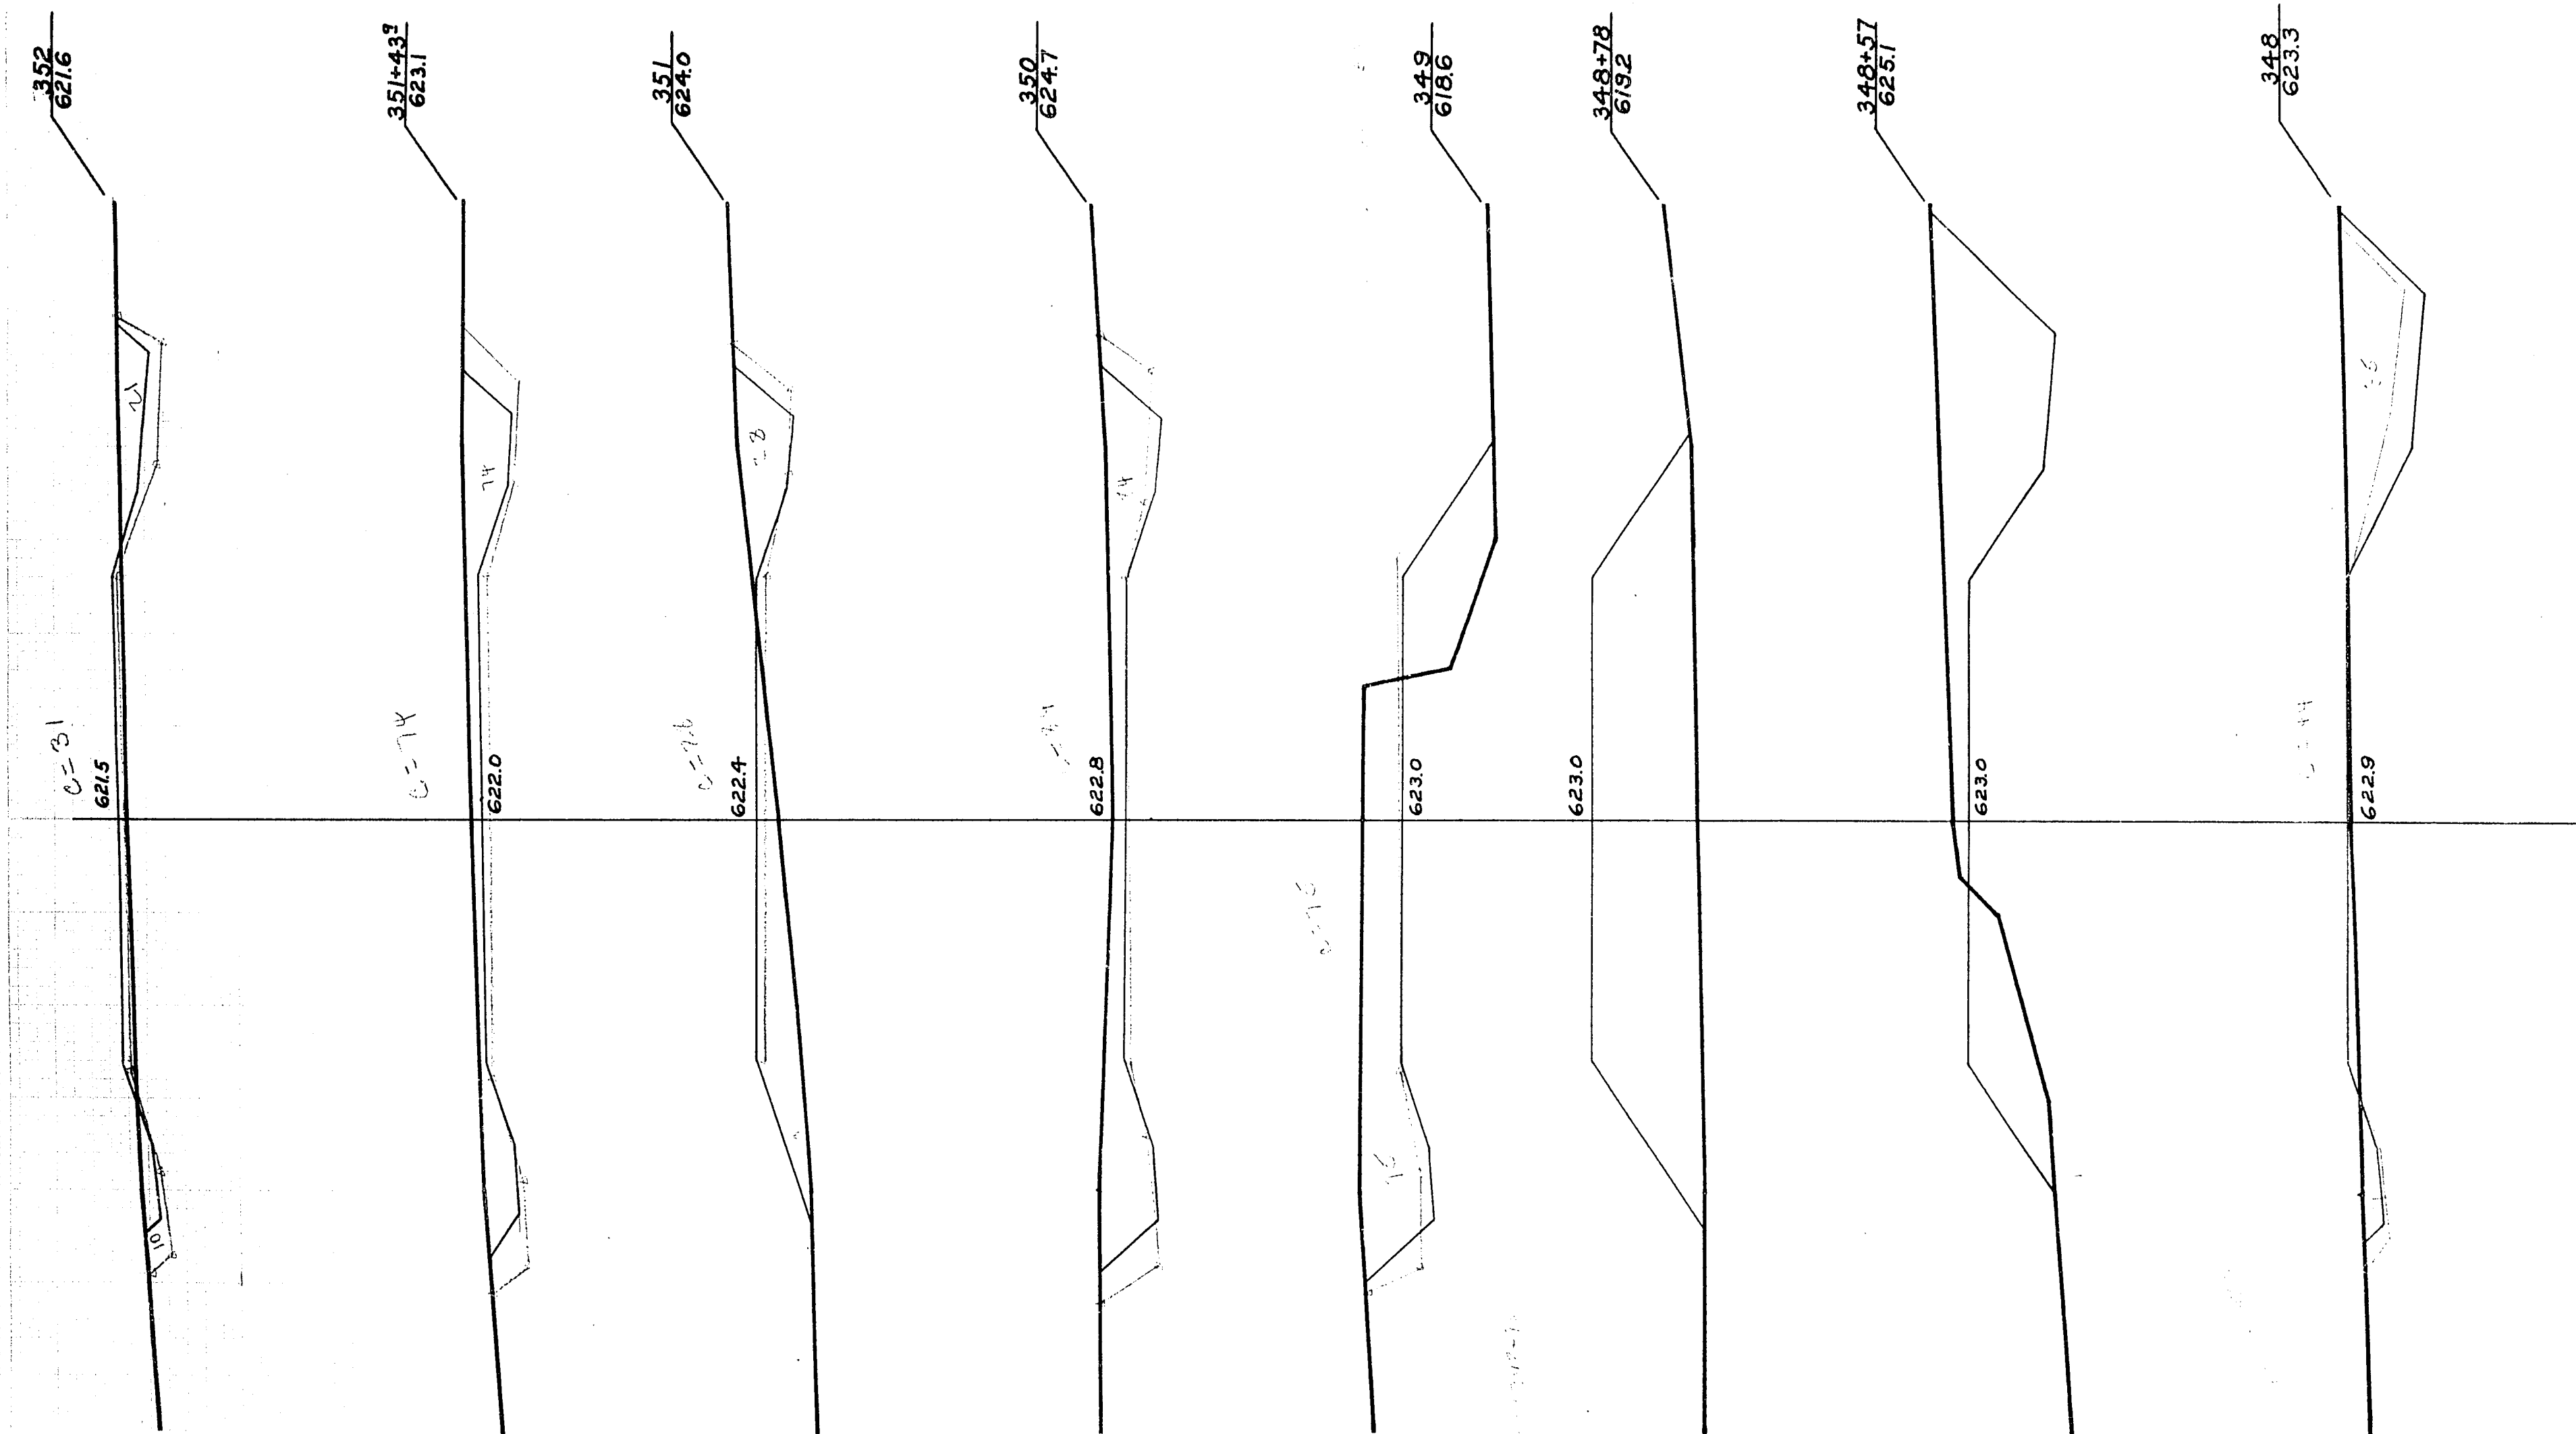
[illegible]

STATION	END AREA			DISTANCE	YARDAGE				
	CUT				CUT				TOTAL FILL
	EARTH	ROCK	FILL		EARTH	L. ROCK	S. ROCK	TOTAL	
334 + 29 ⁵	0		102	70 ⁵				15	194
335	11		47					76	107
336	30		11					87	74
337	17		29					59	109
338	15		30					72	94
339	24		21					80	76
340	19		20					59	83
341	13		25					57	102
342	18		30					61	123
343	15		39					72	122
344	24		27					100	87
345	30		20					115	74
346	32		20					148	57
347	48		15						
TOTAL.								1001	1001

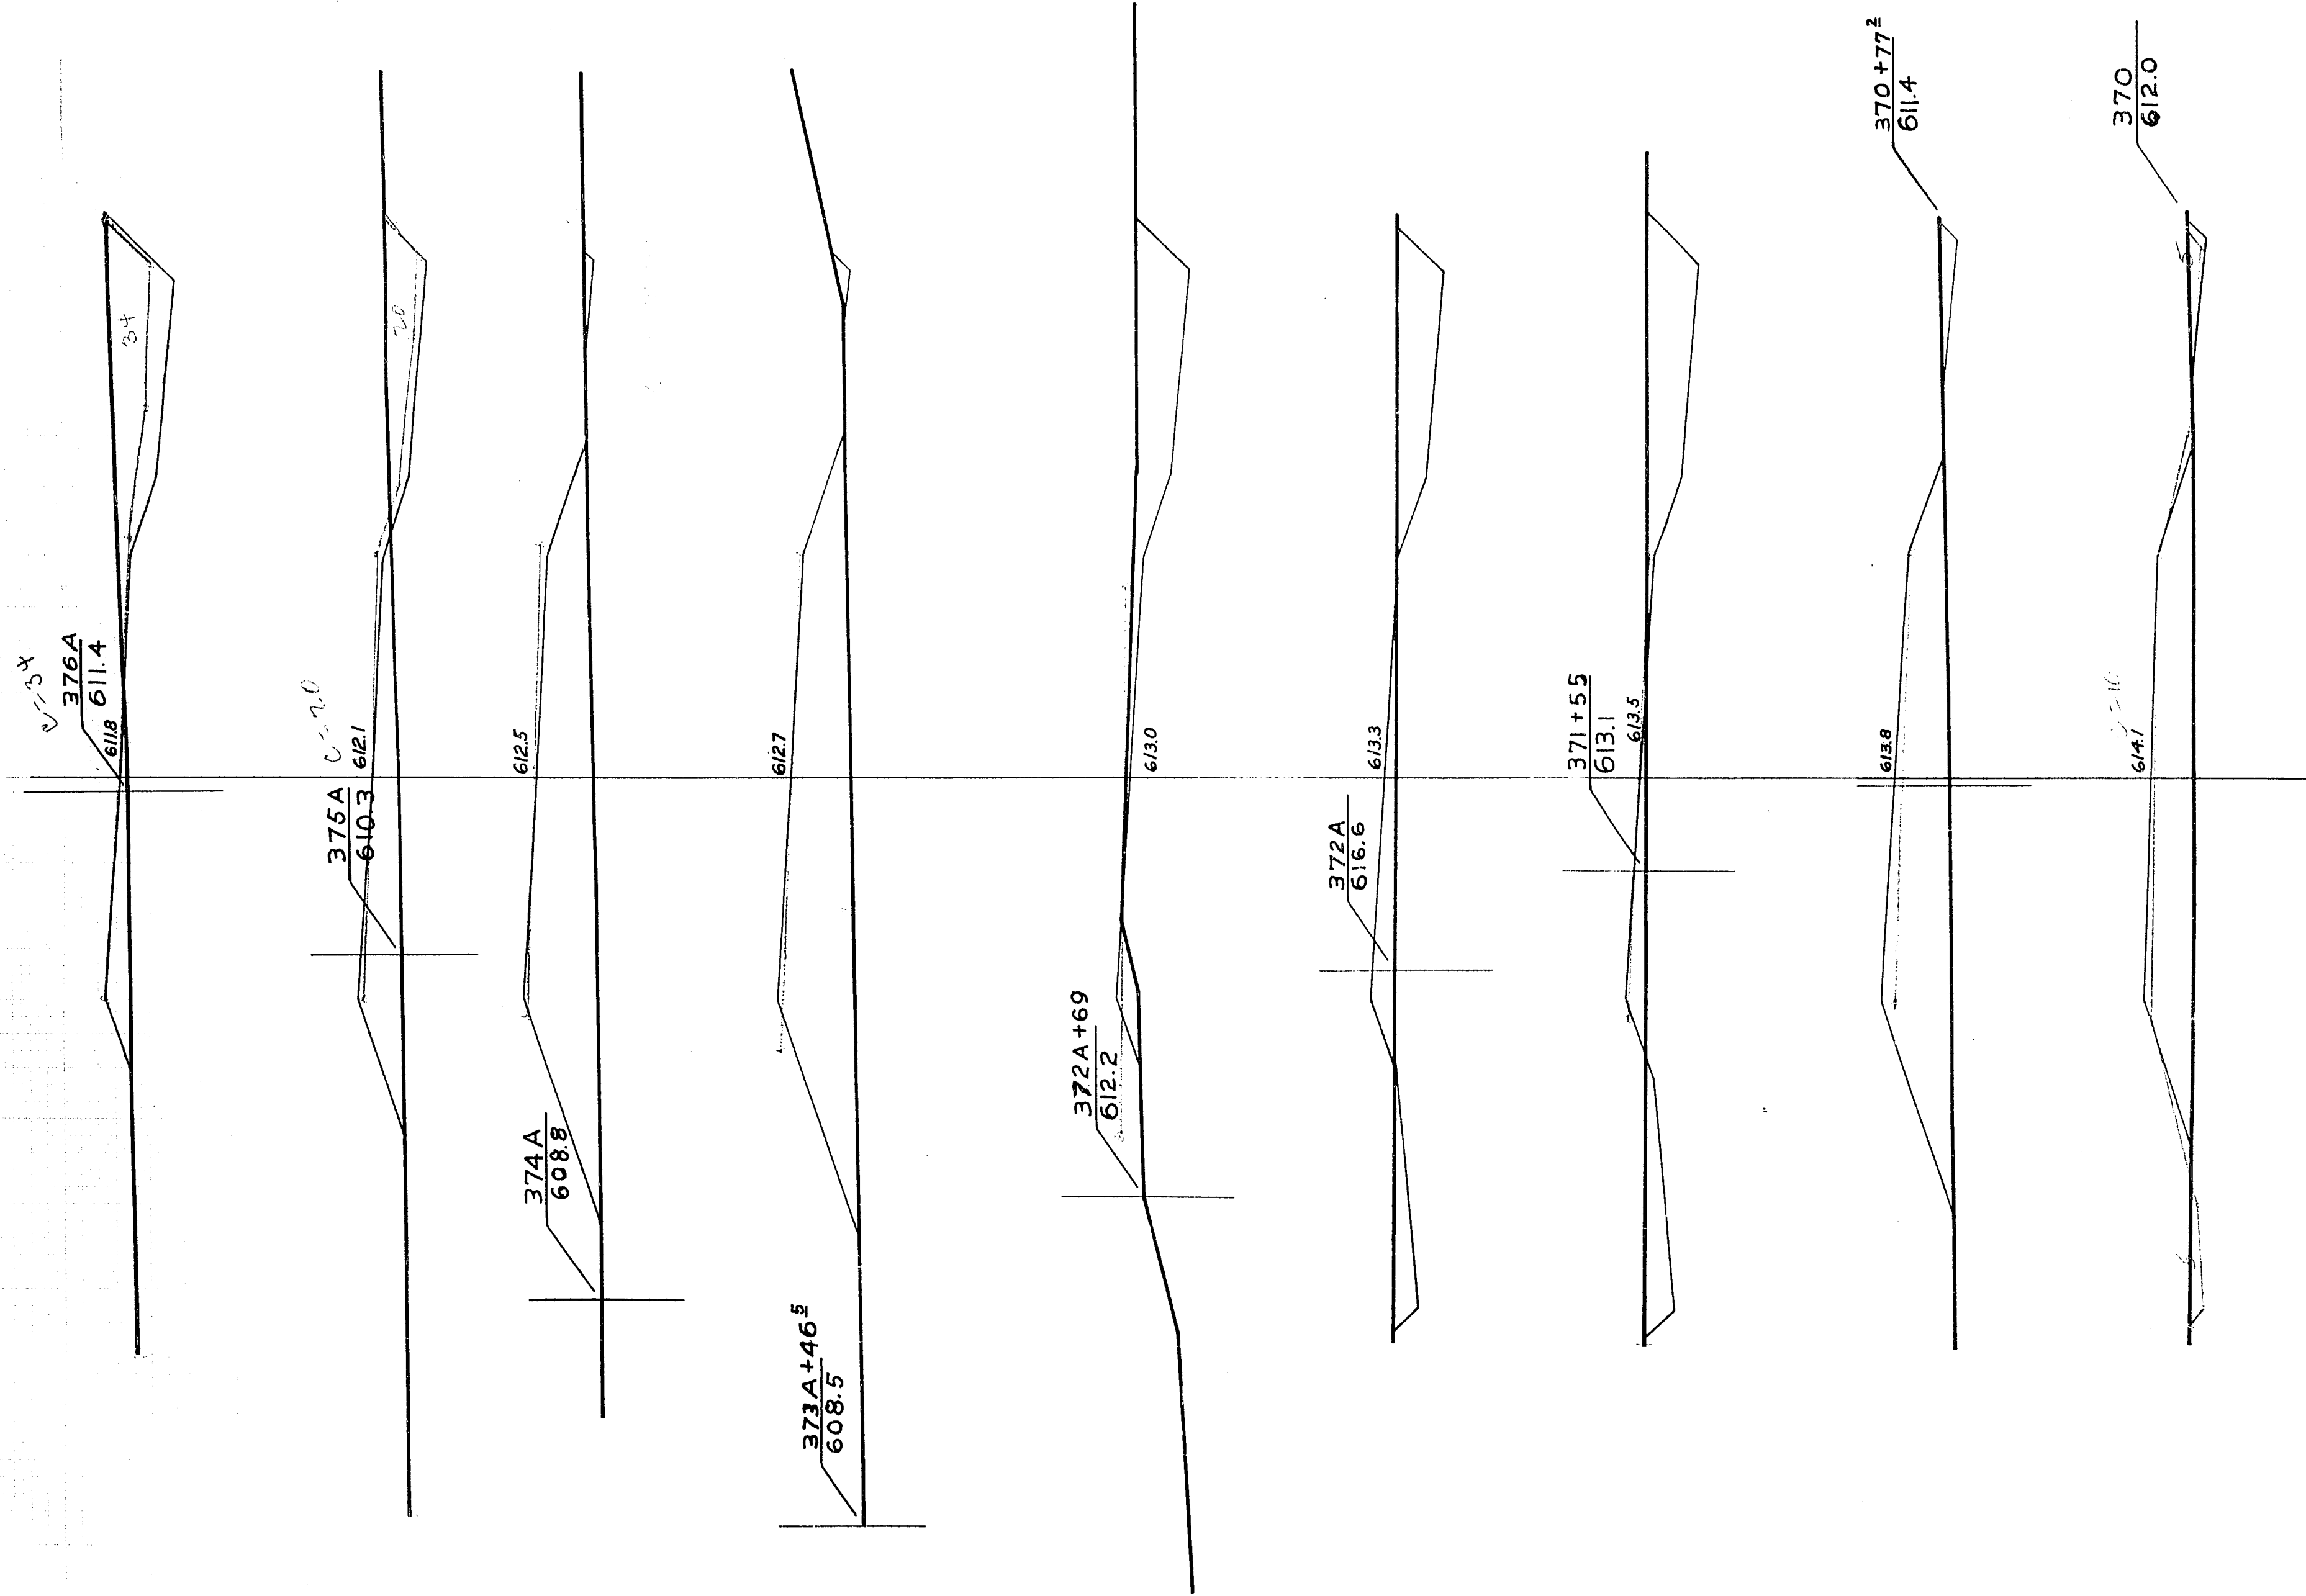


FED. ROAD DIST. NO.	STATE	State AID PROJ. NO.	SHEET NO.	TOTAL SHEETS
4	WISC.	9408	78	111

DIVISION JOB NO. 9408

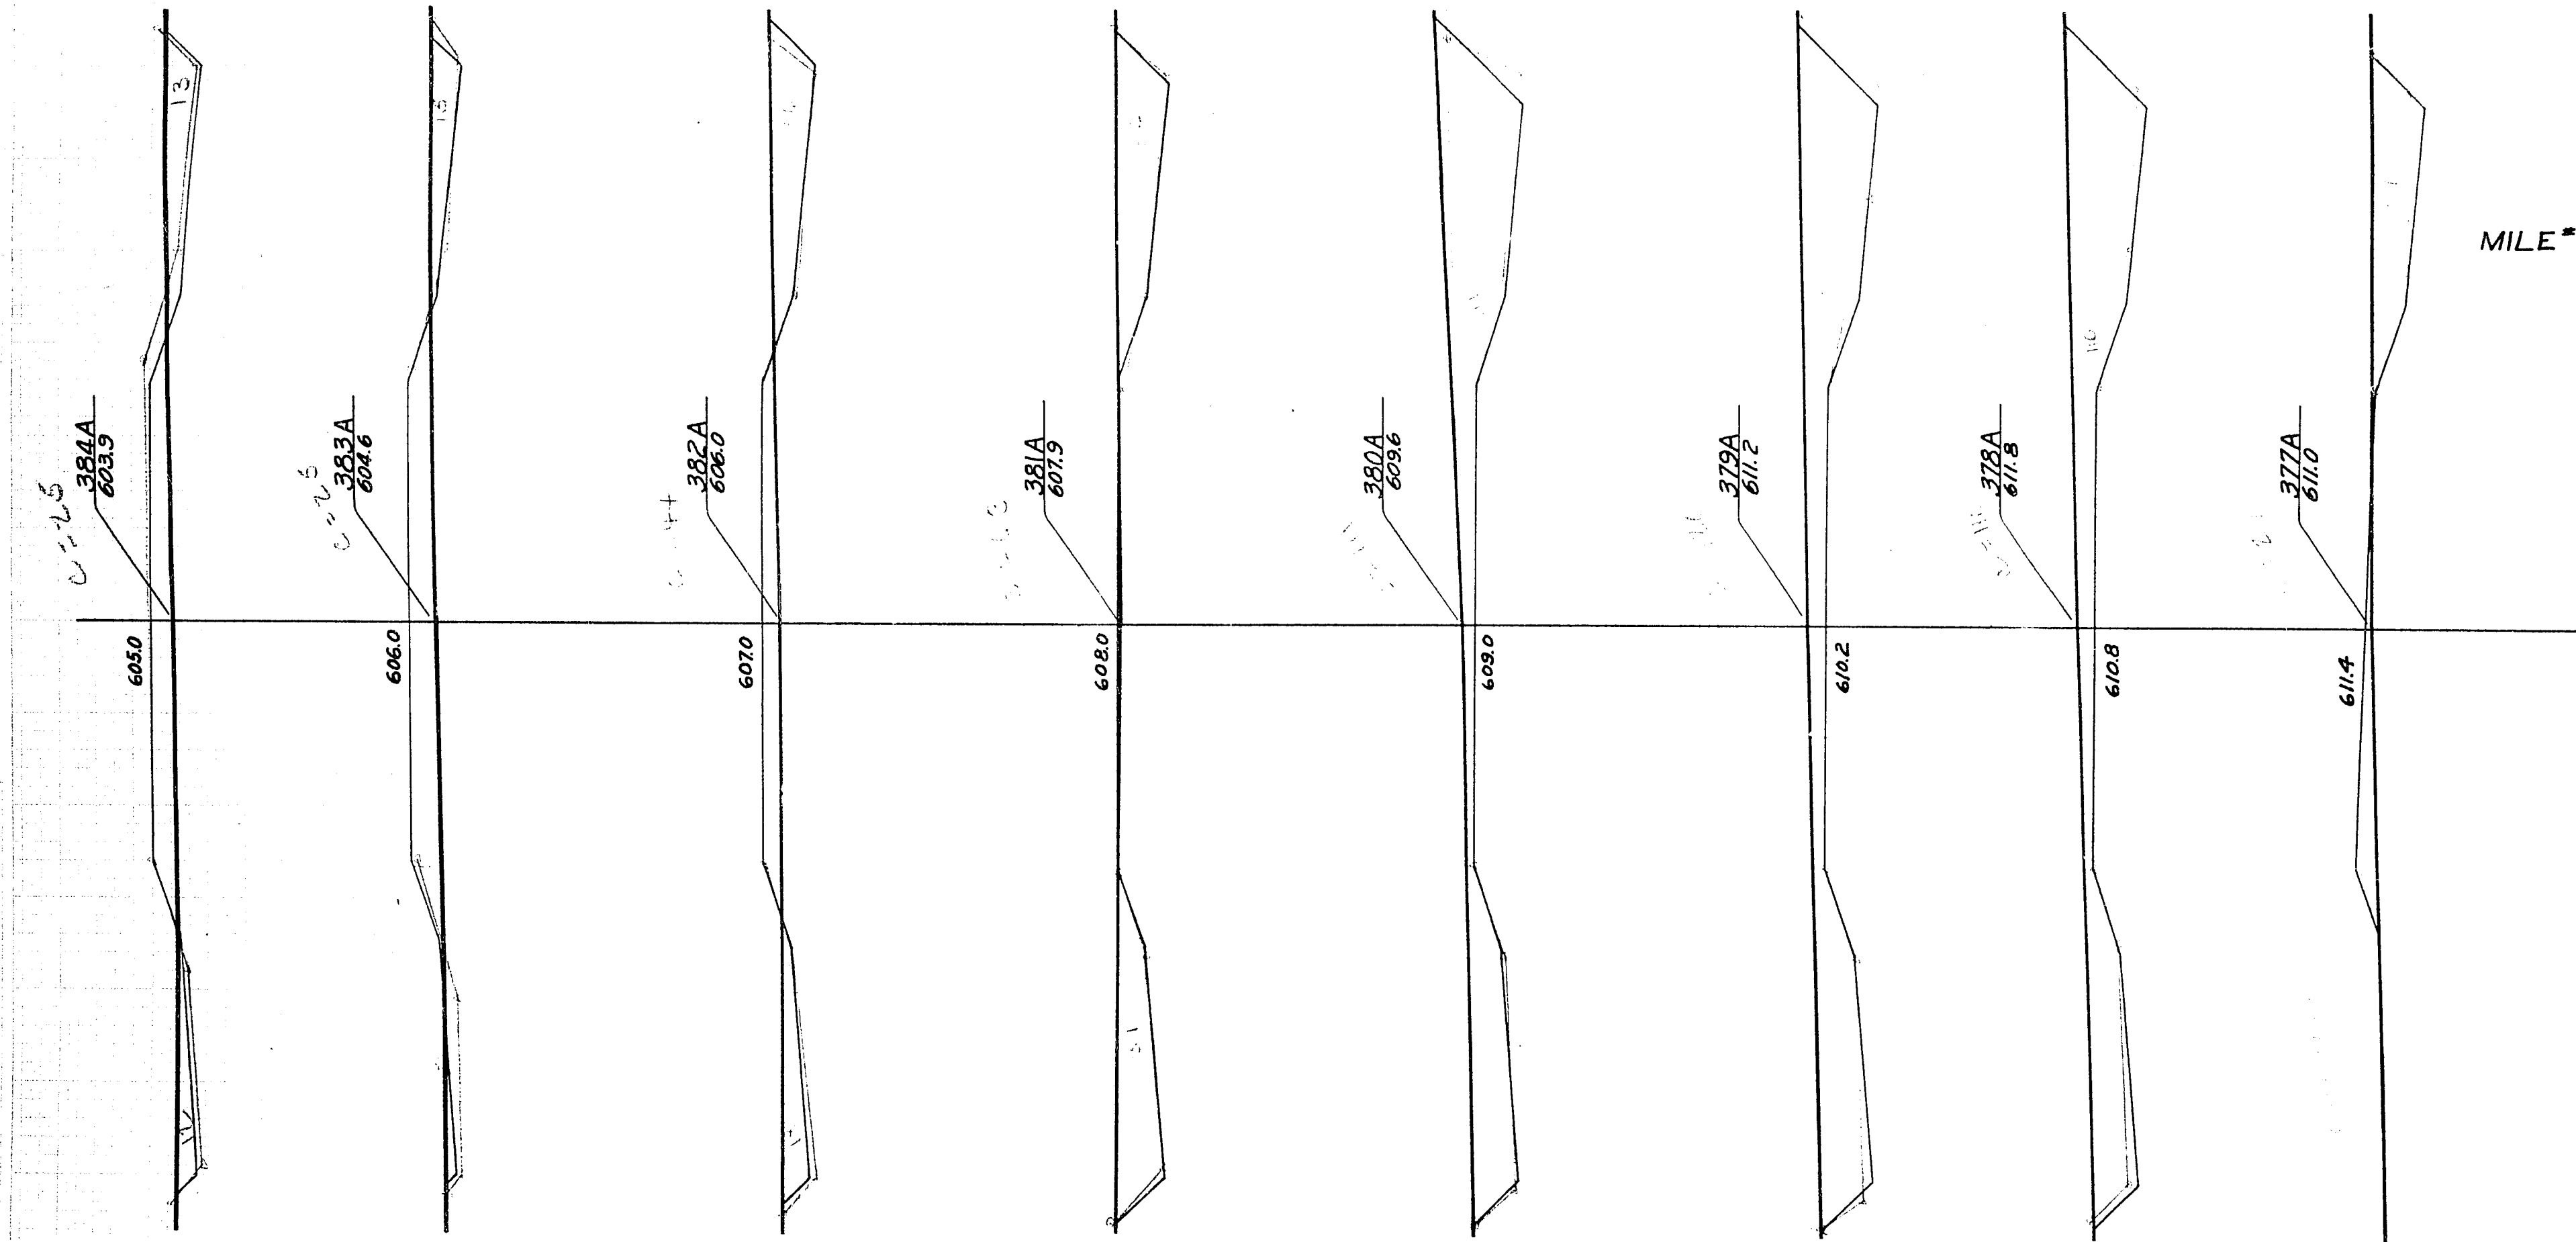
[illegible]

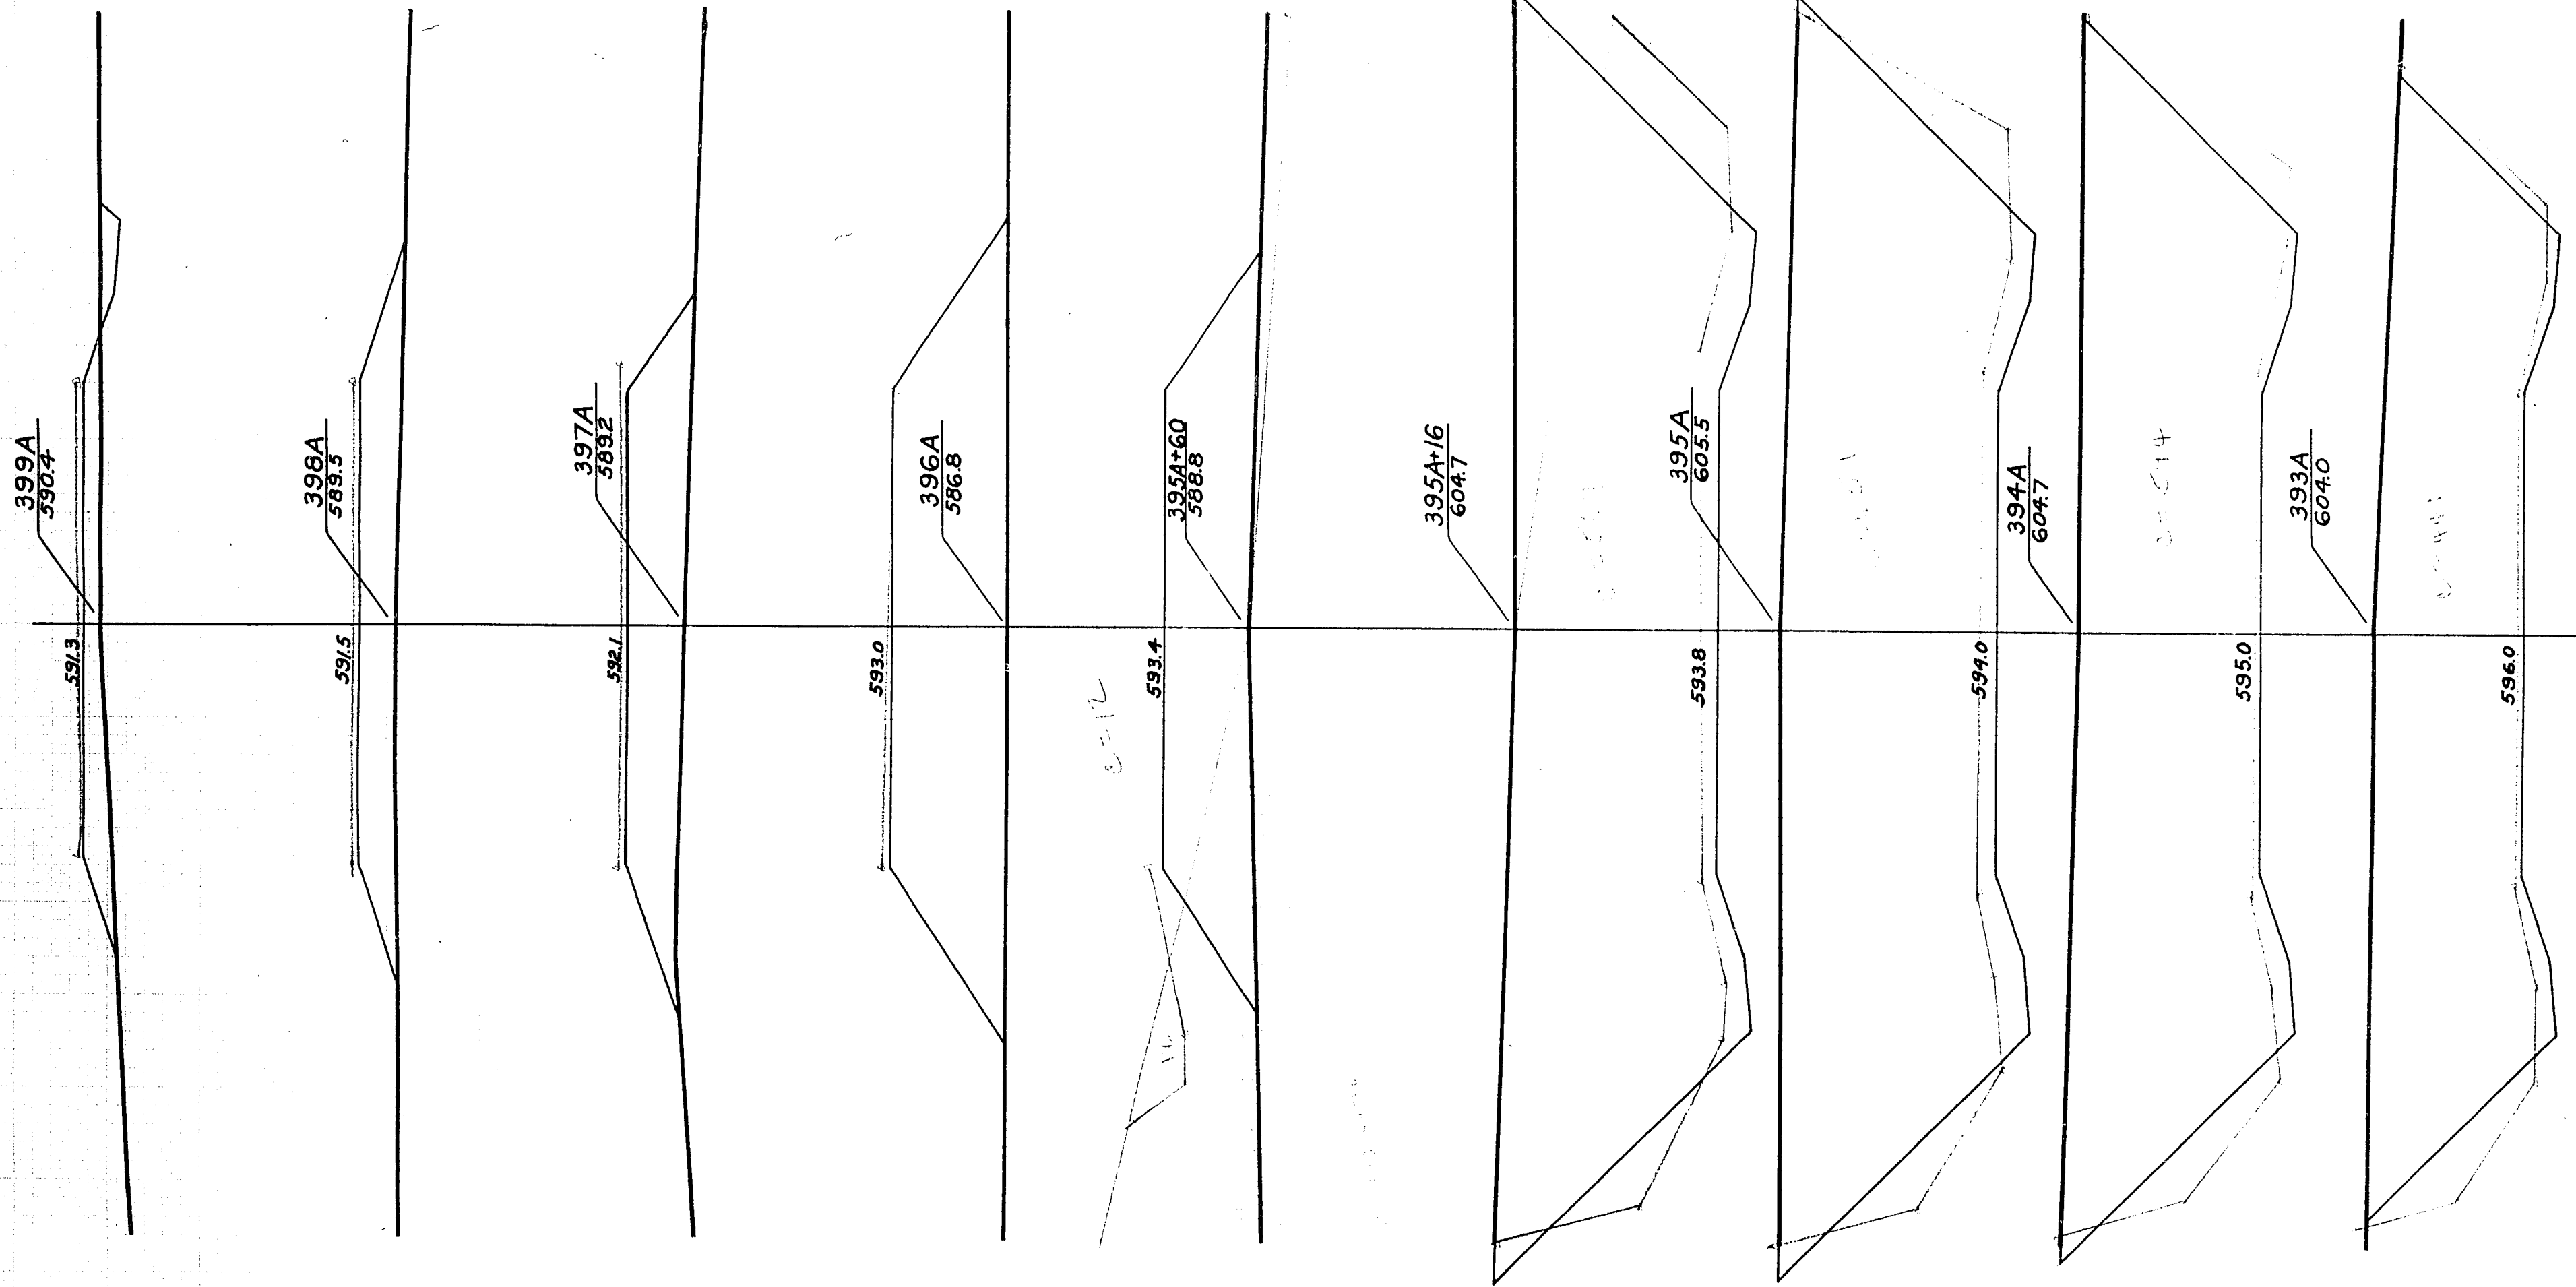
[illegible]



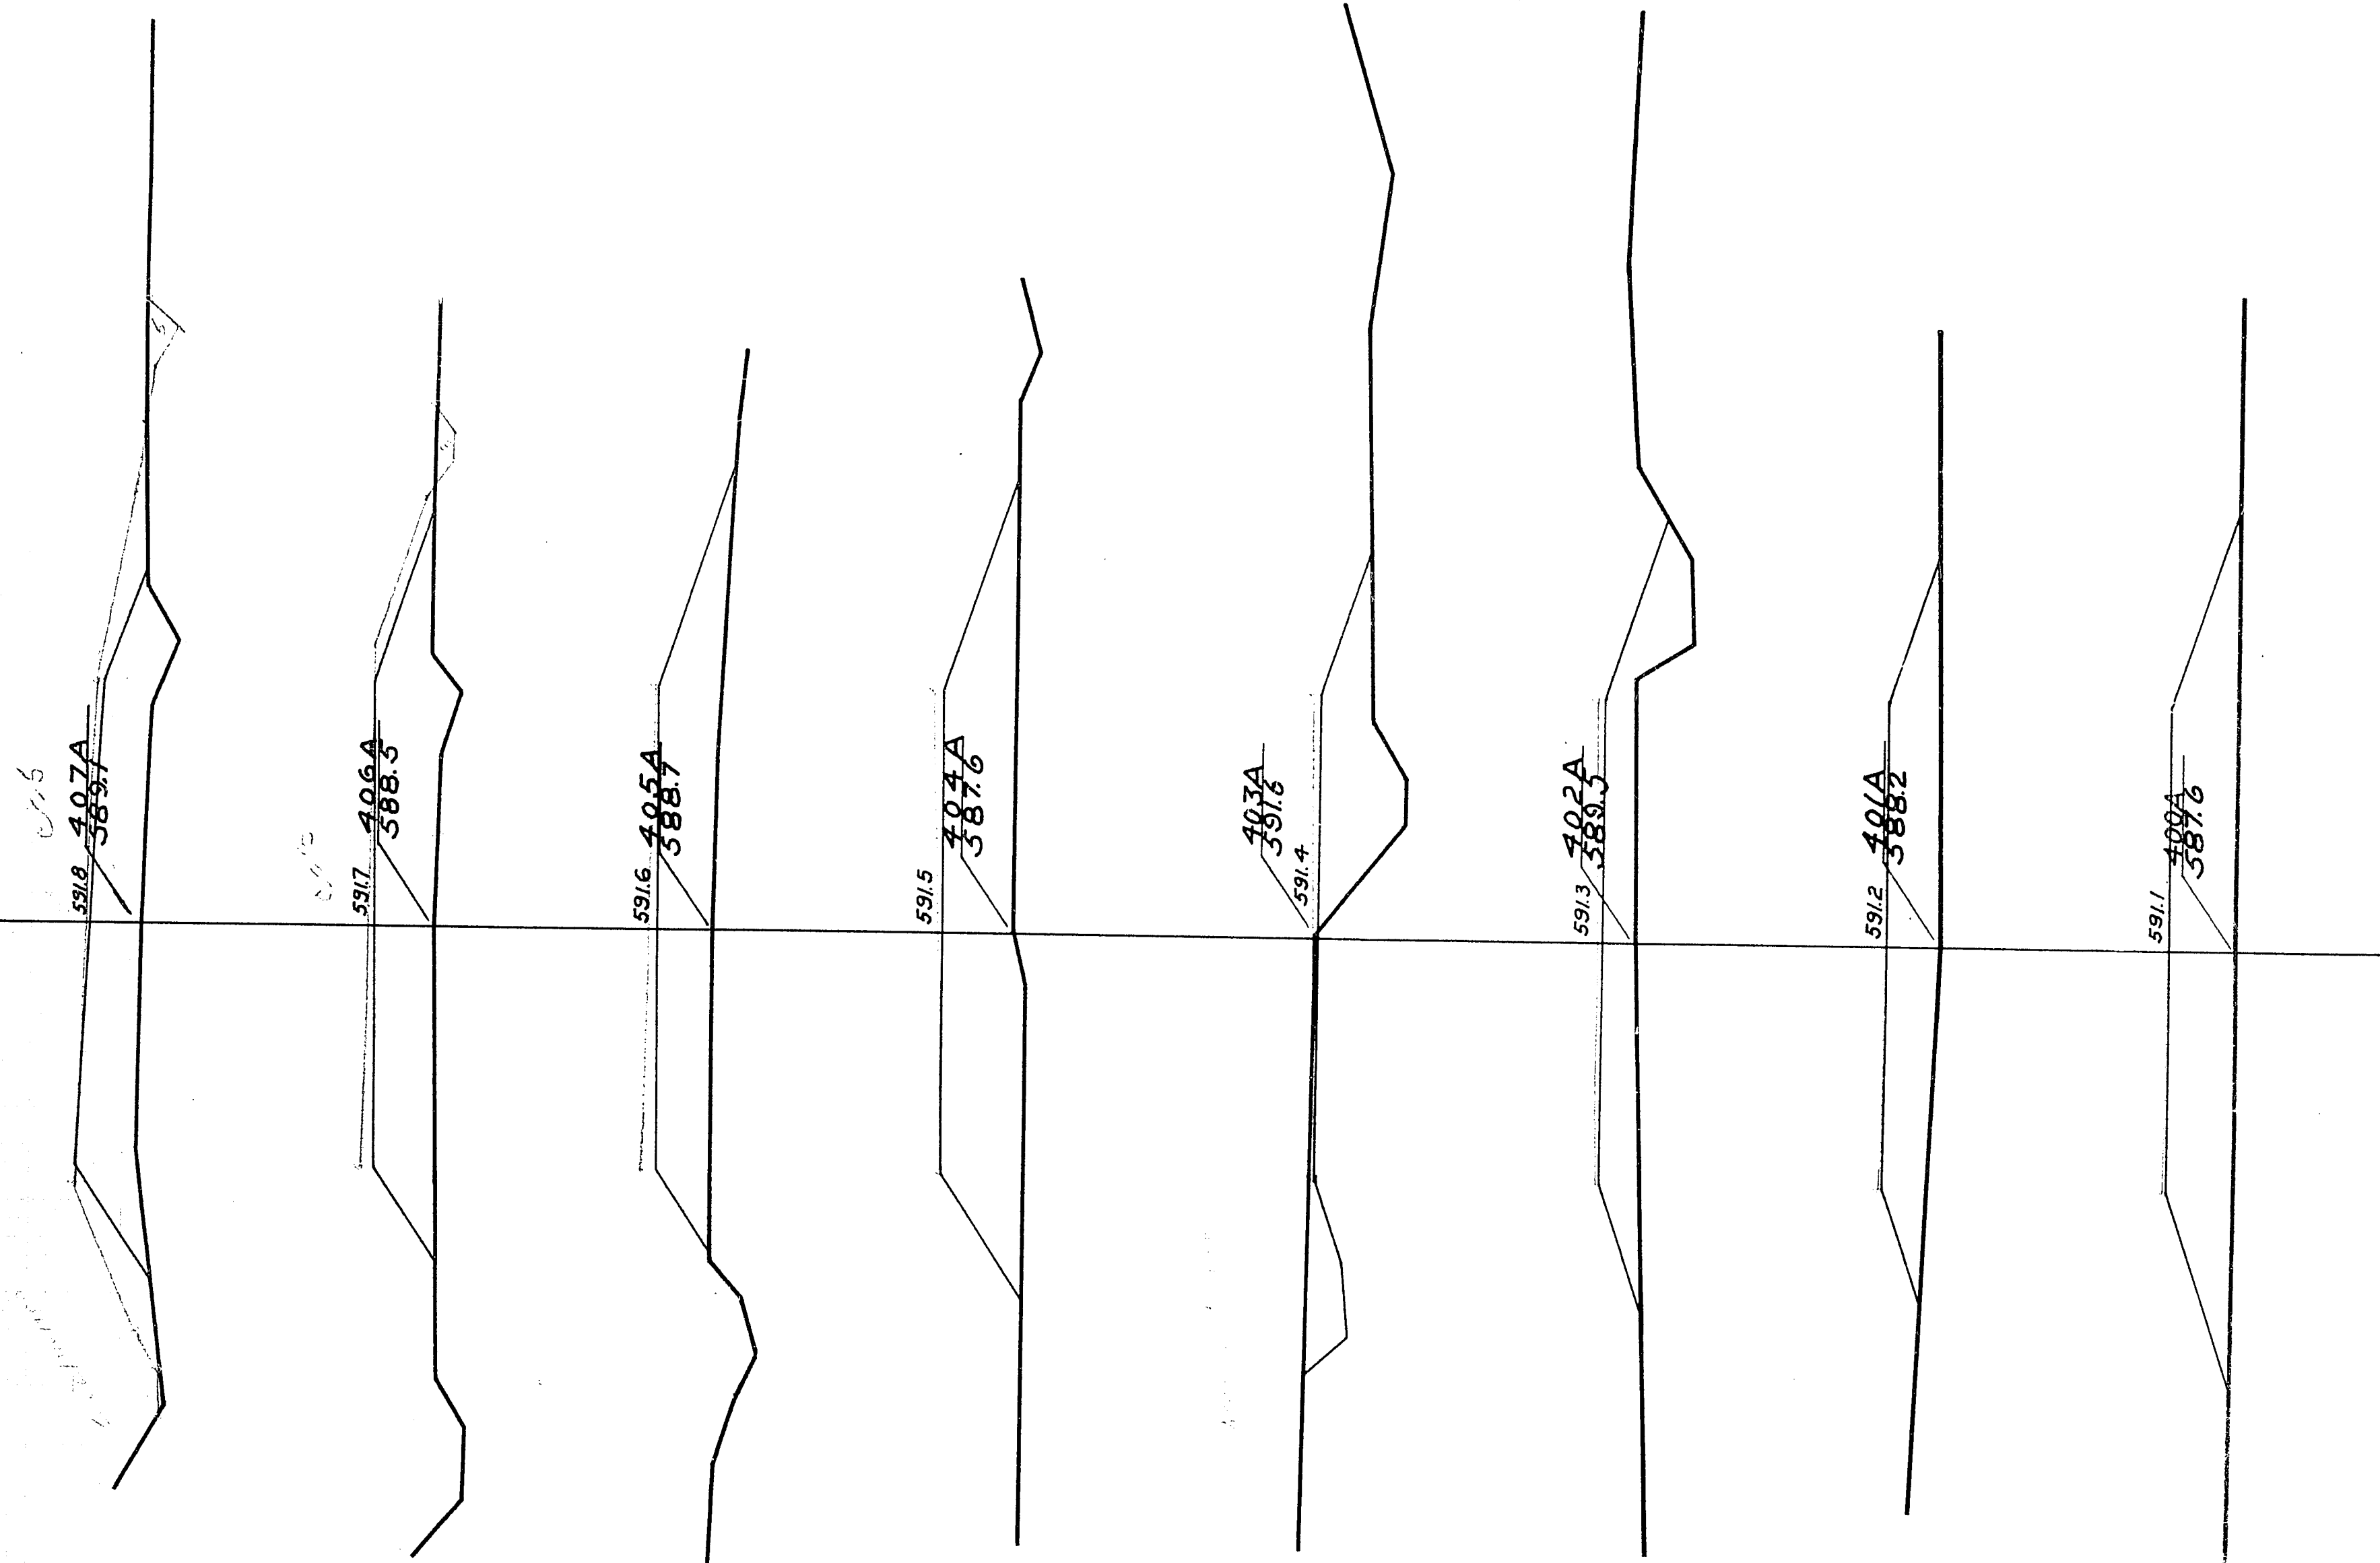
STATION	END AREA			YARDAGE				
	CUT		DISTANCE	CUT				TOTAL FILL
	EARTH	ROCK		EARTH	L. ROCK	S. ROCK	TOTAL	
369	34		35					
370	5		87				72	226
+77	5		113				15	285
371	64		12				100	181
55							93	28
372	46		20				126	35
+69	51		7				67	174
373	46		132				2	200
55	2						54	339
374	1		126				152	130
375	28		53					
376	54		17					
TOTAL							681	1598

FED. ROAD DIST. NO.	STATE	State AID PROJ. NO.	SHEET NO.	TOTAL SHEETS
4	WISC.	9408	82	111
DIVISION JOB NO.			9408	

[illegible]

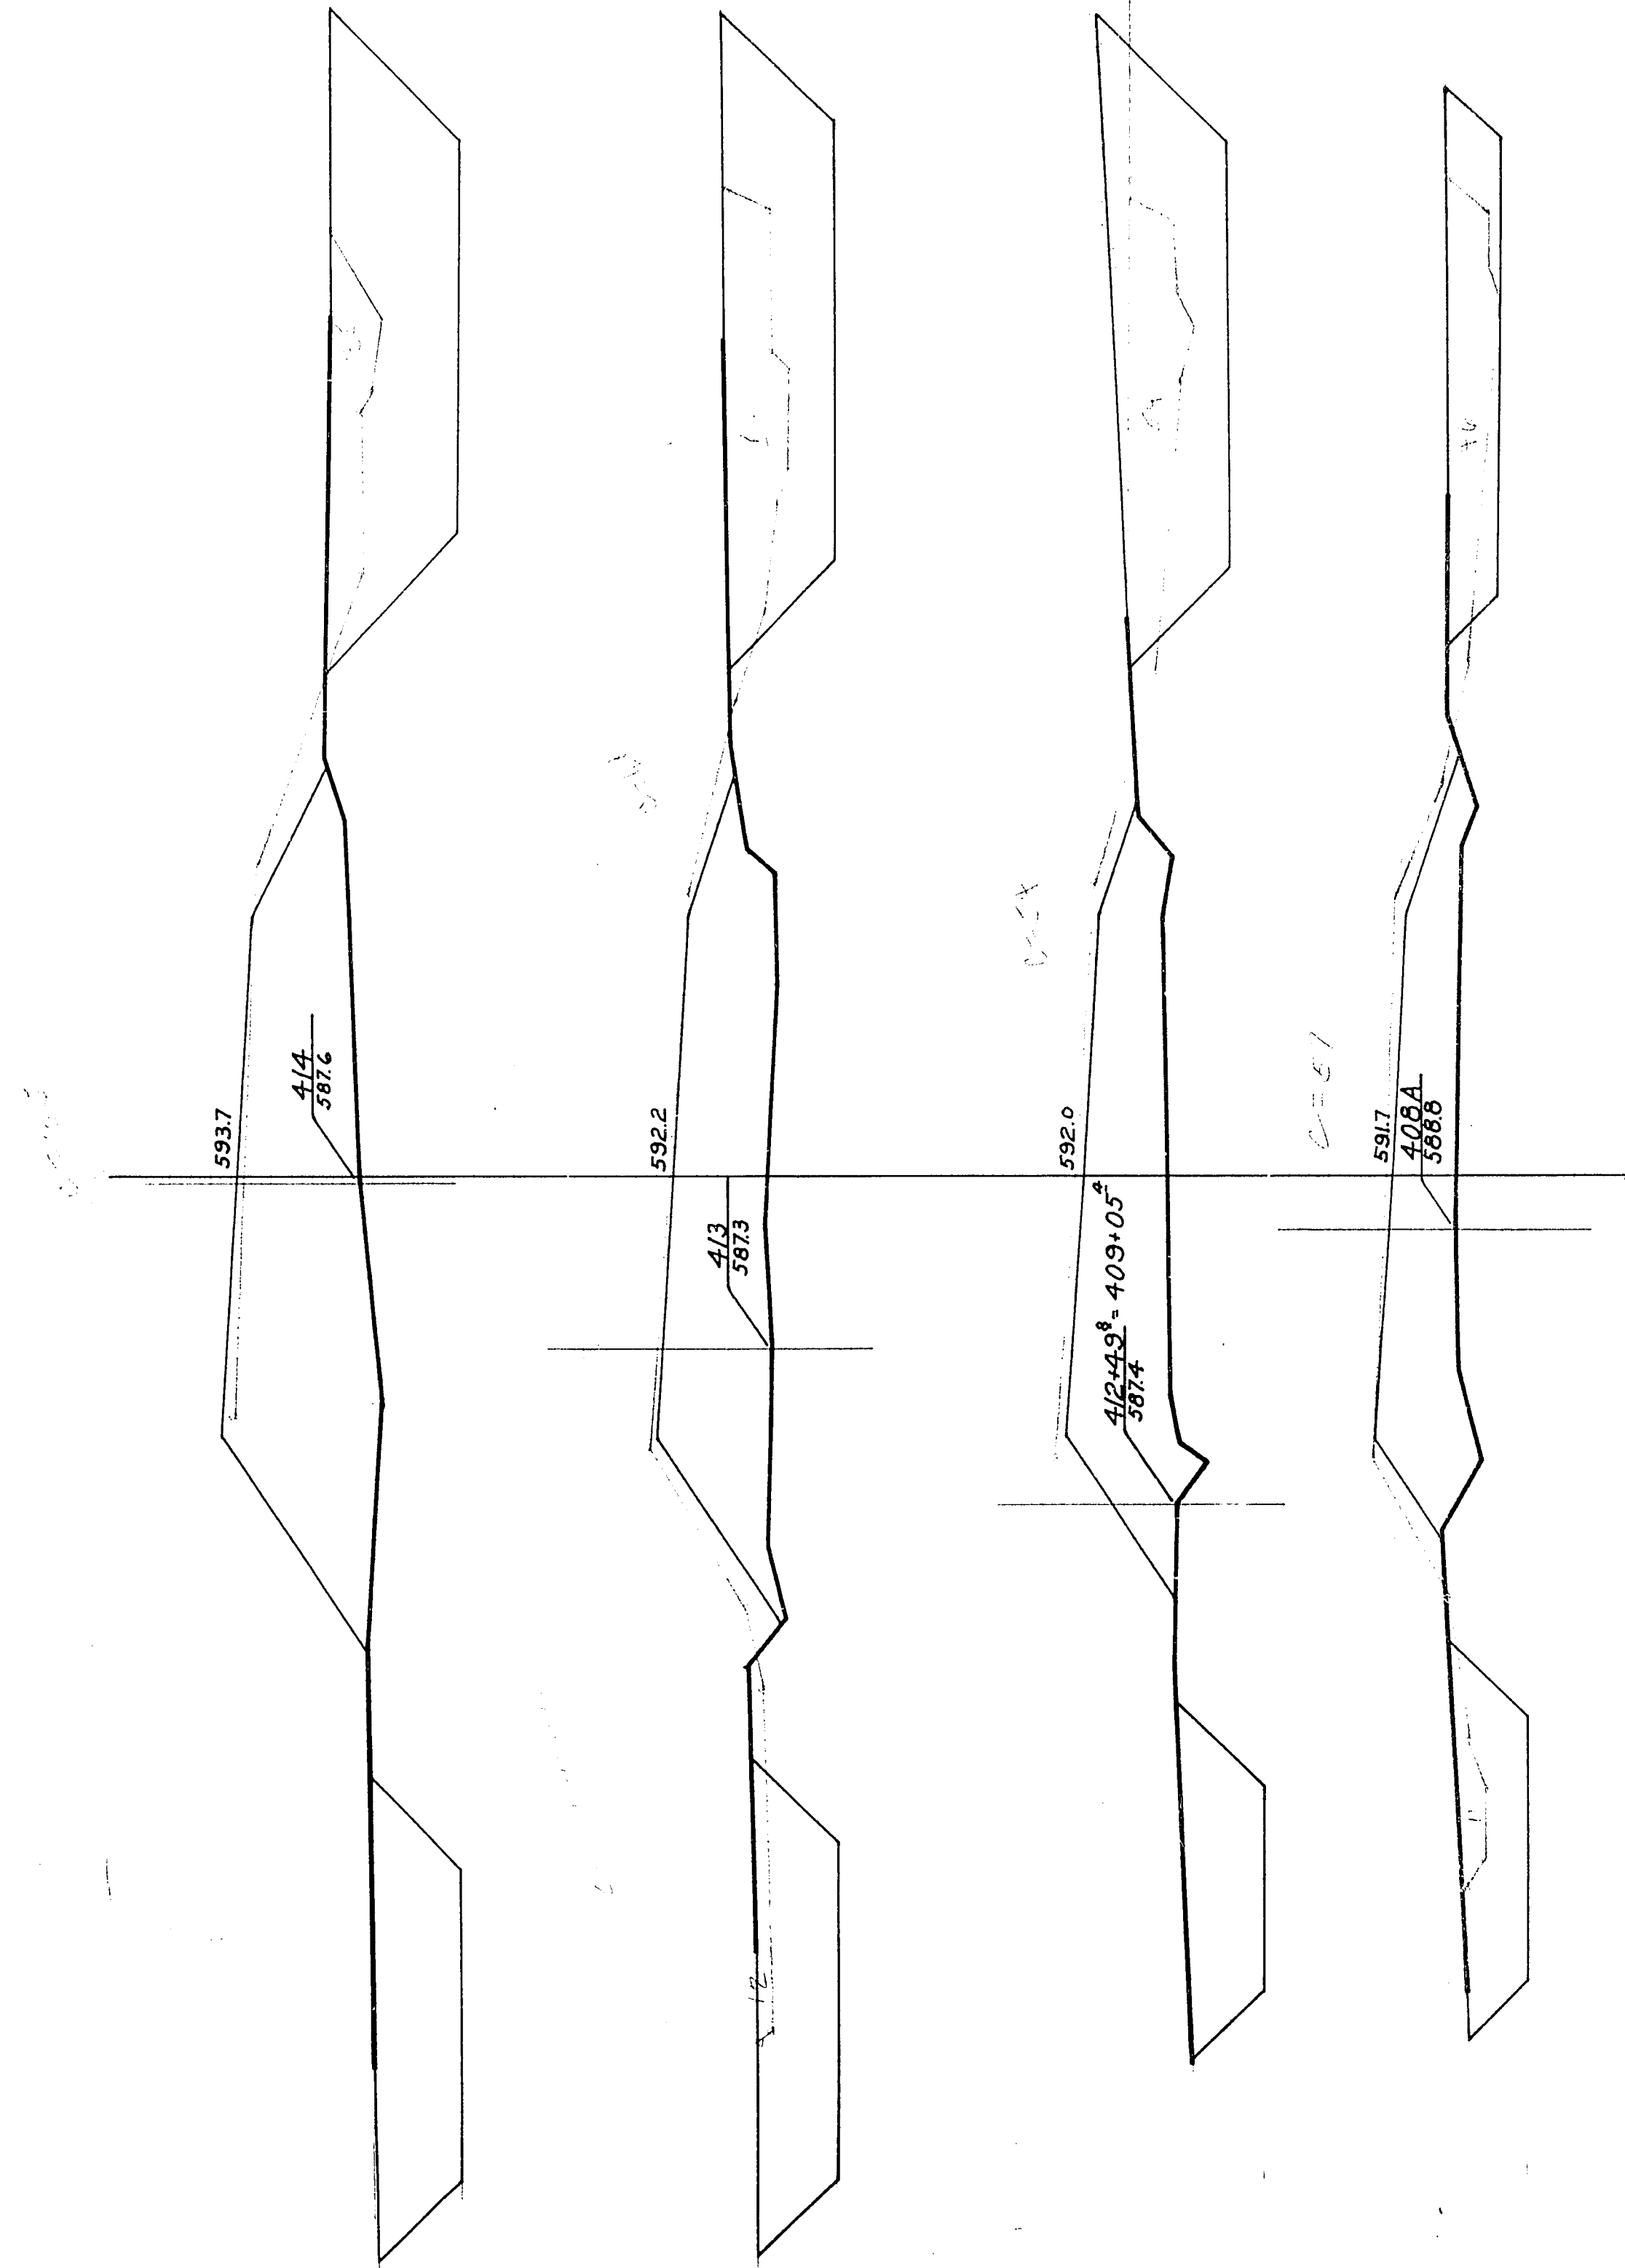


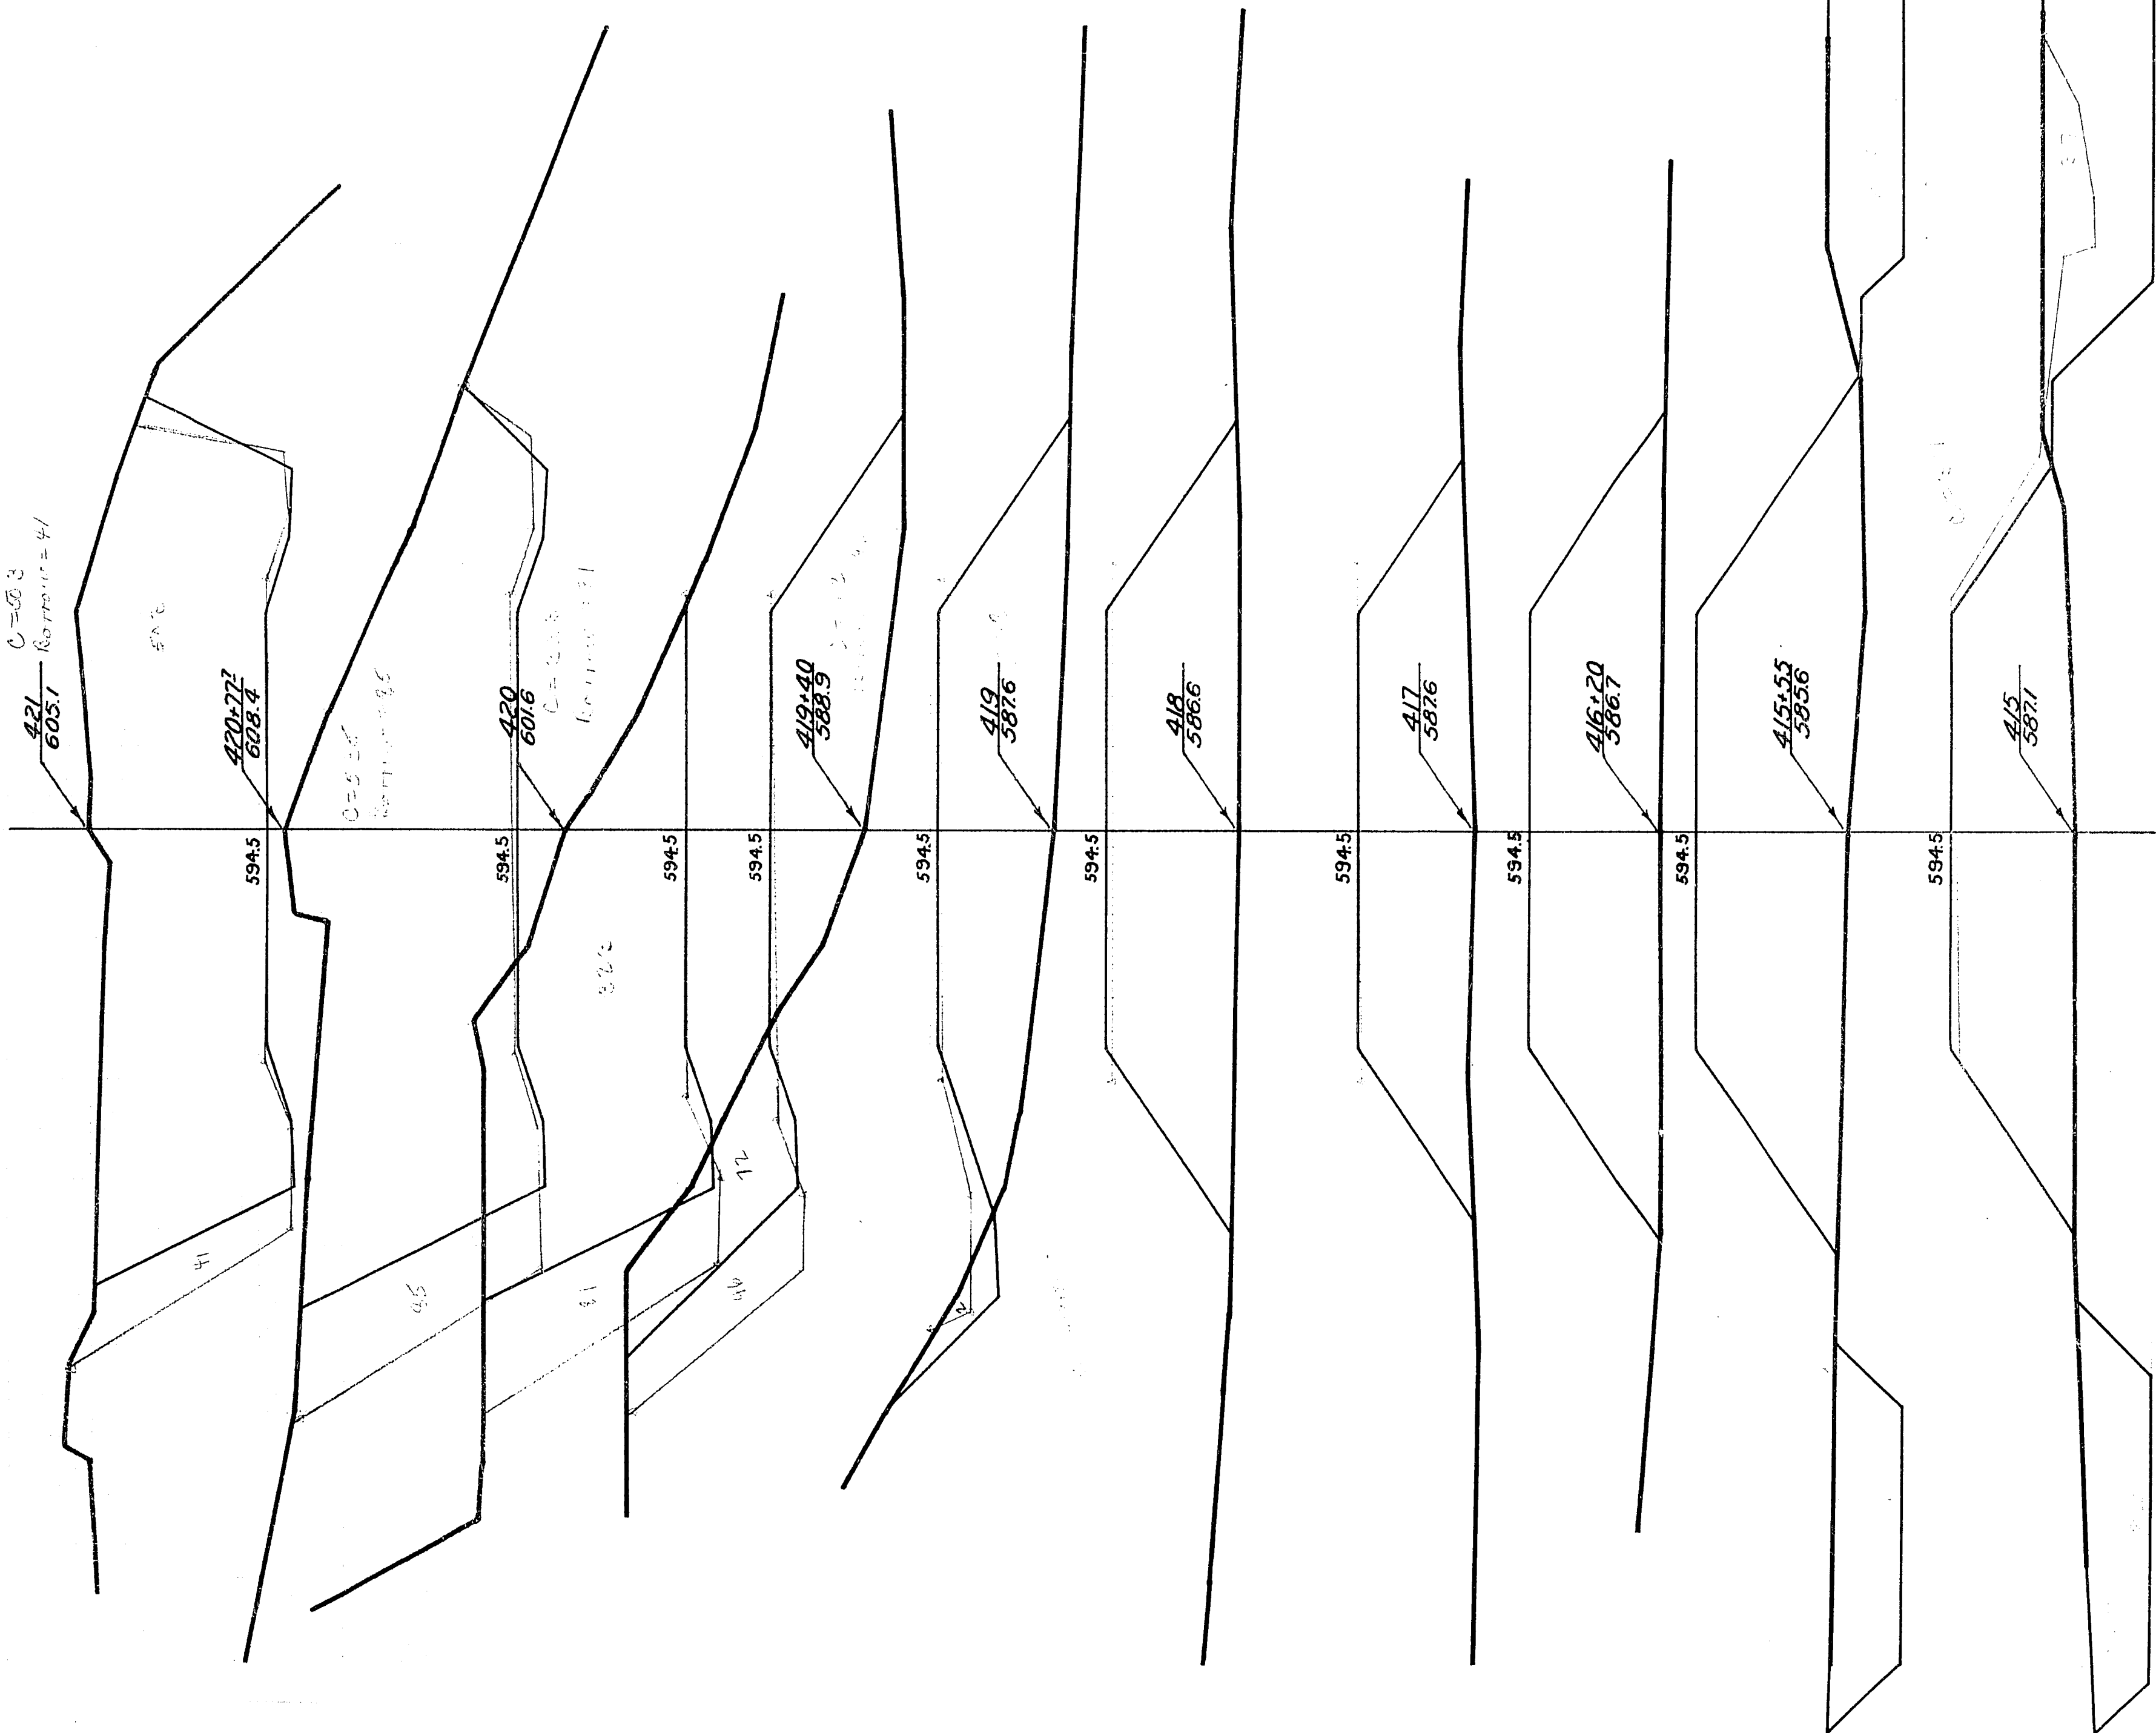
STATION	END AREA			DISTANCE	YARDAGE					
	CUT		FILL		CUT				TOTAL FILL	
	EARTH	ROCK			EARTH	L. ROCK	S. ROCK	TOTAL		
392	142		0							
393	442		0					1081	0	
394	579		0					1891	0	
395	680		0					2332	0	
				16				398	0	
+16	662		0					785	135	
+60	0		165							
+80	0			40				0	285	
396	0		220					0	589	
397	0		98					0	311	
398	0		70					9	193	
399	5		34							

[illegible]

FED. ROAD DIST. NO.	STATE	State AID PROJ. NO.	SHEET NO.	TOTAL SHEET
4	WISC.	9408	86	111

DIVISION JOB NO. 9408

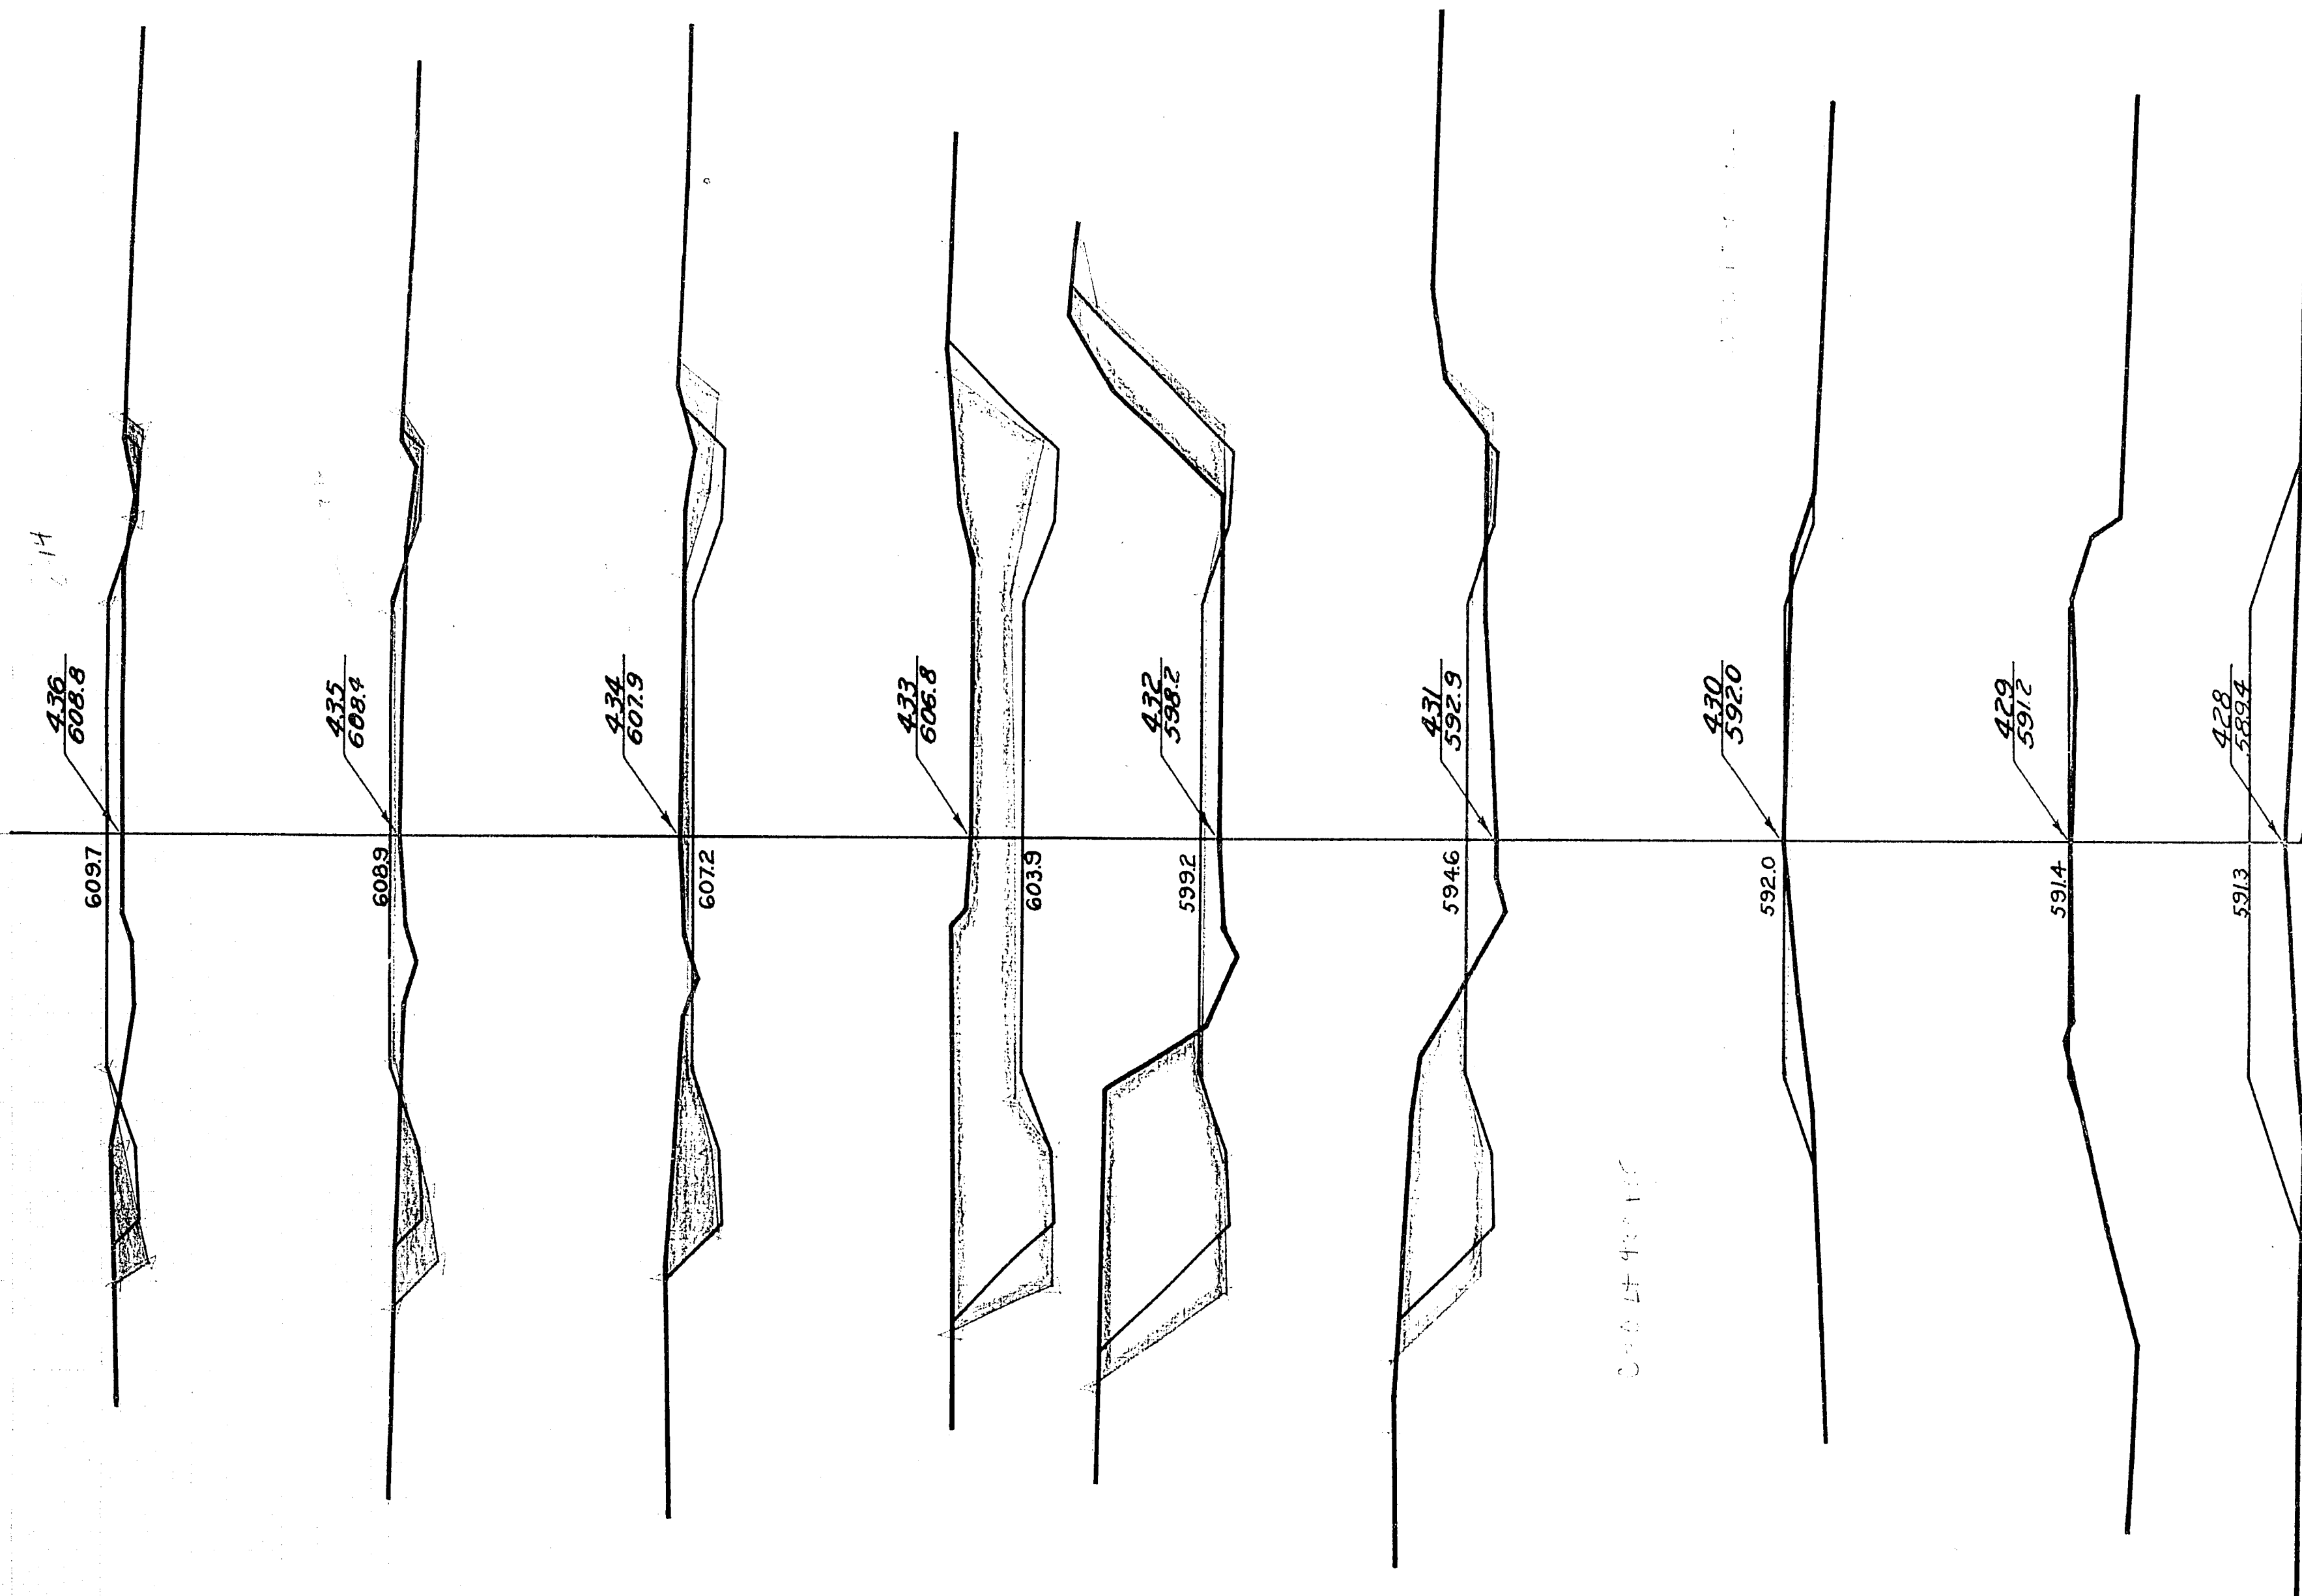
[illegible]



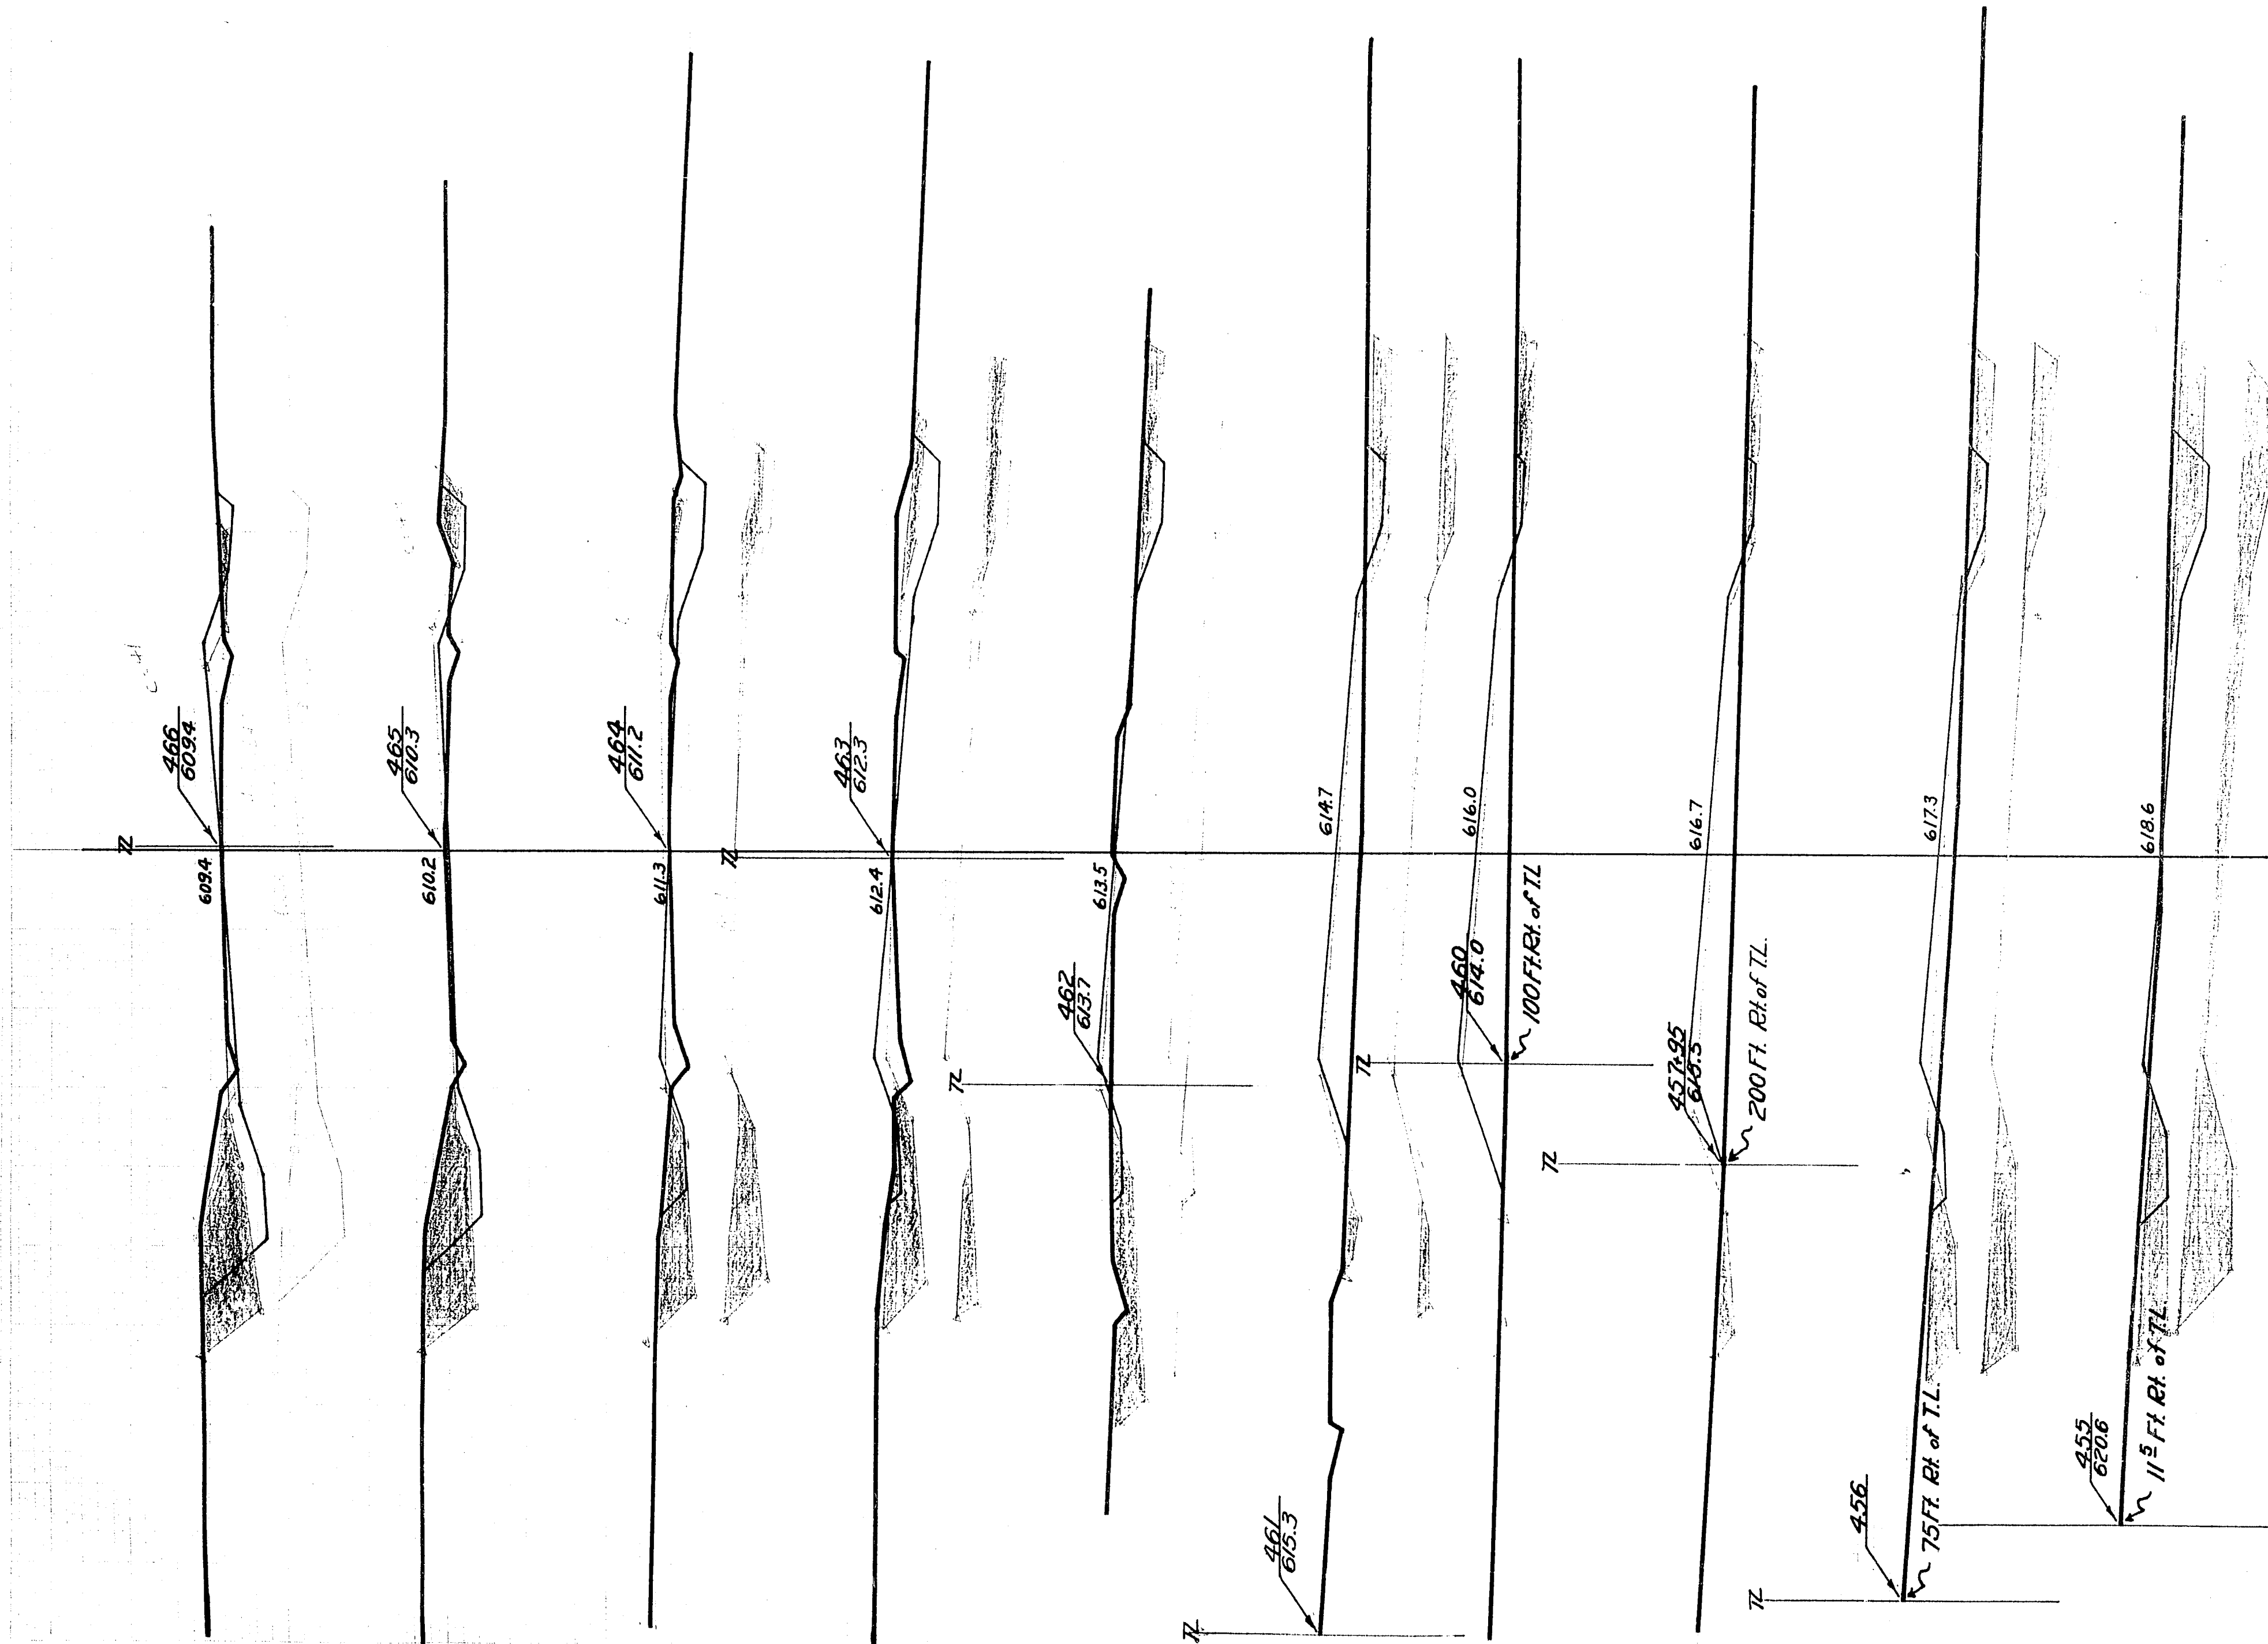
STATION	END AREA			DISTANCE	YARDAGE				
	CUT		FILL		CUT				TOTAL FILL
	EARTH	ROCK			EARTH	L. ROCK	S. ROCK	TOTAL	
414	248		242	100				931	987
415	255		257						
+25			0	25					119
+55	190							454	
	0								
416					Bridge				
+51	0		299	49				0	489
417	0		239						
				100				0	991
418	0		296	50				0	
+50	0								
				50				15	1006
419	15		247	40				69	309
+40	79		170						
				60				454	190
420	330		0	77				1283	0
+77	562		0						
				22				450	0
421	519		0						
TOTAL.								3656	4632

[illegible]

FED. ROAD DIST. NO.	STATE	STATE AID PROJ. NO.	SHEET NO.	TOTAL SHEETS
4	WISC.	9408	90	111
DIVISION		JOB NO. 9408		

[illegible]

[illegible]



STATION	END AREA			YARDAGE				
	EARTH	ROCK	FILL	CUT				TOTAL FILL
454	137		0					
455	38		4					
456	11		28					
457	3		58					
95								
460	3		75					
461	6		45					
462	16		7					
463	30		15					
464	24		8					
465	33		5					
466	45		11					
TOTAL								

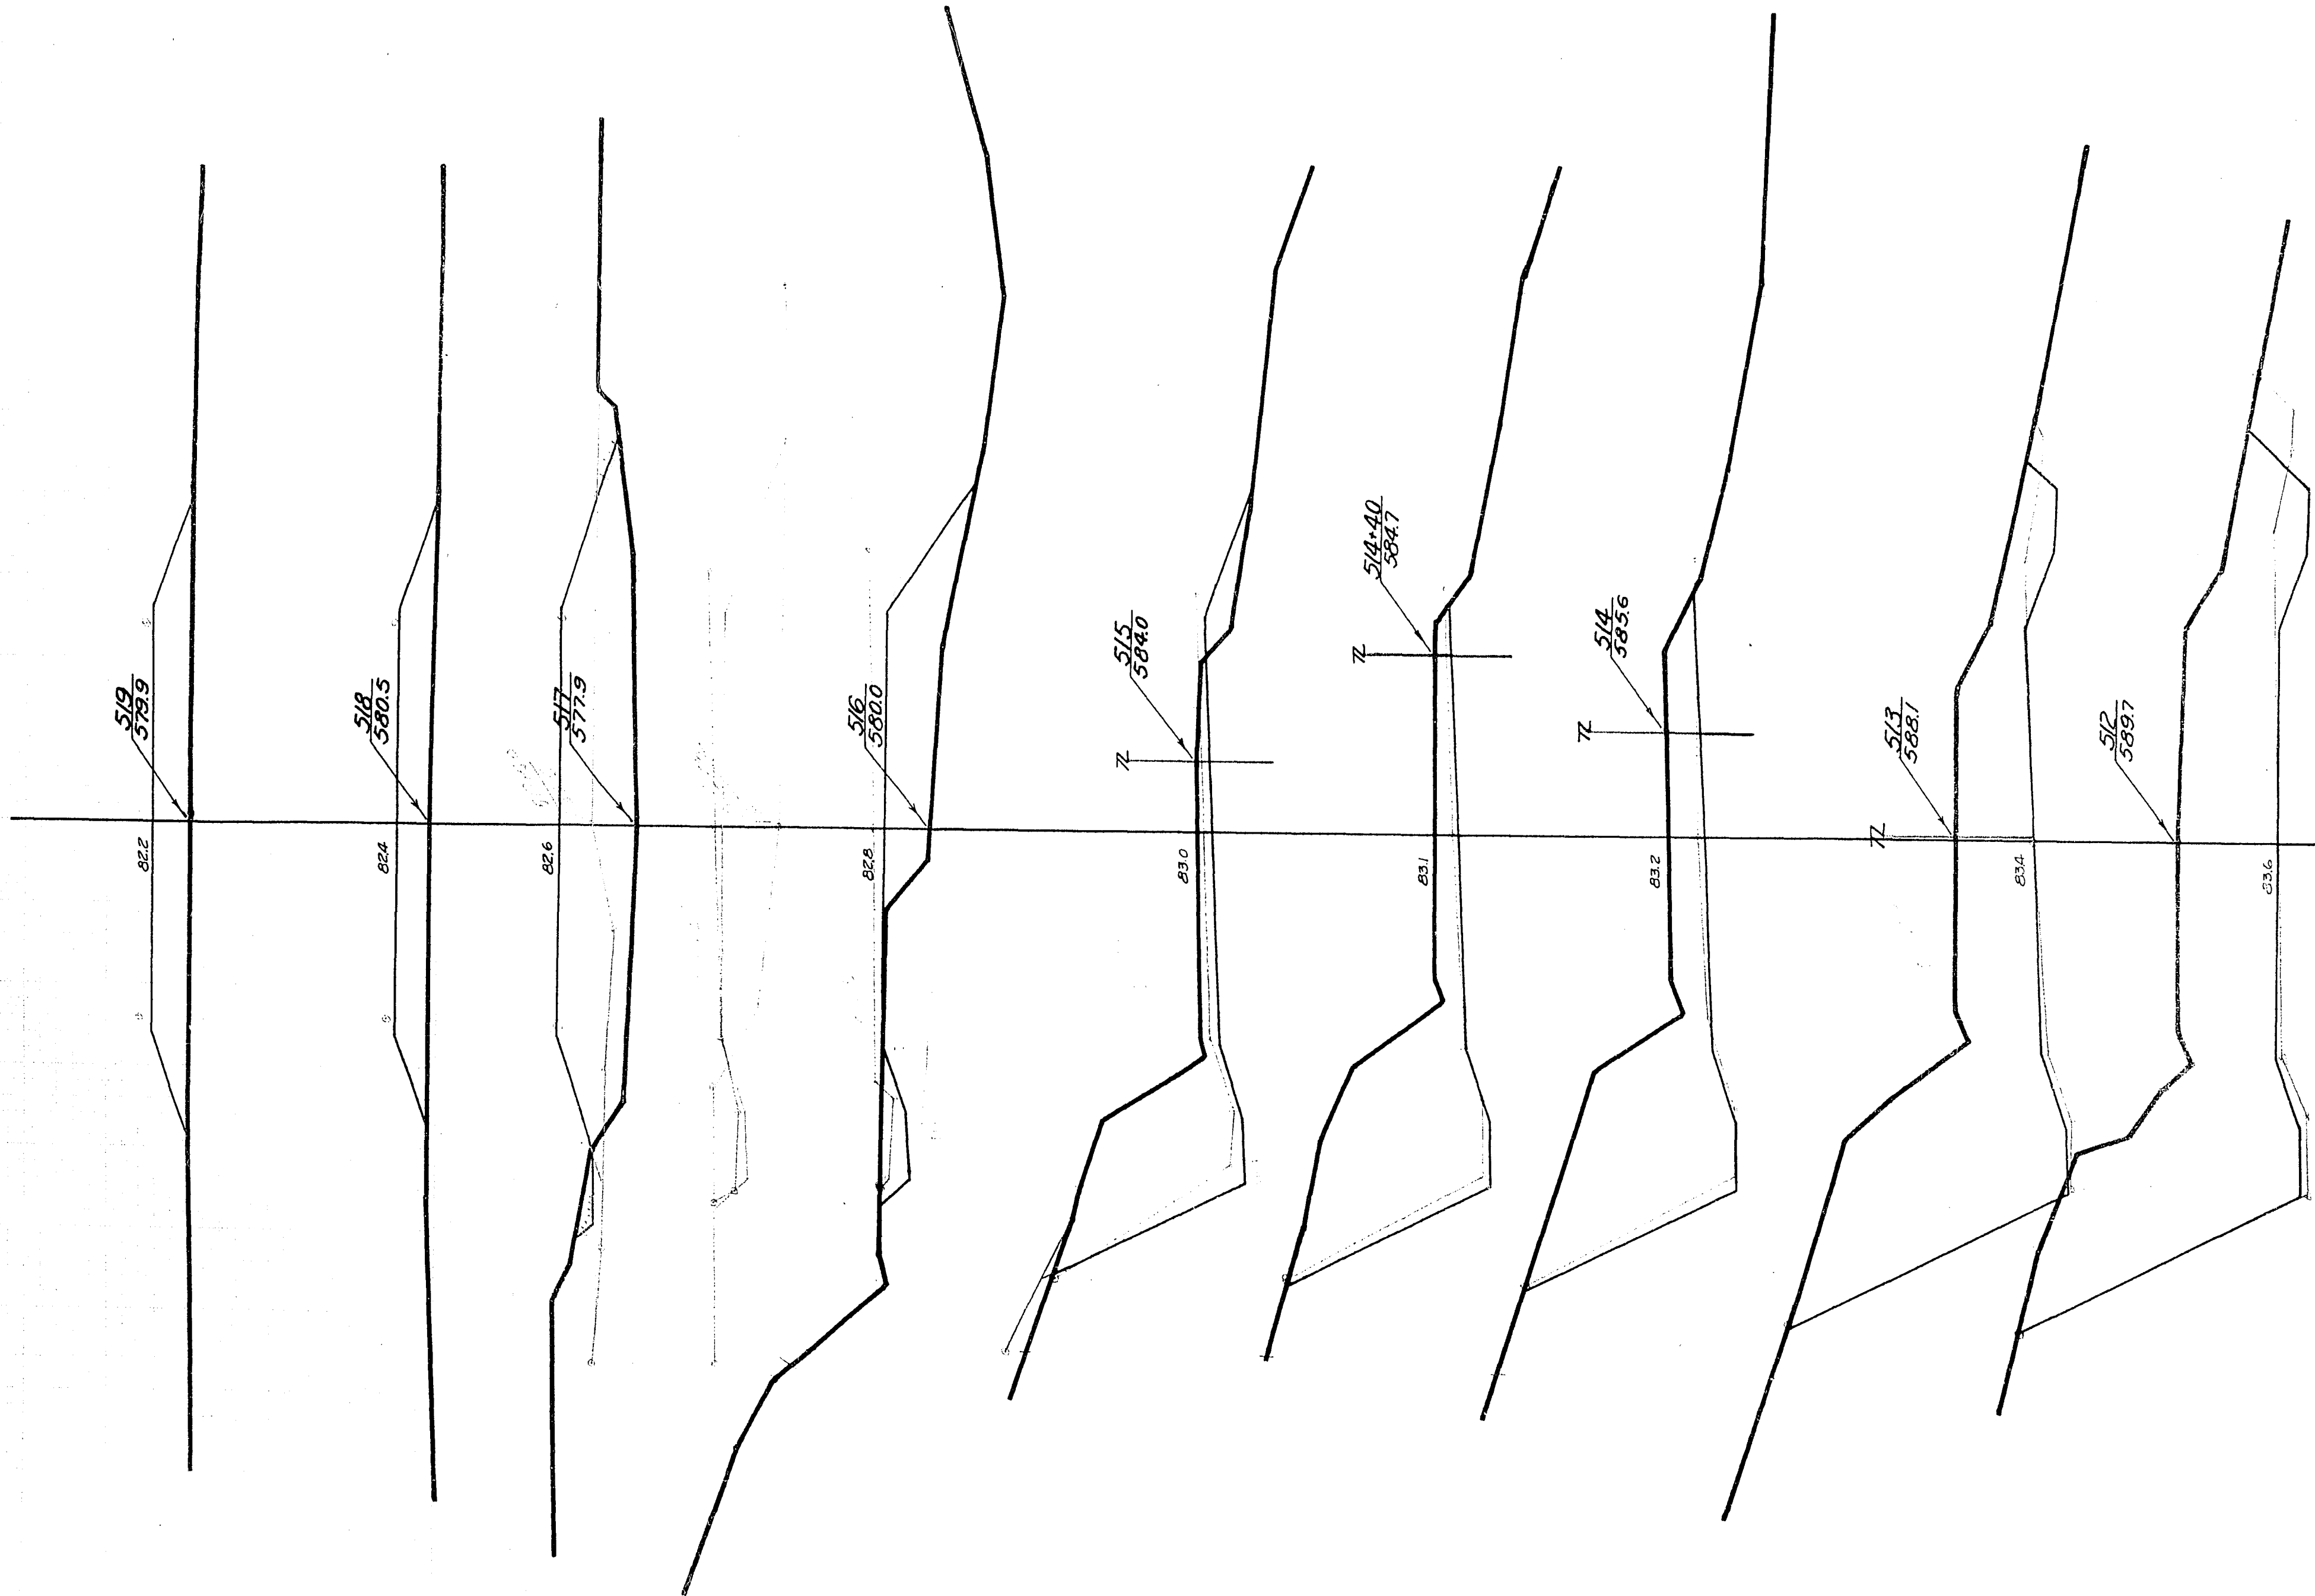
[illegible]

FED. ROAD DIST. NO.	STATE	STATE AID PROJ. NO.	SHEET NO.	TOTAL SHEETS
4	WISC.	9408	97	111
DIVISION		JOB NO. 9408		

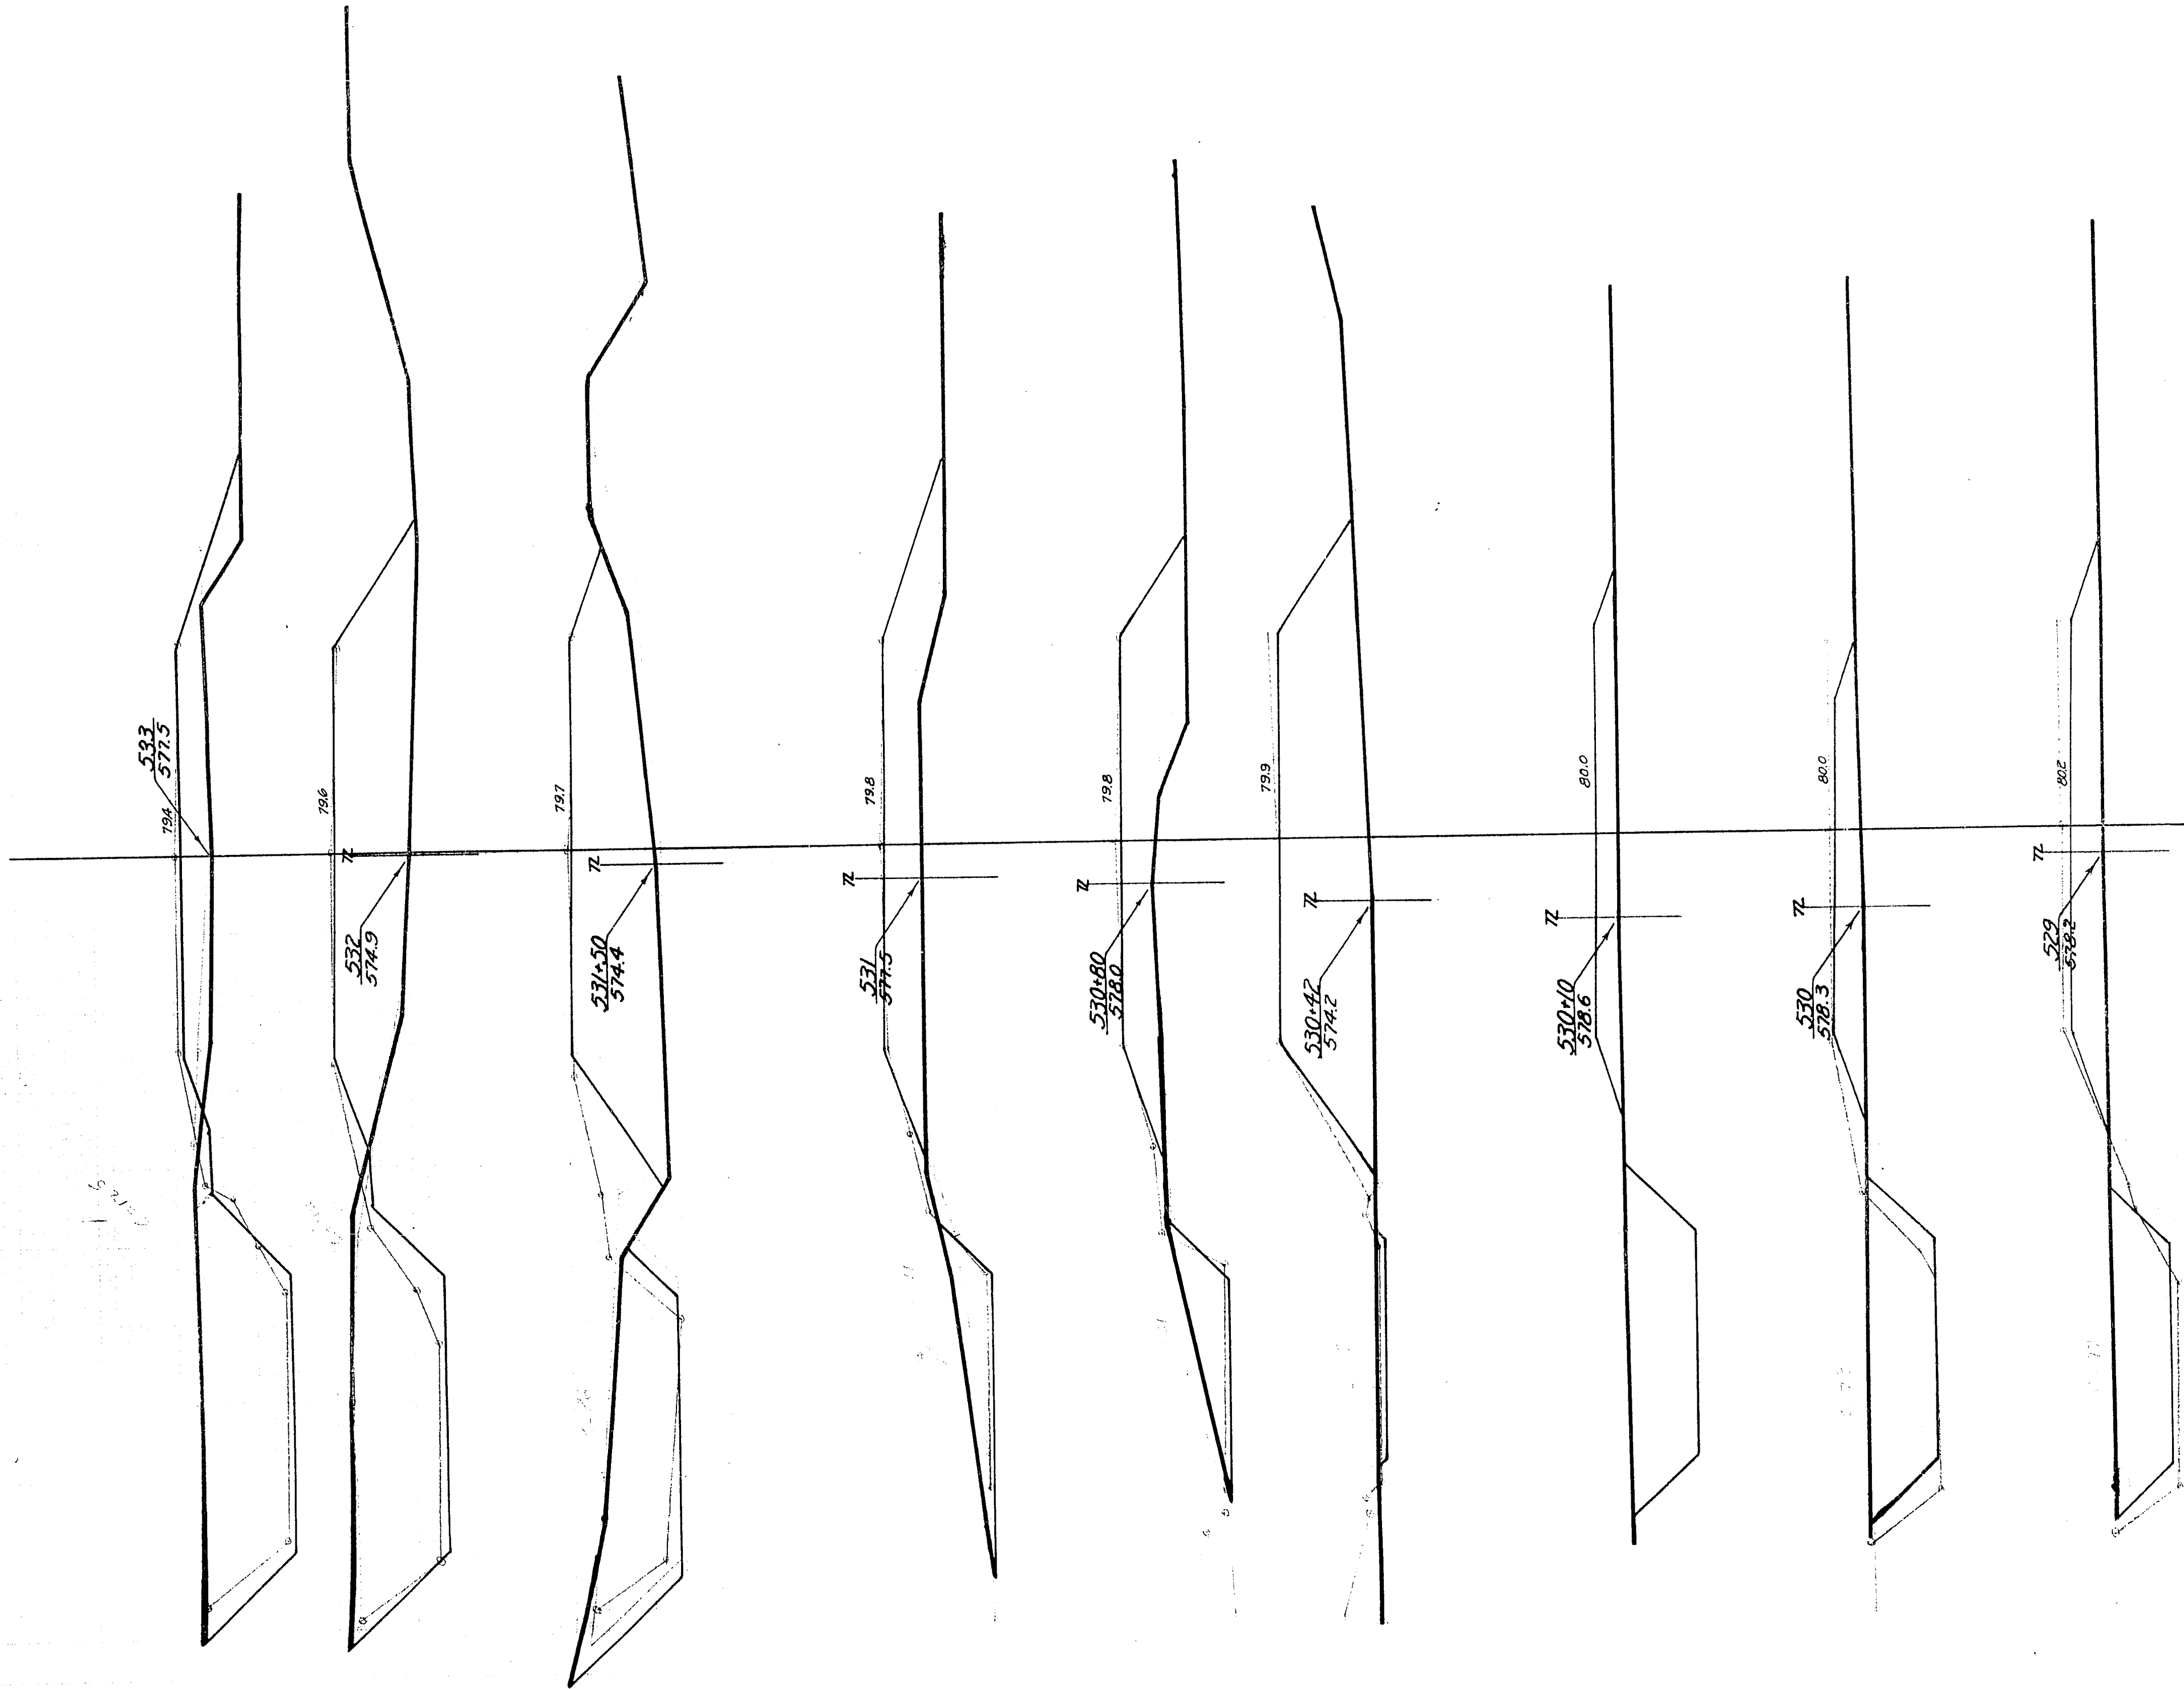
[illegible]

[illegible]

FED. ROAD DIST. NO.	STATE	STATE AID PROJ. NO.	SHEET NO.	TOTAL SHEETS
4	WISC.	9408	99	111
DIVISION JOB NO. 9408				

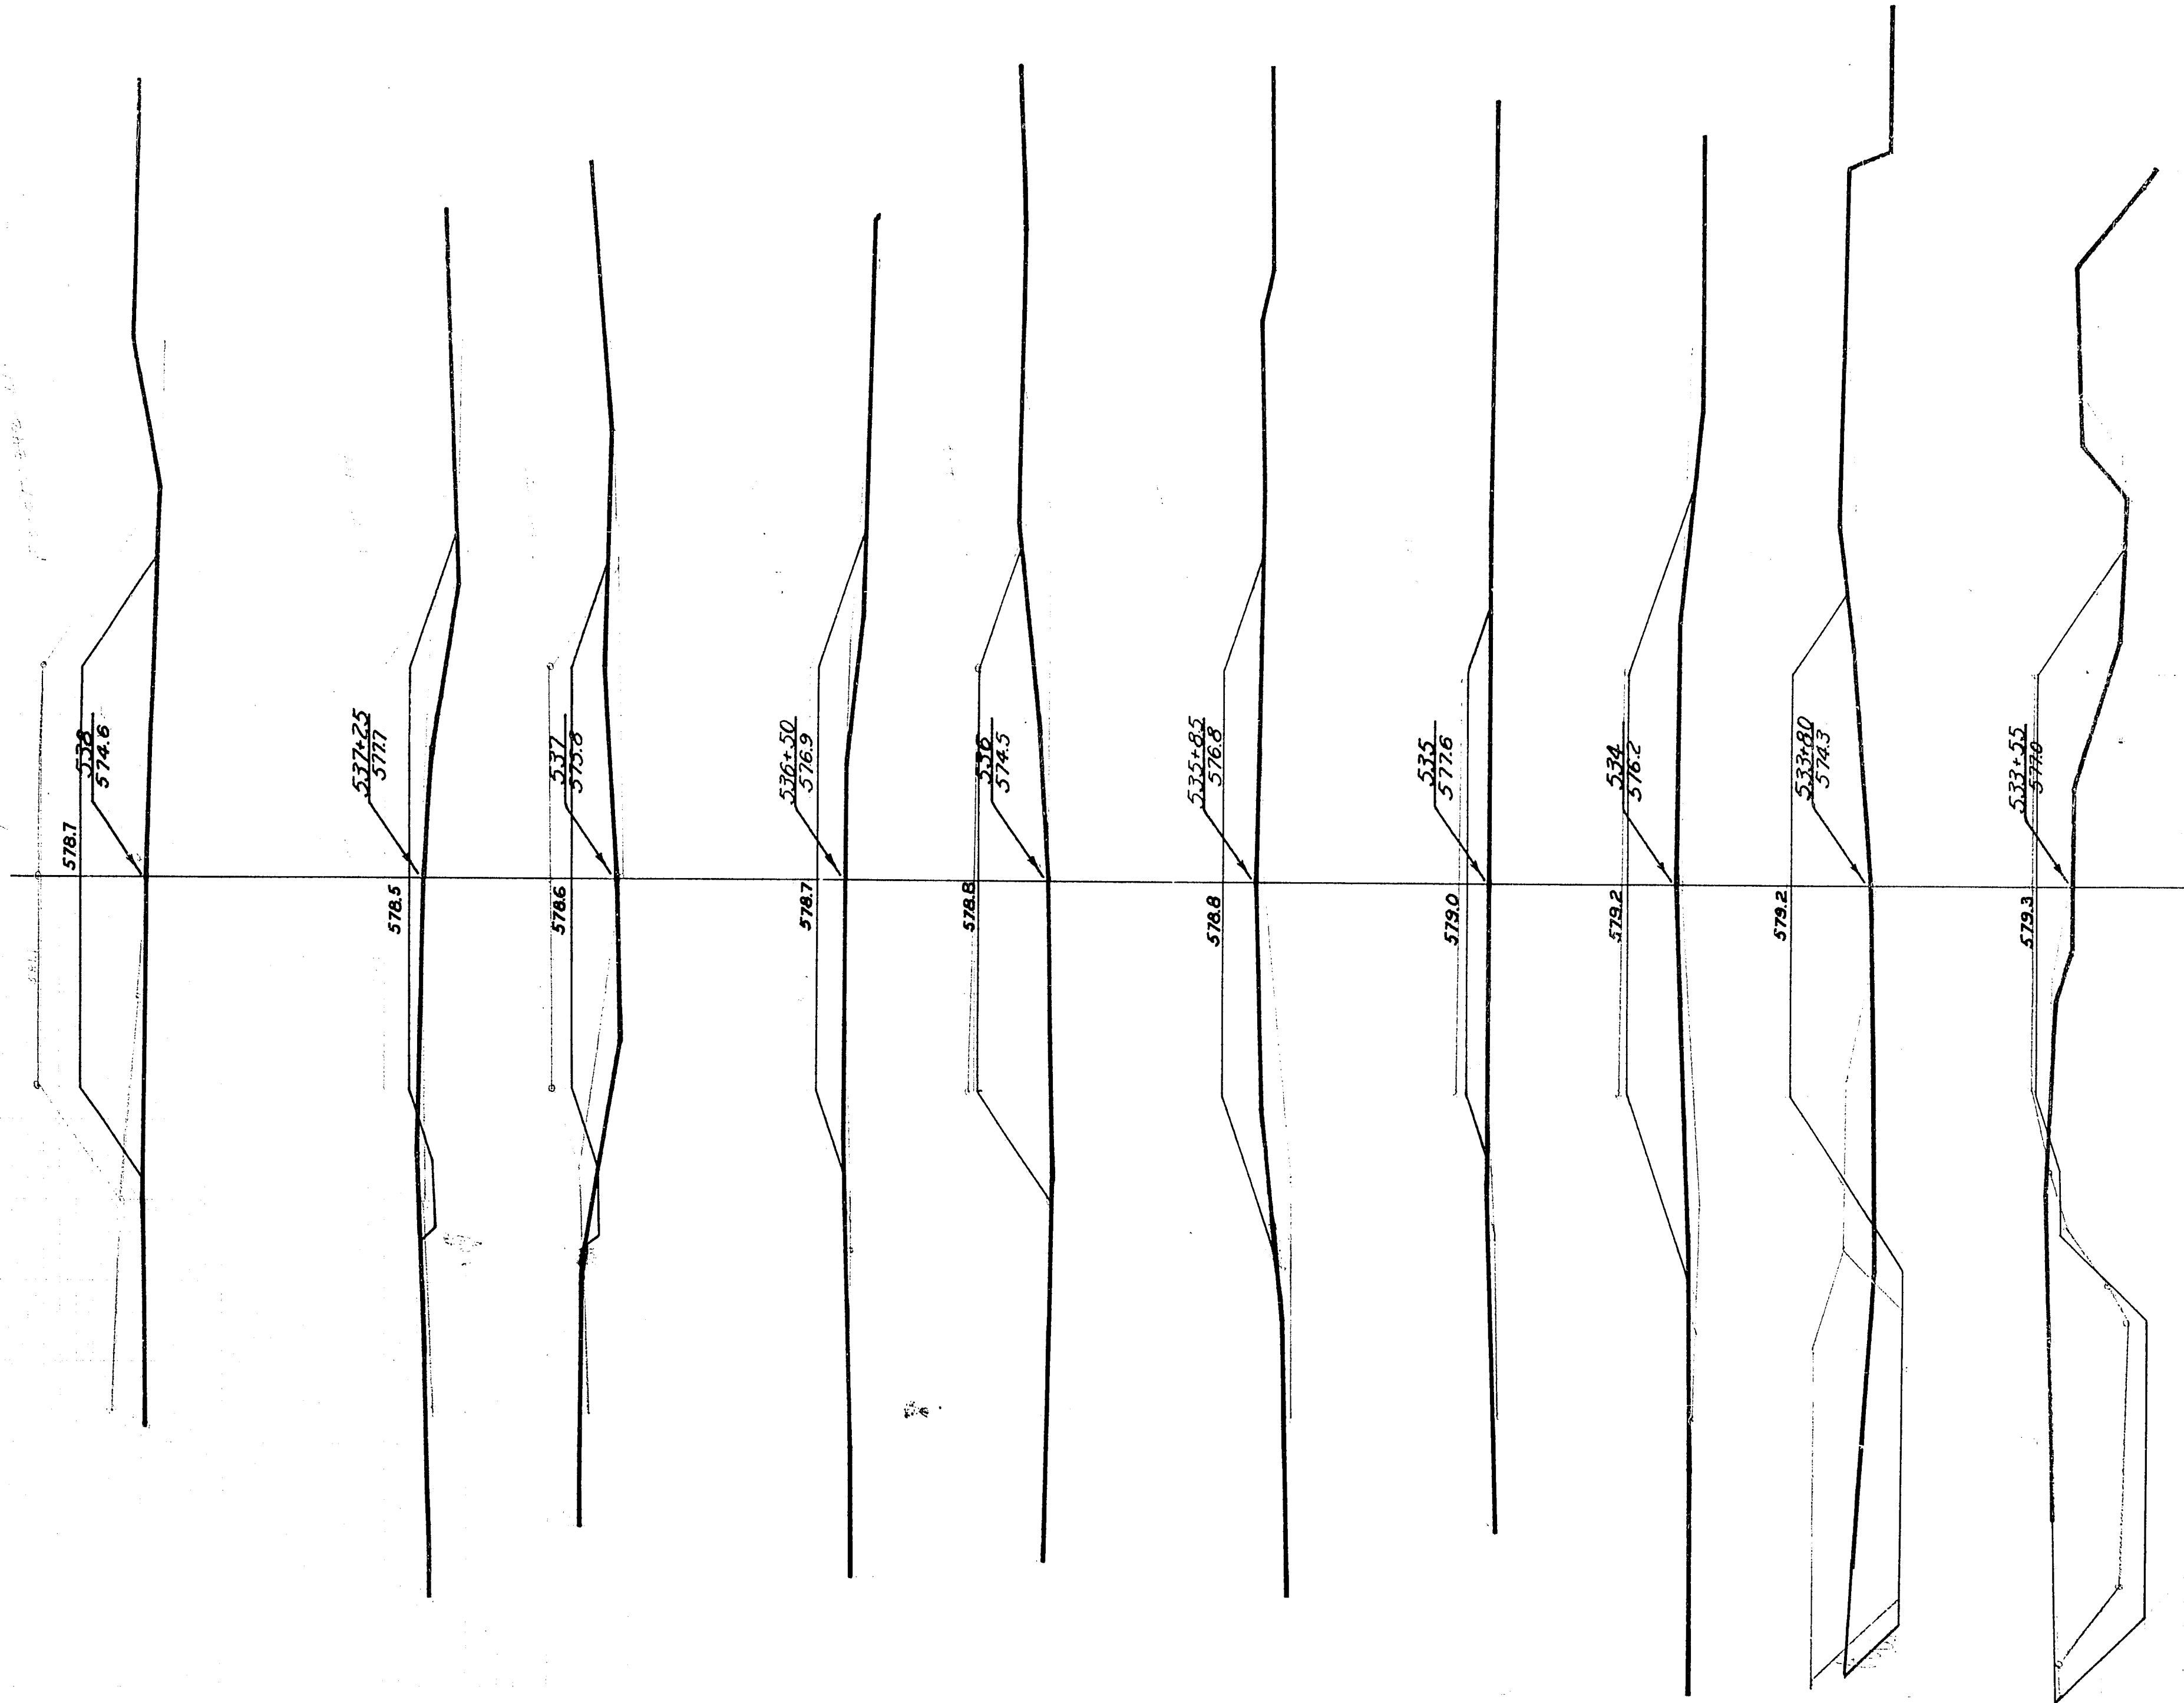
[illegible]

[illegible]



STATION	END AREA			YARDAGE				
	CUT			DISTANCE	CUT			
	EARTH	ROCK	FILL		EARTH	L. ROCK	S. ROCK	TOTAL
528	61		62					231 235
529	64		65					257 213
530	75		50	099				28 19
+10	80		48	312				52 139
+42	8		187	38				26 202
+80	28		99	20				20 72
531	29		95	50				122 244
+50	103		170	50				226 296
532	141		150	100				517 393
533	138		62					
TOTAL								4479

FED. ROAD DIST. NO.	STATE	StateAID PROJ. NO.	SHEET NO.	TOTAL SHEETS
4	WISC.	9408	102	111
DIVISION JOB NO.			9408	

[illegible]

[illegible]

FED. ROAD DIST. NO.	STATE	5% ¹ /CAID PROJ. NO.	SHEET NO	TOTAL SHEETS
4	WISC.	9408	104	111

DIVISION JOB NO. 94-08

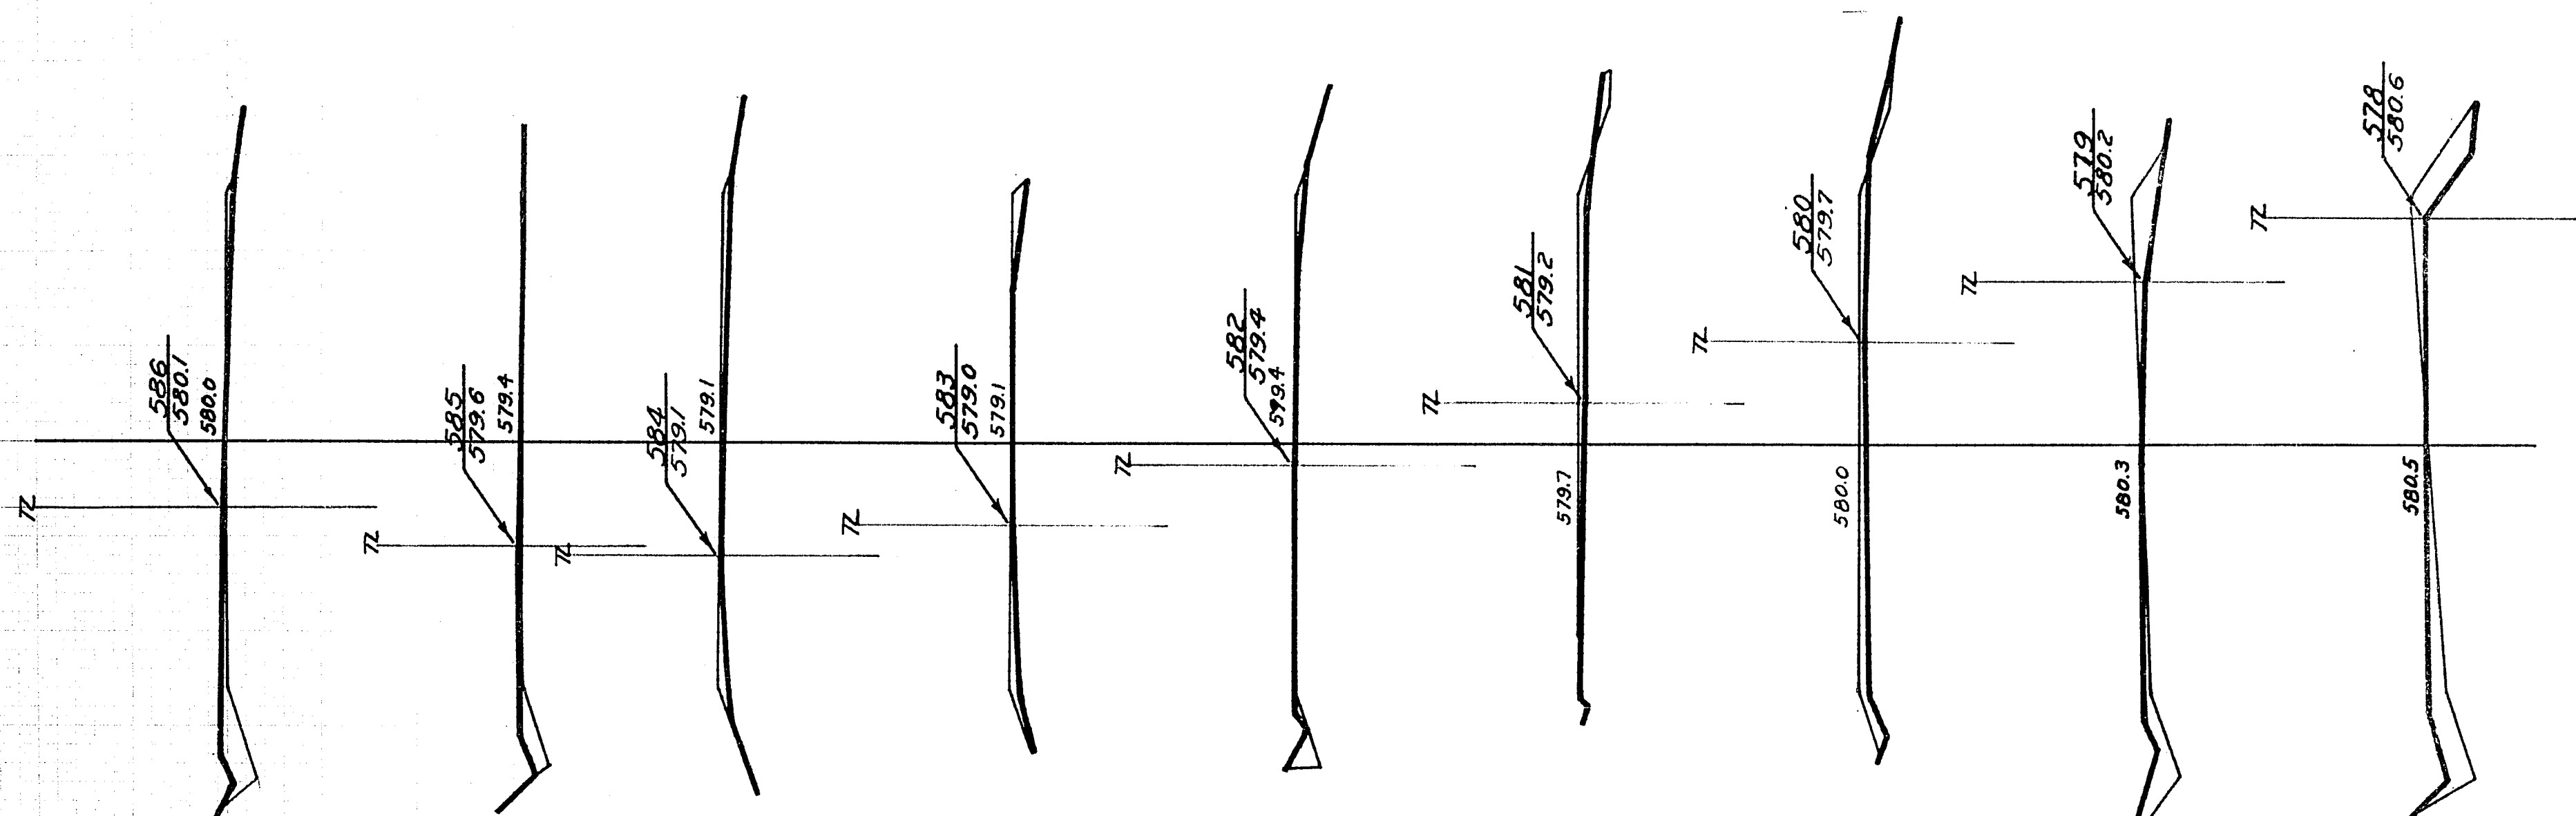
[illegible]

DIVISION JOB NO. 9408

[illegible]

[illegible]

FED. ROAD DIST. NO.	STATE	AID PROJ. NO.	SHEET NO.	TOTAL SHEETS
4	WISC.			

DIVISION JOB NO

[illegible]

FED. ROAD DIST. NO.	STATE	AID PROJ. NO.	SHEET NO.	TOTAL SHEETS
4	WISC.			

DIVISION JOB NO. ---

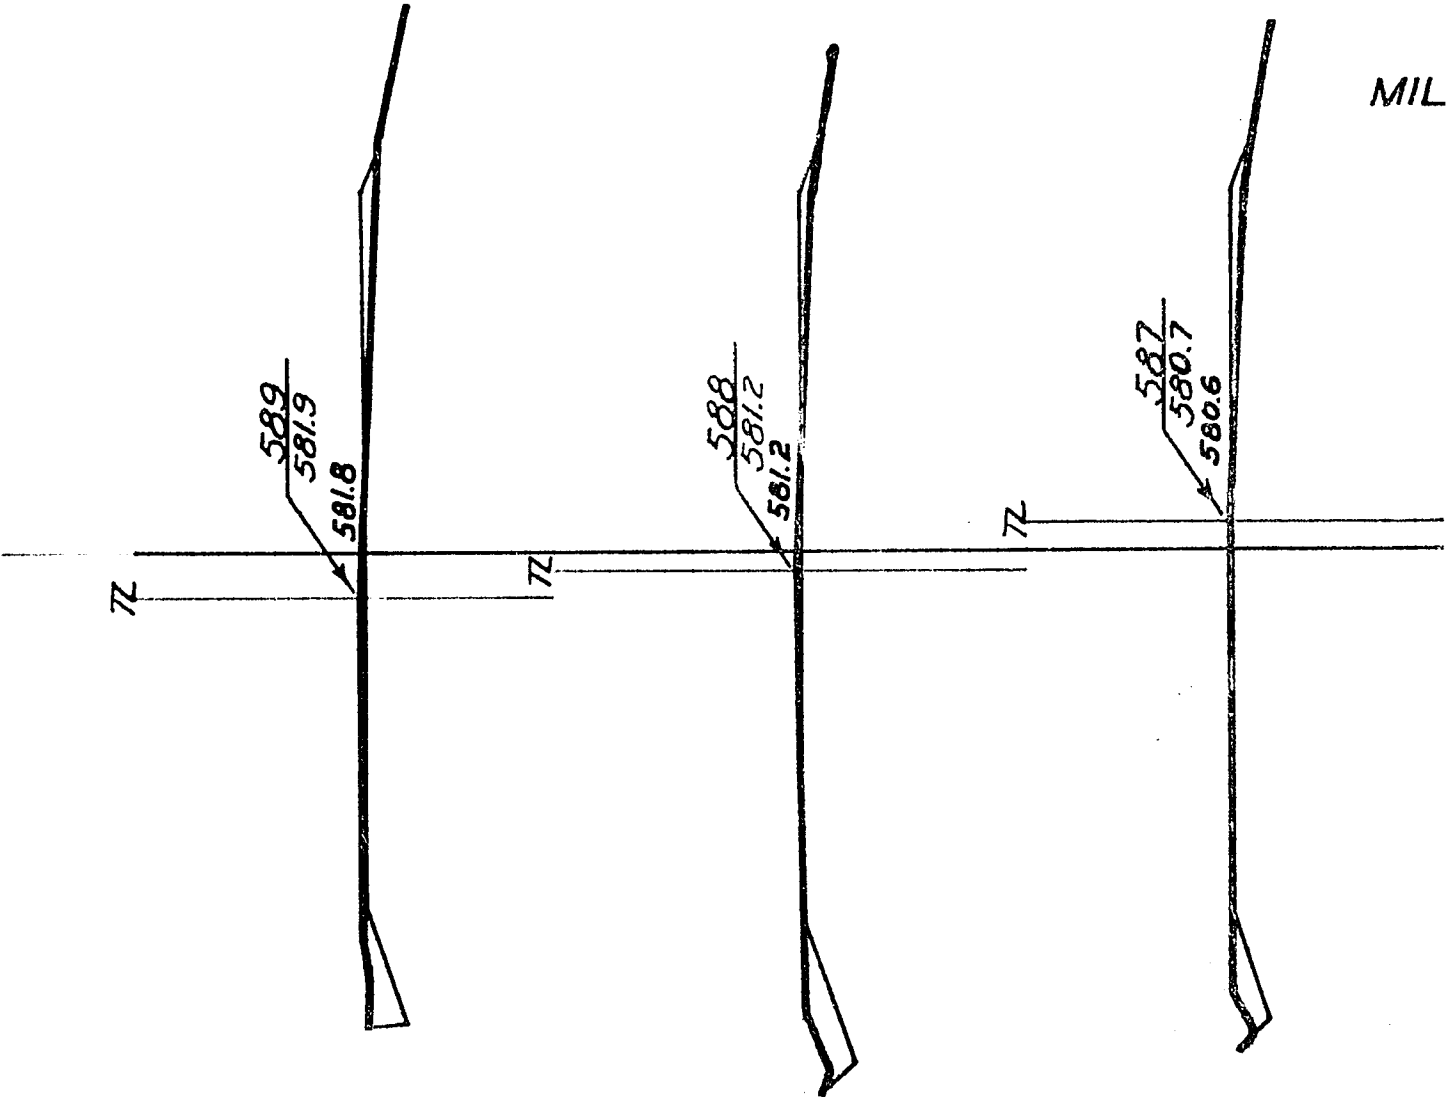
[illegible]

FED. ROAD DIST. NO.	STATE	AID PROJ. NO.	SHEET NO.	TOTAL SHEETS
4	WISC.			

DIVISION JOB NO

[illegible]

STATION	END AREA			DISTANCE	YARDAGE				
	CUT				CUT				TOTAL FILL
	EARTH	ROCK	FILL		EARTH	L. ROCK	S. ROCK	TOTAL	
586	10		1						
587	4		1					26	4
				99				17	6
588	5		2						
				100°				15	7
589	3		2						
				57°				4	2
+57° 0			0						
TOTALS				15,936	13,965				



MILE * 11 TOTALS

FED. ROAD DIST. NO.	STATE	AID PROJ. NO.	SHEET NO.	TOTAL SHEETS
4	WISC.			

DIVISION JOB NO.

[illegible]

