



Bench Marks			
NO	STA	DESCRIPTION	ELEV.
4	38+70	In 30" elm 60 ft. Lt.	1056.14
5	44+25	In 24" oak 5' ft Rt.	1106.65

Pipe Culvt. Reqd. for Approaches			
STA	SIZE	LOCAT.	OWNER
53+00	2'-18"x22'	L&R	Robinson

9408 B III
9408

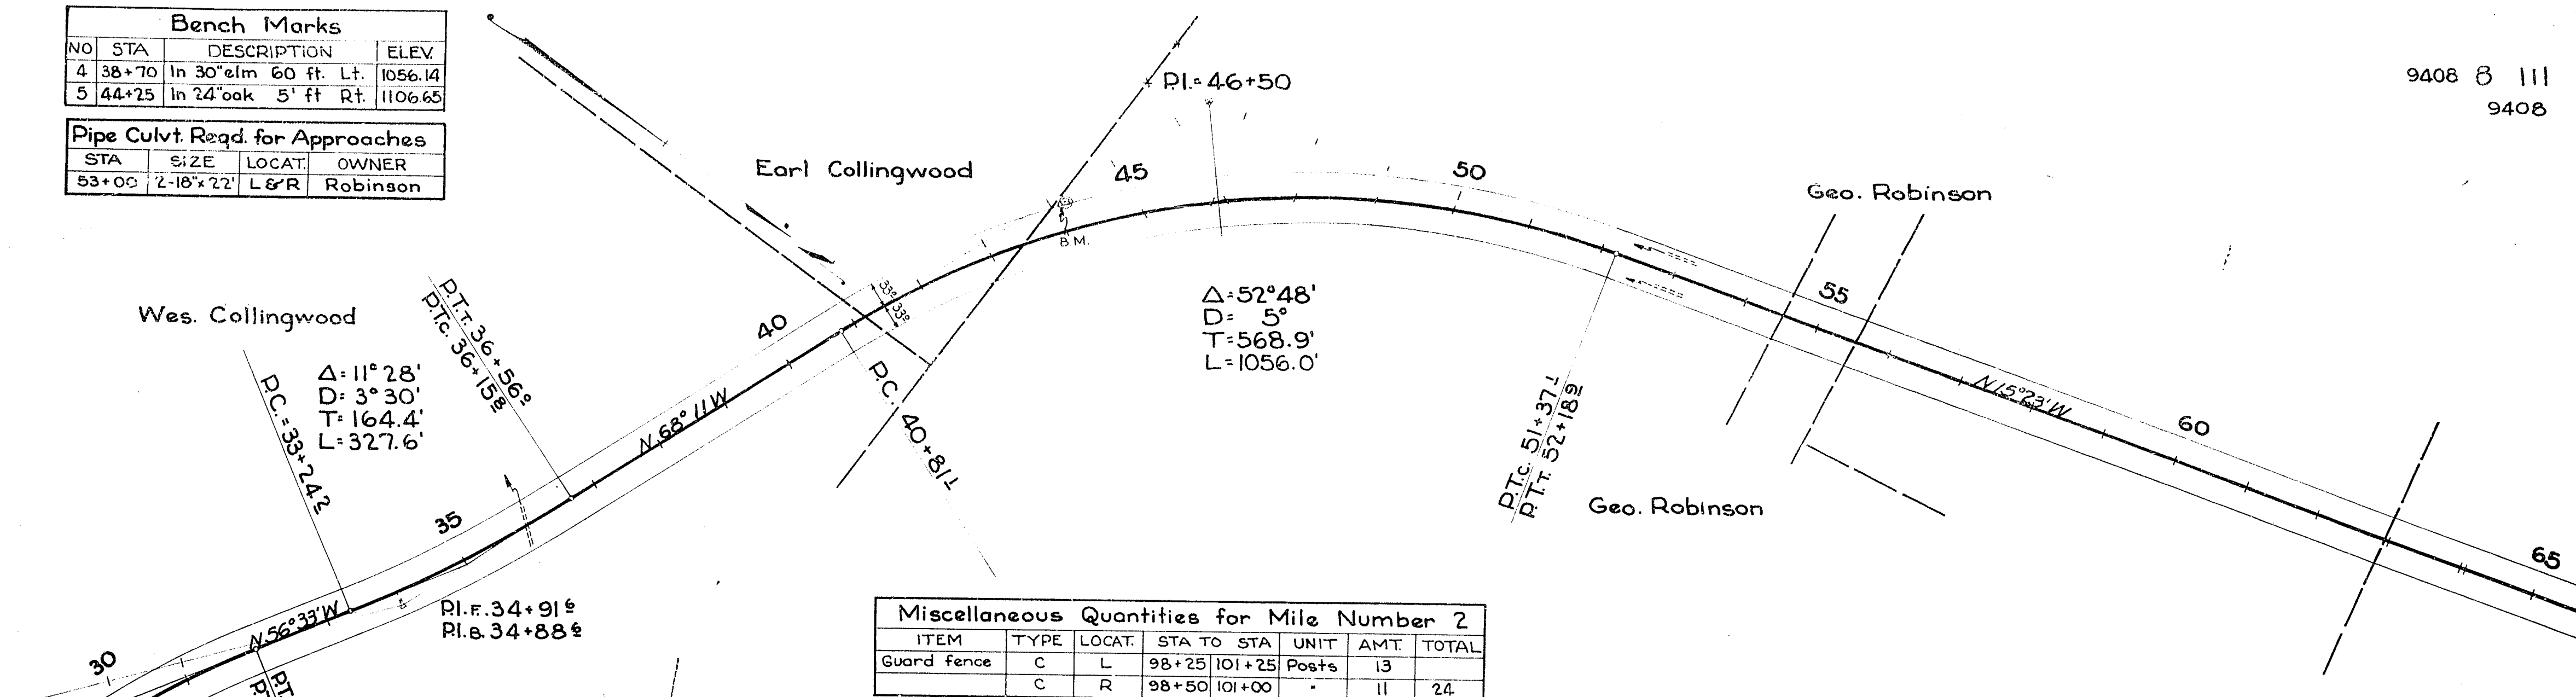

Miscellaneous Quantities for Mile Number 2						
ITEM	TYPE	LOCAT.	STA TO STA	UNIT	AMT.	TOTAL
Guard fence	C	L	98+25 101+25	Posts	13	
	C	R	98+50 101+00	"	11	24

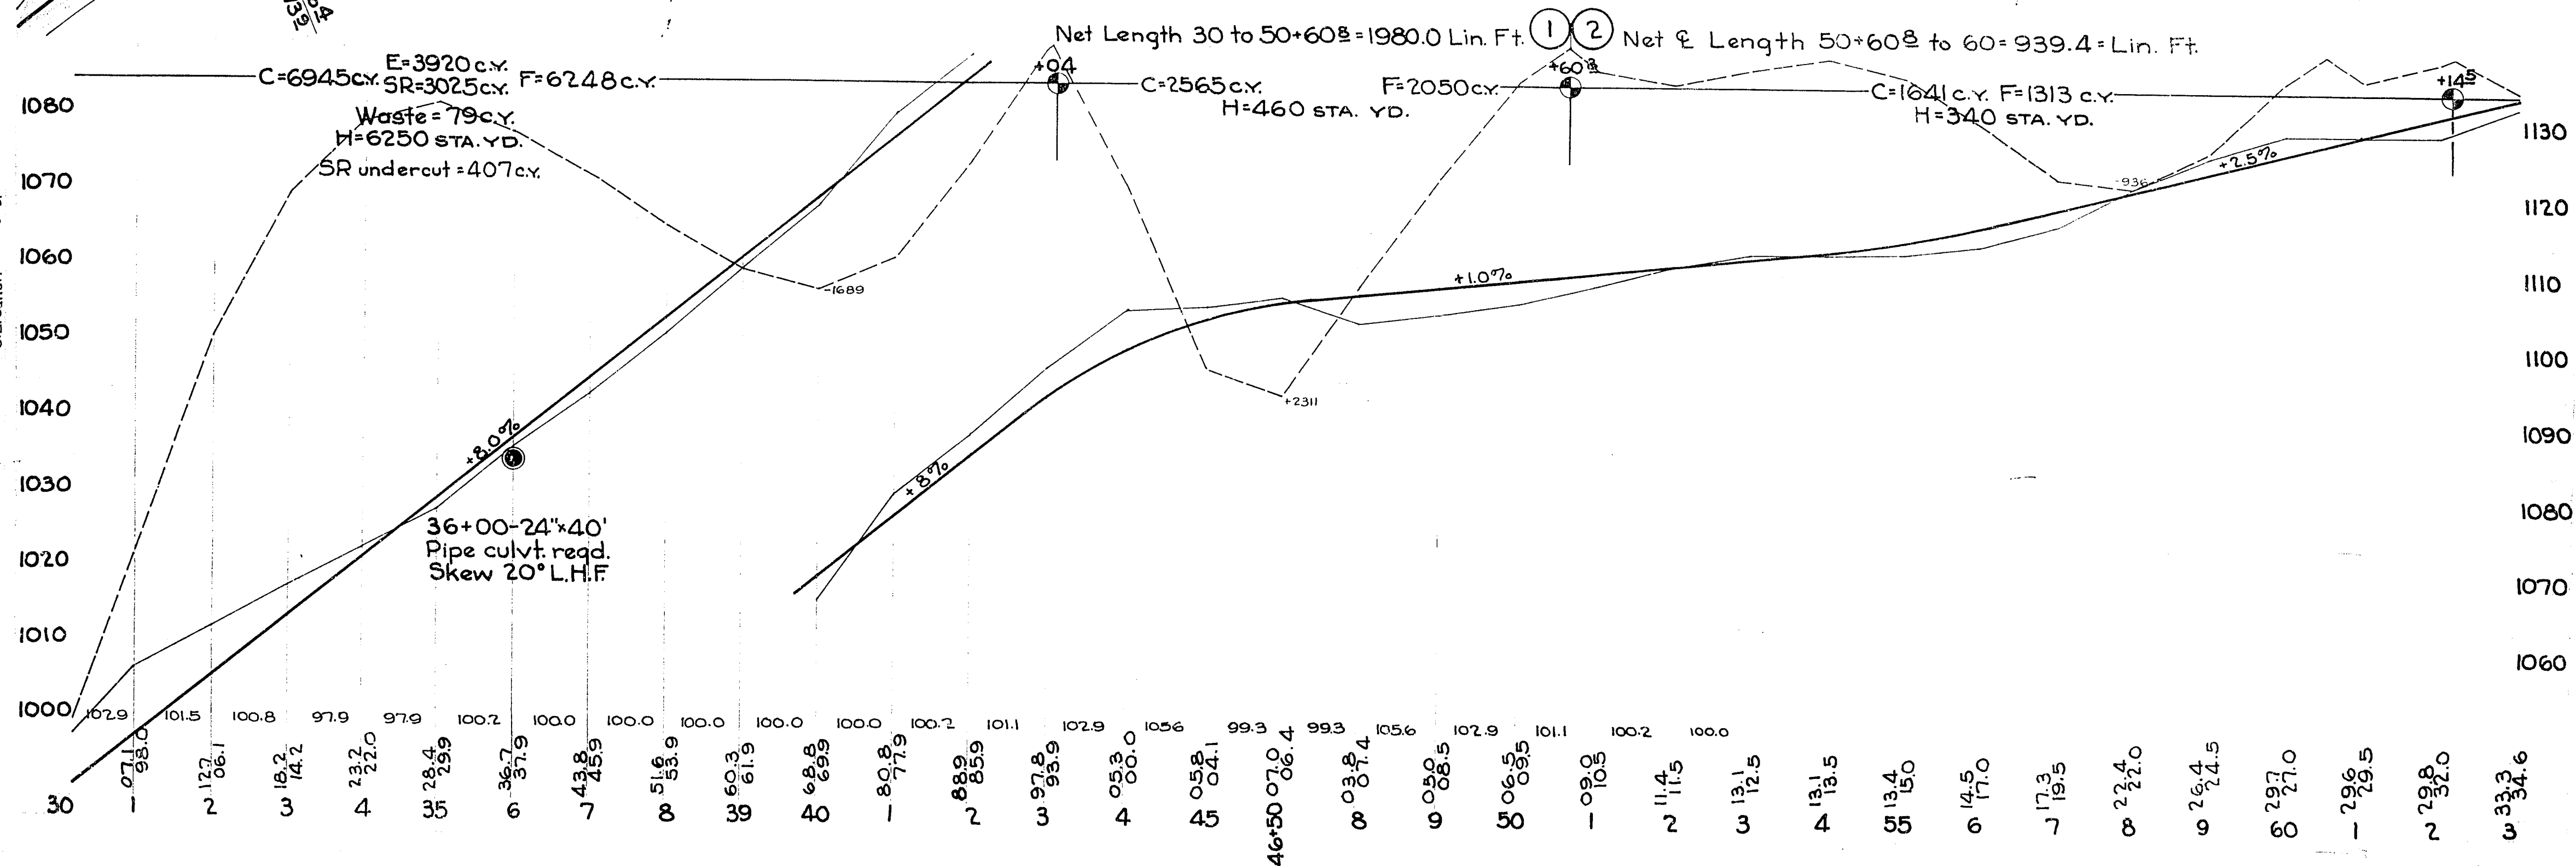

Bench Marks			
NO	STA	DESCRIPTION	ELEV.
7	93+80	In crotch of apple tree	1060.36
8	109+15	On stump 20 ft. Rt.	1020.27


9408 10 111
9408

LR Sub
L.R. Sullivan
L.W. Kelly
A.E. Austin

9408


LR Sub
L.R. Sullivan
L.W. Kelly
H.O. Callan

9408

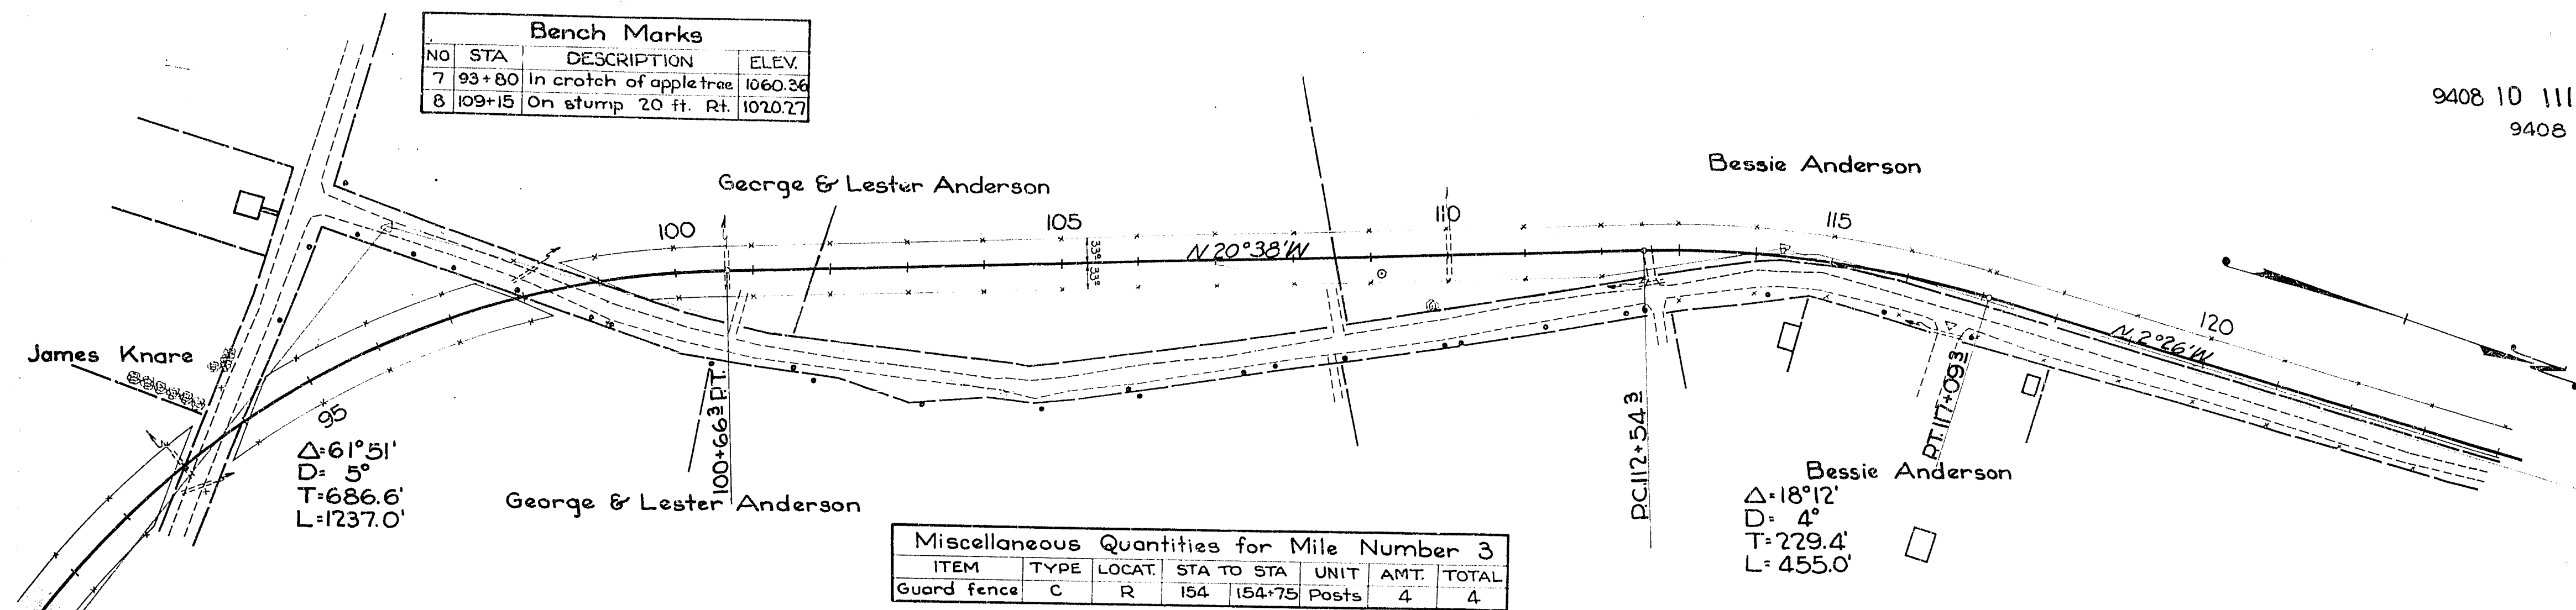


Miscellaneous Quantities for Mile Number 3						
ITEM	TYPE	LOCAT.	STA TO STA	UNIT	AMT.	TOTAL
Guard fence	C	R	154 154+75	Posts	4	4

Pipe Culvt. Req'd. for Approaches			
STA	SIZE	LOCAT.	OWNER
93+50	18" x 30'	R	Side road
98+50	18" x 34'	L	" "
112+70	18" x 22'	R	G. Anderson
117+00	18" x 22'	R	B. "

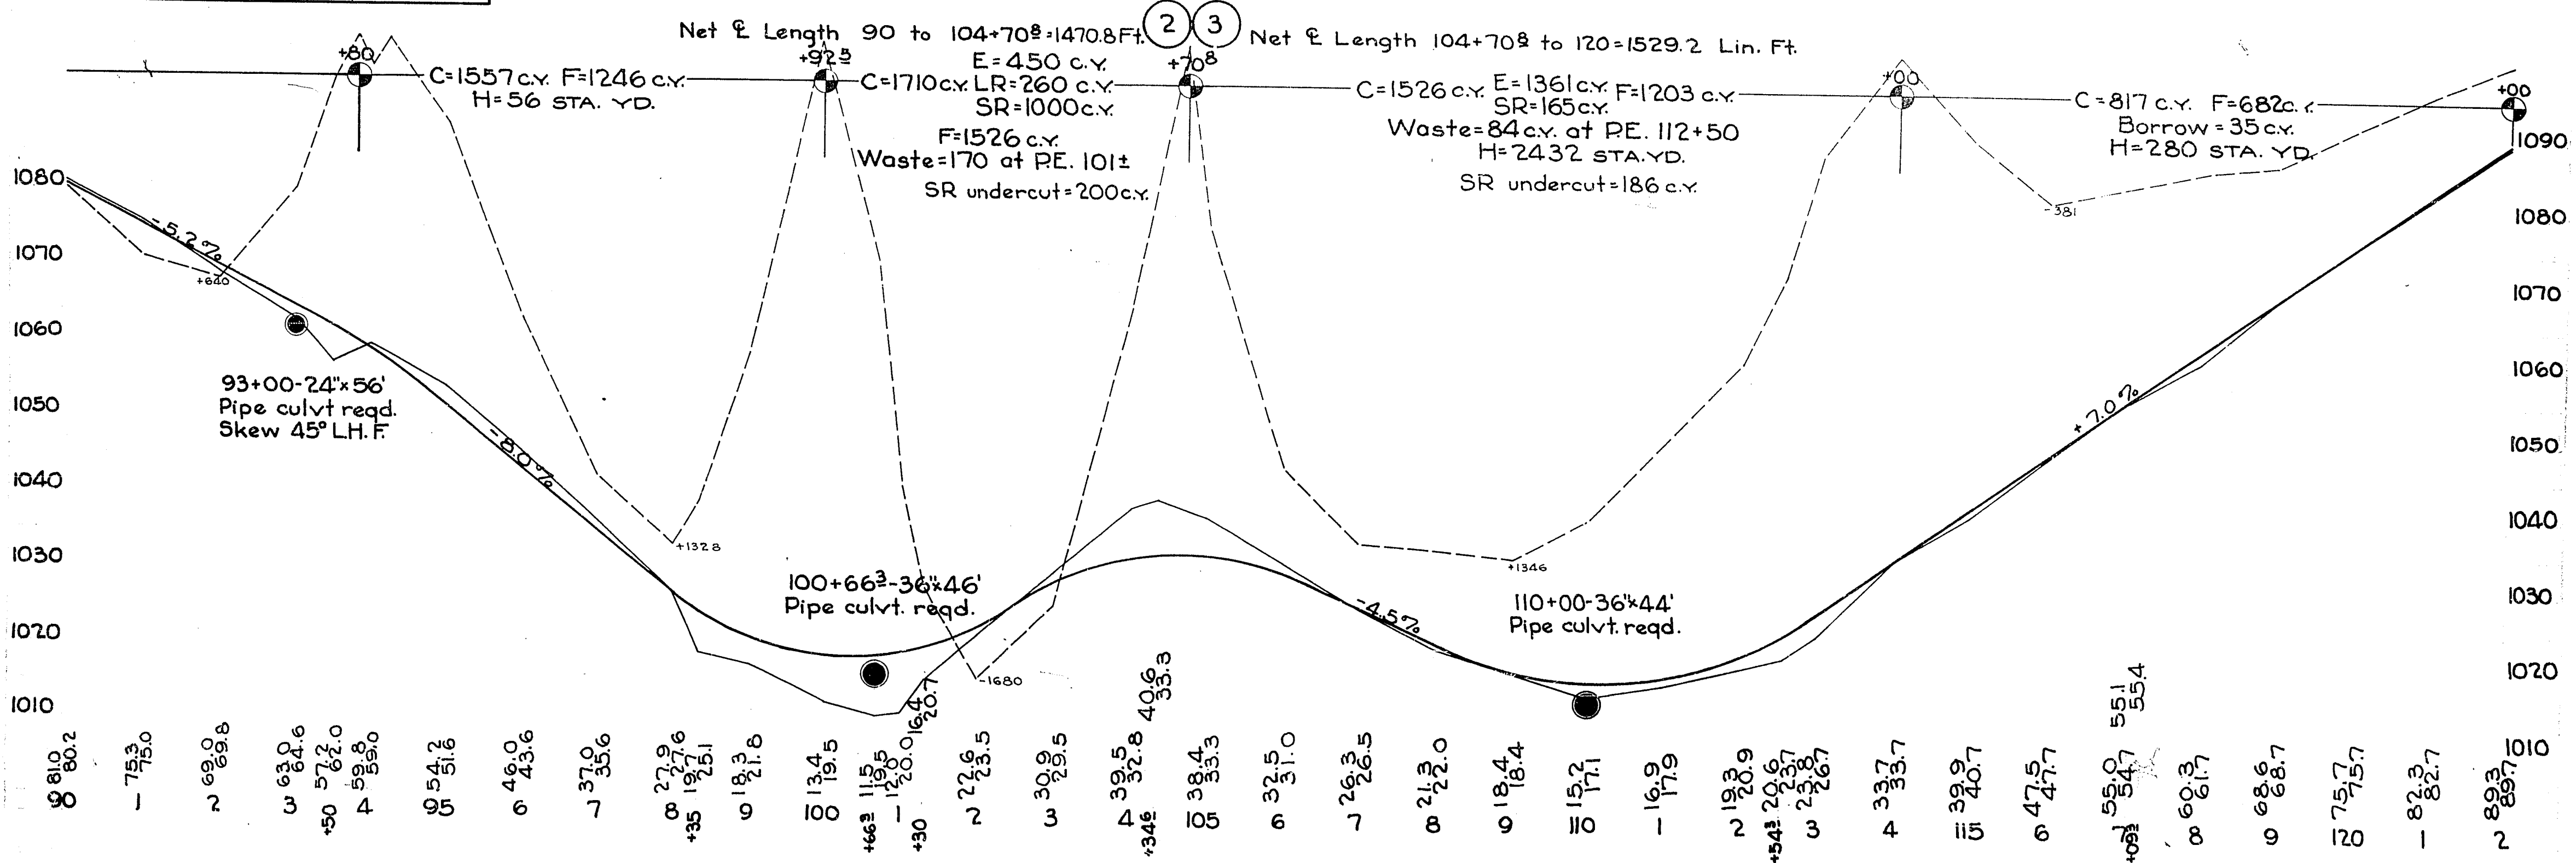


Bench Marks			
NO	STA	DESCRIPTION	ELEV.
9	124+75	In 36" in. oak tree 10' R	1101.68
10	138+60	In 30" in oak tree 75' R	1120.35

9408 || ||
9408

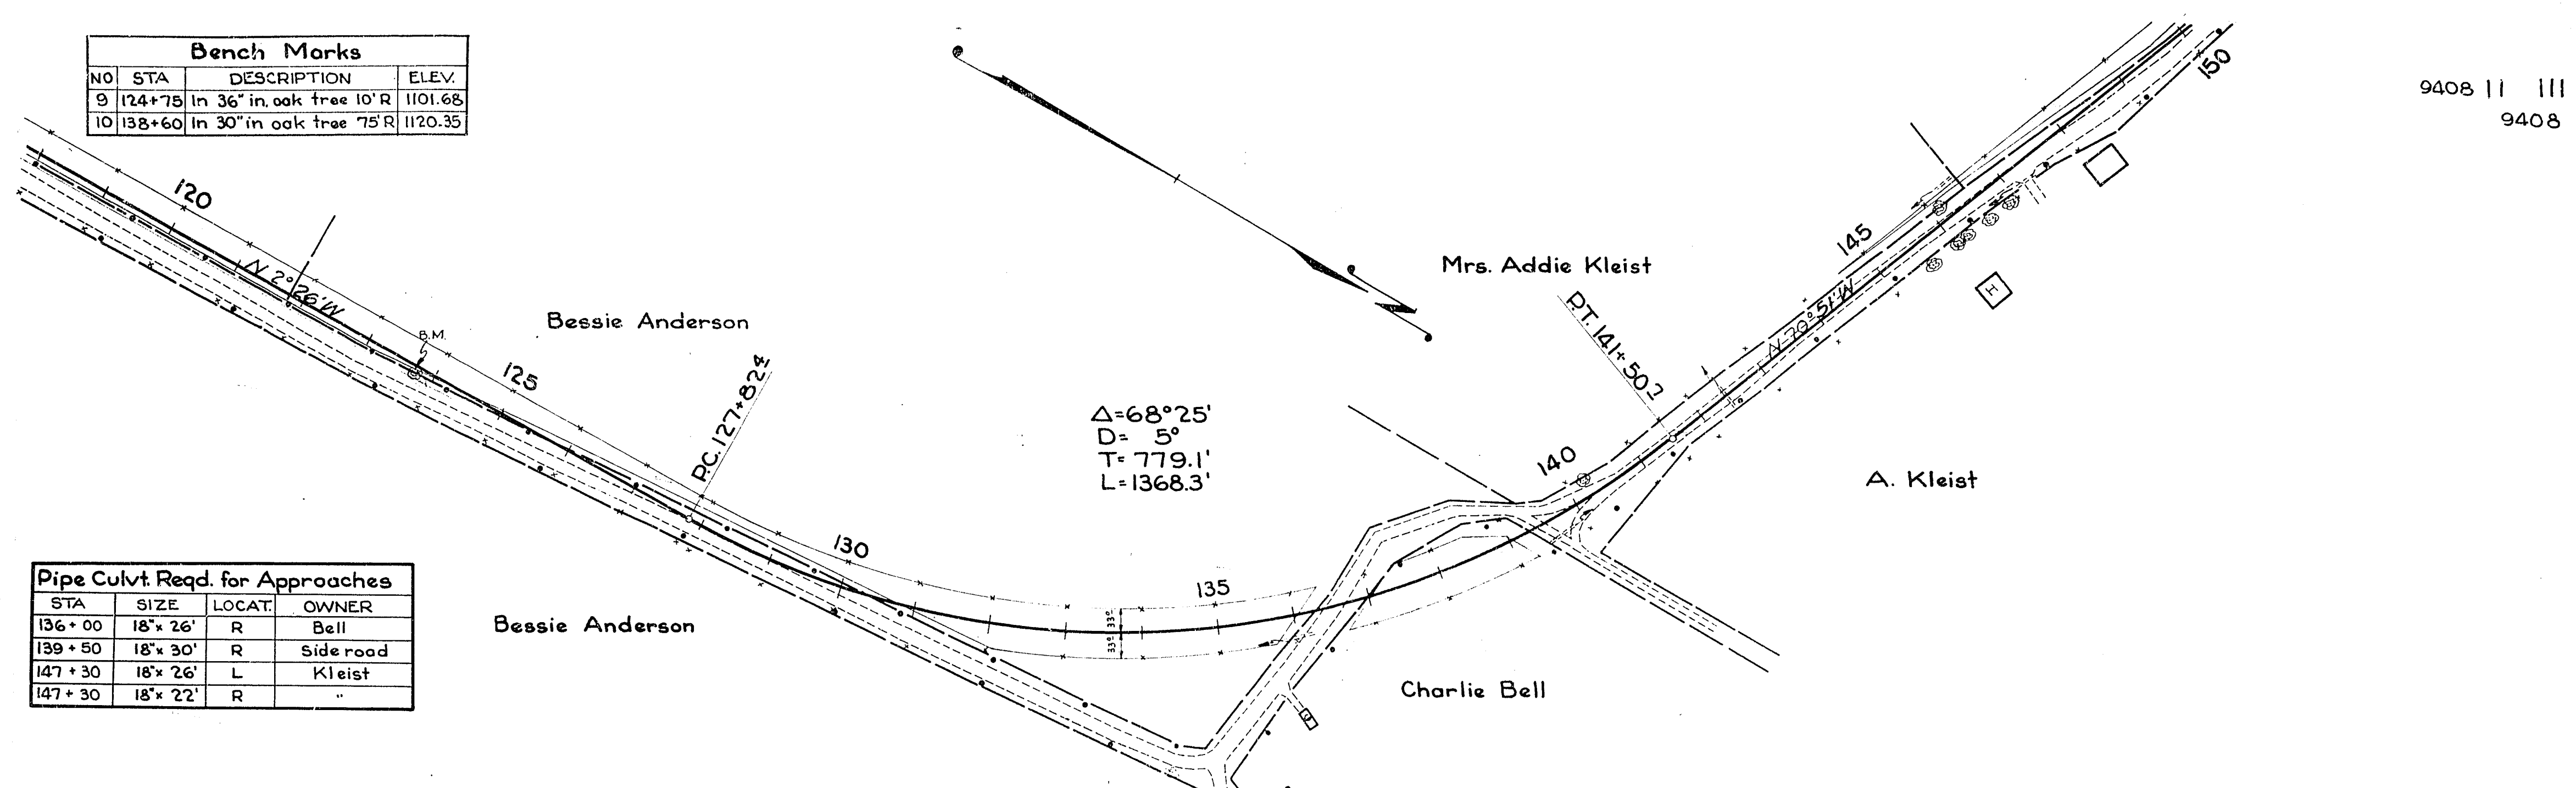

Pipe Culvt. Req'd. for Approaches			
STA	SIZE	LOCAT.	OWNER
136+00	18" x 26'	R	Bell
139+50	18" x 30'	R	Sideroad
147+30	18" x 26'	L	Kleist
147+30	18" x 22'	R	"



Net & Length 120 to 150 = 3000 Lin. Ft.

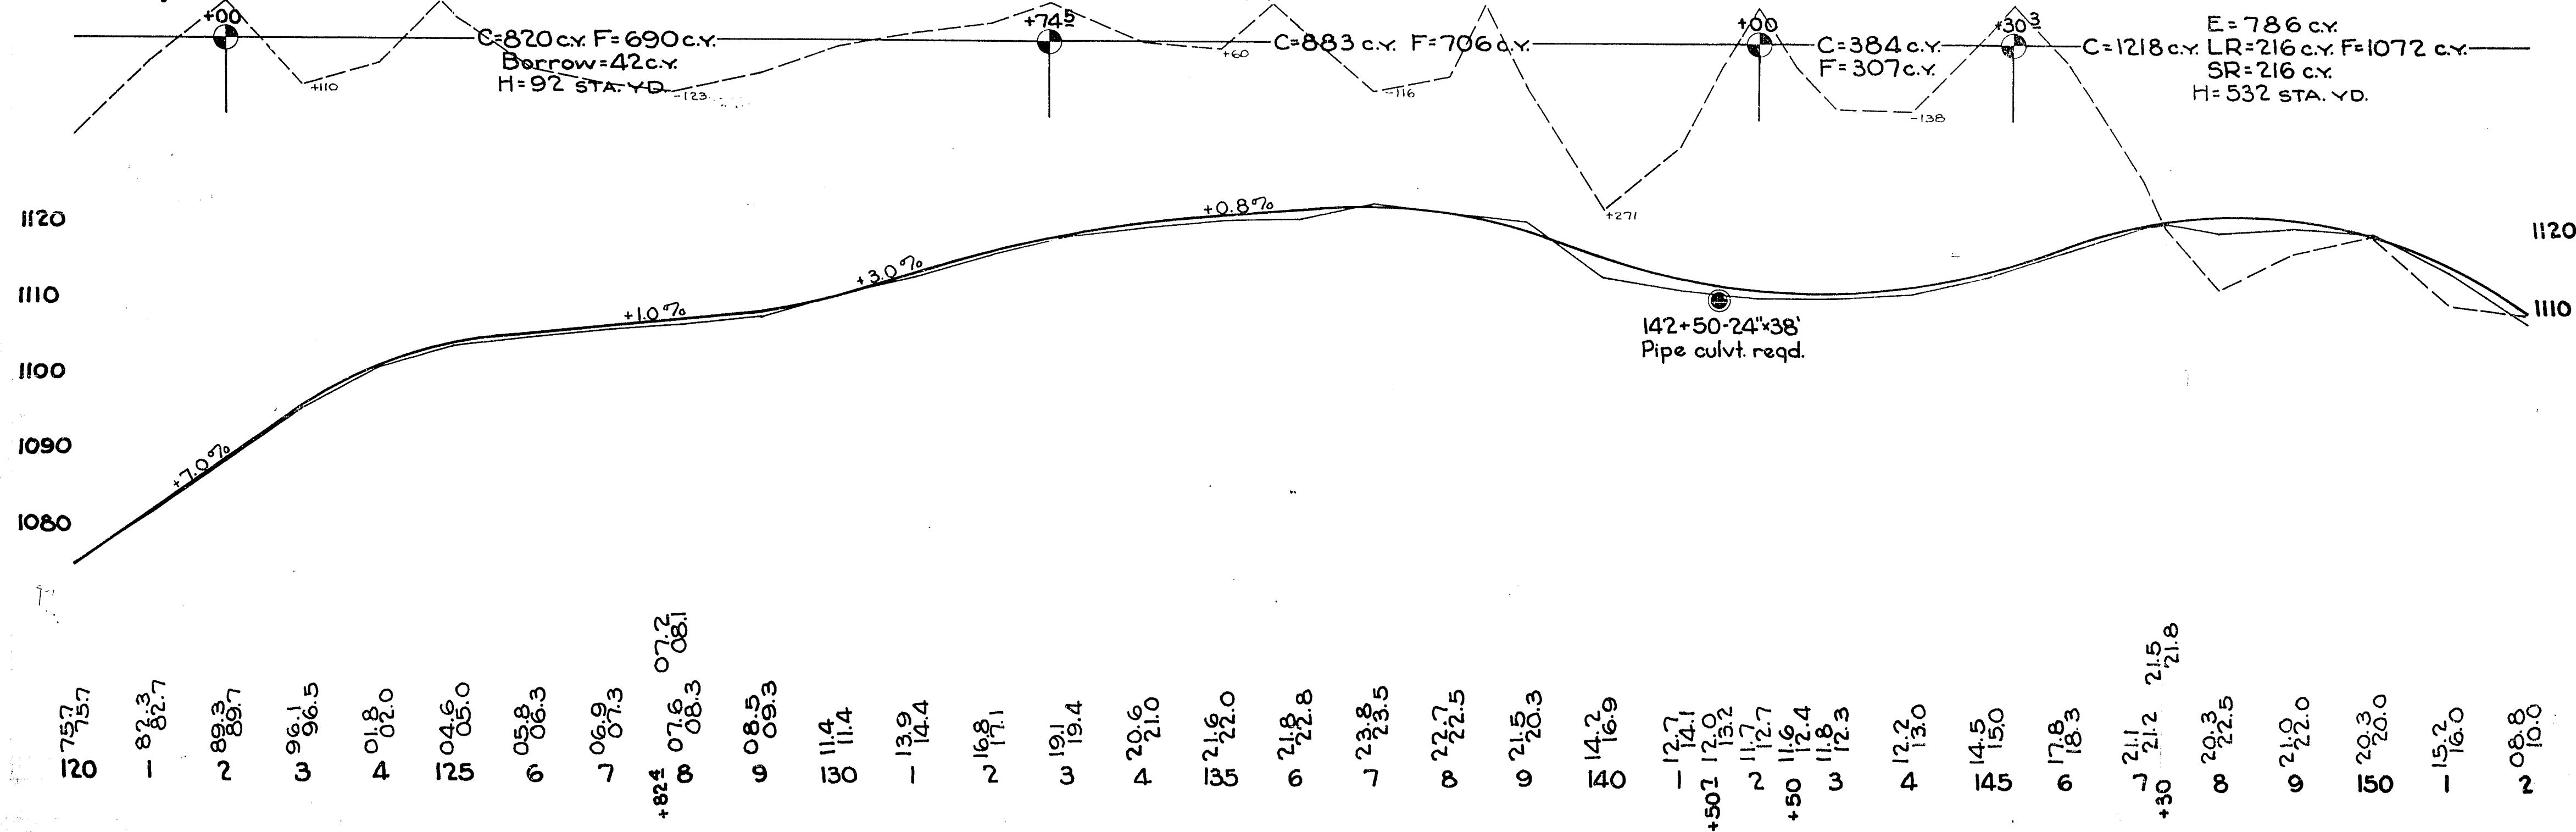

Bench Marks			
NO	STA	DESCRIPTION	ELEV.
11	156+45	In 12" walnut 30' Left	1109.52
12	166+50	In 36" oak tree 40' R	1111.06
13	175+50	In 36" oak tree 40' R	1120.39

Miscellaneous Quantities for Mile Number 4							
ITEM	TYPE	LOCAT.	STA TO STA	UNIT	AMT.	TOTAL	
Clear. & Grub			177 179	Acres	0.22		
			185 191	"	0.69	0.91	
Guard fence	C	L	165 166+50	Posts	7		
	C	L	181 182+25	"	6		
	C	R	193+75 195+00	"	6		
	C	L&R	201+75 203+25	"	14	33	

9408 12. III
9408

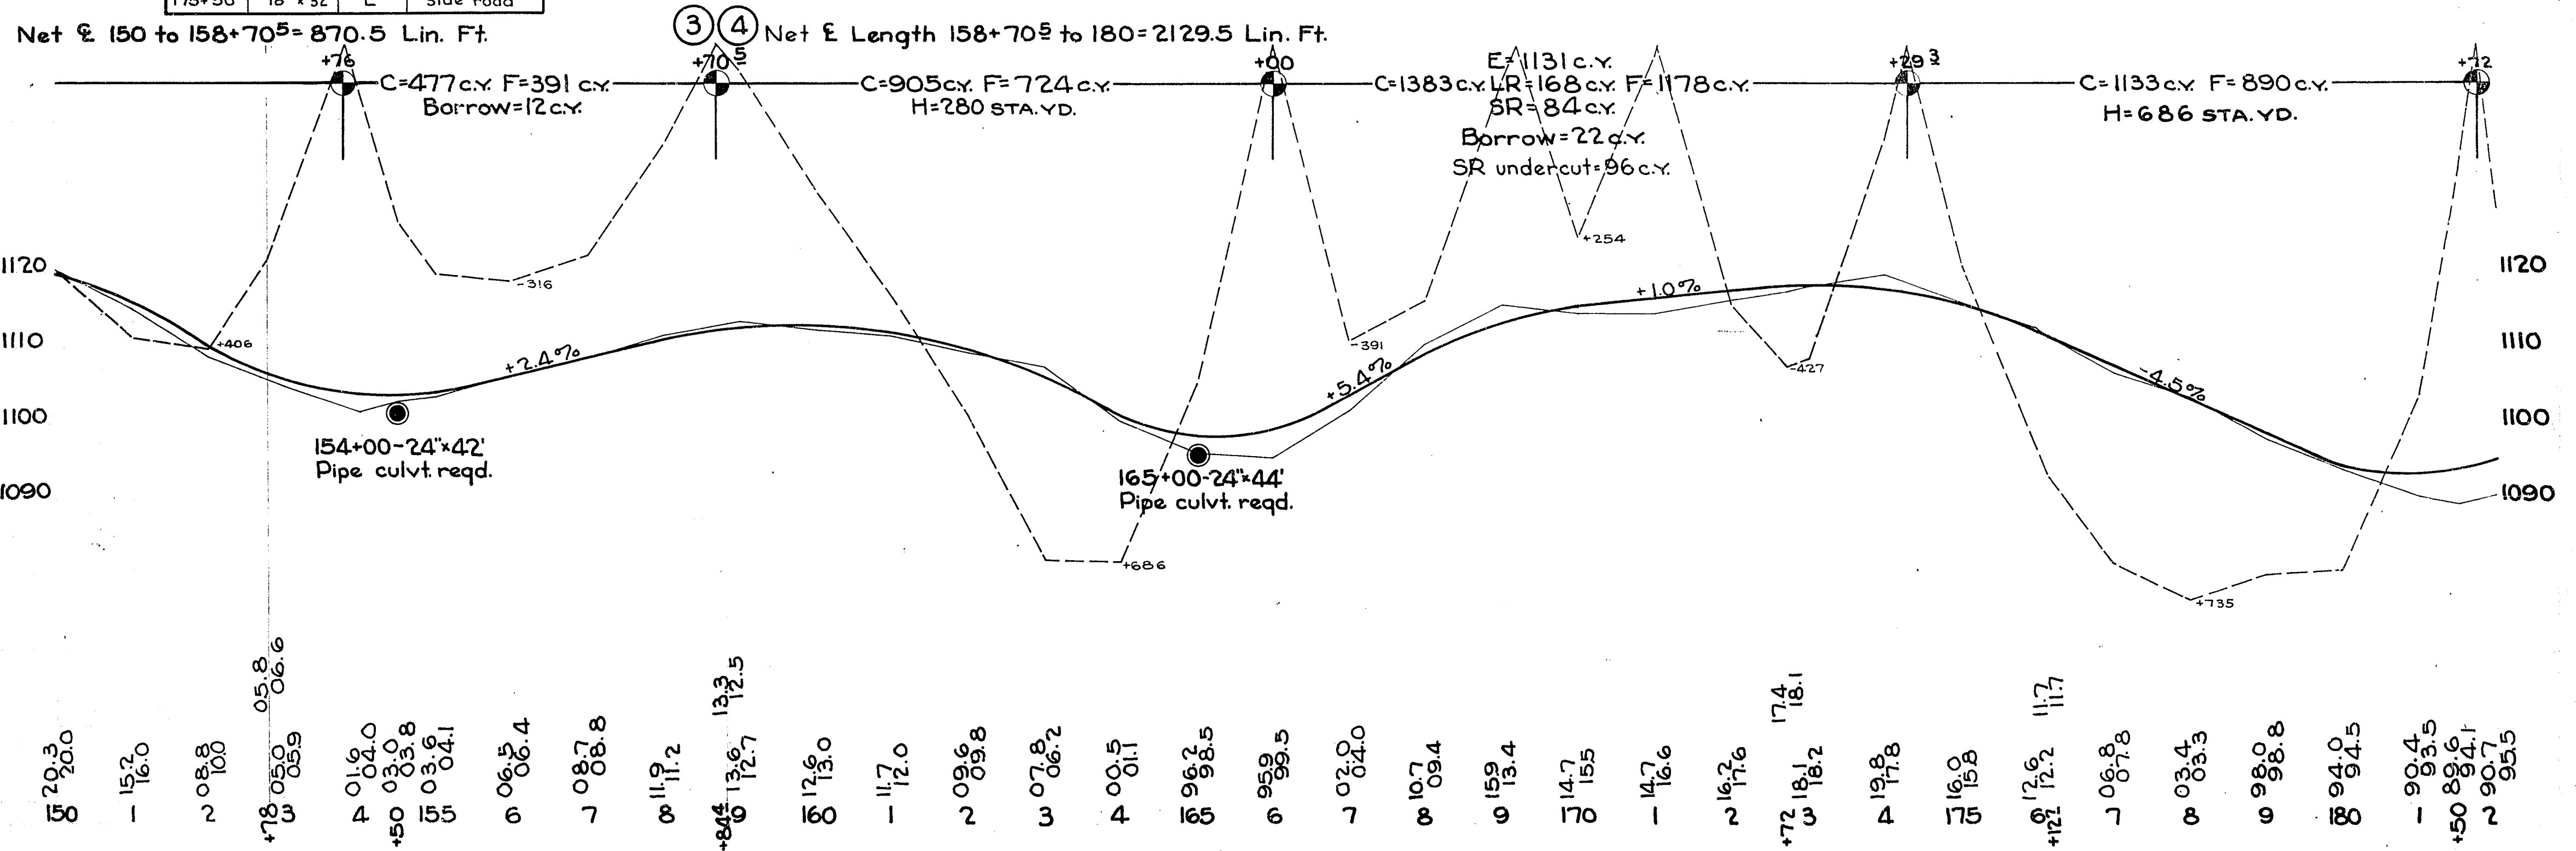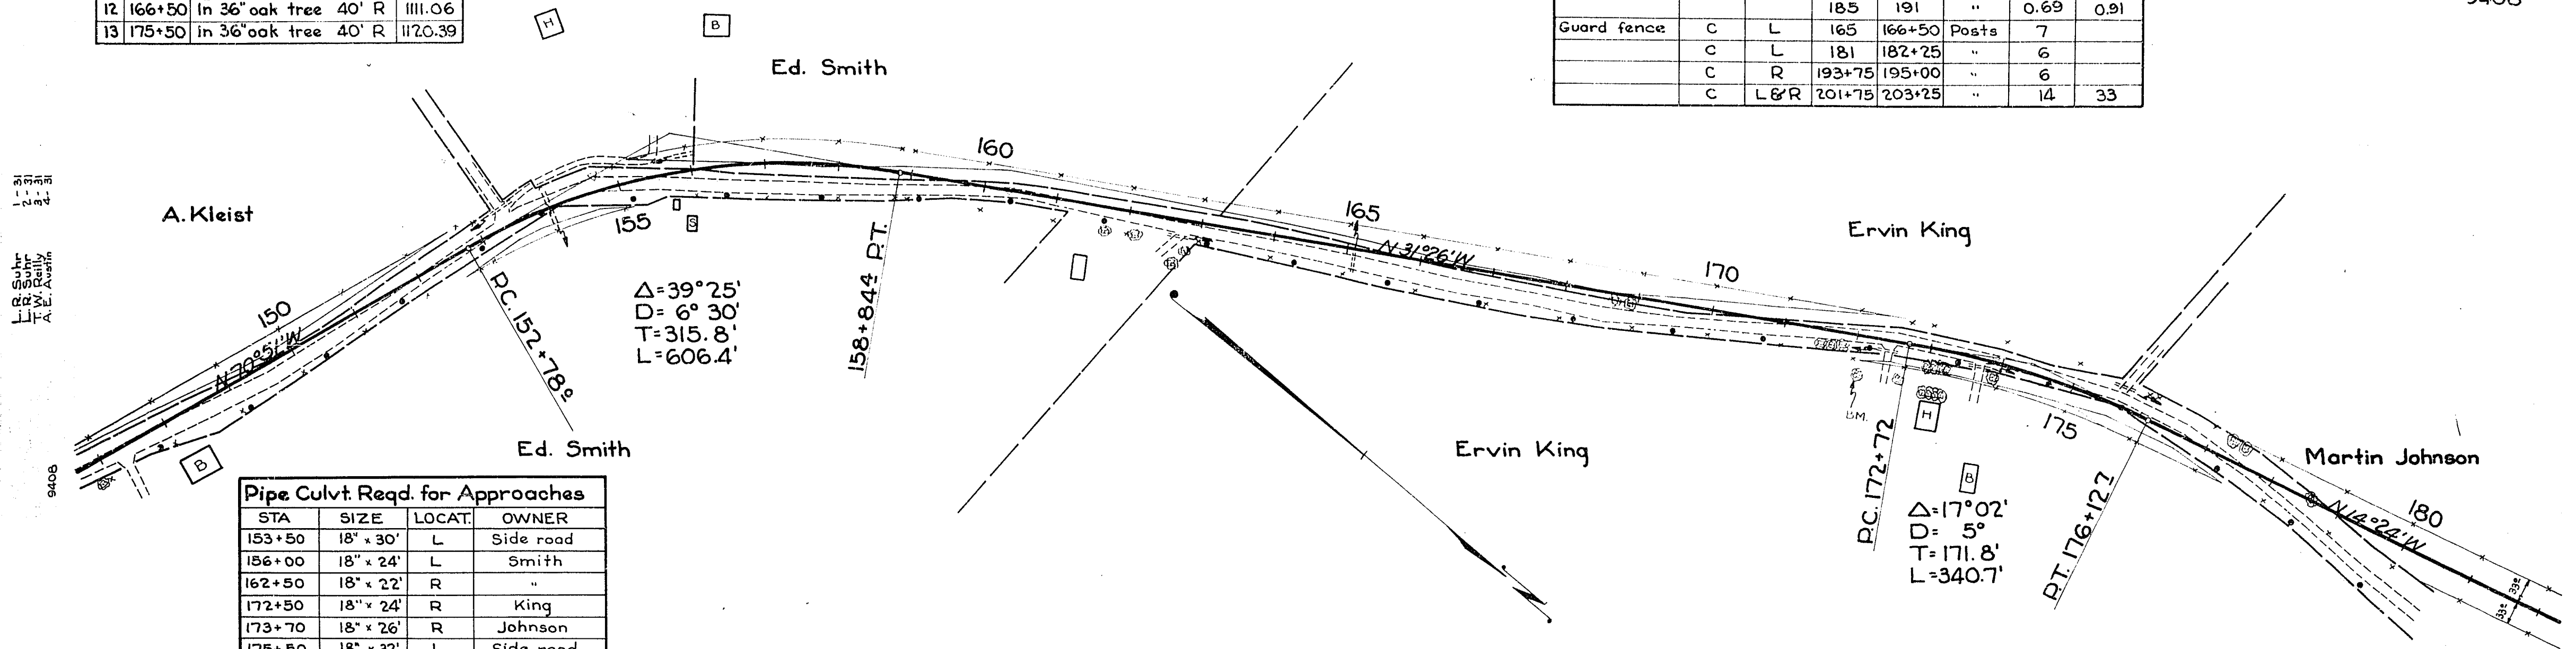

Bench Marks			
NO	STA	DESCRIPTION	ELEV.
14	182+30	In 12" oak Right 115 ft.	1100.87
15	188+30	In 18" oak Right 60 ft.	1111.20
16	204+70	In stump Right 35 ft.	1091.29

9408 13 III
9408

Martin Johnson

Morgan Torgenson


Martin Johnson

Will Schlomer


Ervin King

Pipe Culvt. Req'd. for Approaches			
STA	SIZE	LOCAT.	OWNER
188+00	18" x 26'	L	Johnson
191+70	18" x 32'	L	Side road
210+00	18" x 24'	R	Schlomer

Net & Length 180 to 214+98=3104.1 Lin. Ft.

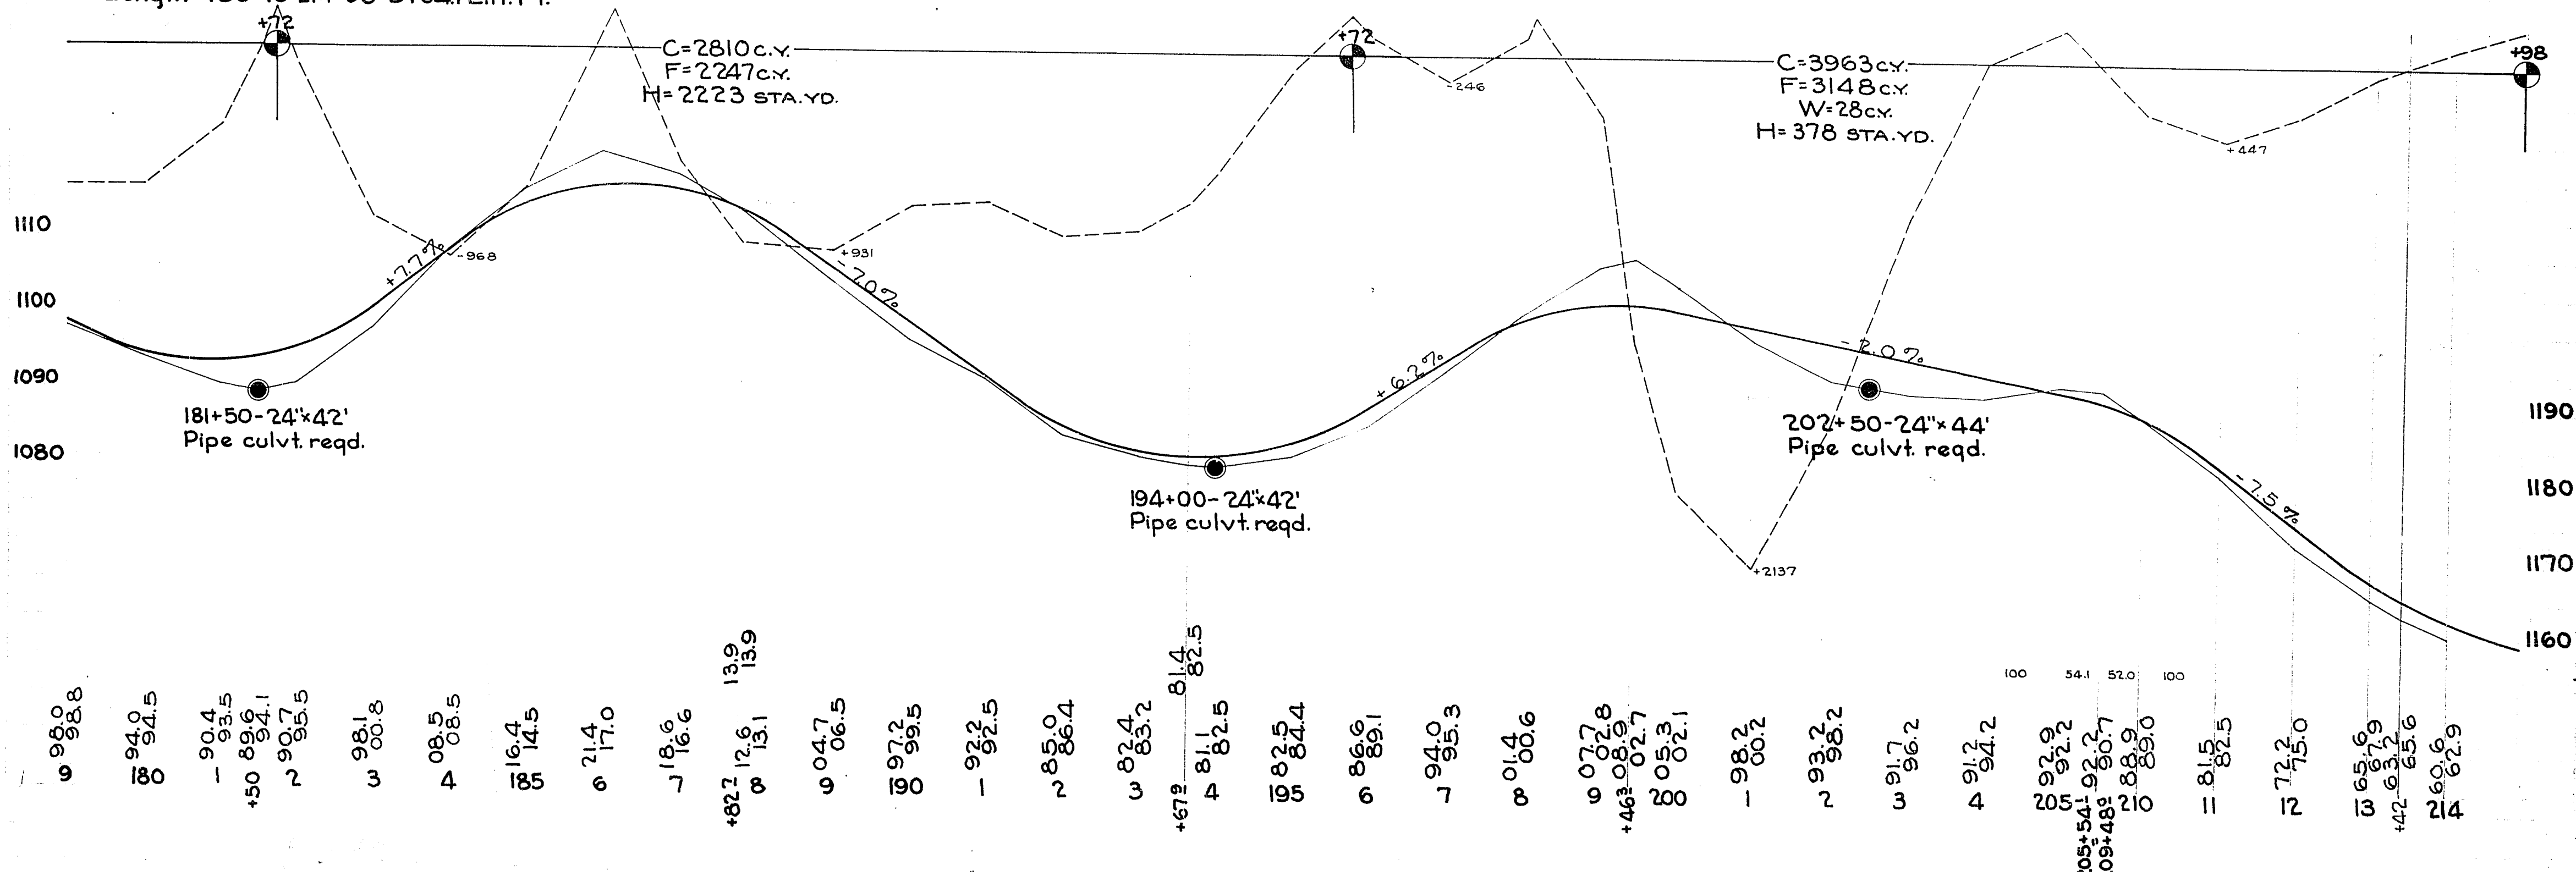


Bench Marks			
NO	STA	DESCRIPTION	ELEV.
17	234+86	In 15" oak tree on fence R	984.04

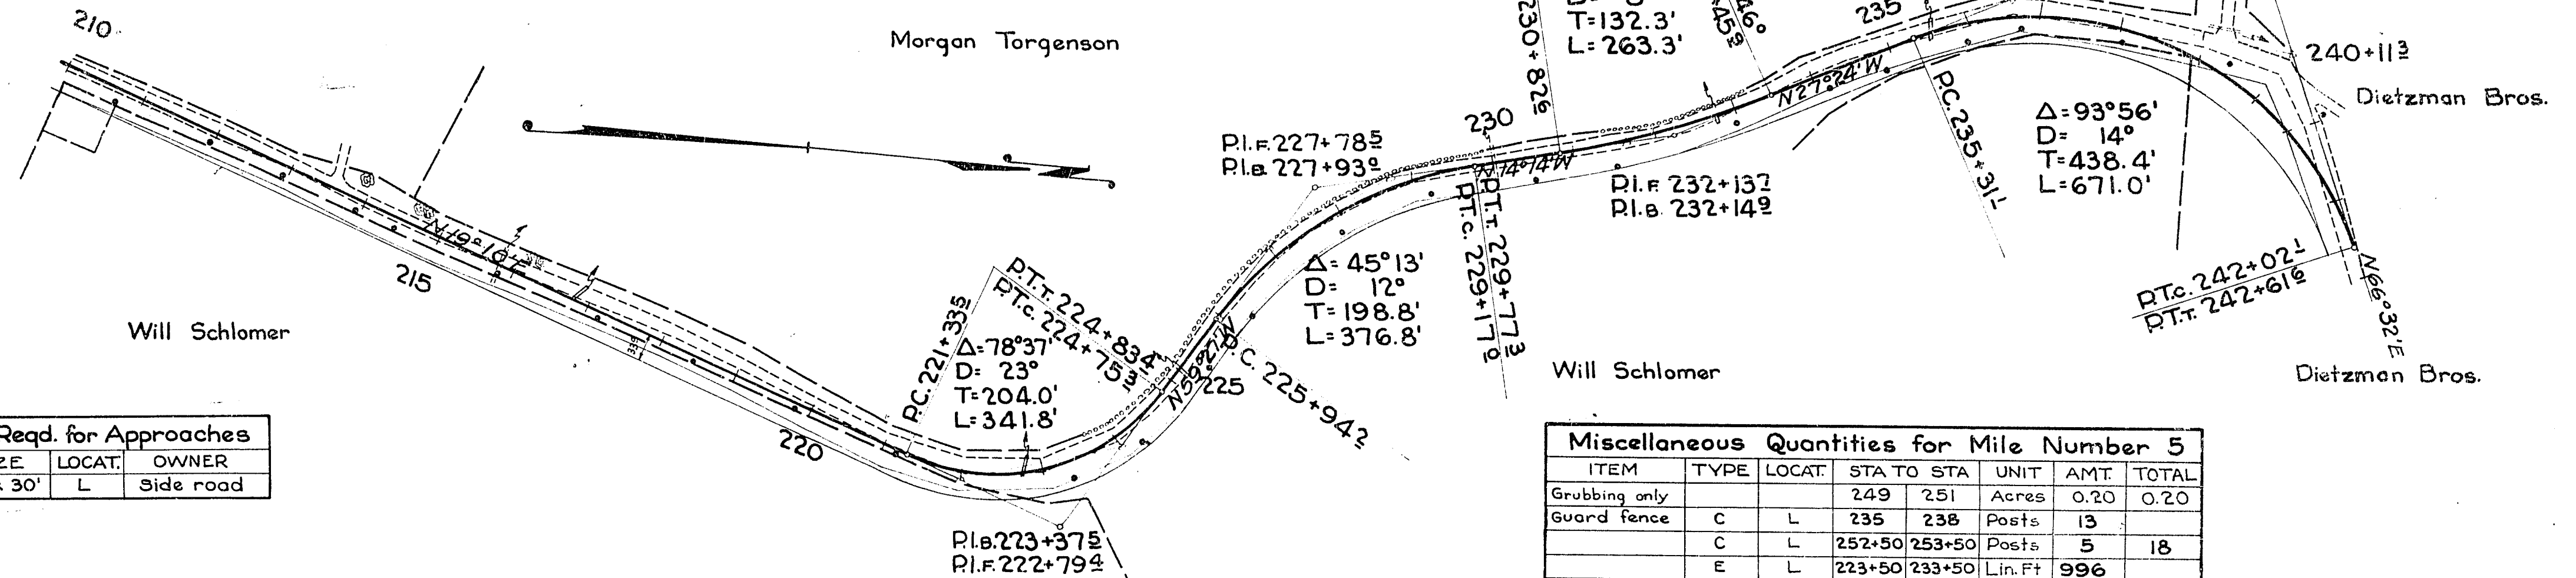

Pipe Culvt. Req'd. for Approaches			
STA	SIZE	LOCAT.	OWNER
239+30	18" x 30'	L	Side road



Miscellaneous Quantities for Mile Number 5						
ITEM	TYPE	LOCAT.	STA TO STA	UNIT	AMT.	TOTAL
Grubbing only			249 251	Acres	0.20	0.20
Guard fence	C	L	235 238	Posts	13	
	C	L	252+50 253+50	Posts	5	18
	E	L	223+50 233+50	Lin. Ft.	996	
	E	R	245+25 247+00	"	180	
	E	R	252+25 253+50	"	120	
	E	R	255+00 256+75	"	180	
	E	R	258+25 264+62	"	636	2112

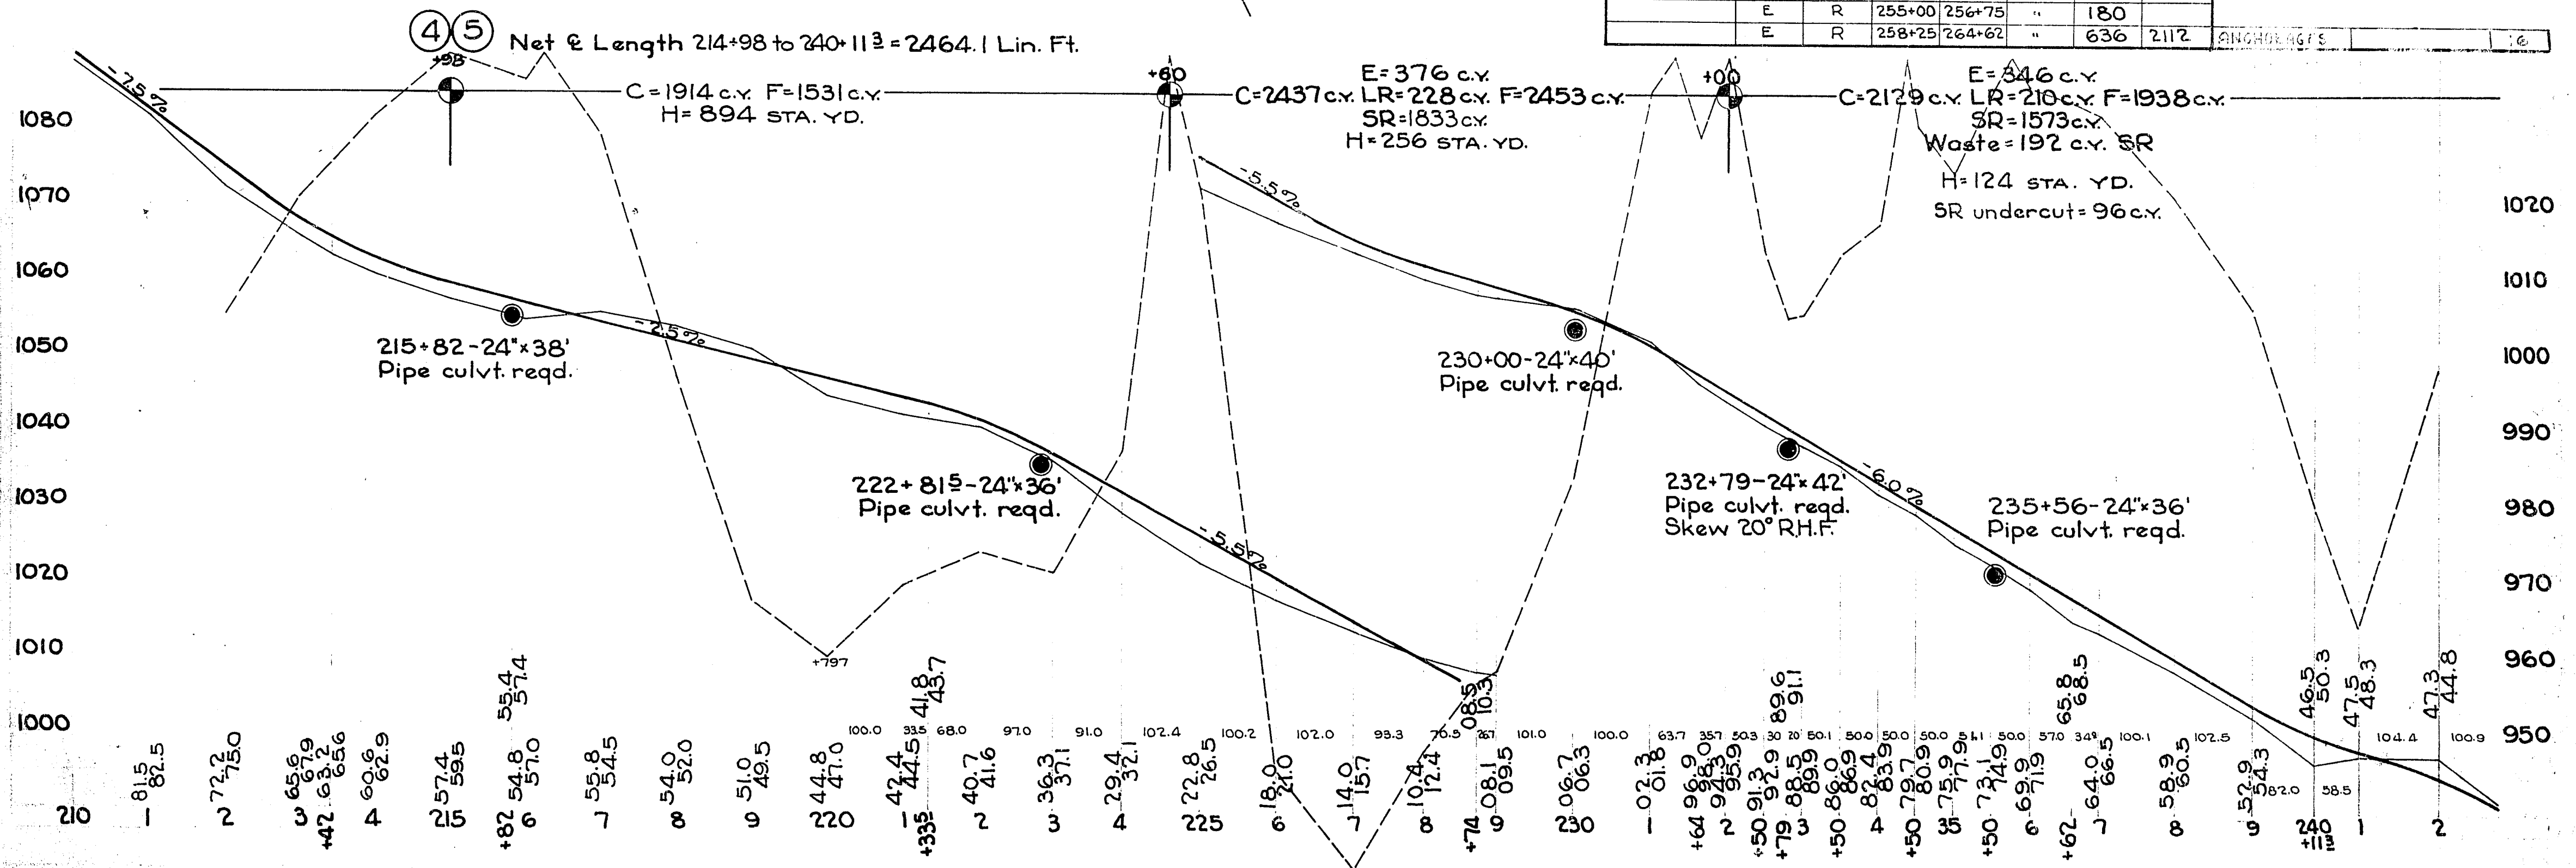


Miscellaneous Quantities for Mile Number 6							
ITEM	TYPE	LOCAT.	STA TO STA	UNIT	AMT.	TOTAL	
Guard fence	E	R	264+62 273	Lin. Ft.	840	840	
	C	R	273 276	Posts	13		
	C	R	278 280+50	"	11		
	C	R & L	286+25 286+75	"	6		
	C	L	293 301+50	"	35	65	
ANCHORAGES				NO.	4	4	


Bench Marks			
NO	STA	DESCRIPTION	ELEV.
18	248+00	In 8" oak 40 ft. Right	907.45
19	263+58	In 12" oak on Rt. fence	816.35

Pipe Culvt. Req'd. for Approaches			
STA	SIZE	LOCAT.	OWNER
245+67	18" x 24'	L	Dietzman

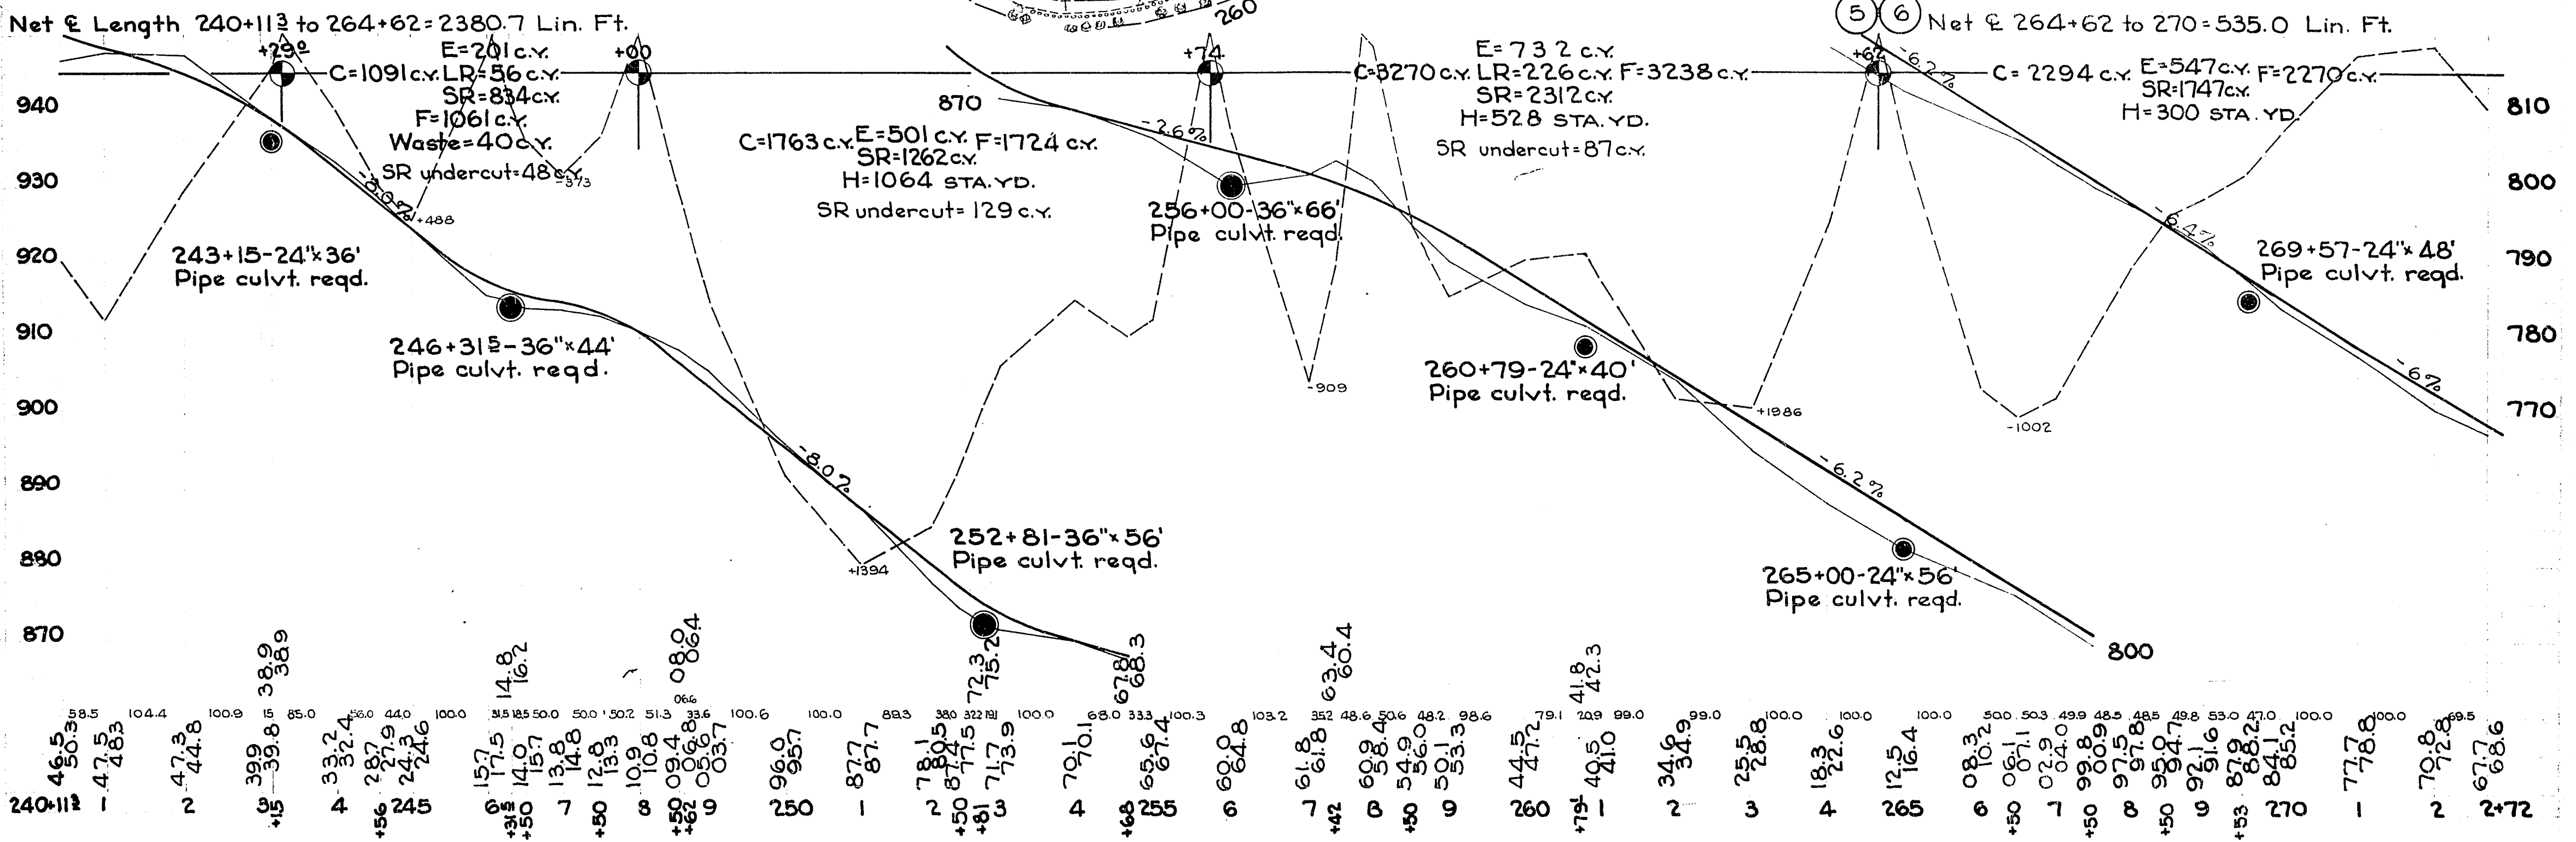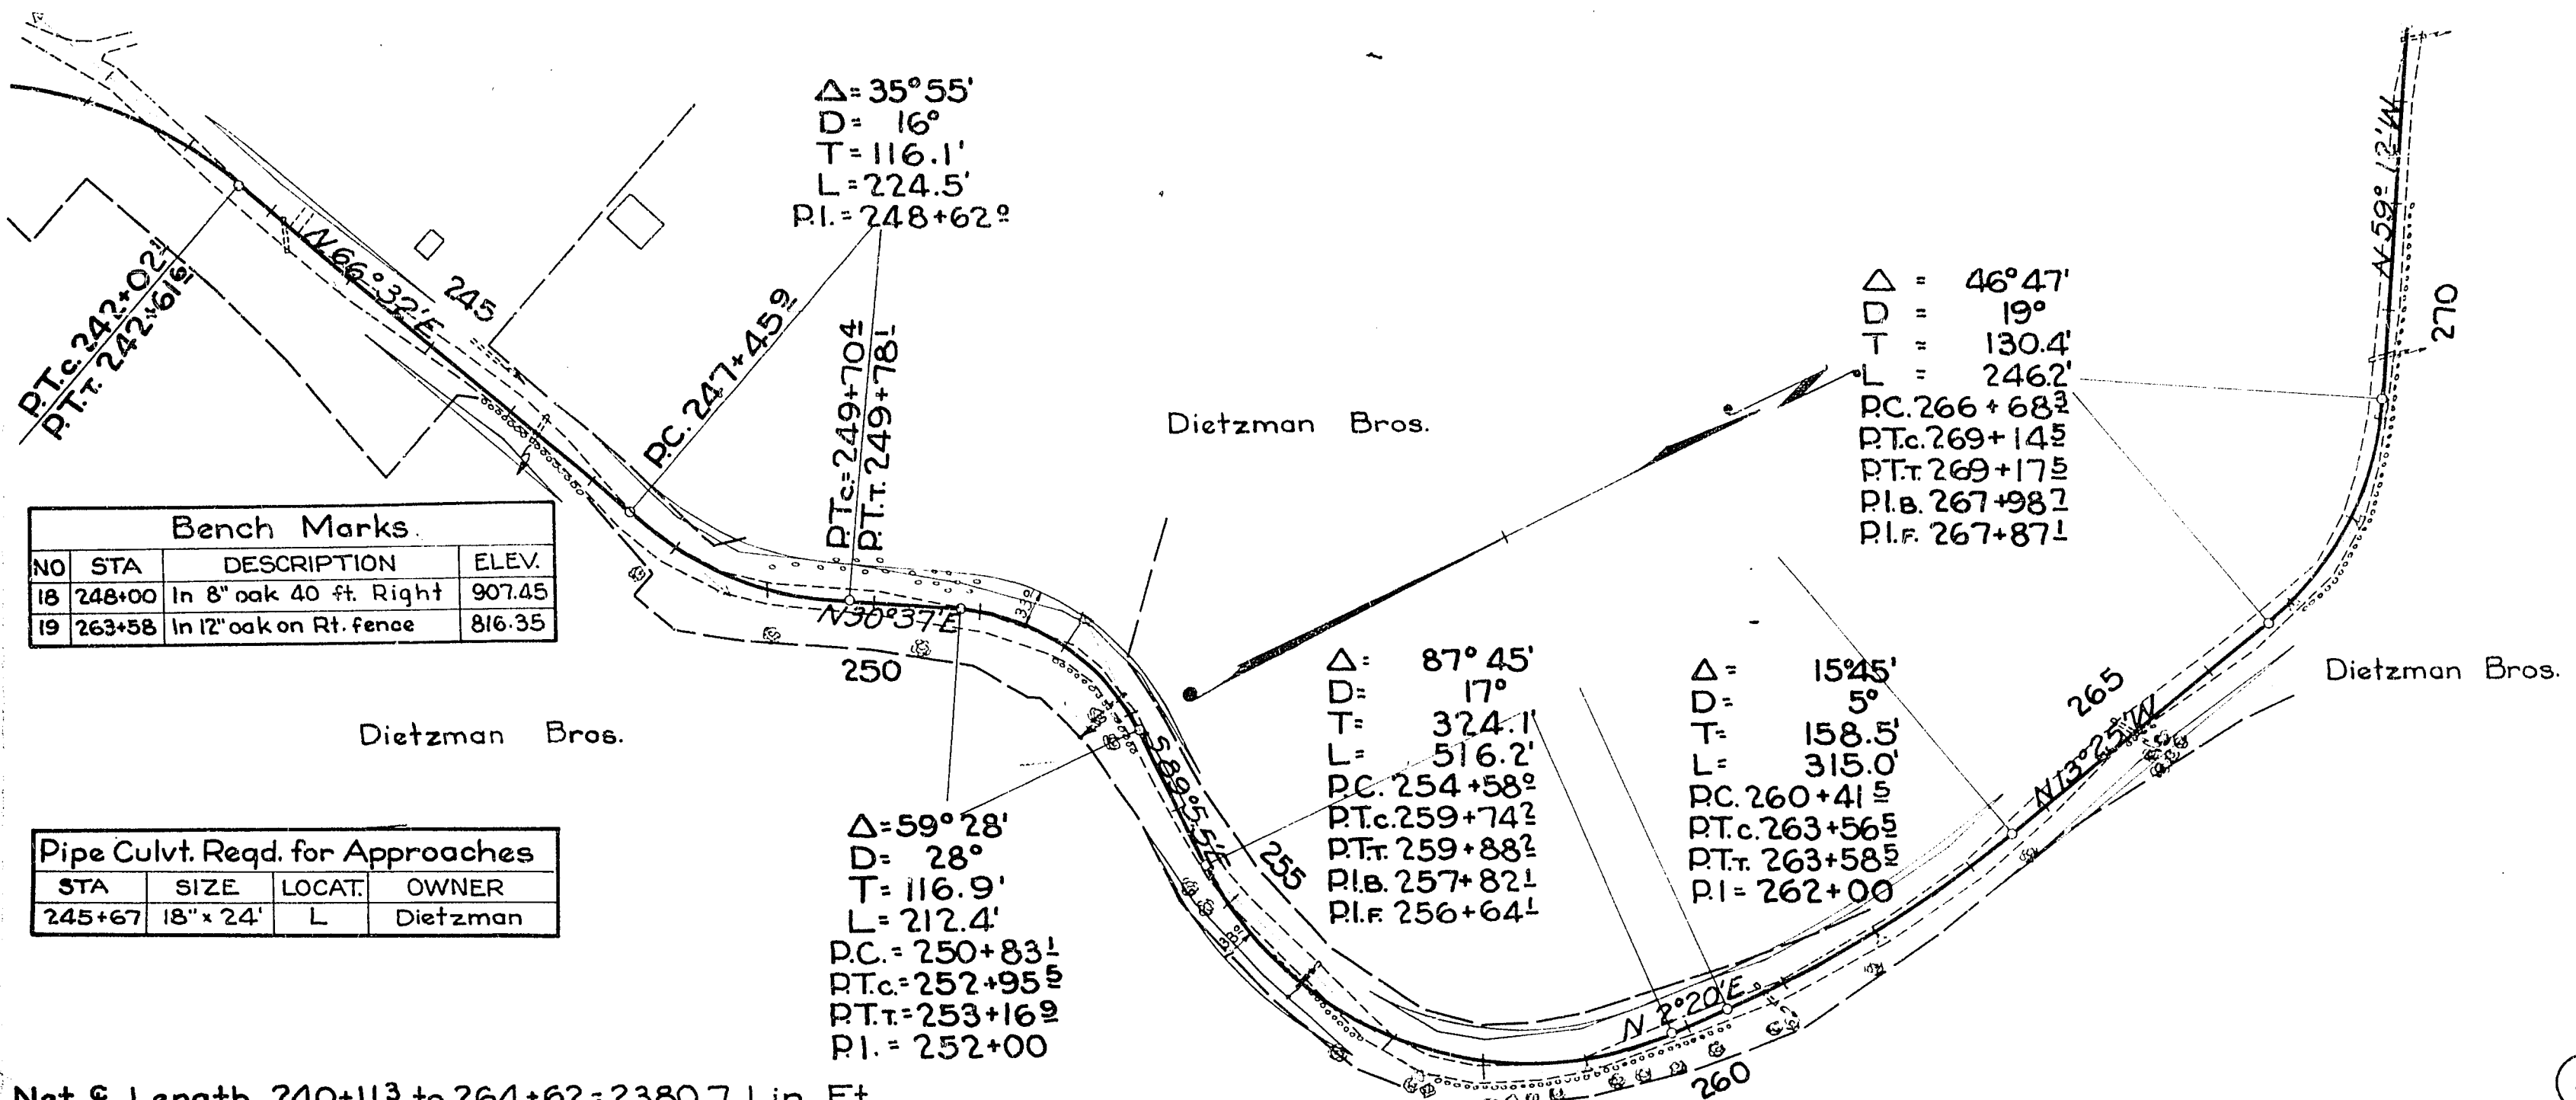


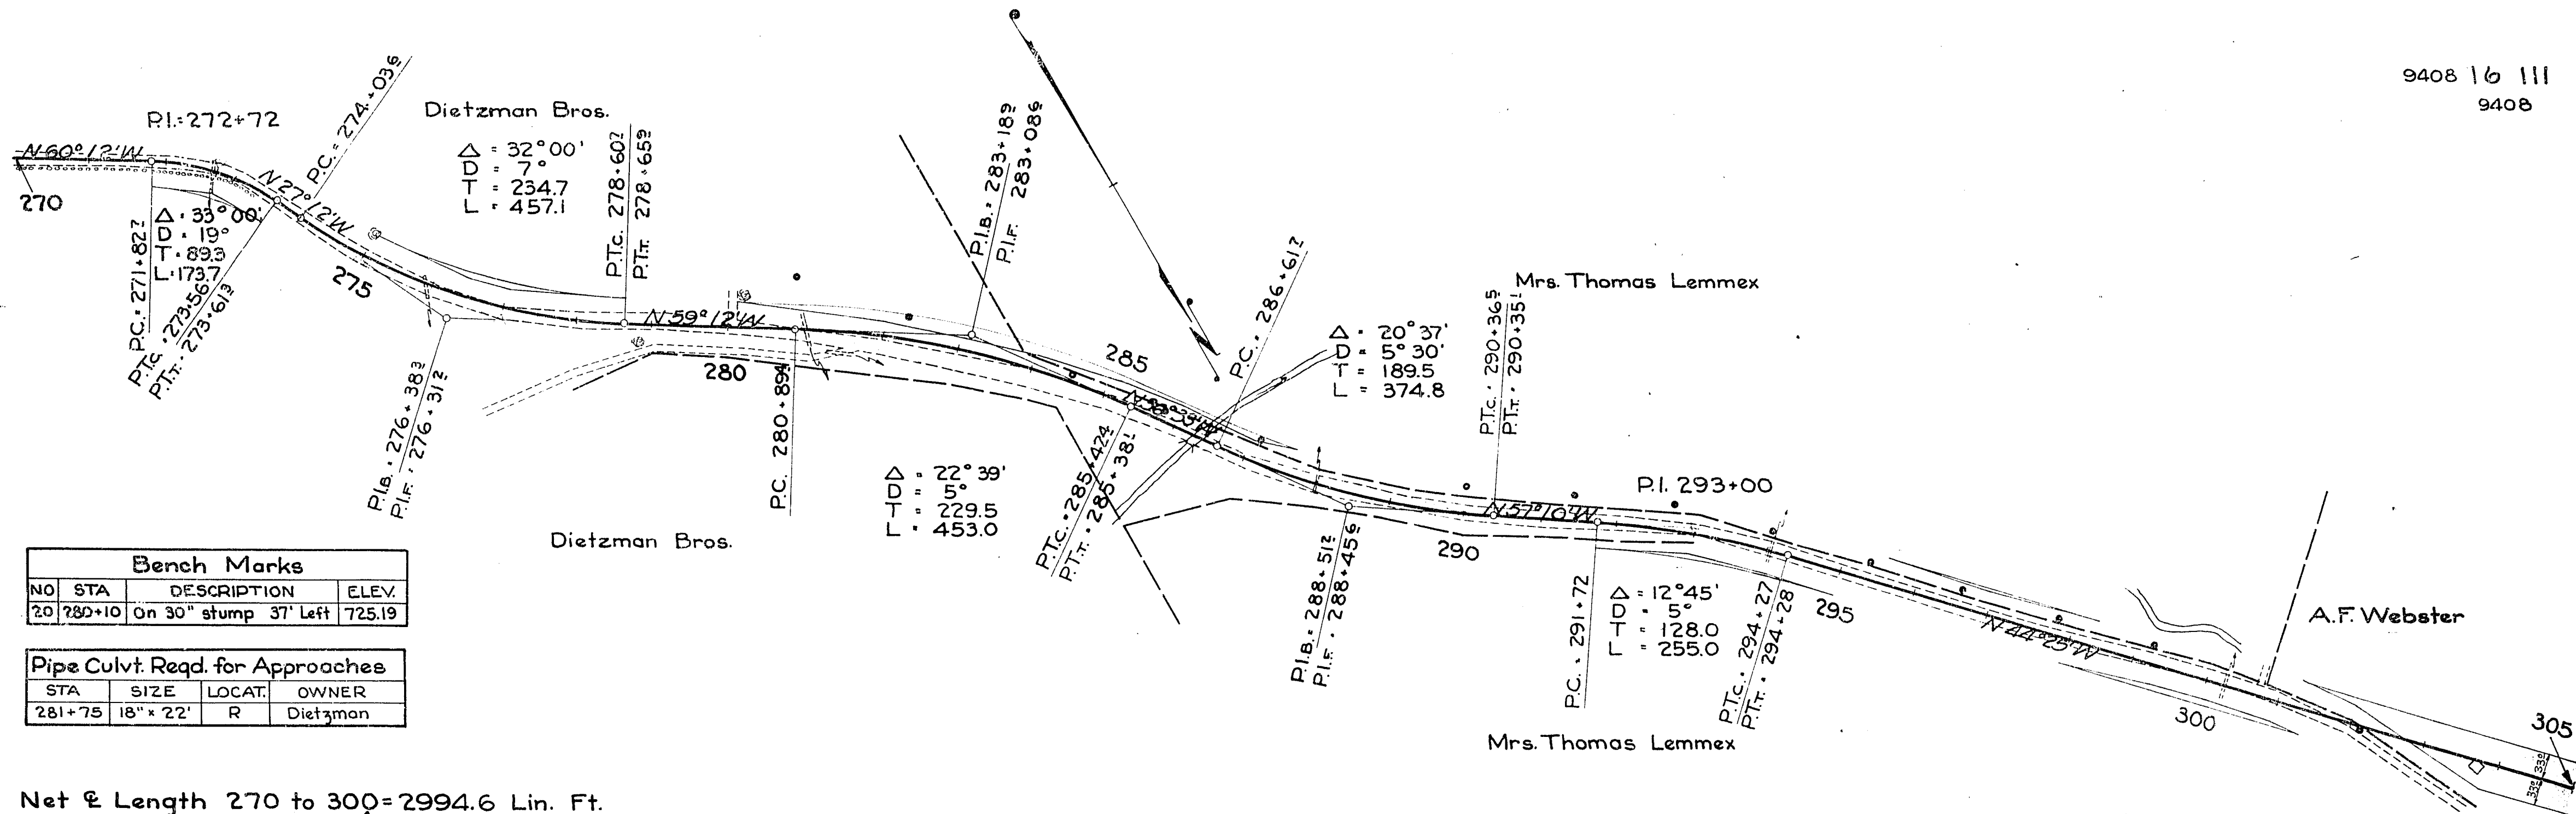


Net & Length 270 to 300 = 2994.6 Lin. Ft.

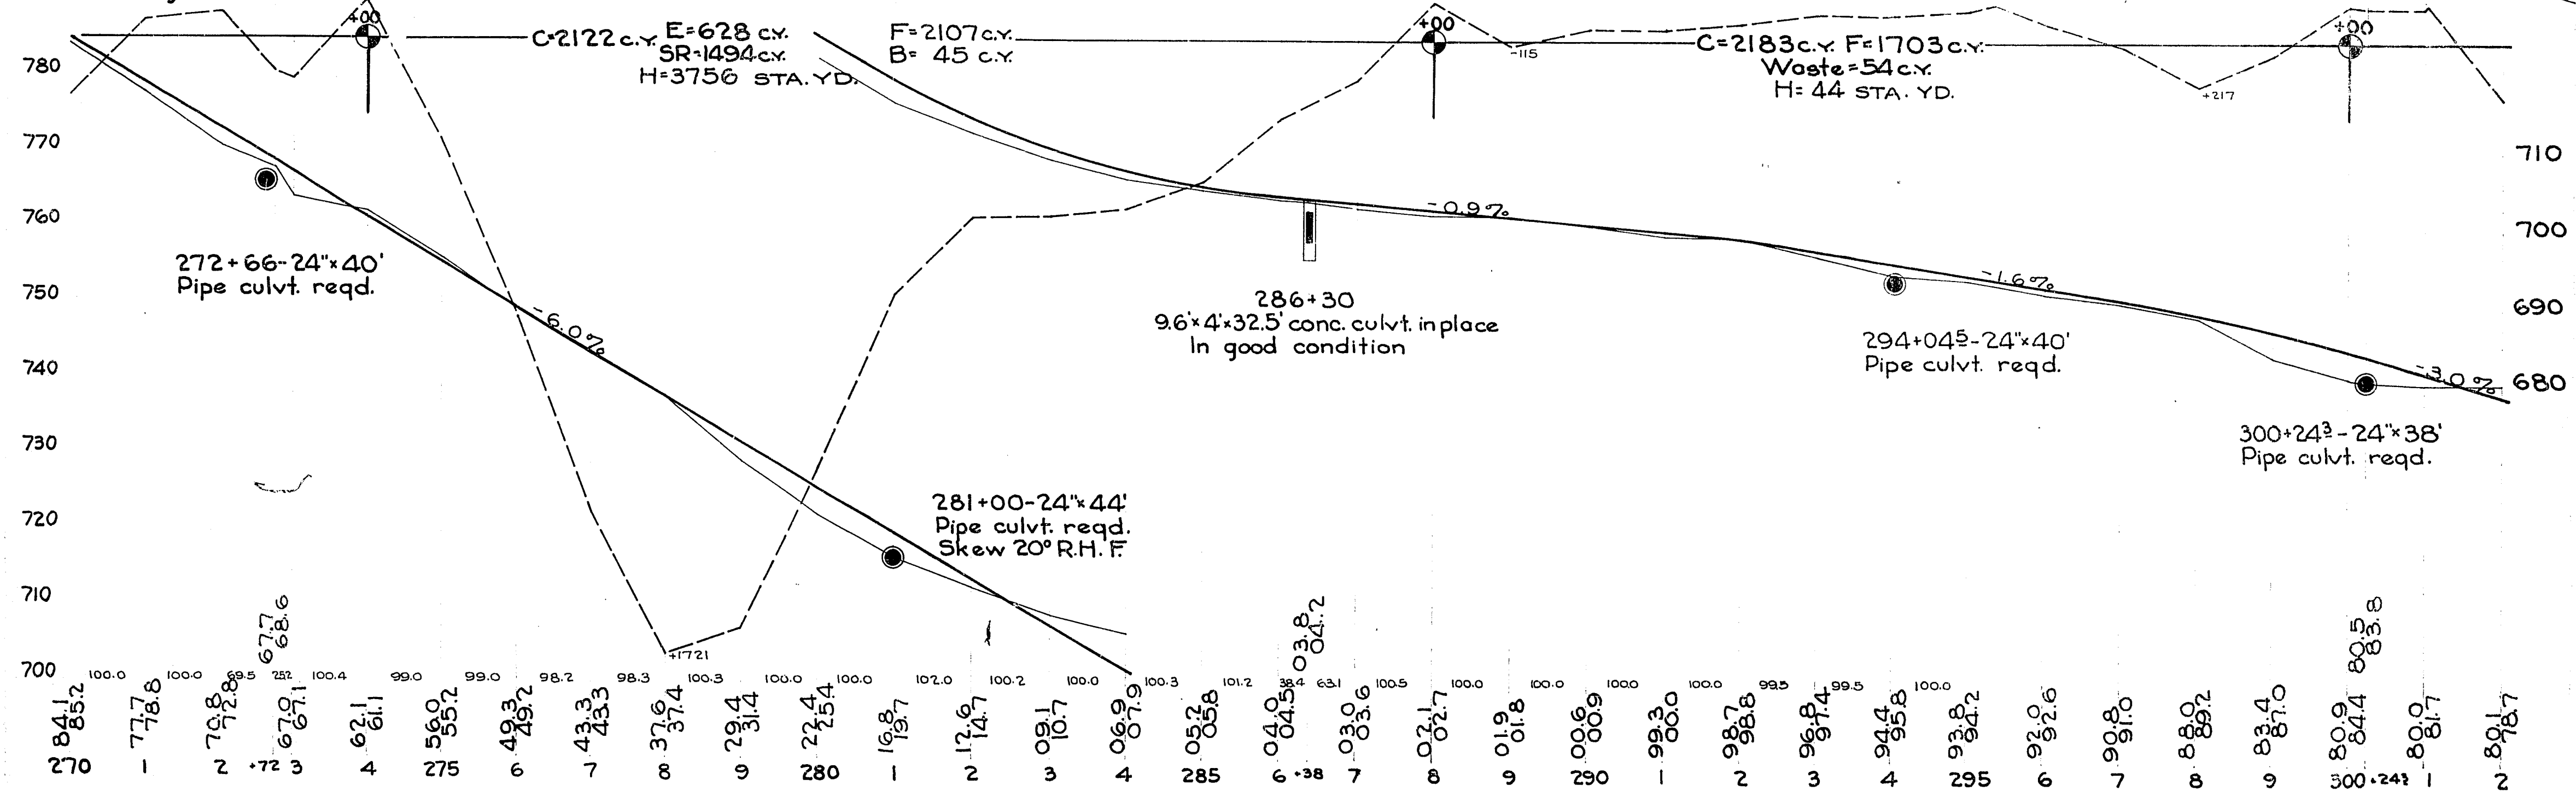

9408 17 III
9408

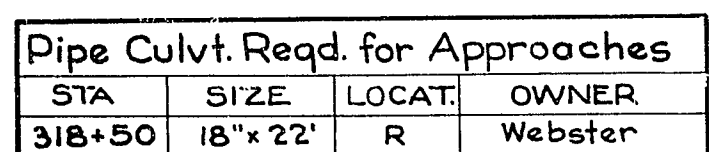


Miscellaneous Quantities for Mile Number 7						
ITEM	TYPE	LOCAT.	STA TO	STA	UNIT	AMT. TOTAL
Guard fence	C	R	348	349	Posts	5 5
ANCHORAGES					NO.	

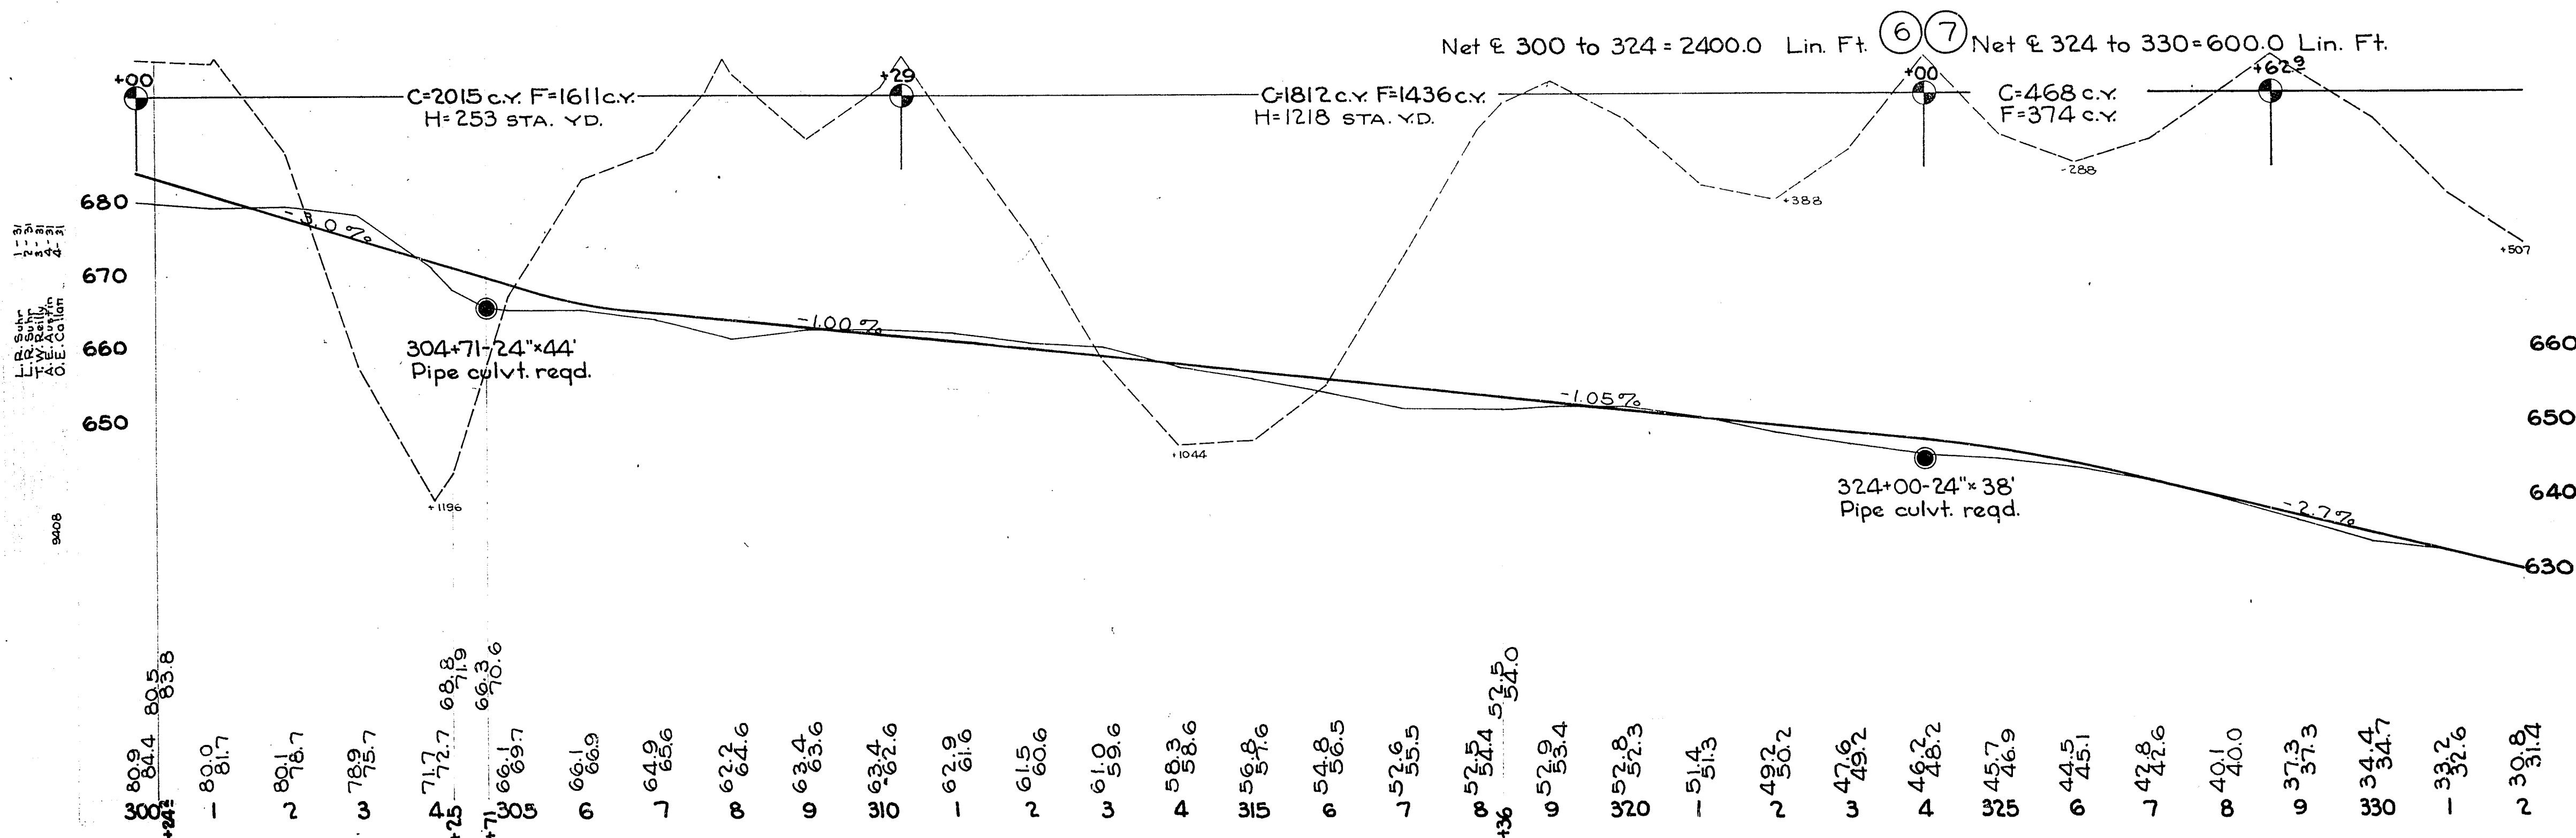

Bench Marks			
NO	STA	DESCRIPTION	ELEV.
22	333+50	In 18" willow 60 Ft. Rt.	630.49
23	348+75	In 6" elm tree 65 Ft. Rt.	625.12

Pipe Culvt. Req'd. for Approaches			
STA	SIZE	LOCAT	OWNER
334	18" x 24'	R	Burris
346	18" x 30'	R	Side Road

9408 18 III
9408

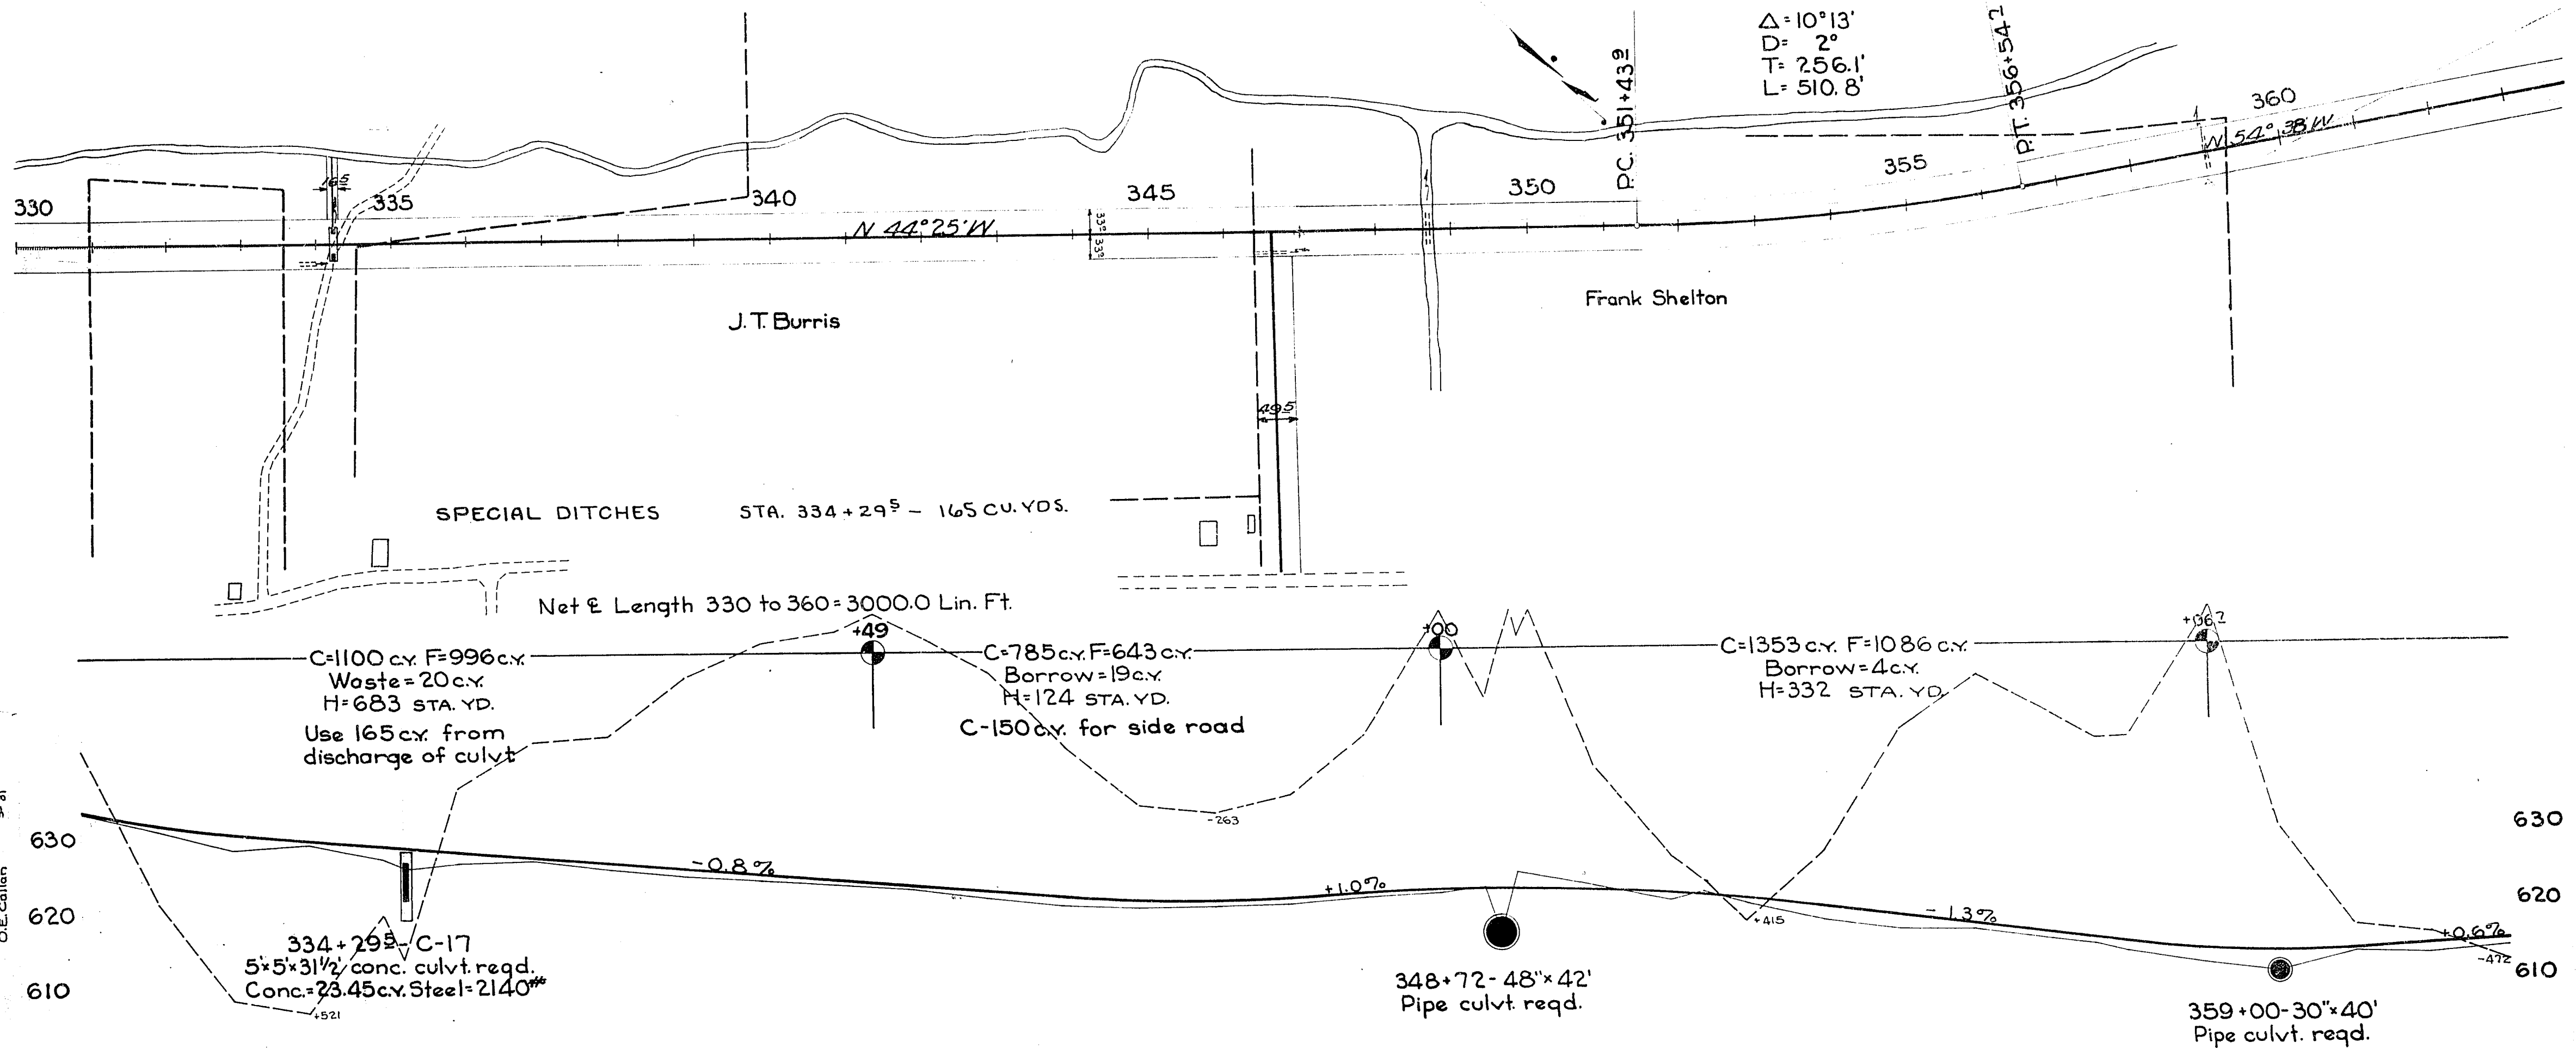


330	34.4	34.7	-	33.2	32.6	2	30.8	31.4	3	30.1	30.6	4	28.0	29.8	26.8	29.6	335	27.5	29.0	6	27.7	28.2	7	26.4	27.4	8	25.5	26.6	9	24.9	25.8	340	24.1	25.0	-	23.5	24.2	2	22.3	23.4	3	21.2	22.6	4	20.9	22.0	345	21.1	21.9	6	21.2	22.0	7	22.1	22.6	8	22.7	22.9	57	23.9	23.0	17.3	23.0	78	25.2	23.0	350	23.5	22.8	-	21.3	22.4	43.9	22.6	2	21.0	21.5	3	18.8	20.4	4	17.4	19.1	355	17.2	17.8	6	16.0	16.5	54.7	15.3	15.9	14.2	15.2	8	12.8	14.5	9	11.5	14.1	360	14.0	14.4	-	13.7	15.0	2	14.8	15.5
-----	------	------	---	------	------	---	------	------	---	------	------	---	------	------	------	------	-----	------	------	---	------	------	---	------	------	---	------	------	---	------	------	-----	------	------	---	------	------	---	------	------	---	------	------	---	------	------	-----	------	------	---	------	------	---	------	------	---	------	------	----	------	------	------	------	----	------	------	-----	------	------	---	------	------	------	------	---	------	------	---	------	------	---	------	------	-----	------	------	---	------	------	------	------	------	------	------	---	------	------	---	------	------	-----	------	------	---	------	------	---	------	------

Bench Marks			
NO	STA	DESCRIPTION	ELEV.
24	376+25	In 40" elm tree 48' Rt.	613.94


Miscellaneous Quantities for Mile Number 8						
ITEM	TYPE	LOCAT.	STA TO STA	UNIT	AMT.	TOTAL
Clear. & Grub.			407 409	Acres	0.32	0.32
Guard. fence	E	L & R	408+04 415+25	Lin Ft.	744	744
	C	L	416+50 418+50	Posts	9	
	C	R	416+50 419+50	"	13	22
ANCHORAGES				NO.	8	

9408 19 111
9408

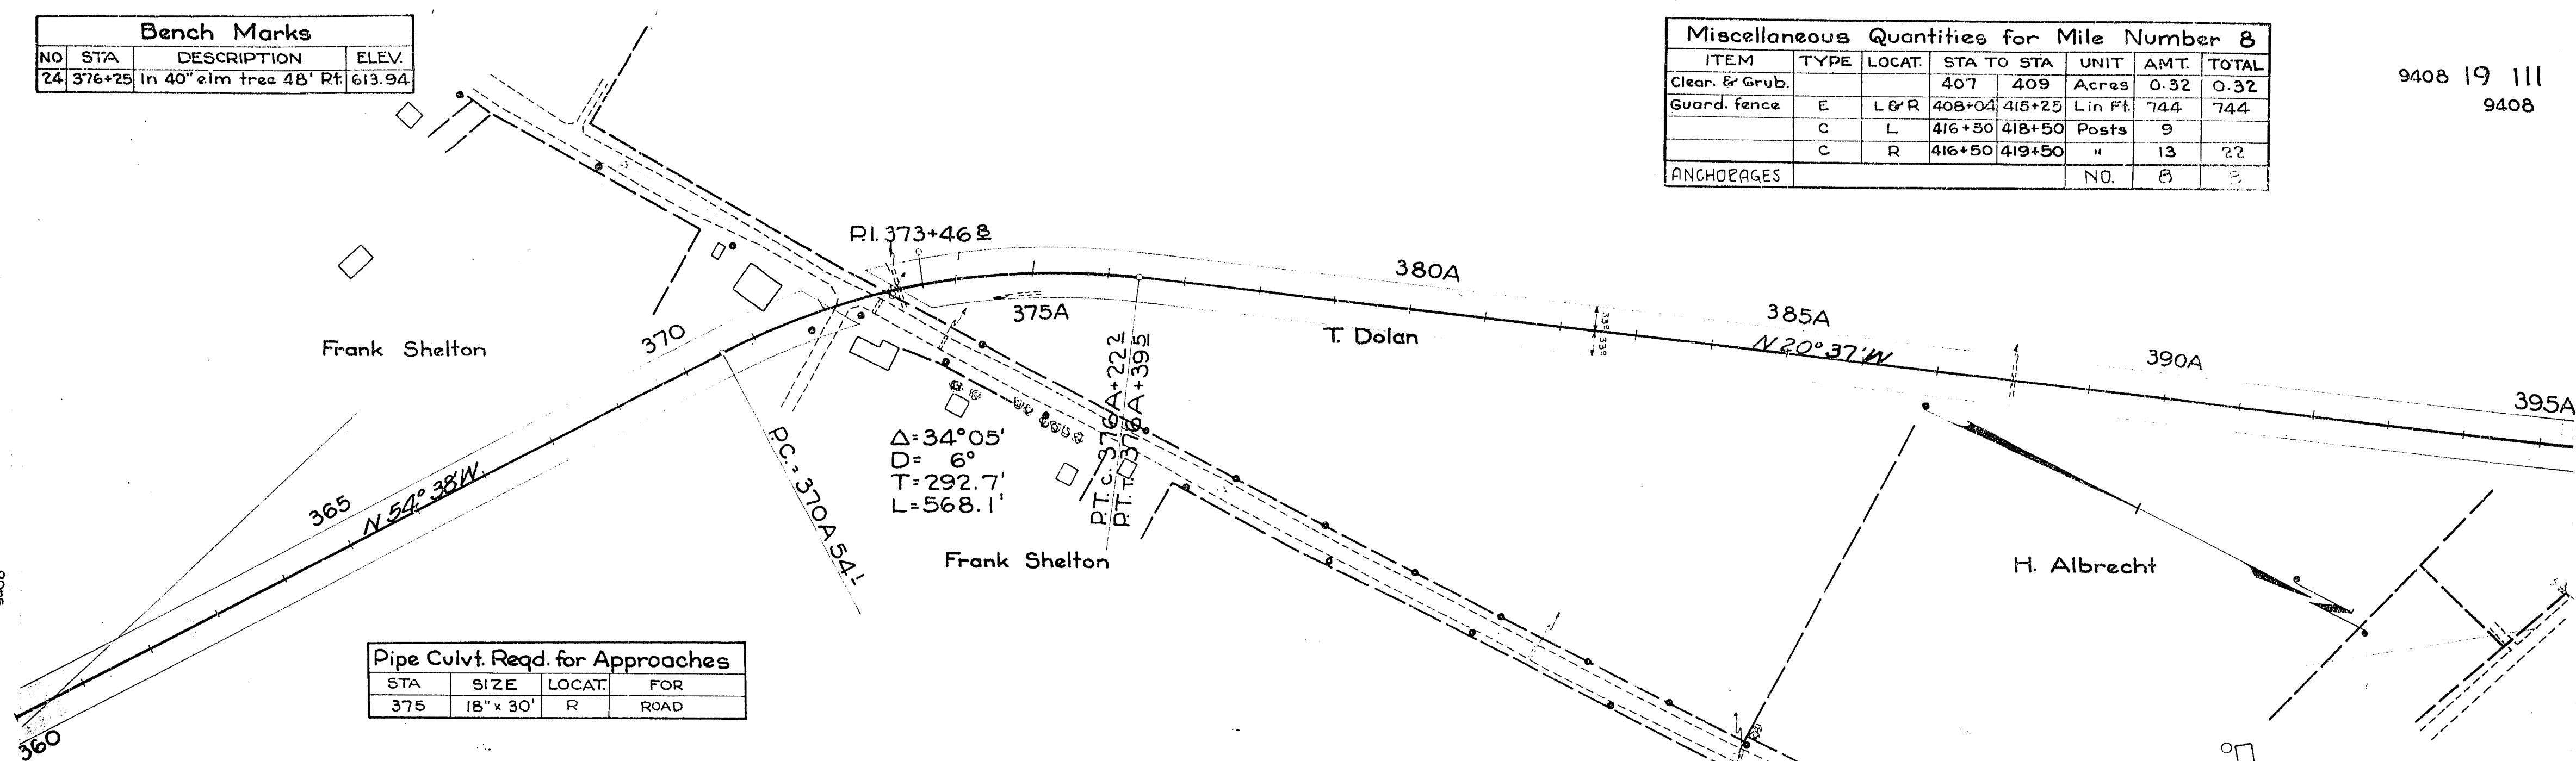


Pipe Culvt. Req'd. for Approaches			
STA	SIZE	LOCAT.	FOR
375	18" x 30'	R	ROAD

Net E Length 360 to 379A+29 = 1911.7 Lin. Ft. (7) (8) Net E Length 379+29 to 390A = 1071.0 Lin. Ft.

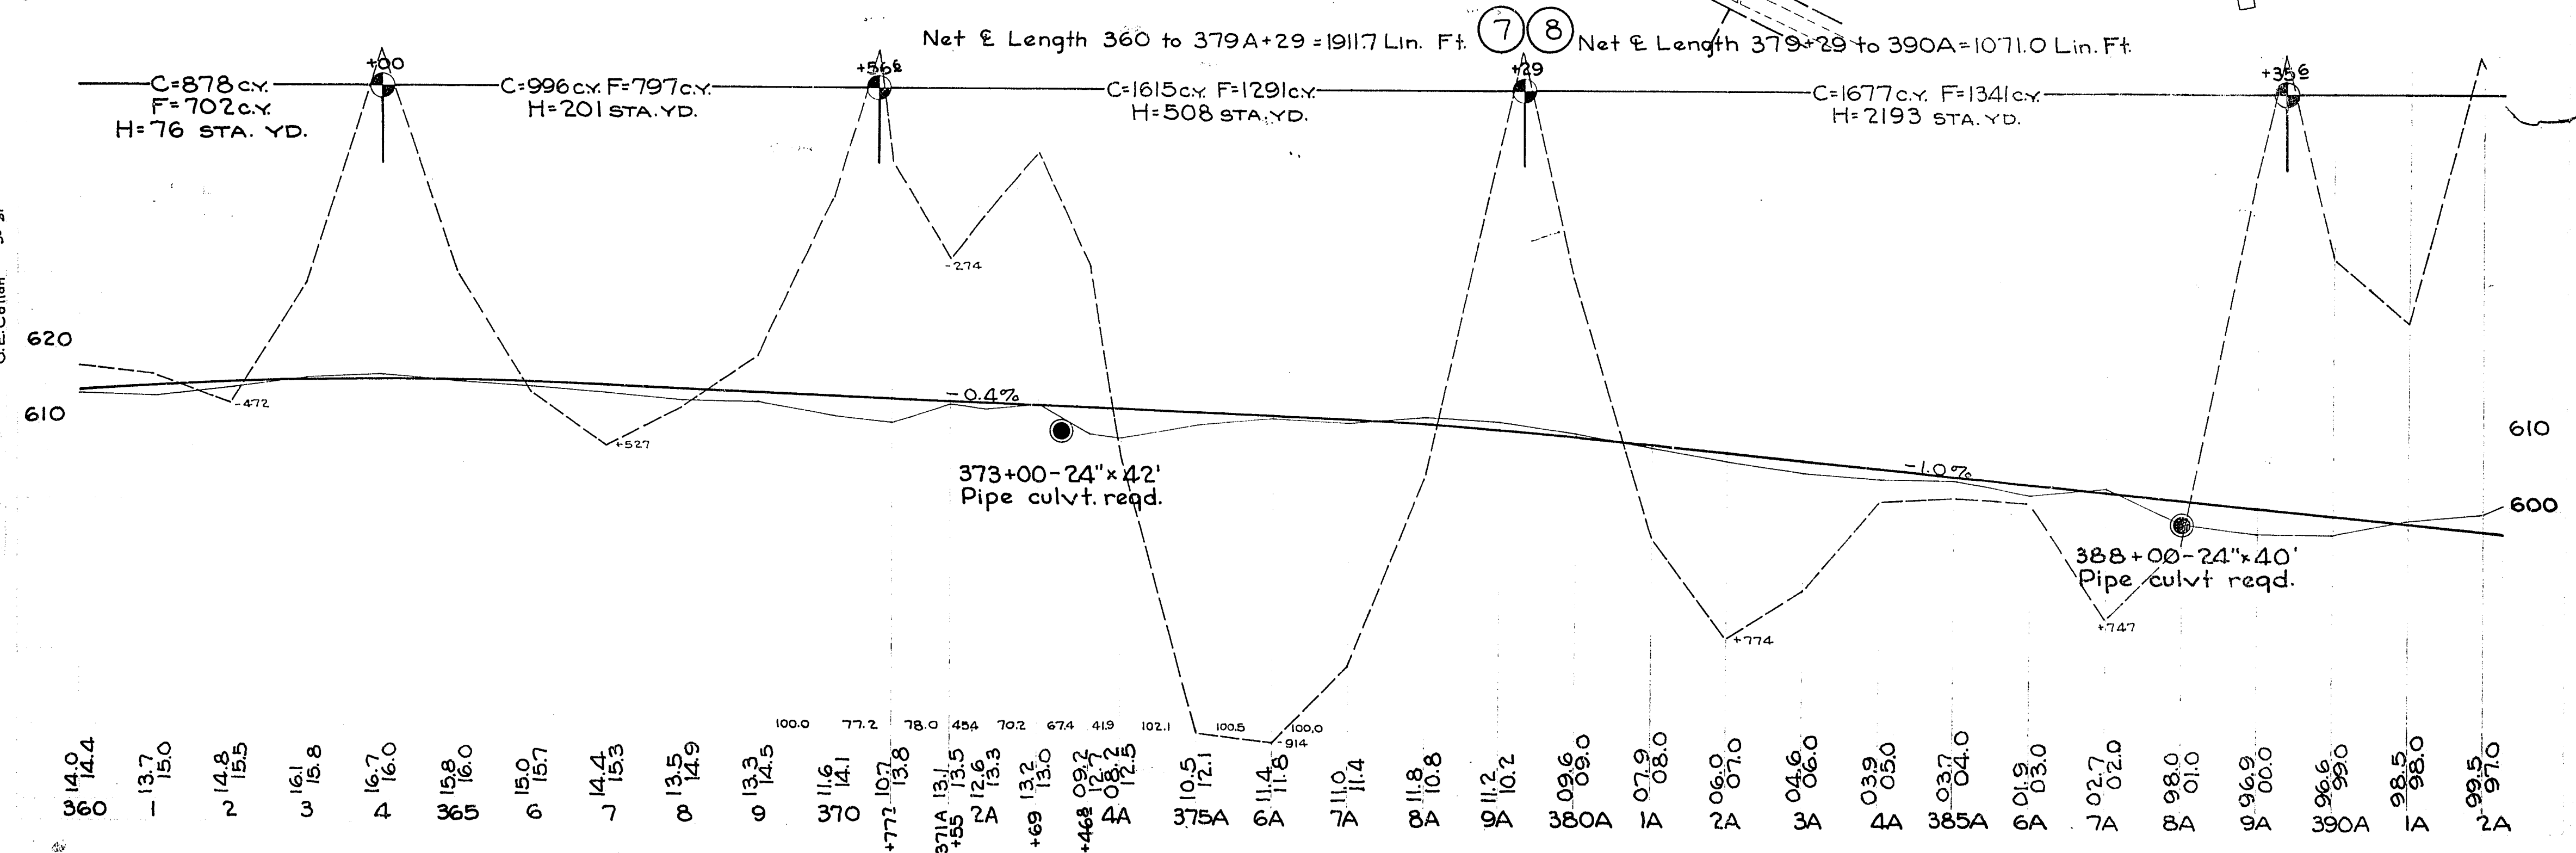


Bench Marks			
NO	STA	DESCRIPTION	ELEV.
25	398+65	In 15" elm tree 7' Rt.	593.32
26	416+30	On stump 4 Feet Left	589.06

9408 20 III
9408

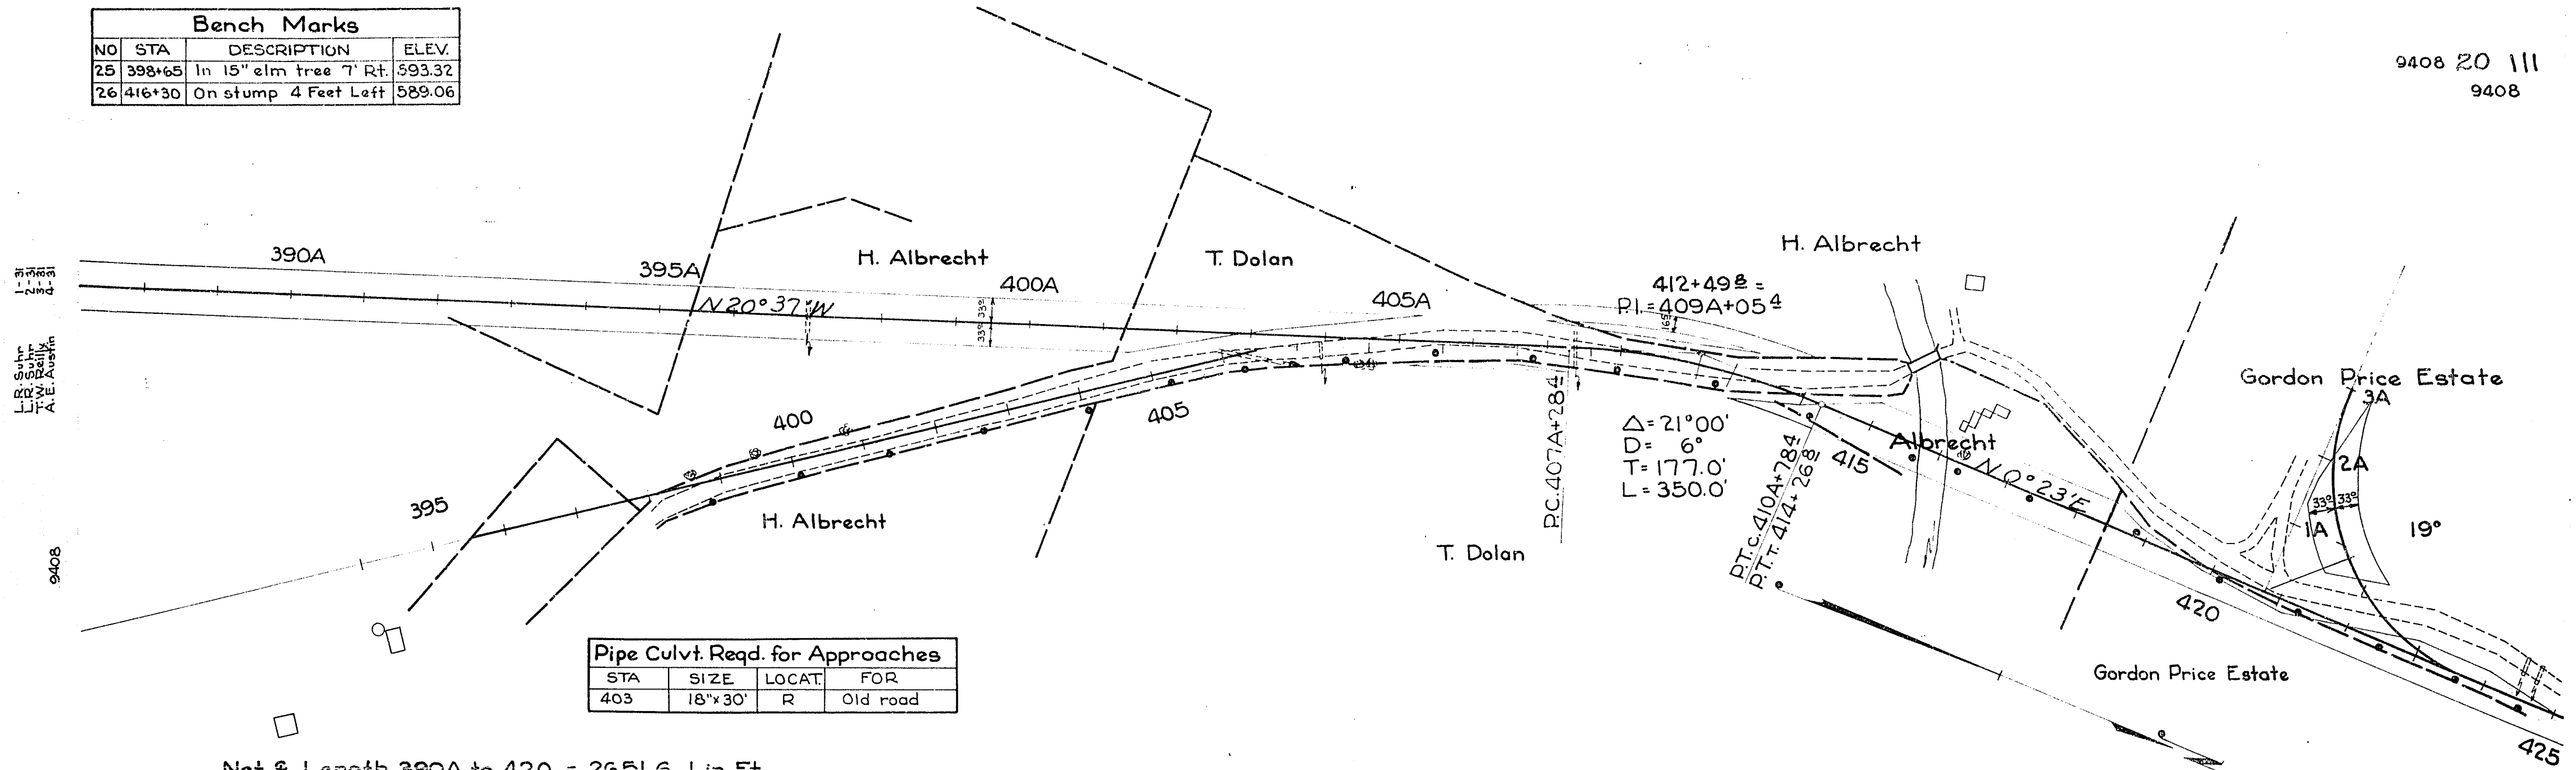

Pipe Culvt. Req'd. for Approaches			
STA	SIZE	LOCAT.	FOR
403	18"x30'	R	Old road

Net $\pm$ Length 390A to 420 = 2651.6 Lin. Ft.


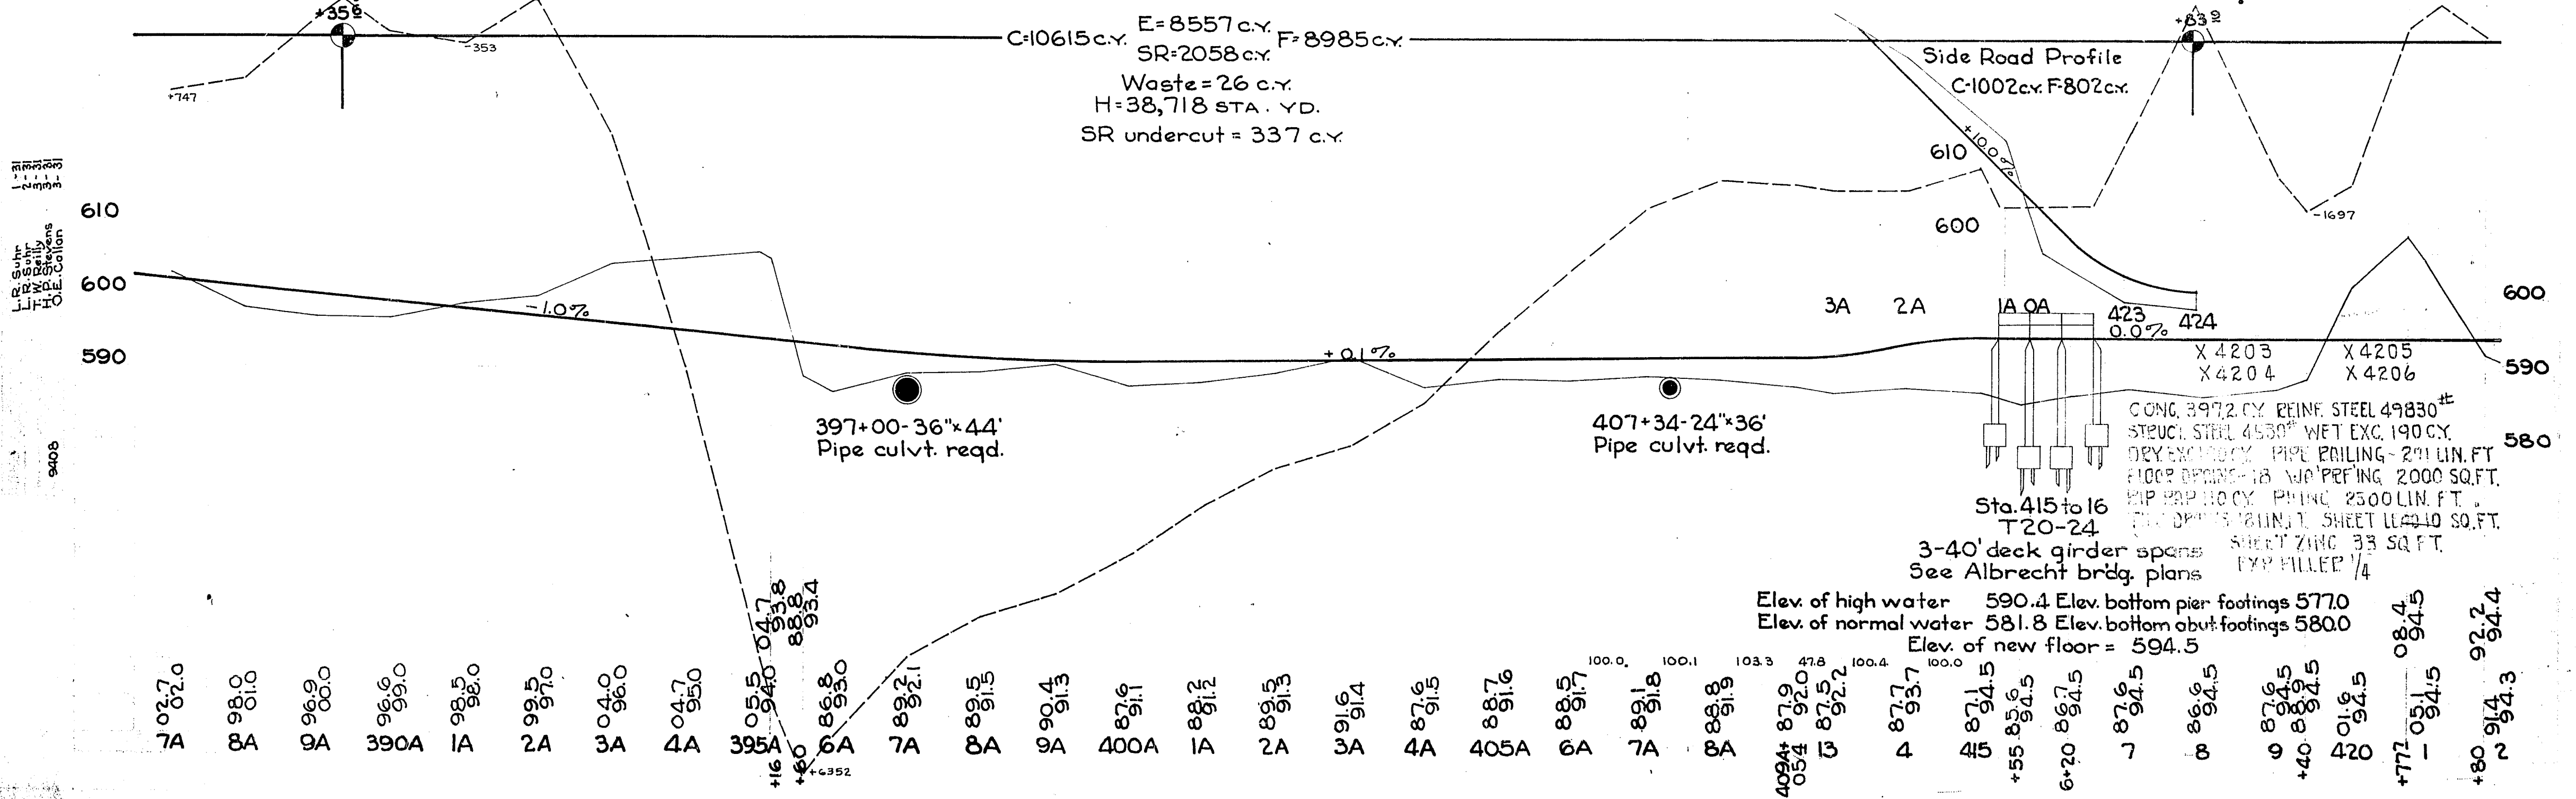


CONG. 3972 CY REINF. STEEL 49830#
 STEEL 4530# WET EXC. 190 CY
 DRY EXC. 100 CY PIPE RAILING - 201 LIN. FT.
 FLOOR DRIVE - 18 W/ PREF. 2000 SQ. FT.
 PIPE RAILING - 100 LIN. FT. 2500 LIN. FT.
 FLOOR DRIVE - 18 W/ PREF. 2000 SQ. FT.
 SHEET PILING 33 SQ. FT.
 3-40' deck girder spans
 See Albrecht brdg. plans


Bench Marks			
NO	STA	DESCRIPTION	ELEV.
27	429+47	On S.W. wing of bridge	594.98
28	433+39	On base of flag post	609.68

Pipe Culvt. Req'd. for Approaches			
STA	SIZE	LOCAT.	OWNER
422+50	18"x30'	L	Side road
433+00	2-18"x26'	L&R	School - Price

STATE

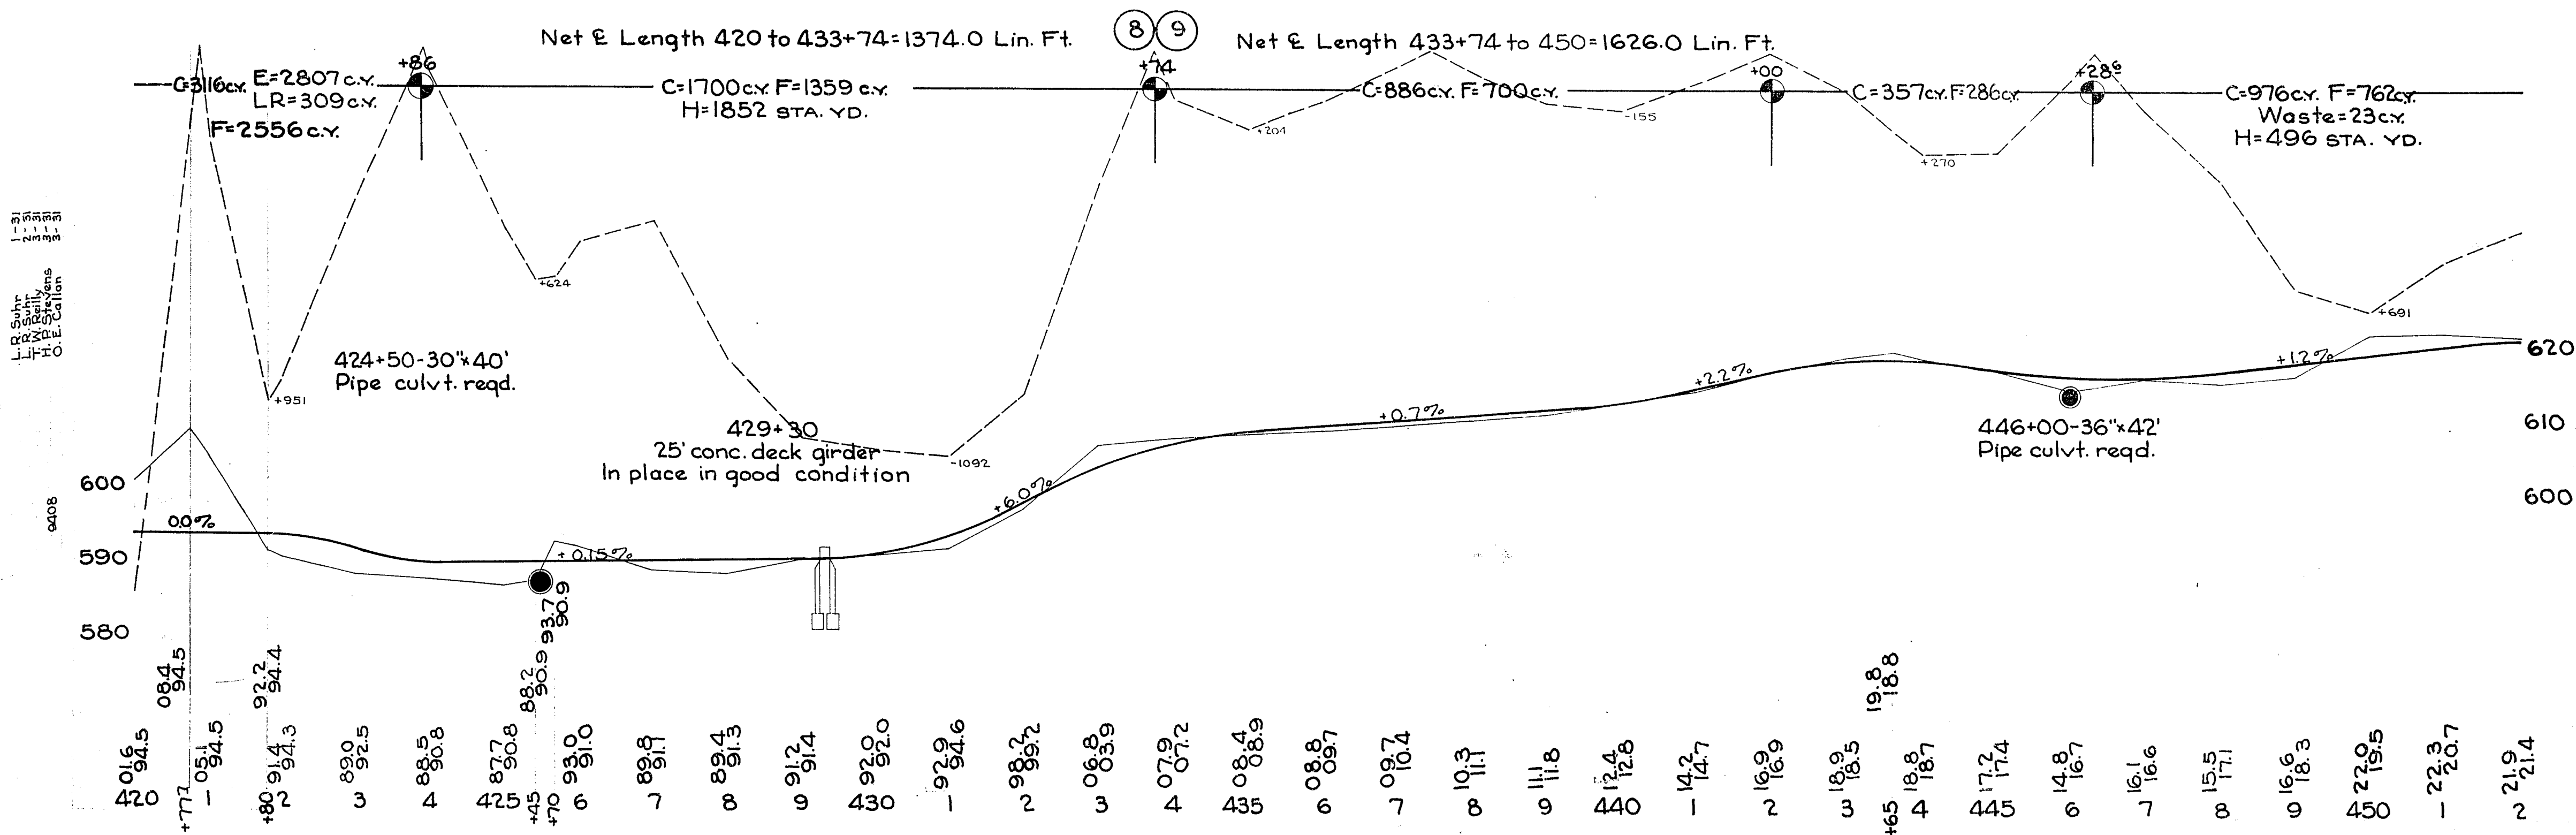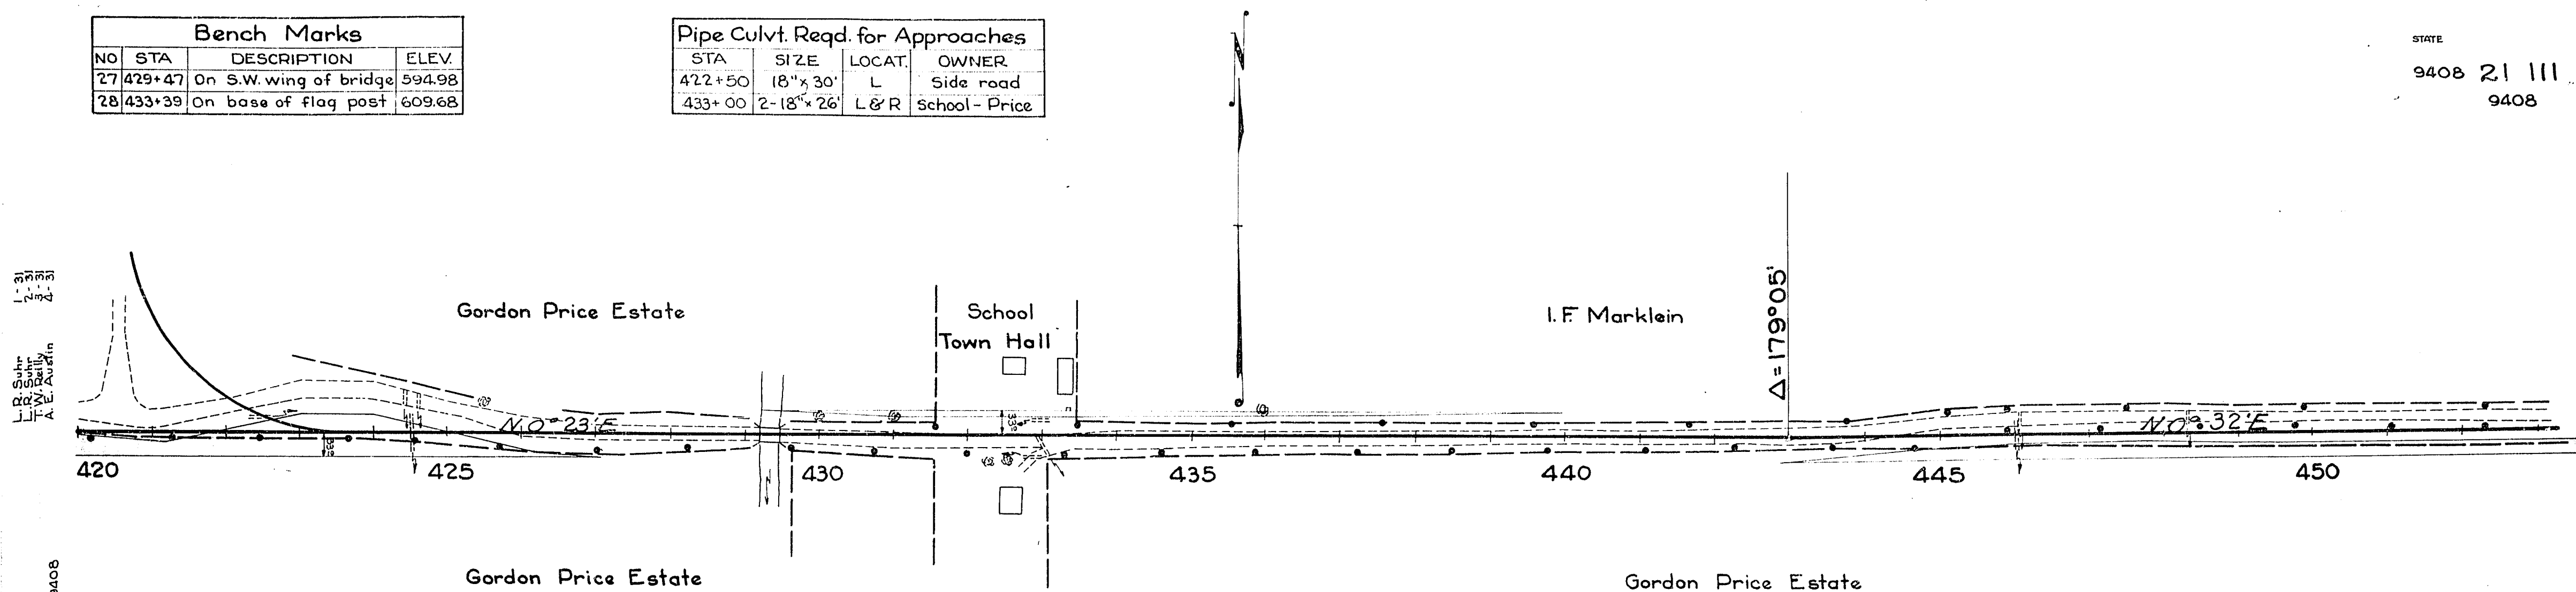9408 21 III
9408

Bench Marks			
NO	STA	DESCRIPTION	ELEV.
29	457+00	In dead tree on road L	626.78
30	471+50	N.W. corner of sidewalk R	606.04
31	479+00	N.W. wing of culvert	612.92

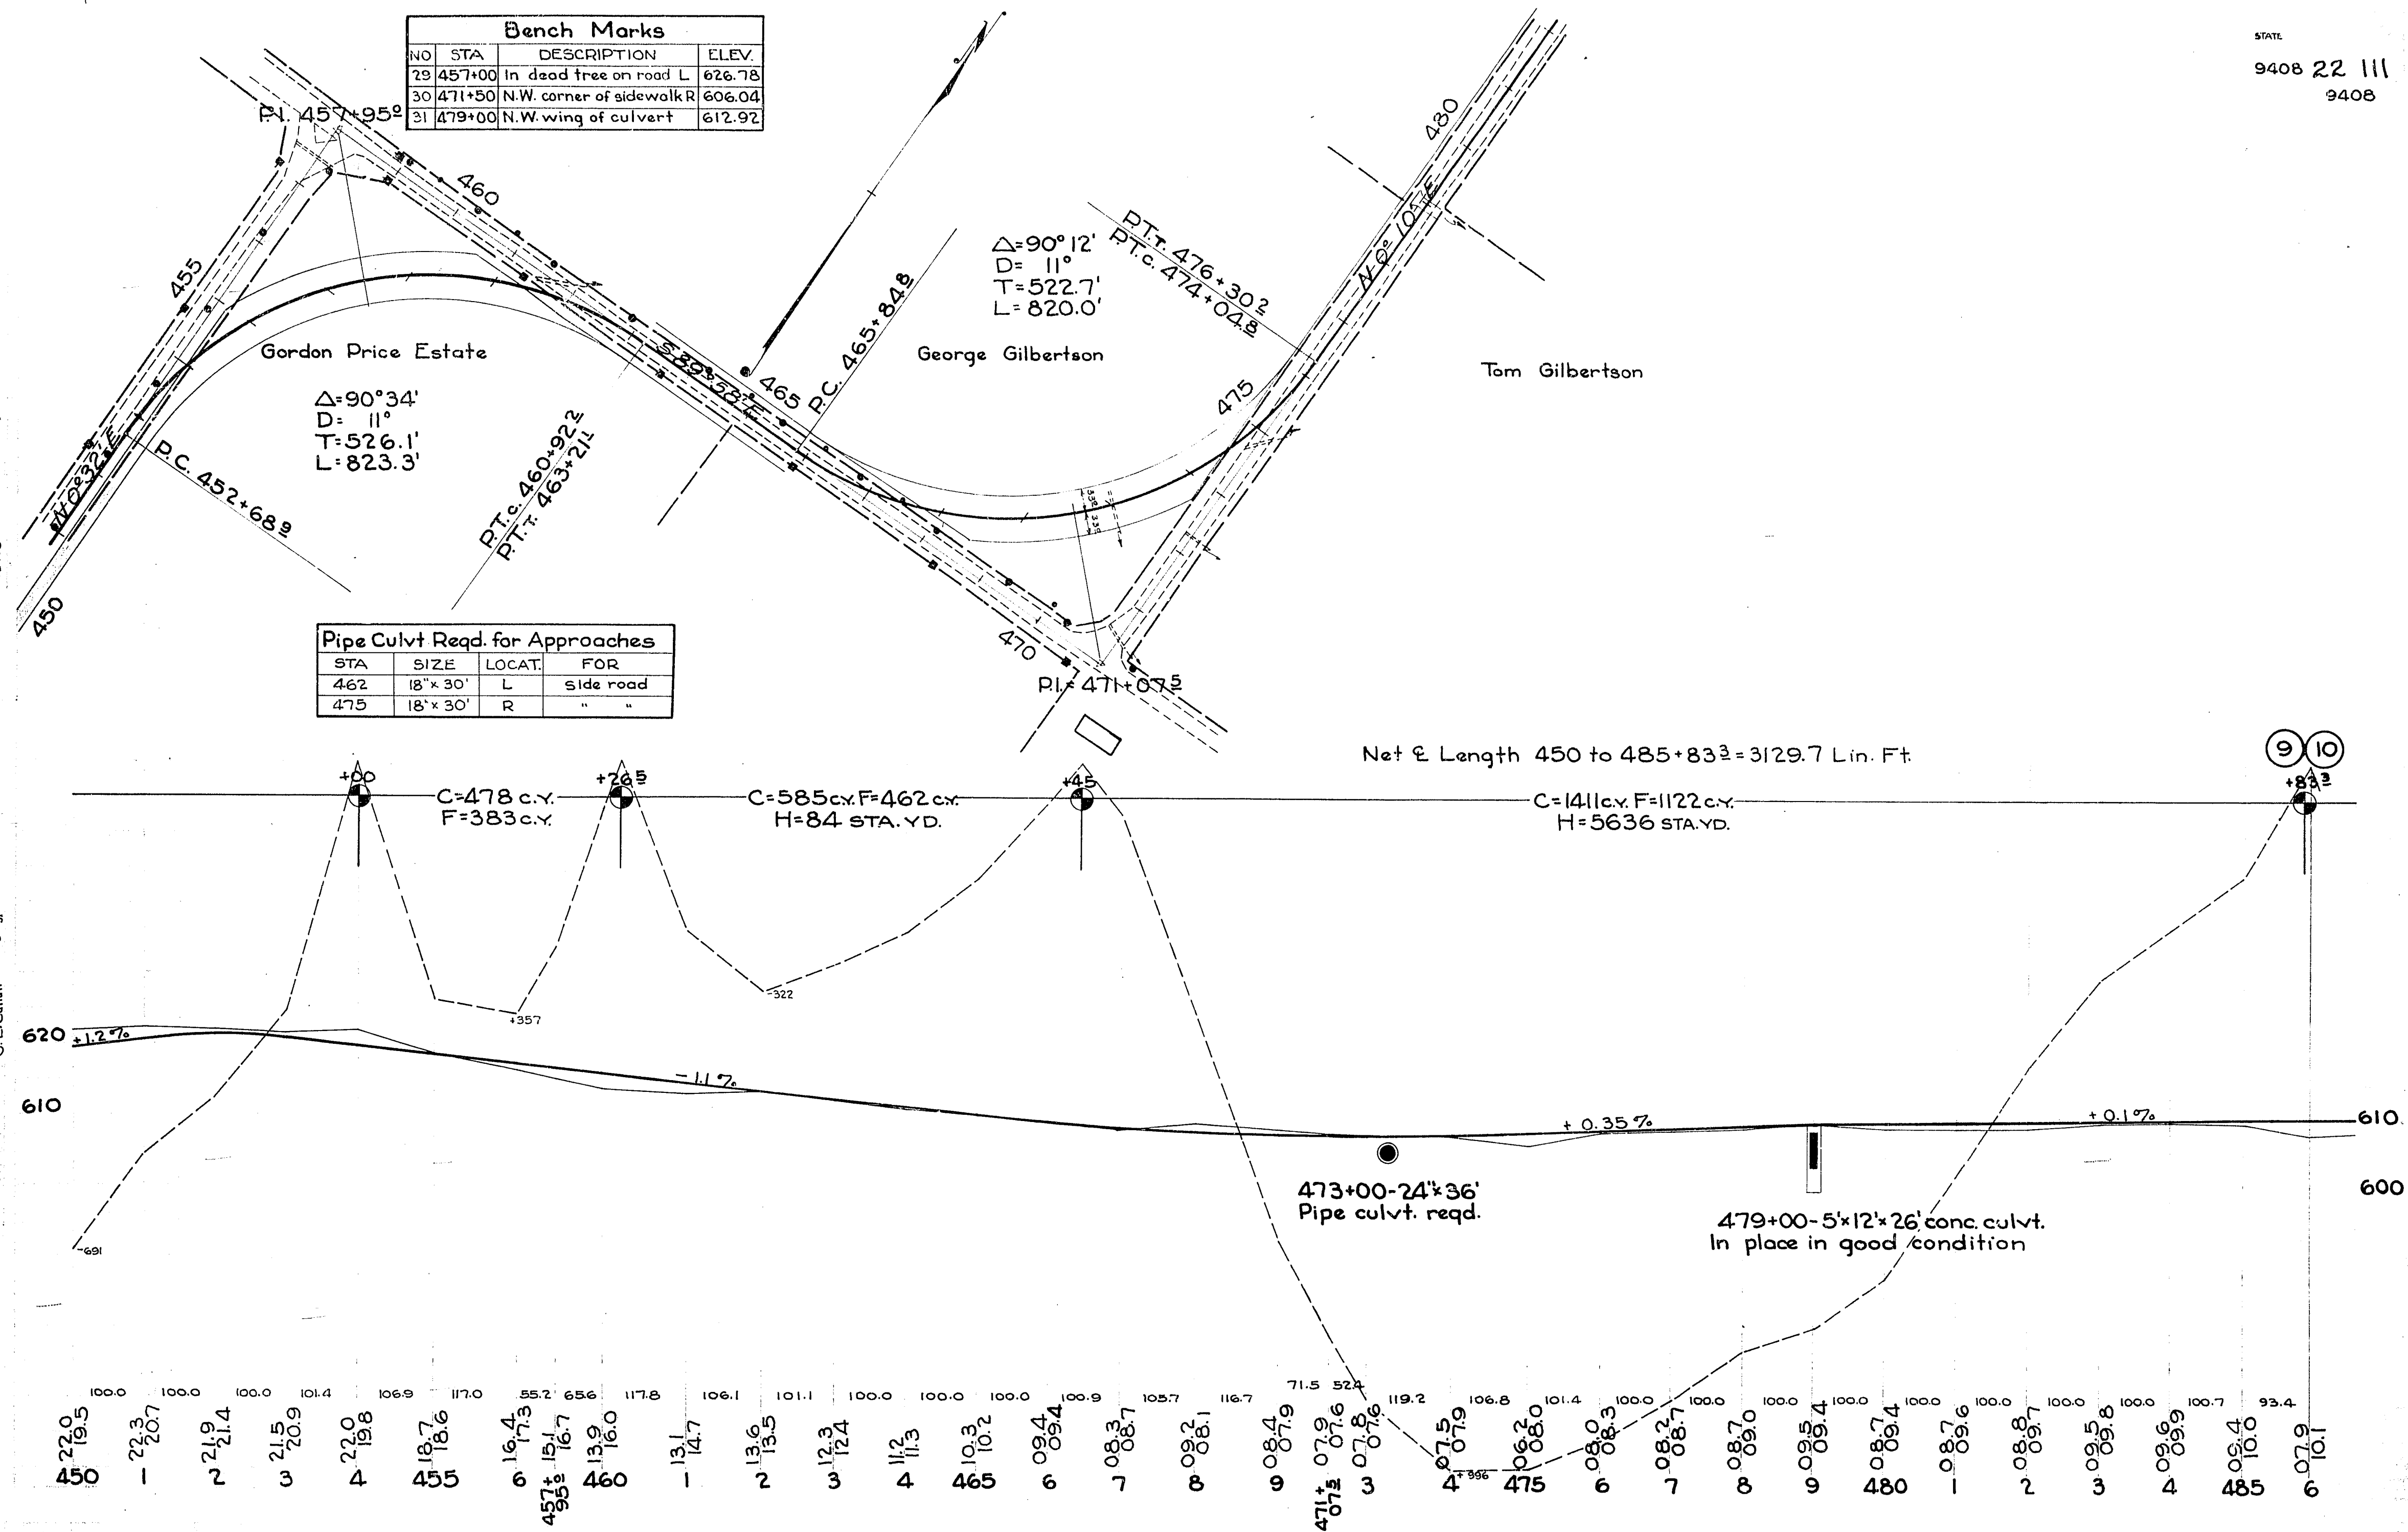


Bench Marks			
NO	STA	DESCRIPTION	ELEV.
32	485+33	On top of steel post	612.45
33	504+26	On parapet wall Rt.	590.06

Pipe Culvt. Req'd. for Approaches			
STA	SIZE	LOCAT.	OWNER
495	18" x 24"	R	Gilbertson
503	18" x 22"	R	Larson

Miscellaneous Quantities for Mile Number 10							
ITEM	TYPE	LOCAT.	STA. TO STA.	UNIT	AMT.	TOTAL	
Clear. & Grub.			530 533+80	Acres	0.61	0.61	
Guard fence	C	L	504+10 504+35	Posts	3		
	C	R	503+75 504+50	"	4		
	C	L & R	530+25 530+75	"	6		
	C	L	533+75 534+00	"	2	15	



STATE

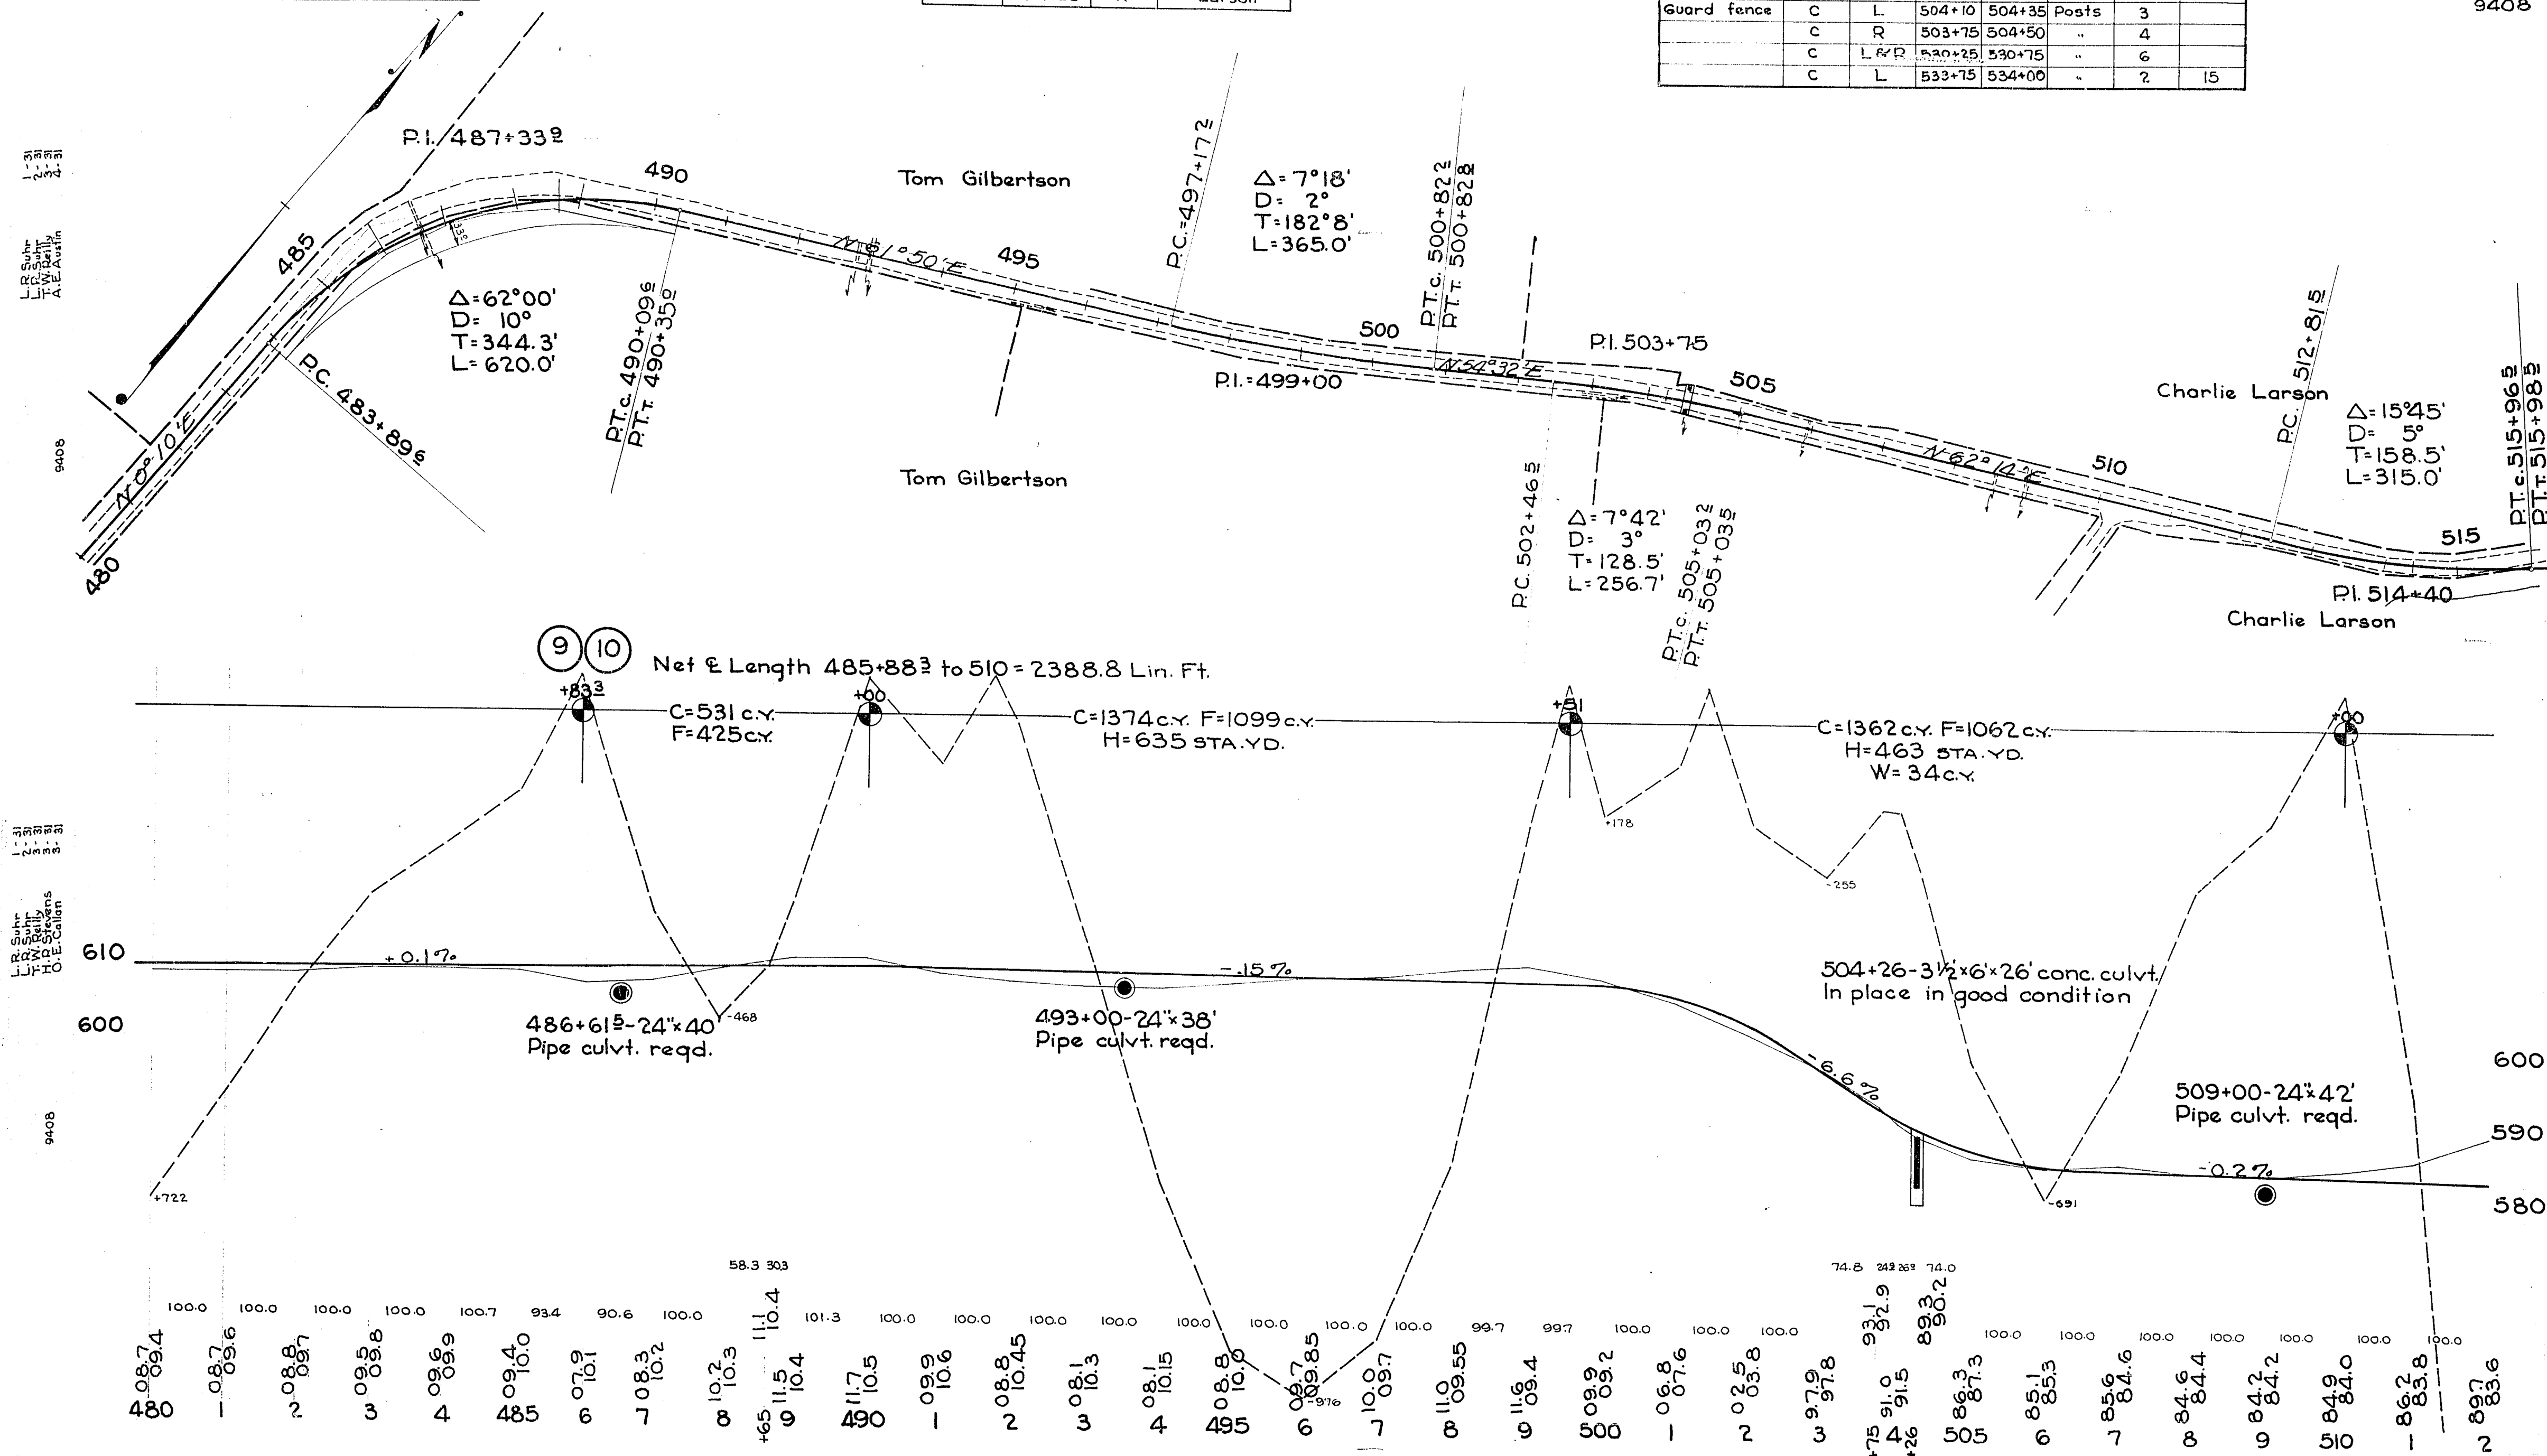9408 23 III
9408

Bench Marks			
NO	STA	DESCRIPTION	ELEV.
34	517+80	In 48" oak tree 6' L.t.	580.40
35	533+55	In root of 12" oak 10' R	577.06


Miscellaneous Quantities for Mile Number 11						
ITEM	TYPE	LOCAT.	STA TO STA	UNIT	AMT.	TOTAL
Clear. & Grub.			551 554	Acres	0.35	
Clearing only			533+80 551	"	1.95	2.30
Grubbing only			538 545	"	0.56	0.91
Rip Rap			543+10 544+90	C.Y.	80.0	80.0
Guard fence	E R		571 578	Lin. Ft.	700.0	700.0
	C L		542+50 544+50	Posts	5	
	C L		549+50 552+50	"	8	
	C L		555 558+50	"	8	
	C R		560+50 569+50	"	19	
	C L		560+50 571+00	"	24	
	C R		578 590	"	49	113

STATE
9408 24 111
9408

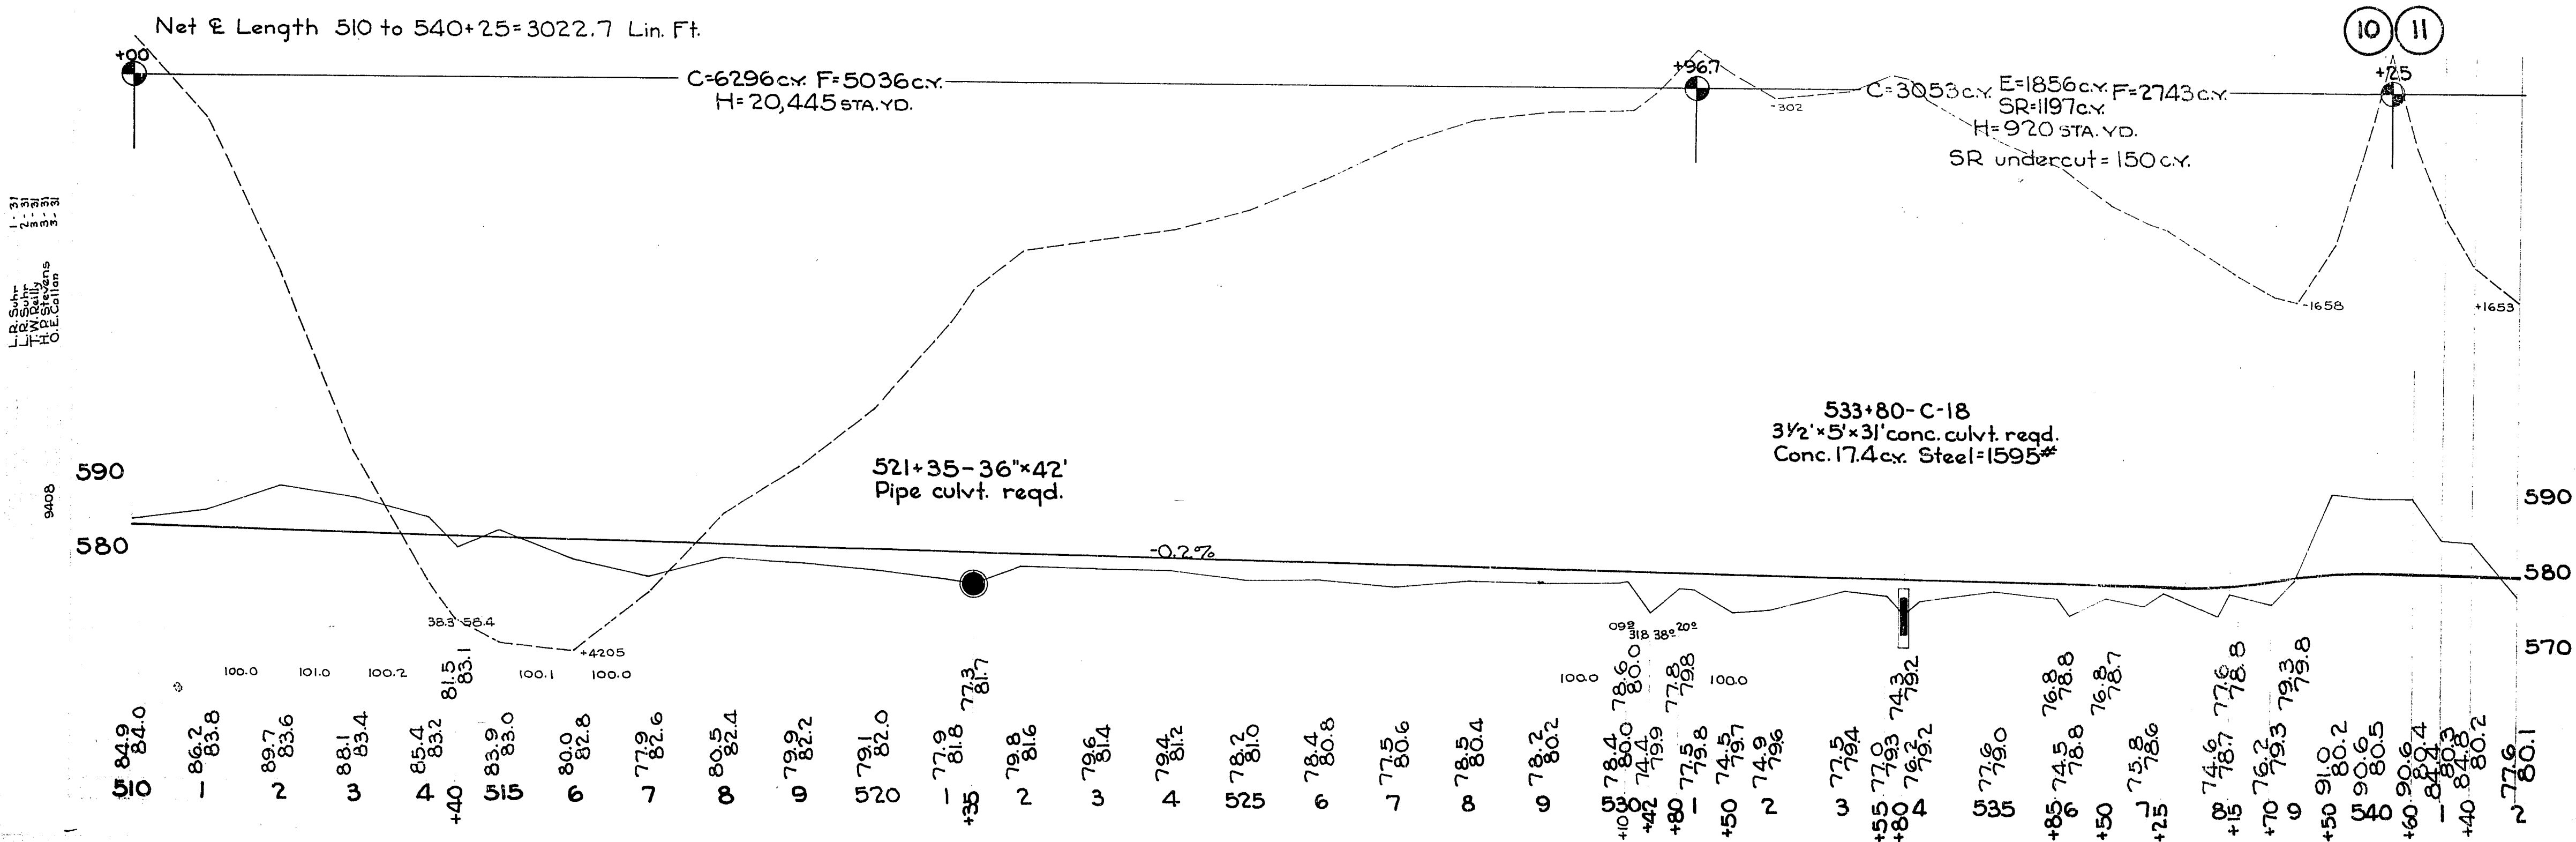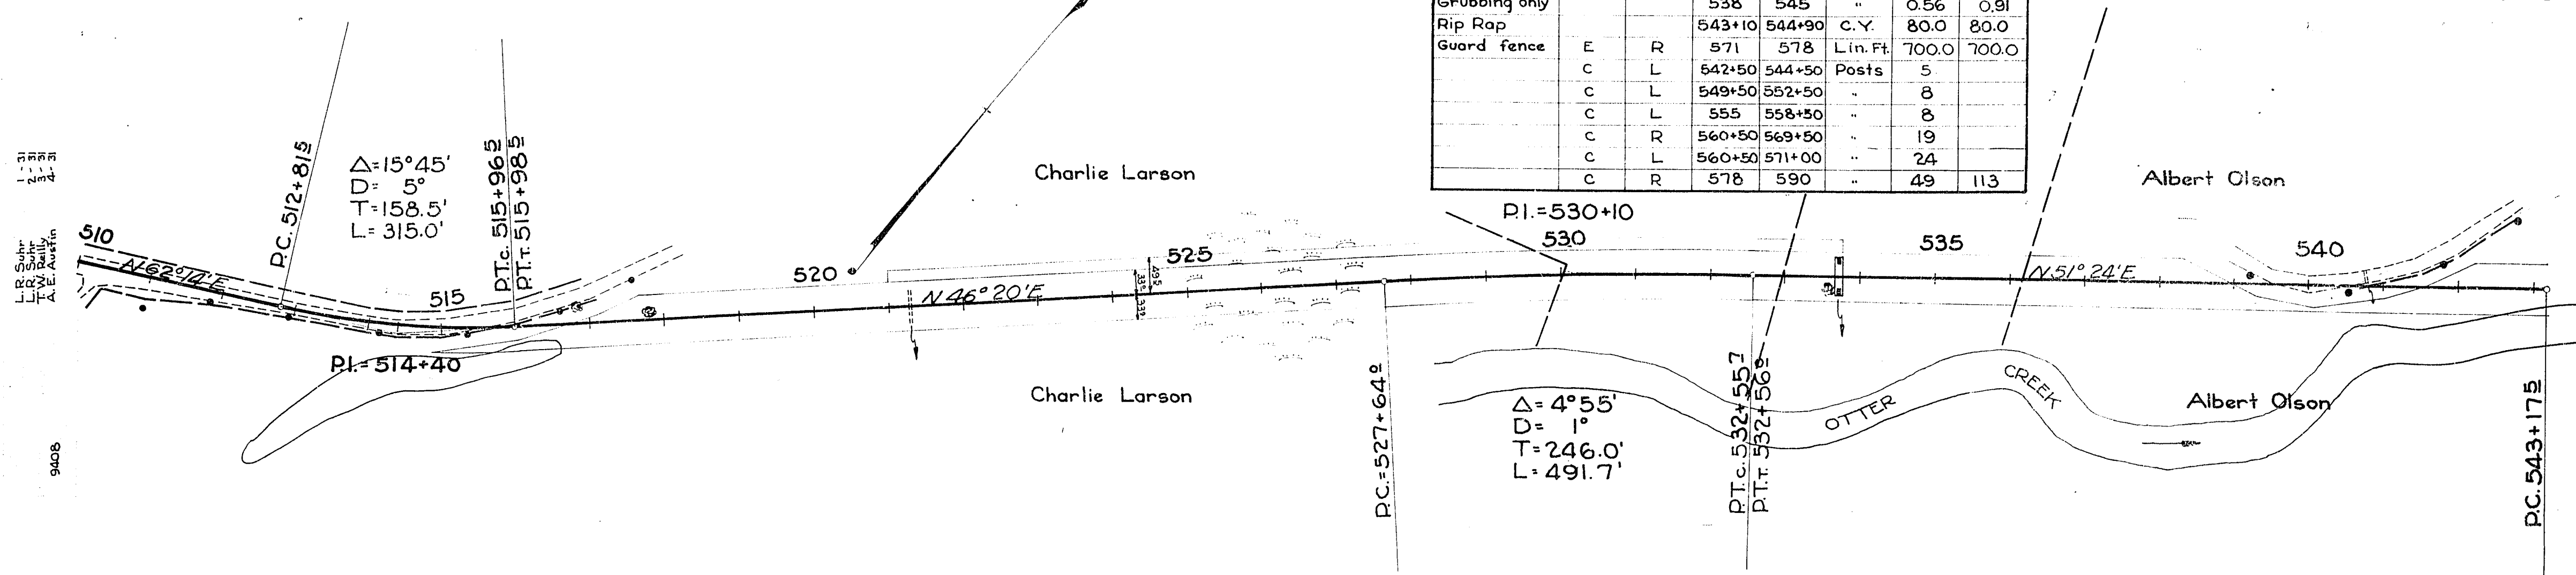


Bench Marks			
NO	STA	DESCRIPTION	ELEV.
36	553+30	On top of stump 30' R	617.11
37	563+00	In 12" oak tree 40' Rt.	575.68

STATE
9408 25 III
9408

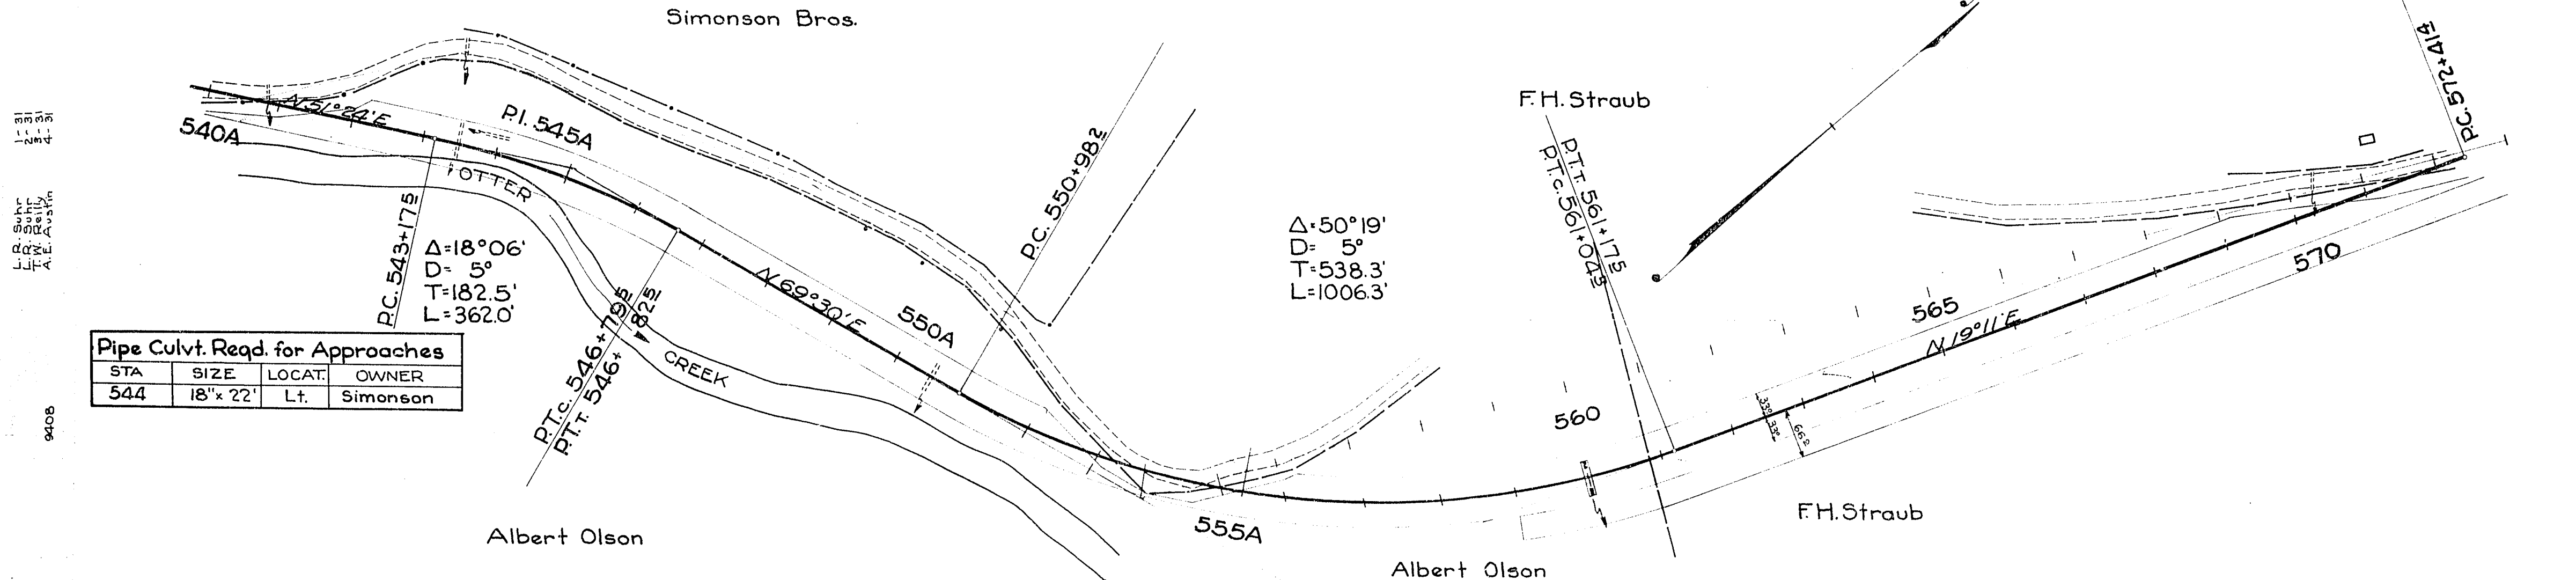

Pipe Culvt. Req'd. for Approaches			
STA	SIZE	LOCAT.	OWNER
544	18" x 22"	Lt.	Simonson

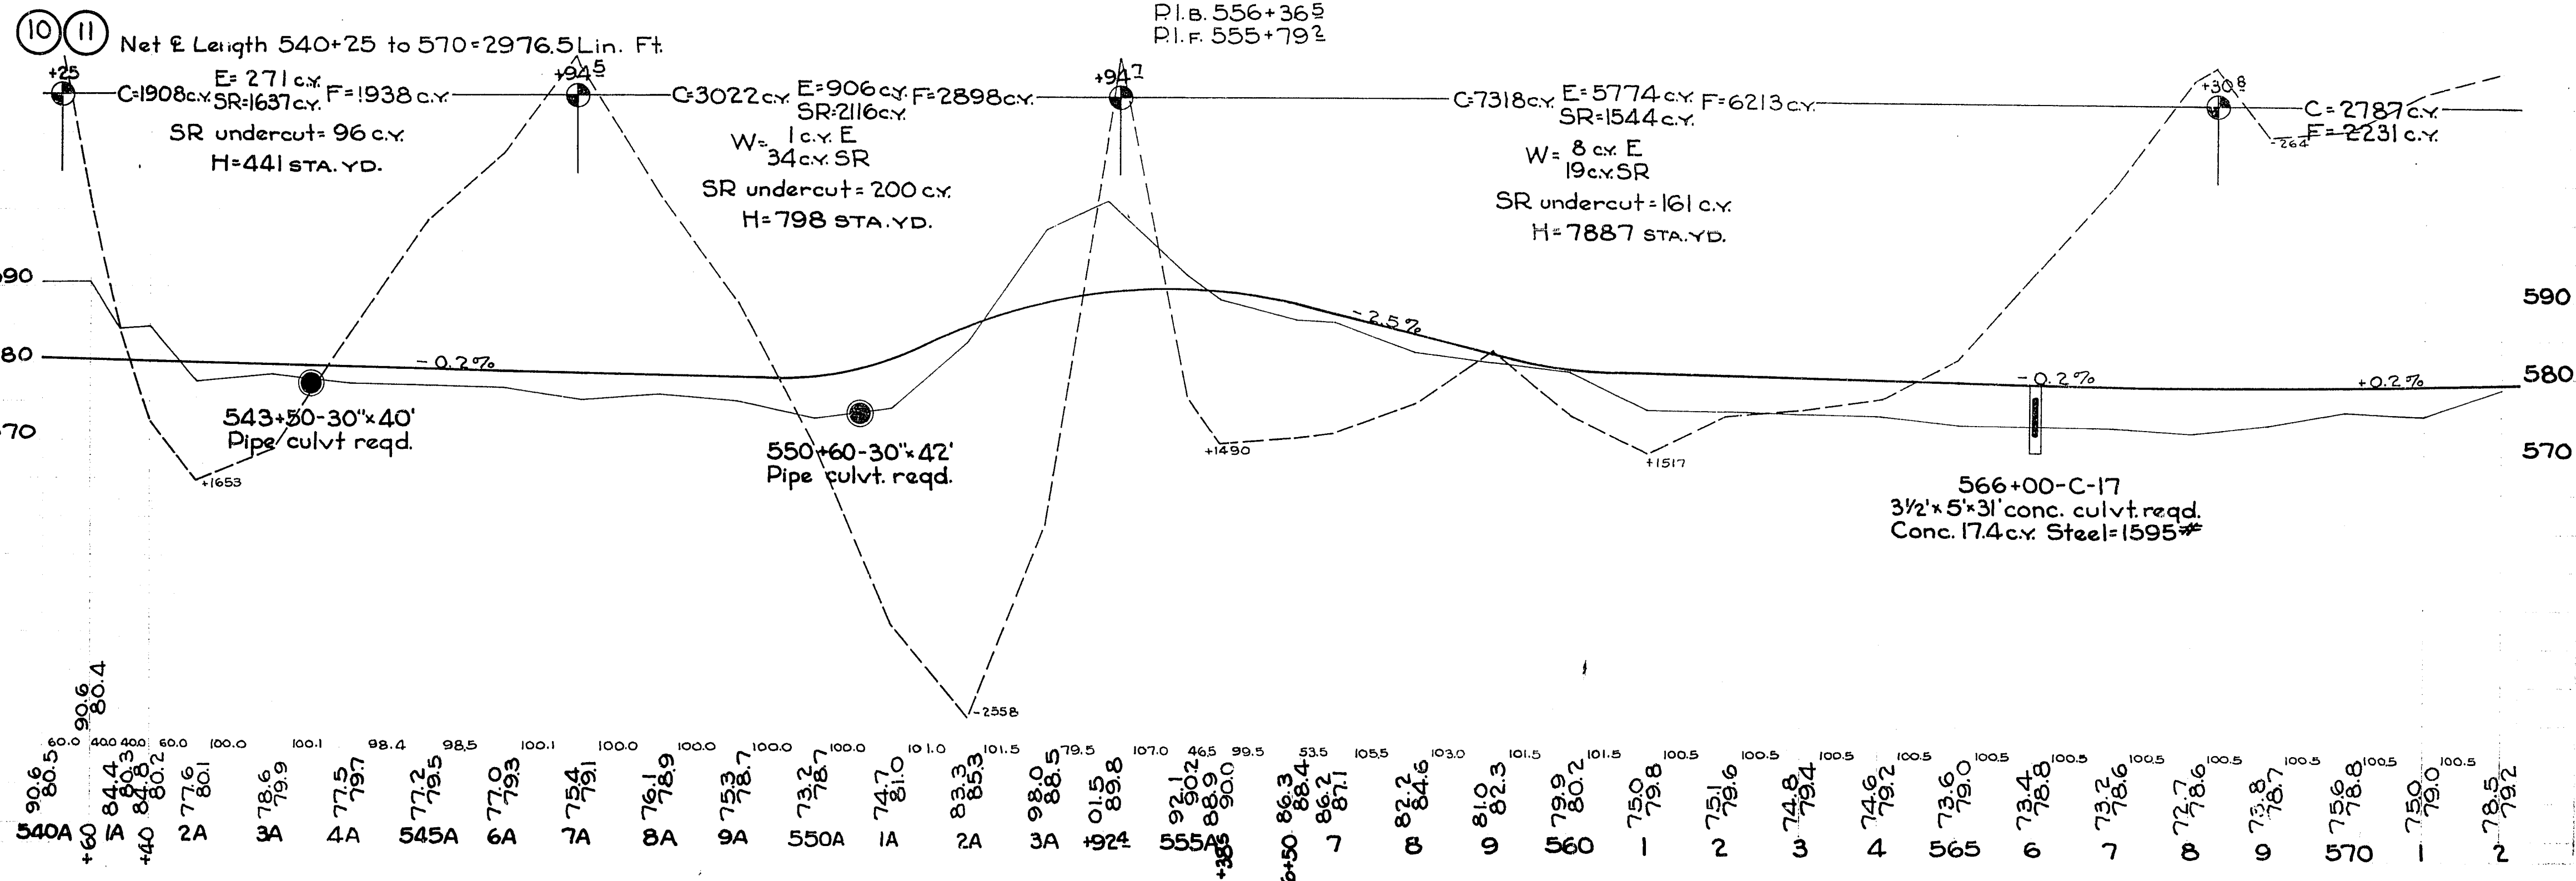

Bench Marks			
NO	STA	DESCRIPTION	ELEV.
38	572+85	On N.W. wing of culvt.	580.79
39	577+80	In leaning tree 5 Ft. R.	580.63

STATE
9408 26 111
9408

1-31
2-31
4-31

R. Suhr
L.R. Suhr
L.T. W. Rely
A. E. Austin

1-31
2-31
4-31

R. Suhr
L.R. Suhr
L.T. W. Rely
A. E. Austin

