

56

INDEX OF SHEETS

Sheet No.	Title
Sheet No. 2+2.1	Typical Sections and Details
Sheet No. 3	Estimate of Quantities
Sheet No. —	Miscellaneous Quantities
Sheet No. —	Right of Way Plat
Sheet No. 5	Plan and Profile
Sheet No. 4-4.3	Standard Detail Drawings
Sheet No. —	Sign Plates
Sheet No. —	Structure Plans
Sheet No. —	Computer Earthwork Data
Sheet No. —	Cross Sections

TOTAL SHEETS = 9



DESIGN DESIGNATION

A.D.T.	= 3500 (91)
A.D.T.	=
D.H.V.	=
D.	=
T.	=
DESIGN SPEED	=
ESALS	=

CONVENTIONAL SIGNS

PLAN	PROFILE
CORPORATE LIMITS	GRADE LINE
PROPERTY LINE	ORIGINAL GROUND
LOT LINE	MARSH OR ROCK PROFILE
LIMITED HIGHWAY EASEMENT	SPECIAL DITCH
EXISTING RIGHT OF WAY	PROFILE EXISTING TRAVELWAY
NEW RIGHT OF WAY	GRADE ELEVATION
SLOPE INTERCEPT	CULVERT
DRAIN TILE	EROSION CONTROL DEVICES
REFERENCE LINE	SILT FENCE
CULVERT IN PLACE	INTERCEPTING EMBANKMENT
CULVERT REQUIRED (Prof. 10)	EROSION BALES
DRIVEWAY / CULVERT - PROPOSED	EROSION MAT
COMBUSTIBLE FLUIDS	DITCH DIKE
	INLET / DISCHARGE APRONS, FLUMES, ETC.

STATE OF WISCONSIN DEPARTMENT OF TRANSPORTATION

STATE HIGHWAY REHABILITATION-MAINTENANCE PROJECT


NORTH LEEDS-PORTAGE ROAD

(NORTH LEEDS-MURRAY ROAD)

U.S.H. 51

COLUMBIA COUNTY

STATE PROJECT NUMBER
6020-1-63

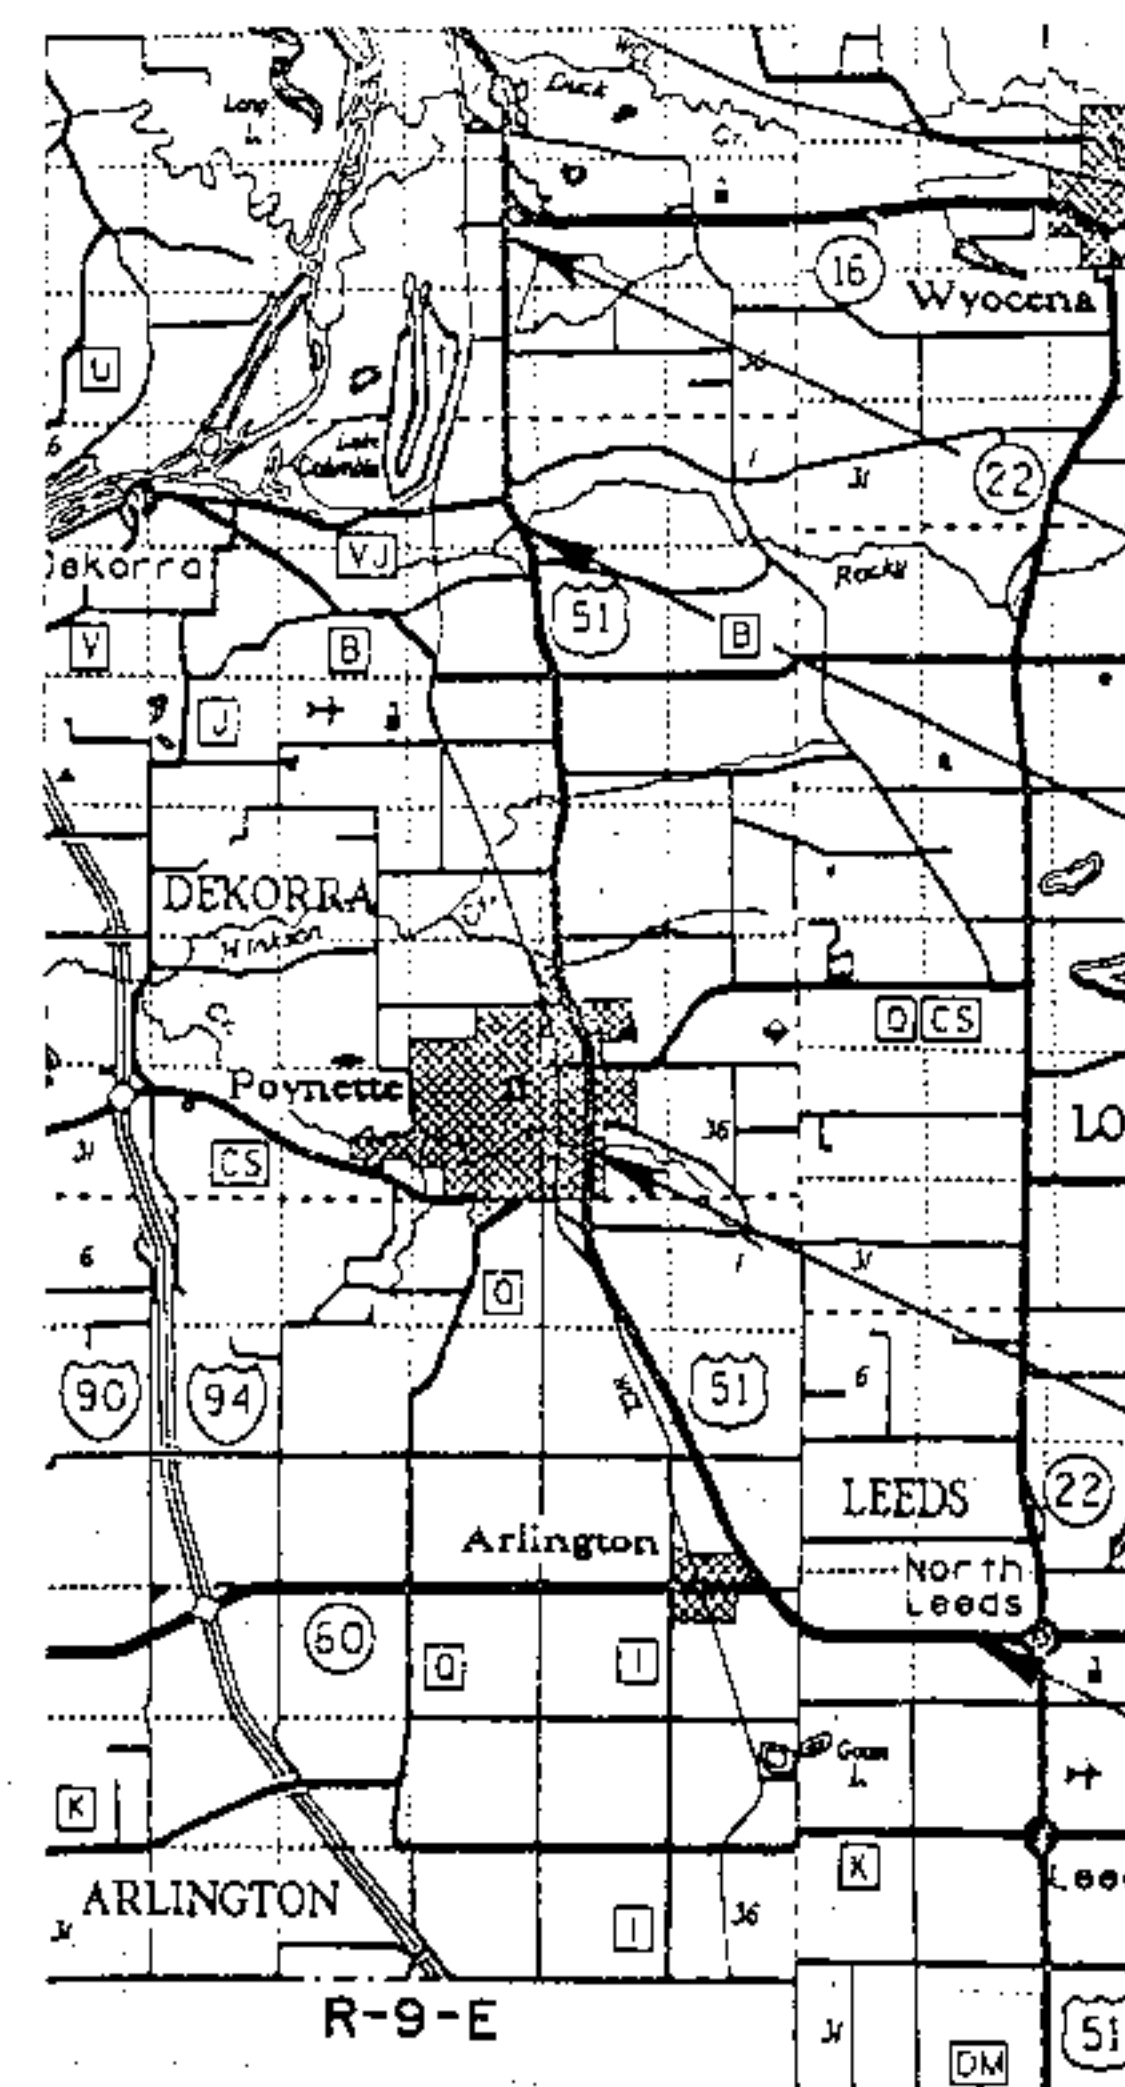

END PROJECT 6020-01-63
LOG MILE 13.05

EXCEPTION TO C
LOG MILE 10.67 (B-11-862)

EXCEPTION TO C
LOG MILE 5.76 (B-11-861)

BEGIN PROJECT 6020-01-63
LOG MILE 0.00

LAYOUT
SCALE 0 2 Mi.

TOTAL NET LENGTH OF CENTERLINE = 13.040 MI.

STATE OF WISCONSIN DEPARTMENT OF TRANSPORTATION	
PREPARED BY	
Surveyor	
Designer	C. NEUHAUSER
District Examiner	
District Supervisor	K. KONKEL
Proj. Dev. Engineer	
C.O. Examiner	E.N. BENISCH
APPROVED FOR DISTRICT OFFICE	
DATE: 3/7/95	<i>[Signature]</i>
AUTHORIZED FOR CENTRAL OFFICE MAINTENANCE	
DATE: 3/20/96	<i>[Signature]</i>