





BEGIN PROJECT 6020-01-63
LOG MILE 0.00


EXCEPTION TO NET $\varnothing$ LENGTH
BRIDGE B-11-861

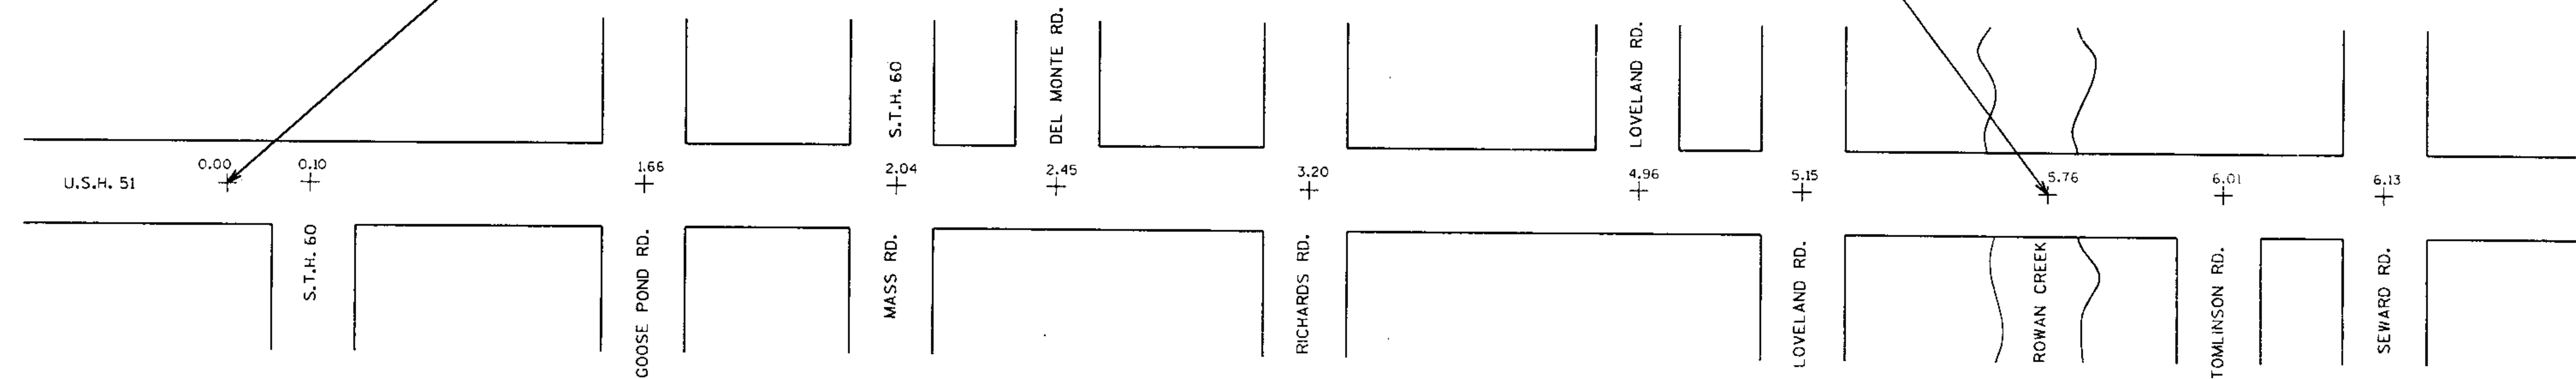

EXCEPTION TO NET $\varnothing$ LENGTH
BRIDGE B-11-862

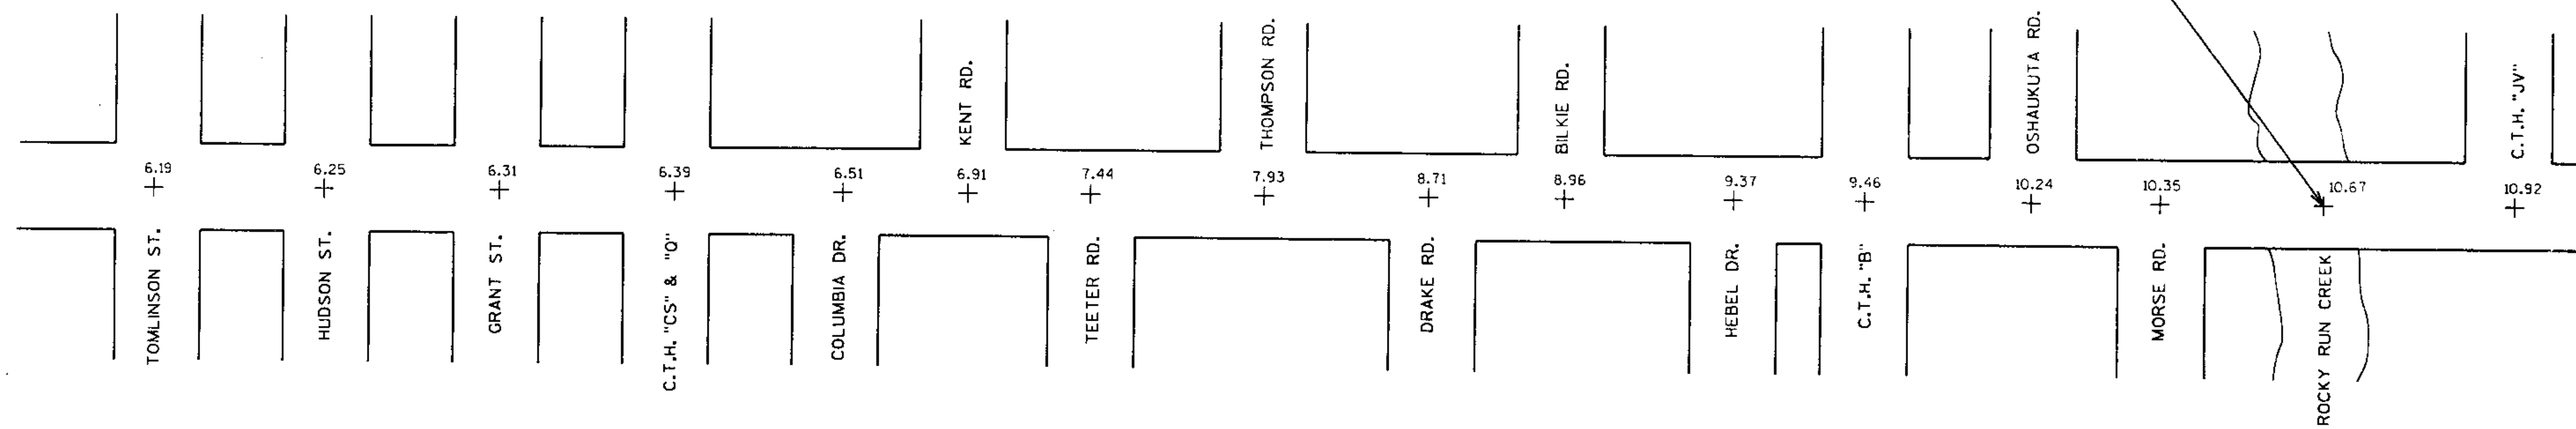

END PROJECT 6020-01-63
LOG MILE 13.05

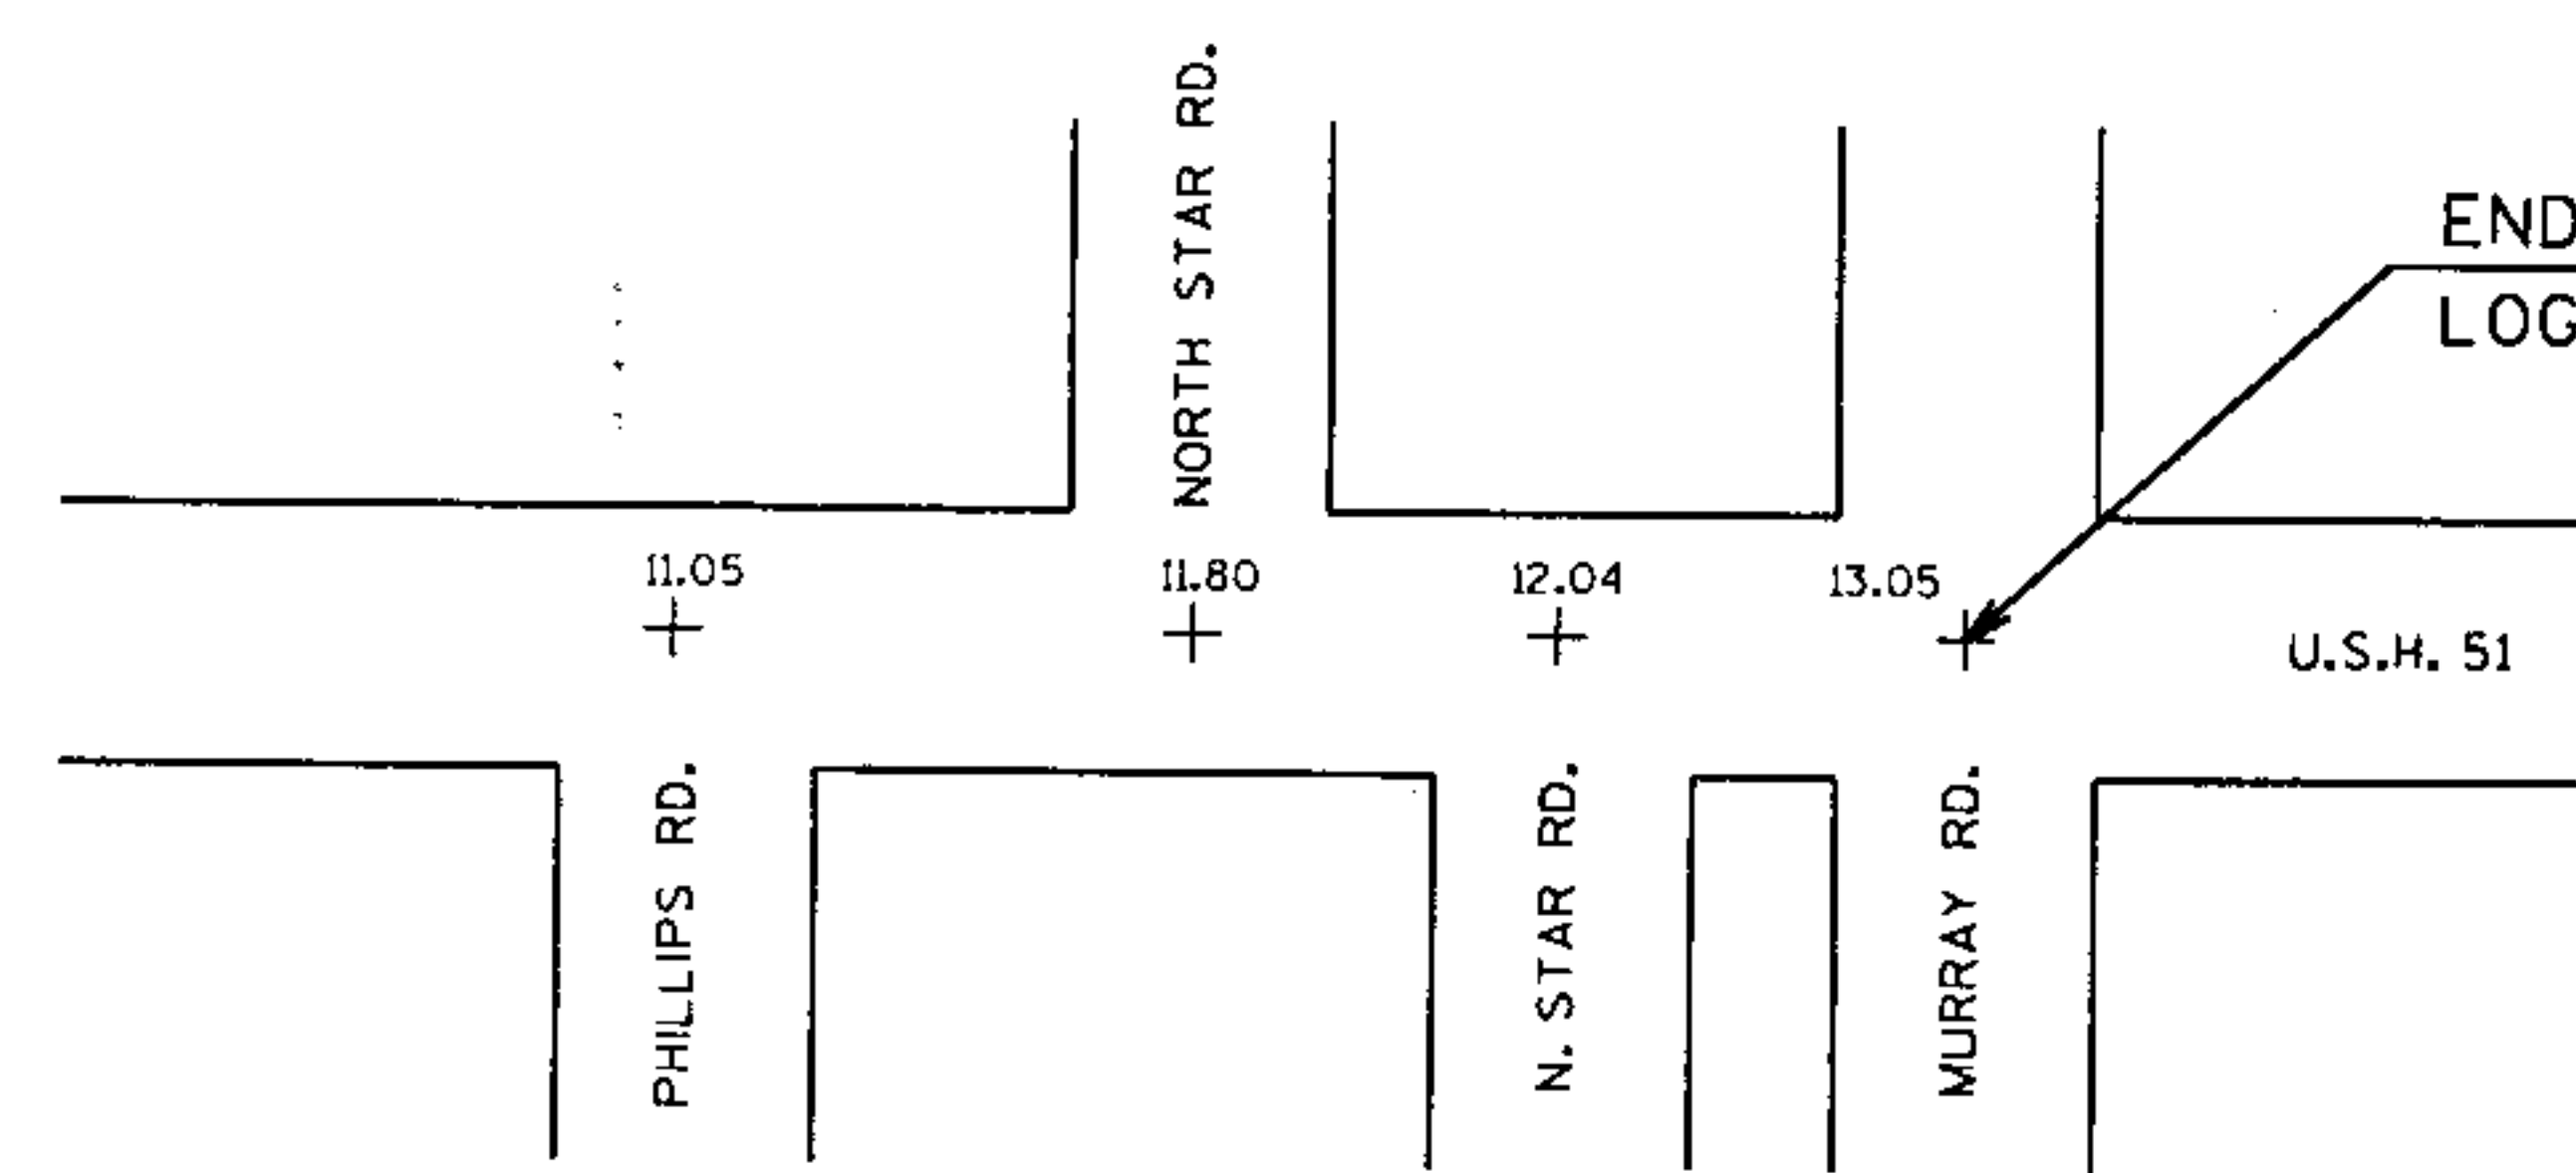

NOTE: THIS LINE DIAGRAM NOT TO SCALE

LEVELS ON + 1.2, 3.4, 5.6, 7.8, 9.9, 11.1, 12.3, 61.5, 62.7