

LAX


Project ID: 1018-00-72

COUNTY: JUNEAU

DEC 07
ORDER OF SHEETS

Section No. 1 Title
Section No. 2 Typical Sections and Details
Section No. 3 Estimate of Quantities
Section No. 3 Miscellaneous Quantities
~~Section No. 4 Right of Way Plan~~
Section No. 5 Plan and Profile (Includes Erosion Control Plans)
Section No. 6 Standard Detail Drawings
Section No. 7 Sign Plates
Section No. 8 Structure Plans
~~Section No. 9 Computer Earthwork Data~~
Section No. 9 Cross Sections

TOTAL SHEETS = 54

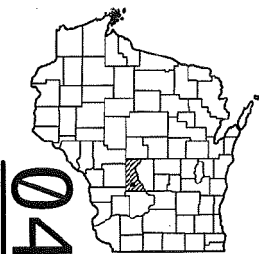


DESIGN DESIGNATION

A.A.D.T. 2008 = 5400
A.A.D.T. 2028 = 7000
D.H.V. 2028 = 826
D. = 62/38
T. = 6.8%
DESIGN SPEED = 50 mph
ESALS = 1,029,300

CONVENTIONAL SYMBOLS


PLAN

CORPORATE LIMITS
PROPERTY LINE
LOT LINE
LIMITED HIGHWAY EASEMENT
EXISTING RIGHT OF WAY
PROPOSED OR NEW R/W LINE
SLOPE INTERCEPT
REFERENCE LINE
EXISTING CULVERT
PROPOSED CULVERT
(Box or Pipe)
COMBUSTIBLE FLUIDS
MARSH AREA
WOODED OR SHRUB AREA
EDGE OF STREAM
RAILROAD
FENCE

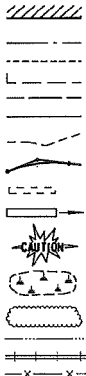


PROFILE

GRADE LINE
ORIGINAL GROUND
MARSH OR ROCK PROFILE
(To be noted as such)
SPECIAL DITCH
GRADE ELEVATION
CULVERT (Profile View)
UTILITIES
ELECTRIC
FIBER OPTIC
GAS
SANITARY SEWER
STORM SEWER
TELEPHONE
WATER
UTILITY PEDESTAL
POWER POLE
TELEPHONE POLE

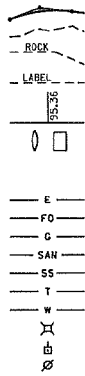

END CONSTRUCTION
STA. 40+90

BEGIN PROJECT
END PROJECT
STA. 500+00

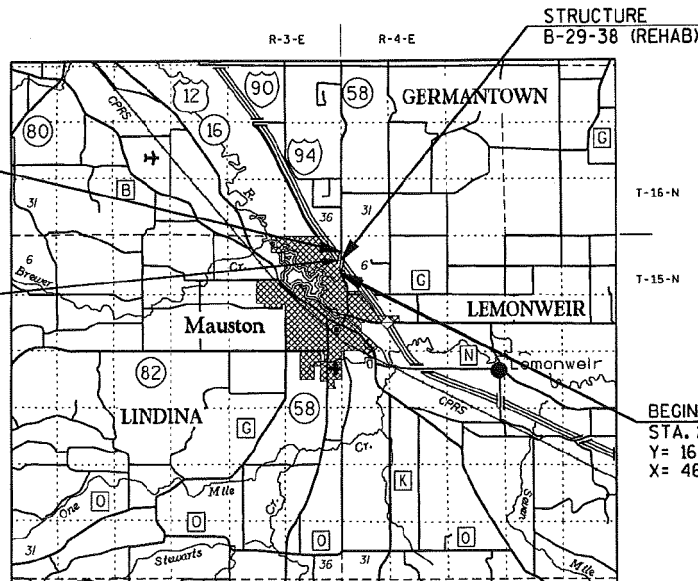

LAYOUT
Scale 0 1 2 MI.
TOTAL NET LENGTH OF CENTERLINE = 0.000 MI.

Coordinates on this plan are referenced to the
Wisconsin County Coordinate System
(WCCS), Juneau County.

STATE OF WISCONSIN DEPARTMENT OF TRANSPORTATION PLAN OF PROPOSED IMPROVEMENT MAUSTON - NEW LISBON (STH 58 OVERHEAD AND APPROACHES) IH 90/94 JUNEAU COUNTY

STATE PROJECT NUMBER
1018-00-72

STATE PROJECT	FEDERAL PROJECT	
	PROJECT	CONTRACT
1018-00-72	IM 2007621	1

ORIGINAL PLANS PREPARED BY:
MSA
TRANSPORTATION • MUNICIPAL
DEVELOPMENT • ENVIRONMENTAL
200 South Orchard Road, WI 53001
(608) 271-1800 FAX: (608) 271-1801
© MSA PROFESSIONAL SERVICES

WISCONSIN
QUIRIN R. KLICK
E-30535
BARABOO WI
PROFESSIONAL ENGINEER

9-10-07
Date
Signature

STATE OF WISCONSIN
DEPARTMENT OF TRANSPORTATION

PREPARED BY
Surveyor MSA Professional Services, Inc.
Designer MSA Professional Services, Inc.
Project Manager Rainy Yehke
District Examiner RRY
District Supervisor JRV
C.O. Examiner Carl Wagonmiller

APPROVED FOR REGIONAL OFFICE
DATE: 09/10/07
Signature

BURIED TELEPHONE:
VERIZON
ATTN: DENNIS BATES
100 COMMUNICATIONS DRIVE
SUN PRAIRIE, WI 53590
PHONE: 608-857-1405

**BURIED FIBER OPTIC:
AT&T
ATTN: CARL DONAHUE
866 ROCKCREEK ROAD
PLANO, IL 60545
PHONE: 847-420-9115**

**OVERHEAD ELECTRIC;
ALLIANT ENERGY
ATTN: GARY QUADE
1000 MAIN STREET
P.O. BOX 769
DUBUQUE, IA 52004-0769
PHONE: 563-584-7395**

* - NOT A MEMBER
OF DIGGERS HOTLINE.

MSA PROFESSIONAL SERVICES, INC.
ATTN.: QUIRIN R. KLINK P.E.
1230 SOUTH BOULEVARD
BARABOO, WI 53913
PHONE: 608-355-8965

DEPARTMENT OF NATURAL RESOURCES
ATTN.: ANTHONY FISCHER
473 GRIFFITH DRIVE
WISCONSIN RAPIDS, WI 54494
PHONE: 715-421-7867

ROB NELSON, DPW
303 MANSION STREET
MAUSTON, WI 53948
PHONE: 608-847-6676

DISTURBED AREAS WITHIN THE RIGHT-OF-WAY, EXCEPT THE AREAS WITHIN THE FINISHED SHOULDER POINTS SHALL BE FERTILIZED, SEEDED AND MULCHED AS DIRECTED BY THE ENGINEER. OVERSOW PERMANENT SEEDING AREAS WITH TEMPORARY SEED AT 15 LBS. PER 1000 SQUARE FEET.


THE LOCATIONS OF EXISTING AND PROPOSED UTILITY INSTALLATIONS AS SHOWN ON THE PLANS ARE APPROXIMATE. THERE MAY BE OTHER UTILITY INSTALLATIONS WITHIN THE AREA THAT ARE NOT SHOWN.

NO TREES OR SHRUBS ARE TO BE REMOVED WITHOUT APPROVAL OF THE ENGINEER.


ELEVATIONS SHOWN ON THIS PLAN ARE REFERENCED TO A U.S.G.S. ELEVATION ON A WISDOT BRASS DISK ON STRUCTURE B-29-36 (H 90/94 EB OVER CTH G), ELEV. 904.42.

THE 5" HMA PAVEMENT TYPE E-3 SHALL CONSIST OF A 2½" UPPER LAYER AND A 2½" LOWER LAYER.
THE ¾" HMA PAVEMENT TYPE E-3 OVERLAY SHALL CONSIST OF A SINGLE LAYER.

SILT FENCE SHALL BE PLACED AS SHOWN ON THE PLAN OR AS DIRECTED BY THE ENGINEER AND IN PLACE PRIOR TO BRIDGE REMOVAL.

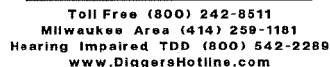


THE RUNOFF COEFFICIENTS OF SURFACE DRAINAGE AT THE PROJECT SITES WILL NOT BE CHANGED FROM BEFORE TO AFTER CONSTRUCTION. THE TOTAL AREA OF THE PROJECT IS 8.71 ACRES. THE TOTAL AREA EXPECTED TO BE DISTURBED BY CONSTRUCTION ACTIVITIES IS 2.63 ACRES.

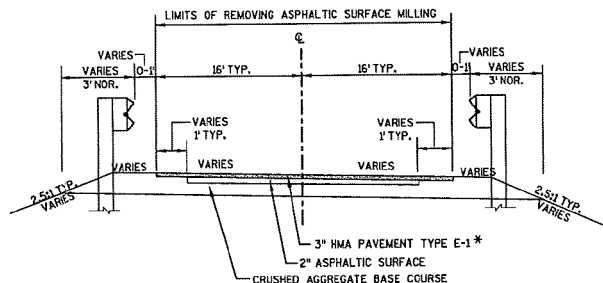

* - 1 1/4" MIN. OF EXISTING HMA PAVEMENT TYPE E-1 TO BE MILLED.


TYPICAL EXISTING SECTION

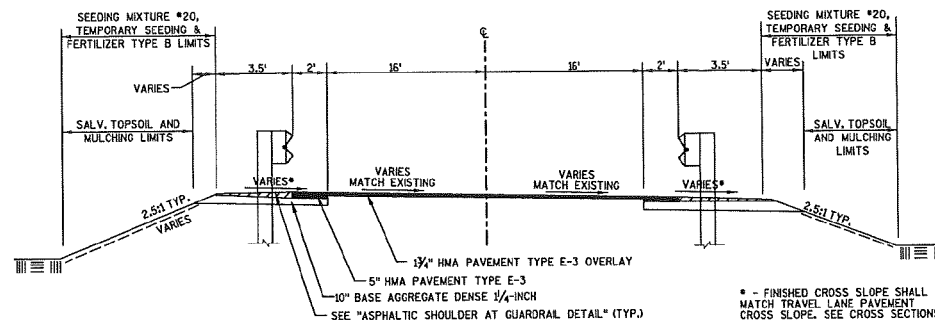

* - FINISHED CROSS SLOPE SHALL MATCH TRAVEL LANE PAVEMENT CROSS SLOPE. SEE CROSS SECTIONS.


TYPICAL FINISHED SECTION



STA. 27+12 - STA. 30+50
STA. 35+75 - STA. 38+76.43
NOTE: STA. 26+50 - STA. 27+12 AND STA. 38+76.43 - STA. 40+90
(OUTSIDE OF NORMAL BEAM GUARD AREA).
UTILIZE 13/4" HMA PAVEMENT TYPE E-3 OVERLAY. SEE CROSS SECTIONS.

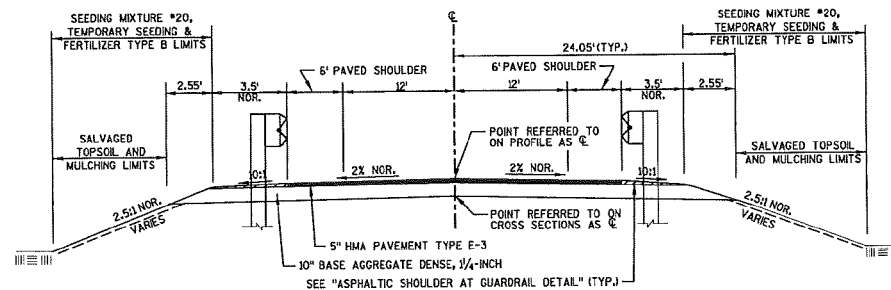

TYPICAL FINISHED SECTION

STA. 30+50 - STA. 31+62.25
STA. 34+60.02 - STA. 35+75

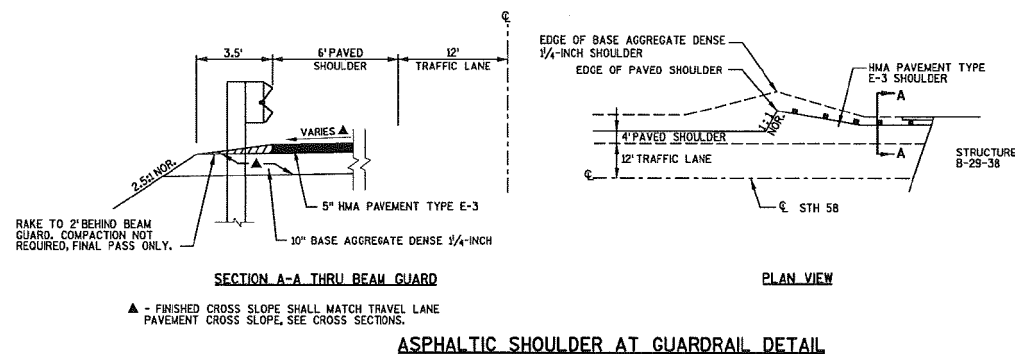

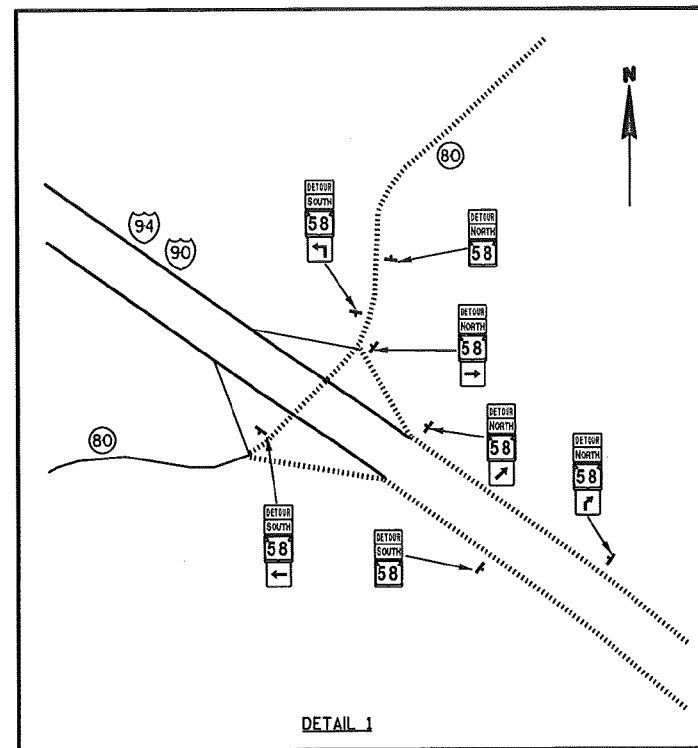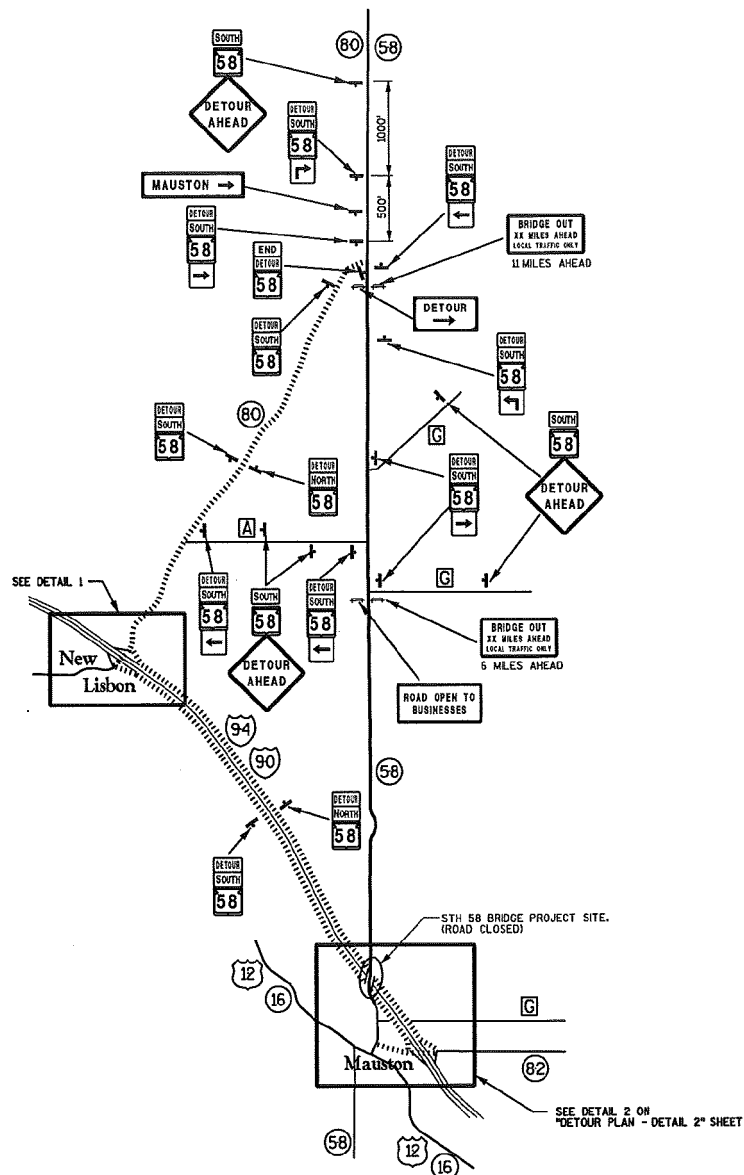

LEGEND

- SIGN ON PERMANENT SUPPORT
- BARRICADE AND 2 TYPE A LIGHTS WITH/WITHOUT SIGN
- DETOUR ROUTE

TRAFFIC CONTROL NOTES

1. ALL TYPE III BARRICADES SHALL HAVE AN EQUIVALENT WIDTH OF 8 FEET.
2. THE EXACT LOCATION AND SPACING OF ALL SIGNS AND DEVICES SHALL BE ADJUSTED TO FIT FIELD CONDITIONS AS APPROVED BY THE ENGINEER.
3. ALL SIGNS INAPPROPRIATE TO THE STATUS OF THE CONTROL ZONE INCLUDING PRE-EXISTING SIGNING IN THE VICINITY, SHALL BE COVERED OR REMOVED AS DIRECTED BY THE ENGINEER.
4. "NO" SIGNS ARE THE SAME AS "M" SIGNS EXCEPT THE BACKGROUND IS REFLECTIVE ORANGE.
5. SIZE 3 SIGNS ARE TO BE USED ON THE INTERSTATE ONLY.

SIGN PLATE DETAILS

SEE "DETOUR PLAN - DETAIL 2" SHEET FOR SIGN PLATE DETAILS.

PROJECT NO:1018-00-72

HWY: STH 58

COUNTY: JUNEAU

DETOUR PLAN

SHEET

5


E

FILE NAME : K:\p1anshts\930532\detour.dgn

PLOT DATE : 9/10/2007

PLOT BY : **...plotter...** PLOT NAME :

PLOT SCALE : **...plotscale...** WISDOT/CADDs SHEET 42

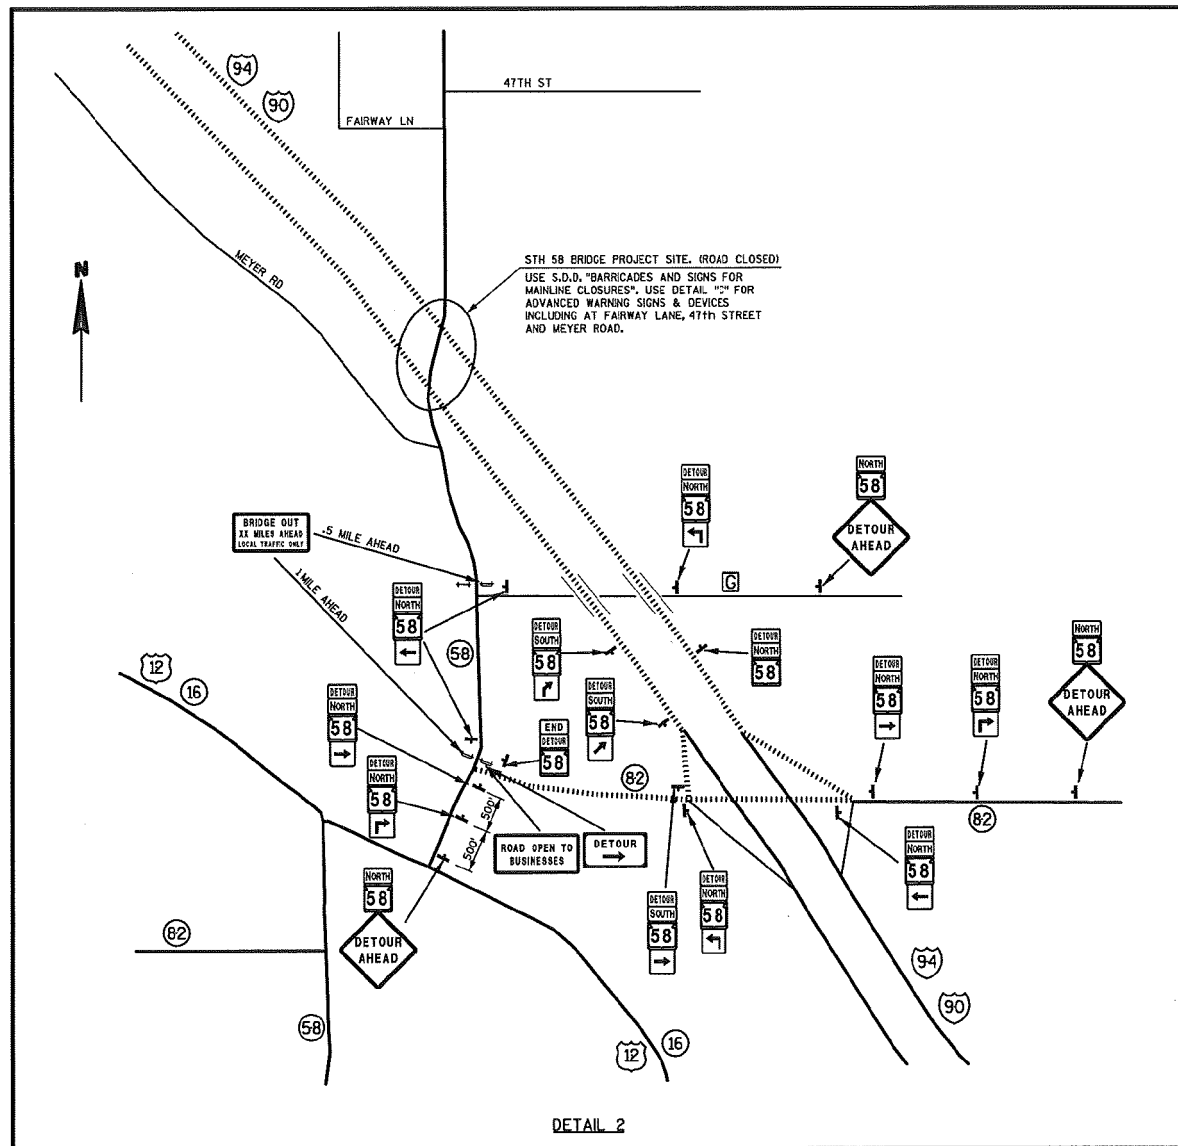

DETAIL 2

SIGN PLATE DETAILS

	SIZE 2	SIZE 3		SIZE 2	SIZE 3
	M1-6 24" x 24"	36" x 36"		M05-1R 21" x 21"	30" x 30"
	M3-1 24" x 12"	30" x 15"		M05-2R 21" x 21"	30" x 30"
	M3-3 24" x 12"	30" x 15"		M06-1 21" x 21"	30" x 30"
	M4-6 24" x 12"	30" x 15"		M06-1A 21" x 21"	30" x 30"
	M4-8 24" x 12"	30" x 15"		M06-2 21" x 21"	30" x 30"
	M05-1L 21" x 21"	30" x 30"			

	W20-2 48" x 48"		R11-3b 60" x 30"
	W20-2 48" x 48"		R10-61 (MOD) 36" x 24"
	W20-3 48" x 48"		M4-9R 30" x 24"
	W20-2 48" x 48"		R11-2 48" x 30"
			R11-2 (MOD) 48" x 30"
			D1-1R 72" x 18"

LEGEND

- SIGN ON PERMANENT SUPPORT
- BARRICADE AND 2 TYPE A LIGHTS WITH/WITHOUT SIGN
- DETOUR ROUTE

TRAFFIC CONTROL NOTES

- ALL TYPE III BARRICADES SHALL HAVE AN EQUIVALENT WIDTH OF 8 FEET.
- THE EXACT LOCATION AND SPACING OF ALL SIGNS AND DEVICES SHALL BE ADJUSTED TO FIT FIELD CONDITIONS AS APPROVED BY THE ENGINEER.
- ALL SIGNS INAPPROPRIATE TO THE STATUS OF THE CONTROL ZONE INCLUDING PRE-EXISTING SIGNING IN THE VICINITY, SHALL BE COVERED OR REMOVED AS DIRECTED BY THE ENGINEER.
- "MOP" SIGNS ARE THE SAME AS "M" SIGNS EXCEPT THE BACKGROUND IS REFLECTIVE ORANGE.
- SIZE 3 SIGNS ARE TO BE USED ON THE INTERSTATE ONLY.

PROJECT NO:1018-00-72

HWY: STH 58

COUNTY: JUNEAU

DETOUR PLAN - DETAIL 2

SHEET

6

E

FILE NAME : K:\p1\shfa\930532\Detour.dgn

PLOT DATE : 9/10/2007

PLOT BY : 99...plotuser...58 PLOT NAME :

PLOT SCALE : 99...plotsc19...99 WISDOT/CADDs SHEET 42

DATE 17SEP07		ESTIMATE OF QUANTITIES			
LINE				1018-00-72	
NUMBER	ITEM	ITEM DESCRIPTION	UNIT	TOTAL	QUANTITY
0010	108.3100.S	INCENTIVE/DISINCENTIVE FOR INTERIM COMPLETION OF WORK	CD	7.000	7.000
0020	201.0105	CLEARING	STA	1.000	1.000
0030	201.0205	GRUBBING	STA	1.000	1.000
0060	203.0200	REMOVING OLD STRUCTURE (STATION) 03. STA. 33+11	LS	1.000	1.000
0090	203.0210.S	ABATEMENT OF ASBESTOS CONTAINING MATERIAL (STRUCTURE) 03. B-29-38	LS	1.000	1.000
0120	203.0225.S	DEBRIS CONTAINMENT (STRUCTURE) 03. B-29-38	LS	1.000	1.000
0140	204.0165	REMOVING GUARDRAIL ***	LF	1,920.000	1,920.000
0150	204.0170	REMOVING FENCE	LF	155.000	155.000
0160	205.0100	EXCAVATION COMMON ***	CY	750.000	750.000
0200	206.1000	EXCAVATION FOR STRUCTURES BRIDGES (STRUCTURE) 04. B-29-38	LS	1.000	1.000
0210	208.0100	BORROW	CY	2,283.000	2,283.000
0220	210.0100	BACKFILL STRUCTURE	CY	80.000	80.000
0270	213.0100	FINISHING ROADWAY (PROJECT) 04. 1018-00-72	EACH	1.000	1.000
0280	305.0120	BASE AGGREGATE DENSE 1 1/4-INCH	TON	1,400.000	1,400.000
0290	415.2000.S	INCENTIVE STRENGTH CONCRETE PAVEMENT	DOL	500.000	500.000
0300	416.0050	CONCRETE PAVEMENT APPROACH SLAB ***	SY	144.000	144.000
0310	416.1010	CONCRETE SURFACE DRAINS ***	CY	12.000	12.000
0320	455.0105	ASPHALTIC MATERIAL PG58-28	TON	46.000	46.000
0330	455.0605	TACK COAT	GAL	110.000	110.000
0350	460.1103	HMA PAVEMENT TYPE E-3	TON	775.000	775.000
0360	502.0100	CONCRETE MASONRY BRIDGES ***	CY	386.000	386.000
0370	502.0400.S	INCENTIVE STRENGTH CONCRETE STRUCTURES	DOL	3,088.000	3,088.000
0410	502.3100	EXPANSION DEVICE (STRUCTURE) 04. B-29-38	LS	1.000	1.000
0420	502.3210.S	PIGMENTED PROTECTIVE SURFACE TREATMENT ***	SY	260.000	260.000
0430	502.5010	MASONRY ANCHORS TYPE L NO. 6 BARS ***	EACH	176.000	176.000
0450	505.0605	BAR STEEL REINFORCEMENT HS COATED BRIDGES ***	LB	87,500.000	87,500.000
0460	506.3015	WELDED STUD SHEAR CONNECTORS 7/8X6-INCH ***	EACH	1,284.000	1,284.000
0470	506.3020	WELDED STUD SHEAR CONNECTORS 7/8X7-INCH ***	EACH	321.000	321.000
0530	509.1500	CONCRETE SURFACE REPAIR	SF	70.000	70.000
0560	514.0445	FLOOR DRAINS TYPE GC ***	EACH	6.000	6.000
0570	514.2625	DOWNSPOUT 6-INCH ***	LF	95.000	95.000
0580	516.0500	RUBBERIZED MEMBRANE WATERPROOFING ***	SY	20.000	20.000
0610	517.0900.S	PREPARATION AND COATING OF TOP FLANGES 03. B-29-38	LS	1.000	1.000
0650	517.3000.S	STRUCTURE OVERCOATING CLEANING AND PRIMING (STRUCTURE) 04. B-29-38	LS	1.000	1.000
0660	606.0100	RIPRAP LIGHT	CY	54.000	54.000
0670	614.0150	ANCHOR ASSEMBLIES FOR STEEL PLATE BEAM GUARD	EACH	4.000	4.000
0680	614.0200	STEEL THRIE BEAM STRUCTURE APPROACH ***	LF	82.600	82.600
0690	614.0305	STEEL PLATE BEAM GUARD CLASS A ***	LF	1,625.000	1,625.000
0700	614.0370	STEEL PLATE BEAM GUARD ENERGY ABSORBING TERMINAL	EACH	4.000	4.000
0710	616.0100	FENCE WOVEN WIRE (HEIGHT) 01. 4-FOOT	LF	155.000	155.000
0720	619.1000	MOBILIZATION	EACH	0.390	0.390

- 801.37 T

DATE 17SEP07		ESTIMATE OF QUANTITIES			1018-00-72
LINE	ITEM	ITEM DESCRIPTION	UNIT	TOTAL	QUANTITY
0730	625.0500	SALVAGED TOPSOIL ***	SY	8,500.000	8,500.000
0740	627.0200	MULCHING ***	SY	10,000.000	10,000.000
0750	628.1504	SILT FENCE	LF	2,100.000	2,100.000
0760	628.1520	SILT FENCE MAINTENANCE	LF	2,100.000	2,100.000
0770	628.1905	MOBILIZATIONS EROSION CONTROL	EACH	2.000	2.000
0780	628.1910	MOBILIZATIONS EMERGENCY EROSION CONTROL	EACH	2.000	2.000
0790	628.2004	EROSION MAT CLASS I TYPE B	SY	100.000	100.000
0800	628.7504	TEMPORARY DITCH CHECKS	LF	50.000	50.000
0810	629.0210	FERTILIZER TYPE B **p**	CWT	6.700	6.700
0820	630.0120	SEEDING MIXTURE NO. 20 **p**	LB	250.000	250.000
0830	630.0200	SEEDING TEMPORARY **p**	LB	150.000	150.000
0840	630.0300	SEEDING BORROW PIT	LB	20.000	20.000
0870	638.2102	MOVING SIGNS TYPE II	EACH	4.000	4.000
0880	638.2602	REMOVING SIGNS TYPE II	EACH	4.000	4.000
0890	638.3000	REMOVING SMALL SIGN SUPPORTS	EACH	4.000	4.000
0900	638.4000	MOVING SMALL SIGN SUPPORTS	EACH	4.000	4.000
0910	642.5001	FIELD OFFICE TYPE B	EACH	0.410	0.410
0950	643.0100	TRAFFIC CONTROL (PROJECT) 04. 1018-00-72	EACH	1.000	1.000
0960	643.0300	TRAFFIC CONTROL DRUMS	DAYS	3,360.000	3,360.000
0970	643.0420	TRAFFIC CONTROL BARRICADES TYPE III	DAYS	2,240.000	2,240.000
0980	643.0705	TRAFFIC CONTROL WARNING LIGHTS TYPE A	DAYS	3,520.000	3,520.000
0990	643.0715	TRAFFIC CONTROL WARNING LIGHTS TYPE C	DAYS	1,280.000	1,280.000
1000	643.0800	TRAFFIC CONTROL ARROW BOARDS	DAYS	160.000	160.000
1010	643.0900	TRAFFIC CONTROL SIGNS	DAYS	2,240.000	2,240.000
1020	643.1000	TRAFFIC CONTROL SIGNS FIXED MESSAGE	SF	21.000	21.000
1030	643.1050	TRAFFIC CONTROL SIGNS PORTABLE CHANGEABLE MESSAGE	DAY	80.000	80.000
1040	643.2000	TRAFFIC CONTROL DETOUR (PROJECT) .01 1018-00-72	EACH	1.000	1.000
1050	643.3000	TRAFFIC CONTROL DETOUR SIGNS	DAYS	12,480.000	12,480.000
1060	645.0130	GEOTEXTILE FABRIC TYPE R	SY	215.000	215.000
1070	646.0106	PAVEMENT MARKING EPOXY 4-INCH	LF	5,760.000	5,760.000
1080	650.4500	CONSTRUCTION STAKING SUBGRADE ***	LF	227.000	227.000
1090	650.5000	CONSTRUCTION STAKING BASE ***	LF	227.000	227.000
1130	650.6500	CONSTRUCTION STAKING STRUCTURE LAYOUT (STRUCTURE) 04. 8-29-38	LS	1.000	1.000
1140	650.8000	CONSTRUCTION STAKING RESURFACING REFERENCE ***	LF	915.000	915.000
1180	650.9910	CONSTRUCTION STAKING SUPPLEMENTAL CONTROL 04. 1018-00-72	LS	1.000	1.000
1190	650.9920	CONSTRUCTION STAKING SLOPE STAKES	LF	525.000	525.000
1200	690.0100	SAWING EXISTING PAVEMENT	LF	64.000	64.000
1210	ASP.1T0A	ON-THE-JOB TRAINING APPRENTICE AT \$5.00/HR	HRS	82.000	82.000
1220	ASP.1T0G	ON-THE-JOB TRAINING GRADUATE AT \$5.00/HR	HRS	492.000	492.000
1230	SPV.0060	SPECIAL 01. BEAM GUARD CURB	EACH	4.000	4.000

201.0105 CLEARING				
201.0205 GRUBBING				
STATION	-	STATION	CLEARING STA	GRUBBING STA
28+00	-	29+00	1	1
TOTALS:			1	1

ALL ITEMS LISTED ARE CATEGORY 0010, UNLESS OTHERWISE NOTED.

416.0050 CONCRETE PAVEMENT APPROACH SLAB				
STATION	-	STATION	APPR. SLAB SY	
31+35.25	-	31+62.25	72	
34+60.02	-	34+87.02	72	
TOTALS:			144	

614.0200 STEEL THREE BEAM STRUCTURE APPROACH				
STATION	-	STATION	LOCATION	LF
31+21.65	-	31+42.3	RT	20.65
31+51.65	-	31+72.3	LT	20.65
34+49.6	-	34+70.25	RT	20.65
34+79.6	-	35+00.25	LT	20.65
TOTAL:				82.6

204.0165 REMOVING GUARDRAIL				
STATION	-	STATION	LOCATION	LF
27+00	-	31+72	LT	466
27+05	-	31+42	RT	505
34+50	-	39+50	RT	530
34+80	-	38+83	LT	430
TOTAL:				1920

416.1010 CONCRETE SURFACE DRAINS				
STATION	LOCATION	CY		
31+40	RT	3		
31+70	LT	3		
34+60	RT	3		
34+80	LT	3		
TOTAL:			12	

NOTE: ALL SURFACE DRAINS ARE FLUME TYPE 3.

614.0305 STEEL PLATE BEAM GUARD CLASS A				
STATION	-	STATION	LOCATION	LF
27+53.30	-	31+51.65	LT	400
27+70.20	-	31+21.65	RT	350
34+70.25	-	40+18.00	RT	550
35+00.25	-	39+28.10	LT	325
TOTAL:				1625

204.0170 REMOVING FENCE				
STATION	-	STATION	LOCATION	LF
30+50	-	31+50	RT	115
31+70	-	31+75	LT	5
34+40	-	34+45	RT	5
34+70	-	34+95	LT	30
TOTAL:				155

455.0105 ASPHALTIC MATERIAL PG58-28				
455.0605 TACK COAT				
460.1103 HMA PAVEMENT TYPE E-3				
STATION	-	STATION	MATERIAL TON	TACK GAL
28+50	-	27+12	2	5
27+12	-	30+50	13	35
30+50	-	31+62	7	10
34+60	-	35+75	7	10
35+75	-	38+76	11	30
38+76	-	40+90	6	20
TOTALS:			46	110

614.0370 STEEL PLATE BEAM GUARD ENERGY ABSORBING TERMINAL				
STATION	-	STATION	LOCATION	EACH
27+04.00	-	27+53.30	LT	1
27+19.60	-	27+70.20	RT	1
38+26.10	-	38+76.40	LT	1
40+18.00	-	40+67.90	RT	1
TOTAL:				4

205.0100 EXCAVATION COMMON				
208.0100 BORROW				
STATION	-	STATION	EX. COMMON C.Y.	FILL C.Y. (1)
26+50	-	30+50	146	1234
30+50	-	31+62	193	462
34+60	-	35+75	217	46
35+75	-	40+90	194	591
TOTALS:			750	2333

(1) - NOT A BID ITEM - FOR INFORMATIONAL PURPOSES ONLY.
(2) - FILL EXPANSION 30%

606.0100 RIPRAP LIGHT				
645.0130 GEOTEXTILE FABRIC TYPE R				
STATION	LOCATION	RIPRAP CY	FABRIC SY	
31+34	RT	14	55	
31+62	LT	14	55	
34+61	RT	16	65	
34+88	LT	10	40	
TOTALS:			54	215

616.0100 FENCE WOVEN WIRE 4-FT				
STATION	-	STATION	LOCATION	LF
30+50	-	31+50	RT	115
31+70	-	31+75	LT	5
34+40	-	34+45	RT	5
34+70	-	34+95	LT	30
TOTAL:				155

305.0120 BASE AGGREGATE DENSE 1 1/4-INCH				
STATION	-	STATION	1 1/4-INCH TON	
26+50	-	30+50	360	
30+50	-	31+62	330	
34+60	-	35+75	340	
35+75	-	40+90	370	
TOTALS:			1400	

625.0500 SALVAGED TOPSOIL				
627.0200 MULCHING				
629.0210 FERTILIZER TYPE B				
630.0120 SEEDING MIXTURE NO. 20				
630.0200 SEEDING TEMPORARY				
630.0300 SEEDING BORROW PIT				
STATION	-	STATION	SALV. TOPSOIL S.Y.	MULCHING S.Y.
26+50	-	31+62	4600	4600
34+60	-	40+90	3050	3050
BORROW AREA			1350	0.9
UNDISTRIBUTED			850	0.6
TOTALS:			8500	10000

PROJECT NO: 1018-00-72

HWY: IH 90/94

COUNTY: JUNEAU

MISCELLANEOUS QUANTITIES

SHEET

9

E

FILE NAME : K:\p1018\shs\930532WQ.DGN

PLOT DATE : 9/10/2007

PLOT BY : ***plotuser*** PLOT NAME :

PLOT SCALE : ***plotscale*** WISDOT/CADD SHEET 43

628.1504	SILT FENCE				
628.1520	SILT FENCE MAINTENANCE				
STATION	-	STATION	LOCATION	FENCE	MAINT.
				LF	LF
26+60	-	31+40	RT	310	310
27+00	-	29+90	LT	530	530
31+60			LT	60	60
34+60			RT	80	80
34+80			LT	40	40
35+50	-	40+60	RT	530	530
35+75	-	39+15	LT	350	350
UNDISTRIBUTED				200	200
TOTALS:				2100	2100

ALL ITEMS LISTED ARE CATEGORY 0010, UNLESS OTHERWISE NOTED.

643.1000 TRAFFIC CONTROL FIXED MESSAGE

LOCATION	SIGN	CODE	SF	COMMENTS
STH 58/STH 82	R10-61 (MOD)	6		ROAD OPEN TO BUSINESSES
STH 58/STH 80	D1-1R	9		HAUSTON -->
STH 58/CTH G	R10-61 (MOD)	6		ROAD OPEN TO BUSINESSES
TOTALS:				
21				

690.0100 SAWING EXISTING PAVEMENT

STATION	L.F.
26+50	32
40+90	32
TOTAL:	
64	

628.2004 EROSION MAT CLASS I TYPE B

STATION	-	STATION	LOCATION	SY
38+60	-	38+90	LT	30
40+40	-	40+60	RT	20
UNDISTRIBUTED				100
TOTAL:				100

646.0106 PAVEMENT MARKING EPOXY 4-INCH

STATION	-	STATION	LF	COMMENTS
26+50	-	40+90	2880	WHITE EDGE LINE
26+50	-	40+90	2880	DBL. YLM CL.
TOTAL:				
5760				

SPV.0060.01 BEAM GUARD CURB

STATION	LOCATION	EACH
31+40	RT	1
31+70	LT	1
34+50	RT	1
34+80	LT	1
TOTAL:		
4		

628.7504 TEMPORARY DITCH CHECKS

STATION	LOCATION	LF
38+62	LT	10
38+93	LT	10
40+38	RT	10
UNDISTRIBUTED		20
TOTAL:		
50		

650.4500 CONSTRUCTION STAKING SUBGRADE
650.5000 CONSTRUCTION STAKING BASE
650.8000 CONSTRUCTION STAKING RESURFACING REFERENCE
650.9520 CONSTRUCTION STAKING SLOPE STAKES

STATION	-	STATION	SUBGRADE	BASE	REFERENCE	STAKES
			LF	LF	LF	LF
26+50	-	30+50	--	--	400	--
30+50	-	31+62	112	112	--	112
31+62	-	34+60	--	--	--	298
34+60	-	35+75	115	115	--	115
35+75	-	40+90	--	--	515	--
TOTALS:			227	227	915	525

EARTHWORK TABLE

	CUT CY	FILL CY	EXP. FILL (1) CY	MASS HAUL CY
26+50	21	162	211	-190
27+12	24	163	212	-188
27+62	33	133	173	-140
28+50	36	334	434	-398
29+50	32	442	575	-543
30+50	END MILL & OVERLAY/BEGIN RECONSTRUCT			
30+50	130	305	396	-266
31+25	63	157	204	-141
31+62	STRUCTURE B-29-39			
34+60	72	3	4	68
35+00	145	43	56	89
35+75	END RECONSTRUCT/BEGIN MILL & OVERLAY			
35+75	32	126	164	-132
36+50	42	179	232	-190
37+50	33	74	96	-63
38+26	26	58	75	-49
38+76	26	80	104	-78
39+25	22	19	25	-3
40+25	10	29	38	-28
40+68	3	26	34	-31
40+90				
TOTALS	750	2333	3033	-2283 (BORROW)

(1) - INCLUDES 30% EXPANSION FACTOR

638.2102 MOVING SIGNS TYPE II
638.4000 MOVING SMALL SIGN SUPPORTS

STATION	LOCATION	SIGNS EACH	SUPPORTS EACH
28+30	RT	1	1
31+55	LT	1	1
35+00	RT	1	1
38+00	LT	1	1
TOTALS:		4	4

650.6500 CONSTRUCTION STAKING STRUCTURE LAYOUT

STRUCTURE	LS
B-29-38	1
TOTAL:	
1	


NOTE: CATEGORY 0020 ITEM


638.2602 REMOVING SIGNS TYPE II
638.3000 REMOVING SMALL SIGN SUPPORTS

STATION	LOCATION	SIGNS EACH	SUPPORTS EACH	COMMENTS
31+53	LT	1	1	OBJECT MARKER
31+42	RT	1	1	OBJECT MARKER
34+50	RT	1	1	OBJECT MARKER
34+75	LT	1	1	OBJECT MARKER
TOTALS:		4	4	

643.0300 TRAFFIC CONTROL DRUMS
643.0420 TRAFFIC CONTROL BARRICADES TYPE III
643.0705 TRAFFIC CONTROL WARNING LIGHTS TYPE A
643.0710 TRAFFIC CONTROL WARNING LIGHTS TYPE C
643.0800 TRAFFIC CONTROL ARROW BOARDS
643.0800 TRAFFIC CONTROL SIGNS
643.3000 TRAFFIC CONTROL DETOUR SIGNS
643.1050.S TRAFFIC CONTROL SIGNS PORTABLE CHANGEABLE MESSAGE

LOCATION	DRUMS DAYS	BARRICADES DAYS	TYPE A LIGHTS DAYS	TYPE C LIGHTS DAYS	ARROW BOARD DAYS	SIGNS DAYS	DETOUR SIGNS DAYS	PORTABLE MESSAGE DAYS
PROJECT LIMITS	--	1440	2240	--	--	1120	--	--
DETOUR ROUTE	--	640	1280	--	--	320	12480	--
IH 90/94 LANE CLOSURE	3360	160	--	1280	160	800	--	80
TOTALS:								
3360 2240 3520 1280 160 2240 12480 80								

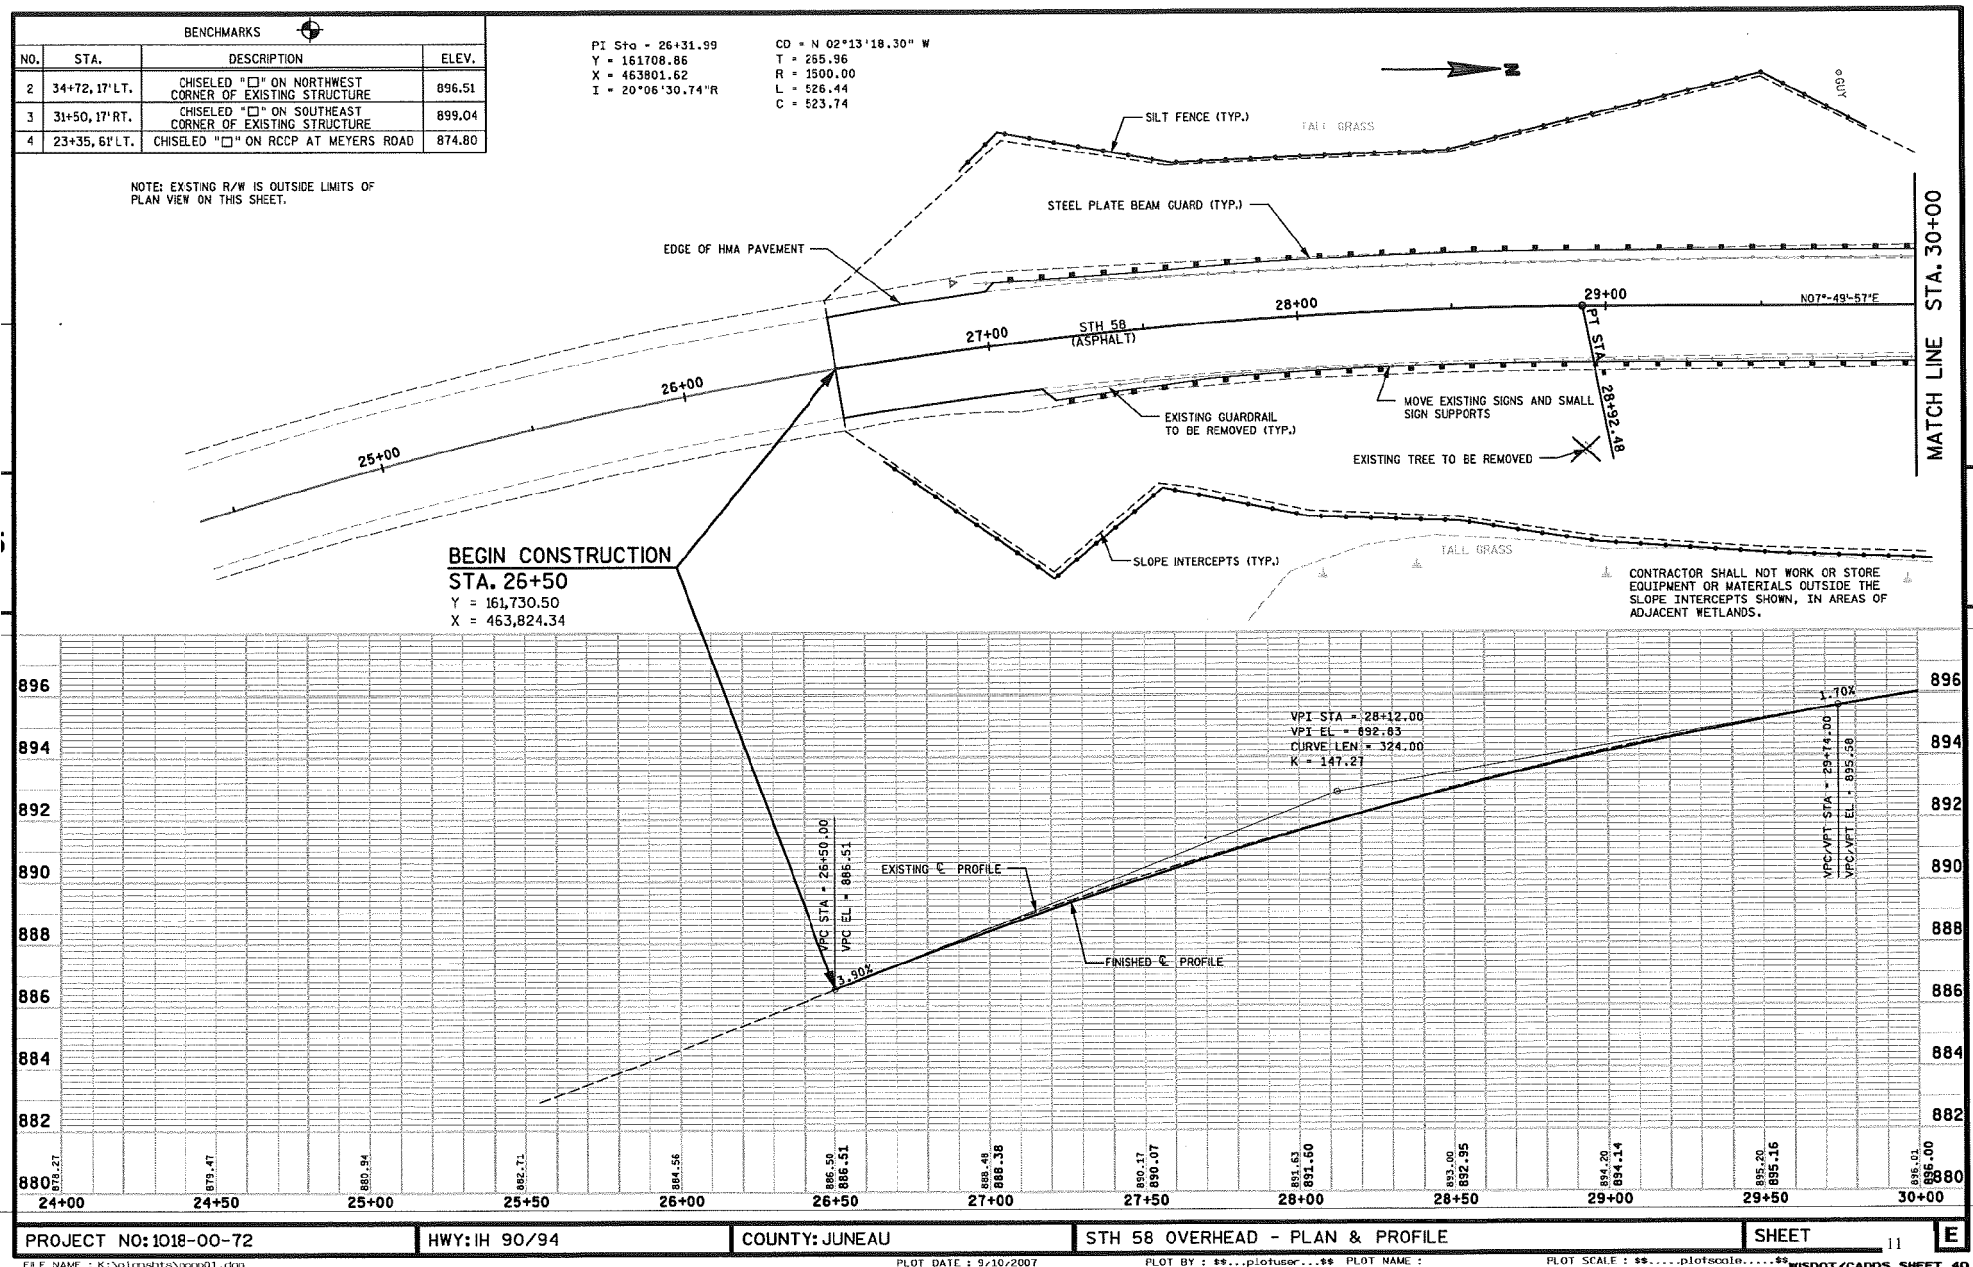

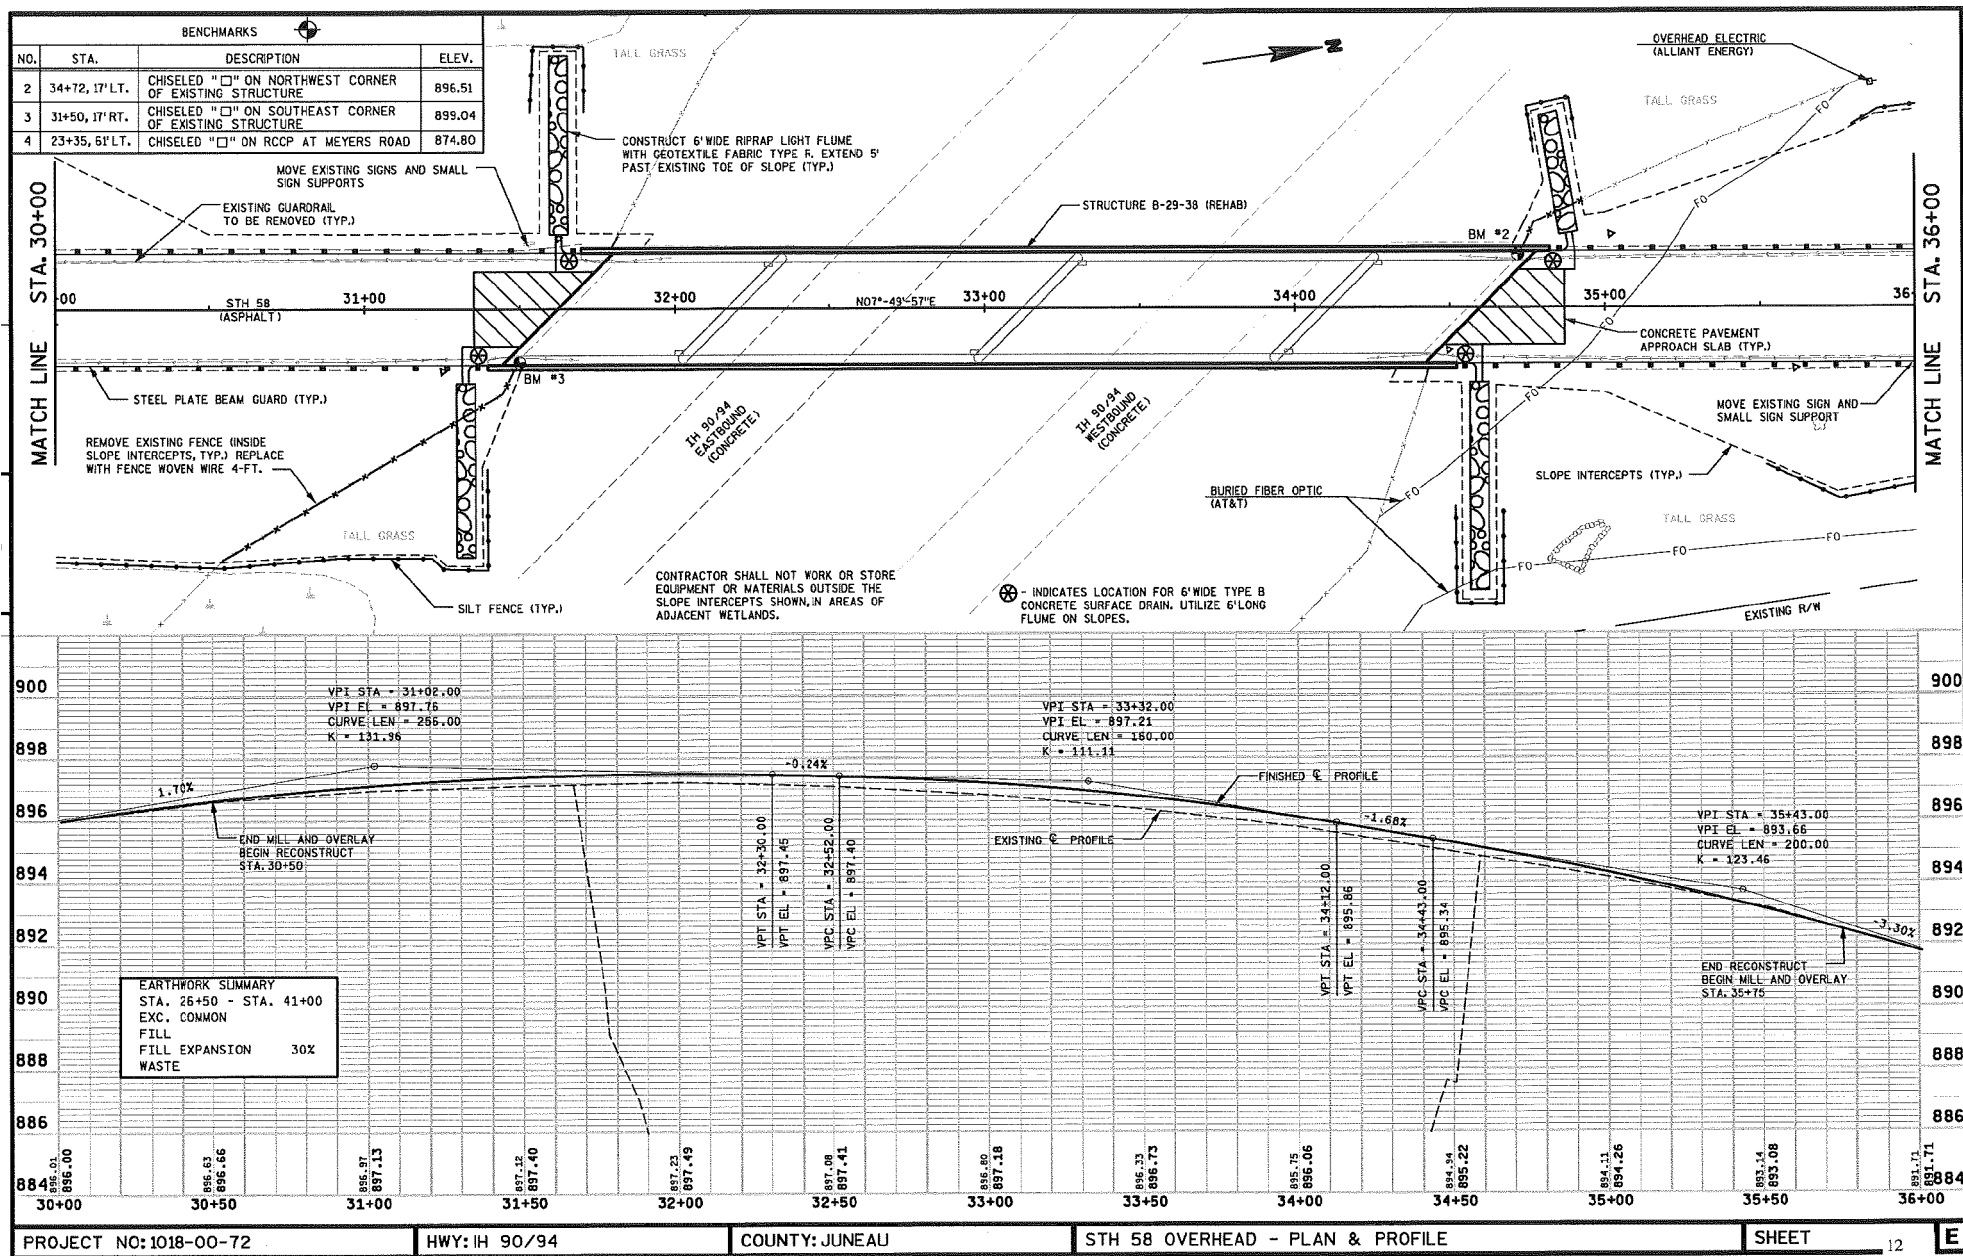

PROJECT NO: 1018-00-72

HWY: IH 90/94

COUNTY: JUNEAU

STH 58 OVERHEAD - PLAN & PROFILE

SHEET

12

E

FILE NAME: K:\plans\sta\pomp02.dgn

PLOT DATE: 9/10/2007


PLOT BY: **...plotuser...** PLOT NAME:

PLOT SCALE: **...plotscale...** WISDOT/CADDs SHEET 40


Standard Detail Drawing List

08D2-4	CONCRETE SURFACE DRAIN FLUME TYPE AT STRUCTURES
08E8-3	TYPICAL INSTALLATIONS OF EROSION BALES / TEMPORARY DITCH CHECKS
08E9-6	SILT FENCE
12A3-9	NAME PLATE (STRUCTURES)
13B2-5	CONCRETE PAVEMENT APPROACH SLAB
14B15-5A	STEEL PLATE BEAM GUARD, CLASS "A" INSTALLATION & ELEMENTS
14B15-5B	STEEL PLATE BEAM GUARD, CLASS "A" INSTALLATION & ELEMENTS
14B18-5A	STEEL PLATE BEAM GUARD, CLASS "A" (AT BRIDGES, OBSTACLES AND SIDEROADS/DRIVEWAYS)
14B20-6A	STEEL THRIE BEAM STRUCTURE APPROACH
14B20-6B	STEEL THRIE BEAM STRUCTURE APPROACH, CONNECTION TO SQUARE END AND VERTICAL FACED PARAPETS
14B24-4A	STEEL PLATE BEAM GUARD ENERGY ABSORBING TERMINAL
14B24-4B	STEEL PLATE BEAM GUARD ENERGY ABSORBING TERMINAL
14B24-4C	STEEL PLATE BEAM GUARD ENERGY ABSORBING TERMINAL
15B1-7A	WOVEN WIRE FENCE
15B1-7B	WOVEN WIRE FENCE
15C2-4A	BARRICADES AND SIGNS FOR MAINLINE CLOSURES
15C2-4B	BARRICADES AND SIGNS FOR MAINLINE CLOSURES
15C2-4C	DETOUR SIGNING FOR MAINLINE CLOSURES
15C6-5	SIGNING & MARKING FOR TWO LANE BRIDGES
15C8-10A	PAVEMENT MARKING (MAINLINE)
15D12-2	TRAFFIC CONTROL, LANE CLOSURE, SPEEDS GREATER THAN 40 M.P.H.
15D27-1	TRAFFIC CONTROL, SHOULDER CLOSURE ON DIVIDED ROADWAY, SPEEDS GREATER THAN 40 MPH




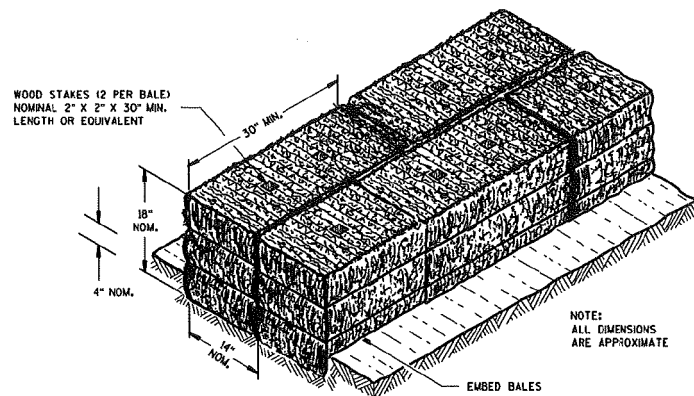

SECTION A-A

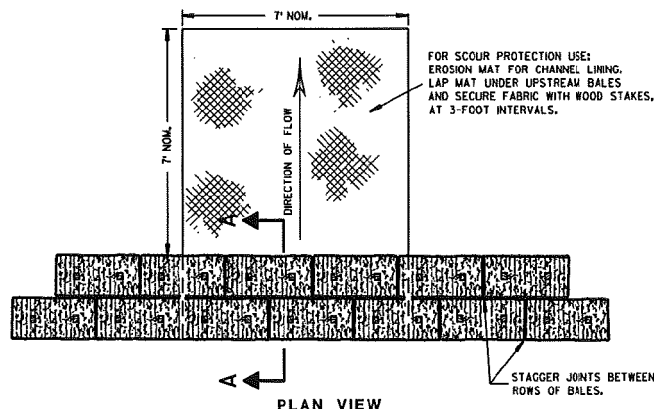

PLAN VIEW

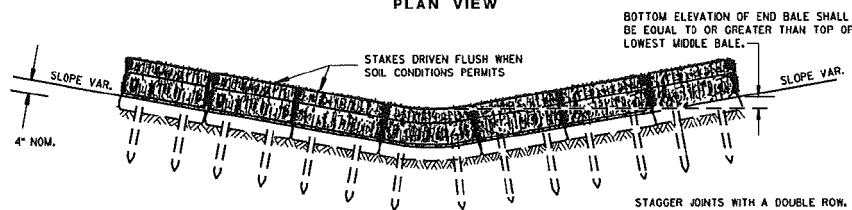


FRONT ELEVATION

TEMPORARY DITCH CHECK USING EROSION BALES ①

GENERAL NOTES


DETAILS OF CONSTRUCTION, MATERIALS AND WORKMANSHIP NOT SHOWN ON THIS DRAWING SHALL CONFORM TO THE PERTINENT REQUIREMENTS OF THE STANDARD SPECIFICATIONS AND THE APPLICABLE SPECIAL PROVISIONS.

- ① TEMPORARY DITCH CHECKS EITHER EROSION BALES OR MANUFACTURED SHALL BE PAID FOR UNDER THE BD ITEM OF TEMPORARY DITCH CHECK. THE DEPARTMENT WILL NOT PAY FOR TEMPORARY DITCH CHECKS CONSTRUCTED OF A SINGLE ROW OF EROSION BALES.

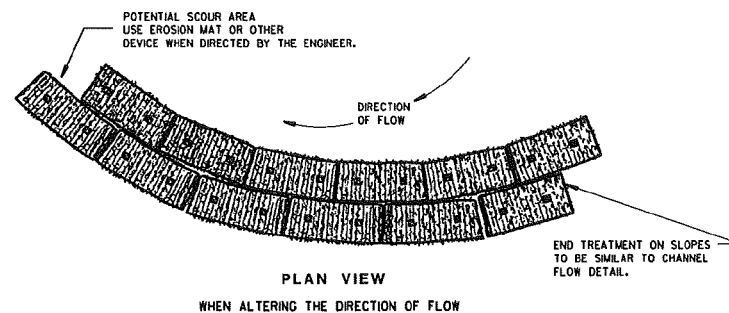


PLAN VIEW

WHEN ALTERING THE DIRECTION OF FLOW

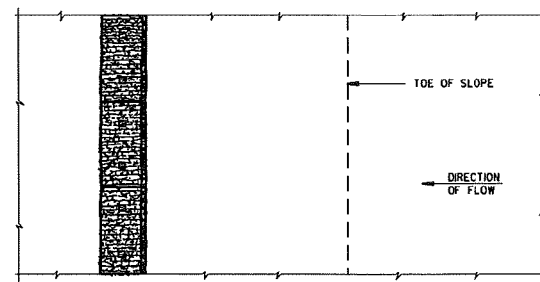


PLAN VIEW

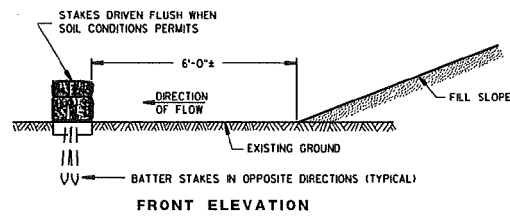


FRONT ELEVATION

WHEN EXISTING GROUND SLOPES AWAY FROM FILL SLOPE
EROSION BALES FOR SHEET FLOW

TYPICAL INSTALLATIONS OF EROSION BALES / TEMPORARY DITCH CHECKS	
STATE OF WISCONSIN DEPARTMENT OF TRANSPORTATION	
APPROVED 6/04/02 DATE	CHEF ROADWAY DEVELOPMENT ENGINEER
FHWA	

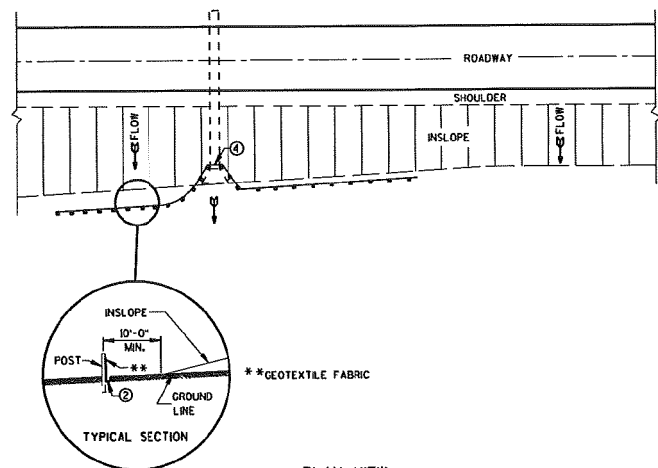


PLAN VIEW
TYPICAL APPLICATION OF SILT FENCE

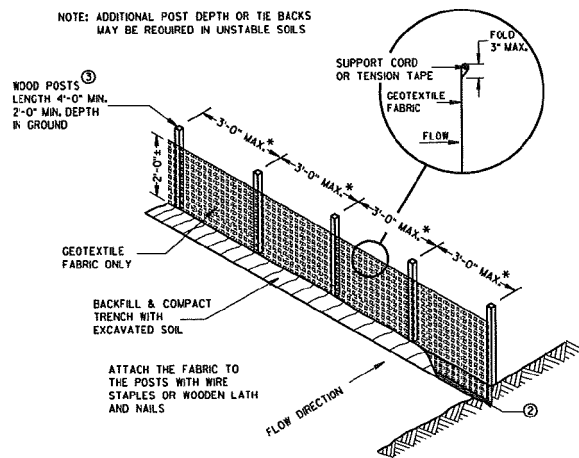


SILT FENCE

* NOTE: 8'-0" POST SPACING ALLOWED IF A WOVEN GEOTEXTILE FABRIC IS USED.

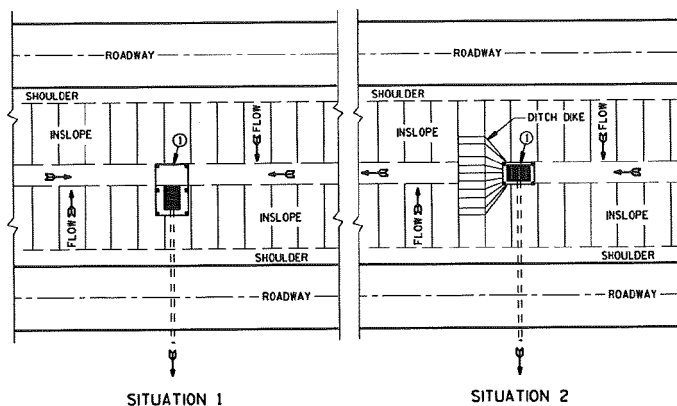


PLAN VIEW
SILT FENCE AT MEDIAN SURFACE DRAINS

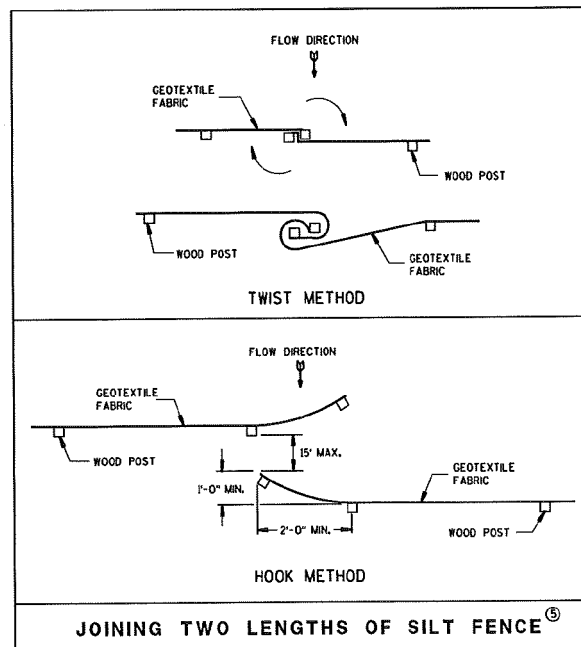


GENERAL NOTES

DETAILS OF CONSTRUCTION NOT SHOWN ON THIS DRAWING SHALL CONFORM TO THE PERTINENT REQUIREMENTS OF THE STANDARD SPECIFICATIONS AND APPLICABLE SPECIAL PROVISIONS.

- ① HORIZONTAL BRACE REQUIRED WITH 2" x 4" WOODEN FRAME OR EQUIVALENT AT TOP OF POSTS.
- ② FOR MANUAL INSTALLATIONS THE TRENCH SHALL BE A MINIMUM OF 4" WIDE & 6" DEEP TO BURY AND ANCHOR THE GEOTEXTILE FABRIC. FOLD MATERIAL TO FIT TRENCH AND BACKFILL & COMPACT TRENCH WITH EXCAVATED SOIL.
- ③ WOOD POSTS SHALL BE A MINIMUM SIZE OF 1/4" x 1/4" OF OAK OR HICKORY.
- ④ SILT FENCE TO EXTEND ACROSS THE TOP OF THE PIPE.
- ⑤ CONSTRUCT SILT FENCE FROM A CONTINUOUS ROLL IF POSSIBLE BY CUTTING LENGTHS TO AVOID JOINTS. IF A JOINT IS NECESSARY USE ONE OF THE FOLLOWING TWO METHODS: A) OVERLAP THE END POSTS AND TWIST, OR ROTATE, AT LEAST 180 DEGREES, B) HOOK THE END OF EACH SILT FENCE LENGTH.

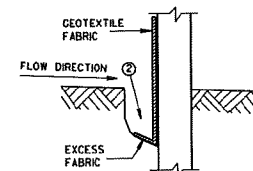

TRENCH DETAIL

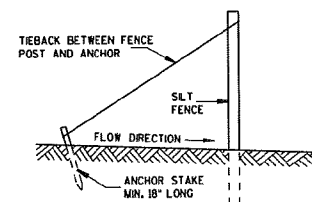


SILT FENCE TIE BACK
(WHEN REQUIRED BY THE ENGINEER)

SILT FENCE	
STATE OF WISCONSIN DEPARTMENT OF TRANSPORTATION	
APPROVED 4-29-05 DATE	CHEF ROADWAY DEVELOPMENT ENGINEER
FHWA	




B-40-400-1A


APPROVED
2/26/07 /S/ Scot Becker
DATE CHIEF STRUCTURAL DEVELOPMENT ENGINEER
FHWA

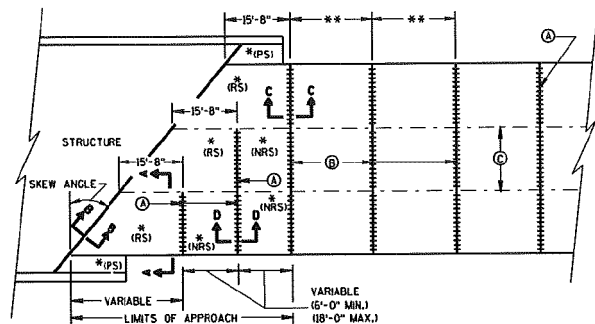

SKewed APPROACH
(PAVEMENT MORE THAN 2 LANES)

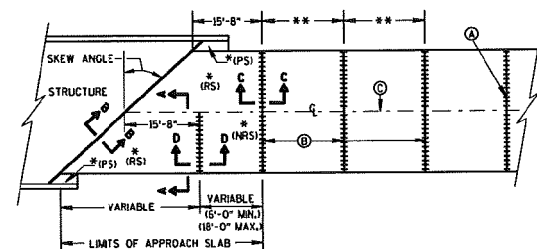


SKEWS > 30°
(PAVEMENT WIDTH ≤ 30')

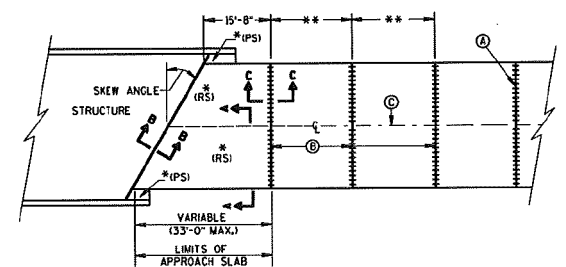


SKEWS ≤ 30°
(PAVEMENT WIDTH ≤ 30')
APPROACH SLAB AND ADJACENT PAVEMENT


- * (RS) = REINFORCED CONCRETE SLAB
 * (PS) = PAVED CONCRETE SHOULDER, CONCRETE PAVEMENT, OR CONCRETE SURFACE DRAIN
 (SEE DETAILS ELSEWHERE IN THE PLAN)
 * (NRS) = NON-REINFORCED CONCRETE SLAB
 ** STANDARD TRANSVERSE JOINT SPACING
 (SEE SDD 13C4, SDD 13C11 & SDD 13C13)
 A STANDARD CONTRACTION JOINT NORMAL TO R OR C
 B 1½" EXPANSION JOINT WITH DOWEL BARS NORMAL TO R OR C
 C STANDARD LONGITUDINAL JOINT AND TIE BARS.

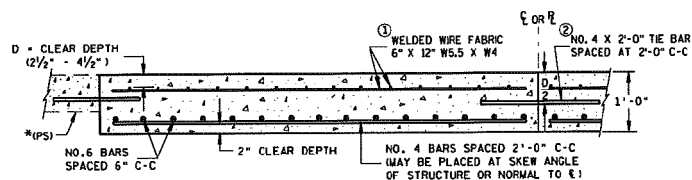

SECTION A-A
REINFORCEMENT POSITIONING DETAIL

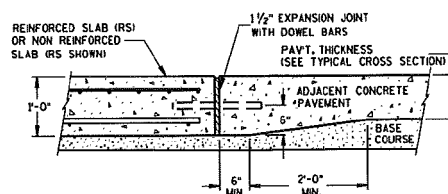

SECTION C-C
TRANSITION DETAIL
APPROACH SLAB TO ADJACENT PAVEMENT

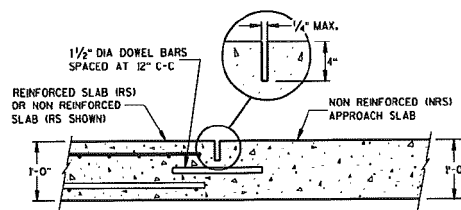

SECTION D-D
CONTRACTION JOINT


GENERAL NOTES

DETAILS OF CONSTRUCTION NOT SHOWN ON THIS DRAWING SHALL CONFORM TO THE STANDARD SPECIFICATIONS AND SPECIAL PROVISIONS.


DOWEL BARS ARE NOT REQUIRED WHEN THE APPROACH SLAB ABUTS AN ASPHALT PAVEMENT OVER BASE COURSE.

SPlicing OF NO. 6 BARS IN THE APPROACH SLAB IS PERMITTED FOR SKEWED STRUCTURES ONLY. SPICES SHALL BE STAGGERED, WITH A MAXIMUM OF ONE SPICE PER BAR. THE LENGTH OF LAP SHALL BE 20 INCHES.

- NO. 4 BARS SPACED AT 2'-0" C-C IN BOTH THE LONGITUDINAL AND TRANSVERSE DIRECTIONS MAY BE USED FOR TOP REINFORCEMENT AS AN ALTERNATIVE TO THE WELDED WIRE FABRIC.
- TIE BARS BETWEEN REINFORCED SLABS MAY BE OMITTED WHERE SLAB REINFORCEMENT EXTEND ACROSS THE CENTERLINE OR REFERENCE LINE.

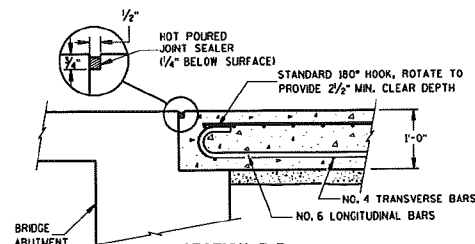

SECTION B-B
BEND DETAIL
BOTTOM REINFORCEMENT

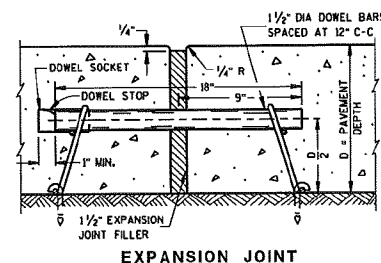

EXPANSION JOINT

CONCRETE PAVEMENT APPROACH SLAB

STATE OF WISCONSIN
DEPARTMENT OF TRANSPORTATION


APPROVED
3/21/07 /s/ Steven W. Krebs
DATE CHIEF MATERIALS MANAGEMENT ENGINEER
FWHA

GENERAL NOTES


DETAILS OF CONSTRUCTION, MATERIALS AND WORKMANSHIP NOT SHOWN ON THIS DRAWING SHALL CONFORM TO THE PERTINENT REQUIREMENTS OF THE STANDARD SPECIFICATIONS, AND THE APPLICABLE SPECIAL PROVISIONS.

1. W6 X 9 OR W6 X 8.5 STEEL POSTS AND NOTCHED PLASTIC BLOCKOUTS ARE ACCEPTABLE ALTERNATIVES FOR 6" X 8" WOOD POSTS WITH WOOD OR PLASTIC BLOCKOUTS. USE APPROVED NOTCHED PLASTIC BLOCKOUTS WITH STEEL POSTS. APPROVED PLASTIC BLOCKOUT DESIGNS MAY VARY FROM THIS TYPICAL DETAIL WHEN USED IN CONJUNCTION WITH STEEL POSTS. DO NOT MIX STEEL POSTS AND WOOD POSTS IN A SINGLE INSTALLATION.
2. USE STRUCTURAL STEEL POSTS CONFORMING TO ASTM A 36. GALVANIZED POSTS ACCORDING TO AASHTO M 111 EITHER SET THE POSTS IN DRILLED HOLES OR DRIVE TO GRADE. REMOVE MUSHROOMING CAUSED BY DRIVING AND REPAIR DAMAGED SPECTER COATING ON GALVANIZED POSTS.
3. INSTALL STEEL POSTS WITH HOLES ON APPROACHING TRAFFIC SIDE.
4. USE EITHER WOOD OR APPROVED PLASTIC BLOCKOUTS ON WOOD POSTS.
5. WHEN SPECIFIED IN THE PLANS, THE SHOULDER HINGE POINT MAY BE BETWEEN THE FRONT FACE OF THE POST AND 2 FEET BEHIND THE BACK OF THE POST, IF EXISTING CONDITIONS DO NOT PERMIT THE DESIRABLE EARTHWORK. INCREASE POST DEPTH TO PROVIDE A MINIMUM EMBEDMENT OF 4'-6" WHERE THE SHOULDER HINGE POINT IS LOCATED BETWEEN THE FRONT FACE OF THE POST AND 2 FEET BEHIND THE BACK OF THE POST.
6. IF ROCK IS ENCOUNTERED DURING EXCAVATION, THE ENGINEER MAY APPROVE USING A 12 INCH DIAMETER POST HOLE EXTENDING 20 INCHES DEEP INTO THE ROCK. PLACE GRANULAR MATERIAL IN THE BOTTOM OF THE HOLE APPROXIMATELY 2 1/2 INCHES DEEP. CUT THE POSTS TO LENGTH AND PLACE IN THE HOLE. BACKFILL WITH MATERIAL EXCAVATED FROM THE HOLE AND COMPACT ADEQUATELY.


INSTALL BEAM GUARD SECTIONS AND ALL NECESSARY HARDWARE ACCORDING TO THE APPLICABLE PLAN AND CURRENT STANDARD AND SUPPLEMENTAL SPECIFICATIONS. ALL DIMENSIONS ARE SUBJECT TO MANUFACTURER'S TOLERANCES EXCEPT WHERE ALLOWABLE TOLERANCES ARE SHOWN.

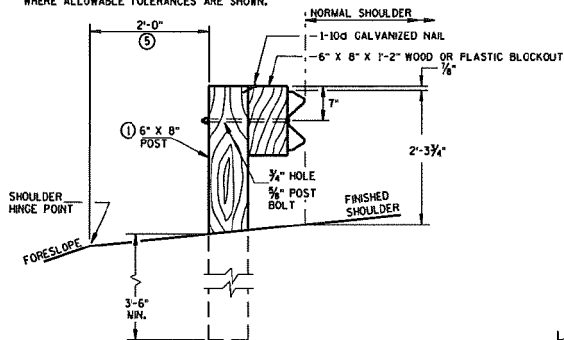


END VIEW
LOCATED ALONG A ROADWAY SHOULDER

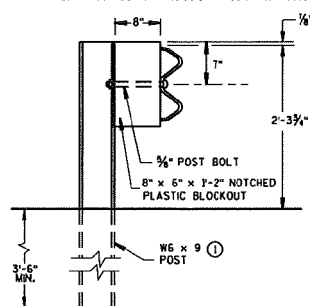


END VIEW
STEEL POST & NOTCHED
PLASTIC BLOCKOUT ALTERNATIVE

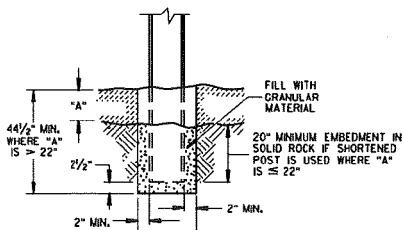


END VIEW
SETTING STEEL OR WOOD POST IN ROCK ⑤

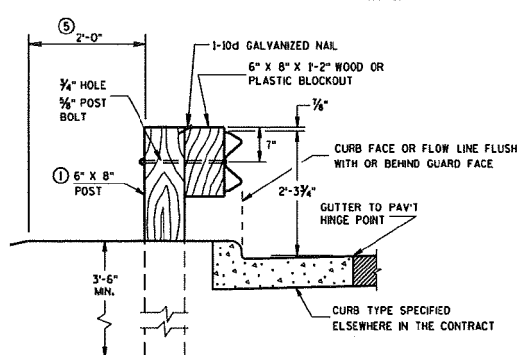


END VIEW
LOCATED ALONG A CURBED ROADWAY

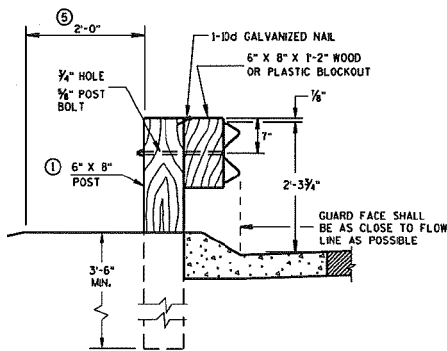


END VIEW
LOCATED ALONG A
MOUNTABLE CURBED ROADWAY

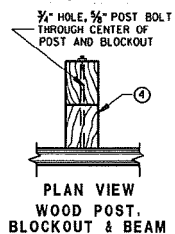

PLAN VIEW
WOOD POST,
BLOCKOUT & BEAM

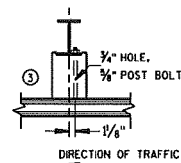


PLAN VIEW
STEEL POST, NOTCHED
PLASTIC BLOCKOUT & BEAM

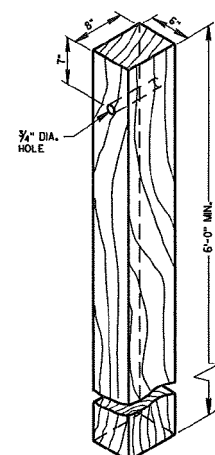


WOOD POST
(6" X 8") NOMINAL

OPTIONAL 3/4" DIA.
HOLE FOR HANDLING
DURING GALVANIZING.
(ONE PERMITTED)

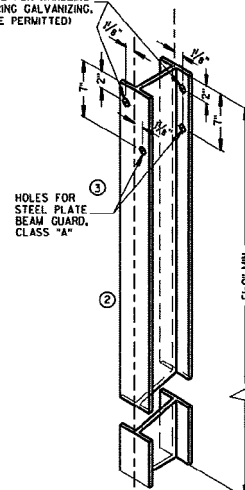


STEEL POST &
HOLE PUNCHING DETAIL
(W6 X 9) ①

ALL HOLES 3/4" DIAMETER EXCEPT AS NOTED

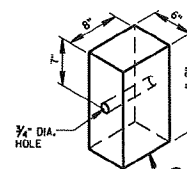



WOOD OR PLASTIC
BLOCKOUT FOR WOOD POSTS

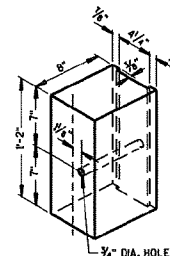

TYPICAL NOTCHED PLASTIC ①
BLOCKOUT FOR STEEL POSTS

STEEL PLATE BEAM GUARD,
CLASS "A"
INSTALLATION & ELEMENTS

STATE OF WISCONSIN
DEPARTMENT OF TRANSPORTATION

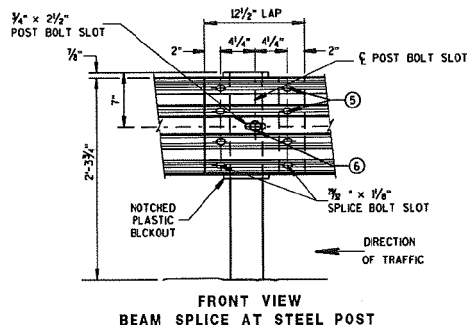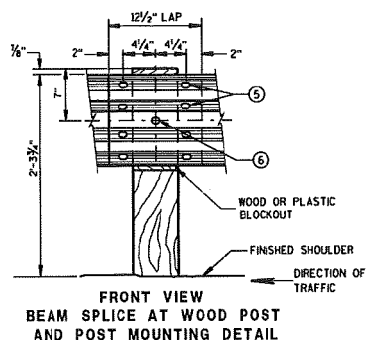


TYPICAL SPLICING DETAILS OF STEEL PLATE BEAM GUARD

REFLECTOR (POST BOLT MOUNT)


DIRECTION OF TRAFFIC

ONE SIDED REFLECTOR DETAIL AND TYPICAL INSTALLATION

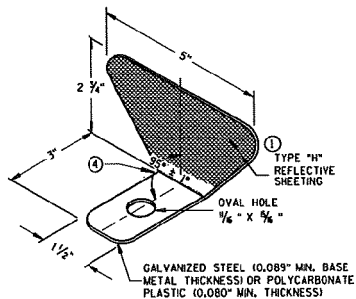


W BEAM TERMINAL CONNECTOR

(USE ONLY ON THE TRAFFIC EXIT END OF ONE WAY BRIDGES)

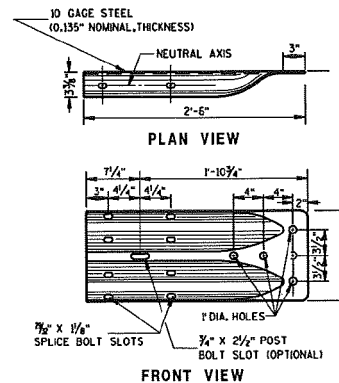


SECTION THRU W BEAM

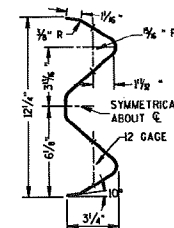



STEEL PLATE BEAM GUARD,
CLASS "A",
INSTALLATION & ELEMENTS

STATE OF WISCONSIN
DEPARTMENT OF TRANSPORTATION


APPROVED
10/23/06 /S/ Jerry H. Zogg
DATE ROADWAY STANDARDS DEVELOPMENT
ENGINEER

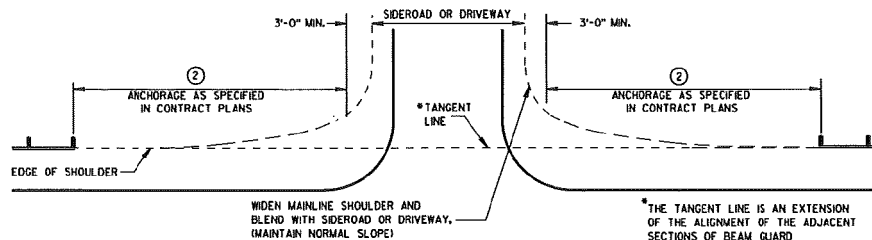

BEAM GUARD AT SIDEROADS OR DRIVEWAYS

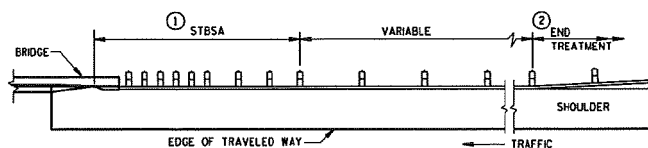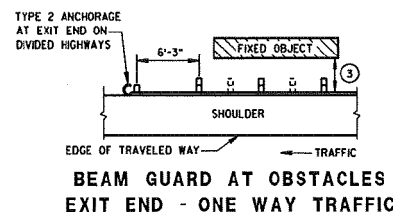

BEAM GUARD AT FULL WIDTH BRIDGES

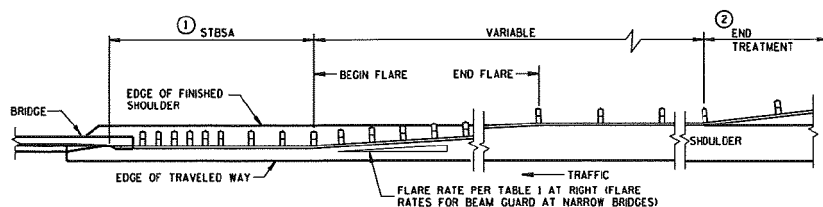

BEAM GUARD AT NARROW BRIDGES
(FLARED TO SHOULDER EDGE, THEN PARALLEL TO ROADWAY)

GENERAL NOTES

DETAILS OF CONSTRUCTION, MATERIALS AND WORKMANSHIP SHALL CONFORM TO THE PERTINENT STANDARD SPECIFICATIONS AND THE APPLICABLE SPECIAL PROVISIONS.


W6 X 9 OR W6 X 8.5 STEEL POSTS WITH NOTCHED PLASTIC BLOCKOUTS ARE ACCEPTABLE ALTERNATIVES FOR 6" X 8" WOOD POSTS WITH WOOD OR PLASTIC BLOCKOUTS. USE APPROVED NOTCHED PLASTIC BLOCKOUTS WITH STEEL POSTS.

THE LOCATIONS AND LENGTHS OF BEAM GUARD ARE SHOWN ELSEWHERE IN THE PLAN.

1 STEEL THRIE BEAM STRUCTURAL APPROACH (STBSA) - SEE SDD 14820.

2 USE AN APPROVED END TREATMENT FOR THE TRAFFIC APPROACH SIDE OF BRIDGE/OBSTACLES. USE TYPE 2 ANCHORAGE ONLY AT THE DOWNSTREAM ENDS OF BEAM GUARD LOCATED ALONG ROADWAYS WITH ONE WAY TRAFFIC.

MINIMUM LATERAL DISTANCE FROM FACE OF BEAM GUARD TO FIXED OBJECT	POST SPACING
3'-6"	3' - 1/2"
4'-6"	6' - 3"

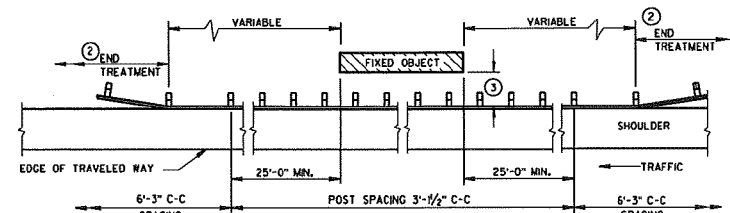

BEAM GUARD AT OBSTACLES - TWO WAY TRAFFIC

(RAIL TO OBSTACLE CLEARANCE 3'-6" TO 4'-6")




**TABLE 1
FLARE RATES FOR BEAM
GUARD AT NARROW BRIDGES**

POSTED SPEED (MPH)	FLARE RATE
25	13:1
30	15:1
35	16:1
40	18:1
45	21:1
50	24:1
55	26:1
65	30:1


**STEEL PLATE BEAM GUARD,
CLASS "A"
(AT BRIDGES, OBSTACLES
AND SIDEROADS/DRIVEWAYS)**

STATE OF WISCONSIN
DEPARTMENT OF TRANSPORTATION


APPROVED
10-23-06 /S/ Jerry H. Zogg
DATE ROADWAY STANDARDS DEVELOPMENT
ENGINEER
FHWA

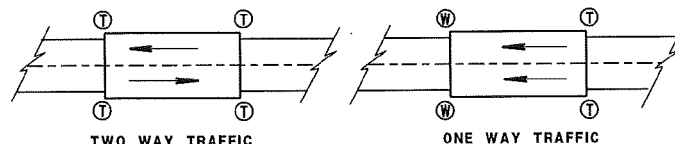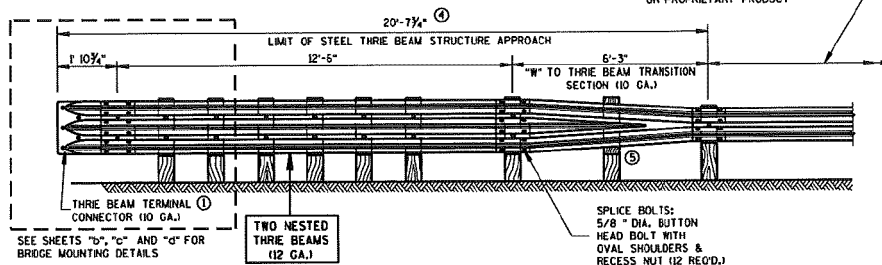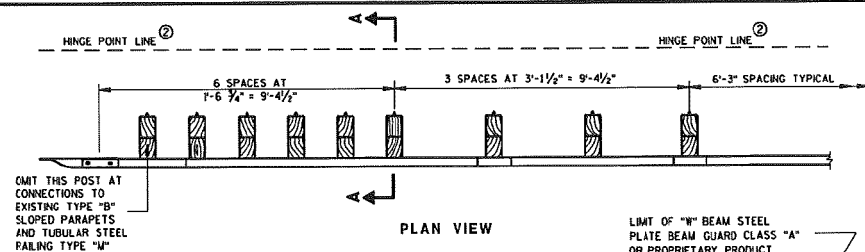


TYPICAL LOCATIONS OF THRIE BEAM AND W-BEAM CONNECTIONS TO BRIDGE

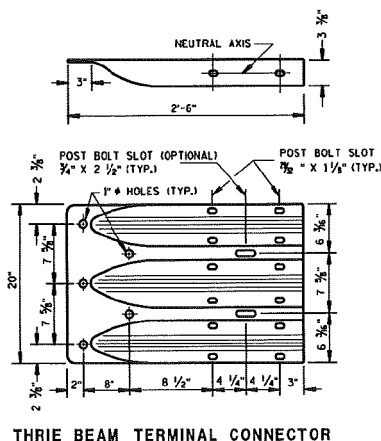


THRIE BEAM TERMINAL CONNECTOR

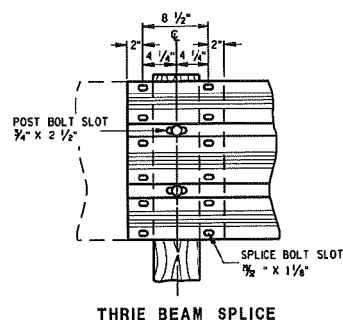

THRIE BEAM SPLICE

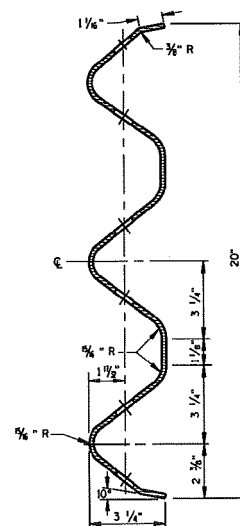

SECTION THRU THRIE BEAM RAIL ELEMENT

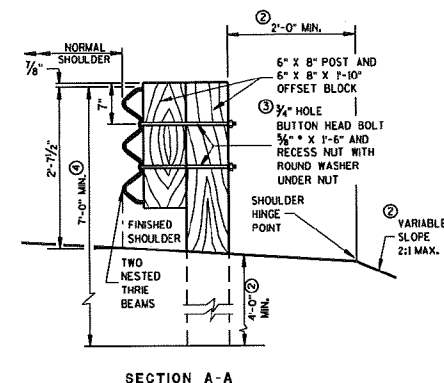

SECTION A-A

STEEL THRIE BEAM STRUCTURE APPROACH

STATE OF WISCONSIN
DEPARTMENT OF TRANSPORTATION

GENERAL NOTES

DETAILS OF CONSTRUCTION, MATERIALS AND WORKMANSHIP NOT SHOWN ON THIS DRAWING SHALL CONFORM TO THE PERTINENT REQUIREMENTS OF THE STANDARD SPECIFICATIONS AND THE APPLICABLE SPECIAL PROVISIONS.

FURNISH AND CONSTRUCT THRIE BEAM STRUCTURAL APPROACH ACCORDING TO THE REQUIREMENTS OF SECTION 614 OF THE STANDARD SPECIFICATIONS. THRIE BEAM SECTIONS SHALL CONFORM TO THE REQUIREMENTS OF AASHTO DESIGNATION M180, CLASS "A", TYPE 2.

BOLT THE THRIE BEAM TO ALL POSTS AND BLOCKOUTS, DRILL OR PUNCH BOLT HOLES IN THE BEAM IF THE POST SPACING IS LESS THAN 6'-3".

DO NOT USE STEEL POSTS AND NOTCHED PLASTIC BLOCKOUTS IN THE STEEL THRIE BEAM STRUCTURAL APPROACH AND THE TRANSITION SECTION OF STEEL PLATE BEAM GUARD, CLASS "A" INSTALLATIONS.

IF ROCK IS ENCOUNTERED DURING EXCAVATION, THE ENGINEER MAY APPROVE USING A 12 INCH DIAMETER POST HOLE EXTENDING 20 INCHES DEEP INTO THE ROCK, PLACE GRANULAR MATERIAL IN THE BOTTOM OF THE HOLE APPROXIMATELY 2 1/2 INCHES DEEP, CUT THE POSTS TO LENGTH AND PLACE IN THE HOLE, BACKFILL WITH MATERIAL EXCAVATED FROM THE HOLE AND COMPACT ADEQUATELY, (SEE SDD 14 B 15-60).


① BRIDGE RAILING TYPE "W" DOES NOT REQUIRE A TERMINAL CONNECTOR.

② MINIMUM EMBEDMENT SHALL BE 4'-0", WHERE EXISTING CONDITIONS DO NOT PERMIT THE APPROPRIATE EARTHWORK SHOWN ON THE PLAN TYPICAL SECTIONS OR DETAILS, THE ENGINEER MAY ALLOW THE REDUCTION OR ELIMINATION OF THE 2 FOOT DISTANCE TO THE HINGE POINT, OTHERWISE BUILD AS THE PLAN SHOWS OR AS THE ENGINEER DIRECTS. IF THE 2 FOOT DISTANCE TO THE HINGE POINT IS REDUCED OR ELIMINATED, INCREASE THE POST EMBEDMENT DEPTH TO 4'-6" OR MORE.


③ BOLTS SHALL CONFORM TO THE REQUIREMENTS OF ASTM F-1554, GRADE 55, NUTS SHALL CONFORM TO THE REQUIREMENTS OF ASTM A-563 DH.

④ ALL WOOD POSTS MUST BE 6" X 8" AND AT LEAST 7'-0" LONG.


⑤ DO NOT ATTACH POST IN "W" TO THRIE BEAM TRANSITION SECTION.

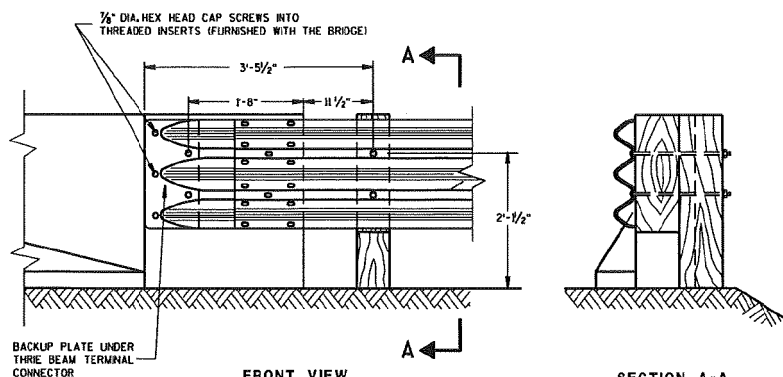


FRONT VIEW
THRIE BEAM CONNECTION TO BRIDGE
PARAPET WITH SQUARE ENDS

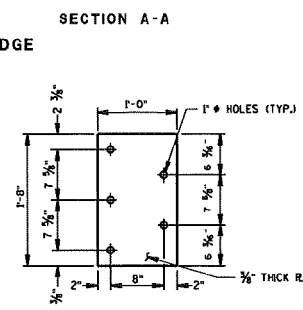


② BACKUP PLATE DETAIL
(USE ONLY AT BRIDGE PARAPET CONNECTIONS)

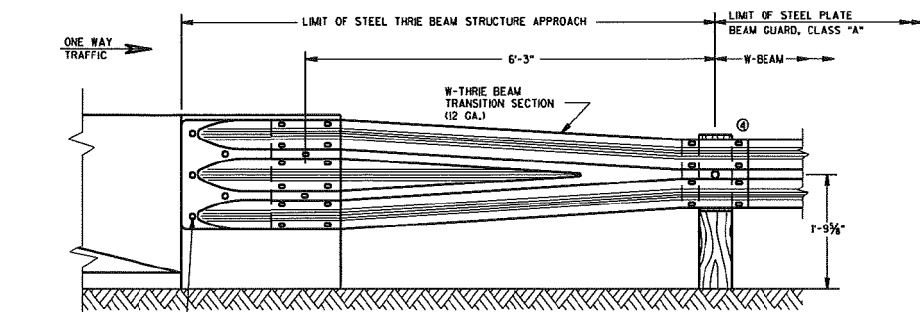

FRONT VIEW
W BEAM TRANSITION AND CONNECTION TO
BRIDGE PARAPETS WITH SQUARE ENDS
(USE ONLY ON THE TRAFFIC EXIT END OF ONE WAY BRIDGES)

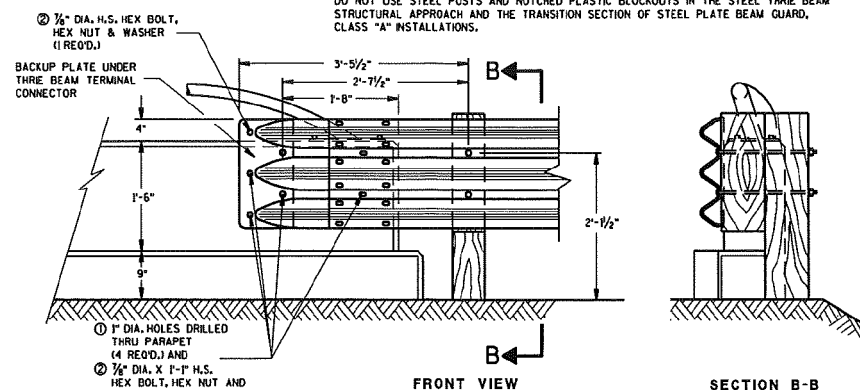

FRONT VIEW
THRIE BEAM CONNECTION
TO VERTICAL FACED PARAPETS

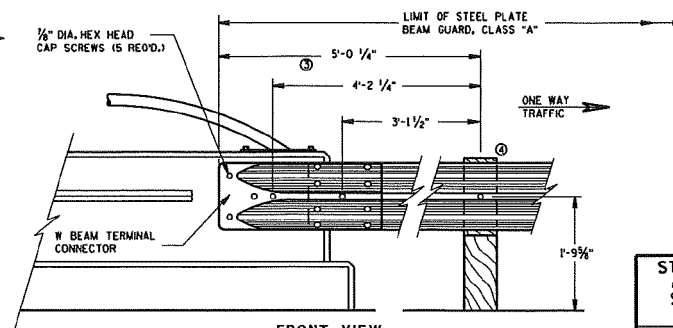

FRONT VIEW
W BEAM CONNECTION TO VERTICAL FACE PARAPET
(USE ONLY ON THE TRAFFIC EXIT END OF ONE WAY BRIDGES)

GENERAL NOTES

THESE ARE TYPICAL CONNECTION DETAILS. ADJUST THE POSITION OF CONNECTIONS TO EXISTING BRIDGES TO FIT THE ACTUAL BRIDGE AND SITE DIMENSIONS.

BOLTS, PLATES, NUTS AND WASHERS SHALL CONFORM TO THE REQUIREMENTS OF ASTM SPECIFICATION A 325, AND BE GALVANIZED IN ACCORDANCE WITH ASTM A 153.

① INCLUDE THE PAYMENT FOR DRILLING BOLT HOLES THROUGH THE PARAPET, AND THE BACKUP PLATE AND ALL BOLTS, NUTS AND WASHERS IN THE ITEM "STEEL THRIE BEAM STRUCTURAL APPROACH".

② EACH BOLT AT THE BACK FACE OF THE PARAPET REQUIRES A HARDENED ROUND STEEL WASHER WITH A 2 1/4" O.D. X 3/8" THICK.

③ THE RECESS FOR A W-BEAM CONNECTION, WHICH EXISTS ON SOME PARAPETS OF THIS TYPE, SHALL BE FILLED WITH A TREATED TIMBER BLOCKOUT. BLOCKOUT SIZE IS 1'-6" X 2'-0" X 3 1/2".

④ W6 X 9 OR W6 X 8.5 STEEL POSTS AND NOTCHED PLASTIC BLOCKOUTS ARE ACCEPTABLE ALTERNATIVES FOR 6" X 8" WOOD POST WITH WOOD OR PLASTIC BLOCKOUTS. USE APPROVED NOTCHED PLASTIC BLOCKOUTS WITH STEEL POSTS.

DO NOT USE STEEL POSTS AND NOTCHED PLASTIC BLOCKOUTS IN THE STEEL THRIE BEAM STRUCTURAL APPROACH AND THE TRANSITION SECTION OF STEEL PLATE BEAM GUARD, CLASS "A" INSTALLATIONS.

STEEL THRIE BEAM STRUCTURE APPROACH, CONNECTION TO SQUARE END AND VERTICAL FACED PARAPETS	
STATE OF WISCONSIN DEPARTMENT OF TRANSPORTATION	
APPROVED 2-12-04 DATE	CHEF ROADWAY DEVELOPMENT ENGINEER
FHWA	


NOTE	QTY.	DESCRIPTION
(1)	4	WOOD BREAKWAY TERMINAL POST: 5/2" X 1/2"
(2)	4	STEEL TUBE: TS 8" X 6" X 0.108", 4'-6" LONG
(3)	4	SOL. PLATE: 2"-0" X 7'-6" X 1/4"
(4)	4	WOOD BREAKWAY CRT POSTS: 6" X 8" X 6'-0"
(5)	6	WOOD OFFSET BLOCKS: 6" X 8" X 1'-2"
(6)	1	PIPE SLEEVE: 2" X 5 1/2" STANDARD PIPE
(7)	1	BEARING PLATE
(8)	1	BCT CABLE ASSEMBLY
(9)	1	CABLE ANCHOR BOX
(10)	1	STRUT & YOKE
(11)	1	STEEL PLATE BEAM, END PANEL 12 GA. 13'-6 1/2" LONG FOR SKT-350, ET-2000 AND ET-2000 PLUS
(12)	3	STEEL PLATE BEAM: 12 GA. 13'-6 1/2"
(13)	1	ET-2000/ET-2000 PLUS GUARDRAIL EXTRUDER OR SKT-350 RAIL HEAD AS FURNISHED BY MANUFACTURER
(14)	1	REFLECTIVE SHEETING: 18" X 18"

- (A) USE 3:1 OR FLATTER SLOPE FOR INSTALLATION ON EXISTING HIGHWAYS.
- (B) DO NOT ATTACH GUARDRAIL TO POST BLOCKS AT POSTS NO. 3, 5 & 7.
- (C) AFTER FINAL ASSEMBLY, RECHECK CABLE TO BE SURE IT IS TAUT AND HAS NOT RELAXED.


STEEL POSTS SHALL NOT BE ALLOWED FOR USE WITH ENERGY ABSORBING TERMINALS.

DO NOT INSTALL REFLECTORS ON THE FIRST 50 FEET OF THE APPROACH END OF THE ENERGY ABSORBING TERMINAL.


* DO NOT ATTACH BLOCKOUTS TO POSTS 1 AND 2.

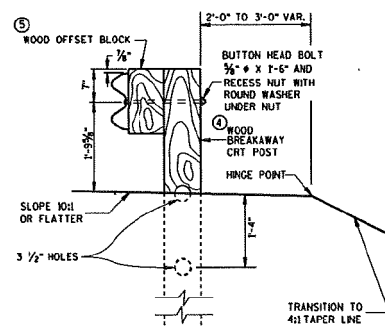


SECTION C-C
TYPICAL AT POST NOS. 4, 6, 8

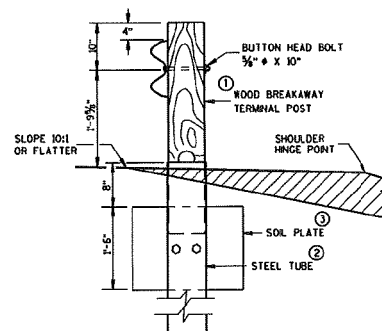

SECTION B-B
TYPICAL AT POST NO. 2*

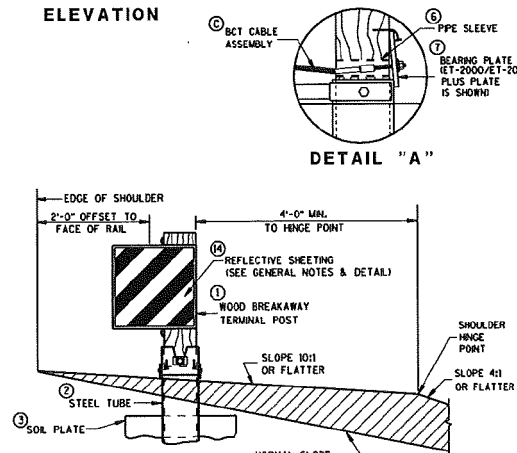


SECTION A-A
TYPICAL AT POST NO. 1*

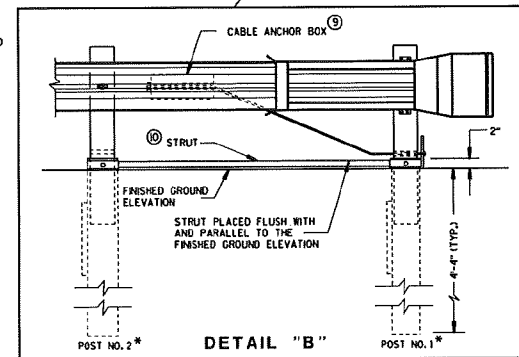


DETAIL "B"

STEEL PLATE BEAM GUARD ENERGY ABSORBING TERMINAL


STATE OF WISCONSIN
DEPARTMENT OF TRANSPORTATION

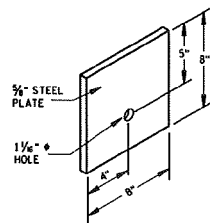

STEEL BEARING PLATE (SKT-350)

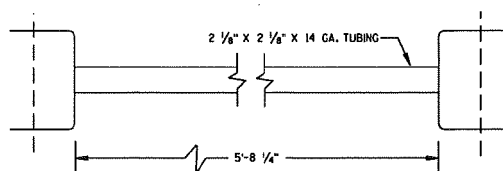


STRUT DETAIL (SKT-350)

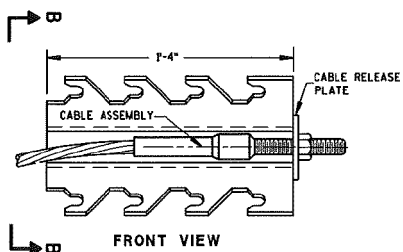


CABLE ANCHOR BOX (SKT-350)


(SKT-350)

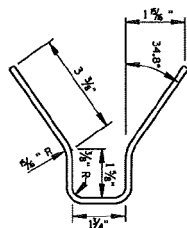


SECTION B-B

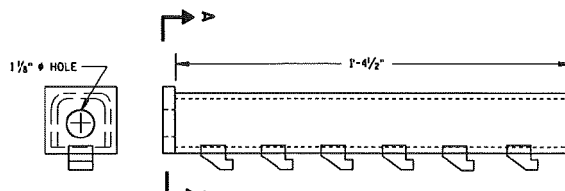


CABLE ANCHOR BOX (ET-2000/ET-2000 PLUS)

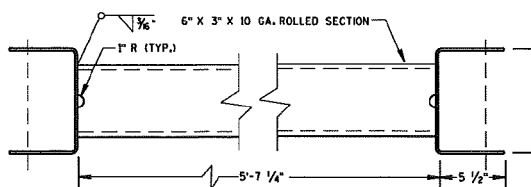

STRUT DETAIL (ET-2000/ET-2000 PLUS)

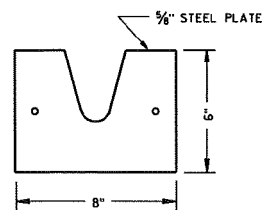


**STEEL BEARING PLATE
(ET-2000/ET-2000 PLUS)**

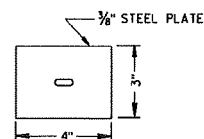


**BEARING PLATE WASHER
(ET-2000/ET-2000 PLUS)**

(ET-2000/ET-2000 PLUS)

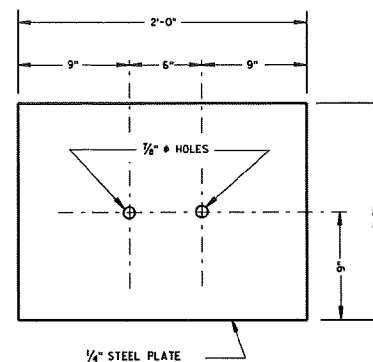


**SOIL PLATE
(SKT-350, ET-2000/ET-2000 PLUS)**

6

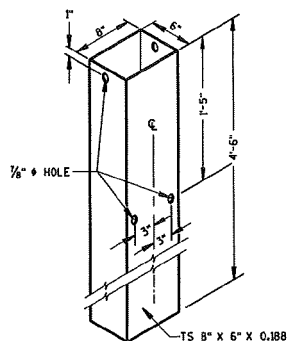


STEEL TUBE

(POSTS NO. 1-4)
THE STEEL TUBE SHALL CONFORM
TO REQUIREMENTS OF ASTM A500

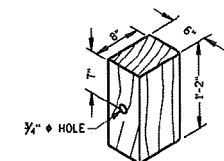


WOOD OFFSET BLOCK

REDD. AT ALL POSTS EXCEPT POST NO'S 1 & 2

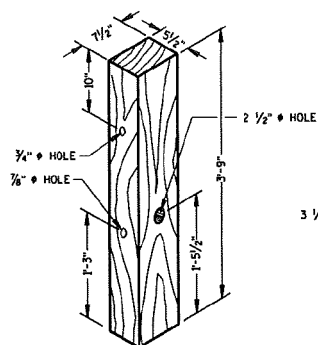

TERMINAL POST


(POSTS NO. 1-4)

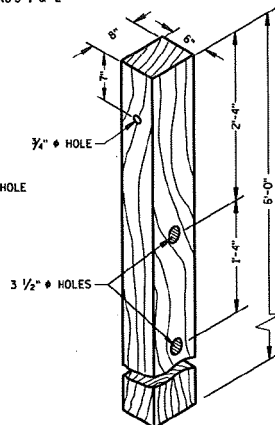

CRT POST


(POSTS NO'S 5-8)

WOOD BREAKAWAY POSTS

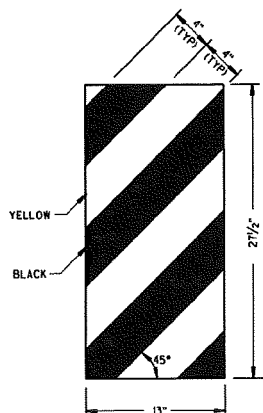

ET-2000 PLUS ONLY

REFLECTIVE SHEETING DETAILS

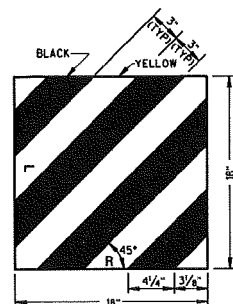

ET-2000 AND SKT-350

GENERAL NOTES

DETAILS OF CONSTRUCTION, MATERIALS AND WORKMANSHIP NOT SHOWN ON THIS DRAWING SHALL CONFORM TO THE PERTINENT REQUIREMENTS OF THE STANDARD SPECIFICATIONS, APPLICABLE SPECIAL PROVISIONS AND MANUFACTURERS INSTRUCTIONS.

STEEL PLATE BEAM GUARD ENERGY ABSORBING TERMINAL SHALL BE EITHER THE EXTRUDER TERMINAL (ET-2000), OR THE SEQUENTIAL KINKING TERMINAL (SKT-350). THE CONTRACTOR SHALL NOT INTERMIX PROPRIETARY PRODUCT MATERIALS.

STEEL PLATE BEAM GUARD, ENERGY ABSORBING TERMINAL SHALL BE PAID FOR AT THE CONTRACT UNIT PRICE EACH, WHICH SHALL INCLUDE HARDWARE, STEEL PLATE BEAM GUARD, POSTS, REFLECTIVE SHEETING AND INSTALLATION AS SHOWN.

REFLECTIVE SHEETING - SHALL CONFORM TO ASTM SPECIFICATION D4956-94. REFLECTIVE SHEETING TYPE III, BACKING CLASS 4, PERFORMANCE REQUIREMENT TYPE III. THE MESSAGE AND LINES SHALL BE APPLIED TO THE SIGNS BY THE SILK SCREEN STENCIL PROCESS USING A BLACK OR DARK STENCIL PASTE AS A TYPE APPROVED BY THE MANUFACTURER OF THE FACE MATERIAL TO WHICH IT IS TO BE APPLIED. MESSAGE UNITS CUT FROM NONREFLECTIVE SHEETING AND APPLIED TO THE SIGN FACE ARE NOT ACCEPTABLE. AFTER THE APPROACH END OF THE STEEL PLATE BEAM GUARD INSTALLATION IS COMPLETE, CLEAN THE AREA WHERE THE REFLECTIVE SHEETING WILL BE APPLIED IN ACCORDANCE WITH THE MANUFACTURERS RECOMMENDATION. ONCE CLEAN, APPLY REFLECTIVE SHEETING DIRECTLY TO THE STEEL PLATE BEAM GUARD AS SHOWN. THE CONTRACTOR SHALL TURN OVER THE MANUFACTURERS WARRANTY FOR THE REFLECTIVE SHEETING TO THE DEPARTMENT FOR POTENTIAL DEALING WITH THE MANUFACTURER. PAYMENT OF REFLECTIVE SHEETING IS INCIDENTAL TO STEEL PLATE BEAM GUARD, ENERGY ABSORBING TERMINAL.

WHEN ROCK IS ENCOUNTERED DURING EXCAVATION, A 12 INCH DIA. POST HOLE EXTENDING 20 INCHES DEEP INTO THE ROCK MAY BE USED IF APPROVED BY THE ENGINEER. GRANULAR MATERIAL SHALL BE PLACED IN THE BOTTOM OF THE HOLE APPROXIMATELY 2 1/2 INCHES DEEP TO PROVIDE DRAINAGE. THE SOIL TUBES SHALL BE FIELD CUT TO LENGTH, PLACED IN THE HOLE AND BACKFILLED WITH ADEQUATELY COMPACTED MATERIAL EXCAVATED FROM THE HOLE.


STEEL PLATE BEAM GUARD ENERGY ABSORBING TERMINAL

STATE OF WISCONSIN
DEPARTMENT OF TRANSPORTATION


APPROVED
6-25-03
DATE
FHW
CHIEF ROADWAY DEVELOPMENT ENGINEER

S.D.D. 14 B 24-4c


S.D.D.15 B 1-7a

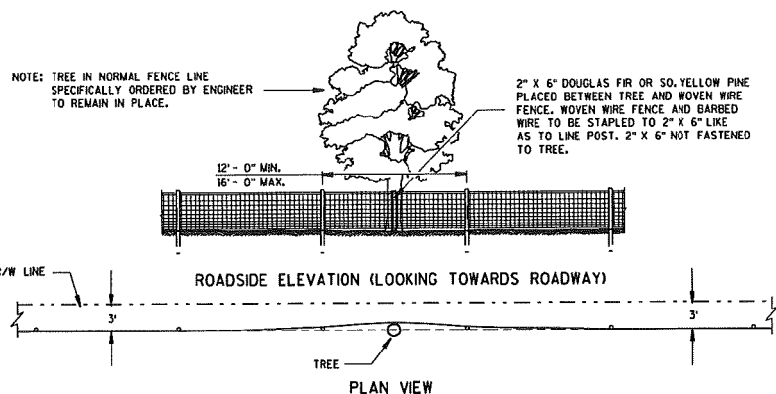


FENCE DESIGN AT TREES REMAINING IN NORMAL FENCE LINE

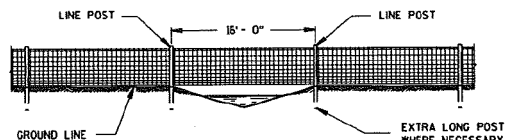


FENCE CONSTRUCTION OVER STREAM COURSES OF 15 FT. OR LESS IN WIDTH

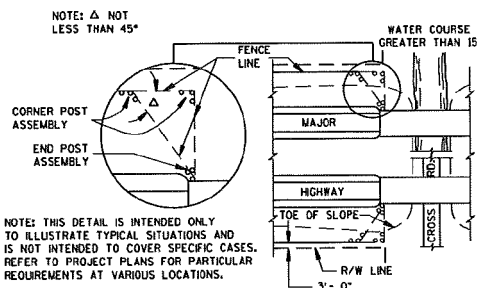


PLAN VIEW
MAJOR HIGHWAY OVERPASS OR STREAM COURSE CROSSING OF GREATER THAN 15 FT. IN WIDTH

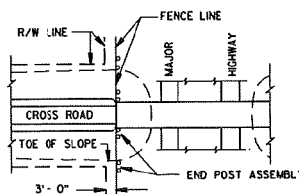

PLAN VIEW
MAJOR HIGHWAY UNDERPASS

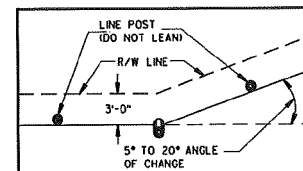



PLAN VIEW
SINGLE POST CORNER

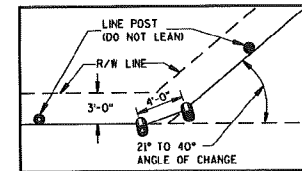

PLAN VIEW
DOUBLE POST CORNER

RIGHT OF WAY LINE CHANGE 40° AND LESS


NOTE: SINGLE AND DOUBLE POSTS SHALL BE A MIN. 6" DIA. X 8'-0" WITH A LEAN OF 4" TOWARD THE OUTSIDE OF THE CURVE. WHEN THE RIGHT OF WAY LINE CHANGE IS MORE THAN 40° USE THE CORNER OR STRETCHER POSTS ASSEMBLY.

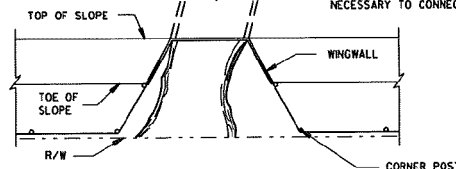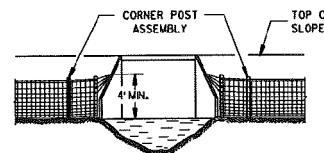


FENCE INSTALLATION TO WINGWALLS

NOTE: PLACE A MINIMUM OF 4 STRANDS OF BARBED WIRE, 6" MAXIMUM CENTERS IN FAN SHAPE CONNECTED TO AN EYE BOLT ON WINGWALL OR SET A LINE POST WHEN NECESSARY TO CONNECT BARBED WIRE.

NOTE: WHEN POSTS ARE DRIVEN THE SMALL END SHALL BE DOWN.

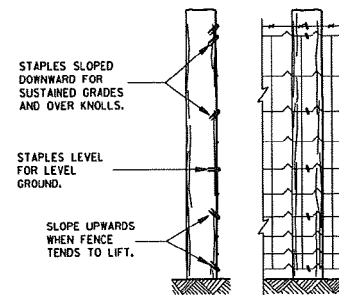

FENCE MOUNTING DETAIL

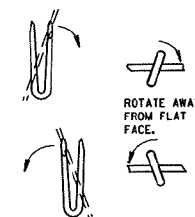

NOTE: THIS STANDARD DETAIL DRAWING CONSISTS OF TWO PLATES AND BOTH ARE REQUIRED WHEN THIS STANDARD IS CALLED FOR IN THE PLANS.


WOVEN WIRE FENCE

STATE OF WISCONSIN
DEPARTMENT OF TRANSPORTATION

APPROVED
12/26/88
DATE


STATE DESIGN ENGINEER FOR HWYS

FIG. 1A

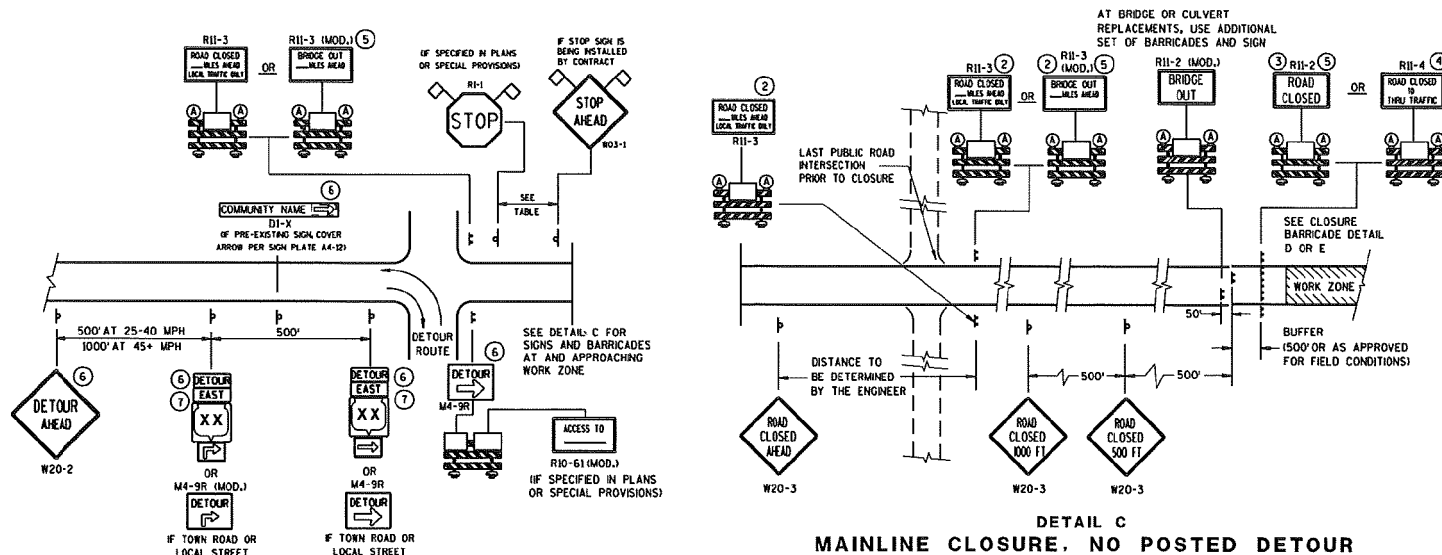

SPEED LIMIT (MPH)	"STOP AHEAD" ADVANCE WARNING DISTANCE (FT)
25	200
30	200
35	350
40	350
45	500
50	550
55	750


SEE SDD 15C2-4b
FOR GENERAL NOTES
AND FOOTNOTES ① THROUGH ⑦

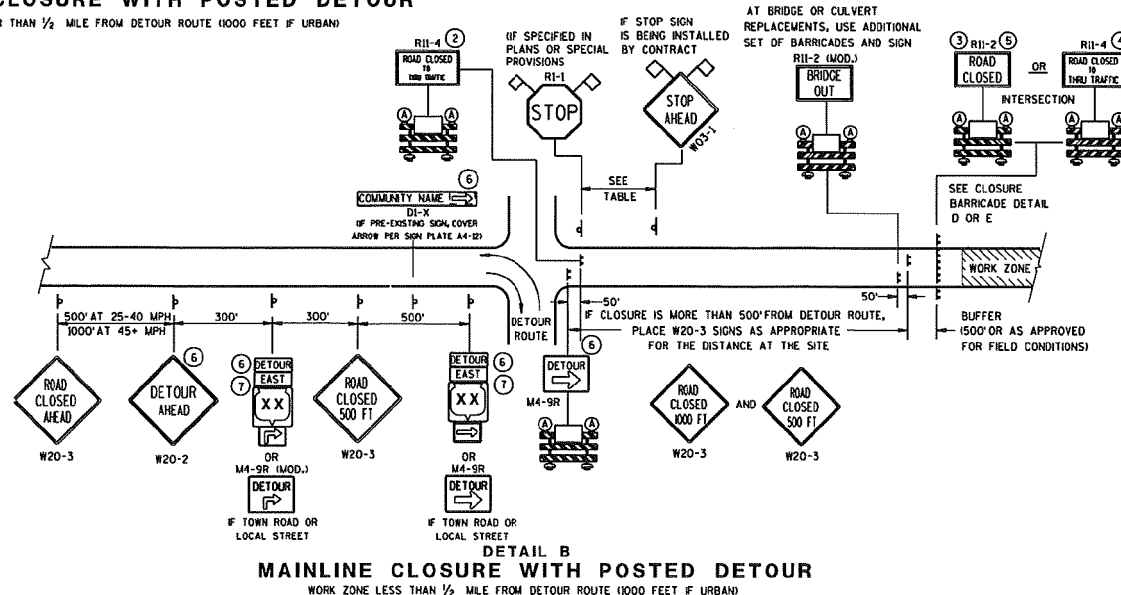


- LEGEND**
- POST MOUNTED SIGN
 - TYPE IN BARRICADES
 - TYPE "A" LOW INTENSITY FLASHING WARNING LIGHT (FOR NIGHT USE)
 - WORK ZONE
 - DETOUR EAST
 - M4-8
 - M3-X
 - M1-4
 - M1-5A
 - M1-6
 - M05-1
 - M06-1
 - FLAGS, 16" X 16" MIN., (ORANGE)

**BARRICADES AND SIGNS
FOR
MAINLINE CLOSURES**

STATE OF WISCONSIN
DEPARTMENT OF TRANSPORTATION

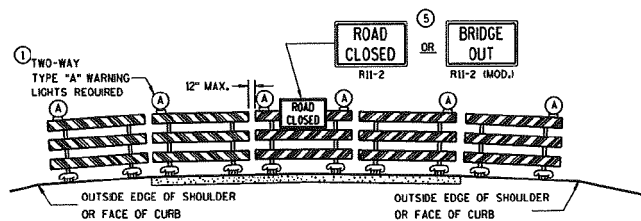

DETAIL D
ROAD CLOSURE BARRICADE DETAIL
APPROACH VIEW

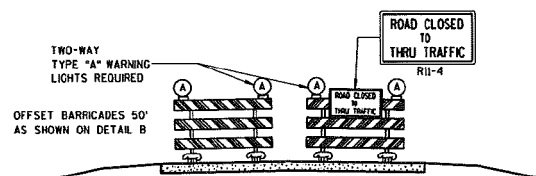

DETAIL E
LANE CLOSURE BARRICADE DETAIL
APPROACH VIEW

SEE SDD 15C2-4a FOR LEGEND

GENERAL NOTES

THE EXACT NUMBER, LOCATION, AND SPACING OF ALL SIGNS AND BARRICADES SHALL BE ADJUSTED TO FIT FIELD CONDITIONS AS APPROVED BY THE ENGINEER.

ANY SIGNS TEMPORARY OR EXISTING, WHICH CONFLICT WITH TRAFFIC CONTROL "IN USE" SHALL BE REMOVED OR COVERED AS NEEDED AND AS APPROVED BY THE ENGINEER.

THE SPACING BETWEEN TRAFFIC CONTROL SIGNS SHOULD BE ADJUSTED TO NOT CONFLICT WITH AND SHOULD PROVIDE A DESIRABLE MINIMUM OF 200 FEET CLEARANCE TO EXISTING SIGNS THAT WILL REMAIN IN PLACE.

BARRICADES THAT MUST BE MOVED FOR A WORK OPERATION SHALL BE IMMEDIATELY RE-ESTABLISHED UPON COMPLETION OF THE OPERATION OR, FOR CONTINUOUS OPERATIONS, AT THE END OF EACH WORKING DAY.

SIGNS THAT WILL BE IN PLACE LESS THAN 7 CONTINUOUS DAYS AND NIGHTS MAY BE MOUNTED ON PORTABLE SUPPORTS.

ALL TYPE III BARRICADES SHALL HAVE RAILS REFLECTORIZED ON BOTH FACES. STRIPES SHALL BE PROPERLY SLOPED DOWN TOWARD THE TRAFFIC SIDE OR AS SHOWN IN THE ROAD CLOSURE BARRICADE DETAIL D FOR FULL ROAD CLOSURES.

TYPE "A" LOW-INTENSITY FLASHING WARNING LIGHTS SHALL BE VISIBLE ON BOTH SIDES OF THE BARRICADE.

THE R11-2, R11-3, M4-9, R11-4 AND R10-61 SIGNS PLACED ON BARRICADES SHALL COVER NO MORE THAN THE TOP RAIL. THE SIGNS SHALL NOT COVER ANY PORTION OF THE MIDDLE OR BOTTOM RAILS.

THE REFLECTIVE SHEETING USED ON R11-2, R11-3, R11-4, R10-61 AND R1-1 SIGNS SHALL COMPLY WITH SUBSECTION 637.2.2.2 OF THE STANDARD SPECIFICATIONS.

"W" AND "M" SIGNS ARE THE SAME AS "W" AND "M" SIGNS EXCEPT THE BACKGROUND IS ORANGE.

ALL SIGNS SHALL BE 48" X 48" UNLESS OTHERWISE NOTED BELOW:

- R11-2 SHALL BE 48" X 30".
- R11-3, R11-4 AND R10-61 SHALL BE 60" X 30".
- M4-9 SHALL BE 30" X 24".
- M3-X AND M4-B SHALL BE 24" X 12", (30" X 15" IF NEEDED TO MATCH EXISTING SIGNS.)
- M1-4, M1-5A, AND M1-6 SHALL BE 24" X 24", (36" X 36" IF NEEDED TO MATCH EXISTING SIGNS.)
- M05-1 AND M06-1 SHALL BE 21" X 21", (30" X 30" IF NEEDED TO MATCH EXISTING SIGNS.)
- D1-X SHALL BE AS SHOWN ON SPECIFIC PROJECT SIGNING DETAIL SHEETS.
- R1-1 SHALL BE 36" X 36".

- 1 TWO WARNING LIGHTS SHALL BE PROVIDED ON THE CENTER BARRICADE AND A MINIMUM OF ONE WARNING LIGHT SHALL BE PROVIDED ON EACH OF THE OTHER BARRICADES WITHIN THE ROADWAY LIMITS. SPACING OF THE WARNING LIGHTS SHALL BE UNIFORM TO THE EDGE OF ROADWAY AS SHOWN (APPROX. 8-FOOT LIGHT SPACING).
- 2 THESE SIGNS AND BARRICADES ARE NOT REQUIRED IF ROAD CLOSURE BEGINS AT INTERSECTION.
- 3 FOR ROAD CLOSURE WITHOUT LOCAL ACCESS TO PROJECT, SEE ROAD CLOSURE BARRICADE DETAIL D.
- 4 FOR ROAD CLOSURE WITH LOCAL ACCESS TO PROJECT, SEE LANE CLOSURE BARRICADE DETAIL E.
- 5 FOR BRIDGE OR CULVERT REPLACEMENTS, SUBSTITUTE "BRIDGE OUT" INSTEAD OF "ROAD CLOSED" ON R11-2 AND R11-3 SIGNS.
- 6 INSTALL DETOUR AND COMMUNITY GUIDE SIGNS AND ARROWS ONLY IF SPECIFIED IN THE CONTRACT. IF THERE ARE EXISTING ROUTE MARKER ASSEMBLIES THAT WILL REMAIN IN PLACE, ADJUST THE LOCATION OF THE DETOUR ROUTE SIGNS TO CORRESPOND WITH THE EXISTING ASSEMBLIES. MODIFY EXISTING SIGNS WHERE POSSIBLE. SEE SPECIFIC PROJECT DETOUR SIGNING DETAIL SHEETS. IF DETOUR SIGNS ARE BEING INSTALLED BY OTHERS, PLACE THE CONTRACTED TRAFFIC CONTROL SIGNS TO ALLOW FOR PLACEMENT OF ALL WARNING, DETOUR AND GUIDE SIGNS AS SHOWN.
- 7 "EAST" CARDINAL DIRECTION MARKERS AND RIGHT TURN ARROWS ARE SHOWN. USE OTHER CARDINAL DIRECTIONS AND ARROWS AS APPROPRIATE.

BARRICADES AND SIGNS FOR MAINLINE CLOSURES

STATE OF WISCONSIN
DEPARTMENT OF TRANSPORTATION


APPROVED


9/16/03

DATE

Thomas N. Nottelmann
CHIEF SIGNS AND MARKING ENGINEER

FWSA


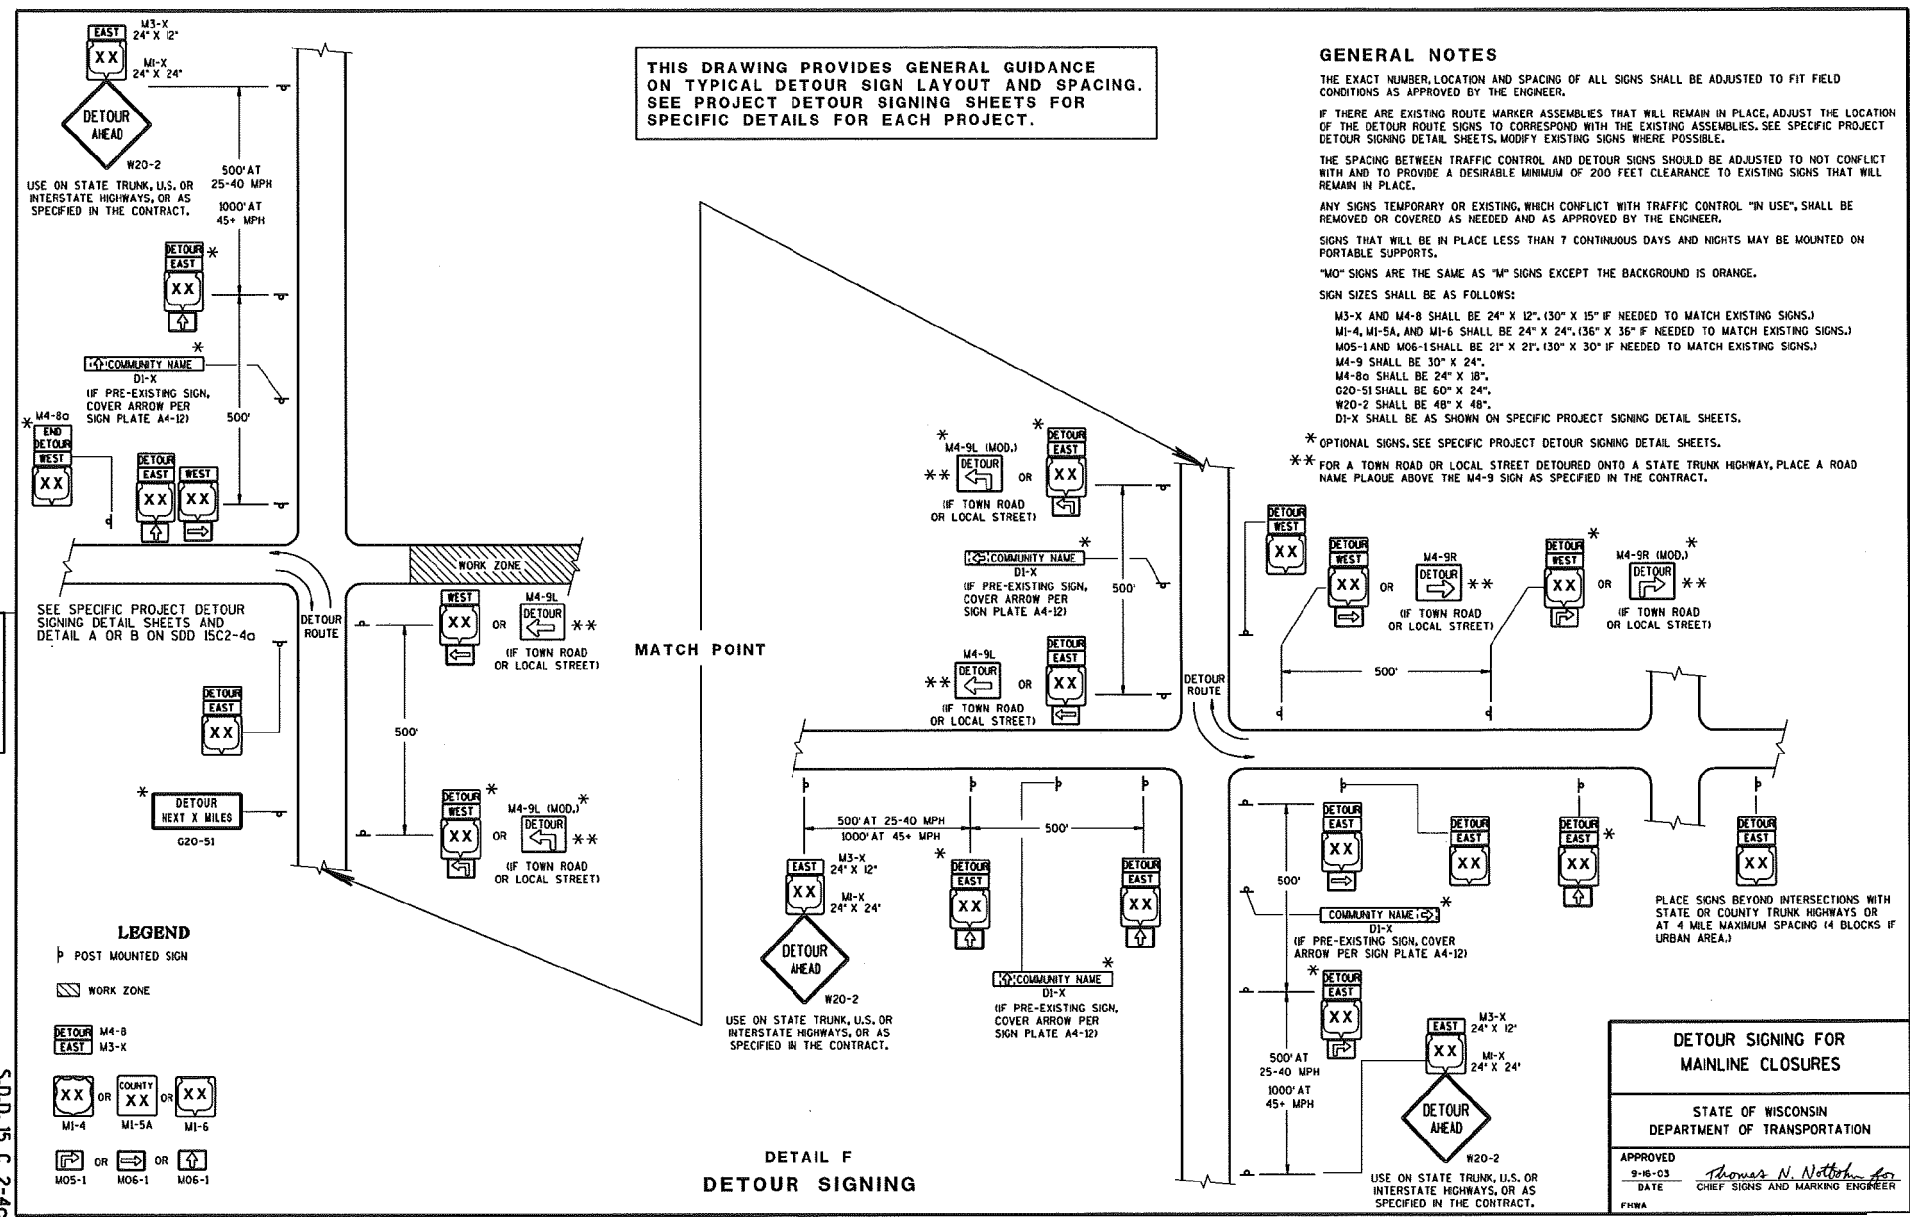


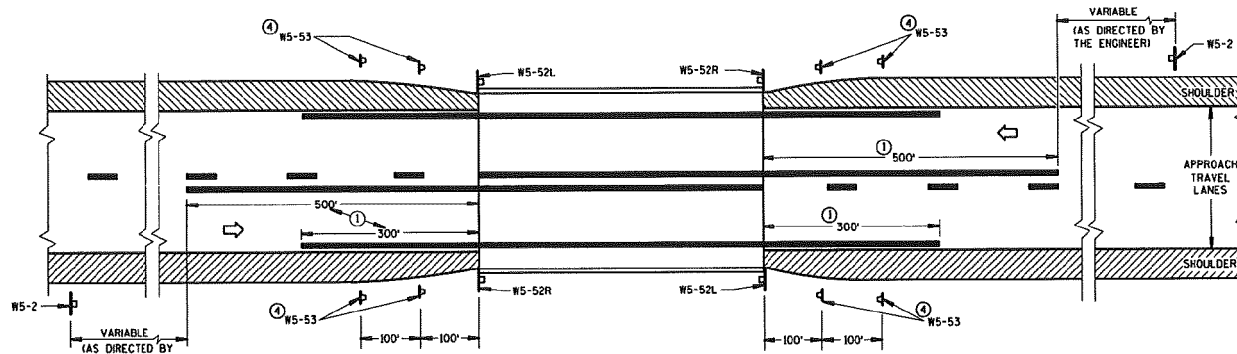

SITUATION 1

WARRANTING CRITERIA:

BRIDGE WIDTH IS AT LEAST 18 FEET BUT LESS THAN 24 FEET

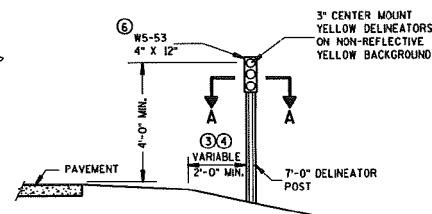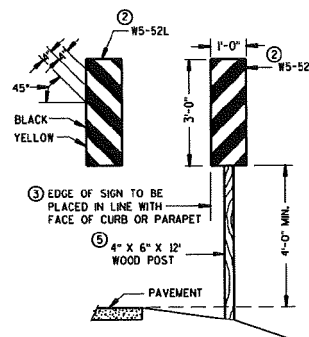


OBJECT MARKER PLACEMENT

GENERAL NOTES


DETAILS OF TRAFFIC CONTROL DEVICES AND INSTALLATION NOT SHOWN ON THIS DRAWING SHALL CONFORM TO THE PERTINENT REQUIREMENTS OF THE STANDARD SPECIFICATIONS, THE SPECIAL PROVISIONS, AND THE MANUAL ON UNIFORM TRAFFIC CONTROL DEVICES.

PAVEMENT MARKING SHOWN ON THIS DRAWING IS NOT REQUIRED UNLESS OTHERWISE SPECIFIED IN THE CONTRACT. WHEN SPECIFIED, PAVEMENT MARKING SHALL CONFORM TO THIS DRAWING AND OTHER CONTRACT REQUIREMENTS.

- ① MINIMUM DISTANCE UNLESS OTHERWISE SHOWN ON THE PLAN.
- ② FACE OF OBJECT MARKERS W5-52R AND W5-52L SHALL BE COVERED WITH TYPE H REFLECTIVE SHEETING.
- ③ LOCATE OBJECT MARKER POST(S) BEHIND GUARDRAIL WHEN PRESENT.
- ④ OBJECT MARKERS (W5-53) SHALL BE LOCATED ALONG A LINE FLARED AWAY FROM THE BRIDGE CORNER TO DELINEATE THE NARROWING OF THE SHOULDER OR BERM.
- ⑤ A 12 FOOT DELINEATOR POST MAY BE USED INSTEAD OF A WOOD POST.
- ⑥ NON-BID ITEM, INCIDENTAL TO OTHER ITEMS.

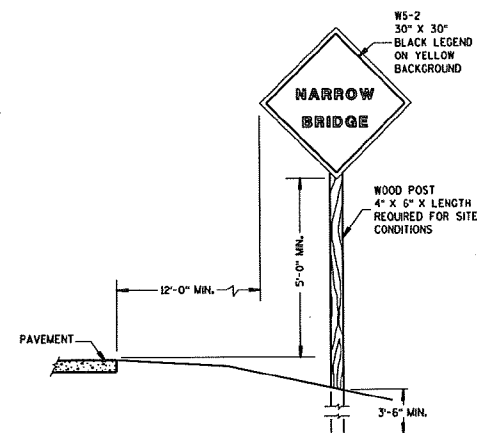

SIGN PLACEMENT

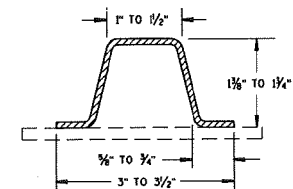


SECTION A-A

(MINIMUM WEIGHT 1.9 LBS. PER FT. AFTER GALVANIZING)


SIGNING & MARKING FOR TWO LANE BRIDGES

STATE OF WISCONSIN
DEPARTMENT OF TRANSPORTATION

APPROVED
9/5/06 /S/ Thomas N. Notbohm
DATE STATE TRAFFIC ENGINEER OF DESIGN
FHWA

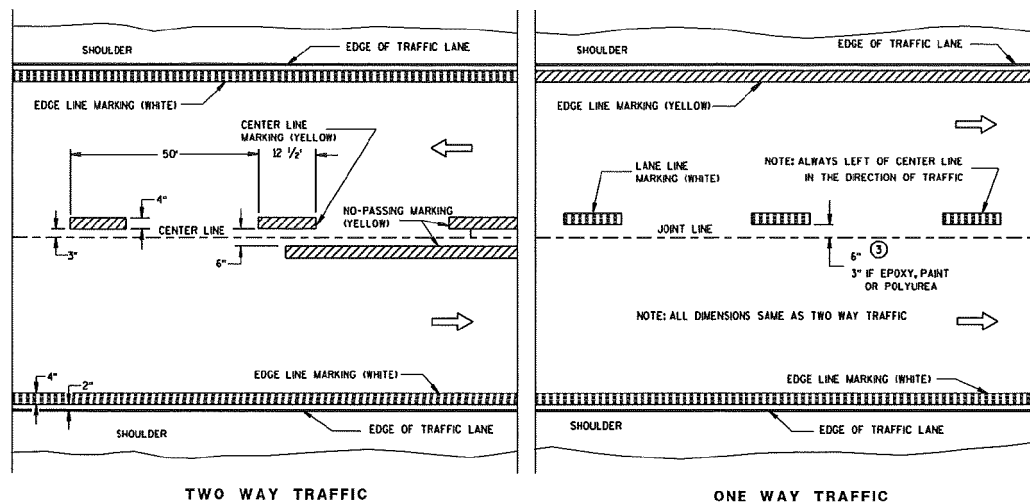

PERMANENT PAVEMENT MARKING

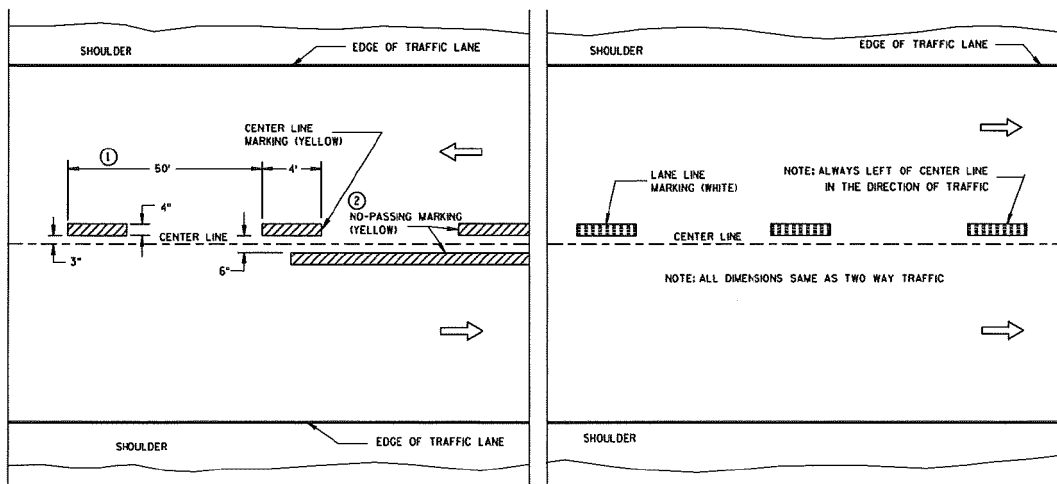

TEMPORARY (INTERMEDIATE) PAVEMENT MARKING
(SHOWS CYCLE FOR TEMPORARY CENTER LINE OR TEMPORARY LANE LINE MARKING)


GENERAL NOTES

DETAILS OF CONSTRUCTION NOT SHOWN ON THIS DRAWING SHALL CONFORM TO STANDARD SPECIFICATIONS AND SPECIAL PROVISIONS.

- 1 HALF CYCLE LENGTHS (25'-0") WITH 2" MINIMUM STRIPE LENGTHS SHALL BE PROVIDED ON ROADWAYS INCLUDING TEMPORARY TRAVELED WAYS WITH REVERSE CURVATURE, CURVATURE OF OVER 5 DEGREES OR WHEN DIRECTED BY THE ENGINEER TO MARK UNUSUAL ALIGNMENT OF THE TRAVELED WAY.
- 2 NO PASSING ZONE TEMPORARY PAVEMENT MARKING IS REQUIRED TO BE PLACED, WHERE APPROPRIATE, ALONG WITH CENTERLINE TEMPORARY PAVEMENT MARKING WHEN A SAME DAY PERMANENT PAVEMENT MARKING ITEM IS INCLUDED IN THE CONTRACT.
- 3 DIMENSION FROM THE WHITE REFLECTIVE EDGE FOR WET REFLECTIVE TAPE PLACEMENT ONLY.

NOTE

ARROW SYMBOL (→) SHOWS DIRECTION OF TRAVEL

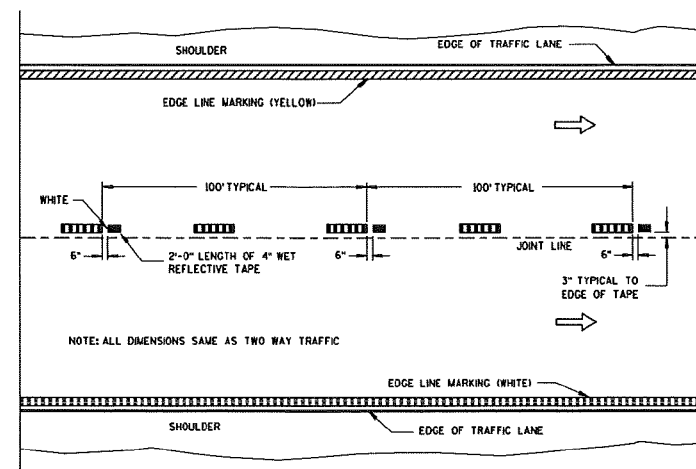

WET REFLECTIVE TAPE SUPPLEMENT TO
SPRAYED OR NON WET REFLECTIVE TAPE LANE LINE

PAVEMENT MARKING (MAINLINE)	
STATE OF WISCONSIN DEPARTMENT OF TRANSPORTATION	
APPROVED 1-16-07	/S/ Thomas N. Notbohm
DATE	STATE TRAFFIC ENGINEER OF DESIGN
FHWA	

LEGEND

- POST WITH ATTACHED SIGN
- POST WITH ATTACHED SIGN IN DRUM
- DRUM WITH WARNING LIGHT (TYPE C)
- DRUM
- ARROW BOARD
- 8" TYPE III BARRICADE
- * X-X- REMOVING PAVEMENT MARKING
- DIRECTION OF TRAFFIC

GENERAL NOTES :

THE EXACT NUMBER, LOCATION, AND SPACING OF ALL SIGNS AND DEVICES SHALL BE ADJUSTED TO FIT FIELD CONDITIONS AS APPROVED BY THE ENGINEER.

THE SPACING BETWEEN SIGNS SHOULD BE ADJUSTED TO NOT CONFLICT WITH AND TO PROVIDE A MINIMUM OF 200 FEET, (500 FEET DESIRABLE) DISTANCE TO EXISTING SIGNS.

THIS LANE CLOSURE IS TYPICAL FOR CLOSING RIGHT LANE - REVERSE FOR CLOSING LEFT LANE.

ALL SIGNS ARE 48"x48" UNLESS OTHERWISE NOTED.

"W0" IS THE SAME AS "W" EXCEPT THE BACKGROUND IS ORANGE.

ANY SIGNS TEMPORARY OR EXISTING, WHICH CONFLICT WITH TRAFFIC CONTROL "IN USE" SHALL BE REMOVED OR COVERED AS NEEDED AND AS APPROVED BY THE ENGINEER. NO WARNING LIGHTS SHALL BE WORKING ON "COVERED" OR "DOWNED" SIGNS.

- CONSIDER GEOMETRICS WHEN LOCATING SIGNS AND ARROW BOARD SO THE DRIVER HAS A CLEAR VIEW OF THE ARROW BOARD AND LANE CLOSURE DRUMS FOR A MINIMUM 1500 FEET IN FRONT OF DRUMS.

FOR A LANE CLOSURE THAT IS IN PLACE LESS THAN 7 CONTINUOUS DAYS AND NIGHTS, THE ADVANCED WARNING SIGNS MAY BE MOUNTED ON PORTABLE SUPPORTS.

GENERAL NOTES CONTINUED:

REMOVE PAVEMENT MARKINGS IF LANE CLOSURE IS TO BE IN PLACE FOR LONGER THAN 7 CONTINUOUS DAYS AND NIGHTS.


WARNING LIGHTS ARE NOT REQUIRED IF THE LANE CLOSURE IS A DAYTIME ONLY OPERATION.

IF THE HORIZONTAL ALIGNMENT IS SUCH THAT A CURVE MAY REQUIRE ADDITIONAL DELINEATION, THE DEVICE SPACING MAY BE DECREASED TO 50 FEET.

IF LANE CLOSURE IS MORE THAN 1 MILE, PLACE A TYPE III BARRICADE APPROXIMATELY EVERY 1/4 MILE ACROSS THE CLOSED LANE TO HELP ENFORCE THE DRUM LINE.

ADJUSTMENTS IN BUFFER SPACE NEED TO BE INCORPORATED WHEN THE LANE CLOSURE OCCURS NEAR AN INTERCHANGE EXIT OR ENTRANCE RAMP. THE LANE CLOSURE MUST MUST TAKE PLACE FAR ENOUGH IN ADVANCE OF AN EXIT OR ENTRANCE RAMP TO STILL ALLOW FOR ADEQUATE BUFFER SPACE. THE MINIMUM LENGTH OF THE BUFFER SPACE BEFORE AN EXIT RAMP SHOULD BE 1/2 THE LENGTH OF THE TRANSITION AREA. THE ENTRANCE RAMP SHOULD BE FOLLOWED BY THE ORIGINAL BUFFER SPACE LENGTH OF 800 FEET DESIRABLE PRIOR TO ANOTHER TRAFFIC CONTROL CHANGE SUCH AS A CROSSOVER MANEUVER.

- * THE LEFT REVERSE CURVE SIGN (W01-4L) IS ONLY REQUIRED WHEN THIS DETAIL IS USED IN COMBINATION WITH "SINGLE LANE CROSSOVER" DETAIL.

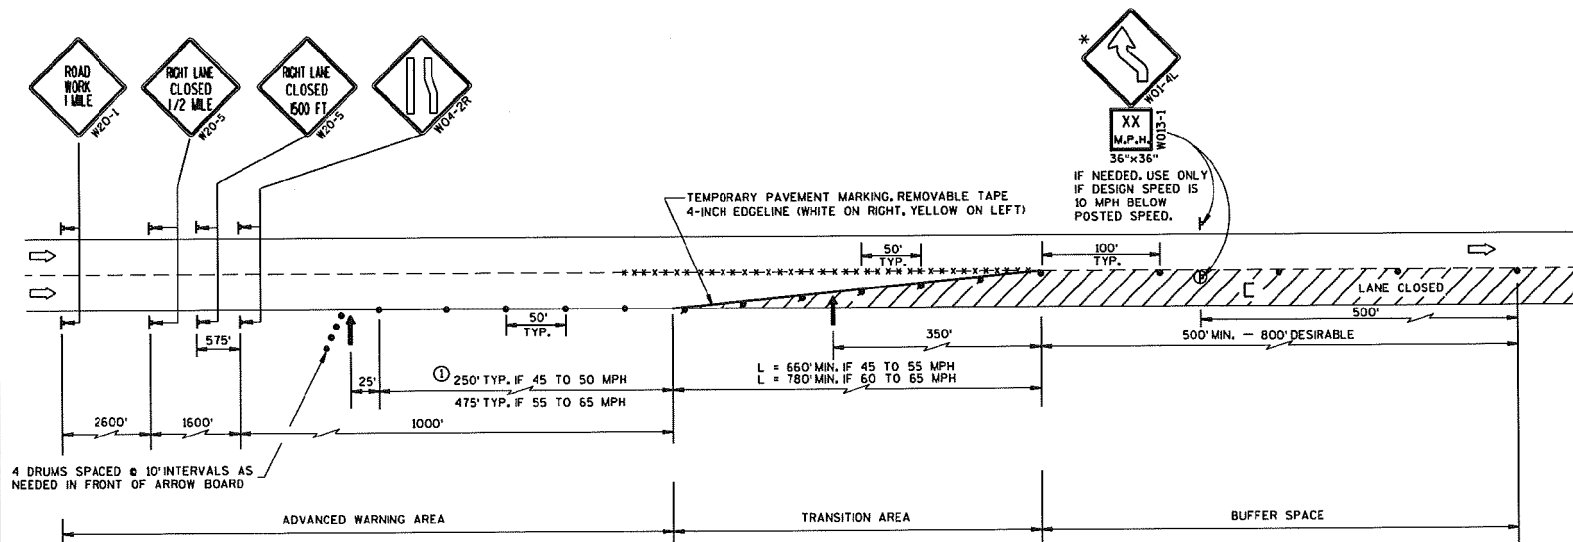

TRAFFIC CONTROL, LANE CLOSURE, SPEEDS GREATER THAN 40 M.P.H.	
STATE OF WISCONSIN DEPARTMENT OF TRANSPORTATION	
APPROVED 8-7-95 DATE	<i>Chris J. Spang</i> for DIRECTOR, OFFICE OF TRAFFIC
PHWA	

SYMBOLS

- TRAFFIC CONTROL DRUM
- ⌋ POST MOUNTED SIGN
- ➡ DIRECTION OF TRAFFIC FLOW
- ⏏ ARROW BOARD IN CAUTION MODE

GENERAL NOTES

THIS DETAIL IS TYPICAL FOR CLOSING THE RIGHT SHOULDER. FOR CLOSING THE LEFT SHOULDER, REVERSE THE TRAFFIC CONTROL.

THIS DETAIL MAY BE USED FOR DIVIDED ROADWAYS WITH ANY NUMBER OF TRAVEL LANES.

THE EXACT NUMBER, LOCATION AND SPACING OF ALL SIGNS AND DEVICES SHALL BE ADJUSTED TO FIT FIELD CONDITIONS AS APPROVED BY THE ENGINEER.

ALL SIGNS ARE 48" X 48" UNLESS OTHERWISE NOTED.

SIGN LAYOUTS SHALL BE IN ACCORDANCE WITH THE FHWA'S MANUAL OF STANDARD HIGHWAY SIGNS OR THE WISCONSIN STANDARD SIGN PLATES.


SIGNS THAT WILL BE IN PLACE LESS THAN 7 CONTINUOUS DAYS AND NIGHTS MAY BE MOUNTED ON PORTABLE SUPPORTS.

ANY SIGNS TEMPORARY OR EXISTING, WHICH CONFLICT WITH TRAFFIC CONTROL "IN USE" SHALL BE REMOVED OR COVERED AS NEEDED AND AS APPROVED BY THE ENGINEER.

CHANNELIZING DEVICES PLACED ADJACENT TO THE WORK AREA SHALL BE PULLED BACK FROM THE TRAVEL LANE WHEN WORK IS NOT IN PROGRESS.

WHEN A RAMP INTERSECTS THE FACILITY ON WHICH THE WORK IS BEING PERFORMED, ADDITIONAL TRAFFIC CONTROLS SHALL BE PROVIDED AS SPECIFIED IN THE PLANS AND/OR THE SPECIAL PROVISIONS OR AS APPROVED BY THE ENGINEER.



*FOR SHORT DURATION SHOULDER WORK OF LESS THAN ONE HOUR, THE W21-50 SIGN MAY BE OMITTED.

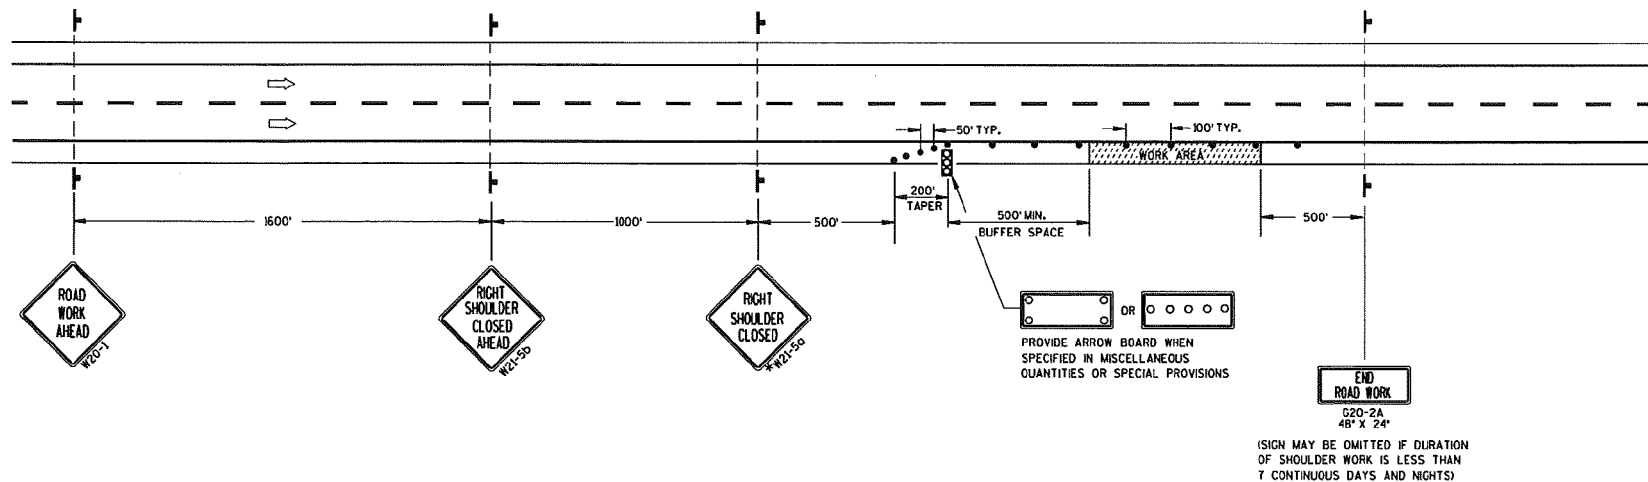

(SIGN MAY BE OMITTED IF DURATION OF SHOULDER WORK IS LESS THAN 7 CONTINUOUS DAYS AND NIGHTS)



TRAFFIC CONTROL, SHOULDER CLOSURE ON DIVIDED ROADWAY, SPEEDS GREATER THAN 40 MPH	
STATE OF WISCONSIN DEPARTMENT OF TRANSPORTATION	
APPROVED 5/23/00 DATE	<i>Oliver J. Spang</i> CHIEF SIGNS AND MARKING ENGINEER
FHWA	

URBAN AREA

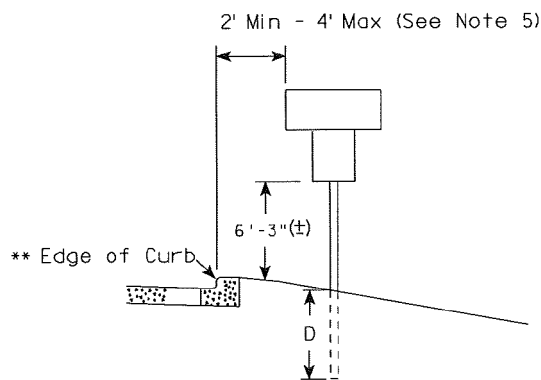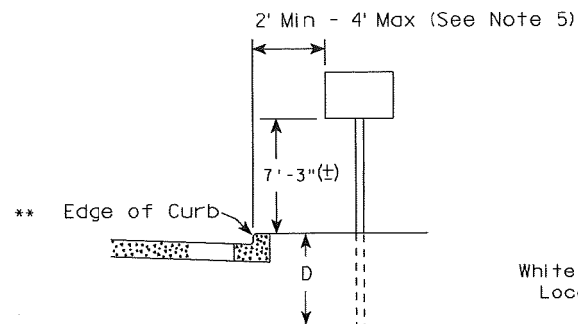

** The existence of curb and gutter does not in itself mandate the vertical clearance illustrated. That height is typically where there is sidewalk adjacent to the roadway or parking is permitted. This same criteria applies to mountable curb as well and measurement shall be taken from flow line.

RURAL AREA (See Note 2)

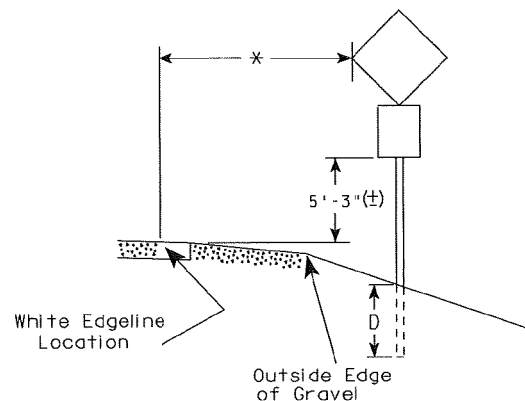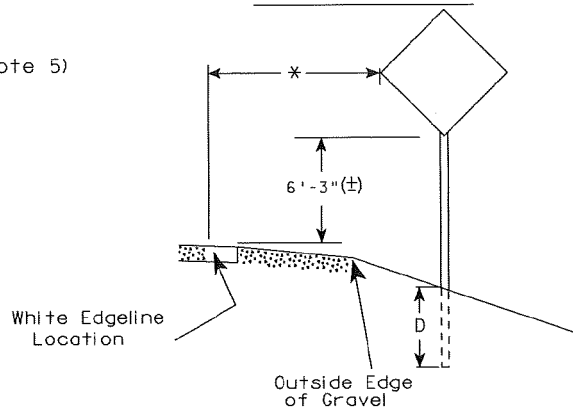

* 6 feet from edge of a paved shoulder or 12 feet from the edge of pavement (edge line location) or 2 feet from outside edge of gravel, whichever is greater unless directed by project engineer.

GENERAL NOTES

1. Signs wider than 4 feet or larger than 20 sq. ft. shall be mounted on multiple posts. Refer to plate A4-4.
2. For expressways and freeways, mounting height is 7'-3" (±) or 6'-3" (±) depending upon existence of a sub-sign.
3. Minimum mounting height for J assemblies (A4-5) is 7'-3" (±) or 6'-3" (±) per urban or rural detail respectively.
4. Minimum mounting height for signs mounted on traffic signal poles is 5'-3" (±).
5. Offset distance shall be consistent with existing signs or consistent throughout length of project.
6. The (±) tolerance for mounting height is 3 inches.
7. Folding stop signs (R1-1F) shall be mounted at a height of 5'-3" (±) or as directed by the Engineer.
8. The Double Arrow sign (W12-1) shall be mounted at a height of 2'-3" (±). The Chevron sign (W1-8), Roundabout Chevron panel (W1-8A), Clearance Markers (W5-52), Mile Markers (D10 series) & End of Road Markers (W5-56 & W5-56A) shall be mounted at a height of 4'-3" (±).

POST EMBEDMENT DEPTH

Area of Sign Installation (Sq. Ft.)	D (Min)
20 or Less	4'
Greater than 20	5'

TYPICAL INSTALLATION OF PERMANENT TYPE II SIGNS ON SINGLE POSTS

WISCONSIN DEPT OF TRANSPORTATION

APPROVED

Matthew R. Rauch
for State Traffic Engineer

DATE 10/25/05

PLATE NO. A4-3.13

PROJECT NO:

HWY:

COUNTY:

SHEET NO: 37

E

FILE NAME : C:\Users\Projects\tr_stop\plate\A43.DGN


PLOT DATE : 25-OCT-2005 13:14

PLOT BY : DOTSJA

PLOT NAME :

PLOT SCALE : 101.303739:1.000000

WISDOT/CADD5 SHEET 42

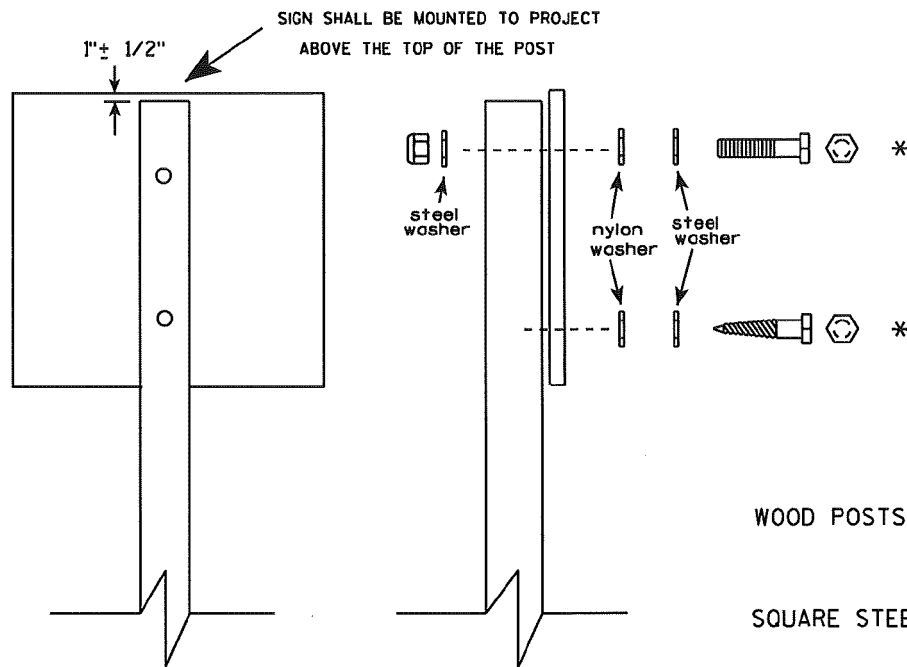

SIGN SHALL BE MOUNTED TO PROJECT
ABOVE THE TOP OF THE POST

1" ± 1/2"

steel washer

nylon washer

steel washer

*

*

Nuts, bolts and lags used for mounting signs shall have hexagonal heads and shall be either :

- Hot dip or mechanically galvanized in accordance with ASTM Designation: A 153, Class D, or
- Cadmium plated in accordance with ASTM Designation : B 766 TYPE 3, Class 12, or
- Electro-galvanized in accordance with ASTM Designation : B 633, TYPE III, SC 3.

Threads on bolts and nuts shall be manufactured with sufficient allowance for the cadmium plate or galvanized coating to permit the nuts to run freely on the bolts.

WOOD POSTS (4" x 4" or 4" x 6")

LAG SCREWS - 3/8" X 3"

MACHINE BOLTS - 5/16" X 6-1/2" or 7" Length w/ nuts


SQUARE STEEL POSTS (2" x 2")

MACHINE BOLTS - 3/8" X 3-1/4" Length w/ nuts

WASHERS (ALL POSTS) -

1-1/4" O.D. X 3/8" I.D. X 1/16" STEEL

1-1/4" O.D. X 3/8" I.D. X .080 NYLON for all Type H signs.

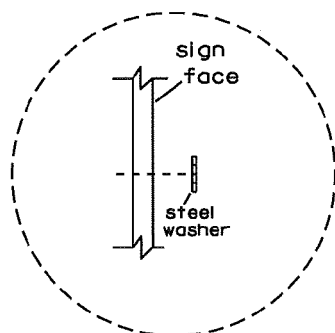

Washer Placement when Sign
Has Other Than Type H or
Type F Face

- * Two different fastening systems are shown for illustration purposes. On any individual sign, either one or the other system shall be used. Actual number of fasteners per sign varies with the sign area, but normally there are two. For a single post installation, all signs greater than 9 sq. ft. require the use of 3 fasteners.

ATTACHMENT OF SIGNS TO POSTS

WISCONSIN DEPT OF TRANSPORTATION

APPROVED *Matthew R. Rauch*
For State Traffic Engineer

DATE 8/30/06 PLATE NO. A4-8.6

PROJECT NO:

FILE NAME : C:\Users\Projects\tr_stcplate\A48.DGN


PLOT DATE : 08-JAN-2007 14:00

PLOT BY : DOTSJA

SHEET NO: 38

E

WISDOT/CADDs SHEET 42

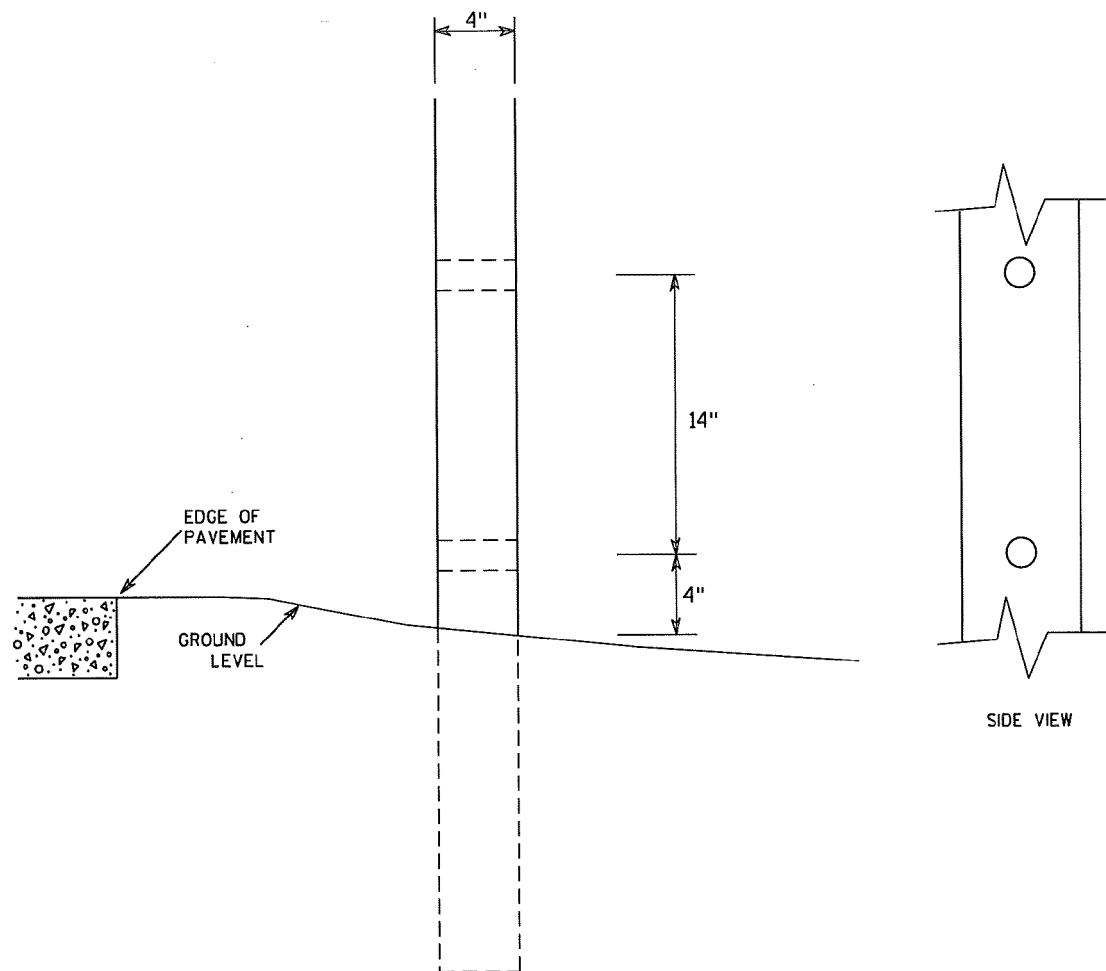

GENERAL NOTES

1. All 4 x 6 Wood Posts shall be modified by having two 1 1/2" diameter holes drilled perpendicular to the roadway centerline.

4 X 6 WOOD POST MODIFICATIONS

WISCONSIN DEPT OF TRANSPORTATION

APPROVED

Christa J. Spang
for State Traffic Engineer

DATE 3/27/97

PLATE NO. A4-11.2

PROJECT NO:

HWY:

COUNTY:

SHEET NO: 39

E

FILE NAME : C:\Users\Projects\tr_std\plate\A411.DGN


PLOT DATE : 10-NOV-2005 10:05

PLOT BY : DOTSJA


PLOT NAME :

PLOT SCALE : 6.207338:1.000000

WISDOT/CADDs SHEET 42

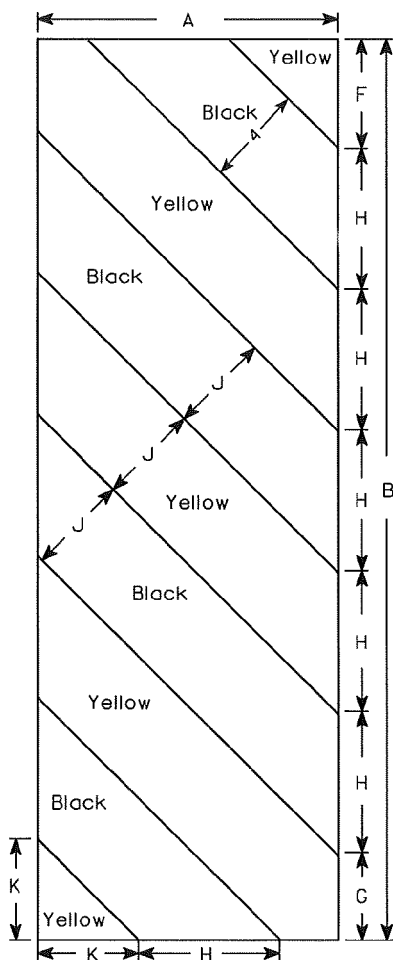

W5-52L

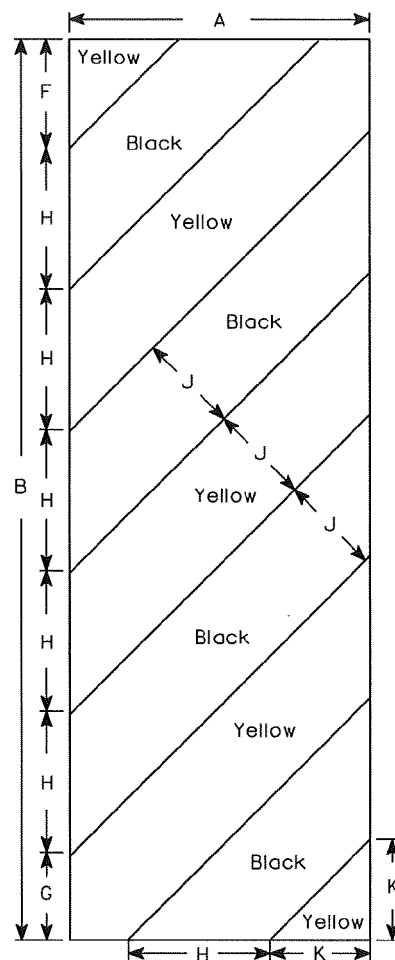

W5-52R

Metric equivalent
for this sign is:

SIZE	
1	
2	300 mm X 900 mm
3	450 mm X 1350 mm
4	
5	

SIZE	A	B	C	D	E	F	G	H	I	J	K	L	M	N	O	P	Q	R	S	T	U	V	W	X	Y	Z	Area sq. ft.	Area sq. m.
1																												
2	12	36				4 ³ / ₈	3 ¹ / ₂	5 ⁵ / ₈	45°	4	4															3.0	0.27	
3	18	54				6	5 ¹ / ₂	8 ¹ / ₂	45°	6	6 ³ / ₁₆															6.75	0.61	
4																												
5																												

NOTES

1. Sign is Type II - Type H Reflective - reference WIS DOT Standard Specification for HIGHWAY and STRUCTURE CONSTRUCTION latest edition.
2. Color:
Background - Yellow
Message - Black
3. Corners may be square or rounded when base material is plywood but borders shall be rounded as shown. When base material is metal, the corners and borders shall be rounded.
4. Alternate colors of stripes as shown.

STANDARD SIGN
W5-52L & W5-52R

WISCONSIN DEPT OF TRANSPORTATION

APPROVED *Christa J. Spang*
for State Traffic Engineer

DATE 8/13/97 PLATE NO. W5-52.7

PROJECT NO:

HWY:

COUNTY:

SHEET NO: 40

E

FILE NAME : C:\Users\Projects\tr_etcd\late\W552.DGN

PLOT DATE : 05-OCT-2005 14:12

PLOT BY : DIT,PH


PLOT NAME :

PLOT SCALE : 4.967363:1.000000


WISDOT/CADDs SHEET 42



18

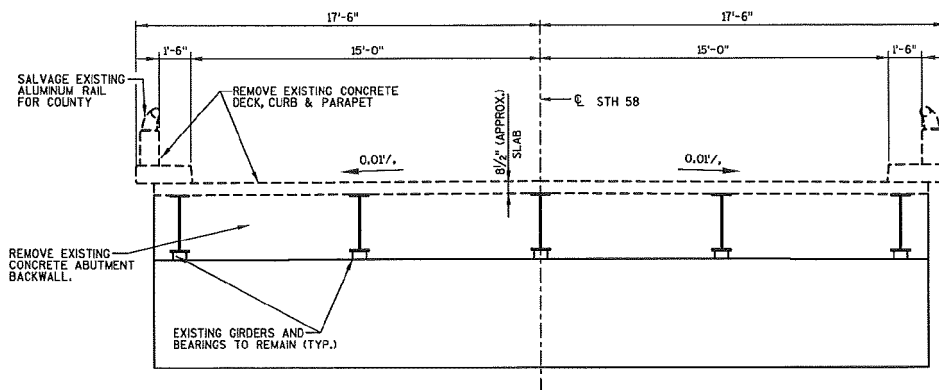

CROSS SECTION THRU EXISTING BRIDGE
(LOOKING NORTH)

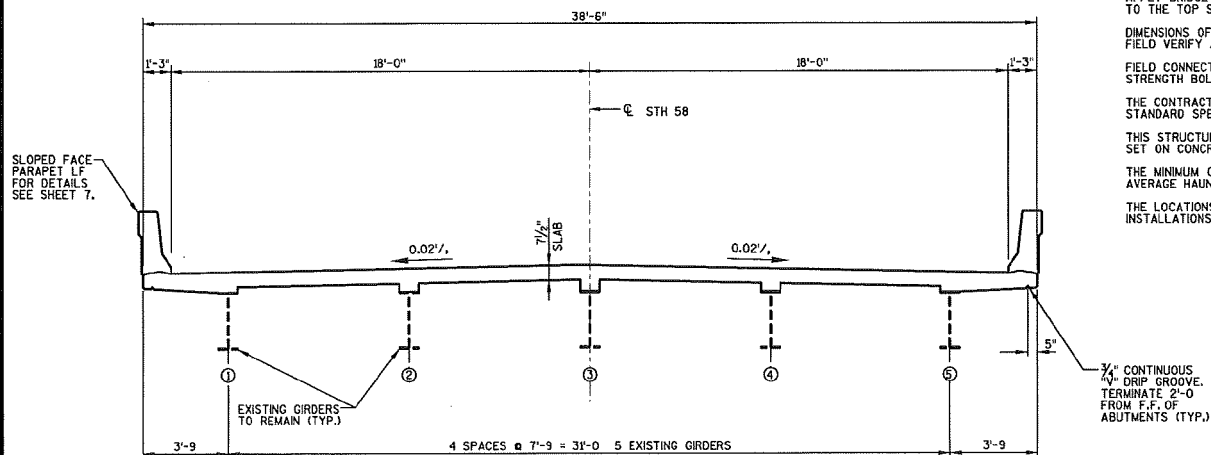

CROSS SECTION THRU BRIDGE
(LOOKING NORTH)

TOTAL ESTIMATED QUANTITIES

		STATE PROJECT NUMBER						SHEET NO.
		1018-00-72						
BID ITEMS	UNIT	SOUTH ABUT.	PIER 1	PIER 2	PIER 3	NORTH ABUT.	SUPER	TOTAL
REMOVING OLD STRUCTURE (STA. 33+10)	LS	-	-	-	-	-	-	1
ABATEMENT OF ASBESTOS CONTAINING MATERIAL STRUCTURE B-29-38	LS	-	-	-	-	-	-	1
DEBRIS CONTAINMENT STRUCTURE B-29-38 REHAB	LS	-	-	-	-	-	-	1
EXCAVATION FOR STRUCTURES BRIDGES B-29-38 REHAB	LS	-	-	-	-	-	-	1
BACKFILL STRUCTURE	CY	40	-	-	-	40	-	80
CONCRETE MASONRY BRIDGES	CY	19.5	-	-	-	19.5	347.0	386
EXPANSION DEVICE STRUCTURE B-29-38 REHAB	LS	-	-	-	-	-	-	1
PIGMENTED PROTECTIVE SURFACE TREATMENT	SY	-	-	-	-	-	260	260
MASONRY ANCHORS TYPE L NO. 6 BARS	EACH	88	-	-	-	88	-	176
BAR STEEL REINFORCEMENT HS COATED BRIDGES	LB	2140	-	-	-	2140	83,220	87,500
WELDED STUD SHEAR CONNECTORS 1/2" x 6-INCH	EACH	-	-	-	-	-	1284	1284
WELDED STUD SHEAR CONNECTORS 1/2" x 7-INCH	EACH	-	-	-	-	-	321	321
CONCRETE SURFACE REPAIR	SF	2	6	2	25	35	-	70
DOWNSPOUT 6-INCH	LF	-	-	-	-	-	95	95
FLOOR DRAINS TYPE GC	SY	-	-	-	-	-	6	6
RUBBERIZED MEMBRANE WATERPROOFING	SY	10	-	-	-	10	-	20
PREPARATION AND COATING OF TOP FLANGES B-29-38 REHAB	LS	-	-	-	-	-	-	1
STRUCTURE OVERCOATING CLEANING AND PRIMING STRUCTURE B-29-38 REHAB	LS	-	-	-	-	-	-	1
ANCHOR ASSEMBLIES FOR STEEL PLATE BEAM GUARD	EACH	-	-	-	-	-	4	4

* - OVERCOATING AND PRIMING BACK FACE OF STEEL DIAPHRAGMS AT ABUTMENTS.

GENERAL NOTES

DRAWINGS SHALL NOT BE SCALED.

BAR STEEL REINFORCEMENT SHALL BE EMBEDDED 2" CLEAR UNLESS OTHERWISE SHOWN OR NOTED.

THE FIRST DIGIT OF A THREE DIGIT BAR MARK OR THE FIRST TWO DIGITS OF A FOUR DIGIT BAR MARK SIGNIFIES THE BAR SIZE.

AT THE ABUTMENTS ALL EXCAVATED VOLUME BELOW THE ROADWAY SUBGRADE NOT OCCUPIED BY THE NEW STRUCTURE SHALL BE BACKFILLED WITH STRUCTURE BACKFILL. THE STRUCTURE BACKFILL ESTIMATED QUANTITIES ASSUMED A 1/2:1 EXCAVATION SLOPE AT THE ABUTMENTS.

APPLY PIGMENTED PROTECTIVE SURFACE TREATMENT TO THE TOP AND ROADWAY FACE OF THE PARAPETS INCLUDING PARAPETS ON ABUTMENT WINGS.

THE EXISTING GROUND LINE SHALL BE USED AS THE UPPER LIMITS OF EXCAVATION AT THE ABUTMENTS.

APPLY BRIDGE SEAT PROTECTION, AS PER SECTION 502.3.12 OF THE STANDARD SPECIFICATIONS, TO THE TOP SURFACES OF ALL ABUTMENTS AND PIERS BELOW EXPANSION DEVICES.

DIMENSIONS OF EXISTING BRIDGE MEMBERS SHOWN ARE BASED ON ORIGINAL PLANS. THE CONTRACTOR SHALL FIELD VERIFY ALL DIMENSIONS AND ELEVATIONS.

FIELD CONNECTIONS, IF NEEDED, SHALL BE MADE WITH 3/4" DIAMETER A325 HIGH-TENSILE STRENGTH BOLTS UNLESS OTHERWISE SHOWN OR NOTED.


THE CONTRACTOR SHALL SUPPLY A NEW NAME PLATE IN ACCORDANCE WITH SECTION 502.3.11 OF THE STANDARD SPECIFICATIONS. NAME PLATE TO SHOW ORIGINAL CONSTRUCTION YEAR 1964.


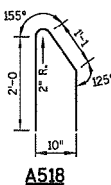
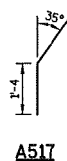
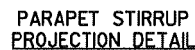
THIS STRUCTURE WILL REHABILITATE THE EXISTING STRUCTURE, B-29-38 REHAB, A FOUR SPAN, 297.8' LONG, STEEL DECK GIRDER SET ON CONCRETE ABUTMENTS AND MULTI-COLUMN PIERS.

THE MINIMUM CONCRETE HAUNCH OVER THE EXISTING GIRDERS SHALL BE 1/4" AND THE HAUNCH CONCRETE QUANTITY IS BASED ON AN AVERAGE HAUNCH DEPTH OF 3" WHICH IS THE MAXIMUM HAUNCH QUANTITY FOR WHICH THE CONTRACTOR WILL BE PAID.

THE LOCATIONS OF EXISTING UTILITY INSTALLATIONS AS SHOWN ON THE PLANS ARE APPROXIMATE. THERE MAY BE OTHER UTILITY INSTALLATIONS WITHIN THE PROJECT AREA THAT ARE NOT SHOWN.




No.	Date	Revision	By
STATE OF WISCONSIN DEPARTMENT OF TRANSPORTATION			
STRUCTURE B-29-38 REHAB			
Const. Spec. WI "03"	Drawn By RLR	Phone Checked DCS	
CROSS SECTION, QUANTITIES & DETAILS			SHEET 2 OF 9

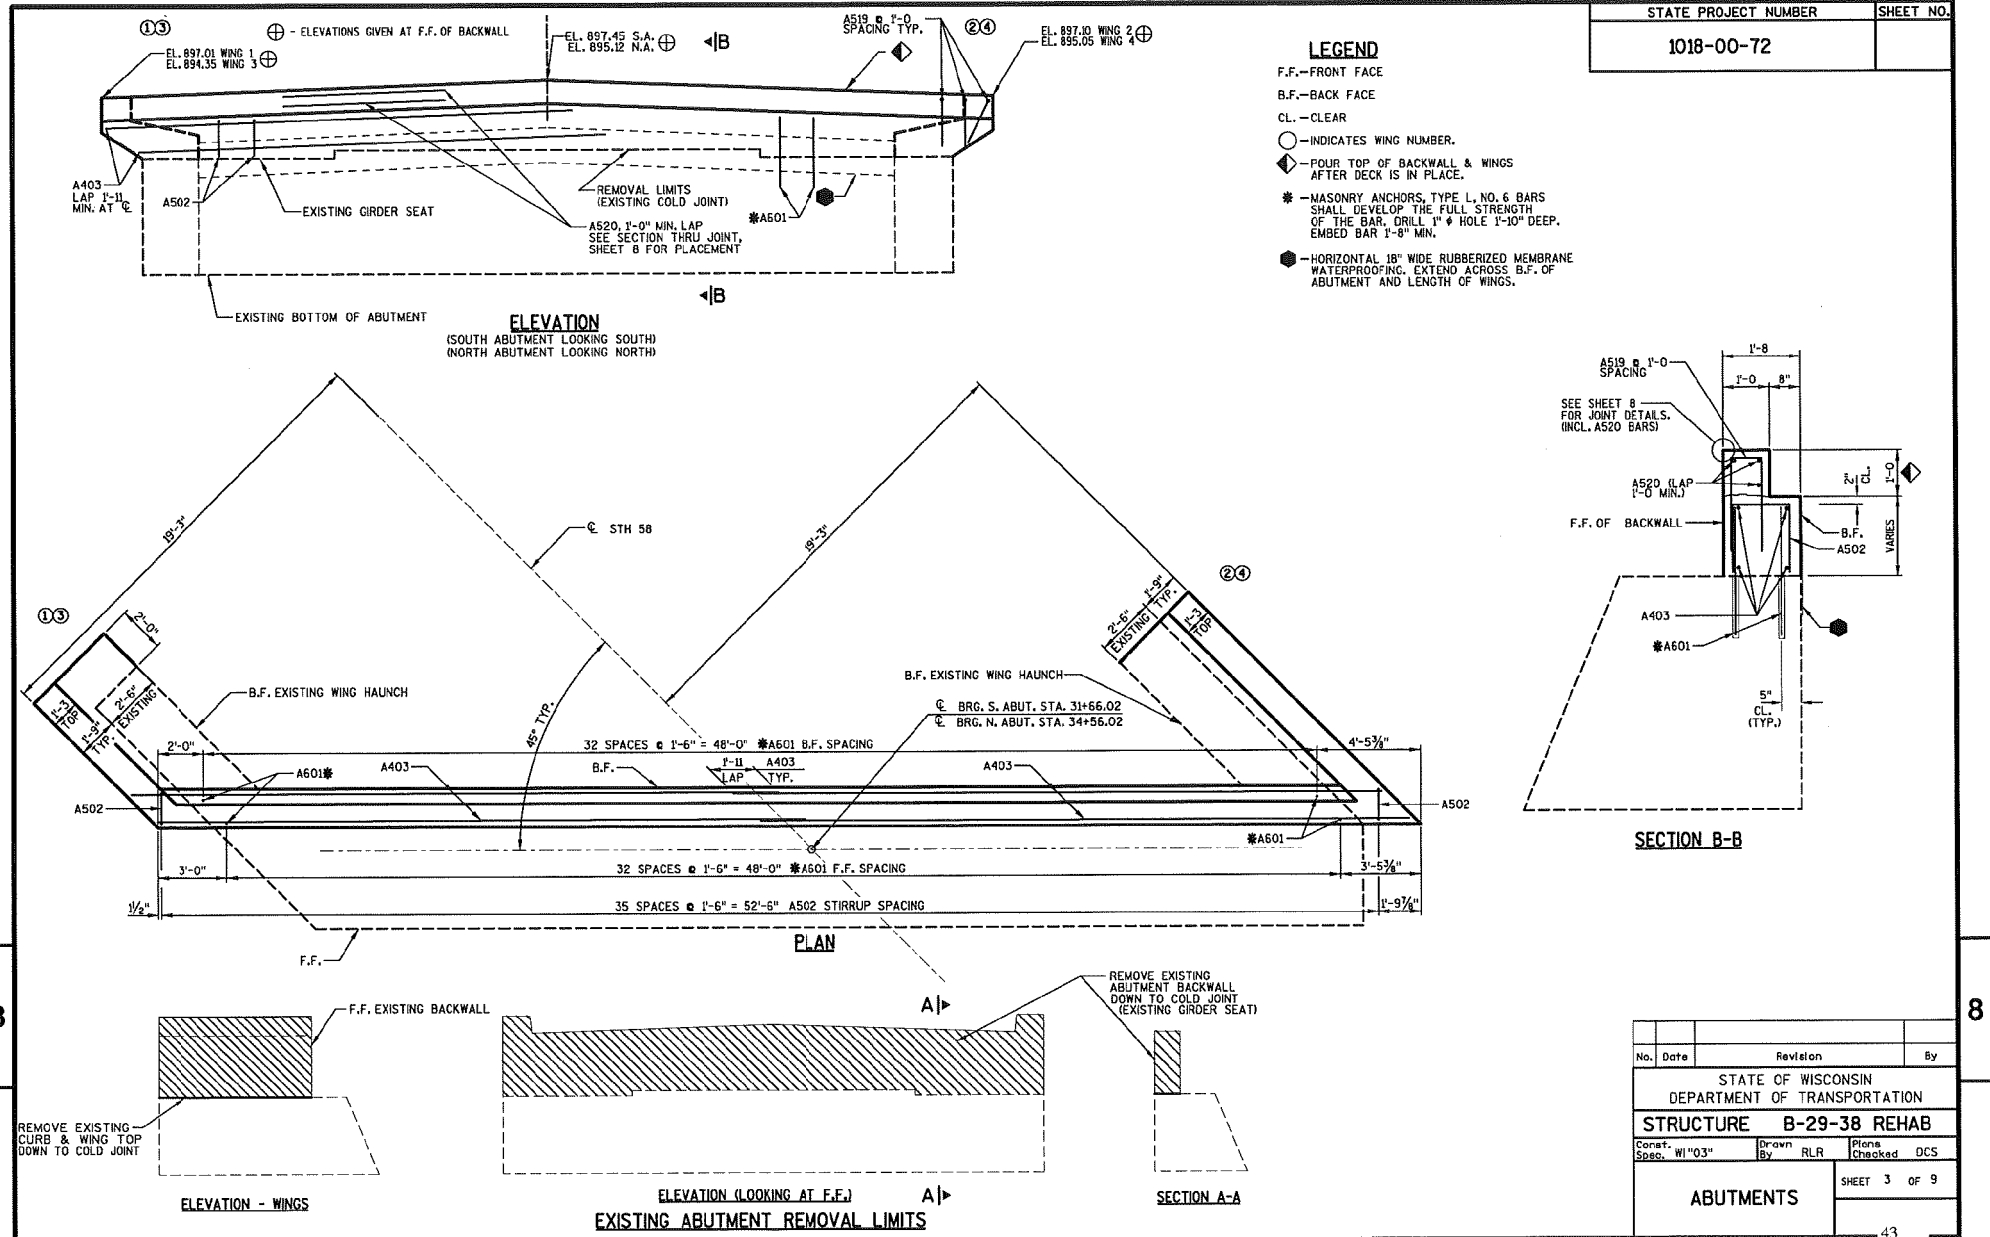



The diagram shows a rectangular plate with a horizontal dimension labeled 'A' and a vertical dimension labeled 'B'.

MARK	A	B
A502	1'-4"	2'-9"
A507	10"	2'-4"
A516	6"	2'-2"
A519	8"	2'-0"

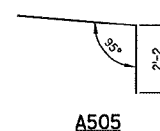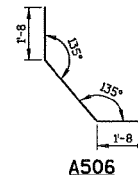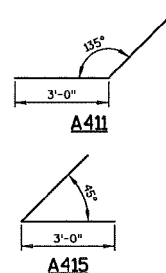

STATE PROJECT NUMBER

1018-00-72

SHEET

SECTION A-A
THRU WINGS 18'3"

SECTION B-B
THRU WINGS 2&4

BILL OF BARS (COATED) 2140 LBS.


MARK	NO. RECD	LENGTH	BENT	LOCATION
* A601	66	4-9		BACKWALL DOWELS - F.F. & B.F. - VERT.
A502	36	6-8	X	BACKWALL - STIRRUP - VERT.
A403	8	28-0		BACKWALL - F.F. & B.F. - HORIZ.
* A604	22	3-6		WINGS - DOWELS - VERT.
A505	24	5-7	X	WINGS - B.F. - TRANS.
A506	24	5-7	X	WINGS - F.F. - TRANS.
A507	23	4-8	X	WINGS - TOP STIRRUP - VERT.
A408	4	9-2		WINGS 1 & 3 - BASE - HORIZ.
A409	3	7-5		WINGS 1 & 3 - TOP - HORIZ.
A610	2	7-5		WINGS 1 & 3 - TOP - HORIZ.
A411	5	6-0	X	WINGS 1 & 3 - CORNER - HORIZ.
A412	4	9-8		WINGS 2 & 4 - BASE - HORIZ.
A413	3	12-7		WINGS 2 & 4 - TOP - HORIZ.
A414	2	12-7		WINGS 2 & 4 - TOP - HORIZ.
A415	5	6-0	X	WINGS 2 & 4 - CORNER - HORIZ.
A516	28	4-4	X	WINGS - PARAPET STIRRUP - VERT.
A517	16	2-4	X	WINGS - PARAPET STIRRUP - VERT.
A518	13	4-4	X	WINGS - PARAPET STIRRUP - VERT.
A519	34	4-6	X	BACKWALL - PAVING BLOCK STIRRUP - VERT.
A520	21	8-0		BACKWALL - PAVING BLOCK - HORIZ.

LEGEND
F.F.—FRONT FACE


DIMENSIONS IN BENDING DETAILS ARE OUT TO OUT OF BAR
EPOXY COAT ALL BARSTEEL REINFORCEMENT.

BAR MARKS ARE FOR THE SOUTH ABUTMENT AS SHOWN. LABEL AND
BUNDLE NORTH ABUTMENT BARS WITH B MARK, B601 THRU B520.
OF WING.

No.	Date	Revision	By
STATE OF WISCONSIN DEPARTMENT OF TRANSPORTATION			
Genet. Specd. WI "03"		Drawn By RLR	Plans Checked DCS
STRUCTURE B-29-38 REHAB			
ABUTMENT DETAILS			SHEET 4 OF 9
			44

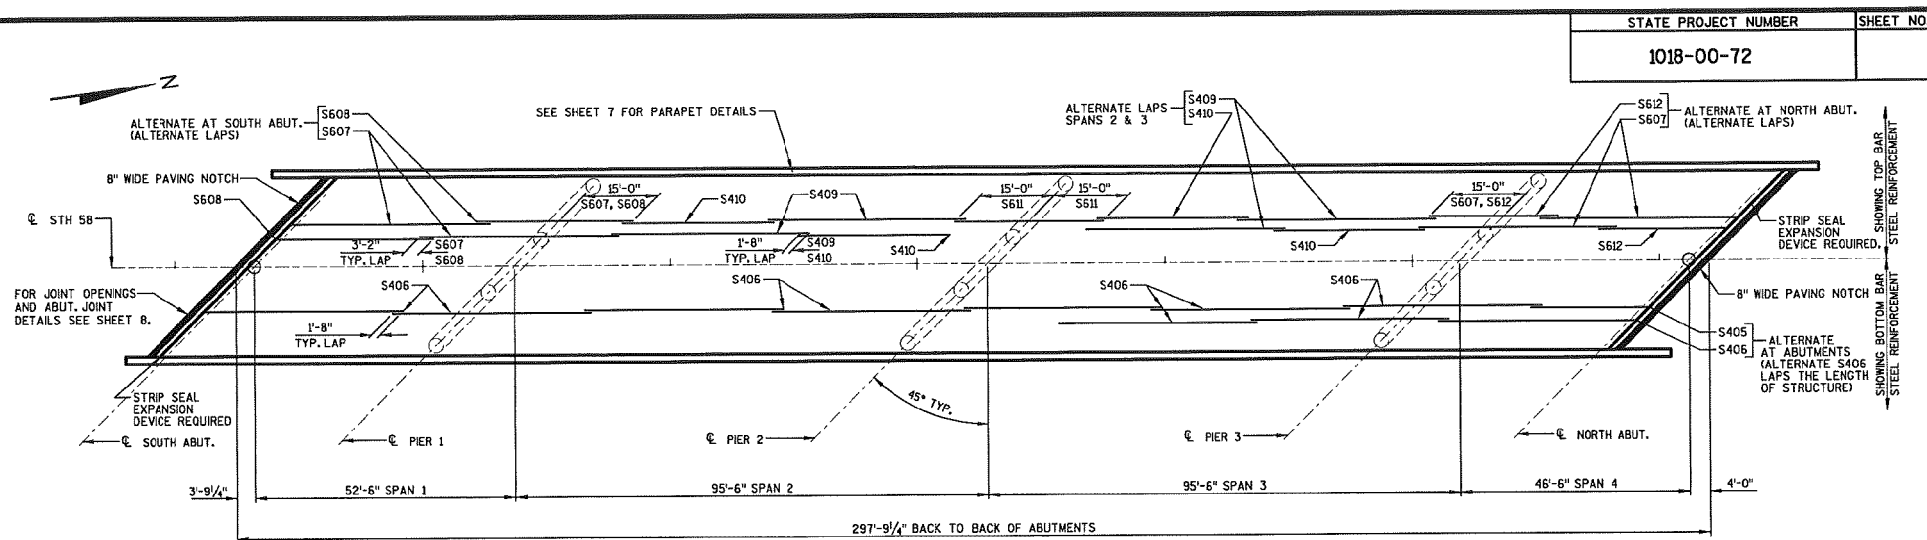

PLAN

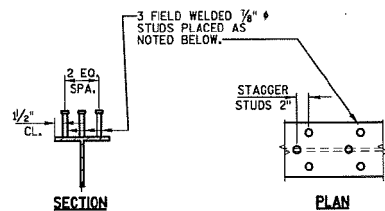

SHEAR CONNECTOR DETAIL & NOTES


STUDS SHALL BE PLACED ON EXISTING GIRDERS.
PLACE 3 STUDS WITHIN 6" OF EACH EXISTING SHEAR
LUG, AVOIDING COVER PLATES.

USE 6" LONG STUDS AT GIRDERS 1,2,4 & 5 AND
7" LONG STUDS AT GIRDER 3.

SHEAR CONNECTORS OR EXISTING ANGLES SHALL PROTRUDE A MINIMUM OF 2" BEYOND THE HAUNCH INTO THE SLAB. MODIFY THE 6" OR 7" STUD NUMBER AND LOCATIONS IF NEEDED AFTER DETERMINING THE "t" HAUNCH THICKNESS.

EXISTING SHEAR ANGLES MAY BE UTILIZED IN LIEU OF SHEAR CONNECTORS PROVIDED THAT THE EXISTING ANGLES ARE NOT DAMAGED AND ARE OF SUFFICIENT LENGTH.

WHEN UTILIZING EXISTING SHEAR ANGLES, ONE ANGLE IS EQUIVALENT TO A SET OF 3 CONNECTORS. [

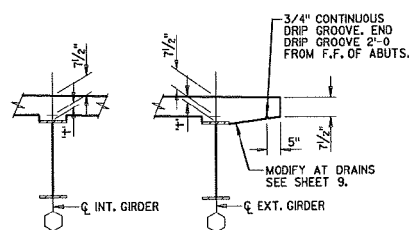


SLAB FORMING DETAILS

TO DETERMINE "t": ELEVATIONS OF THE TOP FLANGES, TOP OF SPLICE PLATES, OR TOP OF COVER PLATES, WHICHEVER APPLIES, SHALL BE TAKEN AT C/L OF BEARINGS, AND AT QUARTER POINTS OF EACH SPAN. THEN FOLLOW THIS PROCESS.

TOP OF DECK ELEV. AT FINAL GRADE
- TOP OF STEEL ELEV. AFTER DECK IS REMOVED
+ DEFLECTION
- SLAB THICKNESS (7 1/2")

= HAUNCH THICKNESS 't'.

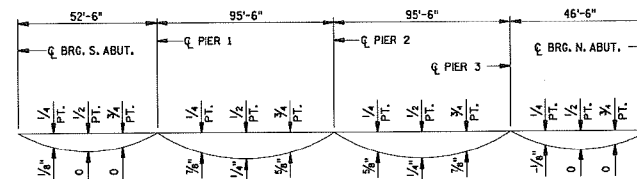



NOTE: THE CONTRACTOR SHALL TAKE TOP OF EXISTING STEEL GIRDER ELEVATIONS BEFORE AND AFTER CONCRETE DECK REMOVAL. (SMALL HOLES MAY BE MADE IN EXISTING CONCRETE TO TOP OF STEEL) NET DIFFERENCES SHOULD BE THE APPROXIMATE DEFLECTION. THE DEAD LOAD DEFLECTION USED IN FORMING THE NEW DECK SHALL BE EITHER THE NET DIFFERENCE UPON REMOVING THE DECK OR THE VALUES SHOWN IN THE DIAGRAM ABOVE, WHICHEVER IS GREATER. THE GENERAL SHAPE & PROPORTION OF THE DIAGRAM ABOVE SHALL BE MAINTAINED.

DEFLECTION DIAGRAM


TOP OF SLAB ELEVATIONS																		
LOCATION	C. BEARING SOUTH ABUT.	SPAN 1				SPAN 2				SPAN 3				SPAN 4				C. BEARING NORTH ABUT
		1/4 PT.	1/2 PT.	3/4 PT.	C. PIER 1	1/4 PT.	1/2 PT.	3/4 PT.	C. PIER 2	1/4 PT.	1/2 PT.	3/4 PT.	C. PIER 3	1/4 PT.	1/2 PT.	3/4 PT.	C. PIER 4	
W. EDGE SLAB	897.10	897.11	897.10	897.08	897.05	896.99	896.68	896.73	896.52	896.27	895.96	895.60	895.20	895.00	894.81	894.60	894.38	
GIRDER 1	897.17	897.18	897.18	897.16	897.13	897.07	896.98	896.83	896.63	896.39	896.09	895.73	895.34	895.14	894.95	894.74	894.52	
GIRDER 2	897.31	897.33	897.34	897.33	897.31	897.25	897.17	897.04	896.86	896.63	896.34	896.01	895.62	895.43	895.23	895.03	894.82	
C. ROAD/GIRDER 3	897.45	897.48	897.49	897.49	897.48	897.42	897.36	897.24	897.08	896.86	896.60	896.28	895.91	895.71	895.52	895.32	895.12	
GIRDER 4	897.27	897.31	897.33	897.34	897.33	897.29	897.23	897.13	896.98	896.78	896.53	896.23	895.88	895.69	895.49	895.30	895.10	
GIRDER 5	897.09	897.14	897.16	897.18	897.18	897.15	897.09	897.01	896.88	896.70	896.47	896.18	895.84	895.66	895.47	895.27	895.08	
E. EDGE SLAB	897.01	897.05	897.08	897.10	897.11	897.08	897.03	896.95	896.83	896.66	896.43	896.15	895.82	895.65	895.46	895.26	895.06	


No.	Date	Revision	By
STATE OF WISCONSIN DEPARTMENT OF TRANSPORTATION			
STRUCTURE		B-29-38	REHAB
Const. Spec.	WI "03"	Drawn By	RLR
		Phone Checked	DCS
SUPERSTRUCTURE		SHEET 5 OF 9	

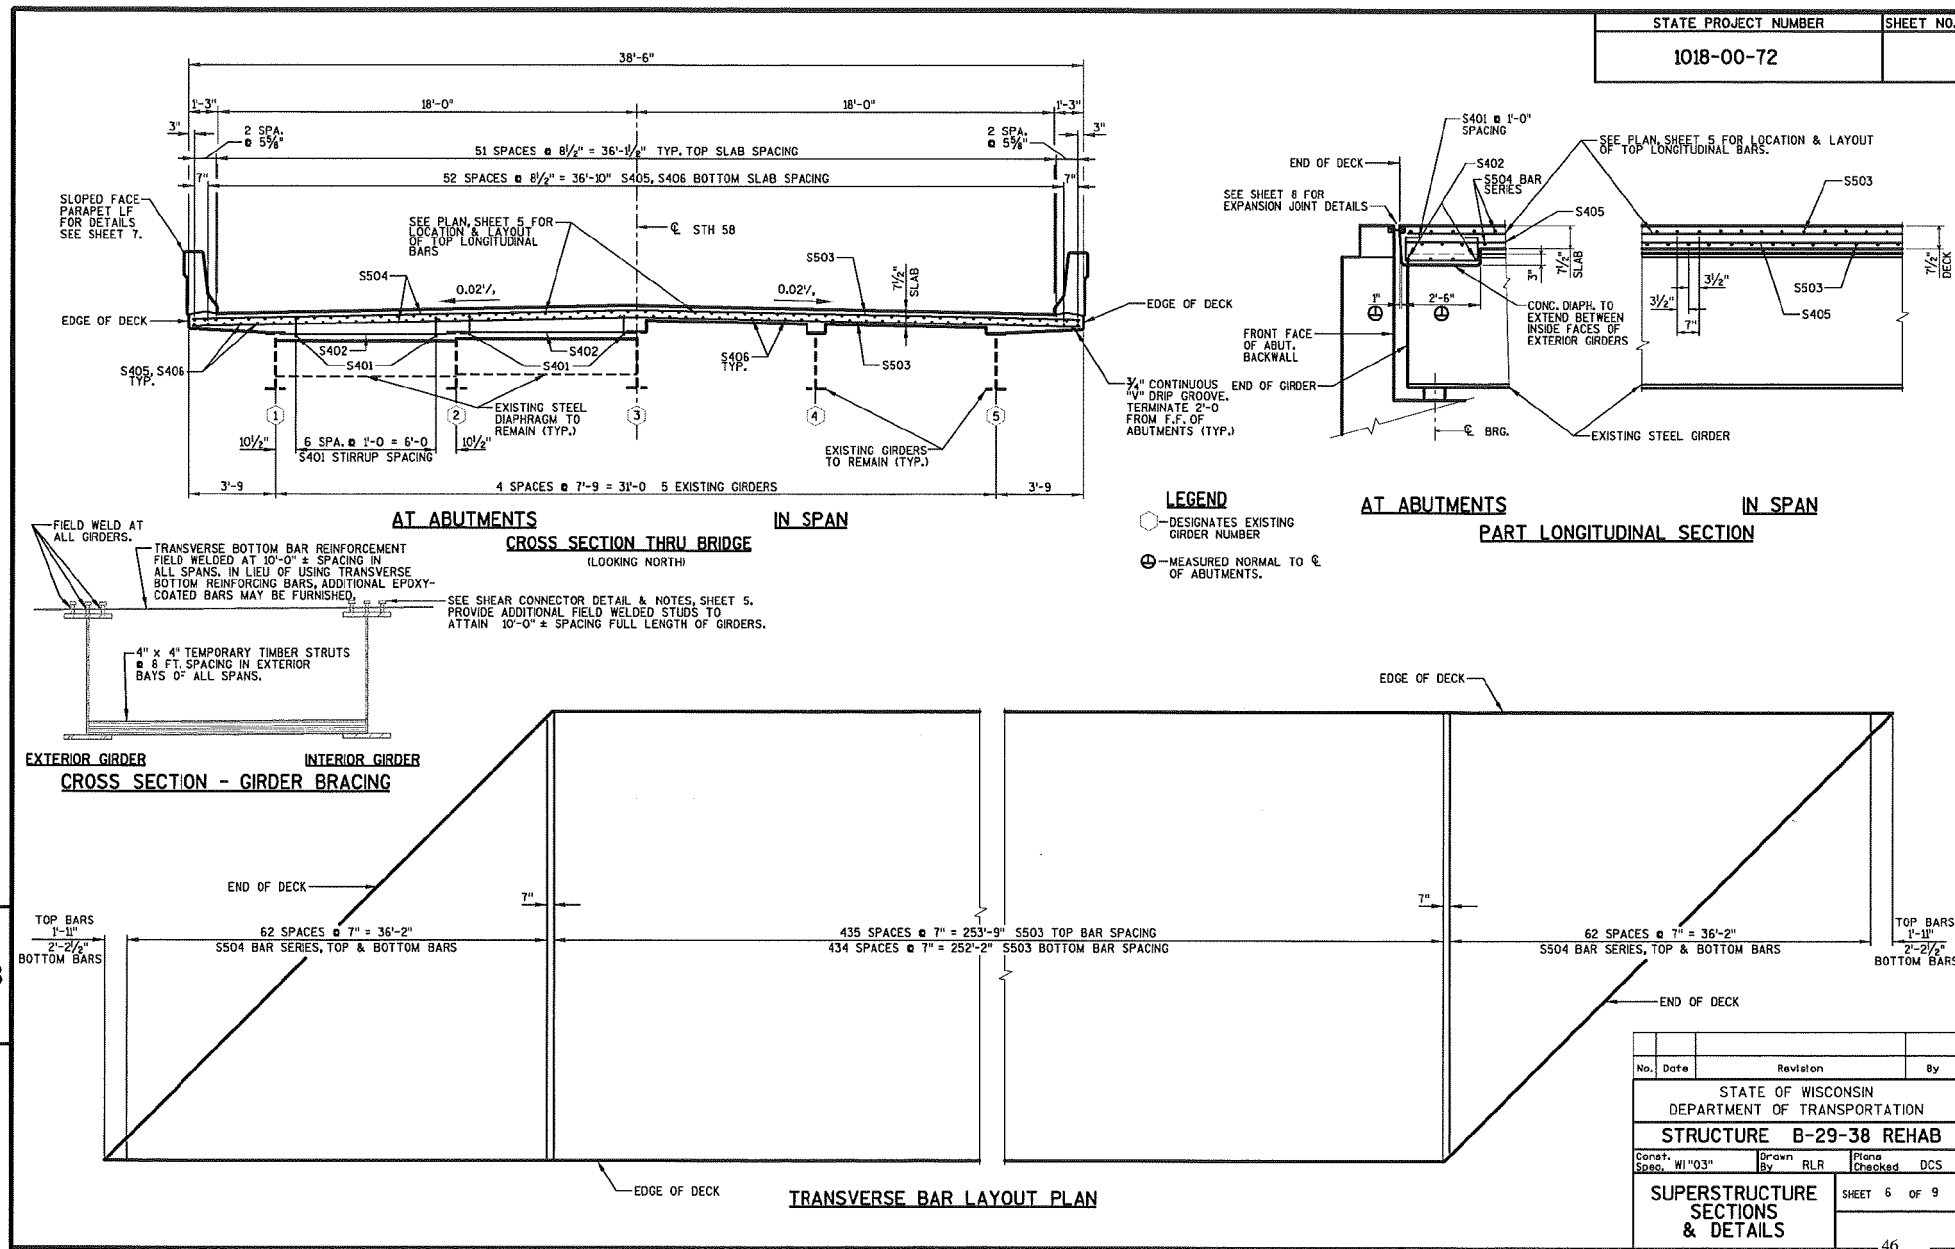

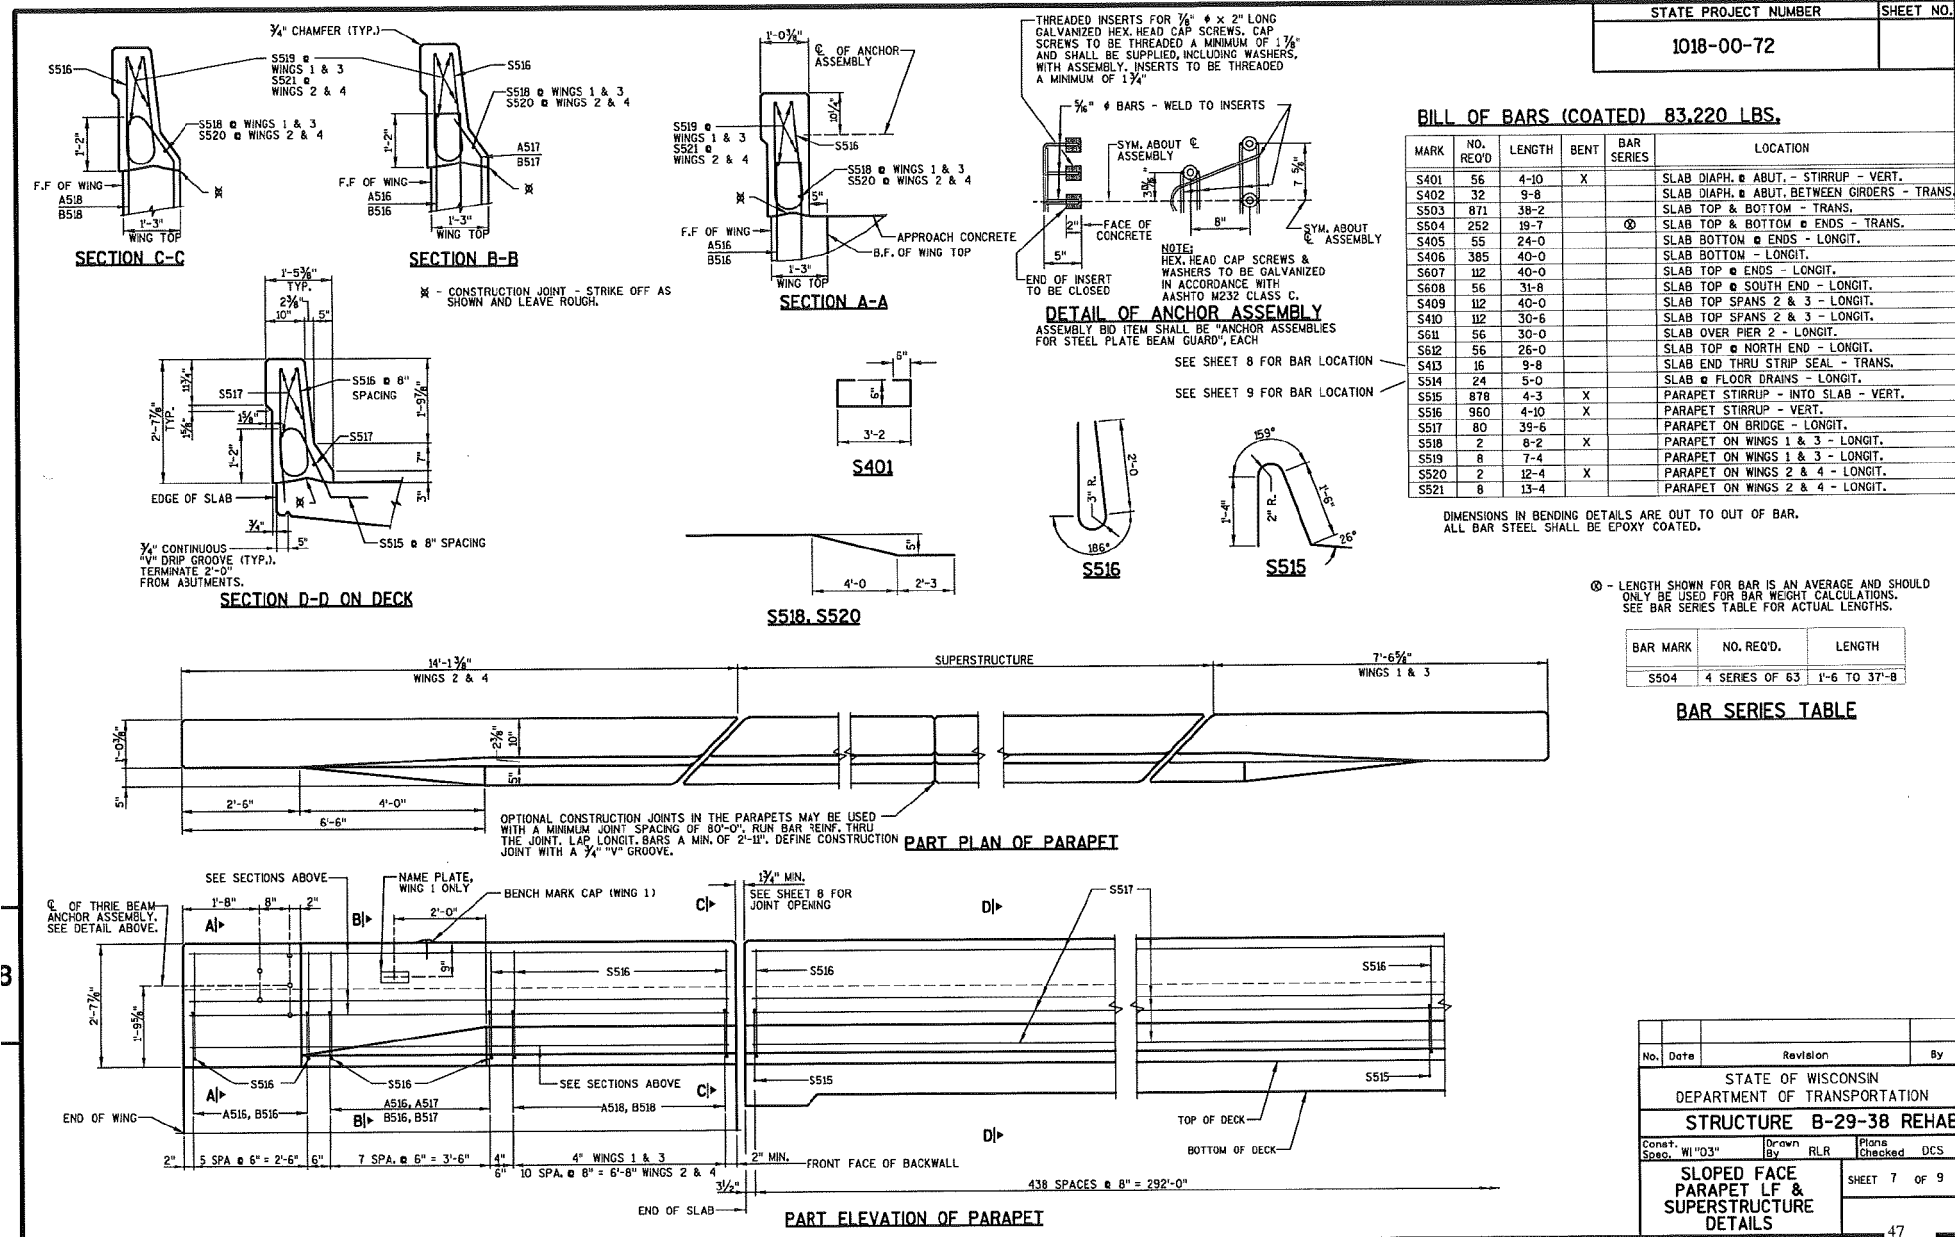

No.	Date	Revision	By
STATE OF WISCONSIN			
DEPARTMENT OF TRANSPORTATION			
STRUCTURE B-29-38 REHAB			
Const. Spec.	W1103	Drawn By	RLR
Plans Checked	DCS		
SLOPED FACE PARAPET LF & SUPERSTRUCTURE DETAILS			SHEET 7 OF 9

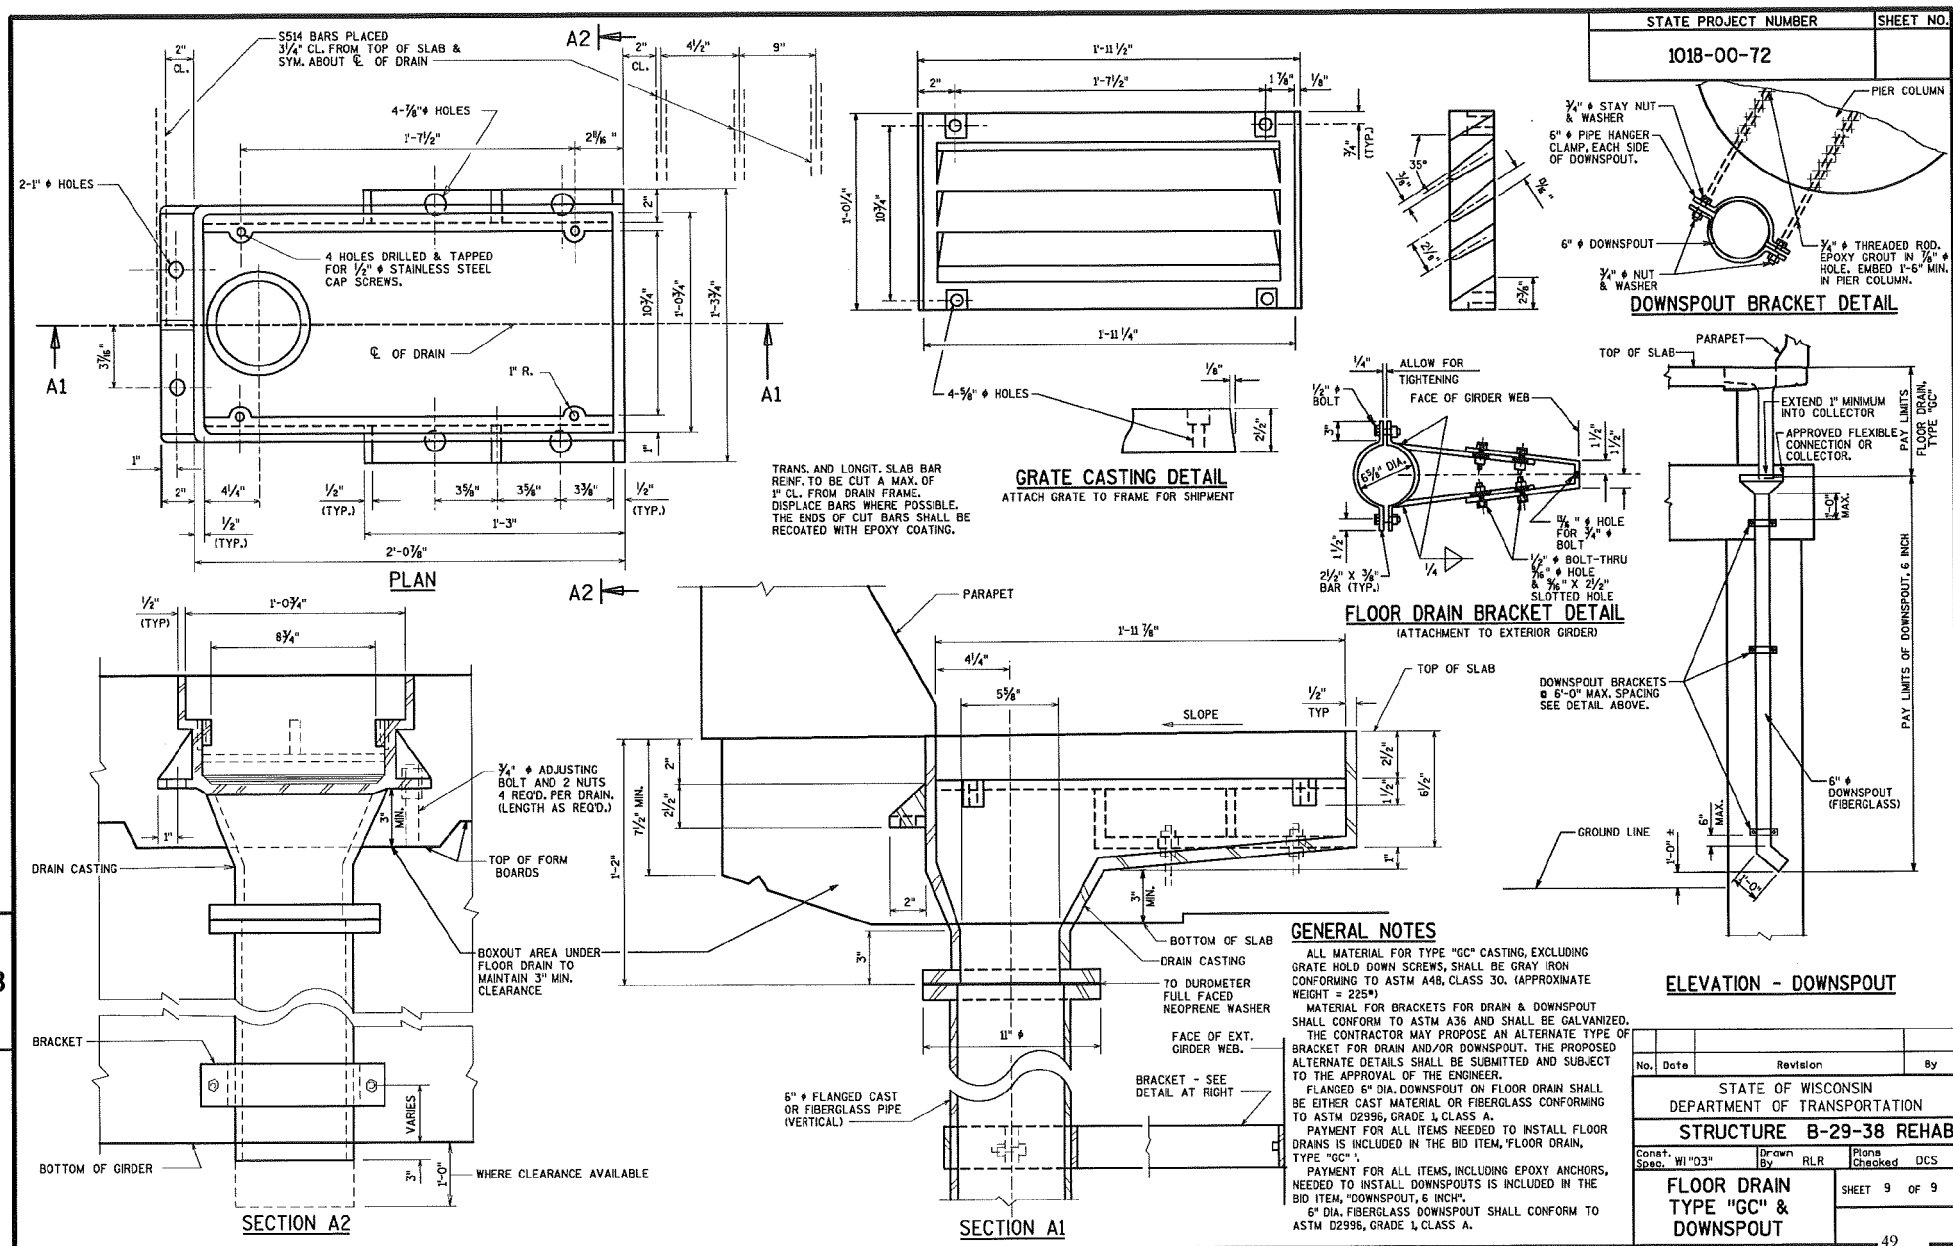

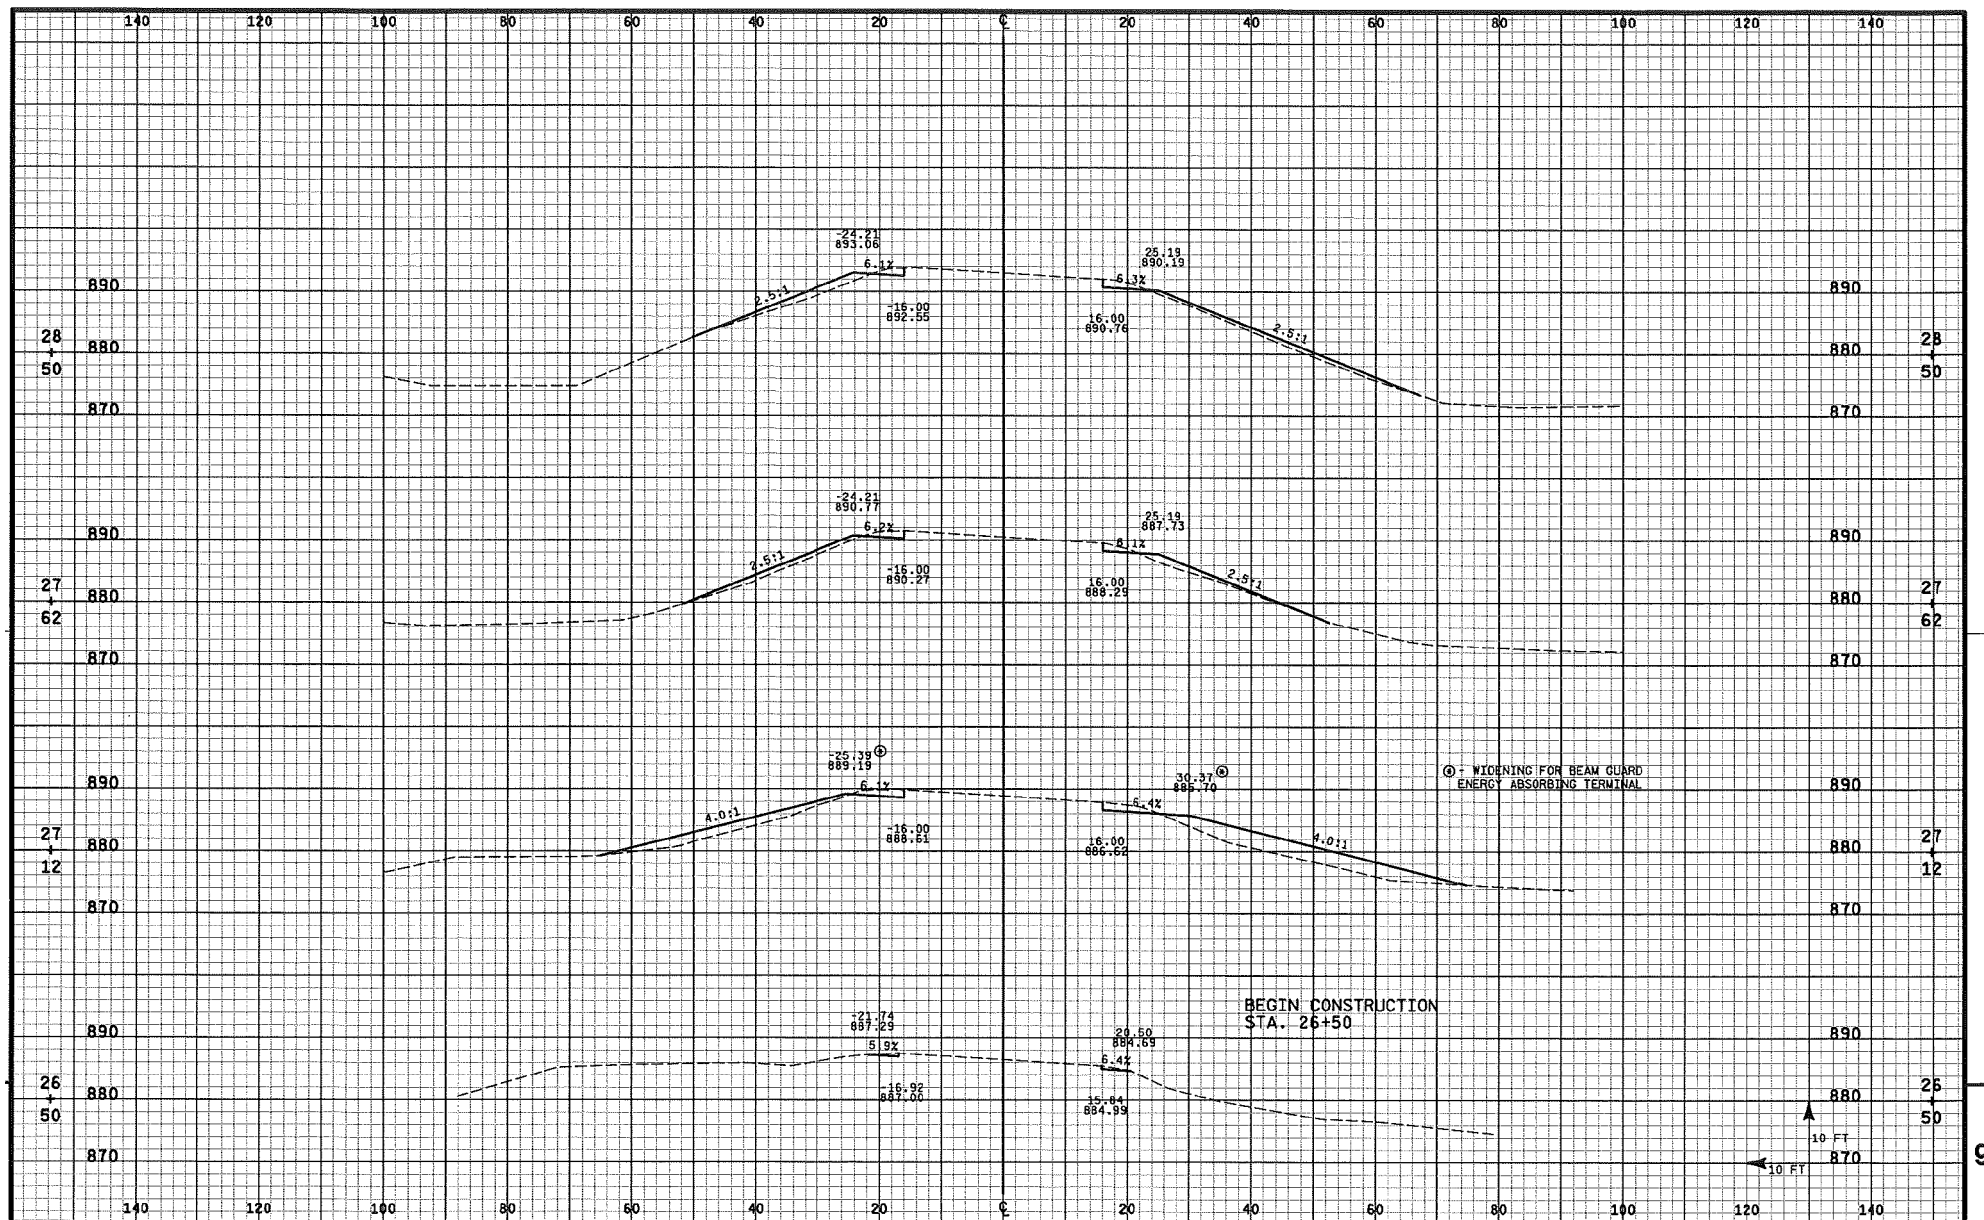

PROJECT NO: 1018-00-72

HWY: STH 58

COUNTY: JUNEAU

CROSS SECTIONS: STH 58

SHEET NO: 50

E


FILE NAME : K:\align\rcd008\03.dgn

PLOT DATE : 9/10/2007

PLOT BY : **...plotuser...** PLOT NAME :

Originator : MSA

PLOT SCALE : **...plotscale...** WISDOT/CADDs SHEET 21

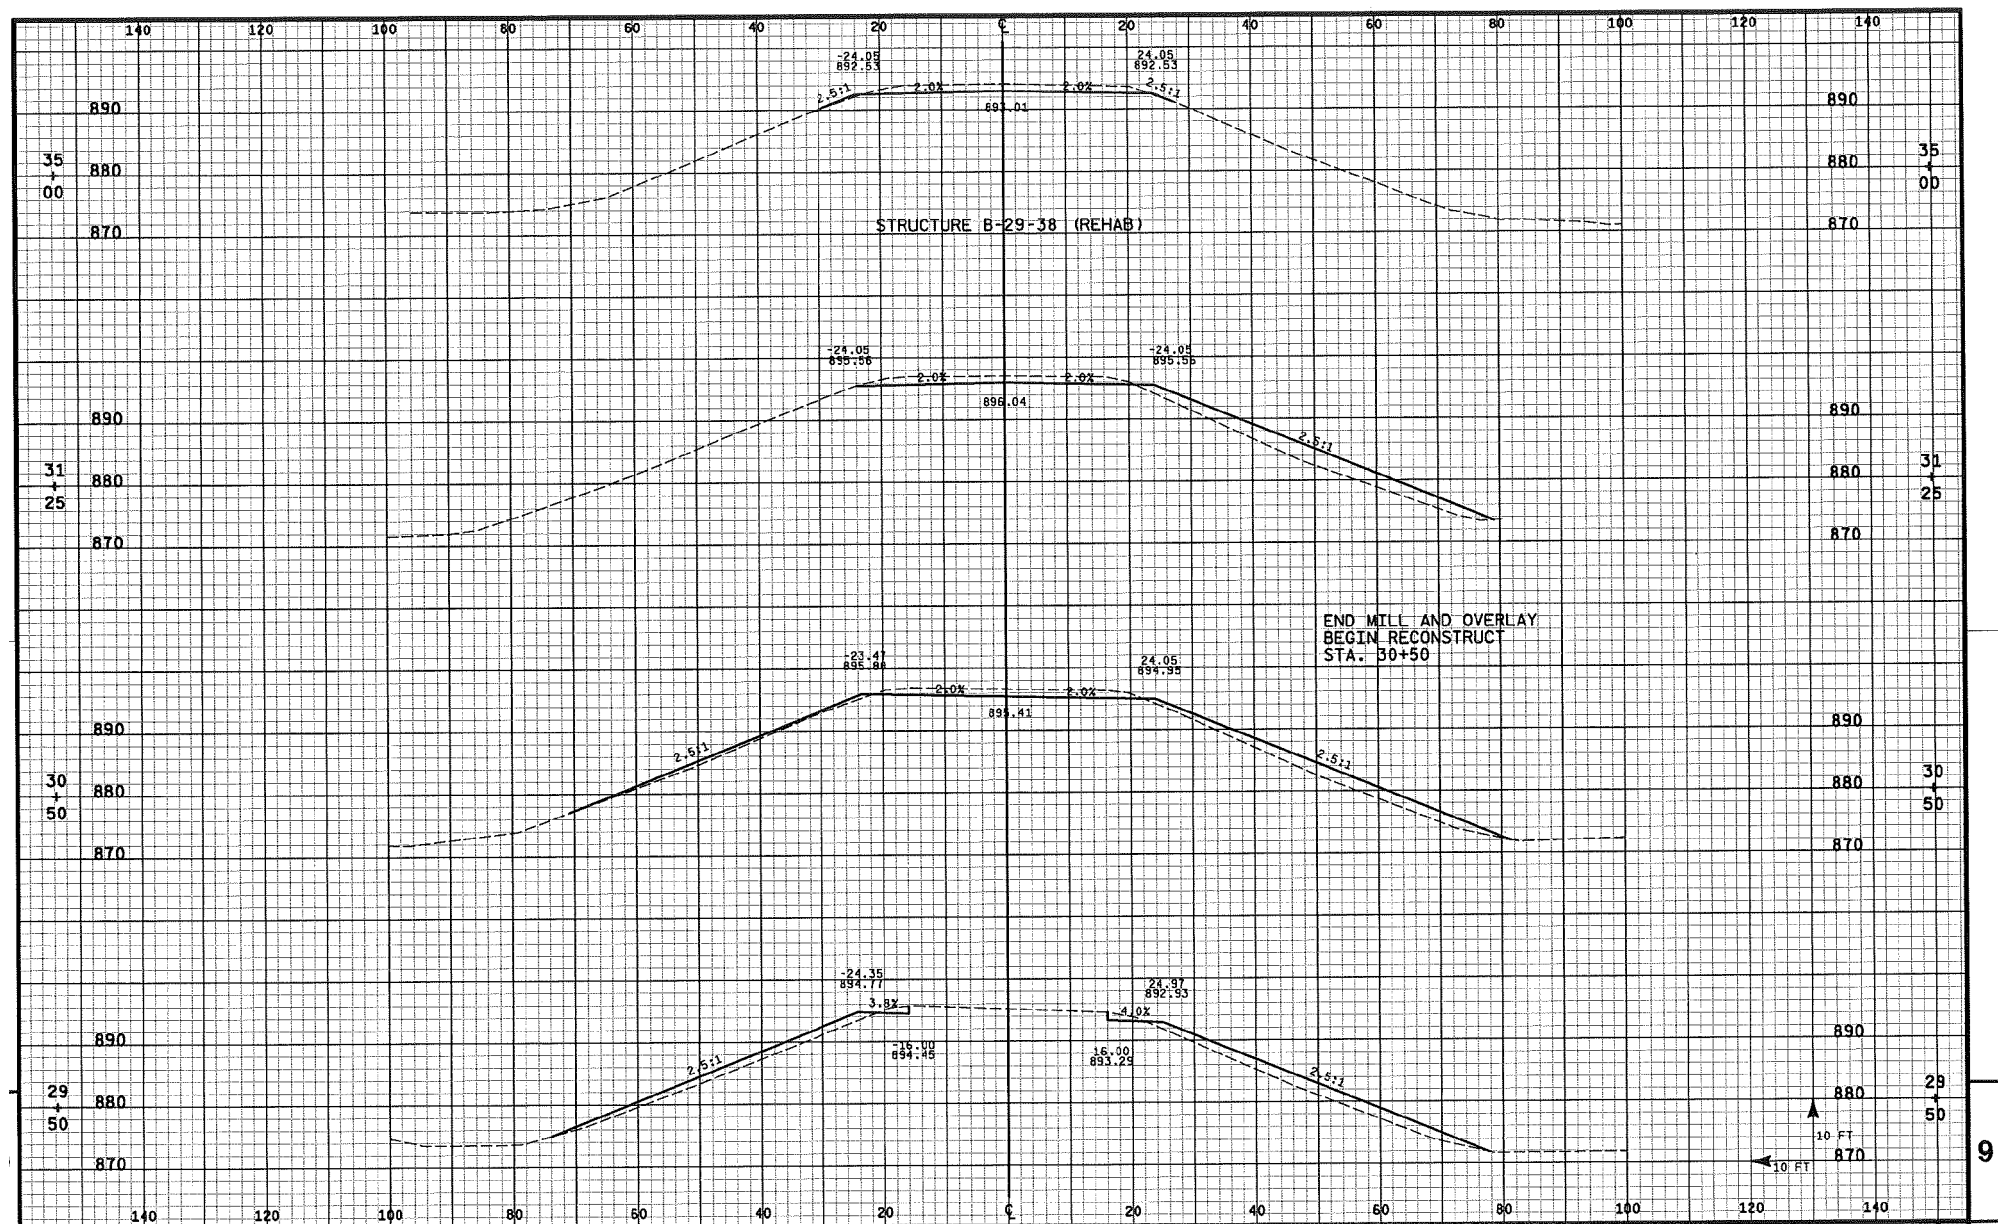

PROJECT NO: 1018-00-72

HWY: STH 58

COUNTY: JUNEAU

CROSS SECTIONS: STH 58

SHEET NO: 51

E

FILE NAME : K:\align\nc005003.dgn


PLOT DATE : 9/10/2007

PLOT BY : ss...plotuser...ss PLOT NAME :

Originator : MSA

PLOT SCALE : ss...plotscale...ss

WISDOT/CADDs SHEET 21

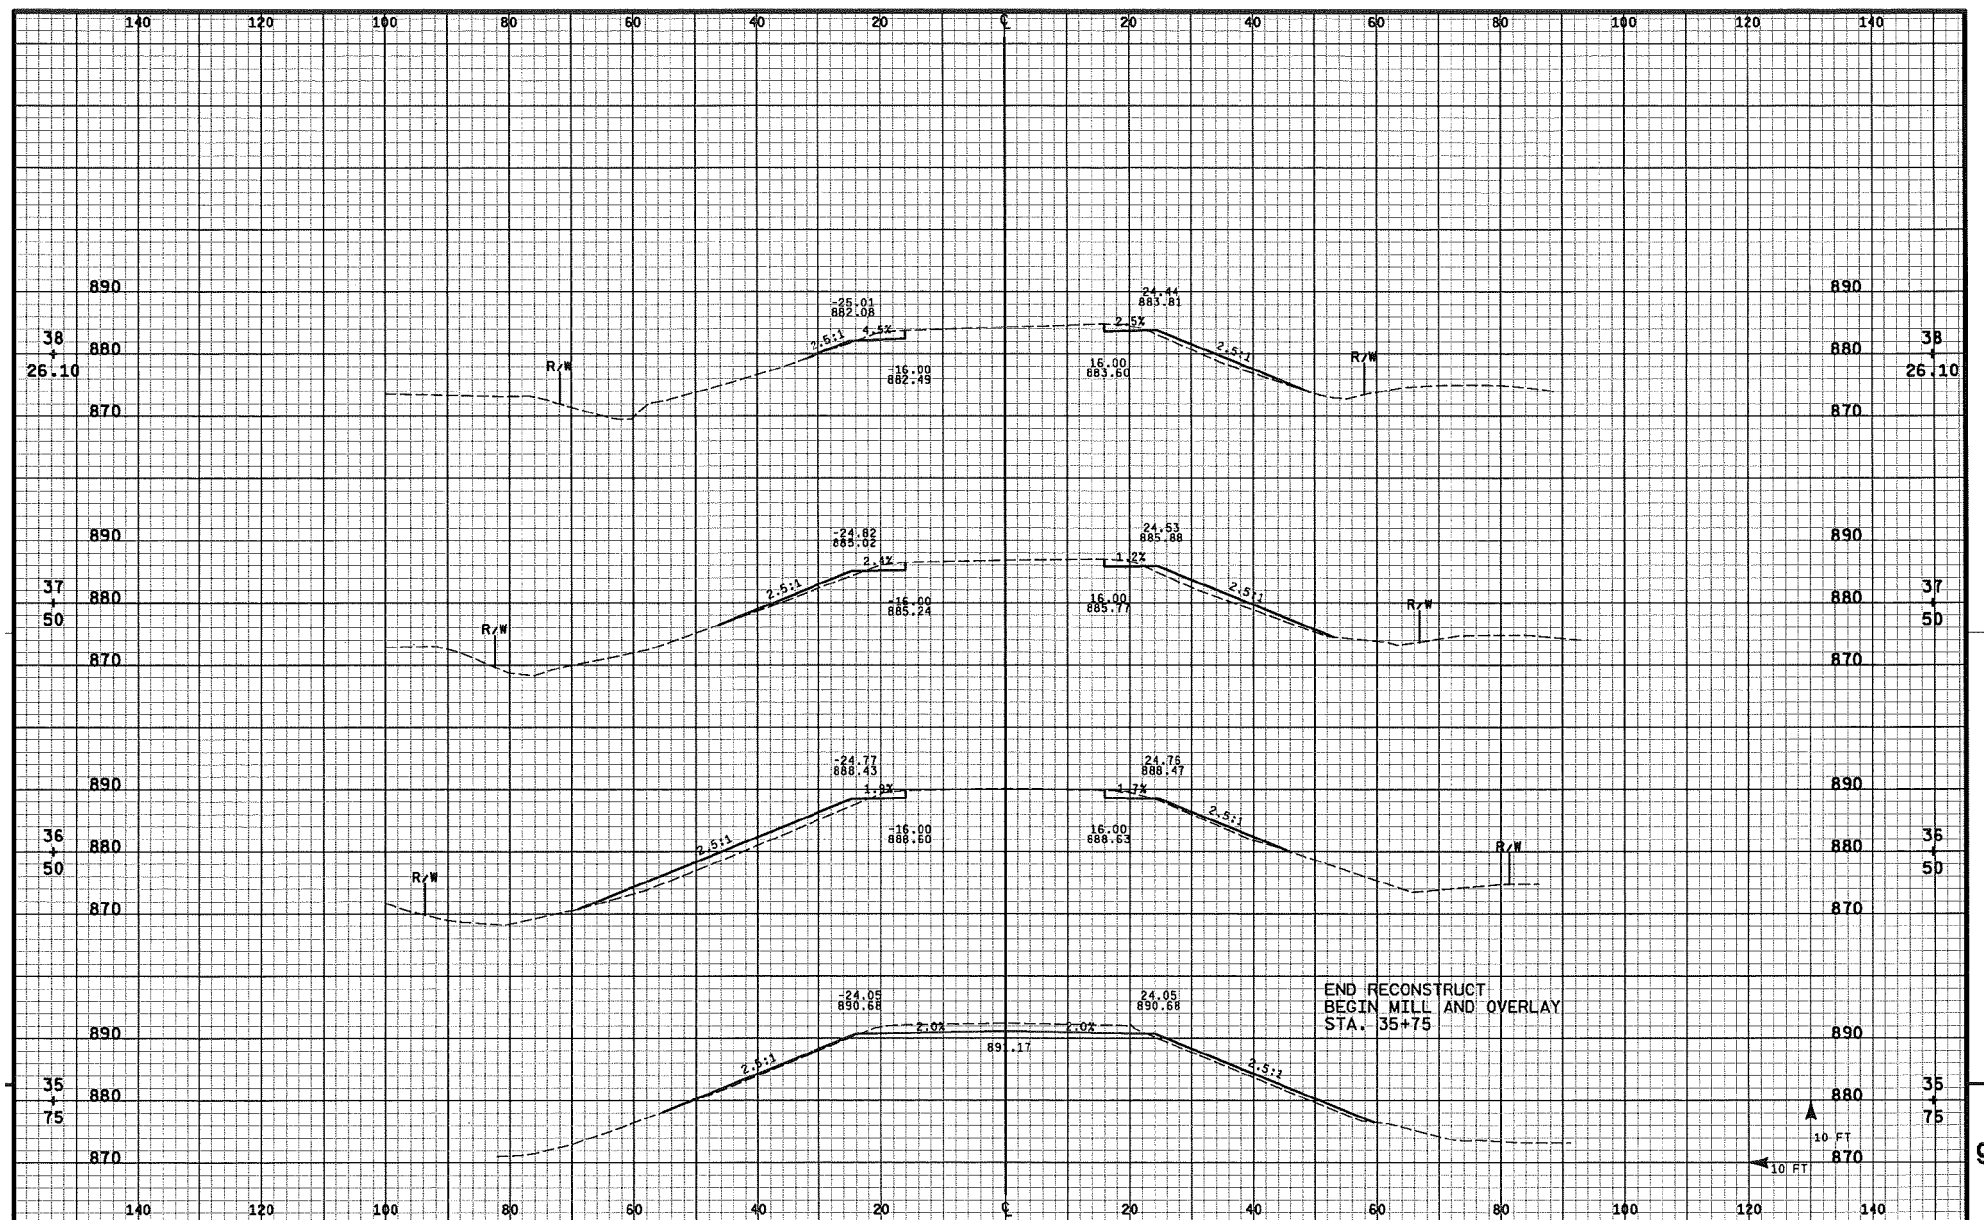

PROJECT NO:1018-00-72

HWY: STH 58

COUNTY: JUNEAU

CROSS SECTIONS: STH 58

SHEET NO:

52

E


FILE NAME : K:\align\rcd10003.dgn

PLOT DATE : 9/10/2007

PLOT BY : \$\$...plotuser...\$\$ PLOT NAME :

Originator : MSA

PLOT SCALE : \$\$...plotscale...\$\$ WISDOT/CADDs SHEET 21

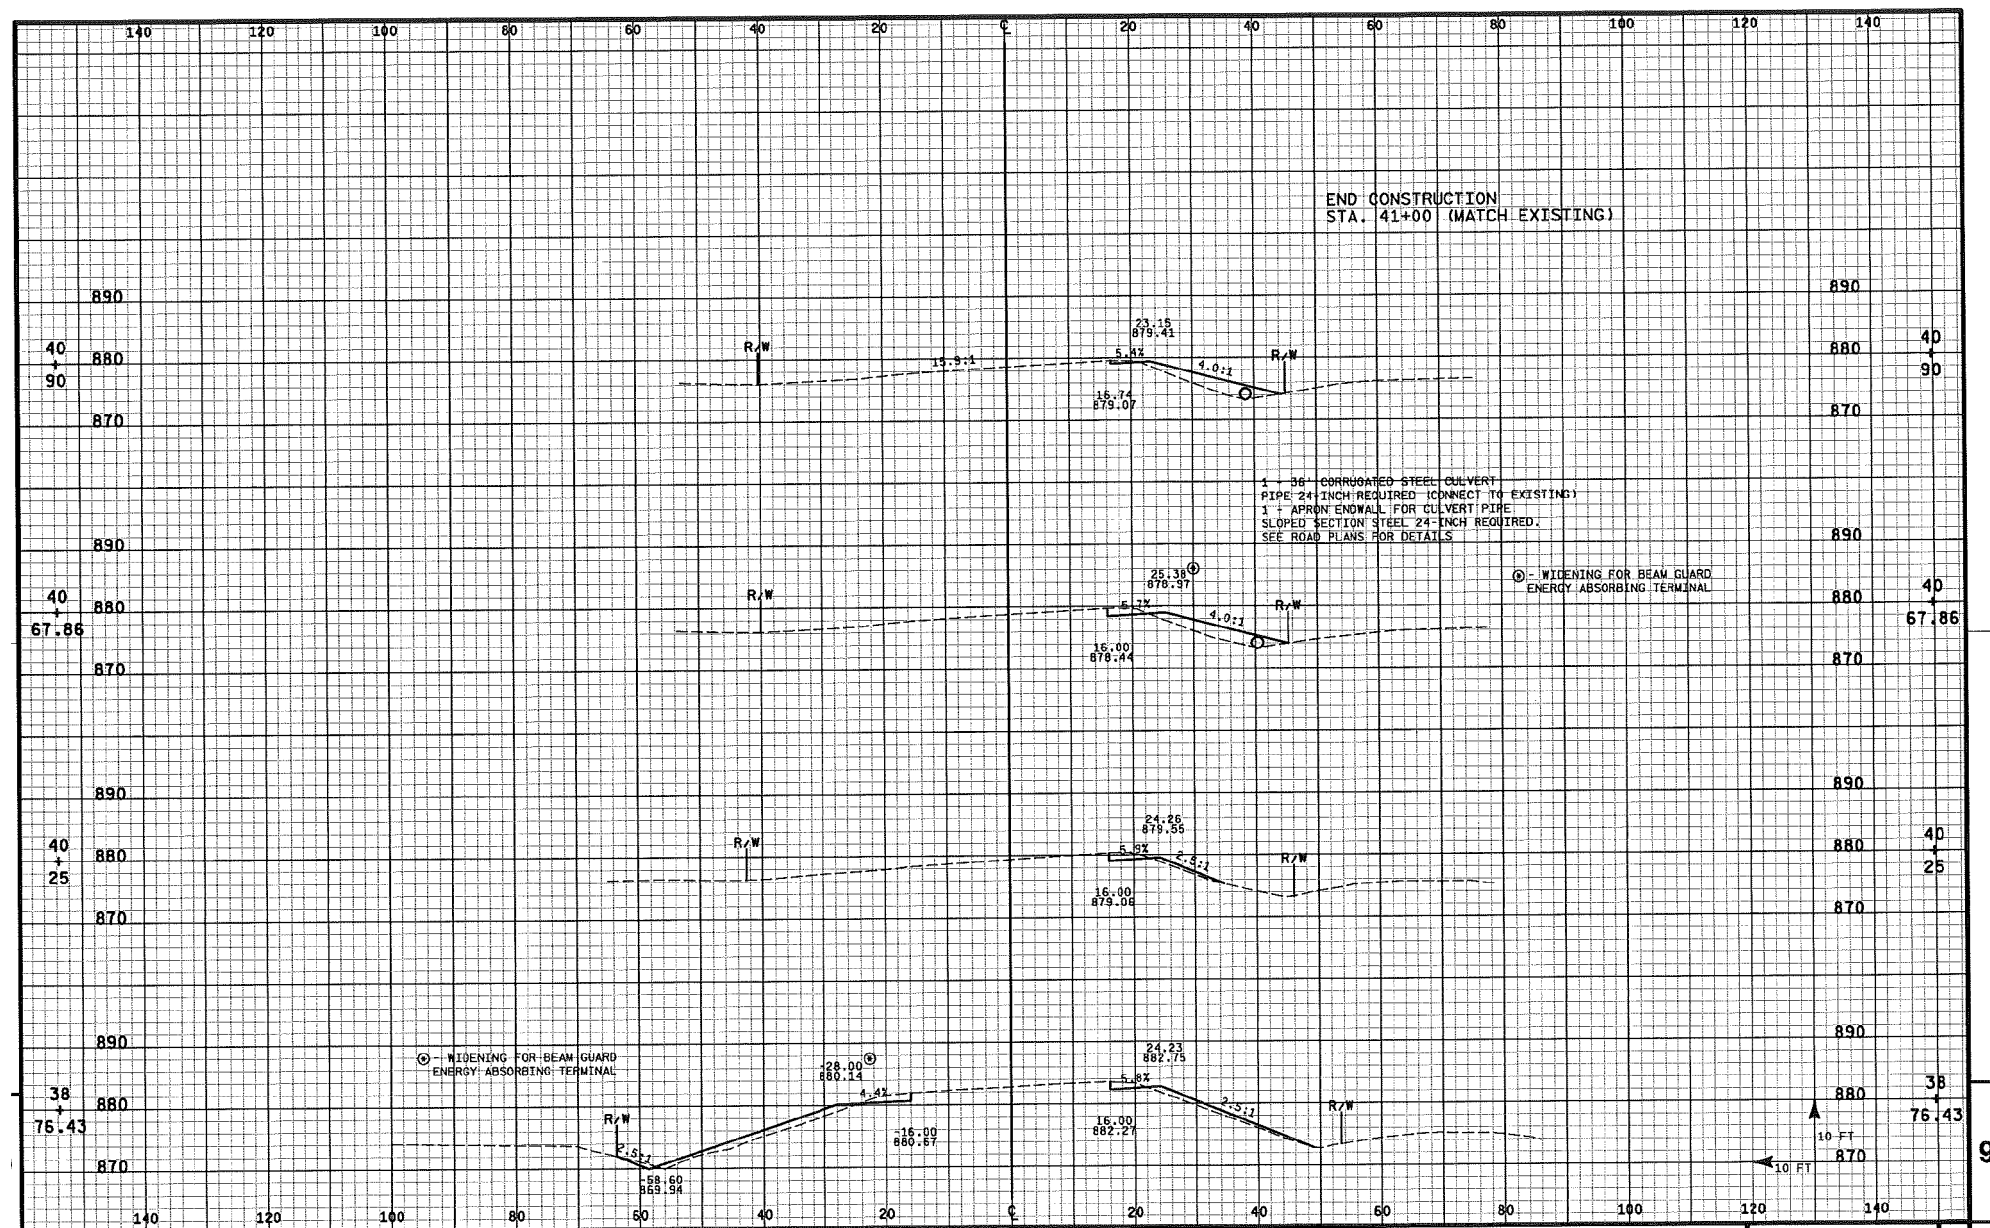

PROJECT NO: 1018-00-72

HWY: STH 58

COUNTY: JUNEAU

CROSS SECTIONS: STH 58

SHEET NO: 53

E

FILE NAME : K:\a11gn\rc011003.dgn

PLOT DATE : 9/10/2007

PLOT BY : \$\$.lotuser...\$ PLOT NAME :

Originator : MSA

PLOT SCALE : \$\$.plot scale...\$ WISDOT/CADD SHEET 21