

Feb 03
INDEX OF SHEETS

Sheet No. 1	Title
Sheet No.	Typical Sections and Details (Includes Erosion Control Plans)
Sheet No.	Estimate of Quantities
Sheet No.	Miscellaneous Quantities
Sheet No.	Right of Way Plat
Sheet No.	Plan and Profile
Sheet No.	Standard Detail Drawings
Sheet No.	Sign Plates
Sheet No. ✓	Structure Plans
Sheet No.	Computer Earthwork Data
Sheet No.	Cross Sections

TOTAL SHEETS = 978



STATE OF WISCONSIN
DEPARTMENT OF TRANSPORTATION
PLAN OF PROPOSED IMPROVEMENT
SAUK CITY - MIDDLETON ROAD
(STH 19 WEST - CTH K)
USH 12
DANE COUNTY

STATE PROJECT	FEDERAL PROJECT	
	PROJECT	CONTRACT
5300-03-74		

AS BUILT CONSTRUCTION PLAN

WORK TYPE EXCAVATION, C&G, CONCRETE PAVEMENT
CONTRACTOR FEDERAL INSURANCE COMPANY
PROJECT MANAGER CURT NEUHAUSER
WORK START-COMPLETED 5/03 - 11/05
PROJECT ENGINEER HEATH SCHOF

STATE PROJECT NUMBER
5300-03-74

DESIGN DESIGNATION

A.D.T. (2003)	=	16,450
A.D.T. (2023)	=	21,400
D.H.V.	=	2,354
D.	=	60-40
T.	=	3.7%
DESIGN SPEED	=	70 MPH
ESALS	=	N/A

BEGIN PROJECT
STA. 1490+00

Y = 436,618.02
X = 2,111,275.83



STRUCTURE
B-13-537

CONVENTIONAL SYMBOLS

COUNTY LINE
CORPORATE LIMITS
PROPERTY LINE
LOT LINE
LIMITED EASEMENT
EXISTING RIGHT OF WAY
PROPOSED OR NEW R/W LINE
SURVEY LINE
SLOPE INTERCEPT
ORIGINAL GROUND
MARSH OR ROCK PROFILE
(To be noted as such)
MARSH AREA
WOODED OR SHRUB AREA



COMBUSTIBLE FLUIDS
UNDERGROUND UTILITIES
GAS
ELECTRIC
TELEPHONE OR TELEGRAPH
COMMUNICATIONS LINE
SERVICE PEDESTAL
POWER POLE
TELEPHONE POLE
RAILROAD
SANITARY SEWER
STORM SEWER
WATER
EXISTING CULVERT
PROPOSED CULVERT
(Box or Pipe)
CULVERT (Profile View)

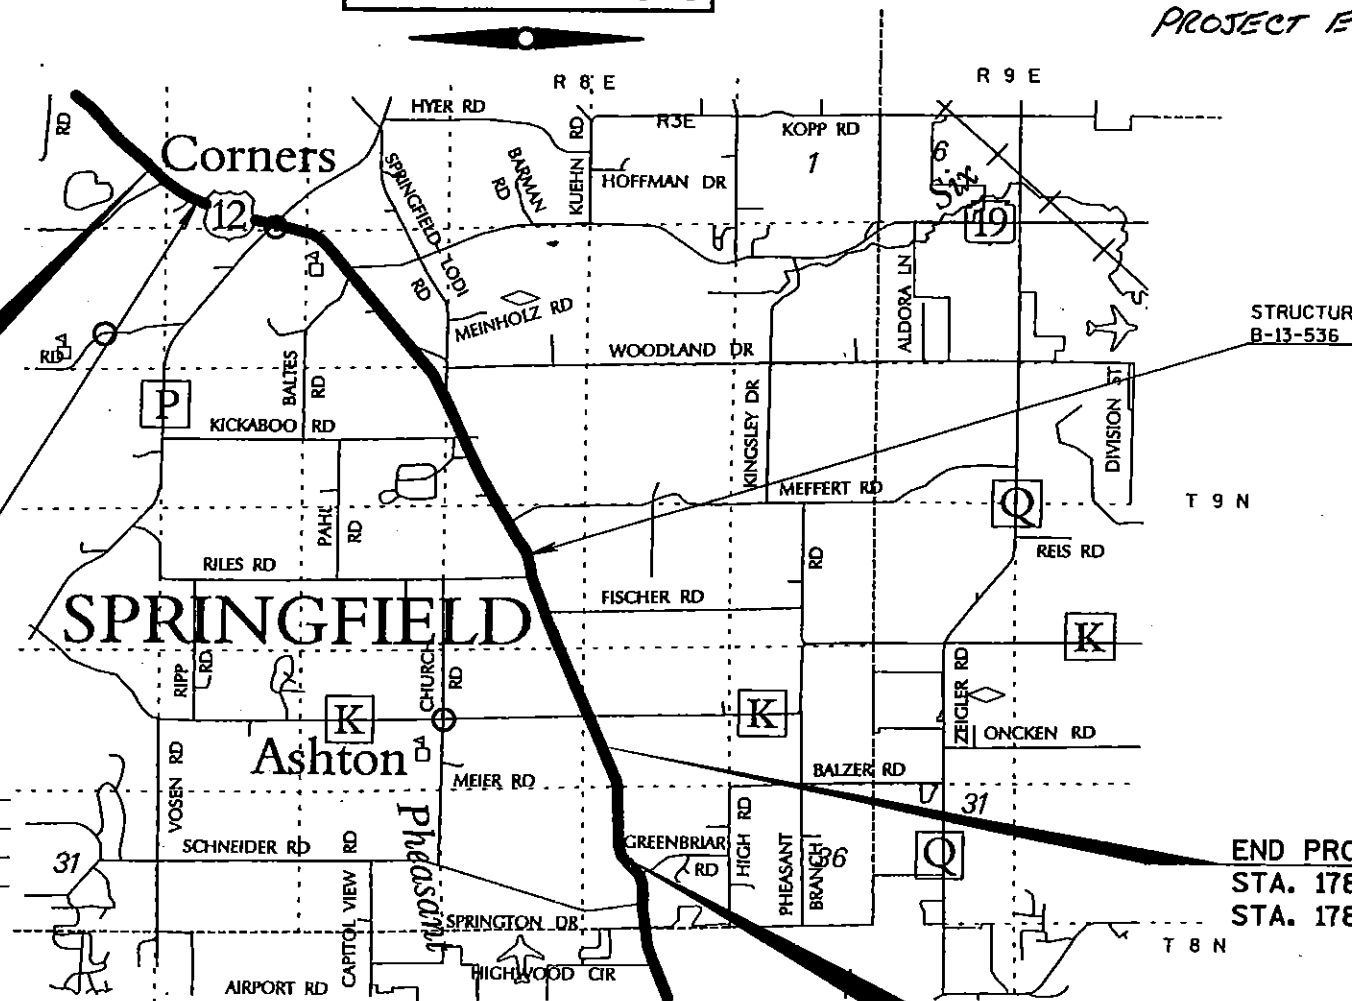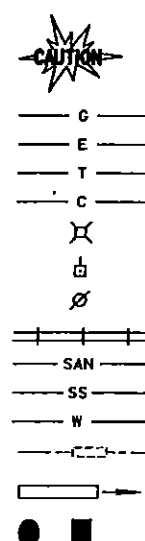

LAYOUT
SCALE 0 1 MI.


TOTAL NET LENGTH OF CENTERLINE = 5.644 MI.

Coordinates on this plan are referenced to the Wisconsin State Plane
Coordinate System (WSPCS), South Zone.

END PROJECT
STA. 1788+01.65 BK. =
STA. 1788+00.00 AH.

END CONSTRUCTION
STA. 1820+00

ORIGINAL
PLANS PREPARED BY

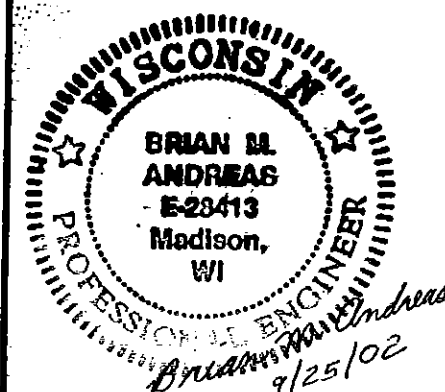

STRAND ASSOCIATES
CONSULTING ENGINEERS
Madison, Wisconsin 53715

STATE OF WISCONSIN
DEPARTMENT OF TRANSPORTATION

PREPARED BY
Surveyor STRAND
Designer STRAND
Project Manager CURT NEUHAUSER
District Examiner
District Supervisor MEH
Proj. Dev. Engineer
C.O. Examiner C. BUJANOWSKI

APPROVED FOR DISTRICT OFFICE
DATE: 9/30/02 Guy Meyer (Signature)