

AS-BUILT PLAN

STATE OF WISCONSIN
DEPARTMENT OF TRANSPORTATION
STATE HIGHWAY REHABILITATION-MAINTENANCE PROJECT
REEDSBURG - BARABOO
CTH PF TO USH 12
STH 136
SAUK COUNTY

STATE PROJECT	FEDERAL PROJECT	
	PROJECT	CONTRACT
5573-03-61	WISC 2010584	1

AS BUILTS

CONTRACTOR : D.L. GASSER CONSTRUCTION
TYPE OF CONSTRUCTION : RESURFACE
CONSTRUCTION DATES: 7/27/10 - 9/20/10
PROJECT LEADER: STEVE SOMERFELD (BTSQUARED)
PROJECT MANAGER: ANNE WALLACE
PROJECT SUPERVISOR: JOHN VON RUDEN
SUBCONTRACTORS: ADAM ENTERPRISES
ASTI SAWING
AUGELLI CONCRETE & EXCAVATING, LLC
CENTURY FENCE COMPANY
FISCHBACH, INC.
IVERSON CONSTRUCTION, LLC
THE KRAEMER COMPANY, LLC
NORTH POINT SPECIALISTS, LLC
ROSHILL ELECTRIC
SAFEMARK, LLC

LAX JUN 10
ORDER OF SHEETS

Section No. 1	Title
Section No. 2	Typical Sections and Details
Section No. 3	Estimate of Quantities
Section No. 3	Miscellaneous Quantities
Section No. 5	Plan
Section No. 6	Standard Detail Drawings
Section No. 7	Sign Plates
Section No. 8	Structure Plans

TOTAL SHEETS = 86

PROJECT ID: 5573-03-61
WITH:



10

DESIGN DESIGNATION

A.A.D.T. (2009)	= 5900
A.A.D.T. (2029)	= 8000
D.H.V.	= 376
D.D.	= 58/42
T.	= 6%
DESIGN SPEED	= 60 MPH
ESALS	= 576,700


CONVENTIONAL SYMBOLS

PLAN	
CORPORATE LIMITS	
REFERENCE LINE	
COMBUSTIBLE FLUIDS	
UTILITIES	
ELECTRIC	— E —
FIBER OPTIC	— FO —
GAS	— G —
SANITARY SEWER	— SAN —
STORM SEWER	— SS —
TELEPHONE	— T —
WATER	— W —
UTILITY PEDESTAL	
POWER POLE	
TELEPHONE POLE	

BEGIN PROJECT 5573-03-61
STA 7+00
X=622776.64
Y=240258.92

EXCEPTION TO C LENGTH
B-56-81: STA 130+60 TO STA 131+30

END PROJECT 5573-03-61
STA 226+34

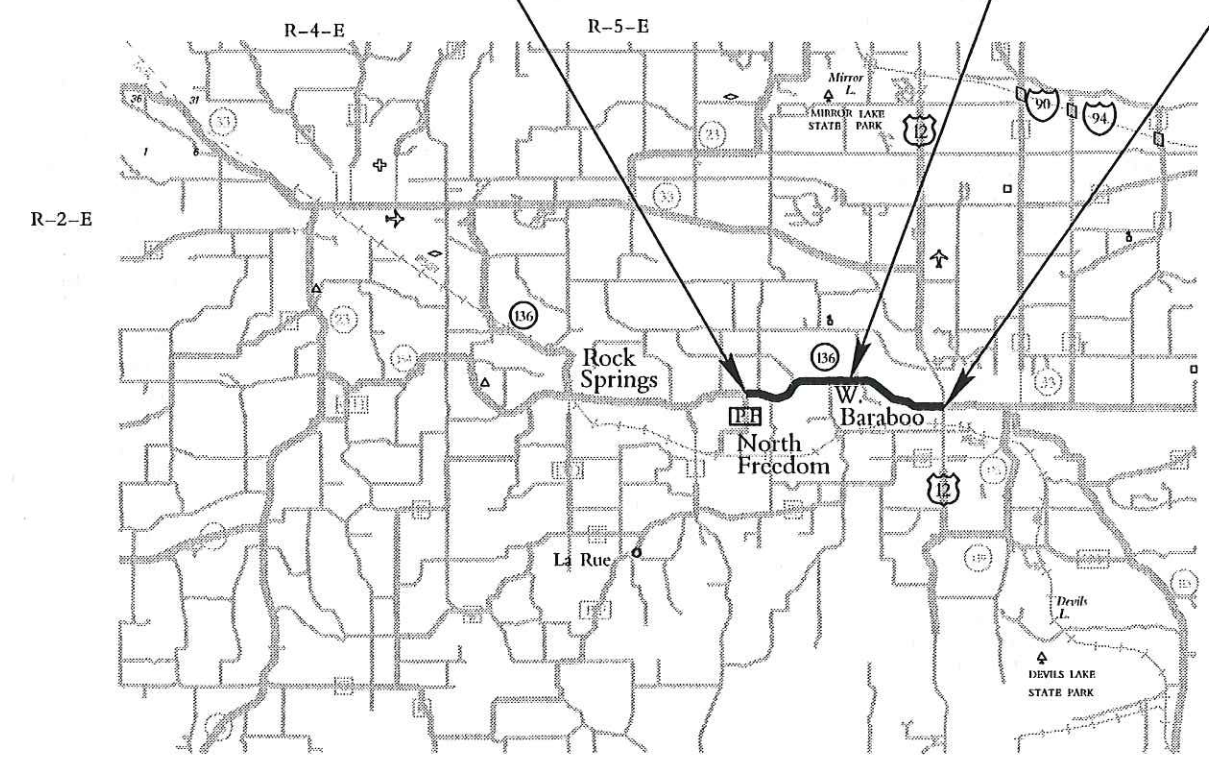

LAYOUT
SCALE 0 1.86 MI.

TOTAL NET LENGTH OF CENTERLINE = 4.15 MI.

STATE OF WISCONSIN DEPARTMENT OF TRANSPORTATION	
PREPARED BY	
Surveyor	WISDOT
Designer	MIKE RUD
Project Manager	JIM SAVOLDELLI
Regional Examiner	BRAD BYOM
Regional Supervisor	JOHN VON RUDEN
C.O. Examiner	JANE ENGLEBRETSSEN
APPROVED FOR THE DEPARTMENT	
DATE: 5/5/09	
(Signature)	

E