

GENERAL NOTES

THE REMOVAL OF CONCRETE DRIVEWAYS SHALL BE MEASURED AND PAID FOR IN ACCORDANCE WITH THE ITEM OF REMOVING CONCRETE SIDEWALK.

NO TREES OR SHRUBS ARE TO BE REMOVED WITHOUT THE APPROVAL OF THE ENGINEER.

MISCELLANEOUS REMOVAL ITEMS REQUIRING RESTORATION OF CONCRETE OR ASPHALTIC CONCRETE, SUCH AS DRIVEWAYS, SIDEWALKS, PEDESTRAIN RAMPS, SIDE STREETS OR INLETS SHALL BE REMOVED TO AN EXISTING JOINT OR SAWED AS DETERMINED BY THE PROJECT ENGINEER, OR AS SHOWN ON THE PLANS.

FILL EXPANSION IS ESTIMATED AT 1.30. YARDAGE IS BALANCED BY EXPANDING THE FILL SECTION. EARTHWORK WASTE MATERIAL SHOWN ON THE EARTHWORK SUMMARY SHALL BE HAULED FROM THE PROJECT, EXCEPT AS DIRECTED BY THE ENGINEER.

ALL EXCESS SALVAGE TOPSOIL SHALL BE REMOVED FROM THE PROJECTS AND NOT USED AS FILL. EXCAVATION BELOW SUBGRADE (EBS) IS NOT USED TO BALANCE YARDAGE, BUT IS MEASURED AND PAID FOR AS EXCAVATION COMMON. THE EXACT LOCATIONS FOR EBS WILL BE DETERMINED BY THE PROJECT ENGINEER.

ALL GRANULAR MATERIAL PLACED UNDER THE CONCRETE SIDEWALKS AND DRIVEWAYS SHALL BE INCIDENTAL TO THE BID ITEM OF CONCRETE SIDEWALKS OR DRIVEWAYS.

THE EXISTING ASPHALTIC PAVEMENT IS TO BE SALVAGED AND USED IN SALVAGED ASPHALTIC PAVEMENT BASE. THE QUANTITY OF SUCH MATERIALS HAS NOT BEEN DEDUCTED FROM THE EXCAVATION COMMON IN THE YARDAGE SUMMARY.

WHEN THE QUANTITY OF THE ITEM OF BASE AGGREGATE DENSE IS MEASURED BY PAYMENT OF THE TON, THE DEPTH OR THICKNESS OF THE COURSE IS APPROXIMATE AND THE ACTUAL THICKNESS WILL DEPEND ON DISTRIBUTION OF MATERIAL AS DIRECTED BY THE ENGINEER.

EXISTING SHOULDER AGGREGATE SHALL BE INCORPORATED INTO THE NEW SHOULDERS UNLESS OTHERWISE DIRECTED BY THE ENGINEER IN THE FIELD. TO BE PAID FOR AS SALVAGED ASPHALTIC PAVEMENT BASE.

SAWCUTS AS SHOWN ON PLANS ARE AT SUGGESTED LOCATIONS AND MAY BE ADJUSTED AT THE DISCRETION OF THE ENGINEER TO BETTER SUIT FIELD CONDITIONS.

THE EXACT LOCATIONS AND LIMITS OF PRIVATE ENTRANCES AND FIELD ENTRANCES SHALL BE DETERMINED BY THE ENGINEER IN THE FIELD.

EXISTING PRIVATE AND FIELD ENTRANCES SHALL BE RESTORED IN KIND AS DIRECTED BY THE ENGINEER.

ALL DRIVEWAYS BETWEEN THE CURB AND SIDEWALK SHALL BE PAVED WITH CONCRETE DRIVEWAY, 6-INCH.

APHALTIC COMMERCIAL AND PRIVATE ENTRANCES SHALL BE SAWCUT AS REQUIRED TO PROVIDE A CLEAN BUTT JOINT TO NEW WORK.

THE CONTRACTOR SHALL PLACE ALL TRAFFIC CONTROL SIGNS IN ADVANCE OF THE PROJECT TERMINI AND ON ALL INTERSECTING ROAD APPROACHES BEFORE BEGINNING ANY WORK ON THE HIGHWAY. THESE SIGNS SHALL REMAIN IN PLACE UNTILL ALL WORK IS COMPLETED AND PERMANENT MARKING IS IN PLACE.

ALL SIDE ROAD INTERSECTIONS SHALL RECEIVE PAVEMENT MARKINGS AS PER STANDARD DETAIL DRAWINGS UNLESS OTHERWISE DETAILED.

ALL CONCRETE PIPE SHALL HAVE JOINT TIES INSTALLED ON THE LAST THREE PIPE JOINTS AND THE ENDWALL JOINT AT BOTH THE INLET AND DISCHARGE ENDS.

GRATE ELEVATION SHOWN ON PLANS IS TO THE FLAG LINE.

INLET DISCHARGED ELEVATIONS FOR DRAINAGE STRUCTURES SHOWN ON THE PLAN ARE APPROXIMATE AND SHALL BE CONFIRMED BY THE ENGINEER IN THE FIELD.

STORM SEWER PIPE LENGTHS ARE CALCULATED TO THE CENTER OF DRAINAGE STRUCTURES.

CONSTRUCT ALL STORM STRUCTURES WITH BENCHING AS SHOWN IN THE STANDARD DETAILS

EXPANSION JOINTS TO BE CONSTRUCTED AT ALL RADIUS POINTS IN CURB AND GUTTER.

CURB AND GUTTER JOINT SPACING SHALL BE 10 FEET UNLESS OTHERWISE AUTHORIZED BY THE ENGINEER IN THE FIELD.

RADIUS DIMENSIONS FOR THE CURB AND GUTTER ARE TO THE FLAG OF THE CURB.

THE CLEAR ZONE FROM BEHIND CURB AND GUTTER IS 2 FEET FROM THE FACE OF THE CURB.

AFTER PLACING CURB & GUTTER, ANY EXCESS CONCRETE PROTRUDING BEYOND THE BACK OF CURB LINE SHALL BE REMOVED BY THE CONTRACTOR BEFORE BACKFILLING.

ALL PLAN VIEW CURB RADI AND TRANSITION POINTS ARE SHOWN TO THE FLAG OF THE CURB.

ALL RADI ARE MEASURED TO THE EDGE OF PAVEMENT UNLESS OTHERWISE SHOWN OR NOTED.

THE LOW SIDE SHOULDER SLOPE ON SUPERELEVATED SECTIONS EQUALS SUPERELEVATION WHEN SUPERELEVATION IS GREATER THAN 0.04 FT./FT. IF SUPERELEVATION IS LESS THAN OR EQUAL TO 0.04 FT./FT., THEN LOW SIDE SHOULDER SLOPE IS 0.04 FT./FT. HIGH SIDE SHOULDER SLOPE ON SUPERELEVATED SECTIONS EQUALS SUPERELEVATION.

DISTURBED AREAS WITHIN THE RIGHT-OF-WAY, EXCEPT THE AREAS WITHIN THE FINISHED SHOULDER POINTS, ARE TO BE FERTILIZED, SEEDED AND MULCHED AS DIRECTED BY THE ENGINEER.

THE EROSION CONTROL FEATURES ARE SHOWN ON THE PLAN AND PROFILE SHEETS AND ARE AT SUGGESTED LOCATIONS. EXACT LOCATION WILL BE DETERMINED BY THE ENGINEER.

PRIOR TO THE INSTALLATION OF TRAFFIC CONTROL DEVICES THE CONTRACTOR SHALL PROVIDE THE ENGINEER AND THE STATE HIGHWAY PATROL WITH THE NAME AND TELEPHONE NUMBER OF A LOCAL PERSON RESPONSIBLE FOR THE EMERGENCY MAINTENANCE OF TRAFFIC CONTROL.

THE LOCATION OF STOP LINES SHALL BE DETERMINED IN THE FIELD BY THE ENGINEER.

ALL EXISTING SIGNS SHALL REMAIN IN PLACE UNTIL CONSTRUCTION OPERATIONS REQUIRE THEIR REMOVAL OR UNLESS THE ENGINEER APPROVES THEIR REMOVAL.

THE LOCATIONS OF THE EXISTING AND PROPOSED UTILITY INSTALLATIONS AS SHOWN ON THE PLANS ARE APPROXIMATE. THERE MAY BE OTHER UTILITY INSTALLATIONS WITHIN THE PROJECT ARE THAT ARE NOT SHOWN.

THE ENGINEER SHALL ADJUST THE LOCATIONS OF ITEMS UNDER THIS CONTRACT TO AVOID CONFLICT WITH THE EXISTING UTILITY FACILITIES.

HMA WEIGHTS CALCULATIONS ARE BASED ON 110 LBS/SY/IN.

THE CONTRACTOR'S PAVING OPERATIONS SHALL BE CONSISTENT WITH THE PLAN TYPICAL SECTIONS AND CONSTRUCTED TO PREVENT HMA LONGITUDINAL JOINTS FROM BEING LOCATED WITHIN A DRIVING, TURNING, PASSING OR PARKING LANE.

CULVERT LENGTHS ARE DESIGNED TO THE NEAREST 2 FOOT INCREMENT. ANY CONSTRUCTION METHOD NECESSARY TO ACHIEVE A 2 FOOT INCREMENT, SUCH AS CONCRETE COLLARS, SHALL BE INCIDENTAL TO THE COST OF THE CULVERT PIPE.

REMOVAL OF EXISTING RETAINING WALL AT STA.8+80' BEN TO STA.9+90' BEN IS INCLUDED AS PART OF THE EXCAVATION QUANTITY FOR THE NEW MODULAR BLOCK GRAVITY RETAINING WALL BEING INSTALLED FROM STA.8+70' BEN TO STA.9+70' BEN. NO EXTRA PAYMENT WILL BE MADE FOR ITS REMOVAL.

THERE ARE VERTICLE CURVES IN THE PROFILE WHICH ARE ASYMETRIC. EACH CURVE IS NOT INDIVIDUALLY LABELED AS ASYMETRIC.



Toll Free (800) 242-8511
Milwaukee Area (414) 259-1181
Hearing Impaired TDD (800) 542-2289
www.DiggersHotline.com

DNR CONTACT

RON GRASSHOFF
DEPARTMENT OF NATURAL RESOURCES
3911 FISH HATCHERY ROAD
FITCHBURG, WI 53711
(608) 275-3481


UTILITIES

ABBREVIATIONS

UTILITY/MUNICIPALITY	CONTACT/ADDRESS	UTILITY TYPE	UTILITY/MUNICIPALITY	CONTACT/ADDRESS	UTILITY TYPE
* CENTURYTEL OF WISCONSIN	BOB DEWITT 333 NORTH FRONT STREET LA CROSSE, WI 54602 608-796-5077 (OFFICE) bob.dewitt@centurytel.com	COMMUNICATION	* ALLIANT ENERGY CORPORATION	GARY QUADE 1000 MAIN STREET PO BOX 769 DUBUQUE, IA 52004-0769 563-584-7395 (OFFICE) 563-599-0433 (MOBILE) Gary.Quade@alliantenergy.com	ELECTRIC & GAS
* CENTURYTEL/TELEVIEW OF WI, INC	TIM KROEZE 201 STARK ST PO BOX 98 RANDOLPH, WI 53956 920-326-2224 (OFFICE) tim.kroeze@centurytel.com	COMMUNICATION			
* CHARTER COMMUNICATIONS	GARY ANDERSON 2701 DANIELS STREET MADISON, WI 53718 608-274-3822 (OFFICE) 608-209-6253 (MOBILE) ganderson@charter.com	COMMUNICATION	AMERICAN TRANSMISSION CO	ANDY EBERHARDT N19 W23993 RIDGEVIEW PKWY WEST PO BOX 47 WAUKESHA, WI 53187-0047 262-506-6864 (OFFICE) 262-424-9354 (MOBILE) aerberhardt@attcll.com	TRANSMISSION
* VERIZON BUSINESS FORMERLY MCI WORLD COM	TONY NEWMAN 2410 PACKER AVE MADISON, WI 53704 608-242-0156 (OFFICE) 608-436-3517 (MOBILE) tony.newman@verizonbusiness.com	COMMUNICATION	* NORTHERN NATURAL GAS CO	JIM CARLSON 7055 VISTA DRIVE - BRISTOL BLDG WEST DES MOINES, IA 50266 515-226-2016 (OFFICE) 515-360-9242 (MOBILE) jim.carlson@nngco.com	GAS
* AT&T WISCONSIN FORMERLY SBC	TOM KIEFER 316 W WASHINGTON AVE - RM 607 MADISON, WI 53703 608-282-7894 (OFFICE) 608-559-7843 (PAGER) tk6192@att.com	COMMUNICATION		BOB BESECKER 5557 CTH D PLATTEVILLE, WI 53818 402-530-2801 (OFFICE) 608-778-8565 (MOBILE) bob.besecker@nngco.com	
* SPRINT COMMUNICATIONS CO LP	JAMES BURTON 5600 N RIVER ROAD - SUITE 500 ROSEMONT, IL 60018 800-788-0751 (OFFICE) 708-917-4903 (MOBILE) james.m.burton@mail.sprint.com	COMMUNICATION	VILLAGE OF ROCK SPRINGS	SHEA HOWARD COMMUNITY CENTER 201 W BROADWAY PO BOX 26 ROCK SPRINGS, WI 53961-0026 608-522-5700 (OFFICE) publicworks@merr.com	WATER & SEWER

B	BARN
BLD	BUILDING
C.J.	CONSTRUCTION JOINT
CONC.	CONCRETE
COR.	CORNER
C.S.C.P.	CORRUGATED STEEL CULVERT PIPE
C.S.P.A.	CORRUGATED STEEL PIPE ARCH
D.H.V.	DESIGN HOURLY VOLUME
V.	DESIGN SPEED
DIA.	DIAMETER
DIM.	DIMENSION
e.	EXTERNAL DISTANCE
E.	EAST
E.C.I.P.	EROSION CONTROL IMPLEMENTATION PLAN
EL. OR ELEV.	ELEVATION
E.J.	EXPANSION JOINT
E.S.A.L.	EQUIVALENT SINGLE AXLE LOAD
E.O.P.	EDGE OF PAVEMENT
F.L.	FLOW LINE
G.	GARAGE
H	HOUSE
H.E.	HIGHWAY EASEMENT
I.E.	INVERT ELEVATION
I.P.	IRON PIN
D.	LANE DISTRIBUTION
L.	LENGTH (OF CURVE)
L.H.F.	LEFT HAND FORWARD
L.C.	LONG CHORD
L.P.	LOW POINT
M.D.	MEDIAN DRAIN
NOR.	NORMAL
N.	NORTH
OH	OVER HEAD ELECTRIC
T.	PERCENT OF TRUCKS
P.L.E.	PERMANENT LIMITED EASEMENT
P.L.	PROPERTY LINE
R.C.A.P.	REINFORCED CONCRETE ARCH PIPE
R.C.C.P.	REINFORCED CONCRETE CULVERT PIPE
R.H.F.	RIGHT HAND FORWARD
RD.	ROAD
R.O.	RUNOFF
S.	SHED
SHR.	SHRINKAGE
S.G.	SUBGRADE
S.E.	SUPERELEVATION
SL.R.C.	SLOPED REINFORCED CONCRETE
S.P.B.G.	STEEL PLATE BEAM GUARD
SS.	STORM SEWER
SSPRC	STORM SEWER PIPE REINFORCED CONCRETE
SSPRCHE	STORM SEWER PIPE REINFORCED CONCRETE HORIZONTAL ELLIPTICAL
TEL.	TELEPHONE
T.I.	TEMPORARY INTEREST
TN.	TOWN
TOS	TOP OF STRUCTURE
TRANS.	TRANSITION
VOL.	VOLUME
W.	WEST

* Denotes Diggers Hotline Member

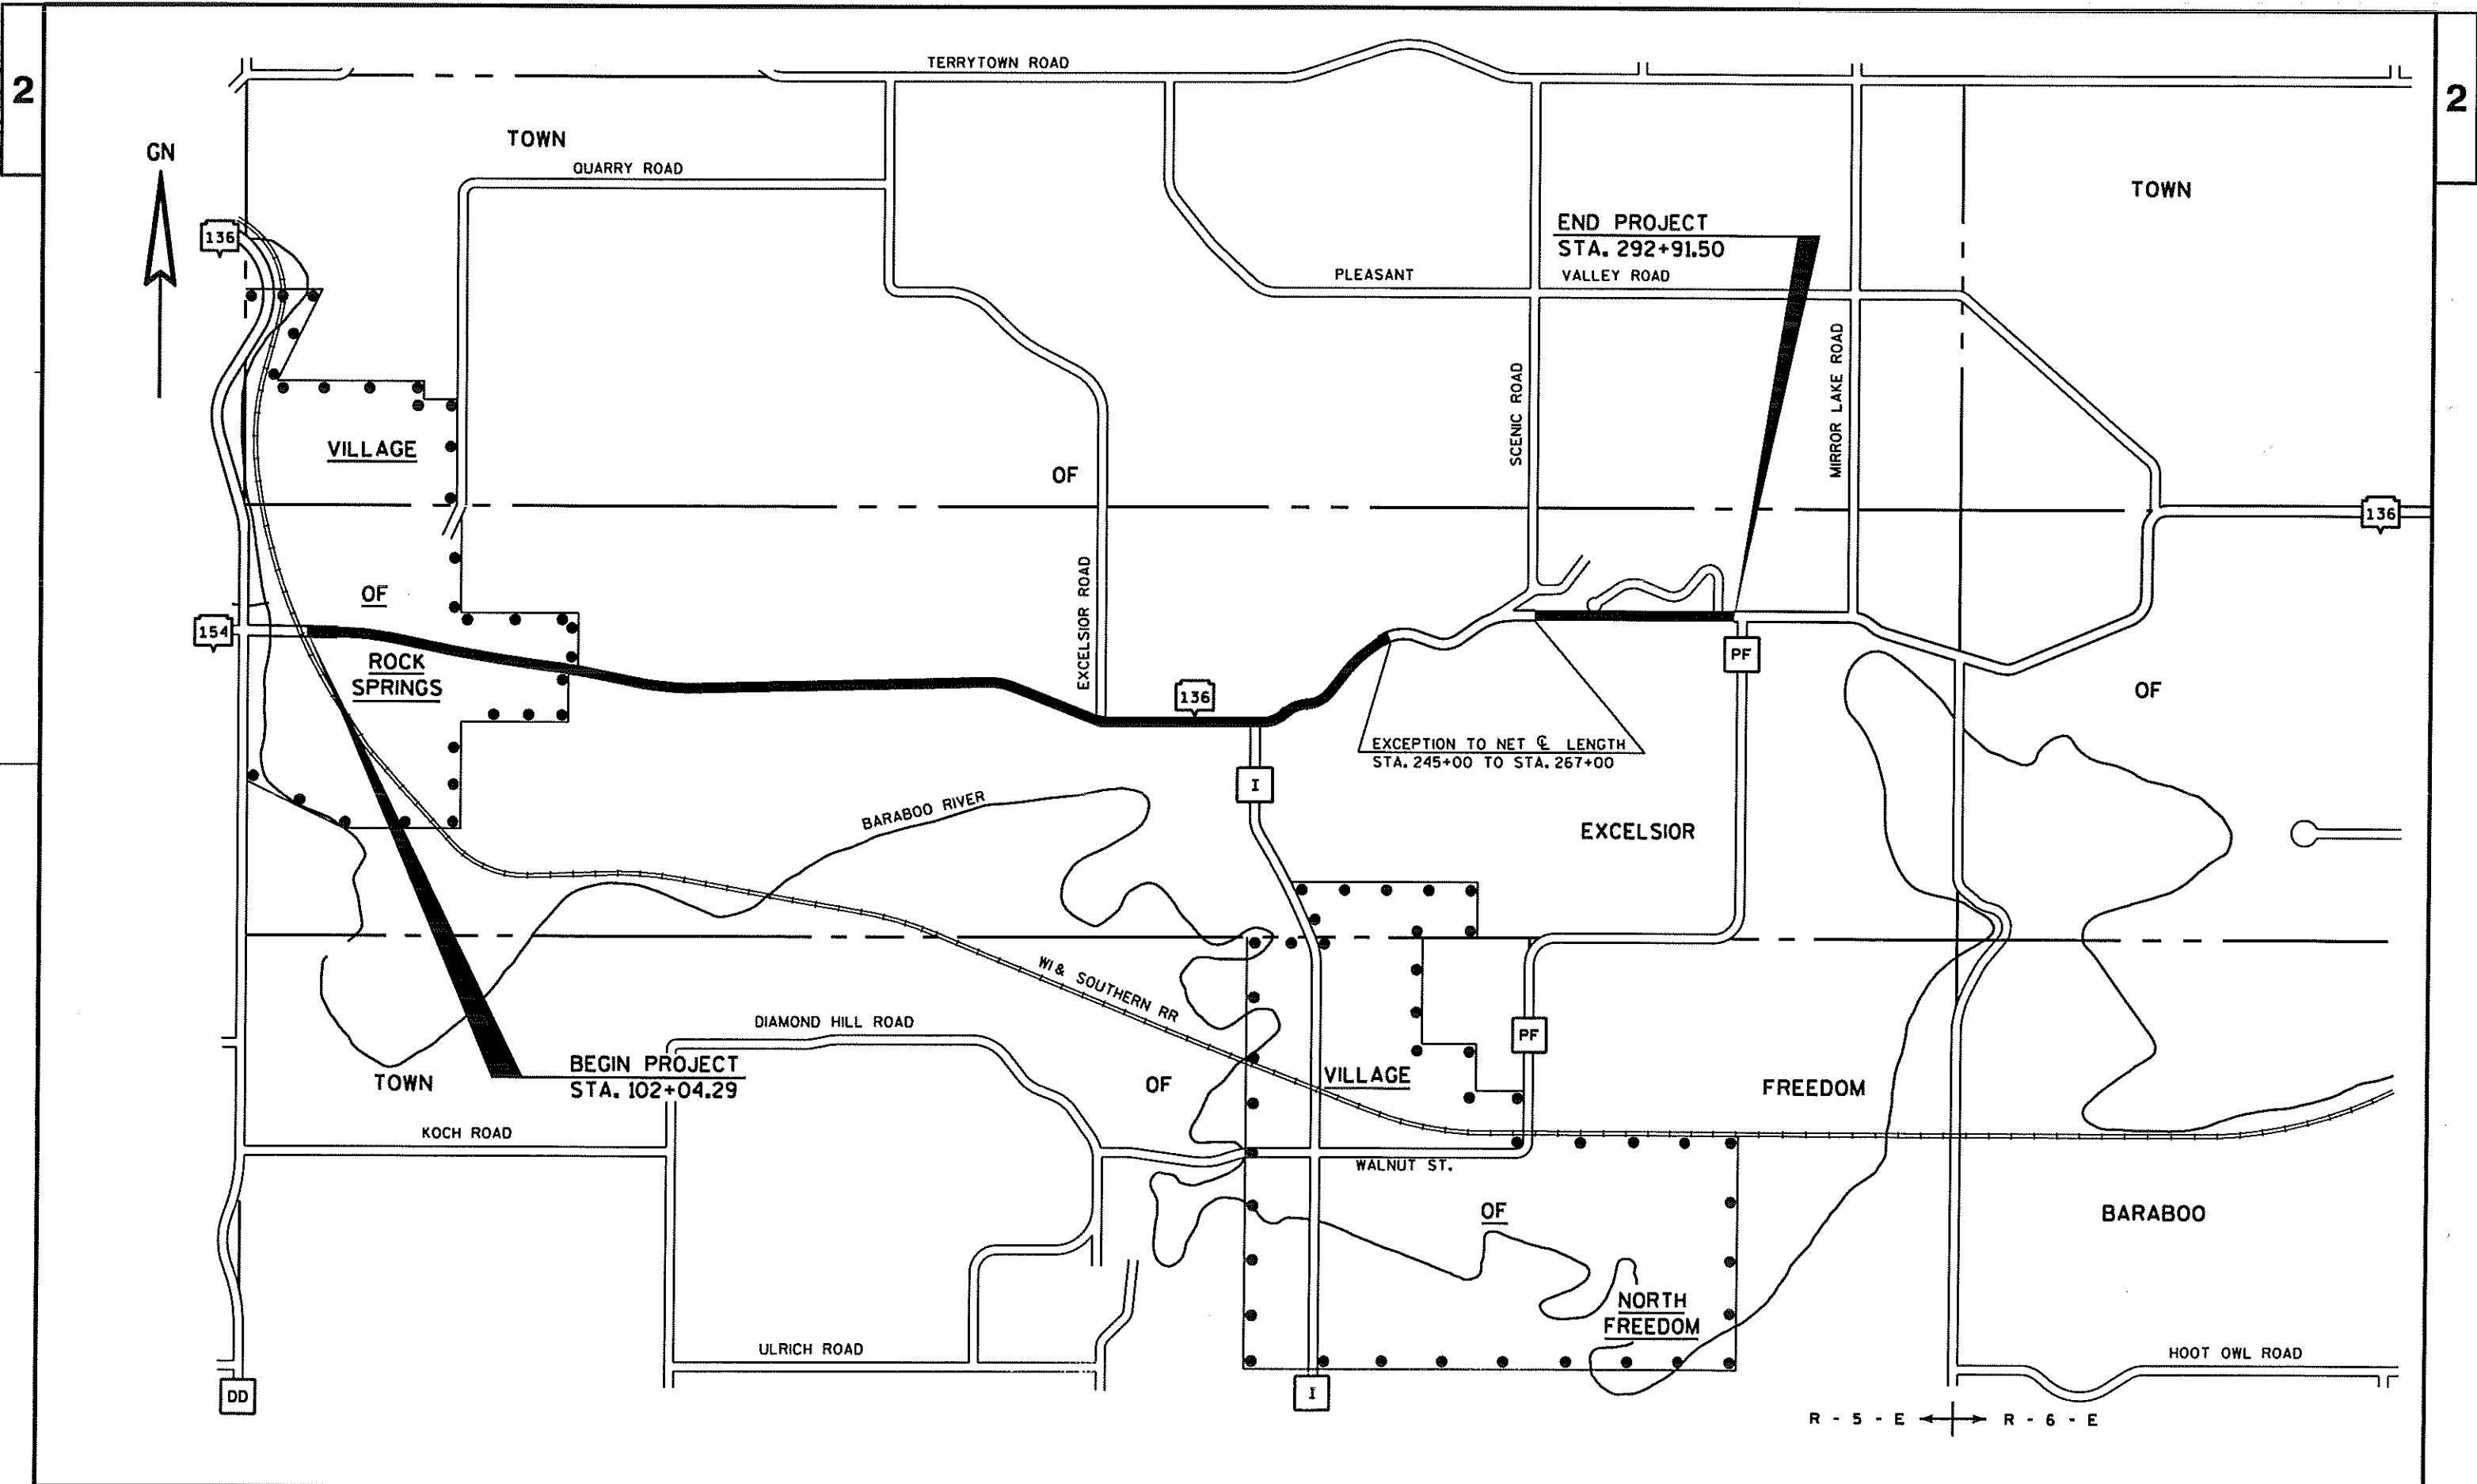




ROCK SURFACE ESTIMATE

I.D. 5573-04-01
ROCK SPRINGS - BARABOO ROAD
(ROCK SPRINGS - CTH 'PF')
STH 136
SAUK COUNTY

STATION	OFFSET	ELEVATION	OFFSET	ELEVATION	OFFSET	ELEVATION
120+00	-25	921.7	25	920.5		
121+00	-30	928.0	2	928.0	30	927.8
122+00	-30	926.5	30	926.0		
123+00	-30	920.0	40	919.0		
138+00	-40	908.5	40	909.0		
139+00	-40	916.0	60	918.0		
140+00	-40	925.5	60	924.5		
141+00	-30	925.5	60	923.5		
151+00	-50	937.0	30	943.0		
152+00	-50	937.0	-14	937.0	9	945.5
152+00	45	945.5				
153+00	-50	940.5	40	942.0		
159+00	-40	925.0	-16	925.5	17	923.0
159+00	50	923.0				
160+00	-60	921.0	-21	921.0	17	921.5
160+00	36	923.5	70	923.5		
161+00	-60	921.0	-21	921.0	17	921.0
161+00	36	923.5	70	923.5		
162+00	-50	913.0	-20	913.0	17	914.0
162+00	43	922.5	70	922.5		
163+00	-40	900.0	60	902.0		




PAVEMENT BORINGS

APPROXIMATE STATION	THICKNESS INCHES
105+00	3.5
111+00	5.5
118+00	2
121+00	3
130+00	3
141+00	2.5
147+00	7
160+00	5
172+00	5
192+00	9
210+00	7.5
222+00	8.5
237+00	10
285+00	6
287+00	10

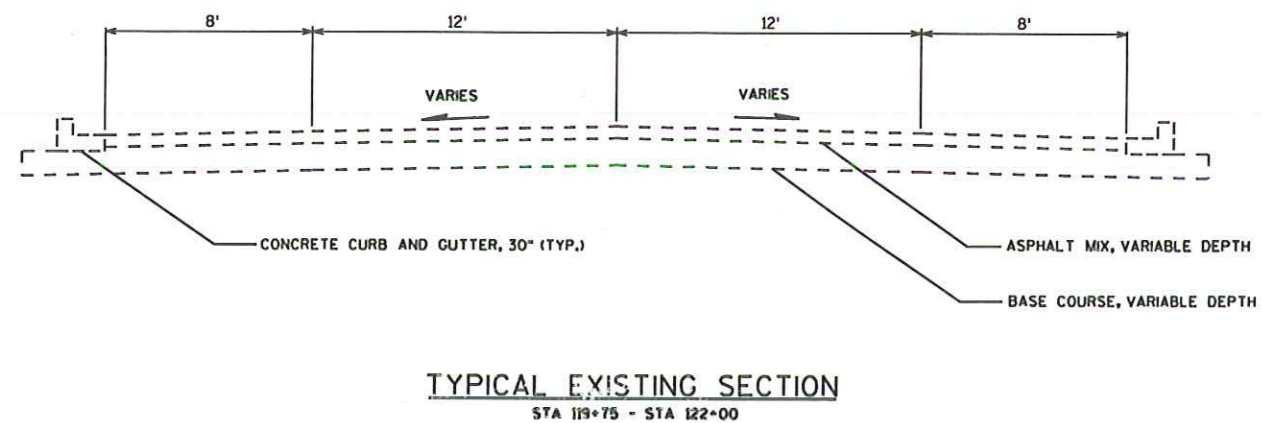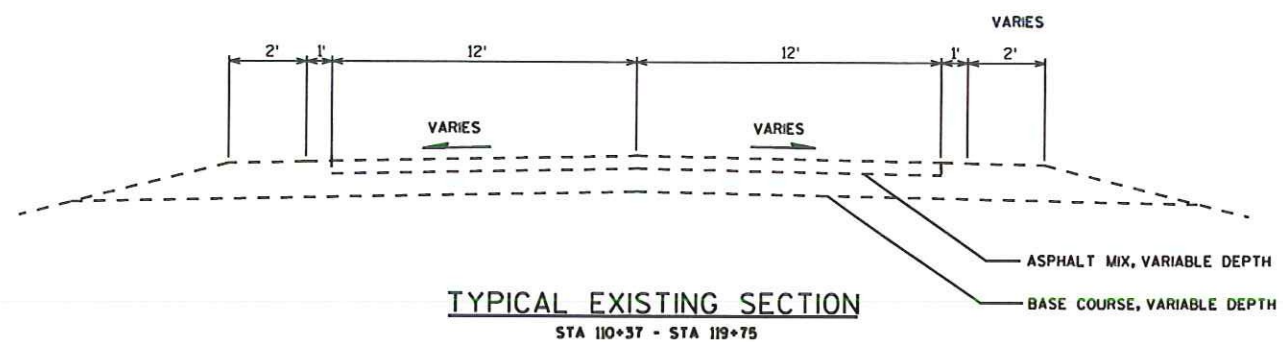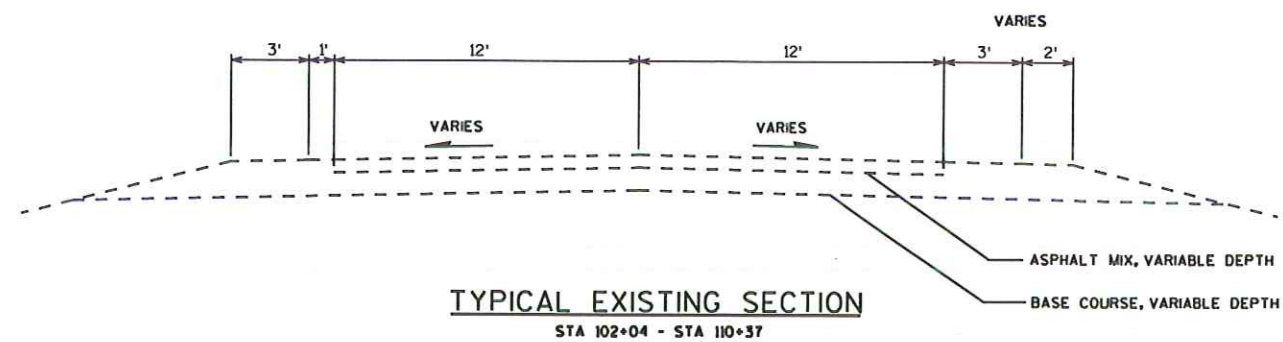


PAVEMENT BORINGS


APPROXIMATE STATION	THICKNESS INCHES
105+00	3.5
111+00	5.5
118+00	2
121+00	3
130+00	3
141+00	2.5
147+00	7
160+00	5
172+00	5
192+00	9
210+00	7.5
222+00	8.5
237+00	10
285+00	6
287+00	10

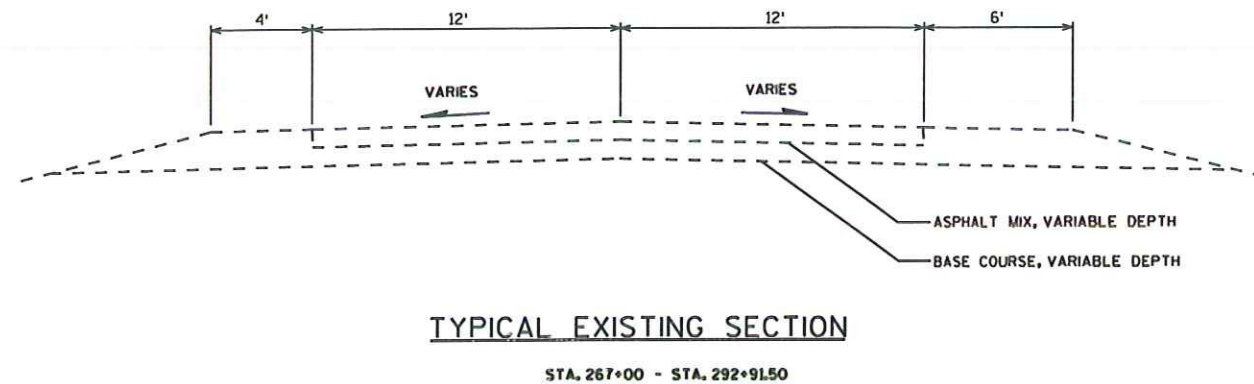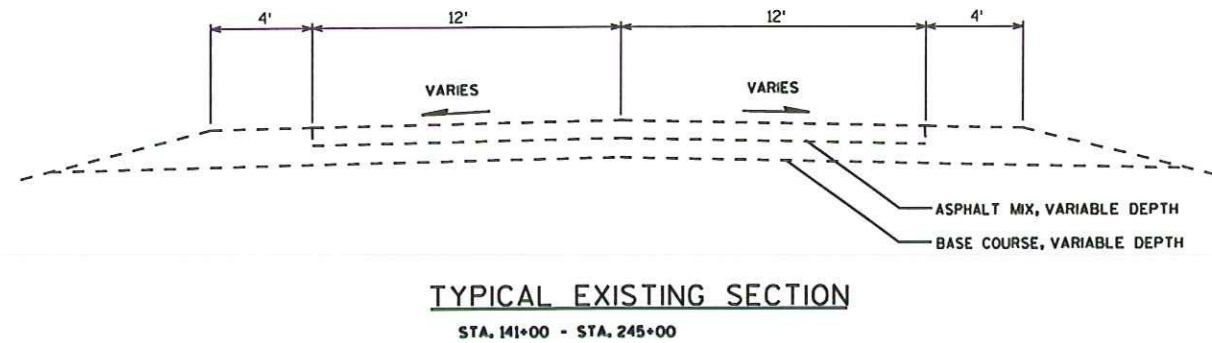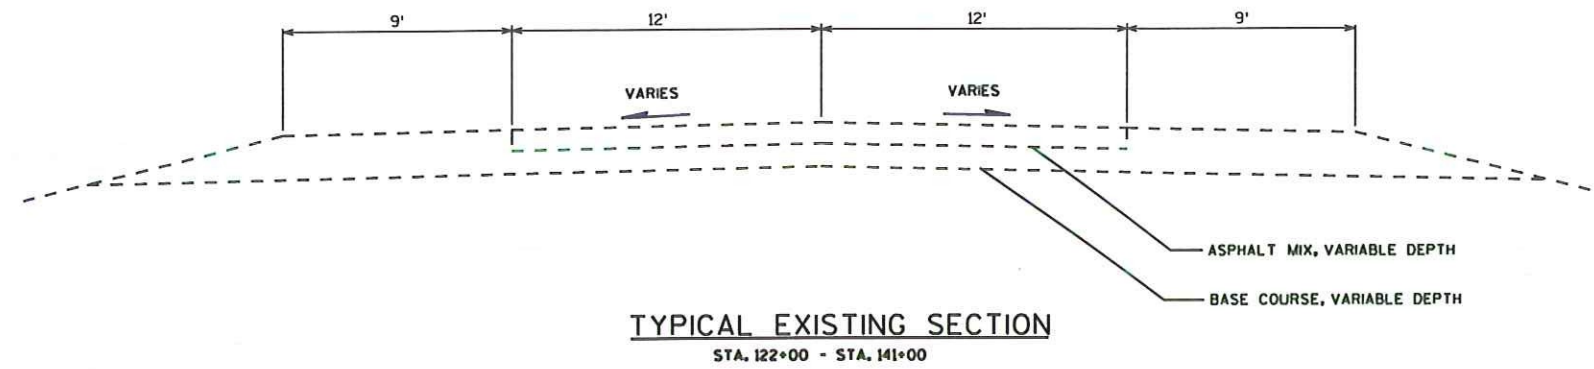**PAVEMENT BORINGS**


APPROXIMATE STATION	THICKNESS INCHES
105+00	3.5
111+00	5.5
118+00	2
121+00	3
130+00	3
141+00	2.5
147+00	7
160+00	5
172+00	5
192+00	9
210+00	7.5
222+00	8.5
237+00	10
285+00	6
287+00	10

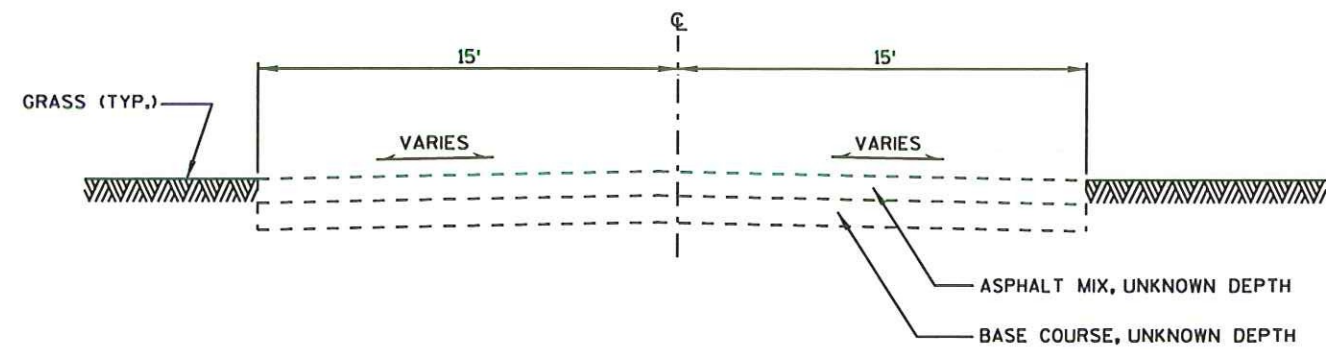


EXISTING TYPICAL SECTION
MADISON ST.

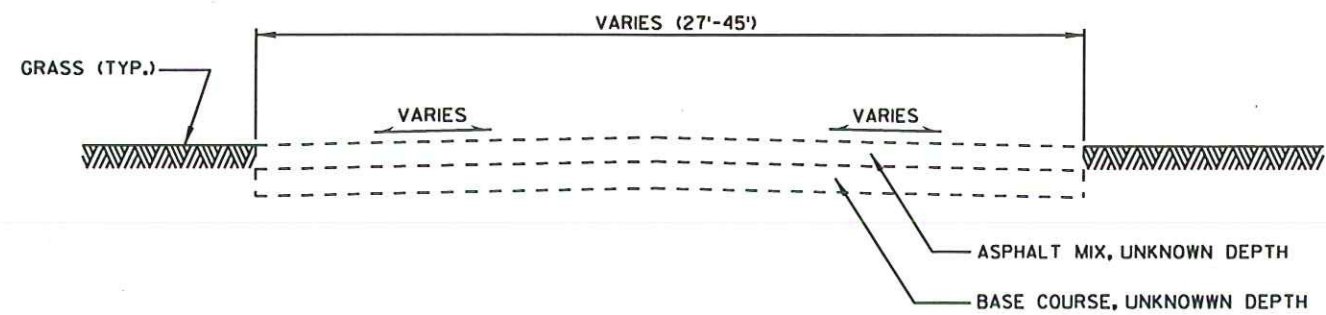


EXISTING TYPICAL SECTION
MONTGOMERY ST.

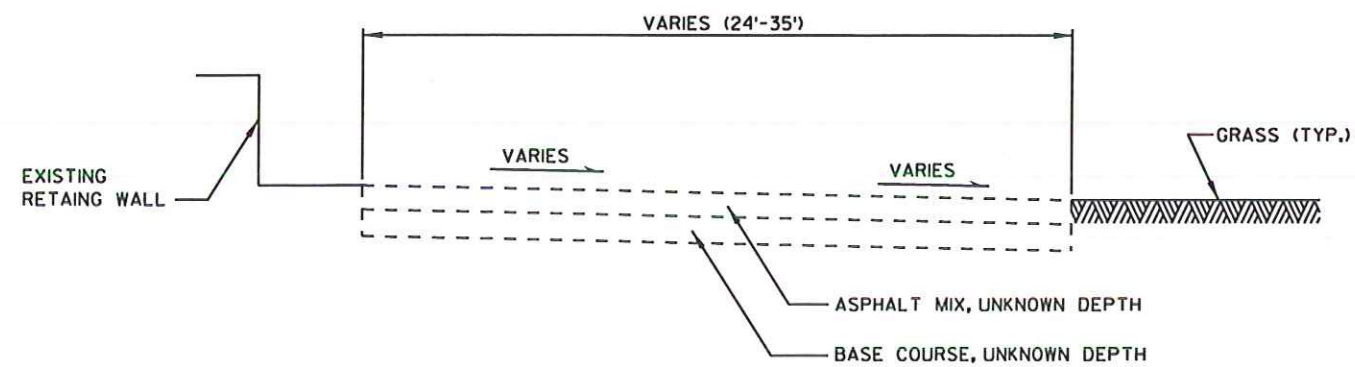




EXISTING TYPICAL SECTION
BENDER ST.

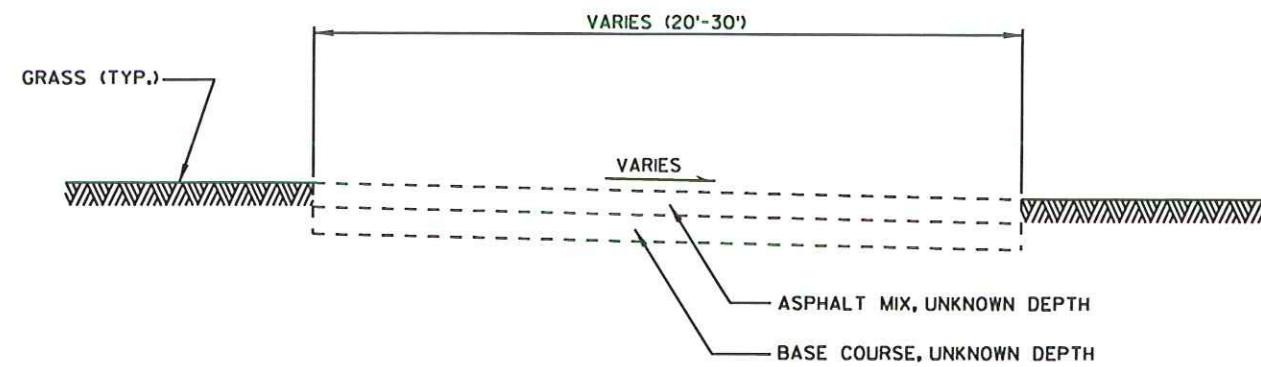


EXISTING TYPICAL SECTION
HOLTZ RD.

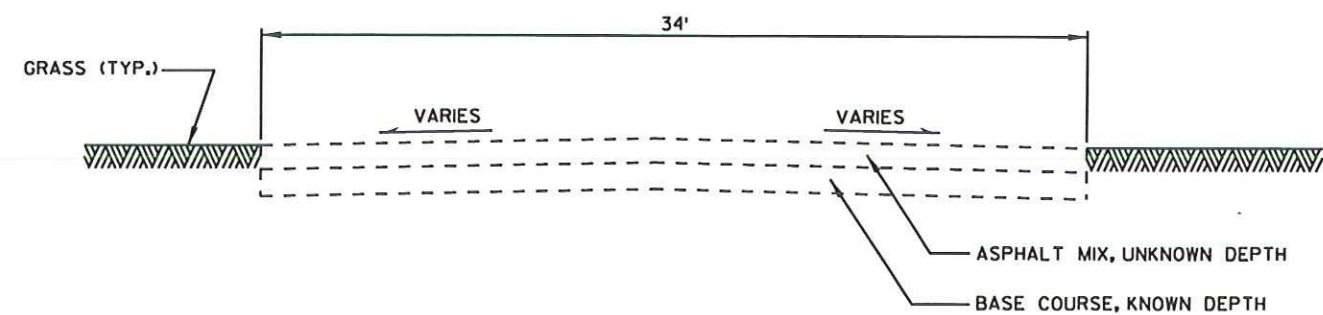


EXISTING TYPICAL SECTION
QUARRY RD.

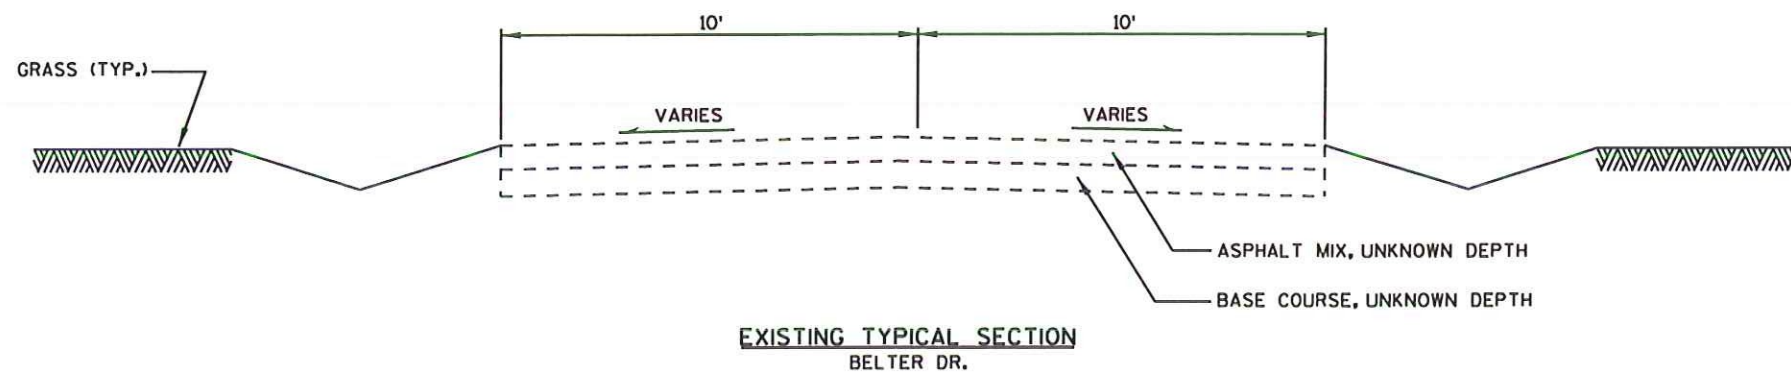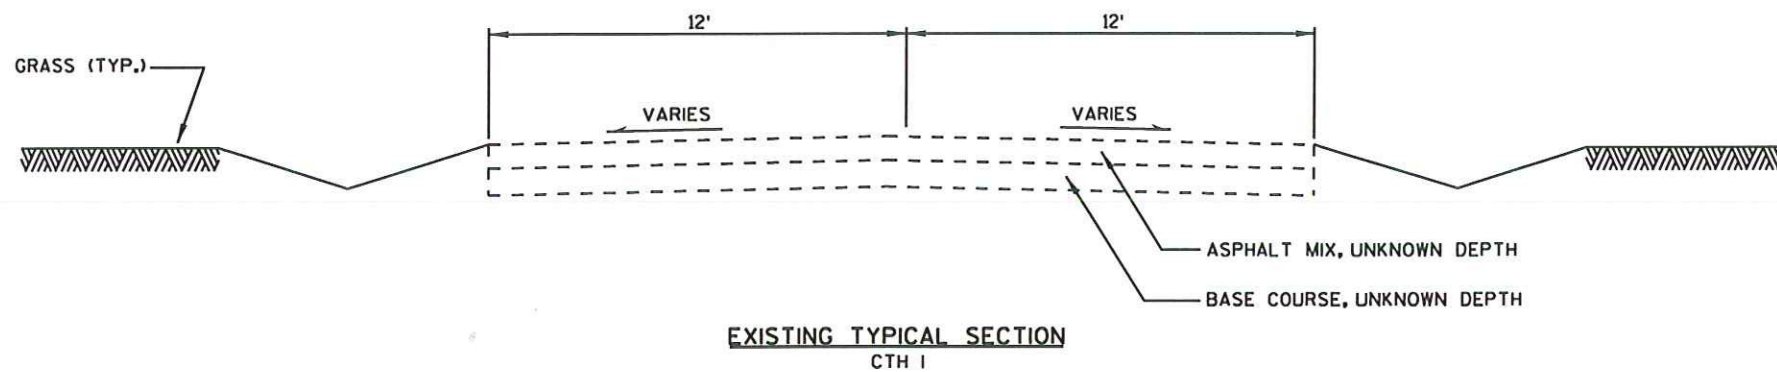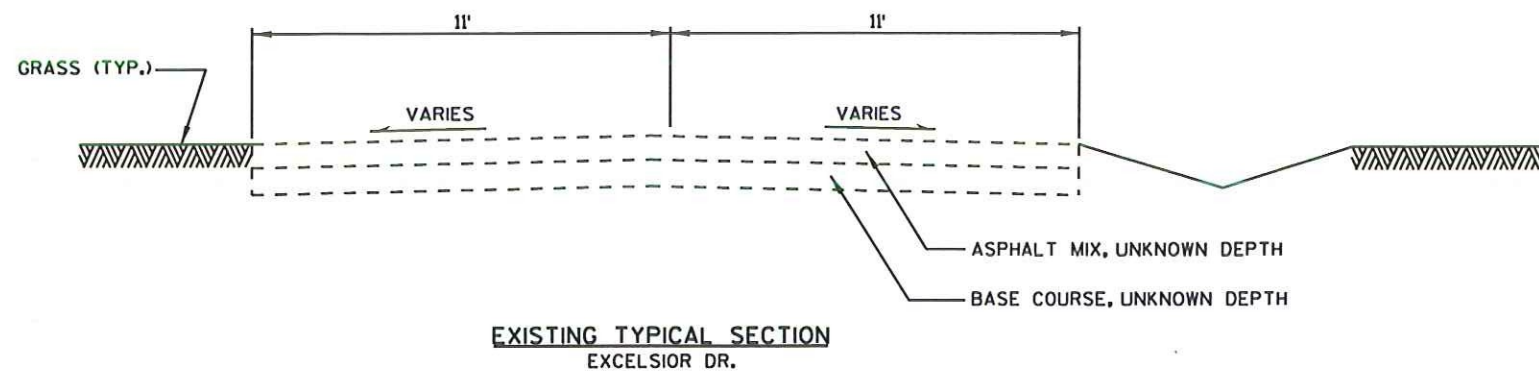

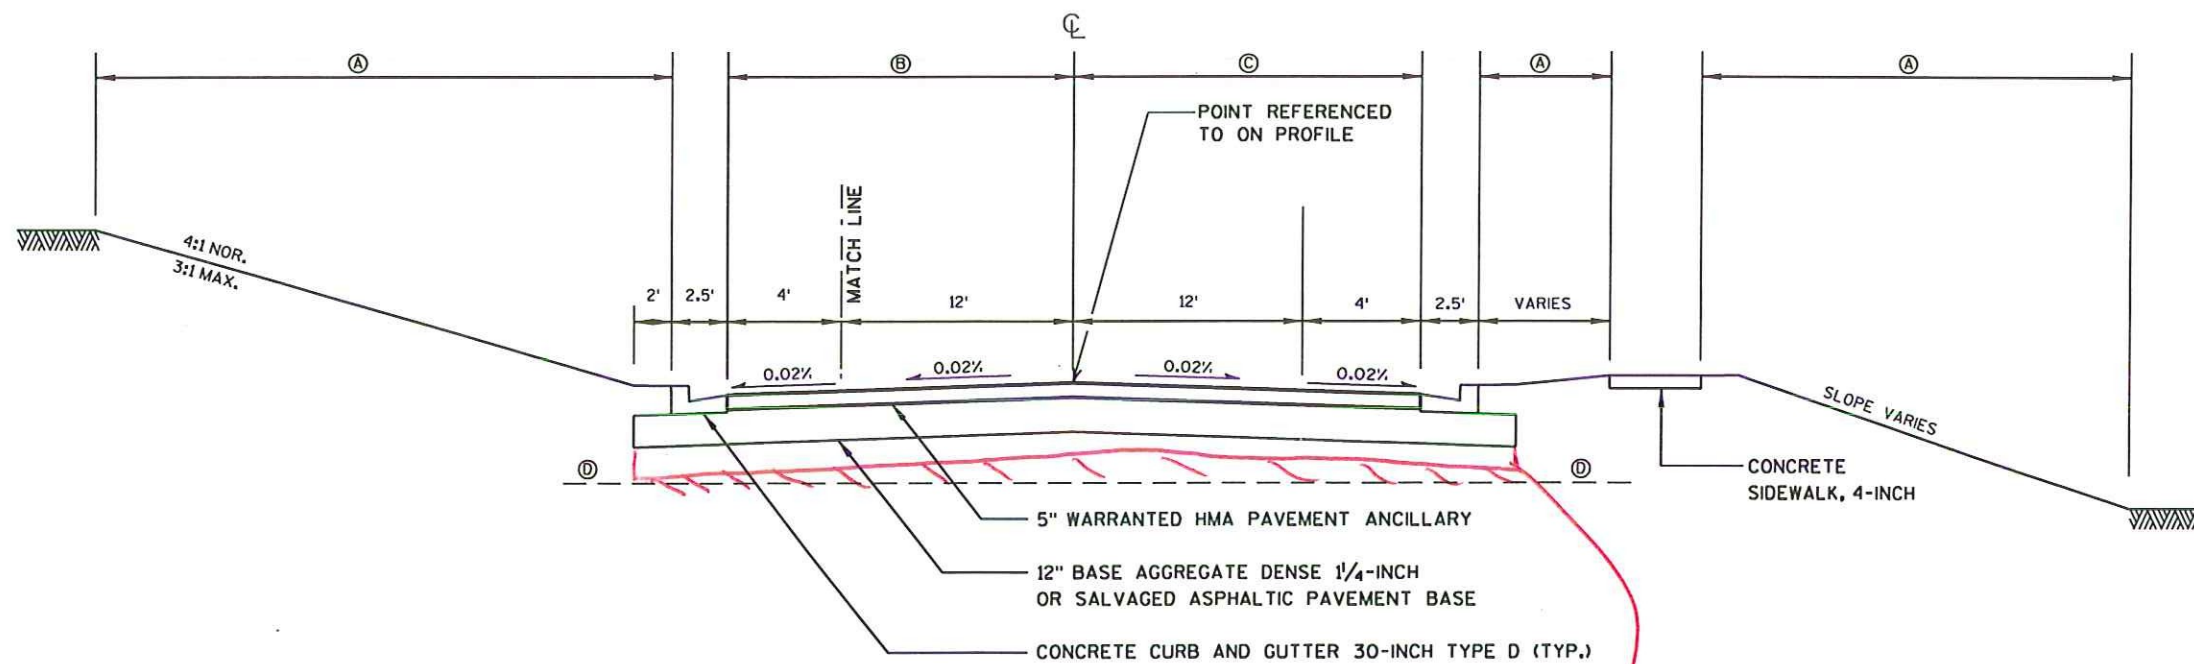

TYPICAL FINISHED SECTION
STA. 102+04.29 - STA. 122+00

1' of select crushed material plus a layer of geogrid below it from STA 113+00 - 116+50

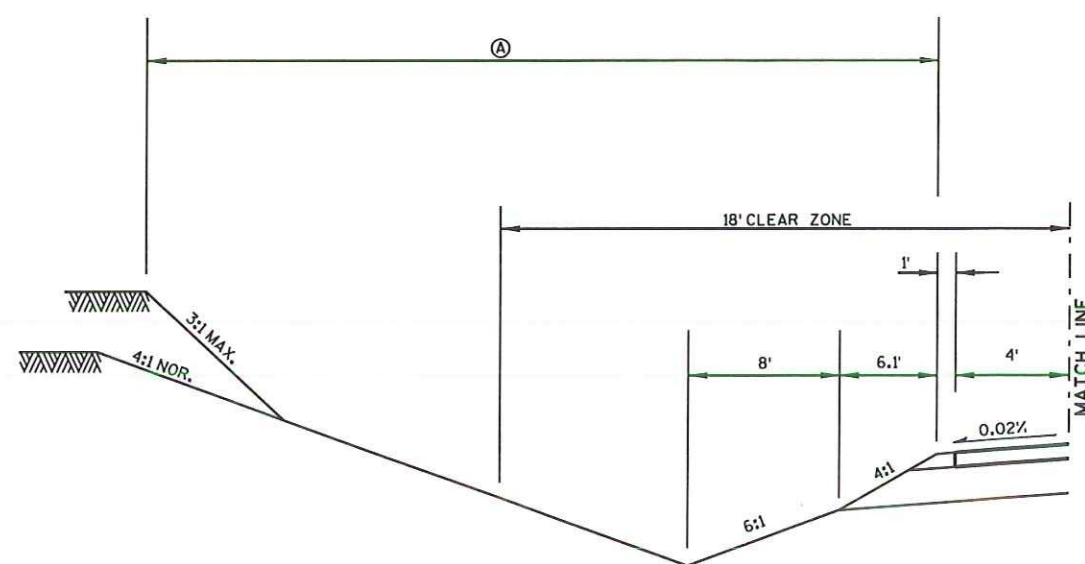


STA. 102+04.29 - STA. 104+29.88 LT



- Ⓐ LAWN SOD; FERTILIZER, TYPE B; AND SALVAGED TOPSOIL
- Ⓑ PAVEMENT WIDTH IS 20' FROM APPROXIMATELY STA. 119+25 TO STA. 122+00.
- Ⓒ PAVEMENT WIDTH IS 18' FROM APPROXIMATELY STA. 119+25 TO STA. 122+00.
- Ⓓ ROCK EXCAVATION FROM APPROXIMATELY STA. 118+00 TO STA. 123+00. SEE CROSS SECTION SHEETS FOR MORE DETAIL.

NOTE:

SALVAGED TOPSOIL SHALL BE PLACED TO A 12-INCH MINIMUM DEPTH ON ALL ROCK CUT DITCH SLOPES FLATTER THAN 2:1. PAID FOR AS "SALVAGED TOPSOIL, SPECIAL". 12-INCH ROCK UNDERCUT PAID FOR AS "ROCK EXCAVATION."

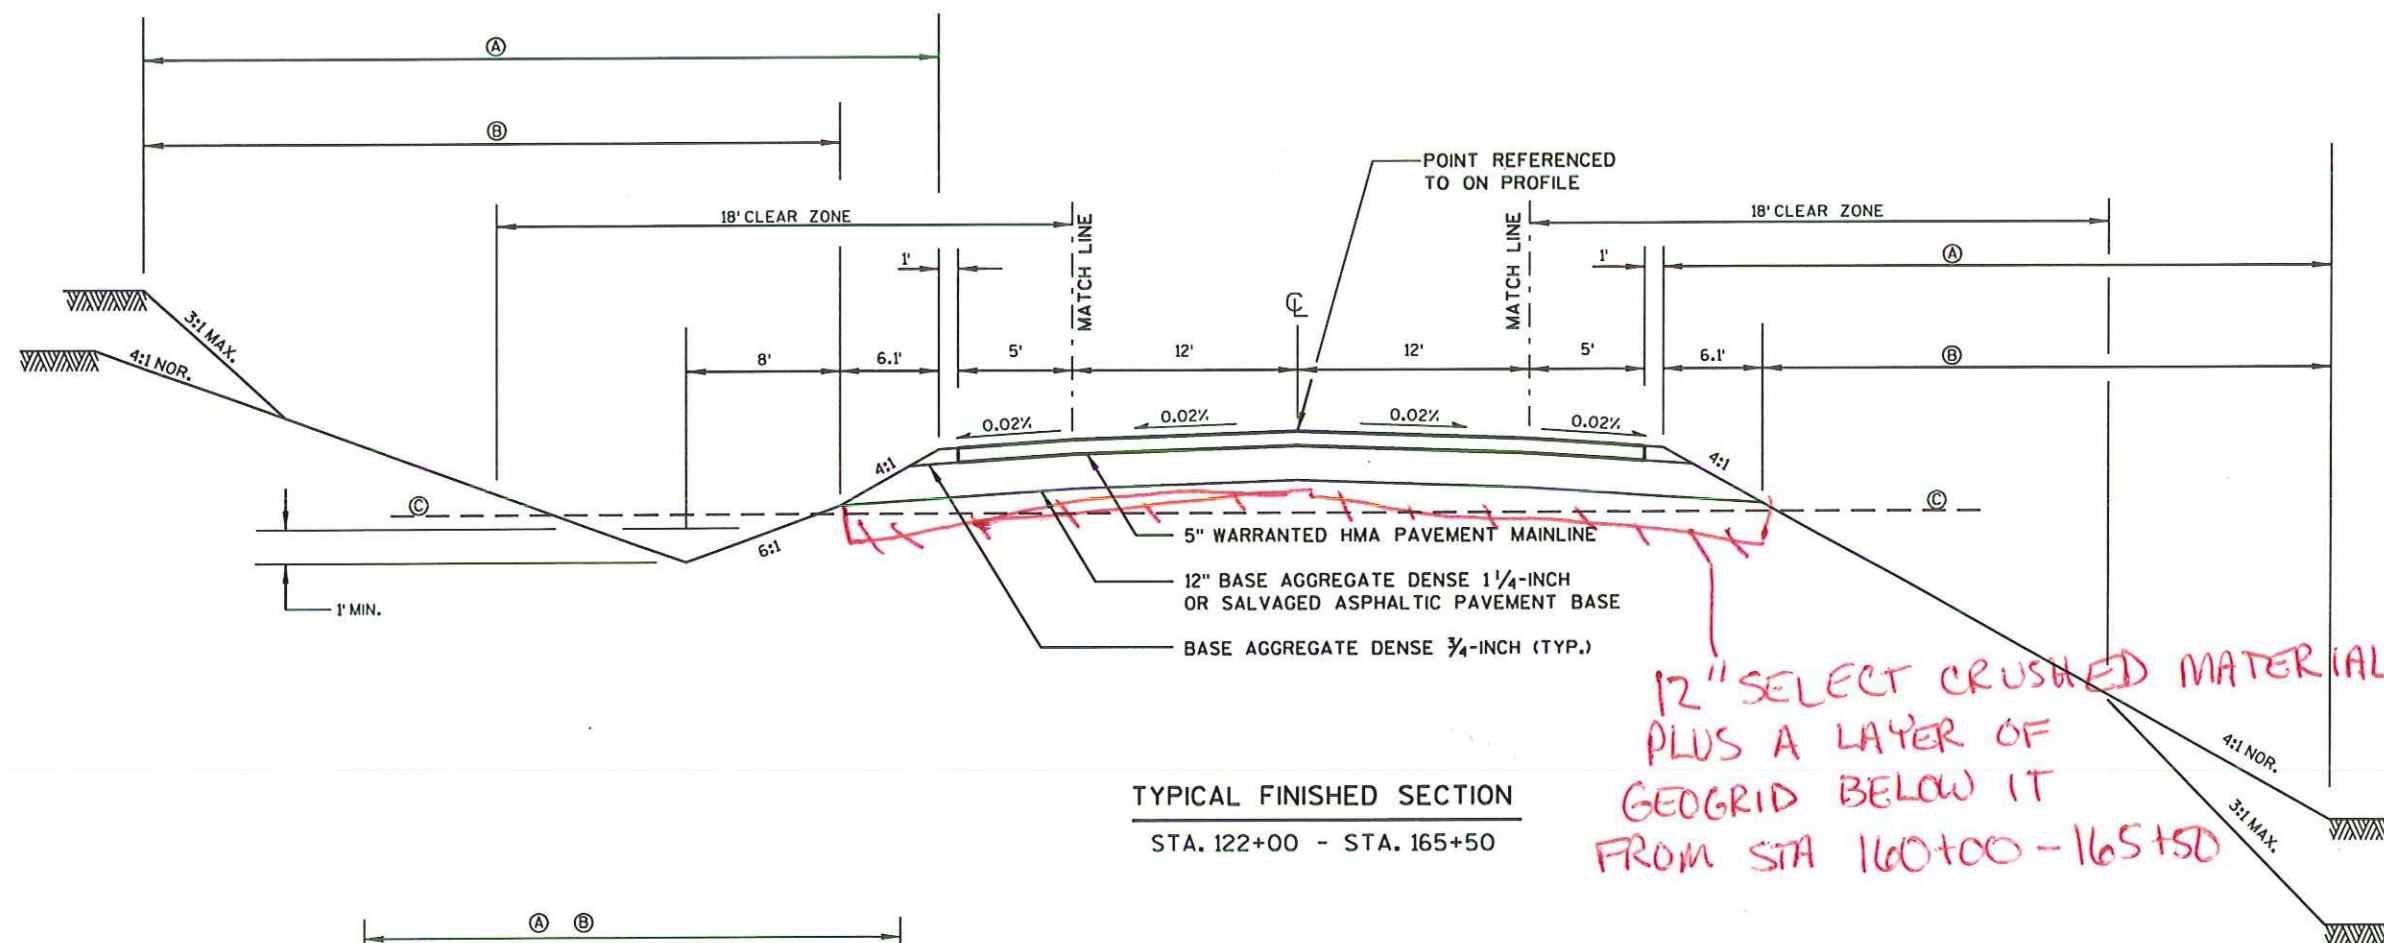

TYPICAL FINISHED SECTION
STA. 122+00 - STA. 165+50

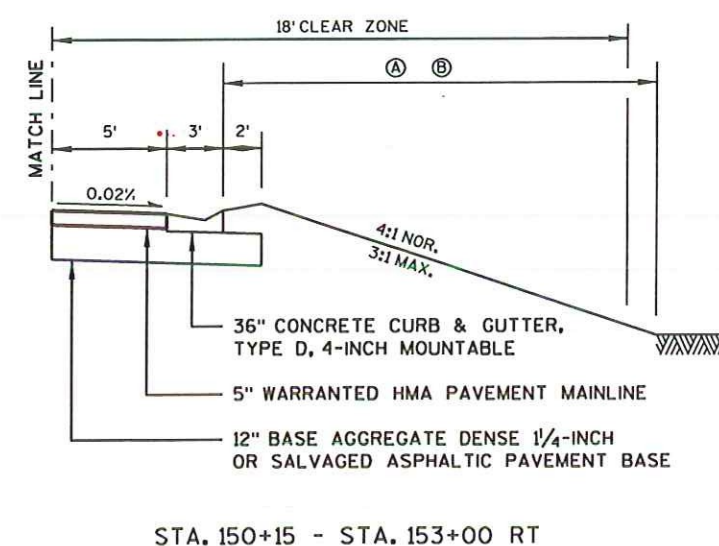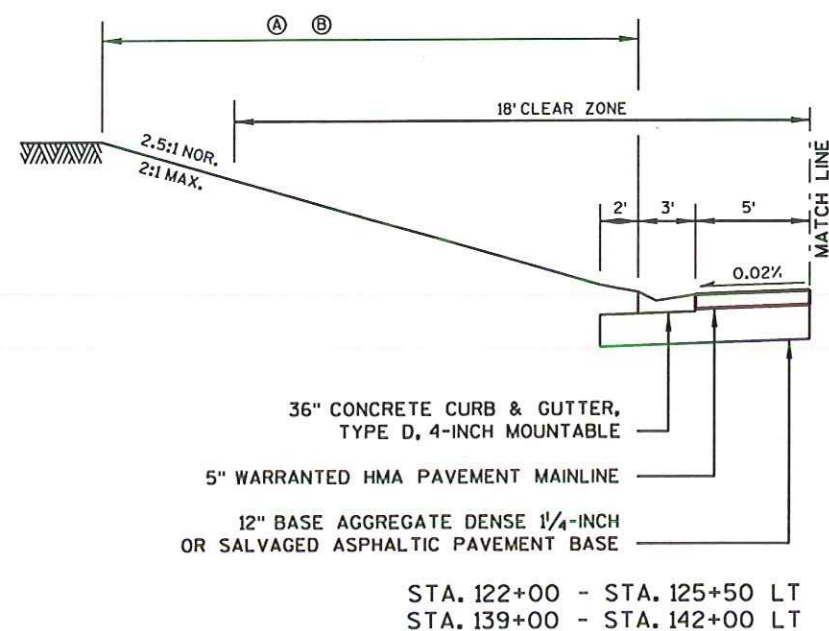

① SEEDING, MIXTURE NO. 30;
SEEDING, TEMPORARY; AND
FERTILIZER, TYPE B


② SALVAGED TOPSOIL AND
MULCHING

③ ROCK EXCAVATION FROM APPROXIMATELY
STA. 138+00 - STA. 141+00
STA. 151+00 - STA. 153+00
STA. 159+00 - STA. 163+00

SEE CROSS SECTION SHEETS FOR
MORE DETAIL

NOTE:


SALVAGED TOPSOIL SHALL BE PLACED TO A 12-INCH MINIMUM DEPTH ON ALL ROCK CUT DITCH SLOPES FLATTER THAN 2:1. PAID FOR AS "SALVAGED TOPSOIL, SPECIAL". 12-INCH ROCK UNDERCUT PAID FOR AS "ROCK EXCAVATION."

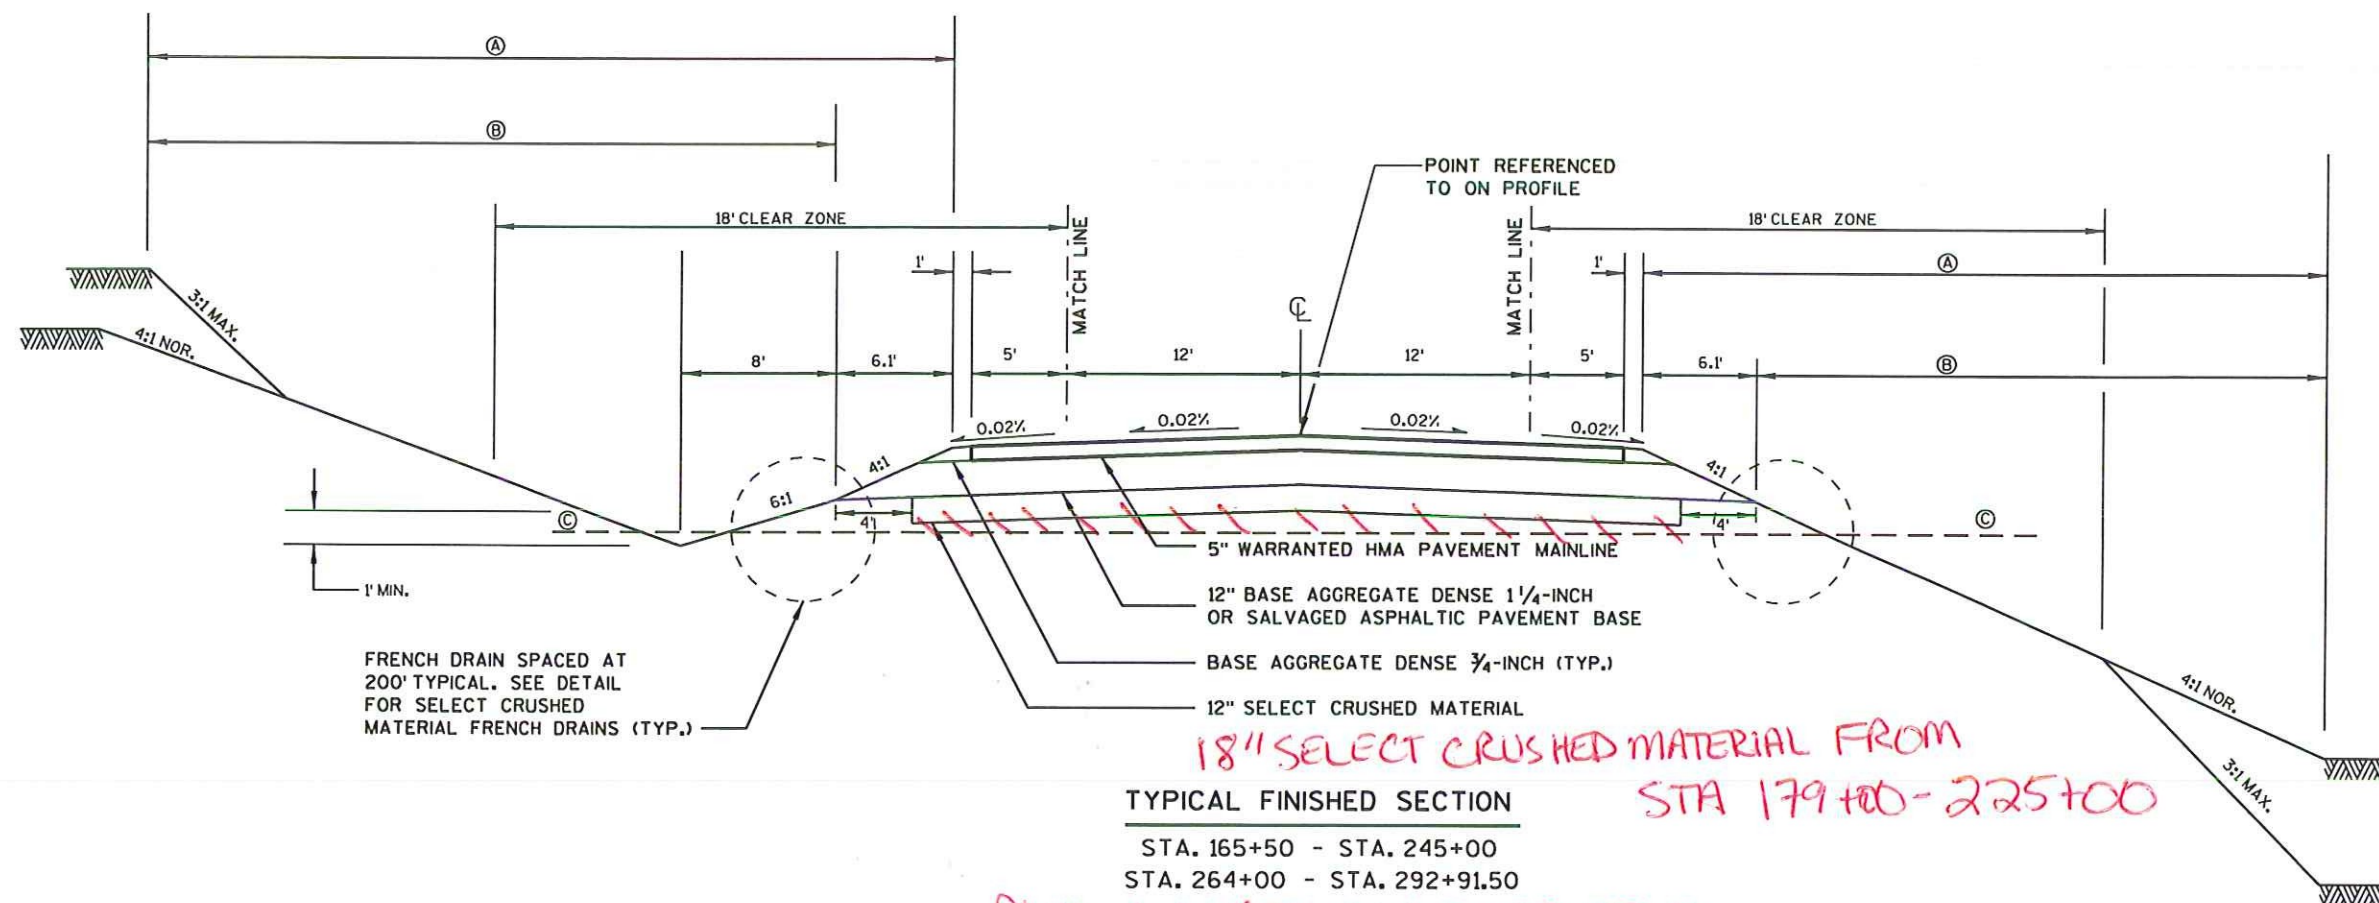


TYPICAL FINISHED SECTION

STA. 165+50 - STA. 245+00
STA. 264+00 - STA. 292+91.50

PLUS A LAYER OF GEOTRID FROM
STA 165+50 - 245+00 AND 267+00 - 280+00

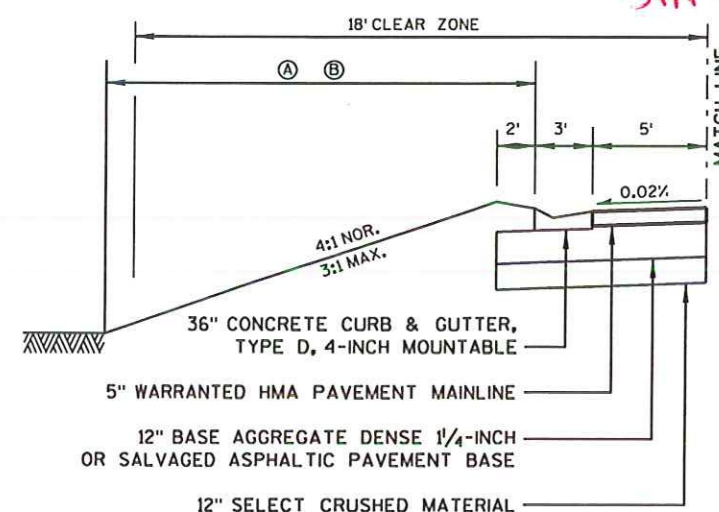


STA. 177+00 - STA. 178+81 LT
STA. 264+00 - STA. 274+63 LT
STA. 282+00 - STA. 290+70 LT

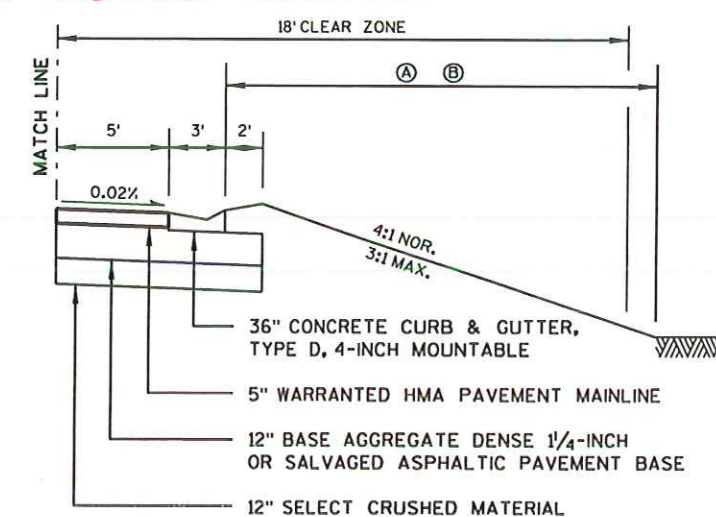


STA. 217+88 - STA. 216+50 RT
STA. 229+25 - STA. 230+55 RT

- Ⓐ SEEDING, MIXTURE NO. 30; SEEDING, TEMPORARY; AND FERTILIZER, TYPE B
 - Ⓑ SALVAGED TOPSOIL AND MULCHING
 - Ⓒ ROCK EXCAVATION FROM APPROXIMATELY STA. 284+00 - STA. 288+00
- SEE CROSS SECTION SHEETS FOR MORE DETAIL

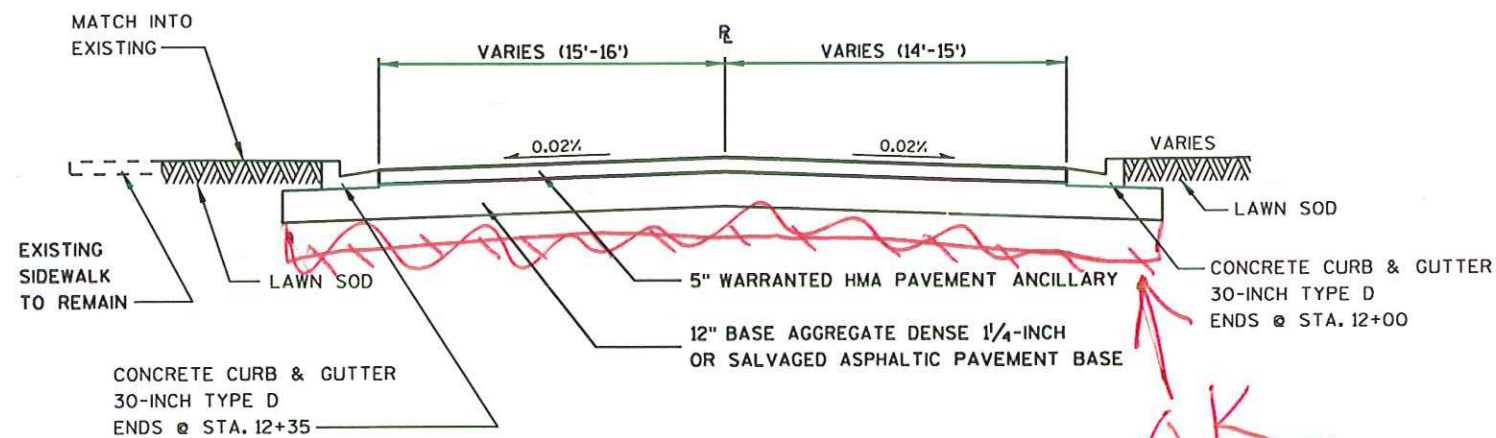


TYPICAL FINISHED SECTION
MADISON ST.

OK
(NO CHANGE)

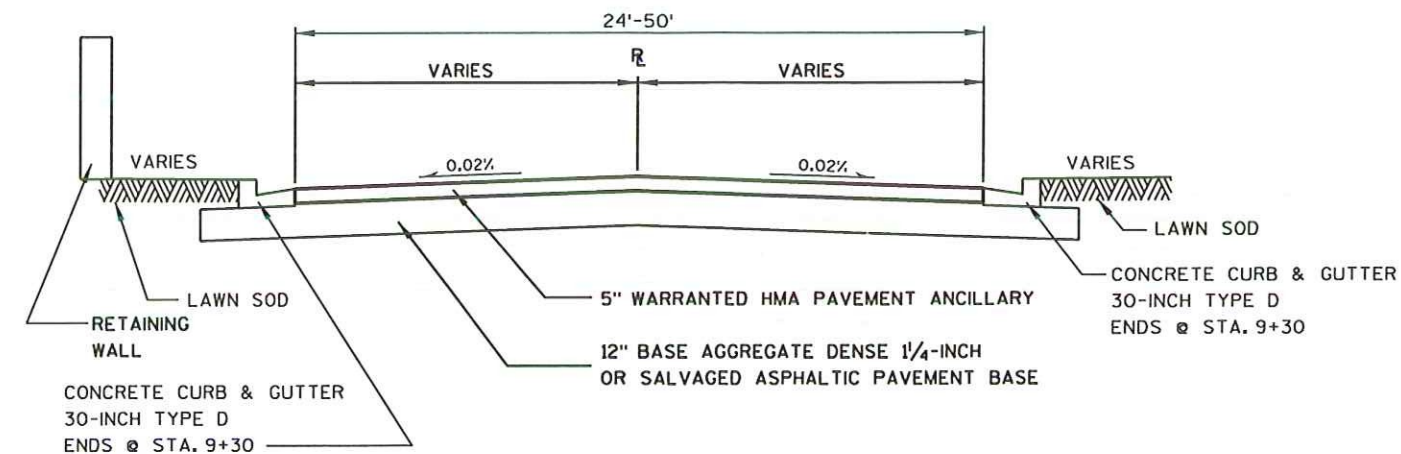


TYPICAL FINISHED SECTION
BENDER ST.


12" SELECT CRUSHED MATERIAL PLUS A LAYER OF GEGRID FOR THE ENTIRE SIDESTREET

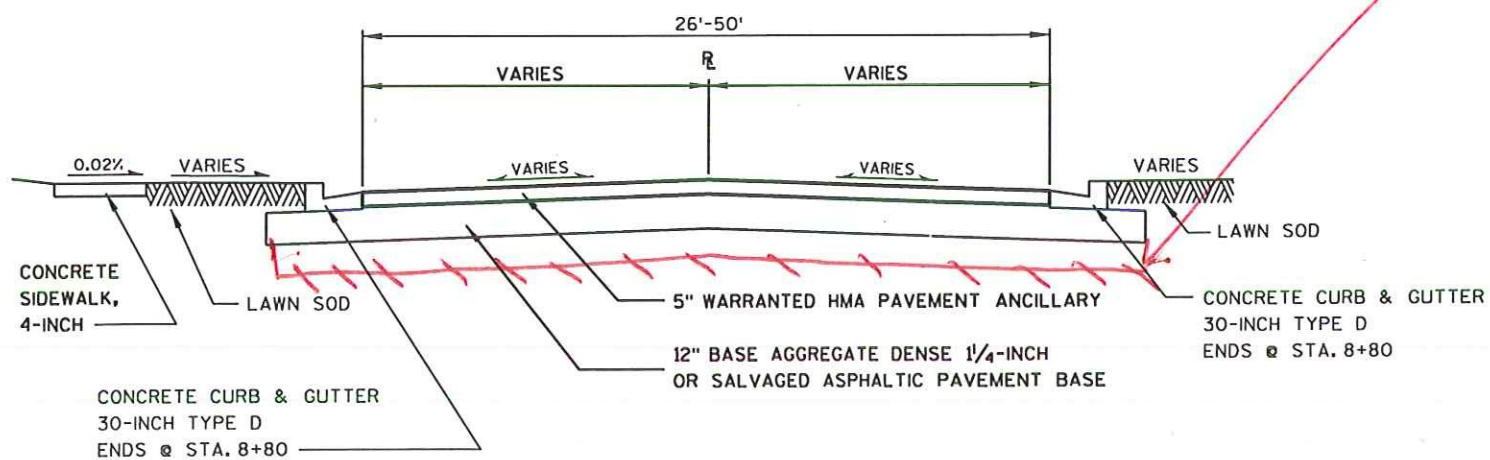


TYPICAL FINISHED SECTION
MONTGOMERY ST.

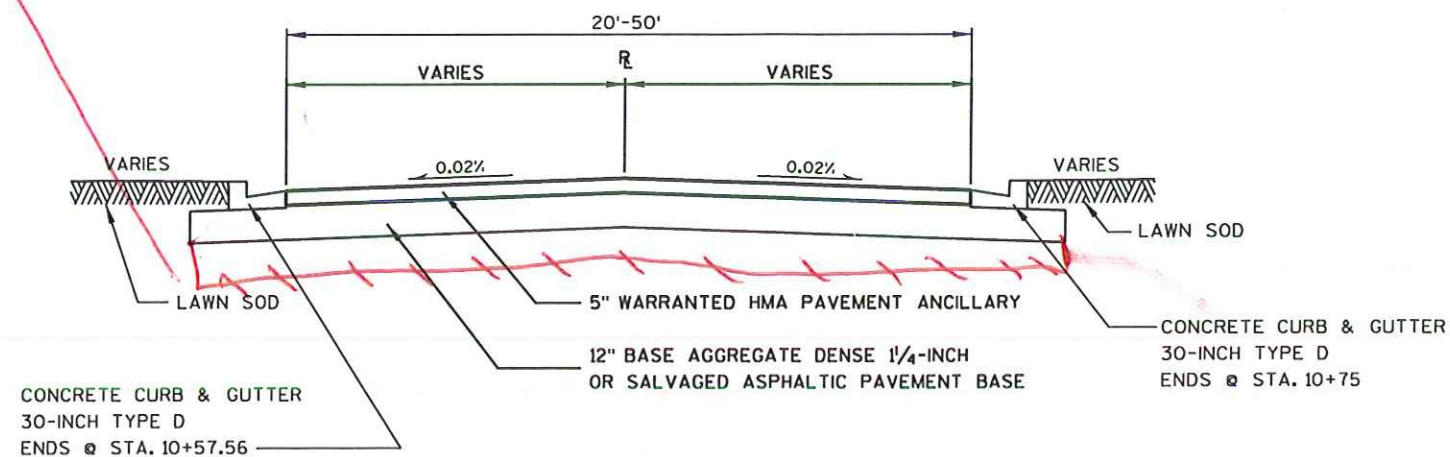


TYPICAL FINISHED SECTION
HOLTZ RD.

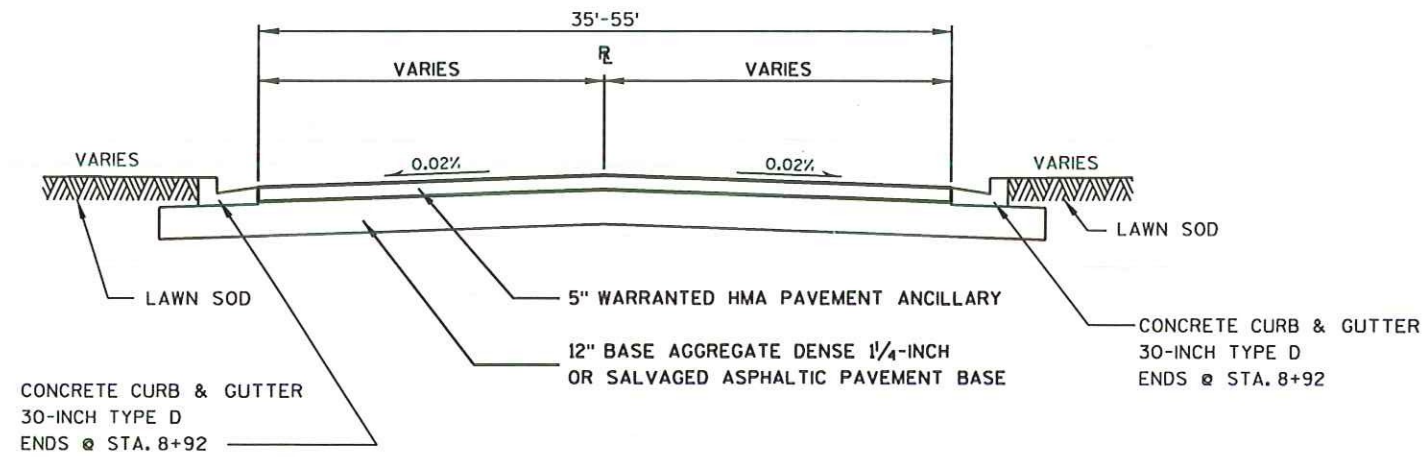


TYPICAL FINISHED SECTION
QUARRY RD.

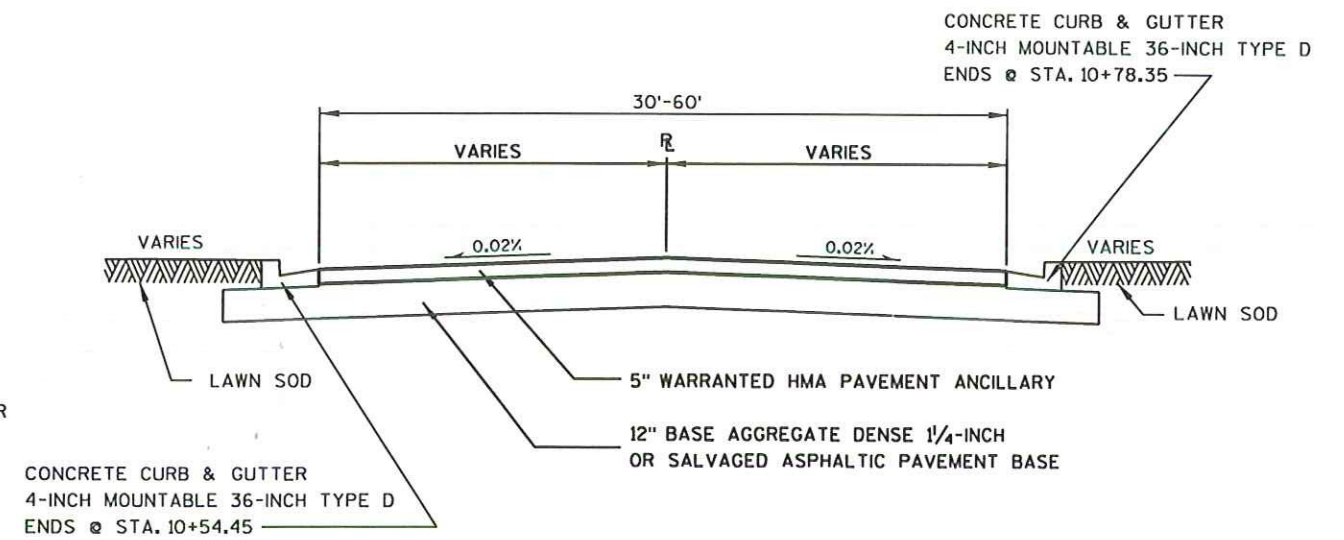

TYPICAL FINISHED SECTION
CTH 1

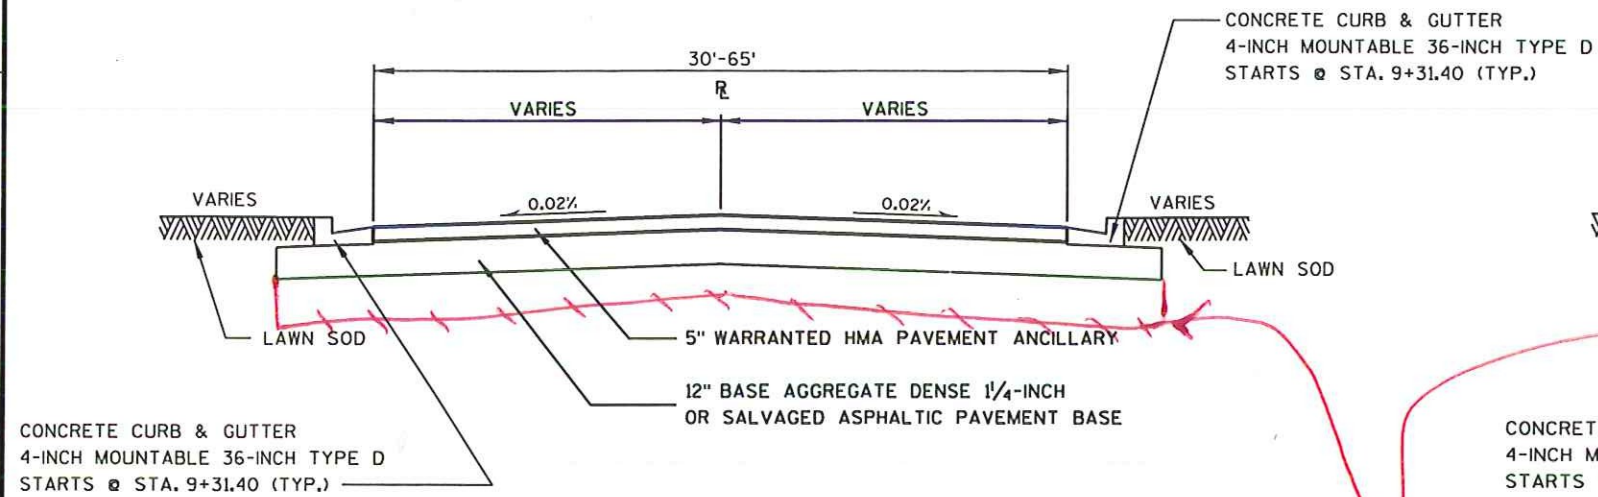


TYPICAL FINISHED SECTION
EXCELSIOR DR.

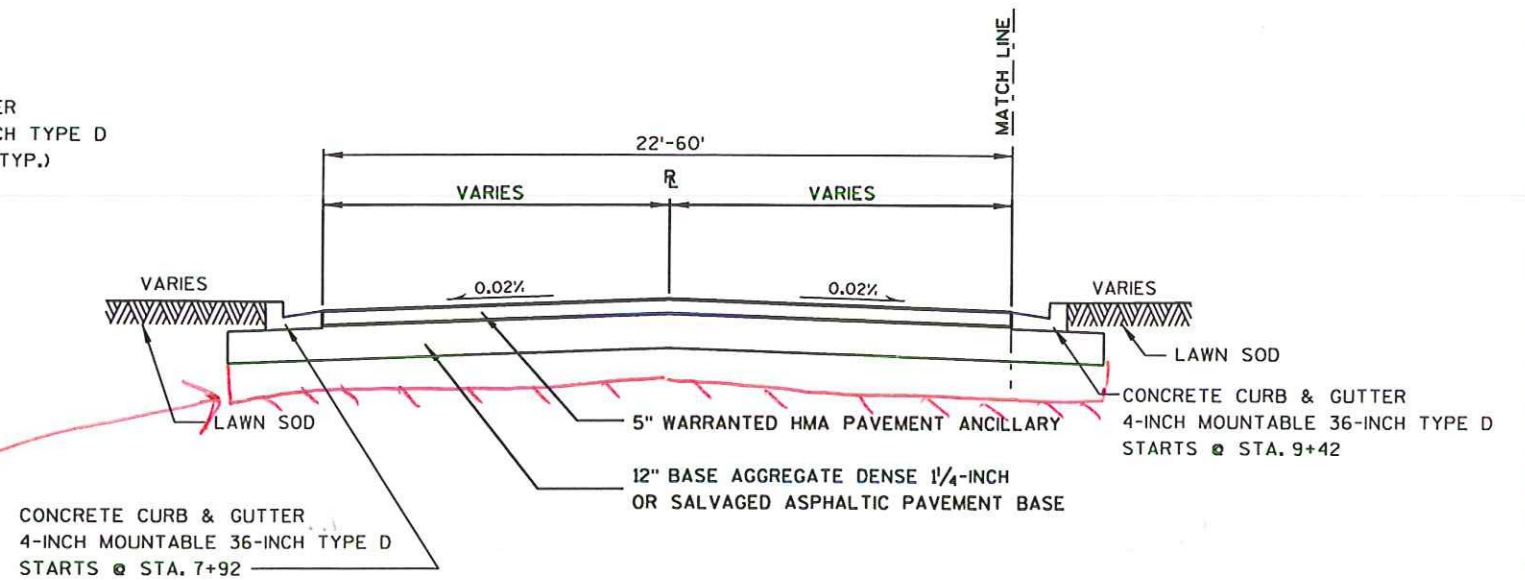

TYPICAL FINISHED SECTION
BELTER DR.


12" SELECT CRUSHED ON EXCELSIOR DR
18" SELECT CRUSHED ON BELTER DR
PLUS A LAYER OF GEOGRID FOR
THE ENTIRE SIDESTREET

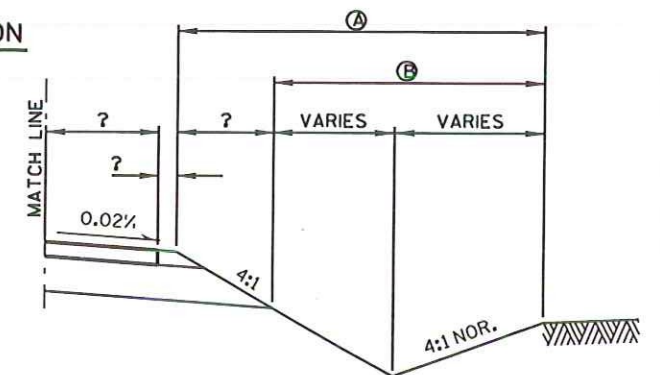

Ⓐ SEEDING, MIXTURE NO. 30;
SEEDING TEMPORARY; AND
FERTILIZER, TYPE B


Ⓑ SALVAGED TOPSOIL AND MULCHING

DRIVEWAY ENTRANCE DETAIL WITH SIDEWALK, CURB & GUTTER

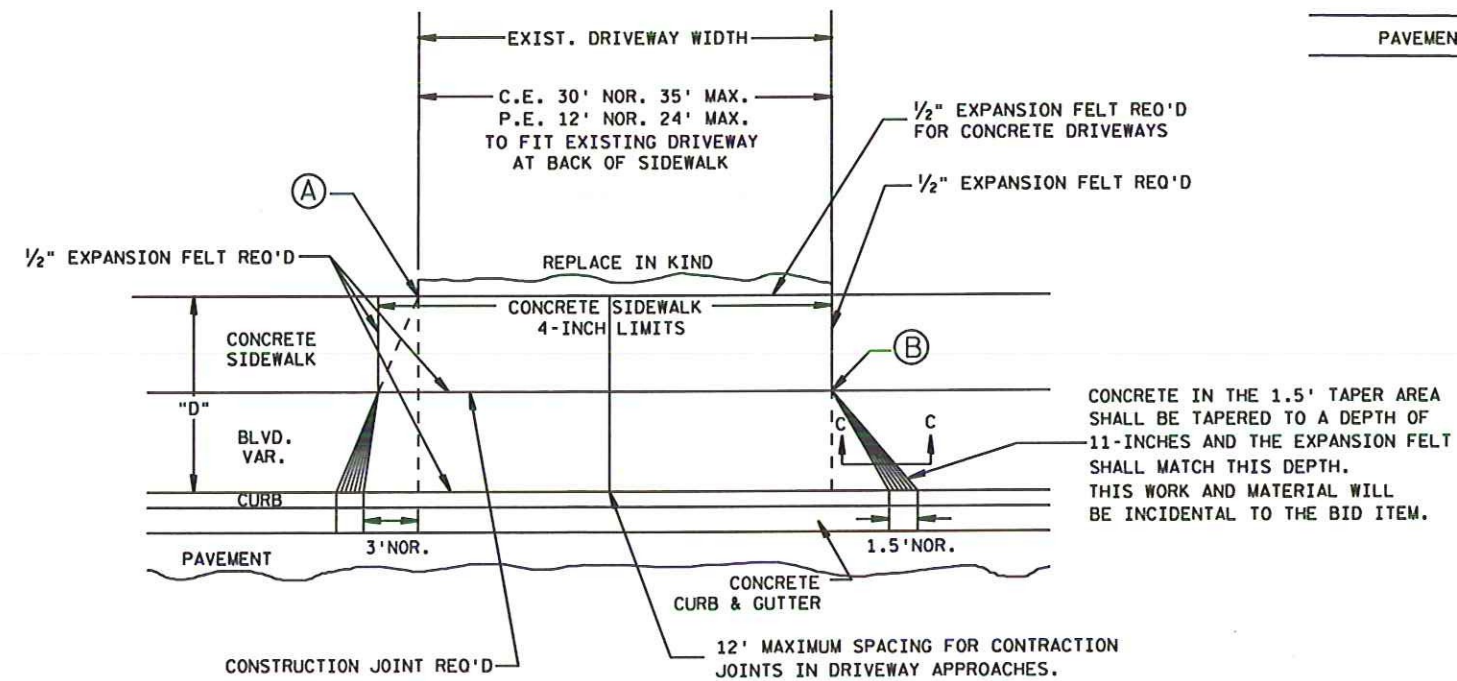


PLAN VIEW

- (A) WHEN "D" IS 13' OR LESS, ALIGN TAPER WITH BACK OF SIDEWALK
- (B) WHEN "D" IS GREATER THAN 13', ALIGN TAPER WITH FRONT OF SIDEWALK

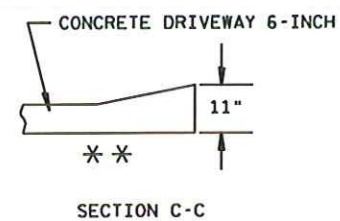

SECTION C-C

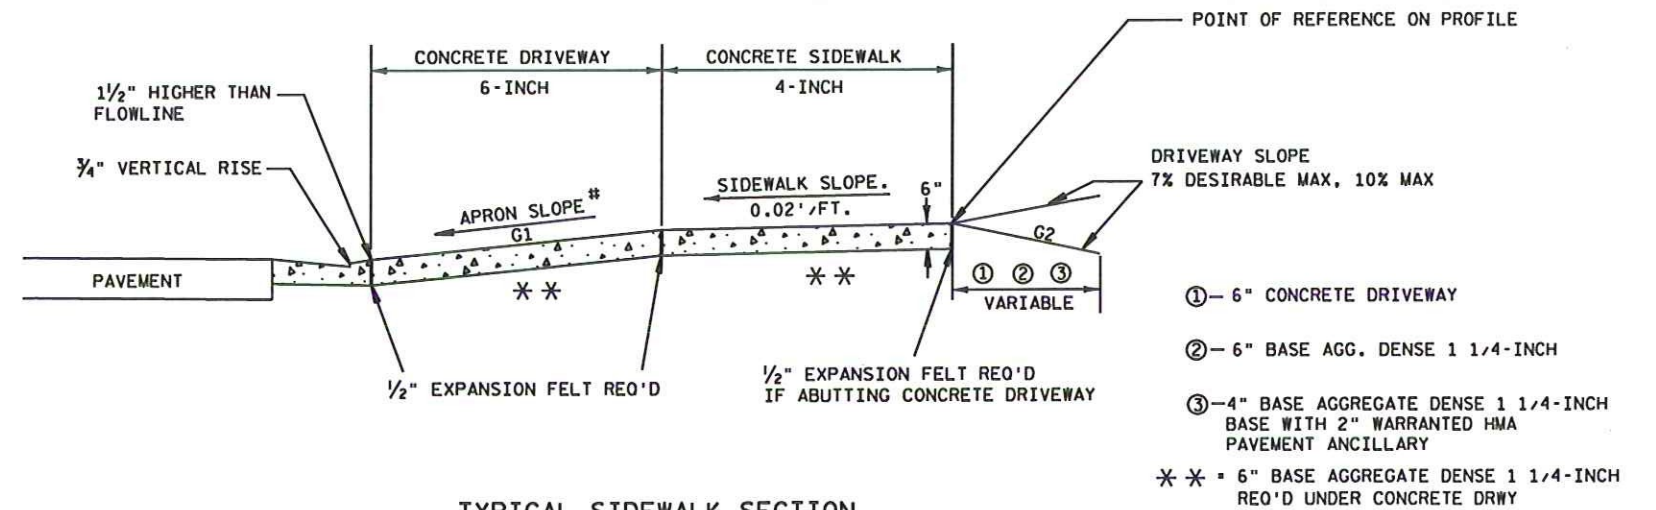


TYPICAL SIDEWALK SECTION


TERRACE WIDTH	APRON SLOPE (G1)		
	MIN %	DESIRABLE %	MAX %
3 FT	7.0	8.5	9.0
4 FT	5.0	7.0	9.0
5 FT	4.0	7.0	9.0
6 FT	4.0	7.0	9.0
7 FT	3.5	7.0	9.0
8 FT	3.0	7.0	9.0

NOTE: ALGEBRAIC DIFFERENCE BETWEEN TANGENT GRADES G1 & G2 TO NOT EXCEED 15%


DEPRESS SIDEWALK PROFILE IF DRIVEWAY APRON EXCEEDS MAX SLOPE

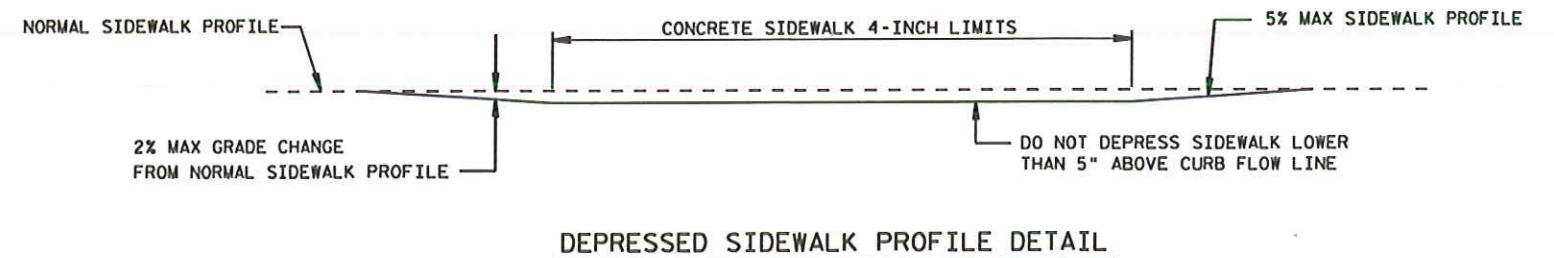



DEPRESSED SIDEWALK PROFILE DETAIL

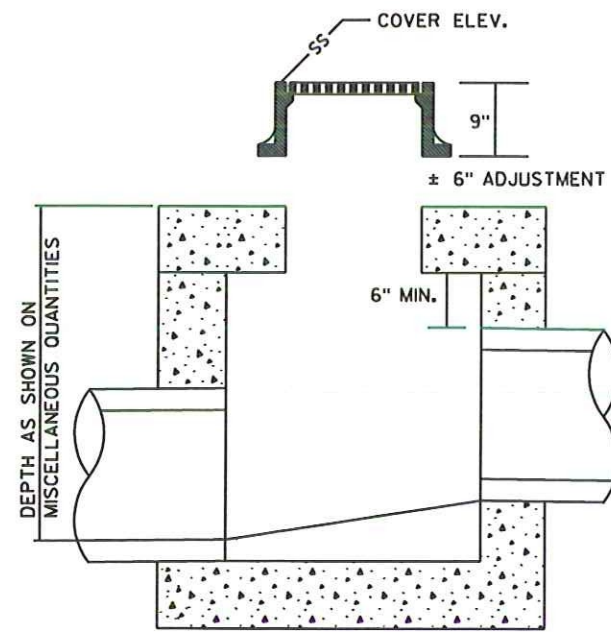

MANHOLE - TYPE 1 OR 3

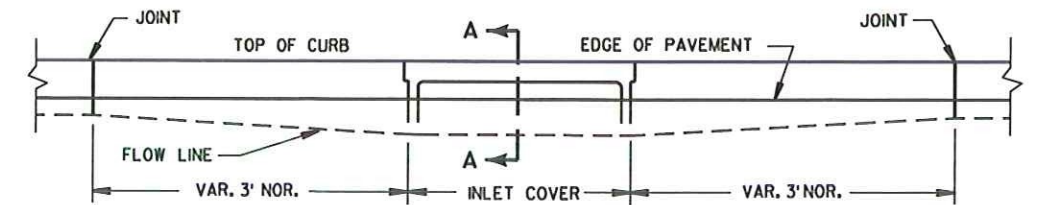DETAIL FOR COMPUTING MANHOLE ELEVATIONS

ELEVATION

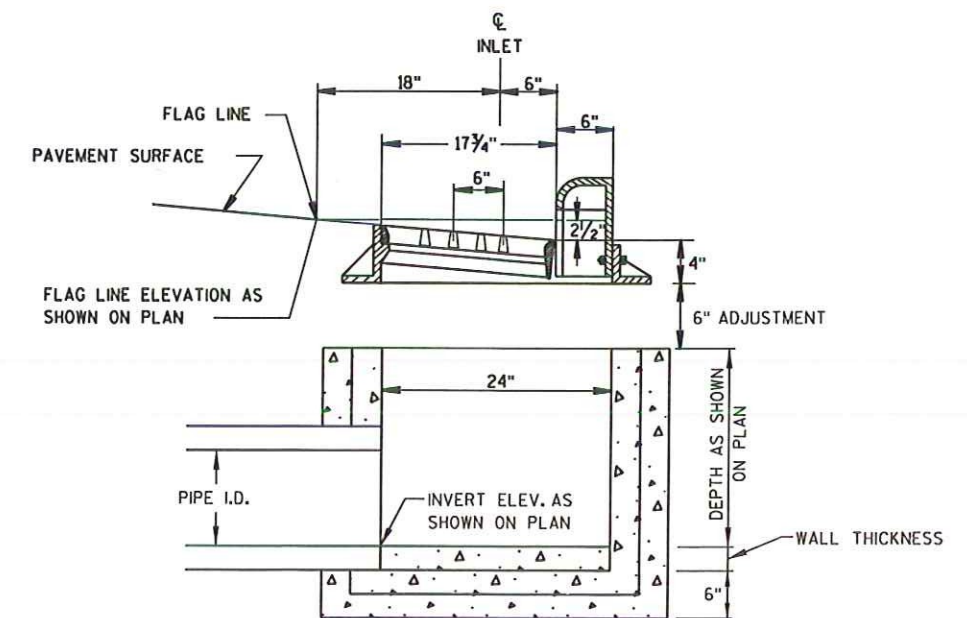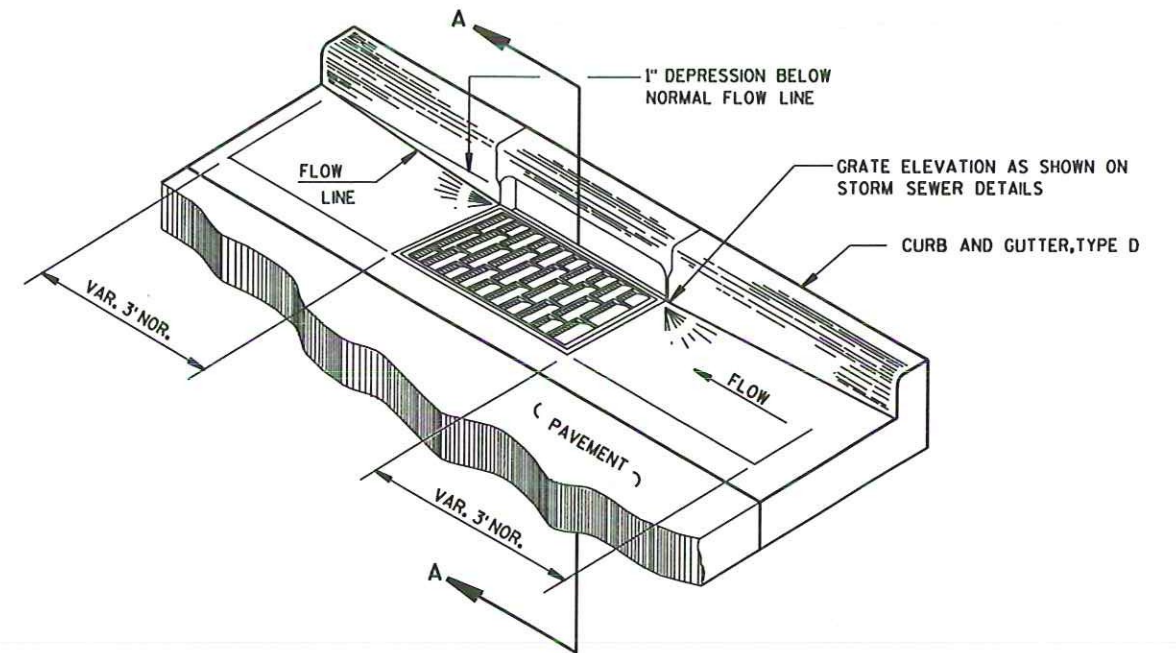


SECTION A-A

DETAIL OF CURB AND GUTTER AT INLETS
(TYPE 3-H INLET SHOWN)

RUNOFF COEFFICIENT TABLE

	HYDROLOGIC SOIL GROUP											
	A			B			C			D		
	SLOPE RANGE (PERCENT)			SLOPE RANGE (PERCENT)			SLOPE RANGE (PERCENT)			SLOPE RANGE (PERCENT)		
LAND USE:	0-2	2-6	6 & OVER	0-2	2-6	6 & OVER	0-2	2-6	6 & OVER	0-2	2-6	6 & OVER
ROW CROPS	.08 .22	.16 .30	.22 .38	.12 .26	.20 .34	.27 .44	.15 .30	.24 .37	.33 .50	.19 .34	.28 .41	.38 .56
MEDIAN STRIP-TURF	.19 .24	.20 .26	.24 .30	.19 .25	.22 .28	.26 .33	.20 .26	.23 .30	.30 .37	.20 .27	.25 .32	.30 .40
SIDE SLOPE-TURF			.25 .32			.27 .34			.28 .36			.30 .38
PAVEMENT:												
ASPHALT	.70 - .95											
CONCRETE	.80 - .95											
BRICK	.70 - .80											
DRIVES, WALKS	.75 - .85											
ROOFS	.75 - .95											
GRAVEL ROADS, SHOULDERS	.40 - .60											


TOTAL PROJECT AREA = 44.05 ACRES
TOTAL AREA EXPECTED TO BE DISTURBED BY CONSTRUCTION ACTIVITIES = 34.65 ACRES

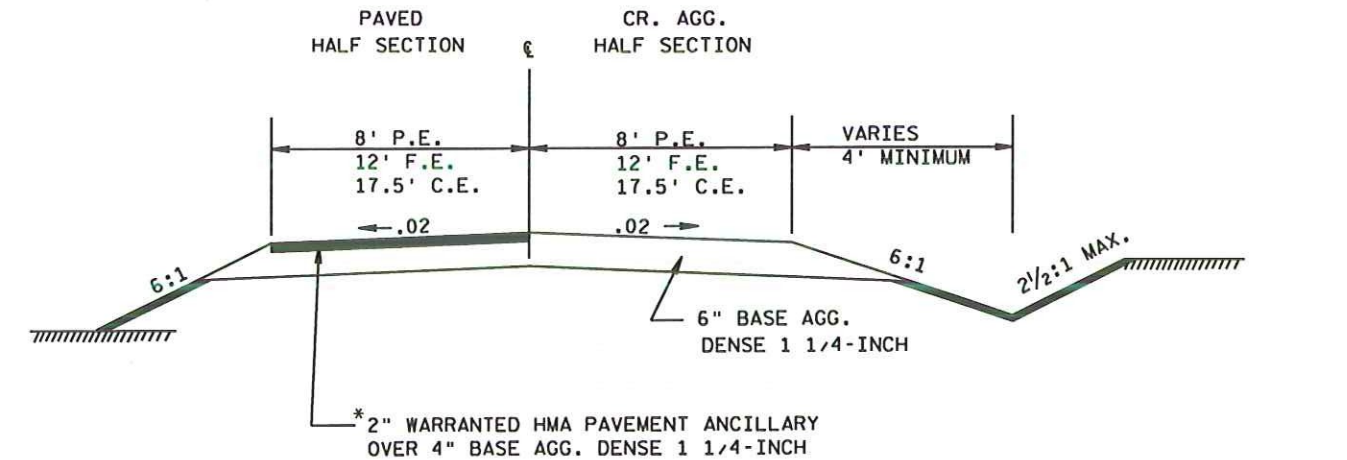


* OR MATCH EXIST.
ASPH. DEPTH

TYPICAL SECTION
FOR PRIVATE ENTRANCES


NOTE:
DRIVEWAY PROFILES NOT EXPECTED TO EXCEED
10%. PLACE LOW POINT OF DRIVEWAY PROFILE
OVER DITCH FLOW LINE.

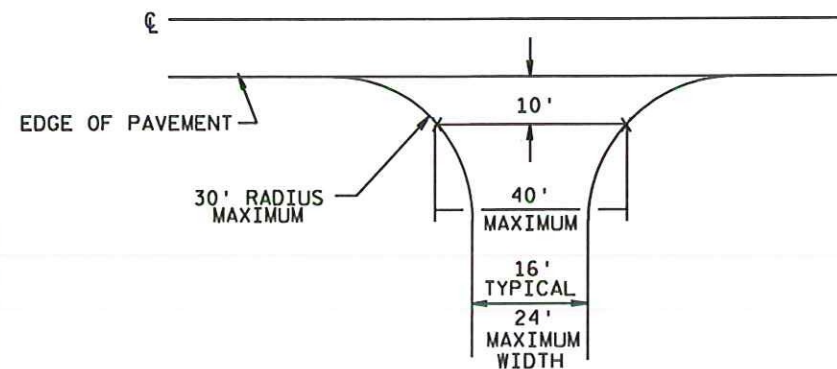

TYPICAL DRIVEWAY DETAIL
(NON-COMMERCIAL RURAL)

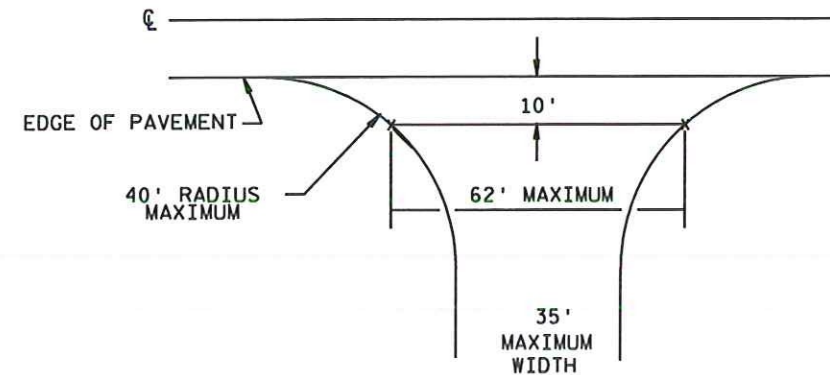


TYPICAL DRIVEWAY DETAIL
(COMMERCIAL RURAL)


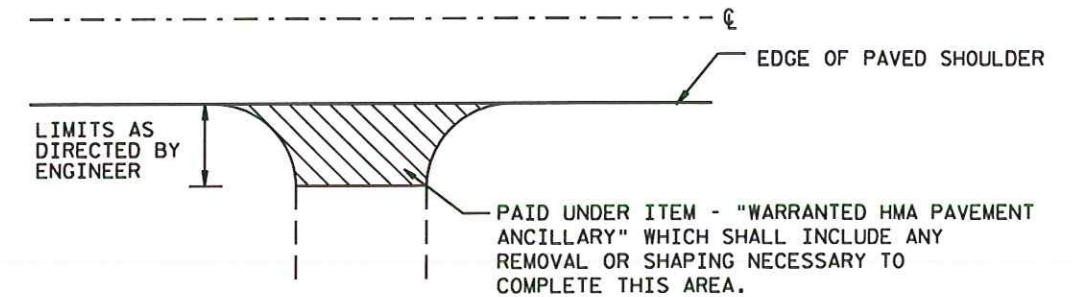


ANY ADDITIONAL BASE AGG. DENSE REQ'D. SHALL BE PAID
UNDER ITEM - "BASE AGGREGATE DENSE 1 1/4-INCH"


RURAL DRIVEWAY DETAIL - ASPHALT

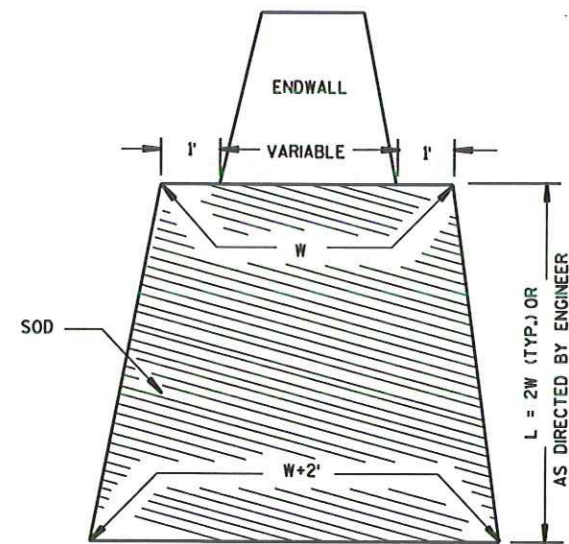


SOD TREATMENT AT CULVERTS

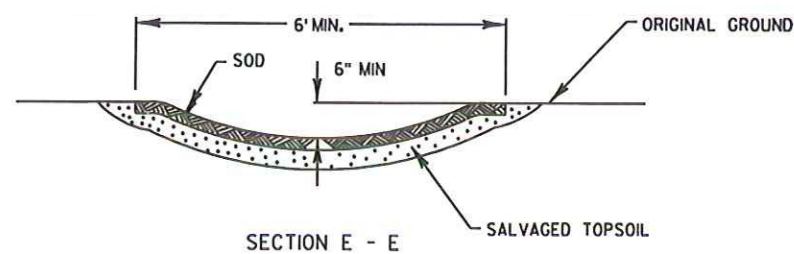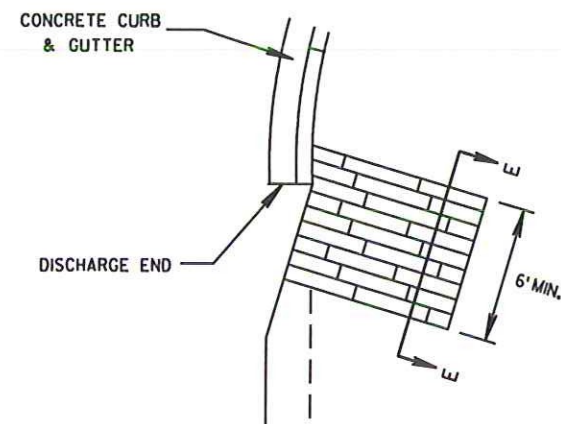


SOD FLUME DETAIL AT CURB ENDS

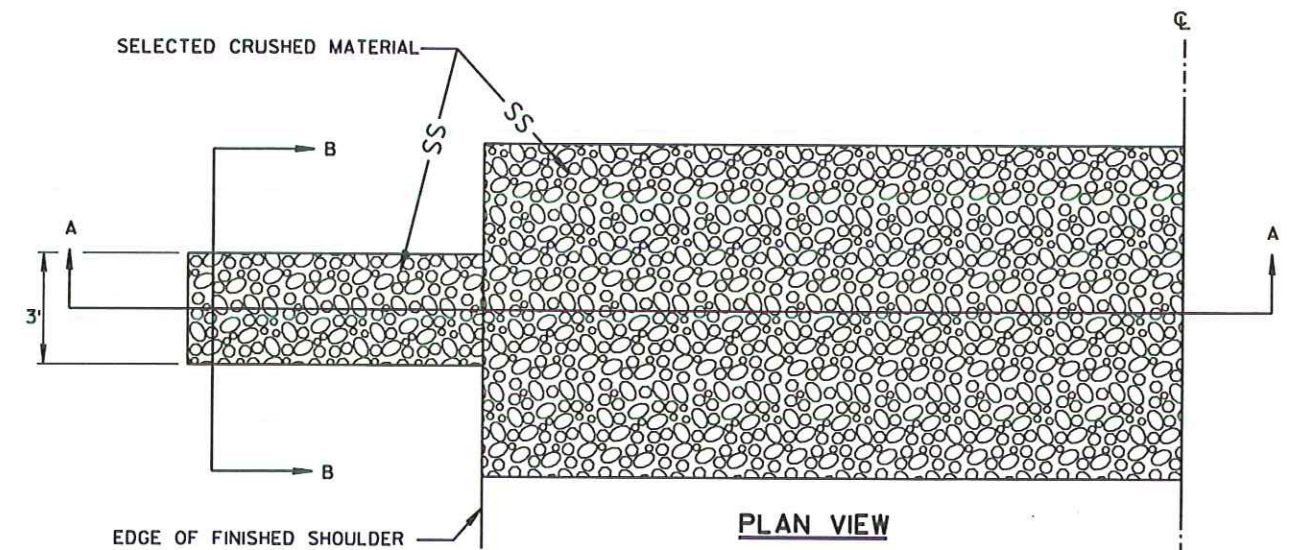

PLAN VIEW

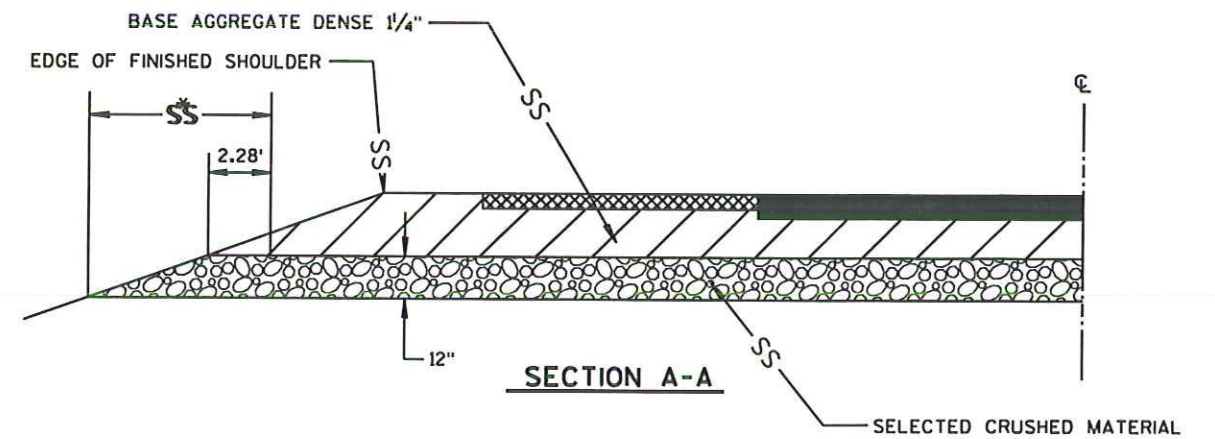

SECTION A-A

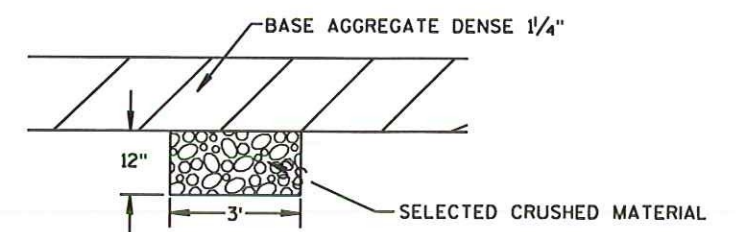


SECTION B-B


*** DETAIL FOR SELECTED CRUSHED MATERIAL FRENCH DRAINS**

(LOCATIONS TO BE DETERMINED IN THE FIELD BY THE ENGINEER, 200' NORMAL)

* EXCAVATION REQUIRED TO CONSTRUCT FRENCH DRAINS SHALL BE CONSIDERED INCIDENTAL TO THE ITEM SELECTED CRUSHED MATERIAL.

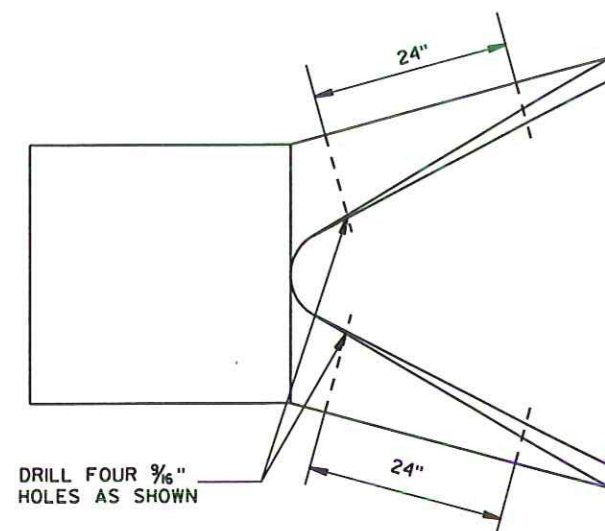



1" ϕ STANDARD PIPE
8" O.C. OR 1" ROD

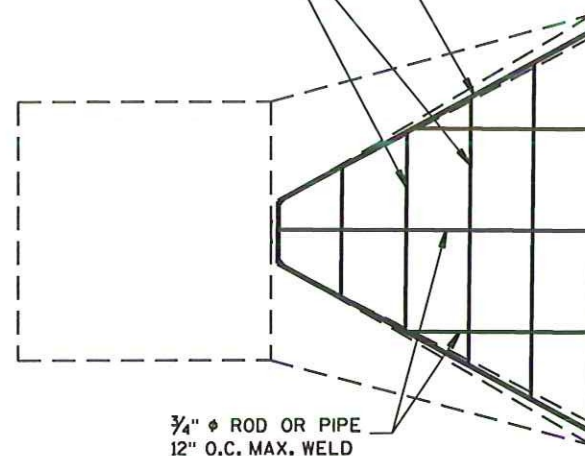


AT EACH PIPE

BOLT GRATE TO CONCRETE ENDWALL
WITH FOUR $\frac{3}{8}$ " X 6" MACHINE BOLTS
PLACE NUTS INSIDE


6" X 4" X $\frac{1}{4}$ " ANGLES (4 REQ'D.)
WELD TO FRAME
PROVIDE $\frac{3}{16}$ " HOLE IN EACH

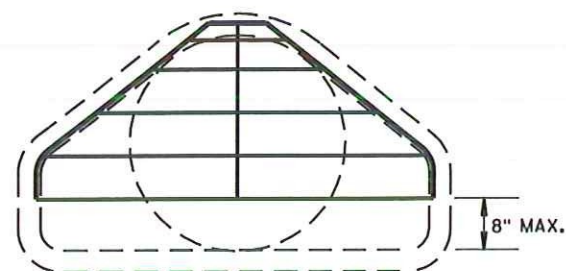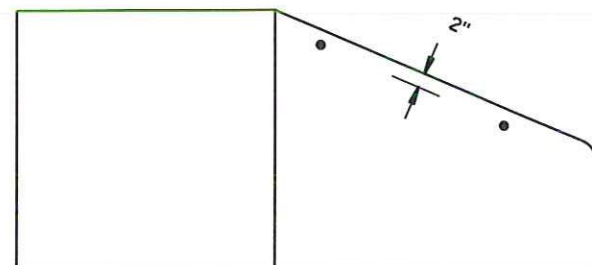


PIPE GRATE DETAIL

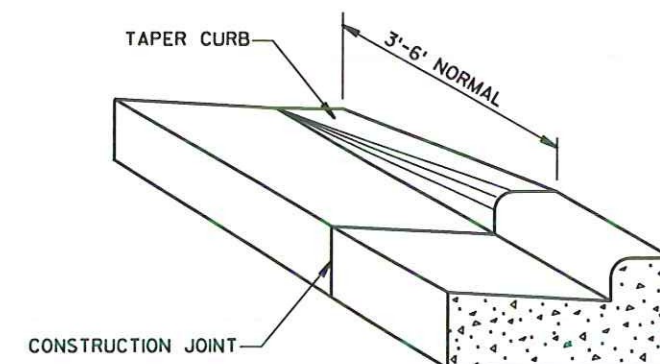





DETAIL OF CURB & GUTTER TERMINI

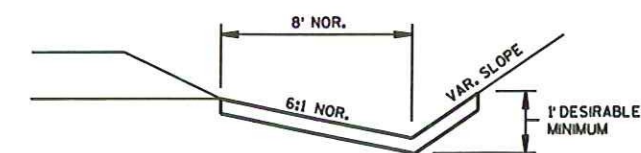

EROSION MAT DETAIL FOR DITCHES

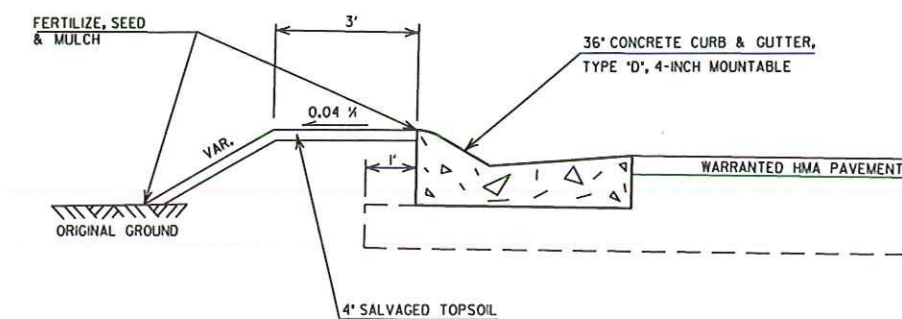


BERM WITH 36-INCH CURB AND GUTTER

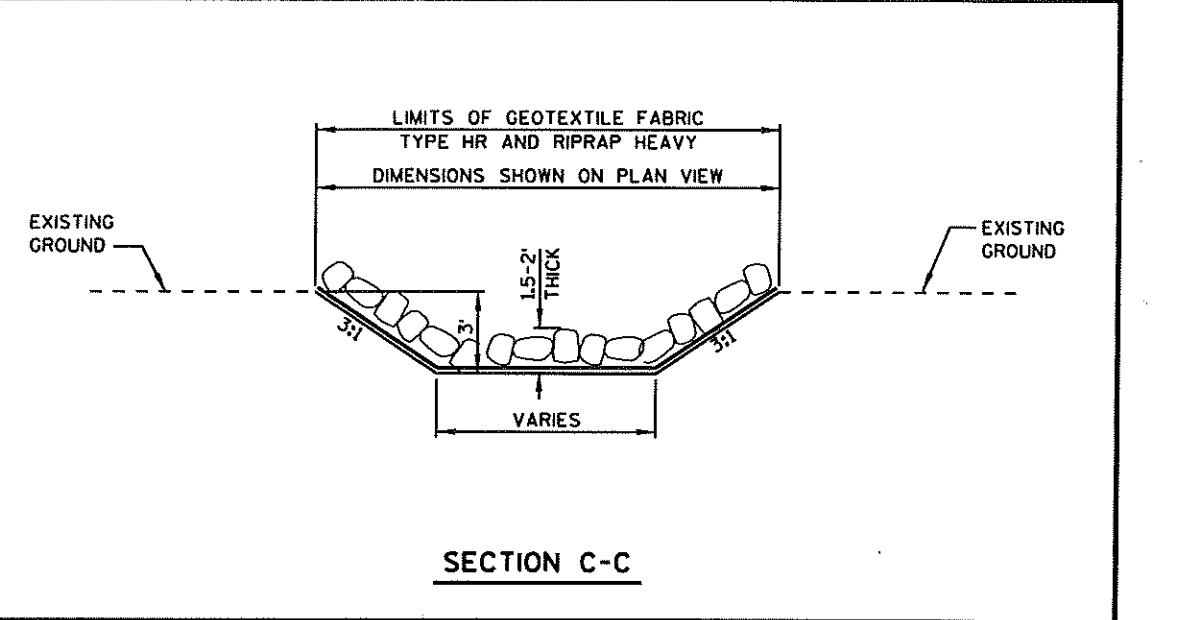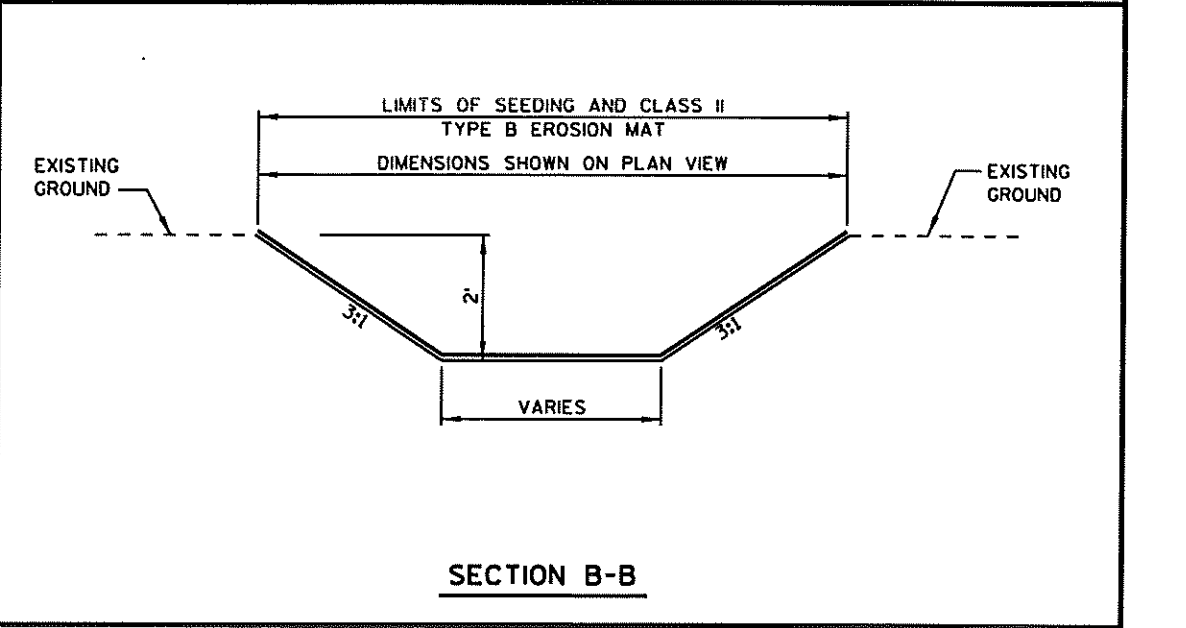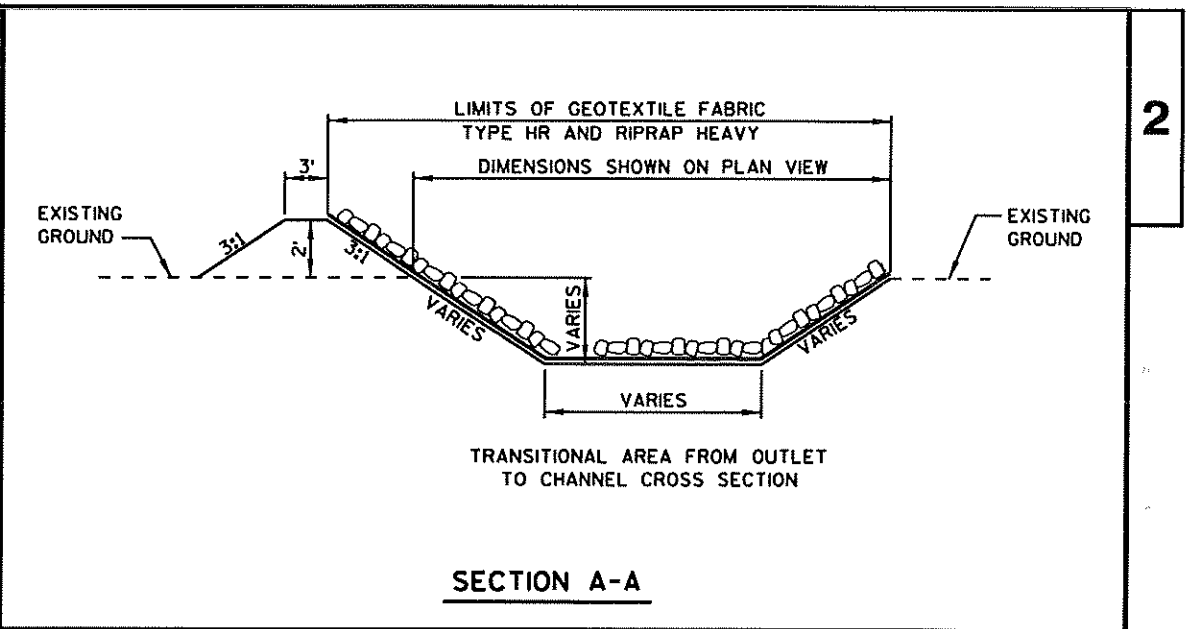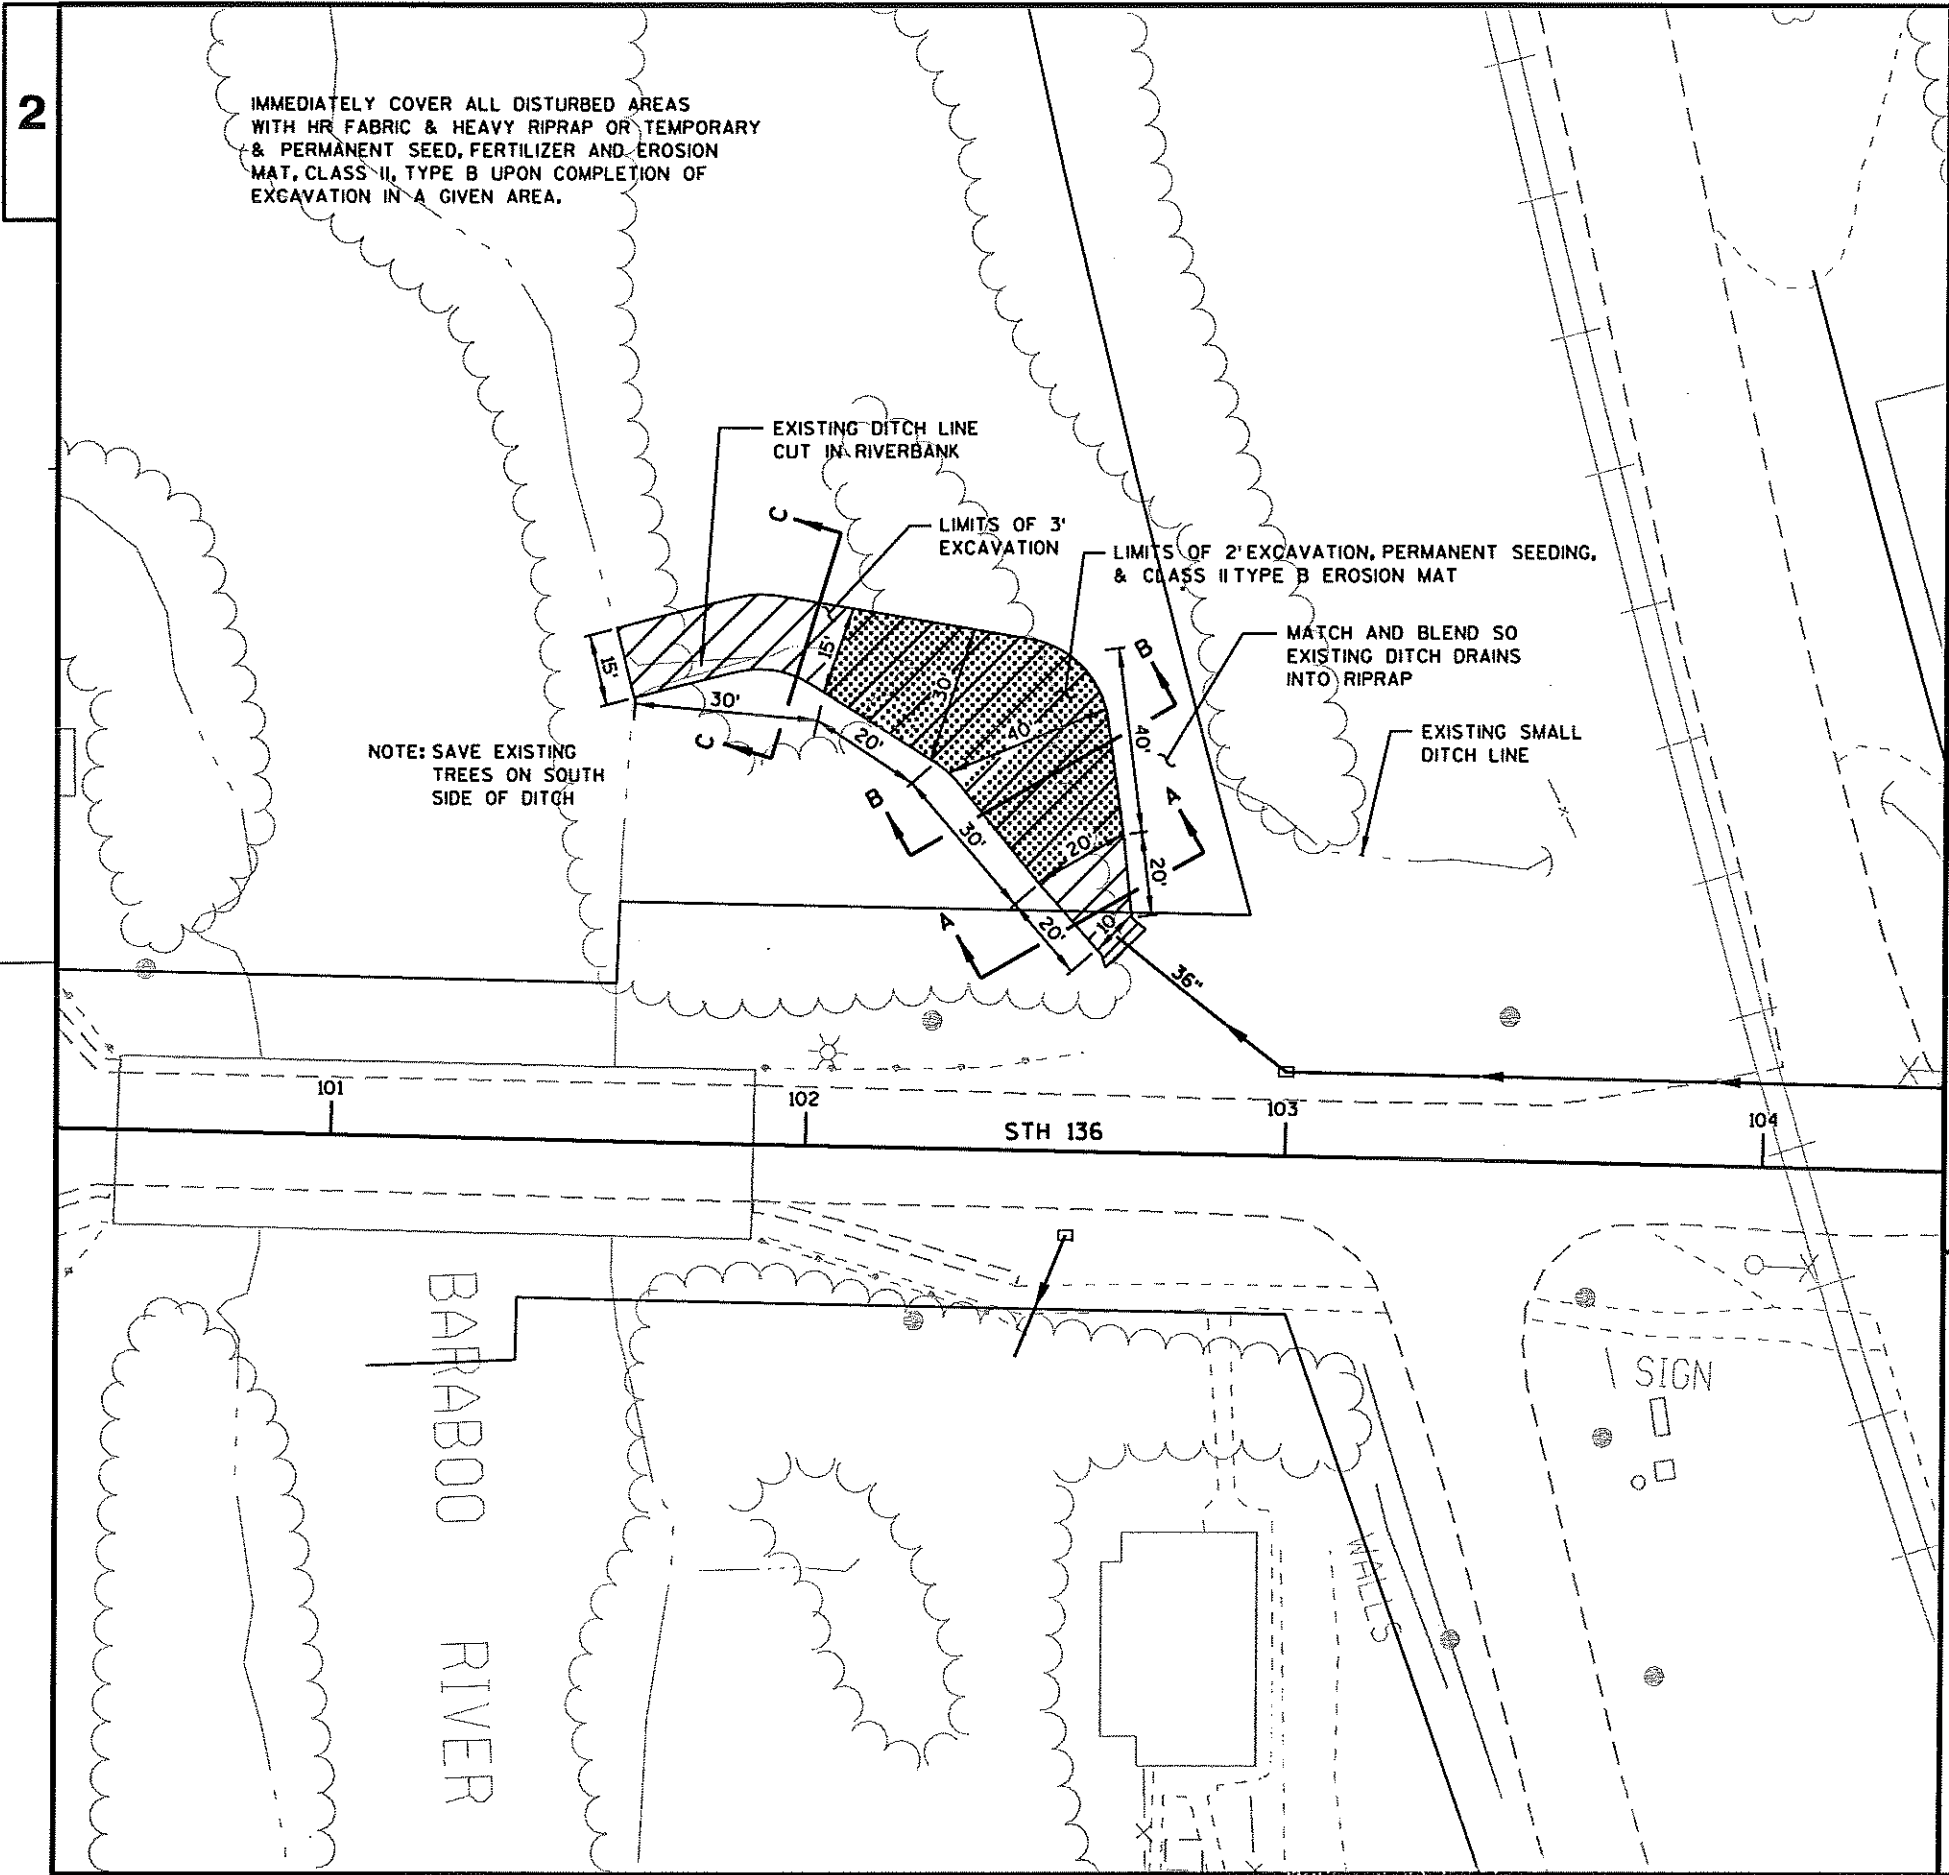


NOTES:
ROCK EXCAVATION WILL BE PAID FOR
AS A SEPERATE BID ITEM, AND IS
INCLUDED IN THE ROCK EXCAVATION
QUANTITIES.

BACKFILL MATERIAL IS INCIDENTAL
TO THE COST OF THE BEAMGUARD

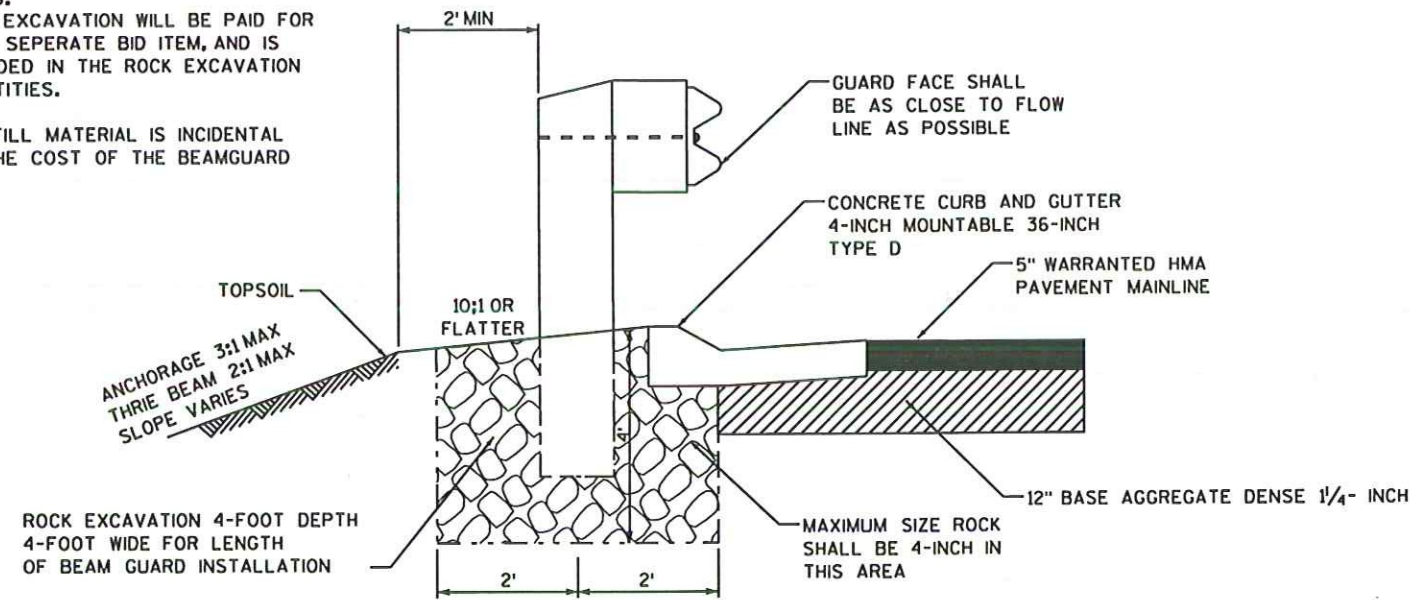


DETAIL FOR ROCK EXCAVATION FOR BEAM GUARD INSTALLATION

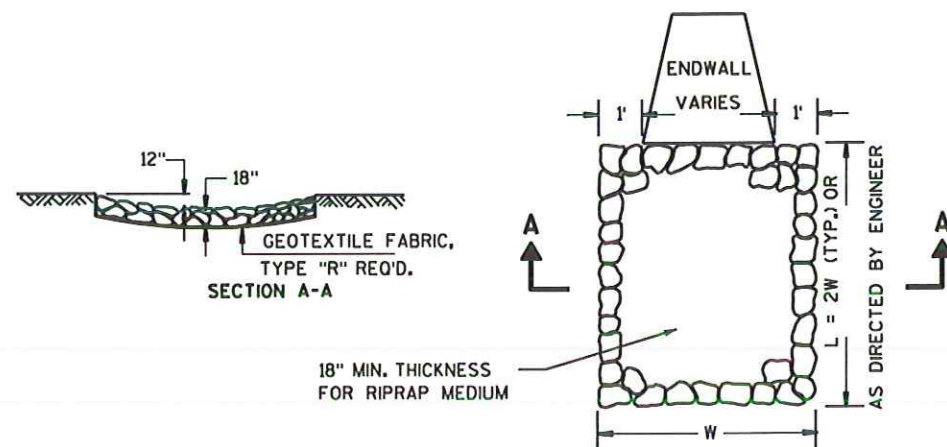


RIPRAP MEDIUM TREATMENT AT CULVERTS

NOTES:
SALVAGED TOPSOIL SHALL BE PLACED TO A 12" MINIMUM
DEPTH ON ALL ROCK CUT DITCH SLOPES FLATTER THAN 2:1.
PAID FOR AS "SALVAGED TOPSOIL, SPECIAL".
12" ROCK UNDERCUT PAID FOR AS "EXCAVATION ROCK".

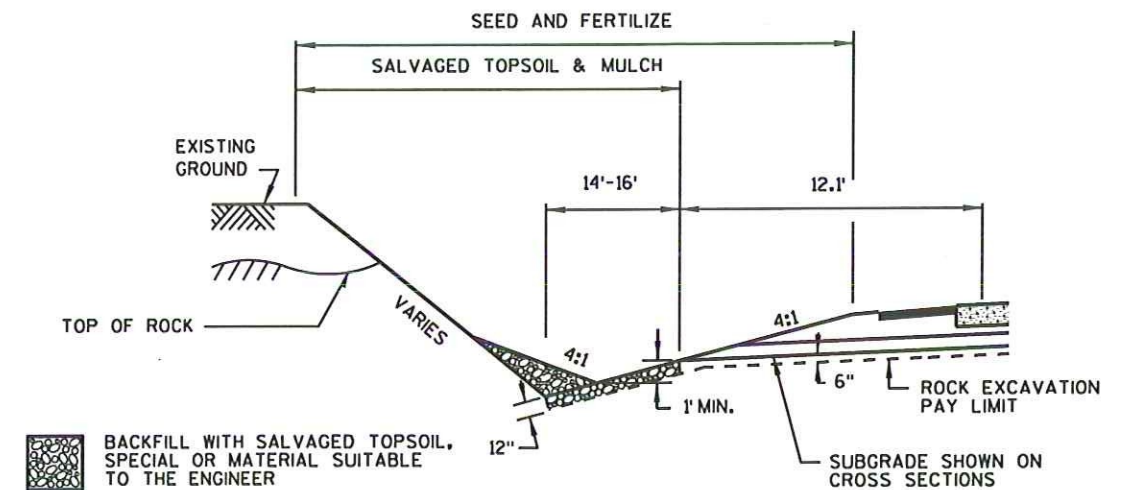


ROCK CUT DETAIL


STA. 138+00 - STA. 141+00
STA. 152+00 - STA. 153+00
STA. 159+00 - STA. 163+00

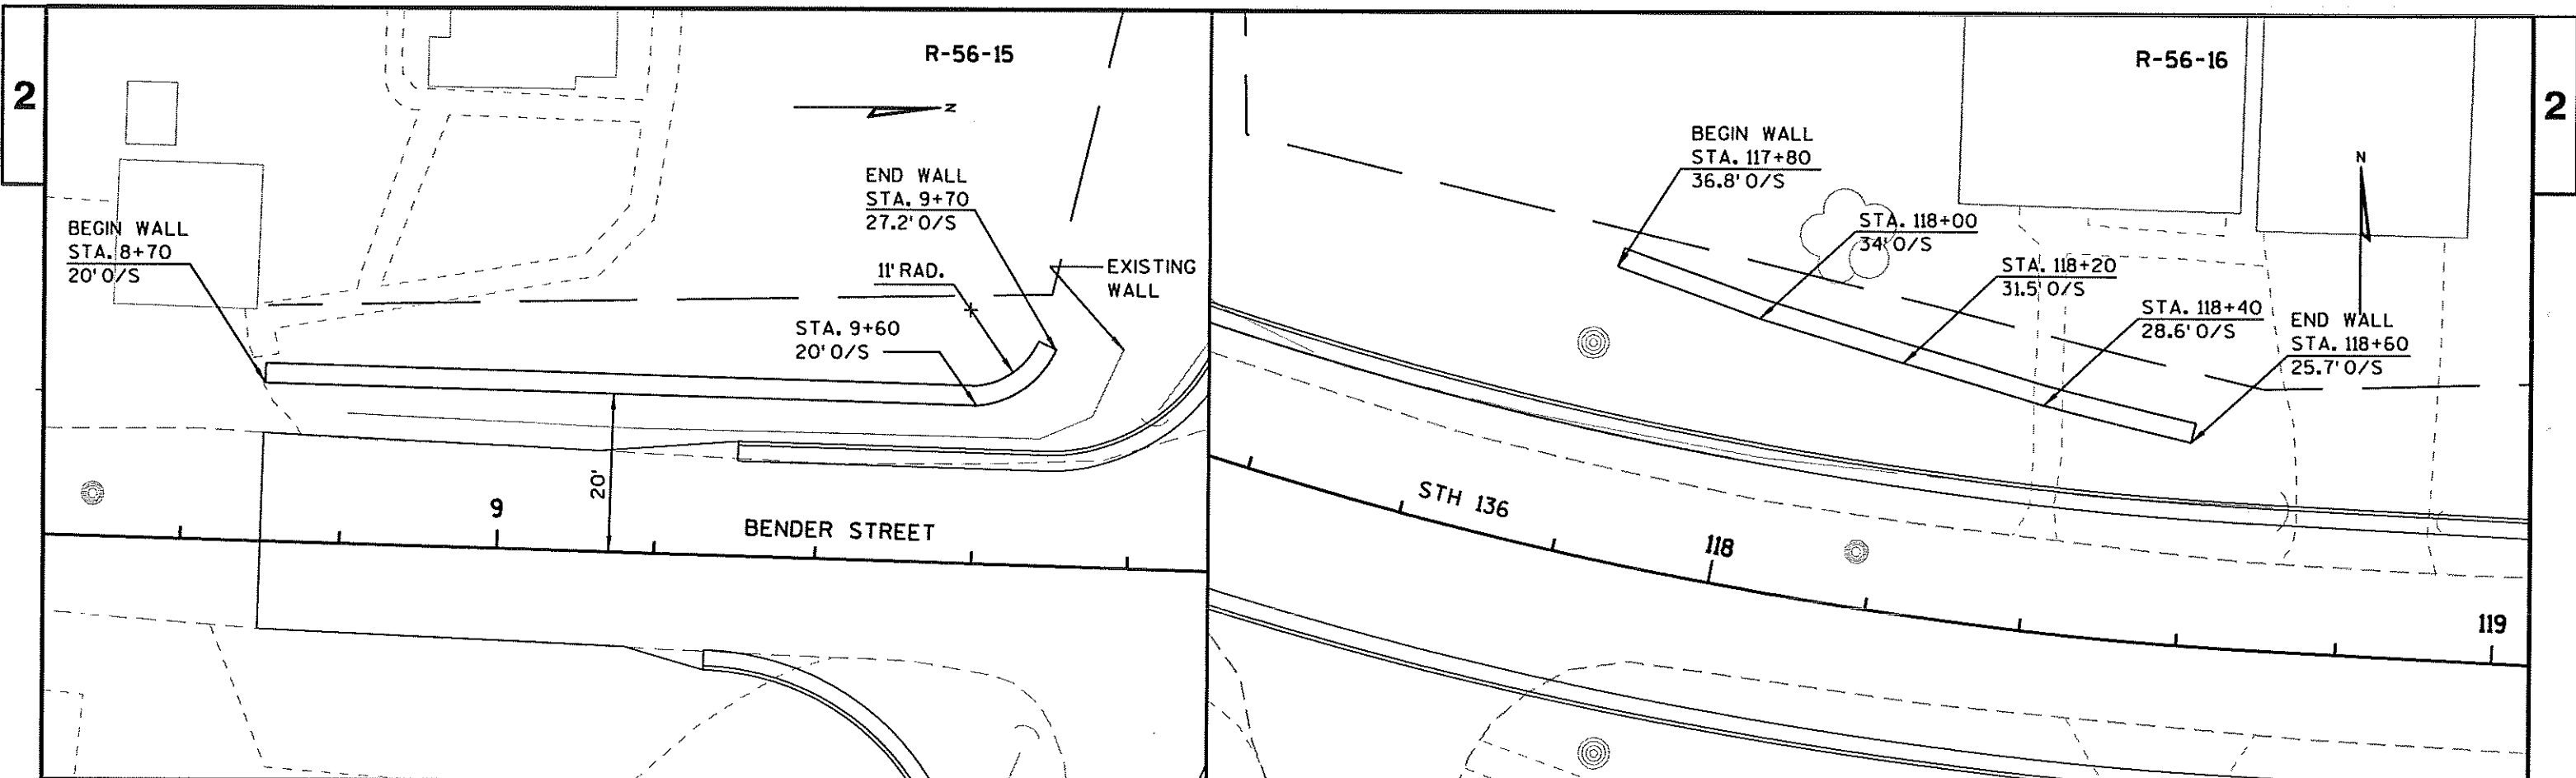

NOTE:
INSTALL ITEM FENCE, CHAIN LINK, 4-FT
AT TOP OF EACH RETAINING WALL

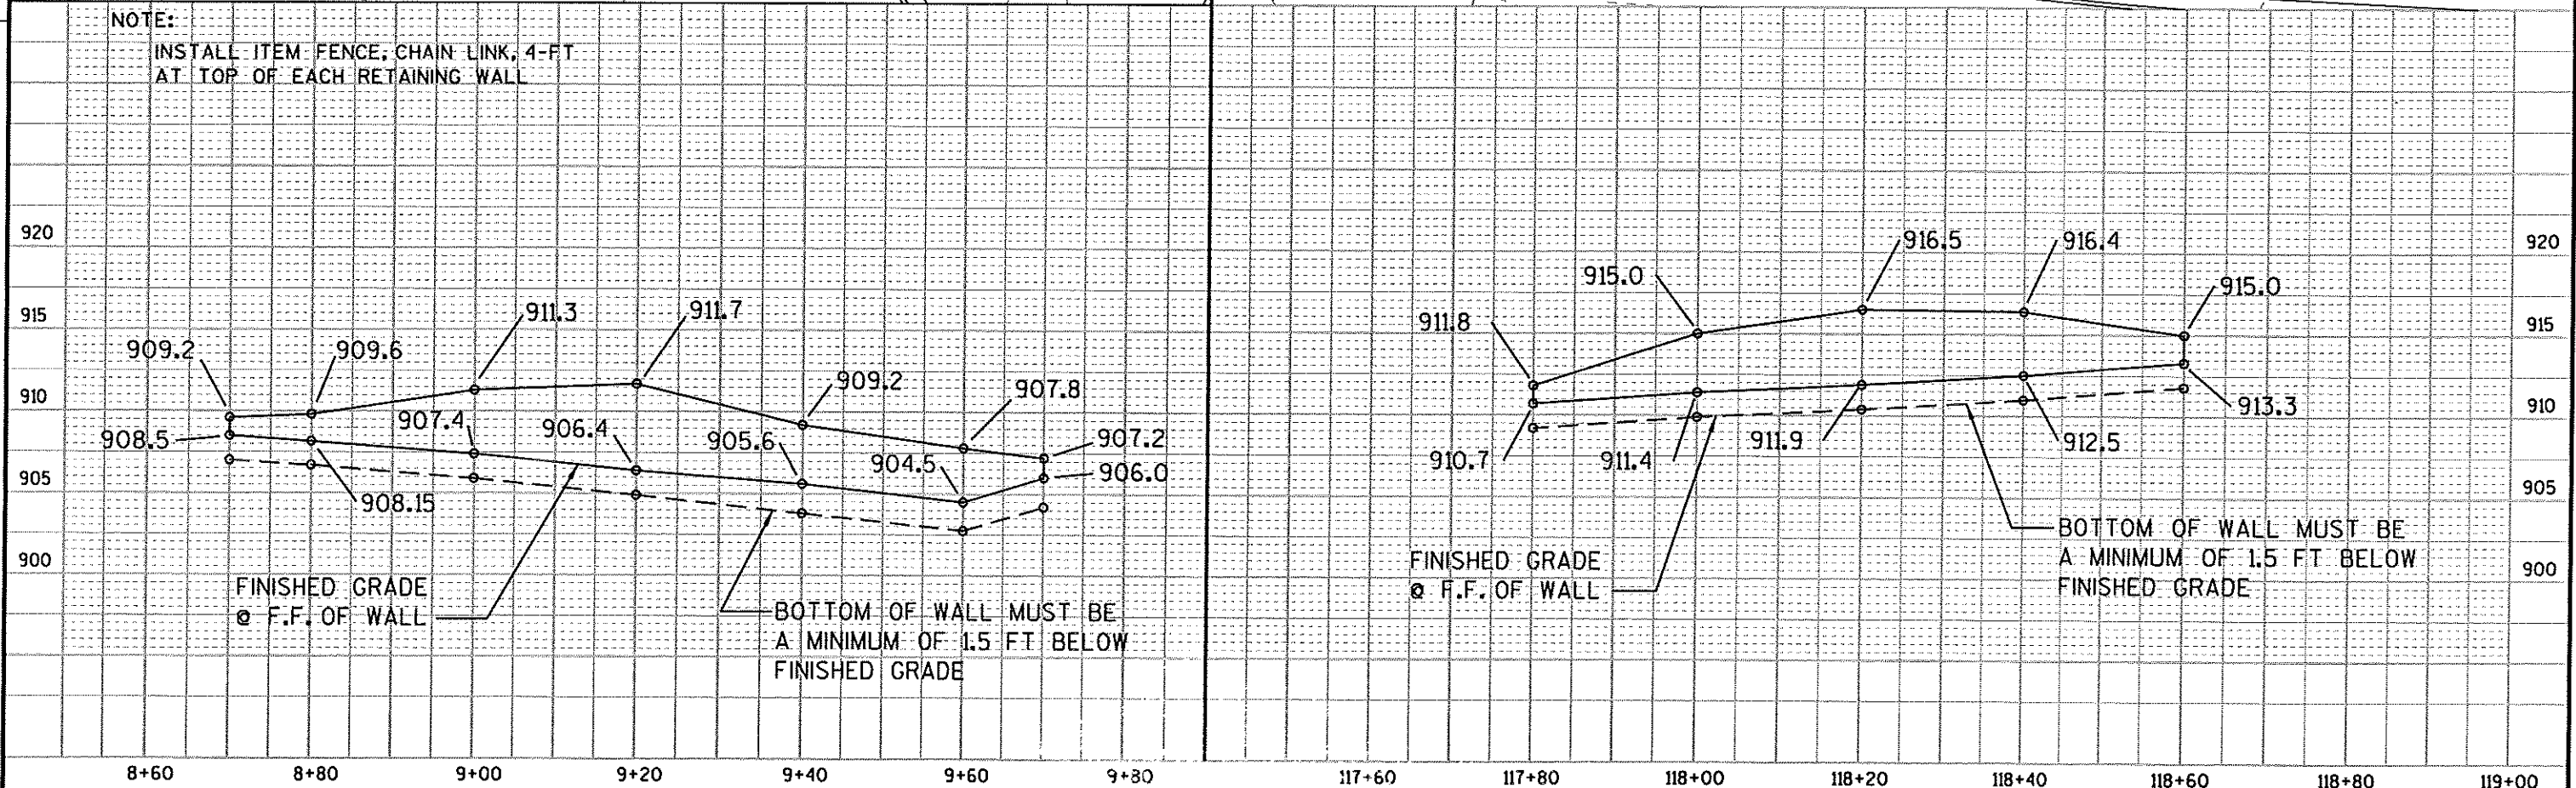

PROJECT NO: 5573-04-72 HWY: STH 136 COUNTY: SAUK RETAINING WALLS R-56-15 & R-56-16 SHEET E

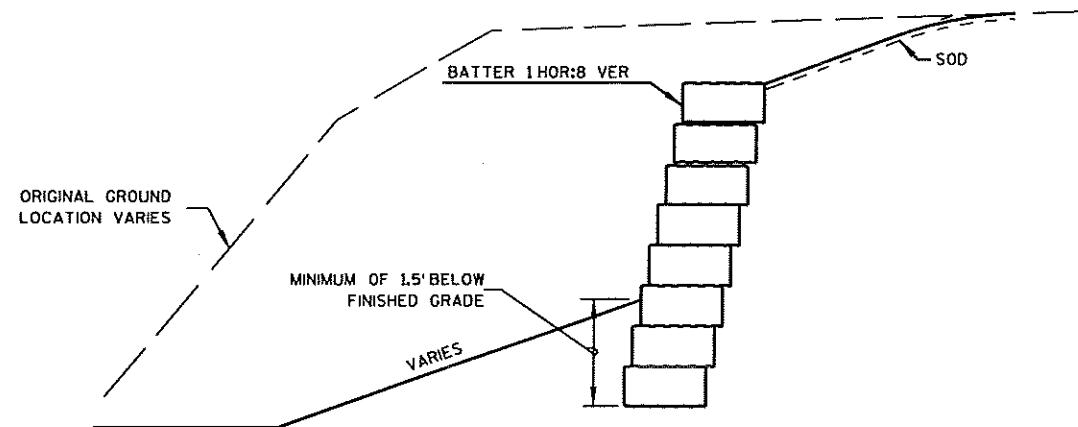

DETAIL FOR MODULAR BLOCK GRAVITY WALL

SOIL BORINGS WERE TAKEN AT ALL WALL LOCAIONS,
AND ARE AVAILABLE FOR REVIEW BY CONTACTING
THE WISDOT GEOTECHNICAL SECTION.

R-56-15 Information

Analysis (DOT Standard)	5 ft. Wall
Sliding (FS>1.5)	1.7
Overturning (FS>2.0)	2.2
Global Stability (FS>1.3)	1.59
Allowable Bearing Capacity (applied FS=2.0) of Silty Sand Layer, based on wall widths & embedment depths shown in table	2,500.00 psf
Minimum Wall Width	2.5 ft.
Minimum Wall Embedment	1.5 feet
Settlement (approx.)	None

Notes:
A setback of 1 hor: 8 ver. was assumed for the block wall
The 5 ft. wall has been designed for 8 hor.: 1 ver. back-slope.
Loadings of 50 psf only were applied. If during construction, heavy construction equipment is operated in close proximity to the wall or if material is stockpiled near the wall, the safety factors for this wall will significantly decrease.
?Allowable bearing capacity of 10,000.00 psf (FS=2) may be used for the sandstone bedrock.

R-56-16 Information


Analysis (DOT Standard)	5 ft. Wall
Sliding (FS>1.5)	1.9
Overturning (FS>2.0)	2.2
Global Stability (FS>1.3)	2.0
Allowable Bearing Capacity (applied FS=2.0) of Sandstone Bedrock	10,000.00 psf
Minimum Wall Width	2.5 ft.
Minimum Wall Embedment	1.5 feet
Settlement (approx.)	None

Notes:
A setback of 1 hor: 8 ver. was assumed for the block wall
The 5 ft. wall has been designed for 4 hor.: 1 ver. back-slope.
Loadings of 50 psf only were applied. If during construction, heavy construction equipment is operated in close proximity to the wall or if material is stockpiled near the wall, the safety factors for this wall will significantly decrease.

R-56-17 Information

Analysis (DOT Standard)	5 ft. Wall
Sliding (FS>1.5)	1.9
Overturning (FS>2.0)	2.2
Global Stability (FS>1.3)	1.7
Allowable Bearing Capacity (applied FS=2.0) of Dense Sand, based on wall widths and embedment depths	4100 psf
Minimum Wall Width	2.5 ft.
Minimum Wall Embedment	1.5 feet
Settlement (approx.)	None


Notes:
A setback of 1 hor: 8 ver. was assumed for the block wall
The 5 ft. wall has been designed for 4 hor.: 1 ver. back-slope.
Loadings of 50 psf only were applied. If during construction, heavy construction equipment is operated in close proximity to the wall or if material is stockpiled near the wall, the safety factors for this wall will significantly decrease.

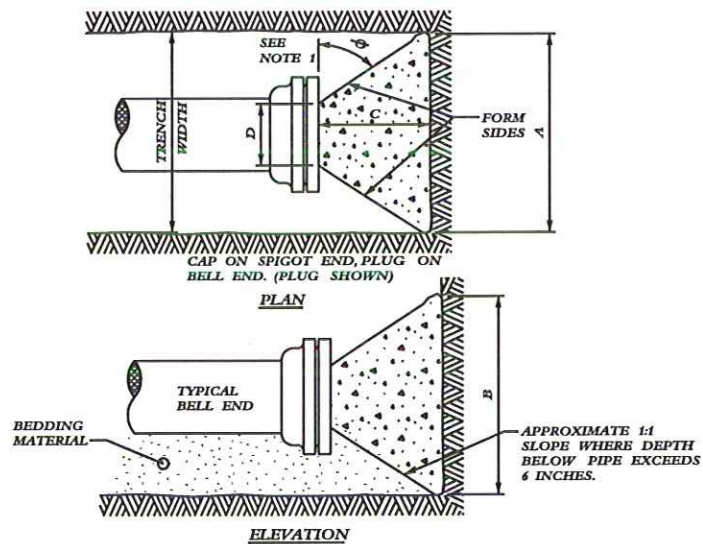

BUTTRESS FOR PLUGS DETAIL
SCALE: NONE


BUTTRESS DIMENSIONS				
DIA.	A	B	C	D
6"	1'- 6"	1'- 2"	SEE NOTE NO. 1	SEE NOTE NO. 2
8"	2'- 0"	1'- 4"		
12"	2'- 5"	1'- 10"	SEE NOTE NO. 1	SEE NOTE NO. 2
16"	3'- 4"	2'- 4"		
20"	4'- 3"	2'- 10"	SEE NOTE NO. 1	SEE NOTE NO. 2
24"	5'- 2"	3'- 4"		
30"	6'- 9"	4'- 0"	SEE NOTE NO. 1	SEE NOTE NO. 2

- NOTES:
1. DIMENSION 'C' SHOULD BE LARGE ENOUGH TO MAKE ANGLE 'O' EQUAL TO OR LARGER THAN 45°.
 2. DIMENSION 'D' EQUALS APPROX. I.D. OF PIPE LESS 2 INCHES. THE CONCRETE SHOULD NOT INTERFERE WITH THE MECHANICAL JOINTS.
 3. WHERE BUTTRESSES ARE NOT POSSIBLE BECAUSE OF POOR SOIL CONDITIONS OR LACK OF ROOM, STRAPPING SHALL BE PERMITTED.
 4. BUTTRESS DIMENSIONS ARE BASED ON A SOIL RESISTANCE OF TWO TONS PER SQ. FT. AND A WATER PRESSURE OF 150 PSI. INFORM THE ENGINEER IF ON-SITE SOIL DOES NOT MEET THIS CONDITION OR PRESSURES EXCEED 150 PSI.
 5. BUTTRESS TO BE POURED AGAINST FIRM UNDISTURBED SOIL, OR DISTURBED SOIL COMPACTED TO 95% OF MODIFIED PROCTOR DENSITY, ASTM D1557.
 6. CONCRETE SHALL HAVE A MINIMUM 7-DAY COMPRESSIVE STRENGTH OF 2000 PSI.
 7. ALL BUTTRESSED FITTINGS SHALL BE WRAPPED IN POLYETHYLENE.

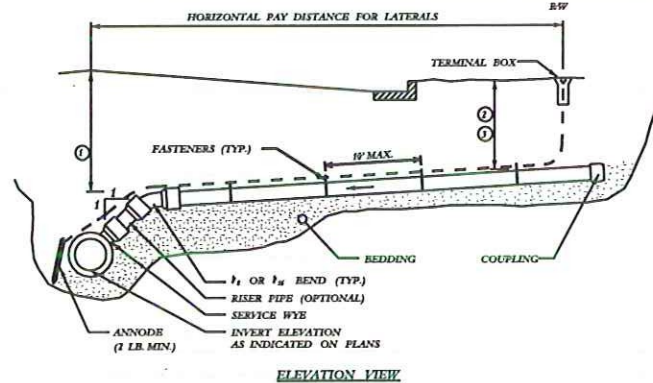


- NOTES FOR LATERAL INSTALLATION:
1. MINIMUM DEPTH OF COVER UNDER ROADWAY = 7 FEET.
 2. MINIMUM DEPTH OF COVER UNDER GRASS AREAS = 5 FT. 11 INCHES.
 3. MINIMUM DEPTH OF COVER UNDER GRASS AREAS WITH FROST PROTECTION = 3 FEET 4 INCHES.
 4. LATERAL SLOPES SHALL BE 18 INCH PER FOOT MIN. AND 12 INCH PER FOOT MAX.
- NOTES FOR TRACER WIRE INSTALLATION:
1. THE TRACER WIRE SHALL REMAIN CONTINUOUS TO THE GREATEST EXTENT POSSIBLE.
 2. NO. 12 GAUGE INSULATED COPPER TRACER WIRE SHALL BE INSTALLED WITH THE NON-CONDUCTIVE SERVICE PIPE TRACER WIRE TERMINAL BOXES SHALL BE INSTALLED AT LOCATIONS SHOWN ON THE PLANS OR AS DETERMINED BY THE ENGINEER OR OWNER. TRACER WIRE INSTALLATION REQUIRES ACCESS POINTS AT LEAST EVERY 100 FEET.
 3. TRACER WIRE SHALL BE RESTRAINED BY CABLE-TIES, TAPE, OR BY NON-CORROSIVE FASTENER APPROVED BY THE ENGINEER, INSTALLED EVERY 10 FEET ALONG SERVICE. DO NOT WRAP TRACER WIRE AROUND THE PIPE.
 4. TRACER WIRE SHALL BE TERMINATED IN A FLUSH MOUNTED TERMINAL BOX WITH A CAST IRON LOCKABLE TOP. SPLICES IN TRACER WIRE SHOULD BE MADE WITH SPLIT BOLT OR COMPRESSION-TYPE CONNECTORS. WIRE NUTS SHALL NOT BE USED. A WATER-PROOF CONNECTION IS NECESSARY TO PREVENT CORROSION. TERMINAL BOX SHALL BE VALCO, OR APPROVED EQUAL.

SANITARY SEWER LATERAL DETAIL
SCALE: NONE

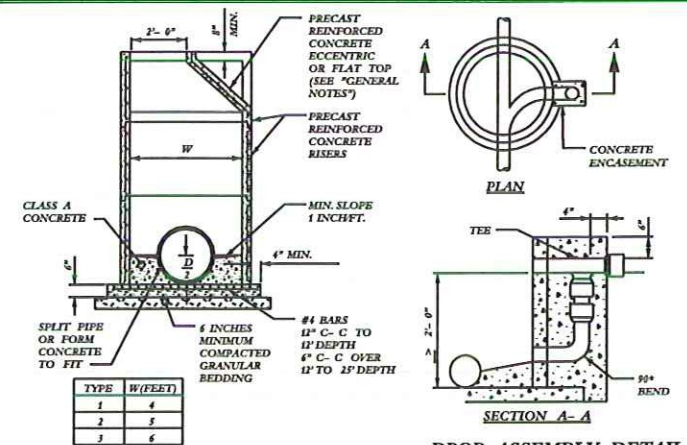


- GENERAL NOTES:
1. DETAILS OF CONSTRUCTION, MATERIALS AND WORKMANSHIP NOT SHOWN ON THIS DRAWING SHALL CONFORM TO THE PERTINENT REQUIREMENTS OF THE STANDARD SPECIFICATIONS AND THE APPLICABLE SPECIAL CONDITIONS.
 2. DETAILED DRAWINGS FOR PROPOSED ALTERNATE DESIGNS FOR UNDERGROUND STRUCTURES SHALL BE SUBMITTED TO THE ENGINEER FOR APPROVAL PROVIDING THAT SUCH ALTERNATE DESIGNS MAKE PROVISION FOR EQUIVALENT CAPACITY AND STRENGTH.
 3. PRECAST REINFORCED BASES SHALL BE PLACED ON A BED OF MATERIAL AT LEAST 4 INCHES IN DEPTH, WHICH MEETS THE REQUIREMENTS FOR GRANULAR BACKFILL. THIS BEDDING SHALL BE COMPACTED AND PROVIDE UNIFORM SUPPORT FOR THE ENTIRE AREA OF THE BASE.
 4. ECCENTRIC CONE TOPS SHALL BE USED ON ALL STRUCTURES 5 FEET OR GREATER IN DEPTH, AND FLAT TOPS SHALL BE USED ONLY ON STRUCTURES LESS THAN 5 FEET IN DEPTH, UNLESS DIRECTED BY THE ENGINEER.
 5. PRECAST REINFORCED CONCRETE RISERS MAY BE PLACED WITH TONGUE UP OR DOWN.
 6. ALL PRECAST INLET UNITS SHALL CONFORM TO THE PERTINENT REQUIREMENTS OF AASHTO DESIGNATION M 19.
 7. DROP CONNECTIONS SHALL BE USED WHEN THE PIPE INVERT IS MORE THAN 2 FEET ABOVE THE MANHOLE INVERT.
 8. PRECAST STRUCTURE MANWAY CLEAR OPENING SHALL MATCH CASTING - REFER TO STANDARD SPECIFICATION DIVISION 11 AND THE APPLICABLE SPECIAL CONDITIONS.
 - OPENING SHALL BE 14" FOR R-150 CASTINGS
 - OPENING SHALL BE 17" FOR R-160 CASTINGS

PRECAST REINFORCED CONCRETE MANHOLE DETAIL
SCALE: NONE

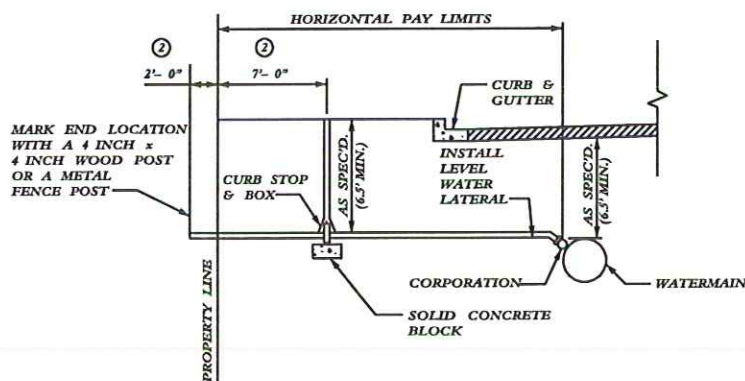


- GENERAL NOTES:
1. SEE PLANS AND SPECIFICATIONS FOR SIZE AND TYPE OF CURB STOP AND BOX CORPORATION AND SERVICE LINE.
 2. COMMUNITY STANDARDS SHALL SUPERSEDE THE DIMENSIONS FROM THE PROPERTY LINE.

WATER SERVICE DETAIL
SCALE: NONE

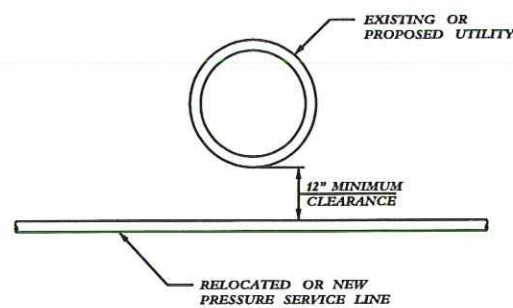


- GENERAL NOTES:
1. PIPE INSULATION SHALL BE INSTALLED AS REQUIRED. SEE "PIPE INSULATION DETAIL."

PRESSURE SERVICE CROSSING DETAIL
SCALE: NONE


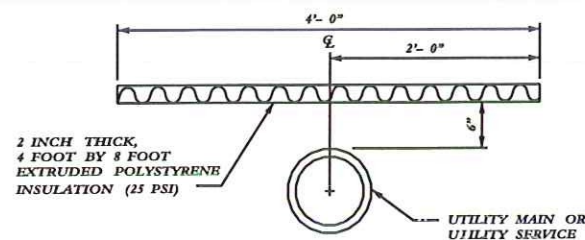


PIPE INSULATION DETAIL
SCALE: NONE



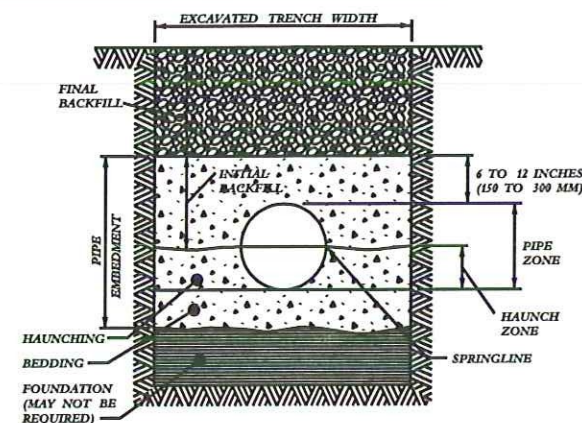


- GENERAL NOTES:
1. DETAILS OF CONSTRUCTION NOT SHOWN ON THIS DRAWING SHALL CONFORM TO ASTM D1111.
 2. CLASS II EMBEDMENT MATERIAL SHALL BE CLEAN, COARSE-GRAINED SOILS WITH LITTLE TO NO FINES. NO PARTICLES LARGER THAN 1 1/2 - INCHES SHALL BE USED IN THE PIPE EMBEDMENT.
 3. WHERE HYDRAULIC GRADIENT EXISTS USE A WELL-GRADED MIXTURE TO MINIMIZE MIGRATION OF FINES FROM ADJACENT SOIL.
 4. CLASS II MATERIAL IS SUITABLE AS A FOUNDATION AND FOR REPLACING OVER-EXCAVATED AND UNSTABLE TRENCH BOTTOM. INSTALL AND COMPACT IN 4-INCH MAXIMUM LAYERS.
 5. INSTALL AND COMPACT BEDDING IN 4-INCH MAXIMUM LAYERS. LEVEL FINAL GRADE BY HAND. MINIMUM DEPTH 4 INCH (4 INCH IN ROCK CUTS).
 6. INSTALL AND COMPACT HAUNCHING IN 4-INCH MAXIMUM LAYERS. WORK IN AROUND PIPE BY HAND TO PROVIDE UNIFORM SUPPORT.
 7. INSTALL AND COMPACT INITIAL BACKFILL TO A MINIMUM OF 6 INCH ABOVE PIPE CROWN.
 8. EMBEDMENT COMPACTION: MINIMUM DENSITY 85% STANDARD PROCTOR. USE HAND TAMPERS OR VIBRATORY COMPACTORS.

CLASS II - FLEXIBLE PIPE EMBEDMENT DETAIL
SCALE: NONE

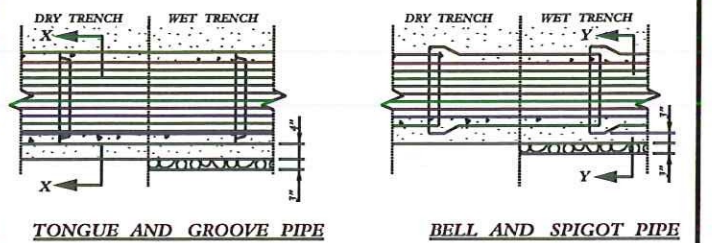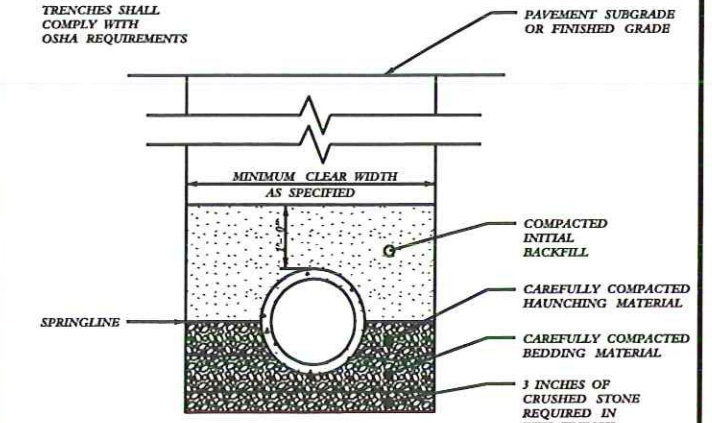


- GENERAL NOTES:
1. BEDDING AND HAUNCHING MATERIAL SHALL BE WELL-GRADED 3/4 TO 1 1/4 INCH CRUSHED STONE OR OTHER NON-COHESIVE MATERIAL NOT SUBJECT TO MIGRATION AND FREE OF DEBRIS, ORGANIC MATERIAL, AND LARGE STONES.
 2. BEDDING MATERIAL TO BE PLACED BEFORE SETTING PIPE, 4 INCH MINIMUM UNDER BARREL WITH 3 INCH MINIMUM UNDER BELL.
 3. INITIAL BACKFILL SHALL BE DENSELY COMPACTED, NON-COHESIVE FINELY DIVIDED MATERIAL FREE OF DEBRIS, ORGANIC MATERIAL, AND LARGE STONES.
 4. IN ROCK OR OTHER INCOMPRESSIBLE MATERIALS, THE TRENCH SHALL BE OVEREXCAVATED A MINIMUM OF 6 - INCHES AND REFILLED WITH GRANULAR MATERIAL.
- CLASS "B" EMBEDMENT FOR RIGID PIPE DETAIL
SCALE: NONE

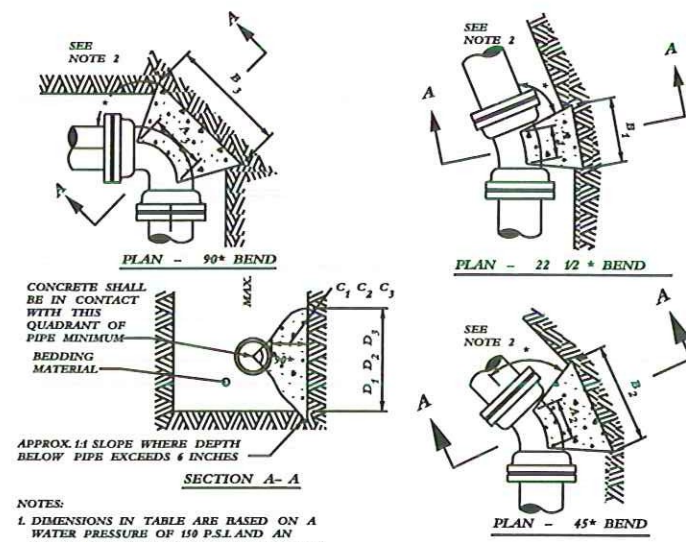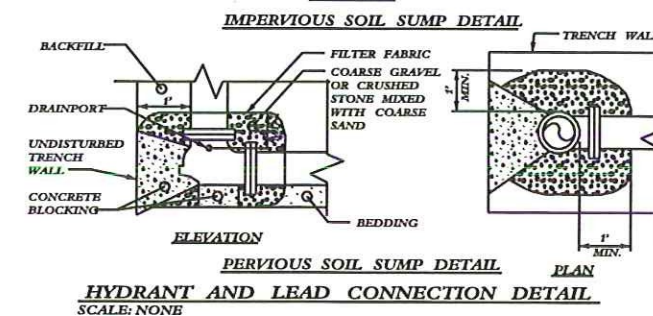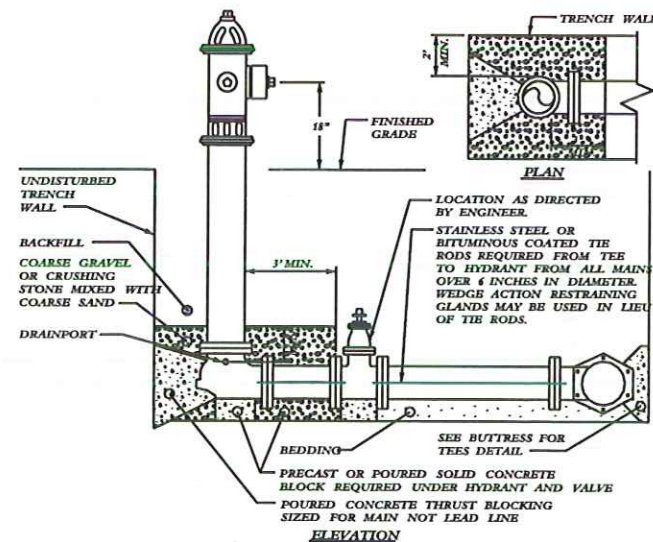

NOTES:

- DIMENSIONS IN TABLE ARE BASED ON A WATER PRESSURE OF 150 P.S.I. AND AN EARTH RESISTANCE OF 2 TONS PER SQ. FT. INFORM THE ENGINEER IF PRESSURES EXCEED 150 PSI OR ON-SITE SOIL DOES NOT MEET THIS CONDITION.
- DIMENSION Q₁ Q₂ Q₃ SHOULD BE LARGE ENOUGH TO MAKE ANGLE θ EQUAL TO OR LARGER THAN 45°.
- DIMENSION A₁ A₂ A₃ SHOULD BE AS LARGE AS POSSIBLE WITHOUT INTERFERING WITH THE MECHANICAL JOINT.
- BUTTRESS TO BE POURED AGAINST FIRM UNDISTURBED SOIL OR DISTURBED SOIL COMPACTED TO 95% OF MODIFIED PROCTOR DENSITY, ASTM D1557.
- ALL BUTTRESSED FITTINGS SHALL BE WRAPPED IN POLYETHYLENE.
- CONCRETE SHALL HAVE A MINIMUM 7-DAY COMPRESSIVE STRENGTH OF 2000 PSI.







PIPE SIZE	45° BENDS			90° BENDS		
	B ₁	D ₁	D ₂	B ₂	D ₂	D ₃
6"	1'-0"	1'-0"	1'-0"	1'-0"	1'-0"	1'-2"
8"	1'-0"	1'-0"	1'-4"	1'-2"	1'-10"	1'-6"
10"	1'-2"	1'-2"	1'-7"	1'-7"	2'-3"	1'-10"
12"	1'-4"	1'-4"	1'-10"	1'-10"	2'-8"	2'-3"
16"	1'-10"	1'-8"	2'-6"	2'-4"	3'-10"	2'-10"
20"	2'-4"	2'-0"	3'-3"	2'-10"	5'-0"	3'-4"
24"	2'-10"	2'-4"	4'-0"	3'-3"	6'-4"	3'-10"

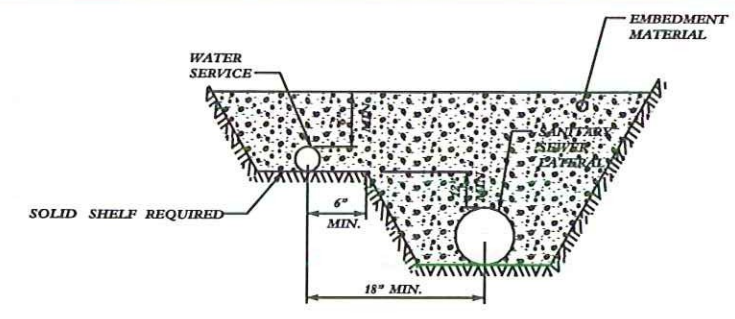

GENERAL NOTES:
1. WATER SERVICES 3 INCHES IN DIAMETER AND LARGER SHALL BE LAID WITH A CLEAR HORIZONTAL SEPARATION NOT LESS THAN 2 FEET FROM THE SANITARY LATERAL.

WATER SERVICE AND SANITARY SEWER LATERAL DETAIL

SCALE: NONE

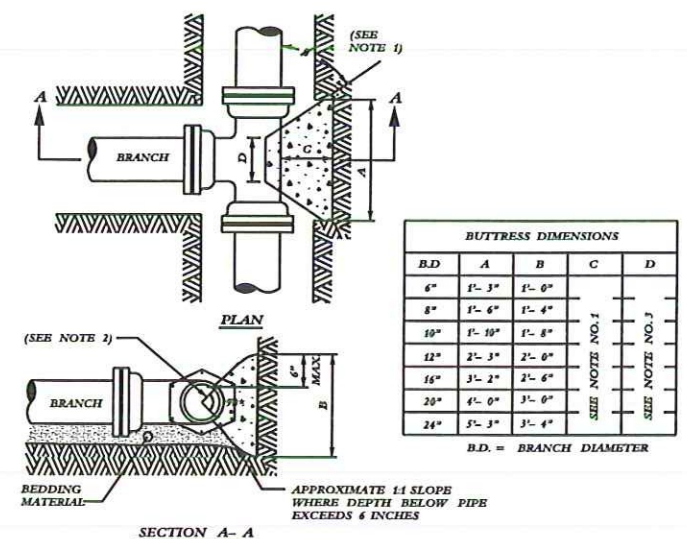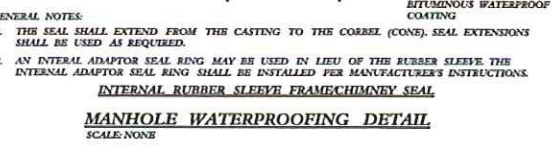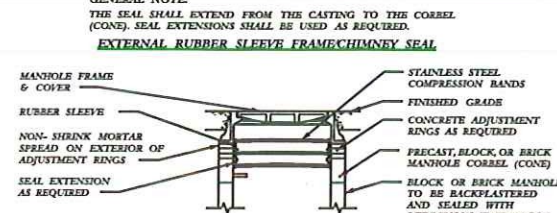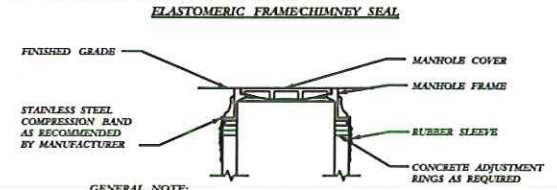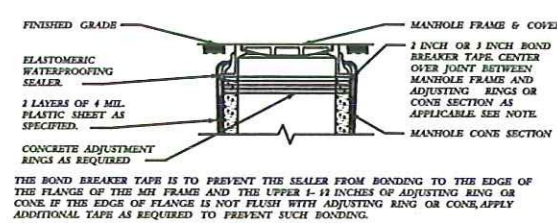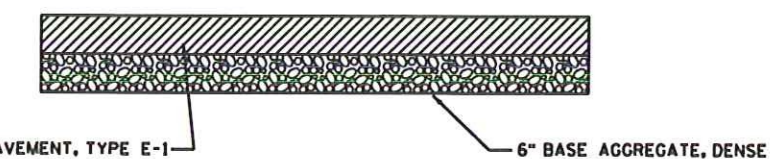


NOTES:


- DIMENSION 'C' SHOULD BE LARGE ENOUGH TO MAKE ANGLE θ GREATER THAN OR EQUAL TO 45°.
- CONCRETE SHOULD BEAR ON THIS QUADRANT OF PIPE AT A MINIMUM.
- DIMENSION 'D' SHOULD BE AS LARGE AS POSSIBLE BUT CONCRETE SHOULD NOT INTERFERE WITH MECHANICAL JOINTS.
- BUTTRESS DIMENSIONS ARE BASED ON A SOIL RESISTANCE OF TWO TONS PER SQ. FT. AND A WATER PRESSURE OF 150 PSI. INFORM THE ENGINEER IF ON-SITE SOIL DOES NOT MEET THIS CONDITION OR PRESSURES EXCEED 150 PSI.
- BUTTRESS TO BE POURED AGAINST FIRM UNDISTURBED SOIL OR DISTURBED SOIL COMPACTED TO 95% OF MODIFIED PROCTOR DENSITY, ASTM D1557.
- CONCRETE SHALL HAVE A MINIMUM 7-DAY COMPRESSIVE STRENGTH OF 2000 PSI.
- ALL BUTTRESSED FITTINGS SHALL BE WRAPPED IN POLYETHYLENE.

B.D.	A	B	C	D
6"	1'-3"	1'-0"		
8"	1'-6"	1'-4"		
10"	1'-10"	1'-8"		
12"	2'-3"	2'-6"		
16"	3'-2"	2'-6"		
20"	4'-0"	3'-0"		
24"	5'-3"	3'-4"		

B.D. = BRANCH DIAMETER

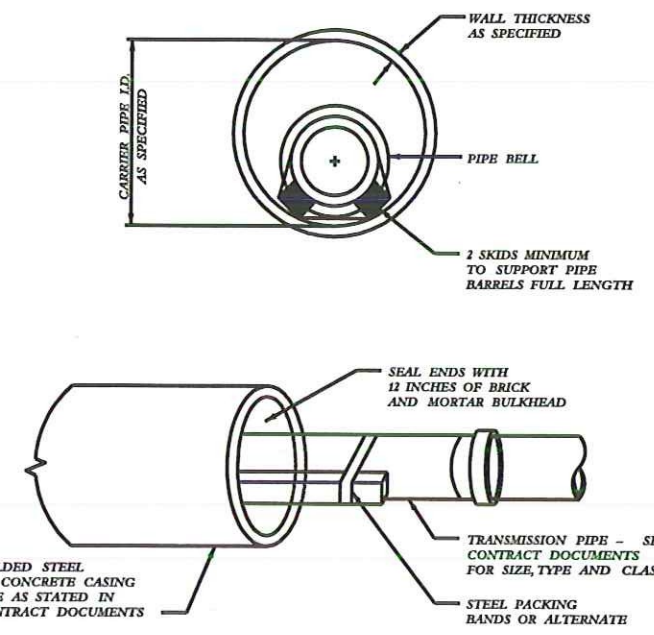


GENERAL NOTES:
1. VOID BETWEEN CARRIER PIPE AND CASING SHALL BE FILLED WITH SAND OR PEA GRAVEL.

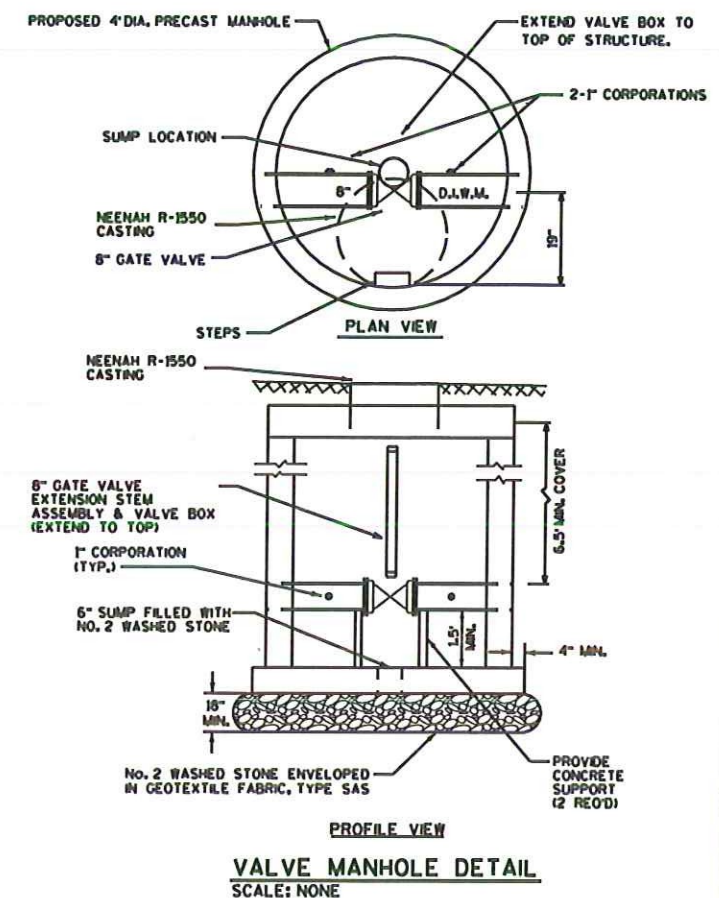


EXCELSIOR INTERSECTION LAYOUT					
PT	STATION	OFFSET	ELEVATION	X COORD	Y COORD
1	8+50.00	15.00'R	885.88	615160.770	239102.435
2	8+50.00	15.00'L	885.88	615190.770	239102.425
3	9+19.33	15.00'R	884.24	615160.750	239033.110
4	9+21.40	15.00'L	884.19	615190.748	239031.026
5	9+29.33	15.00'R	883.99	615160.746	239023.106
6	9+31.40	15.00'L	883.94	615190.745	239021.026
7	207+19.66	31.92'L	882.92	615206.928	238980.019
8	206+53.53	32.05'L	883.31	615144.908	238991.241
9	207+62.68	17.00'L	883.57	615246.766	238961.140
10	206+20.10	17.00'L	884.34	615109.949	238984.603
11	206+88.64	20.59'L	883.74	615175.730	238973.322
12	206+92.25	0.00'R	884.87	615175.724	238952.429
13	206+20.10	57.00'L	--	615120.746	239023.118
14	207+62.68	77.00'L	--	615250.745	239021.008



STA. 9+30"EXC" RT
CONTACT PROJECT ENGINEER BEFORE
FIELD ENTRANCE CONSTRUCTION. FIELD
ENTRANCE TO BE BUILT ACCORDING TO
SPECIAL COMMITMENTS. 24' FIELD
ENTRANCE TO BE HIGH POINT OF RADIUS.

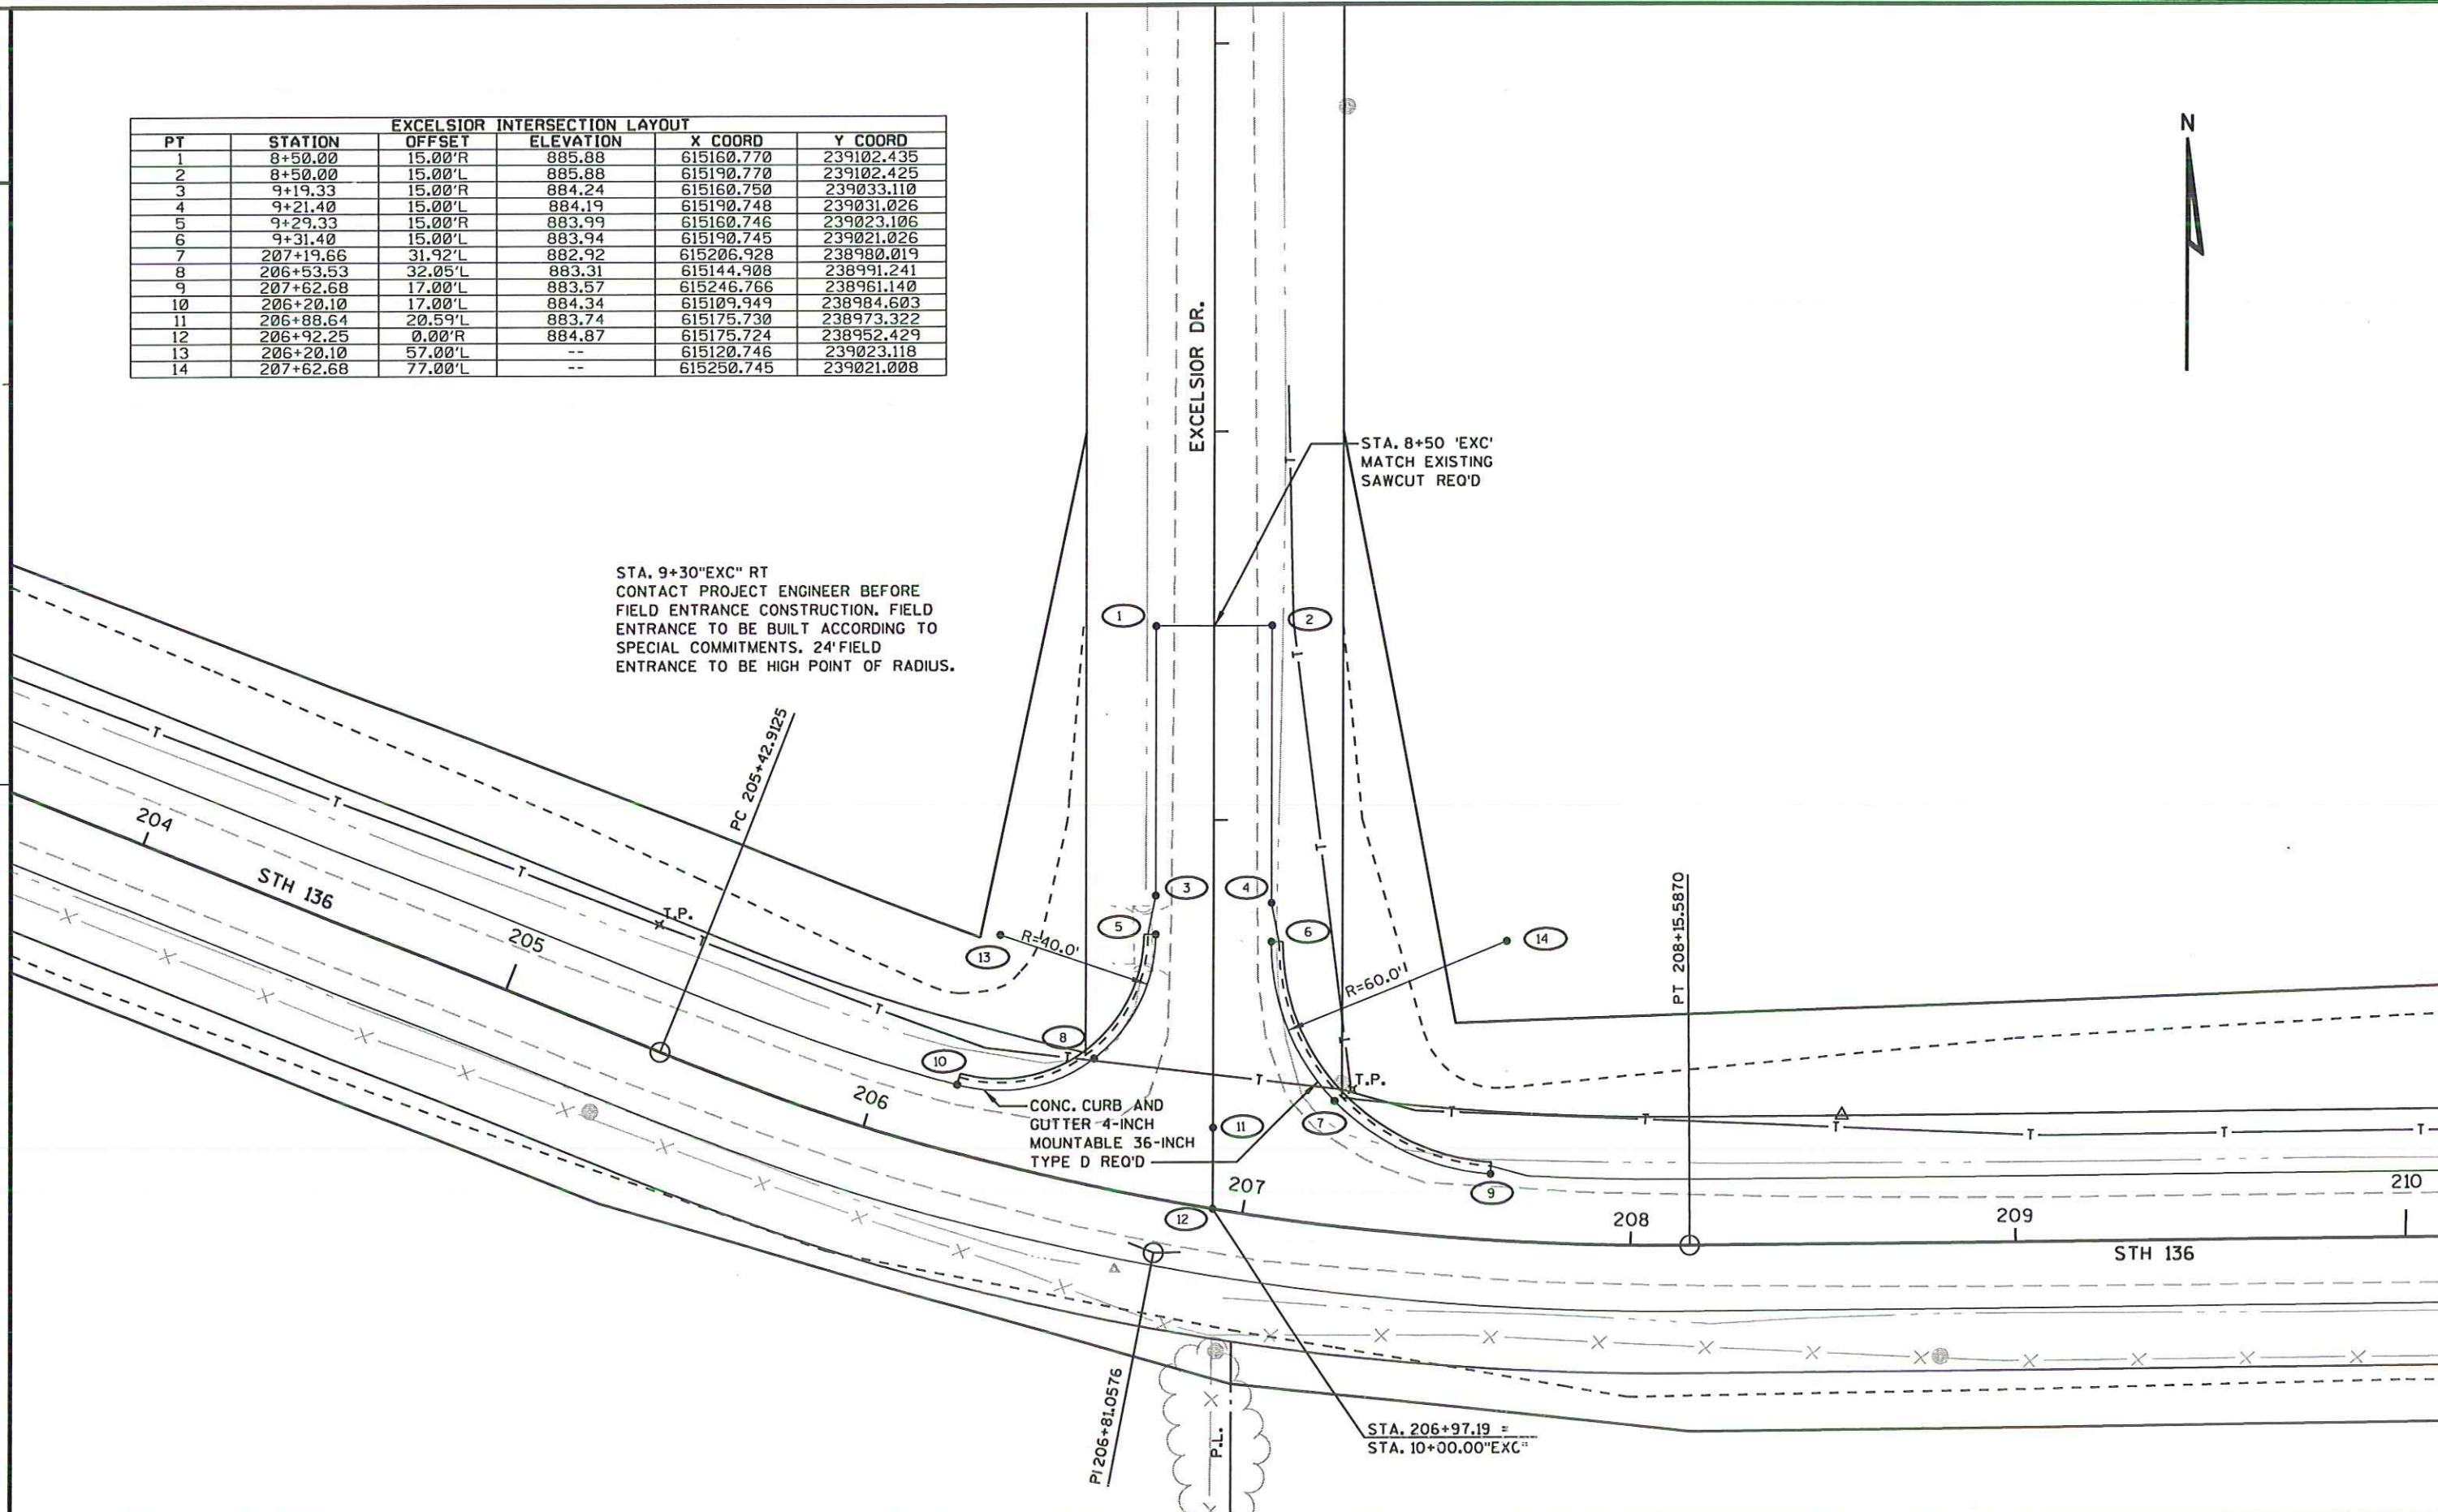

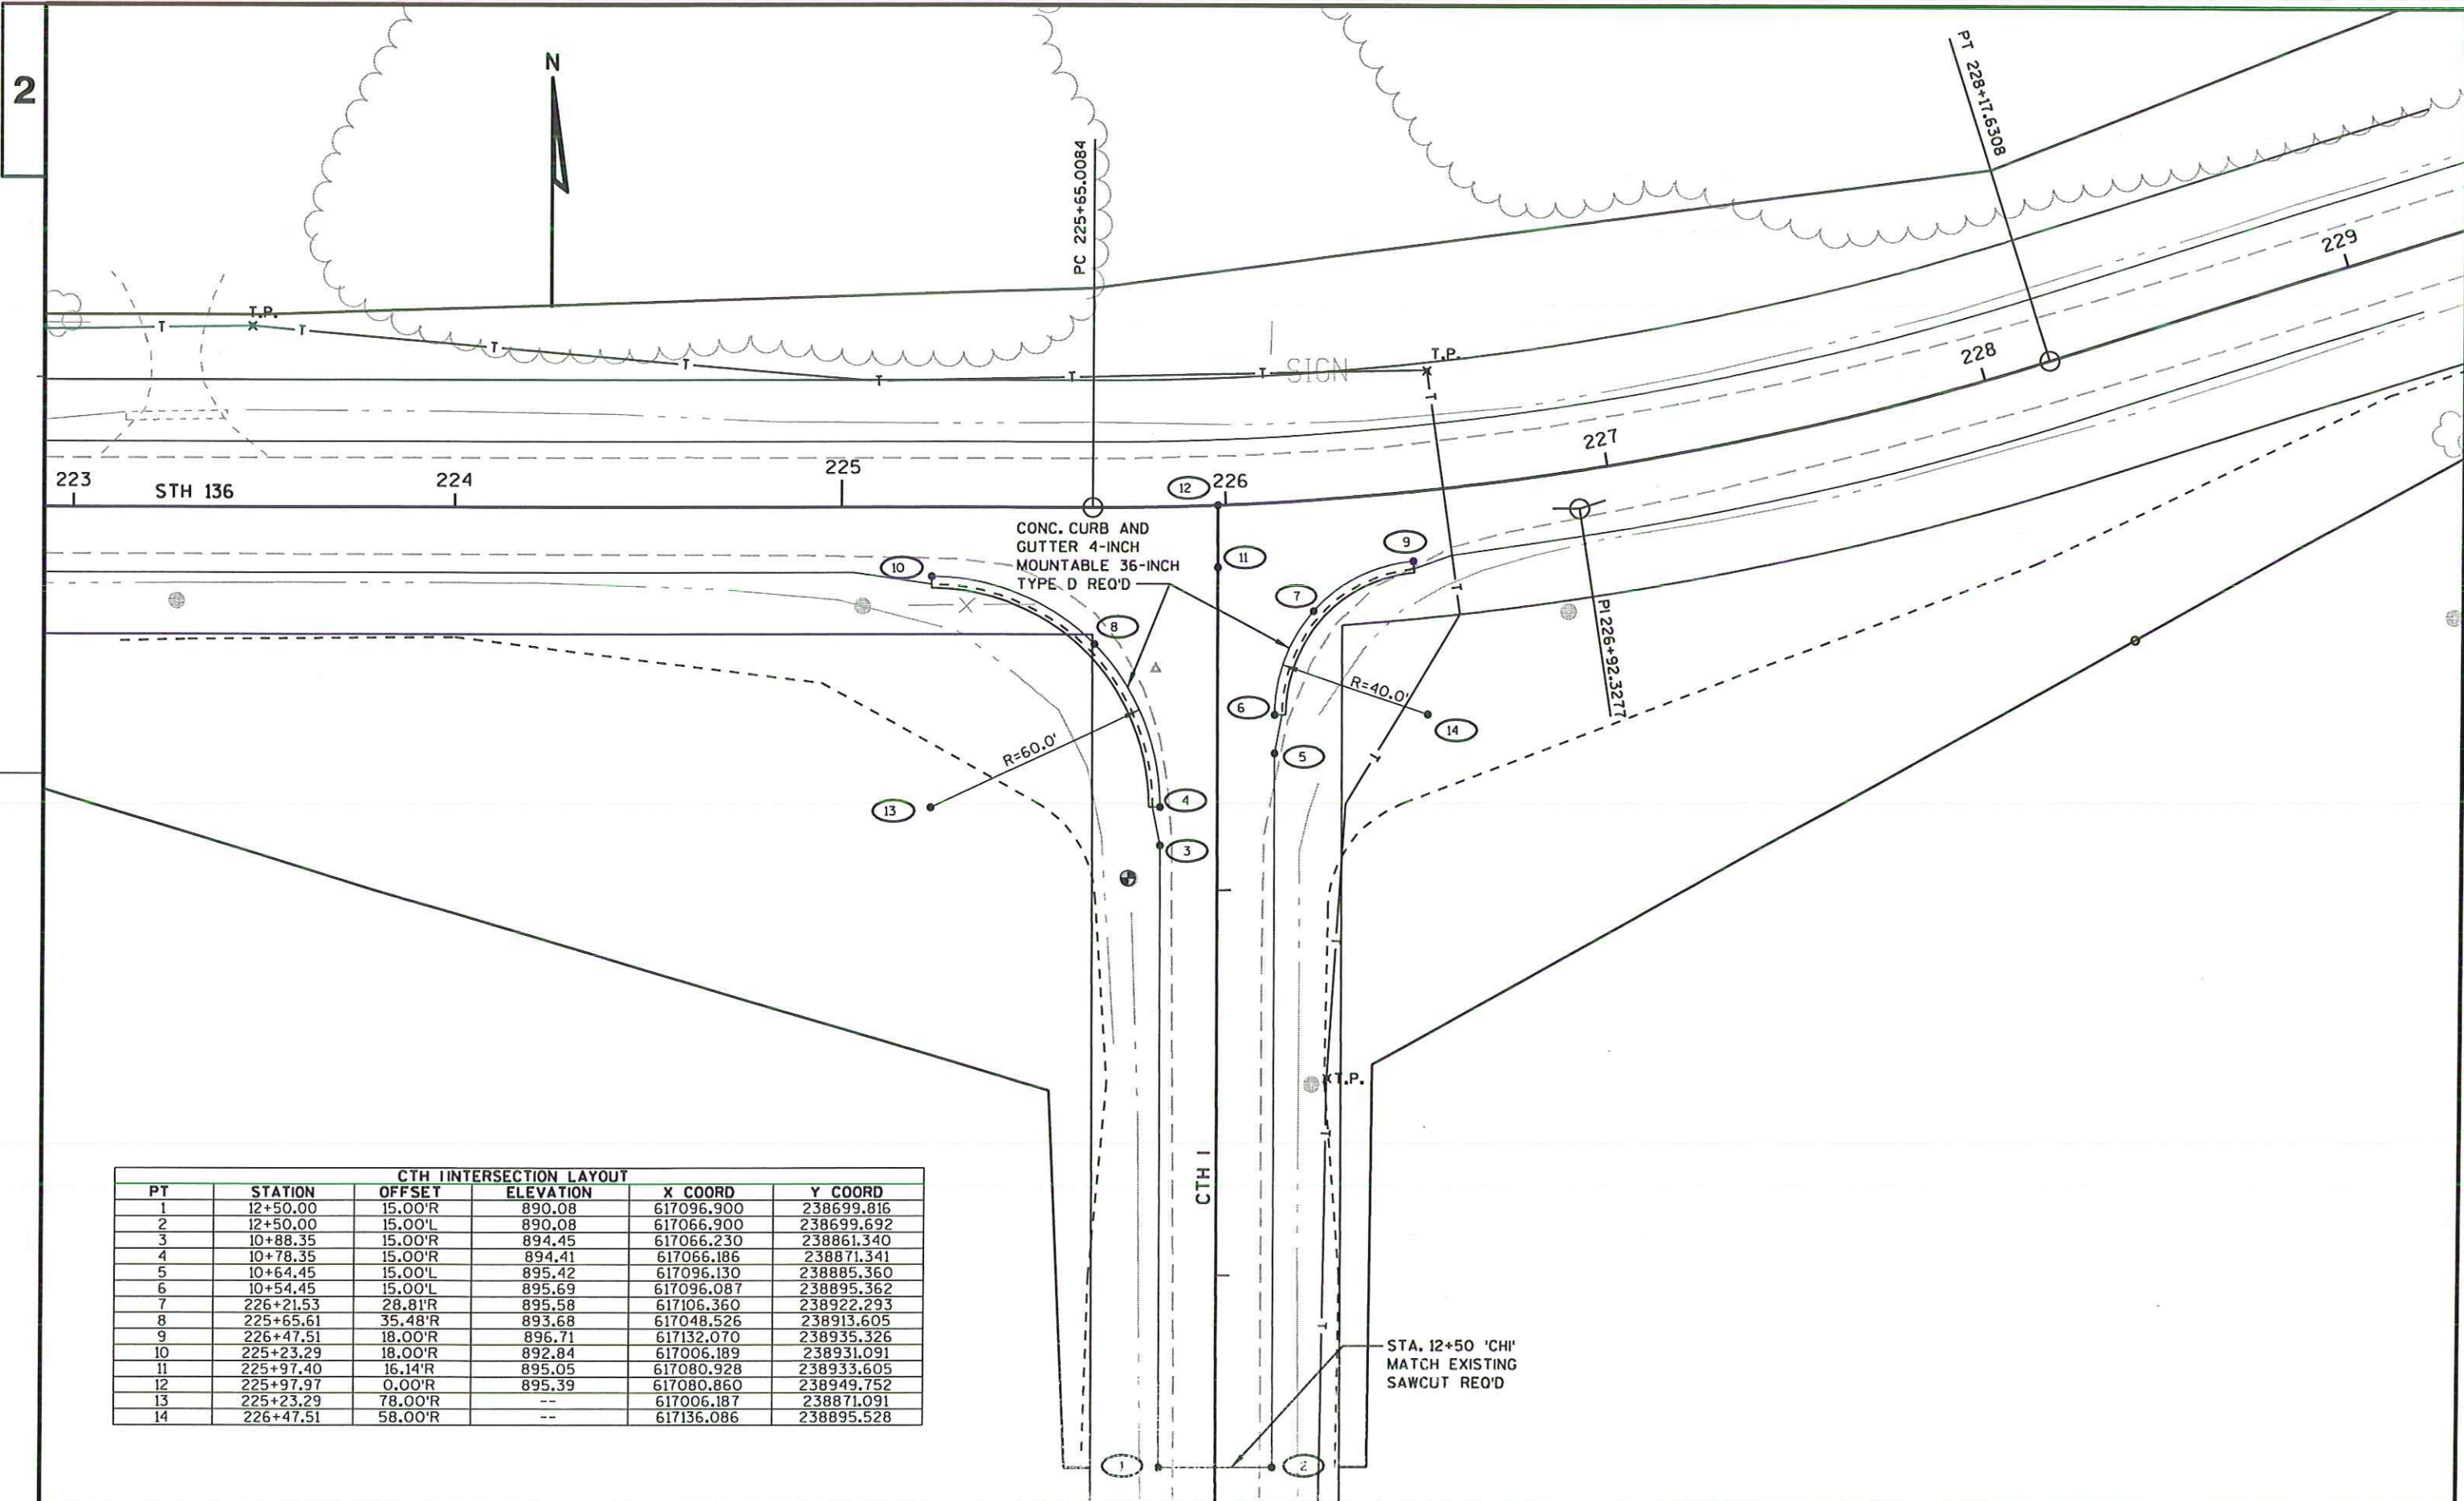

PT	STATION	OFFSET	ELEVATION	X COORD	Y COORD
1	12+50.00	15.00'R	890.08	617096.900	238699.816
2	12+50.00	15.00'L	890.08	617066.900	238699.692
3	10+88.35	15.00'R	894.45	617066.230	238861.340
4	10+78.35	15.00'R	894.41	617066.186	238871.341
5	10+64.45	15.00'L	895.42	617096.130	238885.360
6	10+54.45	15.00'L	895.69	617096.087	238895.362
7	226+21.53	28.81'R	895.58	617106.360	238922.293
8	225+65.61	35.48'R	893.68	617048.526	238913.605
9	226+47.51	18.00'R	896.71	617132.070	238935.326
10	225+23.29	18.00'R	892.84	617006.189	238931.091
11	225+97.40	16.14'R	895.05	617080.928	238933.605
12	225+97.97	0.00'R	895.39	617080.860	238949.752
13	225+23.29	78.00'R	--	617006.187	238871.091
14	226+47.51	58.00'R	--	617136.086	238895.528

PROJECT NO: 5573-04-72

HWY: STH 136

COUNTY: SAUK

INTERSECTION DETAILS

SHEET

E

FILE NAME : r:\Support\CADD\Projects\d1_55730401\021102_id.dgn


PLOT DATE : 12-JUL-2007 07:02

PLOT BY : ddbbg

PLOT NAME :


PLOT SCALE : 40.000000:1.000000

WISDOT/CADD SHEET 42

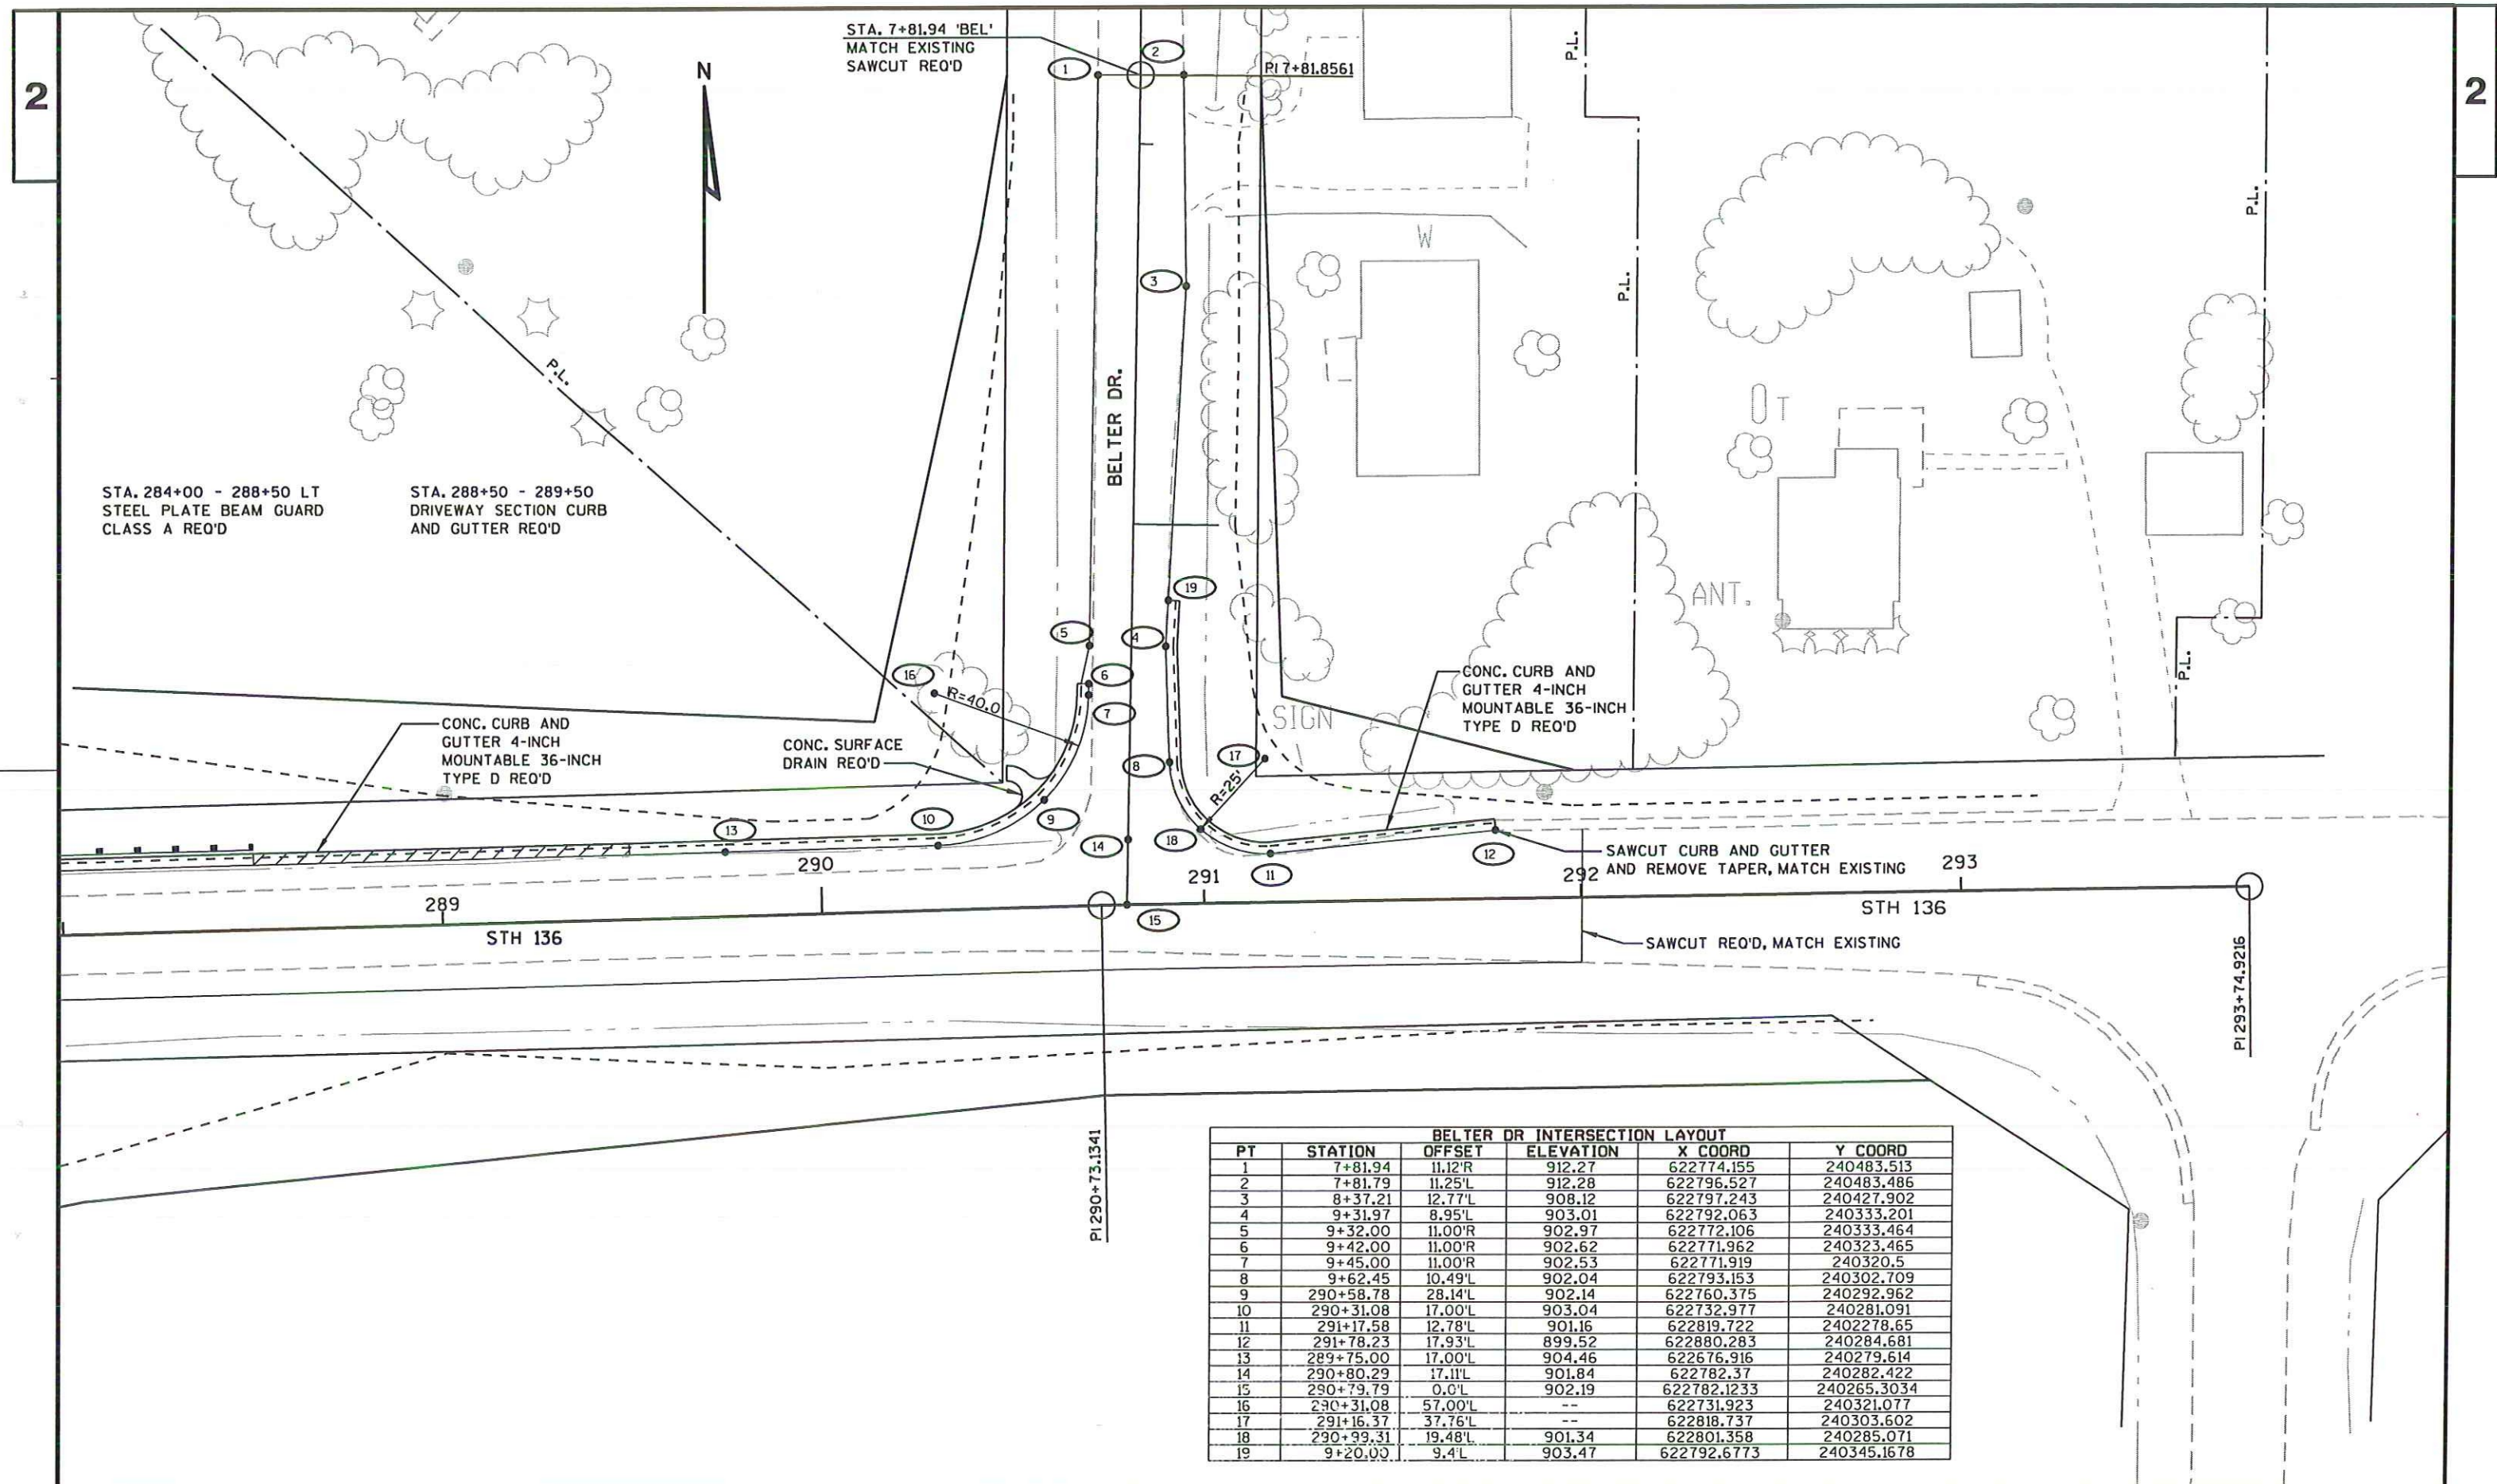

BELTER DR INTERSECTION LAYOUT					
PT	STATION	OFFSET	ELEVATION	X COORD	Y COORD
1	7+81.94	11.12'R	912.27	622774.155	240483.513
2	7+81.79	11.25'L	912.28	622796.527	240483.486
3	8+37.21	12.77'L	908.12	622797.243	240427.902
4	9+31.97	8.95'L	903.01	622792.063	240333.201
5	9+32.00	11.00'R	902.97	622772.106	240333.464
6	9+42.00	11.00'R	902.62	622771.962	240323.465
7	9+45.00	11.00'R	902.53	622771.919	240320.5
8	9+62.45	10.49'L	902.04	622793.153	240302.709
9	290+58.78	28.14'L	902.14	622760.375	240292.962
10	290+31.08	17.00'L	903.04	622732.977	240281.091
11	291+17.58	12.78'L	901.16	622819.722	2402278.65
12	291+78.23	17.93'L	899.52	622880.283	240284.681
13	289+75.00	17.00'L	904.46	622676.916	240279.614
14	290+80.29	17.11'L	901.84	622782.37	240282.422
15	290+79.79	0.0'L	902.19	622782.1233	240265.3034
16	290+31.08	57.00'L	--	622731.923	240321.077
17	291+16.37	37.76'L	--	622818.737	240303.602
18	290+99.31	19.48'L	901.34	622801.358	240285.071
19	9+20.00	9.4'L	903.47	622792.6773	240345.1678

NORTH RAILROAD ST INTERSECTION, MATCH POINTS, AND MAINLINE STOP PTS FOR RR					
PT	STATION	OFFSET	ELEVATION	X COORD	Y COORD
N1	104+54.21	41.00'L	--	605101.070	240037.369
N2	104+27.03	44.83'L	883.9	605073.985	240041.812
N3	104+29.88	35.24'L	884.09	605076.618	240032.162
N4	104+38.70	21.39'L	884.36	605085.122	240018.116
N5	104+54.21	16.00'L	884.46	605100.506	240012.375
N6	104+20.35	16.00'L	884.48	605066.675	240013.138
N7	104+24.96	0.00'L	884.8	605070.900	239997.038
N8	104+22.85	16.00'R	884.48	605068.435	239981.090

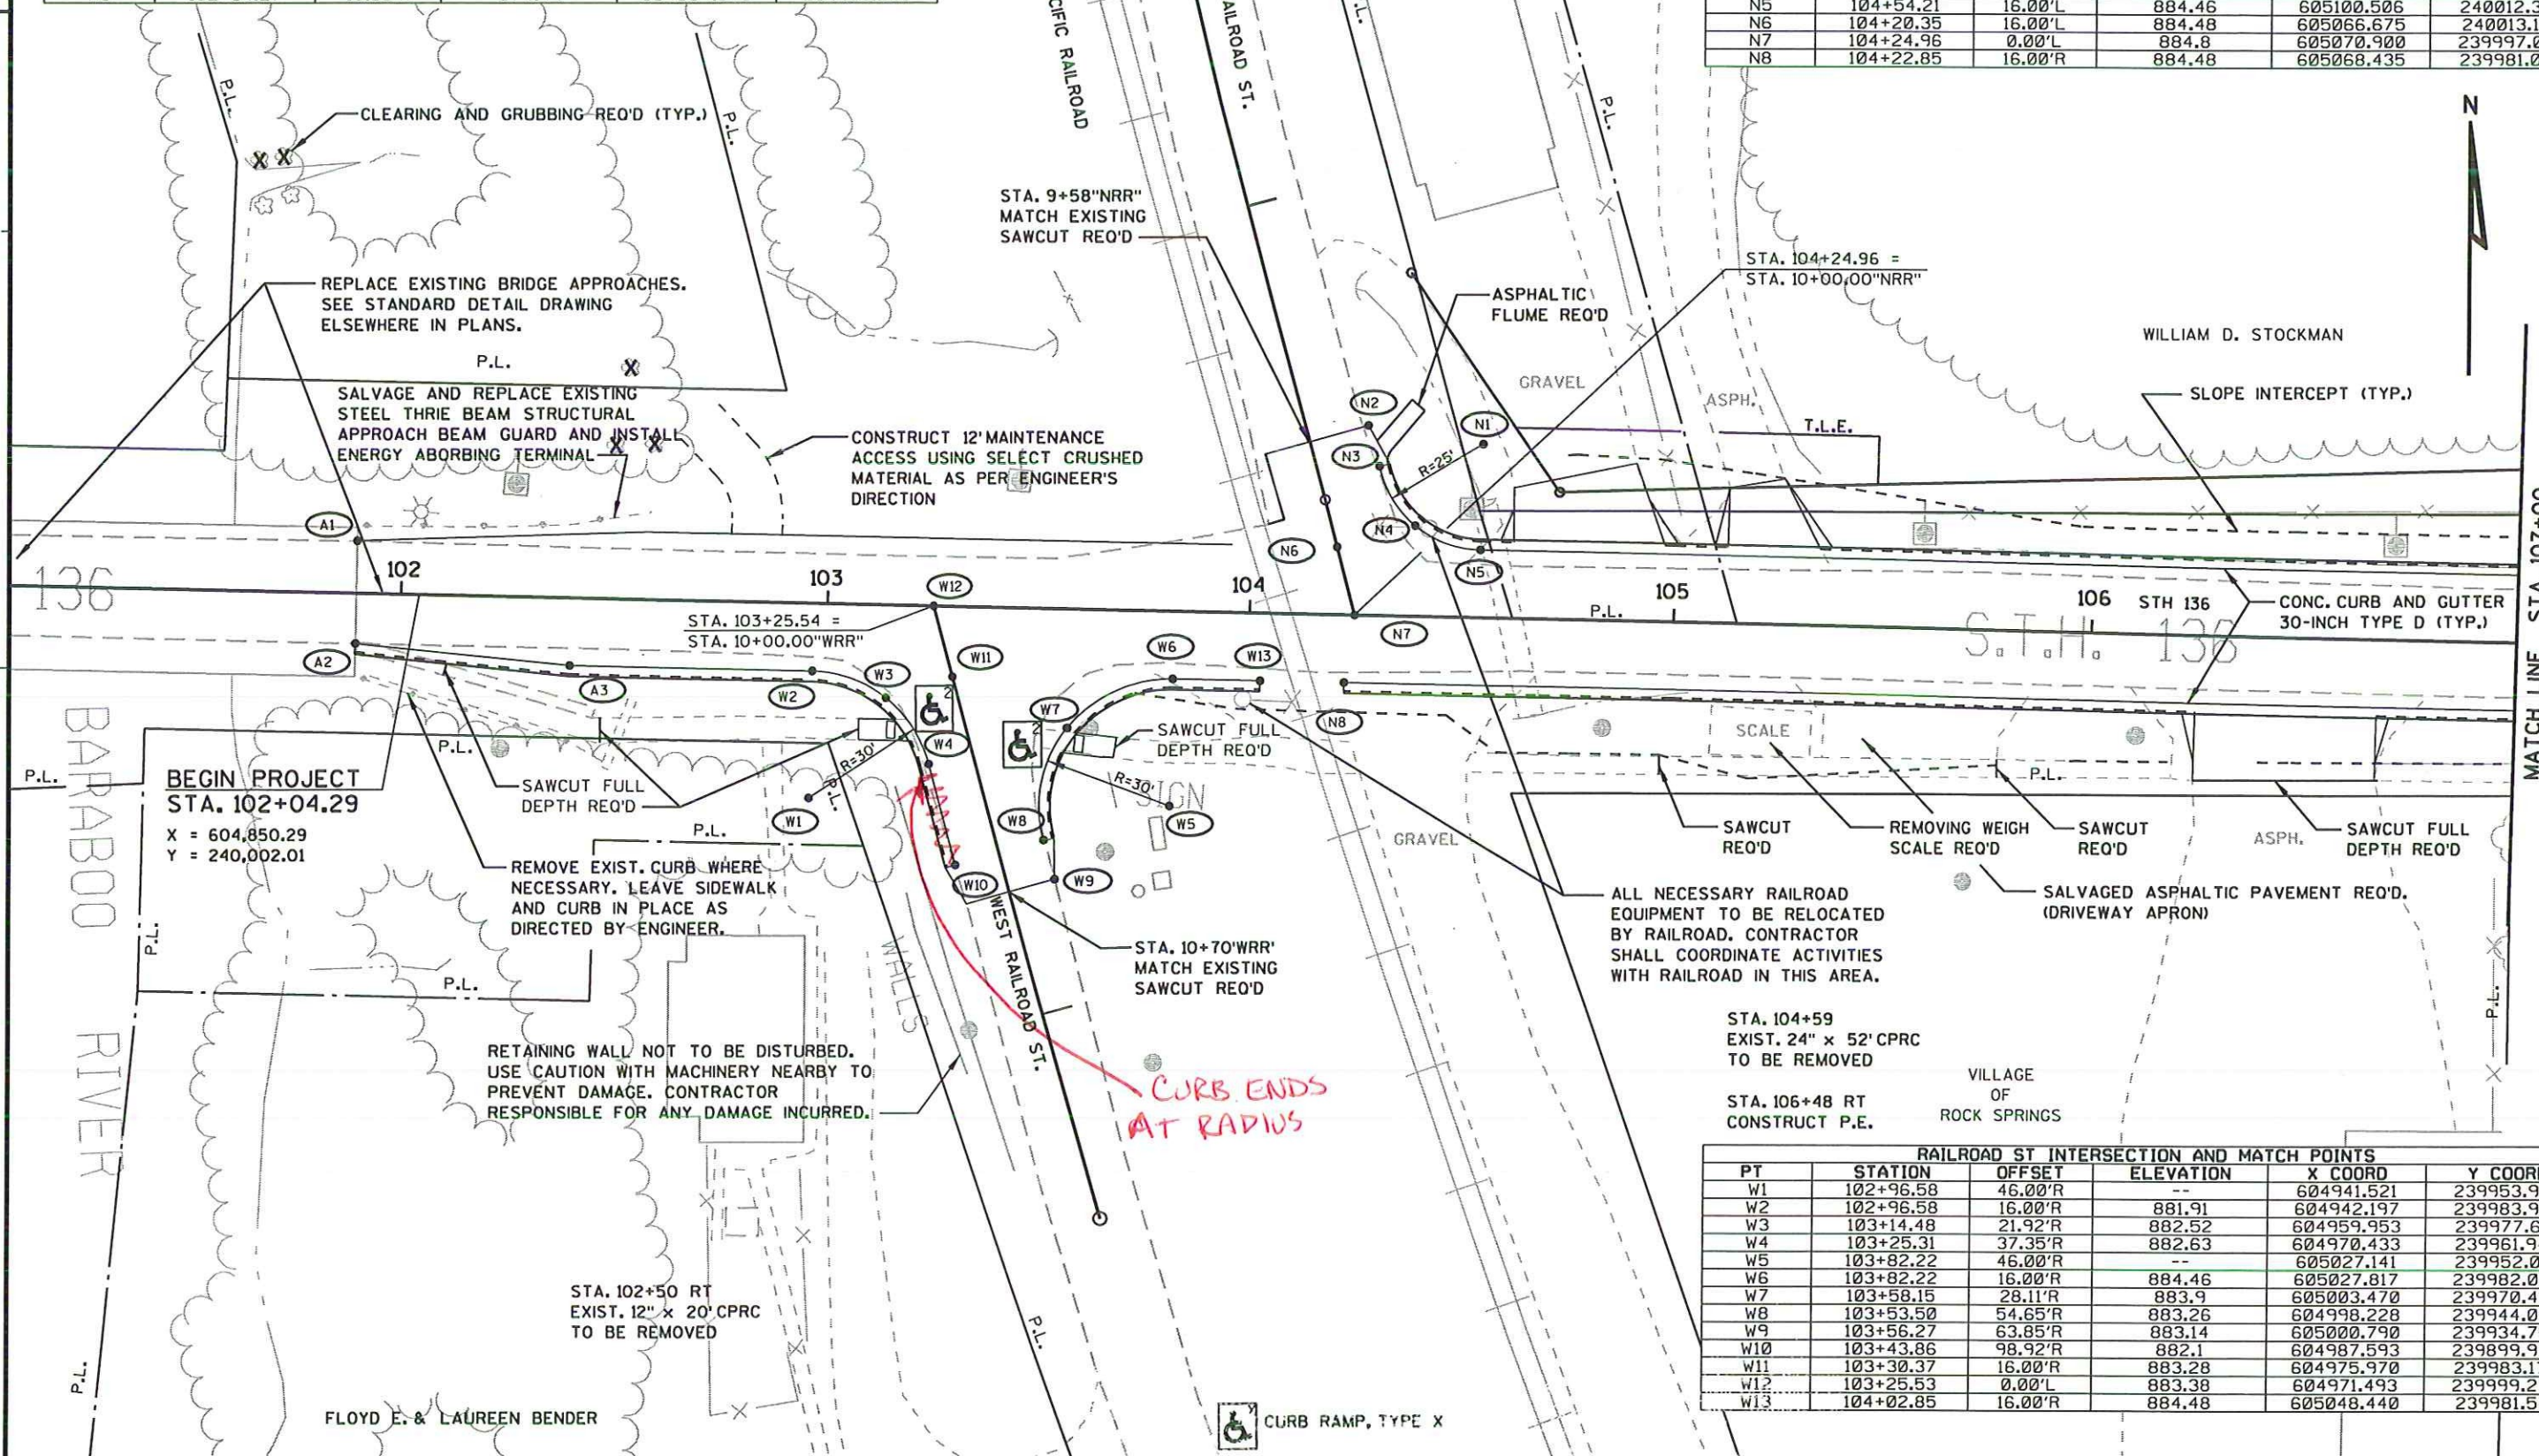


2

PT	STATION	OFFSET	ELEVATION	X COORD	Y COORD
M1	109+97.63	41.00'R	--	605643.047	239947.680
M2	109+97.63	16.00'R	901.47	605643.309	239972.678
M3	110+15.22	23.24'R	901.28	605660.826	239965.256
M4	110+22.62	40.76'R	900.88	605668.047	239947.655
M5	110+77.63	41.00'R	--	605723.047	239946.844
M6	110+77.63	16.00'R	900.99	605723.308	239971.842
M7	110+59.87	23.41'R	900.97	605705.470	239964.622
M8	110+52.63	41.24'R	900.67	605698.047	239946.868
M9	110+37.39	16.00'R	901.28	605683.072	239972.263
M10	110+37.24	0.00'R	901.6	605683.088	239988.263
M11	12+00.00	15.70'L	896.41	605698.589	239788.248
M12	12+10.00	15.70'L	896	605698.589	239778.248
M13	12+35.00	15.47'L	895	605698.329	239753.248
M14	12+35.00	13.85'R	895.03	605669.000	239753.277
M15	12+00.00	14.00'R	895.42	605668.864	239763.277

STA. 109+39 LT
CONSTRUCT P.E.
(39' ASPHALT)STA. 108+70 LT
EXIST. 12" x 16" CSCP
TO BE REMOVEDVILLAGE OF
ROCK SPRINGSSTA. 110+31 LT
CONSTRUCT P.E.
(9' ASPHALT)STA. 110+80 LT
CONSTRUCT P.E.
(10' ASPHALT)STA. 111+30 LT
CONSTRUCT P.E.
(10' ASPHALT)STA. 111+67 LT
CONSTRUCT P.E.
(12' ASPHALT)STA. 113+02 LT
EXIST. 12" x 56" CSCP
TO BE REMOVED

2

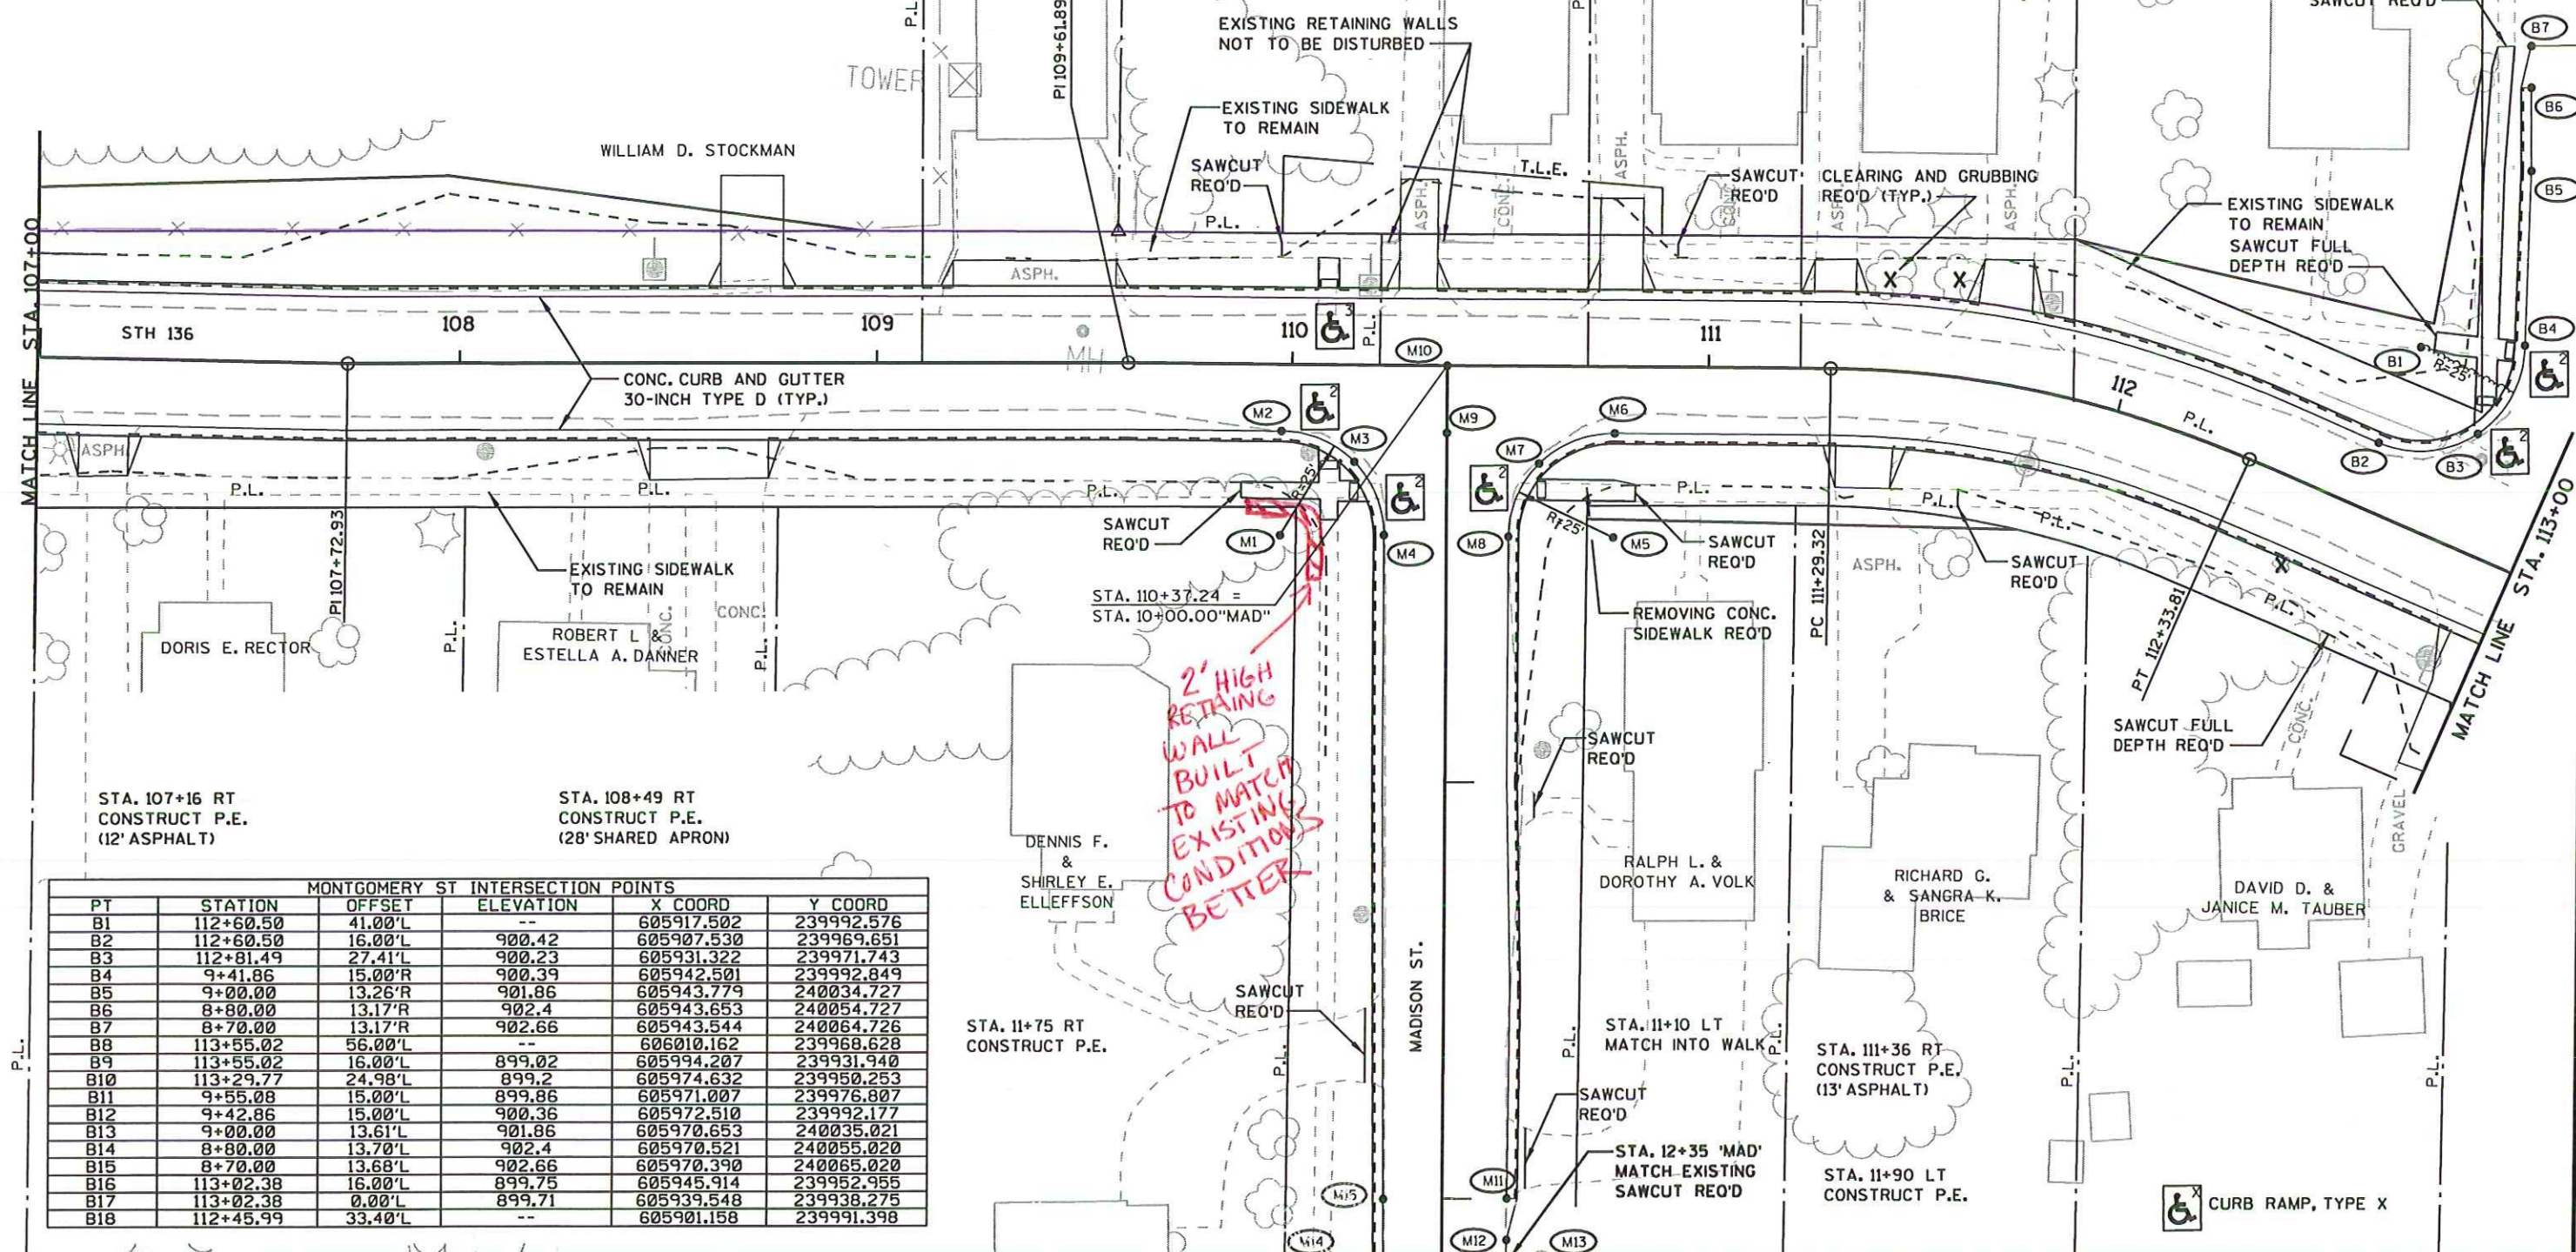

PROJECT NO: 5573-04-72

HWY: STH 136

COUNTY: SAUK

PLAN DETAIL

SHEET

E

FILE NAME : r:\Support\CADD\Projects\dl1_55730401\021202_.pd.dgn


PLOT DATE : 12-11-2007 07:02

PLOT BY : dotbbg

PLOT NAME :

PLOT SCALE : 40.000000:1.000000


WISDOT/CADD SHEET 42


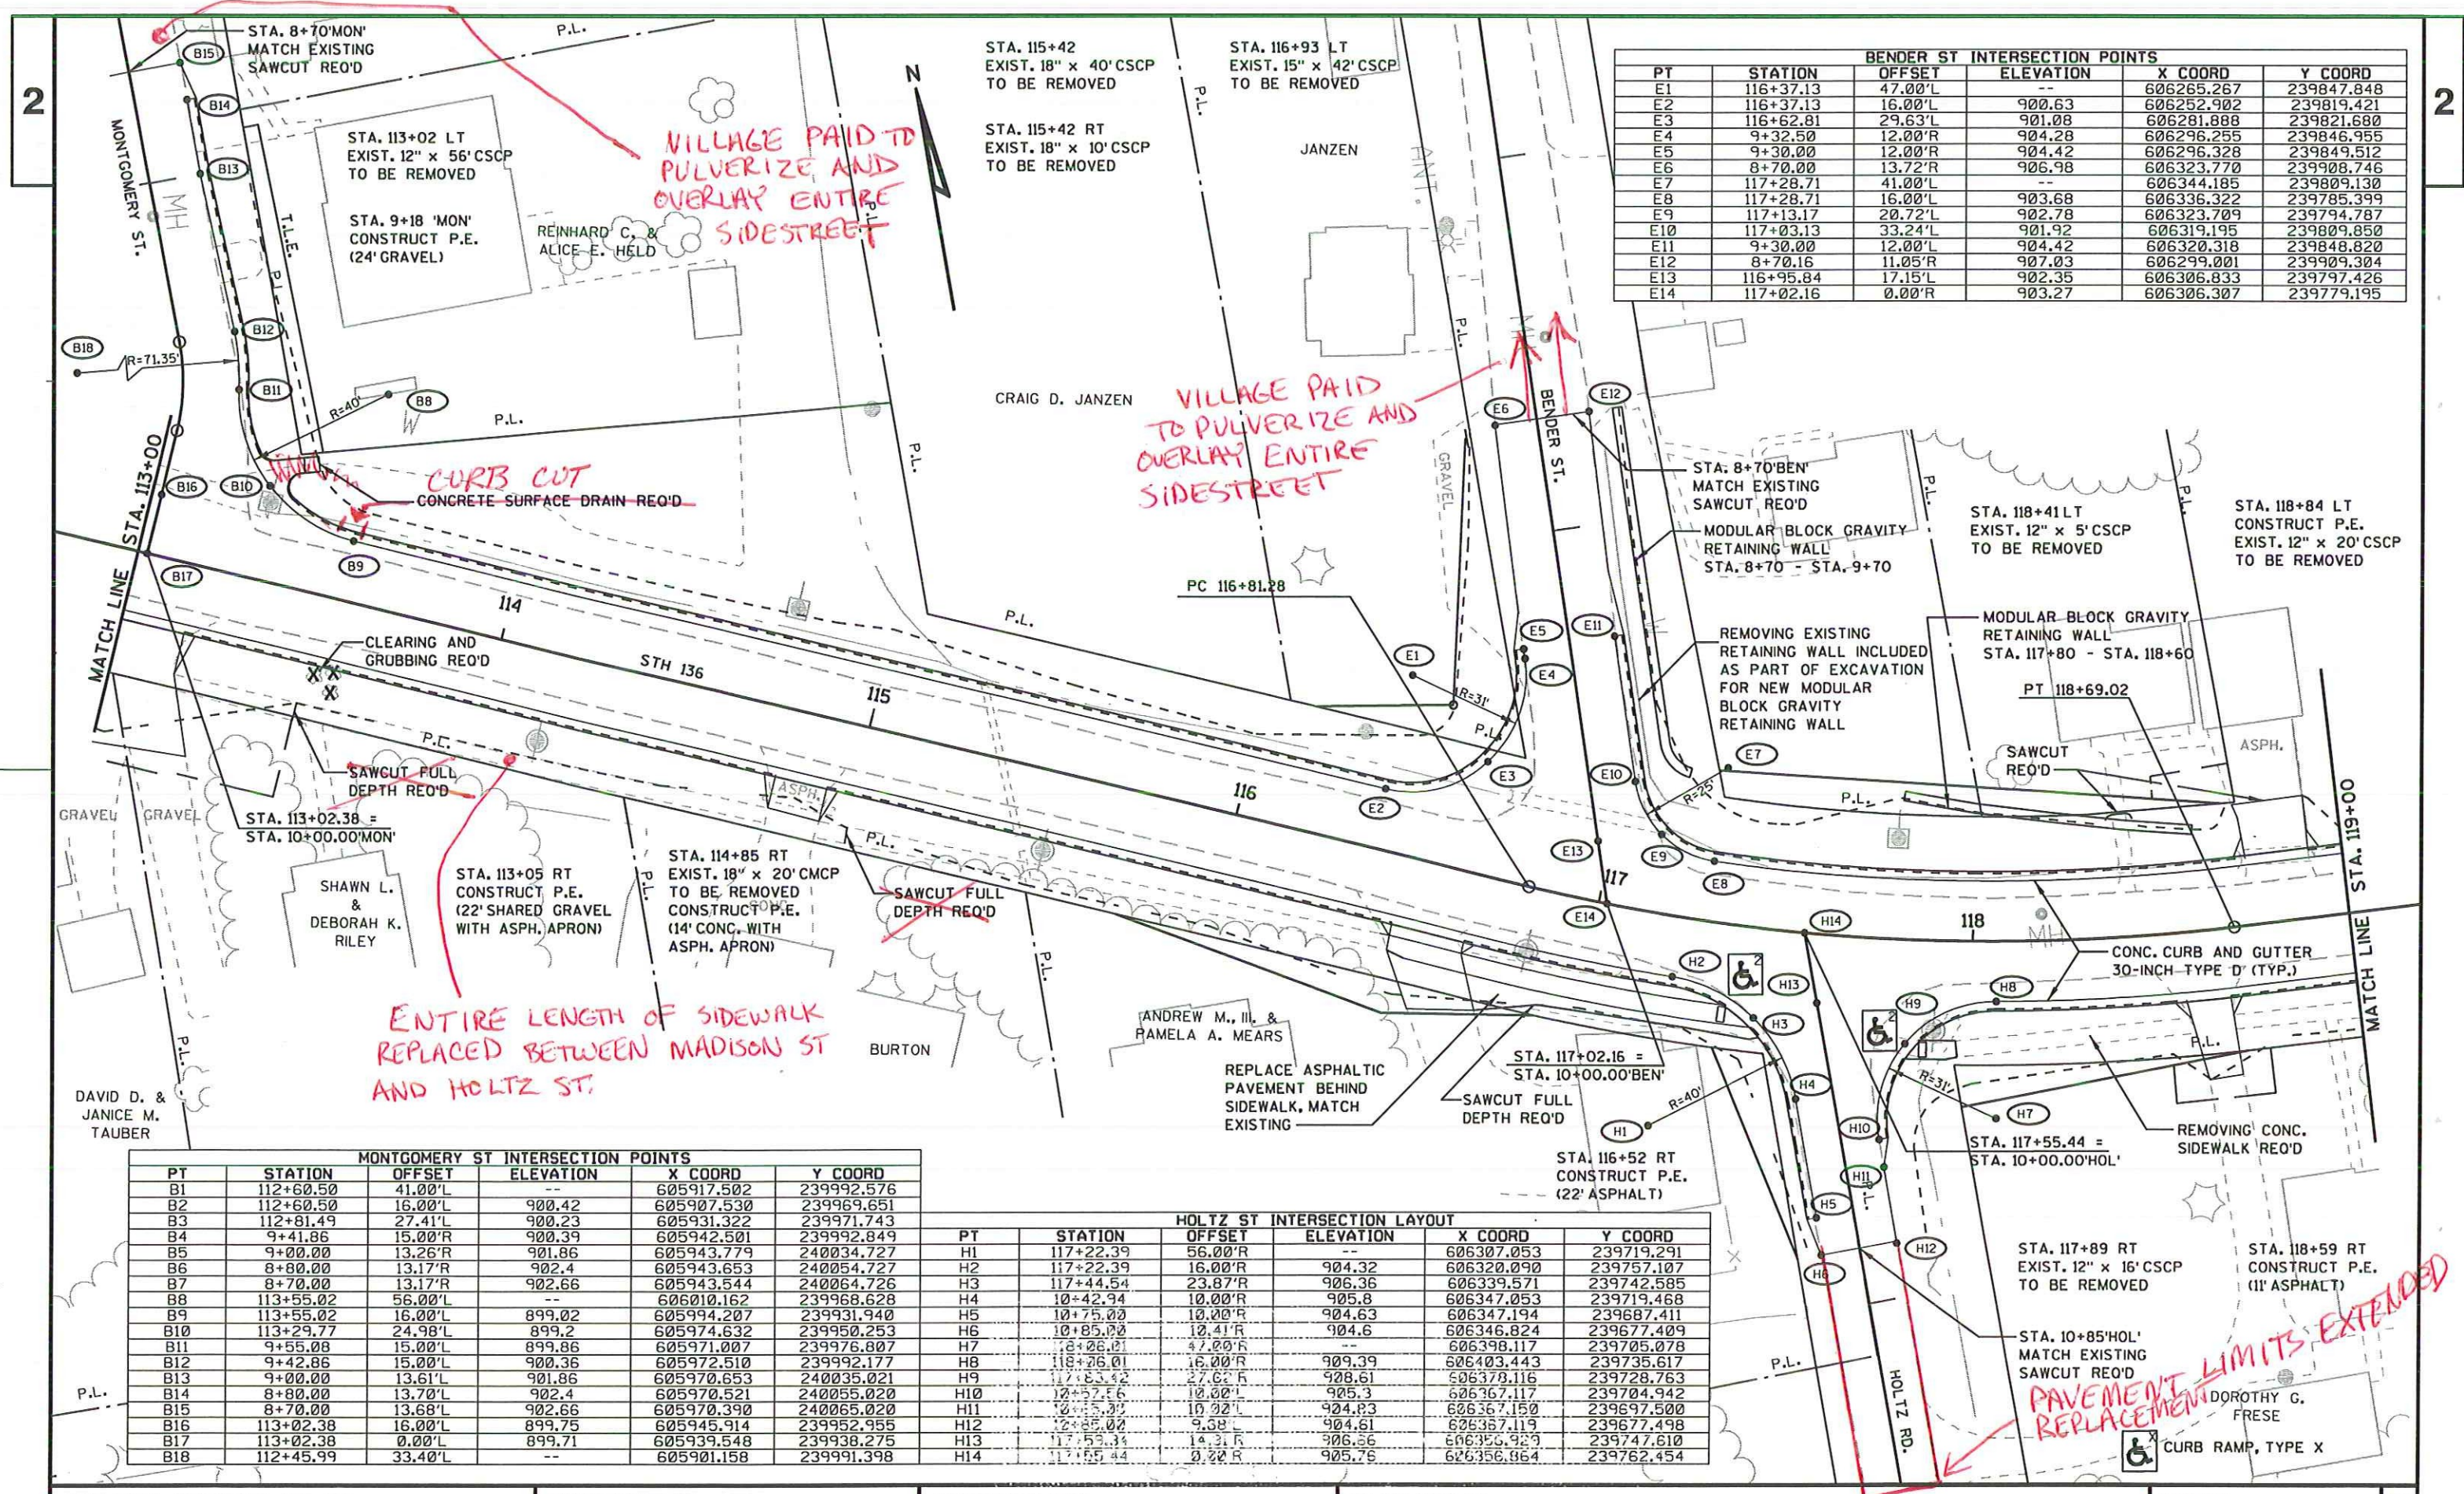


BENDER ST INTERSECTION POINTS					
PT	STATION	OFFSET	ELEVATION	X COORD	Y COORD
E1	116+37.13	47.00'L	---	606265.267	239847.848
E2	116+37.13	16.00'L	900.63	606252.902	239819.421
E3	116+62.81	29.63'L	901.08	606281.888	239821.680
E4	9+32.50	12.00'R	904.28	606296.255	239846.955
E5	9+30.00	12.00'R	904.42	606296.328	239849.512
E6	8+70.00	13.72'R	906.98	606323.770	239908.746
E7	117+28.71	41.00'L	---	606344.185	239809.130
E8	117+28.71	16.00'L	903.68	606336.322	239785.399
E9	117+13.17	20.72'L	902.78	606323.709	239794.787
E10	117+03.13	33.24'L	901.92	606319.195	239809.850
E11	9+30.00	12.00'L	904.42	606320.318	239848.820
E12	8+70.16	11.05'R	907.03	606299.001	239909.304
E13	116+95.84	17.15'L	902.35	606306.833	239797.426
E14	117+02.16	0.00'R	903.27	606306.307	239779.195

MONTGOMERY ST INTERSECTION POINTS					
PT	STATION	OFFSET	ELEVATION	X COORD	Y COORD
B1	112+60.50	41.00'L	---	605917.502	239992.576
B2	112+60.50	16.00'L	900.42	605907.530	239969.651
B3	112+81.49	27.41'L	900.23	605931.322	239971.743
B4	9+41.86	15.00'R	900.39	605942.501	239992.849
B5	9+00.00	13.26'R	901.86	605943.779	240034.727
B6	8+80.00	13.17'R	902.4	605943.653	240054.727
B7	8+70.00	13.17'R	902.66	605943.544	240064.726
B8	113+55.02	56.00'L	---	606010.162	239968.628
B9	113+55.02	16.00'L	899.02	605994.207	239931.940
B10	113+29.77	24.98'L	899.2	605974.632	239950.253
B11	9+55.08	15.00'L	899.86	605971.007	239976.807
B12	9+42.86	15.00'L	900.36	605972.510	239992.177
B13	9+00.00	13.61'L	901.86	605970.653	240035.021
B14	8+80.00	13.70'L	902.4	605970.521	240055.020
B15	8+70.00	13.68'L	902.66	605970.390	240065.020
B16	113+02.38	16.00'L	899.75	605945.914	239952.955
B17	113+02.38	0.00'L	899.71	605939.548	239938.275
B18	112+45.99	33.40'L	---	605901.158	239991.398

HOLTZ ST INTERSECTION LAYOUT					
PT	STATION	OFFSET	ELEVATION	X COORD	Y COORD
H1	117+22.39	56.00'R	---	606307.053	239719.291
H2	117+22.39	16.00'R	904.32	606320.090	239757.107
H3	117+44.54	23.87'R	906.36	606339.571	239742.585
H4	10+42.94	10.00'R	905.8	606347.053	239719.468
H5	10+75.00	10.00'R	904.63	606347.194	239687.411
H6	10+85.00	10.41'R	904.6	606346.824	239677.409
H7	10+06.01	47.00'R	---	606398.117	239705.078
H8	118+26.01	16.00'R	909.39	606403.443	239735.617
H9	117+53.42	27.60'R	908.61	606378.116	239728.763
H10	10+57.56	10.00'L	905.3	606367.117	239704.942
H11	10+55.30	10.02'L	904.83	606367.150	239697.500
H12	10+85.00	9.38'L	904.61	606367.119	239677.498
H13	117+55.31	14.31'R	906.56	606365.929	239747.610
H14	117+55.44	0.00'R	905.76	606356.064	239762.454

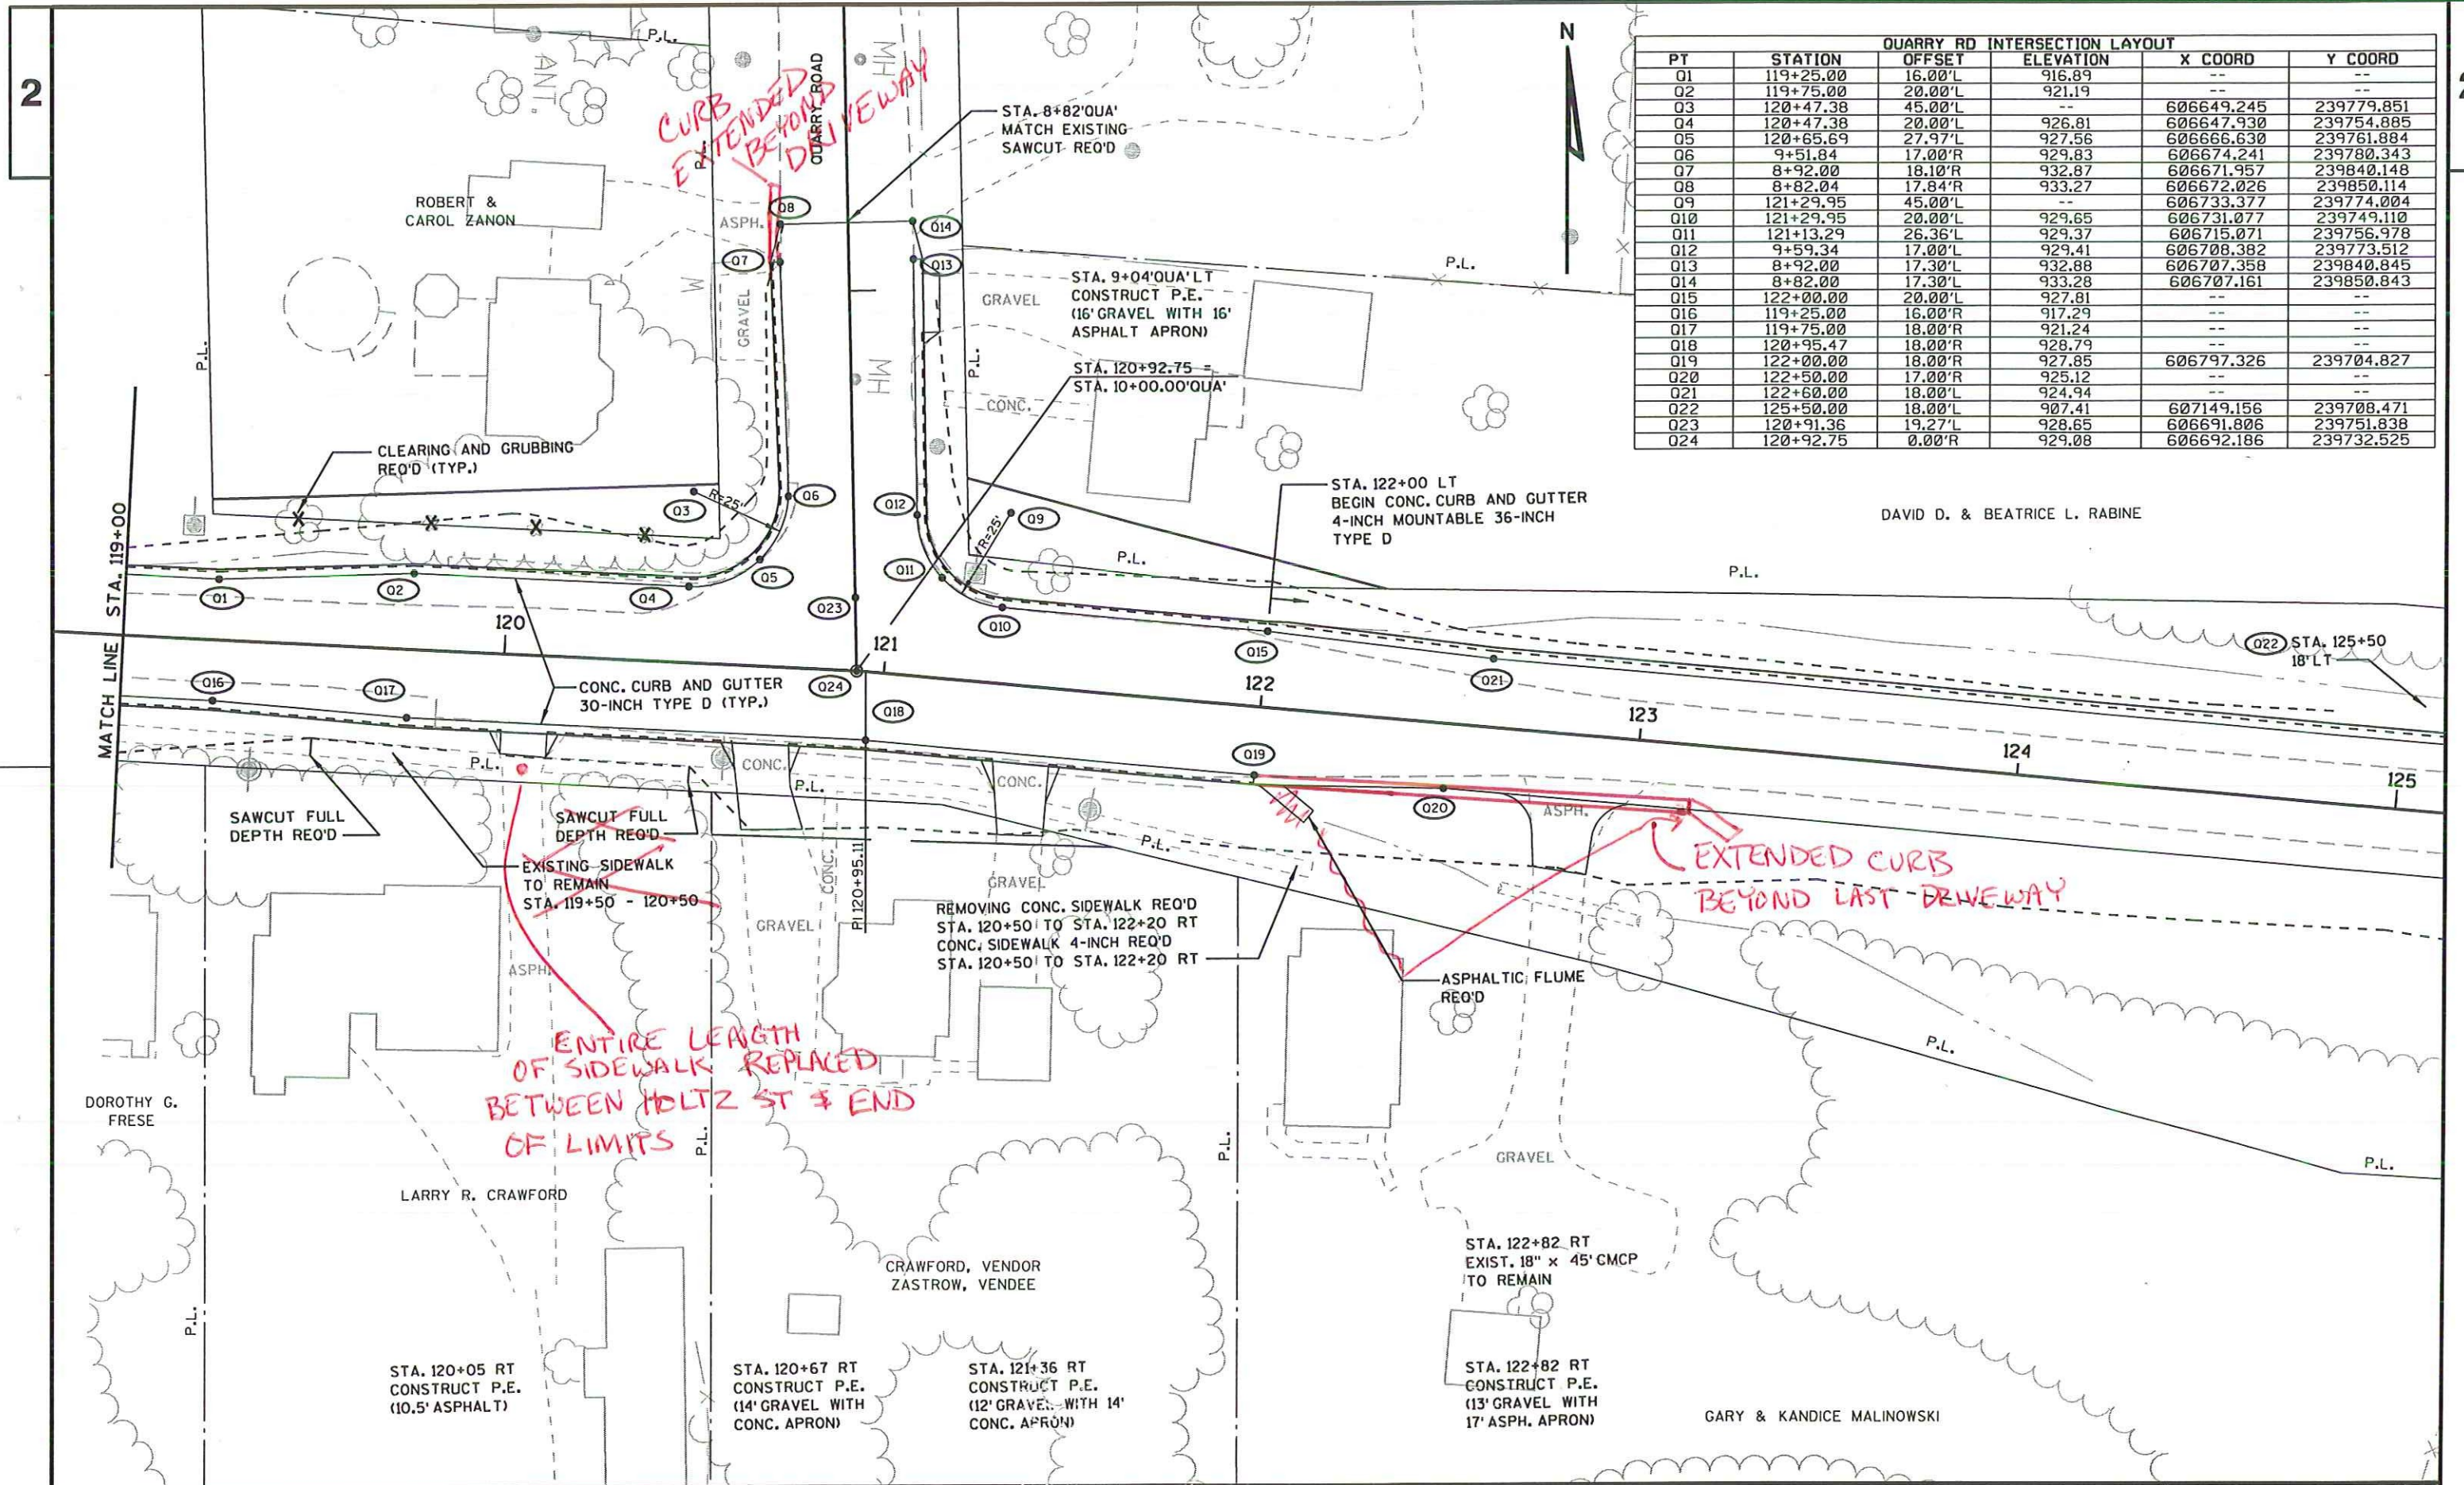

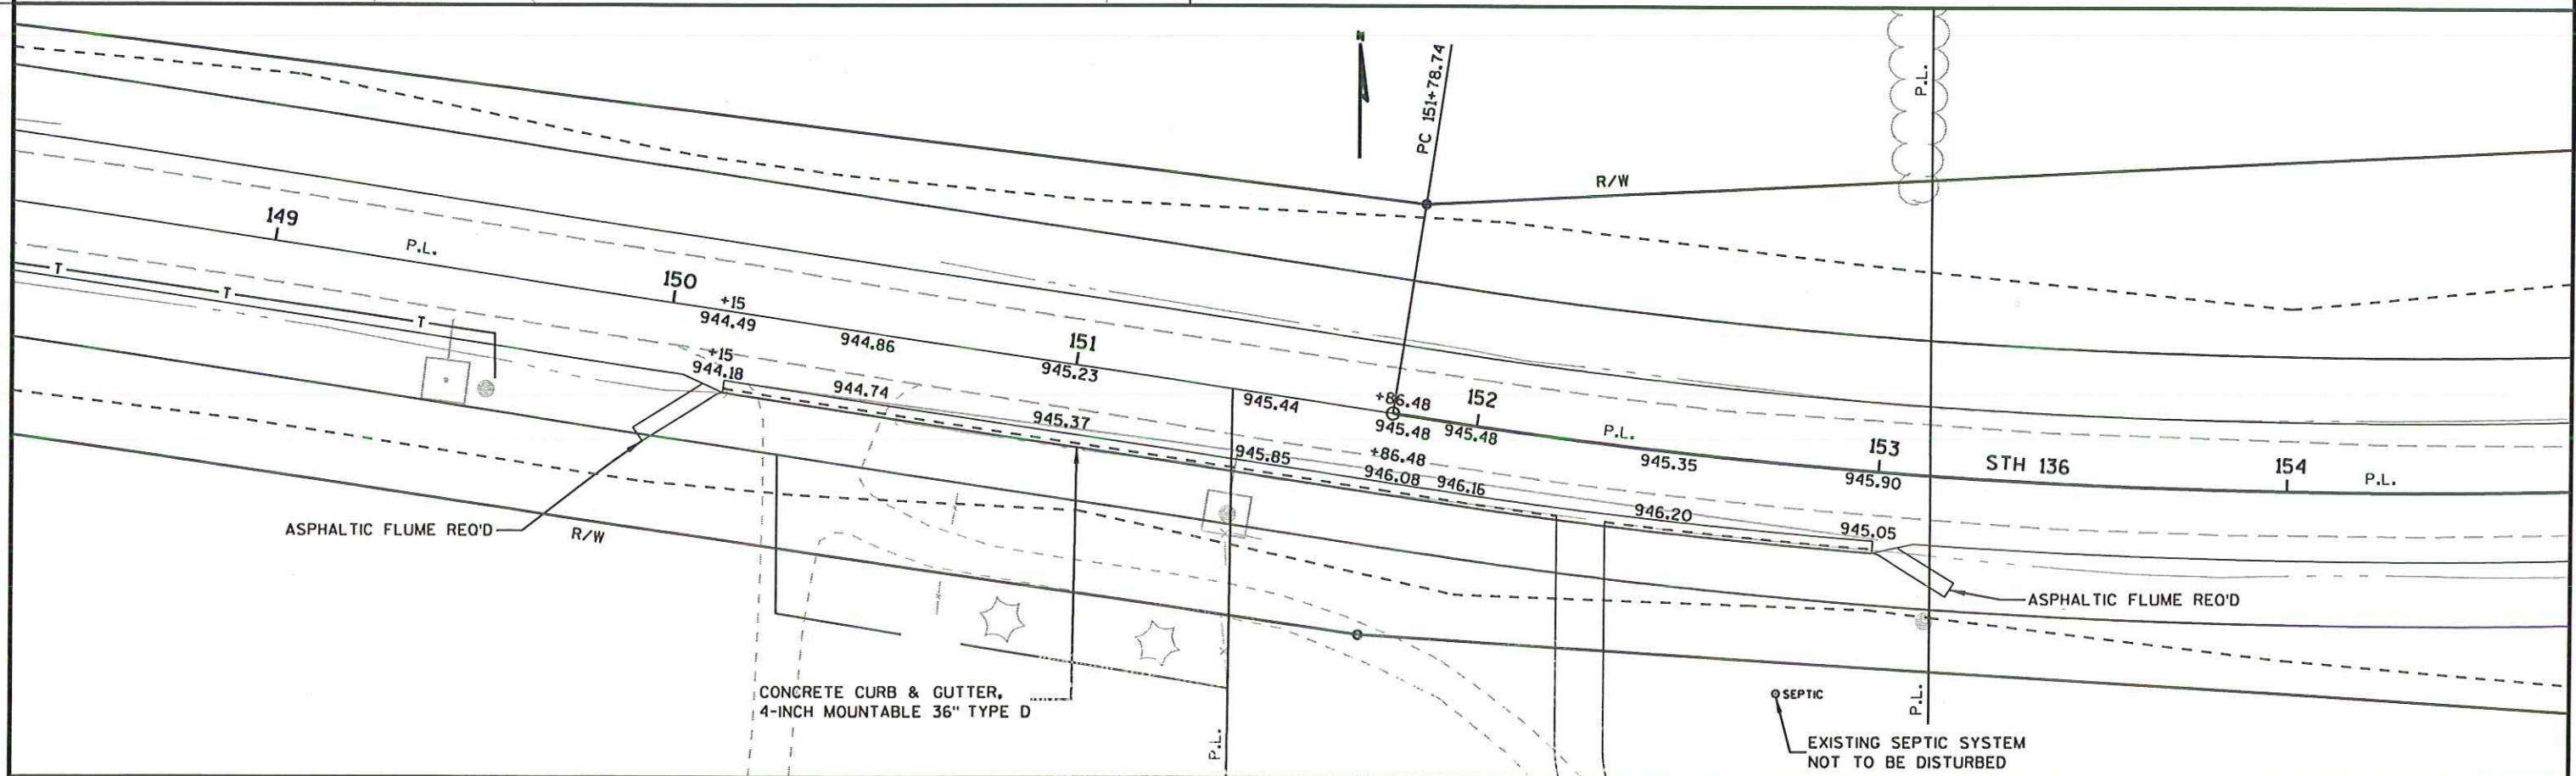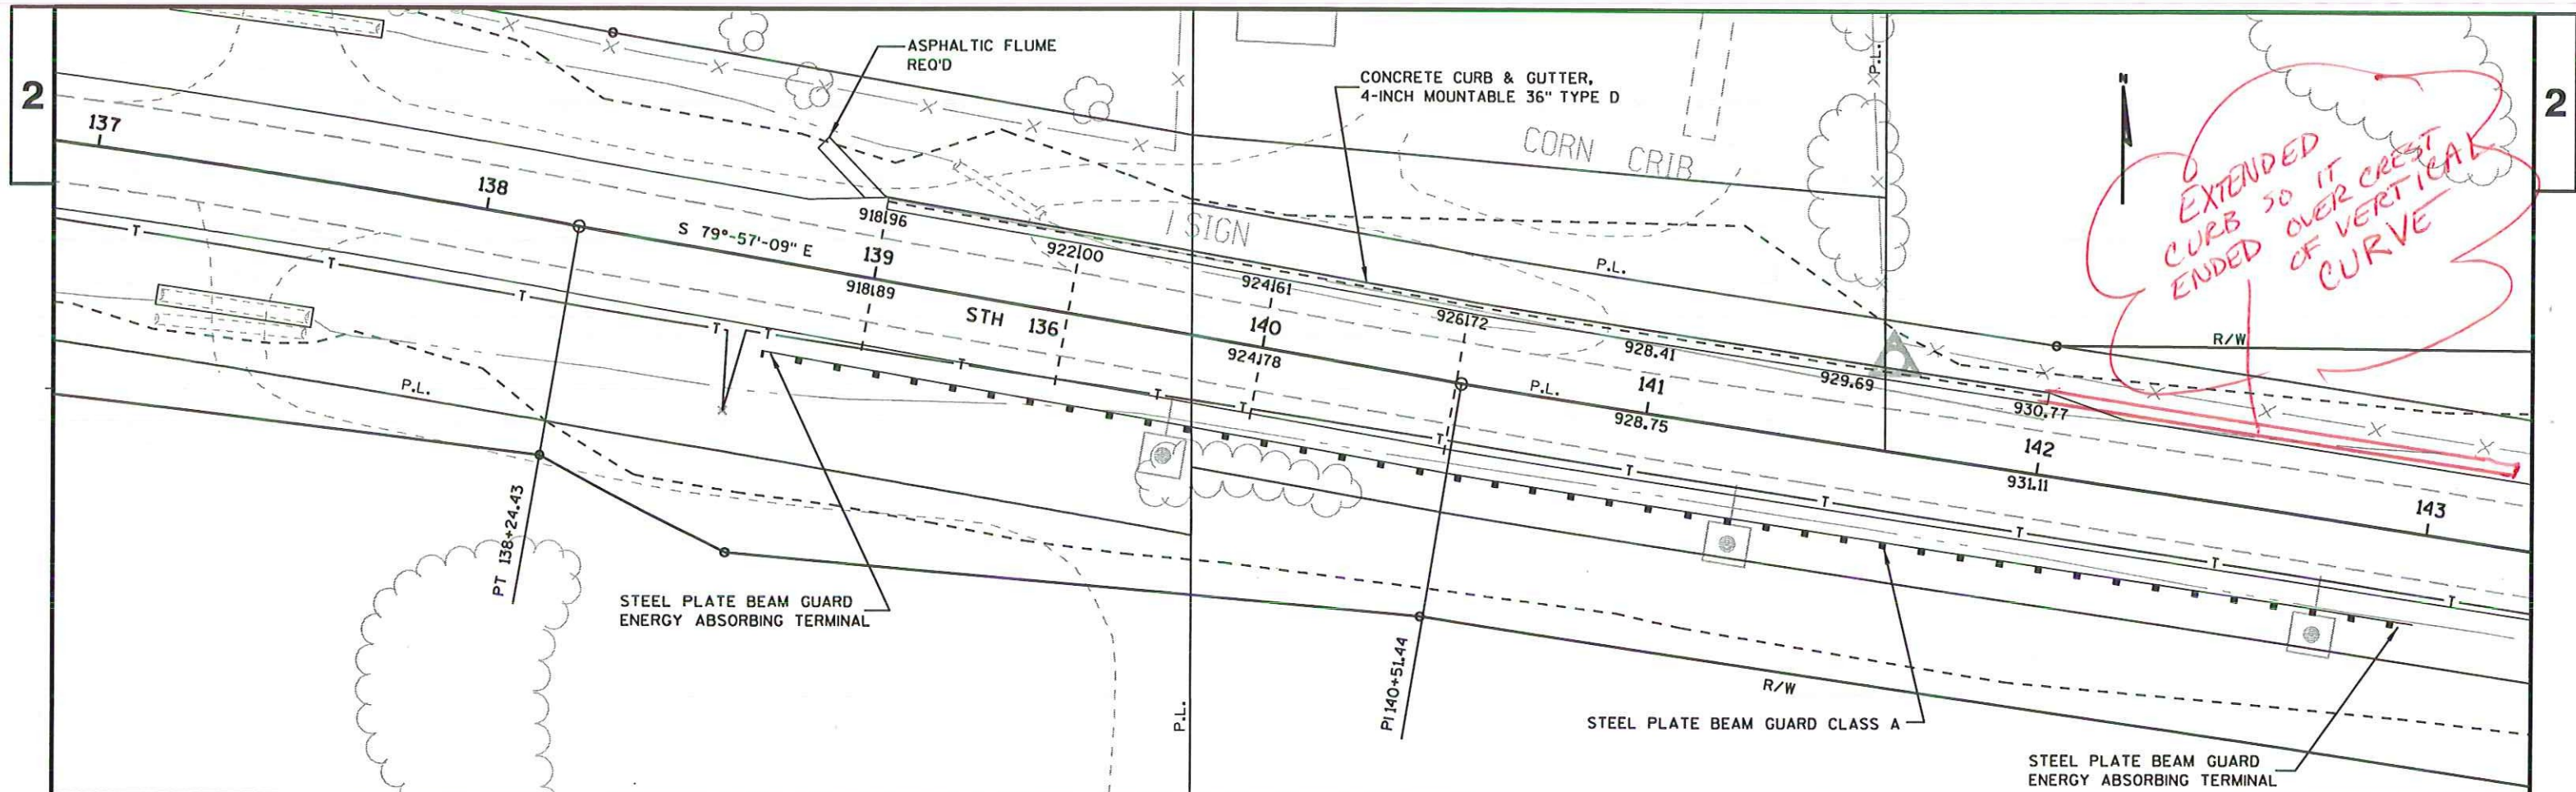

PROJECT NO: 5573-04-72

HWY: STH 136

COUNTY: SAUK

PLAN DETAIL

SHEET

E

FILE NAME : r:\Support\CADD\Projects\dl_55730401\021205_.pd.dgn


PLOT DATE : 12-JUL-2007 07:02


PLOT BY : ddtbbg


PLOT NAME :

PLOT SCALE : 40.000000:1.000000

34
WISDOT/CADD SHEET 42

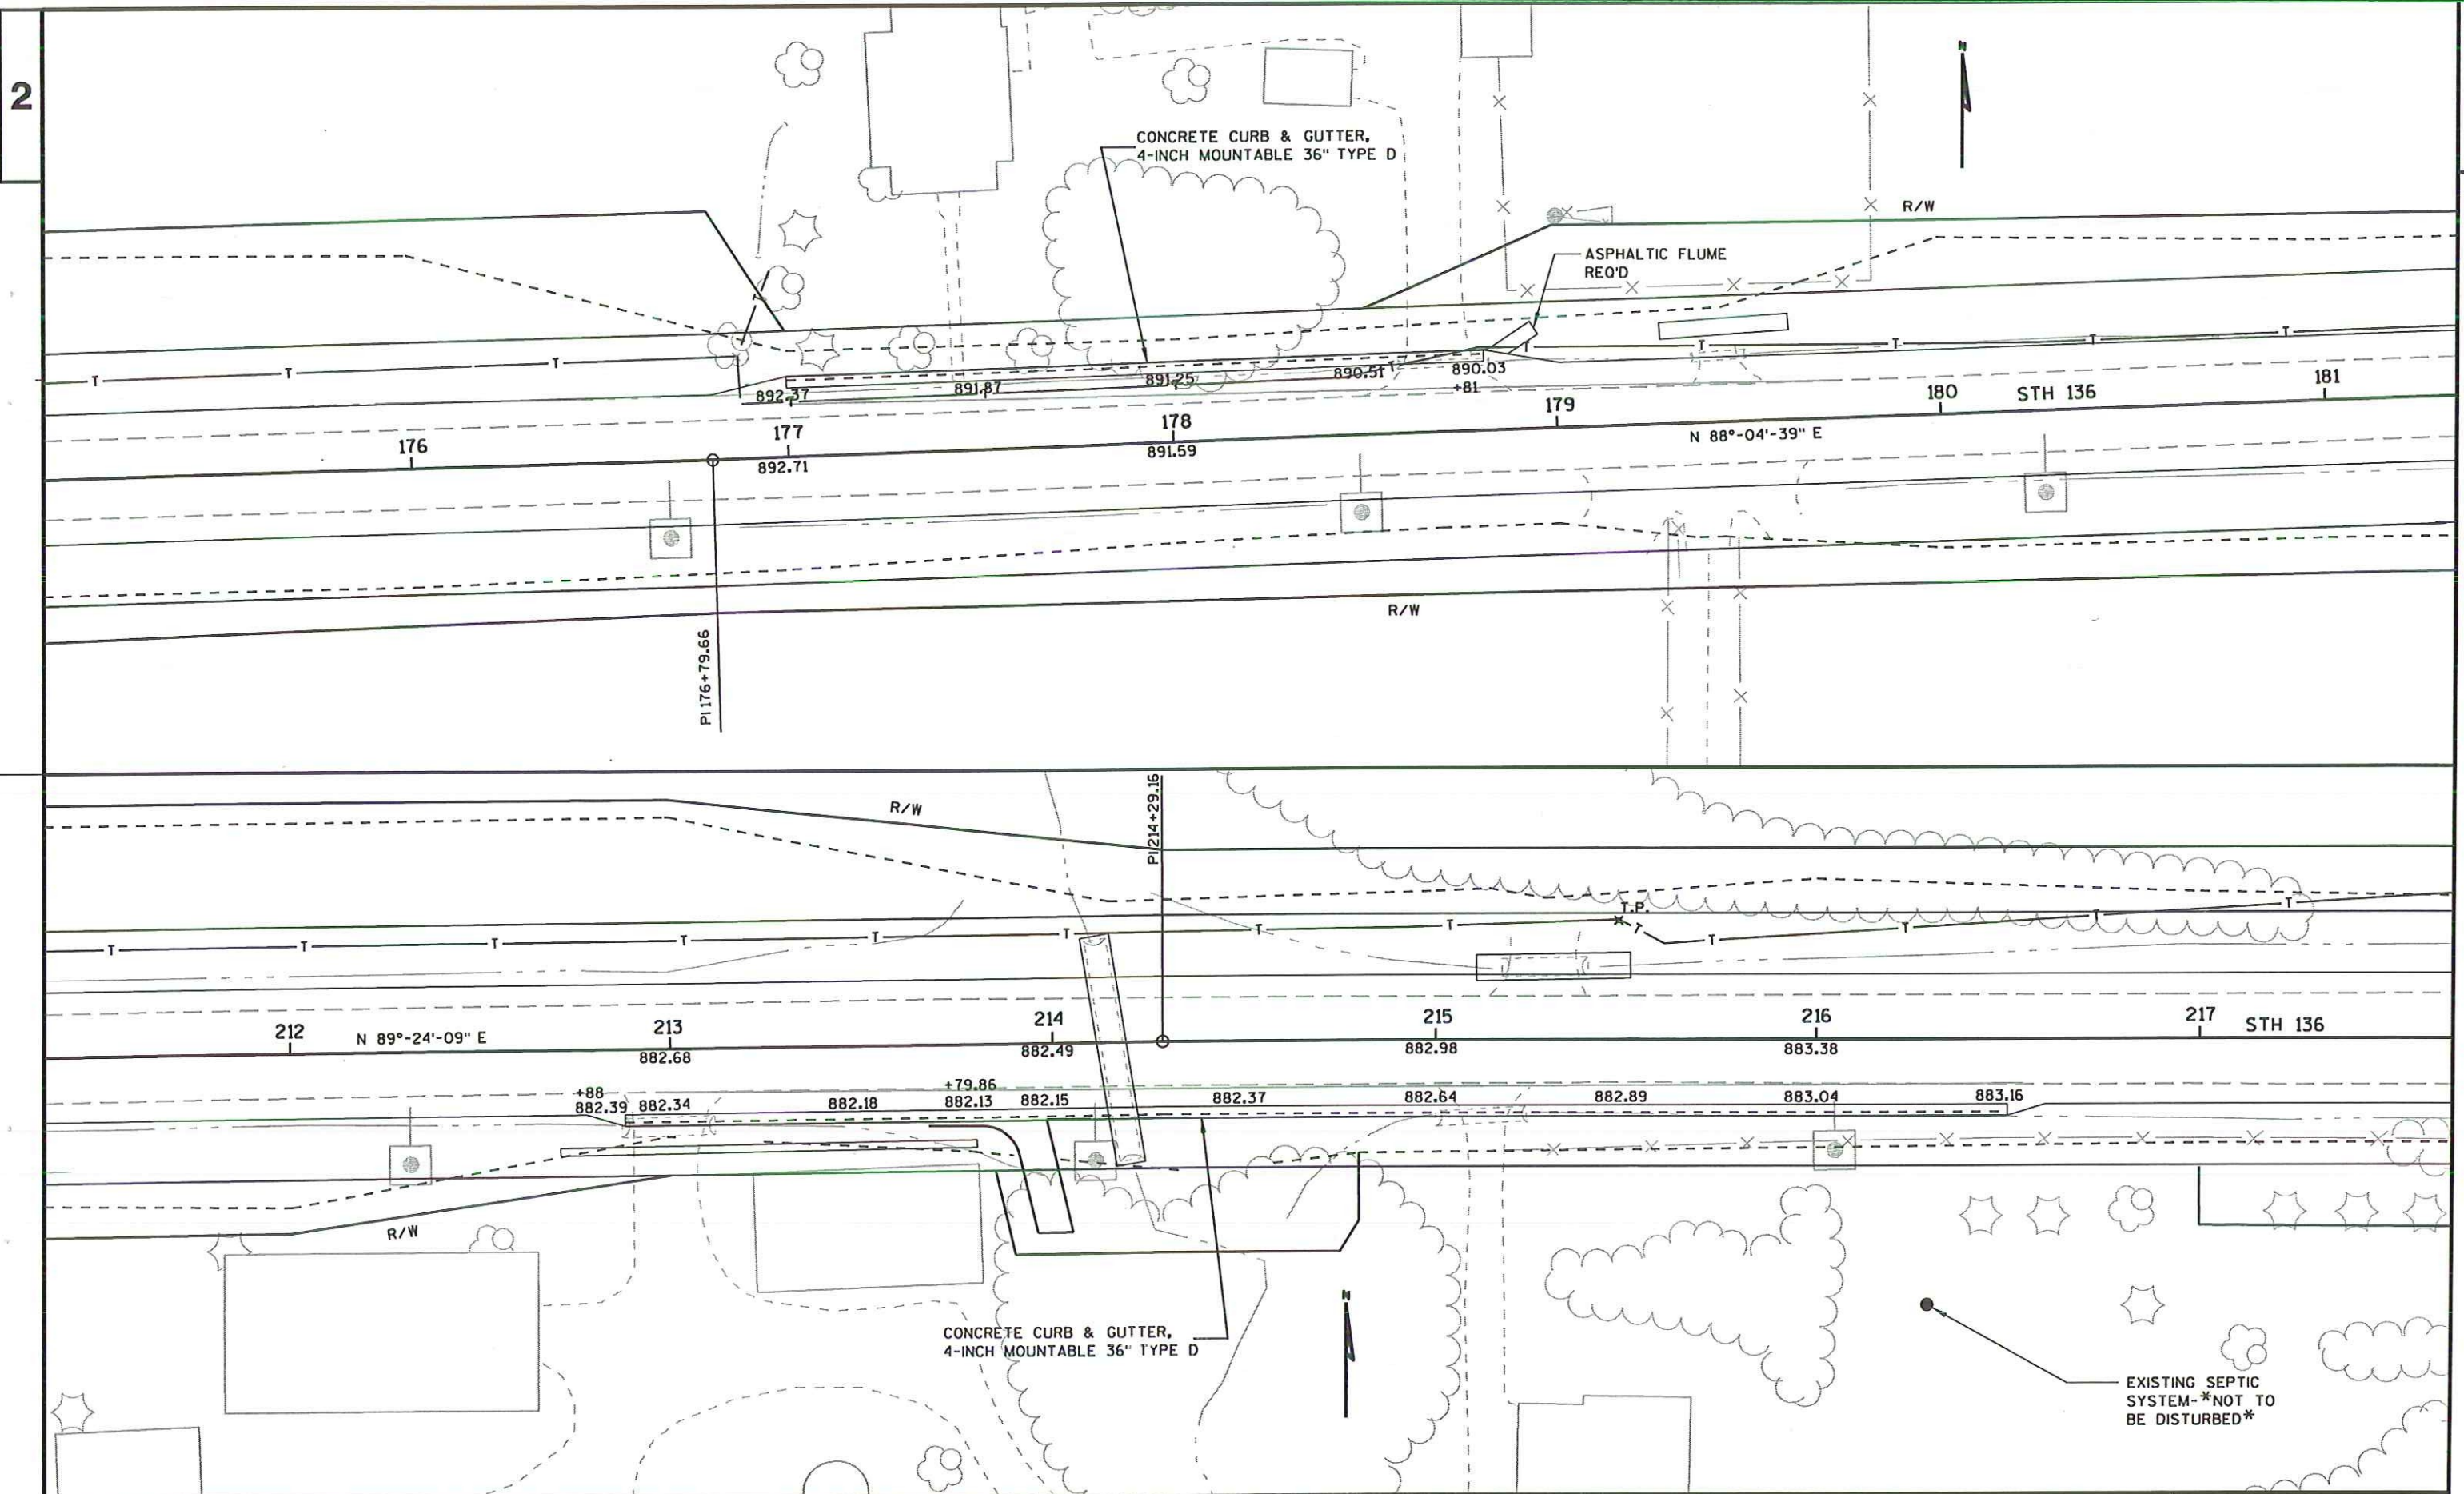

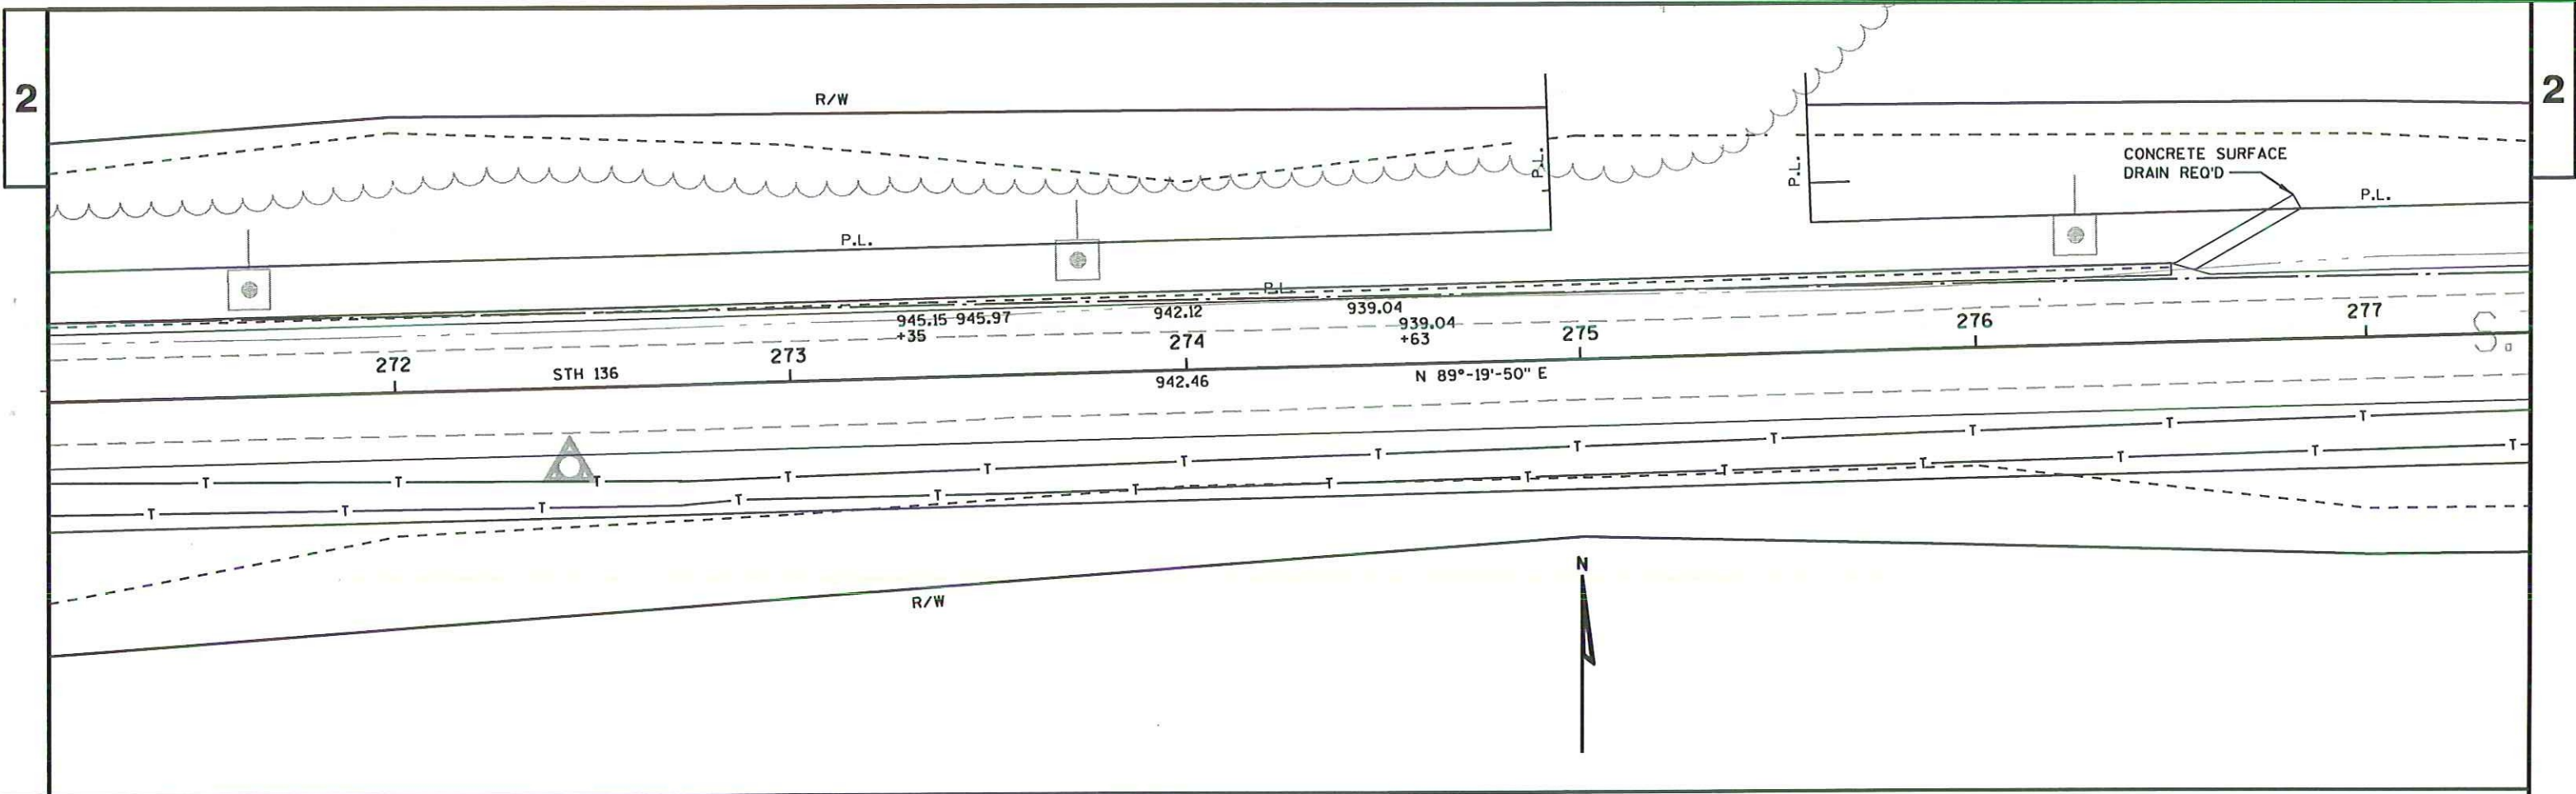

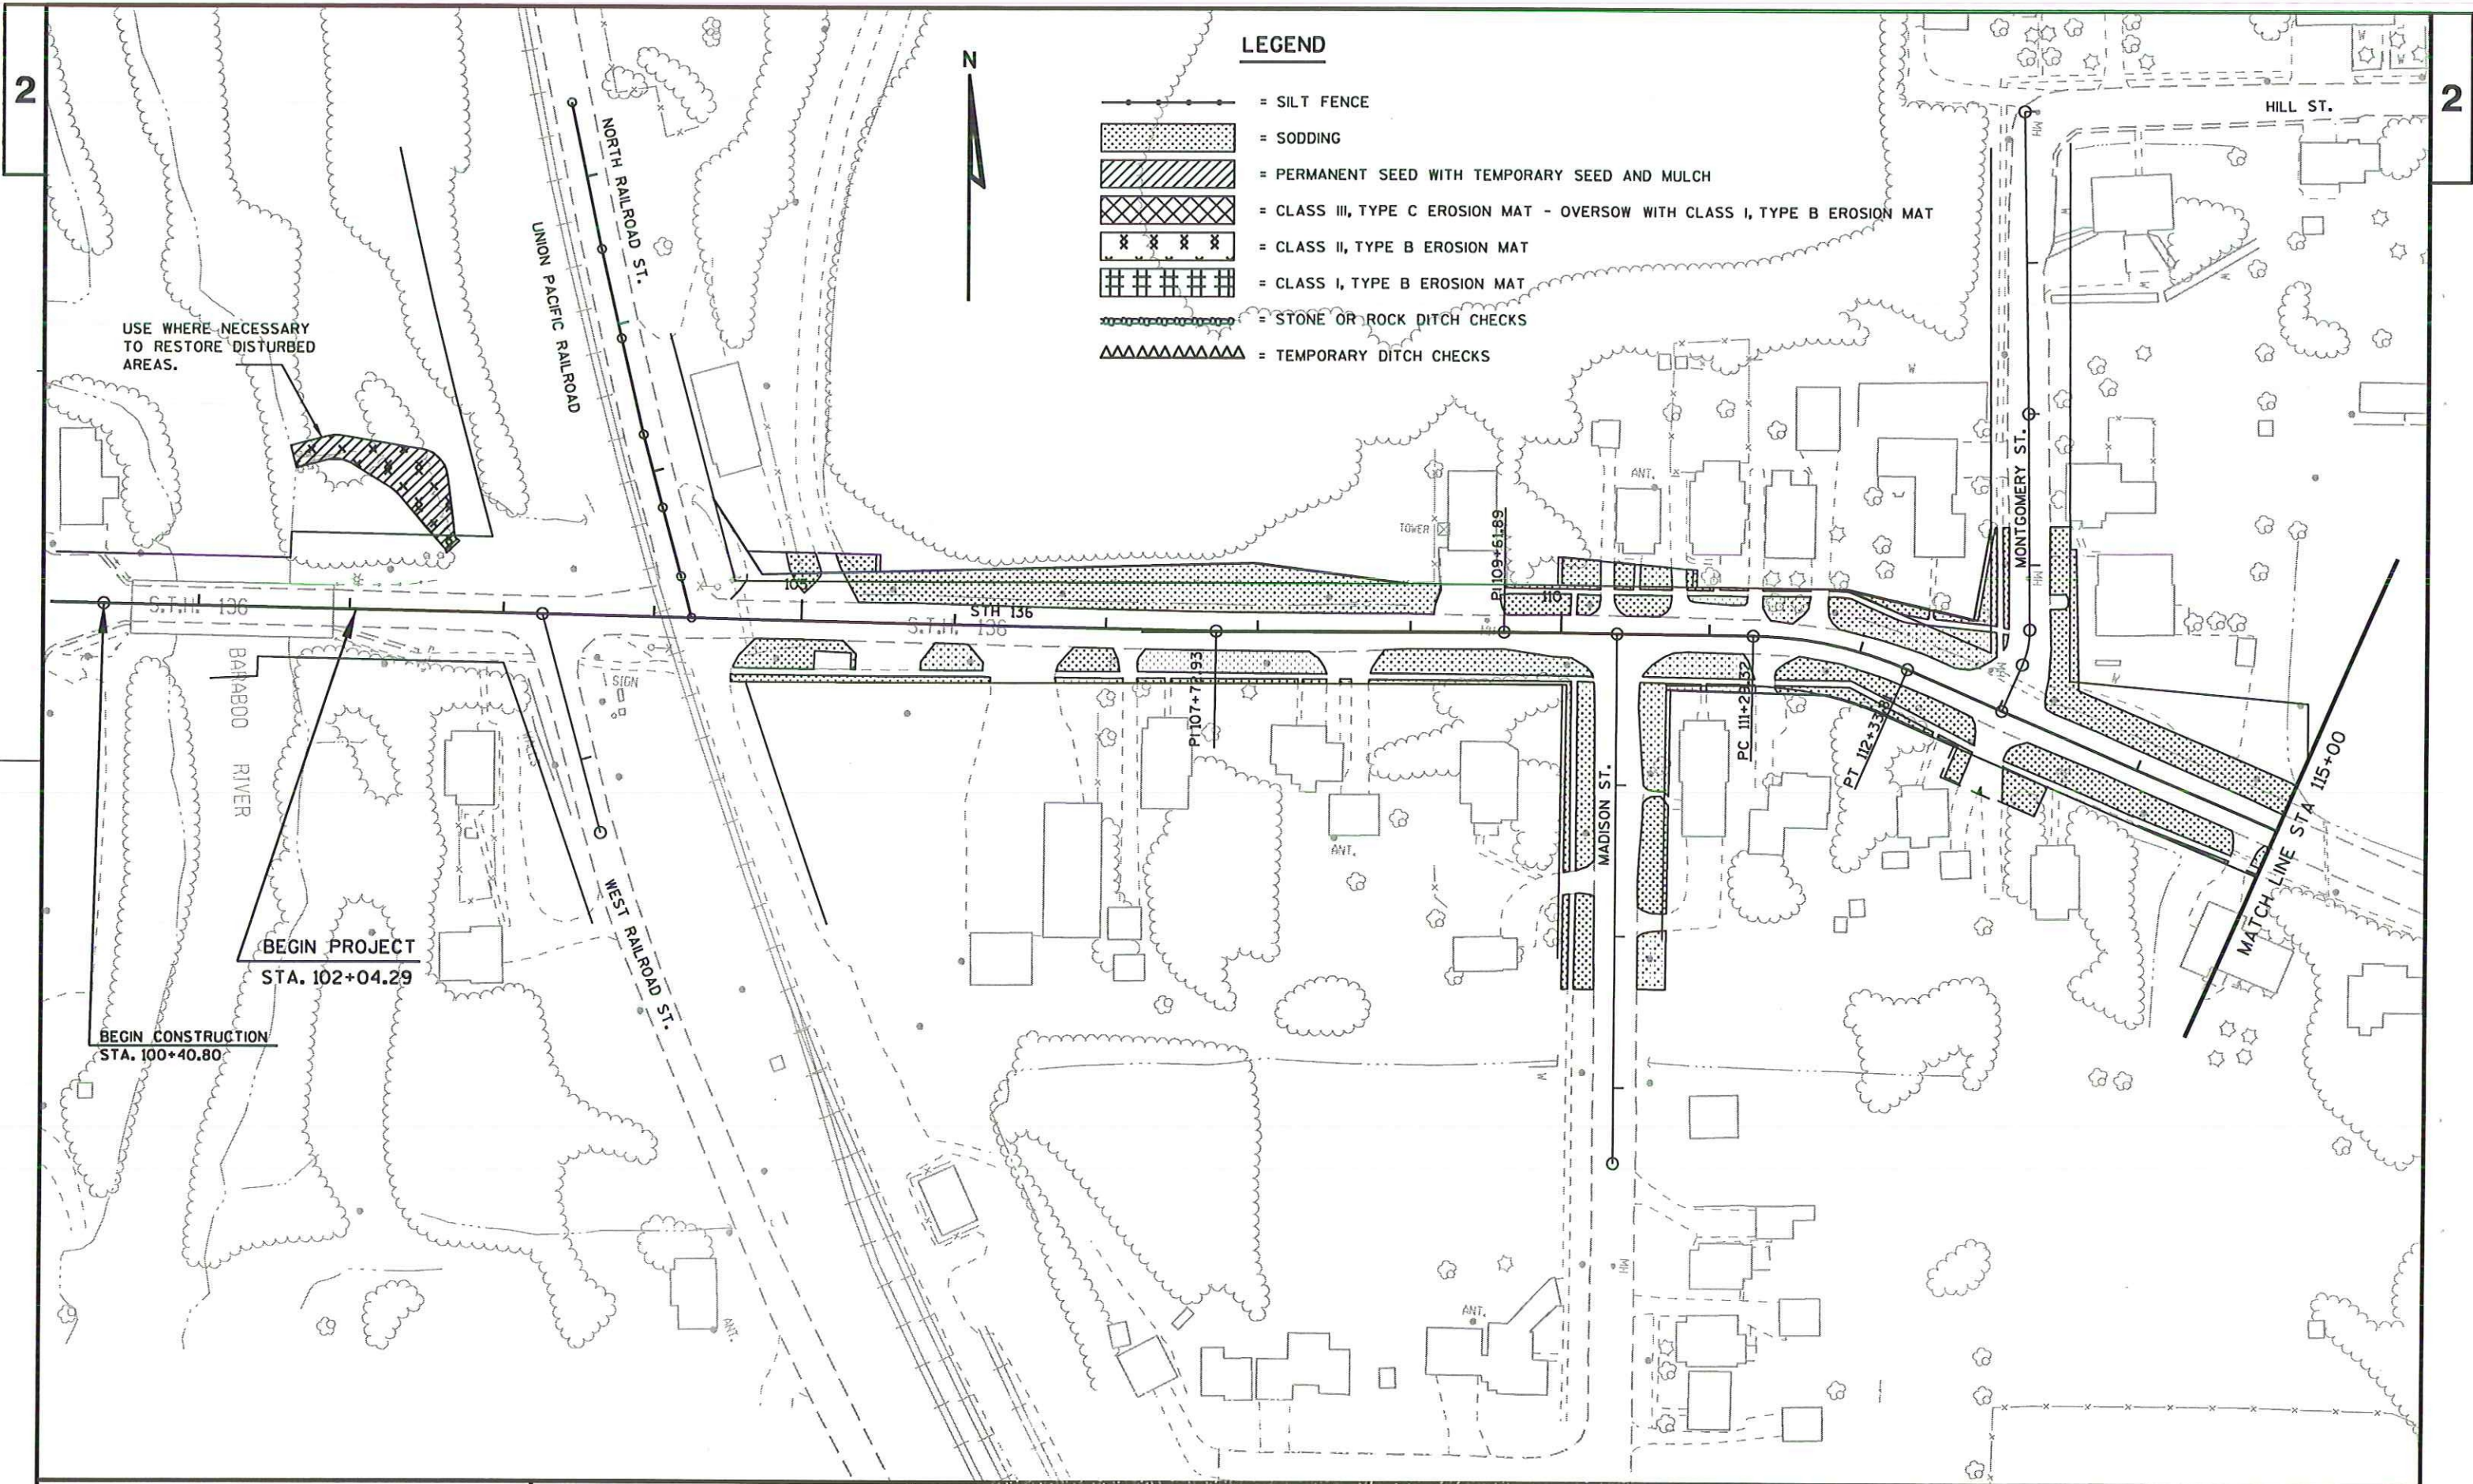

PROJECT NO:5573-04-72

HWY: STH 136

COUNTY: SAUK

EROSION CONTROL

SHEET

E

FILE NAME : r:\Support\CADD\Projects\d1_55730401\022001_ec.dgn


PLOT DATE : 16-JUL-2007 07:47


PLOT BY : dorbbg

PLOT NAME :

PLOT SCALE : 100.000000:1.000000


38
WISDOT/CADD SHEET 42

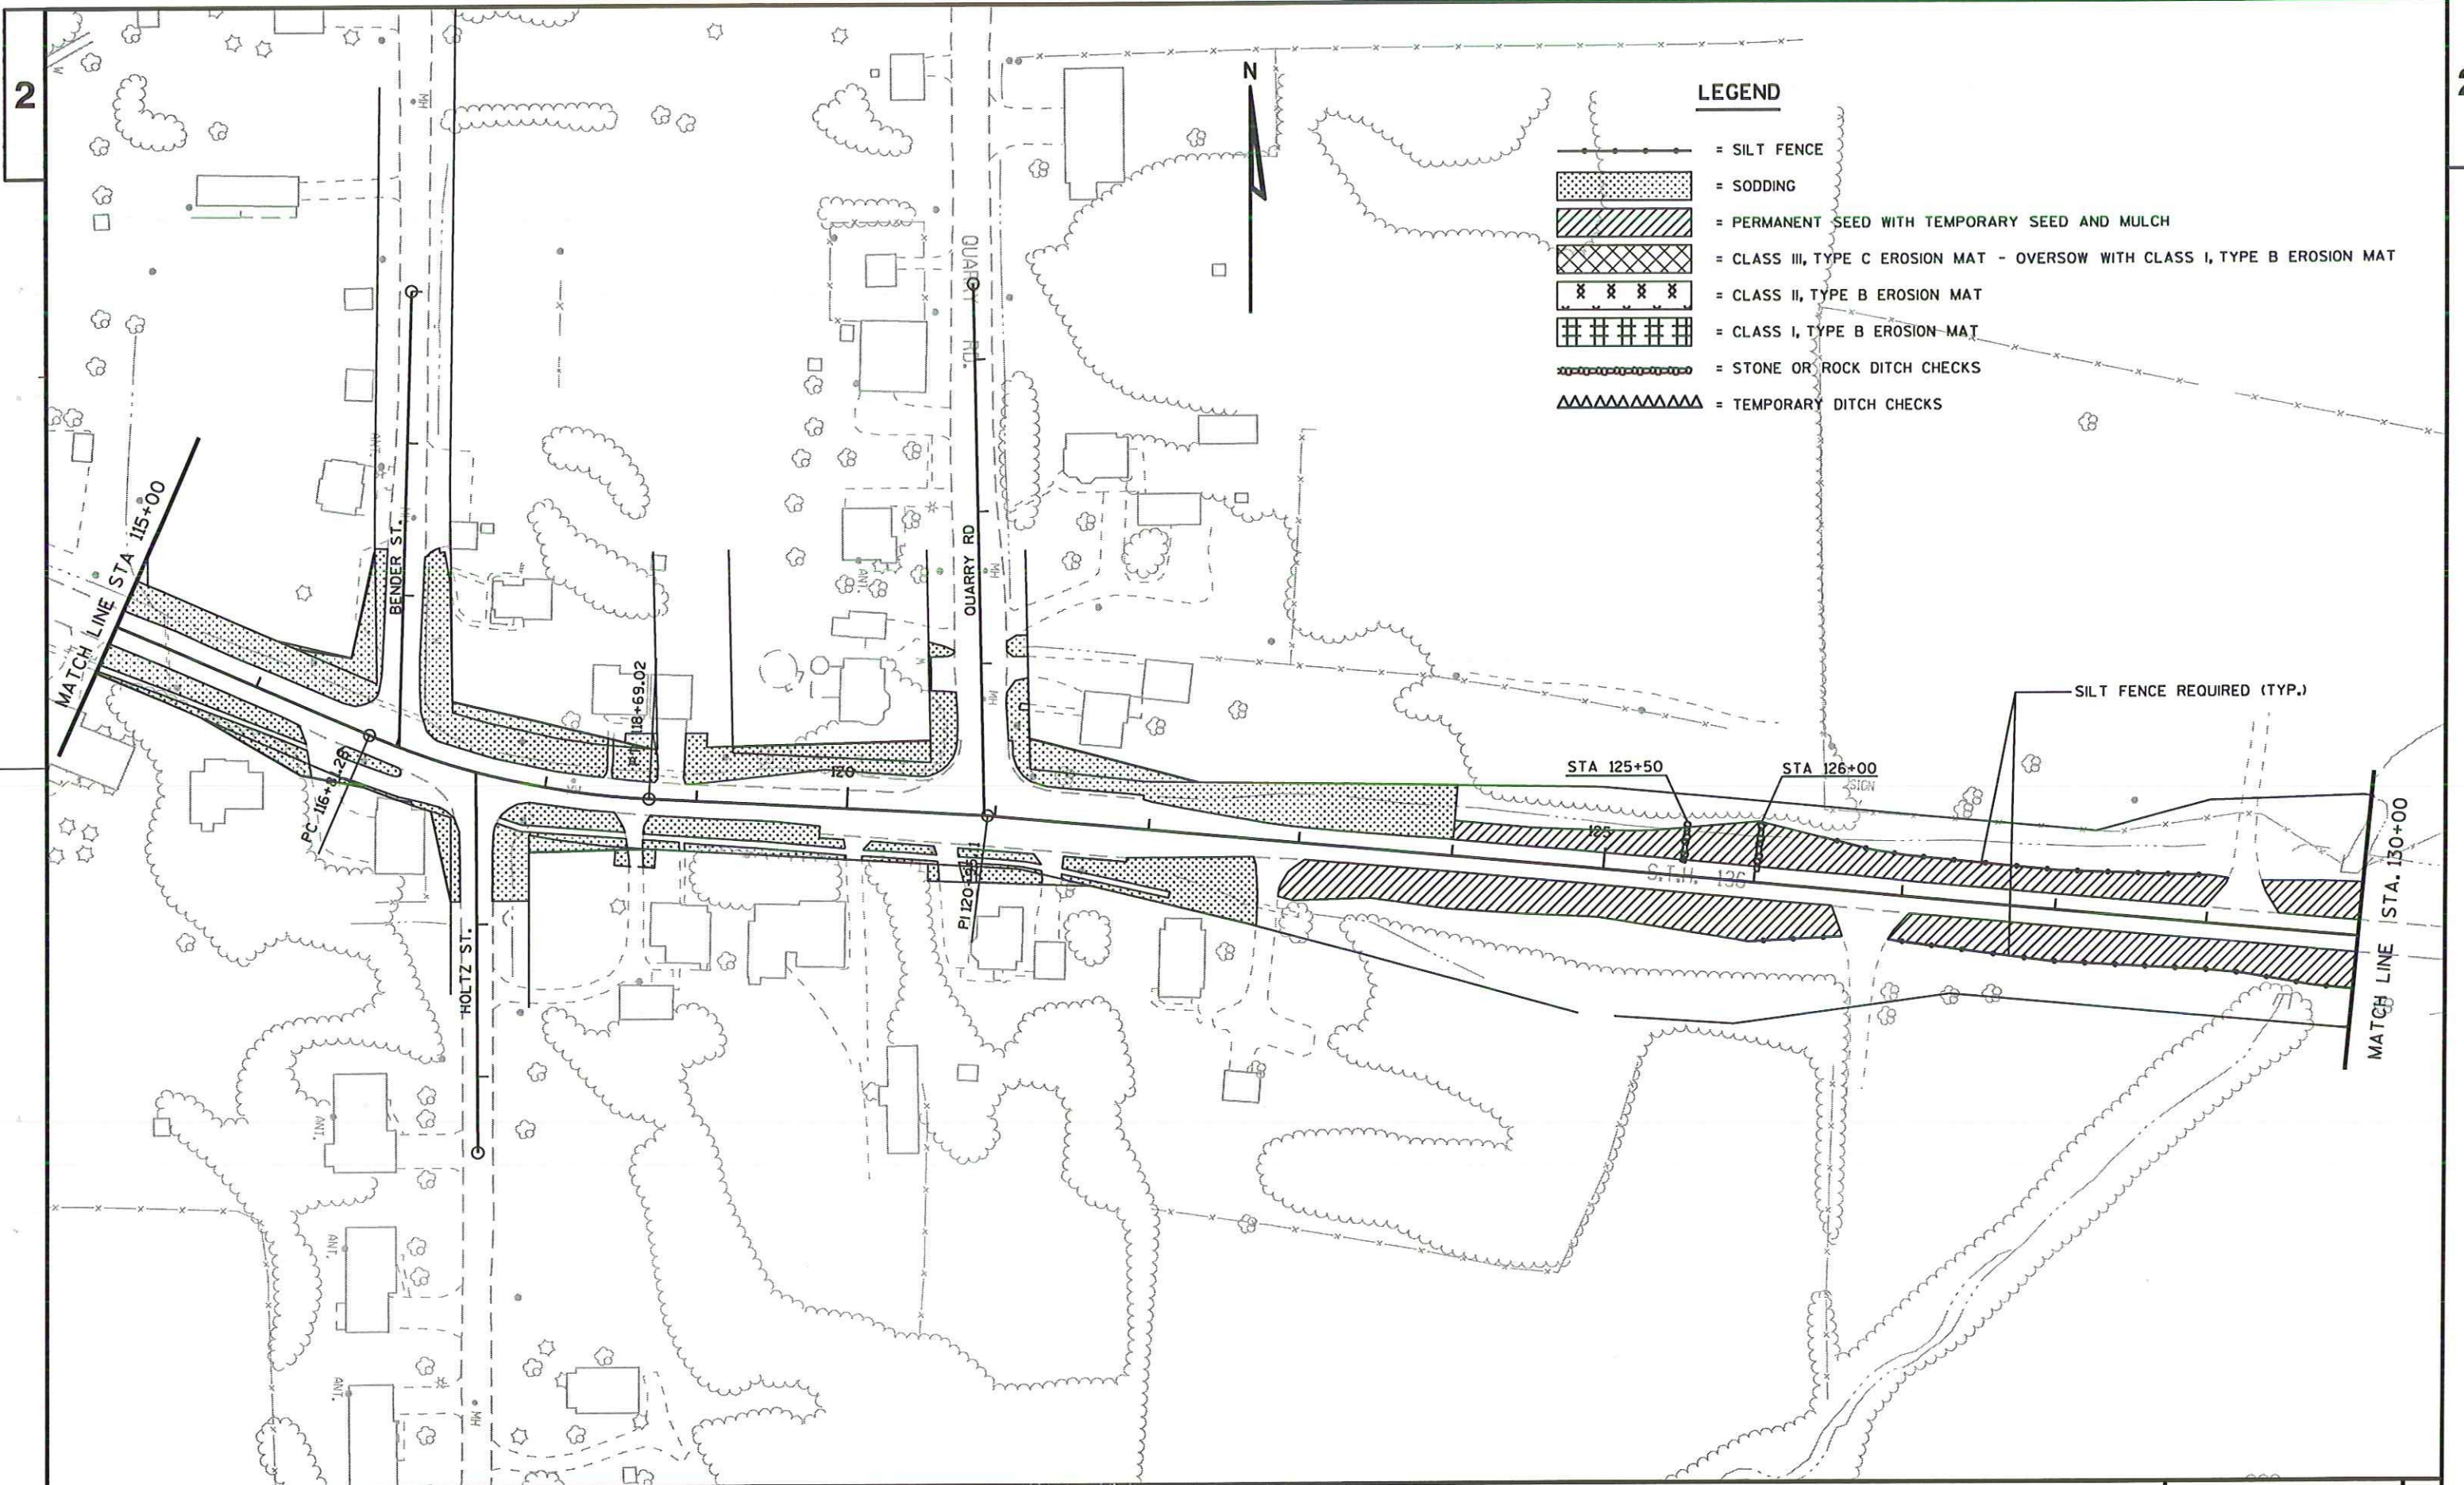

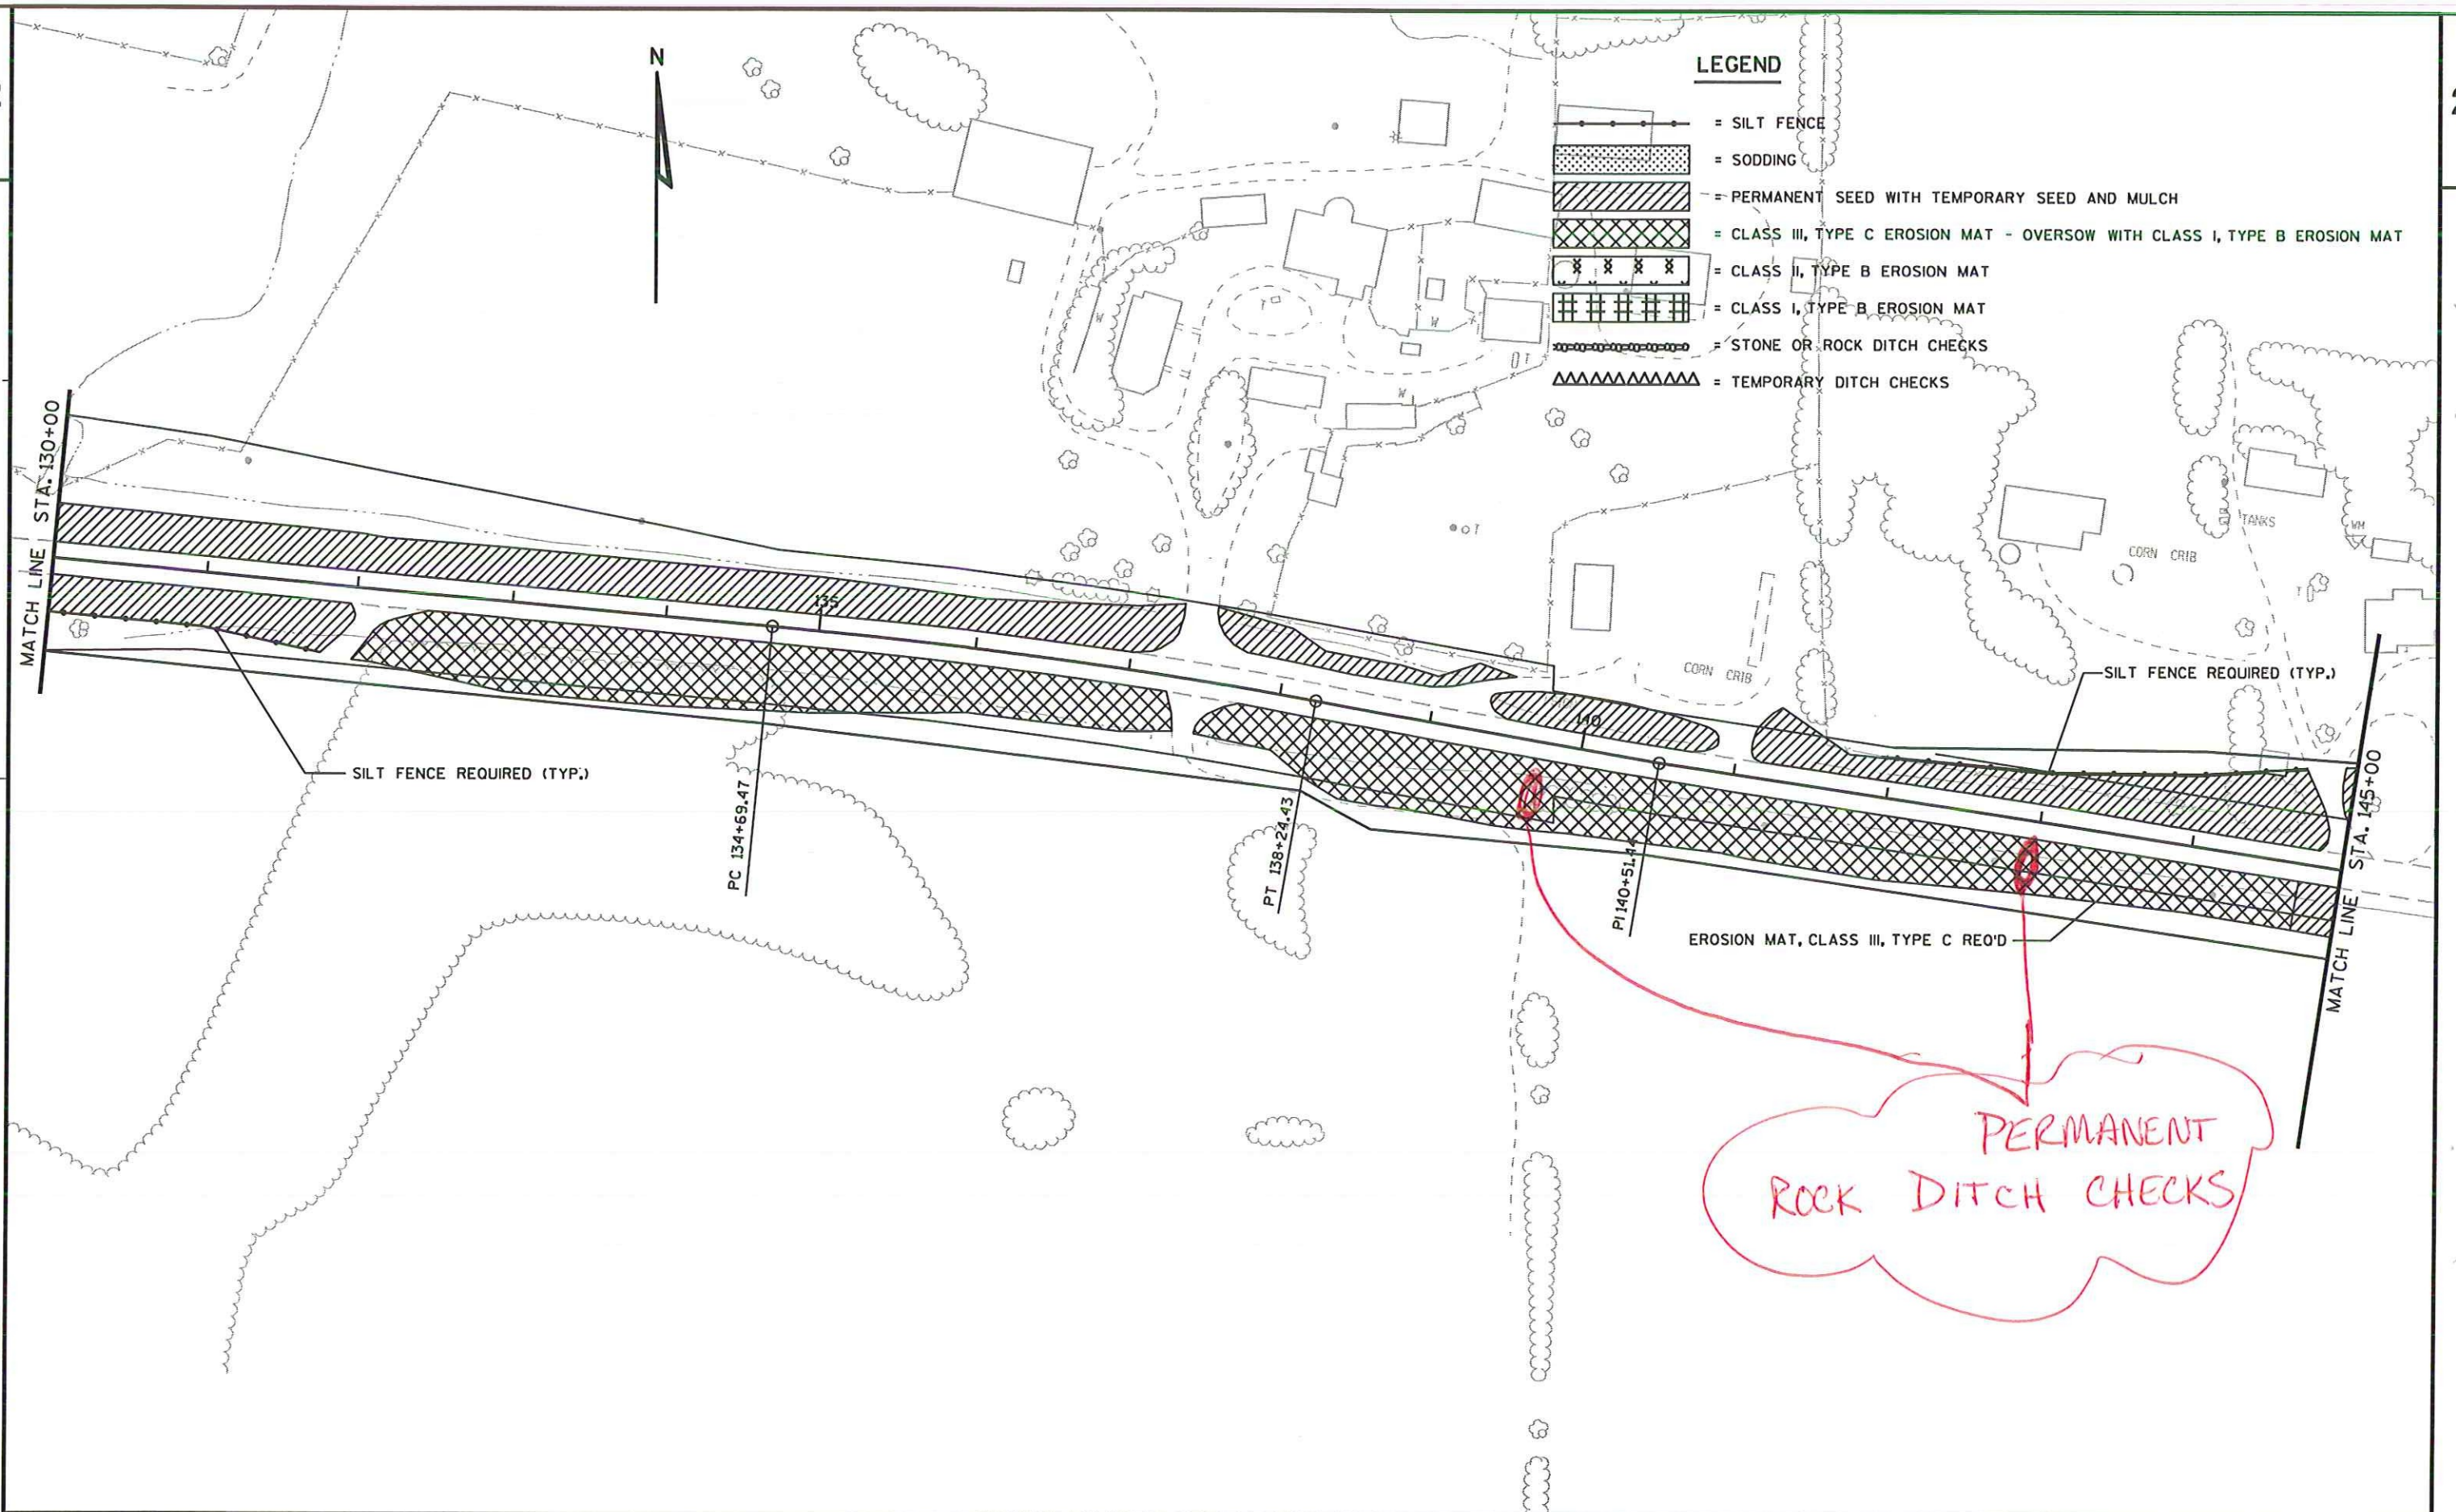


LEGEND


-  = SILT FENCE
-  = SODDING
-  = PERMANENT SEED WITH TEMPORARY SEED AND MULCH
-  = CLASS III, TYPE C EROSION MAT - OVERSOW WITH CLASS I, TYPE B EROSION MAT
-  = CLASS II, TYPE B EROSION MAT
-  = CLASS I, TYPE B EROSION MAT
-  = STONE OR ROCK DITCH CHECKS
-  = TEMPORARY DITCH CHECKS

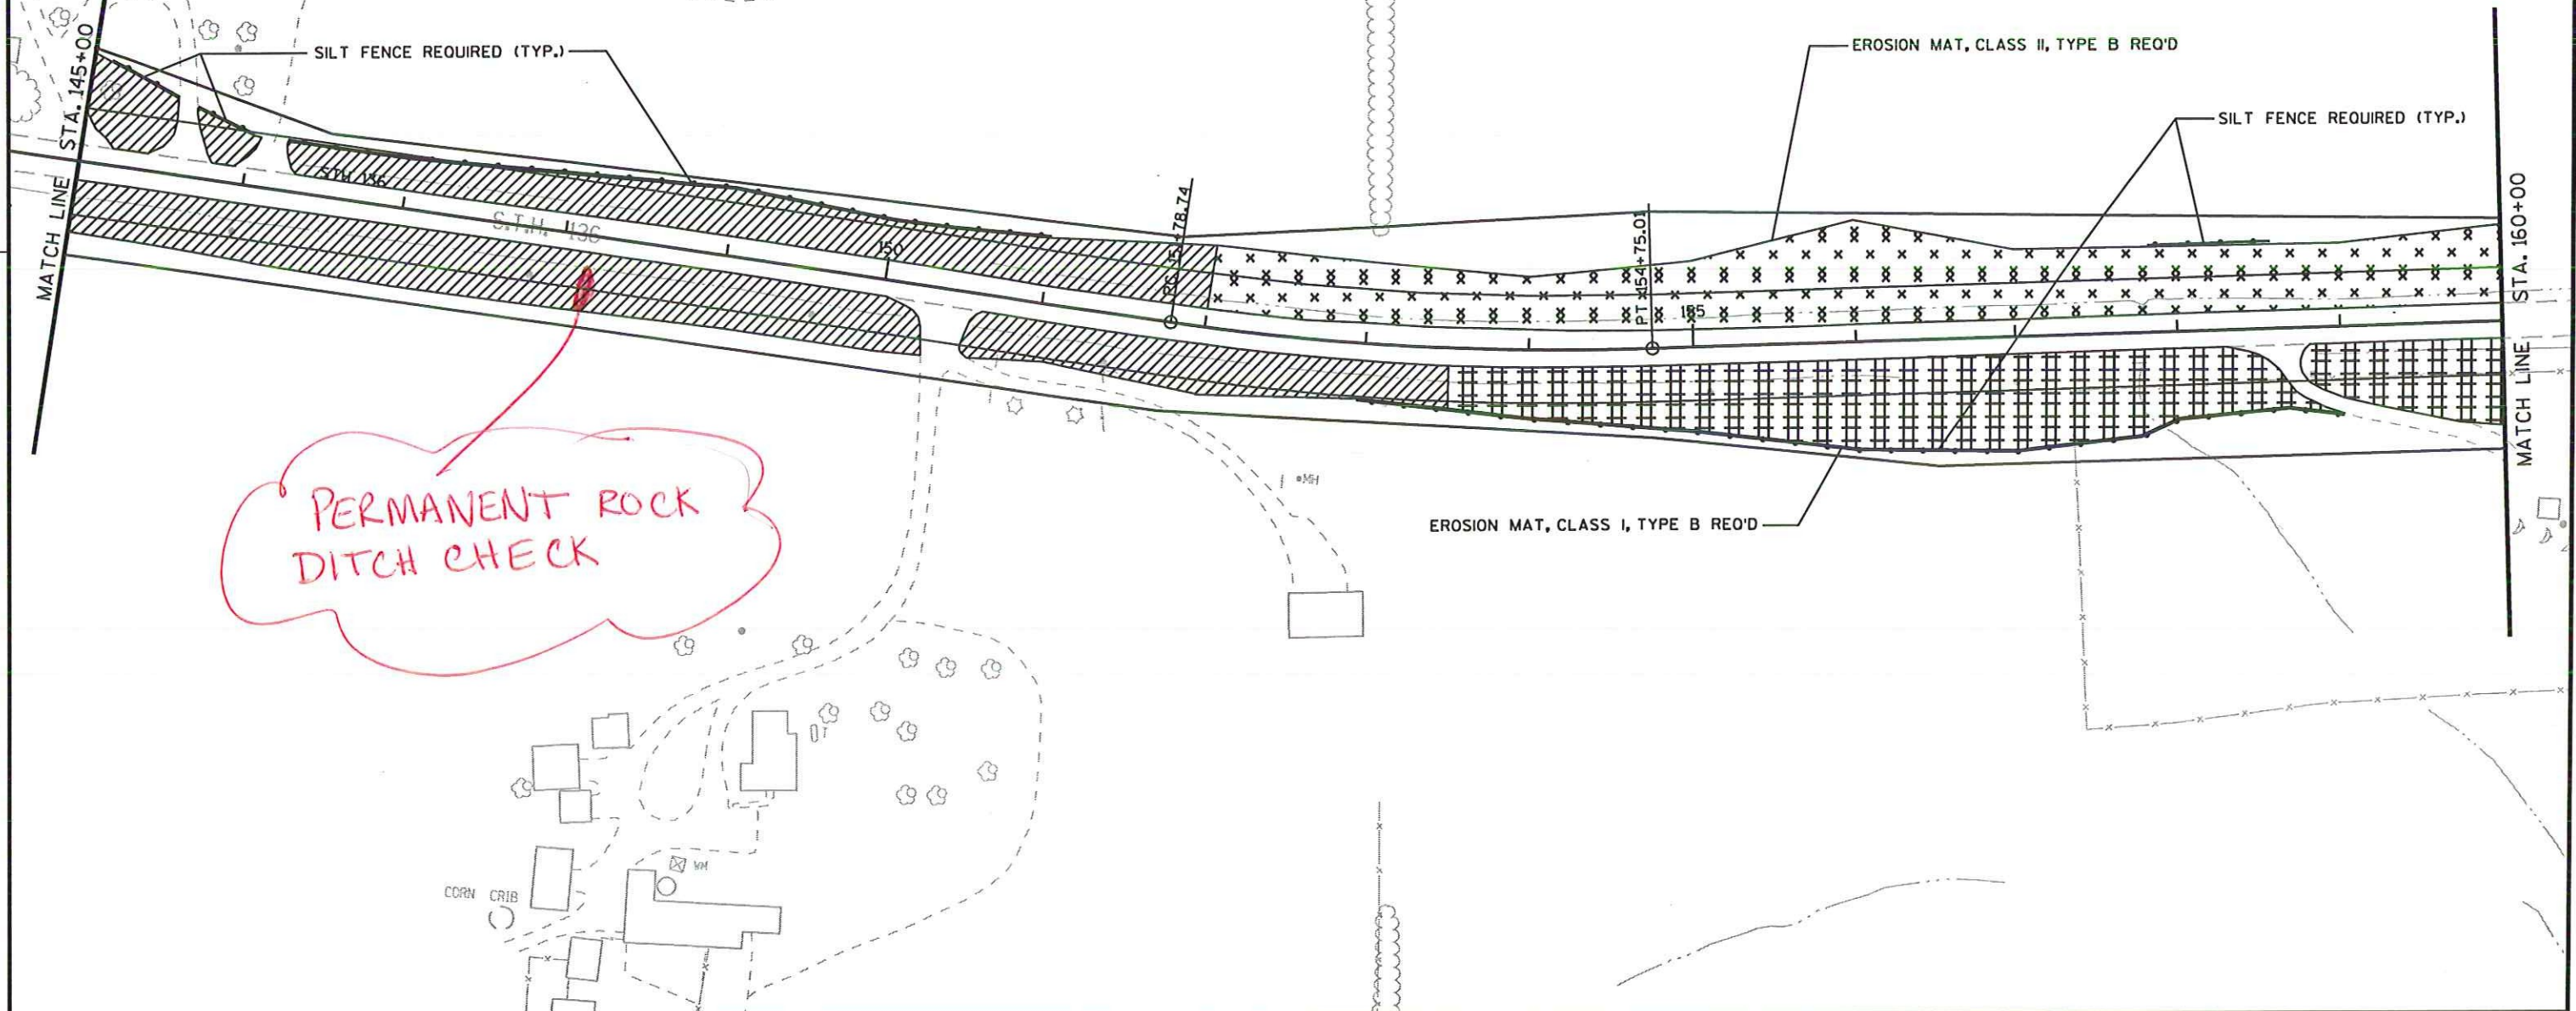

LEGEND

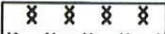-  = SILT FENCE
-  = SODDING
-  = PERMANENT SEED WITH TEMPORARY SEED AND MULCH
-  = CLASS III, TYPE C EROSION MAT - OVERSOW WITH CLASS I, TYPE B EROSION MAT
-  = CLASS II, TYPE B EROSION MAT
-  = CLASS I, TYPE B EROSION MAT
-  = STONE OR ROCK DITCH CHECKS
-  = TEMPORARY DITCH CHECKS

N

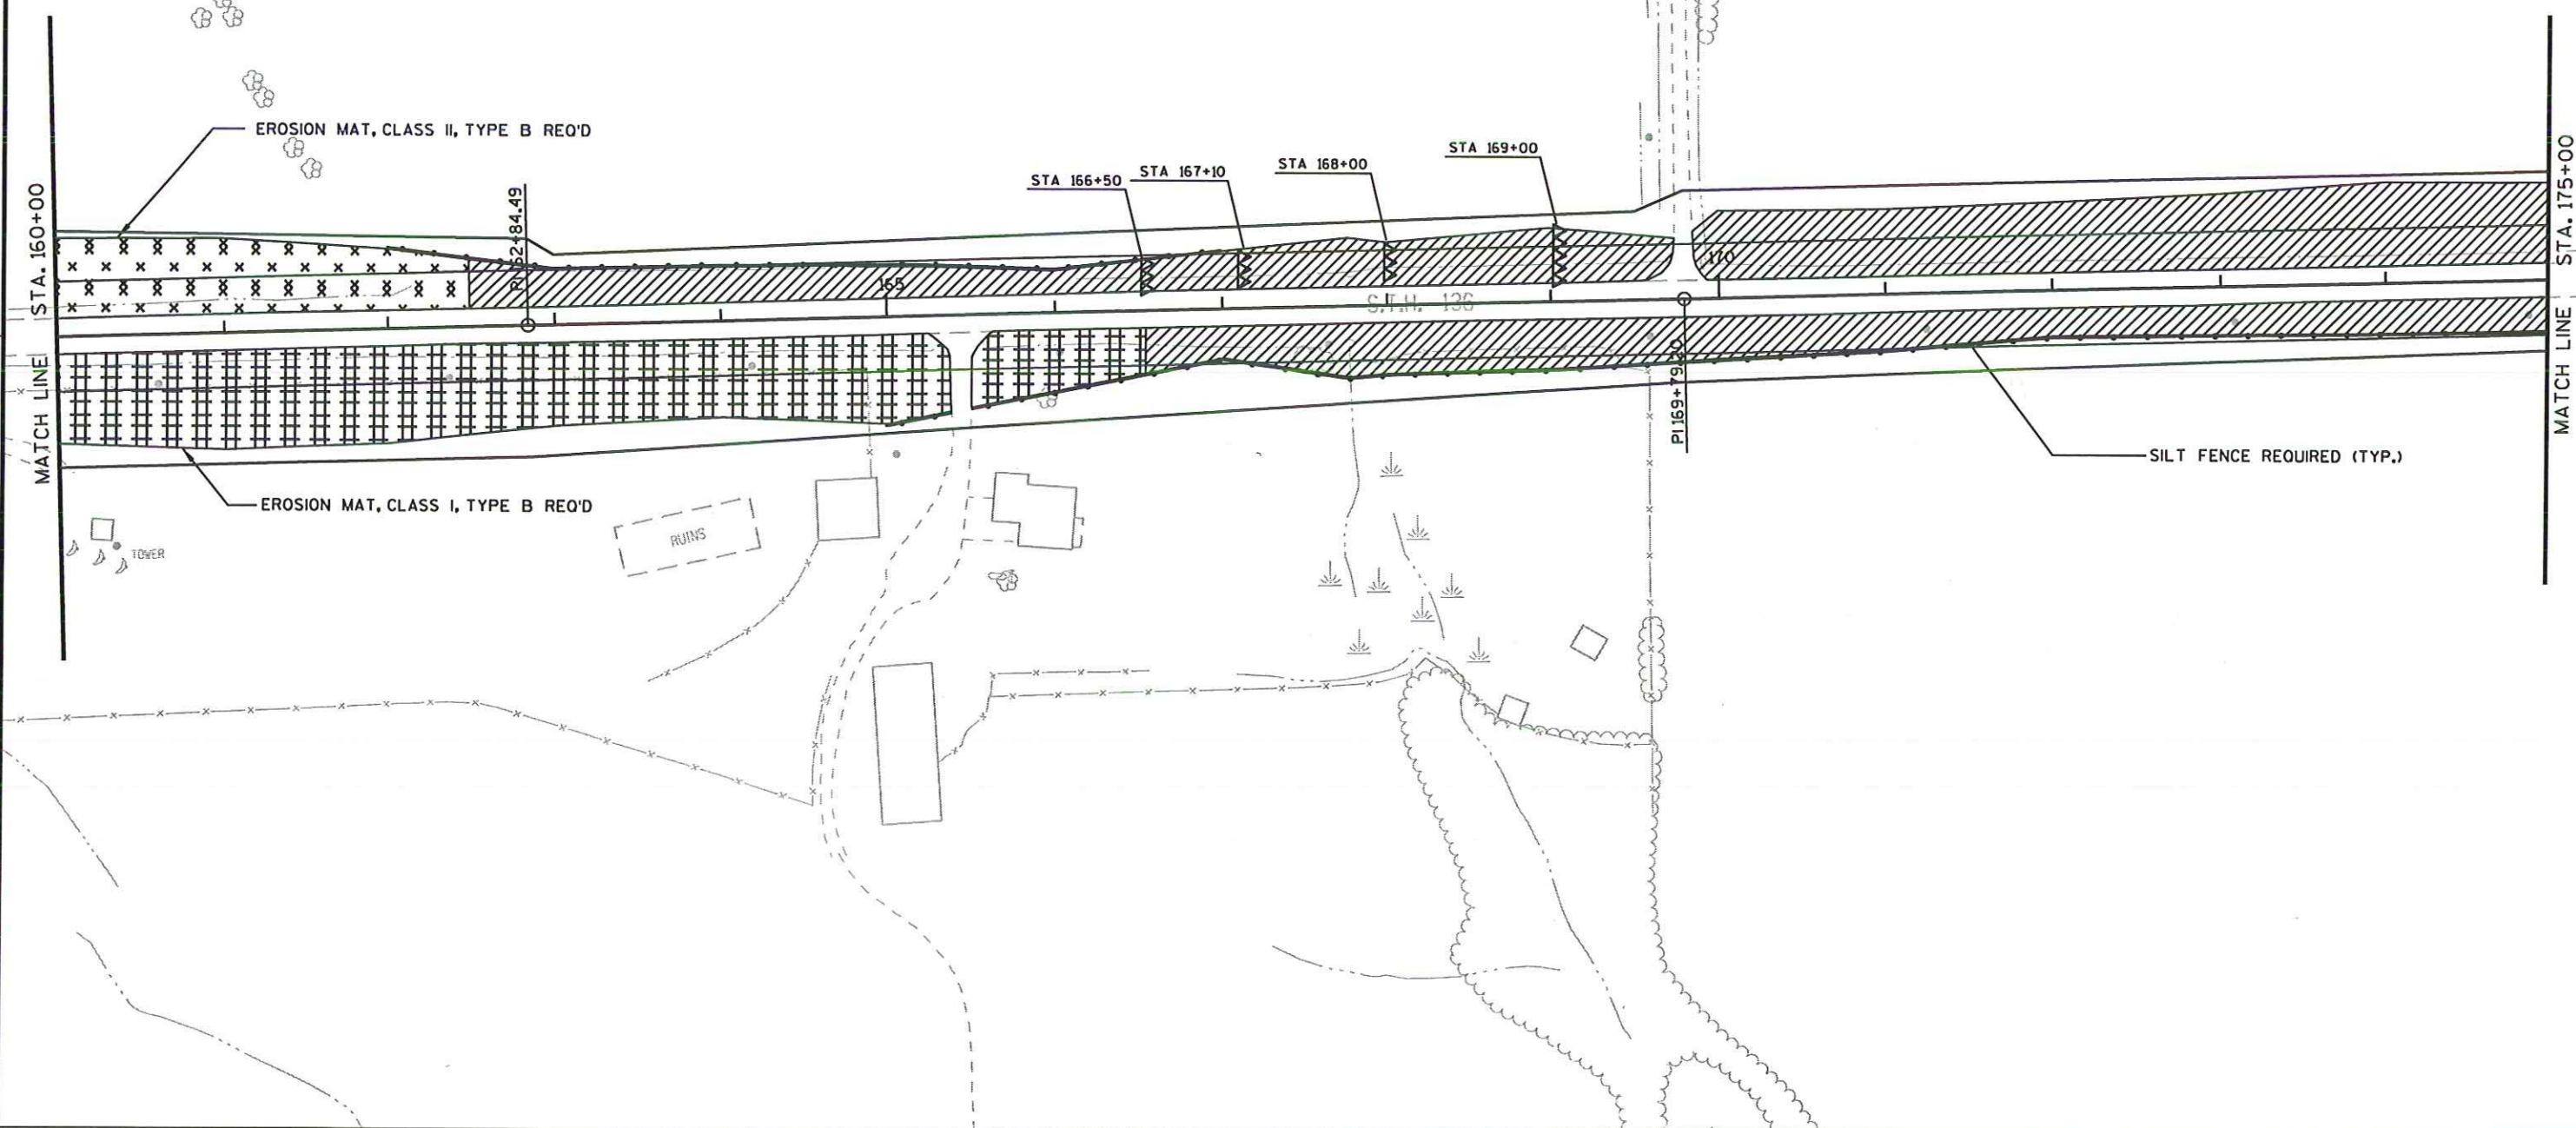

PROJECT NO: 5573-04-72

HWY: STH 136

COUNTY: SAUK

EROSION CONTROL

SHEET

E

FILE NAME : r:\Support\CADD\Projects\dl_55730401\022005_ec.dgn

PLOT DATE : 12-JUL-2007 07:03

PLOT BY : cothbng

PLOT NAME :

PLOT SCALE : 100.000000:1.000000

 
WISDOT/CADD SHEET 42


2


2



LEGEND

-  = SILT FENCE
-  = SODDING
-  = PERMANENT SEED WITH TEMPORARY SEED AND MULCH
-  = CLASS III, TYPE C EROSION MAT - OVERSOW WITH CLASS I, TYPE B EROSION MAT
-  = CLASS II, TYPE B EROSION MAT
-  = CLASS I, TYPE B EROSION MAT
-  = STONE OR ROCK DITCH CHECKS
-  = TEMPORARY DITCH CHECKS

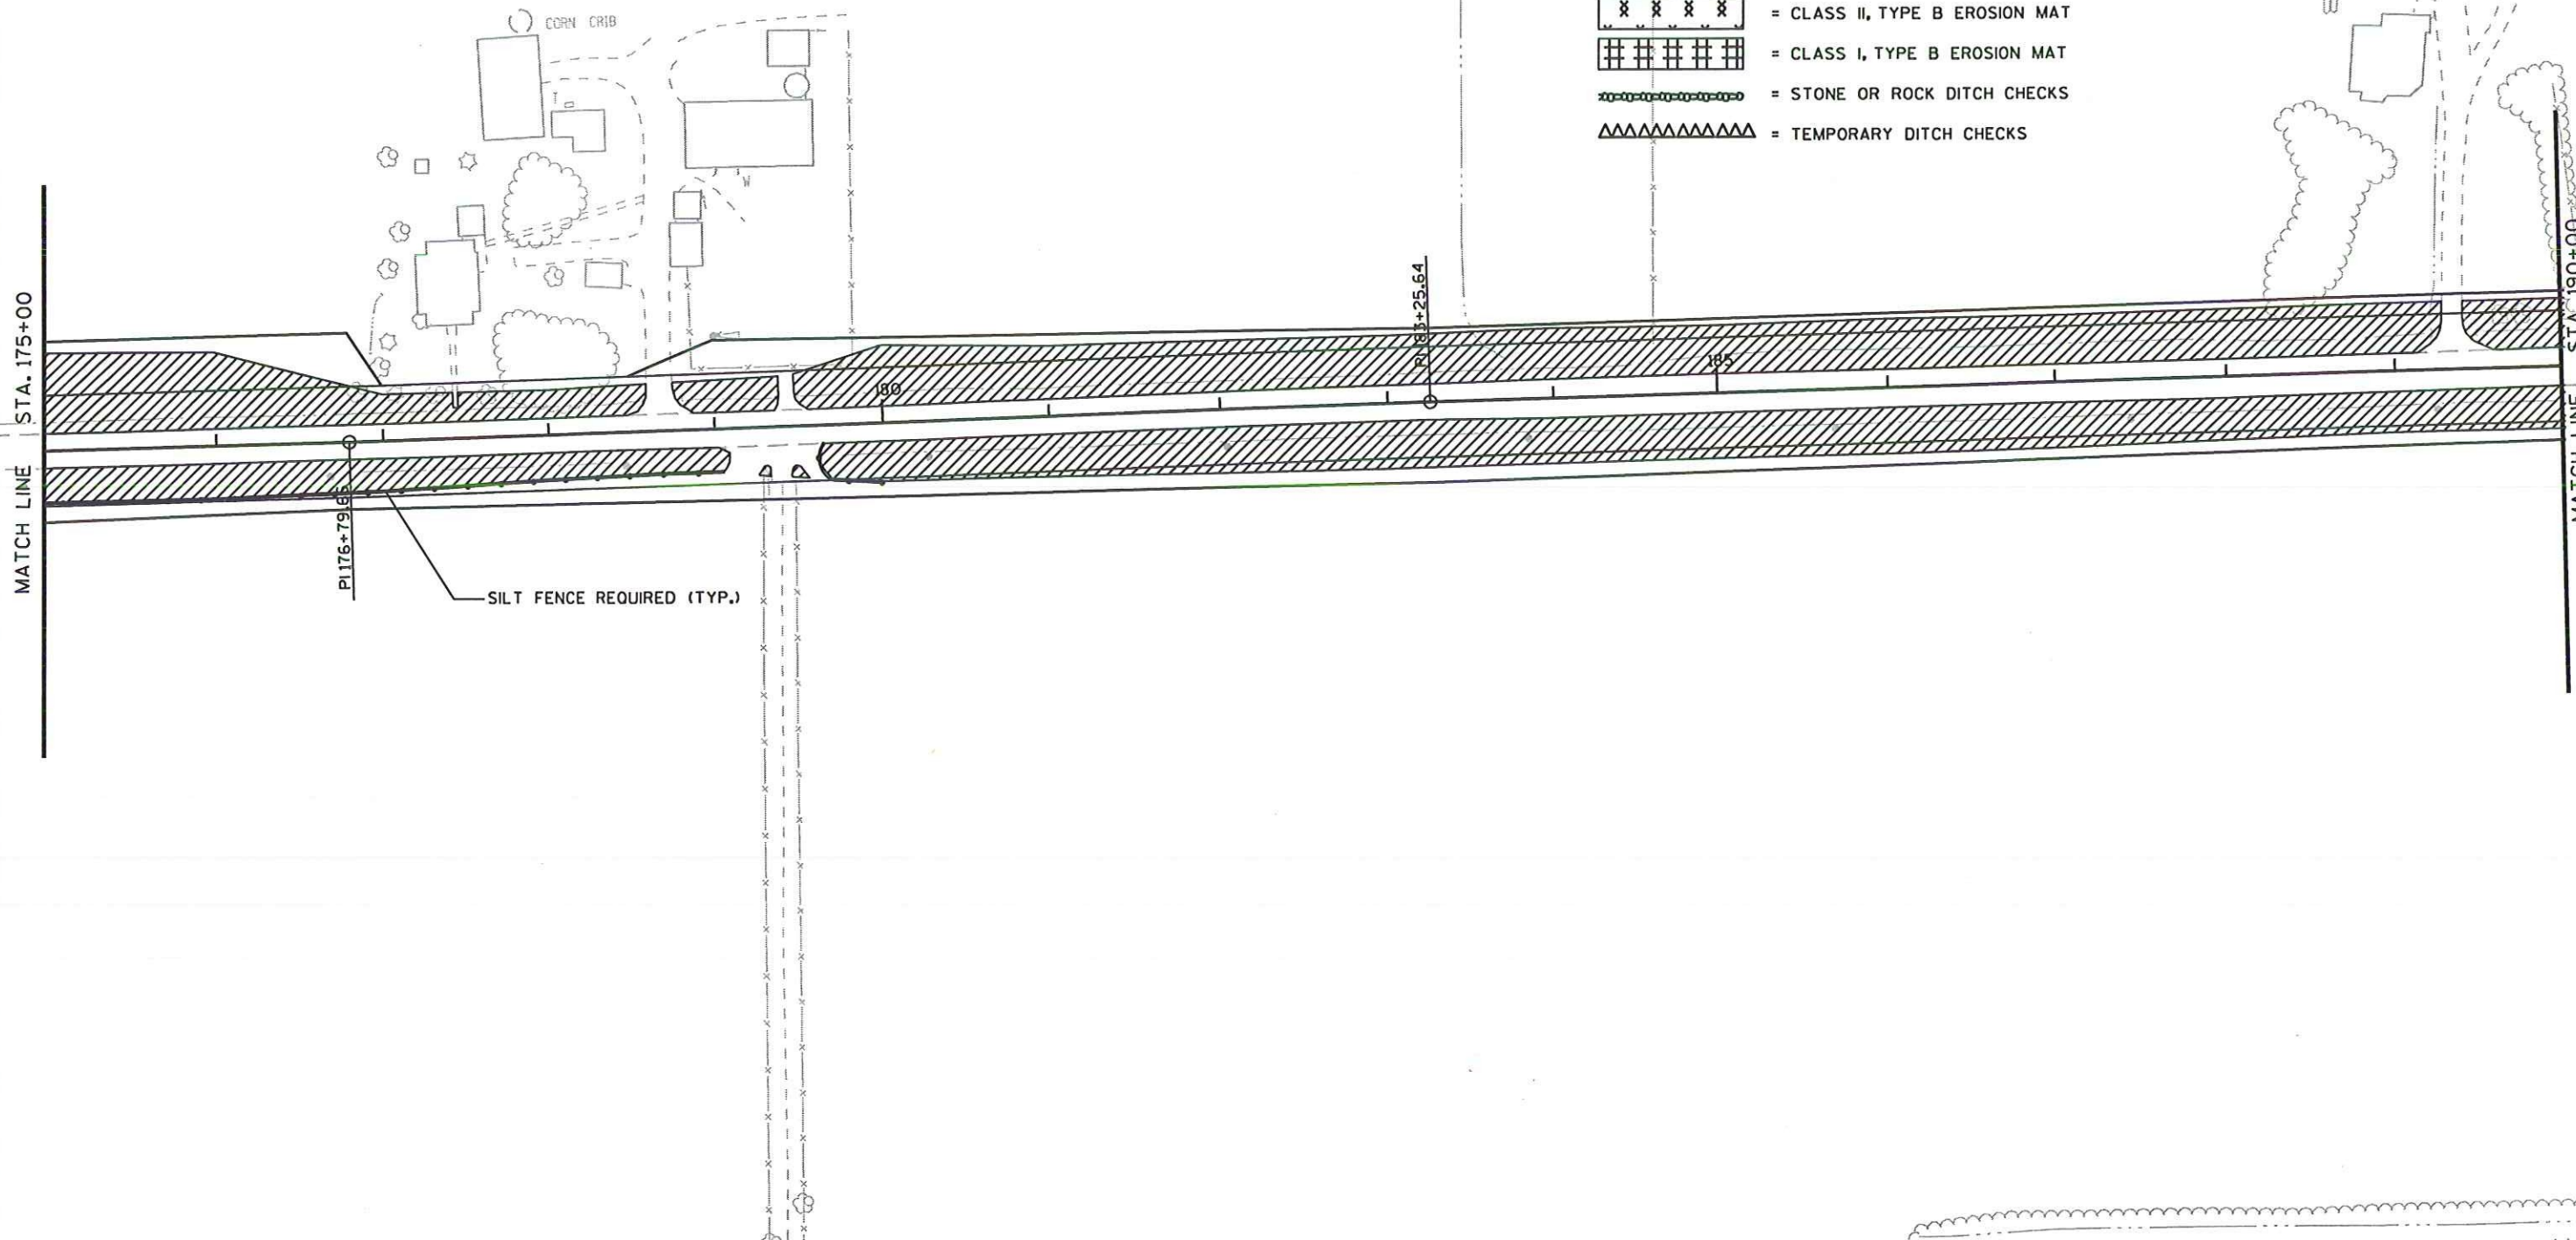

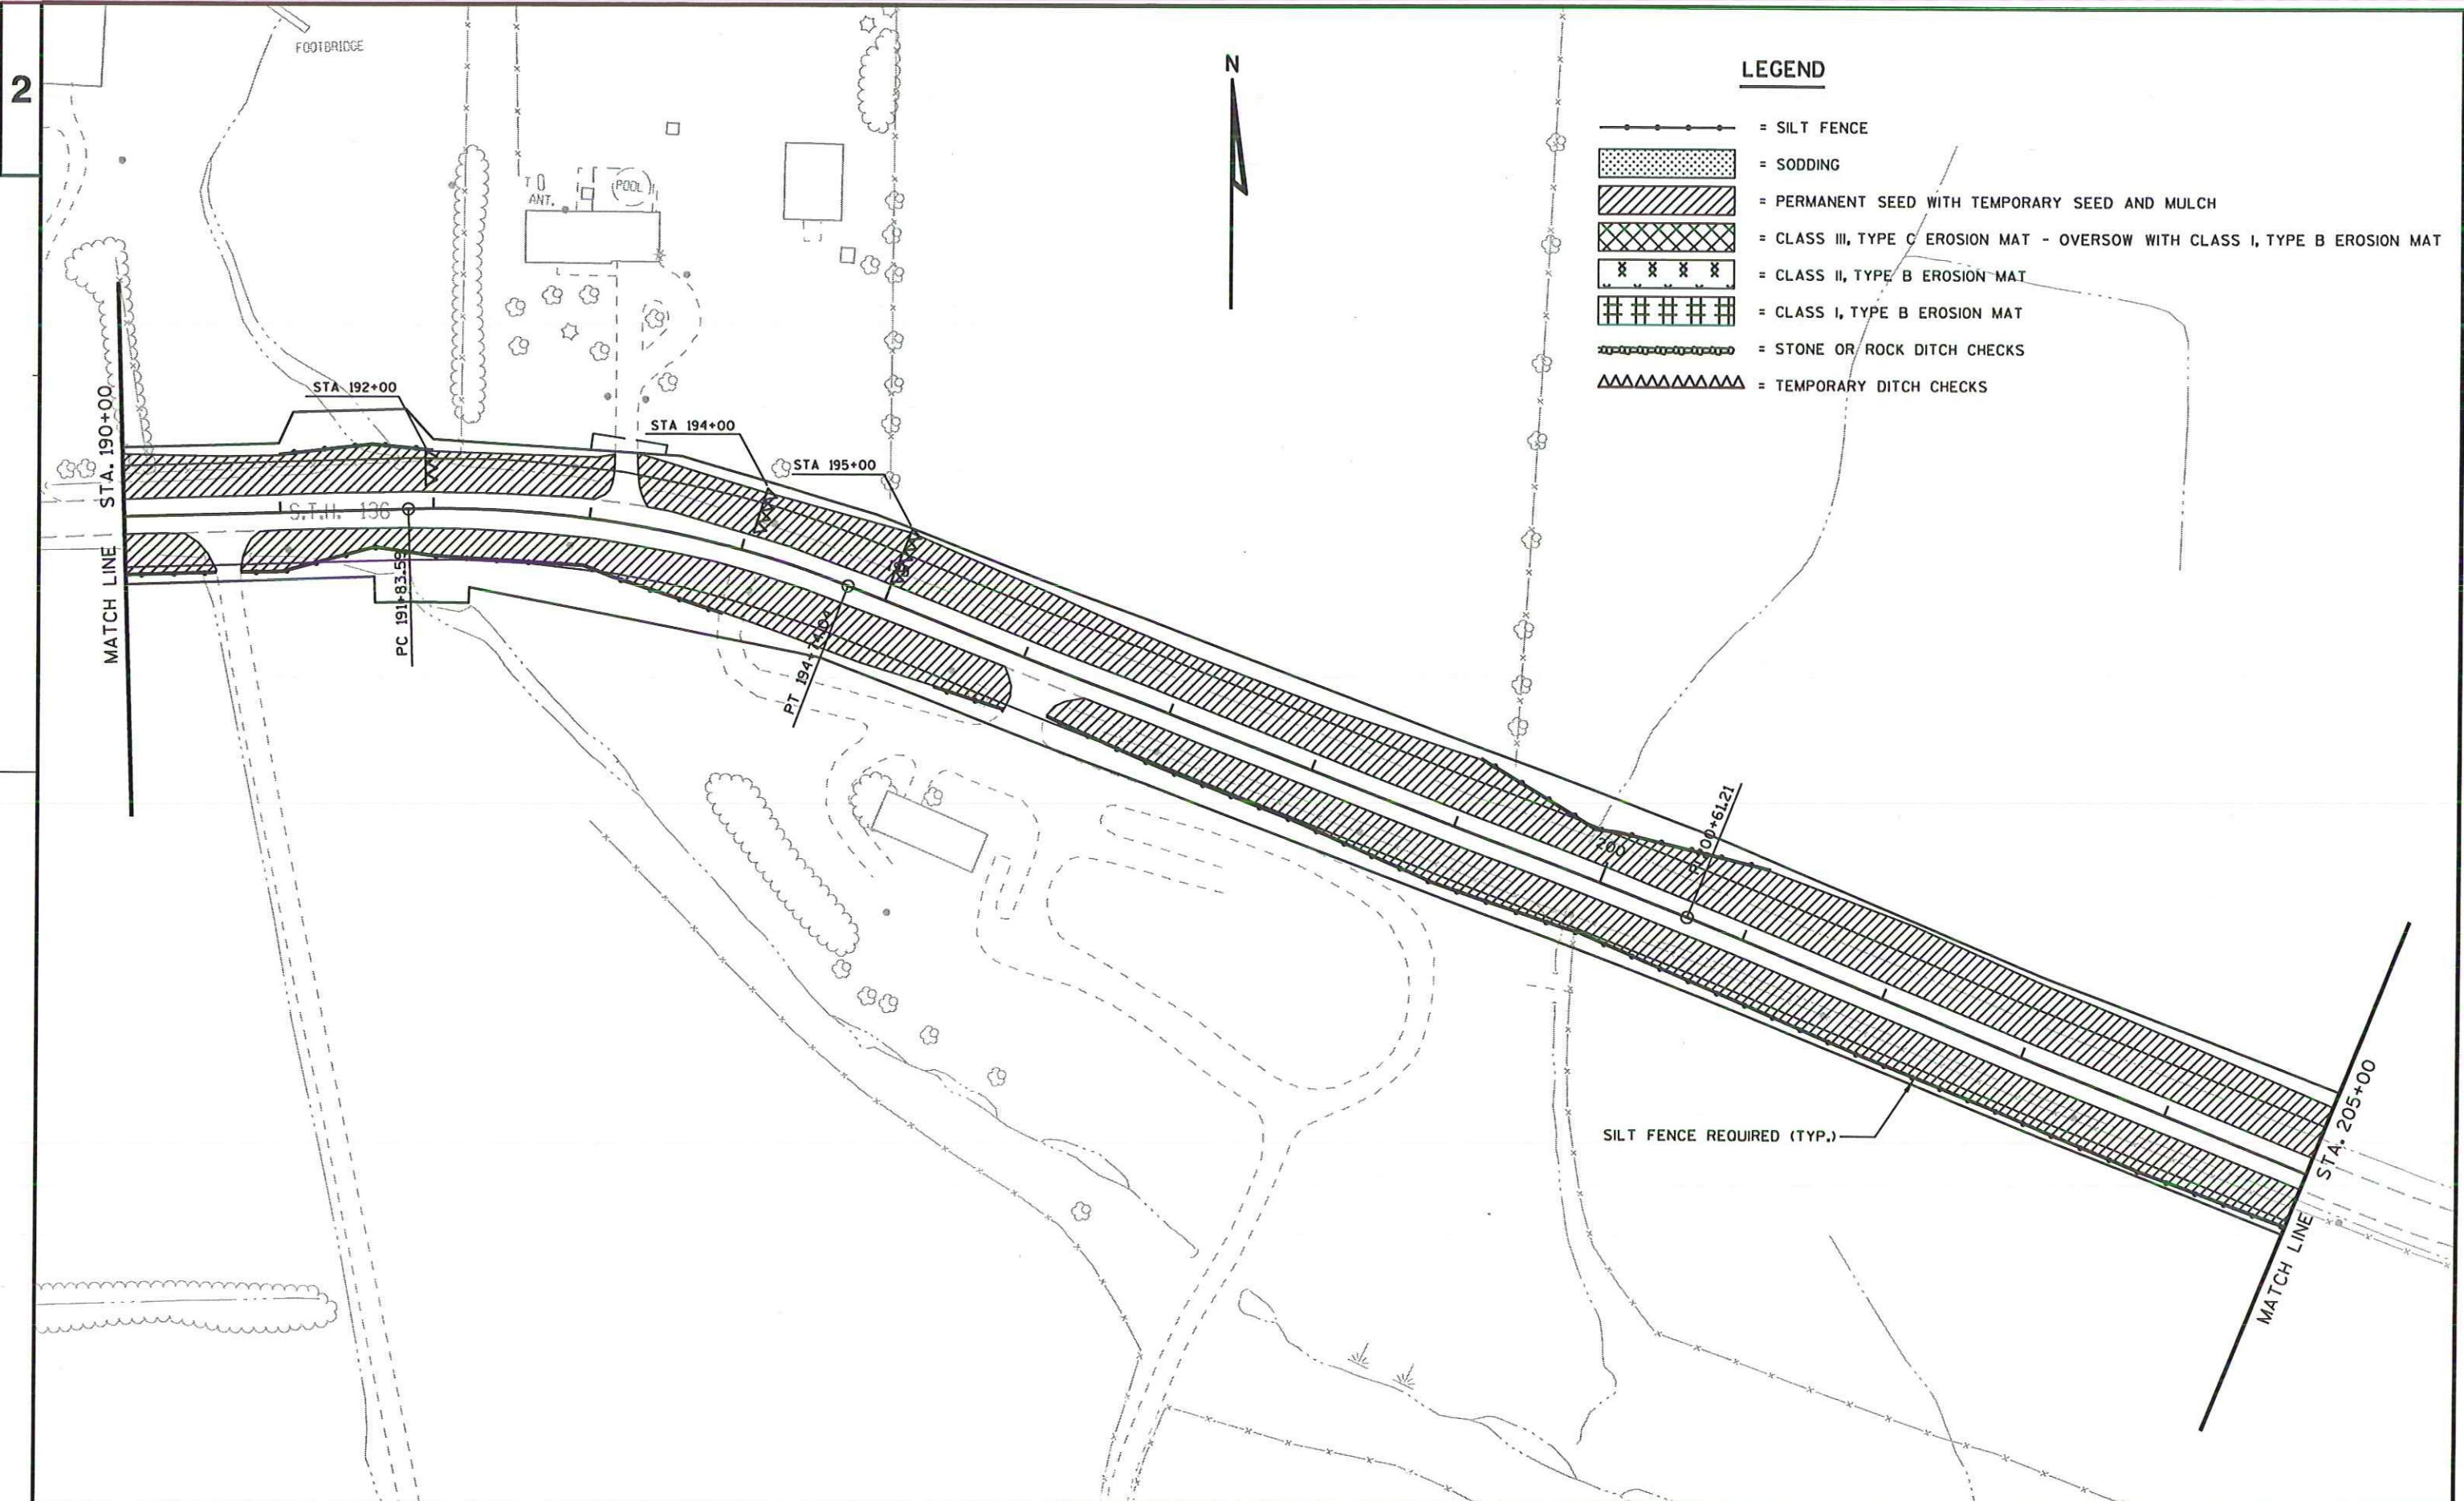

LEGEND

-  = SILT FENCE
-  = SODDING
-  = PERMANENT SEED WITH TEMPORARY SEED AND MULCH
-  = CLASS III, TYPE C EROSION MAT - OVERSOW WITH CLASS I, TYPE B EROSION MAT
-  = CLASS II, TYPE B EROSION MAT
-  = CLASS I, TYPE B EROSION MAT
-  = STONE OR ROCK DITCH CHECKS
-  = TEMPORARY DITCH CHECKS

PROJECT NO:5573-04-72

HWY: STH 136

COUNTY: SAUK

EROSION CONTROL

SHEET

E

FILE NAME : r:\Support\CADD\Projects\d1_55730401\022007_ec.dgn


PLOT DATE : 12-JUL-2007 07:03

PLOT BY : do+bbg

PLOT NAME :

PLOT SCALE : 100.000000:1.000000


WISDOT/CADD SHEET 42

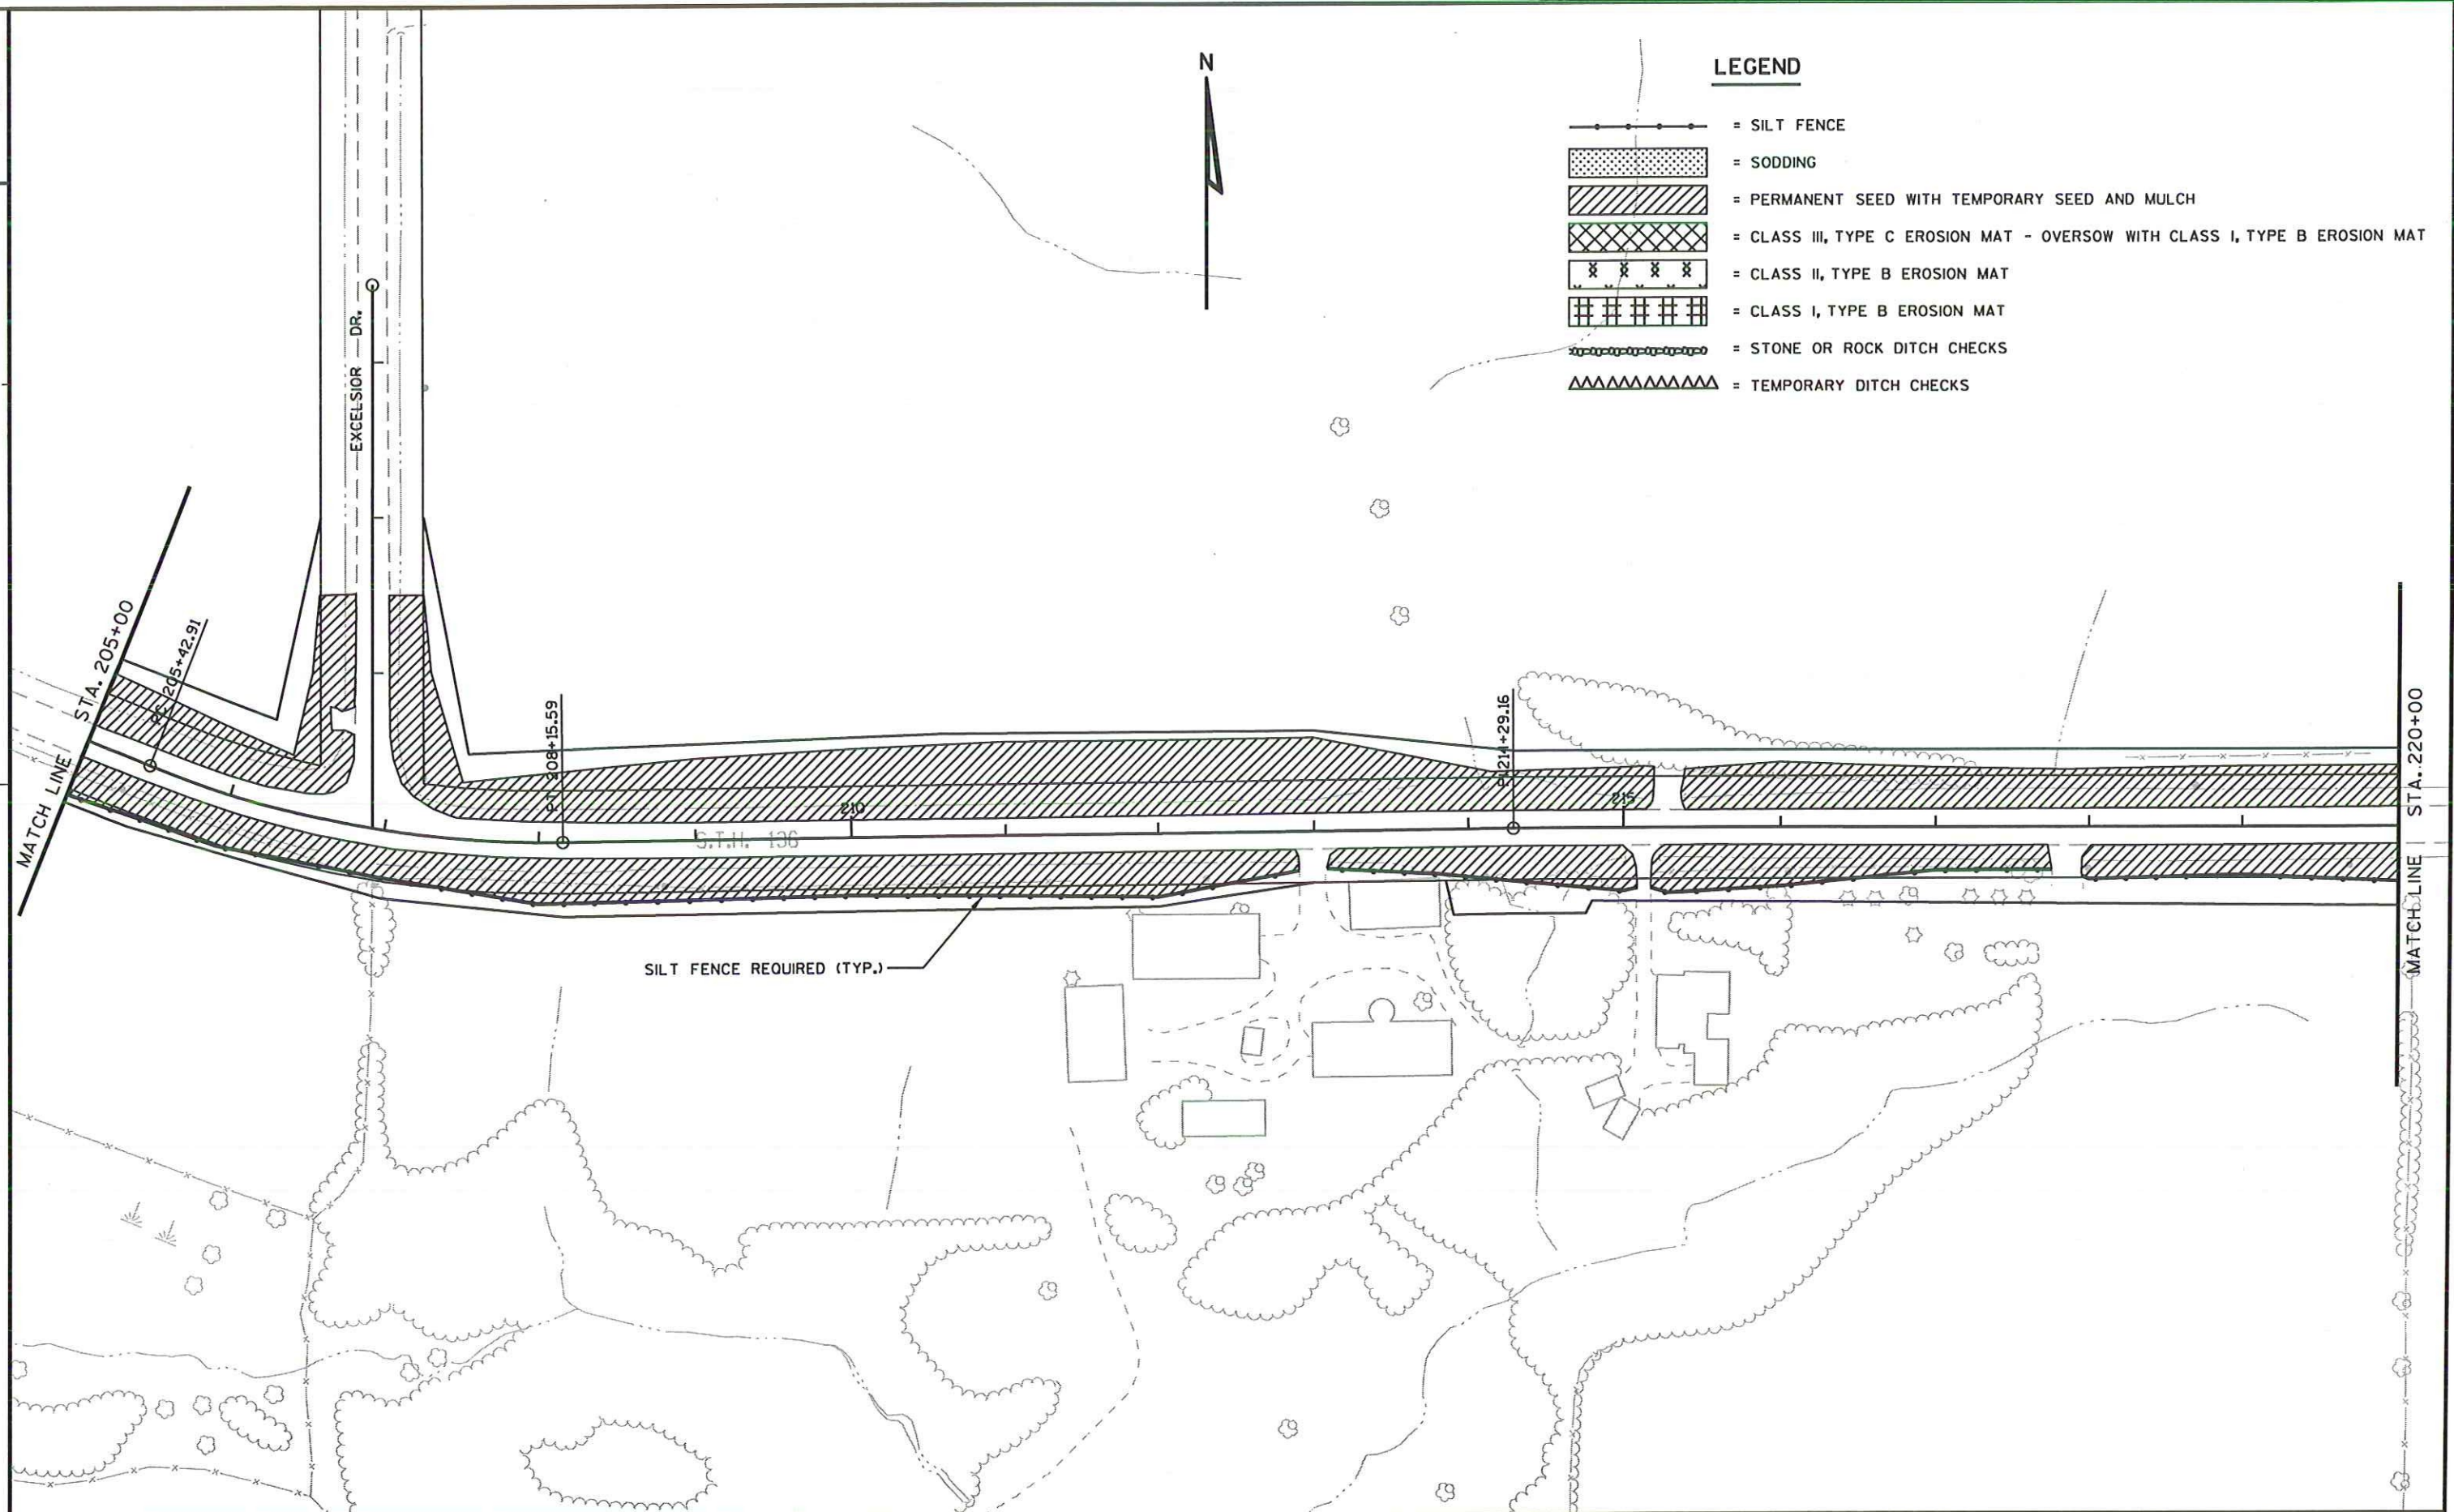





LEGEND

-  = SILT FENCE
-  = SODDING
-  = PERMANENT SEED WITH TEMPORARY SEED AND MULCH
-  = CLASS III, TYPE C EROSION MAT - OVERSOW WITH CLASS I, TYPE B EROSION MAT
-  = CLASS II, TYPE B EROSION MAT
-  = CLASS I, TYPE B EROSION MAT
-  = STONE OR ROCK DITCH CHECKS
-  = TEMPORARY DITCH CHECKS

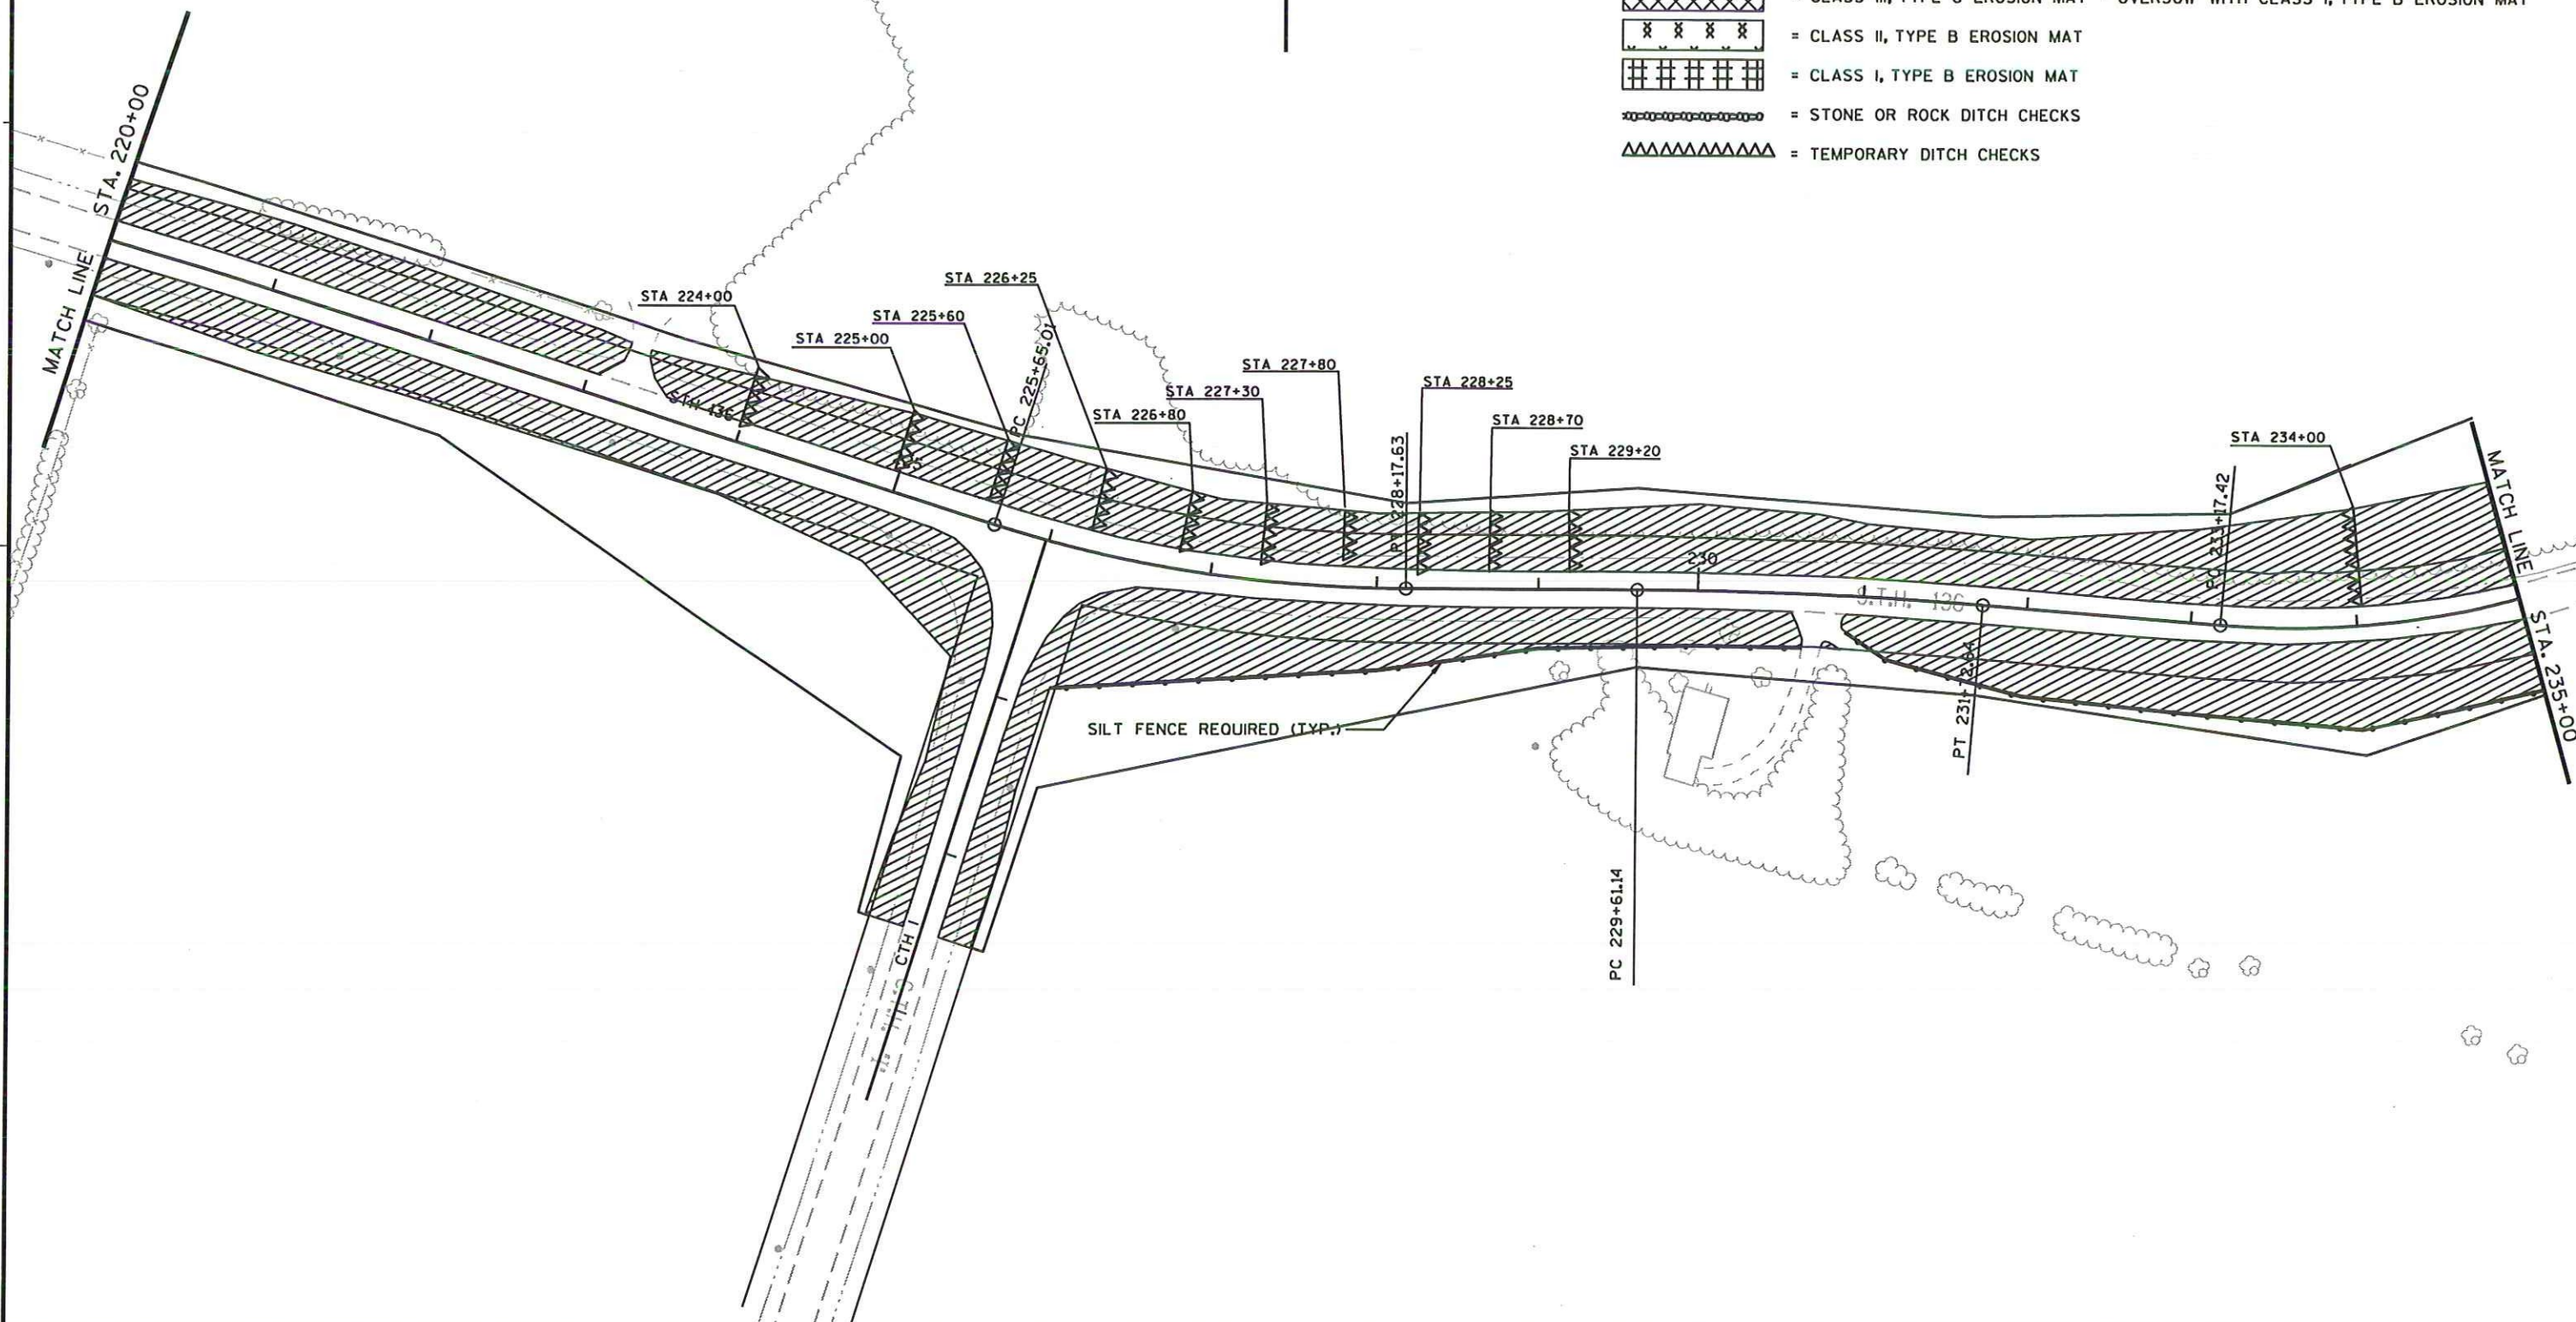

LEGEND

 
-  = SILT FENCE
-  = SODDING
-  = PERMANENT SEED WITH TEMPORARY SEED AND MULCH
-  = CLASS III, TYPE C EROSION MAT - OVERSOW WITH CLASS I, TYPE B EROSION MAT
-  = CLASS II, TYPE B EROSION MAT
-  = CLASS I, TYPE B EROSION MAT
-  = STONE OR ROCK DITCH CHECKS
-  = TEMPORARY DITCH CHECKS

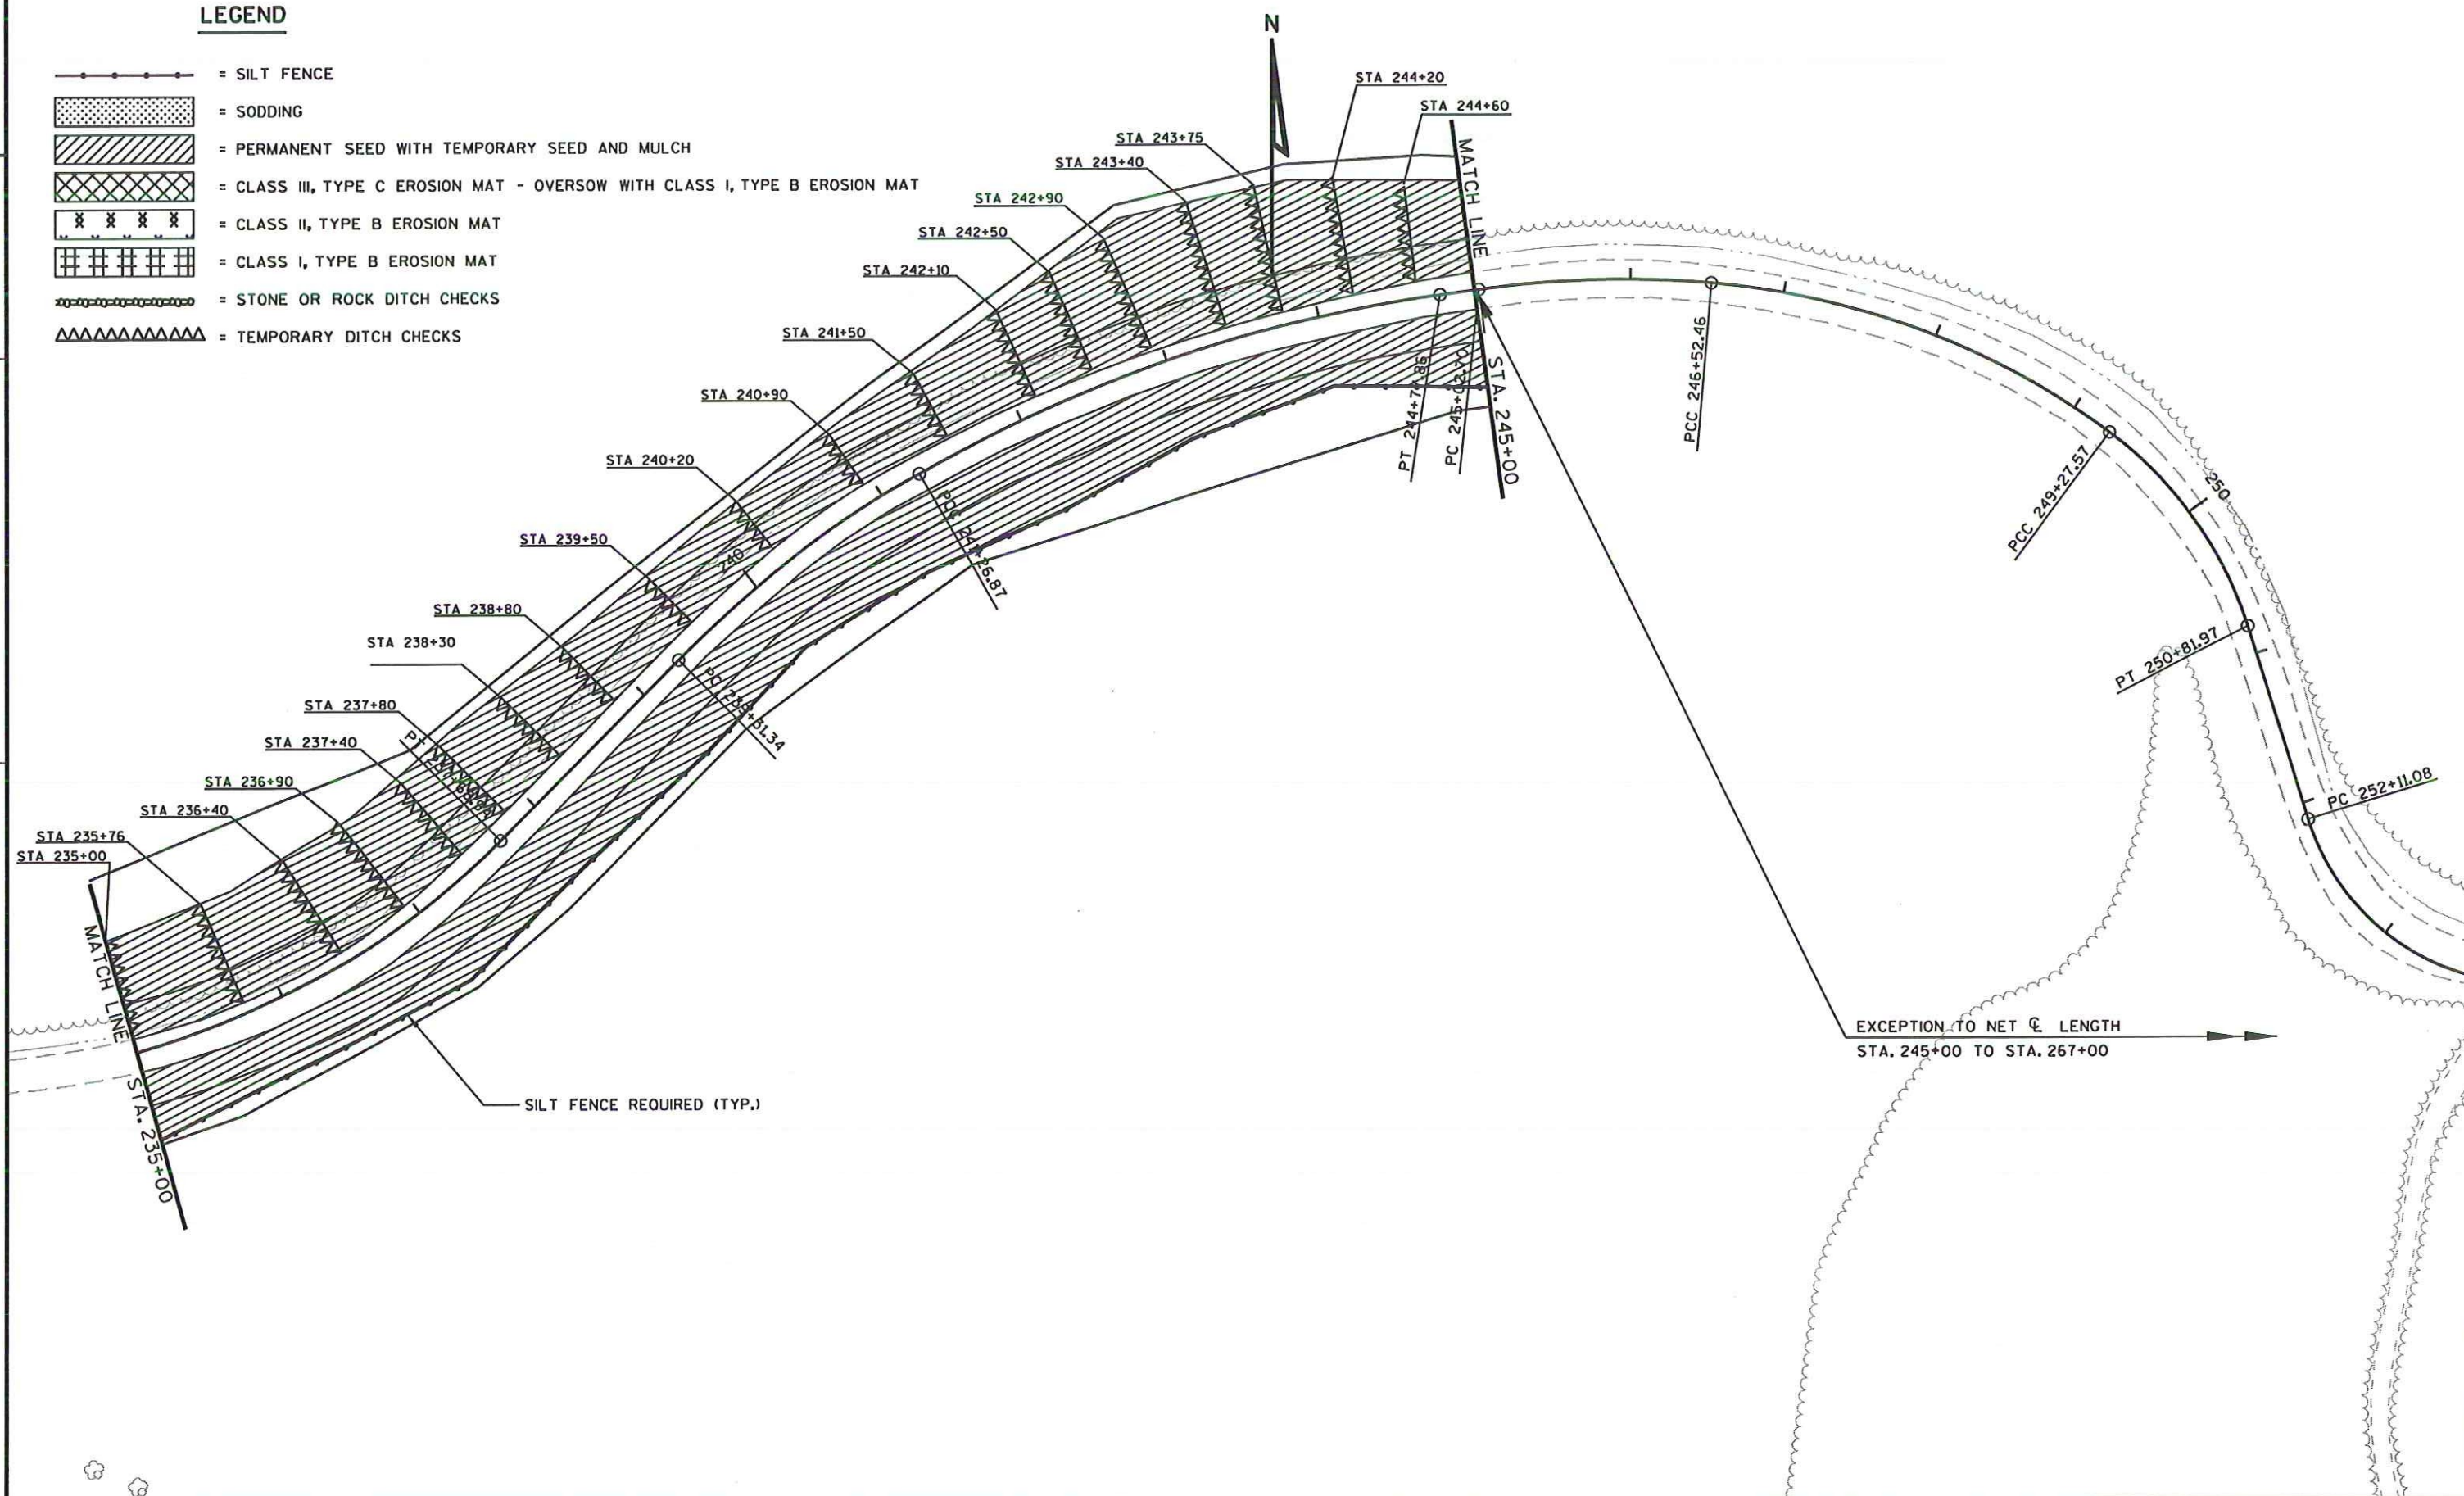


2

2

 LEGEND

-  = SILT FENCE
-  = SODDING
-  = PERMANENT SEED WITH TEMPORARY SEED AND MULCH
-  = CLASS III, TYPE C EROSION MAT - OVERSOW WITH CLASS I, TYPE B EROSION MAT
-  = CLASS II, TYPE B EROSION MAT
-  = CLASS I, TYPE B EROSION MAT
-  = STONE OR ROCK DITCH CHECKS
-  = TEMPORARY DITCH CHECKS

N

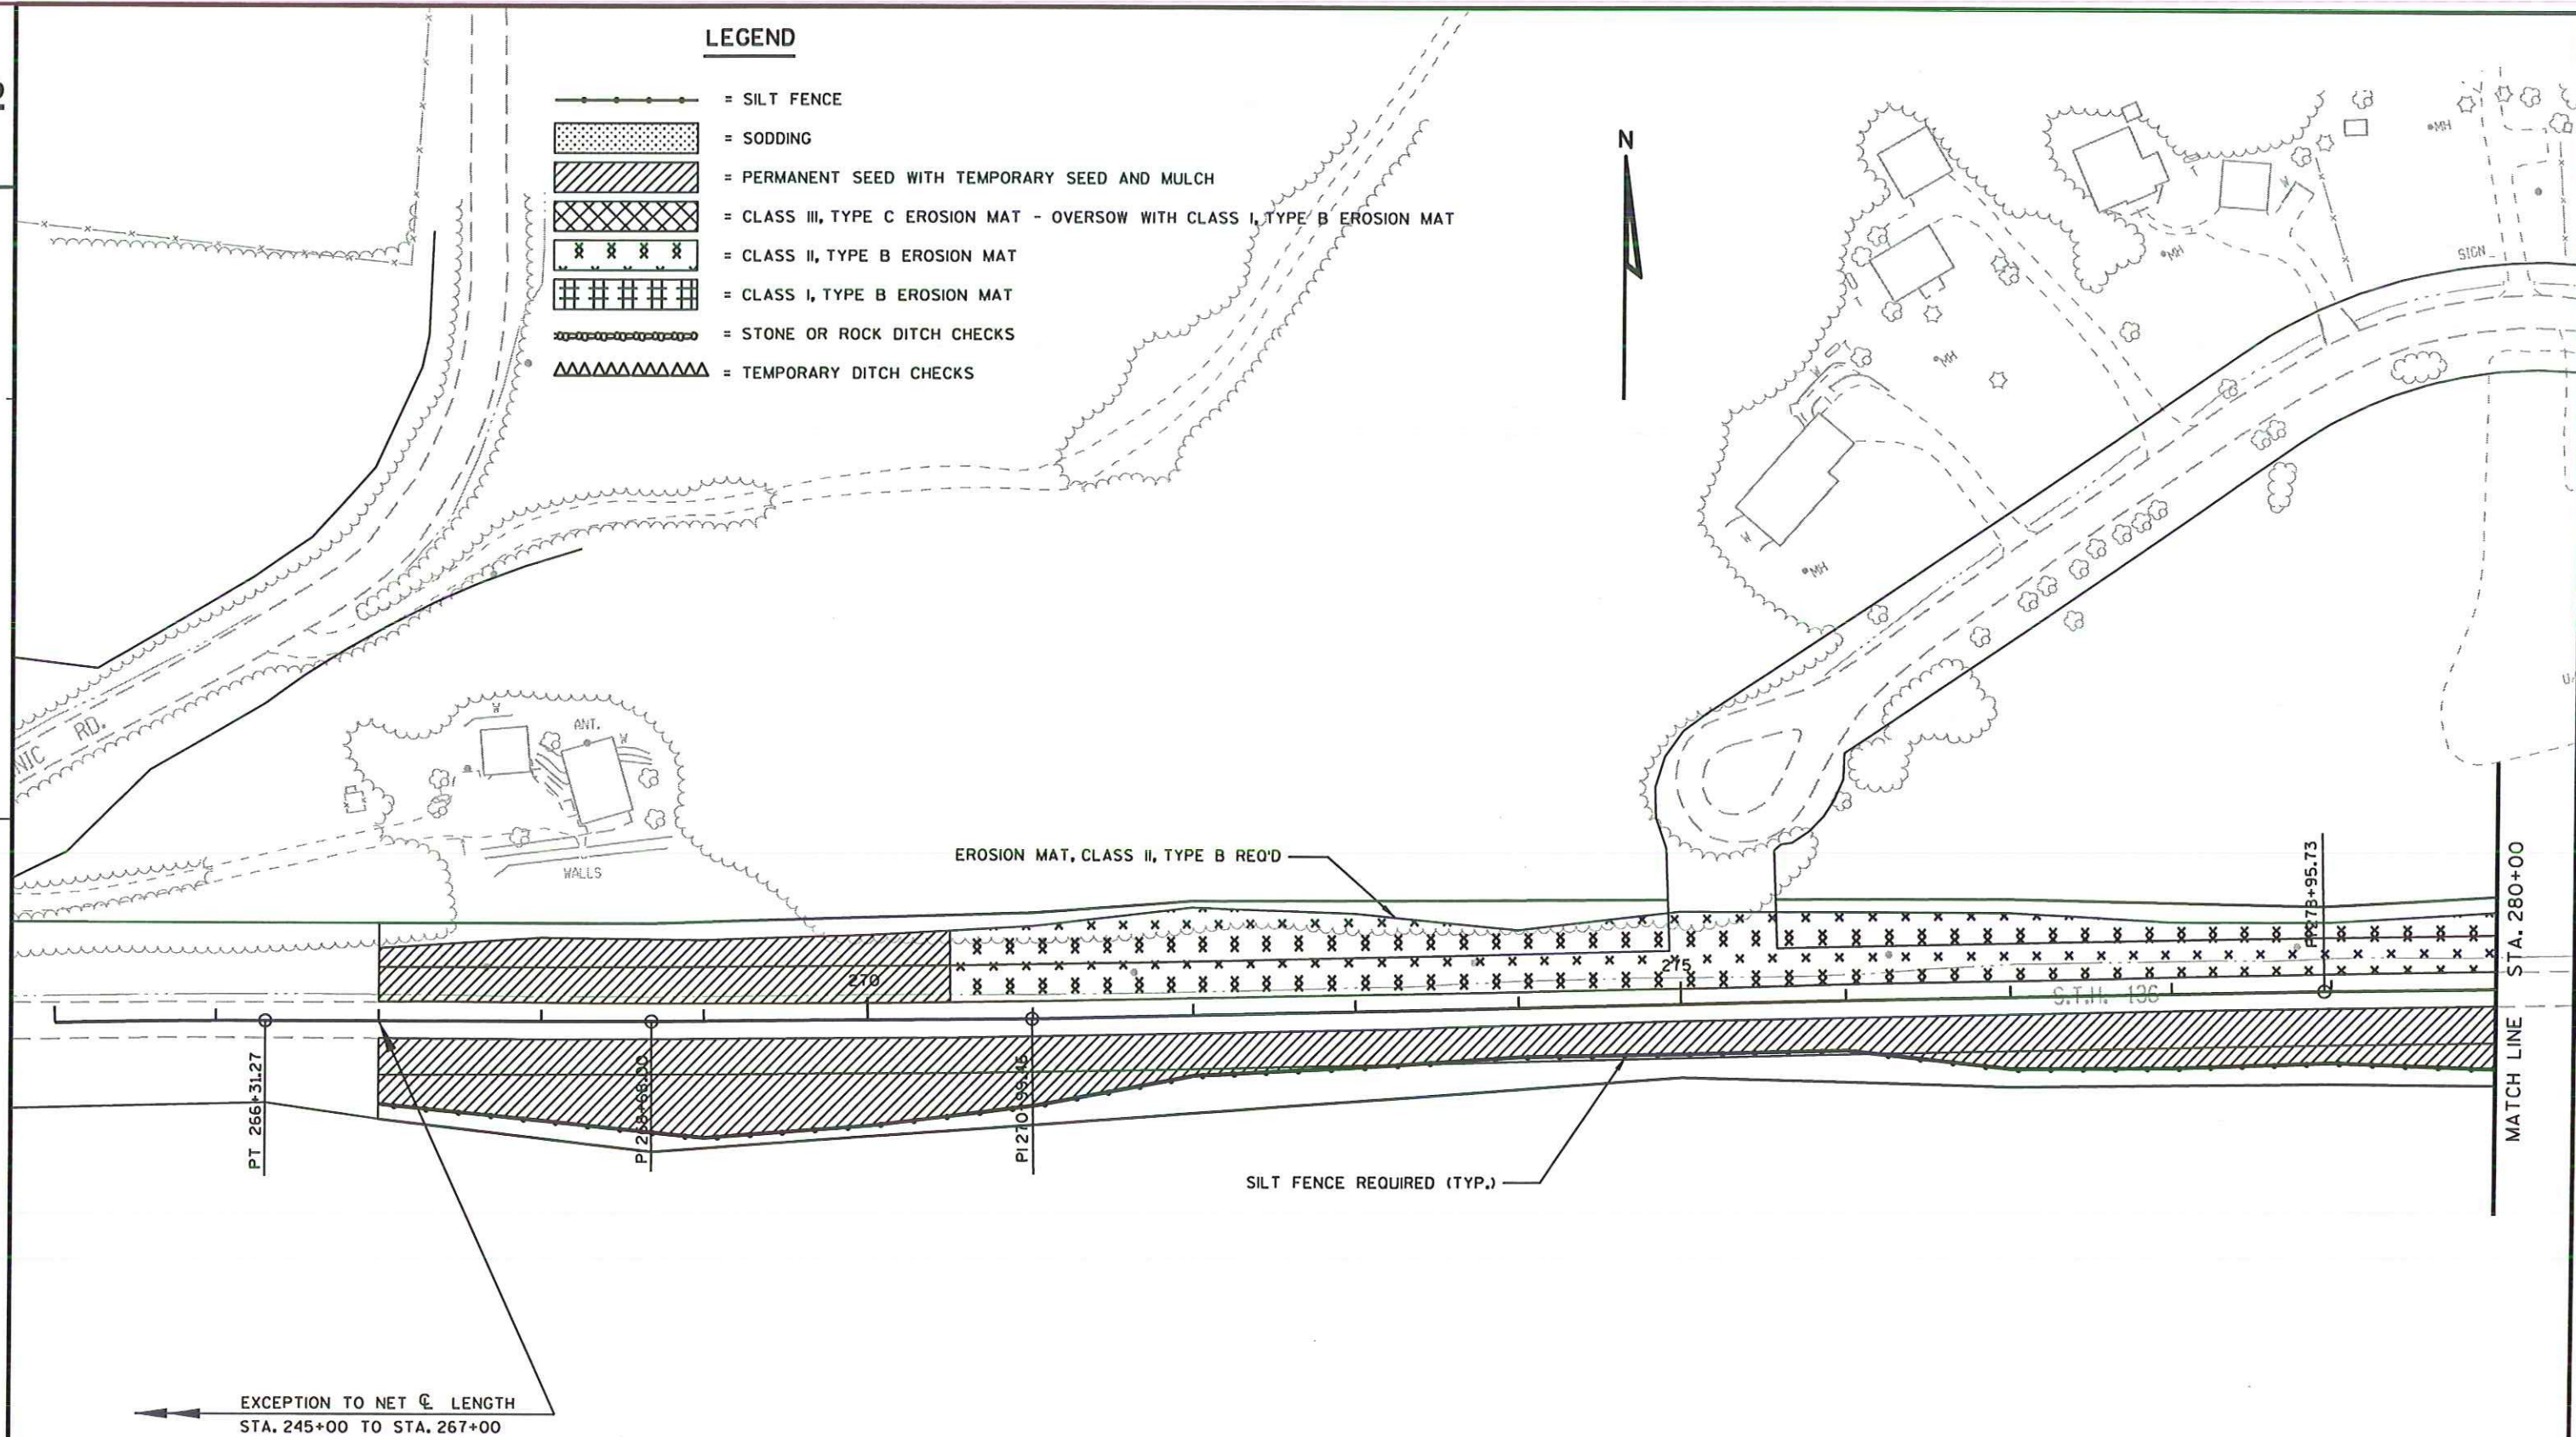

PROJECT NO:5573-04-72

HWY: STH 136

COUNTY: SALIK

EROSION CONTROL

SHEET

E

FILE NAME : r:\Support\CADDs\Projects\d1-55730401\022011_ec.dgn


PLOT DATE : 22-JUL-2007 07:03



PLOT BY : dotbbg


PLOT NAME :

PLOT SCALE : 100.000000:1.000000


WISDOT/CADDs SHEET 42

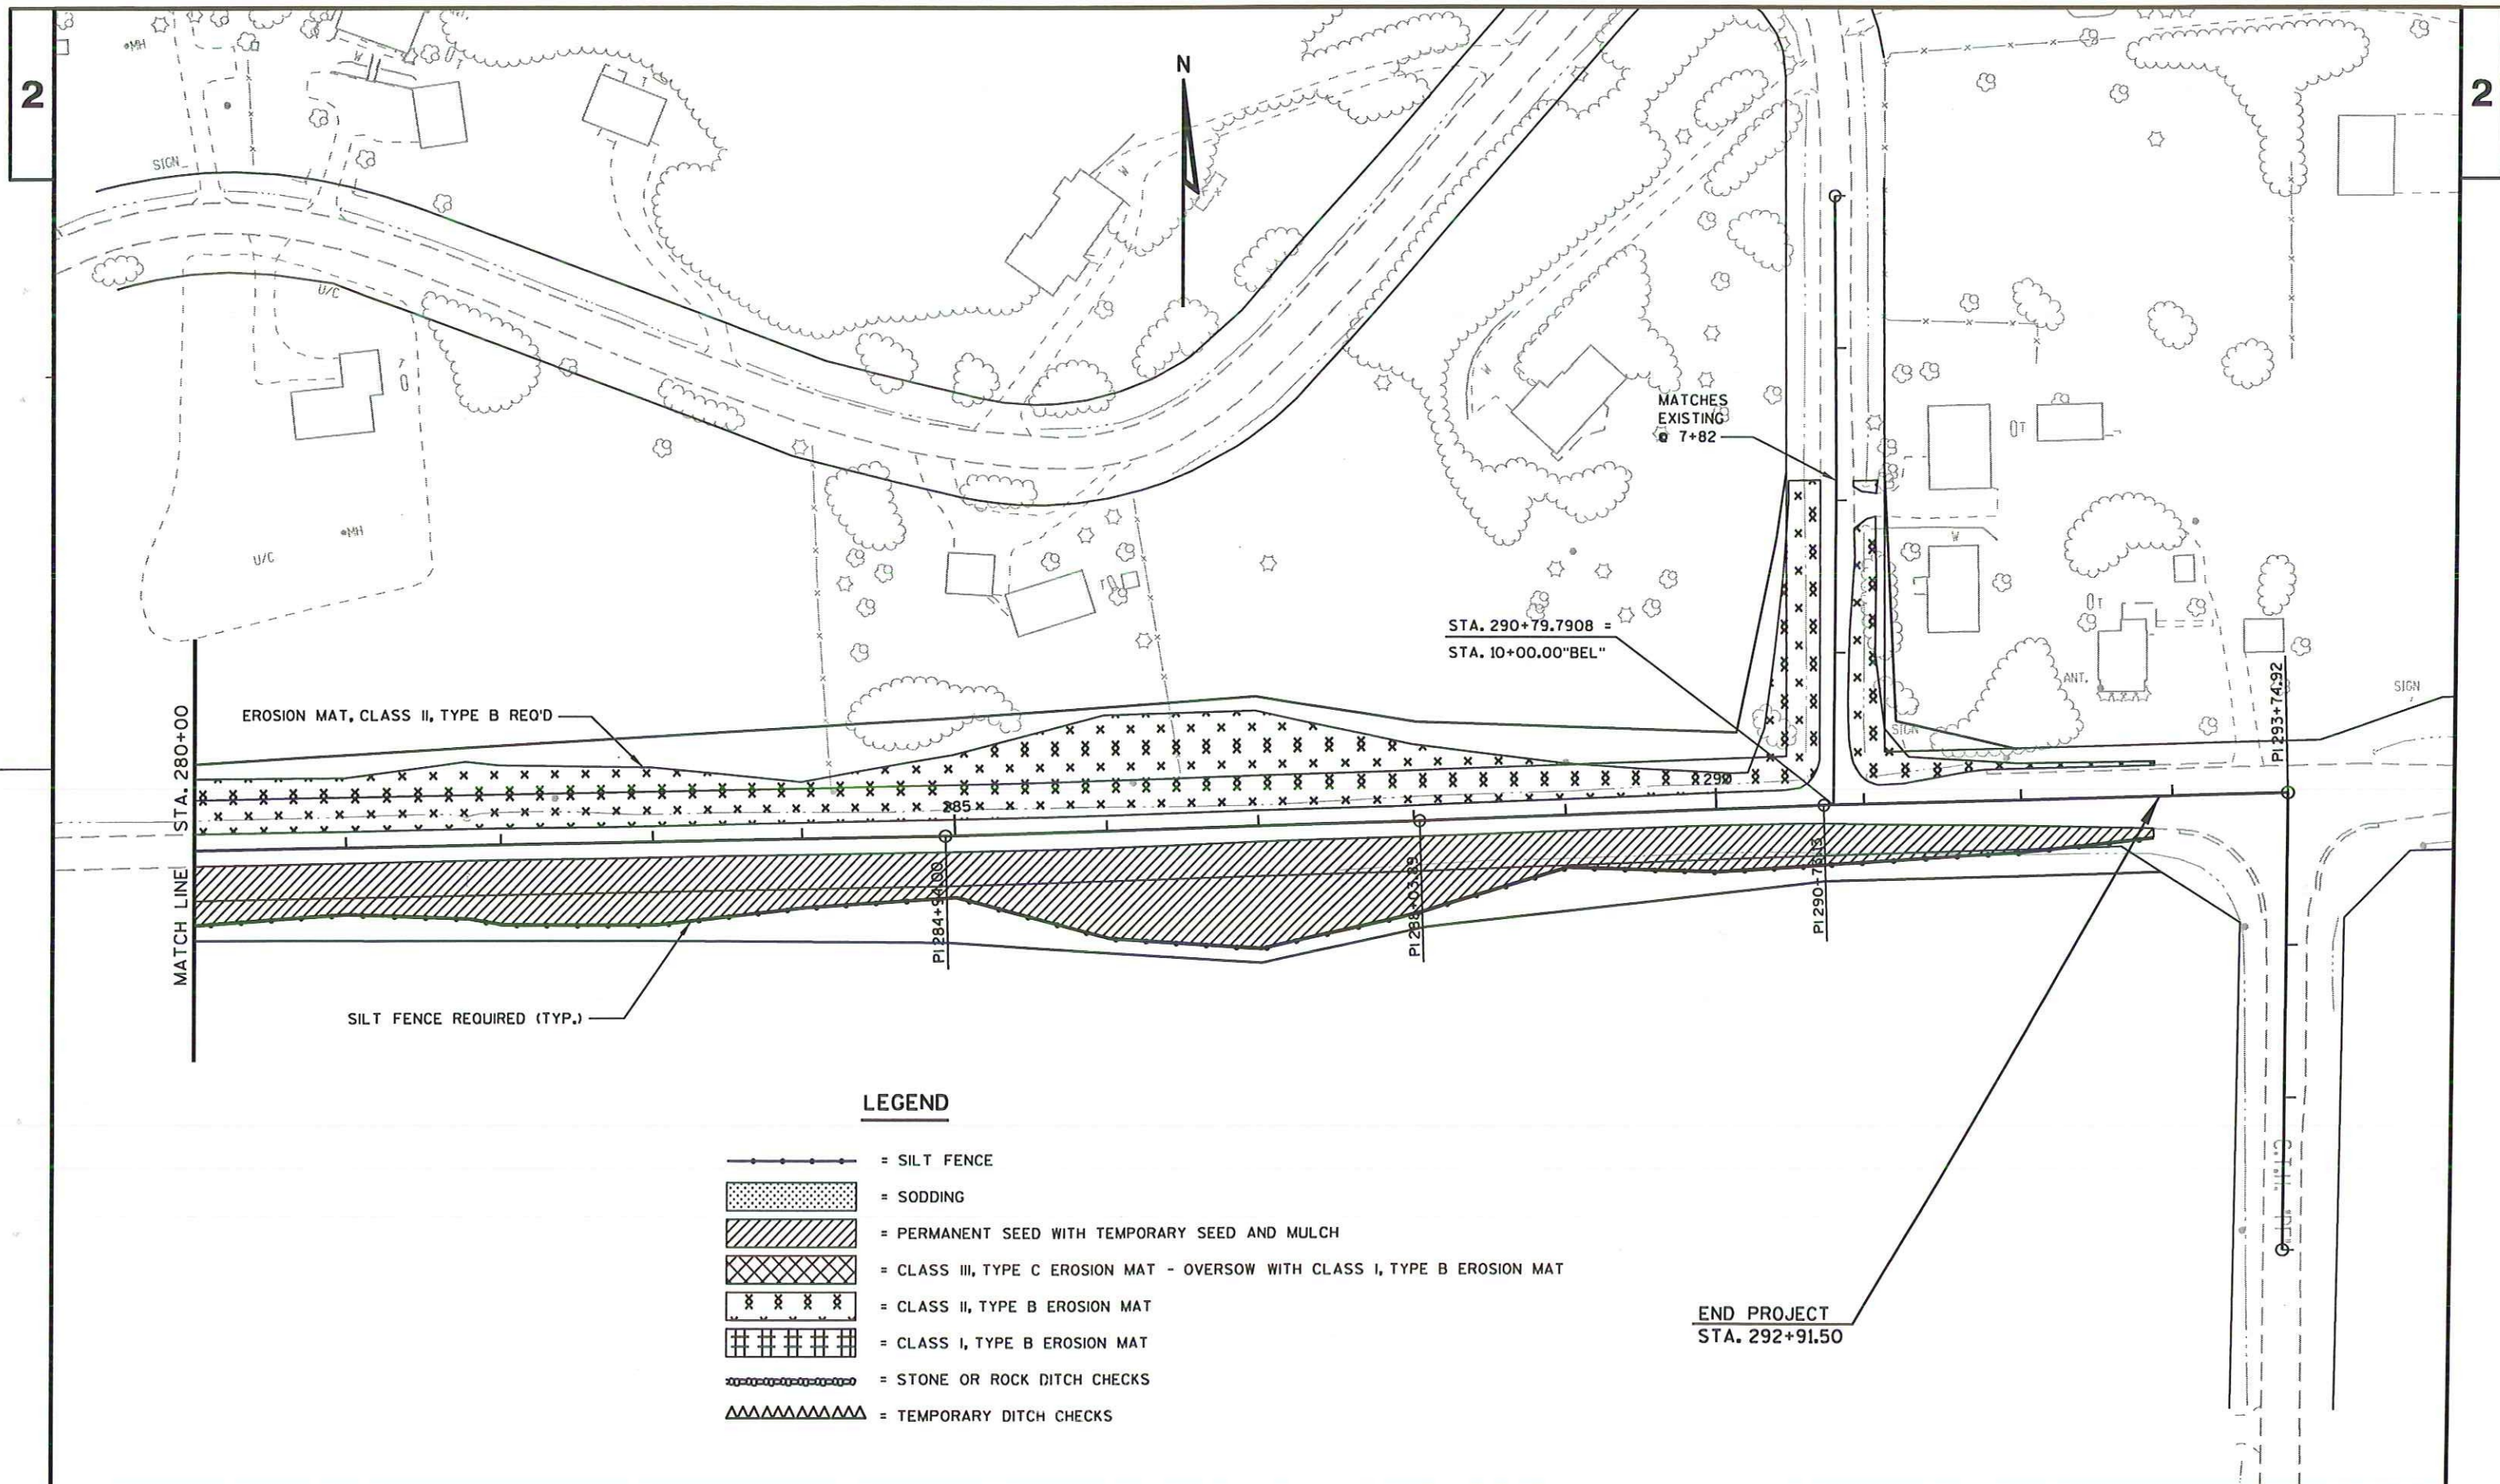


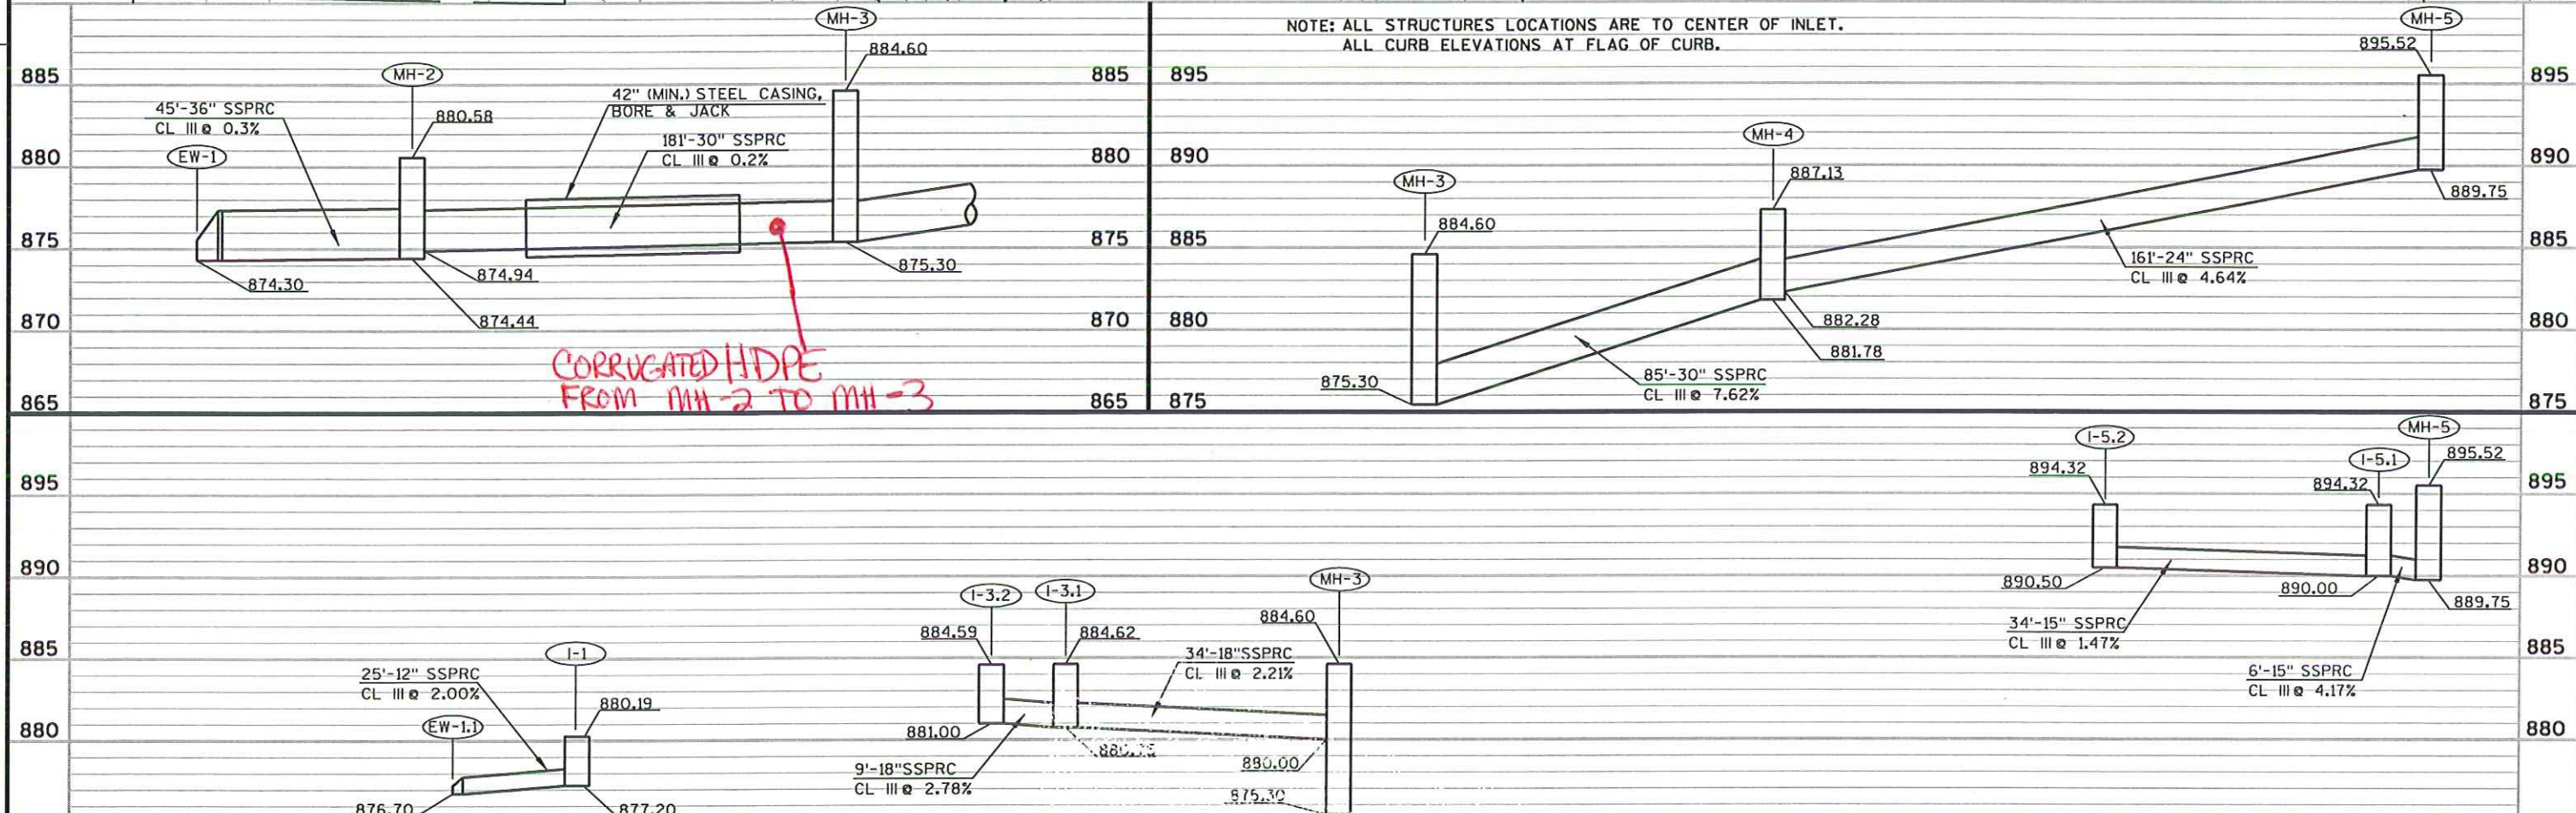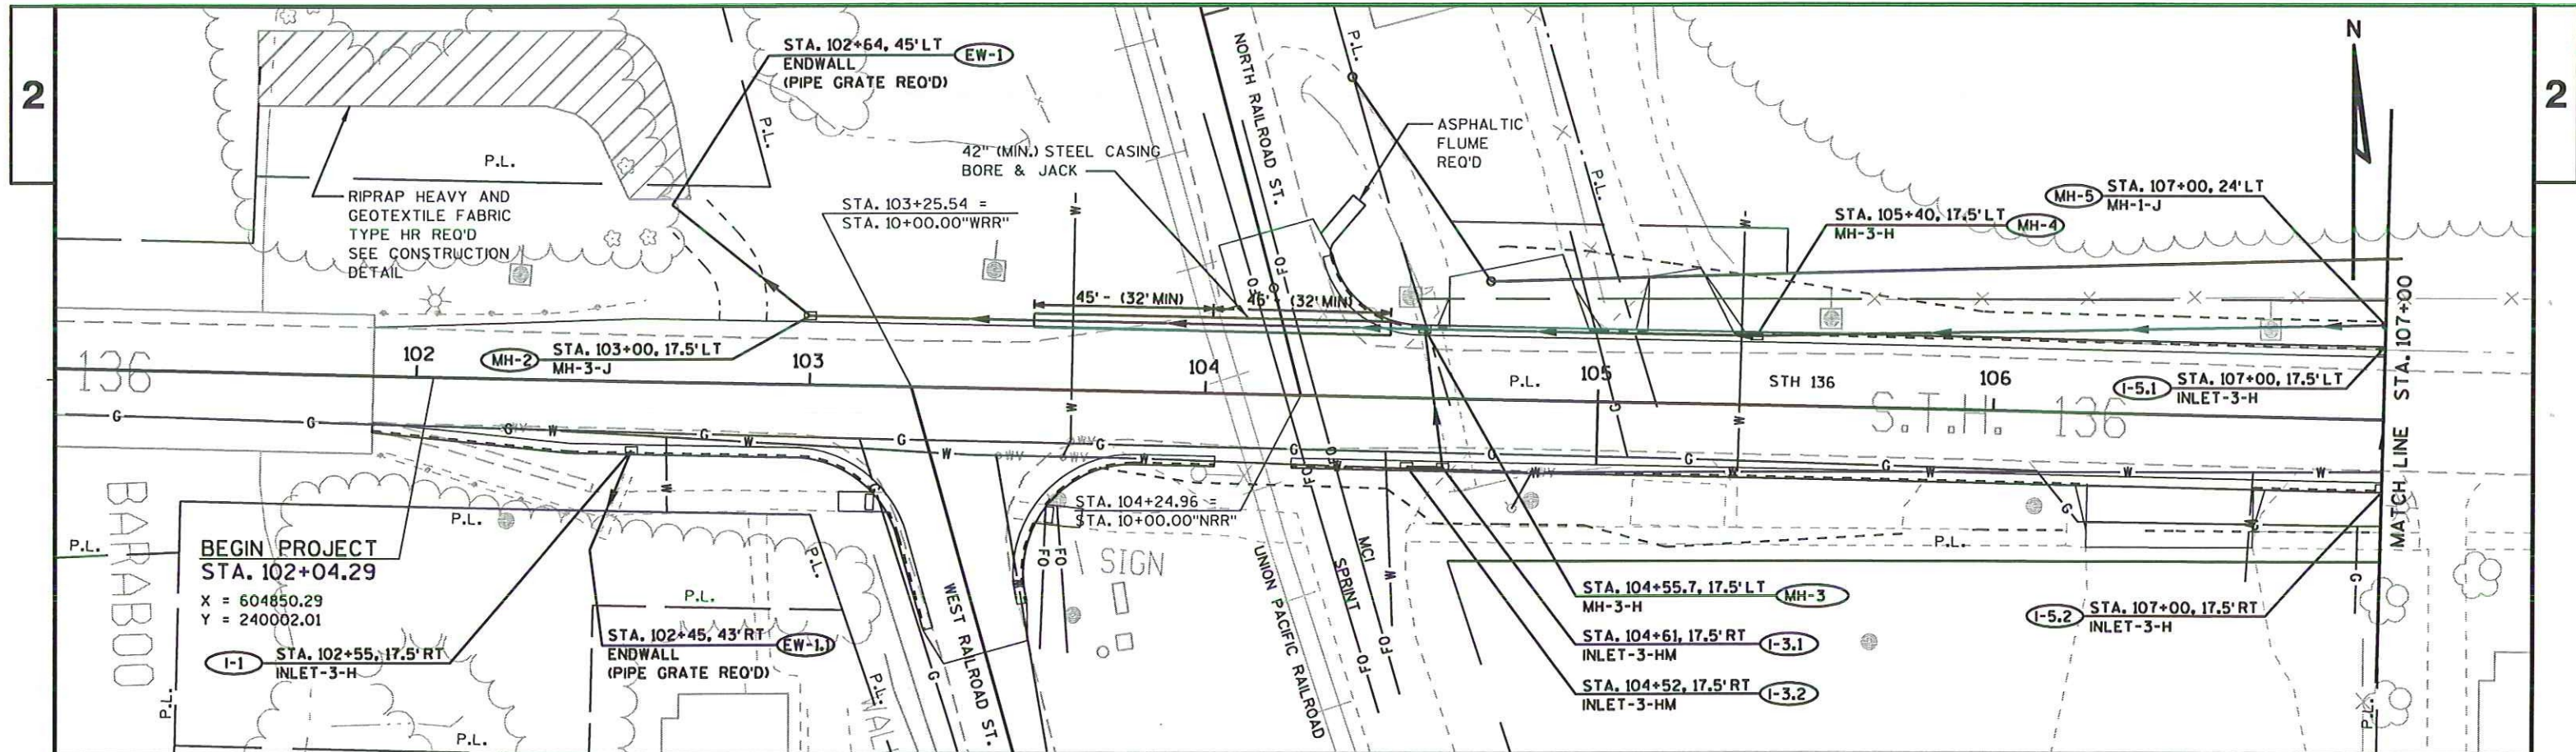

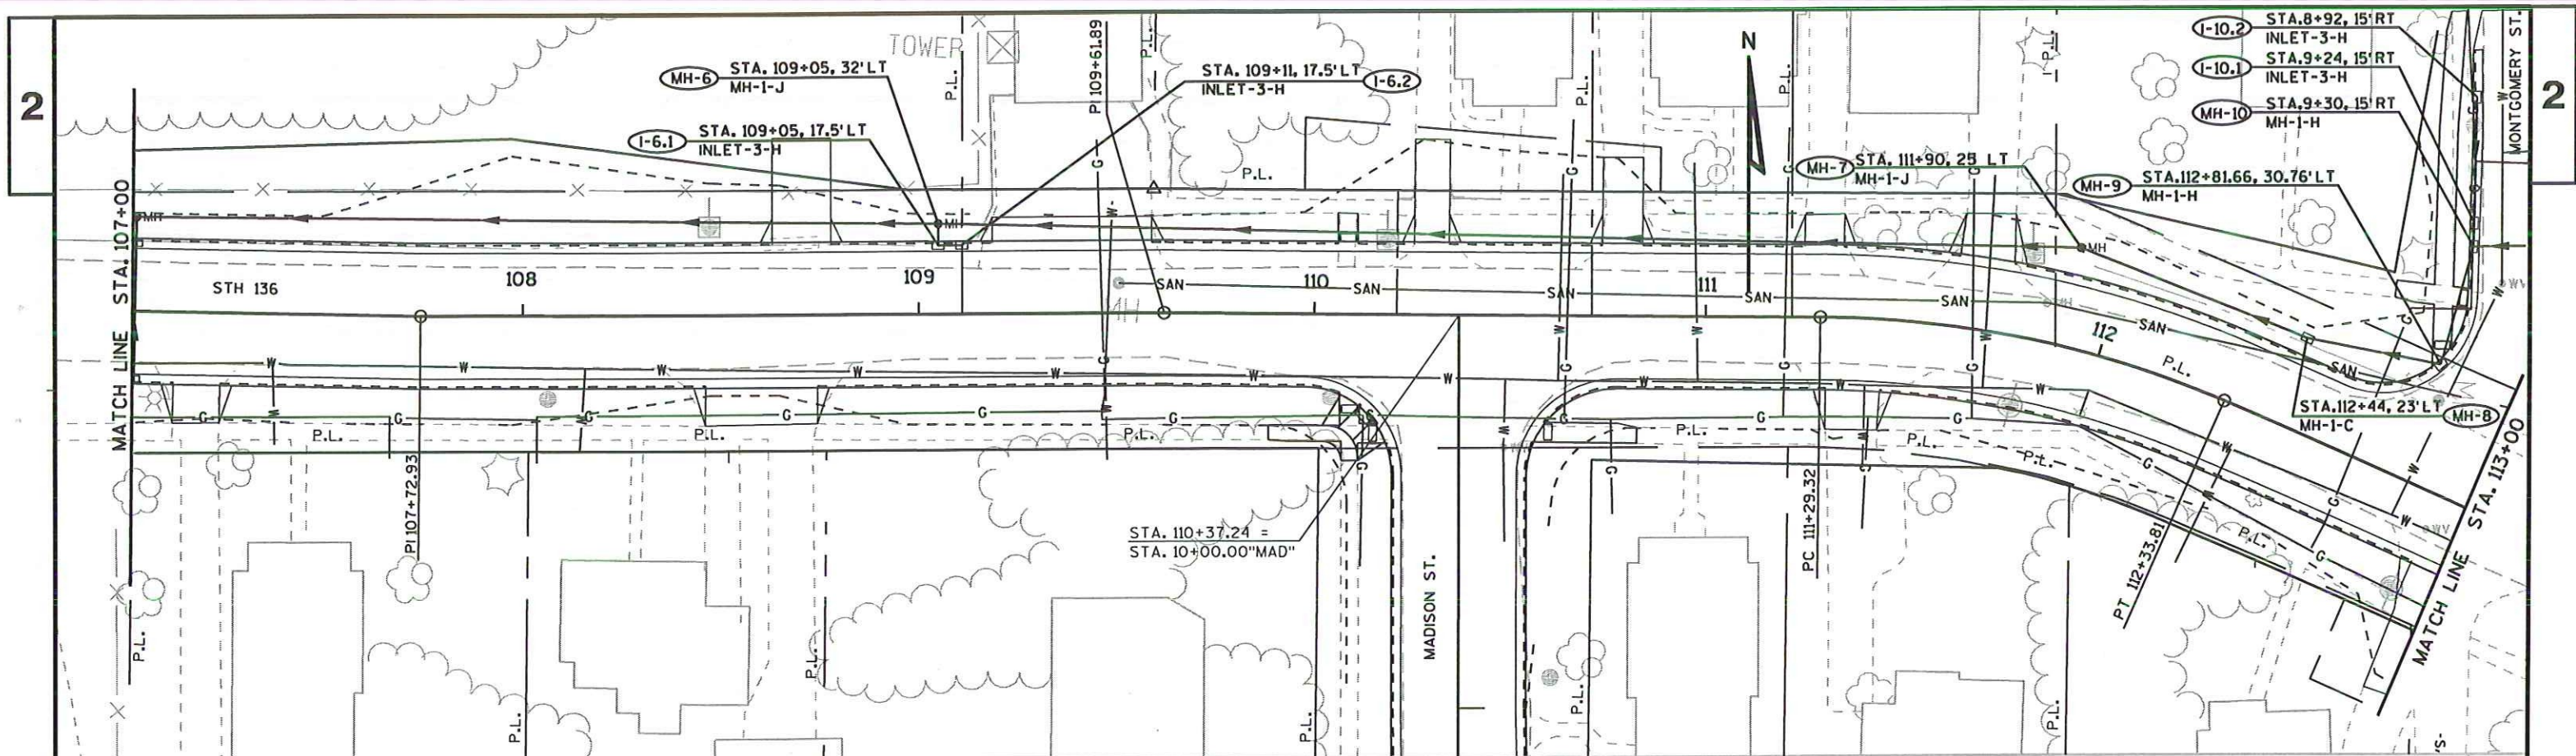


NOTE: ALL STRUCTURES LOCATIONS ARE TO CENTER OF INLET.
ALL CURB ELEVATIONS AT FLAG OF CURB.

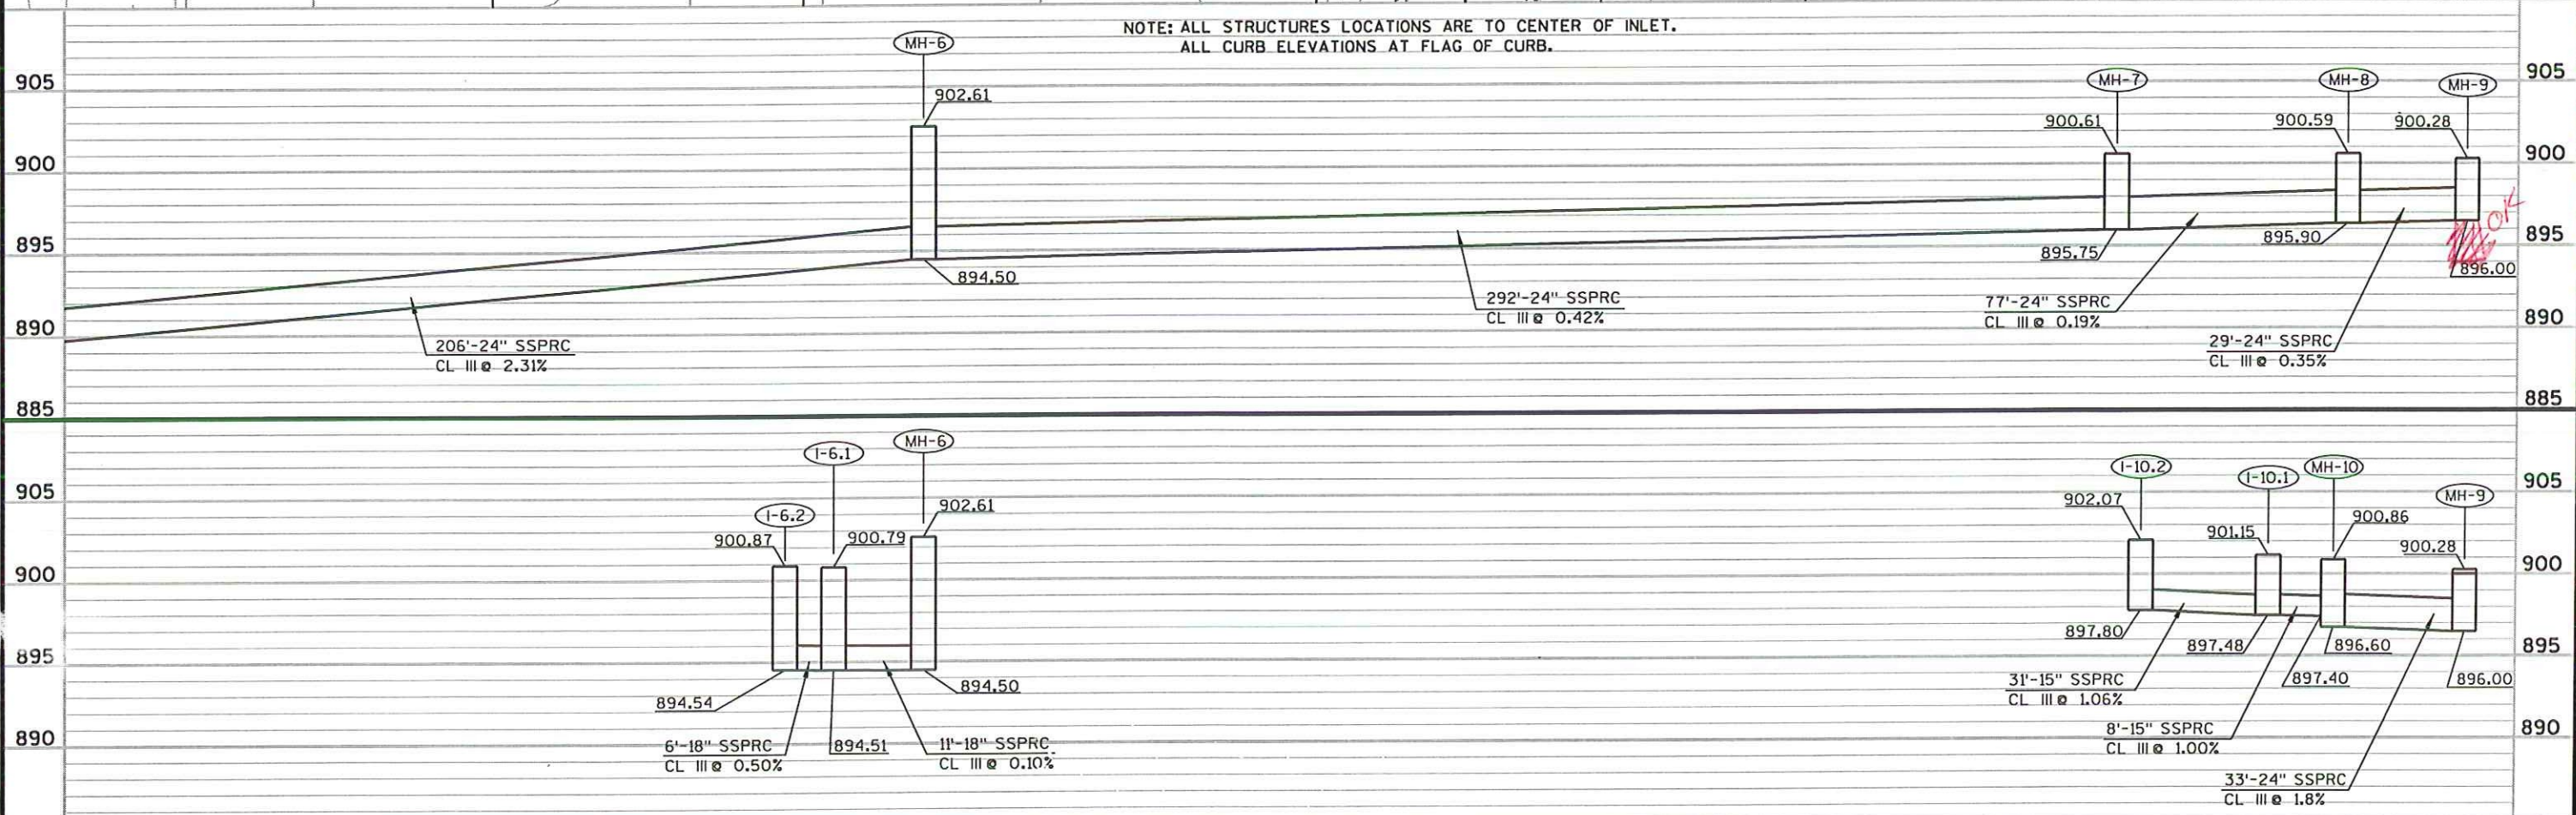

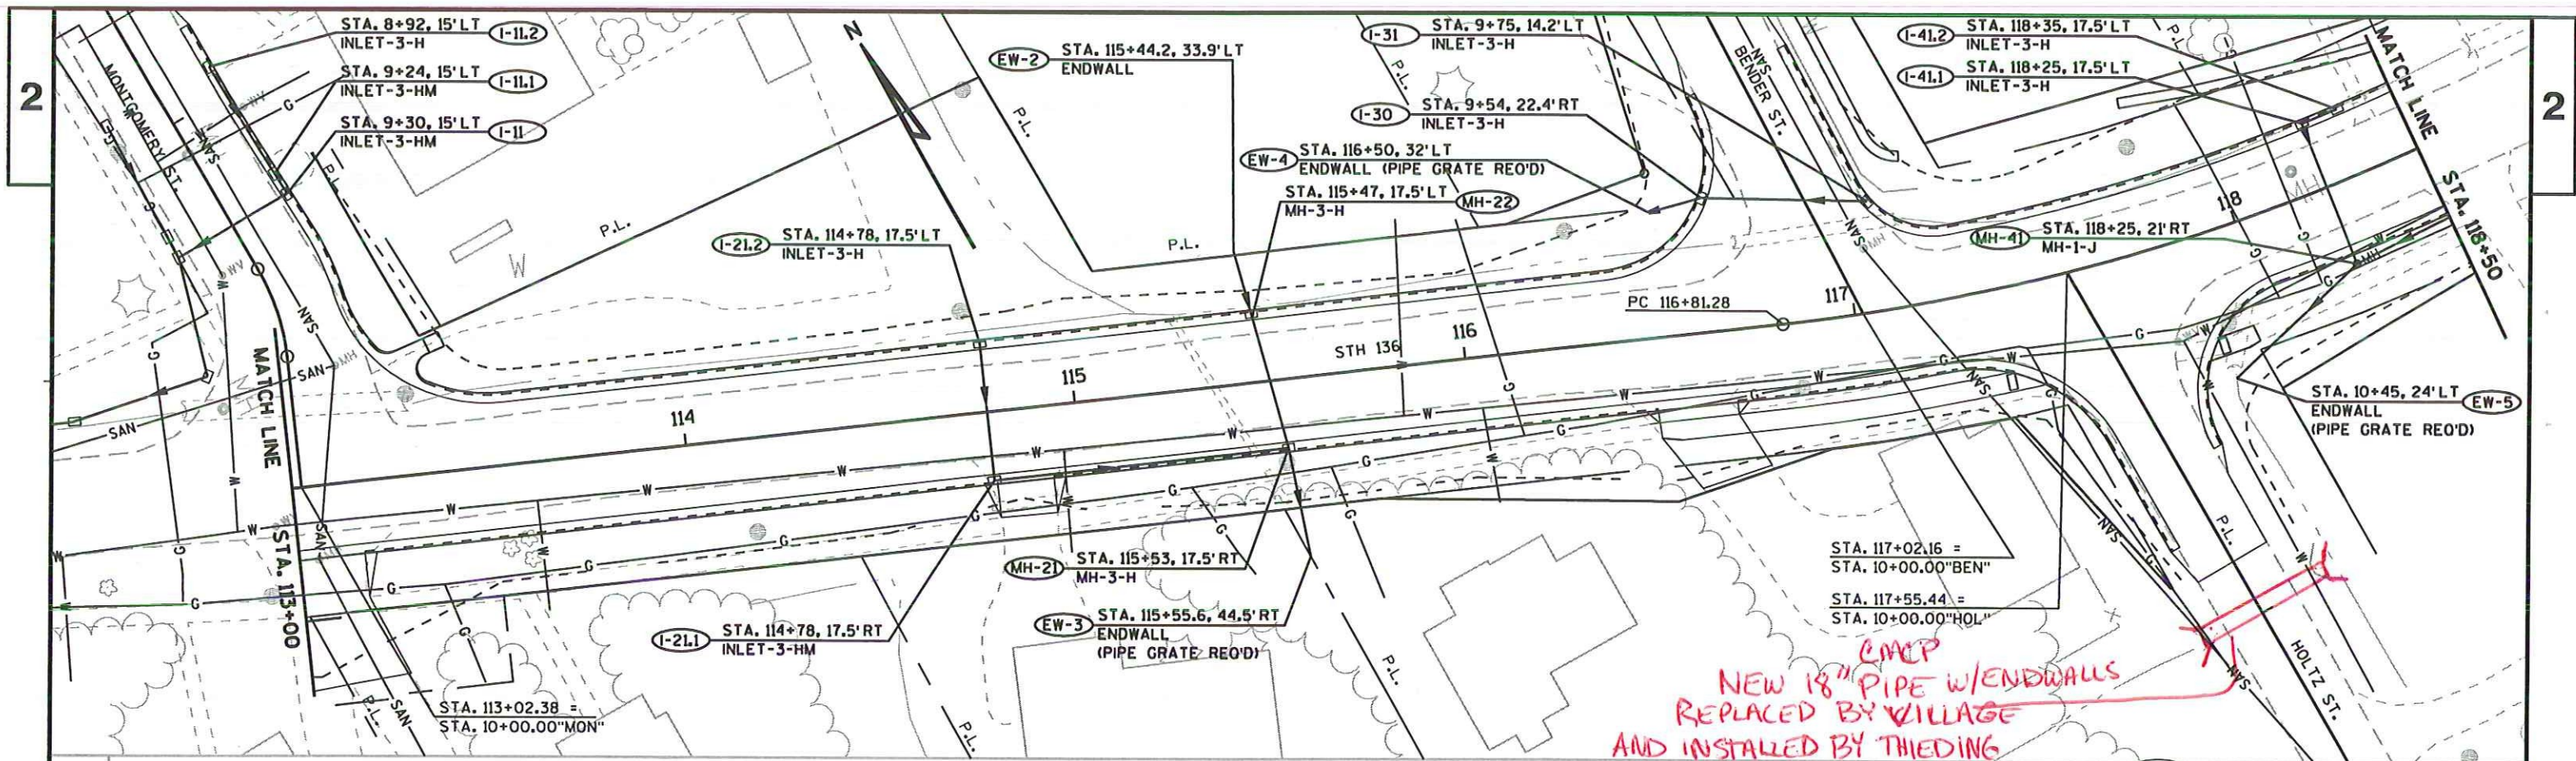

NOTE: ALL STRUCTURES LOCATIONS ARE TO CENTER OF INLET.
ALL CURB ELEVATIONS AT FLAG OF CURB.

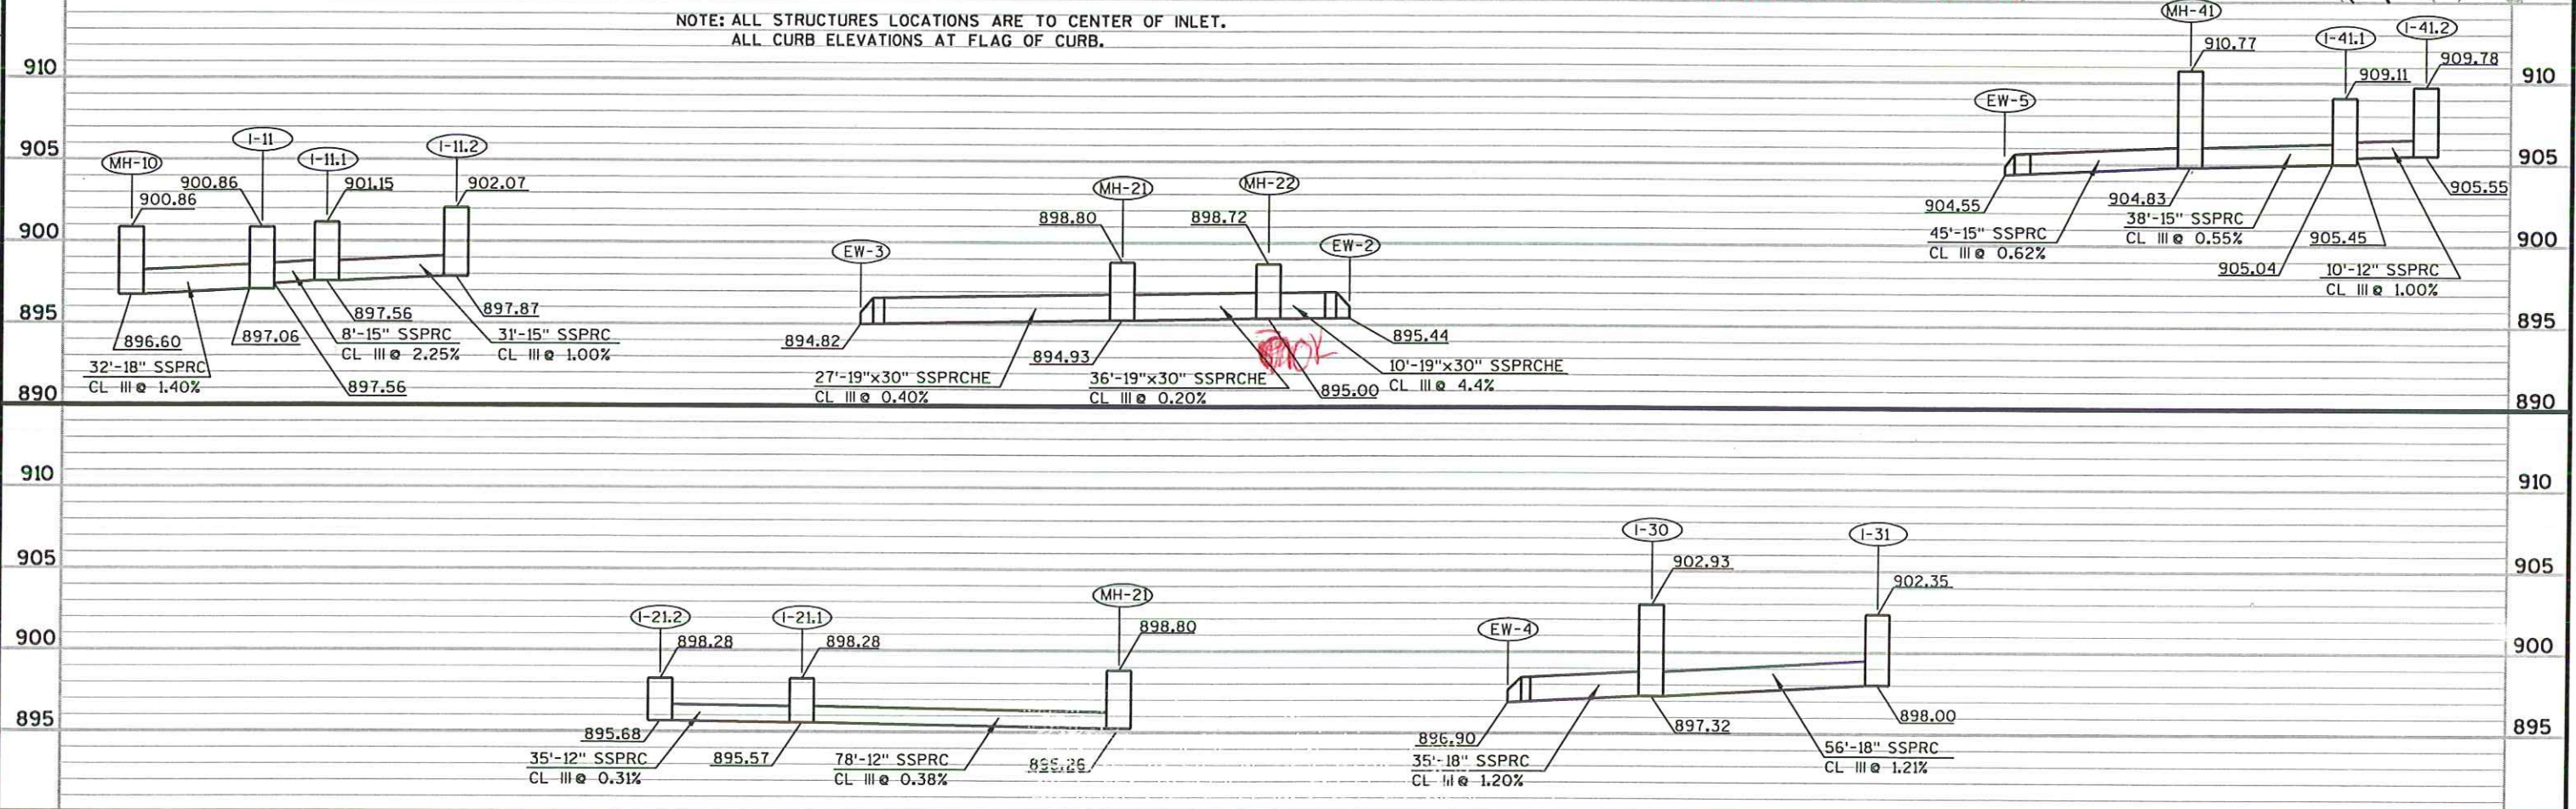

PROJECT NO: 5573-04-72

HWY: STH 136

COUNTY: SAUK

STORM SEWER

SHEET

E

FILE NAME : r:\Support\CADD\Projects\d1_55730401\022503_ss.dgn


PLOT DATE : 12-JUL-2007 07:04

PLOT BY : dotbbg


PLOT NAME :



PLOT SCALE : 40.000000:1.000000



WISDOT/CADD SHEET 41

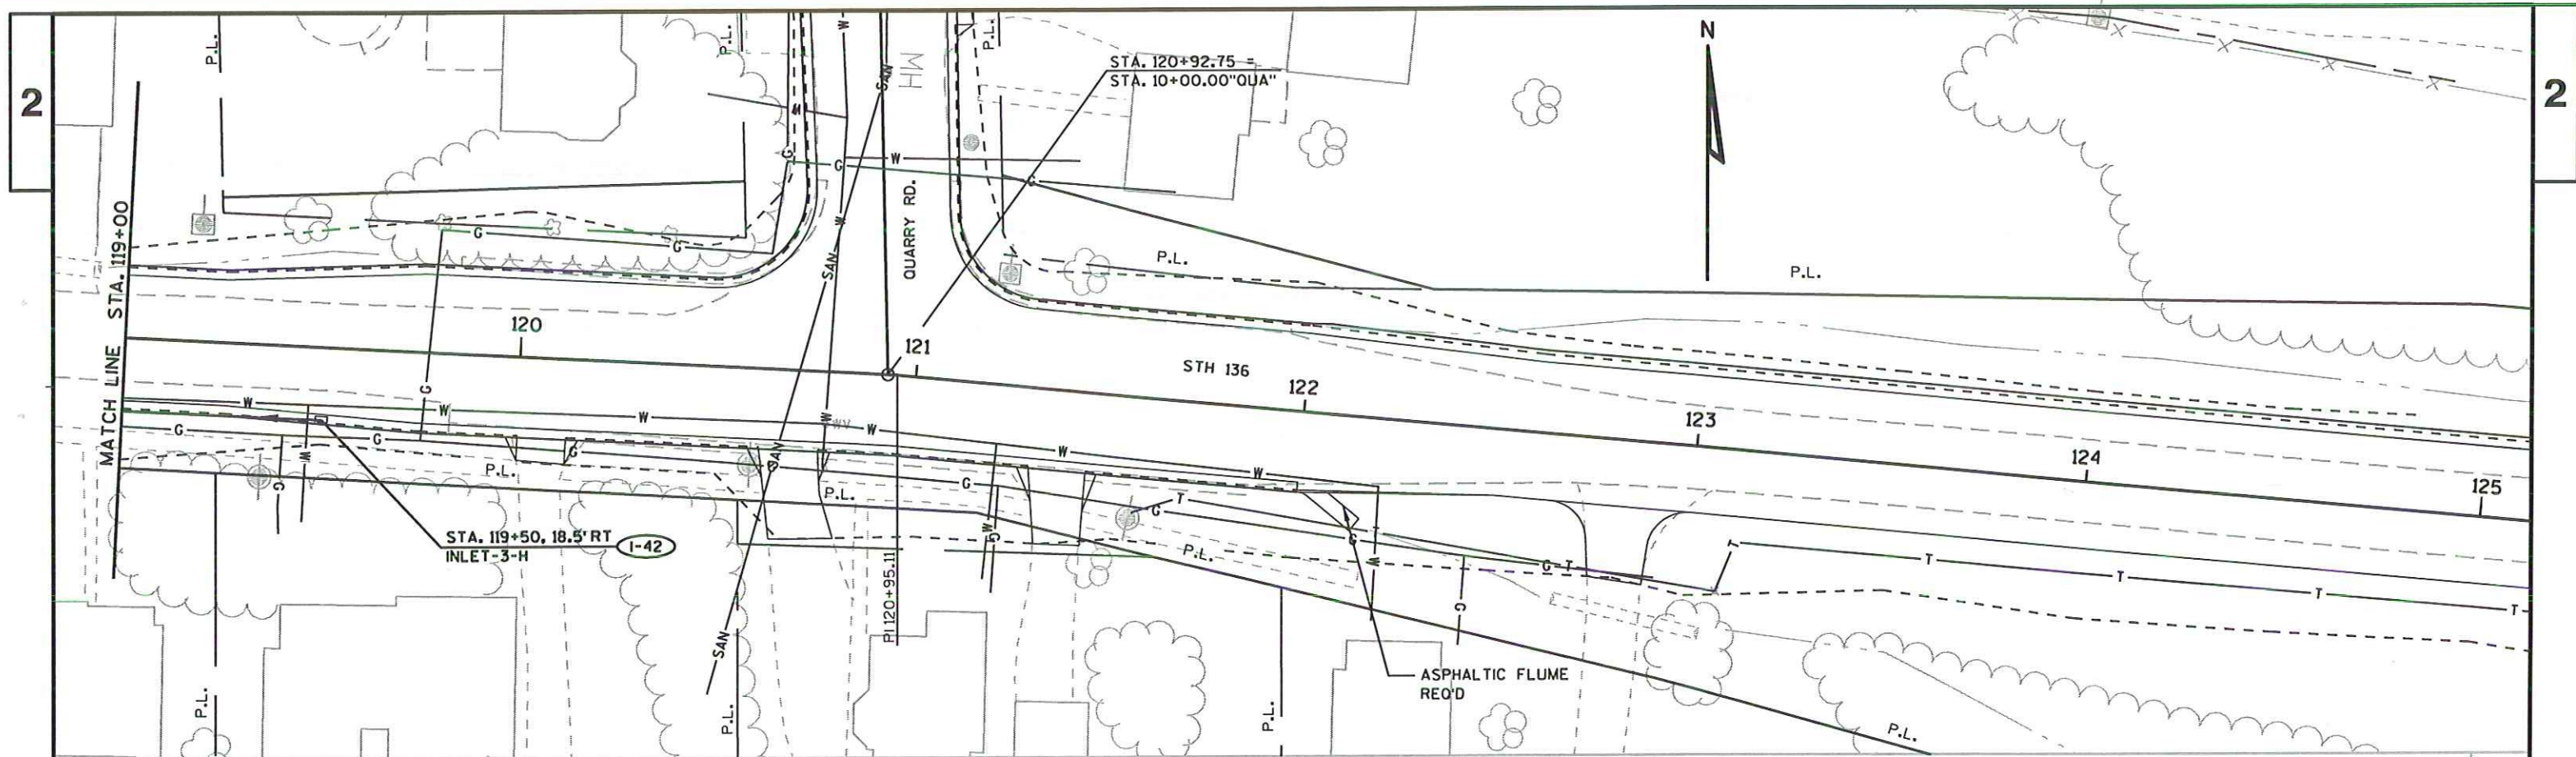


NOTE: ALL STRUCTURES LOCATIONS ARE TO CENTER OF INLET.
ALL CURB ELEVATIONS AT FLAG OF CURB.

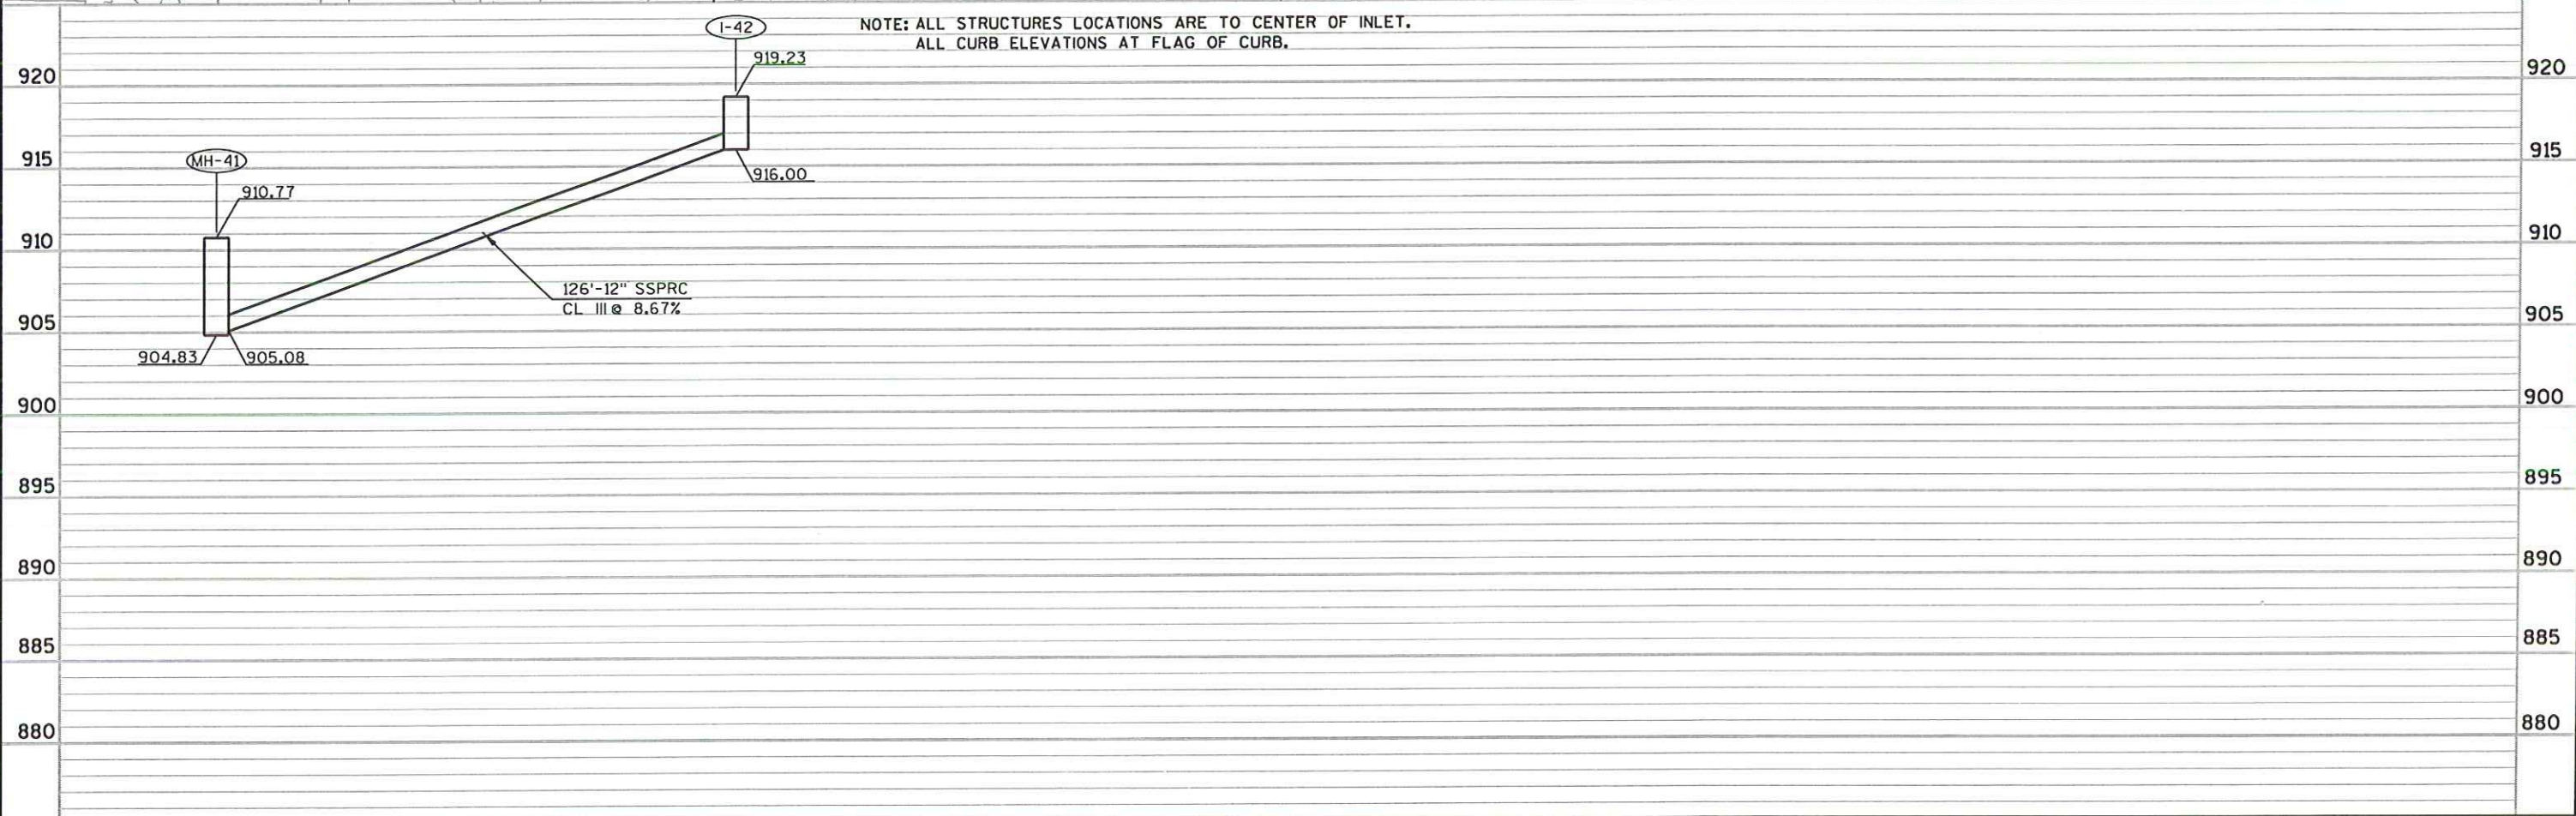

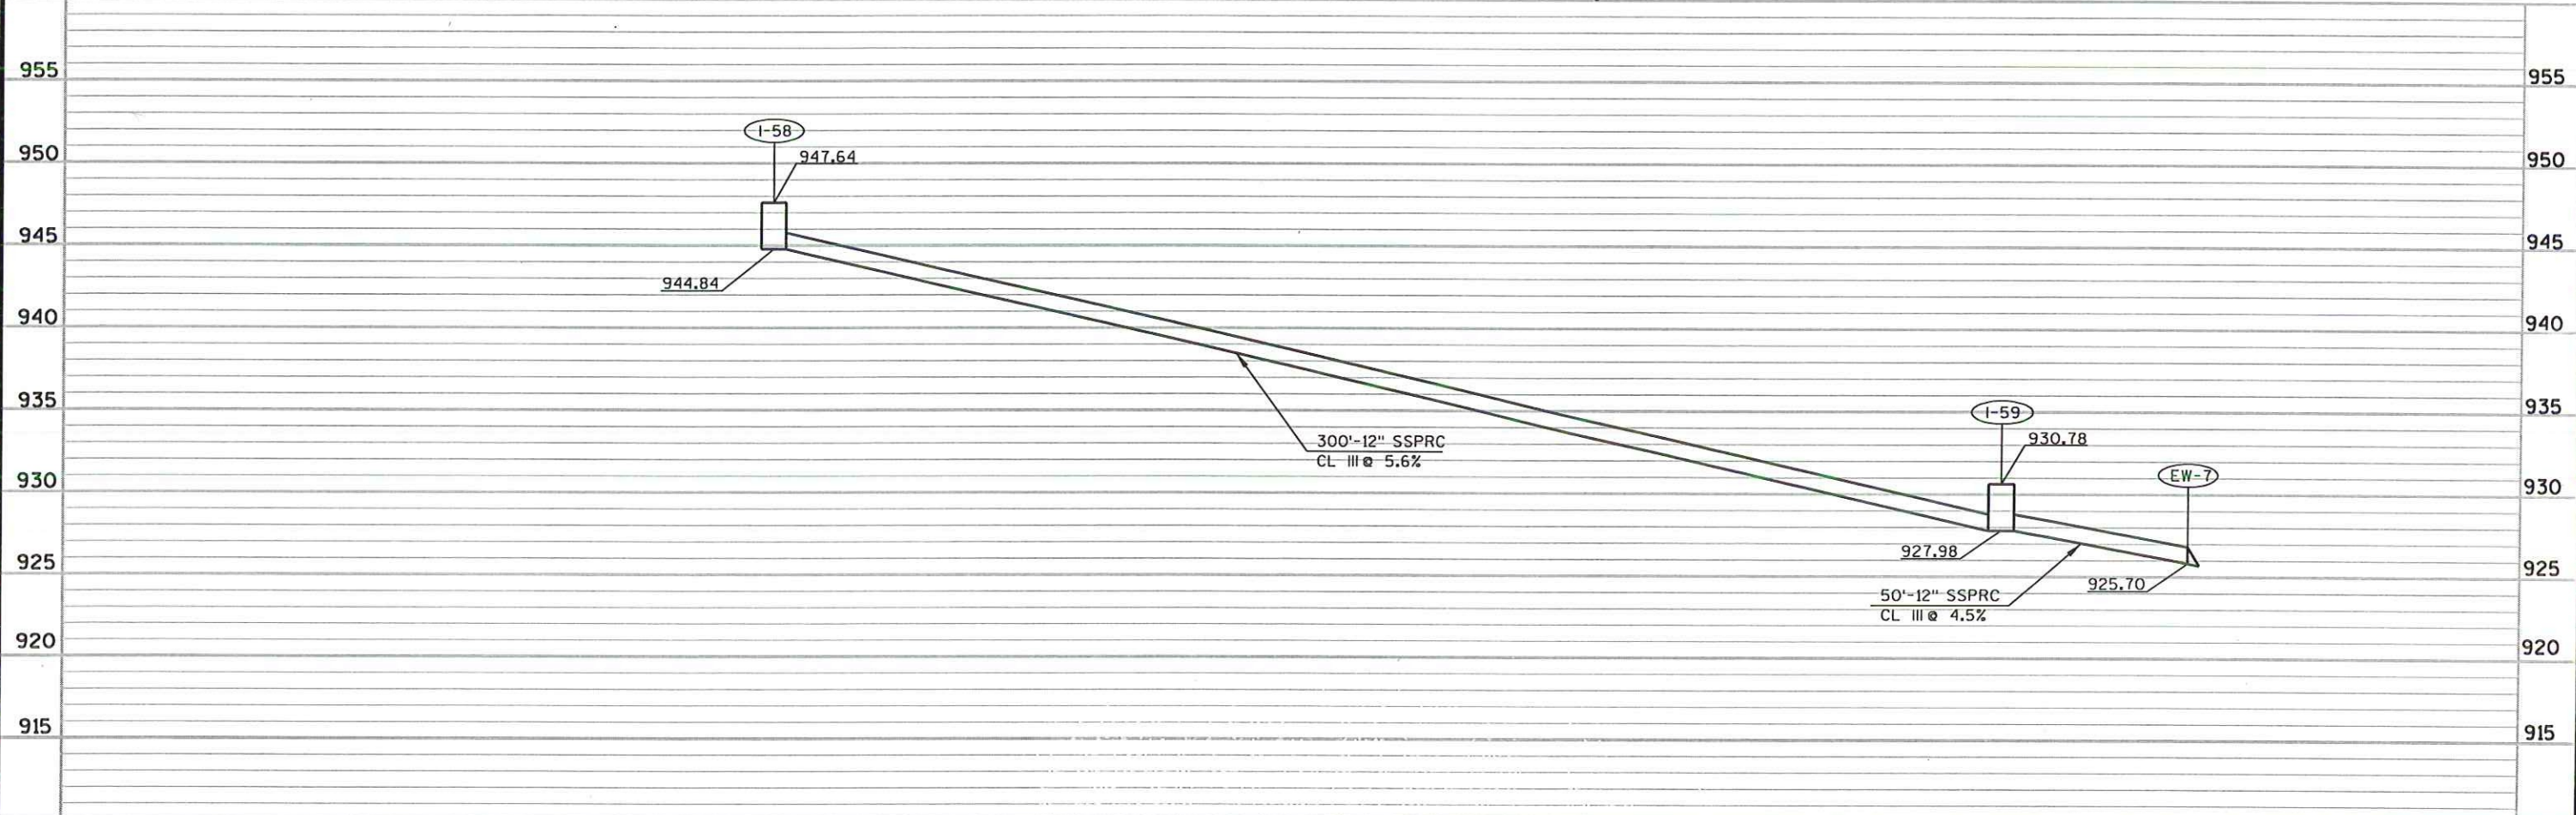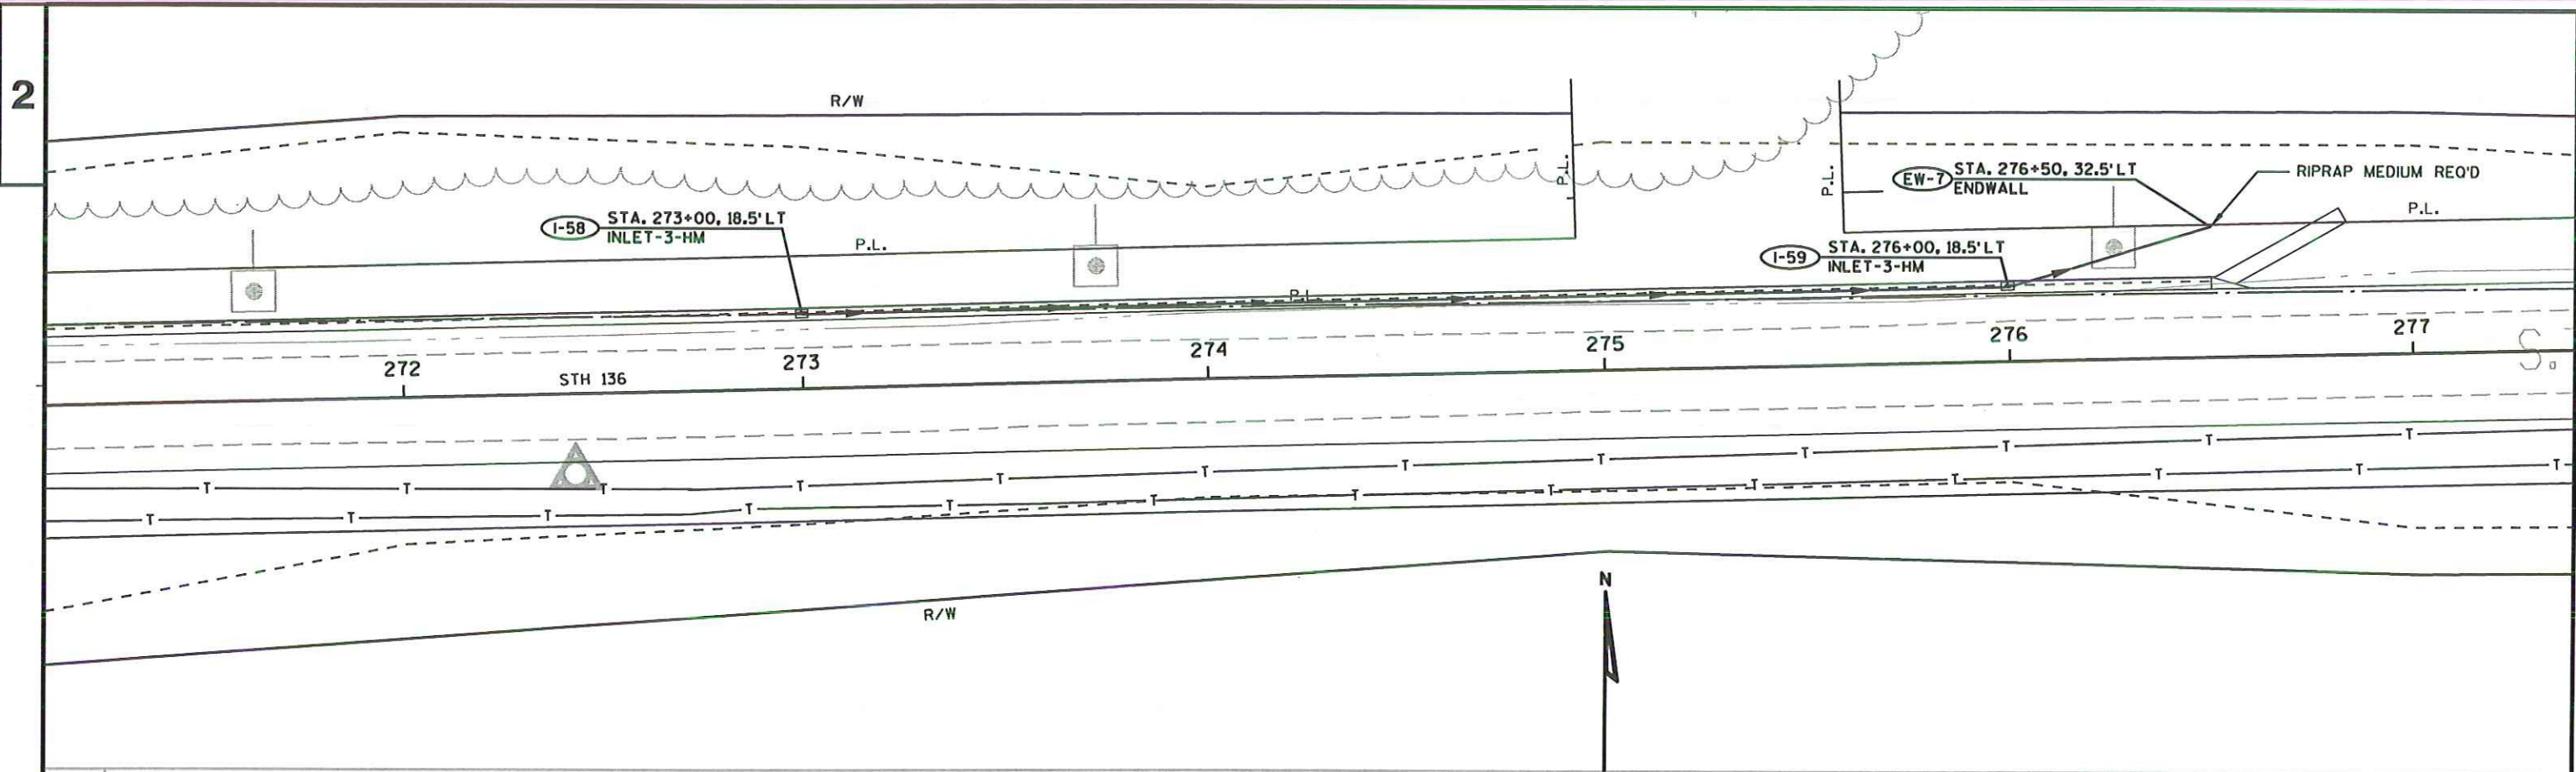

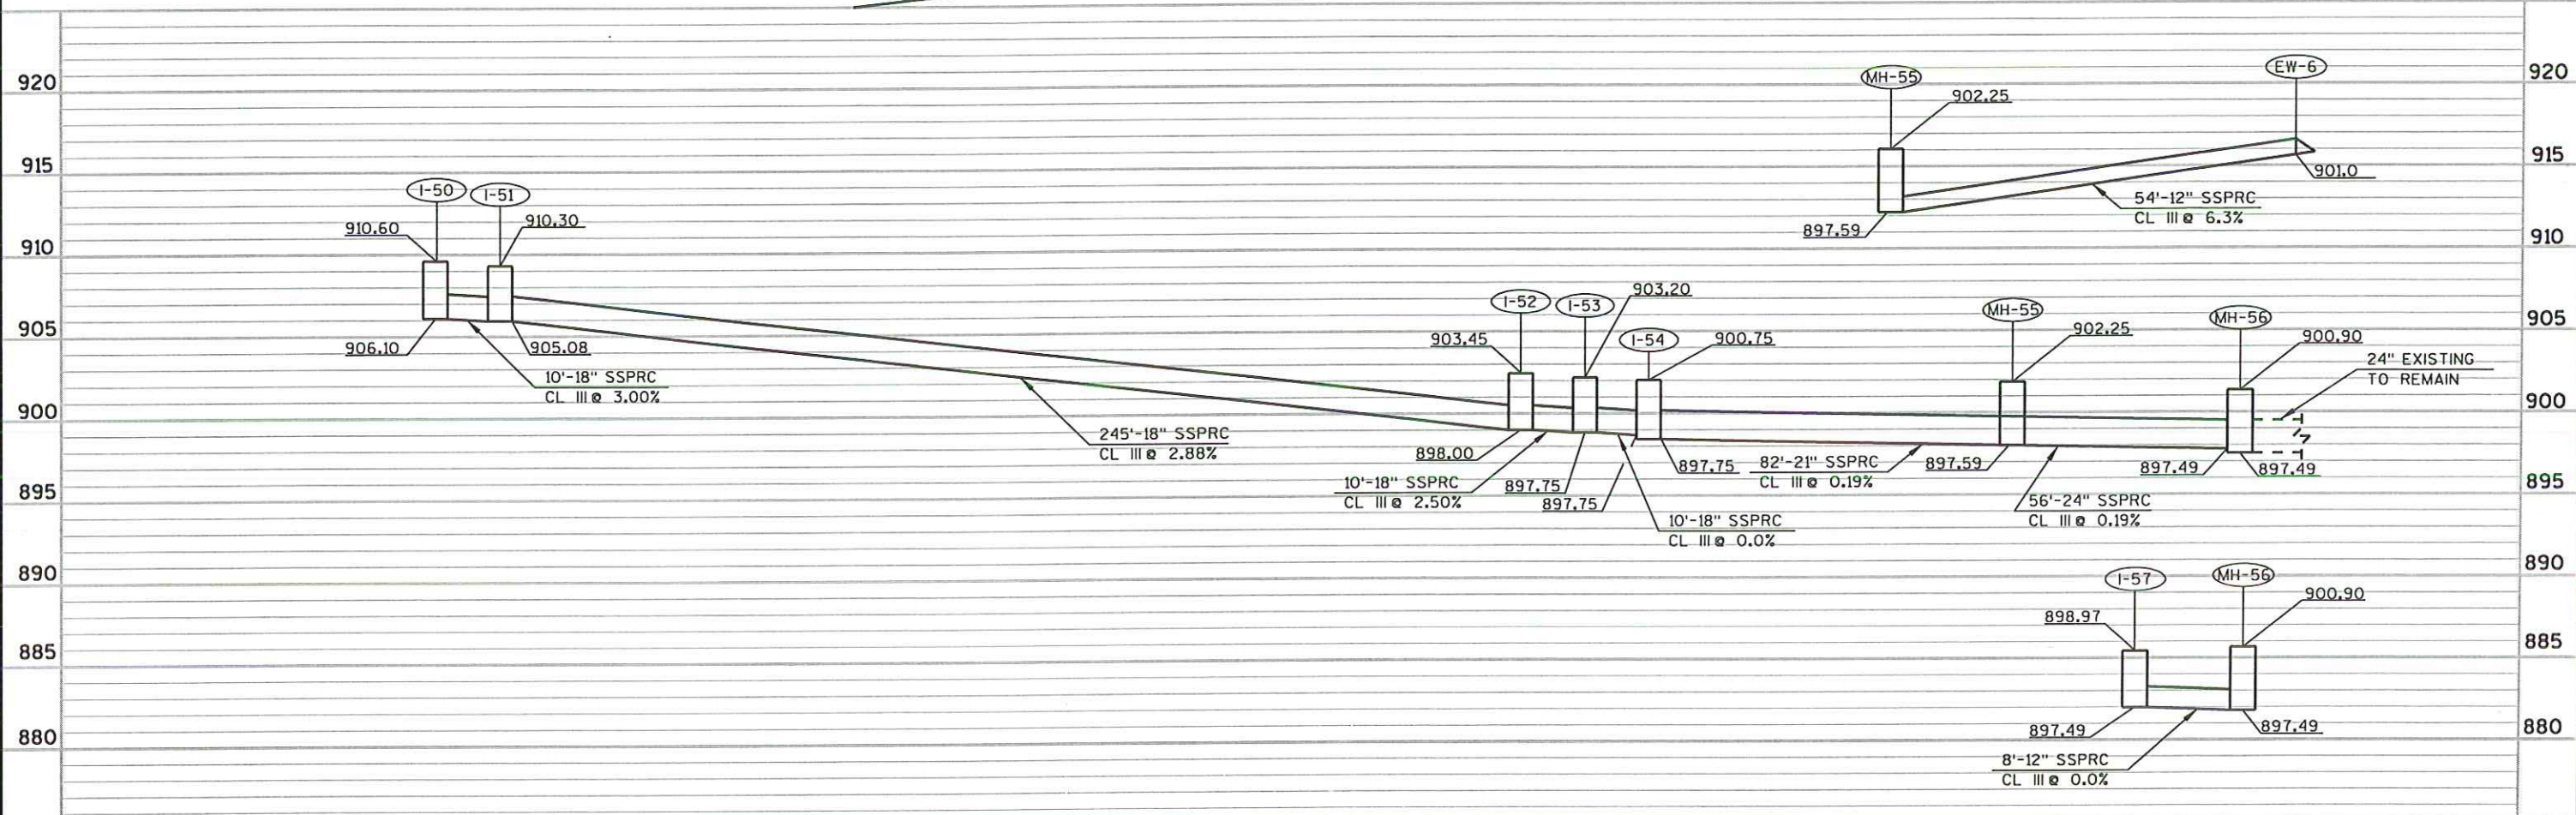
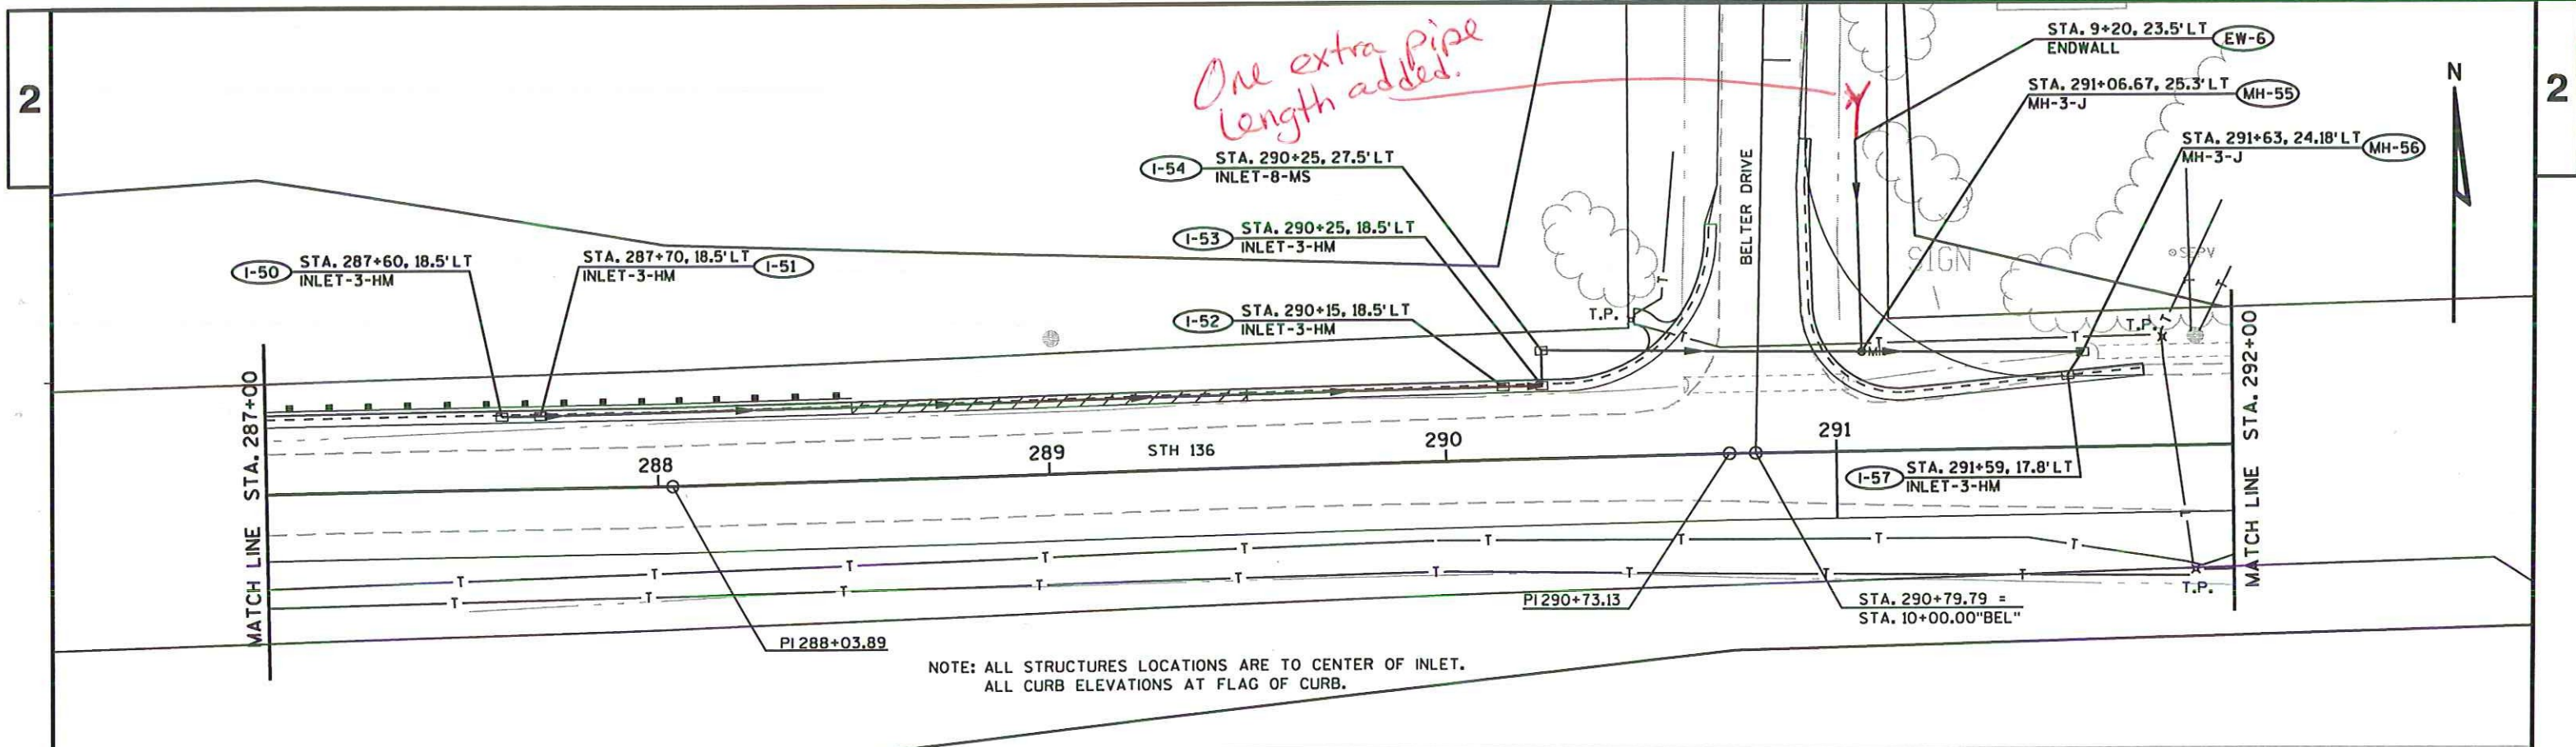




2

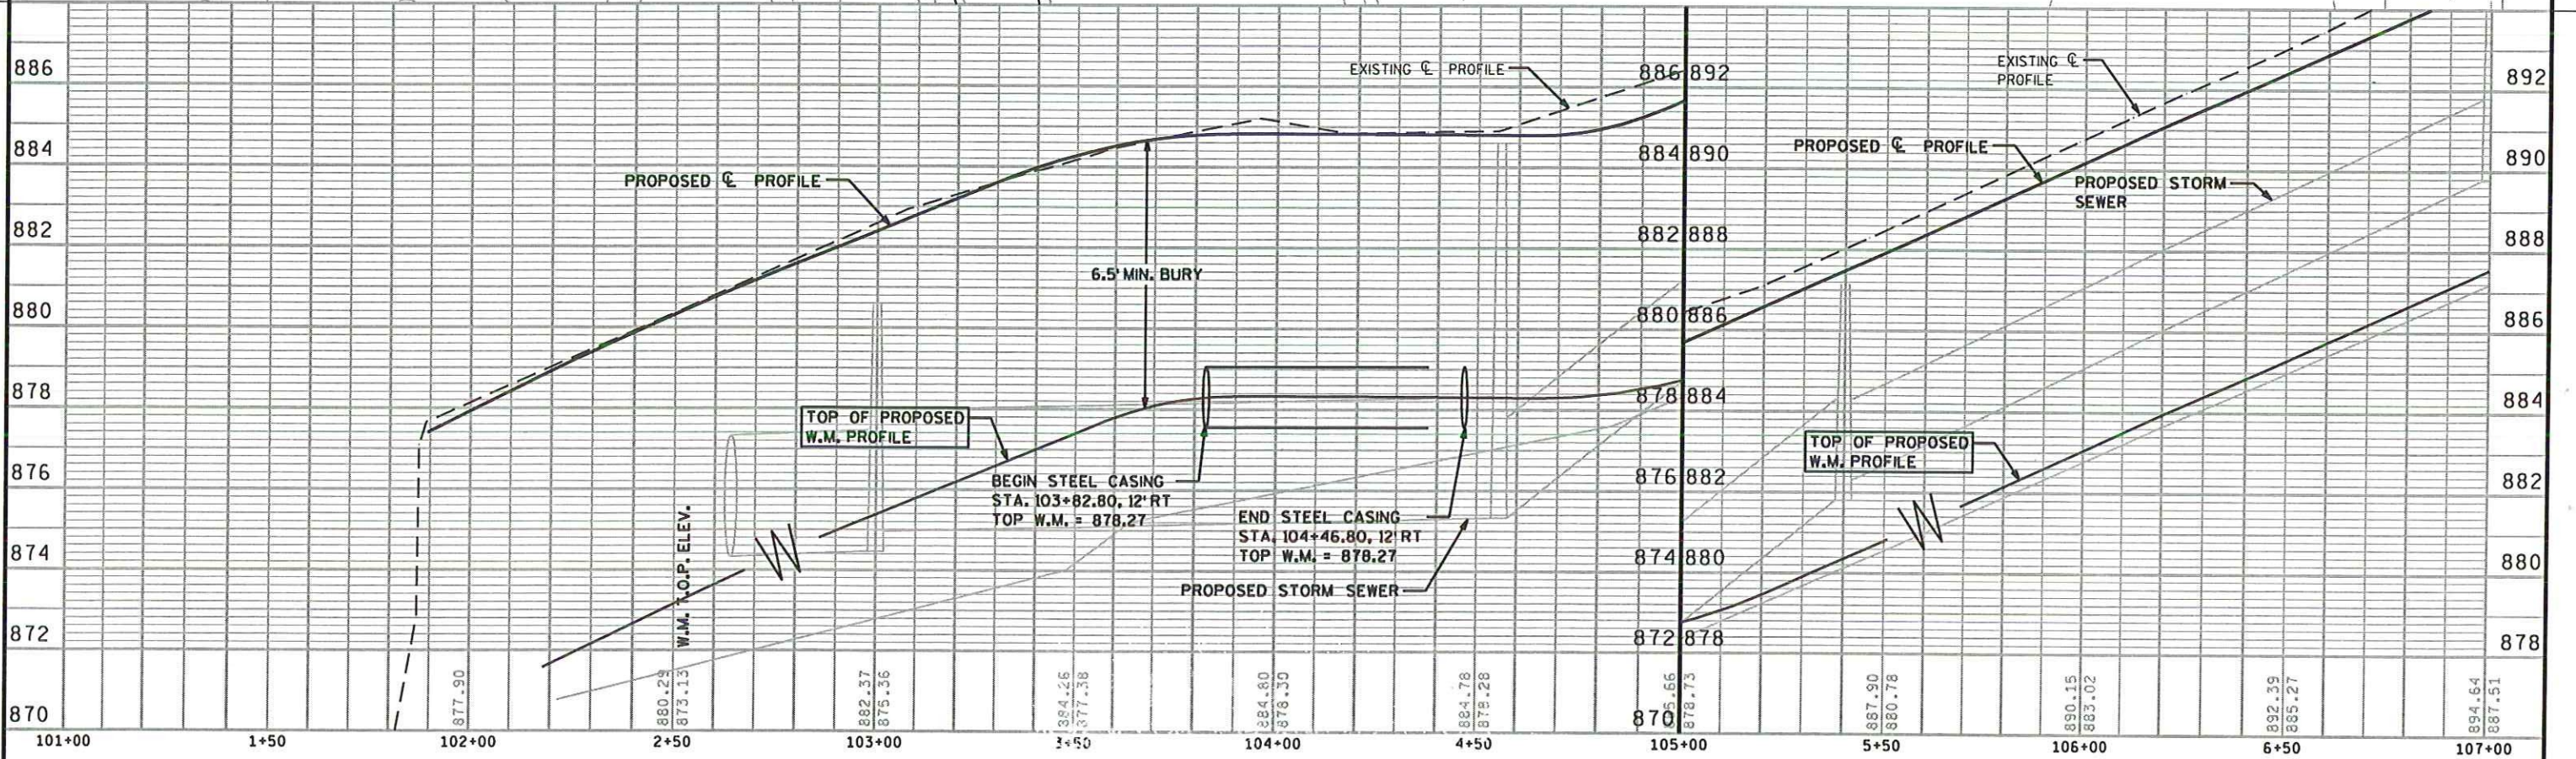


E

56

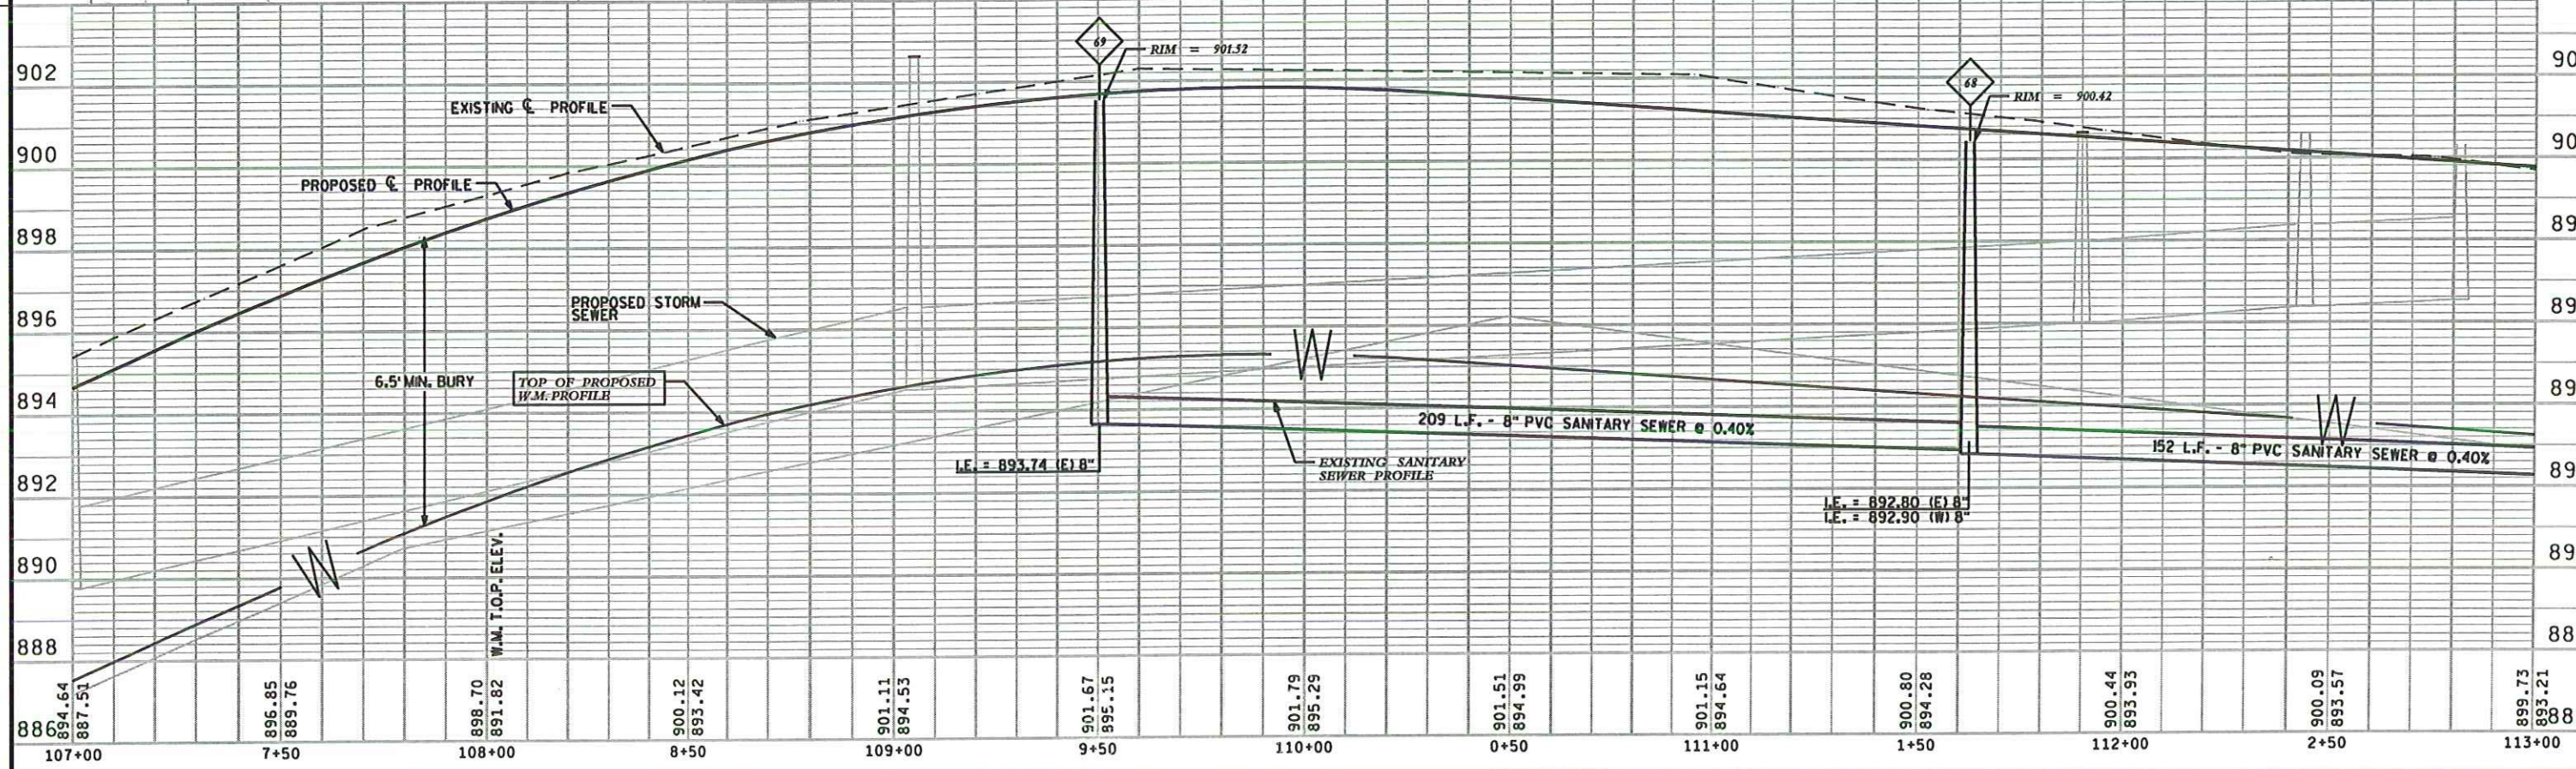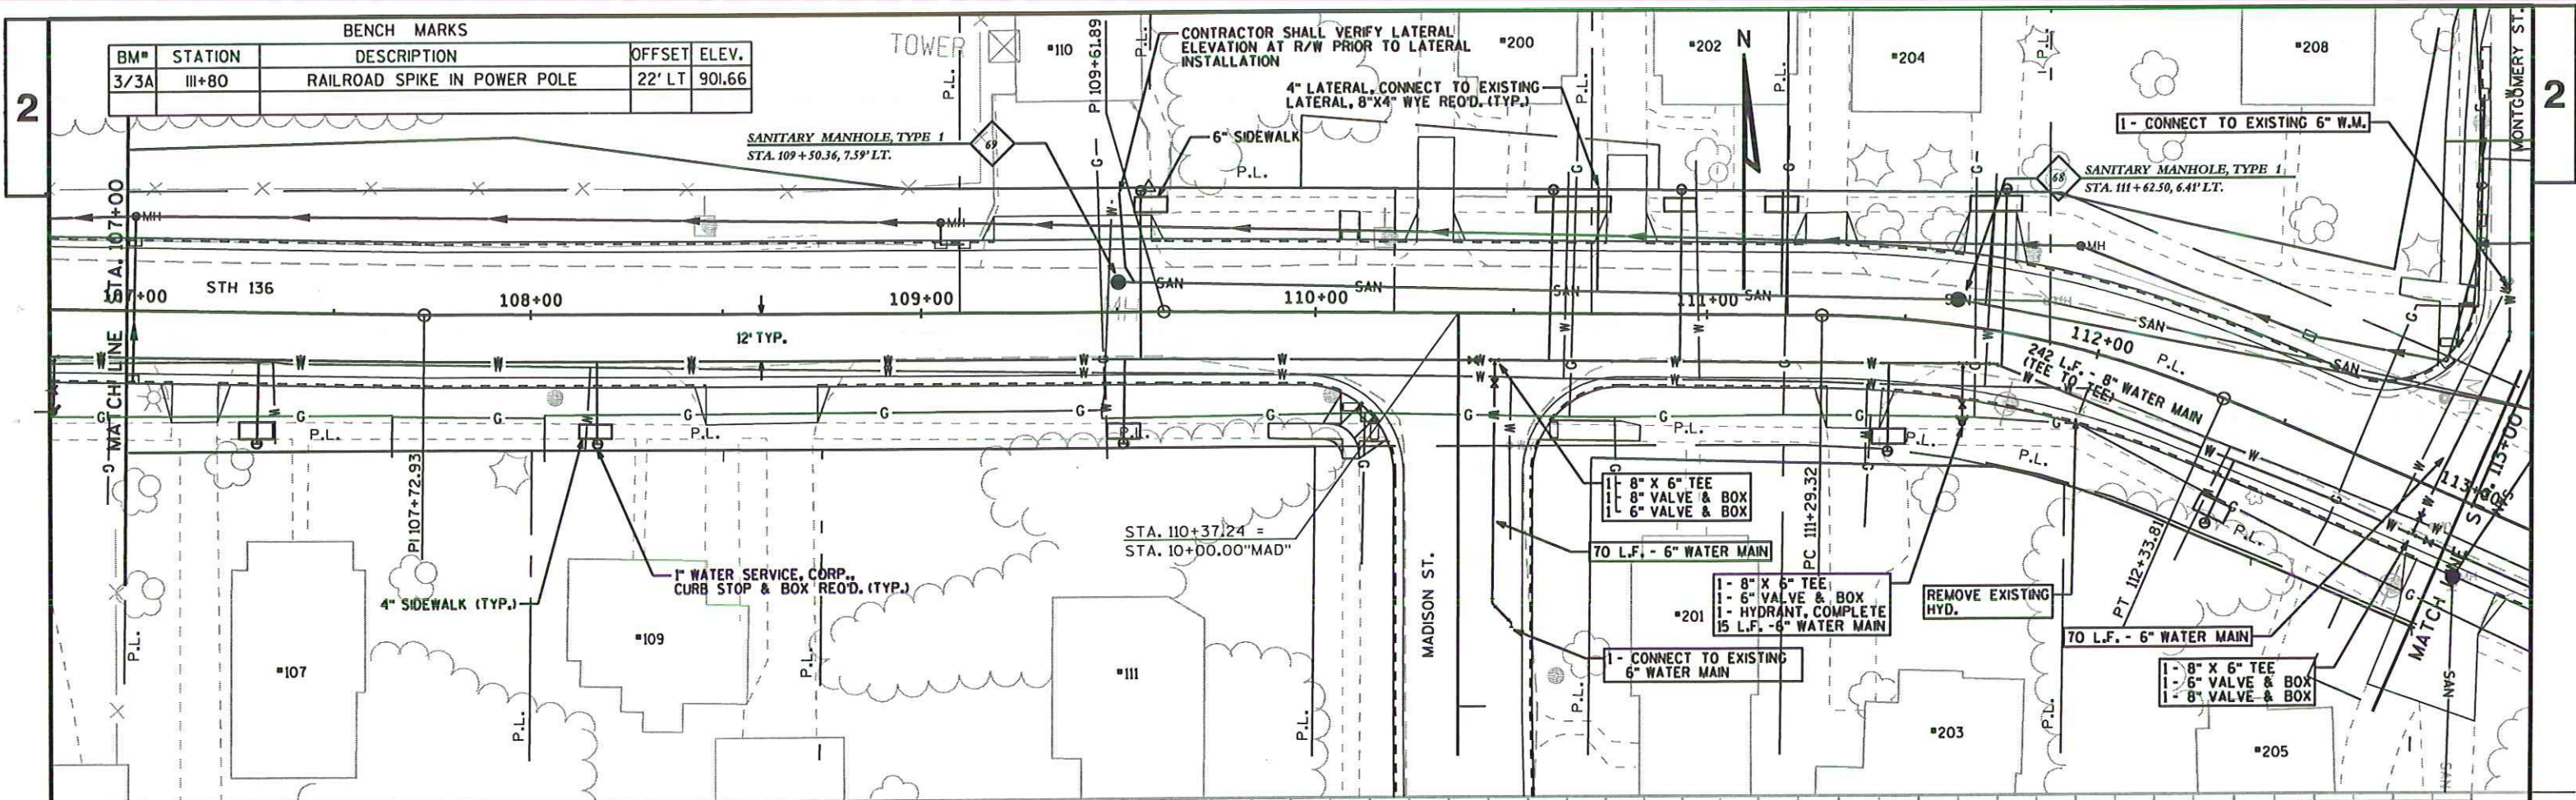

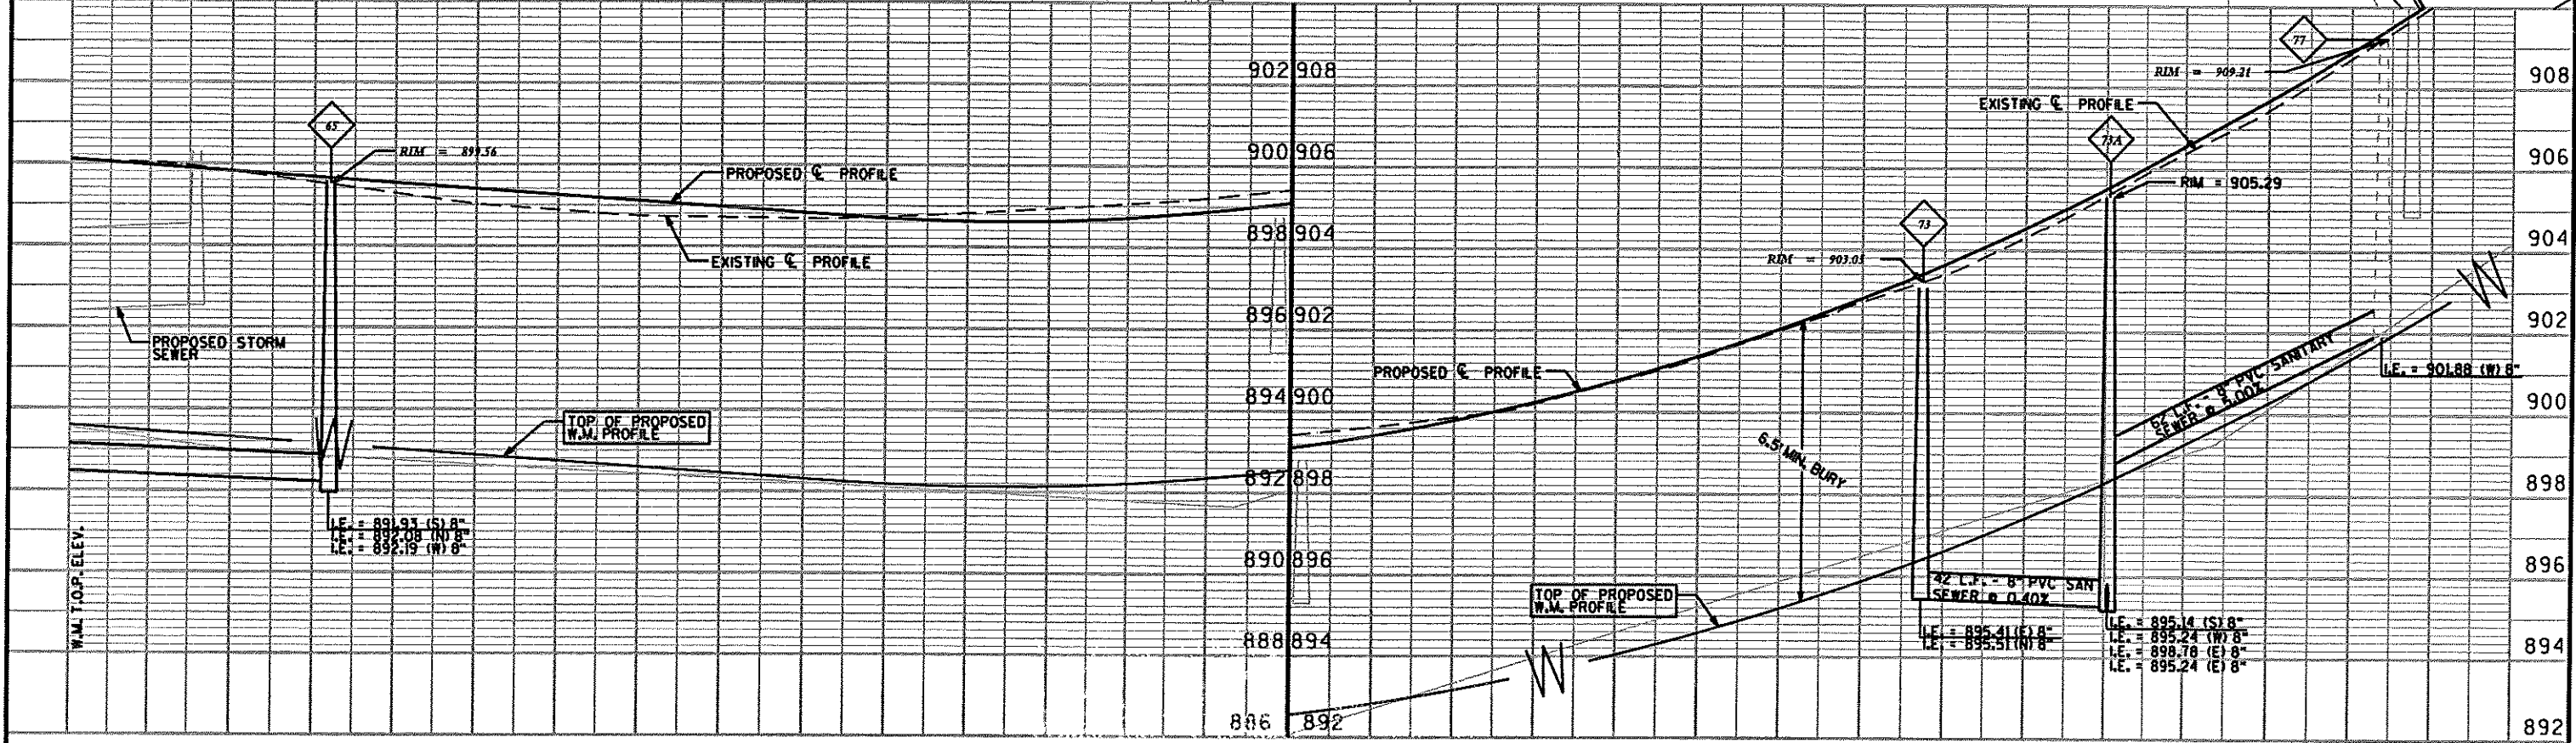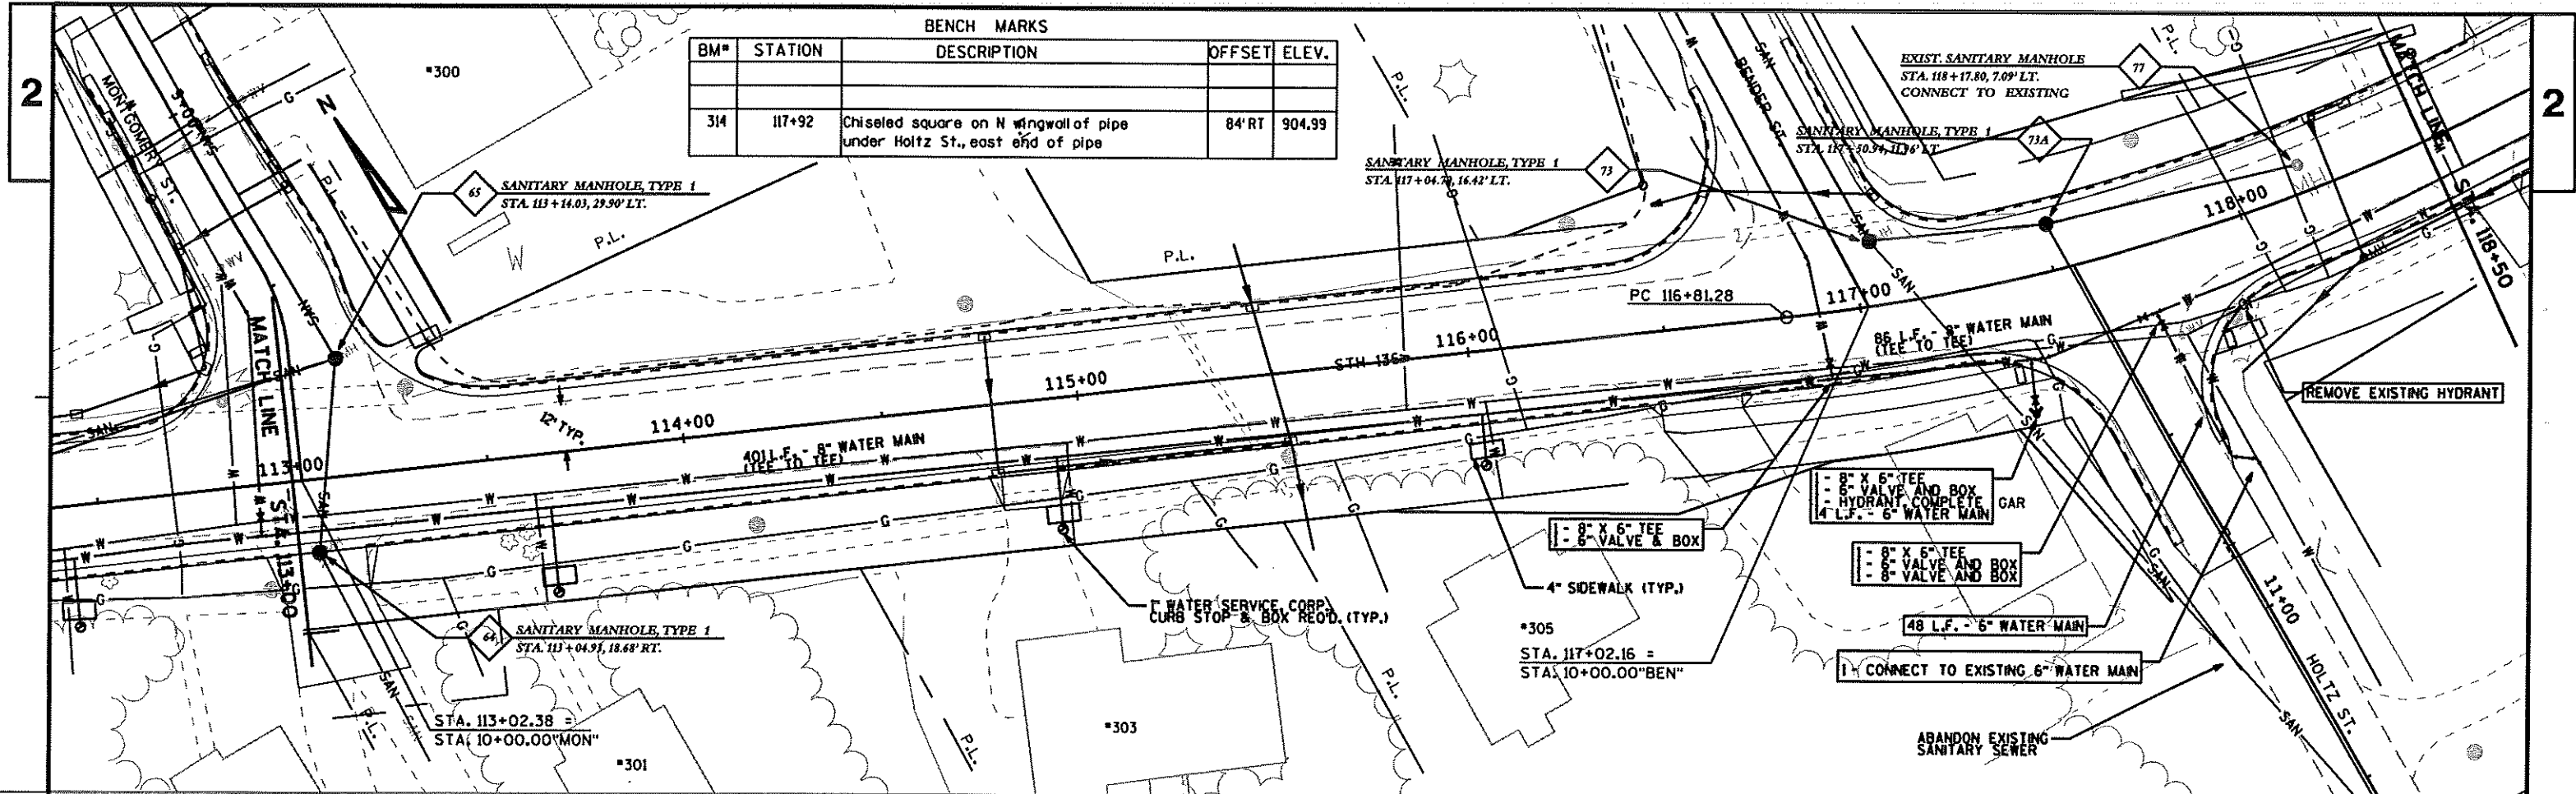


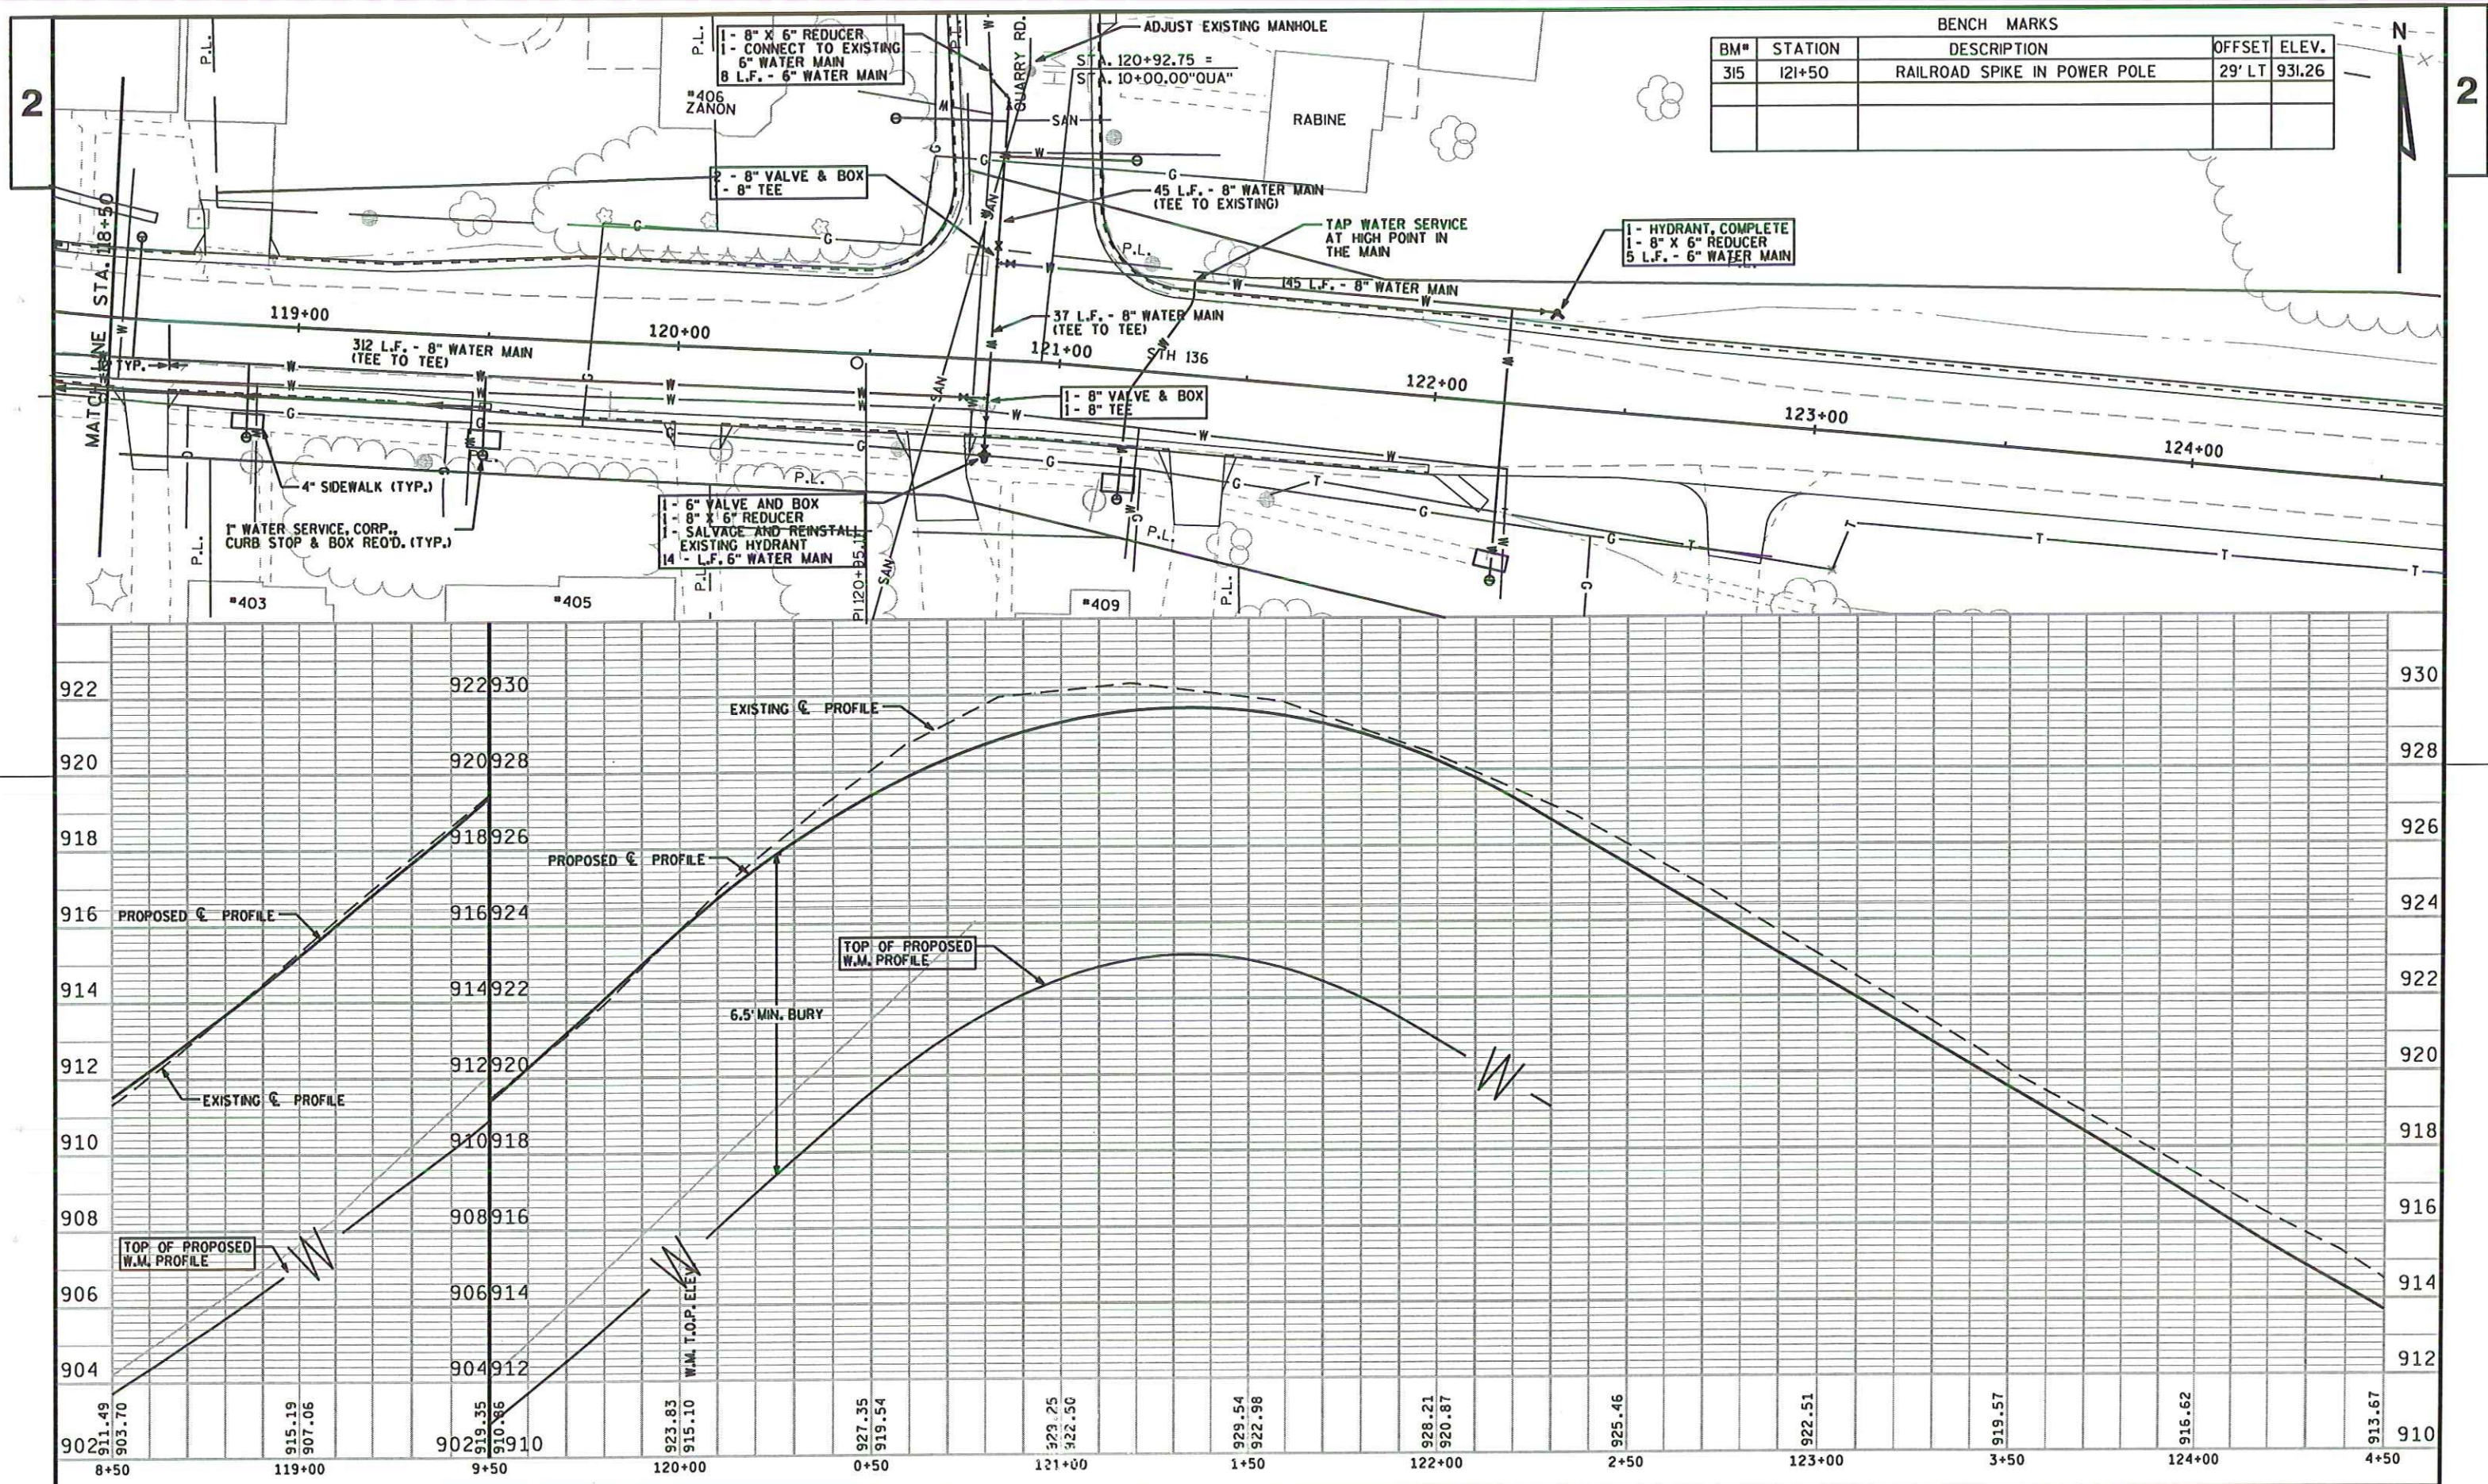


BENCH MARKS				
BM#	STATION	DESCRIPTION	OFFSET	ELEV.
315	121+50	RAILROAD SPIKE IN POWER POLE	29' LT	931.26

2

2

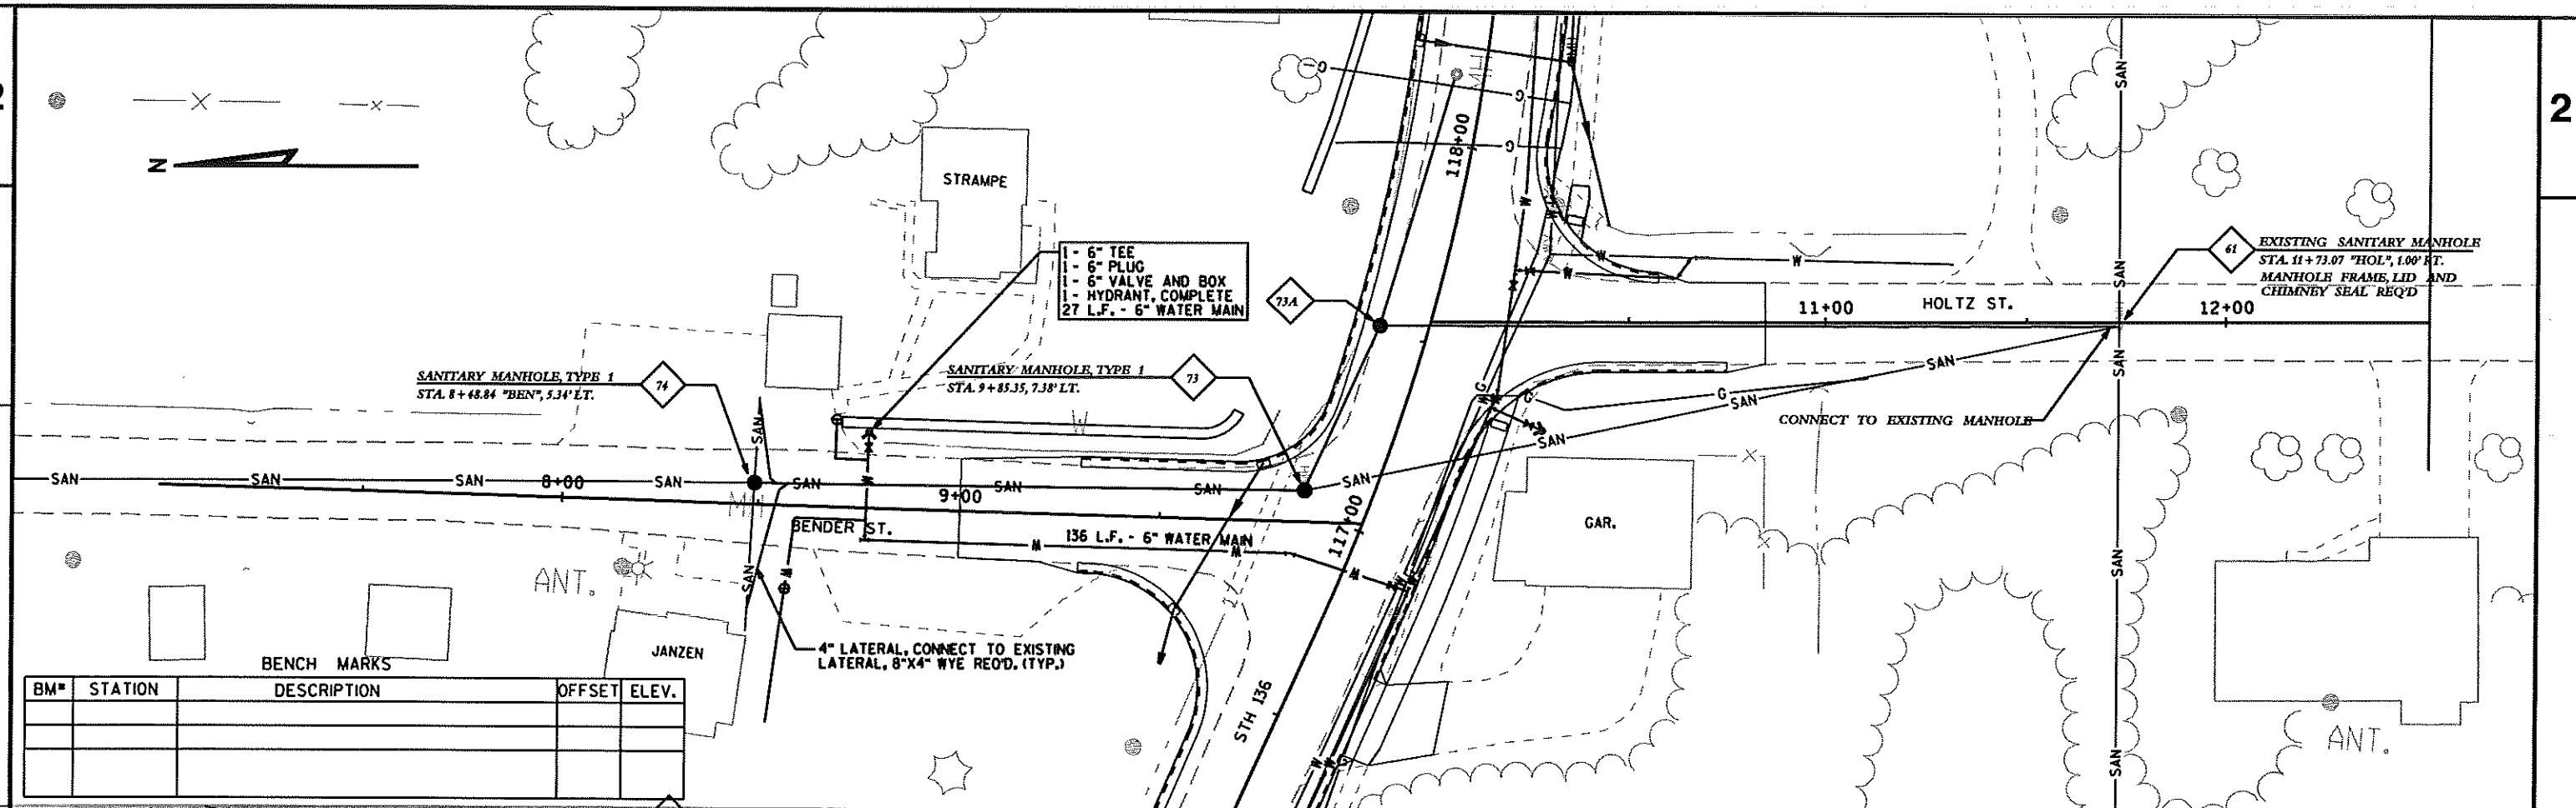

BM#	STATION	DESCRIPTION	OFFSET	ELEV.

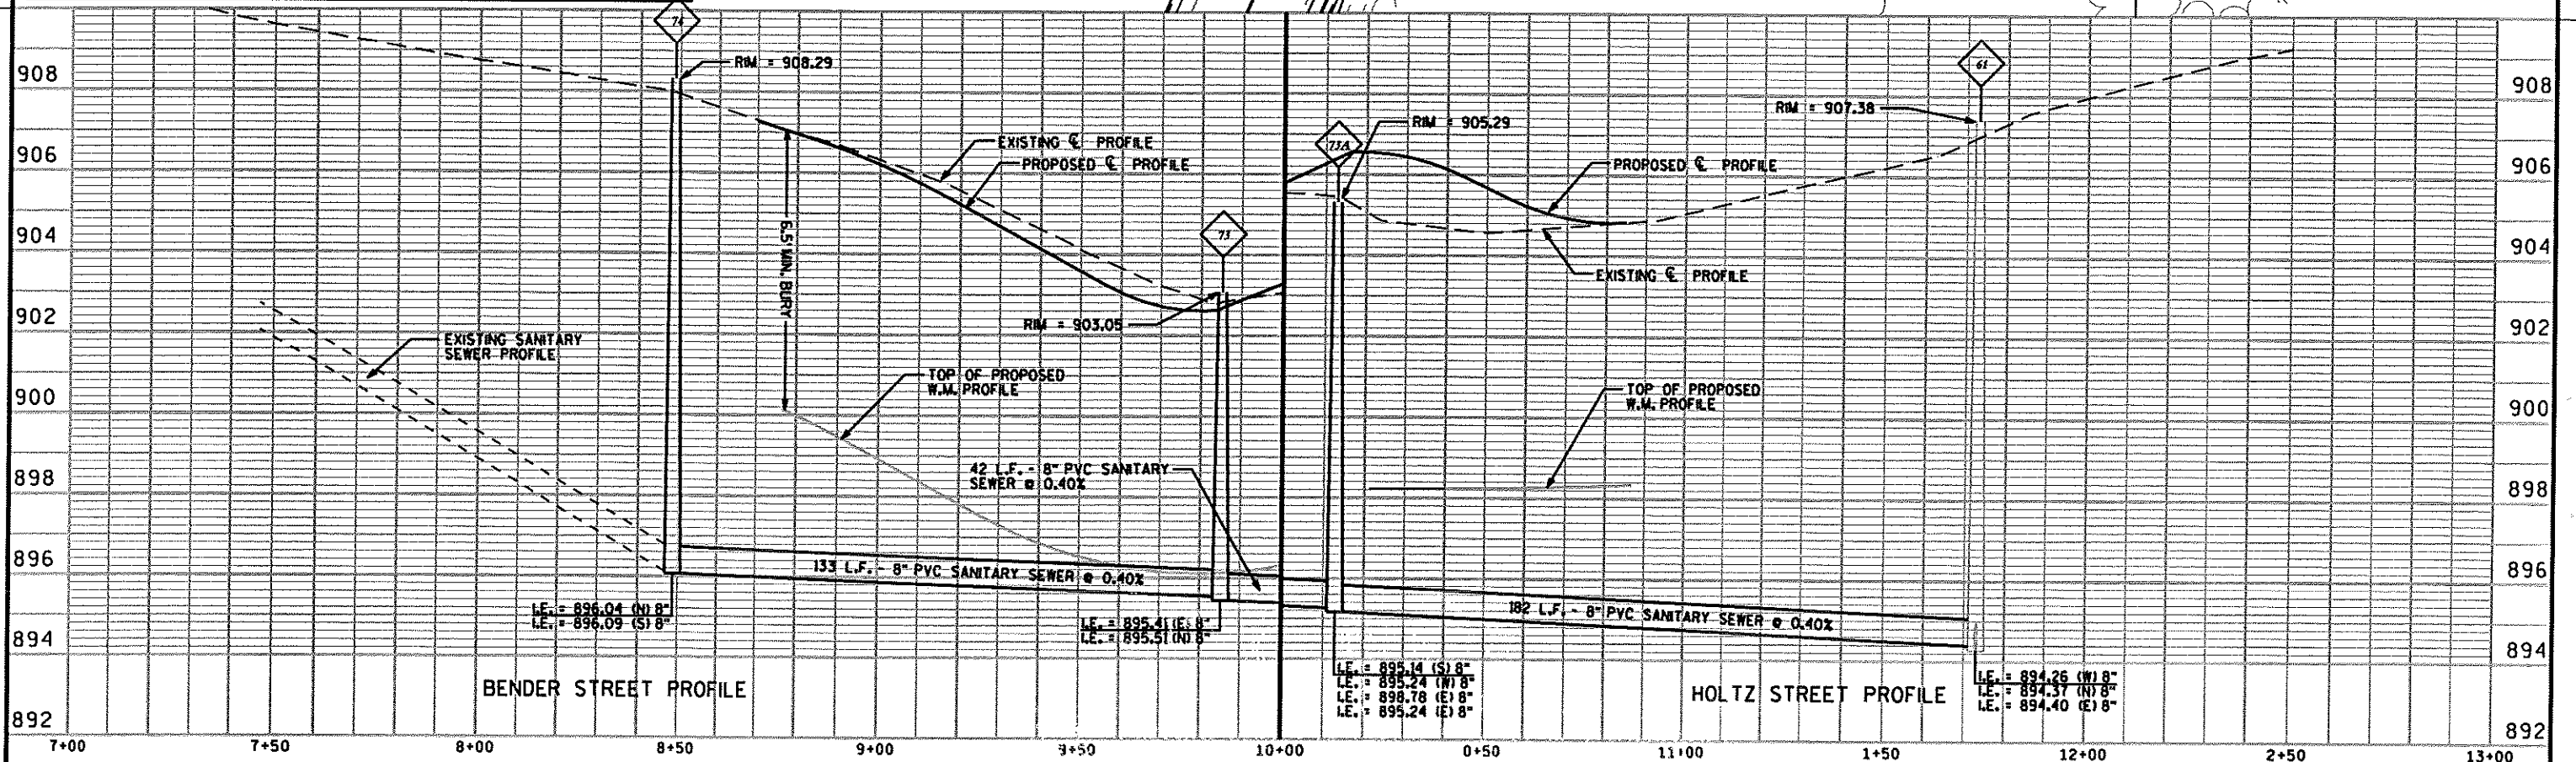

PROJECT NO:5573-04-82

HWY: STH 136

COUNTY: SAUK

WATER MAIN & SANITARY SEWER

SHEET

E

FILE NAME : r:\Support\CADD\SProjects\dl_55730401\023005_up.dgn


PLOT DATE : 12-JUL-2007 07:05



PLOT BY : durbog


PLOT NAME :

PLOT SCALE : 40.000000:1.000000

WISDOT/CALUS SHEET 410

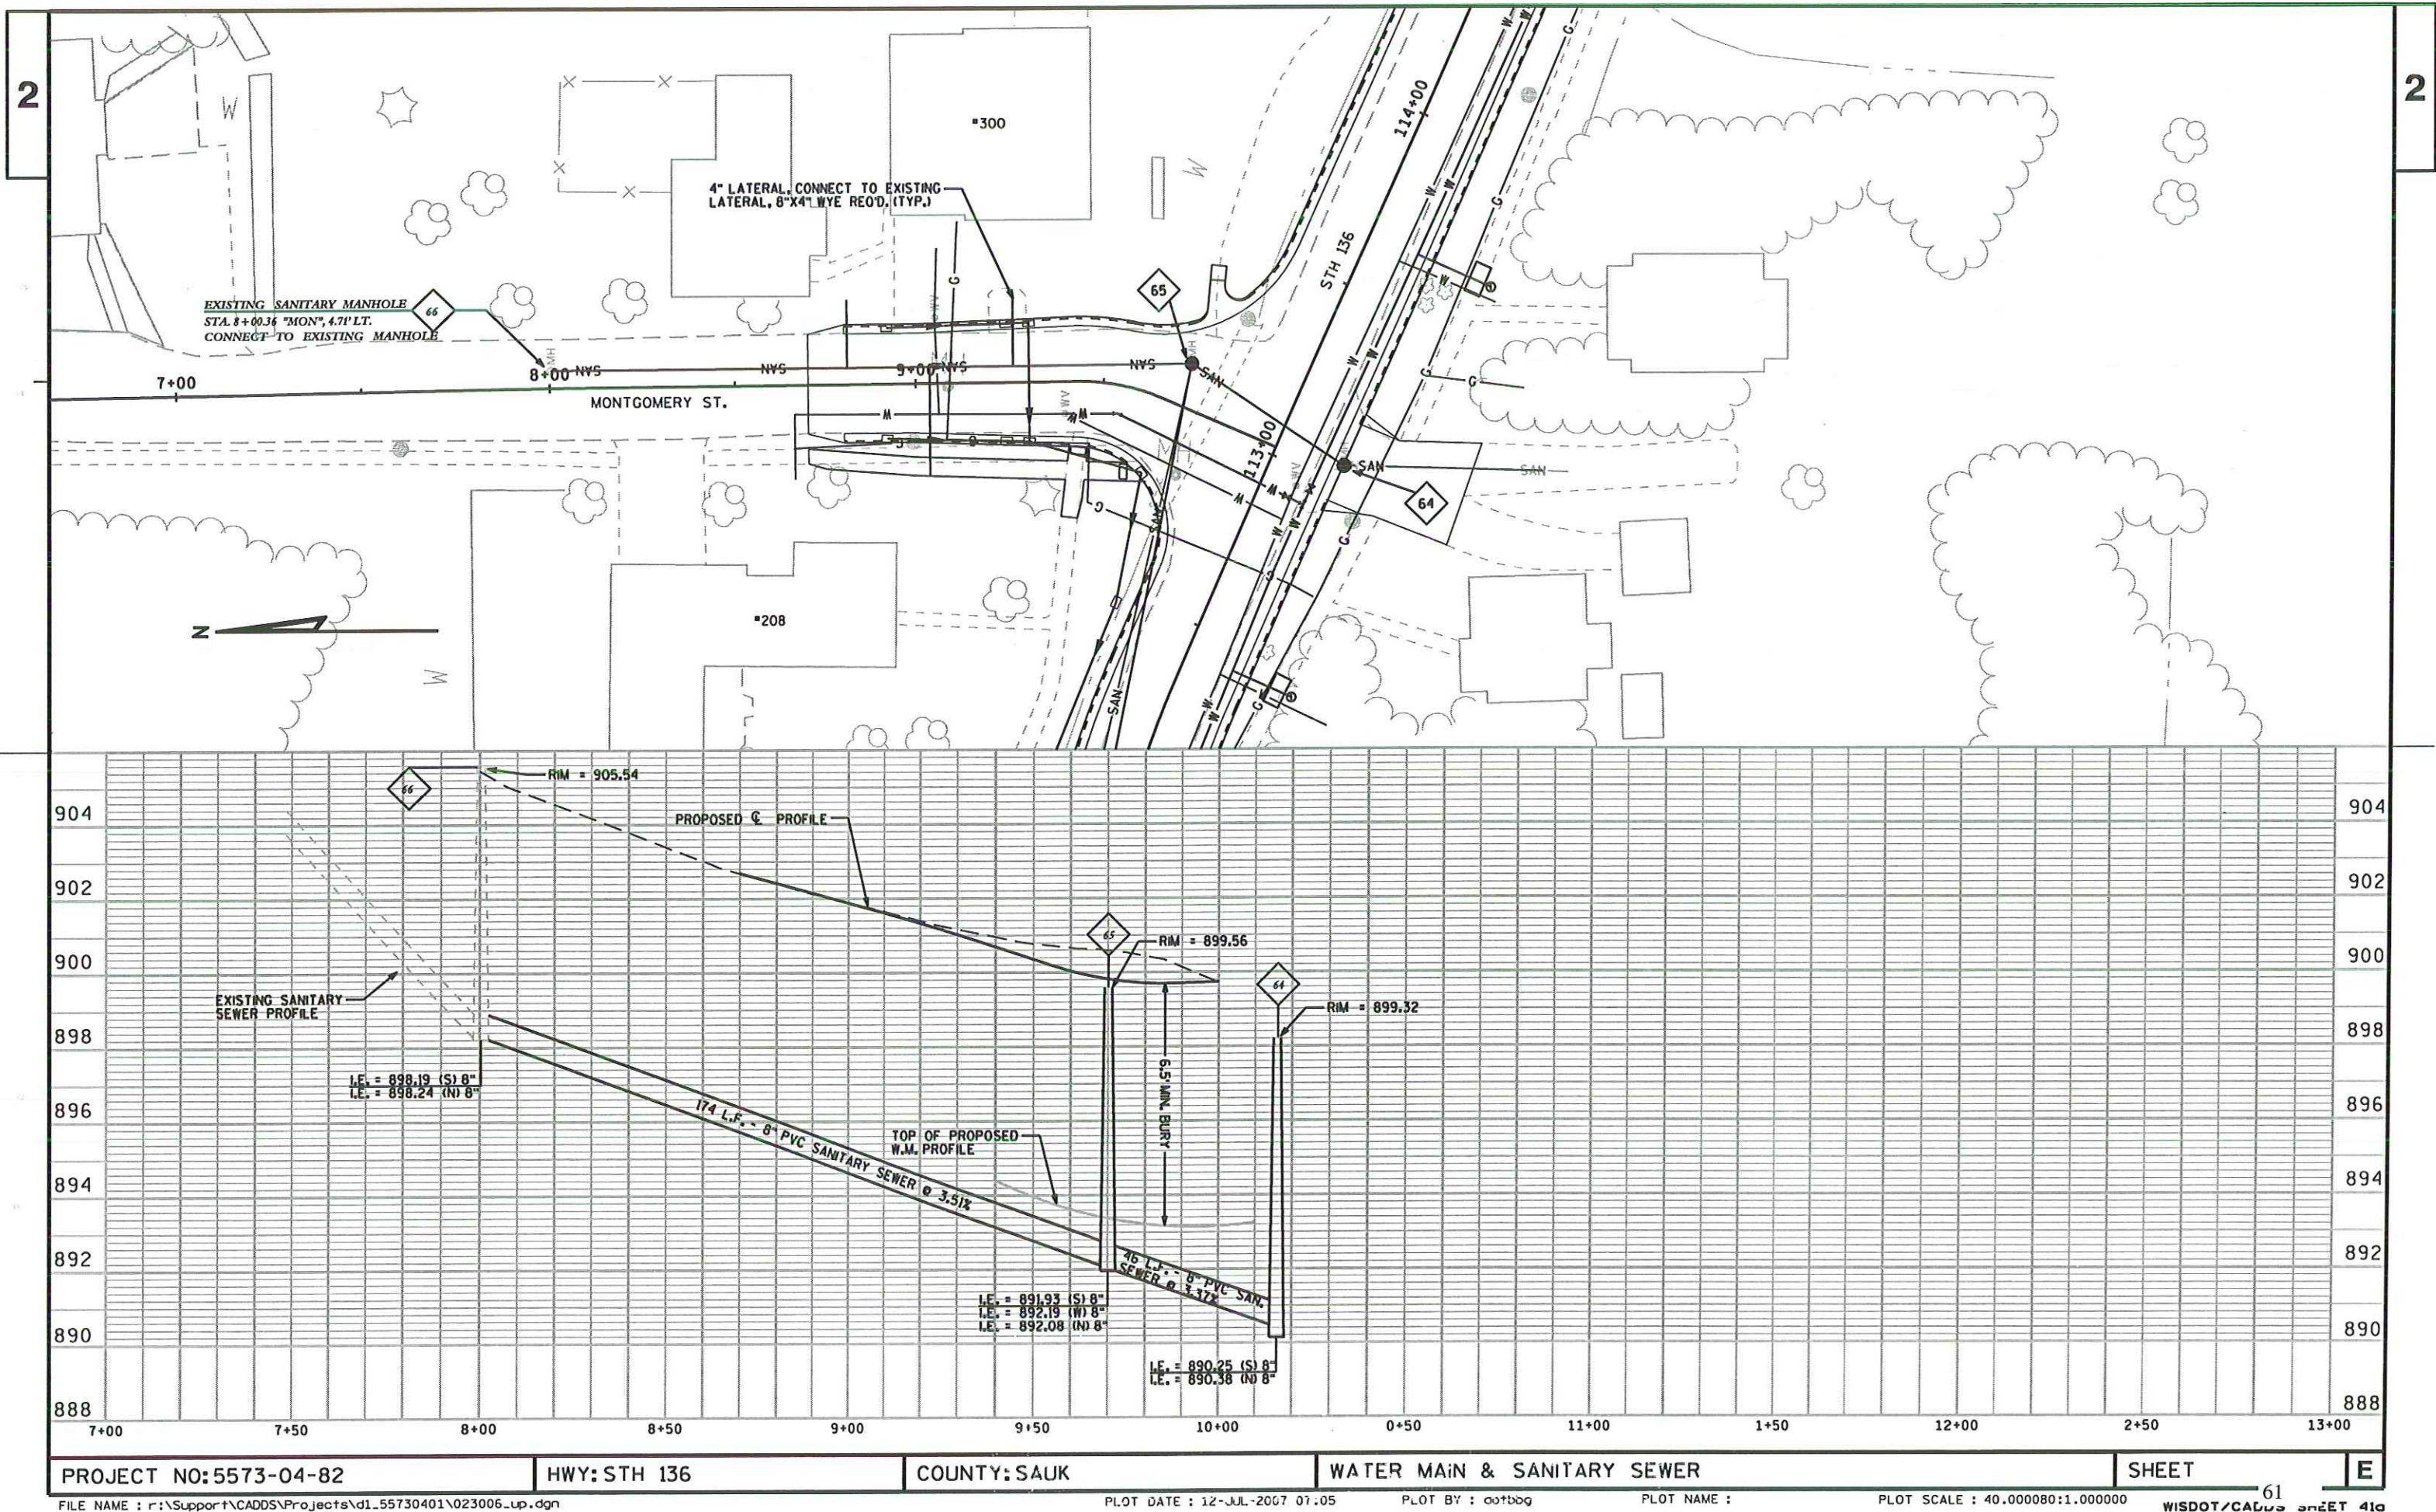


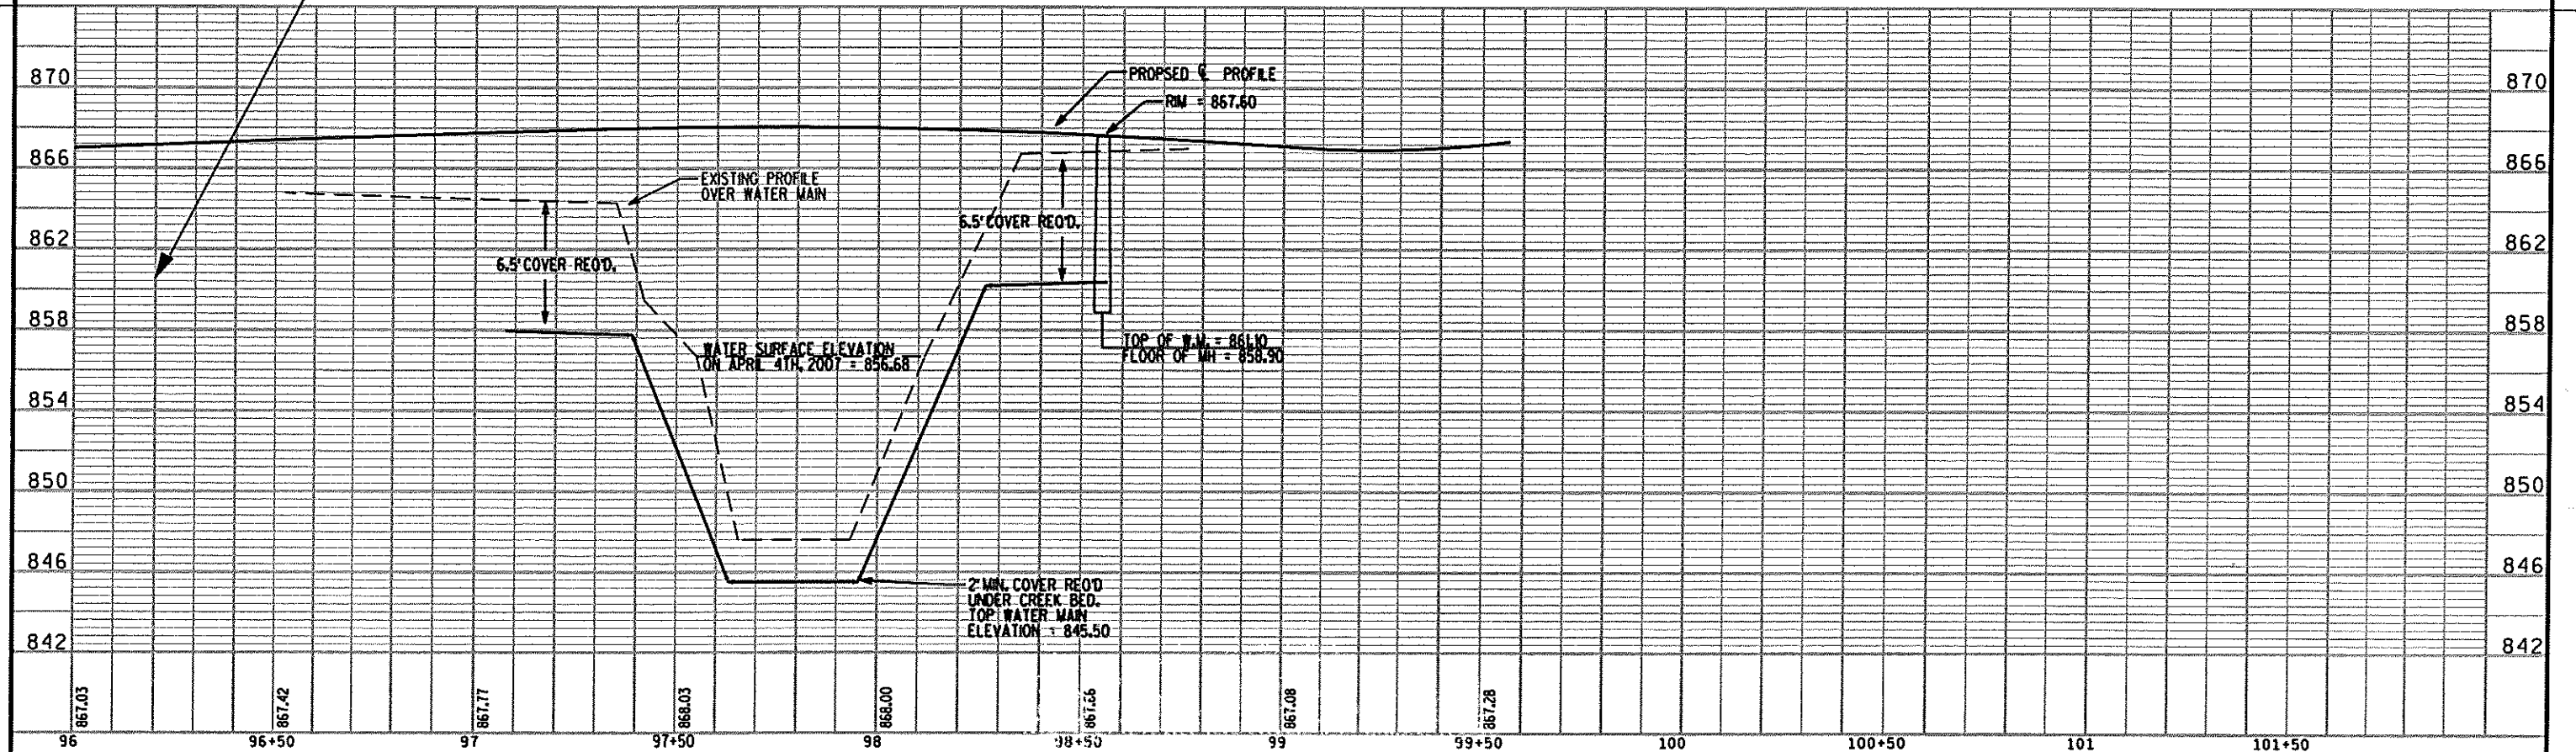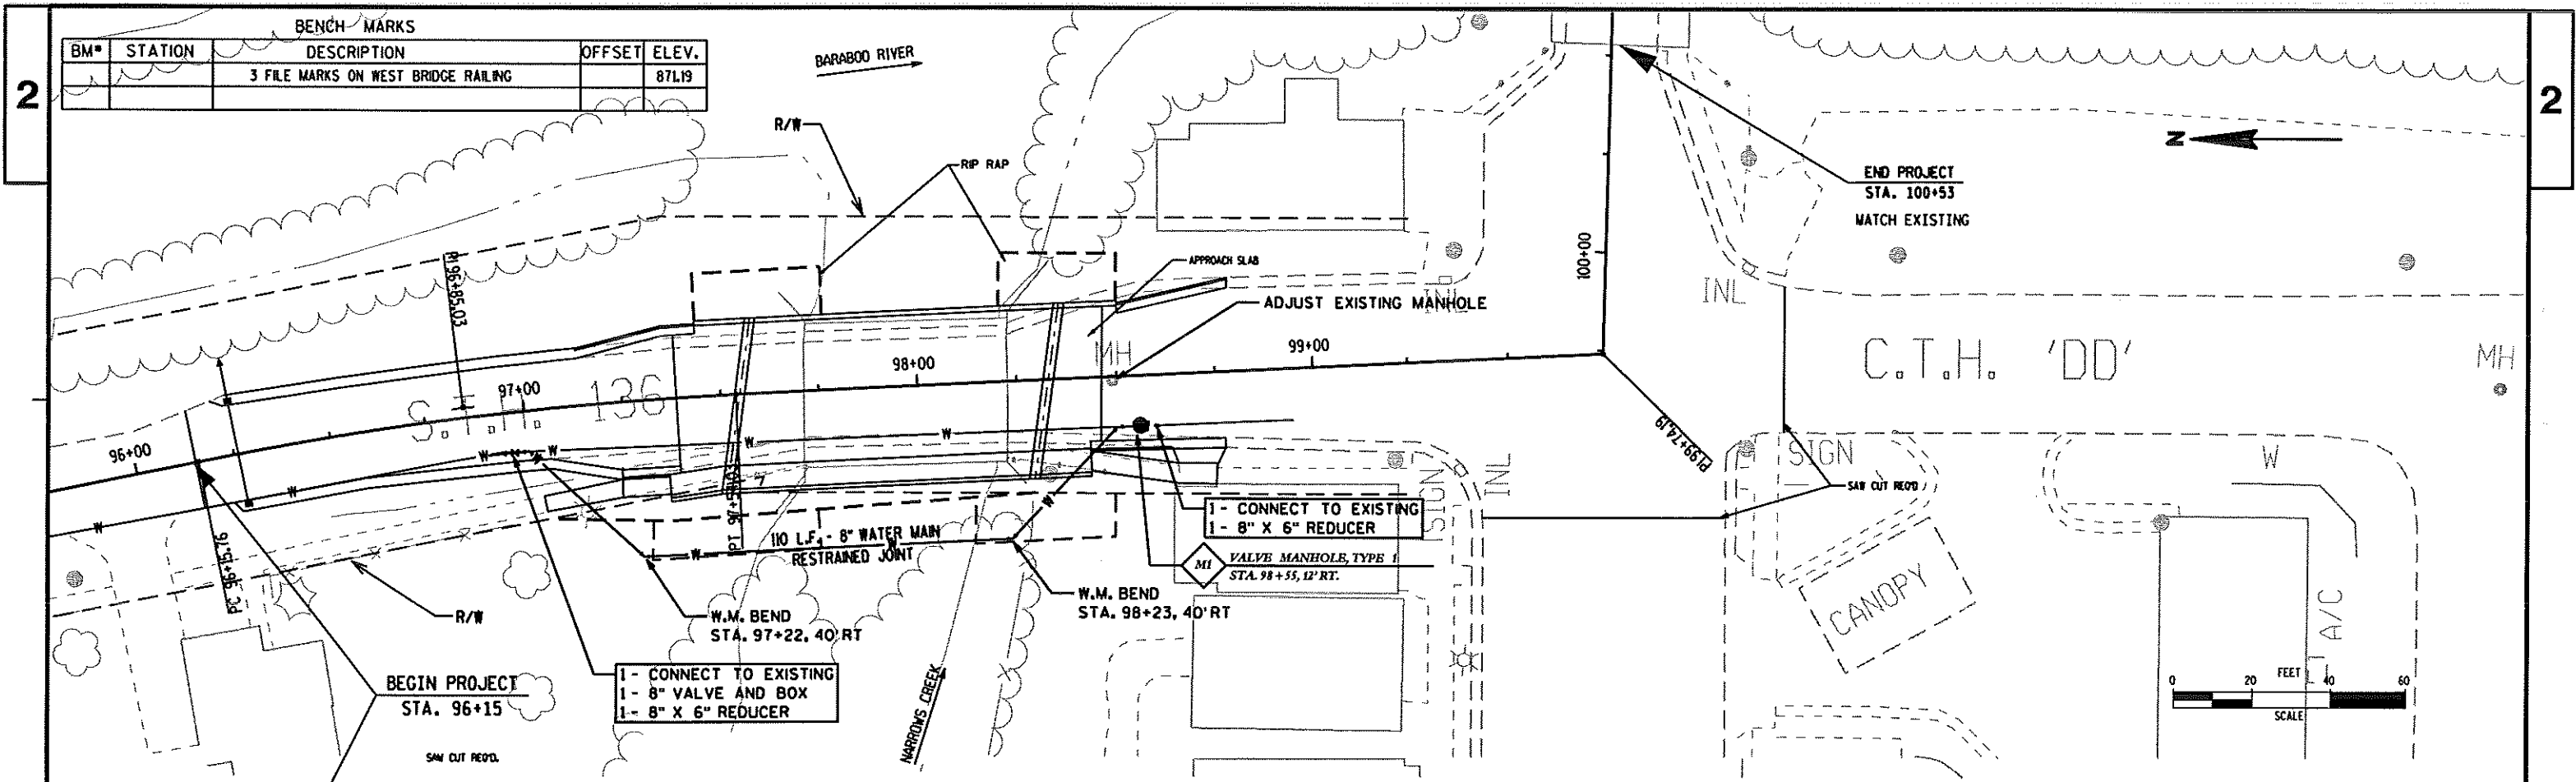

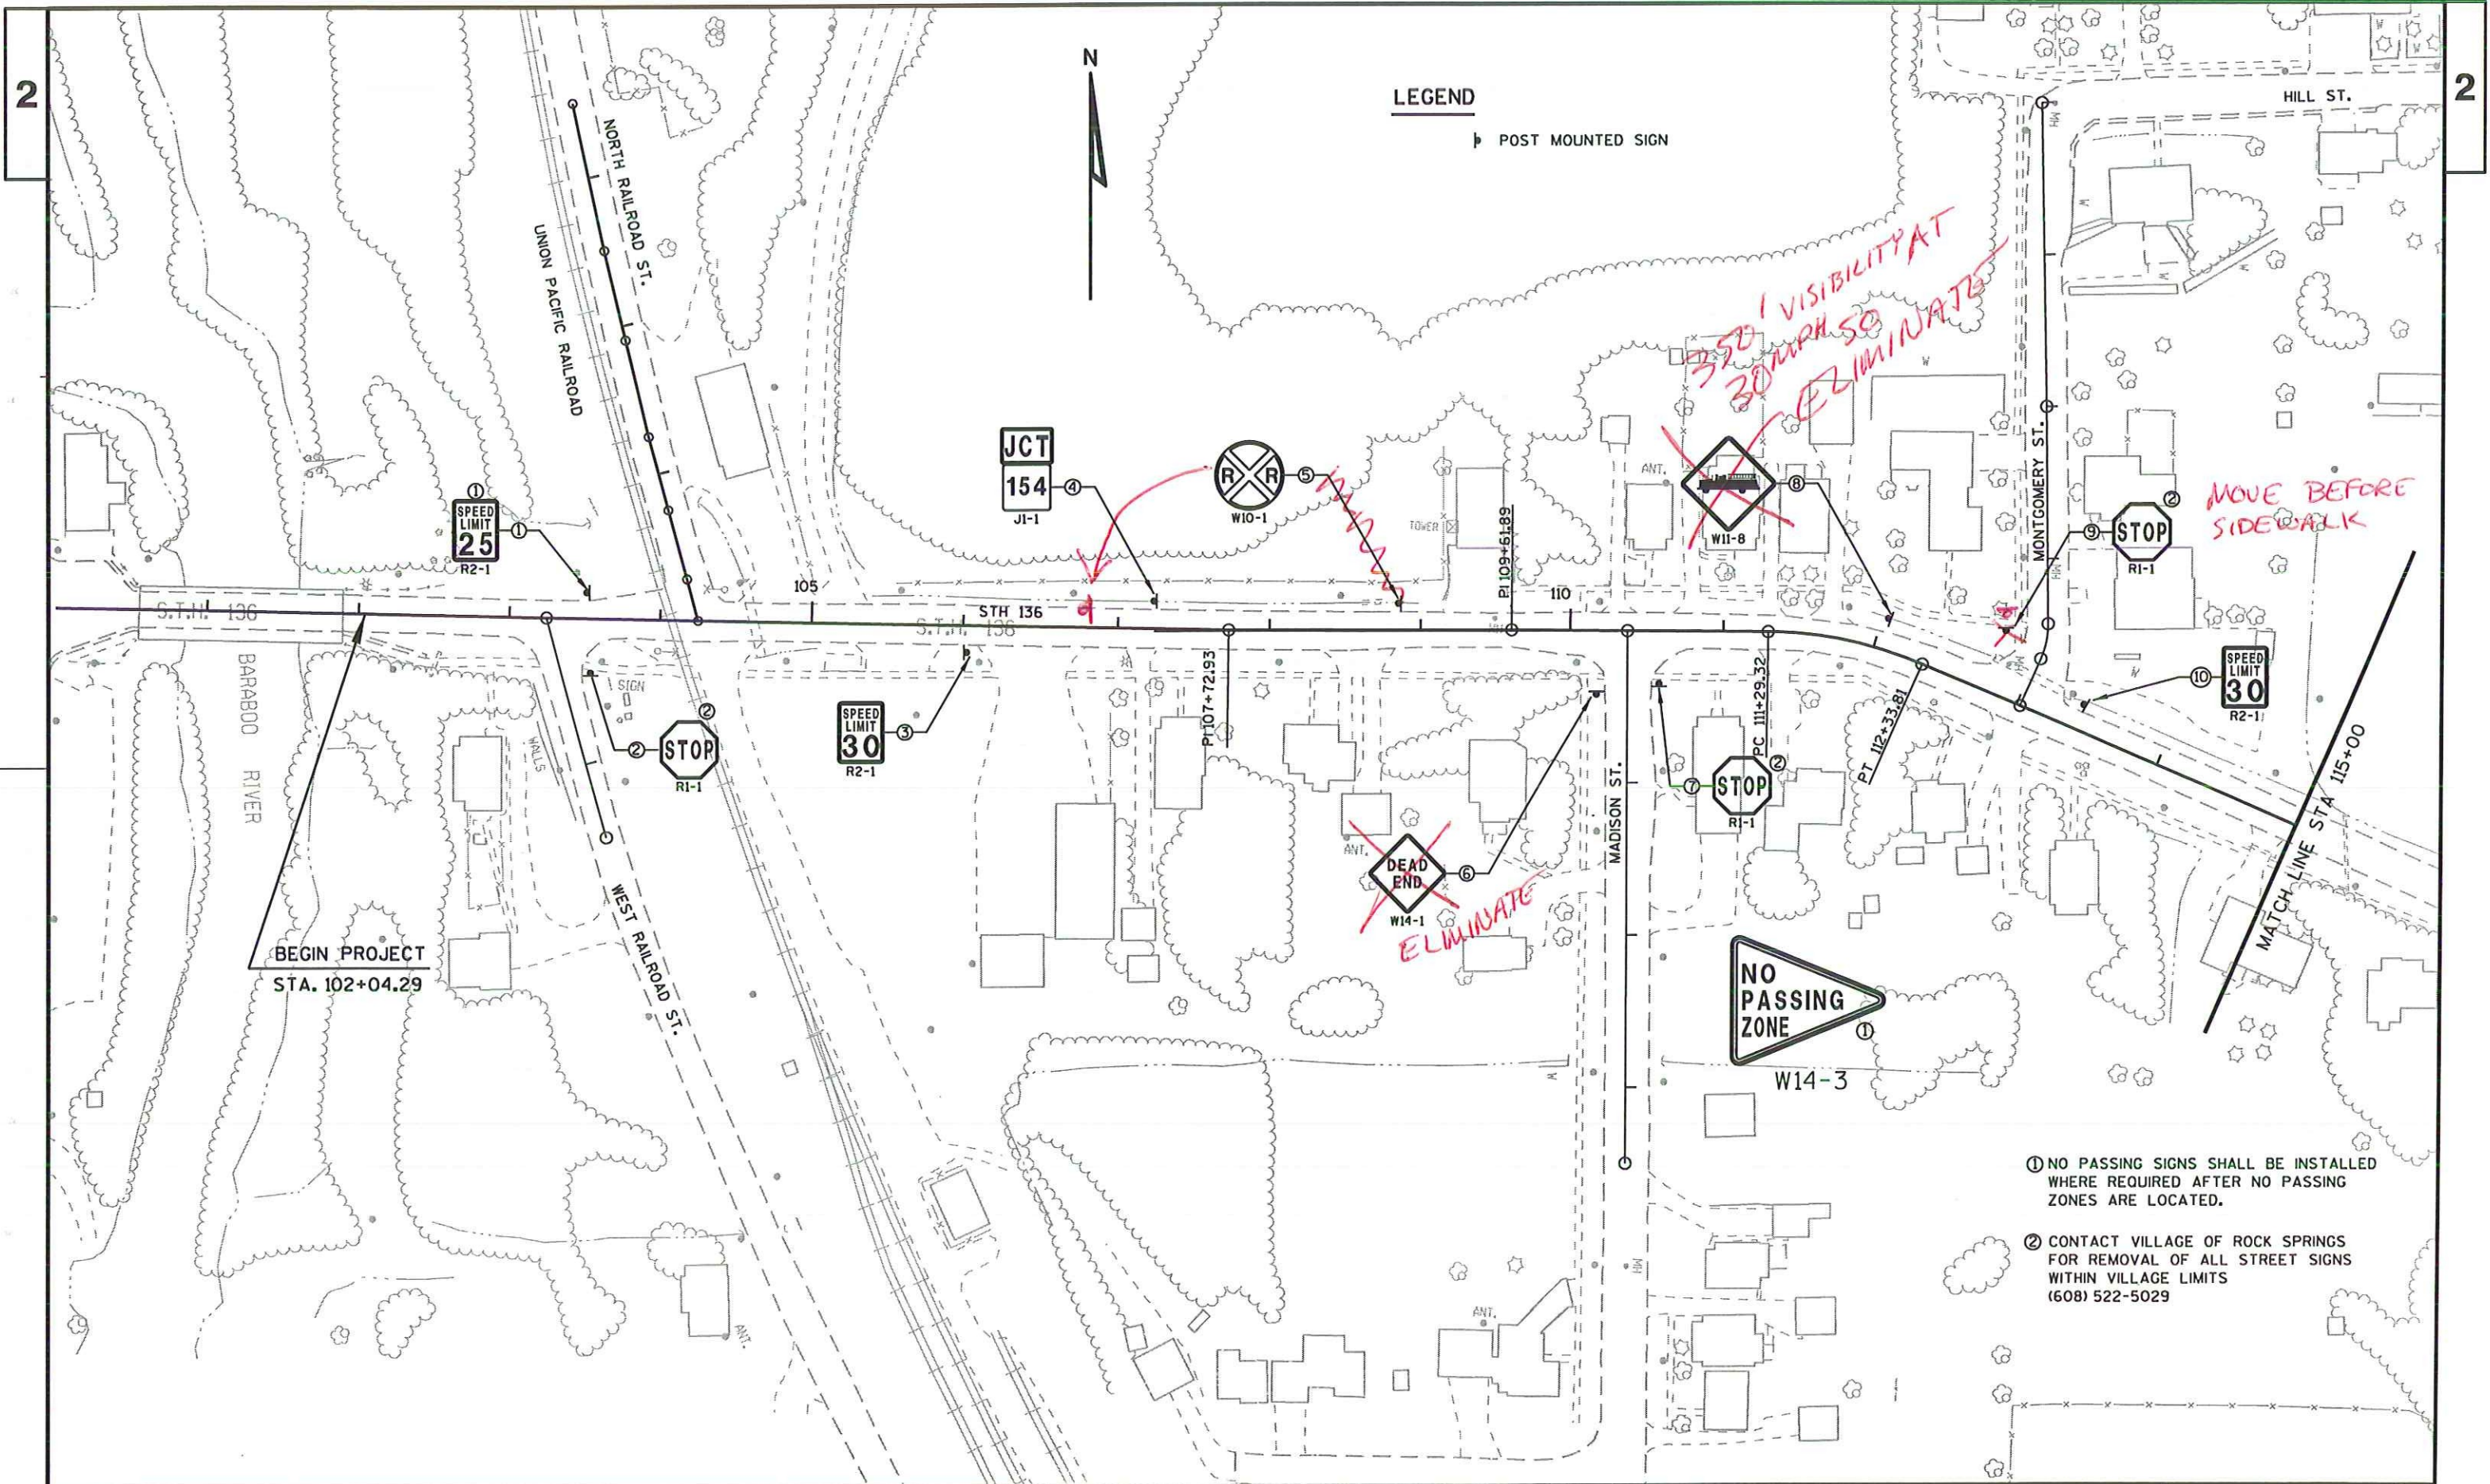

LEGEND

POST MOUNTED SIGN

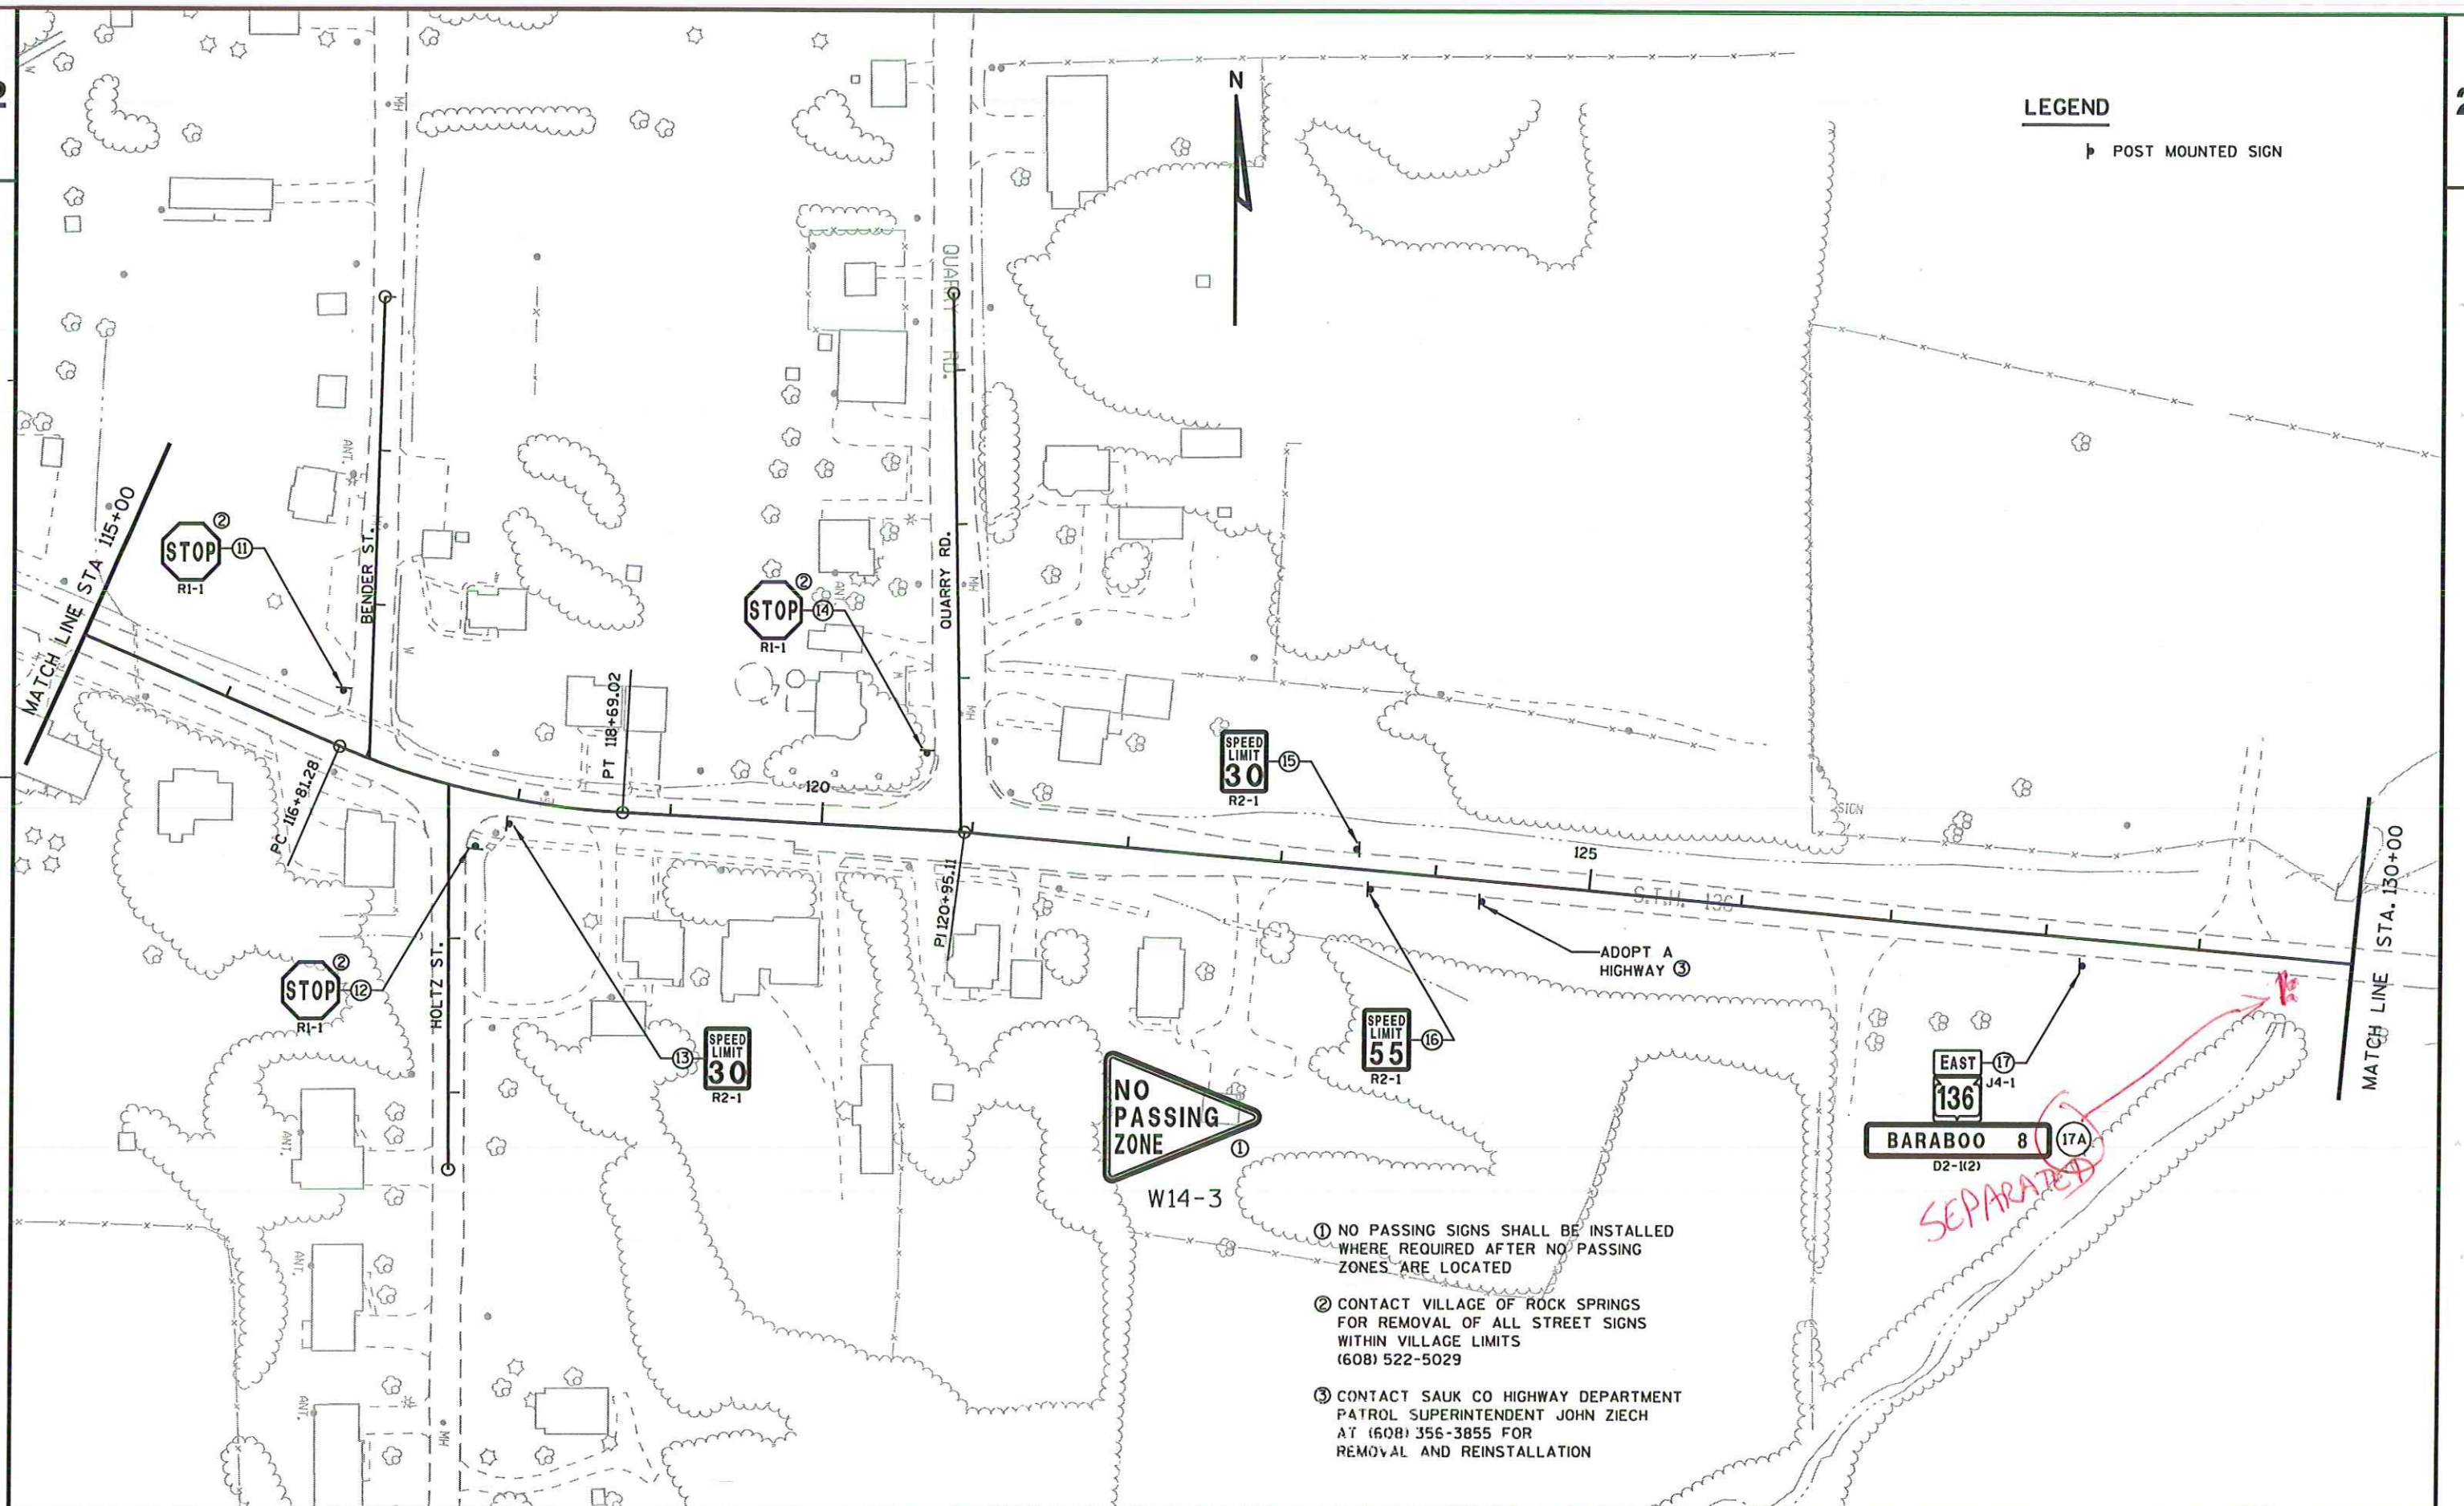

PROJECT NO: 5573-04-72

HWY: STH 136

COUNTY: SAUK

PERMANENT SIGNING

SHEET

1	2	3	466
---	---	---	---	---	---	---	---	---	----	----	-----	-----	
FILE NAME : r:\Support\CADDS\Projects\d1_55730401\023202_ps.dgn


PLOT DATE : 12-JUL-2001 01:05

PLOT BY : dothbg

PLOT NAME :

PLOT SCALE : 100.000000:1.000000

64
WISDOT/CADD SHEET 42

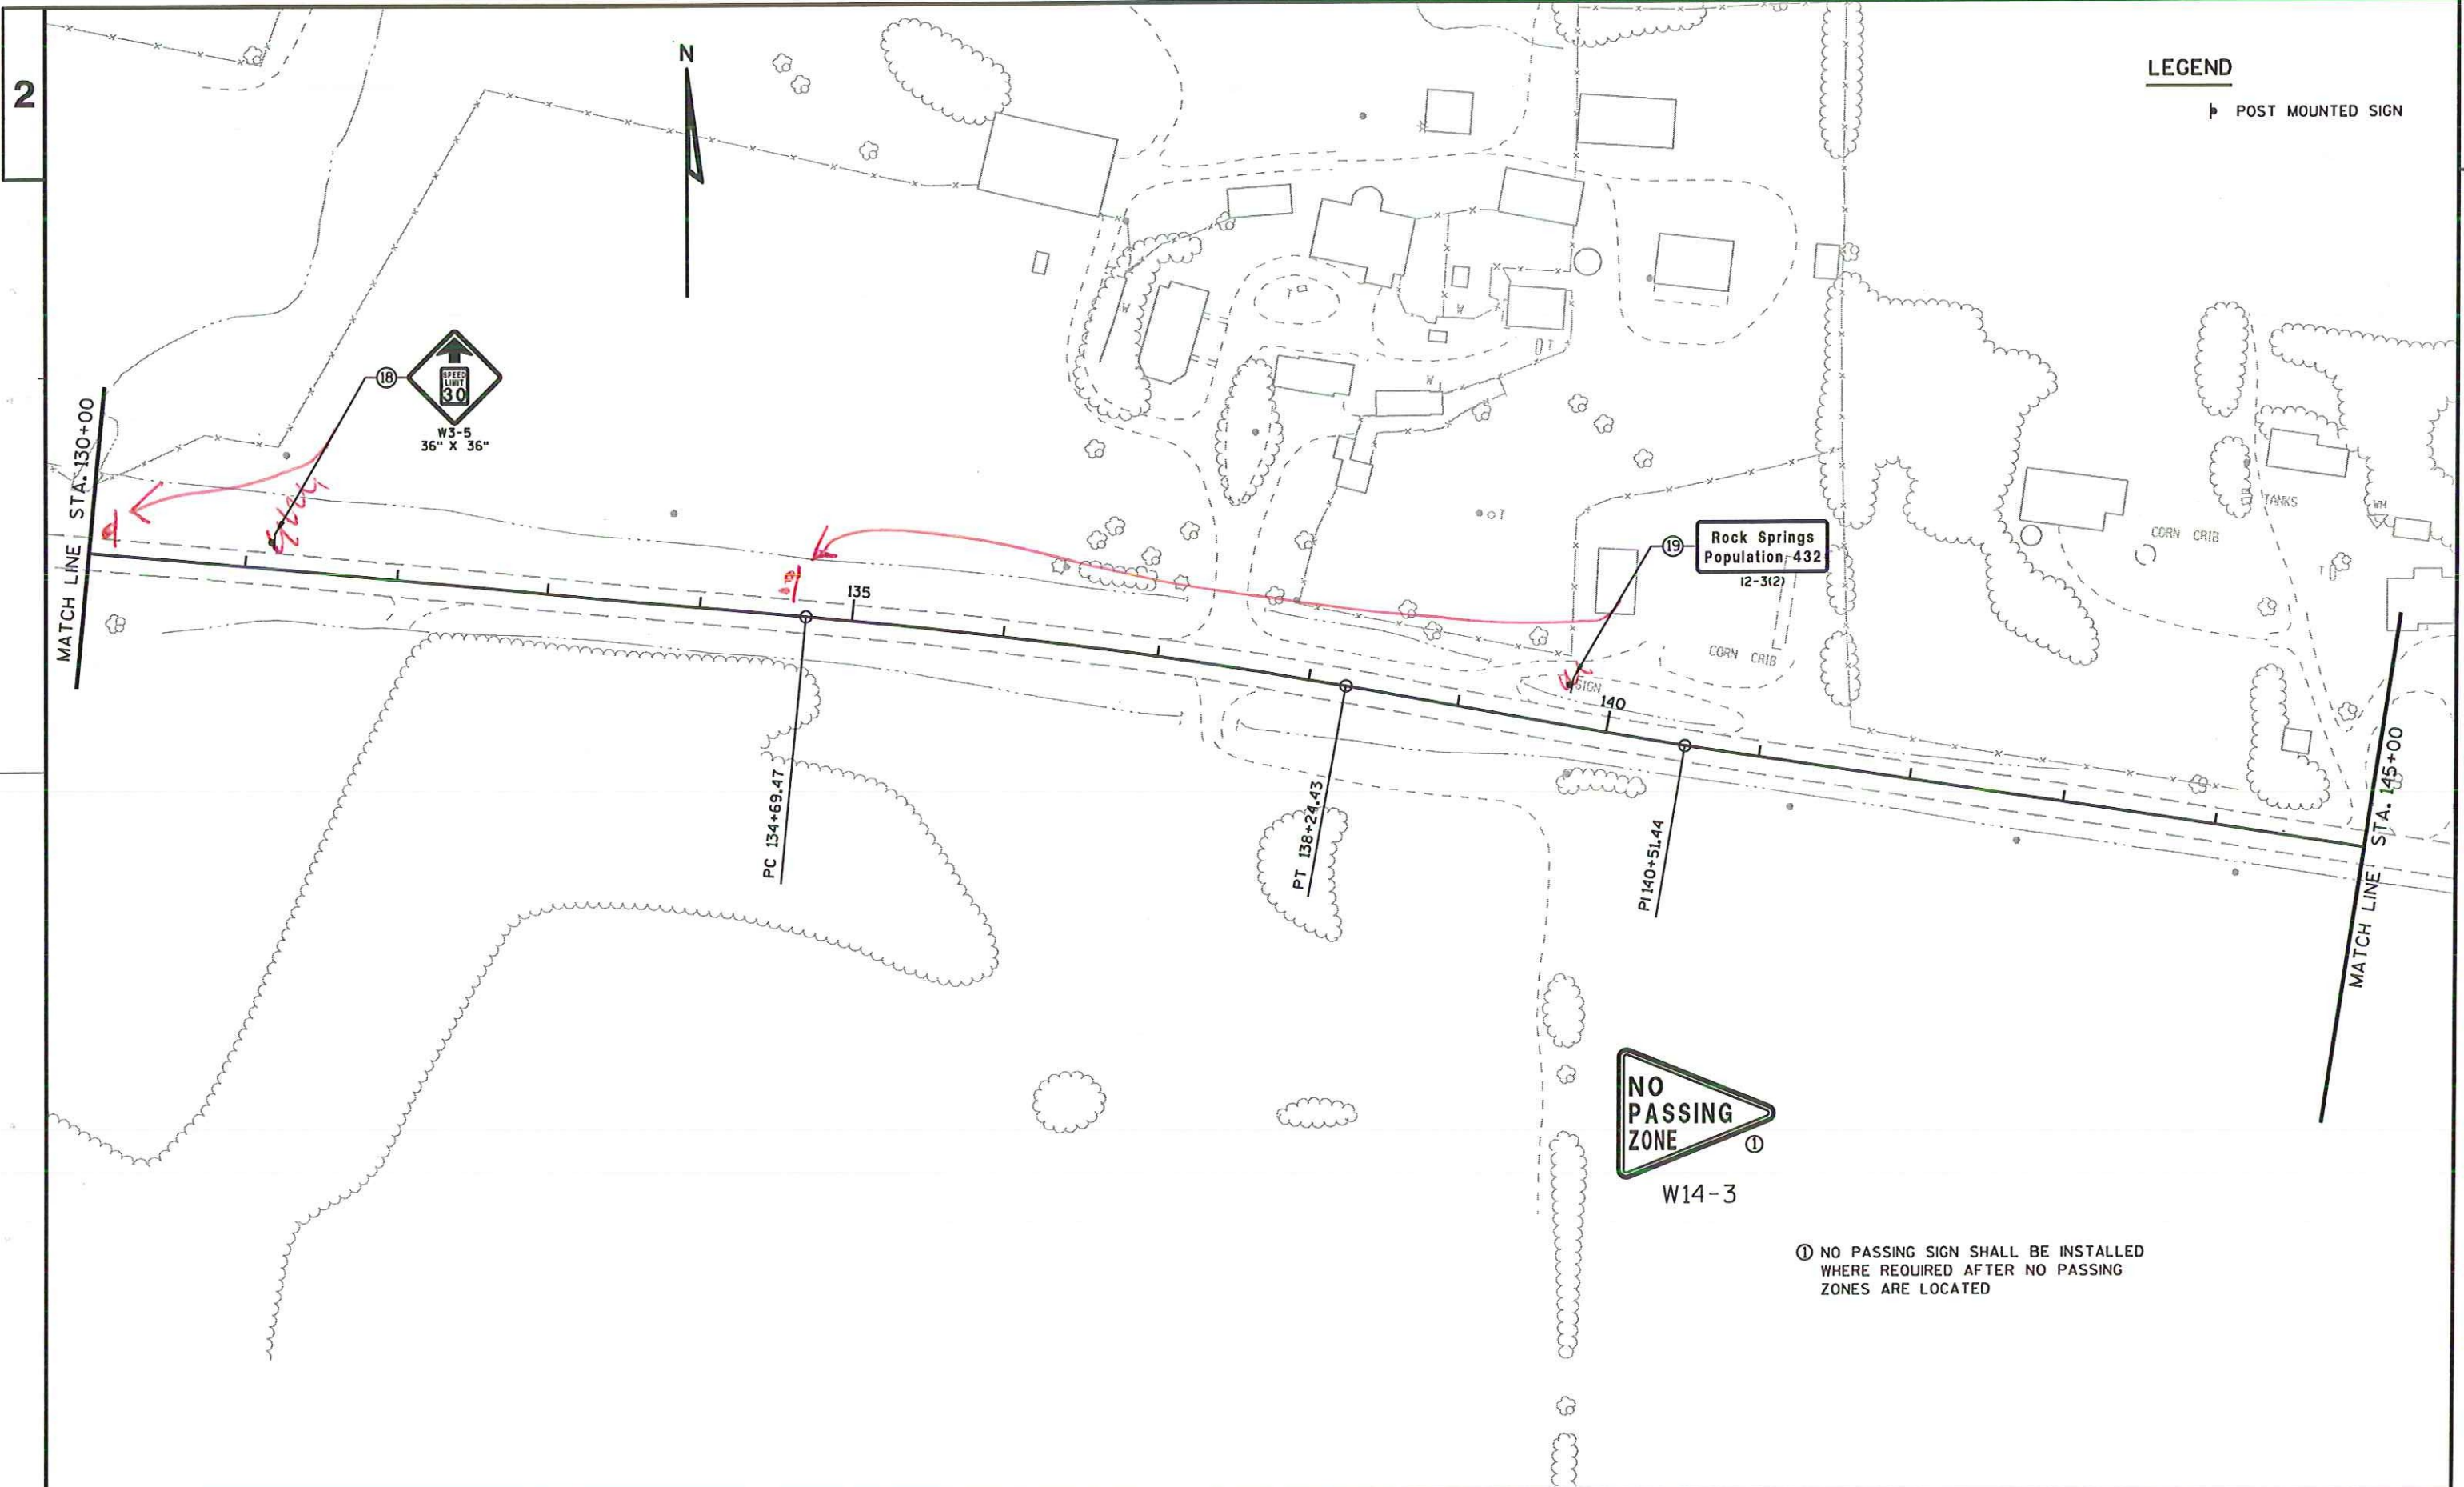


2

2

LEGEND


POST MOUNTED SIGN

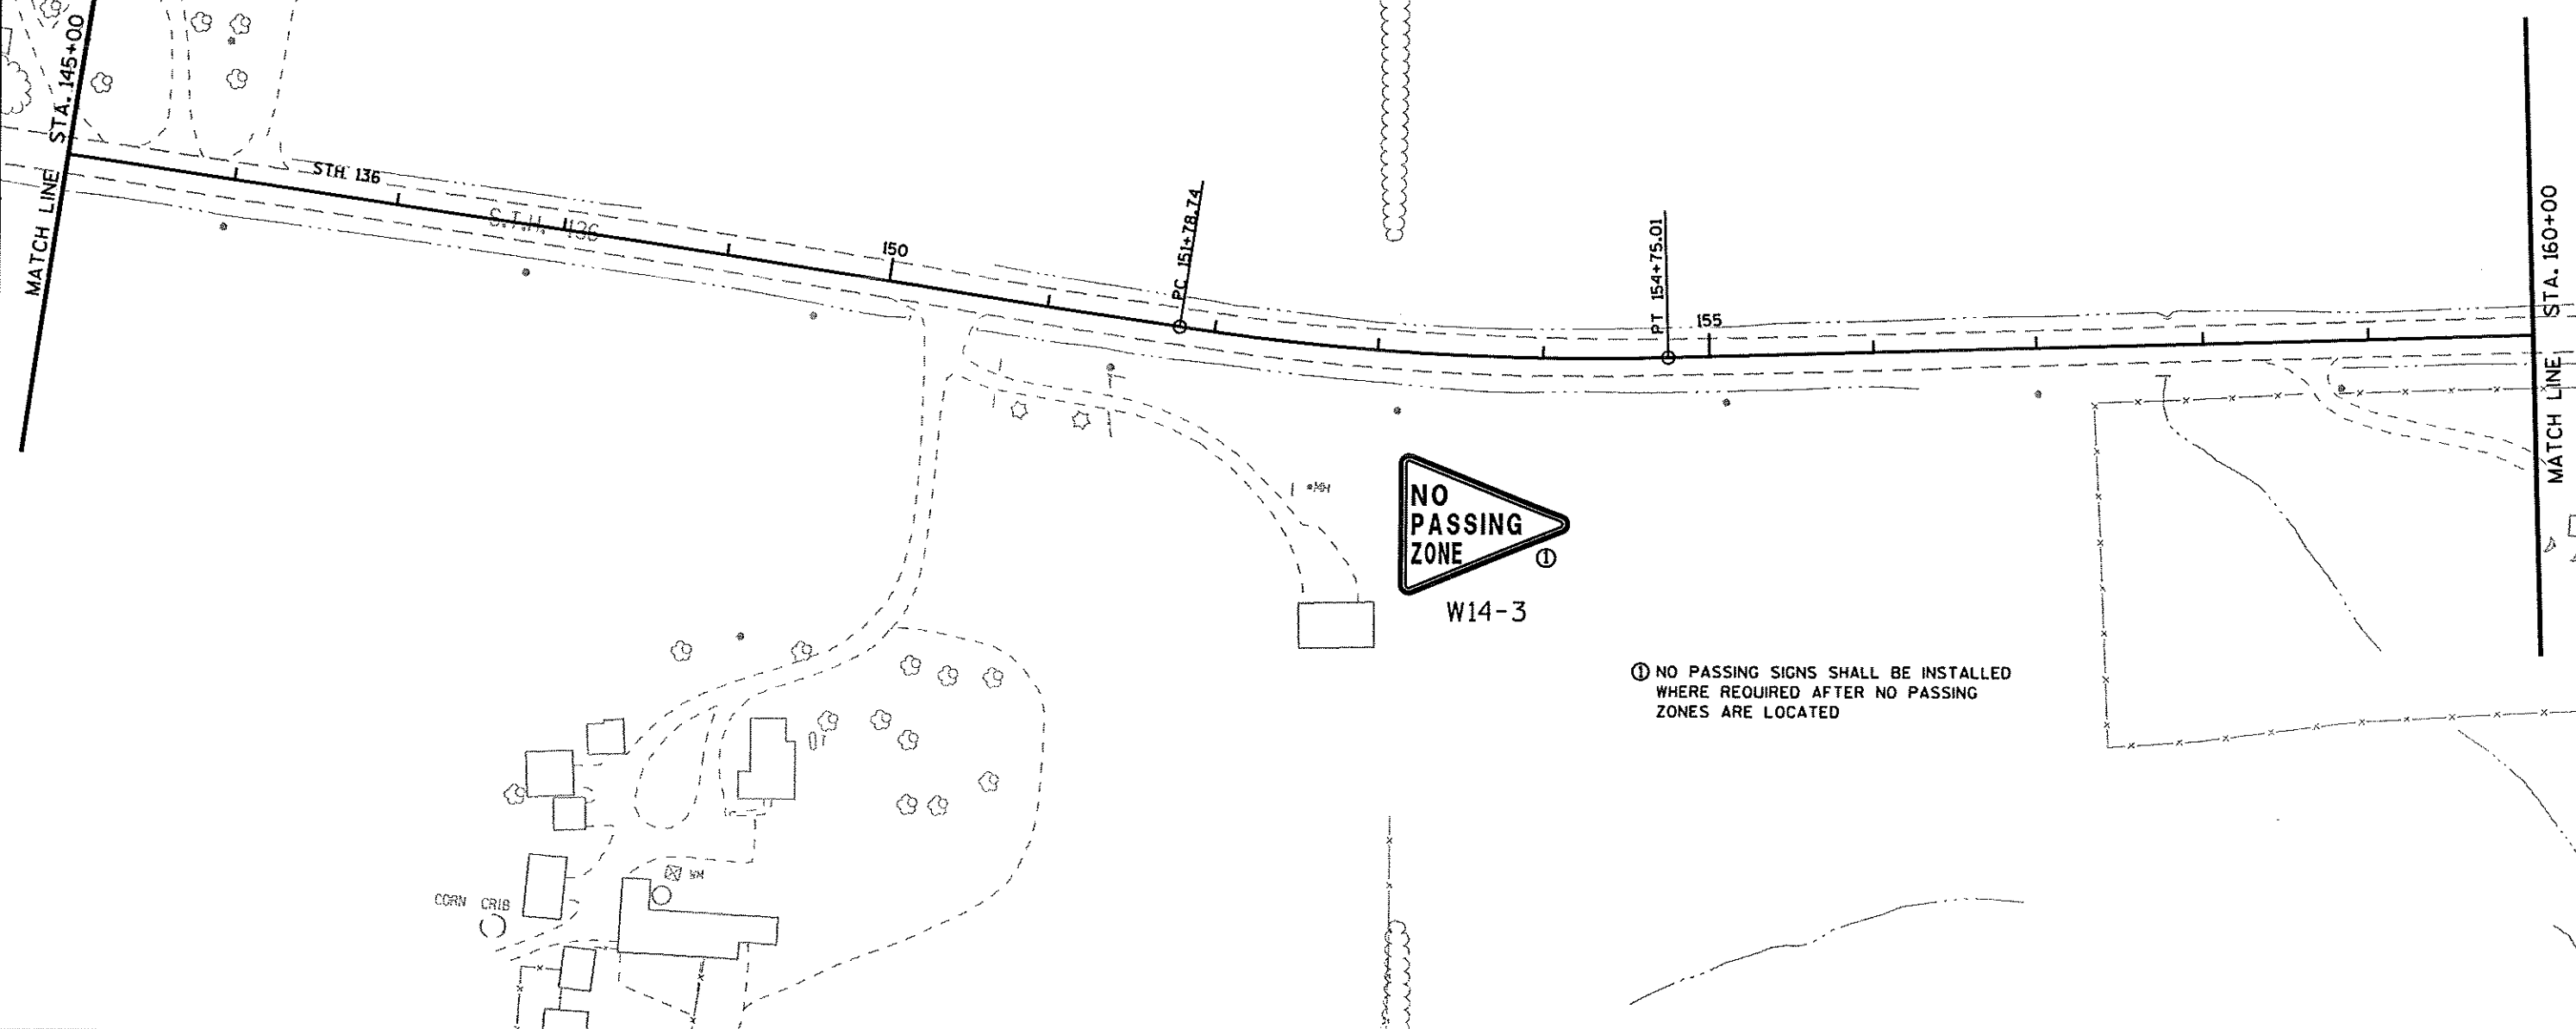

PROJECT NO:5573-04-72	HWY: STH 136	COUNTY: SAUK	PERMANENT SIGNING	SHEET	E
-----------------------	--------------	--------------	-------------------	-------	---

LEGEND

POST MOUNTED SIGN

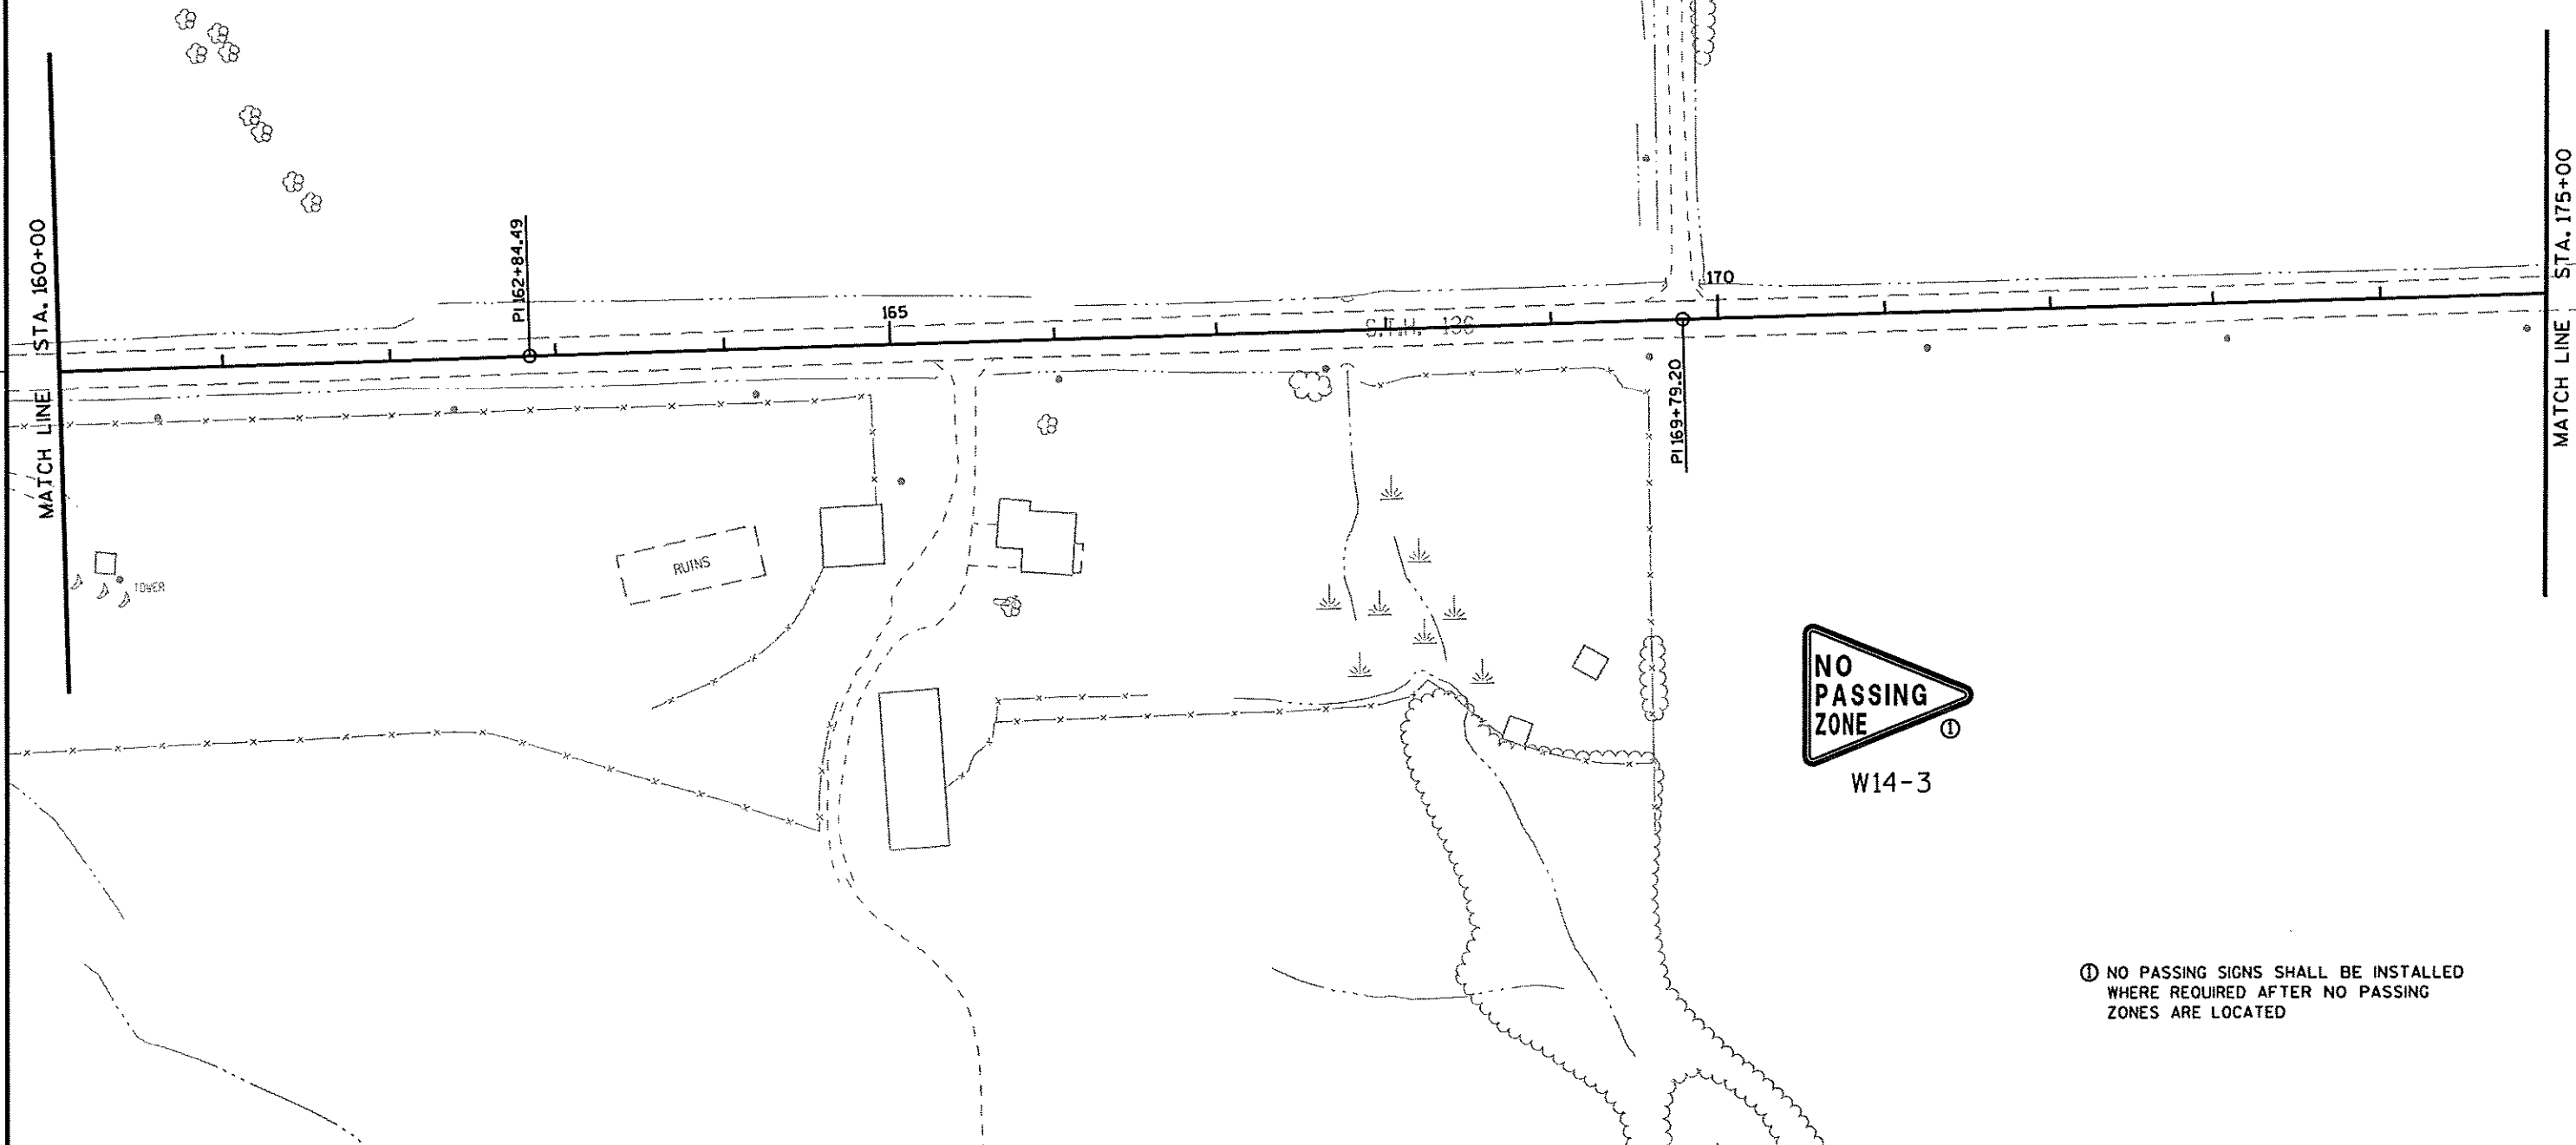

NO
PASSING
ZONE
W14-3

① NO PASSING SIGNS SHALL BE INSTALLED
WHERE REQUIRED AFTER NO PASSING
ZONES ARE LOCATED

2

2


LEGEND

POST MOUNTED SIGN

TANKS

MATCH LINE STA. 175+00

MATCH LINE STA. 190+00

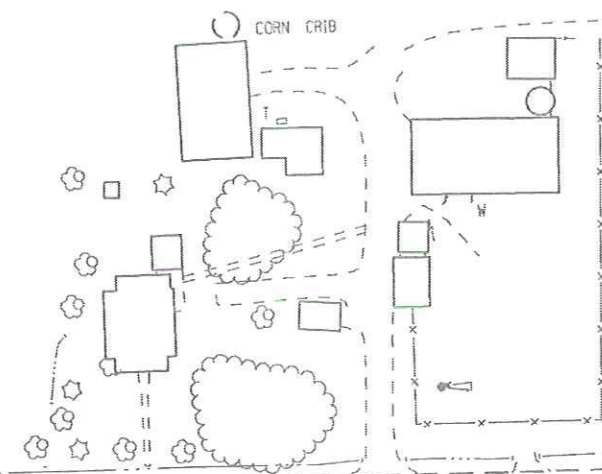


PI 176+79.66

PI 183+25.64

180

185

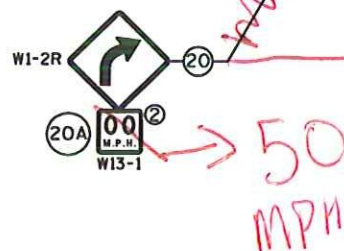

W14-3

① NO PASSING SIGNS SHALL BE INSTALLED WHERE REQUIRED AFTER NO PASSING ZONES ARE LOCATED

② SPEED SHOWN TO BE DETERMINED IN FIELD BY DOT TRAFFIC SECTION CALL DENNIS OLSON AT (608) 246-3254 FOR ARRANGEMENTS

PROJECT NO: 5573-04-72

HWY: STH 136

COUNTY: SAUK

PERMANENT SIGNING

SHEET

E

FILE NAME : r:\Support\CADD\Projects\dl_55730401\023206_ps.dgn


PLOT DATE : 12-JUL-2007 07:05

PLOT BY : ddbog

PLOT NAME :


PLOT SCALE : 100.000000:1.000000

WISDOT/CADD SHEET 42

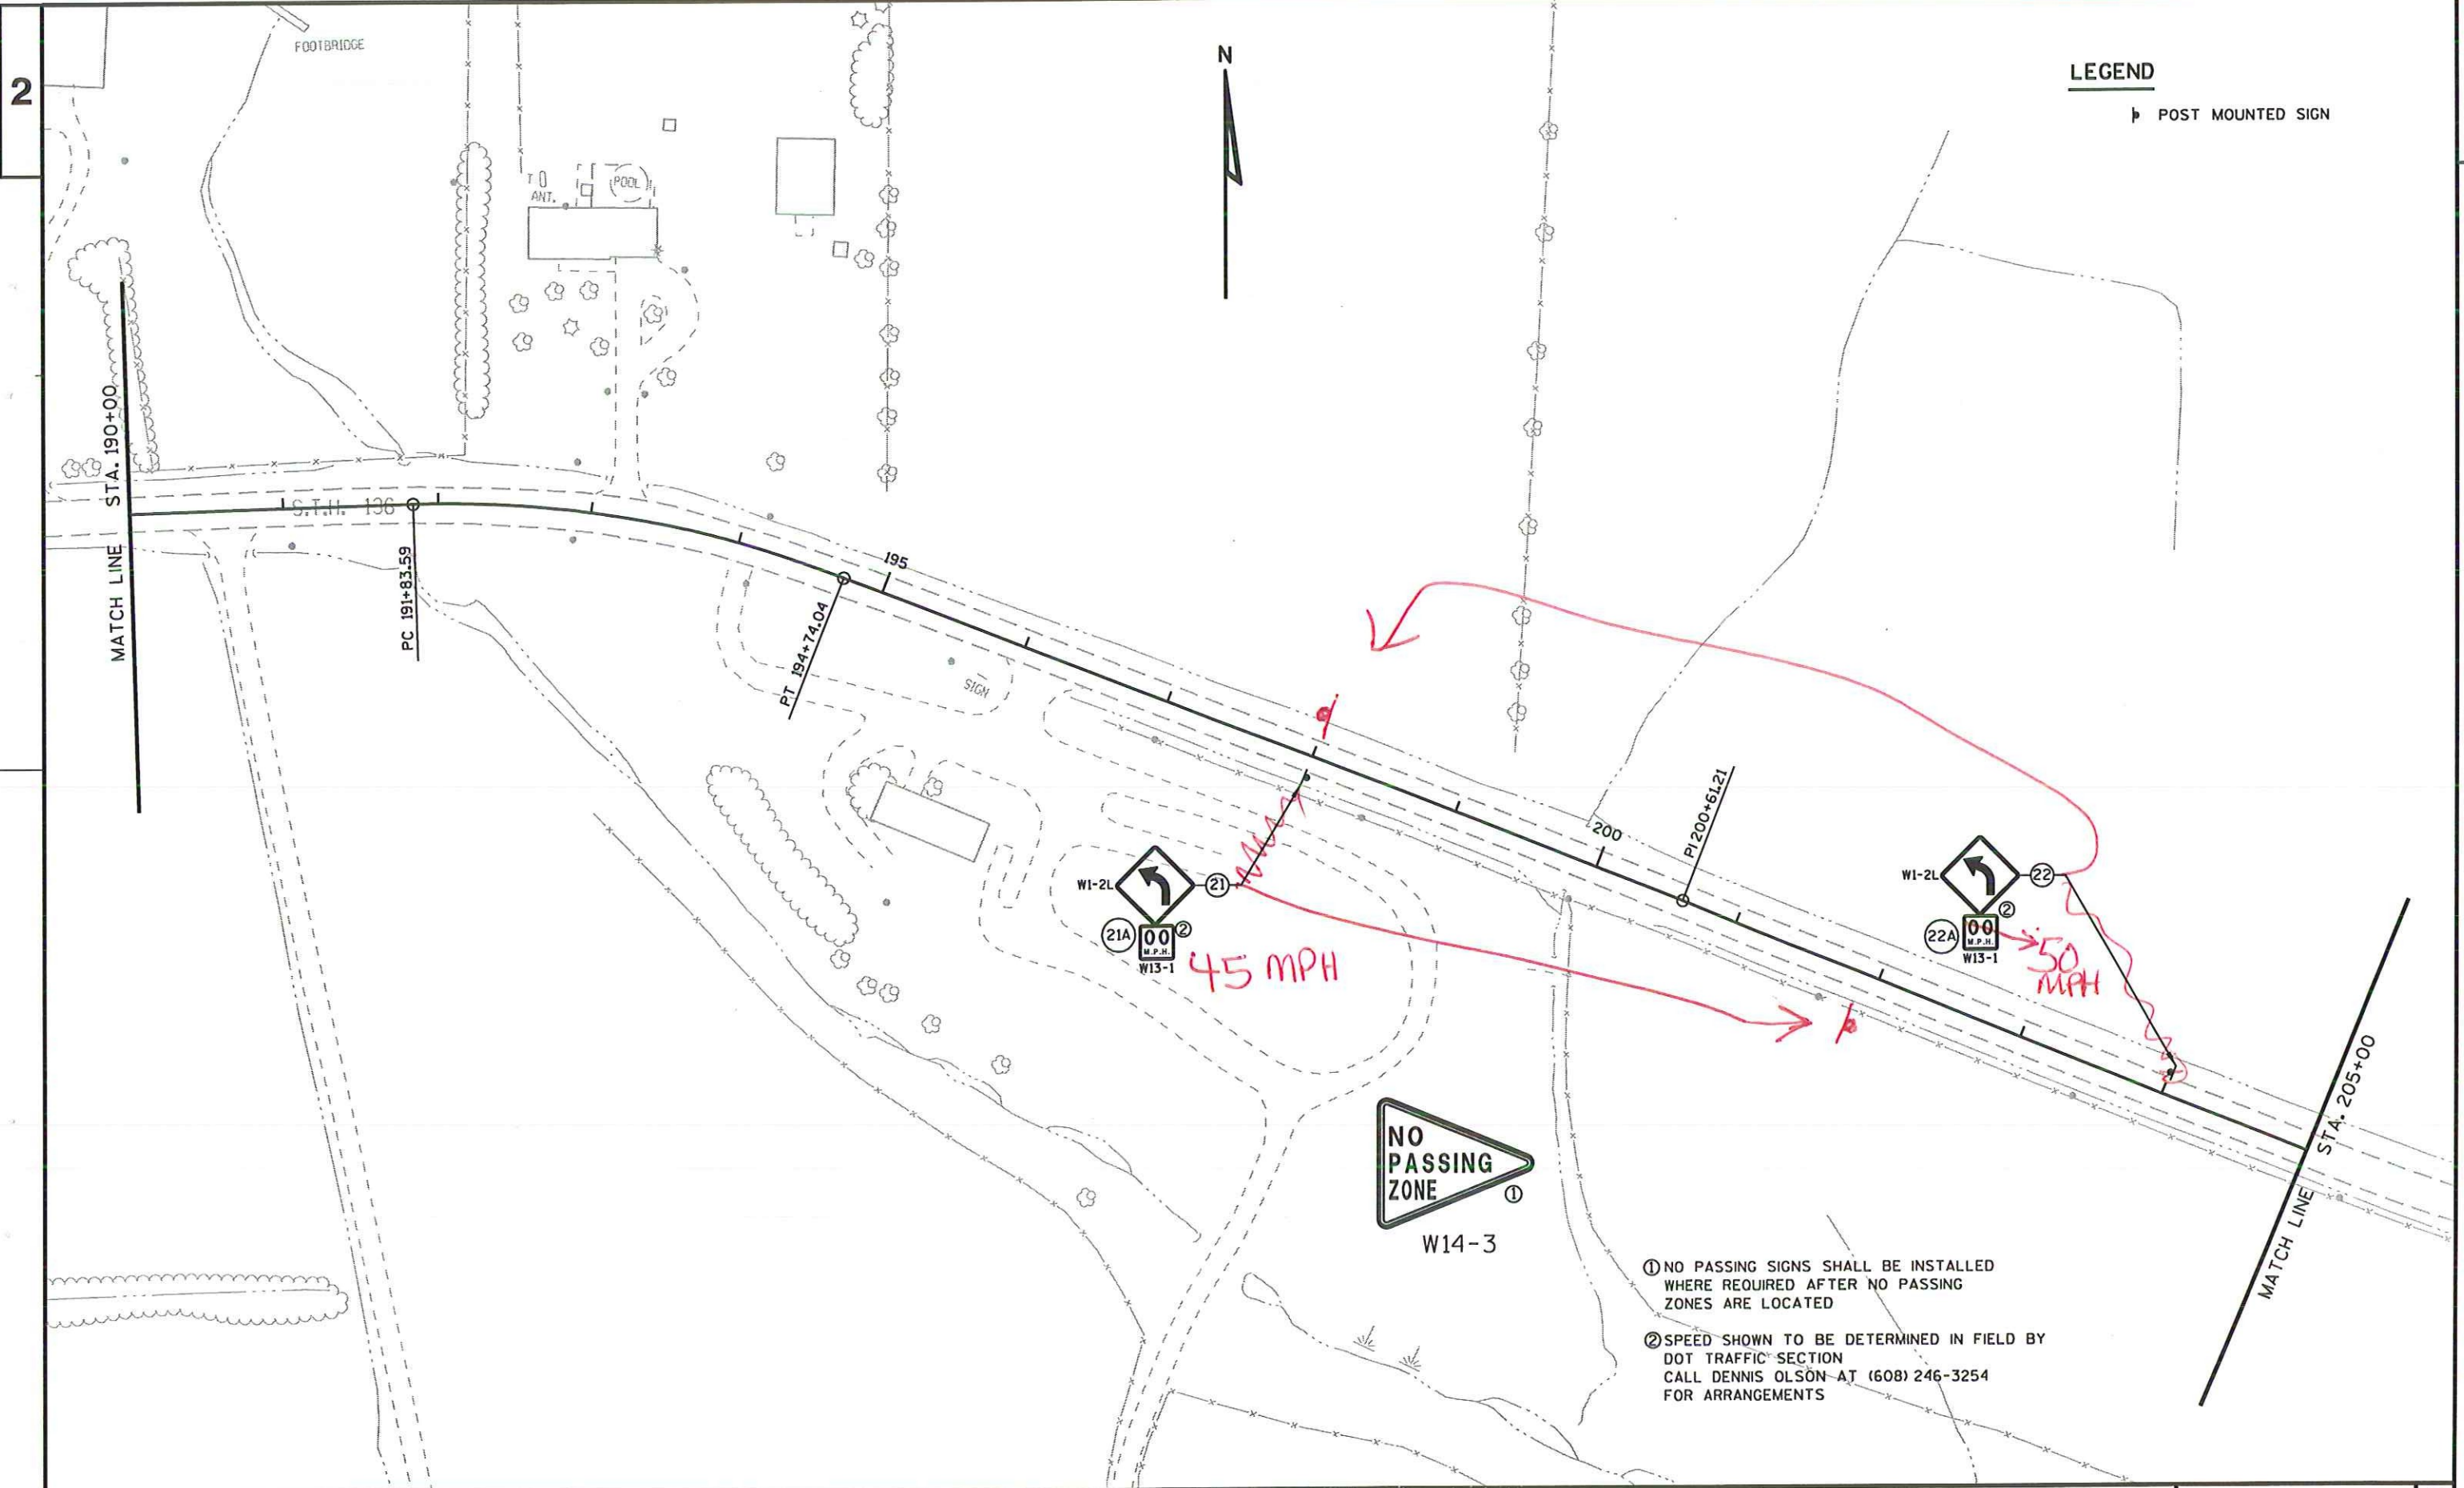

LEGEND

POST MOUNTED SIGN

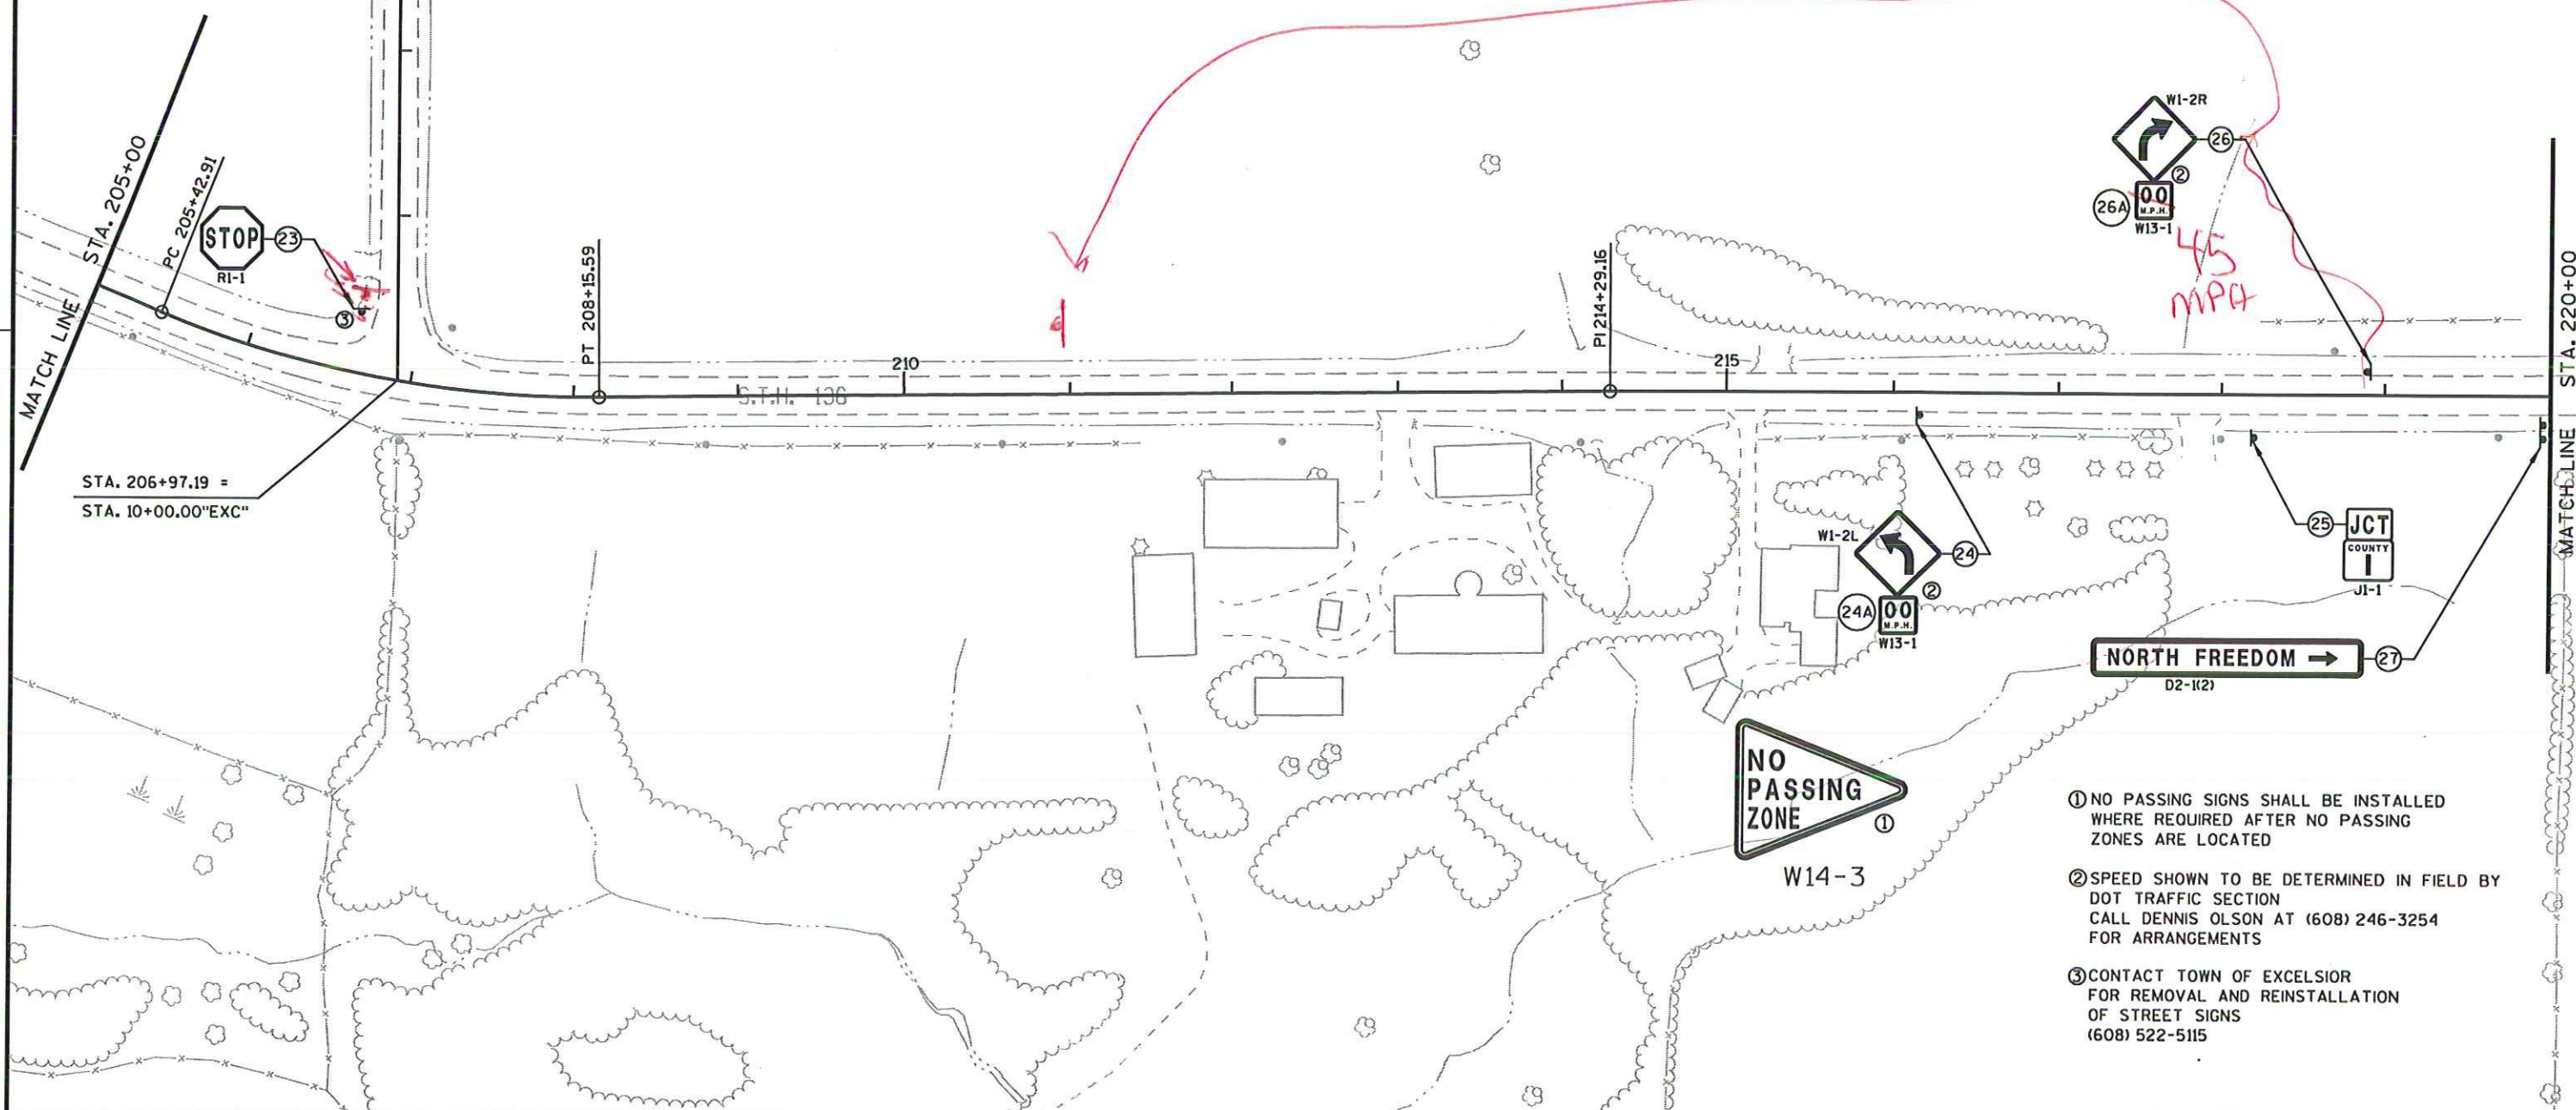

PROJECT NO: 5573-04-72

HWY: STH 136

COUNTY: SAUK

PERMANENT SIGNING

SHEET

E

FILE NAME : r:\Support\CADD\Projects\d1_55730401\023208_ps.dgn

PLOT DATE : 12-JUL-2007 01:05

PLOT BY : dotbbg

PLOT NAME :

PLOT SCALE : 100.000000:1.000000

70
WISDOT/CADD SHEET 42


① NO PASSING SIGNS SHALL BE INSTALLED WHERE REQUIRED AFTER NO PASSING ZONES ARE LOCATED

② SPEED SHOWN TO BE DETERMINED IN FIELD BY DOT TRAFFIC SECTION
CALL DENNIS OLSON AT (608) 246-3254 FOR ARRANGEMENTS

③ CONTACT TOWN OF EXCELSIOR FOR REMOVAL AND REINSTALLATION OF STREET SIGNS
(608) 522-5115

LEGEND

p POST MOUNTED SIGN

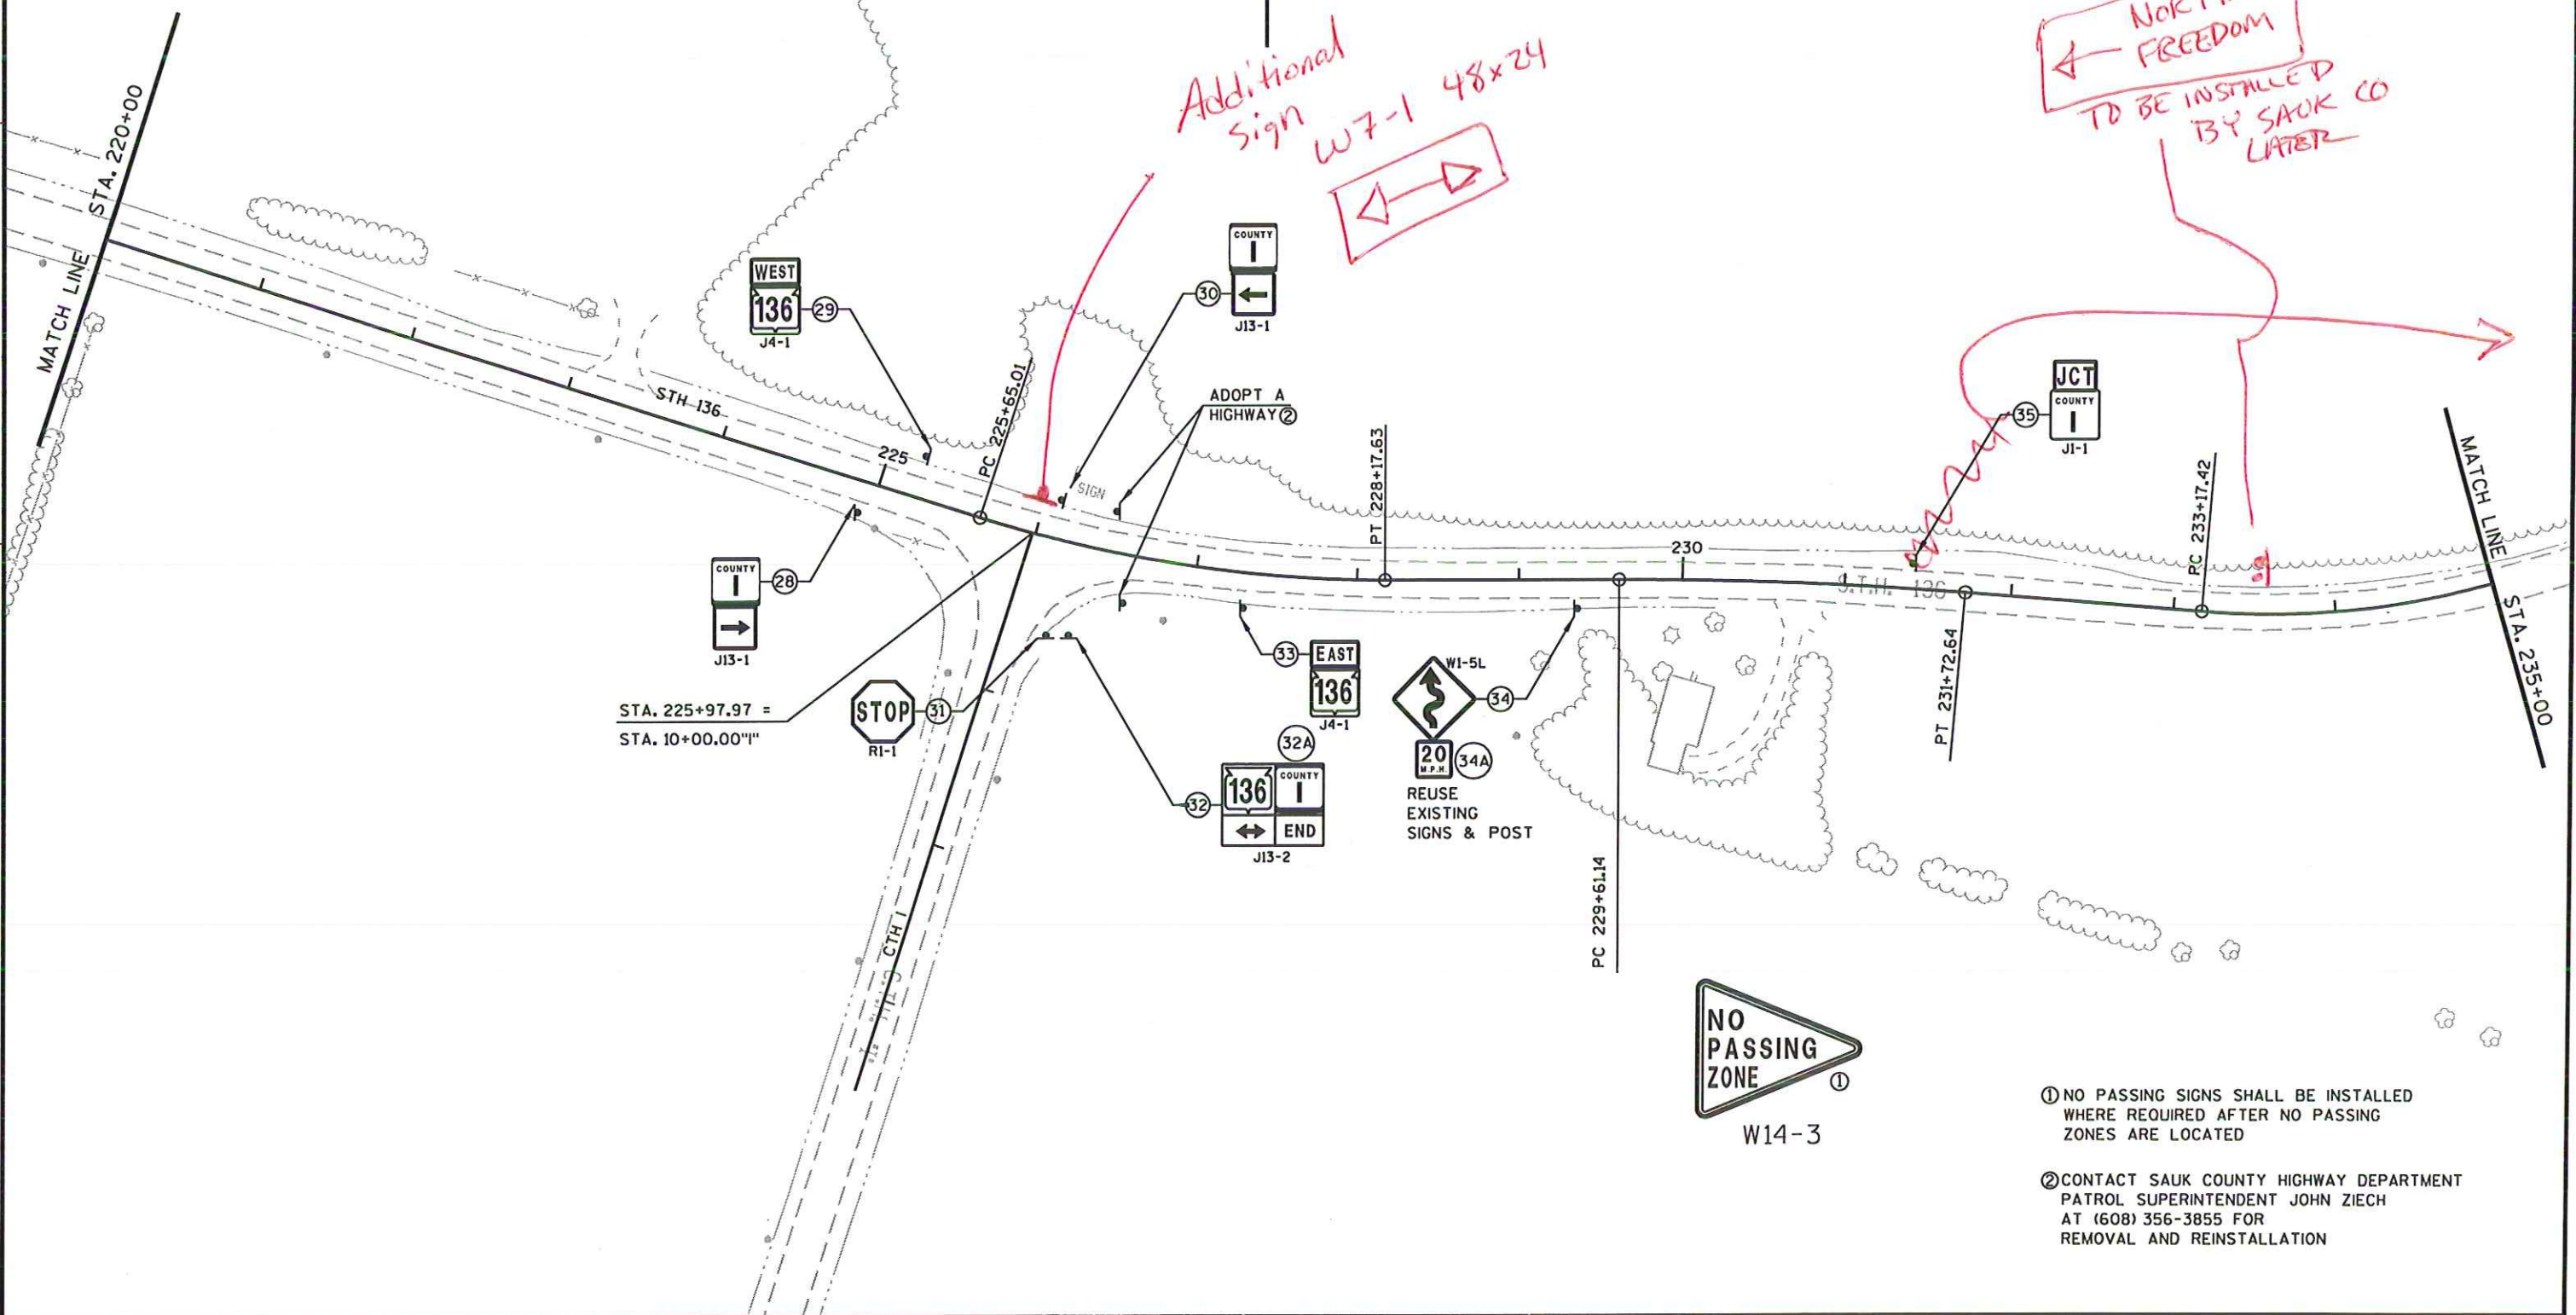

PROJECT NO: 5573-04-72

HWY: STH 136

COUNTY: SAUK

PERMANENT SIGNING

SHEET

E

FILE NAME : r:\Support\CADD\Projects\dl_55730401\023209_ps.dgn

PLOT DATE : 12 JUL 2007 07:06

PLOT BY : acbbg


PLOT NAME :


PLOT SCALE : 100.000476:1.000000

WISDOT/CADD SHEET 42

LEGEND

POST MOUNTED SIGN

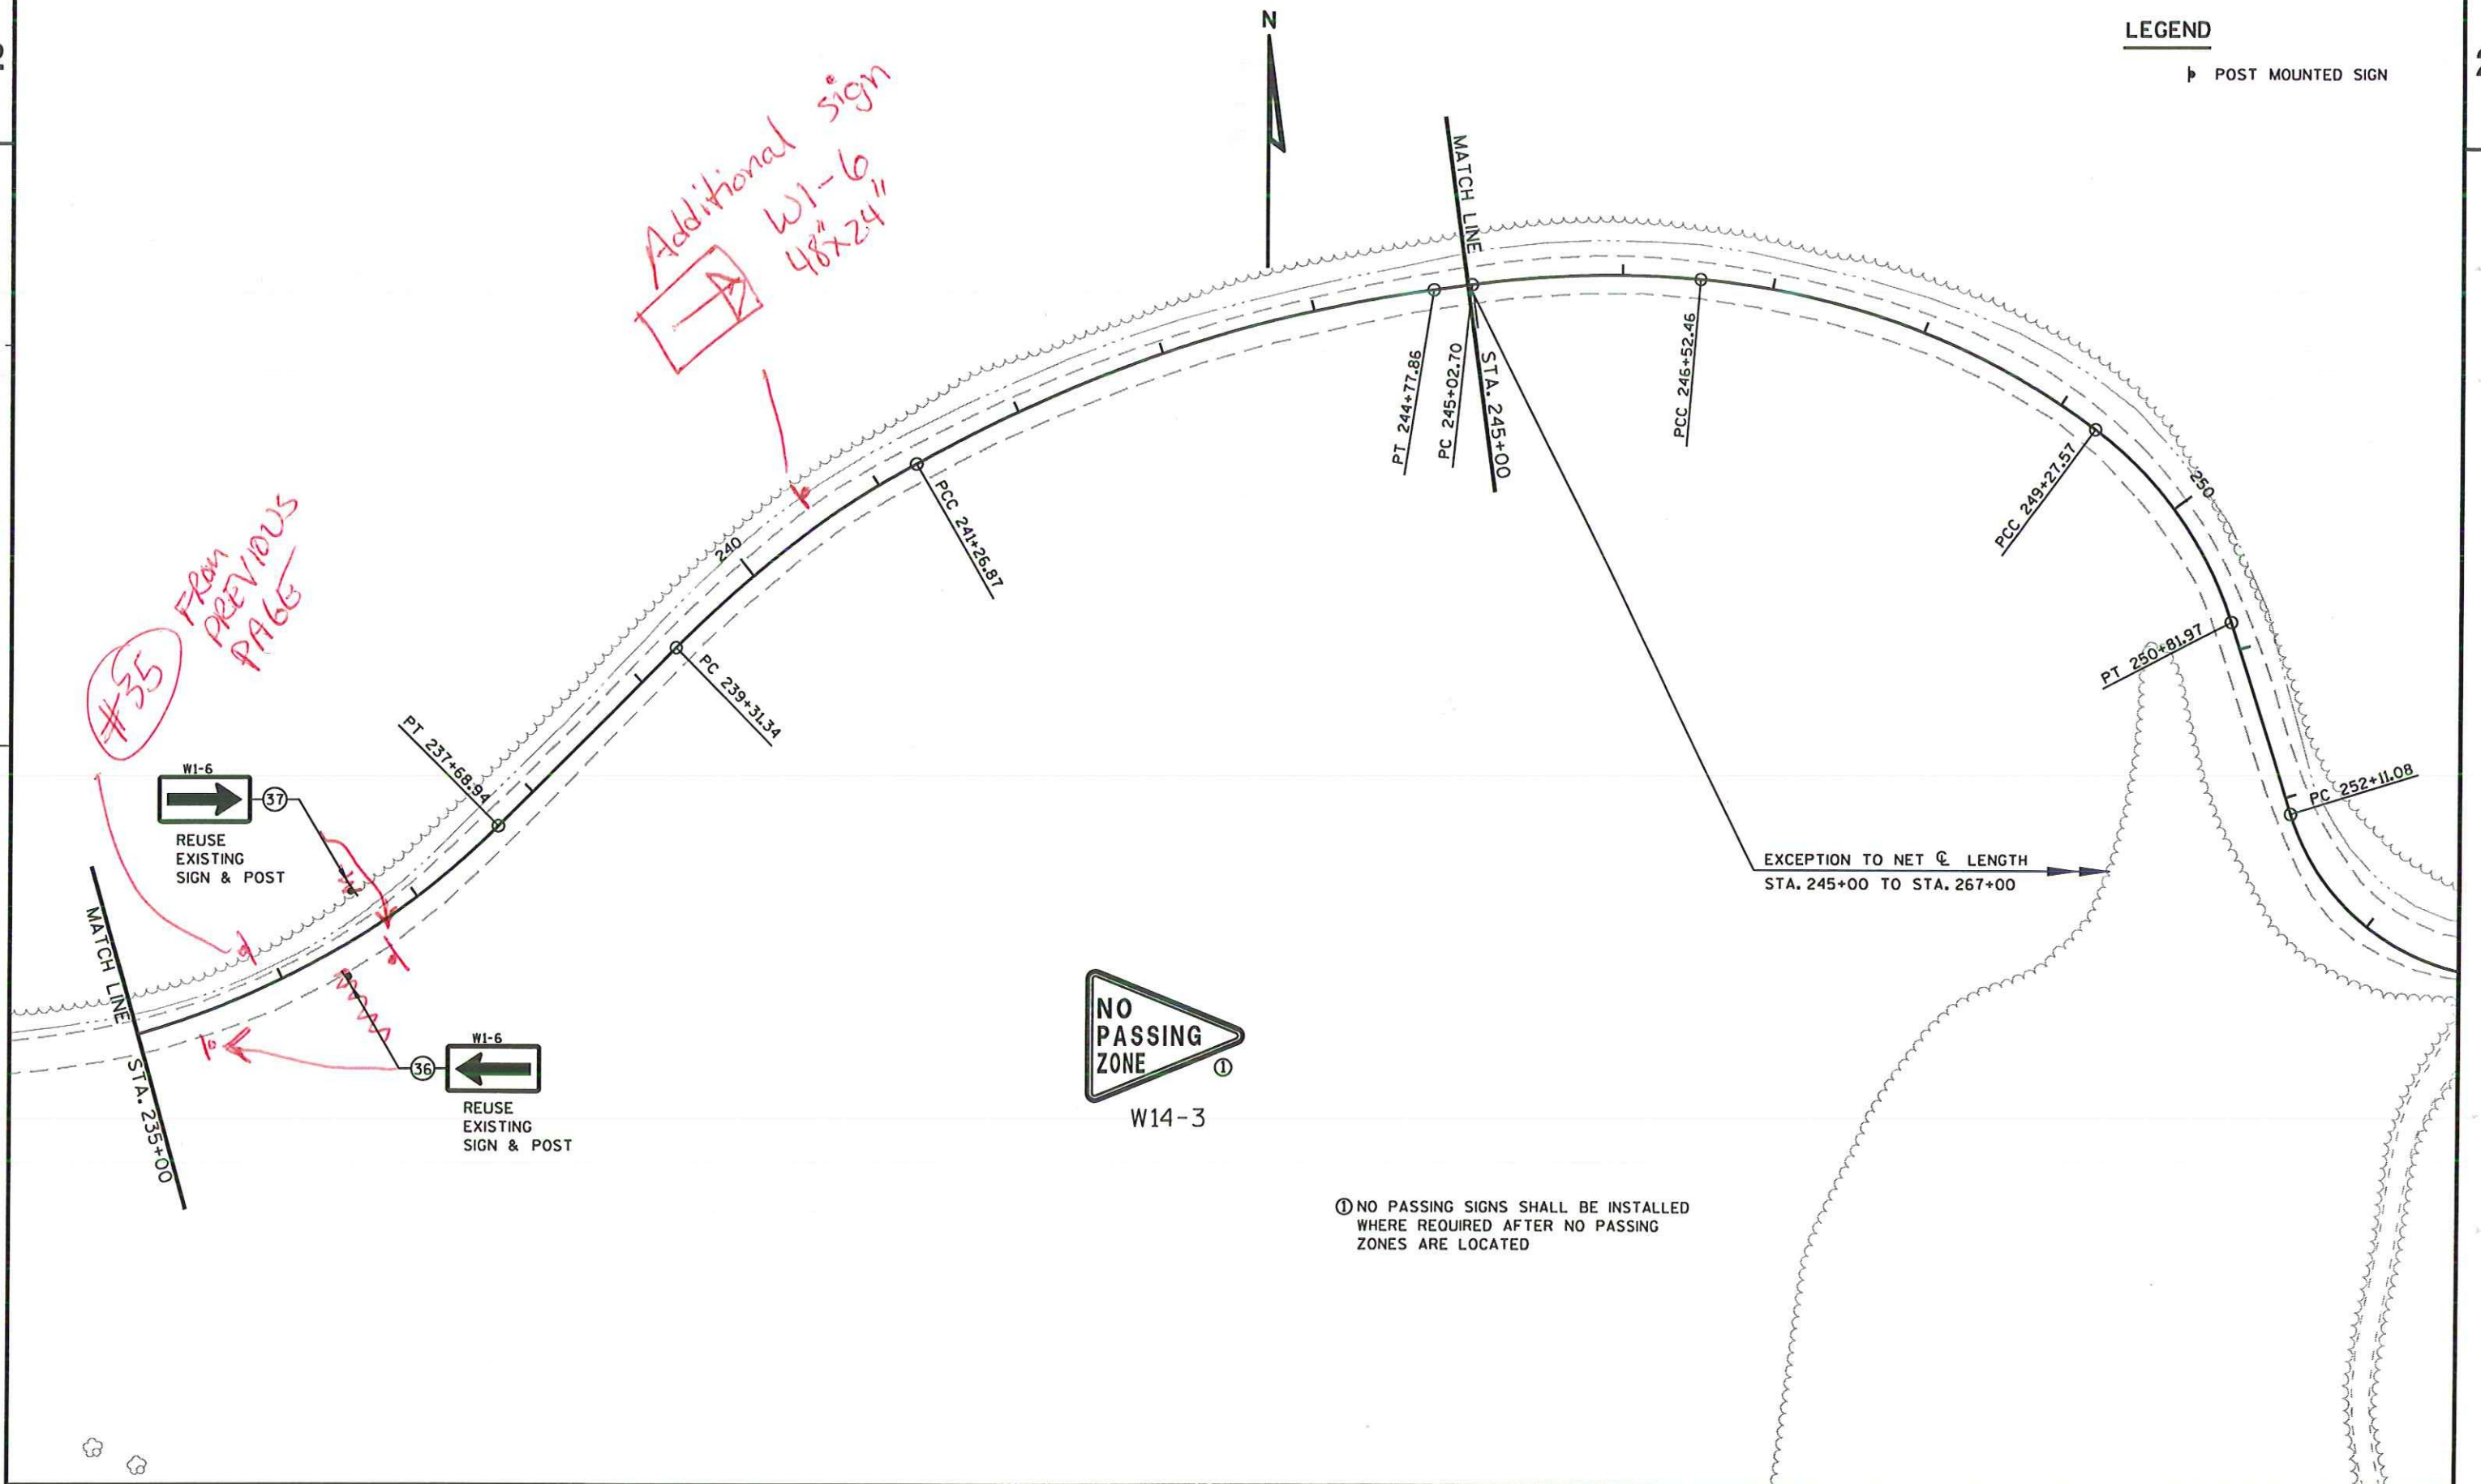

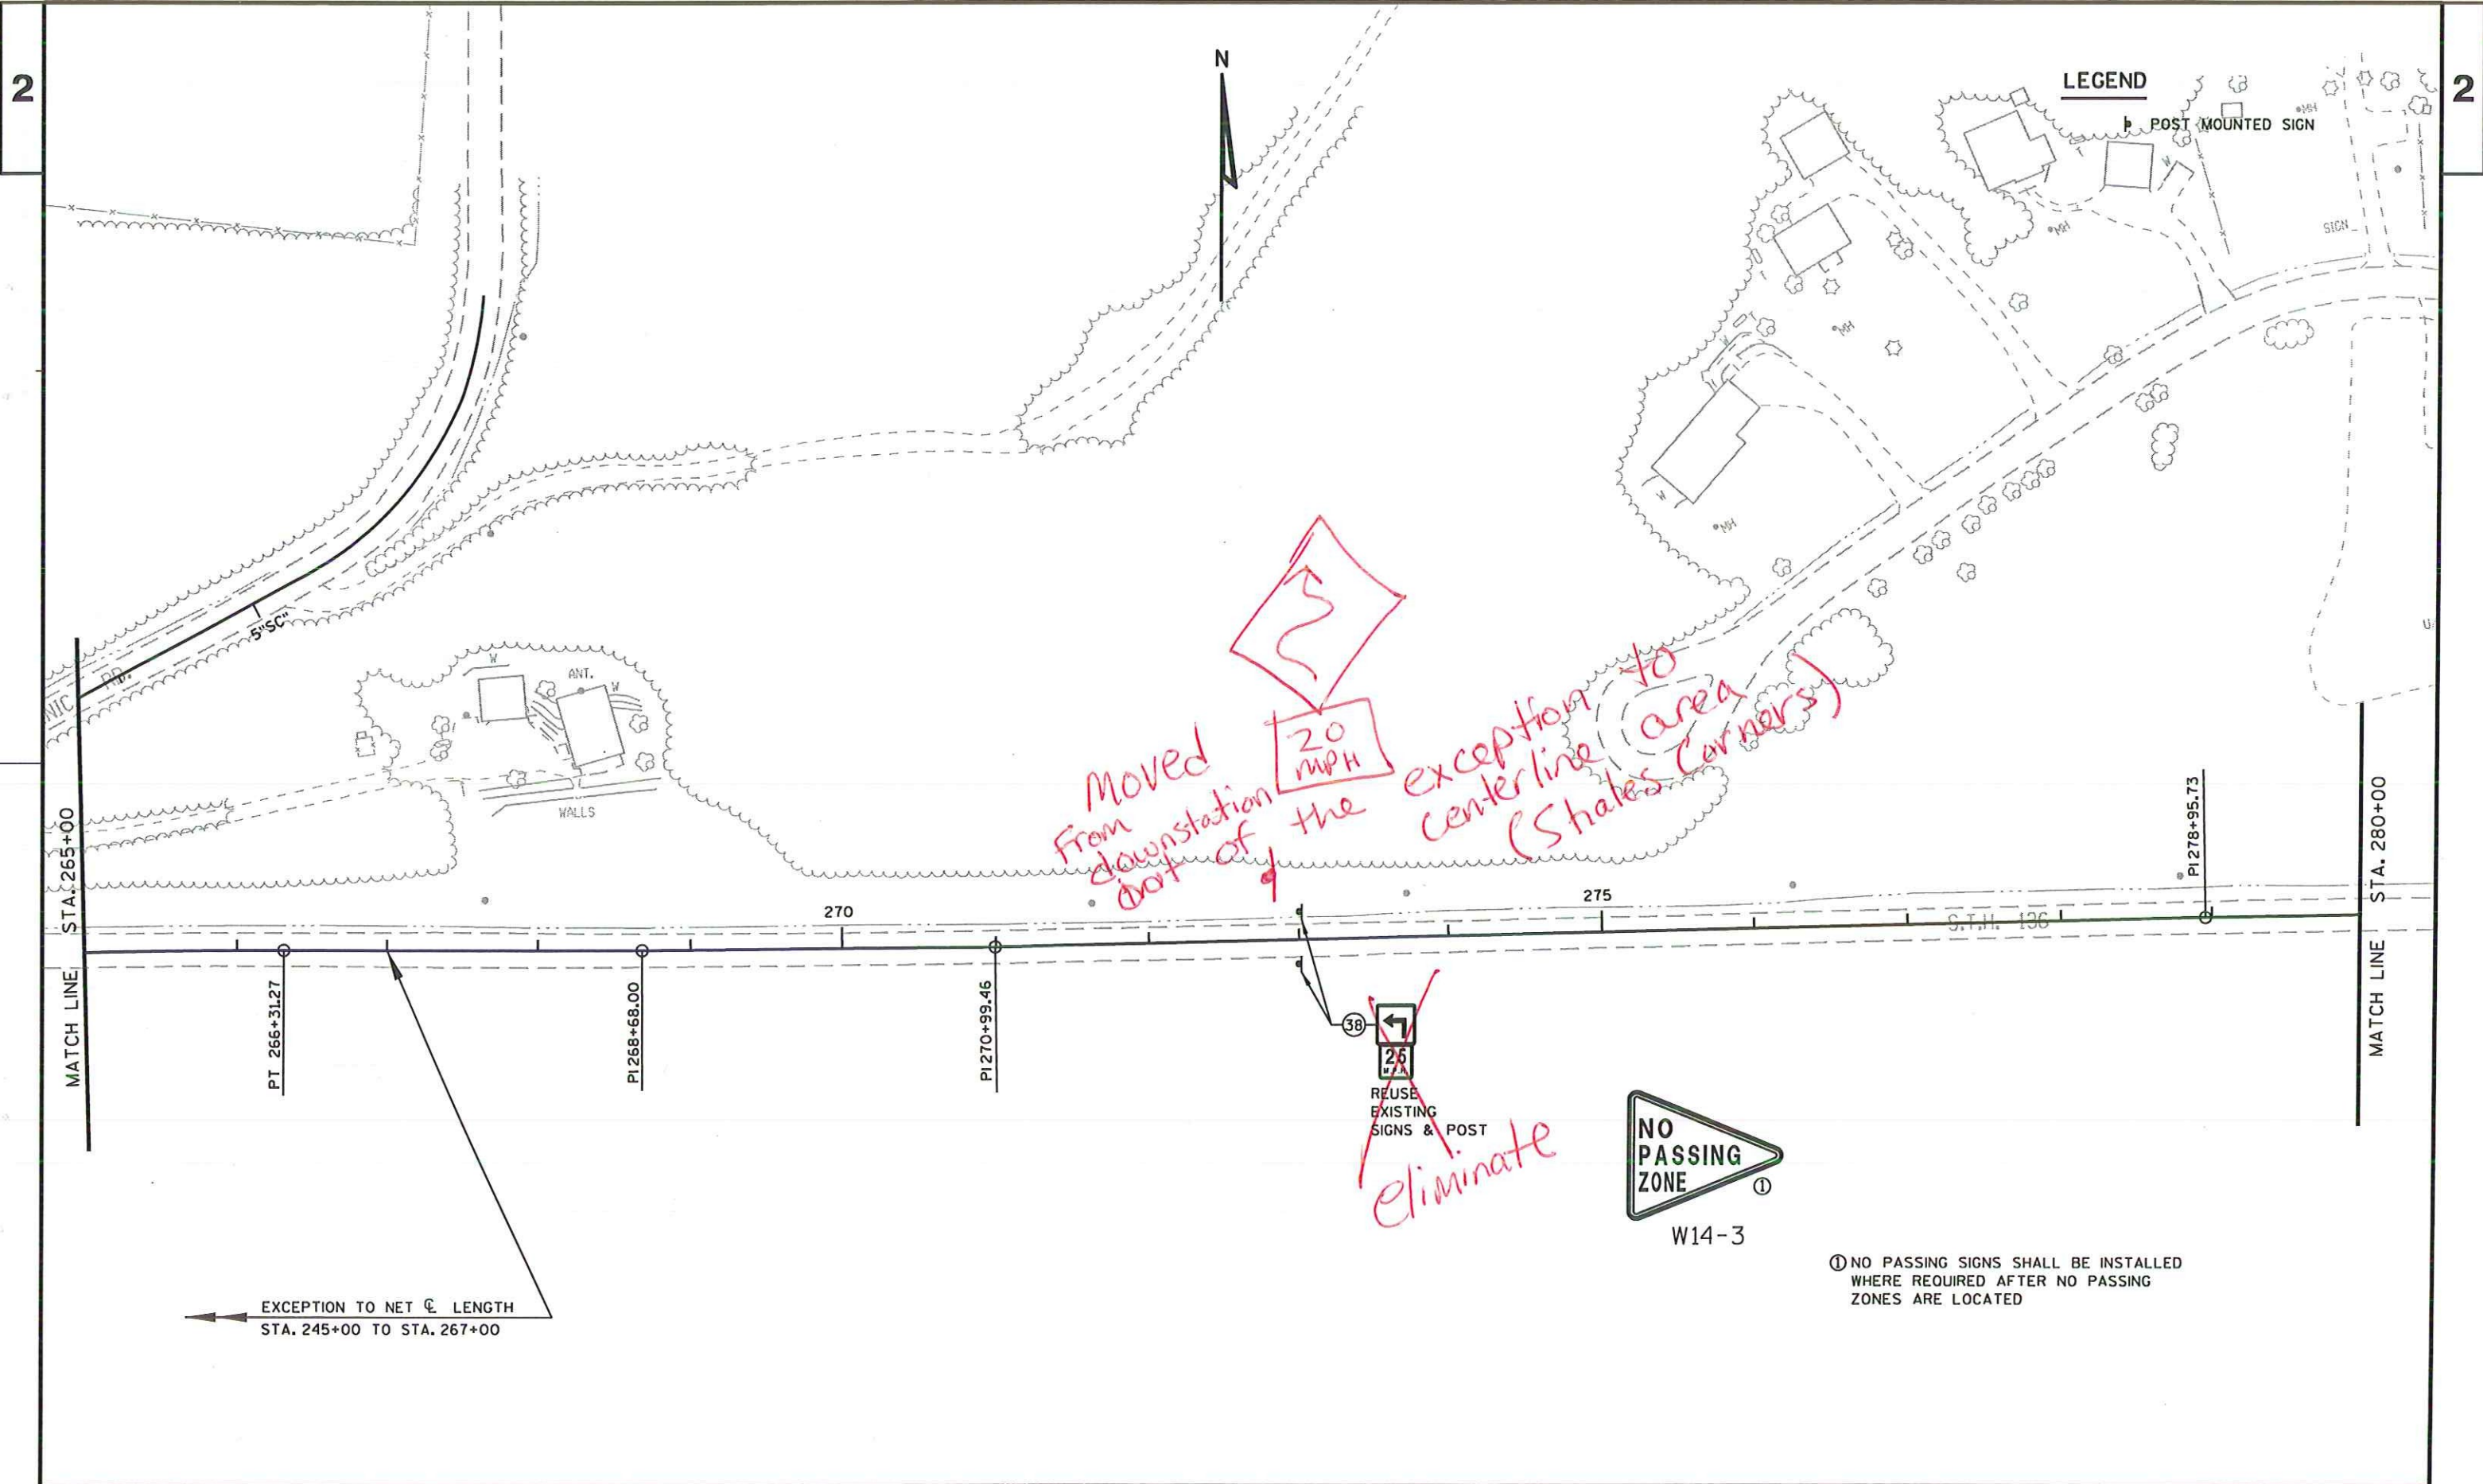

- ①

ROAD CLOSED TO THRU TRAFFIC

R11-4
60" X 30"
- ②

ROAD CLOSED AHEAD

W20-3
- ③

DETOUR AHEAD

W20-2
- ④

WEST

W01-6
48" X 24"
- ⑤

WEST

M 3-4
24" X 12"
- ⑥

ROAD CLOSED 500 FT

W20-3
- ⑦

DETOUR 1000 FT

W20-2
- ⑧

ROAD CLOSED XX MILES AHEAD LOCAL TRAFFIC ONLY

R11-3
60" X 30"
- ⑩

ROAD CLOSED 1000 FT

W20-3
- ⑪

136

MI-6
24" X 24"
- ⑫

ROAD OPEN TO ROCK SPRINGS

R10-61
60" X 30"
- ⑬

BRIDGE OUT XX MILES AHEAD

R11-3C
60" X 24"
- ⑭

BRIDGE OUT


R11-2B
48" X 30"
- ⑮

ACCESS TO ROCK SPRINGS BUSINESSES

R10-70 (MOD)
66" X 36"
- ⑯

← ROCK SPRINGS BLACK ON ORANGE

DI-1
- ROCK SPRINGS**

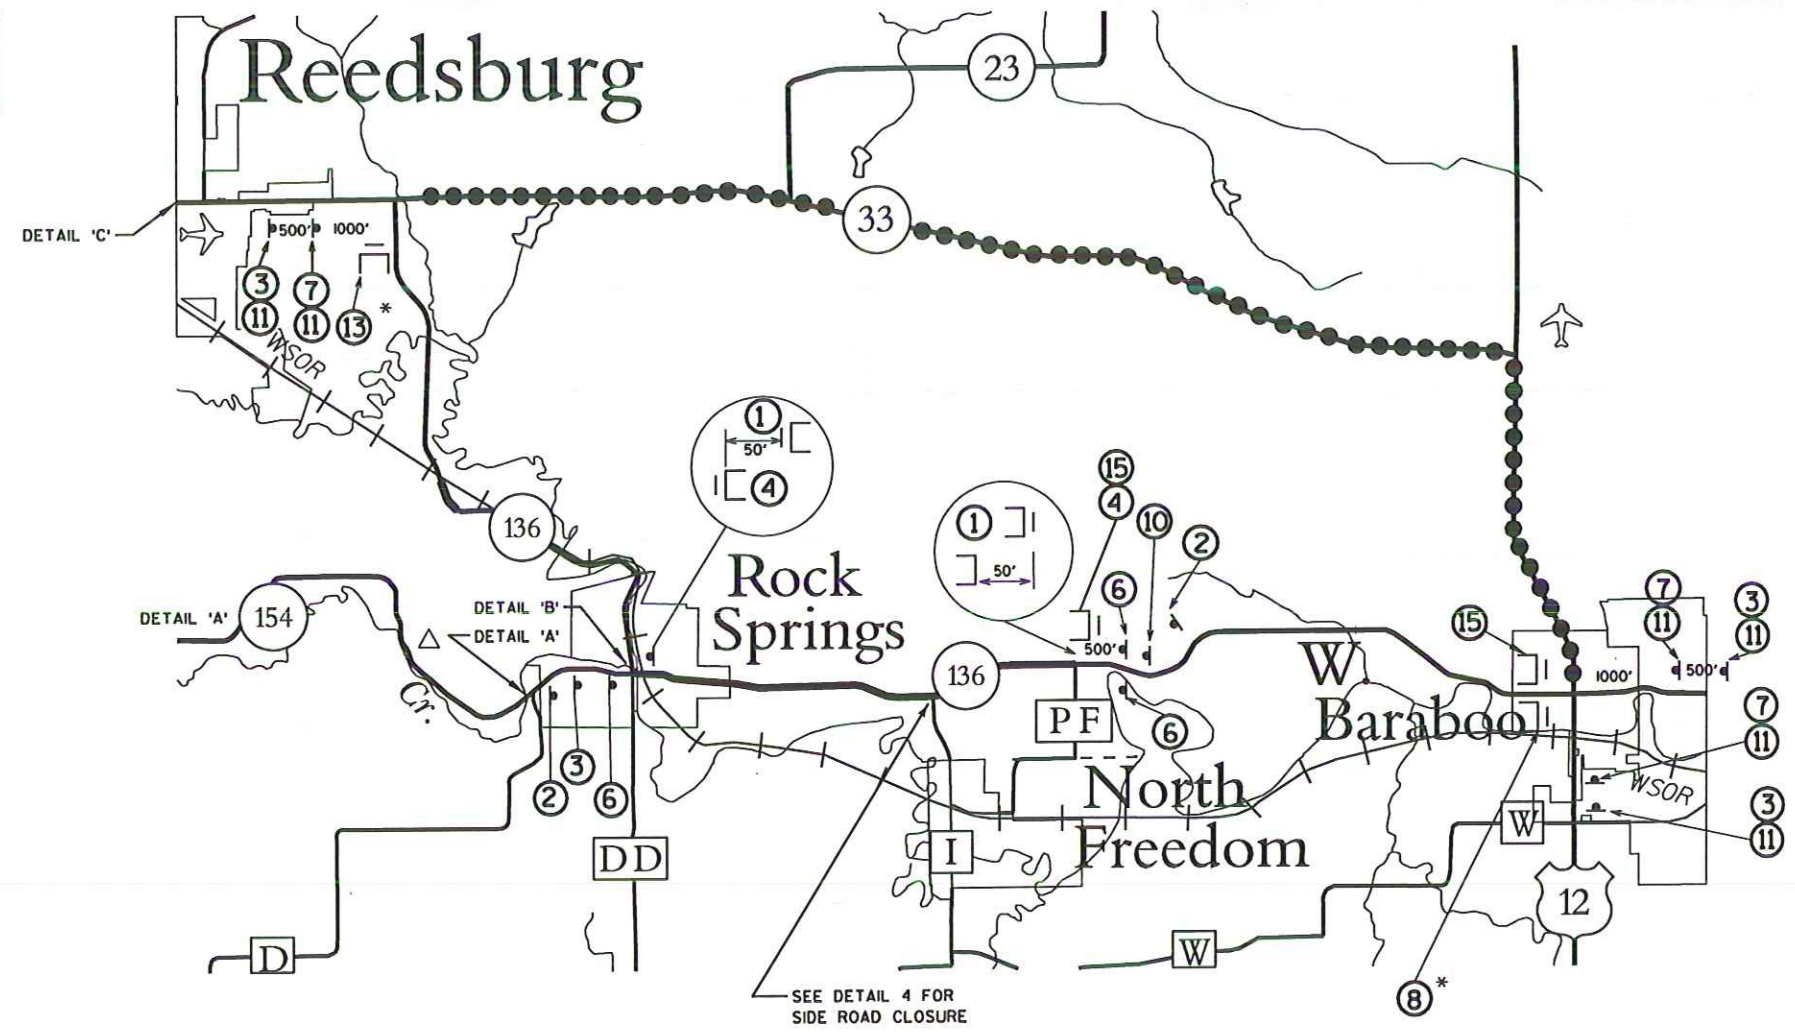

GENERAL NOTES:


ALL EXISTING SIGNS THAT NEED TO BE COVERED SHALL BE COVERED WITH A BLANK ORANGE PANEL.

"WO" SIGNS ARE THE SAME AS "W" SIGNS EXCEPT THE BACKGROUND IS ORANGE.


ALL M3 SERIES SIGNS (NORTH, EAST, SOUTH, WEST) WHICH ARE PART OF ANY DETOUR ROUTE MARKER SIGNING ASSEMBLY OR ATTACHED TO ANY WARNING SIGN SHALL BE BLACK LETTERING ON A WHITE BACKGROUND.

ALL M05 AND M06 ARROW SIGNS SHALL BE THE SAME AS "M" SIGNS EXCEPT THAT THE BACKGROUND IS ORANGE.


- LEGEND**
- POST MOUNTED SIGN
 - TYPE III BARRICADE WITH/WITHOUT ATTACHED SIGN
 - DETOUR ROUTE FOR S.T.H. 136
 - CLOSED - UNDER CONSTRUCTION

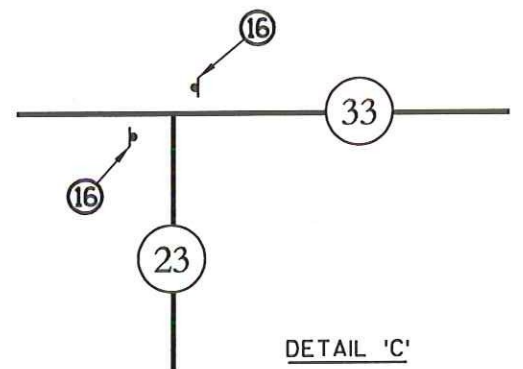


DETAIL 'C'

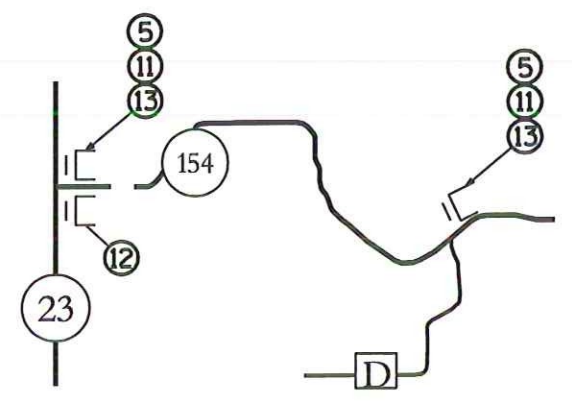

DETAIL 'A'

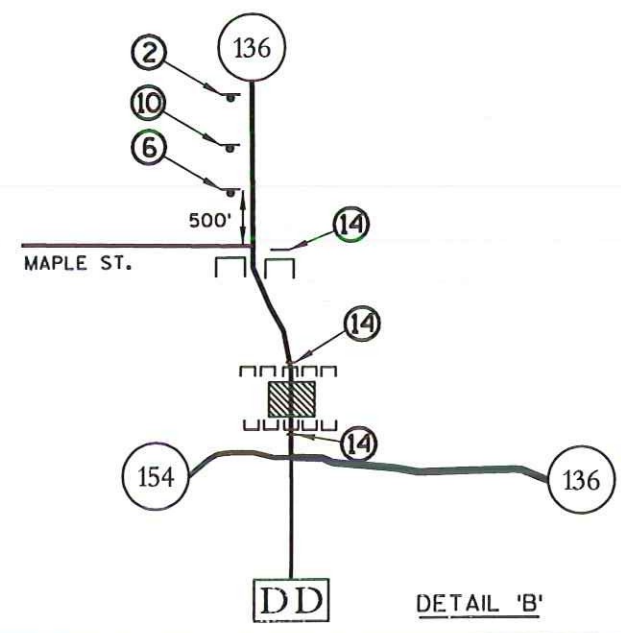

DETAIL 'B'

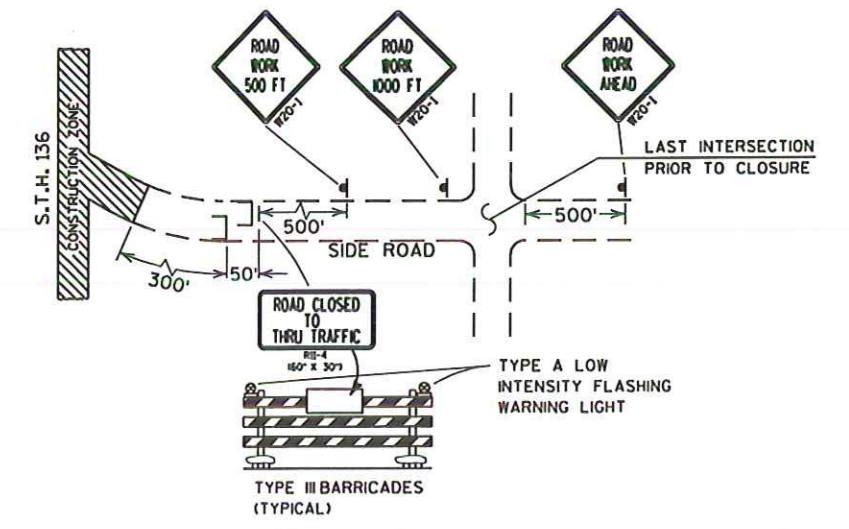

ONE TYPE III BARRICADES USED AT EACH INDICATED POSITION FOR SIDE ROAD CLOSURE.

DETAIL 4
SIDE ROAD CLOSURE

	
M1-4 24" X 24"	M06-1 21" X 21"
	
M1-6 24" X 24"	M05-1L 21" X 21"
	
JCT M 2-1 21" X 15"	M05-1R 21" X 21"
	
DETOUR M4-8 24" X 12"	M06-4 21" X 21"
	
BUSINESS M4-3 21" X 12"	M05-2R 21" X 21"
	
NORTH M3-1 24" X 12"	M06-2 21" X 21"
	
SOUTH M3-3 24" X 12"	M06-2 21" X 21"
	
EAST M3-2 24" X 12"	M06-1 21" X 21"
	
WEST M3-4 24" X 12"	M4-6 24" X 12"
	
M06-6 21" X 21"	END DETOUR M4-8A 24" X 18"
	
TO M4-5 24" X 12"	

GENERAL NOTES

THE EXACT NUMBER, LOCATION, AND SPACING OF ALL SIGNS AND DEVICES SHALL BE ADJUSTED TO FIT FIELD CONDITIONS.

ALL SIGNS ARE 48" X 48" UNLESS OTHERWISE NOTED.

"WO" IS THE SAME AS "W" EXCEPT THE BACKGROUND IS ORANGE.

ANY SIGN TEMPORARY OR EXISTING, WHICH CONFLICT WITH THE TRAFFIC CONTROL "IN USE" SHALL BE REMOVED OR COVERED AS NEEDED.

ANY "STOP" SIGNS WHICH ARE REMOVED FOR A CONSTRUCTION OPERATION SHALL BE IMMEDIATELY RE-ESTABLISHED.

ALL EXISTING SIGNS THAT NEED TO BE COVERED SHALL BE COVERED WITH A BLANK ORANGE PANEL

ALL M3 SERIES SIGNS (NORTH, SOUTH, EAST, WEST) WHICH ARE PART OF ANY DETOUR ROUTE MARKER SIGNING ASSEMBLY OR ATTACHED TO ANY WARNING SIGN SHALL BE BLACK LETTERING ON A WHITE BACKGROUND.

ALL M05 AND M06 ARROW SIGNS SHALL BE THE SAME AS "M" SIGNS EXCEPT THAT THE BACKGROUND IS ORANGE.

LEGEND

	SIGN ON POST		EXISTING SIGN
	DETOUR ROUTE FOR S.T.H. 136		ADDITIONAL SIGN
	COVERING SIGNS WITH BLANK ORANGE PANEL		
	WORK ZONE		

Reedsburg

Rock Springs

North Freedom

W. Baraboo

