



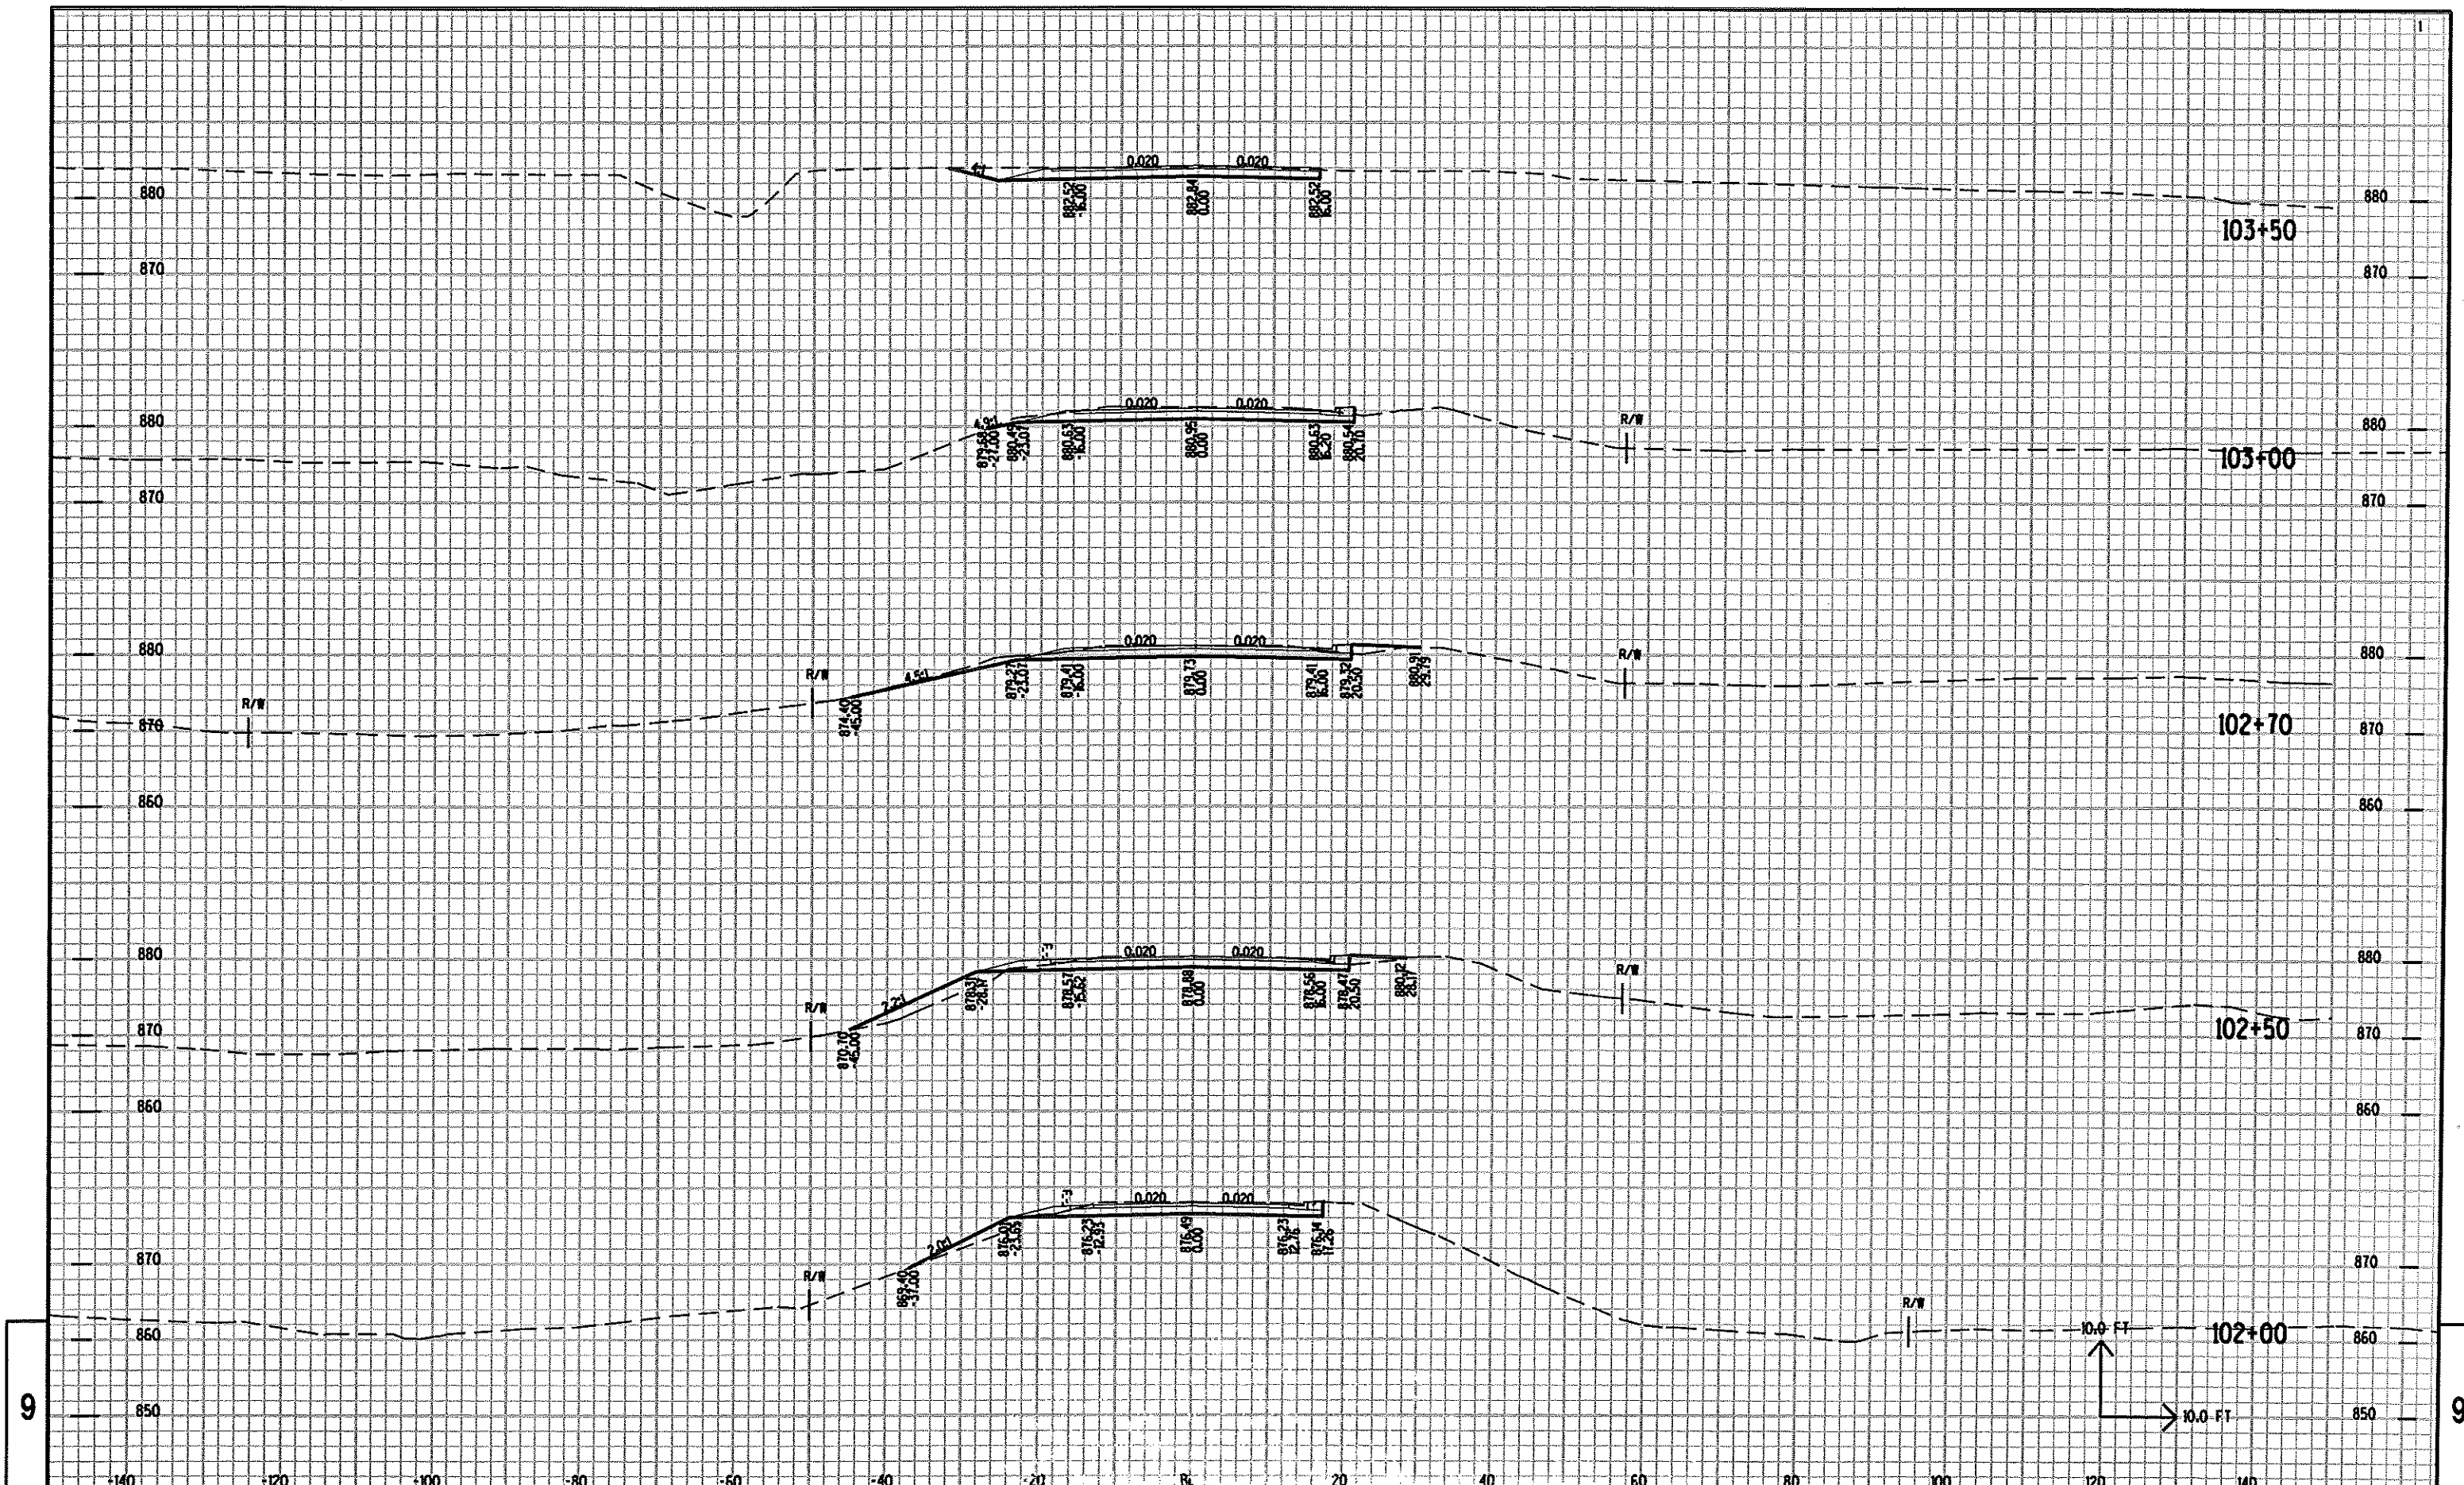

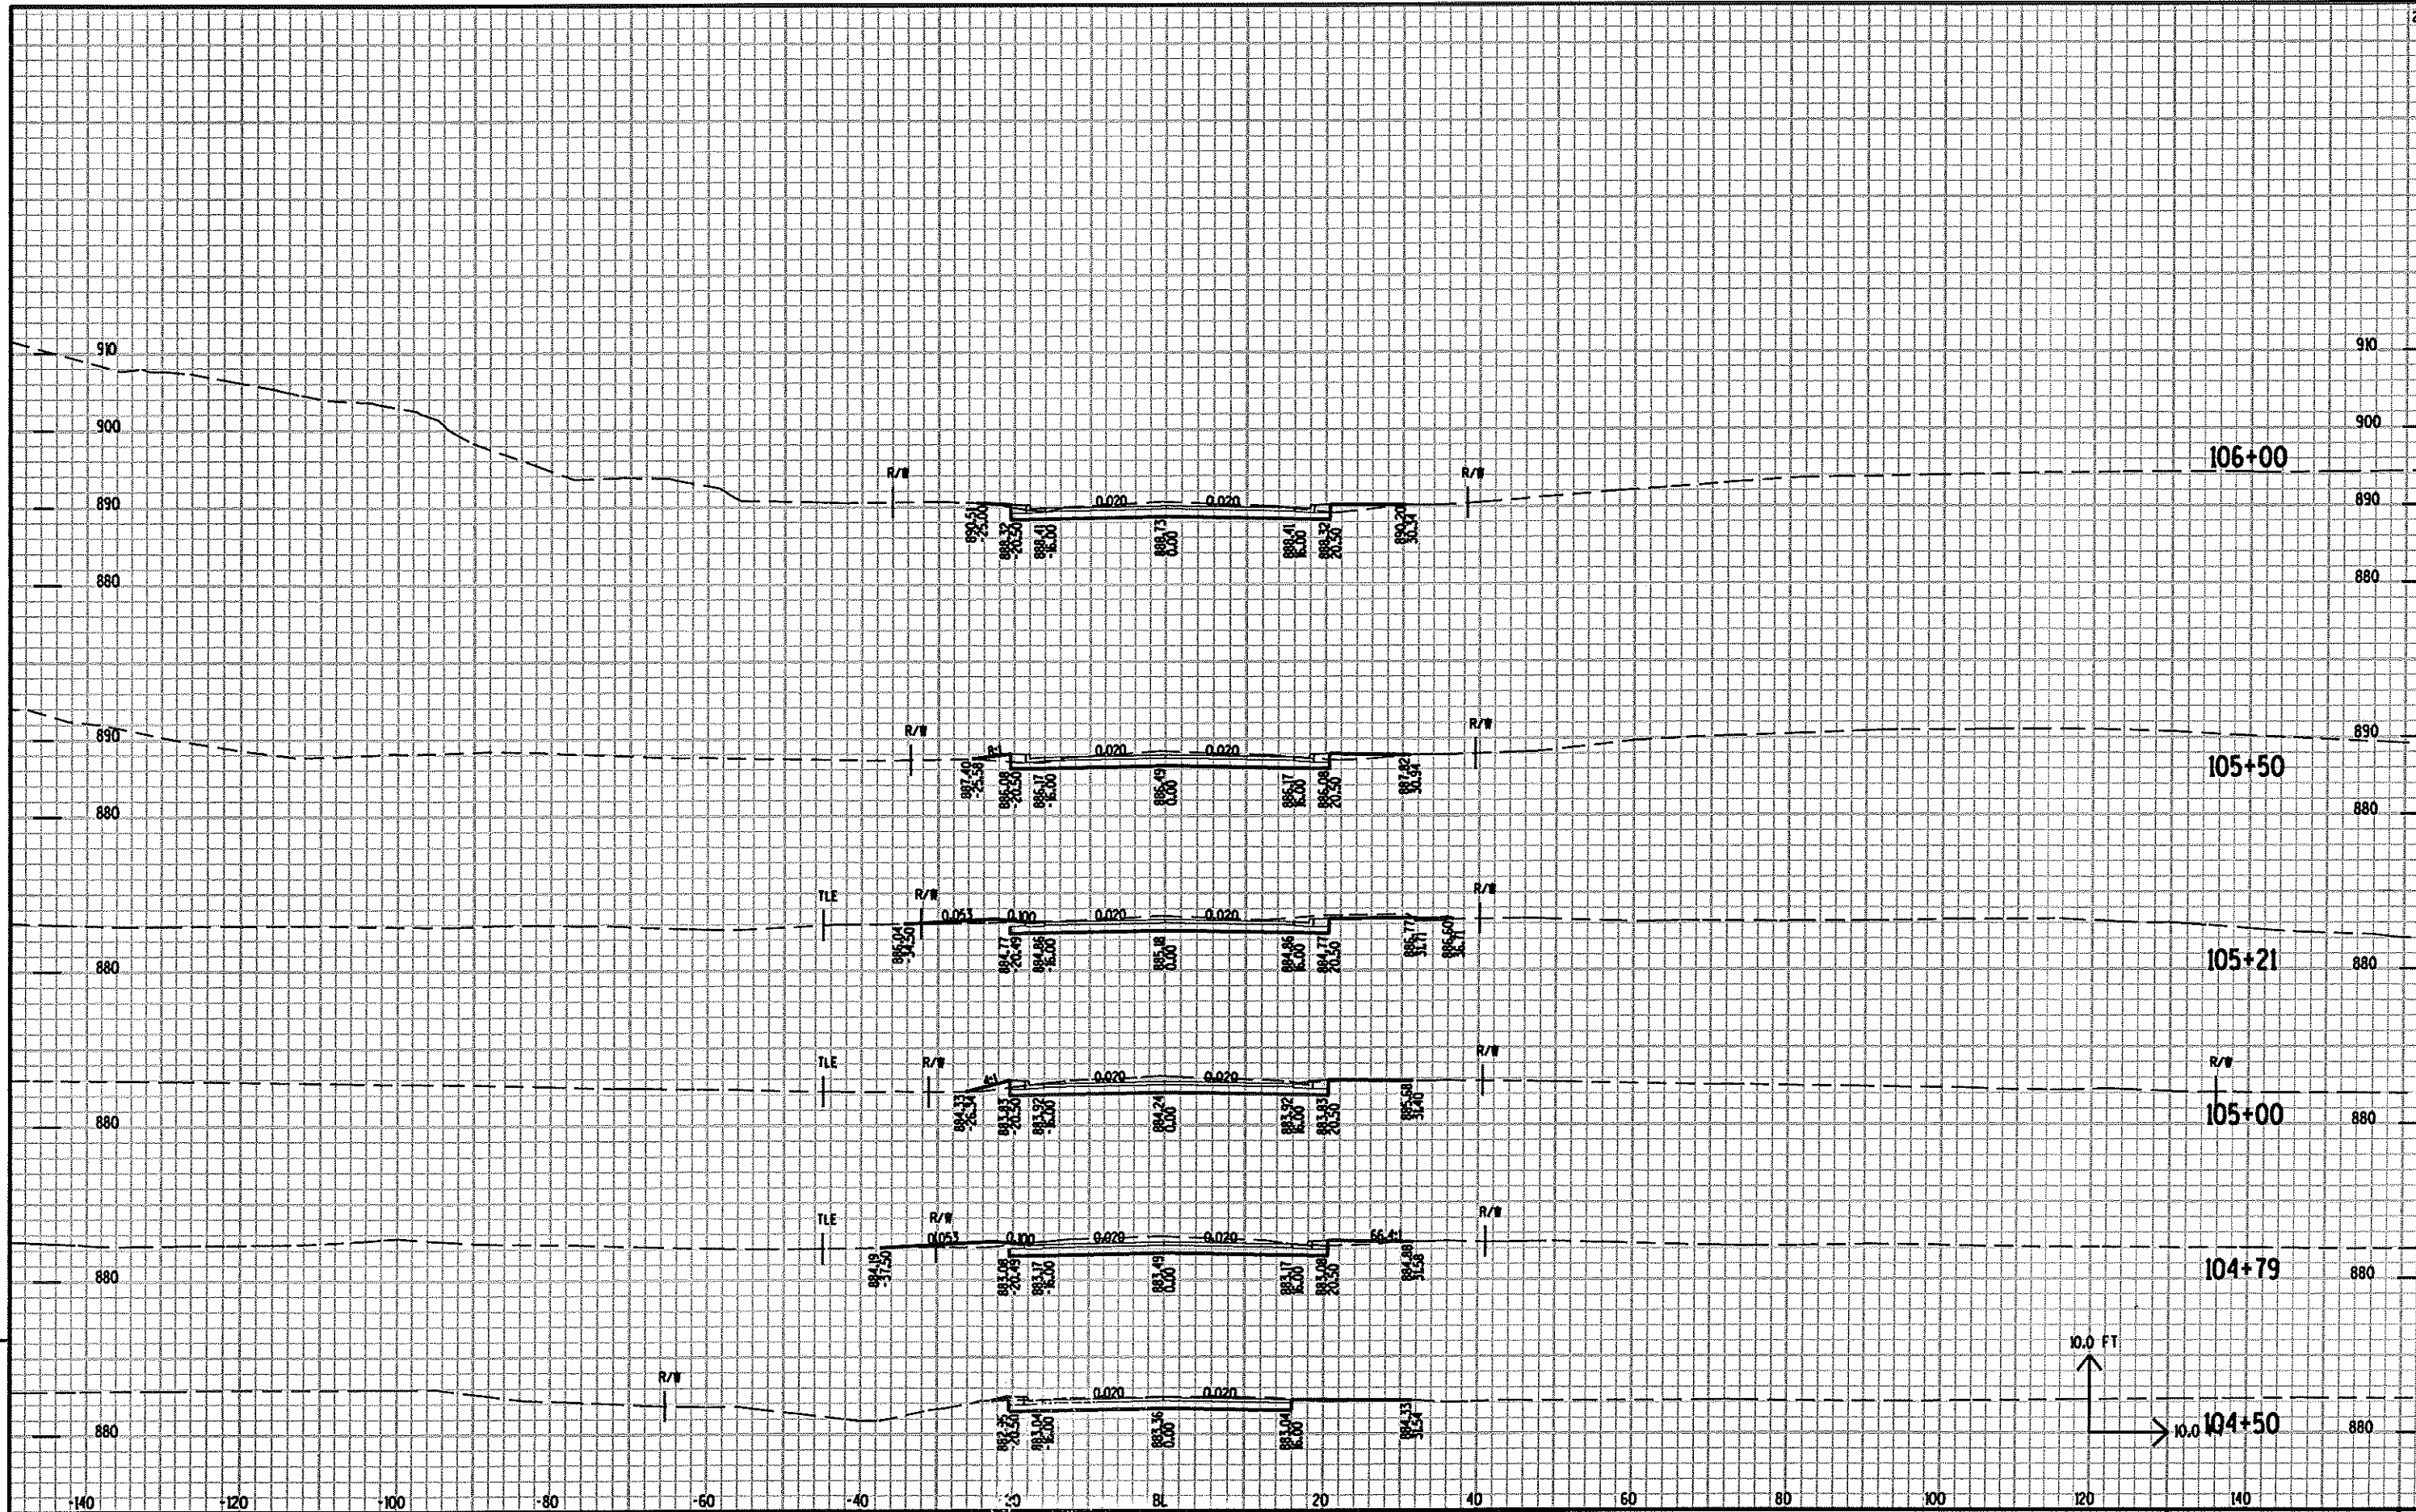

PROJECT NO: 5573-04-72

HWY: STH136

COUNTY: SAILK

STH 136 MAINLINE

SHEET NO: 201

E

FILE NAME : r:\Support\CAD\OS\Projects\vd1.55730401\090201.xs.dgn


PLOT DATE : 12-11-2007 07:11


PLOT BY : dotbbg

PLOT NAME :

PLOT SCALE : 2.000000:1.000000

201

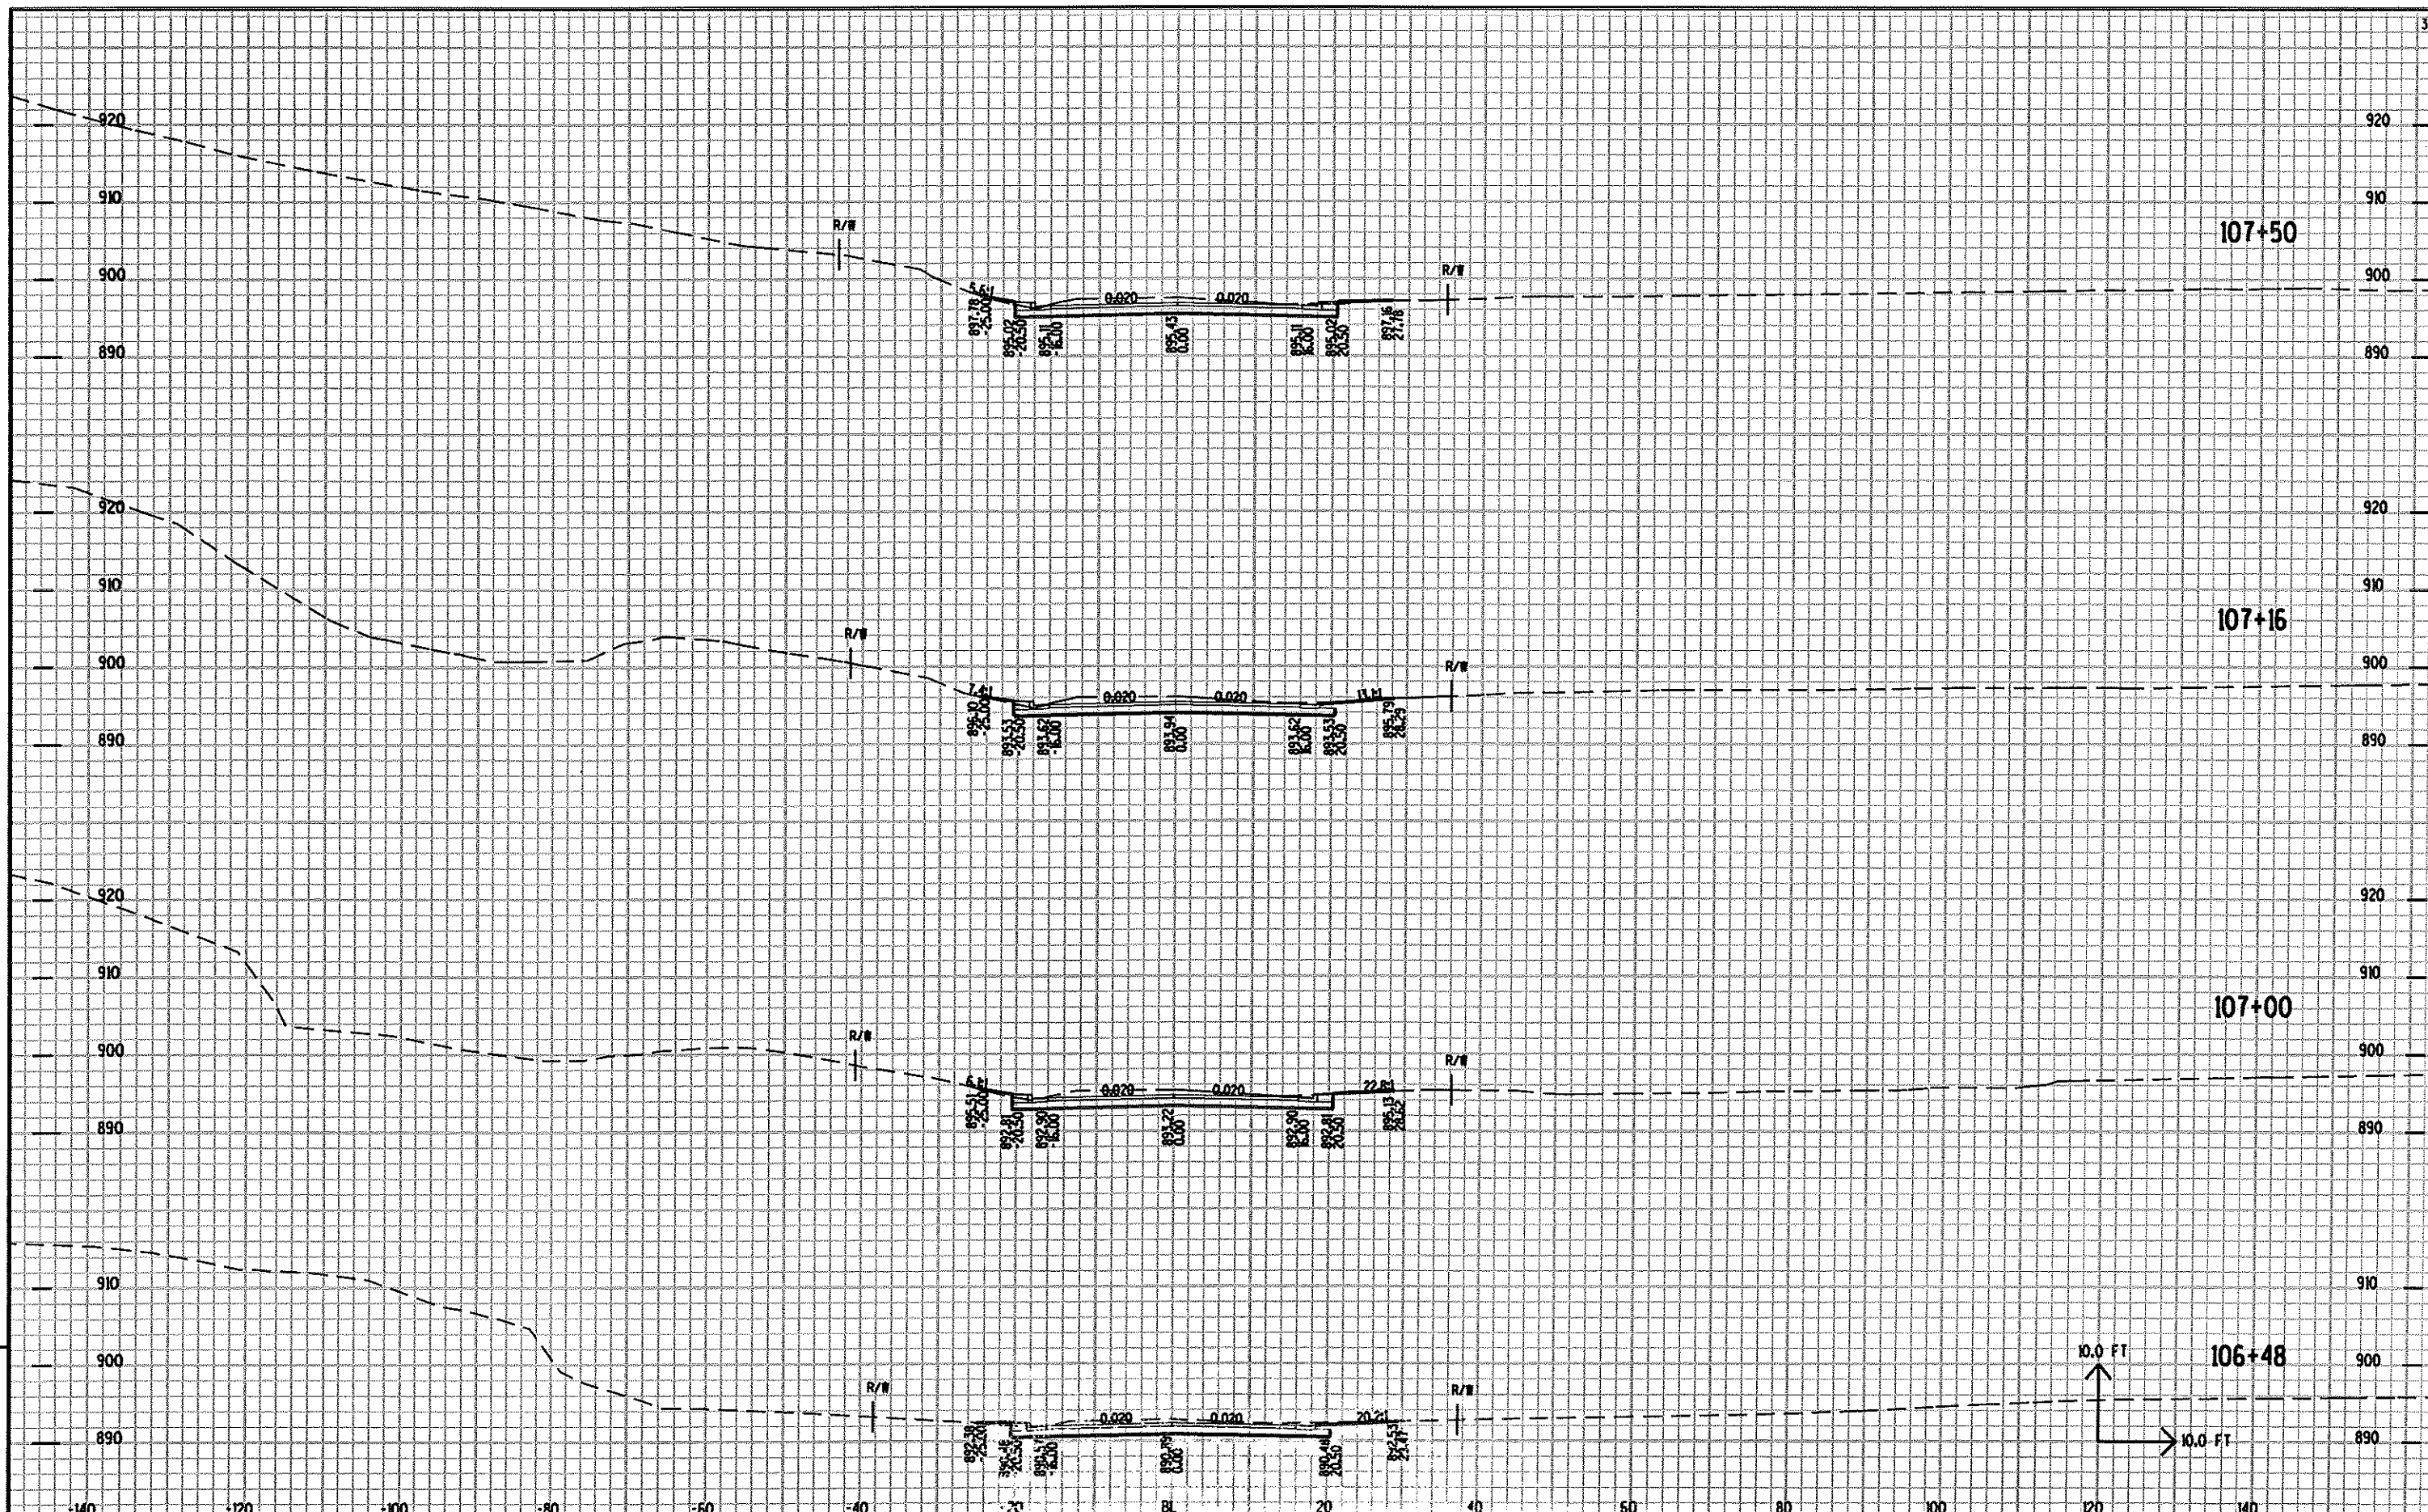

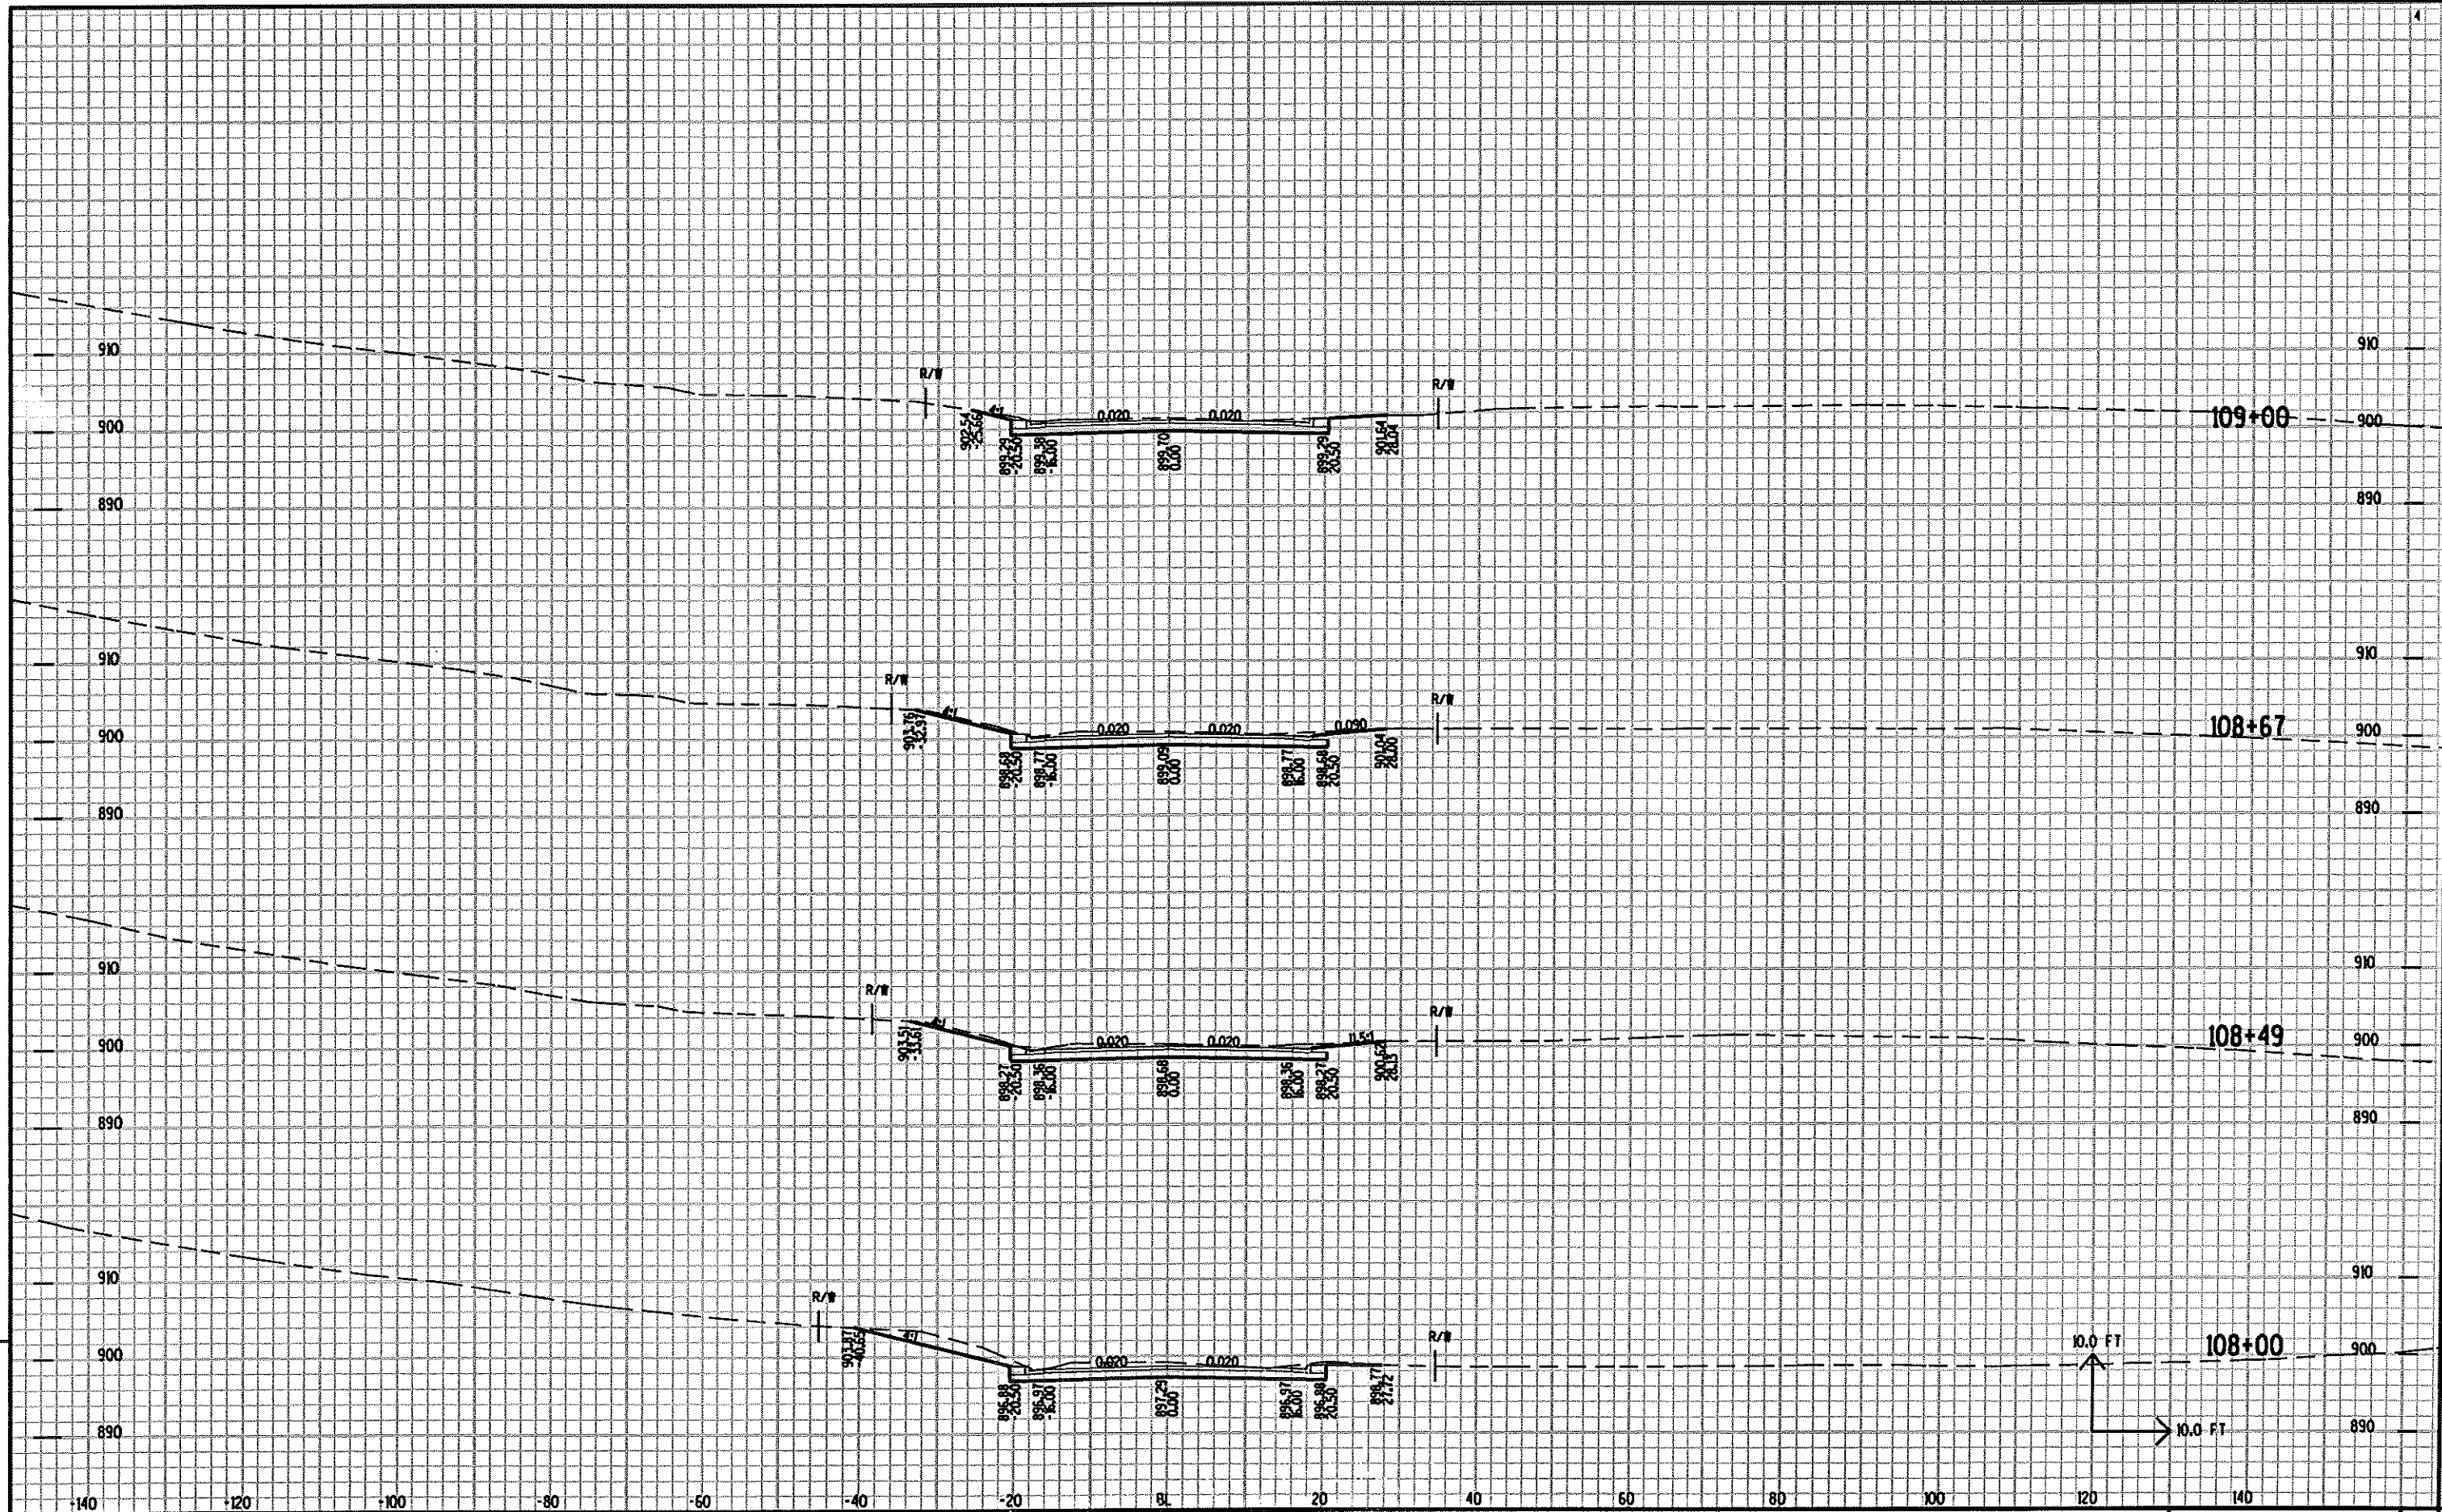

PROJECT NO: 5573-04-72

HWY: STH136

COUNTY: SAUK

STH 136 MAINLINE

SHEET NO:

203

E


FILE NAME : r:\Support\CADSVProjects\vol.55730401\090201.xs.dgn

PLOT DATE : 12 JUL 2007 07:11


PLOT BY : dotbbg

PLOT NAME :

PLOT SCALE : 2.000000:1.000000

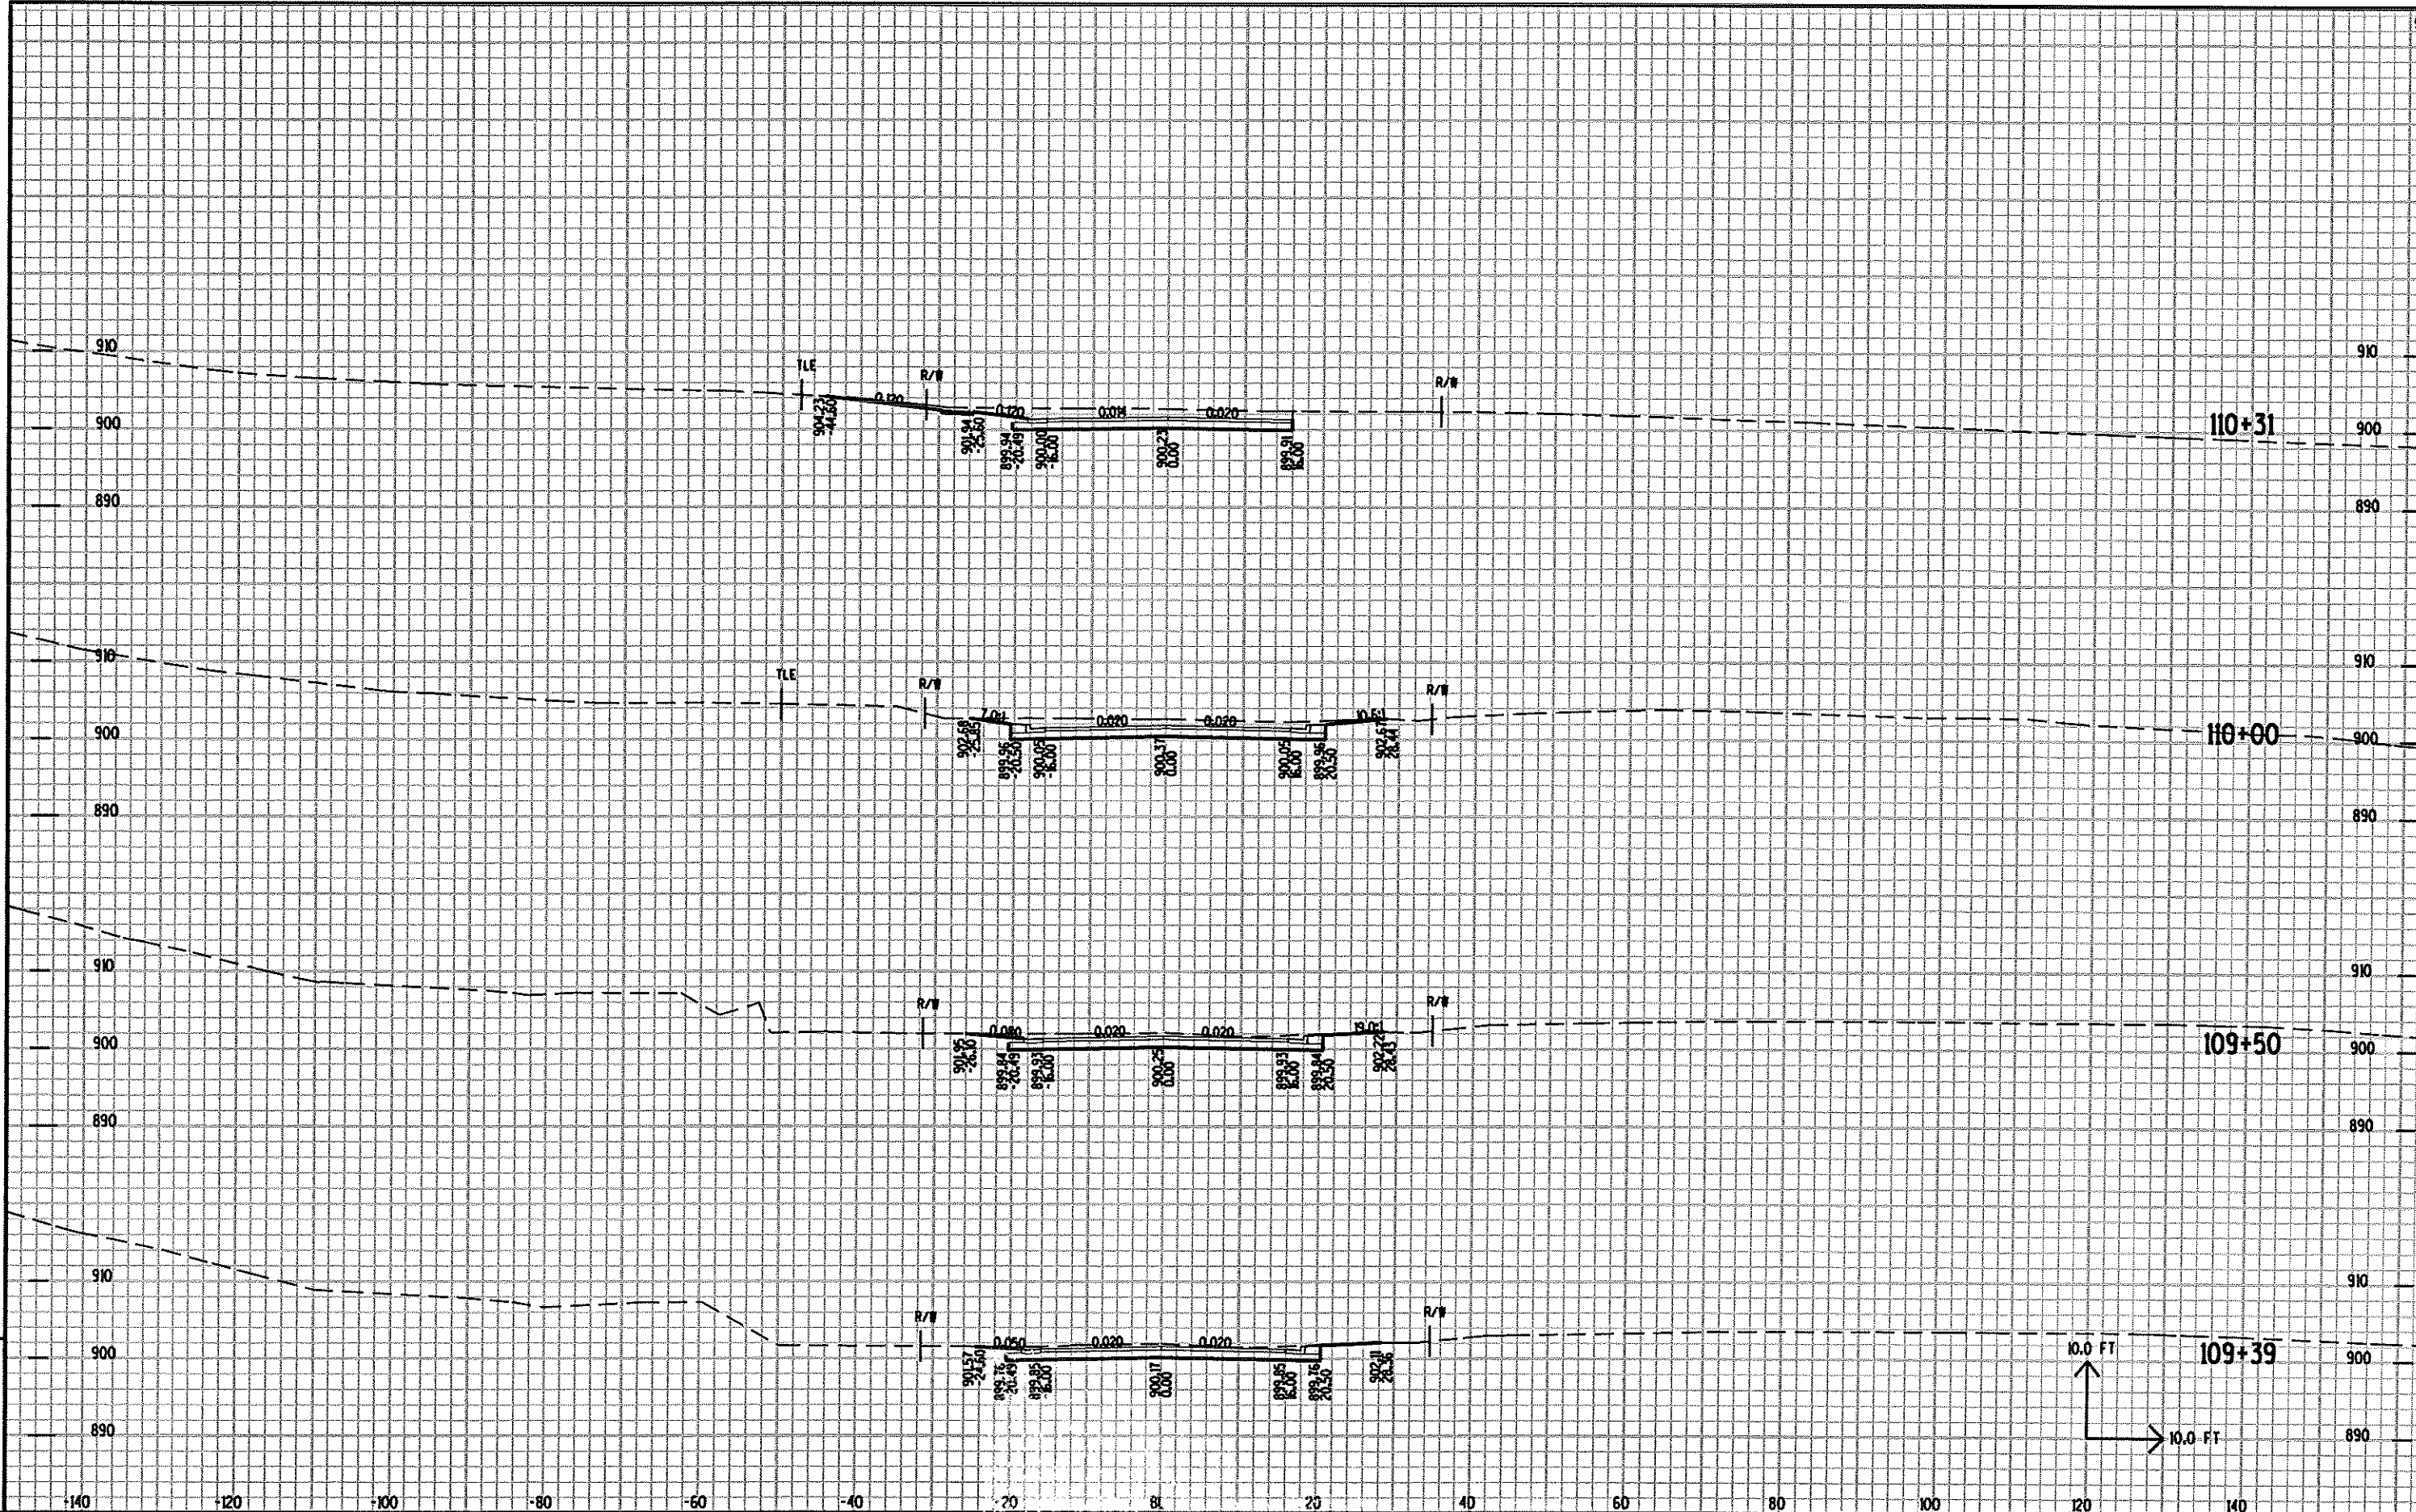



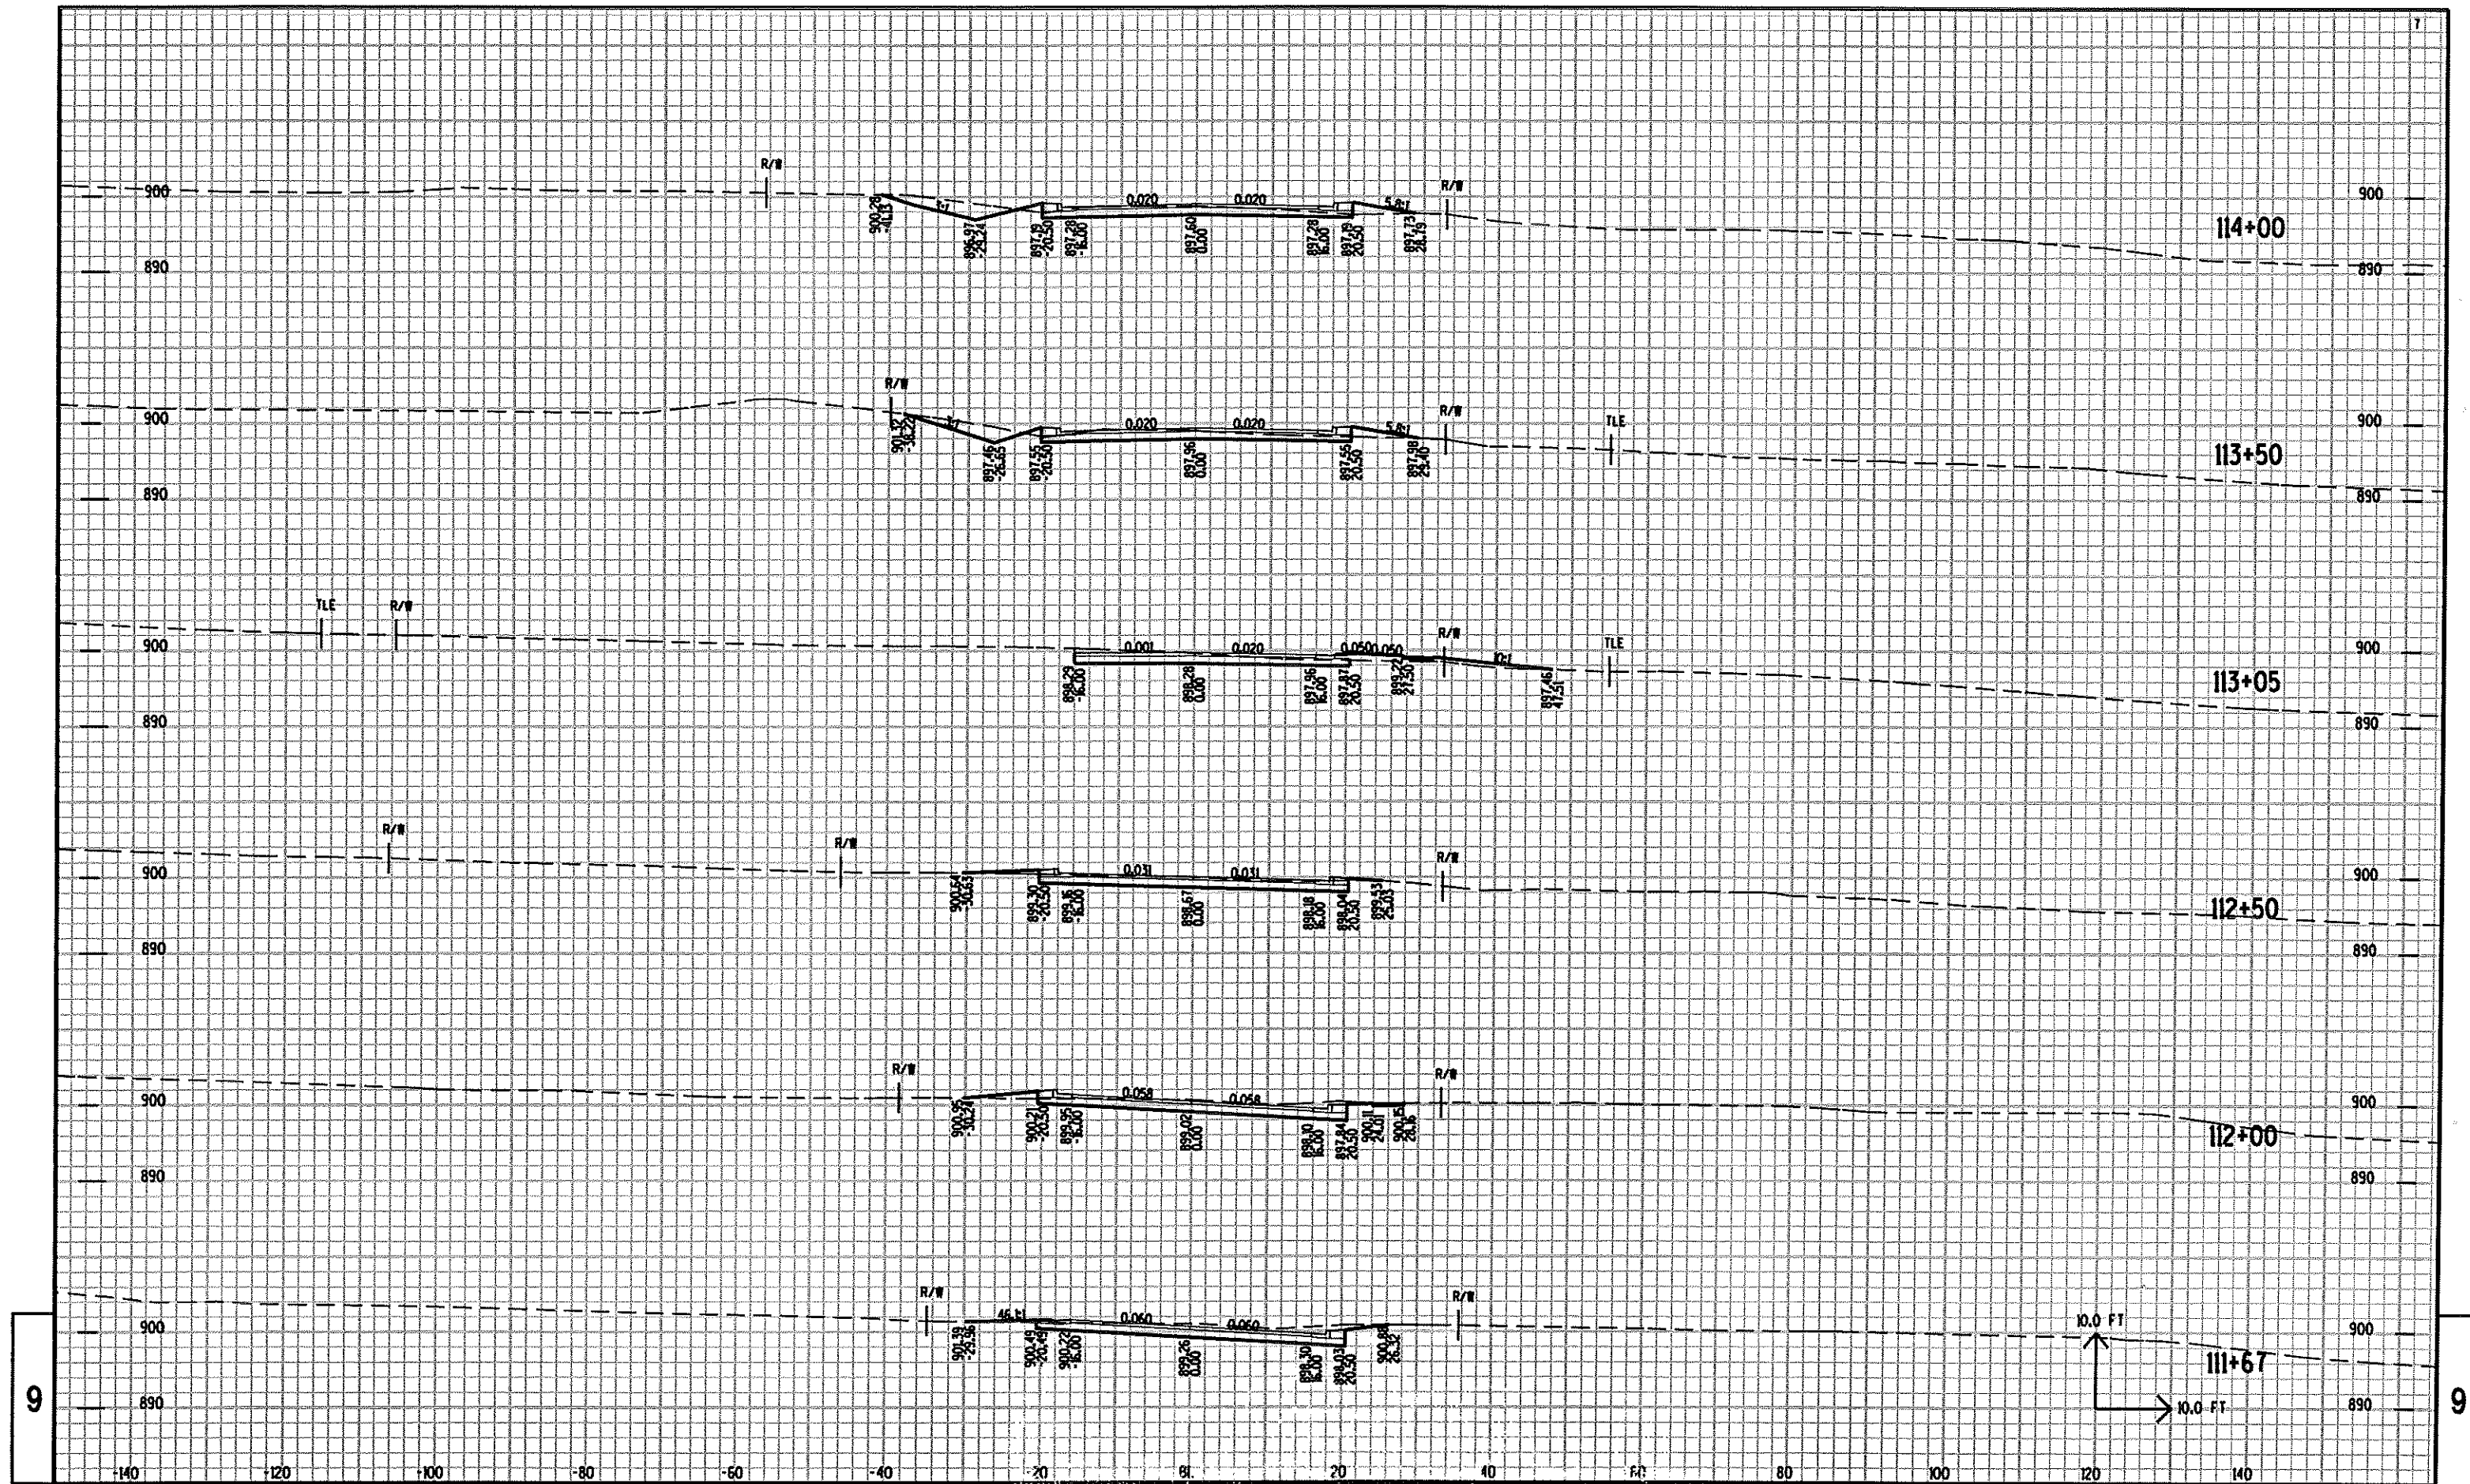

PROJECT NO: 5573-04-72

HWY: STH136

COUNTY: SAUK

STH 136 MAINLINE

SHEET NO:

206

E


FILE NAME : r:\Support\CAADSW\Projects\dl_55730401\090201_xs.DGN


PLOT DATE : 12-JUL-2007 07:12


PLOT BY : dotbag


PLOT NAME :


PLOT SCALE : 2.000000:1.000000

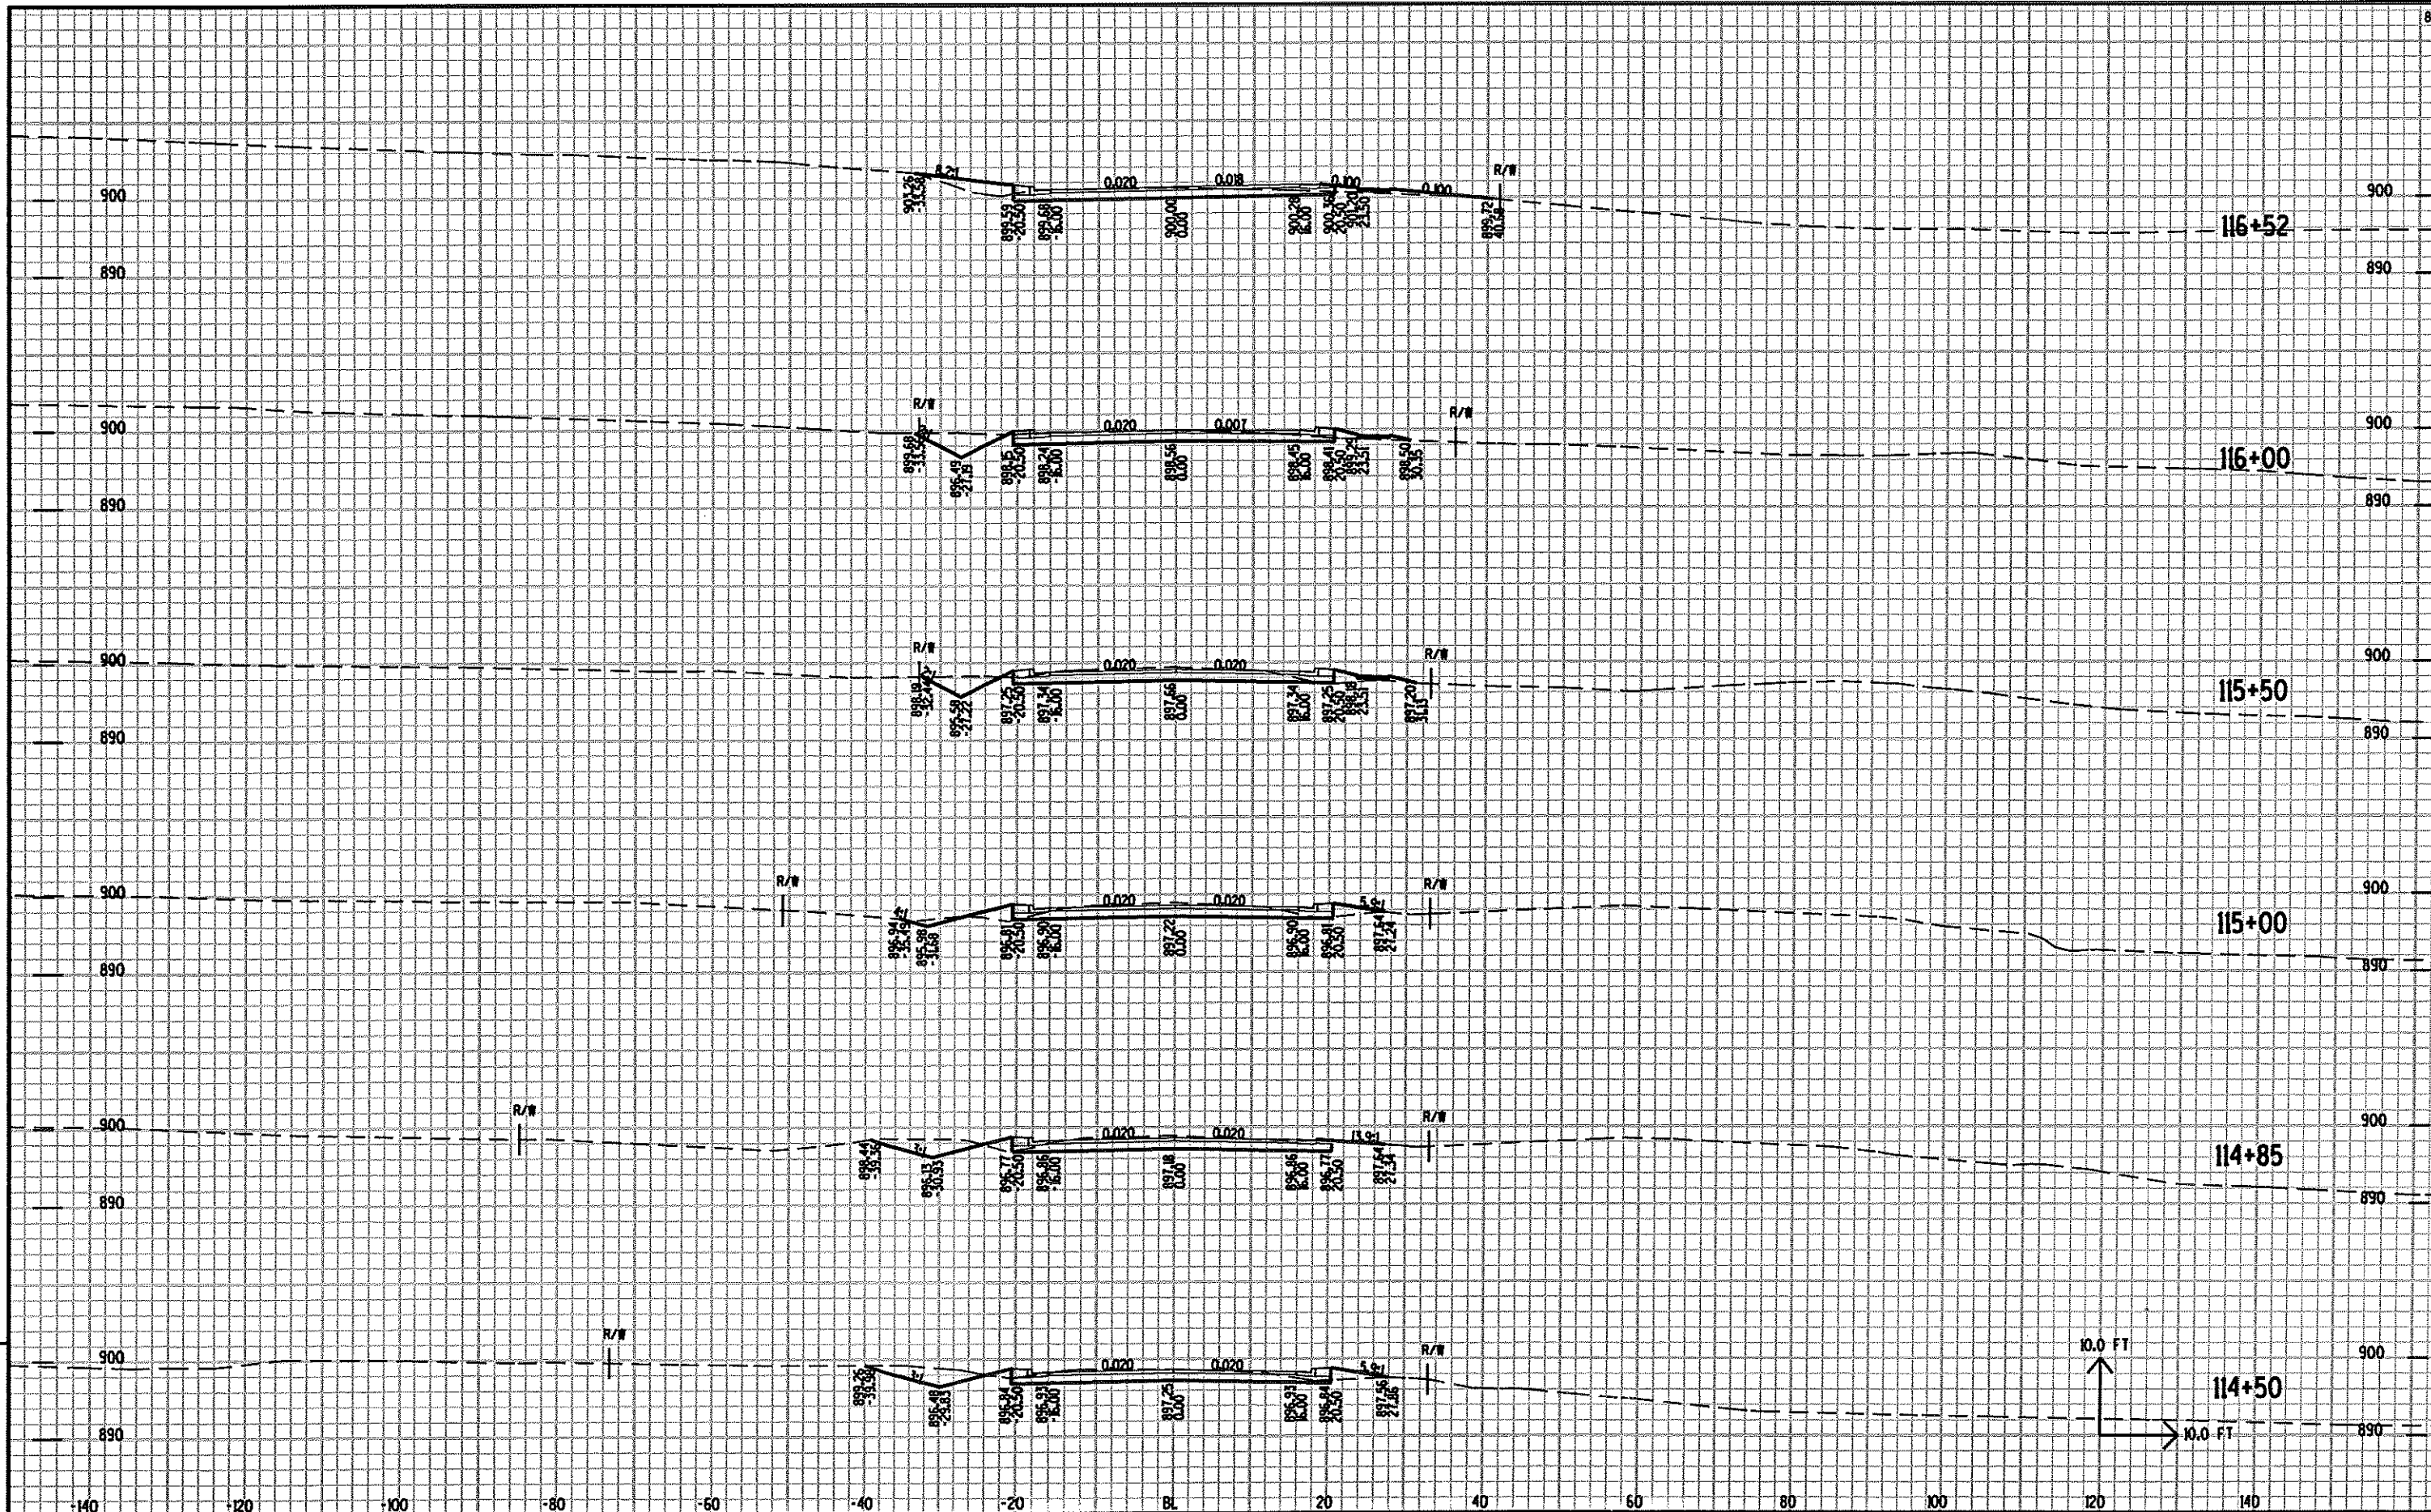

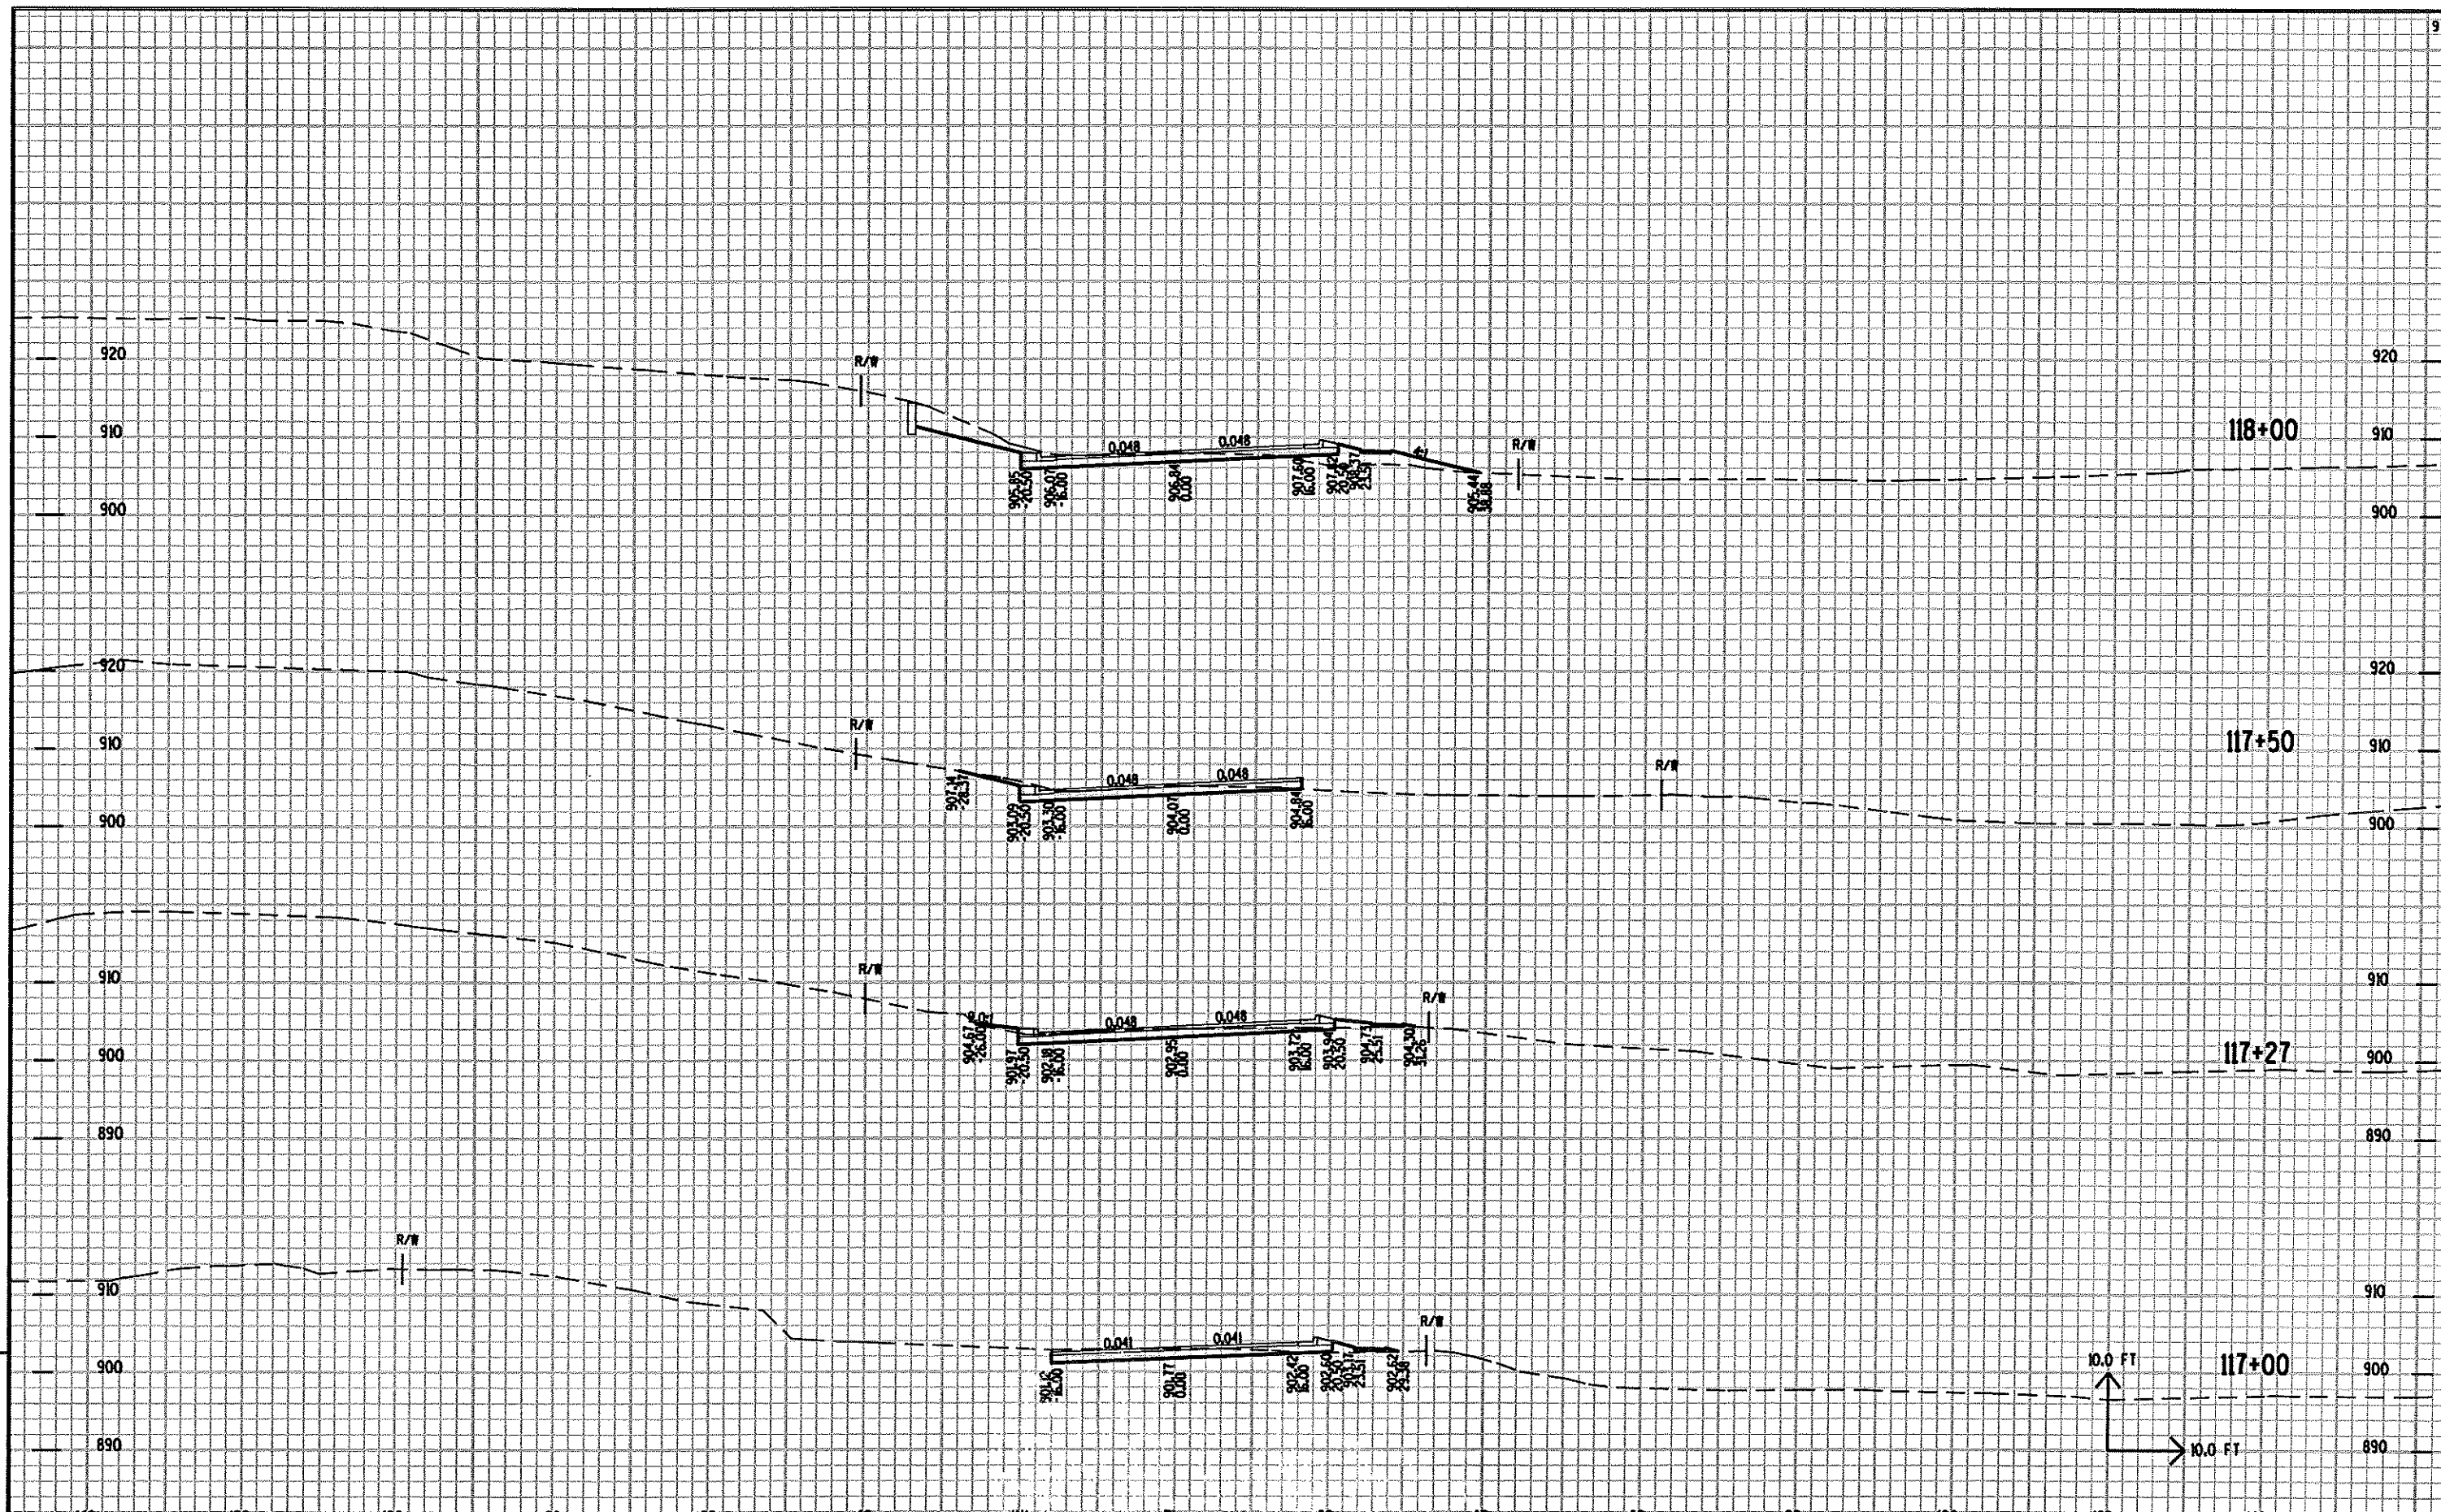

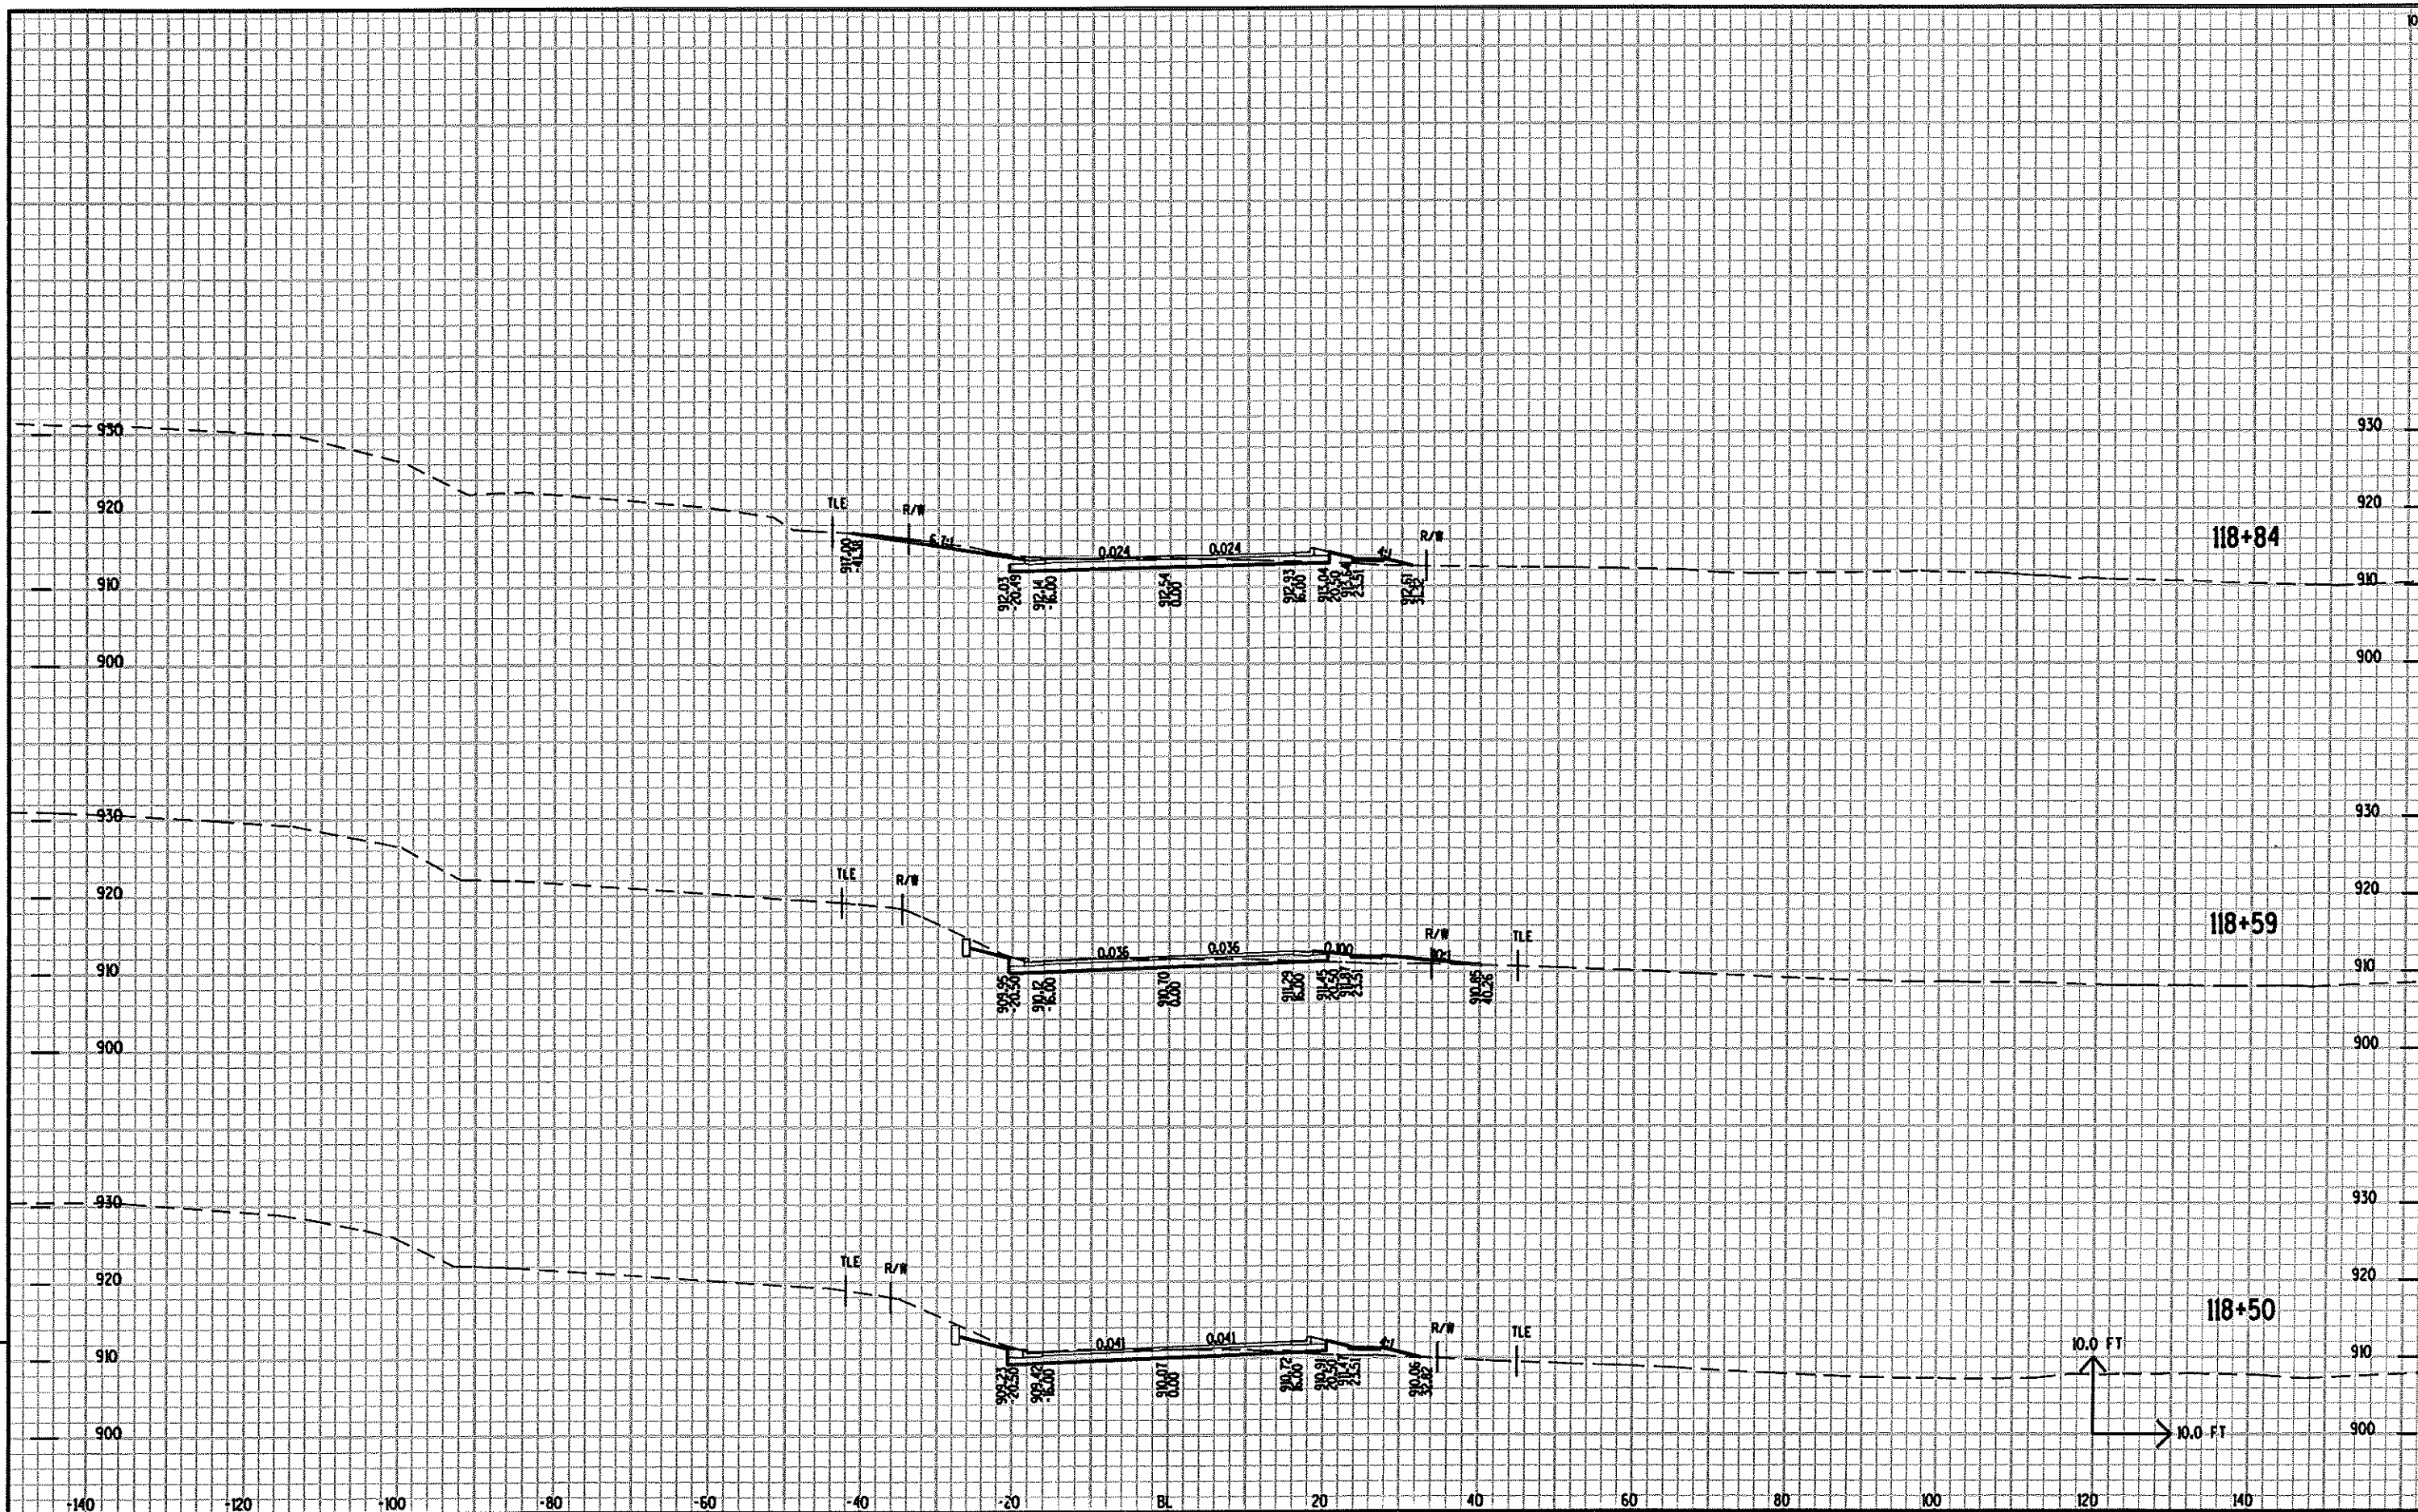

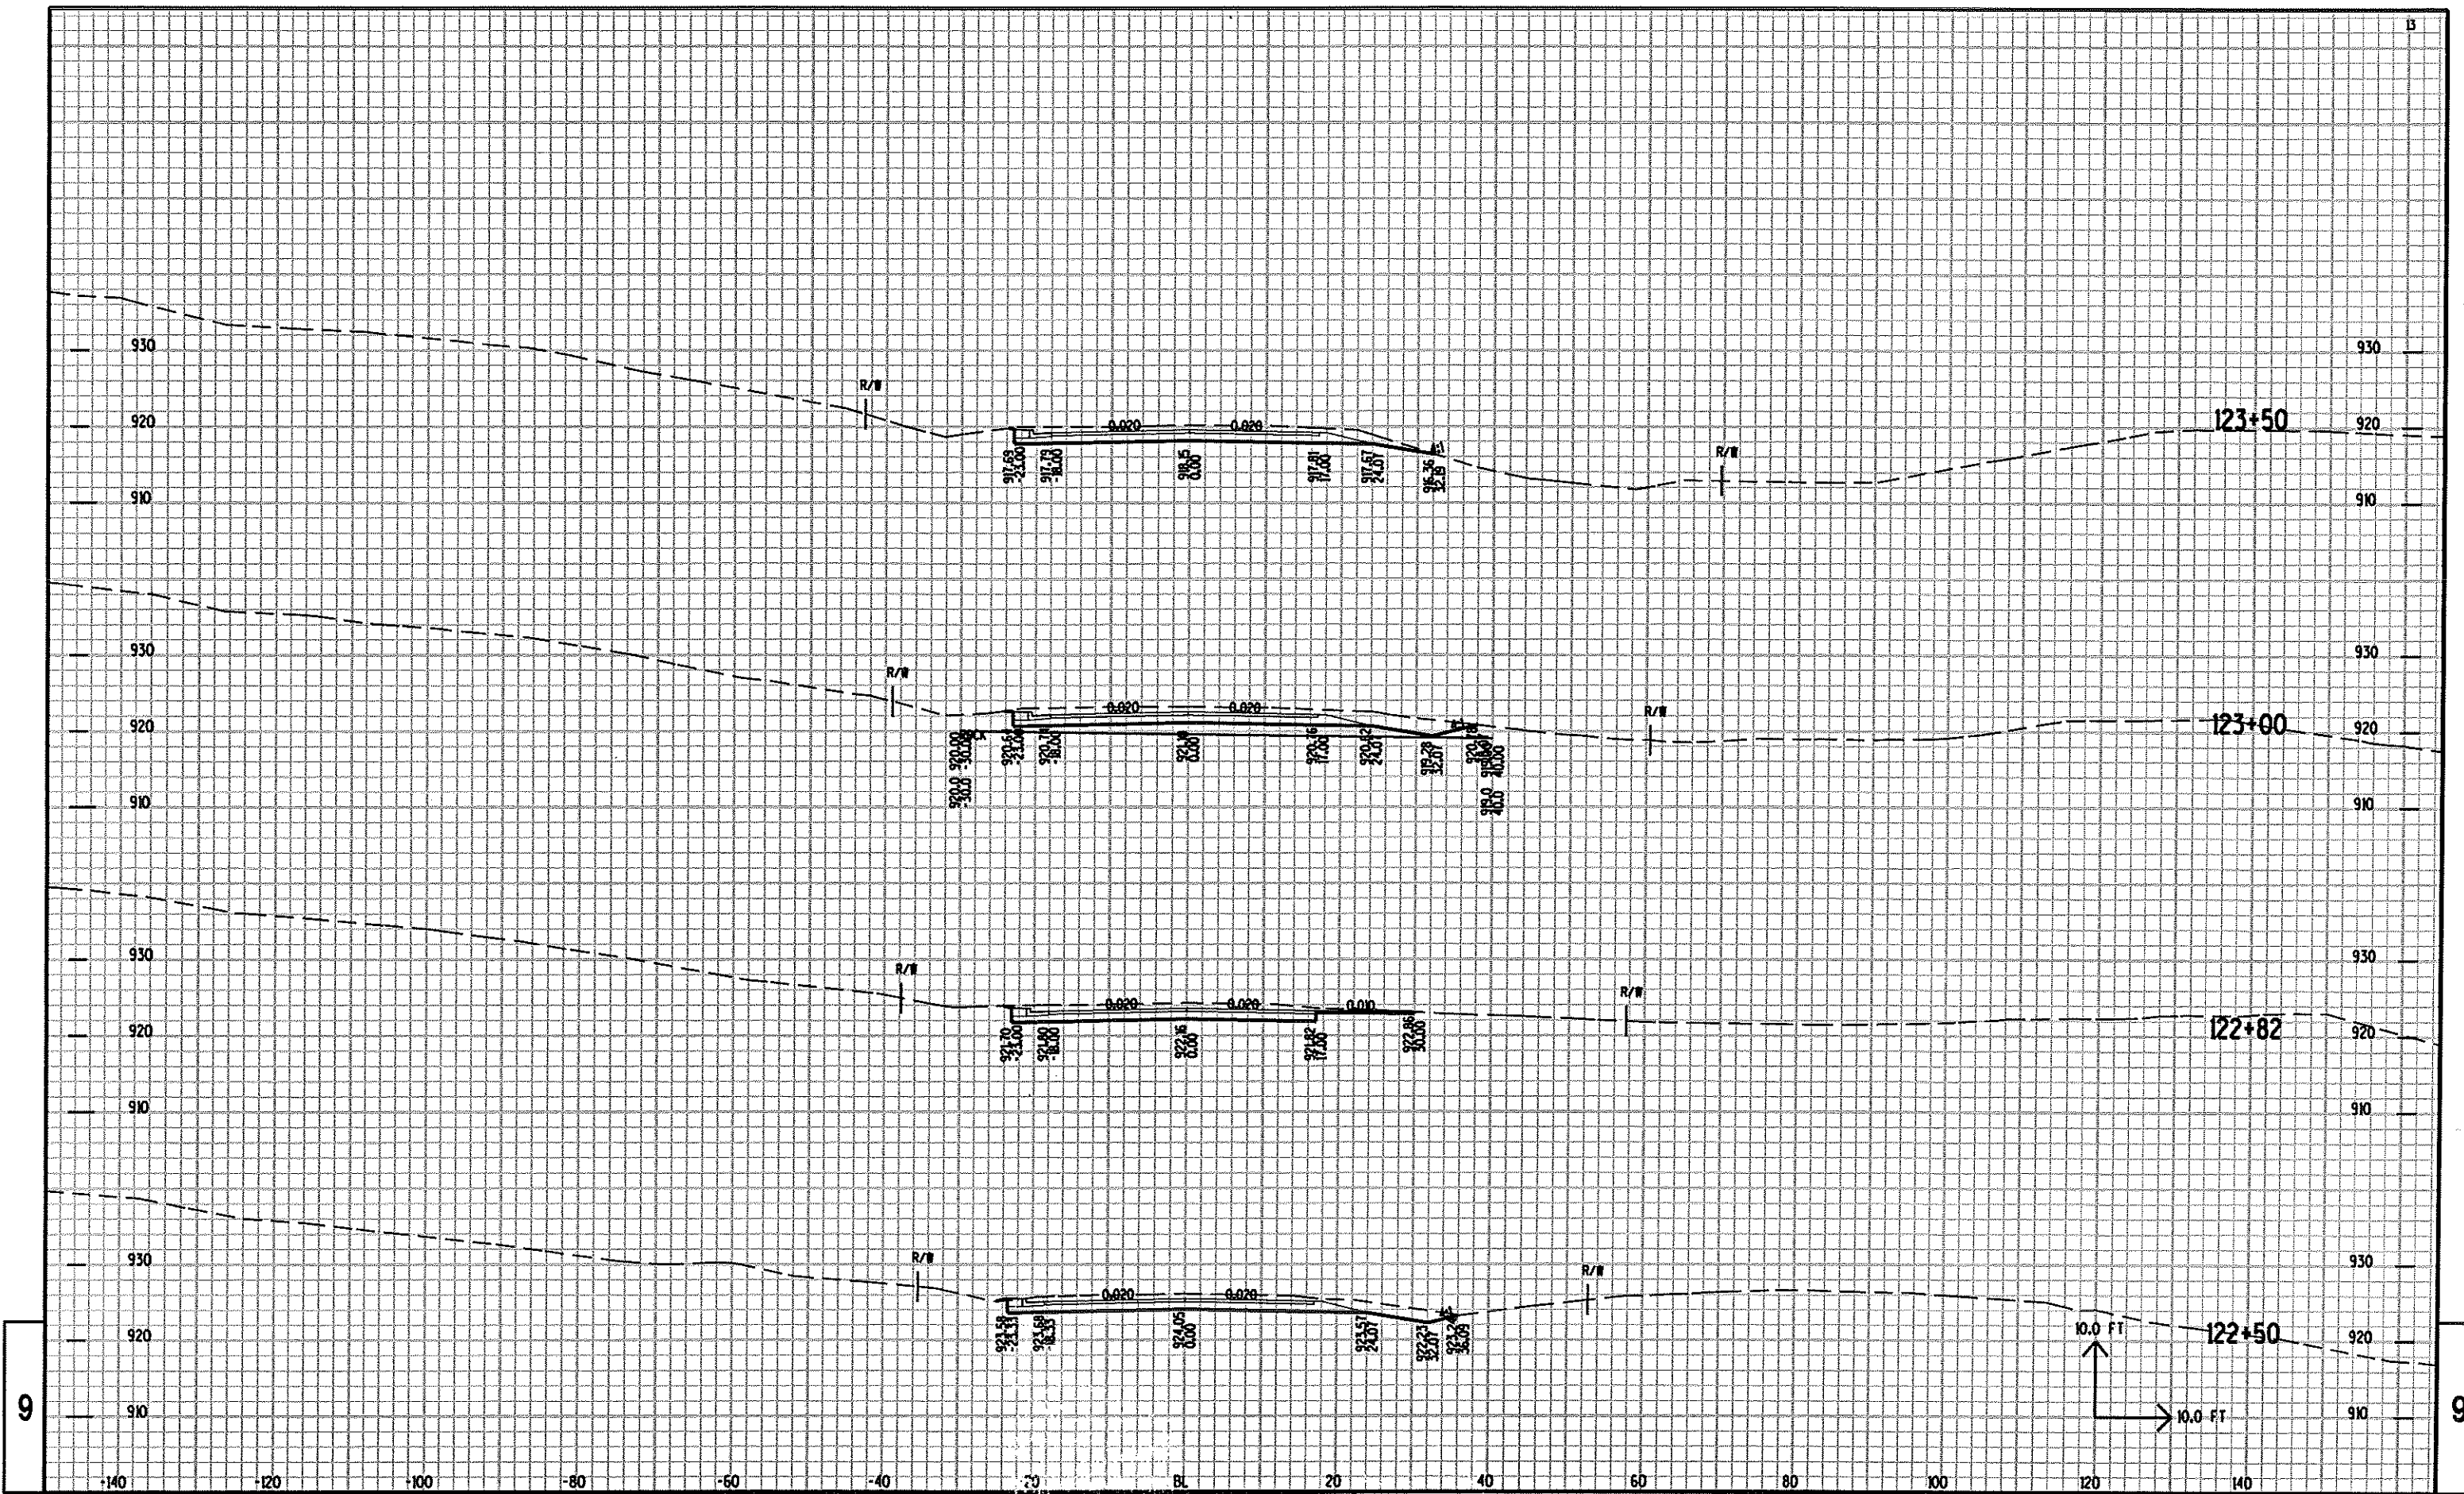

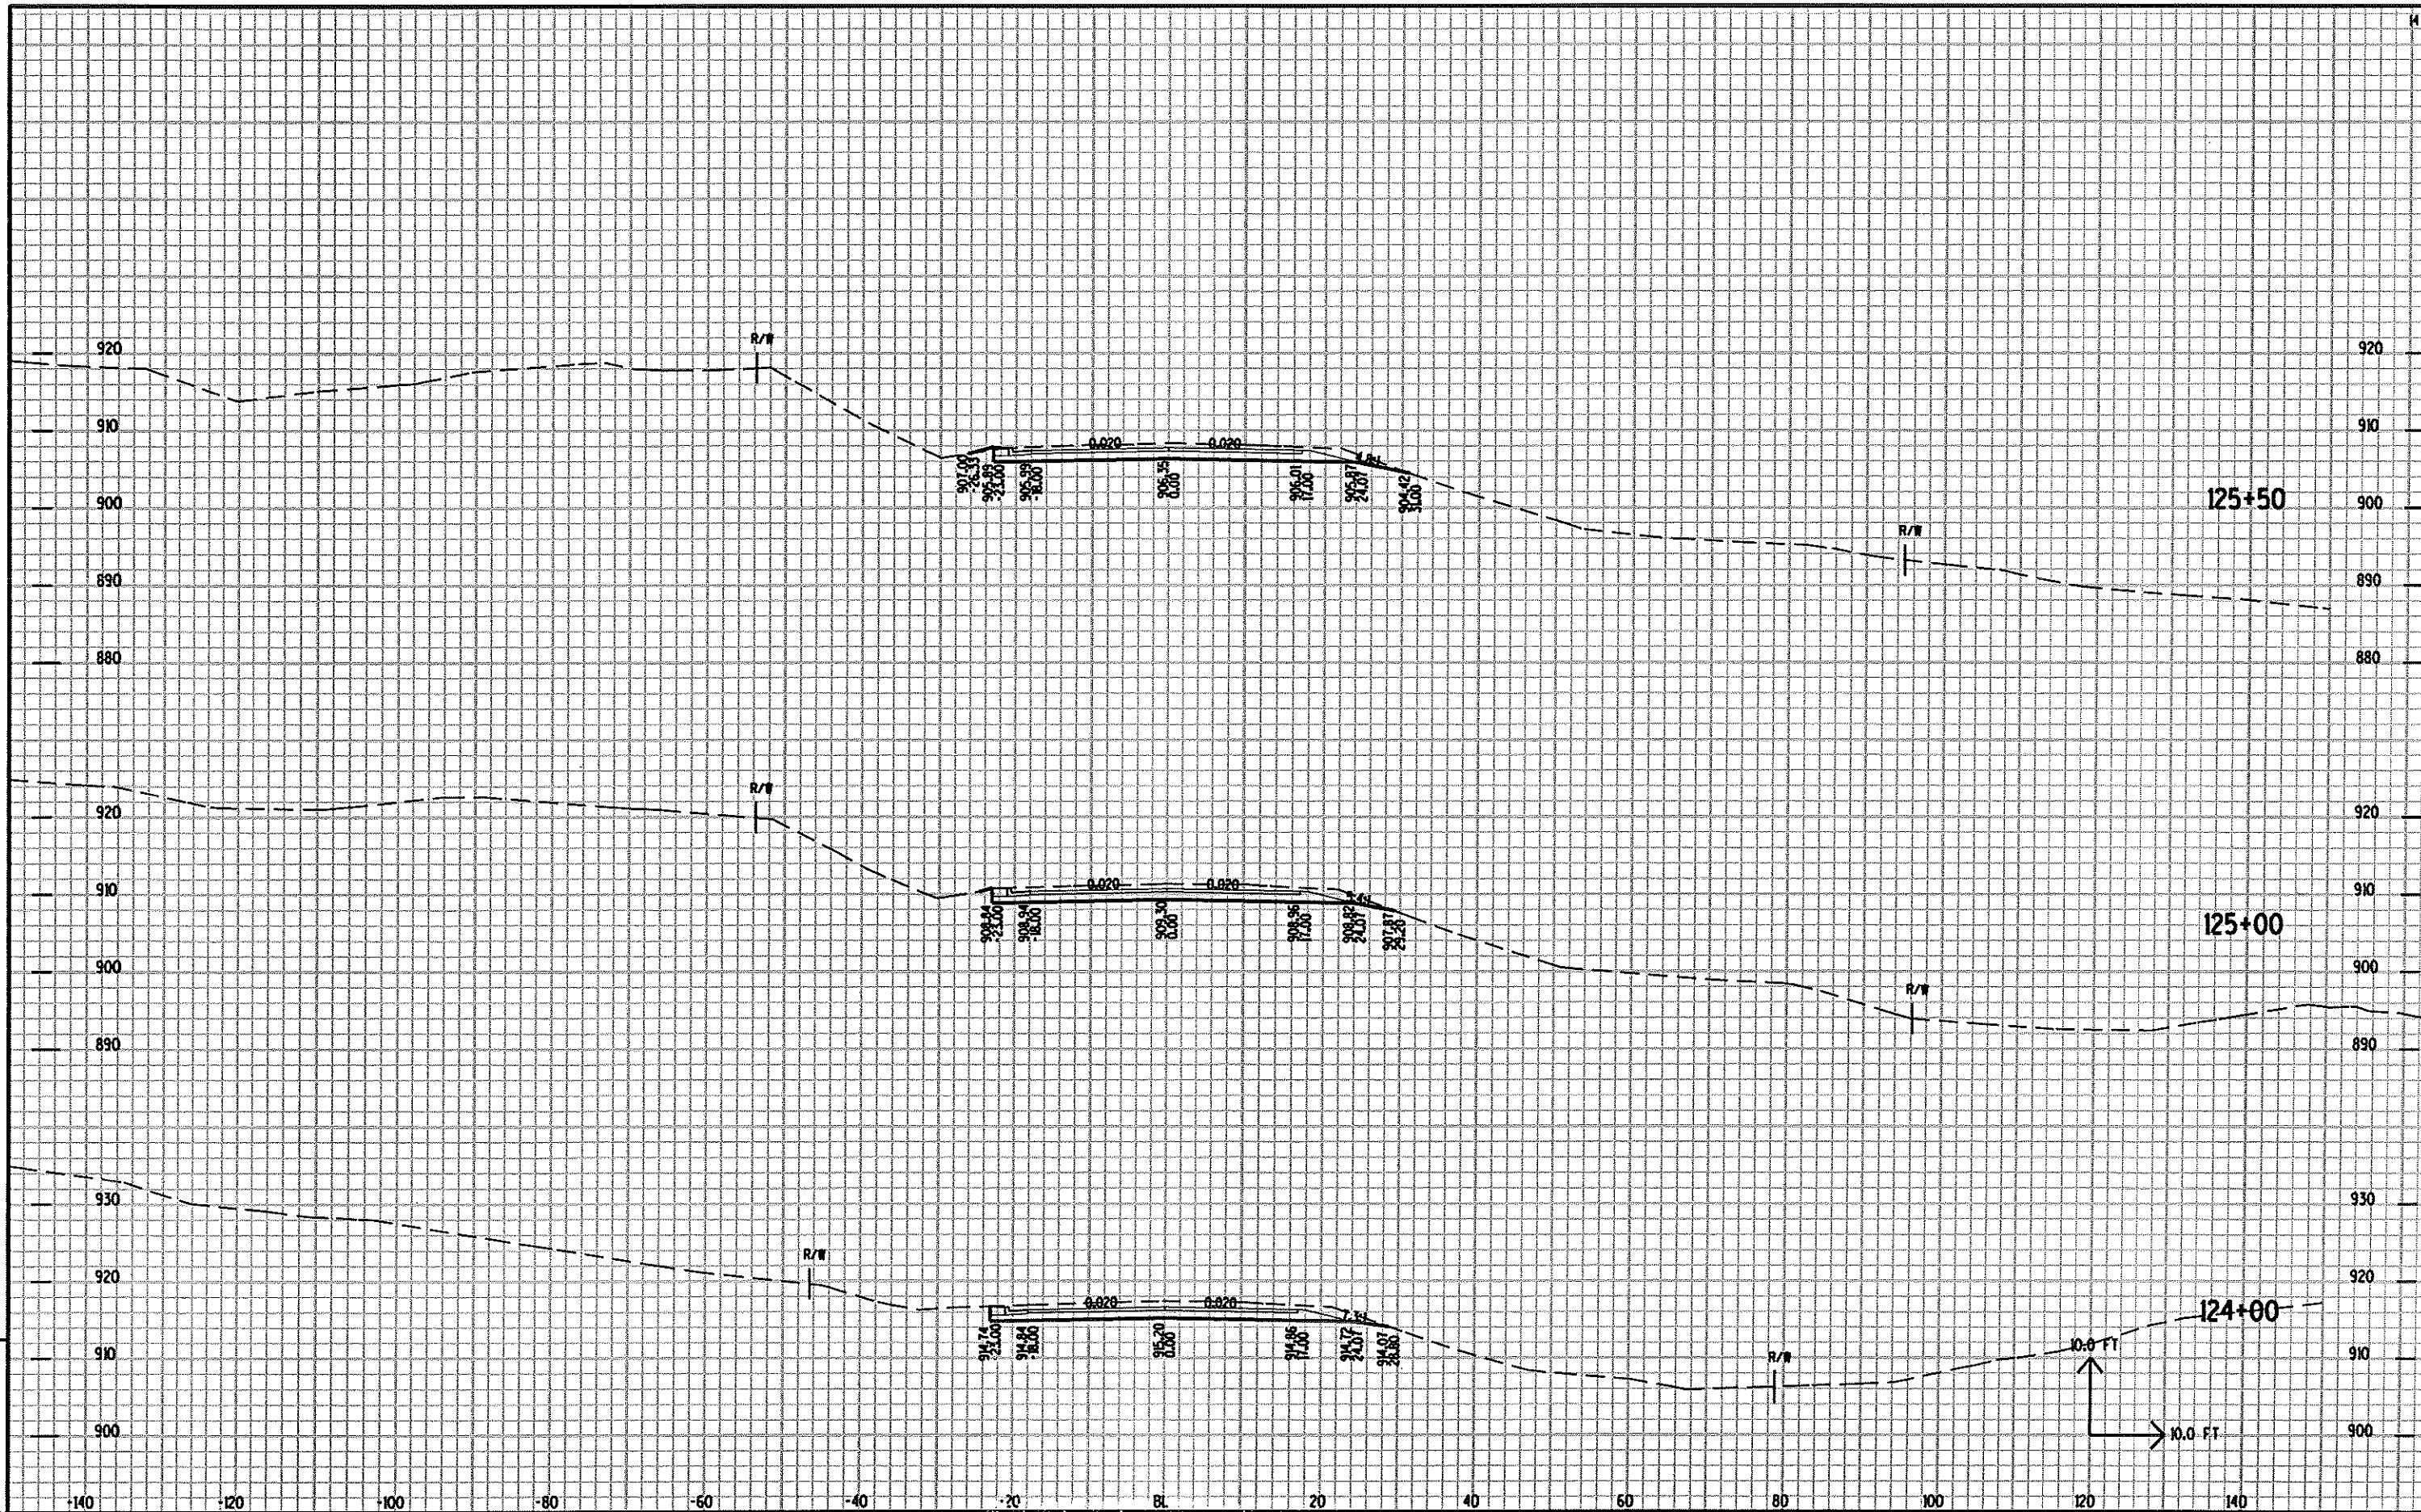

PROJECT NO: 5573-04-72

HWY: STH136

COUNTY: SALUK

STH 136 MAINLINE

SHEET NO:

213

FILE NAME : r:\Support\CA005\Projects\dl_55730401\090201_xs.dgn


PLOT DATE : 12-Jul-2007 07:13


PLOT BY : dotbbg

PLOT NAME :


PLOT SCALE : 2.000000:1.000000


E

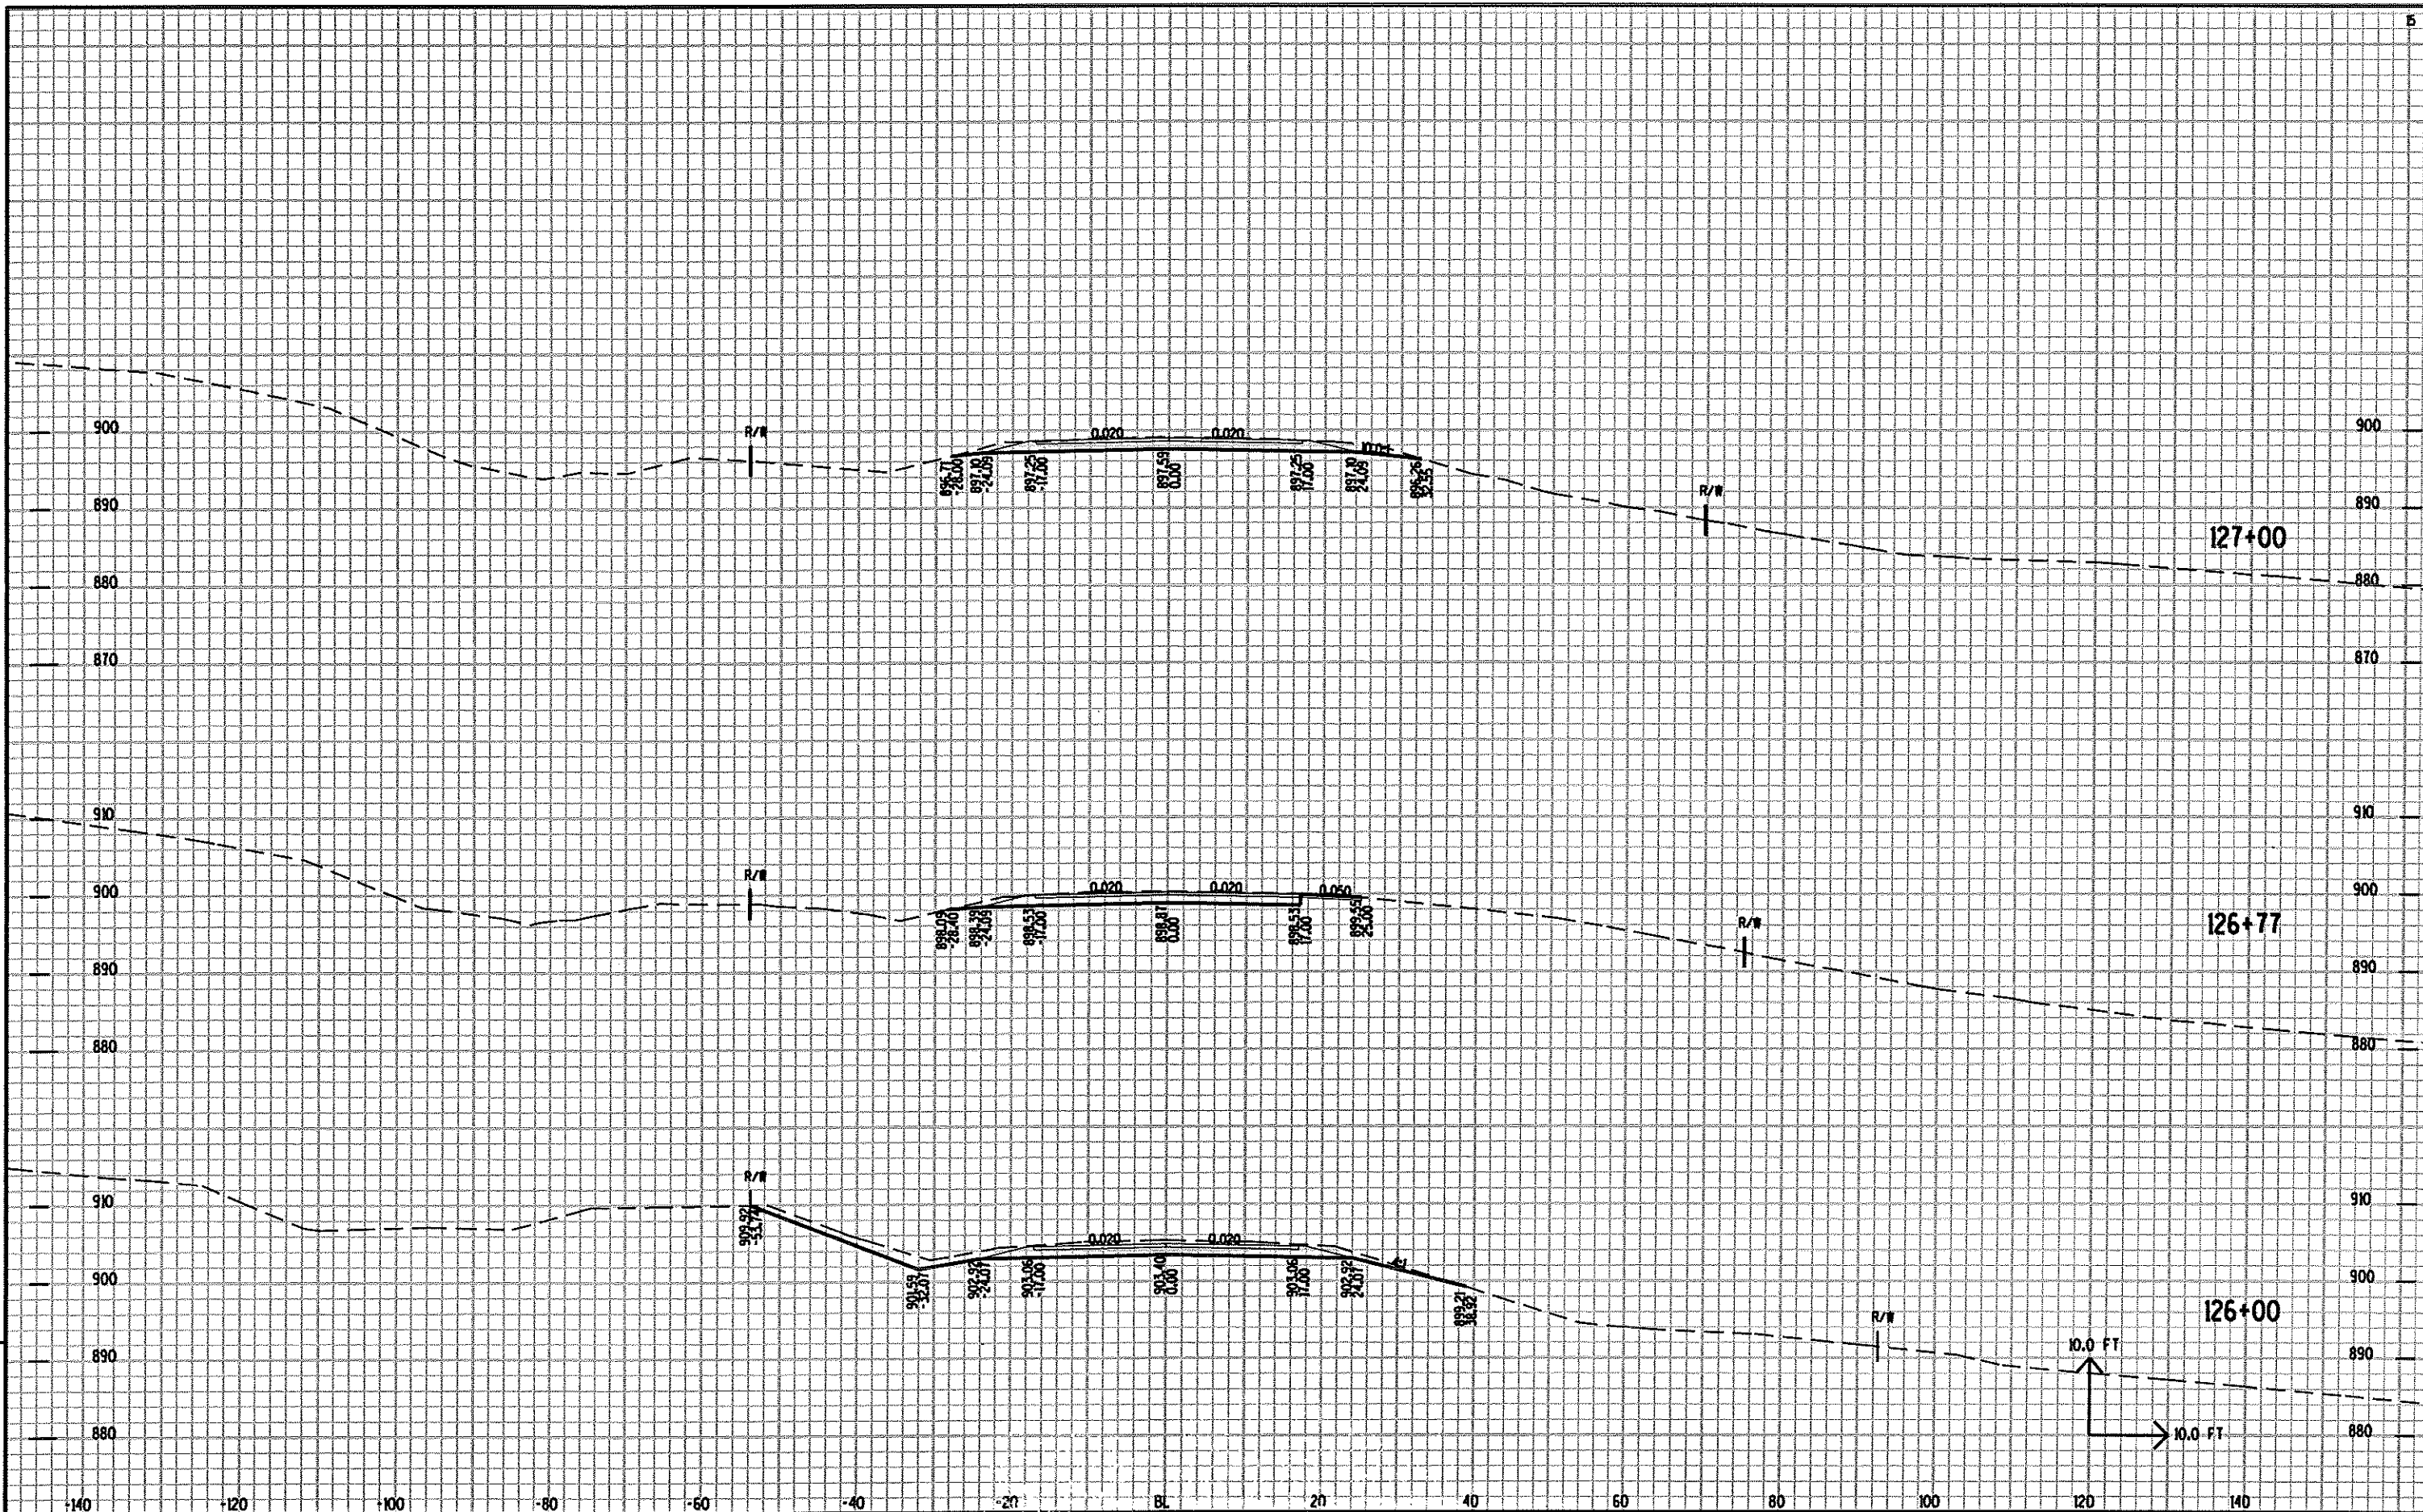


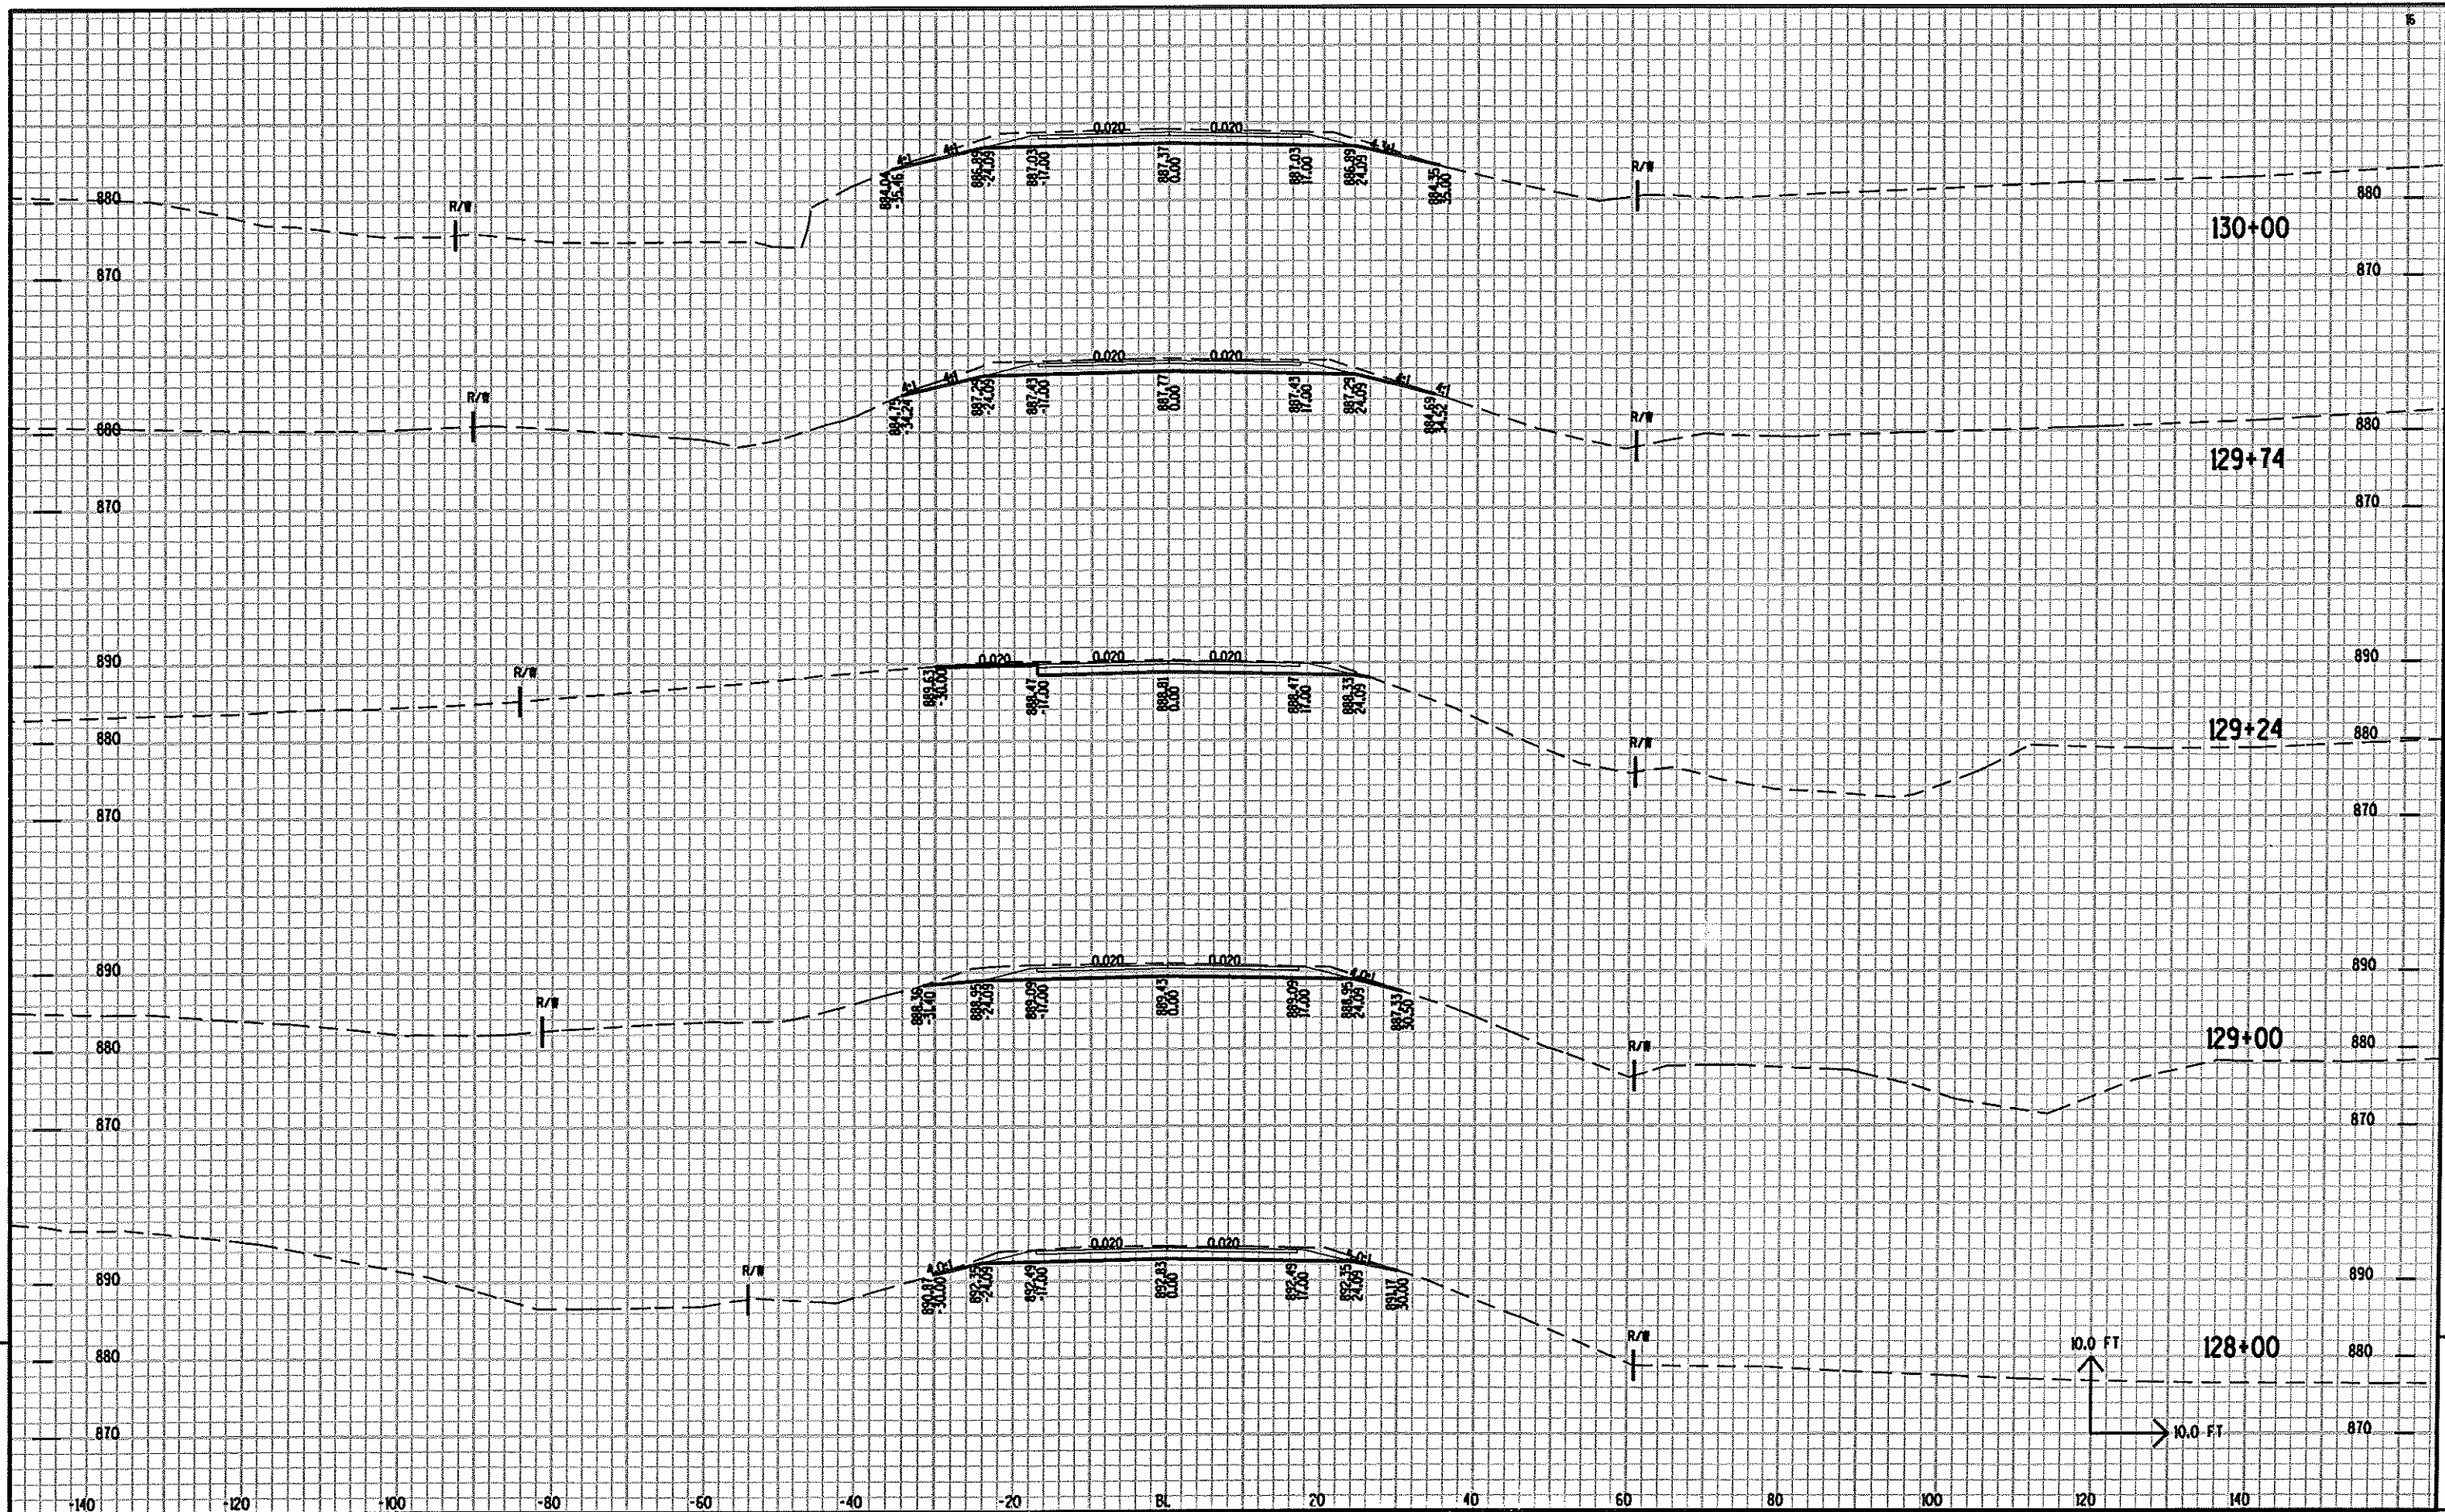



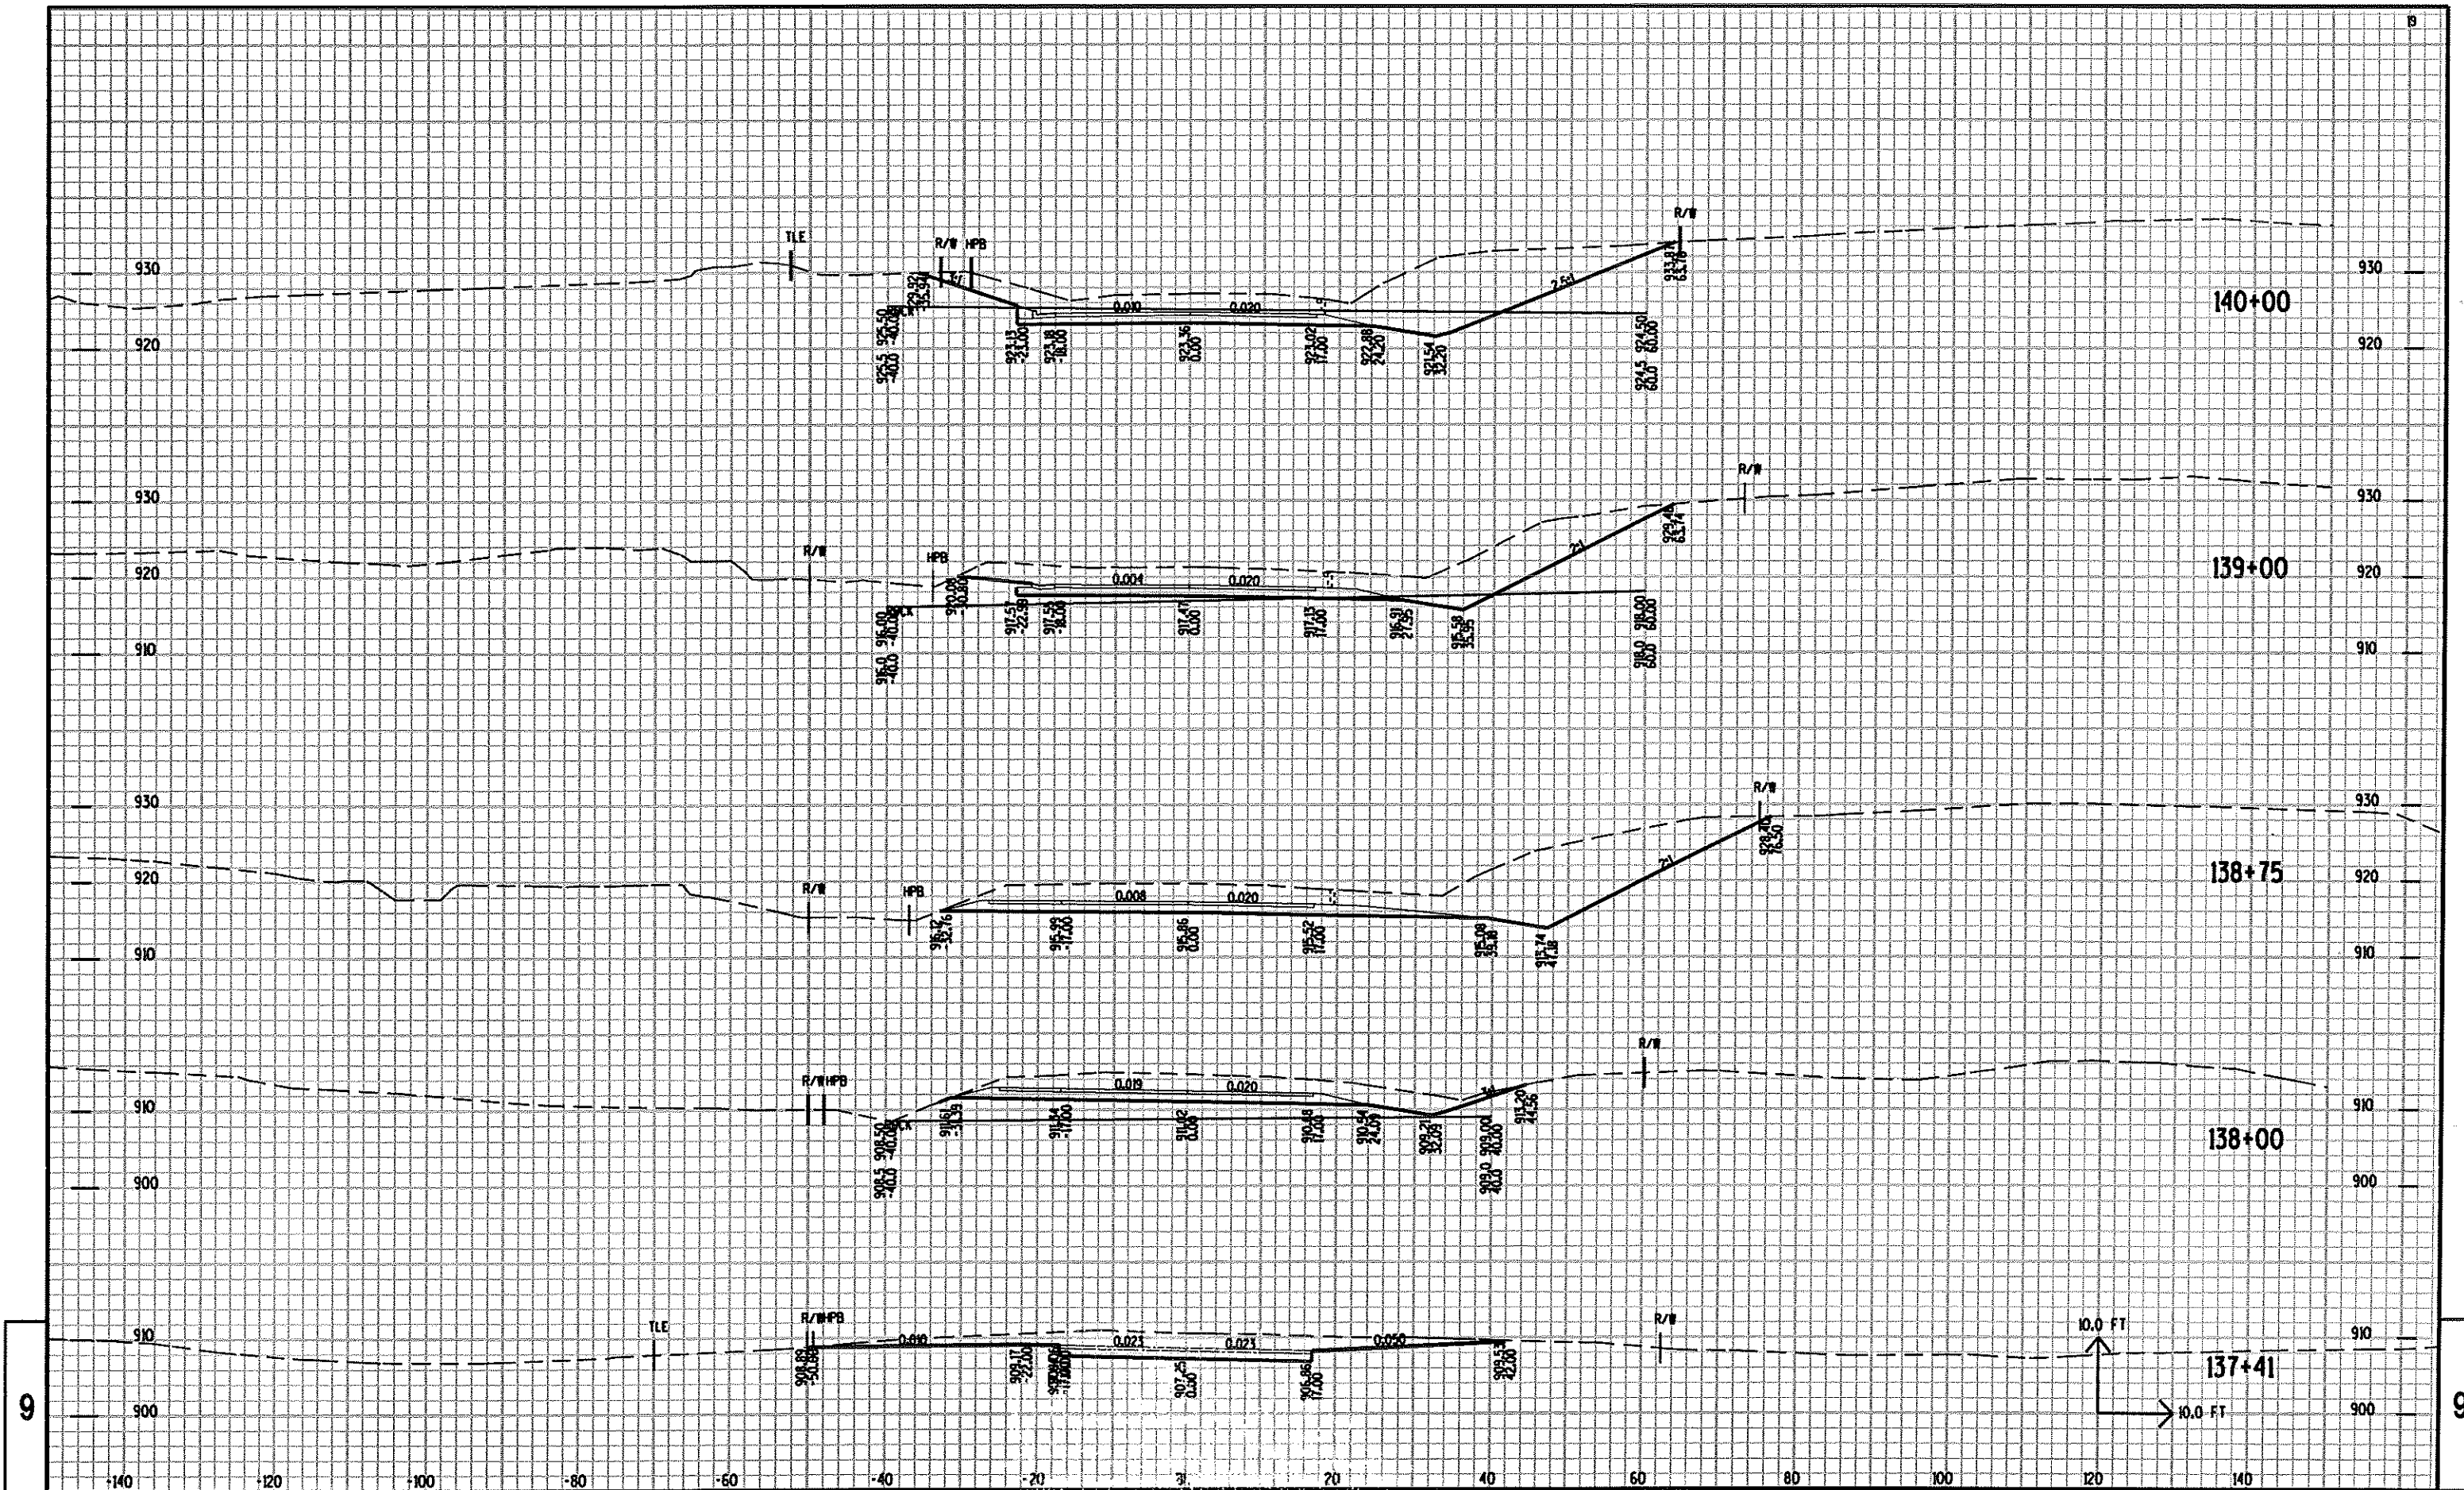


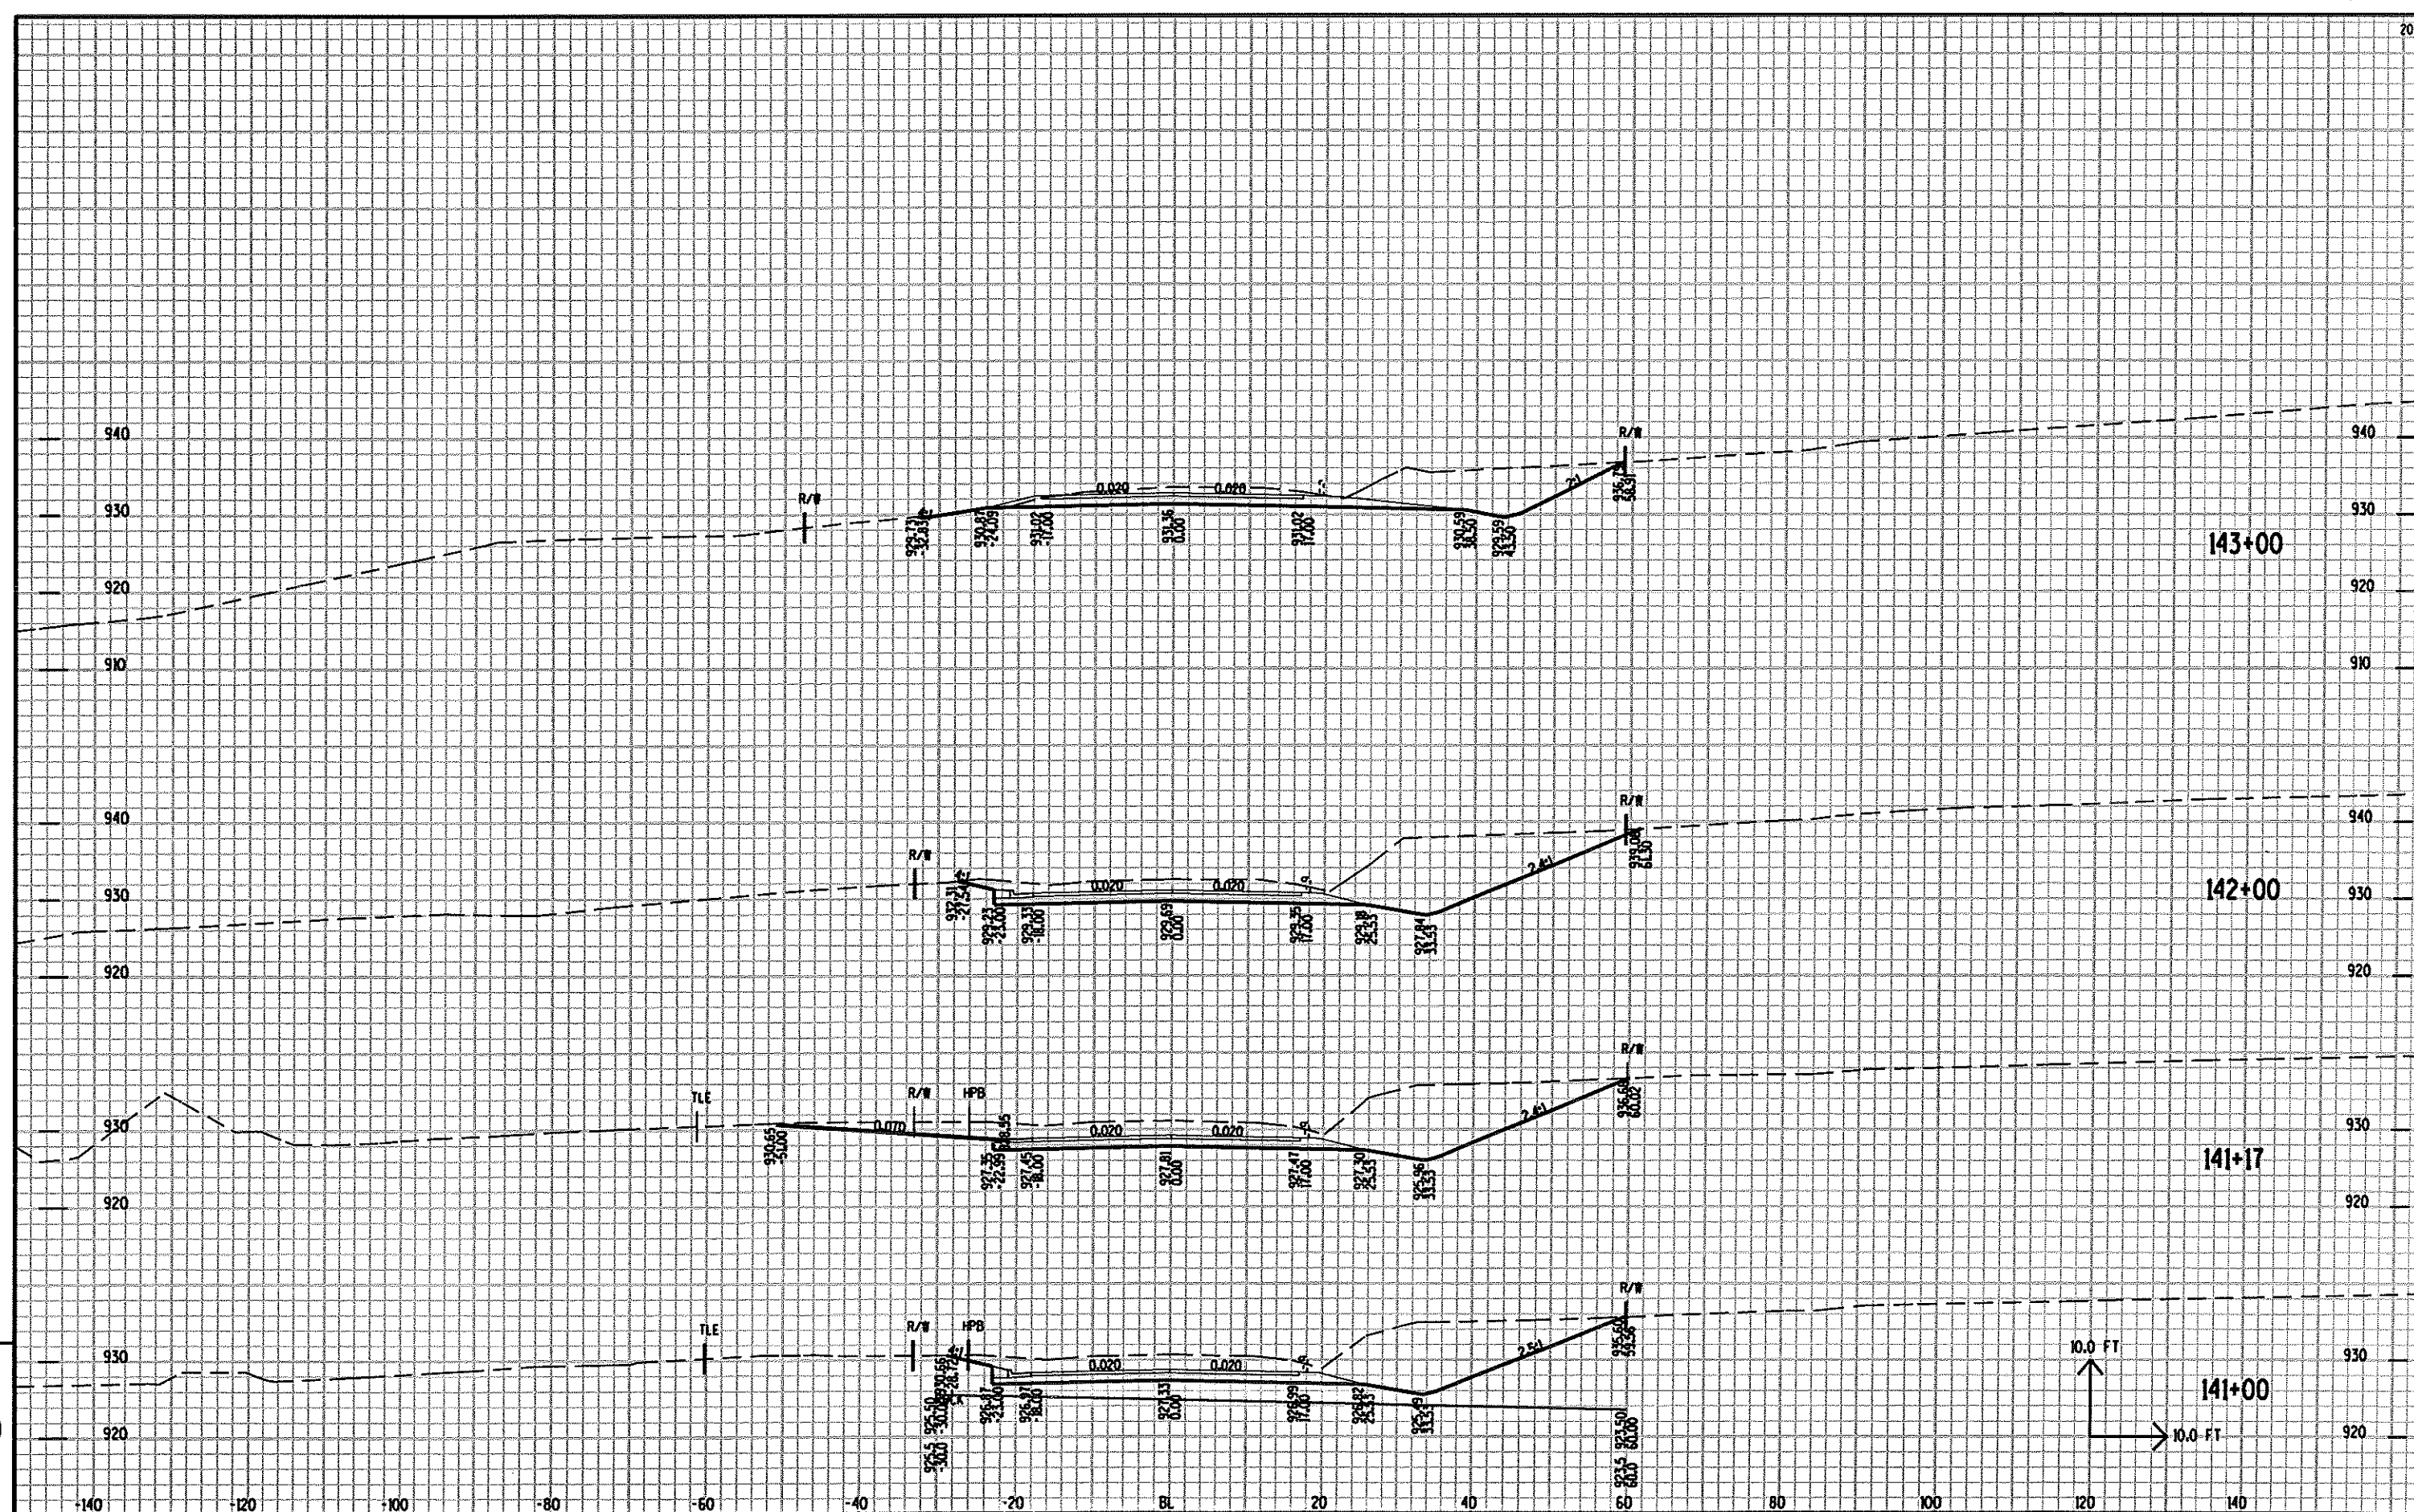

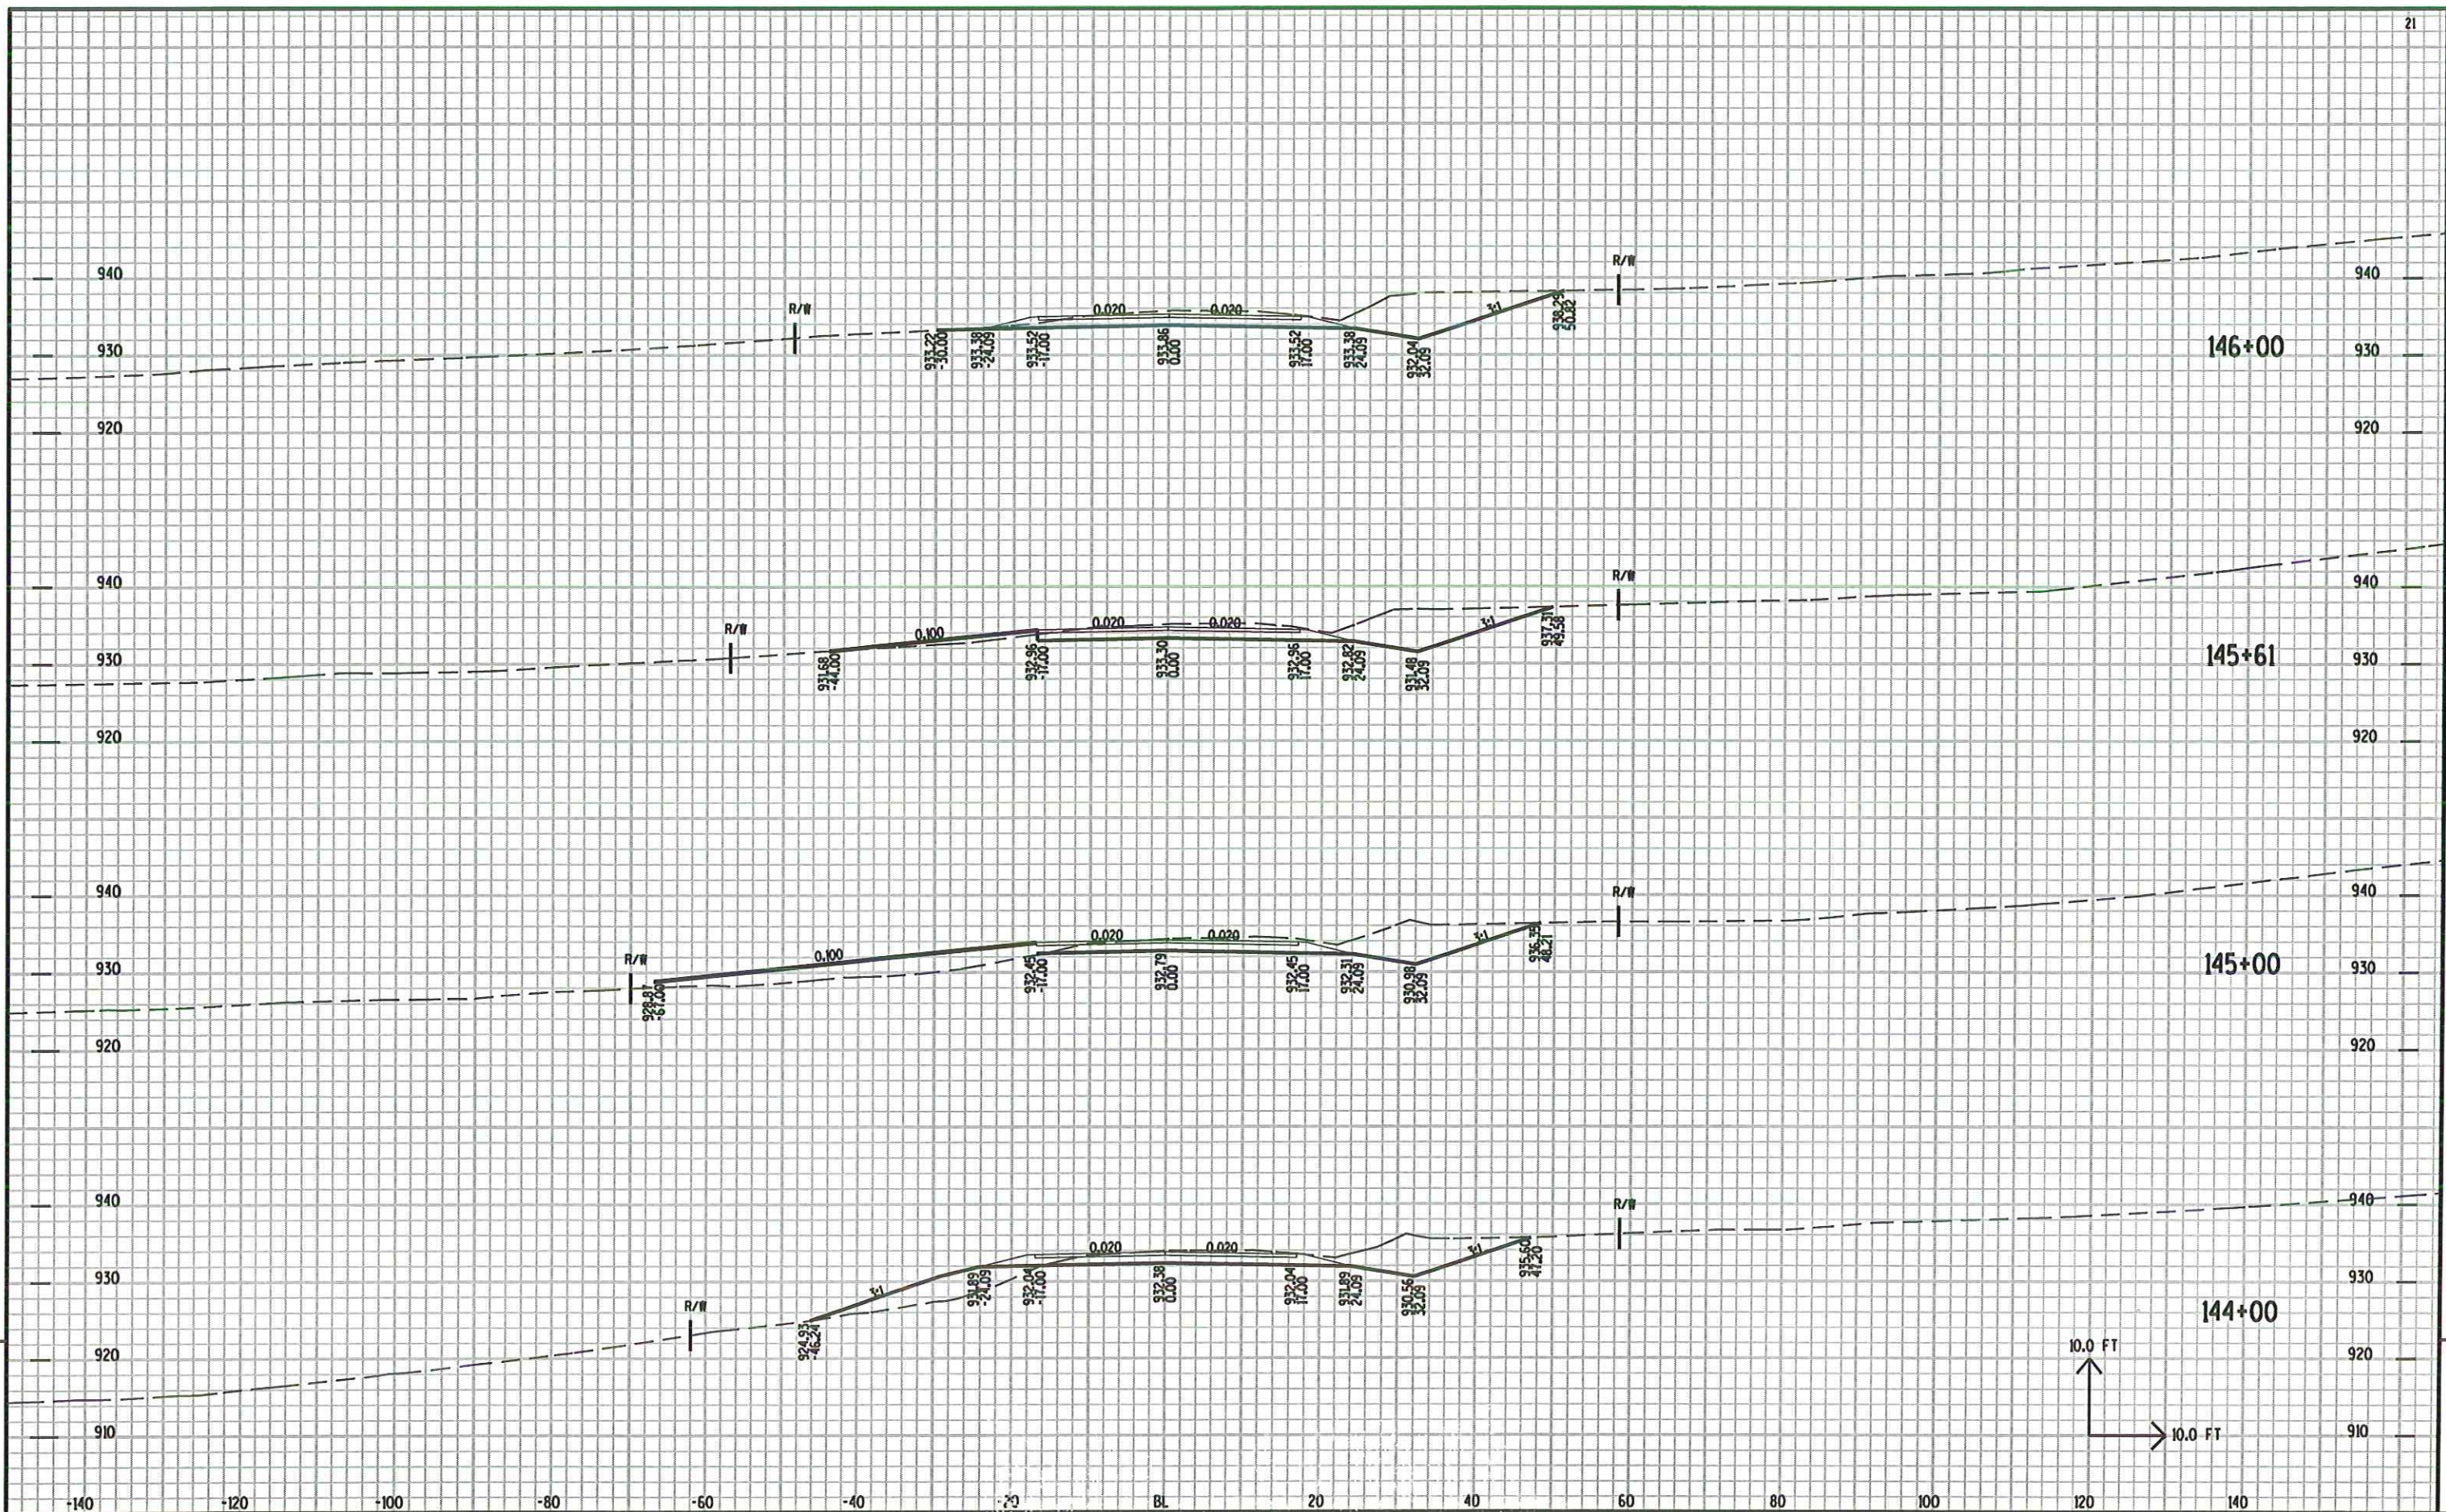

9

9

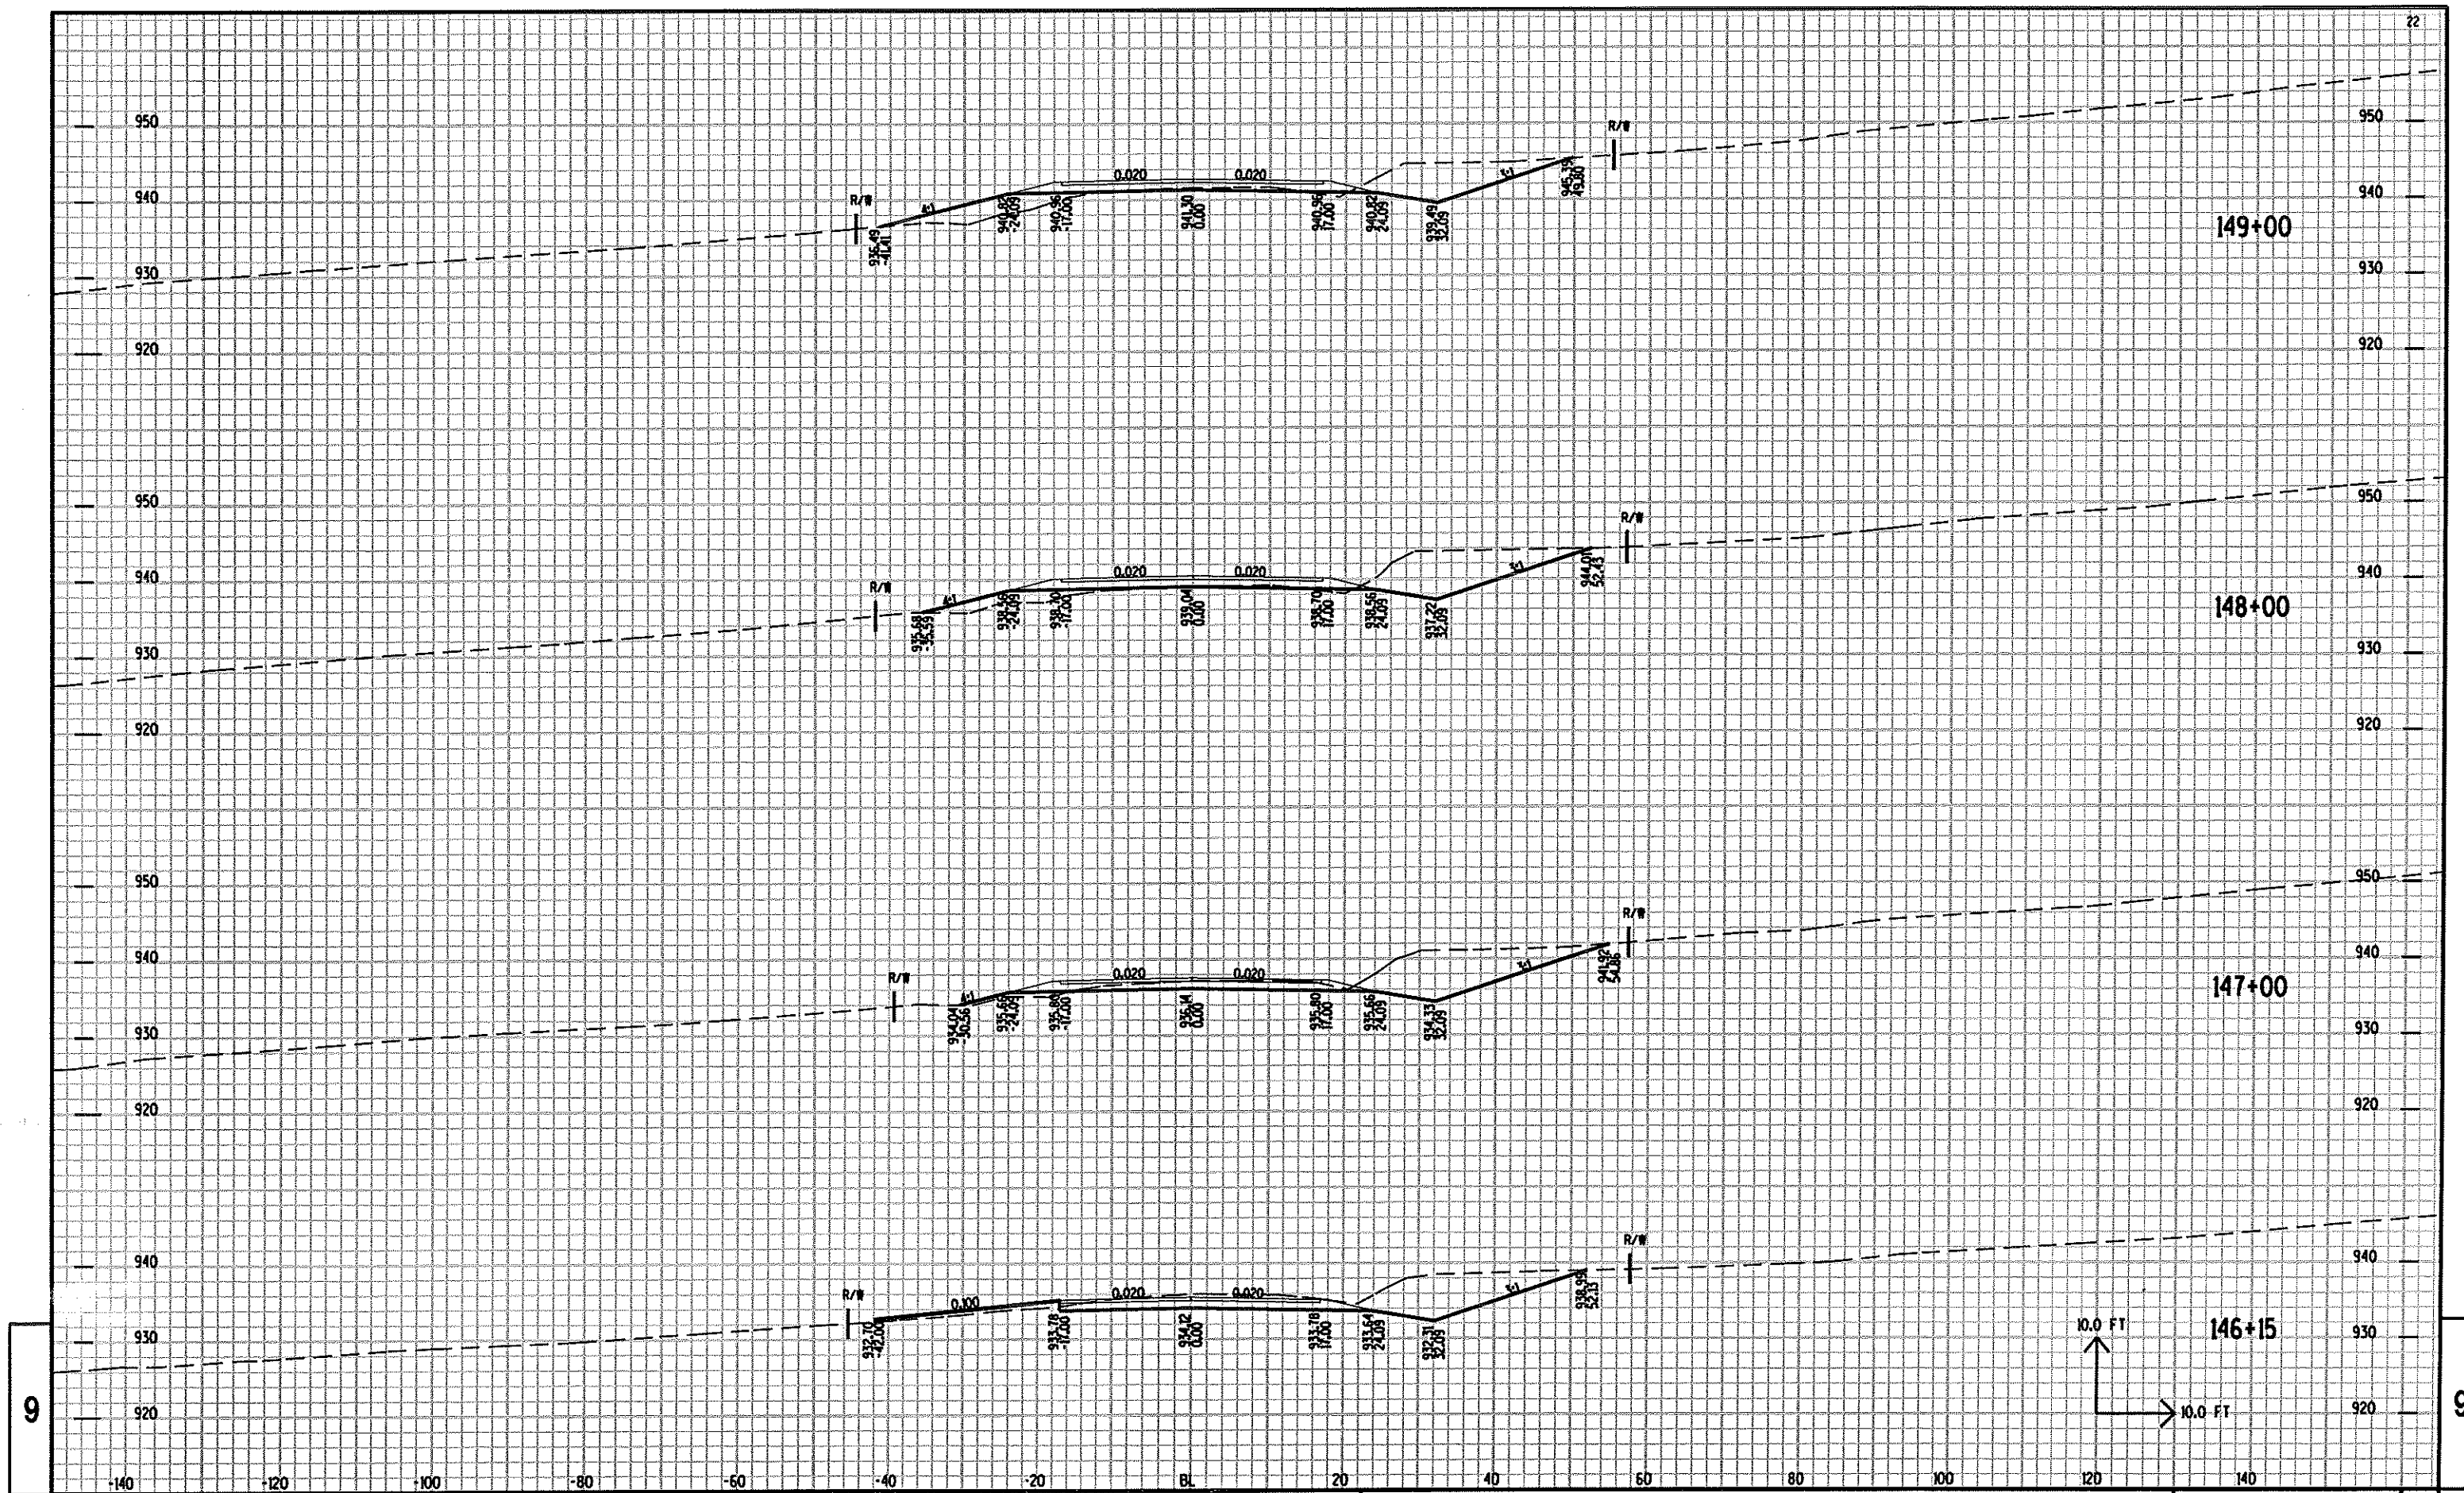

PROJECT NO: 5573-04-72

HWY: STH136

COUNTY: SAUK

STH 136 MAINLINE

SHEET NO:

221

E


FILE NAME : r:\Support\CAADSVProjects\vd1_55730401\090201_xs.dgn


PLOT DATE : 12-JUL-2007 07:15

PLOT BY : dotbbq


PLOT NAME :


PLOT SCALE : 2.000000:1.000000

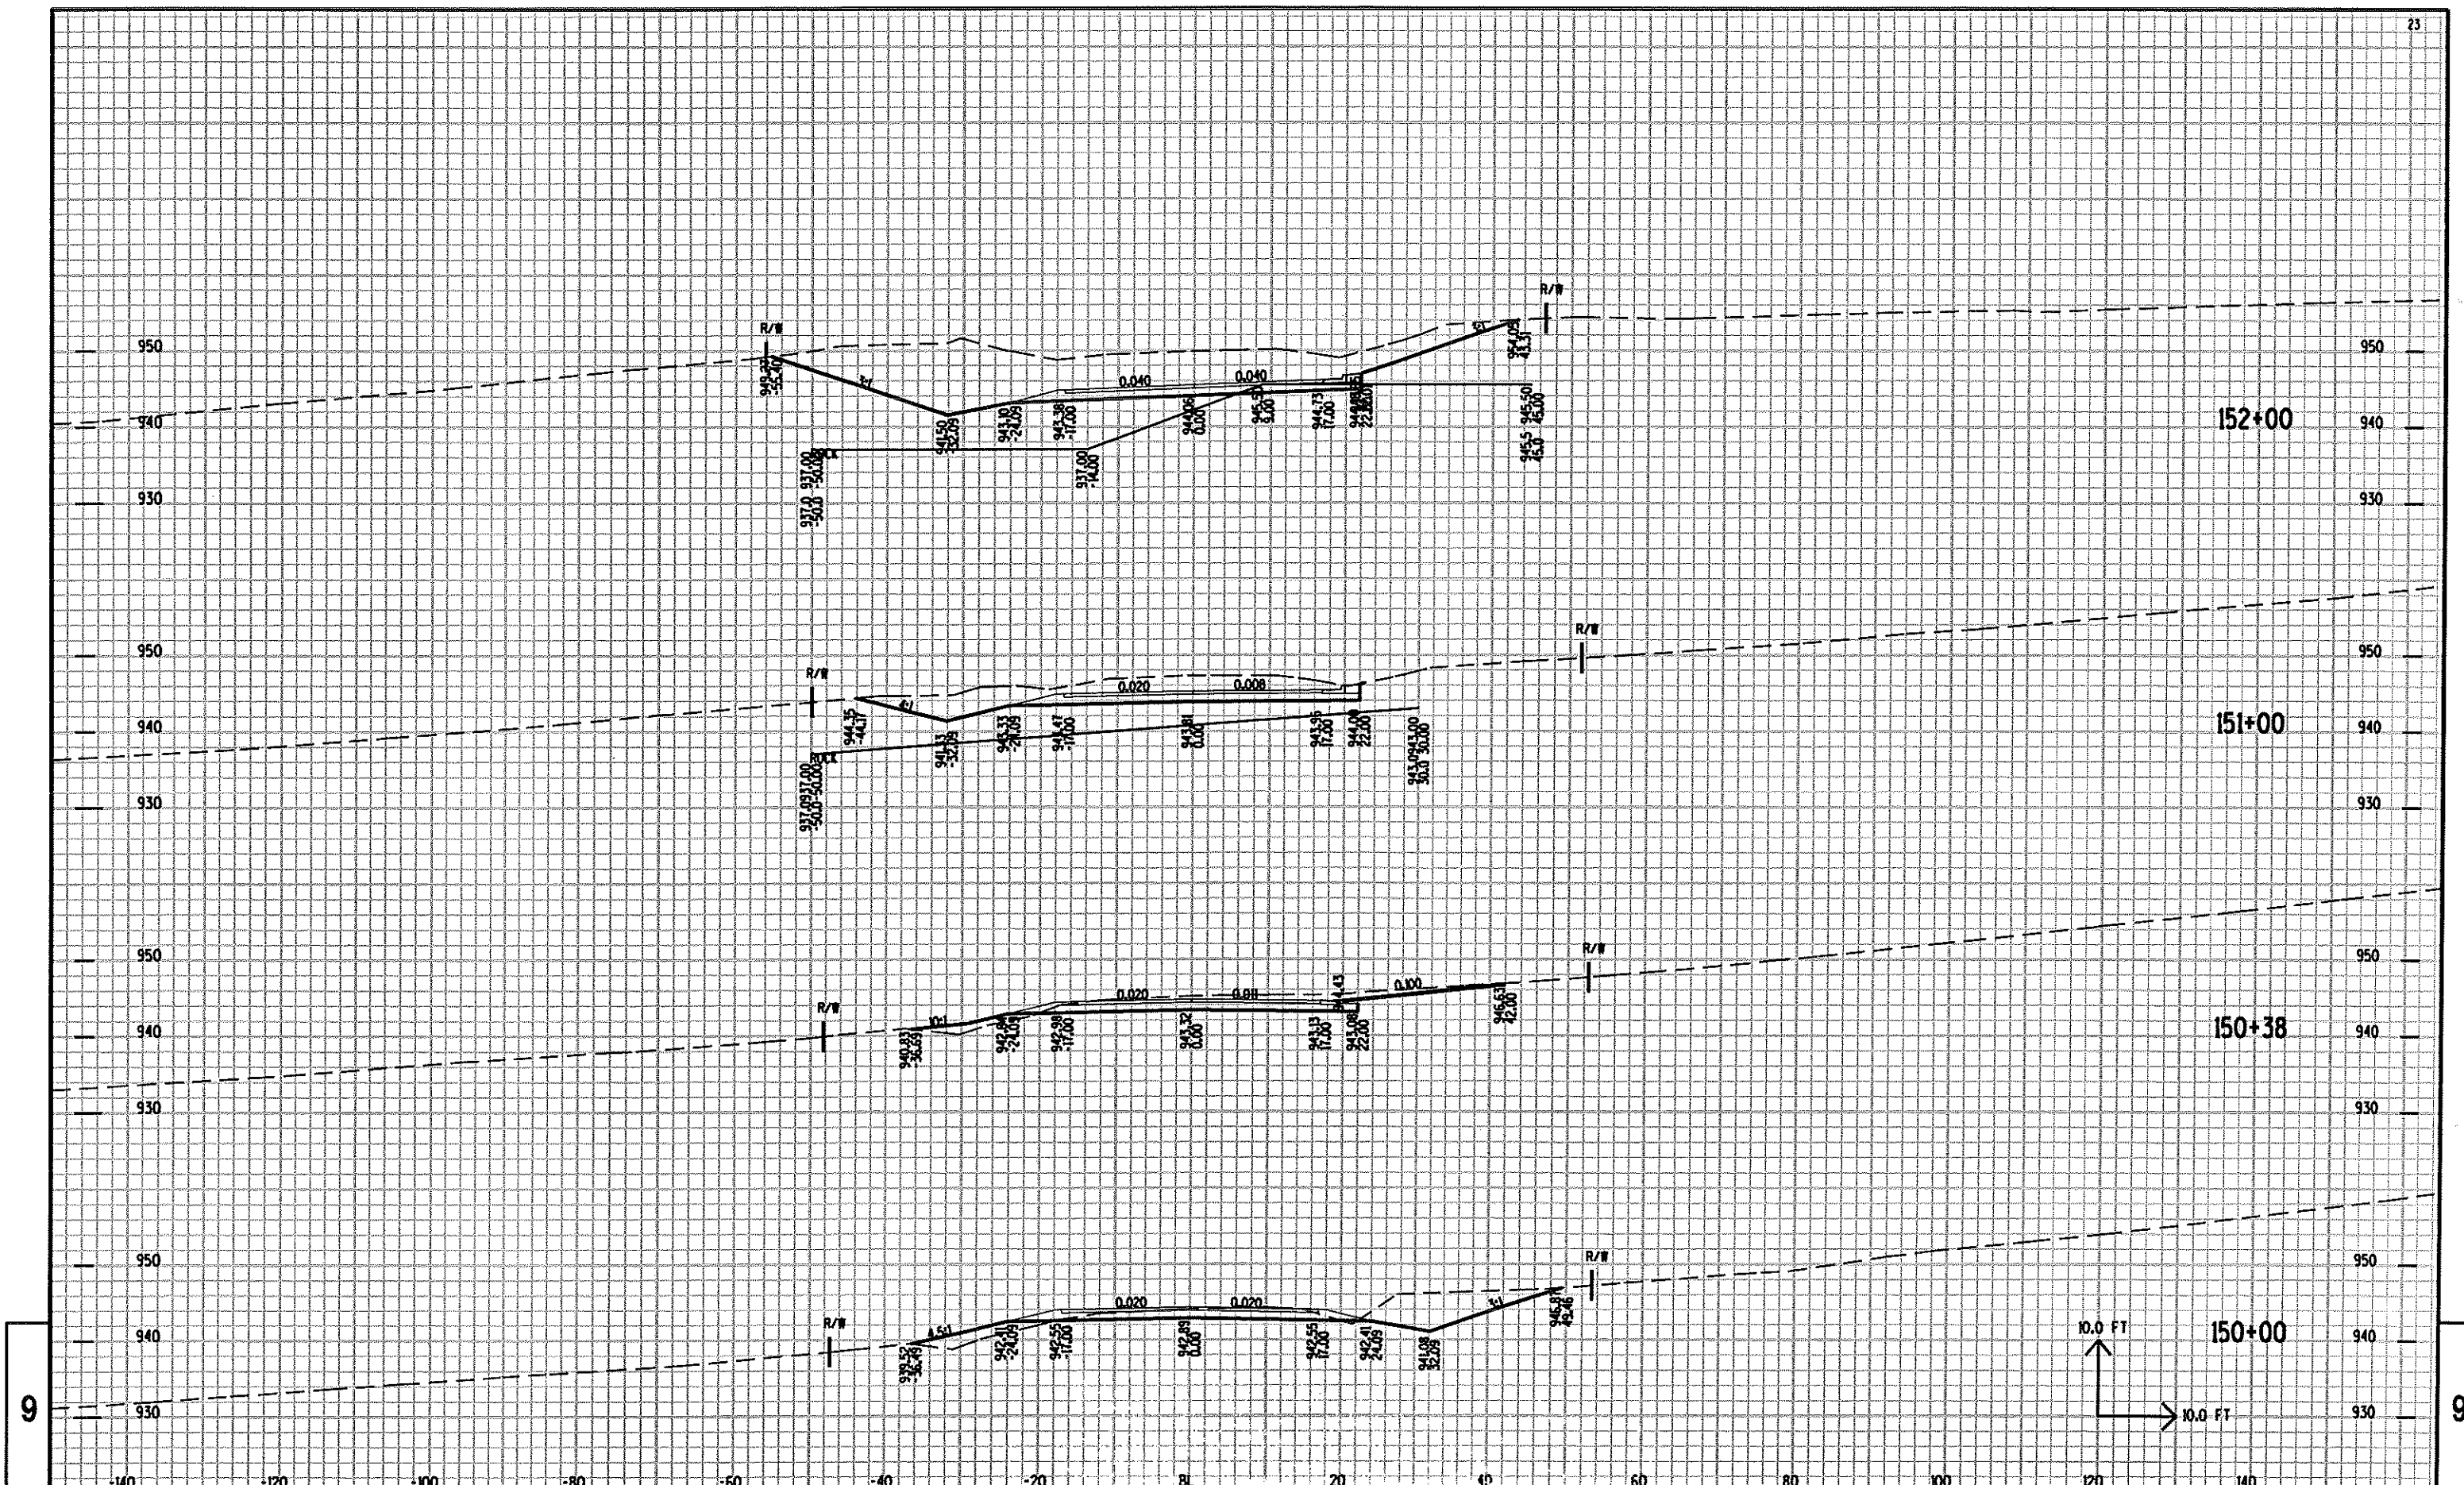

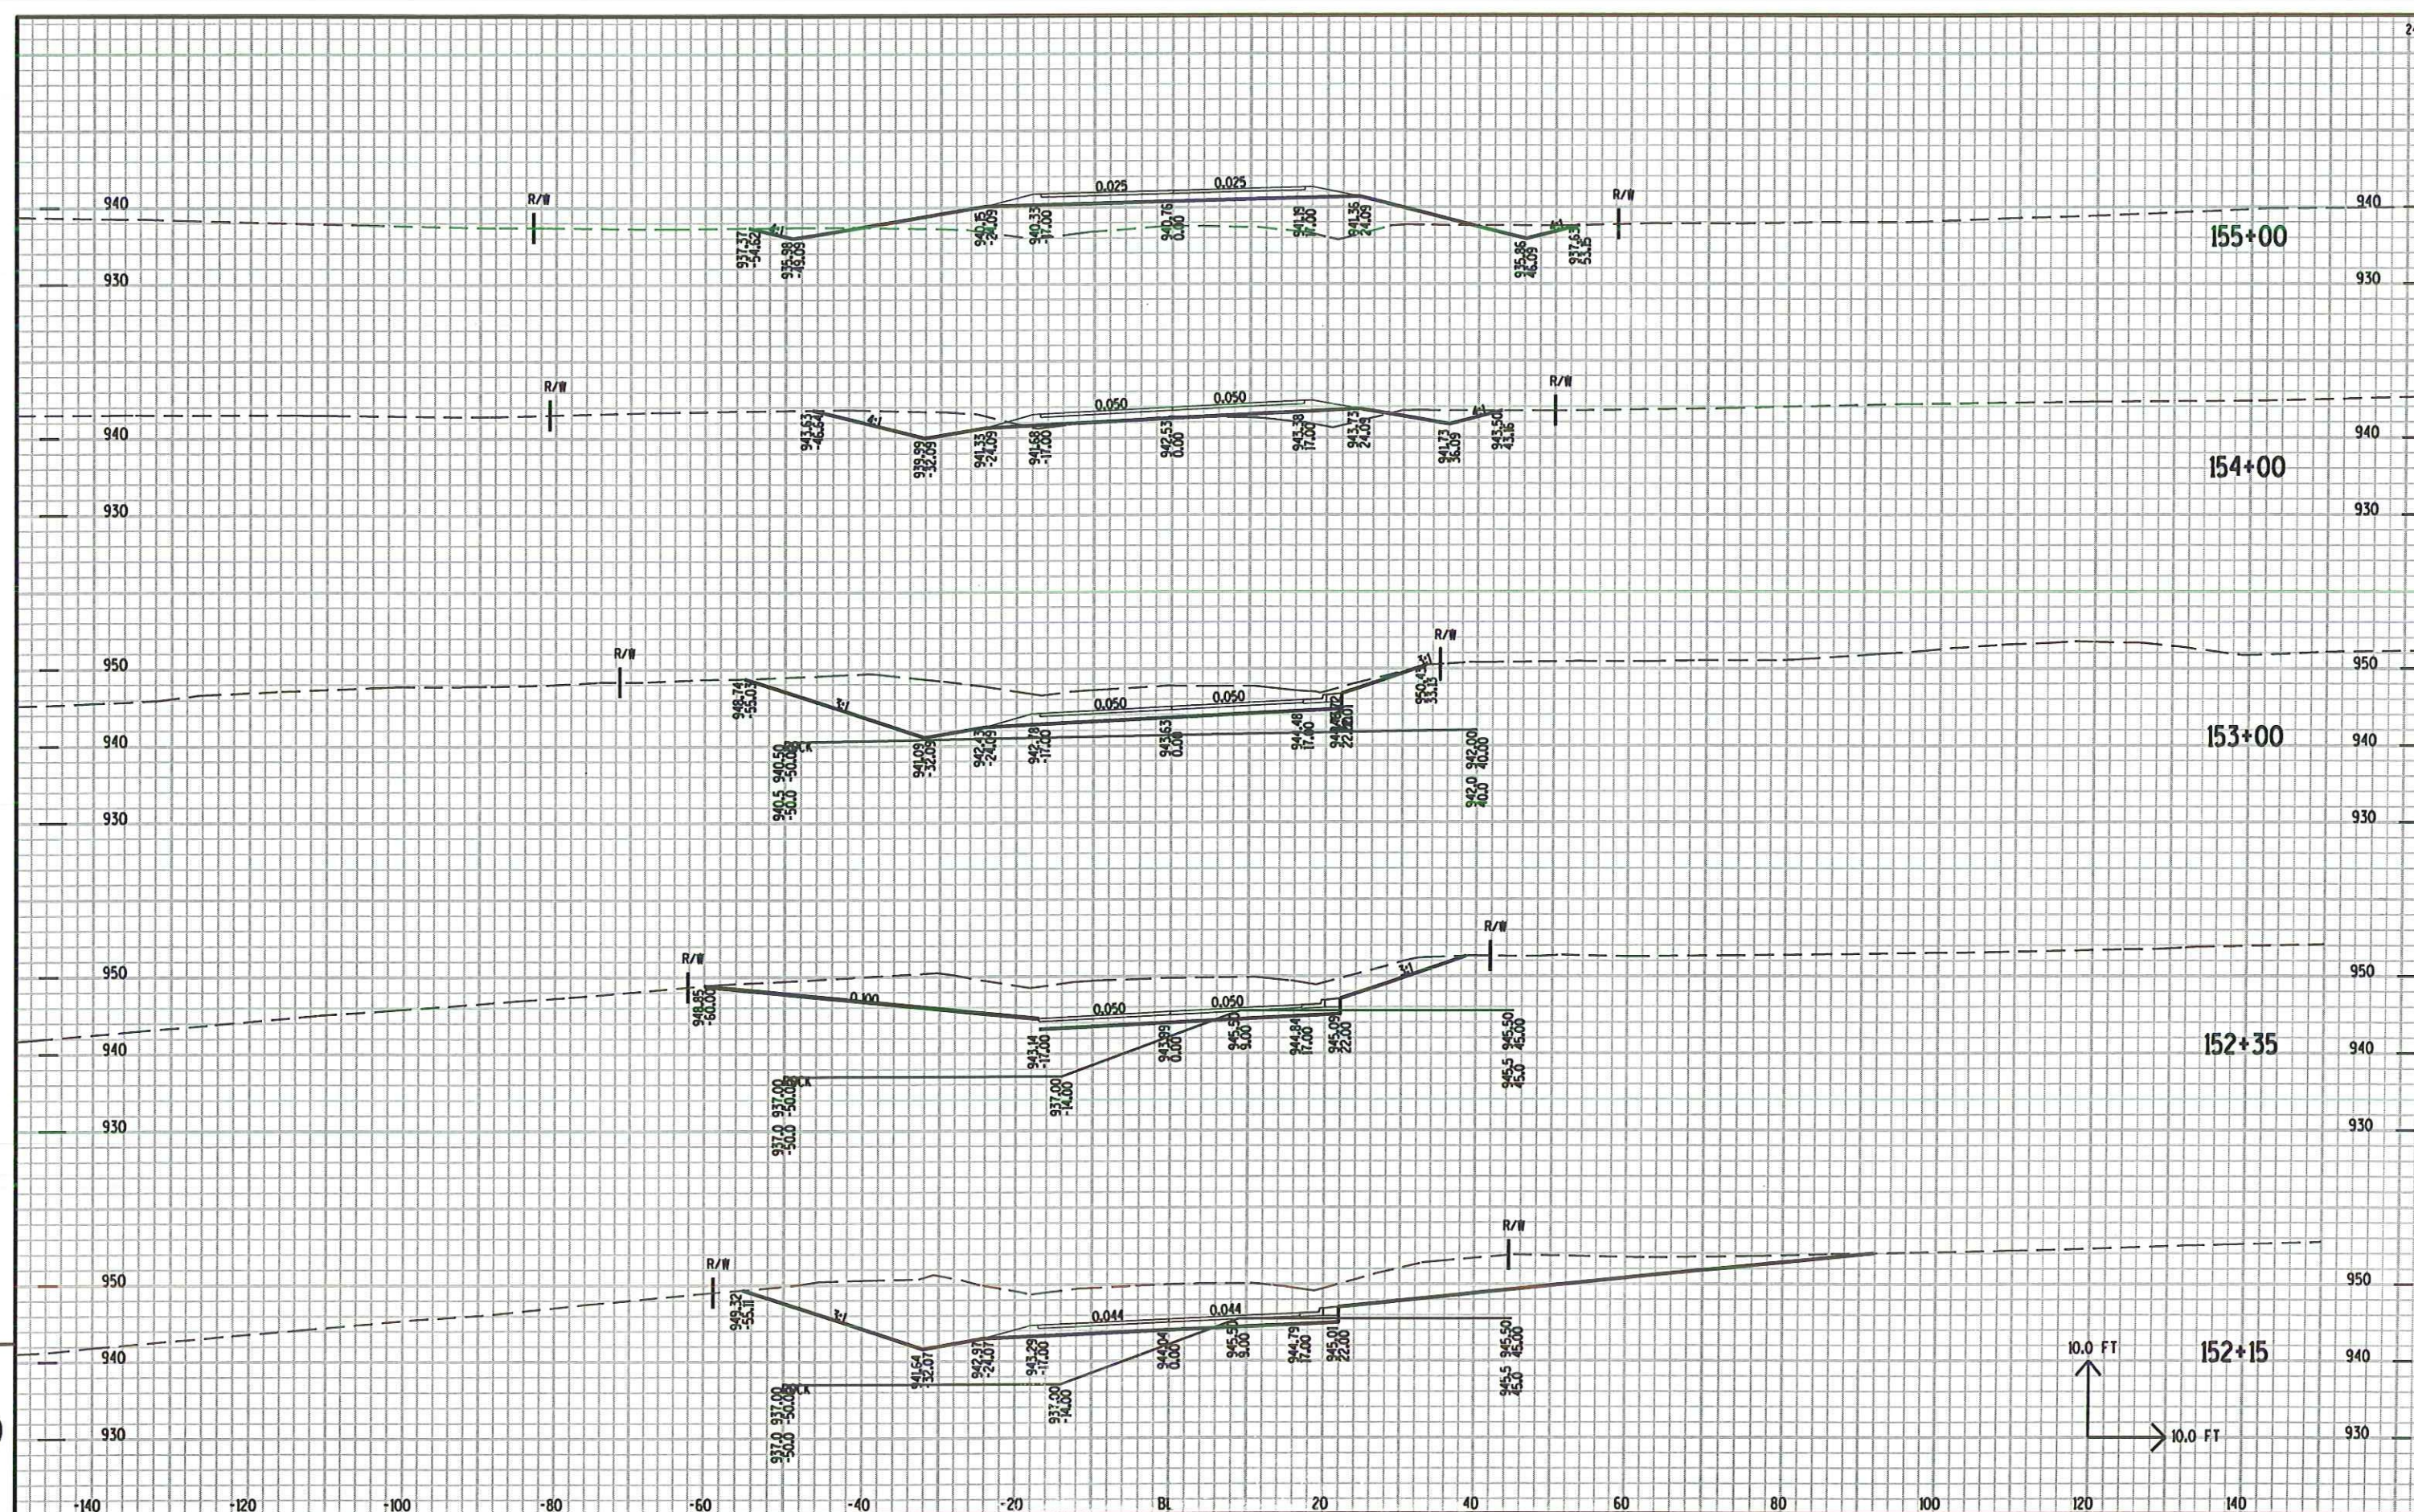



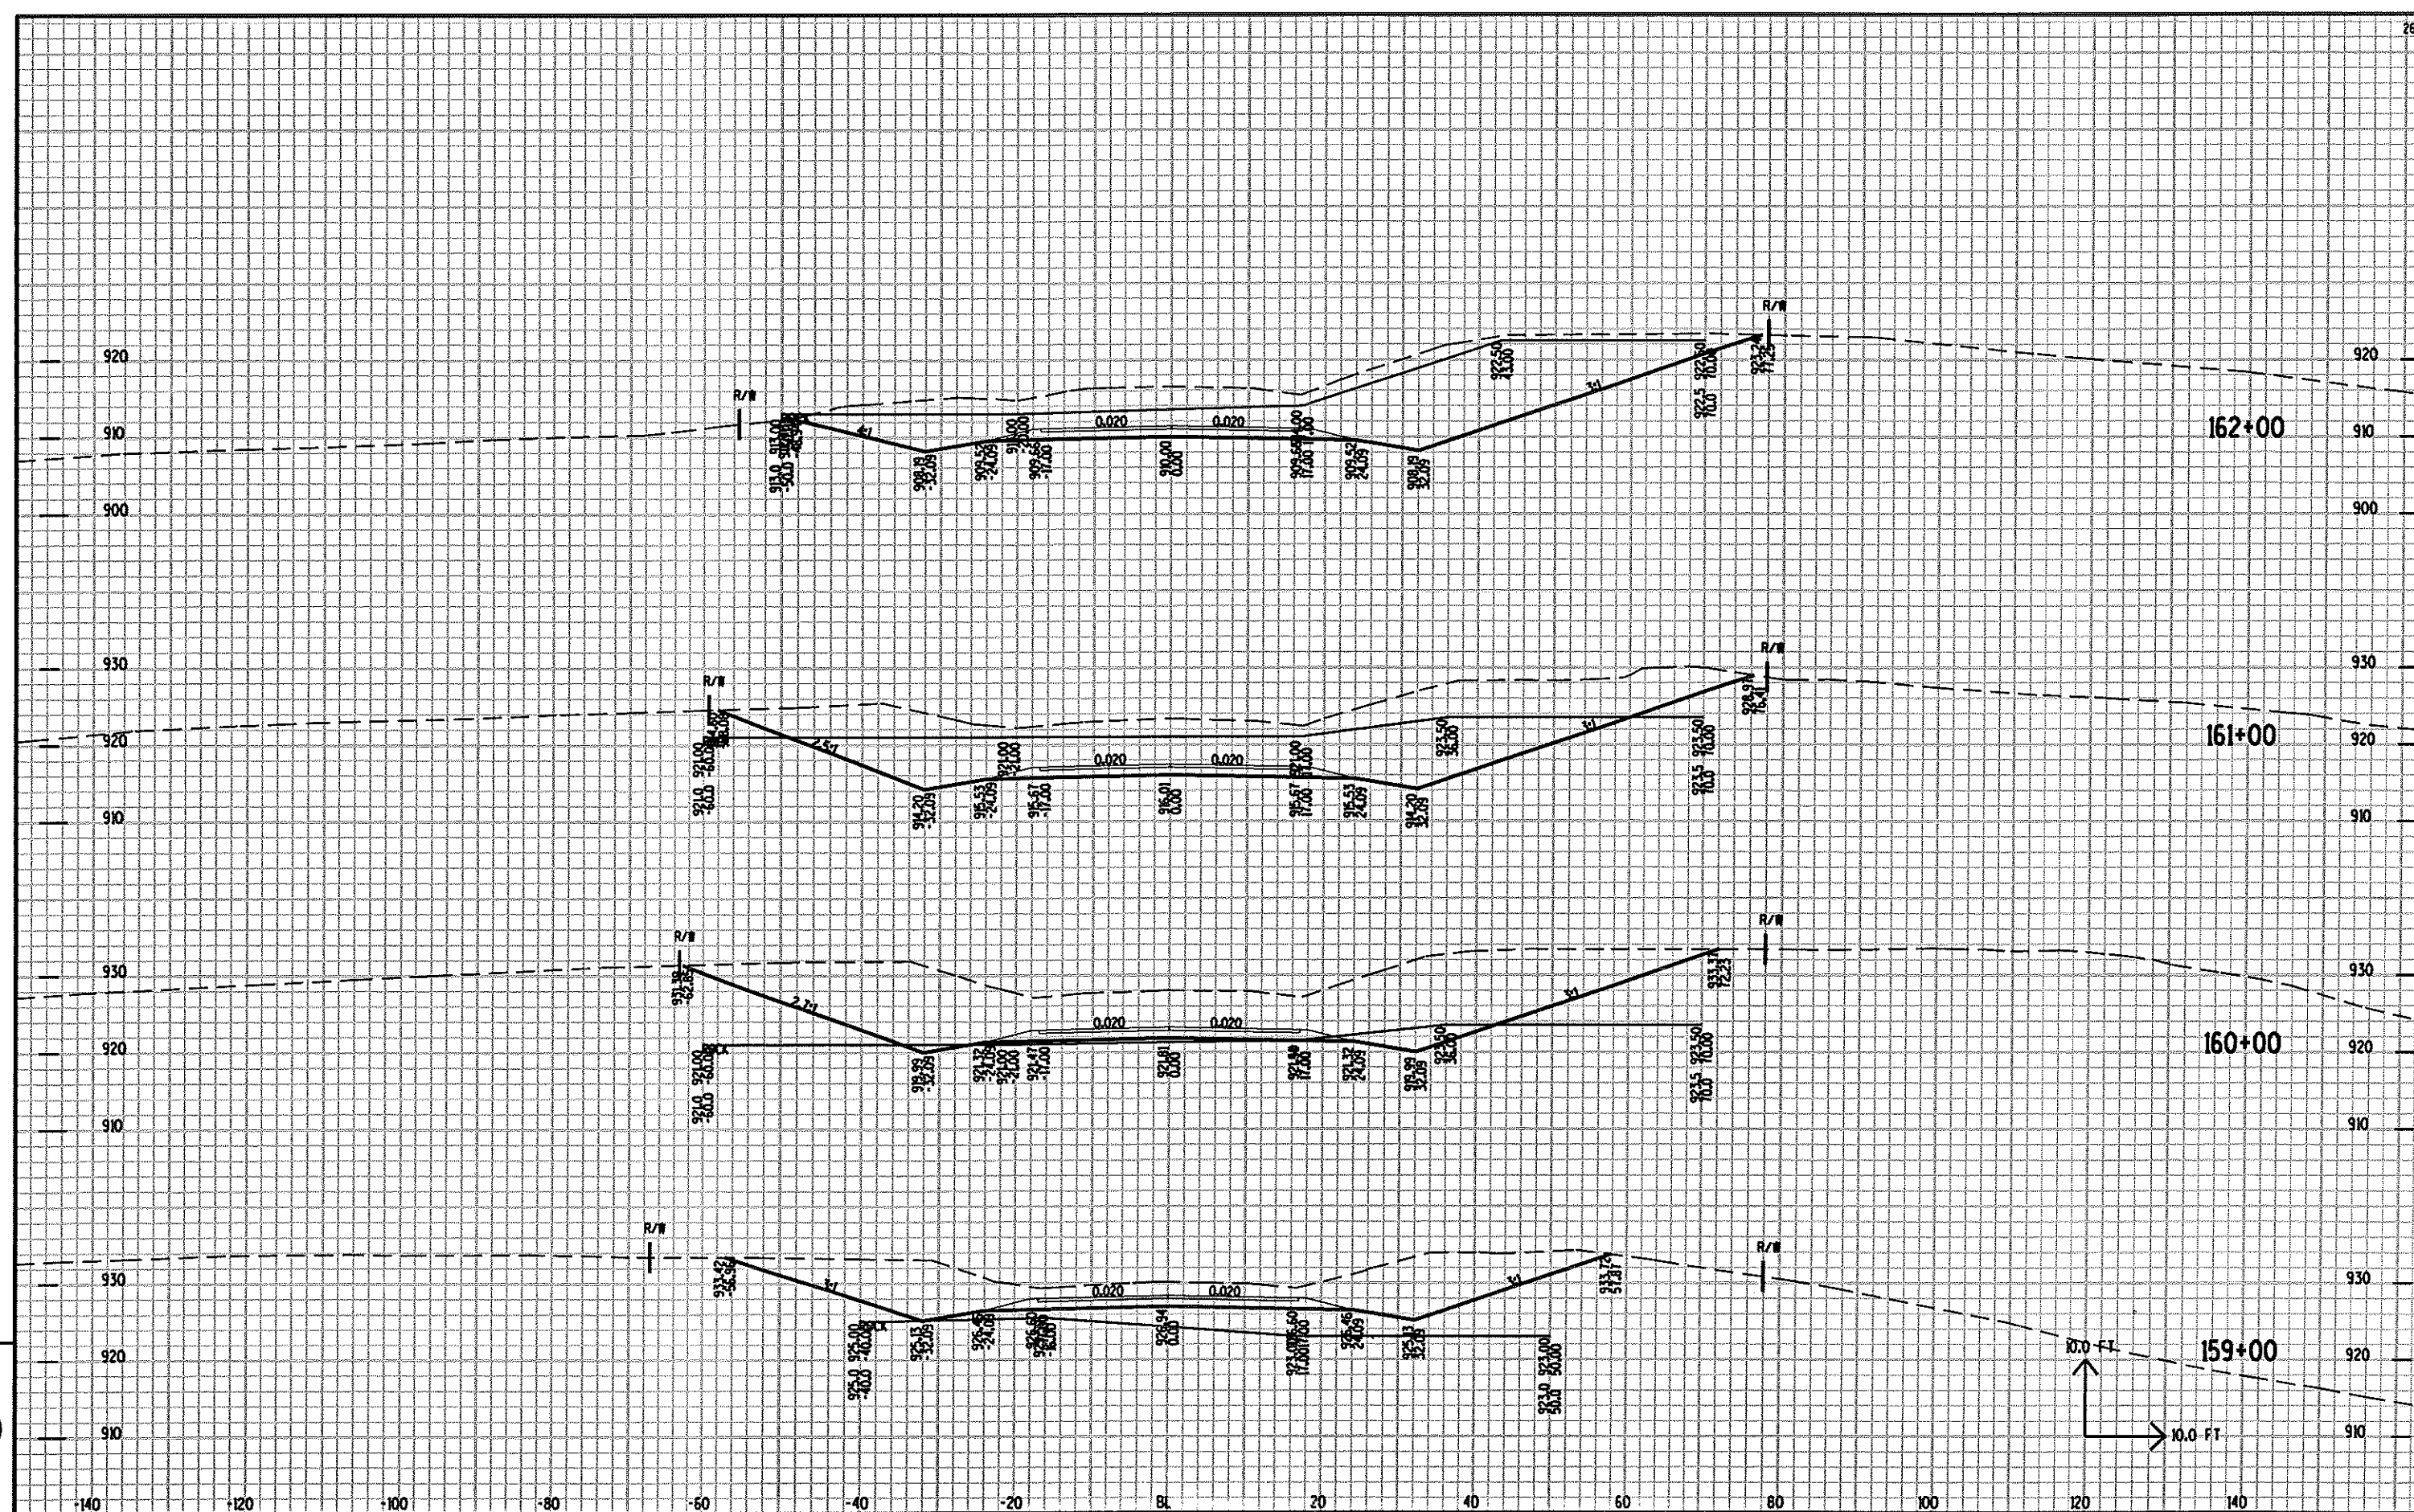


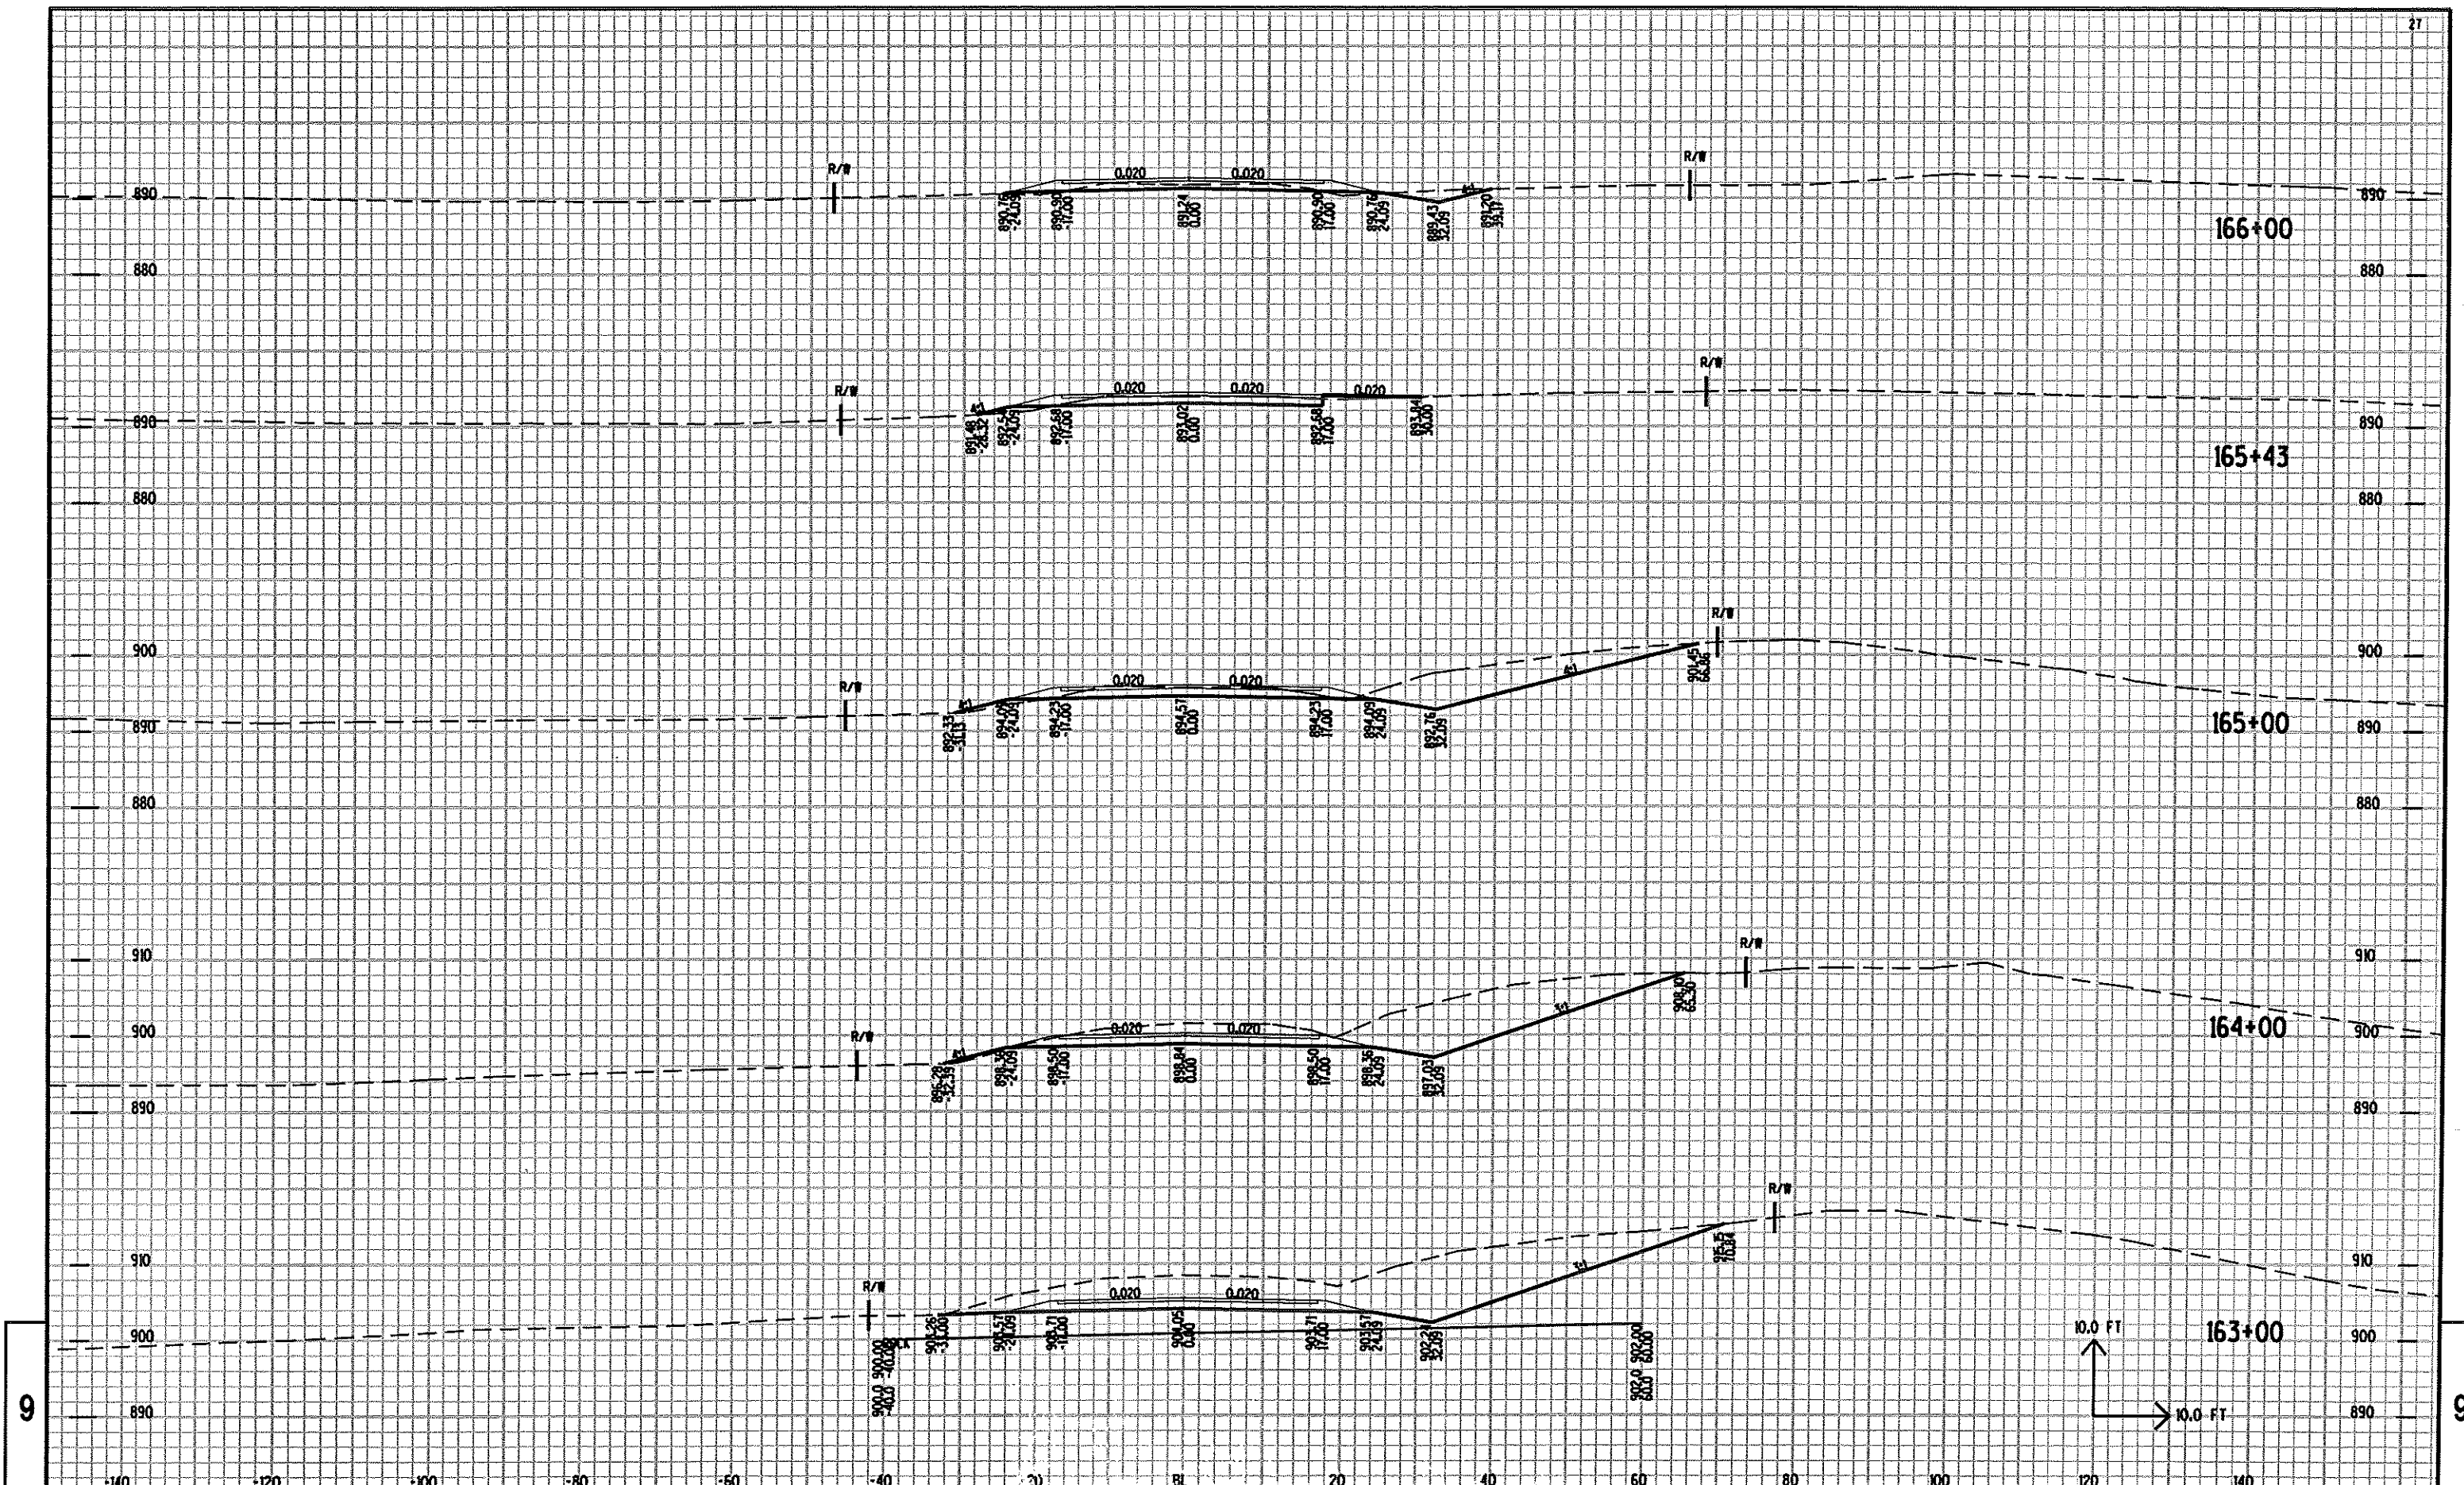



9


9




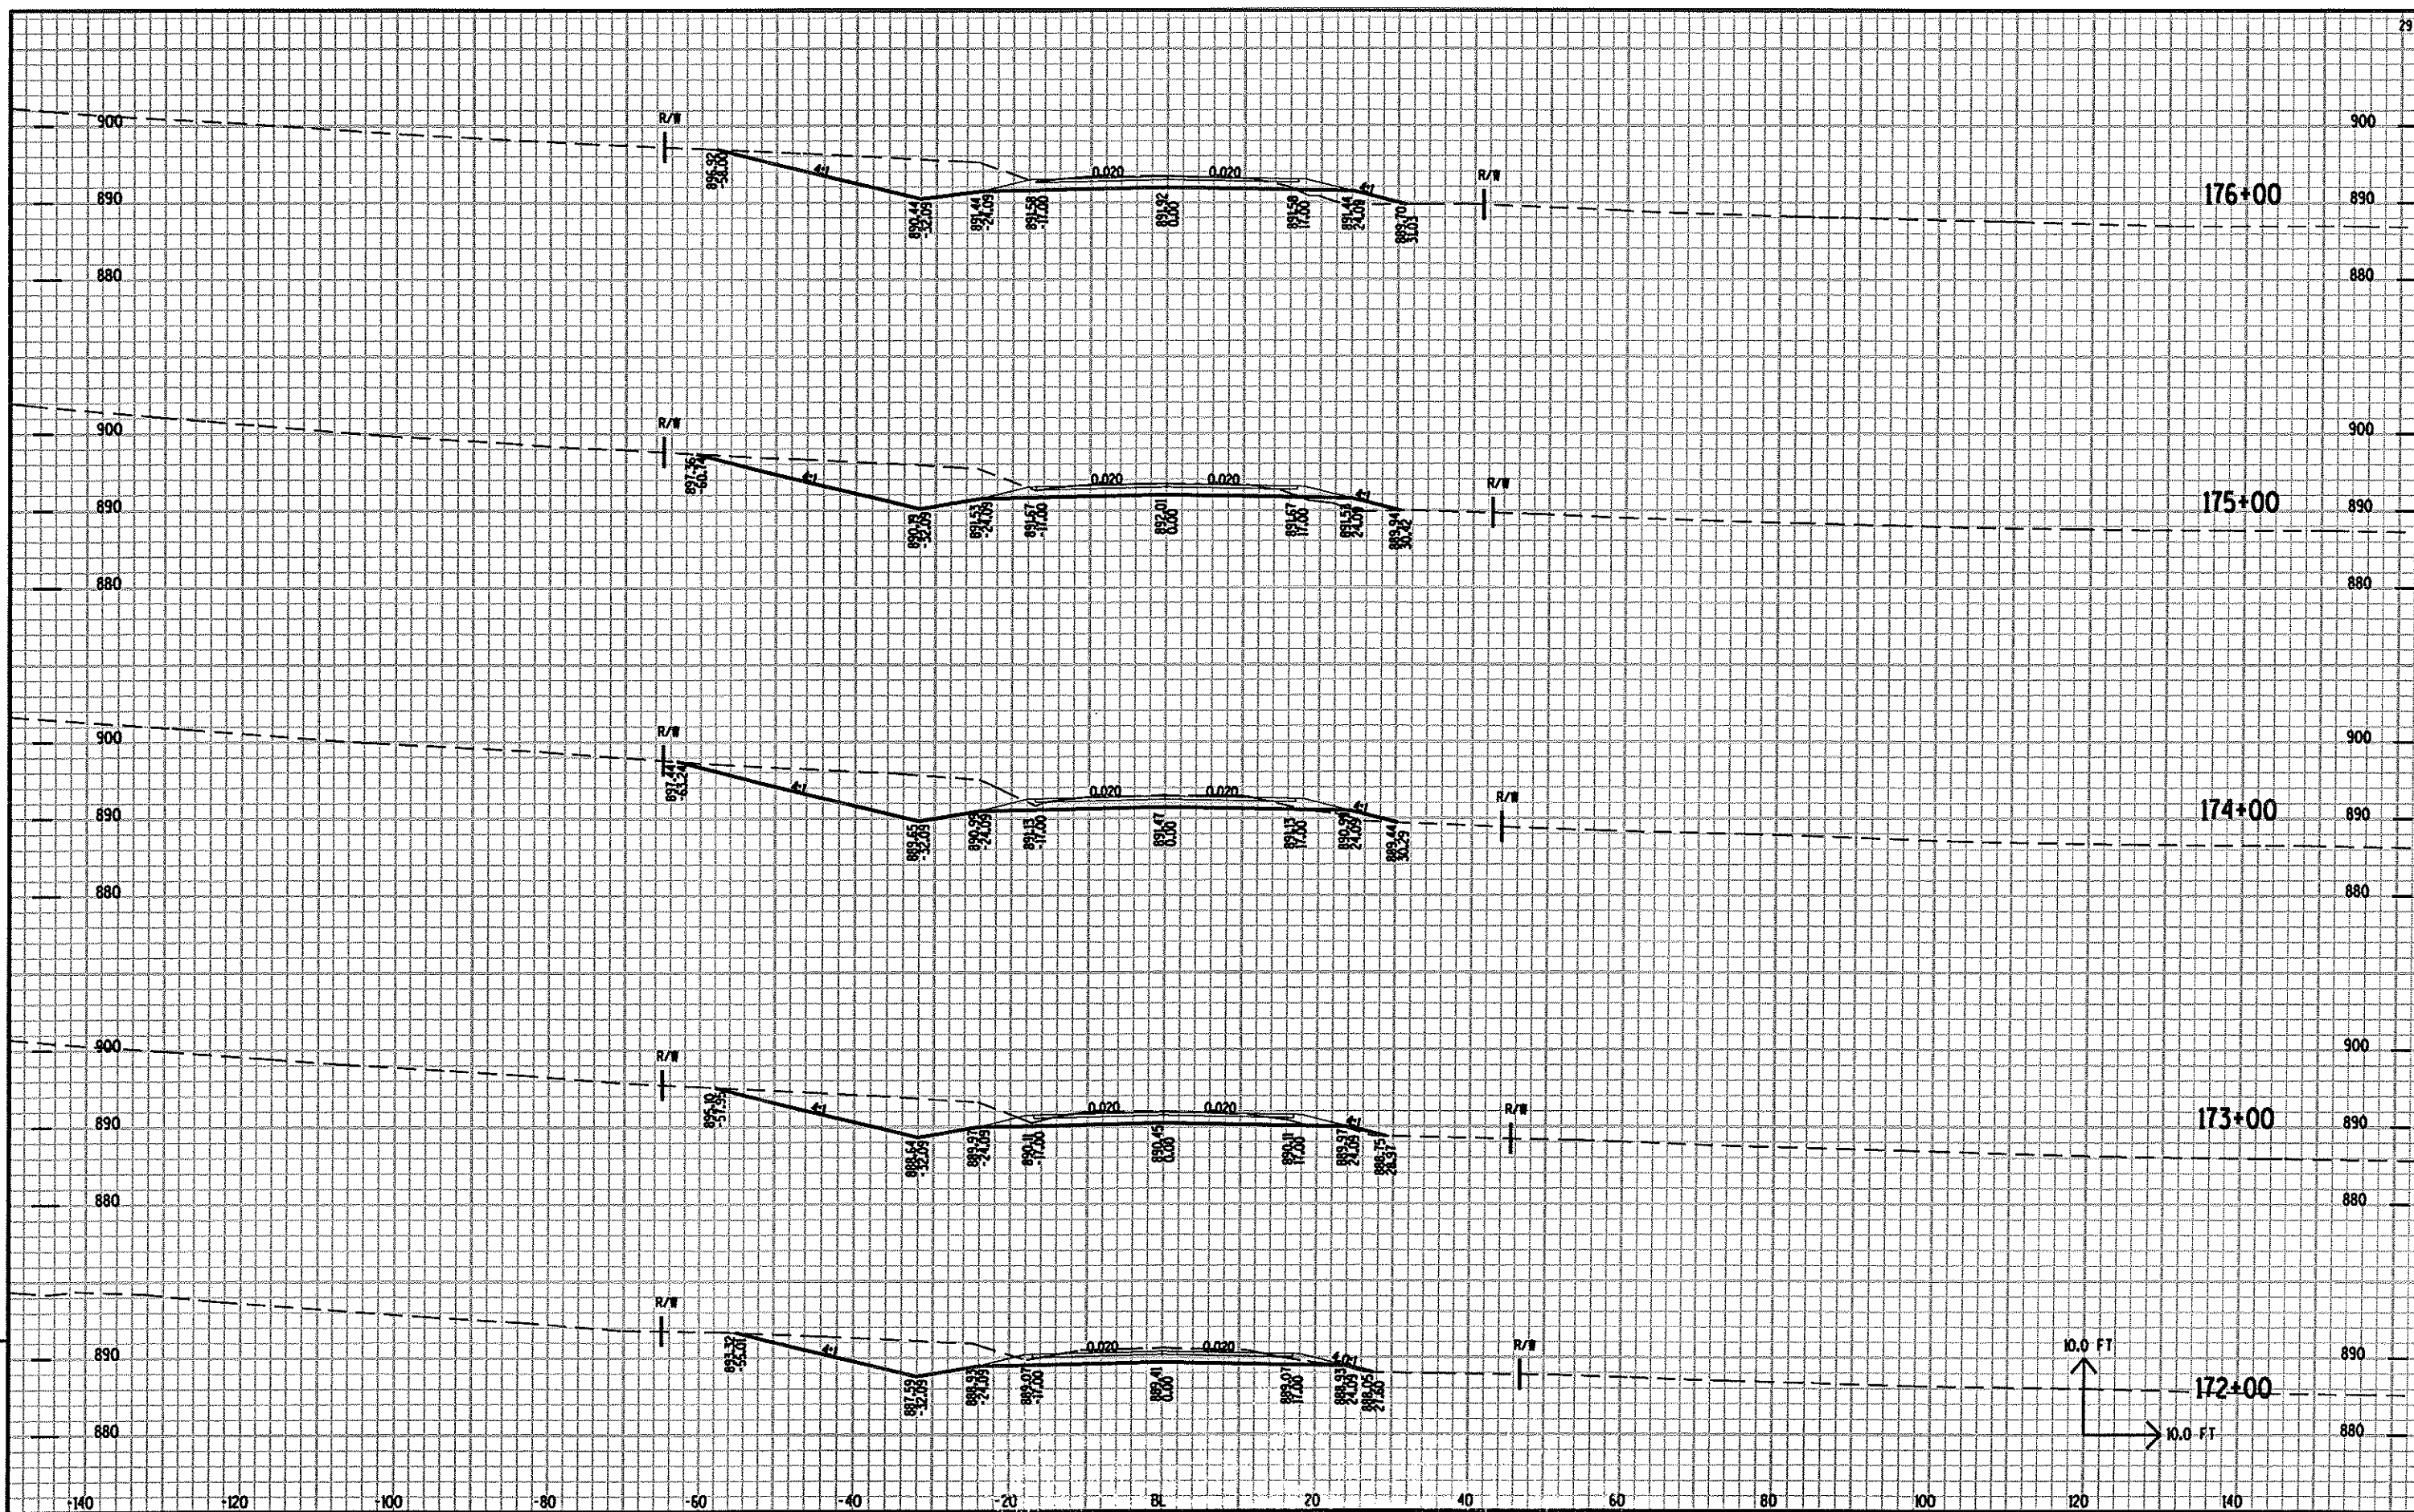


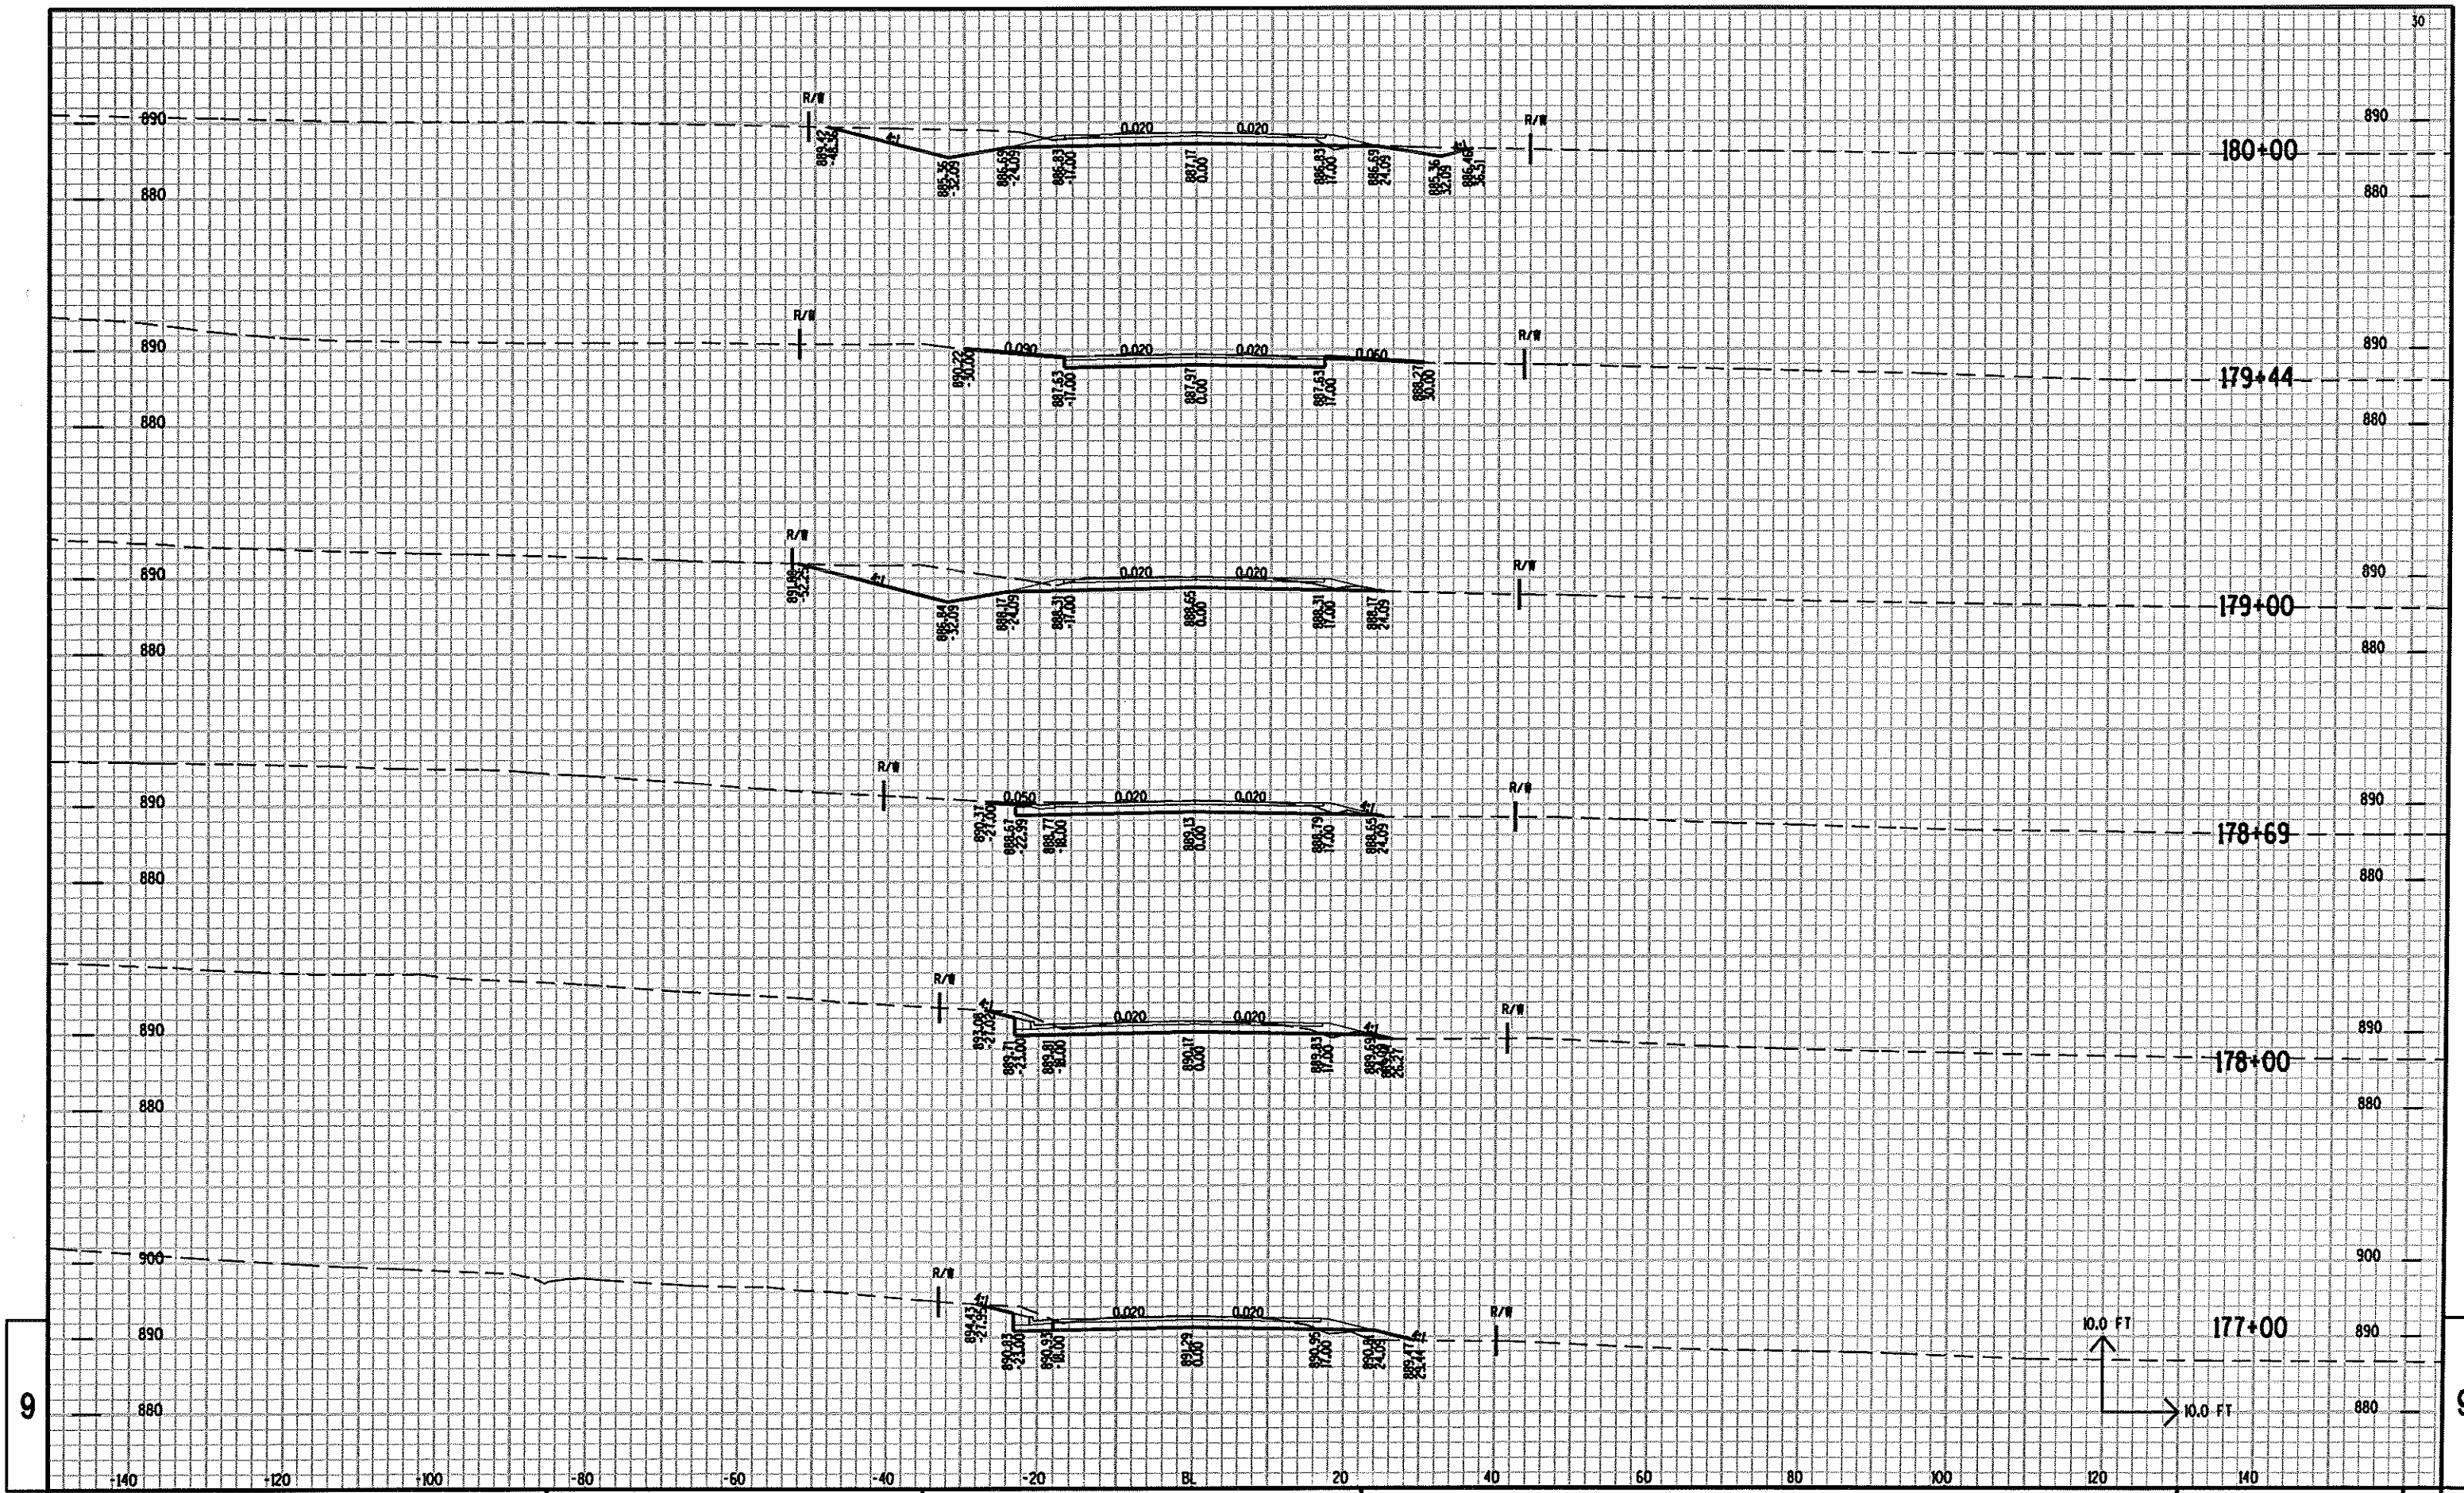

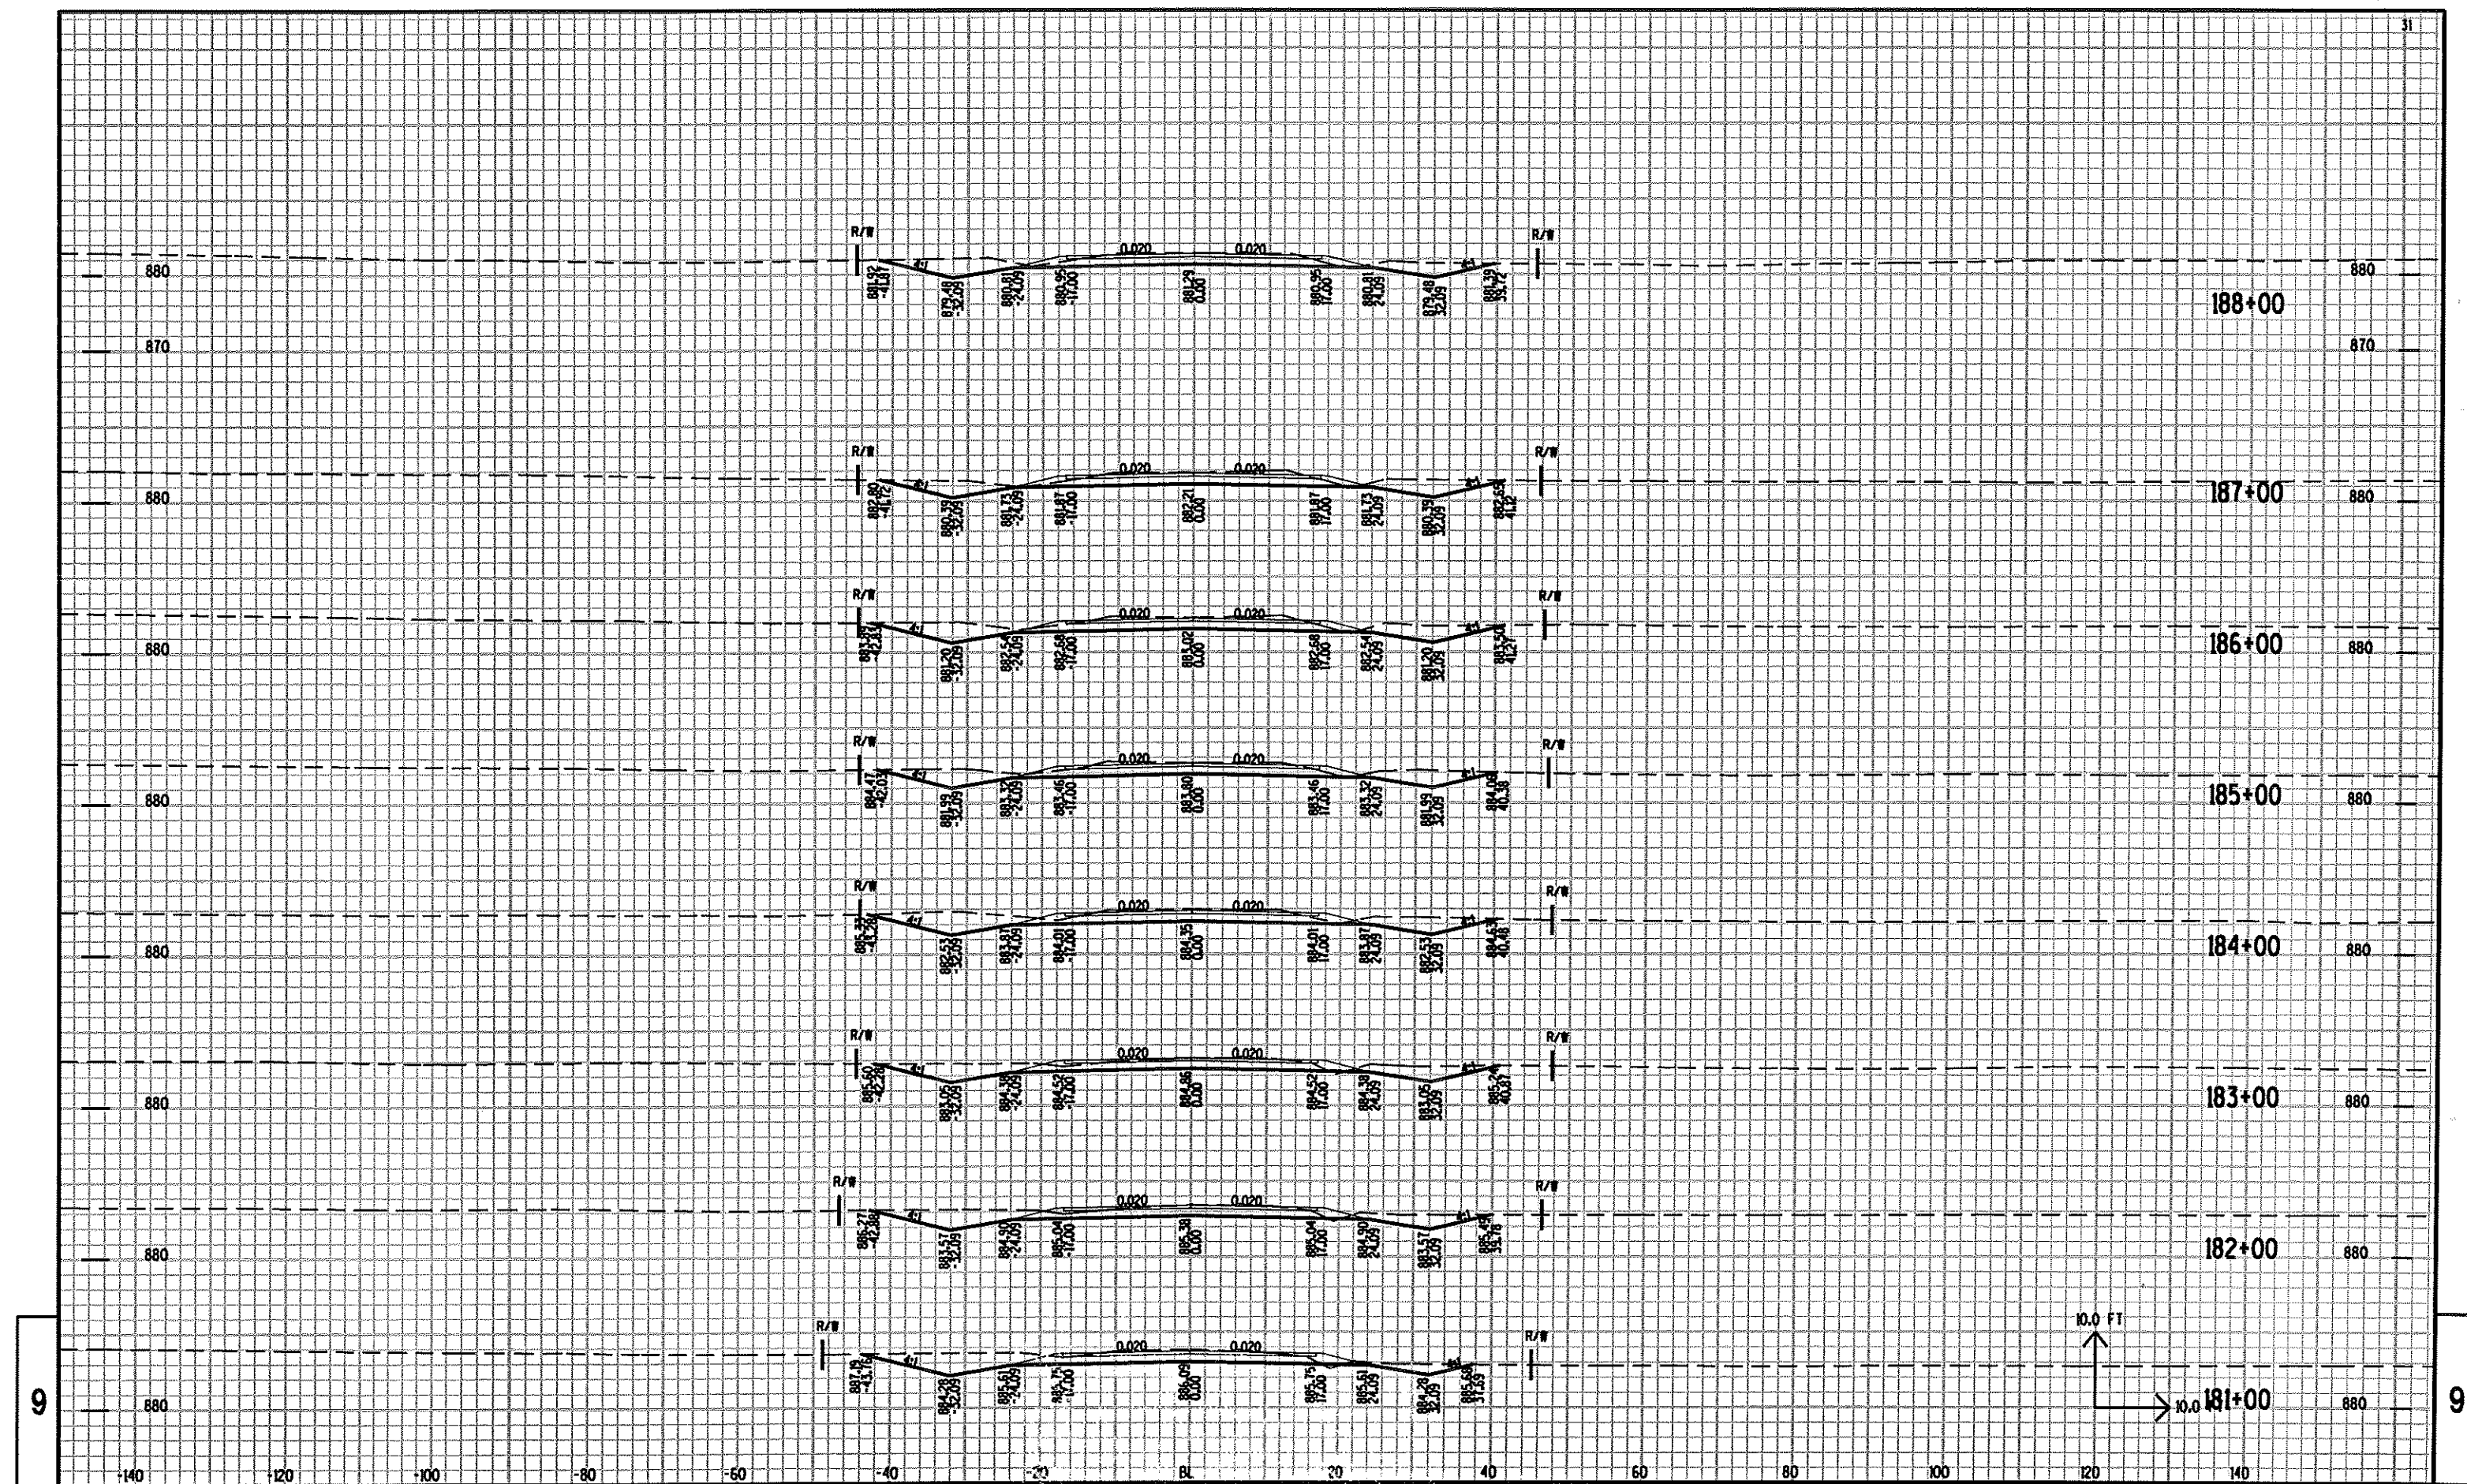

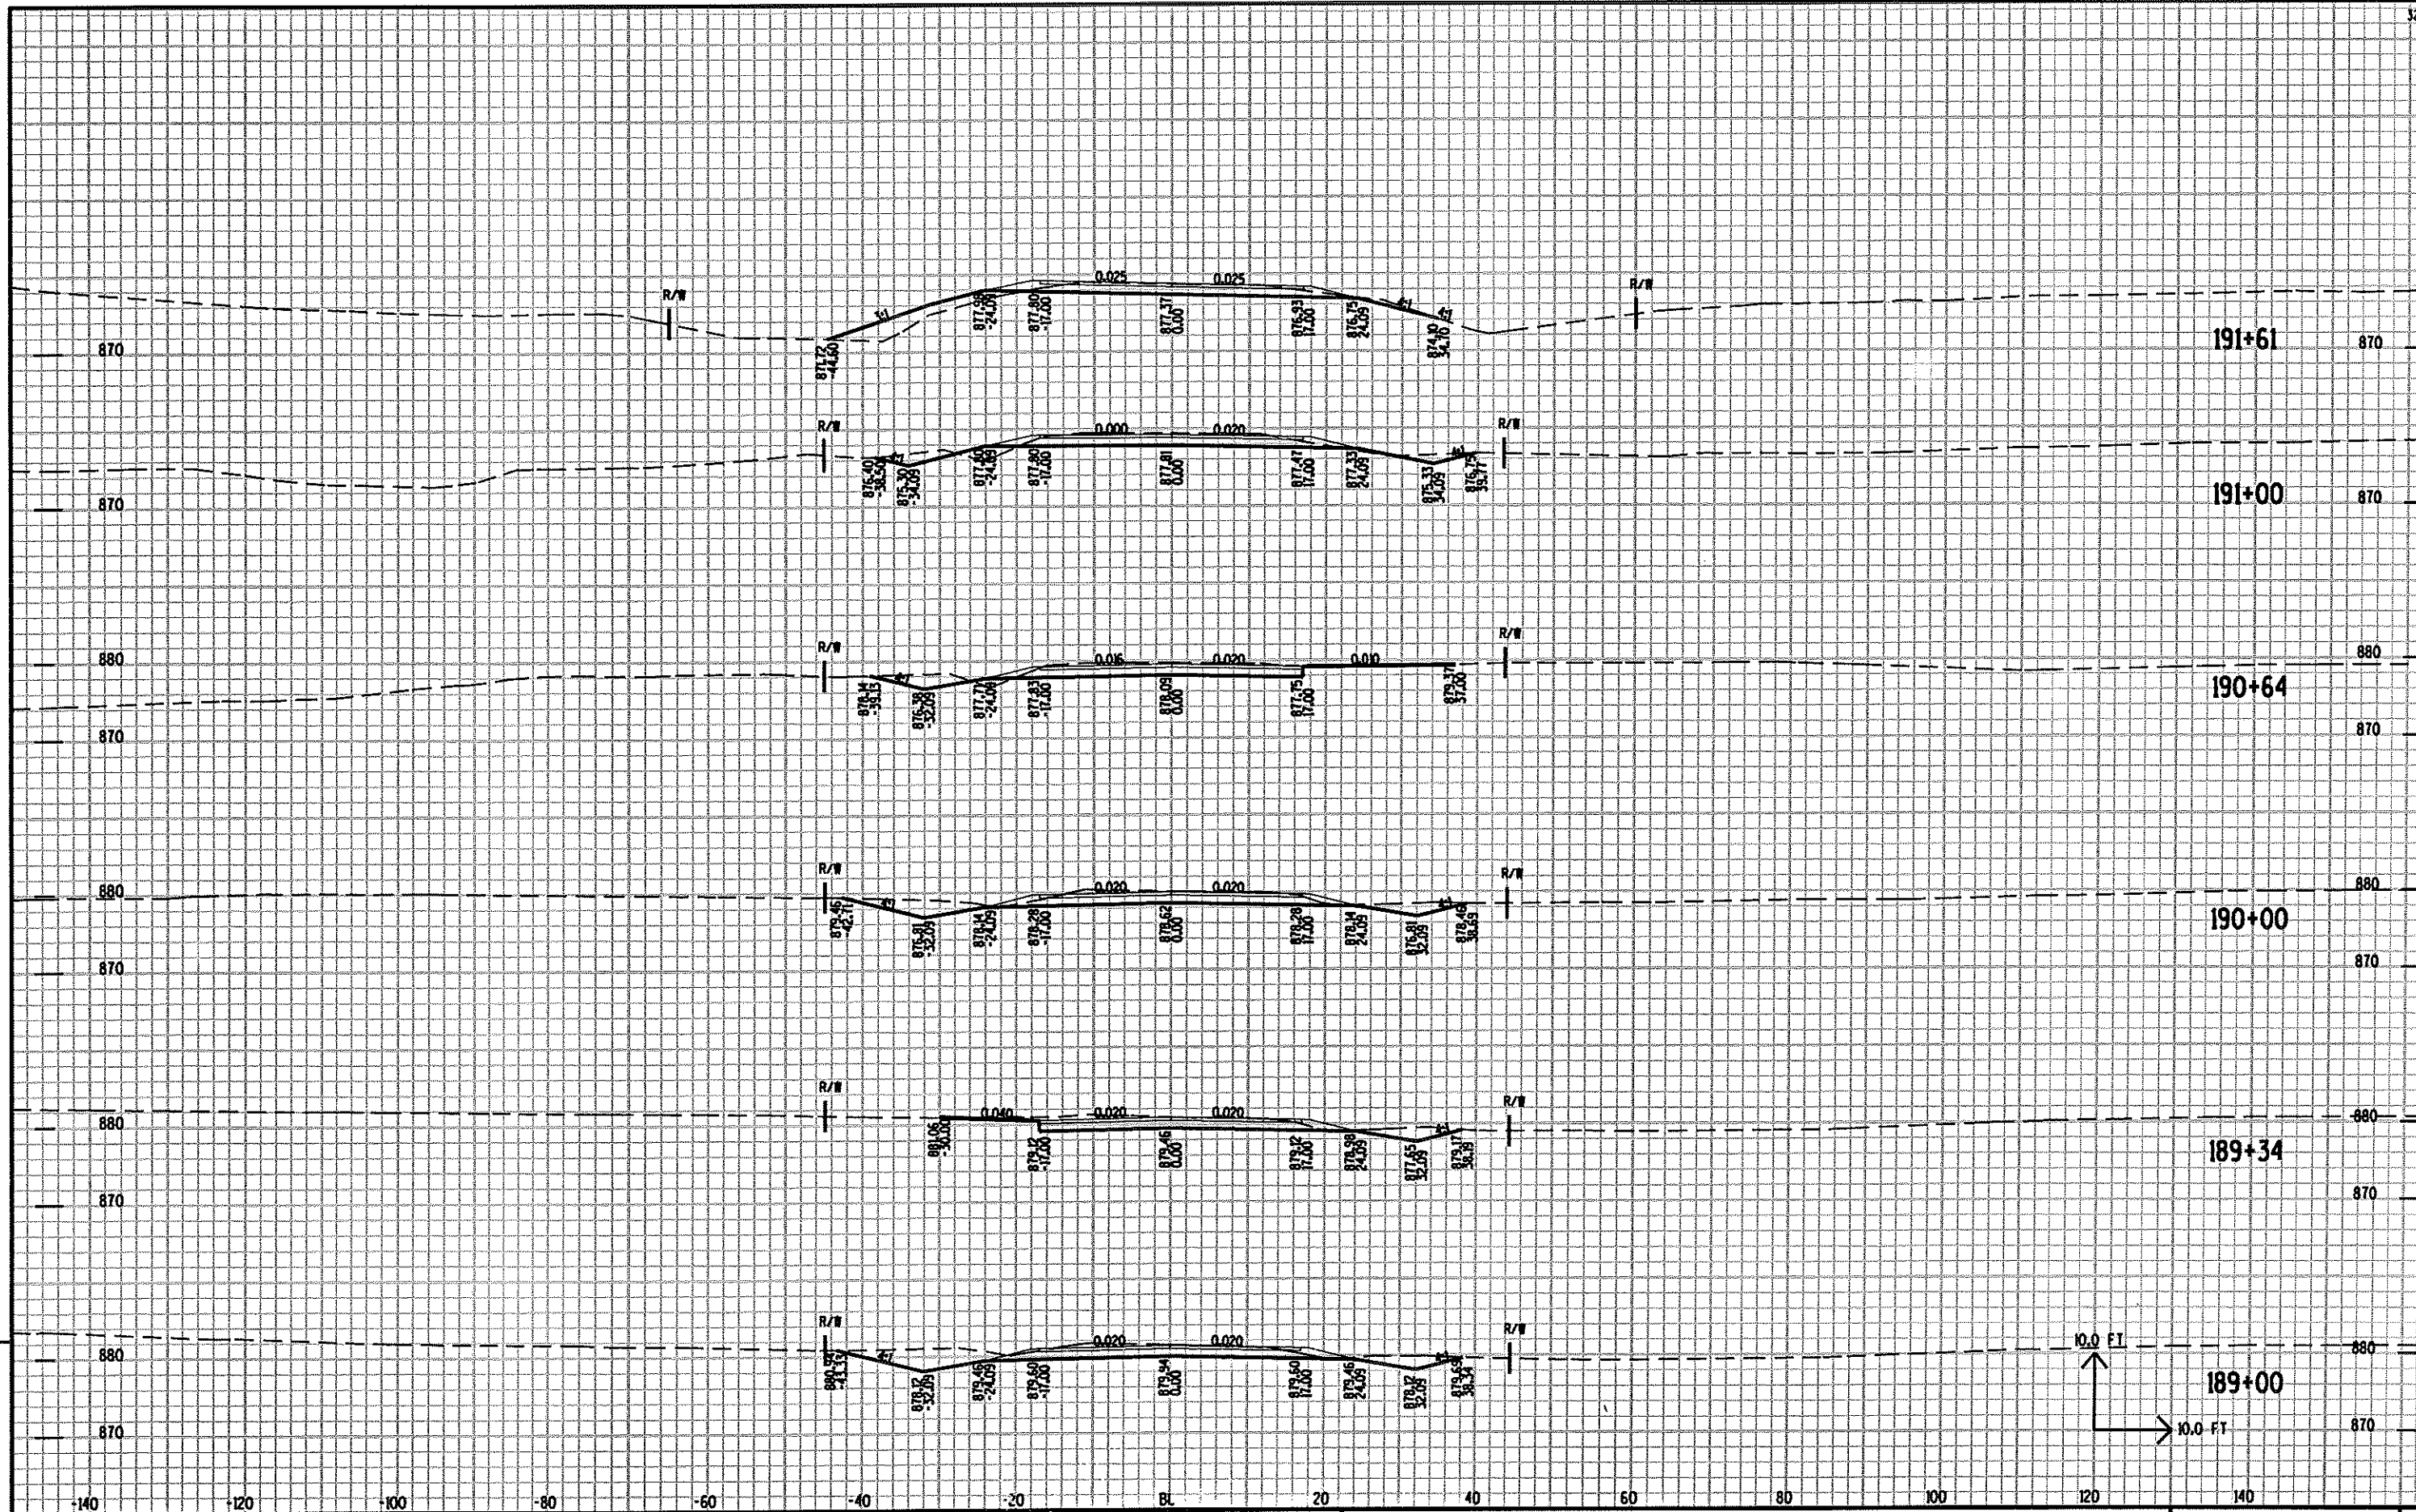

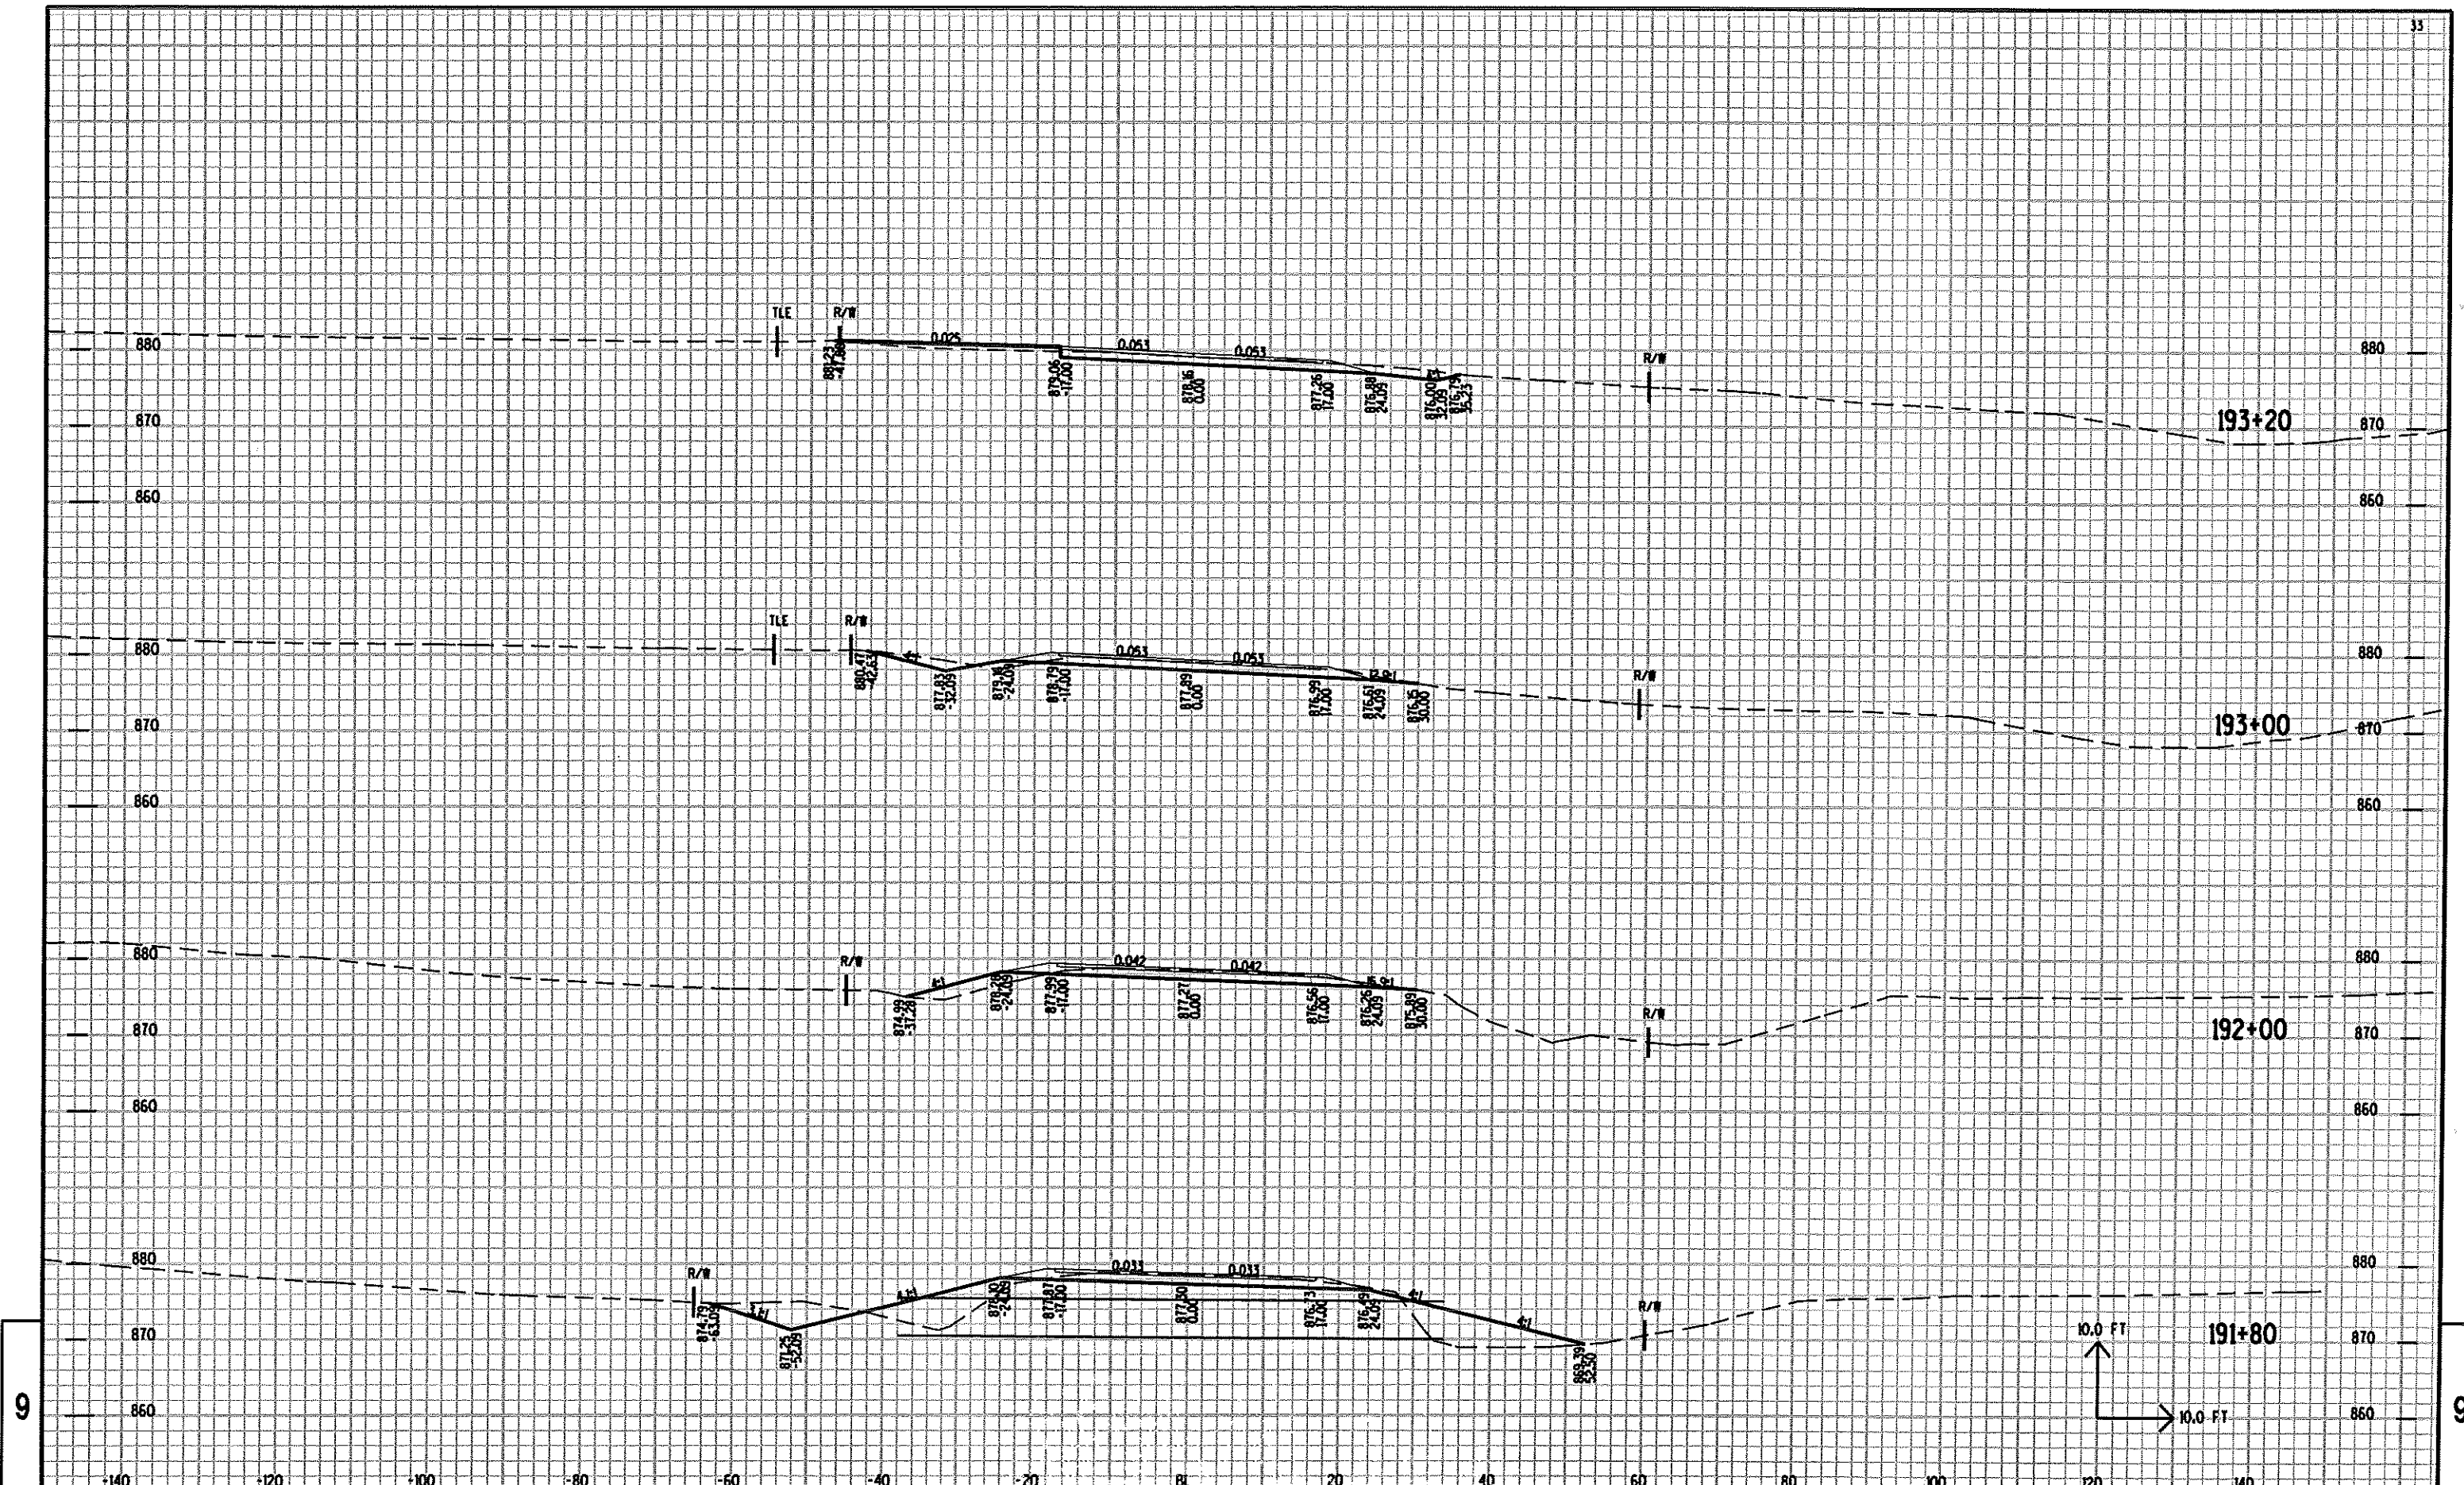

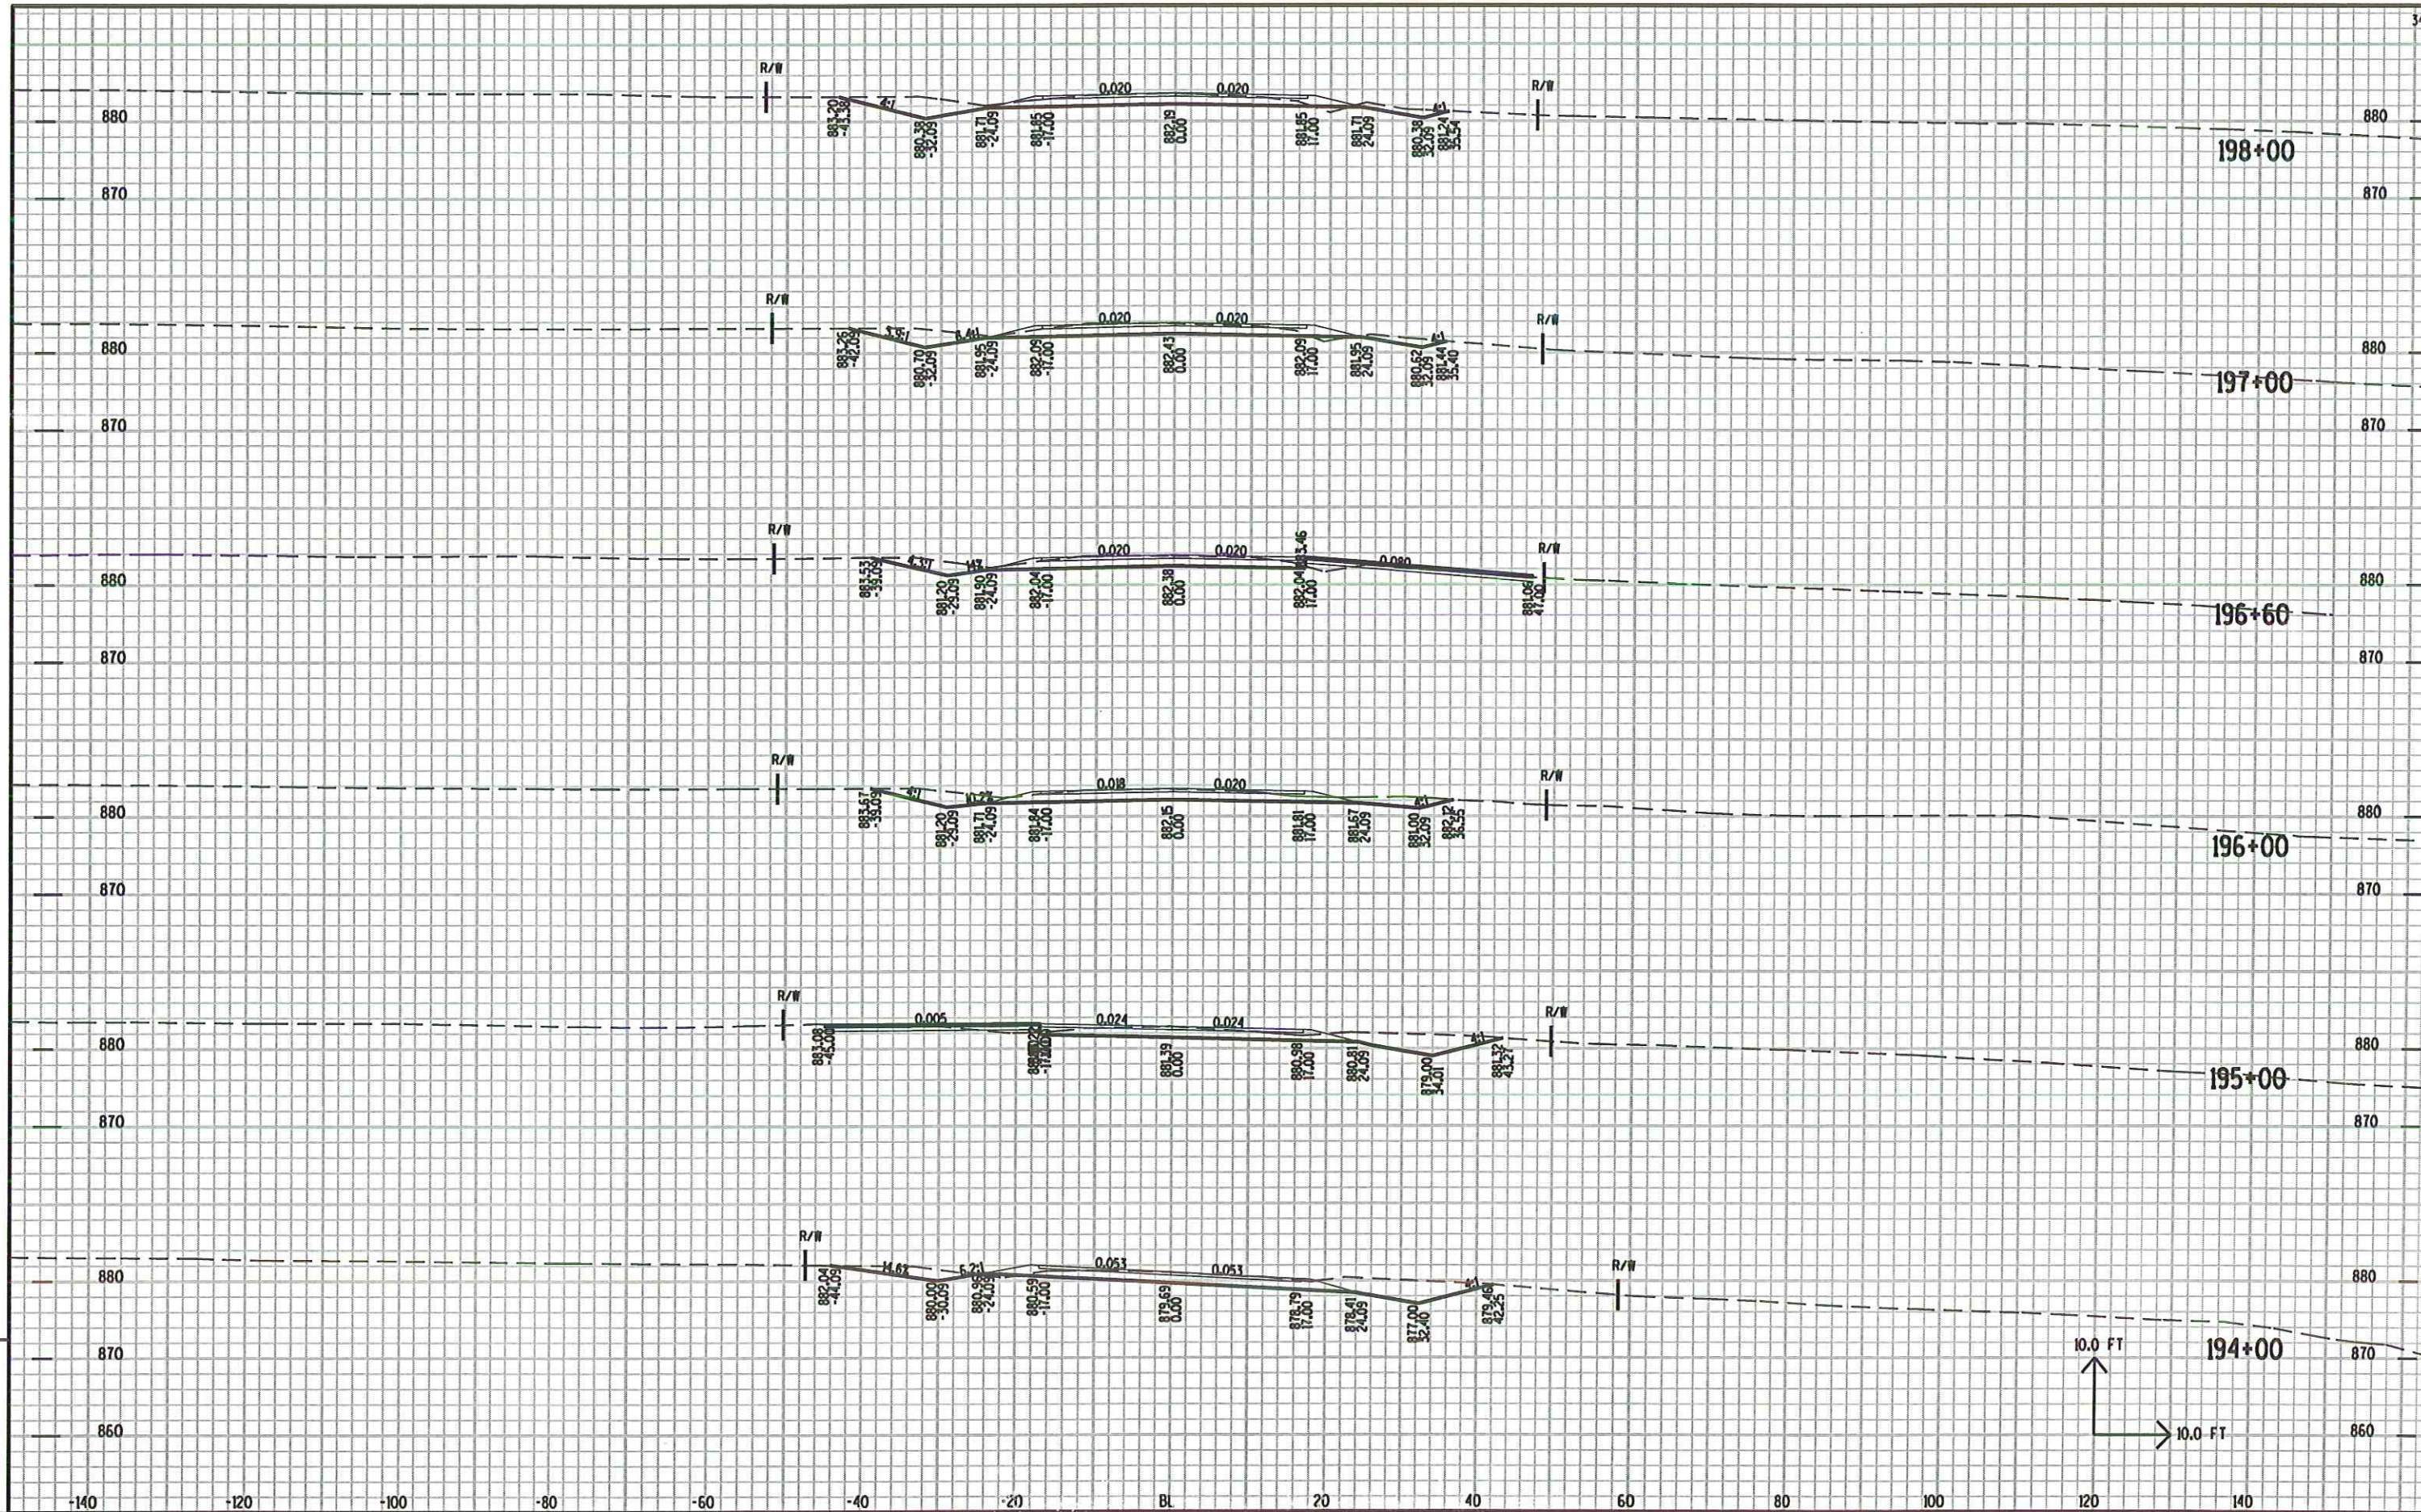

PROJECT NO: 5573-04-72

HWY: STH136

COUNTY: SAUK

STH 136 MAINLINE

SHEET NO:

E

FILE NAME : r:\Support\CAD\SV\Projects\vd1.55730401\090201..xs.DGN


PLOT DATE : 12-JUL-2007 07:17

PLOT BY : dotbbg

PLOT NAME :

PLOT SCALE : 2.000000:1.000000

233

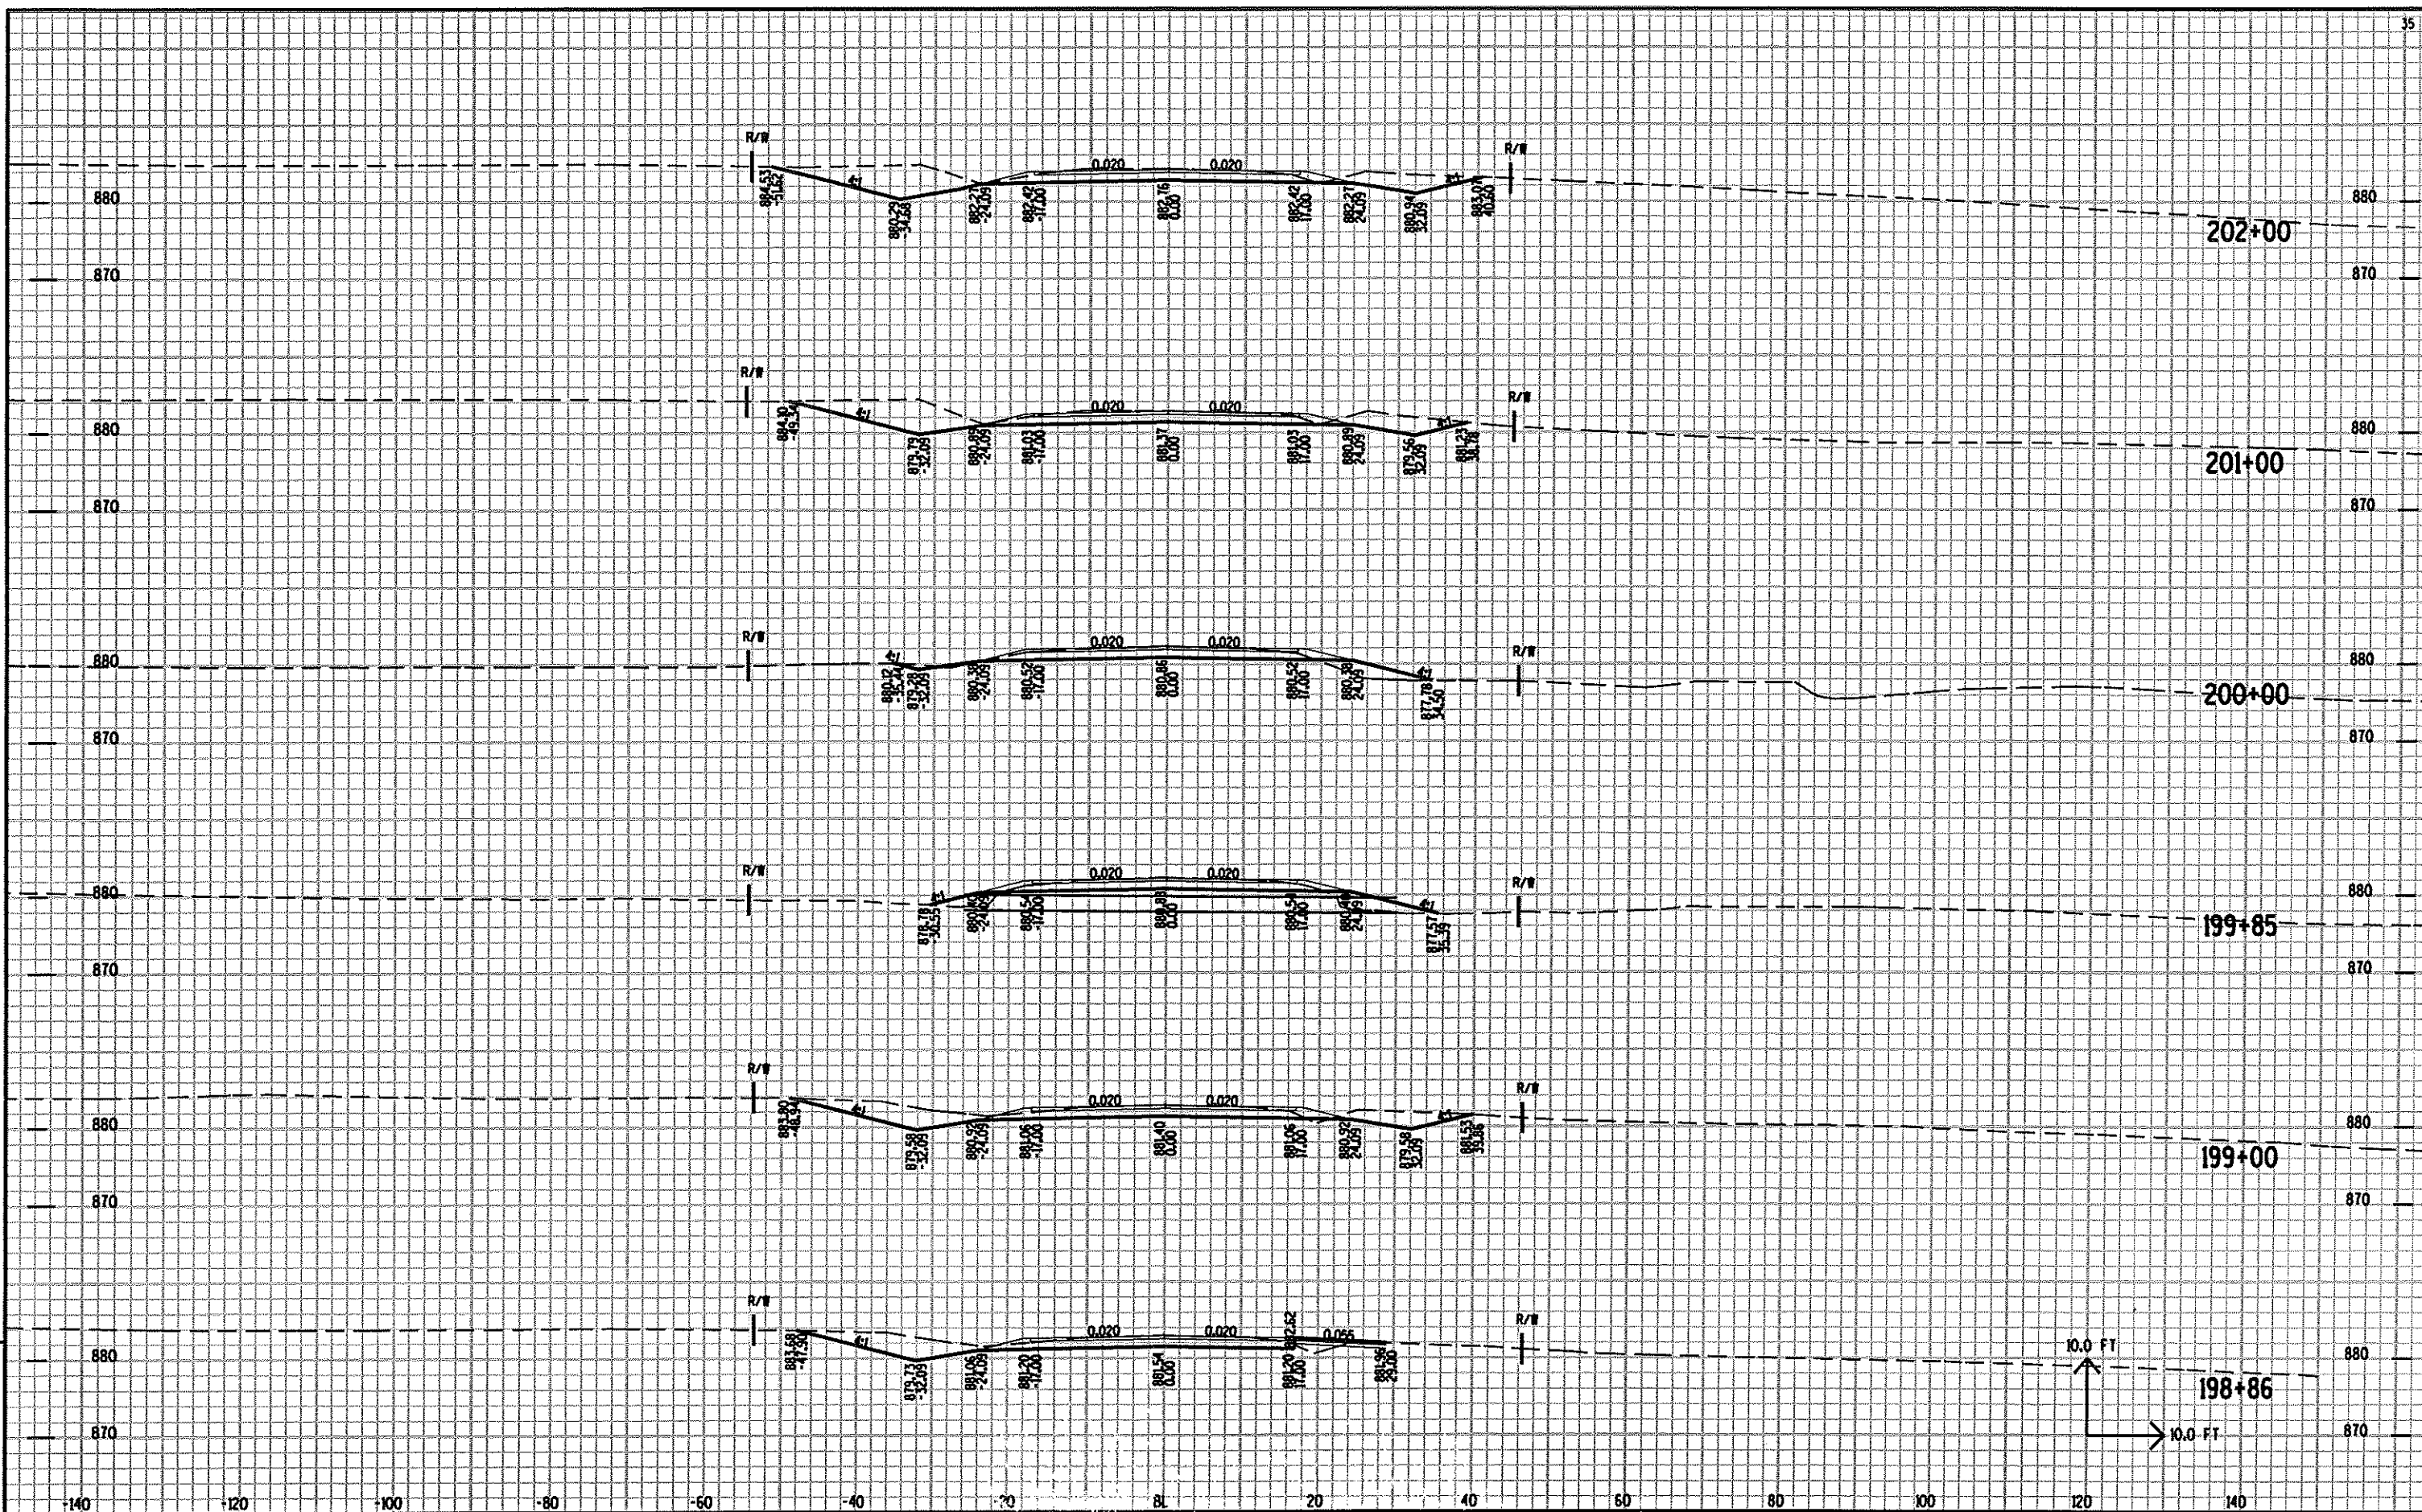

PROJECT NO: 5573-04-72

HWY: STH136

COUNTY: SAUK

STH 136 MAINLINE

SHEET NO:

E


FILE NAME : r:\Support\CAADSV\Projects\vd1.55730401\090201_xs.DGN

PLOT DATE : 12-JUL-2007 07:17

PLOT BY : dottbq


PLOT NAME :


PLOT SCALE : 2.000000:1.000000

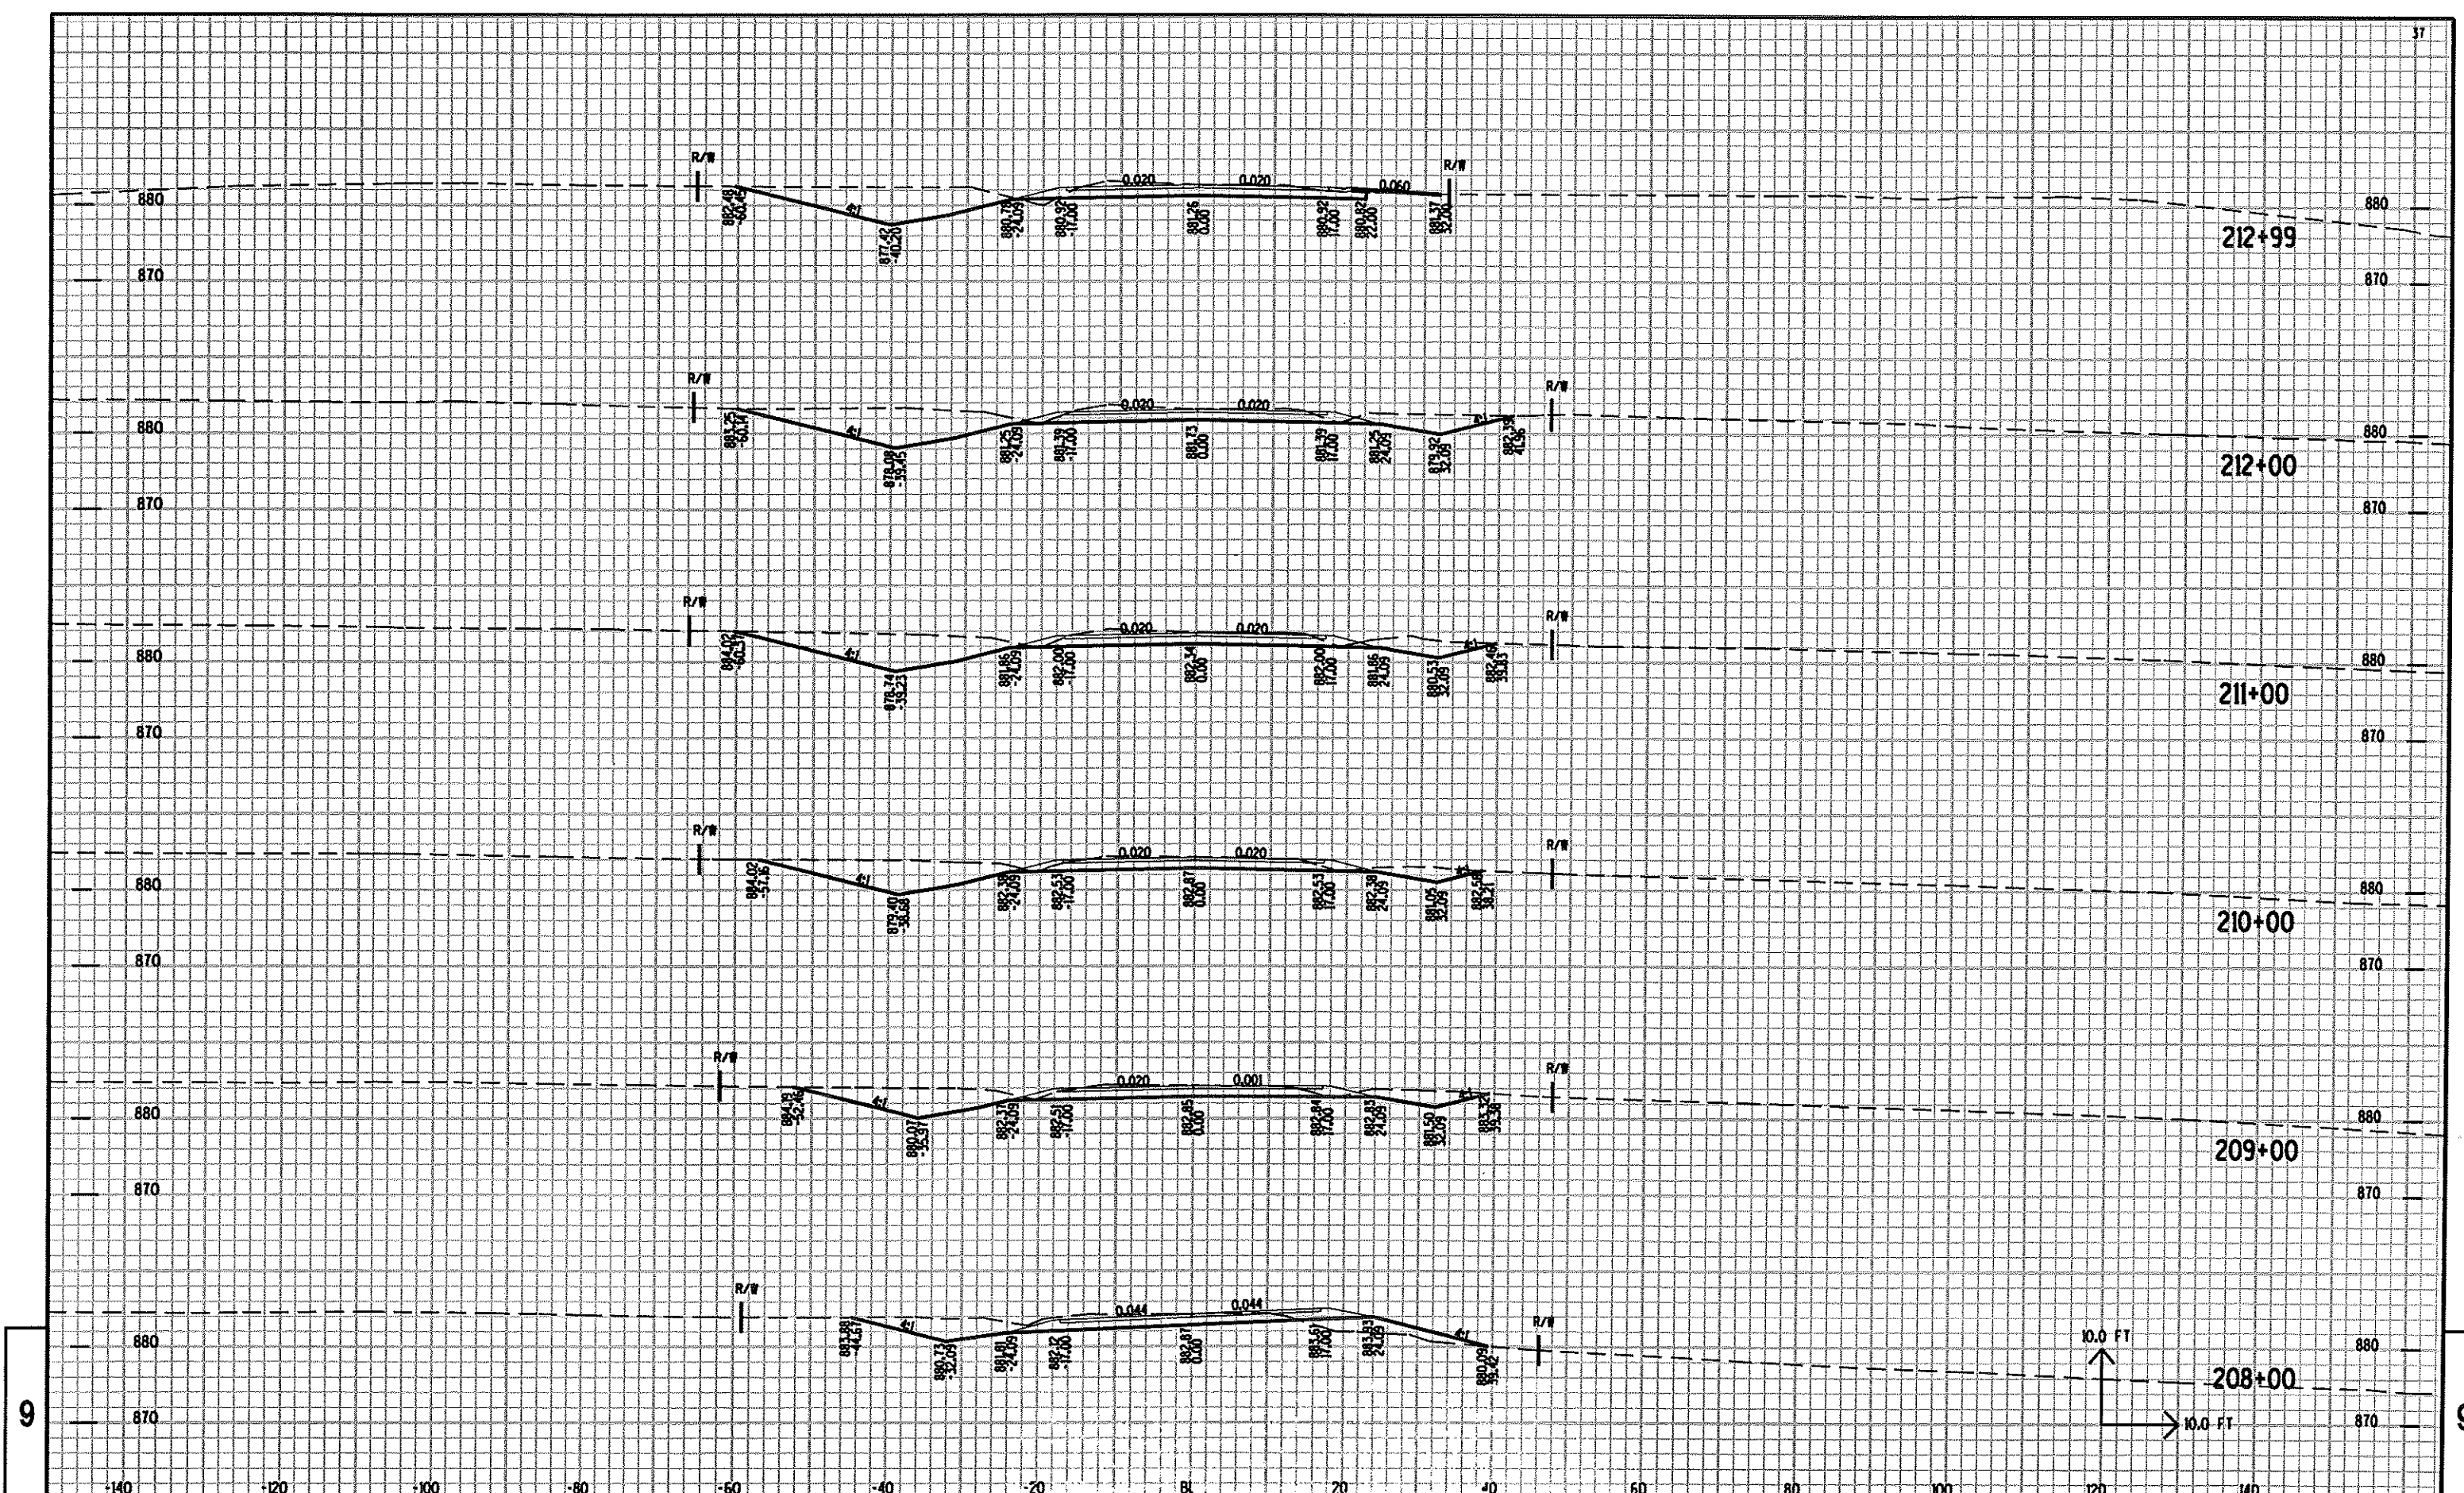


9

9

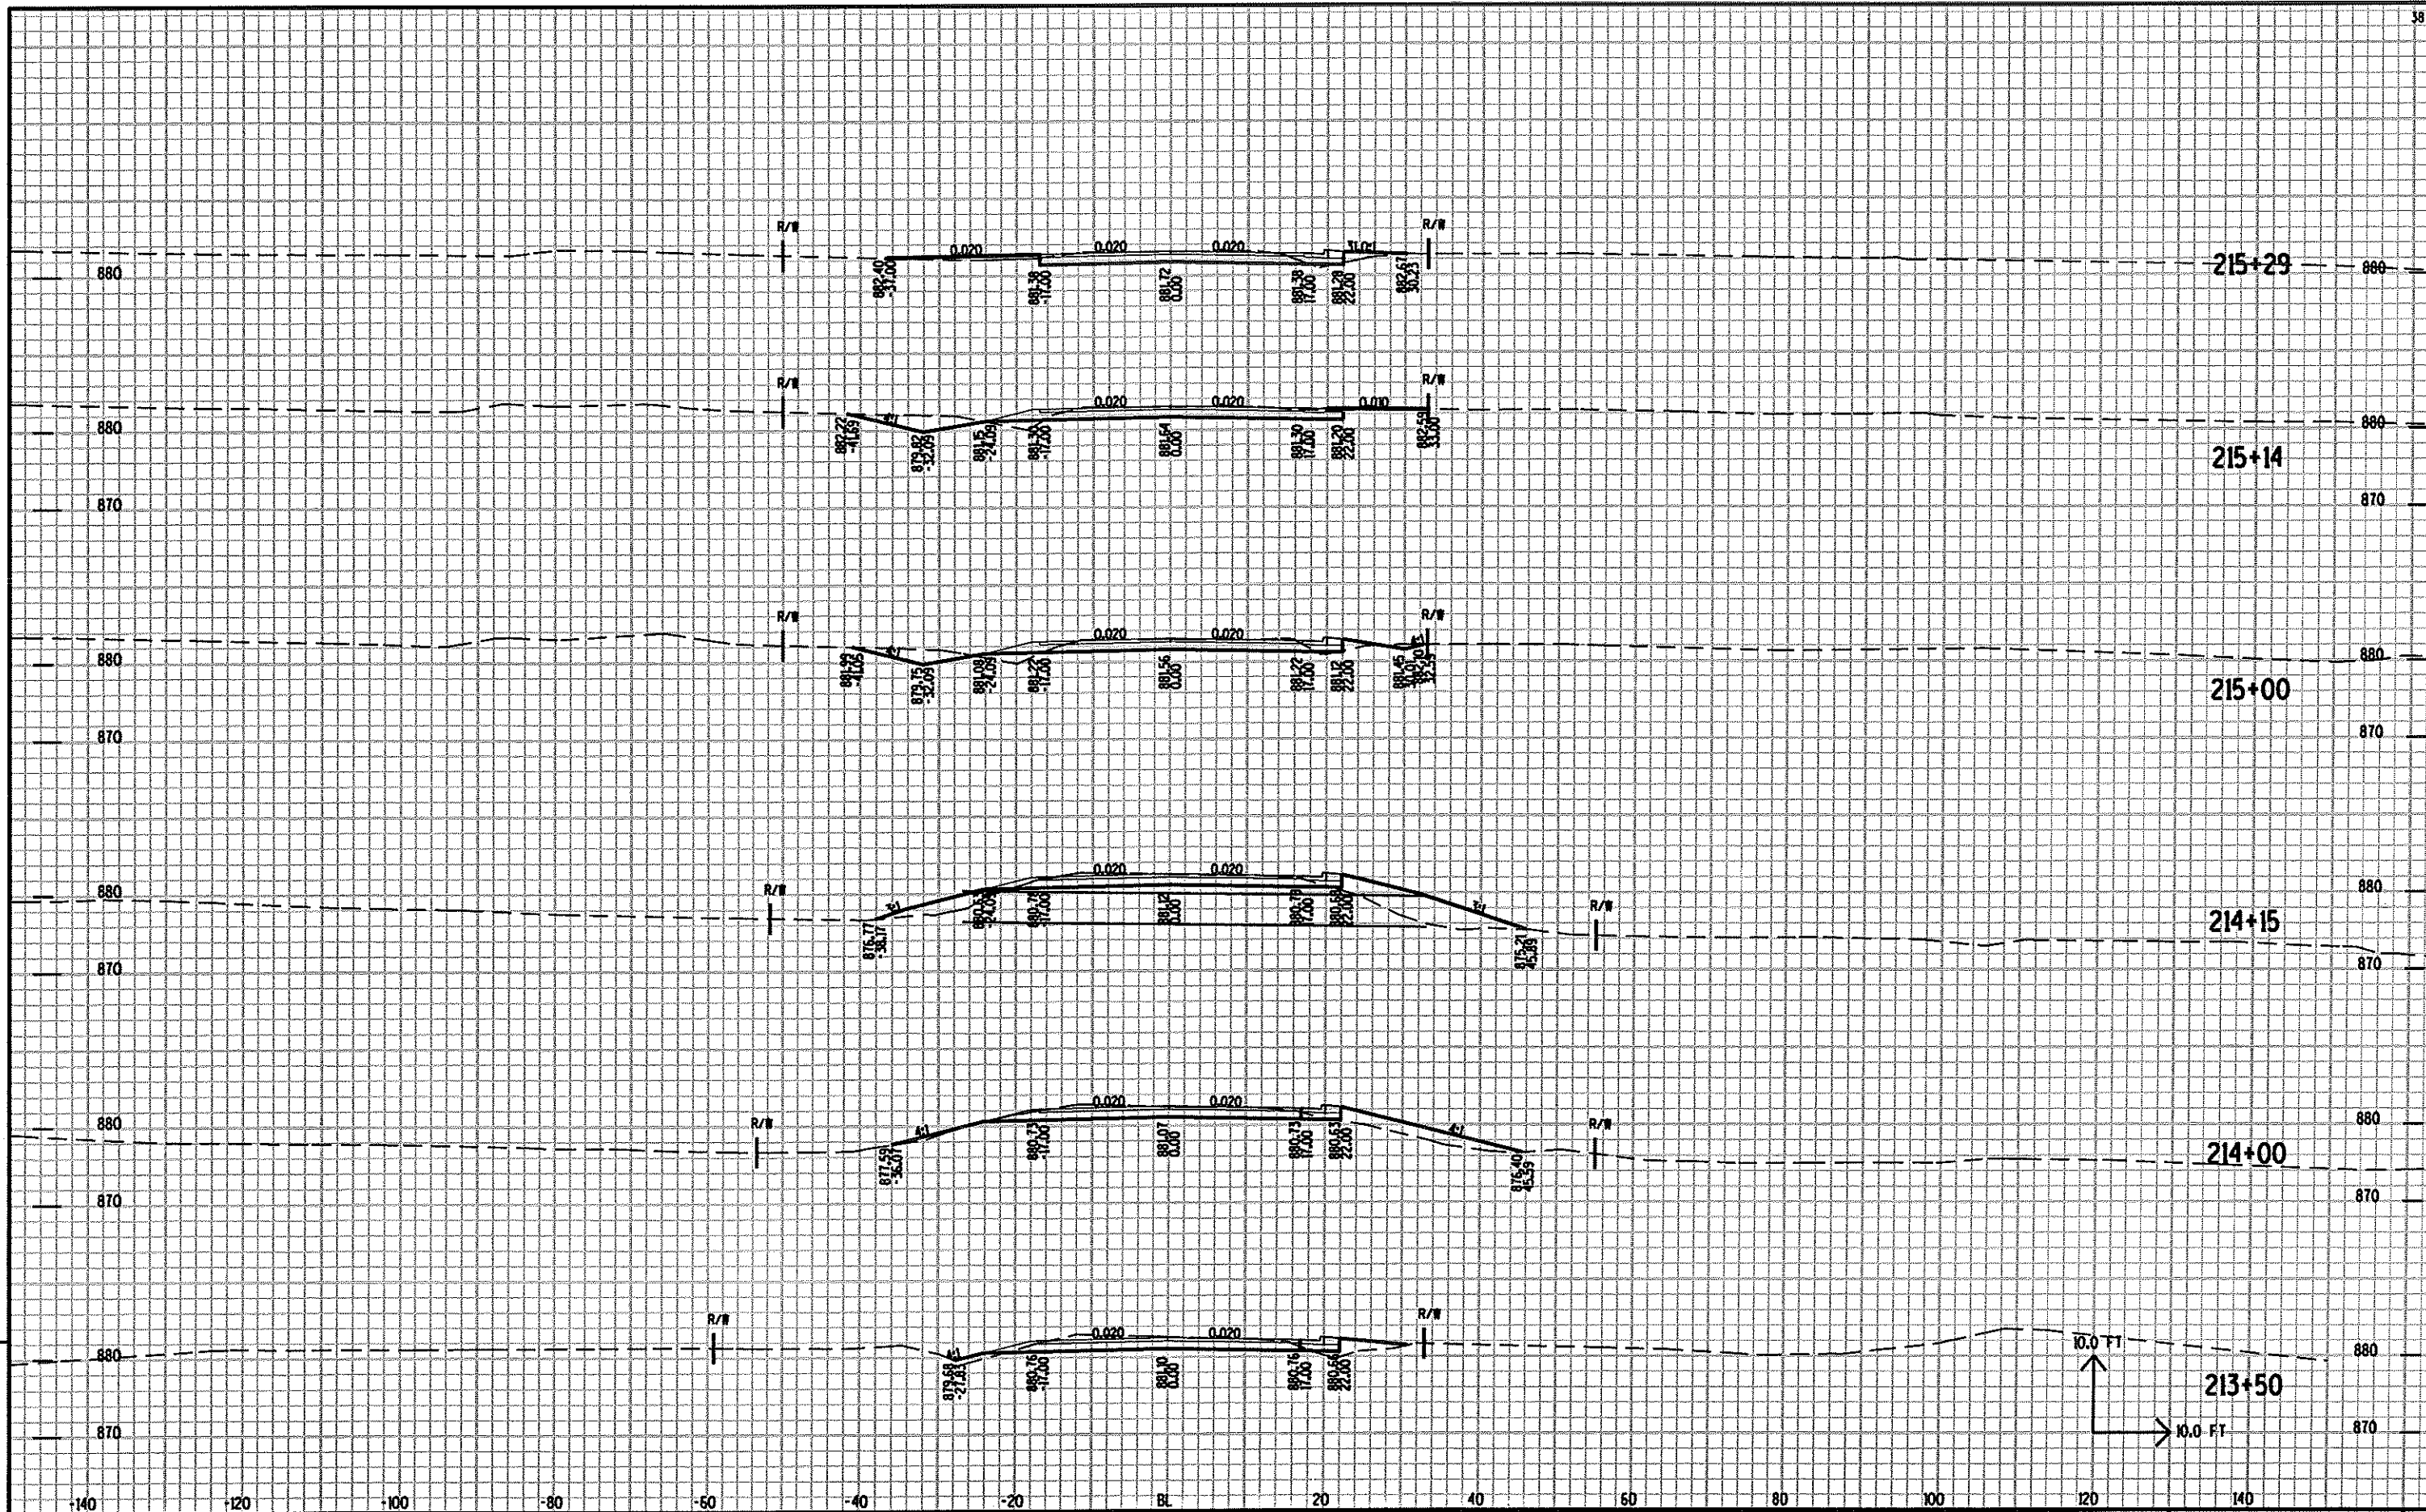

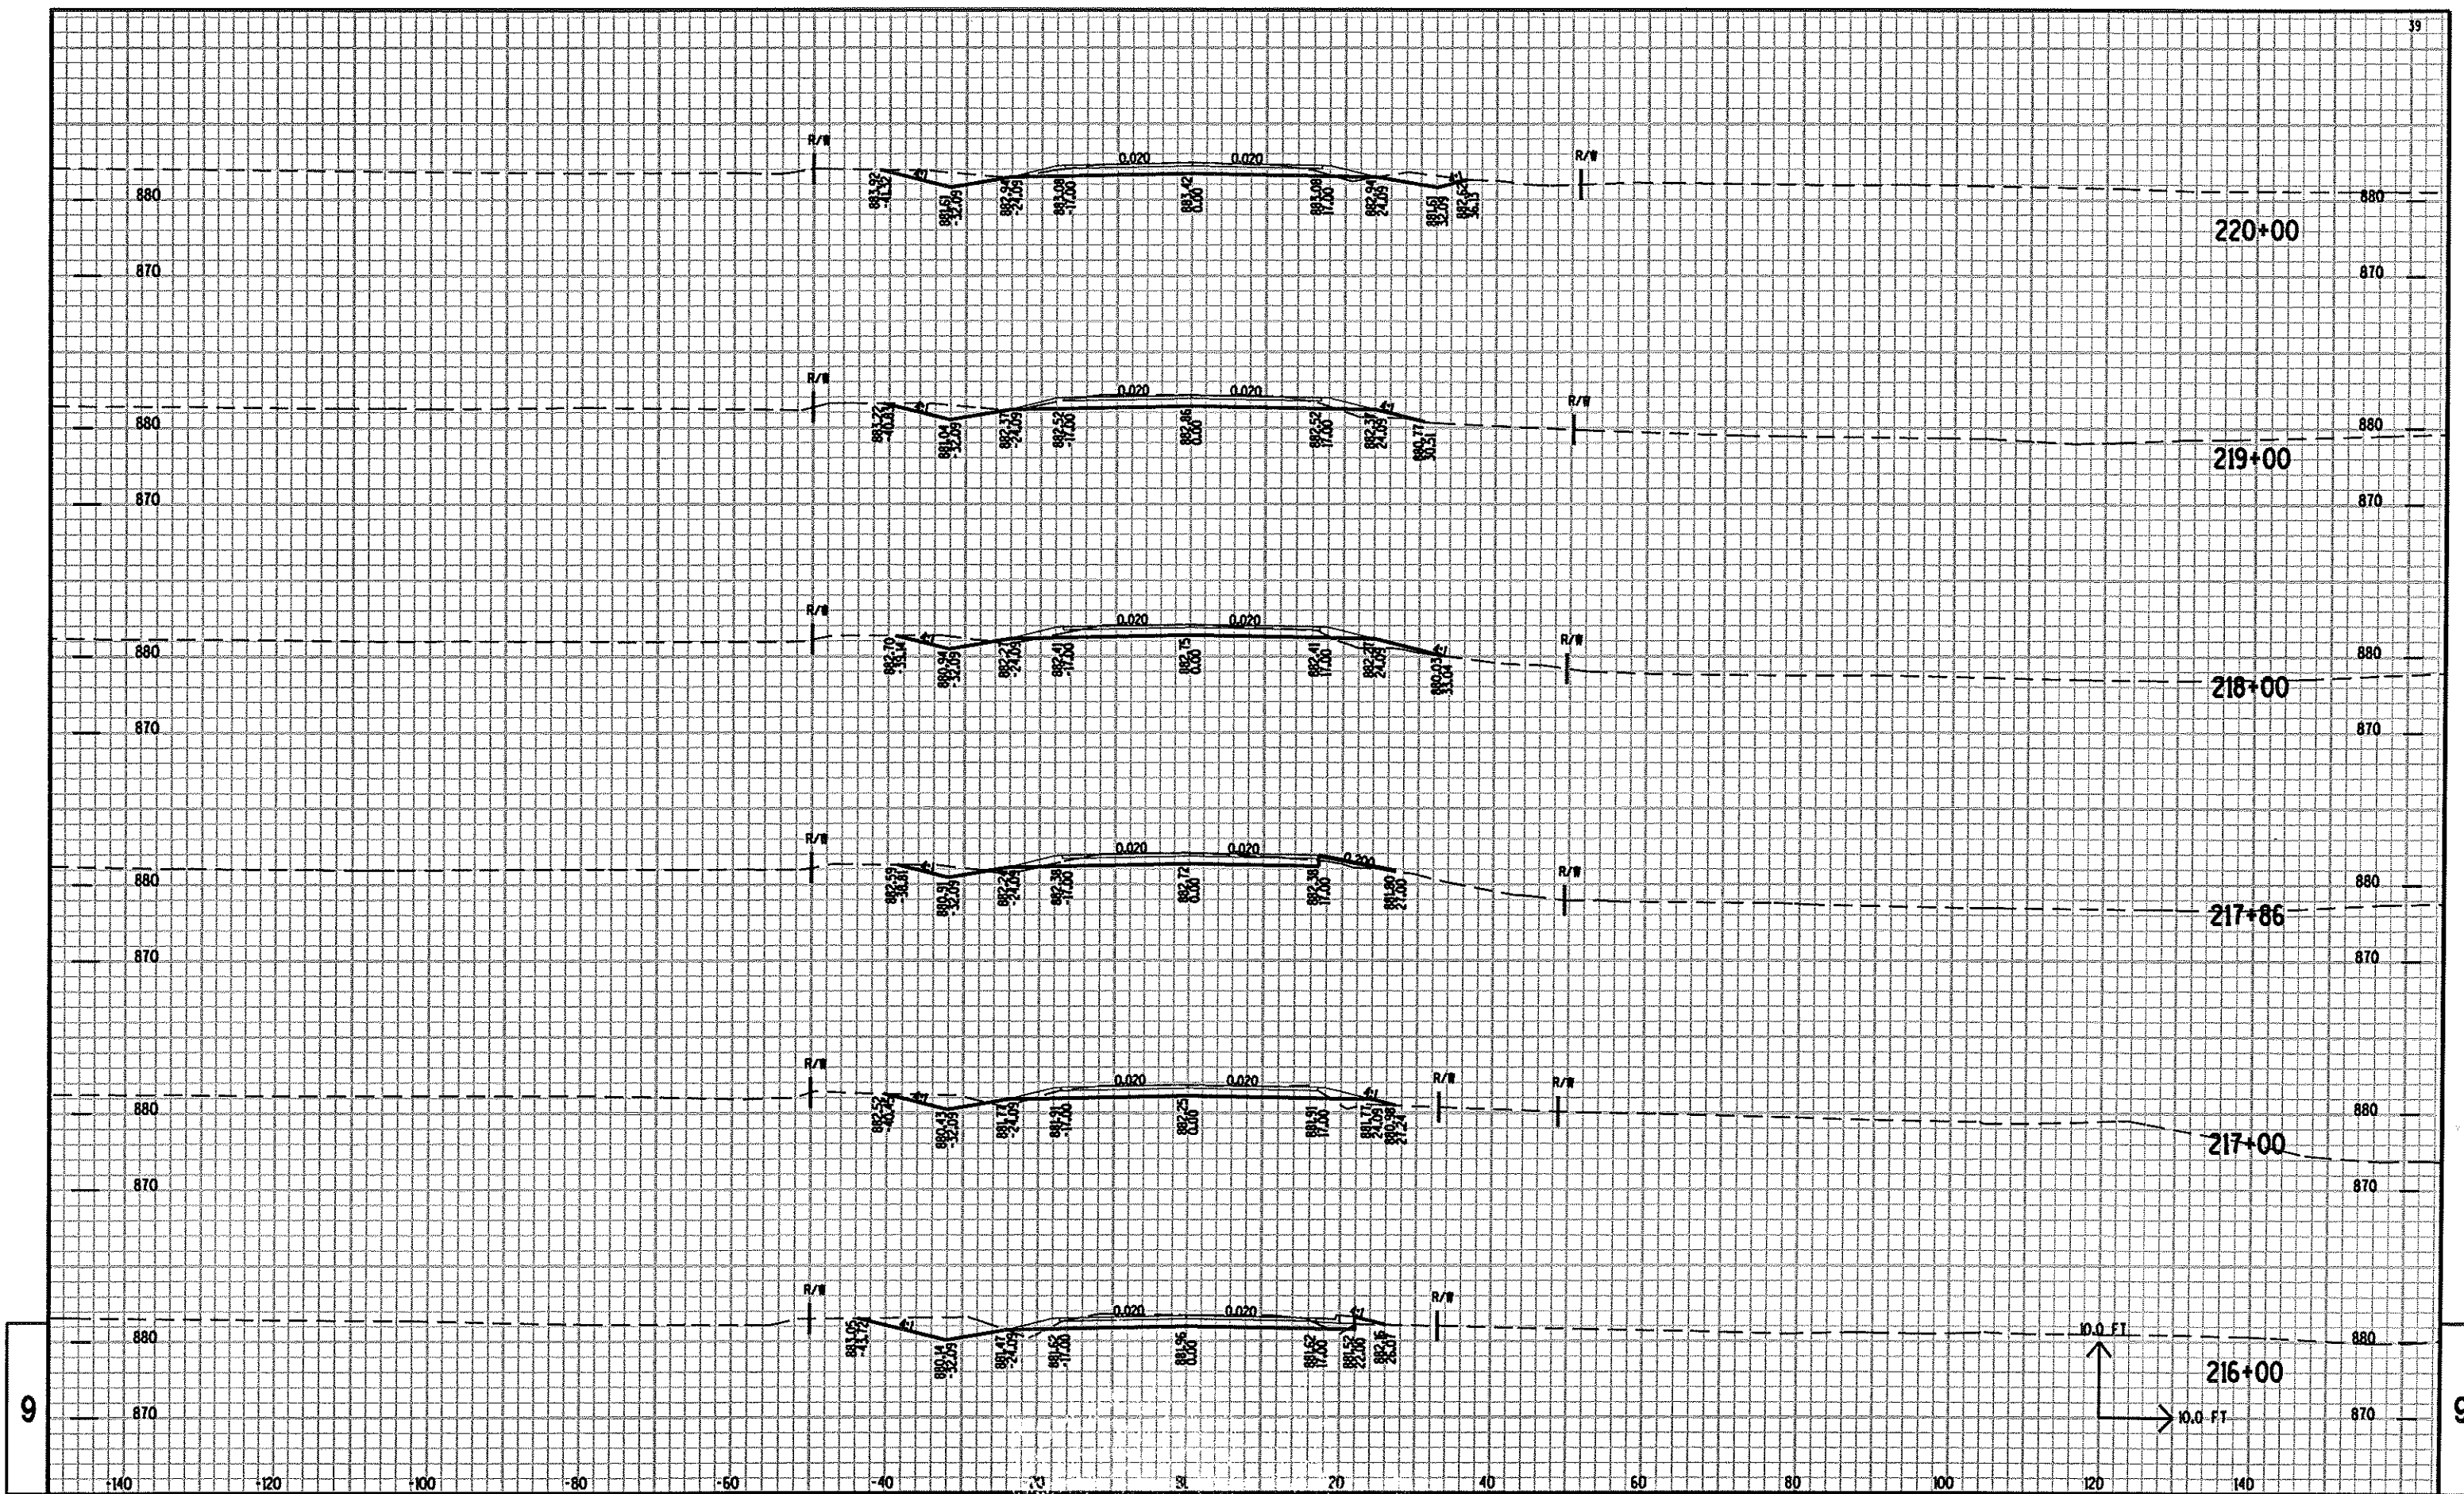

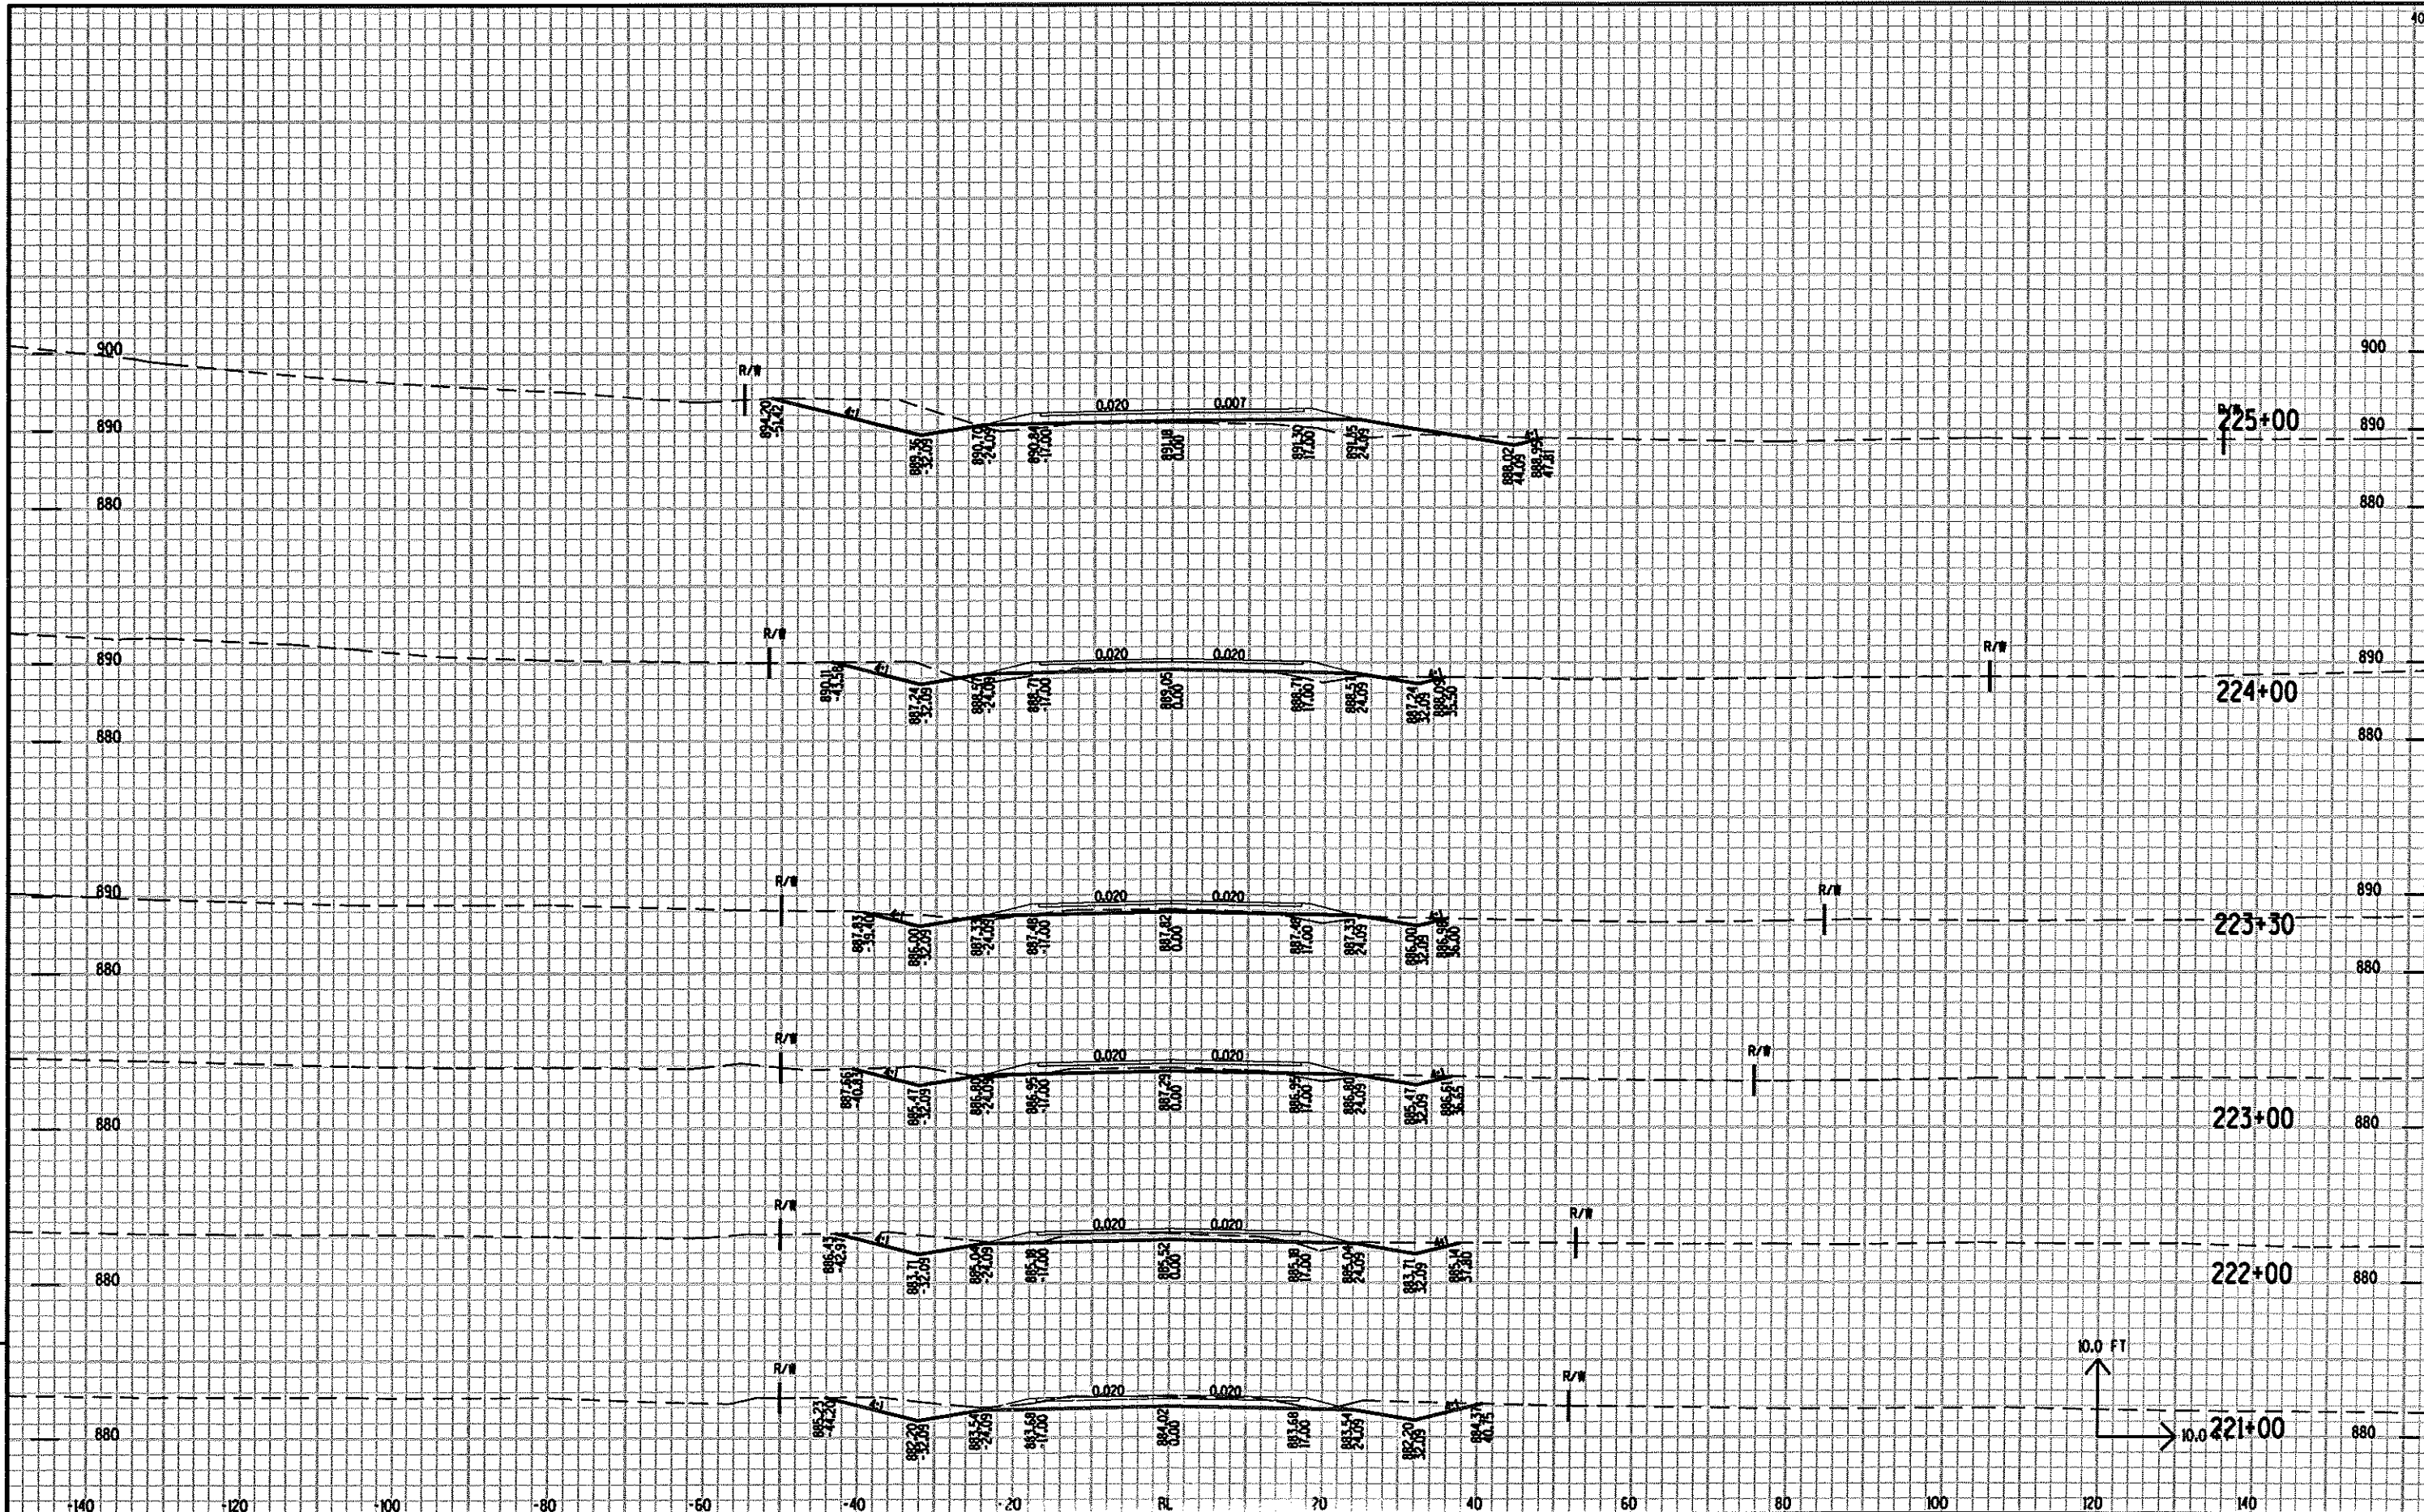

PROJECT NO: 5573-04-72

HWY: STH136

COUNTY: SAUK

STH 136 MAINLINE

SHEET NO:

E

FILE NAME : r:\Support\CA005V\Projects\Vol1_55730401\090201.xs.dgn


PLOT DATE : 12-Jul-2007 07:18


PLOT BY : dotbbg

PLOT NAME :

PLOT SCALE : 2.000000:1.000000


239

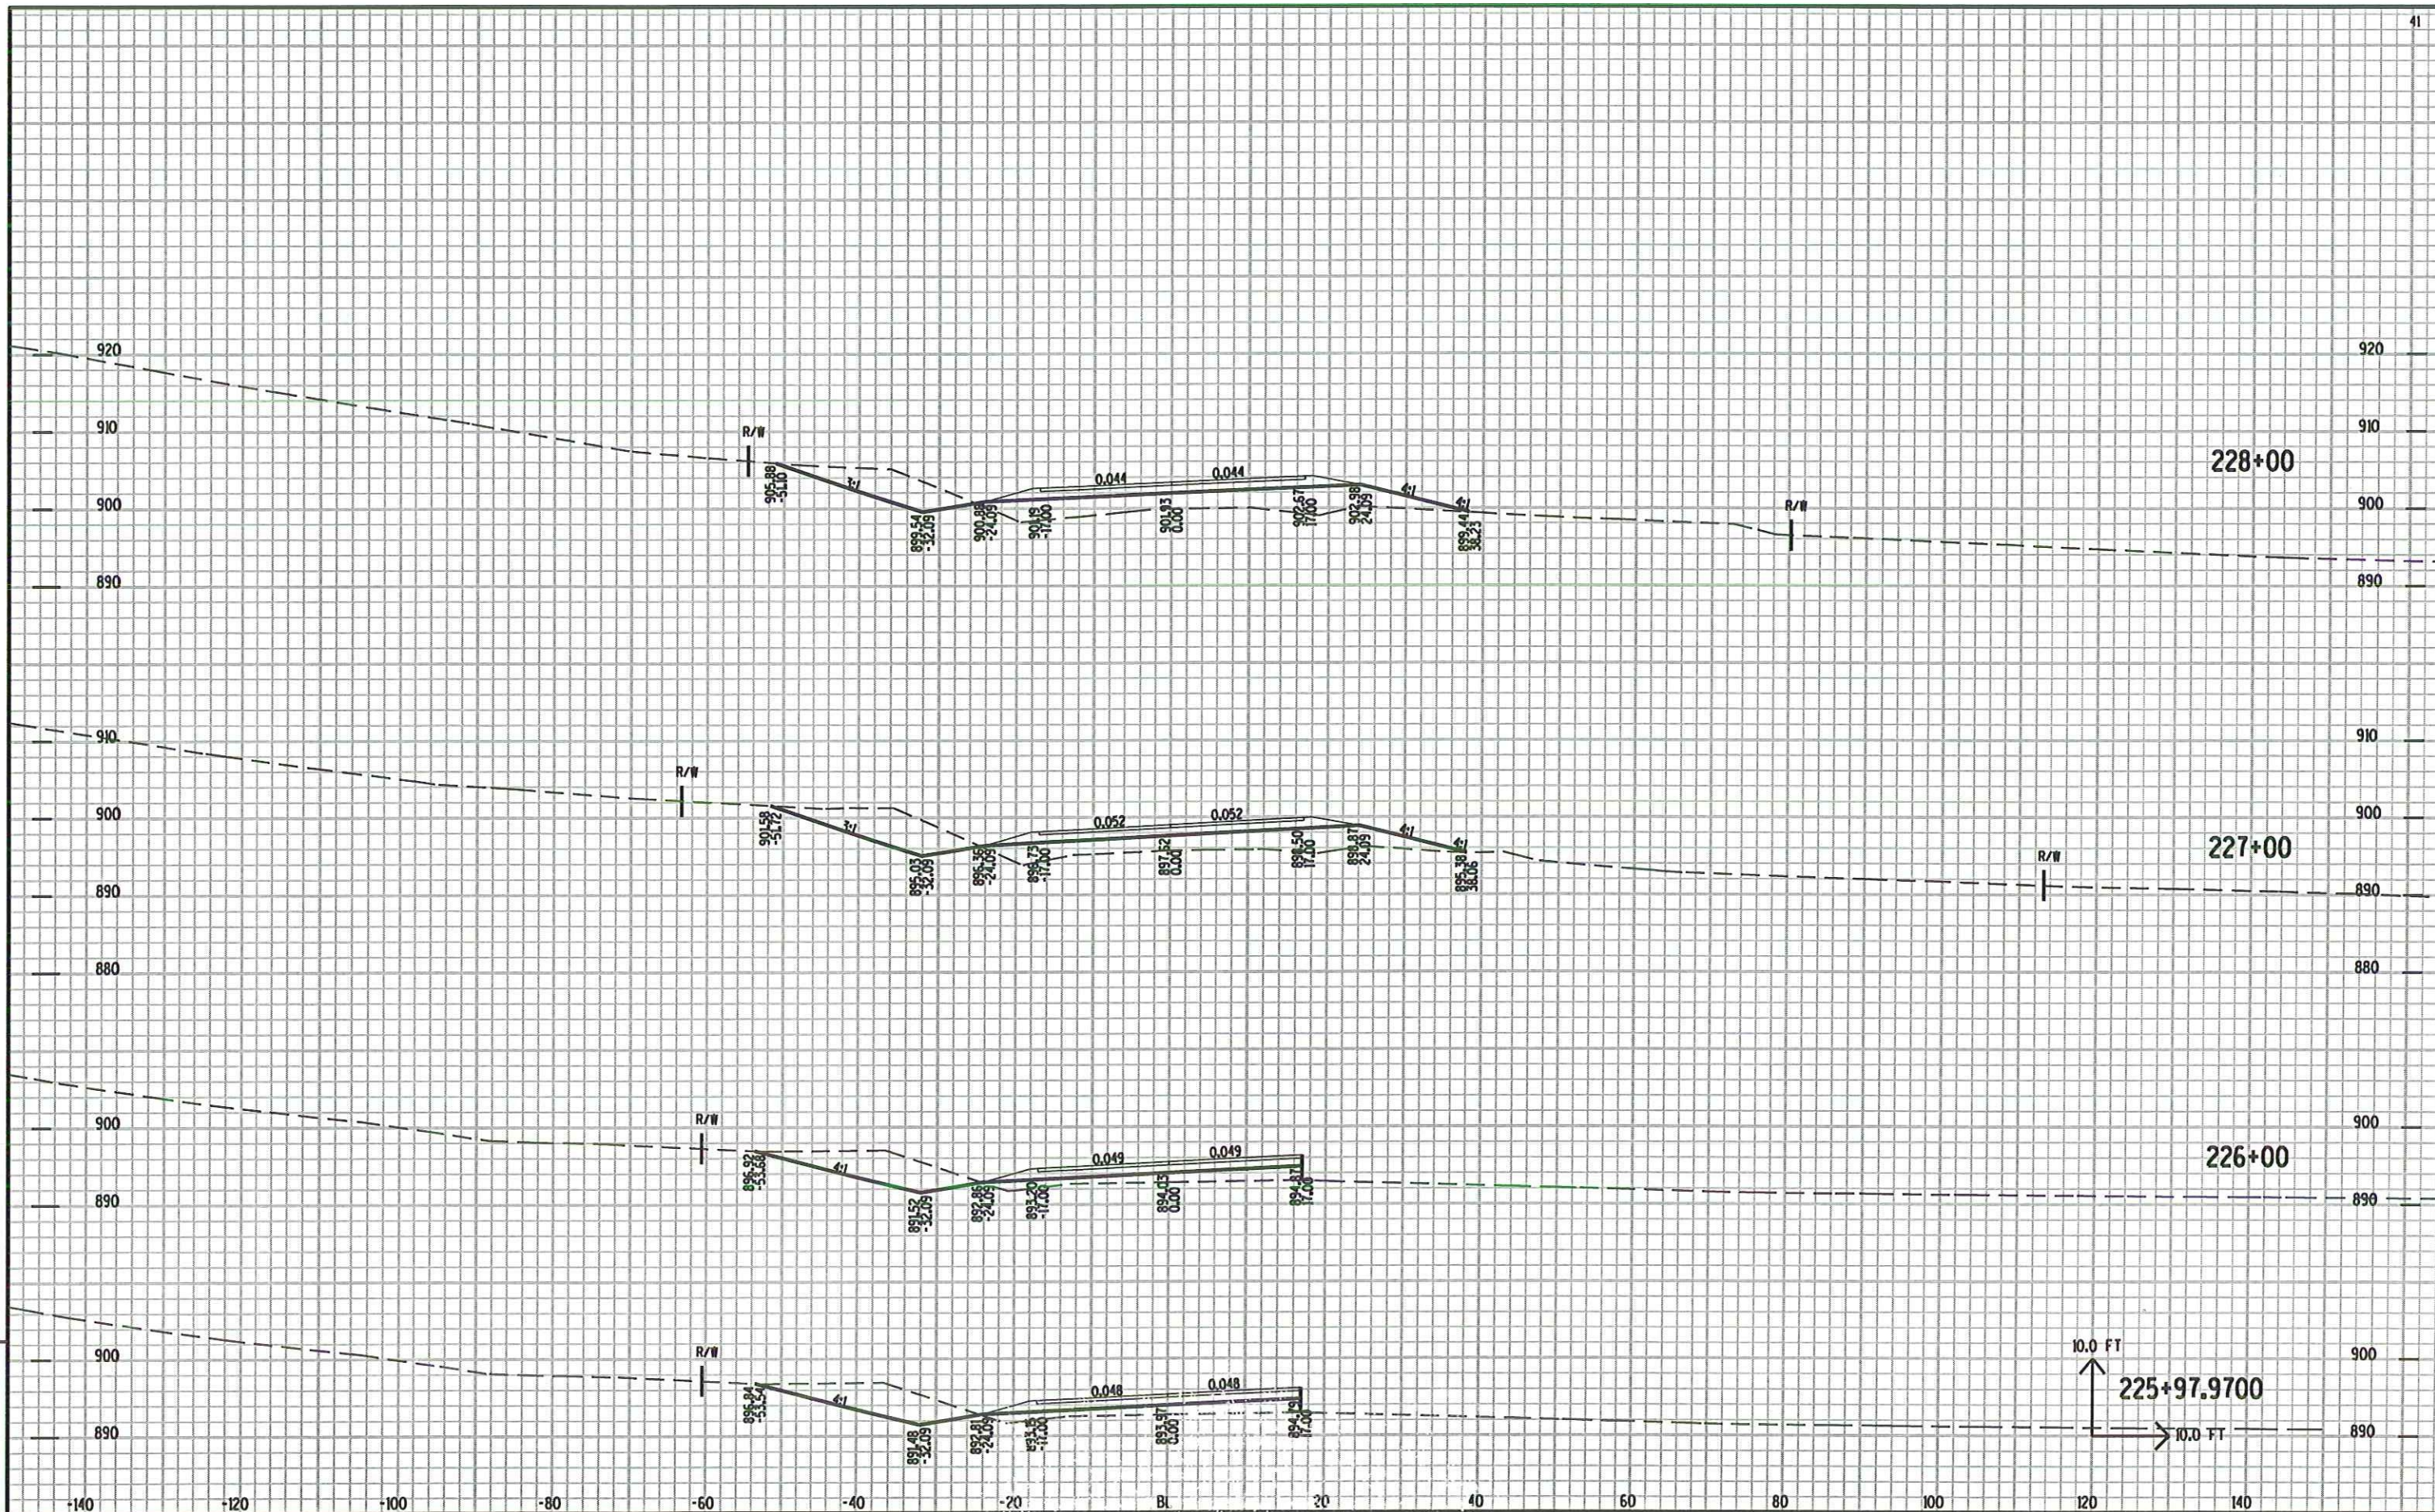


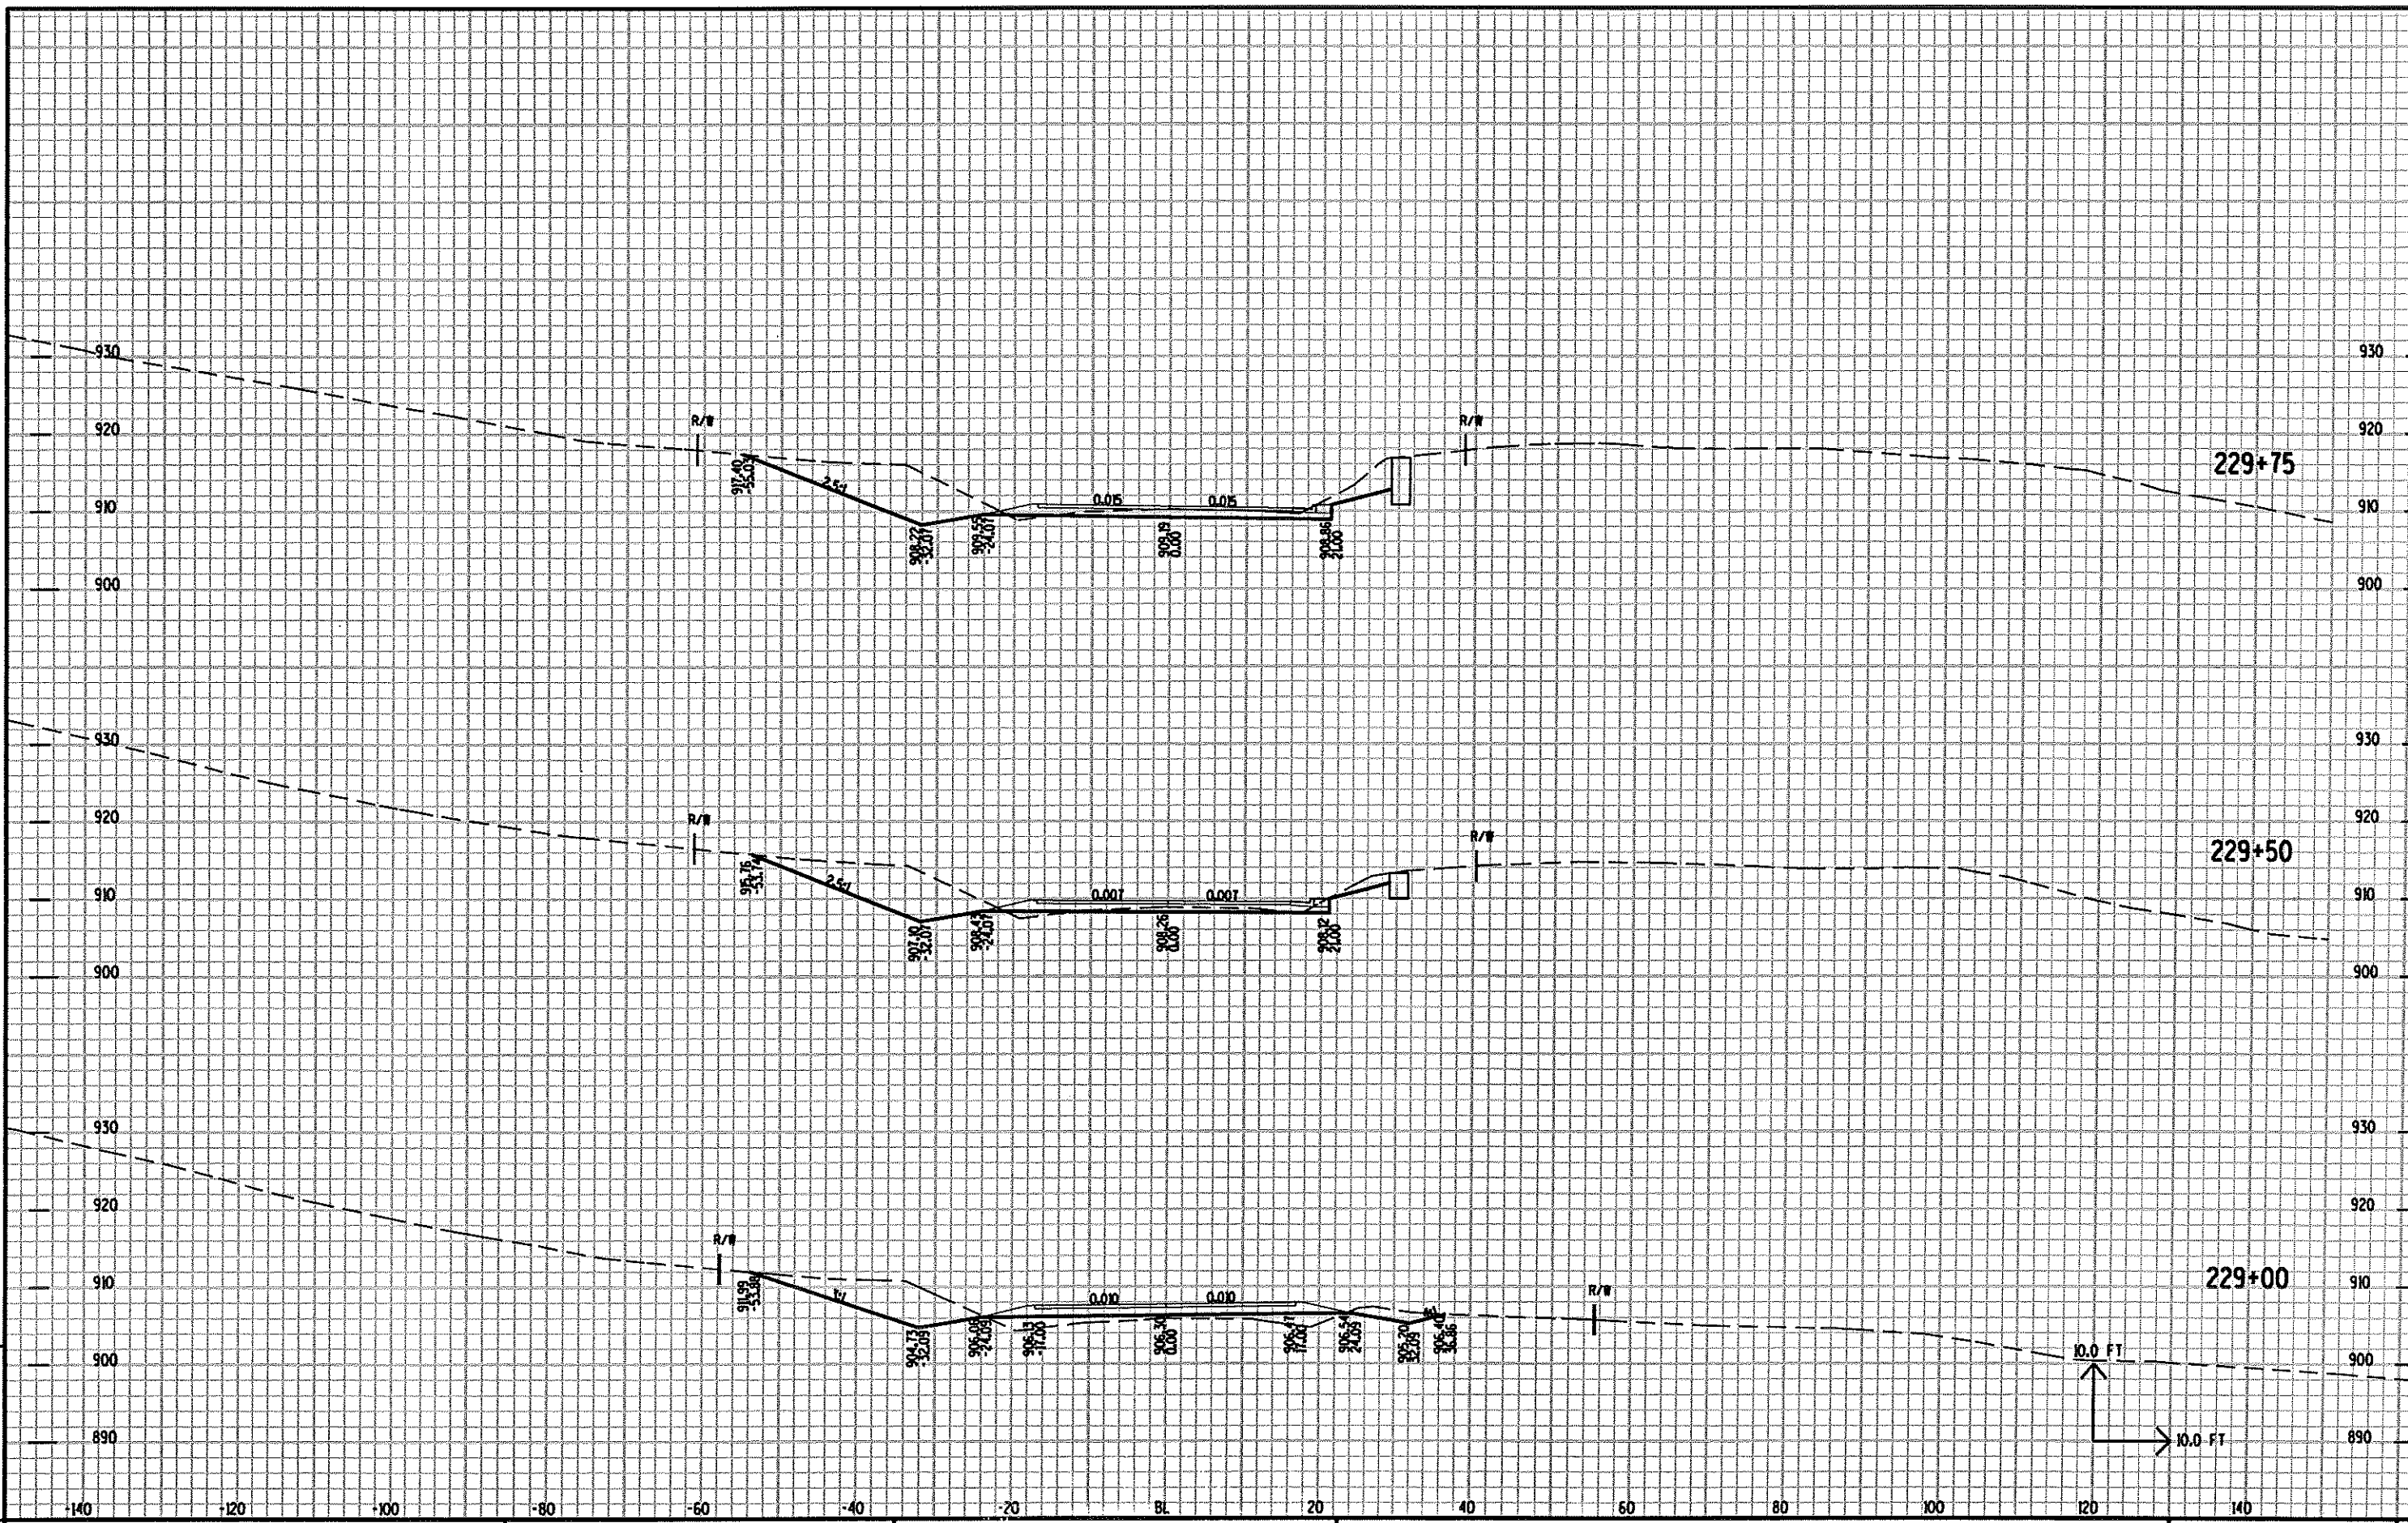



9


9

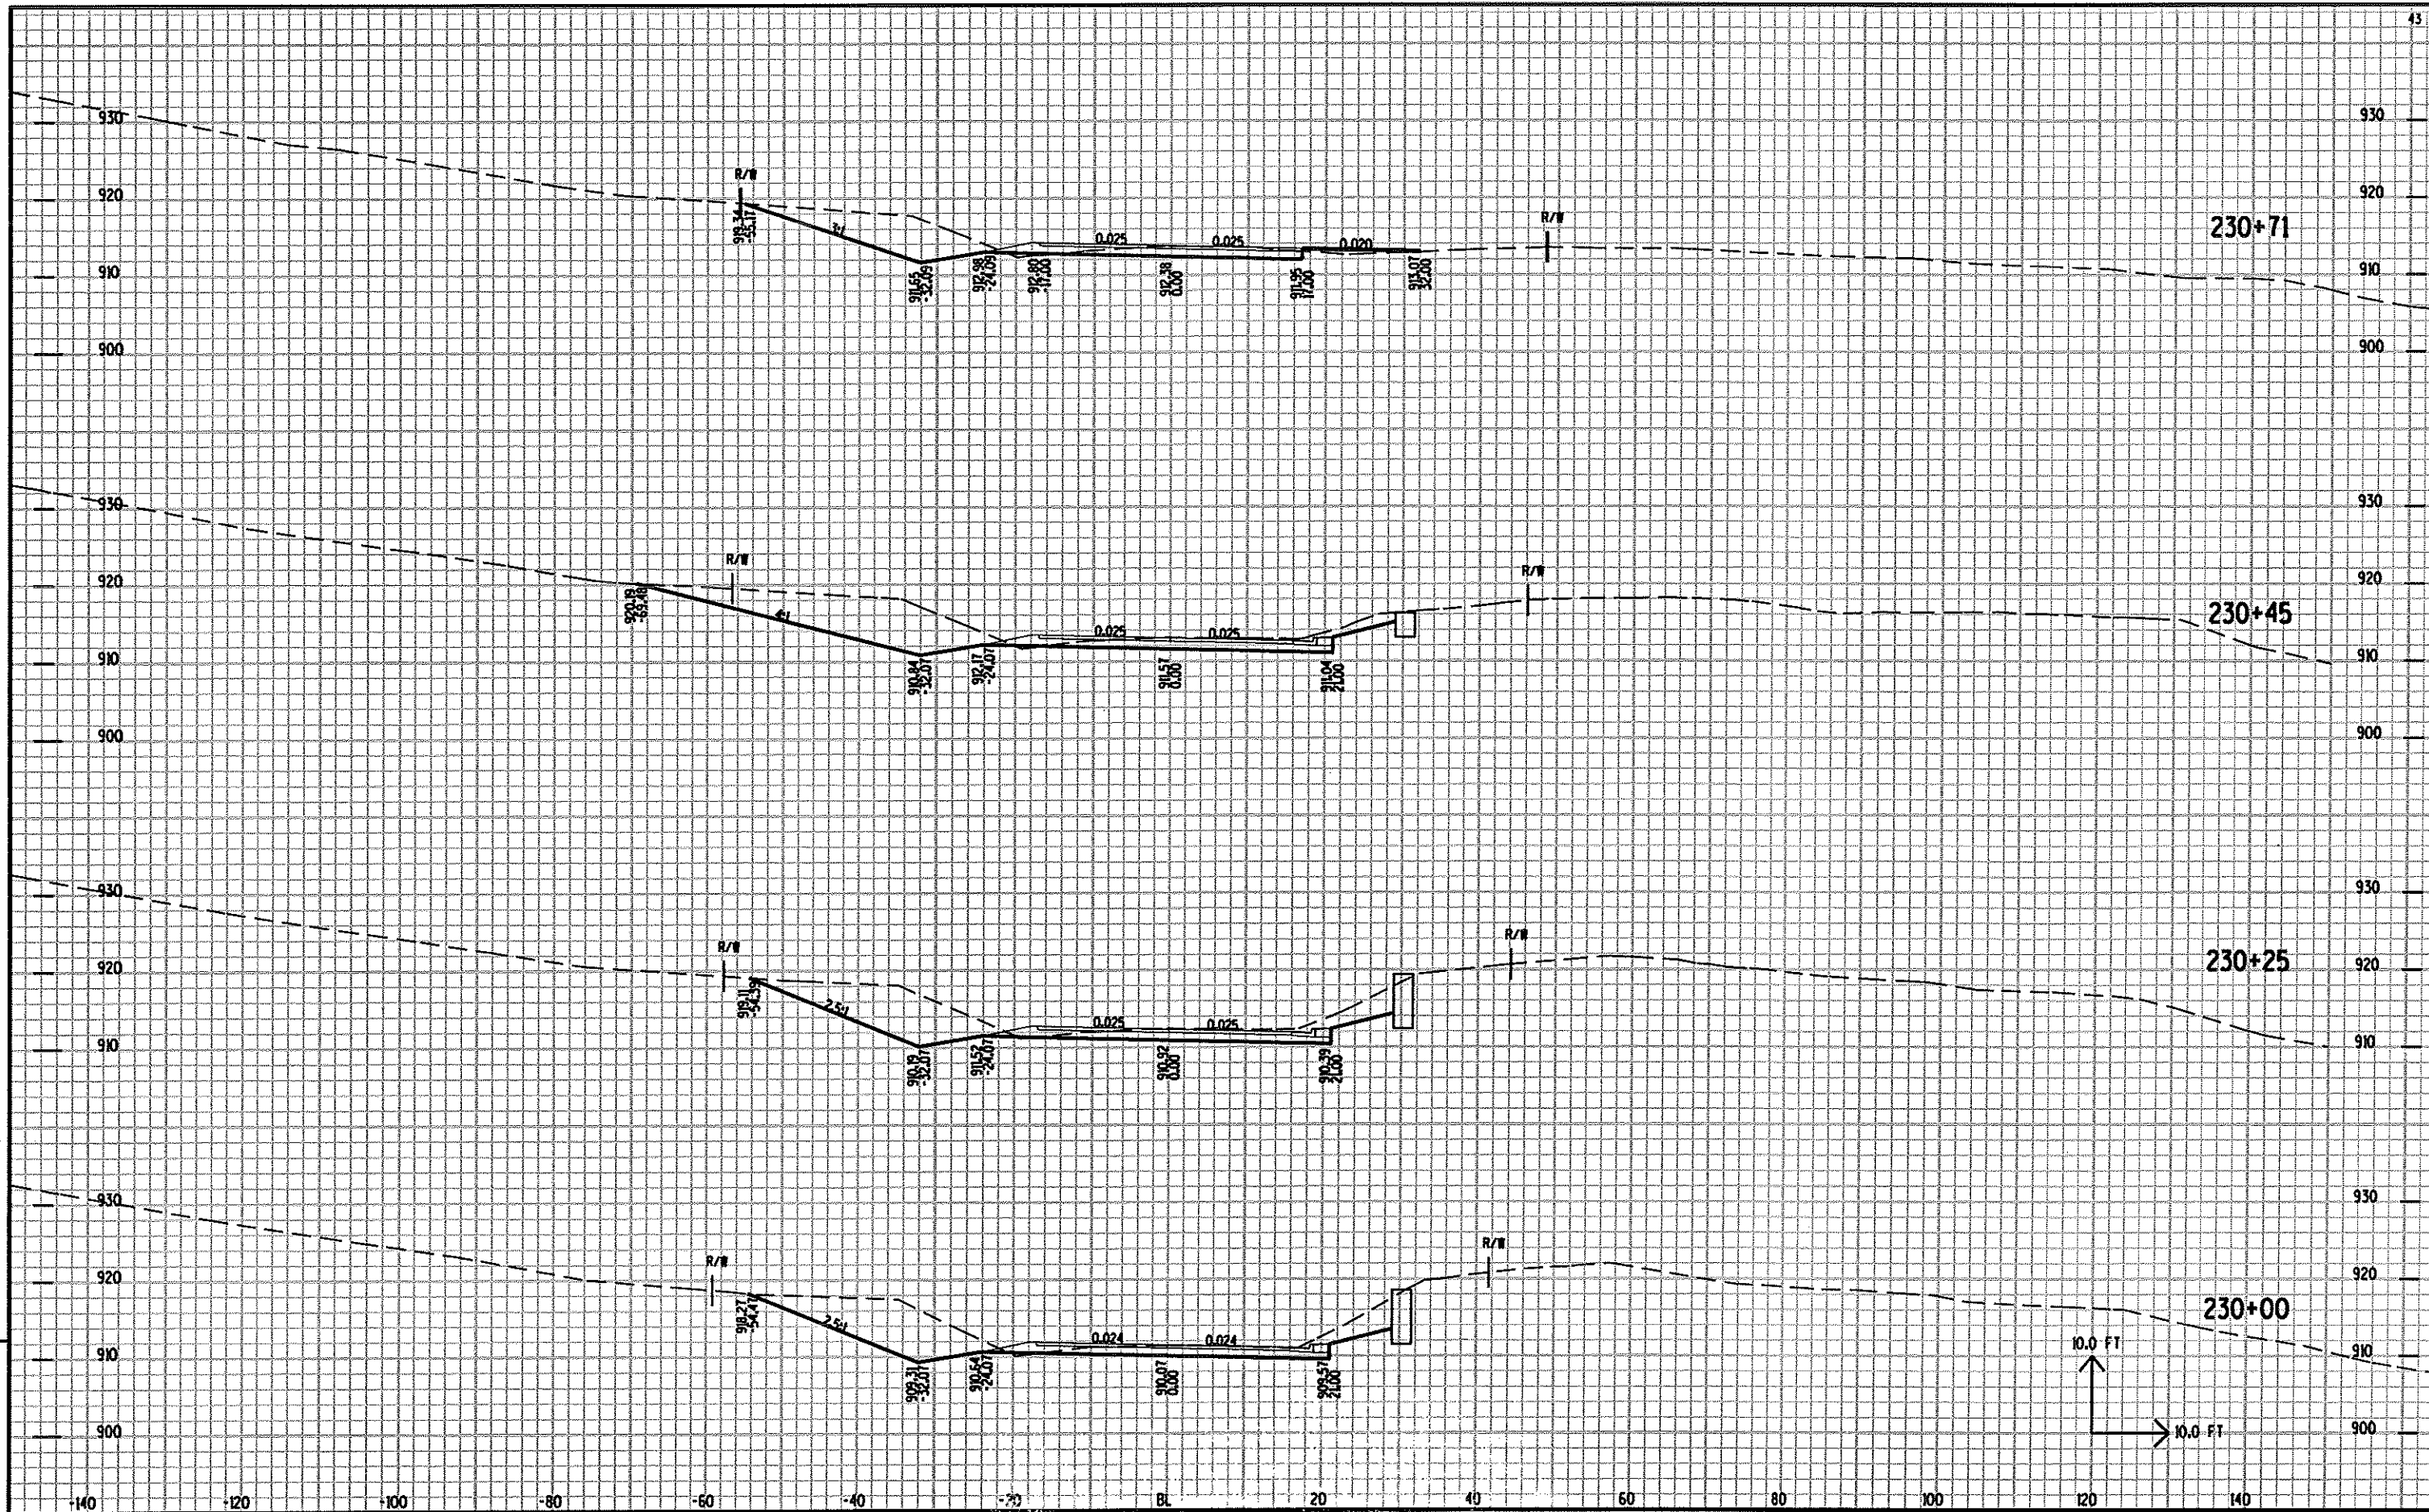

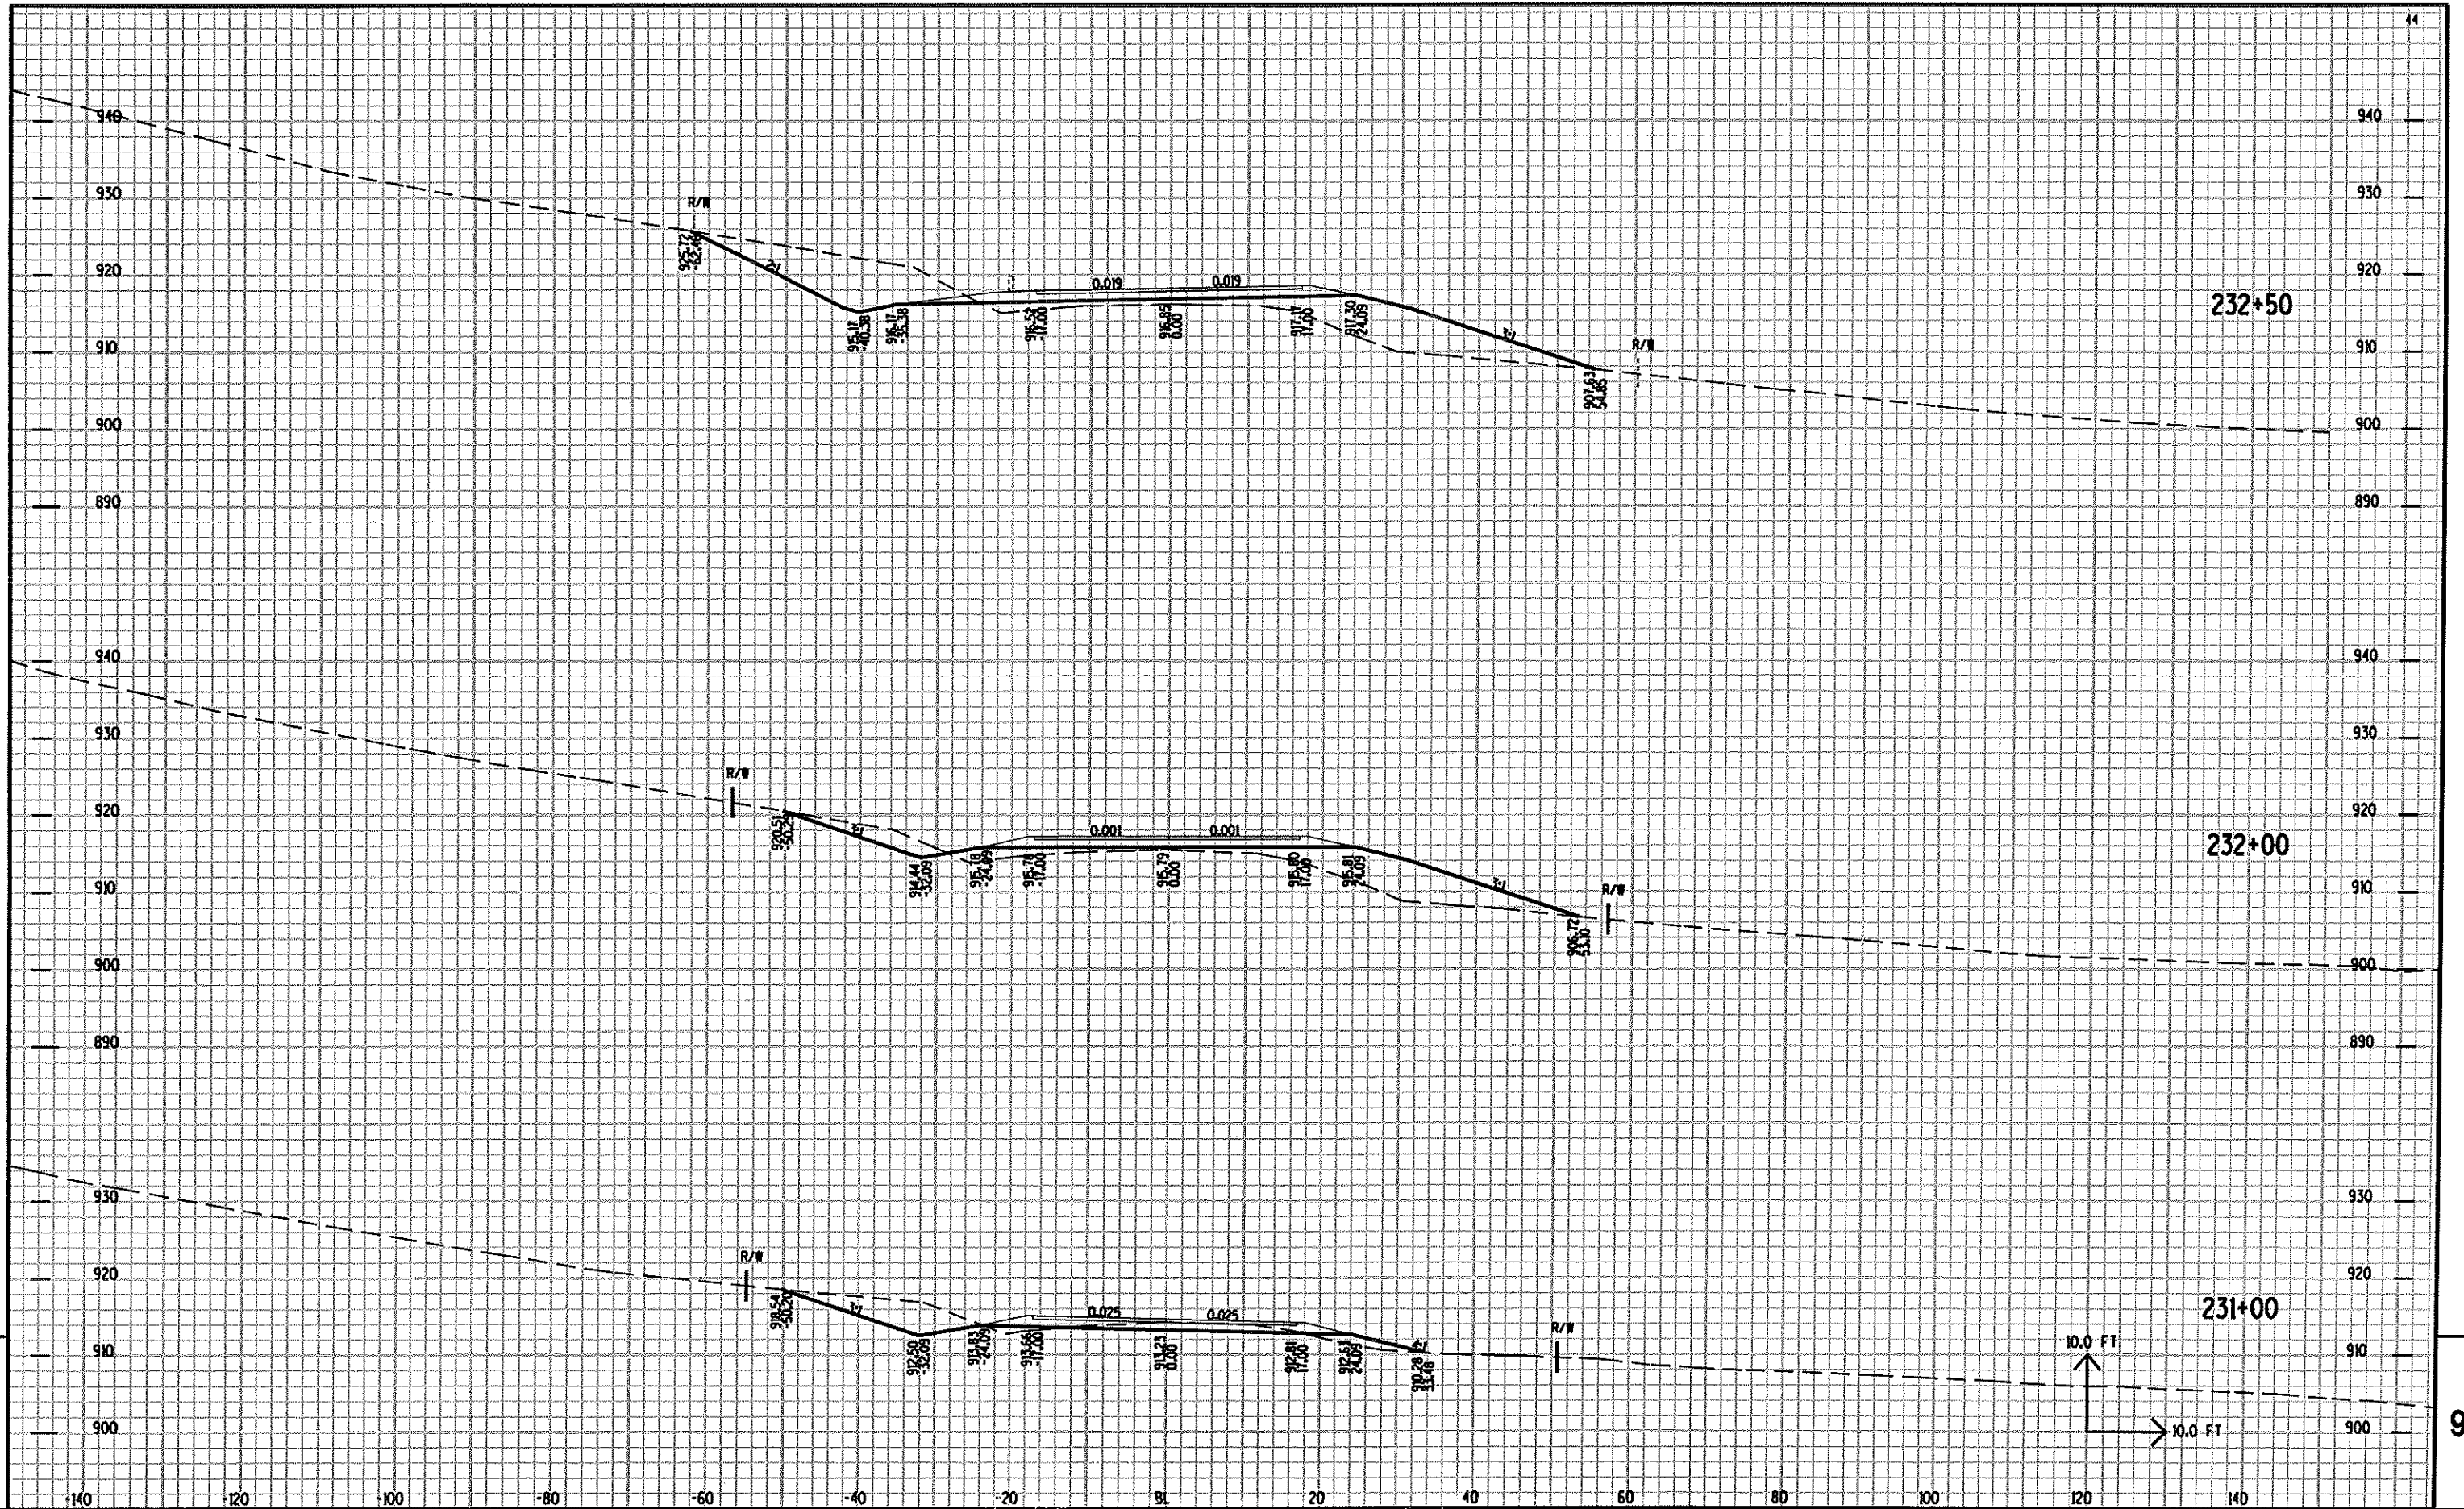

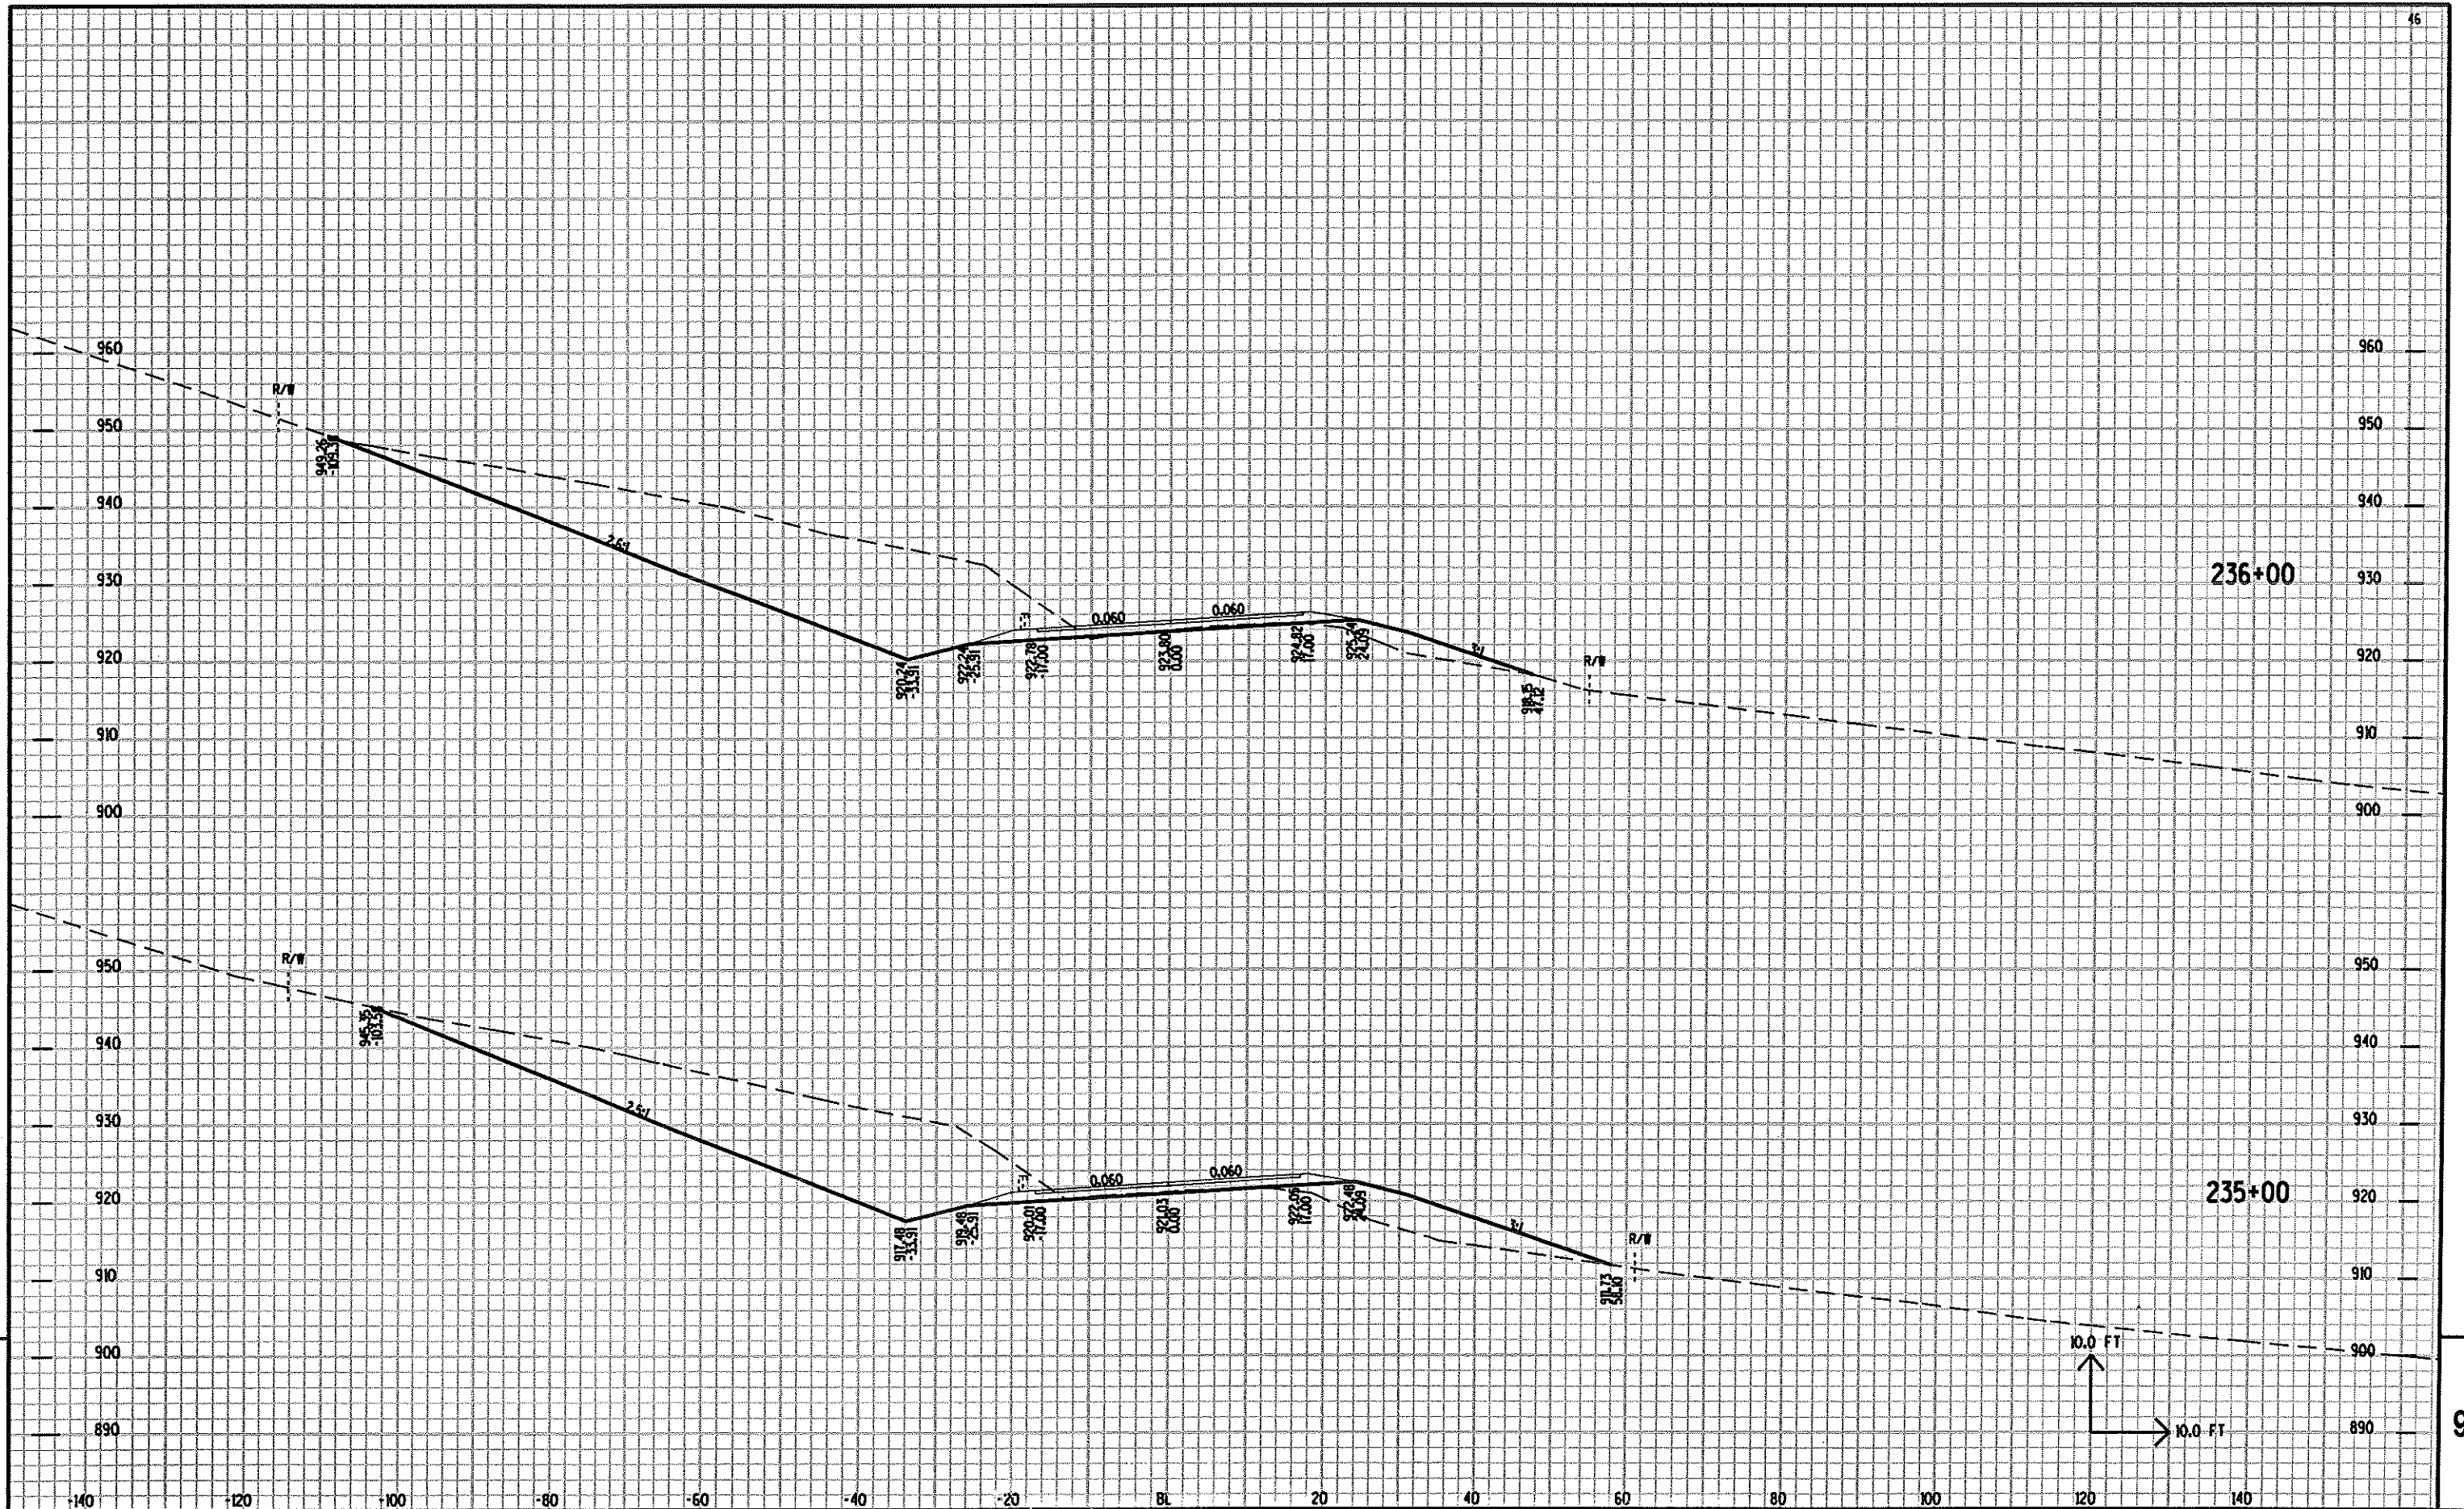

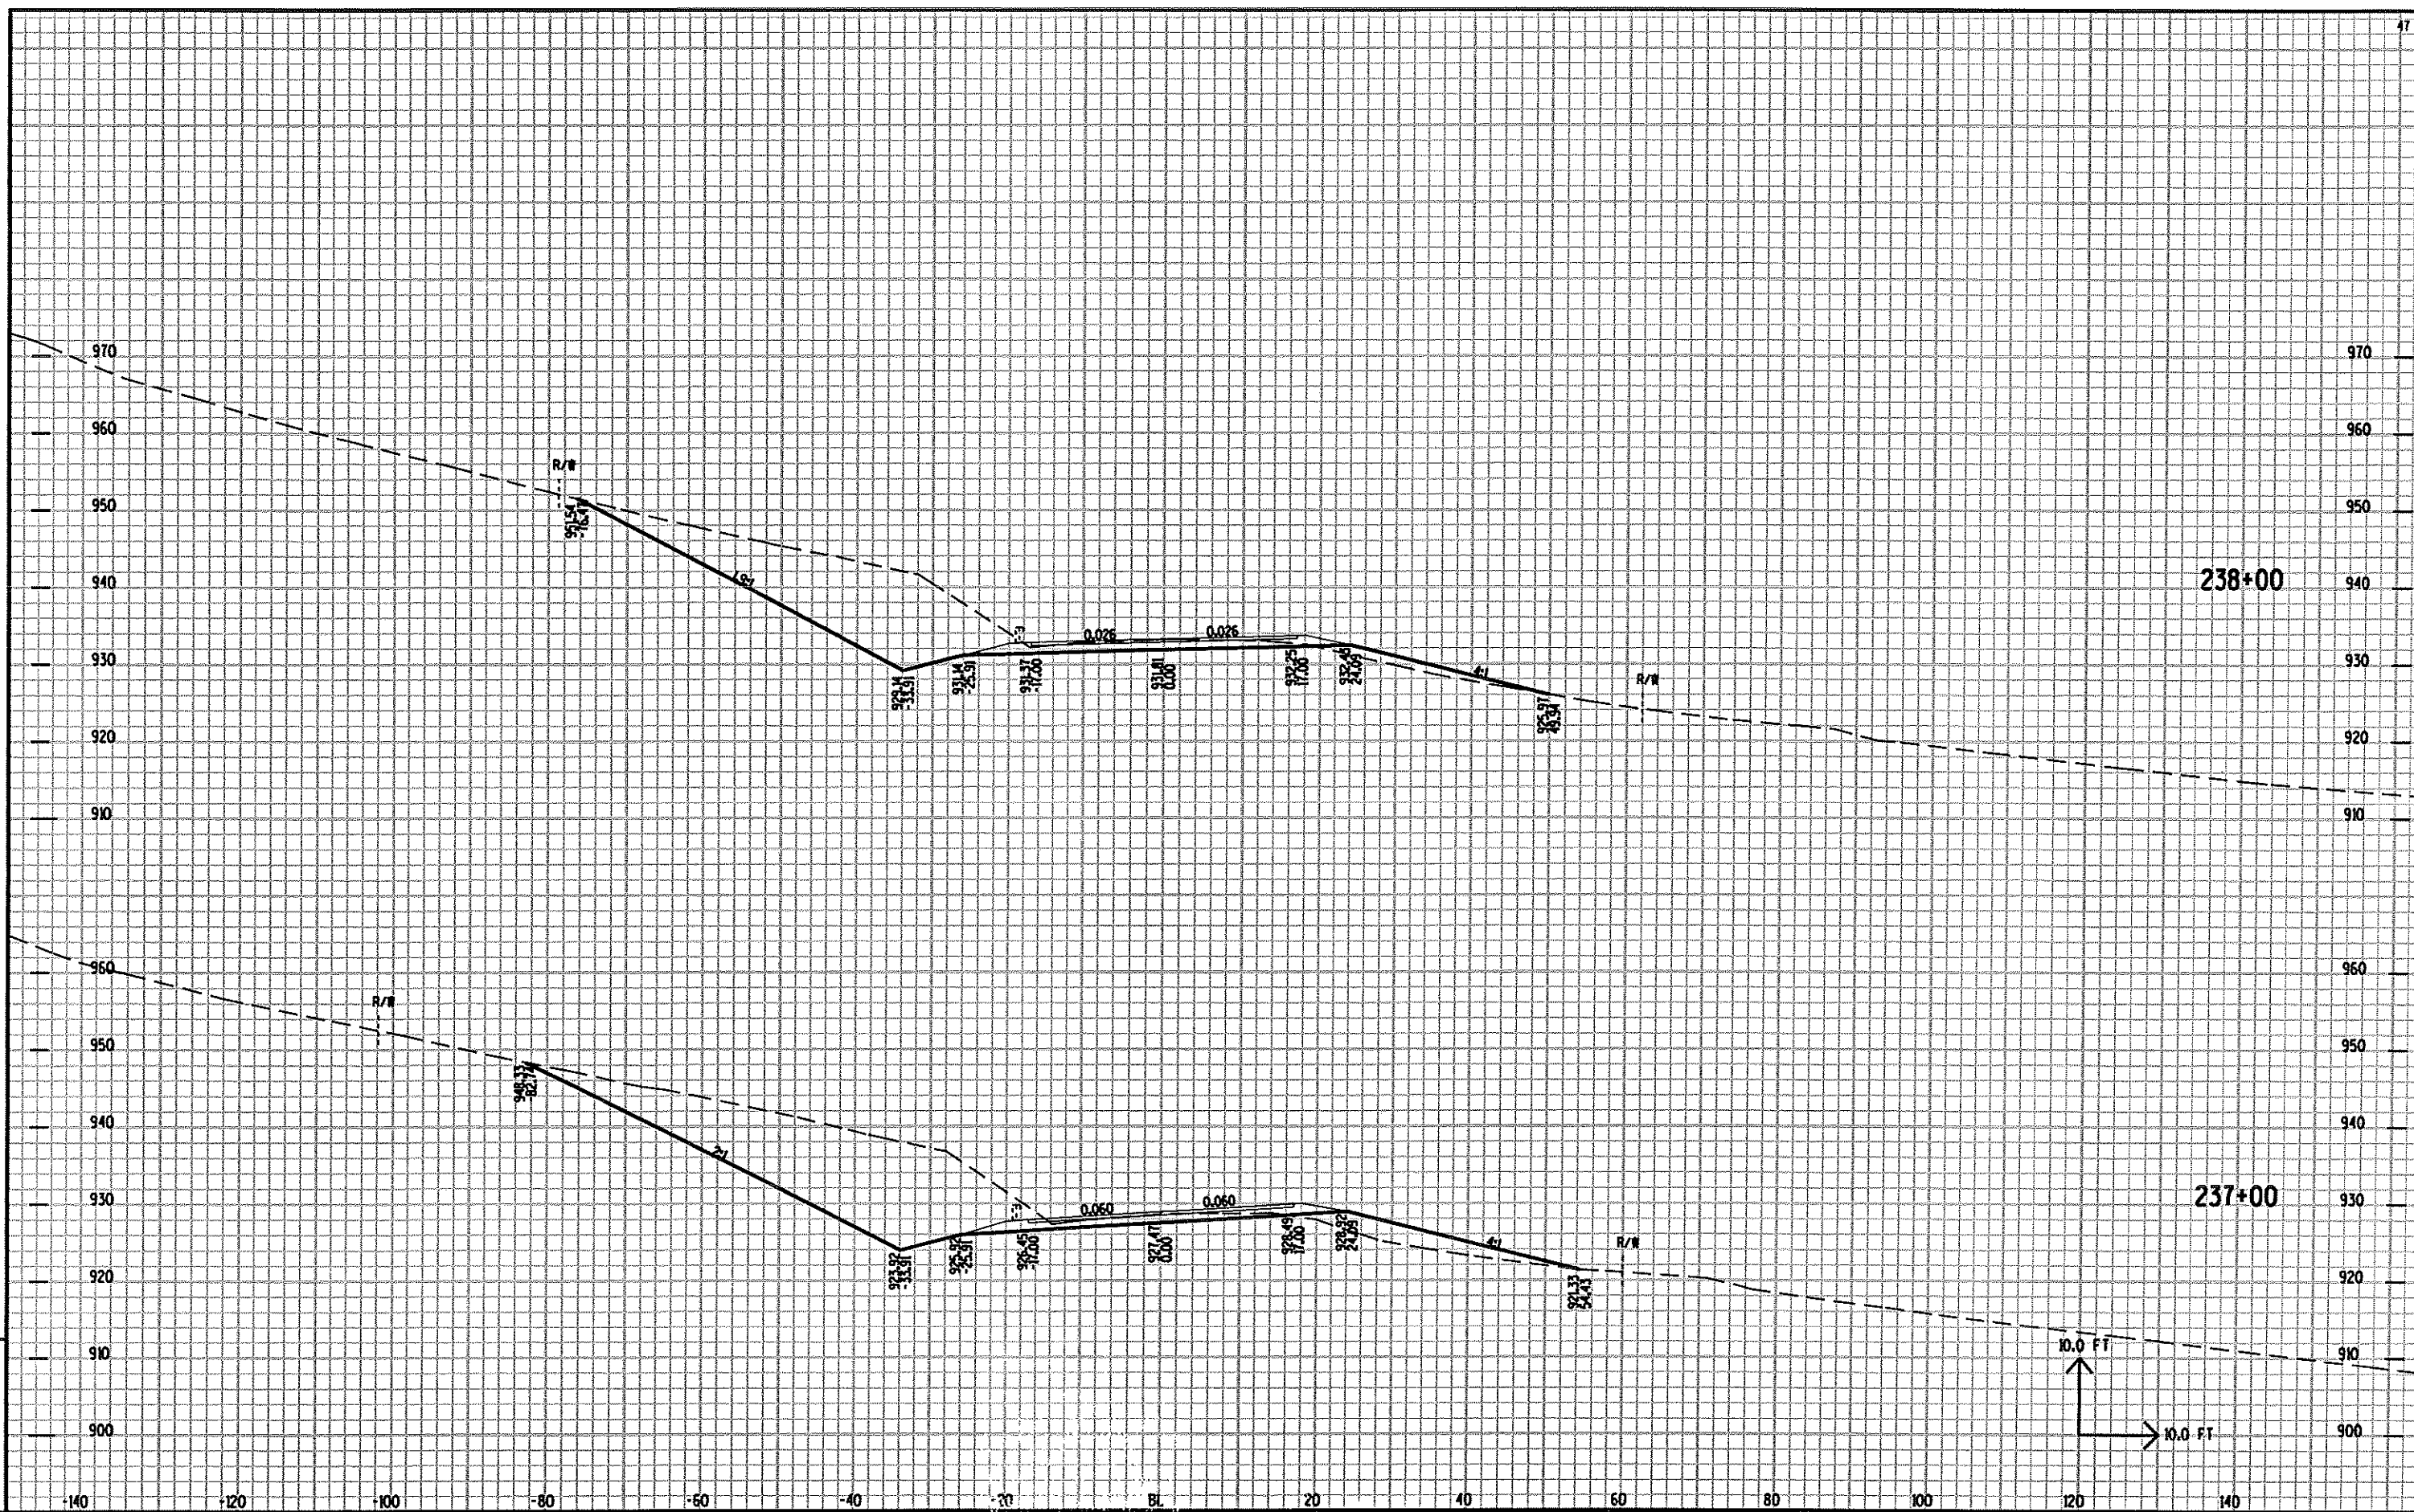

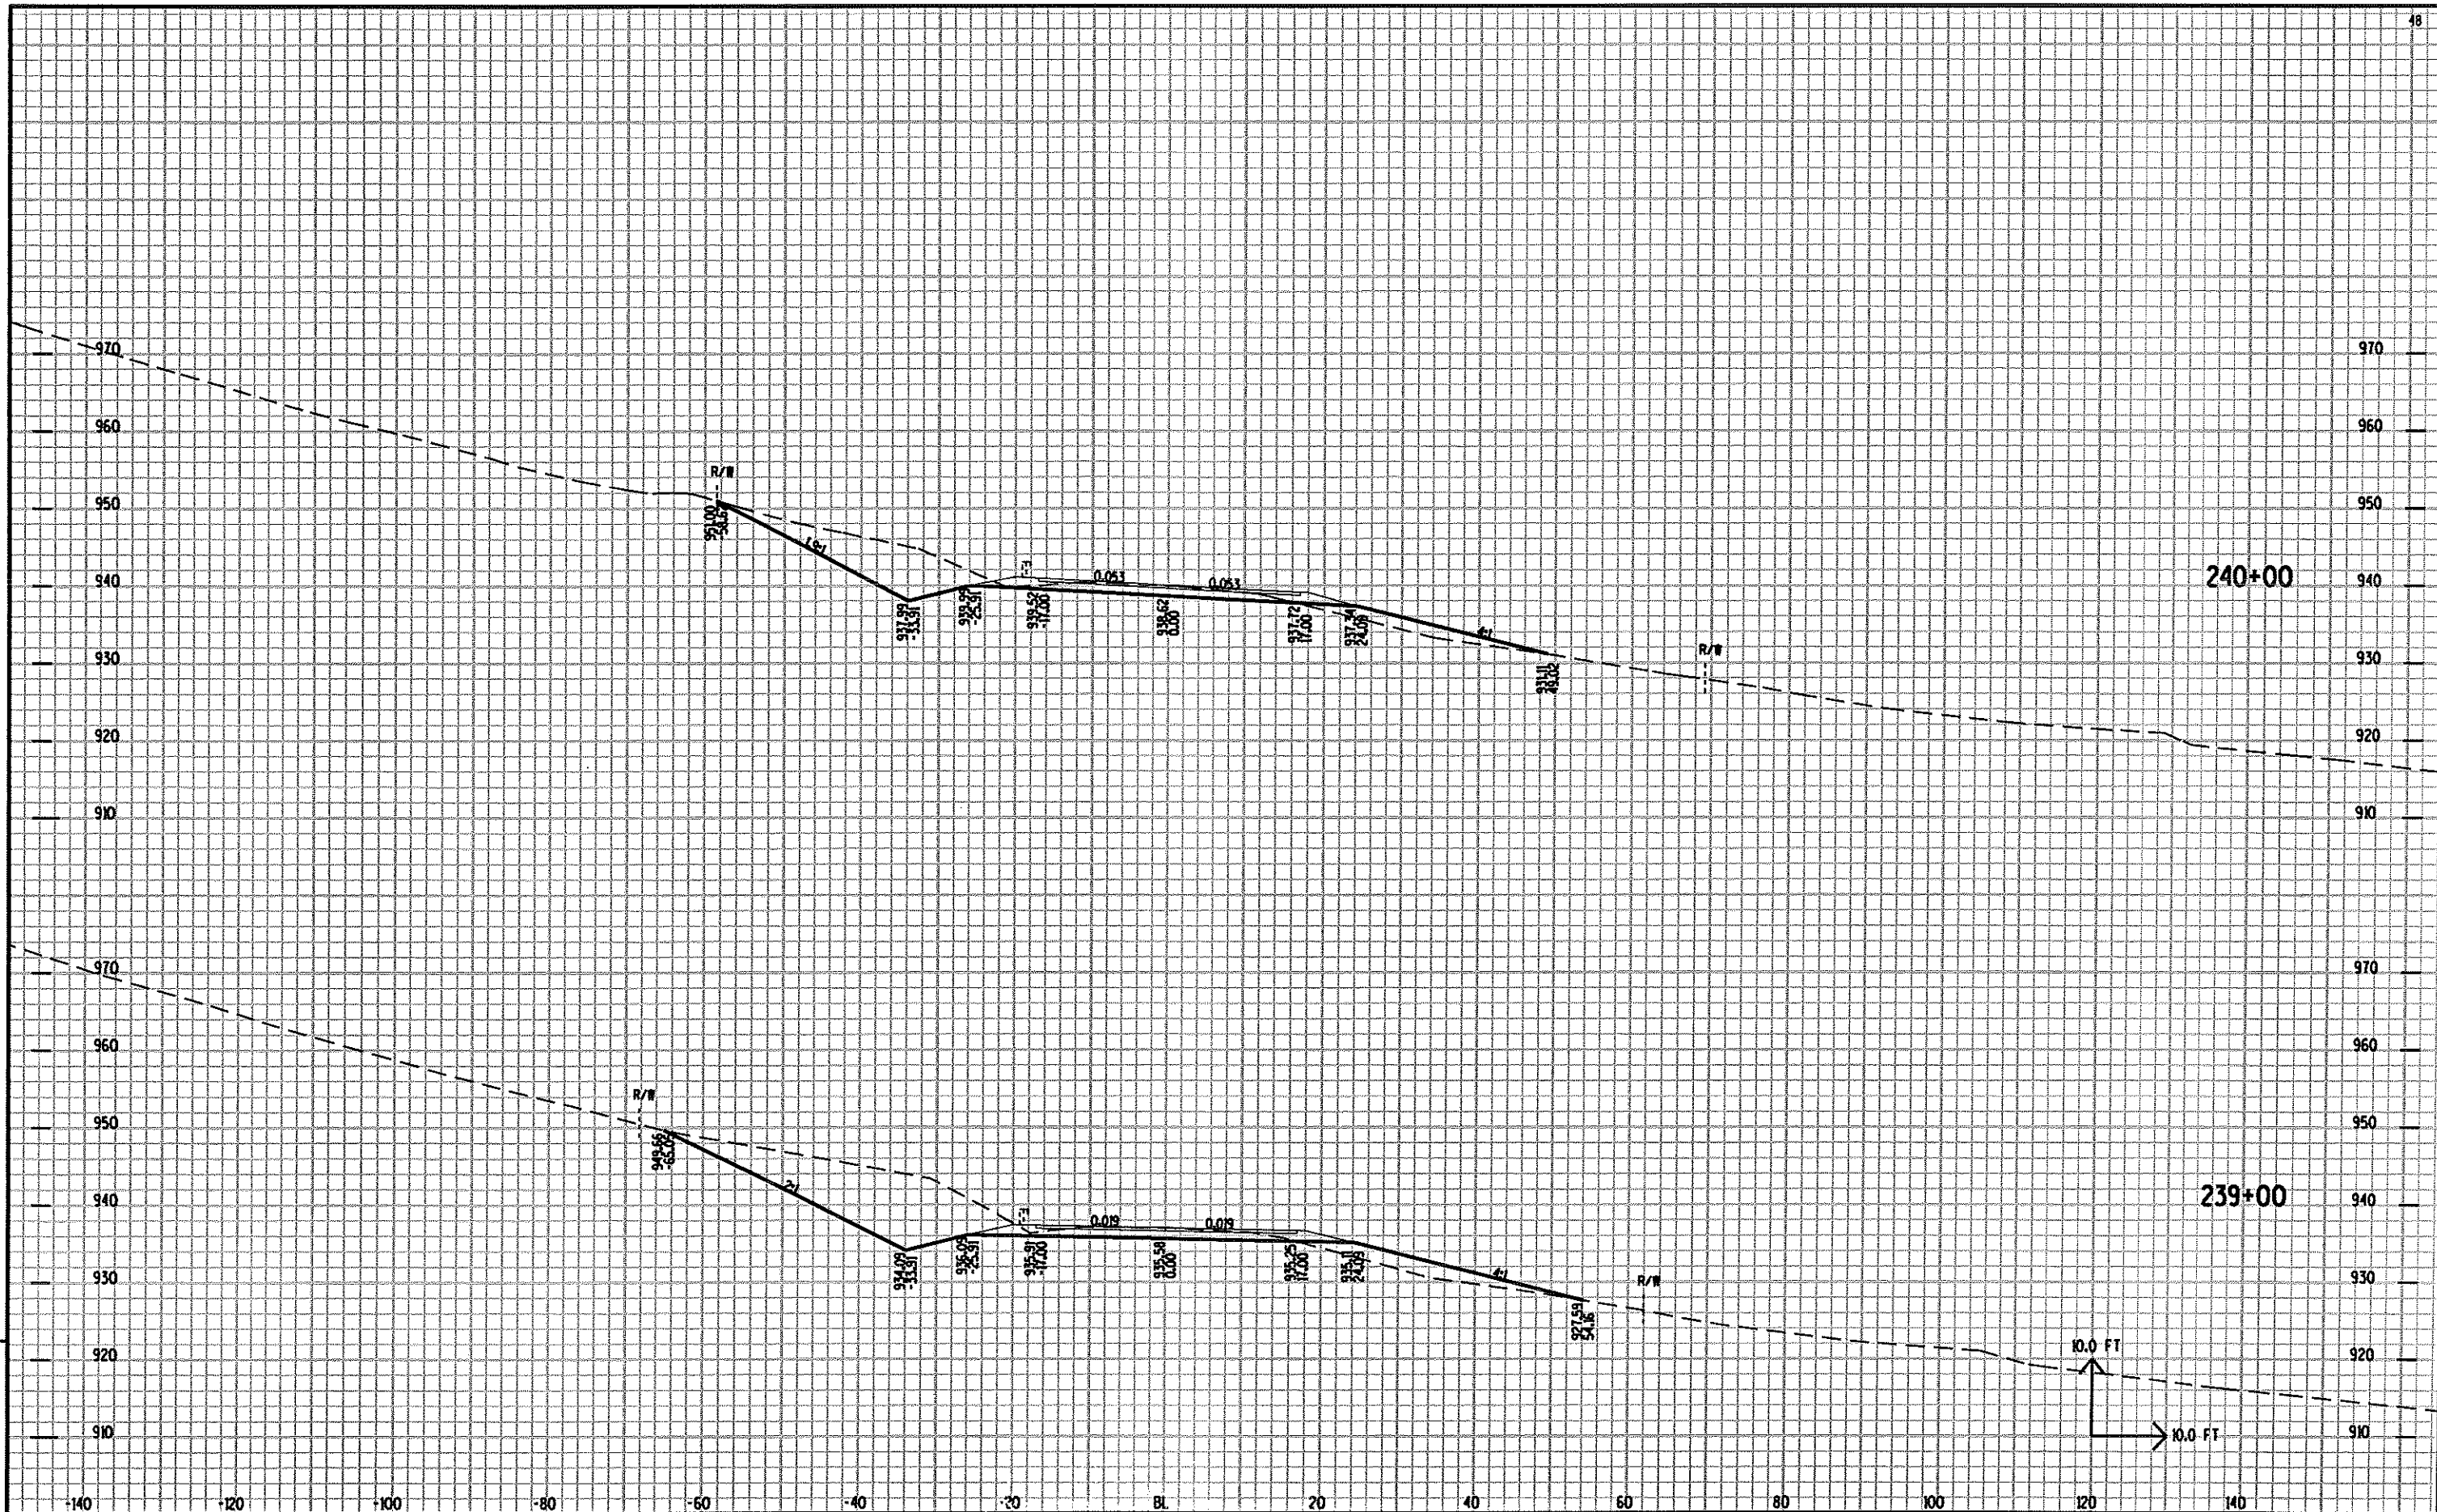

PROJECT NO: 5573-04-72

HWY: STH136

COUNTY: SALIU

STH 136 MAINLINE

SHEET NO:

247

FILE NAME : r:\Support\VCADDS\Projects\dl_55730401\090201_xs.dgn


PLOT DATE : 12-11-2007 07:19


PLOT BY : ddtbbg

PLOT NAME :

PLOT SCALE : 2,000,000:1,000,000


E

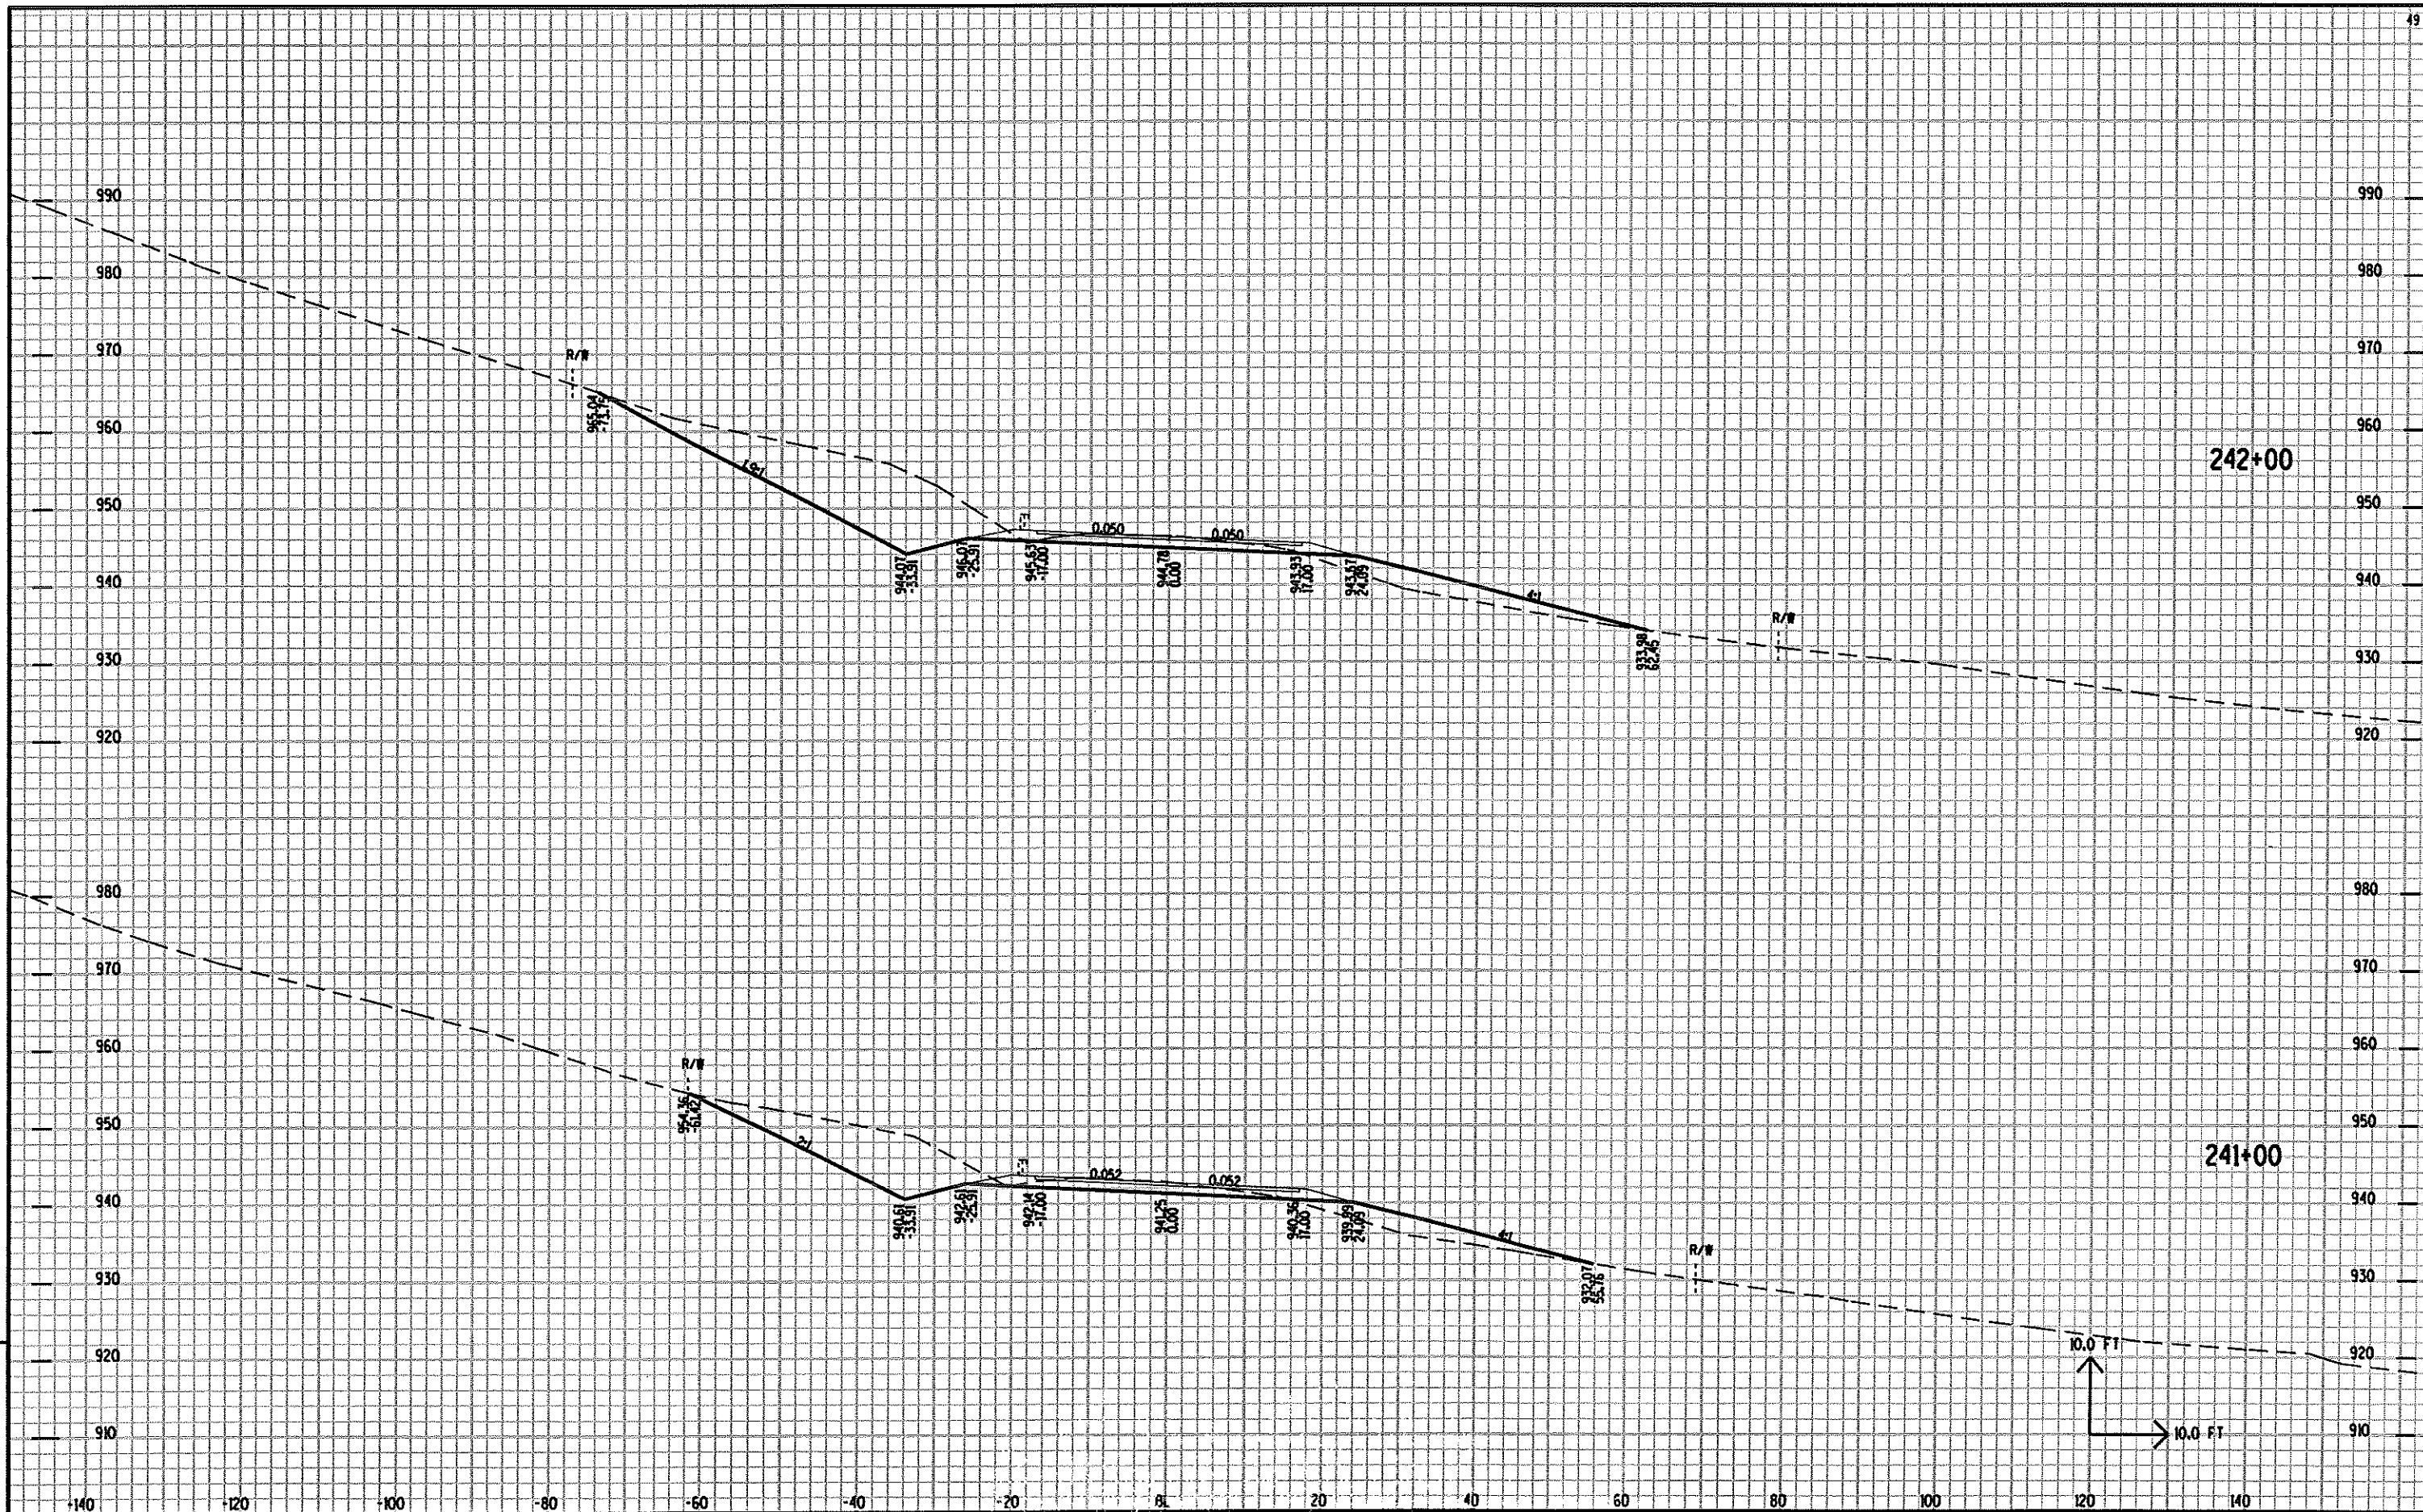

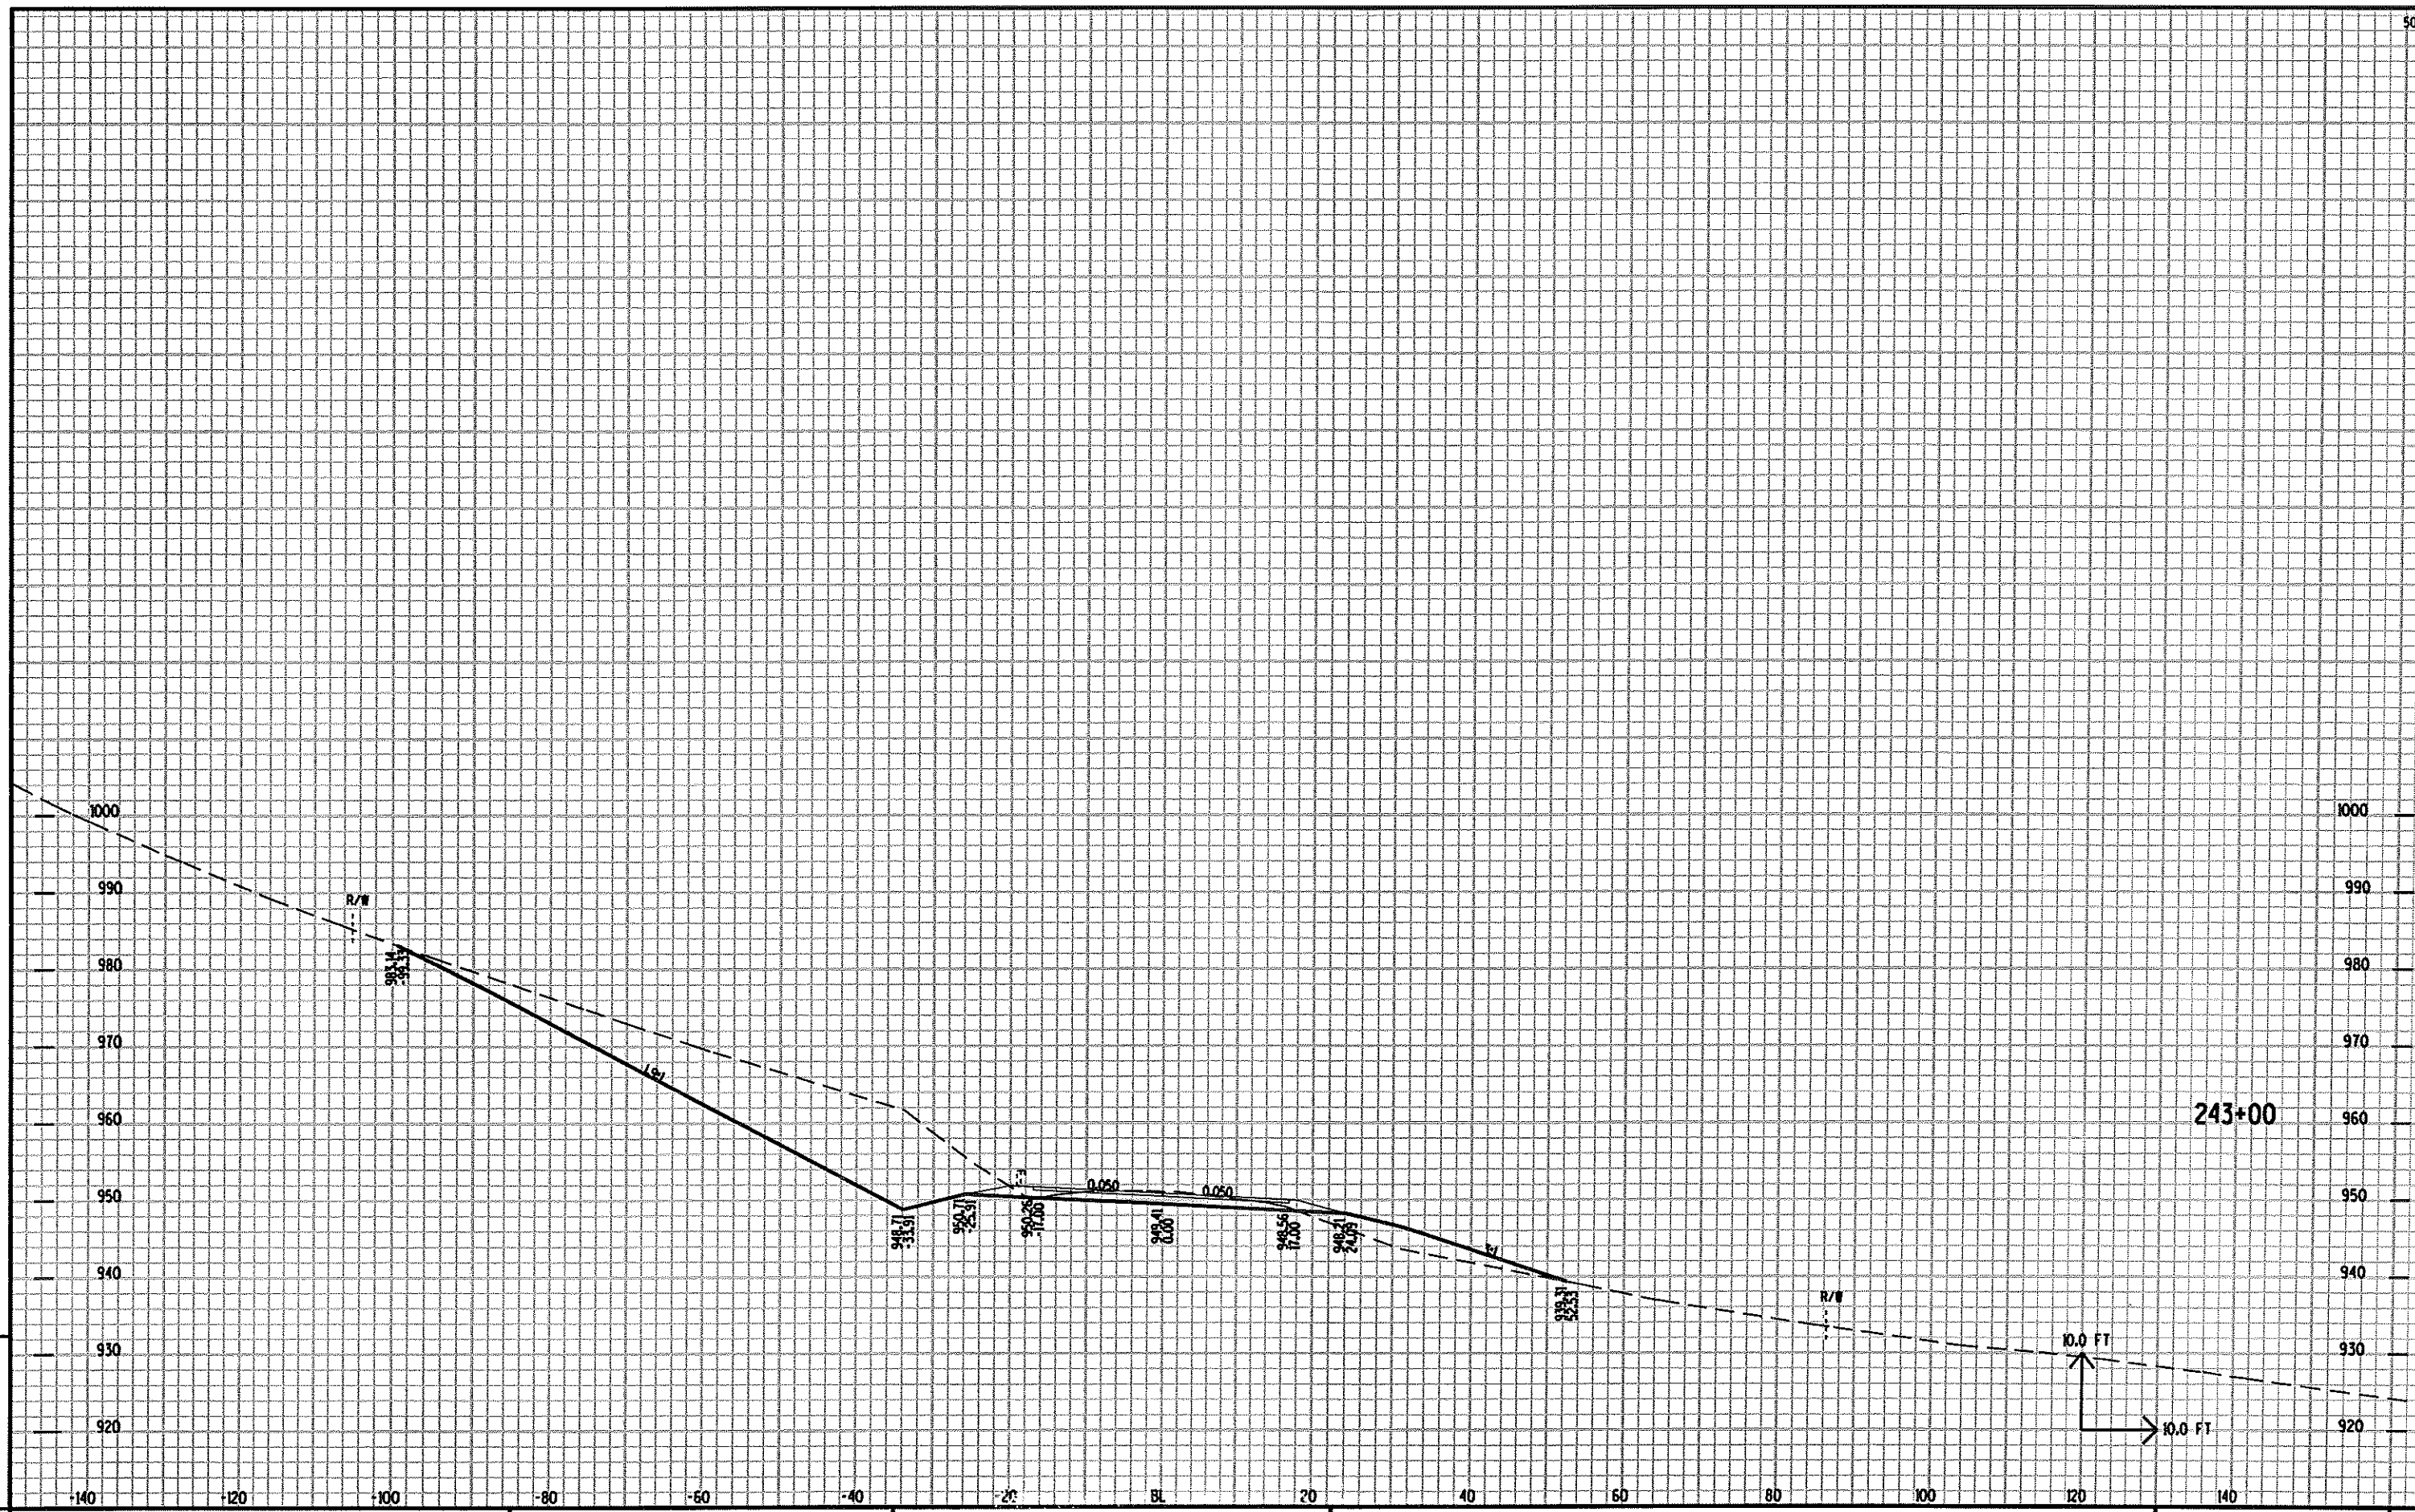


9


9

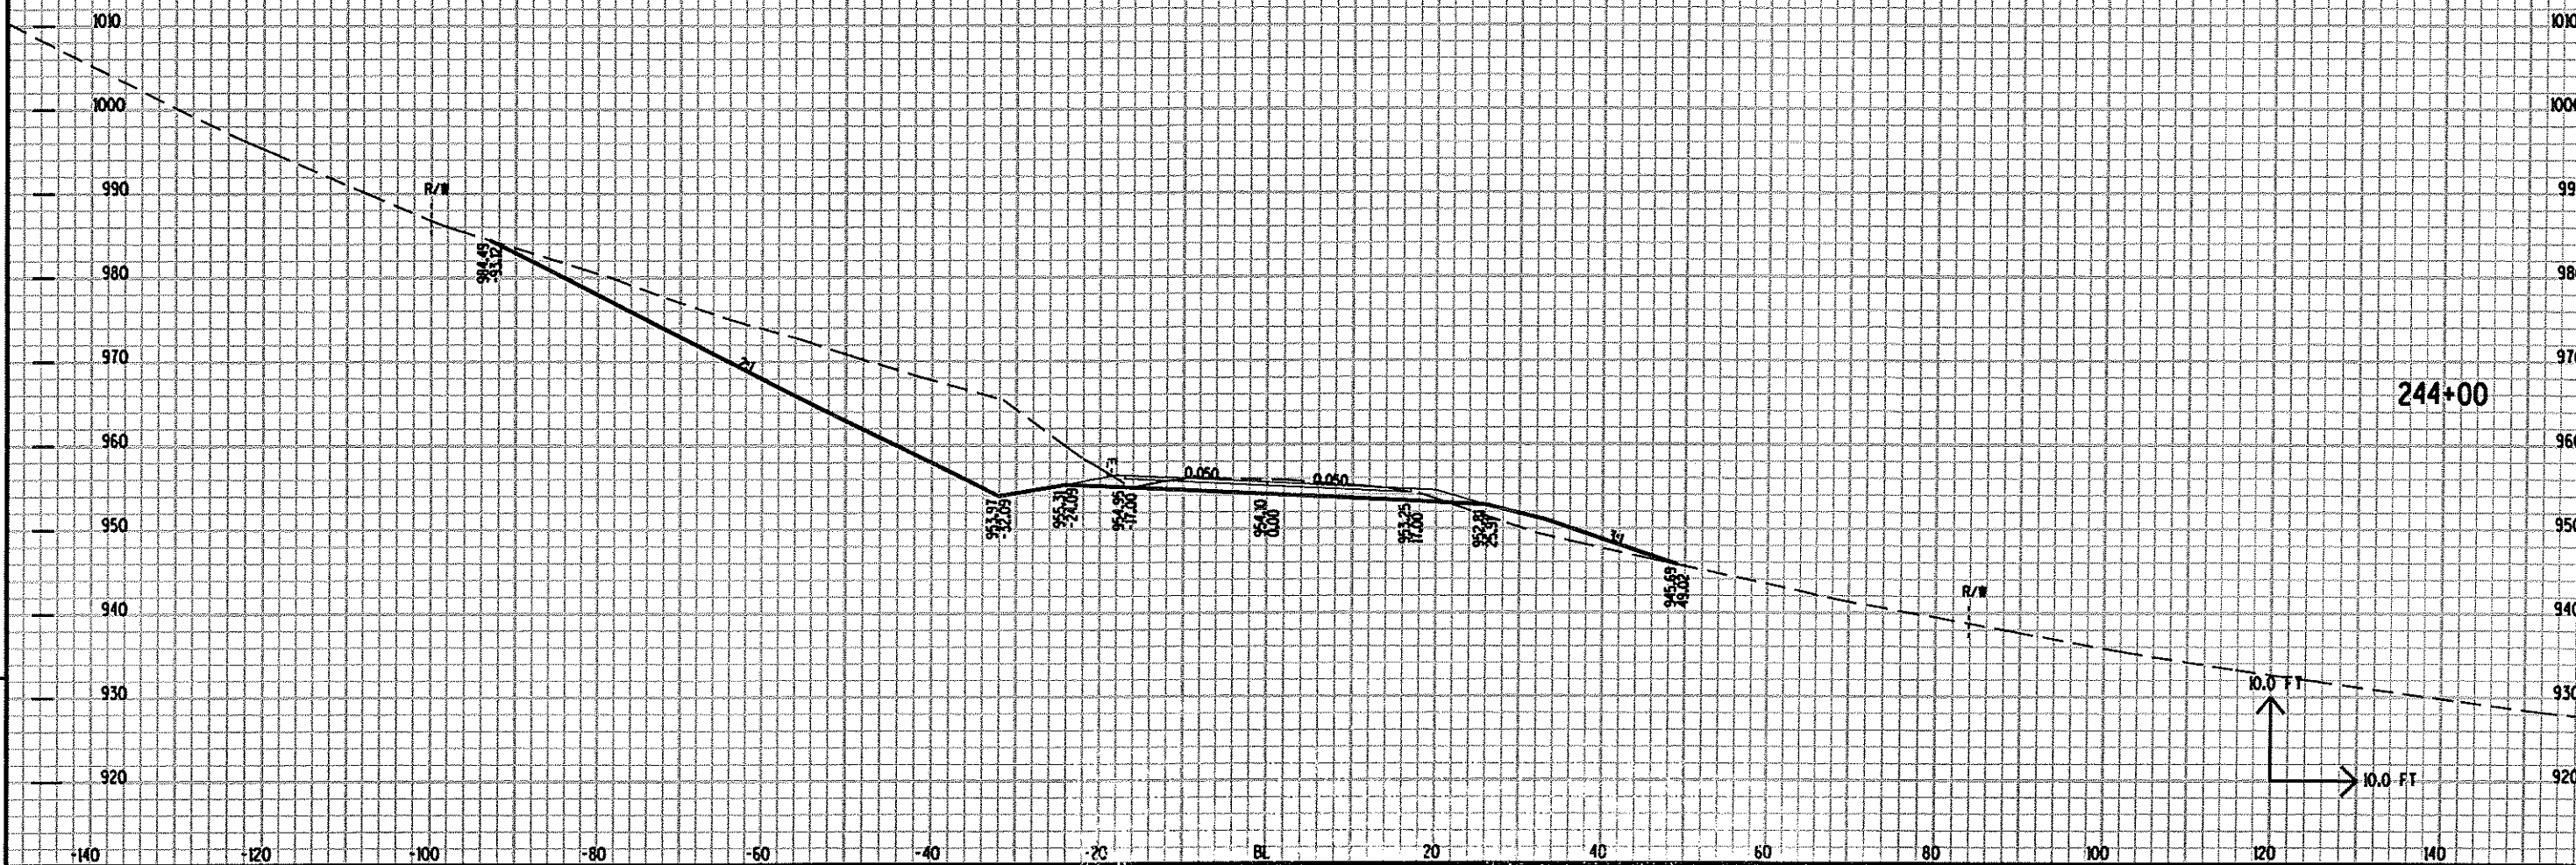


9

9

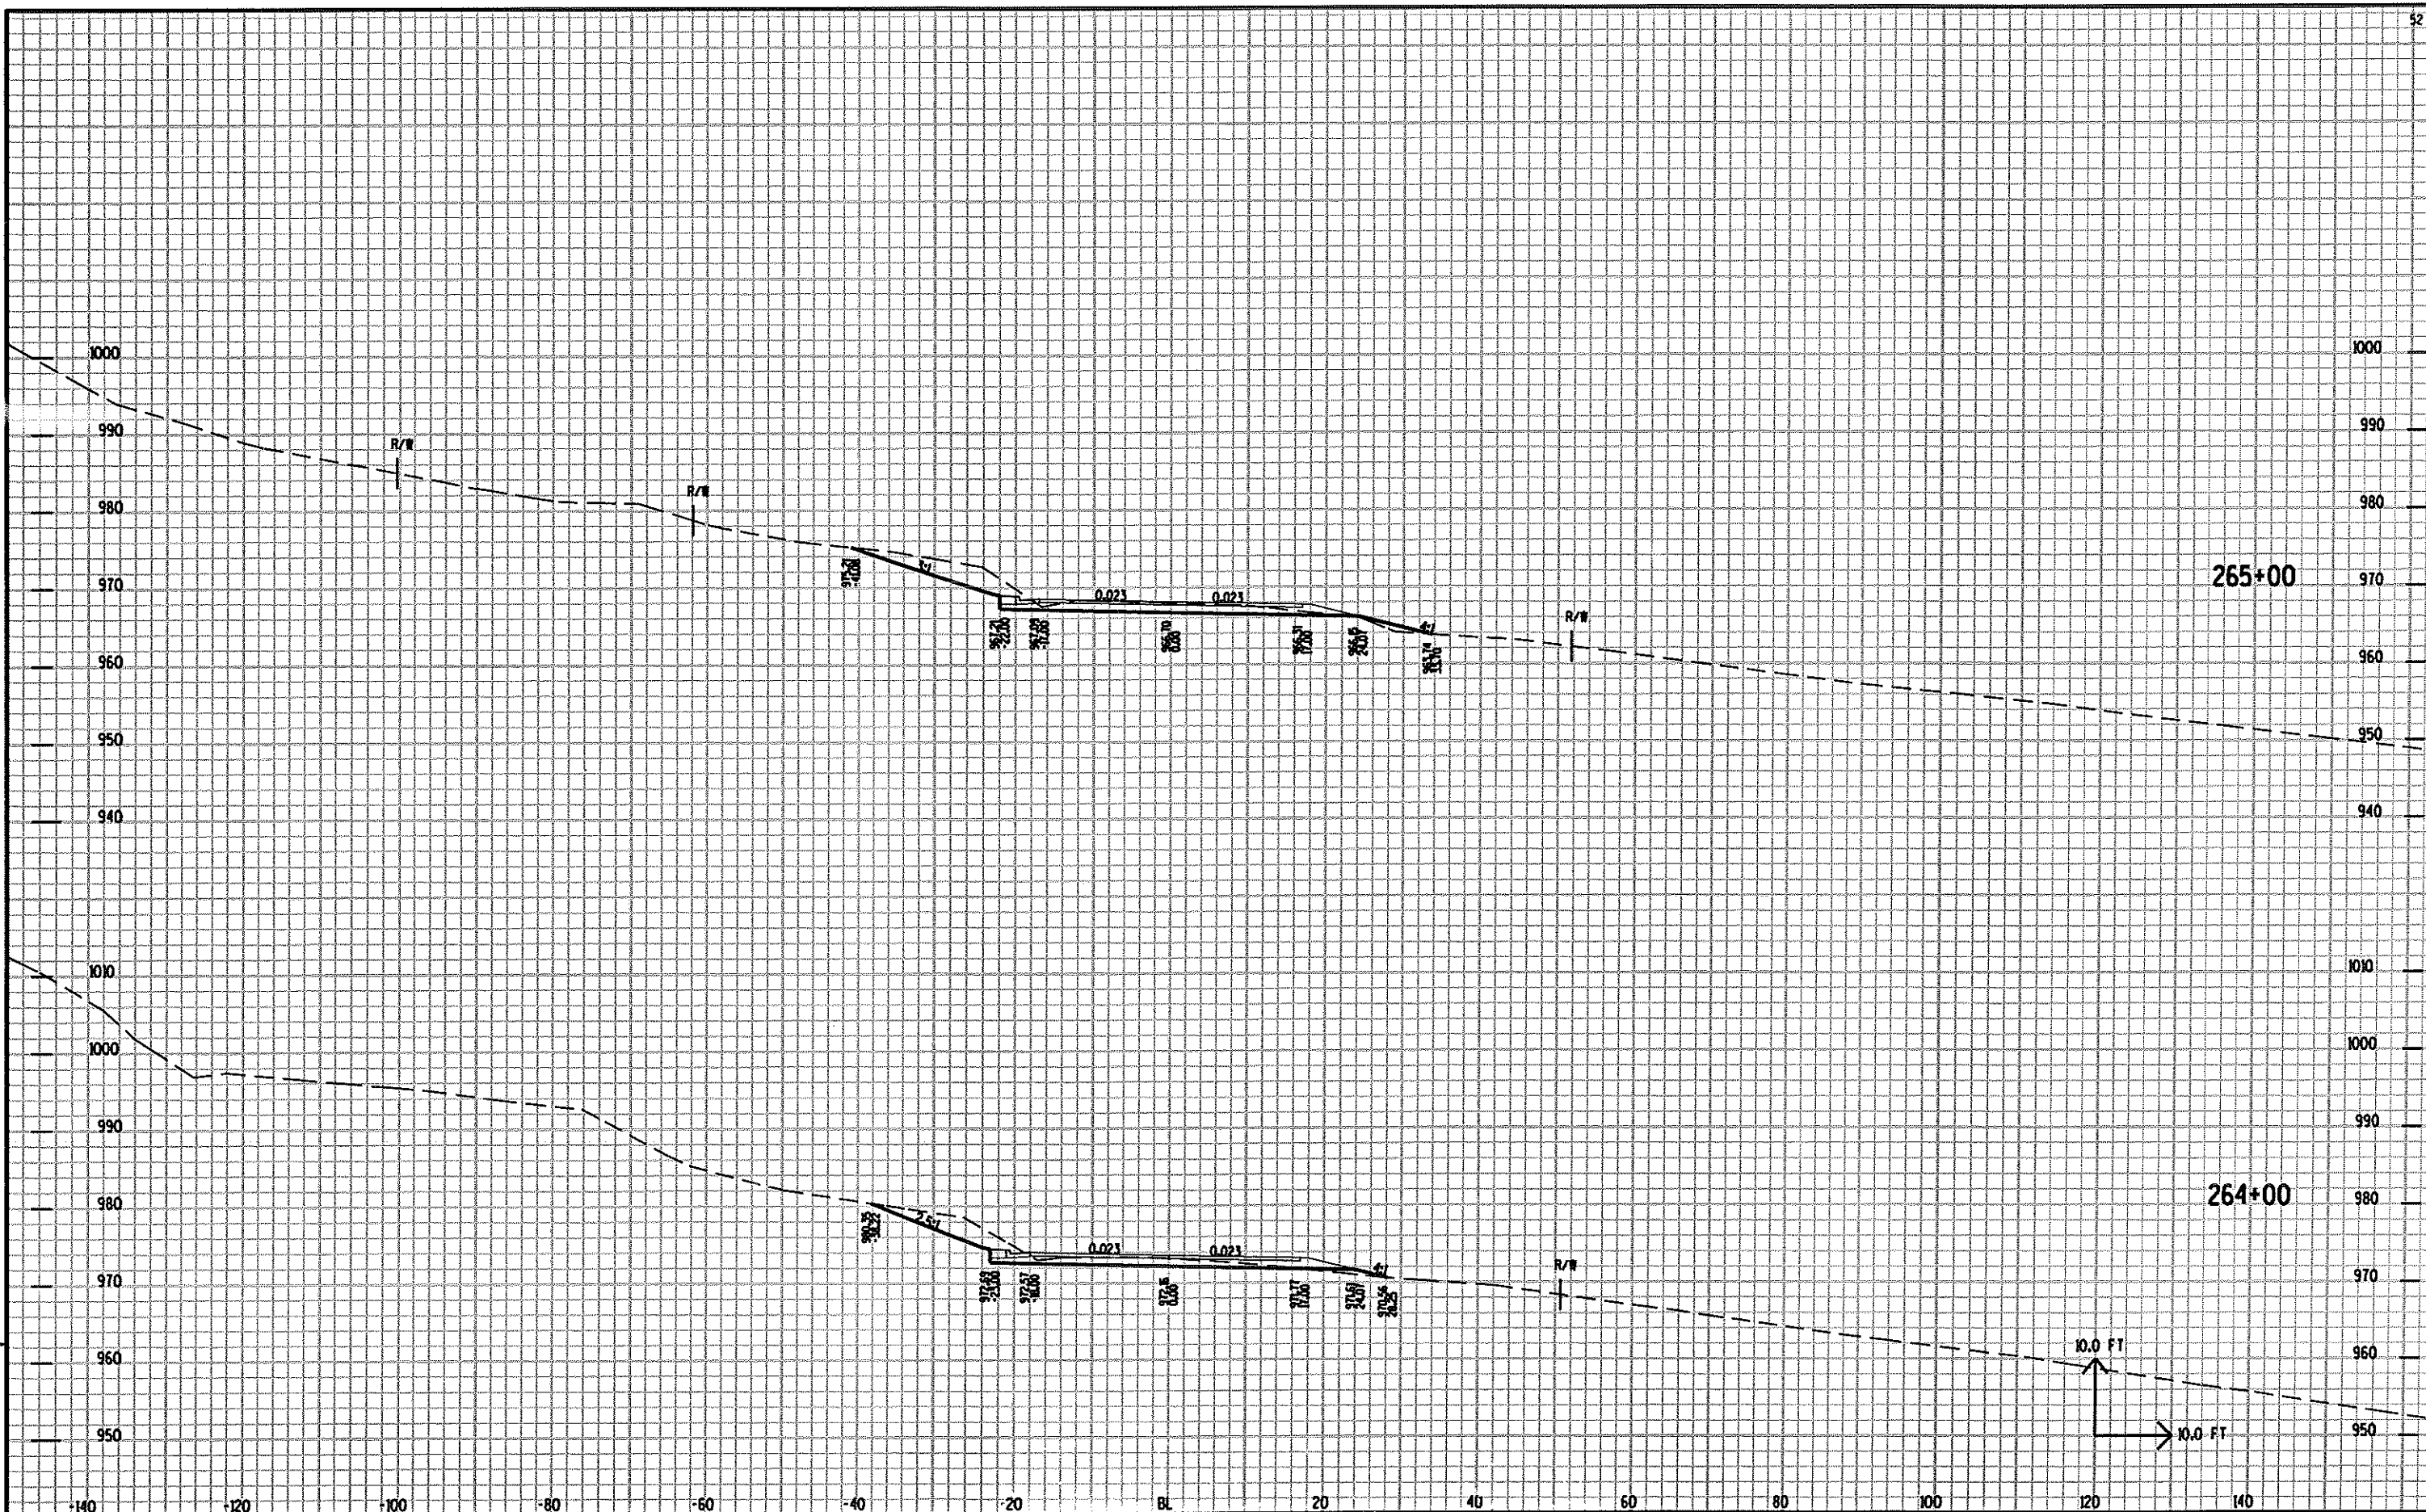


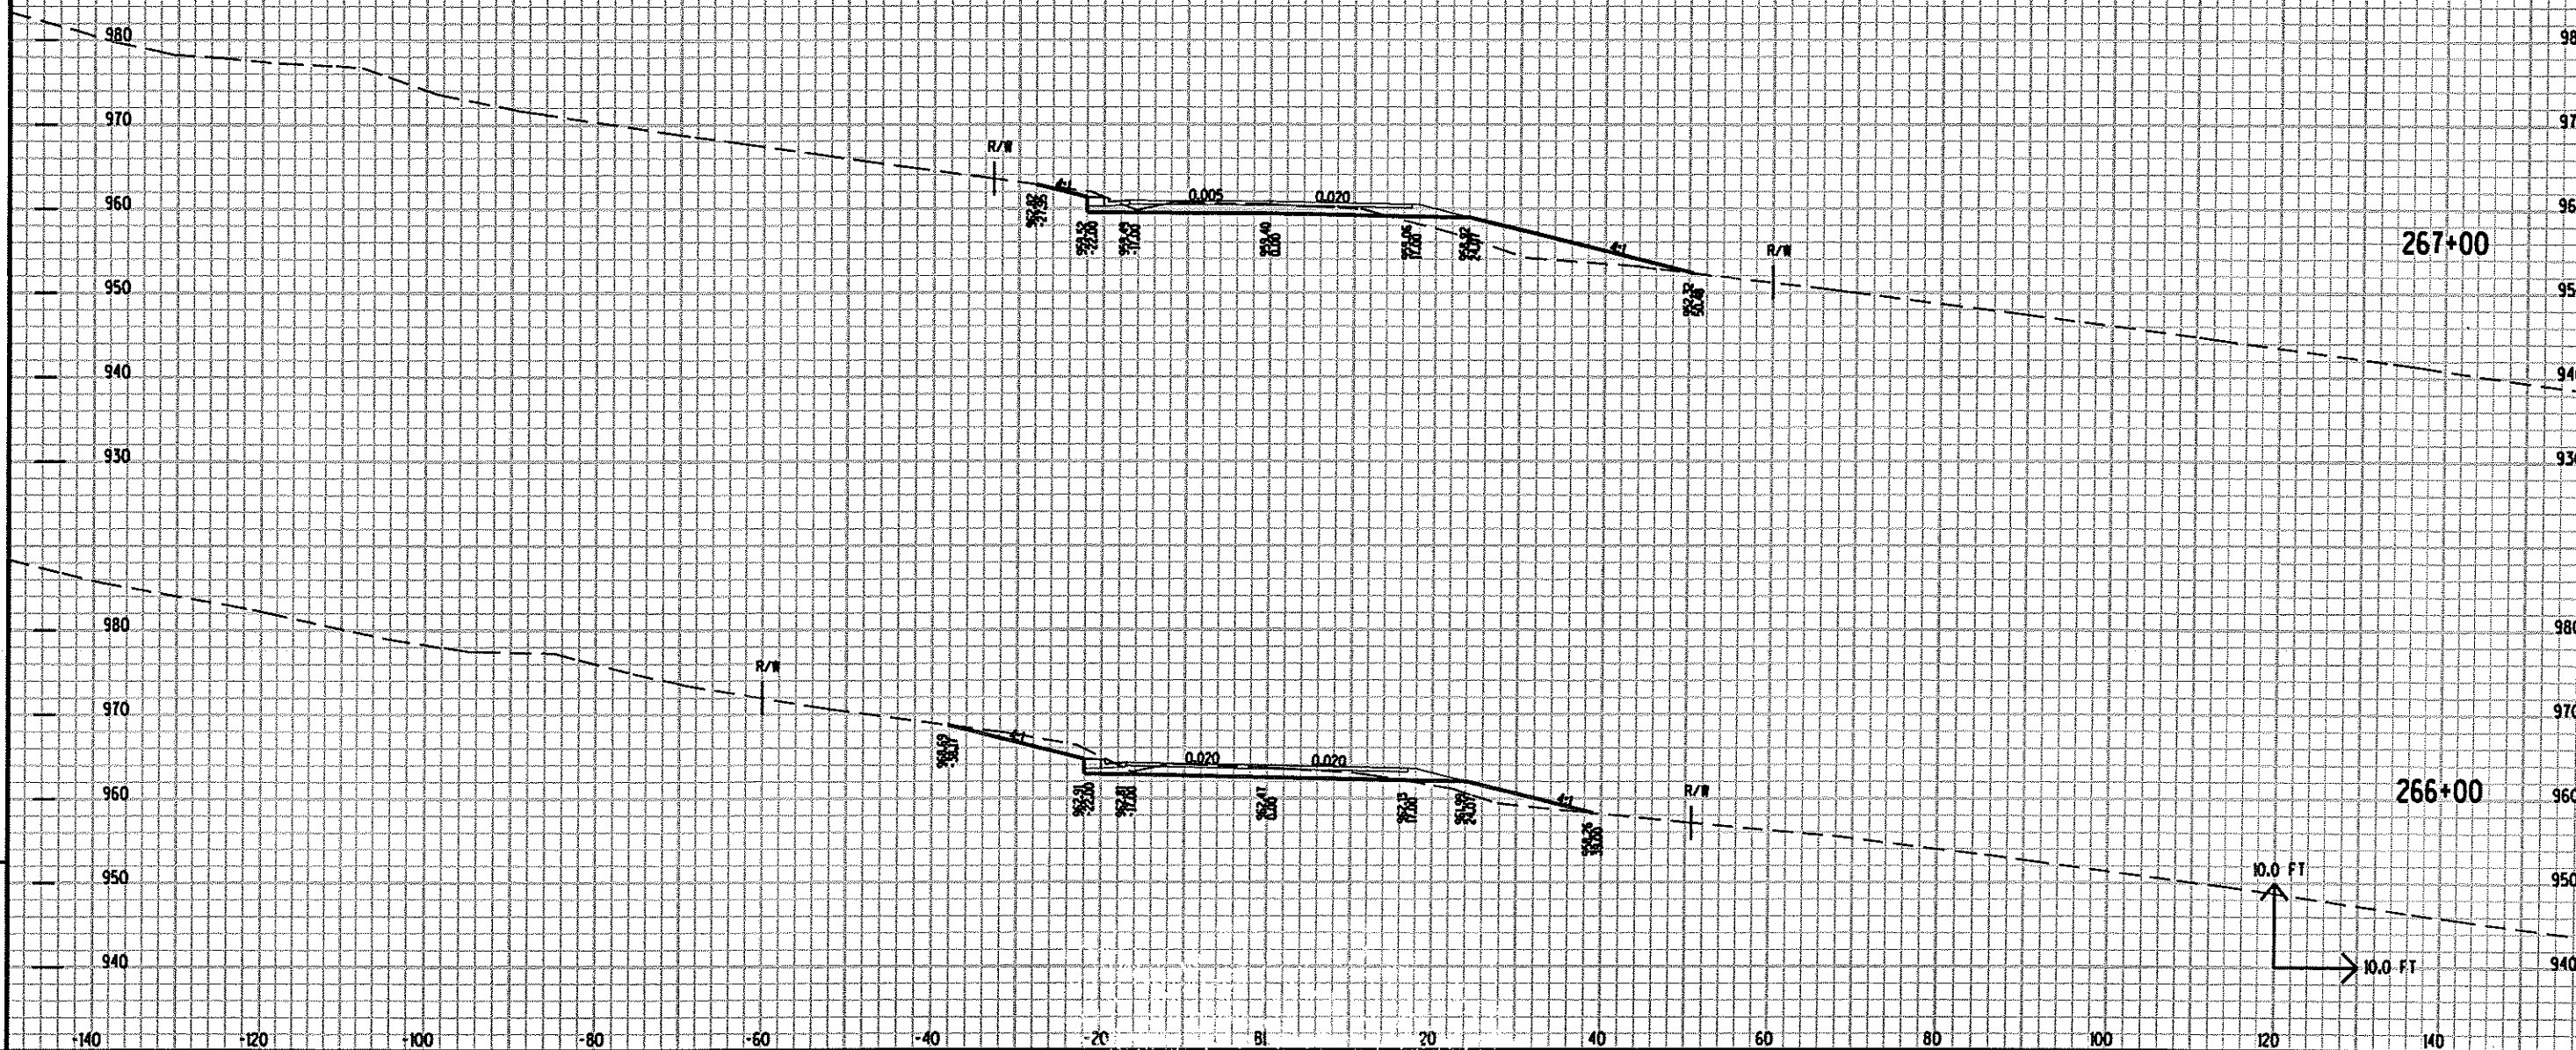

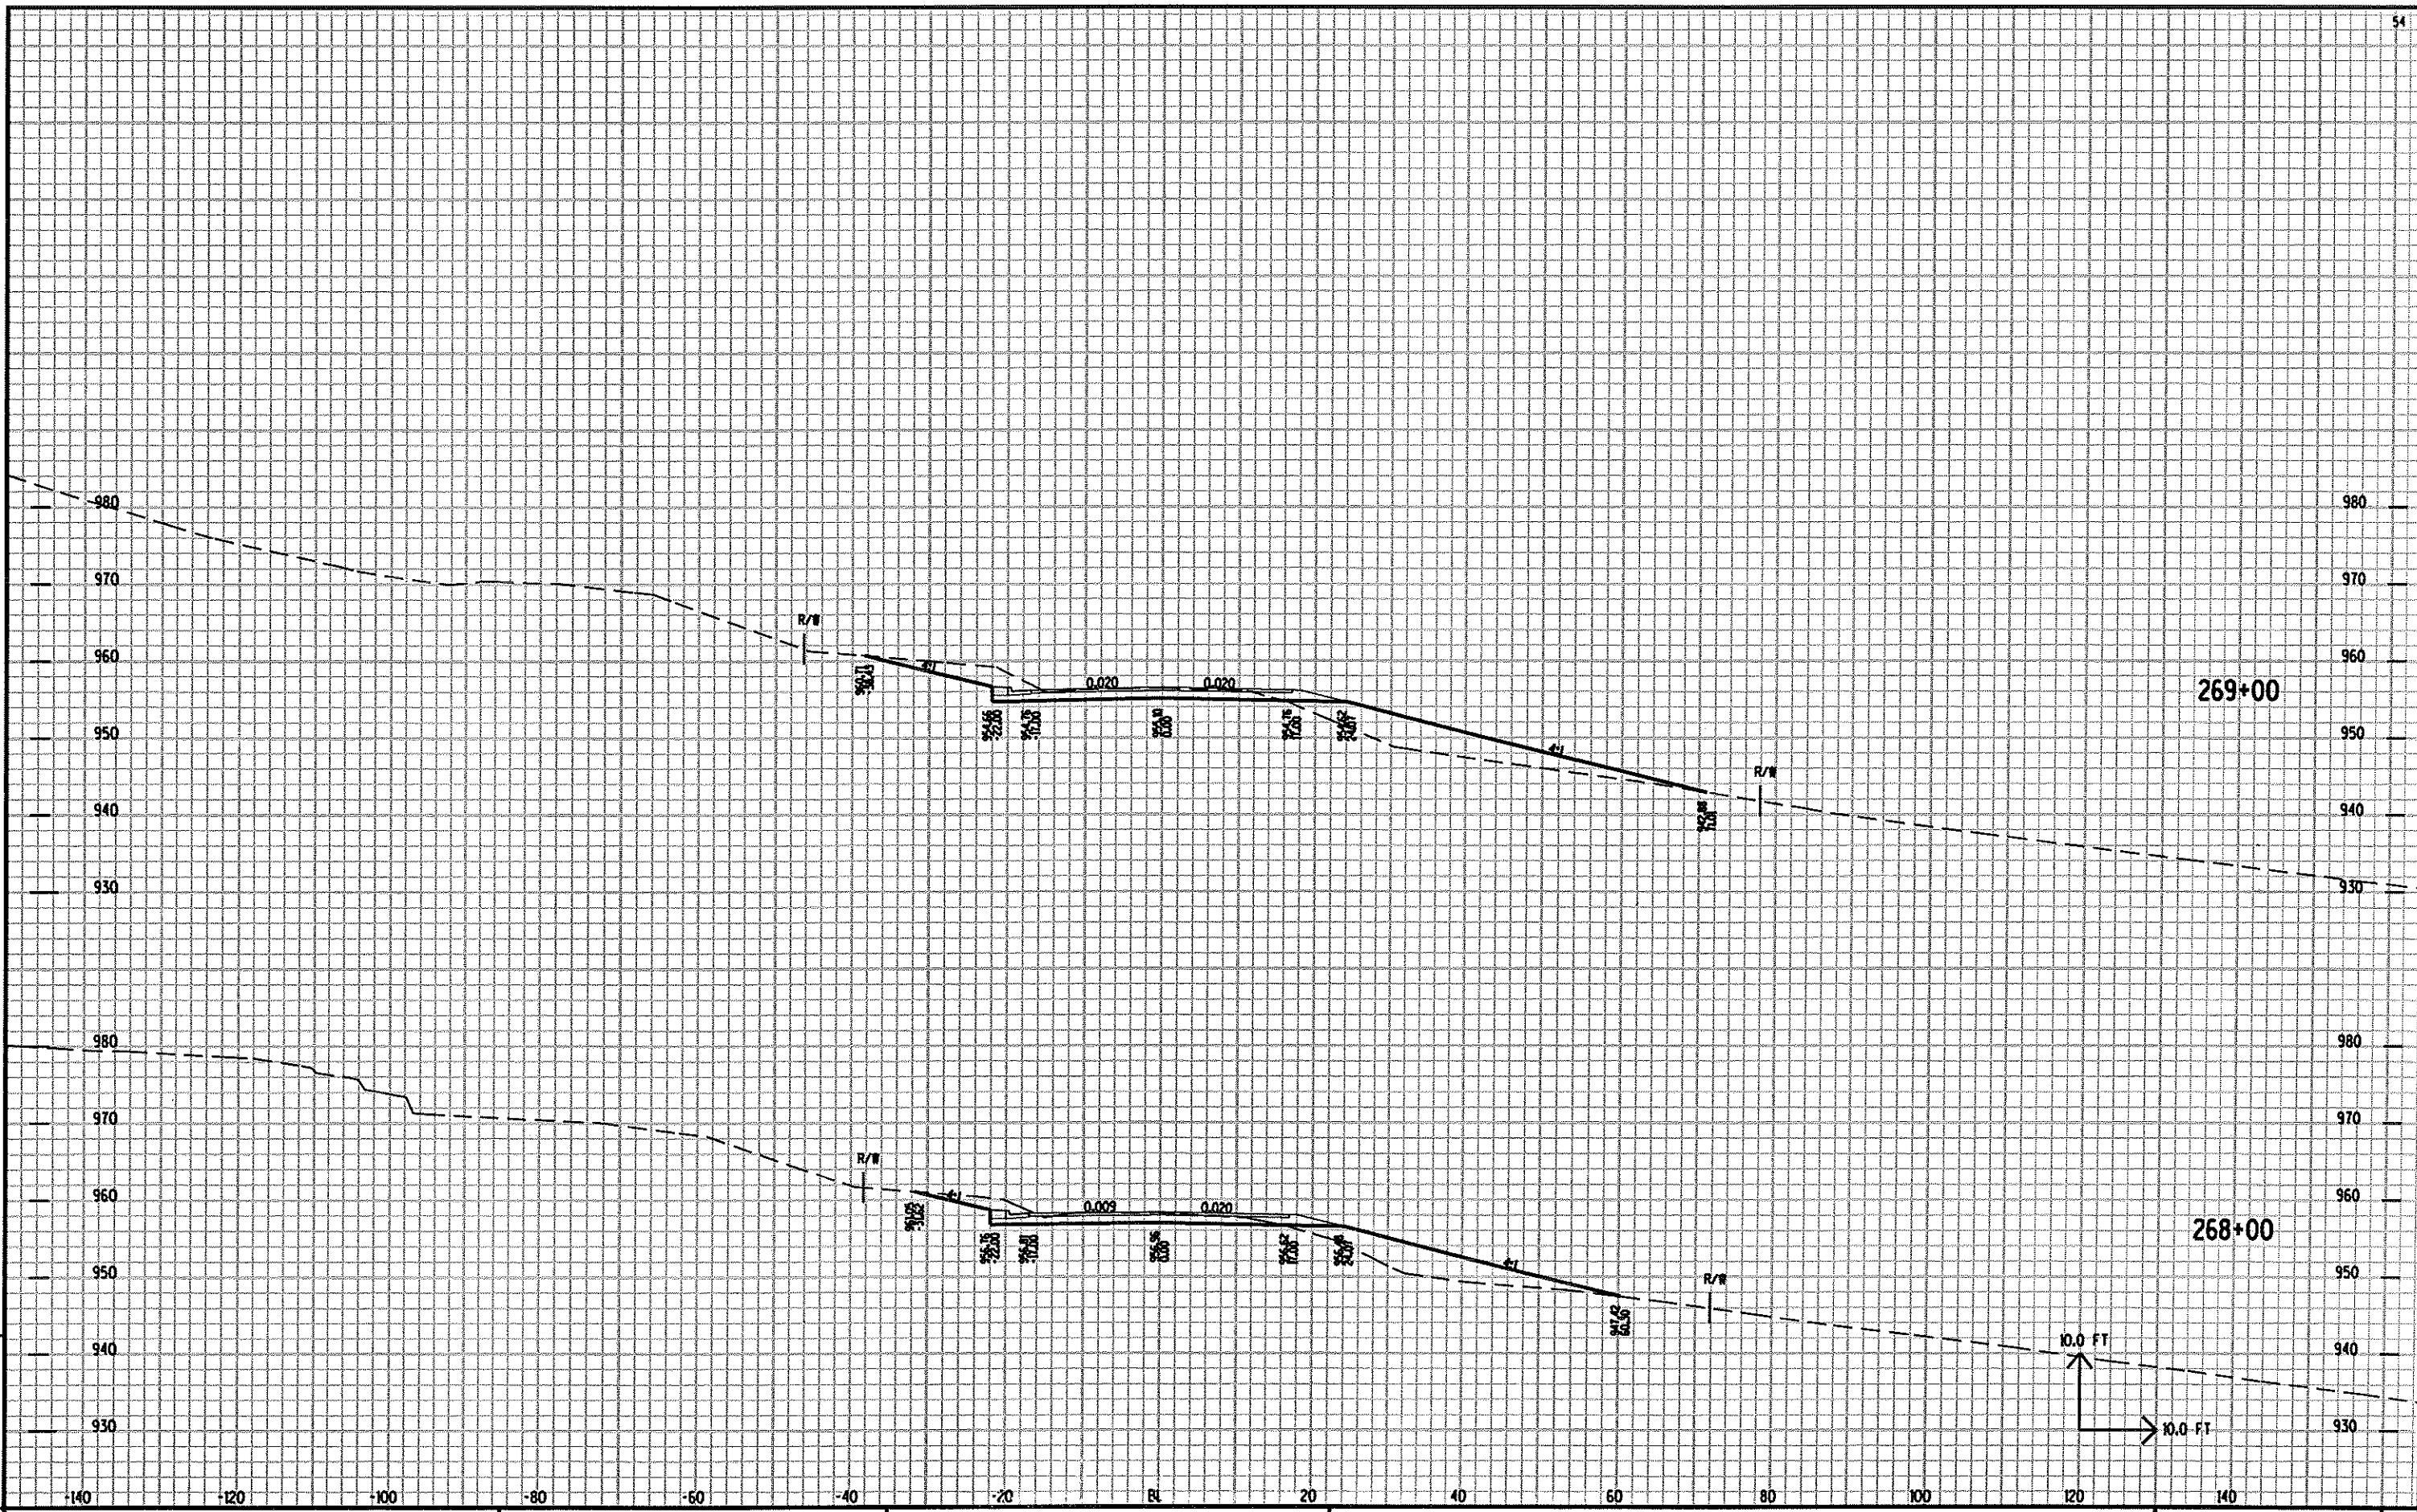


9


9

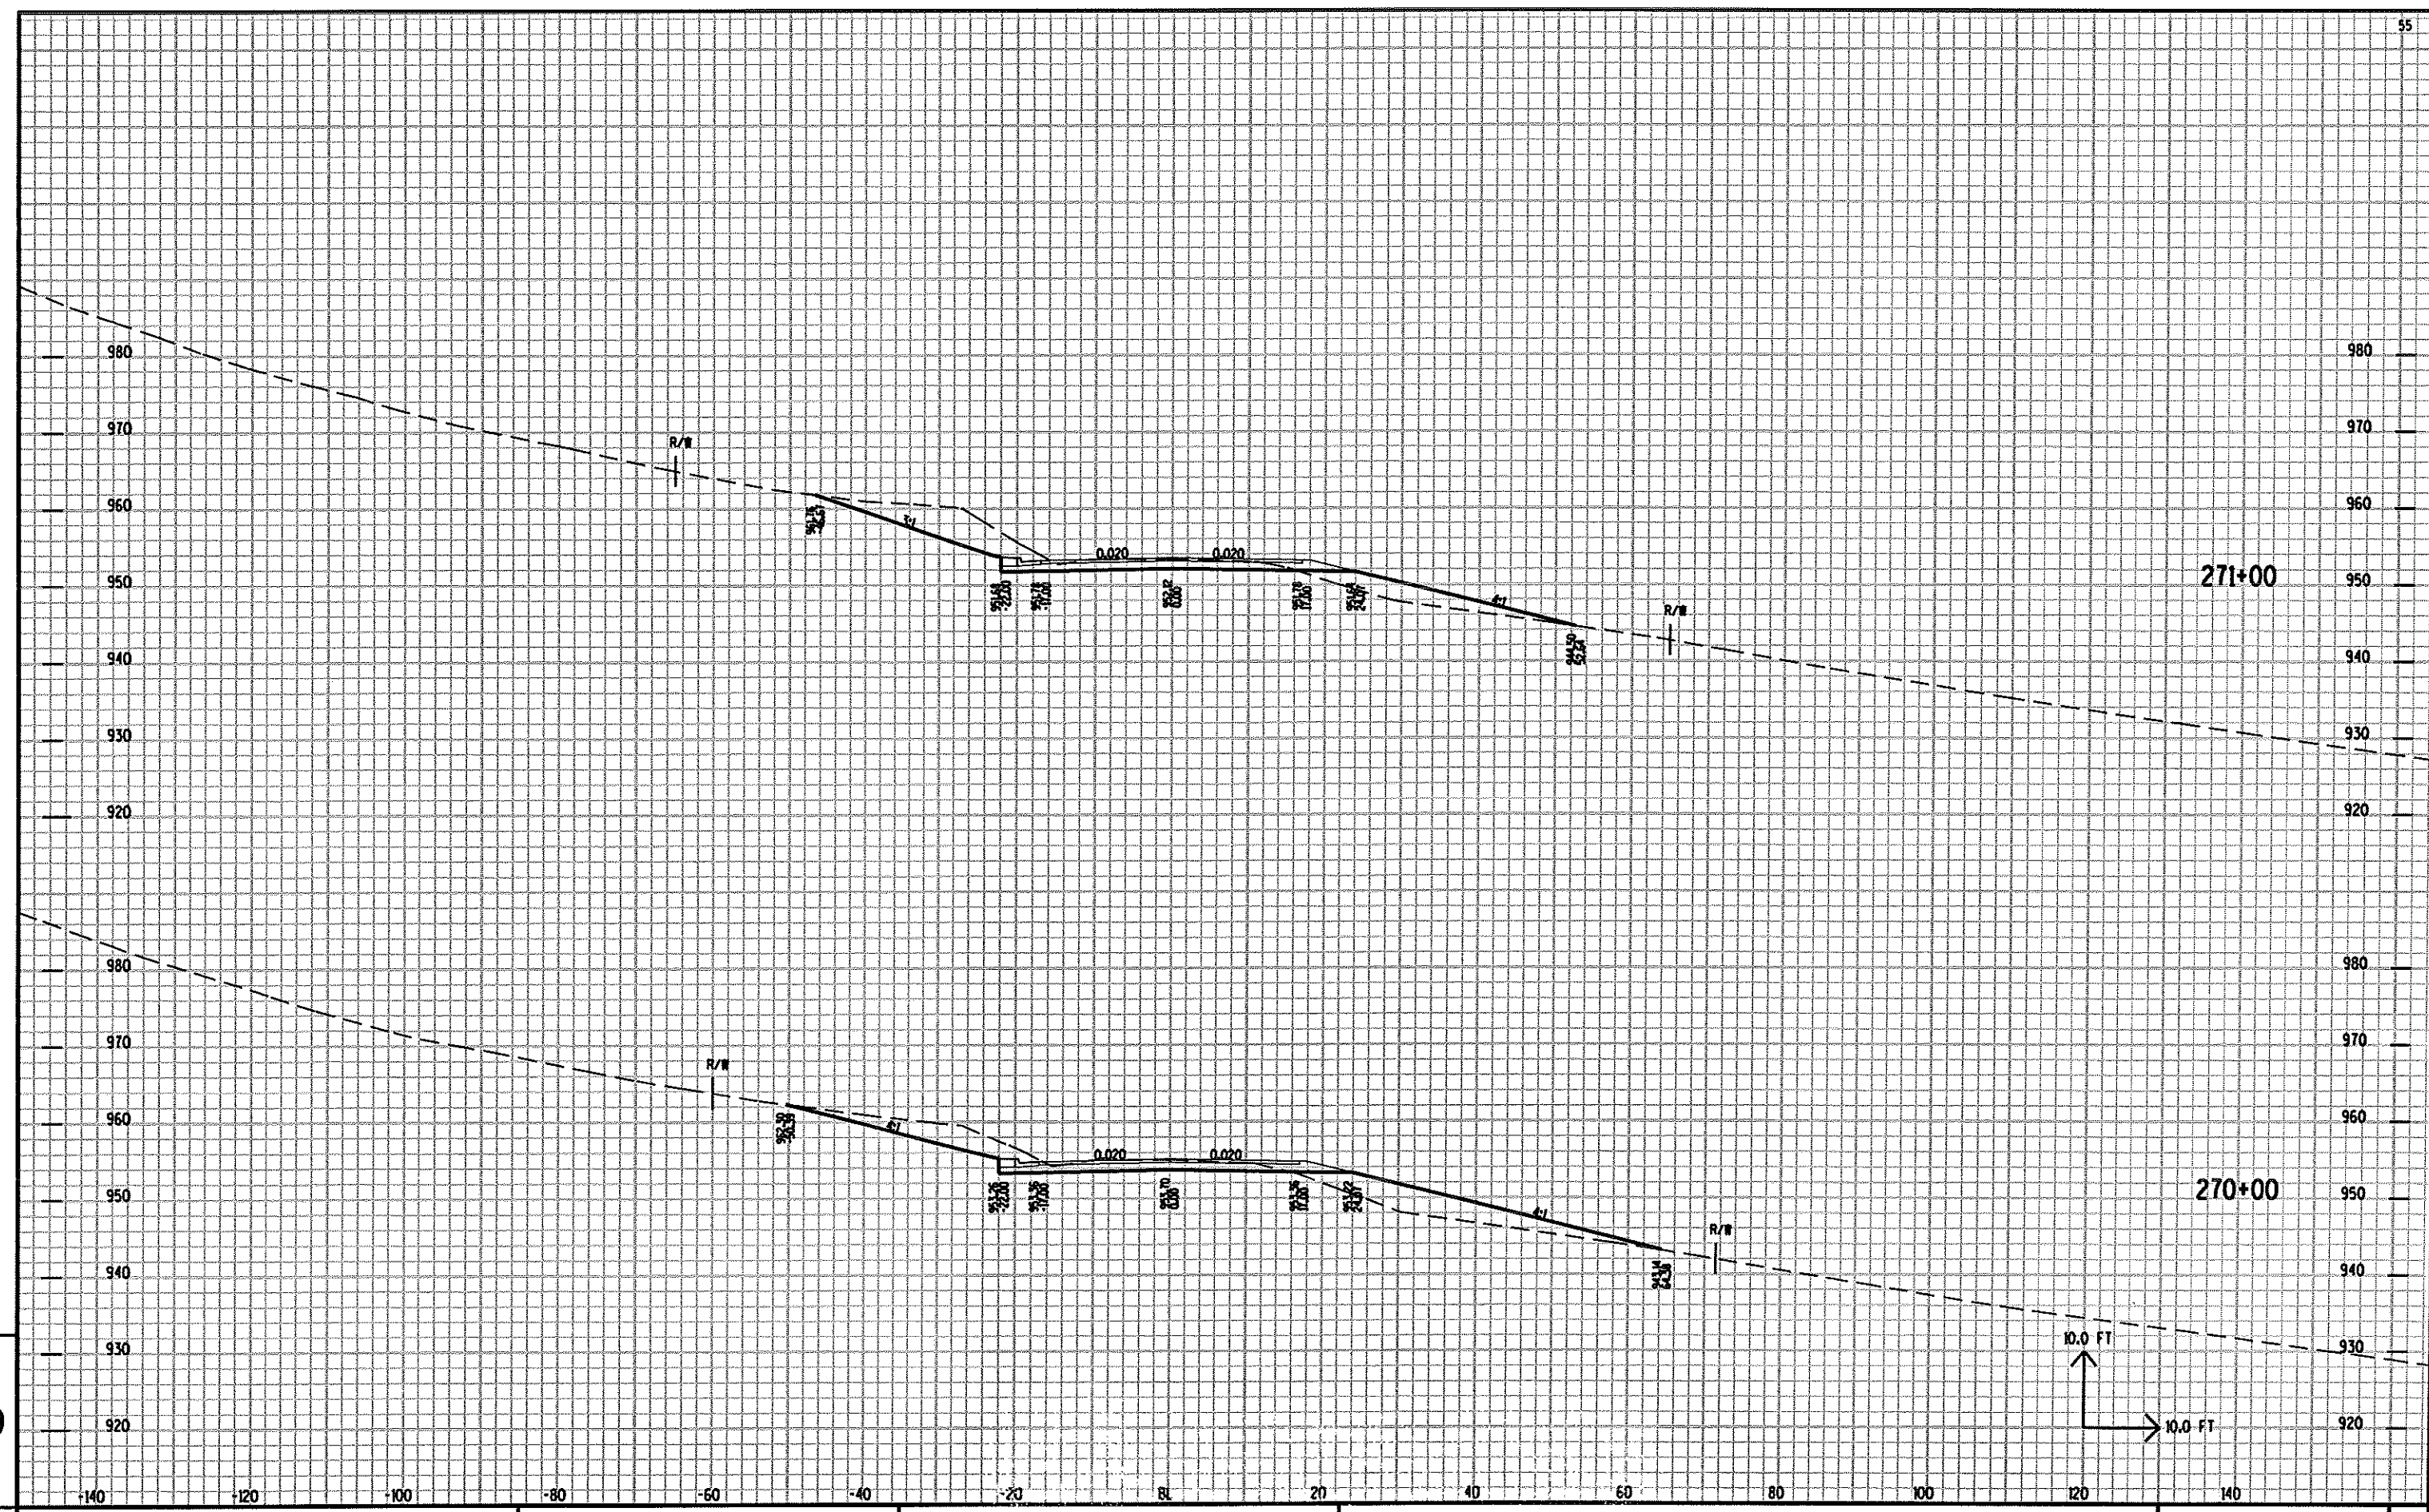



9


9

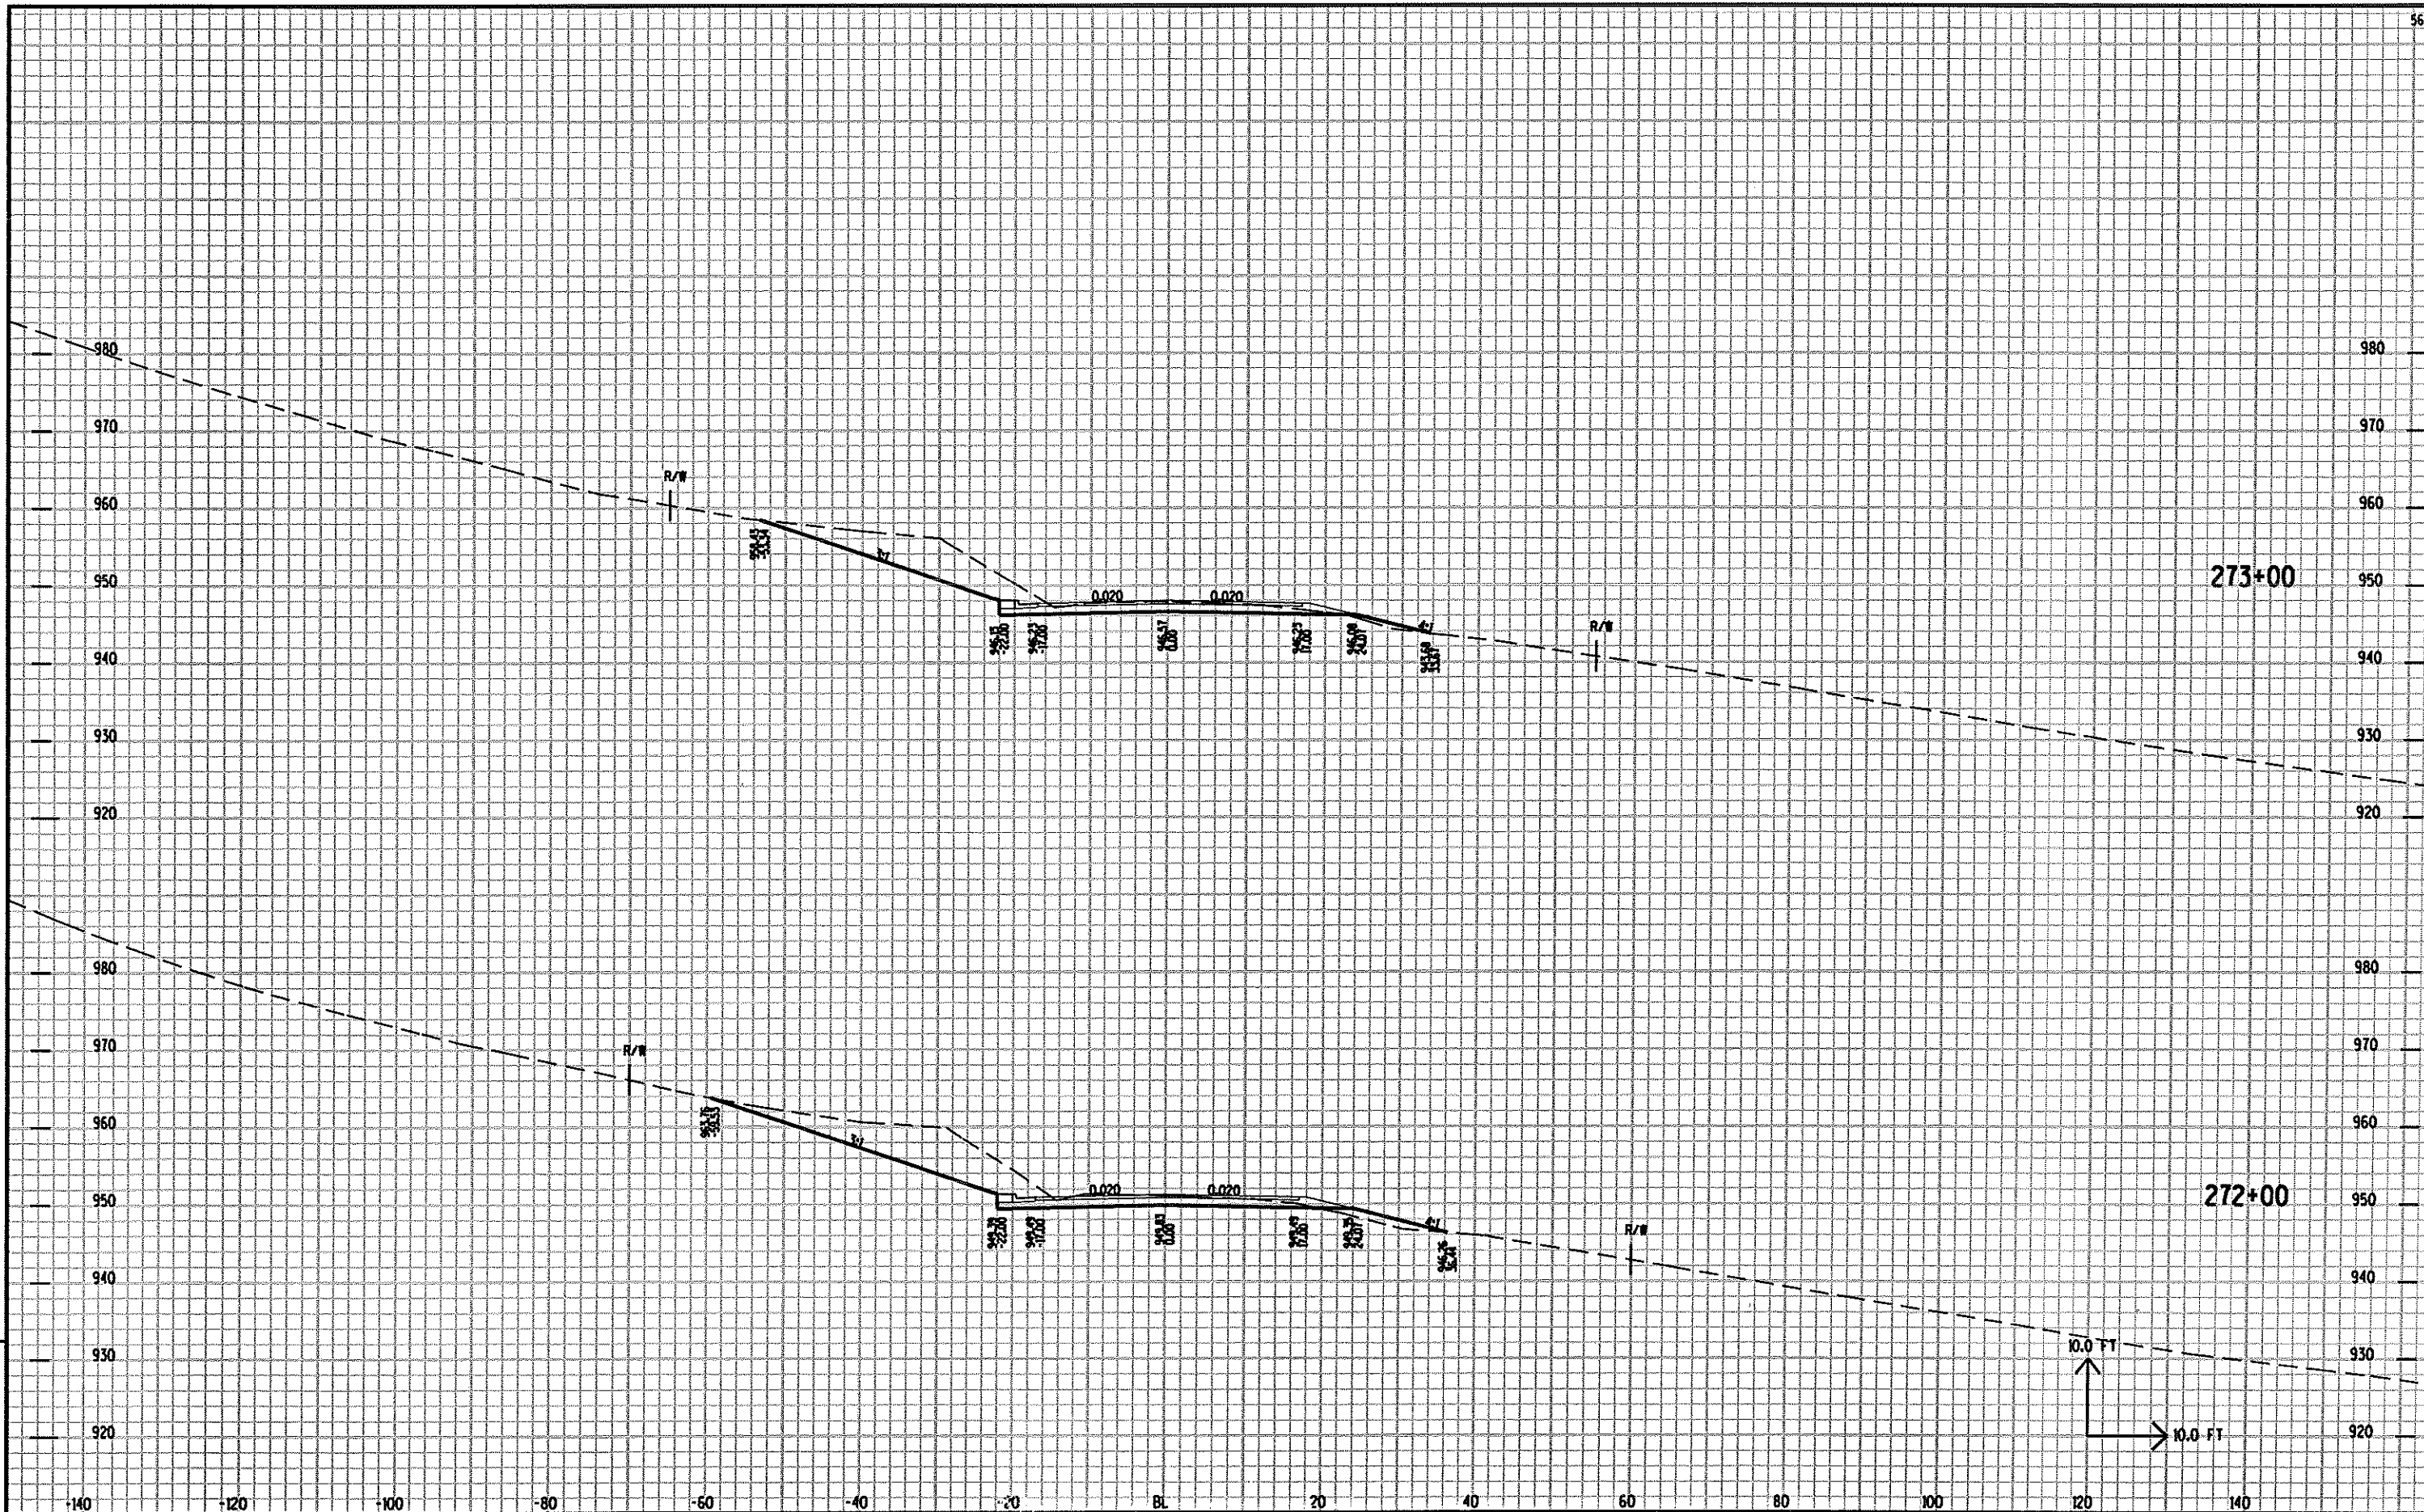


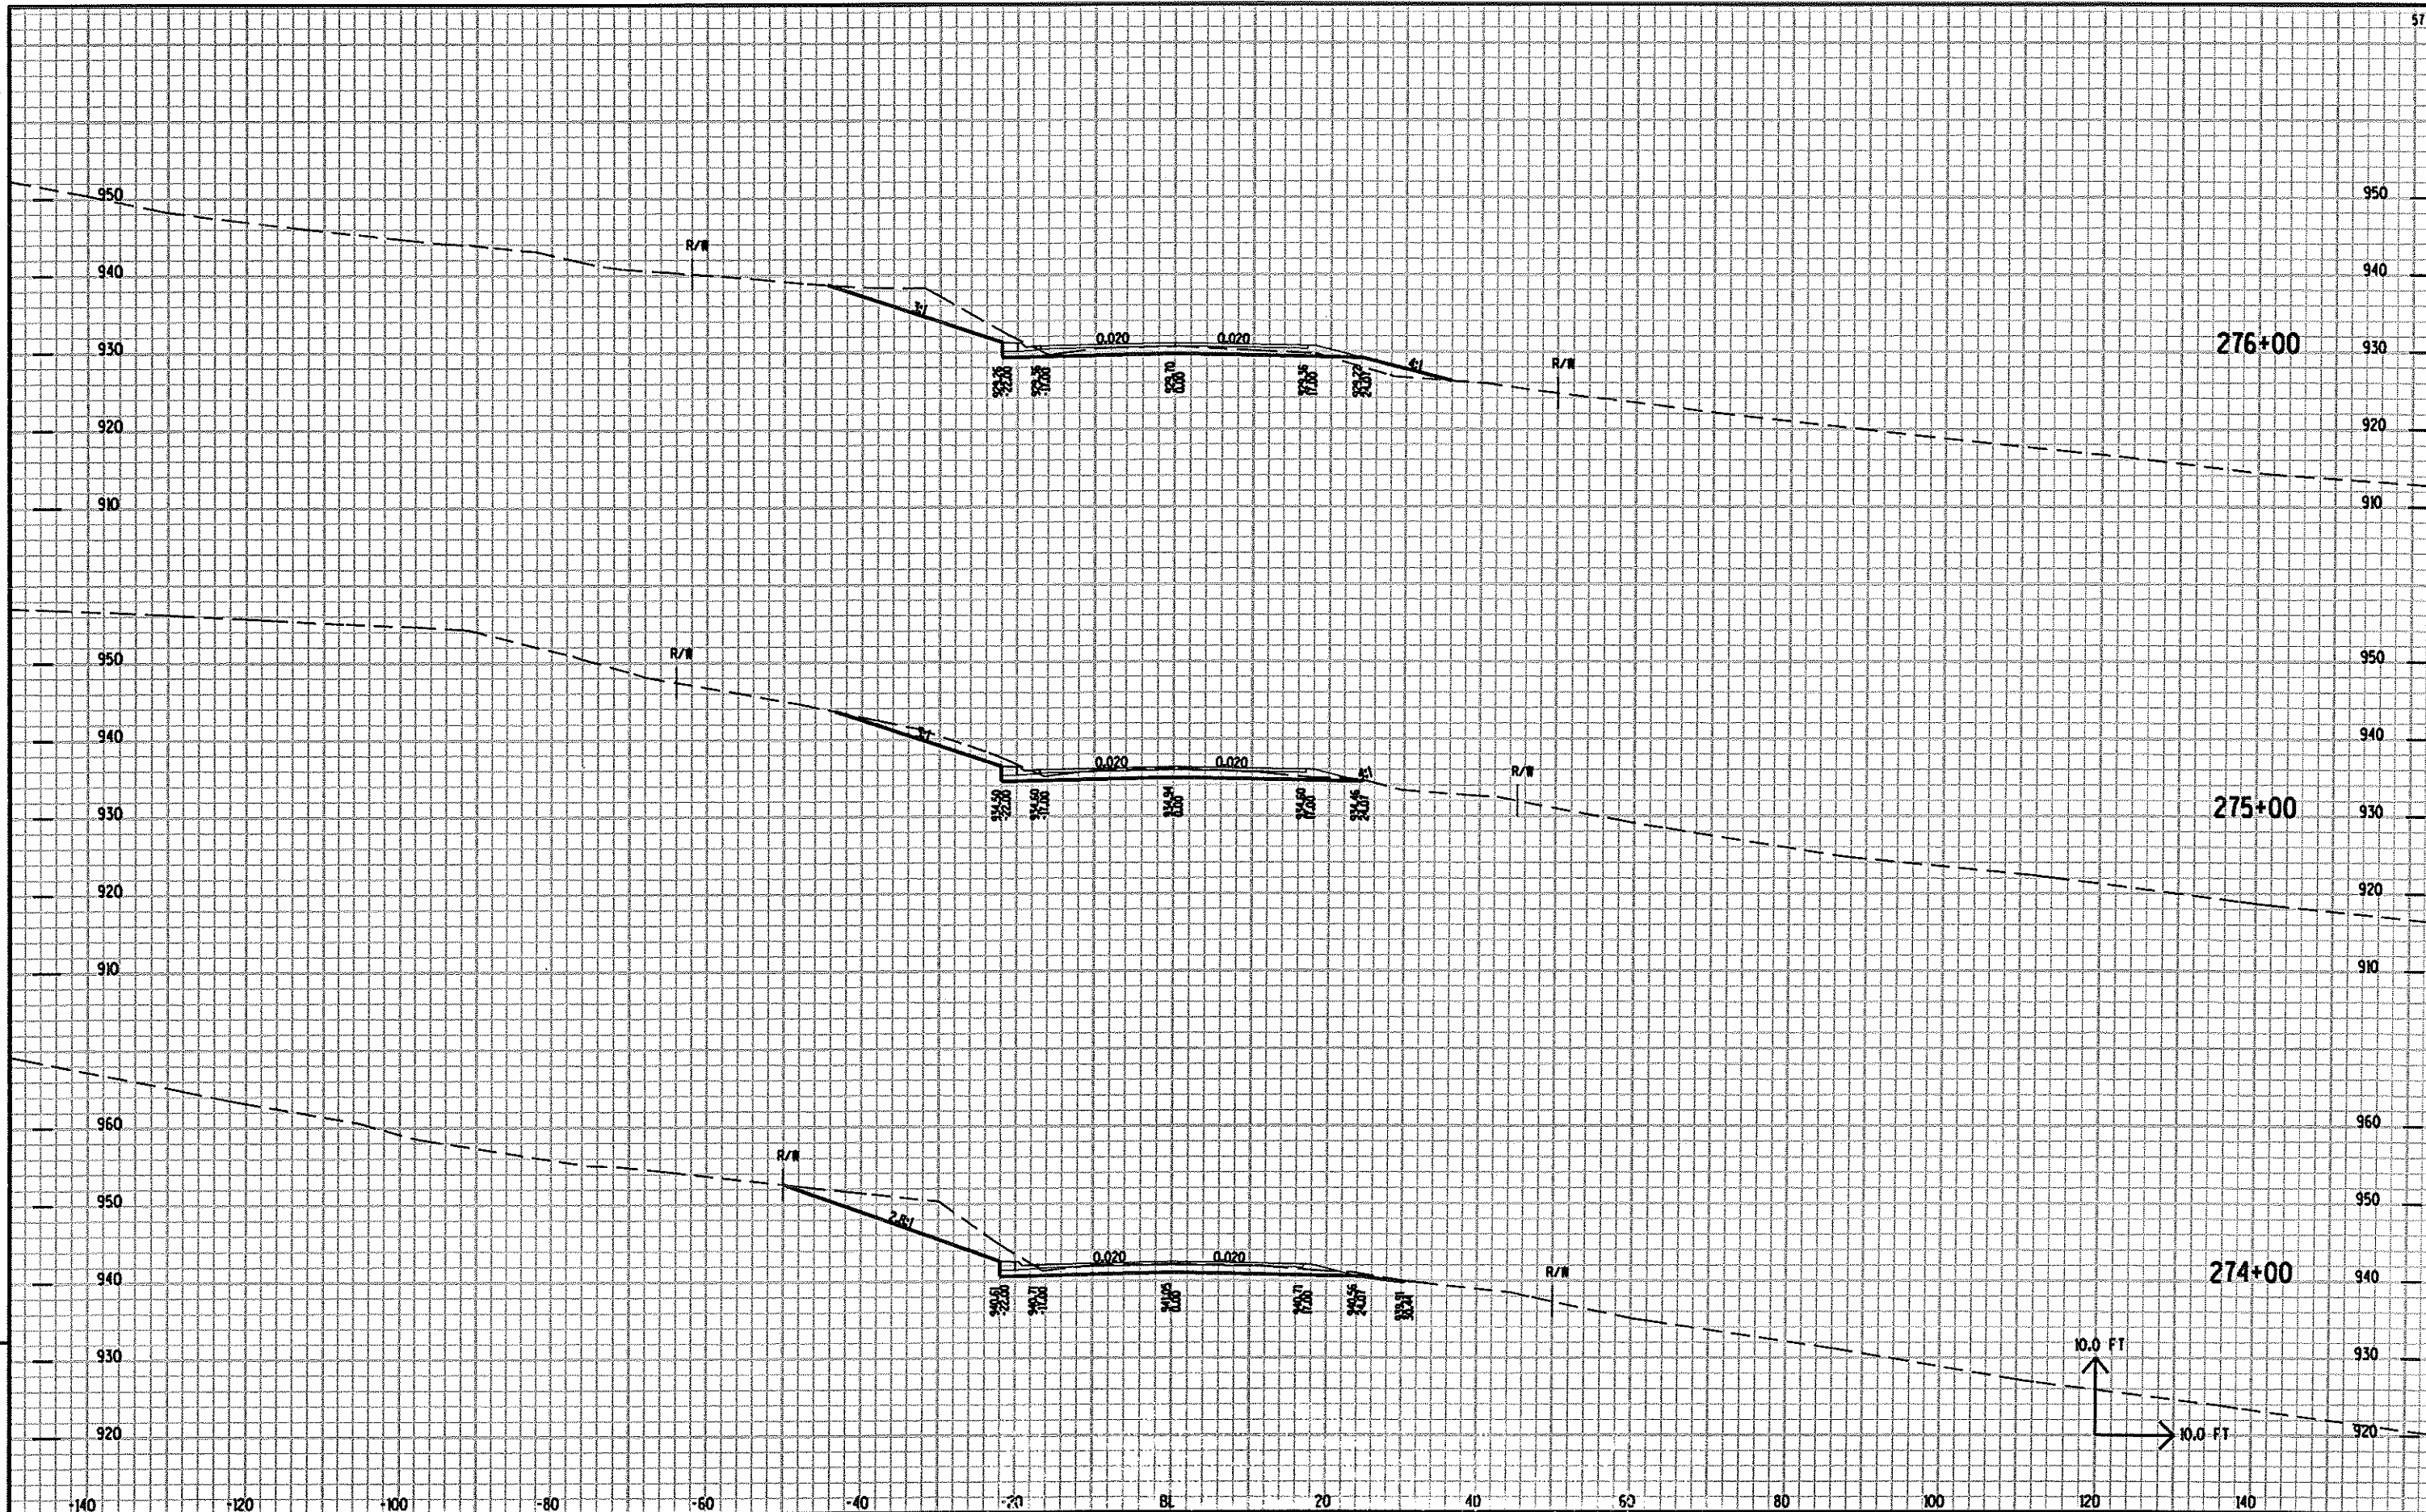


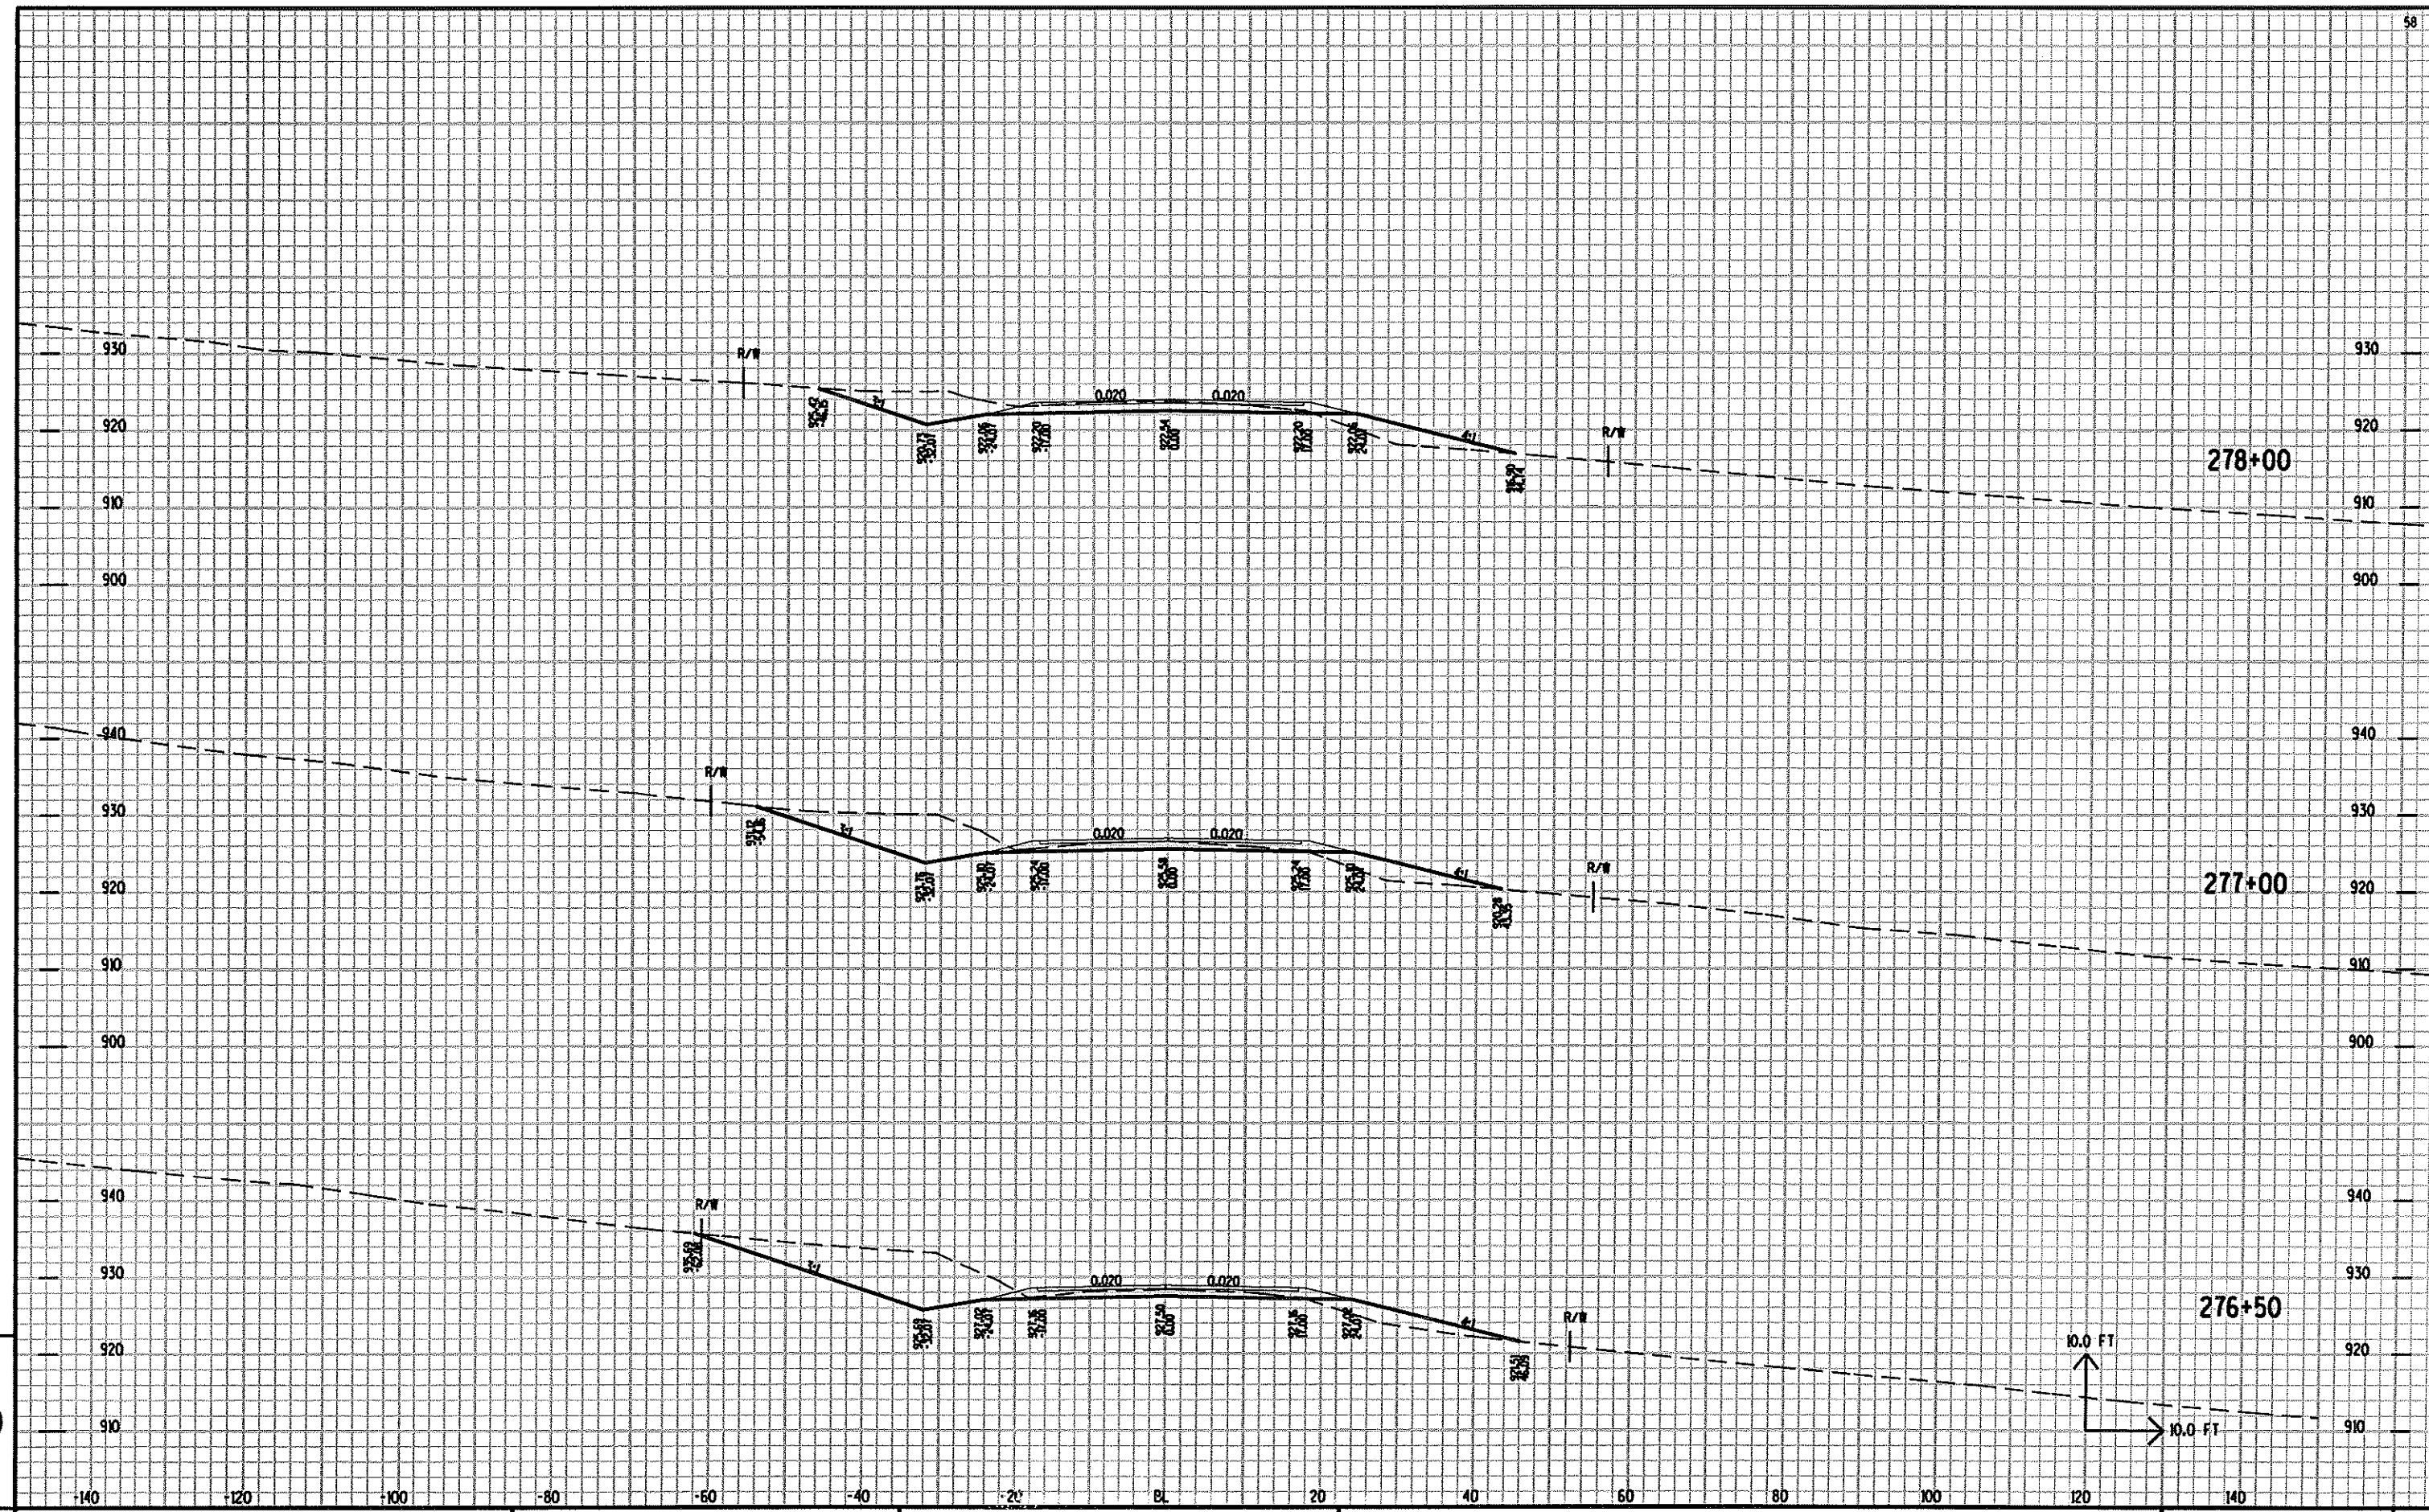

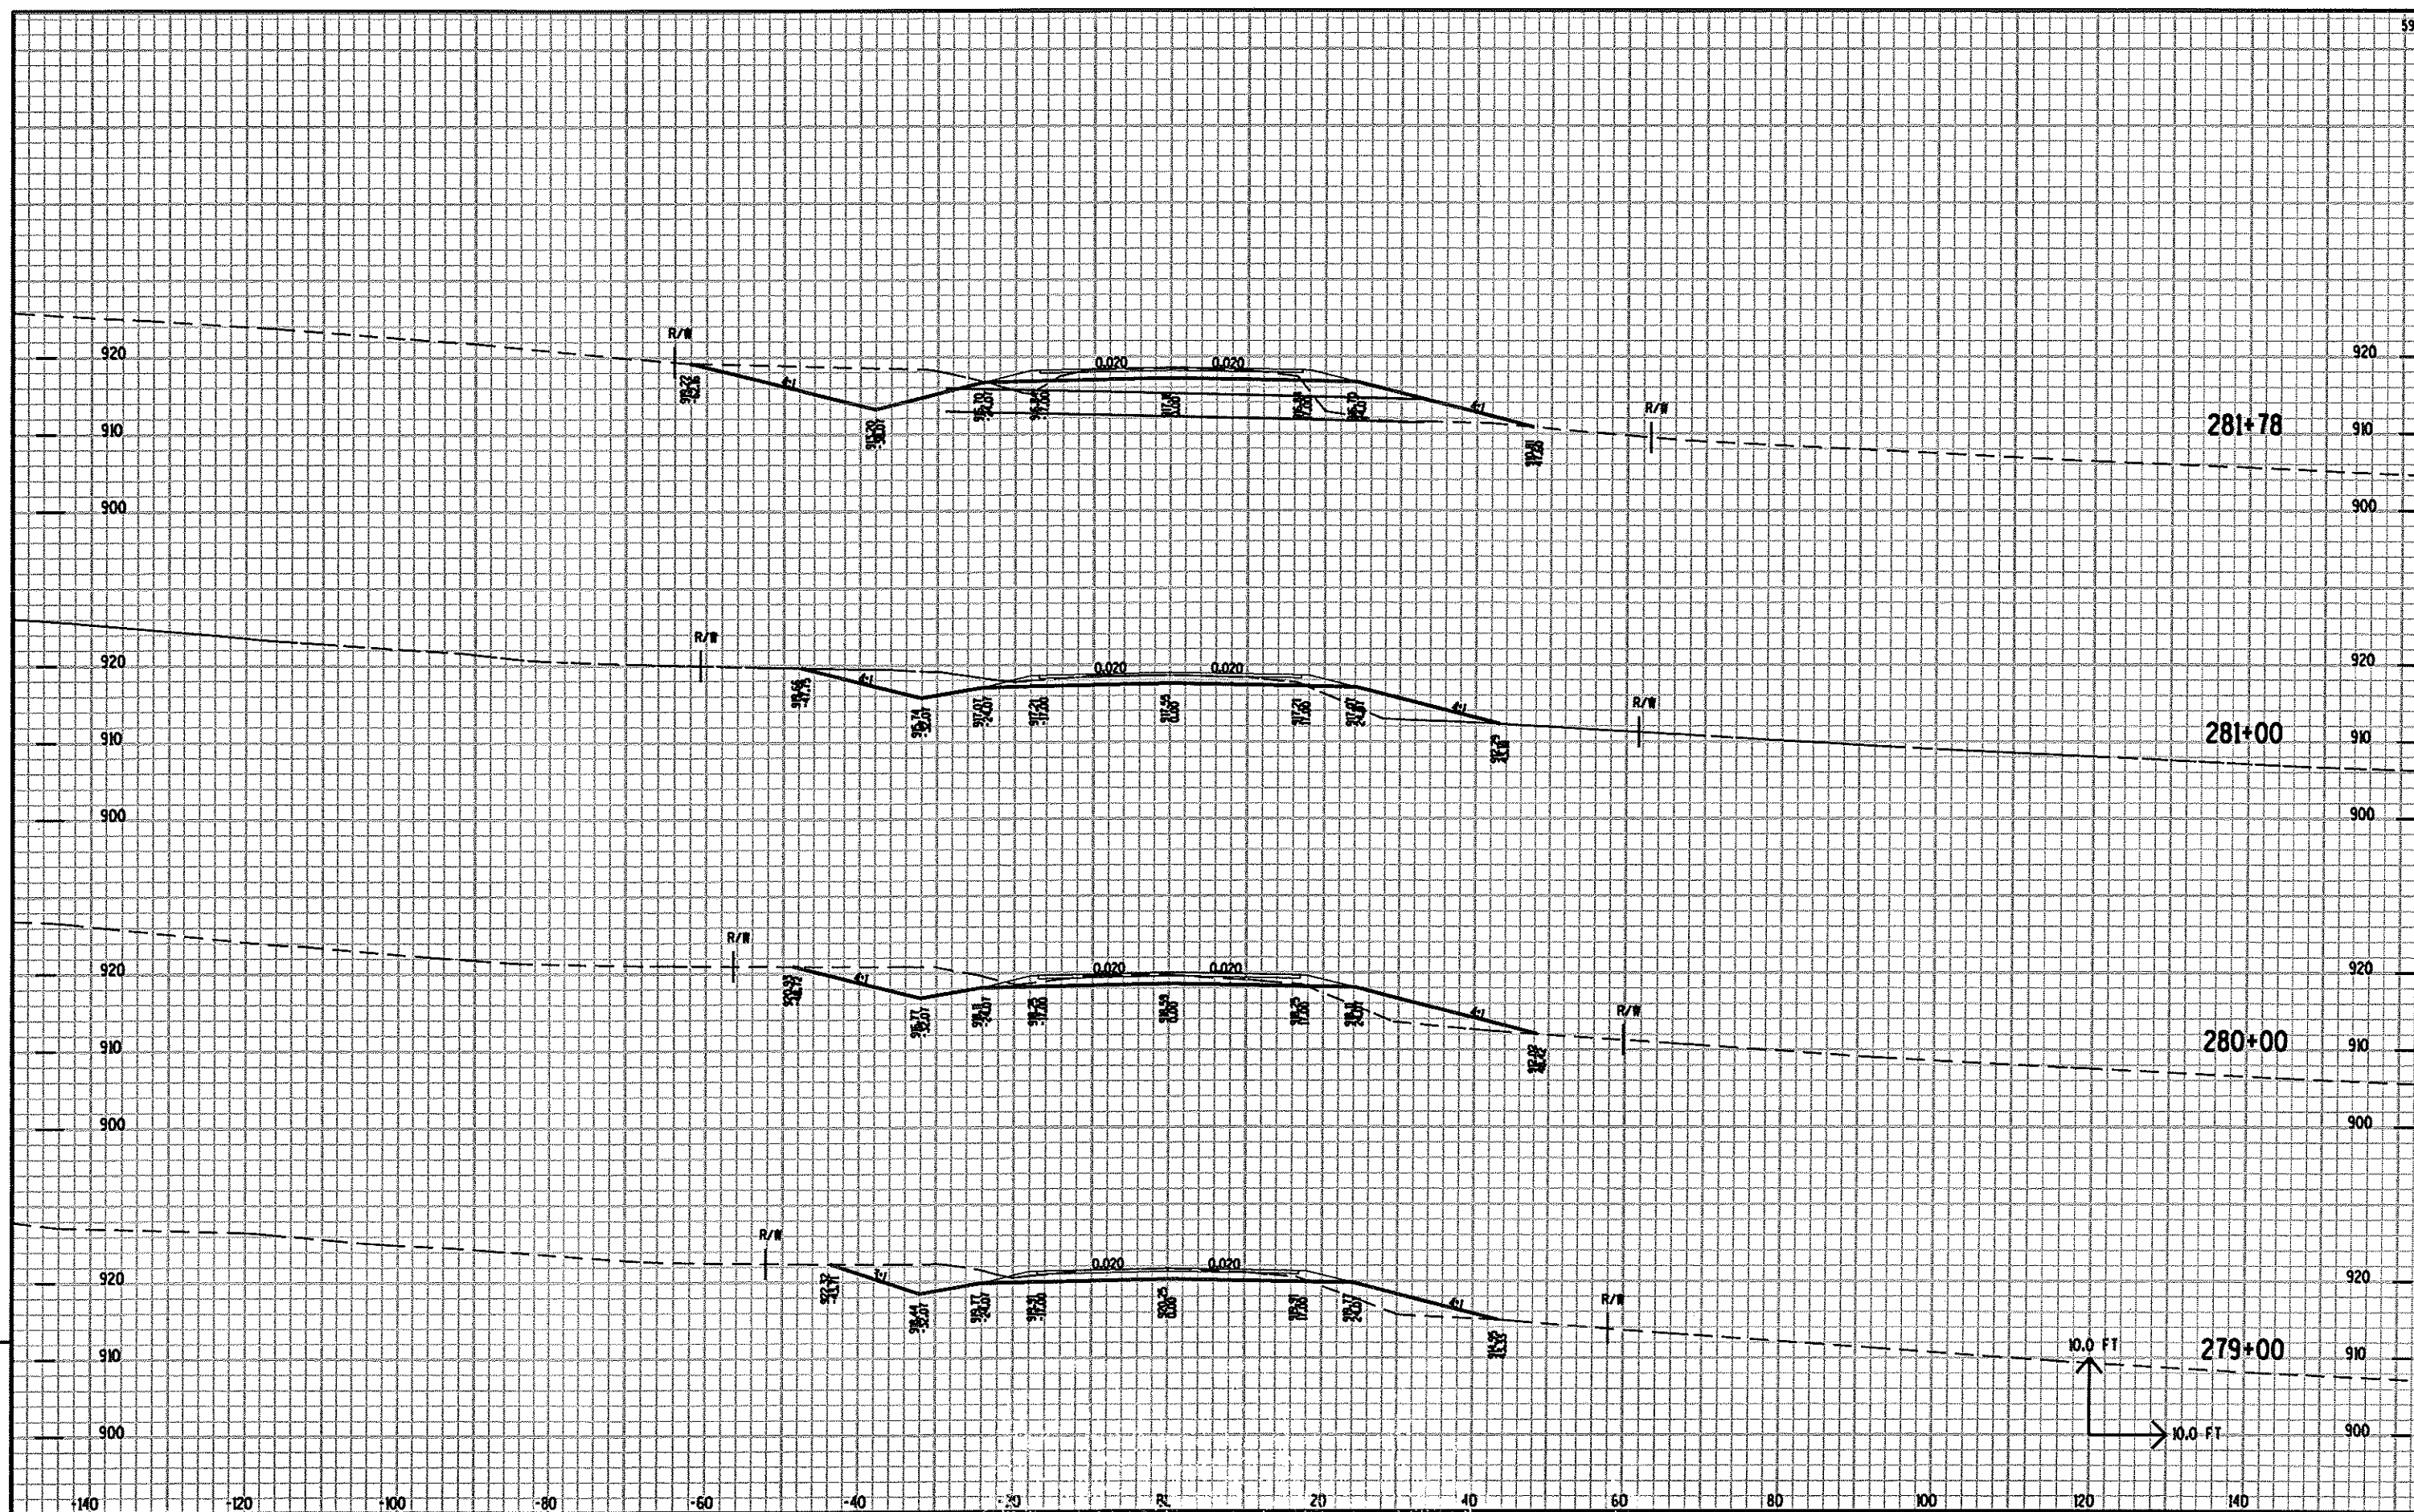

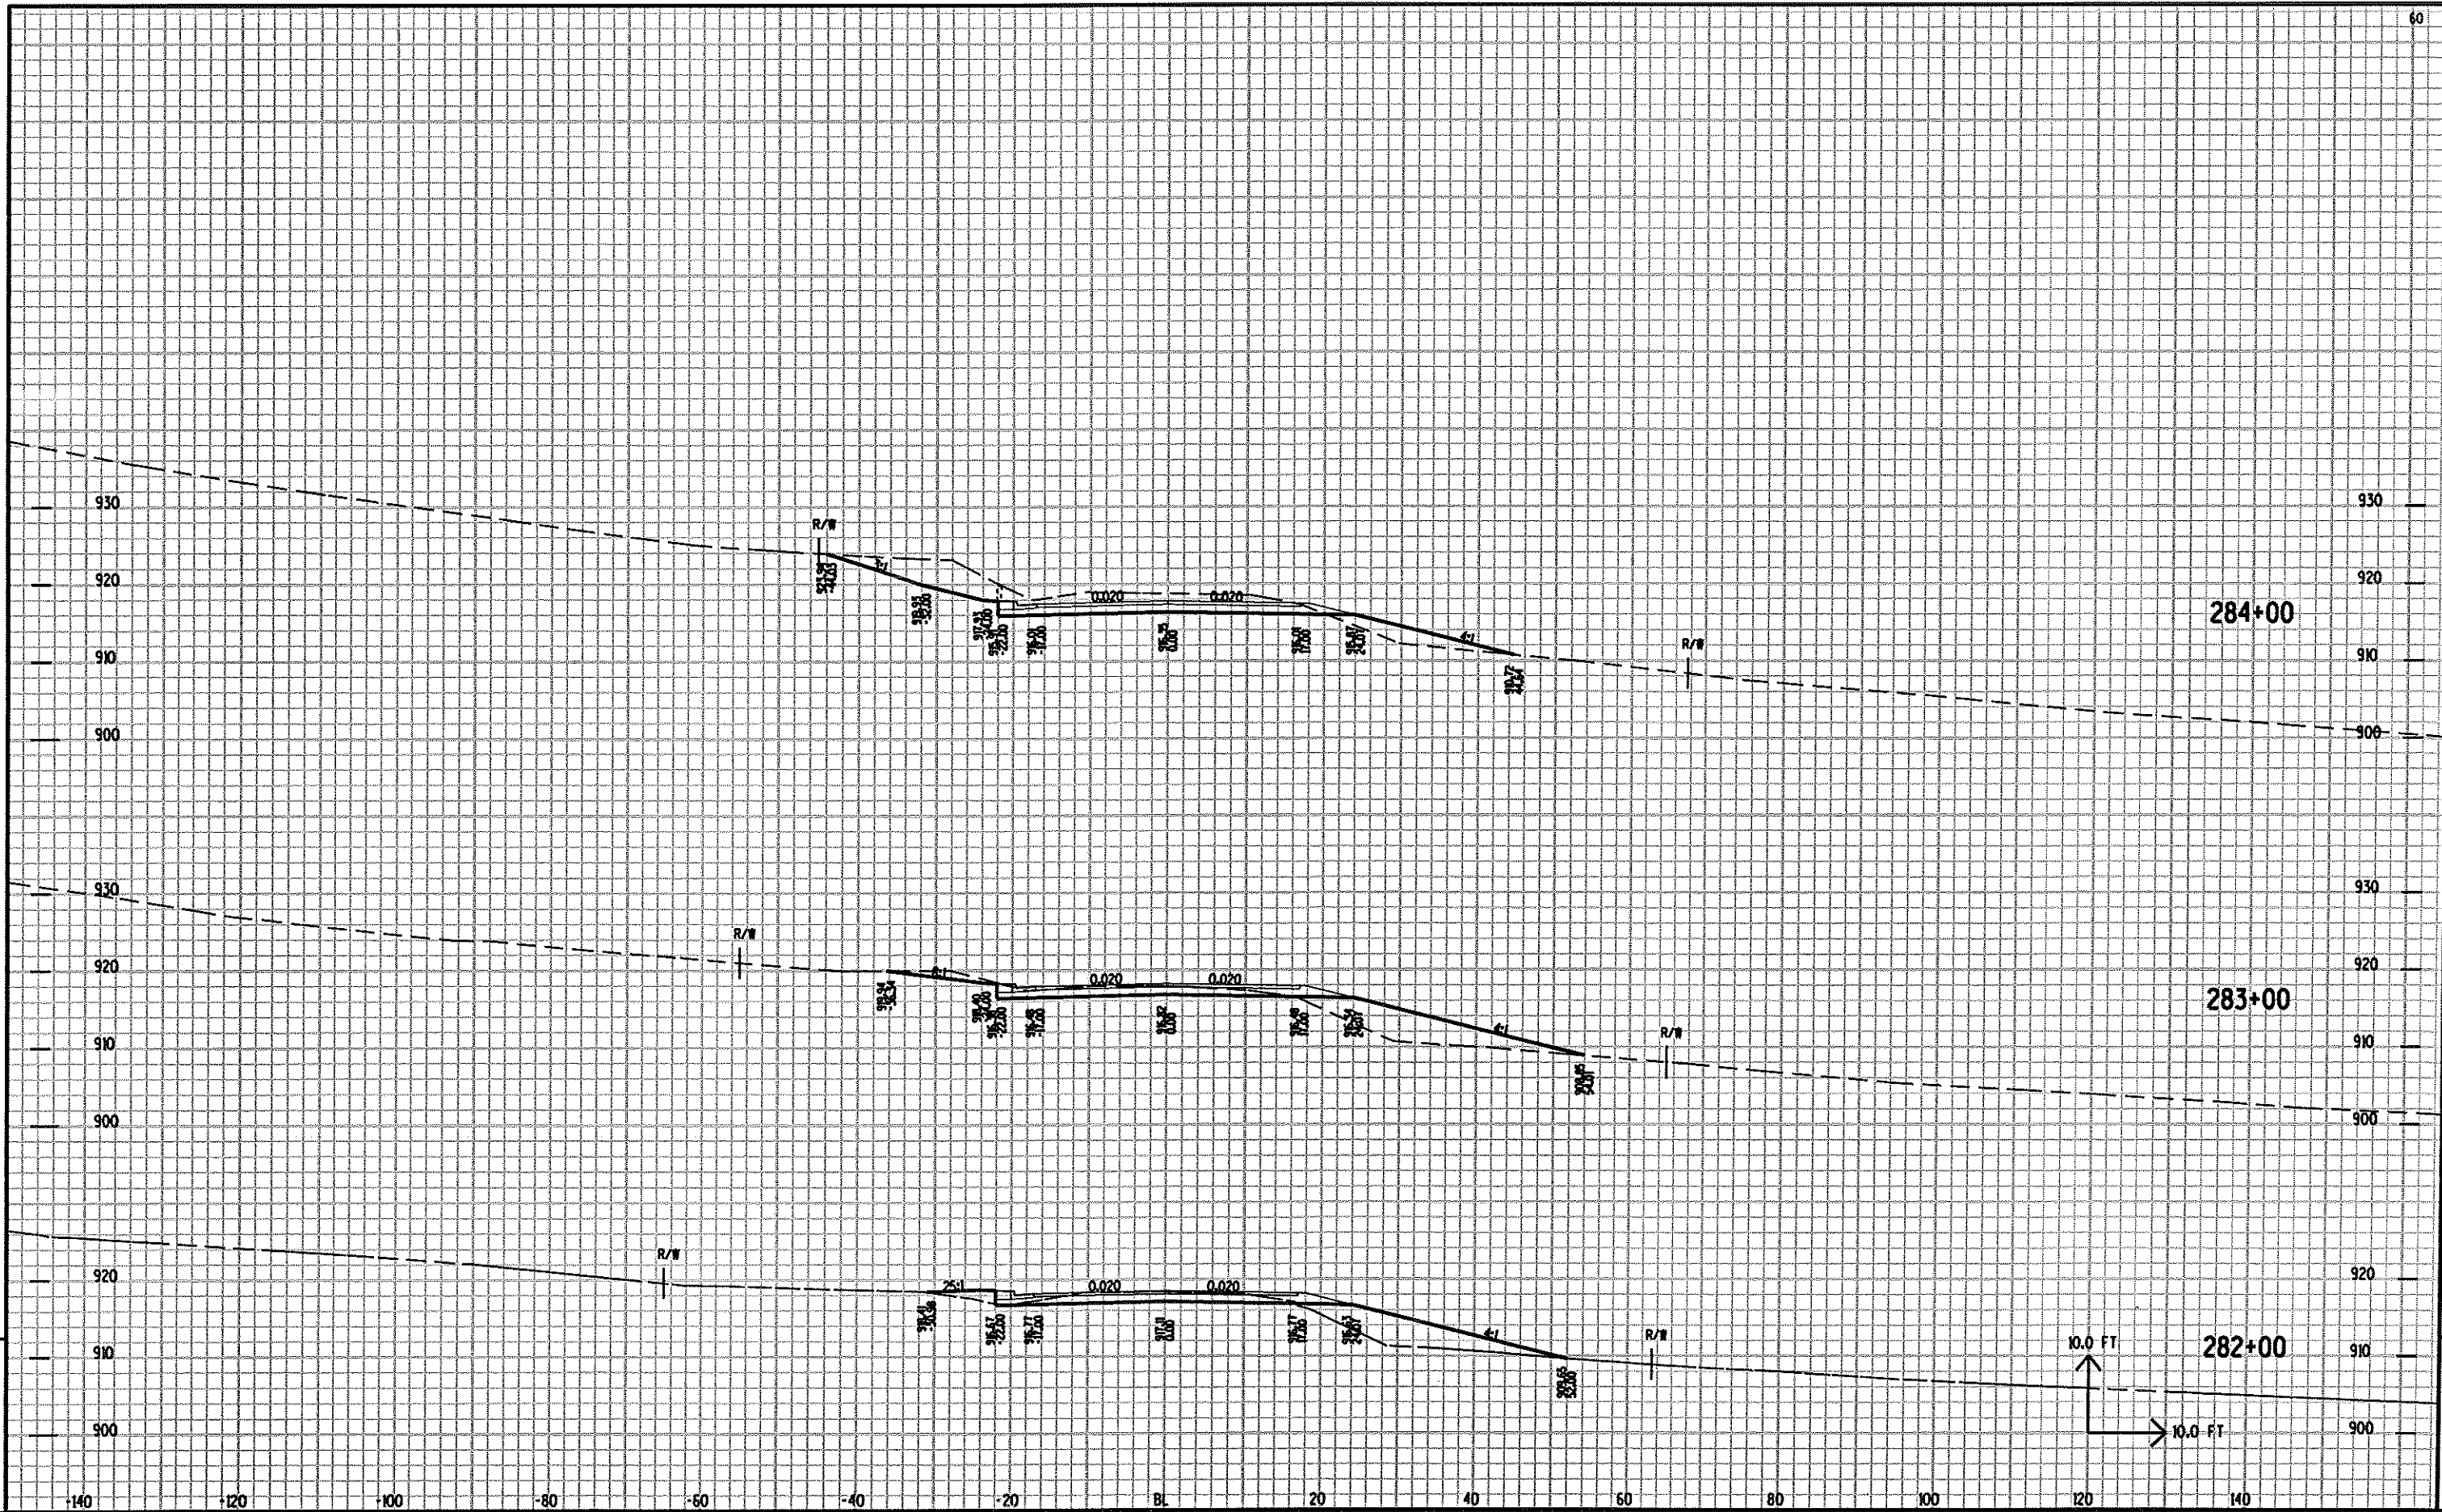


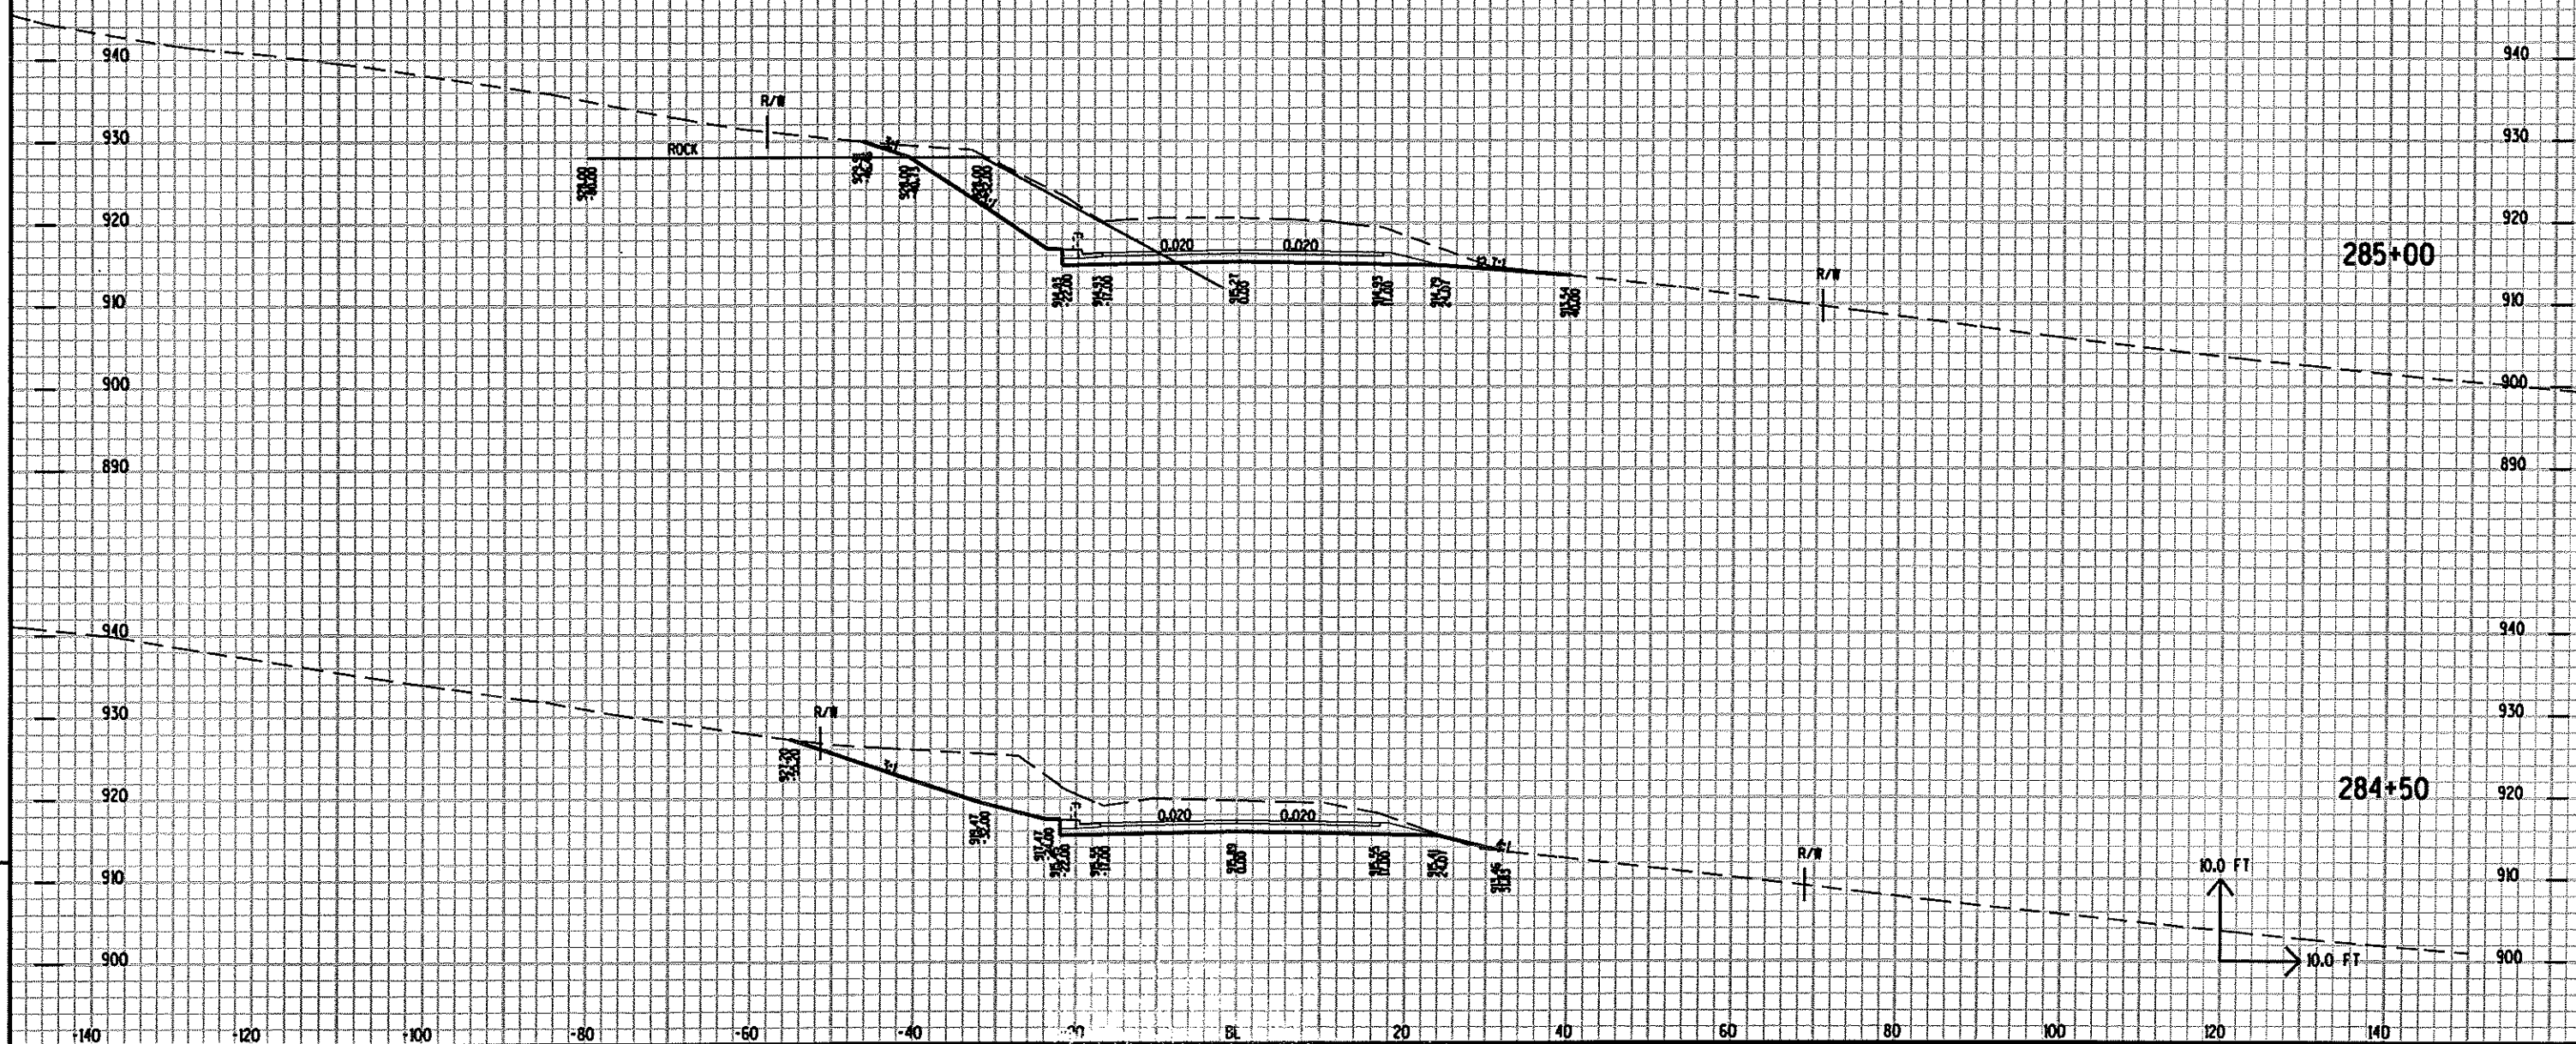


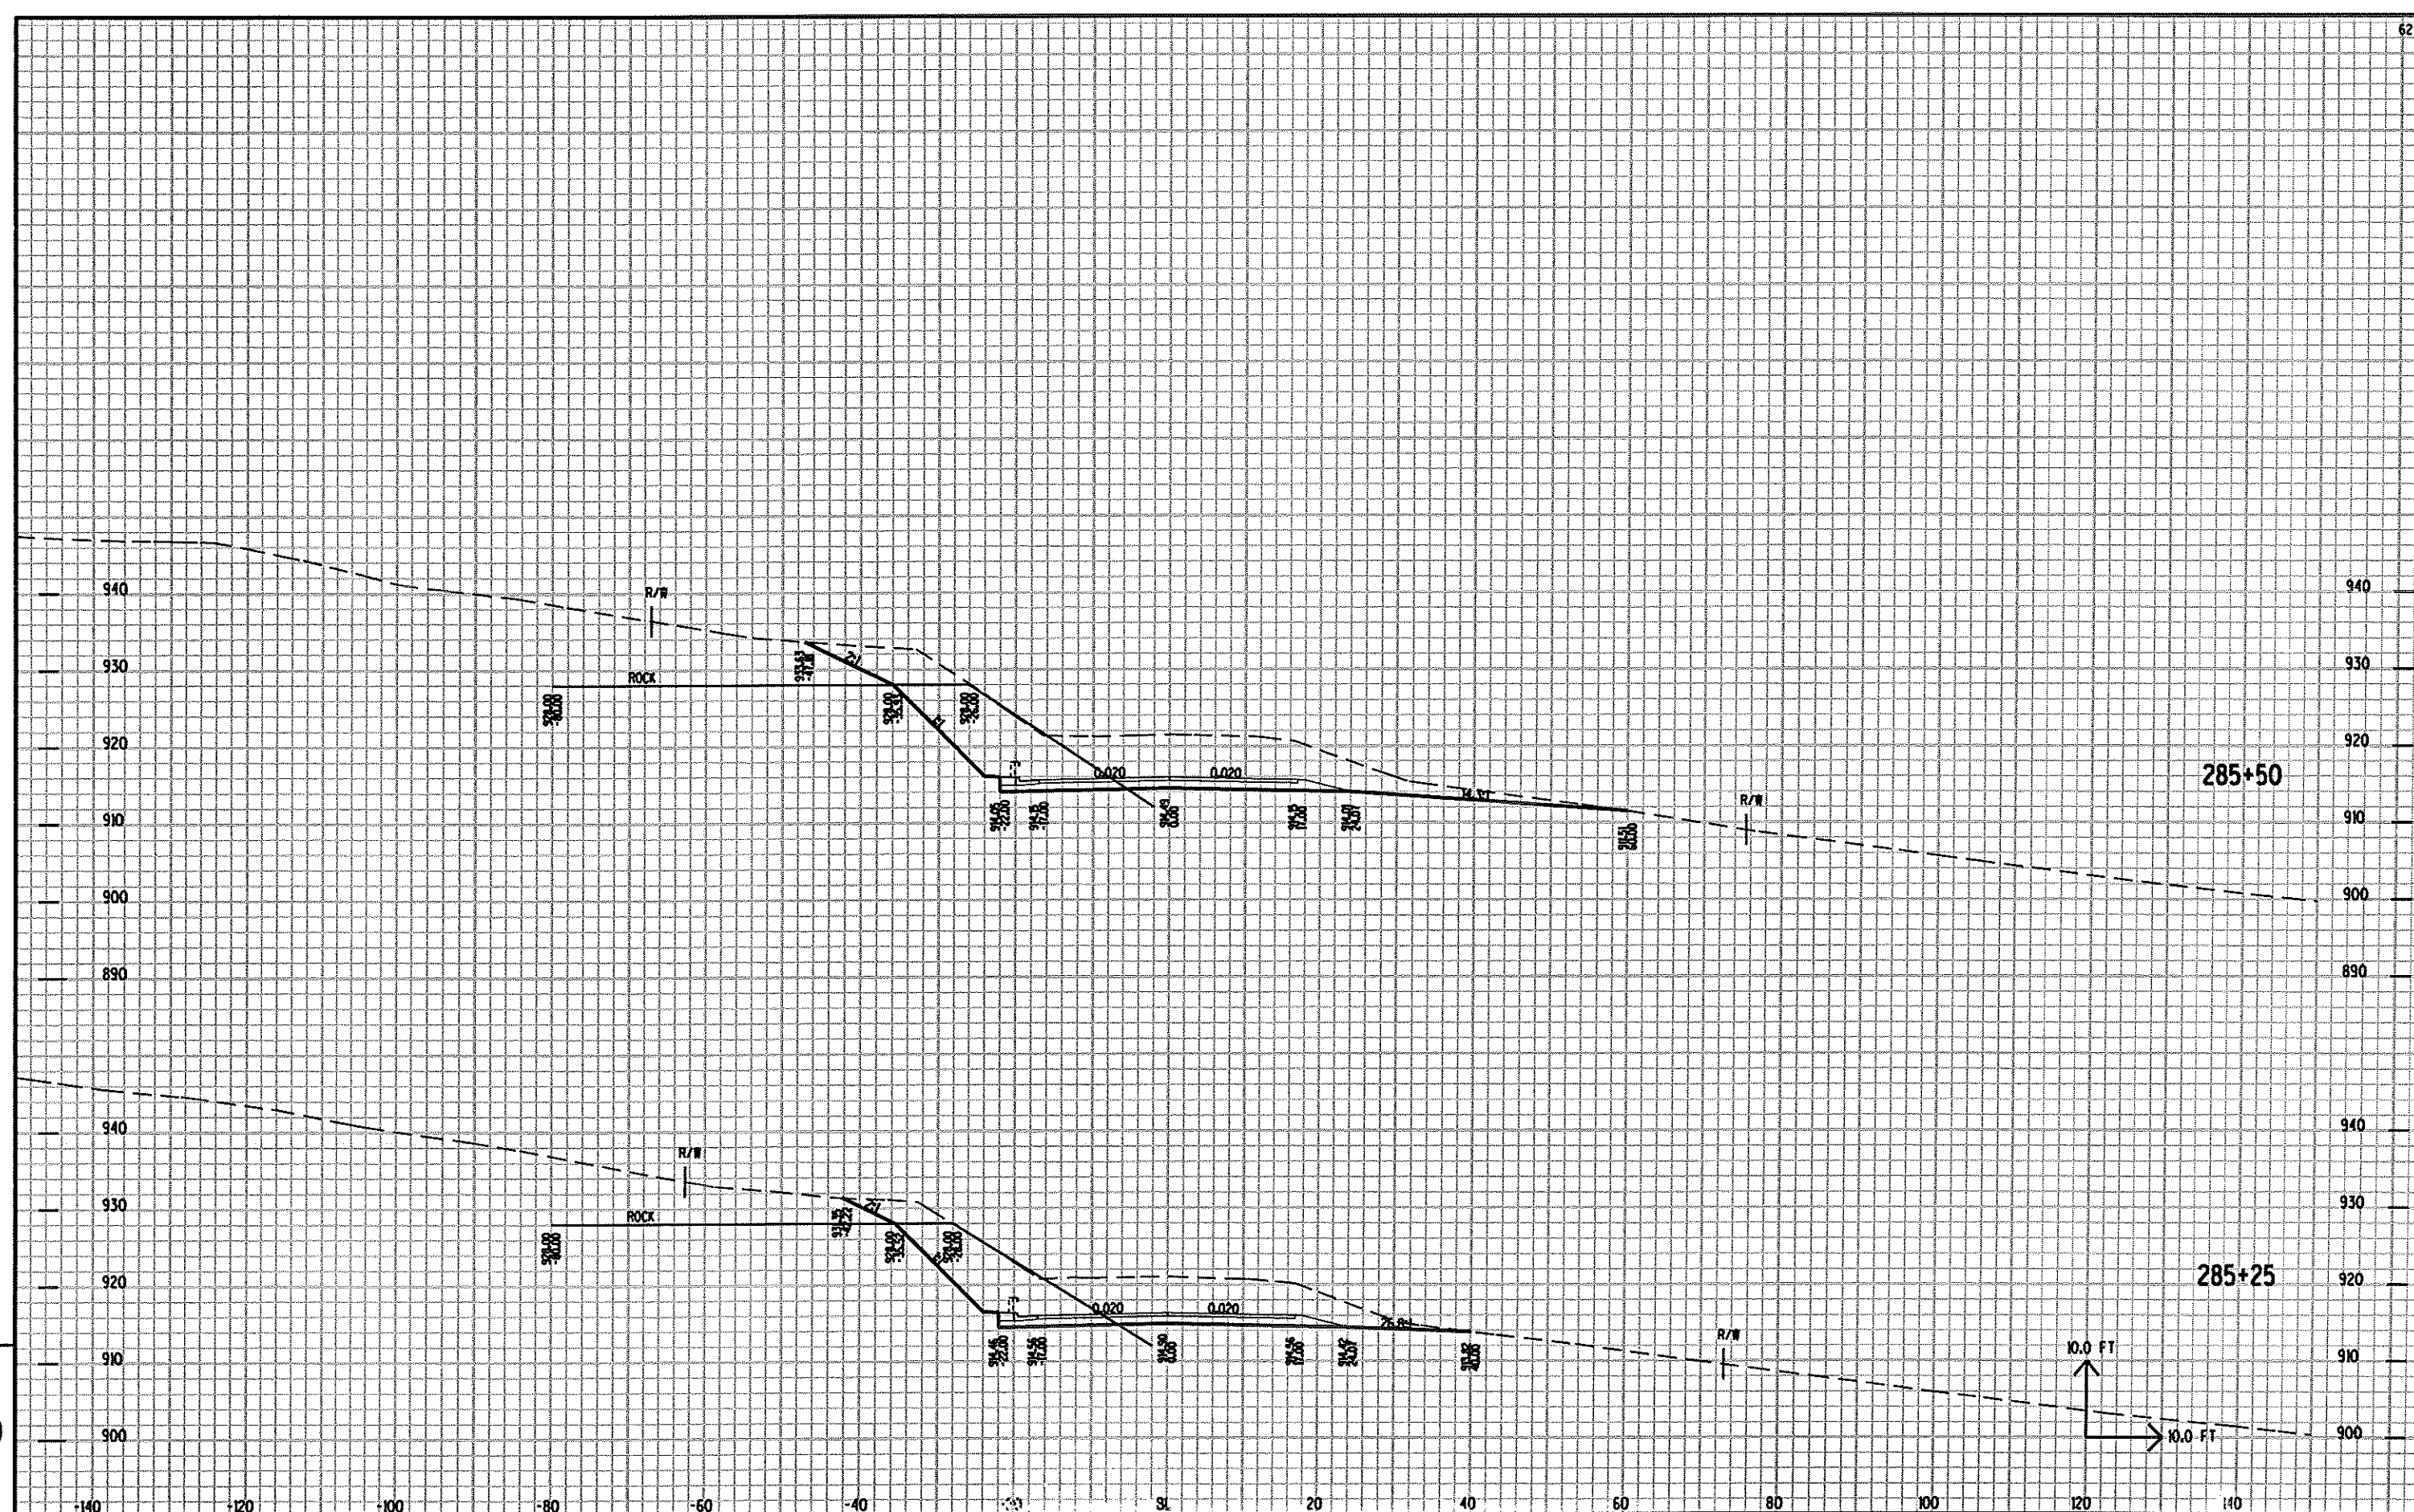



9


9

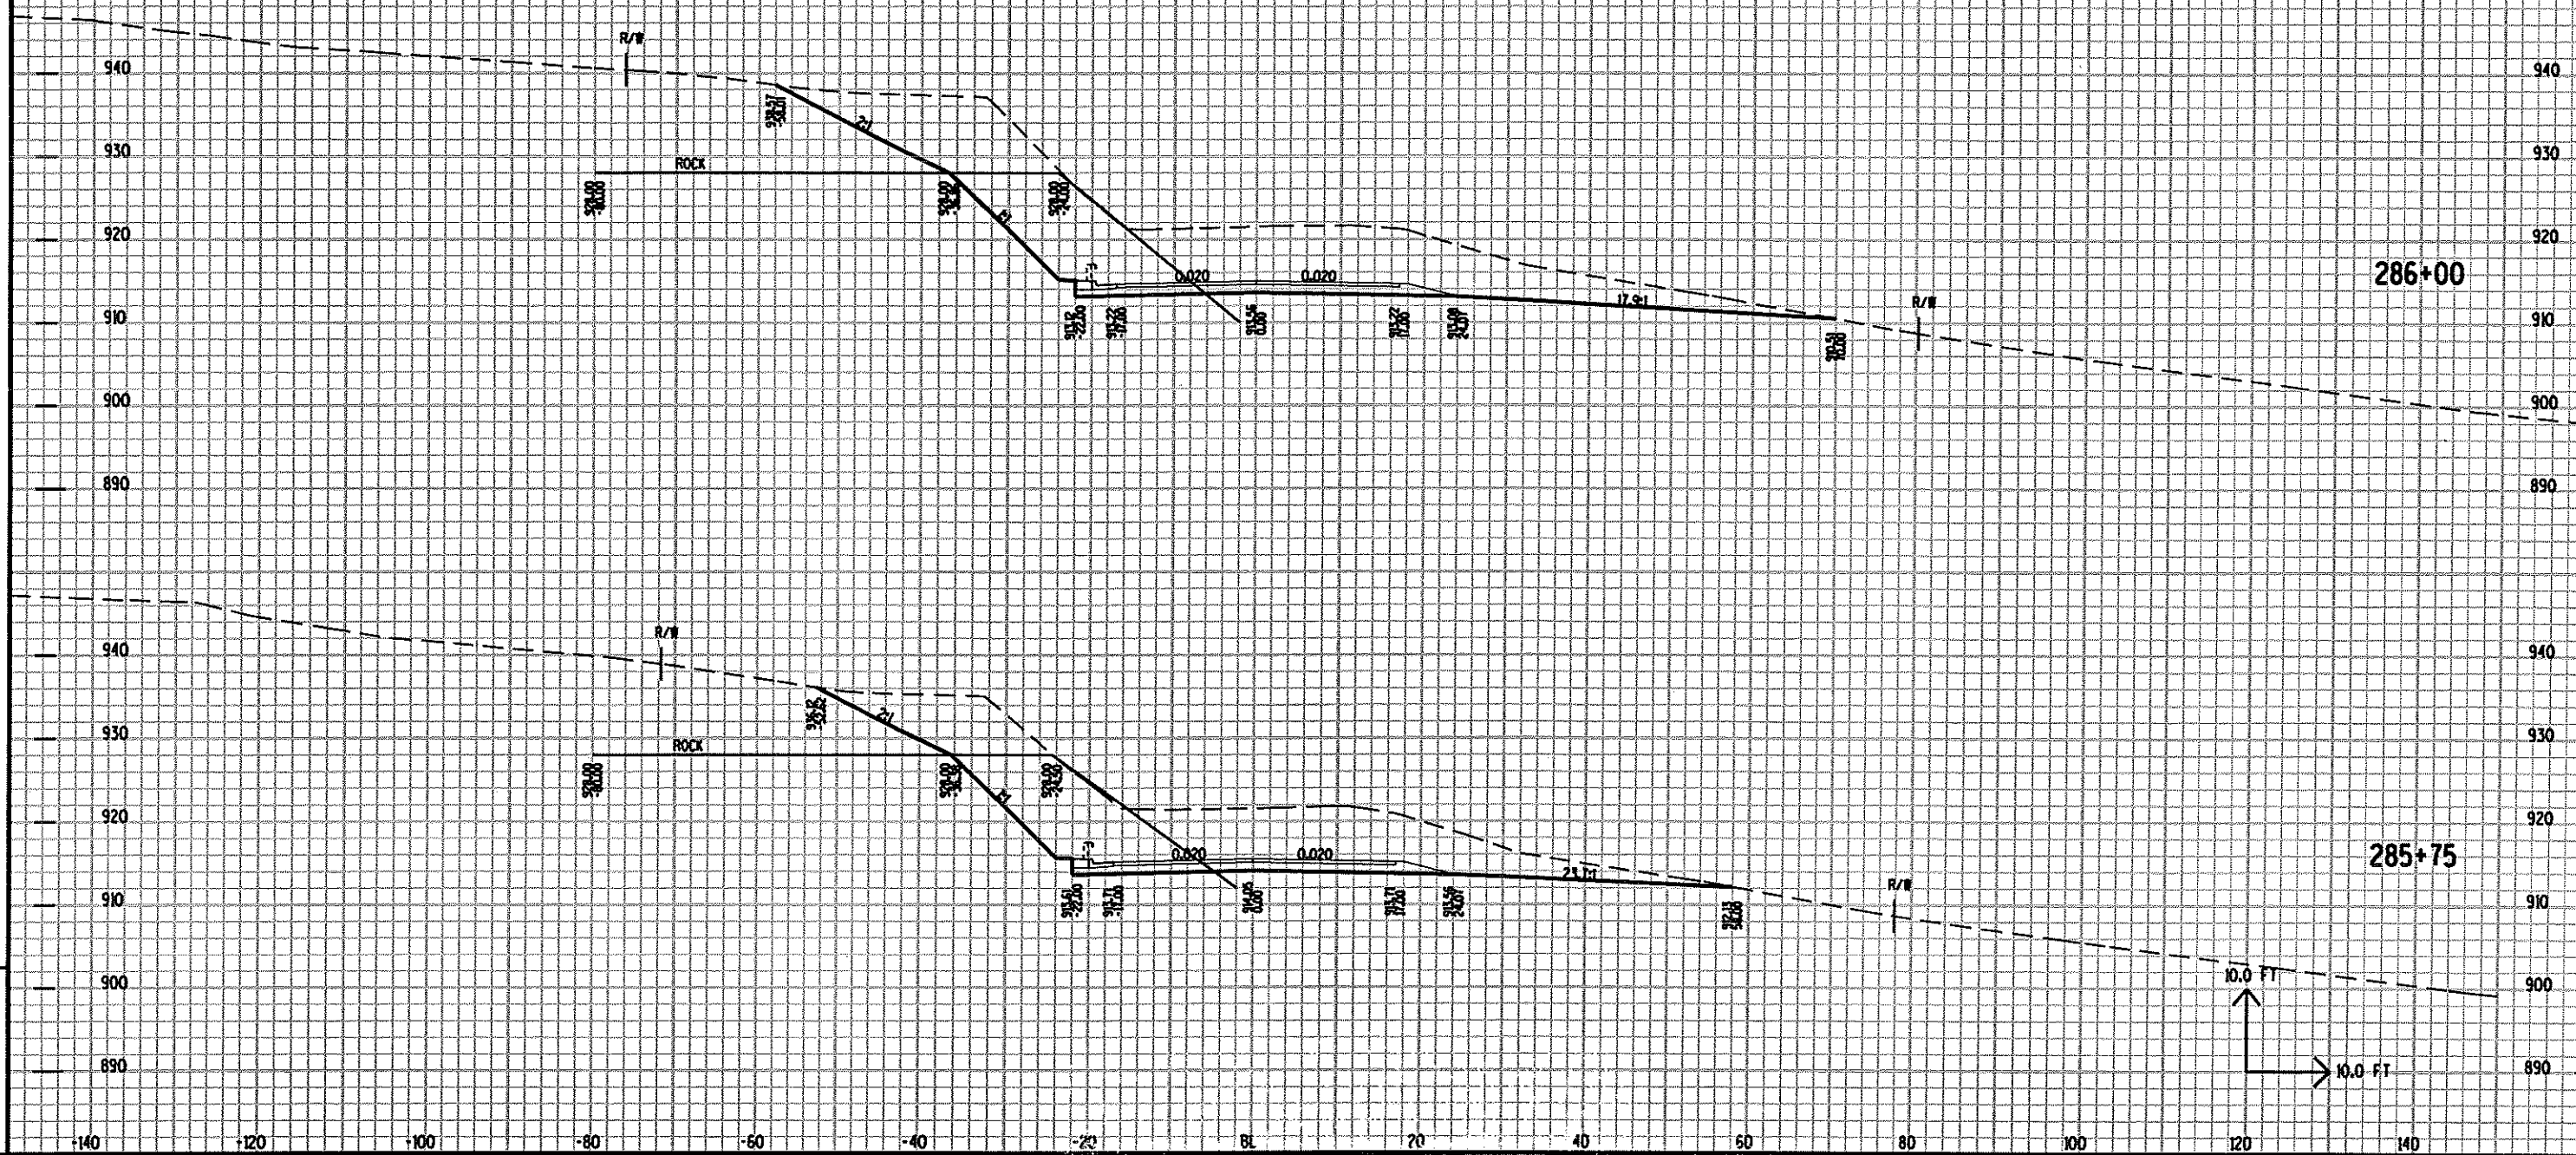

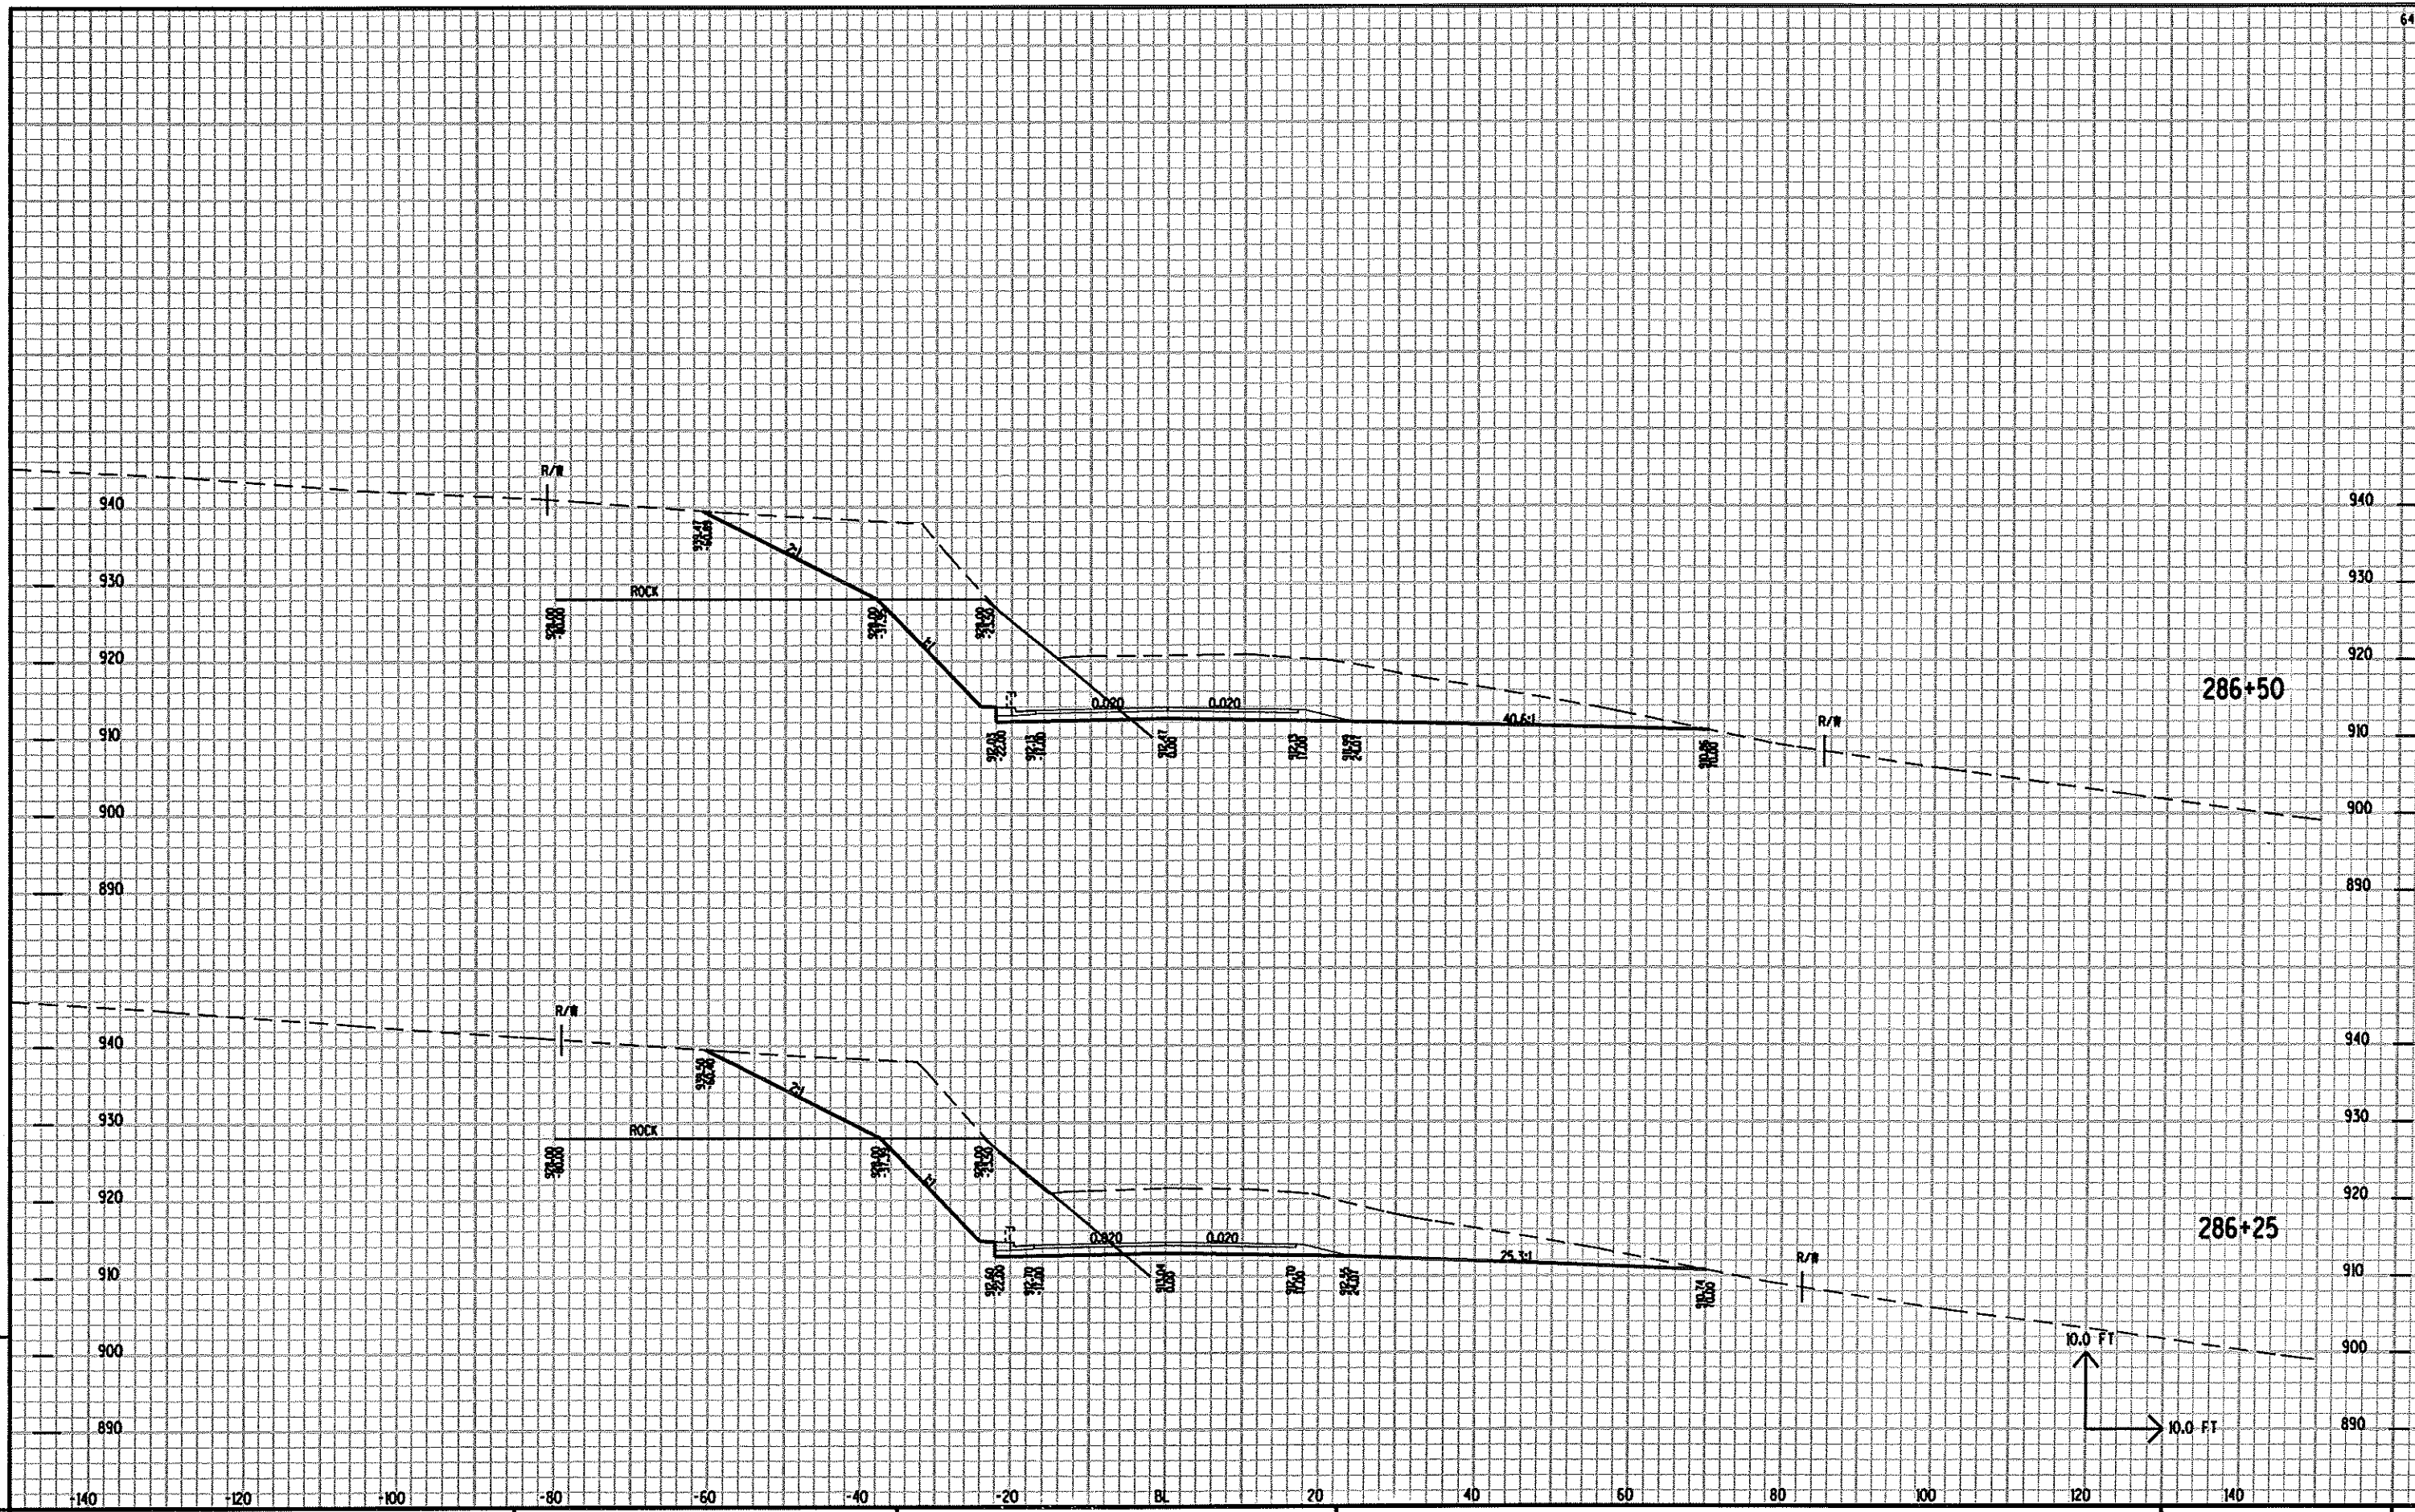

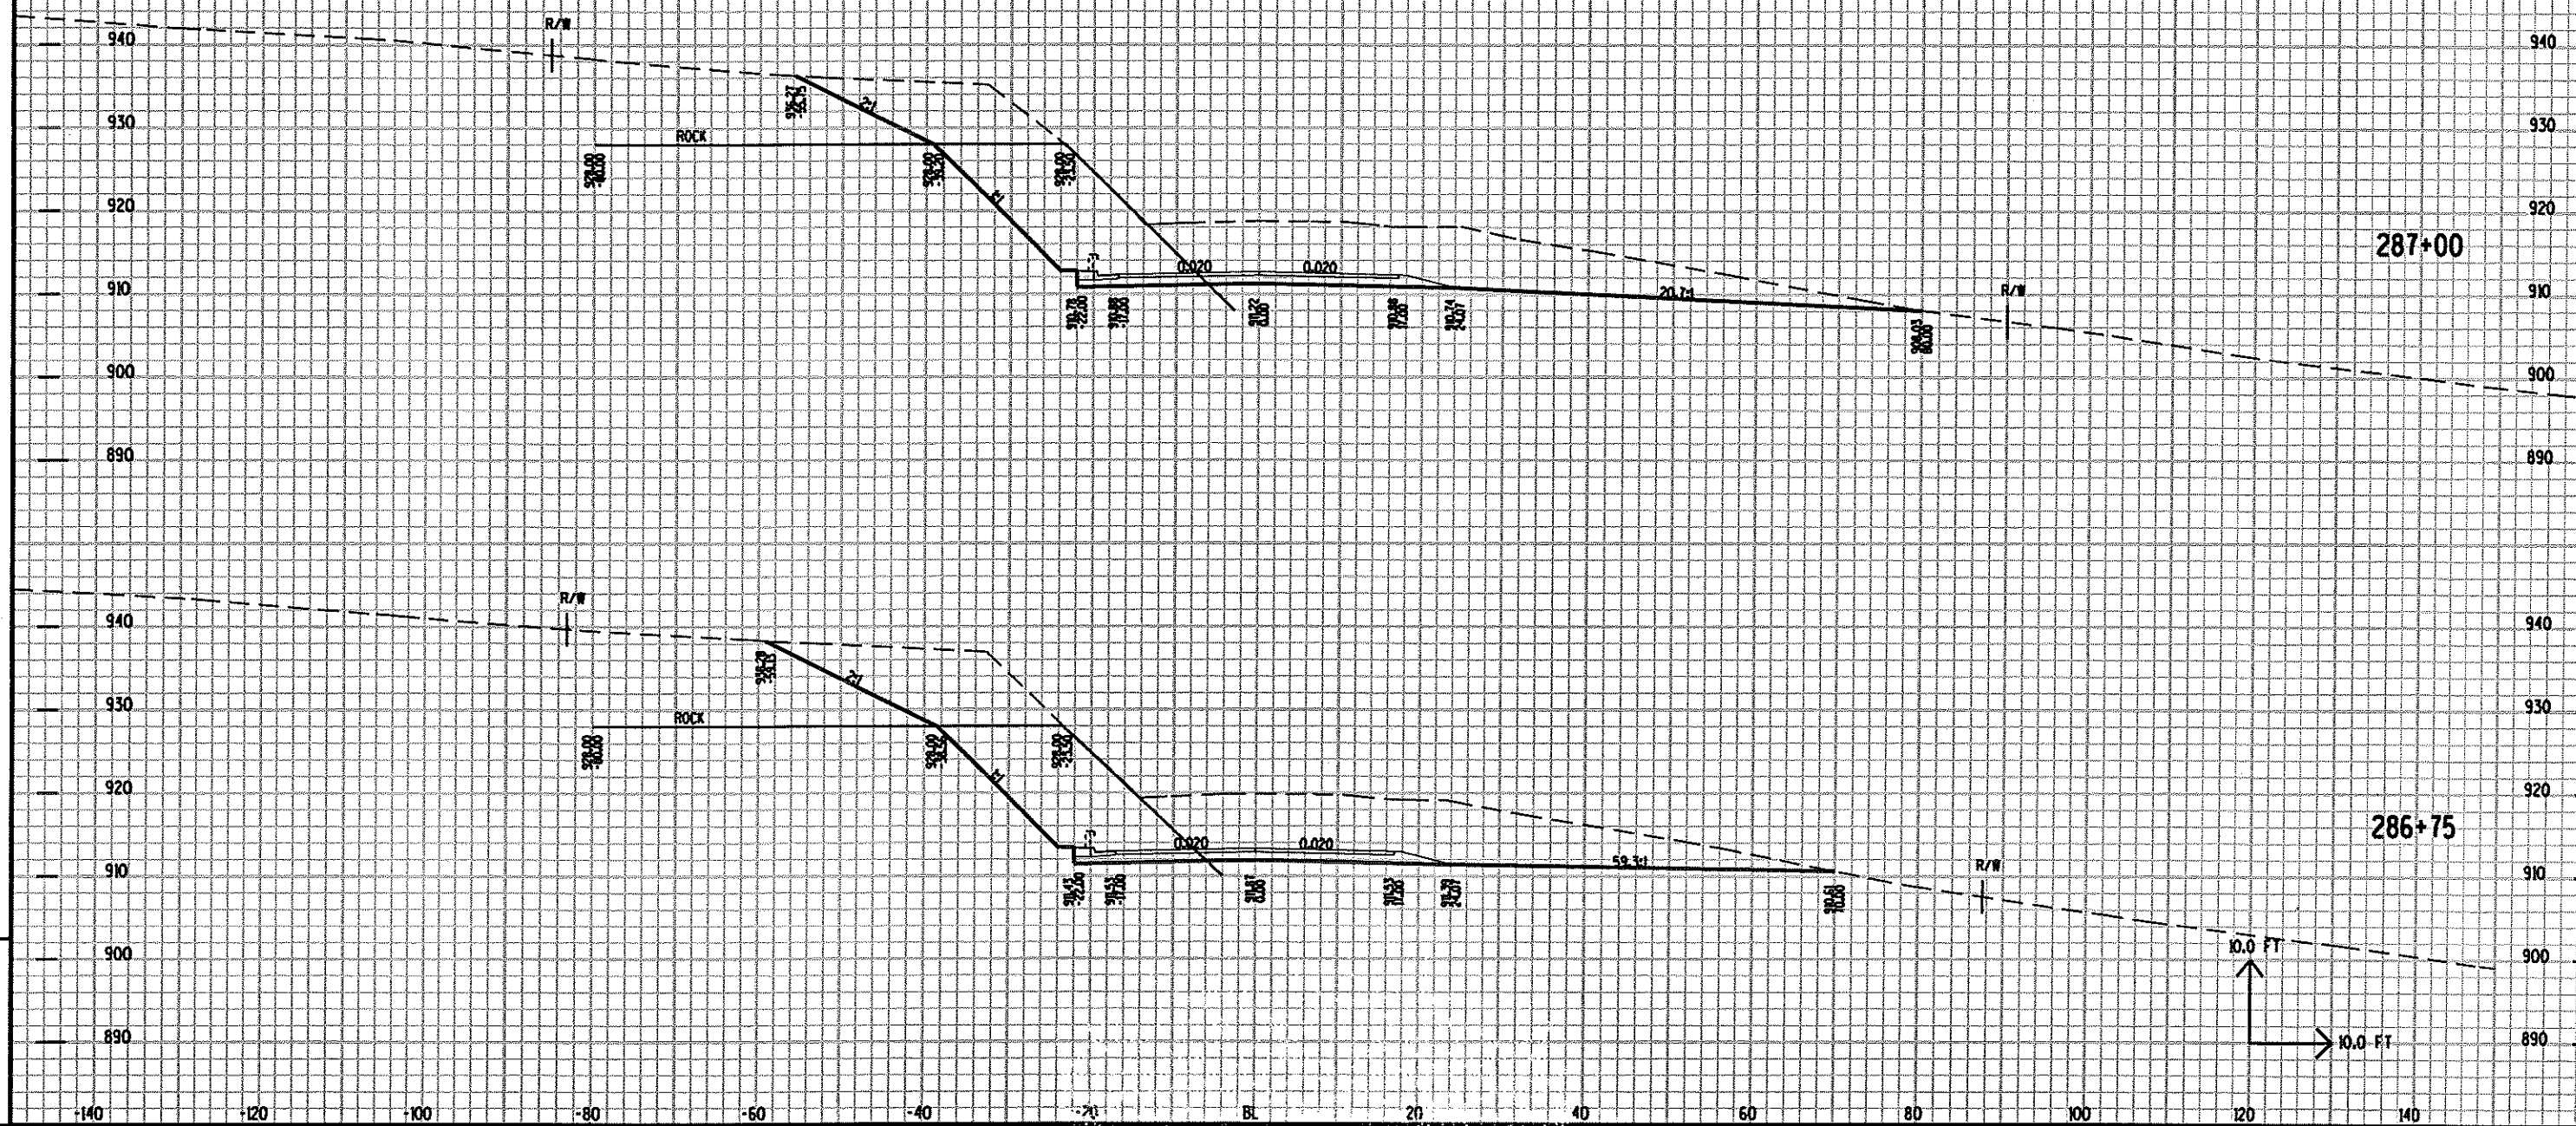


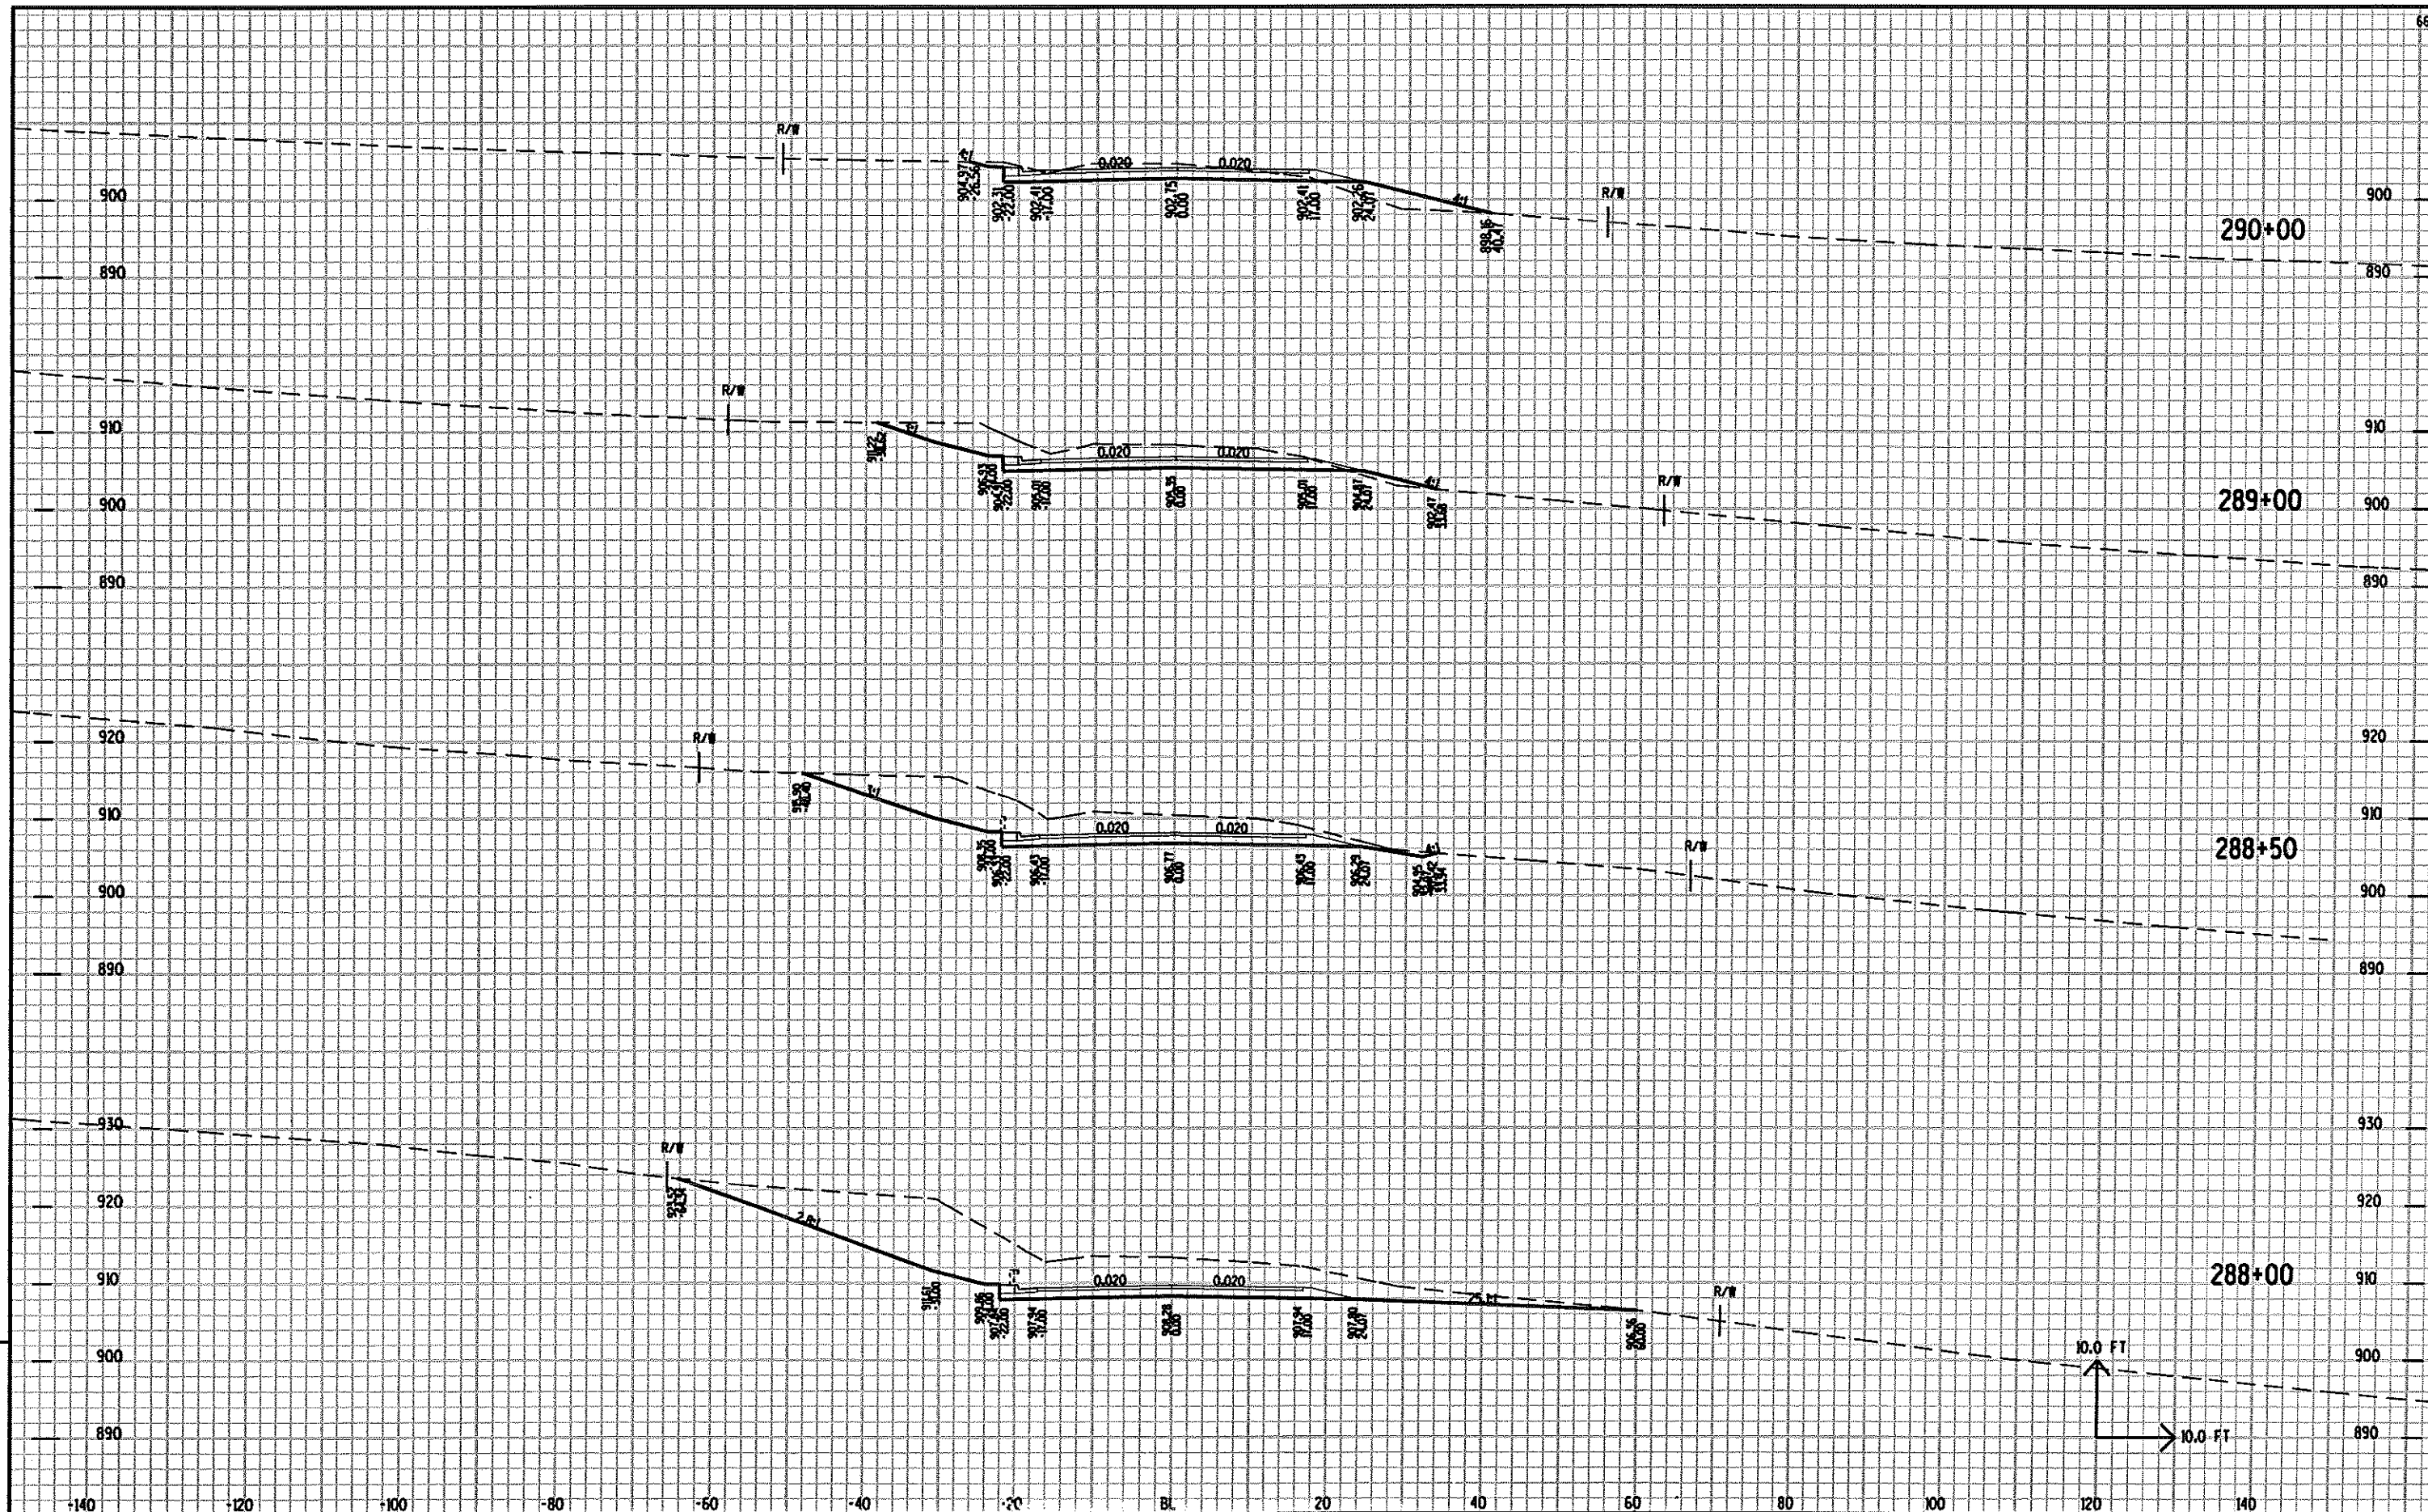


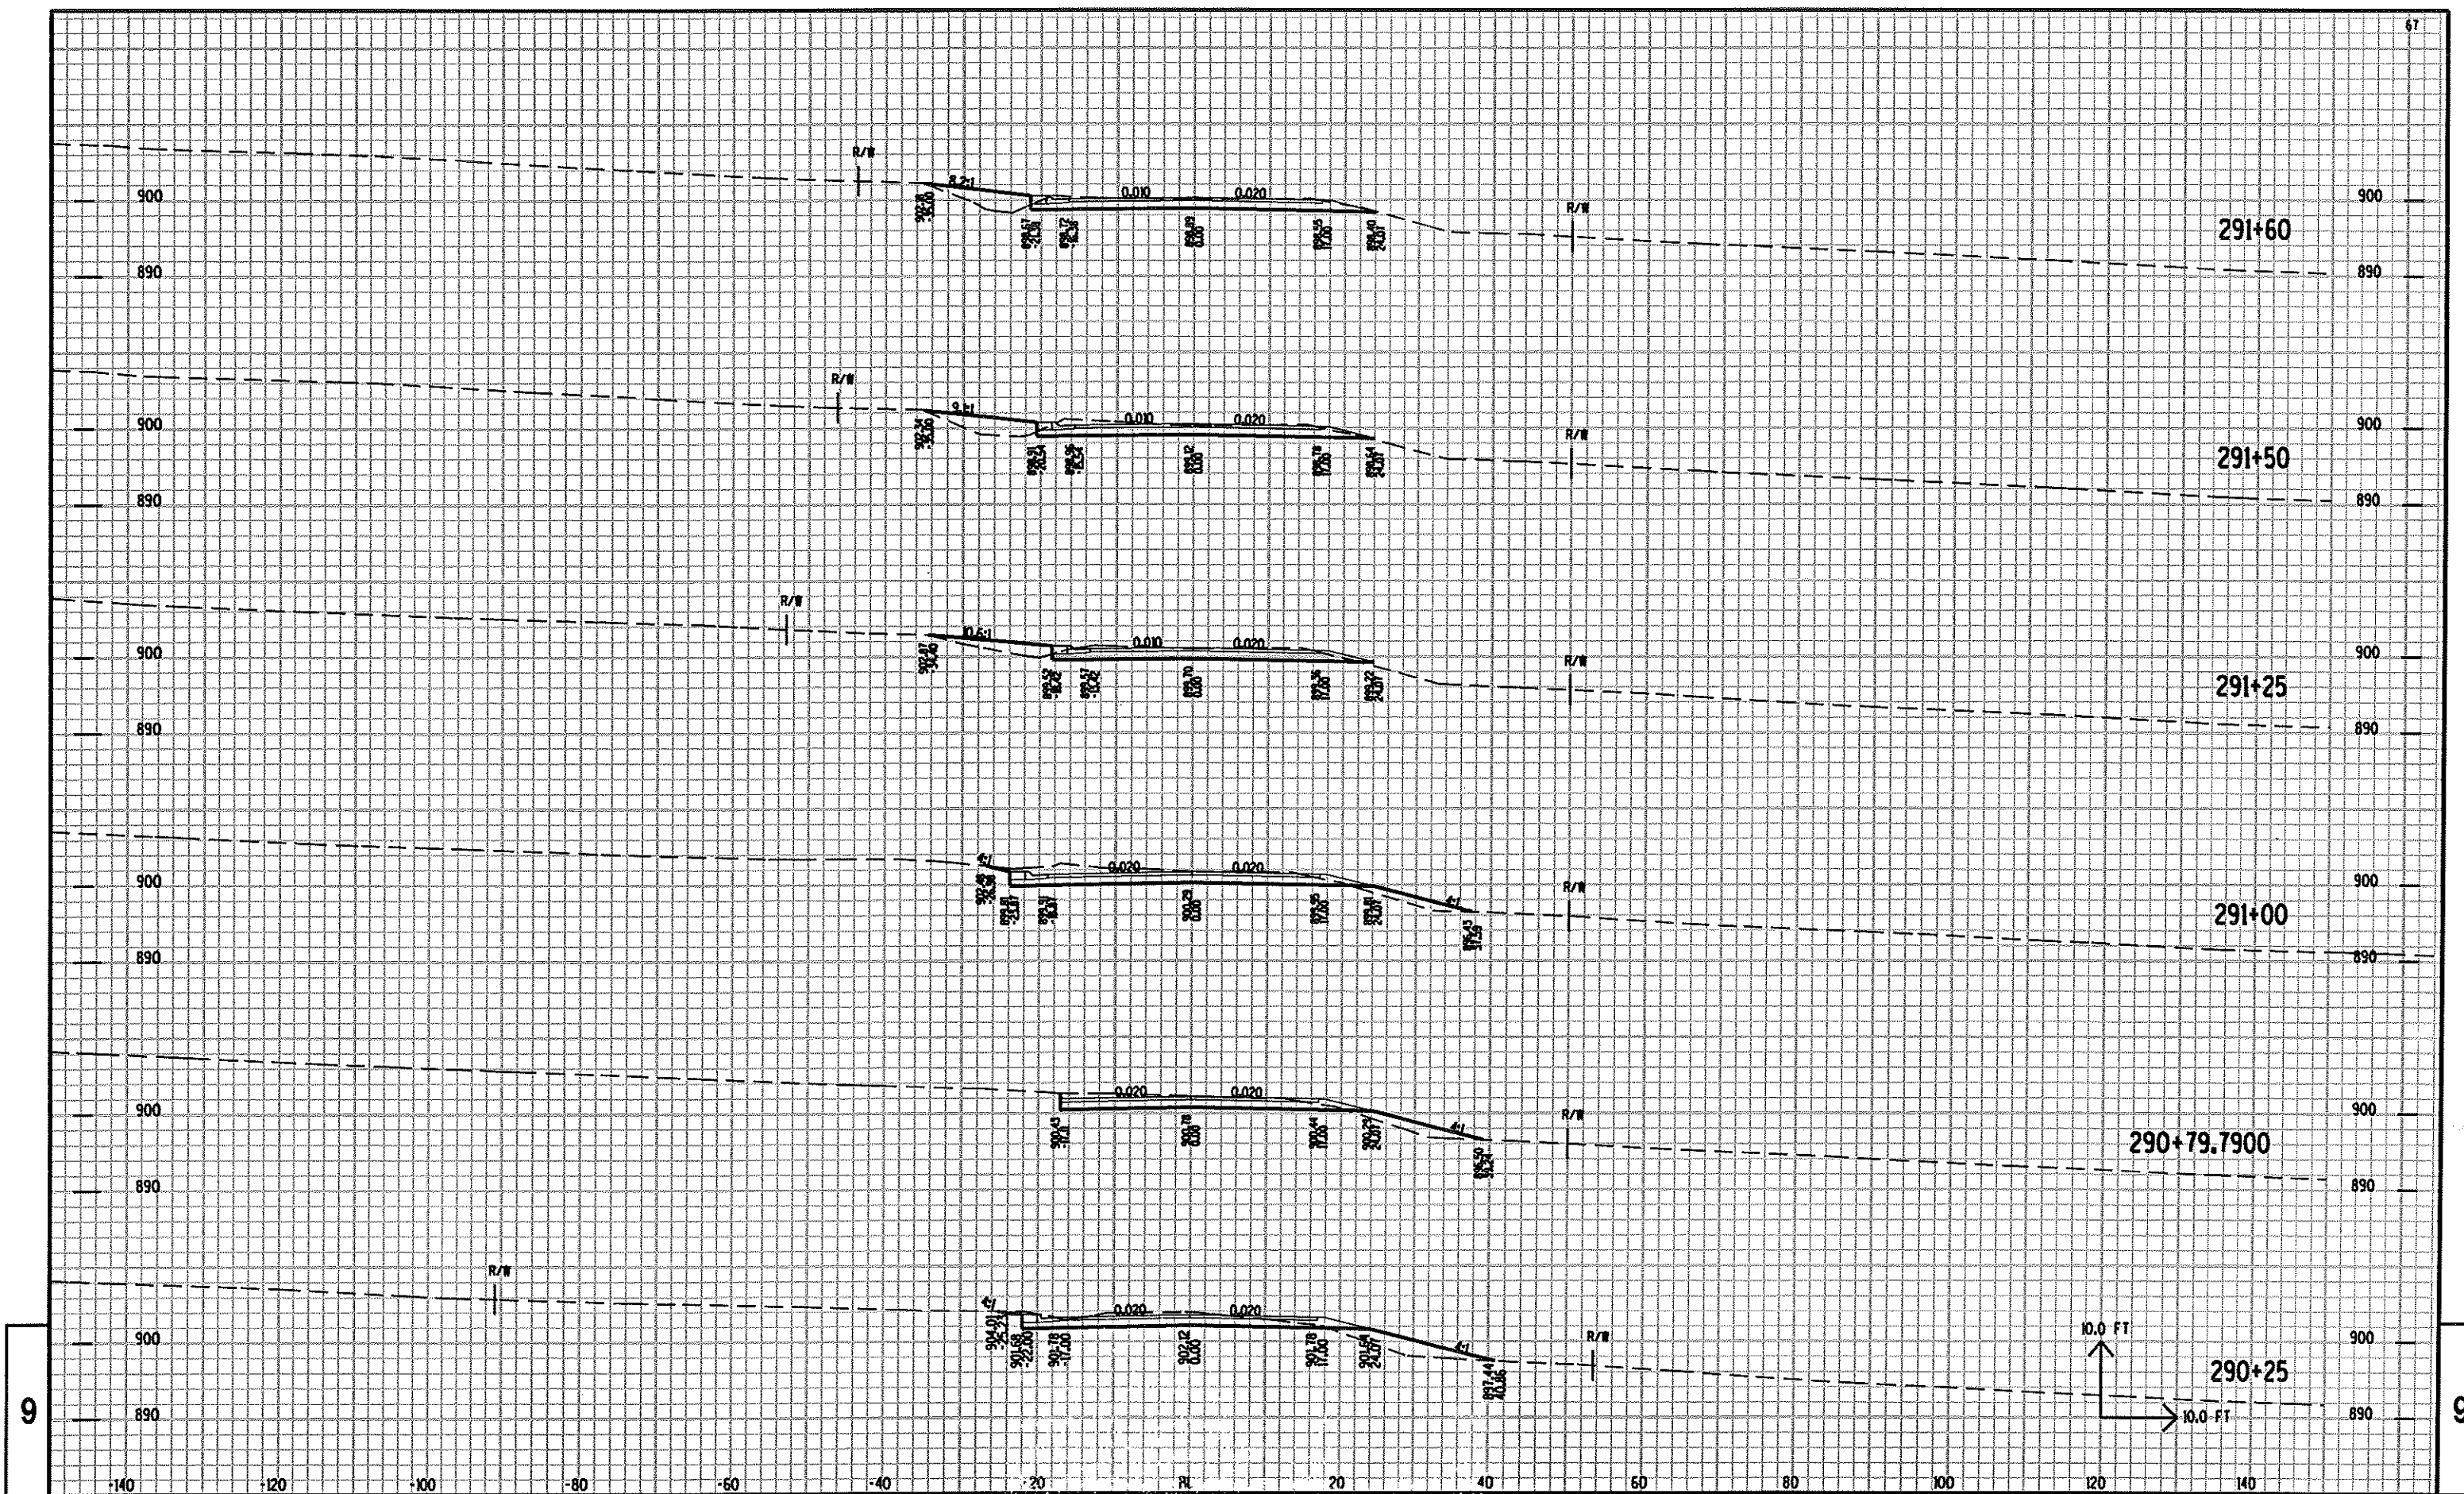



9


9

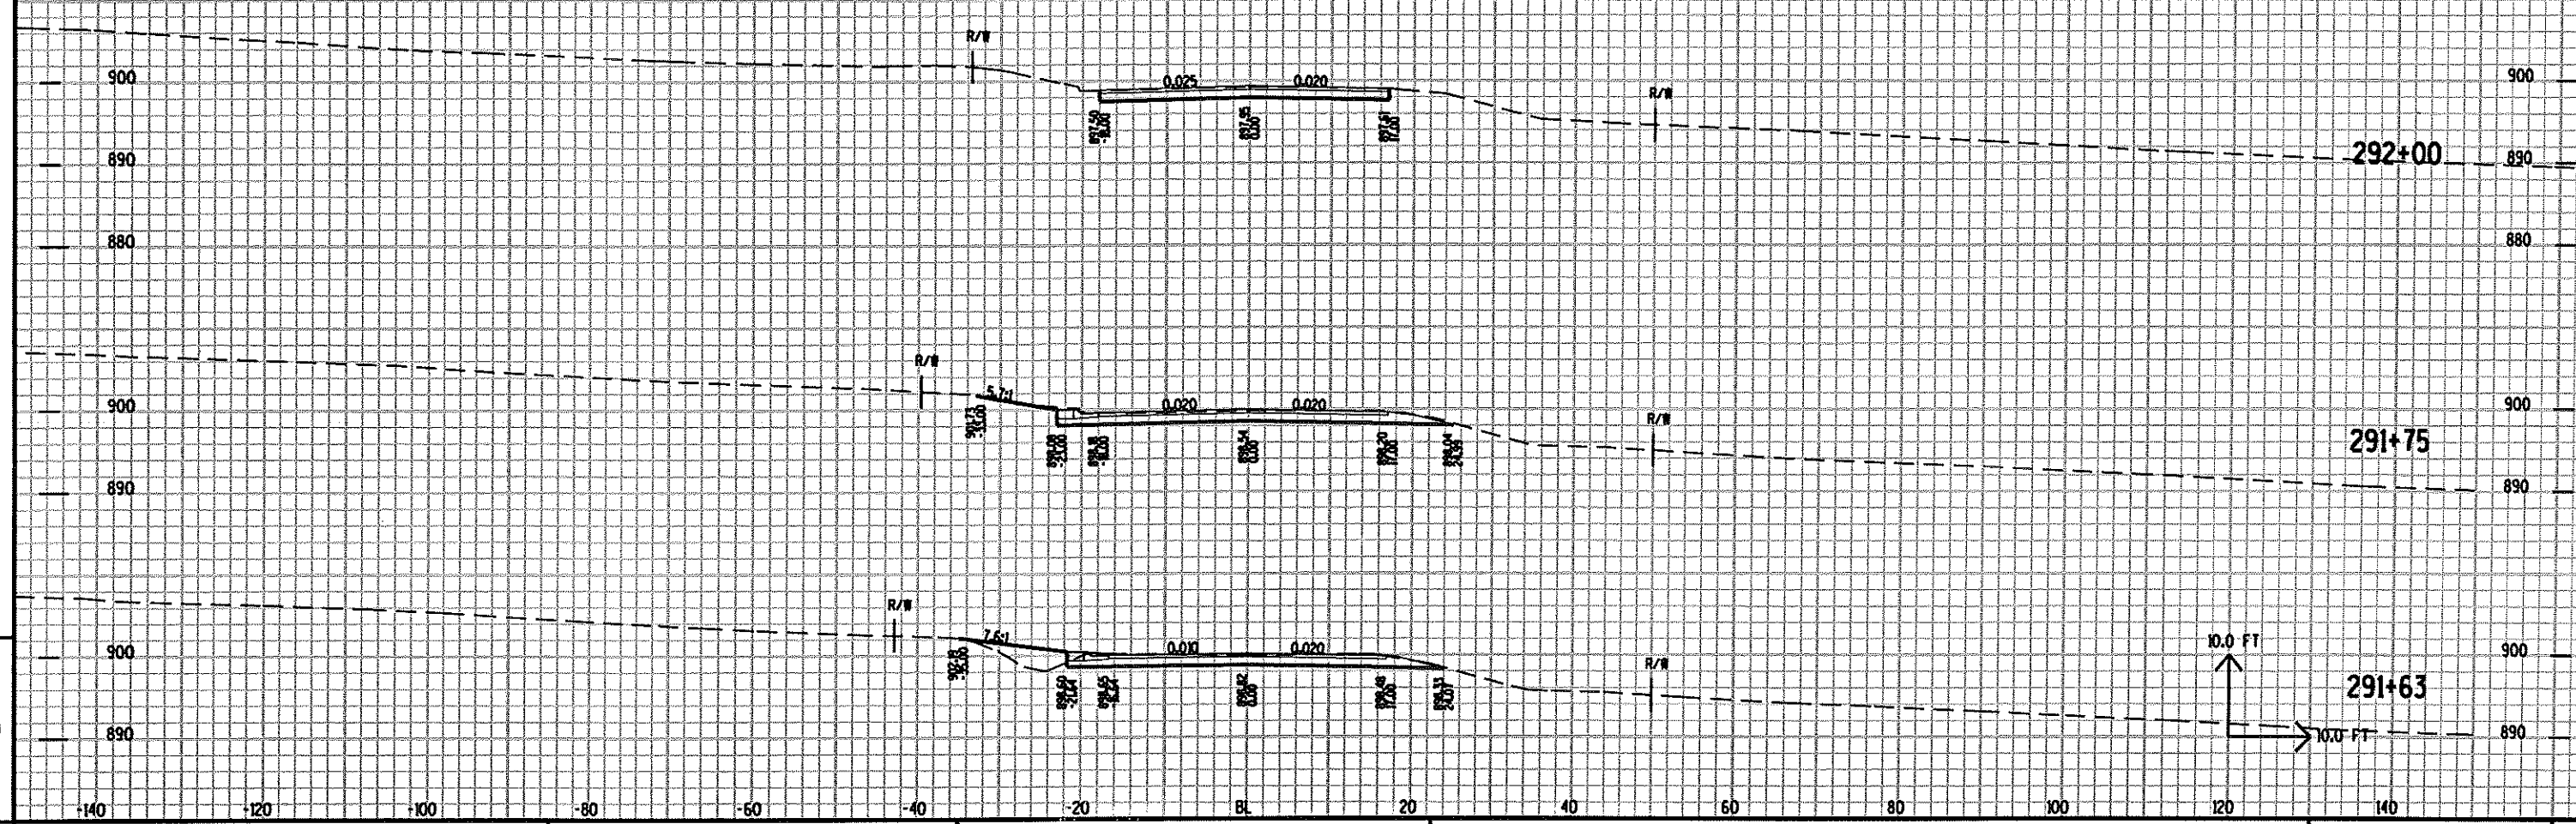


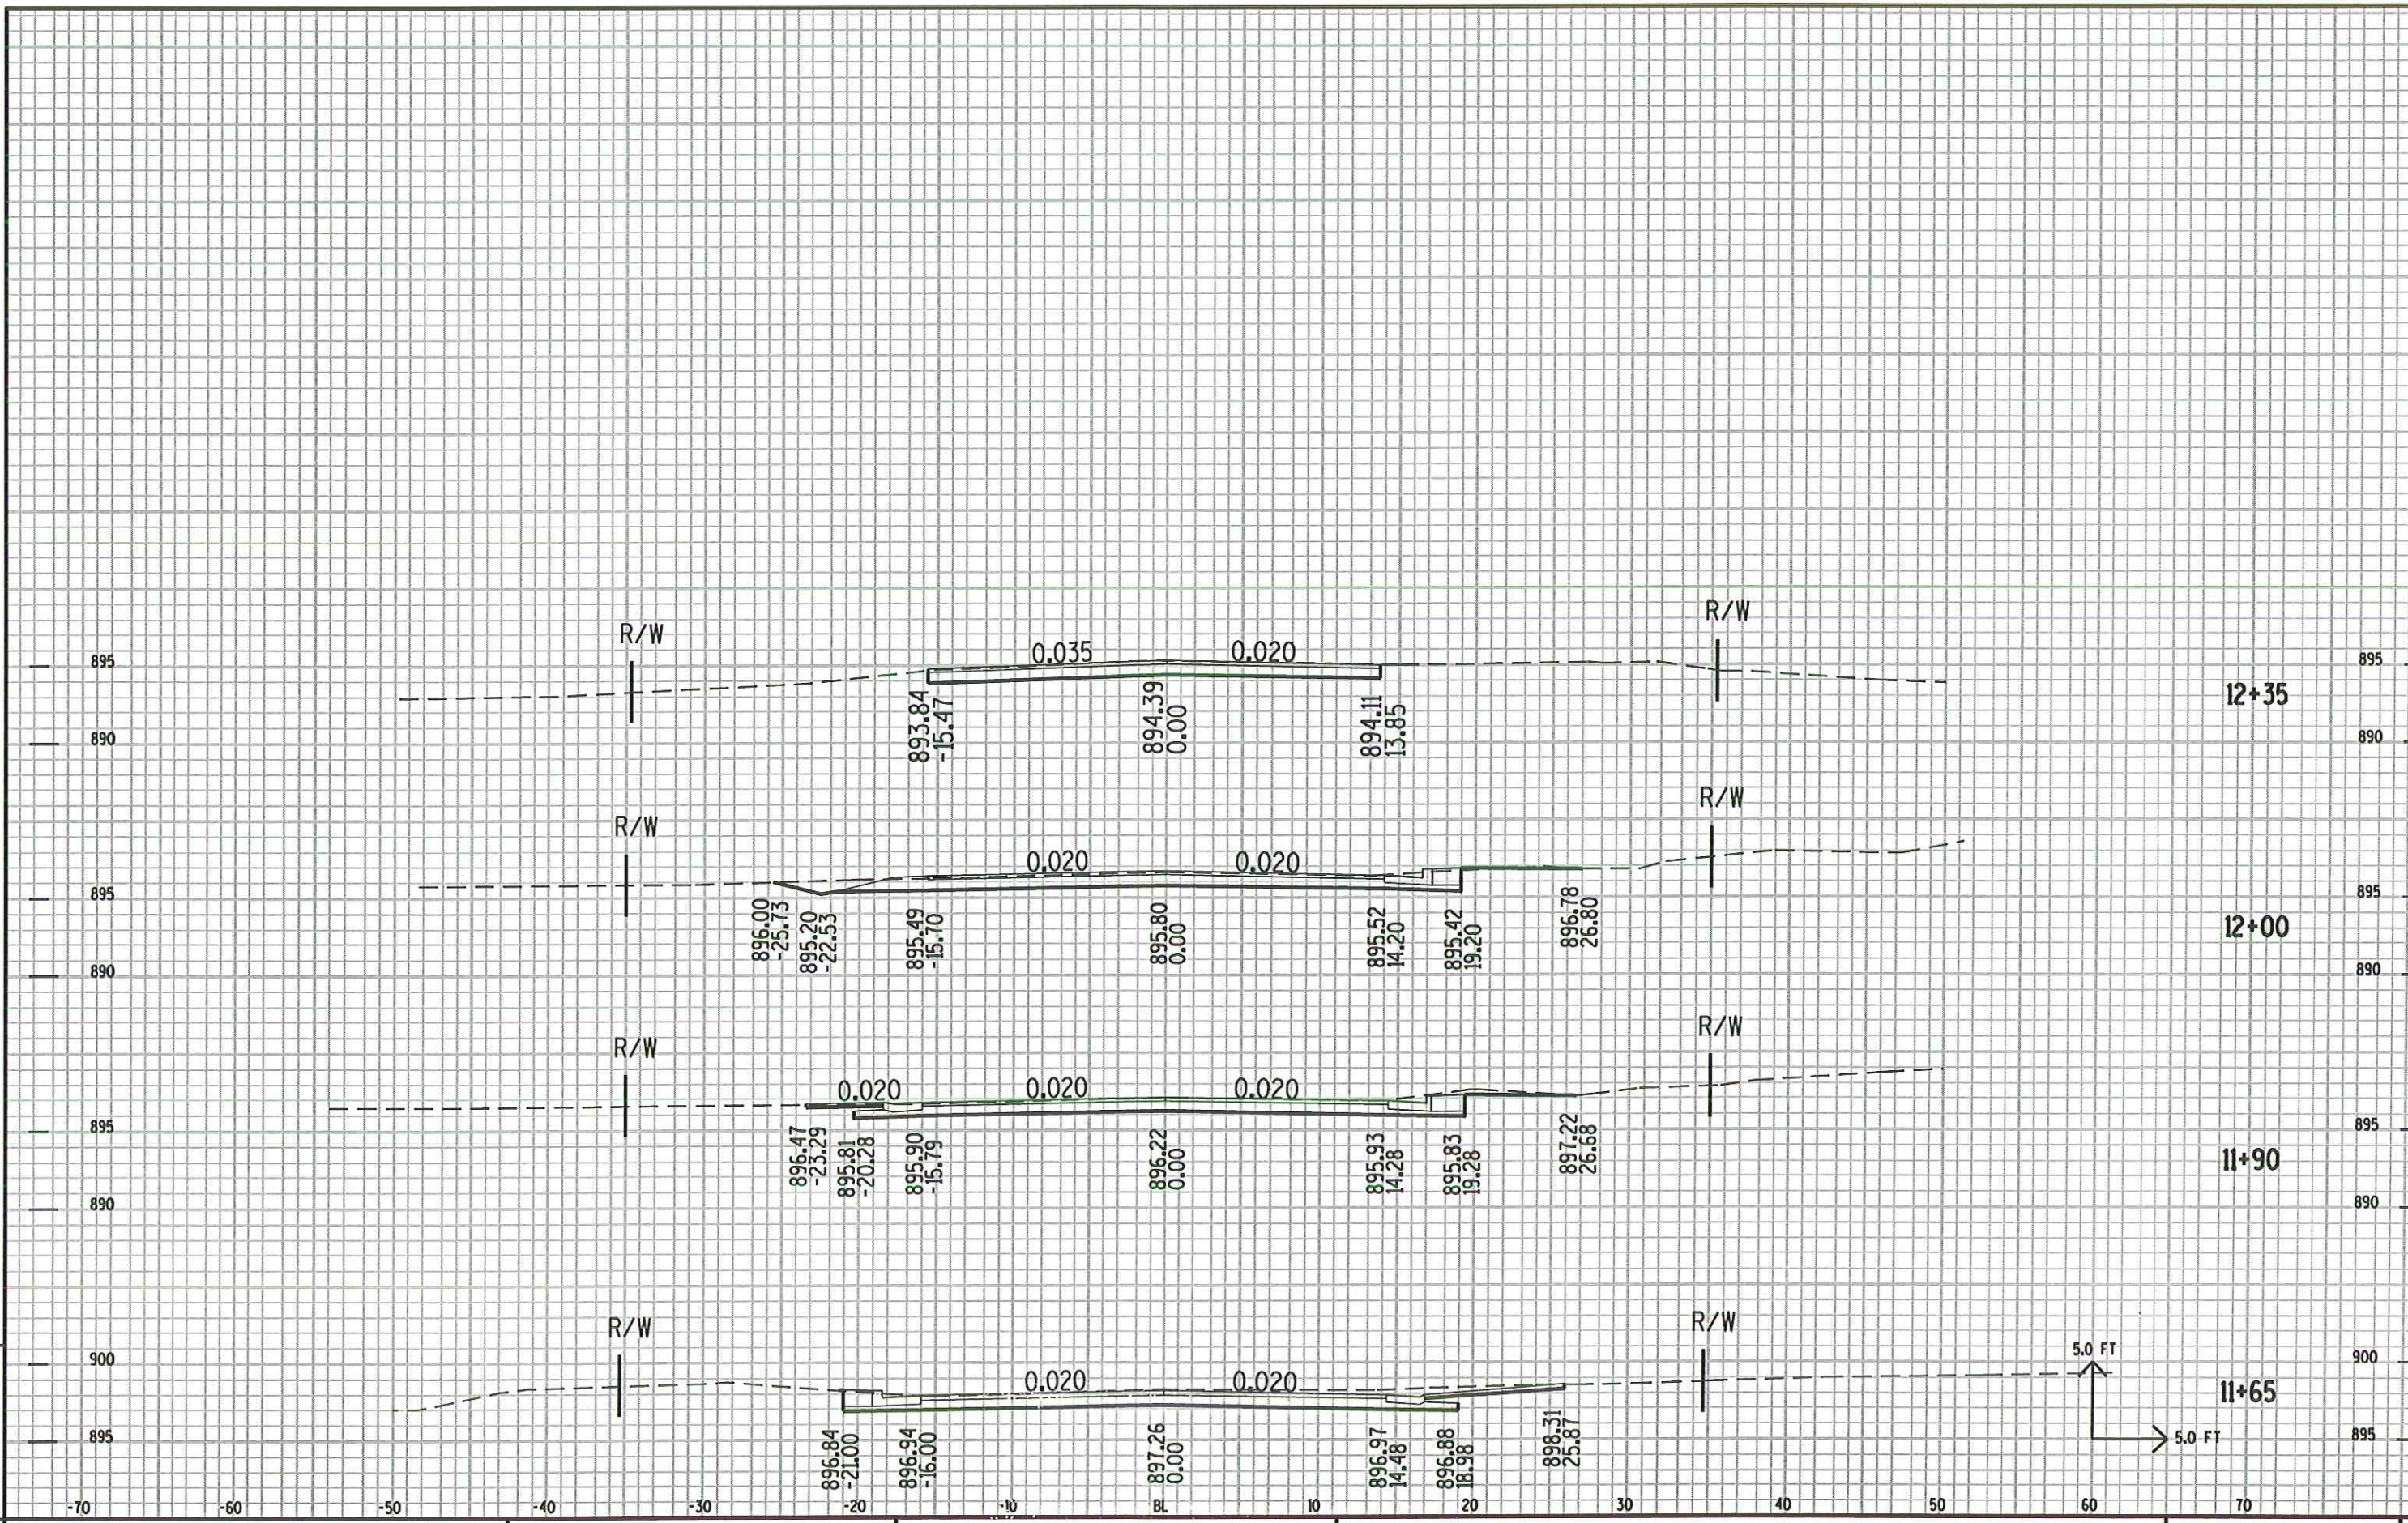


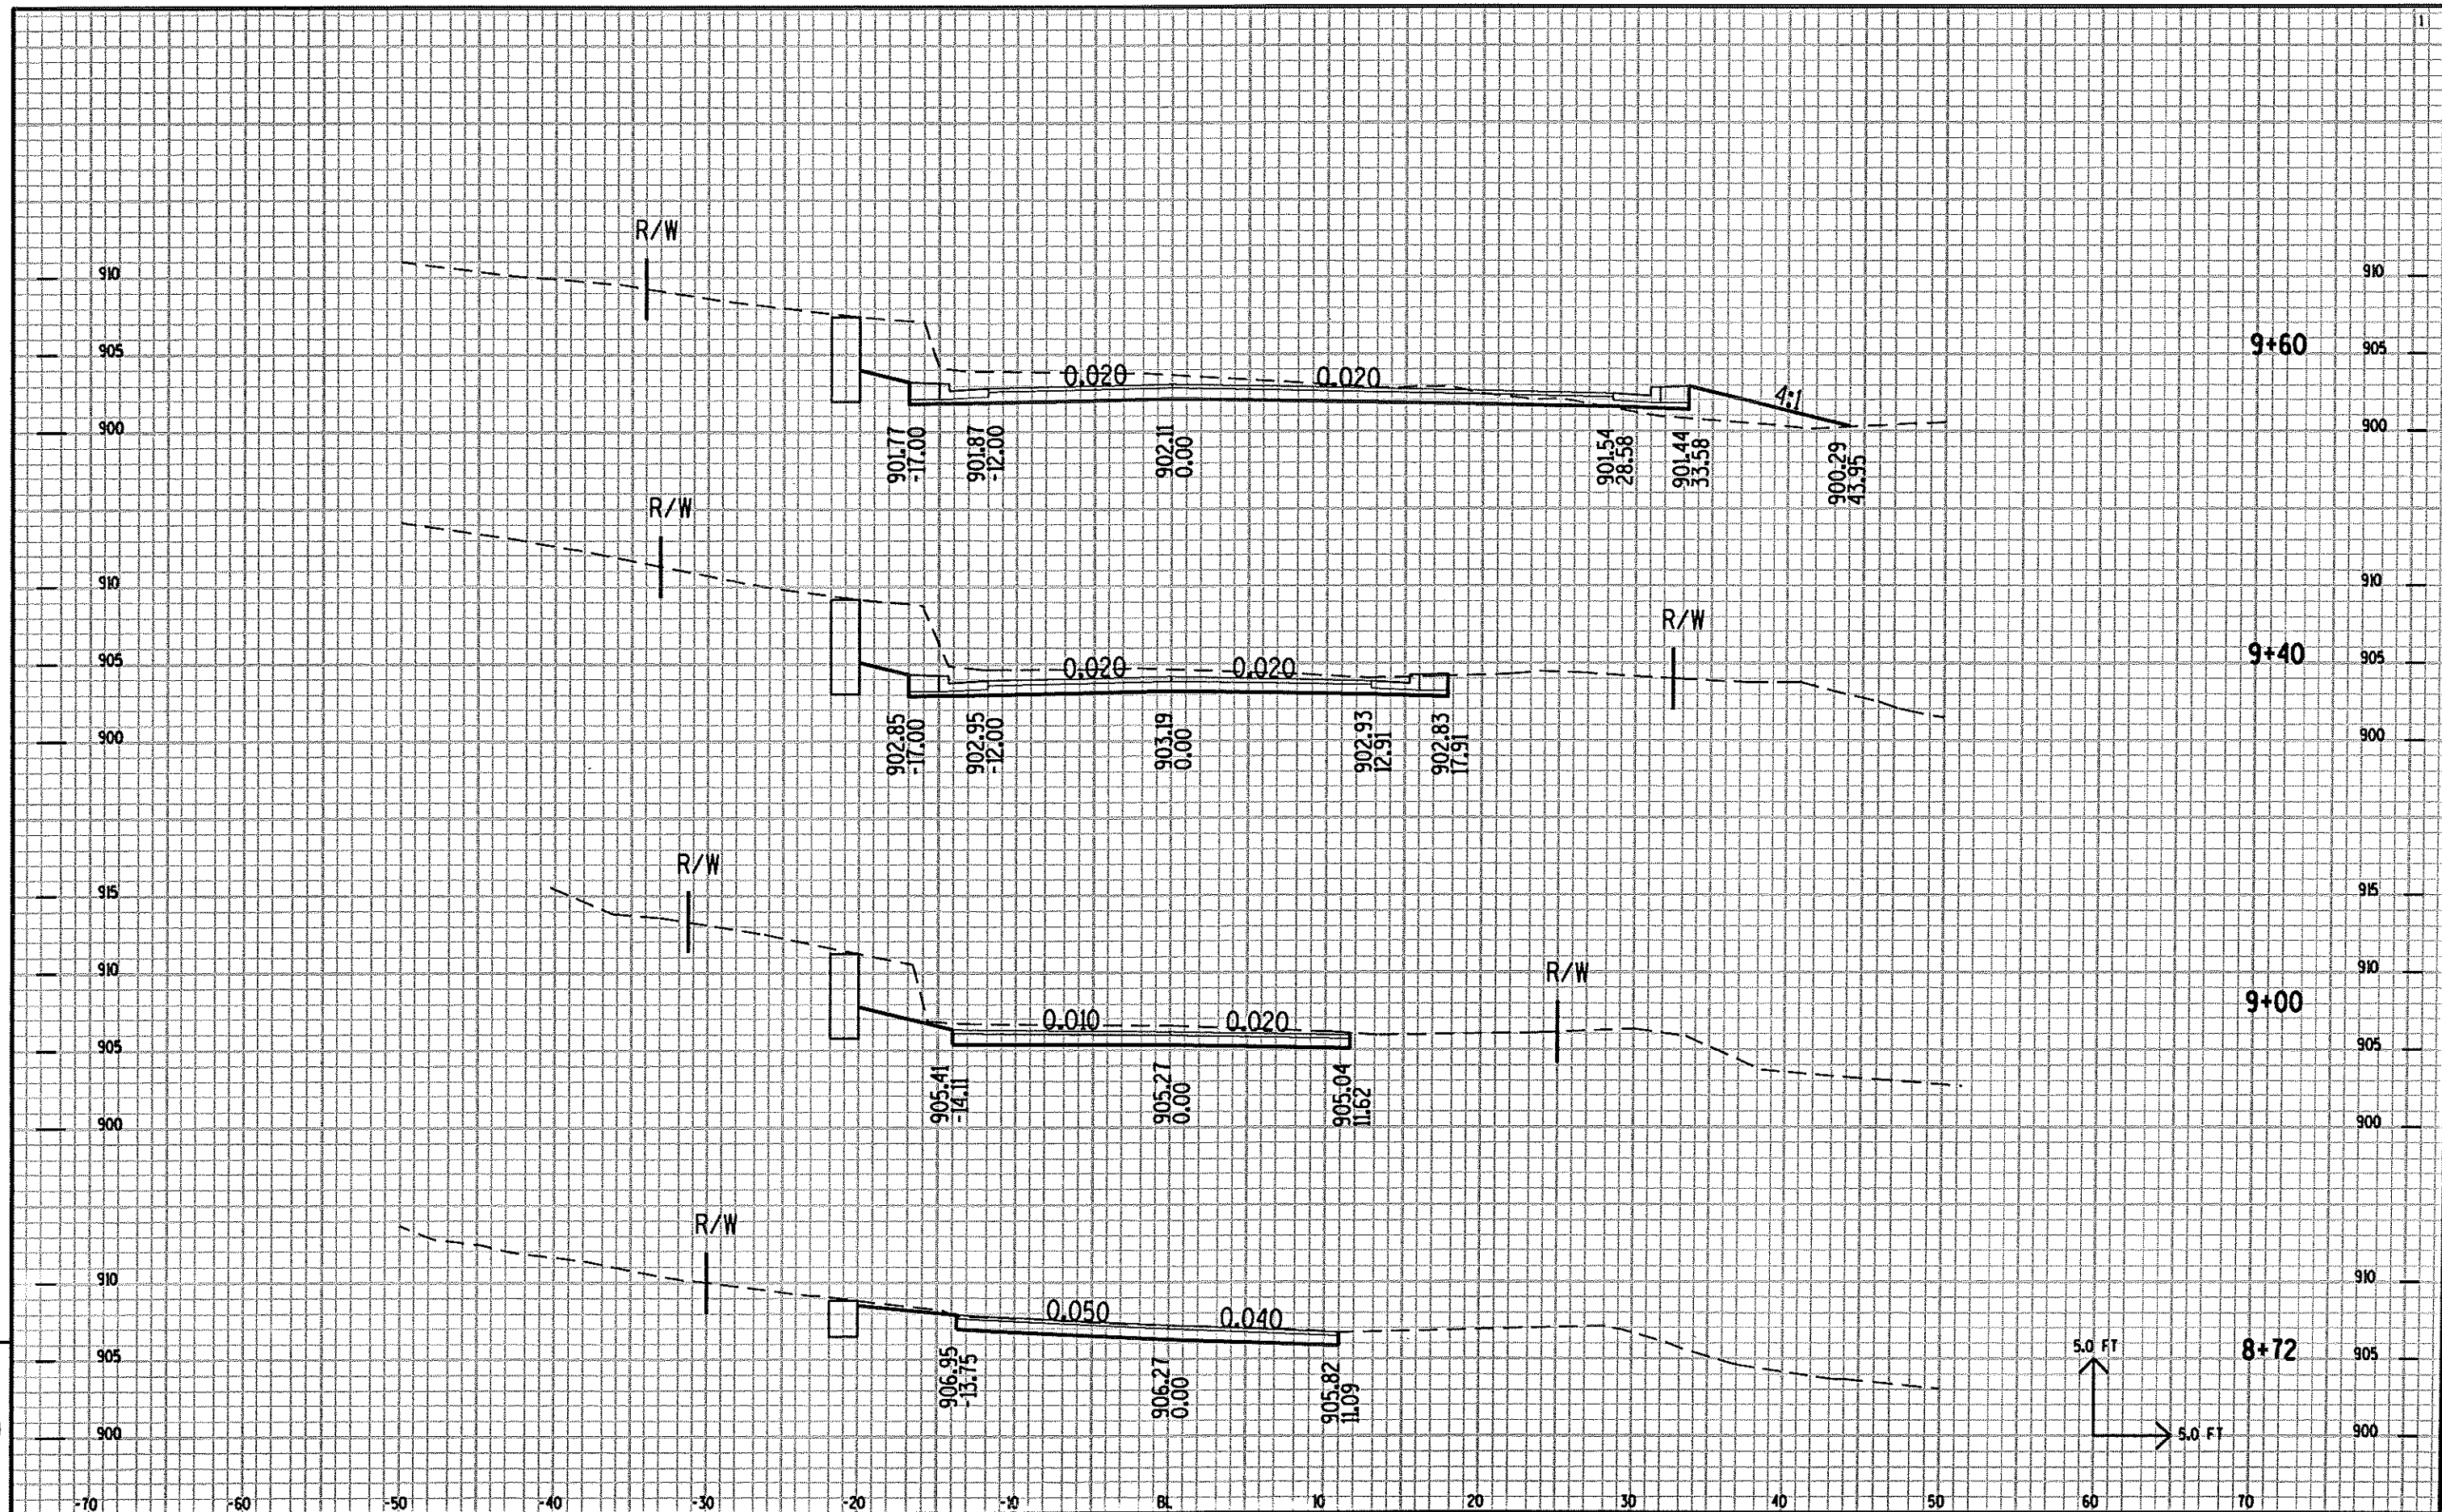


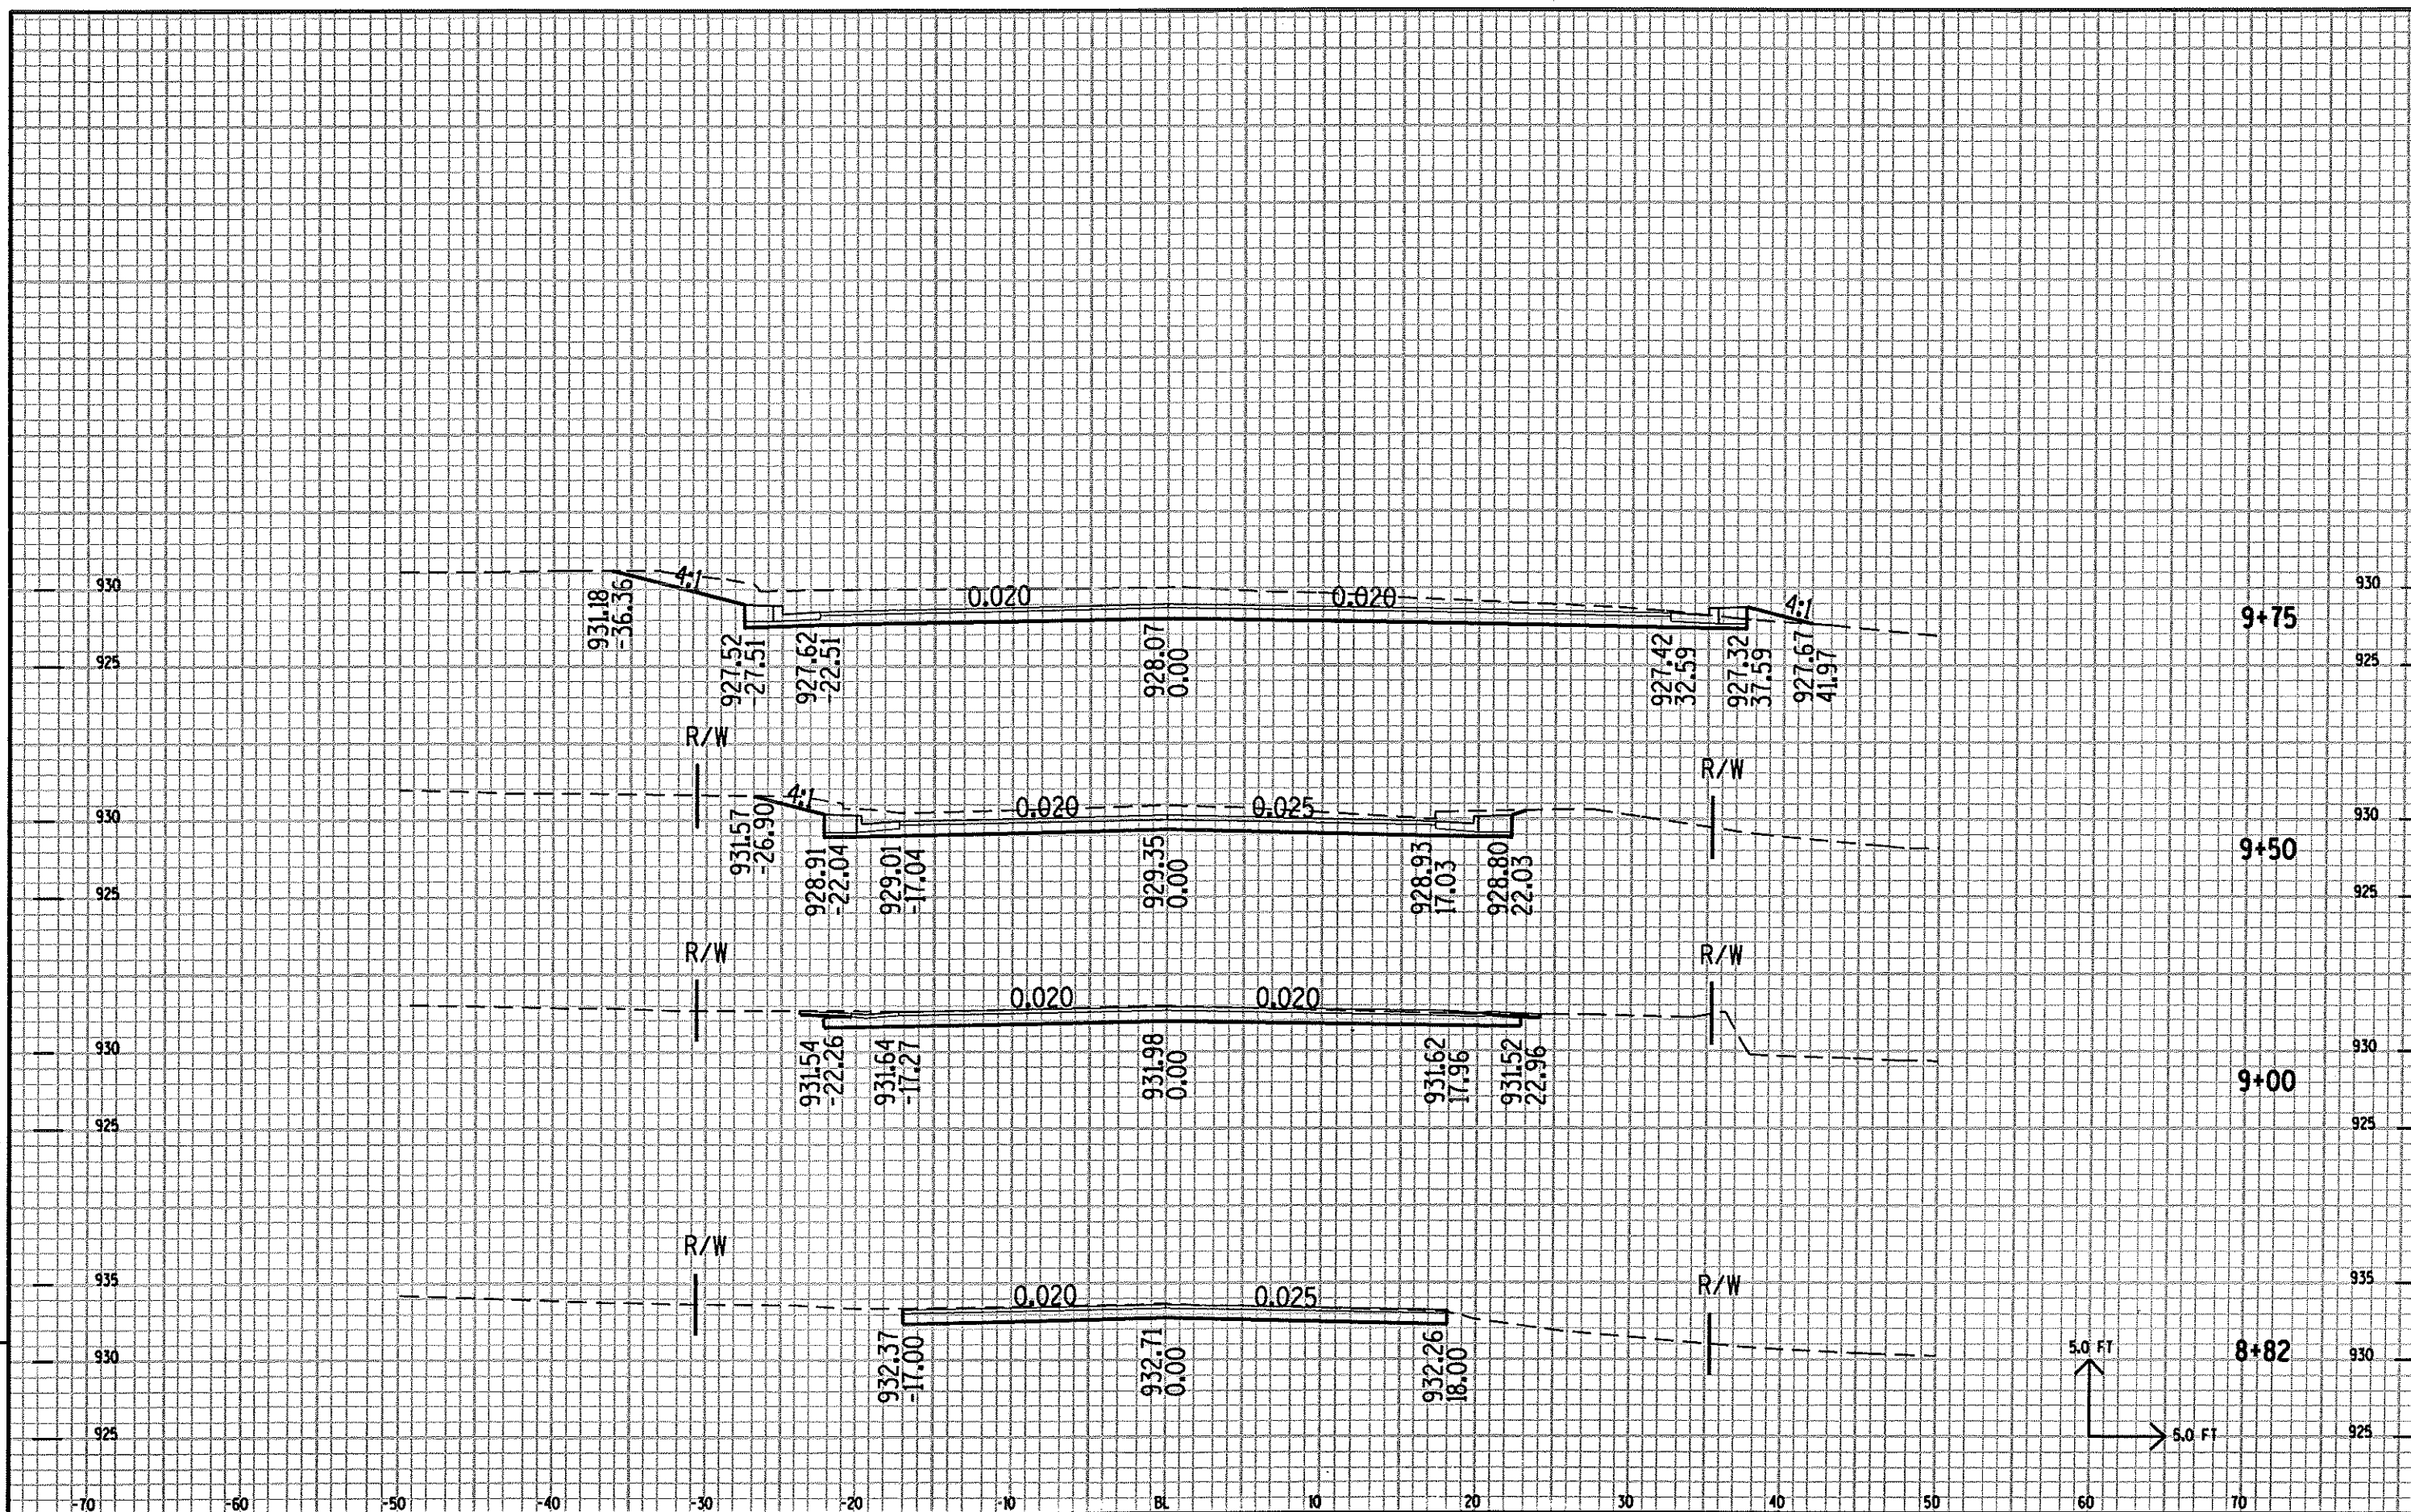

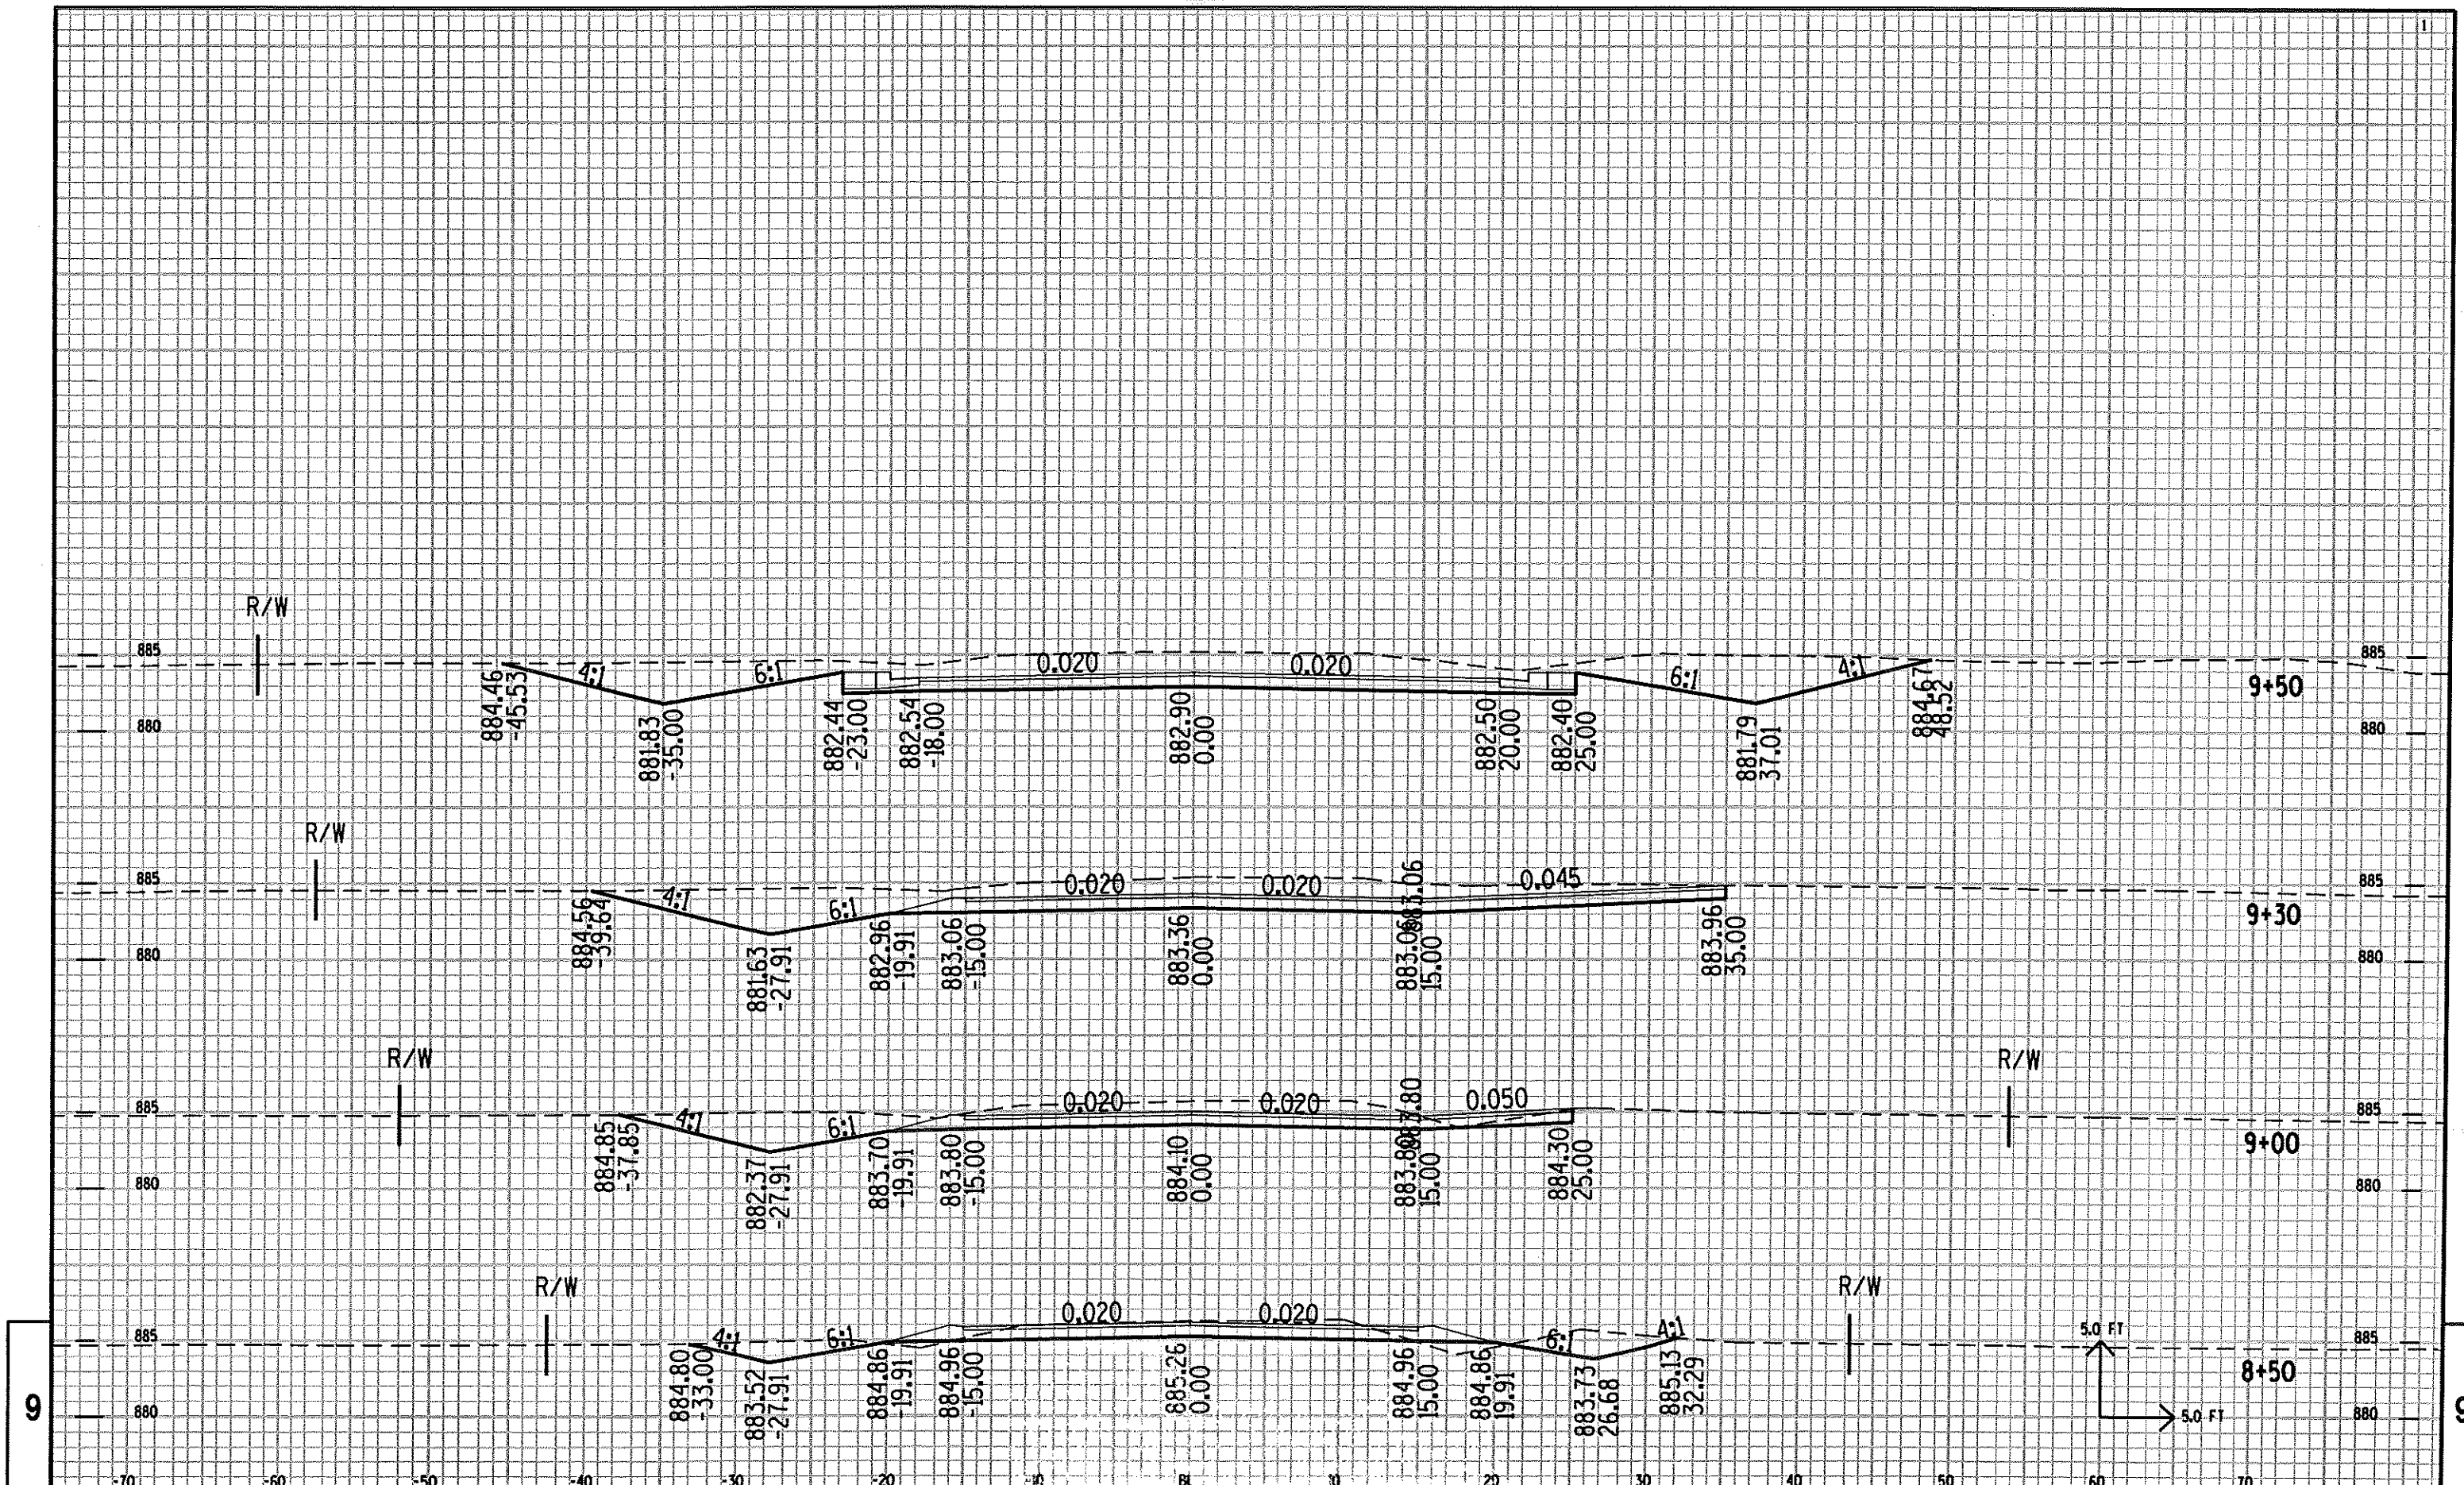

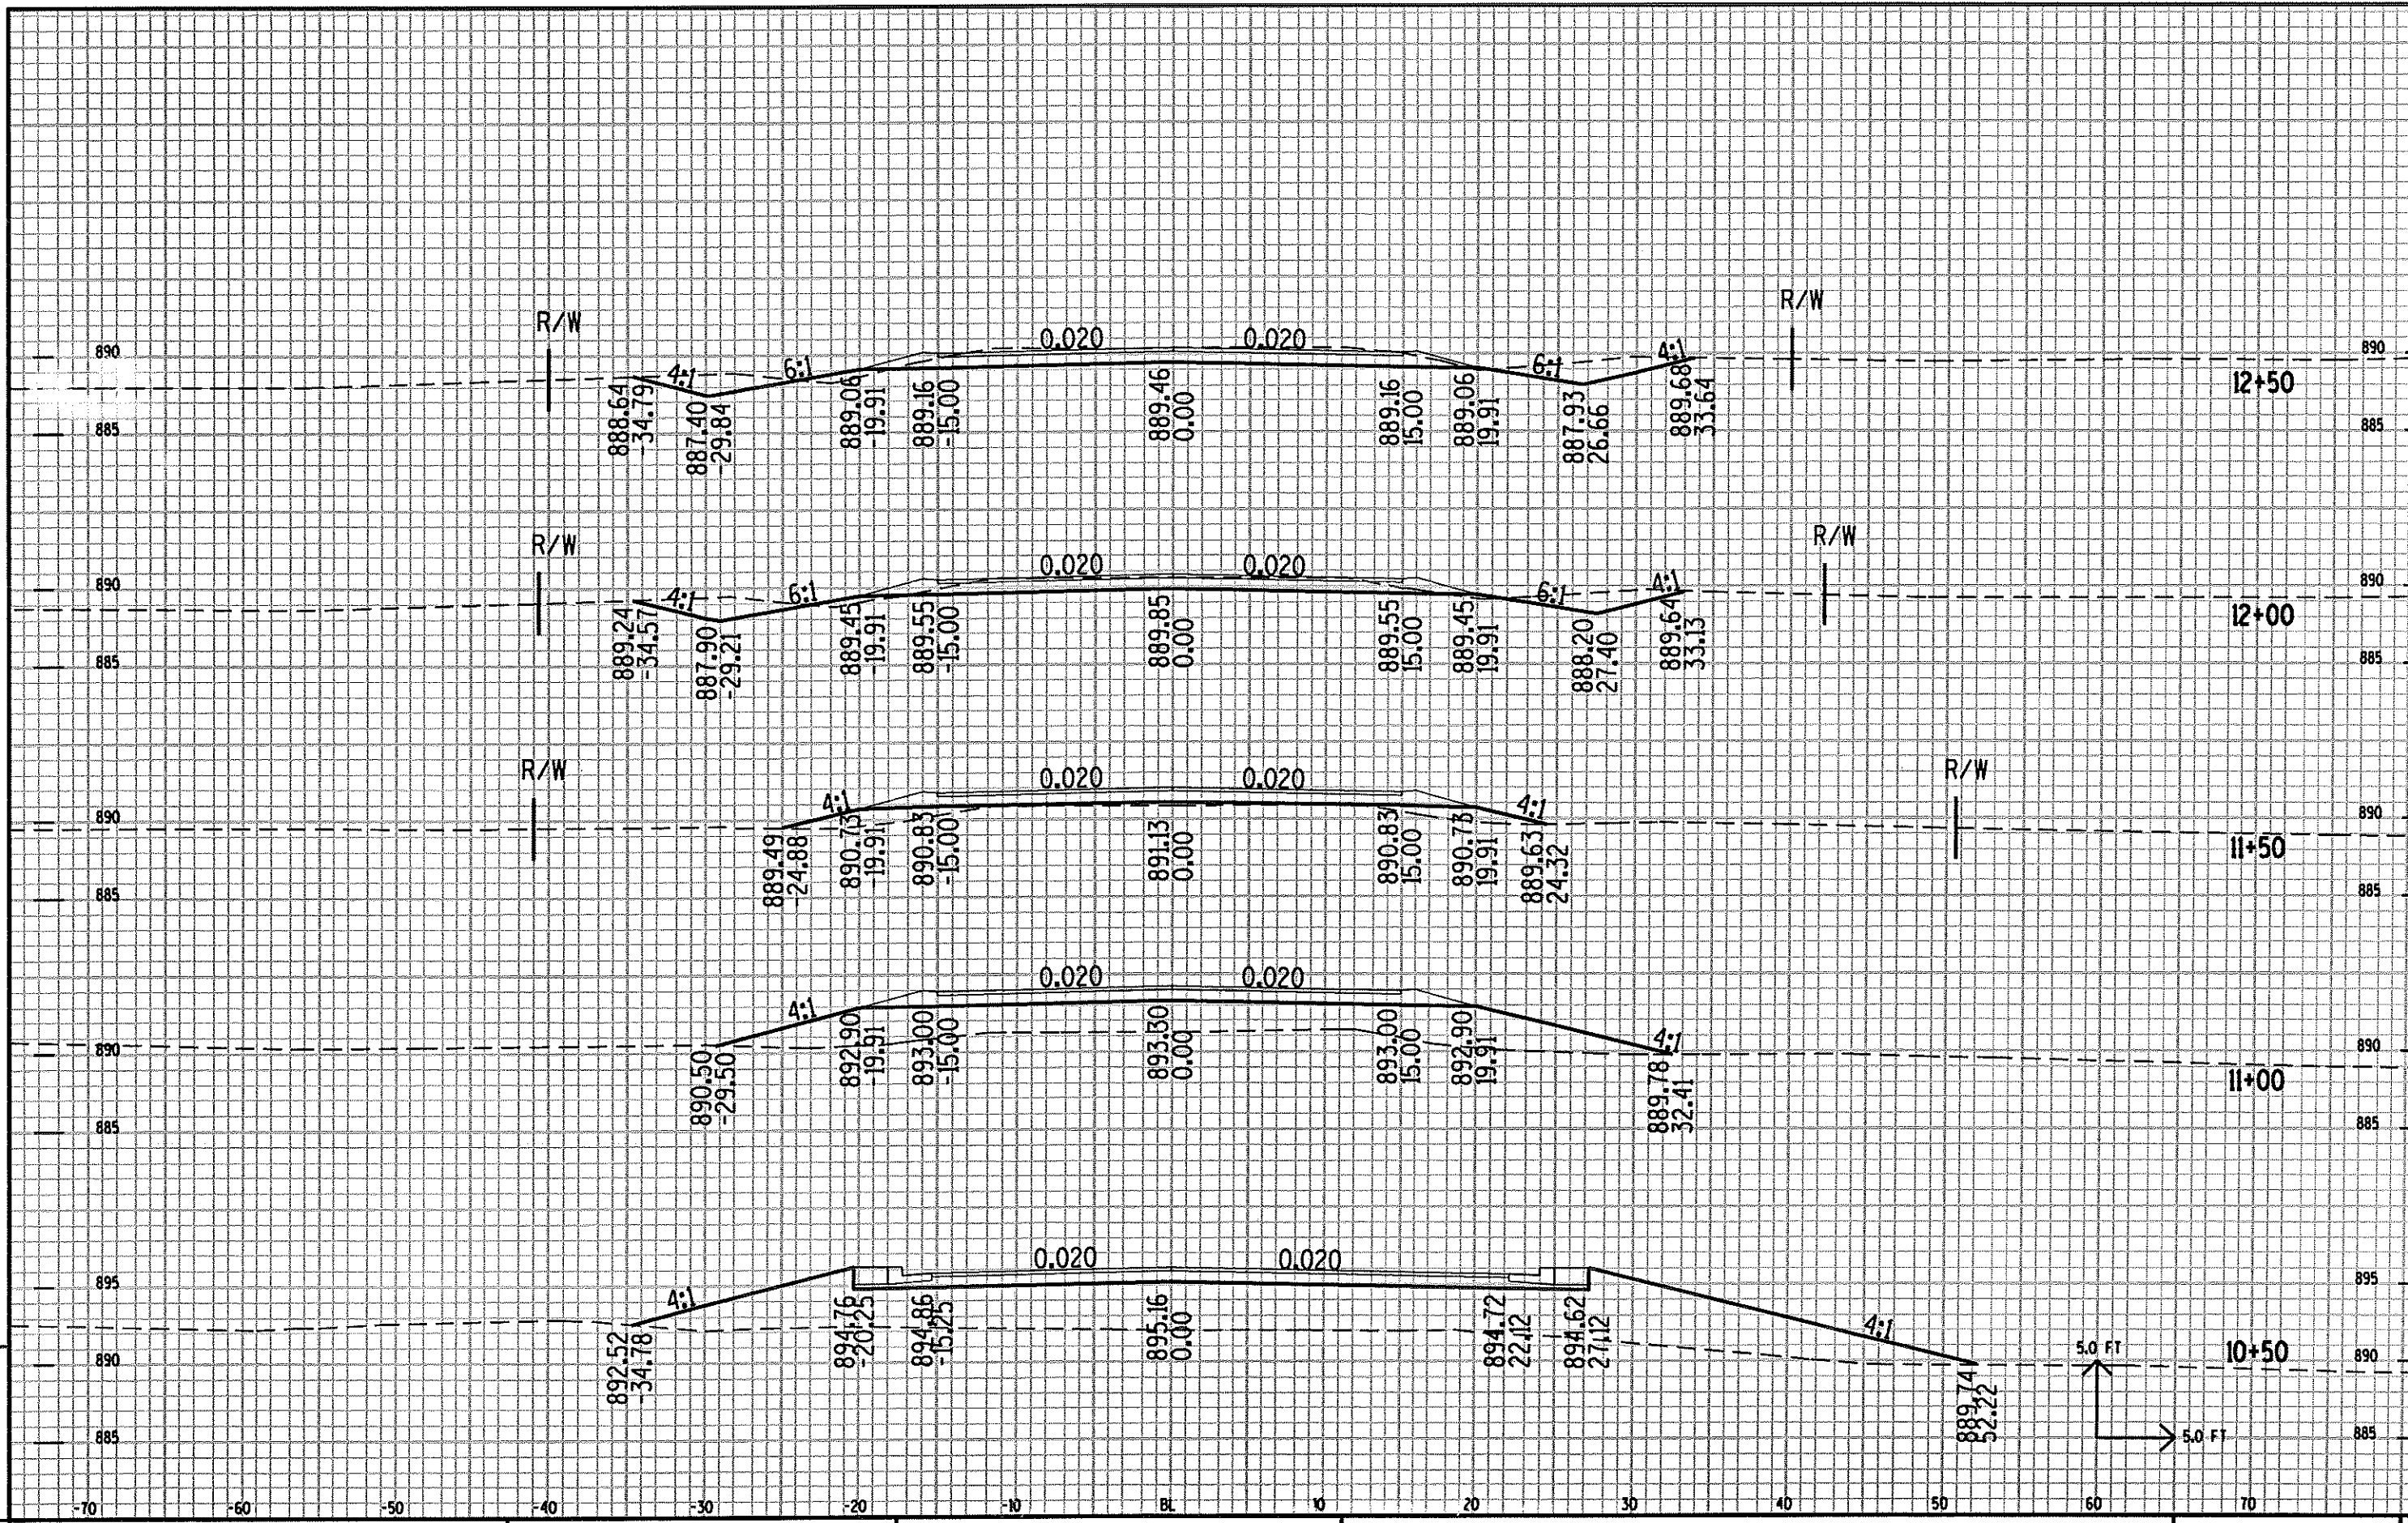

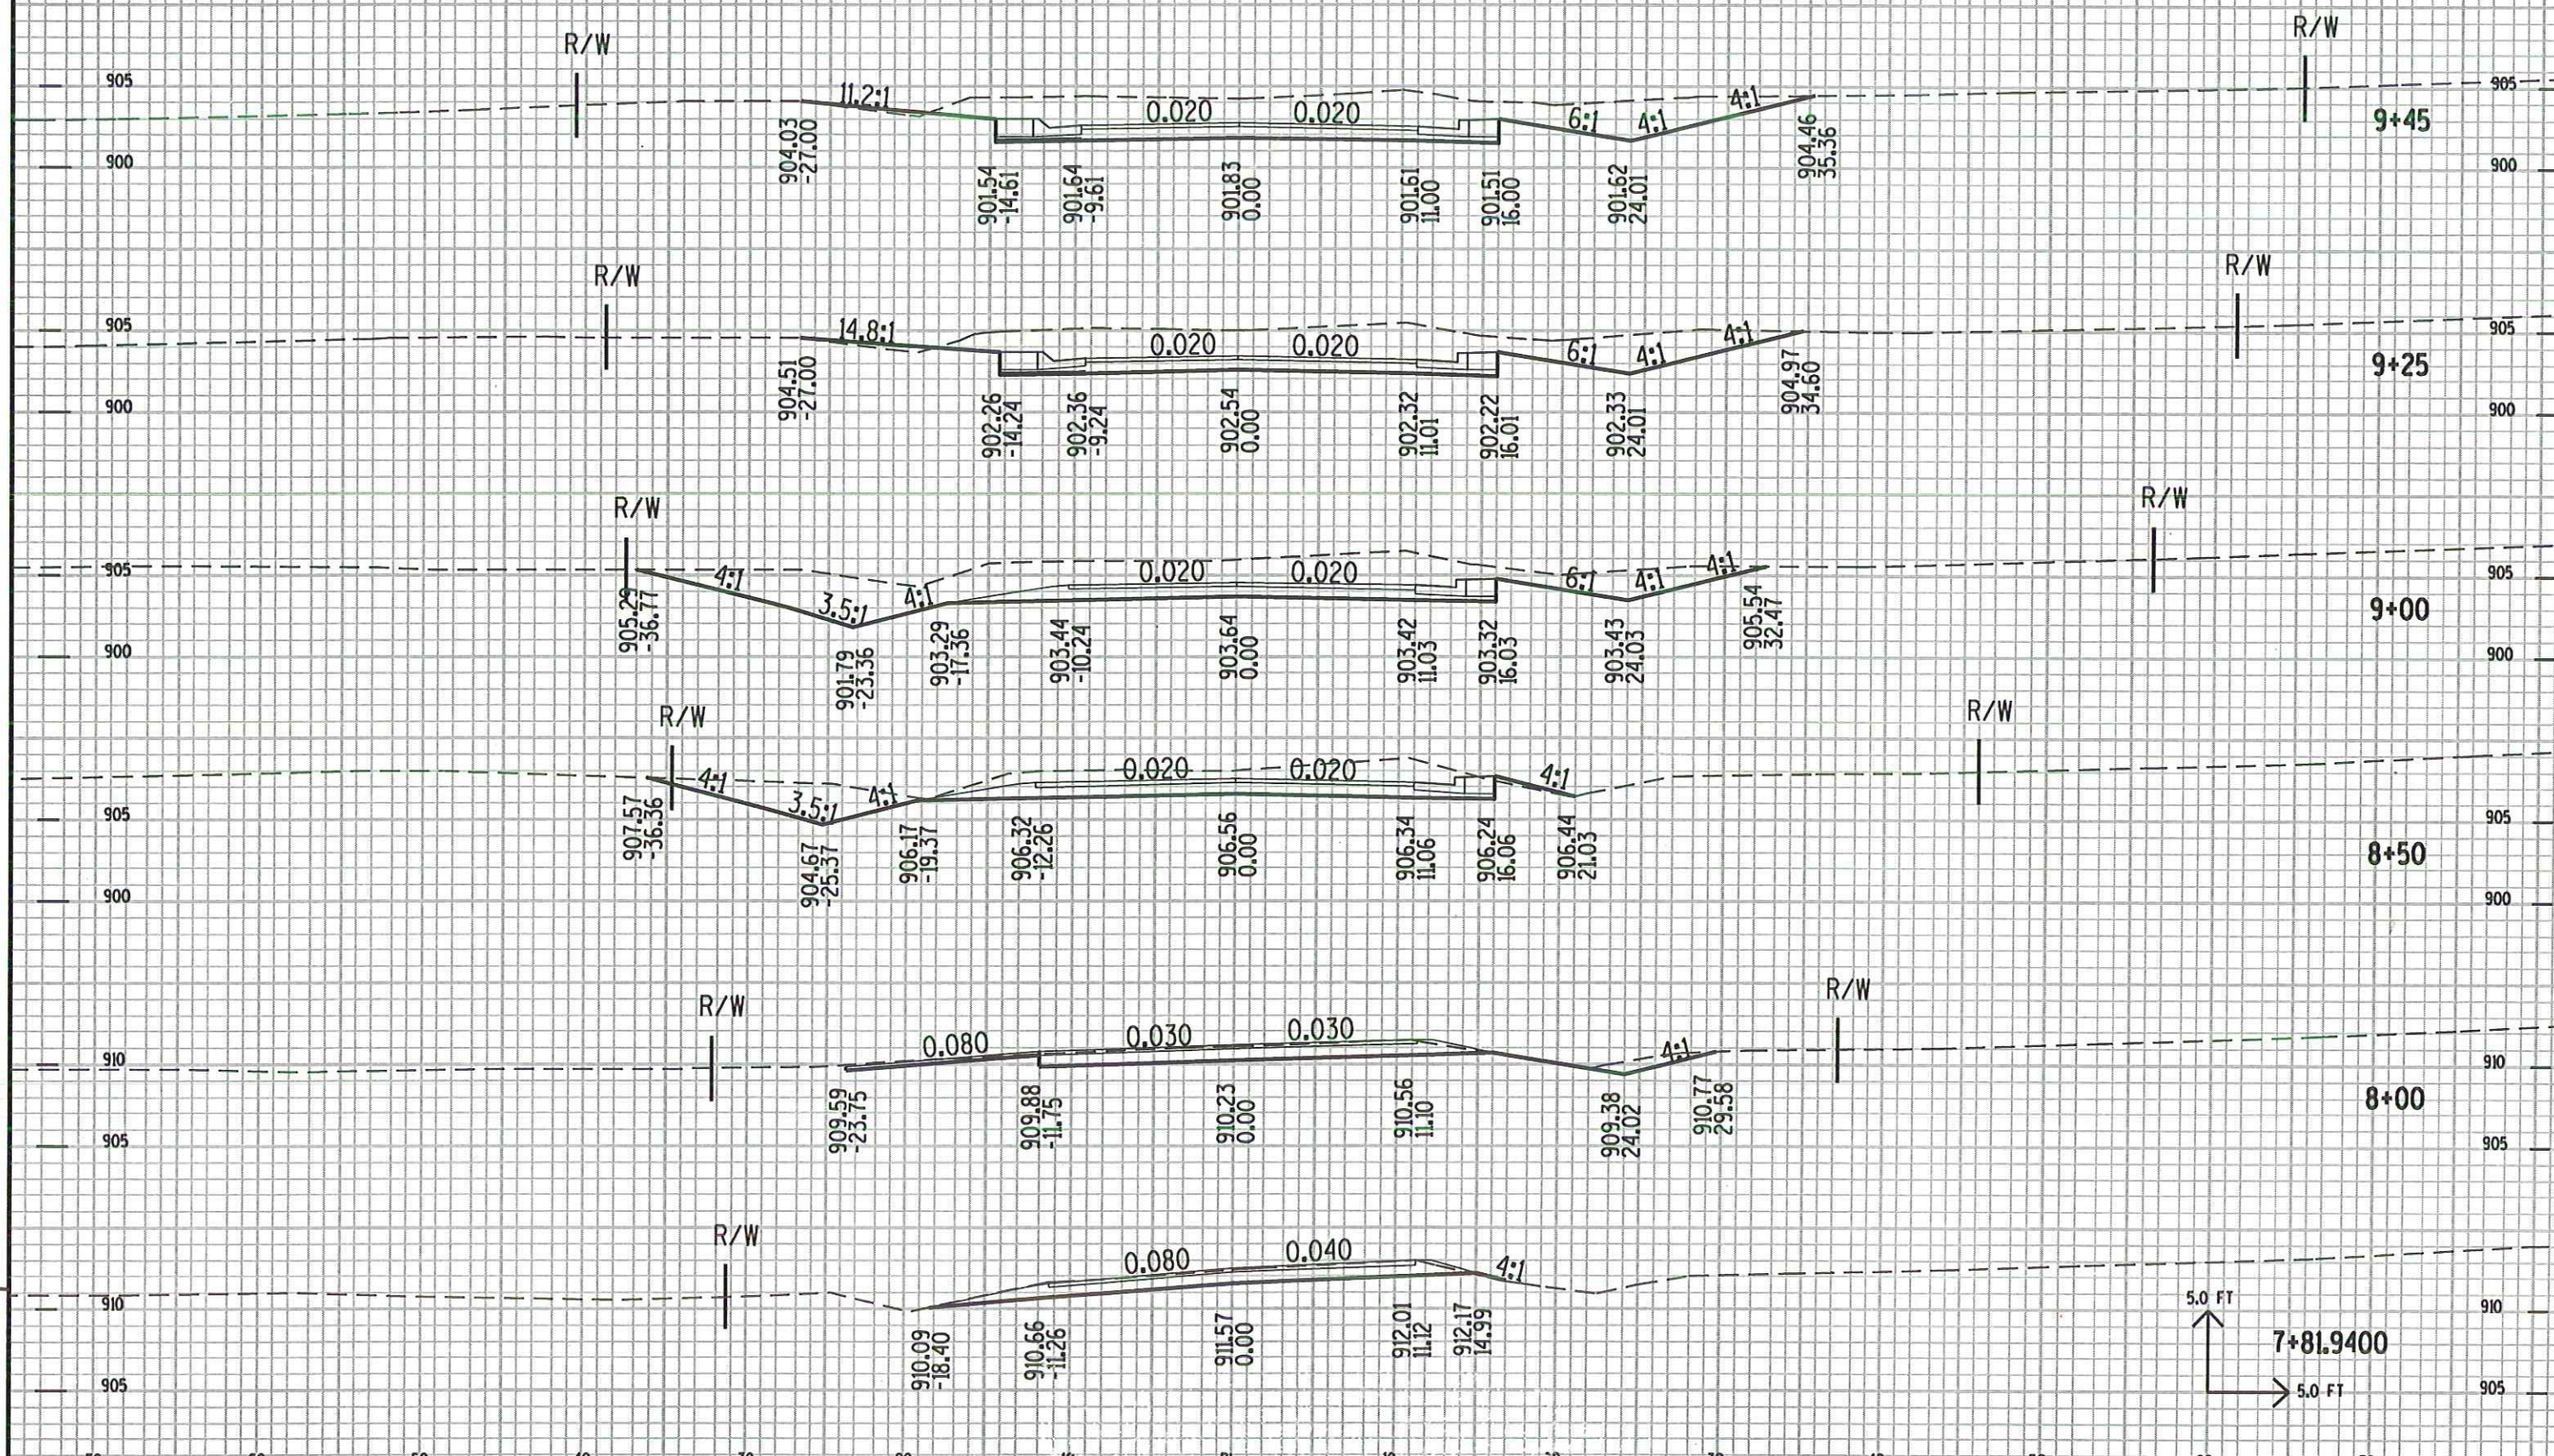

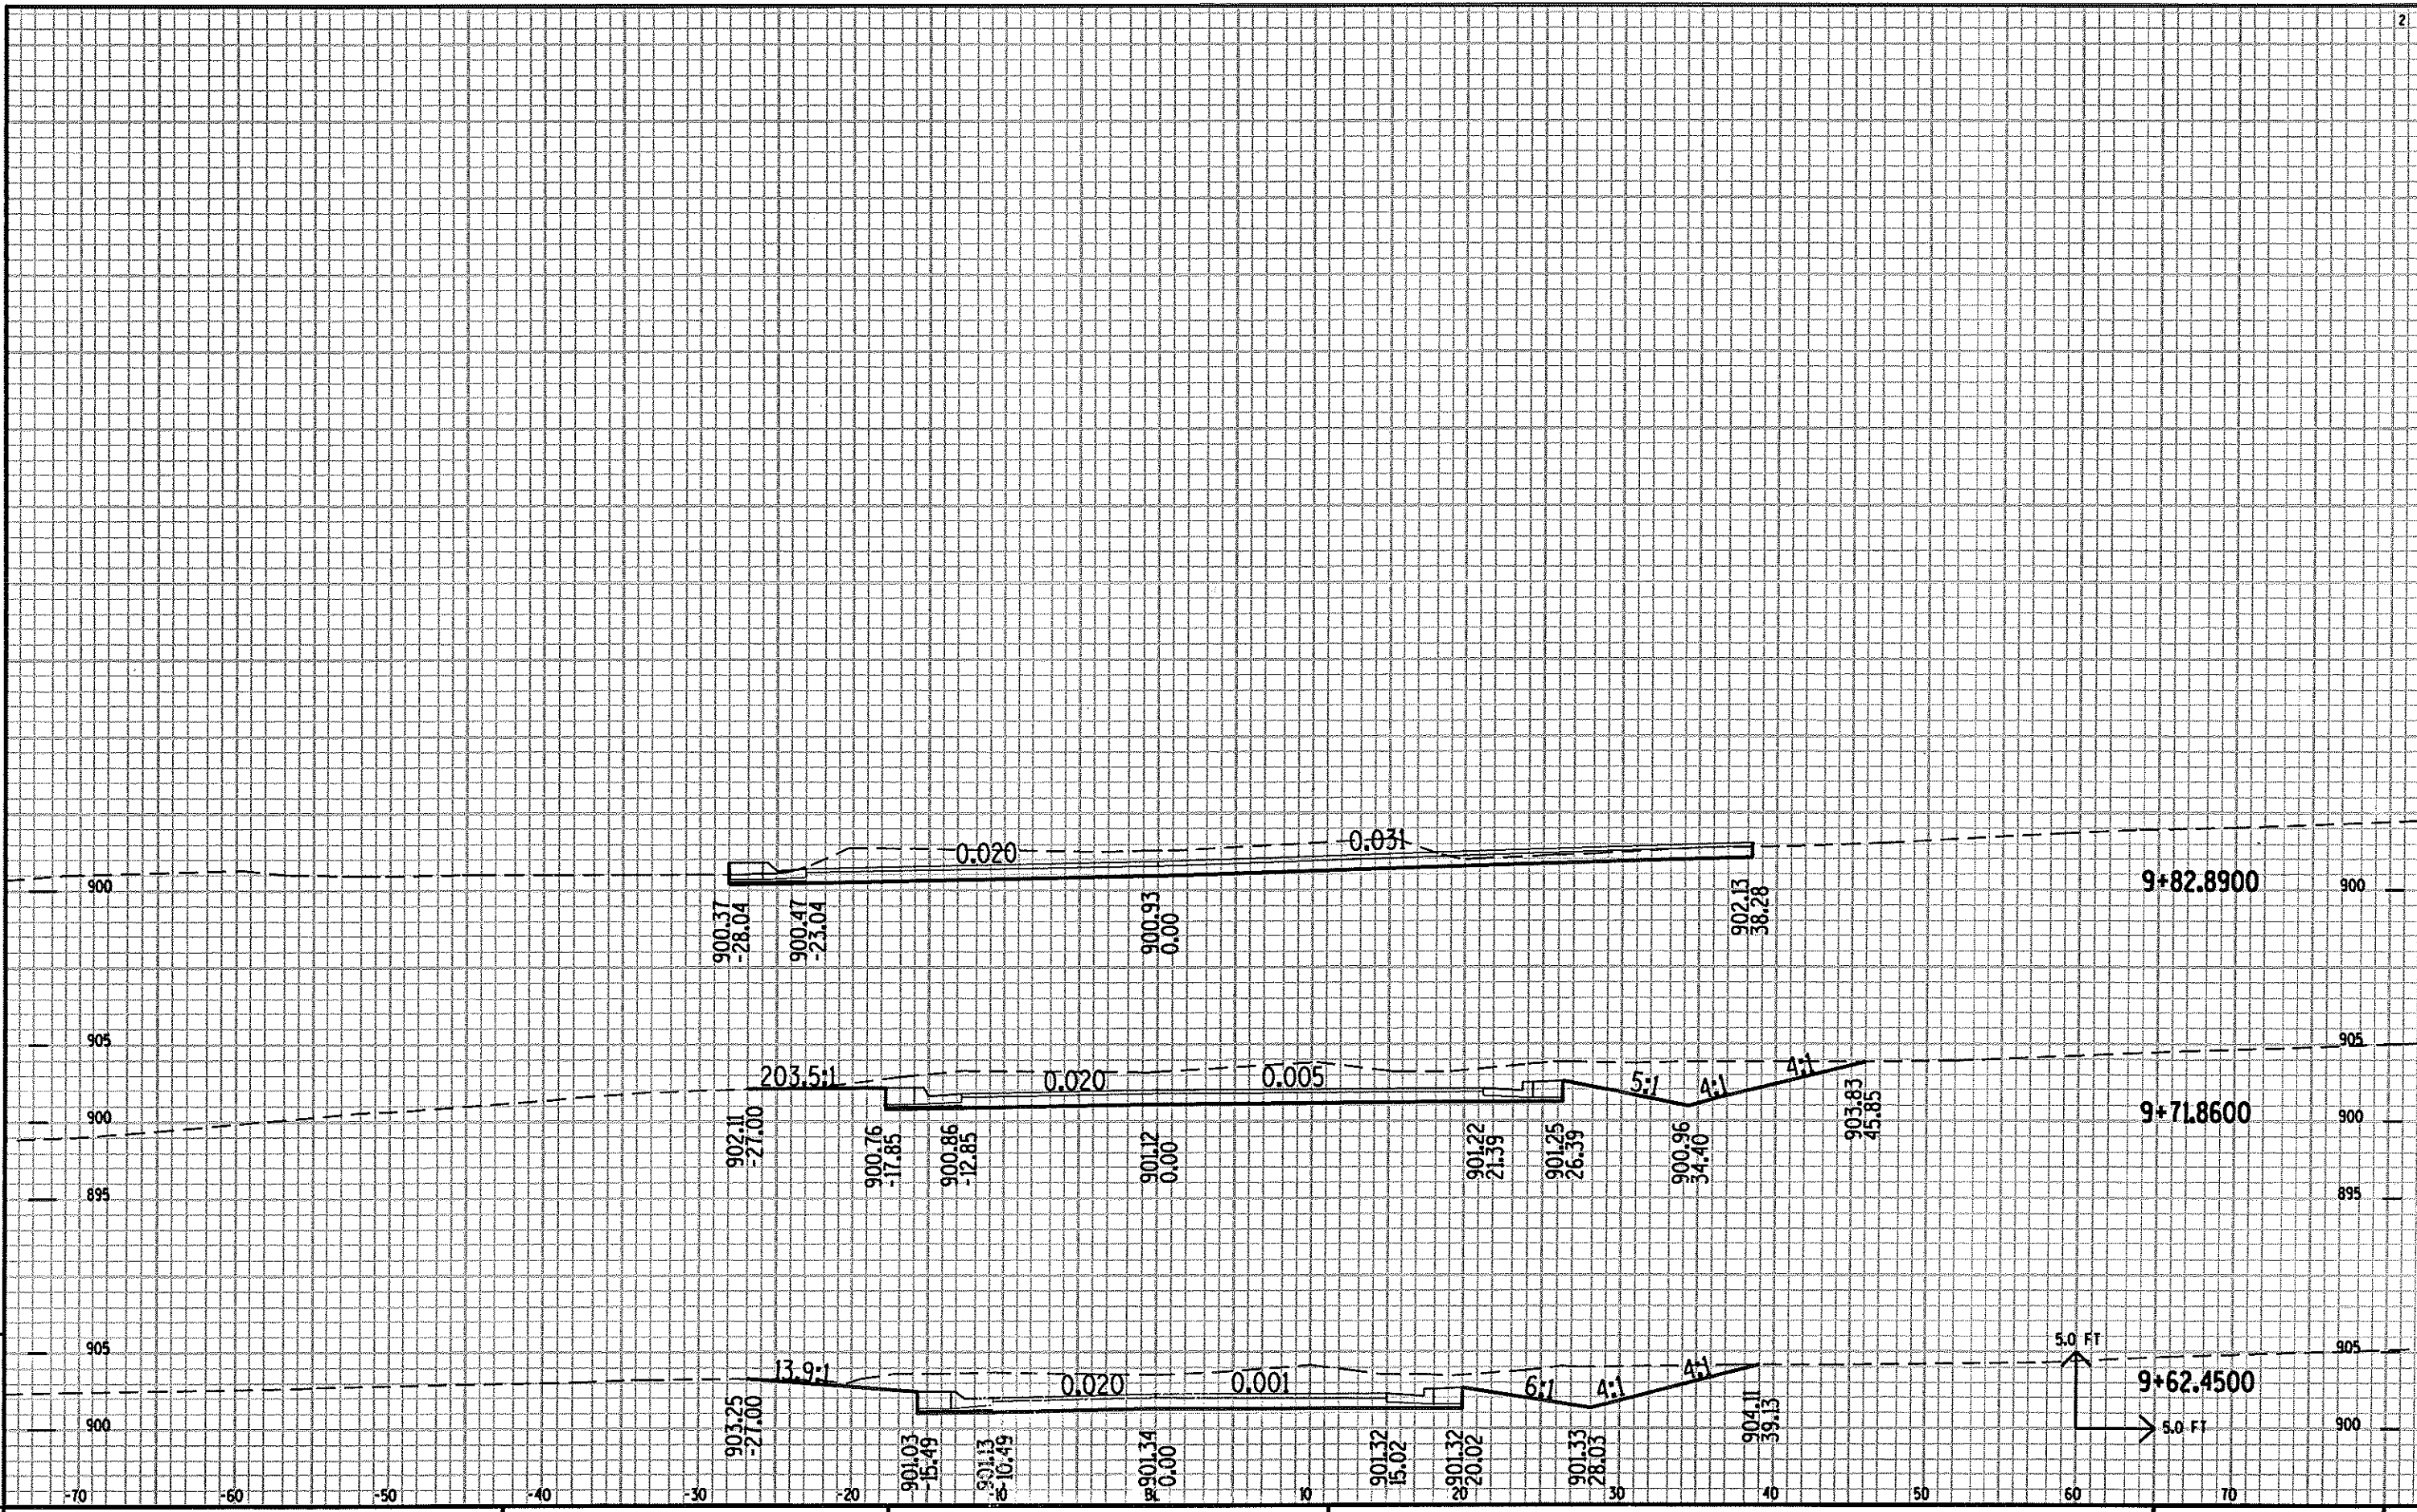

PROJECT NO: 5573-04-72

HWY: STH136

COUNTY: SALK

BELTER DRIVE

SHEET NO:

277

FILE NAME : r:\Support\CAADSV\Projects\vd1_55730401\090209_xs.DGN

PL01 DATE : 12-JUL-2007 01:25

PL01 BY : dotblg

PLOT NAME :

PLOT SCALE : 2.000000:1.000000

E