

LAX PROJECT ID: 7272-00-01 WITH: N/A COUNTY: LA CROSSE

STATE OF WISCONSIN
DEPARTMENT OF TRANSPORTATION


PLAN OF PROPOSED IMPROVEMENT

VILLAGE OF HOLMEN, SUNSET DRIVE
(CTH HD TO CTH DH)
LOCAL STREET
LA CROSSE COUNTY

STATE PROJECT	FEDERAL PROJECT	
	PROJECT	CONTRACT
7272-00-01	WISC 2018141	1

AS-BUILT PLAN
SUPERVISOR: Ian Winger
PROJECT MANAGER: Craig Fisher
PROJECT LEADER: Ryan Franzini
CONTRACTOR: St. Joseph Construction
WORK STARTED: 7/23/18
WORK COMPLETED: 9/17/18

STATE PROJECT NUMBER
7272-00-01

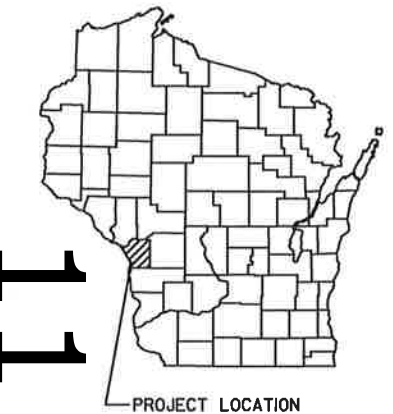


- Subcontractor List
Central State Signing, Inc.
Fowler & Hammer, Inc.
Guide Lines Pavement Marking, LLC
Hard Rock Sawing & Drilling Specialists Co.
Mathy Construction Co.
SJK Engineering

DESIGN DESIGNATION		
A.A.D.T. (2018)	=	3100
A.A.D.T. (2038)	=	3600
D.H.V.	=	100
D.D.	=	59/41
T.	=	3.3%
DESIGN SPEED	=	20 MPH
ESALS	=	270,000

CONVENTIONAL SYMBOLS

PLAN		PROFILE	
CORPORATE LIMITS	////	GRADE LINE	—
PROPERTY LINE	----	ORIGINAL GROUND	- - - -
LOT LINE	----	MARSH OR ROCK PROFILE (To be noted as such)	~~~~
LIMITED HIGHWAY EASEMENT	----	SPECIAL DITCH	----
EXISTING RIGHT OF WAY	----	GRADE ELEVATION	95.36
PROPOSED OR NEW R/W LINE	----	CULVERT (Profile View)	○ □
SLOPE INTERCEPT	----	UTILITIES	
REFERENCE LINE	----	ELECTRIC	— E —
EXISTING CULVERT	----	OVERHEAD UTILITY	— OH —
PROPOSED CULVERT (Box or Pipe)	----	FIBER OPTIC	— FO —
COMBUSTIBLE FLUIDS	CAUTION	GAS	— G —
MARSH AREA	~~~~	SANITARY SEWER	— SAN —
WOODED OR SHRUB AREA	~~~~	STORM SEWER	— SS —
		TELEPHONE	— T —
		WATER	— W —
		UTILITY PEDESTAL	⊗
		POWER POLE	⊕
		TELEPHONE POLE	⊙

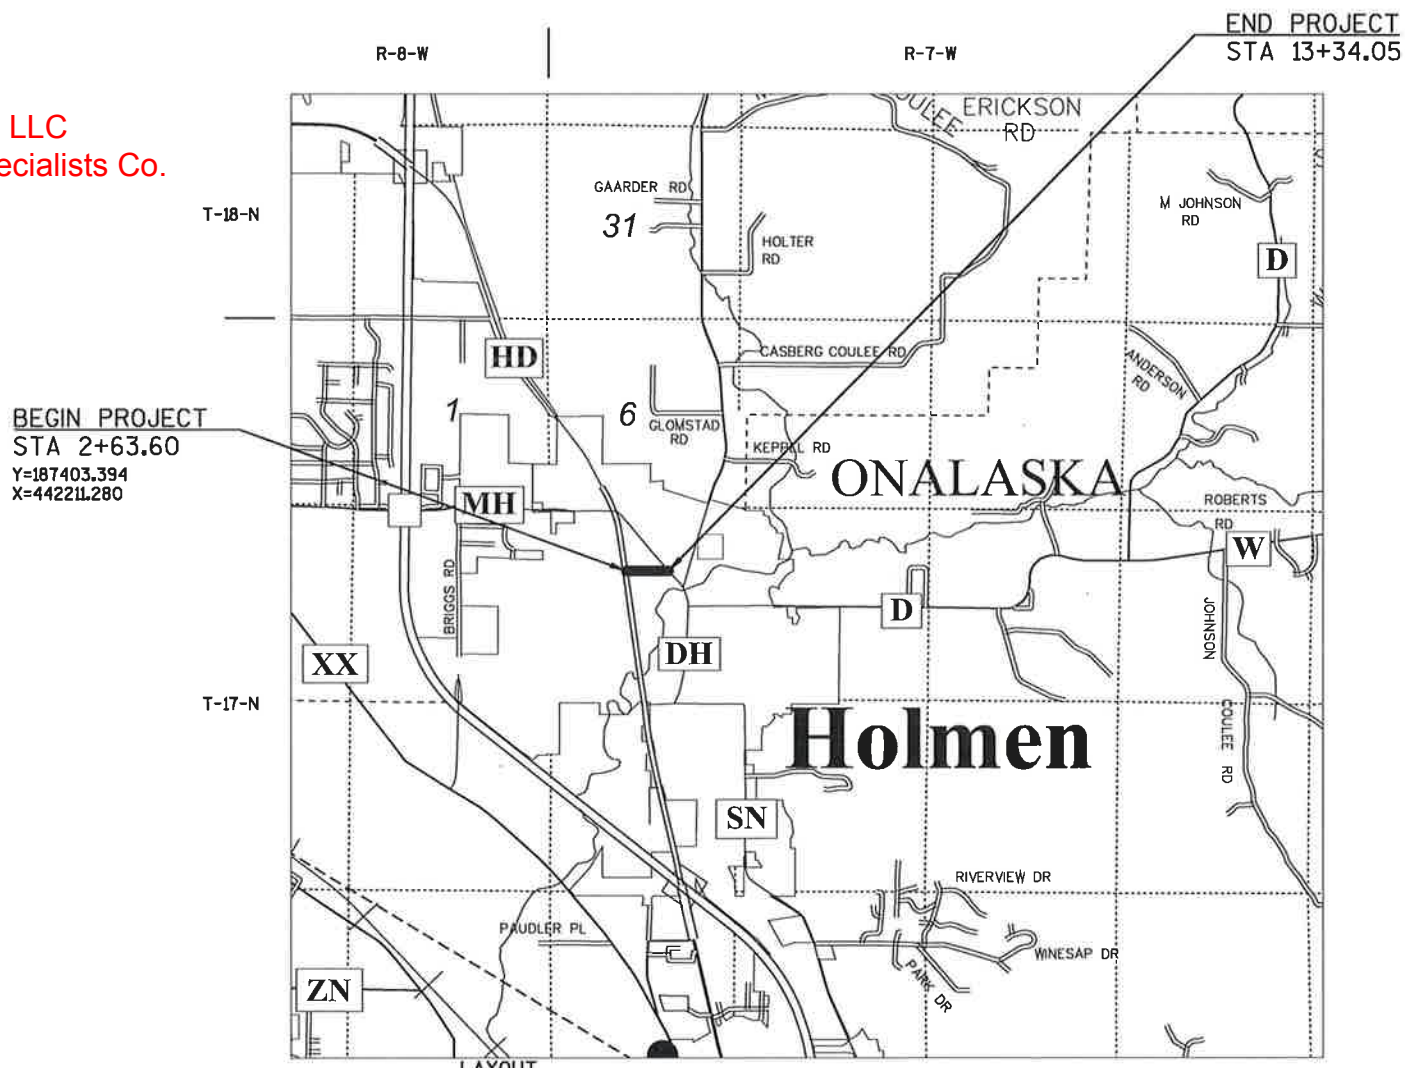

SCALE 0 1 MILE
TOTAL NET LENGTH OF CENTERLINE = 0.203 MI

HORIZONTAL POSITIONS SHOWN ON THIS PLAN ARE WISCONSIN COUNTY COORDINATES, LA CROSSE COUNTY, NAD83 (2011), IN U.S. SURVEY FEET. VALUES ARE GRID COORDINATES, GRID BEARINGS, AND GRID DISTANCES. GRID DISTANCES MAY BE USED AS GROUND DISTANCES.

ACCEPTED FOR VILLAGE OF HOLMEN
10/9/17
DATE

ORIGINAL PLANS PREPARED BY
Cedar corporation
MENOMONIE - MADISON - GREEN BAY - CEDARBURG
www.cedarcorp.com
800-472-7372

WISCONSIN
JOSHUA A. WEISS
87150
OREGON
WI
10.2.2017

STATE OF WISCONSIN
DEPARTMENT OF TRANSPORTATION

PREPARED BY
Surveyor CEDAR CORPORATION
Designer CEDAR CORPORATION
Management Consultant KL ENGINEERING

APPROVED FOR THE DEPARTMENT
DATE: 10/27/17
(Management Consultant Signature)

E

GENERAL NOTES

THE LOCATIONS OF EXISTING AND PROPOSED UTILITY INSTALLATIONS AS SHOWN ON THE PLANS ARE APPROXIMATE. THERE MAY BE OTHER UTILITY INSTALLATIONS WITHIN THE PROJECT AREA THAT ARE NOT SHOWN.

NO TREES OR SHRUBS ARE TO BE REMOVED UNLESS SUCH TREES OR SHRUBS HAVE FIRST BEEN INDICATED FOR REMOVAL BY THE ENGINEER IN THE FIELD.

THE 4.5" HMA PAVEMENT SHALL BE CONSTRUCTED WITH A 2.5" LOWER LAYER OF 3 LT 58-28 S AND A 2" UPPER LAYER OF 4 LT 58-28 S.

BEARINGS REFERENCED TO THE WISCONSIN COUNTY COORDINATE SYSTEM (WCCS), LA CROSSE COUNTY.

DISTURBED AREAS WITHIN THE RIGHT OF WAY ARE TO BE FERTILIZED AND SEEDED AS DIRECTED BY THE ENGINEER. USE SEED MIX NO. 40.

WHEN THE QUANTITY OF THE ITEM OF BASE LAYER OR SURFACE LAYER IS MEASURED FOR PAYMENT BY THE TON, THE DEPTH OF THICKNESS OF THE LAYER SHOWN ON THE PLANS IS APPROXIMATE AND THE ACTUAL THICKNESS WILL DEPEND ON THE DISTRIBUTION OF THE MATERIAL AS DIRECTED BY THE ENGINEER.

STANDARD ABBREVIATIONS

ABUT	ABUTMENT	OFF	OFFSET
AGG	AGGREGATE	PC	POINT OF CURVATURE
ET AL	AND OTHERS	PI	POINT OF INTERSECTION
AADT	ANNUAL AVERAGE DAILY TRAFFIC	PT	POINT OF TANGENCY
BF	BACK FACE	POL	POINT ON LINE
BM	BENCHMARK	PE	PRIVATE ENTRANCE
C/L OR ∅	CENTERLINE	PL	PROPERTY LINE
Δ	CENTRAL ANGLE OR DELTA	PSI	POUNDS/SQUARE INCH
CLR	CLEAR	PROP	PROPOSED
CONC	CONCRETE	R	RADIUS
CONST	CONSTRUCTION	RR	RAILROAD
COR	CORNER	REBAR	REINFORCEMENT BAR
CMP	CORRUGATED METAL PIPE	REQ'D	REQUIRED
CTH	COUNTY TRUNK HIGHWAY	RT	RIGHT
CR	CREEK	RHF	RIGHT-HAND FORWARD
CFS	CUBIC FEET/SECOND	R/W	RIGHT-OF-WAY
CULV	CULVERT	RD	ROAD
D	DEGREE OF CURVE	SEC	SECTION
DHV	DESIGN HOUR VOLUME	S	SOUTH
DIA	DIAMETER	SE	SOUTHEAST
E	EAST	SW	SOUTHWEST
EL	ELEVATION	STH	STATE TRUNK HIGHWAY
EST	ESTIMATED	STA	STATION
FPS	FEET PER SECOND	SE	SUPER ELEVATION
FE	FIELD ENTRANCE	T	TANGENT
FT	FOOT (FEET)	TEL	TELEPHONE
FTG	FOOTING	TEMP	TEMPORARY
FDN	FOUNDATION	TI	TEMPORARY INTEREST
FF	FRONT FACE	TLE	TEMPORARY LIMITED EASEMENT
IP	IRON PIN	TL OR T/L	TRANSIT LINE
LT	LEFT	T	TRUCKS
LHF	LEFT-HAND FORWARD	TYP	TYPICAL
L	LENGTH OF CURVE	U/G	UNDERGROUND
LF	LINEAR FOOT	USH	UNITED STATES HIGHWAY
MAX	MAXIMUM	VAR	VARIABLE
MI	MILE	V	VELOCITY
MIN	MINIMUM	VPC	VERTICAL POINT OF CURVATURE
NC	NORMAL CROWN	VPI	VERTICAL POINT OF INTERSECTION
N	NORTH	VPT	VERTICAL POINT OF TANGENCY
NE	NORTHEAST	W	WEST
NW	NORTHWEST	YB	YARD
NO	NUMBER		

DNR LIAISON

WISCONSIN DEPARTMENT OF NATURAL RESOURCES
MORMON COULEE ROAD
LA CROSSE, WI 54601
(608) 785-9115
KAREN KALVELAGE
karen.kalvelage@wisconsin.gov

DESIGN CONSULTANT

CEDAR CORPORATION
2820 WALTER COMMONS WEST
SUITE 142
MADISON, WI 53718
(608) 237-5842
JOSH WEISS, P.E.
josh.weiss@cedarcorp.com

VILLAGE OF HOLMEN

605 EMPIRE STREET
HOLMEN, WI 54636
(608) 526-3513
DEAN OLSON
dolson@holmenwi.com

UTILITIES

CHARTER COMMUNICATIONS
1228 12TH AVENUE SOUTH
ONALASKA, WI 54560
(608) 317-6213
PERRY McCLELLAN
perry.mcclellan@charter.com

CENTURYLINK
333 NORTH FRONT STREET
LA CROSSE, WI 54601
(608) 796-5142
BRIAN STELPLUGH
brian.stelplugh@centurylink.com

XCEL ENERGY - ELECTRIC
3215 COMMERCE STREET
LA CROSSE, WI 54603
(608) 789-3712
LAURA JORSTAD
laura.jorstad@xcelenergy.com

XCEL ENERGY - GAS
3215 COMMERCE STREET
LA CROSSE, WI 54603
(608) 789-3625
SCOTT ROBERTS
scott.w.roberts@xcelenergy.com

VILLAGE OF HOLMEN
605 EMPIRE STREET
HOLMEN, WI 54636
(608) 526-3513
DEAN OLSON
dolson@holmenwi.com










Dial 811 or (800)242-8511

www.DiggersHotline.com


**DENOTES UTILITIES THAT ARE NOT DIGGERS HOTLINE MEMBERS.

*EXISTING PAVEMENT AND BASE THICKNESSES
WERE DETERMINED FROM DISCUSSIONS WITH THE
VILLAGE OF WEST SALEM

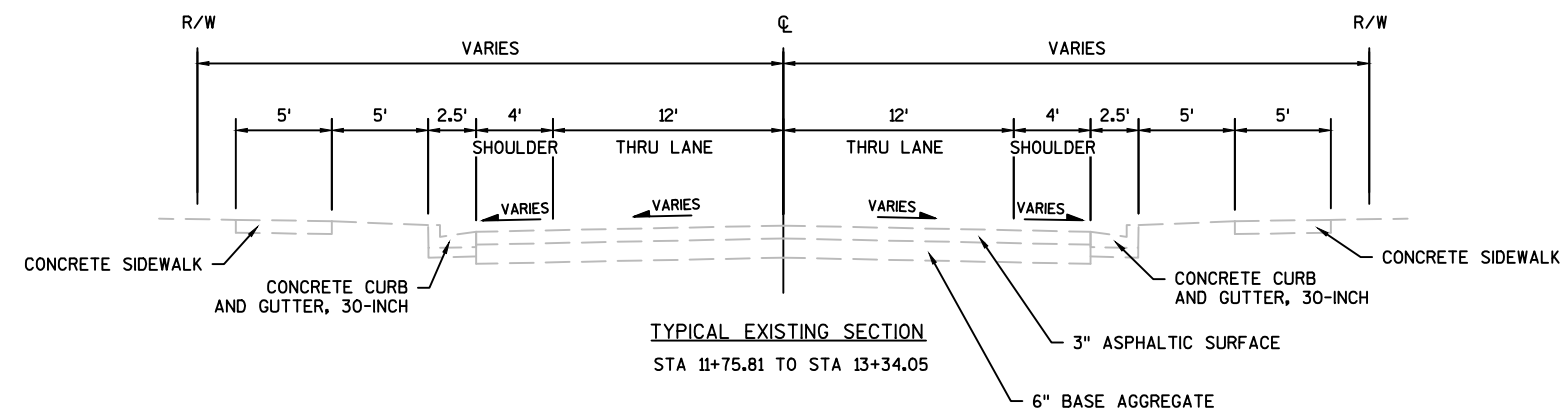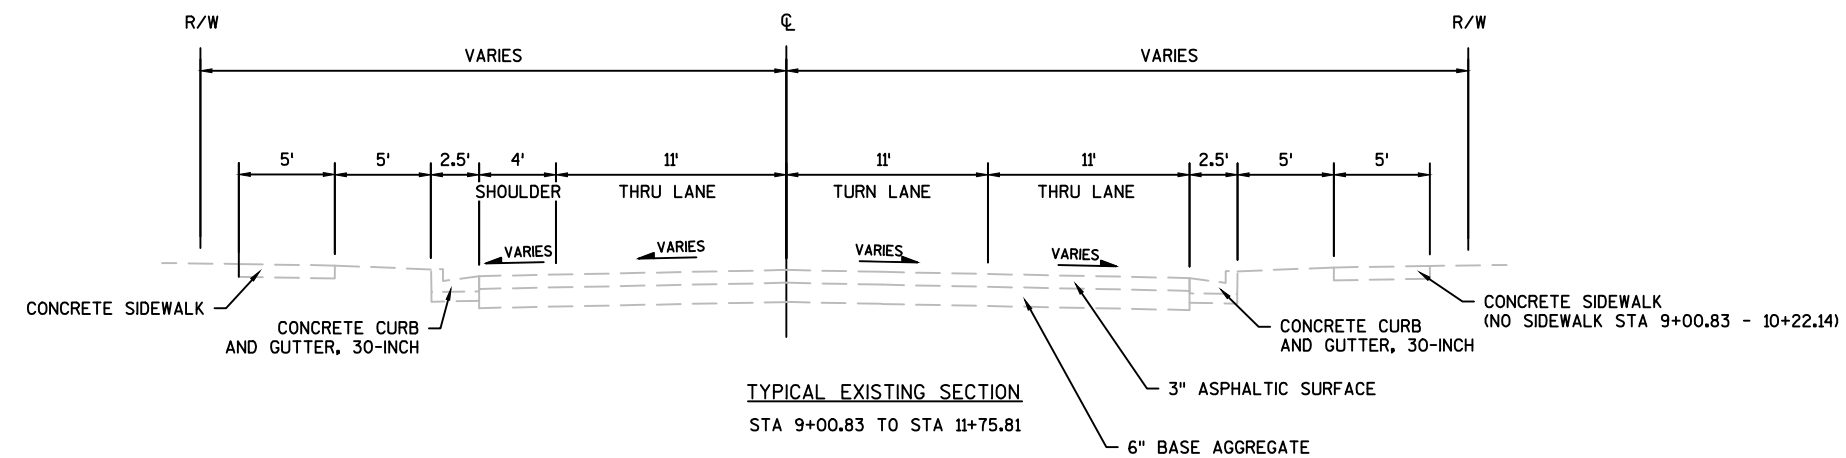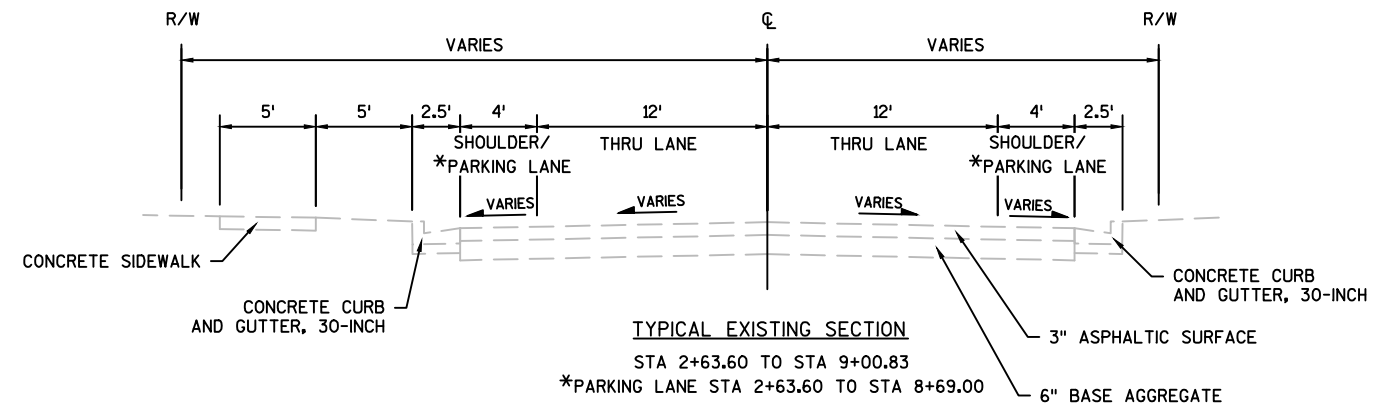

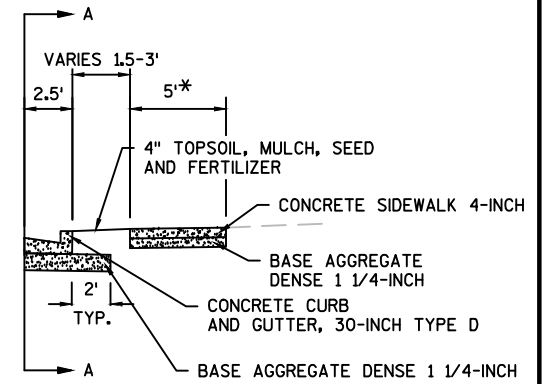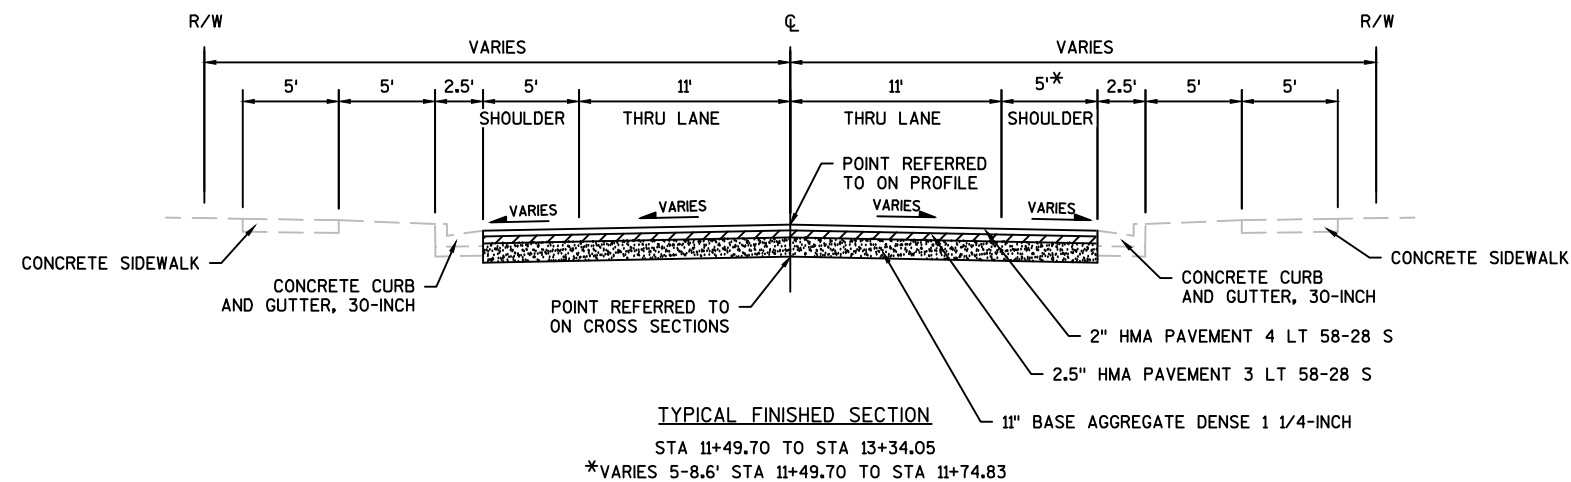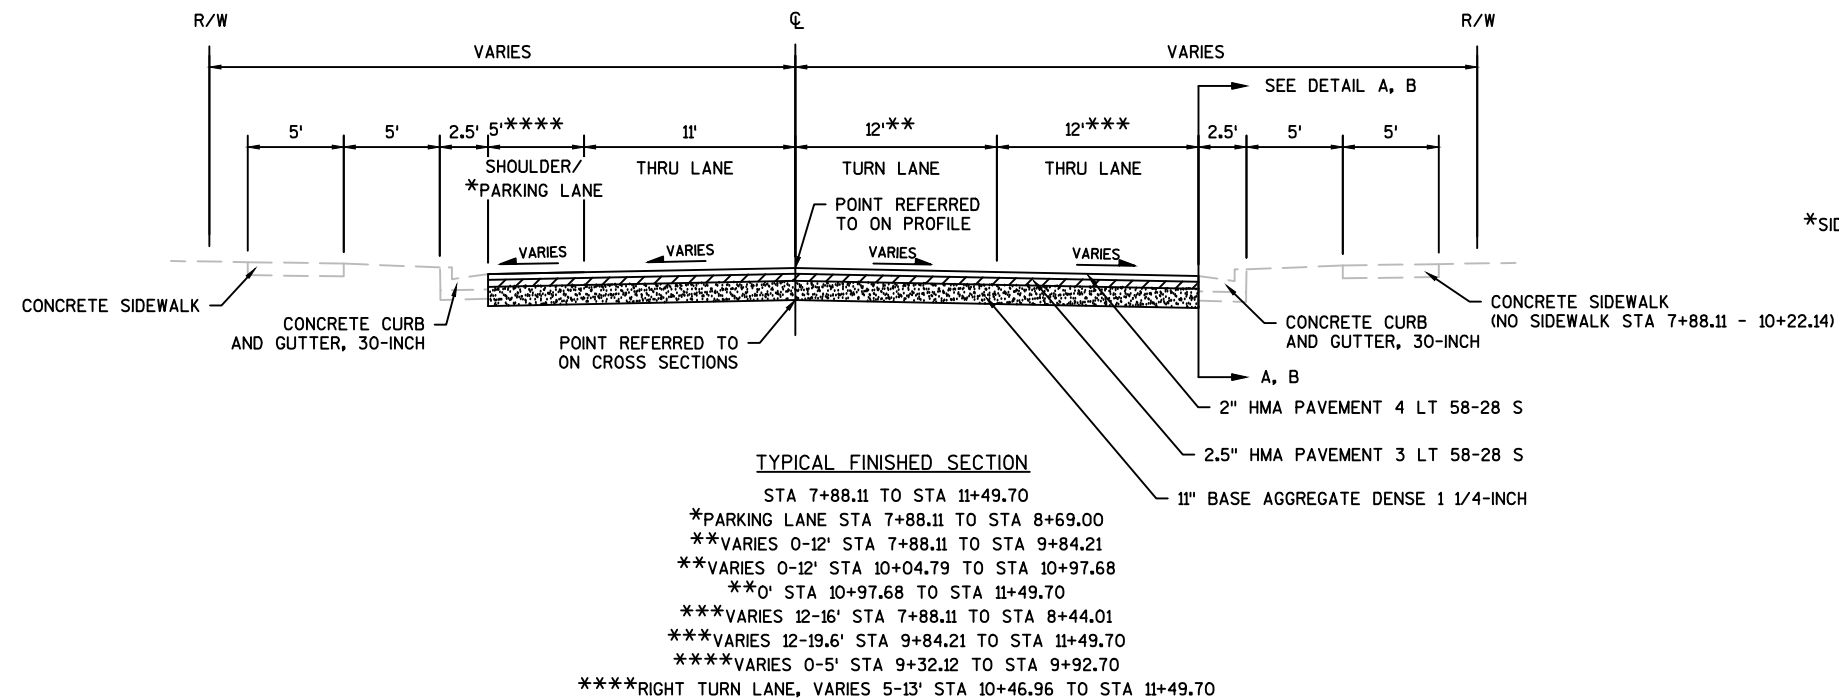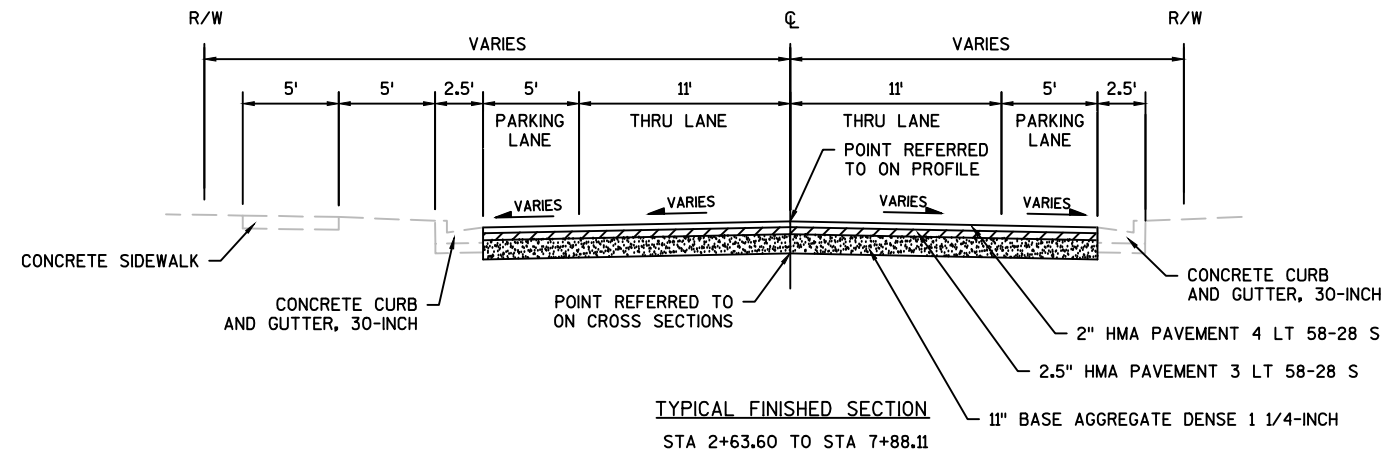


CURB & GUTTER DETAIL
 STA 8+43.95 TO STA 9+26.92
 *SIDEWALK BEGINS AT STA 8+67.16 TO STA 9+26.92

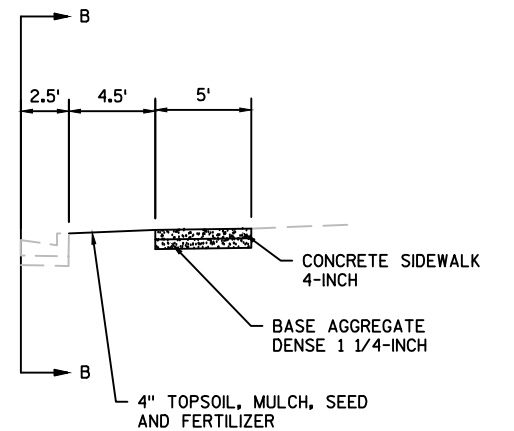

SIDEWALK DETAIL
 STA 9+61.52 TO STA 10+00.71

2

2

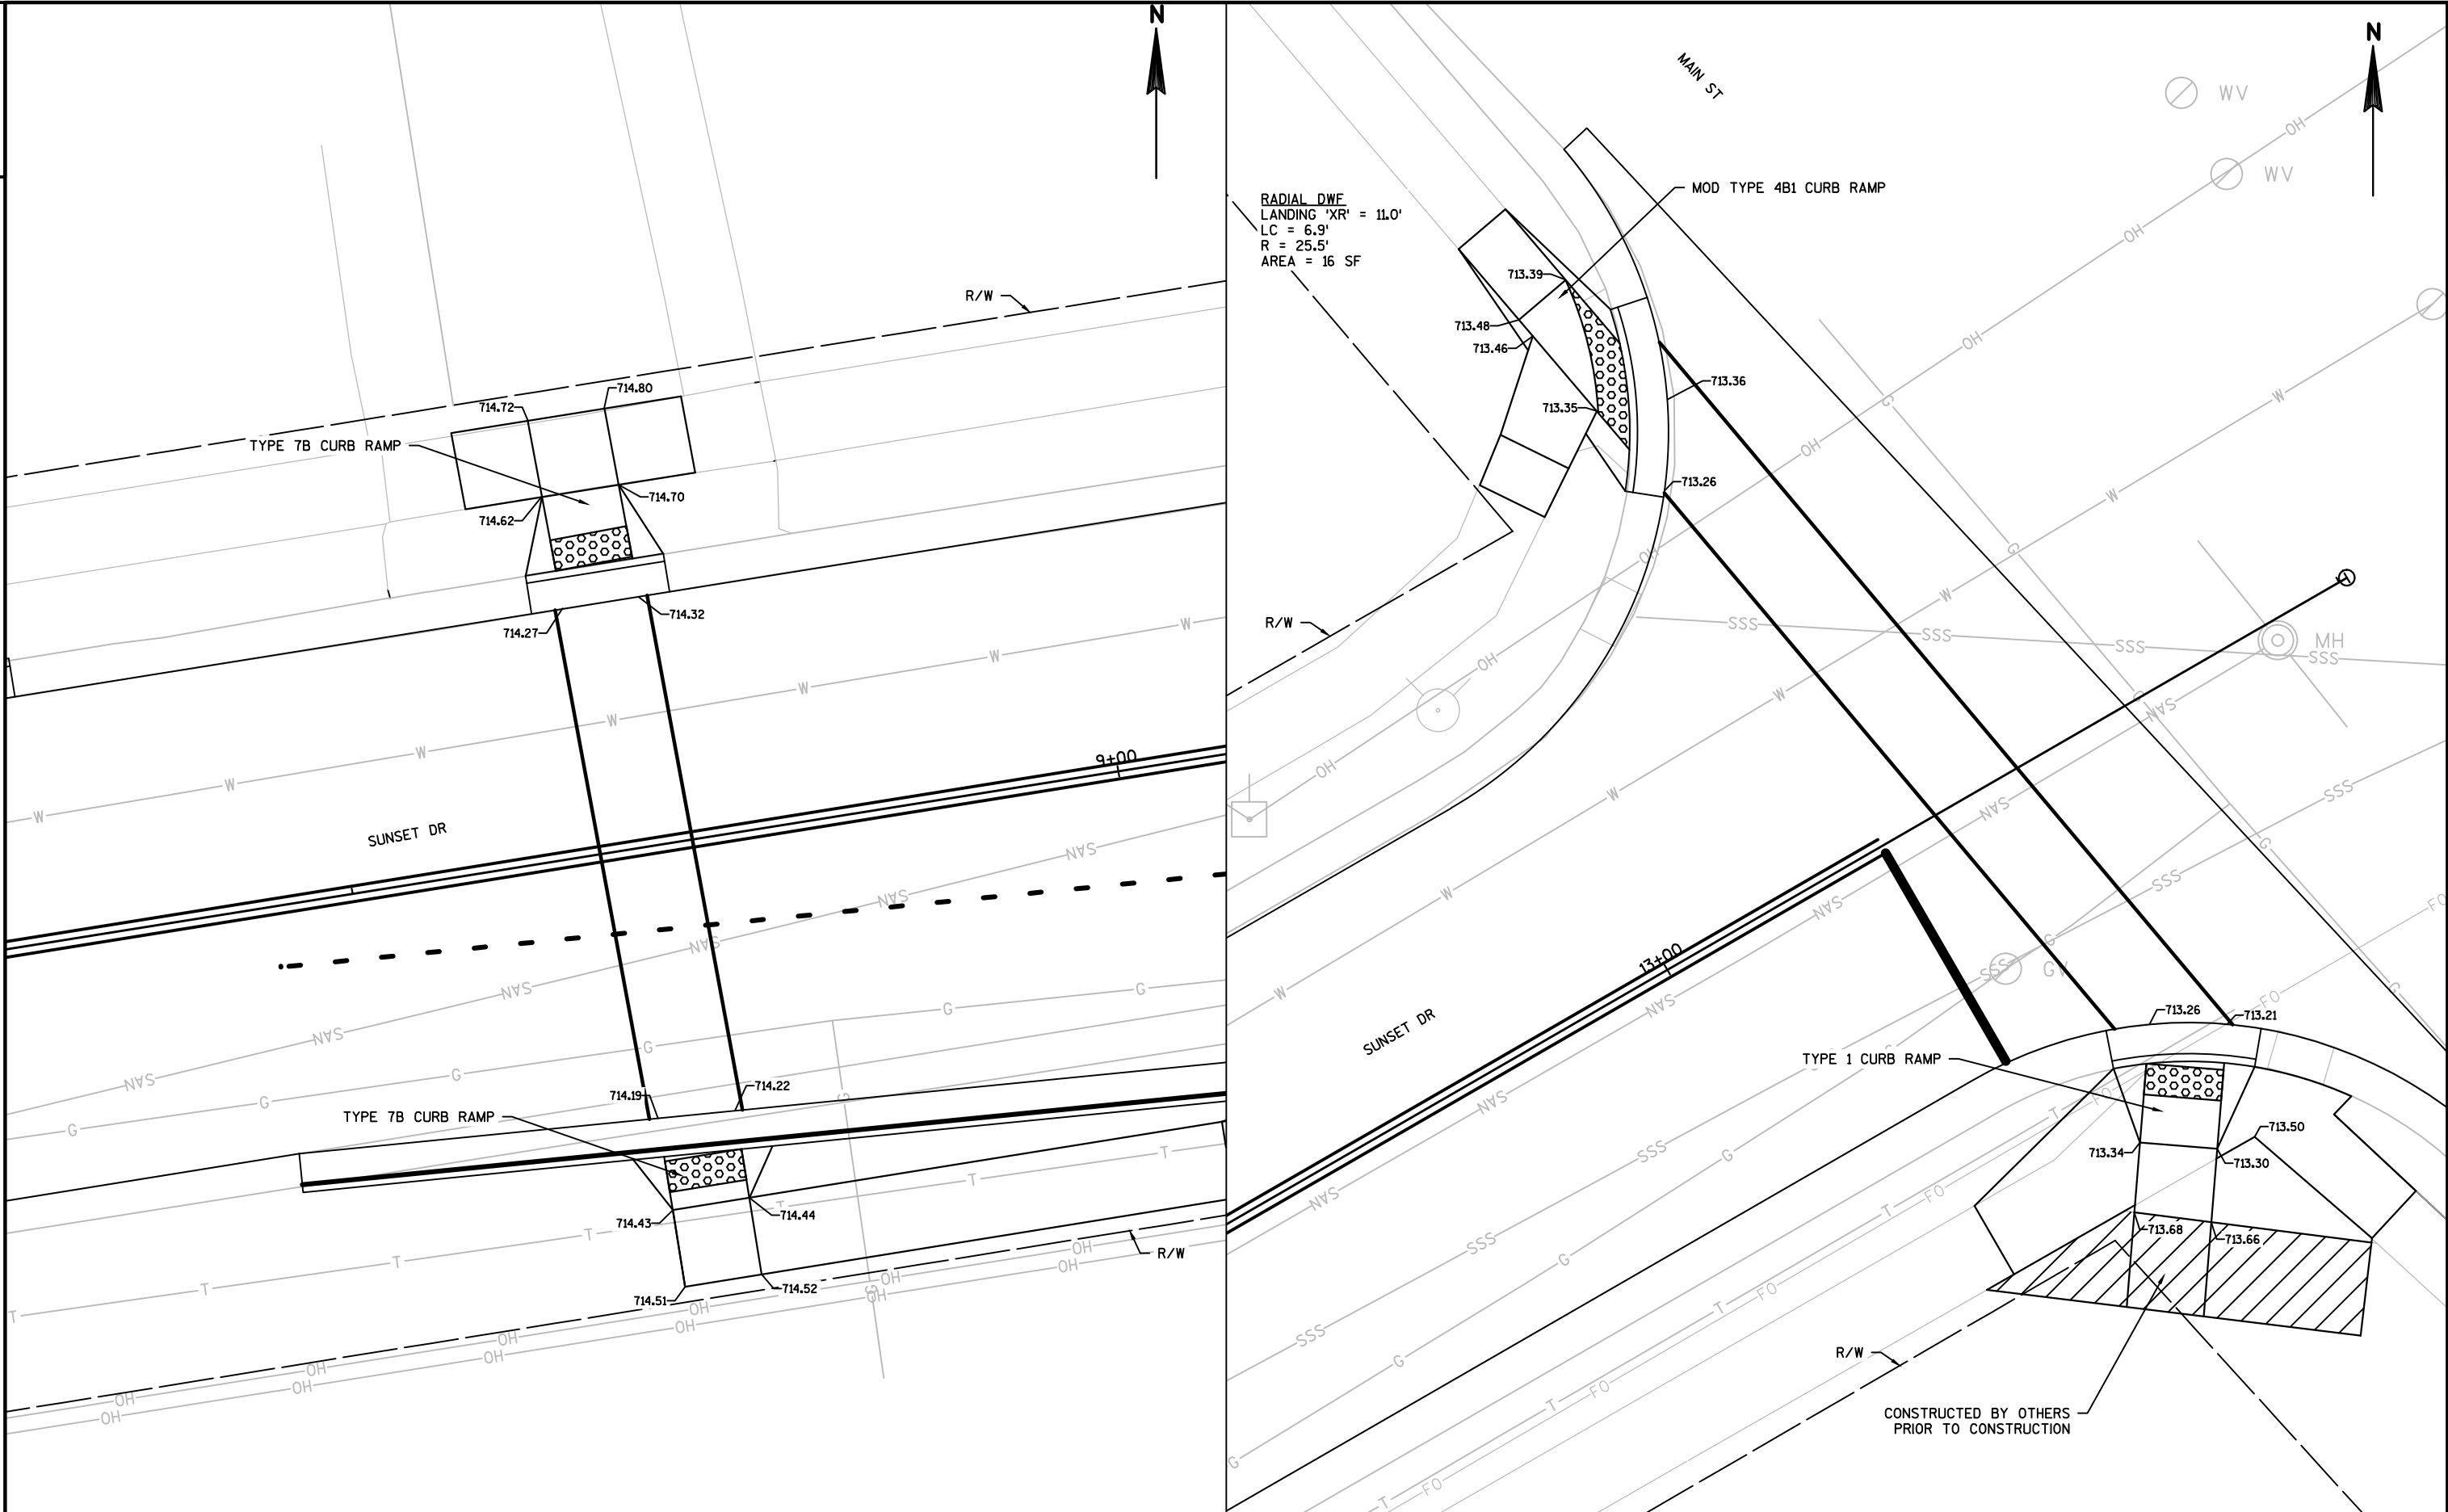

PROJECT NO: 7272-00-01

HWY:LOCAL STREET

COUNTY:LA CROSSE

CURB RAMP DETAILS

SHEET

E

FILE NAME : I:\CLIENTS-MENQ\H5728 HOLMEN VILLAGE OF\001 SUNSET DRIVE PAVEMENT REPLACEMENT\100 CAD\72720000\SHEETSPLAN\021001-CD.DWBL0T DATE : 10/24/2017 1:50 PM
LAYOUT NAME - 01-CD

PLOT BY : BRIAN GENSKOW


PLOT NAME :

PLOT SCALE : 1 IN:10 FT

WISDOT/CADDS SHEET 42

2

2

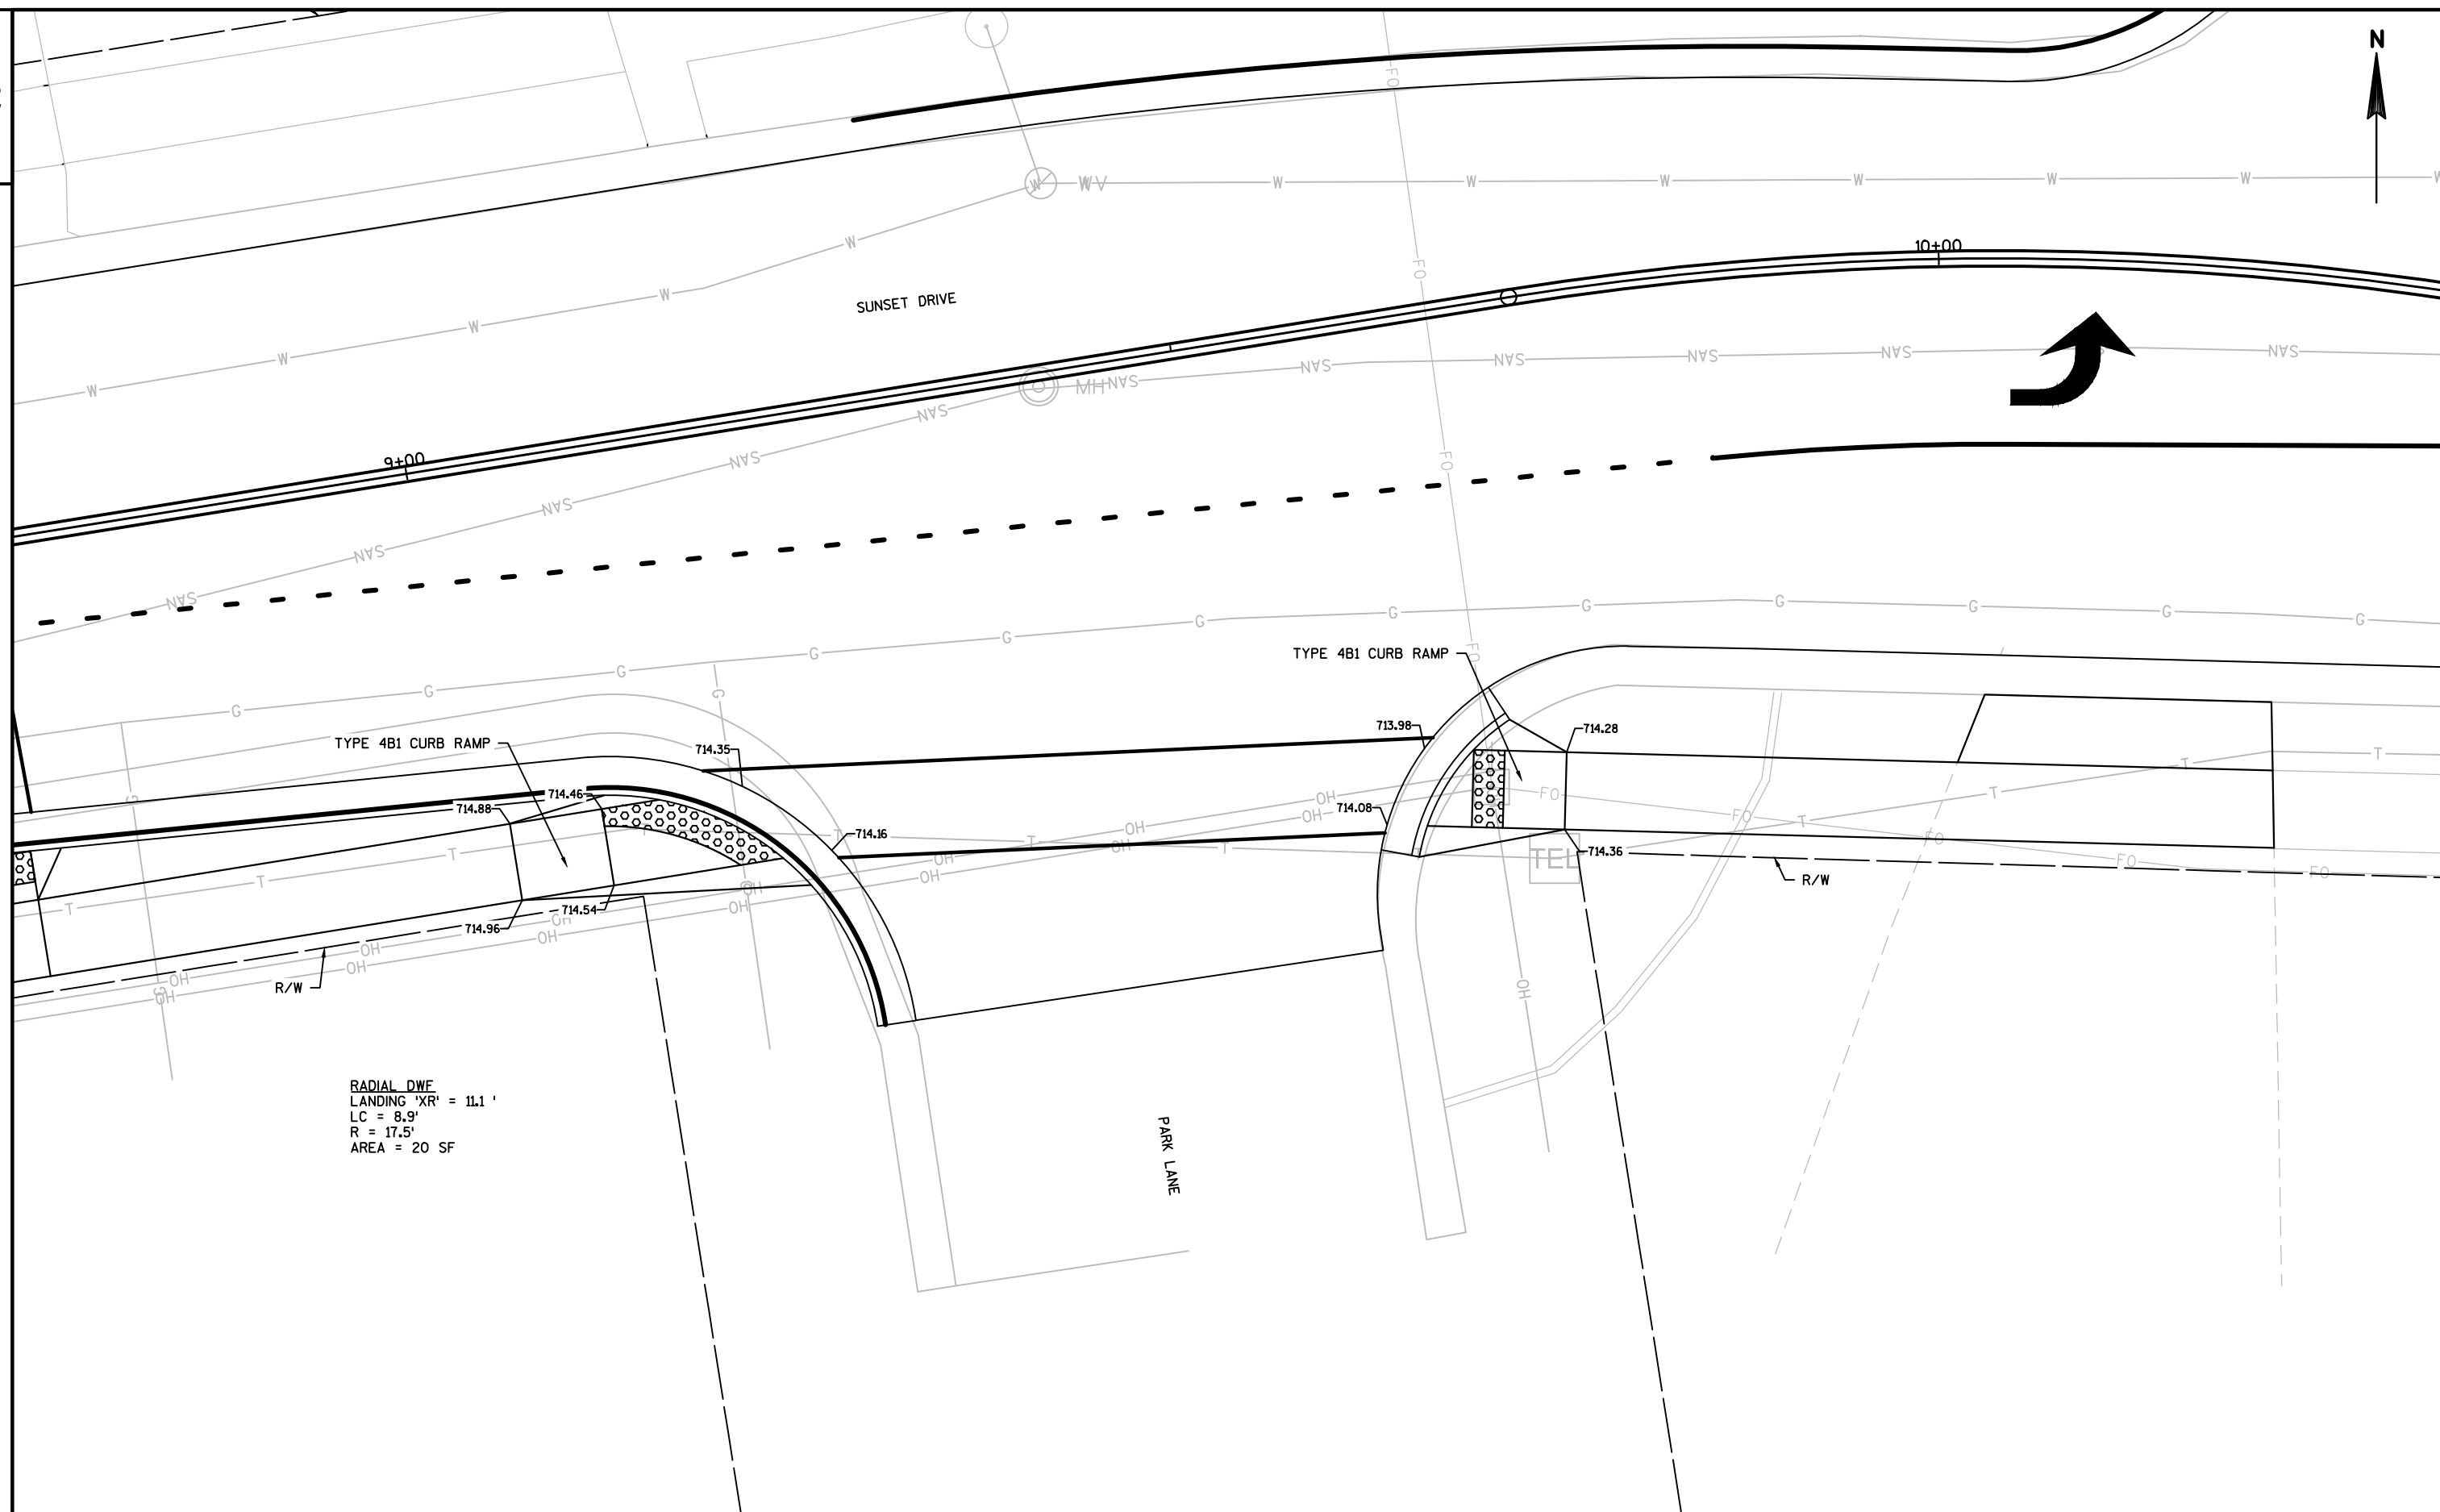

PROJECT NO: 7272-00-01

HWY:LOCAL STREET

COUNTY:LA CROSSE

CURB RAMP DETAILS

SHEET

E


FILE NAME : I:\CLIENTS-MENOV\H5728 HOLMEN VILLAGE OF\001 SUNSET DRIVE PAVEMENT REPLACEMENT\100 CAD\72720000\SHEETSPLAN\021001-CD.DWG PLOT DATE : 10/24/2017 1:49 PM
LAYOUT NAME - 02-CD

PLOT BY : BRIAN GENSKOW

PLOT NAME :

PLOT SCALE : #####

WISDOT/CADDS SHEET 42

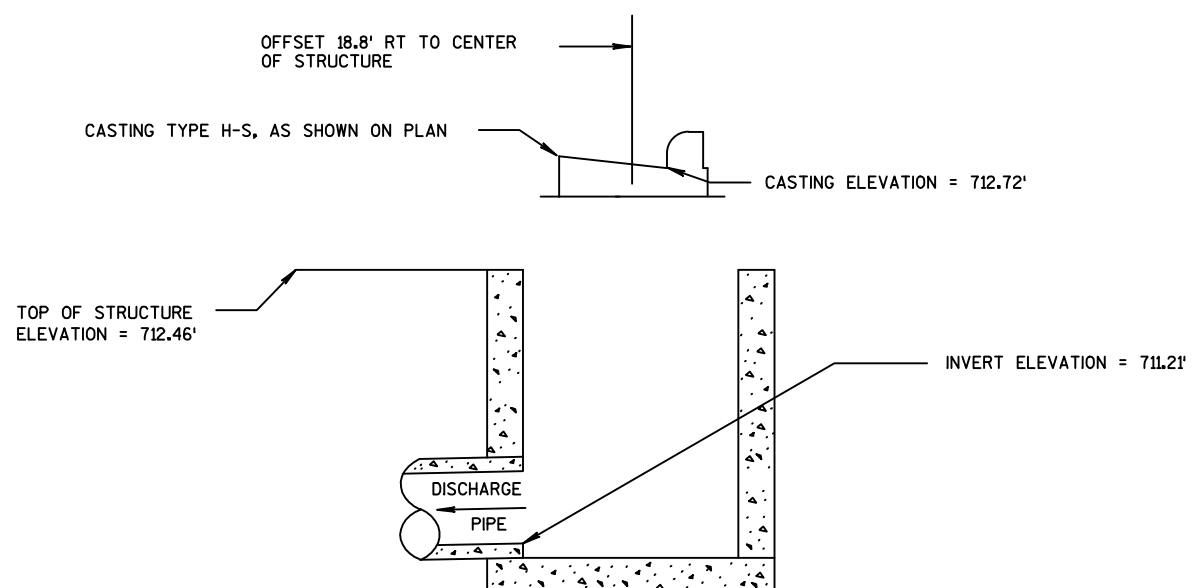

DETAIL OF INLET WITH INLET CASTING

GENERAL NOTES:

GRANULAR BACKFILL REQUIRED AROUND INLET AND MANHOLE (INCIDENTAL TO CONSTRUCTION OF INLET AND MANHOLE)

DETAILS OF CONSTRUCTION, MATERIALS, AND WORKMANSHIP NOT SHOWN ON THIS DRAWING SHALL CONFORM TO THE PERTINENT REQUIREMENTS OF THE STANDARD SPECIFICATIONS, APPLICABLE SPECIAL PROVISIONS, AND S.D.D. FOR INLETS.

Estimate Of Quantities

7272-00-01					
Line	Item	Item Description	Unit	Total	Qty
0002	204.0150	Removing Curb & Gutter	LF	135.000	135.000
0004	204.0155	Removing Concrete Sidewalk	SY	42.000	42.000
0006	204.0220	Removing Inlets	EACH	1.000	1.000
0008	204.0245	Removing Storm Sewer (size) 01. 12-Inch	LF	14.000	14.000
0010	205.0100	Excavation Common	CY	1,830.000	1,830.000
0012	213.0100	Finishing Roadway (project) 01. 7272-00-01	EACH	1.000	1.000
0014	305.0120	Base Aggregate Dense 1 1/4-Inch	TON	2,804.000	2,804.000
0016	416.0160	Concrete Driveway 6-Inch	SY	10.000	10.000
0018	455.0605	Tack Coat	GAL	215.000	215.000
0020	460.2000	Incentive Density HMA Pavement	DOL	680.000	680.000
0022	460.5223	HMA Pavement 3 LT 58-28 S	TON	591.000	591.000
0024	460.5224	HMA Pavement 4 LT 58-28 S	TON	472.000	472.000
0026	601.0411	Concrete Curb & Gutter 30-Inch Type D	LF	497.000	497.000
0028	602.0405	Concrete Sidewalk 4-Inch	SF	546.000	546.000
0030	602.0415	Concrete Sidewalk 6-Inch	SF	613.000	613.000
0032	602.0505	Curb Ramp Detectable Warning Field Yellow	SF	40.000	40.000
0034	602.0605	Curb Ramp Detectable Warning Field Radial Yellow	SF	36.000	36.000
0036	608.0412	Storm Sewer Pipe Reinforced Concrete Class IV 12-Inch	LF	14.000	14.000
0038	611.0639	Inlet Covers Type H-S	EACH	1.000	1.000
0040	611.3230	Inlets 2x3-FT	EACH	1.000	1.000
0042	611.8110	Adjusting Manhole Covers	EACH	5.000	5.000
0044	618.0100	Maintenance And Repair of Haul Roads (project) 01. 7272-00-01	EACH	1.000	1.000
0046	619.1000	Mobilization	EACH	1.000	1.000
0048	624.0100	Water	MGAL	51.000	51.000
0050	625.0100	Topsoil **P**	SY	112.000	112.000
0052	627.0200	Mulching **P**	SY	112.000	112.000
0054	628.1905	Mobilizations Erosion Control	EACH	2.000	2.000
0056	628.1910	Mobilizations Emergency Erosion Control	EACH	2.000	2.000
0058	628.7015	Inlet Protection Type C	EACH	7.000	7.000
0060	629.0210	Fertilizer Type B **P**	CWT	2.200	2.200
0062	630.0140	Seeding Mixture No. 40 **P**	LB	2.600	2.600
0064	630.0200	Seeding Temporary **P**	LB	4.900	4.900
0066	642.5001	Field Office Type B	EACH	1.000	1.000
0068	643.0420	Traffic Control Barricades Type III	DAY	555.000	555.000
0070	643.0705	Traffic Control Warning Lights Type A	DAY	703.000	703.000
0072	643.0900	Traffic Control Signs	DAY	148.000	148.000
0074	643.5000	Traffic Control	EACH	1.000	1.000
0076	646.1020	Marking Line Epoxy 4-Inch	LF	1,272.000	1,272.000

Estimate Of Quantities

7272-00-01					
Line	Item	Item Description	Unit	Total	Qty
0078	646.3020	Marking Line Epoxy 8-Inch	LF	177.000	177.000
0080	646.5020	Marking Arrow Epoxy	EACH	1.000	1.000
0082	646.6120	Marking Stop Line Epoxy 18-Inch	LF	16.000	16.000
0084	646.7120	Marking Diagonal Epoxy 12-Inch	LF	42.000	42.000
0086	646.7420	Marking Crosswalk Epoxy Transverse Line 6-Inch	LF	255.000	255.000
0088	646.8120	Marking Curb Epoxy	LF	236.000	236.000
0090	650.4000	Construction Staking Storm Sewer	EACH	1.000	1.000
0092	650.4500	Construction Staking Subgrade	LF	1,070.000	1,070.000
0094	650.5000	Construction Staking Base	LF	1,070.000	1,070.000
0096	650.5500	Construction Staking Curb Gutter and Curb & Gutter	LF	92.000	92.000
0098	650.9000	Construction Staking Curb Ramps	EACH	6.000	6.000
0100	650.9910	Construction Staking Supplemental Control (project) 01. 7272-00-01	LS	1.000	1.000
0102	690.0150	Sawing Asphalt	LF	186.000	186.000
0104	690.0250	Sawing Concrete	LF	74.000	74.000
0106	SPV.0060	Special 01. Adjust Water Valves	EACH	2.000	2.000

3

REMOVING CURB & GUTTER

STATION - STATION	LOCATION	204.0150 LF	REMARKS
8+44 - 9+27	RT	95	
8+64 - 8+73	LT	9	CURB RAMP
9+58 - 9+67	RT	9	CURB RAMP
13+15 - 13+21	LT	12	CURB RAMP
13+23 - 13+31	RT	10	CURB RAMP
ITEM TOTAL		135	

STORM SEWER REMOVALS

STATION	LOCATION	204.0220 REMOVING INLET EACH	204.0245.01 REMOVING STORM SEWER 12-INCH LF
11+54	RT	1	14
ITEM TOTAL		1	14

REMOVING CONCRETE SIDEWALK

STATION - STATION	LOCATION	204.0155 SY	REMARKS
8+61 - 8+76	LT	8	CURB RAMP
13+07 - 13+16	LT	10	CURB RAMP
13+10 - 13+35	RT	24	CURB RAMP
ITEM TOTAL		42	

FINISHING ROADWAY

PROJECT	LOCATION	213.0100 EACH
7272-00-01	SUNSET DR	1
ITEM TOTAL		1

BASE AGGREGATE DENSE

STATION - STATION	LOCATION	305.0120 1 1/4-INCH TON
2+64 - 13+34	SUNSET DRIVE	2804
ITEM TOTAL		2804

DIVISION	STATIONING	LOCATION	205.0100 COMMON EXCAVATION (CY)	SALVAGED / UNUSABLE PAVEMENT MATERIAL (1)	AVAILABLE MATERIAL (CY) (2)	UNEXPANDED FILL	EXPANDED FILL	MASS ORDINATE +/- (3)	208.0100 BORROW (CY)	
			CUT				FACTOR 1.30			
1	2+64 - 13+34	SUNSET DRIVE	1830	1078	752	2	2	750	0	
GRAND TOTAL			1830	1078	752	2	2	750	0	
TOTAL COMMON EXCAVATION =			1830							0

- 1) SALVAGED/UNUSABLE PAVEMENT MATERIAL IS INCLUDED IN CUT.
- 2) AVAILABLE MATERIAL = CUT MINUS THE SALVAGED/UNUSABLE PAVEMENT MATERIAL
- 3) THE MASS ORDINATE = A + OR - QUANTITY CALCULATED FOR THE DIVISON. A POSITIVE QUANTITY INDICATES AN EXCESS OF MATERIAL.

NOTE: TABLE QUANTITIES ARE
CATEGORY 0010 UNLESS
OTHERWISE NOTED.

3

CONCRETE DRIVEWAY				
STATION - STATION		LOCATION	416.0160 6 INCH SY	REMARKS
10+01 - 10+25		RT	10	
ITEM TOTALS			10	

CONCRETE CURB & GUTTER				
STATION - STATION		LOCATION	601.0411 30-INCH TYPE D LF	REMARKS
2+64 - 3+24		LT	60	
3+54 - 3+69		LT	15	
4+18 - 4+38		LT	20	
5+04 - 5+24		LT	20	
5+62 - 5+74		RT	15	
5+84 - 6+34		LT	50	
6+08 - 6+35		RT	30	
6+61 - 6+81		LT	20	
7+31 - 7+51		LT	20	
7+50 - 7+65		RT	15	
7+85 - 8+15		RT	30	
8+11 - 8+31		LT	20	
8+44 - 9+27		RT	92	
8+64 - 8+73		LT	9	CURB RAMP
9+58 - 9+67		RT	9	CURB RAMP
10+48 - 10+78		RT	30	
11+45 - 11+62		RT	20	
13+15 - 13+21		LT	12	CURB RAMP
13+23 - 13+31		RT	10	CURB RAMP
ITEM TOTAL			497	

ASPHALTIC PAVEMENT ITEMS				
STATION -STATION		LOCATION	455.0605* TACK COAT GAL	460.5223 HMA PAVEMENT 3 LT 58-28 S TON
2+64 - 13+34		SUNSET DRIVE	215	591
ITEM TOTALS			215	591
*APPLICATION RATE = 0.050 GAL/SY				

STORM SEWER STRUCTURE ITEMS									
STATION	OFFSET	TOP STRUCTURE ELEV	CASTING ELEV	BOTTOM STRUCTURE ELEV	DEPTH	611.3230 INLETS 2X3-FT EACH	611.0639 INLET COVERS TYPE H-S EACH	650.4000 CONSTRUCTION STAKING STORM SEWER EACH	REMARKS
11+54	18.8' RT	712.46	712.72	711.21	1.25	1	1	1	
ITEM TOTAL						1	1	1	
NOTE: TABLE QUANTITIES ARE CATEGORY 0010 UNLESS OTHERWISE NOTED.									

3

TOPSOIL, MULCHING, FERTILIZER, AND SEEDING

STATION - STATION	LOCATION	625.0100	627.0200	629.0210	630.0140	630.0200
		TOPSOIL	MULCHING	FERTILIZER	SEEDING	TEMPORARY
		P	**P**	**P**	**P**	**P**
		SY	SY	CWT	LB	LB
2+64 - 3+24	LT	13	13	0.1	0.2	0.4
3+54 - 3+69	LT	3	3	0.1	0.1	0.1
4+18 - 4+38	LT	4	4	0.1	0.1	0.1
5+04 - 5+24	LT	4	4	0.1	0.1	0.1
5+62 - 5+74	RT	3	3	0.1	0.1	0.1
5+84 - 6+34	LT	11	11	0.1	0.2	0.3
6+08 - 6+35	RT	7	7	0.1	0.1	0.2
6+61 - 6+81	LT	4	4	0.1	0.1	0.1
7+31 - 7+51	LT	4	4	0.1	0.1	0.1
7+50 - 7+65	RT	3	3	0.1	0.1	0.1
7+85 - 8+15	RT	7	7	0.1	0.1	0.2
8+11 - 8+31	LT	4	4	0.1	0.1	0.1
8+28 - 9+24	RT	3	3	0.1	0.1	0.1
8+59 - 8+78	LT	3	3	0.1	0.1	0.1
9+60 - 10+03	RT	18	18	0.1	0.3	0.5
13+05 - 13+19	LT	3	3	0.1	0.1	0.1
13+10 - 13+34	RT	8	8	0.1	0.1	0.2
UNDISTRIBUTED		10	10	0.5	1	2
ITEM TOTALS		112	112	2.2	2.6	4.9

P Pay Plan Quantity

TRAFFIC CONTROL

LOCATION	643.5000	643.0420	643.0705	643.0900
	TRAFFIC	BARRICADES	WARNING	SIGNS
	CONTROL	TYPE III	LIGHTS	
	EACH	DAYS	TYPE A	DAYS
PROJECT 7272-00-01	1	--	--	--
SUNSET DR - BEGINNING OF PROJECT	--	111	148	37
IRENE PLACE	--	111	148	37
PARK LANE	--	111	148	37
SUNSET DR - END OF PROJECT	--	222	259	37
ITEM TOTALS	1	555	703	148

INLET PROTECTION

STATION	LOCATION	628.7015
		TYPE C
		EACH
5+69	RT	1
6+00	LT	1
6+15	RT	1
11+50	LT	1
11+54	RT	1
13+08	LT	1
13+32	RT	1
ITEM TOTALS		7

FIELD OFFICE

PROJECT	642.5001
	TYPE B
	EACH
7272-00-01	1
ITEM TOTAL	1

ADJUSTING MANHOLE COVERS

STATION	611.8110	REMARKS
	EACH	
CATEGORY 0020		
4+12	1	SANITARY
7+62	1	SANITARY
9+41	1	SANITARY
11+49	1	SANITARY
11+57	1	STORM
ITEM TOTAL	5	

WATER

STATION -STATION	LOCATION	624.0100	REMARKS
		MGAL	
2+64 - 13+34	SUNSET DR	51	BASE COMPACTION DUST CONTROL
ITEM TOTALS		51	

MOBILIZATIONS

PROJECT	619.1000	628.1905	628.1910
	MOBILIZATION	MOBILIZATIONS	MOBILIZATIONS
	EACH	EROSION	EROSION
		CONTROL	CONTROL
		EACH	EACH
7272-00-01	1	2	2
ITEM TOTALS	1	2	2

NOTE: TABLE QUANTITIES ARE
CATEGORY 0010 UNLESS
OTHERWISE NOTED.

PROJECT NO: 7272-00-01

HWY: LOCAL STREET

COUNTY: LA CROSSE

MISCELLANEOUS QUANTITIES

SHEET

E

3

3

PAVEMENT MARKING

STATION - STATION	LOCATION	646.1020	646.3020	646.5020	646.8120	646.6120	646.7120	646.7420	REMARKS
		MARKING LINE EPOXY 4-INCH LF	MARKING LINE EPOXY 8-INCH LF	MARKING ARROW EPOXY EACH	MARKING CURB EPOXY LF	MARKING STOP LINE EPOXY 18-INCH LF	MARKING DIAGONAL EPOXY 12-INCH LF	MARKING CROSSWALK EPOXY TRANSVERSE LINE 6-INCH LF	
6+80 - 13+16	CENTER LINE	1,272	--	--	--	--	--	--	DOUBLE YELLOW WHITE, SKIP DASH YELLOW
8+45 - 9+84	RT	--	33	--	--	--	--	--	
8+44 - 9+27	RT	--	--	--	95	--	--	--	
8+67 - 8+73		--	--	--	--	--	--	68	
9+16 - 9+63	RT	--	--	--	--	--	--	83	
9+32 - 10+18	LT	--	--	--	91	--	--	--	YELLOW WHITE WHITE, SKIP DASH
9+84 - 10+98	RT	--	120	1	--	--	42	--	
10+47 - 11+53	LT	--	24	--	--	--	--	--	
10+48 - 10+78	RT	--	--	--	30	--	--	--	
11+45 - 11+62	RT	--	--	--	20	--	--	--	
13+15 - 13+30		--	--	--	--	16	--	104	
ITEM TOTALS		1,272	177	1	236	16	42	255	

CONSTRUCTION STAKING

STATION - STATION	LOCATION	650.4500	650.5000	650.5500	650.9000	650.9910
		SUBGRADE LF	BASE LF	CURB & GUTTER LF	CURB RAMPS EA	SUPPLEMENTAL CONTROL (7272-00-01) LS
2+64 - 13+34		1070	1070	--	--	1
8+44 - 9+27	RT	--	--	92	2	--
8+71	LT	--	--	--	1	--
9+62	RT	--	--	--	1	--
13+15 - 13+28	RT/LT	--	--	--	2	--
ITEM TOTALS		1070	1070	92	6	1

SAWING

STATION	LOCATION	690.0150	690.0250
		ASPHALT LF	CONCRETE LF
2+64		32	--
5+74 - 6+07	RT	32	--
8+44	RT	--	3
8+64 - 8+73	LT	--	5
9+24 - 9+67	RT	30	8
13+05 - 13+16	LT	--	14
13+08 - 13+34	RT	--	44
13+34		92	--
ITEM TOTAL		186	74

ADJUST WATER VALVES

		SPV.0060.01	
STATION	LOCATION	EACH	REMARKS
CATEGORY 0020			
6+23	LT	1	
9+43	LT	1	
ITEM TOTAL		2	

NOTE: TABLE QUANTITIES ARE
CATEGORY 0010 UNLESS
OTHERWISE NOTED.

PROJECT NO:7272-00-01


HWY:LOCAL STREET



COUNTY:LA CROSSE

MISCELLANEOUS QUANTITIES

SHEET


E

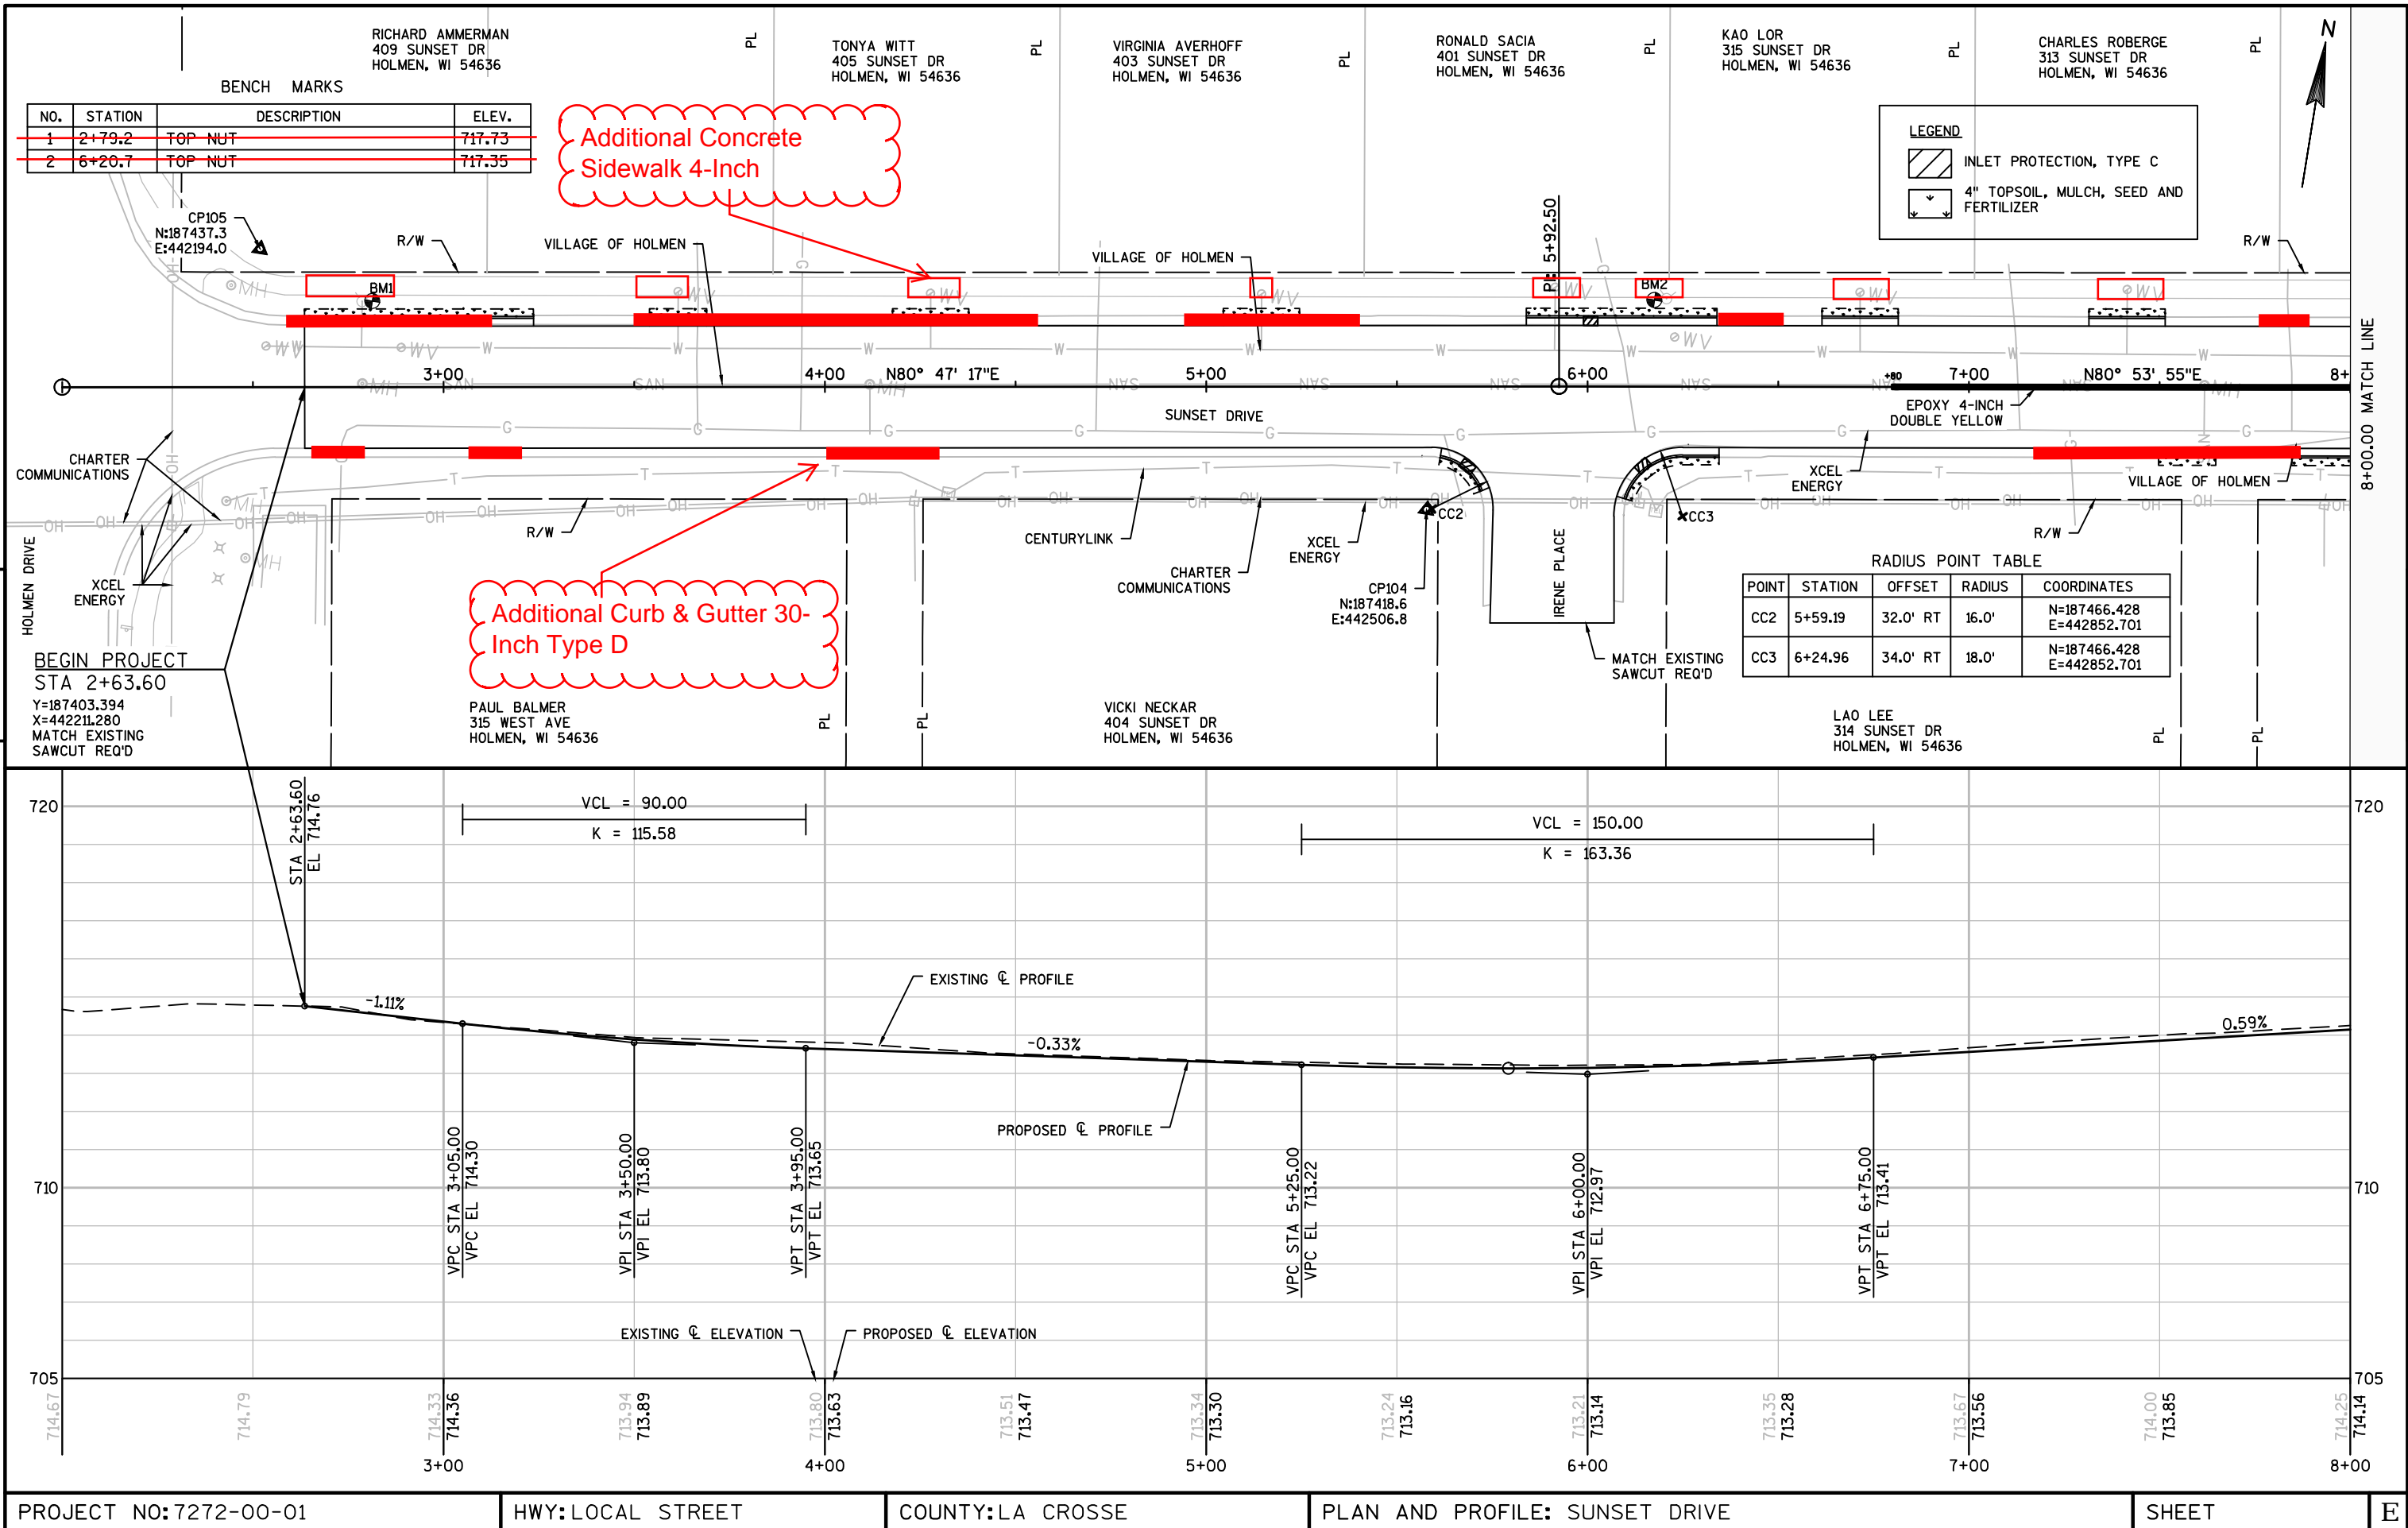

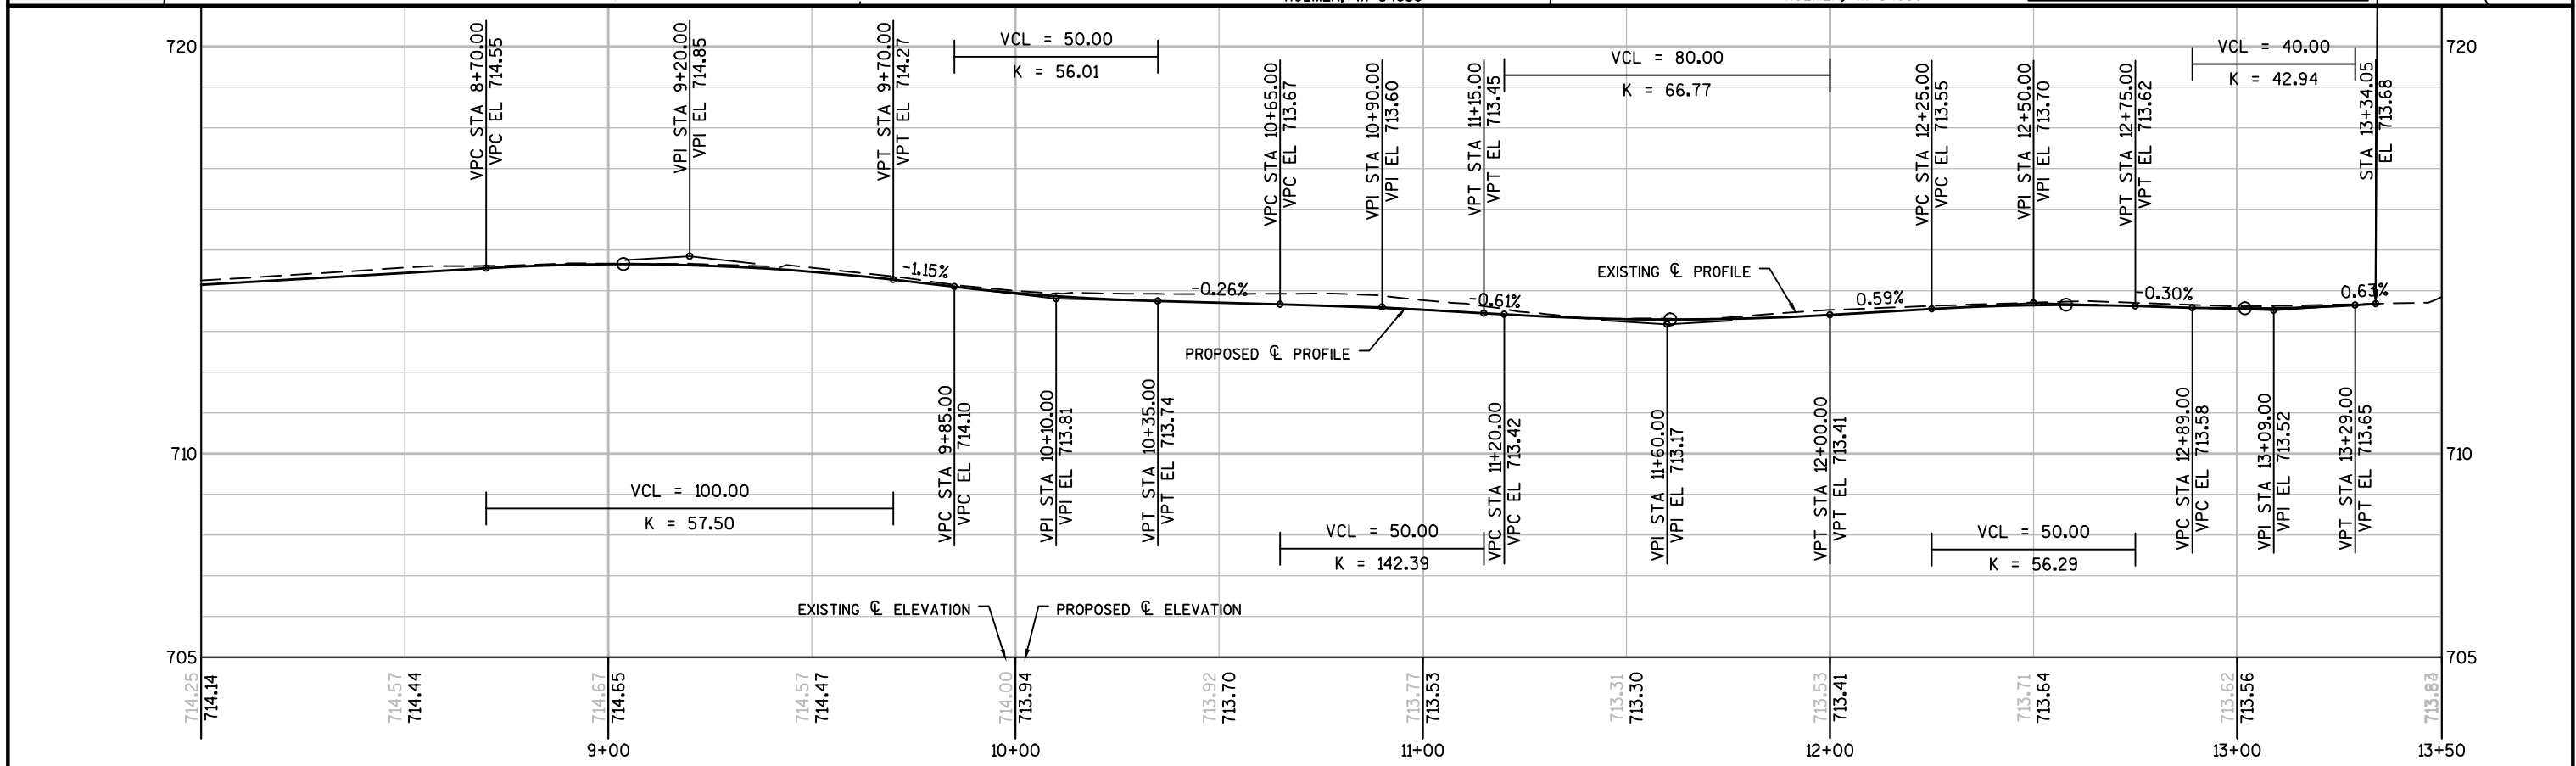
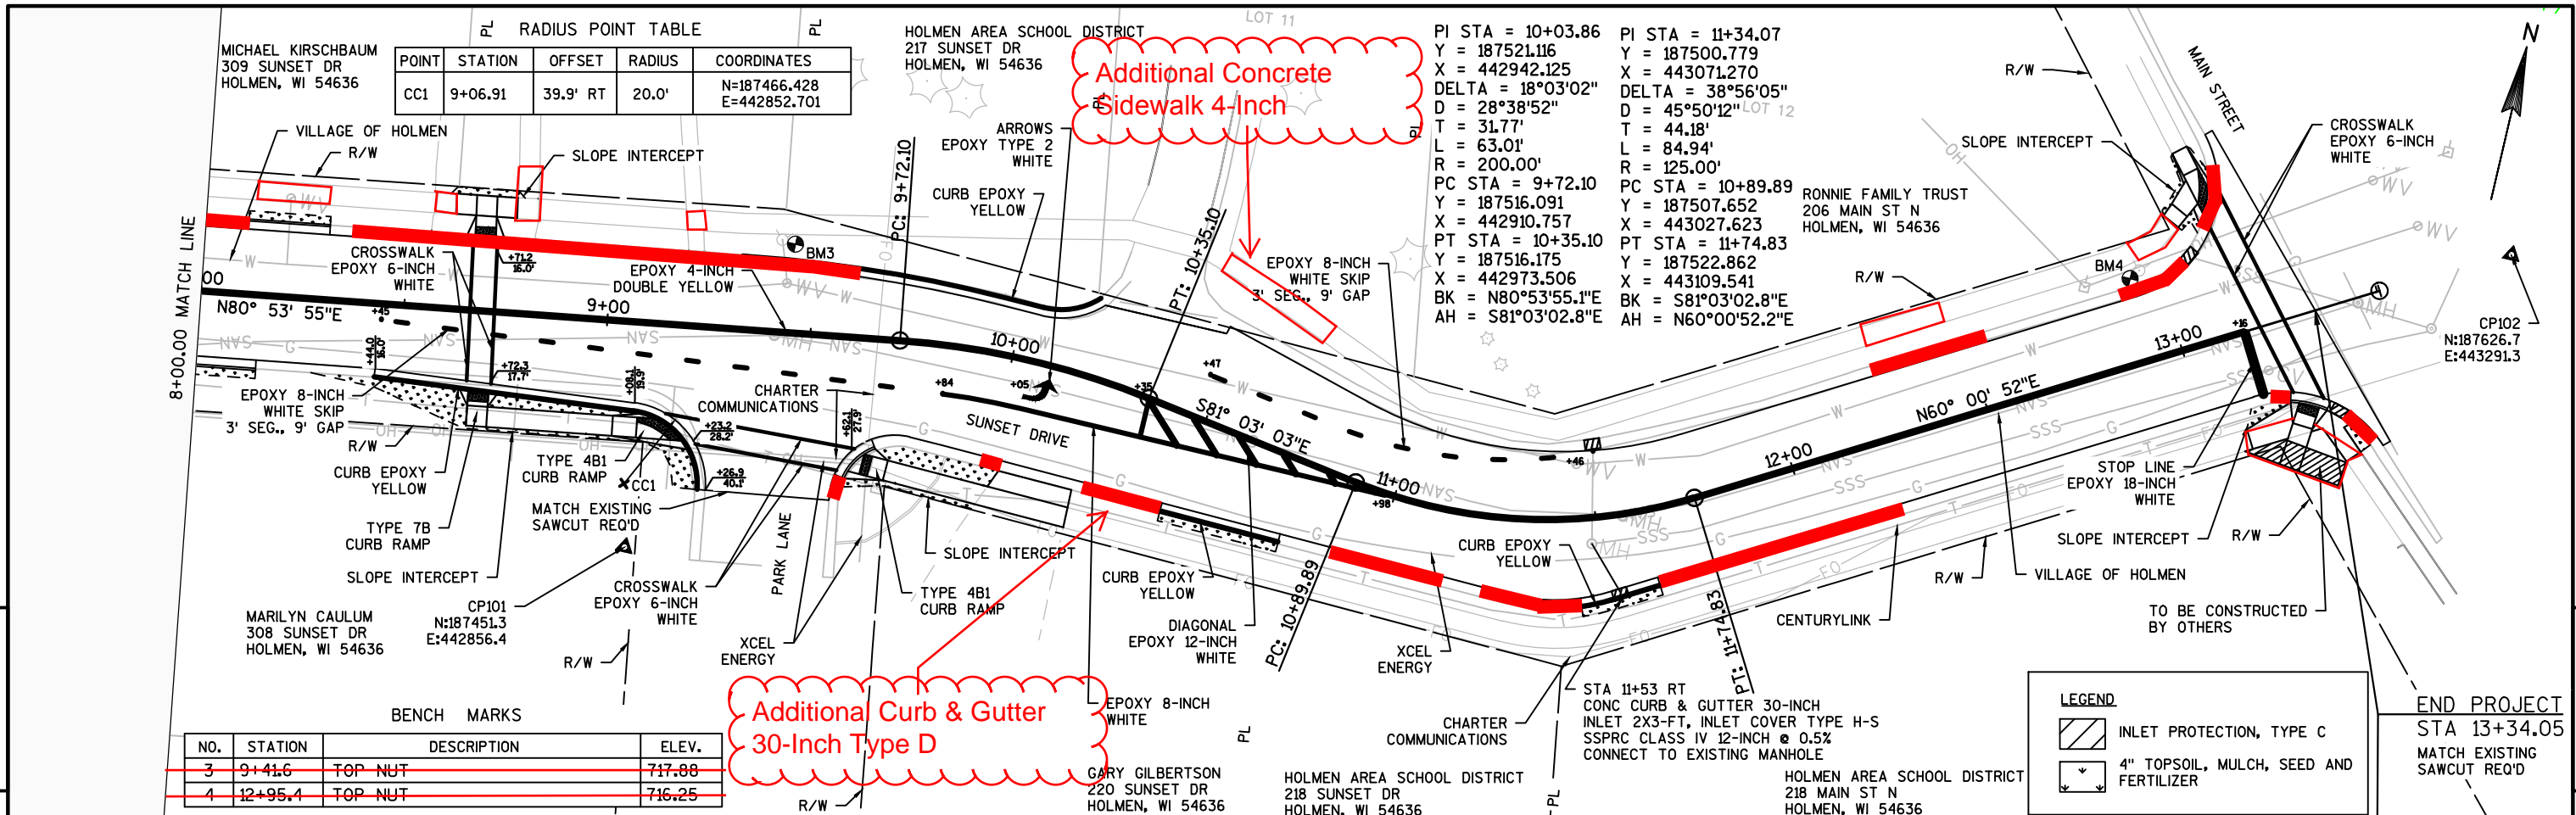


Standard Detail Drawing List





08A05-19A	INLET COVERS TYPE A, H, A-S, H-S & Z
08C07-02	INLETS 2X2-FT, 2X2.5-FT, 2X3-FT AND 2.5X3-FT
08D01-20A	CONCRETE CURB & GUTTER
08D01-20B	CONCRETE CURB, TIES AND CURB AND GUTTER APPLICATIONS
08D05-19D	CURB RAMPS TYPE 4B AND 4B1
08D05-19E	CURB RAMPS TYPES 5, 6, 7A, 7B & 8
08D05-19F	CURB RAMPS RADIAL DETECTABLE WARNING FIELD APPLICATIONS
08D05-19G	CURB RAMPS RECTANGULAR AND RADIAL DETECTABLE WARNING PLATES
08E10-02	INLET PROTECTION TYPE A, B, C AND D
15C02-06A	BARRICADES AND SIGNS FOR MAINLINE CLOSURES
15C02-06B	BARRICADES AND SIGNS FOR MAINLINE CLOSURES
15C03-03	BARRICADES AND SIGNS FOR SIDEROAD CLOSURES
15C07-14C	PAVEMENT MARKING ARROWS
15C08-18A	LONGITUDINAL MARKING (MAINLINE)
15C08-18B	PAVEMENT MARKING (TURN LANES)
15C33-02	STOP LINE AND CROSSWALK PAVEMENT MARKING

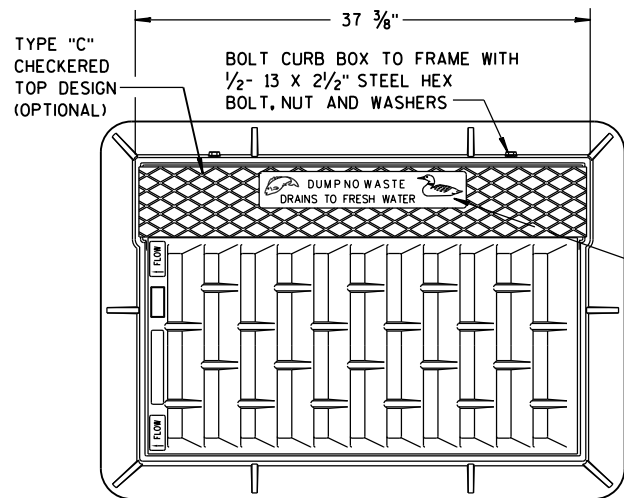

NOTE:
GRATE IS REVERSIBLE.

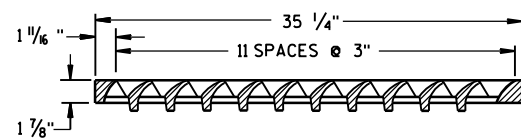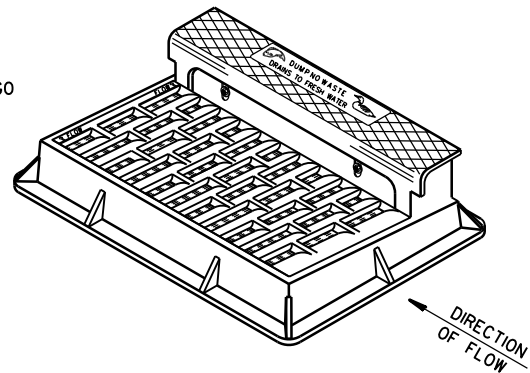


NOTE: CURB BOX HEIGHT ADJUSTABLE 6" TO 9"

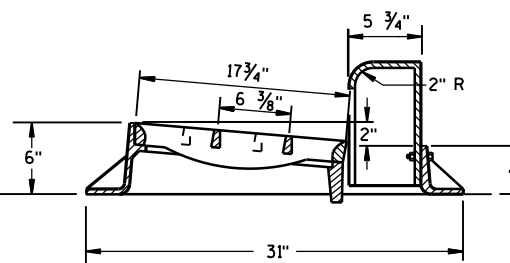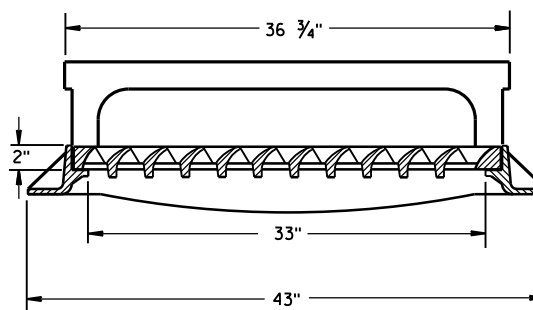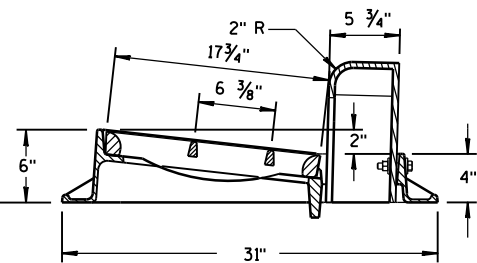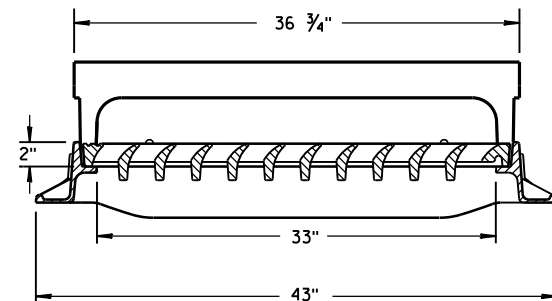


TYPE "H"


NOTE: EITHER CASTING IS ACCEPTABLE

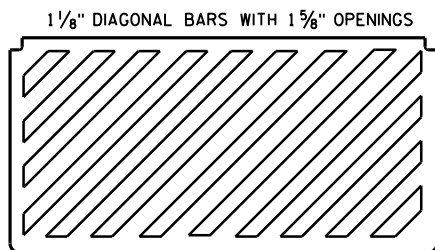

SPECIAL GRATE FOR
TYPE "H" COVER
(MEASURES 35 1/4" X 17 3/4" X 2")
(NOTED AS TYPE H-S ON DRAINAGE TABLE)

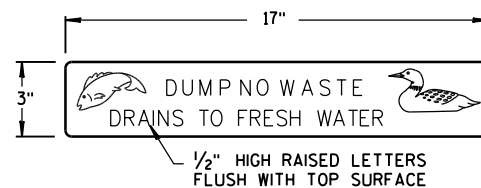


LOGO DETAIL

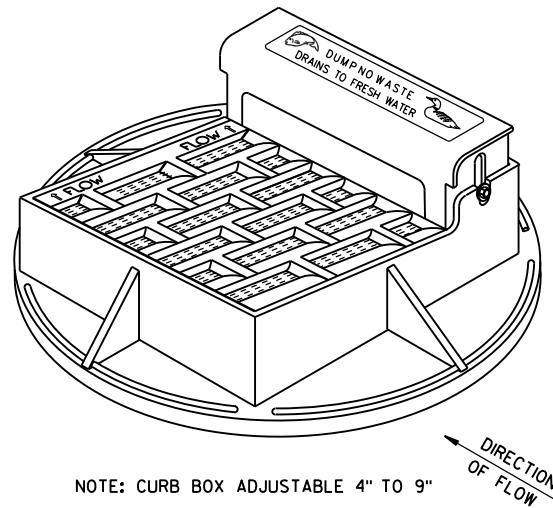


NOTE: CURB BOX ADJUSTABLE 4" TO 9"



NOTE:
GRATE IS REVERSIBLE.

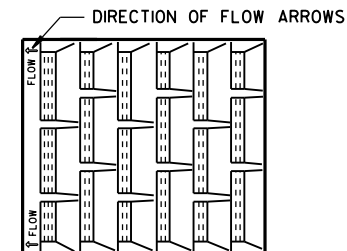



1" DIAGONAL BARS
WITH 1 1/2" OPENINGS

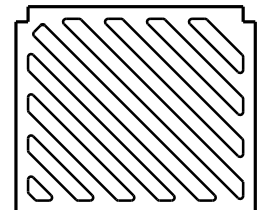


SPECIAL GRATE FOR
TYPE "A" COVER
(MEASURES 19 3/4" X 17" X 1 1/8")
(NOTED AS TYPE A-S ON DRAINAGE TABLE)

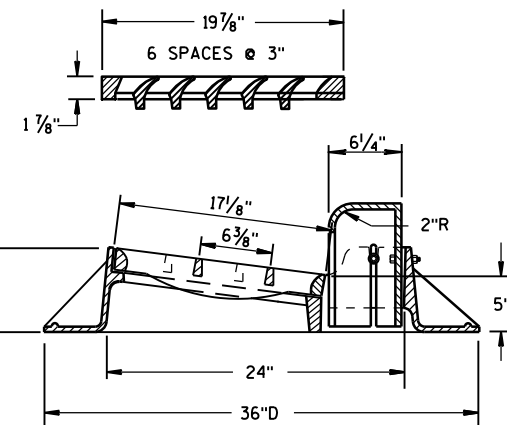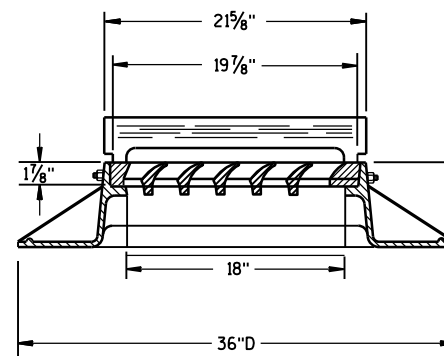

TYPE "A"

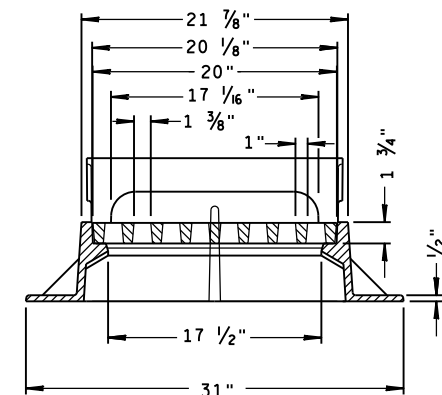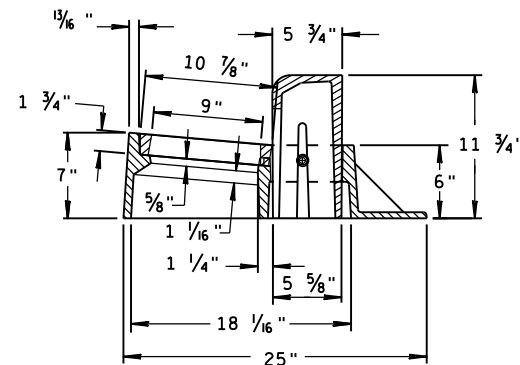


TYPE "Z"

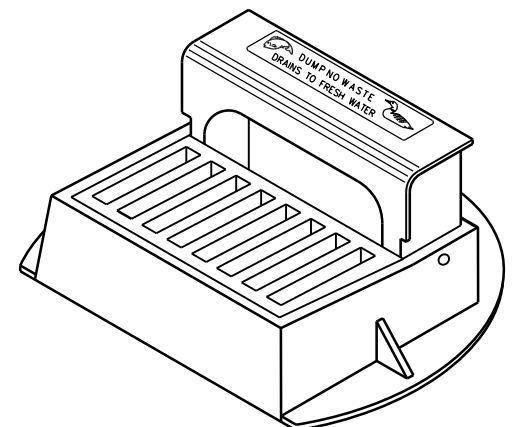


INLET COVERS
TYPE A, H, A-S, H-S & Z

STATE OF WISCONSIN
DEPARTMENT OF TRANSPORTATION


APPROVED
11-27-13
DATE
/S/ Jerry H. Zogg
ROADWAY STANDARDS DEVELOPMENT
ENGINEER
FHWA

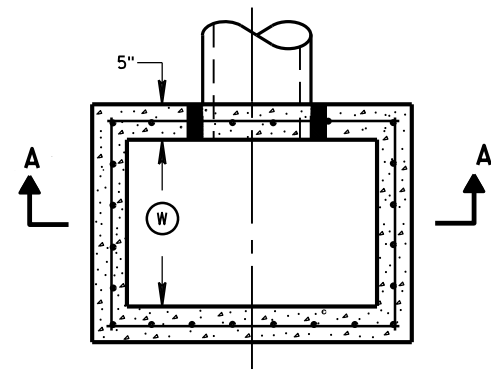


PLAN VIEW

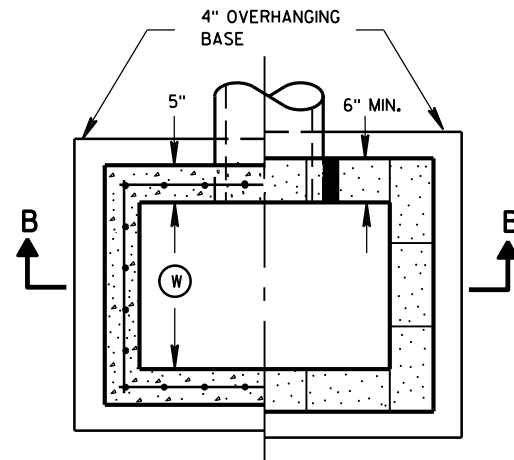


PLAN VIEW

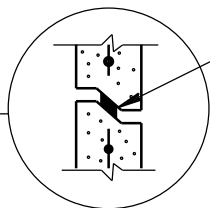


RISER JOINTS TO BE SEALED WITH A BUTYL RUBBER SEAL PER SEALANT MANUFACTURERS RECOMMENDATIONS CONFORMING TO ASTM C 990 (TYP)

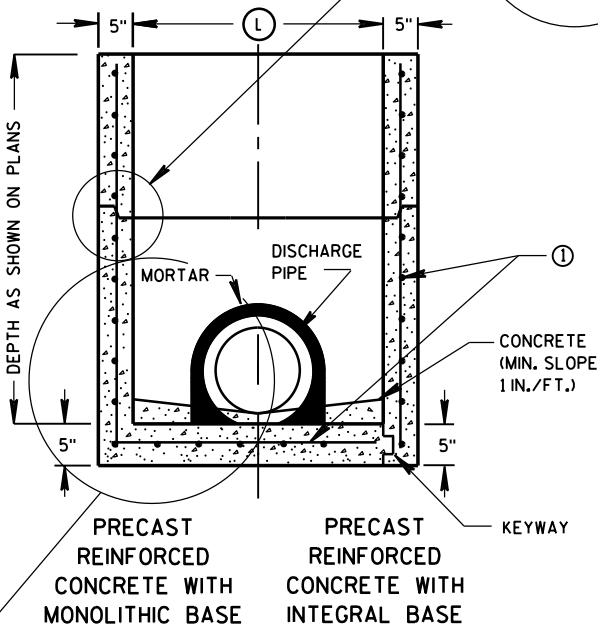

SECTION A-A

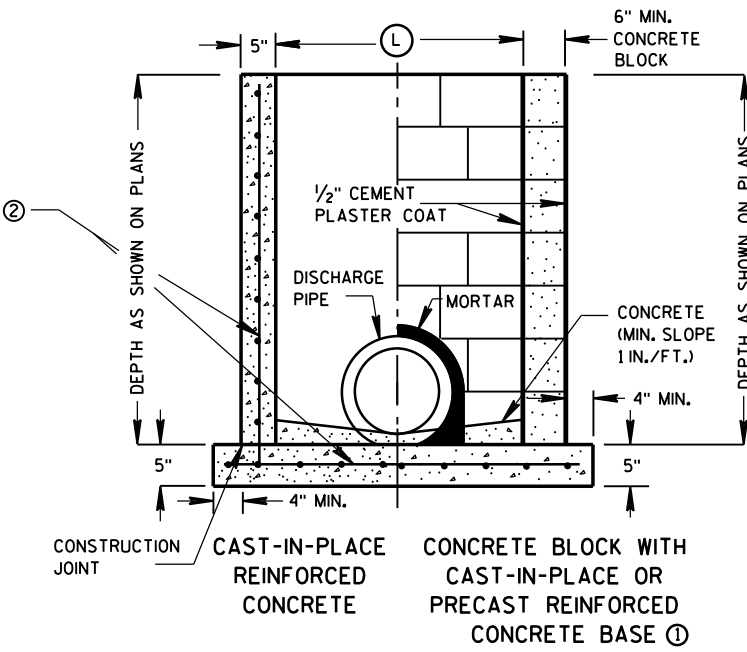

SECTION B-B

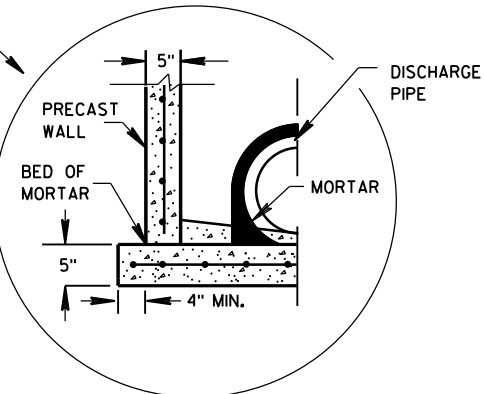

SEPARATE PRECAST REINFORCED CONCRETE BASE OPTION

INLETS 2X2-FT, 2X2.5-FT, 2X3-FT AND 2.5X3-FT

GENERAL NOTES

DETAILS OF CONSTRUCTION, MATERIALS AND WORKMANSHIP NOT SHOWN ON THIS DRAWING SHALL CONFORM TO THE PERTINENT REQUIREMENTS OF THE STANDARD SPECIFICATIONS AND THE APPLICABLE SPECIAL PROVISIONS.

UNLESS OTHERWISE AUTHORIZED IN WRITING BY THE ENGINEER, THE CONTRACTOR SHALL NOT ORDER AND DELIVER PRECAST INLET UNITS REQUIRED FOR THE PROJECT UNTIL A LIST OF SIZES IS FURNISHED BY THE ENGINEER.

DETAILED DRAWINGS FOR PROPOSED ALTERNATE DESIGNS FOR UNDERGROUND DRAINAGE STRUCTURES SHALL BE SUBMITTED TO THE ENGINEER FOR APPROVAL PROVIDING THAT SUCH ALTERNATE DESIGNS MAKE PROVISION FOR EQUIVALENT CAPACITY AND STRENGTH.

ALL PRECAST INLET UNITS SHALL CONFORM TO THE PERTINENT REQUIREMENTS OF ASTM C 913.

ALL DRAINAGE STRUCTURES ARE DESIGNATED ON THE PLANS AS "MANHOLES 3X3-L", "CATCH BASINS 4-B", "INLETS 2X3-H", ETC. THE FIRST NUMBERS DESIGNATES THE SIZE OF THE STRUCTURE, AND THE FOLLOWING LETTER DESIGNATES THE TYPE OF COVER TO BE USED TO COMPRISE THE COMPLETE UNIT.

BASES SHALL BE PLACED ON A BED OF MATERIAL AT LEAST 6 INCHES IN DEPTH, WHICH MEETS THE REQUIREMENTS OF FOUNDATION BACKFILL. THIS BEDDING SHALL BE COMPACTED AND PROVIDE UNIFORM SUPPORT FOR THE ENTIRE AREA OF THE BASE.

ALL BAR STEEL REINFORCEMENT SHALL BE EMBEDDED 2 INCHES CLEAR UNLESS OTHERWISE SHOWN OR NOTED.

PRECAST REINFORCED RISERS SHALL HAVE A TONGUE AND GROOVE JOINT WITH TONGUE UP OR DOWN.

4" OVERHANGING BASES ARE REQUIRED FOR CAST-IN-PLACE REINFORCED CONCRETE AND CONCRETE BLOCK INSTALLATIONS. 4" OVERHANG IS REQUIRED WHEN SEPARATE PRECAST BASE IS PROVIDED. OVERHANG IS NOT REQUIRED ON PRECAST STRUCTURES WITH AN INTEGRAL OR MONOLITHIC BASE.

MAXIMUM INSIDE PIPE DIAMETER DETERMINED BY 3 INCH CLEARANCE ON EACH SIDE OF THE OUTSIDE WALL OF THE PIPE. SEE DETAIL "A". ASSUMES PIPE ENTERS PERPENDICULAR TO THE STRUCTURE.


- ① FOR PRECAST INLETS PROVIDE REINFORCING STEEL IN ACCORDANCE TO ASTM C 913.
- ② CONTRACTOR TO PROVIDE DRAWING(S) STAMPED BY A PROFESSIONAL ENGINEER FOR STEEL REINFORCING DESIGN FOR CAST-IN-PLACE STRUCTURES.

INLET COVER MATRIX

INLET SIZE		INLET COVER TYPE	ALL A'S	ALL B'S	BW	F	ALL H'S	S	T	V	WM
	WIDTH ① (FT)	LENGTH ② (FT)									
2X2-FT	2	2	X	X				X		X	
2X2.5-FT	2	2.5			X			X	X	X	X
2X3-FT	2	3					X				
2.5X3-FT	2.5	3				X					

PIPE MATRIX

INLET SIZE	MAXIMUM INSIDE PIPE DIAMETER	
	WIDTH (IN)	LENGTH (IN)
2X2-FT	12	12
2X2.5-FT	12	18
2X3-FT	12	24
2.5X3-FT	18	24

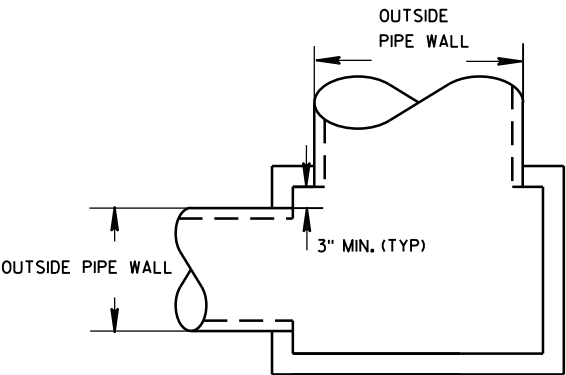


DETAIL "A"


INLETS 2X2-FT, 2X2.5-FT, 2X3-FT AND 2.5X3-FT

STATE OF WISCONSIN
DEPARTMENT OF TRANSPORTATION


APPROVED
Sept., 2016 /S/ Rodney Taylor
DATE ROADWAY STANDARDS DEVELOPMENT
FHWA UNIT SUPERVISOR

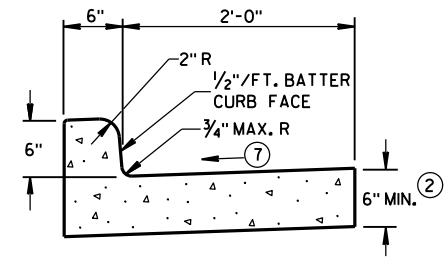


TYPES A^① & D

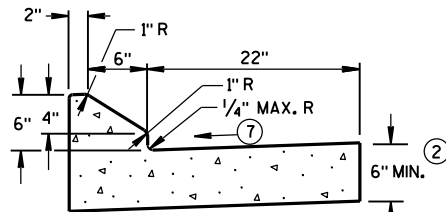


6" SLOPED CURB TYPES G^① & J

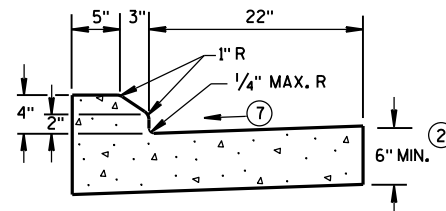

4" SLOPED CURB TYPES G^① & J

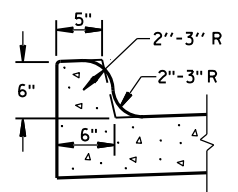


TYPES K^① & L
(OPTIONAL CURB SHAPE)

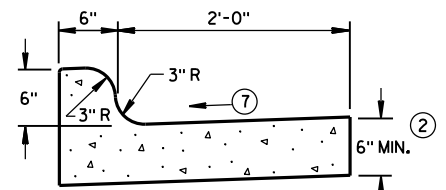


TYPES K^① & L

CONCRETE CURB & GUTTER 30"

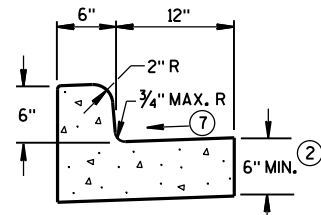


TYPES A^① & D


CONCRETE CURB & GUTTER 18"

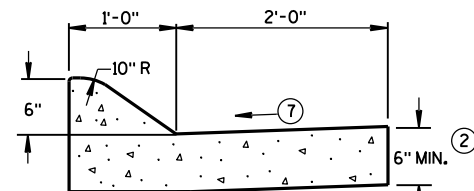

6" SLOPED CURB TYPES A^① & D

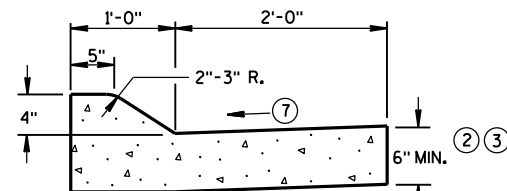


4" SLOPED CURB TYPES A^① & D

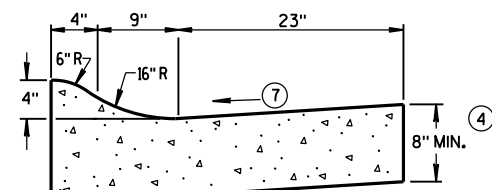

4" SLOPED CURB TYPES R^① & T^⑤


CONCRETE CURB & GUTTER 36"

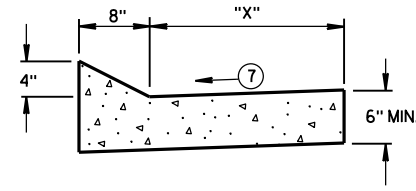


TYPES TBT & TBTT^①

CONCRETE CURB & GUTTER

TBT & TBTT	"X"
30"	22"
36"	28"

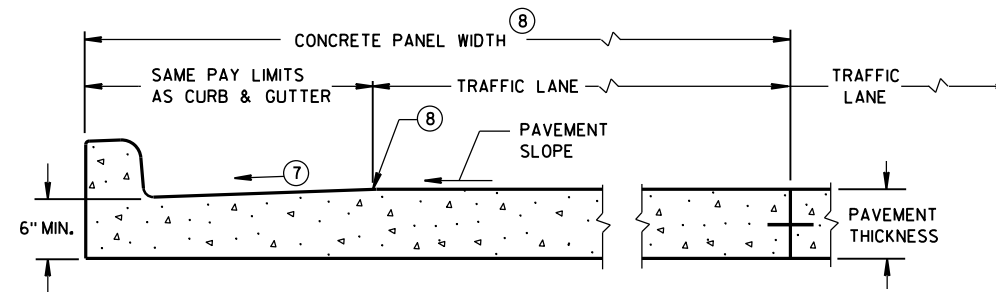

PARTIAL SECTION OF PAVEMENT
WITH INTEGRAL CURB & GUTTER

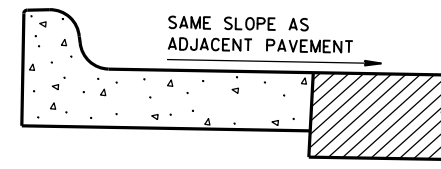

REVERSE SLOPE GUTTER^⑥
(TYPICAL FOR ALL CURB & GUTTER TYPES)

GENERAL NOTES

DETAILS OF CONSTRUCTION, MATERIALS AND WORKMANSHIP NOT SHOWN ON THIS DRAWING SHALL CONFORM TO THE PERTINENT REQUIREMENTS OF THE CONTRACT.

PAVEMENT TIES AND TIE BARS SHALL BE EPOXY COATED IN CONFORMANCE WITH SUBSECTION 505.2.6.2 OF THE STANDARD SPECIFICATIONS.

INTEGRAL CURB & GUTTER SHALL CONFORM TO THE DETAILS SHOWN FOR CONCRETE CURB & GUTTER INCLUDING THE TRANSVERSE GUTTER SLOPE.

WHERE THE TRANSVERSE JOINTS IN THE PAVEMENT ARE REQUIRED TO BE SEALED, THE JOINTS IN THE INTEGRAL CURB AND GUTTER SHALL BE SEALED TO THE FACE OF CURB WITH THE SAME TYPE OF SEALANT. THE COST OF FURNISHING AND INSTALLING THIS SEALANT SHALL BE INCIDENTAL TO THE ITEM CONCRETE CURB AND GUTTER.

UNLESS OTHERWISE SHOWN ON THE TYPICAL CROSS SECTIONS, THE BASE AGGREGATE AND COMMON EXCAVATION LIMITS ARE 2'-0" BEHIND THE BACK OF CURBS.

- ① TIE BARS ARE REQUIRED FOR CURB AND GUTTER TYPES A, G, K, R AND TBTT.
- ② THE BOTTOM OF CURB AND GUTTER MAY BE CONSTRUCTED EITHER LEVEL OR PARALLEL TO THE SLOPE OF THE SUBGRADE OR BASE AGGREGATE PROVIDED A 6" MINIMUM GUTTER THICKNESS IS MAINTAINED.
- ③ USE 8" MINIMUM GUTTER THICKNESS WHEN USED WITH AN ADJACENT CONCRETE TRUCK APRON PLACED BEHIND BACK OF CURB.
- ④ THE BOTTOM OF CURB AND GUTTER MAY BE CONSTRUCTED EITHER LEVEL OR PARALLEL TO THE SLOPE OF THE SUBGRADE OR BASE AGGREGATE PROVIDED A 8" MINIMUM GUTTER THICKNESS IS MAINTAINED.
- ⑤ THE FACE OF CURB IS 6" FROM THE BACK OF CURB.
- ⑥ WHEN REVERSE SLOPE GUTTER IS REQUIRED, THE LOCATION(S) WILL BE SHOWN ELSEWHERE IN THE PLAN.
- ⑦ USE 4% GUTTER CROSS SLOPE UNLESS OTHERWISE NOTED IN THE PLANS.
- ⑧ INCLUDE LONGITUDINAL JOINT AND TIE BARS ALONG LANE EDGE WHEN CONCRETE PANEL WIDTH EXCEEDS THE MAXIMUM WIDTH PER TABLE BELOW. LONGITUDINAL JOINT(S) ARE NOT ALLOWED WITHIN TRAFFIC LANES AND BIKE LANES. LONGITUDINAL JOINT MAY BE SAWED.


PAVEMENT THICKNESS AND MAXIMUM CONCRETE PANEL WIDTH TABLE

PAVEMENT THICKNESS	MAXIMUM PANEL WIDTH
LESS THAN 10"	12'
10" & ABOVE	15'

* BIKE LANE IS NOT SHOWN.


CONCRETE CURB & GUTTER

STATE OF WISCONSIN
DEPARTMENT OF TRANSPORTATION

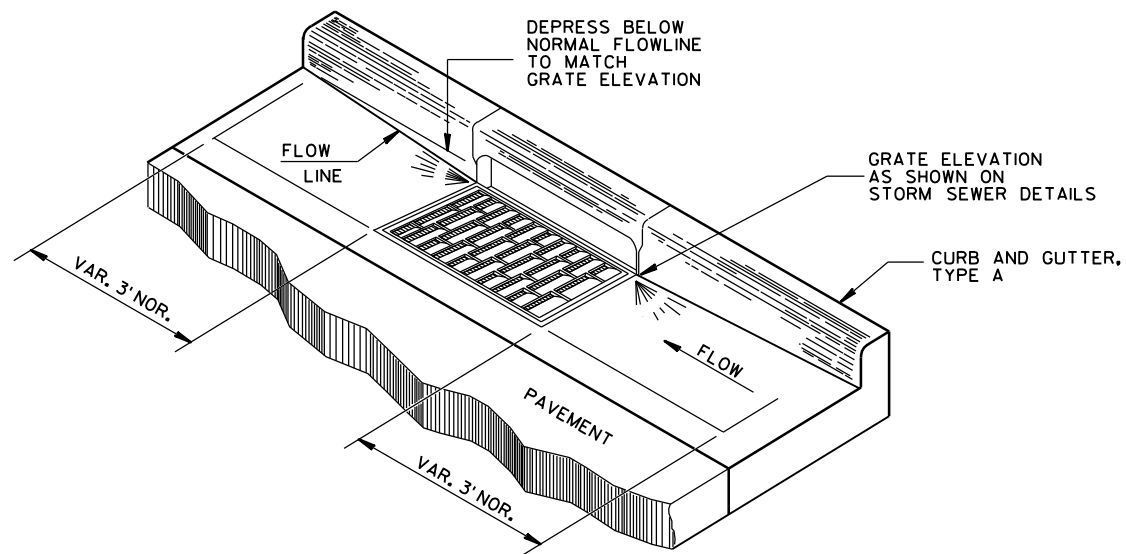


DETAIL OF CURB AND GUTTER AT INLETS

(TYPE H INLET COVER SHOWN)

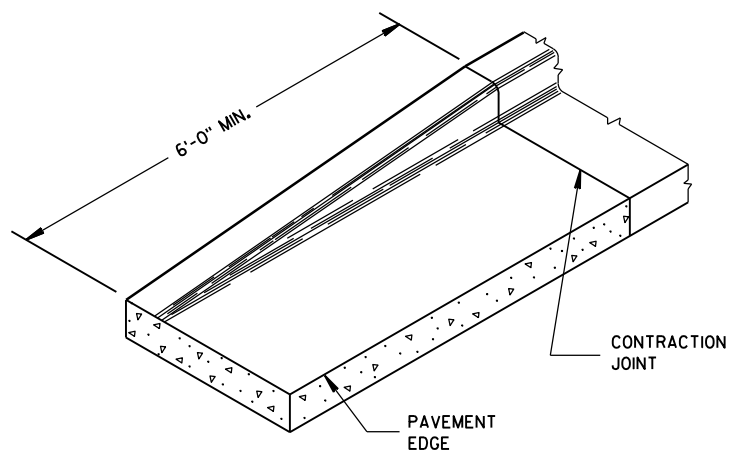


END SECTION CURB & GUTTER

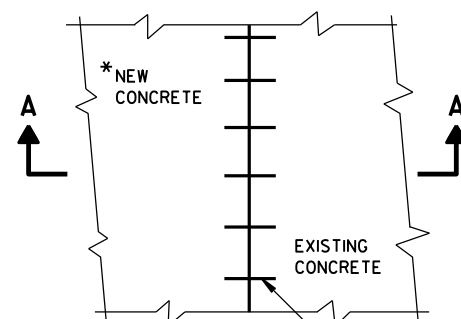

PLAN VIEW

*NEW CURB & GUTTER, SURFACE DRAINS, CONCRETE PAVEMENT OR OTHER NEW CONCRETE.

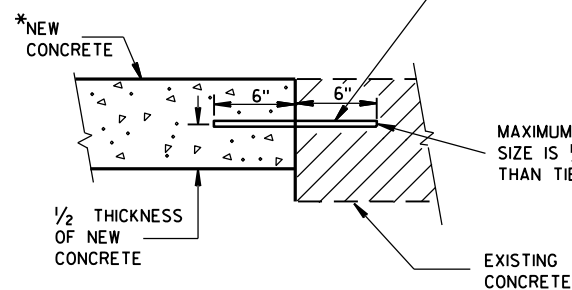

SECTION A-A TIE BARS DRILLED INTO EXISTING PAVEMENT

NO. 6 TIE BARS SPACED 2'-6" C-C, INSTALLED PERPENDICULAR TO THE LONGITUDINAL JOINT.

MAXIMUM DRILL HOLE SIZE IS 1/8" GREATER THAN TIE BAR DIAMETER


GENERAL NOTES

DETAILS OF CONSTRUCTION, MATERIALS AND WORKMANSHIP NOT SHOWN ON THIS DRAWING SHALL CONFORM TO THE PERTINENT REQUIREMENTS OF THE CONTRACT.


PAVEMENT TIES AND TIE BARS SHALL BE EPOXY COATED IN CONFORMANCE WITH SUBSECTION 505.2.6.2 OF THE STANDARD SPECIFICATIONS.

UNLESS OTHERWISE SHOWN ON THE TYPICAL CROSS SECTIONS, THE BASE AGGREGATE AND COMMON EXCAVATION LIMITS ARE 2'-0" BEHIND THE BACK OF CURBS.

- ① TIE BARS ARE REQUIRED FOR CURB AND GUTTER TYPES A, G, K, R AND TBTT.
- ② THE BOTTOM OF CURB AND GUTTER MAY BE CONSTRUCTED EITHER LEVEL OR PARALLEL TO THE SLOPE OF THE SUBGRADE OR BASE AGGREGATE PROVIDED A 6" MINIMUM GUTTER THICKNESS IS MAINTAINED.
- ⑨ REFER TO SDD 8D18 AND SDD 8D19 FOR ADDITIONAL DRIVEWAY ENTRANCE CURB DETAILS.

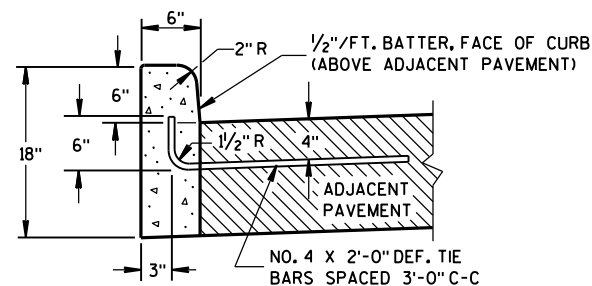


TYPES A^① & D

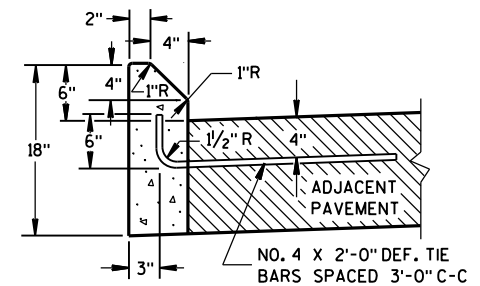


TYPES G^① & J

CONCRETE CURB

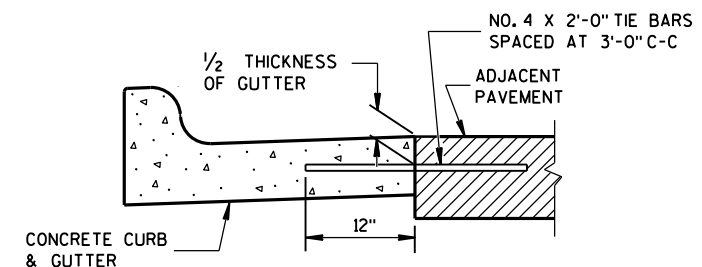

TYPICAL TIE BAR LOCATION^①

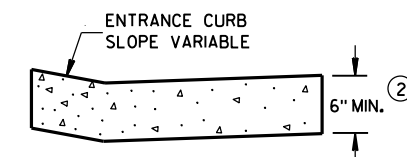

DRIVEWAY ENTRANCE CURB^⑨

(WHEN DIRECTED BY THE ENGINEER)

CONCRETE CURB, TIES AND CURB AND GUTTER APPLICATIONS

STATE OF WISCONSIN
DEPARTMENT OF TRANSPORTATION

APPROVED

June, 2017


DATE

FHWA


/S/ Rodney Taylor

ROADWAY STANDARDS DEVELOPMENT


UNIT SUPERVISOR

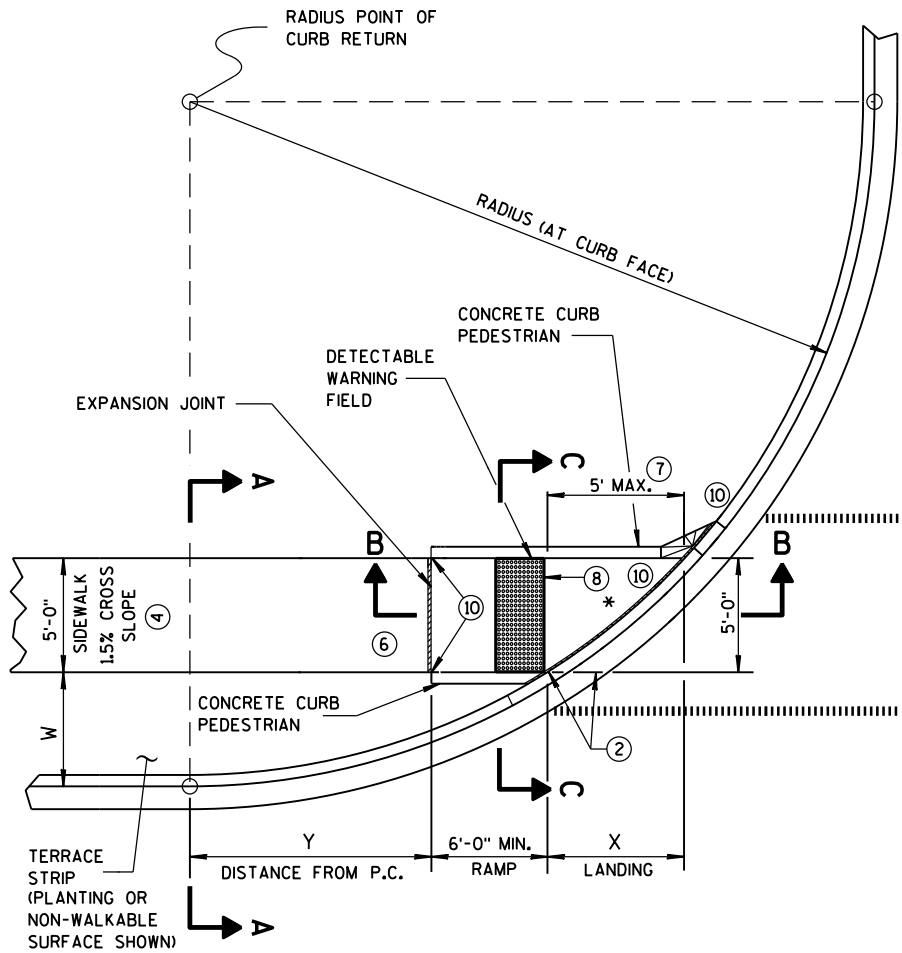

**CURB RAMP TYPE 4B
PLAN VIEW**

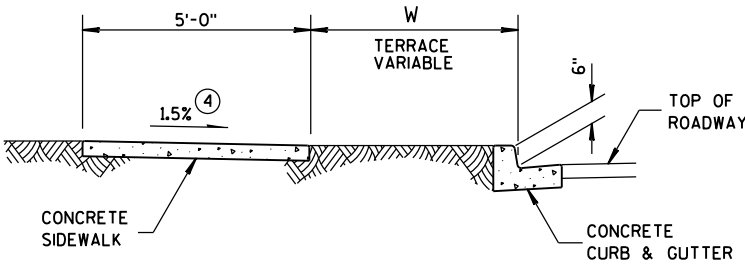

SECTION A-A FOR TYPE 4B

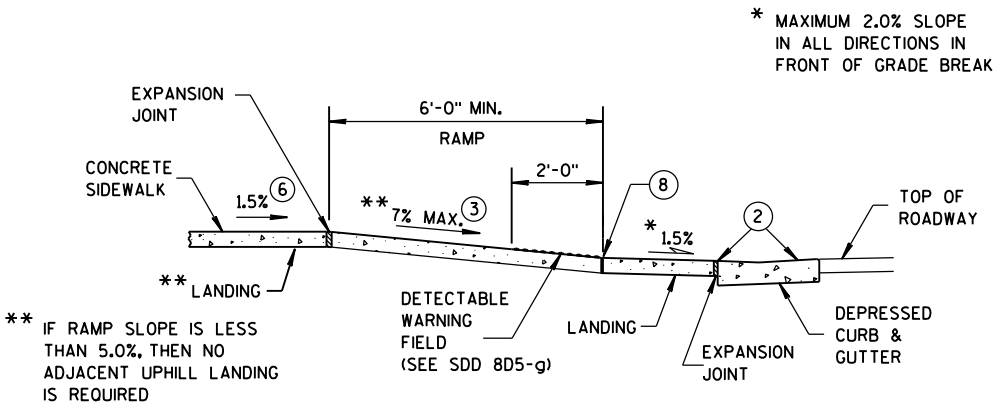


SECTION B-B FOR TYPE 4B

RADIUS (AT CURB FACE)	W = 3' - 0"		W = 4' - 0"		W = 5' - 0"		W = 6' - 0"		W = 7' - 0"		W = 8' - 0"		W = 9' - 0"		W = 10' - 0"	
	X	Y	X	Y	X	Y	X	Y	X	Y	X	Y	X	Y	X	Y
10 FEET	2'-10 1/4"	0'-5"	2'-1"	1'-4 1/2"	1'-5"	2'-1"	0'-10"	2'-7 1/2"	0'-3 1/4"	3'-0 1/4"						
15 FEET	4'-6 3/4"	2'-1 3/4"	3'-9"	3'-5 1/4"	3'-1 1/4"	4'-6"	2'-6 3/4"	5'-4 1/2"	2'-1"	6'-1"	1'-8"	6'-8 1/2"	1'-3 1/4"	7'-2 1/2"	0'-10 3/4"	7'-7 1/4"
20 FEET	5'-9 3/4"	3'-6 1/2"	4'-11 1/2"	5'-1 3/4"	4'-3 1/4"	6'-5 1/2"	3'-8 3/4"	7'-7"	3'-3"	8'-6 1/2"	2'-10"	9'-4 1/2"	2'-5 1/2"	10'-1 1/4"	2'-1 1/4"	10'-9"
30 FEET			6'-9 1/4"	7'-11 1/4"	6'-0 1/4"	9'-8"	5'-5"	11'-1 3/4"	4'-10 3/4"	12'-5 3/4"	4'-5 1/2"	13'-7 3/4"	4'-0 3/4"	14'-8 1/2"	3'-8 1/2"	15'-8 1/4"
40 FEET									6'-1 3/4"	15'-8 1/2"	5'-8"	17'-2"	5'-3"	18'-5 3/4"	4'-10 3/4"	19'-8 1/4"
50 FEET															5'-10 1/4"	23'-2"


INTERMEDIATE RADII CAN BE INTERPOLATED
DIMENSION "Y" IS CALCULATED BASED ON 6'-0" RAMP LENGTH
DIMENSION "X" IS CALCULATED BASED ON 5'-0" SIDEWALK WIDTH

GENERAL NOTES


- AVOID PLACING DRAINAGE STRUCTURES, JUNCTION BOXES OR OTHER OBSTRUCTIONS IN FRONT OF RAMP ACCESS AREAS. DETECTABLE WARNING FIELDS THAT ARE INSTALLED AS A GROUP OR SIDE BY SIDE, SHALL BE FROM THE SAME MANUFACTURER.
- GRADE CHANGE BETWEEN GUTTER FLAG SLOPE AND THE CURB RAMP SLOPE SHALL NOT EXCEED 11%. MAXIMUM GUTTER FLAG SLOPE IS 4%. PROVIDE LONGITUDINAL DRAINAGE AROUND CURB AND AWAY FROM CURB RAMP. NO VERTICAL LIPS OR DISCONTINUITIES GREATER THAN 1/4-INCH ARE ALLOWED. SLOPE OF CURB HEAD OPENING SHALL MATCH THE RAMP SLOPE, MINIMALLY 1.5% AND NOT TO EXCEED 7%. WHEN ADJACENT TO 1.5% LANDING, CONSTRUCT CURB HEAD OPENING AT 1.5% IN THE DIRECTION OF PEDESTRIAN TRAVEL.
- ABSOLUTE MAXIMUM 12H:1V (8.33%) CURB RAMP SLOPE IS ALLOWABLE WITH FLATTENED GUTTER FLAG SLOPE AND NOT TO EXCEED 11% GRADE CHANGE.
- ±0.5% CONSTRUCTION TOLERANCE IN SIDEWALK CROSS SLOPE. THE SIDEWALK CROSS SLOPE SHALL NOT EXCEED 2% WITHOUT PRIOR APPROVAL FROM THE ENGINEER.
- PROVIDE A LEVEL LANDING (MAXIMUM 2% SLOPE) IN ANY DIRECTION OF PEDESTRIAN TRAVEL. STANDARD LANDING SIZE IS 5 FEET X 5 FEET.
- WHEN THIS GRADE BREAK DISTANCE EXCEEDS 5 FEET, USE RADIAL DETECTABLE WARNING FIELD PER SDD 8D5-f.
- PROVIDE GRADE BREAK PERPENDICULAR TO DIRECTION OF WHEELCHAIR TRAVEL.
- INSTALL TRANSITION NOSE. (INCIDENTAL TO OTHER PAY ITEMS). DO NOT MARK TRANSITION NOSE.

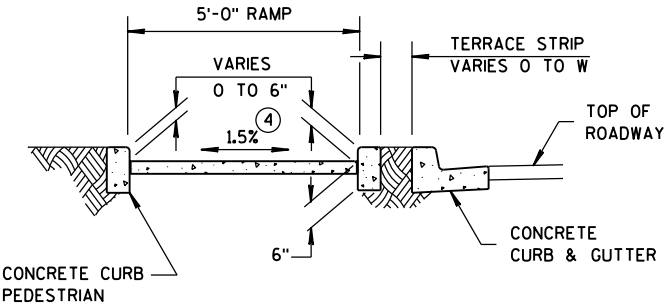


SECTION C-C FOR TYPE 4B

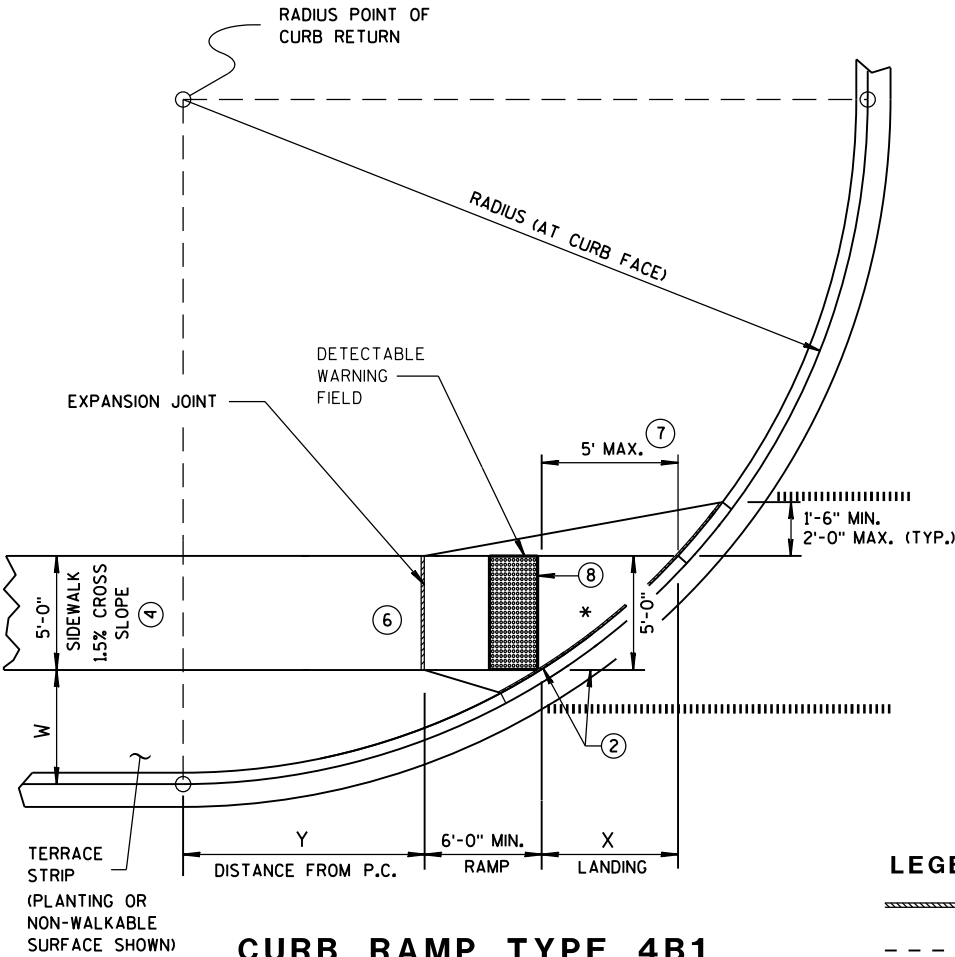

**CURB RAMP TYPE 4B1
PLAN VIEW**

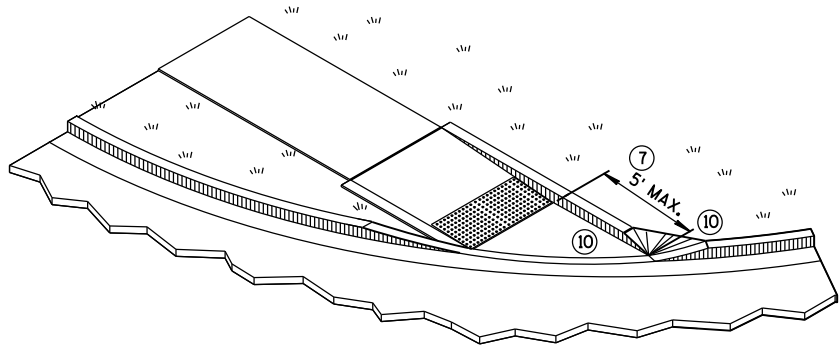

ISOMETRIC VIEW FOR TYPE 4B

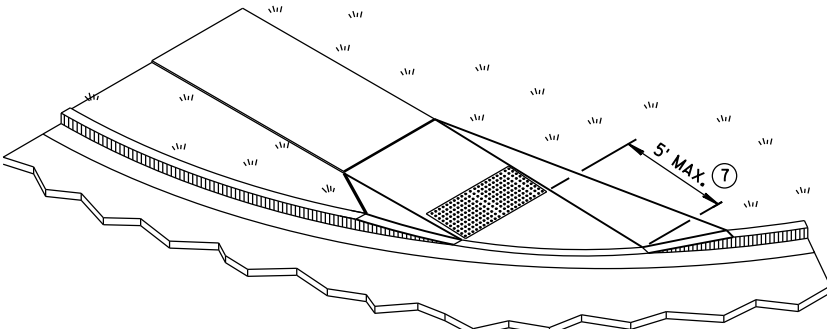


ISOMETRIC VIEW FOR TYPE 4B1

LEGEND

- 1/2" EXPANSION JOINT-SIDEWALK
- CONTRACTION JOINT FIELD LOCATED
- PAVEMENT MARKING CROSSWALK (WHITE)


**CURB RAMPS
TYPE 4B AND 4B1**

STATE OF WISCONSIN
DEPARTMENT OF TRANSPORTATION

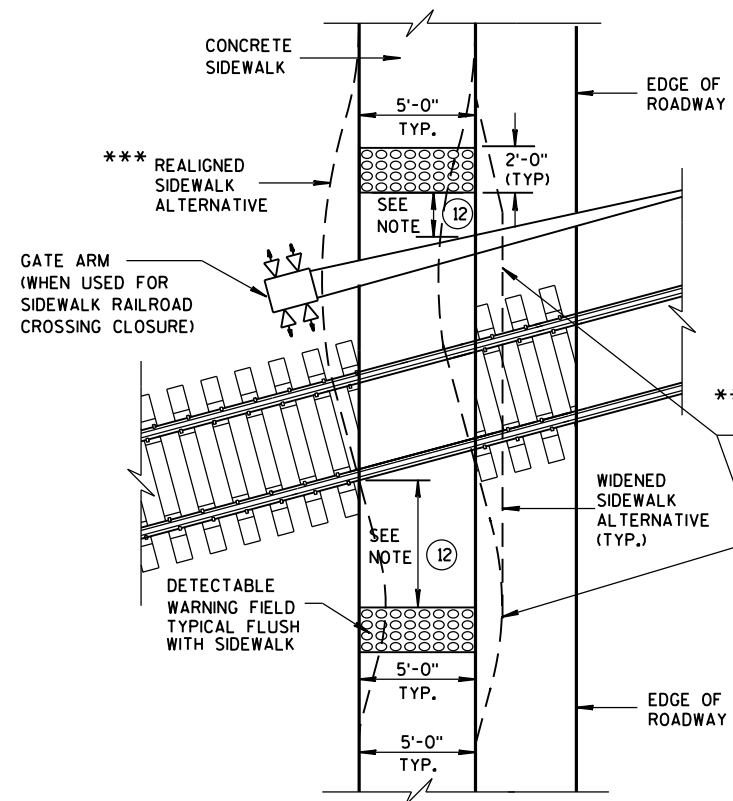


TYPE 8
DETECTABLE WARNINGS
AT RAILROAD CROSSING

REFER TO GENERAL NOTES ② AND ③
FOR ALL ISLAND CURB RAMP

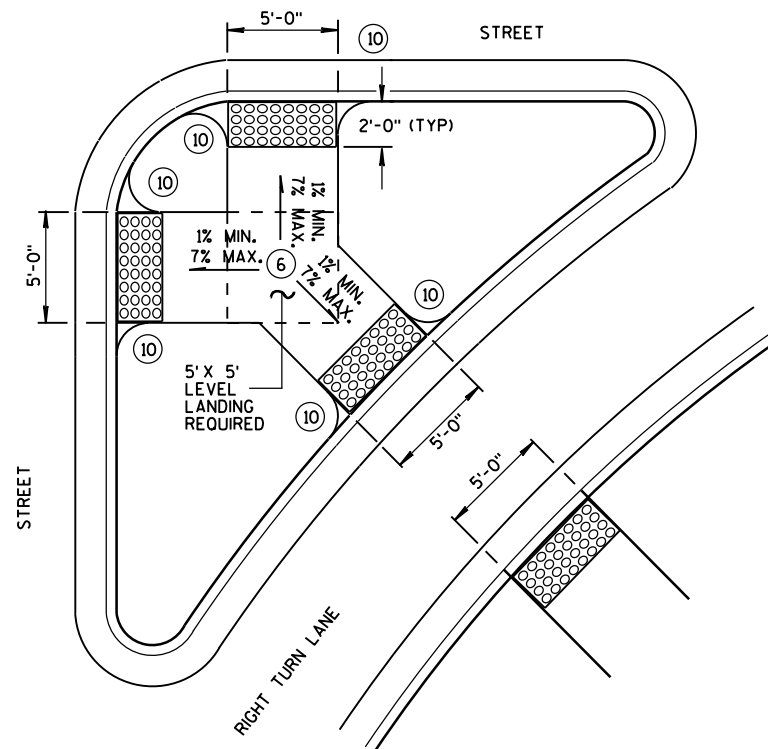


TYPE 6
DETECTABLE WARNING AT ISLANDS

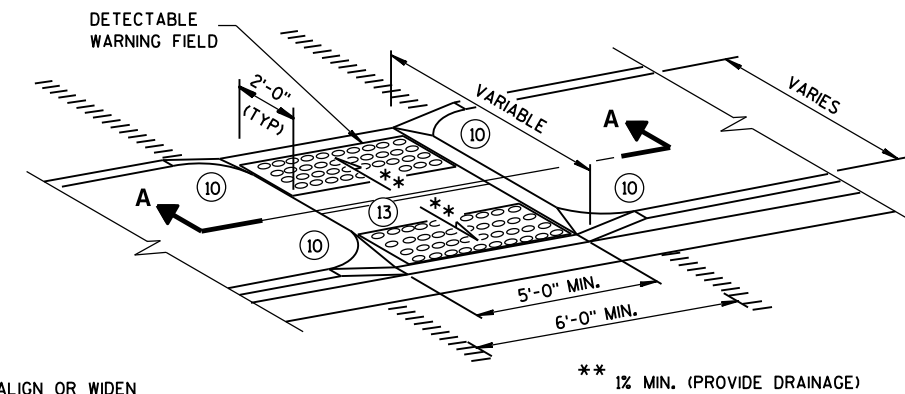


MEDIAN ISLAND
NON-ELEVATED PEDESTRIAN CROSSING
TYPE 5

*** DETAILS TO BE DETERMINED
BY DESIGNER

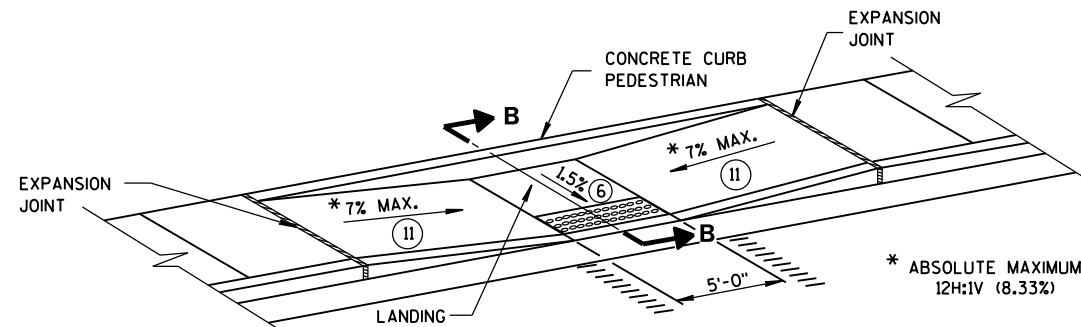

MID-BLOCK CROSSING
TYPE 7A

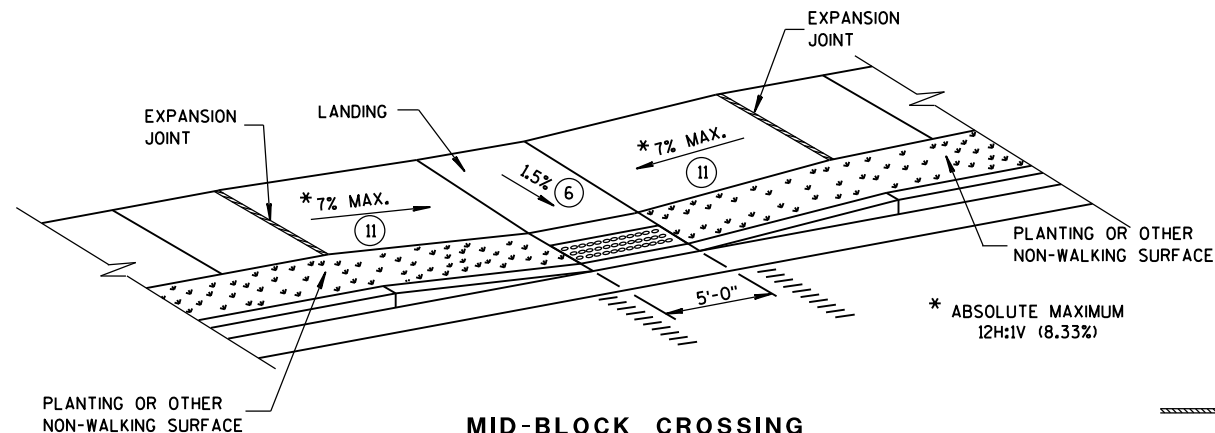

MID-BLOCK CROSSING
TYPE 7B

NOTE: THESE PARALLEL AND PARALLEL/PERPENDICULAR CURB RAMP
MAY BE USED AT INTERSECTIONS AND MID BLOCK LOCATIONS.

GENERAL NOTES

AVOID PLACING DRAINAGE STRUCTURES, JUNCTION BOXES OR OTHER OBSTRUCTIONS IN FRONT OF RAMP ACCESS AREAS.

SIDEWALK CROSS SLOPE SHALL NOT EXCEED 2%.

DETECTABLE WARNING FIELDS THAT ARE INSTALLED AS A GROUP OR SIDE BY SIDE, SHALL BE FROM THE SAME MANUFACTURER.

② GRADE CHANGE BETWEEN GUTTER FLAG SLOPE AND THE CURB RAMP SLOPE SHALL NOT EXCEED 11%. MAXIMUM GUTTER FLAG SLOPE IS 4%. PROVIDE LONGITUDINAL DRAINAGE AROUND CURB AND AWAY FROM CURB RAMP. NO VERTICAL LIPS OR DISCONTINUITIES GREATER THAN 1/4-INCH ARE ALLOWED. SLOPE OF CURB HEAD OPENING SHALL MATCH THE RAMP SLOPE, MINIMALLY 1.5% AND NOT TO EXCEED 7%. WHEN ADJACENT TO 1.5% LANDING, CONSTRUCT CURB HEAD OPENING AT 1.5% IN THE DIRECTION OF PEDESTRIAN TRAVEL.

③ ABSOLUTE MAXIMUM 12H:1V (8.33%) CURB RAMP SLOPE IS ALLOWABLE WITH FLATTENED GUTTER FLAG SLOPE AND NOT TO EXCEED 11% GRADE CHANGE.

④ ±0.5% CONSTRUCTION TOLERANCE IN SIDEWALK CROSS SLOPE. THE SIDEWALK CROSS SLOPE SHALL NOT EXCEED 2% WITHOUT PRIOR APPROVAL FROM THE ENGINEER.


⑥ PROVIDE A LEVEL LANDING (MAXIMUM 2% SLOPE) IN ANY DIRECTION OF PEDESTRIAN TRAVEL. STANDARD LANDING SIZE IS 5 FEET X 5 FEET.

⑩ INSTALL TRANSITION NOSE. (INCIDENTAL TO OTHER PAY ITEMS). DO NOT MARK TRANSITION NOSE.


⑪ SLOPE SIDEWALK TOWARD LANDING AS SHOWN WHERE THERE IS NO TERRACE OR WHERE THE TERRACE WIDTH IS LESS THAN 6 FEET WIDE.

⑫ THE EDGE OF THE DETECTABLE WARNING FIELD NEAREST TO A RAILROAD CROSSING SHALL BE 15 FEET ± 0.1' FROM THE FACE OF THE GATE ARM IF THE GATE ARM EXTENDS ACROSS THE SIDEWALK. WHERE THERE IS NO PEDESTRIAN GATE, THE EDGE OF THE DETECTABLE WARNING FIELD NEAREST TO THE RAILROAD CROSSING SHALL BE 15 FEET FROM THE NEAREST RAIL.

⑬ DO NOT INSTALL DETECTABLE WARNING FIELDS AT THE EDGES OF STREET-LEVEL PEDESTRIAN REFUGE ISLANDS IF A MINIMUM 2-FOOT CONCRETE SURFACE WITHOUT DETECTABLE WARNINGS (MEASURED IN THE DIRECTION OF PEDESTRIAN TRAVEL) CANNOT BE ACHIEVED.

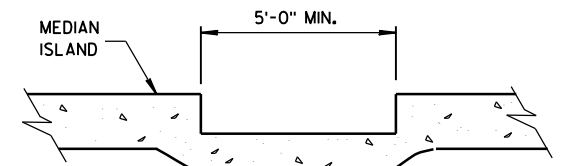

SECTION A-A

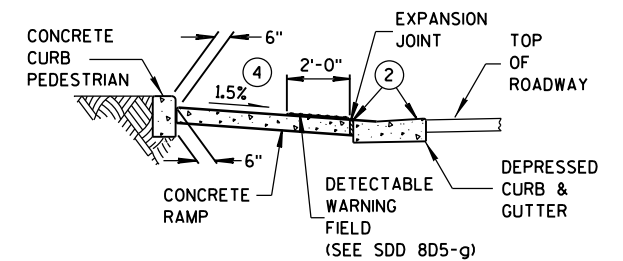


SECTION B-B

LEGEND

- 1/2" EXPANSION JOINT-SIDEWALK
- CONTRACTION JOINT FIELD LOCATED
- PAVEMENT MARKING CROSSWALK (WHITE)

CURB RAMP
TYPES 5, 6, 7A, 7B & 8

STATE OF WISCONSIN
DEPARTMENT OF TRANSPORTATION

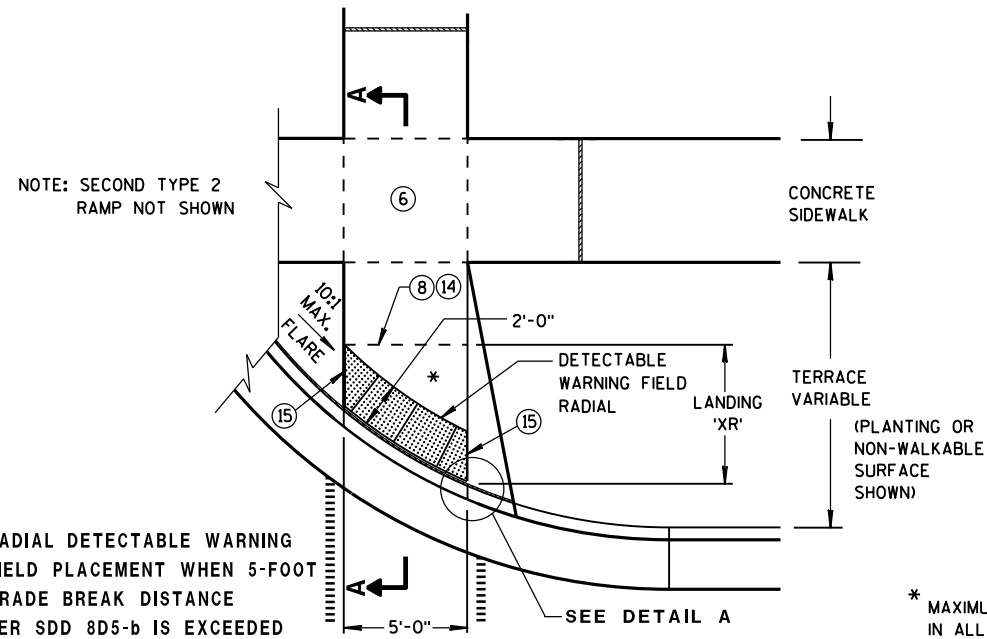


TYPE 2 RAMP PLAN VIEW

(GRADE BREAK DISTANCE GREATER THAN 5 FEET)


(ON LINE WITH SIDEWALK)

RADIAL DETECTABLE WARNING FIELD PLACEMENT WHEN 5-FOOT GRADE BREAK DISTANCE PER SDD 8D5-c IS EXCEEDED

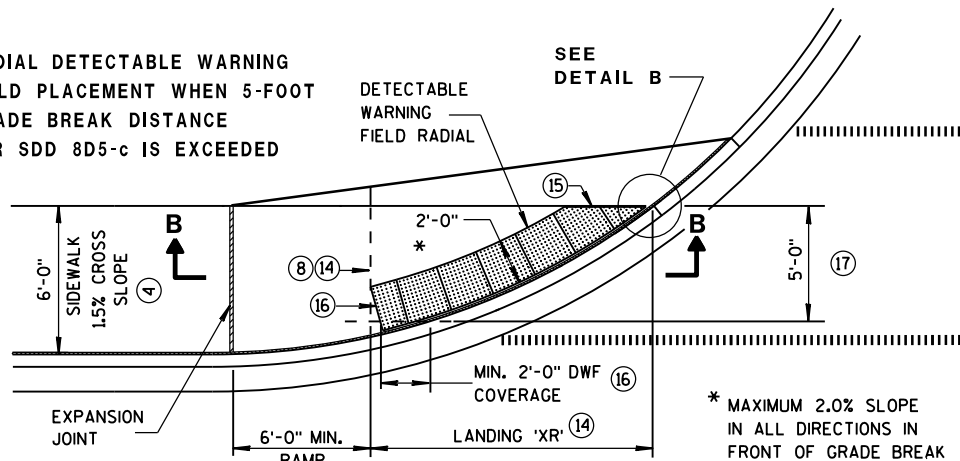



CURB RAMP TYPE 4A1 PLAN VIEW

(GRADE BREAK DISTANCE GREATER THAN 5 FEET)

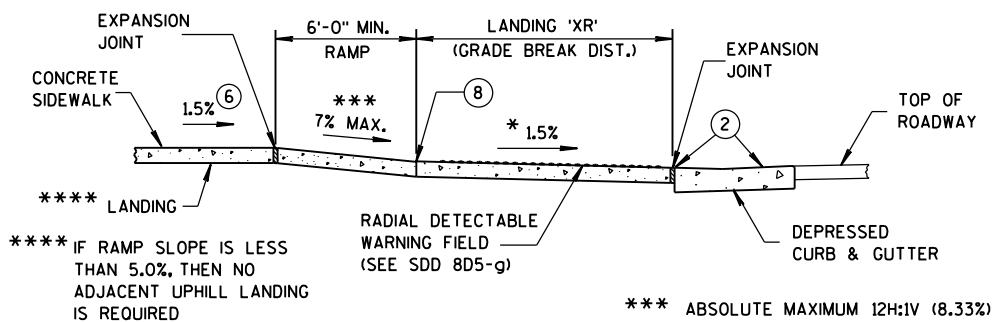

SECTION B-B FOR TYPE 4A1




* MAXIMUM 2.0% SLOPE IN ALL DIRECTIONS IN FRONT OF GRADE BREAK

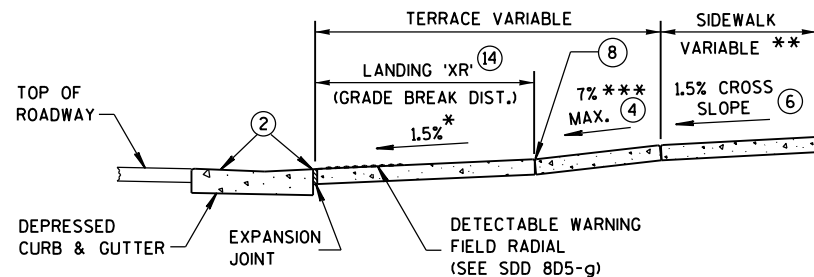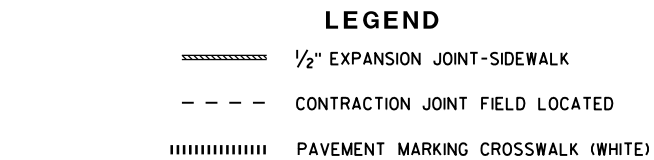

** WIDTH SHOWN ELSEWHERE IN THE PLANS

*** ABSOLUTE MAXIMUM 12H:1V (8.33%)


SECTION A-A

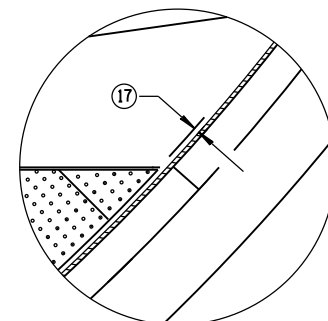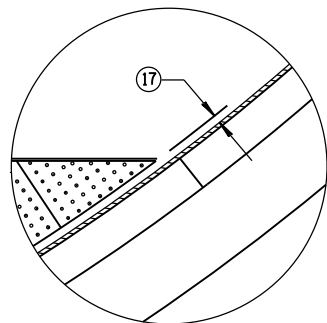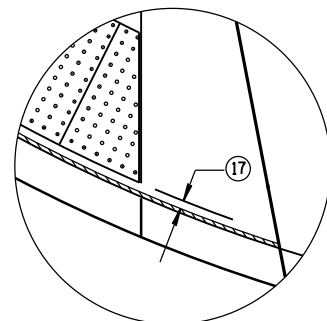

GENERAL NOTES


- AVOID PLACING DRAINAGE STRUCTURES, JUNCTION BOXES OR OTHER OBSTRUCTIONS IN FRONT OF RAMP ACCESS AREAS.
- DETECTABLE WARNING FIELDS (DWFs) THAT ARE INSTALLED AS A GROUP OR SIDE BY SIDE, SHALL BE FROM THE SAME MANUFACTURER.
- APPLY RADIAL DETECTABLE WARNING PLACEMENT SIMILARLY FOR TYPE 4A AND 4A1 CURB RAMPS AND SIMILARLY FOR TYPE 4B AND 4B1 CURB RAMPS. TYPE 4A AND 4B CURB RAMPS ARE NOT SHOWN.
- REFER TO SDD 8D5-g FOR ADDITIONAL RADIAL PLATE REQUIREMENTS.
- FIELD CUTS AT INTERMEDIATE JOINTS WITHIN THE RADIAL DETECTABLE WARNING FIELD ARE PROHIBITED.
- DETERMINE FINAL RADIAL WARNING FIELD CONFIGURATION AND ITS INDIVIDUAL PLATE LOCATIONS. PERFORM PRE-LAYOUT PRIOR TO PLACEMENT IN PLASTIC CONCRETE. FOLLOW MANUFACTURER'S PRODUCT LIST AND INSTALLATION RECOMMENDATIONS.
- GRADE CHANGE BETWEEN GUTTER FLAG SLOPE AND THE CURB RAMP SLOPE SHALL NOT EXCEED 11%. MAXIMUM GUTTER FLAG SLOPE IS 4%. PROVIDE LONGITUDINAL DRAINAGE AROUND CURB AND AWAY FROM CURB RAMP. NO VERTICAL LIPS OR DISCONTINUITIES GREATER THAN 1/4-INCH ARE ALLOWED. SLOPE OF CURB HEAD OPENING SHALL MATCH THE RAMP SLOPE, MINIMALLY 1.5% AND NOT TO EXCEED 7%. WHEN ADJACENT TO 1.5% LANDING, CONSTRUCT CURB HEAD OPENING AT 1.5% IN THE DIRECTION OF PEDESTRIAN TRAVEL.
- ABSOLUTE MAXIMUM 12H:1V (8.33%) CURB RAMP SLOPE IS ALLOWABLE WITH FLATTENED GUTTER FLAG SLOPE AND NOT TO EXCEED 11% GRADE CHANGE.
- ±0.5% CONSTRUCTION TOLERANCE IN SIDEWALK CROSS SLOPE. THE SIDEWALK CROSS SLOPE SHALL NOT EXCEED 2% WITHOUT PRIOR APPROVAL FROM THE ENGINEER.
- PROVIDE A LEVEL LANDING (MAXIMUM 2% SLOPE) IN ANY DIRECTION OF PEDESTRIAN TRAVEL. STANDARD LANDING SIZE IS 5 FEET X 5 FEET.
- PROVIDE GRADE BREAK PERPENDICULAR TO DIRECTION OF WHEELCHAIR TRAVEL.
- CONSULT ENGINEER IF GRADE BREAK LOCATION (END OF LANDING DIMENSION 'XR') REQUIRES FIELD ADJUSTMENT WHEN ESTABLISHING FINAL RADIAL DETECTABLE WARNING FIELD LOCATION.
- FIELD SAW CUTS ALONG RADIAL DETECTABLE WARNING PLATES WILL BE NECESSARY TO MATCH EACH CURB RAMP EDGE. AVOID CUTTING THROUGH DOMES WHENEVER POSSIBLE. MAKE FIELD CUTS TRUE TO LINE AND WITHIN 1/8" DEVIATION. SMOOTH EDGES OF FIELD CUT PLATES.
- USE 1'X 2' RECTANGULAR END PLATE AT END OF TYPE 4A1 RAMP AND PROVIDE MINIMUM 2'-0" DETECTABLE WARNING FIELD COVERAGE (IN DIRECTION OF PEDESTRIAN TRAVEL) ALONG THE ENTIRE CURB RAMP WIDTH.
- A MAXIMUM 3-INCH CONCRETE BORDER WIDTH IS ALLOWABLE IN FRONT OF RADIAL DETECTABLE WARNING FIELD FOR CONSTRUCTABILITY PURPOSES. CONCRETE BORDER WIDTH MAY VARY UP TO 1 INCH.

RADIAL DETECTABLE WARNING FIELD PLACEMENT WHEN 5-FOOT GRADE BREAK DISTANCE PER SDD 8D5-d IS EXCEEDED

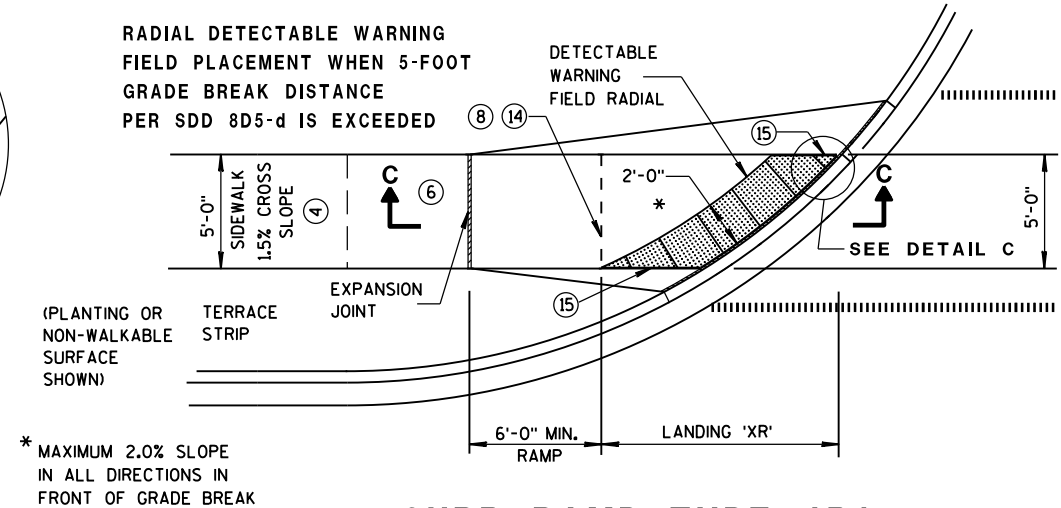

CURB RAMP TYPE 4B1 PLAN VIEW

(GRADE BREAK DISTANCE GREATER THAN 5 FEET)

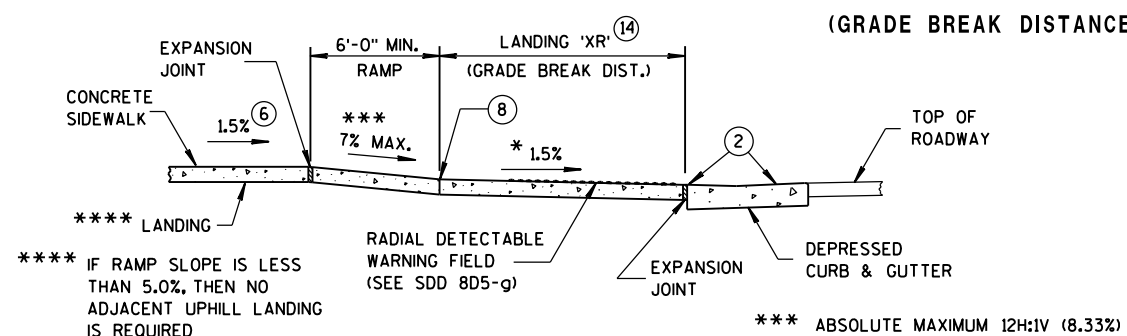



SECTION C-C FOR TYPE 4B1

CURB RAMPS
RADIAL DETECTABLE WARNING
FIELD APPLICATIONS


STATE OF WISCONSIN
DEPARTMENT OF TRANSPORTATION

	MIN.	MAX.
A	1.6"	2.4"
B	0.65"	1.5"
C	*	*
D	0.9"	1.4"

* THE C DIMENSION IS 50% TO 65% OF THE D DIMENSION.

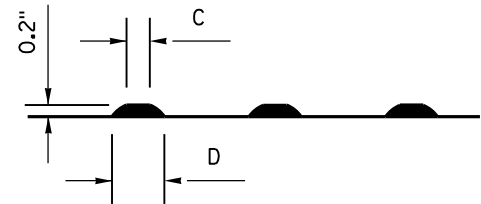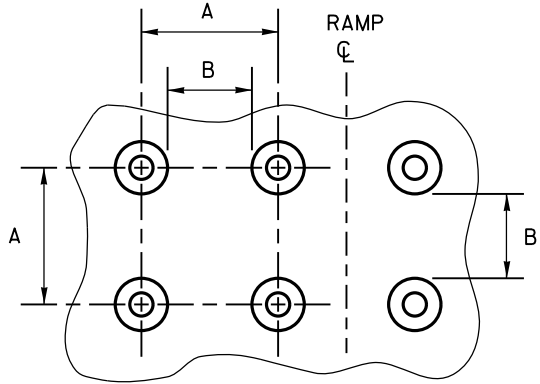

TRUNCATED DOMES
DETECTABLE WARNING PATTERN DETAIL

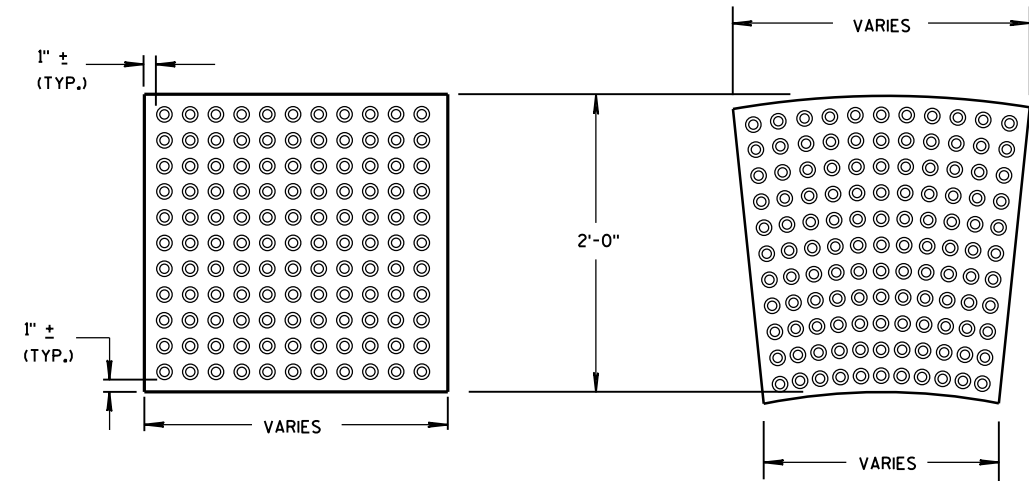

PLAN VIEW

GENERAL NOTES

DETECTABLE WARNING FIELDS THAT ARE INSTALLED AS A GROUP OR SIDE BY SIDE, SHALL BE FROM THE SAME MANUFACTURER.

PLACE ALL DETECTABLE WARNING FIELD SYSTEMS IN ACCORDANCE TO THE MANUFACTURER'S RECOMMENDATION.

FIELD CUTS AT INTERMEDIATE JOINTS WITHIN THE RADIAL DETECTABLE WARNING FIELD ARE PROHIBITED.


DETERMINE FINAL RADIAL WARNING FIELD CONFIGURATION AND ITS INDIVIDUAL PLATE LOCATIONS. PERFORM PRE-LAYOUT PRIOR TO PLACEMENT IN PLASTIC CONCRETE. FOLLOW MANUFACTURER'S PRODUCT LIST AND INSTALLATION RECOMMENDATIONS.

FOR RADIAL DETECTABLE WARNING FIELD APPLICATIONS WHERE STANDARD RADIAL PLATES ARE NOT AVAILABLE AT AN INTERSECTION CURB RADIUS, A COMBINATION OF SQUARE OR RECTANGULAR PLATES AND RADIAL PLATES MAY BE USED TO FORM RADIAL CONFIGURATION. RADIAL WEDGES IN COMBINATION WITH SQUARE PANELS ARE ALSO ACCEPTABLE. FOLLOW MANUFACTURER'S RECOMMENDATIONS.

REFER TO CONTRACT AND STANDARD SPECIFICATIONS FOR FIELD CUTTING REQUIREMENTS.

DO NOT EMBED IN CONCRETE ANY FIELD-CUT PLATES WITH CUT EDGES SHORTER THAN 6 INCHES. CONSULT WITH MANUFACTURER FOR RE-DRILLING AND ANCHORING REQUIREMENTS OF FIELD-CUT PLATES.



15 FIELD SAW CUTS ALONG RADIAL DETECTABLE WARNING PLATES WILL BE NECESSARY TO MATCH EACH CURB RAMP EDGE. AVOID CUTTING THROUGH DOMES WHENEVER POSSIBLE. MAKE FIELD CUTS TRUE TO LINE AND WITHIN 1/8" DEVIATION. SMOOTH EDGES OF FIELD CUT PLATES.

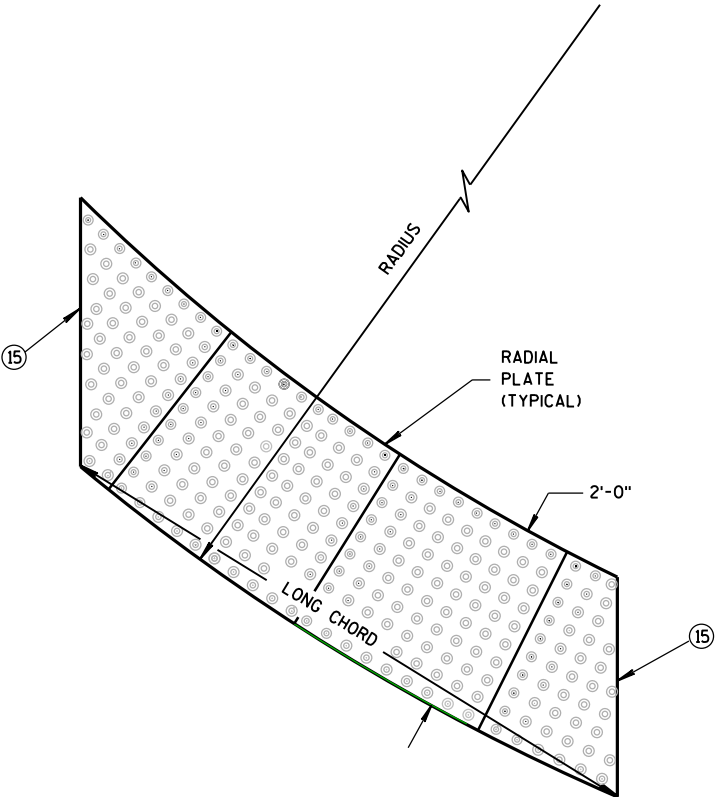

CURB RAMPS
RECTANGULAR AND RADIAL
DETECTABLE WARNING PLATES

STATE OF WISCONSIN
DEPARTMENT OF TRANSPORTATION

APPROVED
June, 2017 /S/ Rodney Taylor
DATE ROADWAY STANDARDS DEVELOPMENT
FHWA UNIT SUPERVISOR

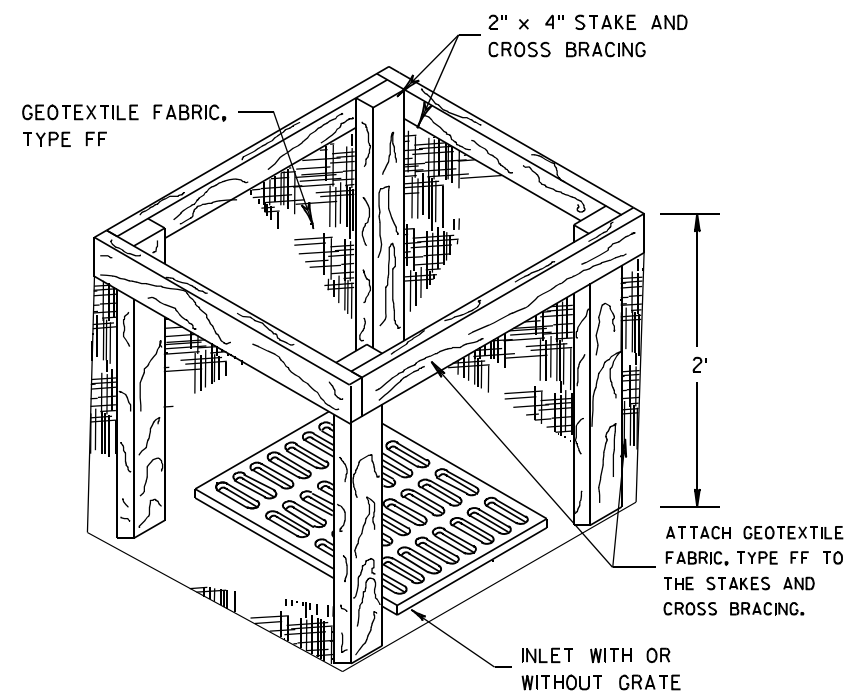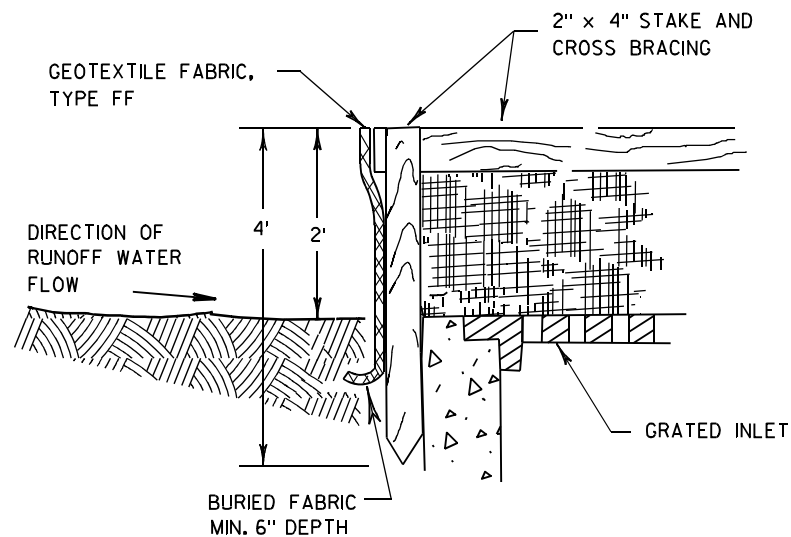

INLET PROTECTION, TYPE A


GENERAL NOTES

INLET PROTECTION DEVICES SHALL BE MAINTAINED OR REPLACED AT THE DIRECTION OF THE ENGINEER.

MANUFACTURED ALTERNATIVES APPROVED AND LISTED ON THE DEPARTMENT'S EROSION CONTROL PRODUCT ACCEPTABILITY LIST MAY BE SUBSTITUTED.


WHEN REMOVING OR MAINTAINING INLET PROTECTION, CARE SHALL BE TAKEN SO THAT THE SEDIMENT TRAPPED ON THE GEOTEXTILE FABRIC DOES NOT FALL INTO THE INLET. ANY MATERIAL FALLING INTO THE INLET SHALL BE REMOVED IMMEDIATELY.

- ① FINISHED SIZE, INCLUDING FLAP POCKETS WHERE REQUIRED, SHALL EXTEND A MINIMUM OF 10" AROUND THE PERIMETER TO FACILITATE MAINTENANCE OR REMOVAL.
- ② FOR INLET PROTECTION, TYPE C (WITH CURB BOX), AN ADDITIONAL 18" OF FABRIC IS WRAPPED AROUND THE WOOD AND SECURED WITH STAPLES. THE WOOD SHALL NOT BLOCK THE ENTIRE HEIGHT OF THE CURB BOX OPENING.
- ③ FLAP POCKETS SHALL BE LARGE ENOUGH TO ACCEPT WOOD 2X4.

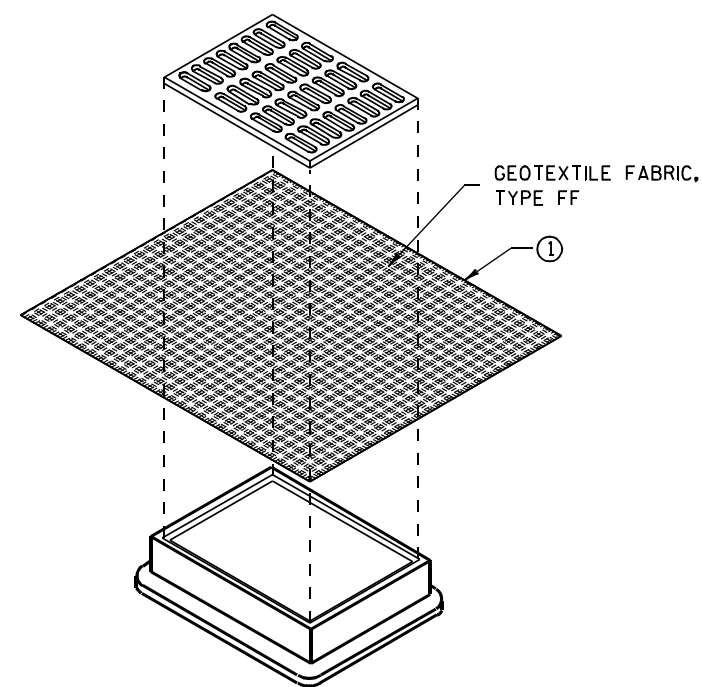

**INLET PROTECTION, TYPE B
(WITHOUT CURB BOX)**

(CAN BE INSTALLED IN ANY INLET WITHOUT A CURB BOX)

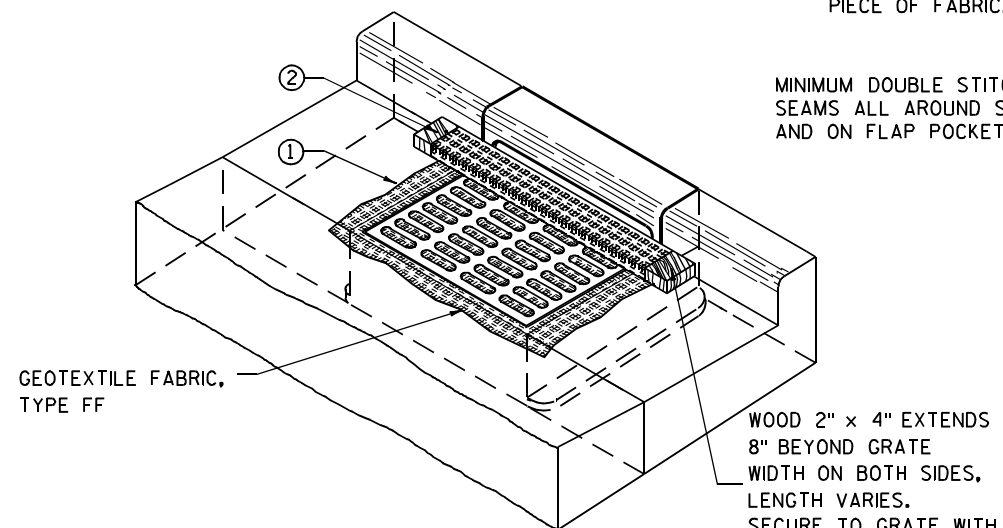

INLET PROTECTION, TYPE C (WITH CURB BOX)

INSTALLATION NOTES

TYPE B & C

TRIM EXCESS FABRIC IN THE FLOW LINE TO WITHIN 3" OF THE GRATE.


THE CONTRACTOR SHALL DEMONSTRATE A METHOD OF MAINTENANCE, USING A SEWN FLAP, HAND HOLDS OR OTHER METHOD TO PREVENT ACCUMULATED SEDIMENT FROM ENTERING THE INLET.

TYPE D

DO NOT INSTALL INLET PROTECTION TYPE D IN INLETS SHALLower THAN 30", MEASURED FROM THE BOTTOM OF THE INLET TO THE TOP OF THE GRATE.

TRIM EXCESS FABRIC IN THE FLOW LINE TO WITHIN 3" OF THE GRATE.

THE INSTALLED BAG SHALL HAVE A MINIMUM SIDE CLEARANCE, BETWEEN THE INLET WALLS AND THE BAG, MEASURED AT THE BOTTOM OF THE OVERFLOW HOLES, OF 3". WHERE NECESSARY THE CONTRACTOR SHALL CINCH THE BAG, USING PLASTIC ZIP TIES, TO ACHIEVE THE 3" CLEARANCE. THE TIES SHALL BE PLACED AT A MAXIMUM OF 4" FROM THE BOTTOM OF THE BAG.

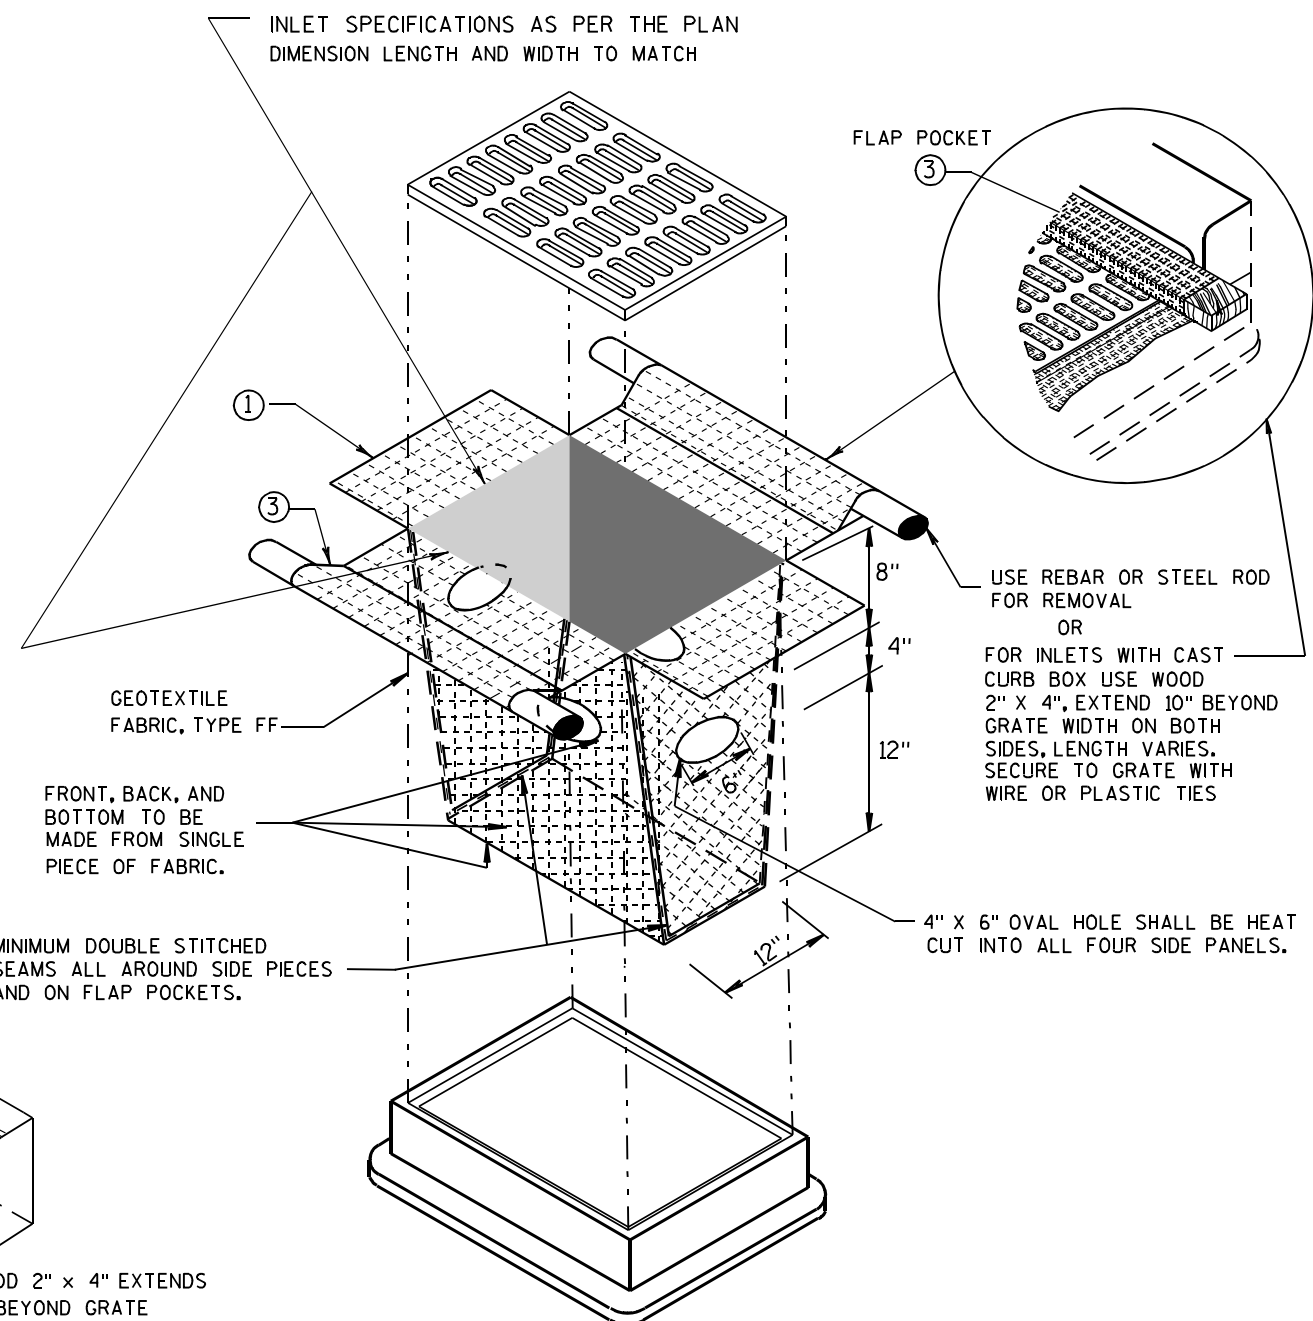


INLET PROTECTION, TYPE D

(CAN BE INSTALLED IN ANY INLET TYPE WITH OR WITHOUT A CURB BOX AS PER NOTE ②)

**INLET PROTECTION
TYPE A, B, C, AND D**

STATE OF WISCONSIN
DEPARTMENT OF TRANSPORTATION


APPROVED
10/16/02 /S/ Beth Cannestra
DATE
CHIEF ROADWAY DEVELOPMENT ENGINEER
FHWA

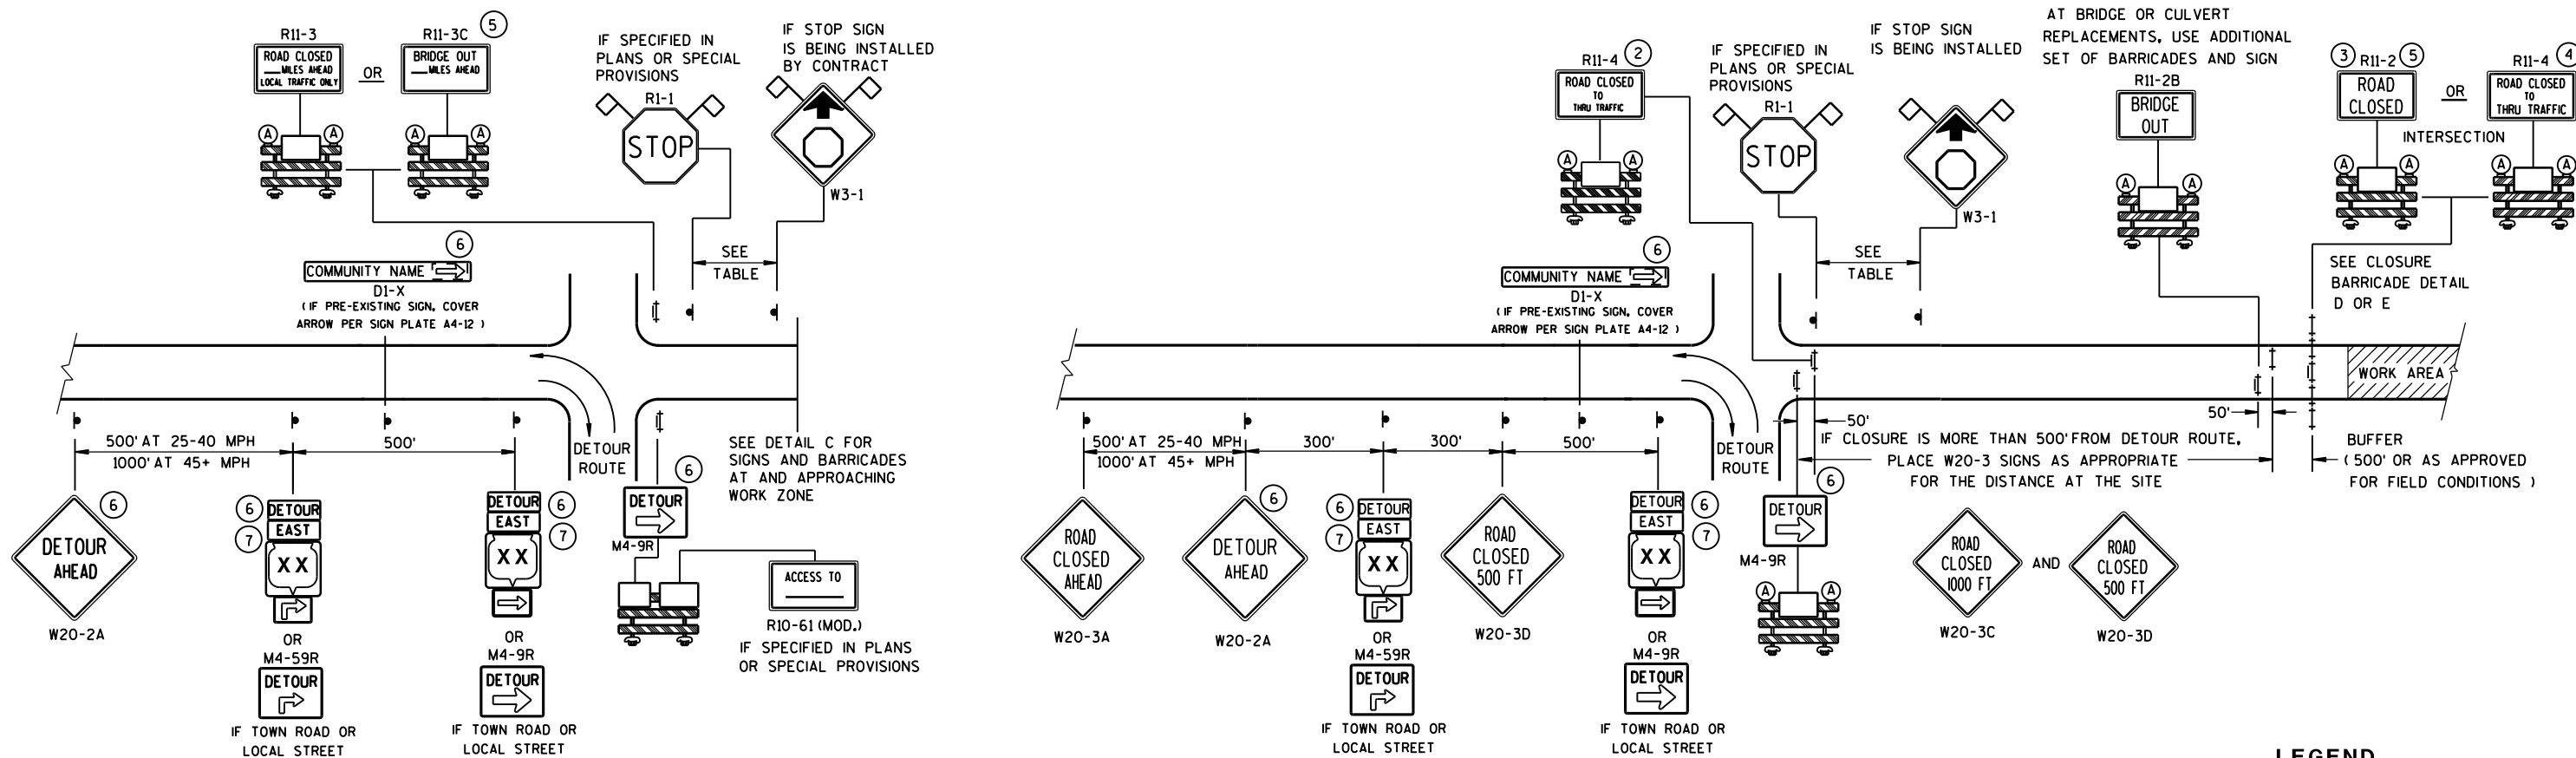

LEGEND

- SIGN ON PERMANENT SUPPORT
- ⊥ TYPE III BARRICADE
- ⊥ TYPE III BARRICADE WITH ATTACHED SIGN
- (A) TYPE "A" WARNING LIGHT (FLASHING)
- ▨ WORK AREA
- DETOUR EAST M4-8 M3-X
- XX OR COUNTY XX OR XX M1-4 M1-5A M1-6
- OR M05-1 M06-1
- ◇ ◇ FLAGS, 16" X 16" MIN., (ORANGE)


SPEED LIMIT (MPH)	"STOP AHEAD" ADVANCE WARNING DISTANCE (FT)
25	200
30	200
35	350
40	350
45	500
50	550
55	750

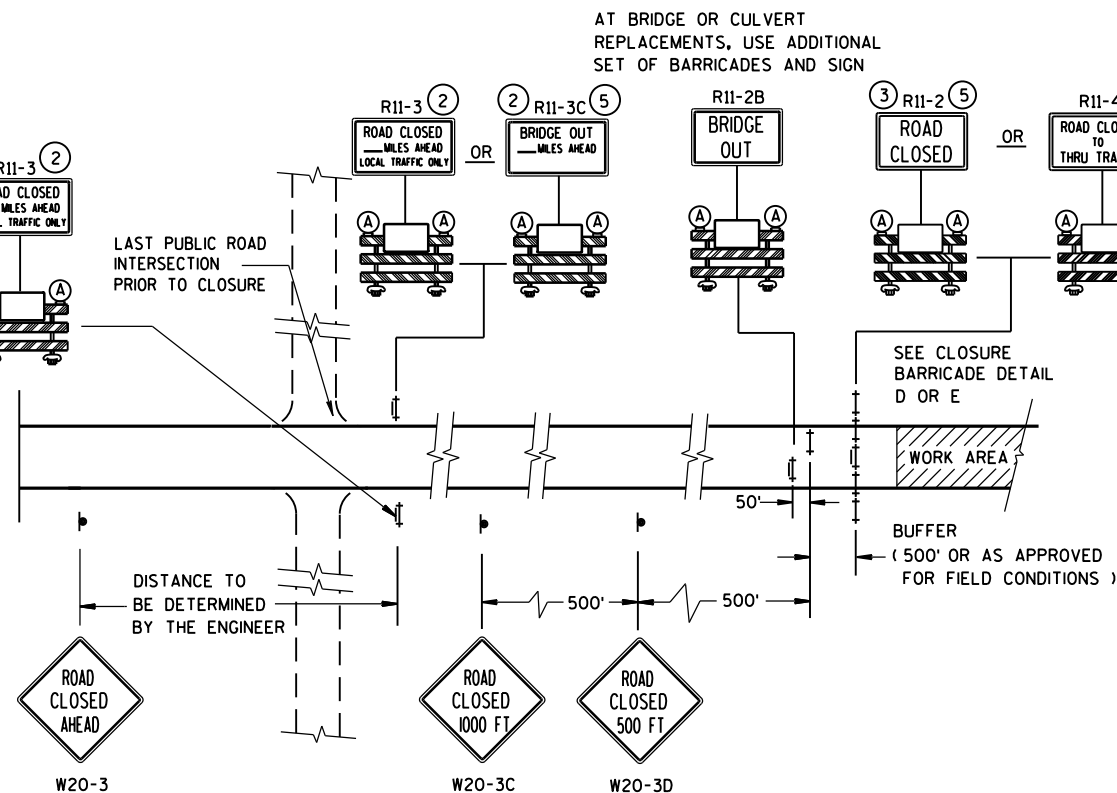


DETAIL C
MAINLINE CLOSURE, NO POSTED DETOUR

SEE SDD 15C2-SHEET "b"
FOR GENERAL NOTES
AND FOOTNOTES ① THROUGH ⑦

BARRICADES AND SIGNS FOR MAINLINE CLOSURES	
STATE OF WISCONSIN DEPARTMENT OF TRANSPORTATION	
Sept. 2015 DATE	/S/ Peter Amokobe Atepe STATEWIDE WORK ZONE TRAFFIC SAFETY ENGINEER
FHWA	

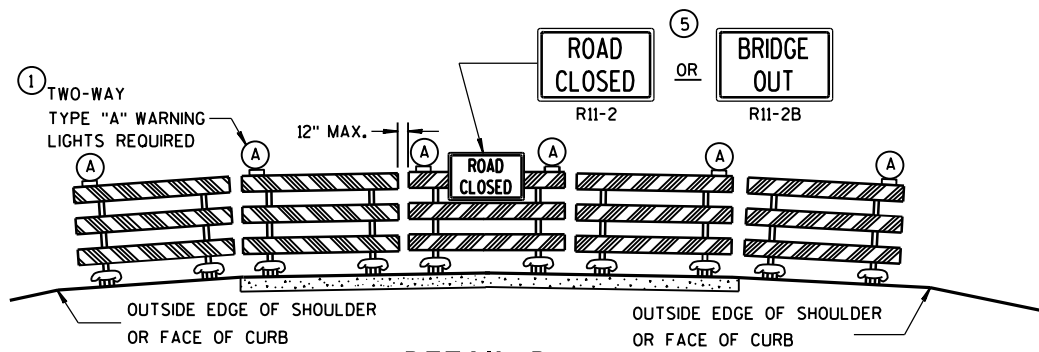

DETAIL D
ROAD CLOSURE BARRICADE DETAIL
APPROACH VIEW

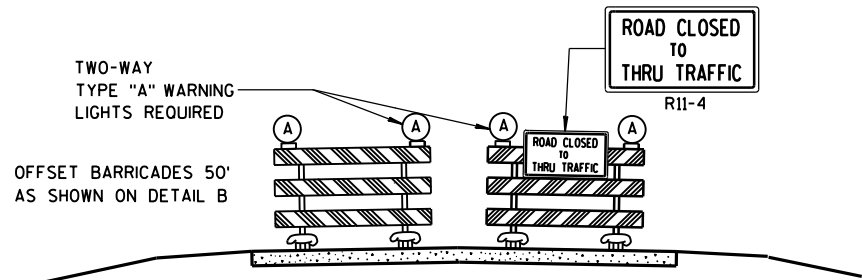

DETAIL E
LANE CLOSURE BARRICADE DETAIL
APPROACH VIEW

SEE SDD 15C2-SHEET "a" FOR LEGEND

GENERAL NOTES

THE EXACT NUMBER, LOCATION, AND SPACING OF ALL SIGNS AND BARRICADES SHALL BE ADJUSTED TO FIT FIELD CONDITIONS AS APPROVED BY THE ENGINEER.

ANY SIGNS TEMPORARY OR EXISTING, WHICH CONFLICT WITH TRAFFIC CONTROL "IN USE" SHALL BE REMOVED OR COVERED AS NEEDED AND AS APPROVED BY THE ENGINEER.

THE SPACING BETWEEN TRAFFIC CONTROL SIGNS SHOULD BE ADJUSTED TO NOT CONFLICT WITH AND SHOULD PROVIDE A DESIRABLE MINIMUM OF 200 FEET CLEARANCE TO EXISTING SIGNS THAT WILL REMAIN IN PLACE.

BARRICADES THAT MUST BE MOVED FOR A WORK OPERATION SHALL BE IMMEDIATELY RE-ESTABLISHED UPON COMPLETION OF THE OPERATION OR, FOR CONTINUING OPERATIONS, AT THE END OF EACH WORKING DAY.

SIGNS THAT WILL BE IN PLACE LESS THAN 7 CONTINUOUS DAYS AND NIGHTS MAY BE MOUNTED ON PORTABLE SUPPORTS.

ALL TYPE III BARRICADES SHALL HAVE RAILS REFLECTORIZED ON BOTH FACES. STRIPES SHALL BE PROPERLY SLOPED DOWN TOWARD THE TRAFFIC SIDE OR AS SHOWN IN THE ROAD CLOSURE BARRICADE DETAIL D FOR FULL ROAD CLOSURES.

TYPE "A" LOW-INTENSITY FLASHING WARNING LIGHTS SHALL BE VISIBLE ON BOTH SIDES OF THE BARRICADE.

THE R11-2, R11-3, M4-9, R11-4 AND R10-61 SIGNS PLACED ON BARRICADES SHALL COVER NO MORE THAN THE TOP RAIL. THE SIGNS SHALL NOT COVER ANY PORTION OF THE MIDDLE OR BOTTOM RAILS.

"WO AND "MO" SIGNS ARE THE SAME AS "W" AND "M" SIGNS EXCEPT THE BACKGROUND IS ORANGE.

ALL SIGNS SHALL BE 48" X 48" UNLESS OTHERWISE NOTED BELOW:


- R11-2 SHALL BE 48" X 30".
- R11-3, R11-4 AND R10-61 SHALL BE 60" X 30".
- M4-9 SHALL BE 30" X 24".
- M3-X SHALL BE 24" X 12". (36" X 18" IF NEEDED TO MATCH EXISTING SIGNS.)
- M4-8 SHALL BE 24" X 12". (30" X 15" IF NEEDED TO MATCH EXISTING SIGNS.)
- M1-4, M1-5A, AND M1-6 SHALL BE 24" X 24". (36" X 36" IF NEEDED TO MATCH EXISTING SIGNS.)
- M05-1 AND M06-1 SHALL BE 21" X 21". (30" X 30" IF NEEDED TO MATCH EXISTING SIGNS.)
- D1-X SHALL BE AS SHOWN ON SPECIFIC PROJECT SIGNING DETAIL SHEETS.
- R1-1 SHALL BE 36" X 36".

- 1 TWO WARNING LIGHTS SHALL BE PROVIDED ON THE CENTER BARRICADE AND A MINIMUM OF ONE WARNING LIGHT SHALL BE PROVIDED ON EACH OF THE OTHER BARRICADES WITHIN THE ROADWAY LIMITS. SPACING OF THE WARNING LIGHTS SHALL BE UNIFORM TO THE EDGE OF ROADWAY AS SHOWN (APPROX. 8-FOOT LIGHT SPACING).
- 2 THESE SIGNS AND BARRICADES ARE NOT REQUIRED IF ROAD CLOSURE BEGINS AT INTERSECTION.
- 3 FOR ROAD CLOSURE WITHOUT LOCAL ACCESS TO PROJECT, SEE ROAD CLOSURE BARRICADE DETAIL D.
- 4 FOR ROAD CLOSURE WITH LOCAL ACCESS TO PROJECT, SEE LANE CLOSURE BARRICADE DETAIL E.
- 5 FOR BRIDGE OR CULVERT REPLACEMENTS, SUBSTITUTE "BRIDGE OUT" INSTEAD OF "ROAD CLOSED" ON R11-2 AND R11-3 SIGNS.
- 6 INSTALL DETOUR AND COMMUNITY GUIDE SIGNS AND ARROWS ONLY IF SPECIFIED IN THE CONTRACT. IF THERE ARE EXISTING ROUTE MARKER ASSEMBLIES THAT WILL REMAIN IN PLACE, ADJUST THE LOCATION OF THE DETOUR ROUTE SIGNS TO CORRESPOND WITH THE EXISTING ASSEMBLIES. MODIFY EXISTING SIGNS WHERE POSSIBLE. SEE SPECIFIC PROJECT DETOUR SIGNING DETAIL SHEETS. IF DETOUR SIGNS ARE BEING INSTALLED BY OTHERS, PLACE THE CONTRACTED TRAFFIC CONTROL SIGNS TO ALLOW FOR PLACEMENT OF ALL WARNING, DETOUR AND GUIDE SIGNS AS SHOWN.
- 7 "EAST" CARDINAL DIRECTION MARKERS AND RIGHT TURN ARROWS ARE SHOWN. USE OTHER CARDINAL DIRECTIONS AND ARROWS AS APPROPRIATE.


BARRICADES AND SIGNS
FOR
MAINLINE CLOSURES

STATE OF WISCONSIN
DEPARTMENT OF TRANSPORTATION


Sept. 2015 /S/ Peter Amokobe Atepe
DATE STATEWIDE WORK ZONE TRAFFIC
FHWA SAFETY ENGINEER

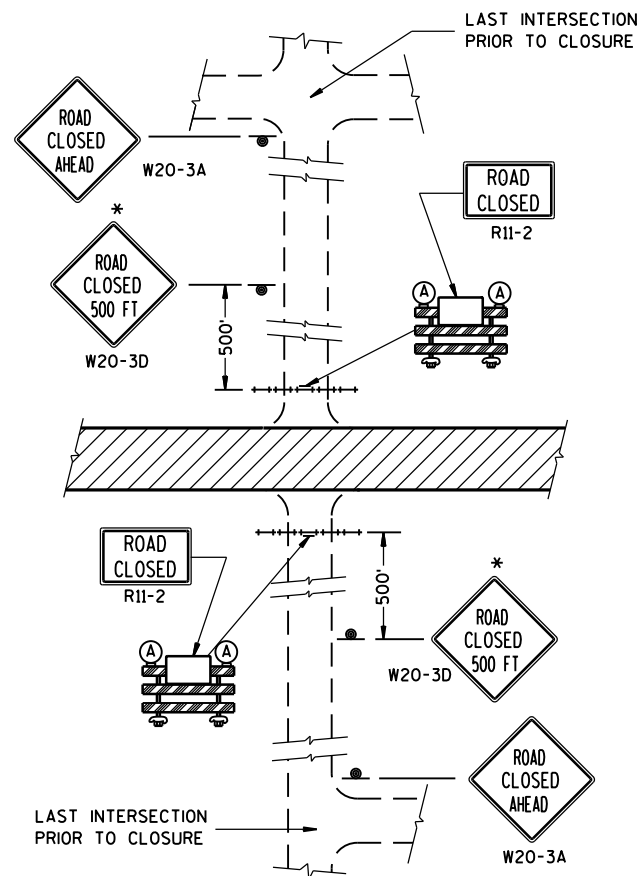


DETAIL 1
(NO ACCESS TO PROJECT)

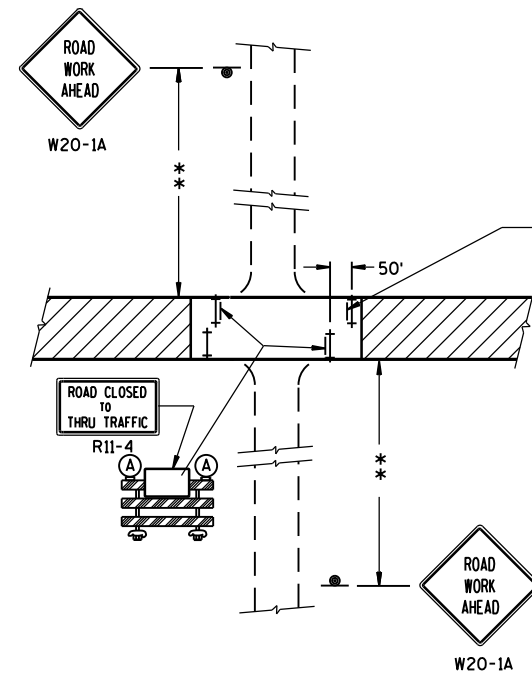

DETAIL 3
(PUBLIC CROSS-TRAFFIC MAINTAINED. CONTRACTOR, LOCAL BUSINESS AND RESIDENT ACCESS).

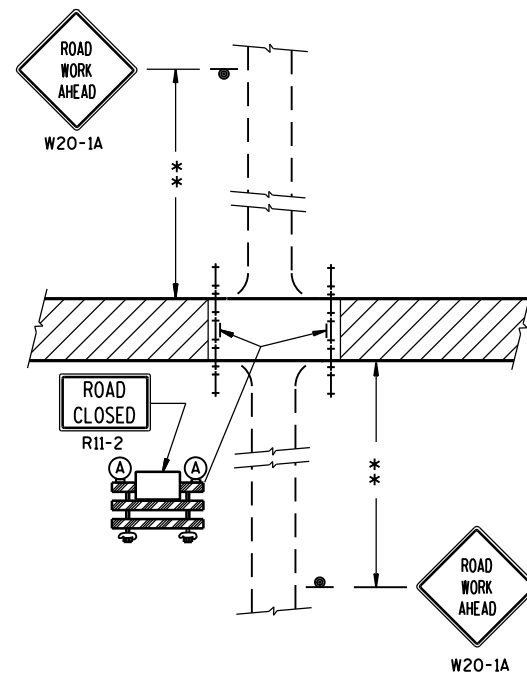

DETAIL 2
(PUBLIC CROSS-TRAFFIC MAINTAINED.
NO ACCESS TO PROJECT).

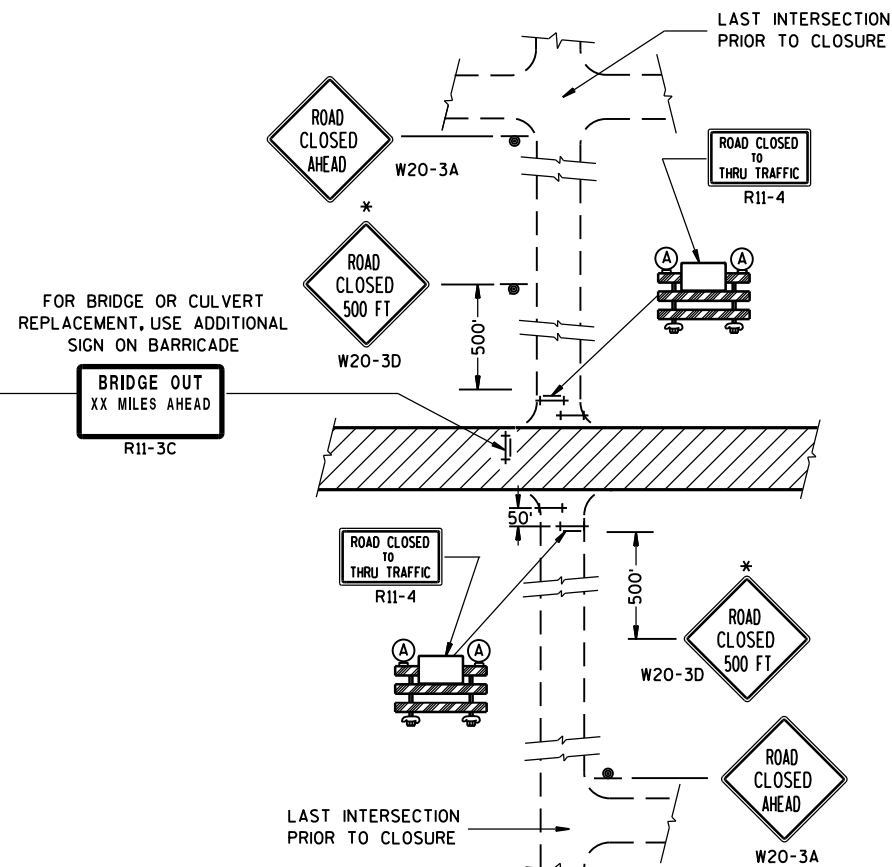

DETAIL 4
(CONTRACTOR, LOCAL BUSINESS AND
RESIDENT ACCESS TO PROJECT)

GENERAL NOTES

THE EXACT NUMBER, LOCATION, AND SPACING OF ALL SIGNS AND BARRICADES SHALL BE ADJUSTED TO FIT FIELD CONDITIONS AS APPROVED BY THE ENGINEER.

ANY SIGNS TEMPORARY OR EXISTING, WHICH CONFLICT WITH TRAFFIC CONTROL "IN USE" SHALL BE REMOVED OR COVERED AS NEEDED AND AS APPROVED BY THE ENGINEER.

THE SPACING BETWEEN TRAFFIC CONTROL SIGNS SHOULD BE ADJUSTED TO NOT CONFLICT WITH AND SHOULD PROVIDE A DESIRABLE MINIMUM OF 200 FEET CLEARANCE TO EXISTING SIGNS THAT WILL REMAIN IN PLACE.

IF A "STOP" SIGN MUST BE REMOVED FOR A WORK OPERATION, A TEMPORARY "STOP" SIGN SHALL BE PLACED PRIOR TO THE SIGN REMOVAL, OR A FLAGGER SHALL BE PROVIDED UNTIL THE SIGN IS RE-ESTABLISHED.

BARRICADES THAT MUST BE MOVED FOR A WORK OPERATION SHALL BE IMMEDIATELY RE-ESTABLISHED UPON COMPLETION OF THE OPERATION OR, FOR CONTINUING OPERATIONS, AT THE END OF EACH WORKING DAY.

SIGNS THAT WILL BE IN PLACE LESS THAN 7 CONTINUOUS DAYS AND NIGHTS MAY BE MOUNTED ON PORTABLE SUPPORTS.

ALL TYPE III BARRICADES SHALL HAVE RAILS REFLECTORIZED ON BOTH FACES. STRIPES SHALL BE PROPERLY SLOPED DOWN TOWARD THE TRAFFIC SIDE OR AS SHOWN IN THE ROAD CLOSURE BARRICADE DETAIL D FOR FULL ROAD CLOSURES.

TYPE "A" LOW-INTENSITY FLASHING WARNING LIGHTS SHALL BE VISIBLE ON BOTH SIDES OF THE BARRICADE.

THE R11-2, R11-3 AND R11-4 SIGNS PLACED ON BARRICADES SHALL COVER NO MORE THAN THE TOP RAIL. THE SIGNS SHALL NOT COVER ANY PORTION OF THE MIDDLE OR BOTTOM RAILS.

ALL SIGNS SHALL BE 48" X 48" UNLESS OTHERWISE NOTED BELOW:

R11-2 SHALL BE 48" X 30".

R11-4 AND R11-3 SHALL BE 60" X 30".

*OMIT THE "ROAD CLOSED 500 FT." SIGN IF THE LAST INTERSECTION IS 500 FT. OR LESS FROM THE WORK ZONE.

**500' MAX. OR AT LAST INTERSECTION WHICHEVER IS CLOSER.

LEGEND

- ⊙ SIGN ON PERMANENT SUPPORT
- ⊢ TYPE III BARRICADE
- ⊢ TYPE III BARRICADE WITH ATTACHED SIGN
- (A) TYPE "A" WARNING LIGHT (FLASHING)
- ▨ WORK AREA

BARRICADES AND SIGNS FOR SIDEROAD CLOSURES

STATE OF WISCONSIN
DEPARTMENT OF TRANSPORTATION

APPROVED

Sept. 2015


DATE

FHWA


/S/ Peter Amakobe Atepe

STATEWIDE WORK ZONE TRAFFIC


SAFETY ENGINEER

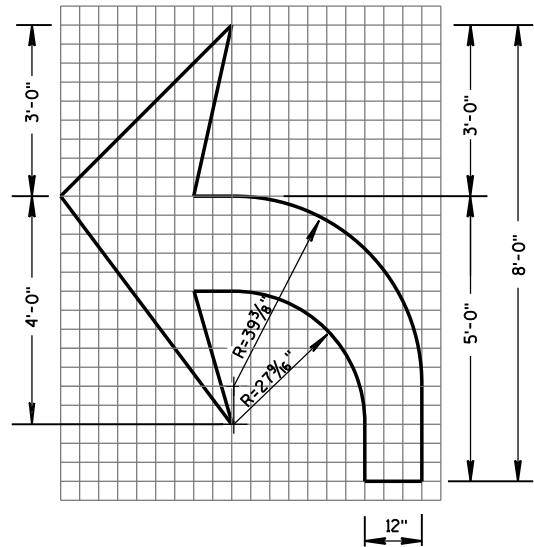


TYPE 2

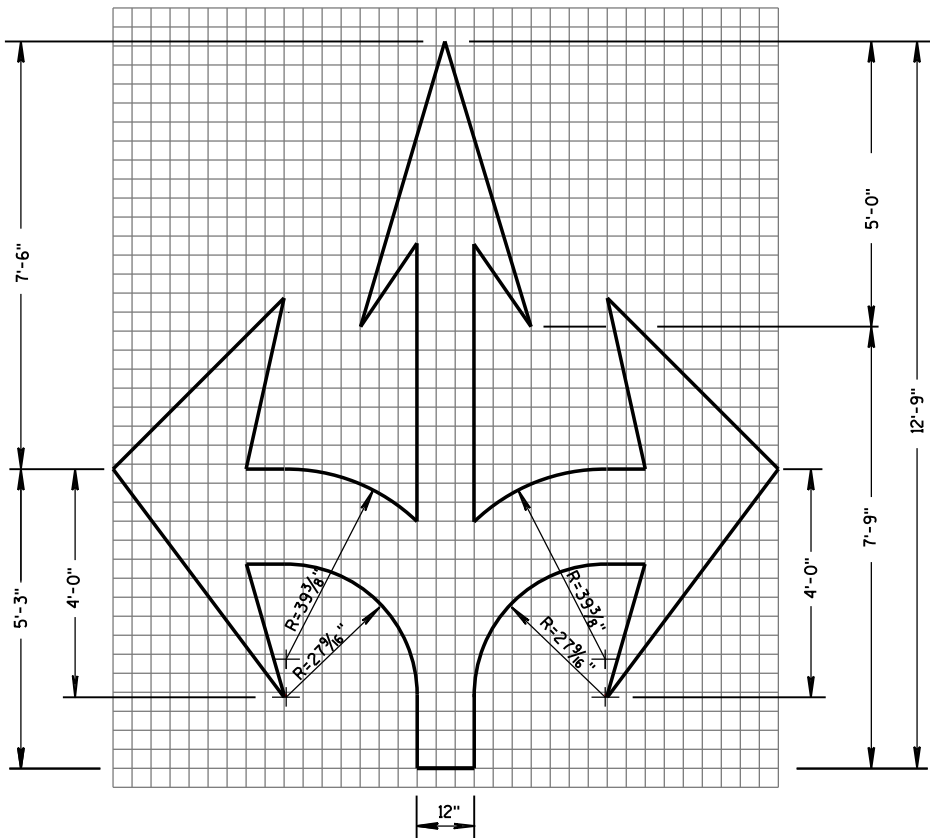


TYPE 6

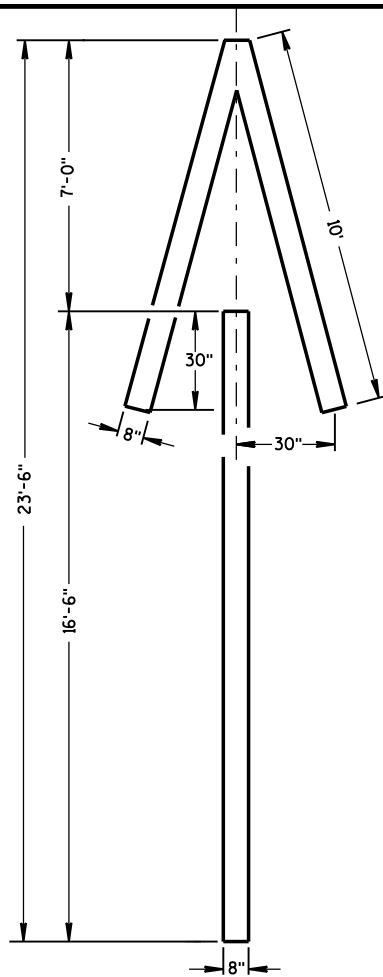


TYPE 4

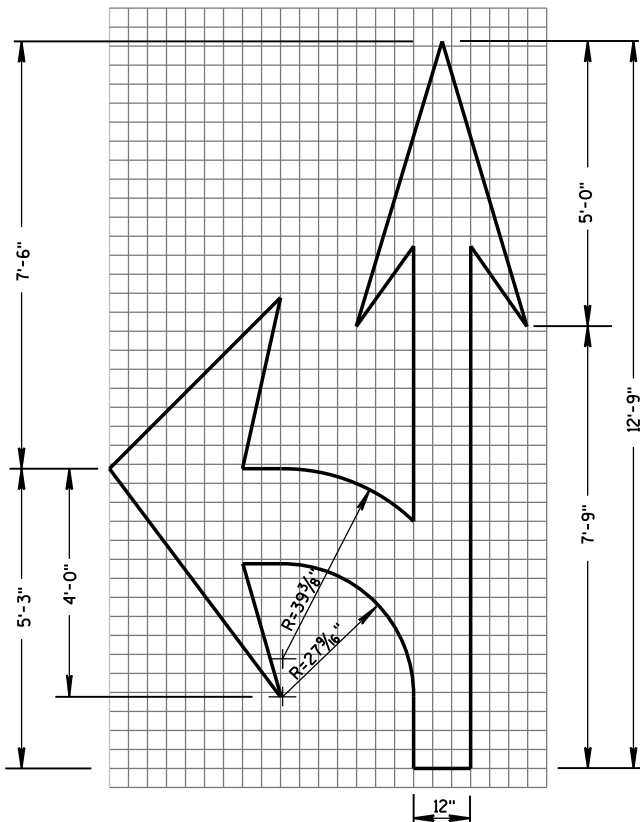

TYPE 3

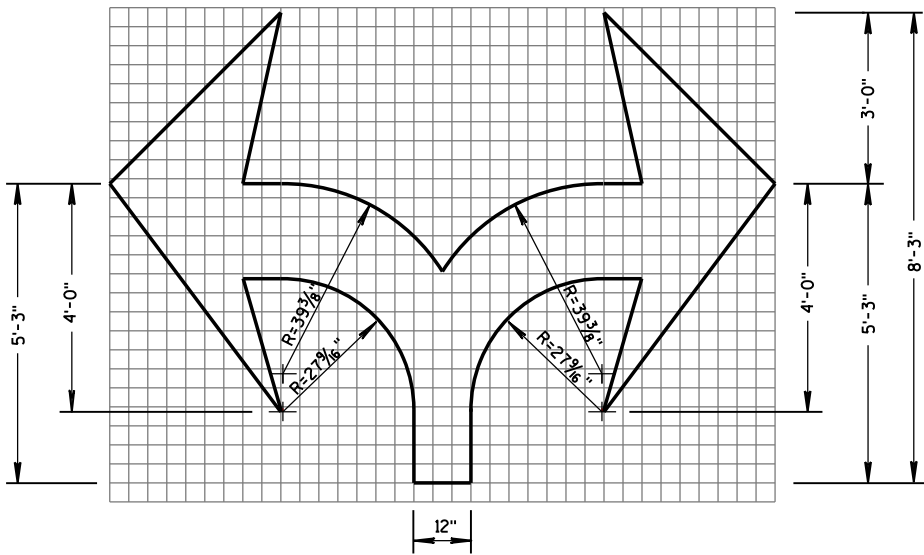


TYPE 7

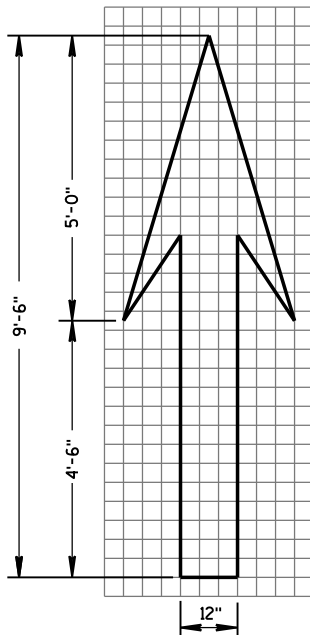

TYPE 1

GENERAL NOTES

DETAILS OF INSTALLATION, MATERIALS AND WORKMANSHIP NOT SHOWN ON THIS DRAWING SHALL CONFORM TO THE PERTINENT REQUIREMENTS OF THE STANDARD SPECIFICATIONS AND APPLICABLE SPECIAL PROVISIONS.

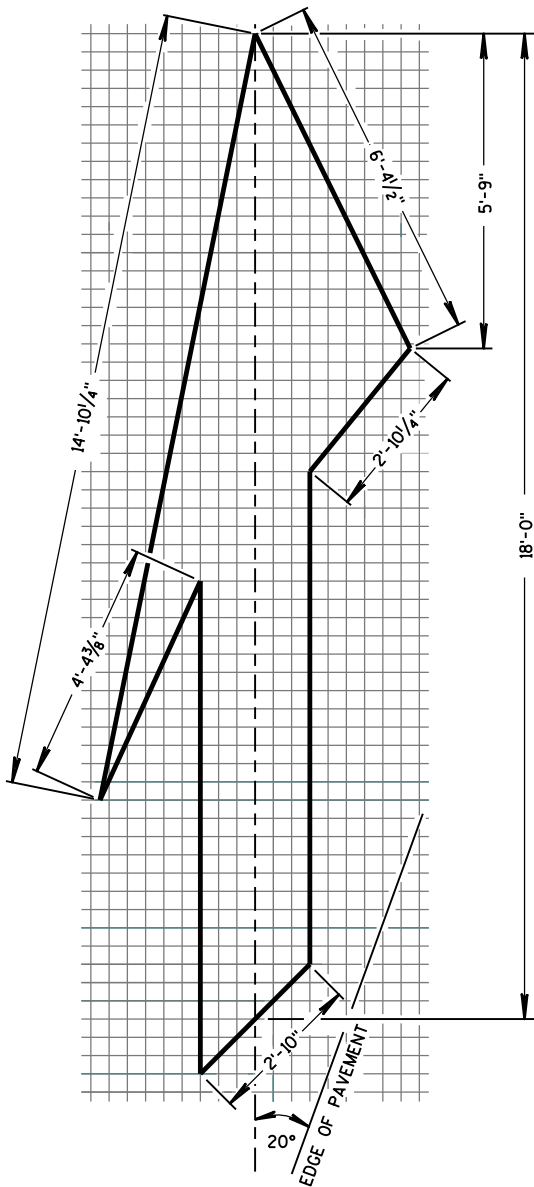


TYPE 5 LANE DROP ARROW


PAVEMENT MARKING ARROWS

STATE OF WISCONSIN
DEPARTMENT OF TRANSPORTATION

APPROVED
June 2017 /S/ Matthew R. Rauch
DATE STATE SIGNING AND MARKING ENGINEER
FHWA

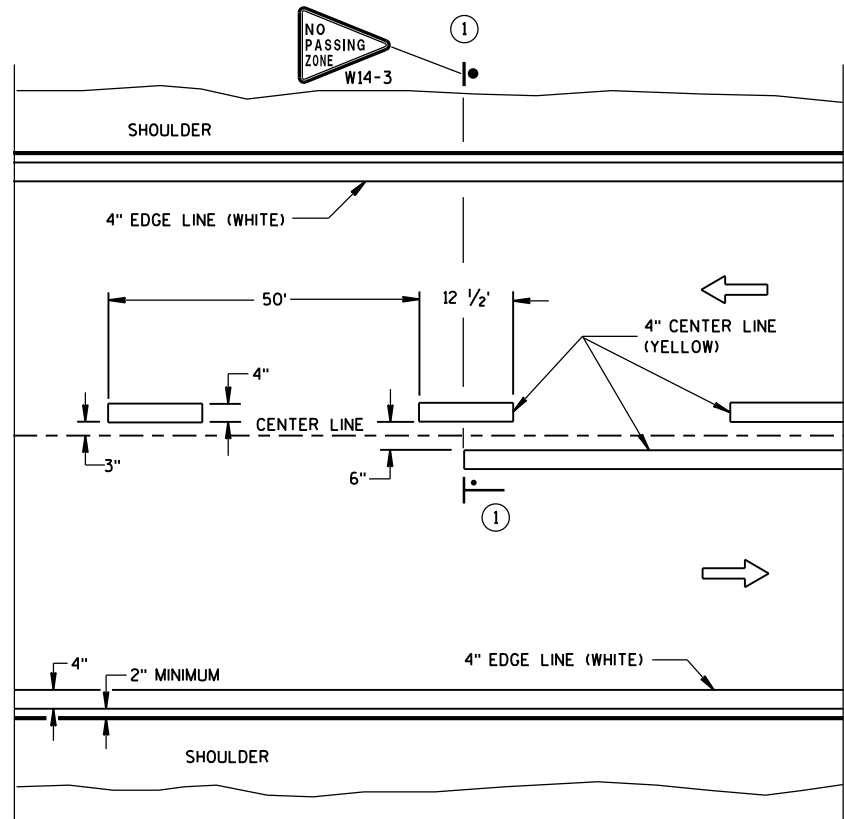


TWO WAY TRAFFIC

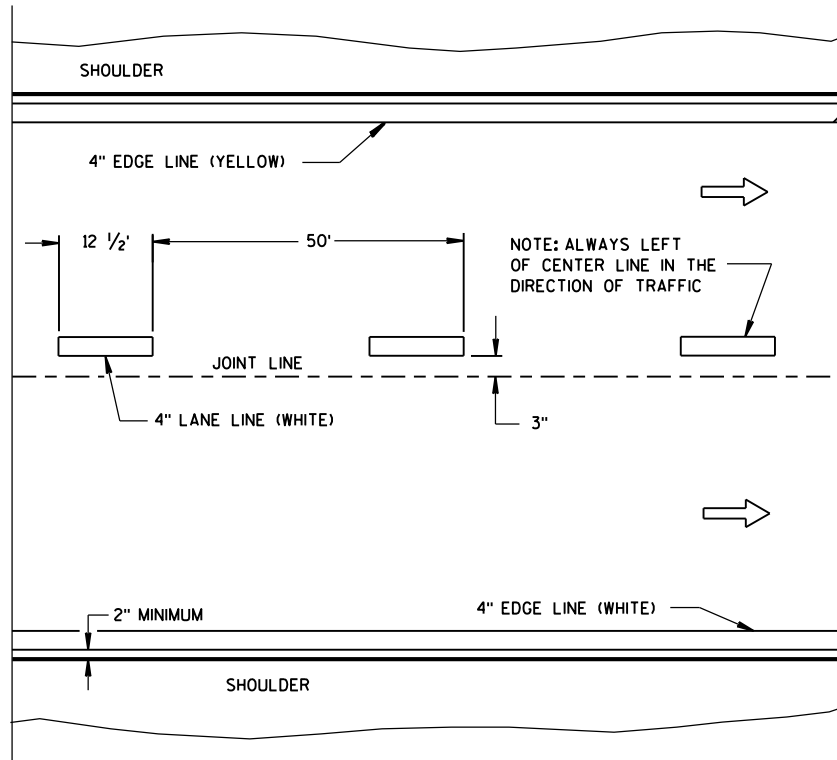


ONE WAY TRAFFIC

PERMANENT PAVEMENT MARKING

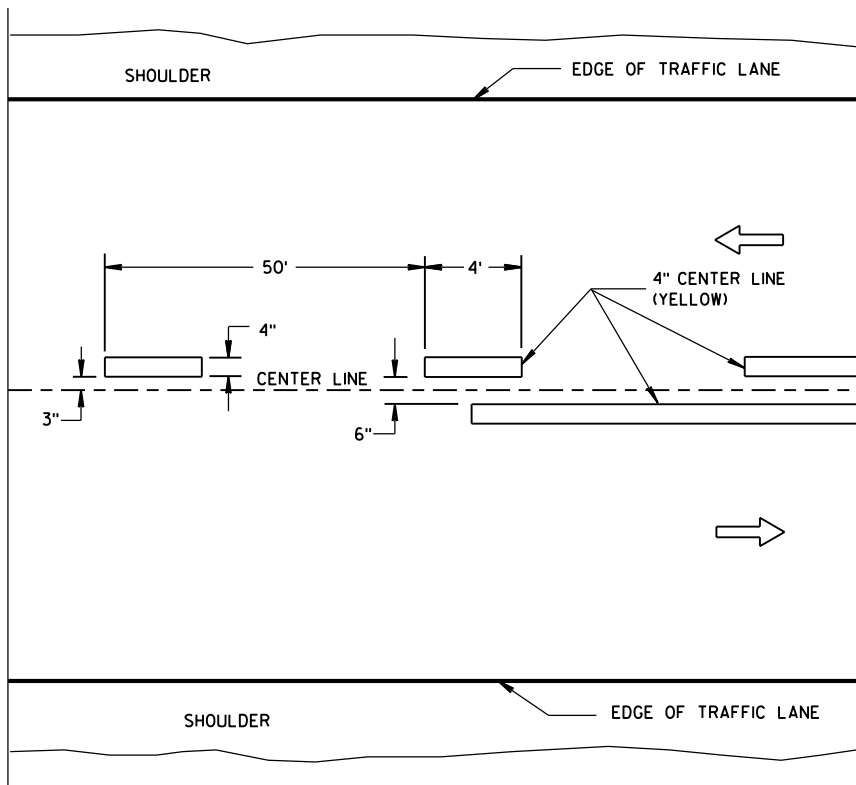

TWO WAY TRAFFIC

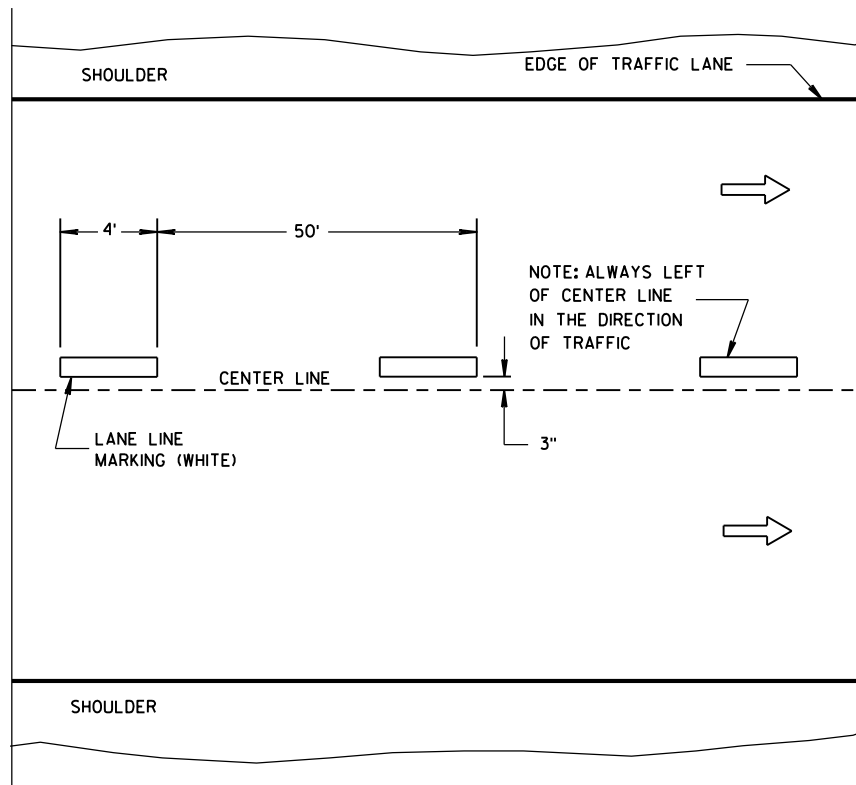

ONE WAY TRAFFIC

TEMPORARY PAVEMENT MARKING

GENERAL NOTES

DETAILS OF CONSTRUCTION NOT SHOWN ON THIS DRAWING SHALL CONFORM TO STANDARD SPECIFICATIONS AND SPECIAL PROVISIONS.

① LOCATE THE NO PASSING ZONE W14-3 SIGN WITHIN 50 FEET OF THE "T" MARKING.

NOTE

ARROW SYMBOL (→) SHOWS DIRECTION OF TRAVEL

LEGEND


—●— "T" MARKING

● POST MOUNTED SIGN

LONGITUDINAL MARKING
(MAINLINE)

STATE OF WISCONSIN
DEPARTMENT OF TRANSPORTATION


APPROVED
June 2017 /S/ Matthew R. Rauch
DATE STATE SIGNING AND MARKING ENGINEER
FHWA

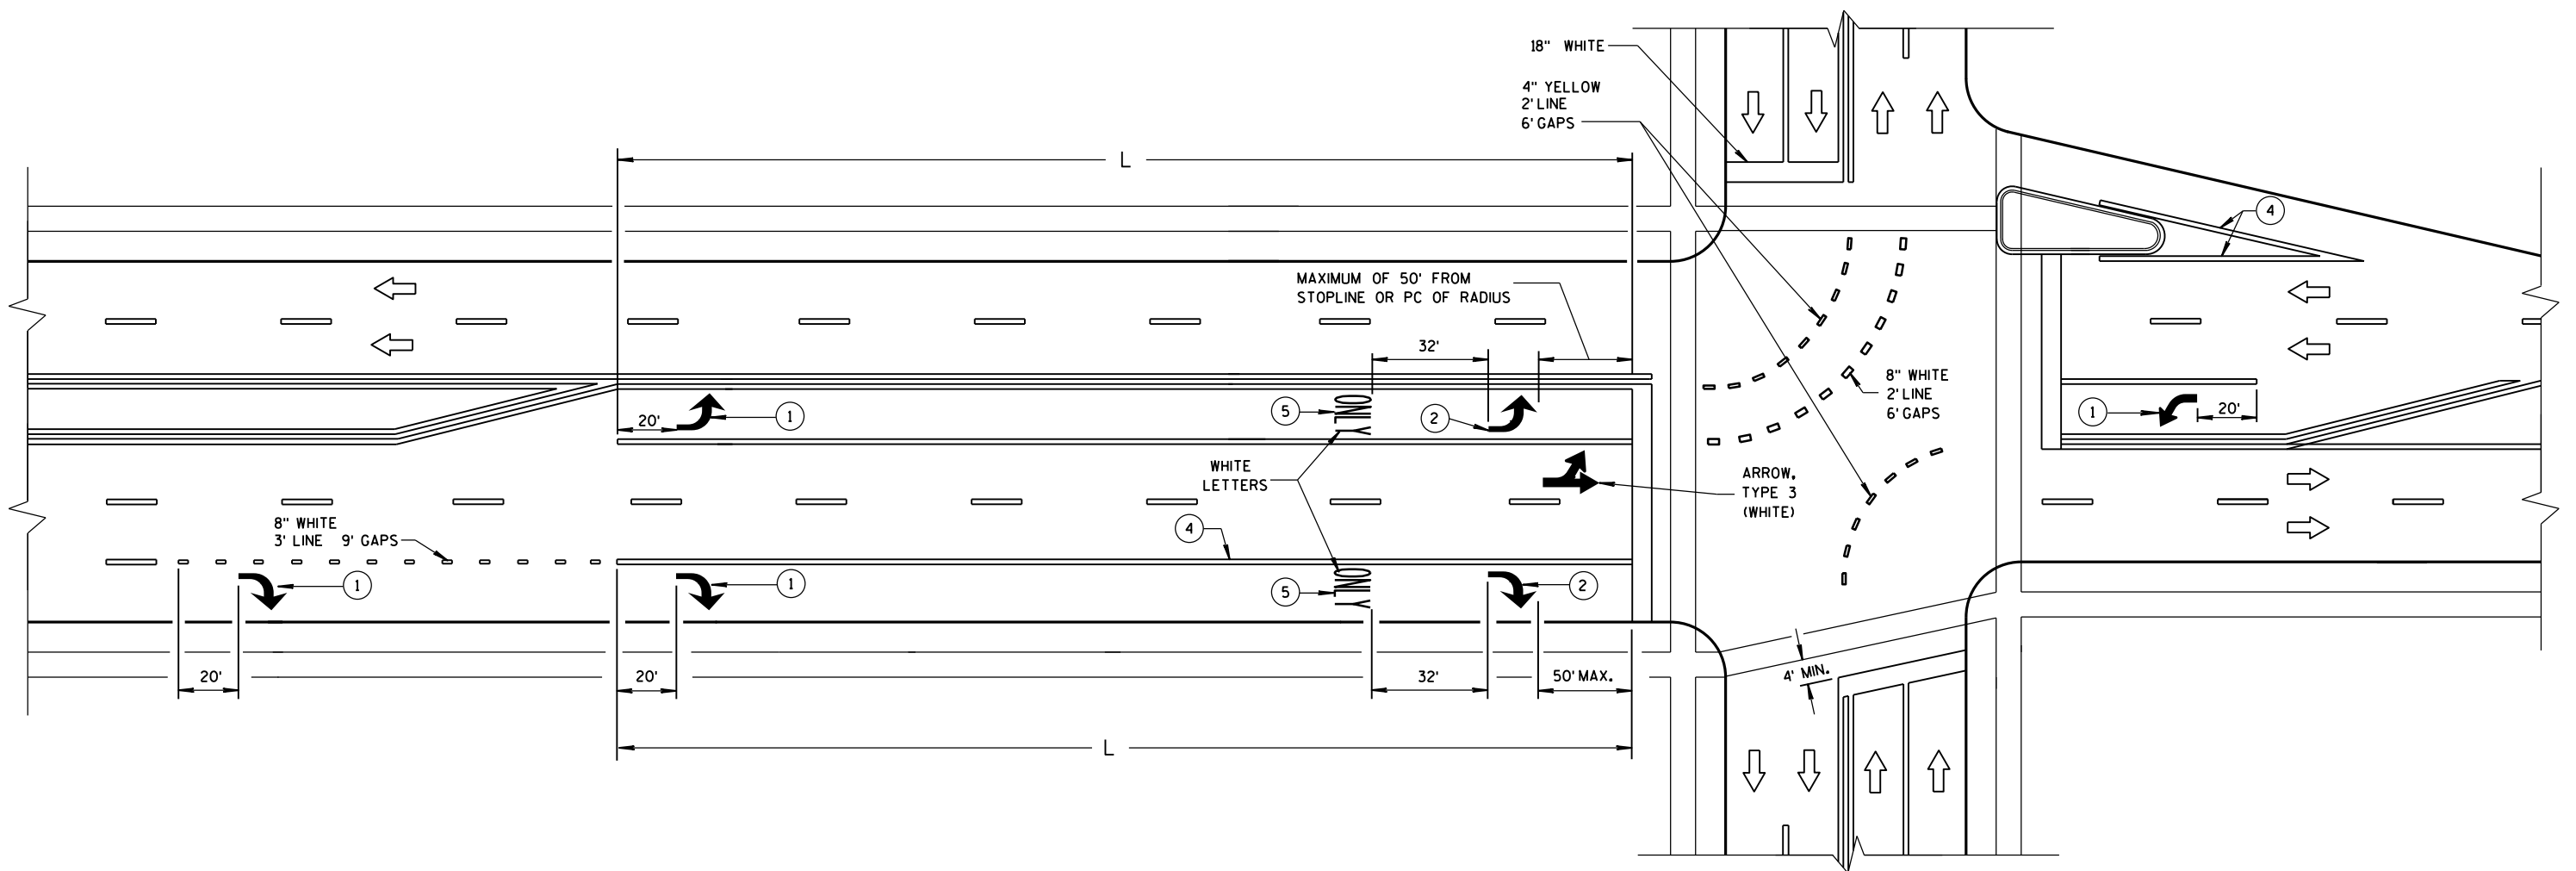

GENERAL NOTES

- ① REQUIRED ARROW, TYPE 2 (WHITE).
- ② REQUIRED ARROW, TYPE 2 (WHITE) WHEN L IS GREATER THAN 78 FEET AND LESS THAN OR EQUAL TO 166 FEET.
- ③ A SET OF ARROWS IS REQUIRED EVERY 400 FEET OR NEAR INTERSECTIONS OR DRIVEWAYS WITH TURNING TRAFFIC.
- ④ 8" WHITE
- ⑤ REQUIRED WORD ONLY WHEN L IS GREATER THAN 166 FEET.


TWO WAY LEFT TURN LANE

NOTE:
ARROW SYMBOL ()
SHOWS DIRECTION OF TRAVEL


L = LENGTH OF TURN BAY

PAVEMENT MARKING
(TURN LANES)


STATE OF WISCONSIN
DEPARTMENT OF TRANSPORTATION

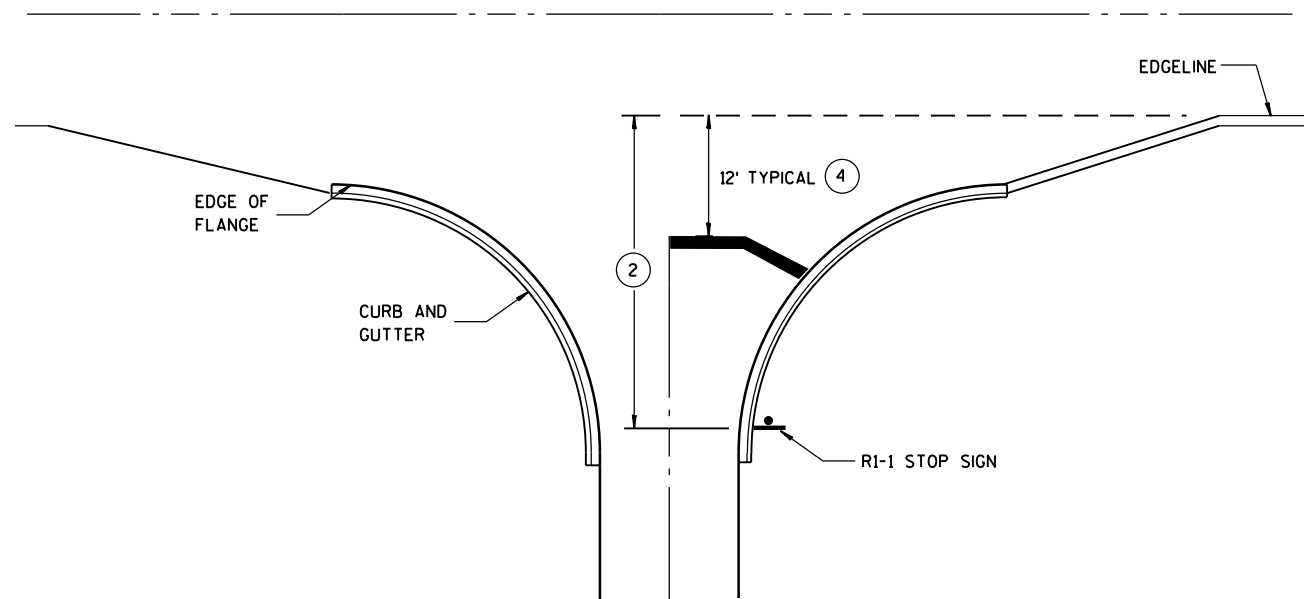


**TYPICAL STOP LINE PAVEMENT MARKING
WITH CURB AND GUTTER**

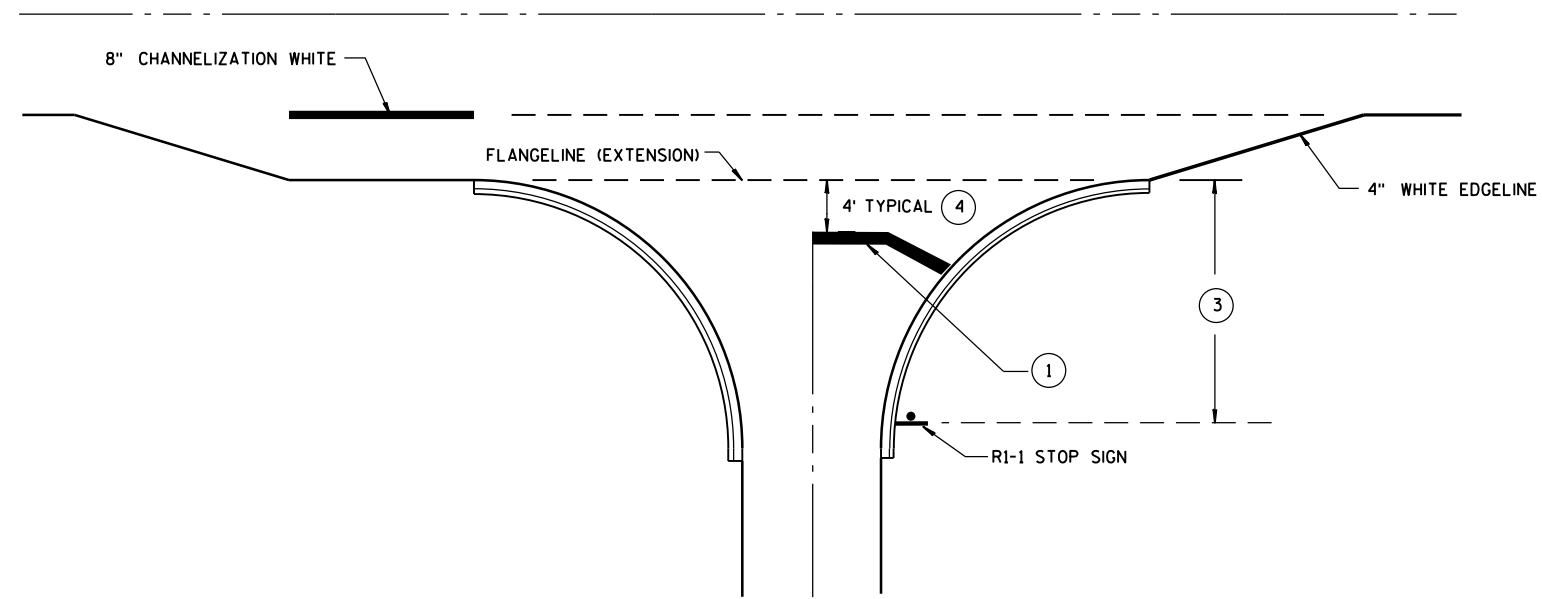

**TYPICAL STOP LINE PAVEMENT MARKING
FOR SIDEROADS WITH RIGHT TURN LANE**

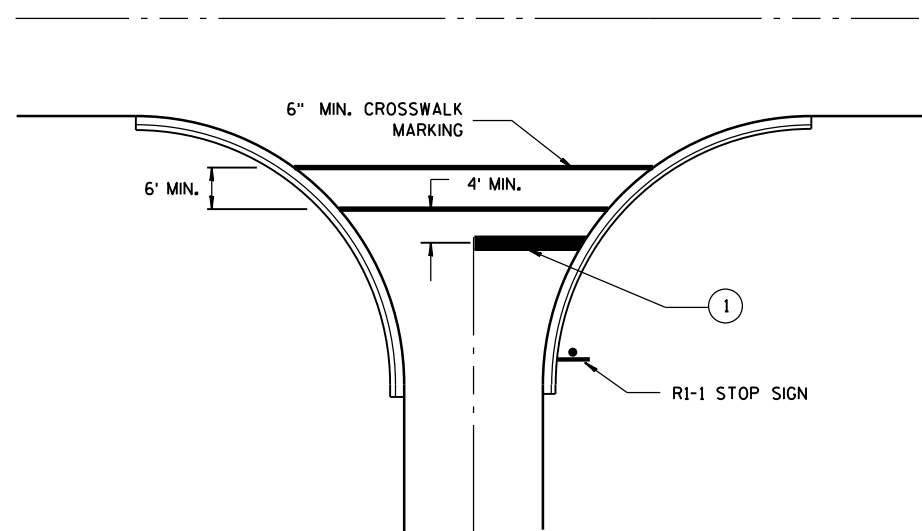

**TYPICAL STOP LINE PAVEMENT MARKING
FOR SIDEROADS WITH CROSSWALK MARKING**

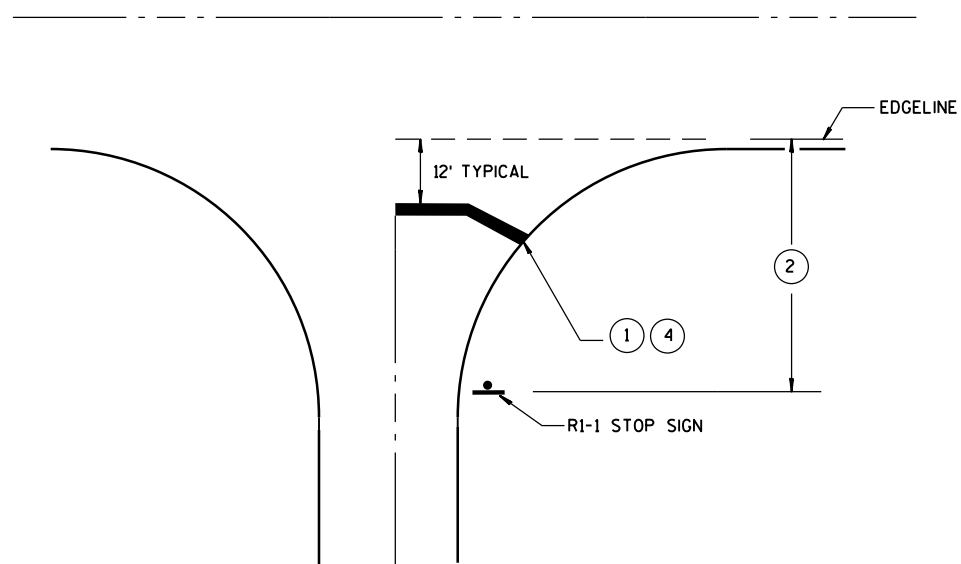

**TYPICAL STOP LINE PAVEMENT MARKING
WITHOUT CURB AND GUTTER**

GENERAL NOTES

- ① 18-INCH STOP LINES MAY BE DELETED OR ADDED BY THE PROJECT ENGINEER BASED ON VISIBILITY AND SIGHT LINES.
- ② IF STOP SIGN IS LESS THAN OR EQUAL TO 40 FEET FROM THE EDGE LINE THAN NO STOP LINE IS REQUIRED.
- ③ IF STOP SIGN IS LESS THAN OR EQUAL TO 30 FEET FROM THE FLANGELINE EXTENSION THAN NO STOP LINE IS REQUIRED.
- ④ MOVE CLOSER TO EDGE OF TRAVEL LANE AS NEEDED FOR VISIBILITY AND SIGHT LINES. (NO CLOSER THAN 4 FEET).

STOP LINE AND CROSSWALK PAVEMENT MARKING


STATE OF WISCONSIN
DEPARTMENT OF TRANSPORTATION


APPROVED


4-18-2016
DATE


FHWA


/S/ Matthew R. Rauch
STATE SIGNING AND MARKING ENGINEER

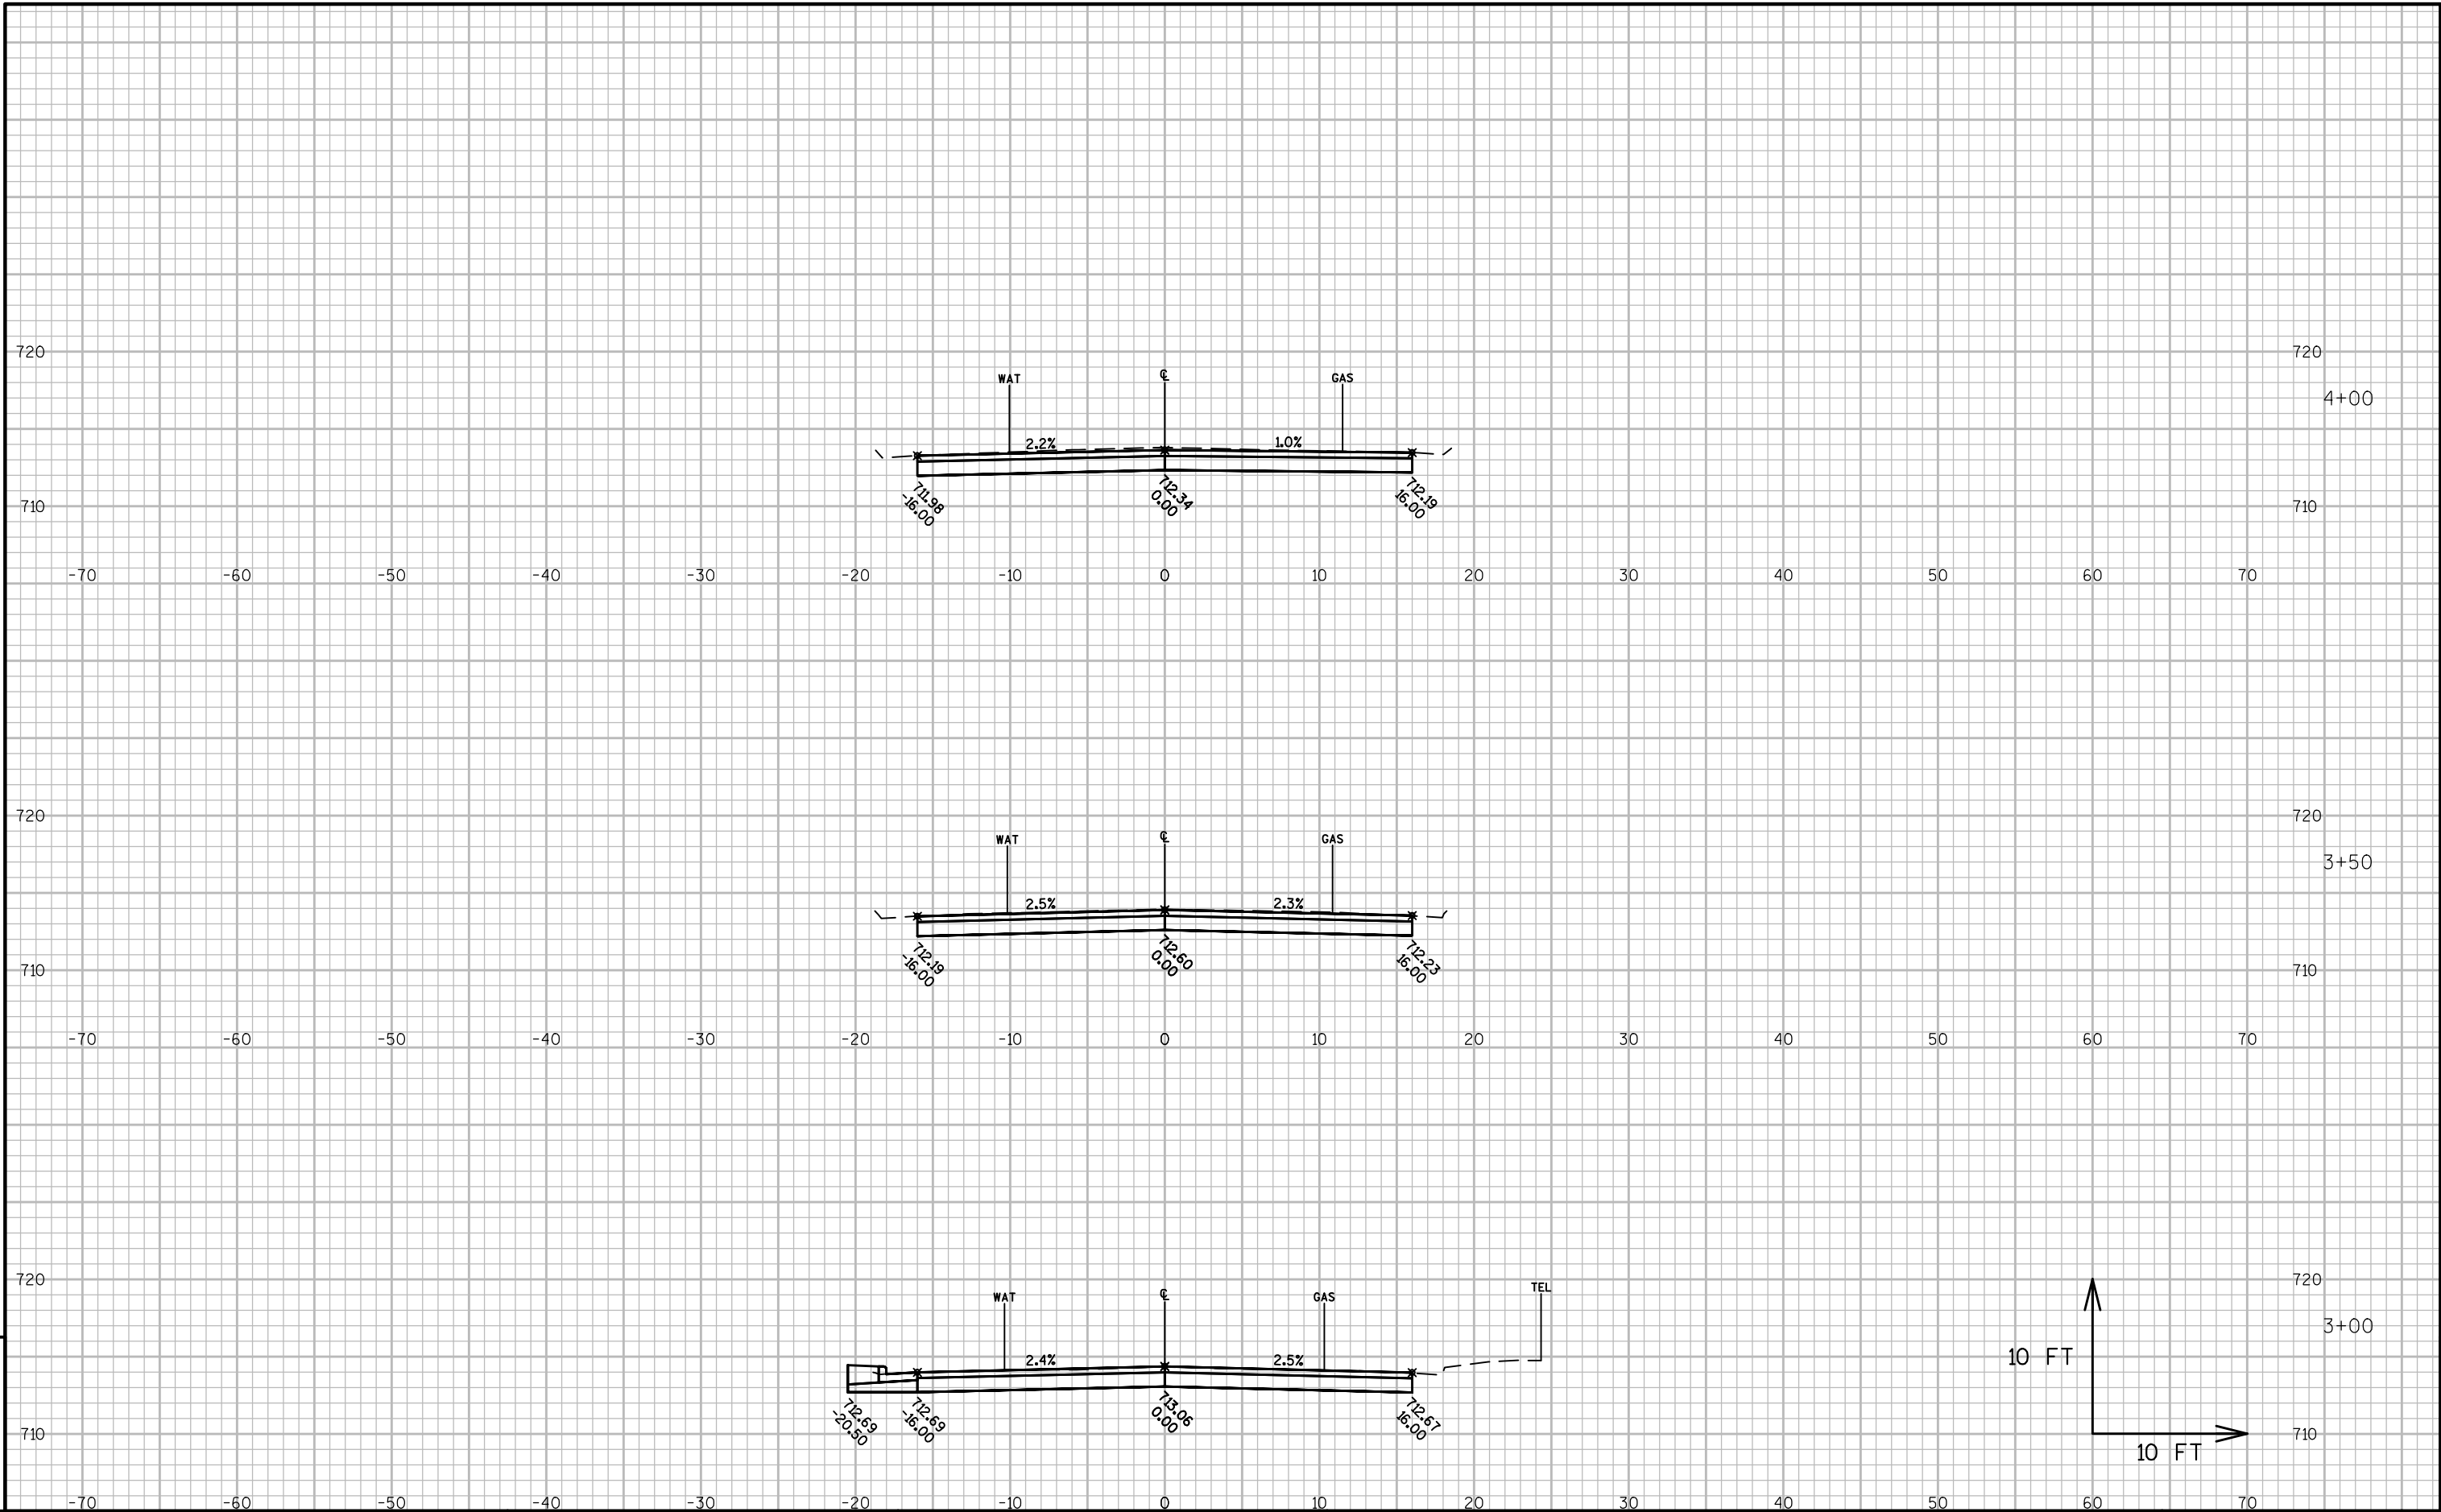


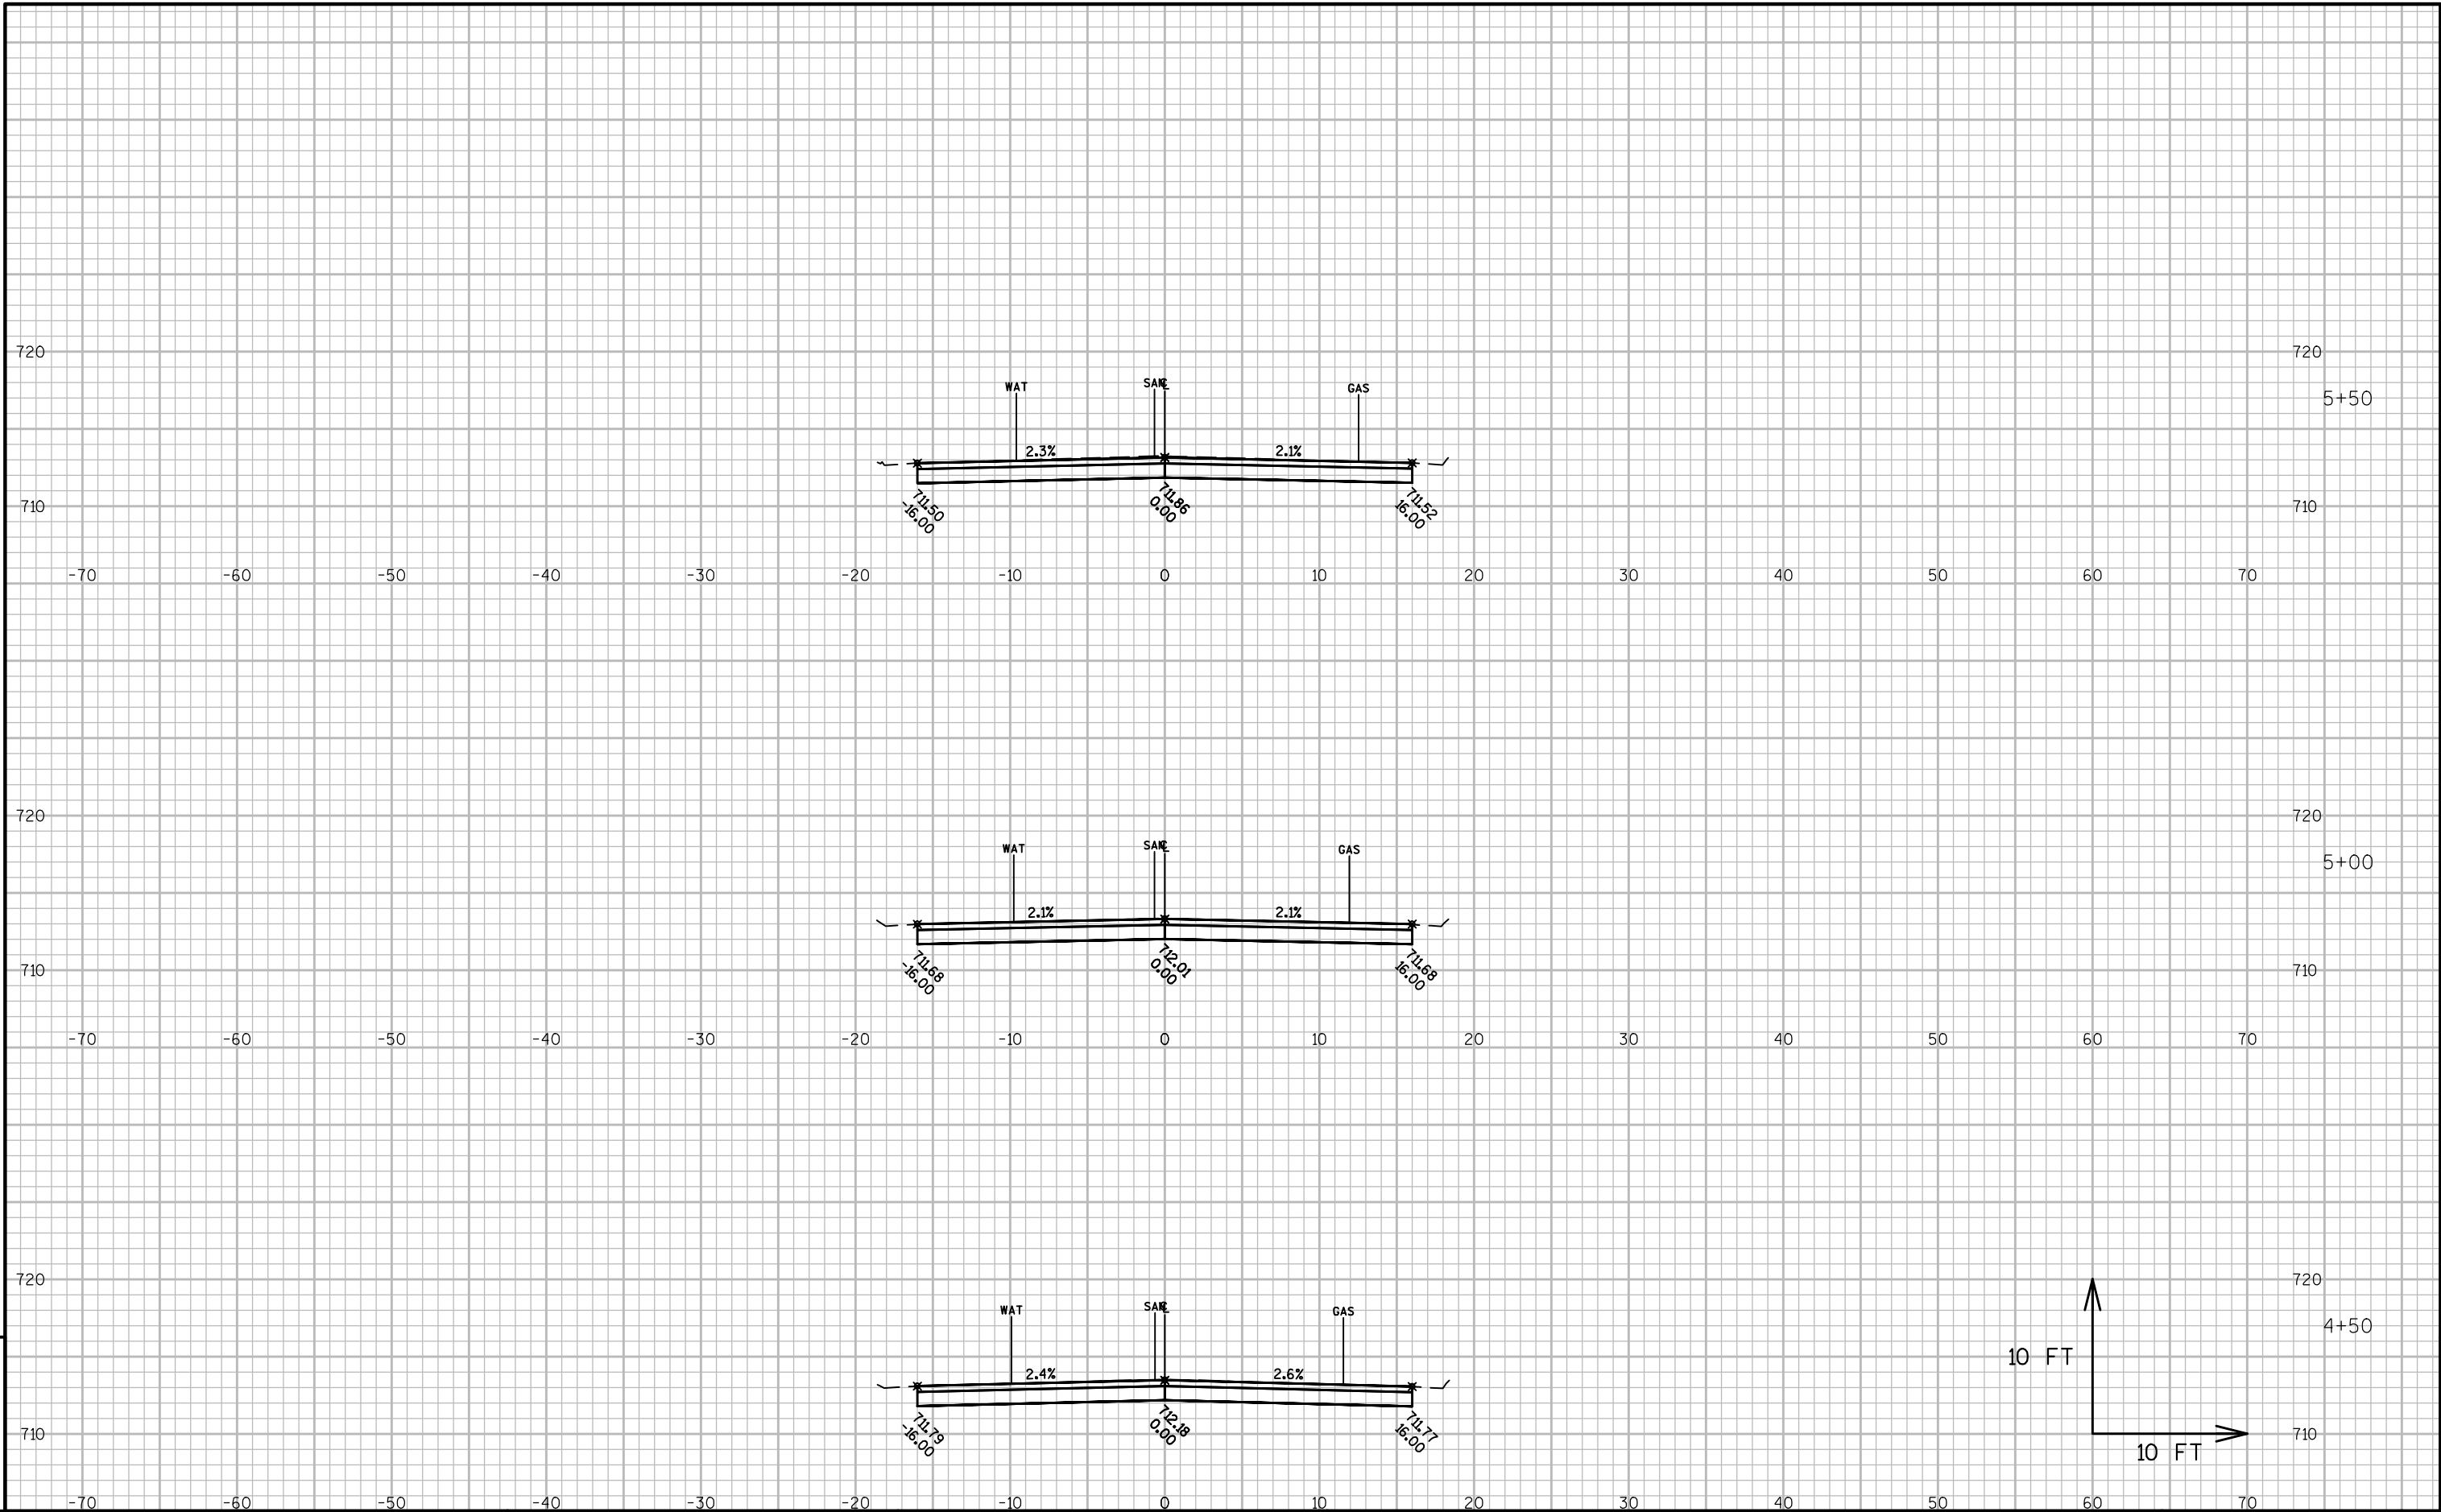


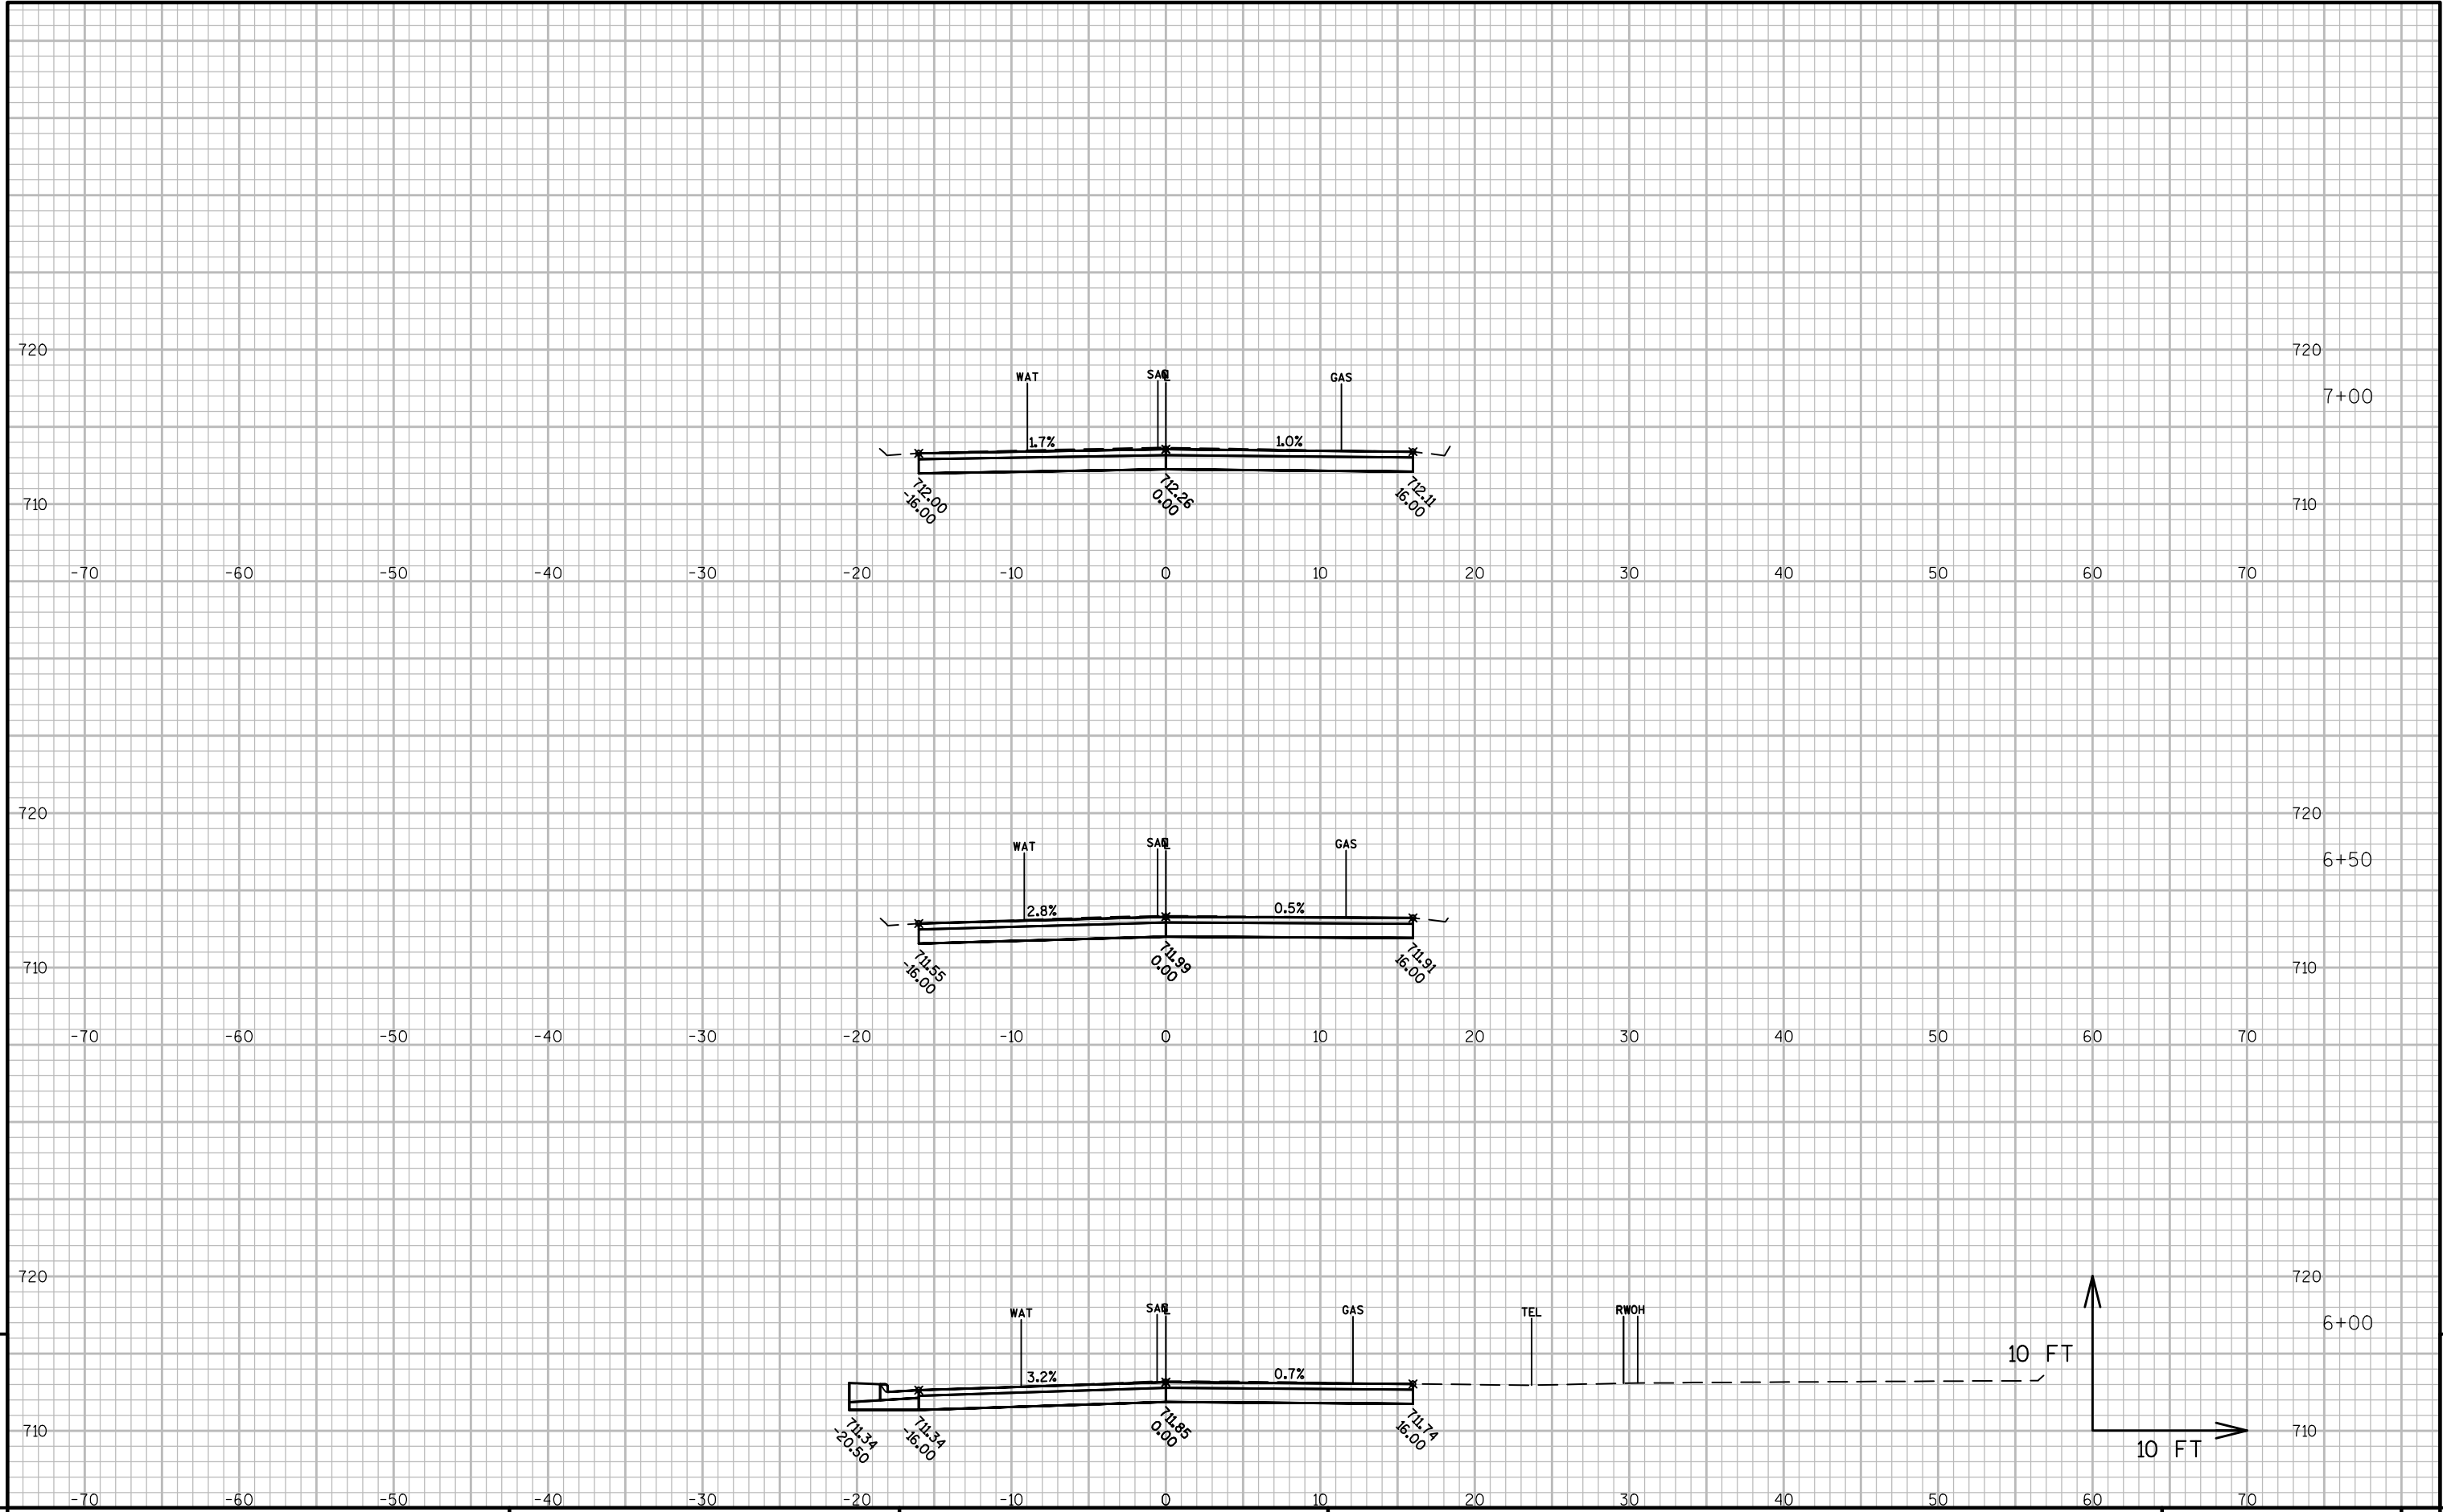

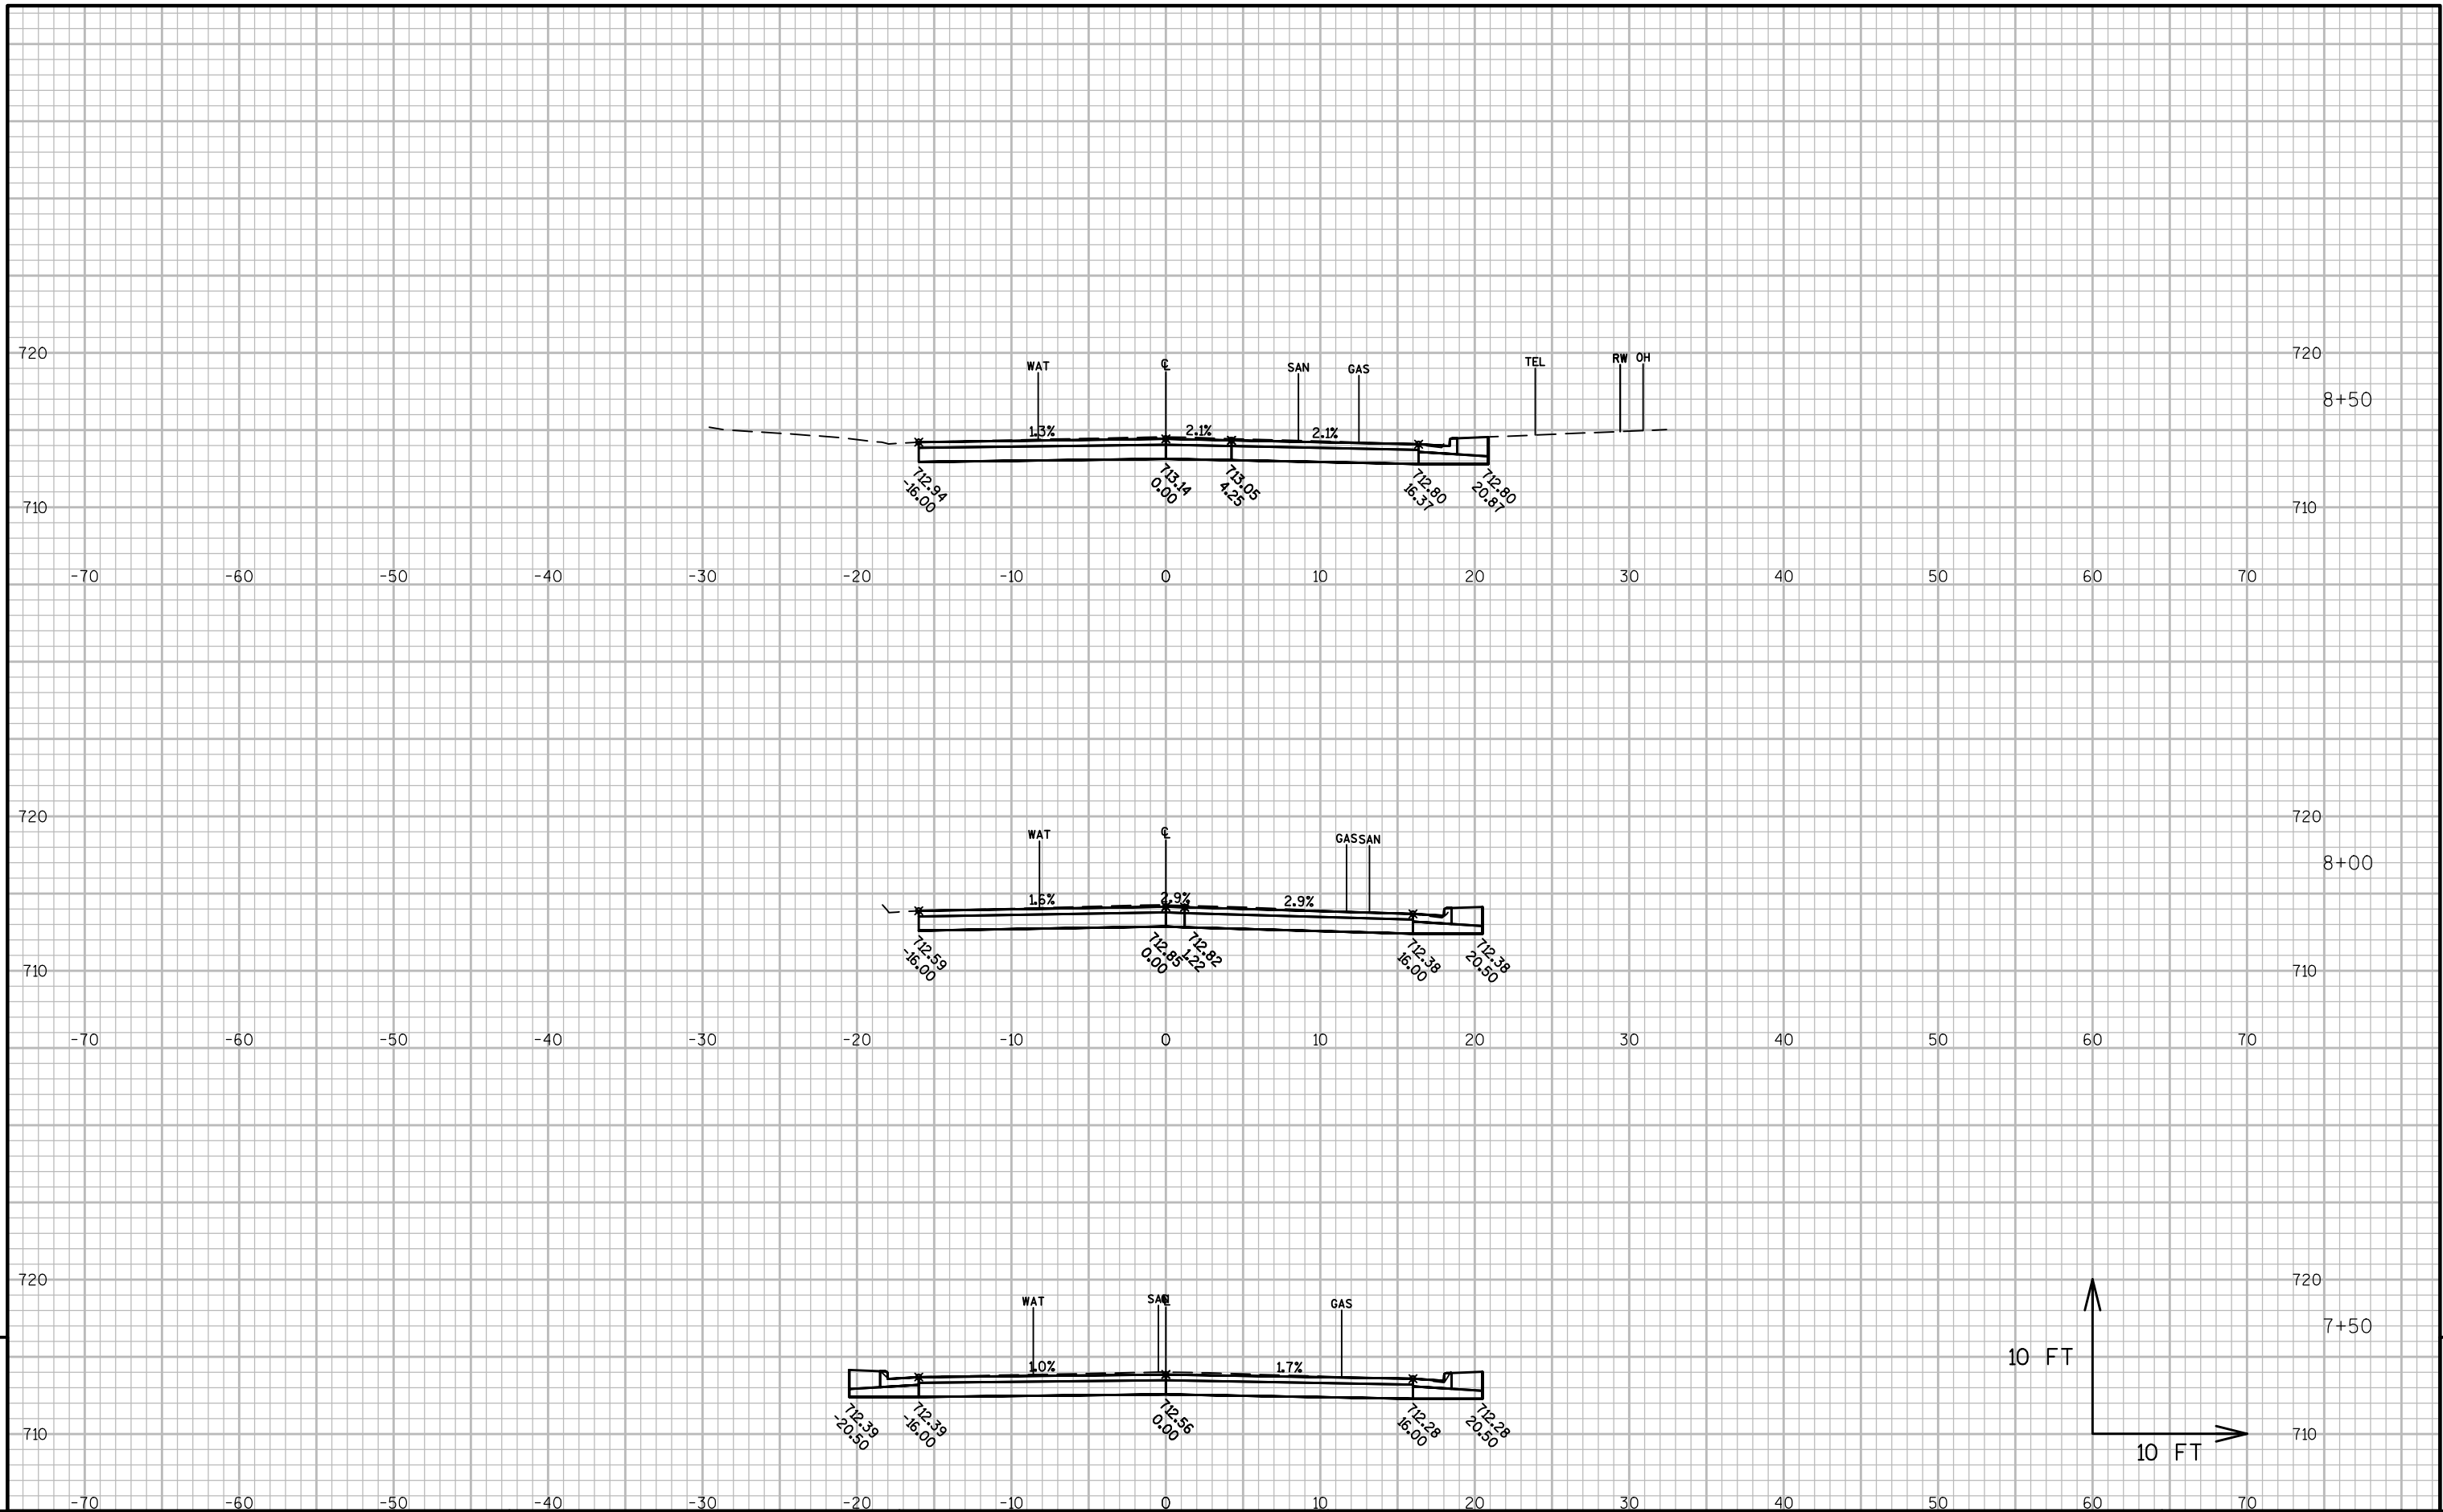

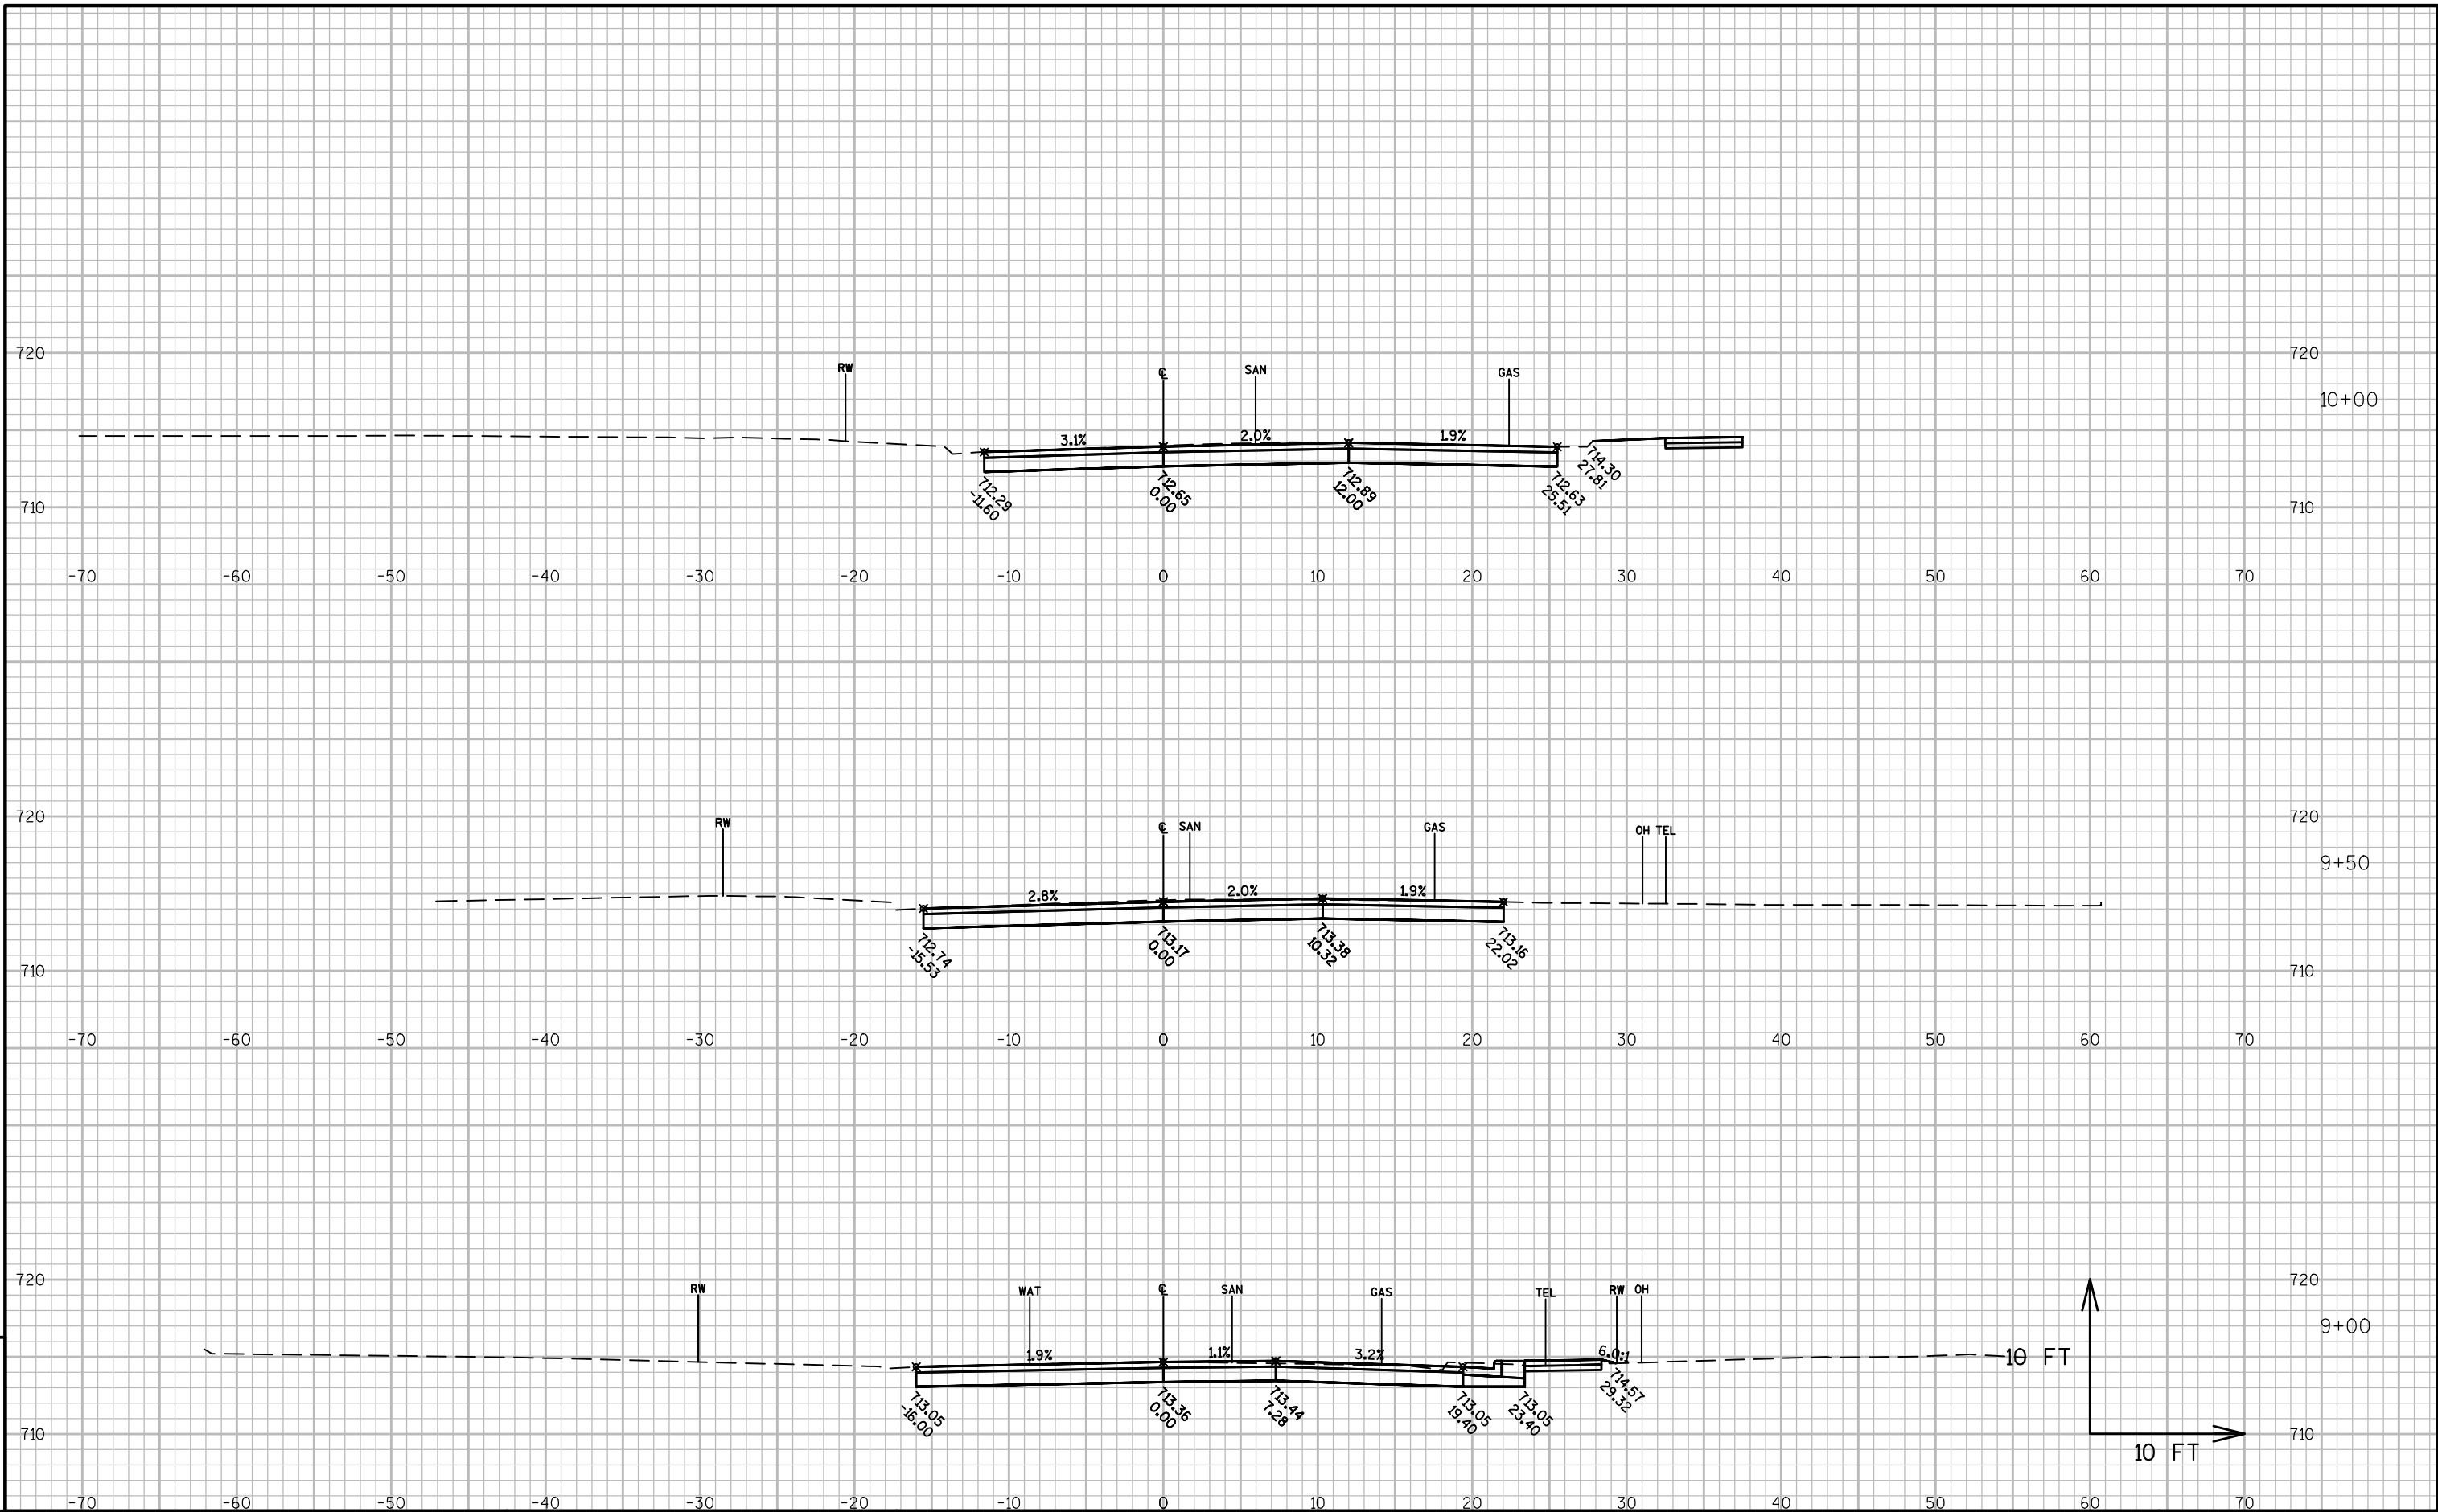

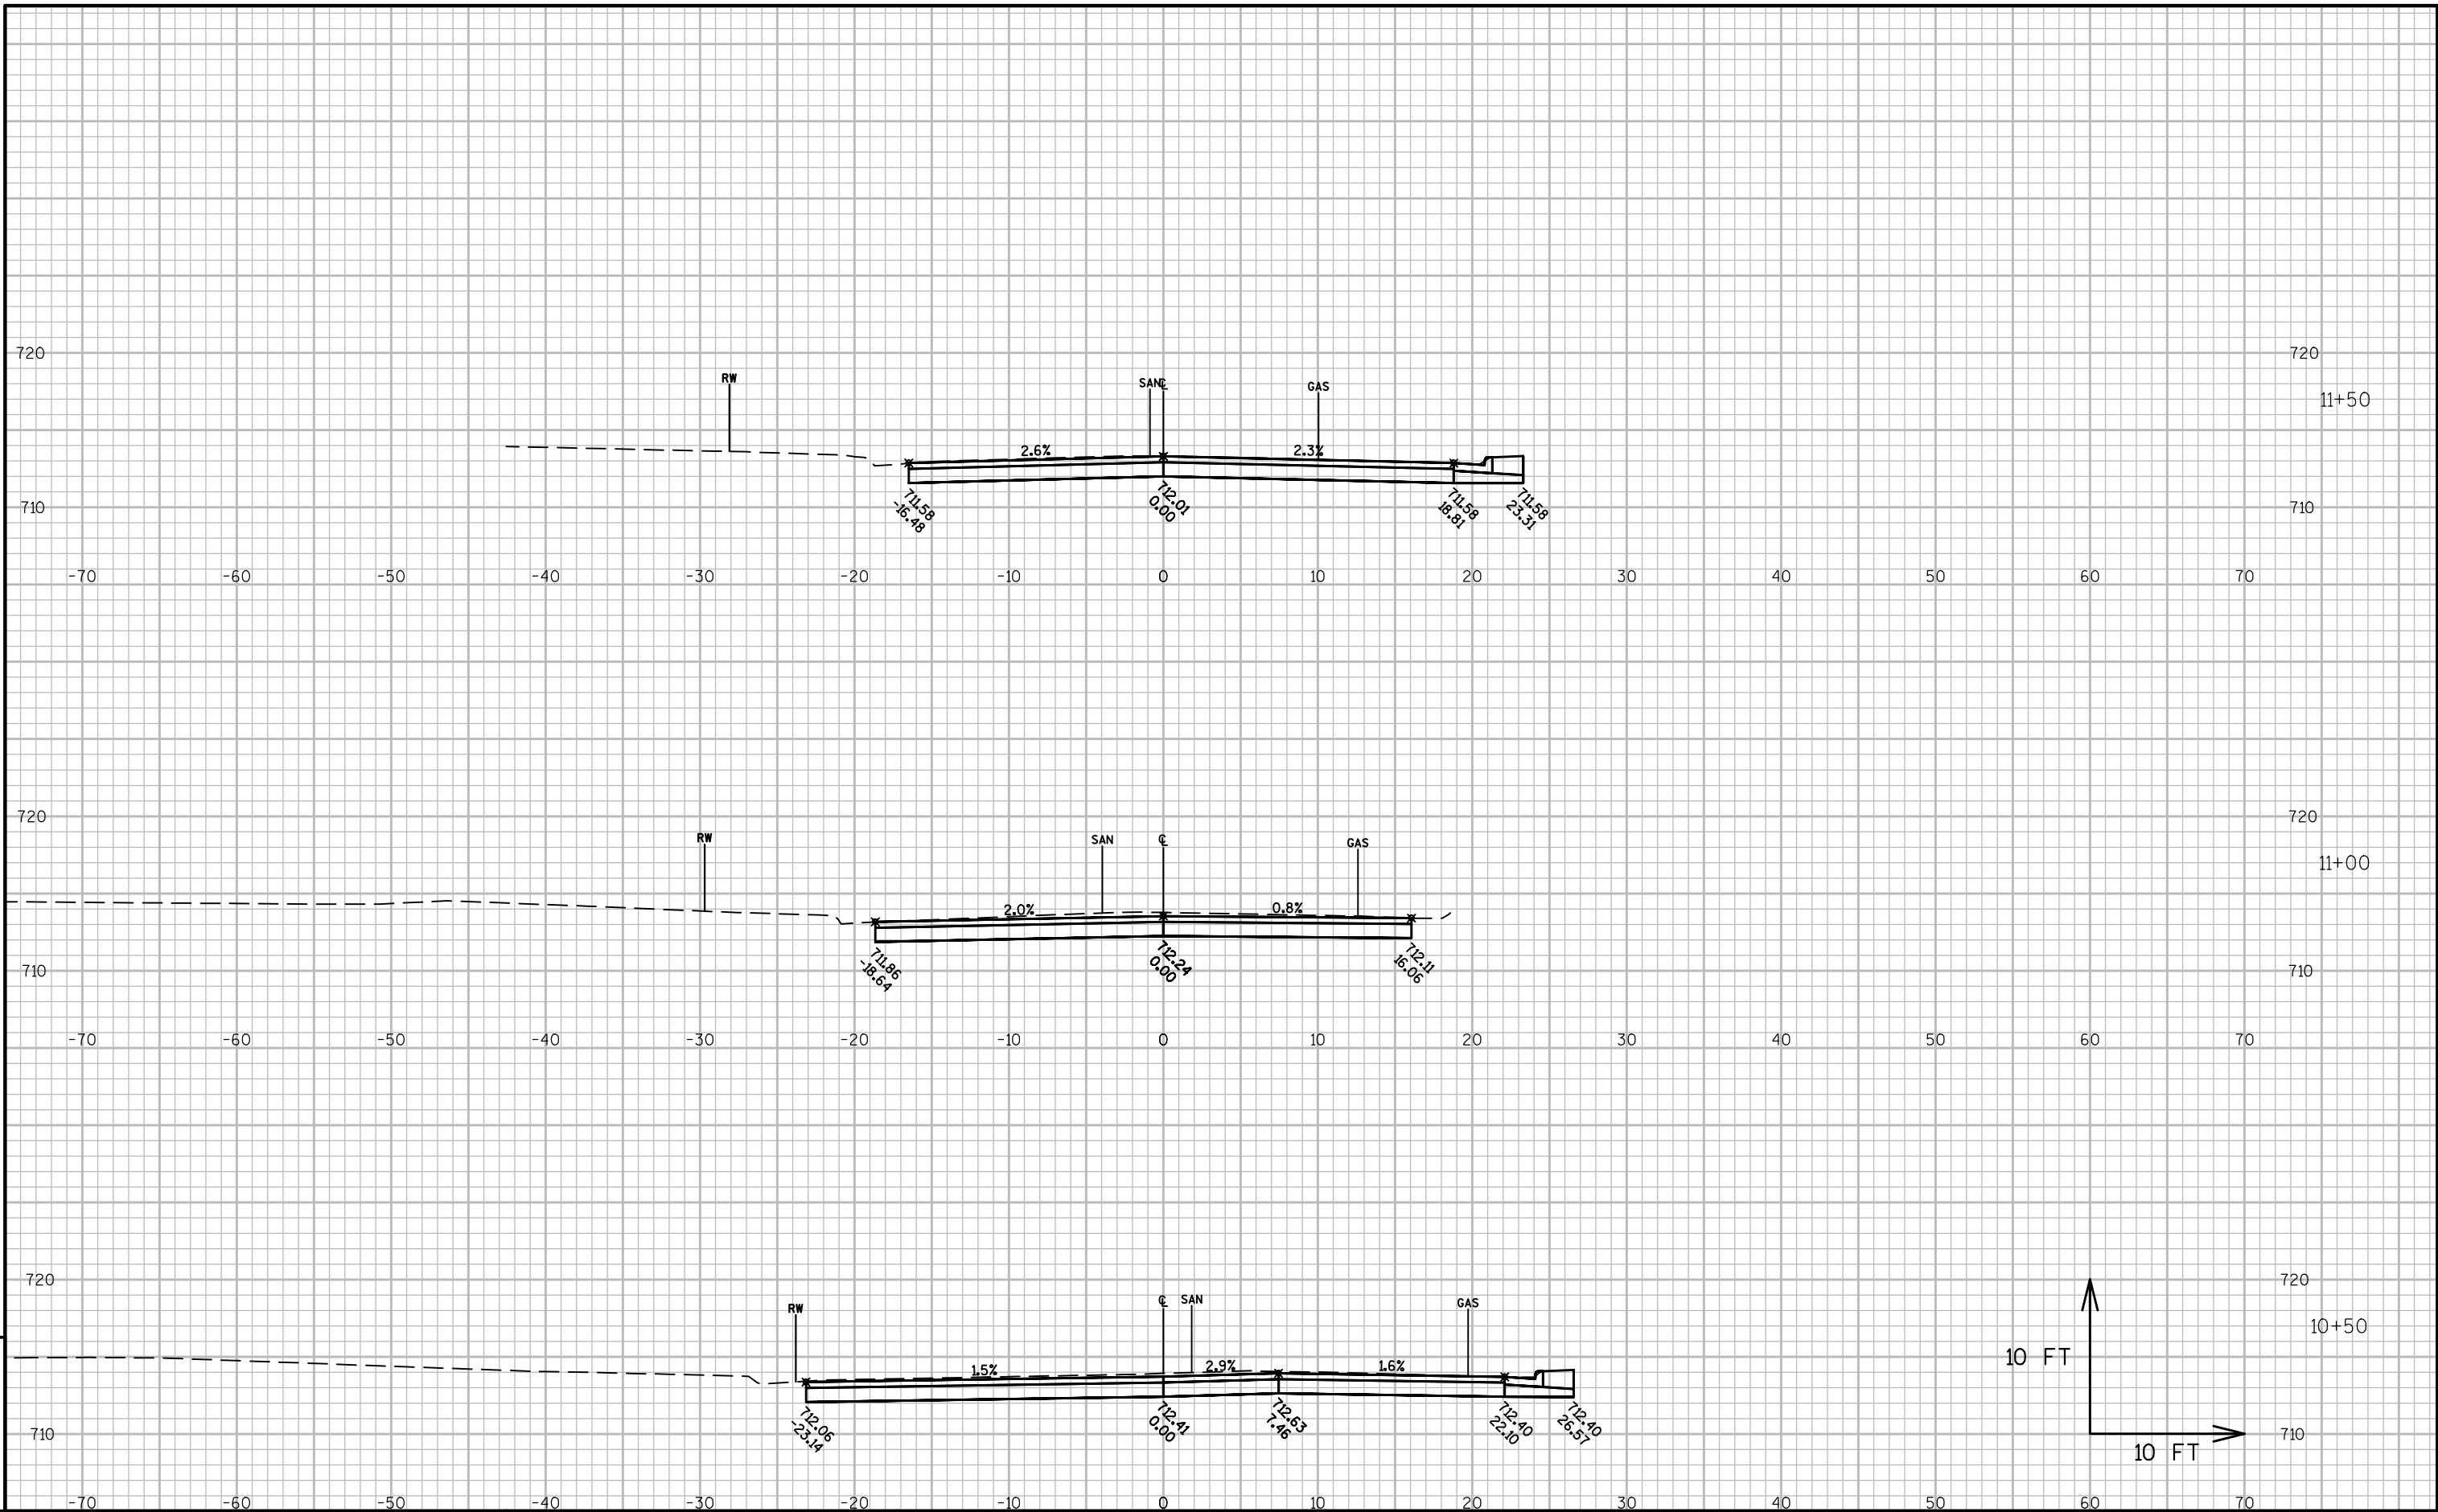

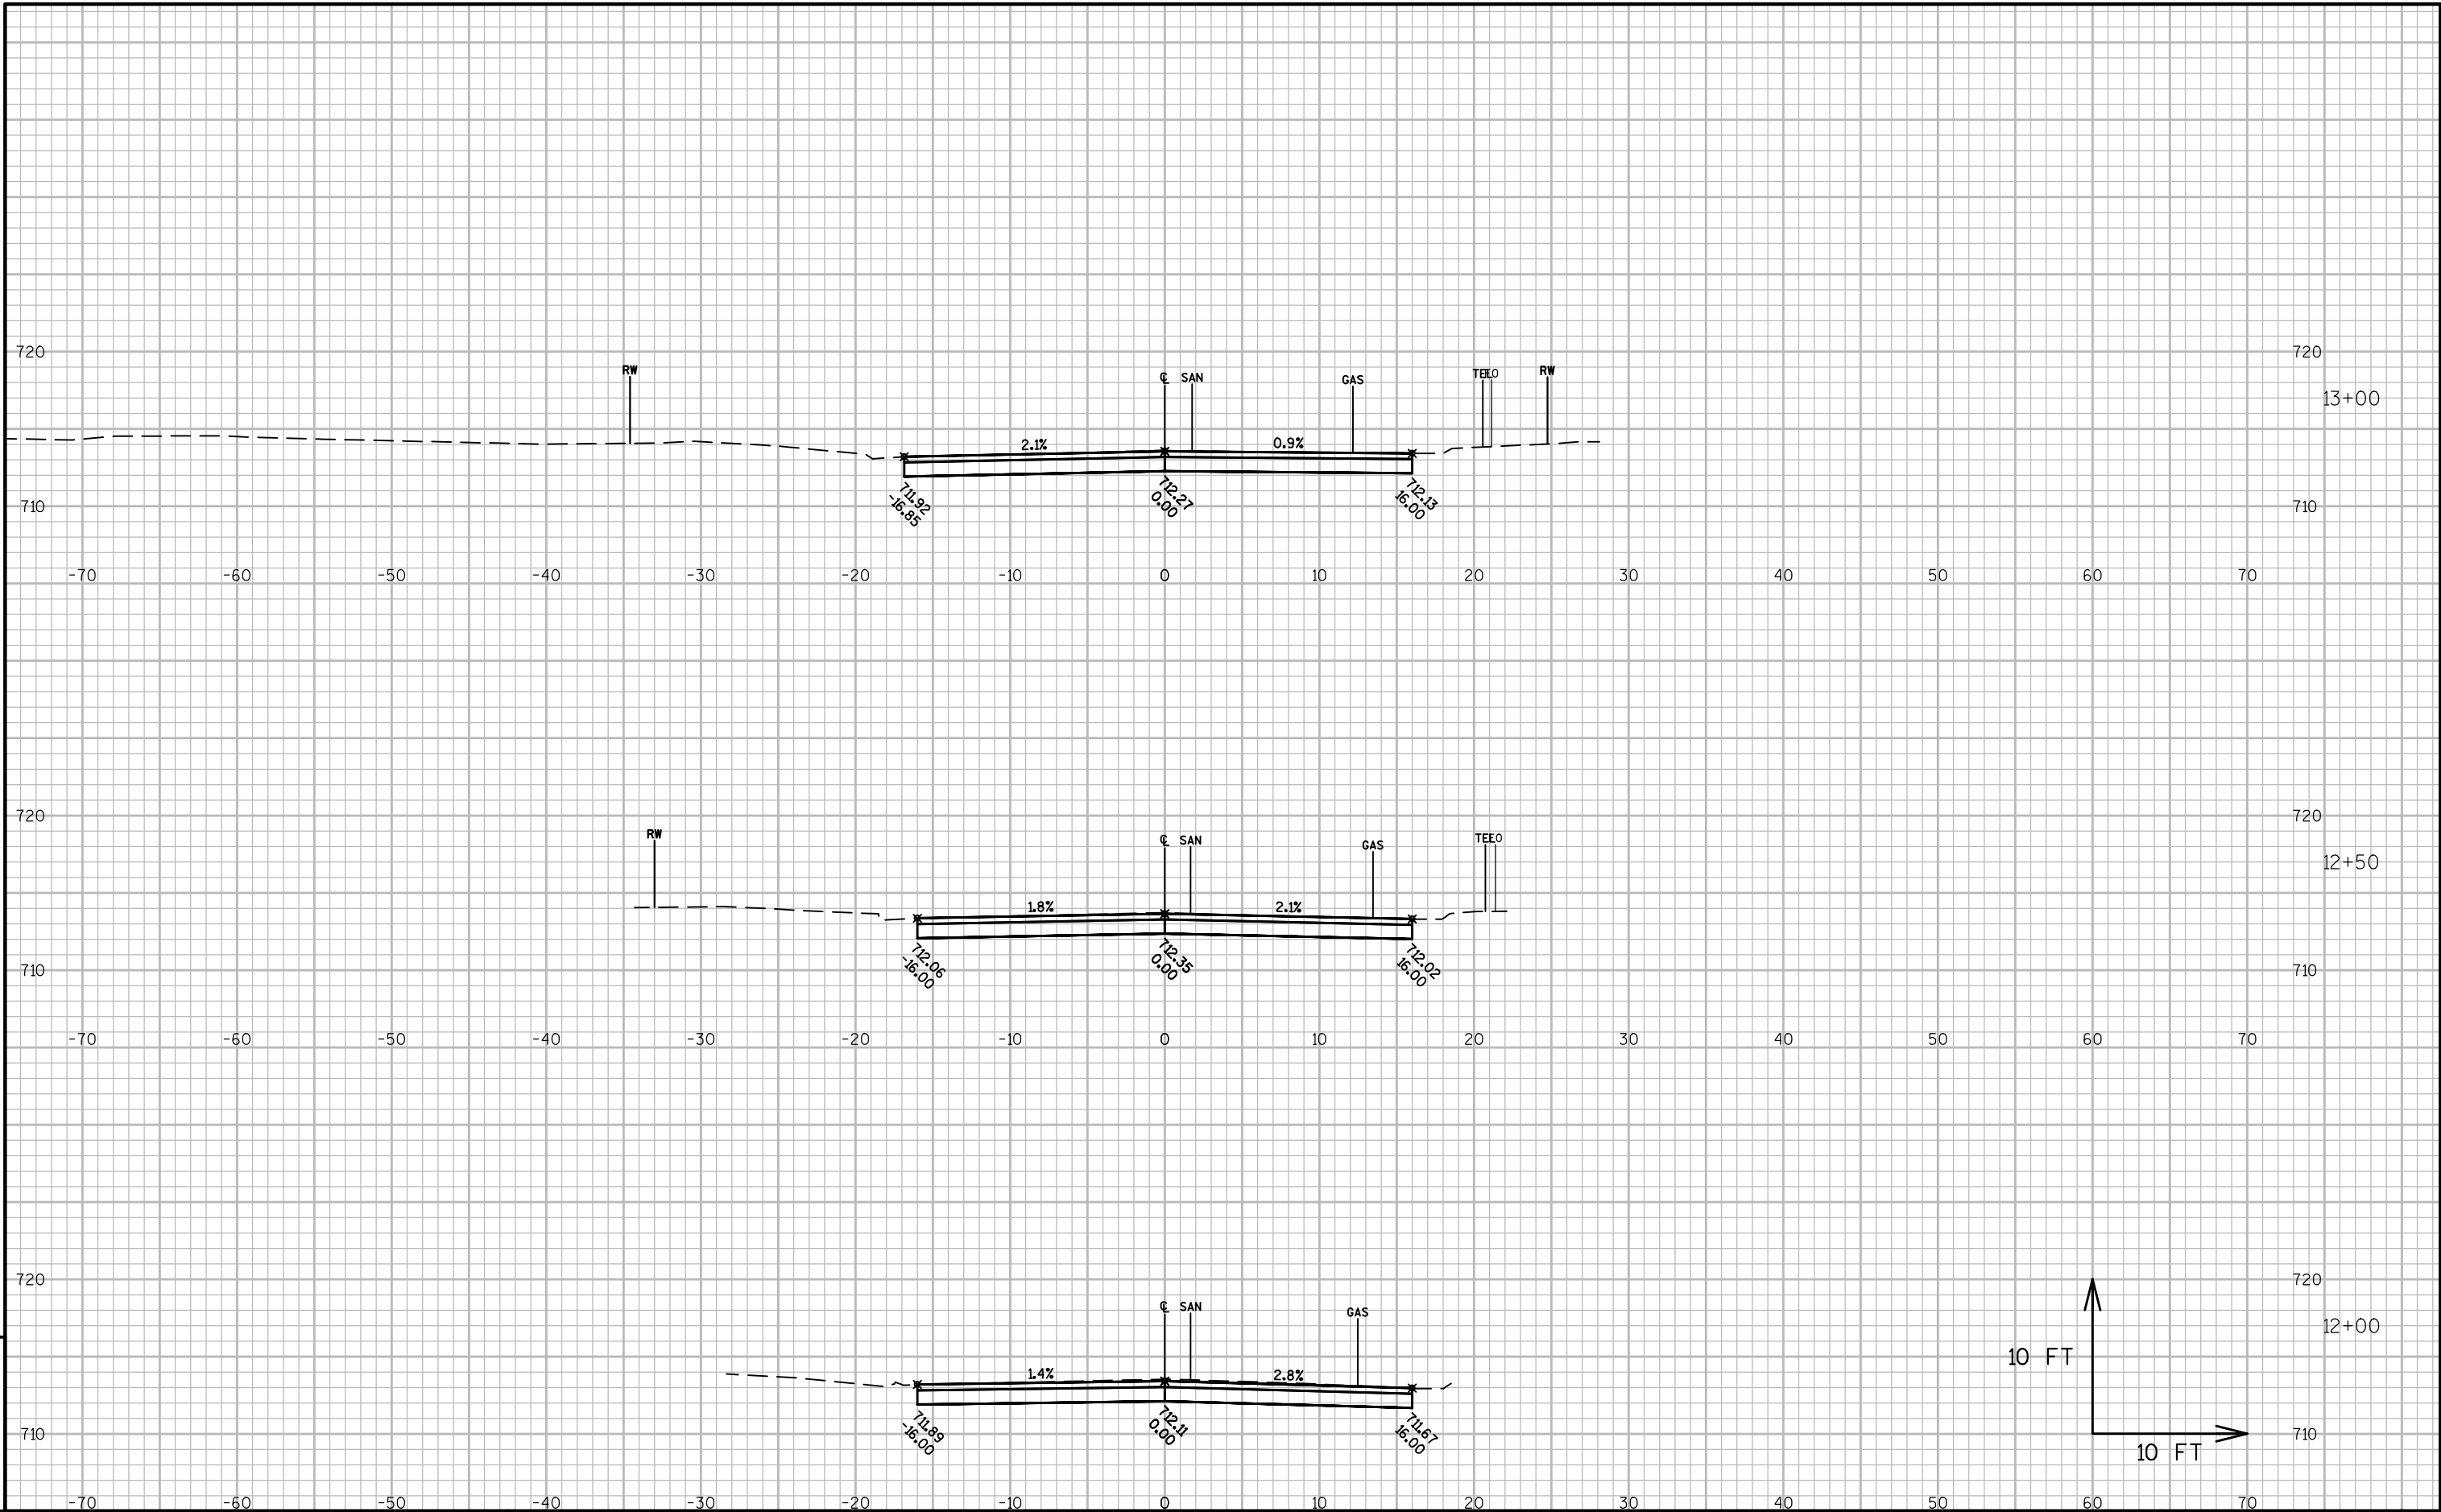



Wisconsin Department of Transportation

Dedicated people creating transportation solutions
through innovation and exceptional service.

<http://www.dot.wisconsin.gov>