

NOT COVERED BY PARAPET

ELEVATIONS AND
DIMENSIONS GIVEN
AT THIS LOCATION

3 EQ. SPA.
(8" MAX.)
= 2'-0"

5 EQ. SPA.
A616
BF

②

WING 2 SECTION


SLOPE
TO DRAIN

BUMP OUT TO
PROVIDE 9"
CONC. COVER
TO PILE.


INCORRECT PILE
LOCATION

FF - FRONT FACE
BF - BACK FACE
EF - EACH FACE


- ① OPTIONAL KEYED CONSTRUCTION JOINT FORMED BY BEVELED 2" X 6" KEYWAY, WITH MEMBRANE ON BACK FACE.
- ② PIPE UNDERDRAIN WRAPPED (6-INCH), SLOPE 0.5% MIN. TO SUITABLE DRAINAGE.
- ③ STRIKE-OFF AS SHOWN AND LEAVE ROUGH.

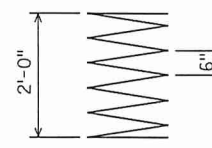


A401

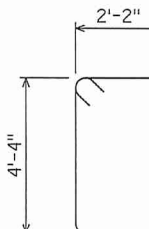


A503

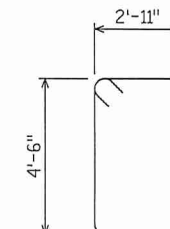

A509

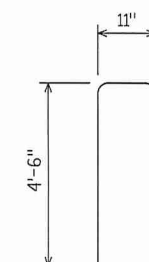


A512

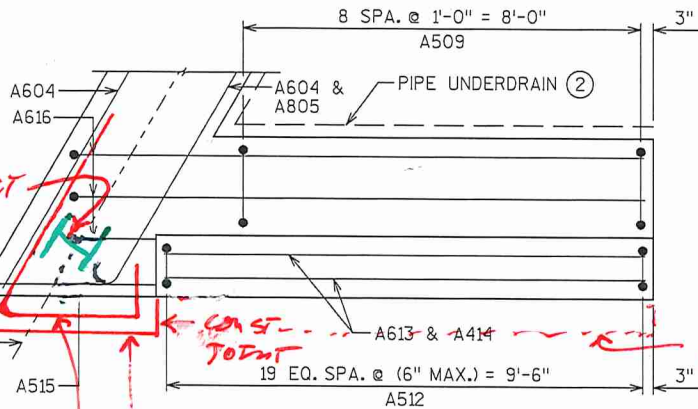


WING 2 PLAN



A805

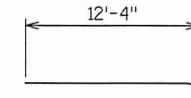


A611

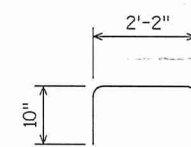

A507

#5 NEW BARS

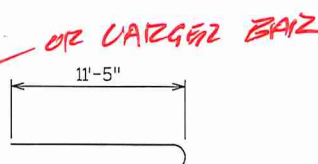

A616

O.K. TO
SHIFT OUT THE
WING ALSO.

BUMP FORM TO PROVIDE 9"
MIN. COVER TO PILE

DETAIL #1


PLOT DATE : 12/18/2017

ADD A BENT #5 BAR TO
MATCH EACH A604

NO.	DATE	REVISION	BY
STATE OF WISCONSIN DEPARTMENT OF TRANSPORTATION			
STRUCTURE B-62-252			
DRAWN BY		ERJ	PLANS CK'D. CEB
WEST ABUTMENT DETAILS			SHEET 5 OF 11

NOT COVERED BY PARAPET



ELEVATIONS AND
DIMENSIONS GIVEN
AT THIS LOCATION

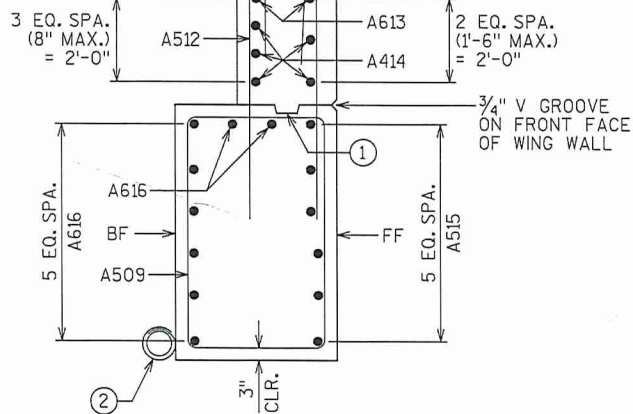


WING 2 SECTION

FF - FRONT FACE
BF - BACK FACE
EF - EACH FACE


- ① OPTIONAL KEYED CONSTRUCTION JOINT FORMED BY BEVELED 2" X 6" KEYWAY, WITH MEMBRANE ON BACK FACE.
- ② PIPE UNDERDRAIN WRAPPED (6-INCH), SLOPE 0.5% MIN. TO SUITABLE DRAINAGE.
- ③ STRIKE-OFF AS SHOWN AND LEAVE ROUGH.

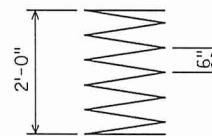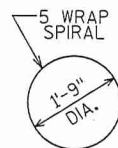


A401

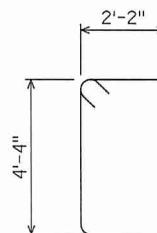

A503

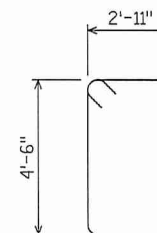


A509

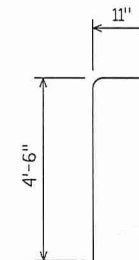

A512

IN CORRECT
PIPE LOCATION

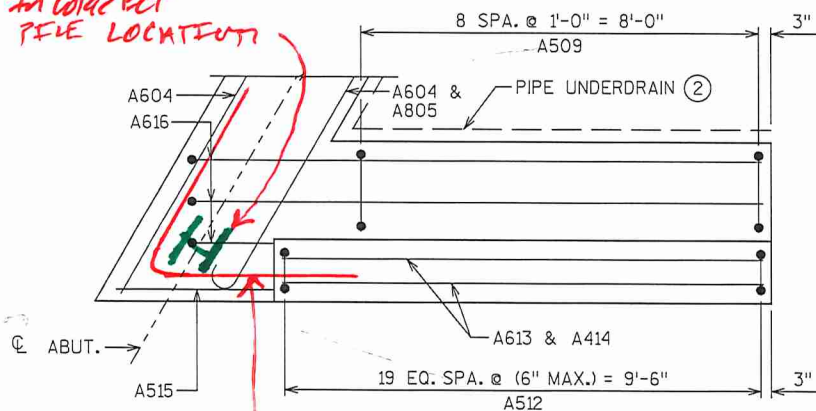


WING 2 PLAN

NEW #6 BARS TO MATCH
EACH A604


4'-0"
4'-0"

#6 NEW BARS
OR LARGER
BARS


DETAIL #2

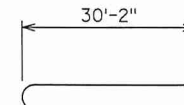


A805

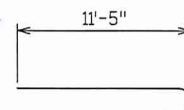

A616

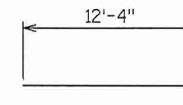

A611

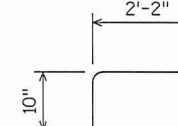

A507

NO.	DATE	REVISION	BY
STATE OF WISCONSIN DEPARTMENT OF TRANSPORTATION			
STRUCTURE B-62-252			
DRAWN BY		ERJ	PLANS CK'D. CEB
WEST ABUTMENT DETAILS			SHEET 5 OF 11