


NOT COVERED BY PARAPET

ELEVATIONS AND
DIMENSIONS GIVEN
AT THIS LOCATION

3 EQ. SPA.
(8" MAX.)
= 2'-0"

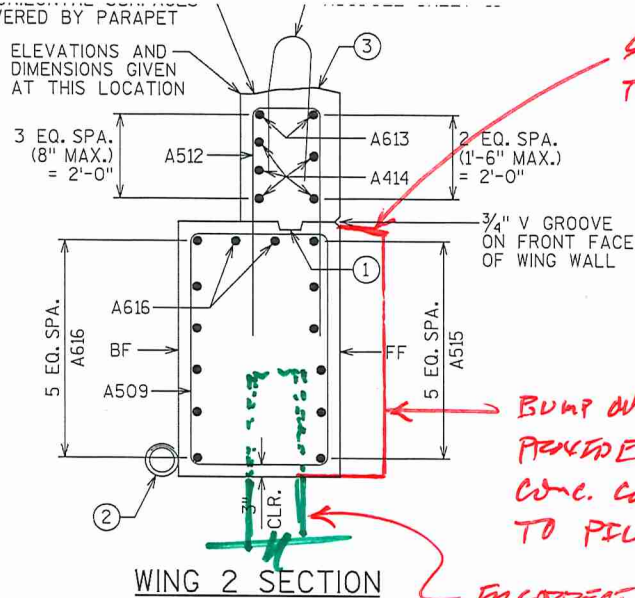


WING 2 SECTION


INCORRECT PILE
LOCATION

FF - FRONT FACE
BF - BACK FACE
EF - EACH FACE


- ① OPTIONAL KEYED CONSTRUCTION JOINT FORMED BY BEVELED 2" X 6" KEYWAY, WITH MEMBRANE ON BACK FACE.
- ② PIPE UNDERDRAIN WRAPPED (6-INCH), SLOPE 0.5% MIN. TO SUITABLE DRAINAGE.
- ③ STRIKE-OFF AS SHOWN AND LEAVE ROUGH.

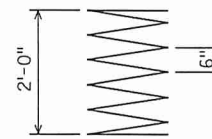


A401

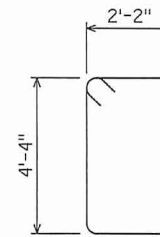


A503

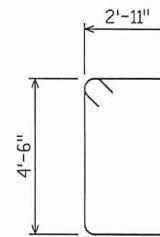

A509

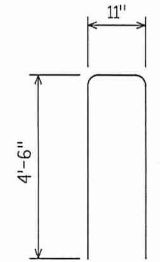


A512

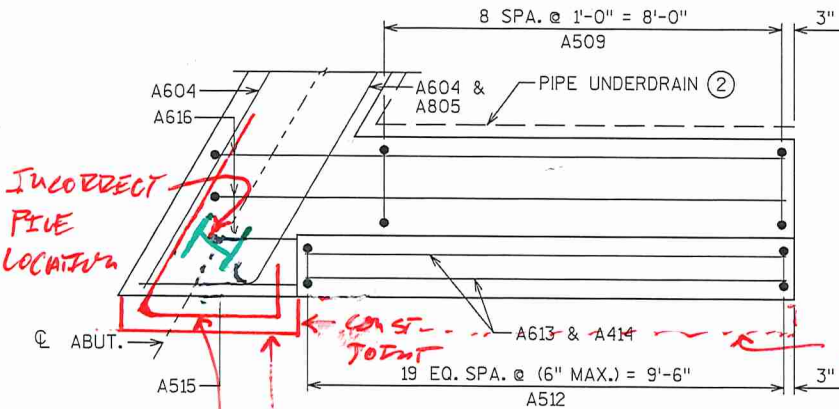


WING 2 PLAN




A805

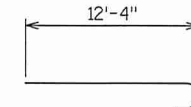

A611

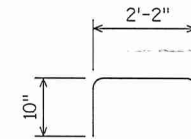

A507

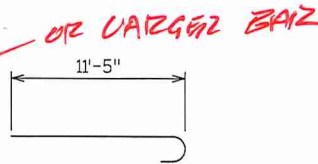

A616

#5 NEW BAR

O.K. TO
SHIFT OUT THE
WING ALSO.

BUMP FORM TO PROVIDE 9"
MIN. COVER TO PILE

ADD A BENT #5 BAR TO
MATCH EACH A604

PLOT DATE : 12/18/2017

DETAIL #1

NO.	DATE	REVISION	BY
STATE OF WISCONSIN DEPARTMENT OF TRANSPORTATION			
STRUCTURE B-62-252			
DRAWN BY		ERJ	PLANS CK'D. CEB
WEST ABUTMENT DETAILS			SHEET 5 OF 11