


NOT COVERED BY PARAPET



ELEVATIONS AND
DIMENSIONS GIVEN
AT THIS LOCATION

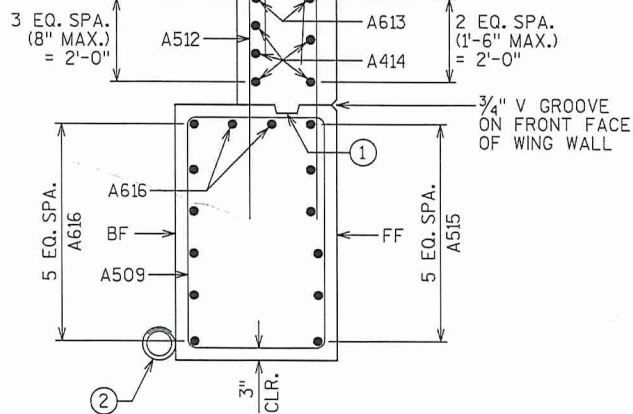


WING 2 SECTION

FF - FRONT FACE
BF - BACK FACE
EF - EACH FACE


- ① OPTIONAL KEYED CONSTRUCTION JOINT FORMED BY BEVELED 2" X 6" KEYWAY, WITH MEMBRANE ON BACK FACE.
- ② PIPE UNDERDRAIN WRAPPED (6-INCH), SLOPE 0.5% MIN. TO SUITABLE DRAINAGE.
- ③ STRIKE-OFF AS SHOWN AND LEAVE ROUGH.

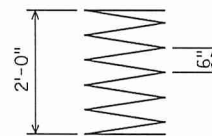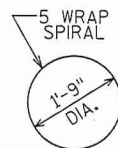


A401

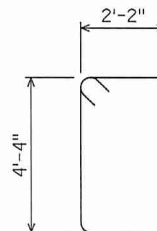

A503

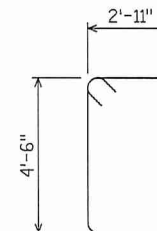


A509

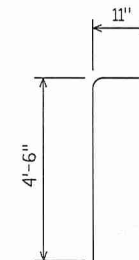

A512

IN CORRECT
PIPE LOCATION

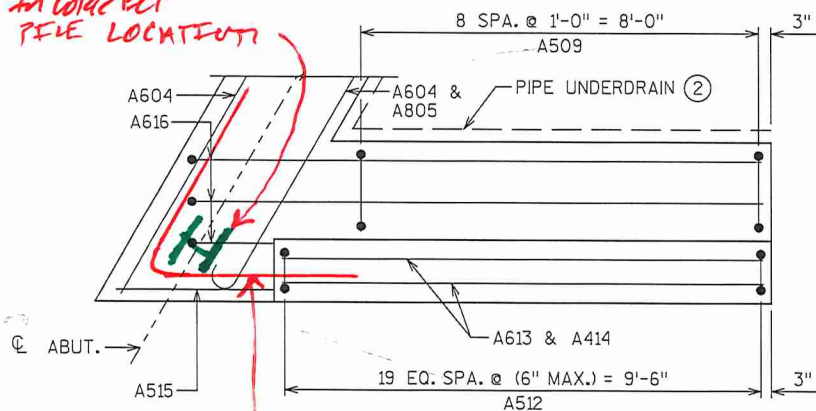


WING 2 PLAN

NEW #6 BARS TO MATCH
EACH A604


4'-0"
4'-0"

#6 NEW BARS
OR LARGER
BARS


DETAIL #2

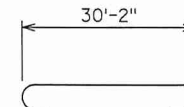


A805

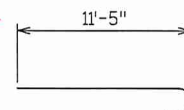

A616

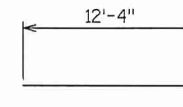

A611

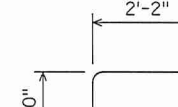

A507

NO.	DATE	REVISION	BY
STATE OF WISCONSIN DEPARTMENT OF TRANSPORTATION			
STRUCTURE B-62-252			
DRAWN BY		ERJ	PLANS CK'D. CEB
WEST ABUTMENT DETAILS			SHEET 5 OF 11