

LAX

PROJECT ID:

7102-00-70

COUNTY:

MONROE

WITH: N/A

DECEMBER 2018

ORDER OF SHEETS

Section No. 1	Title
Section No. 2	Typical Sections and Details
Section No. 3	Estimate of Quantities
Section No. 3	Miscellaneous Quantities
Section No. 4	Right of Way Plan
Section No. 5	Plan and Profile (Includes Erosion Control Plan)
Section No. 6	Standard Detail Drawings
Section No. 7	Sign Plates
Section No. 8	Structure Plans
Section No. 9	Computer Earthwork Data
Section No. 9	Cross Sections

TOTAL SHEETS = 36

Sheets Revised: 3, 5, 7, 24, 26, and 28



Project Location



DESIGN DESIGNATION

A.A.D.T. 2019	=	125
A.A.D.T. 2039	=	150
D.H.V.	=	<15 (EST.)
D.D.	=	60/40 (EST.)
T.	=	10% (EST.)
DESIGN SPEED	=	35 MPH
ESALS	=	37,000

CONVENTIONAL SYMBOLS

PLAN

CORPORATE LIMITS

PROPERTY LINE

LOT LINE

LIMITED HIGHWAY EASEMENT

EXISTING RIGHT OF WAY

PROPOSED OR NEW R/W LINE

SLOPE INTERCEPT

REFERENCE LINE

EXISTING CULVERT

PROPOSED CULVERT
(Box or Pipe)

COMBUSTIBLE FLUIDS

MARSH AREA

WOODED OR SHRUB AREA

PROFILE

GRADE LINE

ORIGINAL GROUND

MARSH OR ROCK PROFILE
(To be noted as such)

SPECIAL DITCH

GRADE ELEVATION

CULVERT (Profile View)

UTILITIES

ELECTRIC

FIBER OPTIC

GAS

SANITARY SEWER

STORM SEWER


TELEPHONE

WATER

UTILITY PEDESTAL

POWER POLE

TELEPHONE POLE

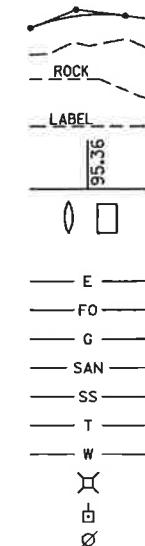

STATE OF WISCONSIN DEPARTMENT OF TRANSPORTATION

PLAN OF PROPOSED IMPROVEMENT

TOWN OF LA GRANGE, DOLPHIN ROAD

(MILL CREEK BRIDGE B-41-0312)


LOCAL STREET
MONROE COUNTY

STATE PROJECT NUMBER

7102-00-70

AS-BUILT PLAN

SUPERVISOR: Jim Savoldelli
PROJECT MANAGER: Brian Meyer
PROJECT LEADER: Matt Palkowski
CONTRACTOR: Radtke Contractors Inc.
CONSTRUCTION STARTED: 04/29/2019
SUBSTANTIALLY COMPLETE: 07/03/2019

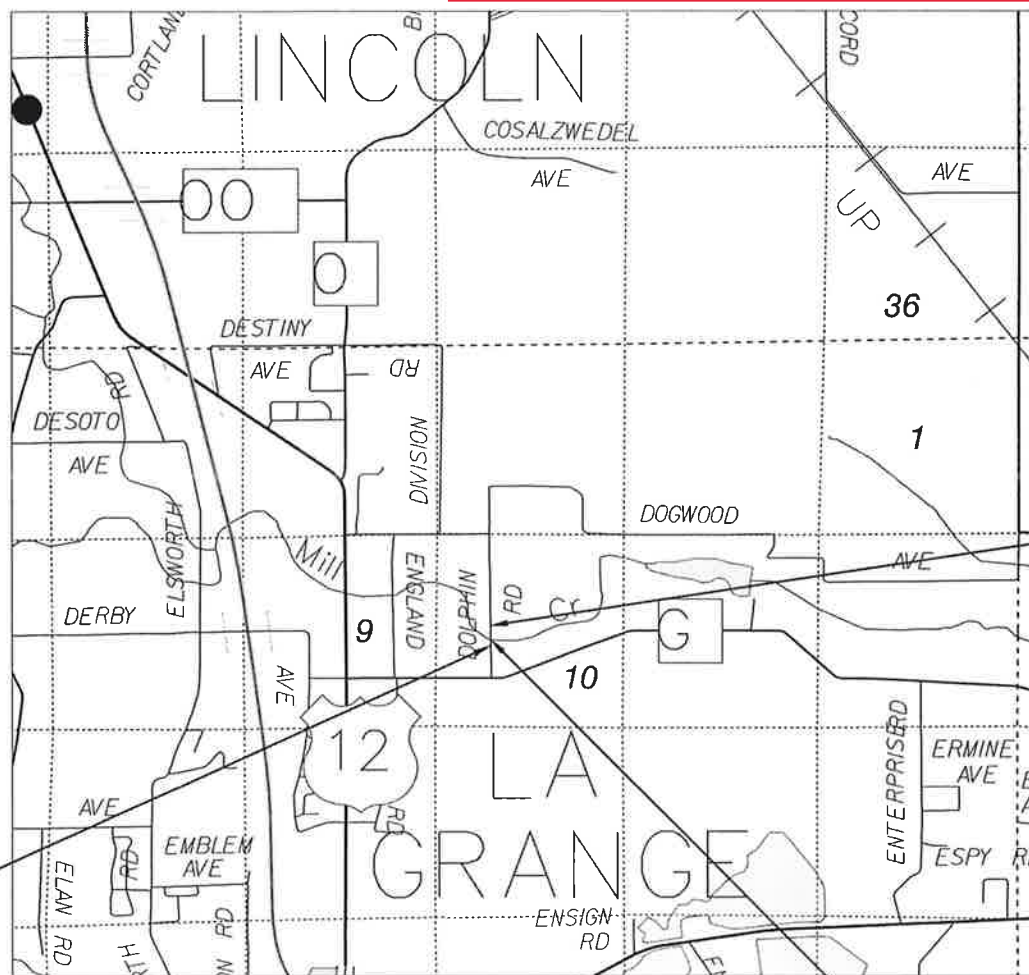

BEGIN PROJECT
STA. 8+75
Y=418,642.13
X=710,863.48

T-19-N

END PROJECT
STA. 11+50

T-18-N

R-1-W

STRUCTURE B-41-312

LAYOUT
SCALE 0 1 MILE

TOTAL NET LENGTH OF CENTERLINE = 0.052 MI

HORIZONTAL POSITIONS SHOWN ON THIS PLAN ARE WISCONSIN COUNTY COORDINATES, MONROE COUNTY, NAD83 (2011), IN U.S. SURVEY FEET. VALUES ARE GRID COORDINATES, GRID BEARINGS, AND GRID DISTANCES. GRID DISTANCES MAY BE USED AS GROUND DISTANCES.

STATE PROJECT

7102-00-70

FEDERAL PROJECT

PROJECT

CONTRACT

ACCEPTED FOR
TOWN OF LA GRANGE

5/22/18 *John Snyder*
(Date) (Signature)

ACCEPTED FOR
COUNTY OF MONROE

05/18/2018 *John Snyder*
(Date) (Highway Commissioner)

ORIGINAL PLANS PREPARED BY

MSA

TRANSPORTATION & ENGINEERING
1230 South Boulevard, Garden, WI 53031
608-596-2777 1-800-924-2435 Fax 608-596-7779



DATE: 5/15/18 *Jolie A. Snyder*
(Professional Engineer)

STATE OF WISCONSIN
DEPARTMENT OF TRANSPORTATION

PREPARED BY

Surveyor: MSA PROFESSIONAL SERVICES, INC.
Designer: MSA PROFESSIONAL SERVICES, INC.

Management Consultant: KL ENGINEERING, INC.

APPROVED FOR THE DEPARTMENT

DATE: 7/23/18 *Jeff Melville*
(Management Consultant Signature)

STANDARD ABBREVIATIONS

AC	ACRE	F/L	FLOW LINE	SALV	SALVAGED
AGG	AGGREGATE	FT	FOOT	SAN	SANITARY SEWER
<	ANGLE	GN	GRID NORTH	SECT	SECTION
ASPH	ASPHALTIC	HR	HANDICAP RAMP	SHLDR	SHOULDER
AC	ASPHALT CEMENT	HT	HEIGHT	SW	SIDEWALK
ADT	AVERAGE DAILY TRAFFIC	CWT	HUNDREDWEIGHT	S	SOUTH
B & B	BALLED AND BURLAPPED	HYD	HYDRANT	SB	SOUTHBOUND
BM	BENCH MARK	IN DIA	INCH DIAMETER	SPECS	SPECIFICATIONS
CB	CATCH BASIN	INL	INLET	SQ	SQUARE
℄ OR C/L	CENTER LINE	ID	INSIDE DIAMETER	SF OR SQ FT	SQUARE FEET
C-C	CENTER TO CENTER	I	INTERSECTION ANGLE	SY	SQUARE YARD
CONC	CONCRETE	IE	INVERT ELEVATION	SSPRC	STORM SEWER
CO	COUNTY	IP	IRON PIPE OR PIN		PIPE REINFORCED CONCRETE
CTH	COUNTY TRUNK HIGHWAY	JCT	JUNCTION	STD	STANDARD
CY	CUBIC YARD	L	LENGTH OF CURVE	SDD	STANDARD DETAIL DRAWINGS
CULV	CULVERT	LF	LINEAR FOOT	STH	STATE TRUNK HIGHWAYS
CP	CULVERT PIPE	LC	LONG CHORD OF CURVE	STA	STATION
CPRC	CULVERT PIPE	LCB	LONG CHORD BEARING	SS	STORM SEWER
	REINFORCED CONCRETE	LS	LUMP SUM	T	TANGENT
C & G	CURB AND GUTTER	MH	MANHOLE	TEL	TELEPHONE
D	DEGREE OF CURVE	N	NORTH	TEMP	TEMPORARY
DHV	DESIGN HOUR VOLUME	Y	NORTH GRID COORDINATE	TLE	TEMPORARY LIMITED EASEMENT
DIA OR ϕ	DIAMETER	OE	OUTLET ELEVATION	T	TON
DIST	DISTRICT	OL	OUT LOT	TC	TOP OF CURB
DWY	DRIVEWAY	OD	OUTSIDE DIAMETER	TN	TOWN
E	EAST	OH	OVERHEAD LINES	TRANS	TRANSITION
X	EAST GRID COORDINATE	PAVT	PAVEMENT	T	TRUCKS (percent of)
EB	EASTBOUND	PLE	PERMANENT LIMITED EASEMENT	TYP	TYPICAL
ELEC	ELECTRIC	PC	POINT OF CURVATURE	UNCL	UNCLASSIFIED
EL OR ELEV	ELEVATION	PI	POINT OF INTERSECTION	USH	UNITED STATES HIGHWAY
EMB	EMBANKMENT	PT	POINT OF TANGENCY	VAR	VARIABLE
EW	ENDWALL	PCC	PORTLAND CEMENT CONCRETE	VERT	VERTICAL
ESALS	EQUIVALENT SINGLE	LB	POUND	VC	VERTICAL CURVE
	AXLE LOADS	PE	PRIVATE ENTRANCE	VOL	VOLUME
EXC	EXCAVATION	R OR RAD	RADIUS	WM	WATER MAIN
EBS	EXCAVATION BELOW	RR	RAILROAD	WV	WATER VALVE
	SUBGRADE	R	RANGE	W	WEST
EXIST	EXISTING	℄ OR R/L	REFERENCE LINE	WB	WESTBOUND
EXP	EXPANSION	REQD	REQUIRED	YD	YARD
F-F	FACE TO FACE	RT	RIGHT		
FERT	FERTILIZER	R/W	RIGHT-OF-WAY		
FE	FIELD ENTRANCE	RD	ROAD		

RUNOFF COEFFICIENT TABLE

	HYDROLOGIC SOIL GROUP											
	A			B			C			D		
	SLOPE RANGE (PERCENT)			SLOPE RANGE (PERCENT)			SLOPE RANGE (PERCENT)			SLOPE RANGE (PERCENT)		
LAND USE:	0-2	2-6	6 & OVER	0-2	2-6	6 & OVER	0-2	2-6	6 & OVER	0-2	2-6	6 & OVER
ROW CROPS	.08	.16	.22	.12	.20	.27	.15	.24	.33	.19	.28	.38
	.22	.30	.38	.26	.34	.44	.30	.37	.50	.34	.41	.56
MEDIAN STRIP-TURF	.19	.20	.24	.19	.22	.26	.20	.23	.30	.20	.25	.30
	.24	.26	.30	.25	.28	.33	.26	.30	.37	.27	.32	.40
SIDE SLOPE-TURF			.25			.27			.28			.30
			.32			.34			.36			.38
PAVEMENT:												
ASPHALT	.70 - .95											
CONCRETE	.80 - .95											
BRICK	.70 - .80											
DRIVES, WALKS	.75 - .85											
ROOFS	.75 - .95											
GRAVEL ROADS, SHOULDERS	.40 - .60											

TOTAL PROJECT AREA = 0.42 ACRES
TOTAL AREA EXPECTED TO BE DISTURBED BY CONSTRUCTION ACTIVITIES = 0.32 ACRES

DESIGN CONTACT

MSA PROFESSIONAL SERVICES, INC.
ATTN: JOLIE SNYDER
1230 SOUTH BOULEVARD
BARABOO, WI 53913
608-355-8912
JSNYDER@MSA-PS.COM

COUNTY CONTACT

MONROE COUNTY
ATTN: DAVID OHNSTAD, HIGHWAY COMMISSIONER
803 WASHINGTON STREET
SPARTA, WI 54656
608-269-8740
DAVID.OHNSTAD@CO.MONROE.WI.US

TOWN CONTACT

TOWN OF LA GRANGE
ATTN: JOHN GUTHRIE, TOWN CHAIR
27645 ENTITY AVENUE
TOMAH, WI 54660
608-343-0775
TOWNOFLAGRANGEBOARDCHAIR@GMAIL.COM

DNR LIAISON


WISCONSIN DEPARTMENT OF
NATURAL RESOURCES
ATTN: KAREN KALVELAGE
3550 MORMON COULEE ROAD
LA CROSSE, WI 54601
608-785-9115
KAREN.KALVELAGE@WISCONSIN.GOV

UTILITIES

COMMUNICATION:
CENTURYLINK
ATTN: BRET CLARK
311 SOUTH COURT STREET
SPARTA, WI 54656
608-269-0819
BRET.CLARK@CENTURYLINK.COM

ELECTRIC:
OAKDALE ELECTRIC COOPERATIVE
ATTN: TRAVIS CHAMPLIN
489 N. OAKWOOD STREET
OAKDALE, WI 54649
608-372-8848
TRAVIS@OAKDALEREC.COM

* NOT A MEMBER OF
DIGGERS HOTLINE

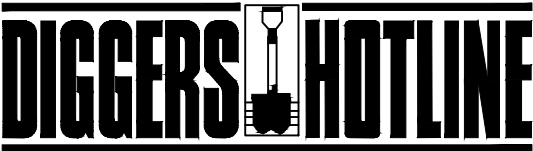

Dial 811 or (800) 242-8511
www.DiggersHotline.com

GENERAL NOTES

DISTURBED AREAS WITHIN THE RIGHT-OF-WAY, EXCEPT THE AREAS WITHIN THE FINISHED SHOULDER POINTS, SHALL BE FERTILIZED, SEEDED AND MULCHED AS DIRECTED BY THE ENGINEER. OVERSOW PERMANENT SEEDING AREAS WITH TEMPORARY SEED.

THE LOCATIONS OF EXISTING UTILITY INSTALLATIONS AS SHOWN ON THE PLANS ARE APPROXIMATE. THERE MAY BE OTHER UTILITY INSTALLATIONS WITHIN THE AREA THAT ARE NOT SHOWN.


NO TREES OR SHRUBS ARE TO BE REMOVED WITHOUT APPROVAL OF THE ENGINEER.

ELEVATIONS SHOWN ON THIS PLAN ARE REFERENCED TO USGS NAVD 88 (2012 ADJUSTED). BENCHMARKS WERE LOCATED IN THE FIELD USING GPS TECHNOLOGY.

THE 3½" ASPHALTIC SURFACE SHALL CONSIST OF A 1¾" UPPER LAYER WITH 12.5MM NOMINAL SIZE AGGREGATE AND A 1¾" LOWER LAYER 12.5MM NOMINAL SIZE AGGREGATE.


SILT FENCE AND TURBIDITY BARRIER TO BE PLACED AS SHOWN ON THE PLAN OR AS DIRECTED BY THE ENGINEER AND IN PLACE PRIOR TO CONSTRUCTION OR BRIDGE REMOVAL.

WETLANDS ARE PRESENT OUTSIDE THE EXISTING SLOPE INTERCEPTS. AREAS OUTSIDE THE SLOPE INTERCEPTS SHALL NOT BE DISTURBED.

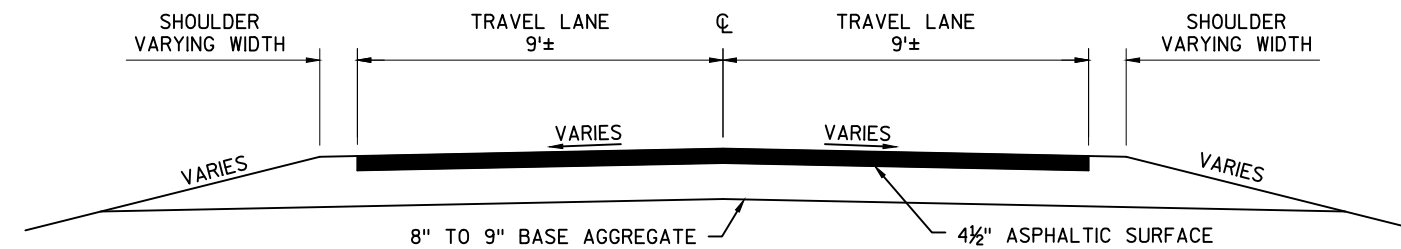

EXISTING TYPICAL SECTION

DOLPHIN ROAD

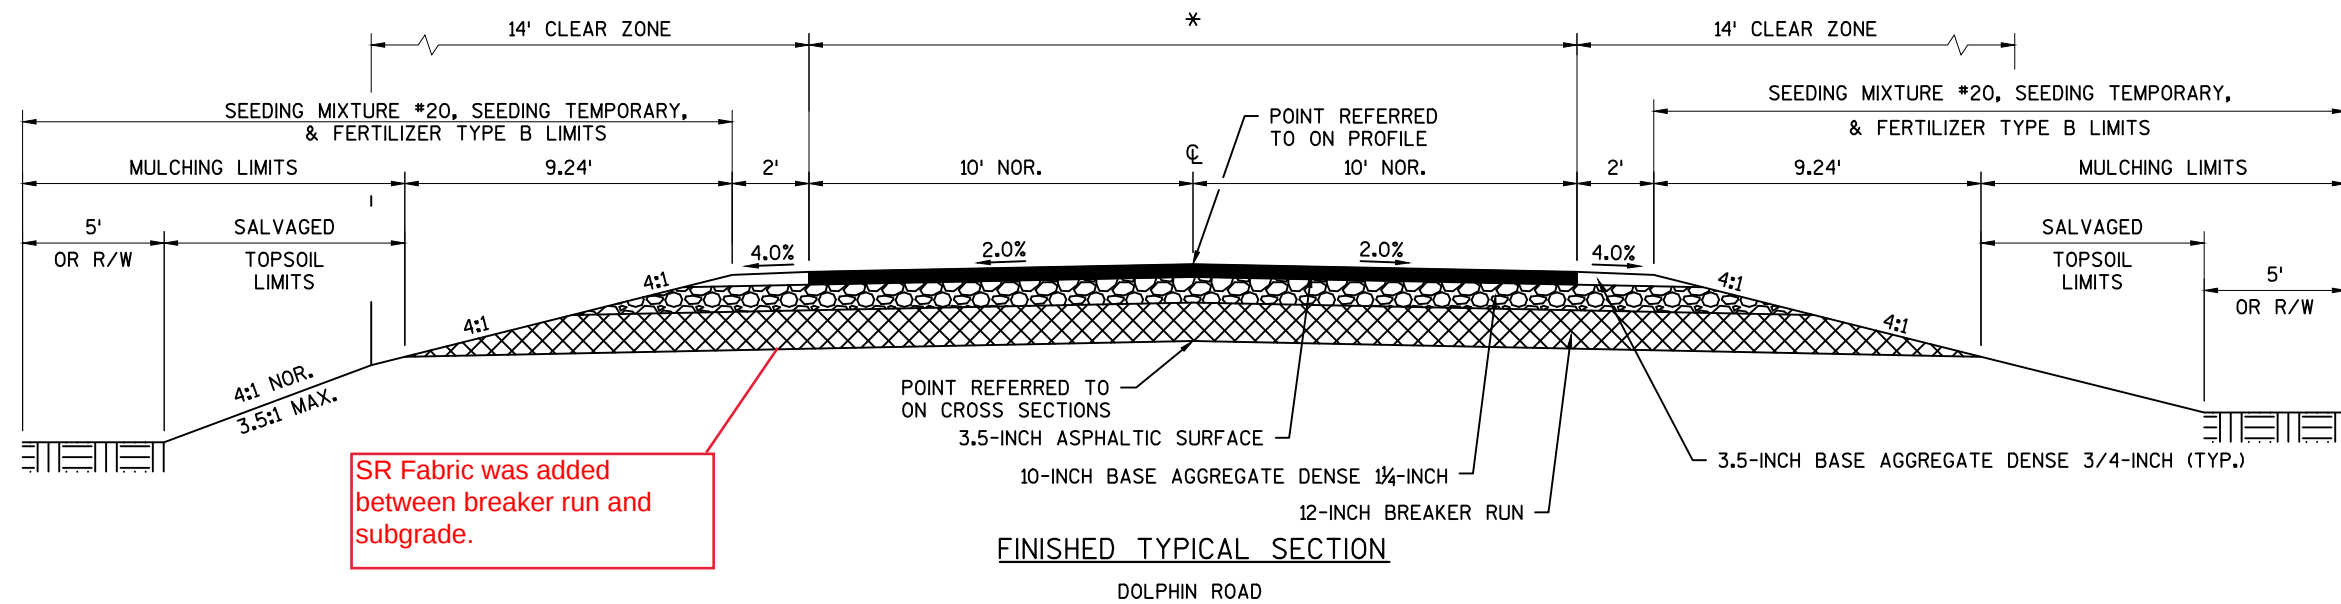

FINISHED TYPICAL SECTION

DOLPHIN ROAD

* - TAPER PAVEMENT WIDTH FROM 24.0' AT THE ENDS OF THE BRIDGE TO 20.0' AT STA. 9+50 AND STA. 10+50.



Estimate Of Quantities

7102-00-70

Line	Item	Item Description	Unit	Total	Qty
0002	203.0600.S	Removing Old Structure Over Waterway With Minimal Debris (station) 01. 10+00	LS	1.000	1.000
0004	204.0165	Removing Guardrail	LF	112.000	112.000
0006	205.0100	Excavation Common **P**	CY	569.000	569.000
0008	206.1000	Excavation for Structures Bridges (structure) 01. B-41-312	LS	1.000	1.000
0010	210.1500	Backfill Structure Type A	TON	270.000	270.000
0012	213.0100	Finishing Roadway (project) 01. 7102-00-70	EACH	1.000	1.000
0014	305.0110	Base Aggregate Dense 3/4-Inch	TON	24.000	24.000
0016	305.0120	Base Aggregate Dense 1 1/4-Inch	TON	440.000	440.000
0018	311.0110	Breaker Run	TON	585.000	585.000
0020	455.0605	Tack Coat	GAL	27.000	27.000
0022	465.0105	Asphaltic Surface	TON	104.000	104.000
0024	502.0100	Concrete Masonry Bridges	CY	130.000	130.000
0026	502.3200	Protective Surface Treatment	SY	171.000	171.000
0028	505.0400	Bar Steel Reinforcement HS Structures	LB	5,770.000	5,770.000
0030	505.0600	Bar Steel Reinforcement HS Coated Structures	LB	14,750.000	14,750.000
0032	513.4061	Railing Tubular Type M 01. B-41-312	LF	81.000	81.000
0034	516.0500	Rubberized Membrane Waterproofing	SY	12.000	12.000
0036	550.2106	Piling CIP Concrete 10 3/4 X 0.365-Inch	LF	245.000	245.000
0038	606.0300	Riprap Heavy	CY	80.000	80.000
0040	612.0406	Pipe Underdrain Wrapped 6-Inch	LF	160.000	160.000
0042	618.0100	Maintenance And Repair of Haul Roads (project) 01. 7102-00-70	EACH	1.000	1.000
0044	619.1000	Mobilization	EACH	1.000	1.000
0046	624.0100	Water	MGAL	46.000	46.000
0048	625.0500	Salvaged Topsoil	SY	480.000	480.000
0050	627.0200	Mulching	SY	790.000	790.000
0052	628.1504	Silt Fence	LF	615.000	615.000
0054	628.1520	Silt Fence Maintenance	LF	615.000	615.000
0056	628.1905	Mobilizations Erosion Control	EACH	2.000	2.000
0058	628.1910	Mobilizations Emergency Erosion Control	EACH	2.000	2.000
0060	628.6005	Turbidity Barriers	SY	190.000	190.000
0062	629.0210	Fertilizer Type B	CWT	0.700	0.700
0064	630.0120	Seeding Mixture No. 20	LB	30.000	30.000
0066	630.0200	Seeding Temporary	LB	30.000	30.000
0068	634.0612	Posts Wood 4x6-Inch X 12-FT	EACH	4.000	4.000
0070	637.2230	Signs Type II Reflective F	SF	12.000	12.000
0072	638.2602	Removing Signs Type II	EACH	4.000	4.000
0074	638.3000	Removing Small Sign Supports	EACH	4.000	4.000

Addendum No. 1, Remove Pay Plan Quantity

Estimate Of Quantities

7102-00-70

Line	Item	Item Description	Unit	Total	Qty
0076	642.5001	Field Office Type B	EACH	1.000	1.000
0078	643.0420	Traffic Control Barricades Type III	DAY	1,420.000	1,420.000
0080	643.0705	Traffic Control Warning Lights Type A	DAY	2,130.000	2,130.000
0082	643.0900	Traffic Control Signs	DAY	1,136.000	1,136.000
0084	643.5000	Traffic Control	EACH	1.000	1.000
0086	645.0111	Geotextile Type DF Schedule A	SY	60.000	60.000
0088	645.0120	Geotextile Type HR	SY	150.000	150.000
0090	650.4500	Construction Staking Subgrade	LF	237.000	237.000
0092	650.5000	Construction Staking Base	LF	237.000	237.000
0094	650.6500	Construction Staking Structure Layout (structure) 01. B-41-312	LS	1.000	1.000
0096	650.9910	Construction Staking Supplemental Control (project) 01. 7102-00-70	LS	1.000	1.000
0098	650.9920	Construction Staking Slope Stakes	LF	237.000	237.000
0100	690.0150	Sawing Asphalt	LF	36.000	36.000
0102	715.0502	Incentive Strength Concrete Structures	DOL	780.000	780.000

3

204.0165 REMOVING GUARDRAIL

204.0165 REMOVING GUARDRAIL		
STATION - STATION	LOCATION	LF
9+54 - 9+82	LT	28
9+54 - 9+82	RT	28
10+18 - 10+46	LT	28
10+18 - 10+46	RT	28
TOTALS:		112

305.0110 BASE AGGREGATE DENSE 3/4-INCH
305.0120 BASE AGGREGATE DENSE 1 1/4-INCH
311.0110 BREAKER RUN
624.0100 WATER

		BASE AGGREGATE DENSE 3/4-INCH		BASE AGGREGATE DENSE 1 1/4-INCH		BREAKER RUN	WATER*
STATION	- STATION	TON	TON	TON	TON	TON	MGAL
8+75.00	- 9+78.71	10	195	260			9
10+17.29	- 11+50.00	14	245	325			12
TOTALS:		24	440	585			21

*ADDITIONAL QUANTITY INCLUDED WITH EROSION CONTROL ITEMS

628.1504 SILT FENCE
628.1520 SILT FENCE MAINTENANCE

			FENCE	MAINT.
STATION	- STATION	LOCATION	LF	LF
8+75	- 9+93	LT	120	120
8+75	- 9+82	RT	105	105
10+27	- 11+50	LT	125	125
10+04	- 11+50	RT	140	140
UNDISTRIBUTED			125	125
TOTALS:			615	615

643.0420 TRAFFIC CONTROL BARRICADES TYPE III
643.0705 TRAFFIC CONTROL WARNING LIGHTS TYPE A
643.0900 TRAFFIC CONTROL SIGNS

		TRAFFIC CONTROL BARRICADES TYPE III	TRAFFIC CONTROL BARRICADES TYPE III	TRAFFIC CONTROL WARNING LIGHTS TYPE A	TRAFFIC CONTROL WARNING LIGHTS TYPE A	TRAFFIC CONTROL SIGNS	TRAFFIC CONTROL SIGNS
LOCATION	DAYS	EACH	DAYS	EACH	DAYS	EACH	DAYS
CTH G INTERSECTION	71	2	142	4	284	4	284
BEGINNING OF PROJECT	71	7	497	10	710	3	213
END OF PROJECT	71	7	497	10	710	4	284
DOGWOOD AVE INTERSECTION	71	2	142	4	284	3	213
UNDISTRIBUTED	71	2	142	2	142	2	142
TOTALS:			1,420		2,130		1,136

455.0605 TACK COAT
465.0105 ASPHALTIC SURFACE

			TACK COAT	ASPHALTIC SURFACE
STATION	- STATION		GAL	TON
8+75	- 9+78.71		12	46
10+17.29	- 11+50.00		15	58
TOTALS:			27	104

*618.0100 MAINTENANCE AND REPAIR OF HAUL ROADS

*MAINTENANCE AND REPAIR OF HAUL ROADS	
DESCRIPTION	EACH
PROJECT 7102-00-70	1
TOTAL:	1

* CATEGORY 0030 ITEM

205.0100 EXCAVATION COMMON ****p**** **Addendum No. 1, Remove Pay Plan Quantity**

		EXC. COMMON	FILL	EXPANDED FILL	WASTE
LOCATION		CY (3)	CY (1)	CY (2)	CY
STA 8+75 - STA. 9+78.71		240	67	87	153
STA 10+17.29 - STA 11+50		329	39	50	279
TOTALS:		569	106	137	432

(1) - NOT A BID ITEM - FOR INFORMATIONAL PURPOSES ONLY.
(2) - FILL EXPANSION 30%
(3) - EXISTING ASPHALTIC PAVEMENT IS INCLUDED IN COMMON EXCAVATION TOTALS. SEE EARTHWORK TABLE.

625.0500 SALVAGED TOPSOIL
627.0200 MULCHING
629.0210 FERTILIZER TYPE B
630.0120 SEEDING MIXTURE NO. 20
630.0200 SEEDING TEMPORARY
624.0100 WATER

			SALVAGED TOPSOIL		MULCHING	FERTILIZER	SEEDING #20	SEEDING TEMPORARY	WATER*
STATION	- STATION	LOCATION	SY	SY	CWT	LB	LB	MGAL	
8+75	- 9+80	RT	75	130	0.10	5	5	4	
8+75	- 9+80	LT	105	155	0.15	6	6	5	
10+16	- 11+50	RT	90	165	0.15	6	6	5	
10+16	- 11+50	LT	115	180	0.15	7	7	6	
UNDISTRIBUTED			95	160	0.15	6	6	5	
TOTALS:			480	790	0.70	30	30	25	

*ADDITIONAL QUANTITY INCLUDED WITH BASE AGGREGATE ITEMS.

634.0612 POSTS WOOD 4x6-INCH x 12-FT
637.2230 SIGNS TYPE II REFLECTIVE F
638.2602 REMOVING SIGNS TYPE II
638.3000 REMOVING SMALL SIGN SUPPORTS

		SIGN CODE	SIZE	SIGNS TYPE II REFLECTIVE F SF	WOOD POSTS EACH	REMOVING SIGNS TYPE II EACH	REMOVING SMALL SIGN SUPPORTS EACH	COMMENTS
STATION	LOCATION							
9+75	RT	W5-52R	12"x36"	3	1	-	-	OBJECT MARKER
9+81	RT	-	-	-	-	1	1	EXISTING OBJECT MARKER
9+82	LT	W5-52L	12"x36"	3	1	-	-	OBJECT MARKER
9+81	LT	-	-	-	-	1	1	EXISTING OBJECT MARKER
10+45	RT	W5-52L	12"x36"	3	1	-	-	OBJECT MARKER
10+19	RT	-	-	-	-	1	1	EXISTING OBJECT MARKER
10+21	LT	W5-52R	12"x36"	3	1	-	-	OBJECT MARKER
10+19	LT	-	-	-	-	1	1	EXISTING OBJECT MARKER
TOTALS:				12	4	4	4	

650.4500 CONSTRUCTION STAKING SUBGRADE
650.5000 CONSTRUCTION STAKING BASE
650.9920 CONSTRUCTION STAKING SLOPE STAKES
650.9910 CONSTRUCTION STAKING SUPPLEMENTAL CONTROL 7102-00-70

		SUBGRADE	BASE	SLOPE STAKES	SUPPLEMENTAL CONTROL
STATION	- STATION	LF	LF	LF	LS
8+75	- 9+78.71	104	104	104	-
10+17.29	- 11+50	133	133	133	-
TOTALS:		237	237	237	1



690.0150 SAWING ASPHALT

STATION	LF
8+75	18
11+50	18
TOTAL:	36

p - PAY PLAN QUANTITY
NOTE: ALL ITEMS ARE CATEGORY 0010 UNLESS NOTED OTHERWISE.

3


BENCH MARKS			
NO.	STATION	DESCRIPTION	ELEV.
1	9+81.76, 8.7' RT	CHIS SQ ON SE WINGWALL	958.73
2	8+44.05, 23.4' LT	PK IN TOP OF 24" CMP	958.86
3	11+86.61, 25.1' RT	2 POLE NAILS IN 12" ELM	956.38

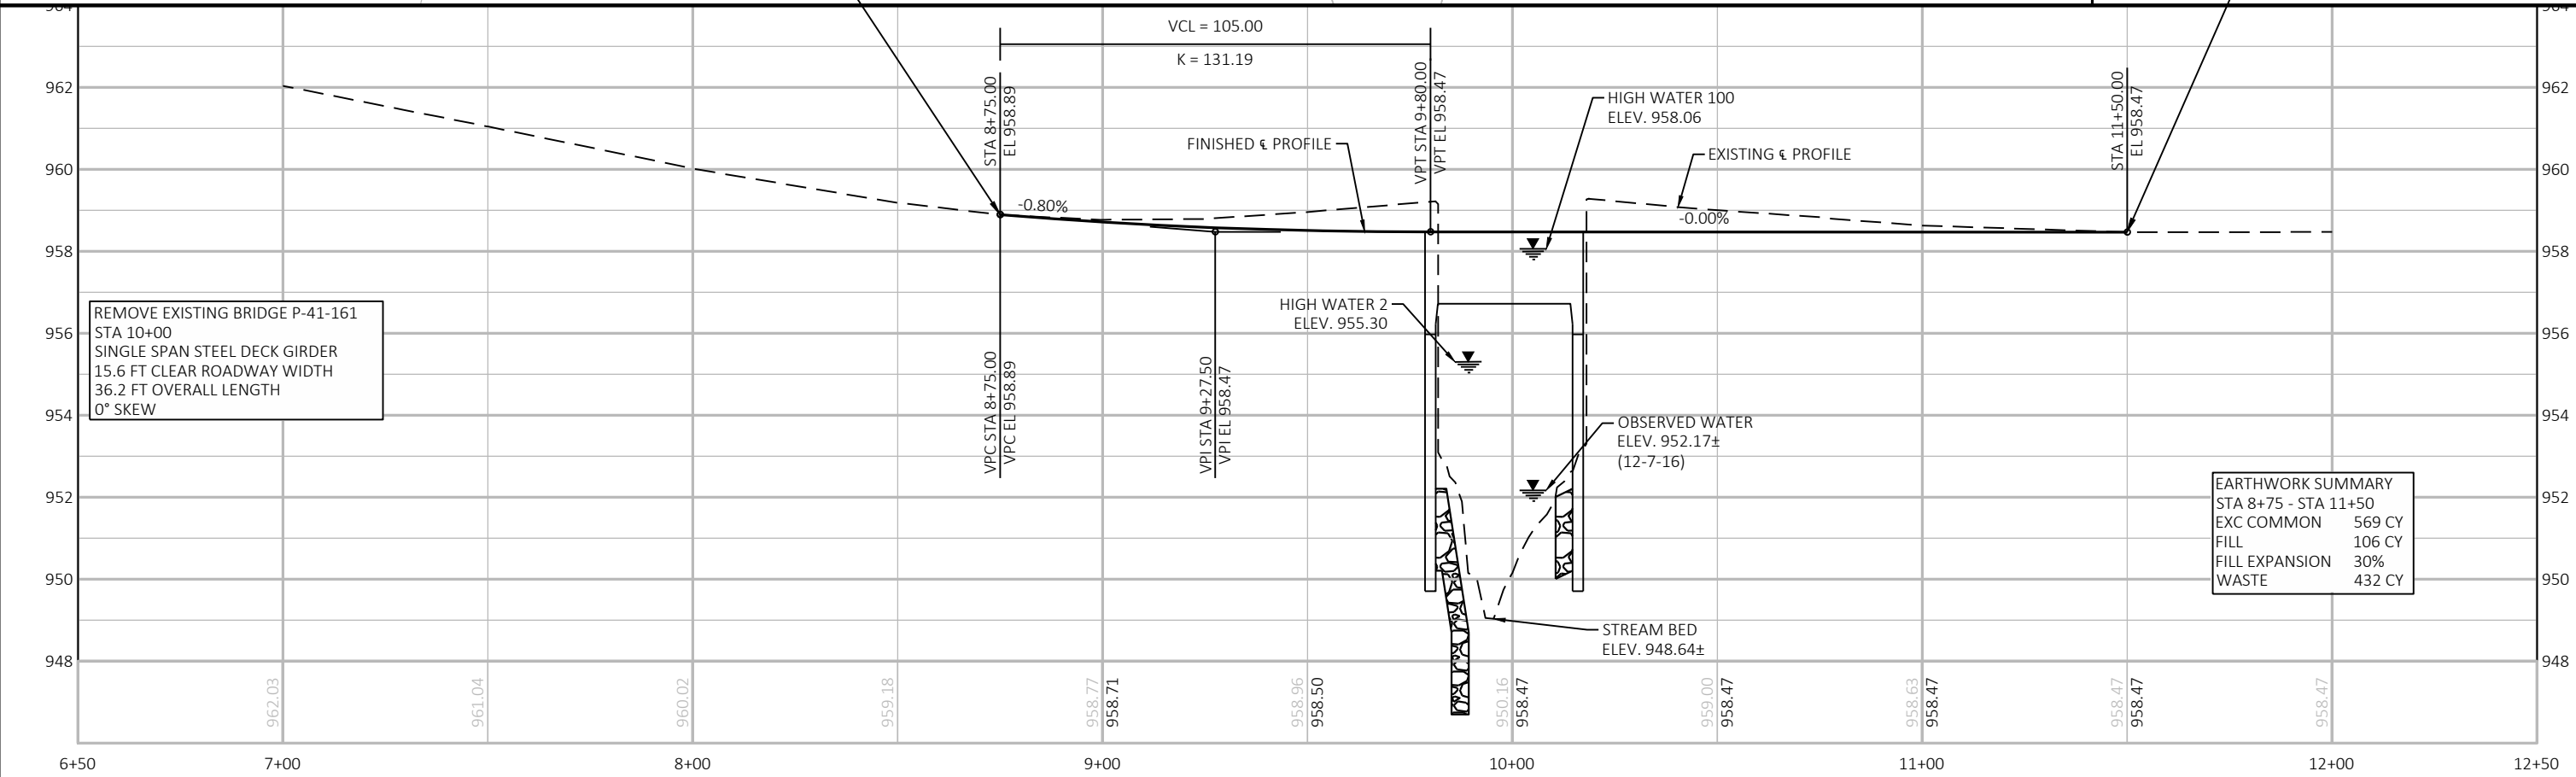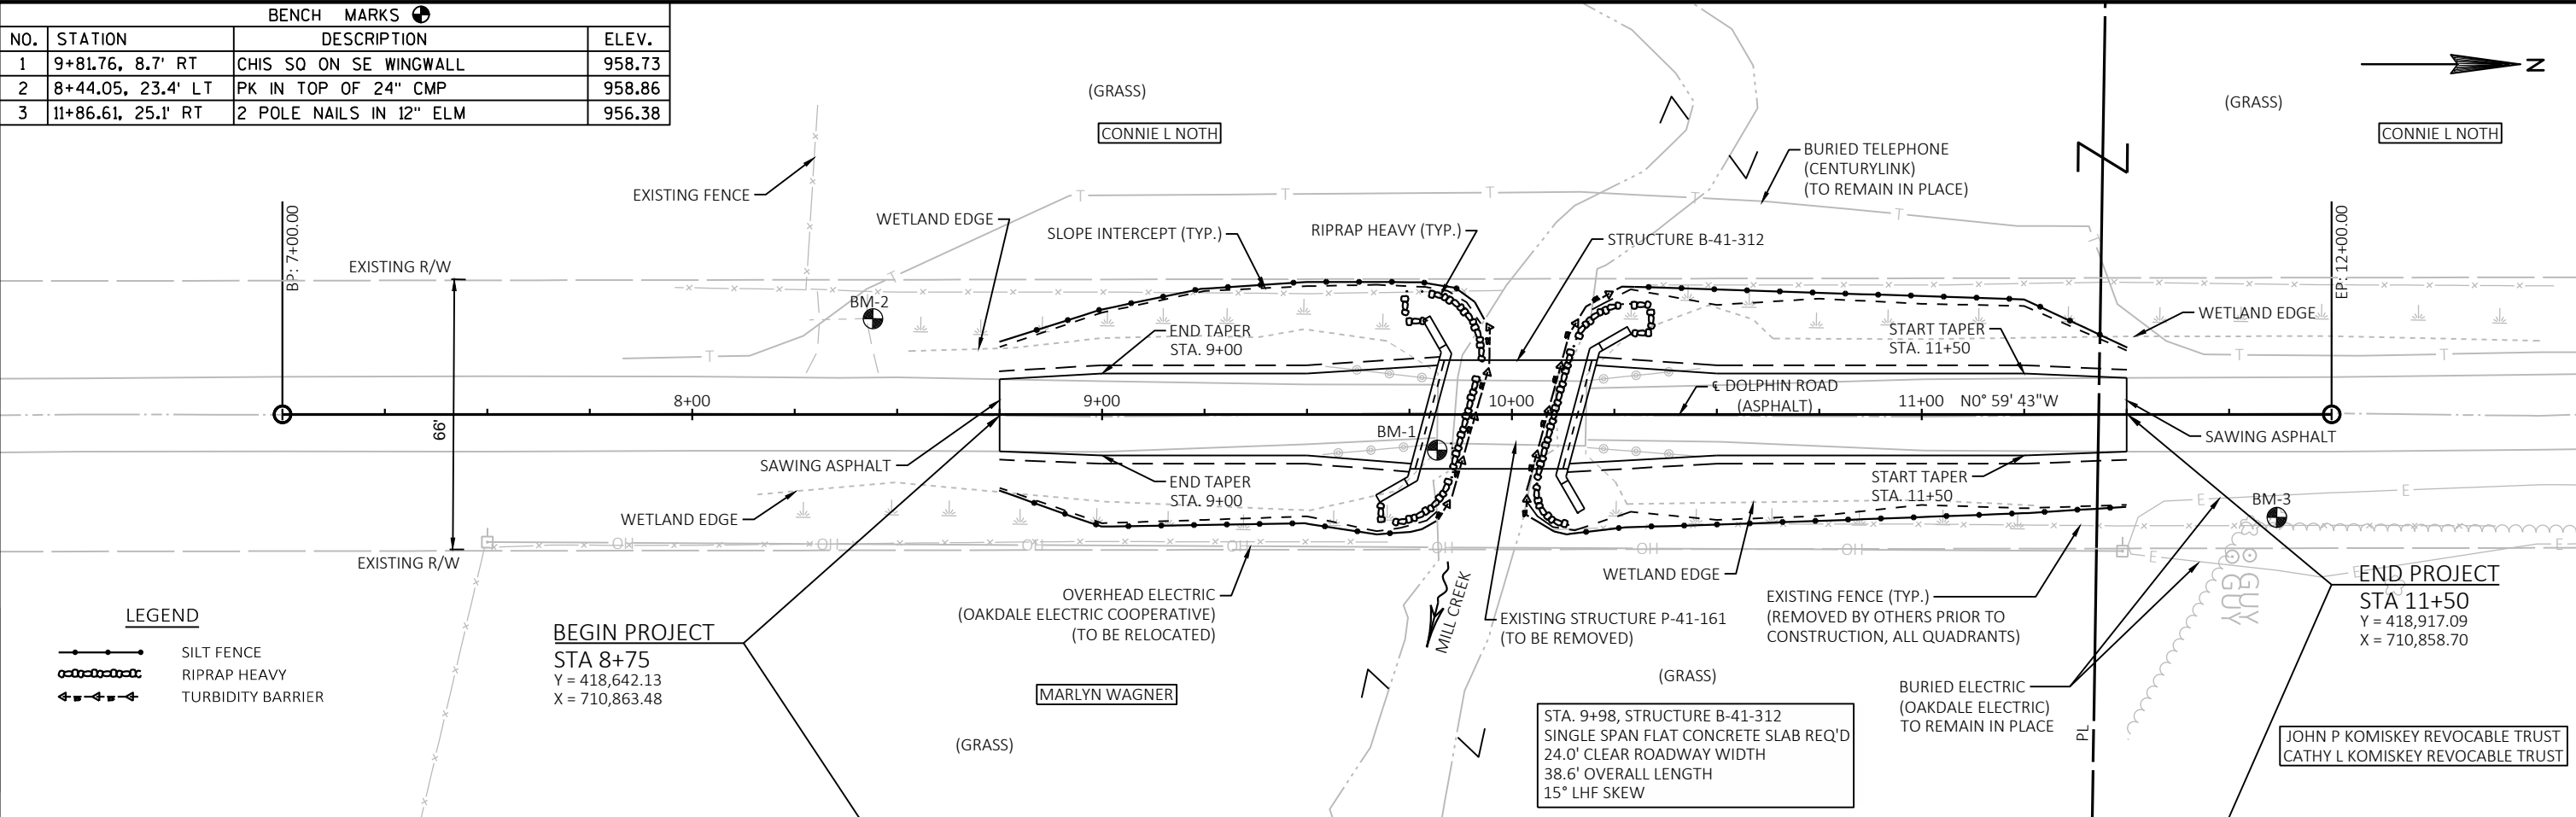


PROJECT NO: 7102-00-70	HWY: TOWN ROAD	COUNTY: MONROE	PLAN AND PROFILE: DOLPHIN ROAD	SHEET 5
------------------------	----------------	----------------	--------------------------------	---------

Standard Detail Drawing List


08E09-06	SILT FENCE
08E11-02	TURBIDITY BARRIER
12A03-10	NAME PLATE (STRUCTURES)
15C02-06A	BARRICADES AND SIGNS FOR MAINLINE CLOSURES
15C02-06B	BARRICADES AND SIGNS FOR MAINLINE CLOSURES
15C06-09	SIGNING & MARKING FOR TWO LANE BRIDGES
15C11-07B	CHANNELIZING DEVICES DRUMS, CONES, BARRICADES AND VERTICAL PANELS
15D38-02A	TEMPORARY TRAFFIC CONTROL SIGN MOUNTING
15D38-02B	ATTACHMENT OF SIGNS TO POSTS

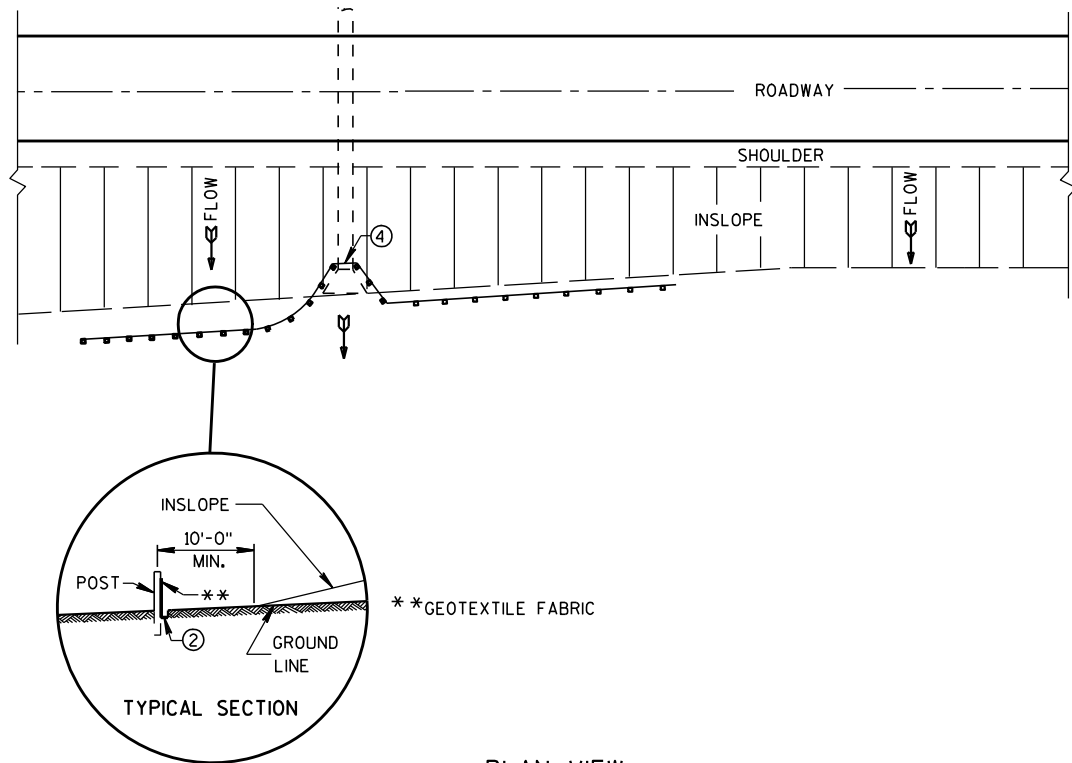


PLAN VIEW
TYPICAL APPLICATION OF SILT FENCE

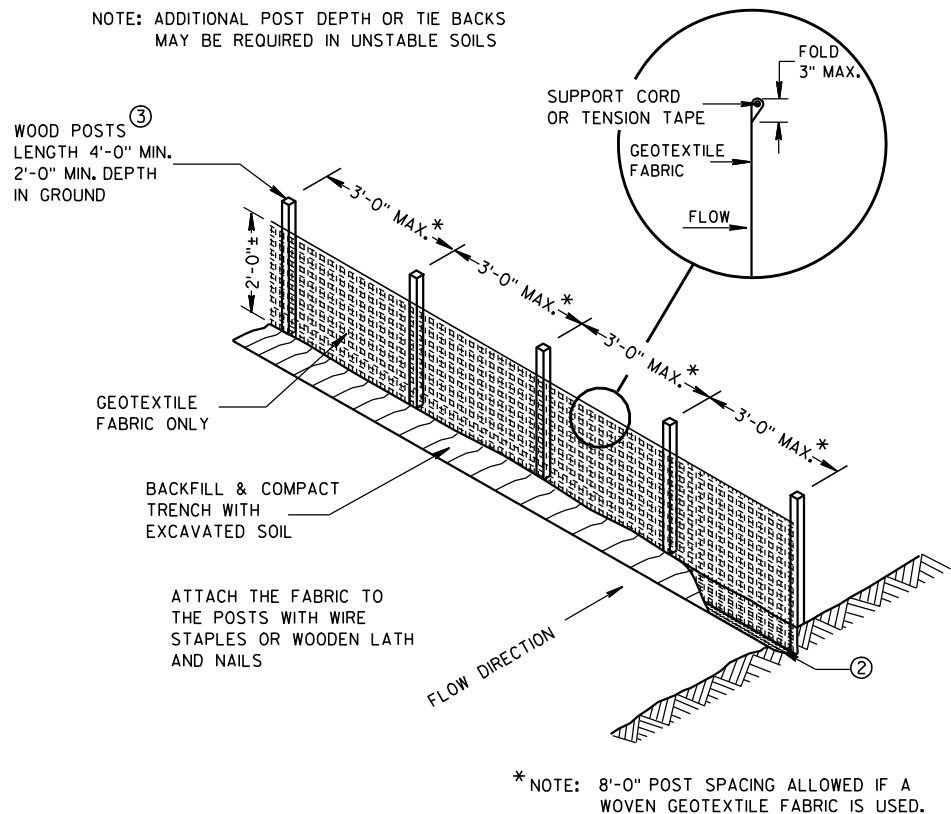

SILT FENCE

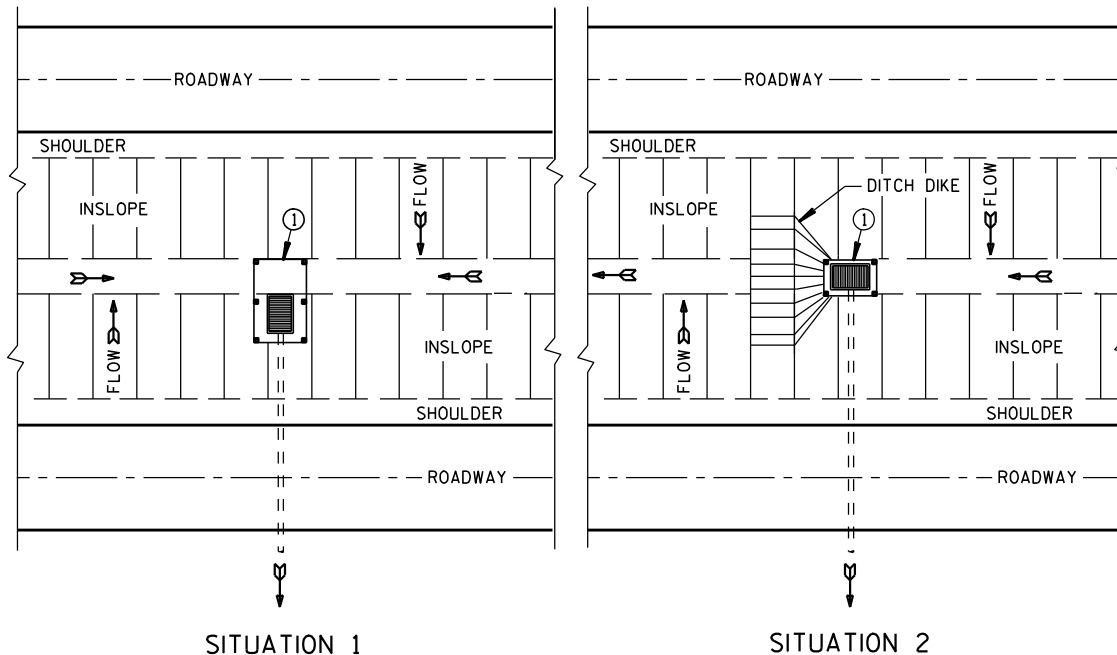

PLAN VIEW
SILT FENCE AT MEDIAN SURFACE DRAINS

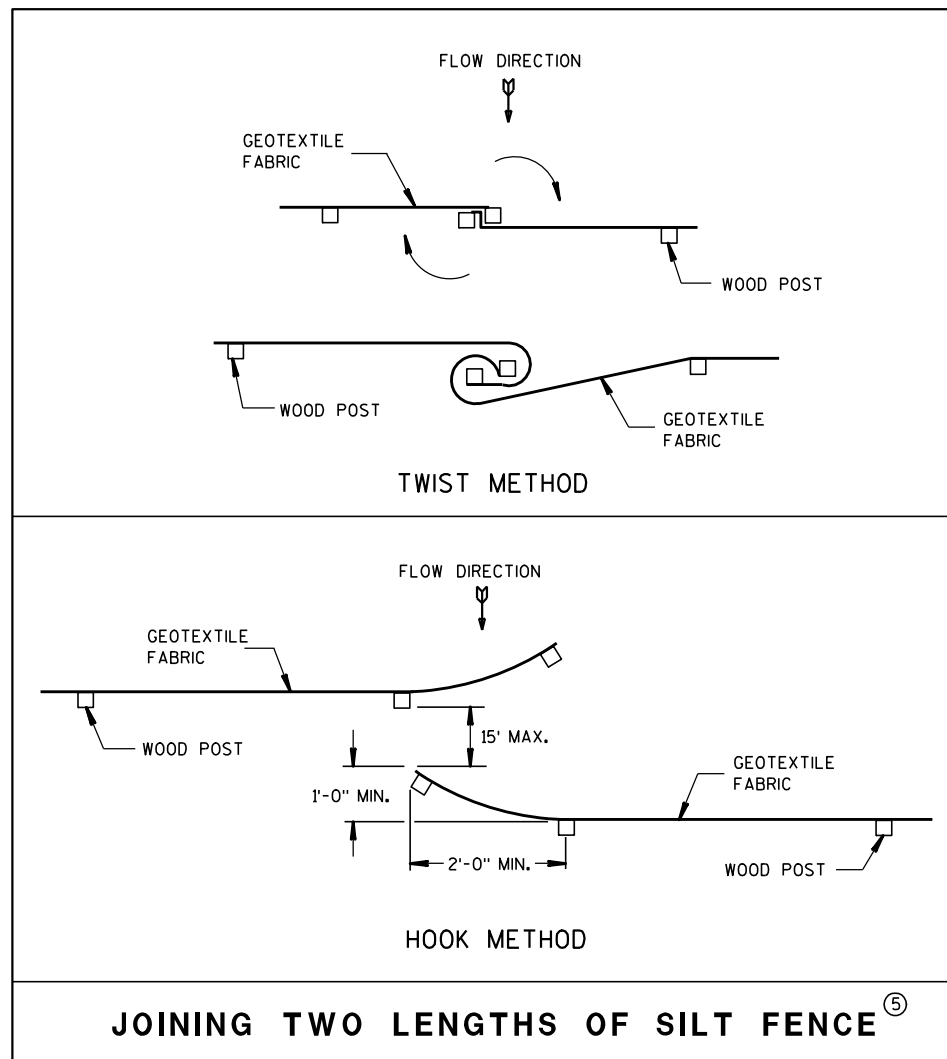


JOINING TWO LENGTHS OF SILT FENCE (5)


GENERAL NOTES

DETAILS OF CONSTRUCTION NOT SHOWN ON THIS DRAWING SHALL CONFORM TO THE PERTINENT REQUIREMENTS OF THE STANDARD SPECIFICATIONS AND APPLICABLE SPECIAL PROVISIONS.

- ① HORIZONTAL BRACE REQUIRED WITH 2" X 4" WOODEN FRAME OR EQUIVALENT AT TOP OF POSTS.
- ② FOR MANUAL INSTALLATIONS THE TRENCH SHALL BE A MINIMUM OF 4" WIDE & 6" DEEP TO BURY AND ANCHOR THE GEOTEXTILE FABRIC. FOLD MATERIAL TO FIT TRENCH AND BACKFILL & COMPACT TRENCH WITH EXCAVATED SOIL.
- ③ WOOD POSTS SHALL BE A MINIMUM SIZE OF 1 1/8" X 1 1/8" OF OAK OR HICKORY.
- ④ SILT FENCE TO EXTEND ACROSS THE TOP OF THE PIPE.
- ⑤ CONSTRUCT SILT FENCE FROM A CONTINUOUS ROLL IF POSSIBLE BY CUTTING LENGTHS TO AVOID JOINTS. IF A JOINT IS NECESSARY USE ONE OF THE FOLLOWING TWO METHODS; A) OVERLAP THE END POSTS AND TWIST, OR ROTATE, AT LEAST 180 DEGREES, B) HOOK THE END OF EACH SILT FENCE LENGTH.

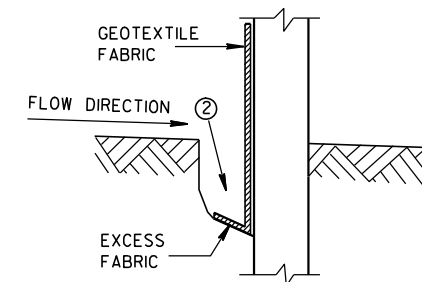

TRENCH DETAIL

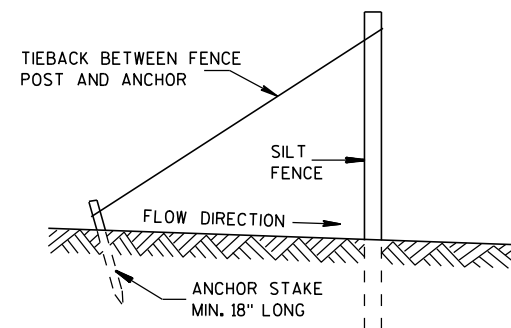


SILT FENCE TIE BACK
(WHEN REQUIRED BY THE ENGINEER)

SILT FENCE

STATE OF WISCONSIN
DEPARTMENT OF TRANSPORTATION

APPROVED
4-29-05 /S/ Beth Canestra
DATE CHIEF ROADWAY DEVELOPMENT ENGINEER
FHWA

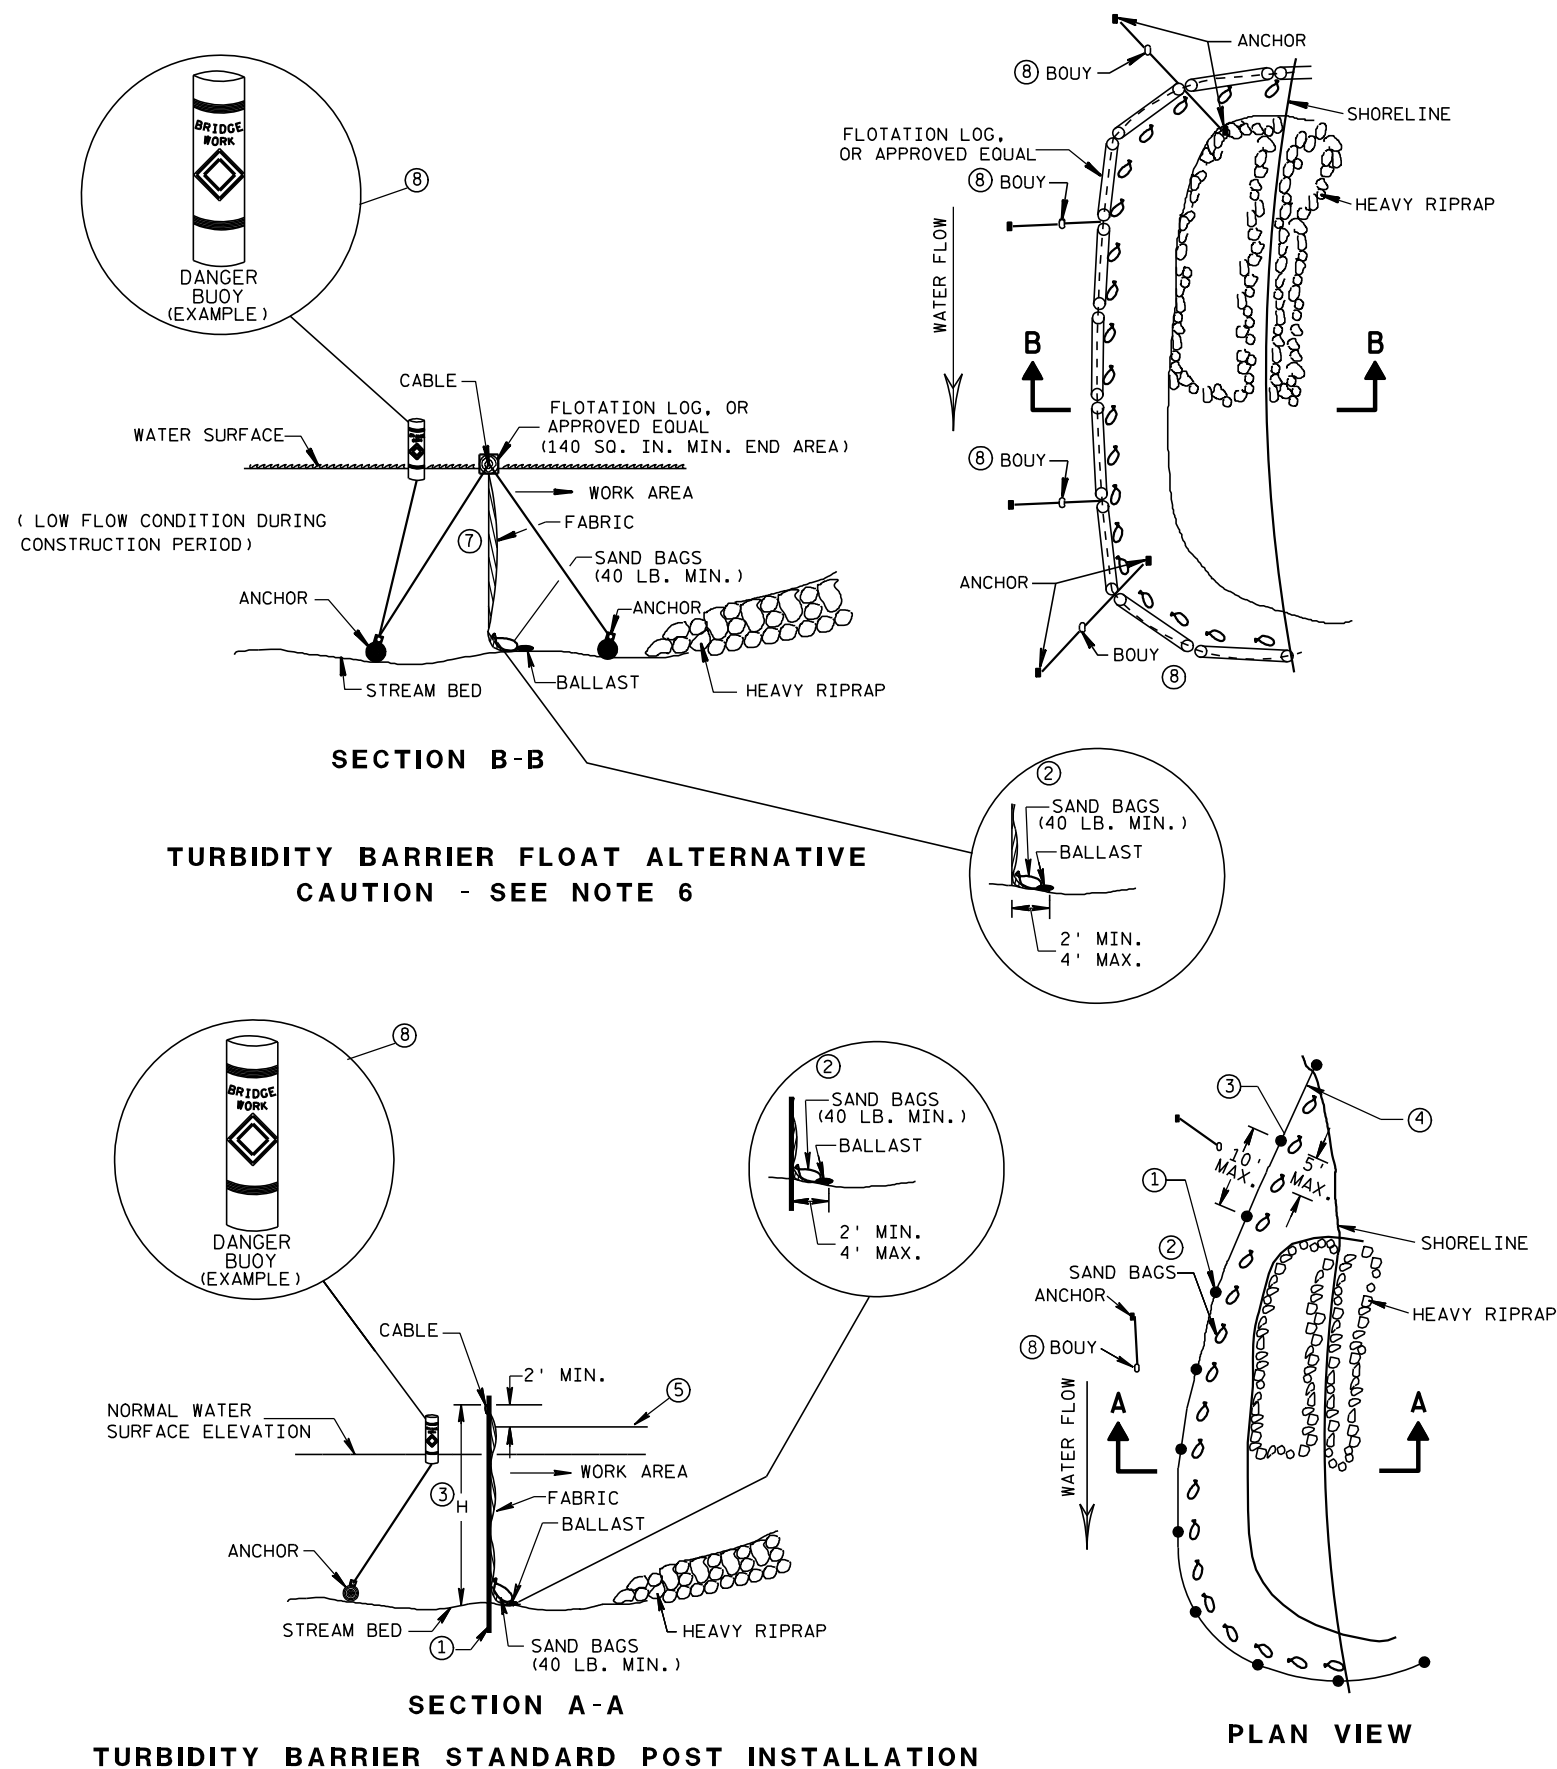


GENERAL NOTES

DETAILS OF CONSTRUCTION, MATERIALS AND WORKMANSHIP NOT SHOWN ON THIS DRAWING SHALL CONFORM TO THE PERTINENT REQUIREMENTS OF THE STANDARD SPECIFICATIONS AND THE APPLICABLE SPECIAL PROVISIONS.

TURBIDITY BARRIER MAY BE REMOVED AT THE ENGINEERS DISCRETION, WHEN PERMANENT EROSION CONTROL MEASURES HAVE BEEN ESTABLISHED.

- ① DRIVEN STEEL POSTS, PIPES, OR CHANNELS. LENGTH SHALL BE SUFFICIENT TO SECURELY SUPPORT BARRIER AT HIGH WATER ELEVATIONS.
- ② SANDBAGS TO BE USED AS ADDITIONAL BALLAST WHEN ORDERED BY THE ENGINEER TO MEET ADVERSE FIELD CONDITIONS. SPACE AS APPROPRIATE FOR SITE CONDITIONS.
- ③ WHEN BARRIER HEIGHT, H, EXCEEDS 8 FT., POST SPACING MAY NEED TO BE DECREASED.
- ④ IN WATERWAYS SUBJECT TO FLUCTUATING WATER ELEVATIONS, PROVISIONS SHOULD BE MADE TO ALLOW THE WATER TO EQUALIZE ON EACH SIDE OF THE BARRIER. THIS MAY BE ACCOMPLISHED BY LEAVING A PORTION OF THE BARRIER OPEN ON THE UPSTREAM END.
- ⑤ ESTIMATED HIGH WATER ELEVATION DURING CONSTRUCTION PERIOD. MINIMUM BARRIER HEIGHT SHALL BE 2' GREATER THAN EITHER THE 02 ELEVATION OR THE ESTIMATED HIGH WATER ELEVATION DURING CONSTRUCTION, WHICHEVER IS GREATER.
- ⑥ FLOAT ALTERNATIVE WILL ONLY BE ALLOWED WITH WRITTEN APPROVAL OF THE ENGINEER, AND IS MEANT FOR LOCATIONS WHERE BED ROCK PREVENTS THE INSTALLATION OF POSTS.
- ⑦ ALLOW SUFFICIENT SLACK VERTICALLY AND HORIZONTALLY SO THAT SEDIMENT BUILD UP WILL NOT SEPARATE OR LOWER THE TURBIDITY BARRIER.
- ⑧ USE AS DIRECTED BY COAST GUARD OR DNR PERMIT WHEN WORKING IN NAVIGABLE WATERWAYS.

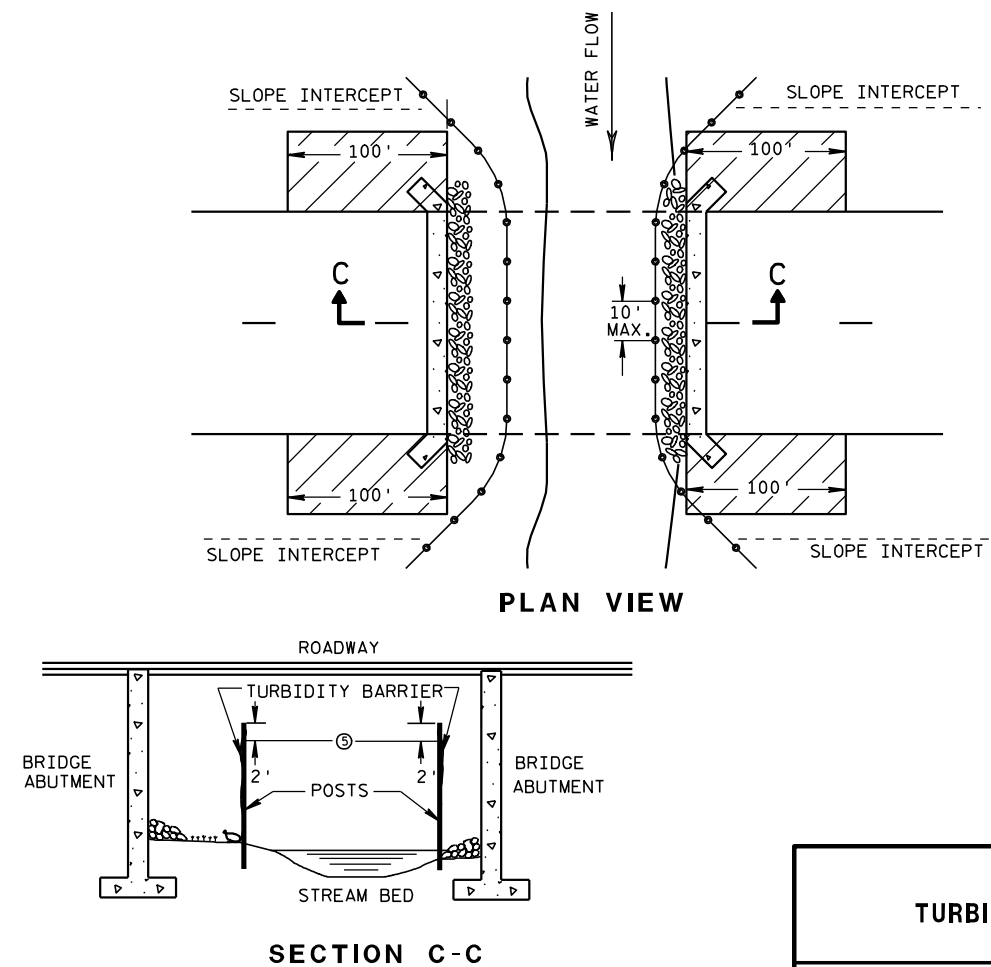

TURBIDITY BARRIER DETAIL SHOWING TYPICAL PLACEMENT AT STRUCTURES

TURBIDITY BARRIER


STATE OF WISCONSIN
DEPARTMENT OF TRANSPORTATION

APPROVED


6/04/02
DATE

FHWA

/S/ Beth Canestra
CHIEF ROADWAY DEVELOPMENT ENGINEER

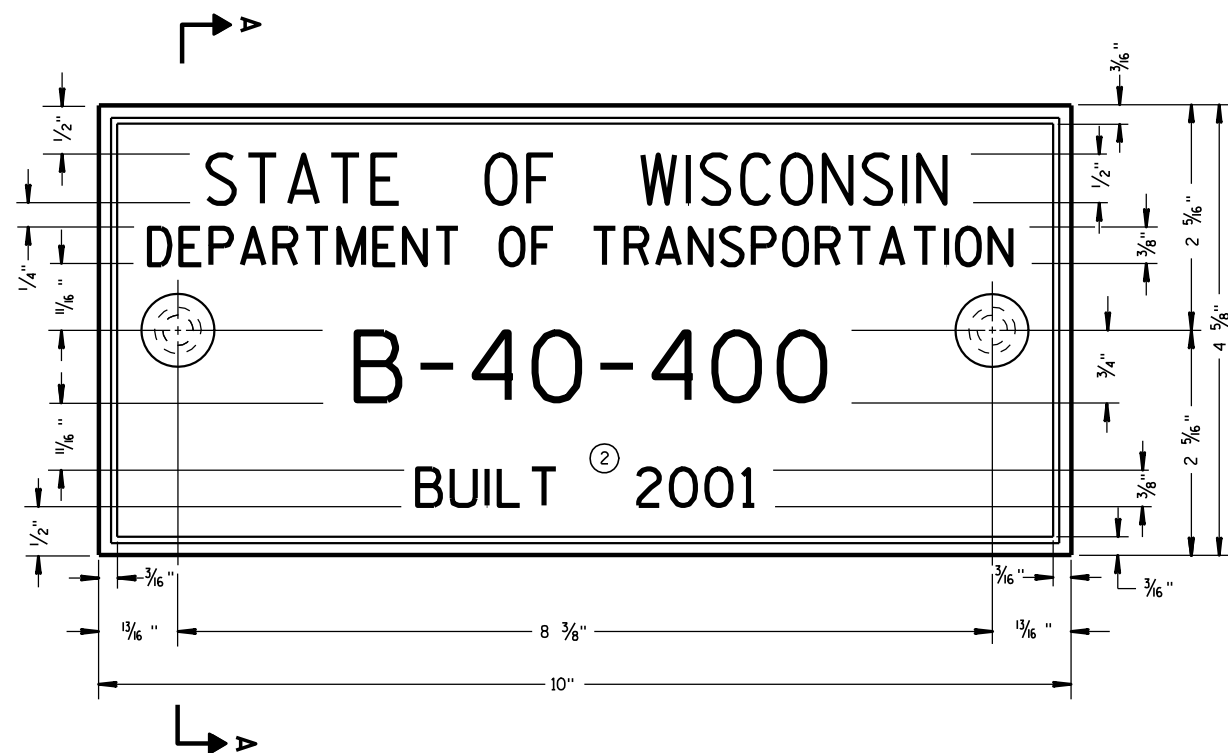

TYPICAL NAME PLATE
(BRIDGES, CULVERTS, AND RETAINING WALLS)

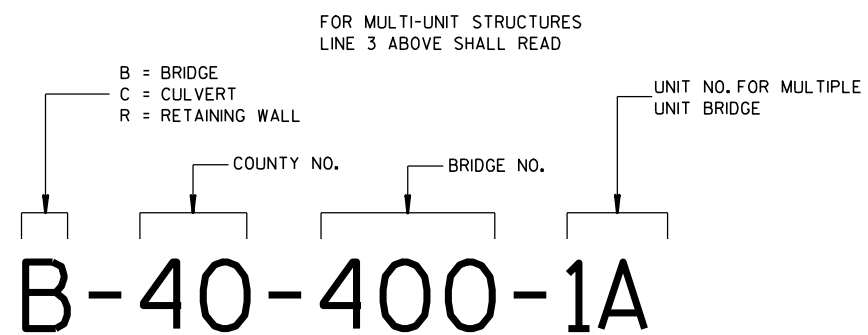


**NUMBERING DESIGNATION
MULTI-UNIT STRUCTURES**

GENERAL NOTES


NAME PLATES TO BE INSTALLED ON BRIDGES, CULVERTS, AND RETAINING WALLS SHALL CONFORM TO THE REQUIREMENTS OF SECTION 502.3.11 OF THE STANDARD SPECIFICATIONS.

THE BRIDGE NUMBER AND YEAR BUILT SHOWN ON THIS DRAWING ARE EXAMPLES ONLY. SEE CONSTRUCTION PLANS FOR INDIVIDUAL NUMBERING AND YEAR BUILT.

- 1 EPOXY RESIN SHALL BE FROM AN APPROVED MANUFACTURER AND USED IN ACCORDANCE WITH MANUFACTURER'S RECOMMENDATIONS.
- 2 REHABILITATION OF AN EXISTING STRUCTURE SHOULD USE THE DATE OF ORIGINAL STRUCTURE CONSTRUCTION.

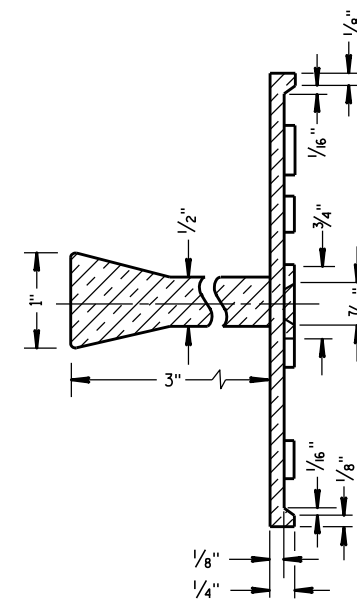


SECTION A-A

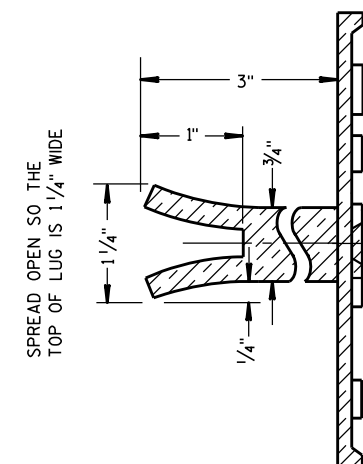

ALTERNATE LUG

- 1 ADHERE ANCHOR LUG TO PRECAST RETAINING WALL WITH EPOXY RESIN.

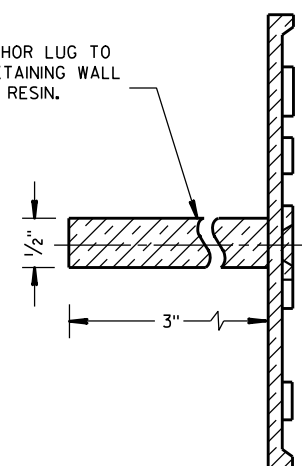

ALTERNATE LUG
(FOR ATTACHMENT TO PRECAST STRUCTURES)

**NAME PLATE
(STRUCTURES)**


STATE OF WISCONSIN
DEPARTMENT OF TRANSPORTATION

APPROVED

3/26/10
DATE


FHWA

/S/ Scot Becker
CHIEF STRUCTURAL DEVELOPMENT ENGINEER

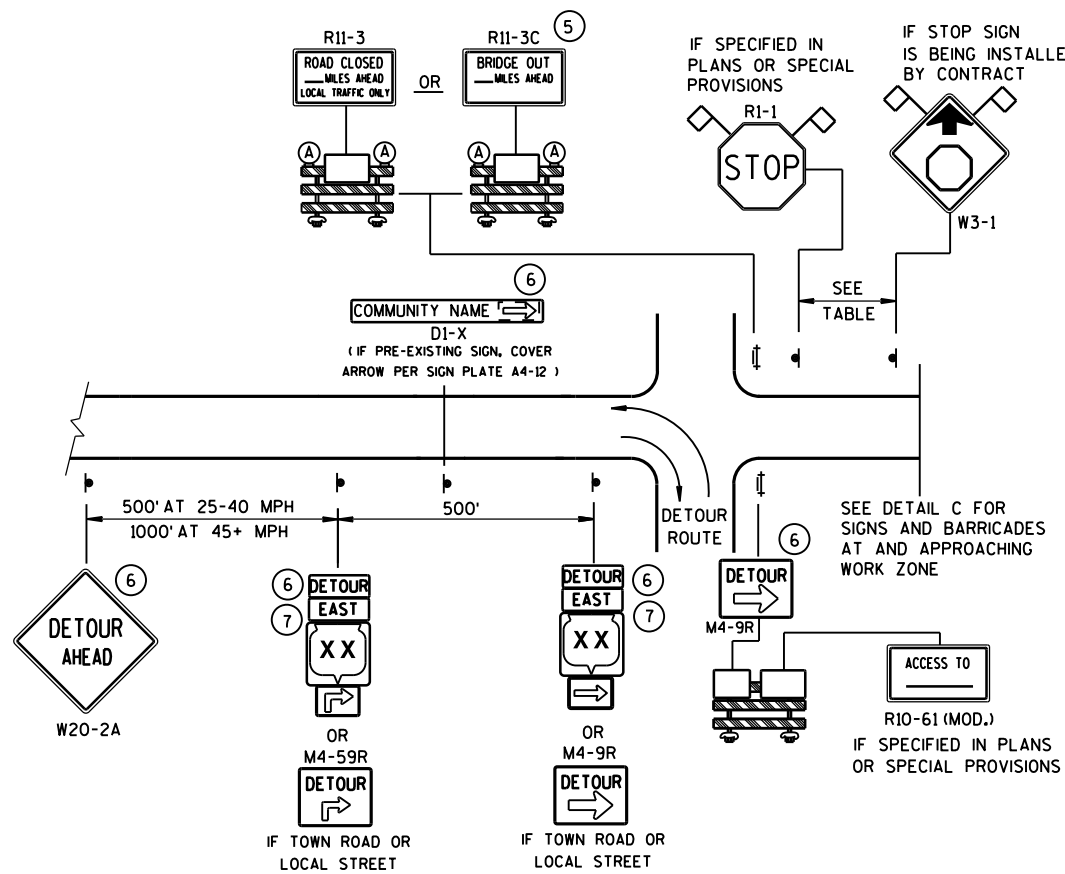


DETAIL A
MAINLINE CLOSURE WITH POSTED DETOUR

WORK ZONE GREATER THAN 1/2 MILE FROM DETOUR ROUTE (1000 FEET IF URBAN)

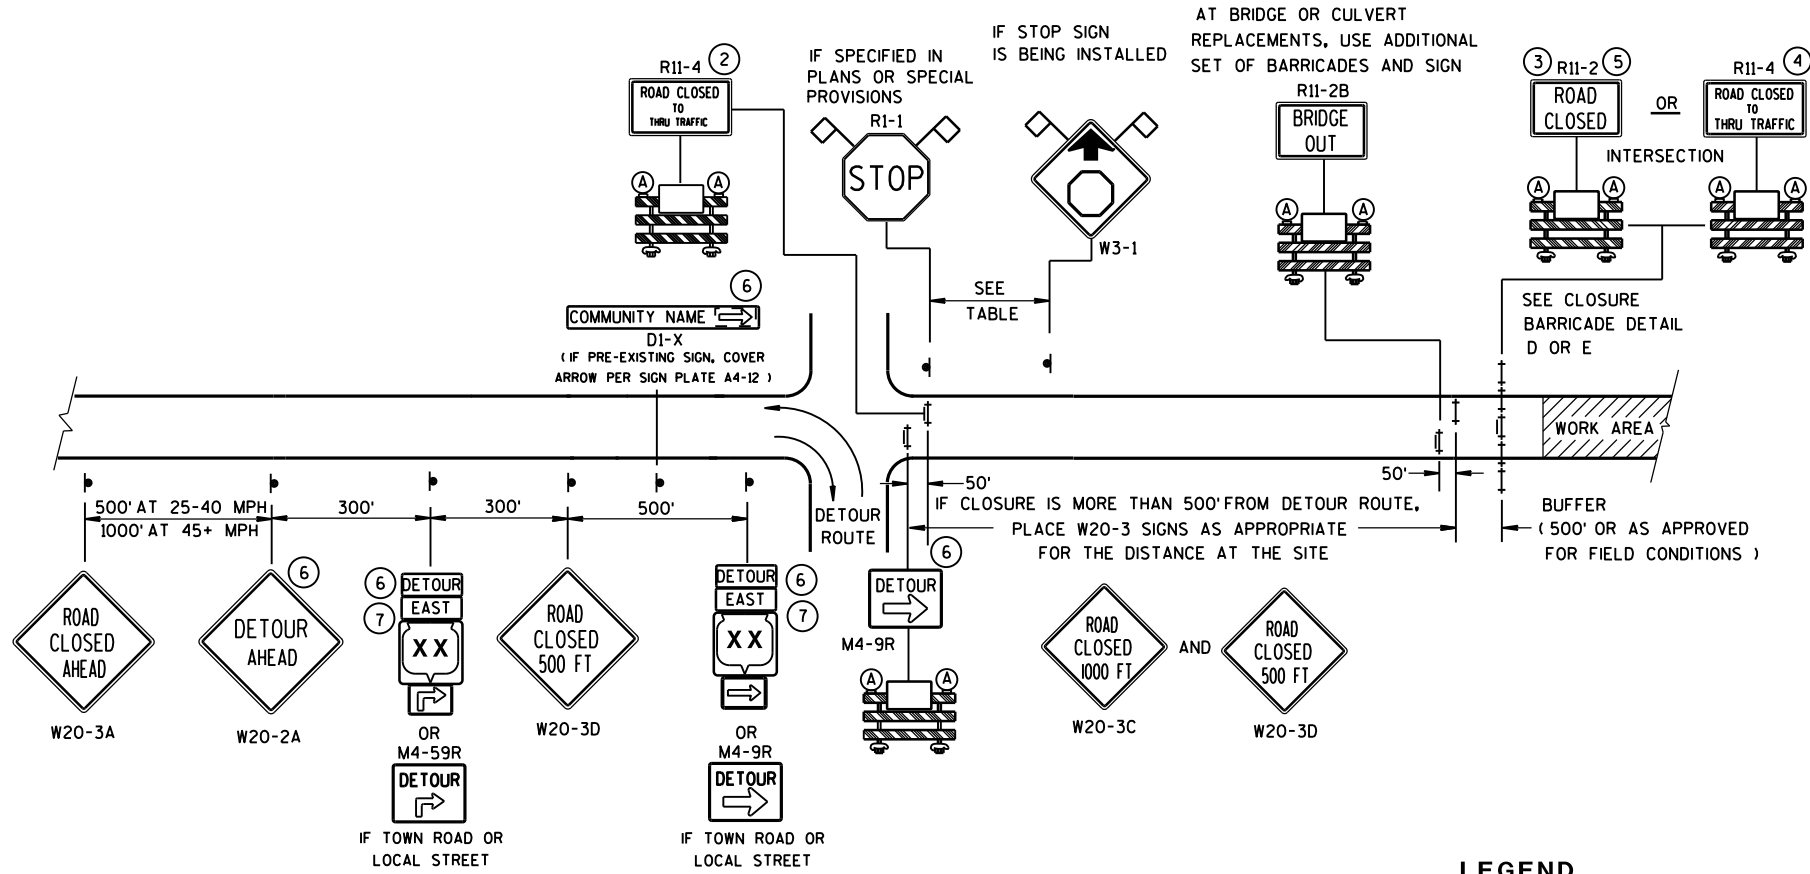

DETAIL B
MAINLINE CLOSURE WITH POSTED DETOUR

WORK ZONE LESS THAN 1/2 MILE FROM DETOUR ROUTE (1000 FEET IF URBAN)


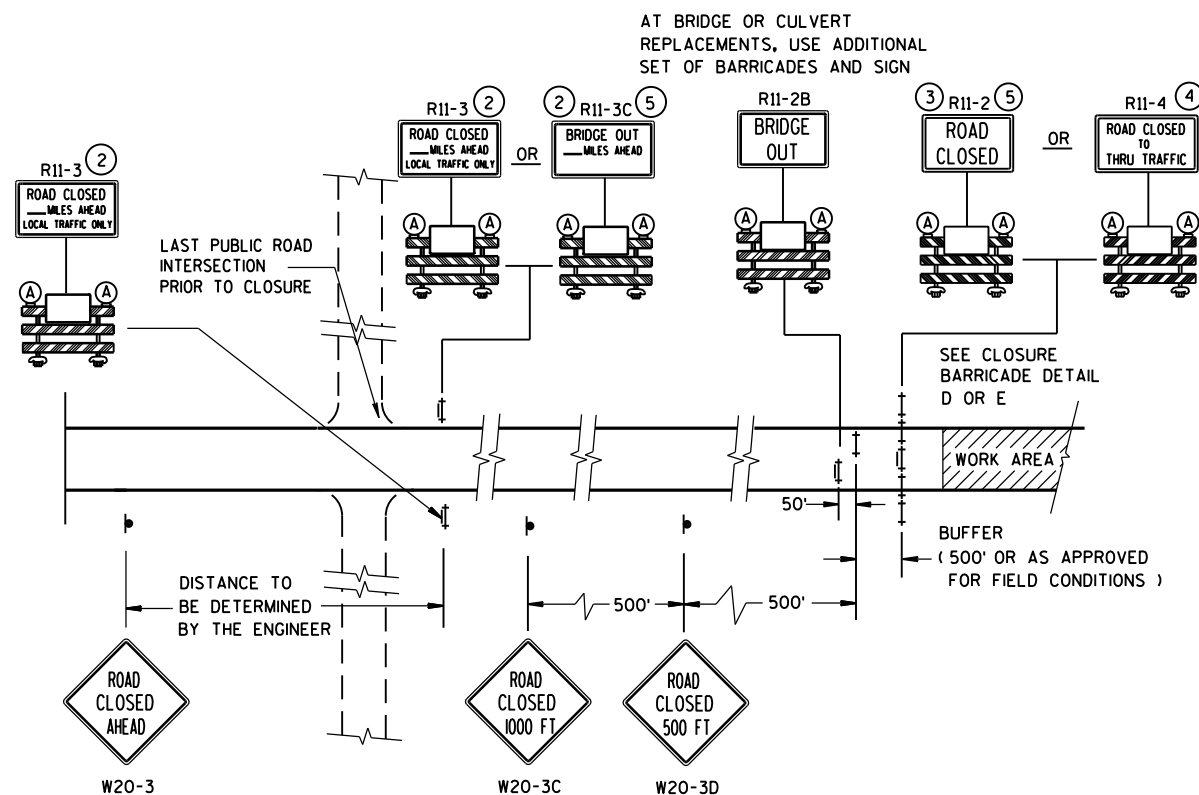


DETAIL C
MAINLINE CLOSURE, NO POSTED DETOUR

SPEED LIMIT (MPH)	"STOP AHEAD" ADVANCE WARNING DISTANCE (FT)
25	200
30	200
35	350
40	350
45	500
50	550
55	750

SEE SDD 15C2-SHEET "b"
FOR GENERAL NOTES
AND FOOTNOTES ① THROUGH ⑦

BARRICADES AND SIGNS FOR MAINLINE CLOSURES	
STATE OF WISCONSIN DEPARTMENT OF TRANSPORTATION	
Sept. 2015 DATE	/S/ Peter Amokobe Atepe STATEWIDE WORK ZONE TRAFFIC SAFETY ENGINEER

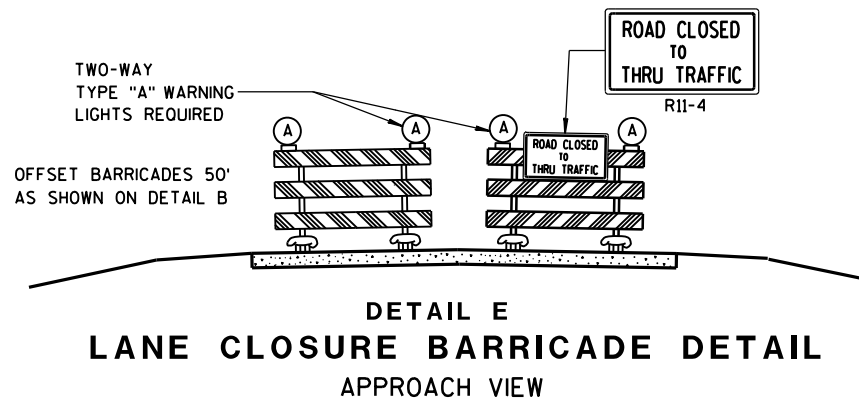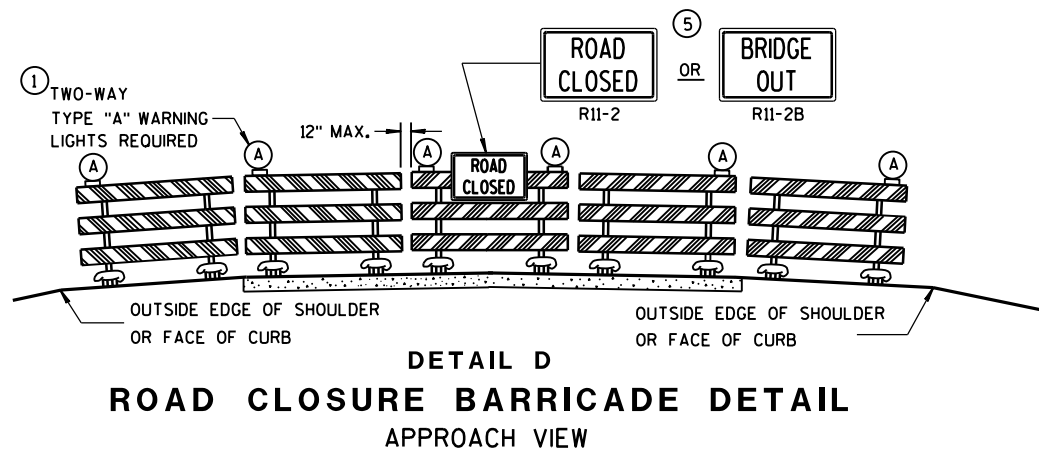

SEE SDD 15C2-SHEET "a" FOR LEGEND

GENERAL NOTES

THE EXACT NUMBER, LOCATION, AND SPACING OF ALL SIGNS AND BARRICADES SHALL BE ADJUSTED TO FIT FIELD CONDITIONS AS APPROVED BY THE ENGINEER.

ANY SIGNS TEMPORARY OR EXISTING, WHICH CONFLICT WITH TRAFFIC CONTROL "IN USE" SHALL BE REMOVED OR COVERED AS NEEDED AND AS APPROVED BY THE ENGINEER.

THE SPACING BETWEEN TRAFFIC CONTROL SIGNS SHOULD BE ADJUSTED TO NOT CONFLICT WITH AND SHOULD PROVIDE A DESIRABLE MINIMUM OF 200 FEET CLEARANCE TO EXISTING SIGNS THAT WILL REMAIN IN PLACE.

BARRICADES THAT MUST BE MOVED FOR A WORK OPERATION SHALL BE IMMEDIATELY RE-ESTABLISHED UPON COMPLETION OF THE OPERATION OR, FOR CONTINUING OPERATIONS, AT THE END OF EACH WORKING DAY.

SIGNS THAT WILL BE IN PLACE LESS THAN 7 CONTINUOUS DAYS AND NIGHTS MAY BE MOUNTED ON PORTABLE SUPPORTS.

ALL TYPE III BARRICADES SHALL HAVE RAILS REFLECTORIZED ON BOTH FACES. STRIPES SHALL BE PROPERLY SLOPED DOWN TOWARD THE TRAFFIC SIDE OR AS SHOWN IN THE ROAD CLOSURE BARRICADE DETAIL D FOR FULL ROAD CLOSURES.

TYPE "A" LOW-INTENSITY FLASHING WARNING LIGHTS SHALL BE VISIBLE ON BOTH SIDES OF THE BARRICADE.

THE R11-2, R11-3, M4-9, R11-4 AND R10-61 SIGNS PLACED ON BARRICADES SHALL COVER NO MORE THAN THE TOP RAIL. THE SIGNS SHALL NOT COVER ANY PORTION OF THE MIDDLE OR BOTTOM RAILS.

"WO AND "MO" SIGNS ARE THE SAME AS "W" AND "M" SIGNS EXCEPT THE BACKGROUND IS ORANGE.

ALL SIGNS SHALL BE 48" X 48" UNLESS OTHERWISE NOTED BELOW:

R11-2 SHALL BE 48" X 30".

R11-3, R11-4 AND R10-61 SHALL BE 60" X 30".

M4-9 SHALL BE 30" X 24".

M3-X SHALL BE 24" X 12". (36" X 18" IF NEEDED TO MATCH EXISTING SIGNS.)

M4-8 SHALL BE 24" X 12". (30" X 15" IF NEEDED TO MATCH EXISTING SIGNS.)

M1-4, M1-5A, AND M1-6 SHALL BE 24" X 24". (36" X 36" IF NEEDED TO MATCH EXISTING SIGNS.)


M05-1 AND M06-1 SHALL BE 21" X 21". (30" X 30" IF NEEDED TO MATCH EXISTING SIGNS.)

D1-X SHALL BE AS SHOWN ON SPECIFIC PROJECT SIGNING DETAIL SHEETS.

R1-1 SHALL BE 36" X 36".

- ① TWO WARNING LIGHTS SHALL BE PROVIDED ON THE CENTER BARRICADE AND A MINIMUM OF ONE WARNING LIGHT SHALL BE PROVIDED ON EACH OF THE OTHER BARRICADES WITHIN THE ROADWAY LIMITS. SPACING OF THE WARNING LIGHTS SHALL BE UNIFORM TO THE EDGE OF ROADWAY AS SHOWN (APPROX. 8-FOOT LIGHT SPACING).
- ② THESE SIGNS AND BARRICADES ARE NOT REQUIRED IF ROAD CLOSURE BEGINS AT INTERSECTION.
- ③ FOR ROAD CLOSURE WITHOUT LOCAL ACCESS TO PROJECT, SEE ROAD CLOSURE BARRICADE DETAIL D.
- ④ FOR ROAD CLOSURE WITH LOCAL ACCESS TO PROJECT, SEE LANE CLOSURE BARRICADE DETAIL E.
- ⑤ FOR BRIDGE OR CULVERT REPLACEMENTS, SUBSTITUTE "BRIDGE OUT" INSTEAD OF "ROAD CLOSED" ON R11-2 AND R11-3 SIGNS.
- ⑥ INSTALL DETOUR AND COMMUNITY GUIDE SIGNS AND ARROWS ONLY IF SPECIFIED IN THE CONTRACT. IF THERE ARE EXISTING ROUTE MARKER ASSEMBLIES THAT WILL REMAIN IN PLACE, ADJUST THE LOCATION OF THE DETOUR ROUTE SIGNS TO CORRESPOND WITH THE EXISTING ASSEMBLIES. MODIFY EXISTING SIGNS WHERE POSSIBLE. SEE SPECIFIC PROJECT DETOUR SIGNING DETAIL SHEETS. IF DETOUR SIGNS ARE BEING INSTALLED BY OTHERS, PLACE THE CONTRACTED TRAFFIC CONTROL SIGNS TO ALLOW FOR PLACEMENT OF ALL WARNING, DETOUR AND GUIDE SIGNS AS SHOWN.
- ⑦ "EAST" CARDINAL DIRECTION MARKERS AND RIGHT TURN ARROWS ARE SHOWN. USE OTHER CARDINAL DIRECTIONS AND ARROWS AS APPROPRIATE.

BARRICADES AND SIGNS FOR MAINLINE CLOSURES	
STATE OF WISCONSIN DEPARTMENT OF TRANSPORTATION	
Sept. 2015 DATE	/S/ Peter Amokobe Atepe STATEWIDE WORK ZONE TRAFFIC SAFETY ENGINEER
FHWA	

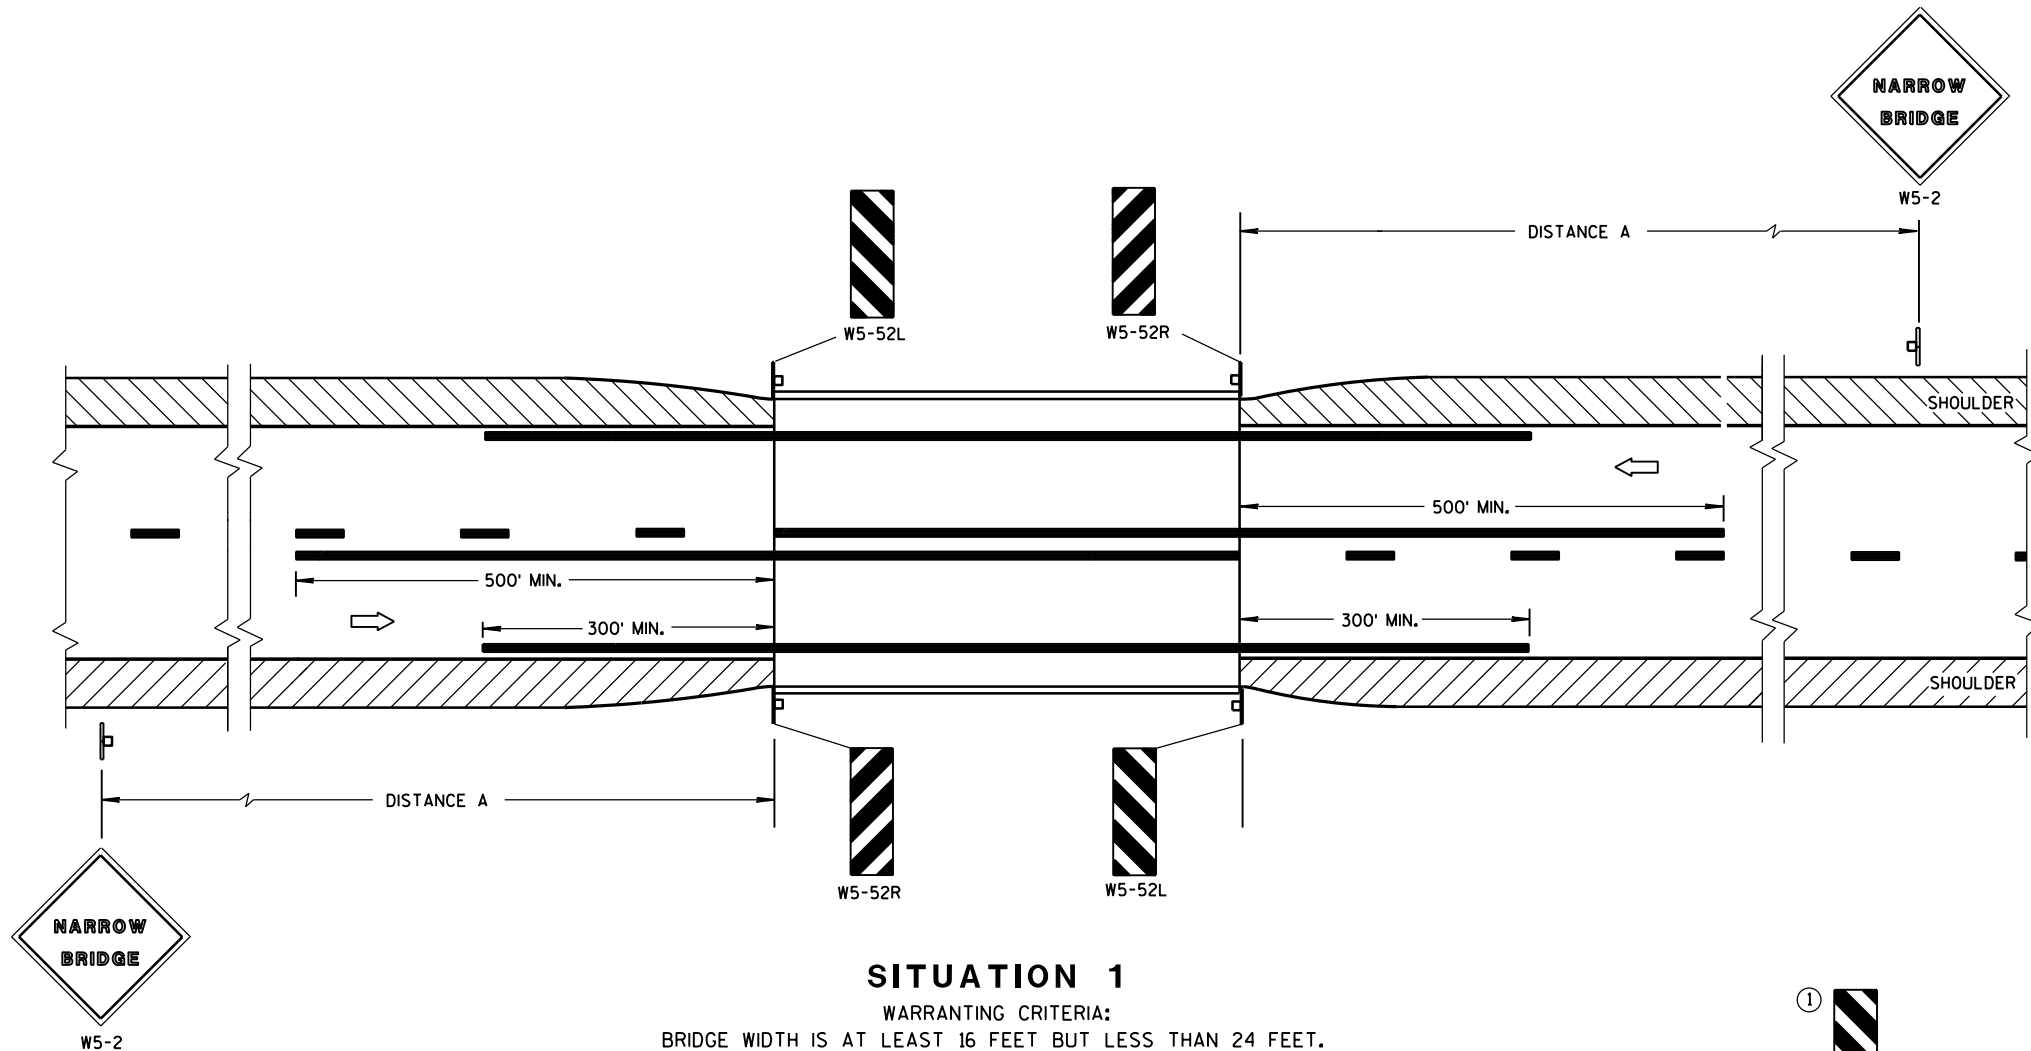

DISTANCE TABLE

POSTED OR 85th PERCENTILE SPEED	DISTANCE "A "
25	150'
30	200'
35	250'
40	300'
45	400'
50	550'
55	750'

GENERAL NOTES


DETAILS OF TRAFFIC CONTROL DEVICES AND INSTALLATION NOT SHOWN ON THIS DRAWING SHALL CONFORM TO THE PERTINENT REQUIREMENTS OF THE STANDARD SPECIFICATIONS, THE SPECIAL PROVISIONS, AND THE MANUAL ON UNIFORM TRAFFIC CONTROL DEVICES.

LOCATE W5-52 SIGN POST(S) BEHIND GUARDRAIL WHEN PRESENT.

PLACE THE EDGE OF THE W5-52 SIGN IN LINE WITH FACE OF CURB OR PARAPET.

① OMIT ON ONE-WAY TRAVELLED WAYS.

➡ DIRECTION OF TRAFFIC

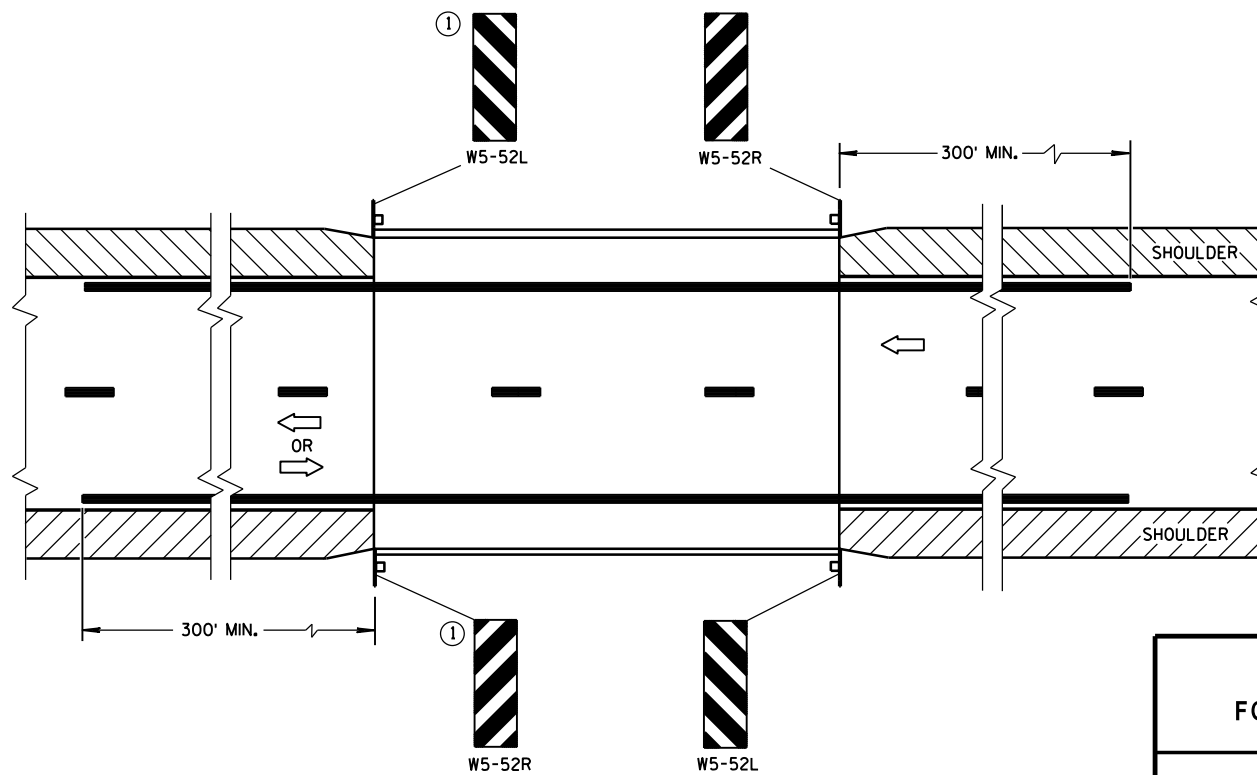

SITUATION 2

WARRANTING CRITERIA:

1. BRIDGE WIDTH IS AT LEAST 24 FEET AND
2. BRIDGE SHOULDER WIDTH IS LESS THAN 6 FEET.

SIGNING & MARKING FOR TWO LANE BRIDGES


STATE OF WISCONSIN
DEPARTMENT OF TRANSPORTATION

APPROVED


June 2017
DATE

/S/ Matthew R. Rauch
STATE SIGNING AND MARKING ENGINEER

FHWA

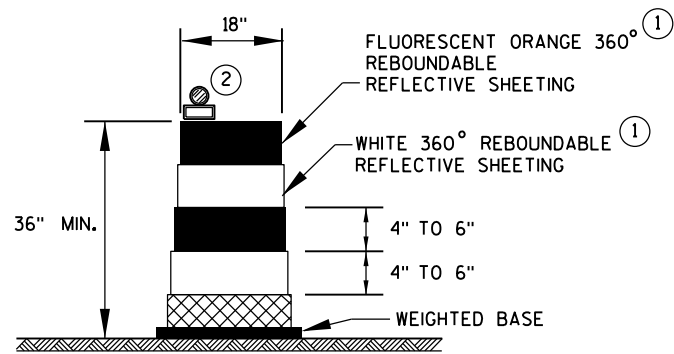

DRUM

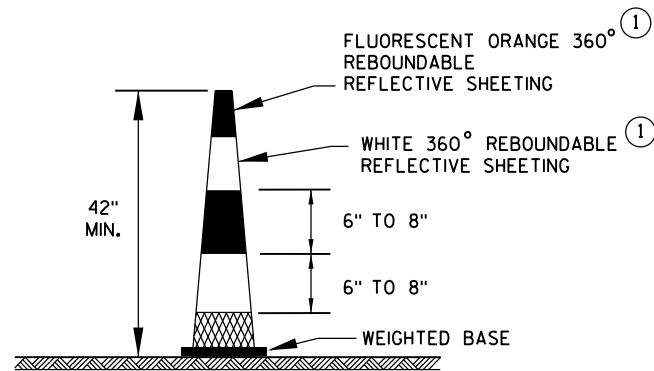


42" CONE

DO NOT USE IN TAPERS
1/2 SPACING OF DRUMS


GENERAL NOTES

- ① REFLECTIVE SHEETING SHALL FOLLOW THE REQUIREMENTS IN THE APPROVED PRODUCTS LISTING FOR SIGN SHEETING.
- ② LOCATION OF WARNING LIGHTS WHEN SHOWN ON THE PLAN.

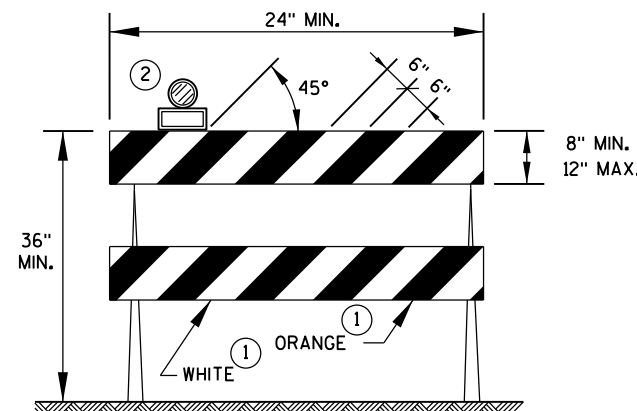


TYPE 2 BARRICADE

FOR RAILS LESS THAN 36" LONG, 4" WIDE STRIPES MAY BE USED.
ALL STRIPES SHALL SLOPE DOWNWARD TO THE TRAFFIC SIDE FOR CHANNELIZATION.

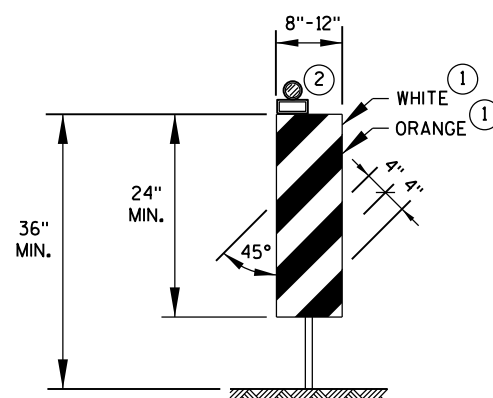

VERTICAL PANEL

THE STRIPES SHALL SLOPE DOWNWARD TO THE TRAFFIC SIDE FOR CHANNELIZATION.

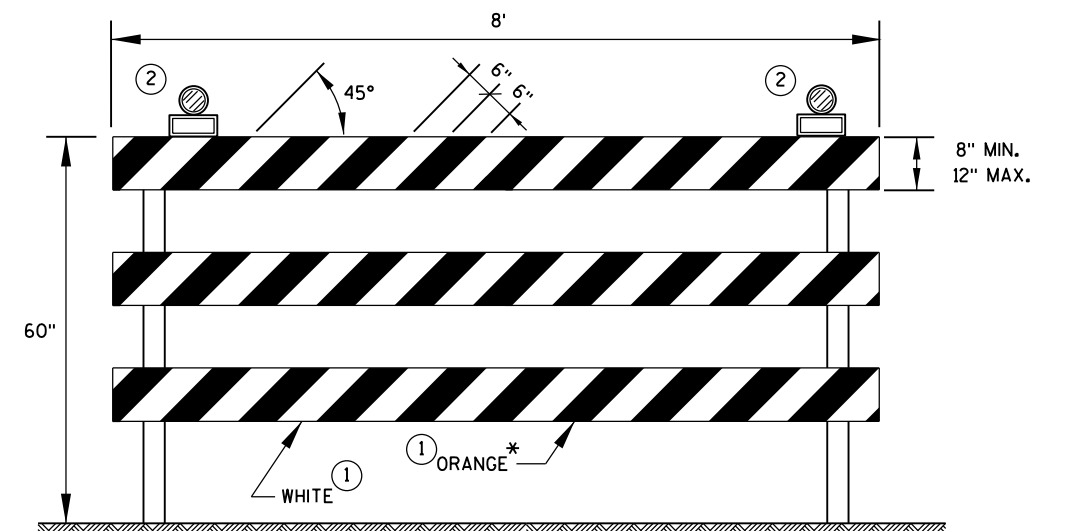

TYPE 3 BARRICADE

IF SIGN MOUNTED, DO NOT COVER MORE THAN 50% OF THE TOP TWO RAILS OR 33% OF THE TOTAL AREA OF THE THREE RAILS.

* IF USED FOR A PERMANENT APPLICATION, USE RED SHEETING.

CHANNELIZING DEVICES
DRUMS, CONES, BARRICADES
AND VERTICAL PANELS


STATE OF WISCONSIN
DEPARTMENT OF TRANSPORTATION

APPROVED

June 2017
DATE

FHWA

/S/ Andrew Heidtke
WORK ZONE ENGINEER

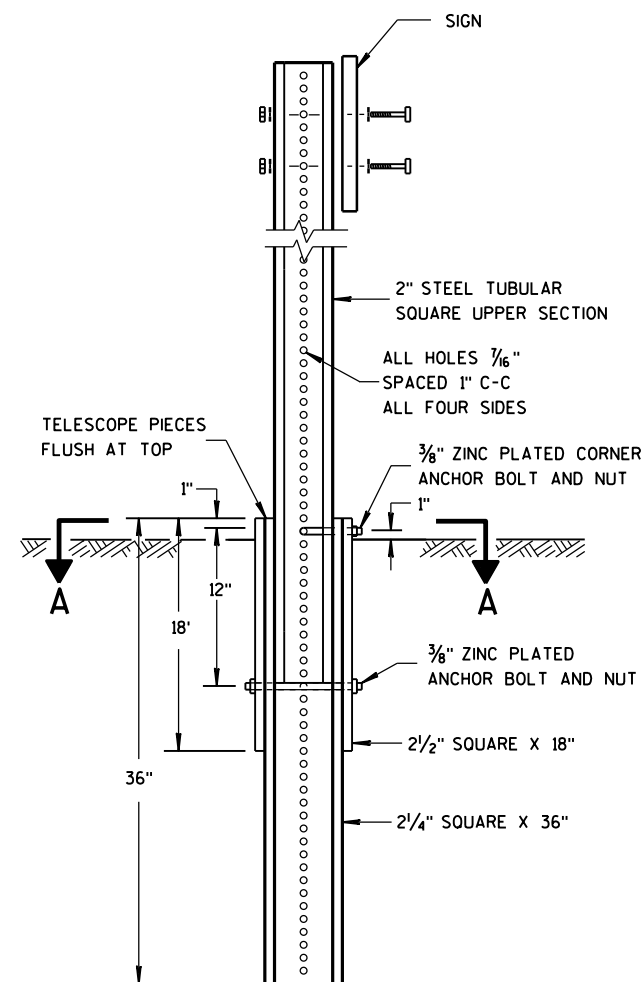


DETAIL OF TUBULAR
STEEL SIGN POST


TUBULAR STEEL POSTS

AREA OF SIGN INSTALLATION (SQ. FT.)	NUMBER OF REQUIRED TUBULAR STEEL POSTS
9 OR LESS	1
GREATER THAN 9 LESS THAN OR EQUAL TO 18	2
GREATER THAN 18 LESS THAN OR EQUAL TO 27	3

SIGNS WIDER THAN 3 FEET OR LARGER THAN 9 SQ. FT. SHALL
BE MOUNTED ON MULTIPLE POSTS (SEE ABOVE TABLE).
SIGNS LARGER THAN 27 SQ. FT. SHALL NOT BE MOUNTED
ON TUBULAR STEEL POSTS.

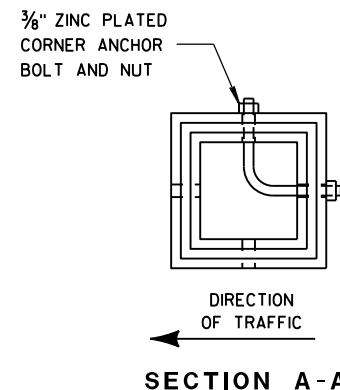


SECTION A-A

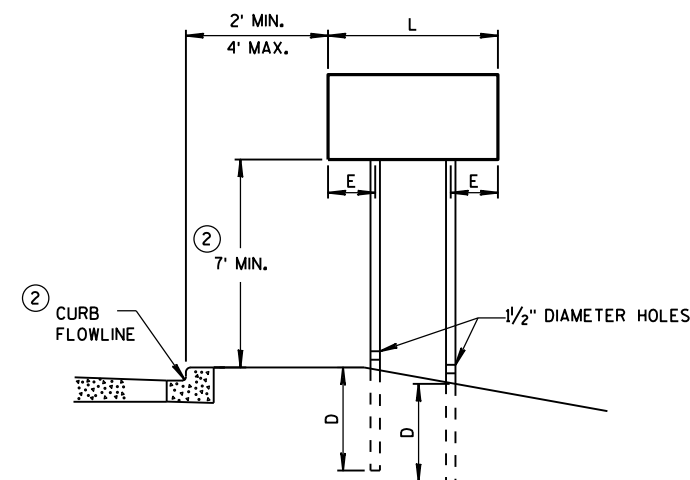


URBAN AREA

POST MOUNTING DETAIL FOR TEMPORARY TRAFFIC CONTROL FIXED MESSAGE SIGNS

WOOD POST EMBEDMENT DEPTH	
AREA OF SIGN INSTALLATION (SQ. FT.)	D (MIN)
20 OR LESS	4'
GREATER THAN 20	5'

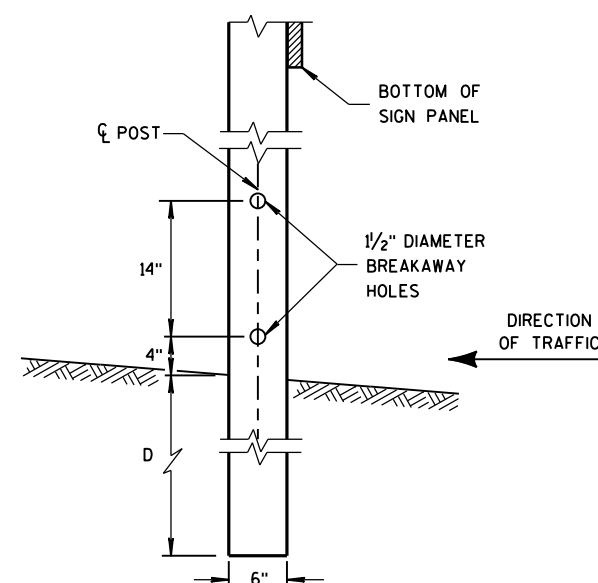

4 "x6 " WOOD POST
MODIFICATION

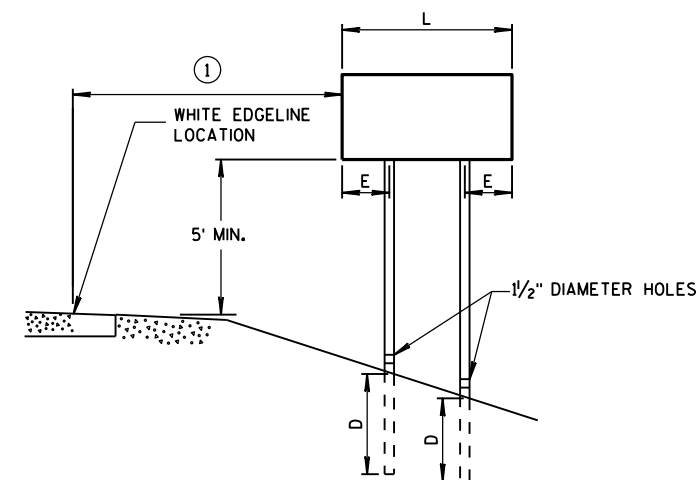

RURAL AREA

POST SPACING REQUIREMENTS		NUMBER OF WOOD POSTS REQUIRED
L	E	
48" OR LESS AND LESS THAN 20 SQ. FT.	-	1
LESS THAN 60"	12"	2
60" TO 120"	L/5	2
GREATER THAN 120" LESS THAN 168"	12"	3
168" AND GREATER	12"	4


SEE NOTE ③

GENERAL NOTES

- ① 6 FEET FROM THE EDGE OF PAVEMENT (EDGE LINE LOCATION) UNLESS OTHERWISE DIRECTED BY THE PROJECT ENGINEER. LATERAL OFFSET SHOULD BE ADJUSTED TO AVOID THE DITCH FLOWLINE.
- ② THE EXISTENCE OF CURB AND GUTTER DOES NOT IN ITSELF MANDATE THE VERTICAL CLEARANCE ILLUSTRATED. THAT HEIGHT IS TYPICALLY MEASURED WHERE THERE IS SIDEWALK ADJACENT TO THE ROADWAY OR PARKING IS PERMITTED. IN THE ABSENCE OF SIDEWALK, VERTICAL CLEARANCE IS MEASURED FROM THE TOP OF THE CURB. IF NO SIDEWALK AND NO PARKING, VERTICAL CLEARANCE MAY BE REDUCED TO 5 FOOT MINIMUM. OFFSET OF SIGNS IS MEASURED FROM THE CURB FLOWLINE.
- ③ FOR SIGNS REQUIRING 4 POSTS, SPACE INTERMEDIATE POSTS EVENLY.

TEMPORARY TRAFFIC CONTROL
SIGN MOUNTING

STATE OF WISCONSIN
DEPARTMENT OF TRANSPORTATION

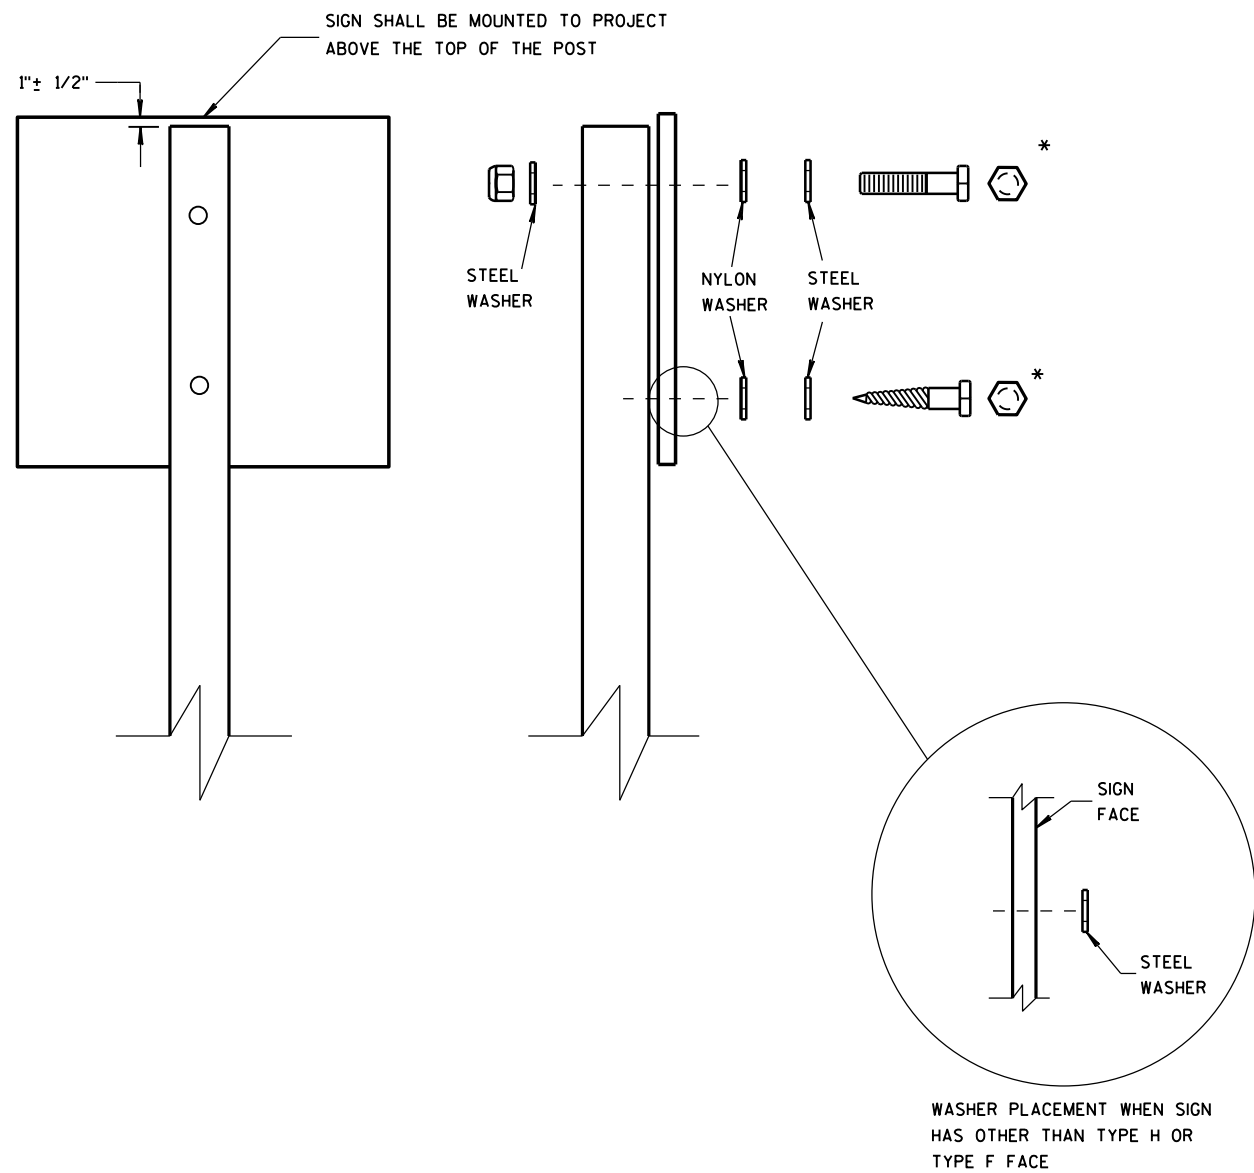

NUTS, BOLTS AND LAGS USED FOR MOUNTING SIGNS SHALL HAVE HEXAGONAL HEADS AND SHALL BE EITHER:

- A. HOT DIP GALVANIZED IN ACCORDANCE WITH ASTM DESIGNATION: A 153, CLASS D, OR SC 3
- B. ELECTRO-GALVANIZED IN ACCORDANCE WITH ASTM DESIGNATION: B 633, TYPE III, SC 3

THREADS ON BOLTS AND NUTS SHALL BE MANUFACTURED WITH SUFFICIENT ALLOWANCE FOR THE CADMIUM PLATE OR GALVANIZED COATING TO PERMIT THE NUTS TO RUN FREELY ON THE BOLTS.

- WOOD POSTS (4" x 4" or 4" x 6")
- LAG SCREWS - 3/8" X 3"
 - MACHINE BOLTS - 5/16" X 6-1/2" OR 7" LENGTH W/ NUTS


- SQUARE STEEL POSTS (2" x 2")
- MACHINE BOLTS - 3/8" X 3-1/4" LENGTH W/ NUTS
 - RIVETS - 9/32" (6605-9-6) BULB-TITE, TRI-FOLD, ALUMINUM BODY/MANDREL O.D. FLANGE .720-.765 INCH, GRIP RANGE .042-.375 INCH

- WASHERS (ALL POSTS) -
- 1-1/4" O.D. X 3/8" I.D. X 1/16" STEEL
 - 1-1/4" O.D. X 3/8" I.D. X .080 NYLON FOR ALL TYPE H SIGNS


* TWO DIFFERENT FASTENING SYSTEMS ARE SHOWN FOR ILLUSTRATION PURPOSES. ON ANY INDIVIDUAL SIGN, EITHER ONE OR THE OTHER SYSTEM SHALL BE USED. ACTUAL NUMBER OF FASTENERS PER SIGN VARIES WITH THE SIGN AREA. FOR A SINGLE POST INSTALLATION, ALL SIGNS GREATER THAN 9 SQ. FT. REQUIRE THE USE OF 3 FASTENERS.

ATTACHMENT OF SIGNS TO POSTS	
STATE OF WISCONSIN DEPARTMENT OF TRANSPORTATION	
APPROVED June 2017 DATE	/S/ Andrew Heldtke WORK ZONE ENGINEER
FHWA	



URBAN AREA

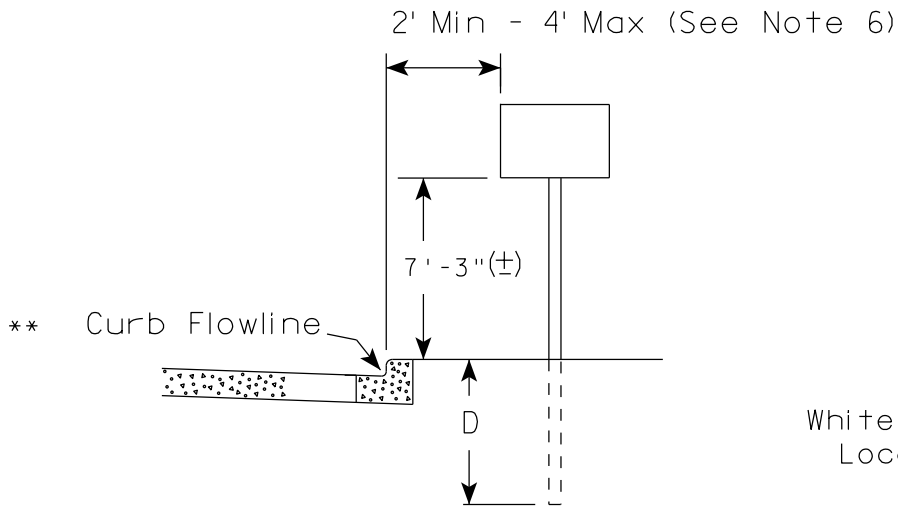

RURAL AREA (See Note 2)

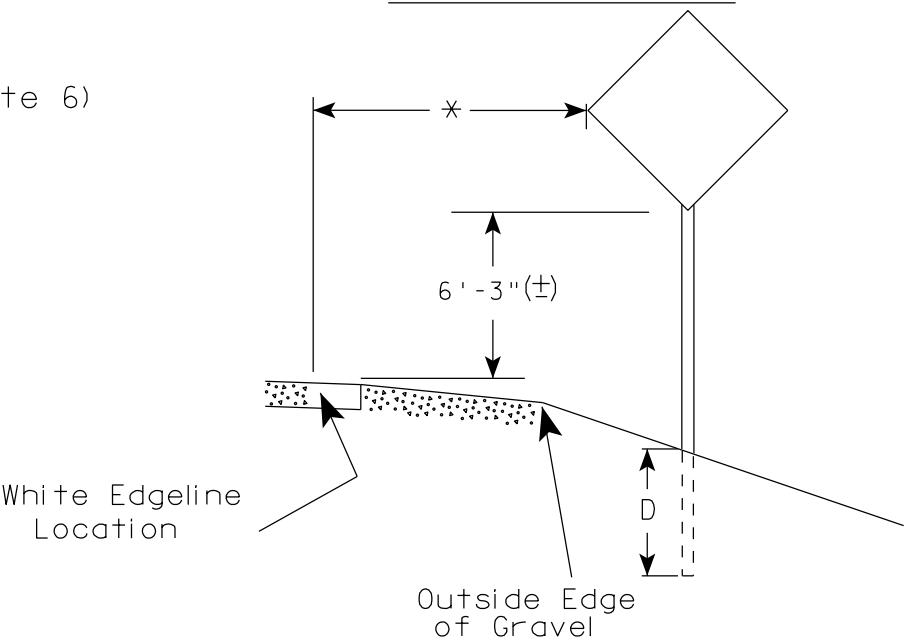

- GENERAL NOTES
1. Signs wider than 4 feet or 20 sq.ft or larger, shall be mounted on multiple posts. Refer to plate A4-4.
 2. If signs are mounted on barrier wall, see A4-10 sign plate.
 3. For expressways and freeways, mounting height is 7'- 3" (±) or 6'-3" (±) depending upon existence of a sub-sign.
 4. Minimum mounting height for J assemblies (A2-1S) is 7'-3" (±) or 6'-3" (±) per urban or rural detail respectively.
 5. Minimum mounting height for signs mounted on traffic signal poles is 5'- 3" (±).
 6. Offset distance shall be consistent with existing signs or consistent throughout length of project.
 7. The (±) tolerance for mounting height is 3 inches.
 8. Folding signs shall be mounted at a height of 5'-3" (±) or as directed by the Engineer.
 9. The Double Arrow sign (W12-1) shall be mounted at a height of 2'-3" (±). The Chevron sign (W1-8), Roundabout Chevron panel (R6-4B), Enhanced Reference Markers, Clearance Markers (W5-52), Mile Markers (D10 series), In Road Object Markers (W5-54) & End of Road Markers (W5-56) shall be mounted at a height of 4'-3" (±).

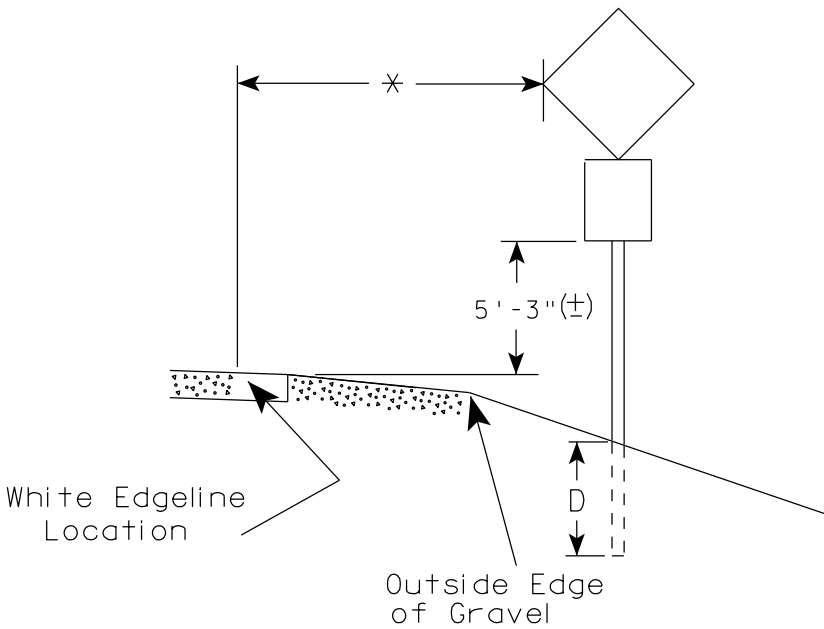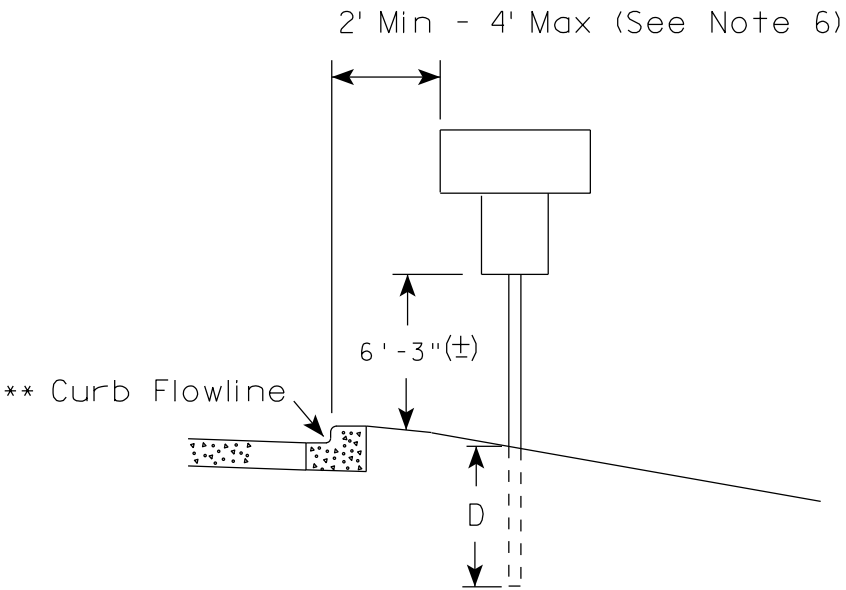

POST EMBEDMENT DEPTH

Area of Sign Installation (Sq.Ft.)	D (Min)
20 or Less	4'
Greater than 20	5'

* * The existence of curb and gutter does not in itself mandate the vertical clearance illustrated. That height is typically measured where there is sidewalk adjacent to the roadway or parking is permitted. In the absence of sidewalk vertical clearance is measured from the top of the curb. Offset of signs is measured from the flow line.


* 6 feet from edge of a paved shoulder or 12 feet from the edge of pavement (edge line location) or 2 feet from outside edge of gravel, whichever is greater unless directed by project engineer.

TYPICAL INSTALLATION
OF PERMANENT TYPE II
SIGNS ON SINGLE POSTS

WISCONSIN DEPT OF TRANSPORTATION

APPROVED
Matthew R. Rauch
for State Traffic Engineer

DATE 7/23/15 PLATE NO. A4-3.20

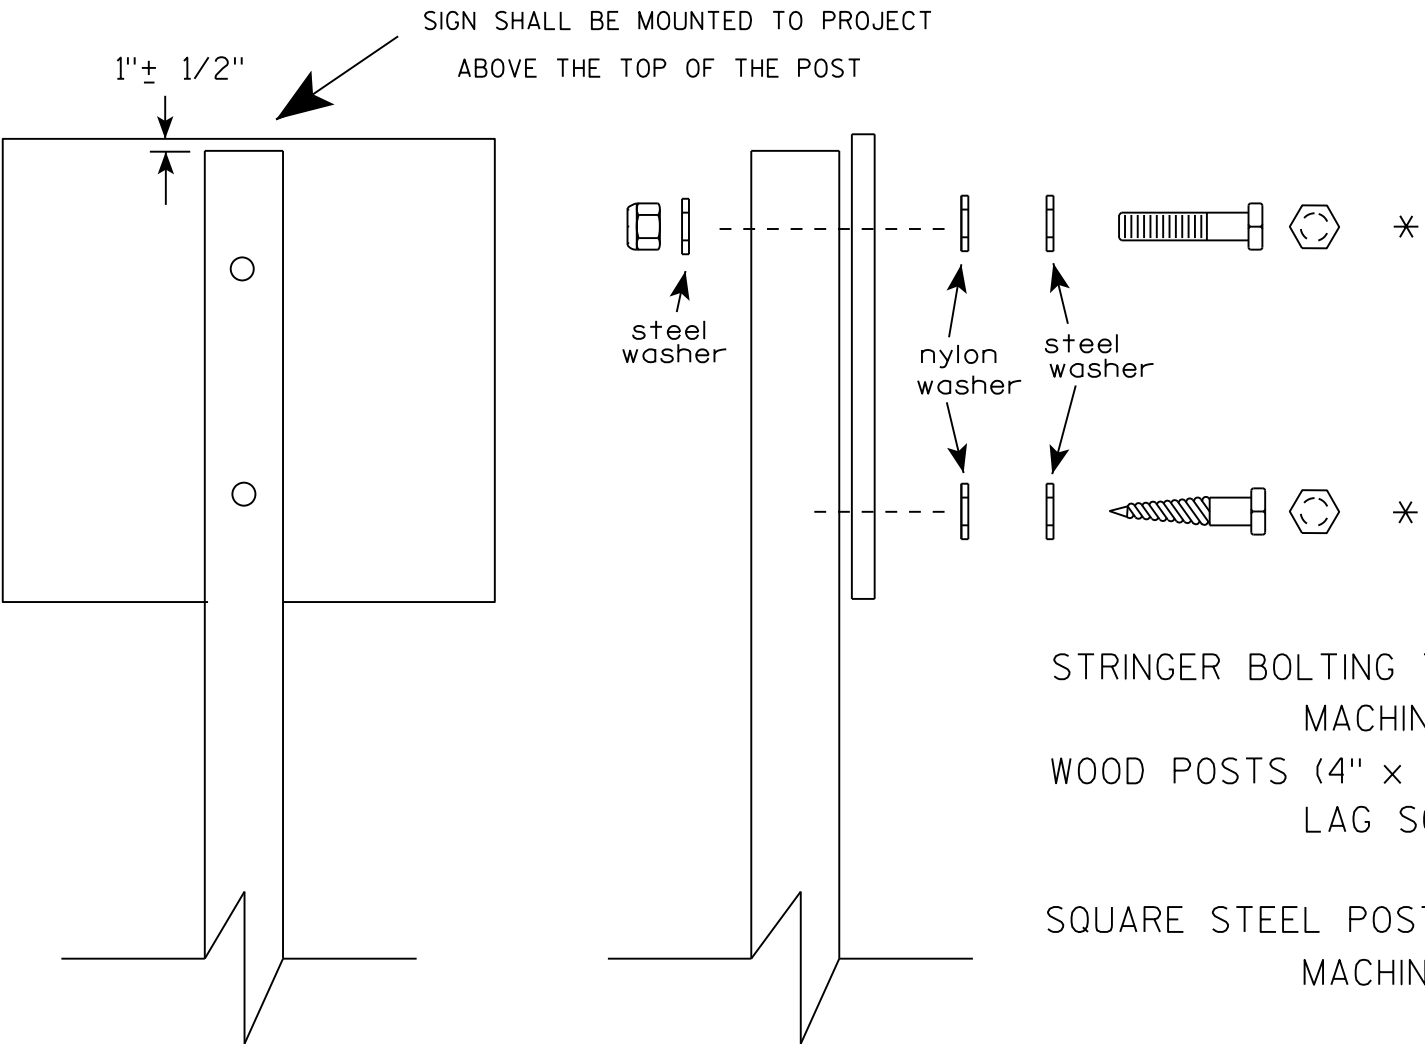

Nuts, bolts and lags used for mounting signs shall have hexagonal heads and shall be either :

- a. Hot dip galvanized in accordance with ASTM Designation: A 153, Class D, or SC 3
- b. Electro-galvanized in accordance with ASTM Designation : B 633, TYPE III, SC 3.


Threads on bolts and nuts shall be manufactured with sufficient allowance for the cadmium plate or galvanized coating to permit the nuts to run freely on the bolts.

- STRINGER BOLTING TO ALUMINUM SIGNS (SEE SIGN PLATE A4-18)
- MACHINE BOLTS - 5/16" X 1-3/4" Length w/ lock nuts
- WOOD POSTS (4" x 4" or 4" x 6")
- LAG SCREWS - 3/8" X 3" (NO STRINGERS ON BACK OF SIGN)
 - 3/8" X 4" (STRINGERS ON BACK OF SIGN)
- SQUARE STEEL POSTS (2" x 2")
- MACHINE BOLTS - 3/8" X 3-1/4" Length w/ nuts (NO STRINGER ON BACK OF SIGN)
 - 3/8" X 5" Length w/ nuts (STRINGERS ON BACK OF SIGN)
- RIVETS - 9/32" (6605-9-6) BULB-TITE, TRI-FOLD, ALUMINUM BODY/MANDREL
- O.D. FLANGE .720-.765 INCH, GRIP RANGE .042-.375 INCH
- WASHERS (ALL POSTS) -
- 1-1/4" O.D. X 3/8" I.D. X 1/16" STEEL
 - 1-1/4" O.D. X 3/8" I.D. X .080 NYLON

* Two different fastening systems are shown for illustration purposes. On any individual sign, either one or the other system shall be used. Actual number of fasteners per sign varies with the sign area, but normally there are two. For a single post installation, all signs greater than 9 sq. ft. require the use of 3 fasteners.

ATTACHMENT OF SIGNS TO POSTS	
WISCONSIN DEPT OF TRANSPORTATION	
APPROVED	<i>Matthew R. Rauch</i> For State Traffic Engineer
DATE 8/11/16	PLATE NO. A4-8.8

7

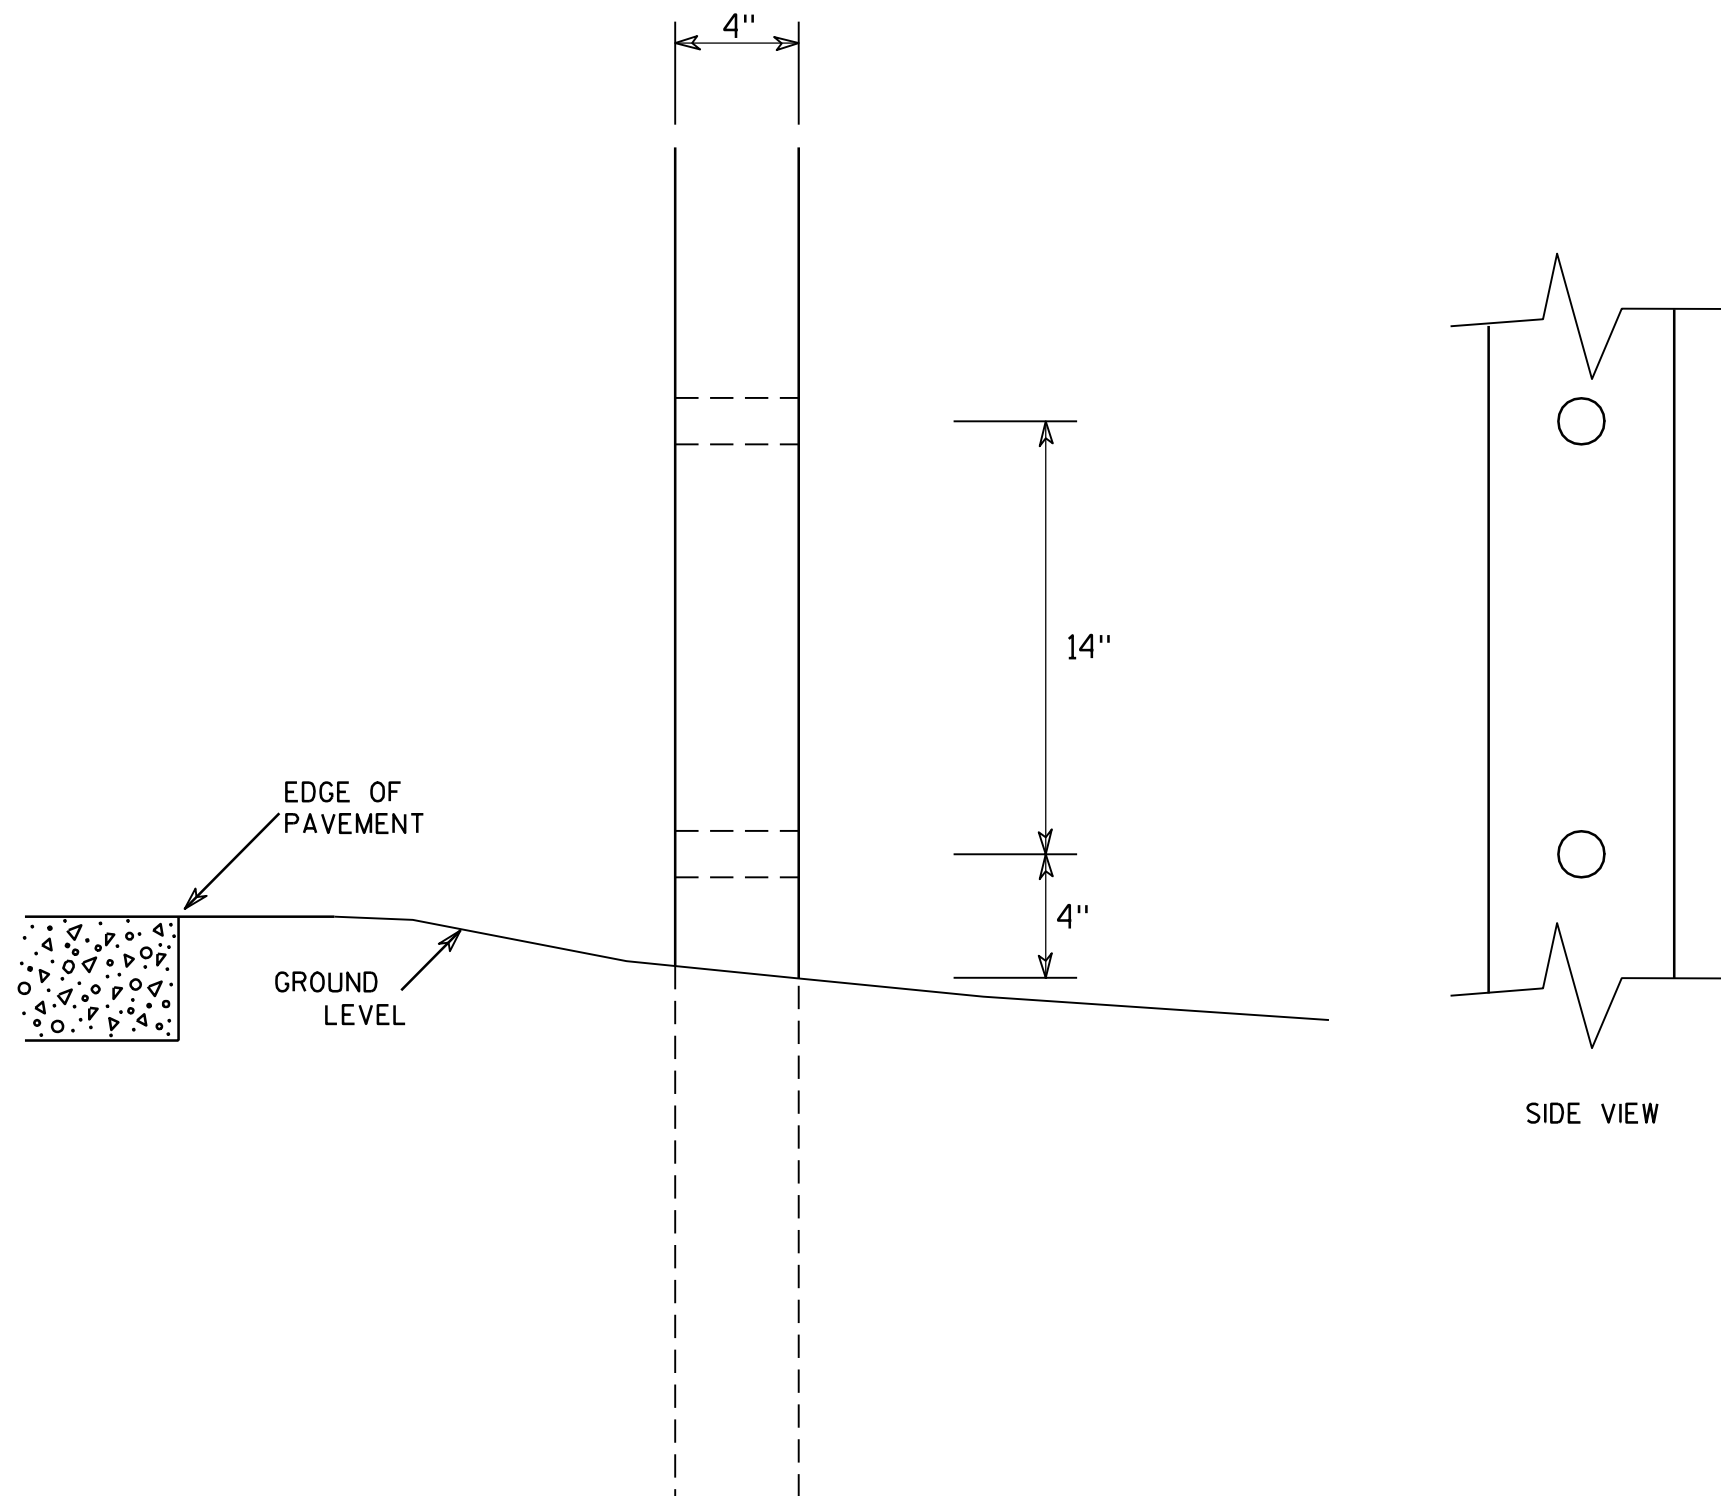GENERAL NOTES

1. All 4 x 6 Wood Posts shall be modified by having two 1½" diameter holes drilled perpendicular to the roadway centerline.

7

**4 X 6 WOOD POST
MODIFICATIONS**

WISCONSIN DEPT OF TRANSPORTATION

APPROVED

Chester J. Spang
for State Traffic Engineer

DATE 3/27/97

PLATE NO. A4-11.2



PROJECT NO:

HWY:

COUNTY:

SHEET NO:

E

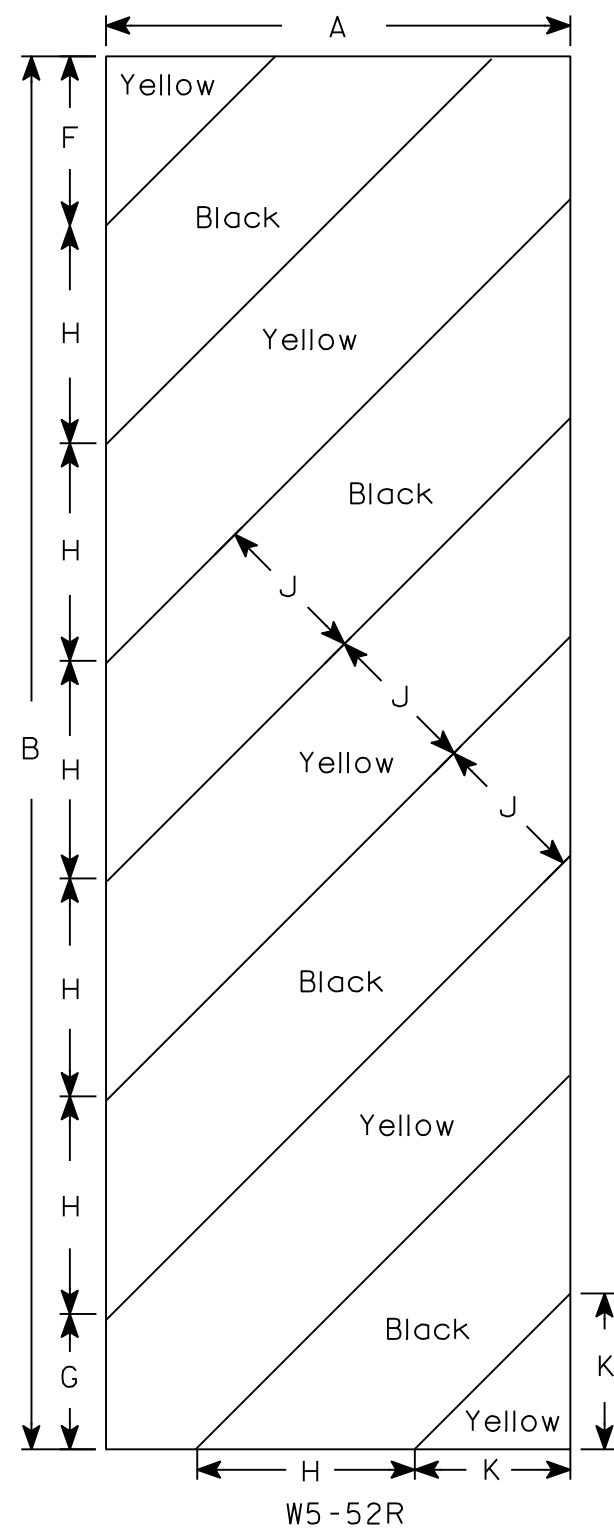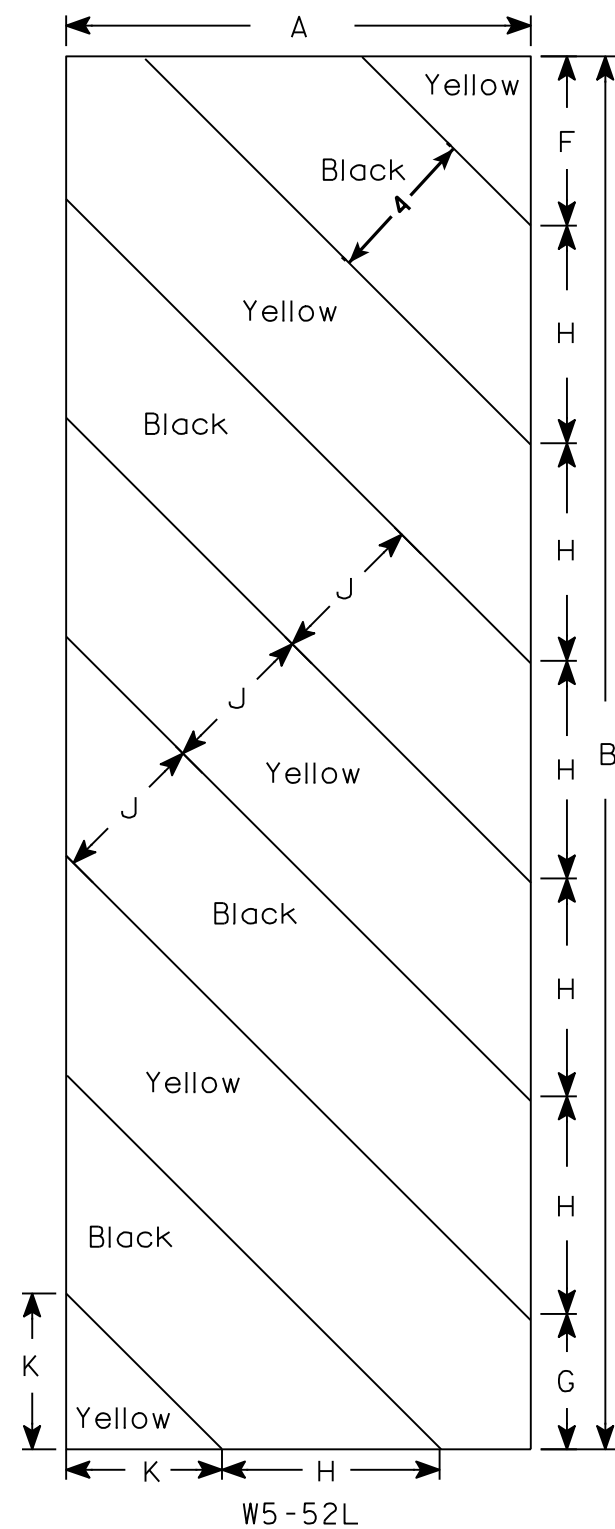

NOTES

- 1. Sign is Type II - Type F Reflective - reference WIS DOT Standard Specification for HIGHWAY and STRUCTURE CONSTRUCTION latest edition.
- 2. Color:
Background - Yellow
Message - Black
- 3. Corners may be square or rounded when base material is plywood but borders shall be rounded as shown. When base material is metal, the corners and borders shall be rounded.
- 4. Alternate colors of stripes as shown.

SIZE	A	B	C	D	E	F	G	H	I	J	K	L	M	N	O	P	Q	R	S	T	U	V	W	X	Y	Z	Area sq. ft.
1																											
2S	12	36				4 3⁄8	3 1⁄2	5 5⁄8	45°	4	4																3.0
2M	12	36				4 3⁄8	3 1⁄2	5 5⁄8	45°	4	4																3.0
3	18	54				6	5 1⁄2	8 1⁄2	45°	6	6 5⁄6																6.75
4																											
5																											

STANDARD SIGN
W5-52L & W5-52R

WISCONSIN DEPT OF TRANSPORTATION

APPROVED *Matthew R. Rauch*
for State Traffic Engineer

DATE 5/29/12 PLATE NO. W5-52.9

PROJECT NO:

HWY:

COUNTY:

SHEET NO:

E

NO.	STA./OFFSET	DESCRIPTION	ELEV.
1	9+81.76, 8.7' RT	CHIS SO ON SE WING WALL	958.73
2	8+44.05, 23.4' LT	PK NAIL IN TOP OF 24" CMP	958.86
3	11+86.61, 25.1' RT	2 POLE NAILS IN 12" ELM	956.38

DESIGN DATA

LIVE LOAD:

DESIGN LOADING : HL-93

INVENTORY RATING FACTOR : 1.12

OPERATIONAL RATING FACTOR : 1.45

WISCONSIN STANDARD PERMIT VEHICLE (WIS-SPV) = 250 KIPS.

STRUCTURE IS DESIGNED FOR A FUTURE WEARING SURFACE OF 20 POUNDS PER SQUARE FOOT.

TRAFFIC DATA:

A.A.D.T. (2019) = 125

A.A.D.T. (2039) = 150

R.D.S. = 35 MPH

MATERIAL PROPERTIES:

CONCRETE MASONRY, SLAB $f'_c = 4,000$ P.S.I.
ALL OTHER $f'_c = 3,500$ P.S.I.HIGH-STRENGTH BAR STEEL REINFORCEMENT, GRADE 60 $f_y = 60,000$ P.S.I.

FOUNDATION DATA:

ABUTMENTS TO BE SUPPORTED ON PILING CIP CONCRETE $10\frac{3}{4} \times 0.365$ -INCH DRIVEN TO A REQUIRED DRIVING RESISTANCE OF 100 TONS * PER PILE AS DETERMINED BY THE MODIFIED GATES DYNAMIC FORMULA. ESTIMATED PILE LENGTHS ARE 20'-0" AT THE SOUTH ABUTMENT BODY AND WINGS, AND 15'-0" AT THE NORTH ABUTMENT BODY AND WINGS.

* THE FACTORED AXIAL RESISTANCE OF PILES IN COMPRESSION USED FOR DESIGN IS THE REQUIRED DRIVING RESISTANCE MULTIPLIED BY A RESISTANCE FACTOR OF 0.5 USING MODIFIED GATES TO DETERMINE DRIVEN PILE CAPACITY.

HYDRAULIC DATA:

100 YEAR FREQUENCY

DRAINAGE AREA	19.7 SQ. MI.
Q ₁₀₀	1,270 C.F.S.
VELOCITY	7.4 FT./SEC.
WATERWAY AREA	172 SQ. FT.
SCOUR CRITICAL CODE	8
HIGH WATER 100 ELEVATION	958.06
O ₂ ELEVATION (380 C.F.S.)	955.30
VELOCITY ₂	2.9 FT./SEC.

ROADWAY OVERFLOW DESIGN FREQUENCY

OVERTOPPING FREQUENCY > 100 YEARS


CONSULTANT DESIGN CONTACT:
JOLIE SNYDER
(608) 355-8912BRIDGE OFFICE CONTACT:
WILLIAM DREHER
(608) 266-8489

LIST OF DRAWINGS

1. GENERAL PLAN
2. CROSS SECTION, QUANTITIES & NOTES
3. SUBSURFACE EXPLORATION
4. SOUTH ABUTMENT
5. SOUTH ABUTMENT DETAILS
6. NORTH ABUTMENT
7. NORTH ABUTMENT DETAILS
8. SUPERSTRUCTURE
9. RAILING TUBULAR TYPE M




NO.	DATE	REVISION	BY
MSA TRANSPORTATION • MUNICIPAL DEVELOPMENT • ENVIRONMENTAL 1230 South Boulevard Danbury, VT 05813 608-356-2771 1-800-382-4505 Fax: 608-356-2770			
STATE OF WISCONSIN DEPARTMENT OF TRANSPORTATION ACCEPTED <i>William C. Dreher</i> 08/03/18 CHIEF STRUCTURES DESIGN ENGINEER DATE			
STRUCTURE B-41-312			
DOLPHIN ROAD OVER MILL CREEK			
COUNTY	MONROE	TOWN/CITY/VILLAGE	LA GRANGE
DESIGN SPEC.	AASHTO LRFD BRIDGE DESIGN SPECIFICATIONS		
DESIGNED BY	JAS	CHK'D.	DHW
DRAWN BY	RLR	PLANS	CHK'D. JAS
GENERAL PLAN			SHEET 1 OF 9

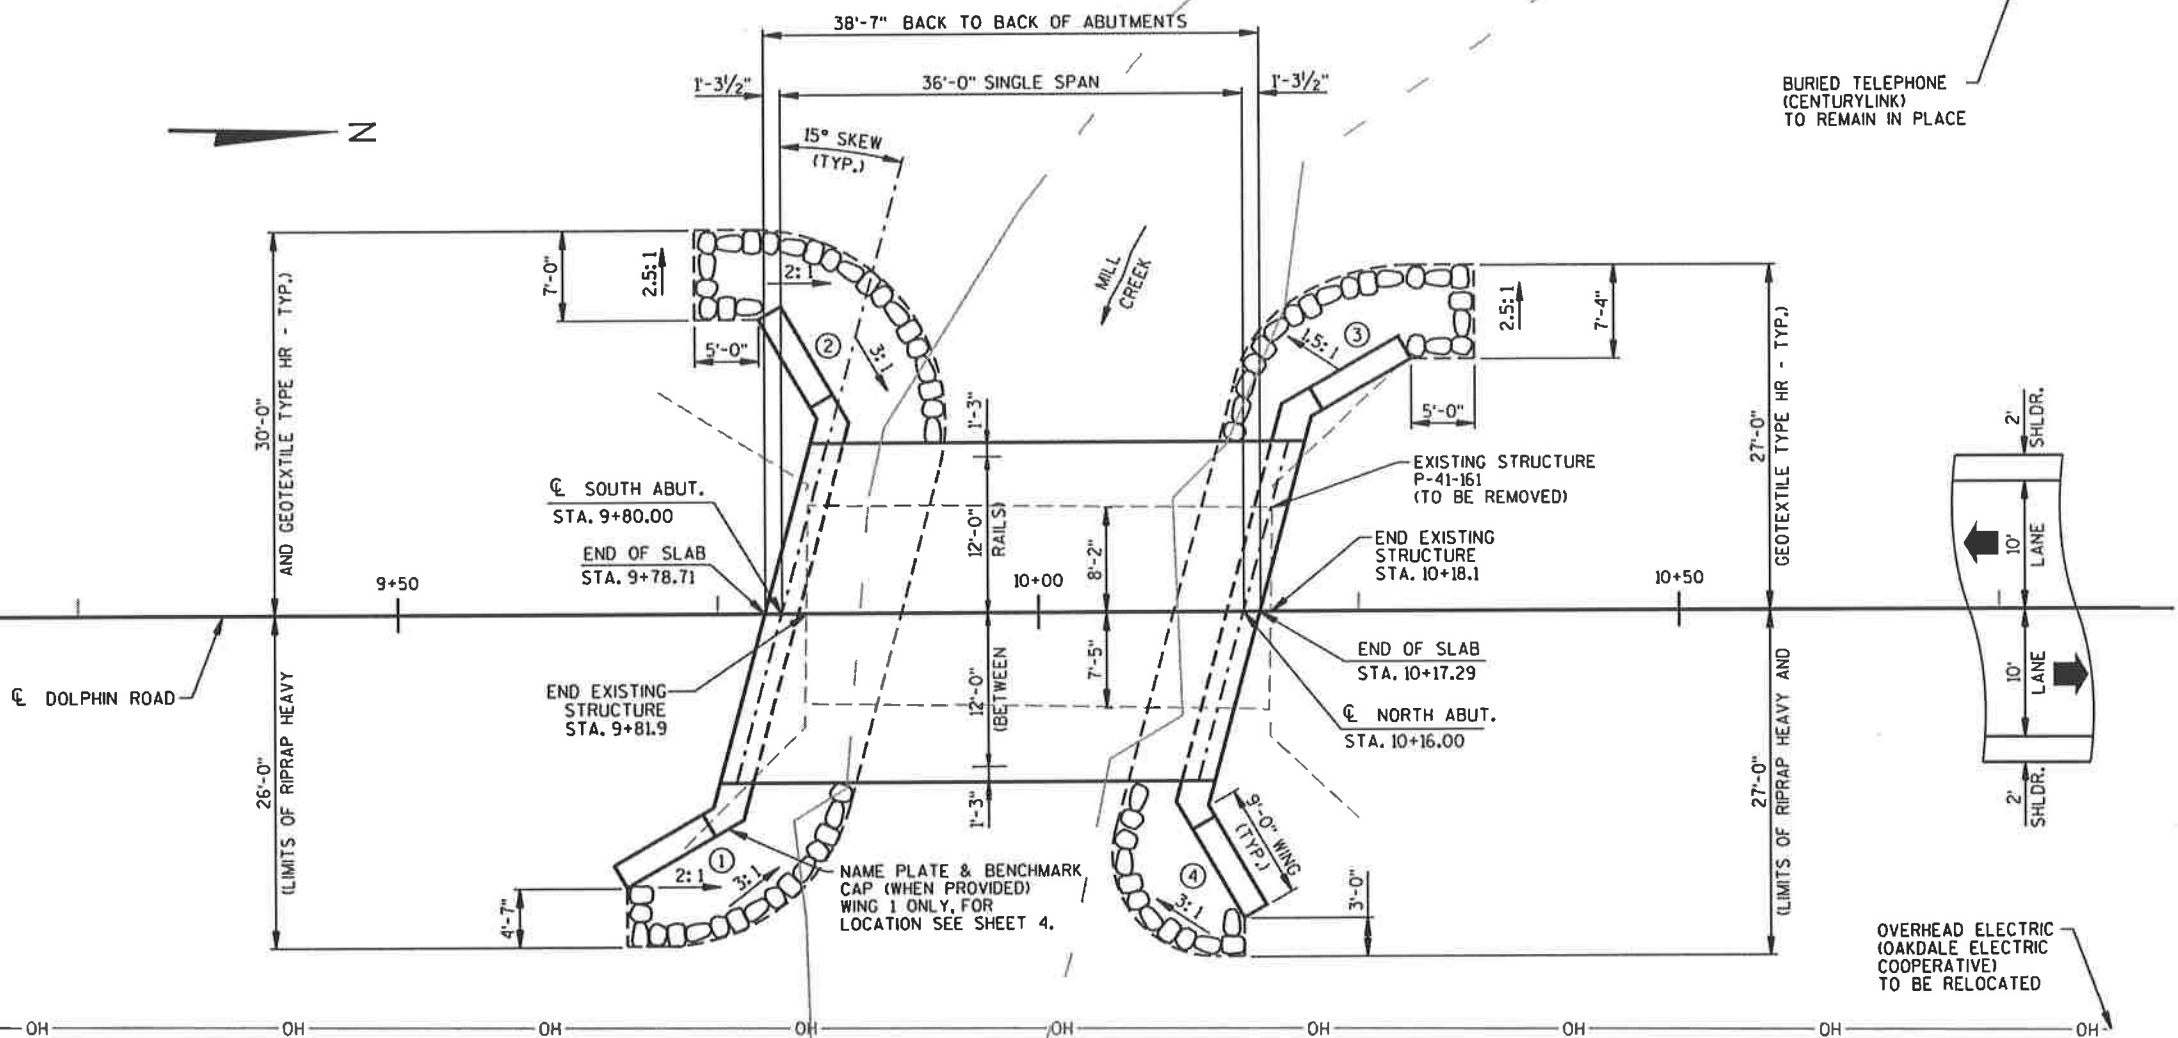

PLAN

(SINGLE SPAN FLAT CONCRETE SLAB)

○ - INDICATES WING NUMBER

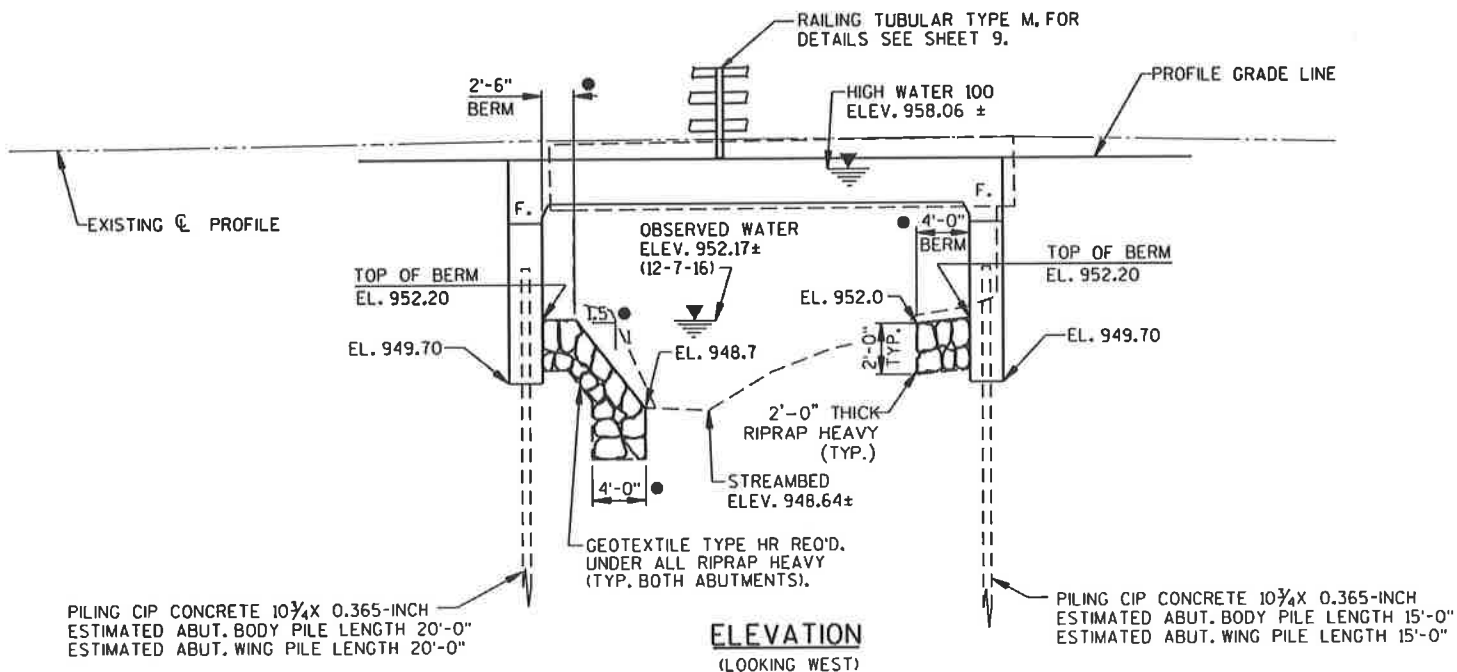● - NORMAL TO $\mathcal{C}$ OF SUBSTRUCTURE

ELEVATION

(LOOKING WEST)

DRAWINGS SHALL NOT BE SCALED.

BAR STEEL REINFORCEMENT SHALL BE EMBEDDED 2" CLEAR UNLESS SHOWN OR NOTED OTHERWISE.

THE FIRST DIGIT OF A THREE DIGIT BAR MARK AND THE FIRST TWO DIGITS OF A FOUR DIGIT BAR MARK SIGNIFY THE BAR SIZE.

THE SLOPE OF THE FILL IN FRONT OF THE ABUTMENTS SHALL BE COVERED WITH RIPRAP HEAVY AND GEOTEXTILE TYPE HR TO THE LIMITS SHOWN ON SHEET 1 AND ON THE ABUTMENT SHEETS OR AS DIRECTED BY THE ENGINEER.

THE EXISTING GROUNDLINE SHALL BE THE UPPER LIMITS OF "EXCAVATION FOR STRUCTURES" FOR THE ABUTMENTS.

SLAB FALSEWORK SHALL BE SUPPORTED ON PILES OR THE SUBSTRUCTURE, UNLESS AN ALTERNATE METHOD IS APPROVED BY THE ENGINEER.

THIS STRUCTURE WILL REPLACE THE EXISTING STRUCTURE, P-41-161, A 36.2 FT. LONG, SINGLE SPAN STEEL DECK GIRDER ON FULL RETAINING CONCRETE ABUTMENTS WITH 15.6 FT. CLEAR ROADWAY WIDTH.

EXCAVATION BELOW THE ABUTMENT AND ABUTMENT BEDDING MATERIALS REQUIRES ENGINEER APPROVAL. GEOTEXTILE SHALL BE SET AT THE BOTTOM OF EXCAVATION AND EXTEND 2'-0" ABOVE BOTTOM OF ABUTMENT.


③-B-BACKFILL PAY LIMITS, BACKFILL BEYOND BACKFILL PAY LIMITS SHALL BE INCIDENTAL TO EXCAVATION FOR STRUCTURES. LIMITS OF EXCAVATION SHALL BE DETERMINED BY THE CONTRACTOR.

THE BACKFILL QUANTITIES ARE BASED ON THE PAY LIMITS SHOWN ON THE PLANS AND MAY NOT REFLECT ACTUAL PLACED QUANTITIES. "BACKFILL STRUCTURE TYPE A" REQUIRED DIRECTLY BEHIND ABUTMENTS AND ABUTMENT WINGS FOR 3 FEET. BACKFILL PLACED BEYOND PAY LIMITS OR EXCEEDING PLAN QUANTITIES SHALL BE INCIDENTAL TO EXCAVATION FOR STRUCTURES.

DO NOT PLACE FILL ABOVE 3'-0" FROM THE BOTTOM OF THE ABUTMENT UNTIL THE SUPERSTRUCTURE IS IN PLACE.

PROTECTIVE SURFACE TREATMENT SHALL BE APPLIED TO THE TOP AND EDGES OF SLAB, TO THE OUTSIDE 1'-0" OF THE UNDERSIDE OF SLAB, TO THE TOPS OF WINGS, TO THE EXPOSED FRONT FACES OF WINGS, AND TO THE EXPOSED ABUTMENT FACES EXTENDING TO 1'-0" IN FROM THE EDGE OF SLAB.

ELEVATIONS SHOWN ON THIS PLAN ARE REFERENCED TO USGS NAVD 88 (2012 ADJUSTED). BENCHMARK REFERENCES AT THE PROJECT SITE WERE SET BY THE CONSULTANT USING GPS TECHNOLOGY.

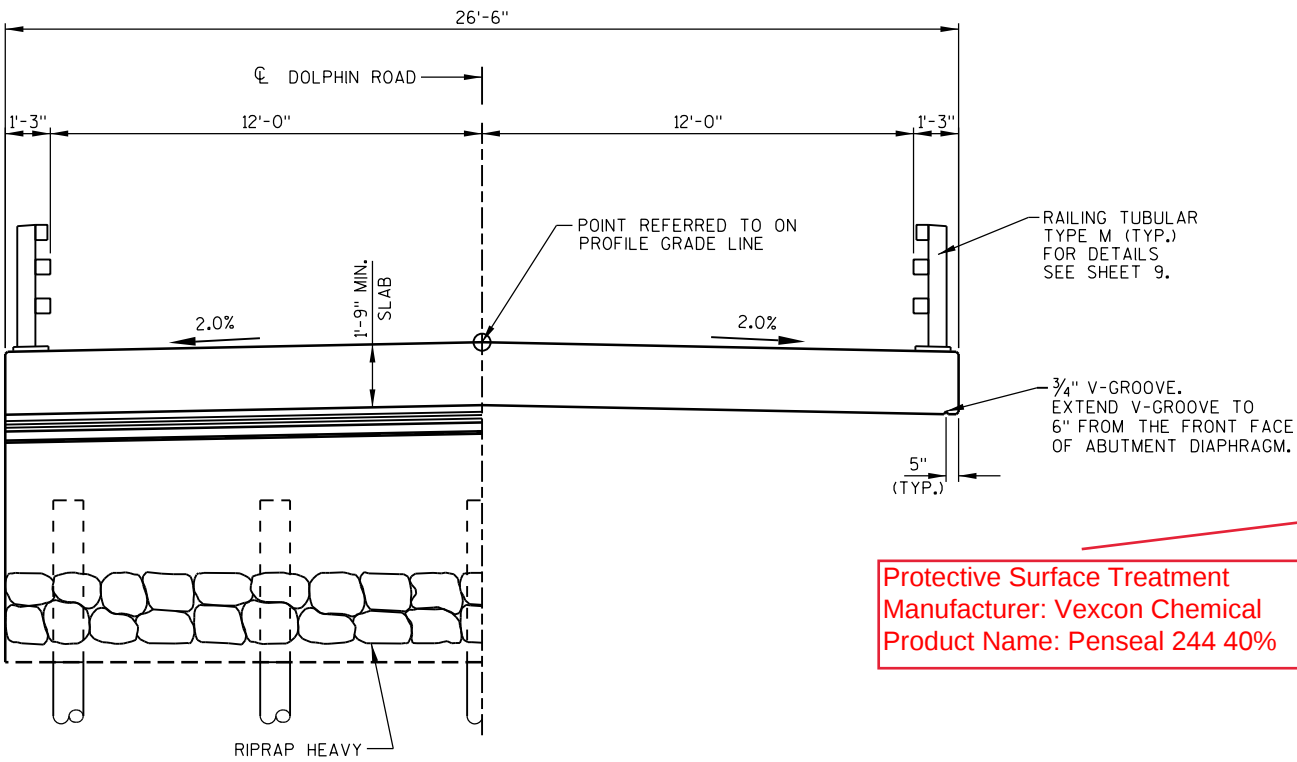


Protective Surface Treatment
Manufacturer: Vexcon Chemical
Product Name: Penseal 244 40%

AT ABUTMENTS IN SPAN
CROSS SECTION THRU BRIDGE
(LOOKING NORTH)

A 3D perspective view of a rectangular prism. The dimensions are labeled as follows: L (length), W_1 (width), W_2 (width), H (height), 1 (height), 1.5 (width), and $3'$ (width).

L = OUT-TO-OUT OF ABUTMENT
H = AVERAGE ABUTMENT FILL HEIGHT
W1 = WING 1 LENGTH
W2 = WING 2 LENGTH
 $V_{CF} = (L)(3.0')(H) + (L)(0.5)(1.5H)(H) + (0.5)(H)(W1+W2)(3.0')$
 $V_{TON} = V_{CF} (2.0)/27$

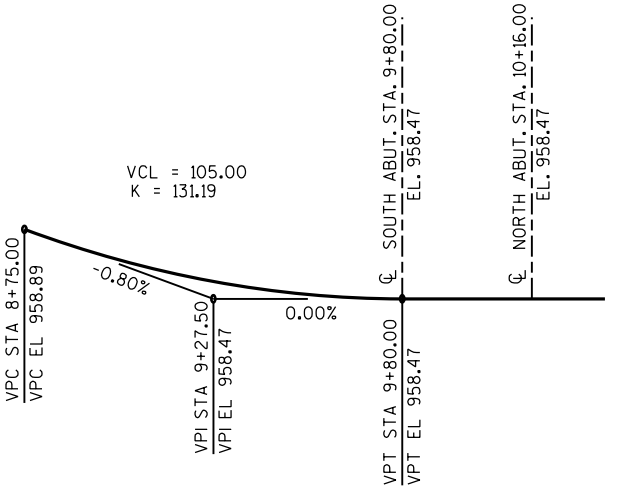

PROFILE GRADE LINE - DOLPHIN ROAD

● — NORMAL TO $\mathbb{C}$ OF SUBSTRUCTURE

ITEM NUMBER	BID ITEM	UNIT	SOUTH ABUT.	NORTH ABUT.	SUPER	TOTAL
203.0600.S.01	REMOVING OLD STRUCTURE OVER WATERWAY WITH MINIMAL DEBRIS STATION 10+00	LS	-	-	-	1
206.1000.01	EXCAVATION FOR STRUCTURES BRIDGES B-41-312	LS	-	-	-	1
210.1500	BACKFILL STRUCTURE TYPE A	TON	135	135	-	270
502.0100	CONCRETE MASONRY BRIDGES	CY	30	30	70	130
502.3200	PROTECTIVE SURFACE TREATMENT	SY	18	18	135	171
505.0400	BAR STEEL REINFORCEMENT HS STRUCTURES	LB	2885	2885	-	5770
505.0600	BAR STEEL REINFORCEMENT HS COATED STRUCTURES	LB	1505	1505	11740	14750
513.4061.01	RAILING TUBULAR TYPE M B-41-312	LF	-	-	81	81
516.0500	RUBBERIZED MEMBRANE WATERPROOFING	SY	6	6	-	12
550.2106	PILING CIP CONCRETE 10 3/4 X 0.365-INCH	LF	140	105	-	245
606.0300	RIPRAP HEAVY	CY	50	30	-	80
612.0406	PIPE UNDERDRAIN WRAPPED 6-INCH	LF	80	80	-	160
645.0111	GEOTEXTILE TYPE DF SCHEDULE A	SY	30	30	-	60
645.0120	GEOTEXTILE TYPE HR	SY	90	60	-	150
	NON-BID ITEMS					
	PREFORMED FILLER	SIZE				½" & ¾"

NO.	DATE	REVISION	BY
STATE OF WISCONSIN DEPARTMENT OF TRANSPORTATION			
STRUCTURE		B-41-312	
		DRAWN BY RLR	PLANS CK'D. JAS
CROSS SECTION, QUANTITIES & NOTES		SHEET 2 OF 9	



BORING #	DATE COMPLETED	NORTHING (Y)	EASTING (X)
1	6-12-2017	418,739.0	710,857.8
2	6-12-2017	418,795.2	710,864.8
BORINGS COMPLETED BY: CHOSEN VALLEY TESTING, INC.			
REPORT COMPLETED BY: CHOSEN VALLEY TESTING, INC.			
ALL COORDINATES REFERENCED TO WCCS NAD 83(2011) MONROE COUNTY			


STATE PROJECT NUMBER

7102-00-70

MATERIAL SYMBOLS

	ASPHALT		TOPSOIL		PEAT
	CONCRETE		FILL		GRAVEL
	SAND		CLAY		SILT
	BOULDERS OR COBBLES		LIMESTONE		BEDROCK (UNKNOWN)
	SHALE		SANDSTONE		IGNEOUS/META

LEGEND OF BORING

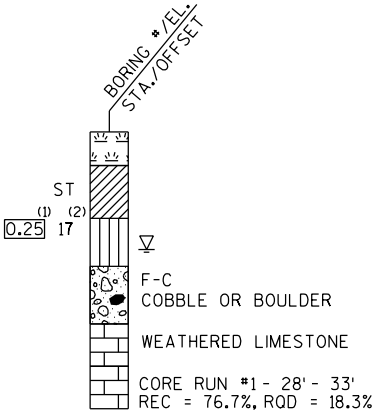

(1) UNCONFINED STRENGTH, AS DETERMINED BY A POCKET PENETROMETER (TSF)

(2) UNLESS OTHERWISE, SPECIFIED THE SPT 'N' VALUE IS BASED ON AASHTO T-206, STANDARD PENETRATION TEST. THE SPT 'N' VALUE PRESENTED HAS NOT BEEN CORRECTED FOR OVERBURDEN PRESSURE OR HAMMER EFFICIENCY.

GROUND WATER ELEVATION

- ▽ AT TIME OF DRILLING
- ▽ END OF DRILLING
- ▽ AFTER DRILLING

ABBREVIATIONS


F-FINE M-MEDIUM C-COARSE ST-SHELBY TUBE


SUBSURFACE EXPLORATION FOR FOUNDATION DESIGN AND BIDDERS INFORMATION

BORINGS WERE COMPLETED AT POINTS APPROXIMATELY AS INDICATED ON THIS DRAWING TO OBTAIN INFORMATION CONCERNING THE CHARACTER OF SUBSURFACE MATERIALS FOUND AT THE SITE. BECAUSE THE INVESTIGATED DEPTHS ARE LIMITED AND THE AREA OF THE BORINGS IS VERY SMALL IN RELATION TO THE ENTIRE SITE, THE WISCONSIN DEPARTMENT OF TRANSPORTATION DOES NOT WARRANT SIMILAR SUBSURFACE CONDITIONS BELOW, BETWEEN, OR BEYOND THESE BORINGS. VARIATIONS IN SOIL CONDITIONS SHOULD BE EXPECTED AND FLUCTUATIONS IN GROUNDWATER LEVELS MAY OCCUR.


NO.	DATE	REVISION	BY
STATE OF WISCONSIN DEPARTMENT OF TRANSPORTATION			
STRUCTURE		B-41-312	
DRAWN BY		RLR	PLANS CK'D. JAS
SUBSURFACE EXPLORATION		SHEET 3 OF 9	

THE SPT "N" VALUE IS GIVEN FOR BLOWS/FT. WHERE DOUBLE VALUES ARE GIVEN, THEY INDICATE BLOWS FOR FIRST 6 INCHES AND THEN ADVANCEMENT AFTER 50 BLOWS.

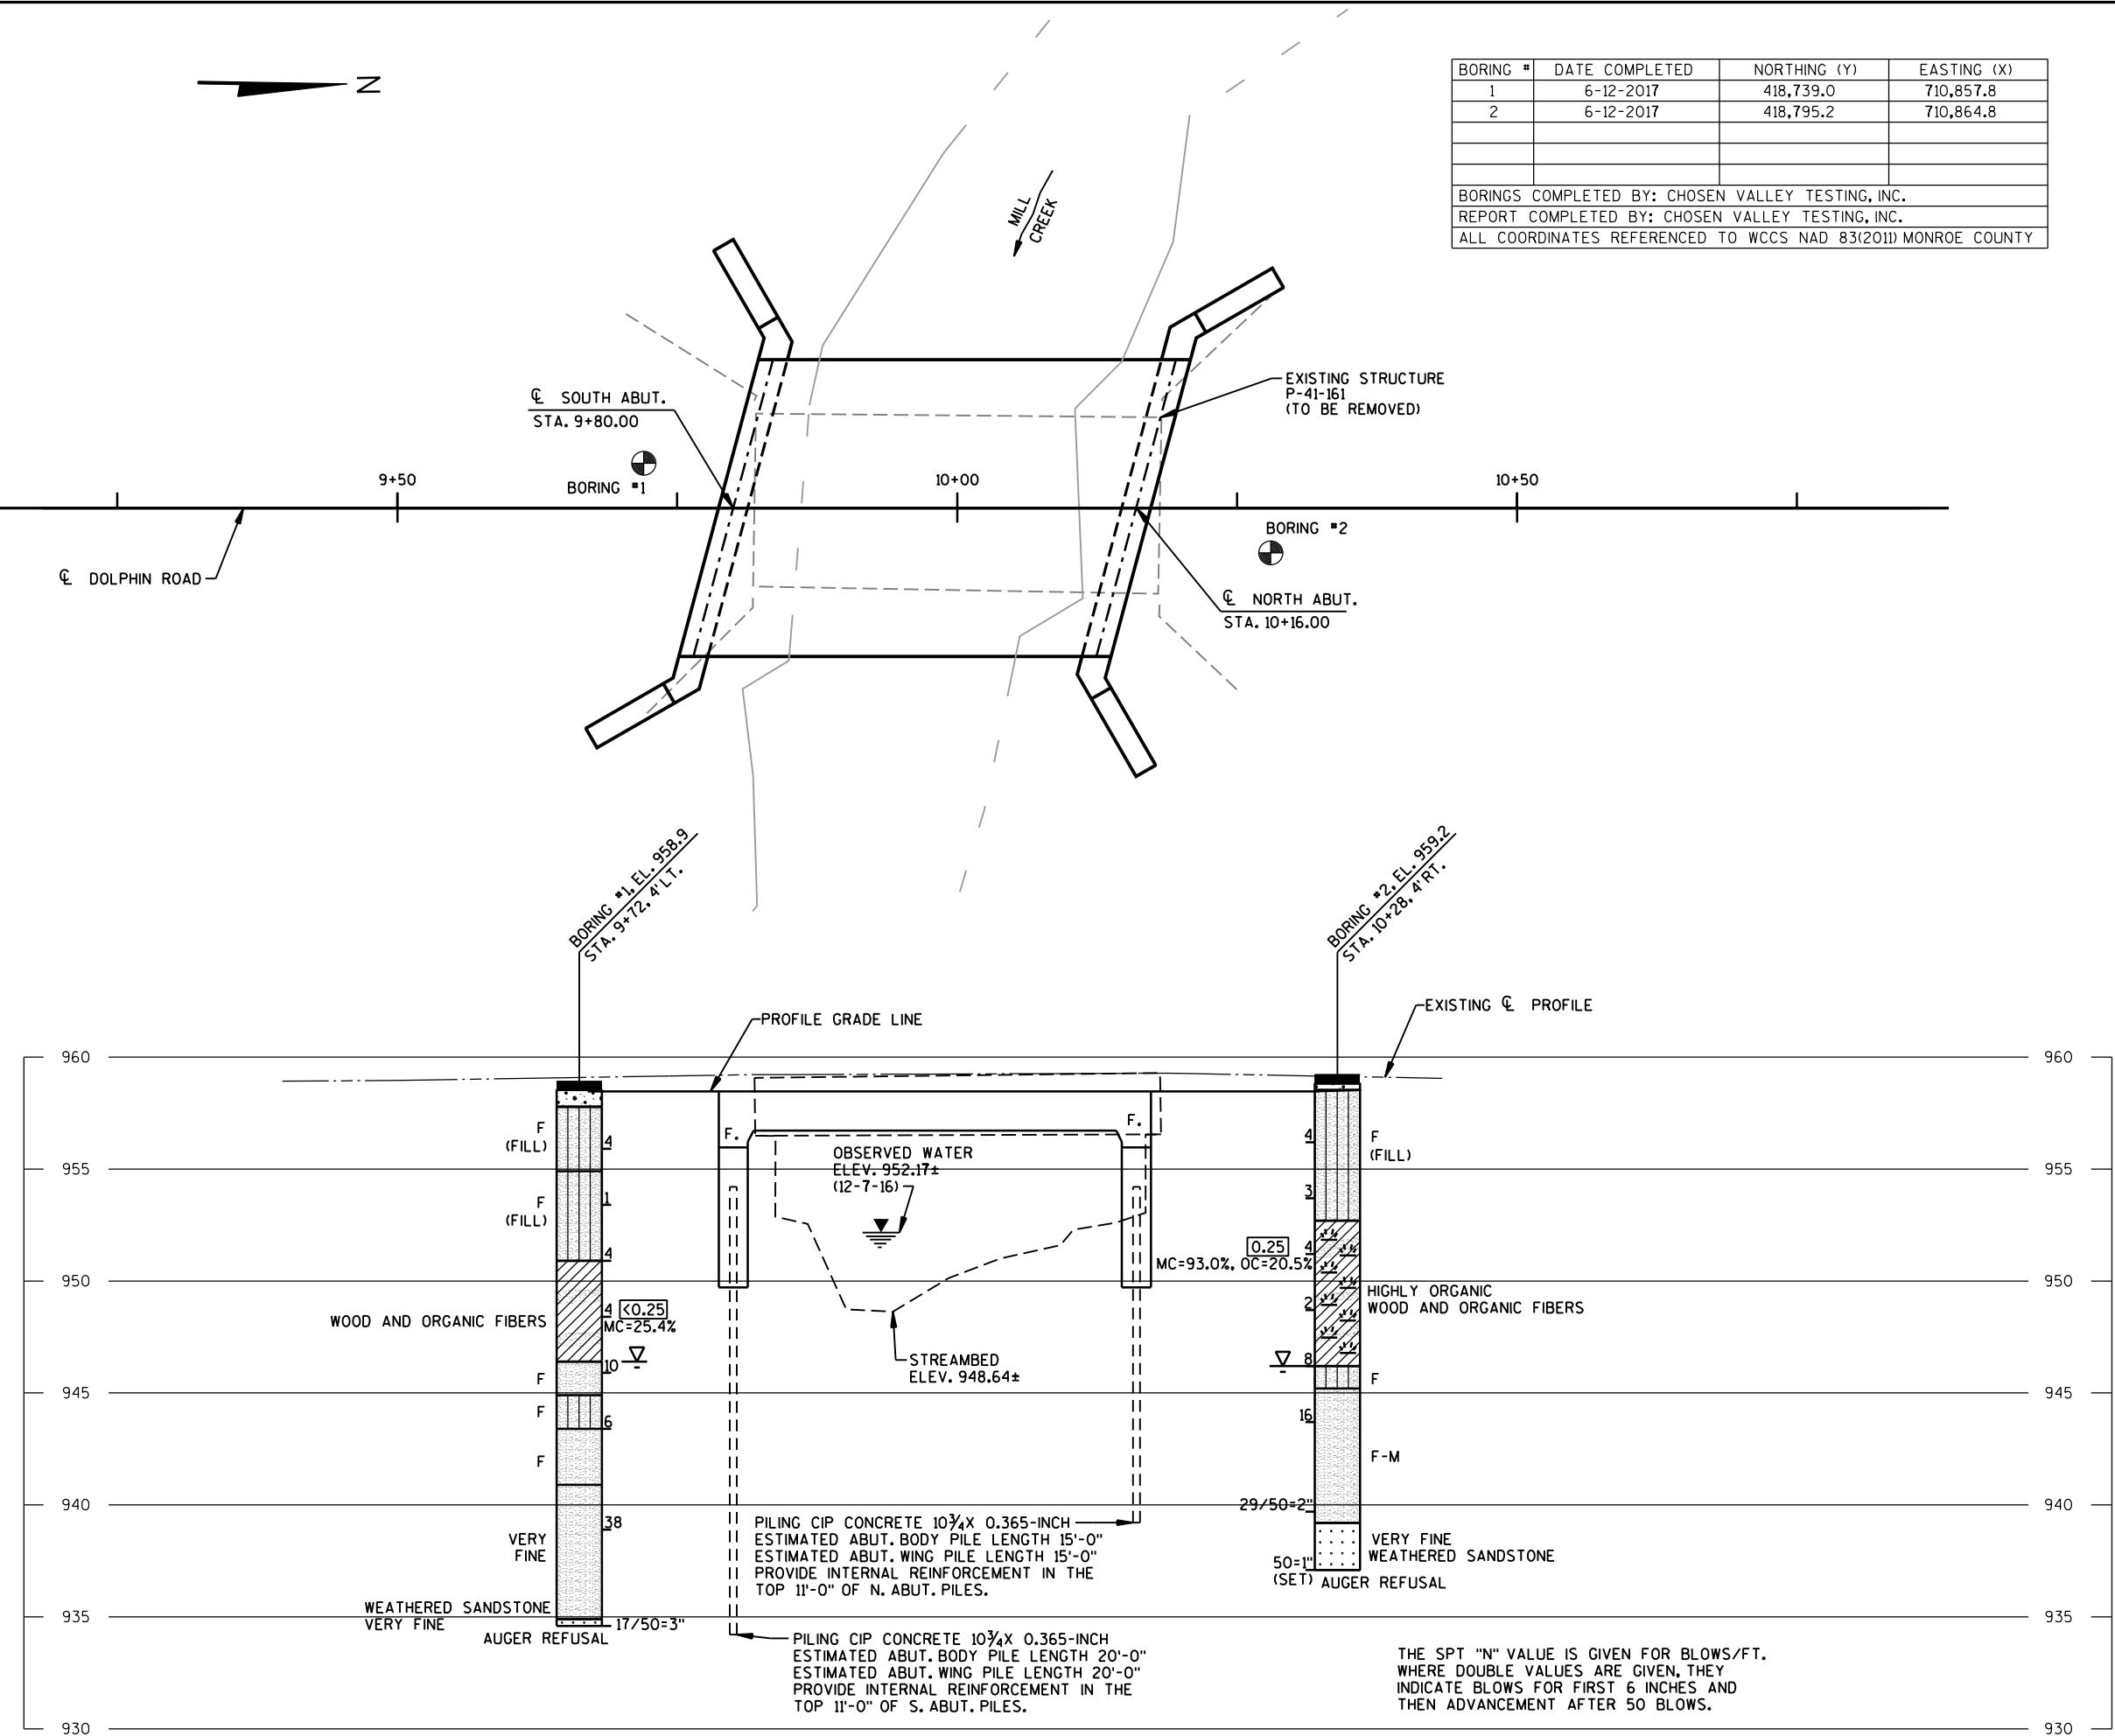


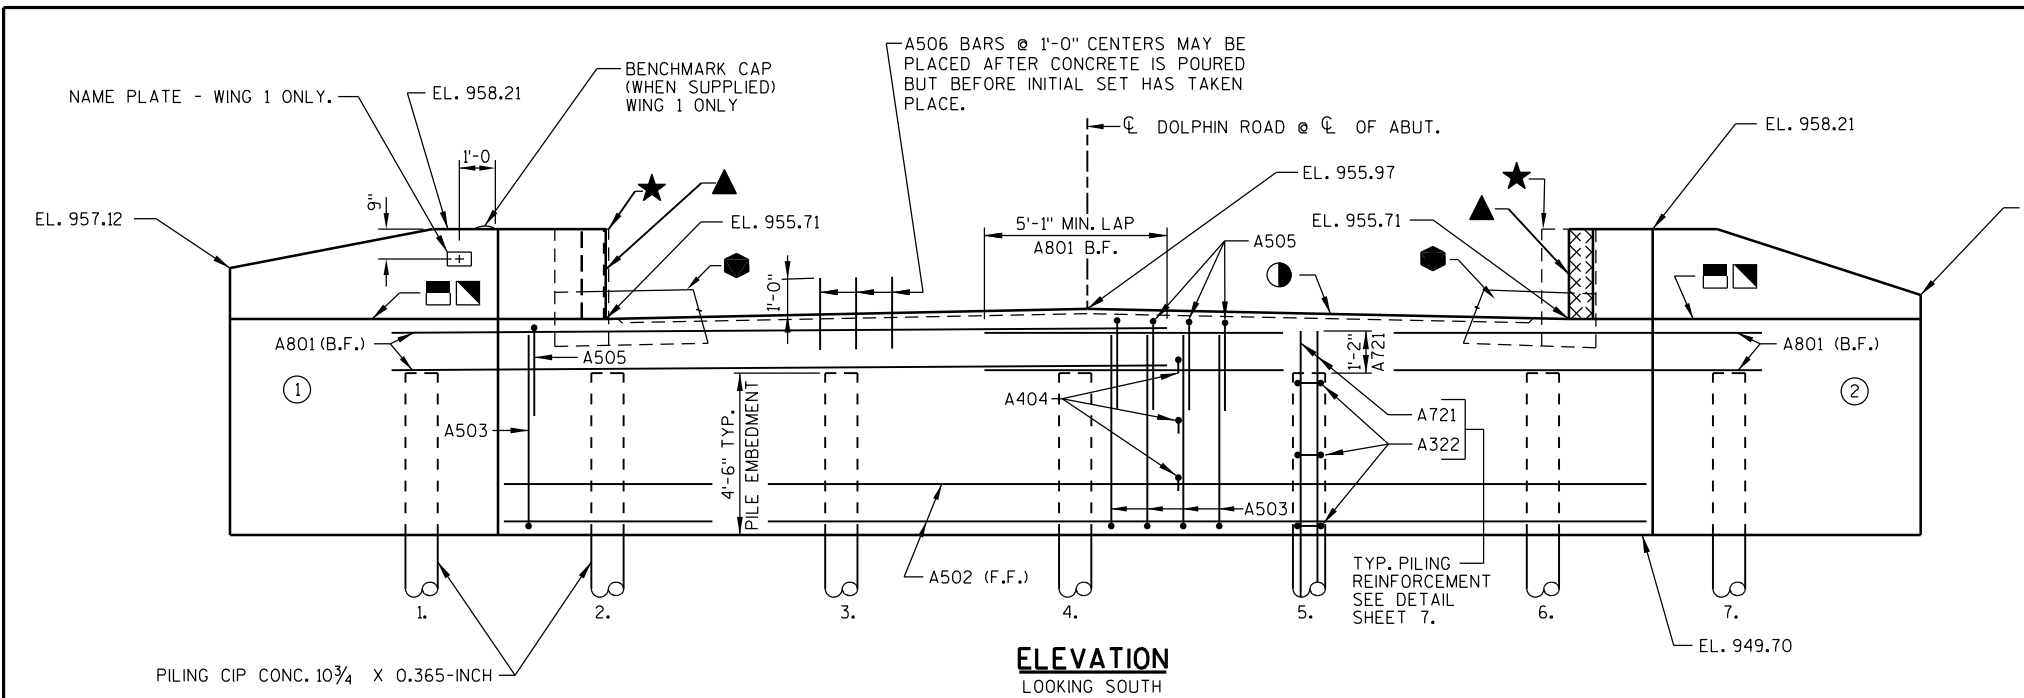

ELEVATION
LOOKING SOUTH

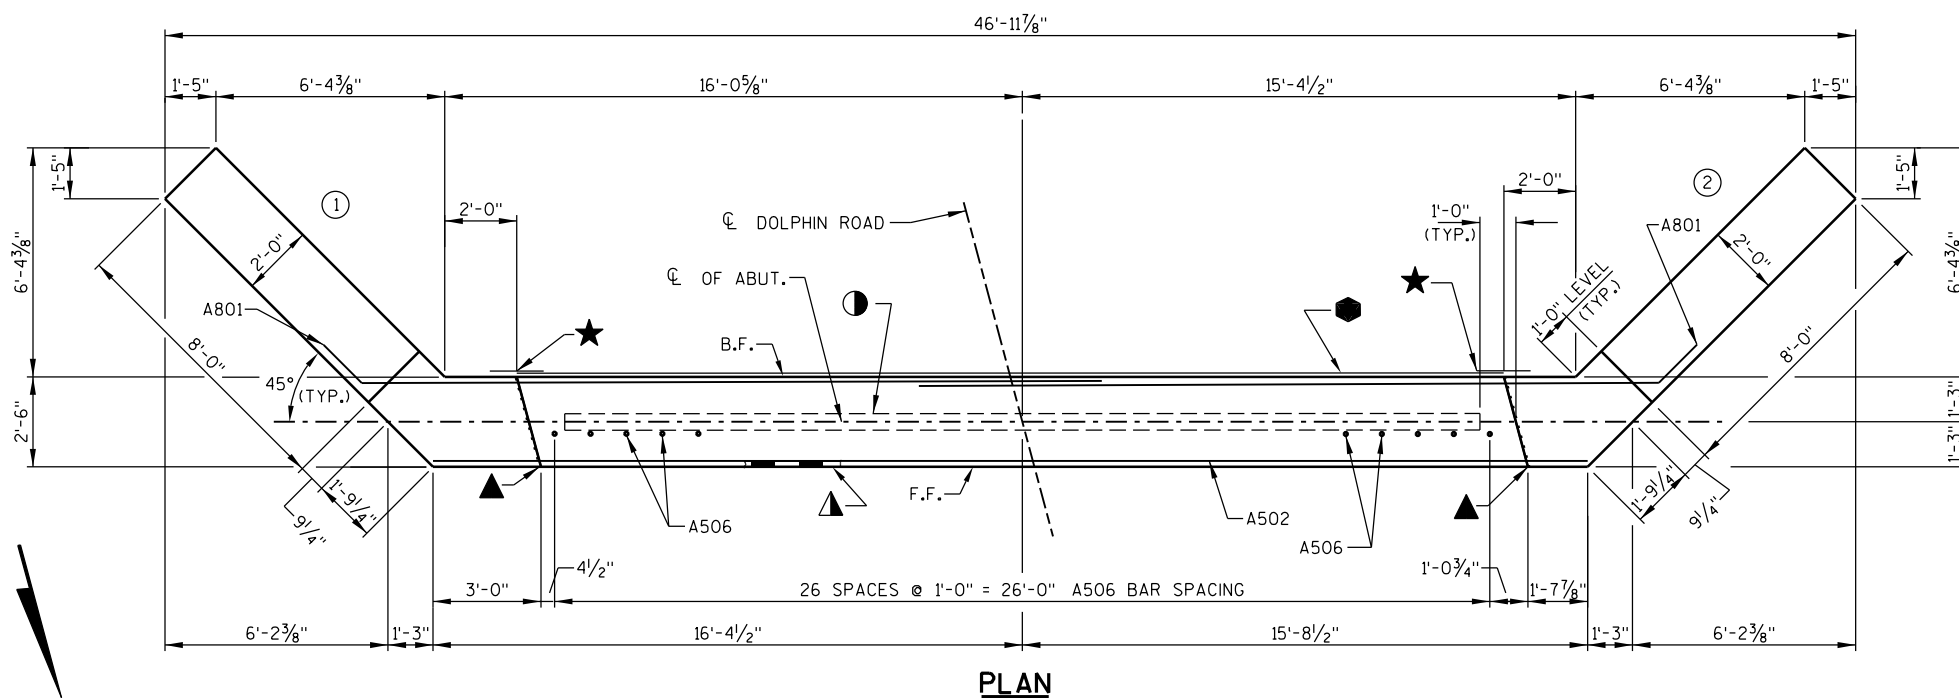


PLAN

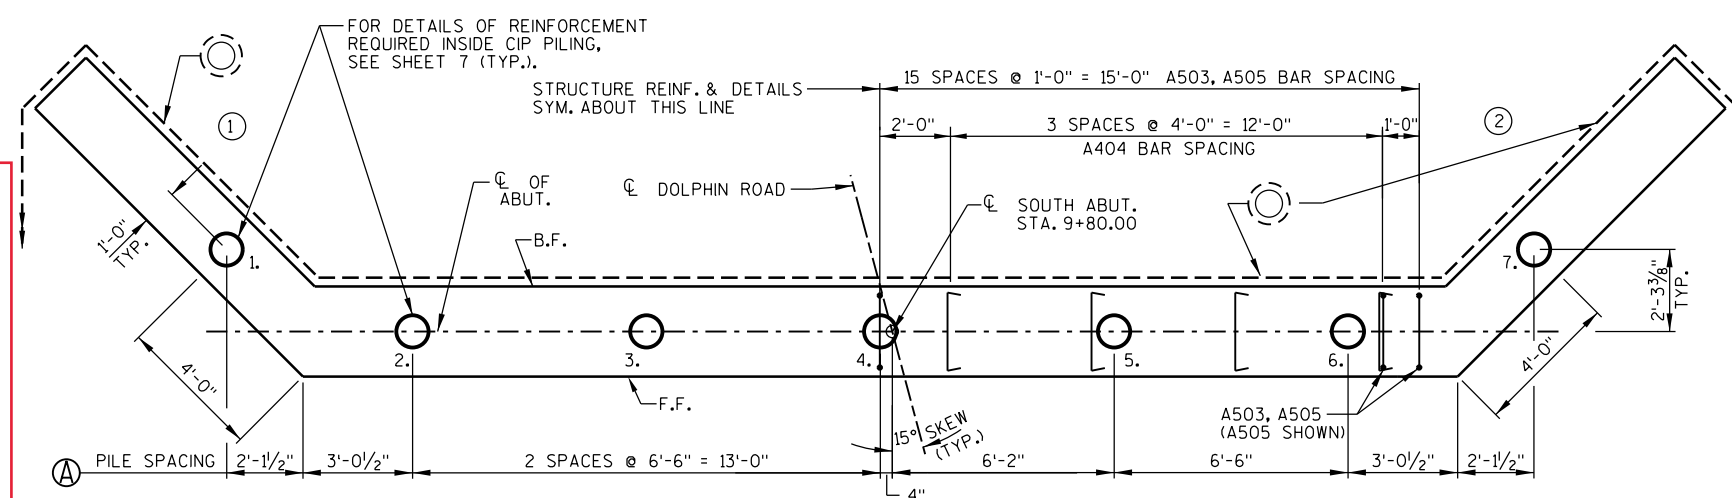


PILE PLAN

NOTE:
FOR WING DETAILS SEE SHEET 5.

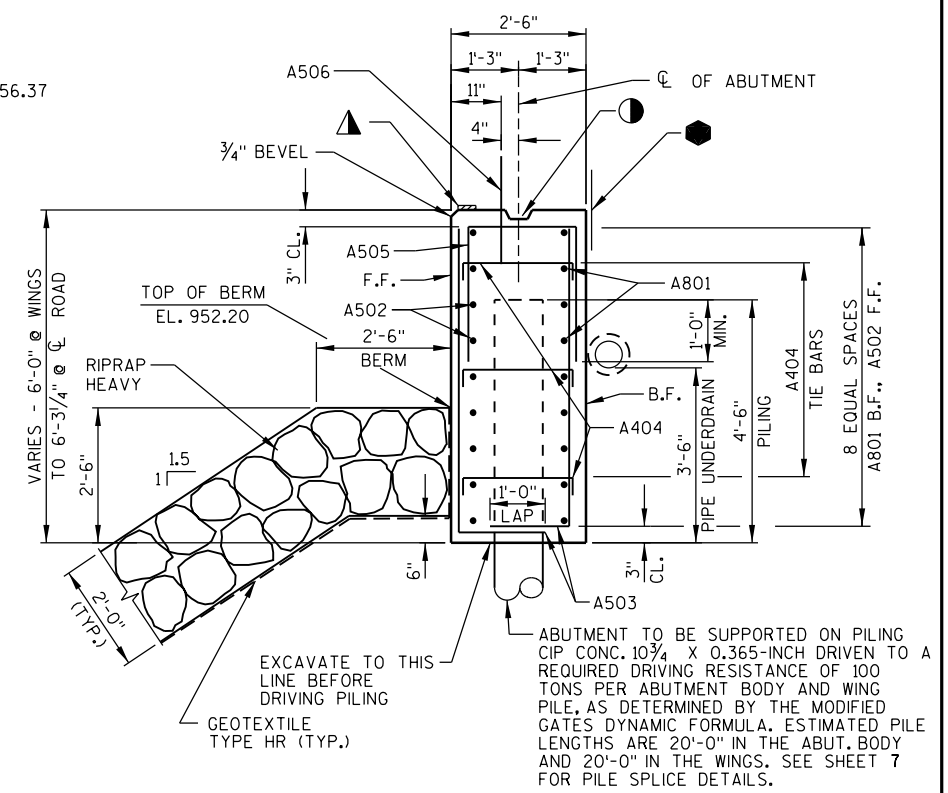

TYPICAL SECTION THRU ABUTMENT

- LEGEND**
- — KEYED CONSTRUCTION JOINT FORMED BY BEVELED 2x6.
 - ▲ — 1/2" FILLER EXTEND AS SHOWN. SEAL ALL EXPOSED HORIZ. & VERT. SURFACES OF FILLER WITH NON-STAINING GRAY, NON-BITUMINOUS JOINT SEALER. (1" DEEP & HOLD 1/8" BELOW SURFACE OF CONCRETE).
 - ▲ — 4"x 3/4" FILLER, EXTEND FULL LENGTH OF ABUTMENT BETWEEN EDGES OF SLAB.
 - ★ — VERTICAL 18" WIDE RUBBERIZED MEMBRANE WATERPROOFING. EXTEND FROM 9" BELOW BRIDGE SEAT TO TOP OF WINGS.
 - — HORIZONTAL 18" WIDE RUBBERIZED MEMBRANE WATERPROOFING. EXTEND BETWEEN WINGS.
 - — OPTIONAL KEYED CONST. JOINT ON WING FORMED BY BEVELED 2 X 6. IF JOINT IS USED, PLACE ● ON B.F. OF WING. COST OF ● IS INCIDENTAL TO BID ITEM "CONCRETE MASONRY BRIDGES".
 - ◻ — 3/4" "V" GROOVE ON FRONT FACE OF WING WALL, REQUIRED ONLY WHERE CONSTRUCTION JOINT IS USED.
 - — PIPE UNDERDRAIN WRAPPED 6-INCH. EXTEND THRU GEOTEXTILE FABRIC AT FACE OF RIPRAP HEAVY. SLOPE 0.5% MIN. TO SUITABLE DRAINAGE. PROVIDE RODENT SHIELD AT ENDS OF PIPE. FOR RODENT DETAILS, SEE SHEET 5.
 - Ⓐ — EXISTING FOUNDATION TYPE IS UNKNOWN. IF EXISTING PILING ARE PRESENT AND THEY CONFLICT WITH THE NEW PILES, ADJUST THE LOCATION OF THE NEW PILES UP TO AN 8'-0" MAXIMUM PILE SPACING. KEEP PILES 2 AND 6 BETWEEN A MINIMUM OF 2'-0" AND A MAXIMUM OF 3'-3" FROM THE ABUTMENT F.F. CORNERS.
 - — INDICATES WING NUMBER F.F.—FRONT FACE B.F.—BACK FACE CL.—CLEAR

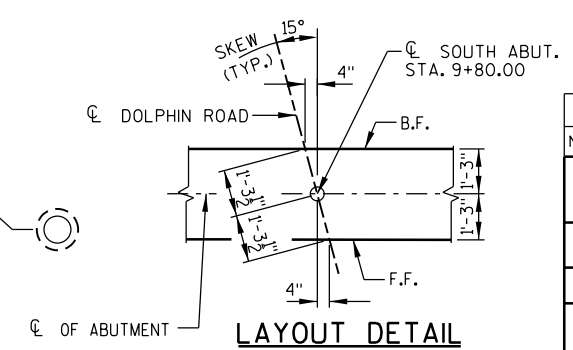

LAYOUT DETAIL





Pile numbers 6 and 4 were cut 1 foot below plan grade. The falsework had to match and since the contractor cut pile numbers 2 and 4 on the north abutment they had to cut pile numbers 6 and 4 on the south abutment. The designers were okay with cutting pile number 6 and 4.

NO.	DATE	REVISION	BY
STATE OF WISCONSIN DEPARTMENT OF TRANSPORTATION			
STRUCTURE		B-41-312	
DRAWN BY		RLR	PLANS CK'D. JAS
SOUTH ABUTMENT		SHEET 4 OF 9	

SEE LEGEND ON SHEET 4 FOR DESCRIPTION OF

STATE PROJECT NUMBER

7102-00-70

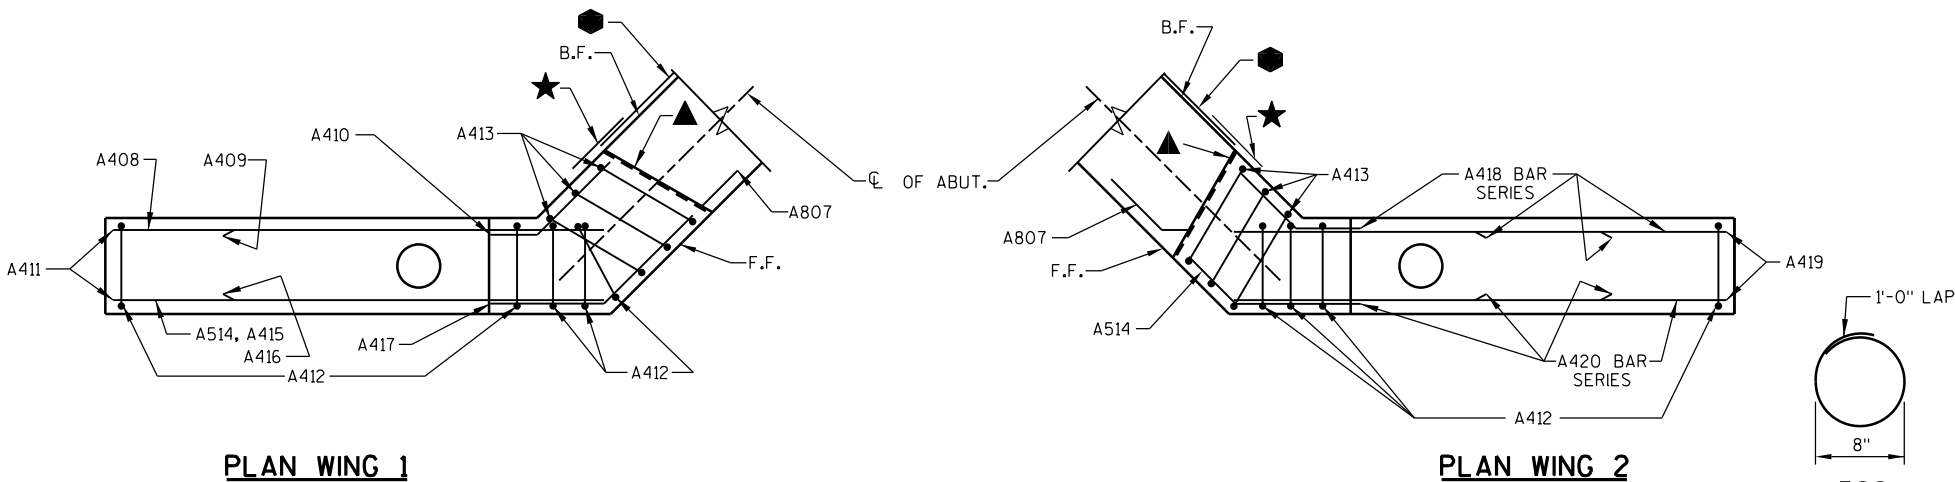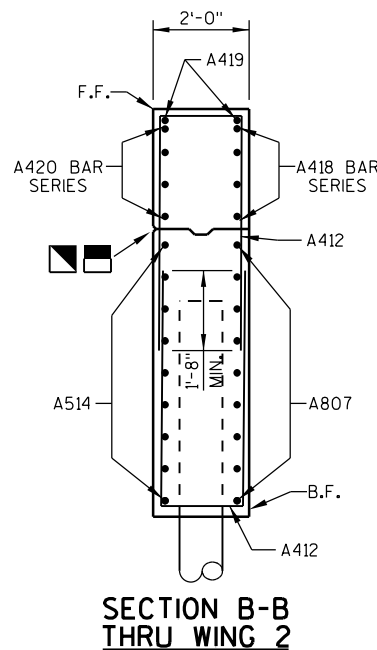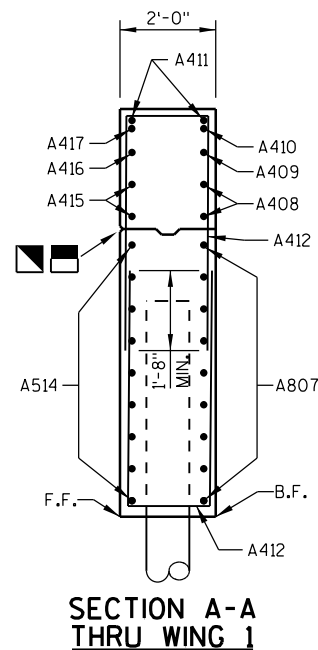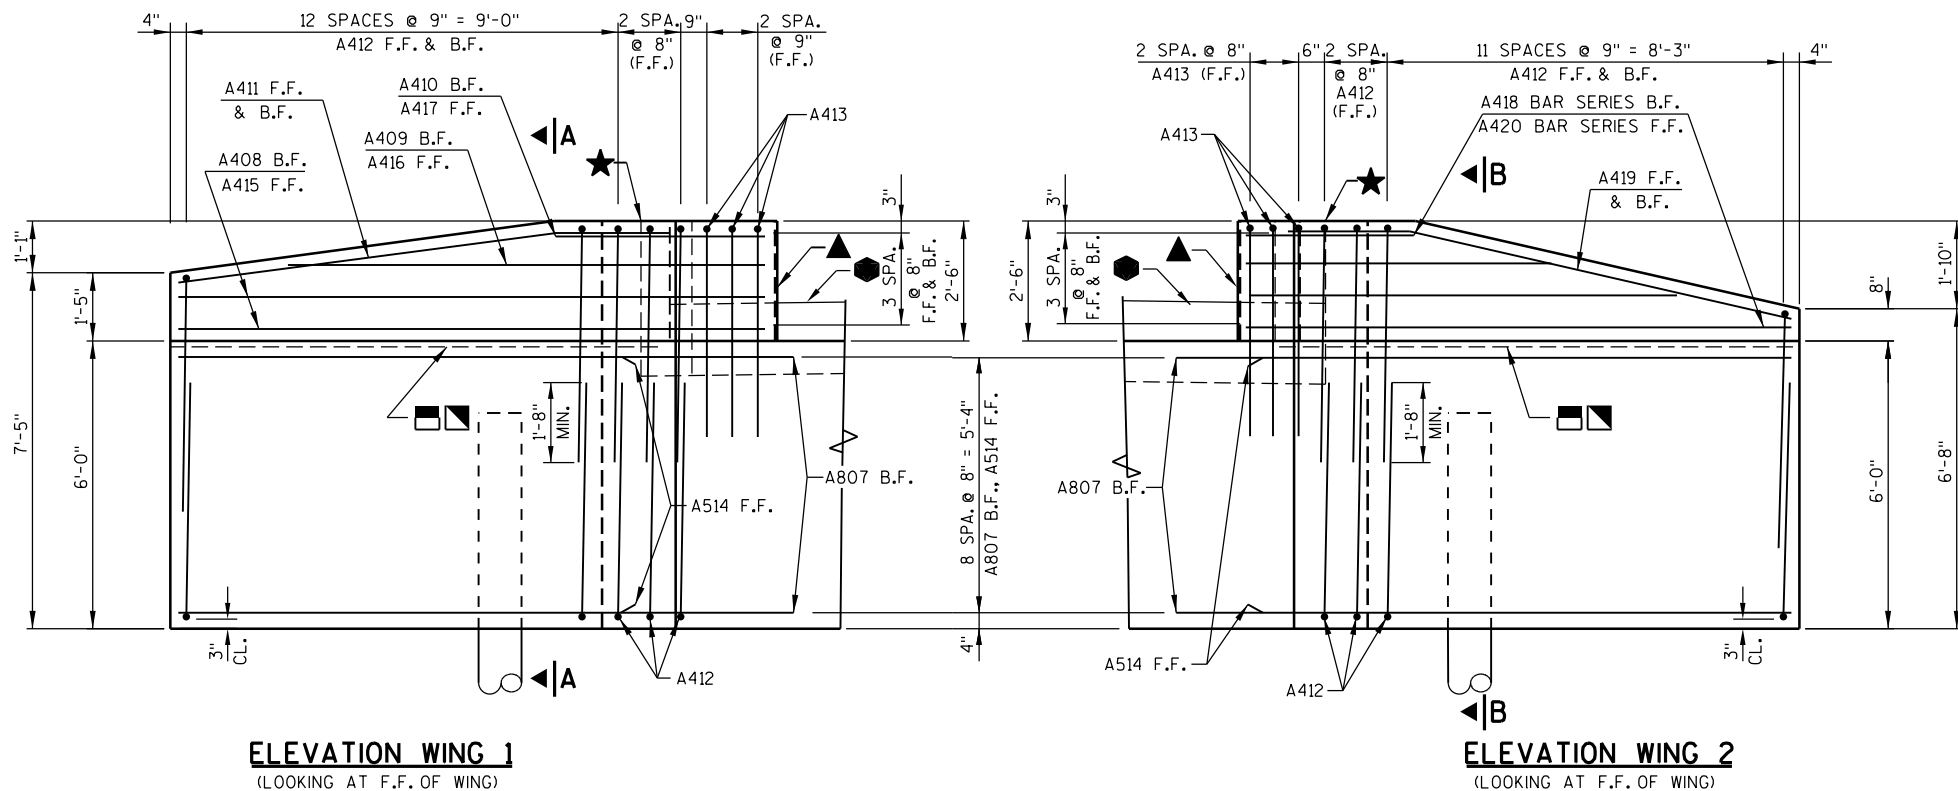

COATED 1505 LBS.
UNCOATED 2885 LBS.

BILL OF BARS (SOUTH ABUT.)


MARK	NUMBER REQUIRED COATED	NUMBER REQUIRED UNCOATED	LENGTH	BENT	BAR SERIES	LOCATION
A801	-	18	22'-0"	X		ABUTMENT BODY - B.F. - HORIZ.
A502	-	9	32'-0"			ABUTMENT BODY - F.F. - HORIZ.
A503	-	62	7'-0"	X		ABUTMENT BODY - F.F. & B.F. - VERT.
A404	-	24	2'-9"	X		ABUTMENT BODY - TIES - HORIZ.
A505	-	31	7'-1"	X		ABUTMENT BODY - TOP - VERT.
A506	27	-	2'-0"			ABUTMENT BODY - TOP DOWEL - VERT.
A807	18	-	13'-2"	X		WINGS - B.F. - HORIZ.
A408	2	-	10'-9"	X		WING 1 - B.F. - HORIZ.
A409	1	-	8'-6"	X		WING 1 - B.F. - HORIZ.
A410	1	-	3'-0"	X		WING 1 - B.F. - HORIZ.
A411	2	-	10'-3"	X		WING 1 - F.F. & B.F. - TOP - HORIZ.
A412	58	-	11'-4"	X		WINGS - F.F. & B.F. - VERT.
A413	6	-	10'-4"	X		WINGS - F.F. & B.F. - TOP - VERT.
A514	18	-	11'-8"	X		WINGS - F.F. - HORIZ.
A415	2	-	12'-9"	X		WING 1 - F.F. - HORIZ.
A416	1	-	10'-6"	X		WING 1 - F.F. - HORIZ.
A417	1	-	4'-11"	X		WING 1 - F.F. - HORIZ.
A418	4	-	6'-11"	X		WING 2 - B.F. - HORIZ.
A419	2	-	10'-6"	X		WING 2 - F.F. & B.F. - TOP - HORIZ.
A420	4	-	7'-9"	X		WING 2 - F.F. - HORIZ.
A721	-	28	13'-0"			PILING 1 - 7 - VERT.
A322	-	49	3'-2"	X		PILING 1 - 7 - TIES - HORIZ.

DIMENSIONS IN BENDING DETAILS ARE OUT TO OUT OF BAR.

RODENT SHIELD NOTES:

ORIENT SHIELD SO SLOTS ARE VERTICAL.

THE RODENT SHIELD SHALL BE A PVC GRATE SIMILAR TO THIS DETAIL. THE GRATE IS COMMERCIALY AVAILABLE AS A FLOOR STRAINER. A PIPE COUPLING IS REQUIRED FOR THE ATTACHMENT OF THIS SHIELD TO THE EXPOSED END OF THE PIPE UNDERDRAIN. THE SHIELD SHALL BE FASTENED TO THE PIPE COUPLING WITH TWO OR MORE NO. 10 x 1-INCH STAINLESS STEEL SHEET METAL SCREWS. THE RODENT SHIELD, PIPE COUPLING AND SCREWS, SHALL BE INCLUDED IN THE BID ITEM "PIPE UNDERDRAIN WRAPPED 6-INCH".

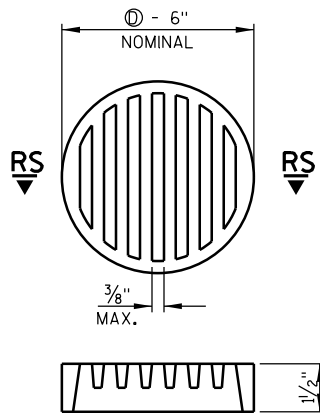

RODENT SHIELD

① - DIMENSIONS ARE APPROXIMATE. THE GRATE IS SIZED TO FIT INTO A PIPE COUPLING.

MARK	A	B
A801	1'-6"	45°
A807	1'-6"	45°
A514	1'-6"	45°
A408	1'-11"	45°
A409	1'-11"	45°
A410	1'-11"	45°
A411	2'-5"	8°
A415	2'-7"	45°
A416	2'-7"	45°
A417	2'-7"	45°
A418	1'-9"	45°
A412	2'-6"	13°
A420	1'-5"	45°

MARK	C	D
A404	4 1/2"	2'-2"
A505	2'-7"	2'-2"
A412	4'-11"	1'-8"
A413	4'-2"	2'-2"


BAR MARK	NO. REQ'D.	LENGTH
A418	1 SERIES OF 4	3'-1" TO 10'-9"
A420	1 SERIES OF 4	3'-11" TO 11'-7"

BAR SERIES TABLE

① - LENGTH SHOWN FOR BAR IS AN AVERAGE AND SHOULD ONLY BE USED FOR BAR WEIGHT CALCULATIONS. SEE BAR SERIES TABLE FOR ACTUAL LENGTHS. BENT BARS IF USED IN BAR SERIES TABLE SHALL BE BENT AFTER CUTTING.



NO.	DATE	REVISION	BY
STATE OF WISCONSIN DEPARTMENT OF TRANSPORTATION			
STRUCTURE B-41-312			
DRAWN BY RLR		PLANS CK'D. JAS	
SOUTH ABUTMENT DETAILS		SHEET 5 OF 9	

FOR WING DETAILS SEE SHEET 7.

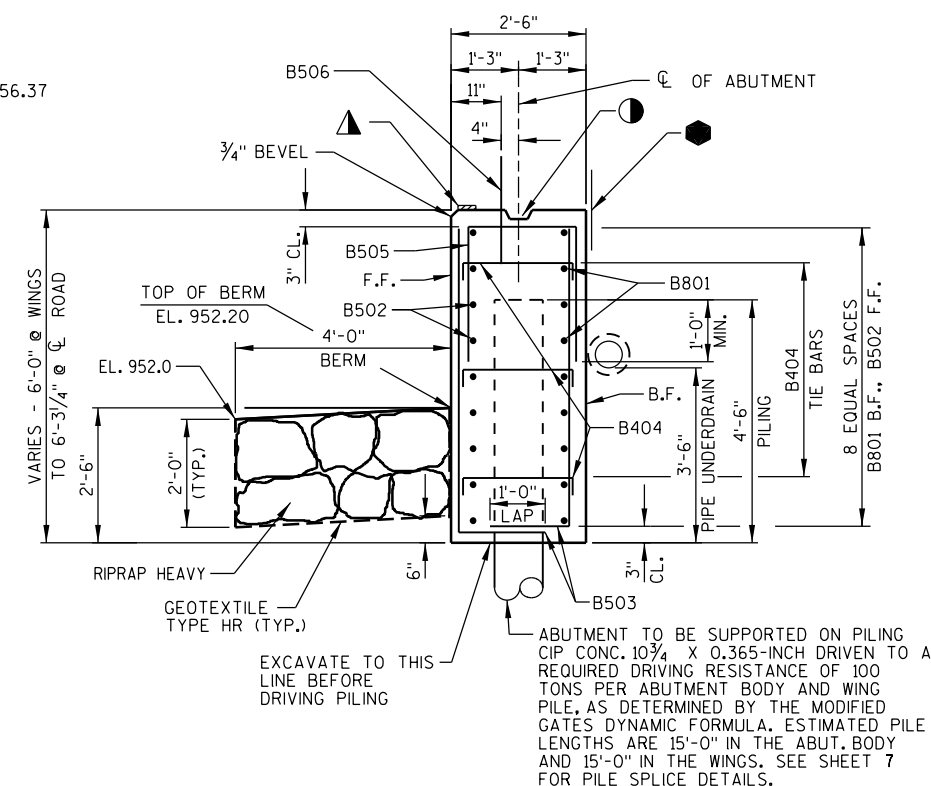


- — KEYED CONSTRUCTION JOINT FORMED BY BEVELED 2x6.
- — 1/2" FILLER EXTEND AS SHOWN. SEAL ALL EXPOSED HORIZ. & VERT. SURFACES OF FILLER WITH NON-STAINING GRAY, NON-BITUMINOUS JOINT SEALER. (1" DEEP & HOLD 1/8" BELOW SURFACE OF CONCRETE).
- — 4"x 3/4" FILLER, EXTEND FULL LENGTH OF ABUTMENT BETWEEN EDGES OF SLAB.
- — VERTICAL 18" WIDE RUBBERIZED MEMBRANE WATERPROOFING. EXTEND FROM 9" BELOW BRIDGE SEAT TO TOP OF WINGS.
- — HORIZONTAL 18" WIDE RUBBERIZED MEMBRANE WATERPROOFING. EXTEND BETWEEN WINGS.
- — OPTIONAL KEYED CONST. JOINT ON WING FORMED BY BEVELED 2 X 6. IF JOINT IS USED, PLACE ON B.F. OF WING. COST OF IS INCIDENTAL TO BID ITEM "CONCRETE MASONRY BRIDGES".
- — 3/4" "V" GROOVE ON FRONT FACE OF WING WALL, REQUIRED ONLY WHERE CONSTRUCTION JOINT IS USED.
- — PIPE UNDERDRAIN WRAPPED 6-INCH. EXTEND THRU GEOTEXTILE FABRIC AT FACE OF RIPRAP HEAVY. SLOPE 0.5% MIN. TO SUITABLE DRAINAGE. PROVIDE RODENT SHIELD AT ENDS OF PIPE. FOR RODENT DETAILS, SEE SHEET 5.
- — EXISTING FOUNDATION TYPE IS UNKNOWN. IF EXISTING PILING ARE PRESENT AND THEY CONFLICT WITH THE NEW PILES, ADJUST THE LOCATION OF THE NEW PILES UP TO AN 8'-0" MAXIMUM PILE SPACING. KEEP PILES 2 AND 6 BETWEEN A MINIMUM OF 2'-0" AND A MAXIMUM OF 3'-3" FROM THE ABUTMENT F.F. CORNERS.
- — INDICATES WING NUMBER

F.F.—FRONT FACE
B.F.—BACK FACE
CL.—CLEAR

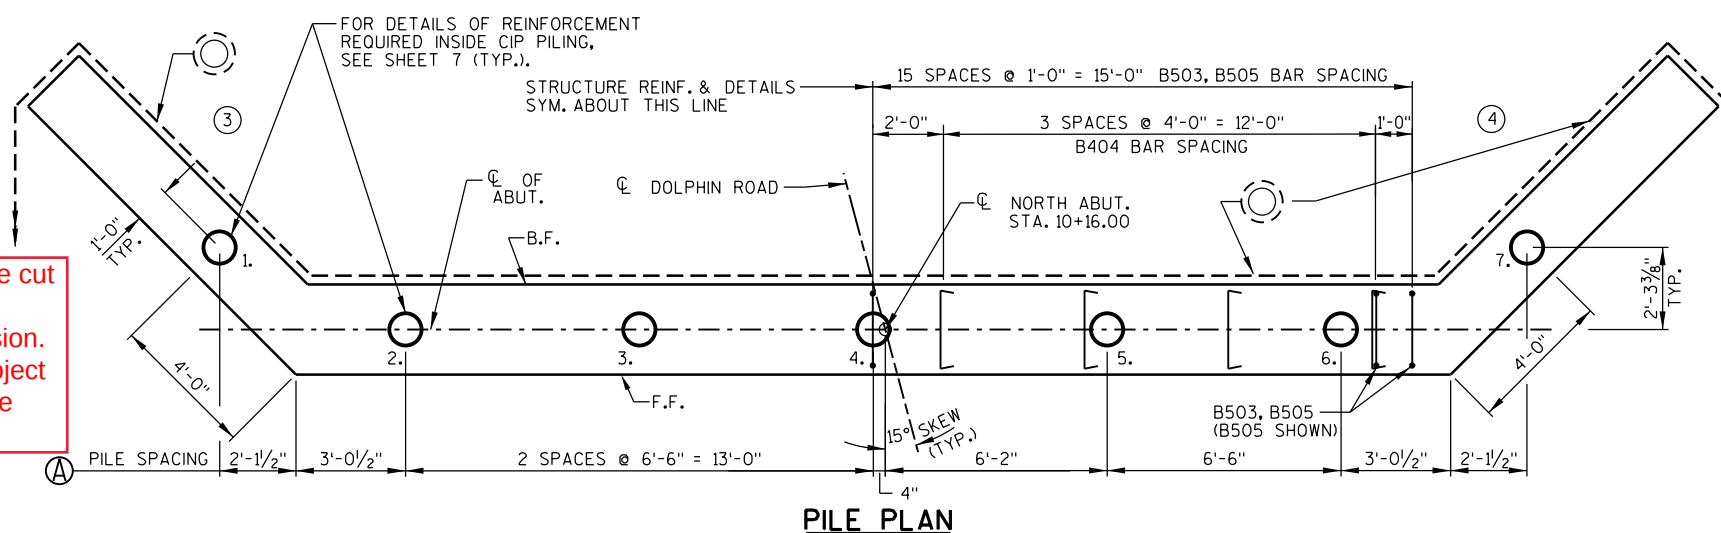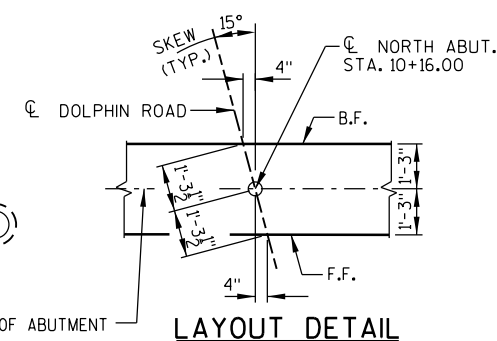

8

5848028 06.dgn 4/25/2018 8:32:03 AM mabaska

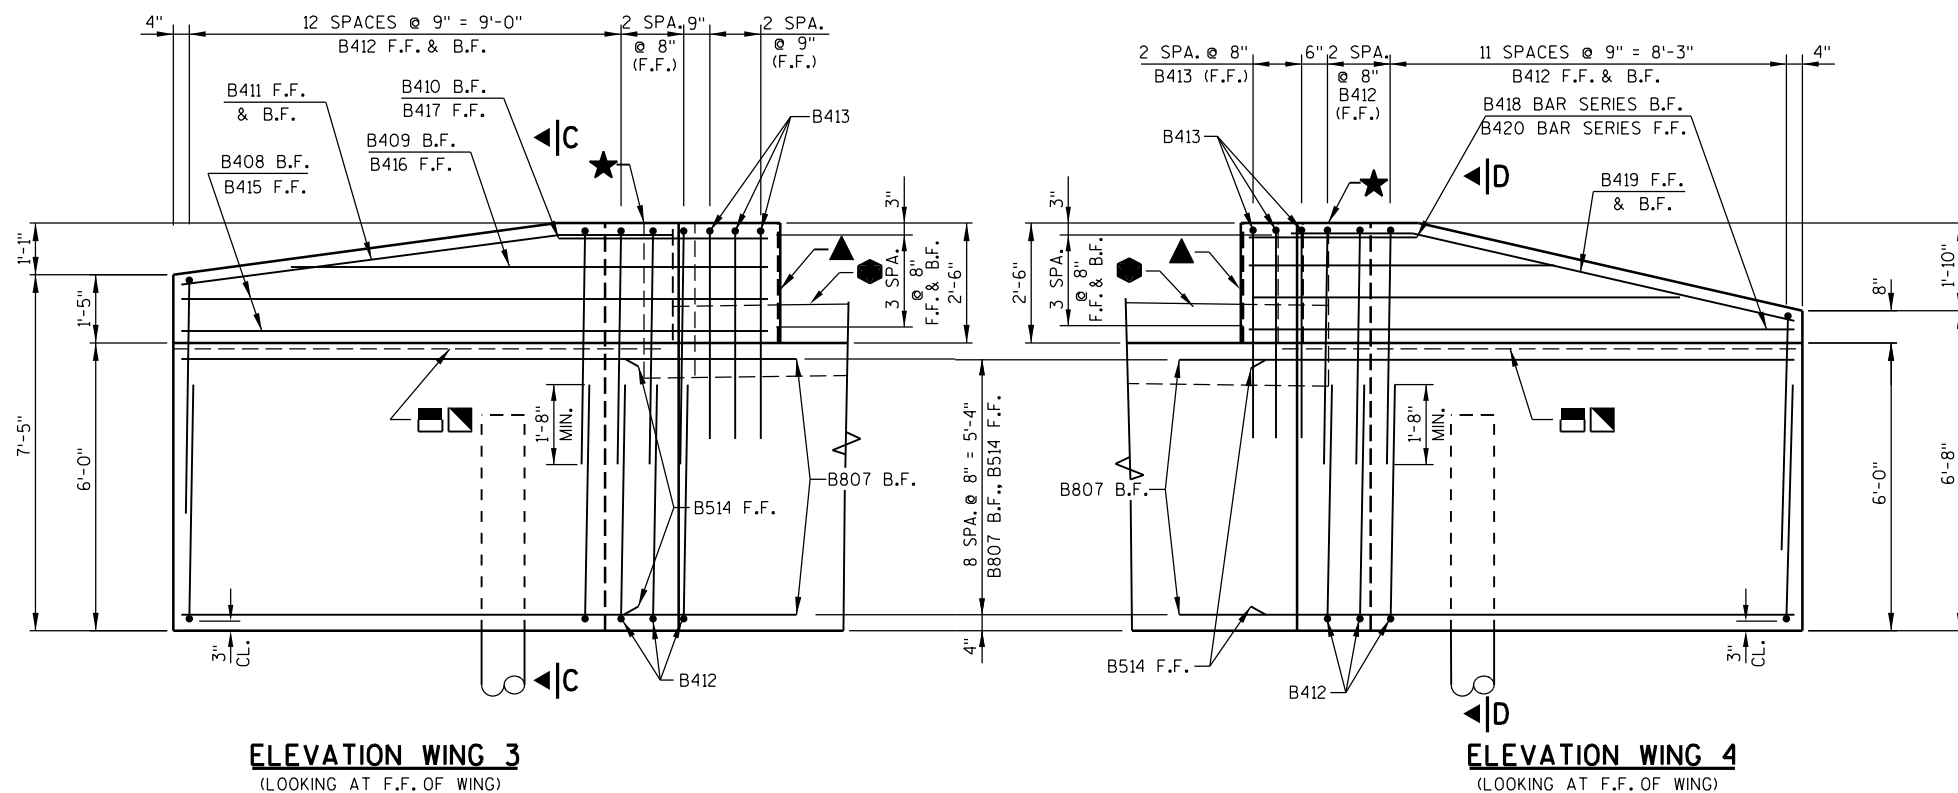
SEE LEGEND ON SHEET
6 FOR DESCRIPTION OF

ELEVATION WING 3

(LOOKING AT F.F. OF WING)

ELEVATION WING 4

(LOOKING AT F.F. OF WING)

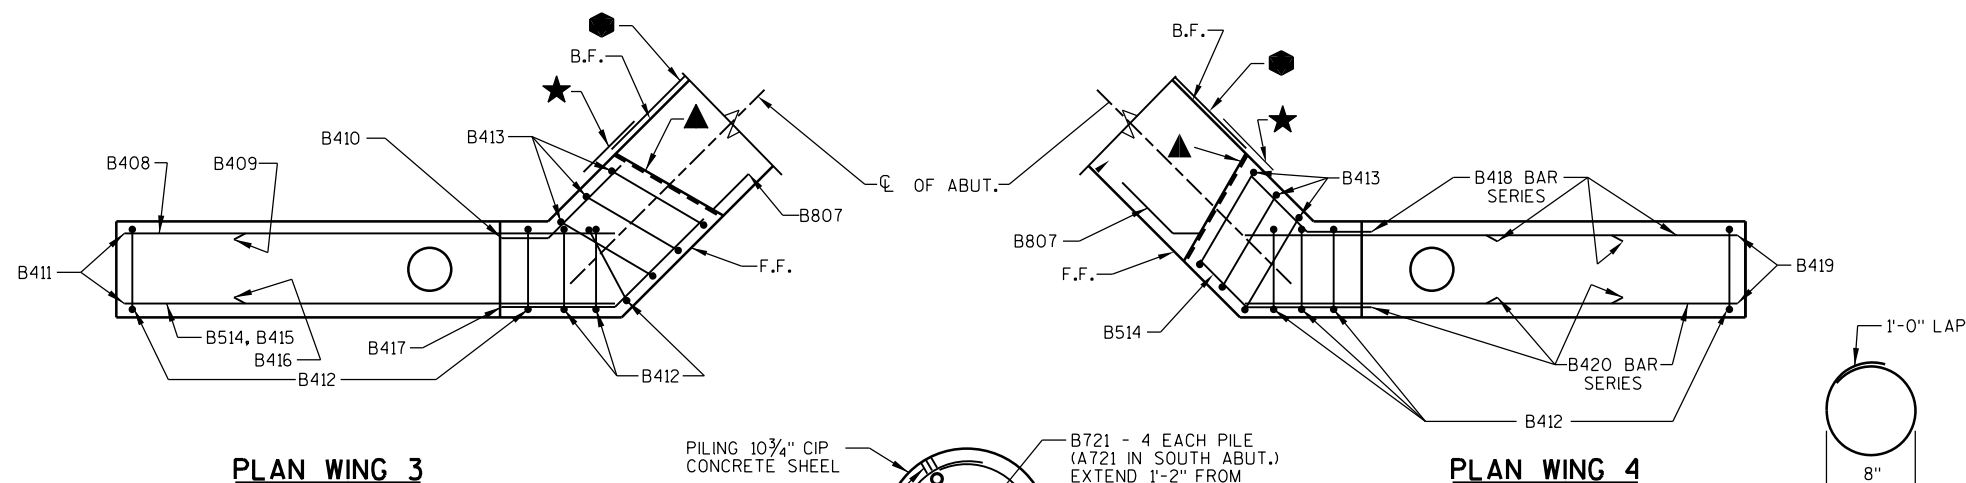

PLAN WING 3

GENERAL NOTES

ALL SLAB THICKNESS DIMENSIONS ARE MINIMUM. ANY TOLERANCES NECESSARY TO CORRECT CONSTRUCTION DISCREPANCIES ARE TO BE PLUS (+).

TOP TRANSVERSE BARS IN SLAB SHALL BE SUPPORTED BY INDIVIDUAL BAR CHAIRS AT APPROXIMATELY 3'-0" CENTERS EACH WAY. BOTTOM LONGITUDINAL BARS SHALL BE SUPPORTED BY CONTINUOUS BAR CHAIRS AT APPROXIMATELY 4'-0" CENTERS.

ALL TRANSVERSE BAR STEEL REINFORCEMENT SHALL BE PLACED ON THE SKEW.

SURVEY TOP OF SLAB ELEVATIONS

LOCATION	SPAN POINT	WEST SLAB EDGE	C/L DOLPHIN ROAD	EAST SLAB EDGE
SOUTH ABUT.	1.0	958.195	958.45	958.2
	1.5	958.22	958.495	958.27
NORTH ABUT.	2.0	958.2	958.42	958.195

PRIOR TO RELEASING SLAB FALSEWORK, TAKE TOP OF SLAB ELEVATIONS AT THE C. OF ABUTMENTS AND AT THE 0.5 PTS. TO VERIFY CAMBER. TAKE ELEVATIONS ALONG EDGE OF SLAB AND CROWN OR C. RECORD THE ELEVATIONS IN THE ABOVE TABLE FOR THE "AS BUILT" PLANS.

TOP OF SLAB ELEVATIONS AND CAMBER VALUES

LOCATION	SPAN POINT	EAST SLAB EDGE	C/L DOLPHIN ROAD	WEST SLAB EDGE	CAMBER VALUE (INCHES)
SOUTH ABUT.	1.0	958.21	958.47	958.21	0.0
	1.1	958.21	958.47	958.21	0.3
	1.2	958.21	958.47	958.21	0.6
	1.3	958.21	958.47	958.21	0.8
	1.4	958.21	958.47	958.21	0.9
	1.5	958.21	958.47	958.21	0.9
	1.6	958.21	958.47	958.21	0.9
	1.7	958.21	958.47	958.21	0.8
	1.8	958.21	958.47	958.21	0.6
NORTH ABUT.	1.9	958.21	958.47	958.21	0.3
	2.0	958.21	958.47	958.21	0.0

BILL OF BARS (COATED) 11,740 LBS.

MARK	NO. REQ'D.	LENGTH	BENT	LOCATION
S501	54	7'-3"	X	DIAPHRAGM @ ABUTS. - LONGIT.
S902	27	38'-2"		SLAB BOTTOM - LONGIT.
S1003	26	30'-5"		SLAB BOTTOM - LONGIT.
S504	94	27'-1"		SLAB TOP & BOTTOM - TRANS.
S405	30	38'-2"		SLAB TOP - LONGIT.
S606	28	12'-0"	X	SLAB TOP @ RAIL POST, 2 PER POST
S607	40	6'-0"		SLAB TOP @ RAIL POST, 4 PER POST
S608	16	6'-0"	X	SLAB TOP @ RAIL END POST AS NOTED


DIMENSIONS IN BENDING DETAILS ARE OUT TO OUT OF BAR. EPOXY COAT ALL SUPERSTRUCTURE BAR STEEL REINFORCEMENT.

CAMBER DIAGRAM

CAMBER SPANS AS SHOWN ABOVE AND IN THE TABLE OF VALUES TO PROVIDE FOR DEAD LOAD DEFLECTION AND FUTURE CREEP. CAMBER DOES NOT INCLUDE ALLOWANCE FOR FORM SETTLEMENT. DEAD LOAD DEFLECTION APPROXIMATES 1/3 OF CAMBER VALUES SHOWN.

TO DETERMINE FALSEWORK ELEVATION AT EDGE OF SLAB, CROWN OR REFERENCE LINE, FOLLOW THIS PROCEDURE:

- TOP OF SLAB ELEVATION AT FINAL GRADE
- SLAB THICKNESS
- + CAMBER
- + FORM SETTLEMENT/DEFLECTION DUE TO PLACEMENT OF SLAB CONCRETE (TO BE COMPUTED BY THE CONTRACTOR)
- = TOP OF SLAB FALSEWORK ELEVATION

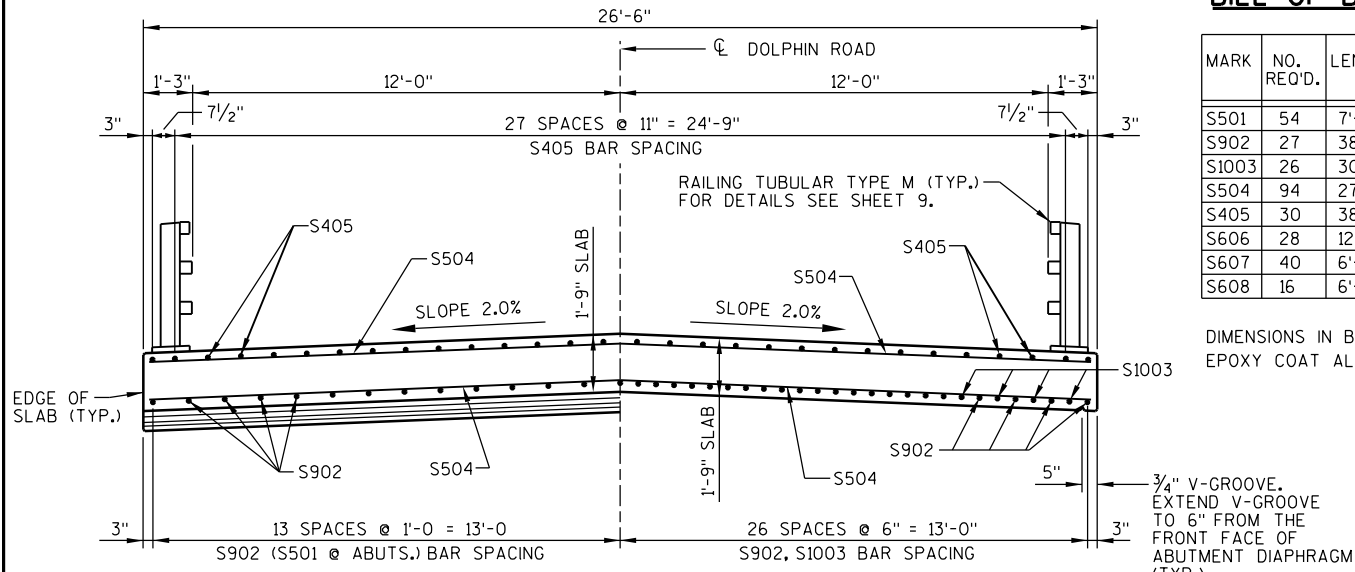


AT ABUTMENTS



IN SPAN

CROSS SECTION THRU BRIDGE

(LOOKING NORTH)

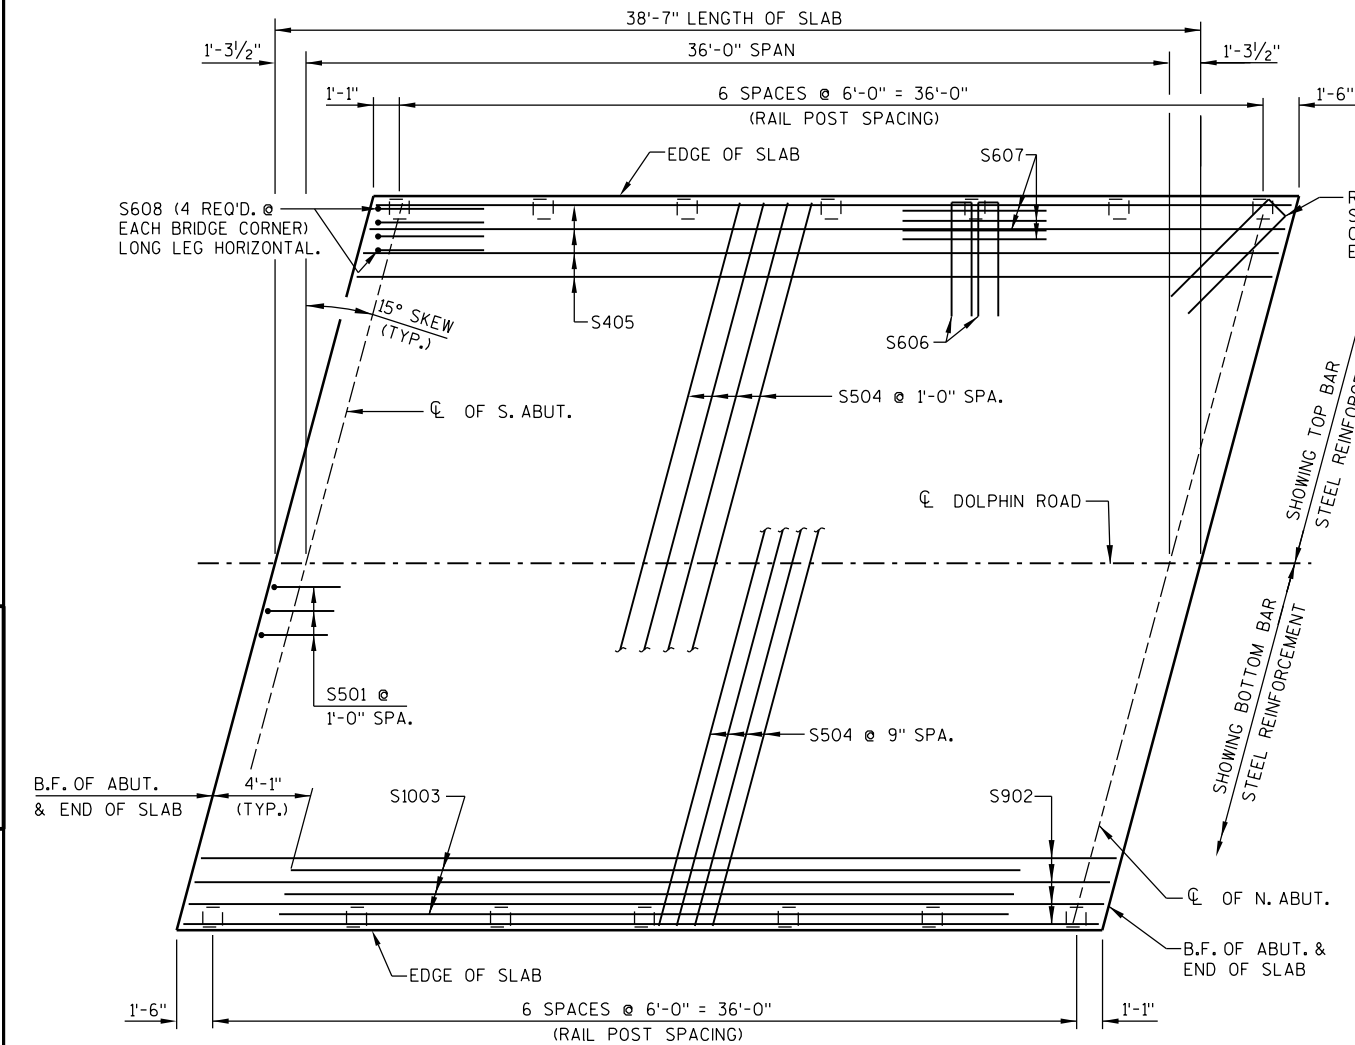

PLAN

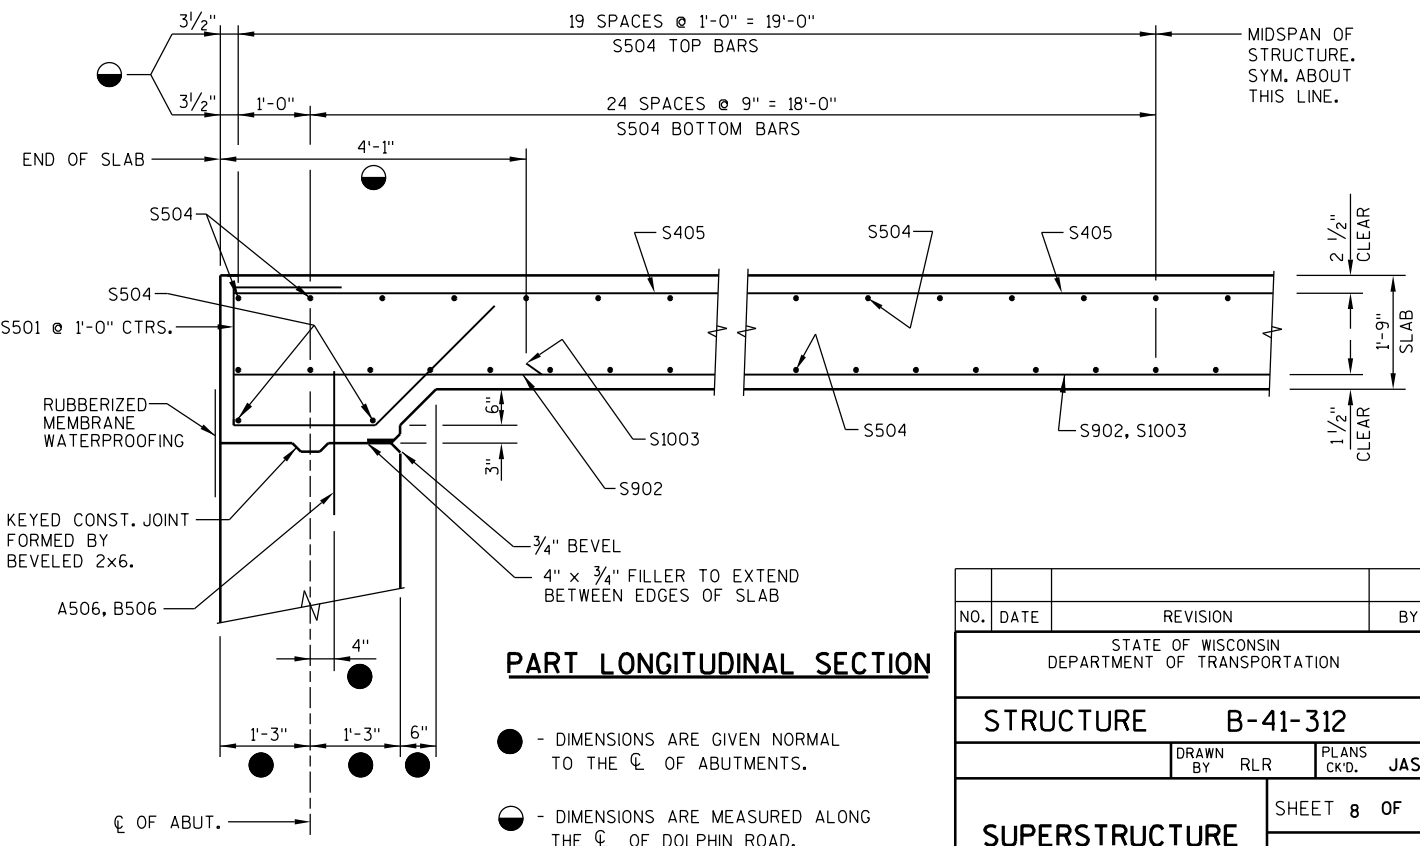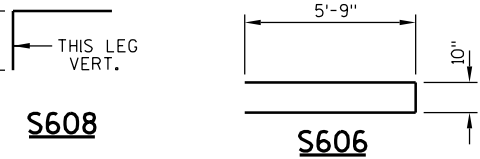

PART LONGITUDINAL SECTION

- - DIMENSIONS ARE GIVEN NORMAL TO THE C. OF ABUTMENTS.
- - DIMENSIONS ARE MEASURED ALONG THE C. OF DOLPHIN ROAD.


NO.	DATE	REVISION	BY
STATE OF WISCONSIN DEPARTMENT OF TRANSPORTATION			
STRUCTURE B-41-312			
DRAWN BY RLR		PLANS CK'D. JAS	
SUPERSTRUCTURE			SHEET 8 OF 9

LEGEND


- ① W6 x 25 WITH 1/8" X 1/2" HORIZ. SLOTS ON EACH SIDE OF POST FOR BOLT NO.6. CUT BOTTOM OF POST TO MATCH CROSS SLOPE OF ROADWAY. PLACE POST VERTICAL. PLACE POSTS NORMAL TO GRADE LINE.
- ② PLATE 1/4" X 11 3/4" X 1'-8" WITH 1 5/8" X 1 5/8" SLOTTED HOLES FOR ANCHOR BOLTS NO.3. WELD TO NO.1 AS SHOWN. SLOTS PARALLEL TO SHORT SIDE OF PLATE.
- ③ ASTM A449 - 1/6" DIA. ANCHOR BOLTS WITH NUT AND HARDENED WASHER (ALL GALVANIZED). 5 REQ'D. PER POST. THREAD 3" AND PLACE NORMAL TO PLATE NO.2. CHAMFER TOP OF BOLTS BEFORE THREADING. USE 1'-3" LONG.
- ④ 5/8" X 11" X 1'-8" ANCHOR PLATE (GALVANIZED) WITH 1 3/8" DIA. HOLES FOR ANCHOR BOLTS NO.3
- ⑤ TS 5 x 4 x 0.25 STRUCTURAL TUBING. ATTACH TO NO.1 WITH NO.6.
- ⑤A TS 5 x 5 x 0.25 STRUCTURAL TUBING. ATTACH TO NO.1 WITH NO.6.
- ⑥ 7/8" DIA. A325 SLOTTED ROUND HEAD BOLT WITH NUT, 3/8" X 1 5/8" X 1 5/8" WASHER, AND LOCK WASHER (2 REQ'D. AT EACH RAIL TO POST LOCATION).
- * ⑦ 1/2" THK. BACK-UP PLATE WITH 2 - 7/8" X 1 1/2" THREADED SHOP WELDED STUDS (NO.12). BOLT TO RAIL AS SHOWN IN DETAIL. REQUIRED AT THRIE BEAM GUARD RAIL ATTACHMENTS ONLY. PLACE SYMMETRICALLY ABOUT TUBES NO.5A.
- * ⑧ 1" DIA. HOLES IN PLATE NO.7 & TUBES NO.5A FOR 7/8" DIA. A325 BOLTS WITH HEX NUTS AND WASHERS. 6 HOLES IN TUBES AND PLATE NO.7.
- ⑨ SPLICE SLEEVE FABRICATED FROM 1/4" PLATE. PROVIDE "SLIDING FIT".
- ⑩ 3/8" X 3 5/8" X 2'-4" PLATE. 2 PER RAIL. USED IN NO.5 & 5A.
- ⑩A 3/8" X 2 5/8" X 2'-4" PLATE USED IN NO.5, 3/8" X 3 5/8" X 2'-4" PLATE USED IN NO.5A. 2 PER RAIL.
- ⑪ 7/8" φ A325 ROUND HEAD BOLT WITH NUT, WASHER, AND LOCK WASHER. USE 1 5/8" X 1 1/4" LONGIT. SLOTTED HOLES AT FIELD JOINTS IN PLATE NO.10A.
- * ⑫ 7/8" DIA. X 1 1/2" LONG THREADED SHOP WELDED STUDS (2 REQ'D).
- * ⑬ 3/8" X 8" X 1'-6" ANCHOR PLATE, BOLT TO RAIL AS SHOWN IN DETAIL. REQ'D. AT THRIE BEAM GUARD RAIL ATTACHMENTS ONLY. PLACE SYM. ABOUT TUBES NO.5A.
- * ⑭ 7/8" DIA. X 2" LONG A325 HEX BOLT WITH NUT AND WASHER (5 REQUIRED).
- * ⑮ 1" φ HOLES IN TUBES NO.5A FOR 7/8" DIA. A325 ROUND HEAD BOLT WITH NUT, WASHER, AND LOCK WASHER (4 REQ'D.). 4 HOLES IN TUBES.

GENERAL NOTES


1. BID ITEM SHALL BE "RAILING TUBULAR TYPE M B-41-312" WHICH INCLUDES ALL ITEMS SHOWN.
2. RAIL POST AND BASE PLATES SHALL CONFORM TO THE REQUIREMENTS OF ASTM A709 GRADE 50. HOLLOW RAILING STRUCTURAL TUBING SHALL CONFORM TO THE REQUIREMENTS OF ASTM A500 GRADE B OR C WITH A CERTIFIED FY = 50 KSI. ANCHOR PLATES, AND SPLICE TUBE PLATES SHALL CONFORM TO THE REQUIREMENTS OF ASTM A709 GRADE 36.
3. THE NUT SECURING THE POST BASE PLATE TO THE CONCRETE SHALL BE TIGHTENED TO A SNUG FIT AND GIVEN AN ADDITIONAL 1/8 TURN.
4. RAILS SHALL BE CONTINUOUS OVER A MINIMUM OF THREE (3) POSTS WITHOUT SPLICES WHERE POSSIBLE.
5. ENDS OF TUBE SECTIONS SHALL BE SAWED. GRIND SMOOTH EXPOSED EDGES. ALL CUT ENDS SHALL BE TRUE AND SMOOTH.
6. WELD IS THE SAME ON BOTH FLANGES. FLANGE WELD DOES NOT REQUIRE MAGNETIC PARTICLE TESTING.
7. FILL BOLT SLOT OPENINGS IN POST SHIMS AND PLATE NO.2 AND CAULK AROUND PERIMETER OF PLATE NO.2 WITH NON-STAINING GRAY NON-BITUMINOUS JOINT SEALER. STEEL POST SHIMS MAY BE USED UNDER POSTS WHERE REQ'D. FOR ALIGNMENT.
8. POST BASE PLATES SHALL BE FLAT WITH ALL SURFACES SMOOTH AND FREE FROM WARP AND ALL EDGES SMOOTH, STRAIGHT AND VERTICAL. ALL PLATE CUTS SHALL BE MACHINE OR MACHINE FLAME CUT.
9. ALL MATERIAL SHALL BE GALVANIZED AFTER FABRICATION. PRIOR TO GALVANIZING, ALL STEEL RAILING POSTS & STEEL TUBING SHALL BE GIVEN A NO.6 BLAST CLEANING BY S.S.P.C. SPECIFICATIONS.
10. PAINTING IS NOT REQUIRED.
11. THIS RAILING MEETS NCHRP REPORT 350 EVALUATION CRITERIA FOR TEST LEVEL 4 (TL-4).
- * ⑫. DO NOT FURNISH ITEMS ⑦ ⑧ ⑫ ⑬ ⑭ AND ⑮. THRIE BEAM RAIL ATTACHMENT IS NOT INCLUDED.

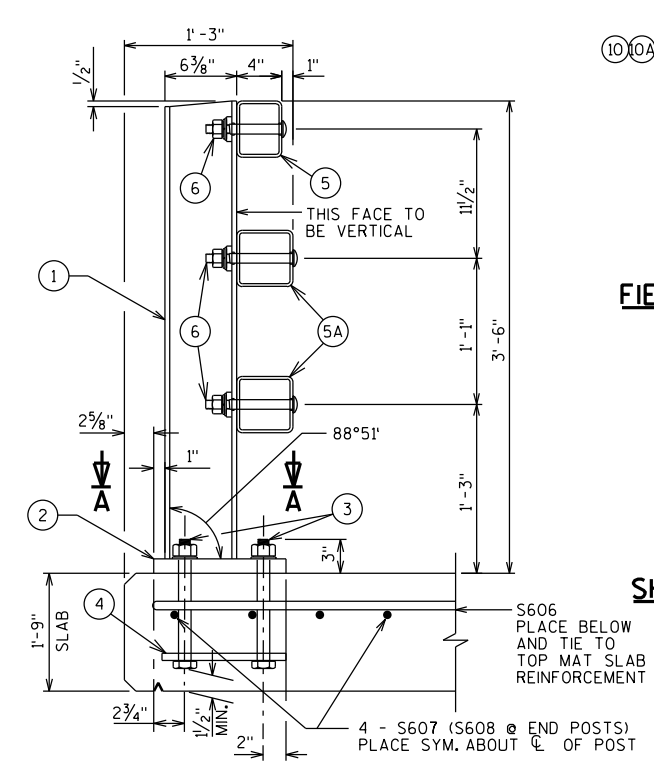


SECTION THRU RAILING ON SLAB

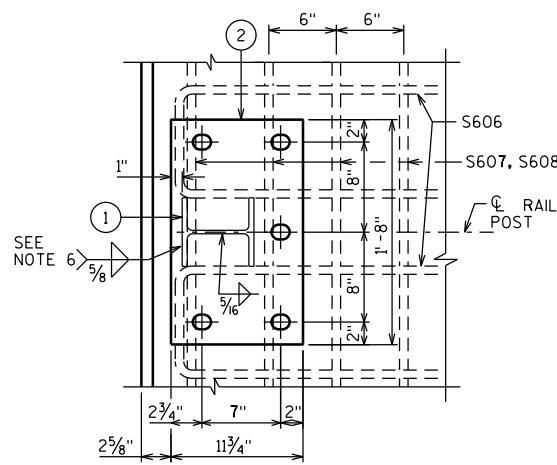


SECTION A-A

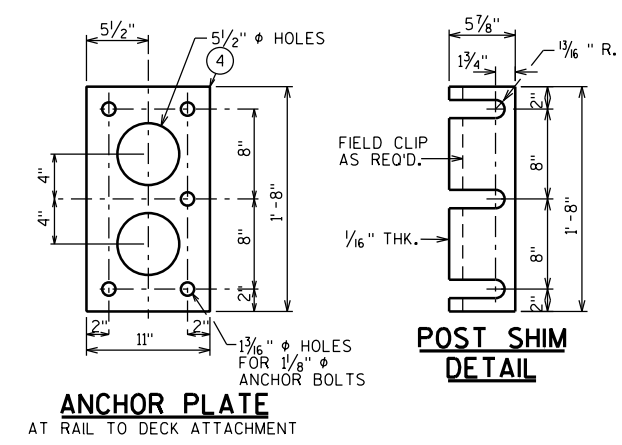

ANCHOR PLATE AT RAIL TO DECK ATTACHMENT

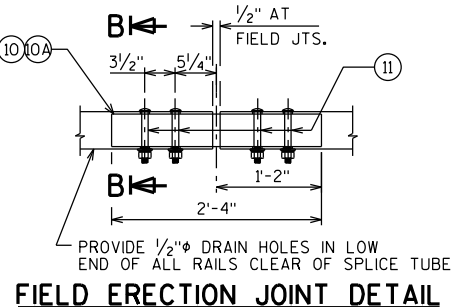


FIELD ERECTION JOINT DETAIL

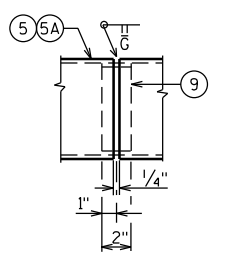


SHOP RAIL SPLICE DETAIL


(LOCATION MUST BE SHOWN ON SHOP DRAWINGS)

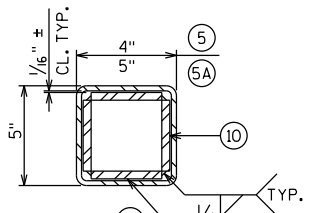


SECTION B-B

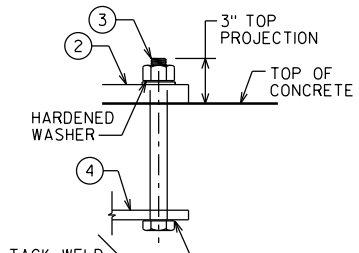

ANCHOR BOLTS

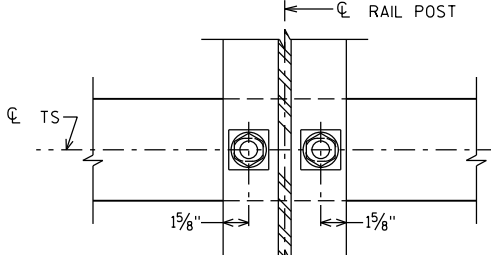


SECTION THRU POST WEB

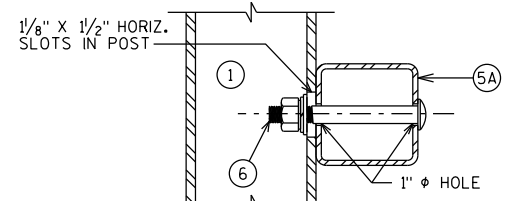

SECTION THRU RAIL


NOTE: CONNECTIONS AT LOWER RAILS SHOWN. CONNECTIONS AT TOP RAIL SIMILAR.

TYPICAL RAIL TO POST CONNECTIONS

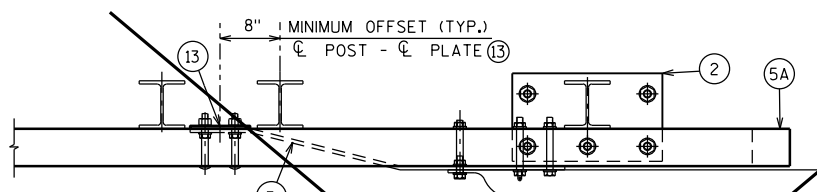


TOP VIEW AT END POST

(THRIE BEAM RAIL ATTACHMENT)

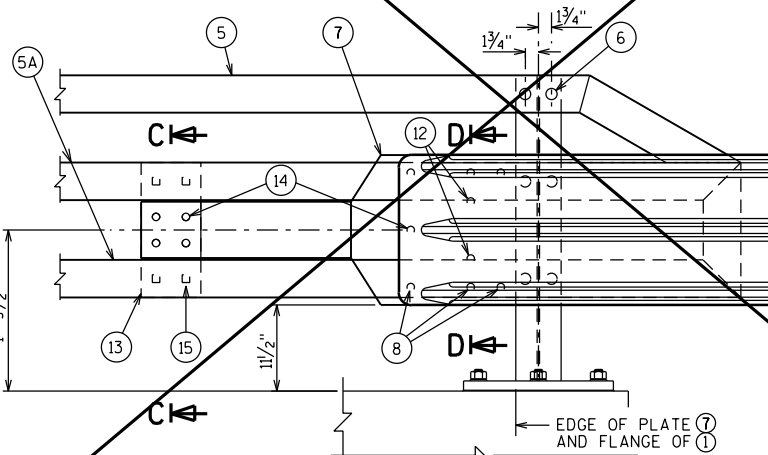


SECTION C-C

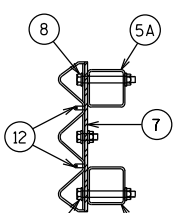


SECTION D-D

DETAIL AT END POST

(THRIE BEAM RAIL ATTACHMENT)

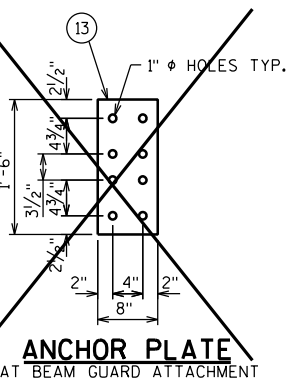


ANCHOR PLATE AT BEAM GUARD ATTACHMENT

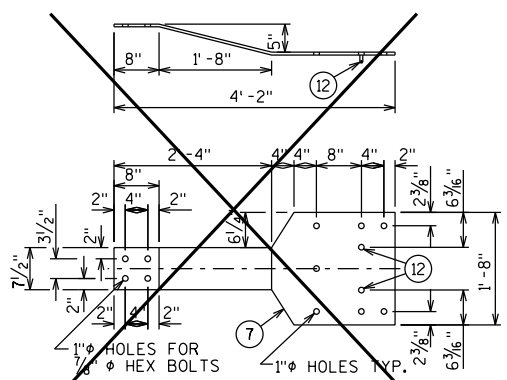

BACK-UP PLATE DETAIL

AT BEAM GUARD ATTACHMENT

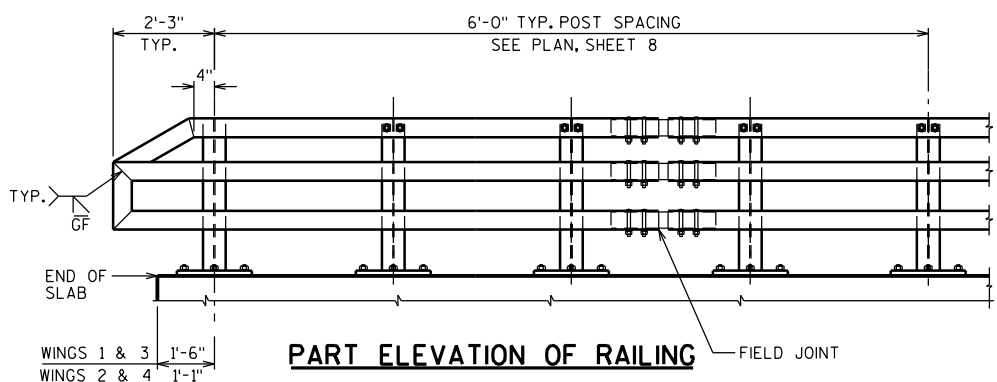


PART ELEVATION OF RAILING


NO.	DATE	REVISION	BY
STATE OF WISCONSIN DEPARTMENT OF TRANSPORTATION			
STRUCTURE		B-41-312	
DRAWN BY RLR		PLANS CK'D. JAS	
RAILING TUBULAR TYPE M		SHEET 9 OF 9	

PROJECT I.D. 7102-00-70 EARTHWORK SUMMARY

STA	EXCAVATION COMMON CY	EXCAVATION ROCK CY	FILL (1) CY	EXPANDED FILL (2) CY	WASTE CY
8+75.00	49	0	5	7	42
9+00.00	116	0	31	40	76
9+50.00	75	0	31	40	35
9+78.71					
STRUCTURE B-41-312					
10+17.29	93	0	11	14	79
10+50.00	126	0	17	22	104
11+00.00	110	0	11	14	96
11+50.00					
SUBTOTALS					
SOUTH APPROACH	240	0	67	87	153
NORTH APPROACH	329	0	39	50	279
TOTALS	569	0	106	137	432
(1) - NOT A BID ITEM - FOR INFORMATIONAL PURPOSES ONLY. (2) - FILL EXPANSION 30%					

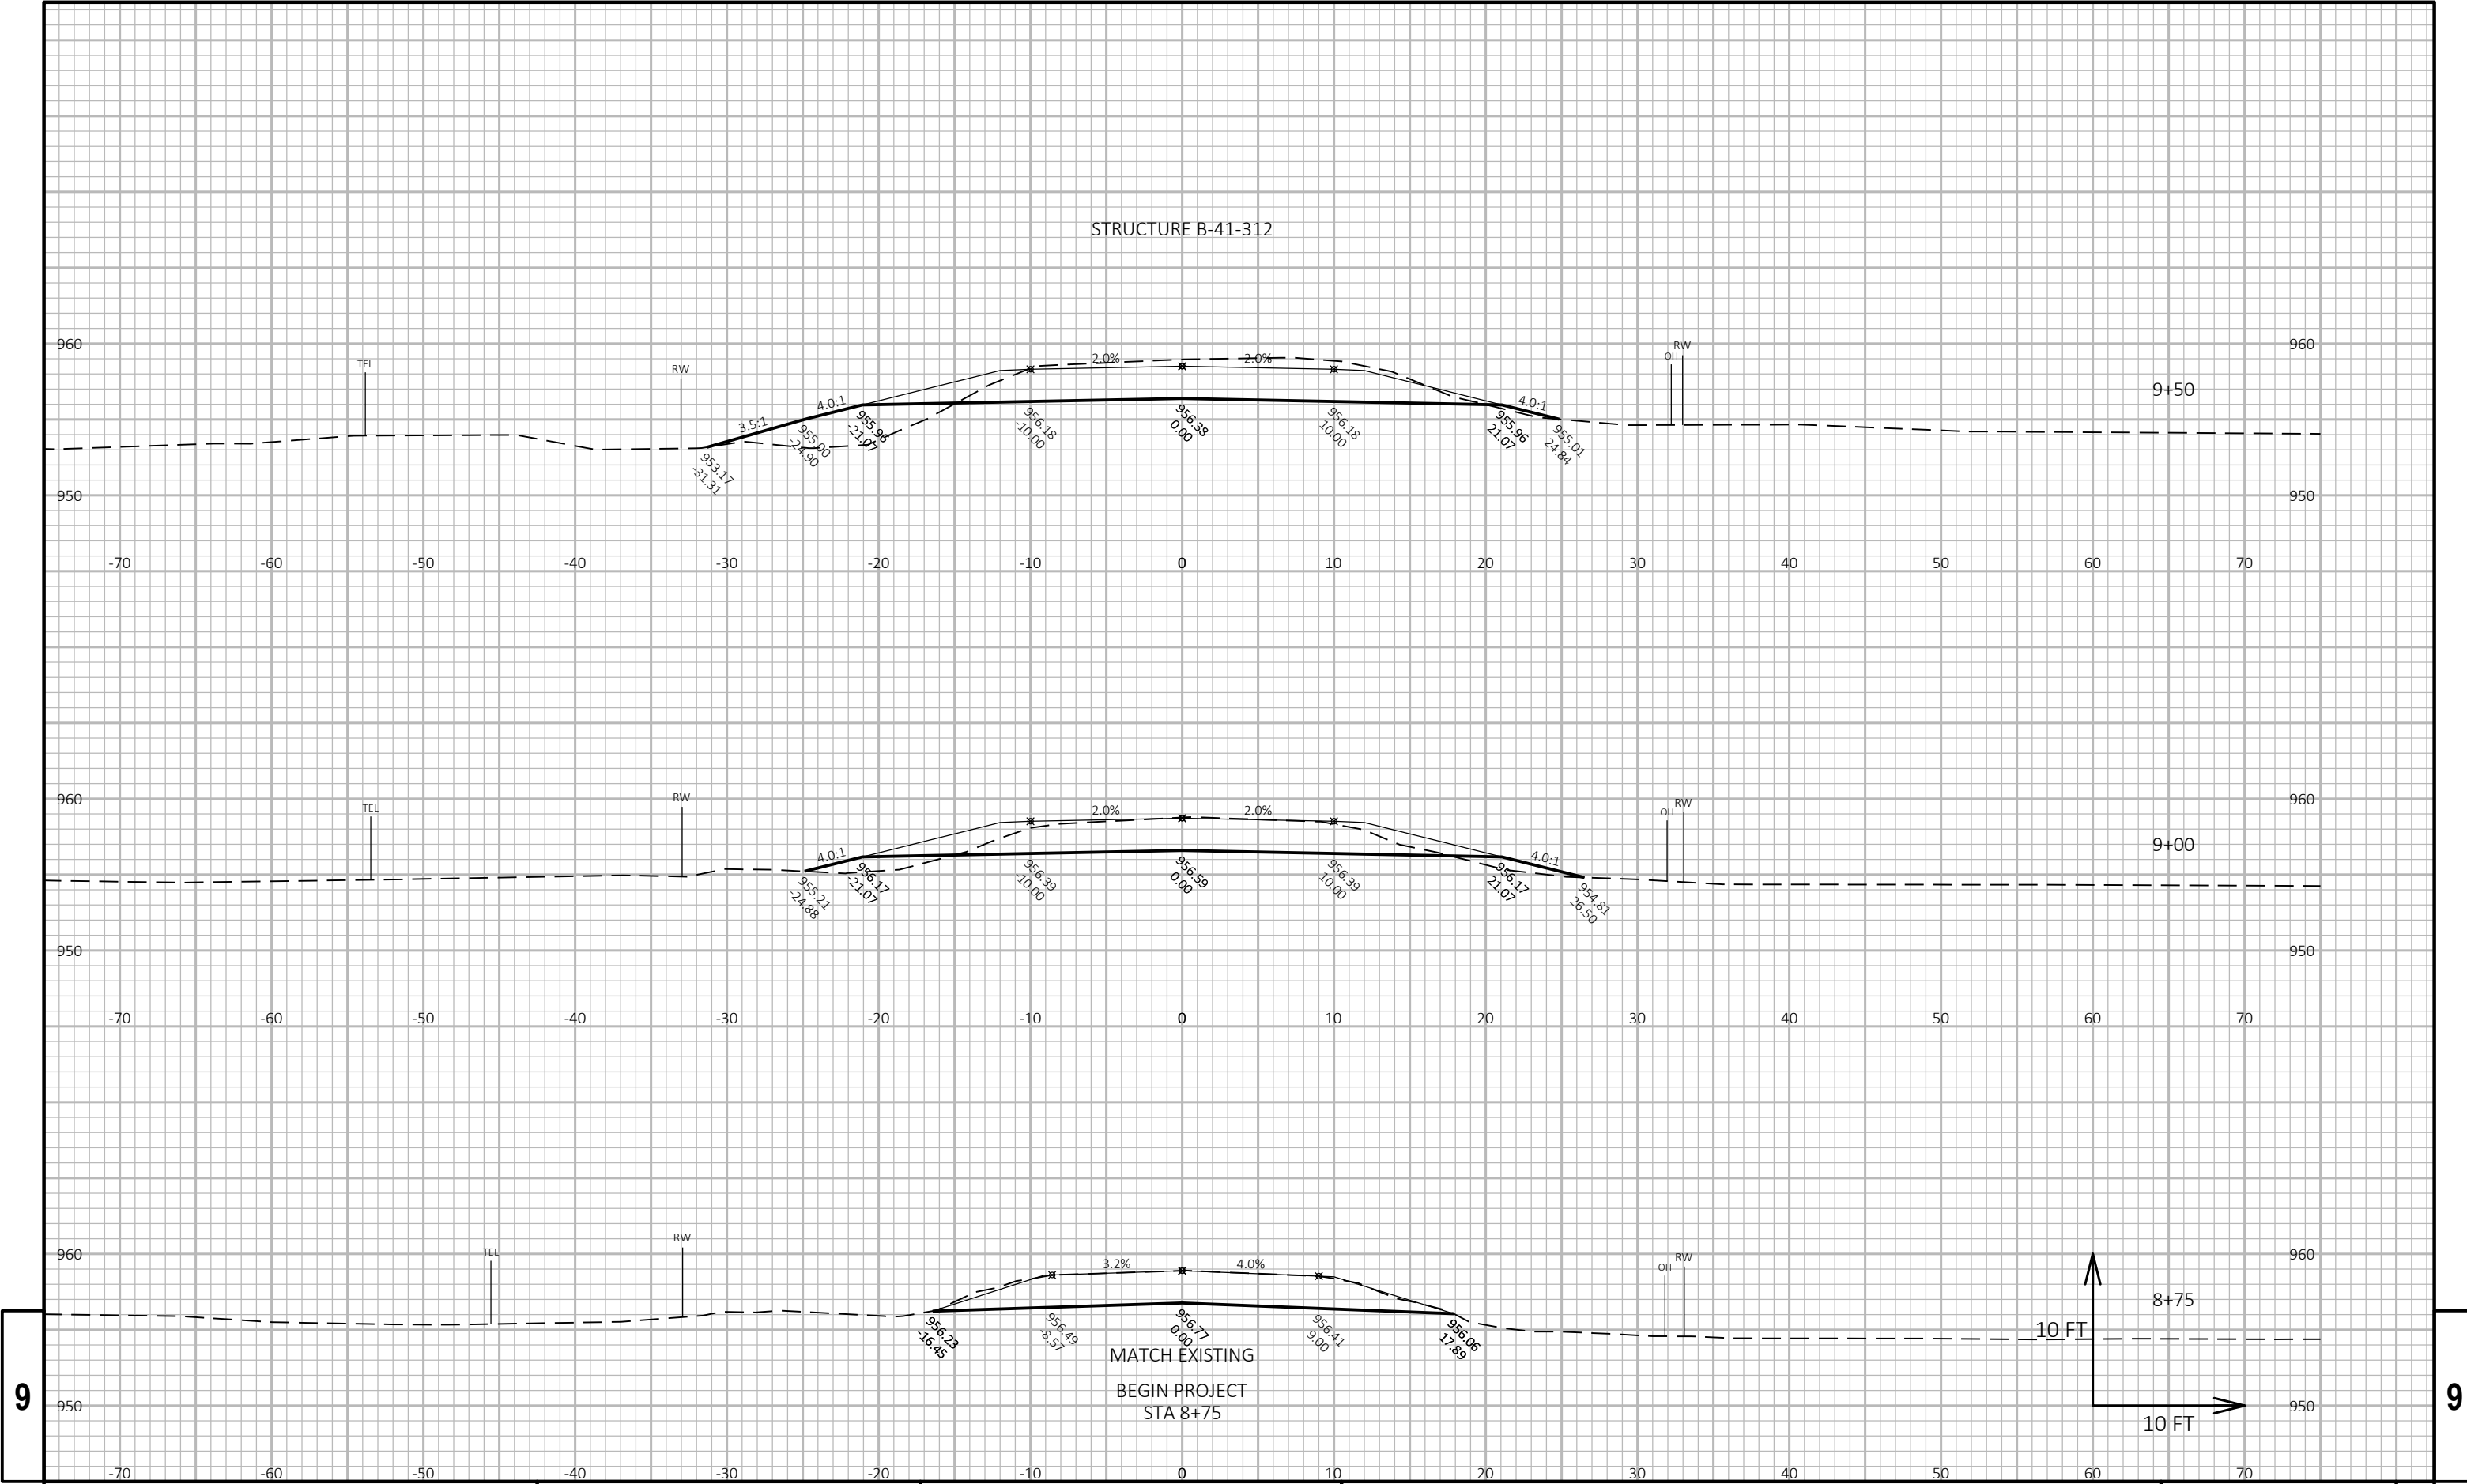

PROJECT NO: 7102-00-70	HWY: TOWN ROAD	COUNTY: MONROE	CROSS SECTIONS: DOLPHIN ROAD	SHEET E
------------------------	----------------	----------------	------------------------------	---------

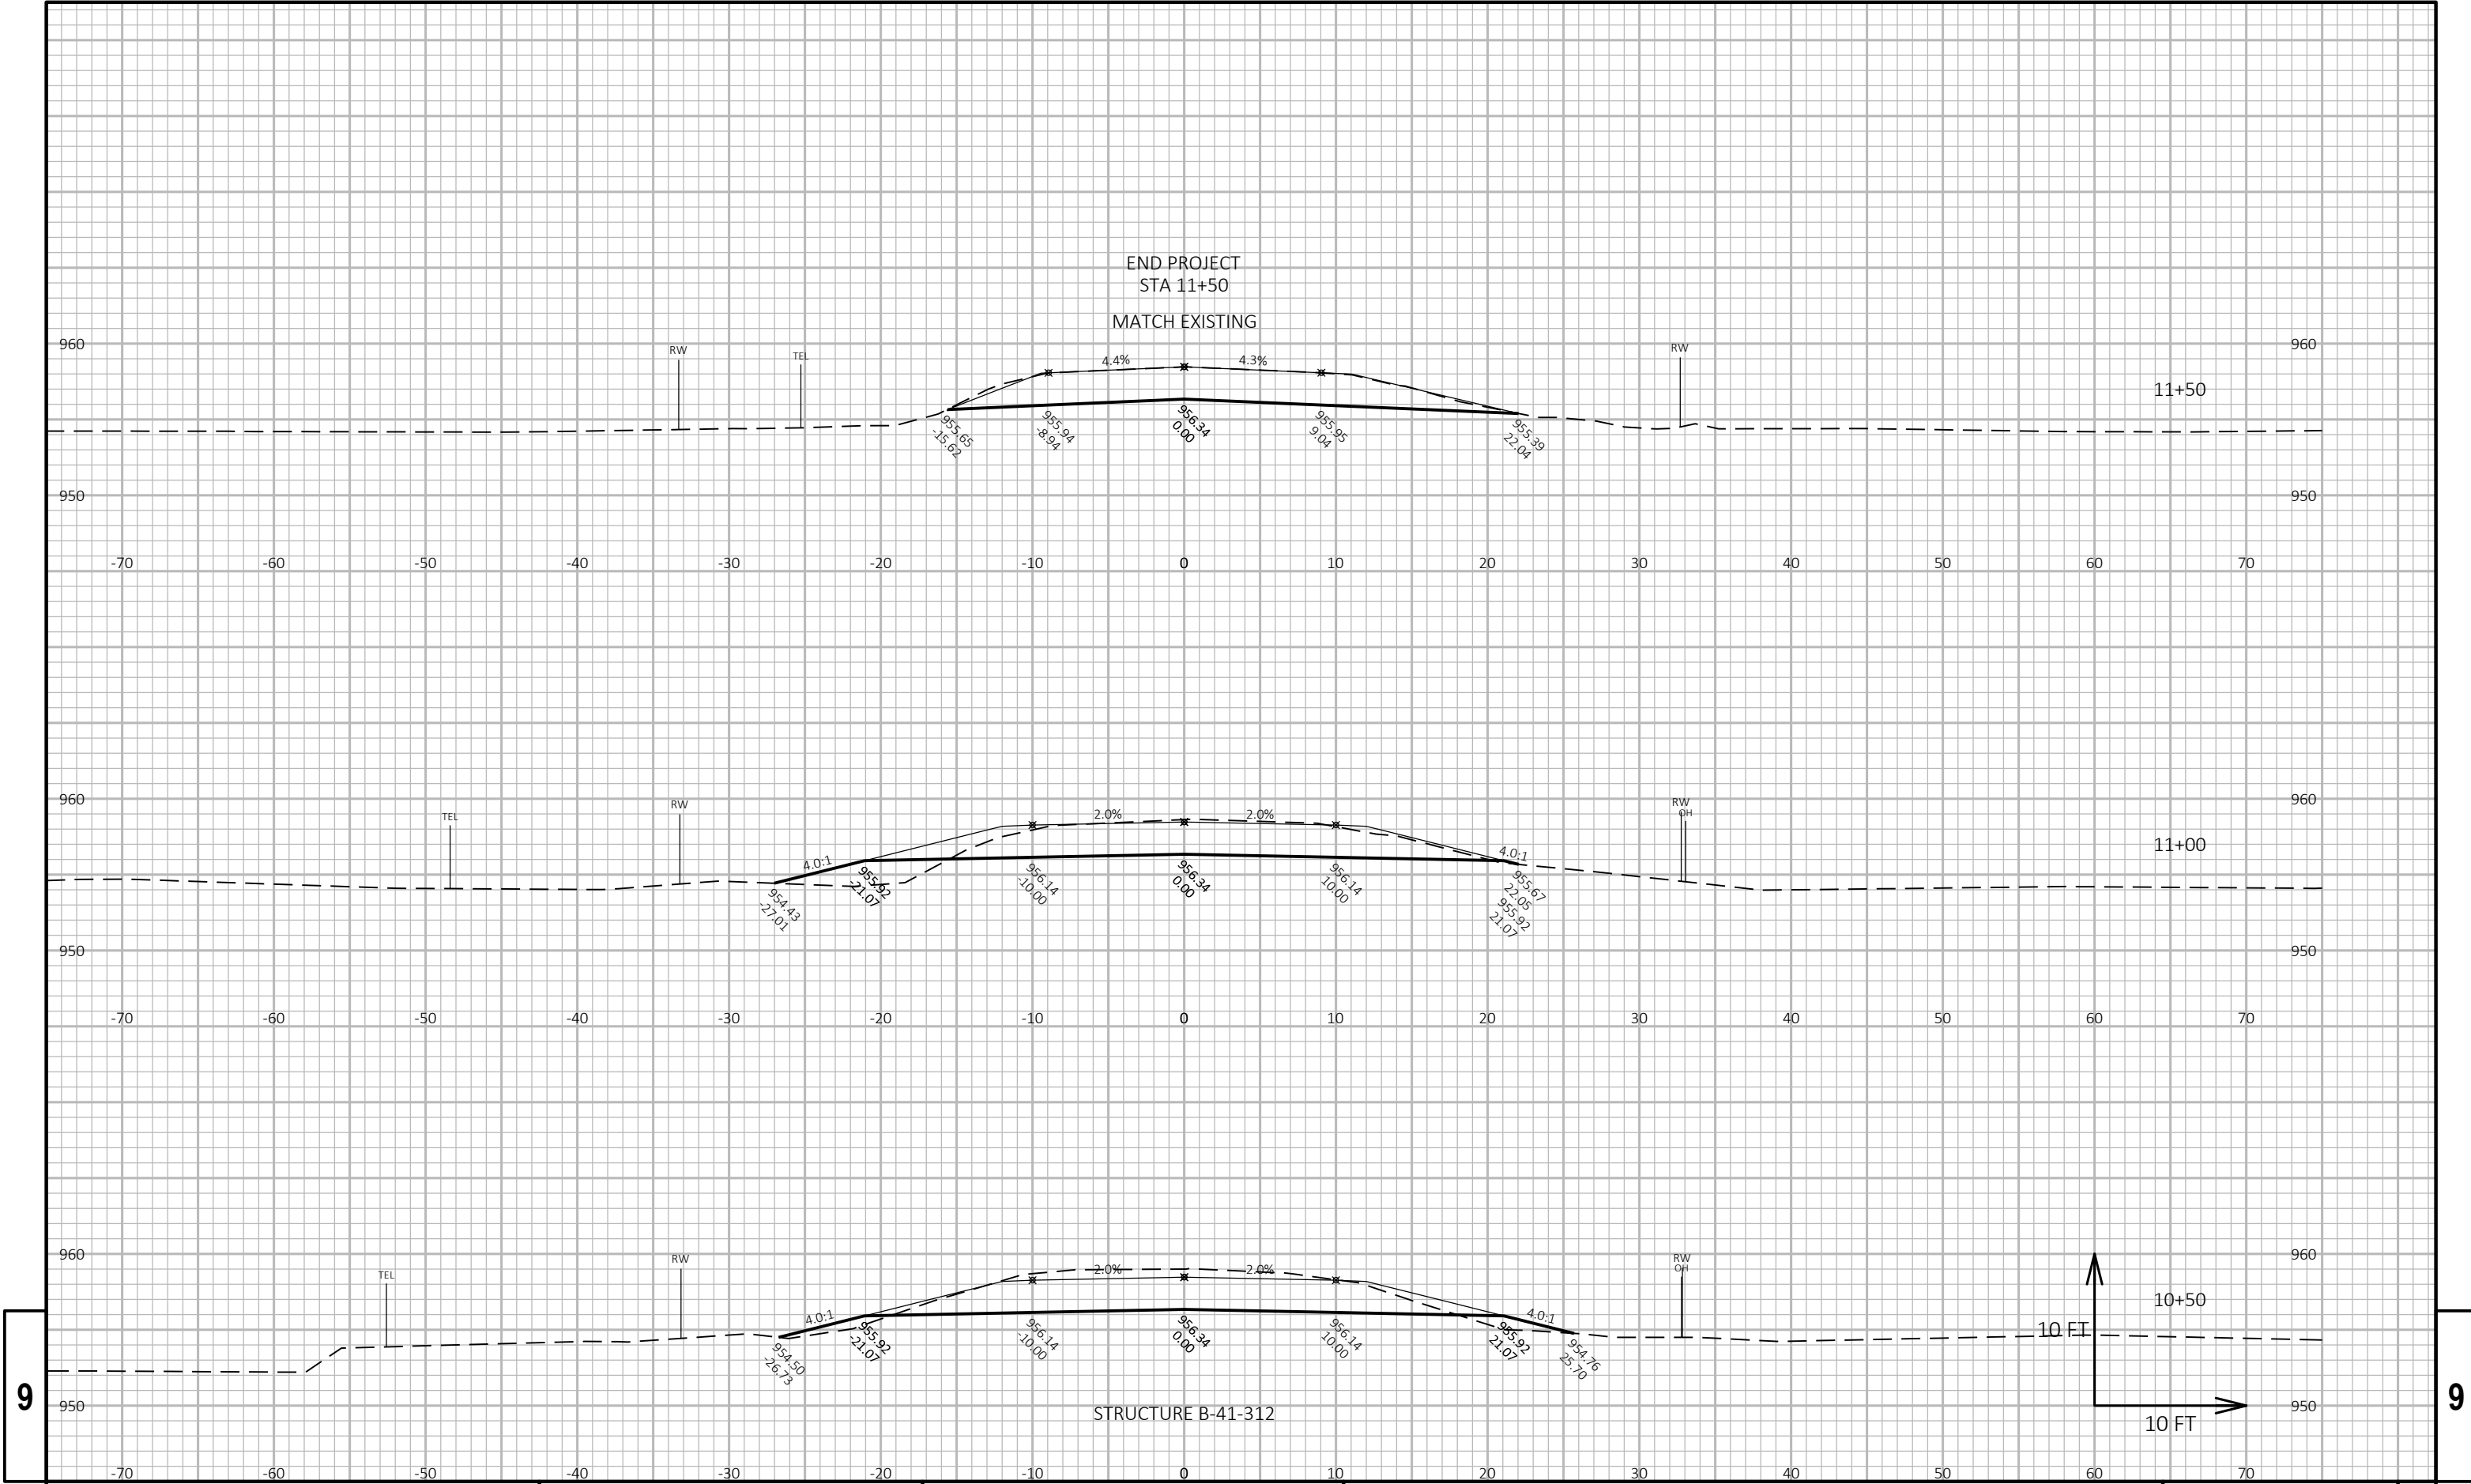

PROJECT NO: 7102-00-70

HWY: TOWN ROAD

COUNTY: MONROE

CROSS SECTIONS: DOLPHIN ROAD

SHEET

E

FILE NAME : P:\58005\58405\5848\05848028\CADD\DESIGN\CORRIDORS\5848028_CORRIDOR_DOLPHIN.DWG
LAYOUT NAME - 090202_xs

PLOT DATE : 5/15/2018 10:46 AM


PLOT BY : JOLIE SNYDER

PLOT NAME :

PLOT SCALE : 1 IN:10 FT HORZ. / 1 IN:10 FT VERT.

WISDOT/CADDs SHEET 49

Notes

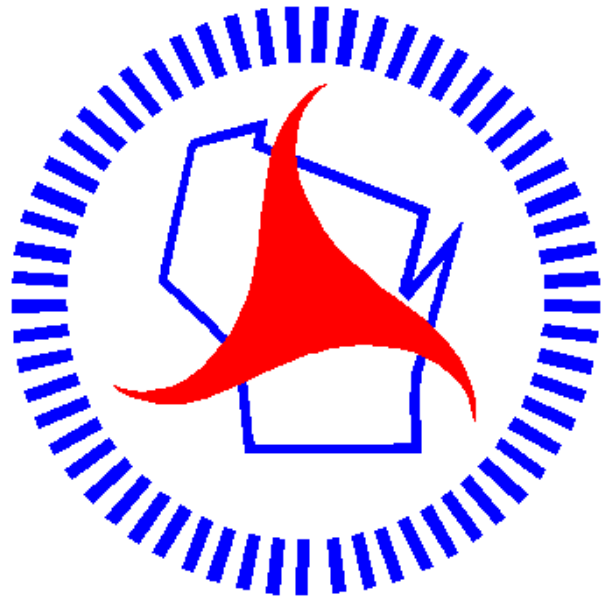

Wisconsin Department of Transportation

Dedicated people creating transportation solutions
through innovation and exceptional service.

<http://www.dot.wisconsin.gov>