

INDEX OF SHEETS

SHEET NO. 1 TITLE
 SHEET NO. 20-22 TYPICAL CROSS SECTIONS, MISCELLANEOUS DETAILS & ALIGNMENT PLAN
 SHEET NO. 3 ESTIMATE OF QUANTITIES
 SHEET NO. 3A MISCELLANEOUS QUANTITIES
 SHEET NO. 40-43 RIGHT OF WAY PLAT
 SHEET NO. 5-7 PLAN AND PROFILE STA. 342+72.63 TO STA. 354+00
 SHEET NO. 8-84 STANDARD DETAILS
 SHEET NO. 9-35 DRAINAGE STRUCTURES
 SHEET NO. 36-40 CROSS SECTIONS



STATE OF WISCONSIN STATE HIGHWAY COMMISSION OF WISCONSIN

PLAN AND PROFILE OF PROPOSED LA CROSSE - TOMAH ROAD (FAUVER HILL SEPARATION & APPROACHES) I. H. 90 LA CROSSE COUNTY PROJ. EACI-90-1(45)5

COUNTY AND HIGHWAY	ROUTE AND SECTION	CLASS AND AGREEMENT		S.P.A. REGION DIVISION	SHEET NUMBER	TOTAL SHEETS
		STATE	FEDERAL			
32.3	90.1		11.45	4 WIS.	1	40


AS BUILT PLAN

CONTRACTOR - NELSON CONST. CO.
 RESIDENT - A. LORENZ
 DATE COMPLETED - 8-2-67

PLAN 1 IN. = 100 FT.
 PROFILE HOR. 1 IN. = 100 FT. VERT. 1 IN. = 10 FT.
 CROSS SECTIONS HOR. 1 IN. = 10 FT. VERT. 1 IN. = 10 FT.

END OF PROJECT I-90-1(21)3
 BEGINNING OF PROJ. EACI-90-1(45)5
 STA. 342+72.63
 21.5' SOUTH & 13.17' WEST OF THE CENTER
 OF SEC II, T16N, R7W.

DESIGN DESIGNATION
 A DT 1962 4,550
 A DT 1986 11,900
 D HV 1986 1,790
 K 15%
 D 60%
 T 10%
 V 70mph

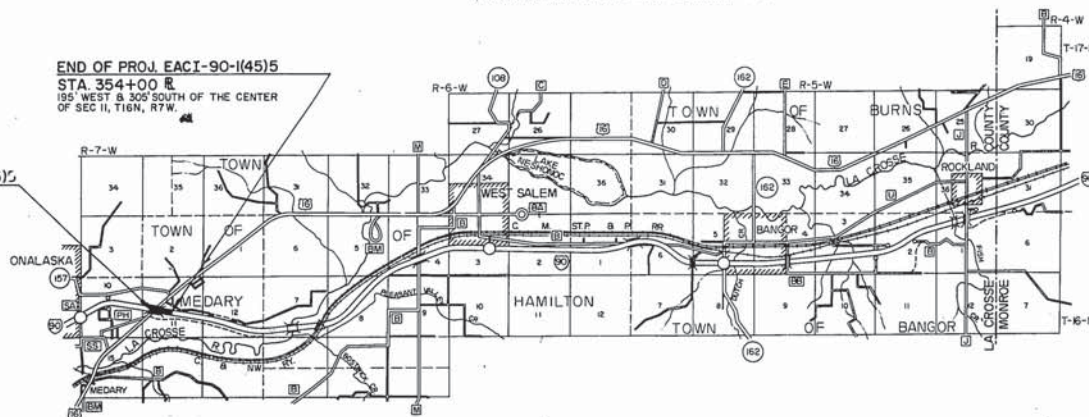

CONVENTIONAL SIGNS

STATE LINE.....
 COUNTY LINE.....
 TOWNSHIP OR RANGE LINE.....
 SECTION LINE.....
 NEW RIGHT OF WAY LINE.....
 PRESENT RIGHT OF WAY LINE.....
 WIRE FENCE {WOVEN.....
 BARBED.....
 LOT LINE.....
 CORPORATE OR CITY LIMITS.....
 PROPERTY LINE.....
 TRAVELED WAY OR P.E.....
 RAILROADS.....
 BASE OR SURVEY LINE.....

CULVERTS IN PLACE.....
 CULVERTS REQUIRED.....
 DROP INLET.....
 POWER POLE.....
 TELEPHONE OR TELEGRAPH POLE.....
 RIGHT OF WAY MARKERS.....
 REFERENCE STAKE FOR HUBS ONLY.....
 MARSH.....
 HEDGE.....
 TREES.....
 GROUND ELEVATION..... DATUM LINE
 GRADE ELEVATION..... DATUM LINE

APPROVED INTERSTATE LOCATION.....
 INTERCHANGE (MAIN LINE UNDER).....
 INTERCHANGE (MAIN LINE OVER).....
 HWY. GRADE SEPARATION (MAIN LINE UNDER).....
 RAILROAD GRADE SEPARATION.....
 COMBINATION HWY.-RAILROAD SEPARATION.....
 OTHER BRIDGES (MAIN LINE OVER).....
 FRONTAGE ROAD (LOCAL OR STATE).....
 TERMINATED CROSS ROAD.....


LAYOUT
 SCALE 1 MILE

TOTAL NET LENGTH OF CENTERLINE = 0.24 MI.

CONTROL OF ACCESS
 WITHIN THE LIMITS OF THE PROJECT WHERE CONTROL OF ACCESS LINE IS SHOWN THUS NO ACCESS IS PERMITTED TO THE INTERSTATE TRAFFIC LANES.

STATE HIGHWAY COMMISSION OF WISCONSIN MADISON, WIS.	
SURVEYOR: AERO & D.E.K.	NOTES MADE: L.A.B.
DIVISION COMPUTER: L.A.B.	DATE: 4/13/66
DIVISION CHECKER: A.A.J.	DATE: 4/13/66
RECOMMENDED FOR APPROVAL: DATE: 4/13/66	
APPROVED: DATE: 4/13/66	
DEPARTMENT OF COMMERCE BUREAU OF PUBLIC ROADS	
APPROVED: DATE:	


EAC 190-1(45)5 025

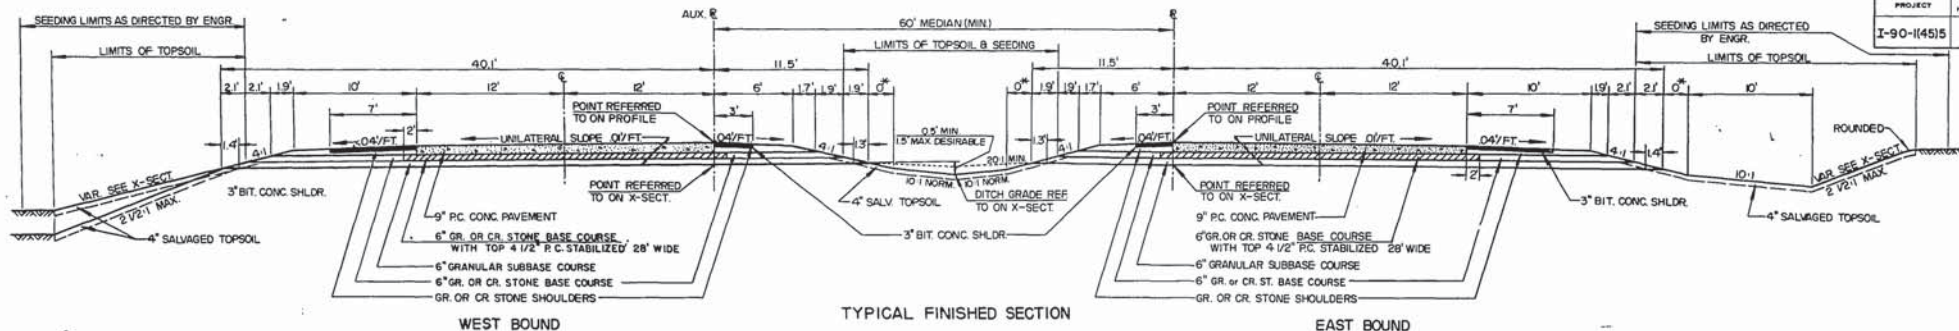

NOTE: P.C. SURFACING, GR. OR CR. STONE BASE COURSE, BASE STABILIZATION, BITUMINOUS CONCRETE SURFACE, & GRAVEL OR CRUSHED STONE BASE COURSE FOR SHOULDERS ON MAINLINE AND TEMPORARY CONNECTION ARE NOT A PART OF THIS CONTRACT.

BITUMINOUS CONCRETE SURFACING AND GRAVEL OR CRUSHED STONE BASE COURSE FOR SHOULDERS ON SOUTH FRONTAGE ROAD AND TEMP. TOWN ROAD ARE NOT A PART OF THIS CONTRACT.


* VARY THIS DIMENSION TO ATTAIN SPECIAL DITCH GRADES

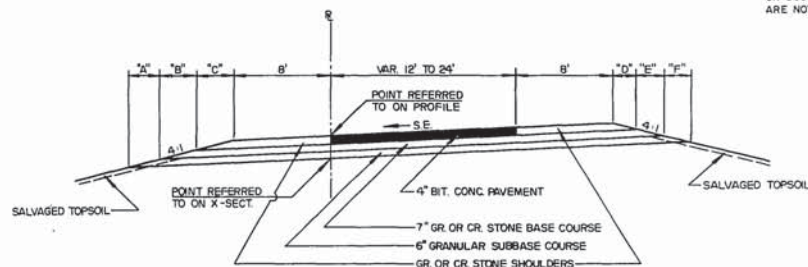


TYPICAL SUPERELEVATED SECTION
TEMPORARY CONNECTION

DISTANCES FOR SUPERELEVATED SECTION (FEET)


S.E.	"A"	"B"	"C"	"D"	"E"	"F"
0.01 RT.	1.9	2.2	2.1	1.2	2.4	2.1
0.02 RT.	1.9	2.1	2.0	1.6	2.5	2.2
0.03 RT.	1.8	2.1	1.9	2.1	2.6	2.3
0.04 RT.	1.7	2.0	1.9	2.6	2.7	2.4
0.05 RT.	1.7	1.9	1.8	2.7	2.9	2.5
0.06 RT.	1.6	1.9	1.7	2.8	3.0	2.6
0.07 RT.	1.6	1.8	1.7	3.0	3.2	2.8
0.08 RT.	1.5	1.8	1.6	3.2	3.4	2.9
0.01 LT.	2.1	2.4	1.2	2.1	2.2	1.9
0.02 LT.	2.2	2.5	1.6	2.0	2.1	1.9
0.03 LT.	2.3	2.6	2.1	1.9	2.1	1.8
0.04 LT.	2.4	2.7	2.6	1.9	2.0	1.7
0.05 LT.	2.5	2.9	2.7	1.8	1.9	1.7
0.06 LT.	2.6	3.0	2.8	1.7	1.9	1.6
0.07 LT.	2.8	3.2	3.0	1.7	1.8	1.6
0.08 LT.	2.9	3.4	3.2	1.6	1.8	1.5

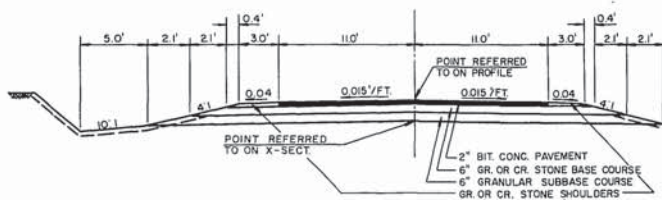

TYPICAL SECTION
SOUTH FRONTAGE ROAD STA. 340"N"+40-354"N"+00

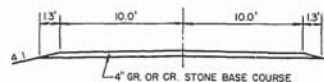

TYPICAL SECTION
PRIVATE ENTRANCE

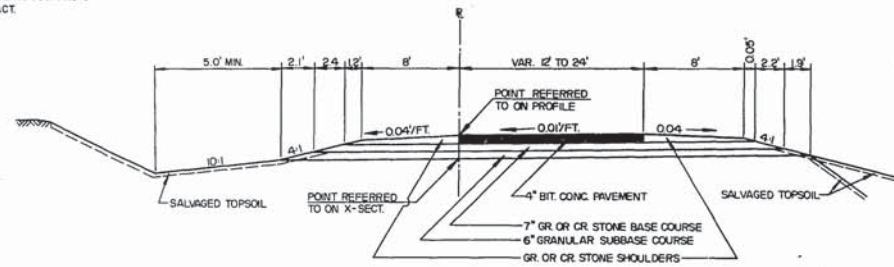


TYPICAL SECTION
TEMPORARY CONNECTION

TYPICAL SECTION
TEMP. TOWN ROAD STA. 354"E"+00-STA. 363"E"+65.94

TYPICAL CROSS SECTION
FOR

MAINLINE
TEMPORARY CONNECTION
SOUTH FRONTAGE ROAD
TOWN ROAD TEMP. CONN.

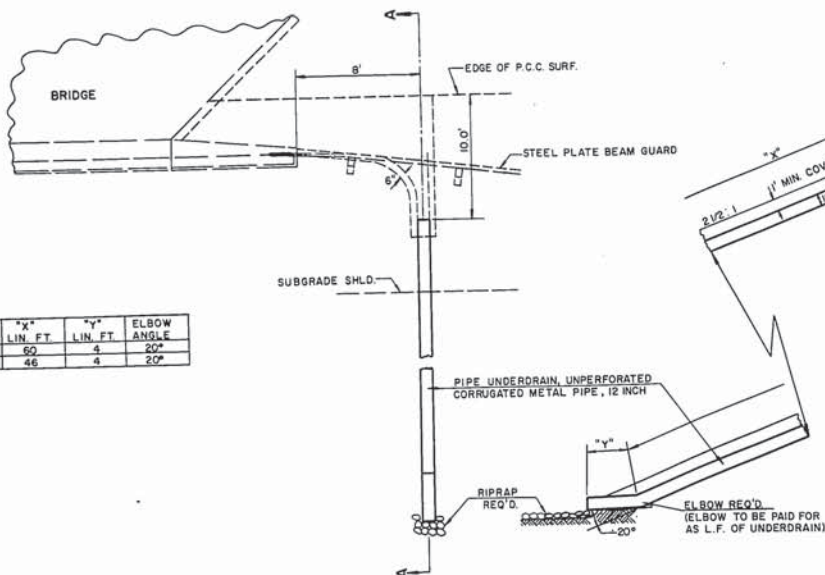

LOC.	"X" LIN. FT.	"Y" LIN. FT.	ELBOW ANGLE
B-32-53	60	4	20°
B-32-54	46	4	20°

SURFACE DRAIN AT BRIDGES
(CONC. PORTION NOT A PART OF THIS CONTRACT)

SECTION A-A


- STANDARD DETAIL DRAWINGS**
- 6-2.6.4 APRON ENDWALLS FOR CULVERT PIPE AND PIPE ARCH.
 - 7-1.3.4 MARKER POSTS
 - 7-4.1.4 CONSTRUCTION BARRICADE.
 - 8-2.1.4 SODDED BACKSLOPE FLUME & INTERCEPTING EMBANKMENT.
 - 9-1.1.4 DESIGN AND LAYOUT DETAILS FOR SIDE ROAD AT GRADE INTERSECTIONS.

NOTE:
THE MARKER POSTS AT CULVERTS SHOWN ON THE STANDARD PLATE 7-1.3.4 ARE NOT REQUIRED.

GENERAL NOTES

1. THE REFERENCE LINE (R) IS THE MEDIAN EDGE OF THE EASTBOUND PAVEMENT. THE AUXILIARY REFERENCE LINE (AUX. R) IS THE MEDIAN EDGE OF THE WESTBOUND PAVEMENT.
2. SALVAGED TOPSOIL TO BE PLACED ON ALL CUT SLOPES AND ALL FILL SLOPES TO AN APPROXIMATE DEPTH OF 4" AT TIME OF PLACING.
3. ALL RIGHT OF WAY EXCLUSIVE OF THE ROADBED AND AREAS ALREADY COVERED WITH SUITABLE GRASSES SHALL BE SEED.
4. NO TREES OR SHRUBS SHALL BE REMOVED UNLESS SUCH TREES OR SHRUBS HAVE BEEN DESIGNATED FOR REMOVAL BY THE ENGINEER.
5. SHRINKAGE IS VARIABLE AND ESTIMATED AT 25% FOR UNCLASSIFIED AND BORROW EMBANKMENTS AND 20% FOR GRANULAR SUBBASE COURSE.
6. CURVE DATA IS BASED ON ARC DEFINITION.
7. WHEN THE QUANTITY OF THE ITEMS OF SUBBASE, BASE, OR SURFACE COURSE IS MEASURED FOR PAYMENT BY THE TON OR CUBIC YARD, THE DEPTH OR THICKNESS OF THE COURSE SHOWN ON THE PLANS IS APPROXIMATE AND THE ACTUAL THICKNESS WILL DEPEND ON THE DISTRIBUTION OF THE MATERIAL AS DIRECTED BY THE ENGINEER.
8. THE EXACT LOCATION OF PRIVATE ENTRANCES TO BE DETERMINED IN THE FIELD BY THE ENGINEER.
9. STRAW MULCH ALL SLOPES STEEPER THAN 4:1.

MISCELLANEOUS DETAILS

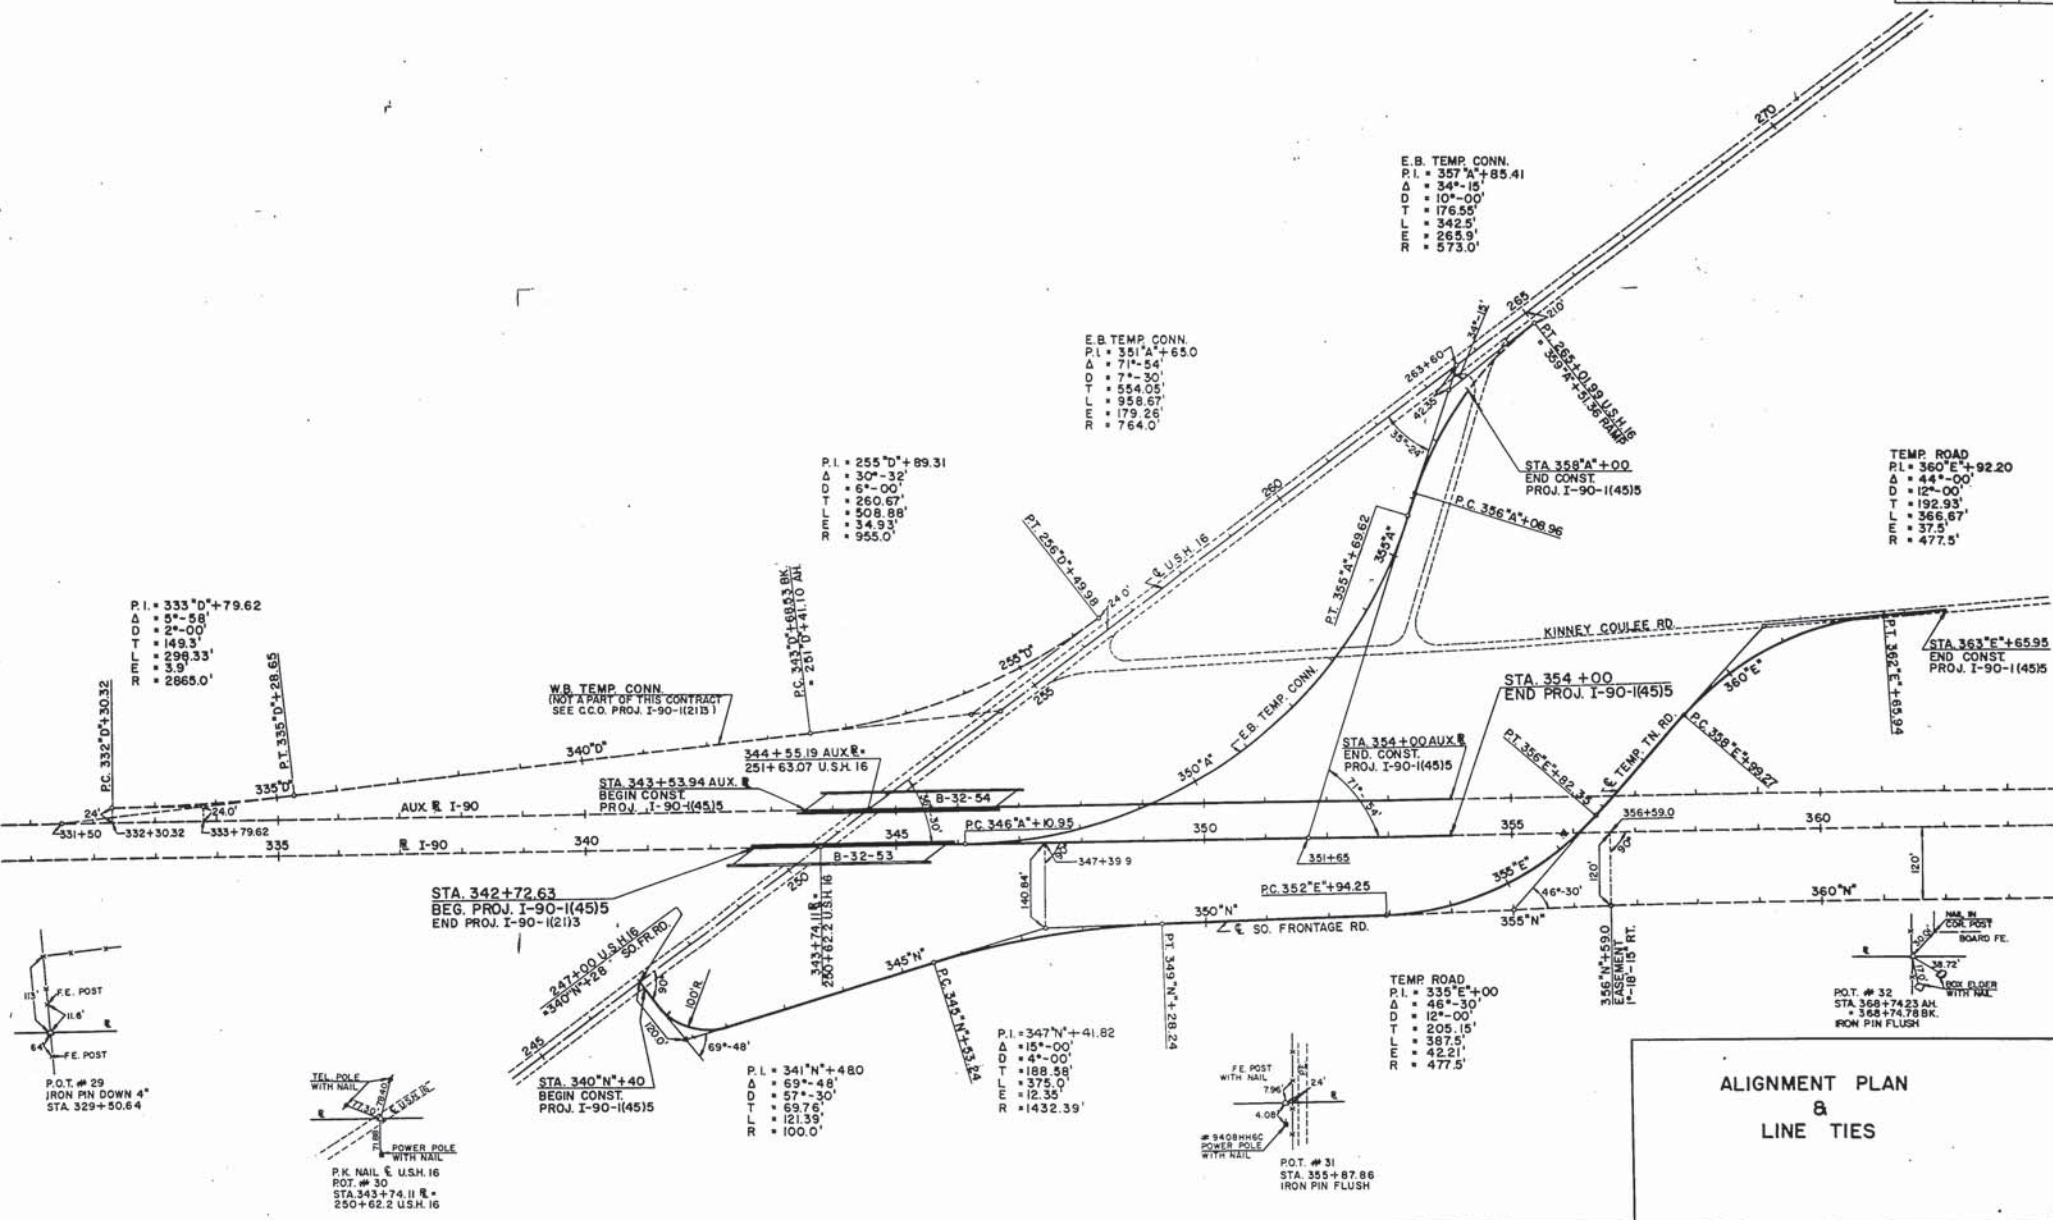

DETAIL SUMMARY OF MISCELLANEOUS QUANTITIES

CLEARING AND GRUBBING

Sta. - Sta.
352+00 - 356+00
362+00 - 364+00

Clearing
Sta. 1
2

Grubbing
Sta. 1
2

Sta. - Sta.
340+00 - 345+00
345+00 - 349+00
349+00 - 354+00
354+00 - 363+00

Location
S. Front. Rd.
S. Front. Rd.
S. Front. Rd.
Temp. Road

Sta. 71.39
80.89
71.39
81.61

C.Y. 392
303
351
788

GRANULAR SUBBASE COURSE

Sta. - Sta.
347+00 - 351+00
347+75 - 351+00
345+00 - 358+00
340+00 - 351+00

Location
E.B.
W.B.
"A" Line
"N" Line

C.Y. 530
760
1,300
1,010

Priv. Ent.
Priv. Ent.
Intersec.

C.Y. 10
20
55
90

TOPSOIL, SEEDING & FERTILIZER

Location
Mainline
"A" Line
Town Road
Undistributed

Salv.
Topsoil
S.Y. 11,272
1,439
6,295
594

Fertilizer
Cwt. 10.0
1.0
5.7
1.3

Seeding
S.Y. 11,272
28,139
6,295
594

SODDING
Location
W. Abut., B-32-53
E. Abut., B-32-53
W. Abut., Median
E. Abut., Median
W. Abut., B-32-54
E. Abut., B-32-54
E.B.

S.Y. 268
713
336
320
611
262
50
80

PIPE CULVERTS - CROSS DRAIN PIPES

Station
347+00
354+00

Location
E.B. Temp.
E.B. Temp.

Type
C.P. Cl. III
C.P. Cl. III

Diam.
18"
24"

L.F. 66
76

Apron
Endwalls
2
2

Marker Posts

MINOR SIDE ROAD & PRIVATE ENTRANCE PIPES

Station
340+00
345+00

Location
S. Front. Rd.
S. Front. Rd.

Type
C.P. Cl. III*
C.P. Cl. III*

Diam.
24"
24"

L.F. 88
144

Apron
Endwalls
2
2

Skew
20° RHP

Marker Posts

*R.C.C.P., Steel or Aluminum

PIPE UNDERDRAIN, IMPERFORATED CORRUGATED METAL PIPE, 12 INCH

Station
345+00
347+00

Location
Surf. Drain, B-32-53
Surf. Drain, B-32-54

Diam.
12"
12"

L.F. 64
50

Rt. 1
1

Remarks
20° Elbow
20° Elbow

Marker Posts

CALCIUM CHLORIDE SURFACE TREATMENT

Sta. - Sta.
340+00 - 363+00
Undistributed

Width
21.0'

Tons
14.65
0.35

MARKER POSTS

Sta. - Sta.
352+70
353+70

Location
Lt.
Rt.

No.
5
5

PROJECT


I-90-1(45)5

SHEET NO. 3A

TOTAL SHEETS 40

OFFICIAL PLAT ON FILE WITH
THE REGISTER OF DEEDS OFFICE

COUNTY AND HIGHWAY	ROUTE AND SECTION	CLASS AND AGREEMENT	STATE	FEDERAL	B.P.R. REGION DIVISION	SHEET NUMBER	TOTAL SHEETS
32.3	901	13.3	4	WIS	48	40	40
CONST PROJECT		1-90-1 (45) 5				40	40

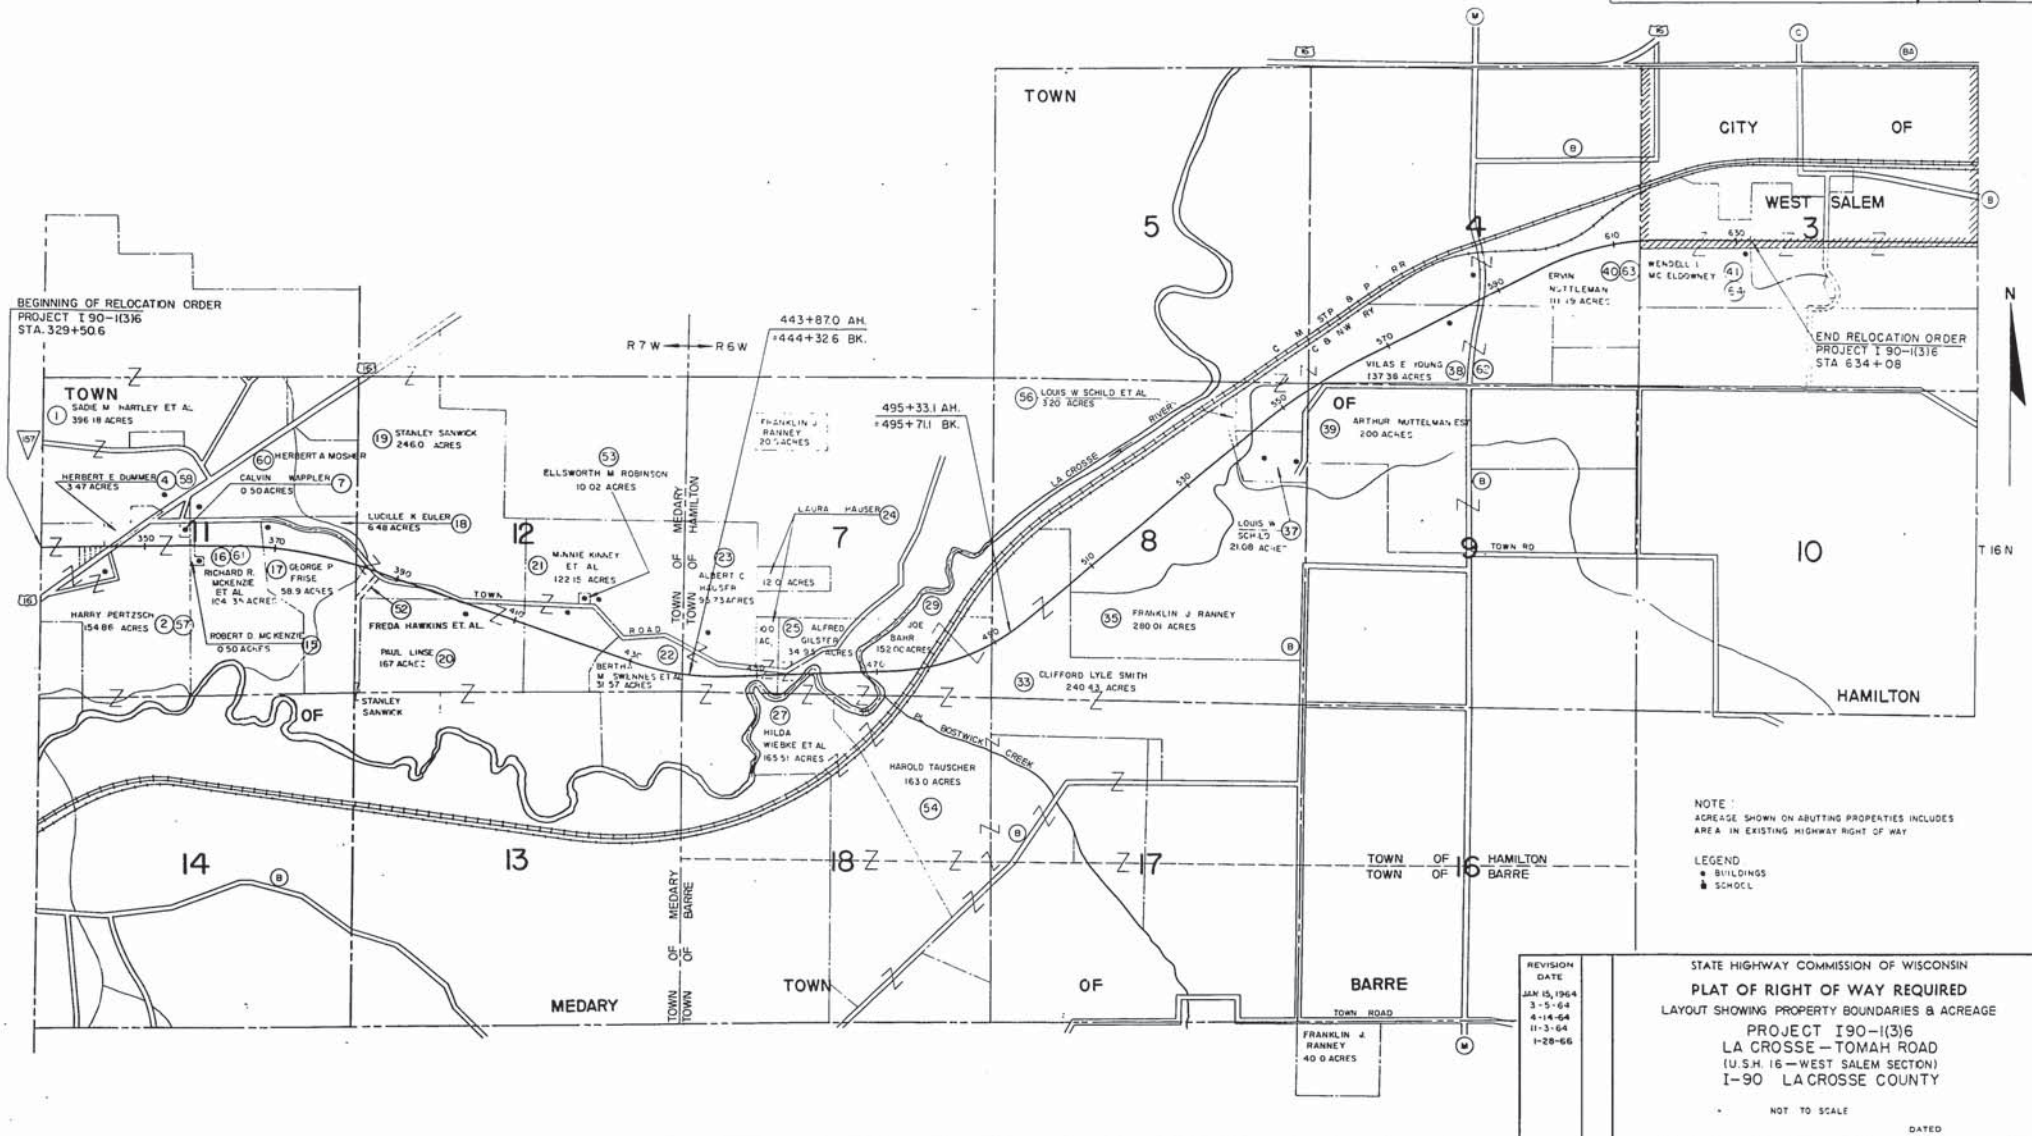



SCHEDULE OF LANDS AND INTERESTS REQUIRED

COUNTY AND HIGHWAY	ROUTE AND SECTION	CLASS AND AGREEMENT		S. P. R. REGION DIVISION	SHEET NUMBER	TOTAL SHEETS
		STATE	FEDERAL			
32.3	90.1		13.3	4 WIS.	4.7	
CONST. PROJECT		1-90-1 (45) 5			41	40


[illegible]

LEGEND
 UUUUUUU
 DENOTES
 NO ACCESS

STATE HIGHWAY COMMISSION OF WISCONSIN
PLAT OF RIGHT OF WAY REQUIRED
 PROJECT I 90-1(3)6
 LA CROSSE - TOMAH ROAD
 (U.S.H.16 - WEST SALEM SECTION)
 INTERSTATE HIGHWAY 90 LA CROSSE COUNTY

LENGTH=5.784 MILES.


DATA

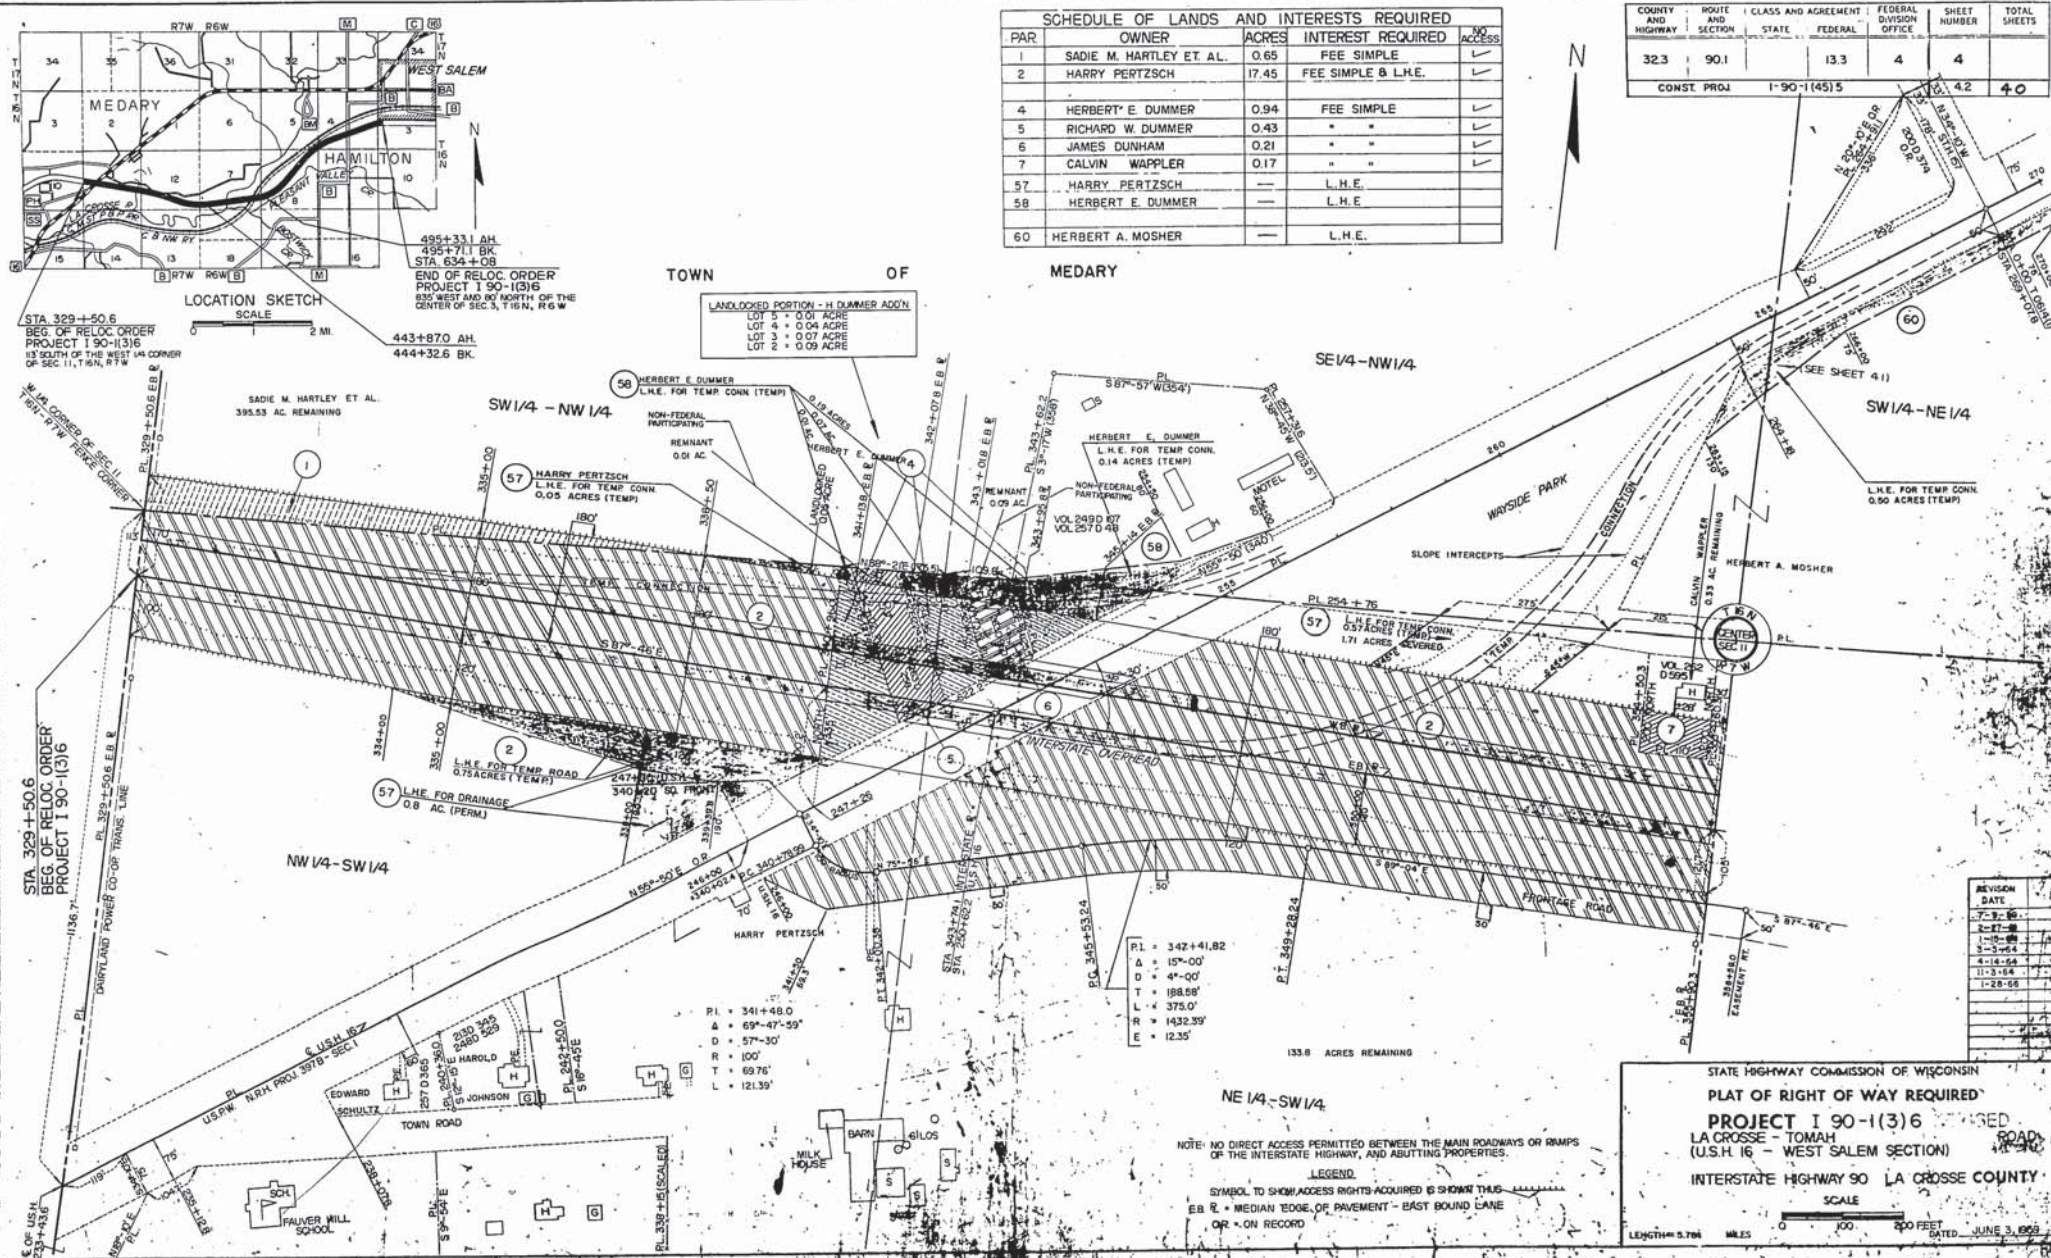

LEGEND
 SYMBOL TO SHOW ACCESS RIGHTS ACQUIRED IS SHOWN THUS
 E = MEDIAN EDGE OF PAVEMENT EAST BOUND LANE
 O R = ON RECORD

NOTE: NO DIRECT ACCESS PERMITTED BETWEEN THE MAIN ROADWAYS OR RAMPS OF THE INTERSTATE HIGHWAY, AND ADJUTING PROPERTIES.

COUNTY AND HIGHWAY	ROUTE AND SECTION	CLASS AND AGREEMENT	FEDERAL	FEDERAL DIVISION OFFICE	SHEET NUMBER	TOTAL SHEETS
32.3	90.1	13.3	4	4.1	4.1	4.0
CONST. PROJ.	1-90-1 (45) 5				4.3	4.0

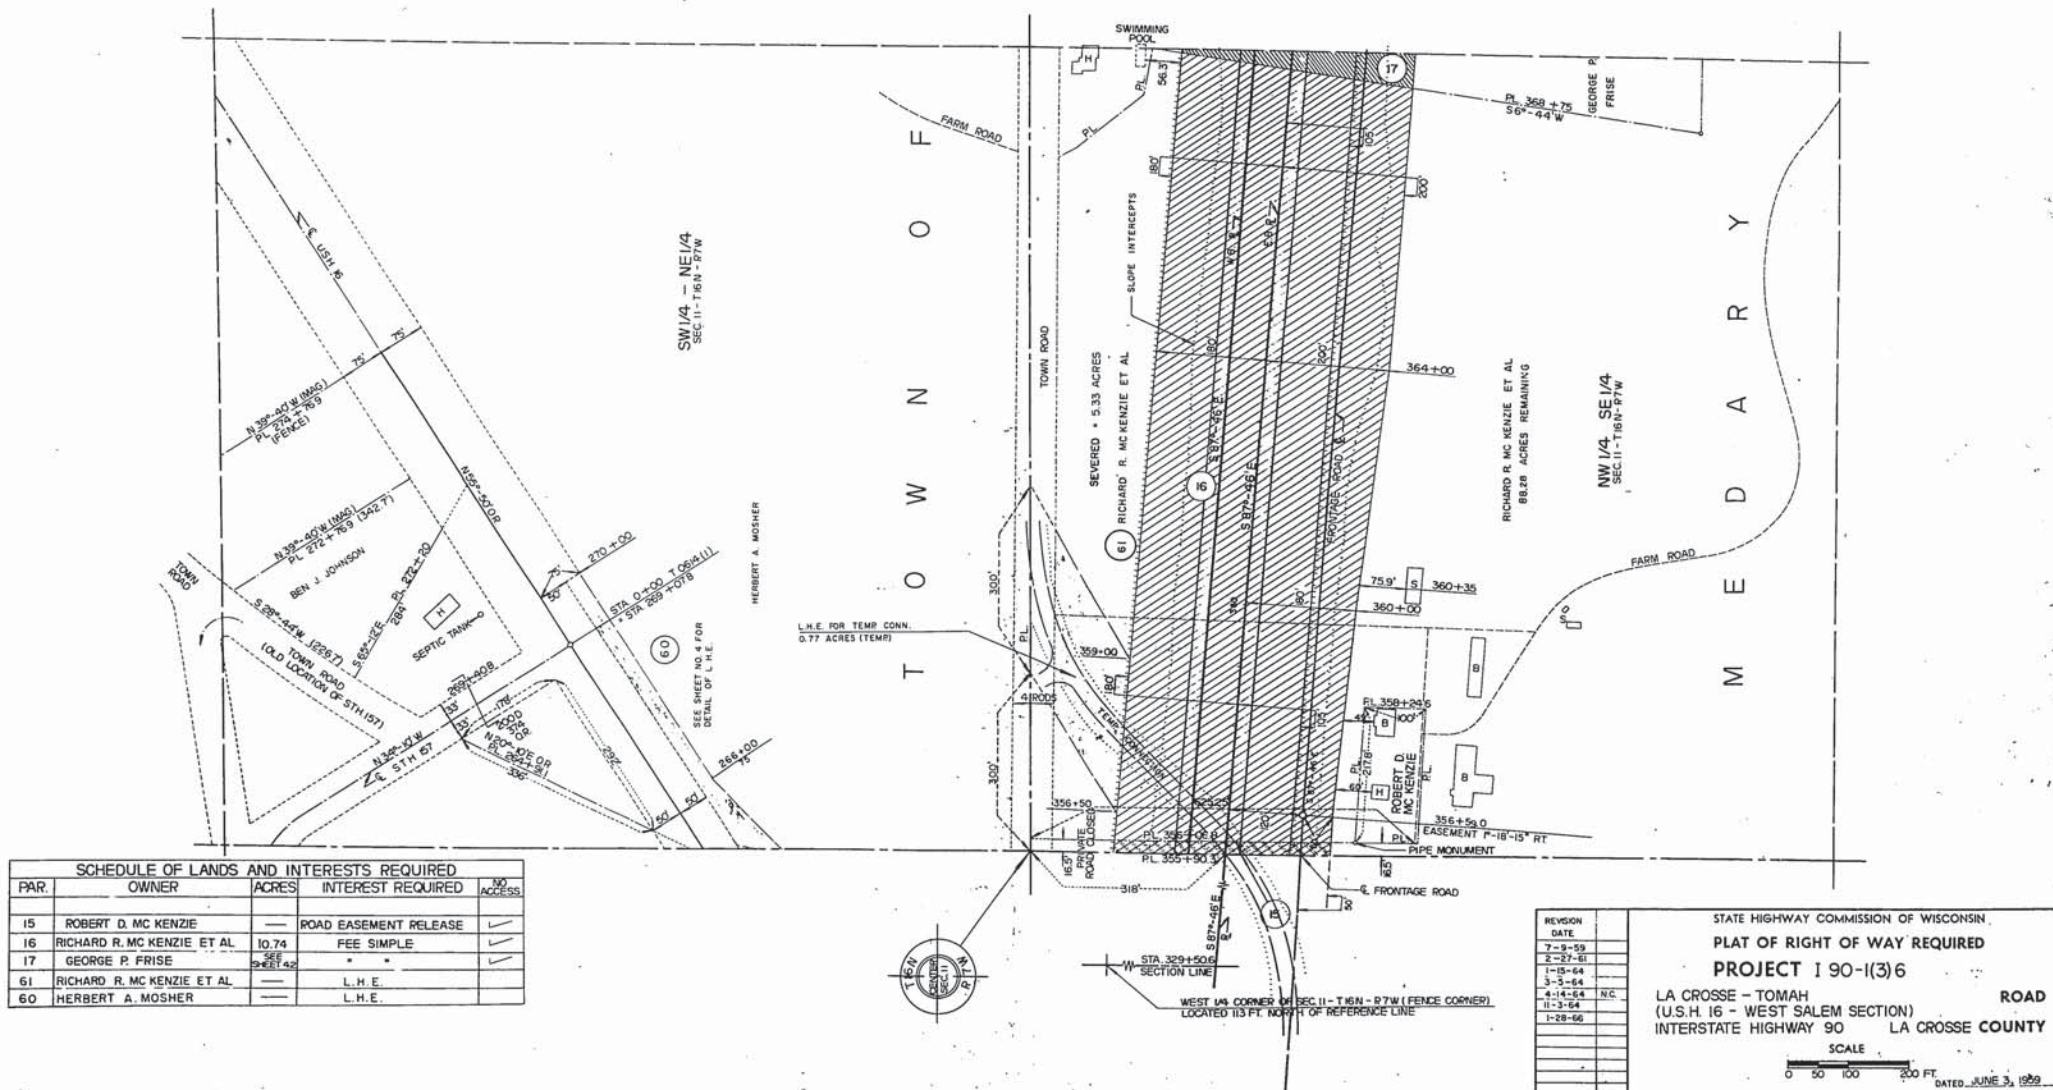






SCHEDULE OF LANDS AND INTERESTS REQUIRED				
PAR.	OWNER	ACRES	INTEREST REQUIRED	NO. ACCESS
15	ROBERT D. MC KENZIE	—	ROAD EASEMENT RELEASE	✓
16	RICHARD R. MC KENZIE ET AL.	10.74	FEE SIMPLE	✓
17	GEORGE P. FRISE	88.28	FEE SIMPLE	✓
61	RICHARD R. MC KENZIE ET AL.	—	L.H.E.	✓
60	HERBERT A. MOSHER	—	L.H.E.	✓

REVISION	DATE
1	7-9-59
2	2-27-61
3	1-15-64
4	3-5-64
5	4-14-64
6	11-3-64
7	1-28-66

STATE HIGHWAY COMMISSION OF WISCONSIN
 PLAT OF RIGHT OF WAY REQUIRED
 PROJECT 1 90-1(3) 6
 LA CROSSE - TOMAH
 (U.S.H. 16 - WEST SALEM SECTION)
 INTERSTATE HIGHWAY 90 LA CROSSE COUNTY
 ROAD
 SCALE
 0 50 100 200 FT.
 DATED JUNE 3, 1969





X

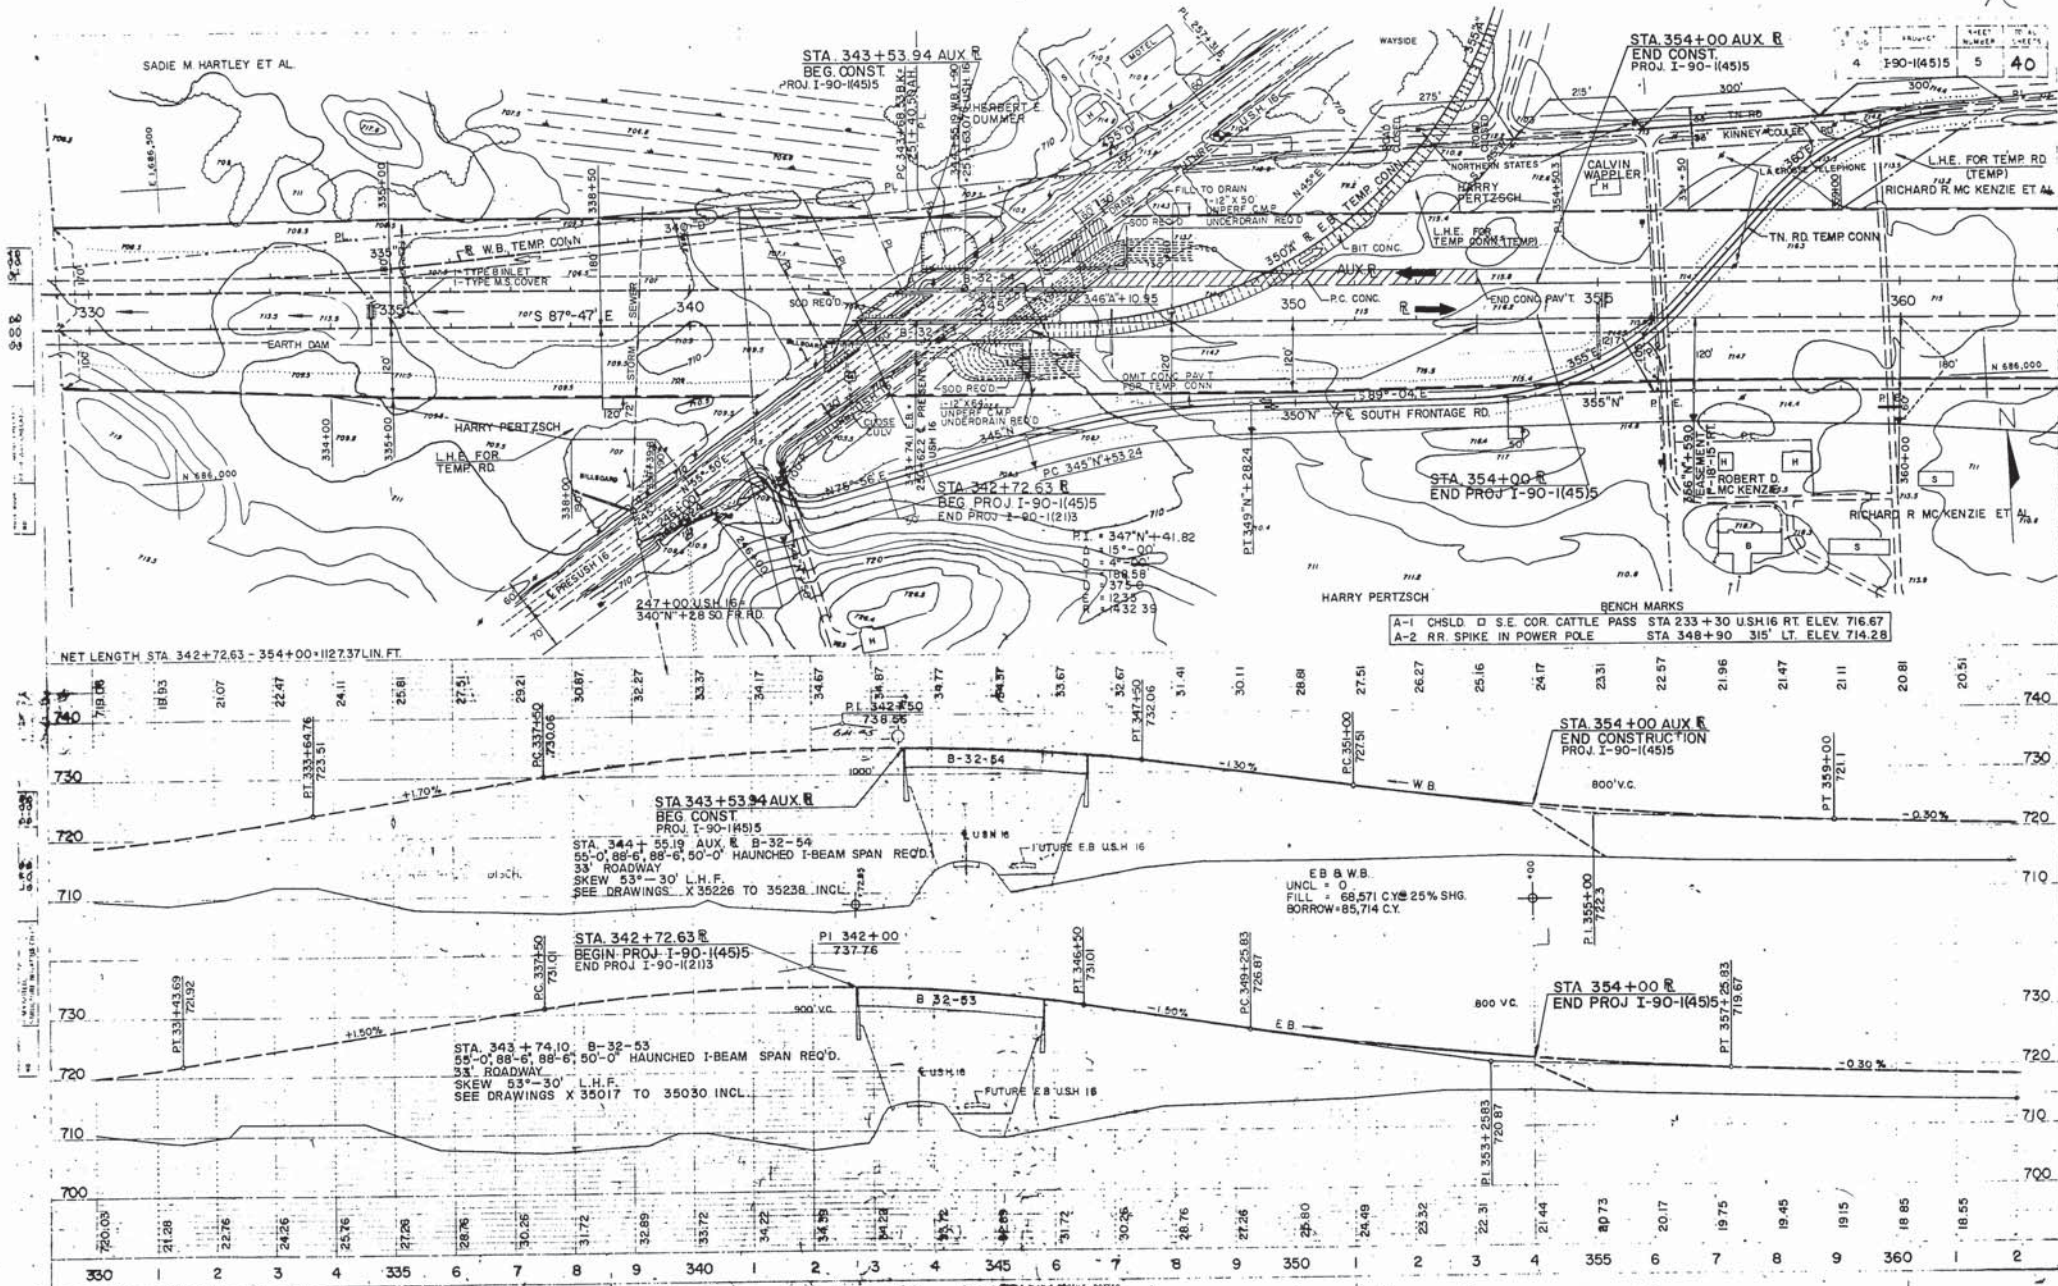

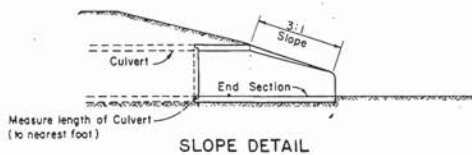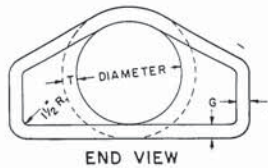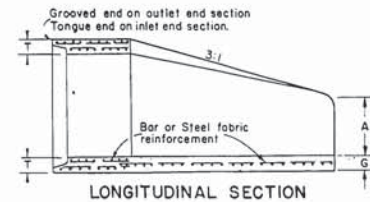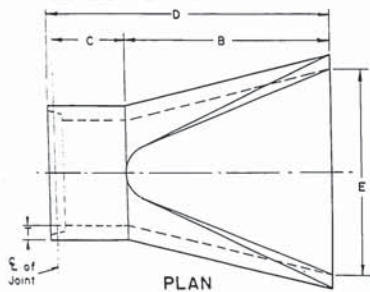

DIA.	APPROX. WEIGHT/SECTION	SLOPE	T	A	B	C	D	E	G
18"	990	3 to 1	2 1/2"	9"	27"	46"	73"	36"	2 1/2"
21"	1280	3 to 1	2 3/4"	9"	36"	37 1/2"	73 1/2"	42"	2 3/4"
24"	1520	3 to 1	3"	9 1/2"	43 1/2"	30"	73 1/2"	48"	3"
27"	1930	3 to 1	3 1/4"	10 1/2"	49 1/2"	24"	73 1/2"	54"	3 1/4"
30"	2190	3 to 1	3 1/2"	12"	54"	19 1/2"	73 1/2"	60"	3 1/2"
36"	4100	3 to 1	4"	15"	63"	34 1/2"	97 1/2"	72"	4"
42"	5380	3 to 1	4 1/2"	21"	63"	35"	98"	78"	4 1/2"
48"	6550	3 to 1	5"	24"	72"	26"	98"	84"	5"

REINFORCED CONCRETE APRON ENDWALLS

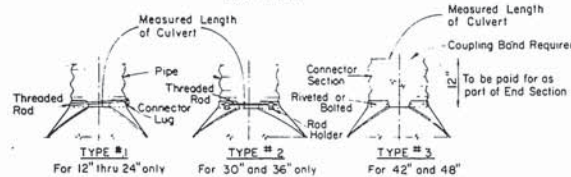
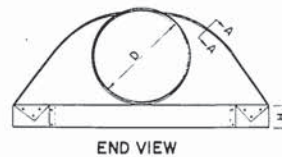
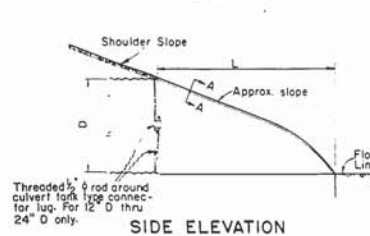
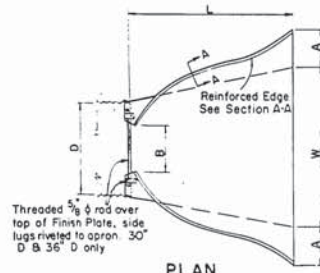


CONNECTION DETAILS

D	Gage Min.	A	B	H	L	W	Approx. Slope	Fabrication Remarks
16"	16"	8"	10"	6"	31"	36"	2 1/2 to 1	1 Piece
21"	16"	9"	12"	6"	36"	42"	"	"
24"	16"	10"	13"	6"	41"	48"	"	"
30"	14"	12"	16"	8"	51"	60"	"	"
36"	14"	14"	19"	9"	60"	72"	"	2 Pieces, C. Splice
42"	12"	16"	22"	11"	69"	84"	"	"
48"	12"	18"	27"	12"	78"	90"	2 1/4 to 1	"


Note: All splices to be lap riveted or bolted.

METAL AND ALUMINUM APRON ENDWALLS

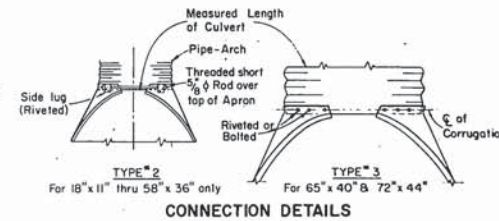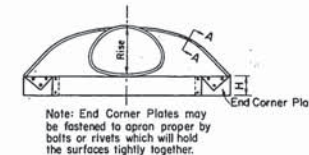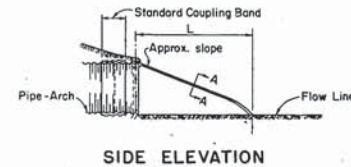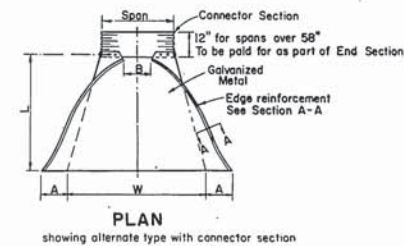

Pipe-Arch Dimensions	Gage Min.	A	B	H	L	W	Approx. Slope	Fabrication Remarks
18" x 11"	16"	7"	9"	6"	19"	30"	2 1/2 to 1	1 Piece
22" x 13"	16"	7"	10"	6"	23"	36"	"	"
25" x 16"	16"	8"	12"	6"	28"	42"	"	"
29" x 18"	16"	9"	14"	6"	32"	48"	"	"
36" x 22"	14"	10"	16"	6"	39"	60"	"	"
43" x 27"	14"	12"	18"	8"	46"	75"	"	"
50" x 31"	12"	13"	21"	9"	53"	85"	"	2 Pieces, C. Splice
58" x 36"	12"	18"	26"	12"	63"	90"	"	"
65" x 40"	12"	18"	30"	12"	70"	102"	2 1/4 to 1	"
72" x 44"	12"	18"	33"	12"	77"	114"	"	3 Pieces, 2 Splices equal distance from C

Note: All splices to be lap riveted or bolted.

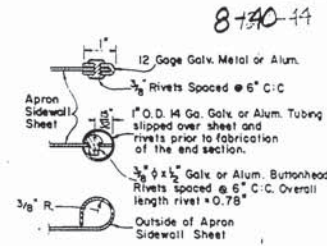

SECTION A-A

GENERAL NOTES

Details of construction not shown on this drawing shall conform to the pertinent requirements of the Standard Specifications and the applicable Special Provisions.
Reinforced concrete apron endwalls shall conform to the pertinent requirements of the Standard AASHTO Designation: M170, Class II (Wall B).
Metal apron endwalls shall conform to the pertinent requirements of the Standard AASHTO Designation: M36.
Aluminum apron endwalls shall conform to the pertinent requirements of the Standard AASHTO Designation: M-196-62 I.

NOTE:

Variations of the dimensions and designs shown hereon will be permitted providing equivalent capacity and structural integrity are attained, and prior approval of the Engineer is obtained.


Reinf. concrete apron endwalls shall be used with concrete pipe culvert installations, metal apron endwalls shall be used with corr. metal pipe culvert installations, and Aluminum endwalls shall be used with corr. aluminum culvert installations.

APRON ENDWALLS FOR CULVERT PIPE & PIPE ARCH


STATE HIGHWAY COMMISSION OF WISCONSIN

BY ENGINEER: *[Signature]* DATE: *4/2/65*


BY SURVEYOR: *[Signature]* DATE: *4/2/65*

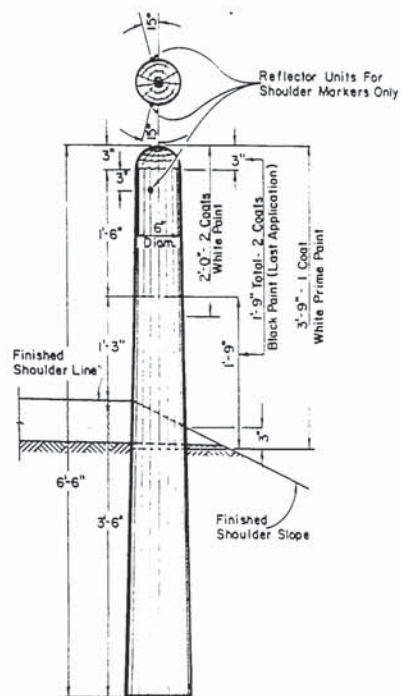


MARKER POST FOR
ROAD SHOULDERS AND CULVERTS

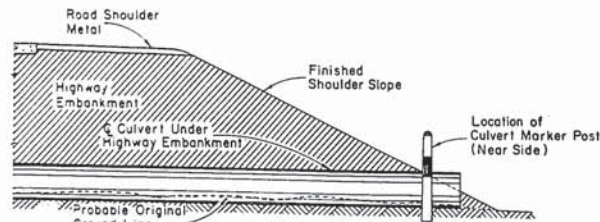


SECTION
SHOWING RELATIVE LOCATION OF
MARKER POST FOR CULVERTS

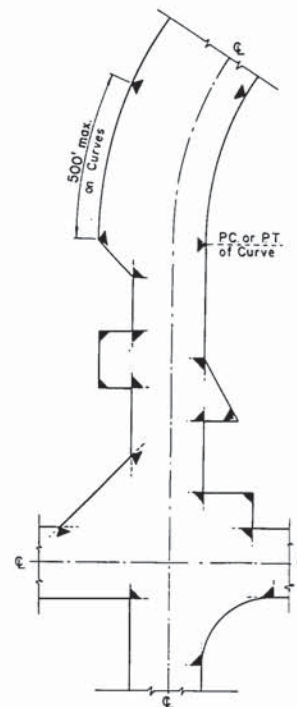

LOCATION DIAGRAM
SHOWING TYPICAL LOCATIONS OF
MARKER POSTS FOR RIGHT OF WAY

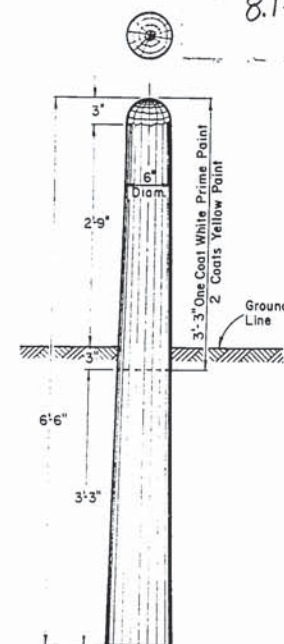

MARKER
POST
FOR
RIGHT OF WAY

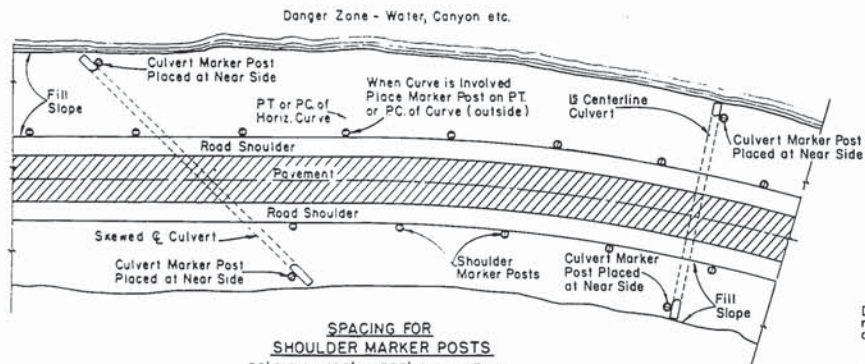

SPACING FOR
SHOULDER MARKER POSTS
50' C/C for 100' to 500' Danger Zones
100' C/C for Over 500' Danger Zones

LOCATION DIAGRAM
SHOWING RELATIVE LOCATIONS OF SHOULDER MARKER POSTS
AND CULVERT MARKER POSTS

MARKER POSTS FOR ROAD SHOULDERS AND CULVERTS

MARKER POST FOR RIGHT OF WAY

GENERAL NOTES

Details of Construction not shown on this drawing shall conform to the pertinent requirements of the Standard Specifications and the applicable Special Provisions.

MARKER POSTS FOR RIGHT OF WAY

Right of Way Marker Posts shall be erected in advance of Grading Operations. Posts shall be placed at the outer limits of the Highway Right of Way, but entirely within the Right of Way, and shall be so placed that the outer edge of the posts shall be tangent to the Right of Way line or lines extended. The exact location of all Right of Way Posts will be staked in the field by the Engineer.

REFLECTOR UNITS

Reflector Units shall have plastic crystal lens 7/8" in diameter. Unit assembly shall be a minimum of 7/8" in length. Reflector Units shall be furnished with flared expanding metal clips for wood mounting. Units shall be mounted in tightest fit possible and securely stayed in posts. Reflector Units shall be installed in Road Shoulder Marker Posts only.

MARKER POSTS & MARKER POSTS FOR RIGHT OF WAY

STATE HIGHWAY COMMISSION OF WISCONSIN

RECOMMENDED FOR APPROVAL

2-5-63


APPROVED

2/6/63
DATE


J. A. Pelt
ENGINEER OF DESIGN

E. L. Rutledge
STATE HIGHWAY ENGINEER

PLATE NO. 7-134

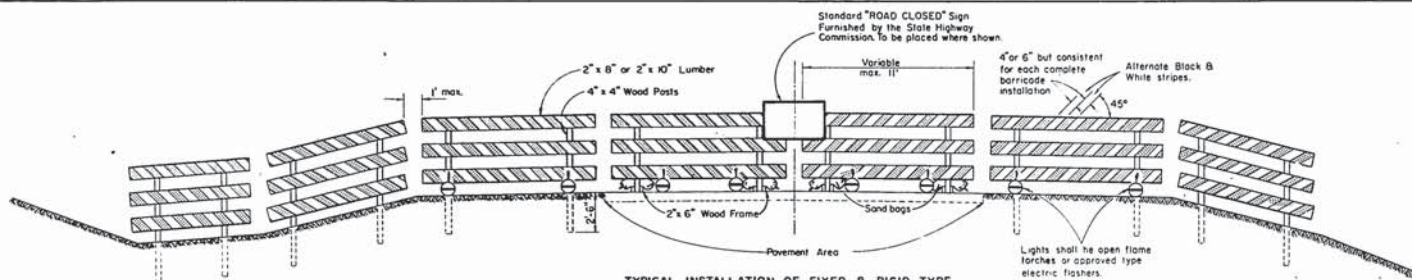

TYPICAL INSTALLATION OF FIXED & RIGID TYPE

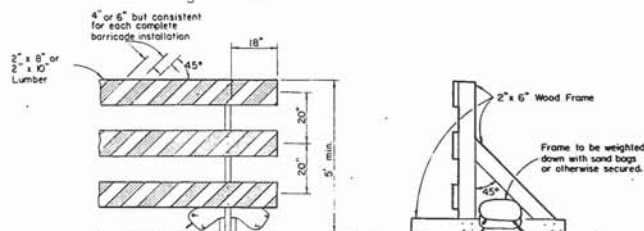


ALTERNATE TYPE INSTALLATION (RIGID)




ALTERNATE TYPE INSTALLATION (DEMOUNTABLE)

CLASS I BARRICADE

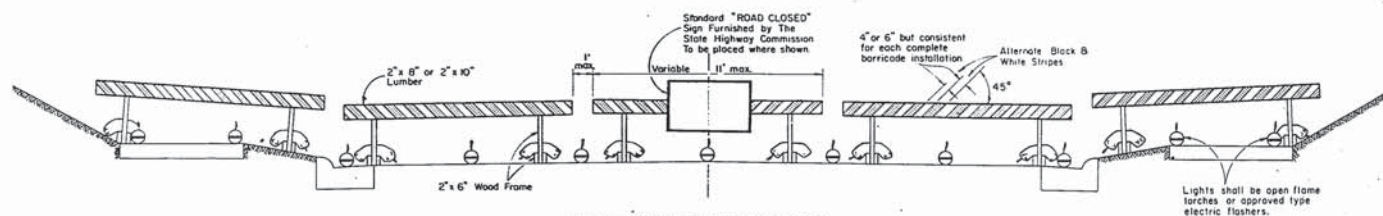

TYPICAL INSTALLATION OF RIGID TYPE

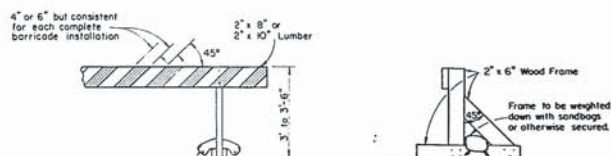

ALTERNATE TYPE INSTALLATION (RIGID)



ALTERNATE TYPE INSTALLATION (DEMOUNTABLE)

CLASS II BARRICADE

GENERAL NOTES:

The Contractor shall construct, place and maintain barricades as shown on this drawing and as required by the Standard Specifications for the duration of the project at all points of highway closure. Barricades shall be painted as shown hereon and structurally maintained for maximum visibility at all times, for the duration of the respective project.

CLASS I BARRICADE

Shall be used at points of closure where road is closed to traffic. Gates or movable sections of barricade shall be provided when necessary, for access of equipment or other authorized vehicles only.

CLASS II BARRICADE

May be used only where the hazard to traffic is relatively small, and for the more or less continuous delimiting of a restricted roadway, or for temporary daytime use.

LUMBER & FABRICATION

Lumber shall be of a grade structurally sound and sufficiently rigid to satisfactorily support and maintain the purpose and intent of a barricade facility. The fabrication of the barricade shall be in accord with good pertinent wood-working practices.

PAINTING

Barricades shall be painted as shown hereon in alternate black and white stripes. Black stripes shall be painted with weather resistant and durable black paint. White stripes shall be painted with weather resistant and durable white paint. White stripes shall be painted with a prime coat of good grade wood primer, followed by two coats of white 'Cotit Reflective Liquid' (Minnesota Mining Co.) or equivalent, or reflective sheeting wide angle, flat top 'Scotch-lite' brand material (Minnesota Mining Co.) or equivalent.

DIRECTION OF DIAGONAL STRIPES

Where a barricade extends entirely across the roadway and no vehicle access provision, the stripes shall slope downward toward the highway centerline.

Where vehicle access is permitted, the stripes shall slope downward in the direction toward which vehicles must turn in detouring.

Where both right and left turns are provided for, the stripes shall slope downward in both directions from the center.

MEASUREMENT & PAYMENT

All barricades, unless otherwise provided for in the plans and/or special provisions shall be furnished, placed, and maintained as noted above, and no additional compensation will be allowed but shall be construed to be included in the price bid for other items.

NOTE:

Lighting devices for barricades shall conform to the requirements of the Standard Specifications.

NOTE:

All lumber or timber dimensions shown hereon are nominal.

CONSTRUCTION BARRICADE

STATE HIGHWAY COMMISSION OF WISCONSIN


RECOMMENDED FOR APPROVAL:

DATE 2-5-62 J. L. Pelt ENGINEER OF DESIGN


APPROVED: DATE 2/4/62 P. C. Rustum STATE HIGHWAY ENGINEER

PLATE NO. 7-4.1.4

8.3-40

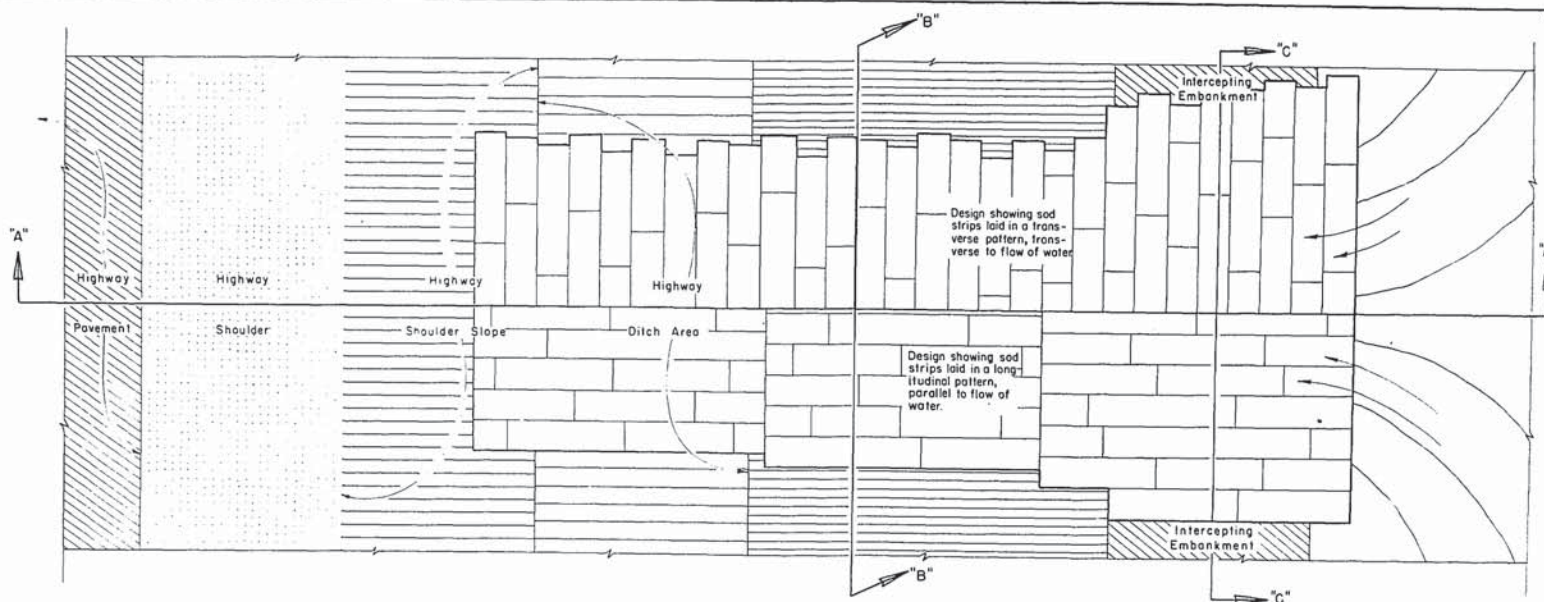

PLAN VIEW OF SODDED BACKSLOPE FLUME

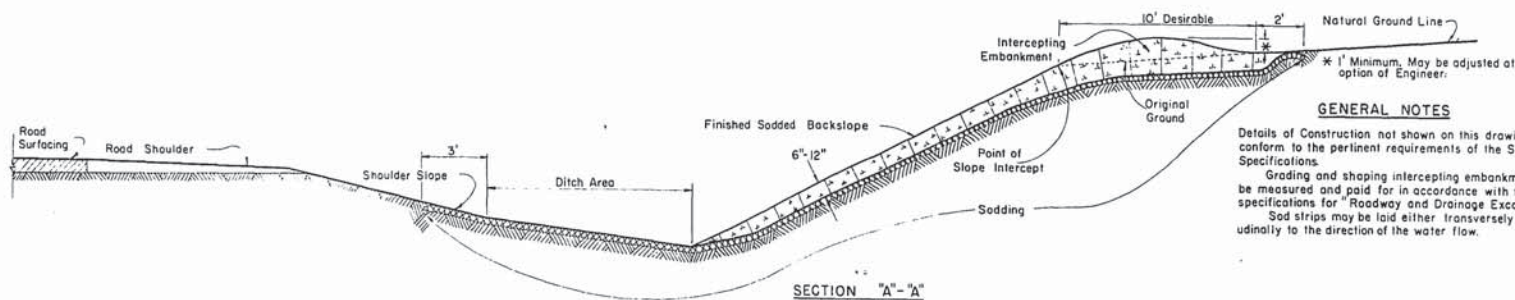


GENERAL NOTES

Details of Construction not shown on this drawing shall conform to the pertinent requirements of the Standard Specifications.

Grading and shaping intercepting embankment will be measured and paid for in accordance with the standard specifications for "Roadway and Drainage Excavation".

Sod strips may be laid either transversely or longitudinally to the direction of the water flow.

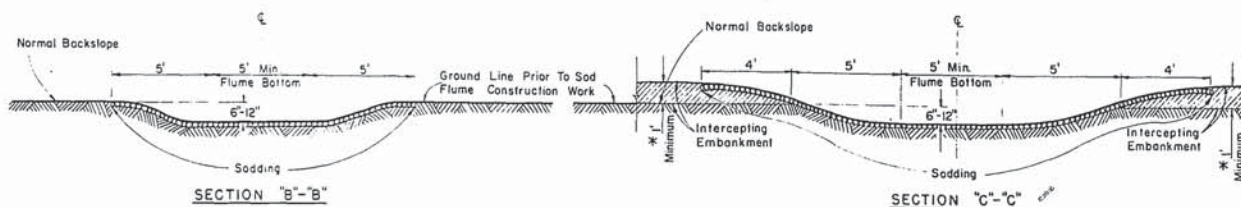

NOTE: Dimensions shown may be adjusted at the option of the Engineer to fit local conditions.

SODDED BACKSLOPE FLUME & INTERCEPTING EMBANKMENT

STATE HIGHWAY COMMISSION OF WISCONSIN


RECOMMENDED FOR APPROVAL:

2-5-63
DATE

APPROVED:

2/6/63
DATEJ. L. Pitt
ENGINEER OF DESIGNC. L. Rustgen
STATE HIGHWAY ENGINEER

PLATE NO. 8-2.1.4

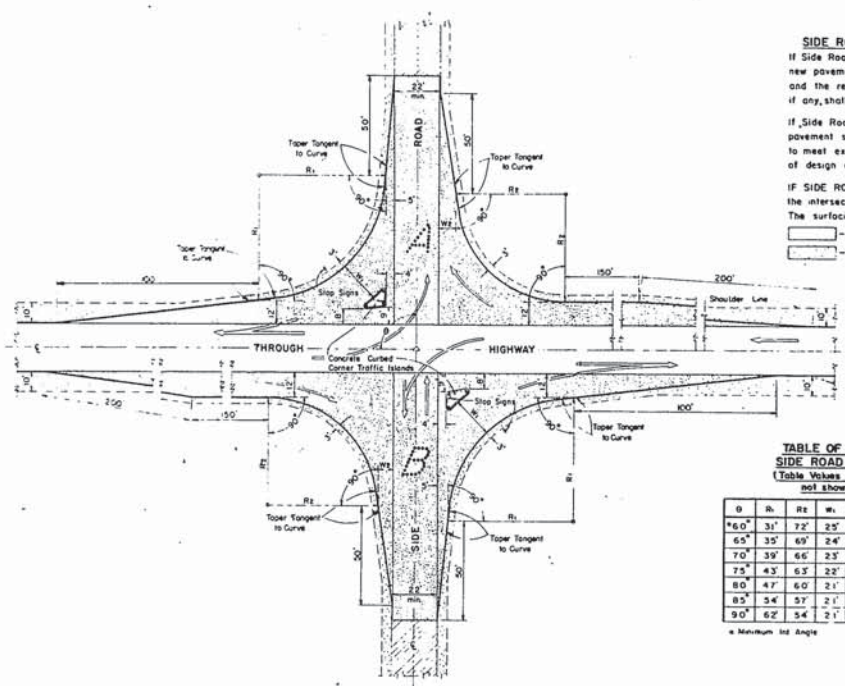


SIDE ROAD SURFACING NOTE
 If Side Road is not presently surfaced, new pavement shall be placed as shown, and the remainder to construction limits, if any, shall be gravel or crushed stone surfaced.
 If Side Road is presently paved, new pavement shall be placed only as necessary to meet existing pavement, and to limits of design as shown.
 If SIDE ROAD IS THE CONSTRUCTION PROJECT, the intersection geometrics remain as shown. The surfacing shall be same as for the project.
 — Pavement
 — Gravel or Crushed Stone

TABLE OF VALUES FOR VARIABLE SIDE ROAD INTERSECTION ANGLES
 (Table Values for Angles between 60° & 120° not shown shall be interpolated)

θ	R ₁	R ₂	W ₁	W ₂	θ	R ₁	R ₂	W ₁	W ₂
*60°	31'	72'	25'	10'	95°	70'	52'	20'	8'
65°	35'	69'	24'	9'	100°	80'	50'	20'	8'
70°	39'	66'	23'	8'	105°	95'	48'	20'	8'
75°	43'	63'	22'	8'	110°	104'	46'	19'	8'
80°	47'	60'	21'	8'	115°	122'	44'	19'	8'
85°	54'	57'	21'	8'	*120°	143'	42'	19'	8'
90°	62'	54'	21'	8'					

* Minimum Int. Angle

** Maximum Int. Angle

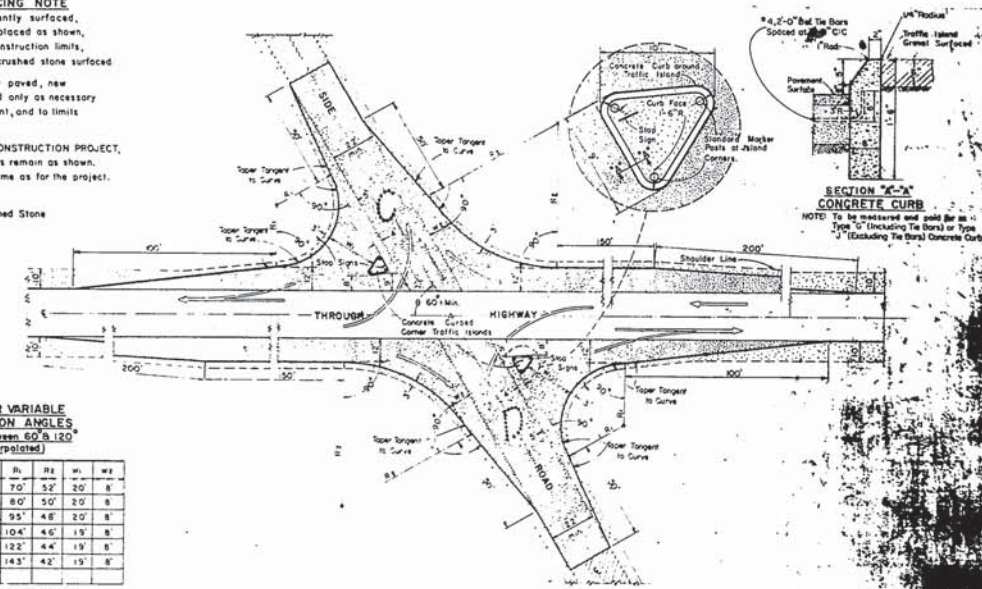

SECTION "K-K" CONCRETE CURB
 NOTE: To be measured and paid for as Type "D" (Including Tie Bars) or Type "J" (Excluding Tie Bars) Concrete Curb.

MAJOR SIDE ROAD INTERSECTION DESIGN DETAILS
 To be used only when current ADT on Through Highway is 1500 or over, and on Side Road is Over 200

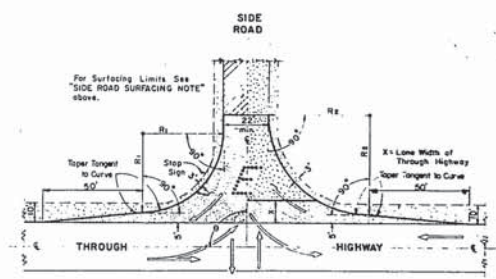


TABLE OF VALUES FOR VARIABLE SIDE ROAD INTERSECTION ANGLES
 (Table Values for Angles between 60° & 120° not shown shall be interpolated)

θ	R ₁	R ₂	θ	R ₁	R ₂
*60°	40'	50'	95°	45'	45'
65°	40'	50'	100°	50'	48'
70°	40'	50'	105°	55'	47'
75°	40'	50'	110°	60'	46'
80°	40'	50'	115°	65'	45'
85°	40'	50'	**120°	70'	44'
90°	40'	50'			

* Minimum Int. Angle

** Maximum Int. Angle

GENERAL NOTES
 Designs 24", 36", 42" or 48" may be used interchangeably in combination or separately for any one complete intersection depending upon Traffic Volume, Intersection Type, and Surfacing of each approach.
 Details on this drawing are for Minimum Design Only, and not applicable to Special Conditions, as shown elsewhere on the plans.

MINOR SIDE ROAD INTERSECTION DESIGN DETAILS
 To be used when current ADT on Through Highway is Less than 1500 or on Side Road is Less than 200

DESIGN & LAYOUT DETAILS FOR SIDE ROAD INTERSECTIONS (RURAL IN CHARACTER)

STATE HIGHWAY COMMISSION OF WISCONSIN

Recommended For Approval

DATE: 8-5-62

APPROVED: [Signature]

DATE: 7/6/63

EXT: [Signature]



GENERAL NOTES

DRAWINGS SHALL NOT BE SCALED.

BAR STEEL REINFORCEMENT SHALL BE IMBEDDED 8" CLEAR UNLESS OTHERWISE SHOWN OR NOTED.

BEVEL EXPOSED EDGES OF CONCRETE 1" UNLESS OTHERWISE SPECIFIED.

NOT-POURED ELASTIC TYPE JOINT SEALER SHALL CONFORM TO ASTM D6901, D1190.

1. GENERAL PLAN.	Y35017
2. SUPERSTRUCTURE	Y35018
3. SUPERSTRUCTURE	Y35019
4. SUPERSTRUCTURE DETAILS.	Y35020
5. BEARING DETAILS.	Y35021
6. EXPANSION JOINT & HOLD-DOWN DEVICE.	Y35022
7. RAIL PADMOUNT DETAILS.	Y35023
8. DETAILS FOR TYPE "B" TUBULAR ALUMINUM & STEEL RAILING.	Y35024
9. WEST ABUTMENT.	Y35025
10. EAST ABUTMENT.	Y35026
11. ABUTMENT DETAILS.	Y35027
12. PIERS, 1 & 3.	Y35028
13. SUBSURFACE OXYDRATION.	Y35029
14. BILL OF BBS.	Y35030


LIVELOAD: HS-20 MDG.	
ALLOWABLE DESIGN STRESS: 1	
CONCRETE MASONRY, GRADE AB	fs = 1,600 p.s.i.
BAR STEEL REINFORCEMENT:	fs = 80,000 p.s.i.
STRUCTURAL STEEL	
A36 M. A36	fs = 20,000 p.s.i.
A36 M. A44 3/8" AND UNDER	fs = 27,000 p.s.i.
OVER 3/8" TO 1 1/2" INCL.	fs = 25,000 p.s.i.

FOUNDATIONS
ABUTMENTS SHALL BE SUPPORTED ON TREATED TIMBER PILES.
PILES WITH A MIN. BEARING CAPACITY OF 20 TONS PER PILE AND
55' TO 65' LONG SHALL BE USED TO CARRY THE MAIN
PIERS TO BE SUPPORTED ON TREATED TIMBER PILES WITH
A MIN. BEAR. CAPACITY OF 20 TONS PER PILE, 55' TO 65' LONG.
PILING AT THE ABUTMENTS AND PIERS SHALL BE
DESIGNED SO THAT THE MAX. FLD. SECTION IS BELOW
SL. 100.0.

A.D.T. : 9,600 (1975 E-WAY)
A.N.V. : 1,440 (1975)

MINIMUM BEARING WAS REACHED AT
15' IN BRITISHES AND 20' 25' IN AERS



STATE HIGHWAY COMMISSION OF WISCONSIN	
GENERAL PLAN	
ON <u>LA CROSSE</u>	BY <u>MR. MEDARY</u> 343.3741 E.C.L.
SECTION <u>11</u>	TOWN <u>16N</u> RANGE <u>7W</u>
DISTRICT <u>WISCONSIN</u>	SECTION <u>16</u> TOWNSHIP <u>16N</u> RANGE <u>7W</u>
DATE <u>1964</u>	BY <u>MR. MEDARY</u> 1963
APPROVED <u>H.B. Scholtz</u>	DATE <u>1964</u> J.C.K.
STATE HIGHWAY COMMISSION	
STRUCTURE <u>B - 32 - 53</u>	SHEET <u>1</u> OF <u>14</u>

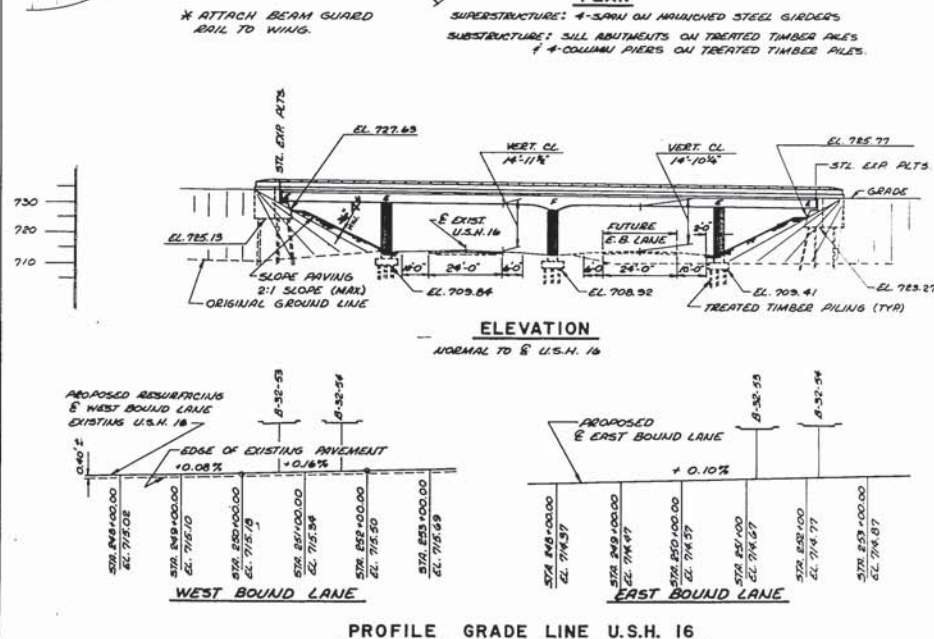

B/D ITEMS	UNIT	SUPER	H.ABUT	PIER 1	PIER 2	PIER 3	E.ABUT	TOTAL
EXCAVATION FOR STRUCTURES	C.Y.		45	90	70	90	45	340
CONCRETE MASONRY	C.Y.	\$85.1	80.5	56.1	58.1	55.1	82.8	\$422
BAR STEEL REINFORCEMENT	L.B	\$4,500	2,580	6,470	6,180	6,520	2,520	18,770
STRUCTURAL CARBON STEEL	L.B	105,300						105,300
STRUCTURE LOW ALLOY STEEL	L.B	119,300						119,300
LUBRICATED BRONZE PLATES	L.B	238						238
BEARING PADS	S.F.	28						28
UNTREATED TIMBER TEST PILING	C.Y.							/
TREATED TIMBER PILING DEL	L.F.		1575	1980	1980	1980	1470	8988
TREATED TIMBER PILING DIVIDU	L.F.		1575	1980	1980	1980	1470	8988
TUBULAR RAILING - TYPE G	L.F.	605						605
SLOPE RAYING - GRAVELLED GRADE	S.Y.		300				270	570
CONCRETE								
KRM-B/D ITEMS								
HARDWOOD TIMBER & BOLTS	S.F.		1				1	2
ALUMINUM OF ZINC PLATE	L.B	41						41

* 5 TEST PILES REQ'D. DRIVE 1-65'-0" TEST PILE @ EACH PIER & 1-75'-0" LONG @ EACH ABUT.

FOR RAIL DETAILS
SEE SHEET 74A

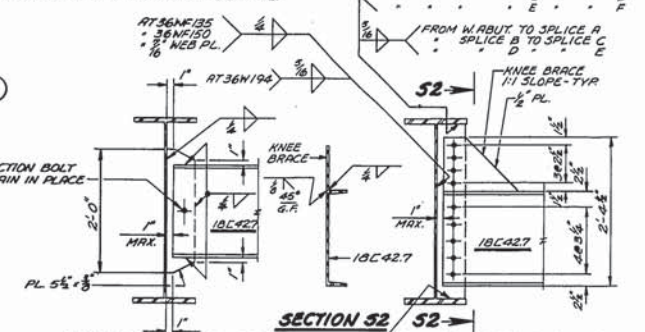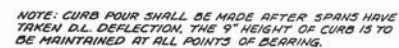


ALTERNATE DIAPHRAGM CONNECTION

[illegible]


AT PIER 2



Δ DENOTES DEFLECTION JOINT IN CURB AND RAIL PARAPET
SEE SHEET 7

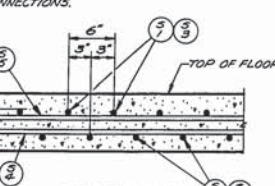

8" MIN. WELD LENGTH

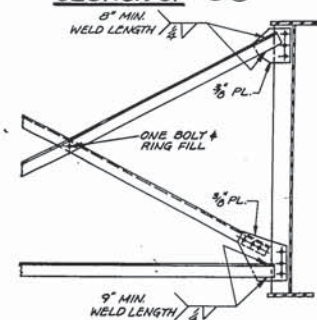

ALTERNATE X-FRAME CONNECTION
AT PIER 2 ONLY

REVISED	STATE HIGHWAY COMMISSION OF WISCONSIN		
	SUPERSTRUCTURE		
	DESIGN SPEC. <i>R.R.S.H.D. 61</i>	LOADING <i>H20-M18</i>	CONST. SPEC. <i>1963</i>
	DATE <i>5-24-66</i>	DESIGN <i>J.S.B.</i>	DRAWN <i>SK</i> C.D. <i>S.J.K.</i>
STRUCTURE B-32-53		SHEET 2 of 14	

PART ELEVATION GIRDER



SECTION 53

X35019



LOCATION	SPAN 1		SPAN 2		SPAN 3		SPAN 4		
	%	kg	%	kg	%	kg	%	kg	
GRADER	73.4.16	73.4.22	73.4.17	73.4.00	73.5.00	73.5.16	73.5.41	73.5.22	73.5.00
"	73.4.21	73.4.17	73.5.12	73.5.97	73.5.00	73.5.75	73.5.42	73.5.34	73.5.00
"	73.4.16	73.4.11	73.4.07	73.5.93	73.5.03	73.5.71	73.5.42	73.5.25	73.5.03
"	73.4.14	73.4.04	73.4.01	73.5.09	73.5.00	73.5.69	73.5.41	73.5.25	73.5.00
"	73.4.07	73.4.04	73.4.01	73.5.09	73.5.00	73.5.69	73.5.41	73.5.25	73.5.00


TOP OF SLAB ELEVATIONS

LOCATION	€ BRG. NABUT	€ SPALCE A	€ PIER 1	€ SPALCE B	€ SPALCE C	€ PIER 2	€ SPALCE D	€ SPALCE E	€ PIER 3	€ SPALCE F	€ BRG. EABUT
GARDER 1	734.30	734.19	734.11	734.03	733.74	733.58	733.41	732.95	732.79	732.55	732.25
* 2	735.26	734.18	734.07	734.00	733.75	733.58	733.41	732.95	732.83	732.62	732.26
* 3	734.17	734.09	734.02	733.95	733.71	733.57	733.42	733.00	732.85	732.66	732.34
* 4	734.09	734.03	733.97	733.91	733.69	733.56	733.41	732.02	732.59	732.70	732.51

TOP OF STEEL ELEVATIONS

LOCATION	€ BRG. W. BUT	€ SPLICE A	€ PIER 1	€ SPLICE B	€ SPLICE C	€ PIER 2	€ SPLICE D	€ SPLICE E	€ PIER 3	€ SPLICE F	€ BRG. E. BUT
GIRDER 1	793.65	793.60	793.40	793.46	793.15	792.99	792.00	792.36	792.17	791.44	791.50
* 2	793.50	793.56	793.44	793.42	793.12	792.92	792.00	792.41	792.20	792.05	791.63
* 3	793.51	793.50	793.40	793.30	793.10	792.92	792.01	792.43	792.23	792.07	791.60
* 4	793.44	793.44	793.35	793.34	793.07	792.90	792.00	792.45	792.26	792.10	791.79

THESE ELEVATIONS ARE TO TOP OF STEEL (TOP OF SPLICE PLG. AT SPLICE) AND THEY ARE FOR THE MATERIAL A3
ERECTED. THE ELEVATION OF THE TOP OF STEEL AT THE FIELD SPLICE POINTS SHALL BE CHECKED AND CORRECTED,
IF POSSIBLE, AFTER ERECTION AND BEFORE PERMANENTLY WELDING OR BOLTING THE DIAPHRAGMS IN PLACE.

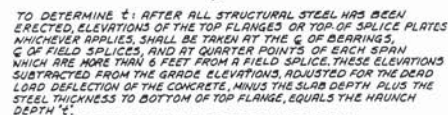

SLAB THICKNESS DIAGRAM


KEYWAY ON E SLAB FORMED FROM
SURFACED, BEVELED 2"x2"
RUN STEEL THRU JOINT




SECTION 54

BLOCKING DIAGRAM

DIMENSION	a	b	c	d	e	f	g	h	i	j	k
WURDELT	2°-0 $\frac{1}{8}$ "	1°-11 $\frac{1}{8}$ "	1°-10 $\frac{1}{8}$ "	1°-9 $\frac{1}{8}$ "	1°-6 $\frac{1}{8}$ "	1°-4 $\frac{1}{8}$ "	1°-2 $\frac{1}{8}$ "	0°-0 $\frac{1}{8}$ "	0°-6 $\frac{1}{8}$ "	0°-4 $\frac{1}{8}$ "	0
• 2	1°-11 $\frac{1}{8}$ "	1°-10 $\frac{1}{8}$ "	1°-9 $\frac{1}{8}$ "	1°-8 $\frac{1}{8}$ "	1°-5 $\frac{1}{8}$ "	1°-3 $\frac{1}{8}$ "	1°-1 $\frac{1}{8}$ "	0°-5 $\frac{1}{8}$ "	0°-6 $\frac{1}{8}$ "	0°-3 $\frac{1}{8}$ "	0
• 3	1°-9 $\frac{1}{8}$ "	1°-8 $\frac{1}{8}$ "	1°-6 $\frac{1}{8}$ "	1°-7 $\frac{1}{8}$ "	1°-4 $\frac{1}{8}$ "	1°-2 $\frac{1}{8}$ "	1°-0 $\frac{1}{8}$ "	0°-0 $\frac{1}{8}$ "	0°-5 $\frac{1}{8}$ "	0°-3 $\frac{1}{8}$ "	0
• 4	1°-8 $\frac{1}{8}$ "	1°-7 $\frac{1}{8}$ "	1°-6 $\frac{1}{8}$ "	1°-5 $\frac{1}{8}$ "	1°-3 $\frac{1}{8}$ "	1°-2 $\frac{1}{8}$ "	1°-0 $\frac{1}{8}$ "	0°-5 $\frac{1}{8}$ "	0°-5 $\frac{1}{8}$ "	0°-3 $\frac{1}{8}$ "	0

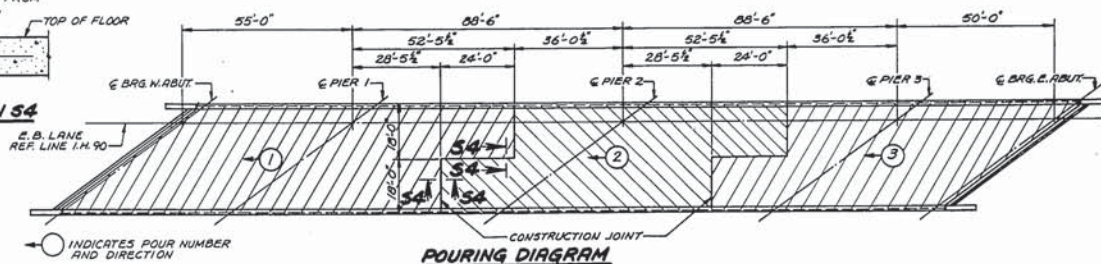


NOTE: TWO OR MORE POURS MAY BE COMBINED AND THE TRANSVERSE CONSTRUCTION JOINTS OMITTED IF THE POUR FOR AN ENTIRE SPAN OF THE BRIDGE IS SPREAD TO A CONSTRUCTION JOINT CAN BE COMPLETED WITHIN FOUR HOURS AFTER CONCRETE OVER THE ADJACENT PIER IS PLACED.
DIRECTION OF POUR MAY BE REVERSED IF PORTION OF POUR FROM THE PIER CAN BE COMPLETED IN A FOUR HOUR PERIOD.

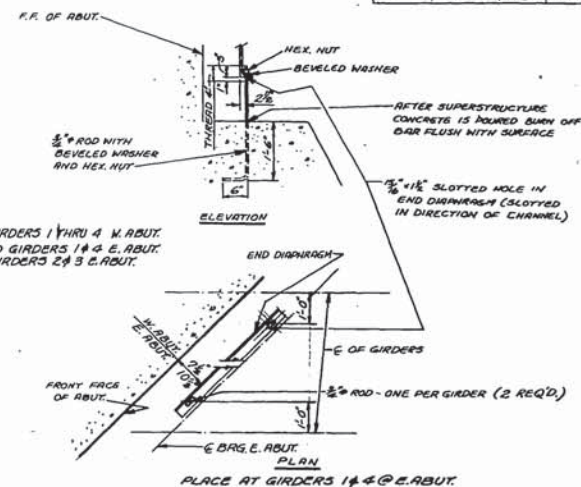


TEMPORARY HOLD DOWN DEVICE


(TO BE PAID FOR AS STRUCT. CARBON STEEL.)
IF POURING SEQUENCE IS REVISED TO TERMINATE
AT W. ABUT. PLACE TEMPORARY HOLD DOWN DEVICE
AT EACH GIRDER AT WEST ABUT.

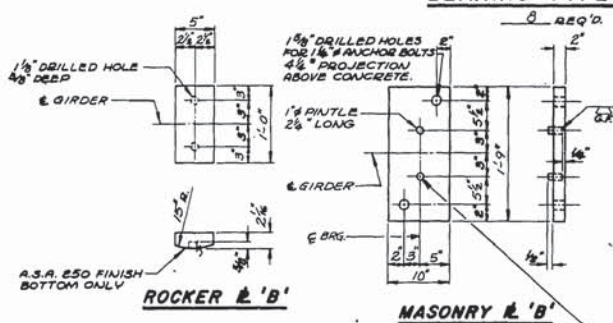

BEARING TYPE 'B'

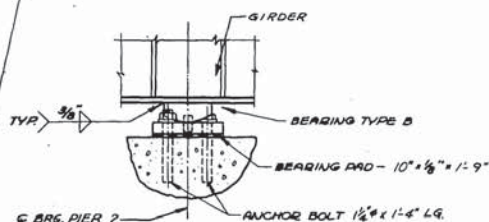

BEARING TYPE 'B'
ASSEMBLY

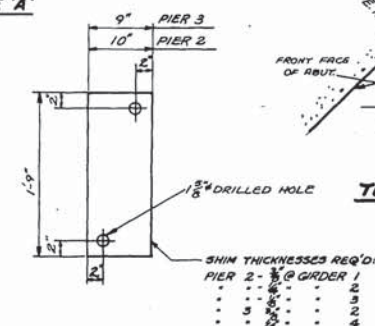

SHIM PLATE DETAIL

BEARING NOTES


ALL PLATE CUTS SHALL BE MACHINE OR MACHINE FLAME CUTS.

ANCHOR BOLTS SHALL BE THREADED 3". PROVIDE ONE STANDARD WROUGHT WASHER AND ONE HEX. NUT PER BOLT.


ALL MATERIAL INCLUDING SHIMS BUT EXCLUDING ANCHOR BOLTS, NUTS AND WASHERS SHALL BE MADE OF A282 STEEL WITH A CORROSION RESISTANCE OF 4 OR MORE TIMES THAT OF A36 STEEL.

THE TOP 4-1/2" OF ANCHOR BOLTS, WASHERS AND NUTS SHALL BE GALVANIZED.

ALL MATERIAL IN BEARINGS, INCLUDING SHIMS BUT EX-
CLUDING BRONZE PLATES AND BEARING PADS SHALL BE PAID
FOR AT THE UNIT PRICE BID FOR STRUCTURAL LOW ALLOY
STEEL.

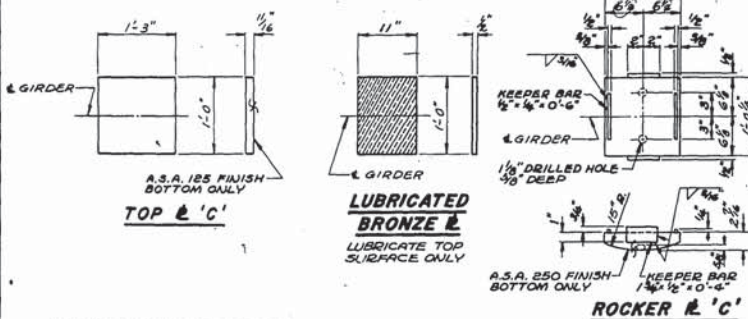

BEARING TYPE 'C'

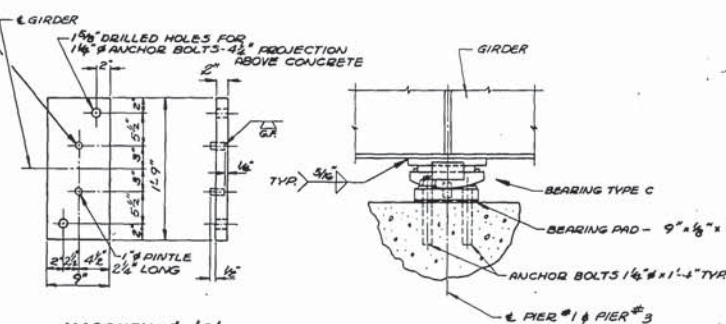

BEARING TYPE 'C'
ASSEMBLY

NOTE: TOP PLATE OF EXPANSION BEARING TO BE FINISHED IN DIRECTION OF MOVEMENT.

<div style="border: 1px solid black; width: 40px; height: 40px; margin: 2px;"></div> <div style="border: 1px solid black; width: 40px; height: 40px; margin: 2px;"></div> <div style="border: 1px solid black; width: 40px; height: 40px; margin: 2px;"></div> <div style="border: 1px solid black; width: 40px; height: 40px; margin: 2px;"></div>	STATE HIGHWAY COMMISSION OF WISCONSIN		
	BEARING DETAILS		
	DESIGN SPEC <i>AASHTO M</i>	LOADING _____	CONCRETE <i>1963</i>
	DATES <i>5-26-66</i>	DESIGN _____	DRAWN <i>SM</i> TRS. <i>J.C.W.</i>
STRUCTURE <i>B-32-53</i>		SHEET <i>5</i> OF <i>14</i>	

3" x 1/2" HARDWOOD PLANK - ROWDY WIDTH, WITH 1/2" x 1/2" x 1/2" HARDWOOD KEEL AT APPROX. 5'-0" CTRS. REMOVE BOARDS AND PLANK WHEN PLACING AND FINISHING SLAB (NON-SID ITEM)


* AT 60° F.

* LONG. DIM. OF 1/2" x 1/2" SLOTTED HOLE PARALLEL TO REF. LINE


S. P. R. DIVISION	PROJECT	SHEET NUMBER	TOTAL SHEETS
4	I90-1(45)5	14	40

LEGEND


1. S.T. 6" W.F. 39.5# - ROADWAY WIDTH.
2. 2" x 4" x 1/2" - ROADWAY WIDTH.
3. BAR 2" x 1/2" - ROWDY. WELD TO L#2 WITH 2 LINES OF 1/2" FILLET WELD, 2 @ 6".
4. BAR 2" x 1/2" - ROWDY. WELD TO L#2 WITH 2 LINES OF 1/2" FILLET WELD, 2 @ 6".
5. FABRICATE FROM 1/2" WELDED PLATE, WELD TO STEM & FLG. OF S.T.#1 WITH 1/2" FILLET WELD NEAR AND FAR SIDE.
6. 3/8" MIN. LAMINATED & SLOTTED SHIM.
7. DRILL HD. CAP SCREW 1/2" x 2 1/2" WITH 50 NUTS 4'-0" CTRS. GREASE FOR EASY REMOVAL. 1/2" x 1/2" KEEPER BAR - WELD TO L#2 TO KEEP 50 NUT FROM TURNING.
8. 1/2" x 1/2" SLOTTED HOLE IN L#2. 1/2" HOLE CSK 1/2" DEEP IN ST#1. 1/2" SLOT IN BAR #3 AS SHOWN. (HOLE IN L#2 PARALLEL TO GIRDERS) & L#2.
9. VENT HOLES. 1/2" PLACED AT 2'-0" CENTERS ON L#2 AND S.T.#1.
10. 1/2" BENT BAR @ 0'-9" ALTERNATE CENTERS BETWEEN GIRDERS. 1'-3" LONG. WELD TO S.T.#1.
11. 3/8" BENT BAR @ 1'-0" CENTERS. 2'-0" LONG. WELD TO L#2.
12. 2" x 1/2" x 1/2" x 0'-3" @ 5'-0" CENTERS. WELD TO L#2.
13. 1/2" BOLT IN 2 1/2" LEG FOR BOLT #13.
14. 1/2" BOLT x 0'-9" LG & NUT. TACK WELD NUT TO L#12.
15. SUPPORT TEE - FABRICATE FROM 3/8" PL. WELD TO ST#1.
16. 3/8" PL. CHAMFER AS SHOWN.
17. 3/8" PL. CHAMFER AS SHOWN. WELD TO PL#16 WITH 1 LINE OF 1/2" FILLET WELD.
18. 3/8" BENT BAR x 1'-3" LG. WELD TO PL#15 & PL#16.
19. PROVIDE 1/2" HOLES AT 3'-0" CTRS. FOR BOLT #20. FIELD WELD TO DAM.
20. BLOCK & BOLT FOR SHIPMENT WITH PIPE SLEEVE AND 1/2" BOLT. PROVIDE 1/2" HOLES AT 3'-0" CTRS. IN ST#1 & L#2 FOR 1/2" BOLT.

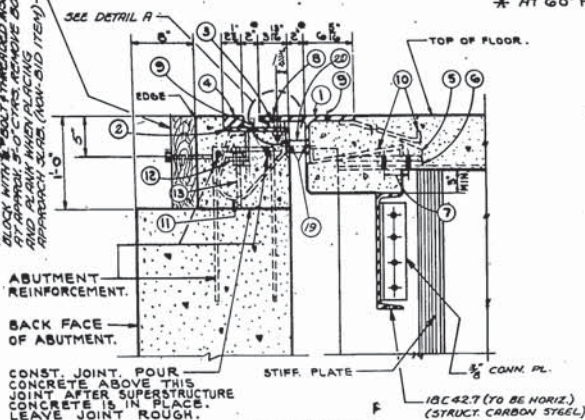


SECTION E1

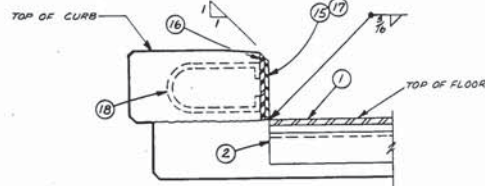


DETAIL AT CURB

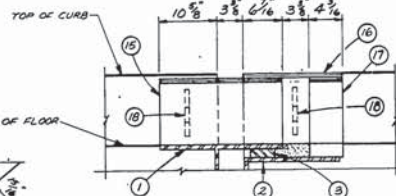


ELEV. CURB JOINT

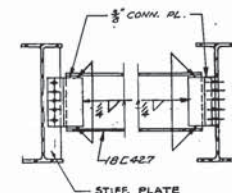

ALTERNATE DIAPHRAGM CONNECTION

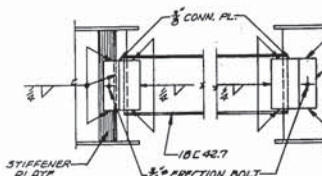

TYPICAL DIAPHRAGM CONNECTION

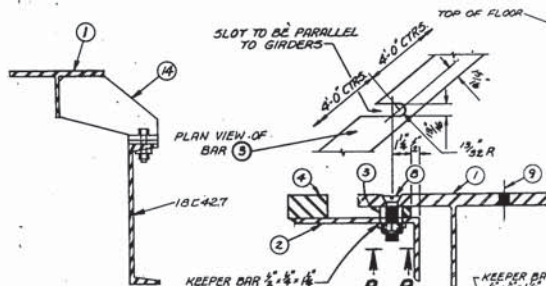


SUPPORT TEE
(PLACE AT MIDPOINT OF CHANNELS)


DETAIL A

SECTION A

- NOTES**
1. EXPANSION JOINT SHALL BE BUILT TO CONFORM TO ROWDY, CROWN & GRADE. AFTER CONCRETE HAS SET REMOVE BOLTS NO. 6 AND FILL HOLES WITH HOT POURED ELASTIC TYPE JOINT SEALER.
 2. AFTER CONCRETE HAS SET THE JOINT SHALL BE THOROUGHLY CLEANED. APPLY ± 1/2" COAT OF BITUMASTIC TO METAL SURFACES FORMING THE JOINT AND FILL WITH HOT POURED ELASTIC TYPE JOINT SEALER.
 3. ONE FIELD SPLICE IS PERMITTED IN JOINTS OVER 30 FT. IN LENGTH.
 4. ALL MATERIAL IN EXPANSION JOINT SHALL BE PAID FOR AS STRUCTURAL CARBON STEEL.

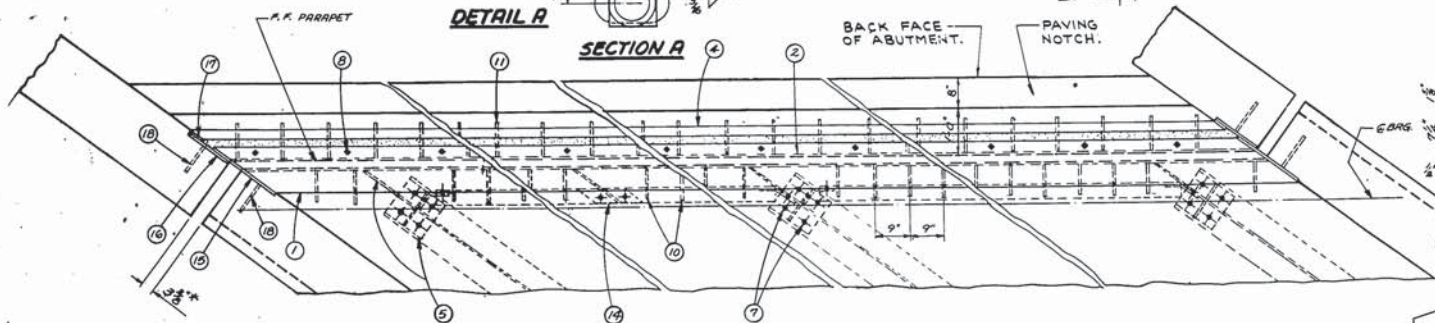

PLAN
(AT WEST AND EAST ABUTS.)

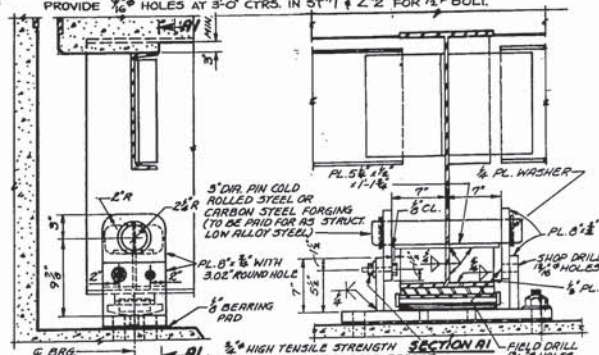

ELEVATION

SECTION A1

PIN DETAIL

GIRDER DETAIL

ANCHOR BOLT DETAIL

HOLD-DOWN DEVICE DETAILS

MASONRY PLATE

NOTE: PLACE HOLD-DOWN DEVICES AT BEAMS 243 AT E. ABUT. ONLY

STATE HIGHWAY COMMISSION OF WISCONSIN

EXPANSION JOINT AND HOLD-DOWN DEVICE

DESIGNED BY A.A.S.H.O. (S)

DATE 12-24-66


ST.D.

BY J.C.K.

STRUCTURE B-32-53


SHEET 6 OF 14

X35022

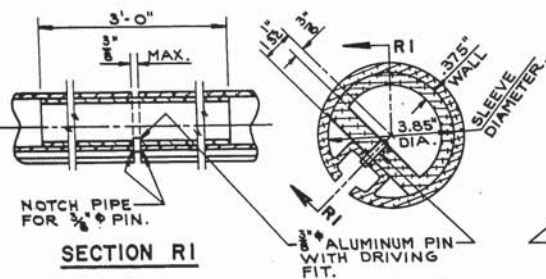


RAIL SPLICE DETAIL

ALUMINUM RAILING DETAILS

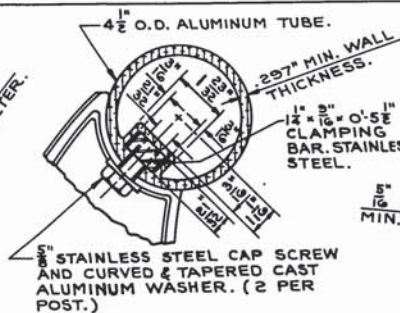


DETAIL OF RAIL ATTACHMENT TO POST

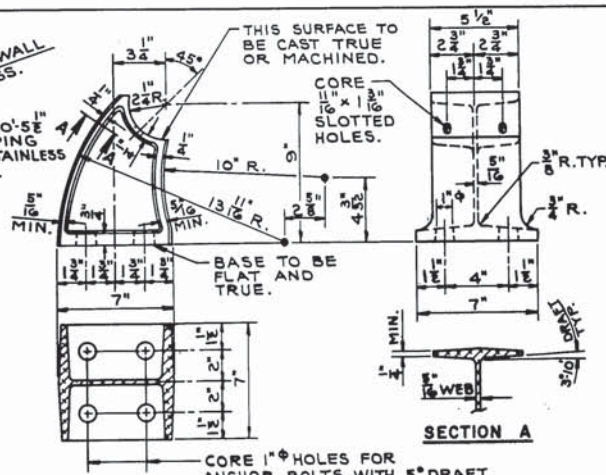

ALUMINUM POST CASTING

NOTES

RAILING SPLICES SHALL BE LOCATED SUCH THAT $\frac{1}{2}$ OF SPLICE IS $\frac{1}{2}$ PANEL LENGTH ± 4 " OFF NEAREST POST.
ALUMINUM SHIMS SHALL BE USED UNDER POSTS AND END PLATES WHERE REQUIRED FOR ALIGNMENT.
RAILING SHALL BE FABRICATED IN TWO AND THREE PANEL LENGTHS.
ANCHOR BOLTS, NUTS & WASHERS TO BE STAINLESS STEEL.
WALL THICKNESS OF TUBING SHOWN ABOVE SHALL BE MINIMUM NOMINAL AVERAGE WALL THICKNESS.

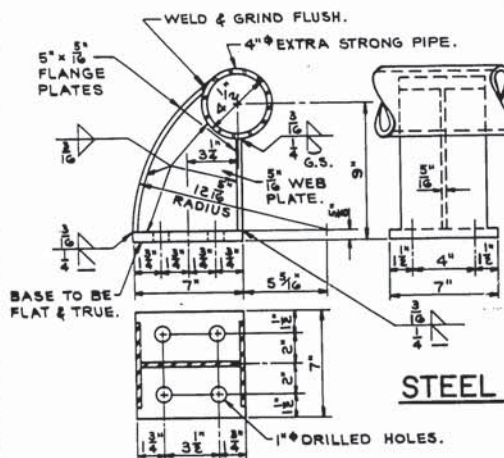


STEEL RAILING DETAILS

NOTES

RAILING SHALL BE FABRICATED IN 2 & 3 PANEL LENGTHS.
STEEL SHIMS SHALL BE USED UNDER POSTS AND UNDER END PLATES WHERE REQUIRED FOR ALIGNMENT.
THE FOLLOWING MATERIALS SHALL BE USED:
RAILING SHALL BE 4" EXTRA STRONG PIPE CONFORMING TO ASTM DESIGNATION A53, GRADE B.
SLEEVES SHALL BE 3/4" O.D. x 1/2" THICK SEAMLESS MECHANICAL TUBING MADE OF STEEL WITH A MINIMUM ULTIMATE TENSILE STRENGTH OF 60,000 P.S.I. AND A MINIMUM ELONGATION OF 10%.
POSTS SHALL BE FABRICATED FROM MATERIAL CONFORMING TO ASTM DESIGNATION A36.
ANCHOR BOLTS TO BE MADE FROM MATERIAL CONFORMING TO ASTM A307.
CAULK EXPOSED OPENINGS BETWEEN SHIMS WITH LEAD WOOL.
GALVANIZE ENTIRE RAILING AFTER FABRICATION INCLUDING NUTS, WASHERS, SHIMS AND TOP 3/2" OF ANCHOR BOLTS.

STEEL POST DETAILS

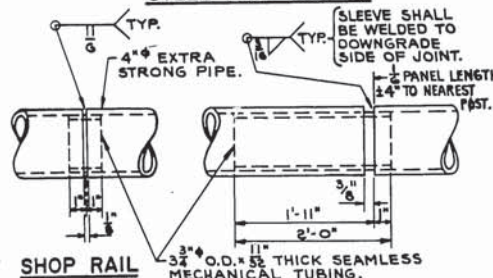


SHOP RAIL


FIELD ERECTION

JOINT DETAIL


THE LOCATION OF THE SHOP SPLICE SHALL BE SHOWN ON THE SHOP DRAWINGS.

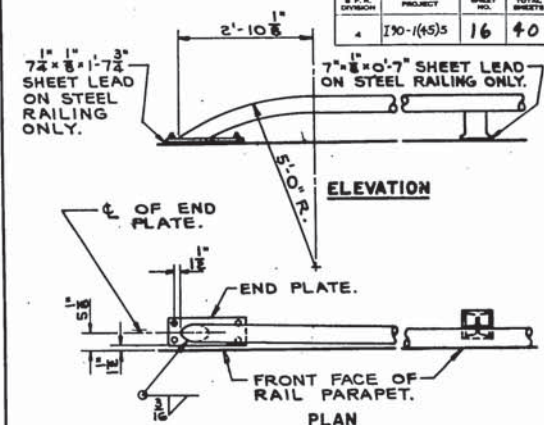


DETAIL OF RAIL BEND AT ABUTMENTS

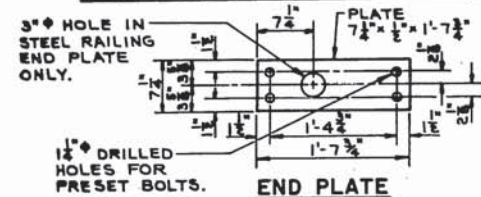

END PLATE

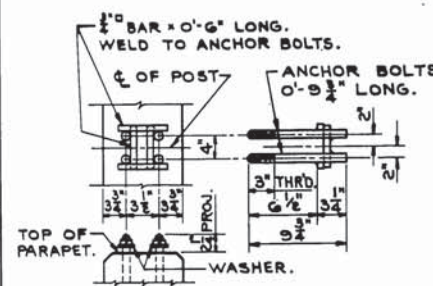


AT POSTS

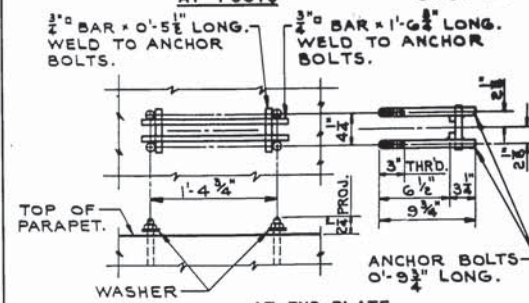


AT END PLATE

ANCHOR BOLT SETTING DETAILS

THE SHANK AND ROOT OF THREAD DIAMETER FOR ANCHOR BOLTS SHALL BE A MINIMUM OF 0.62 INCHES.

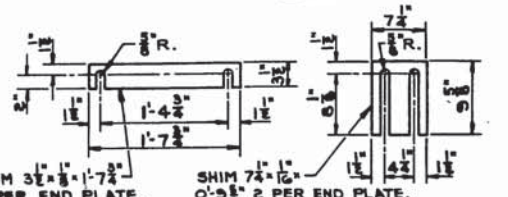

END PLATE SHIM DETAILS

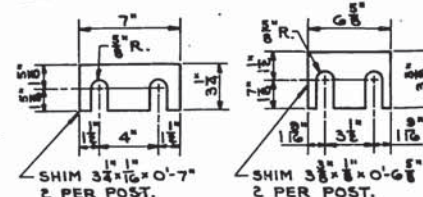

POST SHIM DETAILS

WORK THIS SHEET WITH SHEET TITLED "RAIL PARAPET DETAILS"

STATE HIGHWAY COMMISSION OF WISCONSIN	PROJECT NO.	170-1(45)5	SHEET NO.	16	TOTAL SHEETS	40
DETAILS FOR TYPE "G" TUBULAR ALUMINUM & STEEL RAILING	DESIGNED BY	R.R.S.H.D.W.	DATE	1/14/53	DRAWN BY	J.C.K.
STRUCTURE	B-32-53	SHEET	8	OF	14	




ELEVATION



PLAN



○ INDICATES BATTERED PILES 3'/FT.

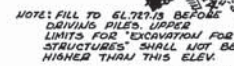

SECTION AA


REVISED	STATE HIGHWAY COMMISSION OF WISCONSIN		
	WEST ABUTMENT		
	DESIGN SPEC. <i>P.R.3 NO. 61</i>	LOADING <i>N510</i> <i>2500</i>	CONCR. SPEC. <i>1905</i>
	DATE <i>8-24-64</i>	DESIGN <i>S.D.</i>	DRAWN <i>E.F.D.</i> CRD. <i>J.C.K.</i>
STRUCTURE	B - 32 - 53		SHEET 9 of 14



ELEVATION





○ INDICATES BATTERED PILES 3'/FT.

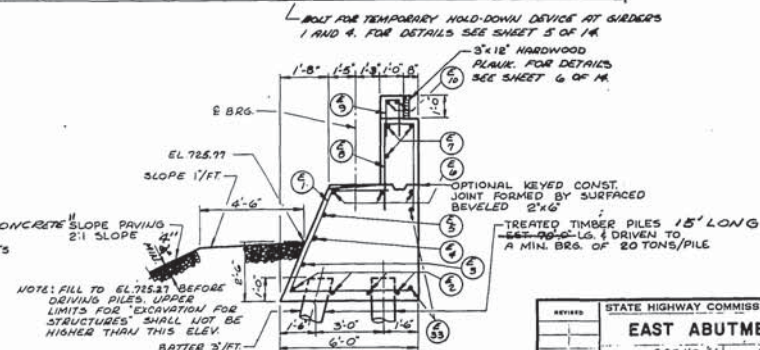

SECTION AA








NOTE: FILL TO EL. 725.27 BEFORE
DRIVING PILES. UPPER
LIMITS FOR "EXCAVATION FOR
STRUCTURES" SHALL NOT BE
HIGHER THAN THIS ELEV.

REVISED	STATE HIGHWAY COMMISSION OF WISCONSIN		
EAST ABUTMENT			
DESIGN SPEC. <i>A.R.S. NO. 21</i>	LOADING <i>N550</i>	CORSET. <i>1965</i>	
DRAWN <i>5-2-66</i>	DESIGN <i>5B</i>	DRAWN <i>5B</i>	CD. <i>J.C.K.</i>
STRUCTURE <i>B - 32 - 53</i>		SHEET <i>10</i> OF <i>14</i>	

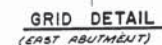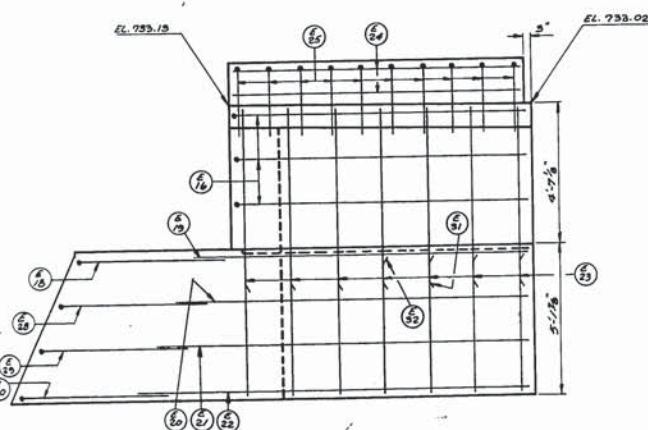

STATE HIGHWAY COMMISSION OF WISCONSIN	
KEYWORD	ABUTMENT DETAILS
DESIGN BY: <u>RAJNO</u>	LOADING: <u>W20</u>
DATE: <u>12-26-86</u>	CONTRACT: <u>1065</u>
DESIGN: <u>RAJNO</u>	CHK: <u>J.C.K.</u>
STRUCTURE: <u>B-32-53</u>	SHEET: <u>11</u> of <u>14</u>

B. & P. DIVISION	PROJECT	SHEET NO.	TOTAL SHEETS
4	I 90-1(45)S	20	40

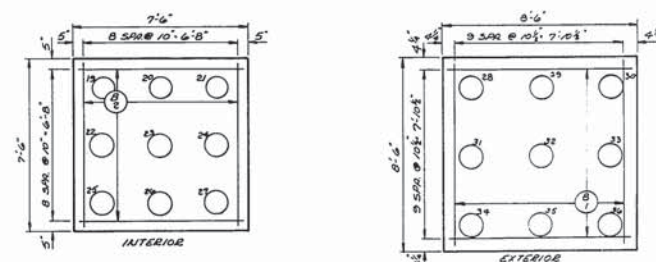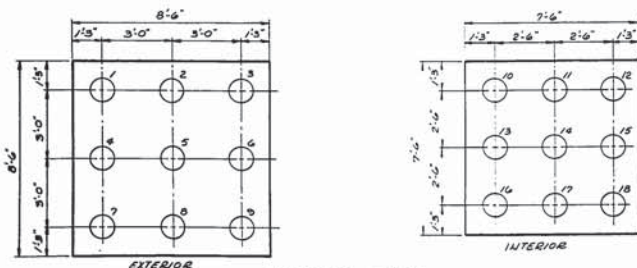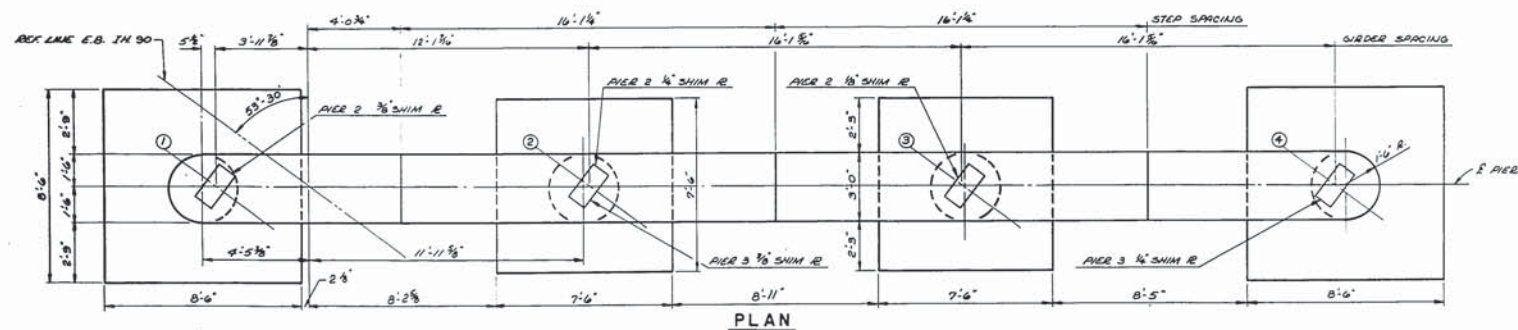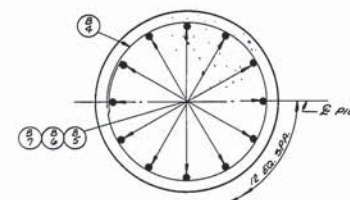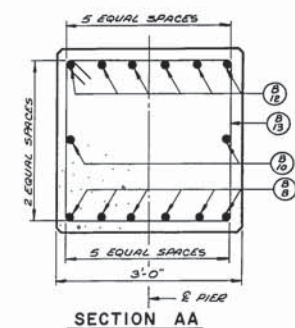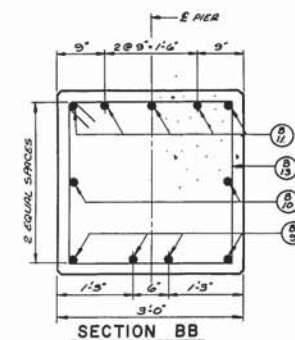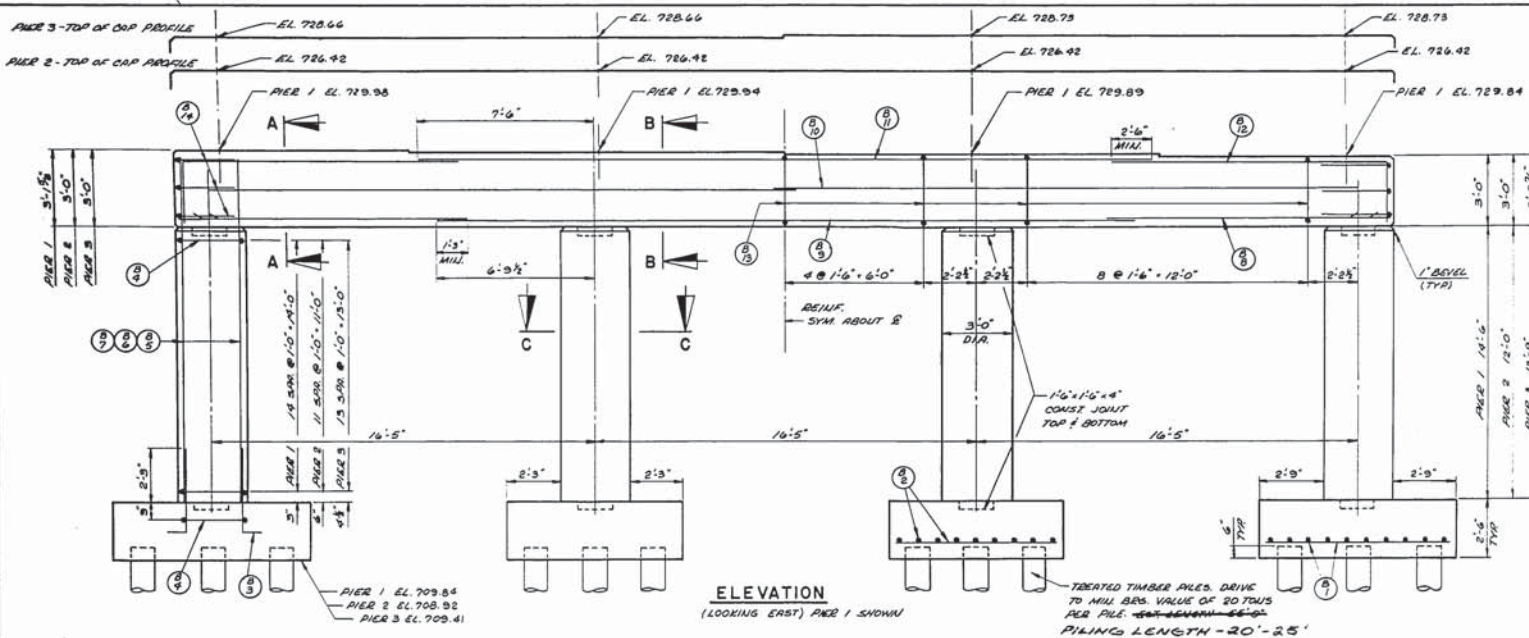

SECTION CC CONCRETE MASONRY

	PIER 1	PIER 2	PIER 3
FOOTINGS	23.3 C.Y.	23.3 C.Y.	23.3 C.Y.
COLUMNS	15.2 C.Y.	12.6 C.Y.	14.4 C.Y.
CAPS	17.6 C.Y.	17.2 C.Y.	17.4 C.Y.
TOTAL	56.1 C.Y.	53.1 C.Y.	55.1 C.Y.

REVIEWED	STATE HIGHWAY COMMISSION OF WISCONSIN
DESIGNED BY	RA.S.H.D. '61
CHECKED BY	RA.S.H.D. '61
DATE	5-2-60
SCALE	AS SHOWN
PROJECT	1960
STRUCTURE	B-32-53
SHEET	12 OF 14

X35028

FOR THE DESIGN OF THE STRUCTURE FOUNDATION, TO OBTAIN
RELATIVE DATA CONCERNING THE CHARACTER OF MATERIAL IN AND UPON
WHICH THE FOUNDATION MIGHT BE BUILT, BORINGS AND/OR SOUNDINGS
WERE MADE AT POINTS APPROXIMATELY AS INDICATED ON THIS DRAWING
WITH THE LOG OF SUCH EXPLORATION DATA AS INTERPRETED FOR SUCH
DESIGN PURPOSE AS SHOWN. THE EXPLORATIONS WERE MADE BY OR-
DINARY AND CONVENTIONAL METHODS AND CAN BE DEEMED ADEQUATE FOR
SUCH PURPOSE. HOWEVER, SINCE IT IS A MATTER OF COMMON KNOW-
LEDGE THAT THE EXACT CHARACTER OF ANY MATERIAL, AND ITS REACTION
IS DIFFICULT TO DETERMINE FROM SUCH SURFACE EXPLORATION AND
THAT THE AREA OF THE LOG OF MATERIAL IS THE SITE WHERE THE
FOUNDATIONS ARE BUILT MAY VARY SUBSTANTIALLY FROM THAT INDICATED
BY THE LOG THEY ARE MADE AVAILABLE TO THE BIDDERS SIMPLY FOR
WHAT THEY ARE WORTH, WITHOUT ANY WARRANTY, EXPRESSED OR IMPLIED
THAT THE MATERIAL TO BE ENCOUNTERED IN BUILDING THE FOUNDATION
WILL CONFORM THEREWITH. IF THE LOG IS USED BY THE CONTRACTOR
IN MAKING HIS BID, IT IS HEREBY EXPRESSLY STIPULATED THAT
THE COMMISSION ACCEPTS NO RESPONSIBILITY FOR SAID USE.

UNLESS OTHERWISE SPECIFIED THE SLOWS PER FOOT AT THE
LOCATIONS INDICATED ARE BASED ON DRIVING A 2" O.D. X 1/4" SPLIT
SPONGE SAMPLER WITH A 140 LB. HAMMER HAVING A FREE FALL OF
30 INCHES. THE TESTS WERE MADE AT A POINTS IMMEDIATELY BELOW A
DAPED OR OPEN HOLE ELIMINATING SIDE
FRICTION ON THE DRIVE PIPE.



SUPERSTRUCTURE 94,310 #						
POUR MARK	NO.	SIZE	LENGTH	SPACING	LOCATION	DET.
S 1	86	6	35-9	6	Floor-Top-Transverse	T
S 2	86	6	36-0	6	" Bottom-Transverse	T
S 3	961	6	35-0	6	" " " "	"
S 4	400	5	36-9	Shown	" " Longitudinal	"
S 5	284	5	36-9	"	" " Top-Longitudinal	"
S 6	24	5	15-0	"	" " Symmetrical about 4 Piers	"
S 7	564	5	3-0	1-0	Curb-Transverse	G
S 8	8	5	28-9	Shown	" " Longitudinal-Span 1	"
S 9	24	5	30-9	"	" " Spans 2 & 3	"
S 10	8	5	26-3	"	" " Span 4	"
S 11	564	5	5-0	1-0	" " & Rail Parapet	D
R 1	16	5	18-3	Shown	Rail Parapet	"
R 2	40	5	23-3	"	" " " "	"
R 3	8	5	13-9	"	" " " "	"
R 4	8	5	20-9	"	" " " "	"
R 5	8	5	19-9	"	" " " "	"
R 6	8	5	14-9	"	" " " "	"
R 7	8	5	25-9	"	" " " "	"
R 8	8	5	8-9	"	" " " "	"
R 9	8	5	22-6	"	" " " "	"

WEST ABUTMENT 2,580 #						
POUR MARK	NO.	SIZE	LENGTH	SPACING	LOCATION	DET.
A 1	29	4	13-9	2-0	Body-Space to Miss Piling	F
A 2	8	4	29-3	Shown	" Horizontal	"
A 3	2	4	29-3	"	" " " "	"
A 4	2	4	30-0	"	" " " "	"
A 5	2	4	30-6	"	" " " "	"
A 6	6	6	30-9	"	" " " "	"
A 7	6	4	30-0	"	Parapet-Horizontal	"
A 8	38	5	9-6	1-6	Body & Parapet	B
A 9	56	5	5-0	1-0	Parapet	B
A 10	14	4	7-9	Shown	" Horizontal-Do Not Lap	"
A 11	2	4	14-6	1-6	Wing 1-Horizontal	"
A 12	2	4	13-3	1-6	" " " "	"
A 13	2	4	12-3	1-6	" " " "	"
A 14	2	6	11-3	1-6	" " " "	"
A 15	7	4	9-3	1-6	" " " "	"
A 16	10	4	10-9	1-6	Wings 1 & 2-Horizontal	A
A 17	1	4	7-3	1-6	Wing 2-Horizontal-Corner	M
A 18	4	4	2-6	1-6	" " " "	C
A 19	2	6	12-3	1-6	" " " "	"
A 20	2	4	13-3	1-6	" " " "	"
A 21	2	4	14-3	1-6	" " " "	"
A 22	2	4	15-3	1-6	" " " "	"
A 23	7	4	9-6	1-6	" " 2-Vertical	"
A 24	8	5	7-3	Shown	Railing Parapet-Horizontal	"
A 25	22	5	5-9	1-0	" " " "	B
A 26	16	5	2-6	Shown	Grid	"
A 27	16	5	4-3	"	" " " "	A
A 28	1	4	6-9	1-6	Wing 2-Horizontal-Corner	M
A 29	1	4	6-3	1-6	" " " "	M
A 30	1	4	5-6	1-6	" " " "	P
A 31	4	4	10-0	Shown	Body-Horizontal at Wings	"
A 32	8	5	5-6	6	Rail Parapet	B
A 33	8	5	3-3	Shown	" " " "	"
A 34	14	5	5-9	1-6	Wings 1 & 2-Vertical	"
A 35	5	4	4-9	1-6	Wing 1-Vertical	"
A 36	4	4	4-9	1-6	" " 2 " "	"
A 37	2	4	10-9	1-6	Wings 1 & 2-Horizontal	N


PIERS 1, 2, & 3 19,370 #						
POUR MARK	NO.	SIZE	LENGTH	SPACING	LOCATION	DET.
B 1	120	6	8-0	10#	Footings-Exterior-Piers 1, 2 & 3	"
B 2	108	6	7-0	10	" Interior " 1, 2 & 3	A
B 3	144	9	4-6	Shown	" & Columns-Piers 1, 2 & 3	J
B 4	12	4	9-6	"	" Hoops	"
B 4	164	4	9-6	1-0	Columns-Hoops	J
B 5	48	9	17-3	Shown	" Pier 1 only	"
B 6	48	9	14-9	"	" " 2 "	"
B 7	48	9	16-6	"	" " 3 "	"
B 8	36	9	12-3	"	Cap-Ends	"
B 9	12	5	30-0	"	Bottom	"
B 10	12	4	25-0	"	" " " "	"
B 11	15	9	31-6	"	" Top	A
B 12	36	7	15-3	"	" " Ends	L
B 13	81	4	11-6	1-6	" Stirrups	H
B 14	18	5	6-9	Shown	" " " "	"

EAST ABUTMENT 2,520 #						
POUR MARK	NO.	SIZE	LENGTH	SPACING	LOCATION	DET.
E 1	29	4	13-9	2-0	Body-Space to Miss Piling	F
E 2	8	4	29-3	Shown	" Horizontal	"
E 3	2	4	30-0	"	" " " "	"
E 4	2	4	30-6	"	" " " "	"
E 5	2	4	30-9	"	" " " "	"
E 6	6	6	31-0	"	" " " "	"
E 7	6	4	30-0	"	Parapet-Horizontal	"
E 8	38	5	9-6	1-6	Body & Parapet	B
E 9	56	5	5-0	1-0	Parapet	B
E 10	14	4	7-9	Shown	" Horizontal-Do Not Lap	"
E 11	2	4	14-6	1-6	Wing 3-Horizontal	"
E 12	2	4	13-9	1-6	" " " "	"
E 13	2	4	12-9	1-6	" " " "	"
E 14	2	6	12-0	1-6	" " " "	"
E 15	7	4	9-3	1-6	" " 3-Vertical	"
E 16	12	4	10-9	1-6	Wings 3 & 4-Horizontal	A
E 17	4	4	2-6	1-6	Wing 3-Horizontal-Corner	C
E 18	1	4	5-6	1-6	" " " "	D
E 19	2	6	13-0	1-6	" " " "	"
E 20	2	4	13-9	1-6	" " " "	"
E 21	2	4	14-6	1-6	" " " "	"
E 22	2	4	15-6	1-6	" " " "	"
E 23	7	4	9-6	1-6	" " 4-Vertical	"
E 24	8	5	9-3	Shown	Railing Parapet-Horizontal	"
E 25	20	5	5-9	1-0	" " " "	B
E 26	16	5	2-6	Shown	Grid	"
E 27	16	5	4-6	"	" " " "	A
E 28	1	4	5-9	1-6	Wing 4-Horizontal-Corner	M
E 29	1	4	5-6	1-6	" " " "	M
E 30	1	4	5-0	1-6	" " " "	M
E 31	14	5	5-9	1-6	Wings 3 & 4-Vertical	"
E 32	9	4	4-9	1-6	" " 3 & 4 "	"
E 33	4	4	10-0	Shown	Body-Horizontal at Wings	"

BAR BENDING DETAILS

DIMENSIONS IN BENDING DETAILS ARE OUT TO OUT. OMIT DETAILS WHERE DIMENSIONS ARE BLANK.

MARK	DIM. "A"	DIM. "B"
A0, E0	1'-4"	4'-1"
A9, E9	0"	8'-2"
A25, E25	5'-4"	2'-7 1/2"
A32	4'-4"	2'-7"

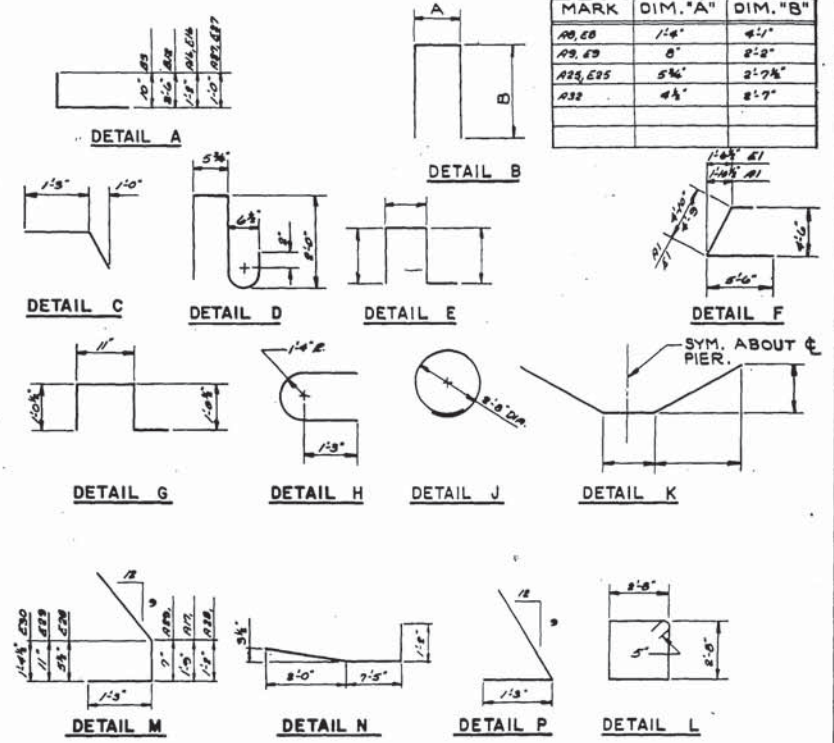

MARK & CUT ALL BARS ALONG THIS LINE. MAKE ALL CUTS NORMAL TO BAR AXIS.

"H" IS NUMBER OF BARS, BEFORE CUTTING.

MARK	C	D	E	F	G	H	SETS REQ'D.
31	367 1	17'-8"	35'-0"	2'-1"	33'-0"	45	2
	367 2	18'-1"					2
	367 3	17'-0"	36'-0"	2'-4"	33'-0"	45	2
32	367 4	18'-2"					2

CUT, BUNDLE & MARK. (MARK WITH BAR NO. & SET NO.)

BENT BARS, IF USED, IN CUTTING DIAGRAM SHALL BE BENT AFTER CUTTING.

† CUTTING DIAGRAM

STATE HIGHWAY COMMISSION OF WISCONSIN



BILL OF BARS

DESIGN BY: R.A.S.N.O. 61 / DRAWN BY: M.E.G. / CHECKED BY: J.C.W. / DATE: 1/26/59

STRUCTURE B - 32 - 53 SHEET 14 OF 14


X35030

COUNTY & HIGHWAY	ROUTE & SECTION	CLASS & AGREEMENT	F.P.R. DIVISION	PROJECT	SHEET NO.	TOTAL SHEETS
72.3	90.1	13.1	4	I 90-1(45)S	23	40

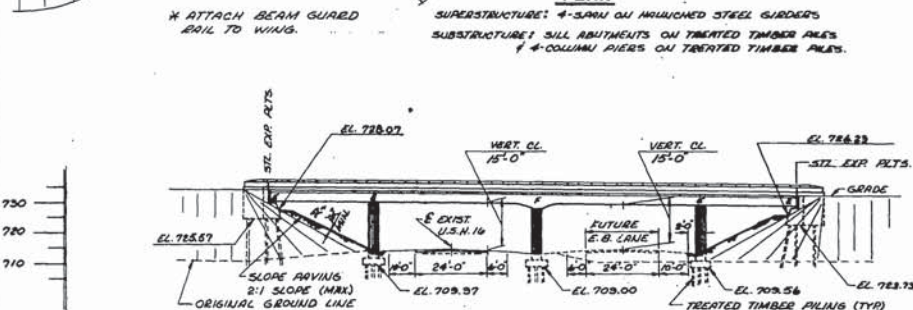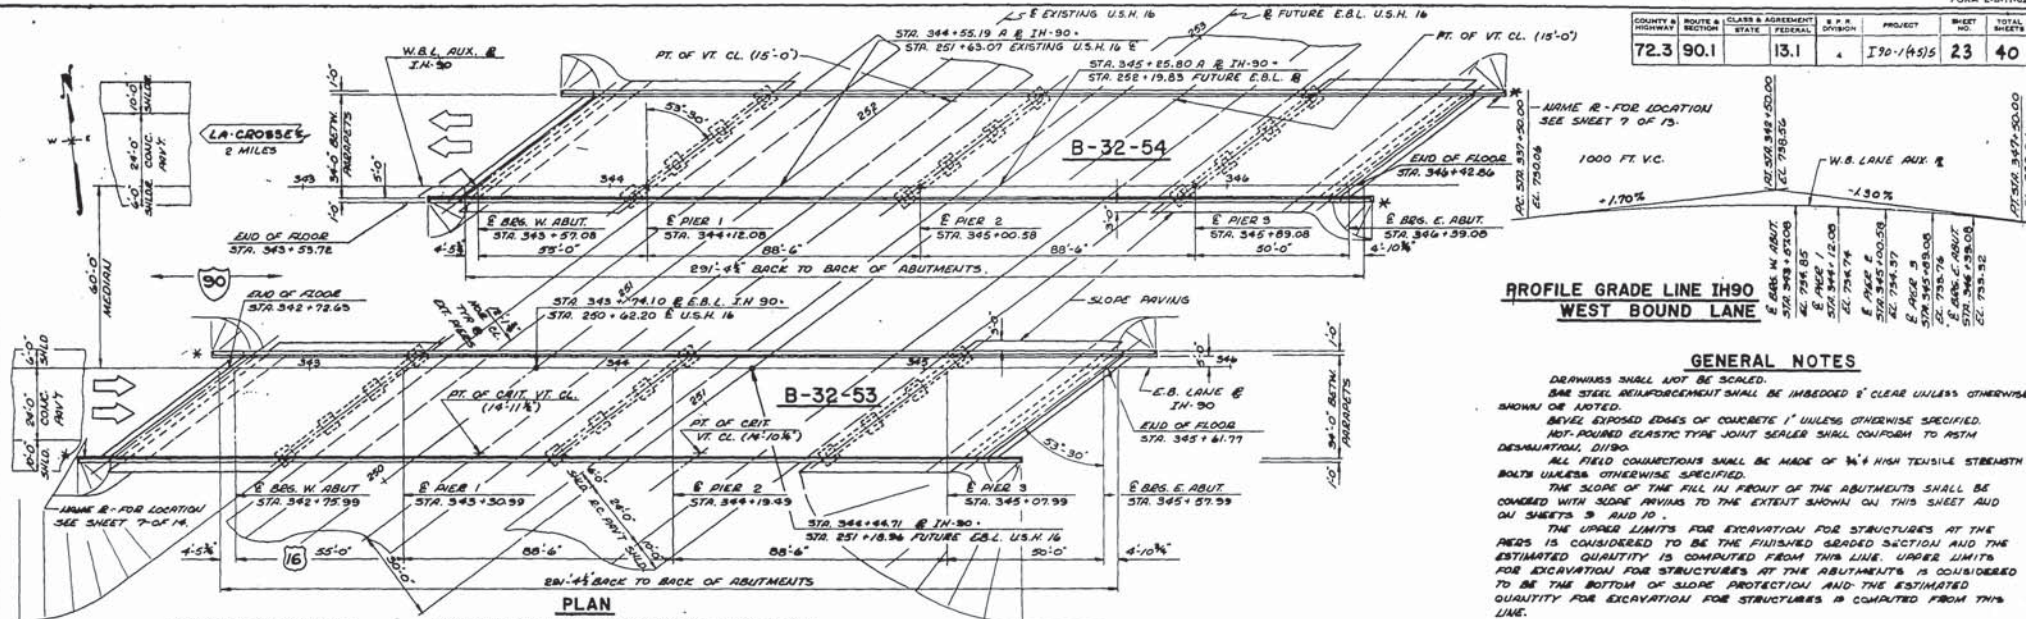

ELEVATION

NORMAL TO U.S.H. 16

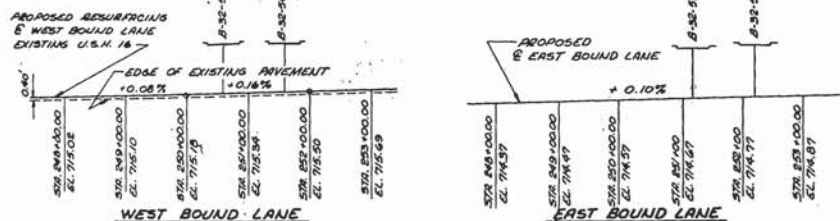

PROFILE GRADE LINE U.S.H. 16

LIST OF DRAWINGS

1. GENERAL PLAN	X35226
2. SUPERSTRUCTURE	X35227
3. SUBSTRUCTURE	X35228
4. SUPERSTRUCTURE DETAILS	X35229
5. BRIDGE DETAILS	X35230
6. BRIDGE JOINT & HOLD-DOWN DEVICE	X35231
7. RAIL BARBICUT DETAILS	X35232
8. DETAILS FOR TYPE 'G' TUBULAR ALUMINUM & STEEL RAILING	X35233
9. WEST ABUTMENT	X35234
10. EAST ABUTMENT	X35235
11. ABUTMENT DETAILS	X35236
12. PIERS 1 & 3	X35237
13. BILL OF MATERIALS	X35238
NOTE: FOR SUBSURFACE EXPLORATION USE B-32-53. SEE SHEET X35029.	

TOTAL ESTIMATED QUANTITIES

BID ITEMS	UNIT	SUPER	W. ABUT	PIER 1	PIER 2	PIER 3	E. ABUT	TOTAL
EXCAVATION FOR STRUCTURES	C.Y.		45	90	70	90	45	340
CONCRETE MASONRY	C.Y.	295.1	81.3	57.1	54.8	56.9	85.3	630.5
BAR STEEL REINFORCEMENT	LB	943.10	2510	6710	6220	6560	2610	119,920
STRUCTURAL CARBON STEEL	LB	109,300						109,300
STRUCTURAL LOW ALLOY STEEL	LB	119,800						119,800
LUBRICATED BRONZE PLATES	LB	238						238
BEARING PADS	S.F.	26						26
UNTREATED TIMBER TEST PILING	C.S.							1
TREATED TIMBER PILING DEL	L.F.		1575	1980	1980	1980	1470	8985
TREATED TIMBER PILING DRIVEN	L.F.		1575	1980	1980	1980	1470	8985
TUBULAR RAILING - TYPE 'G'	L.F.	605						605
SLOPE RAVING - BRUSHED-GRASS	S.Y.		305				275	580
CONCRETE								
NON-BID ITEMS								
HARDWOOD TIMBER & BOLTS	BB.		1				1	2
ALUMINUM OR ZINC PLATE	S.F.	41						41

* 5 TEST PILES REQ'D. DRIVE 1-45'-0" TEST PILE @ EACH PIER & 1-75'-0" LONG @ EACH ABUT.

PROFILE GRADE LINE I90
WEST BOUND LANE

GENERAL NOTES

DRAWINGS SHALL NOT BE SCALED.
 BAR STEEL REINFORCEMENT SHALL BE IMBEDDED 2" CLEAR UNLESS OTHERWISE SHOWN OR NOTED.
 BAYEL EXPOSED EDGES OF CONCRETE 1" UNLESS OTHERWISE SPECIFIED.
 NOT-POURED ELASTIC TYPE JOINT SEALER SHALL CONFORM TO ASTM DESIGNATION, D1180.
 ALL FIELD CONNECTIONS SHALL BE MADE OF 3/4" HIGH TENSILE STRENGTH BOLTS UNLESS OTHERWISE SPECIFIED.
 THE SLOPE OF THE FILL IN FRONT OF THE ABUTMENTS SHALL BE CONFORMED WITH SLOPE RAVING TO THE EXTENT SHOWN ON THIS SHEET AND ON SHEETS 3 AND 10.
 THE UPPER LIMITS FOR EXCAVATION FOR STRUCTURES AT THE PIERS IS CONSIDERED TO BE THE FINISHED GRADED SECTION AND THE ESTIMATED QUANTITY IS COMPUTED FROM THIS LINE. UPPER LIMITS FOR EXCAVATION FOR STRUCTURES AT THE ABUTMENTS IS CONSIDERED TO BE THE BOTTOM OF THE BOTTOM PROTECTION AND THE ESTIMATED QUANTITY FOR EXCAVATION FOR STRUCTURES IS COMPUTED FROM THIS LINE.

DESIGN DATA

LIVELOAD: HS-20 MOD.
 ALLOWABLE DESIGN STRESS:
 CONCRETE MASONRY, GRADE AA 14,000 p.s.i.
 BAR STEEL REINFORCEMENT 18,000 p.s.i.
 STRUCTURAL STEEL 36,000 p.s.i.
 A.S.T.M. A99 36,000 p.s.i.
 A.S.T.M. A99 36,000 p.s.i.
 OVER 1/2" 18,000 p.s.i.

FOUNDATION
 ABUTMENTS SHALL BE SUPPORTED ON TREATED TIMBER PILES. PILING WITH A MIN. BEARING CAPACITY OF 20 TONS PER PILE AND 20'-0" LONG. W. ABUT. & E. ABUT. SHALL BE 20'-0" LONG. PIERS TO BE SUPPORTED ON TREATED TIMBER PILING WITH A MIN. BEARING CAPACITY OF 20 TONS PER PILE AND 20'-0" LONG. PILING AT PINE ABUTMENTS AND PIERS SHALL BE DRIVEN TO THAT FINAL FID ELEVATION IS BELOW EL. 660.0.


TRAFFIC VOLUME

A.D.T. = 3,600 (1975 2-WAY)
 A.D.T. = 1,490 (1975)
 MINIMUM BEARING WAS REACHED AT 15' IN ABUTMENTS AND 20'-25' IN PIERS.

STATE HIGHWAY COMMISSION OF WISCONSIN			
GENERAL PLAN			
BY: LA-CROSSE	IN: MEDARY	DATE: 1/10/75	SCALE: 1/4" = 1'-0"
DESIGN: H.B. Schutt	IN: MEDARY	DATE: 1/10/75	SCALE: 1/4" = 1'-0"
APPROVED: H.B. Schutt	IN: MEDARY	DATE: 1/10/75	SCALE: 1/4" = 1'-0"
STRUCTURE B-32-54 SHEET 1 OF 13			

X35226

NOTE: TOP AND BOTTOM TRANSVERSE BARS IN SLAB SHALL BE SUPPORTED BY CONTINUOUS BAR CHAIRS ON OR ADJACENT TO EACH GIRDER AND BY INDIVIDUAL BAR CHAIRS AT 3'-0" CTRS. AT APPROXIMATELY THE 1/3 POINTS BETWEEN GIRDERS.

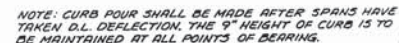

ALTERNATE DIAPHRAGM
CONNECTION

CONNECTION PLATE SIZES FOR BOLTED DIAPHRAGM CONNECTIONS SHALL BE THE SAME SIZE AS FOR WELDED DIAPHRAGM CONNECTIONS EXCEPT FOR LENGTH. BOLTED DIAPHRAGM CONNECTIONS TO BE MADE WITH 3/4" HIGH TENSILE STRENGTH BOLTED DIAPHRAGM CONNECTIONS MAY BE USED IN PLACE OF WELDED DIAPHRAGM CONNECTIONS, HOWEVER PAY QUANTITIES SHALL BE BASED ON WELDED DIAPHRAGM CONNECTIONS.



PART PLAN









PART PLAN

X 35227

S.P.R. DIVISION	PROJECT	SHEET NO.	TOTAL SHEETS
4	I 90-1(45)5	25	40

* NO FIELD WELDING FOR CONSTRUCTION PURPOSES PERMITTED IN THIS AREA

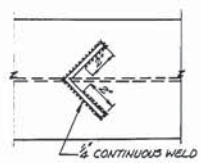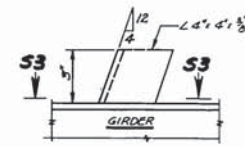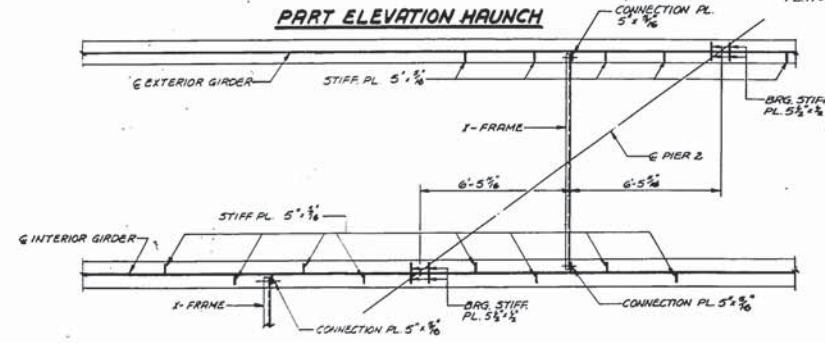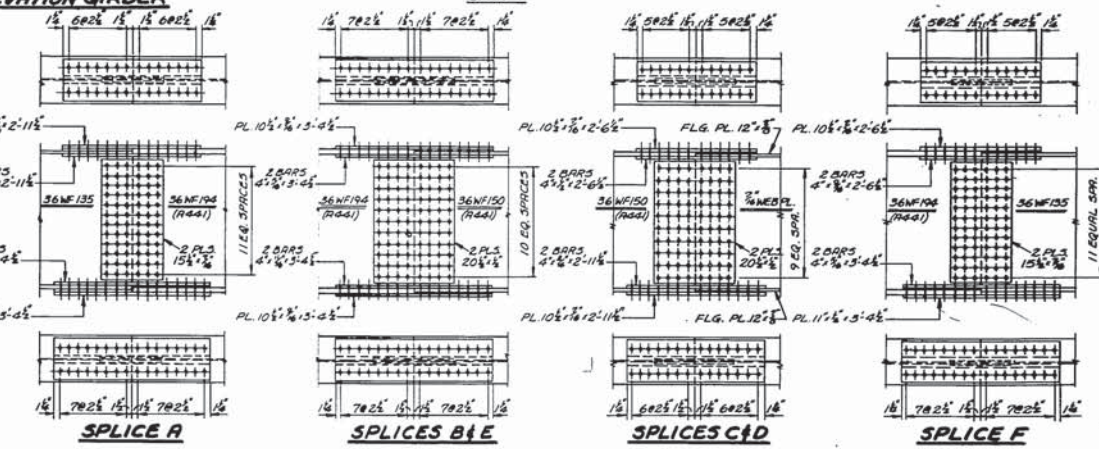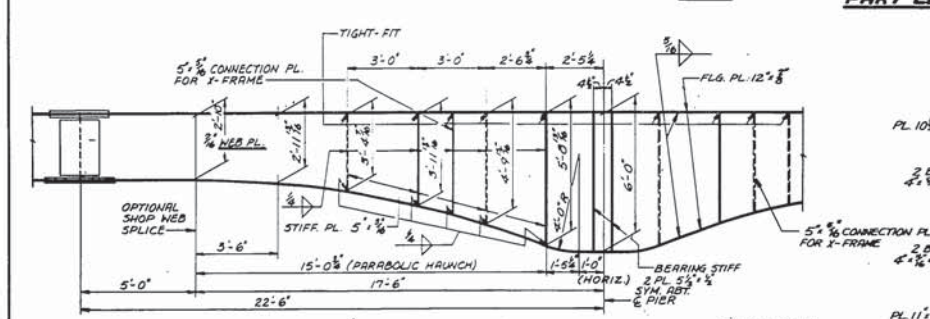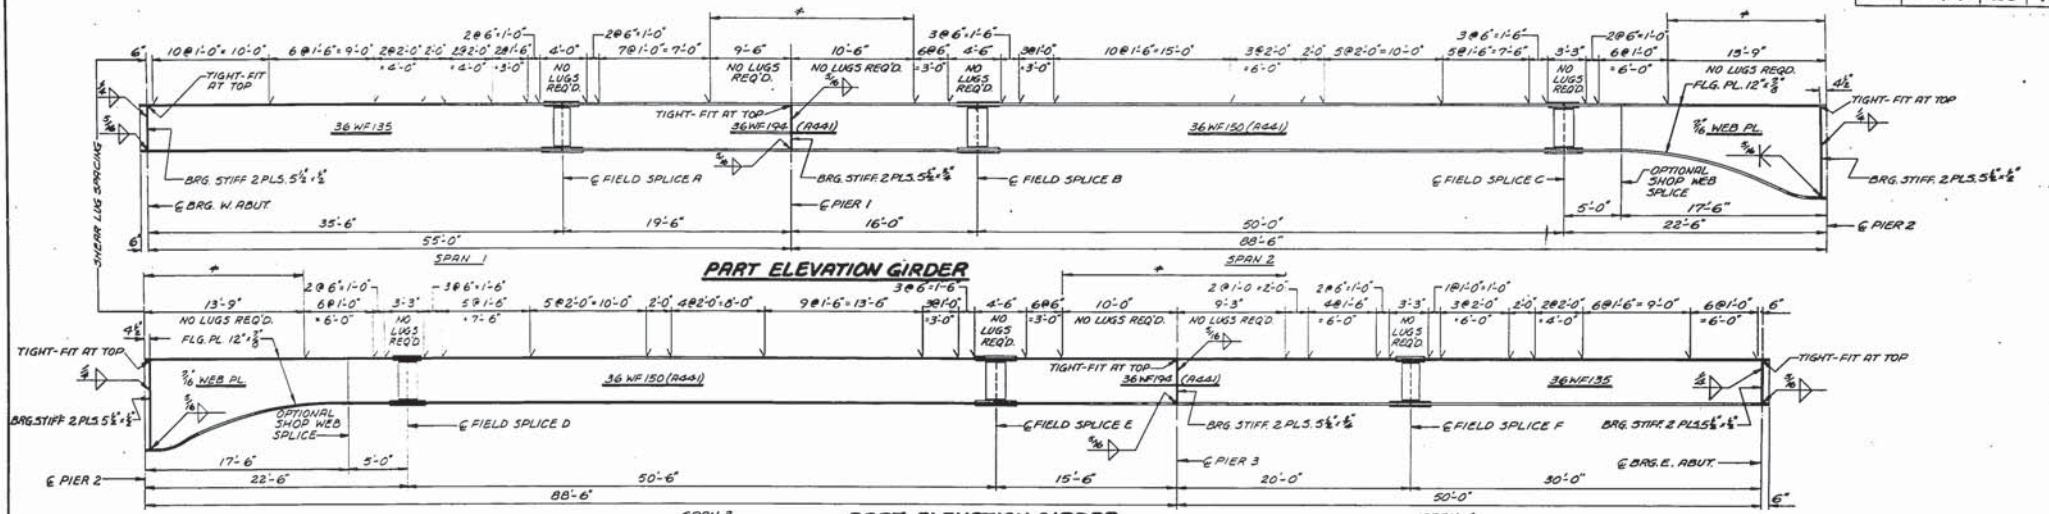


NOTE: PROVIDE FILL PLATES AS REQUIRED AT SPLICES. 1/8" MINIMUM THICKNESS.

DESIGNED BY	STATE HIGHWAY COMMISSION OF WISCONSIN
CHECKED BY	STATE HIGHWAY COMMISSION OF WISCONSIN
APPROVED BY	STATE HIGHWAY COMMISSION OF WISCONSIN
DATE	1971-8-9-46
DESIGNER	J. S. G.
INCHES	3/4"
SCALE	1" = 10'-0"
STRUCTURE	B-32-54
SHEET	5 OF 13

X 72222

D.P.R. DIVISION	PROJECT	SHEET NUMBER	TOTAL SHEETS
4	I 90-1 (45) 5	26	40

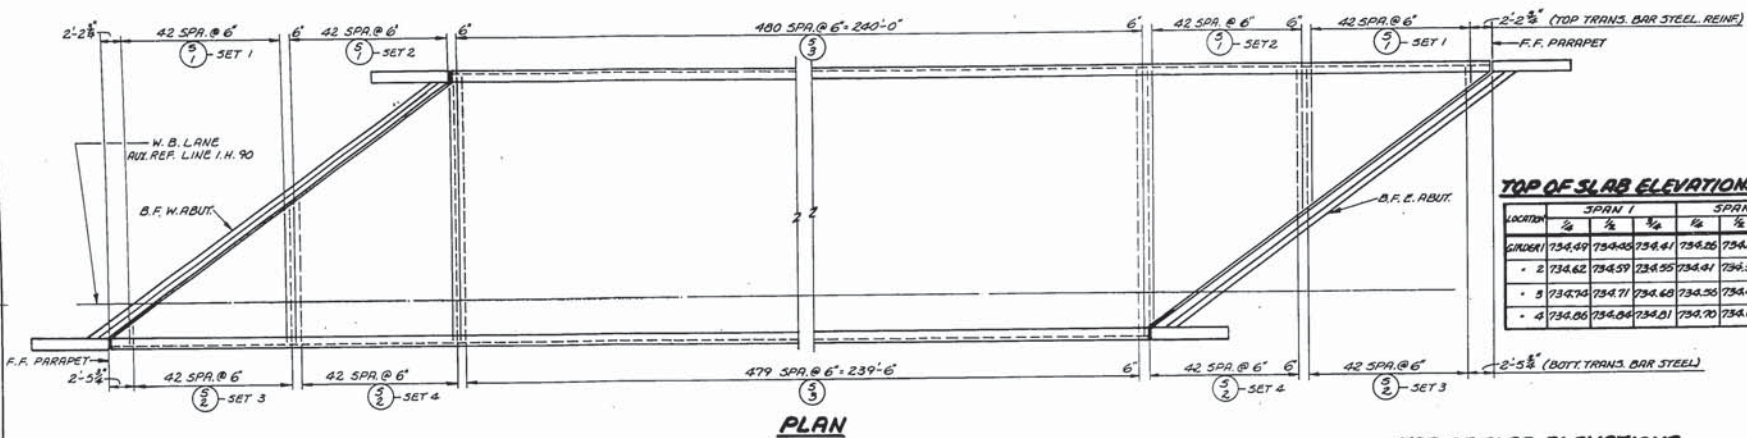

TOP OF SLAB ELEVATIONS AT QUARTER POINTS OF SPANS

LOCATION	SPAN 1			SPAN 2			SPAN 3			SPAN 4		
	1/4	1/2	3/4	1/4	1/2	3/4	1/4	1/2	3/4	1/4	1/2	3/4
GIRDER 1	734.49	734.45	734.41	734.26	734.15	734.03	733.75	733.57	733.07	732.95	732.06	
2	734.62	734.59	734.55	734.41	734.31	734.20	733.92	733.76	733.59	733.20	733.17	733.05
3	734.74	734.71	734.68	734.56	734.47	734.36	734.11	733.96	733.79	733.50	733.59	733.27
4	734.86	734.84	734.81	734.70	734.62	734.52	734.20	734.14	733.98	733.71	733.60	733.49

TOP OF SLAB ELEVATIONS


LOCATION	E. BRG. W. ABUT.	E. SPLICE A	E. PIER 1	E. SPLICE B	E. SPLICE C	E. PIER 2	E. SPLICE D	E. SPLICE E	E. PIER 3	E. SPLICE F	E. BRG. E. ABUT.
GIRDER 1	734.53	734.43	734.36	734.29	734.03	733.89	733.73	733.33	733.19	733.00	732.69
2	734.65	734.55	734.50	734.44	734.20	734.07	733.92	733.54	733.40	733.22	732.92
3	734.77	734.69	734.64	734.58	734.37	734.24	734.10	733.74	733.61	733.44	733.13
4	734.88	734.82	734.77	734.72	734.53	734.41	734.28	733.93	733.81	733.65	733.37

TOP OF STEEL ELEVATIONS

LOCATION	E. BRG. W. ABUT.	E. SPLICE A	E. PIER 1	E. SPLICE B	E. SPLICE C	E. PIER 2	E. SPLICE D	E. SPLICE E	E. PIER 3	E. SPLICE F	E. BRG. E. ABUT.
GIRDER 1	733.87	733.84	733.73	733.71	733.42	733.23	733.12	732.76	732.56	732.40	732.03
2	733.99	733.98	733.88	733.86	733.59	733.41	733.31	732.96	732.78	732.63	732.26
3	734.11	734.11	734.01	734.01	733.75	733.59	733.49	733.17	732.98	732.84	732.49
4	734.22	734.24	734.15	734.15	733.91	733.75	733.67	733.36	733.19	733.05	732.71

THESE ELEVATIONS ARE TO TOP OF STEEL (TOP OF SPLICE PLS. AT SPLICE) AND THEY ARE FOR THE MATERIAL AS ERRECTED. THE ELEVATION OF THE TOP OF STEEL AT THE FIELD SPLICE POINTS SHALL BE CHECKED AND CORRECTED, IF POSSIBLE, AFTER ERECTION AND BEFORE PERMANENTLY WELDING OR BOLTING THE DIAPHRAGMS IN PLACE.

DEFLECTION DIAGRAM

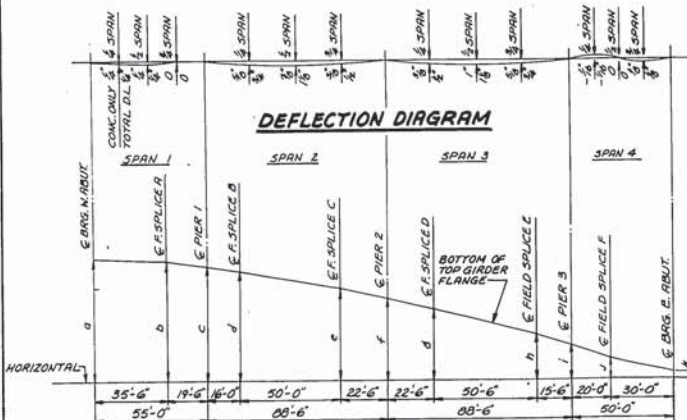


BLOCKING DIAGRAM

DIMENSION	a	b	c	d	e	f	g	h	i	j	k
GIRDER 1	1'-10 1/2"	1'-8 3/4"	1'-7 3/4"	1'-7 3/4"	1'-4 3/8"	1'-2 3/8"	1'-0 3/8"	0'-7 3/8"	0'-5 3/8"	0'-3 3/8"	0
2	1'-0 3/8"	1'-7 3/4"	1'-6 3/8"	1'-6 3/8"	1'-5 3/8"	1'-1 3/8"	1'-0 3/8"	0'-7 3/8"	0'-5 3/8"	0'-3 3/8"	0
3	1'-7 3/4"	1'-6 3/8"	1'-5 3/8"	1'-5 3/8"	1'-2 3/8"	1'-1 3/8"	0'-11 3/8"	0'-7 3/8"	0'-5 3/8"	0'-3 3/8"	0
4	1'-6 3/8"	1'-5 3/8"	1'-4 3/8"	1'-4 3/8"	1'-1 3/8"	1'-0 3/8"	0'-11 3/8"	0'-6 3/8"	0'-5 3/8"	0'-3 3/8"	0

TO DETERMINE δ : AFTER ALL STRUCTURAL STEEL HAS BEEN ERRECTED, ELEVATIONS OF THE TOP FLANGES OR TOP OF SPLICE PLATES WHICHEVER APPLIES, AND AT QUARTER POINTS OF EACH SPAN, δ OF FIELD SPLICES, THESE ELEVATIONS SUBTRACTED FROM THE GRADE ELEVATIONS, ADJUSTED FOR THE DEAD LOAD DEFLECTION OF THE CONCRETE, MINUS THE SLAB DEPTH PLUS THE STEEL THICKNESS TO BOTTOM OF TOP FLANGE, EQUALS THE HAUNCH DEPTH δ .

SLAB THICKNESS DIAGRAM

KEYWAY ON E. SLAB FORMED FROM SURFACED, BEVELED 2" x 2" RUN STEEL THRU JOINT

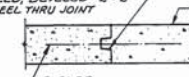

SECTION 54

W.B. LANE
AUX. REF. LINE I.H. 90


INDICATES POUR NUMBER AND DIRECTION

POURING DIAGRAM


NOTE: TWO OR MORE POURS MAY BE COMBINED AND THE TRANSVERSE CONSTRUCTION JOINTS OMITTED IF THE POUR FOR AN ENTIRE SPAN OR THE PORTION OF A SPAN TO A CONSTRUCTION JOINT CAN BE COMPLETED WITHIN FOUR HOURS AFTER CONCRETE OVER THE ADJACENT PIER IS PLACED.
DIRECTION OF POUR MAY BE REVERSED IF PORTION OF POUR FROM THE PIER CAN BE COMPLETED IN A FOUR HOUR PERIOD.

DESIGNED BY	STATE HIGHWAY COMMISSION OF WISCONSIN
DRAWN BY	STRUCTURE DETAILS
CHECKED BY	DESIGN SPEC. R.R.S.N.O. 61
DATE	8-9-66
REVISION	3.3.6
BY	W.L.
DATE	8-9-66
STRUCTURE	B-32-54
SHEET	4 OF 13

 X 35229




ROCKER & 'A'

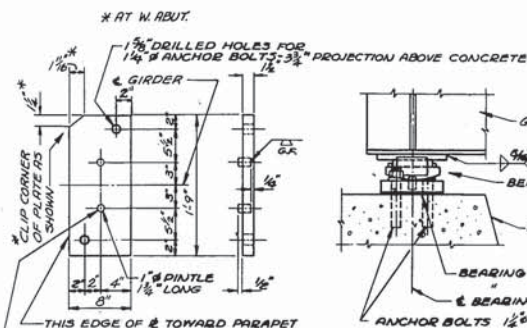


MASONRY & 'A'

AT GIRDERS 2 & 3 E. ABUT. USE
MASONRY PLATE DETAILS AS SHOWN
ON SHEET 6.

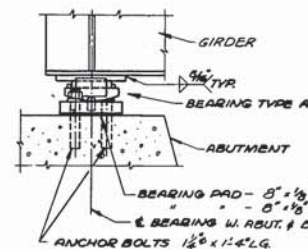

BEARING TYPE 'A'
OUTER ASSEMBLY

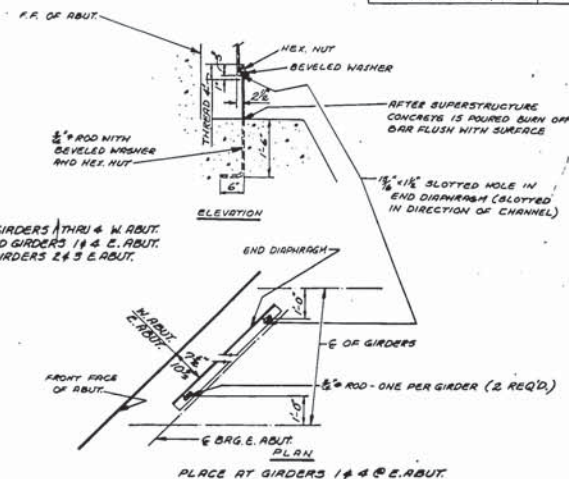


TEMPORARY HOLD DOWN DEVICE

(TO BE PAID FOR AS STRUCK CARBON STEEL.)
IF POURING SEQUENCE IS REVISED TO TERMINATE
AT W. ABUT. PLACE TEMPORARY HOLD DOWN DEVICE
AT EACH GIRDER AT WEST ABUT.



BEARING TYPE 'B'
4 REQ'D.

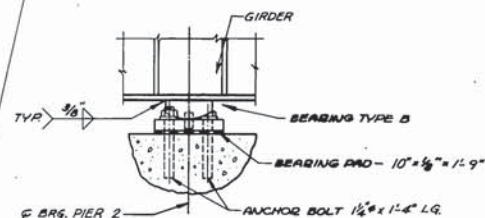


BEARING TYPE 'B'
ASSEMBLY


—1" PINTLE - DRILL PLATE FOR DRIVING FIT
CHAMFER TOP OF PINTLE $\frac{1}{2}$ "



BEARING TYPE 'C'

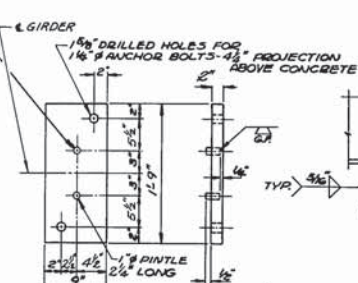

MASONRY & 'C'

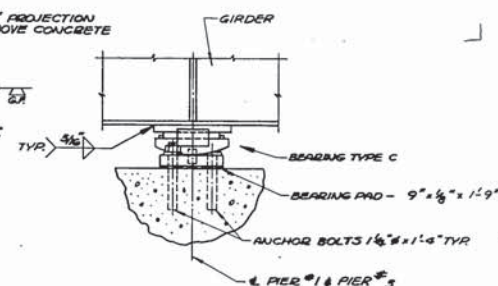

BEARING TYPE 'C'
ASSEMBLY

NOTE: TOP PLATE OF EXPANSION
BEARING TO BE FINISHED IN
DIRECTION OF MOVEMENT.

BEARING NOTES

ALL STRUCTURAL STEEL BEARING PLATES SHALL BE FLAT ROLLED STEEL PLATES WITH ALL SURFACES SMOOTH AND FREE FROM WARP AND ALL EDGES SMOOTH, STRAIGHT AND VERTICAL.

ALL PLATE CUTS SHALL BE MACHINE OR MACHINE FLAME CUTS.

ANCHOR BOLTS SHALL BE THREADED 3", PROVIDE ONE STANDARD WROUGHT WASHER AND ONE HEX. NUT PER BOLT.

ALL MATERIAL EXCLUDING ANCHOR BOLTS, NUTS AND WASHERS SHALL BE MADE OF A36 STEEL WITH A CORROSIVE RESISTANCE OF 4.08 MORE TIMES THAT OF A36 STEEL.

THE TOP $4\frac{1}{2}$ " OF ANCHOR BOLTS, WASHERS AND NUTS SHALL BE GALVANIZED.

ALL MATERIAL IN BEARINGS, INCLUDING SHIMS BUT EX-
CLUDING BRONZE PLATES AND BEARING PADS SHALL BE PAID
FOR AT THE UNIT PRICE BID FOR STRUCTURAL LOW ALLOY
STEEL.


REVISED	STATE HIGHWAY COMMISSION OF WISCONSIN		
	BEARING DETAILS		
DESIGN SPEC	SECTION 61	LOADING	CORRECT: 1963
DATE 6-3-66	DESIGN	DRAWN JMC	CHECK J.C.K.
STRUCTURE B-32-54		SHEET 5 OF 13	

SEE DETAIL A
EDGE
1-0
ABUTMENT REINFORCEMENT.
BACK FACE OF ABUTMENT.
CONST. JOINT POUR CONCRETE ABOVE THIS JOINT AFTER SUPERSTRUCTURE CONCRETE IS IN PLACE. LEAVE JOINT ROUGH.


* AT 60° F.

* LONG. DIM. OF $\frac{1}{8}$ " & $\frac{1}{4}$ " SLOTTED HOLE PARALLEL TO REF. LINE


D & S DIVISION	PROJECT	SHEET NUMBER	TOTAL SHEETS
A	190-1855	28	40

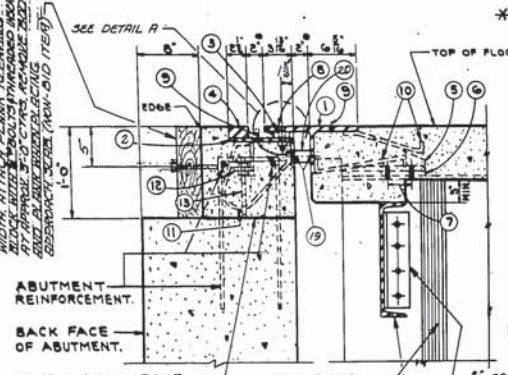


SECTION EI

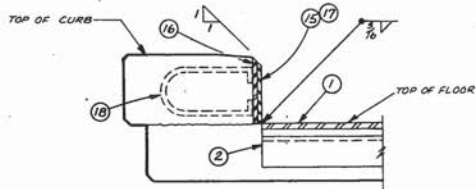

DETAIL AT CURB

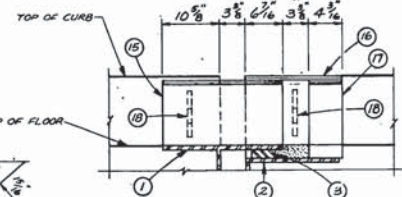


ELEV. CURB JOINT

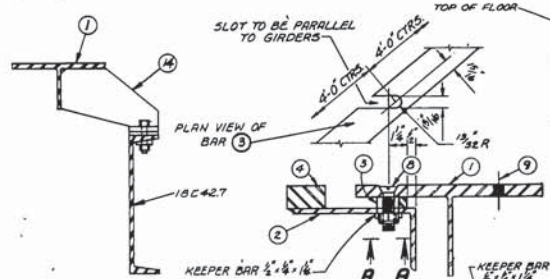


SUPPORT TEE
(PLACE AT MIDPOINT OF CHANNELS)

DETAIL A


SECTION A

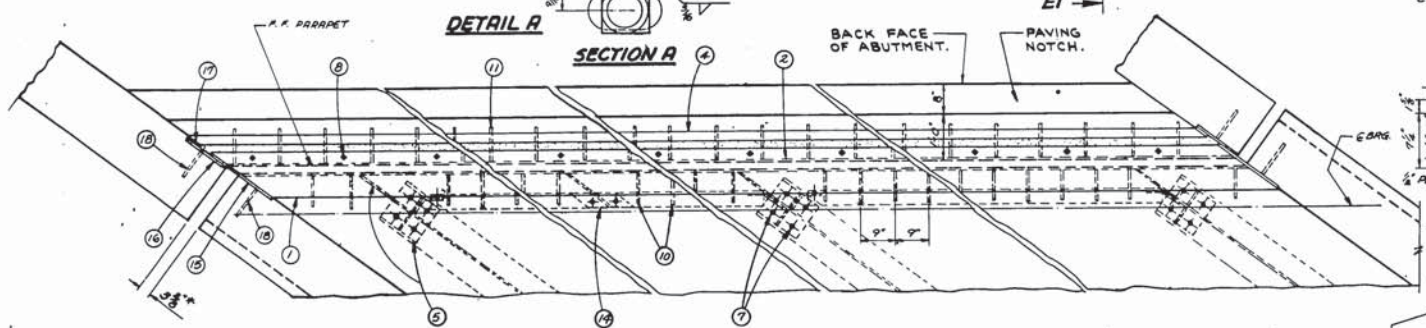

PLAN
(AT WEST AND EAST ABUTS.)

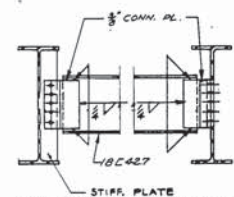

ALTERNATE DIAPHRAGM CONNECTION

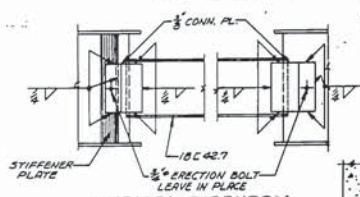

TYPICAL DIAPHRAGM CONNECTION

NOTES


EXPANSION JOINT SHALL BE BUILT TO CONFORM TO ROWY, CROWN & GRADE. AFTER CONCRETE HAS SET REMOVE BOLTS NO. 6 AND FILL HOLES WITH HOT POURED ELASTIC TYPE JOINT SEALER.

AFTER CONCRETE HAS SET THE JOINT SHALL BE THOROUGHLY CLEANED. APPLY $\frac{1}{2}$ " COAT OF BITUMASTIC TO METAL SURFACES FORMING THE JOINT AND FILL WITH HOT POURED ELASTIC TYPE JOINT SEALER.


ONE FIELD SPICE IS PERMITTED IN JOINTS OVER 30 FT. IN LENGTH. ALL MATERIAL IN EXPANSION JOINT SHALL BE PAID FOR AS STRUCTURAL CARBON STEEL.

LEGEND

1. S.T. 6" W.F. 35.5" ROADWAY WIDTH.
2. L 8" x 4" x $\frac{1}{4}$ " ROADWAY WIDTH.
3. BAR 2" x $\frac{1}{2}$ " ROWY. WELD TO L#2 WITH 2 LINES OF $\frac{1}{4}$ " FILLET WELD.
4. BAR 2" x $\frac{1}{2}$ " ROWY. WELD TO L#2 WITH 2 LINES OF $\frac{1}{4}$ " FILLET WELD.
5. FABRICATE FROM $\frac{1}{2}$ " WELDED PLATE. WELD TO STEM & FLG. OF S.T.#1 WITH $\frac{1}{4}$ " FILLET WELD NEAR AND FAR SIDE.
6. $\frac{3}{8}$ " MIN. LAMINATE SHOW & SLOTTED SHIM.
7. DRILL HOLES IN STRINGER FLG. IN FIELD FOR $\frac{3}{4}$ " BOLTS.
8. $\frac{3}{4}$ " FLAT HD. CAP SCREW x 0-2" WITH 3/8" NUT @ 4'-0" CTRS. GREASE FOR EASY REMOVAL. $\frac{3}{4}$ " x $\frac{1}{2}$ " KEEPER BAR WELD TO L#2 TO KEEP SO NUT FROM TURNING.
9. $\frac{1}{2}$ " SLOTTED HOLE IN L#2. $\frac{1}{2}$ " HOLE CSM. $\frac{1}{2}$ " DEEP IN ST#1. $\frac{1}{2}$ " SLOT IN BAR#9 AS SHOWN. (HOLE IN L#2 PARALLEL TO GIRDERS).
10. VENT HOLES. $\frac{1}{2}$ " PLACED AT 2'-0" CENTERS ON L#2 AND S.T.#1.
11. $\frac{1}{2}$ " BENT BAR @ 0'-5" ALTERNATE CENTERS BETWEEN GIRDERS.
12. $\frac{1}{2}$ " BENT BAR @ 1'-0" CENTERS. 2'-0" LONG. WELD TO L#2.
13. $\frac{1}{2}$ " x $\frac{1}{2}$ " x $\frac{1}{4}$ " x 0'-3" @ 3'-0" CENTERS. WELD TO L#2. PROVIDE $\frac{1}{2}$ " HOLE IN 2" LEG FOR BOLT #13.
14. $\frac{1}{2}$ " BOLT x 0'-9" LG & NUT. TACK WELD NUT TO L#2.
15. SUPPORT TEE - FABRICATE FROM $\frac{1}{2}$ " PL. WELD TO ST#1.
16. $\frac{3}{8}$ " PL - CHAMFER AS SHOWN.
17. $\frac{3}{8}$ " PL - CHAMFER AS SHOWN. WELD TO PL#16 WITH 1 LINE OF $\frac{1}{4}$ " FILLET WELD.
18. $\frac{3}{8}$ " BENT BAR x 1'-5" LG. WELD TO PL#15 & PL#16.
19. PROVIDE $\frac{1}{2}$ " HOLES AT 3'-0" CTRS. FOR BOLT #20.
20. BLOCK & BOLT FOR SHIPMENT WITH PIPE SLEEVE AND $\frac{1}{2}$ " BOLT.

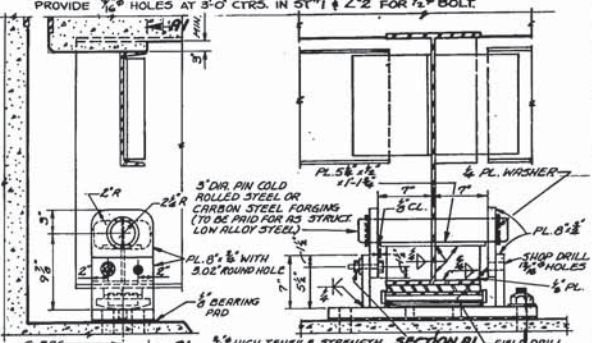

ELEVATION

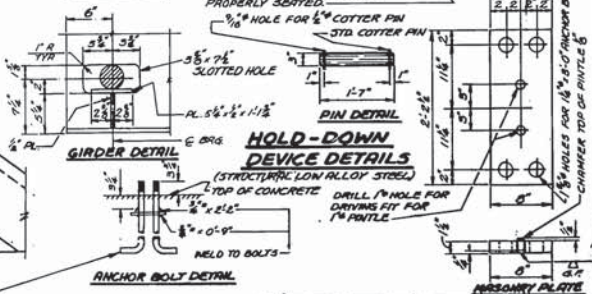

ANCHOR BOLT DETAIL

HOLD-DOWN DEVICE DETAILS


(STRUCTURAL LOW ALLOY STEEL)

DRILL $\frac{1}{8}$ " HOLE FOR DAYING FIT FOR 1" RIVET

WELD TO BOLTS

STATE HIGHWAY COMMISSION OF WISCONSIN	EXPANSION JOINT AND HOLD-DOWN DEVICE
DESIGNED BY: A.A.S.H.O. & L. J. C. J.	DATE: 5-9-46
STRUCTURE: B-32-54	SHEET: 6 OF 13

X 35231

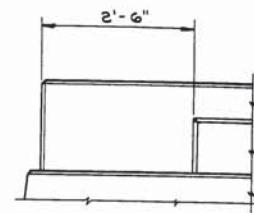

VIEW SHOWING OUTSIDE
FACE OF RAIL PARAPET
TYPICAL ALL WINGS

AT EAST ABUTMENT




WHERE PARAPETS AND CURBS ARE POURED CONTINUOUSLY FROM END TO END THEY SHALL BE SEPARATED AT THE DEFLECTION JOINTS BY A PIECE OF $\frac{1}{8}$ " ZINC OR ALUMINUM PLATE CUT AS SHOWN IN SECTION "B" OF SHADED AREA. IF CONSTRUCTION JOINTS IN PARAPETS AND CURBS ARE USED AT THE DEFLECTION JOINTS ONE SIDE OF JOINT SHALL BE COATED WITH BITUMINOUS PAINT AND PLATE SEPARATORS MAY BE OMITTED.

COST OF 1 1/4" Φ GALVANIZED PIPE SLEEVES
AND 3/4" Φ BARS TO BE INCLUDED IN UNIT PRICE
BID FOR CONCRETE MASONRY.


WORK THIS SHEET WITH SHEET TITLED
"DETAILS FOR TYPE "G" TUBULAR ALUMINUM
AND STEEL RAILING".

ALL POST SPACINGS ARE TAKEN HORIZONTALLY ALONG C OF RAILING AT BASE OF POSTS. ALL POSTS SHALL BE SET NORMAL TO GRADE.


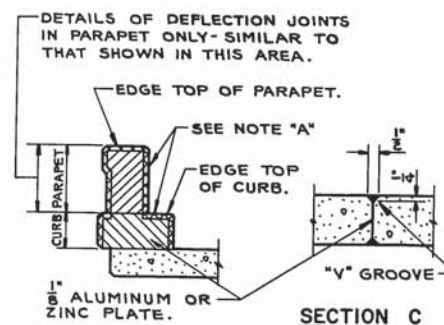


SECTION B
SHOWING DEFLECTION
JOINT IN CURB AND
PARAPET AT PIERS.

REVISED		STATE HIGHWAY COMMISSION OF WISCONSIN			
		RAIL PARAPET DETAILS			
		DESIGN SPEC <i>R.R. 3, H.O. 8</i>		LOADING	CONST. <i>1963</i>
		DATE <i>6-5-66</i>		DESIGN	DRAWN <i>JMK</i>
				CHK. <i>JMK</i>	
STRUCTURE		B-32-54		SHEET 7 of 13	

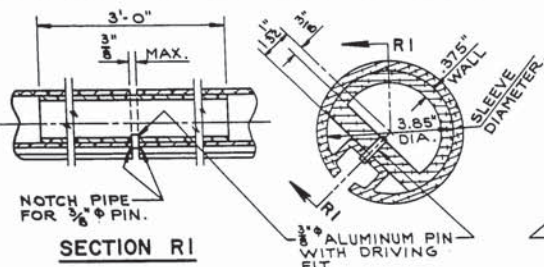


ALUMINUM RAILING DETAILS

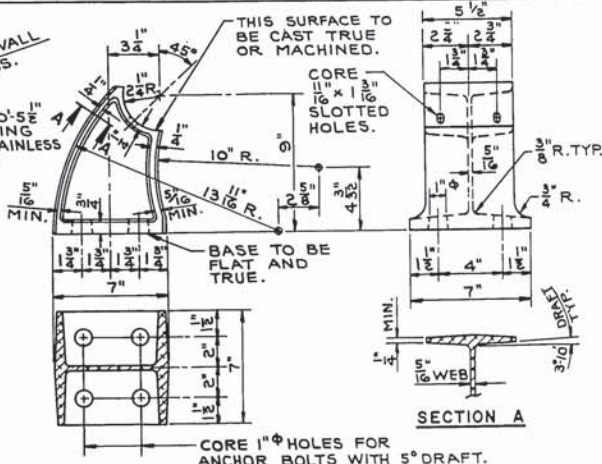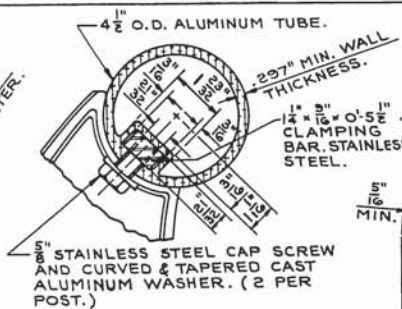

NOTES

RAILING SPLICES SHALL BE LOCATED SUCH THAT $\frac{1}{2}$ OF SPLICE IS $\frac{1}{2}$ PANEL LENGTH $\pm 4"$ OFF NEAREST POST. ALUMINUM SHIMS SHALL BE USED UNDER POSTS AND END PLATES WHERE REQUIRED FOR ALIGNMENT. RAILING SHALL BE FABRICATED IN TWO AND THREE PANEL LENGTHS. ANCHOR BOLTS, NUTS & WASHERS TO BE STAINLESS STEEL. WALL THICKNESS OF TUBING SHOWN ABOVE SHALL BE MINIMUM NOMINAL AVERAGE WALL THICKNESS.

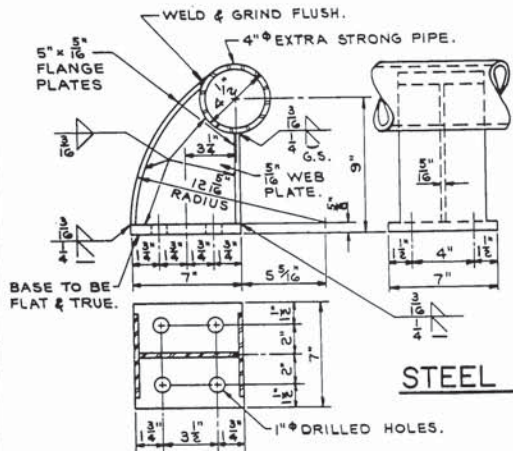


STEEL RAILING DETAILS

NOTES

RAILING SHALL BE FABRICATED IN 2 & 3 PANEL LENGTHS. STEEL SHIMS SHALL BE USED UNDER POSTS AND UNDER END PLATES WHERE REQUIRED FOR ALIGNMENT. THE FOLLOWING MATERIALS SHALL BE USED: RAILING SHALL BE 4" EXTRA STRONG PIPE CONFORMING TO ASTM DESIGNATION A53, GRADE B. SLEEVES SHALL BE 3 1/2" O.D. x 1/2" THICK SEAMLESS MECHANICAL TUBING MADE OF STEEL WITH A MINIMUM ULTIMATE TENSILE STRENGTH OF 60,000 P.S.I. AND A MINIMUM ELONGATION OF 10%. POSTS SHALL BE FABRICATED FROM MATERIAL CONFORMING TO ASTM DESIGNATION A36. ANCHOR BOLTS TO BE MADE FROM MATERIAL CONFORMING TO ASTM A307. CAULK EXPOSED OPENINGS BETWEEN SHIMS WITH LEAD WOOL. GALVANIZE ENTIRE RAILING AFTER FABRICATION INCLUDING NUTS, WASHERS, SHIMS AND TOP 3 1/2" OF ANCHOR BOLTS.



STEEL POST DETAILS

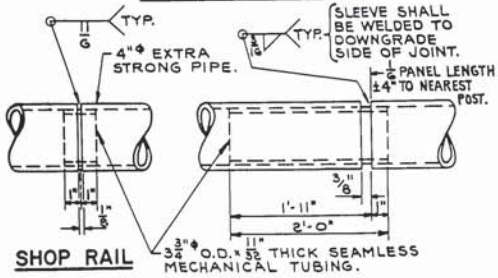



SHOP RAIL SPLICE DETAIL

THE LOCATION OF THE SHOP SPLICE SHALL BE SHOWN ON THE SHOP DRAWINGS.



FIELD ERECTION JOINT DETAIL

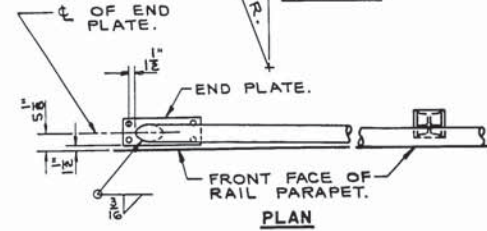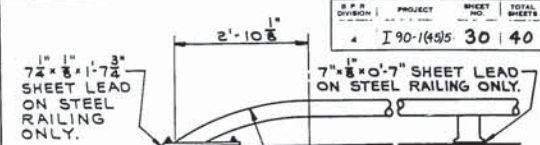

DETAIL OF RAIL BEND AT ABUTMENTS

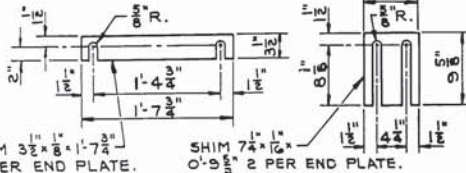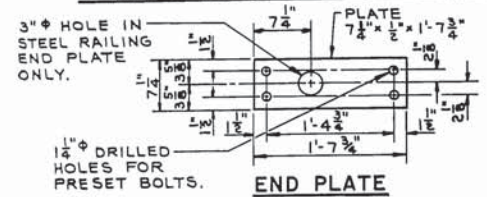


END PLATE SHIM DETAILS

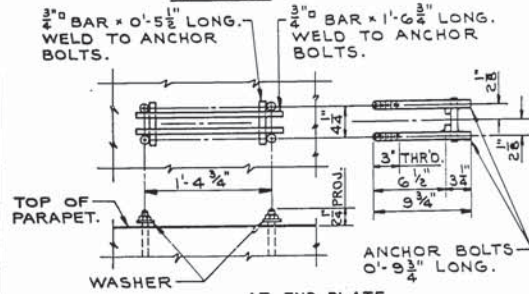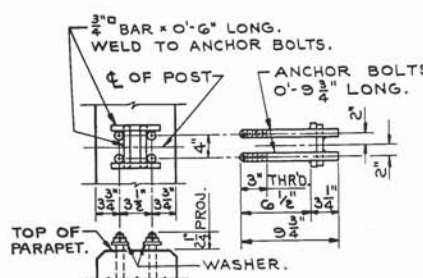

ANCHOR BOLT SETTING DETAILS





THE SHANK AND ROOT OF THREAD DIAMETER FOR ANCHOR BOLTS SHALL BE A MINIMUM OF 0.62 INCHES.

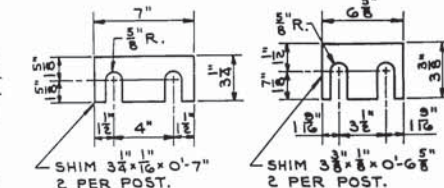





POST SHIM DETAILS

WORK THIS SHEET WITH SHEET TITLED "RAIL PARAPET DETAILS"

STATE HIGHWAY COMMISSION OF WISCONSIN	PROJECT NO. 90-1(4)5	SHEET NO. 30	TOTAL SHEETS 40
DETAILS FOR TYPE "G" TUBULAR ALUMINUM & STEEL RAILING			
DESIGN BY A.R.S.H.D. 61	LOADING	1963	
DATE 6-9-66	DESIGN	DATE 20	CHK J.C.K.
STRUCTURE B-32-54	SHEET 6 OF 13		

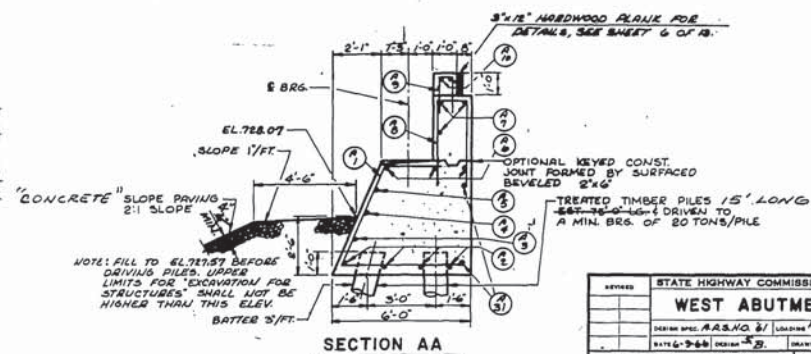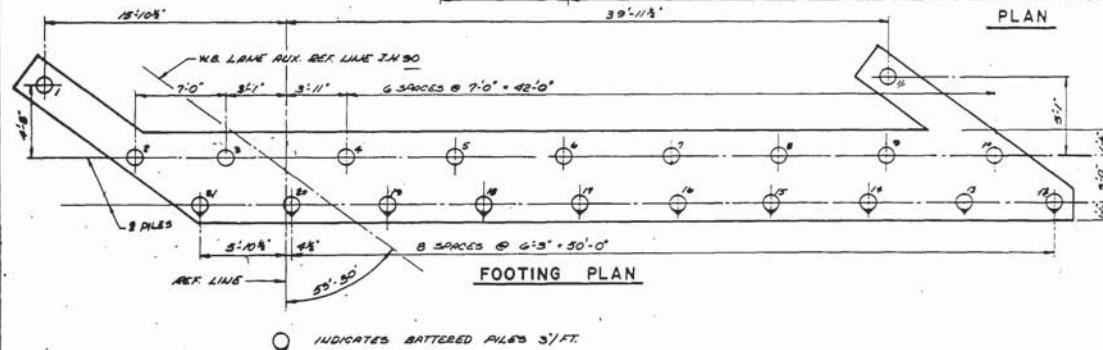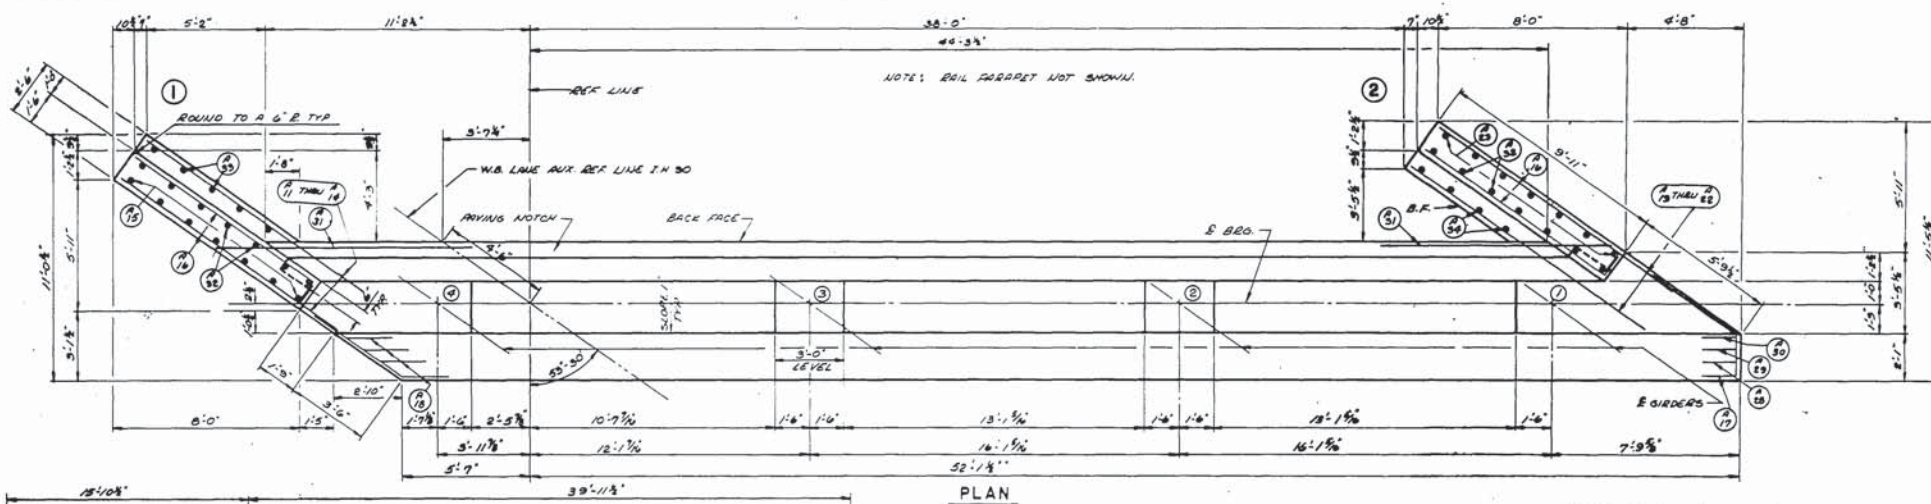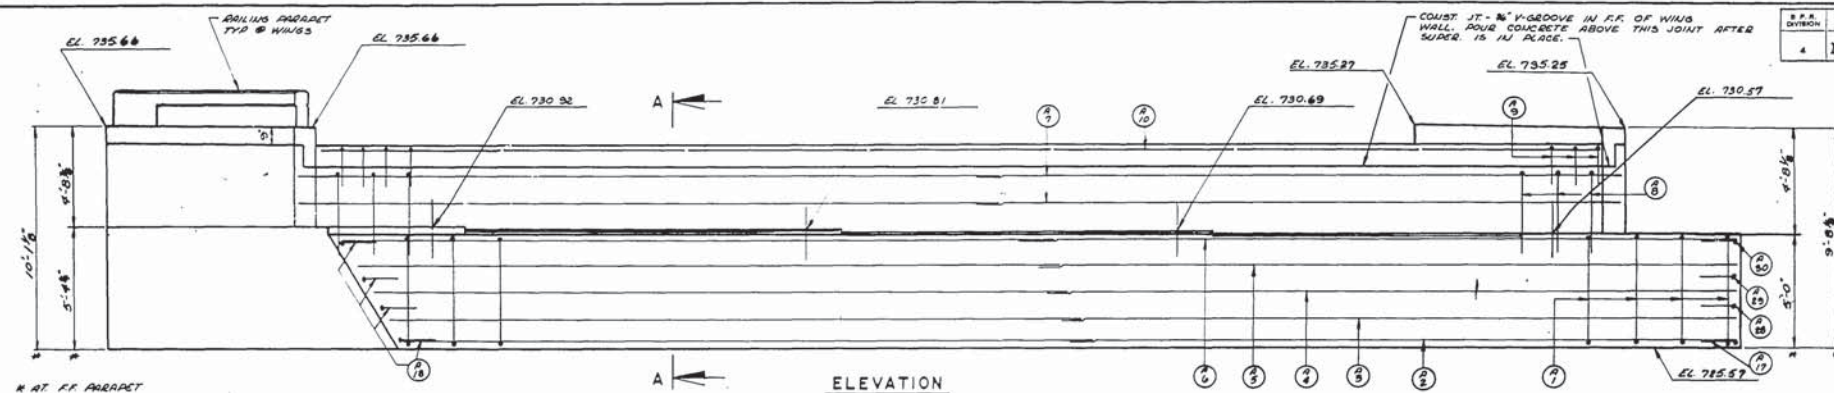


REVISED	STATE HIGHWAY COMMISSION OF WISCONSIN		
	WEST ABUTMENT		
	DESIGN SPEC. ARS.NG 61	LOADING M_{10} CRD	CONTRACT 1963
DATE 6-24-66	DESIGN X_B	DRAWN $E.T.A.$	CHK. J.C.K.
STRUCTURE B - 32 - 54		SHEET 9 OF 13	

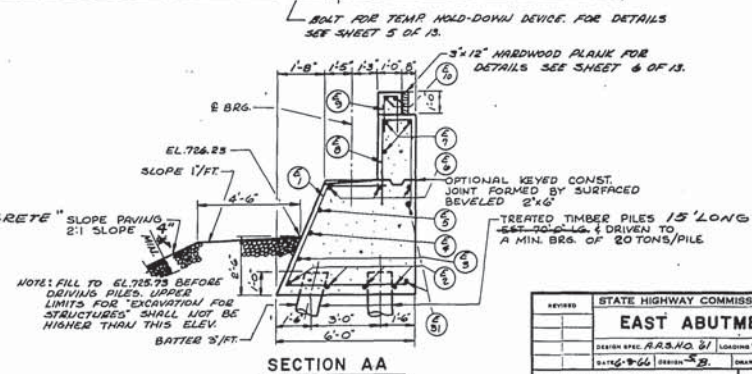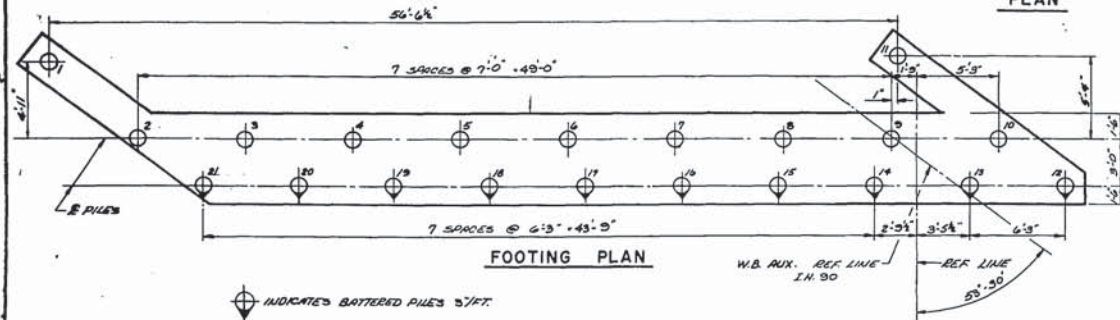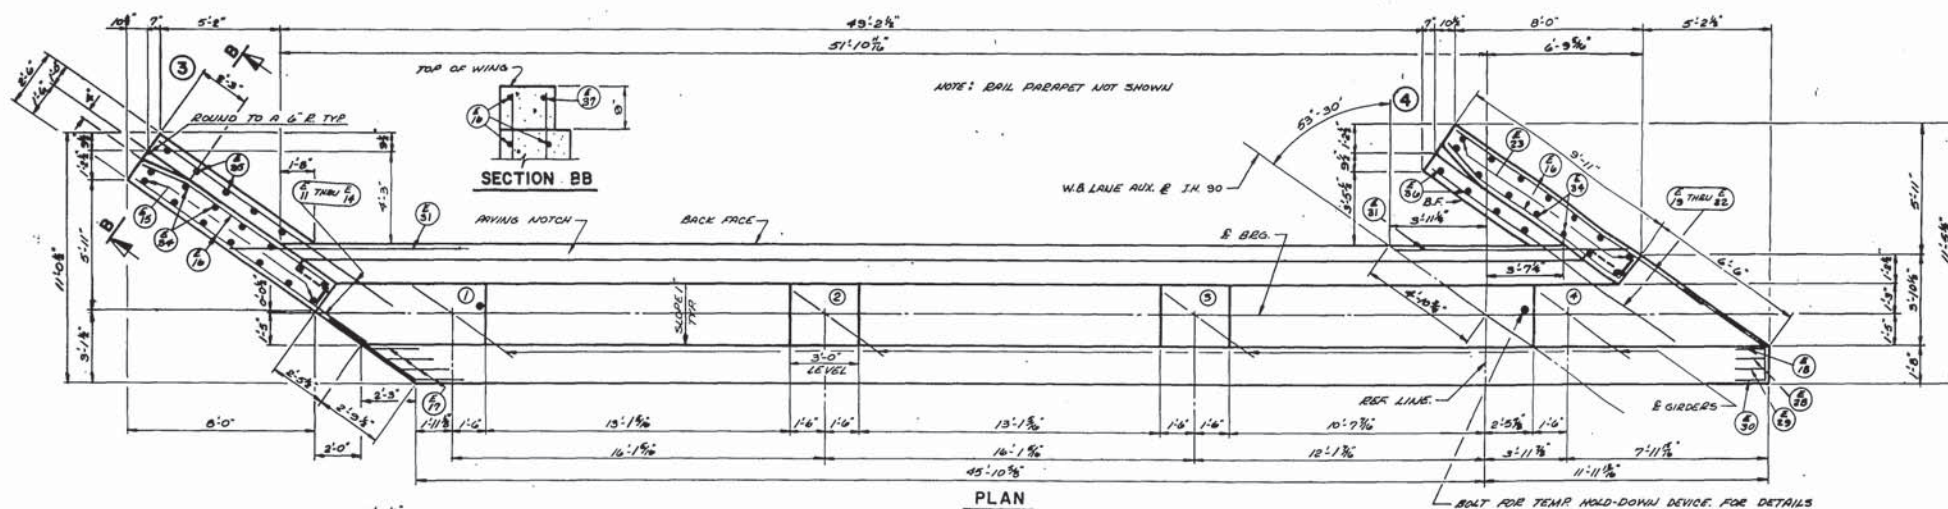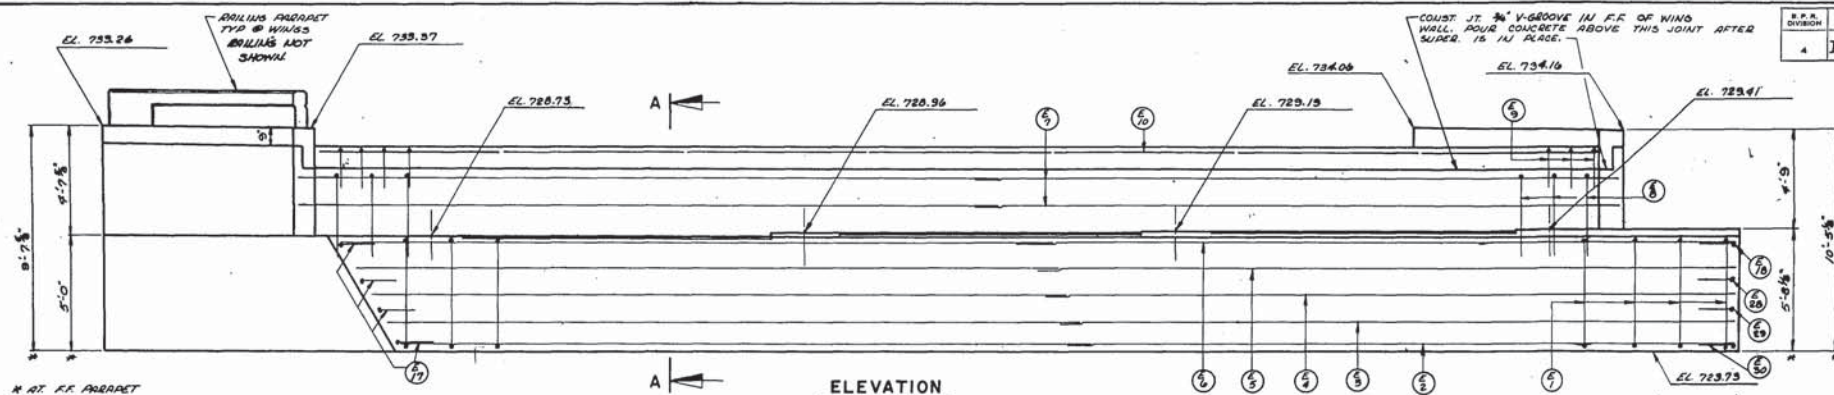


KEYWORD		STATE HIGHWAY COMMISSION OF WISCONSIN			
		EAST ABUTMENT			
		DESIGN SPEC. <u>AR.SHO. 61</u>	LOADING <u>H950</u>	CONTRACT <u>1963</u>	
		DATE <u>6-66</u>	DESIGN <u>S.B.</u>	DRAWN <u>E.D.</u>	CRD. <u>J.C.K.</u>
STRUCTURE <u>B - 32 - 54</u>				SHEET <u>10</u> OF <u>13</u>	


DIVISION	PROJECT	SHEET NO.	TOTAL SHEETS
4	I 90-1(45)8	33	40

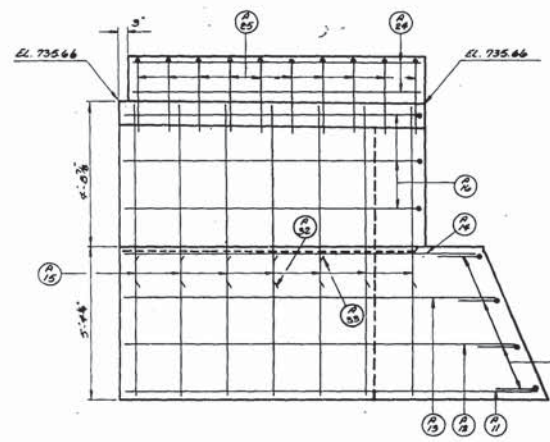


WING 1

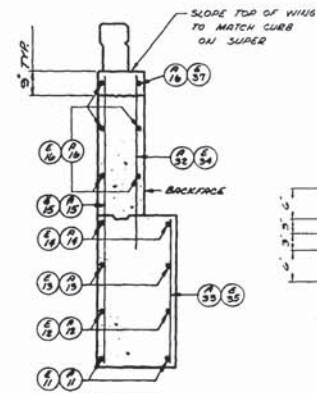

SECTION THRU WINGS 1 & 3

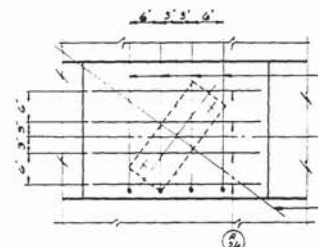


GRID DETAIL (WEST ABUTMENT ONLY)

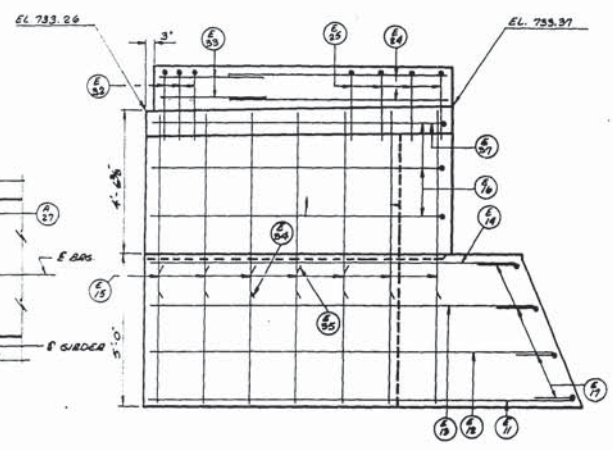


WING 3


NOTE: FOR RAIL PARAPET REINF DETAILS SEE SHT. 7 OF 13.

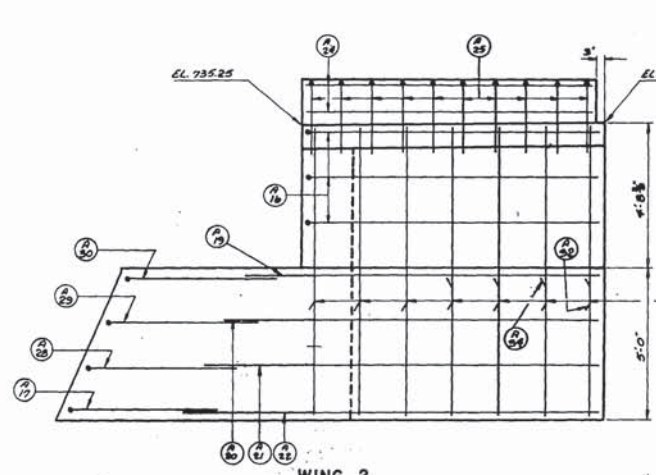


WING 2

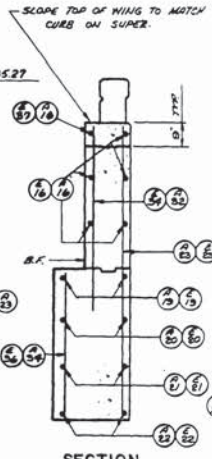

SECTION THRU WINGS 2 & 4

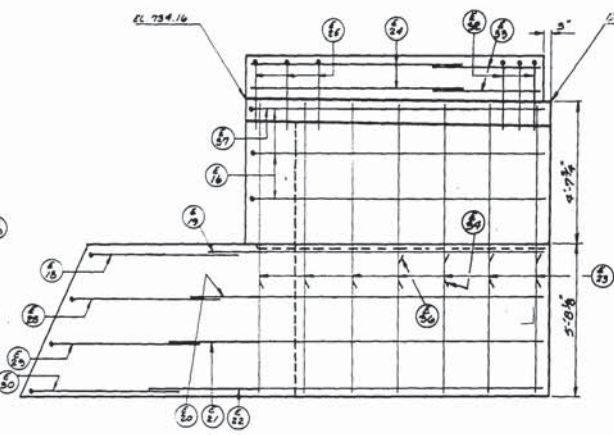




WING 4

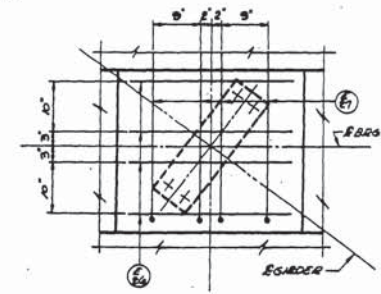

GRID DETAIL (EAST ABUTMENT)


DESIGNED BY	STATE HIGHWAY COMMISSION OF WISCONSIN
CHECKED BY	ABUTMENT DETAILS
DATE	10/10/81
BY	10/10/81
STRUCTURE	B-32-54
SHEET	11 OF 13

X 35236

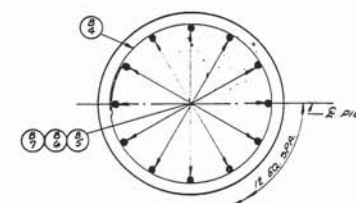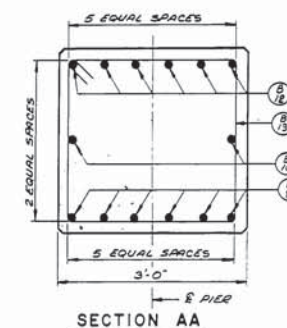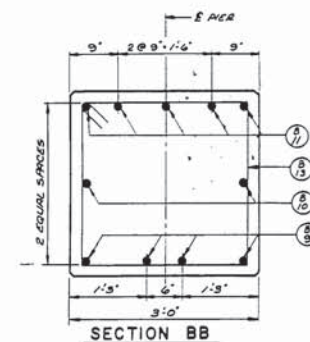


	<u>PAGE 1</u>	<u>PAGE 2</u>	<u>PAGE 3</u>
FOOTINGS	23.3 C.Y.	23.3 C.Y.	28.8 C.Y.
COLUMNS	15.4 C.Y.	12.8 C.Y.	14.7 C.Y.
CAPS	18.4 C.Y.	18.7 C.Y.	18.9 C.Y.
TOTAL	57.1 C.Y.	54.8 C.Y.	56.9 C.Y.

OFFICE	STATE HIGHWAY COMMISSION OF WISCONSIN		
	PIERS 1, 2, & 3		
DESIGN SPEC	R.A.S.H.O.W.	LOG NO.	AD 20 AND
			DATE: 1965
DATE	6-3-64	DESIGN	BY: J.C.K.
STRUCTURE	B - 32 - 54	SHEET	12 OF 13

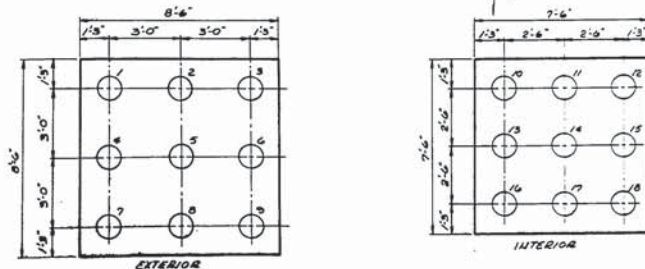

FOOTING PLAN

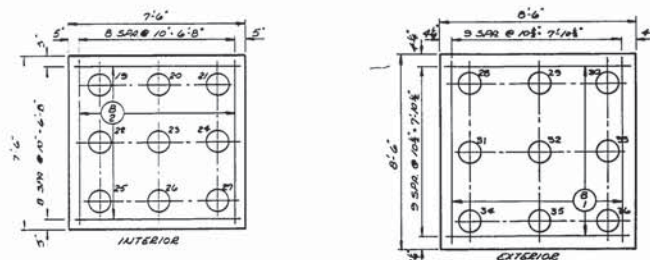

REINFORCEMENT PLAN

SUPERSTRUCTURE

94,310 #

POUR	MARK	NO.	SIZE	LENGTH	SPACING	LOCATION	DET.
S 1	86	6	35-9	6		Floor-Top-Transverse	T
S 2	86	6	36-0	6		Bottom-Transverse	T
S 3	961	6	35-0	6			
S 4	400	5	36-9		Shown	Longitudinal	
S 5	264	5	36-9			Top-Longitudinal	
S 6	24	5	15-0			Symmetrical about & Piers	
S 7	564	5	3-9	1-0		Curbs-Transverse	G
S 8	8	5	28-9		Shown	Longitudinal-Span 1	
S 9	24	5	30-3			Spans 2 & 3	
S 10	8	5	28-3			Span 4	
S 11	564	5	5-0	1-0		& Rail Parapet	D
R 1	16	5	18-3	Shown		Rail Parapet	
R 2	40	5	23-3				
R 3	8	5	13-9				
R 4	8	5	20-9				
R 5	8	5	19-9				
R 6	8	5	14-9				
R 7	8	5	25-9				
R 8	8	5	8-9				
R 9	8	5	22-6				

WEST ABUTMENT

2,510 #

A 1	29	4	13-9	2-0		Body-Space to Miss Piling	F
A 2	8	4	29-3		Shown	Horizontal	
A 3	2	4	29-6				
A 4	2	4	30-0				
A 5	2	4	30-6				
A 6	6	6	30-9				
A 7	6	4	30-0			Parapet-Horizontal	E
A 8	38	5	9-6	1-6		Body & Parapet	B
A 9	56	5	5-0	1-0		Parapet	B
A 10	14	4	7-9		Shown	Horizontal-Do Not Lap	
A 11	2	4	14-6	1-6		Wing 1-Horizontal	
A 12	2	4	13-3	1-6		" 1 "	
A 13	2	4	12-3	1-6		" 1 "	
A 14	2	6	11-3	1-6		" 1 "	
A 15	7	4	9-9	1-6		" 1-Vertical "	
A 16	12	4	10-9	1-6		Wings 1 & 2-Horizontal	A
A 17	1	4	7-3	1-6		Wing 2-Horizontal-Corner	M
A 18	4	4	2-6	1-6		" 1 "	C
A 19	2	6	12-3	1-6		" 2 "	
A 20	2	4	13-3	1-6		" 2 "	
A 21	2	4	14-3	1-6		" 2 "	
A 22	2	4	15-3	1-6		" 2 "	
A 23	7	4	9-6	1-6		" 2-Vertical "	
A 24	8	5	9-3		Shown	Railing Parapet-Horizontal	
A 25	20	5	5-9	1-0			B
A 26	16	5	2-6		Shown	Grid	
A 27	16	5	4-3				A
A 28	1	4	6-9	1-6		Wing 2-Horizontal-Corner	M
A 29	1	4	6-3	1-6		" 1 "	M
A 30	1	4	5-6	1-6		" 2 "	P
A 31	4	4	10-0		Shown	Body-Horizontal at Wing	
A 32	14	5	5-9	1-6		Wings 1 & 2-Vertical	
A 33	5	4	5-0	1-6		Wing 1-Vertical	
A 34	4	4	4-9	1-6		" 2 "	

PIERS

19,490 #

POUR	MARK	NO.	SIZE	LENGTH	SPACING	LOCATION	DET.
B 1	120	6	8-0	10		Footings-Exterior-Piers 1, 2 & 3	
B 2	108	6	7-0	10		Interior " 1, 2 & 3	
B 3	144	9	4-6		Shown	& Columns-Piers 1, 2 & 3	A
B 4	12	4	9-6			Hoops	J
B 4	164	4	9-6	1-0		Columns-Hoops	J
B 5	48	9	17-6		Shown	Pier 1 only	
B 6	48	9	15-0			" 2 "	
B 7	48	9	16-9			" 3 "	
B 8	36	9	12-3			Lap-Ends	
B 9	12	5	30-0			Bottom	
B 10	12	4	25-0			" Top "	
B 11	15	9	31-6			" Ends "	A
B 12	36	7	15-3			" Stirrups "	L
B 13	81	4	11-6	1-6		" "	H
B 14	18	5	6-9		Shown	" "	

EAST ABUTMENT


2,610 #

E 1	29	4	13-9	2-0		Body-Space to Miss Piling	F
E 2	8	4	29-6		Shown	Horizontal	
E 3	2	4	30-0				
E 4	2	4	30-6				
E 5	2	4	30-9				
E 6	6	6	31-0				
E 7	6	4	30-0			Parapet-Horizontal	
E 8	38	5	9-6	1-6		Body & Parapet	B
E 9	56	5	5-0	1-0		Parapet	B
E 10	14	4	7-9		Shown	Horizontal-Do Not Lap	
E 11	2	4	14-6	1-6		Wing 3-Horizontal	
E 12	2	4	13-9	1-6		" 3 "	
E 13	2	4	12-9	1-6		" 3 "	
E 14	2	6	12-0	1-6		" 3 "	
E 15	7	4	9-3	1-6		" 3-Vertical "	
E 16	10	4	10-9	1-6		Wings 3 & 4-Horizontal	A
E 17	4	4	2-6	1-6		Wing 3-Horizontal-Corner	C
E 18	1	4	5-6	1-6		" 4 "	P
E 19	2	6	13-0	1-6		" 4 "	
E 20	2	4	13-9	1-6		" 4 "	
E 21	2	4	14-6	1-6		" 4 "	
E 22	2	4	15-6	1-6		" 4 "	
E 23	7	4	10-0	1-6		" 4-Vertical "	
E 24	8	5	7-3		Shown	Railing Parapet-Horizontal	
E 25	22	5	5-9	1-0			B
E 26	16	5	2-6		Shown	Grid	
E 27	16	5	4-6				A
E 28	1	4	5-9	1-6		Wing 4-Horizontal-Corner	M
E 29	1	4	5-6	1-6		" 4 "	M
E 30	1	4	5-0	1-6		" 4 "	M
E 31	4	4	10-0		Shown	Body-Horizontal at Wings	
E 32	8	5	5-6			Rail Parapet	B
E 33	8	5	3-3		Shown	" "	
E 34	14	5	6-0	1-6		Wings 3 & 4-Vertical	
E 35	5	4	4-9	1-6		Wing 3-Vertical	
E 36	4	4	5-6	1-6		" 4 "	
E 37	2	4	10-9	1-6		Wings 3 & 4-Horizontal	N

BAR BENDING DETAILS

DIMENSIONS IN BENDING DETAILS ARE OUT TO OUT. OMIT DETAILS WHERE DIMENSIONS ARE BLANK.

S. P. R. DIVISION	PROJECT	SHEET NO.	TOTAL SHEETS
4	I 90-1(49)5	35	40

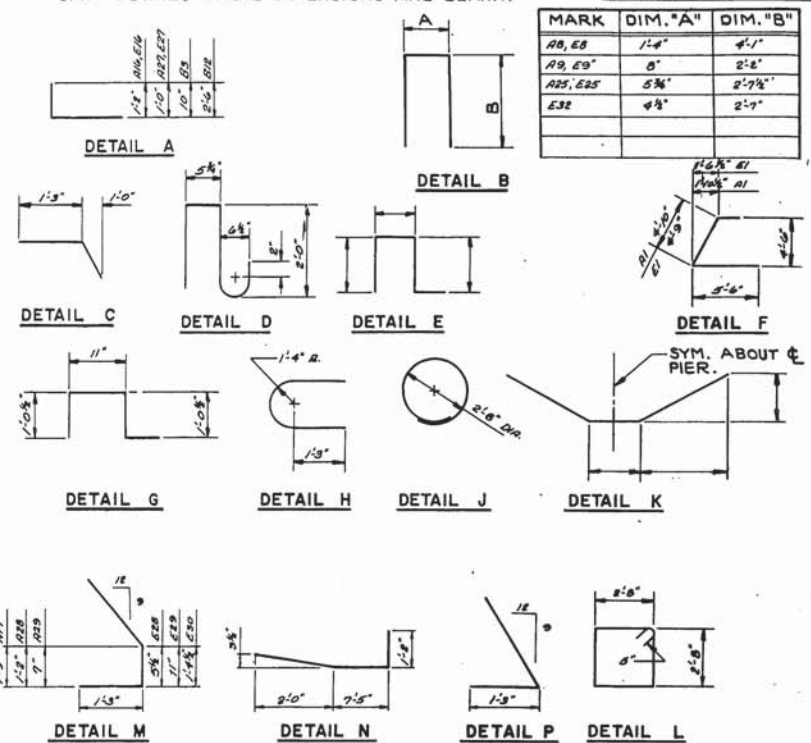

MARK & CUT ALL BARS ALONG THIS LINE. MAKE ALL CUTS NORMAL TO BAR AXIS.

"H" IS NUMBER OF BARS, BEFORE CUTTING.

MARK	C	D	E	F	G	H	SETS REQ'D.
31	SET 1	17'-8"	35'-0"	2'-1"		43	2
	SET 2	18'-1"		35'-8"			2
32	SET 3	17'-10"	36'-0"	2'-8"		43	2
	SET 4	18'-10"		33'-8"			2

CUT, BUNDLE & MARK. (MARK WITH BAR NO. & SET NO.)

BENT BARS, IF USED, IN CUTTING DIAGRAM SHALL BE BENT AFTER CUTTING.

CUTTING DIAGRAM

DESIGNED BY	STATE HIGHWAY COMMISSION OF WISCONSIN
CHECKED BY	
DATE	10/1/50
STRUCTURE	B - 32-54
SHEET	13 OF 13

X35238

S&P REGION DIVISION	PROJECT	SHEET NUMBER	TOTAL SHEETS
4 WIS.	I-90-1(45)5	37	40

STATION	DISTANCE	YARDAGE				
		EXCAVATION				FILL
351						5,630
352						3,556
353						2,806
354						1,417


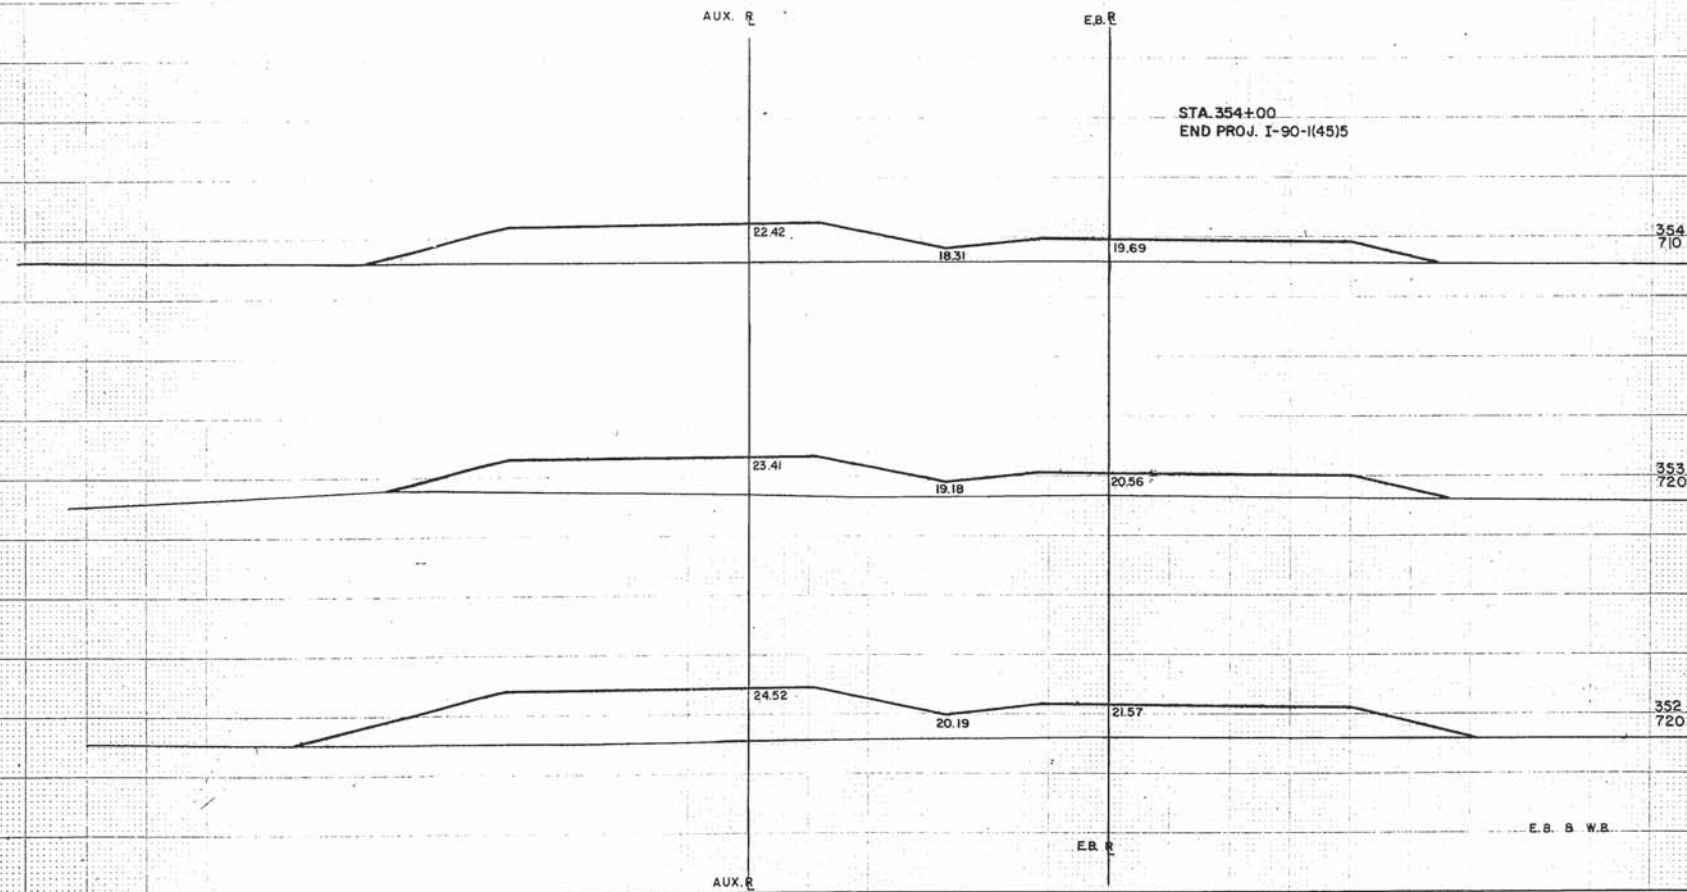


PLATE 3 . FUNCTIONAL CROSS SECTION - OPEN DOTTED
NATIONAL TRACING PAPER DIVISION


State Proj. No. _____ Sheet No. _____ of _____ Sheets

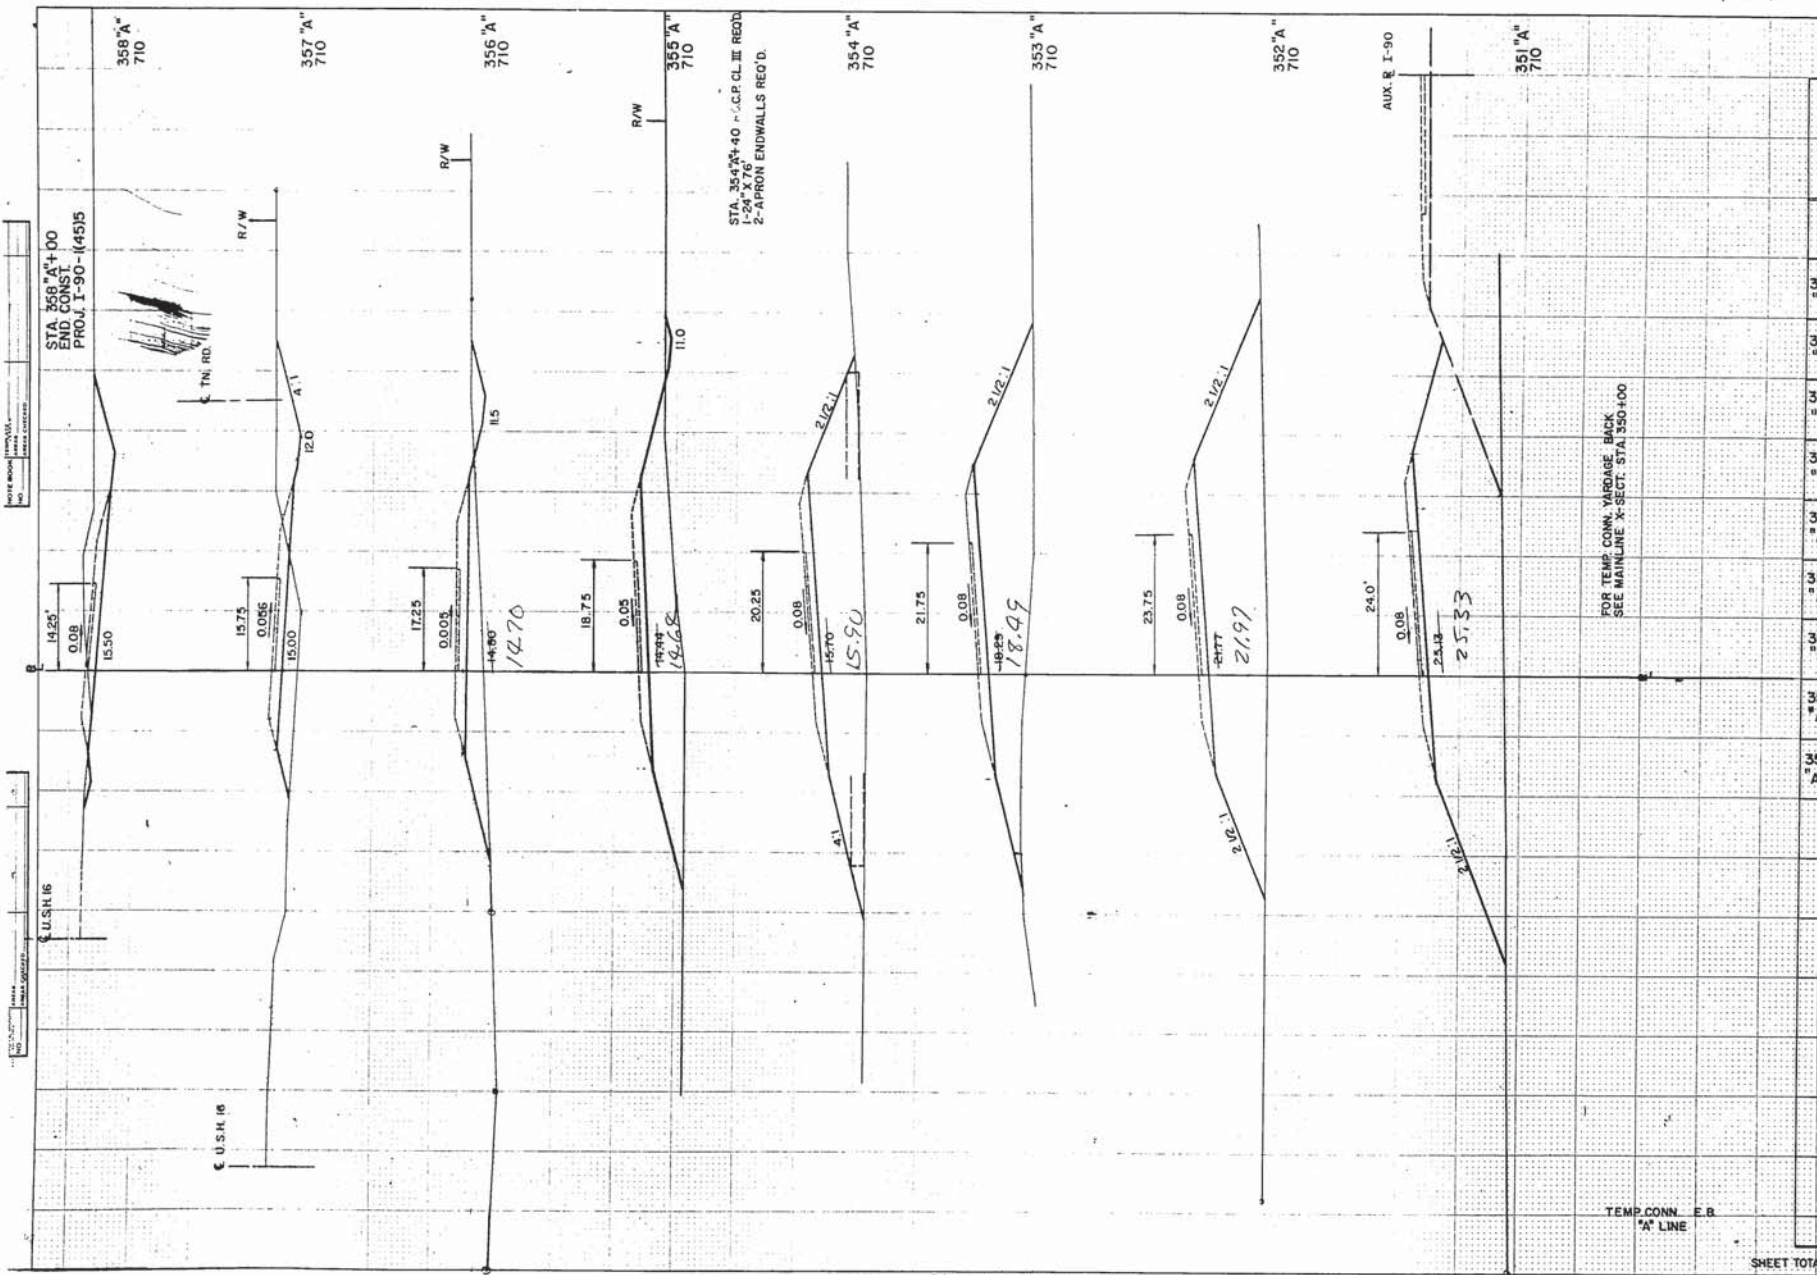

S.P.A. REGION		PROJECT		SHEET NUMBER		TOTAL SHEETS	
4		I-90-(145)5		38		40	
STATION	DISTANCE	YARDAGE					
		EXCAVATION				FILL	
		UNCL					
50 A"							2445
51 A"							3315
52 A"							2445
53 A"							2019
54 A"	19						1648
55 A"	56						898
56 A"	185						435
57 A"	389						167
58 A"							
				</			

FOR TEMP. CONN. YARDAGE BACK
SEE MAINLINE X-SECT. STA 350+00

TEMP. CONN. E.R.
"A" LINE

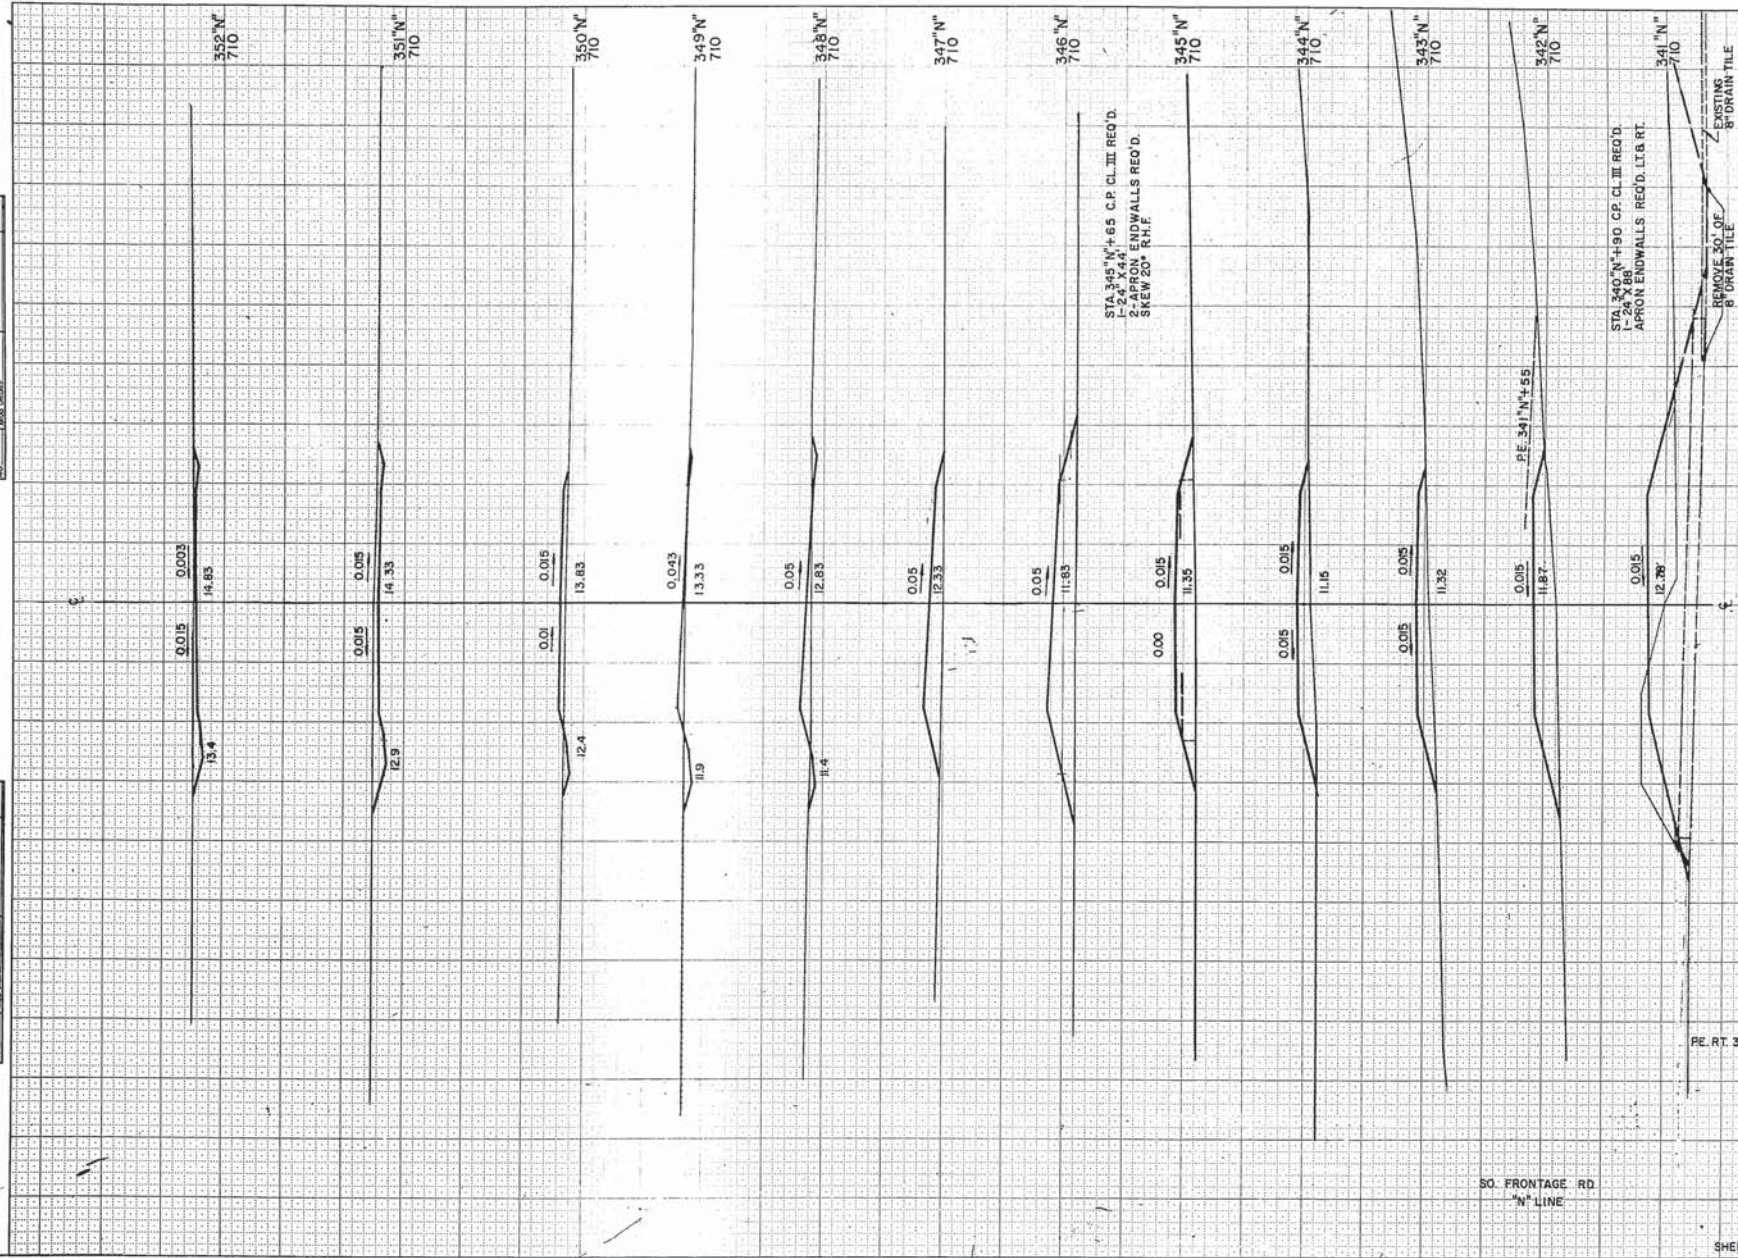

S.P. REGION	PROJECT	SHEET NUMBER	TOTAL SHEETS
WIS.	I-90-(45)5	39	40

STATION	DISTANCE	YARDAGE	
		EXCAVATION	
		UNCL.	FILL
341 "N"		67	98
342 "N"		167	585
343 "N"		0	525
344 "N"			378
345 "N"			465
346 "N"			661
347 "N"			581
348 "N"		9	267
349 "N"		28	115
350 "N"		28	106
351 "N"		130	65
352 "N"		191	0
353 "N"			35
354 "N"			
355 "N"			
TOTAL		520'	388'

STA 363"E" + 65.94
END CONST

STA 360"E" + 30
S.R. LT.

STA 356"E" + 00
P.E. RT. REQ'D

S.P.A. REGION DIVISION		PROJECT	SHEET NUMBER	TOTAL SHEETS
4 WIS.		I-90-11485	40	40
STATION	DISTANCE	YARDAGE		
		EXCAVATION		
		UNCL		FIL
352 E		135		135
353 E		93		96
354 E		28		230
355 E		0		357
356 E		0		474
357 E		0		437
358 E		0		287
359 E		0		313
360 E		0		272
361 E		0		148
362 E		0		53
363 E				50
PE 356 E + 50 RT.				60
S.R. 360 E + 30 RT.				53
SHEET TOTAL		263		