








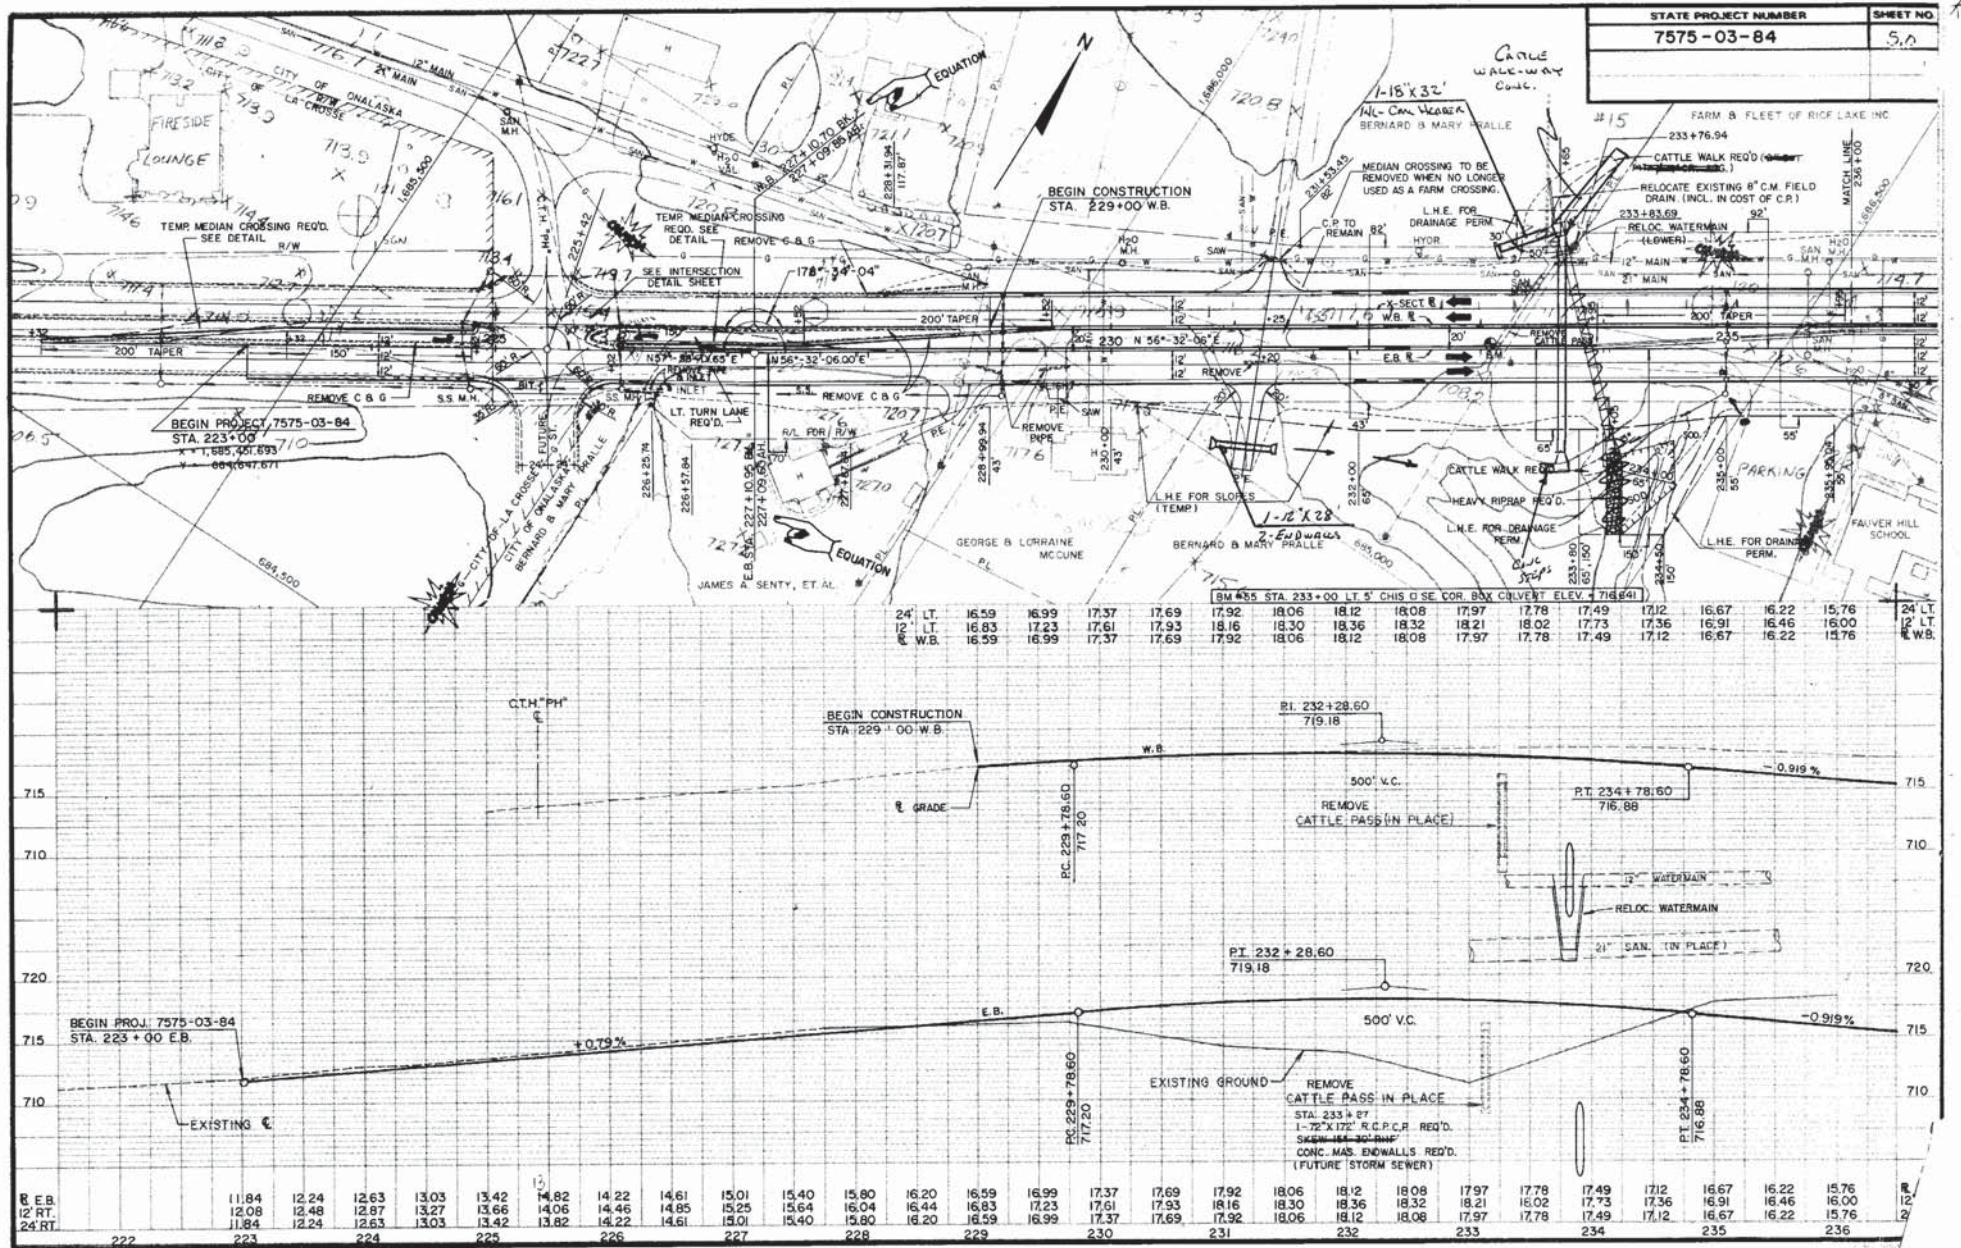


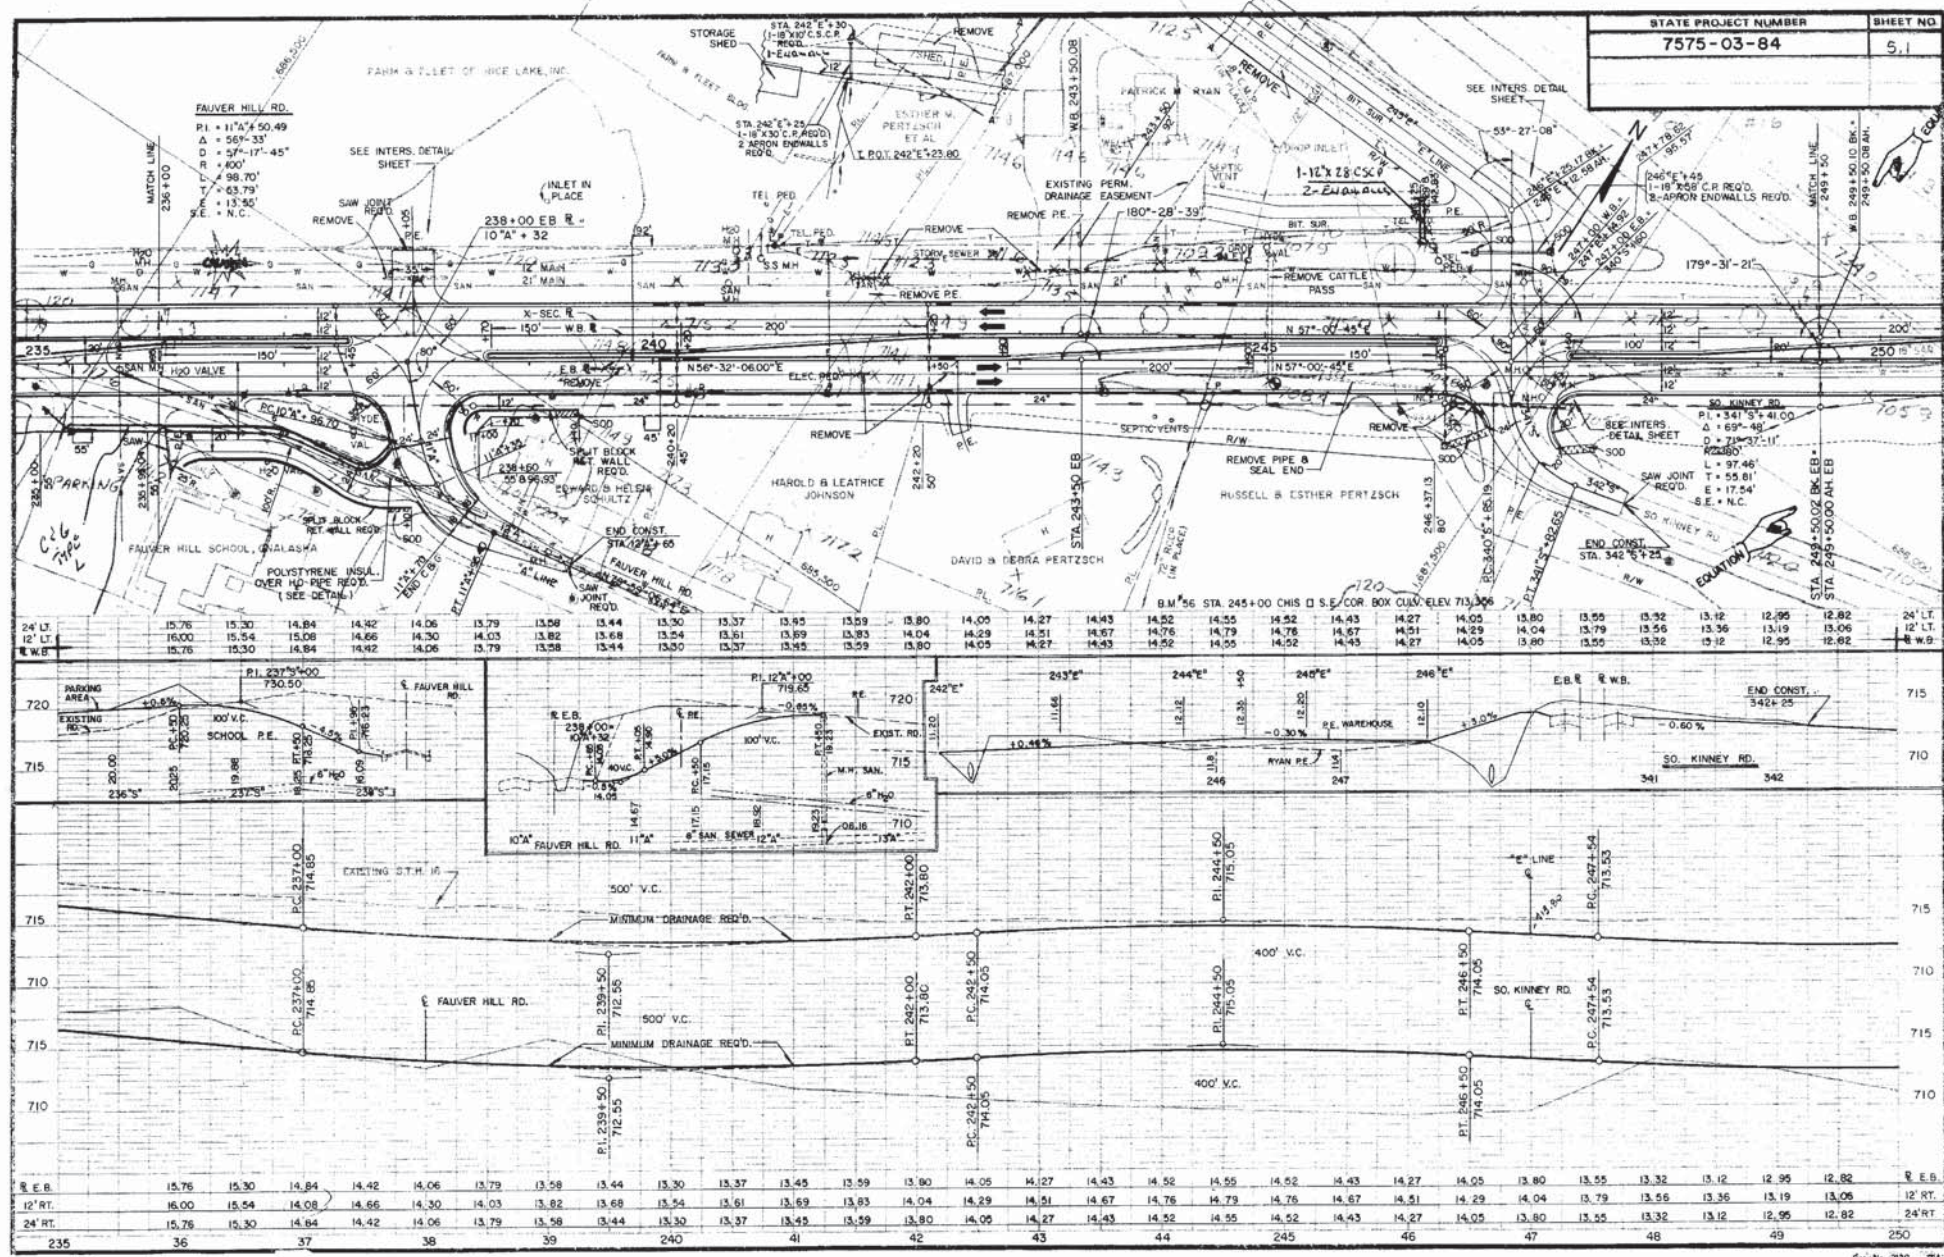


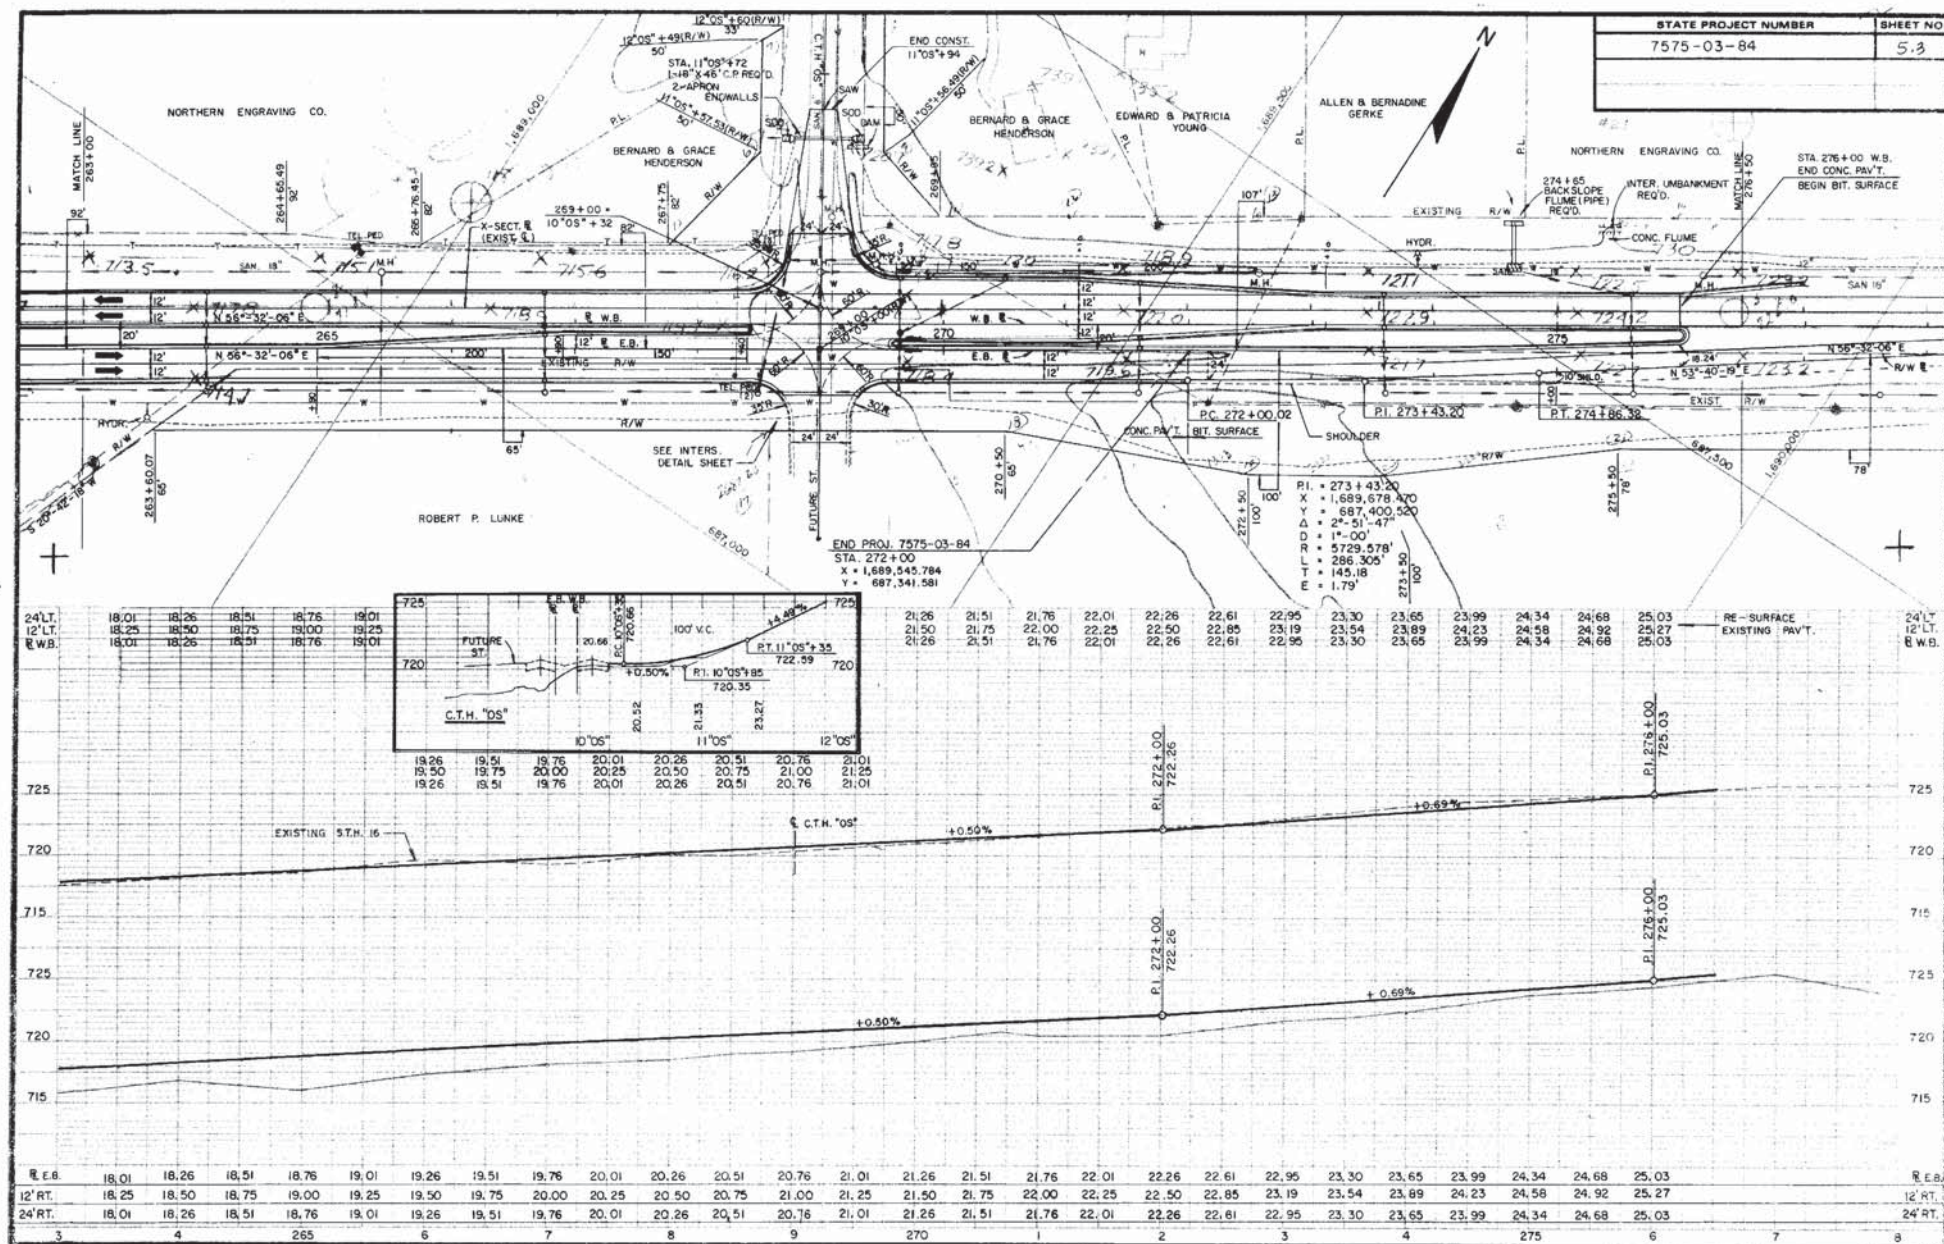


STATE PROJECT NUMBER	SHEET NO.
7575-03-84	54

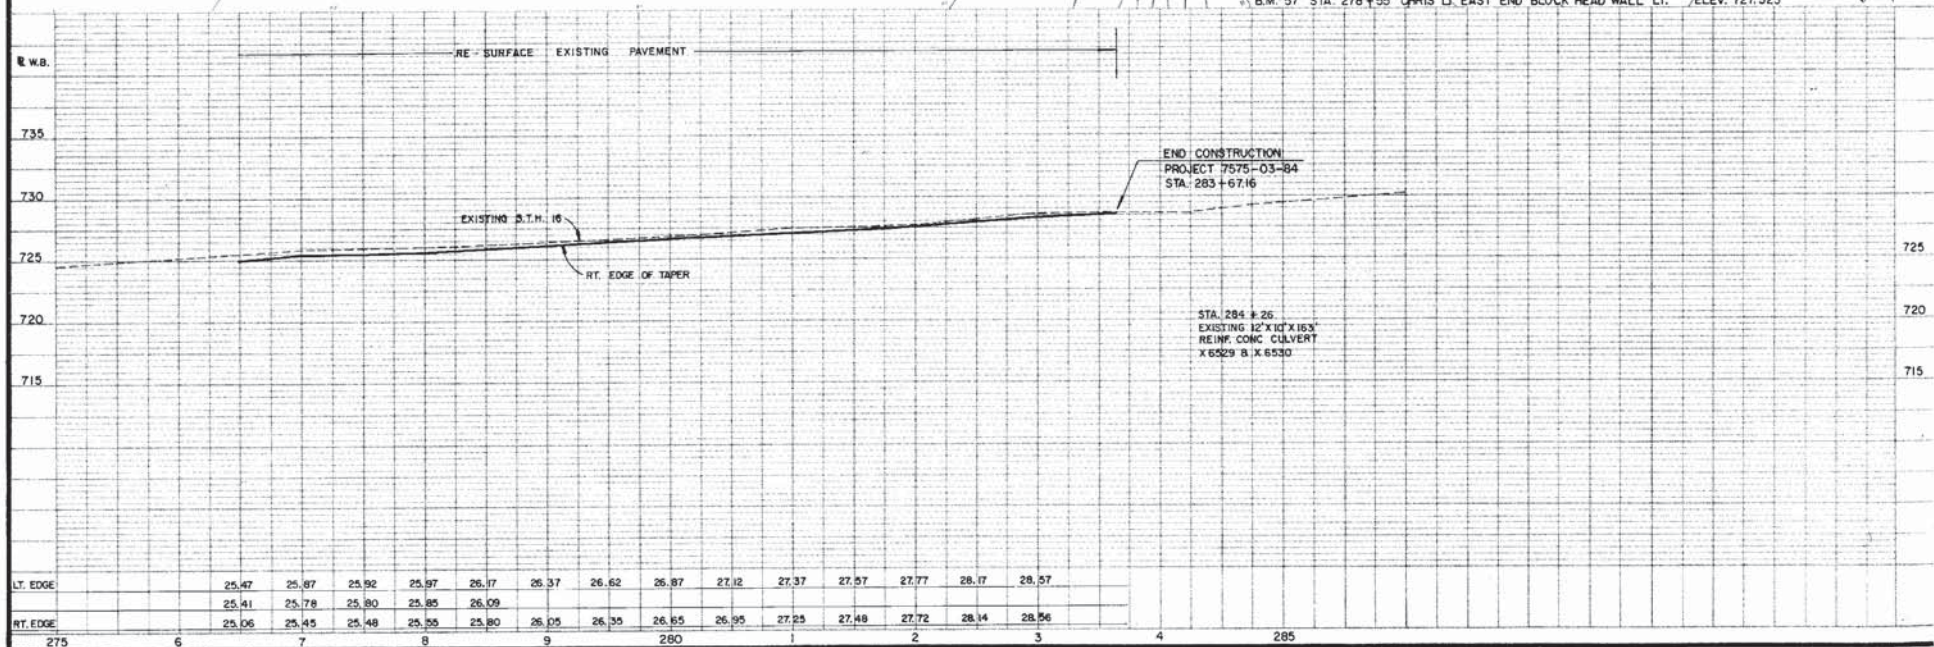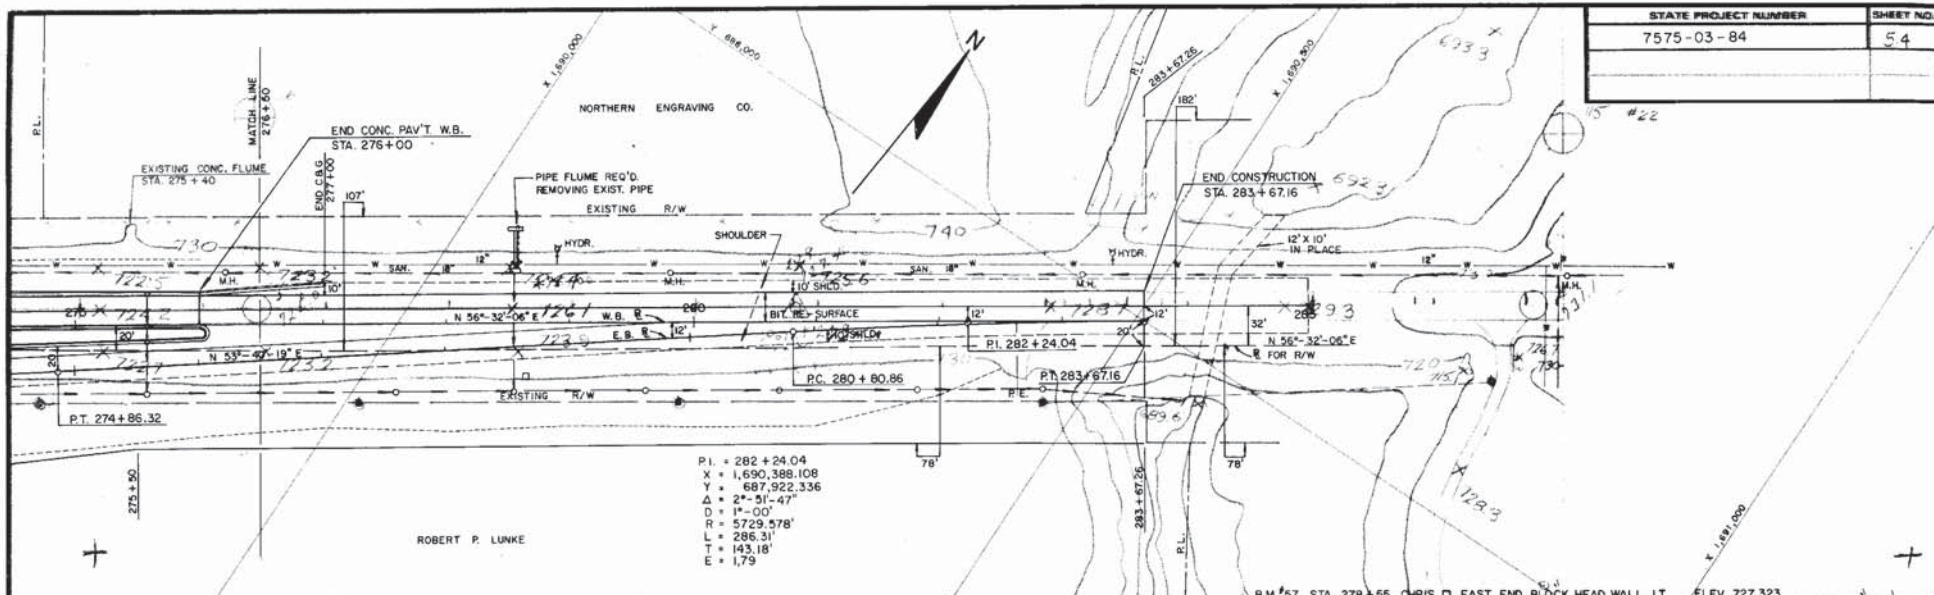

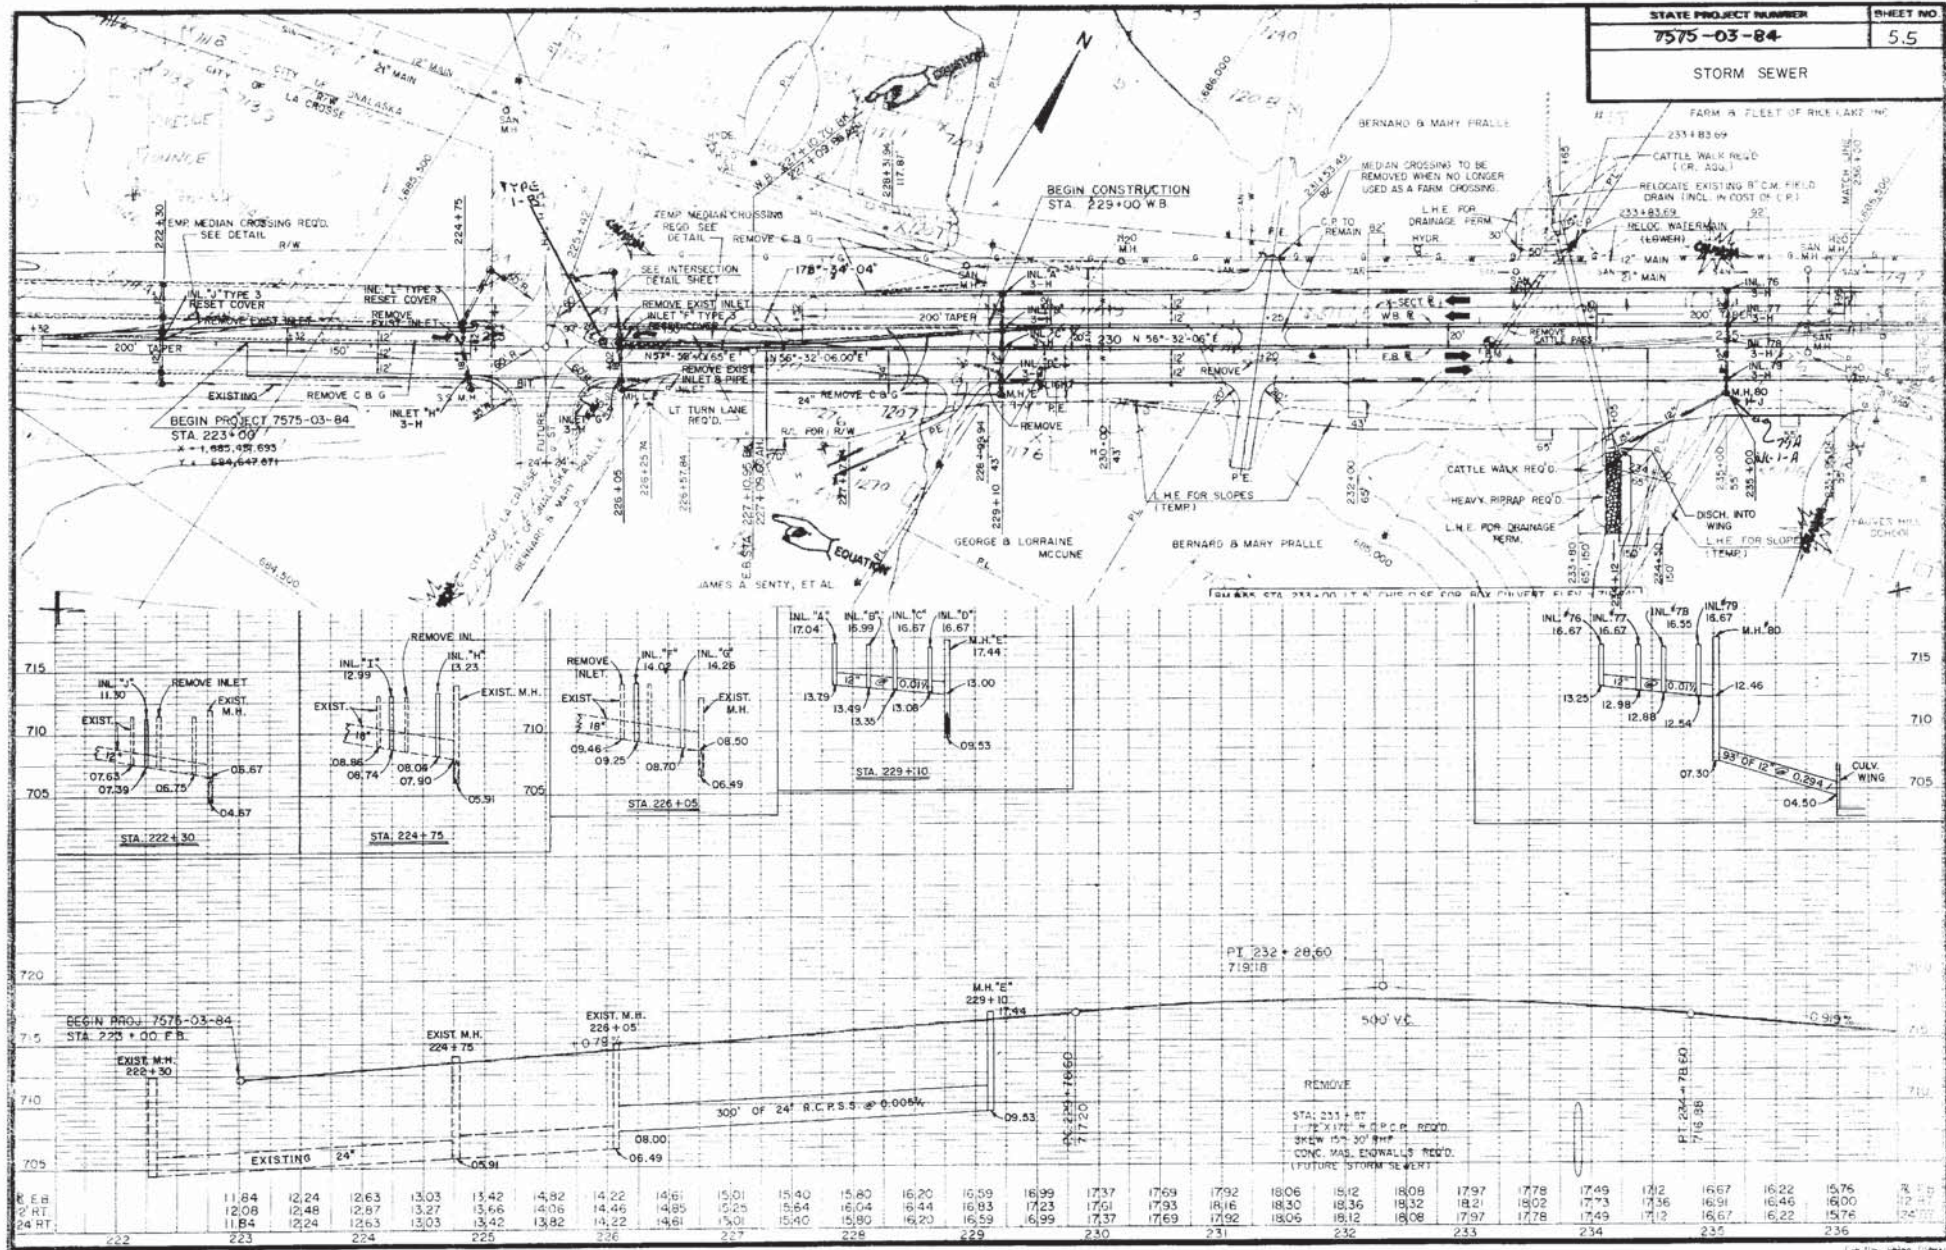

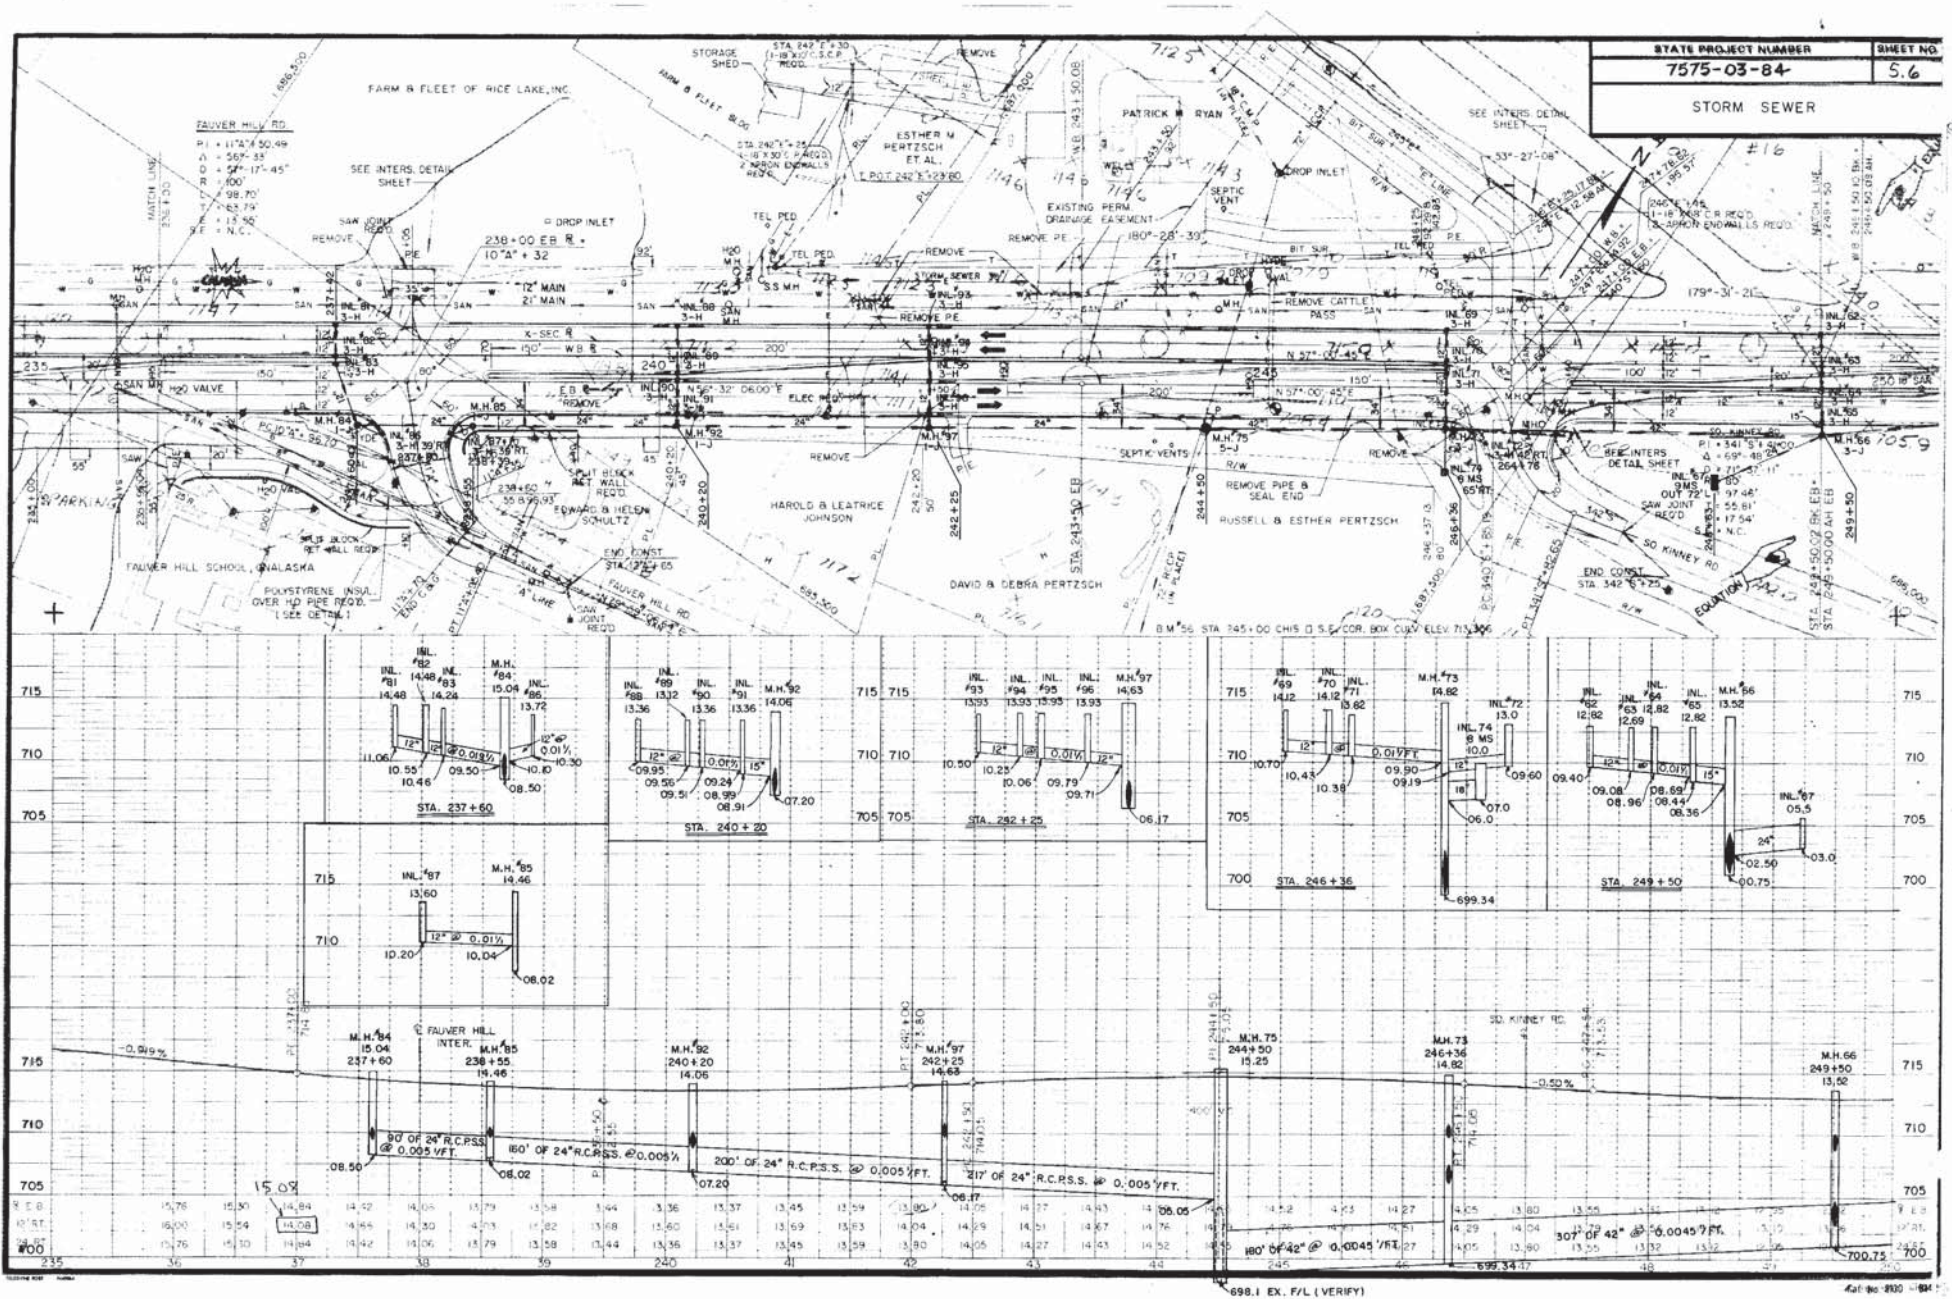

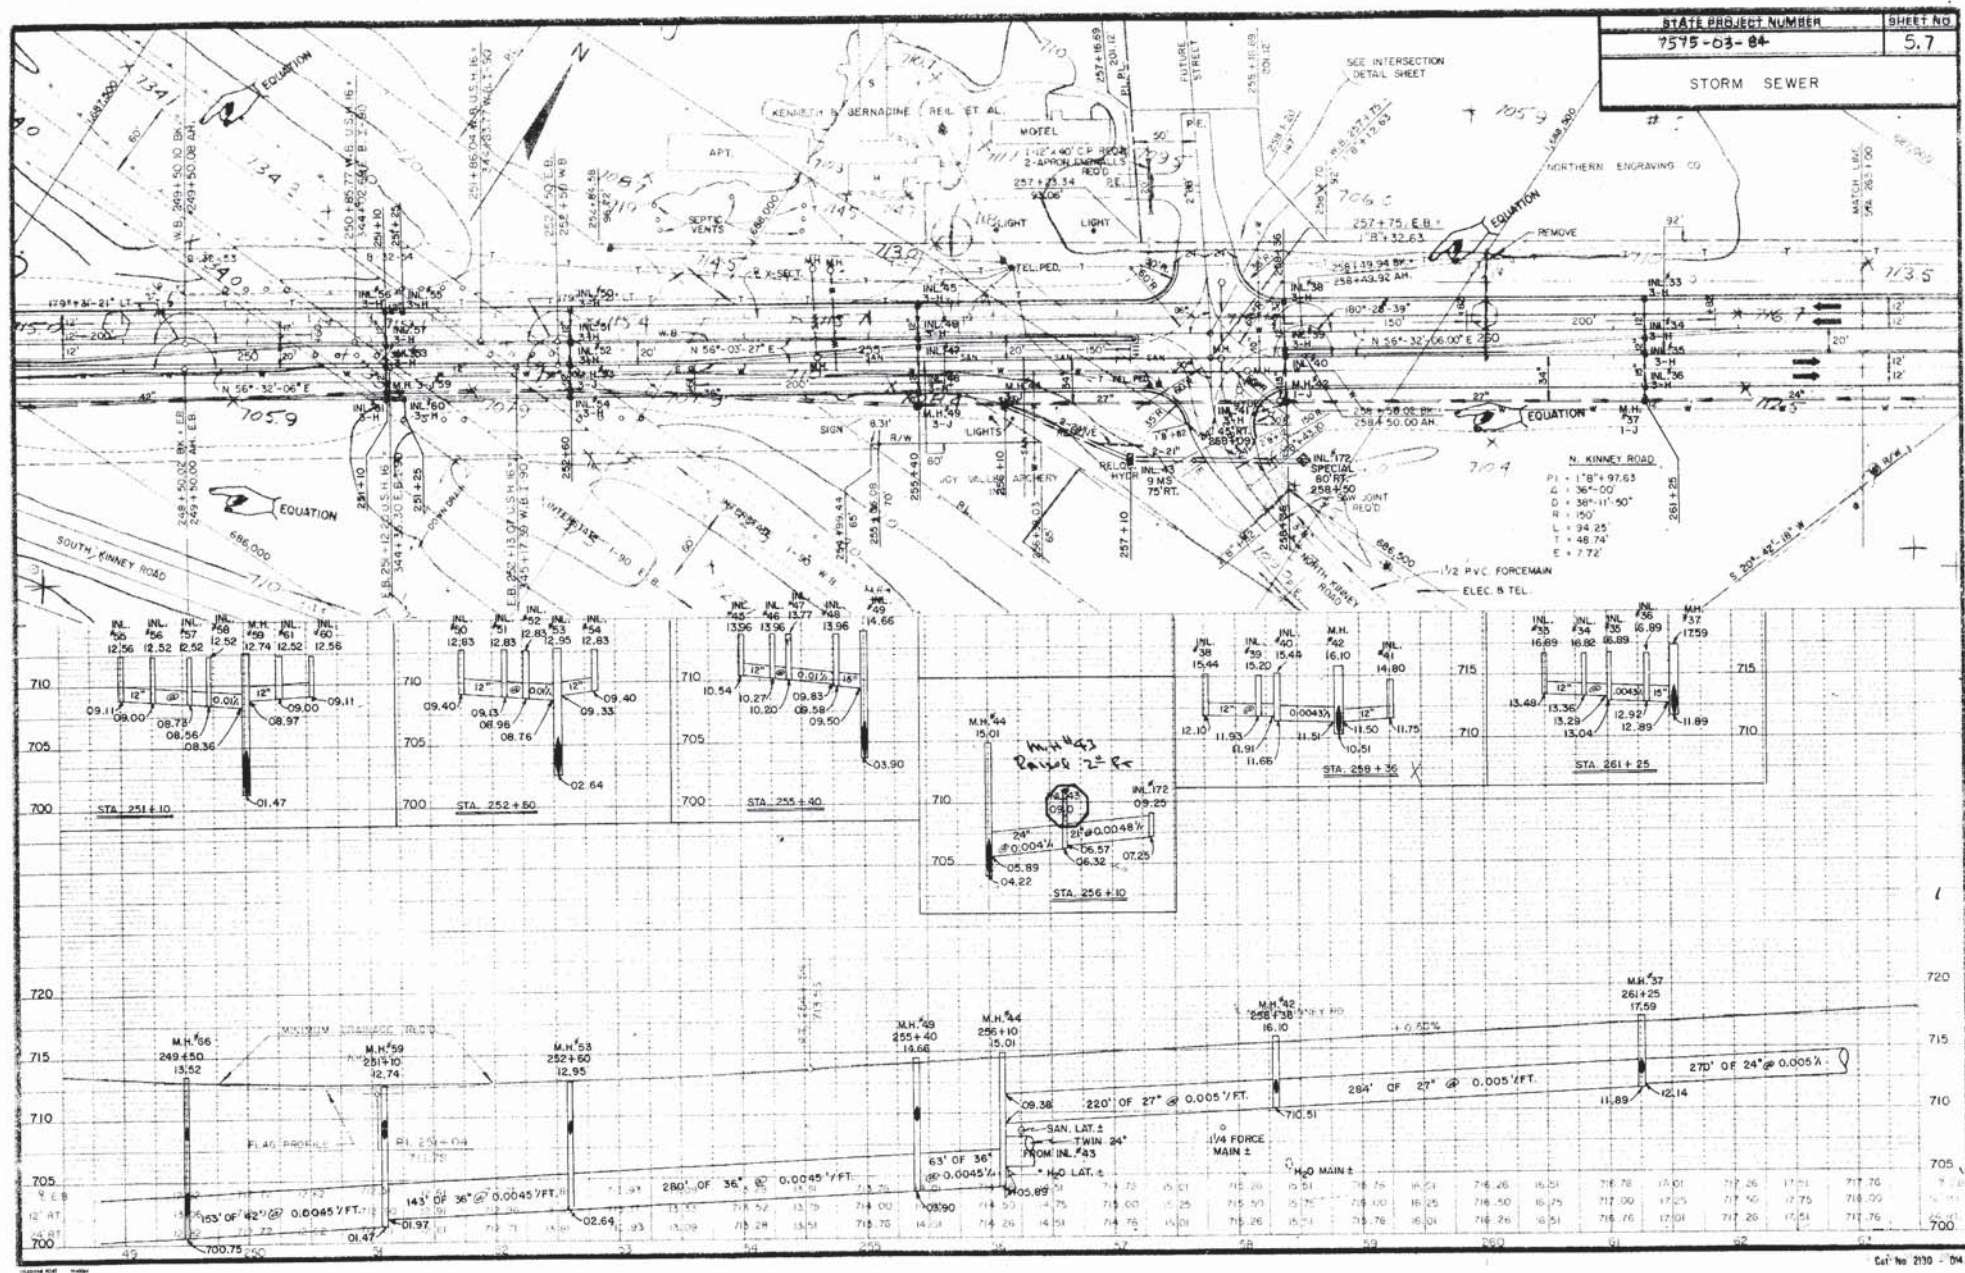

STATE PROJECT NUMBER	SHEET NO.
7575-03-84	5.9
STORM SEWER	

