

STATE OF WISCONSIN DEPARTMENT OF TRANSPORTATION

PLAN OF PROPOSED IMPROVEMENT

LA CROSSE-WEST SALEM ROAD

(C.T.H. "PH"-C.T.H. "OS")
S.T.H. 16

LA CROSSE COUNTY

STATE PROJECT NUMBER
7575-03-84

Scales 5 FT. 5 FT.
PLAN & PROFILE CROSS SECTIONS
0 50 FT. 0 10 FT.

Index of Sheets

Sheet No.	Title
1	Typical Sections and Details
2-2.19	Estimate of Quantities
3-3.3	Miscellaneous Quantities
4-4.4	Right of Way Plat
5-5.9	Plan and Profile
6-6.22	Standard Detail Drawings
7-7.2	Sign Plates
8-8.2	Structure Plans
9-9.28	Computer Earthwork Data
10-10.28	Cross Sections

TOTAL SHEETS = 103




Design Designation

A.O.T. (1985)	= 10,000
A.O.T. (2005)	= 12,400
D.H.V. (2005)	= 1,488
D.	= 60-40
T.	= 9%
V.	= 50 MPH

BEGIN PROJECT 7575-03-84

STA. 223+00
X = 1,685,451.693
Y = 684,647.571

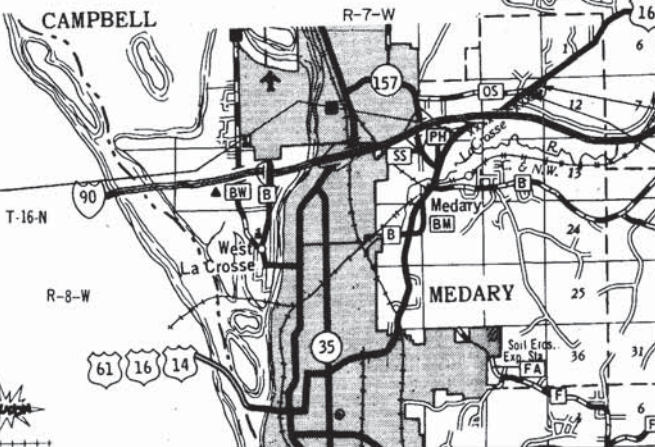

Layout
Scale 0 1/2 1 Mi.

Total Net Length of Centerline = 0.928 Mi. URBAN

Conventional Signs

County Line	---
Township or Range Line	----
Section Line	-----
Corporate or City Limits	=====
Property line	~~~~~
Lot Line	
Existing Right of Way Line	-----
New Right of Way Line	-----
Base or Survey Line	-----
Slope Intercept	-----
Existing Roadway or Private Entrance	-----

Caution Symbol (Combustible fluids under pressure)	-----
Railroads	-----
Fence	-----
Culverts in Place	-----
Culverts Required	-----
Power Pole	-----
Telephone or Telegraph Pole	-----
Right of Way Markers	-----
Marsh	-----
Wooded Area	-----
Grade Elevation	-----

STATE PROJECT	FEDERAL PROJECT	
	PROJECT	CONTRACT
7575-03-84	MAF 056(6)	1

7575-03-84 = 57575-03-84 WHEN COMBINED

As BUILT PLAN

CONTRACTOR: HOFFMAN CONSTRUCTION CO.

SUB-CONTRACTORS: JAMES CAPE & SONS CO.
TIMME, INC.

ZANOCK ELECTRIC
BARRICAOS FLASHERS
CENTURY FENCE CO.
MATNY CONSTRUCTION
ARTHUR OVERSHAW INC.
POLY-CARB, INC.
TRIAO TRUCKING

Asst. Super: J.B. GRUTZIK
Proj. Super: J.E. LUCEY
Proj. BEGIN: 4-21-86

END CONSTR.
STA. 283+00
Proj. Suspended: 11-07-86
Proj. Resumed: 5-13-87
Completed: 5-14-87
END PROJECT 7575-03-84
STA. 272+00
X = 1,689,545.784
Y = 687,341.581

STATE OF WISCONSIN DEPARTMENT OF TRANSPORTATION			
Surveyor	MEW	District Checker	RPM
Designer	L.A.B.	C. O. Checker	RL
District Supervisor	D.B.D.	C. O. Coordinator	KGB
Approved:			
Date	10-25-85		
Approved:			
Date	11-26-85		
Approved:			
Date	11-26-85		
Approved:			
Date	11/27/85		
U. S. DEPARTMENT OF TRANSPORTATION FEDERAL HIGHWAY ADMINISTRATION REGION 5 WISCONSIN DIVISION			
Approved:			
Date			

NOTE: ALL COORDINATES SHOWN ON THIS PLAN
ARE REFERENCED TO THE WISCONSIN
COORDINATE SYSTEM, SOUTH ZONE

Vehicle No. 11

LA CROSSE

7575-3-84
LET.