


PROJECT ID: 5420-02-71 5420-00-72

COUNTY: DANE

ORDER OF SHEETS

- Section No. 1 Title
- Section No. 2 Typical Sections and Details
- Section No. 3 Estimate of Quantities
- Section No. 3 Miscellaneous Quantities
- Section No. 4 Right-of-Way Plan
- Section No. 5 Plan and Profile
- Section No. 6 Standard Detail Drawings
- Section No. 7 Sign Plates
- Section No. 8 Structure Plans
- Section No. 9 Computer Earthwork Data
- Section No. 9 Cross Sections

TOTAL SHEETS = 425

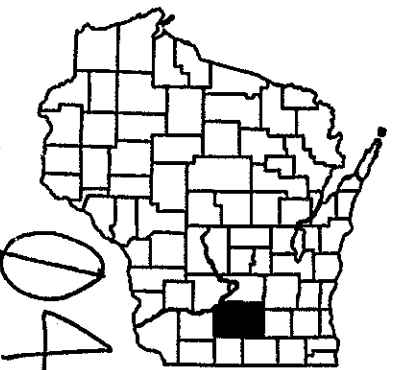


DESIGN DESIGNATION

	DIVISION ST TO HOGAN RD	HOGAN RD TO BONG RD	BONG RD TO RIVER RD	RIVER RD TO C.T.H. M
A.D.T. (2005)	14,850	7,450	12,650	19,950
A.D.T. (2025)	19,800	9,100	15,150	25,700
D.J.V.	-	-	-	-
D.	60-40	60-40	60-40	60-40
T.	6.00%	6.00%	6.00%	6.00%
DESIGN SPEED (MPH)	60	60	60	60
ESALS	3,509,612	1,676,308	2,815,792	4,132,276
Rigid ESALS	441	233	372	581
Flex ESALS	304	160	256	400

CONVENTIONAL SYMBOLS

- PLAN
- CORPORATE LIMITS
- PROPERTY LINE
- LOT LINE
- LIMITED HIGHWAY EASEMENT
- EXISTING RIGHT OF WAY
- PROPOSED OR NEW R/W LINE
- SLOPE INTERCEPT
- REFERENCE LINE
- EXISTING CULVERT
- PROPOSED CULVERT (Box or Pipe)
- COMBUSTIBLE FLUIDS
- MARSH AREA
- WOODED OR SHRUB AREA

- PROFILE
- GRADE LINE
- ORIGINAL GROUND
- MARSH OR ROCK PROFILE (To be noted as such)
- SPECIAL DITCH
- GRADE ELEVATION
- CULVERT (Profile View)
- UTILITIES
- ELECTRIC
- FIBER OPTIC
- GAS
- SANITARY SEWER
- STORM SEWER
- TELEPHONE
- WATER
- UTILITY PEDESTAL
- POWER POLE
- TELEPHONE POLE

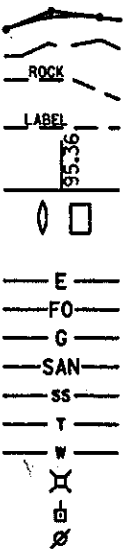

BEGIN CONSTRUCTION
5420-02-71
STATION 82+63.19
Y 525 544.84
X 804 315.84

VILLAGE OF WAUNAKEE

BEGIN PROJECT
5420-02-71
STATION 98+35
Y 525 544.84
X 804 480.84

MADISON - WAUNAKEE RD
S.T.H. 113
(KNUTSON DR - DIVISION ST)
DANE COUNTY

STATE PROJECT NUMBER
5420-00-72

R 9 E

BEGIN PROJECT
5420-00-72
STRUCTURE B-13-556
STATION 341+25.19
Y 510 583.87
X 816 382.88

END PROJECT
5420-00-72
STATION 342+15.19

LAYOUT
SCALE 0 1/2 MI.
TOTAL NET LENGTH OF CENTERLINE = 5.35 MI.

COORDINATES ON THIS PLAN ARE REFERENCED TO THE WISCONSIN COUNTY COORDINATE SYSTEM (WCCS), DANE COUNTY

STATE PROJECT	FEDERAL PROJECT	
	PROJECT	CONTRACT
5420-02-71	STP 2004121	1
5420-00-72	BR 2004120	1

AS BUILT CONSTRUCTION PLAN

WORK TYPE RUBBLIZE, ASPHALT PAVING, RECONSTRUCT
CONTRACTOR HEFFMAN CONSTRUCTION CO.
PROJECT MANAGER MARK SECHAM, P.E.
WORK START-COMPLETED 4/1/04 - 9/29/04

ACCEPTED FOR
VILLAGE / WAUNAKEE

7/1/2003
Date
Signature & Title of Official

ORIGINAL PLANS PREPARED BY

URS
PROFESSIONAL ENGINEER
DAVID L. WEISS
32214 BARABOO, WI
July 1, 2003
Date
Signature

STATE OF WISCONSIN
DEPARTMENT OF TRANSPORTATION

PREPARED BY
Surveyor STRAND ASSOCIATES, INC / URS CORP
Designer DAVID WEISS, URS CORP
Project Manager MICHAEL RAMPETSREITER
District Examiner JEFFREY GUST
District Supervisor ROBERT REUKEMA / JANE EUBANK
C.O. Examiner

APPROVED FOR DISTRICT OFFICE
DATE 9/24/03
Signature

E