B.P.R. DISTRICT OFFICE	PROJECT	SHEET NUMBER	TOTAL SHEETS
WIS. 4	I-90-2(18)165	116	264

FINAL SURVEY — SURVEYED — PLOTTED — NOTE BOOK — AREAS — NO. — AREAS CHECKED — BY — DATE

ORIGINAL SURVEY — SURVEYED — PLOTTED — NOTE BOOK — AREAS — NO. — AREAS CHECKED — BY JAV — DATE 4-7-59

A.R.L. STA. 841+85

799.96

4:1

4:1

190.8

4:1

799.96

4:1

799.96

R/W 90' LT. R.L.

R/W 80' RT. R.L.

841
790

841

840

840
790

A.R.L. STA 840+85

799.96

799.96

4:1

R/W 90' LT. R.L.

R/W 80' RT. R.L.

180 150 120 90 60 30 R.L. 30 60 90

STATION	DISTANCE	YARDAGE EXCAVATION UNCL.	EXCAVATION MARSH	EXCAVATION	EXCAVATION	FILL
100	52	400				4289
SHEET TOTAL		52	400			4289


PLATE 3—CROSS SECTION O. P. R. & R. E. STANDARDS
THE FREDERICK POST CO., CHICAGO

840-841

B.P.R. DISTRICT OFFICE	PROJECT	SHEET NUMBER	TOTAL SHEETS
WIS. 4	I-90-2(12)105	117	264

FINAL SURVEY — SURVEYED — PLOTTED — TEMPLATE — NOTE BOOK — AREAS CHECKED — NO. — DATE —

ORIGINAL SURVEY — SURVEYED — PLOTTED — TEMPLATE — NOTE BOOK — AREAS CHECKED — NO. 118 — BY — DATE 4-18

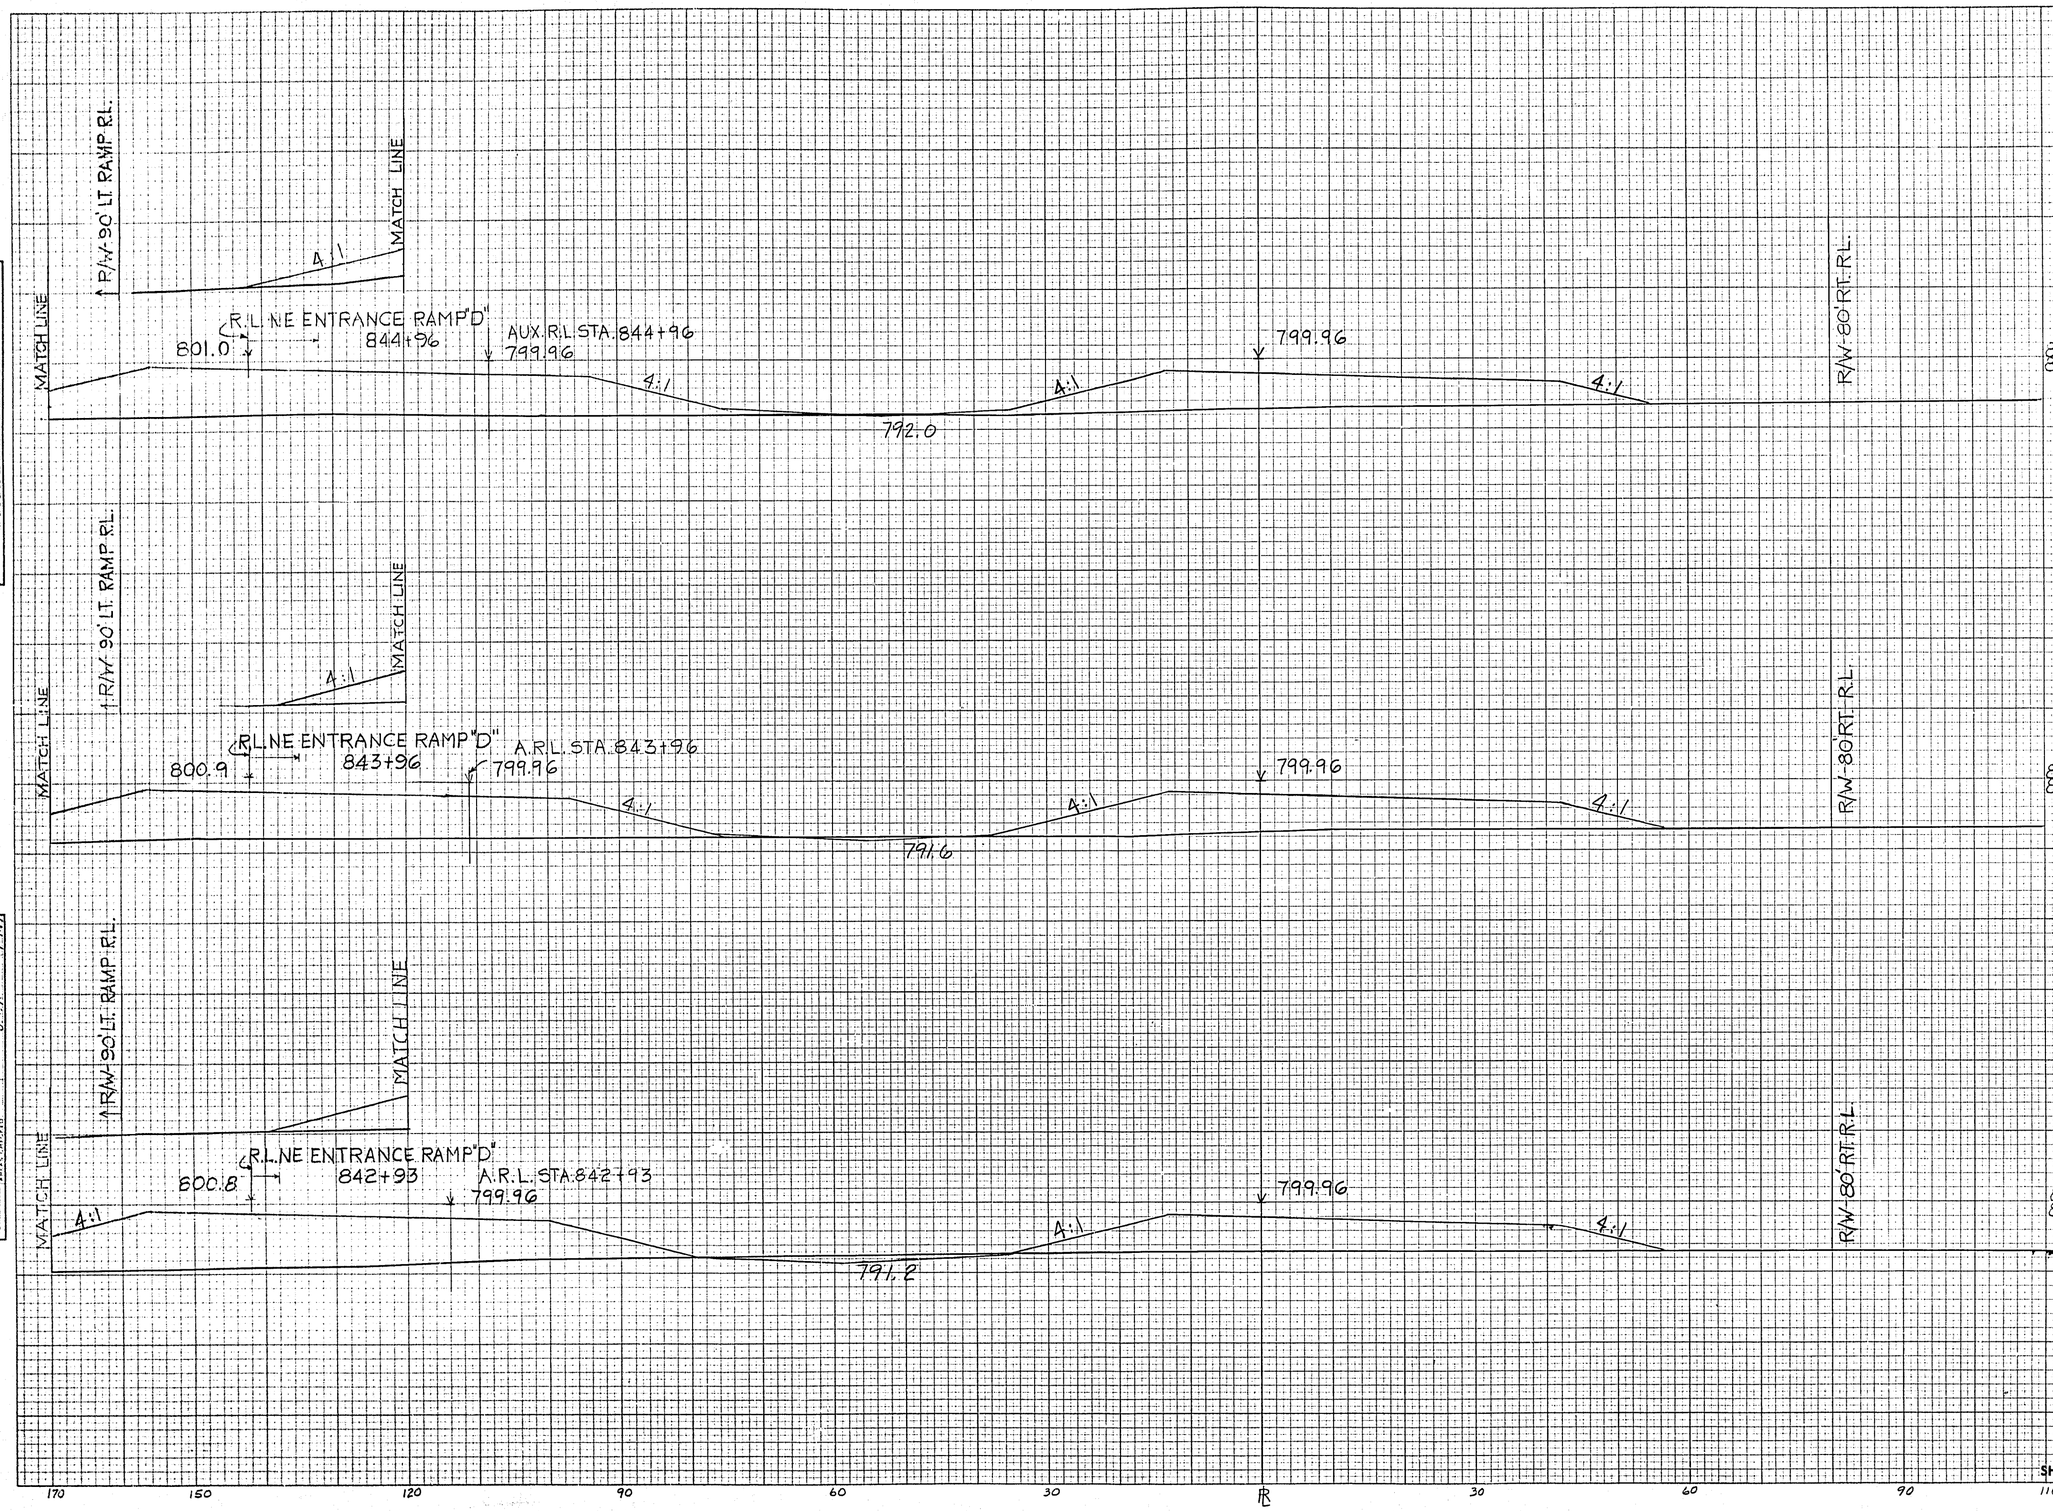

STATION	DISTANCE	YARDAGE EXCAVATION UNCL.				FILL
844						
	100	8				3425
843						
	100	61				3418
842						
	100	100				3685
841						
SHEET TOTAL		169				10532

PLATE 3—CROSS SECTION O. P. R. & B. E. STANDARD
THE FREDERICK POST CO., CHICAGO

842-844

B.P.R. DISTRICT OFFICE	PROJECT	SHEET NUMBER	TOTAL SHEETS
WIS. 4	I-90-2(17)105	118	264

MATCH LINE

4:1

789.30

MATCH LINE

R.L. NE ENTRANCE RAMP "D" 848+00

A.R.L. STA. 848+00 799.96

799.9

4:1

4:1

793.2

799.96

4:1

R/W 80' RT. R.L.

MATCH LINE

4:1

789.35

MATCH LINE

800.5

R.L. NE ENTRANCE RAMP "D" 847+00

A.R.L. STA. 847+00 799.96

799.96

4:1

4:1

4:1

792.8

R/W 80' RT. R.L.

R/W 90' LT. RAMP R.L.

MATCH LINE

4:1

789.4

MATCH LINE

800.9

R.L. NE ENTRANCE RAMP "D" 846+00

A.R.L. STA. 846+00 799.96

799.96

4:1

4:1

4:1

792.4

R/W 80' RT. R.L.

170 150 120 90 60 30 ℄ 30 60 90 110

STATION	DISTANCE	YARDAGE EXCAVATION UNCL.	YARDAGE EXCAVATION	YARDAGE EXCAVATION	YARDAGE EXCAVATION	YARDAGE FILL
847						
847 800						
	100	91				5098
846						
846 800						
	100	23				4448
845						
845 800						3726
	100	0				
844						
SHEET TOTAL		114				13269

FINAL SURVEY — SURVEYED, PLOTTED, NOTE BOOK, TEMPLATE, AREAS, AREAS CHECKED, NO., BY, DATE

ORIGINAL SURVEY — SURVEYED, PLOTTED, TEMPLATE, AREAS, NOTE BOOK, NO., BY, DATE — 11-7-39

PLATE 3—CROSS SECTION O. P. R. & B. E. STANDARD
THE FREDERICK POST CO., CHICAGO

845-847

B.P.R. DISTRICT OFFICE	PROJECT	SHEET NUMBER	TOTAL SHEETS
WIS. 4	I 90-2(11)105	119	264

FINAL SURVEY — DATE — BY — SURVEYED — PLOTTED — NOTE BOOK — TEMPLATE — AREAS — NO. — AREAS CHECKED

ORIGINAL SURVEY — DATE 4-24-58 — BY JJP — SURVEYED TFJ — PLOTTED — NOTE BOOK — TEMPLATE 4-119 — AREAS — NO. — AREAS CHECKED

A.R.L. STA. 851.03
799.96

799.96

795.00

4:1

4:1

R/W-89'RT.RL

STA. 849+85
1-42" x 214' C.P. REQ'D
SKEW 70° L.H.F.

A.R.L. STA. 850+02
799.96

799.96

RAMP "D" FILL

794.0

4:1

R/W-80'RT.RL

MATCH LINE

4:1

MATCH LINE

R.L. NE ENTRANCE RAMP "D"
849+00

799.4

A.R.L. STA. 849+00
799.96

799.96

793.6

4:1

R/W-80'RT.RL

STATION	DISTANCE	YARDAGE EXCAVATION UNCL.	YARDAGE EXCAVATION	YARDAGE FILL
850				
850 800				
	100	0		547.1
849				
849 800				
	100	0		51.14
848				
	100	67		55.46
848 800				
847				
SHEET TOTAL		67		161.57

170 150 120 90 60 30 ℄ 30 60 90 110


PLATE 3—CROSS SECTION O. P. R. & R. E. STANDARD
THE FREDERICK POST CO., CHICAGO

848-850

B.P.R. DISTRICT OFFICE	PROJECT	SHEET NUMBER	TOTAL SHEETS
WIS. 4	I-90-2(18)105	120	264

FINAL SURVEY — SURVEYED — PLOTTED — NOTE BOOK — TEMPLATE — AREAS CHECKED — NO — BY — DATE

ORIGINAL SURVEY — SURVEYED — PLOTTED — NOTE BOOK — TEMPLATE — AREAS CHECKED — NO — BY — DATE — TPL 4-24-68 — J.L.P. — 4-1-37

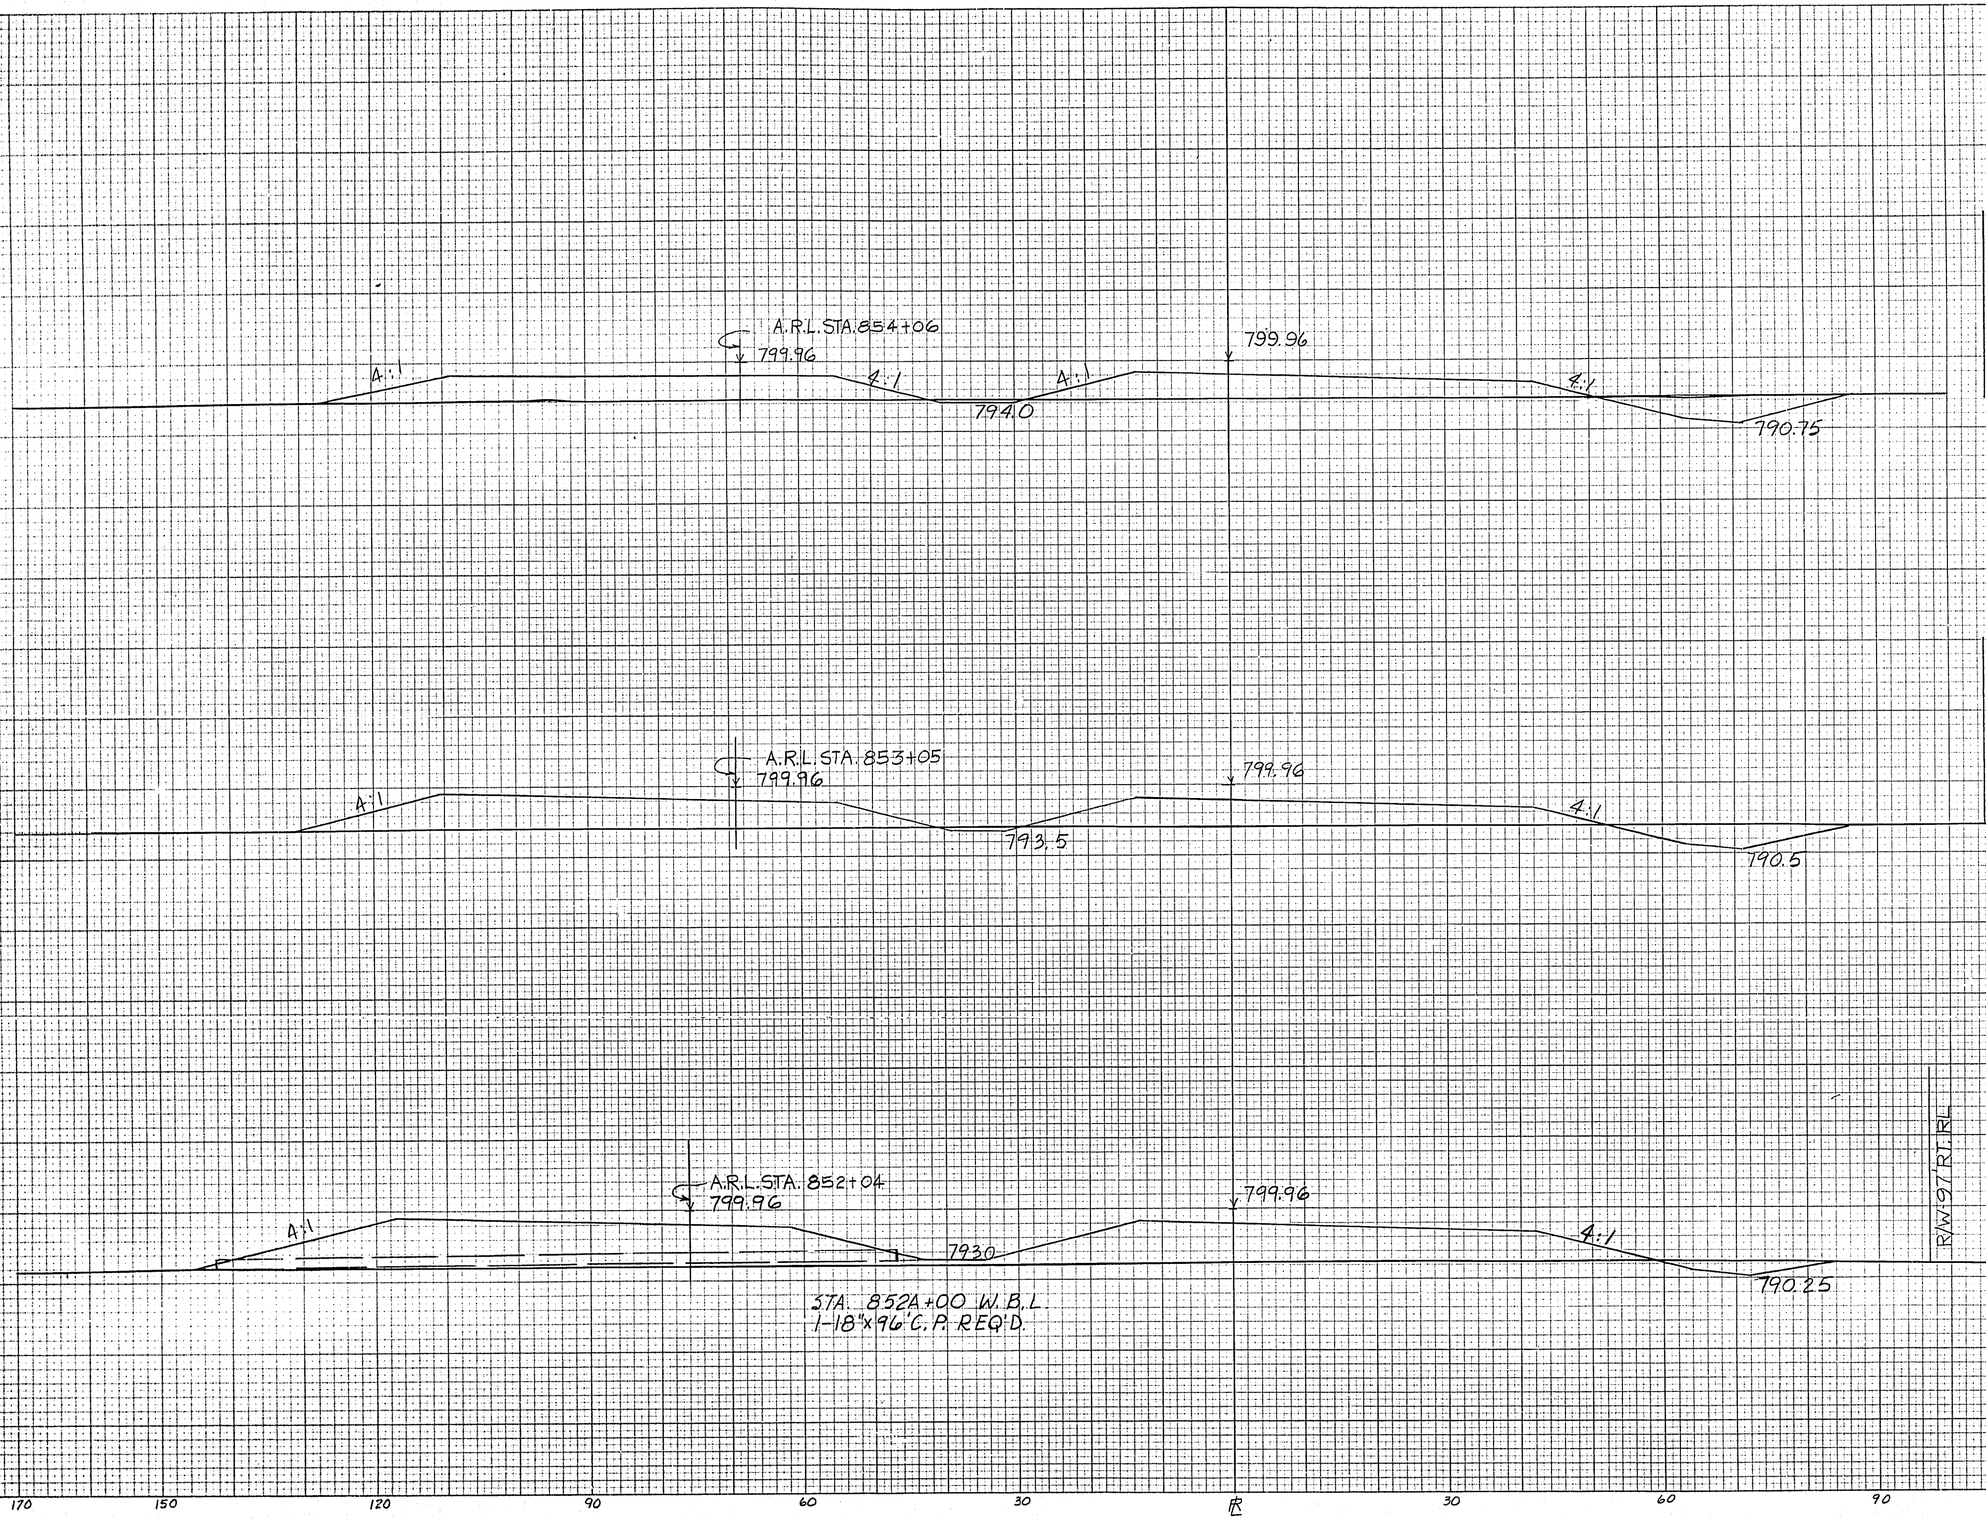

STATION	DISTANCE	YARDAGE EXCAVATION UNCL.	YARDAGE FILL
853			
	100	285	1849
852			
	100	178	2671
851			
	100	48	4436
850			
SHEET TOTAL		511	8956

PLATE 3–CROSS SECTION O. P. R. & R. E. STANDARD
THE FREDERICK POST CO., CHICAGO

851-853

B.P.R. DISTRICT OFFICE	PROJECT	SHEET NUMBER	TOTAL SHEETS
WIS. 4	I-90-2(IX)105	121	264

FINAL SURVEY — SURVEYED / PLOTTED / NOTE BOOK / AREAS / AREAS CHECKED — BY / DATE

ORIGINAL SURVEY — SURVEYED 6-1958 / PLOTTED TPV / NOTE BOOK / AREAS 4-59 / AREAS CHECKED JLE

R.L. NE EXIT RAMP "E" 856+00

798.55

A.R.L. STA. 856+00 799.96

799.96

4:1

795.5

4:1

791.5

R/W-105' RT. R.L.

R.L. NE EXIT RAMP "E" 855+00

797.85

A.R.L. STA. 856+10 799.96

799.96

4:1

795.0

4:1

791.25

R/W-105' RT. R.L.

MATCH LINE

STA. 853E+75 I-18"x16' C.P. REQ'D.

MATCH LINE

R.L. NE EXIT RAMP "E" 853+85

797.48

4:1

A.R.L. STA. 855+08 799.96

799.96

794.5

4:1

791.0

R/W-105' RT. R.L.

STATION	DISTANCE	YARDAGE EXCAVATION UNCL.	YARDAGE EXCAVATION	YARDAGE EXCAVATION	YARDAGE EXCAVATION	YARDAGE FILL
856						
	100	107				2723
855						
	100	228				2209
854						
	100	305				2041
853						
SHEET TOTAL		640				6976


PLATE 3—CROSS SECTION O. P. R. & B. E. STANDARD
THE FREDERICK POST CO., CHICAGO

854-856

B.P.R. DISTRICT OFFICE	PROJECT	SHEET NUMBER	TOTAL SHEETS
WIS. 4	I-90-2(18)105	122	364

FINAL SURVEY — PLOTTED — TEMPLATE — AREAS — AREAS CHECKED — NOTE BOOK — NO. — BY — DATE

ORIGINAL SURVEY — COMPUTED — PLOTTED — TEMPLATE — AREAS — AREAS CHECKED — NOTE BOOK — NO. — BY — DATE — 1-21-58 — 4-11-58

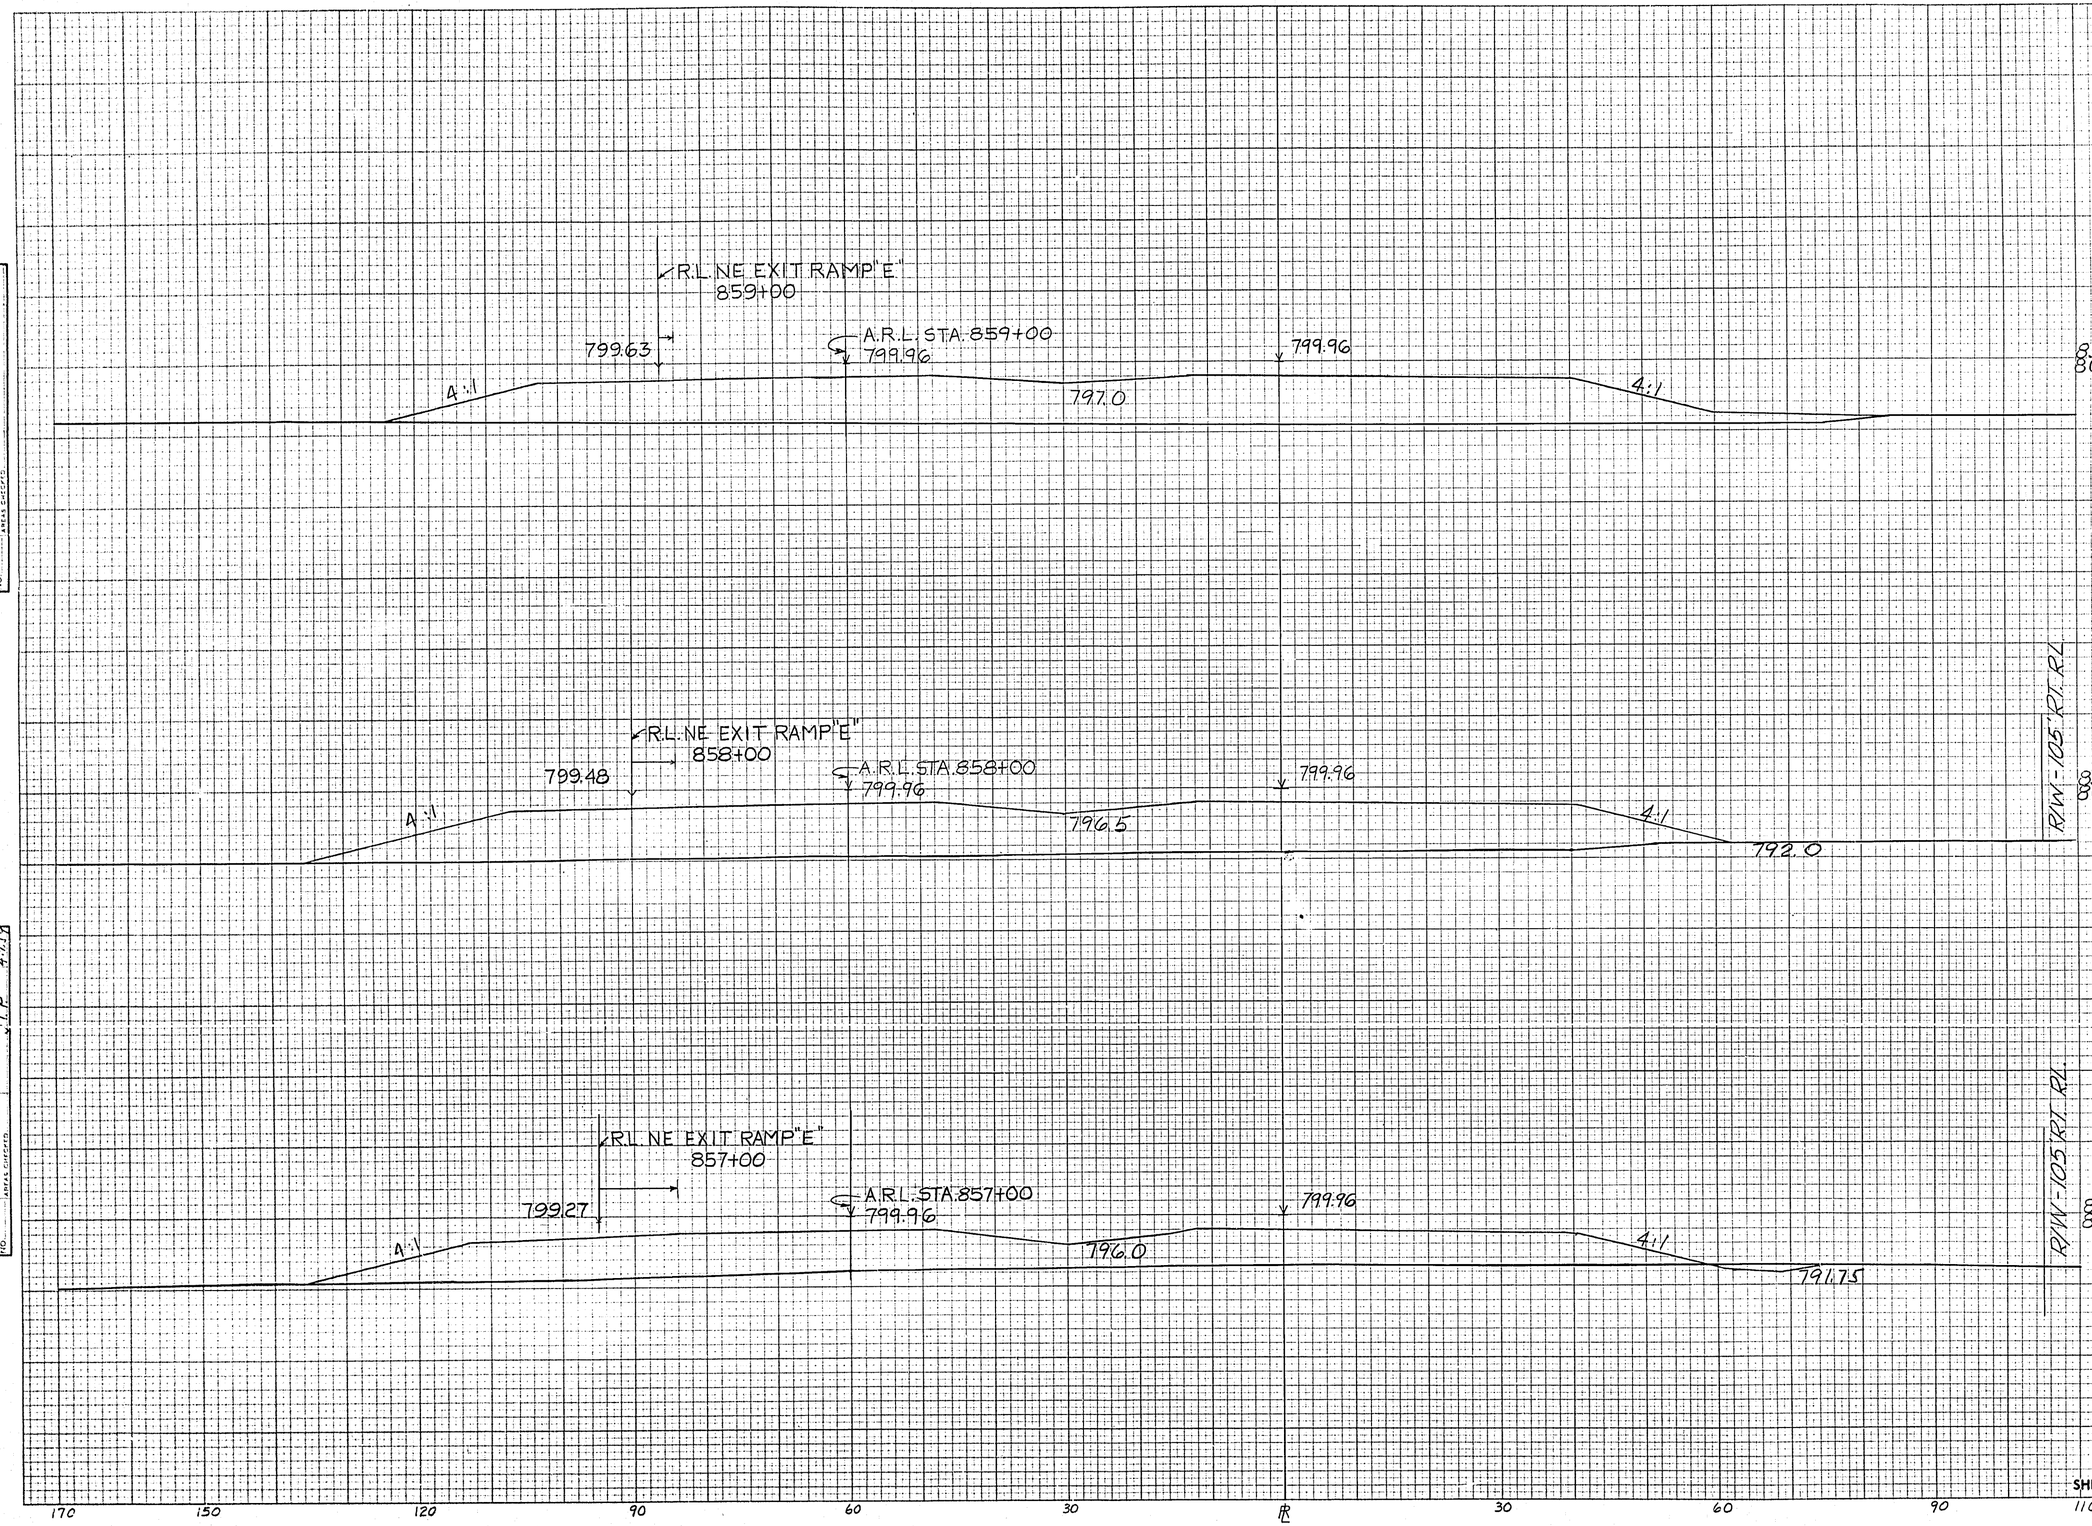

STATION	DISTANCE	YARDAGE EXCAVATION UNCL.	YARDAGE EXCAVATION	YARDAGE EXCAVATION	YARDAGE EXCAVATION	YARDAGE FILL
859 800						
859						
	100	0				4237
858						
858 800						
	100	21				3900
857						
857 800						
	100	51				3075
856						
SHEET TOTAL		72				11212

PLATE 3-CROSS SECTION O. P. R. & R. E. STANDARD
THE FREDERICK POST CO., CHICAGO

857-859

B.P.R. DISTRICT OFFICE	PROJECT	SHEET NUMBER	TOTAL SHEETS
WIS. 4	I-90-2(18)105	173	264

FINAL SURVEY — ICHECKED, PLOTTED, TRACED, NOTE BOOK, TEMPLATE, AREAS, NO, AREAS CHECKED, BY, DATE

ORIGINAL SURVEY — CHECKED, PLOTTED, TRACED, NOTE BOOK, AREAS, NO, AREAS CHECKED, BY, DATE, TOPO 4-78, V.I.P. 4-78

R/W-140' LT. RL.

A.R.L. STA. 862+00
800.04

800.04

R.L. SW EXIT RAMP "B"
862+00
799.18

862+00, 110' RT.
- 333L+00, 134' RT.

A:1

796.5

4:1

R/W-140' LT. RL.

A.R.L. STA. 861+00
799.99

799.99

R.L. SW EXIT RAMP "B"
861+00
799.60

A:1

797.0

4:1

ST. H. 33 FILL

ST. H. 33 FILL

A.R.L. STA. 860+00
799.96

799.96

R.L. SW EXIT RAMP "B"
860+00
799.69

ST. H. 33 FILL

797.5

170 150 120 90 60 30 ℄ 30 60 90 110

STATION	DISTANCE	YARDAGE EXCAVATION UNCL.	YARDAGE FILL
862+00			
862			
	100	0	2331
861			
861+00			
	100	0	2102
860			
860+00			
	100	0	3012
859			
SHEET TOTAL		0	7445

PLATE 3—CROSS SECTION O. P. R. & R. E. STANDARD
THE FREDERICK POST CO., CHICAGO

860-862

B.P.R. DISTRICT OFFICE	PROJECT	SHEET NUMBER	TOTAL SHEETS
WIS. 4	I-90-2(17)105	124	164

FINAL SURVEY — SURVEYED / PLOTTED / TEMPLATE / AREAS CHECKED / NOTE BOOK / NO.

ORIGINAL SURVEY — SURVEYED / PLOTTED / TEMPLATE / AREAS CHECKED / NOTE BOOK / NO.

BY — E.V.E. — J.T.P. — DATE — 2-23-38 — 4-7-38

R/W-146'LT. R.L.

A.R.L. STA. 865+00
800.63

800.36

795.0

A:1

MATCH LINE

R.L. SW EXIT RAMP "B"
865+00

797.92

4:1

MATCH LINE

865
790

864+00 180' RT.
332"L"-00-315' RT.

MATCH LINE

790

110 140 170

R/W-140'LT. R.L.

A.R.L. STA. 864+00
800.23

800.23

795.5

A:1

R.L. SW EXIT RAMP "B"
864+00

798.34

4:1

MATCH LINE

864
790

R/W-140'LT. R.L.

A.R.L. STA. 863+00
800.12

800.12

796.0

A:1

R.L. SW EXIT RAMP "B"
863+00

798.76

4:1

863
790

150 100 50 ℄ 50 100

863+00 - 865+00

STATION	DISTANCE	YARDAGE EXCAVATION UNCL.	YARDAGE FILL
865			
	100	0	6754
864			
	100	0	4004
863			
	100	0	2331
862			
SHEET TOTAL		0	13089

PLATE 3—CROSS SECTION O. P. R. & R. E. STANDARD
THE FREDERICK POST CO., CHICAGO

B.P.R. DISTRICT OFFICE	PROJECT	SHEET NUMBER	TOTAL SHEETS
WIS. 4	I-90-2(18)105	135	264

FINAL SURVEY
SURVEYED
PLOTTED
NOTE BOOK
TEMPLATE
AREAS
NO.
AREAS CHECKED
DATE
BY

ORIGINAL SURVEY
SURVEYED
PLOTTED
NOTE BOOK
TEMPLATE
AREAS
NO.
AREAS CHECKED
DATE
BY
4-22-58
S.K.B.
J.I.P.
4-19

R/W 170' LT. R.L.

A.R.L. STA. 868+00
800.93

800.93

4:1

788.7

795.5

797.5

MATCH LINE

4:1

789.0

R.L. SW ENTRANCE RAMP "C"
868+00

798.32

MATCH LINE

R/W 170' LT. R.L.

A.R.L. STA. 867+00
800.71

800.71

4:1

4:1

789.3

795.0

GRADE TO DRAIN

R/W 53' LT. R.L.

A.R.L. STA. 866+00
800.52

800.52

4:1

789.9

794.5

STA 866A+00 W.B.L.
1-18"x94' C.P. REQ'D.

STATION	DISTANCE	YARDAGE EXCAVATION UNCL.	YARDAGE EXCAVATION	YARDAGE EXCAVATION	YARDAGE EXCAVATION	YARDAGE FILL
868						
868 790	100	86				5291
867						
867 790	100	79				4446
866						
866 790	100	0				4733
865						
SHEET TOTAL		165				14470

150 100 50 ℄ 50 100


866+00 - 868+00

PLATE 3—CROSS SECTION O. P. R. & B. E. STANDARD
THE FREDERICK POST CO., CHICAGO

B.P.R. DISTRICT OFFICE	PROJECT	SHEET NUMBER	TOTAL SHEETS
WIS. 4	I-90-2(13)10 9	136	264

FINAL SURVEY — SURVEYED, PLOTTED, TEMPLATE, NOTE BOOK, AREAS, AREAS CHECKED, NO.

ORIGINAL SURVEY — SURVEYED, PLOTTED, TEMPLATE, NOTE BOOK, AREAS, AREAS CHECKED, NO. — BY E.T.L. DATE 7-28-58 — VLB 4-7-59

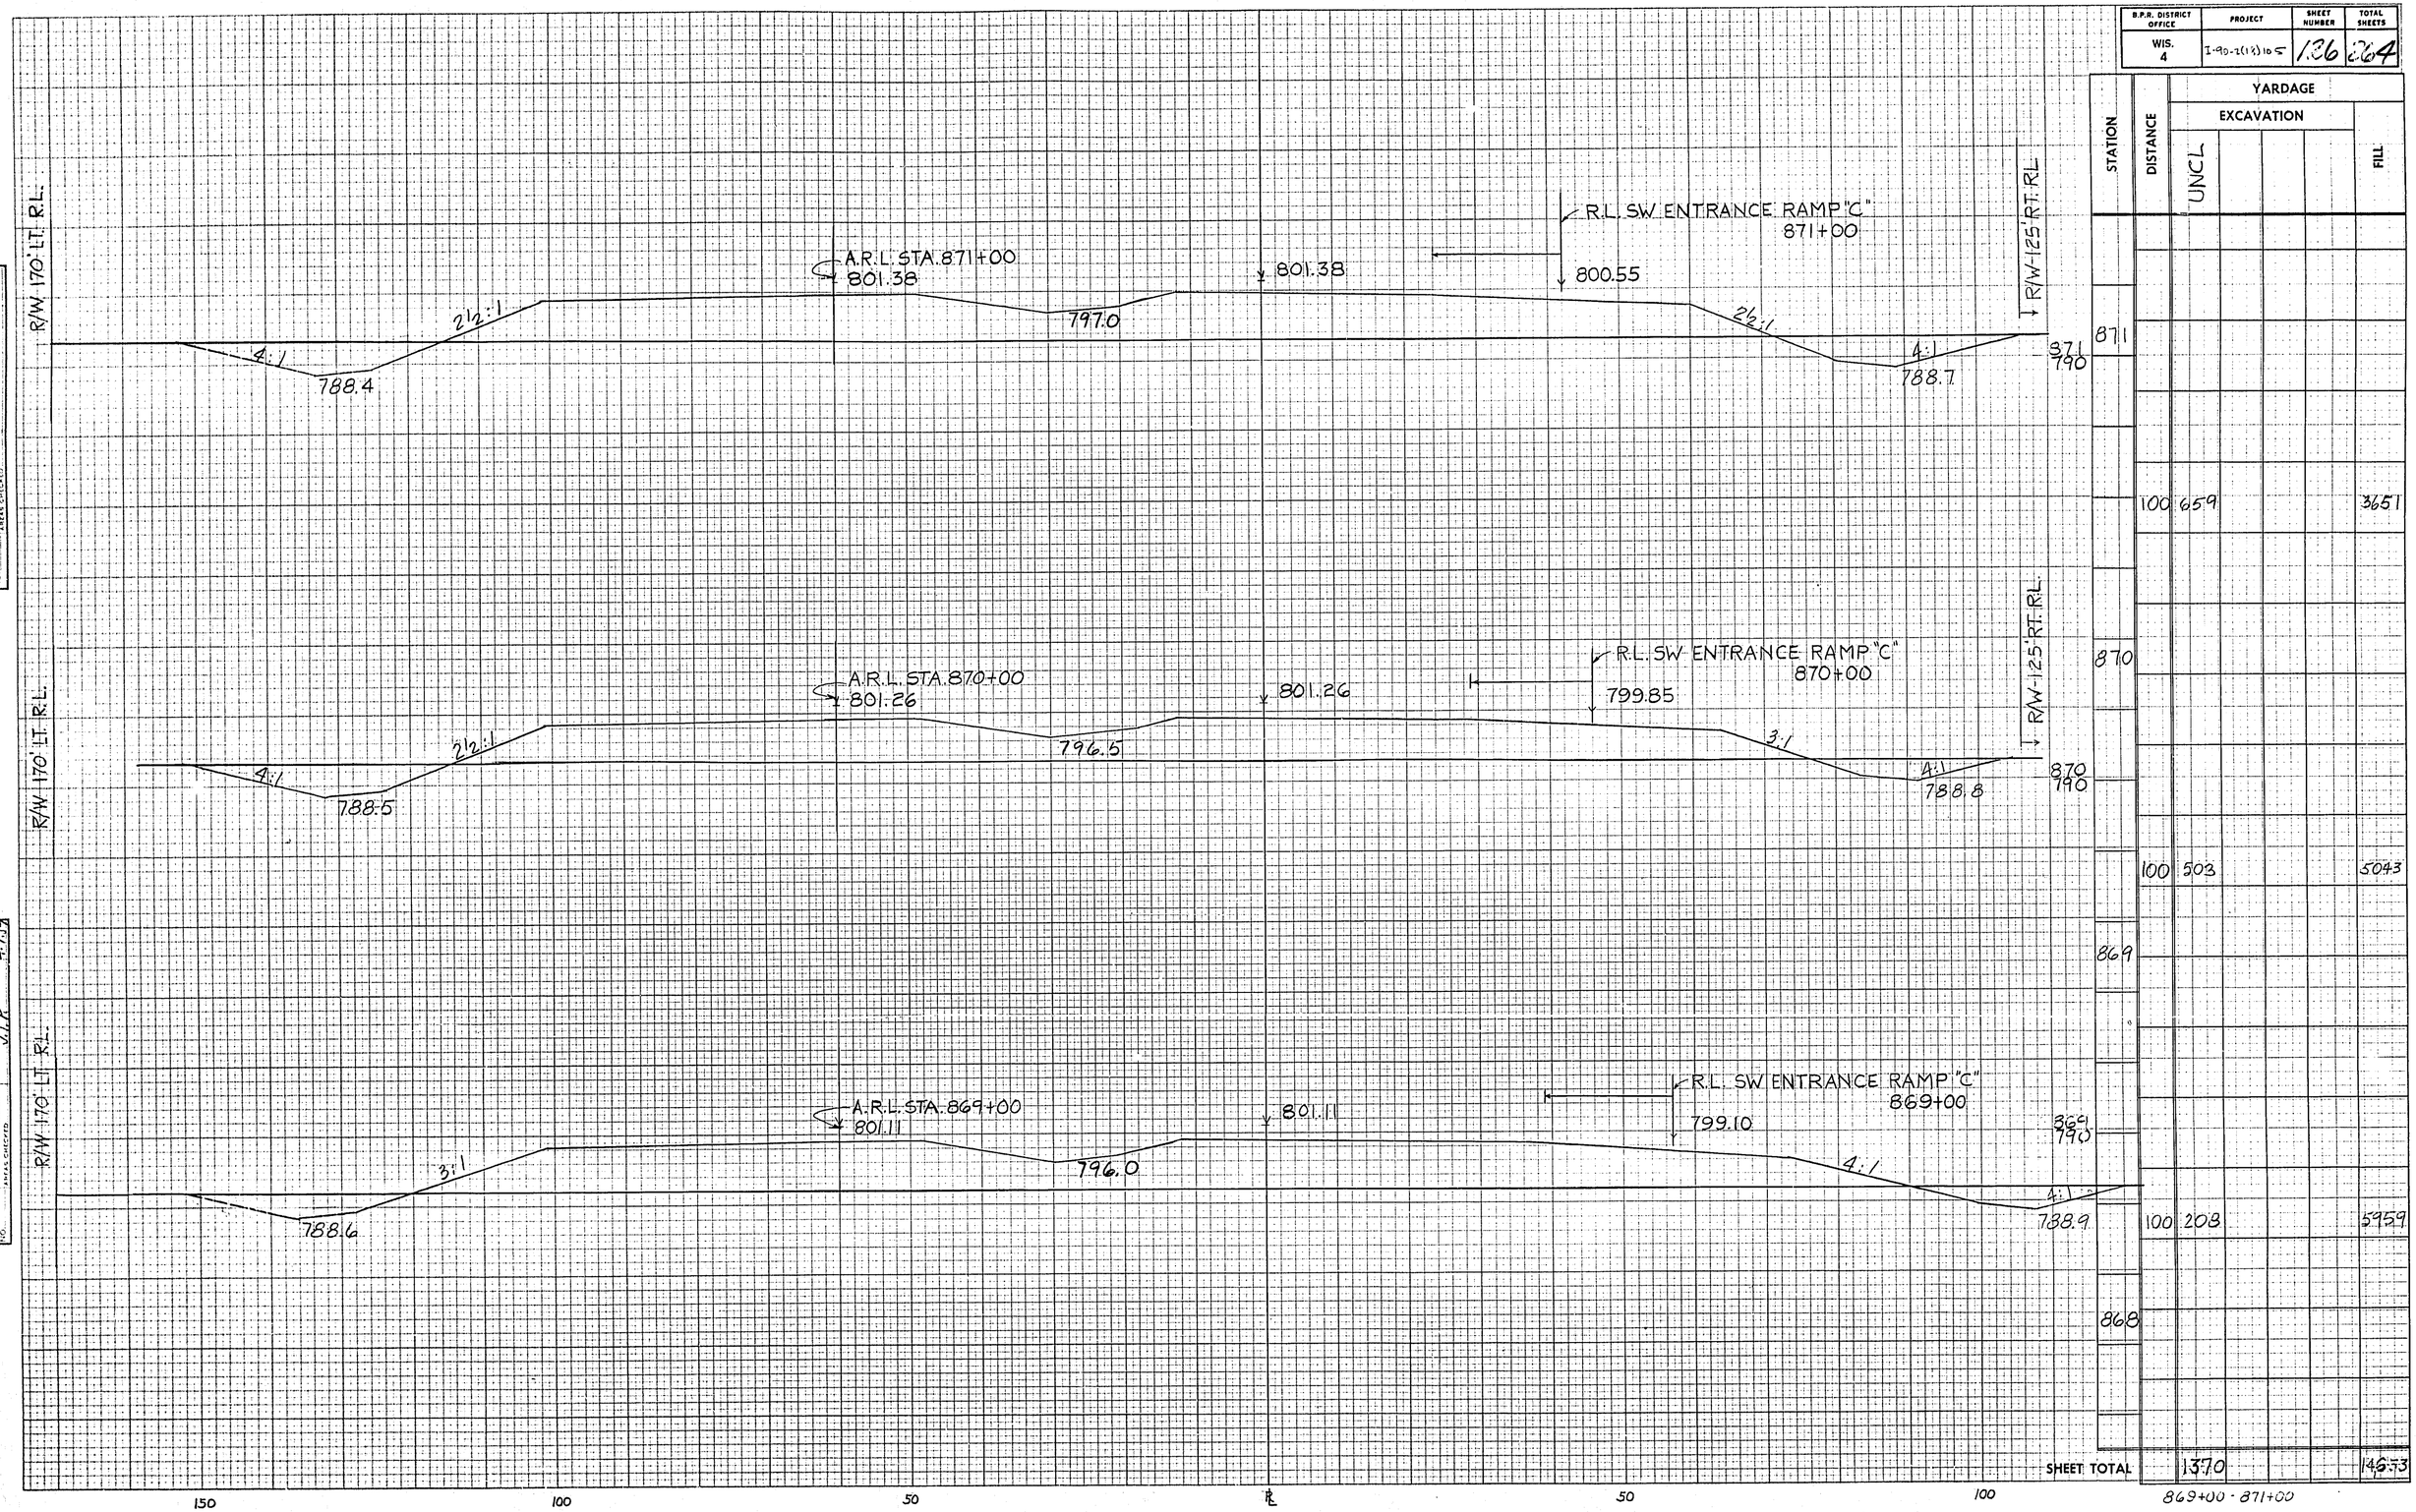

STATION	DISTANCE	YARDAGE EXCAVATION UNCL.	YARDAGE FILL
871			
871 790			
	100	659	3651
870			
870 790			
	100	503	5043
869			
869 790			
	100	208	5959
868			
SHEET TOTAL		1370	14673

869+00 - 871+00

PLATE 3—CROSS SECTION O. P. R. & R. E. STANDARD
THE FREDERICK POST CO., CHICAGO

B.P.R. DISTRICT OFFICE	PROJECT	SHEET NUMBER	TOTAL SHEETS

FINAL SURVEY — SURVEYED, PLOTTED, NOTE BOOK, TEMPLATE, AREAS, VOLS. CHECKED, BY, DATE

ORIGINAL SURVEY — SURVEYED, PLOTTED, NOTE BOOK, TEMPLATE, AREAS, VOLS. CHECKED, BY, DATE — S.C.B. 12/2/58 — 4717

R/W 140' LT. R.L.

A.R.L. STA. 875+50
801.50

801.50

4:1

798.5

4:1

791.6

R/W 100' RT. R.L.

BRIDGE
STRUCT. B-11-31 E.B.L.
STRUCT. B-11-32 W.B.L.

R/W 170' LT. R.L.

A.R.L. STA. 873+00
801.49

801.49

2½:1

798.0

2½:1

788.2

4:1

788.5

R.L. SW ENTRANCE RAMP "C"
873+00

801.10

R/W 125' RT. R.L.

R/W 170' LT. R.L.

A.R.L. STA. 872+00
801.02

801.45

2½:1

797.5

2½:1

788.3

4:1

788.6

R.L. SW ENTRANCE RAMP "C"
872+00

801.02

R/W 125' RT. R.L.

STATION	DISTANCE	YARDAGE EXCAVATION UNCL.	YARDAGE EXCAVATION	YARDAGE EXCAVATION	YARDAGE EXCAVATION	YARDAGE FILL
875 +50						
875+50 790	50	2				946
875						
874 20						
	20	0				687
874						
873 790						
	100	525				4911
873						
	100	894				3377
872						
872 790						
	100	726				3753
871						
SHEET TOTAL		2147				13679

150 100 50 ℄ 50 100

872+00 - 875+50

PLATE 3—CROSS SECTION O. P. R. & R. E. STANDARD
THE FREDERICK POST CO., CHICAGO

B.P.R. DISTRICT OFFICE	PROJECT	SHEET NUMBER	TOTAL SHEETS
WIS. 4	I-90-2(19)105	123	264

FINAL SURVEY — SURVEYED, PLOTTED, TEMPLATE, AREAS CHECKED — NOTE BOOK: — NO. — BY — DATE

ORIGINAL SURVEY — SURVEYED, PLOTTED, TEMPLATE, AREAS CHECKED — NOTE BOOK: — NO. — BY J.T.R. — DATE 7-21-58 — 97.19

R/W 140' LT. RL.

A.R.L. STA. 878+00
801.50
801.50
A:1
797.5
4:1
791.9
R/W 100' RT. RL.

A.R.L. STA. 877+00
801.50
801.50
A:1
797.0
4:1
791.8

A.R.L. STA. 876+00
801.50
801.50
A:1
796.5
4:1
791.7

876A+00 W. B. L.
1-18"x 84' C. P. REQ'D.

170 150 120 90 60 30 ℄ 30 60 90 110

STATION	DISTANCE	YARDAGE EXCAVATION UNCL.	YARDAGE EXCAVATION	YARDAGE EXCAVATION	YARDAGE EXCAVATION	YARDAGE FILL
878						
878 800						
100	12.5					317.8
877						
877 800						
100	10.5					358.6
876						
100	6					200.9
876 800						
875 ± 50						
SHEET TOTAL		23.6				877.3


PLATE 3—CROSS SECTION O. P. R. & R. E. STANDARD
THE FREDERICK POST CO., CHICAGO

876-878

B.P.R. DISTRICT OFFICE	PROJECT	SHEET NUMBER	TOTAL SHEETS
WIS. 4	196-2(18)105	129	264

FINAL SURVEY — SURVEYED, PLOTTED, TEMPLATE, AREAS, AREAS CHECKED, NOTE BOOK, NO., DATE, BY

ORIGINAL SURVEY — SURVEYED 12/16/58, PLOTTED, TEMPLATE, AREAS, AREAS CHECKED LLP 4-7-59, NOTE BOOK, NO., DATE, BY

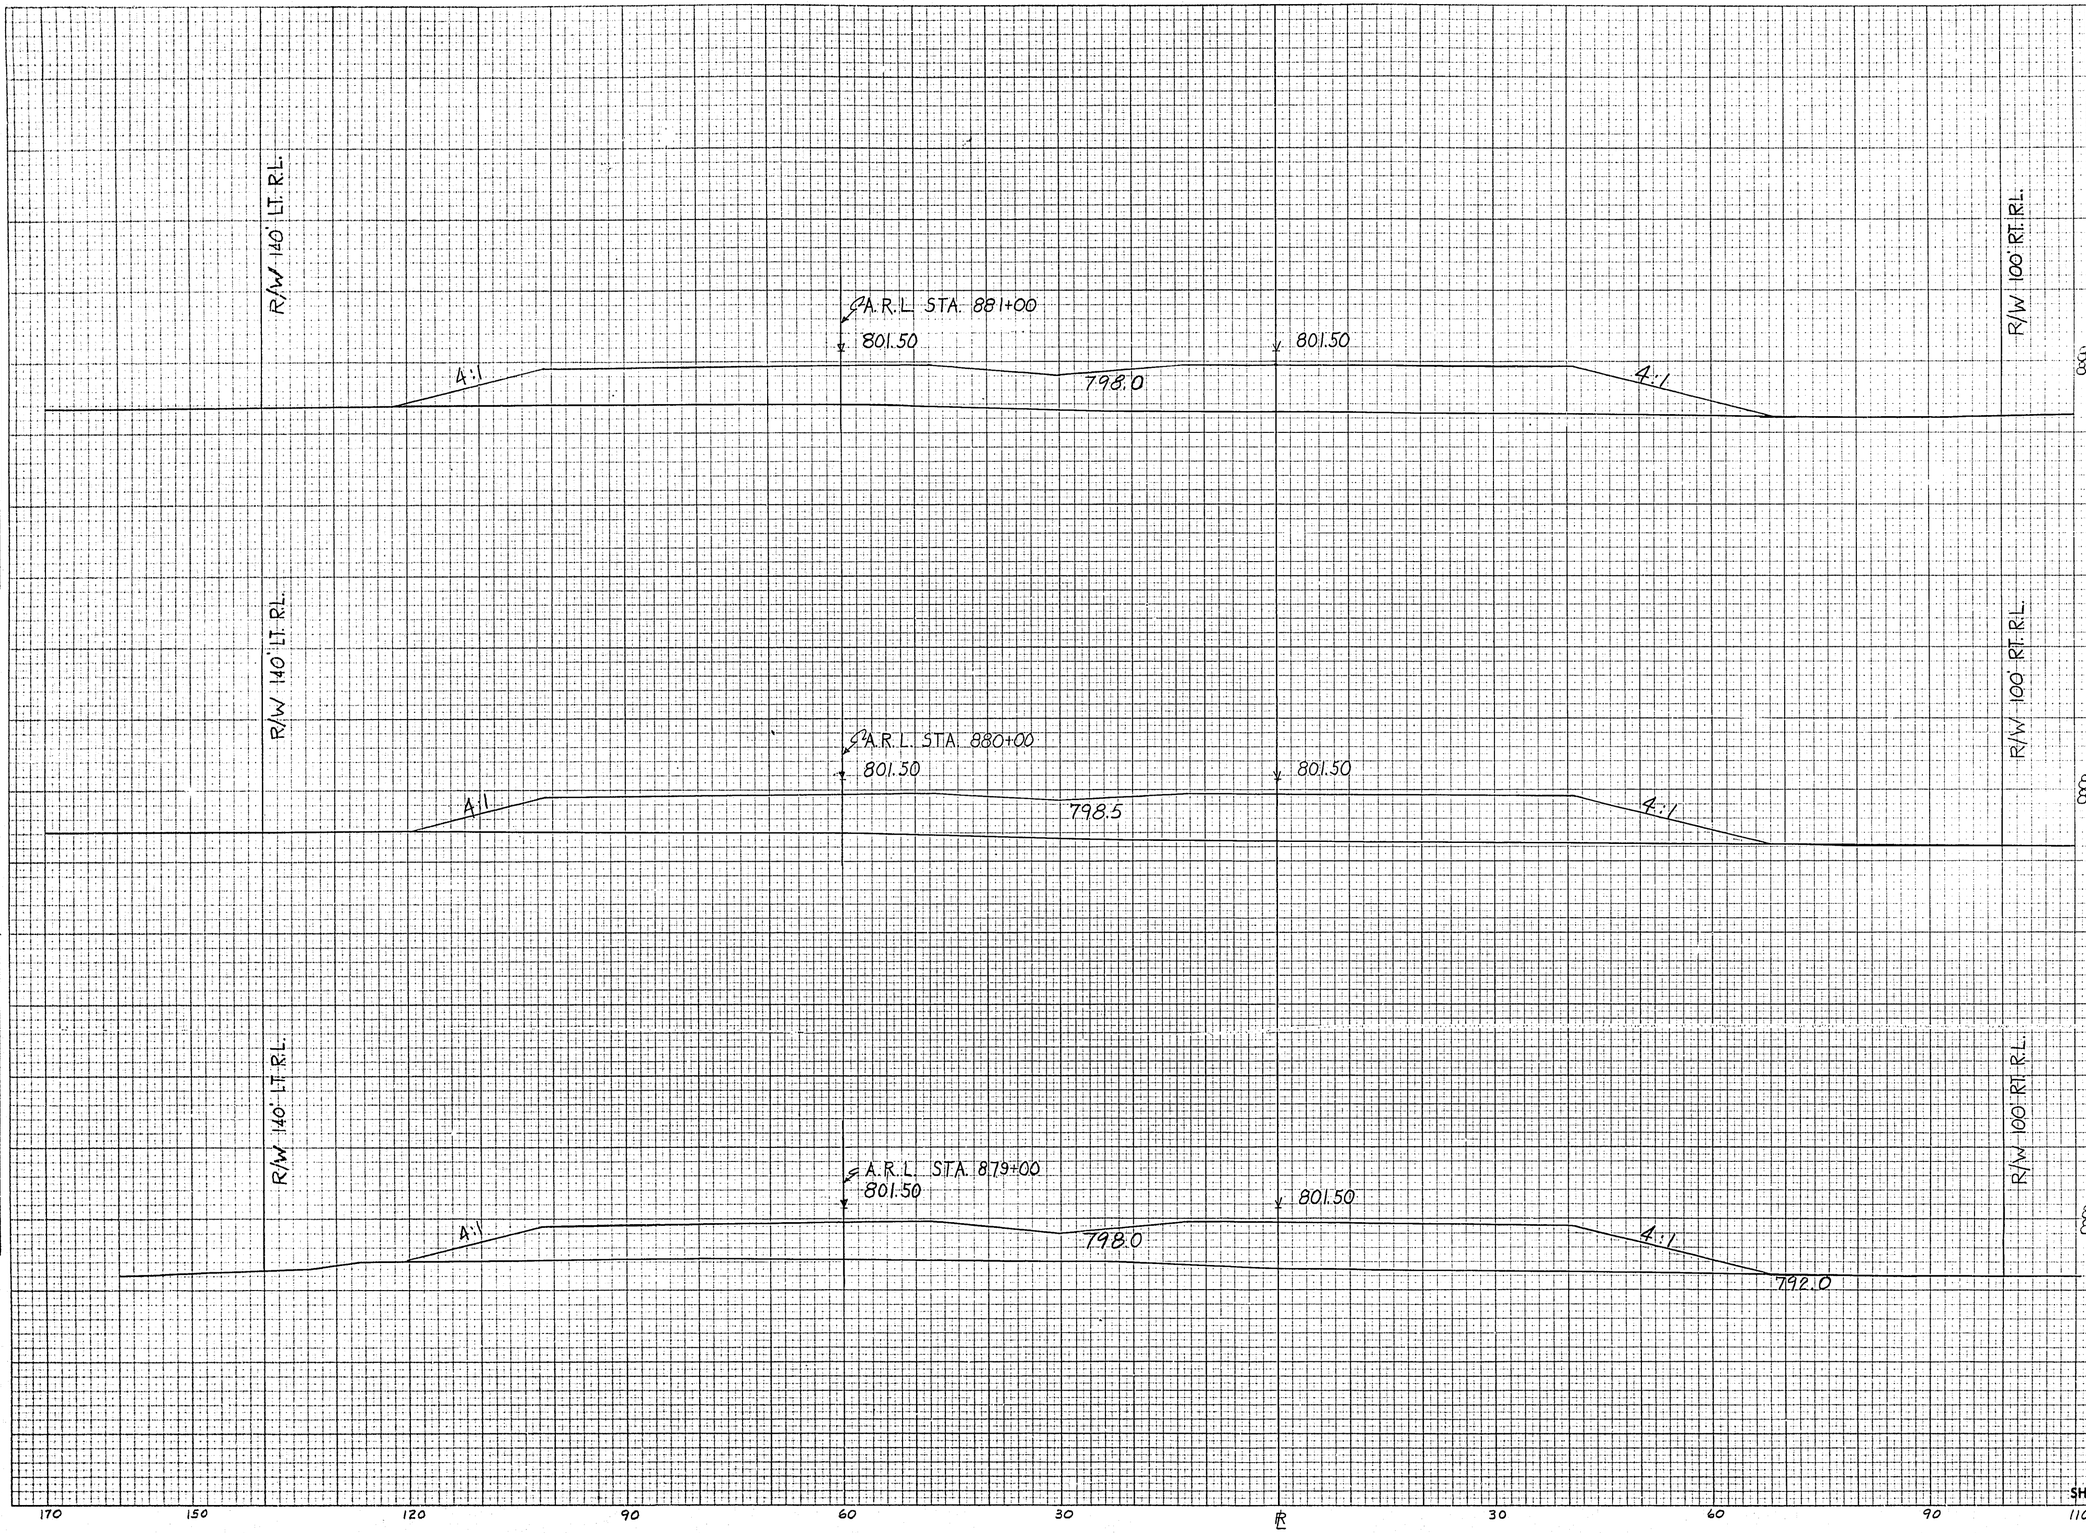

STATION	DISTANCE	YARDAGE EXCAVATION UNCL.		FILL
881				
881 800				
	100	0		3602
880				
880 800				
	100	0		3486
879				
	100	23		3412
879 800				
878				
SHEET TOTAL		23		10500

PLATE 3-CROSS SECTION O. P. R. & R. E. STANDARD
THE FREDERICK POST CO., CHICAGO

879-881

B.P.R. DISTRICT OFFICE	PROJECT	SHEET NUMBER	TOTAL SHEETS
WIS. 4	I-90-2(18)105	130	264

FINAL SURVEY — SURVEYED / PLOTTED / TEMPLATE / AREAS / AREAS CHECKED — NOTE BOOK: — NO. — DATE

ORIGINAL SURVEY — SURVEYED / PLOTTED / TEMPLATE / AREAS / AREAS CHECKED — NOTE BOOK: J.I.P. — NO. 4278 — DATE 1-19-61 4-23-56

R/W 140' LT. R.L.

℄ A.R.L. STA. 884+00
801.50

801.50

4:1

796.5

4:1

R/W 100' RT. R.L.

STA. 884+00 W.B.L.
1-18" x 82' C.P. REQ'D

R/W 140' LT. R.L.

℄ A.R.L. STA. 883+00
801.50

801.50

4:1

797.0

4:1

R/W 100' RT. R.L.

R/W 140' LT. R.L.

℄ A.R.L. STA. 882+00
801.50

801.50

4:1

797.5

4:1

R/W 100' RT. R.L.

170 150 120 90 60 30 ℄ 30 60 90 110

STATION	DISTANCE	YARDAGE EXCAVATION UNCL.				YARDAGE FILL
884						
884 800						
	100	0				3679
883						
883 800						
	100	0				3480
882						
882 800						
	100	0				3509
881						
SHEET TOTAL		0				10,668


PLATE 3—CROSS SECTION O. P. R. & R. E. STANDARD
THE FREDERICK POST CO., CHICAGO

884-884

B.P.R. DISTRICT OFFICE	PROJECT	SHEET NUMBER	TOTAL SHEETS
WIS. 4	I-90-2(19)105	131	214

FINAL SURVEY — SURVEYED — PLOTTED — NOTE BOOK, PAGES — NO. — AREAS CHECKED — BY — DATE

ORIGINAL SURVEY — SURVEYED 12/6/1958 — PLOTTED — NOTE BOOK, PAGES — NO. 687 — AREAS CHECKED J.I.P. — BY — DATE

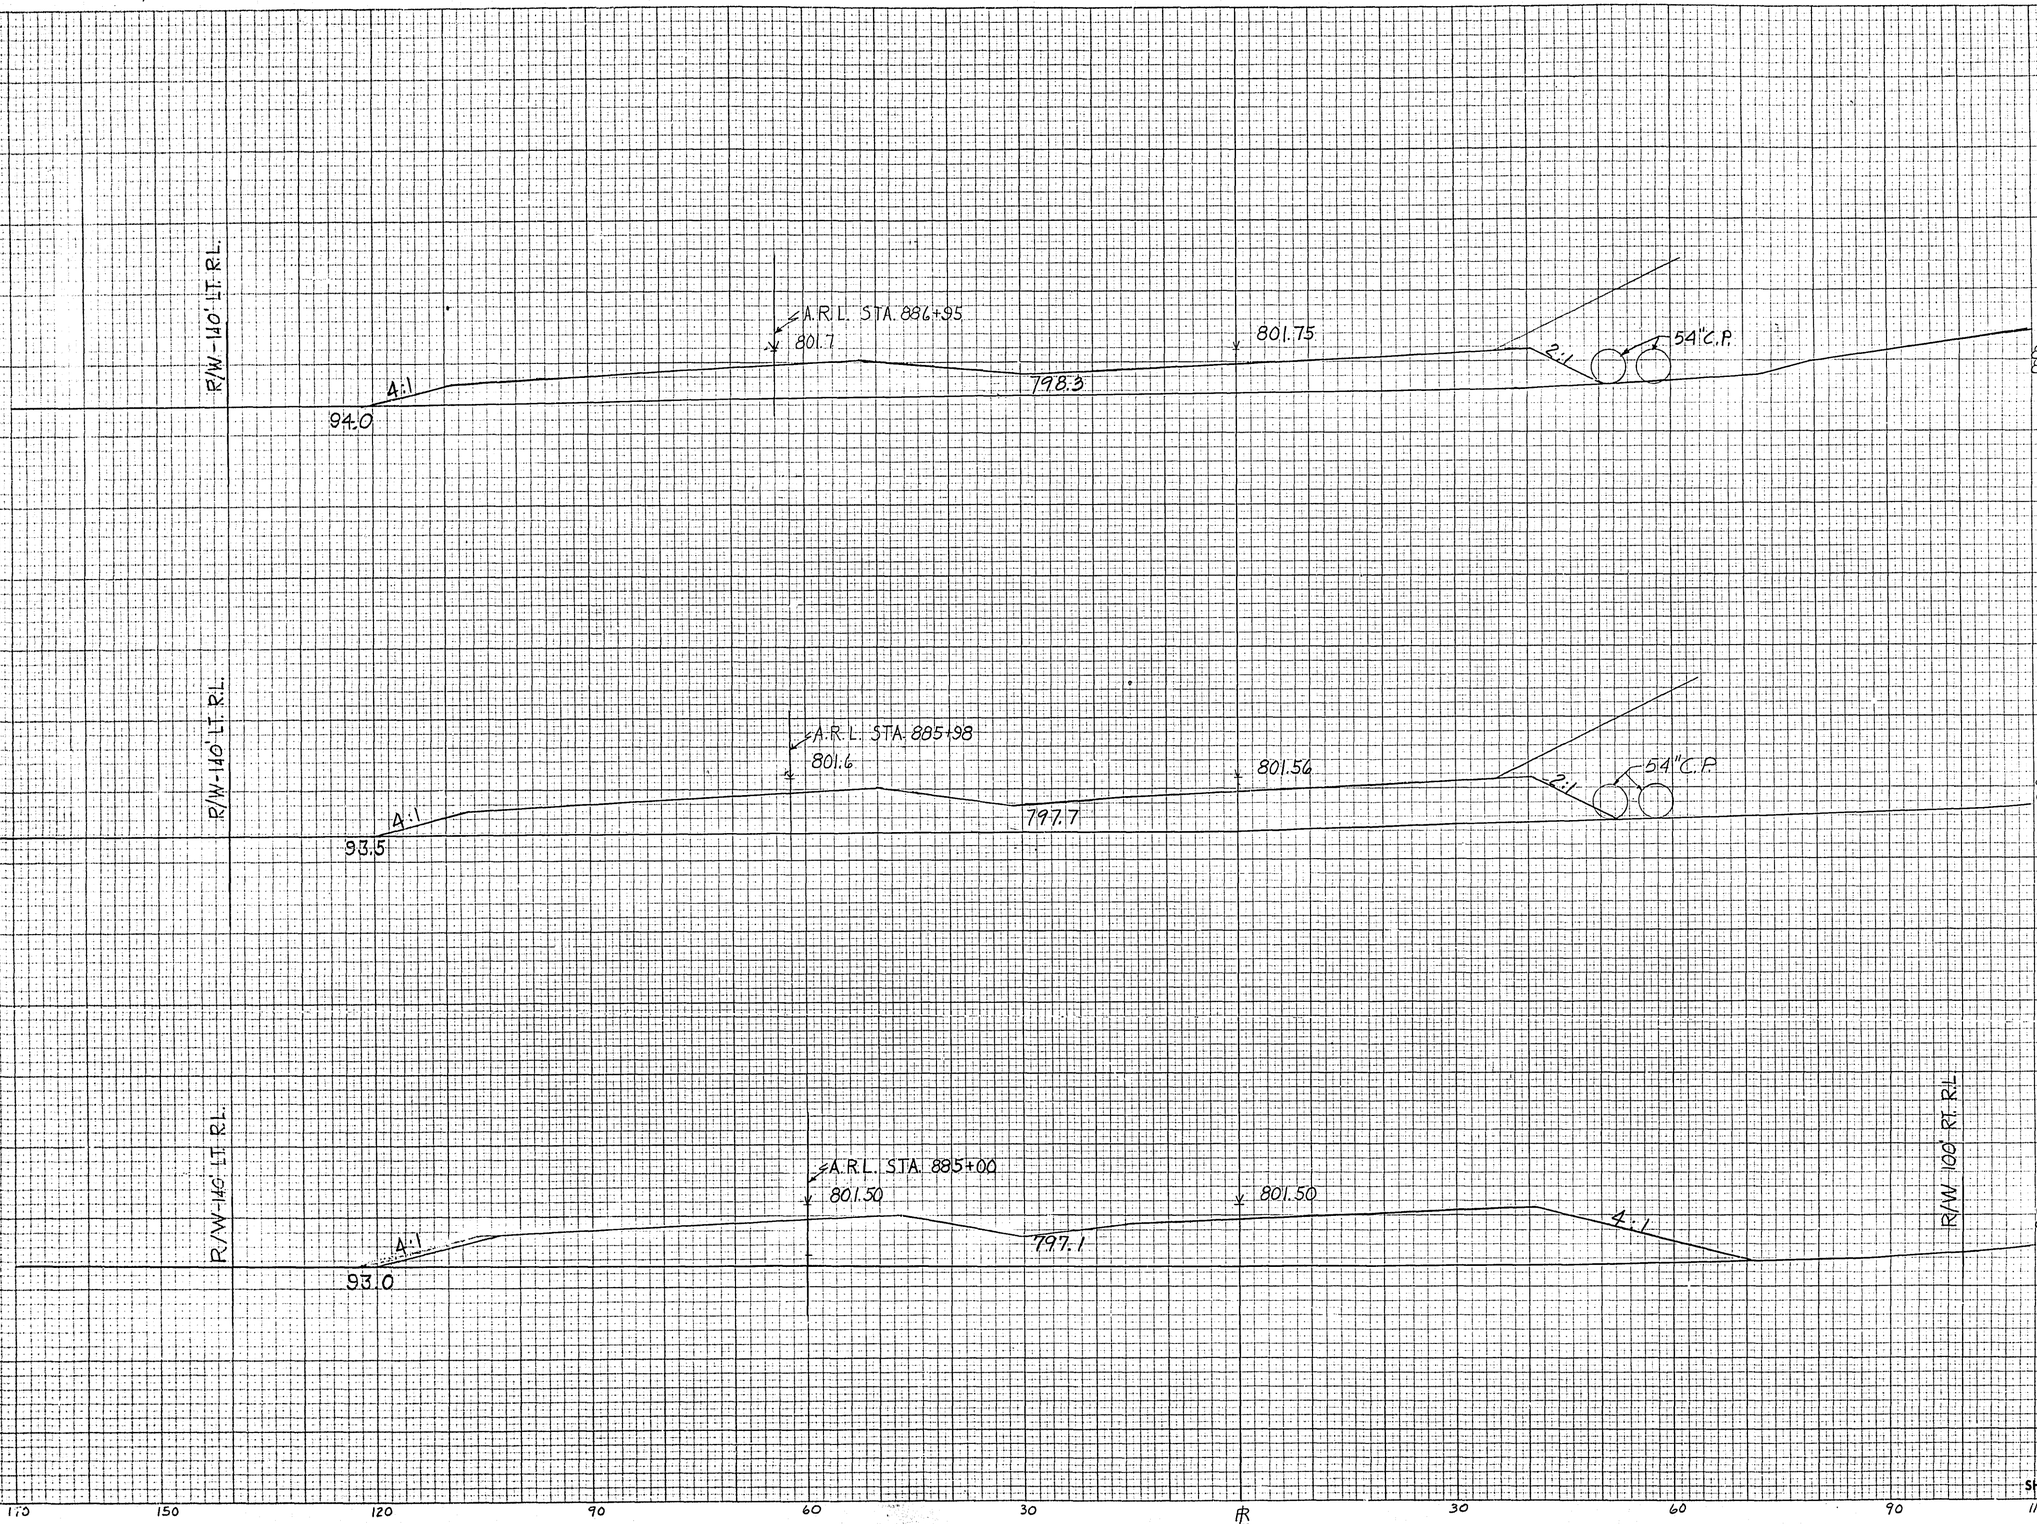

STATION	DISTANCE	YARDAGE EXCAVATION UNCL.	FILL
887			
887 800			
	100	0	2799
886			
886 800			
	100	0	3146
885			
885 800			
	100	0	3836
884			
SHEET TOTAL		0	10081

150 120 90 60 30 ℄ 30 60 90 110

PLATE 3-CROSS SECTION (U. F. R. & R. E. STANDARD)
THE FREDERICK POST CO., CHICAGO

885-887

B.P.R. DISTRICT OFFICE	PROJECT	SHEET NUMBER	TOTAL SHEETS
WIS. 4	I-90-2(18)165	152	264

R/W - 170' LT. R.L.

℄ A.R.L. 889+86
802.7

796.0

797.2

STA. 889A+90 W.B.L.
1-24" x 76' C.P. REQ'D

803.04

799.5

120' RT. R.L. R/W

℄ A.R.L. STA. 888+93
802.3

96.0

797.7

802.48

798.5

2½:1

R/W 120' RT. R.L.

℄ A.R.L. STA. 887+95
801.9

798.2

802.05

797.5

STATION	DISTANCE	YARDAGE EXCAVATION UNCL.				FILL
890						
890 800						
	100	165.7				508
889						
889 800						
	100	928				955
888						
888 800						
	100	170				1997
887						
SHEET TOTAL		2755				3462

170 150 120 90 60 30 ℄ 30 60 90 110

FINAL SURVEY — SURVEYED, PLOTTED, NOTE BOOK, NO. ..., AREAS, DATE


ORIGINAL SURVEY — SURVEYED, PLOTTED, NOTE BOOK, NO. ..., AREAS CHECKED, DATE 7-16-1958, 4.1.2, 4.2.3

PLATE 3—CROSS SECTION O. P. R. & B. E. STANDARD
THE FREDERICK POST CO., CHICAGO

B.P.R. DISTRICT OFFICE	PROJECT	SHEET NUMBER	TOTAL SHEETS
WIS. 4	I-90-2(18)105	133	134

FINAL SURVEY — DATE — BY — SURVEYED — PLOTTED — TEMPLATE — NOTE BOOK — AREAS CHECKED — NO.

ORIGINAL SURVEY — DATE 7-6-58 — BY — SURVEYED — PLOTTED — TEMPLATE — NOTE BOOK — AREAS CHECKED — NO.

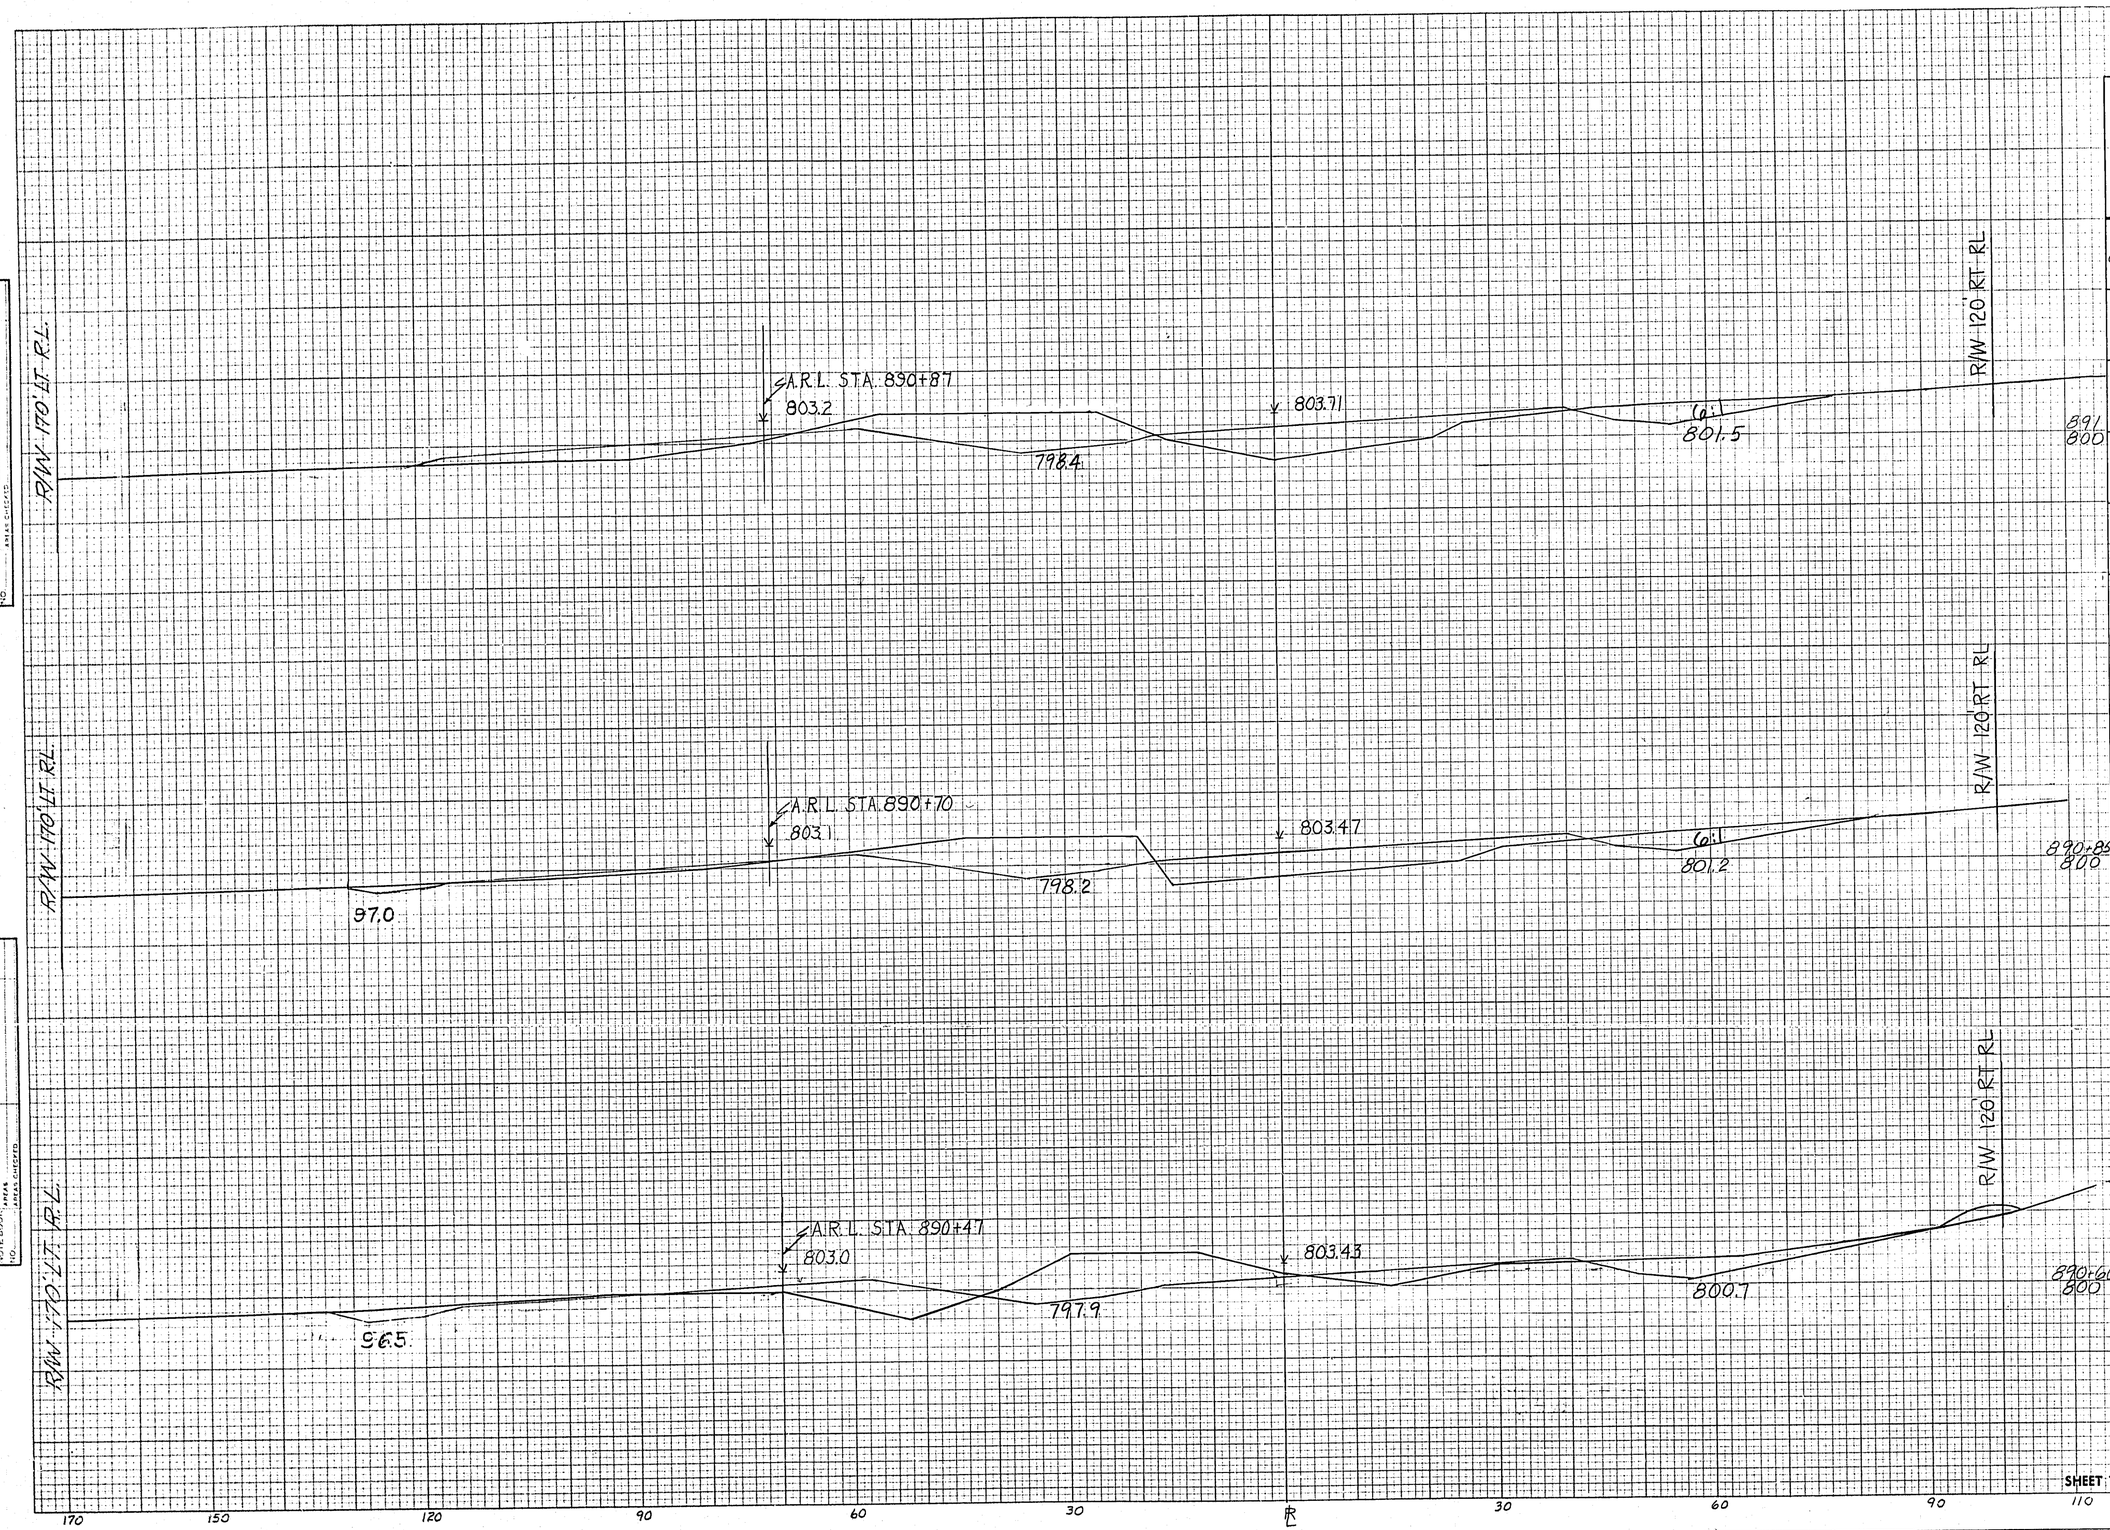

STATION	DISTANCE	YARDAGE EXCAVATION UNCL.				YARDAGE FILL
891						
890+85						
800	15	137				120
890						
85						
	25	247				153
890+85						
800						
890						
+						
60						
	60	351				310
890+60						
800						
890						
SHEET TOTAL		1235				583

170 150 120 90 60 30 ℄ 30 60 90 110

PLATE 3—CROSS SECTION O. P. R. & R. E. STANDARD
THE FREDERICK POST CO., CHICAGO


890+60 - 891

18

B.P.R. DISTRICT OFFICE	PROJECT	SHEET NUMBER	TOTAL SHEETS
WIS. 4	I-90-2(18)105	134	364

FINAL SURVEY — PLOTTED / TRACED / TEMPLATE / AREAS / AREAS CHECKED — DATE — BY — NOTE BOOK — NO.

ORIGINAL SURVEY — PLOTTED / TRACED / TEMPLATE / AREAS / AREAS CHECKED — DATE 6-10-38 — BY L.P.P. — NOTE BOOK — NO. 4185

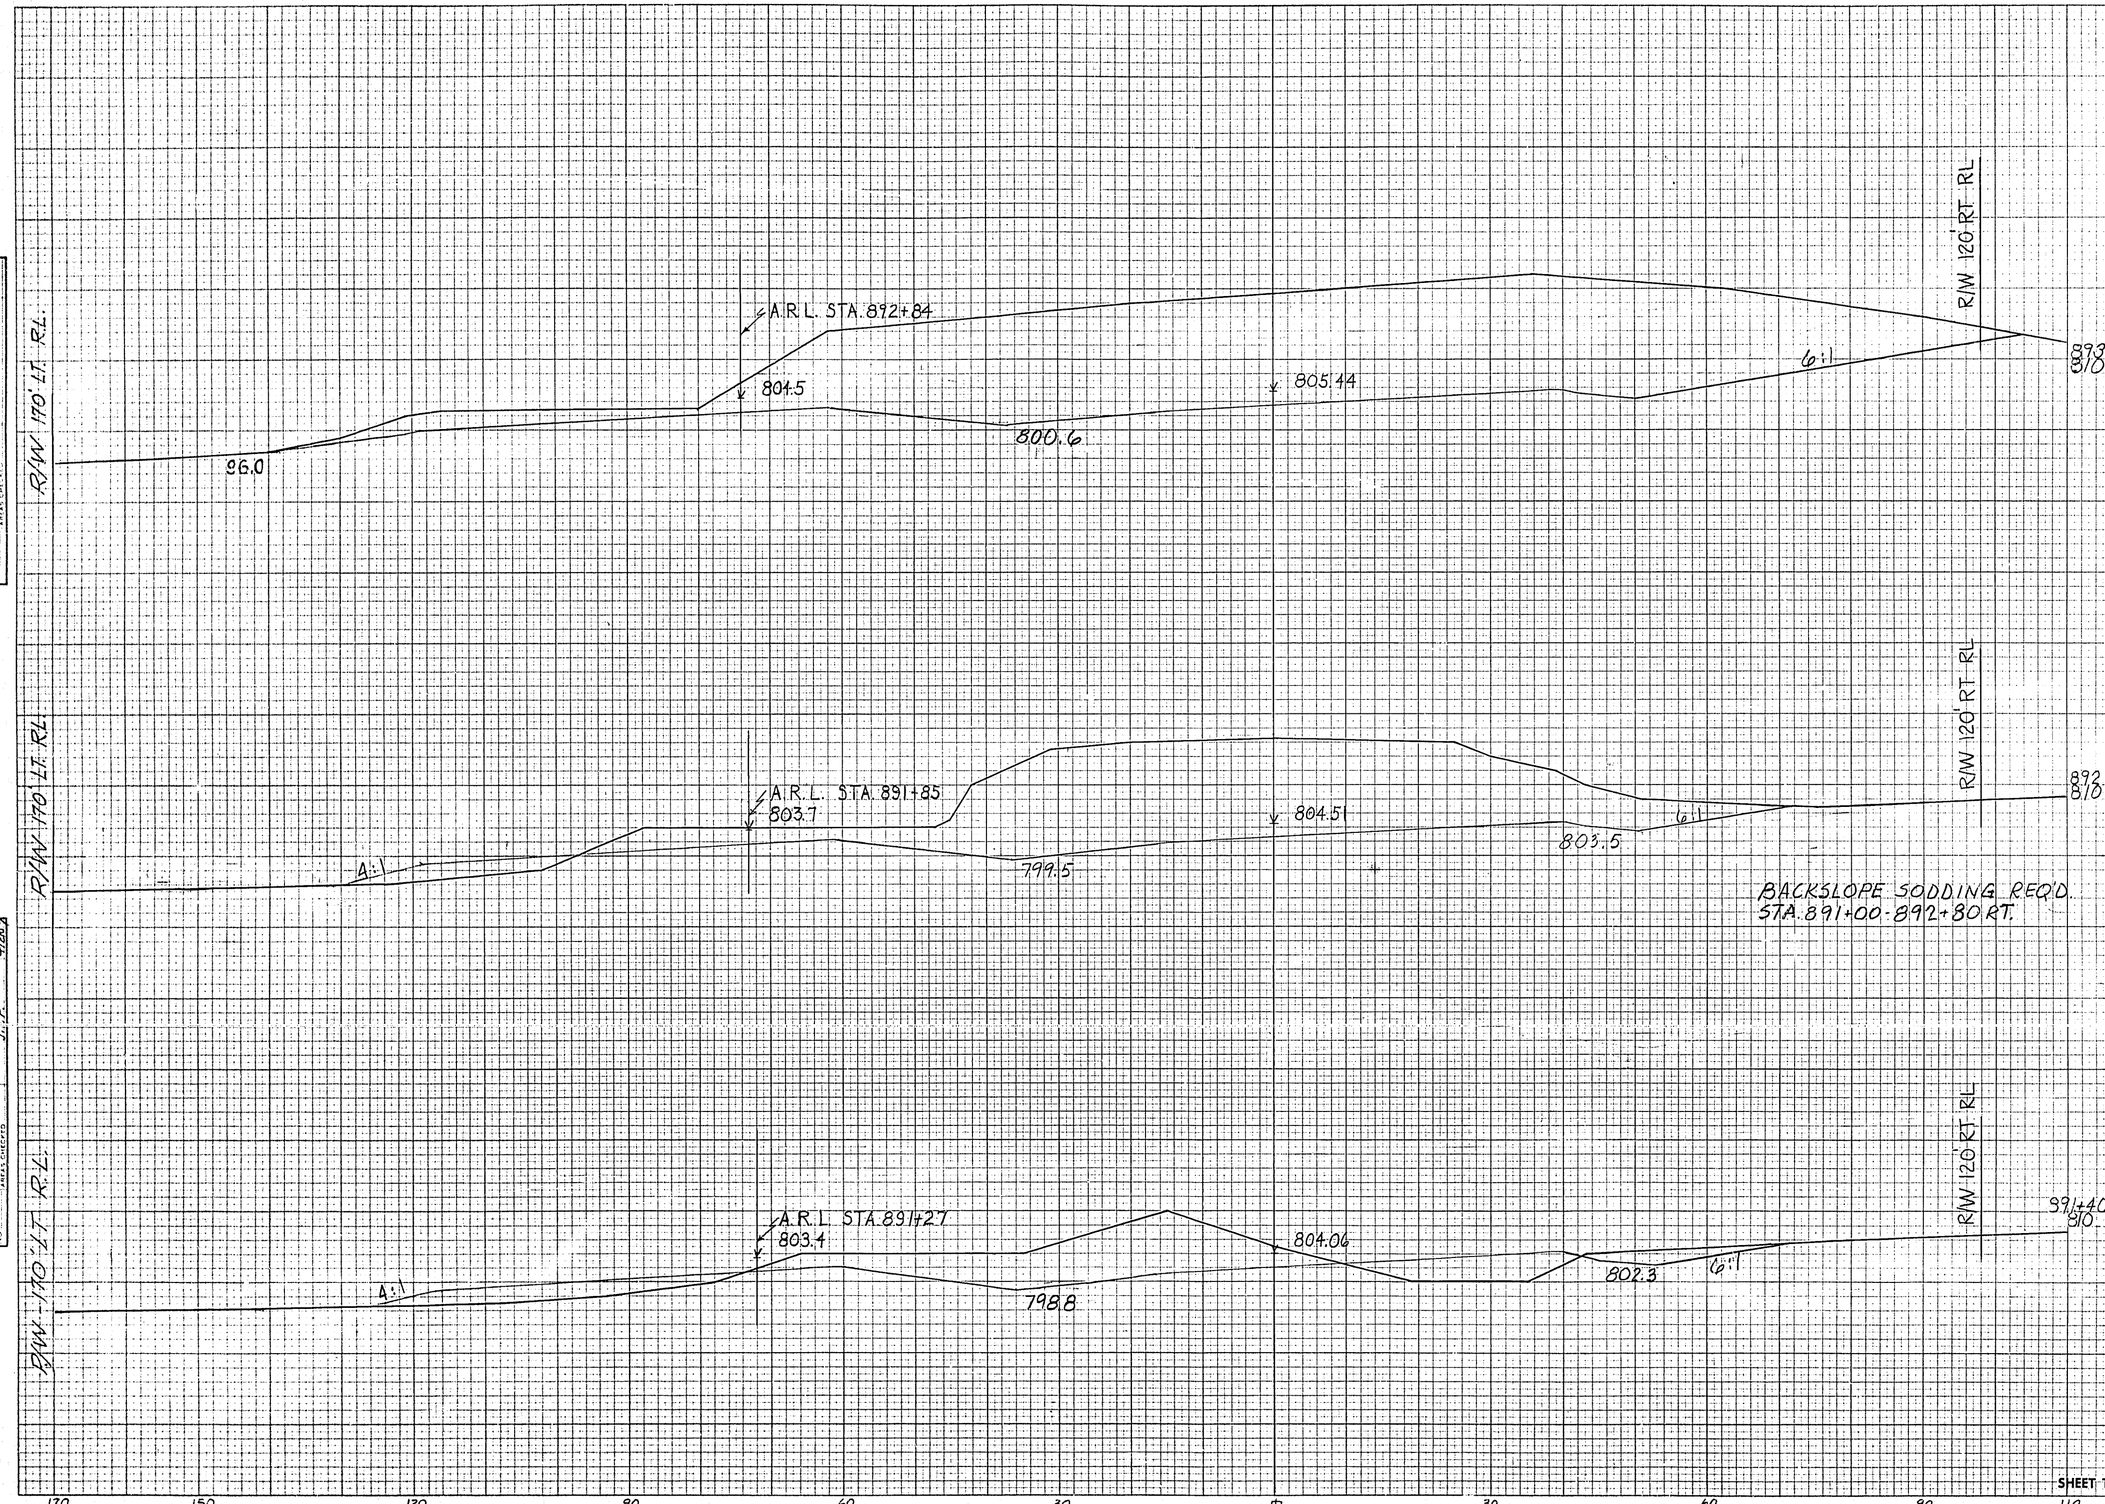

STATION	DISTANCE	YARDAGE EXCAVATION UNCL.	YARDAGE EXCAVATION	YARDAGE EXCAVATION	YARDAGE EXCAVATION	YARDAGE FILL
893						
	100	6837				111
892						
	60	1888				261
891 + 40						
	40	474				307
891						
SHEET TOTAL		9199				679

PLATE 3—CROSS SECTION O. P. R. & R. E. STANDARD
THE FREDERICK POST CO., CHICAGO

19

891+40-893

B.P.R. DISTRICT OFFICE	PROJECT	SHEET NUMBER	TOTAL SHEETS
WIS. 4	I-90-2(18)105	135	264

FINAL SURVEY — SURVEYED, PLOTTED, TEMPLATE, NOTE BOOK, NO., AREAS CHECKED, BY

ORIGINAL SURVEY — SURVEYED, PLOTTED, TEMPLATE, NOTE BOOK, NO., AREAS CHECKED, DATE 11-6-58, BY JLR

R/W 214' LT. RL.

MATCH LINE

230 200 170

810

R/W 194' LT. RL.

MATCH LINE

230 200 170

810

R/W 170' LT. RL.

MATCH LINE

170 150 120 90 60 30 ℄ 30 60 90 110

℄ A.R.L. STA. 895+76
807.1
803.9
808.88

℄ A.R.L. STA. 894+78
806.2
802.8
807.65

℄ A.R.L. STA. 893+82
805.3
801.7
806.48

2½:1

R/W 135' RT. RL.

R/W 135' RT. RL.

R/W 135' RT. RL.

R/W 135' RT. RL.

896
896
810
895
895
810
894
894
810
893

STATION	DISTANCE	YARDAGE EXCAVATION UNCL.				FILL
896						
100	6408					25
895						
100	8841					34
895						
810						
894						
100	8937					29
894						
810						
893						
SHEET TOTAL		24236				88

PLATE 3—CROSS SECTION O. P. R. & R. C. STANDARD
THE FREDERICK POST CO., CHICAGO

B.P.R. DISTRICT OFFICE	PROJECT	SHEET NUMBER	TOTAL SHEETS
WIS. 4	I-90-2(18)105	136	154

FINAL SURVEY — SURVEYED — PLOTTED — TRACED — NOTE BOOK — PAGE — NO. — AREAS CHECKED — BY — DATE

ORIGINAL SURVEY — SURVEYED — PLOTTED — TRACED — NOTE BOOK — PAGE — NO. — AREAS CHECKED — BY J.I.F. — DATE 6-30-58

R/W 240' LT. RL.
94.0
230
200
170
MATCH LINE
800
℄ A.R.L. STA. 897+70
809.0
806.1
811.34
2:1
R/W 135' RT. RL.
898
810

MATCH LINE
R/W 228' LT RL.
93.0
230
200
170
MATCH LINE
800
℄ A.R.L. STA. 896+72
808.0
805.0
810.11
2:1
R/W 135' RT. RL.
897
810

R/W 220' LT. RL.
94.0
230
200
170
MATCH LINE
800
℄ A.R.L. STA. 896+20
807.5
804.4
809.44
2:1
R/W 135' RT. RL.
SOD FLUME AT STA. 896+55
896+45
810
896
+45

MATCH LINE

170 150 120 90 60 30 ℄ 30 60 90 110

STATION	DISTANCE	YARDAGE EXCAVATION UNCL.	FILL
898			
898 810			
	100	11,259	4
897			
897 810			
	55	5367	2
896 + 45			
	45	2903	9
896			
SHEET TOTAL		19,529	15

PLATE 3—CROSS SECTION O. P. R. & R. E. STANDARD
THE FREDERICK POST CO., CHICAGO

896+45 – 898

B.P.R. DISTRICT OFFICE	PROJECT	SHEET NUMBER	TOTAL SHEETS
WIS. 4	I-90-2(18)105	137	364

FINAL SURVEY — SURVEYED — PLOTTED — TEMPLATE — AREAS — NOTE BOOK — NO. — AREAS CHECKED — BY — DATE

ORIGINAL SURVEY — SURVEYED — PLOTTED — TEMPLATE — AREAS — NOTE BOOK — NO. — AREAS CHECKED — BY — DATE — RJJ — 6-23-78 — J.T.B. — 9/18/78

R/W 110' RT. R.L.

A.R.L. STA. 900+31
811.50
814.72
4:1
4:1
5084
900+70
820

MATCH LINE

810

230 200 170

A.R.L. STA. 899+62
810.8
813.80
4:1
807.8

R/W 135' RT. R.L.

900
820

R/W 250' LT. R.L.

MATCH LINE

810

230 200 170

MATCH LINE

A.R.L. STA. 898+67
809.9
812.57
806.95

R/W 135' RT R.L.

899
820

150 100 50 ℄ 50 100

STATION	DISTANCE	YARDAGE EXCAVATION UNCL.				FILL
900 + 70						
	100	3,205				1060
900						
	100	10,203				25
899						
	100	11,752				0
898						
SHEET TOTAL		24,860				1,085

899 - 900 + 70

PLATE 3—CROSS SECTION O. P. R. & B. E. STANDARD
THE FREDERICK POST CO., CHICAGO

B.P.R. DISTRICT OFFICE	PROJECT	SHEET NUMBER	TOTAL SHEETS
WIS. 4	I-90-2(18)10.5	138	264

FINAL SURVEY — SURVEYED — PLOTTED — TRACED — NOTE BOOK — NO — AREAS CHECKED — BY — DATE

ORIGINAL SURVEY — SURVEYED 8/28 — PLOTTED 9/1 — TRACED RW — NOTE BOOK — NO — AREAS CHECKED 9/6/63

A.R.L. STA. 901+57
812.7

816.26

4:1

809.5

902
810

A.R.L. STA. 901+05
812.2

815.59

4:1

4:1

809.0

901
+
45

RWY - 100' RT. R.L.

901 + 45
800

A.R.L. STA. 900+59
811.8

815.03

4:1

4:1

808.65

901
800

STA. 901+00
1-48"×206' C.P. REQ'D

900
+
70

150 100 50 ℄ 50 100

STATION	DISTANCE	YARDAGE EXCAVATION UNCL	YARDAGE EXCAVATION	YARDAGE FILL
902				
	55	933		1329
901 + 45				
	45	0		2297
901				
	30	0		1254
900 + 70				
SHEET TOTAL		933		4880

901 - 902

PLATE 3—CROSS SECTION O. P. R. & R. E. STANDARD
THE FREDERICK POST CO., CHICAGO

B.P.R. DISTRICT OFFICE	PROJECT	SHEET NUMBER	TOTAL SHEETS
WIS. 4	I-90-2(18)105	139	364

FINAL SURVEY — SURVEYED — PLOTTED — TRACED — NOTE BOOK — AREAS — AREAS CHECKED — NO. — DATE — BY

ORIGINAL SURVEY — SURVEYED 6-24-58 — PLOTTED RJJ — TRACED — NOTE BOOK — AREAS — AREAS CHECKED J.L.P. — NO. — DATE 8/18/59 — BY

A.R.L. STA. 904+58
815.7
819.95
5:1
4:1
905
810

A.R.L. STA. 903+56
814.7
818.72
811.2
4:1
4:1

STA. 903A+35 WBL.
1-54"x118' C.P. REQ'D.
SKEW 26° R.H.F.

STA. 904+20 EBL.
1-48"x104' C.P. REQ'D.
SKEW 26° R.H.F.

A.R.L. 902+57
813.7
817.49
810.35
2½:1
4:1
903
810

RWY - 100' RT. R.L.

STATION	DISTANCE	YARDAGE EXCAVATION UNCL.	YARDAGE FILL
905			
905 / 810			
	100	162	3461
904			
904 / 800			
	100	843	3698
903			
	100	2545	753
903 / 810			
902			
SHEET TOTAL		3,556	7,912

150 100 50 ℄ 50 100


903 - 905

PLATE 3-CROSS SECTION O. P. R. & R. E. STANDARD
THE FREDERICK POST CO., CHICAGO

B.P.R. DISTRICT OFFICE	PROJECT	SHEET NUMBER	TOTAL SHEETS
WIS. 4	I-90-2(13)105	140	264

FINAL SURVEY — SURVEYED, PLOTTED, NOTE BOOK, NO., AREAS CHECKED

ORIGINAL SURVEY — SURVEYED, PLOTTED, NOTE BOOK, NO., AREAS CHECKED — DATE 2-7-62 — BY J.J. — J.S.P. — 11-7-62

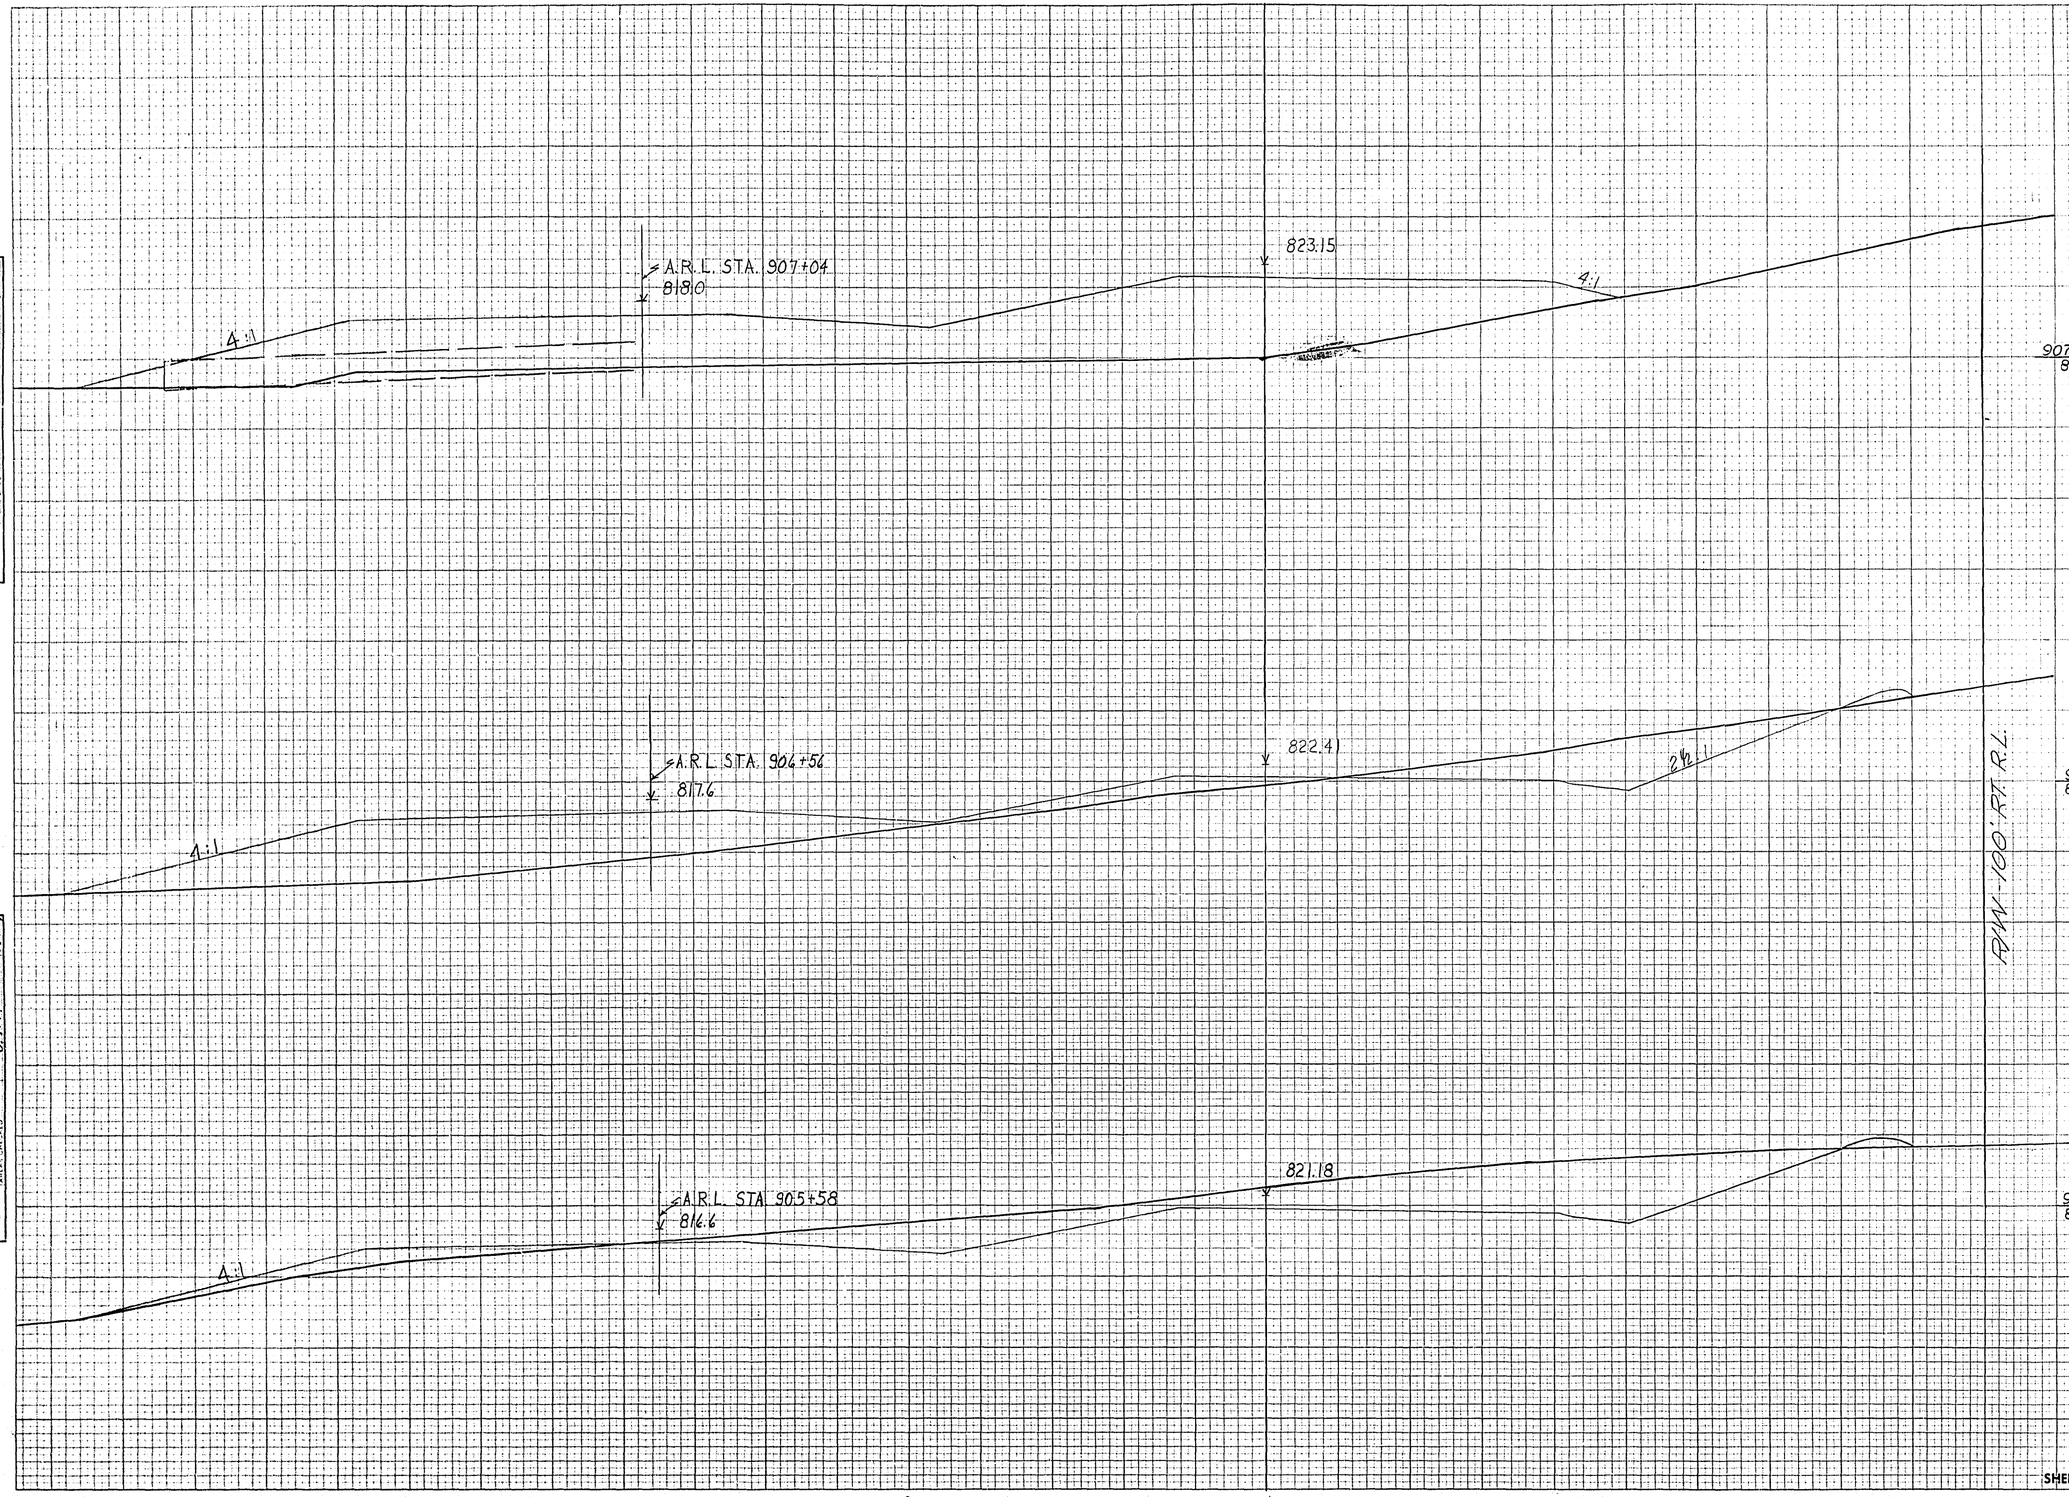

STATION	DISTANCE	YARDAGE EXCAVATION UNCL.	YARDAGE FILL
907 + 60			
	60	257	2492
907			
	100	1682	1586
906			
	100	1416	701
905			
SHEET TOTAL		3355	4779


906 - 907 + 60

PLATE 3—CROSS SECTION O. P. R. & R. E. STANDARD
THE FREDERICK POST CO., CHICAGO

B.P.R. DISTRICT OFFICE	PROJECT	SHEET NUMBER	TOTAL SHEETS
WIS. 4	I-90-2(12)105	14-1	234

FINAL SURVEY — SURVEYED / PLOTTED / NOTE BOOK TEMPLATE / AREAS COMPUTED / NO.

ORIGINAL SURVEY — SURVEYED / PLOTTED / NOTE BOOK / AREAS COMPUTED / NO. — BY JJR — DATE 4/1/65

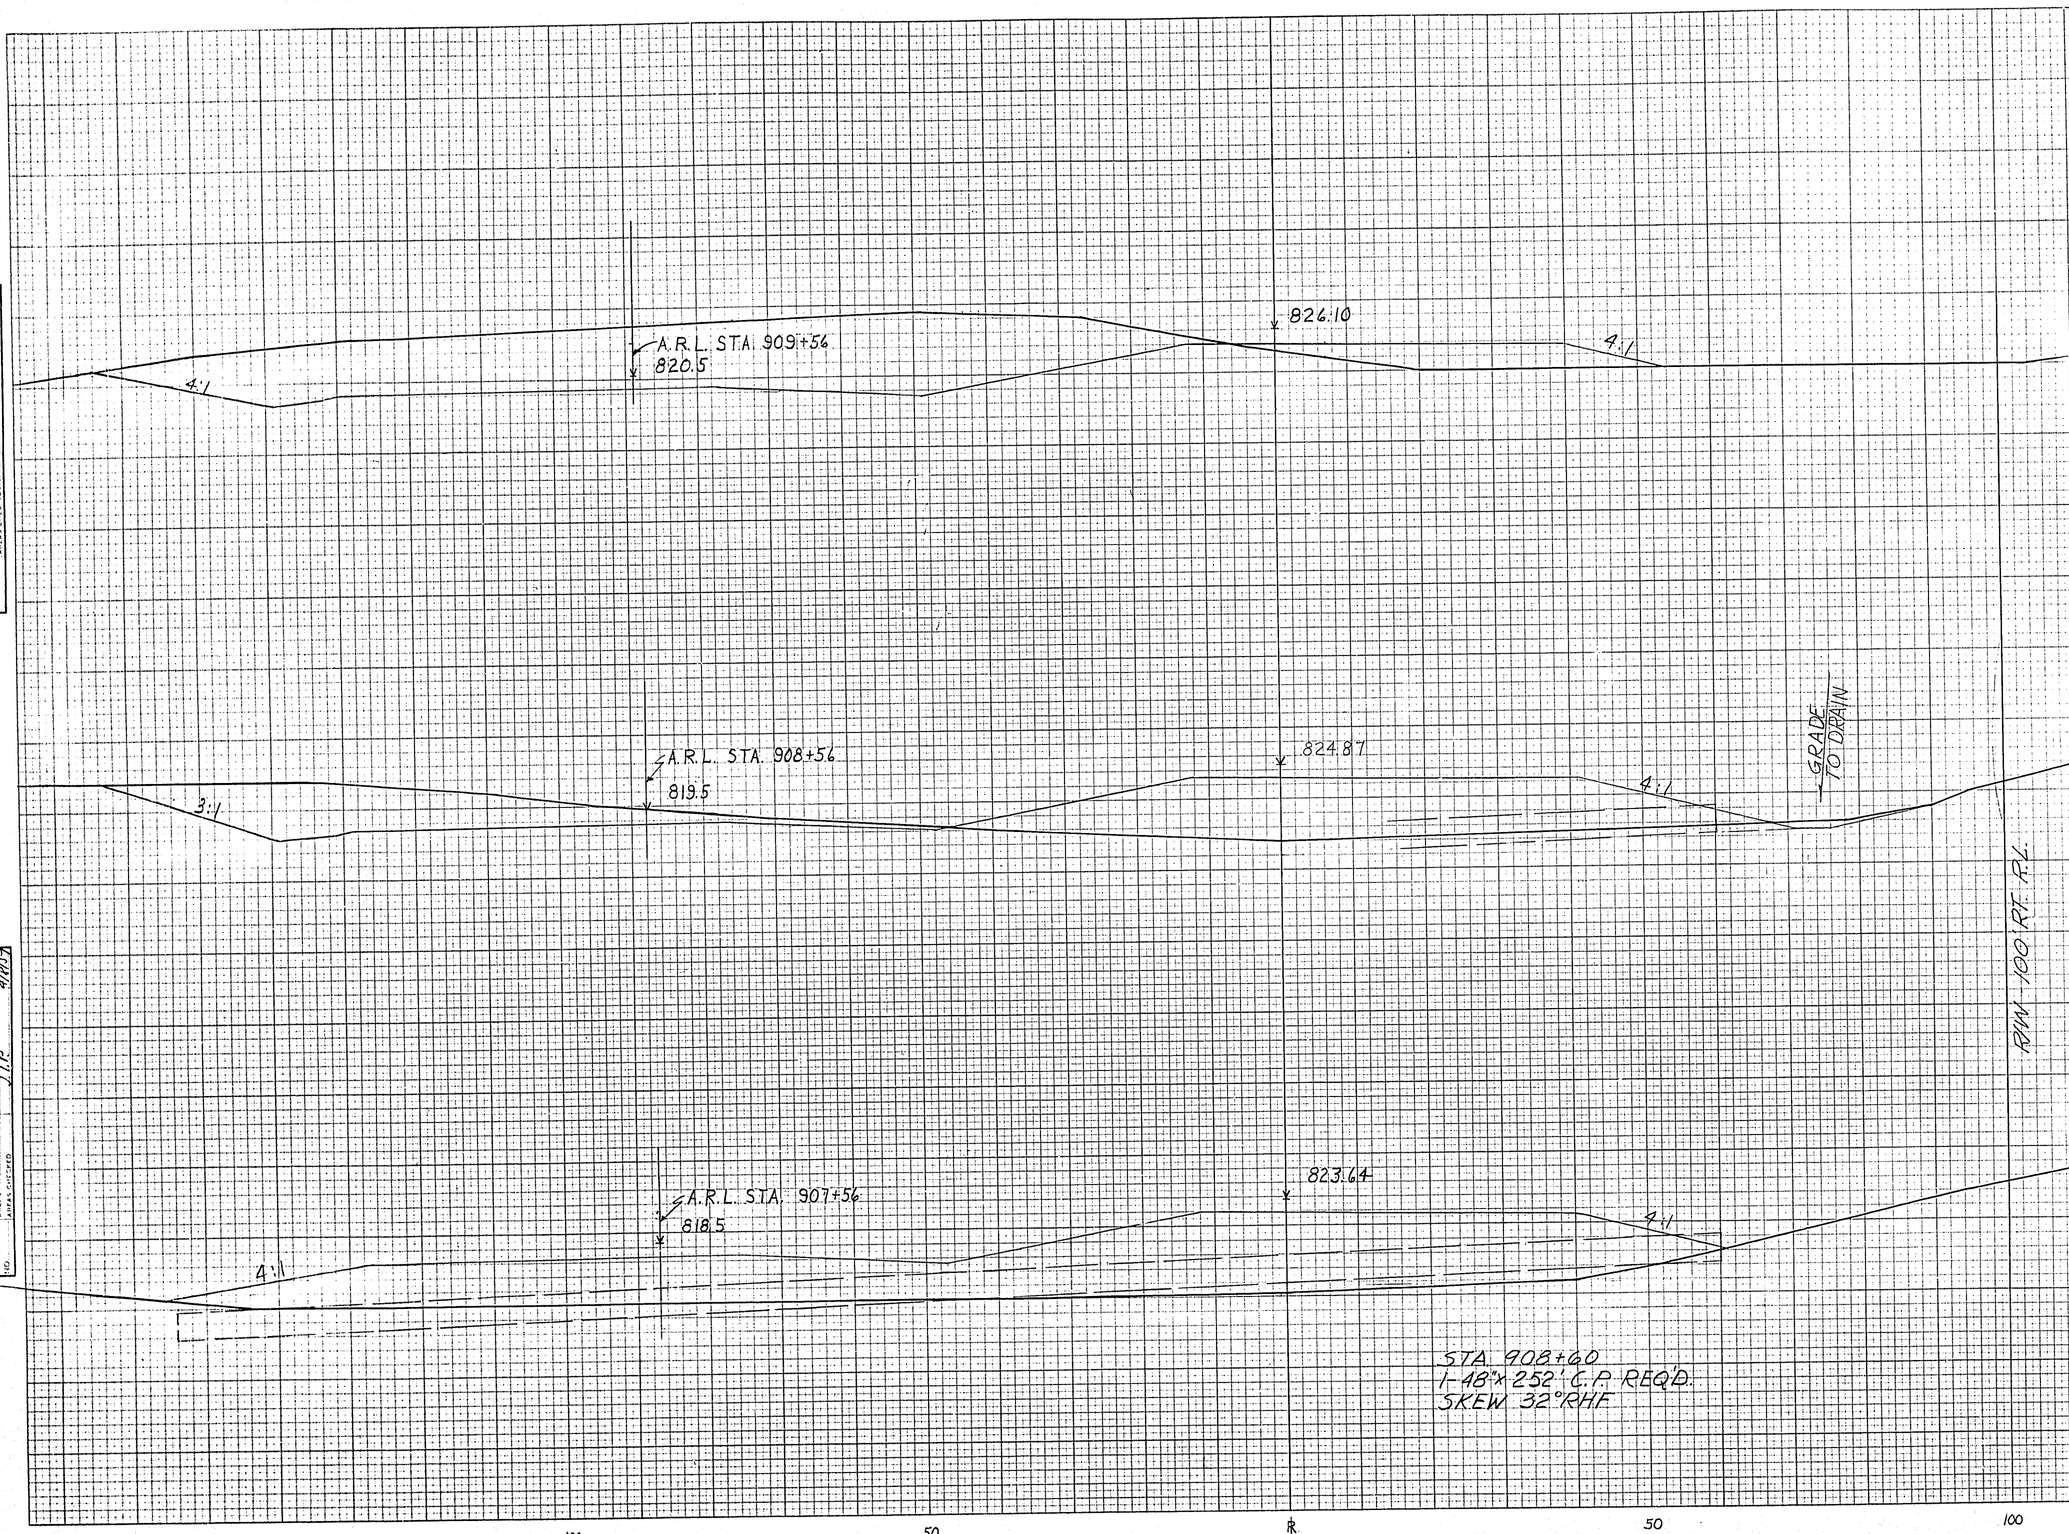

STATION	DISTANCE	YARDAGE EXCAVATION UNCL.	YARDAGE FILL
910			
820	100	2943	1552
909			
909			
820	100	742	4107
908			
908			
820	40	0	2240
907			
± 60			
SHEET TOTAL		3685	7899


908 - 910

PLATE 3—CROSS SECTION O. P. R. & R. E. STANDARD
THE FREDERICK POST CO., CHICAGO

D.P.R. DISTRICT OFFICE	PROJECT	SHEET NUMBER	TOTAL SHEETS
WIS. 4	I-90-2(18)105	142	264

FINAL SURVEY — SURVEYED / PLOTTED / TEMPLATE / AREAS / NOTE BOOK / NO. / AREAS CHECKED

ORIGINAL SURVEY — SURVEYED 6-24-58 / PLOTTED 9-25-58 / TEMPLATE 10-2-58 / AREAS 10-3-58 / NOTE BOOK / NO. / AREAS CHECKED

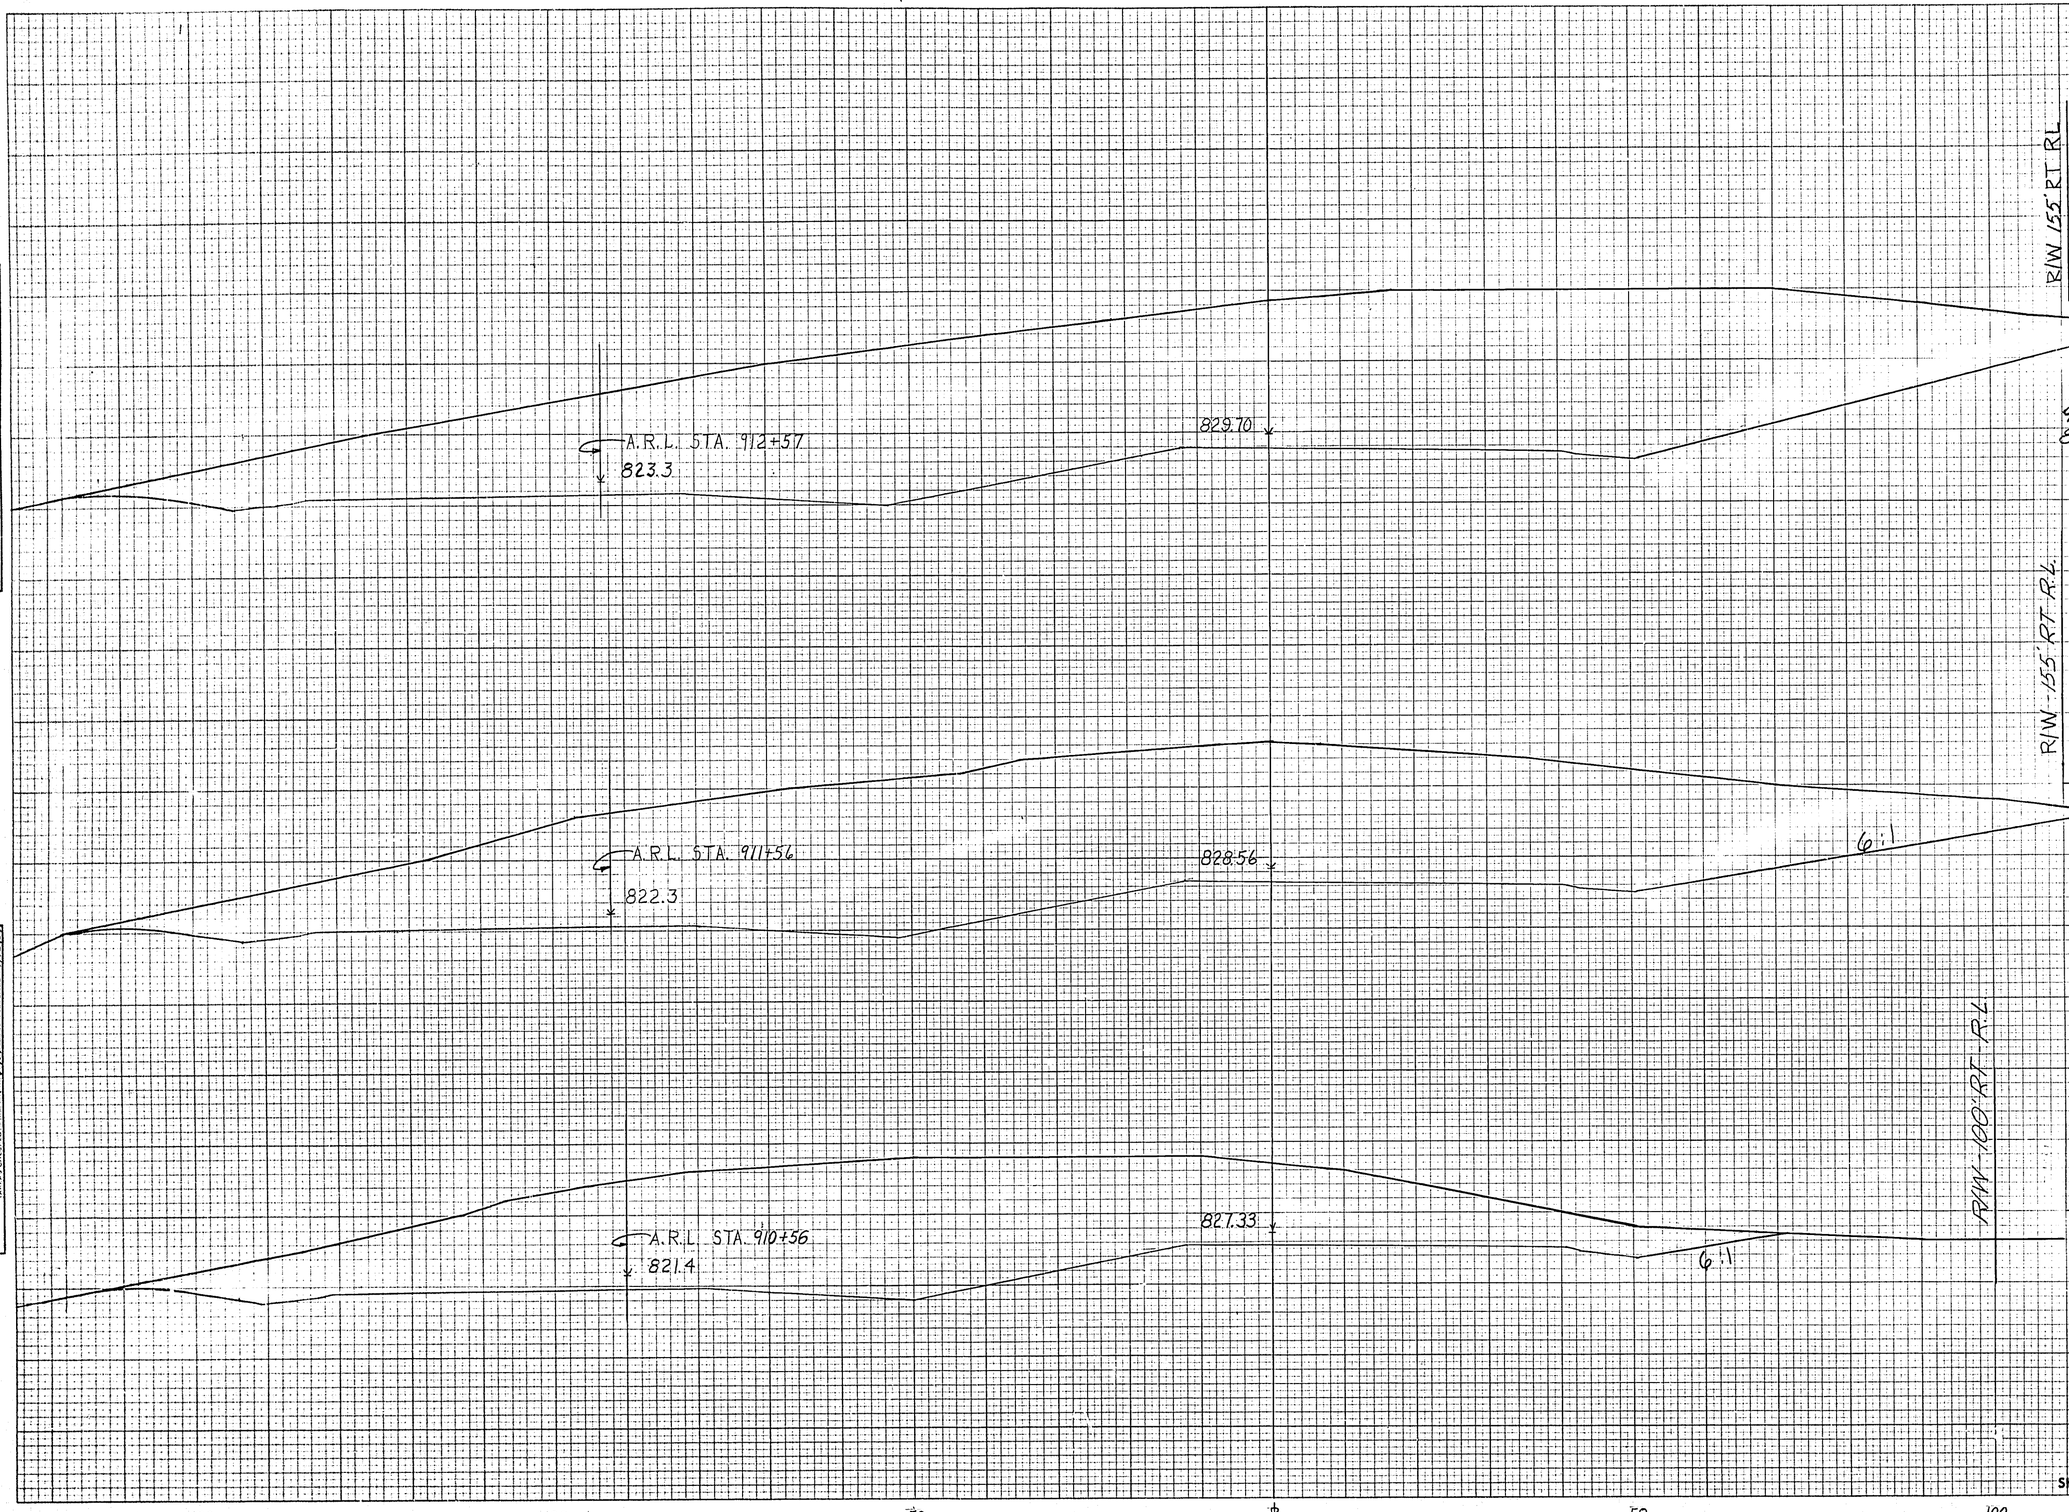

STATION	DISTANCE	YARDAGE EXCAVATION UNCL.	YARDAGE FILL
913			
913 / 830	100	15,526	0
912			
912 / 840	100	11,881	0
911			
911 / 830	100	6334	289
910			
SHEET TOTAL		34,241	289

911 – 913

PLATE 3-CROSS SECTION O. P. R. & R. E. STANDARD
THE FREDERICK POST CO., CHICAGO

B.P.R. DISTRICT OFFICE	PROJECT	SHEET NUMBER	TOTAL SHEETS
WIS. 4	I-90-2(18)105	143	264

FINAL SURVEY — SURVEYED — PLOTTED — NOTE BOOK — TEMPLATE — AREAS COMPUTED — BY — DATE

ORIGINAL SURVEY — SURVEYED 6-25-58 — PLOTTED 7-1-58 — NOTE BOOK — TEMPLATE — AREAS COMPUTED — BY RWJ — DATE 7-2-58

A.R.L. STA. 915+58
825.8
832.08
828.4
6:1
R/W 155' RT RL
MATCH LINE
950
110
130
916
840
916
R/W 155' RT RL
MATCH LINE
850
110
130
915
A.R.L. STA. 914+57
825.1
831.46
2½:1
R/W 155' RT RL
MATCH LINE
850
110
130
914
A.R.L. STA. 913+57
824.3
830.67
R/W 155' RT RL
MATCH LINE
916
840
914
840
913

STATION	DISTANCE	YARDAGE EXCAVATION UNCL.	YARDAGE FILL
100	11717		30
102	14382		30
100	12371		16
SHEET TOTAL		41,990	76

750 700 50 ℄ 30 700

914 - 916

28

PLATE 3—CROSS SECTION O. P. R. & R. E. STANDARD
THE FREDERICK POST CO., CHICAGO

B.P.R. DISTRICT OFFICE	PROJECT	SHEET NUMBER	TOTAL SHEETS
WIS. 4	I-90-2(18)105	144	214

FINAL SURVEY
SUBMITTED
PLOTTED
TEMPLATE
NOTE BOOK
AREAS CHECKED
NO.
DATE
BY

ORIGINAL SURVEY
SUBMITTED 5-28-58
PLOTTED 6-2-58
TEMPLATE
NOTE BOOK
AREAS CHECKED 6-18-58
NO.
DATE
BY RFJ JJP

A.R.L. STA. 918+56
826.8
G:1
823.0
822.0
832.88
828.2
R/W 155' RT. R.L.
919
840
919

A.R.L. STA. 917+95
820
R/W 155' RT. R.L.
918

A.R.L. STA. 917+58
826.6
10:1
822.5
832.79
826.0
SOD FLUME
AT STA. 917+90
918
830
STA 918+00
1-30"x222' C.P. REQ'D.
SKEW 12° L.H.F.
850
MATCH LINE
120
140
R/W 155' RT. R.L.
MATCH LINE
917

A.R.L. STA. 916+58
826.3
2:1
823.0
832.52
827.1
917
840
916

STATION	DISTANCE	YARDAGE EXCAVATION UNCL.				FILL
919						
	100	5318				97
918						
	100	8181				1.01
917						
	100	11317				2.4
916						
SHEET TOTAL		25316				222

150 100 50 ℄ 50 100

917 - 919

PLATE 3—CROSS SECTION O. P. R. & R. E. STANDARD
THE FREDERICK POST CO., CHICAGO

29

B.P.R. DISTRICT OFFICE	PROJECT	SHEET NUMBER	TOTAL SHEETS
WIS. 4	I-90-2(18)195	145	264

FINAL SURVEY — SURVEYED — PLOTTED — TEMPLATE — NOTE BOOK — AREAS CHECKED — NO.

ORIGINAL SURVEY — SURVEYED — PLOTTED — TEMPLATE — NOTE BOOK — AREAS CHECKED — NO.

BY	DATE
RCW	6-25-58
J.T.P.	7-11-58

R/W 120' LT. ARL

6:1

A.R.L. STA. 921+57
826.5

4:1

4:1

832.11

4:1

R/W 125' RT. RL

922
820

MATCH LINE

810

200

170

MATCH LINE

A.R.L. STA. 920+56
826.8

832.54

821.0

2½:1

4:1

R/W 125' RT. RL

921
820

STA. 920A+78 W.B.L.
1-48"x120° C.P. REQ'D.
SKEW 10° R.H.F.

STA. 921+40 E.B.L.
1-42"x136° C.P. REQ'D.
SKEW 10° R.H.F.

A.R.L. STA. 919+56
826.9

832.80

829.0

6:1

6:1

822.9

821.5

R/W 155' RT. R.L.

920
830

STATION	DISTANCE	YARDAGE EXCAVATION UNCL.	YARDAGE EXCAVATION	YARDAGE EXCAVATION	YARDAGE EXCAVATION	YARDAGE FILL
922						
	100	1.26				5828
921						
	100	1951				4880
920						
	100	5955				11
919						
SHEET TOTAL		8032				10719

150 100 50 ℄ 50 100

920 – 922

PLATE 3—CROSS SECTION O. P. R. & R. E. STANDARD
THE FREDERICK POST CO., CHICAGO

B.P.R. DISTRICT OFFICE	PROJECT	SHEET NUMBER	TOTAL SHEETS
WIS. 4	I-90-2(19)105	146	264

FINAL SURVEY — DATE — BY — SURVEYED — PLOTTED — TEMPLATE — NOTE BOOK — PAGE — NO. — AREAS CHECKED

ORIGINAL SURVEY — DATE 1-25-58 — BY BJJ — SURVEYED — PLOTTED — TEMPLATE — NOTE BOOK — PAGE — NO. — AREAS CHECKED VLP 2/11/58

R/W 90 LT ARL

A.R.L. STA. 924+56
825.1

A:1

A:1

830.55

2½:1

R/W 125 RT RL

R/W 90 LT ARL

A.R.L. STA. 923+58
825.6

4:1

4:1

4:1

831.07

2½:1

R/W 125 RT RL

R/W 90 LT ARL

MATCH LINE

820

170

170

A.R.L. STA. 922+58
826.1

4:1

831.59

6:1

R/W 125 RT RL

MATCH LINE

150 100 50 ℄ 50 100

STATION	DISTANCE	YARDAGE EXCAVATION UNCL.	YARDAGE FILL
925			
925 / 830			
	100	4170	192
924			
924 / 830			
	100	2045	545
923			
923 / 830			
	100	311	1478
922			
SHEET TOTAL		6,526	2,215

923 – 925

PLATE 3–CROSS SECTION O. P. R. & R. E. STANDARD
THE FREDERICK POST CO., CHICAGO

B.P.R. DISTRICT OFFICE	PROJECT	SHEET NUMBER	TOTAL SHEETS
WIS. 4	I-90-2(18)105	147	264

FINAL SURVEY — BY — DATE
SURVEYED
PLOTTED
NOTE BOOK, PAGES
NO. AREAS CHECKED

ORIGINAL SURVEY — BY — DATE
SURVEYED — RJJ — 12-28-28
PLOTTED — 5/28/29 — 5-12-29
NOTE BOOK, PAGES — 5 — 71
NO. AREAS CHECKED — JJP — 5-14-29

R/W 90' LT ARL

A.R.L. STA. 927+59
823.4

828.99

820.2

4:1

4:1

R/W 125' RT

R/W 90 LT ARL

MATCH LINE

820

200

170

A.R.L. STA. 926+57
824.0

829.51

820.7

4:1

4:1

3:1

MATCH LINE

R/W 125' RT. R.L.

STA 927+36
1-48"×232' C.P. REQ'D
SKEW 8° R.H.F.

R/W 90' LT ARL

A.R.L. STA. 925+57
821.5

830.03

826.8

821.3

4:1

4:1

R/W 125' RT. R.L.

STATION	DISTANCE	YARDAGE EXCAVATION UNCL.					FILL
928							
928 / 820							
	100	72					3523
927							
927 / 820							
	100	2096					3699
926							
926 / 930							
	100	4107					179
925							
SHEET TOTAL		6575					6401

150 100 50 ℄ 50 100

926 - 928

PLATE 3-CROSS SECTION O. P. R. & R. E. STANDARD
THE FREDERICK POST CO., CHICAGO

B.P.R. DISTRICT OFFICE	PROJECT	SHEET NUMBER	TOTAL SHEETS
WIS. 4	I-90-2(18)105	148	264

FINAL SURVEY — SURVEYED — PLOTTED — TEMPLATE — NOTE BOOK — AREAS — NO. — AREAS CHECKED

ORIGINAL SURVEY — BY — DATE — SURVEYED 6-25-68 — PLOTTED PJJ 7-22-68 — TEMPLATE — NOTE BOOK — AREAS — NO. — AREAS CHECKED JJP 9-19-68

MATCH LINE

R/W 90' LT. ARL

4:1

MATCH LINE 830

200 170 ℄A.R.L. STA. 930+57

821.8

2½:1

4:1

827.43

823.7

R/W 125' RT. R.L.

931 / 830

R/W-90' LT. ARL

4:1

MATCH LINE 830

200 170 ℄A.R.L. STA. 929+57

822.3

2½:1

4:1

827.95

R/W 125' RT. R.L.

930 / 830

R/W 90' LT. ARL

4:1

MATCH LINE 830

200 170 ℄A.R.L. STA. 928+56

822.9

2½:1

4:1

828.47

R/W 125' RT. R.L.

929 / 820

150 100 50 ℄ 50 100

STATION	DISTANCE	YARDAGE EXCAVATION UNCL.	YARDAGE FILL
931			
	100	7097	30
930			
	100	6550	30
929			
	100	3237	342
928			
SHEET TOTAL		16884	402

929 – 931


PLATE 3–CROSS SECTION O. P. R. & R. E. STANDARD
THE FREDERICK POST CO., CHICAGO

53

B.P.R. DISTRICT OFFICE	PROJECT	SHEET NUMBER	TOTAL SHEETS
WIS. 4	I-90-2(18)105	149	264

FINAL SURVEY — BY — DATE — SURVEYED — PLOTTED — TEMPLATE — AREAS CHECKED — NOTE BOOK — NO.

ORIGINAL SURVEY — BY RW — DATE 6-20-58 — SURVEYED — PLOTTED — TEMPLATE 11-12 — AREAS CHECKED 11-13 — NOTE BOOK — NO. 7105

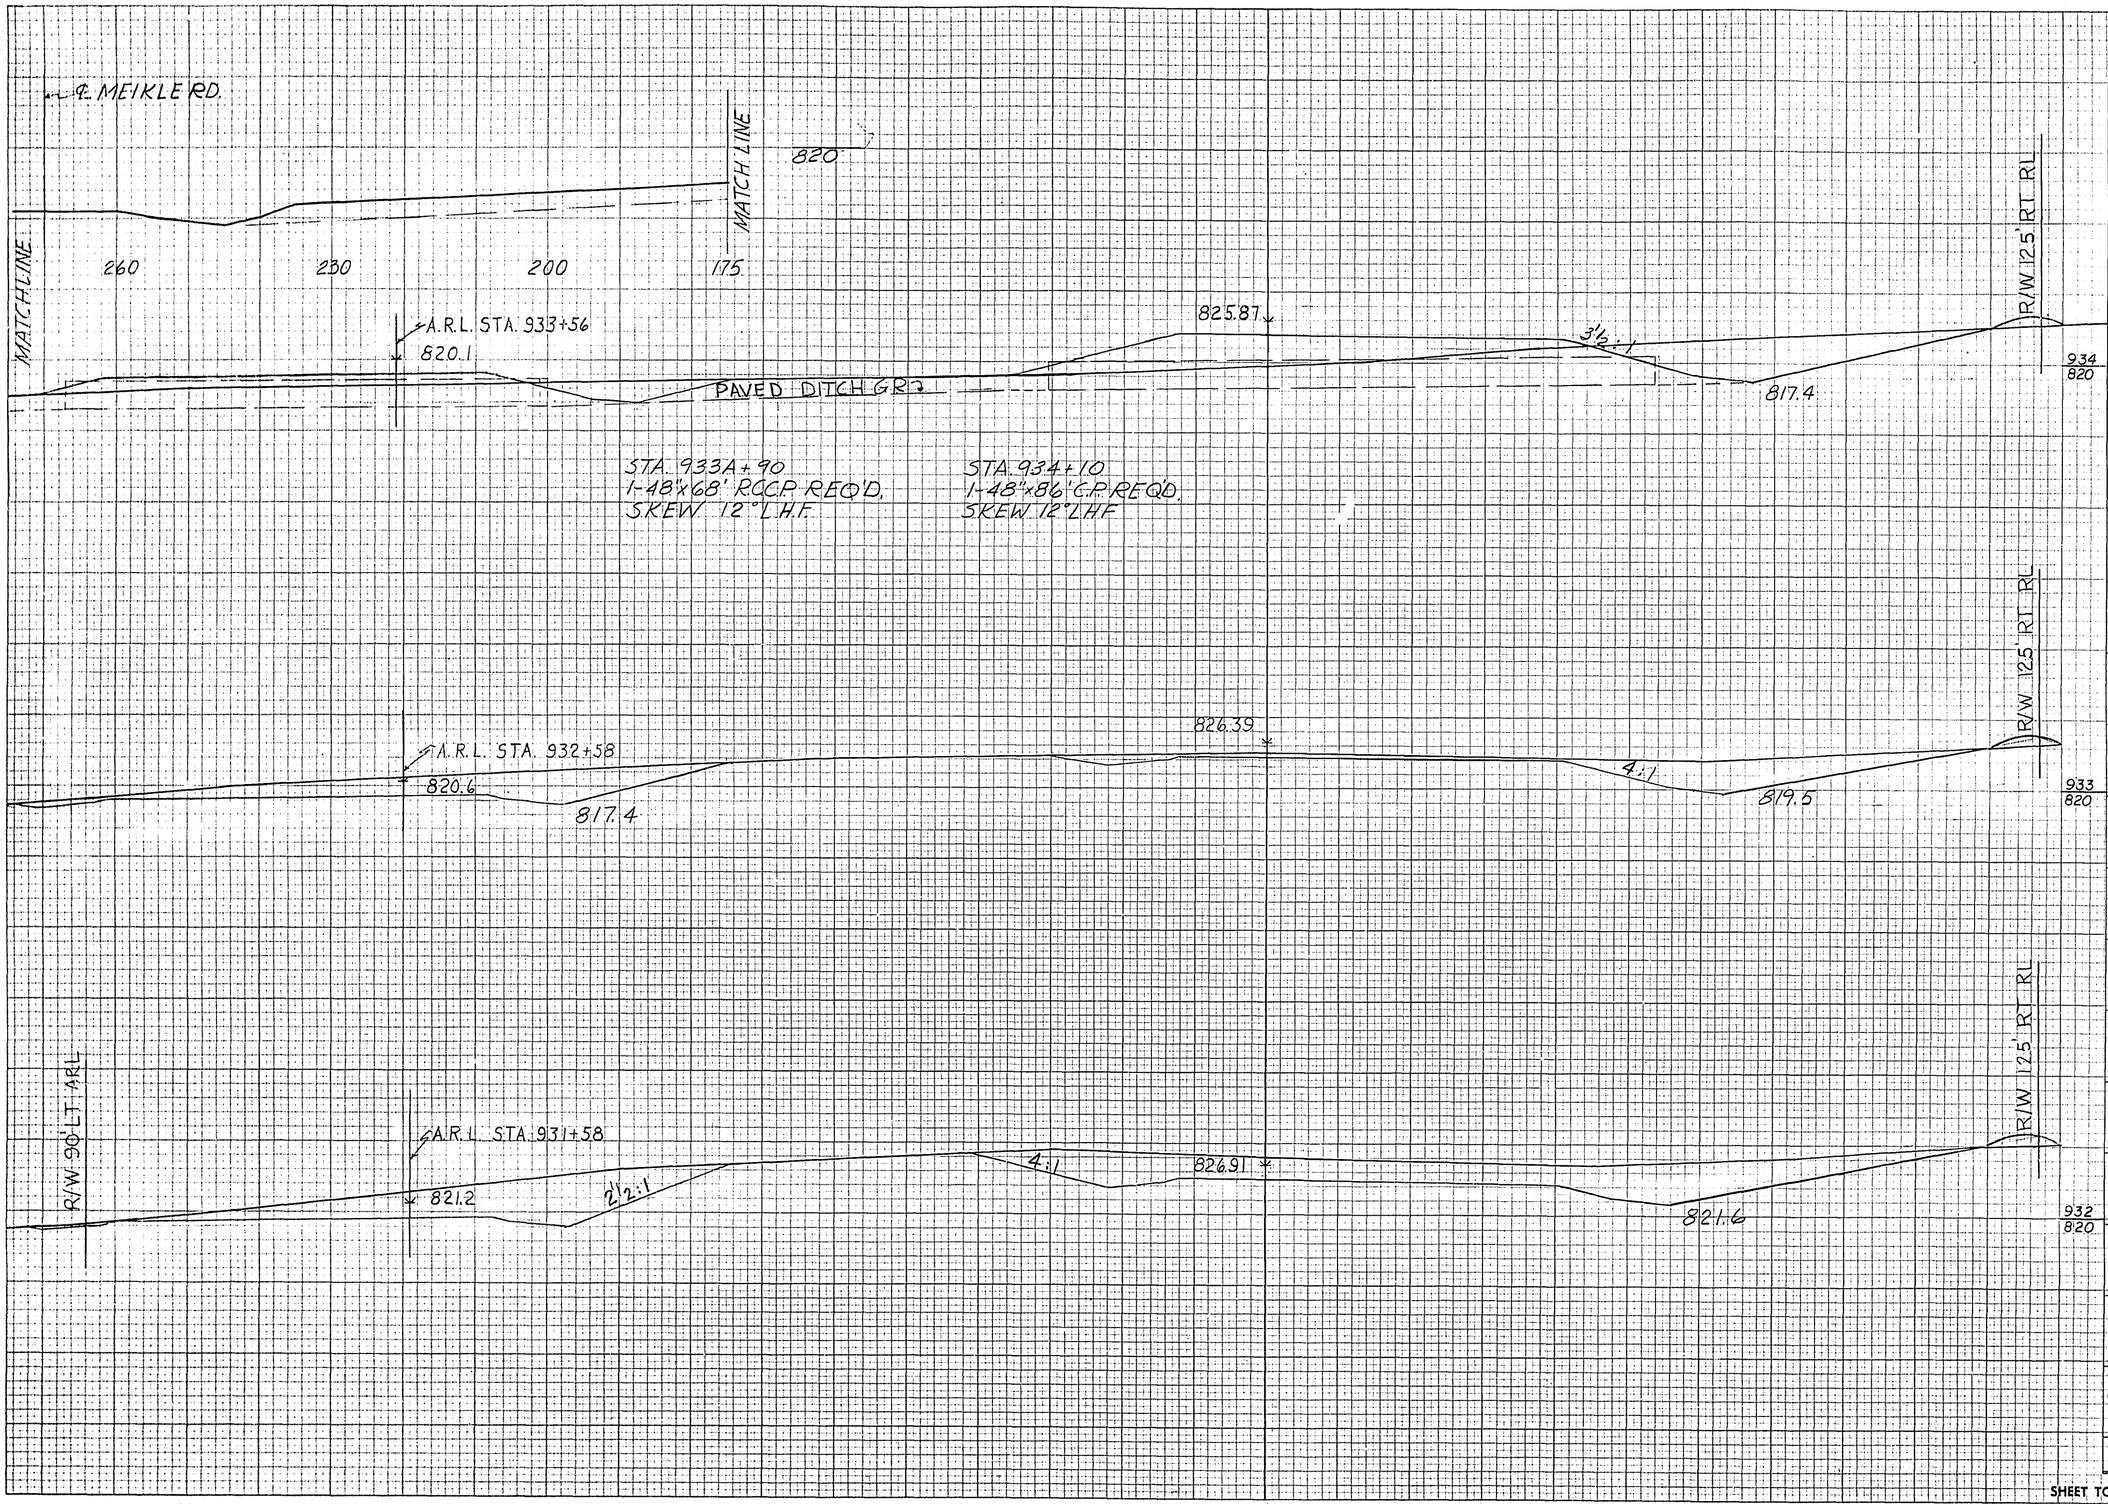

STATION	DISTANCE	YARDAGE EXCAVATION UNCL.	YARDAGE EXCAVATION	YARDAGE FILL
934				
	100	1,133		670
933				
	100	2027		34
932				
	100	4932		35
931				
SHEET TOTAL		8,203		740


932 - 934

PLATE 3-CROSS SECTION O. P. R. & R. E. STANDARD
THE FREDERICK POST CO., CHICAGO

B.P.R. DISTRICT OFFICE	PROJECT	SHEET NUMBER	TOTAL SHEETS
WIS. 4	I-90-2(18)105	150	264

FINAL SURVEY — SURVEYED / PLOTTED / NOTE BOOK / NO. / TEMPLATE / AREAS / AREAS CHECKED

ORIGINAL SURVEY — SURVEYED BY / PLOTTED BY / NOTE BOOK / NO. / TEMPLATE / AREAS / AREAS CHECKED — DATE 6-20-58, 12-2-58

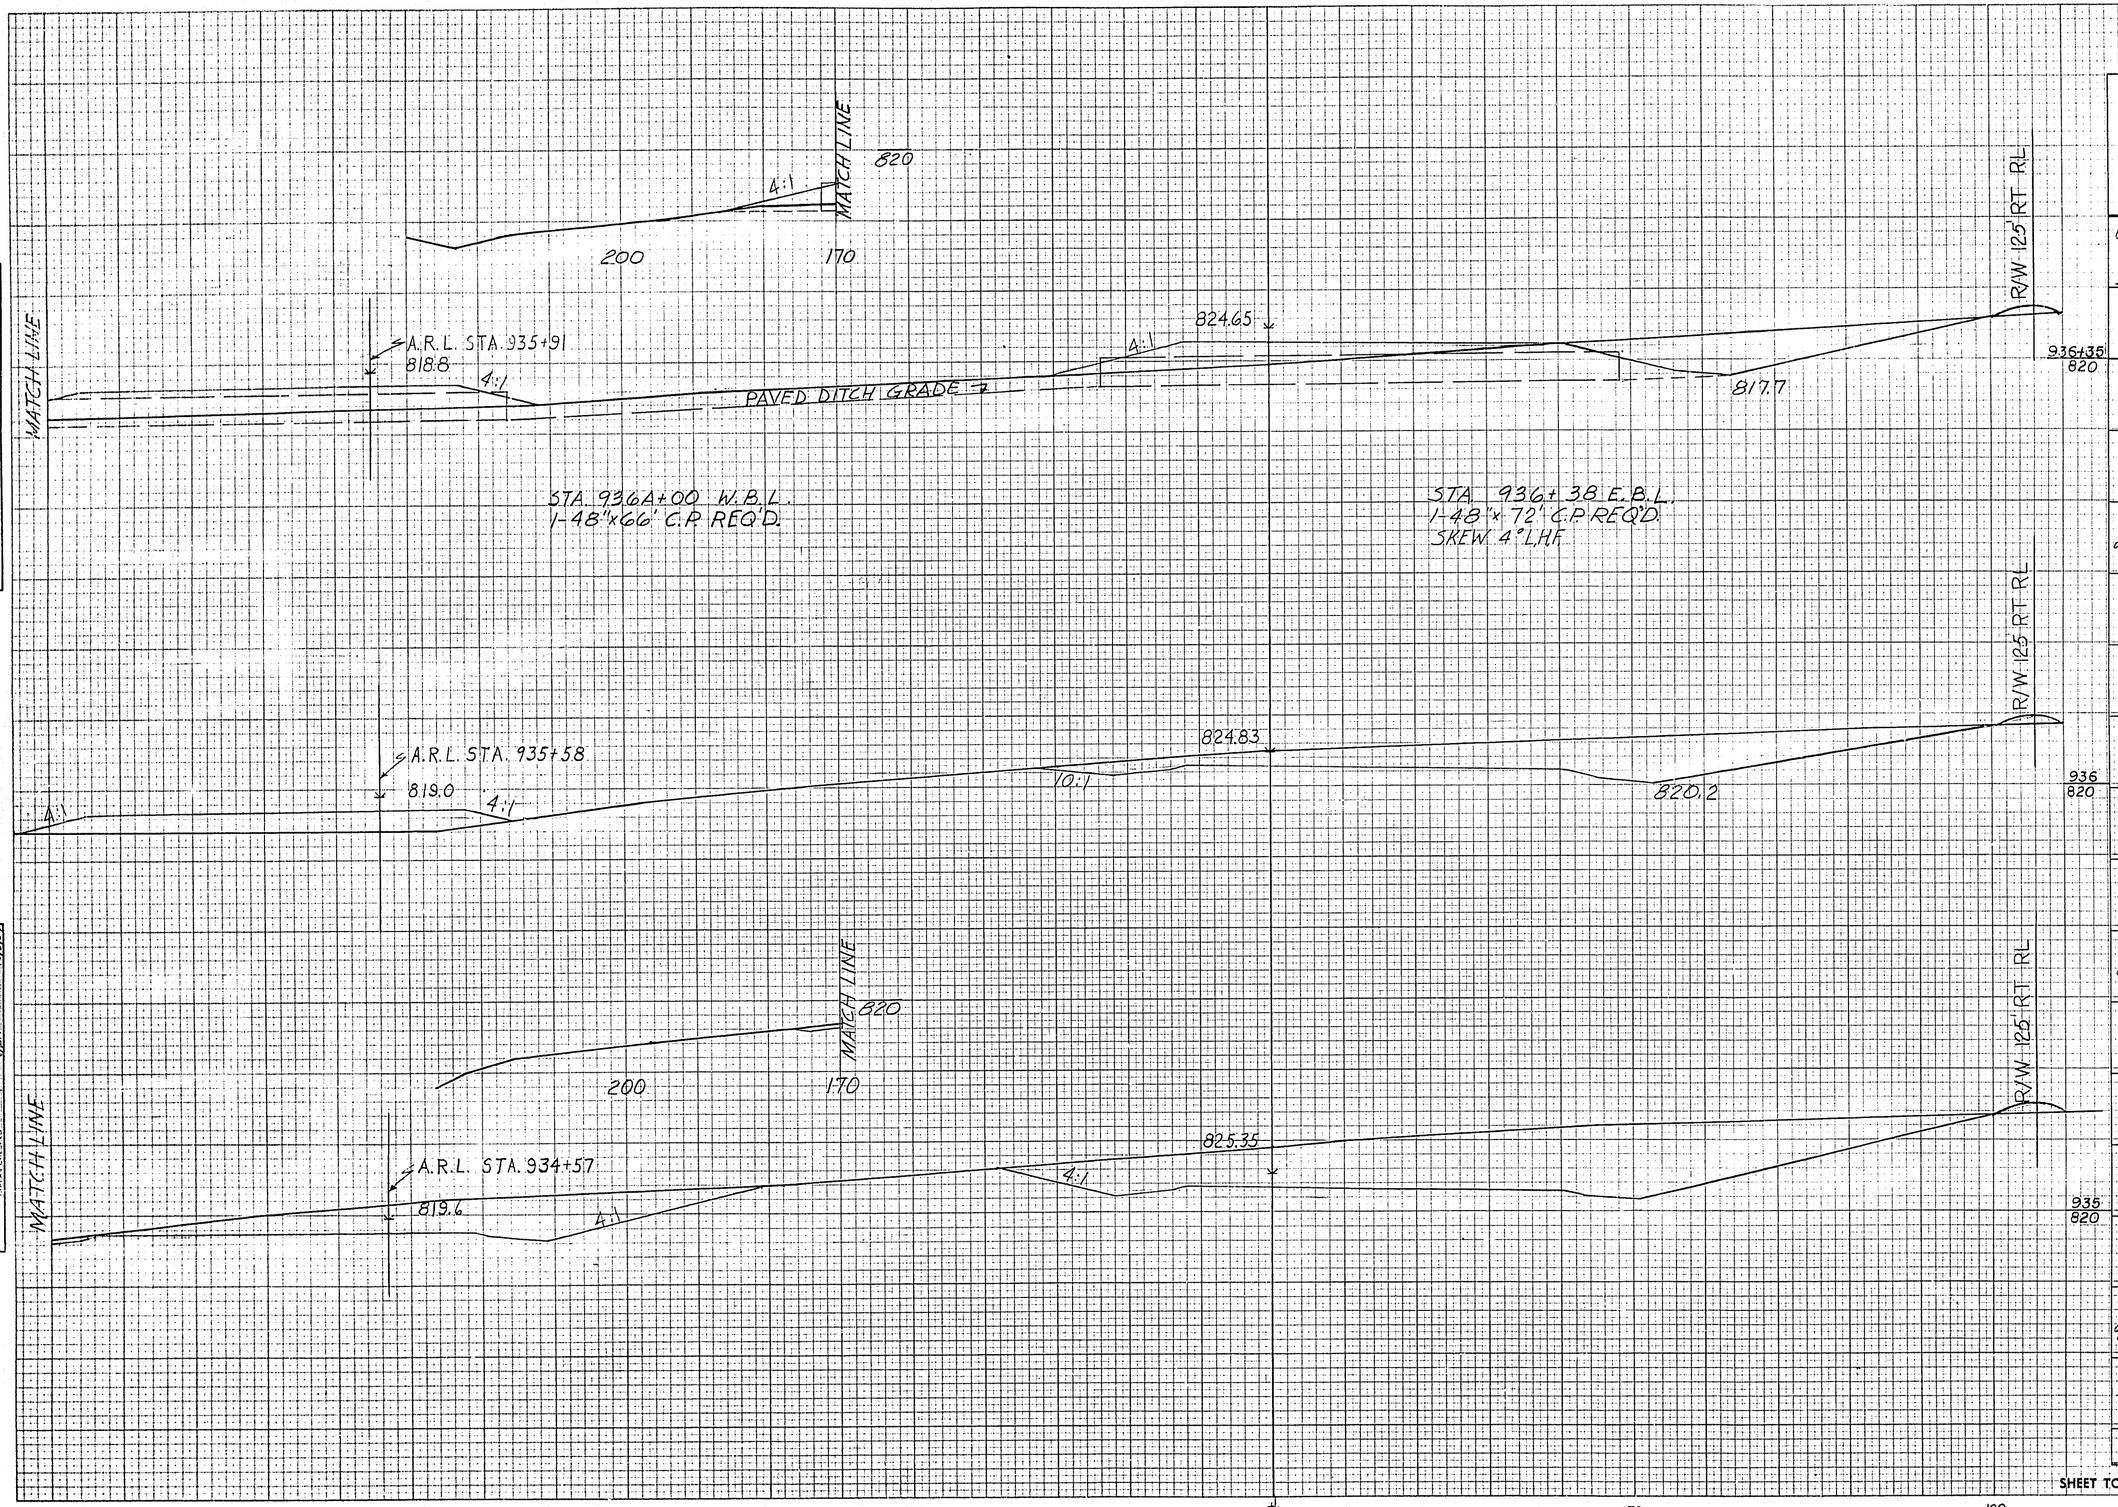

STATION	DISTANCE	YARDAGE EXCAVATION UNCL.				YARDAGE FILL
936 + 35						
	35	403				362
936						
	100	2,317				345
935						
	100	2,936				670
934						
SHEET TOTAL		5,706				1,377


935 - 936+35

PLATE 3–CROSS SECTION O. P. R. & B. E. STANDARD
THE FREDERICK POST CO., CHICAGO

B.P.R. DISTRICT OFFICE	PROJECT	SHEET NUMBER	TOTAL SHEETS
WIS. 4	I-90-2(18)105	150	264

FINAL SURVEY — DATE — BY — SURVEYED — PLOTTED — TEMPLET — NOTE BOOK — AREAS — AREAS CHECKED — NO.

ORIGINAL SURVEY — DATE 6-28-58 — BY EJJ — SURVEYED 7-2-58 — PLOTTED 7-7-58 — TEMPLET SJB — NOTE BOOK — AREAS JAP — AREAS CHECKED 4803 — NO.

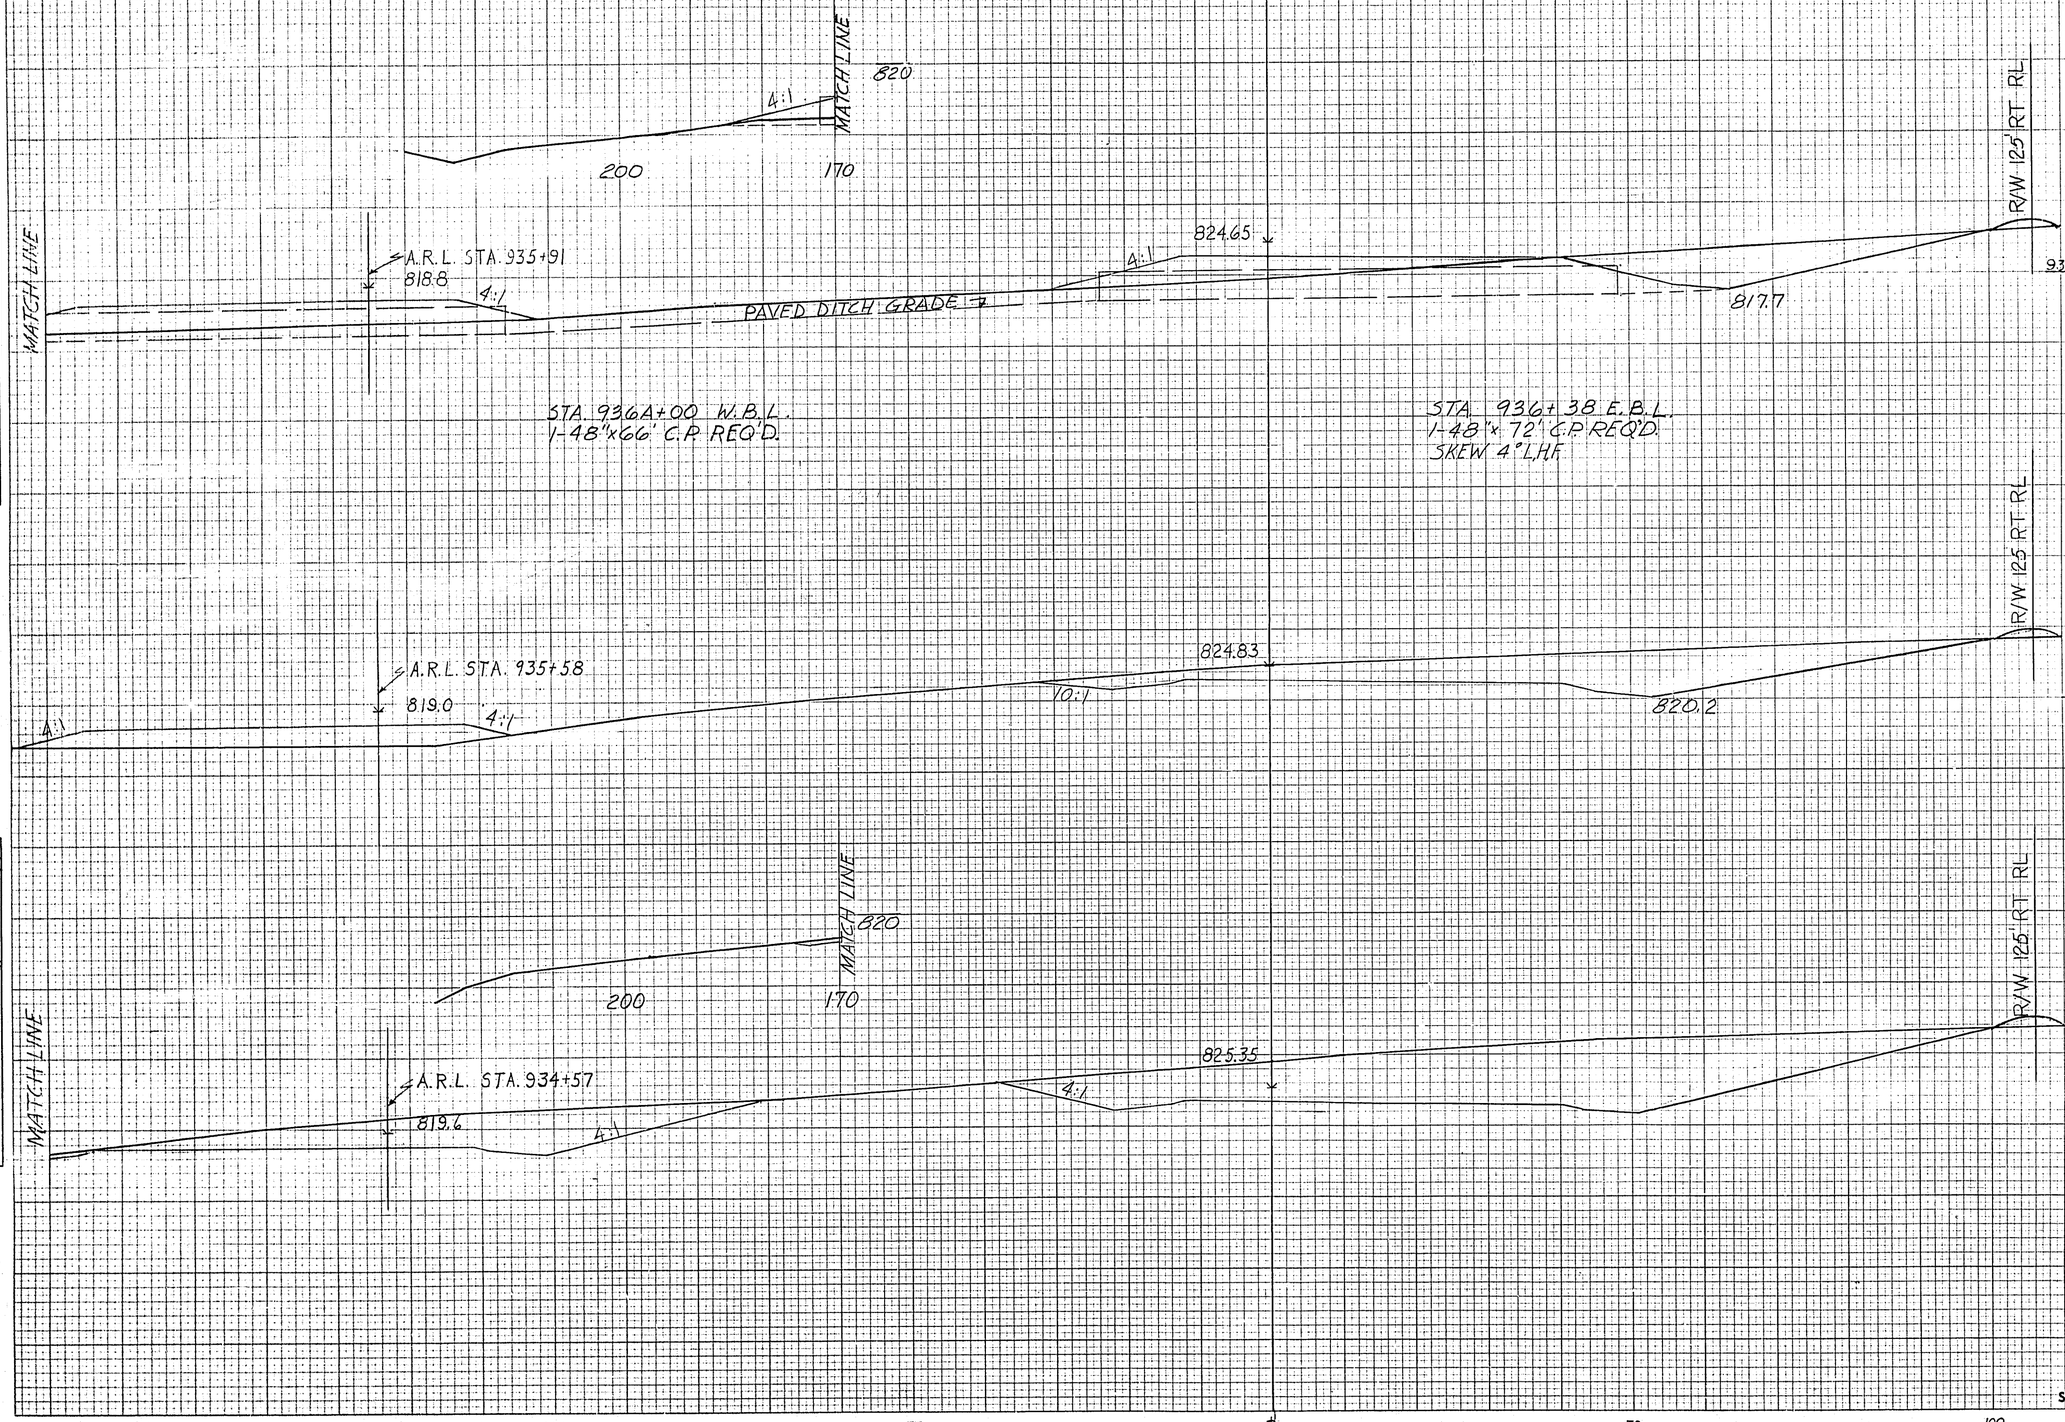

STATION	DISTANCE	YARDAGE EXCAVATION UNCL.				YARDAGE FILL
936 + 35						
	35	403				362
936						
	100	2817				345
935						
	100	2436				670
934						
SHEET TOTAL		5706				1377

935 - 936 + 35

PLATE 3—CROSS SECTION O. P. R. & R. E. STANDARD
THE FREDERICK POST CO., CHICAGO

56

B.P.R. DISTRICT OFFICE	PROJECT	SHEET NUMBER	TOTAL SHEETS
WIS. 4	I-90-2(18)105	151	264

FINAL SURVEY — DATE — BY — NOTE BOOK — NO. — SURVEYED — PLOTTED — TRACED — AREAS — AREAS CHECKED

ORIGINAL SURVEY — DATE 6-28-58 — BY JJR — SURVEYED 2-U — PLOTTED 11 — TRACED Subgr. — AREAS 4015 — AREAS CHECKED

℄ MEIKLE RD.

MATCH LINE

260 230 200 170

4:1

810

R/W 125' RT. RL

A.R.L. STA. 938+58

817.3

814.1

823.27

939 / 820

℄ MEIKLE RD.

MATCH LINE

260 200 170

820

R/W 125' RT. RL

℄ A.R.L. STA. 937+58

817.9

4:1

814.7

4:1

823.79

938 / 820

℄ MEIKLE RD.

MATCH LINE

260 230 200 170

820

R/W 125' RT. RL

℄ A.R.L. STA. 936+58

818.4

4:1

815.2

824.31

937 / 820

150 100 50 ℄ 50 100

STATION	DISTANCE	YARDAGE EXCAVATION UNC L.	YARDAGE FILL
939			
	100	3684	176
938			
	100	3592	88
937			
	65	1182	457
936 + 35			
SHEET TOTAL		8458	731


937-939

PLATE 3—CROSS SECTION O. P. R. & R. E. STANDARD
THE FREDERICK POST CO., CHICAGO

B.P.R. DISTRICT OFFICE	PROJECT	SHEET NUMBER	TOTAL SHEETS
WIS. 4	I-90-2(18)105	1.52	264

FINAL SURVEY — PLOTTED — NOTE BOOK — TEMPLATE — AREAS — AREAS CHECKED — NO — DATE

ORIGINAL SURVEY — PLOTTED — NOTE BOOK — TEMPLATE — AREAS — AREAS CHECKED — NO — BY — DATE 6-20-58 — 4/2/14

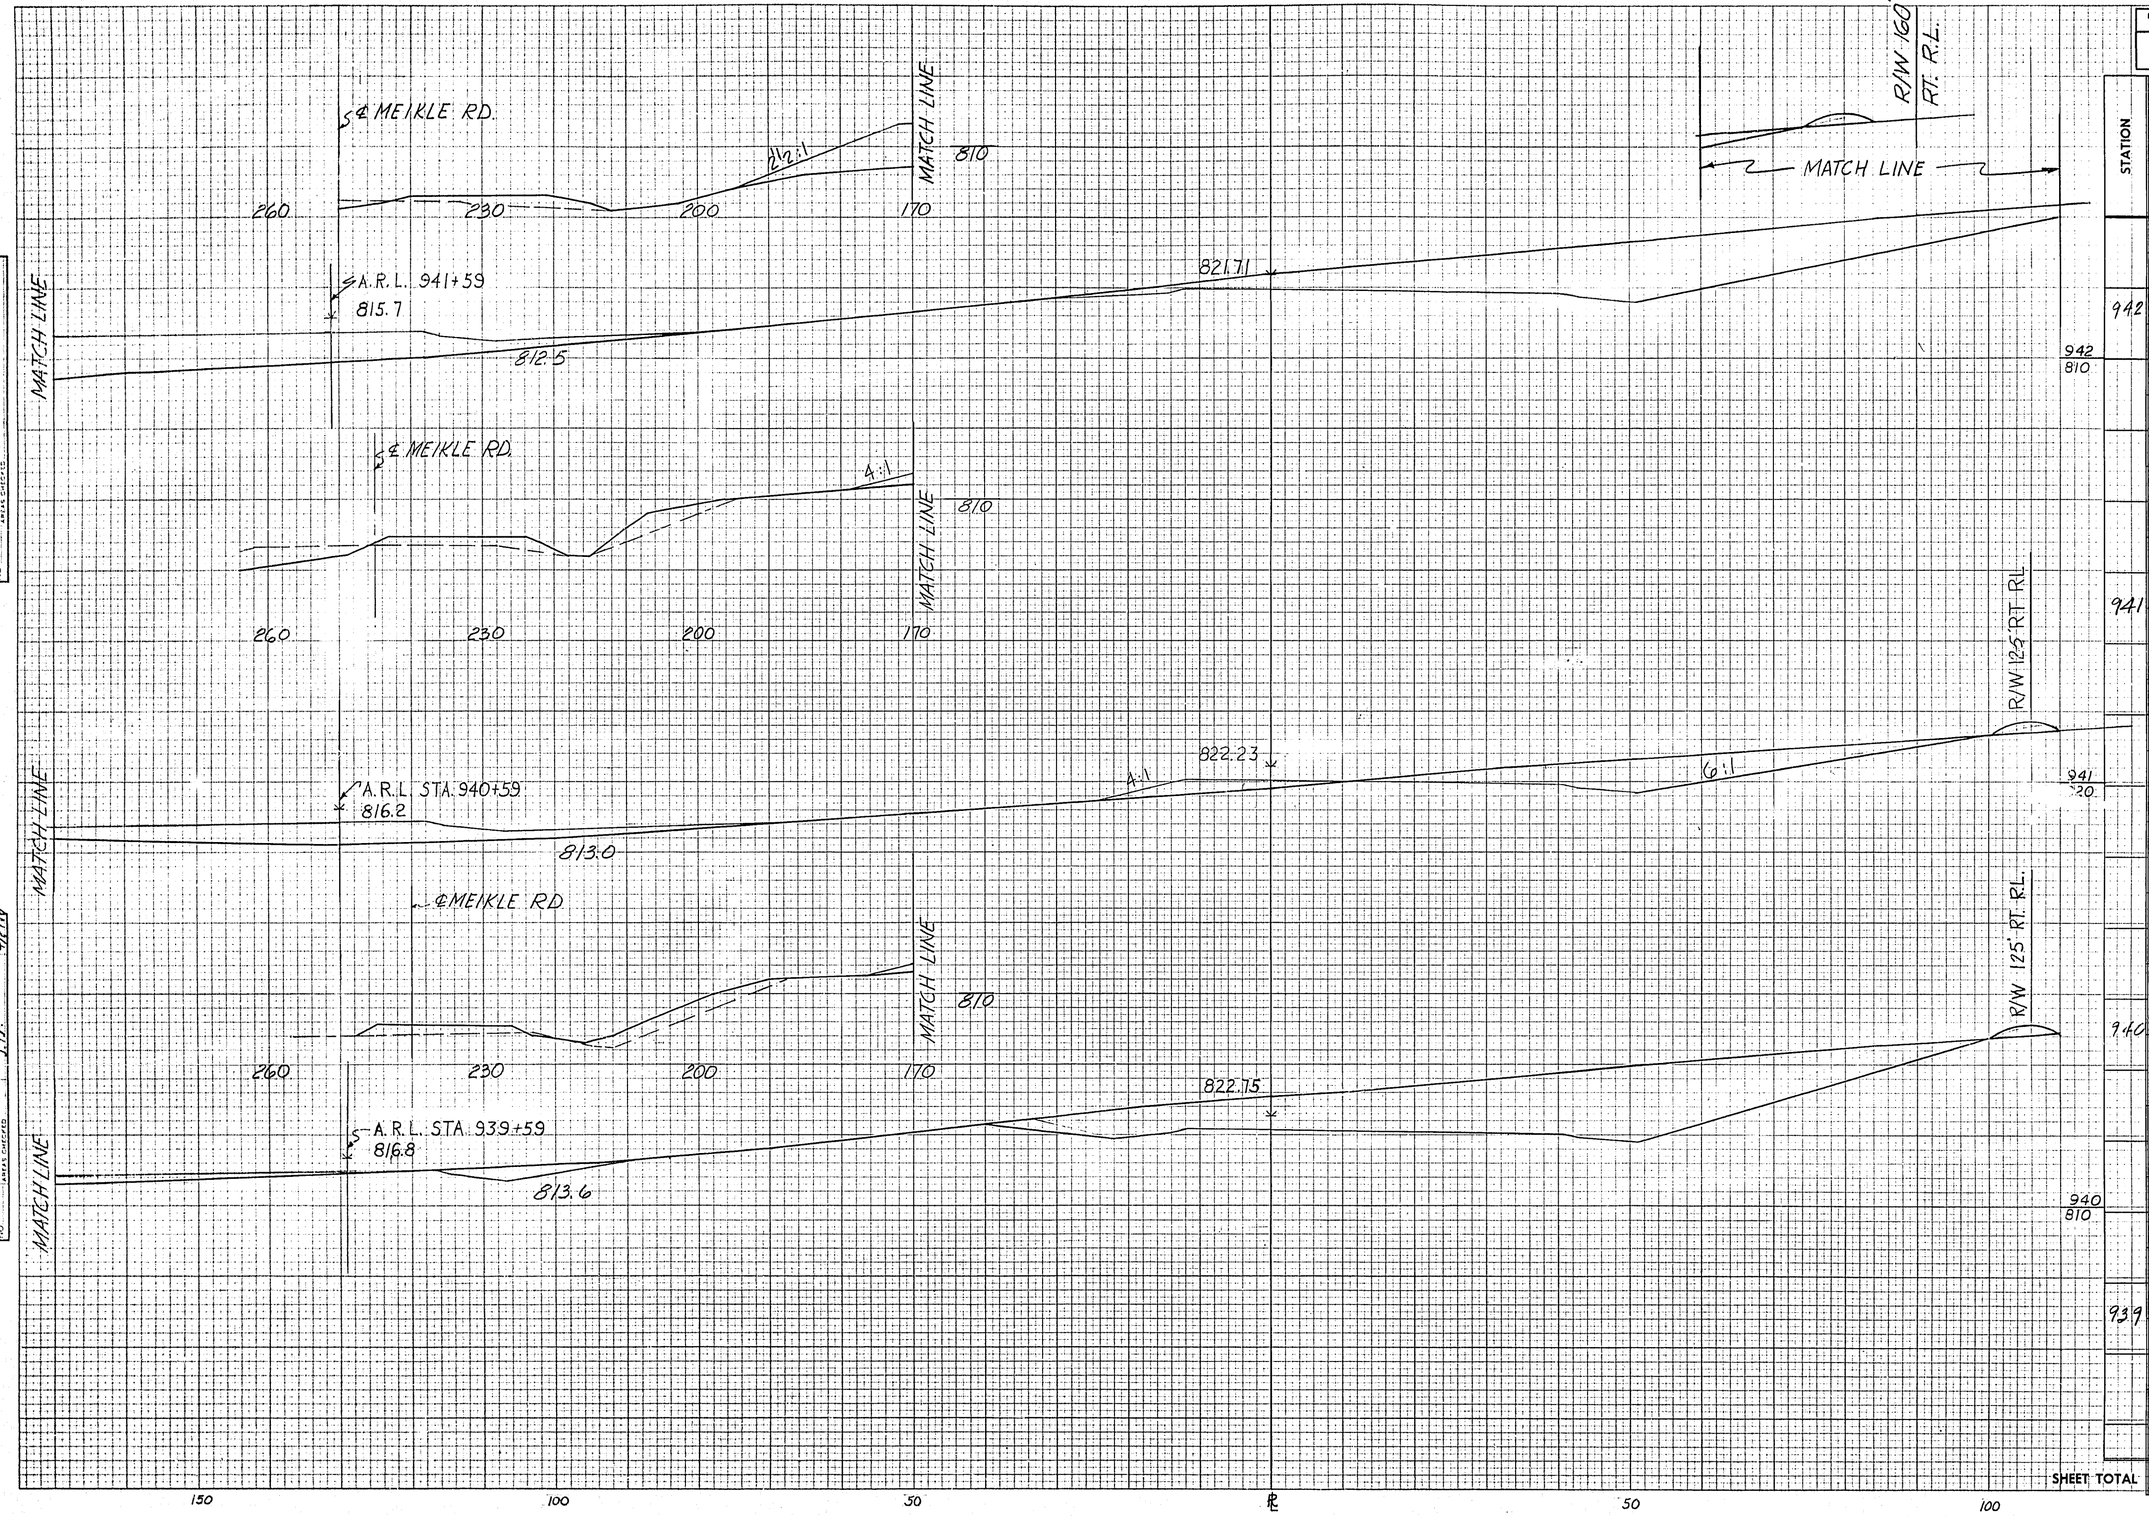

STATION	DISTANCE	YARDAGE EXCAVATION UNCL.	YARDAGE EXCAVATION	YARDAGE FILL
942				
942 / 810				
100	1,481			1174
941				
941 / 20				
100	1,788			566
940				
940 / 810				
100	3961			215
939				
SHEET TOTAL	6,230			1,955

940 - 942

PLATE 3—CROSS SECTION O. P. R. & R. E. STANDARD
THE FREDERICK POST CO., CHICAGO

B.P.R. DISTRICT OFFICE	PROJECT	SHEET NUMBER	TOTAL SHEETS
WIS. 4	140-2(13)105	153	264

FINAL SURVEY — SURVEYED / PLOTTED / NOTE BOOK / NO. / DATE / BY / CHECKED / TEMPLATE / AREAS / AREAS CHECKED

ORIGINAL SURVEY — SURVEYED / PLOTTED / NOTE BOOK / NO. / DATE / BY / CHECKED / TEMPLATE / AREAS / AREAS CHECKED

℄ MEIKLE RD.

MATCH LINE

260 230 200 170

810

A.R.L. 943+59
814.5

4:1

820.67

R/W 160' RT. R.L.

MATCH LINE

944
820

944

943

℄ MEIKLE RD.

MATCH LINE

260 230 200 170

810

A.R.L. 942+59
815.1

821.19

R/W 160' RT. R.L.

MATCH LINE

943
820

942
40

℄ MEIKLE RD.

MATCH LINE

260 230 200 170

810

A.R.L. STA. 942+00
813.4

812.3

821.50

4:1

R/W 160' RT. R.L.

MATCH LINE

942+40
820

942

150 100 50 ℄ 50 100

942+40 – 944

STATION	DISTANCE	YARDAGE EXCAVATION UNCL.	YARDAGE FILL
944			
	100	4,224	553
943			
	60	1,285	396
942 40			
	40	633	474
942			
SHEET TOTAL		6202	1443

PLATE 3–CROSS SECTION O. P. R. & R. E. STANDARD
THE FREDERICK POST CO., CHICAGO

B.P.R. DISTRICT OFFICE	PROJECT	SHEET NUMBER	TOTAL SHEETS
WIS. 4	I-90-2(19)105	154	264

FINAL SURVEY — SURVEYED — PLOTTED — NOTE BOOK — TEMPLATE — AREAS — AREAS CHECKED — NO. — DATE

ORIGINAL SURVEY — SURVEYED — PLOTTED — NOTE BOOK — TEMPLATE — AREAS — AREAS CHECKED — NO. — BY — DATE — 6-28-88 — 41813

℄ MEIKLE RD

SEE MEIKLE RD

2½:1

MATCH LINE

810

260 230 200 170

ARL STA 946+65

812.3

819.11

816.0

807.8

R/W 160' RT. R.L.

840

110 130

947 820

947

946

100 6790 869

℄ MEIKLE RD

SEE MEIKLE RD.

2½:1

MATCH LINE

810

260 230 200 170

819.63

816.5

ARL STA 945+60

813.4

946 820

100 5894 1122

R/W 160' RT. R.L.

MATCH LINE

945

SEE MEIKLE RD.

2½:1

MATCH LINE

810

26.0 230 200 170

100 5134 310

820.15

817.0

ARL STA 944+58

814.0

945 820

944

SHEET TOTAL 17,988 2,301

150 100 50 ℄ 50 100

945-947

STATION	DISTANCE	YARDAGE EXCAVATION UNCL.	YARDAGE EXCAVATION	YARDAGE FILL
947				
	100	6790		869
946				
	100	5894		1122
945				
	100	5134		310
944				
SHEET TOTAL		17,988		2,301

PLATE 3—CROSS SECTION O. P. R. & R. E. STANDARD
THE FREDERICK POST CO., CHICAGO

B.P.R. DISTRICT OFFICE	PROJECT	SHEET NUMBER	TOTAL SHEETS
WIS. 4	I-90-2(18)105	155	264

FINAL SURVEY — DATE — BY — SURVEYED — PLOTTED — TEMPLATE — NOTE BOOK — PAGE — AREAS CHECKED — NO.

ORIGINAL SURVEY — DATE 6-25-58 — BY RDT — SURVEYED — PLOTTED — TEMPLATE Sept. 71 — NOTE BOOK — PAGE 48801 — AREAS CHECKED JJP — NO.

MATCH LINE

260 230 200 170

4:1

MATCH LINE 810

ARL STA. 947+91
812.2

808.1

818.48

6:1

811.1

R/W 160' RT. RL

STATION 948 +20 810

DISTANCE 20

YARDAGE — EXCAVATION — UNCL. — FILL

20 500 362

948

MATCH LINE

260 230 200 170

4:1

MATCH LINE 810

R/W 160' RT. RL

ARL STA 947+71
812.3

806.9 6:1

PAVED DITCH GRADE

818.59

4:1

810.0

948 810 — 50 913 782

STA. 947+83 E.B.L.
1-48"x 92' C.P. REQ'D.
SKEW 18° R.H.F.

947 50

MATCH LINE

260 230 200 170

2½:1

810

MATCH LINE

PAVED DITCH GR.

℄ MEIKLE RD.

R/W 160' RT. RL

ARL STA 947+19
812.6

804.0

2½:1

PAVED DITCH GRADE

818.85

815.7

813.0

947+50 810 — 50 2293 576

947

STA. 947A+14 W.B.L.
1-48"x 100' C.P. REQ'D.
SKEW 19° R.H.F.

SHEET TOTAL 3616 1526

150 100 50 ℄ 50 100

947+50 - 948+20

PLATE 3-CROSS SECTION O. P. R. & R. E. STANDARD
THE FREDERICK POST CO.

48

B.P.R. DISTRICT OFFICE	PROJECT	SHEET NUMBER	TOTAL SHEETS
WIS. 4	I-90-2(13)105	156	264

FINAL SURVEY — DRAFTED / PLOTTED / TEMPLATE / NOTE BOOK / AREAS / AREAS CHECKED / NO. — BY — DATE

ORIGINAL SURVEY — SURVEYED / PLOTTED / TEMPLATE CHKD. TY. / NOTE BOOK / AREAS / AREAS CHECKED / NO. — BY RDJ — DATE 6-23-58 10-1-58 — JTM — APPD

MATCH LINE

2½:1

200

800

170

MATCH LINE

ARL STA. 950+80

810.6

2:1

4:1

817.03

MATCH LINE

830

110

140

R/W 160' RT. R.L.

MATCH LINE

951

820

MATCH LINE

2½:1

200

800

170

MATCH LINE

ARL STA 949+78

811.2

4:1

4:1

817.55

MATCH LINE

830

110

140

R/W 160' RT. R.L.

MATCH LINE

950

820

MATCH LINE

4:1

200

810

170

MATCH LINE

4:1

MATCH LINE

830

110

140

R/W 160' RT. R.L.

MATCH LINE

949

820

ARL STA 948+74

811.8

4:1

4:1

818.07

812.3

MATCH LINE

948

+

20

125

150 100 50 ℄ 50 100

949 – 951

STATION	DISTANCE	YARDAGE EXCAVATION UNCL.				FILL
951						
	100	6486				1544
950						
	100	6165				1119
949						
	80	3779				331
948						
+	20					
SHEET TOTAL		16429				3644

PLATE 3–CROSS SECTION O. P. R. & R. E. STANDARD
THE FREDERICK POST CO., CHICAGO

B.P.R. DISTRICT OFFICE	PROJECT	SHEET NUMBER	TOTAL SHEETS
WIS. 4	I-90-2(18)165	157	264

FINAL SURVEY — SURVEYED — PLOTTED — TEMPLAT — AREAS — AREAS CHECKED — NOTE BOOK — NO. — BY — DATE

ORIGINAL SURVEY — SURVEYED — PLOTTED — TEMPLAT — AREAS — AREAS CHECKED — NOTE BOOK — NO. — BY PJJ — DATE 6-23-58 12-17-58 — 1-1-59 — 1-1-59 — 1-1-59

B.P.R. DISTRICT OFFICE	PROJECT	SHEET NUMBER	TOTAL SHEETS
WIS. 4	I-90-2(18)105	158	264

FINAL SURVEY — DATE — BY — SURVEYED — PLOTTED — NOTE BOOK — AREAS — AREAS CHECKED — NO.

ORIGINAL SURVEY — DATE 6-29-73, 6-25-73, 4/1/74 — BY RJJ, TLY, JJF — SURVEYED 6-29-73, 6-25-73, 4/1/74 — PLOTTED 7-2-73, 7-2-73, 4/2/74 — NOTE BOOK SHEET 114 — AREAS — AREAS CHECKED — NO.

MATCH LINE — 810 — 20:1 — 180 — 150

ARL STA 957+04 — 807.4 — 813.98 — 2½:1 — 4:1

MATCH LINE — 810 — 20:1 — 180 — 150

ARL STA 956+02 — 807.8 — 814.43 — 2½:1 — 4:1

MATCH LINE — 800 — 10:1 — 180 — 150

ARL STA 954+97 — 808.8 — 814.95 — 1½:1 — 4:1

MATCH LINE

R/W 160' RT. RL

R/W 160' RT. RL

R/W 160' RT. R.L.

STATION	DISTANCE	YARDAGE EXCAVATION UNCL.	YARDAGE EXCAVATION	YARDAGE FILL
957 / 810				
957	100	7,844		30
956				
956 / 820	100	10,384		30
955				
955	100	10,334		189
955 / 820				
954				
SHEET TOTAL		28,562		249

955 – 957

150 120 90 60 30 ℄ 30 60 90 120 150

PLATE 3–CROSS SECTION O. P. R. & R. E. STANDARD
THE FREDERICK POST CO., CHICAGO

B.P.R. DISTRICT OFFICE	PROJECT	SHEET NUMBER	TOTAL SHEETS
WIS. 4	I-90-2(18)105	159	264

FINAL SURVEY — SURVEYED / PLOTTED / TEMPLATE AREAS / AREAS CHECKED — NOTE BOOK — NO. — DATE — BY

ORIGINAL SURVEY — SURVEYED 6-23-58 / PLOTTED 7-14-58 / TEMPLATE AREAS EJ / AREAS CHECKED J.T.R. / NOTE BOOK 4015

MATCH LINE — 800 — 180 — 150 — ARL STA 960+13 — 807.1 — 813.36 — 3½:1 — 4:1 — 6:1 — 802.1 — 805.3 — R/W - 160' RT. R.L.

STA. 960A+00 W.B.L.
1-24"x96" C.P. REQ'D.

MATCH LINE — 800 — 180 — 150 — ARL STA 959+11 — 807.1 — 813.45 — 4:1 — 4:1 — 802.4 — 806.5 — R/W - 160' RT. R.L.

MATCH LINE — 800 — 180 — 150 — ARL STA 958+09 — 807.2 — 813.65 — 4:1 — 4:1 — 802.7 — 807.8 — R/W - 160' RT. R.L.

150 120 90 60 30 0 30 60 90 120

STATION	DISTANCE	YARDAGE EXCAVATION UNCL.	YARDAGE EXCAVATION	YARDAGE FILL
960				
	100	747		2810
959				
	100	1164		1925
958				
	100	3874		512
957				
SHEET TOTAL		5785		5247

960 / 810 — 959 / 810 — 958 / 810


958 - 960

PLATE 3—CROSS SECTION O. P. R. & R. E. STANDARD
THE FREDERICK POST CO., CHICAGO

B.P.R. DISTRICT OFFICE	PROJECT	SHEET NUMBER	TOTAL SHEETS
WIS. 4	I-90-2(18)105	160	264

FINAL SURVEY — SURVEYED — PLOTTED — TEMPLATE SHEET — NOTE BOOK — NO. — AREAS CHECKED — BY — DATE

ORIGINAL SURVEY — SURVEYED 6-25-58 — PLOTTED 7-16-58 — TEMPLATE SHEET 7/ — NOTE BOOK — NO. — AREAS CHECKED — BY EJJ — DATE 4/8/59 KJP

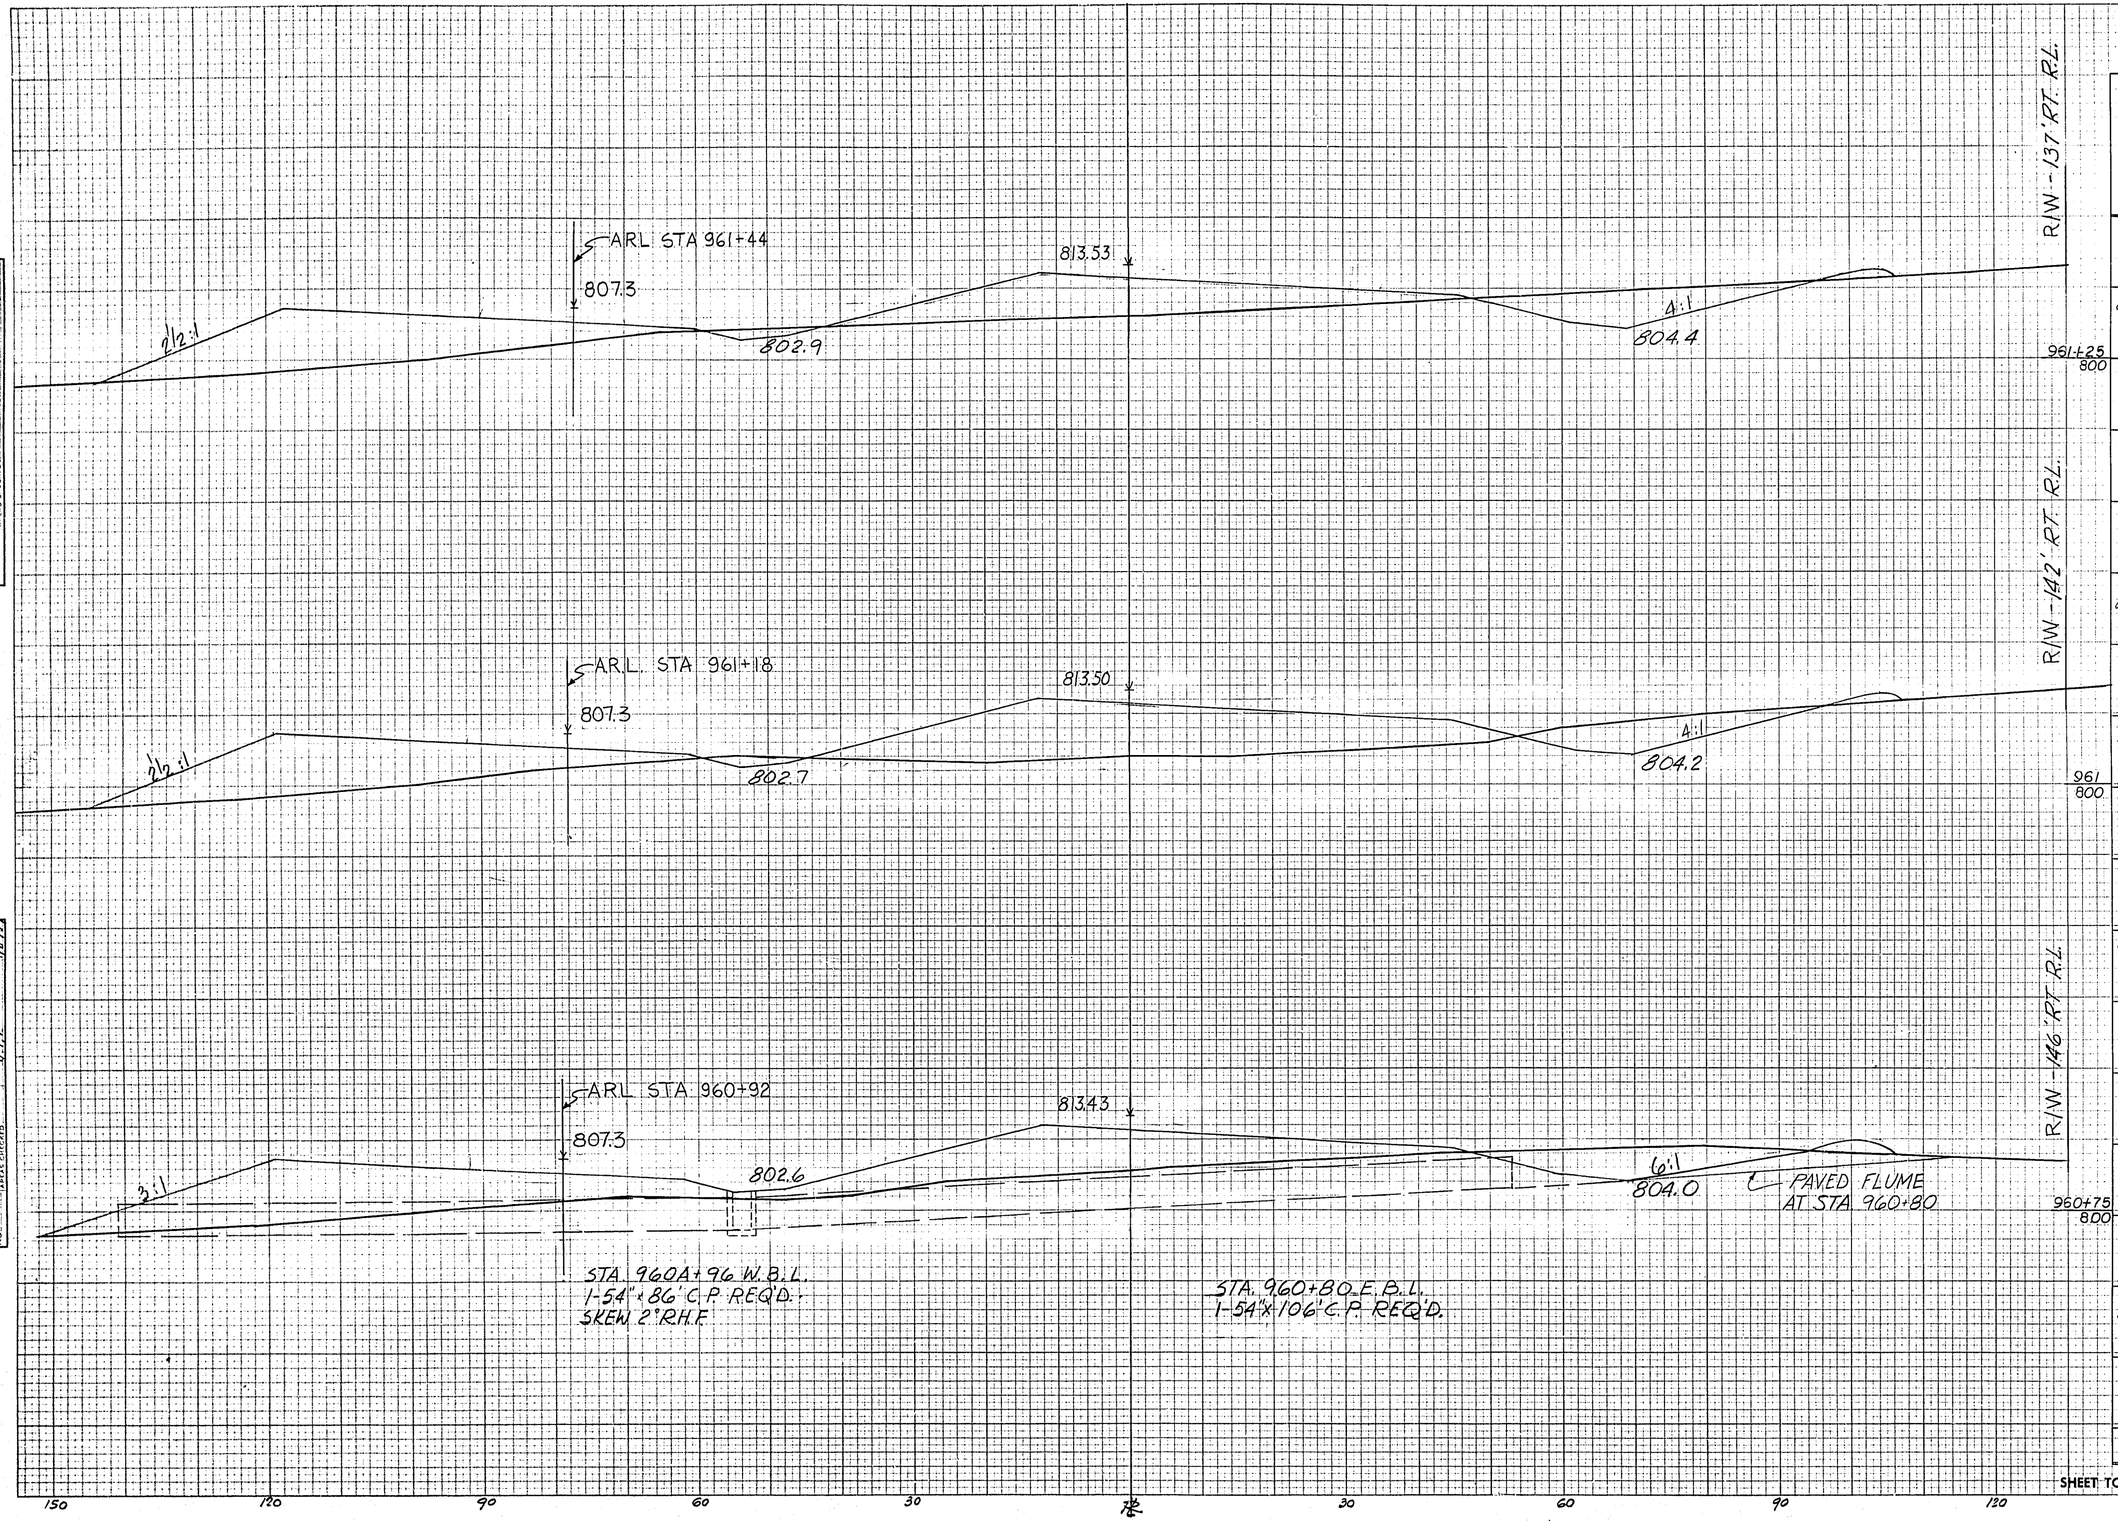

STATION	DISTANCE	YARDAGE EXCAVATION UNCL.				YARDAGE FILL
961 + 25						
	25	129				75.7
961						
	25	116				825
960 + 75						
	75	475				22.56
960						
SHEET TOTAL		660				3,333

960+75 - 961+25

PLATE 3–CROSS SECTION O. P. R. & R. E. STANDARDS
THE FREDERICK POST CO., CHICAGO

B.P.R. DISTRICT OFFICE	PROJECT	SHEET NUMBER	TOTAL SHEETS
WIS. 4	I-90-2(19) 105	160	254

FINAL SURVEY — SURVEYED / PLOTTED / TEMPLATE / AREAS / AREAS CHECKED / NOTE BOOK / NO.

ORIGINAL SURVEY — SURVEYED / PLOTTED / TEMPLATE / AREAS / AREAS CHECKED / NOTE BOOK / NO. — BY RJD, TV, JJP — DATE 6-23-58, 12-16-58, 4-8-59

ARL STA 961+44
807.3
813.53
2½:1
802.9
4:1
804.4
R/W - 137' RT. RL.
961+25
800

ARL STA 961+18
807.3
813.50
2½:1
802.7
4:1
804.2
R/W - 142' RT. RL.
961
800

ARL STA 960+92
807.3
813.43
802.6
6:1
804.0
℄ PAVED FLUME AT STA 960+80
R/W - 146' RT. RL.
960+75
800

STA. 960A+96 W.B.L.
1-54" x 86' C.P. REQ'D.
SKEW 2° RH.F

STA. 960+80 E.B.L.
1-54" x 106' C.P. REQ'D.

150 120 90 60 30 ℄ 30 60 90 120

STATION	DISTANCE	YARDAGE EXCAVATION UNCL.	YARDAGE EXCAVATION	YARDAGE EXCAVATION	YARDAGE EXCAVATION	YARDAGE FILL
961 + 25						
	25	129				757
961						
961 / 800	25	116				825
960 + 75						
	75	415				2276
960+75 / 800						
960						
SHEET TOTAL		660				3838


960+75 - 961+25

PLATE 3—CROSS SECTION O. P. R. & B. E. STANDARD
THE FREDERICK POST CO., CHICAGO

B.P.R. DISTRICT OFFICE	PROJECT	SHEET NUMBER	TOTAL SHEETS
WIS. 4	I-90-2(18)105	161	269

FINAL SURVEY — SURVEYED — PLOTTED — NOTE BOOK — TEMPLATE — AREAS — AREAS CHECKED — BY — DATE

ORIGINAL SURVEY — SURVEYED 6-25-58 — PLOTTED 7-14-58 — TEMPLATE S.B.S.-T.C. — NOTE BOOK — AREAS — AREAS CHECKED — BY RJJ — DATE 8-19-58 — BY JTP — DATE 8-19-58

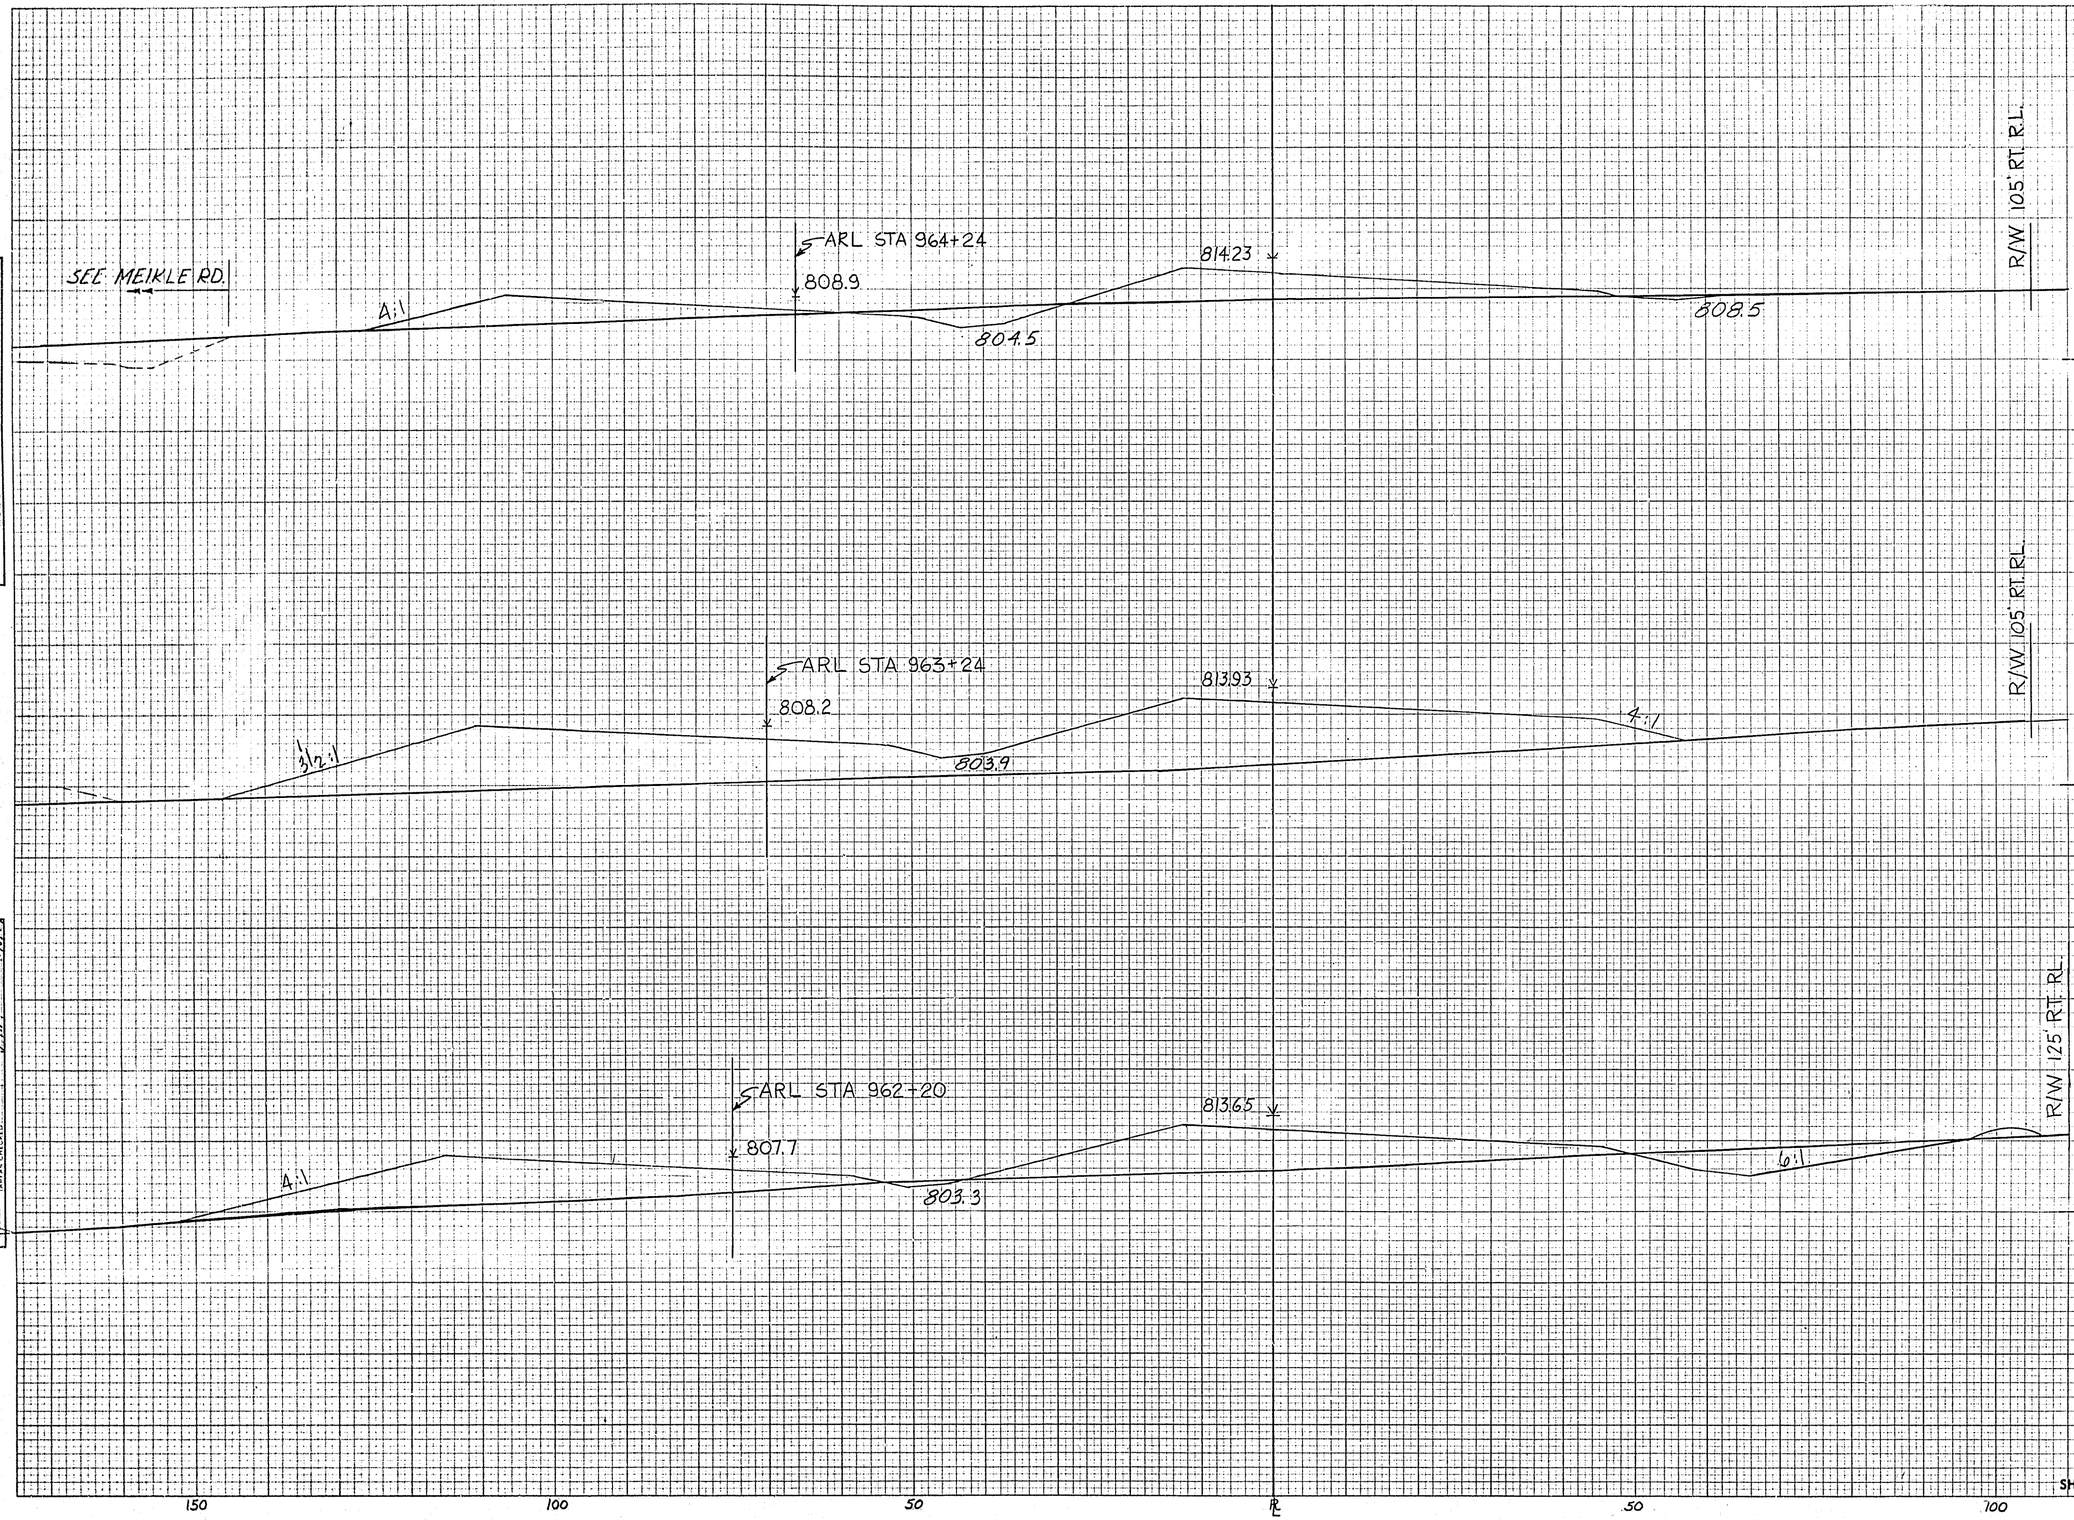

STATION	DISTANCE	YARDAGE EXCAVATION UNCL.	YARDAGE EXCAVATION	YARDAGE EXCAVATION	YARDAGE EXCAVATION	YARDAGE FILL
964						
	100	92				2769
963						
	100	199				3522
962						
	75	362				2009
961 + 25						
SHEET TOTAL		653				8300


962 - 964

PLATE 3—CROSS SECTION O. P. R. & R. E. STANDARD
THE FREDERICK POST CO., CHICAGO

B.P.R. DISTRICT OFFICE	PROJECT	SHEET NUMBER	TOTAL SHEETS
WIS. 4	I-90-2(18)105	102	214

FINAL SURVEY
SURVEYED BY
PLOTTED
NOTE BOOK
NO.
DATE
TEMPLATE
AREAS
AREAS CHECKED

ORIGINAL SURVEY
SURVEYED BY TV DATE 12-4-58
PLOTTED 12-6-58
NOTE BOOK
NO.
TEMPLATE
AREAS
AREAS CHECKED

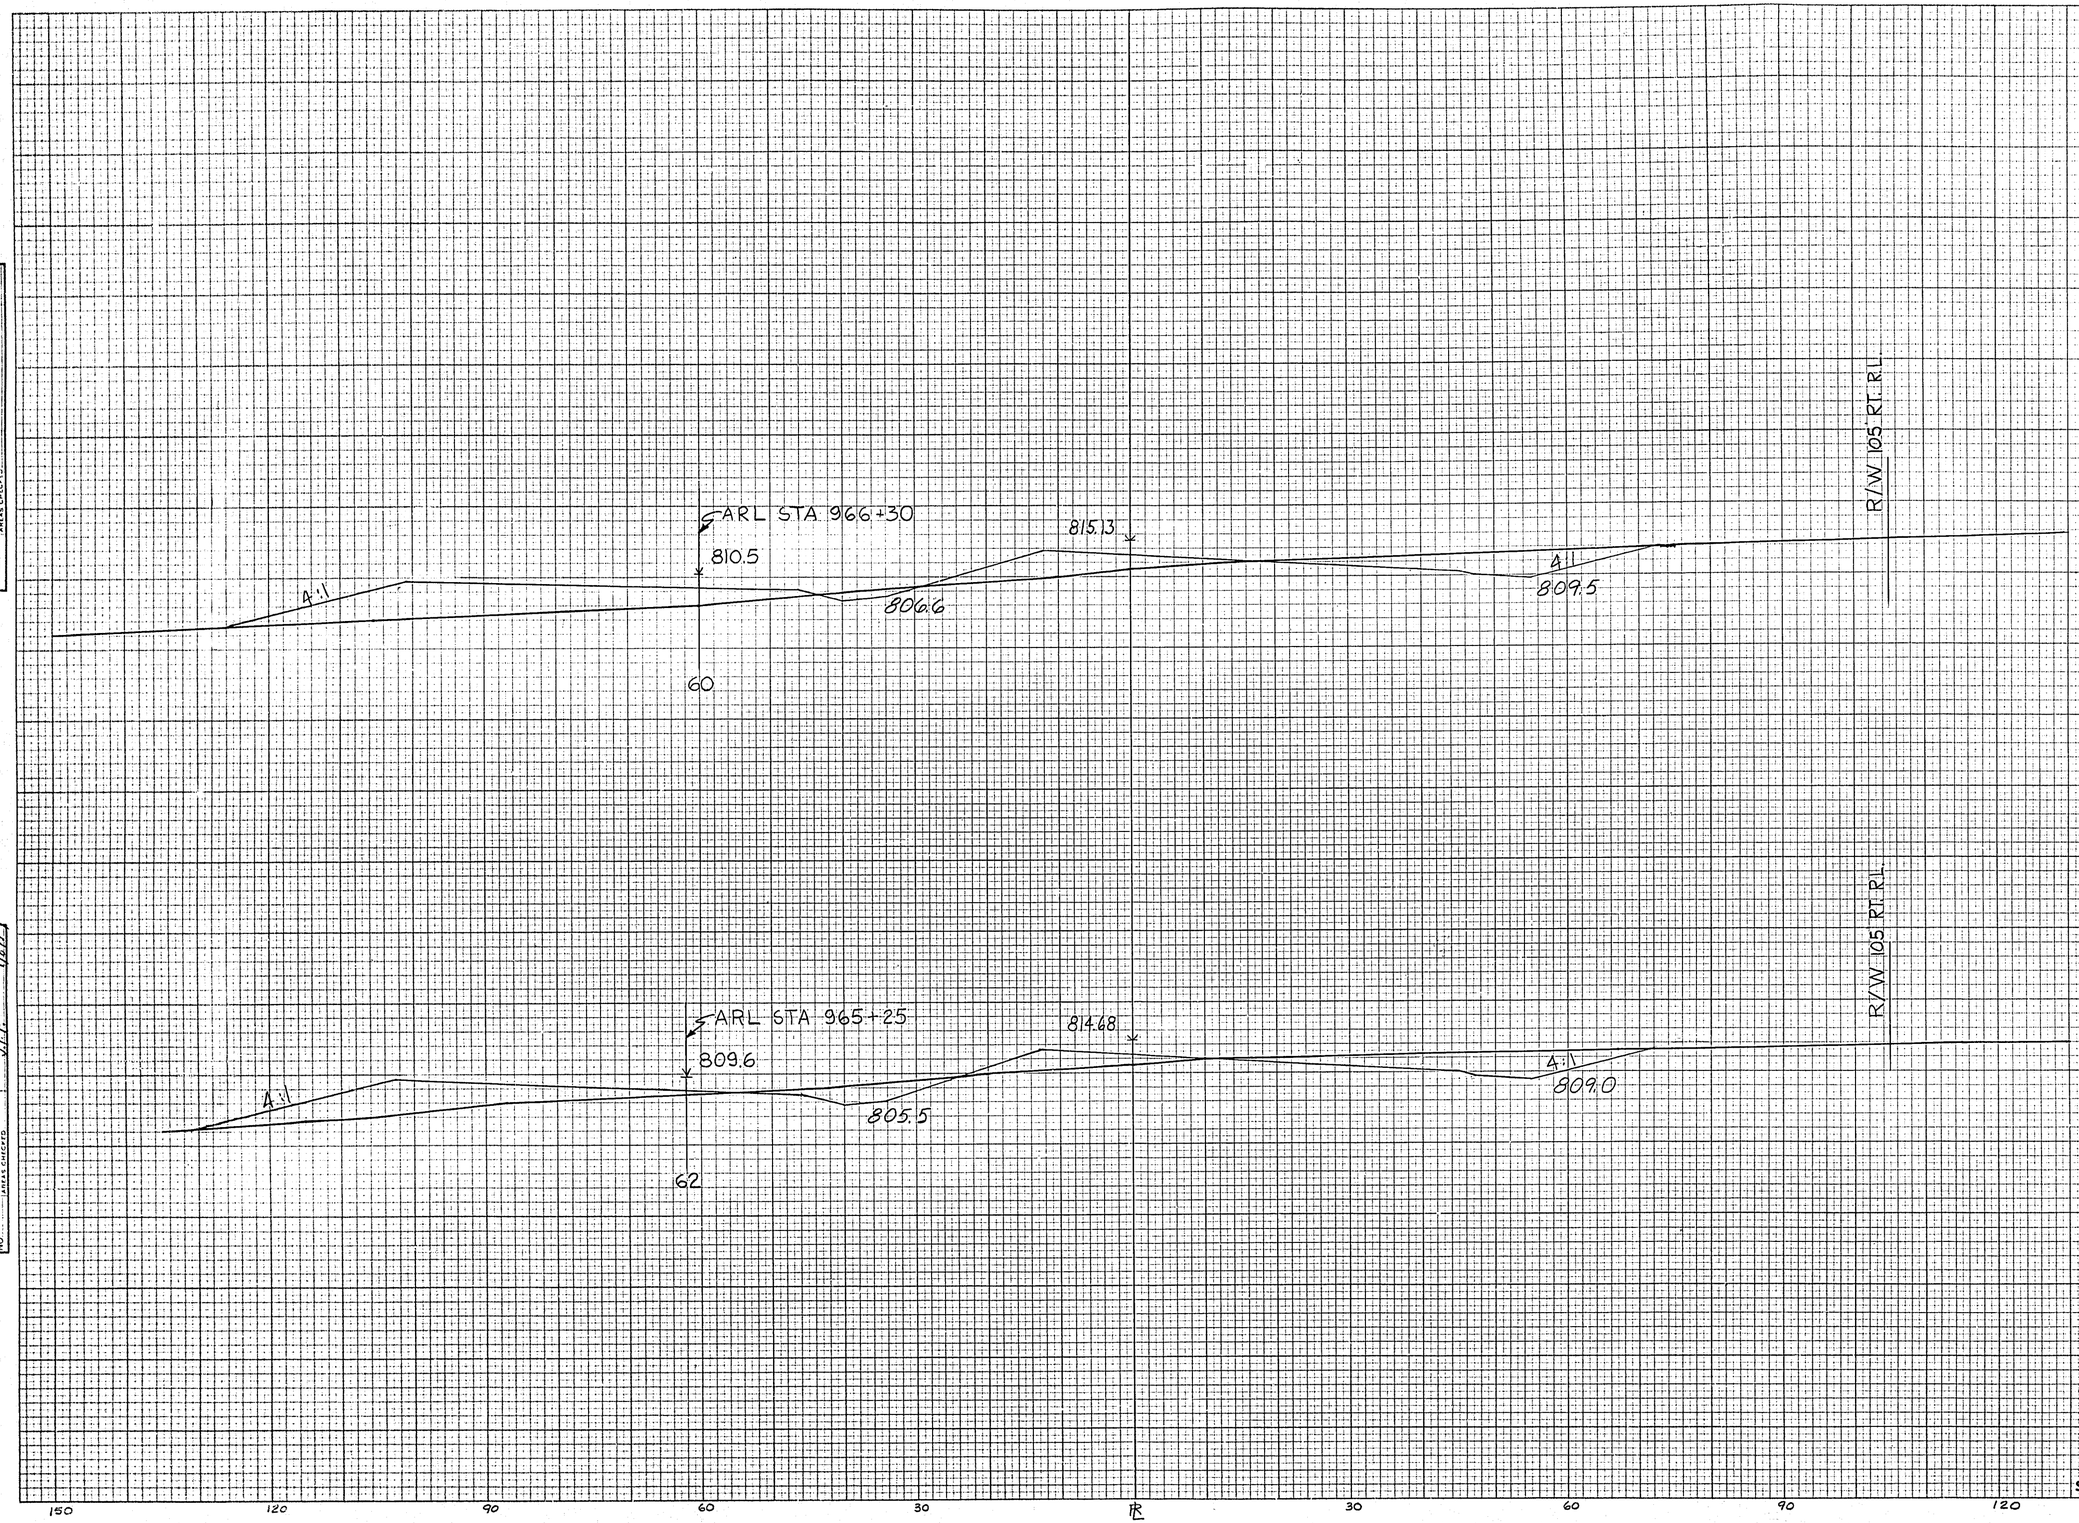

STATION	DISTANCE	YARDAGE EXCAVATION UNCL.				YARDAGE FILL
966						
966 800	100	469				1017
965						
965 800	100	379				779
964						
SHEET TOTAL		848				1996

PLATE 3—CROSS SECTION O. P. R. & R. E. STANDARDS
THE FREDERICK POST CO., CHICAGO

965-966

B.P.R. DISTRICT OFFICE	PROJECT	SHEET NUMBER	TOTAL SHEETS
WIS. 4	I-90-2(18)105	133	214

FINAL SURVEY — SURVEYED, PLOTTED, TEMPLATE, AREAS, AREAS CHECKED — NOTE BOOK: — NO. — BY — DATE

ORIGINAL SURVEY — SURVEYED 4-1-58 — PLOTTED 4-4-58 — NOTE BOOK: TEMPLATE Subgr. T.V. — AREAS P.J.B. — AREAS CHECKED J.J.P. — NO. — BY — DATE

816.16
812.69
6:1
808.8
808.6
812.0
R/W 105' RT. R.L.
960
800
969
R/W 105' RT. R.L.
815.95
812.11
6:1
6:1
808.1
811.5
968
968
800
100 | 1384 | | | 496
815.58
811.37
4:1
807.7
6:1
811.0
R/W 105' RT. R.L.
967
100 | 103 | | | 1260
967
800
100 | 217 | | | 1379
966
60
150 120 90 60 30 ℄ 30 60 90 120
SHEET TOTAL | 1,704 | | | 3135

STATION	DISTANCE	YARDAGE EXCAVATION UNCL.				FILL


PLATE 3—CROSS SECTION O. P. R. & R. E. STANDARD
THE FREDERICK POST CO., CHICAGO

967 - 959

B.P.R. DISTRICT OFFICE	PROJECT	SHEET NUMBER	TOTAL SHEETS
WIS. 4	I-90-2(18)105	164	264

FINAL SURVEY — SURVEYED ____ DATE ____ PLOTTED ____ BY ____ NOTE BOOK TEMPLATE ____ AREAS CHECKED ____ NO. ____

ORIGINAL SURVEY — SURVEYED ____ DATE 4-15-58 PLOTTED ____ BY P.J.S. TEMPLATE SHEET 11 NOTE BOOK ____ AREAS CHECKED J.J.P. 4-17-58 NO. ____

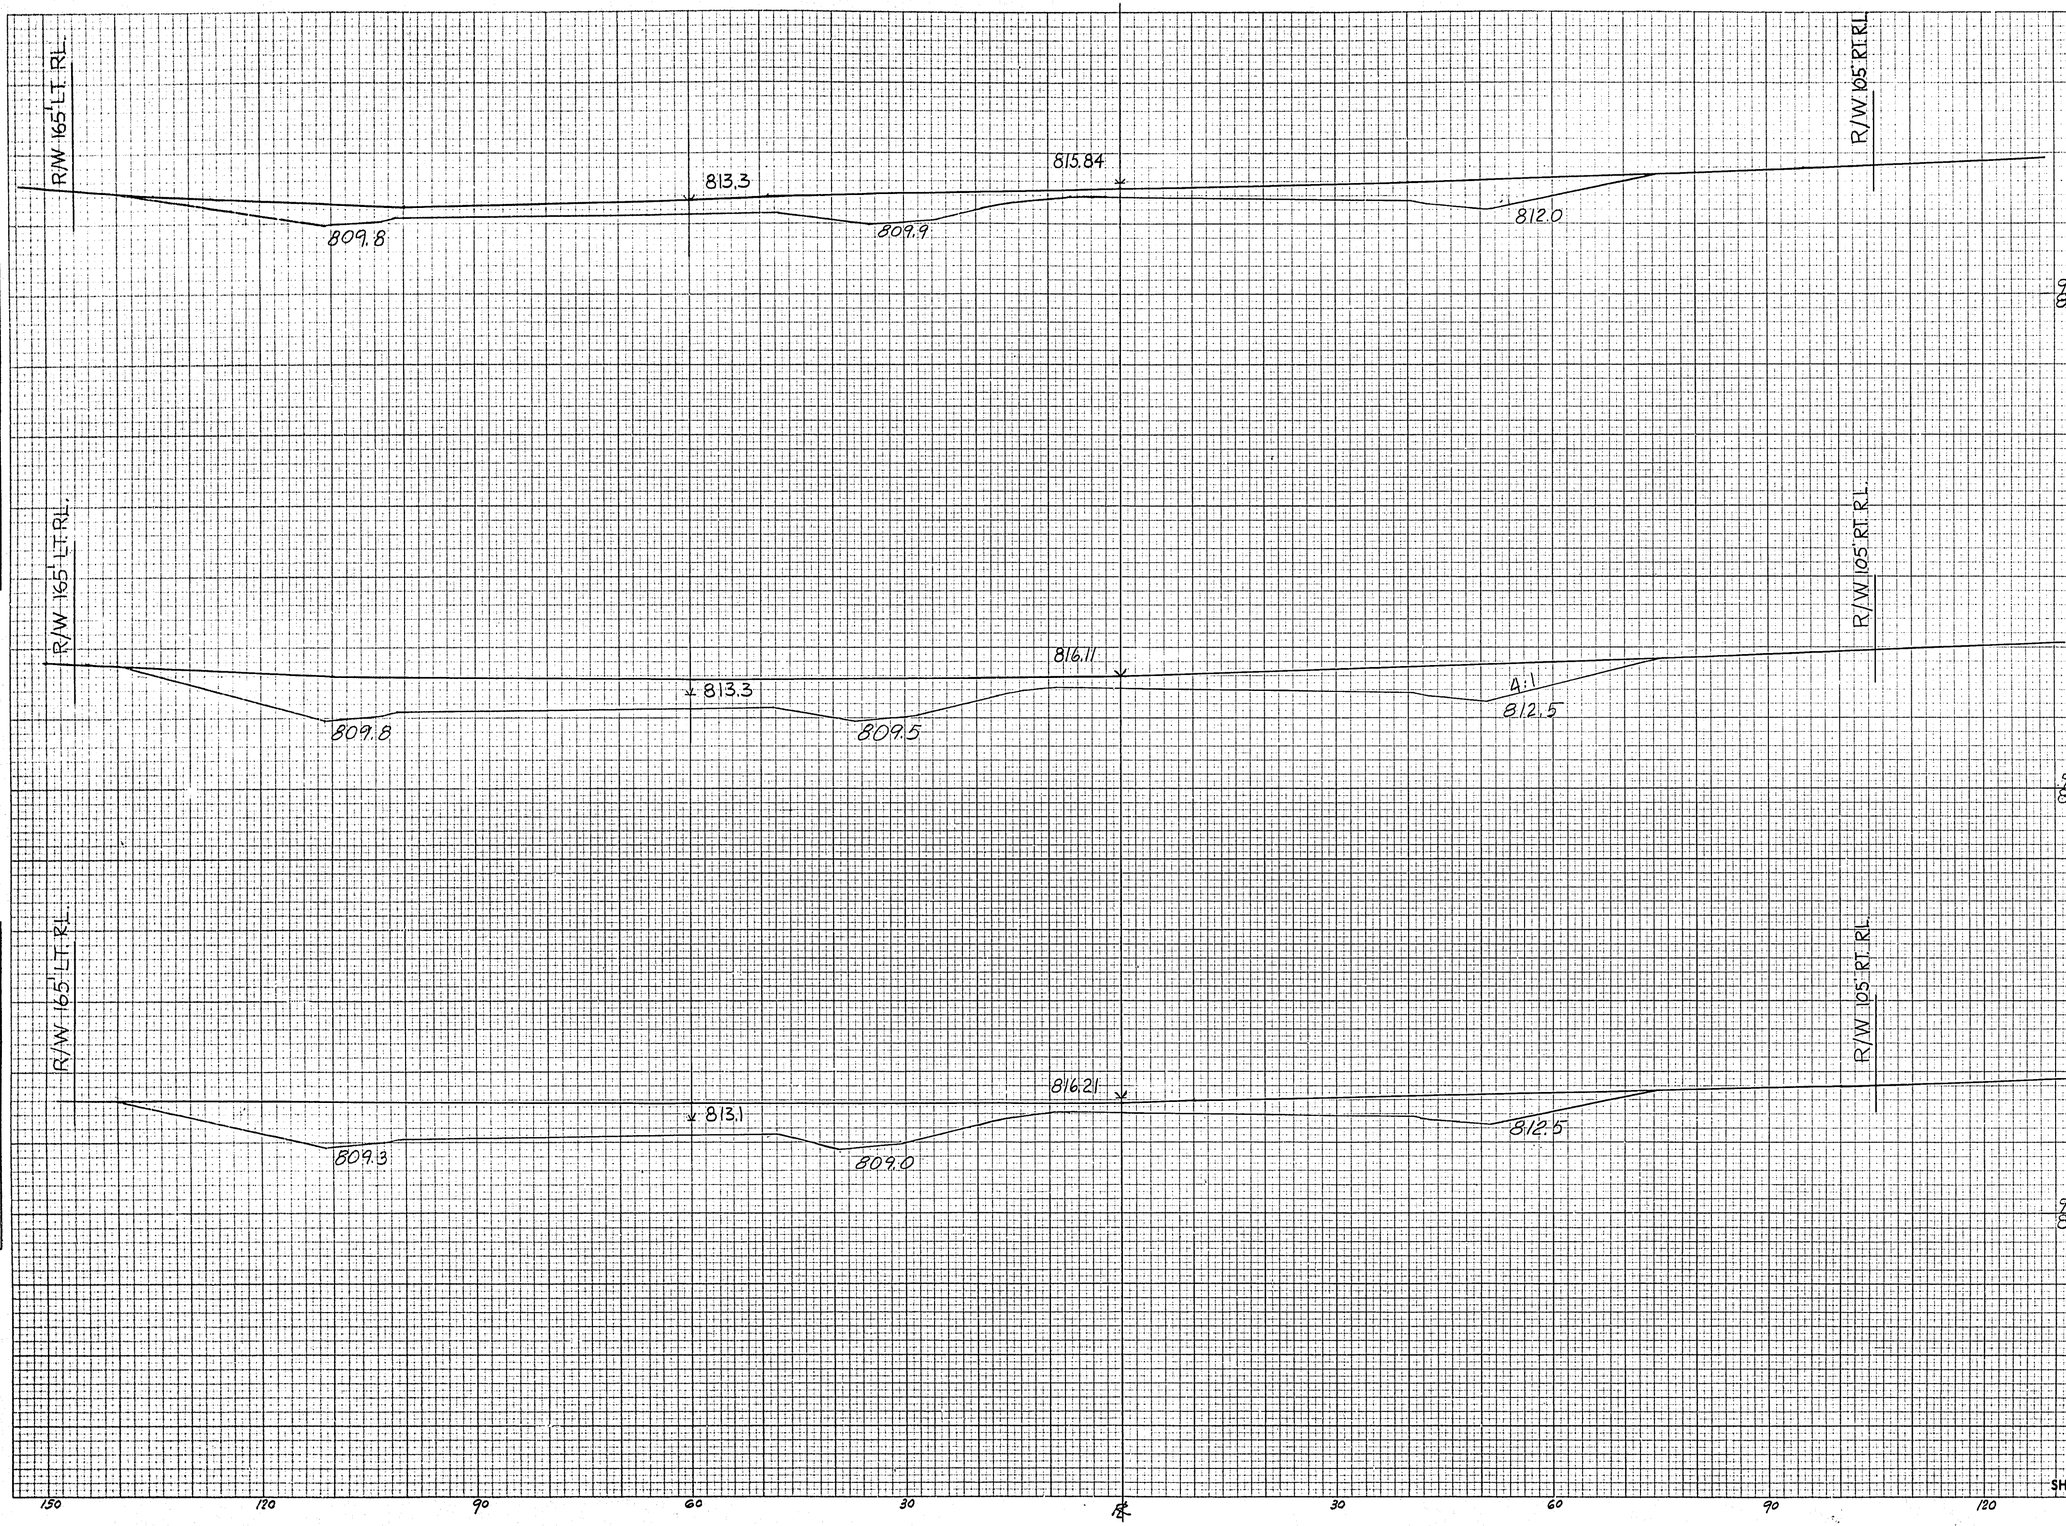

STATION	DISTANCE	YARDAGE EXCAVATION UNCL.			FILL
972 800					
972					
	100	2325			0
971 800					
971					
	100	2935			0
970					
	100	2734			0
970 800					
969					
SHEET TOTAL		8044			0

PLATE 3—CROSS SECTION O. P. R. & R. E. STANDARD
THE FREDERICK POST CO., CHICAGO

970-972

B.P.R. DISTRICT OFFICE	PROJECT	SHEET NUMBER	TOTAL SHEETS
WIS. 4	I-90-2(18)105	165	264

FINAL SURVEY — SURVEYED / PLOTTED / TEMPLATE / AREAS / AREAS CHECKED / NOTE BOOK / NO. — BY / DATE

ORIGINAL SURVEY — SURVEYED / PLOTTED / TEMPLATE / JAMES / AREAS CHECKED / NOTE BOOK / NO. — BY / DATE — JJP — 4/11/63

R/W 165' LT. RL

R/W 165' LT. RL

R/W 165' RT. R.L.

R/W 105' RT. R.L.

R/W 105' RT. RL

R.L.N.W. EXIT RAMP "C"

812.3 — 809.7 — 814.09 — 813.73 — 6:1

812.8 — 808.8 — 4:1 — 810.0 — 814.83 — 811.0

813.2 — 809.3 — 6:1 — 810.3 — 815.42 — 811.5

ARL.

0.3% D.G.

10% D.G.

GROUND LINE

PAVED DITCH

℄ DITCH

4:1 — 2:1 — 1.5'

SECTION X-X

250 200 150 100 50 50 100 150

DITCH PROFILE AT STA. 974+55 @ 18° L.H.F. SKEW

STA. 974+55
TWIN 42" x 170' R.C.C.P. REQ'D.
SKEW 18° LHF

150 120 90 60 30 30 60 90 120

STATION	DISTANCE	YARDAGE EXCAVATION UNCL.	YARDAGE FILL
975			
975 810			
975			
974	100	783	113
974			
974 810	100	1614	0
973			
973 810	100	1832	0
972			
SHEET TOTAL		4229	113

PLATE 3—CROSS SECTION O. P. R. & R. E. STANDARD
THE FREDERICK POST CO., CHICAGO

50

973 - 975

B.P.R. DISTRICT OFFICE	PROJECT	SHEET NUMBER	TOTAL SHEETS
WIS. 4	T-90-2(18)165	166	264

R/W 210' LT. R.L.

R/W 210' LT. R.L.

R/W 165' LT. R.L.

R/W 141' RT. R.L.

R/W 135' RT. R.L.

R.L. N.W. EXIT RAMP STA. 978 "C"+00

MATCH LINE

R.L. N.W. EXIT RAMP STA. 977 "C"+00

R.L. N.W. EXIT RAMP STA. 976 "C"+00

809.7 — 810.99 — 809.66

6:1 — 810.7 — 807.3 — 812.13 — 811.70

811.6 — 808.5 — 813.19 — 812.71 — 6:1

978+00 / 810.00

977+00 / 810.00

976+00 / 810.00

STATION	DISTANCE	YARDAGE EXCAVATION UNCL.	YARDAGE FILL
978			
	100	14285	0
977			
	100	7521	0
976			
	100	2637	113
975			
SHEET TOTAL		24443	113

976+00 - 978+00

150 — 100 — 50 — ℄ — 50 — 100

PLATE 3—CROSS SECTION O. P. R. & R. E. STANDARD
THE FREDERICK POST CO., CHICAGO

FINAL SURVEY — SURVEYED, PLOTTED, TEMPLATE, AREAS, CHECKED, NO. — NOTE BOOK

ORIGINAL SURVEY — SURVEYED 4-17-58, PLOTTED 12-4-58, TEMPLATE 12-4-58, AREAS 4-19-58, CHECKED J.J.P., NO. — NOTE BOOK

B.P.R. DISTRICT OFFICE	PROJECT	SHEET NUMBER	TOTAL SHEETS
WIS. 4	I-90-2(18)105	167	264

STATION	DISTANCE	YARDAGE EXCAVATION UNCL.	YARDAGE EXCAVATION	YARDAGE EXCAVATION	YARDAGE EXCAVATION	YARDAGE FILL
981						
980	100	19,990				0
979	100	22,065				0
978	100	20,618				0
SHEET TOTAL		62,673				0

979+00 - 981+00

R/W 193' LT. RL

R/W 210' LT. RL

MATCH LINE

981+00
820.00

806.8

807.57

4:1

802.0

100 19,990 0

810

MATCH LINE

110

803.2

140

980

980+00
820.00

2½:1

807.8

808.71

R.L. STA. 980+00-53' RT.
= STA. 979"C"+85-48' LT.

R.L. N.W. EXIT RAMP
STA. 979"C"+85

4:1

100 22,065 0

MATCH LINE

820

MATCH LINE

R/W 105' RT.
RAMP R.L.

110

140

STA. 979"C"+30
1-CONC. SURFACE DRAIN
REQ'D

979

R/W 210' LT. RL

MATCH LINE

170

MATCH LINE

100 20,618 0

R.L. N.W. EXIT RAMP
STA. 979"C"+00

979+00
820.00

2½:1

808.8

809.85

808.38

803.6

MATCH LINE

978

150 100 50 ℄ 50 100

FINAL SURVEY
SURVEYED
PLOTTED
NOTE BOOK
TEMPLATE
AREAS
VOLS.
CHECKED
DATE

ORIGINAL SURVEY
SURVEYED 7/1
PLOTTED
NOTE BOOK
TEMPLATE
AREAS
VOLS.
CHECKED

BY	DATE
E.V.E.	9/17/58
E.V.E.	9/24/58
J.L.P.	9/29/58

PLATE 3—CROSS SECTION O. P. R. & R. E. STANDARD
THE FREDERICK POST CO., CHICAGO

B.P.R. DISTRICT OFFICE	PROJECT	SHEET NUMBER	TOTAL SHEETS
WIS. 4	I-90-2(18)105	168	264

FINAL SURVEY — DATE / BY / SURVEYED / PLOTTED / TEMPLATE / NOTE BOOK / NO. / AREAS CHECKED

ORIGINAL SURVEY — DATE / BY / SURVEYED 11/22 / PLOTTED 11/25 / TEMPLATE — / NOTE BOOK 11/25 / NO. 7813 / AREAS CHECKED

R/W 210' LT. R.L.

R/W 216' LT. R.L.

R.L. S.E. ENTRANCE RAMP
STA. 984 "D"+00

804.58 — 804.9 — 805.33 — 803.7

6:1 — 799.2

R.L. STA. 984+00-40' RT. =
RAMP STA. 984 "B"+07-27' LT.

R.L. N.W. ENTRANCE RAMP

STA. 984+00 W. B.L.
1-18"x 78' C.P. REQ'D.

R.L. S.E. ENTRANCE RAMP
STA. 983 "D"+00

805.01 — 805.3 — 805.81 — 801.0

6:1 — 4:1

R.L. STA. 983+00-61' RT. =
RAMP STA. 983 "B"+16-50' LT.

R.L. S.E. ENTRANCE RAMP
STA. 982 "D"+00.0

805.68 — 805.93 — 806.56 — 801.5

802.2 — 4:1

STATION	DISTANCE	YARDAGE EXCAVATION UNCL.	YARDAGE FILL
984+00 800.00			
984			
	100	2469	0
983			
983+00 800.00			
	100	6093	0
982			
	100	13728	0
982+00 300.00			
981			
SHEET TOTAL		22350	0

150 — 100 — 50 — ℄ — 50 — 100


982+00 - 984+00

PLATE 3–CROSS SECTION O. P. R. & R. E. STANDARD
THE FREDERICK POST CO., CHICAGO

B.P.R. DISTRICT OFFICE	PROJECT	SHEET NUMBER	TOTAL SHEETS
WIS. 4	I-90-2(18)165	163	264

FINAL SURVEY — DATE — BY — SURVEYED — PLOTTED — TEMPLATE — NOTE BOOK — AREAS CHECKED — NO.

ORIGINAL SURVEY — DATE 4-30-58, 7-14-58, 4-21-60 — BY E.V.P., J.T.P. — SURVEYED — PLOTTED — TEMPLATE Subgr. 1/ — NOTE BOOK — AREAS — AREAS CHECKED

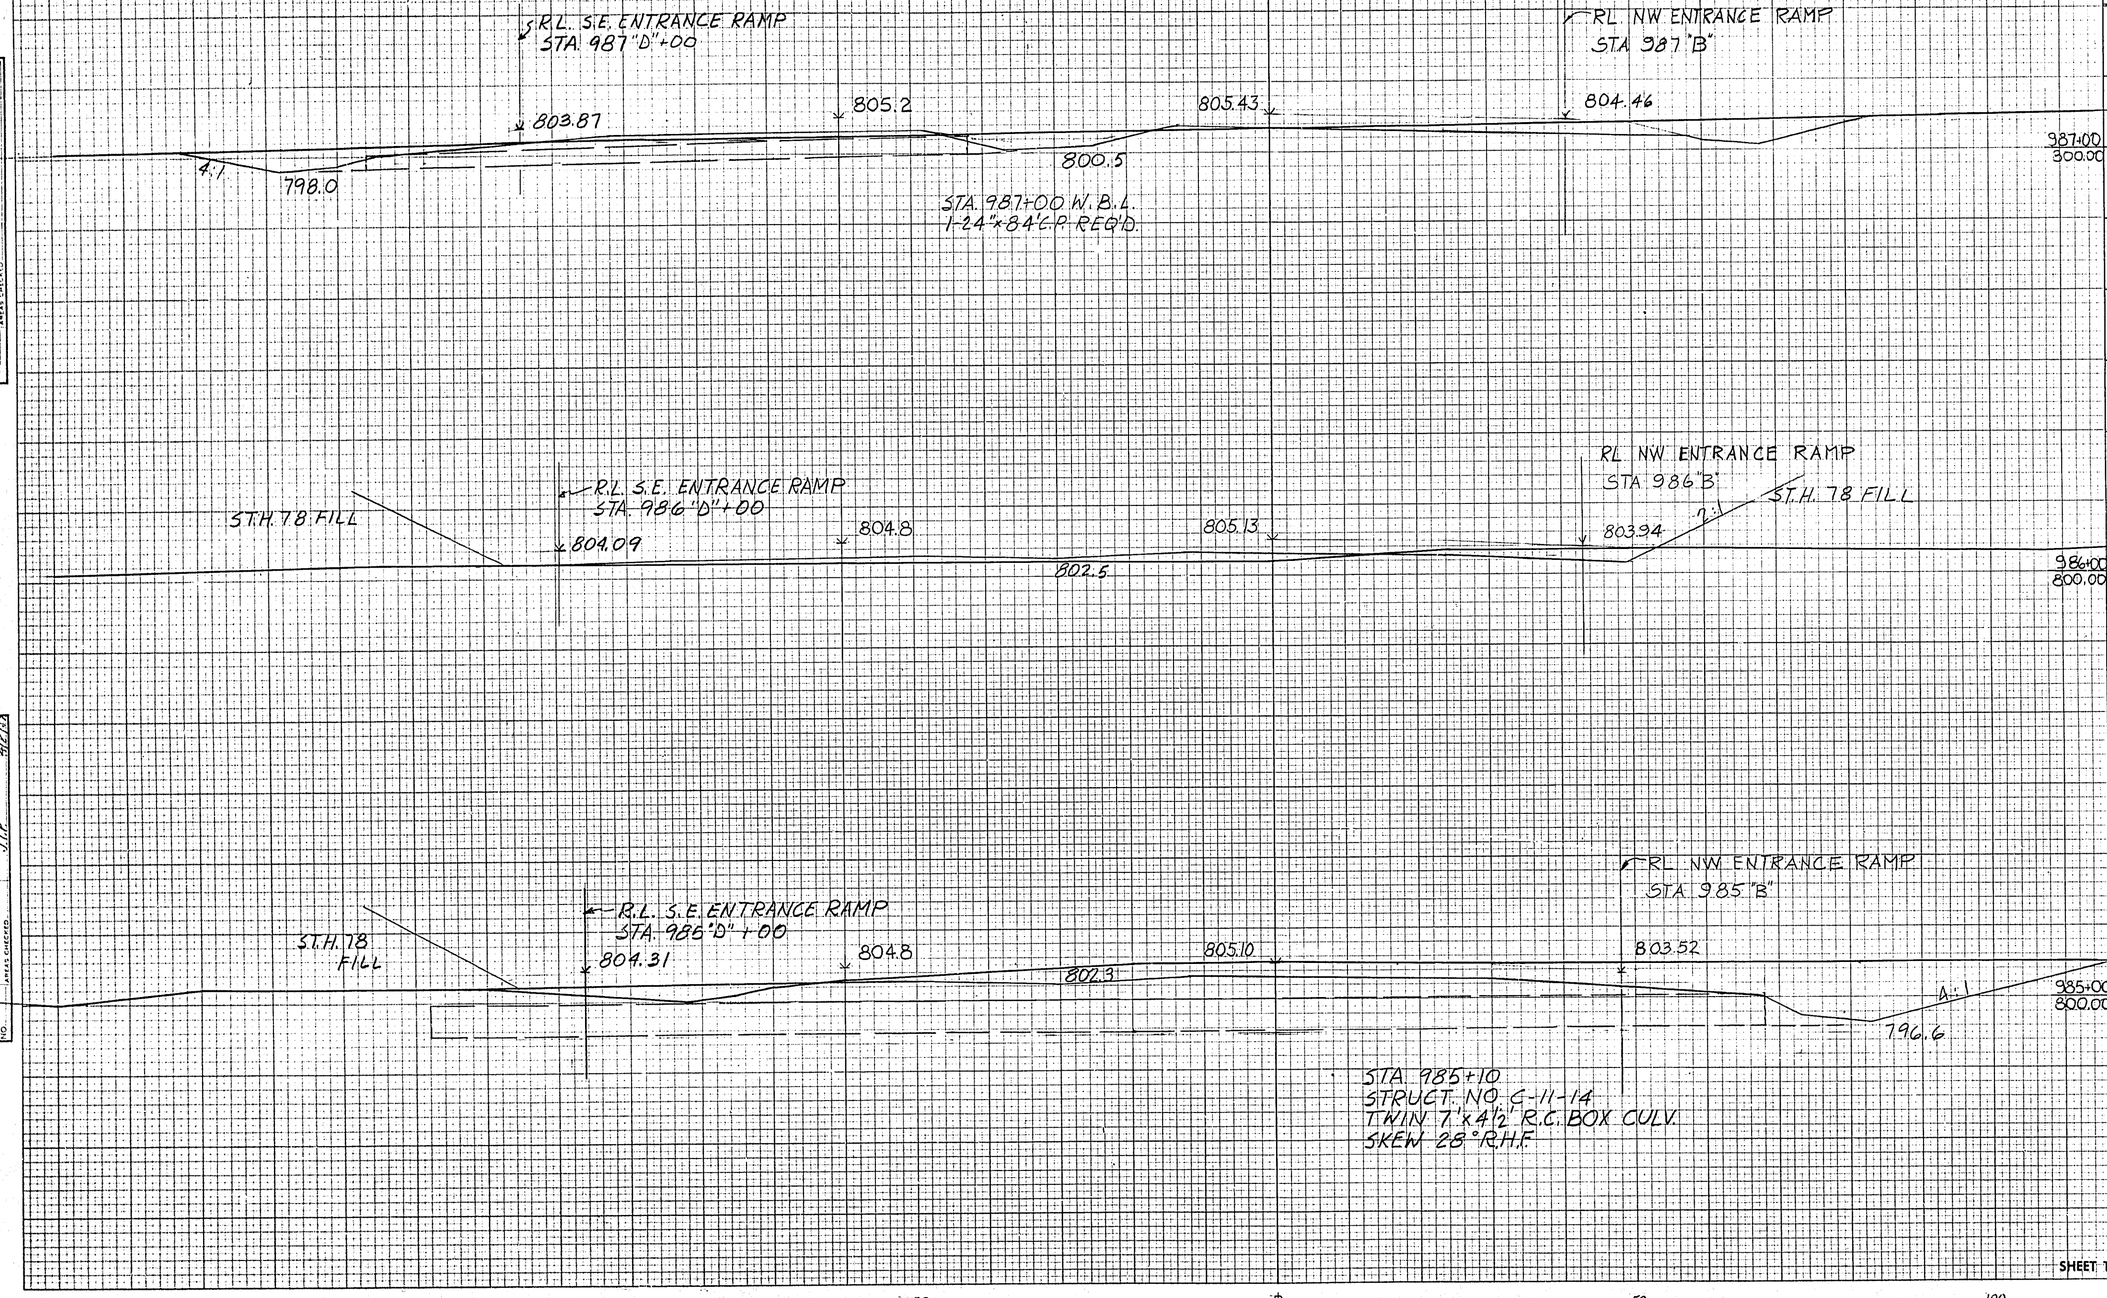

STATION	DISTANCE	YARDAGE EXCAVATION UNCL.	YARDAGE EXCAVATION	YARDAGE EXCAVATION	YARDAGE EXCAVATION	YARDAGE FILL
987	100	501				223
986	100	1099				236
985	100	1902				99
984						
SHEET TOTAL		3502				558

PLATE 3—CROSS SECTION O. P. R. & R. E. STANDARD
THE FREDERICK POST CO., CHICAGO

B.P.R. DISTRICT OFFICE	PROJECT	SHEET NUMBER	TOTAL SHEETS
WIS. 4	I-90-2(18)105	170	264

FINAL SURVEY — SURVEYED / PLOTTED / TEMPLATE / AREAS / NOTE BOOK / NO. / BY / DATE

ORIGINAL SURVEY — SURVEYED / PLOTTED 7-1-68 / TEMPLATE SUBGR. 7-1 / AREAS 8-2-68 / NOTE BOOK / NO. 4963 / BY J.J.D. / DATE

STATION	DISTANCE	YARDAGE EXCAVATION UNCL.	YARDAGE FILL
100	1476		537
100	2169		352
100	1301		219
SHEET TOTAL		5,446	1,108

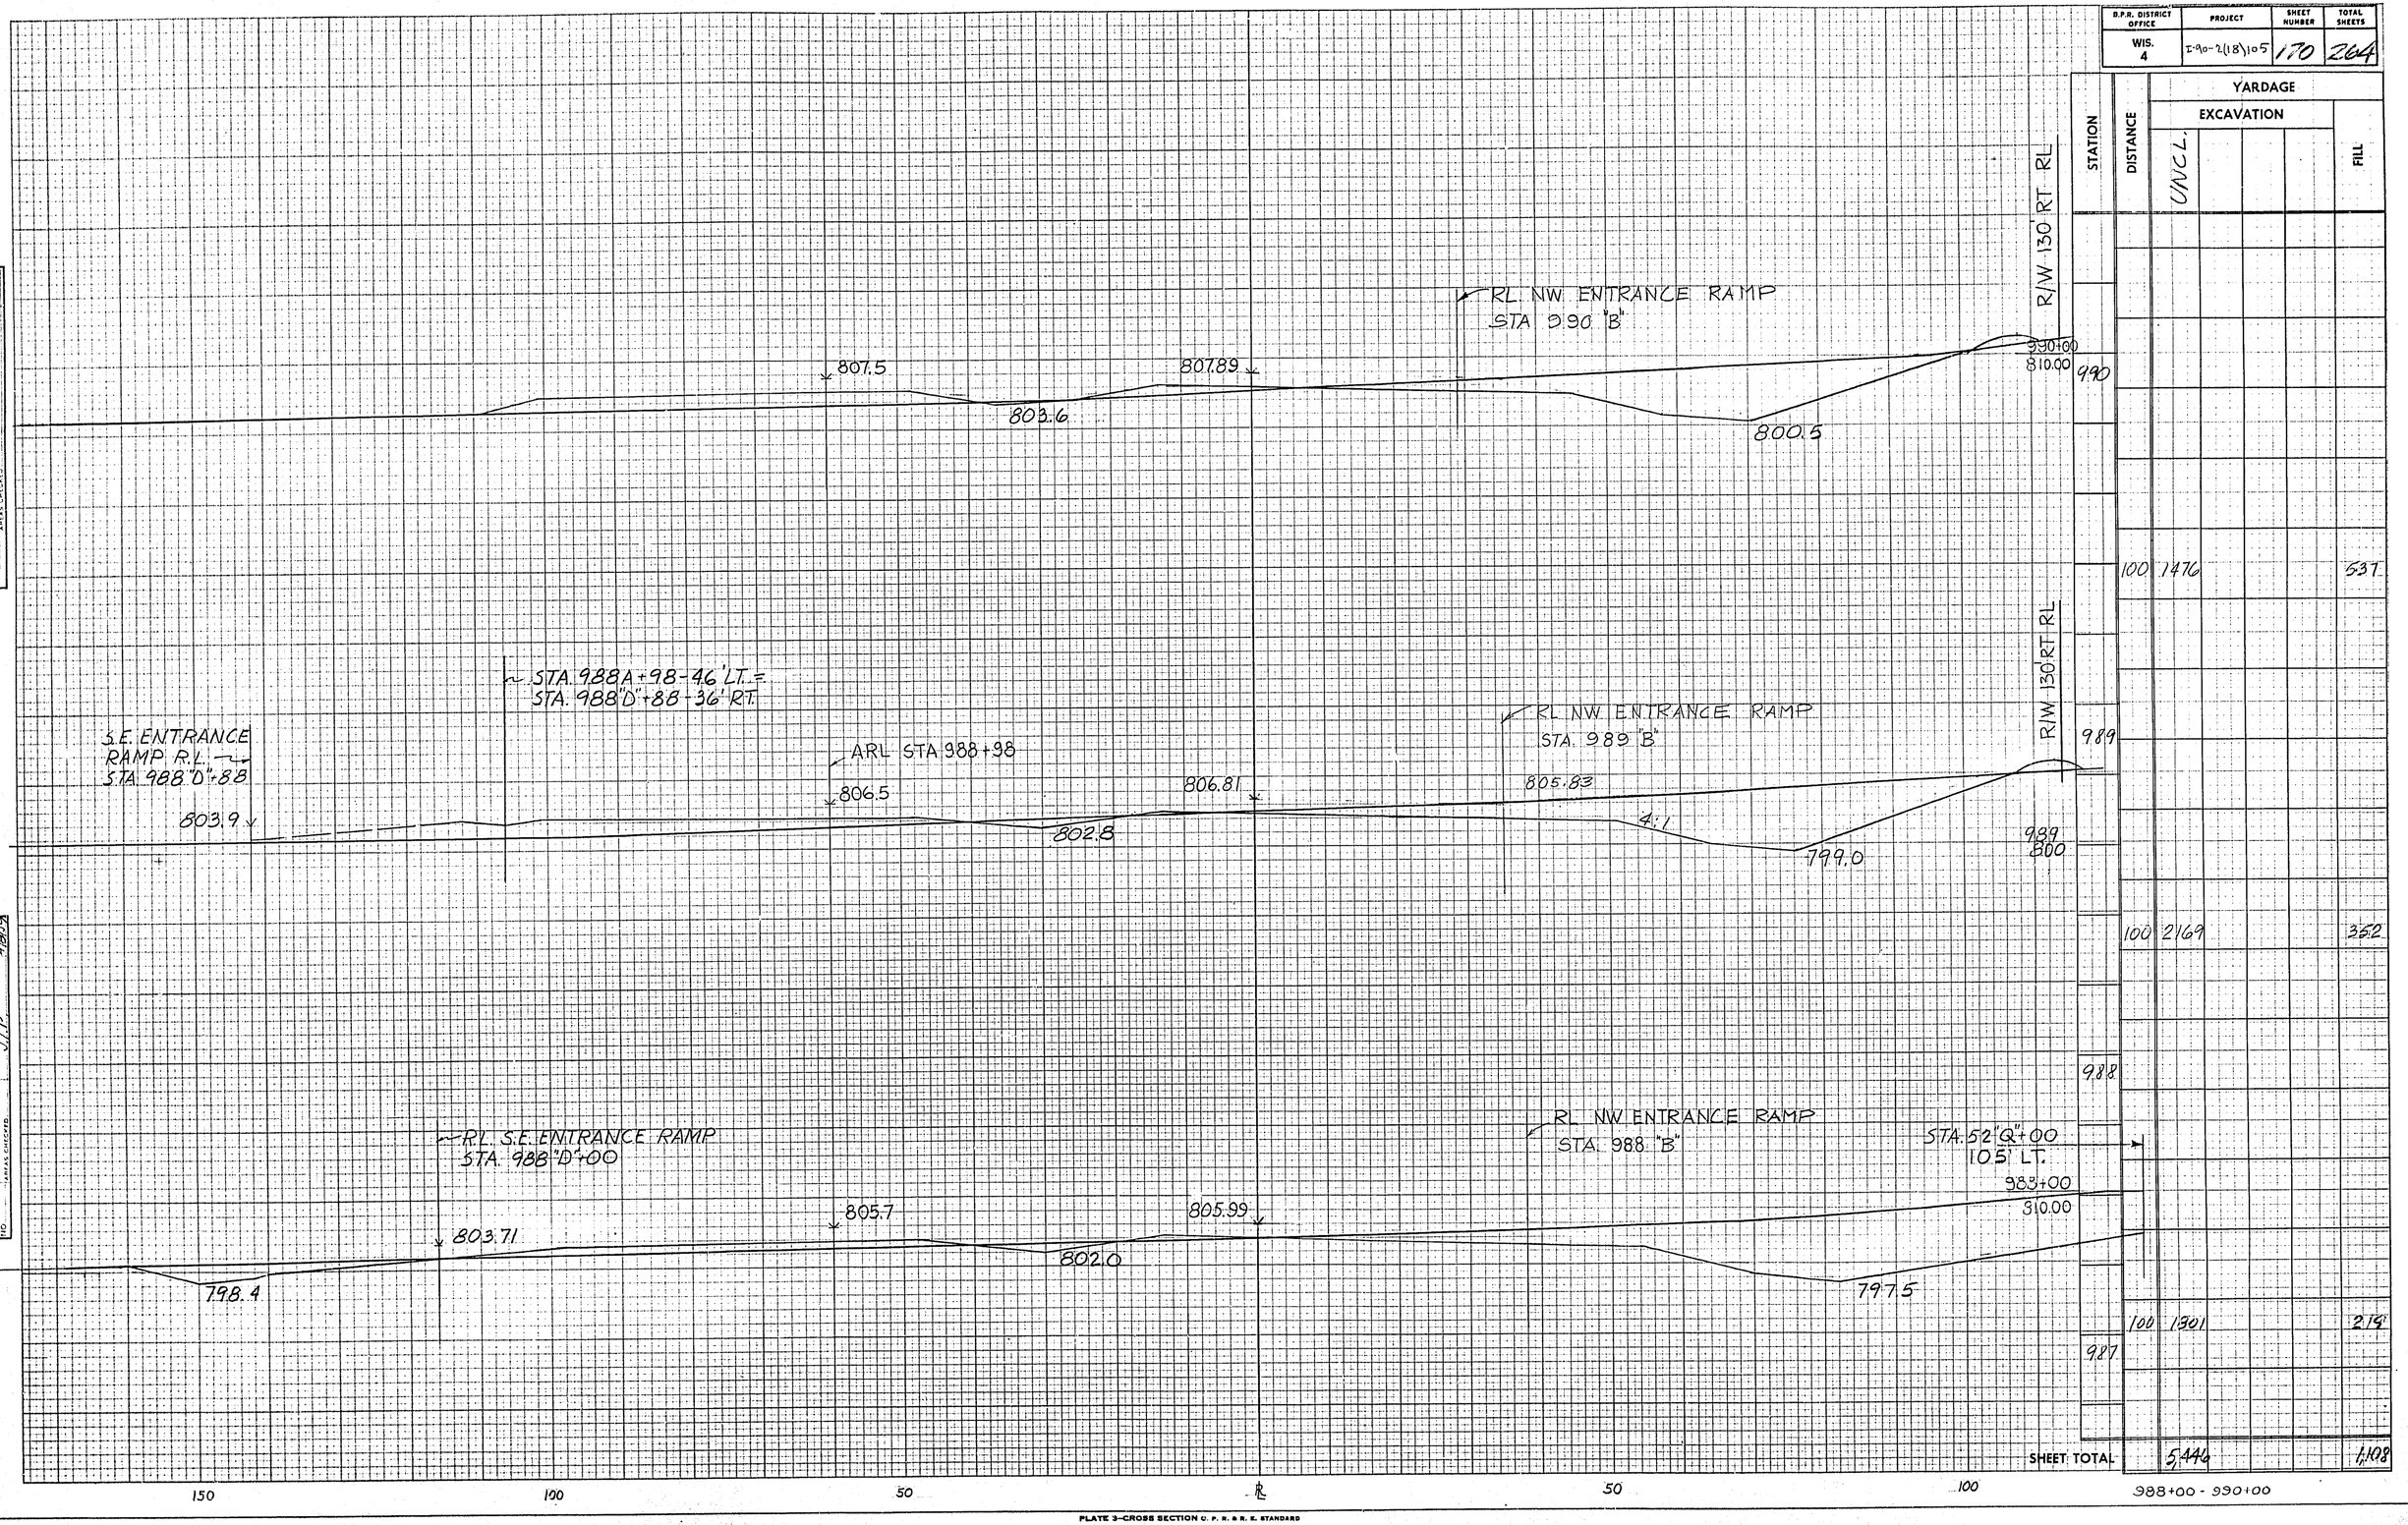


PLATE 3—CROSS SECTION C. P. R. R. R. E. STANDARD
THE FREDERICK POST CO., CHICAGO

55

B.P.R. DISTRICT OFFICE	PROJECT	SHEET NUMBER	TOTAL SHEETS
WIS. 4	I-90-2(18)106	171	264

FINAL SURVEY — SURVEYED / PLOTTED / NOTE BOOK / NO — TEMPLATE / AREAS CHECKED / DATE

ORIGINAL SURVEY — SURVEYED / PLOTTED / NOTE BOOK / NO — TEMPLATE / AREAS CHECKED / BY E.V.B. J.L.P. / DATE 7-21-58 8/18/58

ARL STA 993+06
811.6
811.52
4:1
4:1
4:1
4:1
806.0
805.0
R/W 130' RT RL

ARL STA 992+04
810.2
810.31
4:1
4:1
4:1
2½:1
805.2
803.5
R/W 130' RT RL

ARL STA 991+02
808.2
809.10
4:1
4:1
804.4
802.0
R/W 130' RT RL

150 100 50 ℄ 50 100

STATION	DISTANCE	YARDAGE EXCAVATION UNCL.	YARDAGE FILL
993			
993+00			
810.00			
	100	1721	7330
992			
992+00			
810.00			
	100	1660	1231
991			
	100	1423	917
991+00			
810.00			
990			
SHEET TOTAL		4,804	3,478


991+00 - 993+00

PLATE 3—CROSS SECTION O. P. R. & B. E. STANDARD
THE FREDERICK POST CO., CHICAGO

B.P.R. DISTRICT OFFICE	PROJECT	SHEET NUMBER	TOTAL SHEETS
WIS. 4	I-90-2(18)105	172	264

FINAL SURVEY — SURVEYED — PLOTTED — TEMPLATE — NOTE BOOK — AREAS — NOS. — AREAS CHECKED — BY — DATE

ORIGINAL SURVEY — SURVEYED — PLOTTED — TEMPLATE — NOTE BOOK — AREAS — NOS. — AREAS CHECKED — BY — DATE — S.V.S. 4-31-68 — J.J.P. 4/9/68

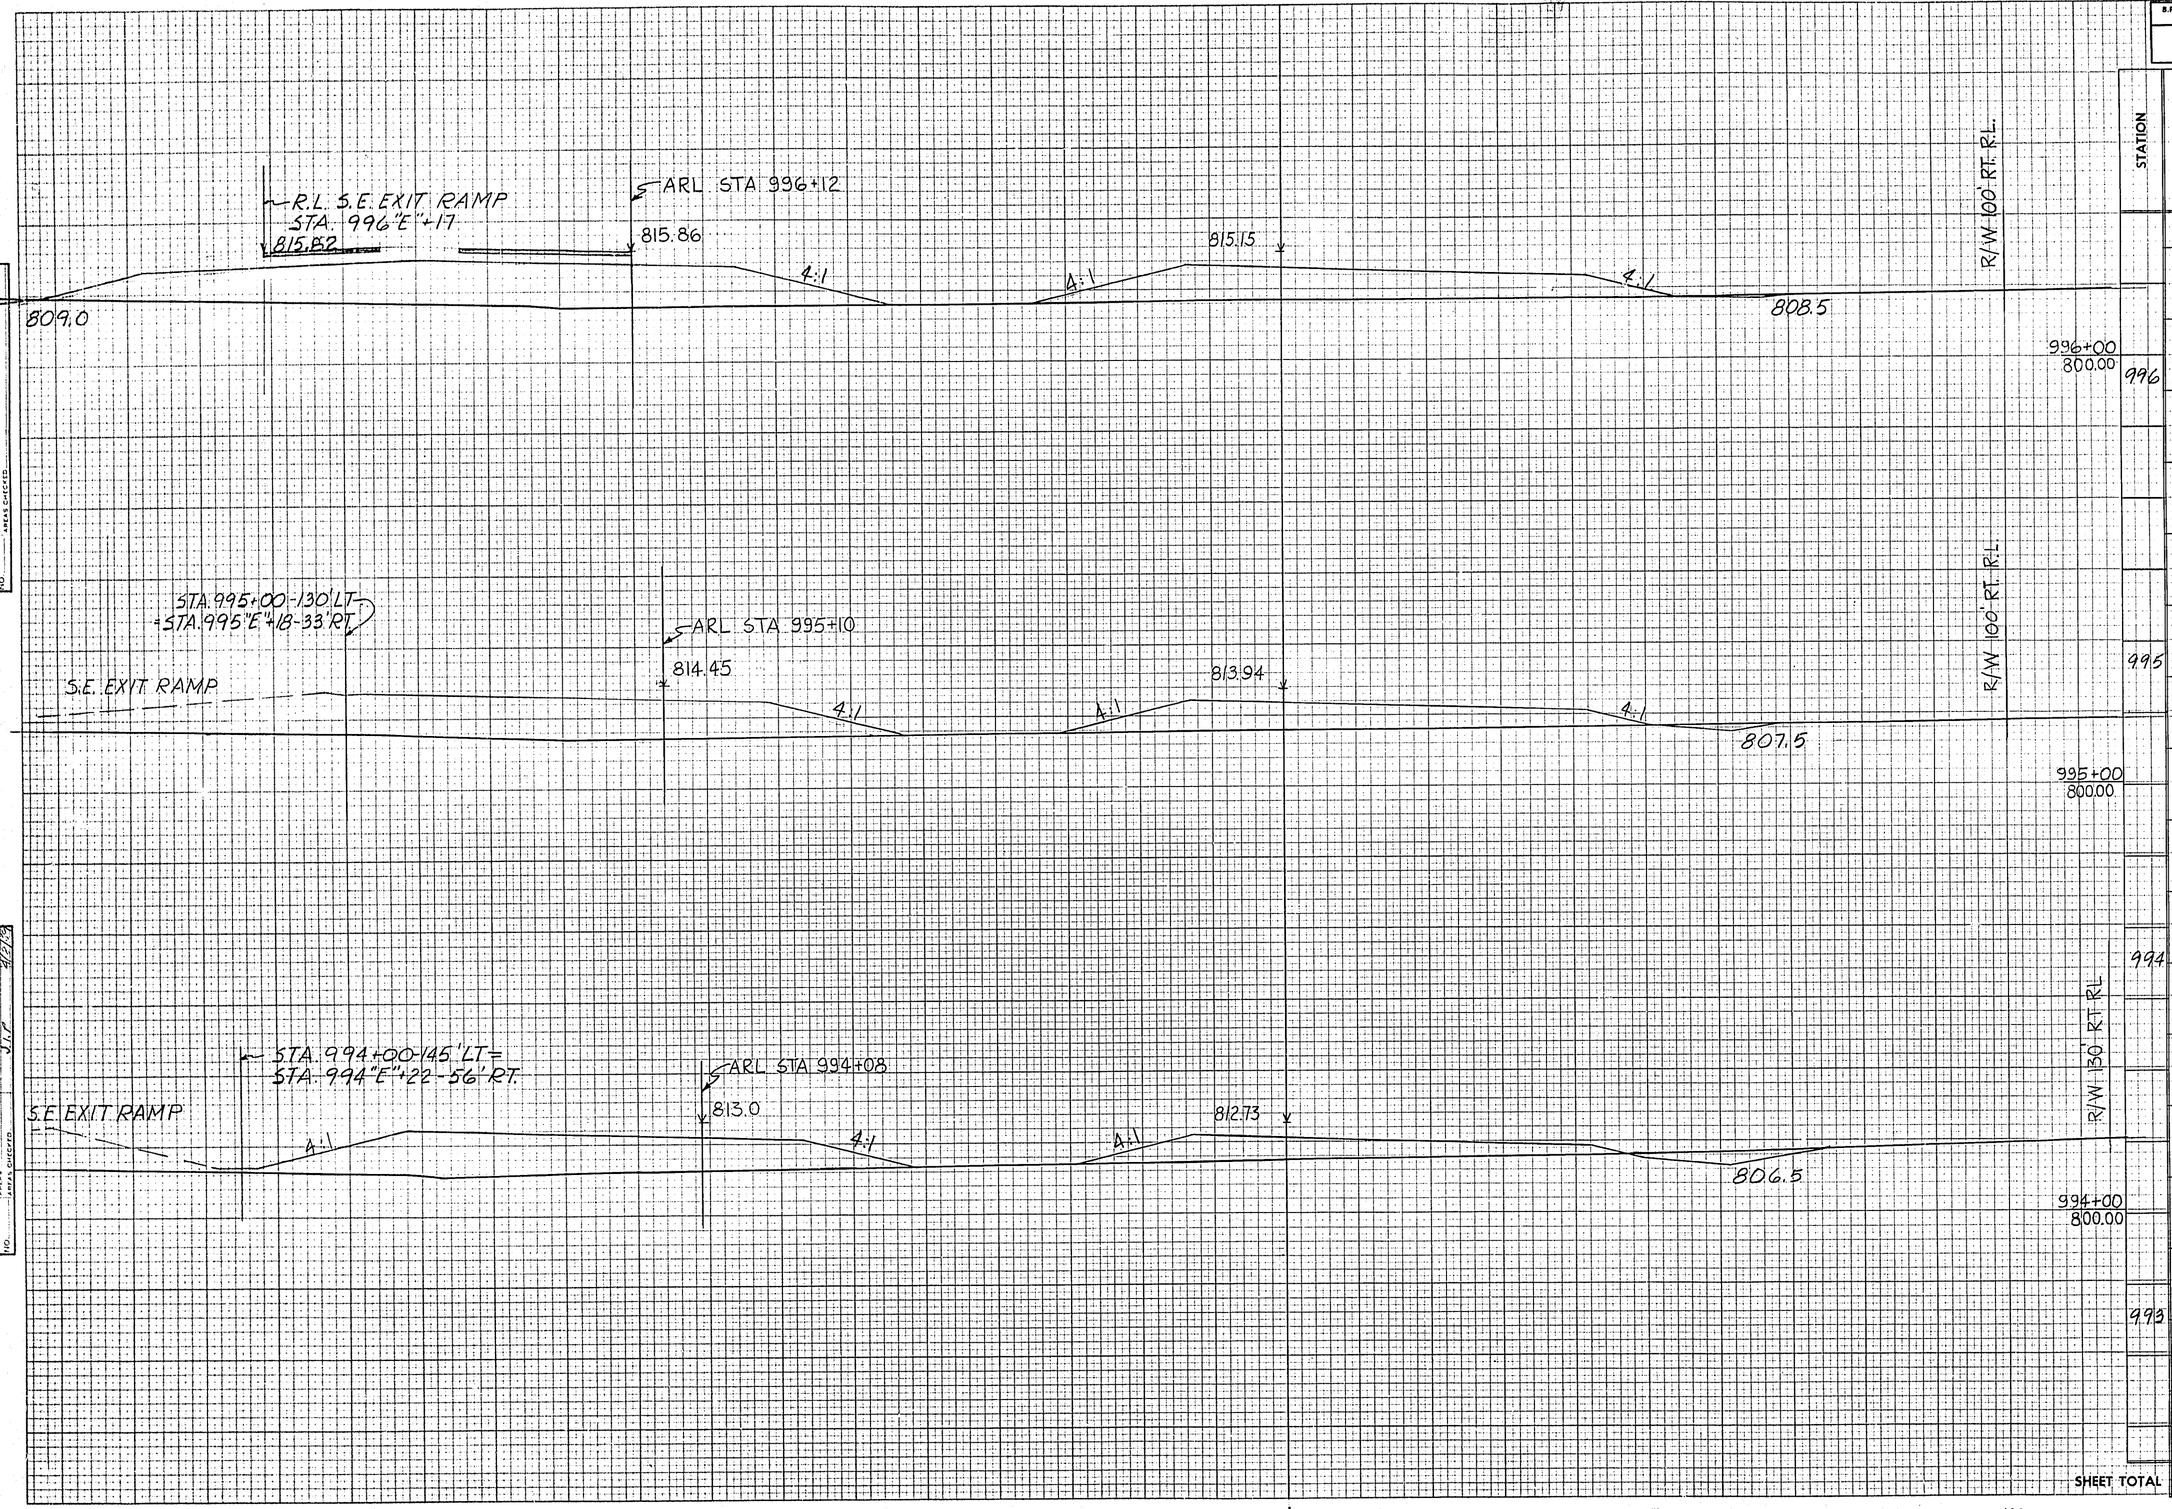

STATION	DISTANCE	YARDAGE EXCAVATION UNCL				FILL
996+00 800.00						
996						
	100	30				2827
995+00 800.00						
995						
	100	73				2301
994						
	100	863				1778
994+00 800.00						
993						
SHEET TOTAL		966				6906

994+00 – 996+00

PLATE 3—CROSS SECTION C. P. R. & R. E. STANDARD
THE FREDERICK POST CO., CHICAGO

B.P.R. DISTRICT OFFICE	PROJECT	SHEET NUMBER	TOTAL SHEETS
WIS. 4	I-90-2(18)105	173	264

R/W 109' LT. ARL

R.L. S.E. EXIT RAMP
STA. 999'E'+18

820.88

ARL STA 999+16

820.0

4:1

4:1

818.78

4:1

4:1

R/W 100' RT. R.L.

R/W 113' LT. ARL

R.L. S.E. EXIT RAMP
STA. 998'E'+16

819.43

ARL STA 998+14

818.6

4:1

4:1

817.57

4:1

4:1

R/W 100' RT. R.L.

R.L. STA. S.E. EXIT RAMP
STA. 997'E'+15

817.83

ARL STA 997+13

817.3

4:1

4:1

816.36

4:1

4:1

R/W 100' RT. R.L.

STATION	DISTANCE	YARDAGE EXCAVATION UNCL.	YARDAGE FILL
999+00	800.00		
999			
	100	0	3796
998			
998+00	800.00		
	100	0	3747
997			
997+00	800.00		
	100	13	3672
996			
SHEET TOTAL		13	11155

150 100 50 ℄ 50 100

997+00 - 999+00

FINAL SURVEY — SURVEYED, PLOTTED, TEMPLATE, AREAS CHECKED, NOTE BOOK, NO.


ORIGINAL SURVEY — BY, DATE, SURVEYED, PLOTTED, TEMPLATE, AREAS CHECKED, NOTE BOOK, NO.

PLATE 3—CROSS SECTION O. P. R. & R. E. STANDARD
THE FREDERICK POST CO., CHICAGO

B.P.R. DISTRICT OFFICE	PROJECT	SHEET NUMBER	TOTAL SHEETS
WIS. 4	I-90-2(18)105	174	266

FINAL SURVEY — DATE — BY — SURVEYED — PLOTTED — TEMPLATE — AREAS — AREAS CHECKED — NOTE BOOK — NO.

ORIGINAL SURVEY — DATE 3/31/58 — BY E.S.E. — SURVEYED — PLOTTED — TEMPLATE — AREAS — AREAS CHECKED — NOTE BOOK — NO. 1116 — 7/8/58

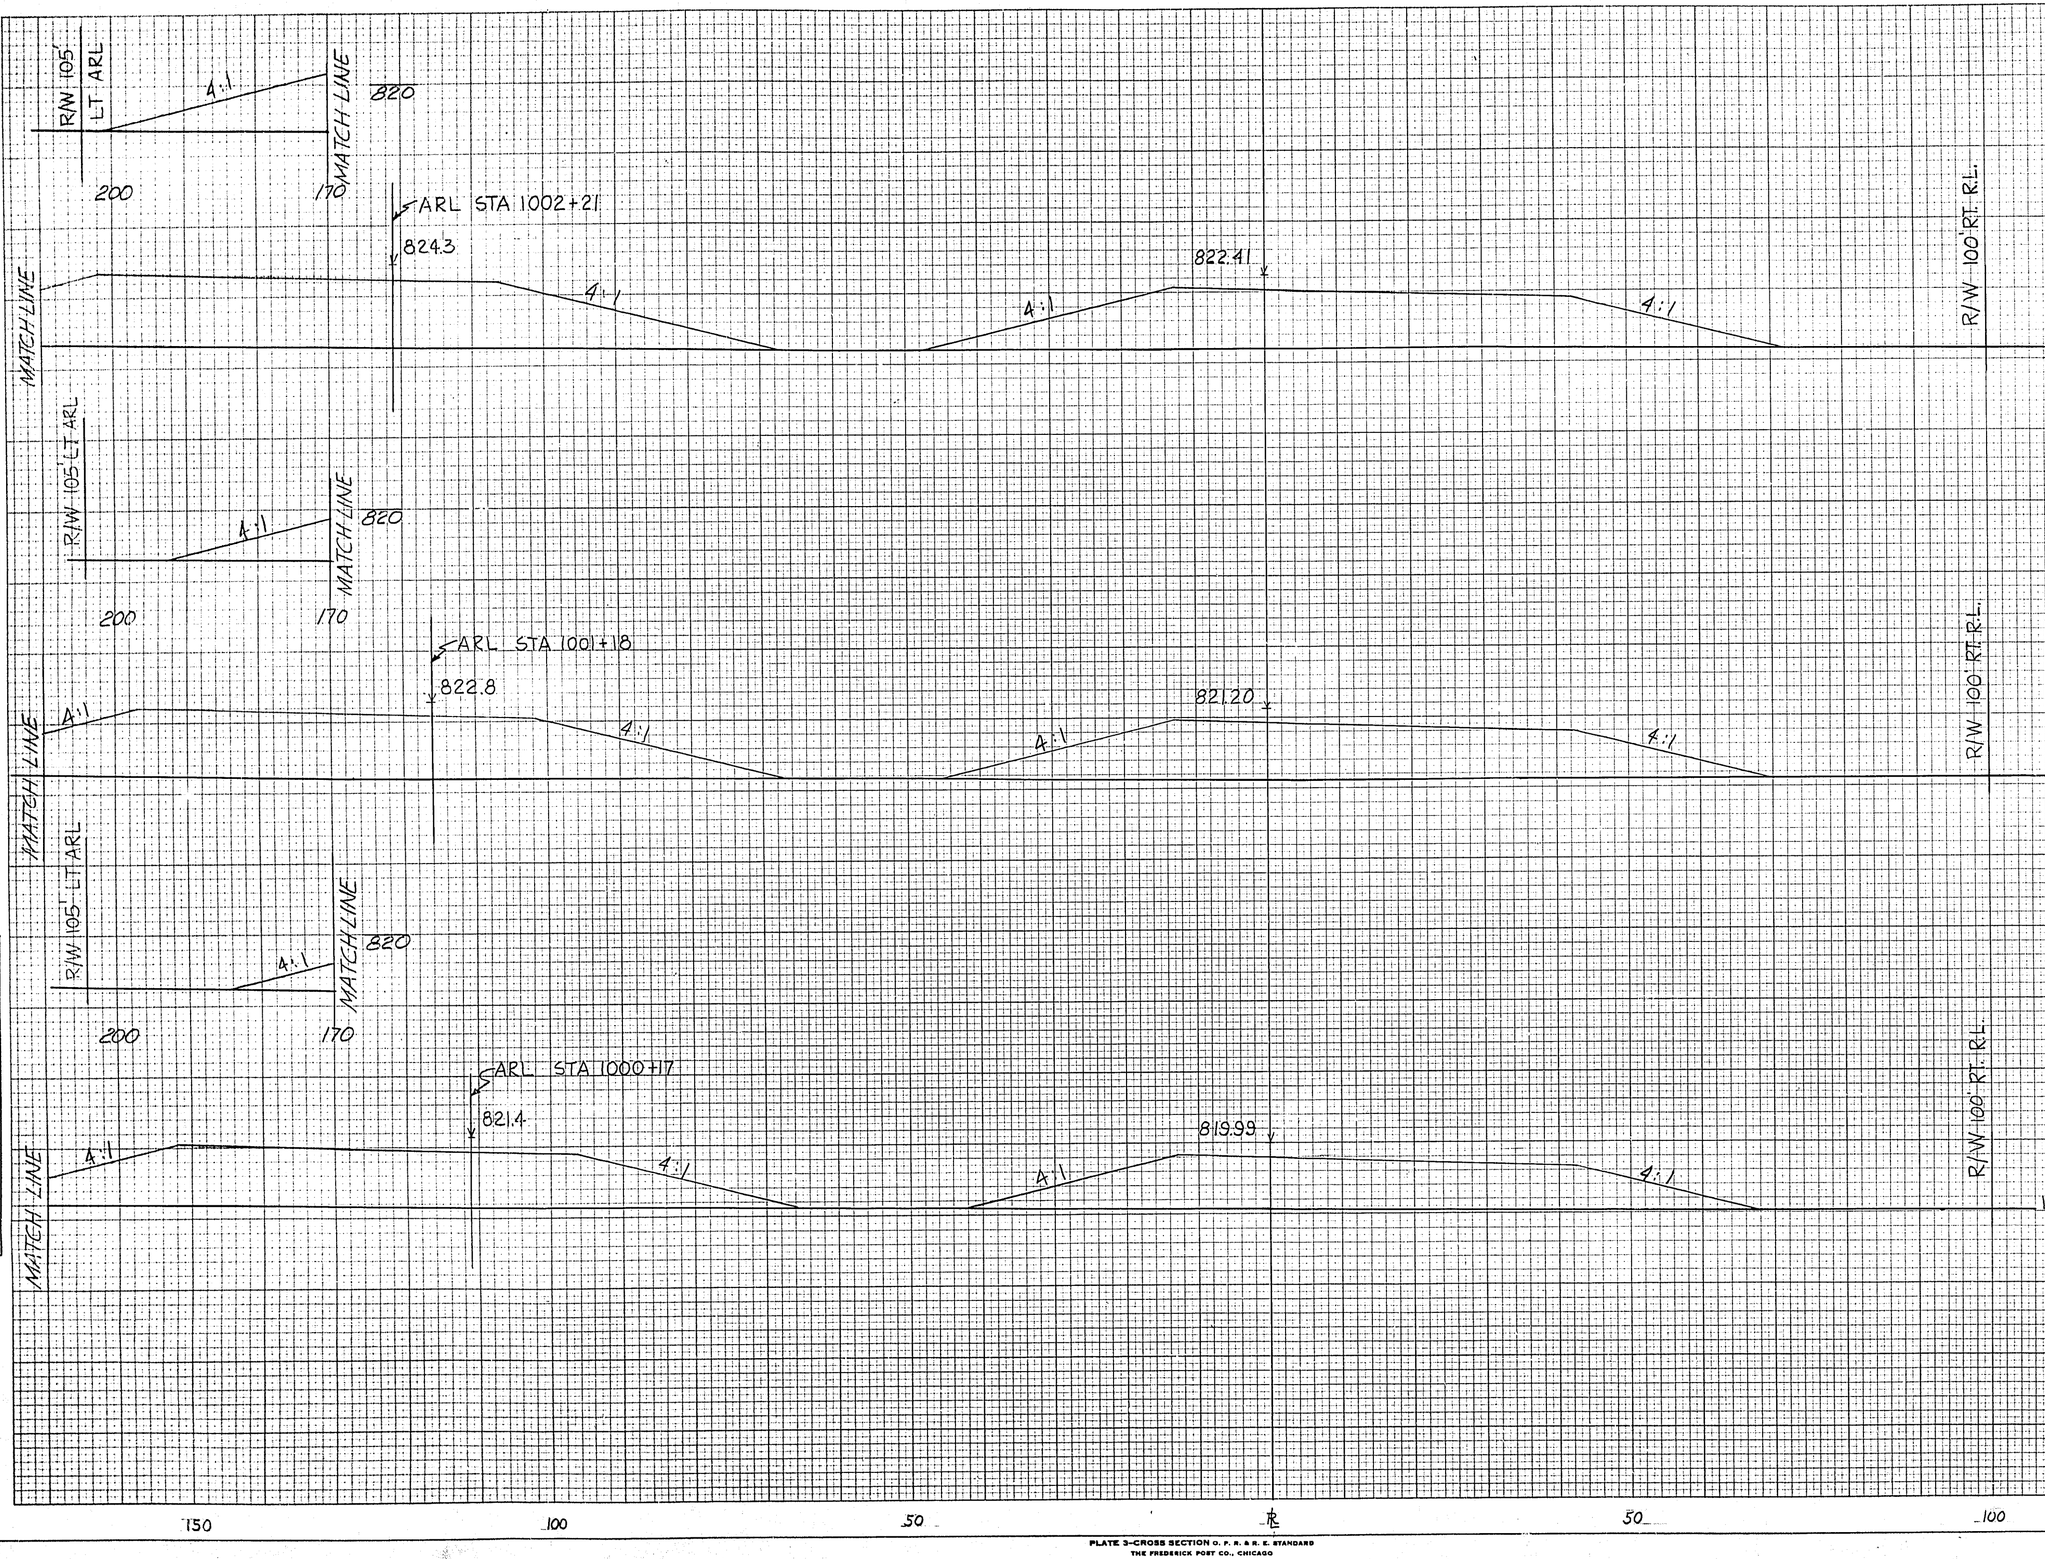

STATION	DISTANCE	YARDAGE EXCAVATION UNCL.	YARDAGE FILL
1002 810			
1002			
	100	0	5766
1001			
1001 810			
	100	0	5130
1000			
1000+00 810			
	100	0	4464
999			
SHEET TOTAL		0	15380

150 100 50 0 50 100

1000+00 - 1002+00

PLATE 3—CROSS SECTION O. P. R. & B. E. STANDARD
THE FREDERICK POST CO., CHICAGO

B.P.R. DISTRICT OFFICE	PROJECT	SHEET NUMBER	TOTAL SHEETS
WIS. 4	I-90-2(18)105	175	264

FINAL SURVEY — SURVEYED / PLOTTED / TEMPLATE / AREAS / AREAS CHECKED — NOTE BOOK — NO — DATE

ORIGINAL SURVEY — SURVEYED / PLOTTED / TEMPLATE / AREAS / AREAS CHECKED — NOTE BOOK — NO — DATE — BY C.V.E. 4-22-58 — 1005

R/W-105' LT. A.R.L.

MATCH LINE

ARL STA 1005+28
828.5

4:1 — 200 — 4:1 — 170 — 820

826.04

4:1 — 4:1

R/W 100' RT. R.L.

1005+00
810.00

1005

R/W 105' LT. A.R.L.

MATCH LINE

4:1 — 200 — 4:1 — 170 — 820

ARL STA 1004+25
827.1

824.83

4:1 — 4:1 — 4:1

814.0 — 812.5

STA. 1004+00 E. B. L.
1-24" x 118' C.P. REQ'D.

1004+00
810.00

1004

R/W-105' LT. A.R.L.

MATCH LINE

4:1 — 200 — 4:1 — 170 — 820

ARL STA 1003+22
825.7

823.62

4:1 — 4:1 — 4:1

812.0

1003+00
810.00

1003

MATCH LINE

R/W 100' RT. R.L.

1002


STATION	DISTANCE	YARDAGE EXCAVATION UNCL.	YARDAGE FILL
1005			
	100	0	5313
1004			
	100	10	6248
1003			
	100	0	6319
1002			
SHEET TOTAL		10	17880

150 — 100 — 50 — ℄ — 50 — 100

1003+00 - 1005+00

PLATE 3—CROSS SECTION O. P. R. & R. E. STANDARD
THE FREDERICK POST CO., CHICAGO

B.P.R. DISTRICT OFFICE	PROJECT	SHEET NUMBER	TOTAL SHEETS
WIS. 4	I-40-2(18)105	176	264

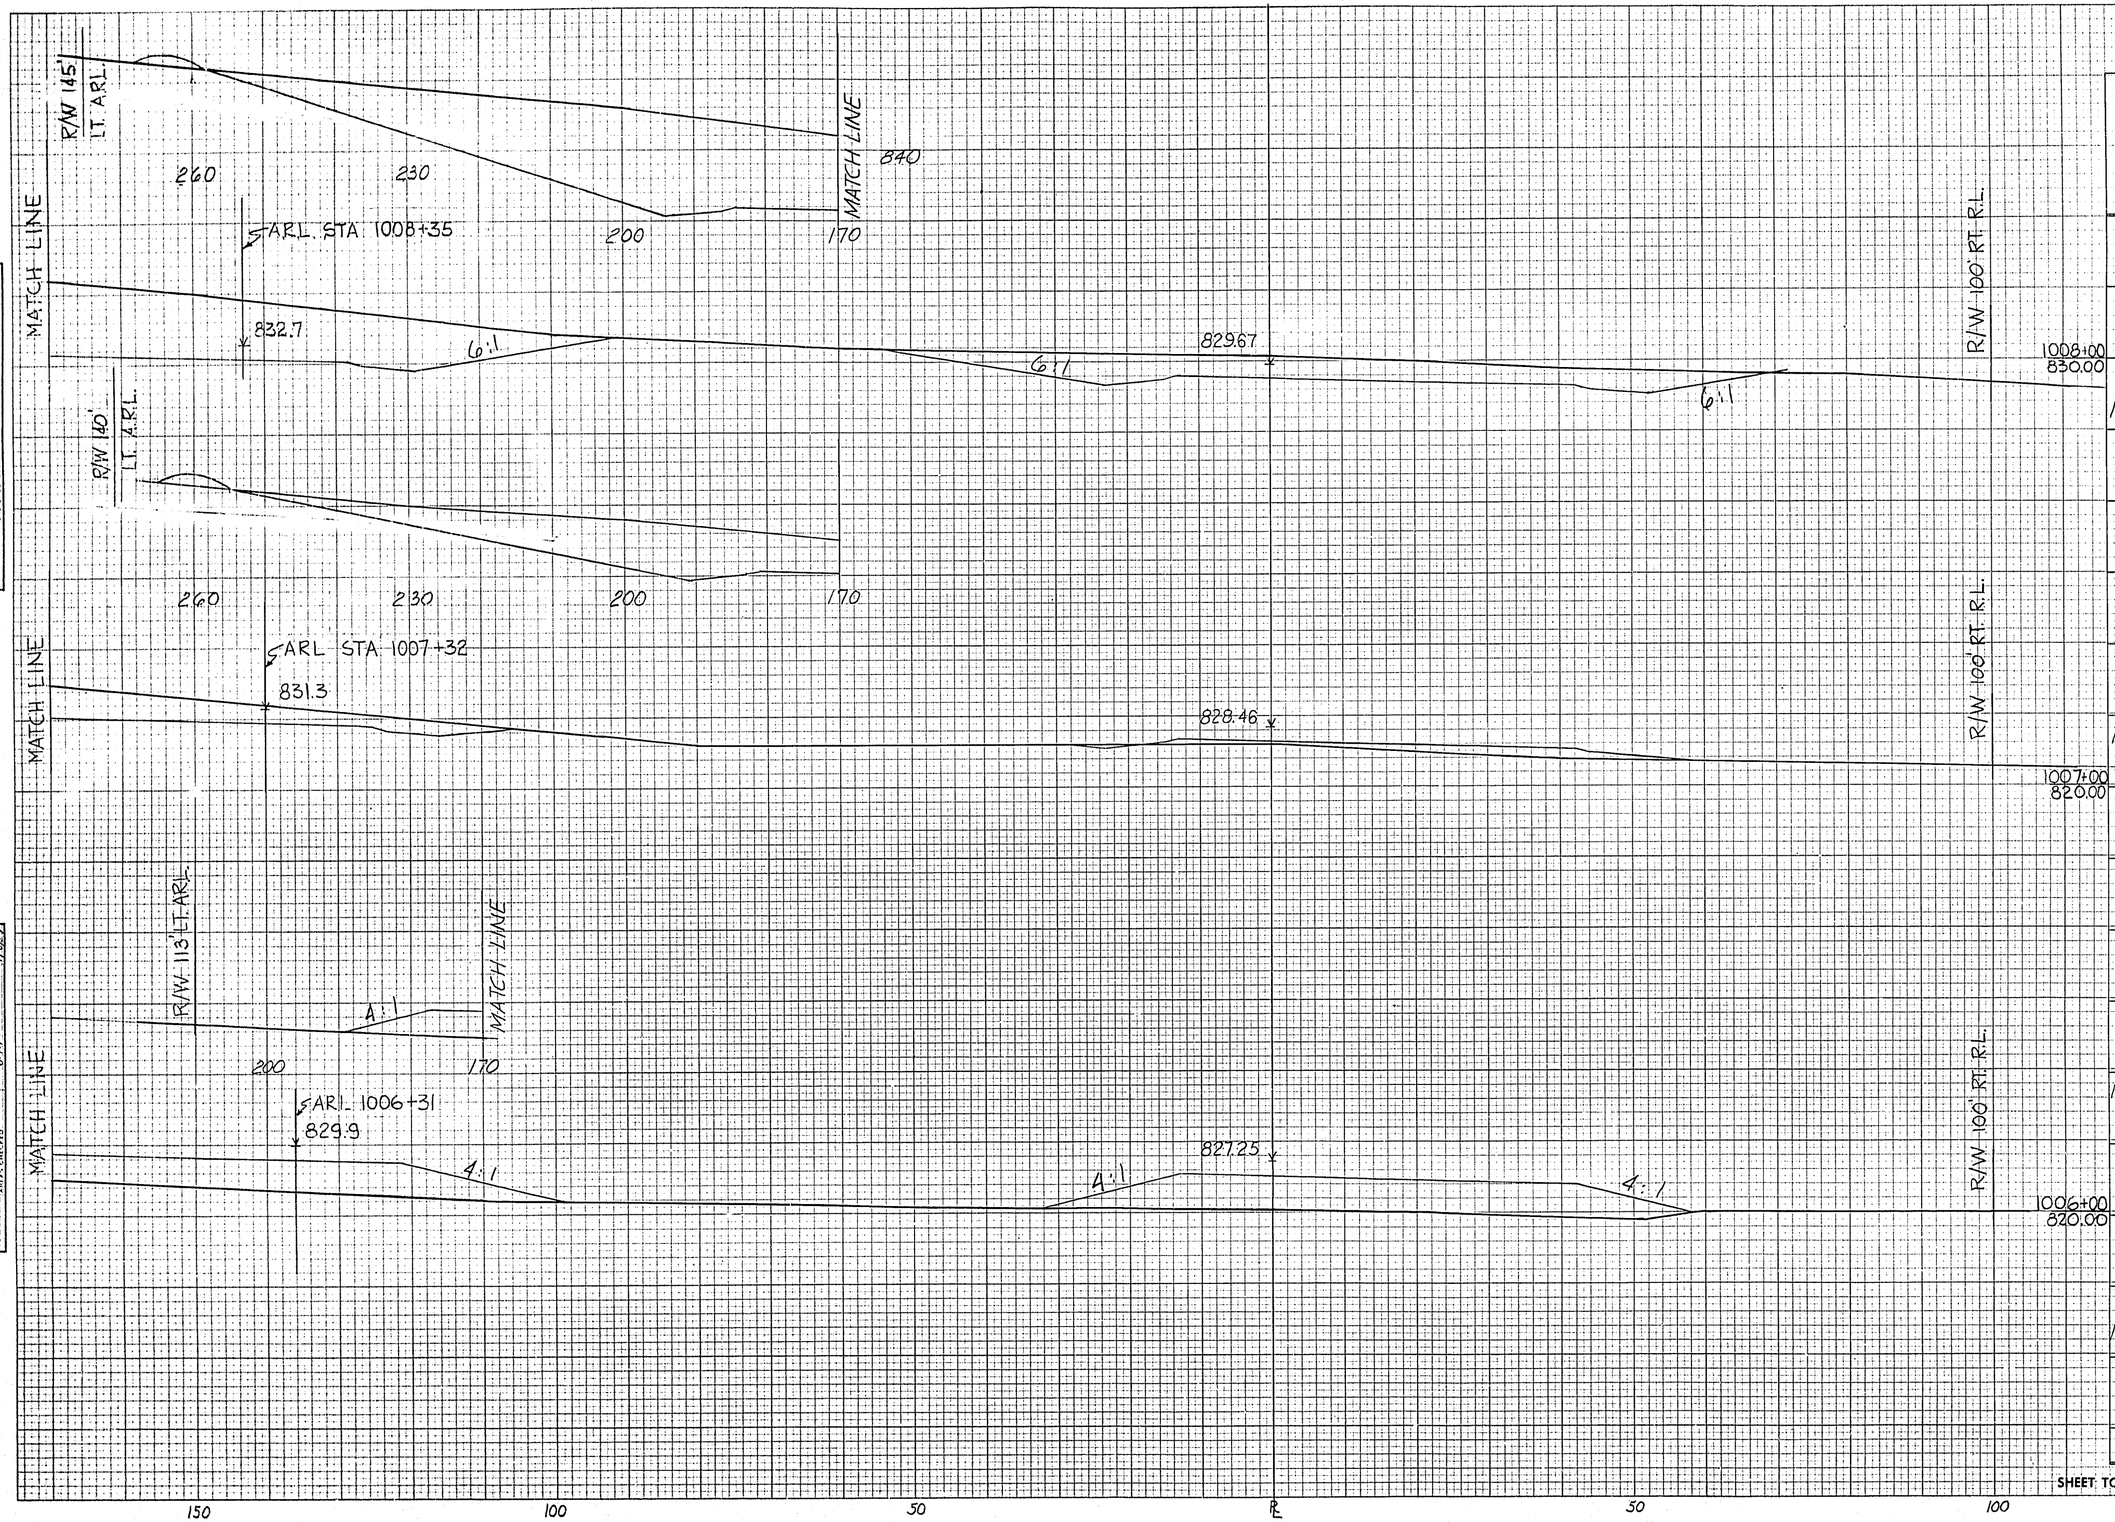

STATION	DISTANCE	YARDAGE EXCAVATION UNCL.	YARDAGE EXCAVATION	YARDAGE EXCAVATION	YARDAGE EXCAVATION	YARDAGE FILL
1008						
100	4025					154
1007						
100	1034					1356
1006						
100	0					3574
1005						
SHEET TOTAL		5059				5,084

1006+00 - 1008+00

FINAL SURVEY — SURVEYED, PLOTTED, NOTE BOOK, NO., AREAS, TEMPLATE, AREAS CHECKED, BY, DATE

ORIGINAL SURVEY — SURVEYED, PLOTTED, NOTE BOOK, NO., AREAS, BY, DATE 2-21-52, JHP, 11882

PLATE 3—CROSS SECTION O. P. R. & R. E. STANDARD
THE FREDERICK POST CO., CHICAGO

B.P.R. DISTRICT OFFICE	PROJECT	SHEET NUMBER	TOTAL SHEETS
WIS. 4	I-90-2(18)105	177	264

FINAL SURVEY — PLOTTED — NOTE BOOK, TEMPLATE, AREAS CHECKED — NO.

ORIGINAL SURVEY — PLOTTED — NOTE BOOK, TEMPLATE, AREAS CHECKED — NO.

BY J.V.P. — DATE 4-22-58 — SHEET

R/W-145'LT.ARL — MATCH LINE — ARL STA 1011+43 — 230 — 200 — 170 — MATCH LINE — R/W-145'LT.ARL

837.0

833.30

R/W 100' RT. R.L.

1011+00
830.00

270 — 240 — 210 — 180

ARL STA 1010+42

835.6

6:1

832.09

6:1

1010+00
830.00

R/W-145'LT.ARL — MATCH LINE — 270 — 230 — 200 — 170 — MATCH LINE

ARL STA 1009+39

834.2

6:1

830.88

6:1

1009+00
830.00

R/W 100' RT. R.L.

STATION	DISTANCE	YARDAGE EXCAVATION UNCL.	YARDAGE FILL
1011			
	100	6499	30
1010			
	100	5327	30
1009			
	100	5779	30
1008			
SHEET TOTAL		17605	90

150 — 100 — 50 — ℄ — 50 — 100

1009+00 - 1011+00

PLATE 3—CROSS SECTION O. P. R. & R. E. STANDARD
THE FREDERICK POST CO., CHICAGO

B.P.R. DISTRICT OFFICE	PROJECT	SHEET NUMBER	TOTAL SHEETS
WIS. 4	I-90-2(13)105	178	264

FINAL SURVEY — PLOTTED — TRACED — NOTE BOOK — TEMPLATE — AREAS — AREAS CHECKED — NO. — DATE —

ORIGINAL SURVEY — SURVEYED — PLOTTED — TRACED — NOTE BOOK — AREAS — AREAS CHECKED — NO. — BY E.V.E. — DATE 6-23-58 — 9077

R/W 145' LT. ARL — MATCH LINE — 260 — 230 — 200 — 170 — MATCH LINE — 850 — R/W 100' RT. R.L.

2 ARL STA 1014+53 — 841.3 — 2½:1 — 2½:1 — 836.93 — 2½:1 — 1014+00 — 840.00

R/W 145' LT. ARL — MATCH LINE — 290 — 260 — 230 — 200 — 170 — MATCH LINE — 850 — R/W 100' RT. R.L.

ARL STA 1013+48 — 839.8 — 2½:1 — 835.72 — 1013+00 — 840.00

R/W 145' LT. ARL — MATCH LINE — 230 — 200 — 170 — MATCH LINE — 840 — R/W 100' RT. R.L.

ARL STA 1012+45 — 838.4 — 834.51 — 1012+00 — 840.00

STATION	DISTANCE	YARDAGE EXCAVATION UNCL.	YARDAGE FILL
1014			
	100	19064	30
1013			
	100	12632	30
1012			
	100	9031	30
1011			
SHEET TOTAL		36727	90

1012+00 - 1014+00

150 — 100 — 50 — ℄ — 50 — 100

PLATE 3—CROSS SECTION O. P. R. & H. E. STANDARD
THE FREDERICK POST CO., CHICAGO

B.P.R. DISTRICT OFFICE	PROJECT	SHEET NUMBER	TOTAL SHEETS
WIS. 4	E-90-2(19)105	179	264

FINAL SURVEY — SURVEYED — PLOTTED — NOTE BOOK — NO — AREAS CHECKED — BY — DATE

ORIGINAL SURVEY — SURVEYED — PLOTTED — NOTE BOOK — NO — AREAS CHECKED — BY TAV — DATE 4-21-58 — JJC — 90-3

R/W-112' LT. ARL — MATCH LINE — ARL STA 1017+61 — 845.3 — 250 — 220 — 190 — 160 — MATCH LINE — 840

840.56 — 6:1 — 6:1 — R/W 100' RT. R.L.

R/W-145' LT. ARL — MATCH LINE — ARL STA 1016+61 — 844.0 — 6:1 — 270 — 240 — 210 — 180 — 150 — MATCH LINE — 840

(6:1) — 839.35 — R/W 100' RT. R.L.

MATCH LINE — ARL STA 1015A+58 — 838.14 — 842.7 — MATCH LINE

R/W 145' LT. ARL — 290 — 260 — 230 — 200 — 170 — R/W 100' RT. R.L.

170 — 150 — 120 — 90 — 60 — 30 — ℄ — 30 — 60 — 90 — 110

STATION	DISTANCE	YARDAGE EXCAVATION INCL.	YARDAGE FILL
1017 850			
1017			
	100	3120	51
1016			
1016 850			
	100	7392	30
1015			
	100	11,995	35
1015 850			
1014			
SHEET TOTAL		22507	111

PLATE 3—CROSS SECTION O. P. R. & R. E. STANDARD
THE FREDERICK POST CO., CHICAGO

1015 - 1017

B.P.R. DISTRICT OFFICE	PROJECT	SHEET NUMBER	TOTAL SHEETS
WIS. 4	I-90-2(18)105	130	264

FINAL SURVEY — SURVEYED — PLOTTED — TEMPLATE — NOTE BOOK — NO. — AREA CHECKED — BY — DATE

ORIGINAL SURVEY — SURVEYED — PLOTTED — TEMPLATE — NOTE BOOK — NO. — AREA CHECKED — BY J.J.P. — DATE 12-1-58

R/W 90' LT. A.R.L.

A.R.L. STA. 1020+62
848.7
4:1 4:1
850
MATCH LINE
844.17
6:1
R/W 100' RT. R.L.
1020 840

AUX. R.L. STA. 1020+25
848.1
2:1 2:1
MATCH LINE

STA. 1020A+25 W.B.L.
STRUCT. NO. C-11-12
DBL. 5'x4'x71' R.C. BOX CULV.

10'
2:1 2:1
SECTION THRU DITCH BETWEEN CULVERTS

240 210 180
MATCH LINE
843.65
2:1 2:1
16% DITCH GRADE
GRADE MEDIAN TO DRAIN TOWARDS CULVERT
GRADE TO DRAIN
+60 840

ARL STA 1019+61
847.6
4:1 4:1
840
MATCH LINE

STA. 1019+60 E.B.L.
STRUCT. NO. C-11-13
DBL. 5'x4'x59'-6" R.C. BOX CULV.

270 240 210 180
MATCH LINE
842.98
4:1 4:1
R/W 100' RT. R.L.
1019 840

ARL STA 1018+61
846.5
4:1 4:1
850
MATCH LINE

240 210 180
MATCH LINE
841.77
R/W 100' RT. R.L.
1018 840

170 150 120 90 60 30 ℄ 30 60 90 110

STATION	DISTANCE	YARDAGE EXCAVATION (UNC L.)	YARDAGE EXCAVATION	YARDAGE EXCAVATION	YARDAGE EXCAVATION	YARDAGE FILL
1020						
	100	43				2813
1019						
	100	26				2487
1018						
	100	632				117
1017						
SHEET TOTAL		701				5417

PLATE 3—CROSS SECTION O. P. R. & V. E. STANDARD
THE FREDERICK POST CO., CHICAGO

65

1018-1020

B.P.R. DISTRICT OFFICE	PROJECT	SHEET NUMBER	TOTAL SHEETS
WIS. 4	I-90-2(13)105	131	264

FINAL SURVEY — PLOTTED — NOTE BOOK TEMPLATE — NO. — AREAS CHECKED — BY

ORIGINAL SURVEY — SURVEYED — PLOTTED — TEMPLATE — AREAS — NOTE BOOK — NO. — BY — DATE — TEV 4-21-58 — JJF 4-18-58

R/W 90' LT. A.R.L.

ARL STA 1023+60
851.5

MATCH LINE

220 190 160 130

850

R/W 100' R.T. R.L.

1023
850

847.56

R/W 90' LT. A.R.L.

ARL 1022+60
850.5

MATCH LINE

230 200 170 140

850

R/W 100' R.T. R.L.

1022
850

846.46

MATCH LINE

R/W 90' LT. ARL.

ARL STA 1021+61
849.7

MATCH LINE

240 210 180 150

850

R/W 100' RT. R.L.

1021
850

845.33

170 150 120 90 60 30 ℄ 30 60 90 110

STATION	DISTANCE	YARDAGE EXCAVATION UNCL.				FILL
1023						
	100	2023				0
1022						
	100	1278				270
1021						
	100	343				1370
1020						
SHEET TOTAL		3644				1640

PLATE 3—CROSS SECTION O. P. R. & R. E. STANDARD
THE FREDERICK POST CO., CHICAGO

66

1021-1023

B.P.R. DISTRICT OFFICE	PROJECT	SHEET NUMBER	TOTAL SHEETS
WIS. 4	I-90-2(13)105	132	264

FINAL SURVEY — SURVEYED, PLOTTED, NOTE BOOK, TEMPLATE, NO., AREAS CHECKED

ORIGINAL SURVEY — SURVEYED, PLOTTED, NOTE BOOK, AREAS, NO., AREAS CHECKED — BY JJP — DATE FEB 23-58 — FIELD

R/W 90' LT. ARL

ARL STA 1026+63

853.9

MATCH LINE

6:1 6:1

220 190 160 130 850

R/W 100' RT. R.L.

1026 850

850.64

R/W 90 LT ARL

ARL STA 1025+62

853.1

4:1

220 190 160 130 850

1025 850

849.65

R/W 90 LT. ARL.

ARL STA 1024+60

852.4

220 190 160 130 850

1024 850

848.62

4:1 4:1

170 150 120 90 60 30 ℄ 30 60 90 110

STATION	DISTANCE	YARDAGE EXCAVATION UNCL.	EXCAVATION			FILL
1026						
1026	100	1709				0
1025						
1025	100	2080				0
1024						
1024	100	2075				0
1023						
SHEET TOTAL		5864				0


PLATE 3—CROSS SECTION O. P. R. & R. E. STANDARD
THE FREDERICK POST CO., CHICAGO

1024-1026

B.P.R. DISTRICT OFFICE	PROJECT	SHEET NUMBER	TOTAL SHEETS
WIS. 4	I-90-2(18)105	133	264

FINAL SURVEY — SURVEYED — PLOTTED — TEMPLATE — NOTE BOOK — AREAS — AREAS CHECKED — DATE — BY — NO.

ORIGINAL SURVEY — SURVEYED — PLOTTED — TEMPLATE — NOTE BOOK — AREAS — AREAS CHECKED — DATE 4-21-58 — BY TSV — NO. VIP 4913

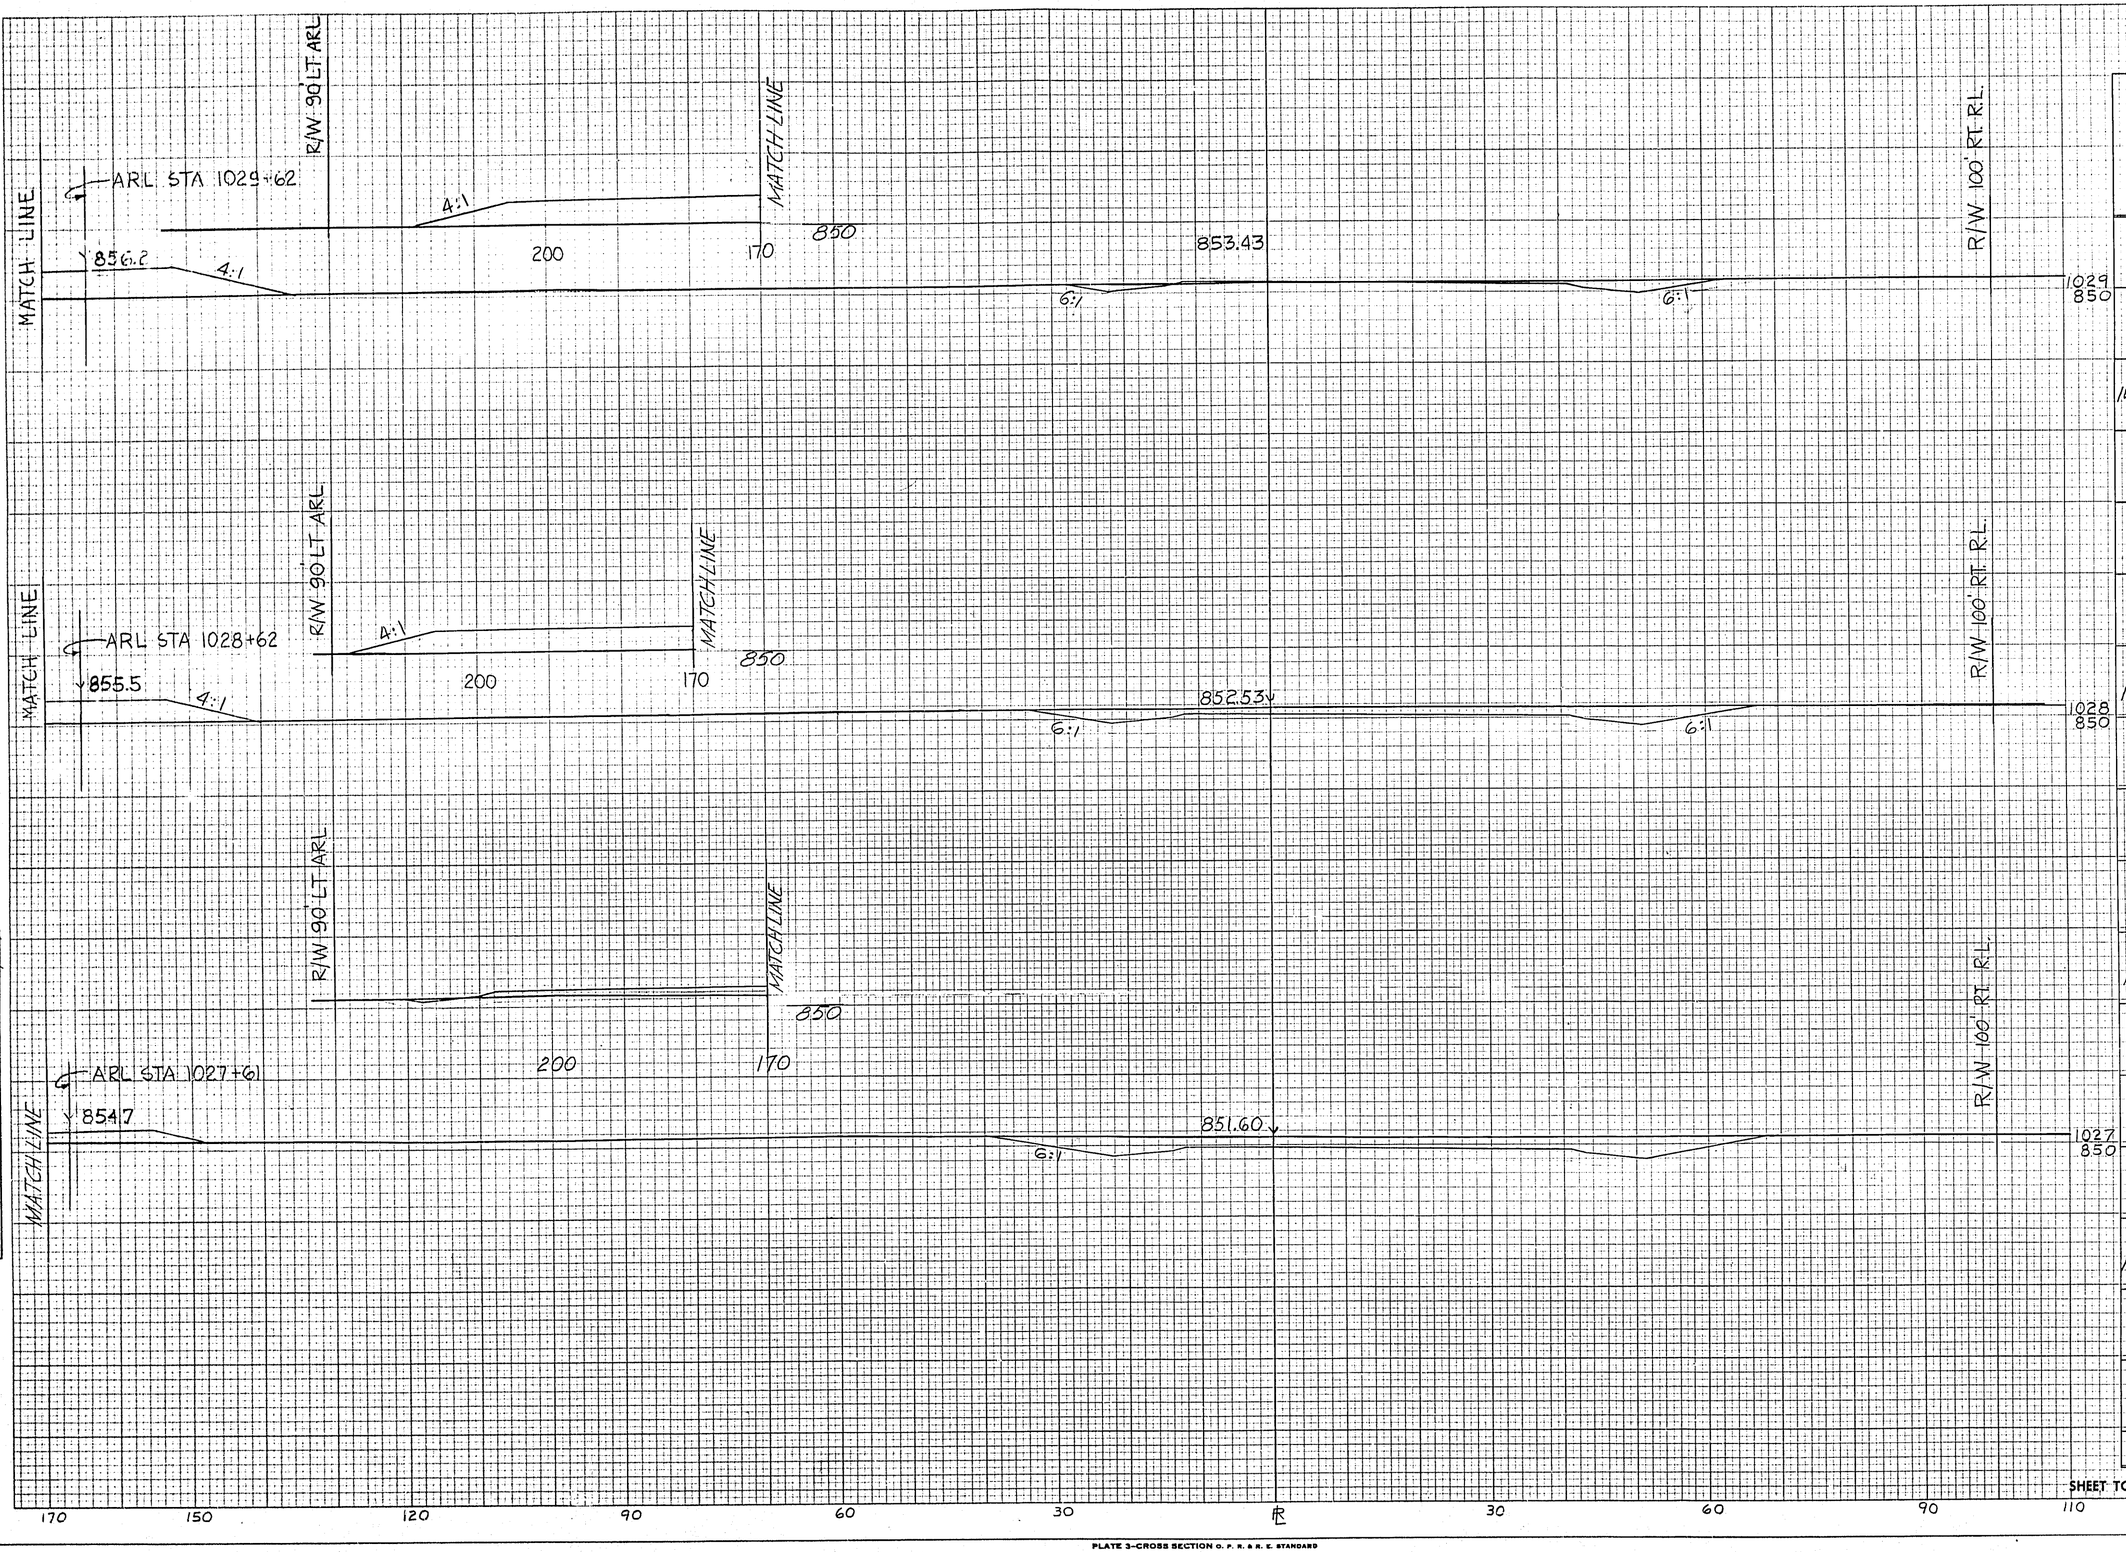

STATION	DISTANCE	YARDAGE EXCAVATION UNCL.				FILL
1029						
	100	298				1004
1028						
	100	565				641
1027						
	100	995				164
1026						
SHEET TOTAL		1,858				1809

PLATE 3—CROSS SECTION O. P. R. & B. E. STANDARD
THE FREDERICK POST CO., CHICAGO

1027-1029

B.P.R. DISTRICT OFFICE	PROJECT	SHEET NUMBER	TOTAL SHEETS
WIS. 4	I-90-2(18)105	134	264

FINAL SURVEY — DATE — BY — SURVEYED — COMPUTED — TEMPLATE — AREAS — NOTE BOOK — AREAS CHECKED — NO.

ORIGINAL SURVEY — DATE 7-10-58 — BY J.L.P. — SURVEYED 7-10-58 — COMPUTED — TEMPLATE — AREAS — NOTE BOOK — AREAS CHECKED — NO. 1008

MATCH LINE

R/W 90' LT. A.R.L.

ARL STA 1032+61

858.5

4:1

200

170

MATCH LINE

850

4:1

856.07

4:1

R/W 100' RT. R.L.

1032
850

R/W 90' LT. A.R.L.

ARL STA 1031+61

857.8

4:1

200

170

MATCH LINE

850

4:1

855.19

4:1

R/W 100' RT. R.L.

1031
850

R/W 90' LT. A.R.L.

ARL 1030+61

857.0

4:1

200

170

MATCH LINE

850

4:1

854.31

R/W 100' RT. R.L.

1030
850

STATION	DISTANCE	YARDAGE EXCAVATION UNCL.	YARDAGE FILL
1032			
	100	0	3264
1031			
	100	9	2311
1030			
	100	71	1437
1029			
SHEET TOTAL		80	7012

170 150 120 90 60 30 ℄ 30 60 90 110

64

PLATE 3—CROSS SECTION O. P. R. & H. E. STANDARD
THE FREDERICK POST CO., CHICAGO

1030-1032

B.P.R. DISTRICT OFFICE	PROJECT	SHEET NUMBER	TOTAL SHEETS
WIS. 4	I-90-2(18)105	165	264

FINAL SURVEY — NOTE BOOK — NO. — DATE — SURVEYED — PLOTTED — TEMPLATE — AREAS CHECKED

ORIGINAL SURVEY — NOTE BOOK: 1112 — NO. 4 — DATE: 7-31-58 — SURVEYED — PLOTTED — TEMPLATE — AREAS CHECKED

MATCH LINE

R/W 95' LT A.R.L.

A.R.L STA 1035+61

860.8

4:1

200

170

850

MATCH LINE

4:1

858.71

4:1

R/W 100' RT R.L.

1035
850

R/W 90' LT A.R.L.

ARL STA 1034+61

860.1

4:1

200

170

850

MATCH LINE

4:1

857.83

4:1

R/W 100' RT R.L.

1034
850

R/W 90' LT A.R.L.

ARL STA 1033+61

859.3

4:1

200

170

850

MATCH LINE

4:1

856.95

4:1

R/W 100' RT R.L.

1033
850

STA 1034+00 W.B.L.
1-24"x112' C.P. REQ'D.

STA 1033+40 E.B.L.
1-24"x90' C.P. REQD

170 150 120 90 60 30 ℄ 30 60 90 110

STATION	DISTANCE	YARDAGE EXCAVATION UNCL.	YARDAGE FILL
1035			
850			
1035			
	100	0	5308
1034			
850			
	100	0	4821
1033			
	100	0	4129
1033			
850			
1032			
SHEET TOTAL		0	14249

PLATE 3—CROSS SECTION O. P. R. & R. E. STANDARD
THE FREDERICK POST CO., CHICAGO

B.P.R. DISTRICT OFFICE	PROJECT	SHEET NUMBER	TOTAL SHEETS
WIS. 4	I-90-2(18)105	136	264

FINAL SURVEY — SURVEYED, PLOTTED, NOTE BOOK, NO., AREAS, AREAS CHECKED

ORIGINAL SURVEY — SURVEYED, PLOTTED, NOTE BOOK, AREAS, AREAS CHECKED

MATCH LINE

R/W 100' LT. ARL.

ARL STA 1038+63
863.1

3:1

MATCH LINE
850

200

170

2½:1

STA. 1038A+20 W.B.L.
1-30"x 118' C.P. REQ'D.
SKEW 15° R.H.F.

861.35

2½:1

3:1

STA. 1038+00 E.B.L.
1-30"x 108' C.P. REQ'D.
SKEW 15° R.H.F.

R/W 100' RT. R.L.

1038
850

1038

R/W 100' LT. ARL.

4:1

MATCH LINE
850

ARL STA 1037+63
862.4

200

170

2½:1

860.47

4:1

4:1

R/W 100' RT. R.L.

1037
850

1037

R/W 100' LT. ARL.

4:1

MATCH LINE
850

200

170

ARL 1036+62
861.6

4:1

859.59

4:1

4:1

R/W 100' RT. R.L.

1036
850

1036

1035

175 150 120 90 60 30 ℄ 30 60 90 110

STATION	DISTANCE	YARDAGE EXCAVATION UNCL.	YARDAGE FILL
1038			
	100	0	6994
1037			
	100	0	6397
1036			
	100	0	5721
		SHEET TOTAL 0	19,112

PLATE 3—CROSS SECTION O. P. R. & R. E. STANDARD
THE FREDERICK POST CO., CHICAGO

B.P.R. DISTRICT OFFICE	PROJECT	SHEET NUMBER	TOTAL SHEETS
WIS. 4	I-96-2(18)105	37	264

FINAL SURVEY — PLOTTED — CHECKED — TEMPLATE — NOTE BOOK — AREAS — NO. — AREAS CHECKED — BY — DATE

ORIGINAL SURVEY — PLOTTED — CHECKED — TEMPLATE — NOTE BOOK — AREAS — NO. — AREAS CHECKED — BY JTP — DATE 12/15/92 — SHT 1 of 1

MATCH LINE

R/W 100' LT. ARL.

ARL STA 1041+62 — 865.5

2½:1 — 2½:1 — 200 — 170 — MATCH LINE — 860 — 2½:1 — 863.99 — 2½:1 — R/W 100' RT. R.L. — 1041 — 850

R/W 100' LT. ARL.

ARL STA 1040+63 — 864.7

2½:1 — 2½:1 — 200 — 170 — MATCH LINE — 860 — 2½:1 — 863.11 — 2½:1 — R/W 100' RT. R.L. — 1040 — 850

R/W 100' LT. A.R.L.

ARL STA 1039+63 — 863.9

2½:1 — 2½:1 — 200 — 170 — MATCH LINE — 860 — 2½:1 — 862.23 — 2½:1 — R/W 100' RT. R.L. — 1039 — 850

170 — 150 — 120 — 90 — 60 — 30 — ℄ — 30 — 60 — 90 — 110


STATION	DISTANCE	YARDAGE EXCAVATION UNCL.	YARDAGE FILL
1041			
	100	0	7691
1040			
	100	0	7554
1039			
	100	0	7937
1038			
SHEET TOTAL		0	23182

PLATE 3—CROSS SECTION O. P. R. & R. E. STANDARD
THE FREDERICK POST CO., CHICAGO

B.P.R. DISTRICT OFFICE	PROJECT	SHEET NUMBER	TOTAL SHEETS
WIS. 4	L-90-2(14)105	133	214

FINAL SURVEY — SURVEYED — PLOTTED — NOTE BOOK — AREAS — AREAS CHECKED — BY — DATE — REV


ORIGINAL SURVEY — SURVEYED 4-21-58 — PLOTTED — NOTE BOOK — AREAS — AREAS CHECKED — BY TJV — DATE 4/1958

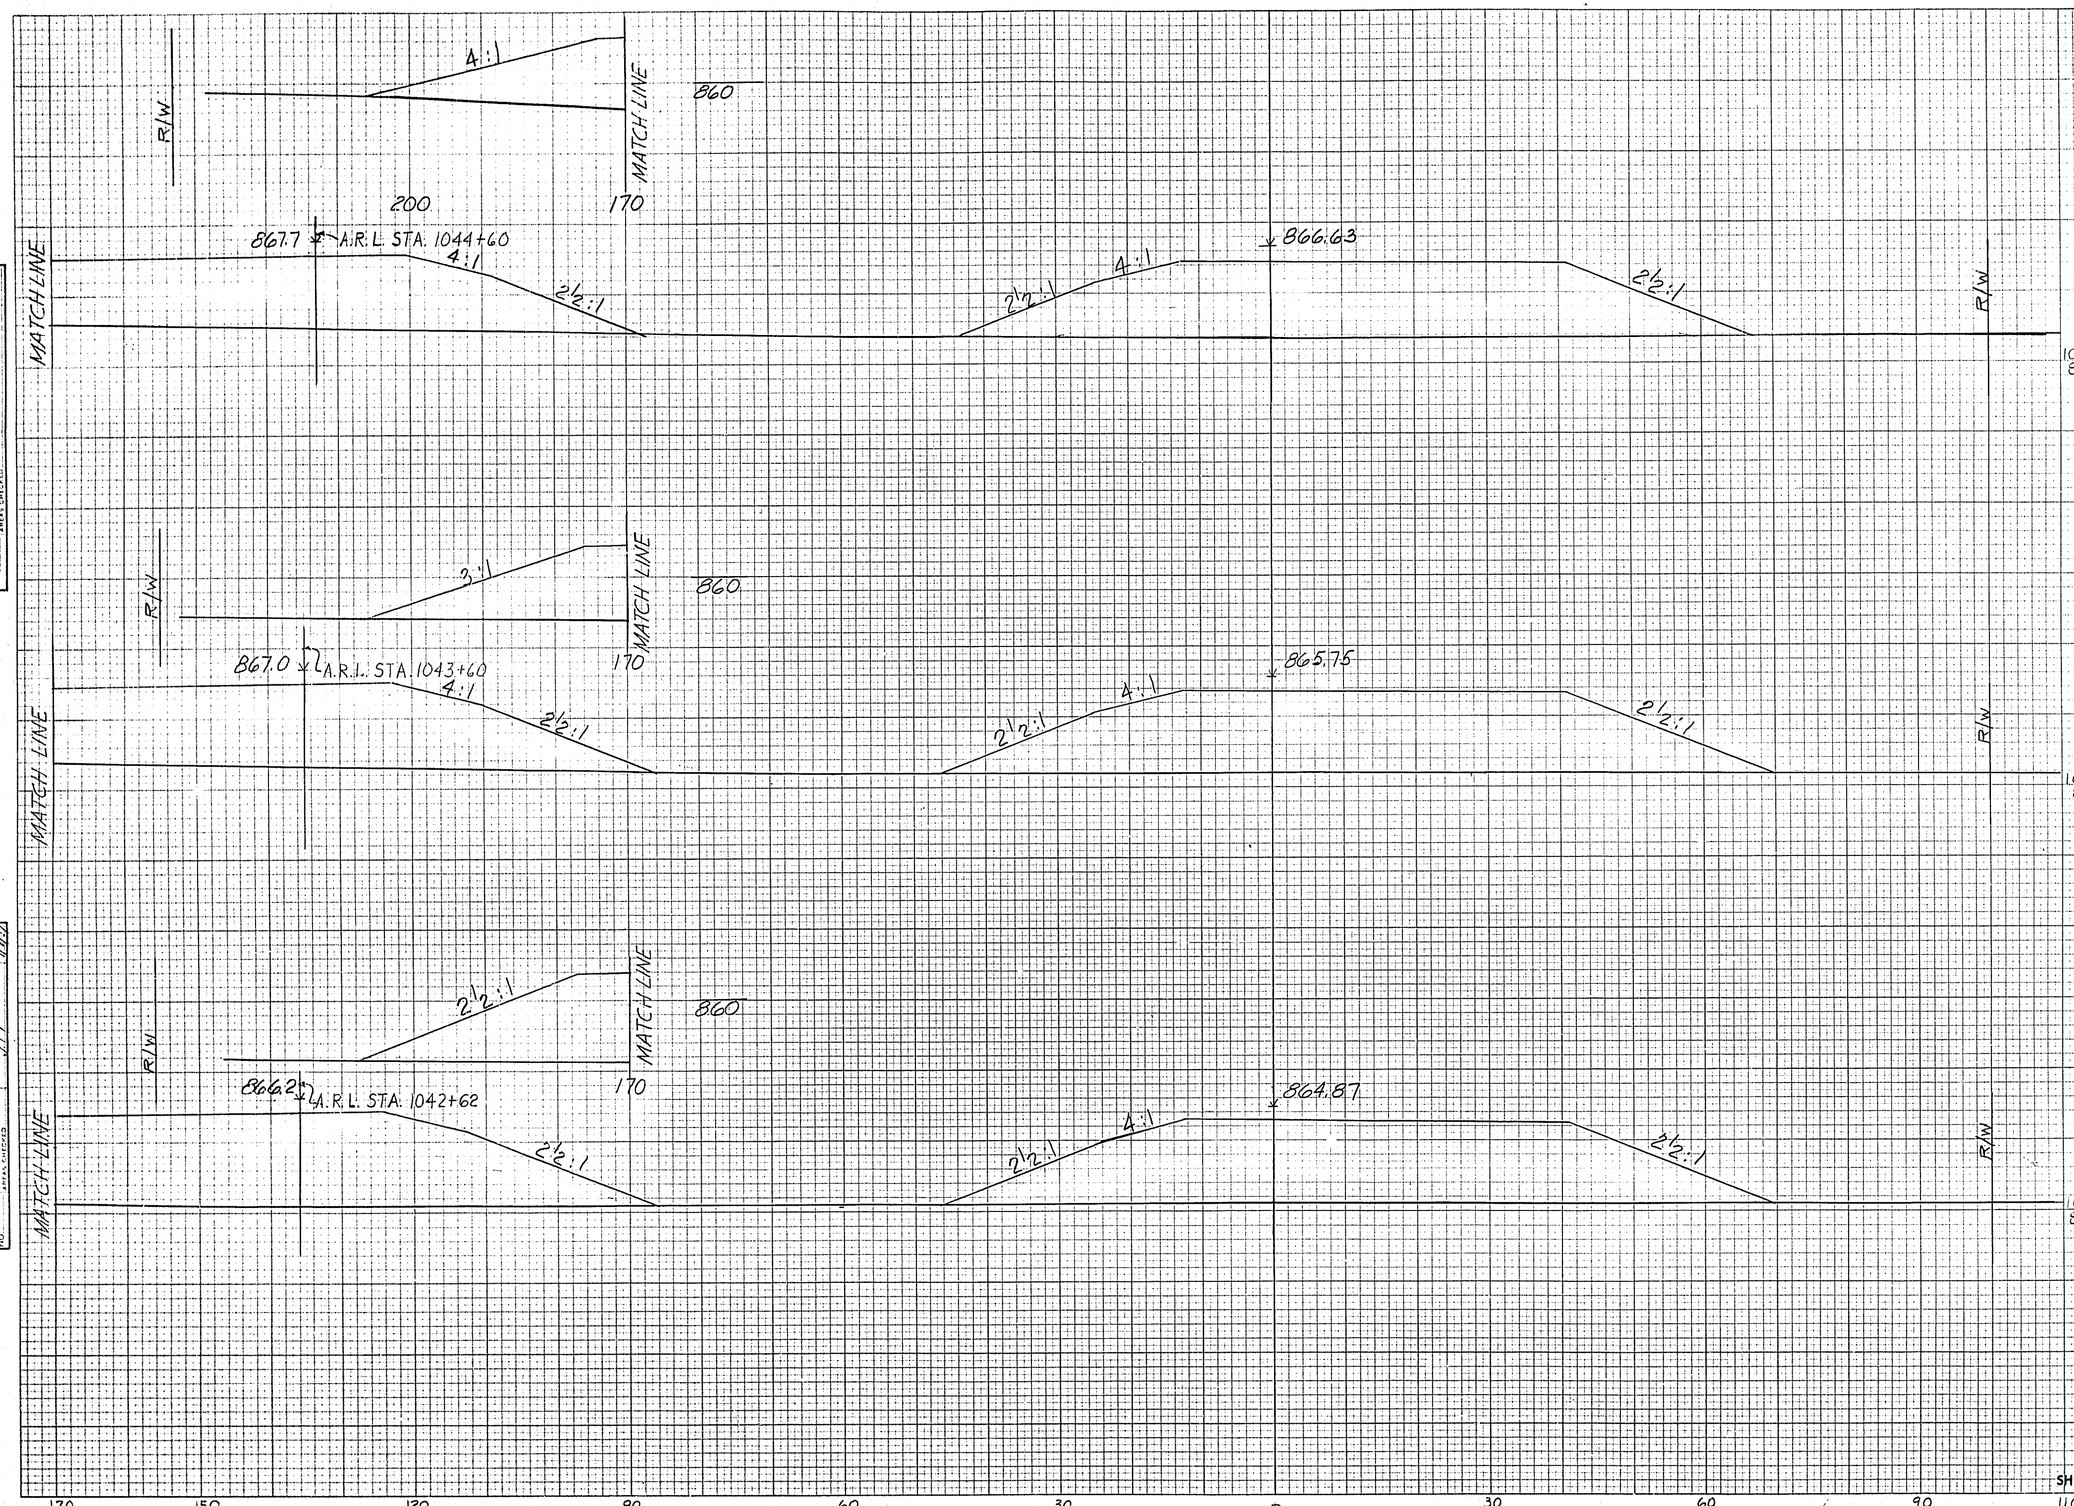

STATION	DISTANCE	YARDAGE EXCAVATION UNCL.	YARDAGE EXCAVATION	YARDAGE EXCAVATION	YARDAGE EXCAVATION	YARDAGE FILL
1044	100	0				7133
1043	100	0				7815
1042	100	0				7911
1041						
SHEET TOTAL		0				22859

PLATE 3—CROSS SECTION O. P. R. & R. E. STANDARD
THE FREDERICK POST CO., CHICAGO

B.P.R. DISTRICT OFFICE	PROJECT	SHEET NUMBER	TOTAL SHEETS
WIS. 4	I-90-2(18)105	139	264

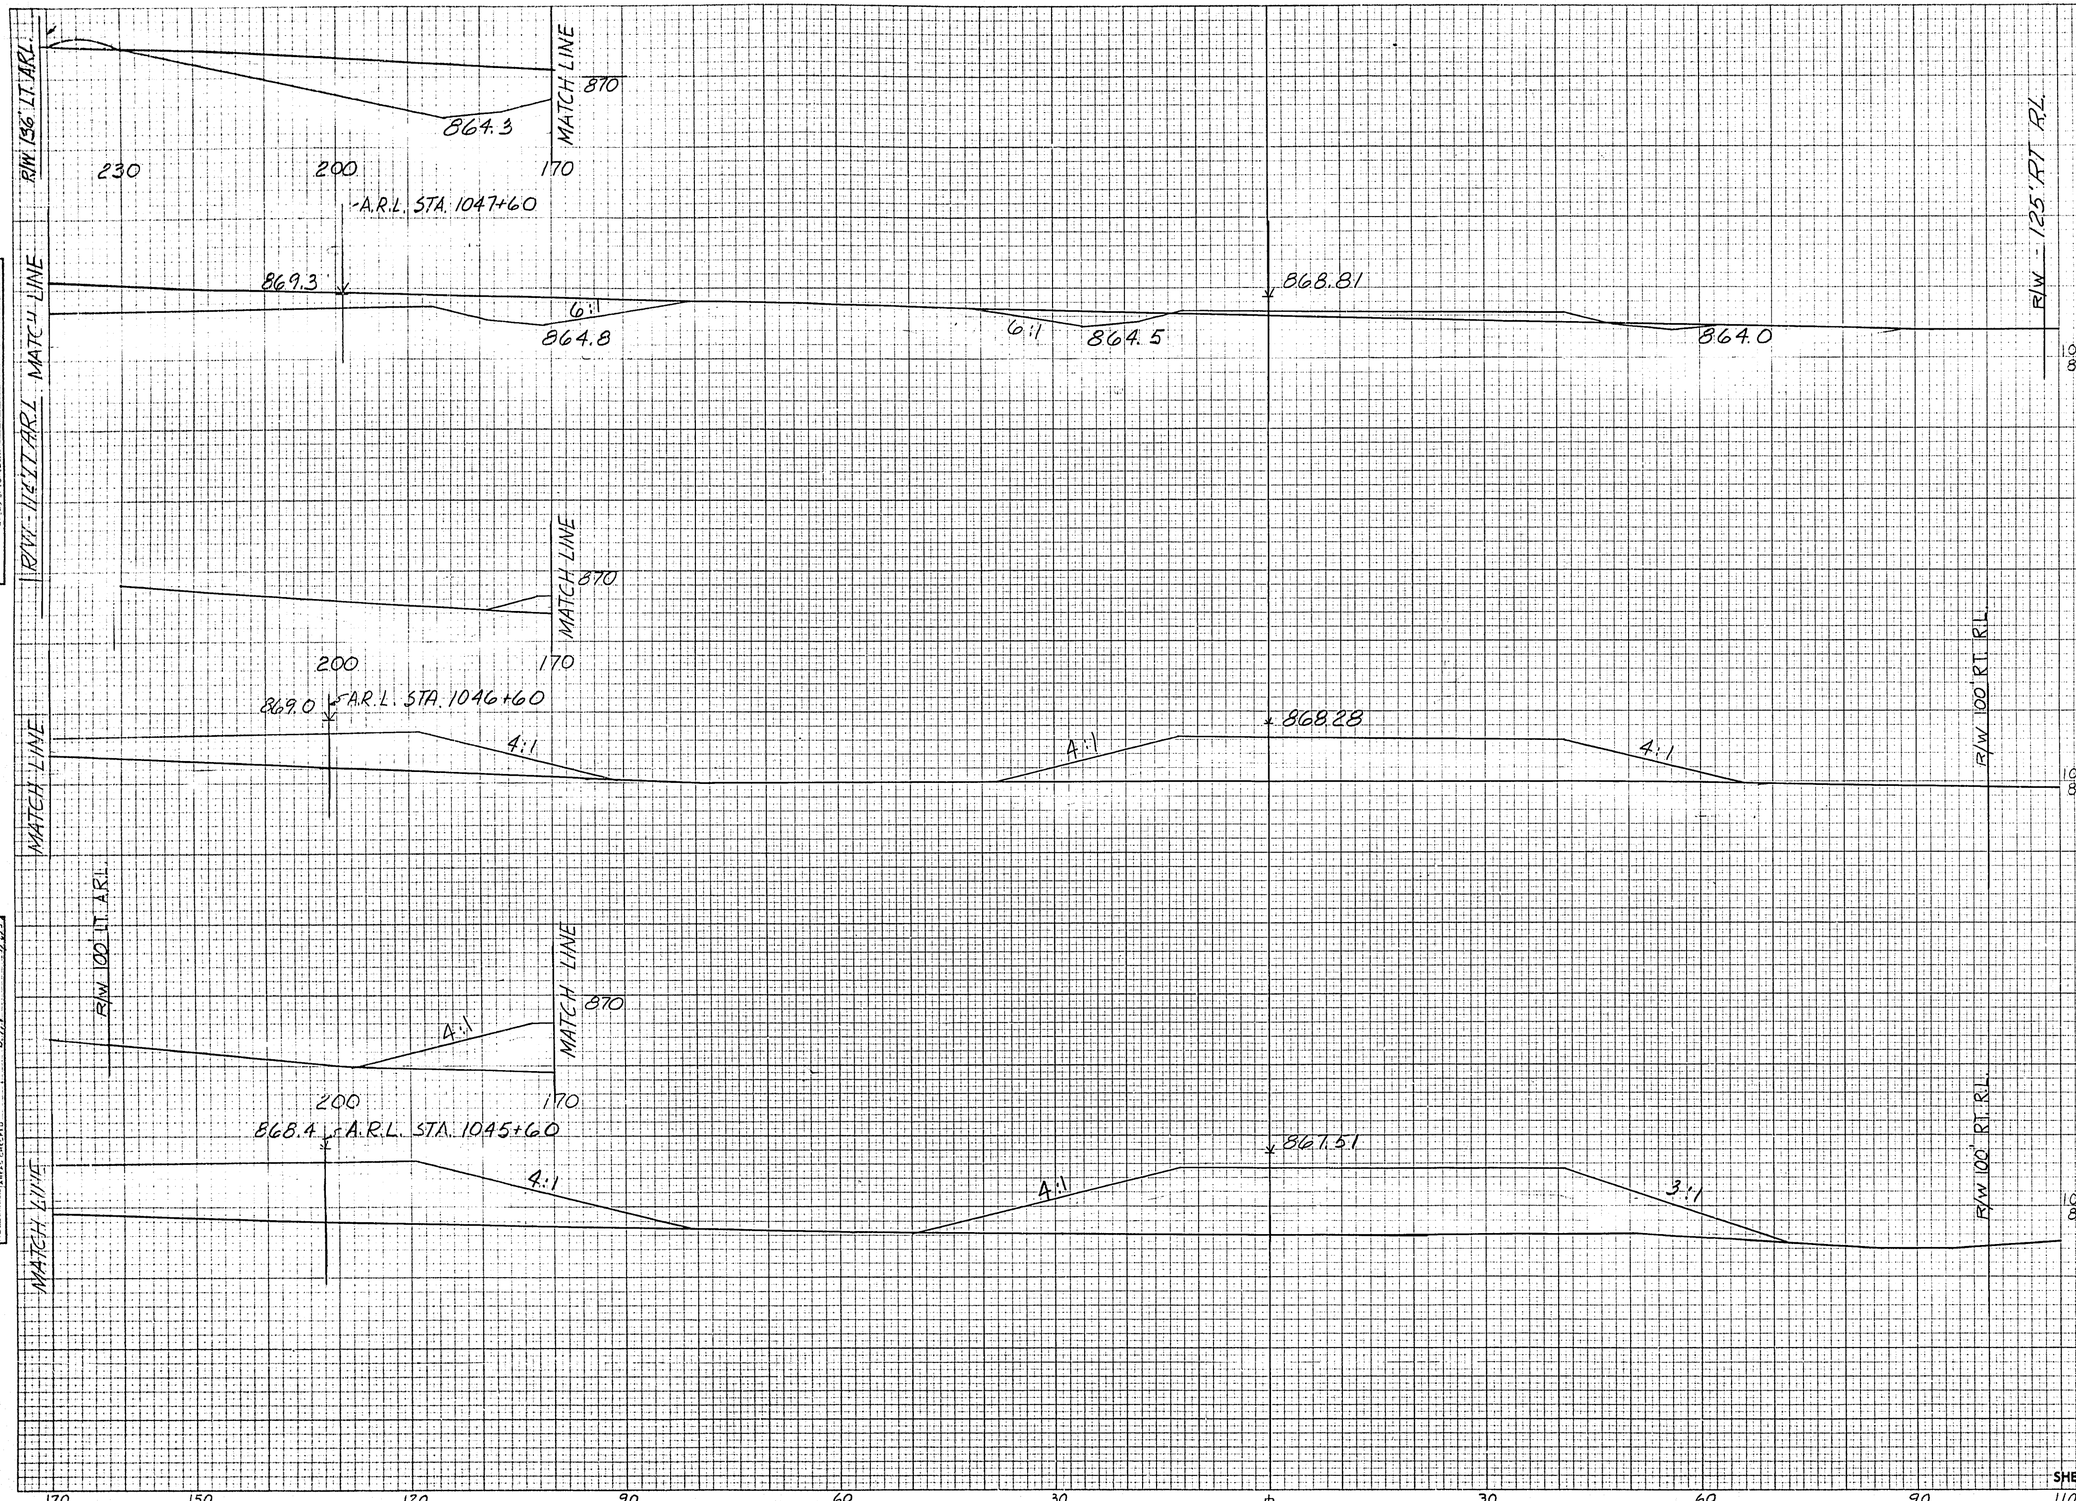

STATION	DISTANCE	YARDAGE EXCAVATION UNCL.	YARDAGE FILL
1047 860			
1047	100	1016	1564
1046 860			
1046	100	0	4233
1045 860			
1045	100	0	6117
1044			
SHEET TOTAL		1,016	11,914

FINAL SURVEY — PLOTTED, TEMPLATE, AREAS, CROSS CHECKED, NOTE BOOK, NO.

ORIGINAL SURVEY — SURVEYED, PLOTTED, TEMPLATE, AREAS, CROSS CHECKED, NOTE BOOK, NO. — BY JLP — DATE 8/1/64

PLATE 3—CROSS SECTION O. P. R. & R. E. STANDARD
THE FREDERICK POST CO., CHICAGO

B.P.R. DISTRICT OFFICE	PROJECT	SHEET NUMBER	TOTAL SHEETS
WIS. 4	I-90-2(18)107	190	264

FINAL SURVEY — SURVEYED — PLOTTED — TEMPLATE — NOTE BOOK — PAGES — AREAS CHECKED — BY — DATE — NO.

ORIGINAL SURVEY — SURVEYED — PLOTTED — TEMPLATE — NOTE BOOK — PAGES — AREAS CHECKED — BY — DATE — NO.

R/W 145' LT. A.R.L.

MATCH LINE

230 200 170

870

869.0 ℄ A.R.L. STA. 1050+60 2½:1 2½:1 869.06

866.0 865.5

R/W 150' RT. R.L.

STATION 1050 870

DISTANCE 1050

YARDAGE — EXCAVATION — UNCL. — FILL

R/W 145' LT. A.R.L.

MATCH LINE

2½:1 865.3

260 230 200 170

870

R/W 150' RT. R.L.

STATION 1049 870

DISTANCE 100 16,622

YARDAGE — EXCAVATION — UNCL. 0

MATCH LINE

869.3 ℄ A.R.L. STA. 1049+60 2½:1 2½:1 869.21

865.8 865.5 865.0

R/W 150' RT. R.L.

STATION 1049 870

DISTANCE 100 11,261

YARDAGE — EXCAVATION — UNCL. 30

R/W 145' LT. A.R.L.

MATCH LINE

864.8

230 200 170

870

STATION 1048

DISTANCE 100 4702

YARDAGE — EXCAVATION — UNCL. 105

MATCH LINE

869.4 ℄ A.R.L. STA. 1048+60 4:1 4:1 869.12

865.3 865.0 864.5 6:1

R/W 150' RT. R.L.

STATION 1048 860

DISTANCE 1047

170 150 120 90 60 30 ℄ 30 60 90 110

SHEET TOTAL 32584 135

PLATE 3-CROSS SECTION O. P. R. & R. E. STANDARD
THE FREDERICK POST CO., CHICAGO

1048 - 1050

75

B.P.R. DISTRICT OFFICE	PROJECT	SHEET NUMBER	TOTAL SHEETS
WIS. 4	I-90-2(18)106	191	264

FINAL SURVEY — SURVEYED, PLOTTED, TEMPLATE, AREAS CHECKED, NOTE BOOK, NO., BY, DATE

ORIGINAL SURVEY — SURVEYED, PLOTTED, TEMPLATE, AREAS CHECKED, NOTE BOOK, NO., BY, DATE 7-21-62-56, 1115, 1165

R/W 145 LT. A.R.L.

MATCH LINE

6:1

230 200 170

870

866.7 ↓ A.R.L. STA. 1053+60

4:1

867.25

R/W 150' RT. R.L.

R/W 145' LT. A.R.L.

MATCH LINE

870

867.7 ↓ A.R.L. STA. 1052+60

2½:1

2½:1

868.08

R/W 150' RT. R.L.

R/W 145' LT. A.R.L.

MATCH LINE

870

868.4 ↓ A.R.L. STA. 1051+60

2½:1

2½:1

868.69

R/W 150' RT. R.L.

170 150 120 90 60 30 ℄ 30 60 90 110

PLATE 3-CROSS SECTION O. P. R. B. B. E. STANDARDS
THE FREDERICK POST CO., CHICAGO

STATION	DISTANCE	YARDAGE EXCAVATION UNCL.	YARDAGE EXCAVATION	YARDAGE FILL
1053 880				
1053				
100	11569			30
1052 880				
1052				
100	15799			20
1051				
1051 880				
100	17811			10
1050				
SHEET TOTAL		45209		60

1051 - 1053

B.P.R. DISTRICT OFFICE	PROJECT	SHEET NUMBER	TOTAL SHEETS
WIS. 4	I-90-3(10)5	122	264

FINAL SURVEY — SURVEYED — PLOTTED — TEMPLATE — NOTE BOOK — AREAS — NO. — AREAS CHECKED — BY — DATE

ORIGINAL SURVEY — SURVEYED — PLOTTED — TEMPLATE — NOTE BOOK — AREAS — NO. — AREAS CHECKED — BY TH — DATE 4-22-58

R/W 110' LT. A.R.L.

A.R.L. STA. 1056+60

862.7

4:1

4:1

4:1

863.51

6:1

R/W 150' RT. R.L.

R/W 110' LT. A.R.L.

A.R.L. STA. 1055+60

864.1

4:1

6:1

6:1

864.91

6:1

R/W 150' RT. R.L.

R/W 124' LT. A.R.L.

MATCH LINE

6:1

190

170

860

A.R.L. STA. 1054+60

865.5

6:1

6:1

866.20

R/W 150' RT. R.L.

MATCH LINE

170 150 120 90 60 30 ℄ 30 60 90 110

STATION	DISTANCE	YARDAGE EXCAVATION UNCL.	YARDAGE FILL
1056 860			
1056			
	100	810	756
1055			
1055 860			
	100	2827	160
1054			
	100	6723	30
1054 360			
1053			
SHEET TOTAL		10,360	946

B.P.R. DISTRICT OFFICE	PROJECT	SHEET NUMBER	TOTAL SHEETS
WIS. 4	I-90-2(18)105	193	264

FINAL SURVEY — SURVEYED, PLOTTED, TEMPLATE, AREAS, AREAS CHECKED, NOTE BOOK, NO., BY, DATE

ORIGINAL SURVEY — SURVEYED, PLOTTED, TEMPLATE, AREAS CHECKED, NOTE BOOK, NO., BY, DATE

MATCH LINE R/W 110' LT. A.R.L.

2½:1 — 190 — 170 — MATCH LINE — 850

858.5 — ℄ A.R.L. STA. 1059+60 — 859.31

2½:1 — 4:1 — 4:1 — 4:1

847.7

R/W 100' RT. R.L.

1059 850

MATCH LINE R/W 110' LT. A.R.L.

3:1 — 190 — 170 — MATCH LINE — 850

859.9 — ℄ A.R.L. STA. 1058+60 — 860.71

3:1 — 4:1 — 4:1 — 4:1

849.0

R/W 100' RT. R.L.

1058 850

MATCH LINE R/W 110' LT. A.R.L.

4:1 — 190 — 170 — MATCH LINE — 850

861.3 — ℄ A.R.L. STA. 1057+60 — 862.11

4:1 — 4:1 — 4:1

854.0

R/W - 117' RT. A.R.L.

1057 850

170 150 120 90 60 30 ℄ 30 60 90 110

STATION	DISTANCE	YARDAGE EXCAVATION UNCL.	YARDAGE FILL
1059			
	100	0	6440
1058			
	100	0	4166
1057			
	100	156	2157
1056			
SHEET TOTAL		156	12,763

PLATE 3—CROSS SECTION O. P. R. & B. E. STANDARD
THE FREDERICK POST CO., CHICAGO

1057-1059

B.P.R. DISTRICT OFFICE	PROJECT	SHEET NUMBER	TOTAL SHEETS
WIS. 4	[illegible]	194	264

A.R.L. STA. 1063+10
853.6
4:1
843.0
4:1
854.41
2½:1
STA. 1062+50 E.B.L.
1-18"×116' C.P. REQ'D.
+50
850
R/W 110' LT. R.L.
840.9
840
170
A.R.L. STA. 1062+60
854.3
2½:1
4:1
843.7
4:1
855.11
2½:1
R/W 100' RT. R.L.
1062
840
1062
100 0 8779
MATCH LINE
R/W 110' LT. R.L.
850
2½:1
190
170
A.R.L. STA. 1061+60
855.7
2½:1
4:1
845.0
4:1
856.51
2½:1
R/W 100' RT. R.L.
1061
840
1061
100 0 9155
MATCH LINE
R/W 110' LT. R.L.
850
2½:1
190
170
A.R.L. STA. 1060+60
857.1
2½:1
4:1
846.3
4:1
857.91
2½:1
R/W 100' RT. R.L.
1060
840
1060
100 0 8772
1059
SHEET TOTAL 0 26408
170 150 120 90 60 30 ℄ 30 60 90 110

FINAL SURVEY — SURVEYED, PLOTTED, NOTE BOOK, TEMPLATE, AREAS, AREAS CHECKED, NO.

ORIGINAL SURVEY — SURVEYED, PLOTTED, TEMPLATE, AREAS, AREAS CHECKED, NOTE BOOK, NO. — BY, DATE

PLATE 3—CROSS SECTION O. P. R. & R. E. STANDARD
THE FREDERICK POST CO., CHICAGO


1060-1062

19

B.P.R. DISTRICT OFFICE	PROJECT	SHEET NUMBER	TOTAL SHEETS
WIS. 4	I-90-2(18)103	195	214

FINAL SURVEY — SURVEYED / PLOTTED / TEMPLATE / AREAS CHECKED — NOTE BOOK — NO.

ORIGINAL SURVEY — BY — DATE — SURVEYED 7/24/58 — PLOTTED — TEMPLATE — AREAS CHECKED J.C.P. 9/10/58 — NOTE BOOK — NO.

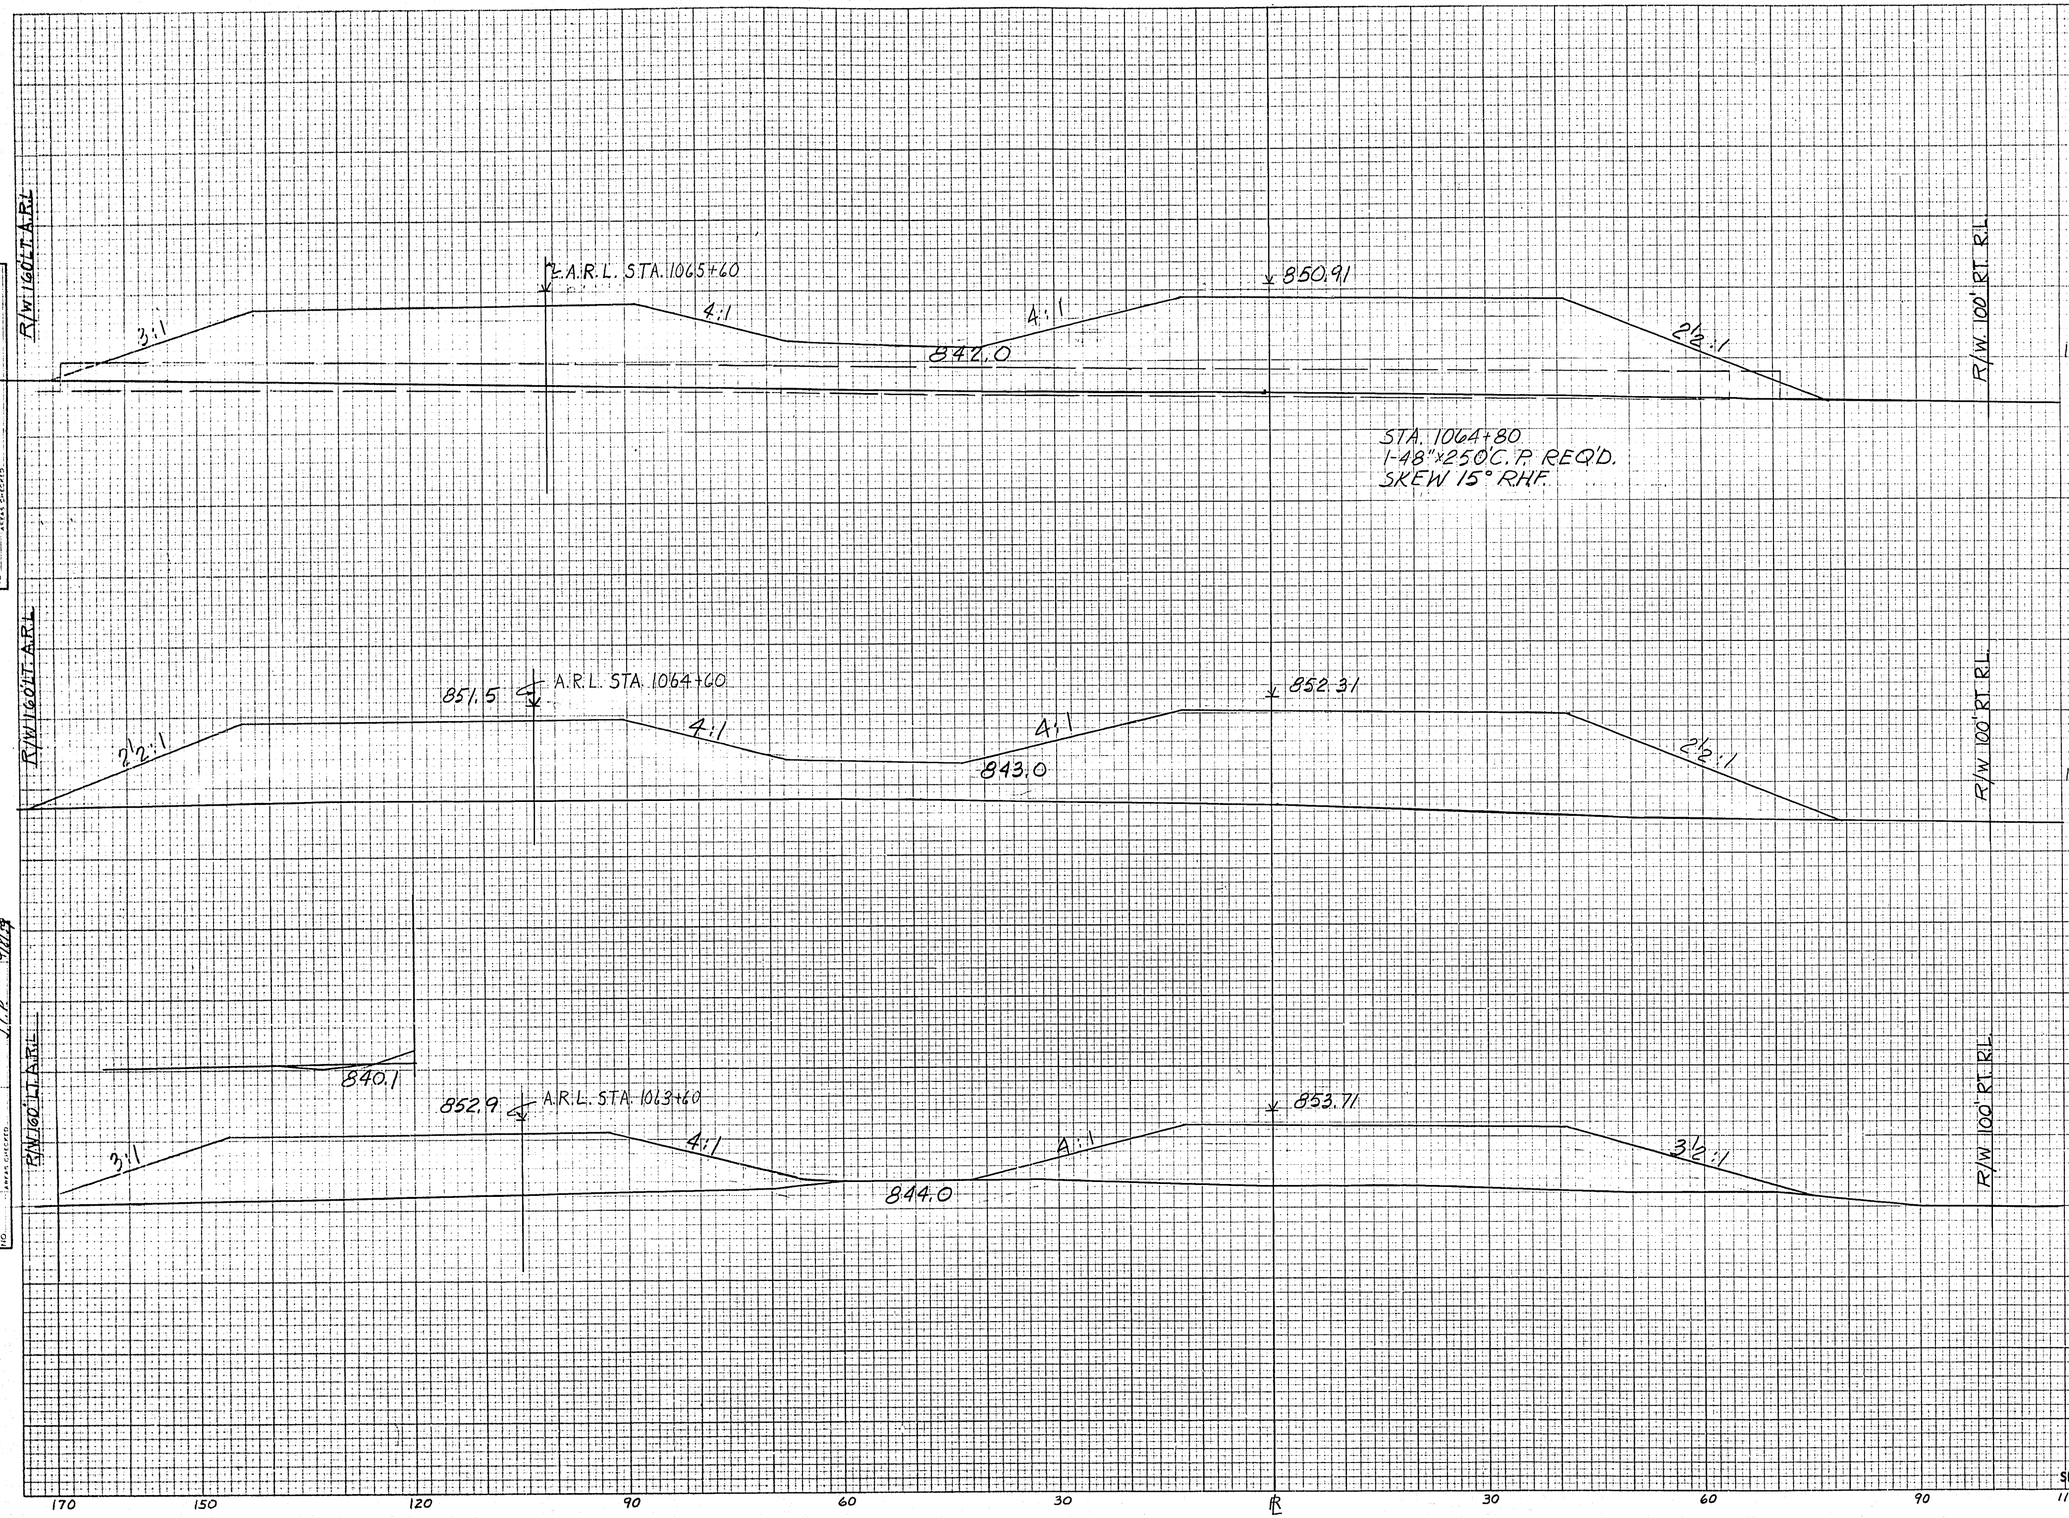


STATION	DISTANCE	YARDAGE: EXCAVATION UNCL.	YARDAGE: EXCAVATION	YARDAGE: FILL
1065 840				
1065				
	100	0		8785
1064				
1064 840				
	100	14		7143
1063				
1063 840				
	100	14		6773
1062				
SHEET TOTAL		28		22934

PLATE 3—CROSS SECTION O. P. R. & R. E. STANDARD
THE FREDERICK POST CO., CHICAGO

B.P.R. DISTRICT OFFICE	PROJECT	SHEET NUMBER	TOTAL SHEETS
WIS. 4	I-90-4(18)125	196	264

FINAL SURVEY — SURVEYED / PLOTTED / TEMPLATE / NOTE BOOK / AREAS / AREAS CHECKED / NO. — BY — DATE

ORIGINAL SURVEY — SURVEYED / PLOTTED / TEMPLATE / NOTE BOOK / AREAS / AREAS CHECKED / NO. — BY — DATE — JFV 12-2-58 — JJK 1-8-59

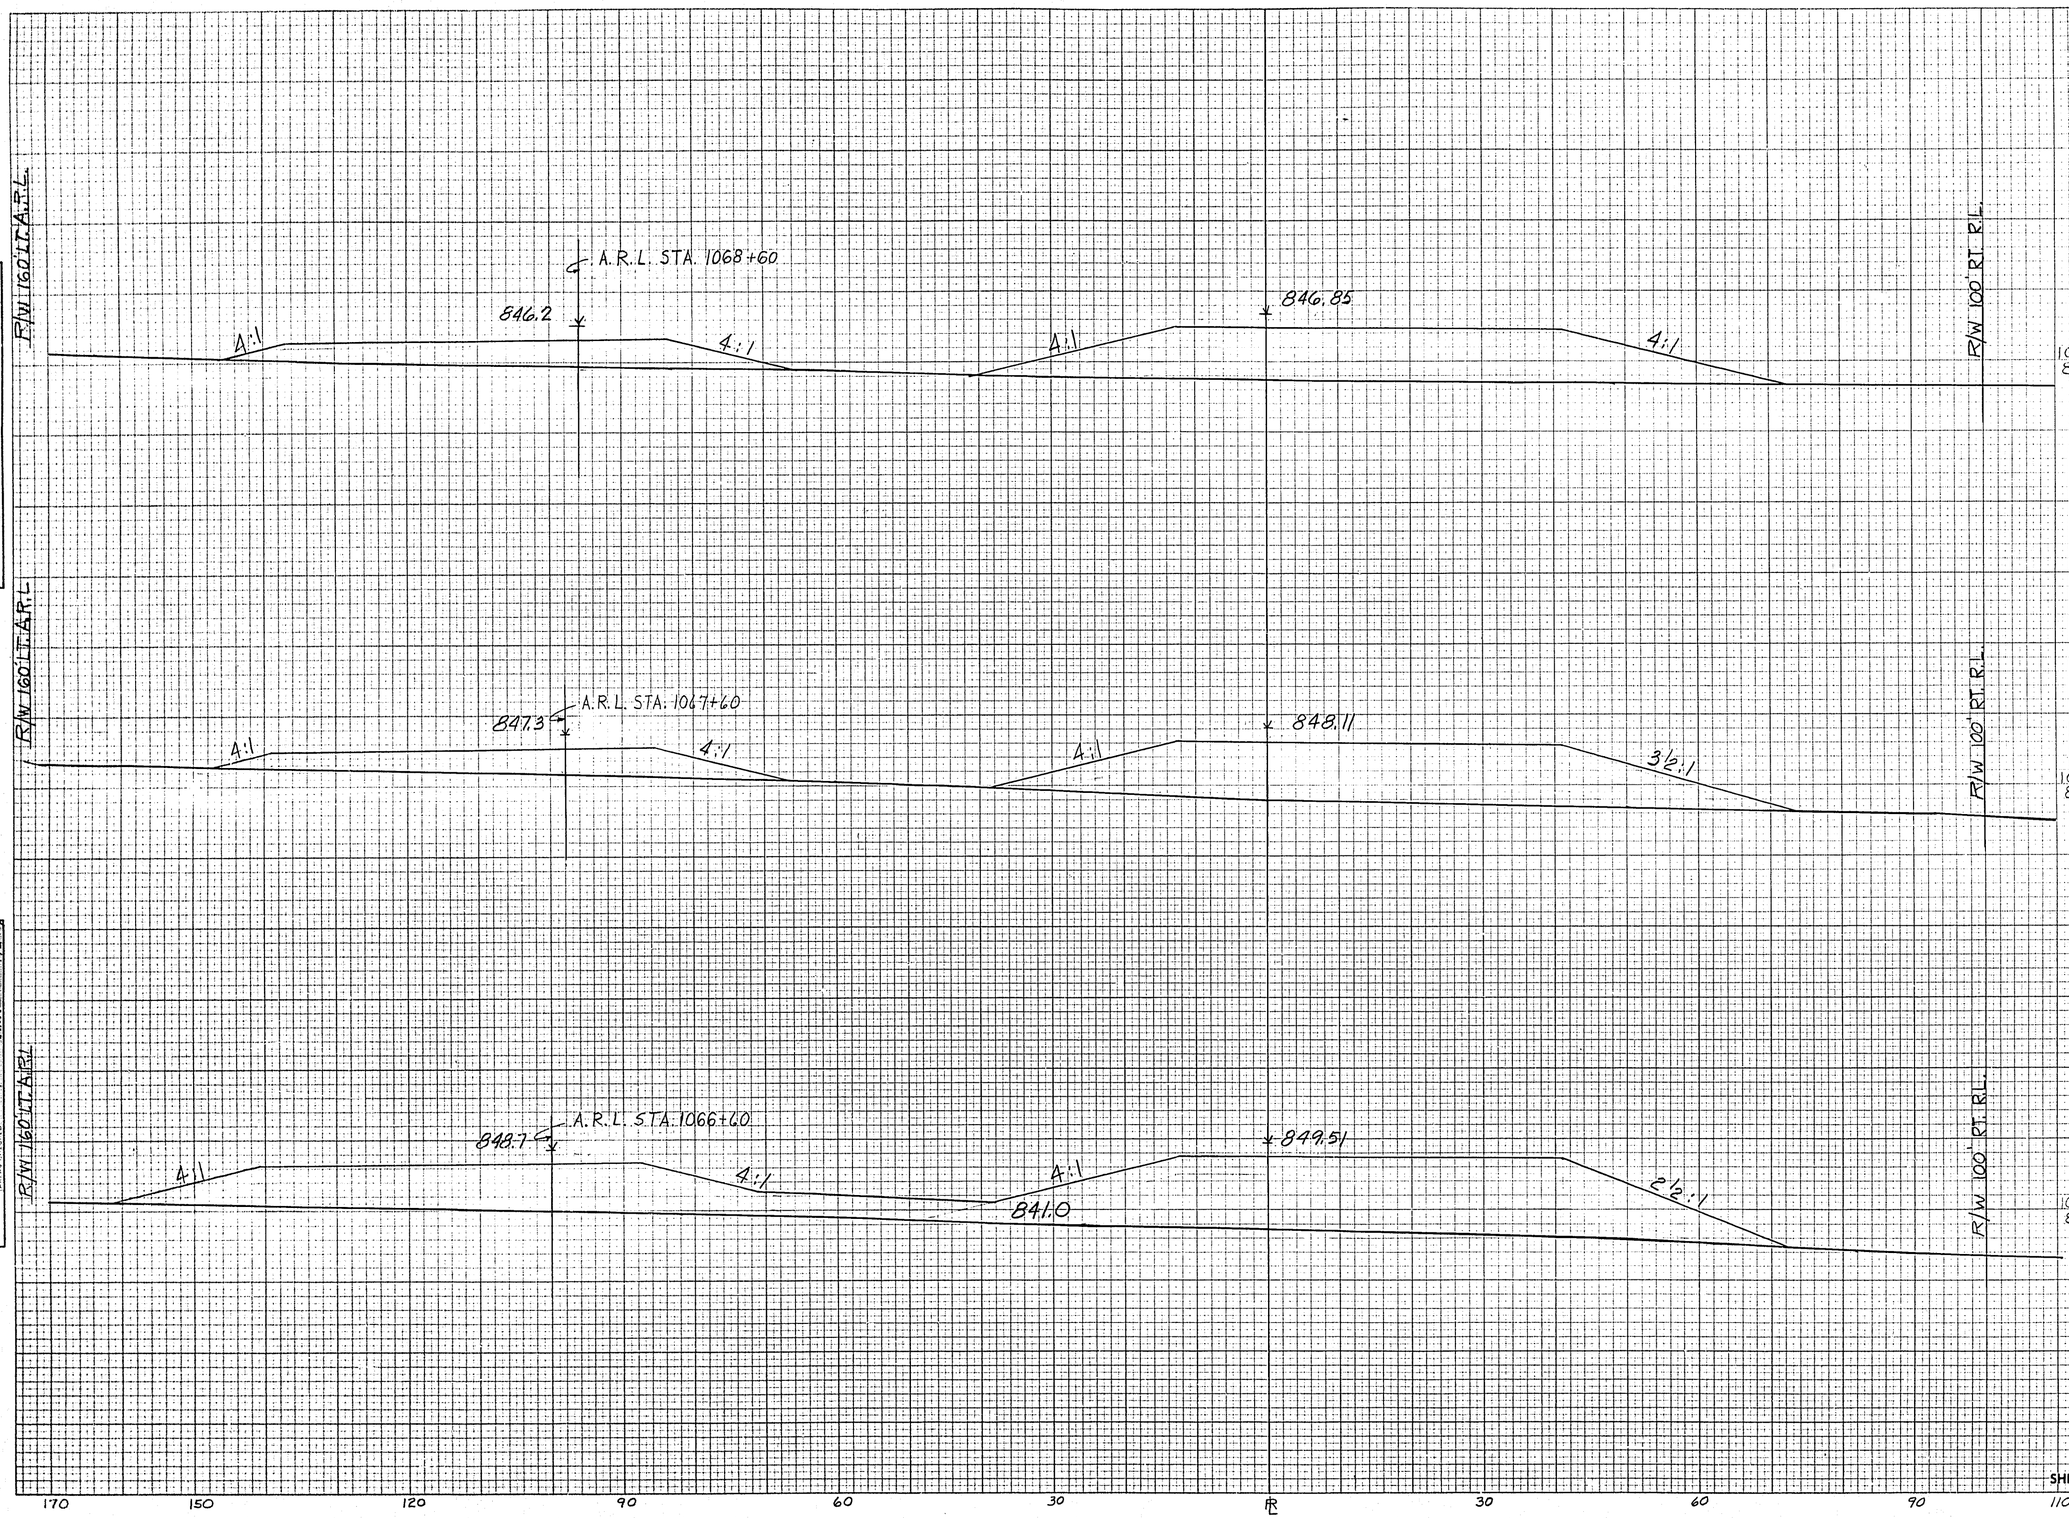

STATION	DISTANCE	YARDAGE EXCAVATION (UNCL.)	YARDAGE EXCAVATION	YARDAGE EXCAVATION	YARDAGE EXCAVATION	YARDAGE FILL
1068						
1068 840						
	100	0				3339
1067						
1067 840	100	0				4398
1066						
	100	0				707.8
1066 840						
1065						
SHEET TOTAL		0				14,815

PLATE 3—CROSS SECTION O. P. R. & B. E. STANDARD
THE FREDERICK POST CO., CHICAGO

B.P.R. DISTRICT OFFICE	PROJECT	SHEET NUMBER	TOTAL SHEETS
WIS. 4	I-90-2(12)105	107	364

FINAL SURVEY — SURVEYED — PLOTTED — TRACED — NOTE BOOK — AREAS — NO — AREAS CHECKED — DATE

ORIGINAL SURVEY — SURVEYED — PLOTTED — TRACED — NOTE BOOK — AREAS — NO — AREAS CHECKED — BY — DATE 4-22-58 — 9/1/5 — J.I.P.

R/W 110' LT. A.R.L.

A.R.L. STA. 1071+60

843.9

4:1

A:1

6:1

836.6

844.25

A:1

4:1

R/W 100' RT. R.L.

1071
840

1071

R/W 110' LT. A.R.L.

844.5

A.R.L. STA. 1070+60

4:1

A:1

836.1

844.91

A:1

4:1

R/W 100' RT. R.L.

1070
840

1070

100 4.1 2759

R/W 110' LT. A.R.L.

844.9

A.R.L. STA. 1070+10

4:1

A:1

835.8

845.32

3½:1

3½:1

4:1

+50
840

1069

100 0 4214

STA. 1070A+10 WBL
1-24"×100' C.P. REQ'D.
STA. 1069+50 EBL
1-24"×110' C.P. REQ'D.

R/W 110' LT. A.R.L.

A.R.L. STA. 1069+40

845.2

4:1

A:1

845.78

4:1

4:1

R/W 100' RT. R.L.

1069
840

100 0 3414

1068

SHEET TOTAL 41 10952

170 150 120 90 60 30 ℄ 30 60 90 110


PLATE 3–CROSS SECTION O. P. R. & R. E. STANDARD
THE FREDERICK POST CO., CHICAGO

1069-1071

B.P.R. DISTRICT OFFICE	PROJECT	SHEET NUMBER	TOTAL SHEETS
WIS. 4	I-90-2(18)10	198	214

FINAL SURVEY — SURVEYED / PLOTTED / TEMPLATE / AREAS CHECKED — NOTE BOOK — NO.

ORIGINAL SURVEY — BY — DATE: FEB. 4-22-58 — SURVEYED / PLOTTED / TEMPLATE / AREAS CHECKED — NOTE BOOK — NO. 1015

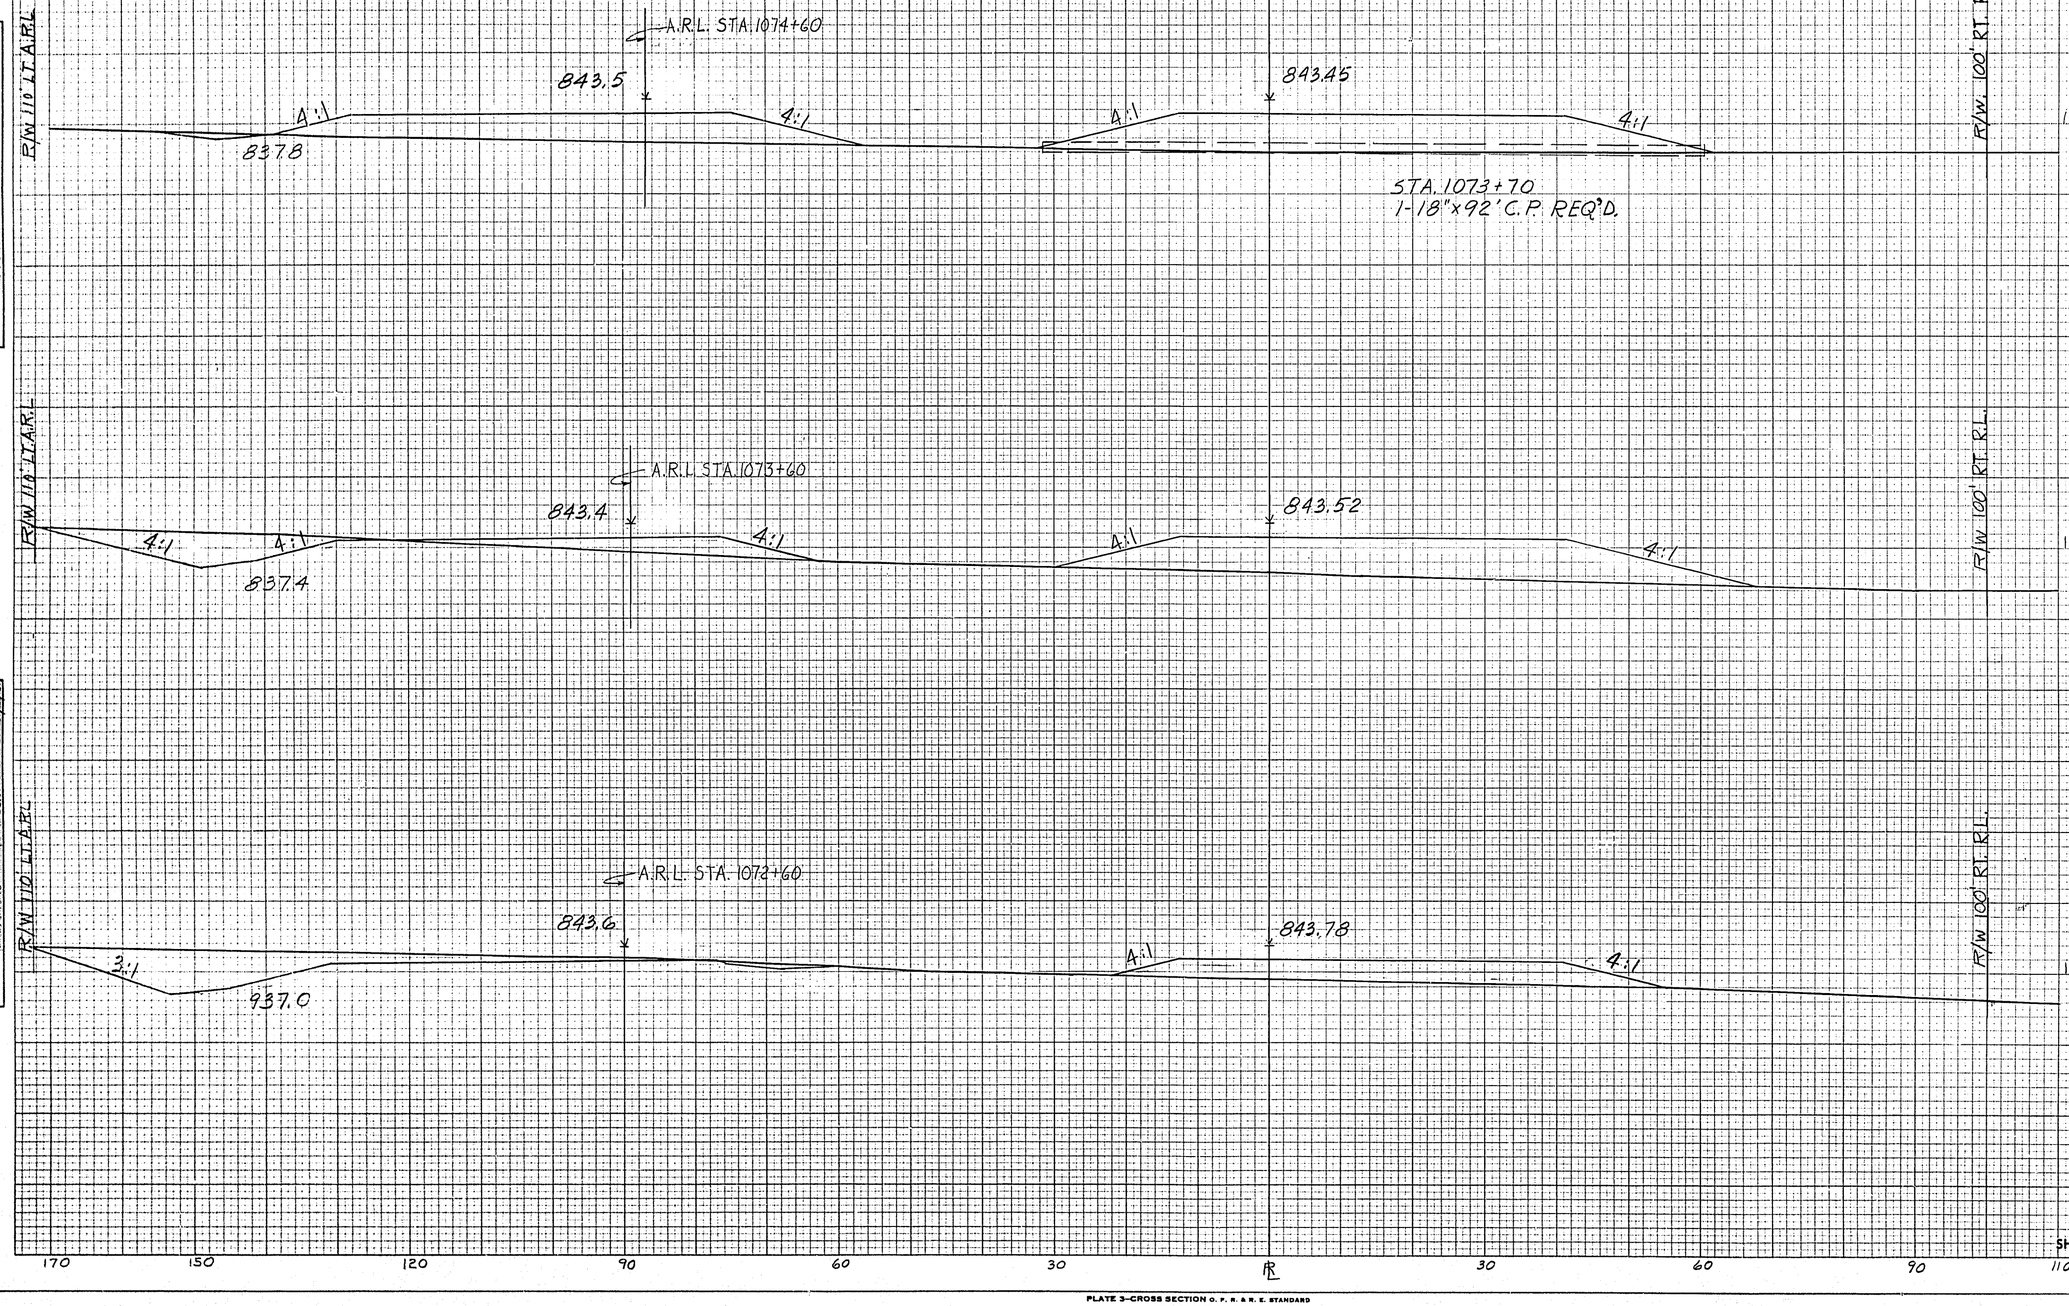

STATION	DISTANCE	YARDAGE EXCAVATION UNCL.	YARDAGE FILL
1074 840			
1074			
	100	227	2085
1073			
1073 840			
	100	579	1268
1072			
1072 840			
	100	407	1221
1071			
SHEET TOTAL		1,213	4,574


PLATE 3—CROSS SECTION O. P. R. & R. E. STANDARD
THE FREDERICK POST CO., CHICAGO

1072 - 1074

B.P.R. DISTRICT OFFICE	PROJECT	SHEET NUMBER	TOTAL SHEETS
WIS. 4	I-90-2(18)107	100	364

FINAL SURVEY — NOTE BOOK — NO. — BY — DATE — SURVEYED — PLOTTED — TEMPLATE — AREAS — AREAS CHECKED

ORIGINAL SURVEY — NOTE BOOK — NO. 1 — BY — DATE 10/16/58 — SURVEYED — PLOTTED — TEMPLATE — AREAS — AREAS CHECKED

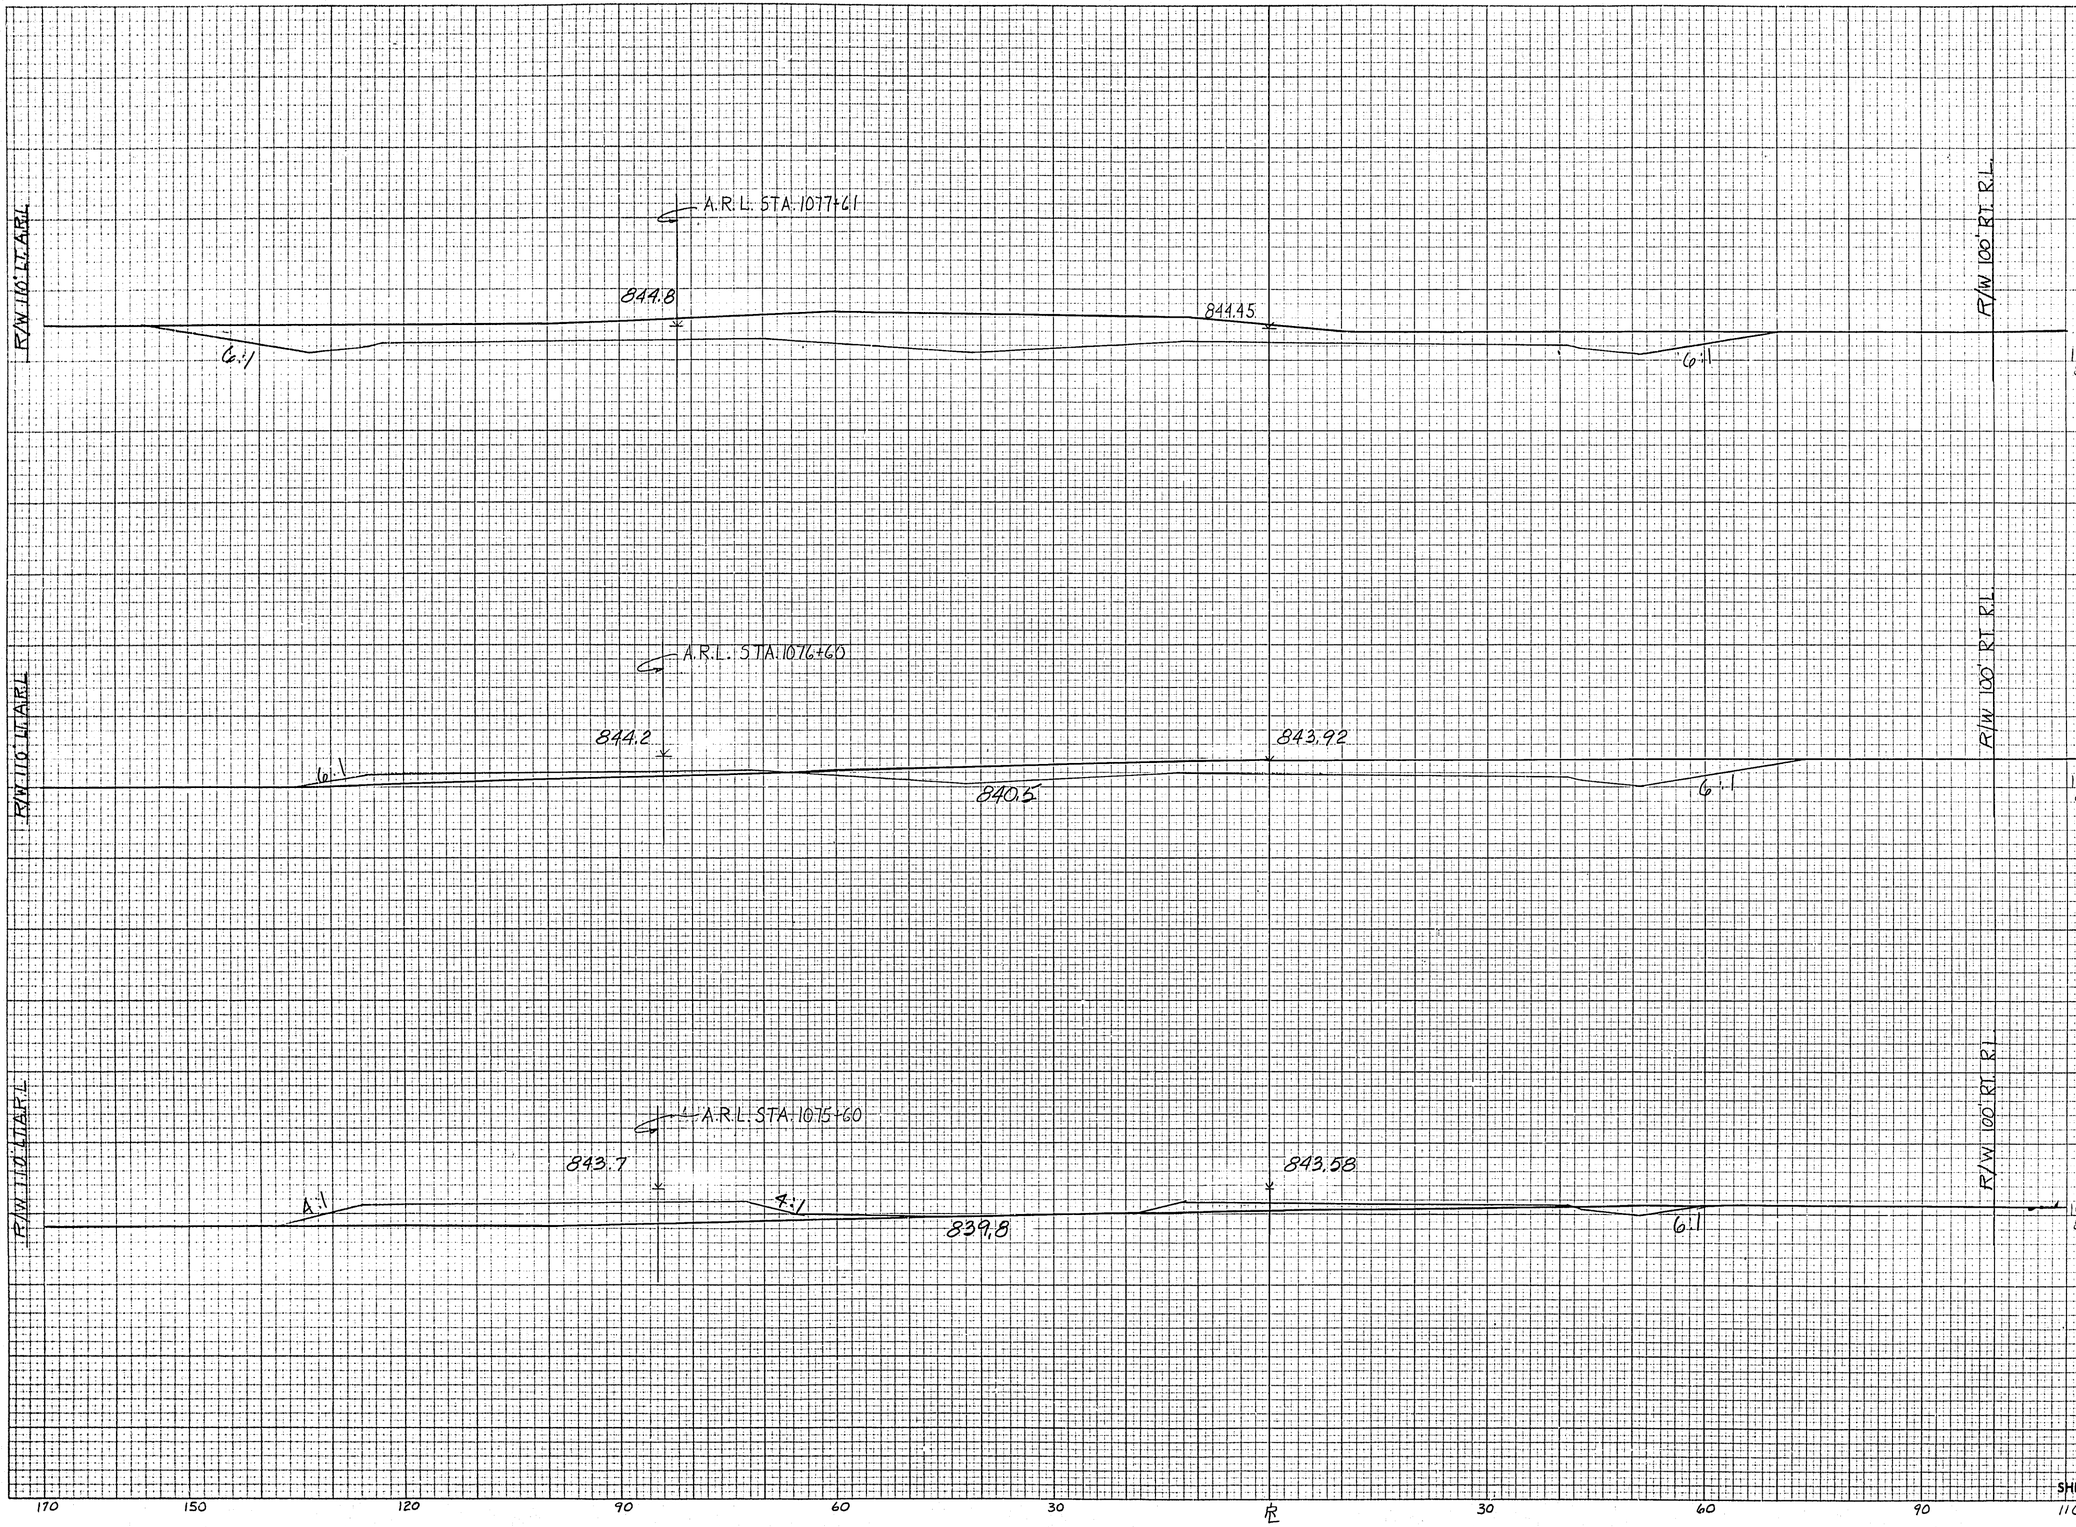

STATION	DISTANCE	YARDAGE EXCAVATION UNCL.	YARDAGE FILL
1077			
	100	16.72	110
1076			
	100	516	570
1075			
	100	35	1647
1074			
SHEET TOTAL		2223	2327

PLATE 3—CROSS SECTION O. P. R. & R. E. STANDARD
THE FREDERICK POST CO., CHICAGO


84

1075-1077

B.P.R. DISTRICT OFFICE	PROJECT	SHEET NUMBER	TOTAL SHEETS
WIS. 4	I-90-2(13)105	220	264

FINAL SURVEY
SURVEYED
PLOTTED
TEMPLATE
AREAS
AREAS CHECKED
NOTE BOOK
NO.

ORIGINAL SURVEY
SURVEYED
PLOTTED
TEMPLATE
AREAS
AREAS CHECKED
NOTE BOOK
NO.
BY TJV 4-22-58 JJP

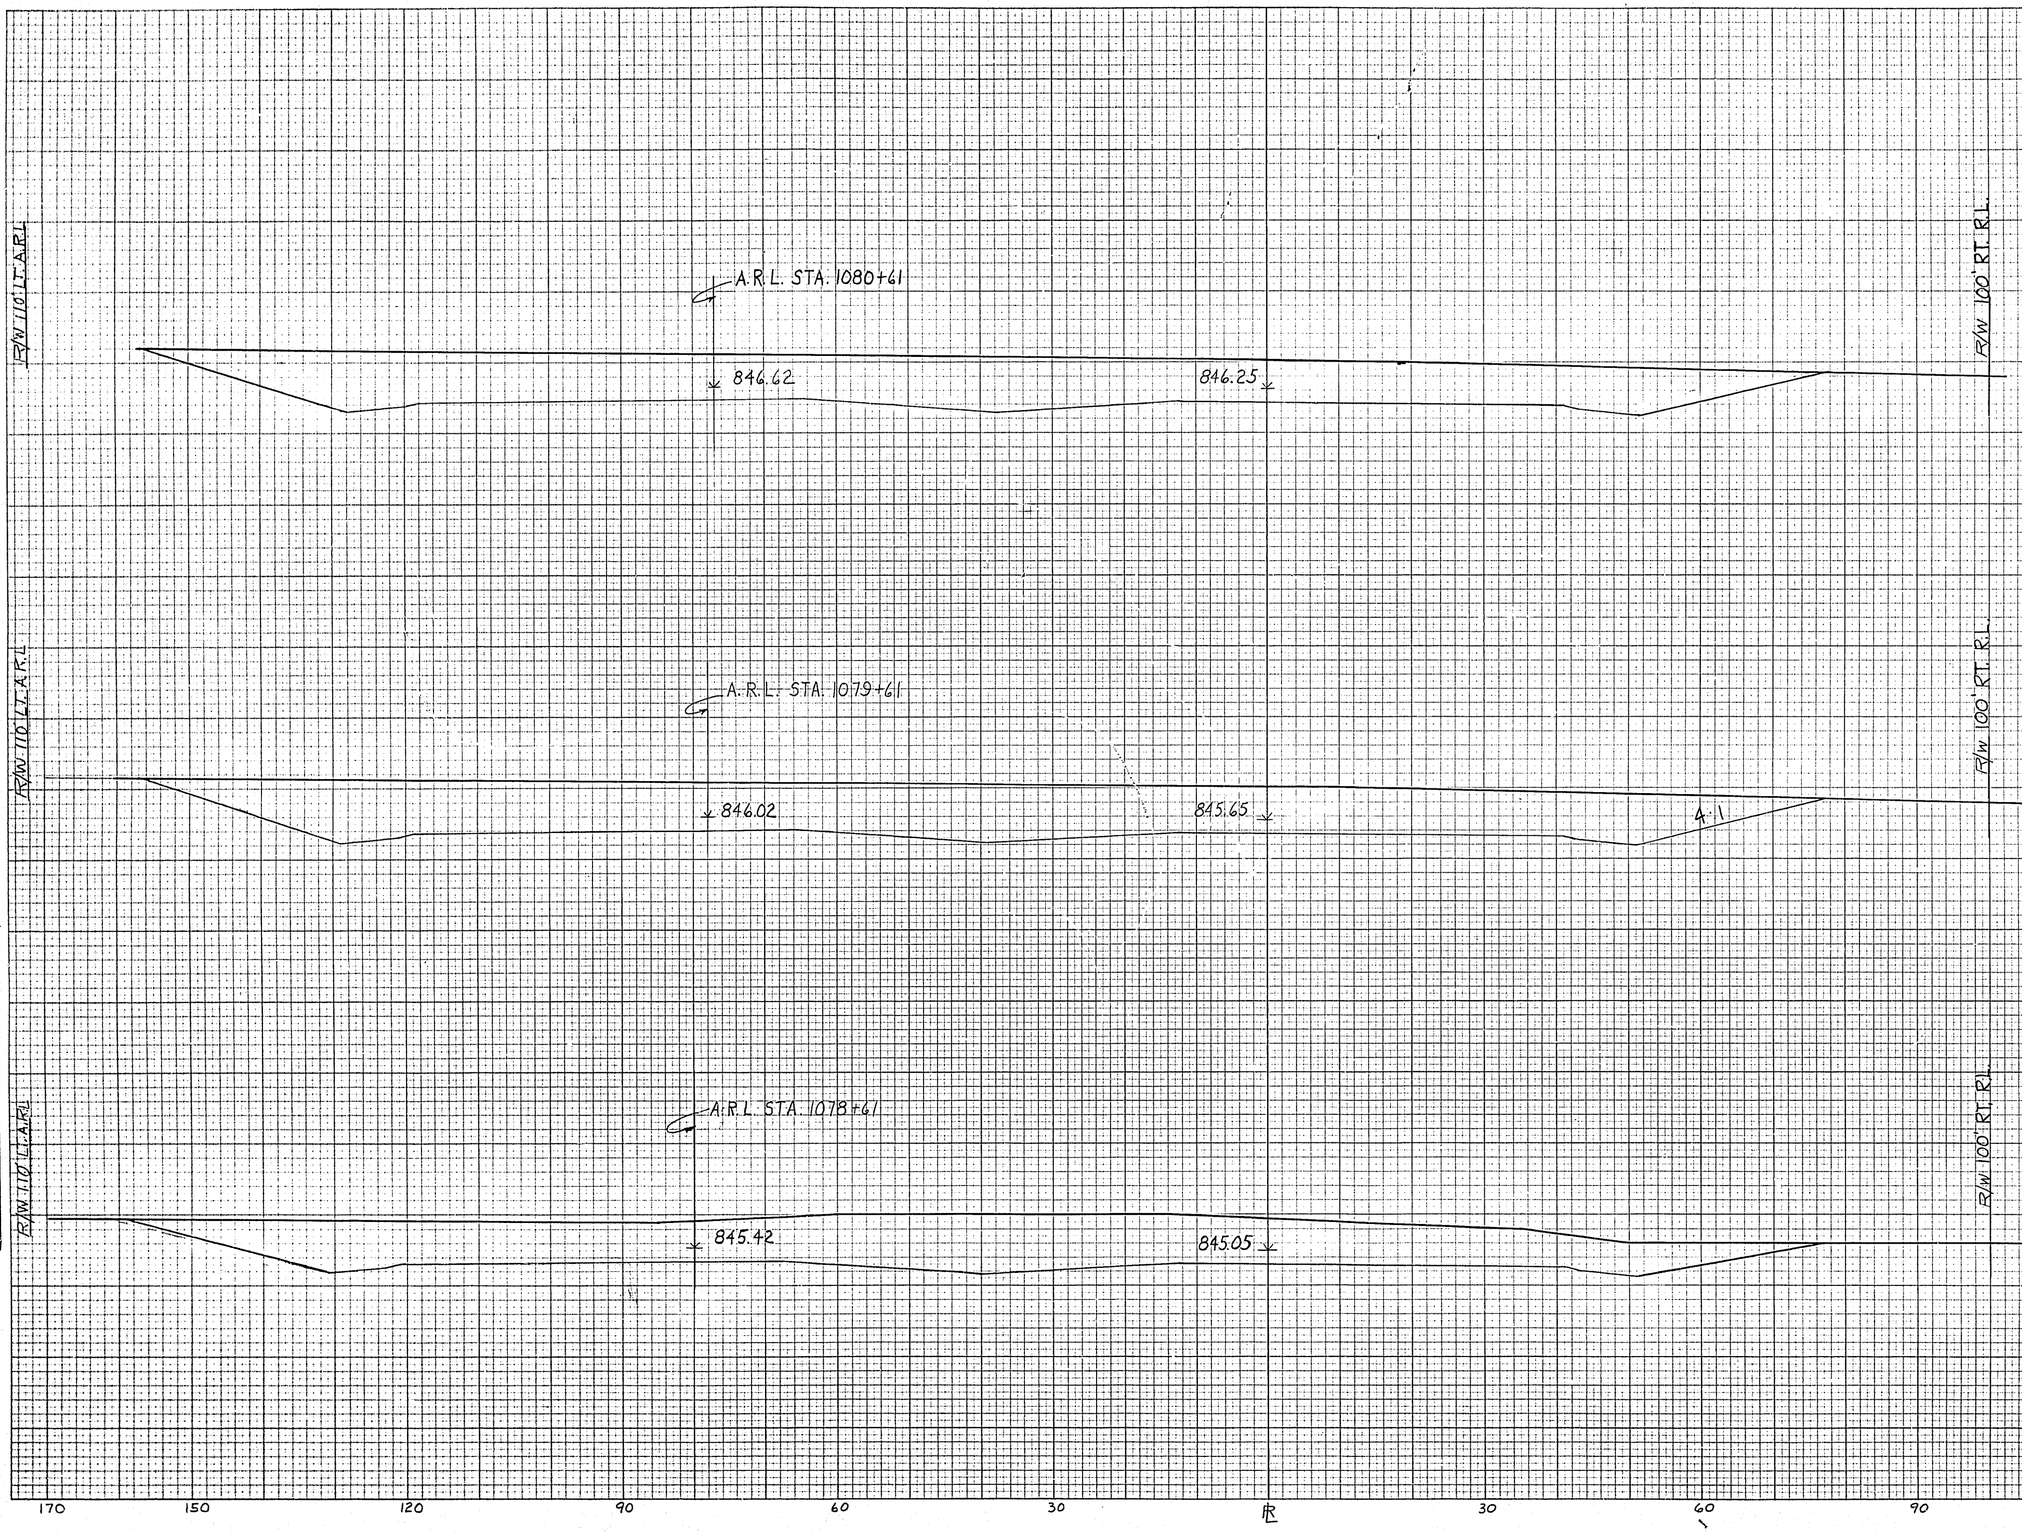

STATION	DISTANCE	YARDAGE EXCAVATION UNCL.	YARDAGE FILL
1080 850			
1080	100	5323	0
1079 850			
1079	100	5241	0
1078 850			
1078	100	3641	0
1077			
SHEET TOTAL		14205	0

PLATE 3-CROSS SECTION O. P. R. & R. E. STANDARD
THE FREDERICK POST CO., CHICAGO

1078-1080

B.P.R. DISTRICT OFFICE	PROJECT	SHEET NUMBER	TOTAL SHEETS
WIS. 4	E-90-2(18)165	201	264

FINAL SURVEY — PLOTTED — NOTE BOOK — TEMPLATE — NO. — AREAS — AREAS CHECKED — DATE

ORIGINAL SURVEY — DIRECTED — PLOTTED — NOTE BOOK — TEMPLATE — NO. — AREAS — AREAS CHECKED — BY — DATE 4-22-58 — 9-10-58

R/W 110' LT. A.R.L.

AUX. R.L. STA. 1083+75

848.50

STA. 1083+75 A
1-18"x80' C.P. REQ'D.

AUX. R.L.
STA. 1083+61

848.42

848.05

4:1

R/W 100' RT. R.L.

R/W 110' LT. A.R.L.

AUX. R.L.
STA. 1082+61

2½:1

847.82

847.45

10:1

R/W 100' RT. R.L.

R/W 110' LT. A.R.L.

AUX. R.L.
STA. 1081+61

847.22

846.85

R/W 106' RT. R.L.

STATION	DISTANCE	YARDAGE EXCAVATION UNCL.	YARDAGE EXCAVATION	YARDAGE EXCAVATION	YARDAGE EXCAVATION	YARDAGE FILL
1083						
1083 8.50						
	100	2581				178
1082						
1082 8.50	100	3678				63
1081						
	100	4643				0
1081 8.50						
1080						
SHEET TOTAL		10902				241


170 150 120 90 60 30 ℄ 30 60 90 110

PLATE 3—CROSS SECTION O. P. R. & R. E. STANDARD
THE FREDERICK POST CO., CHICAGO

B.P.R. DISTRICT OFFICE	PROJECT	SHEET NUMBER	TOTAL SHEETS
WIS. 4	I-90-2(18)105	202	264

FINAL SURVEY — SURVEYED, PLOTTED, TEMPLATE, AREAS, AREAS CHECKED, NOTE BOOK, NO., BY, DATE

ORIGINAL SURVEY — SURVEYED, PLOTTED, TEMPLATE, AREAS, NOTE BOOK, NO. 1, BY J.I.F., DATE 4-27-55 / TP: 4-27-55

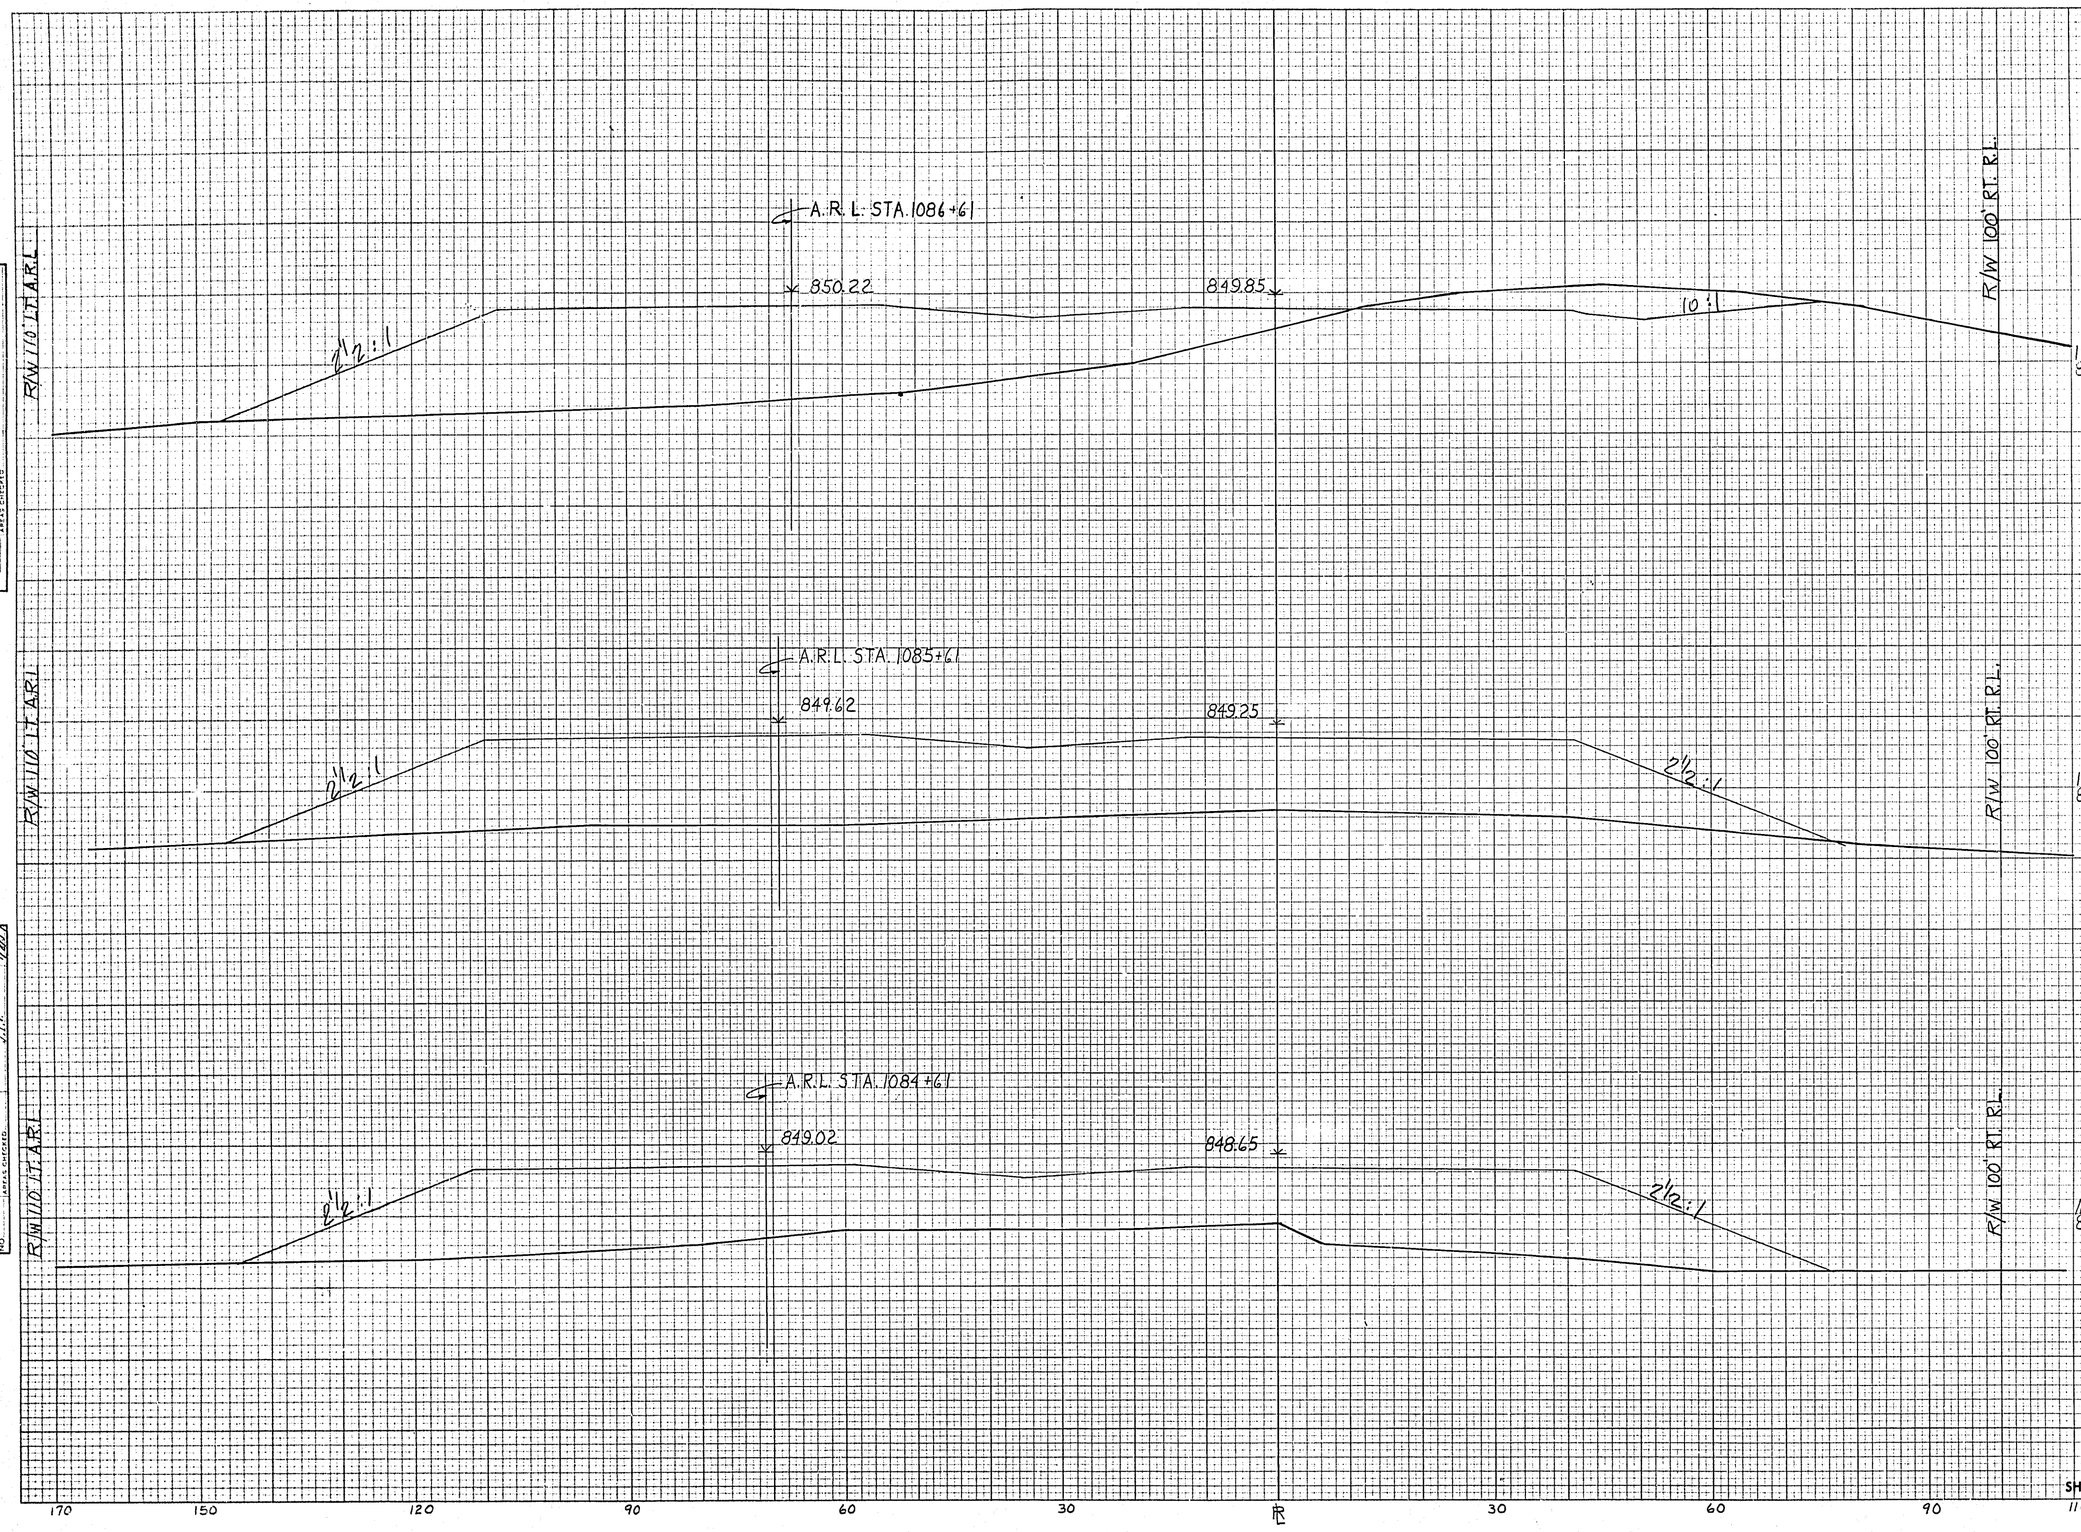


STATION	DISTANCE	YARDAGE EXCAVATION INCL.	YARDAGE EXCAVATION	YARDAGE EXCAVATION	YARDAGE EXCAVATION	YARDAGE FILL
1086						
	100	313				6765
1085						
	100	0				1641
1084						
	100	1002				3701
1083						
SHEET TOTAL		1,315				12107

PLATE 3—CROSS SECTION O. P. R. & R. E. STANDARD
THE FREDERICK POST CO., CHICAGO

B.P.R. DISTRICT OFFICE	PROJECT	SHEET NUMBER	TOTAL SHEETS
WIS. 4	I-90-2(18)105	203	264

FINAL SURVEY — SURVEYED — PLOTTED — NOTE BOOK — NO. — BY — DATE — AREAS CHECKED

ORIGINAL SURVEY — SURVEYED — PLOTTED — NOTE BOOK — NO. — BY J.T.P. — DATE 4-22-58 — AREAS CHECKED J.T.P. 5/8/58

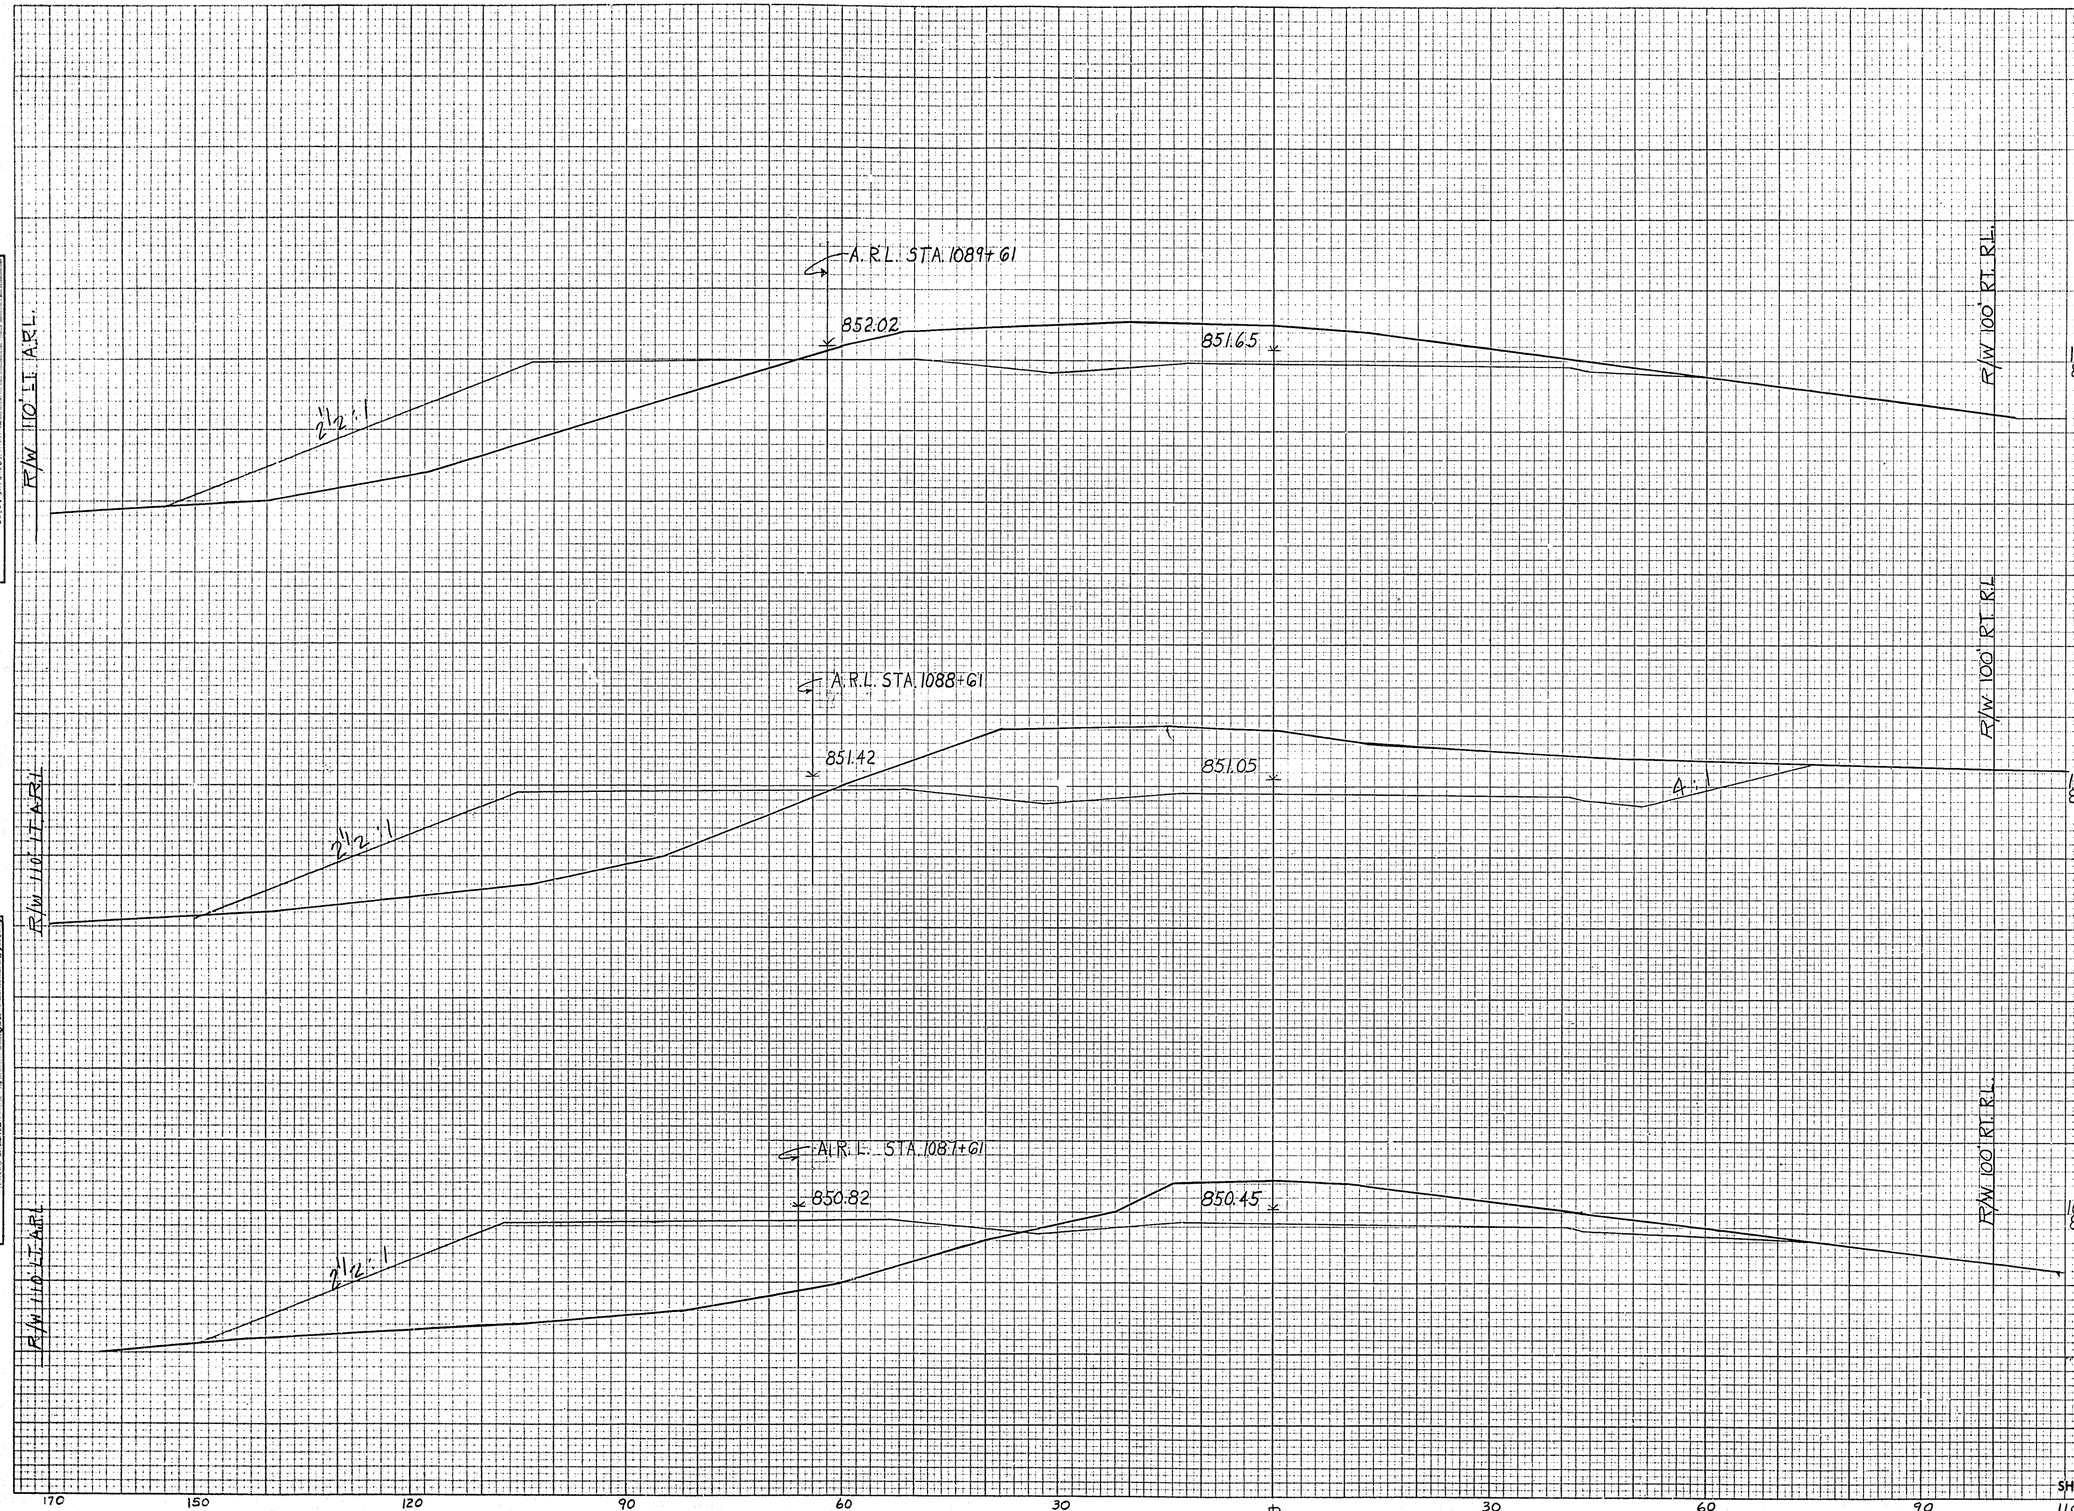

STATION	DISTANCE	YARDAGE EXCAVATION UNCL.	YARDAGE FILL
1089 850			
1089			
	100	2570	2767
1088			
1088 850			
	100	231.7	2994
1087			
	100	943	4538
1087 850			
1086			
SHEET TOTAL		5830	9699

PLATE 3—CROSS SECTION O. P. R. & R. E. STANDARD
THE FREDERICK POST CO., CHICAGO

B.P.R. DISTRICT OFFICE	PROJECT	SHEET NUMBER	TOTAL SHEETS
WIS. 4	I-90-2(18)105	264	264

FINAL SURVEY — SURVEYED — PLOTTED — NOTE BOOK — AREAS — NO — AREAS CHECKED

ORIGINAL SURVEY — SURVEYED — PLOTTED — TEMPLATE Colleges IV — NOTE BOOK — AREAS CHICAGO — NO

BY	DATE
TFV	4-21-58
	7-16-58
	9-18-58

R/W 110' LT. A.R.L.

A.R.L. STA. 1092+62

853.8

853.45

4:1

847.0

850.2

848.3

R/W 100' RT. R.L.

R/W 110' LT. A.R.L.

A.R.L. STA. 1091+61

853.2

852.85

4:1

4:1

846.5

849.5

R/W 100' RT. R.L.

R/W 110' LT. A.R.L.

A.R.L. STA. 1090+61

852.6

852.25

2½:1

2½:1

R/W 100' RT. R.L.

170 150 120 90 60 30 ℄ 30 60 90 110

STATION	DISTANCE	YARDAGE EXCAVATION UNCL.	YARDAGE EXCAVATION	YARDAGE EXCAVATION	YARDAGE EXCAVATION	YARDAGE FILL
1092 850						
1092						
	100	291				193.8
1091 850						
1091						
	100	0				41.45
1090						
	100	884				34.14
1090 850						
1089						
SHEET TOTAL		1175				1497

PLATE 3—CROSS SECTION O. P. R. & R. E. STANDARD
THE FREDERICK POST CO., CHICAGO

B.P.R. DISTRICT OFFICE	PROJECT	SHEET NUMBER	TOTAL SHEETS
WIS. 4	I-90-2(18)105	205	264

FINAL SURVEY — DATE — BY — SURVEYED — PLOTTED — TEMPLATE — NOTE BOOK — AREAS — AREAS CHECKED — NO. ____

ORIGINAL SURVEY — DATE 7-21-58 — BY JTP — SURVEYED — PLOTTED 7-22-58 — TEMPLATE C-SECT. 7-1 — NOTE BOOK 1432 — AREAS — AREAS CHECKED — NO. 4163

R/W 110' LT. ARL.

A.R.L. STA. 1095+61

854.5 — 854.53

848.5 — 851.1 — 850.8

R/W 100' RT. R.L.

R/W 110' LT. ARL.

A.R.L. STA. 1094+60

854.4 — 854.33

20:1 — 848.0 — 851.6 — 850.3

R/W 100' RT. R.L.

R/W 110' LT. ARL.

A.R.L. STA. 1093+62

854.2 — 853.97

4:1 — 847.5 — 850.9 — 6:1 — 849.8

R/W 100' RT. R.L.

STATION	DISTANCE	YARDAGE EXCAVATION UNCL.	YARDAGE EXCAVATION	YARDAGE FILL
1095 850				
1095				
	100	3174		0
1094				
1094 850				
	100	2618		0
1093				
	100	1413		207
1093 850				
1092				
SHEET TOTAL		7225		207

170 150 120 90 60 30 ℄ 30 60 90 110

PLATE 3—CROSS SECTION O. P. R. & B. E. STANDARD
THE FREDERICK POST CO., CHICAGO

1093-1095

90

B.P.R. DISTRICT OFFICE	PROJECT	SHEET NUMBER	TOTAL SHEETS
WIS. 4	I-90-2(18)105	206	264

FINAL SURVEY — SURVEYED, PLOTTED, NOTE BOOK, NO., DATE, BY, AREAS CHECKED

ORIGINAL SURVEY — SURVEYED, PLOTTED, TOPO. KTP. SHEET, NOTE BOOK, NO., TY., AREAS CHECKED, BY JJL, DATE 9/17/73

R/W 110' LT. A.R.L.

A.R.L. STA. 1098+62

853.9

854.17

849.0

849.6

849.3

4:1

R/W 100' RT. R.L.

R/W 110' LT. A.R.L.

A.R.L. STA. 1097+61

854.3

854.45

849.5

850.1

849.8

6:1

R/W 100' RT. R.L.

R/W 110' LT. A.R.L.

A.R.L. STA. 1096+61

854.5

854.51

849.0

850.6

850.3

4:1

R/W 100' RT. R.L.

170 150 120 90 60 30 ℄ 30 60 90 110

STATION	DISTANCE	YARDAGE EXCAVATION UNCL.	YARDAGE EXCAVATION	YARDAGE EXCAVATION	YARDAGE EXCAVATION	YARDAGE FILL
1098 850						
1098						
	100	3664				0
1097 850						
	100	3186				0
1096						
	100	3238				0
1096 850						
1095						
SHEET TOTAL:		10088				0

B.P.R. DISTRICT OFFICE	PROJECT	SHEET NUMBER	TOTAL SHEETS
WIS. 4	I-90-2(18)110.5	207	264

FINAL SURVEY — BLUEPRINTED / PLOTTED / NOTE BOOK / TEMPLATE / AREAS / AREAS CHECKED / NO.

ORIGINAL SURVEY — SURVEYED / PLOTTED / NOTE BOOK / AREAS / AREAS CHECKED / NO. — BY — DATE: 1-17-58, 7-16-58, 9-10-59

R/W 110' LT. A.R.L.

A.R.L. STA. 1101+56

851.8

852.37

848.1

4:1

2½:1

R/W 100' RT. R.L.

A.R.L. STA. 1100+58

852.6

853.13

848.6

5:1

4:1

R/W 100' RT. R.L.

A.R.L. STA. 1099+60

853.3

853.73

848.5

849.1

848.7

6:1

4:1

R/W 100' RT. R.L.

STATION	DISTANCE	YARDAGE EXCAVATION UNCL.	YARDAGE EXCAVATION	YARDAGE EXCAVATION	YARDAGE EXCAVATION	YARDAGE FILL
1101 350						
1101						
	100	0				3681
1100						
1100 850						
	100	1265				888
1099						
1099 950						
	100	3262				0
1098						
SHEET TOTAL		4527				4569

170 150 120 90 60 30 ℄ 30 60 90 110

PLATE 3—CROSS SECTION O. P. R. & B. E. STANDARD
THE FREDERICK POST CO., CHICAGO

92


1099-1101

B.P.R. DISTRICT OFFICE	PROJECT	SHEET NUMBER	TOTAL SHEETS
WIS. 4	I-90-2(11)105	208	264

FINAL SURVEY
NOTE BOOK
NO.
TEMPLATE
AREAS COMPUTED
PLOTTED
CHECKED

ORIGINAL SURVEY
NOTE BOOK
NO.
TEMPLATE Subgr. TV
AREAS COMPUTED J.I.P.
PLOTTED
CHECKED

BY	DATE
TFT	6-22-58
	12-16-58
	9-9-59

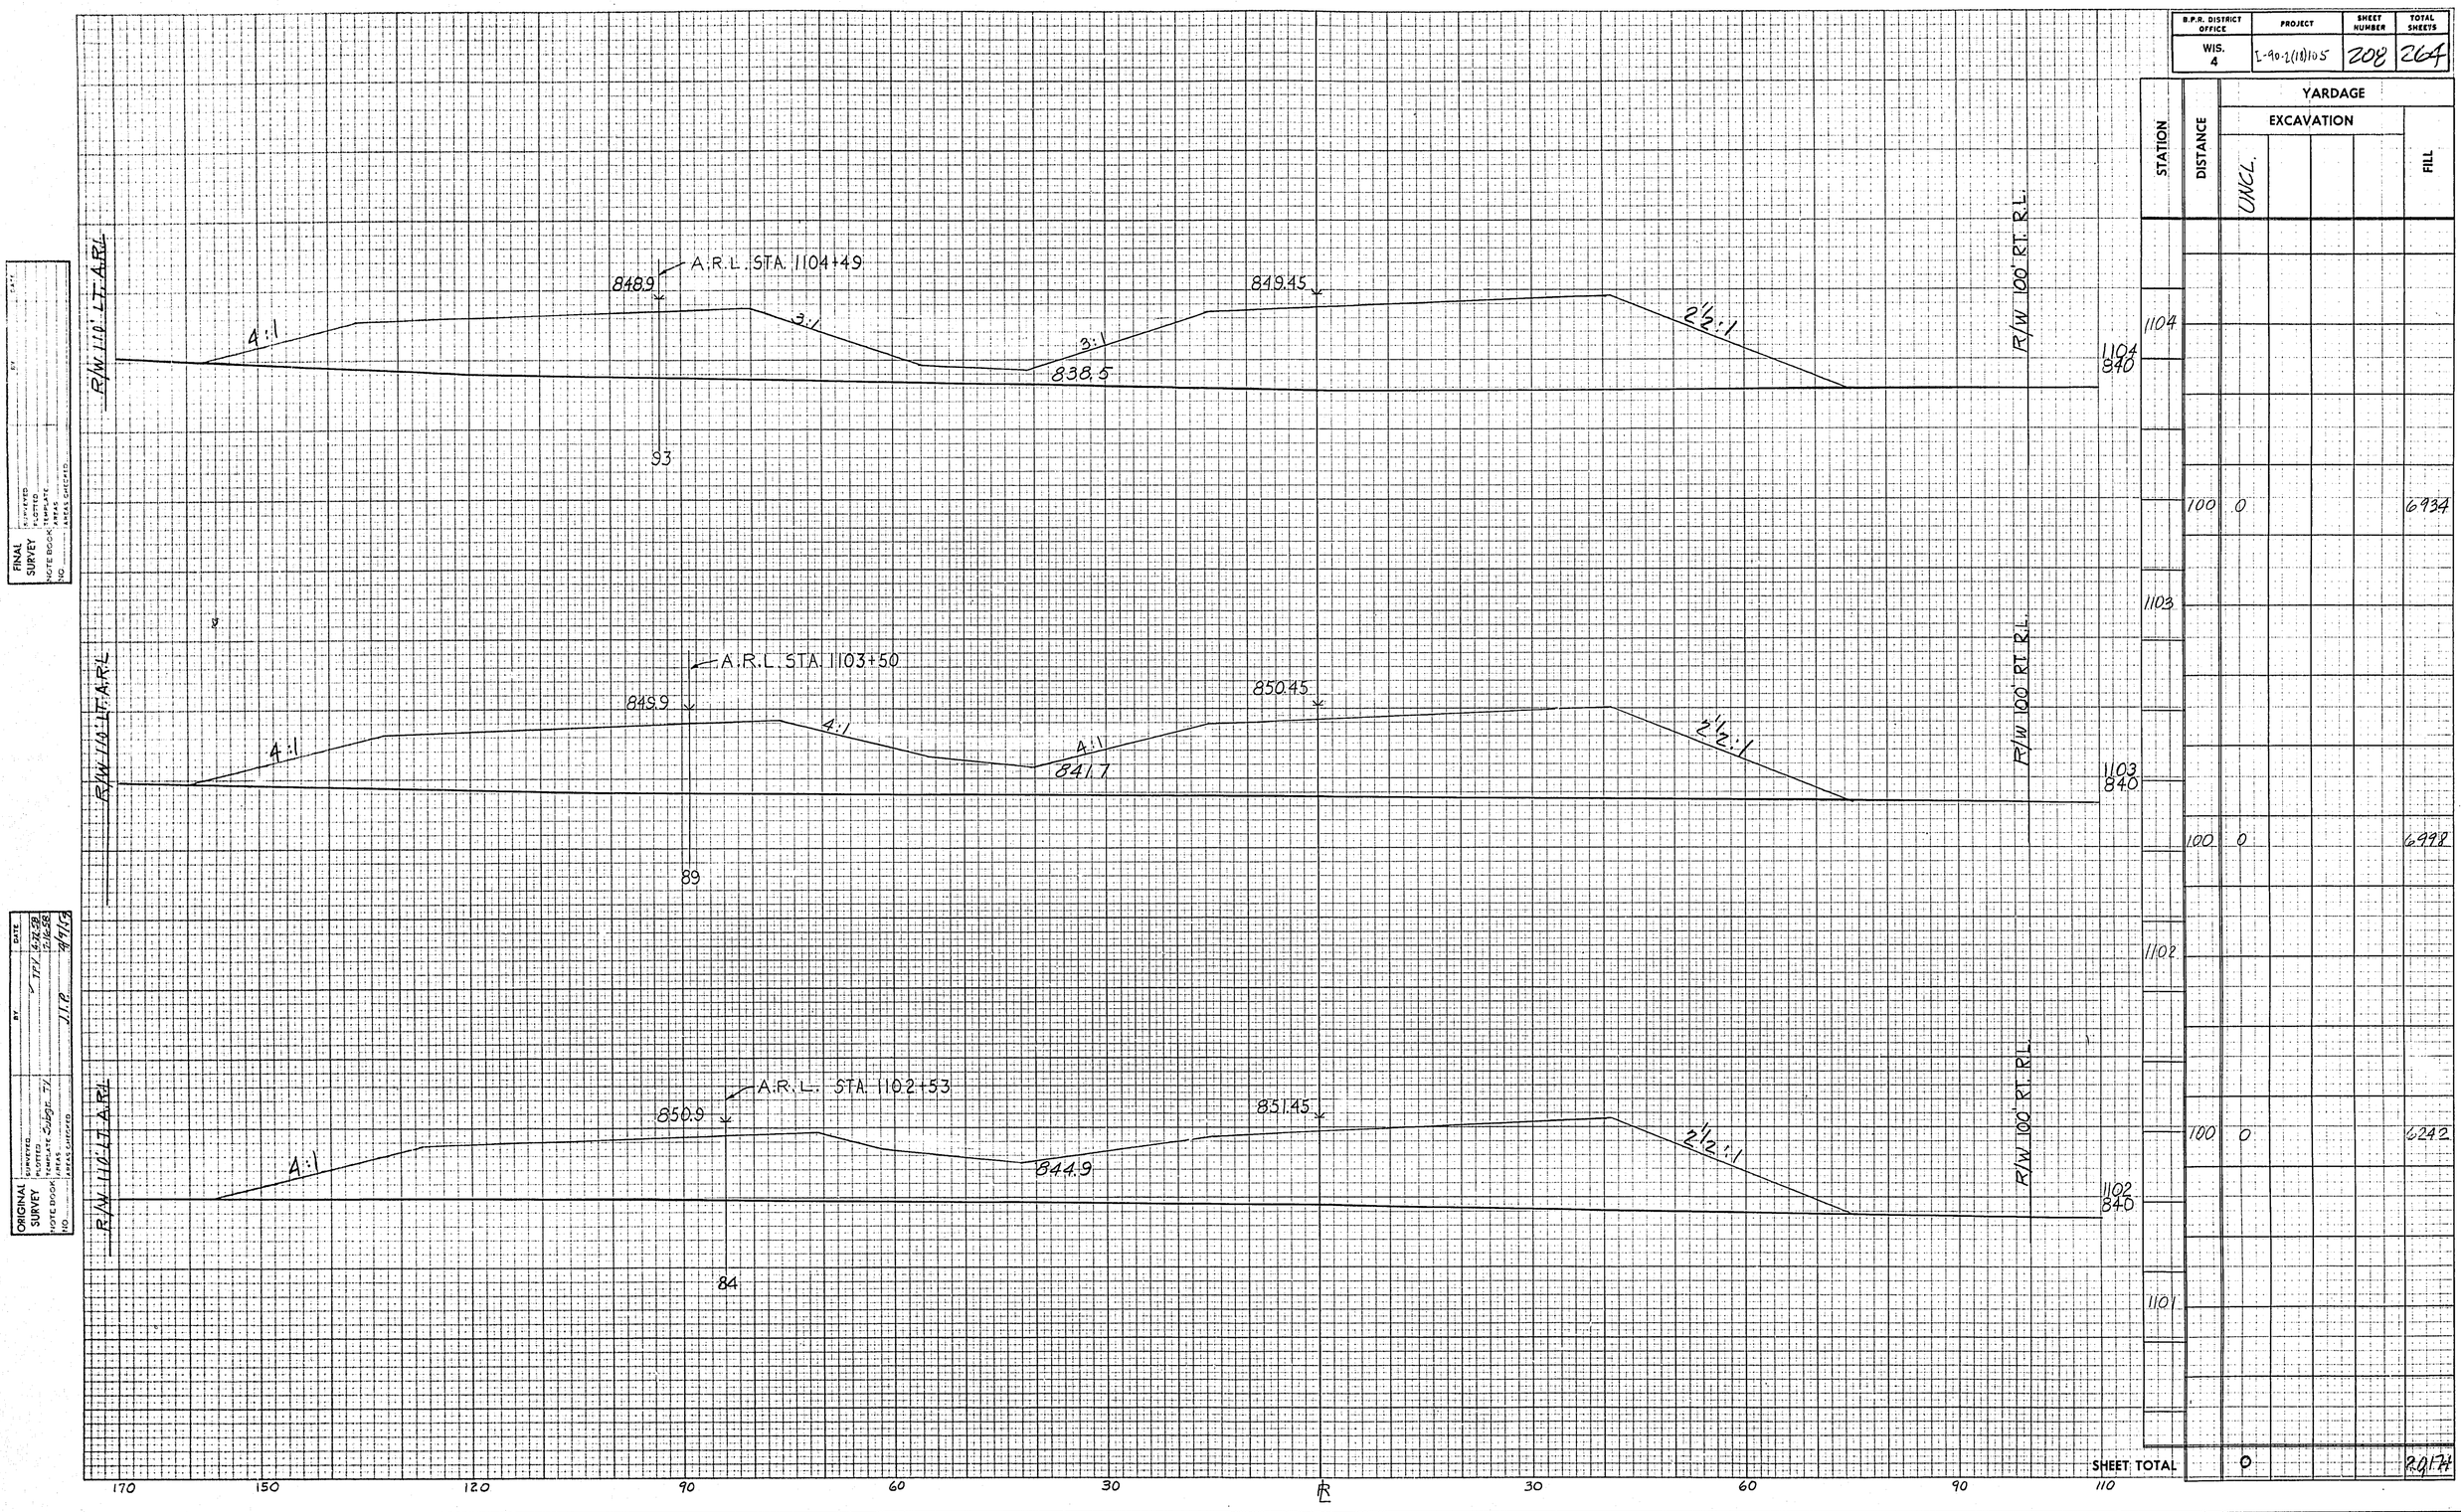


STATION	DISTANCE	YARDAGE EXCAVATION UNCL.	YARDAGE EXCAVATION	YARDAGE EXCAVATION	YARDAGE EXCAVATION	YARDAGE FILL
1104						
1103						
B.P.R. DISTRICT OFFICE	PROJECT	SHEET NUMBER	TOTAL SHEETS
WIS. 4	1-90-2(18)105	209	264

FINAL SURVEY — SURVEYED — PLOTTED — TEMPLATE — AREAS — AREAS CHECKED — NOTE BOOK — NO. — DATE

ORIGINAL SURVEY — SURVEYED — PLOTTED — TEMPLATE 2nd Sept. '54 — AREAS — AREAS CHECKED — NOTE BOOK — NO. — BY — DATE — 7/54 — 4/25/55 — 7/26/55 — 4-9-55 — J.I.P.

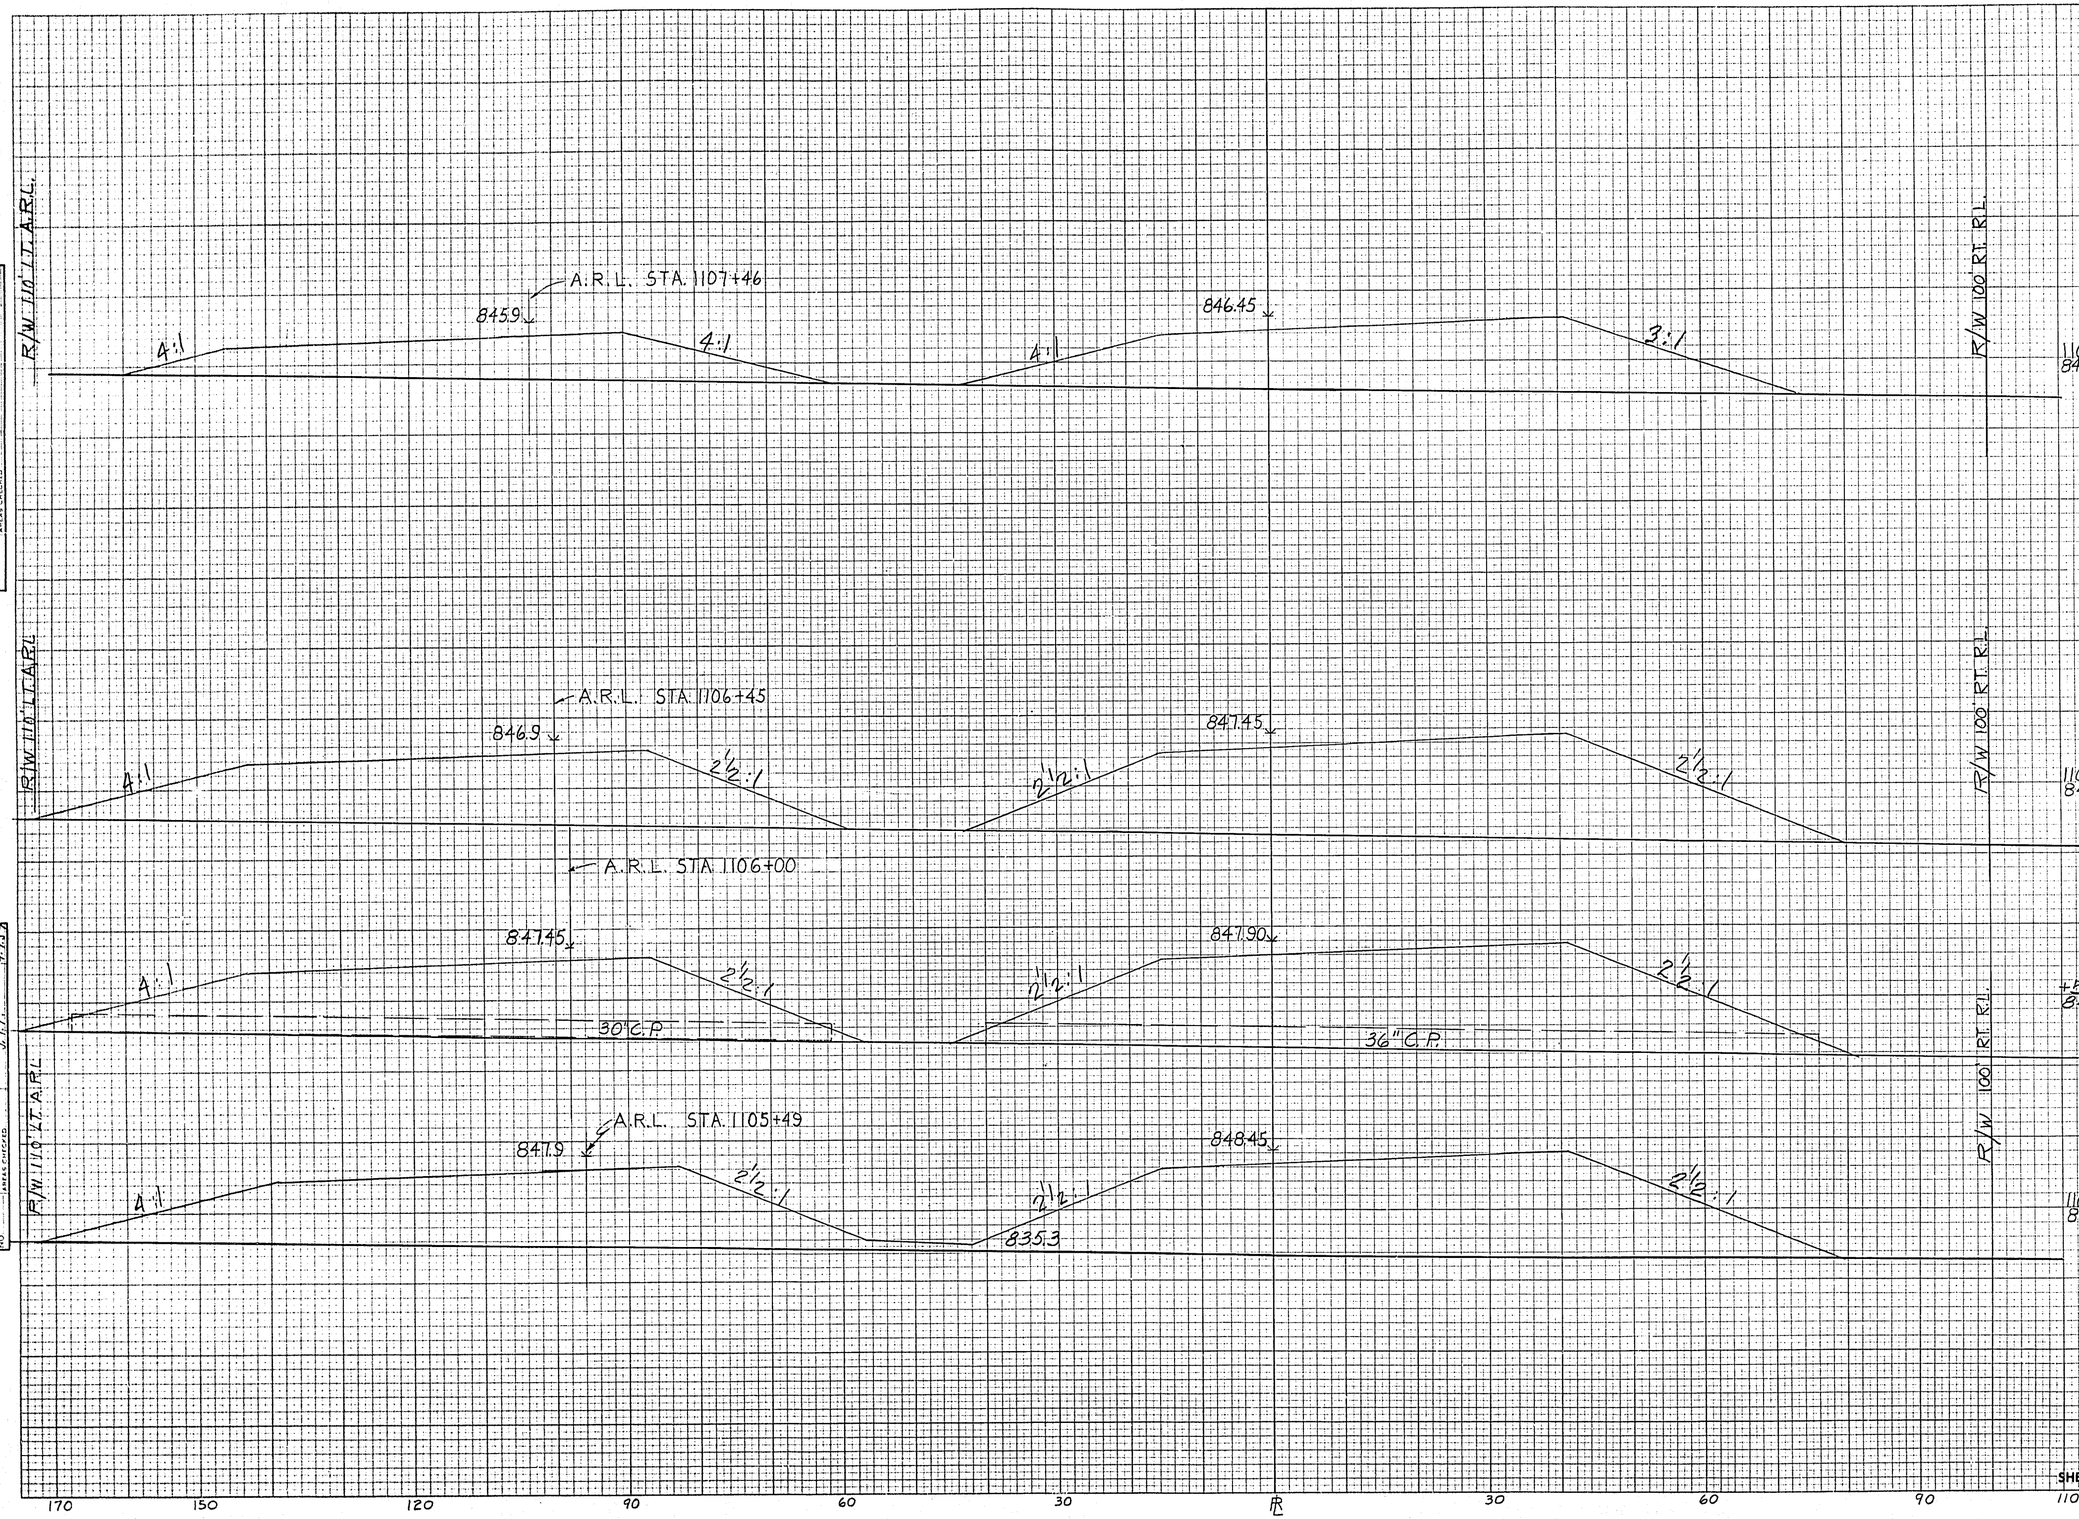

STATION	DISTANCE	YARDAGE EXCAVATION UNCL.	YARDAGE FILL
1107 840			
1107			
	100	0	5878
1106			
1106 840			
	100	0	7555
+55 840			
1105			
1105 840			
	100	0	7290
1104			
SHEET TOTAL		0	20723

PLATE 3—CROSS SECTION O. P. R. & R. E. STANDARD
THE FREDERICK POST CO., CHICAGO

14

1105 - 1107

D.P.R. DISTRICT OFFICE	PROJECT	SHEET NUMBER	TOTAL SHEETS
WIS. 4	I-90-2(18)105	210	264

R/W 110' LT. ARL.

850
843.0
840
180
150
108
A.R.L. STA. 1110+38
(MATCH LINE)
843.0
108
843.45
4:1
R/W 100' RT. R.L.
1110
840

R/W 110' LT. ARL.

850
844.0
840
180
150
120
106
A.R.L. STA. 1109+42
(MATCH LINE)
844.0
106
84445
4:1
R/W 100' RT. R.L.
1109
840

R/W 110' LT. ARL.

850
844.9
840
180
6:1
150
120
105
A.R.L. STA. 1108+44
(MATCH LINE)
844.9
105
845.45
4:1
R/W 100' RT. R.L.
1108
840

170 150 120 90 60 30 ℄ 30 60 90 110

STATION	DISTANCE	YARDAGE EXCAVATION UNCL.	YARDAGE EXCAVATION	YARDAGE FILL
1110				
	100	1684		492
1109				
	100	987		941
1108				
	100	247		2375
1107				
SHEET TOTAL		2918		4,308

FINAL SURVEY
SUBMITTED
PLOTTED
NOTE BOOK TEMPLATE
NO. AREAS
AREAS CHECKED

ORIGINAL SURVEY
SUBMITTED
PLOTTED
NOTE BOOK TEMPLATE Sahgin. 14
NO. AREAS JJR
AREAS CHECKED 4/9/58

BY	DATE
TBV	4-22-58
	2/4/58


PLATE 3—CROSS SECTION O. P. R. & R. E. STANDARD
THE FREDERICK POST CO., CHICAGO

1108-1110

B.P.R. DISTRICT OFFICE	PROJECT	SHEET NUMBER	TOTAL SHEETS
WIS. 4	I-90 2(18) 105	2/1	2/4

FINAL SURVEY — SURVEYED — PLOTTED — NOTE BOOK — NO. — AREAS — AREAS CHECKED — BY — DATE

ORIGINAL SURVEY — SURVEYED — PLOTTED — NOTE BOOK Subgr. 71 — NO. 1112 — AREAS — AREAS CHECKED — BY V.H. — DATE 4-23-58, 4-24-58, 4-28-58

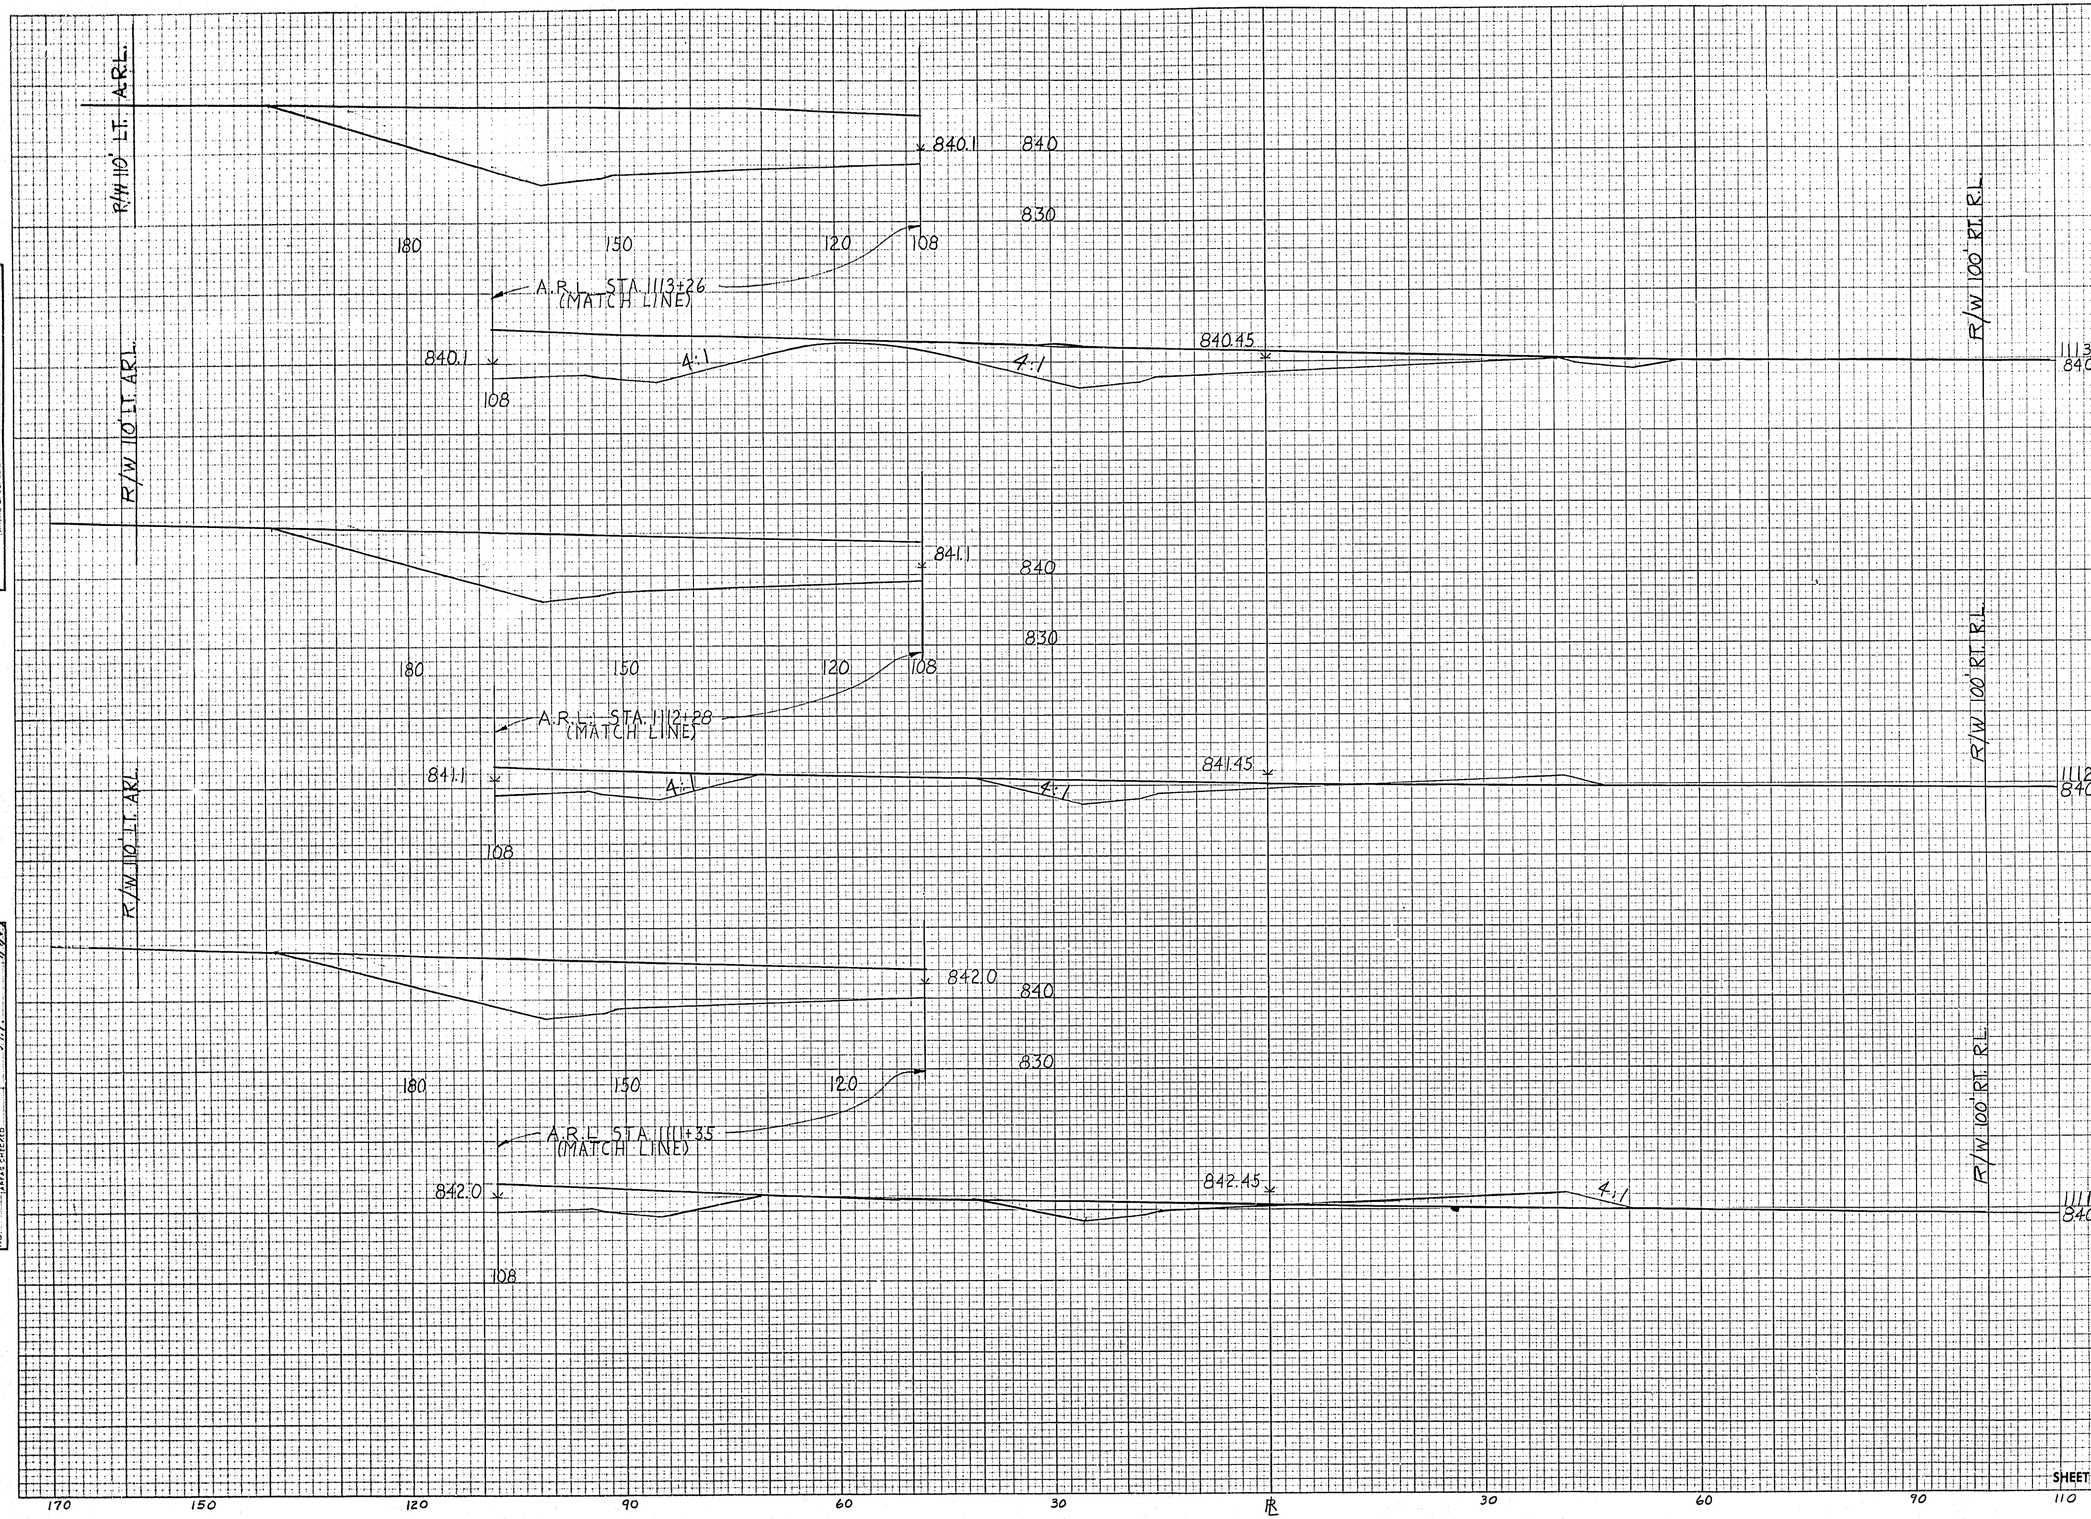

STATION	DISTANCE	YARDAGE EXCAVATION UNCL.				YARDAGE FILL
1113						
1113						
	100	3270				68
1112						
1112						
	100	2256				168
1111						
1111						307
	100	2026				
1110						
SHEET TOTAL		7552				545

PLATE 3—CROSS SECTION O. P. R. & R. E. STANDARD
THE FREDERICK POST CO., CHICAGO

1111-1113

96

B.P.R. DISTRICT OFFICE	PROJECT	SHEET NUMBER	TOTAL SHEETS
WIS. 4	I-90-2(18)105	212	264

FINAL SURVEY — SURVEYED / PLOTTED / NOTE BOOK / NO. / AREAS / AREAS CHECKED

ORIGINAL SURVEY — SURVEYED / PLOTTED 4-22-58 / NOTE BOOK / AREAS / AREAS CHECKED JLR — BY VFL — DATE 4-22-58, 7-16-58

R/W 110' LT. A.R.L.

840 / 830

837.2 — 180 — 150 — 120 — 106

A.R.L. STA. 1116+22 (MATCH LINE)

837.2 — 4:1 — 4:1 — 837.45 — 6:1 — 106

R/W 100' RT. R.L.

R/W 110' LT. A.R.L.

840 / 830

838.1 — 180 — 150 — 120 — 107

A.R.L. STA. 1115+24 (MATCH LINE)

838.1 — 4:1 — 4:1 — 838.45 — 6:1 — 107

R/W 100' RT. R.L.

R/W 110' LT. A.R.L.

840 / 830

839.1 — 180 — 150 — 120 — 108

A.R.L. STA. 1114+26 (MATCH LINE)

839.1 — 4:1 — 4:1 — 839.45 — 6:1 — 108

R/W 100' RT. R.L.

170 — 150 — 120 — 90 — 60 — 30 — ℄ — 30 — 60 — 90 — 110

STATION	DISTANCE	YARDAGE EXCAVATION UNCL.	YARDAGE EXCAVATION	YARDAGE FILL
1116				
	100	5542		25
1115				
	100	5466		25
1114				
	100	4800		25
1113				
SHEET TOTAL		15808		75

1116 840

1115 840

1114 840

PLATE 3-CROSS SECTION O. P. R. & R. E. STANDARD
THE FREDERICK POST CO., CHICAGO


97

1114-1116

B.P.R. DISTRICT OFFICE	PROJECT	SHEET NUMBER	TOTAL SHEETS
WIS. 4	I-90-2(18)105	213	239

FINAL SURVEY — SCALE KEYED, PLOTTED, TEMPLATE, AREAS, AREAS CHECKED, NOTE BOOK, NO., BY, DATE


ORIGINAL SURVEY — SURVEYED, PLOTTED, TEMPLATE, AREAS, AREAS CHECKED, NOTE BOOK, NO., BY, DATE

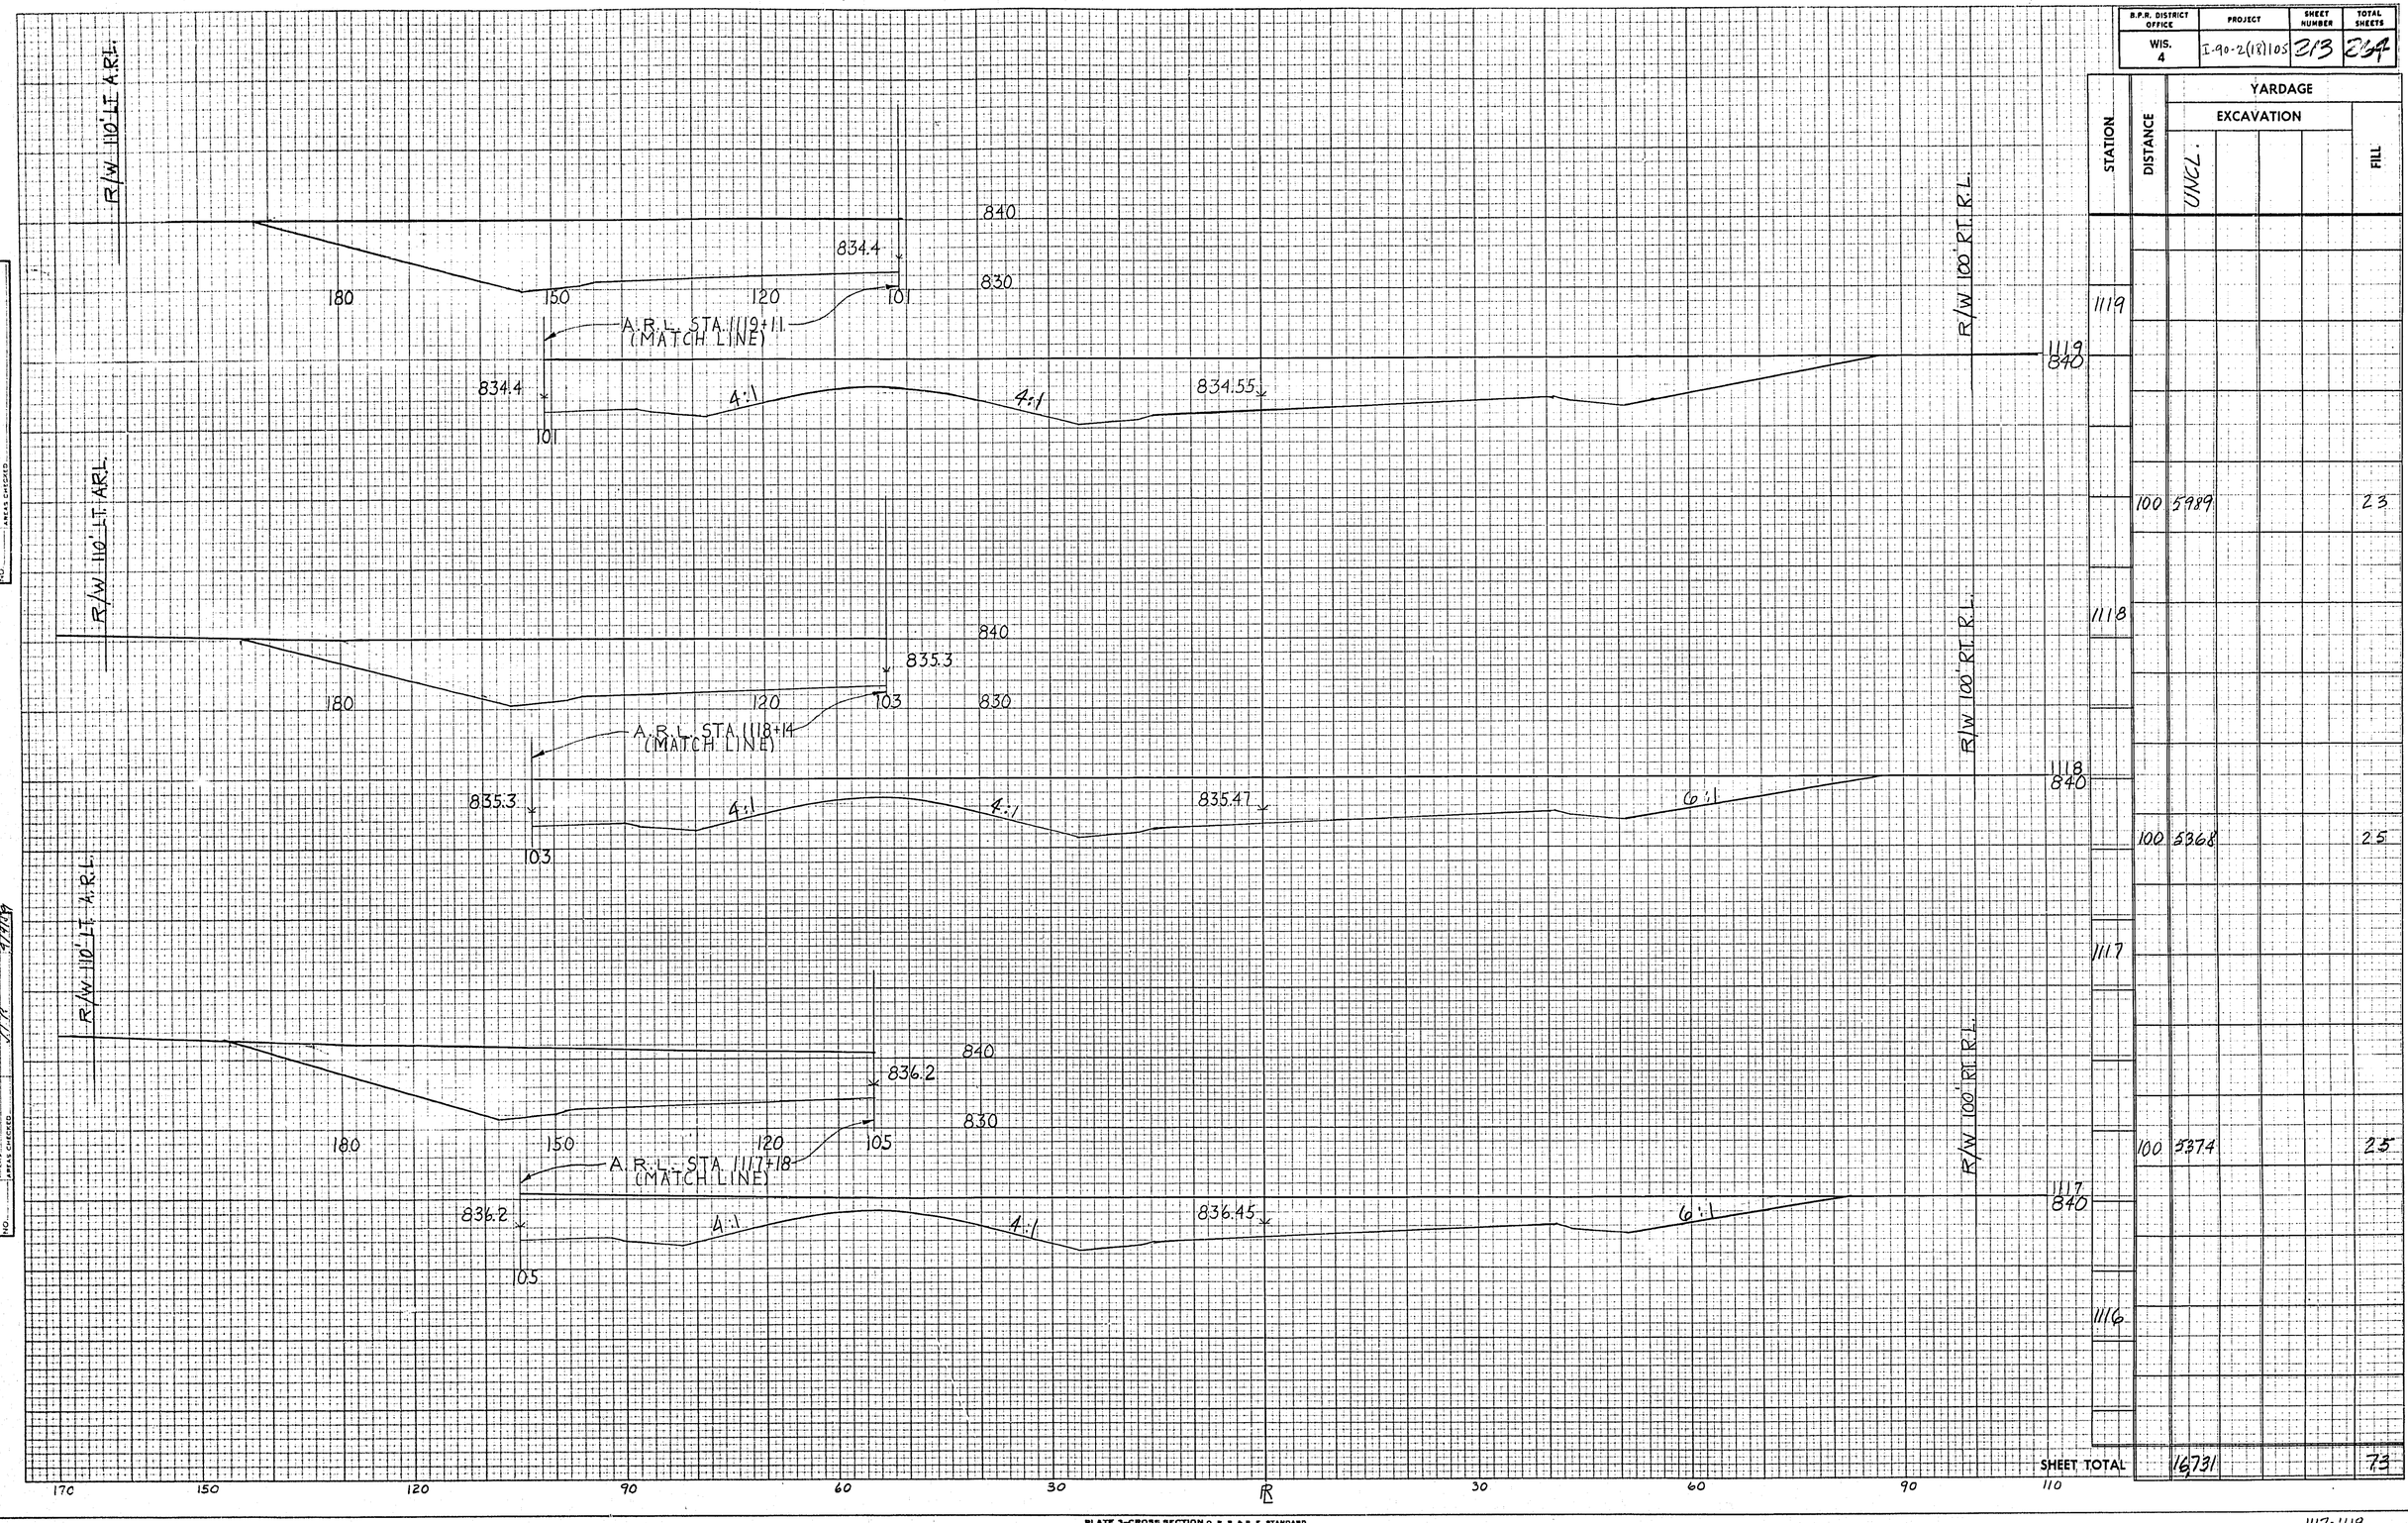

STATION	DISTANCE	YARDAGE EXCAVATION UNCL.	YARDAGE FILL
1119			
	100	5989	23
1118			
	100	5368	25
1117			
	100	5374	25
1116			
SHEET TOTAL		16731	73

PLATE 3—CROSS SECTION O. P. R. & R. E. STANDARD
THE FREDERICK POST CO., CHICAGO

B.P.R. DISTRICT OFFICE	PROJECT	SHEET NUMBER	TOTAL SHEETS

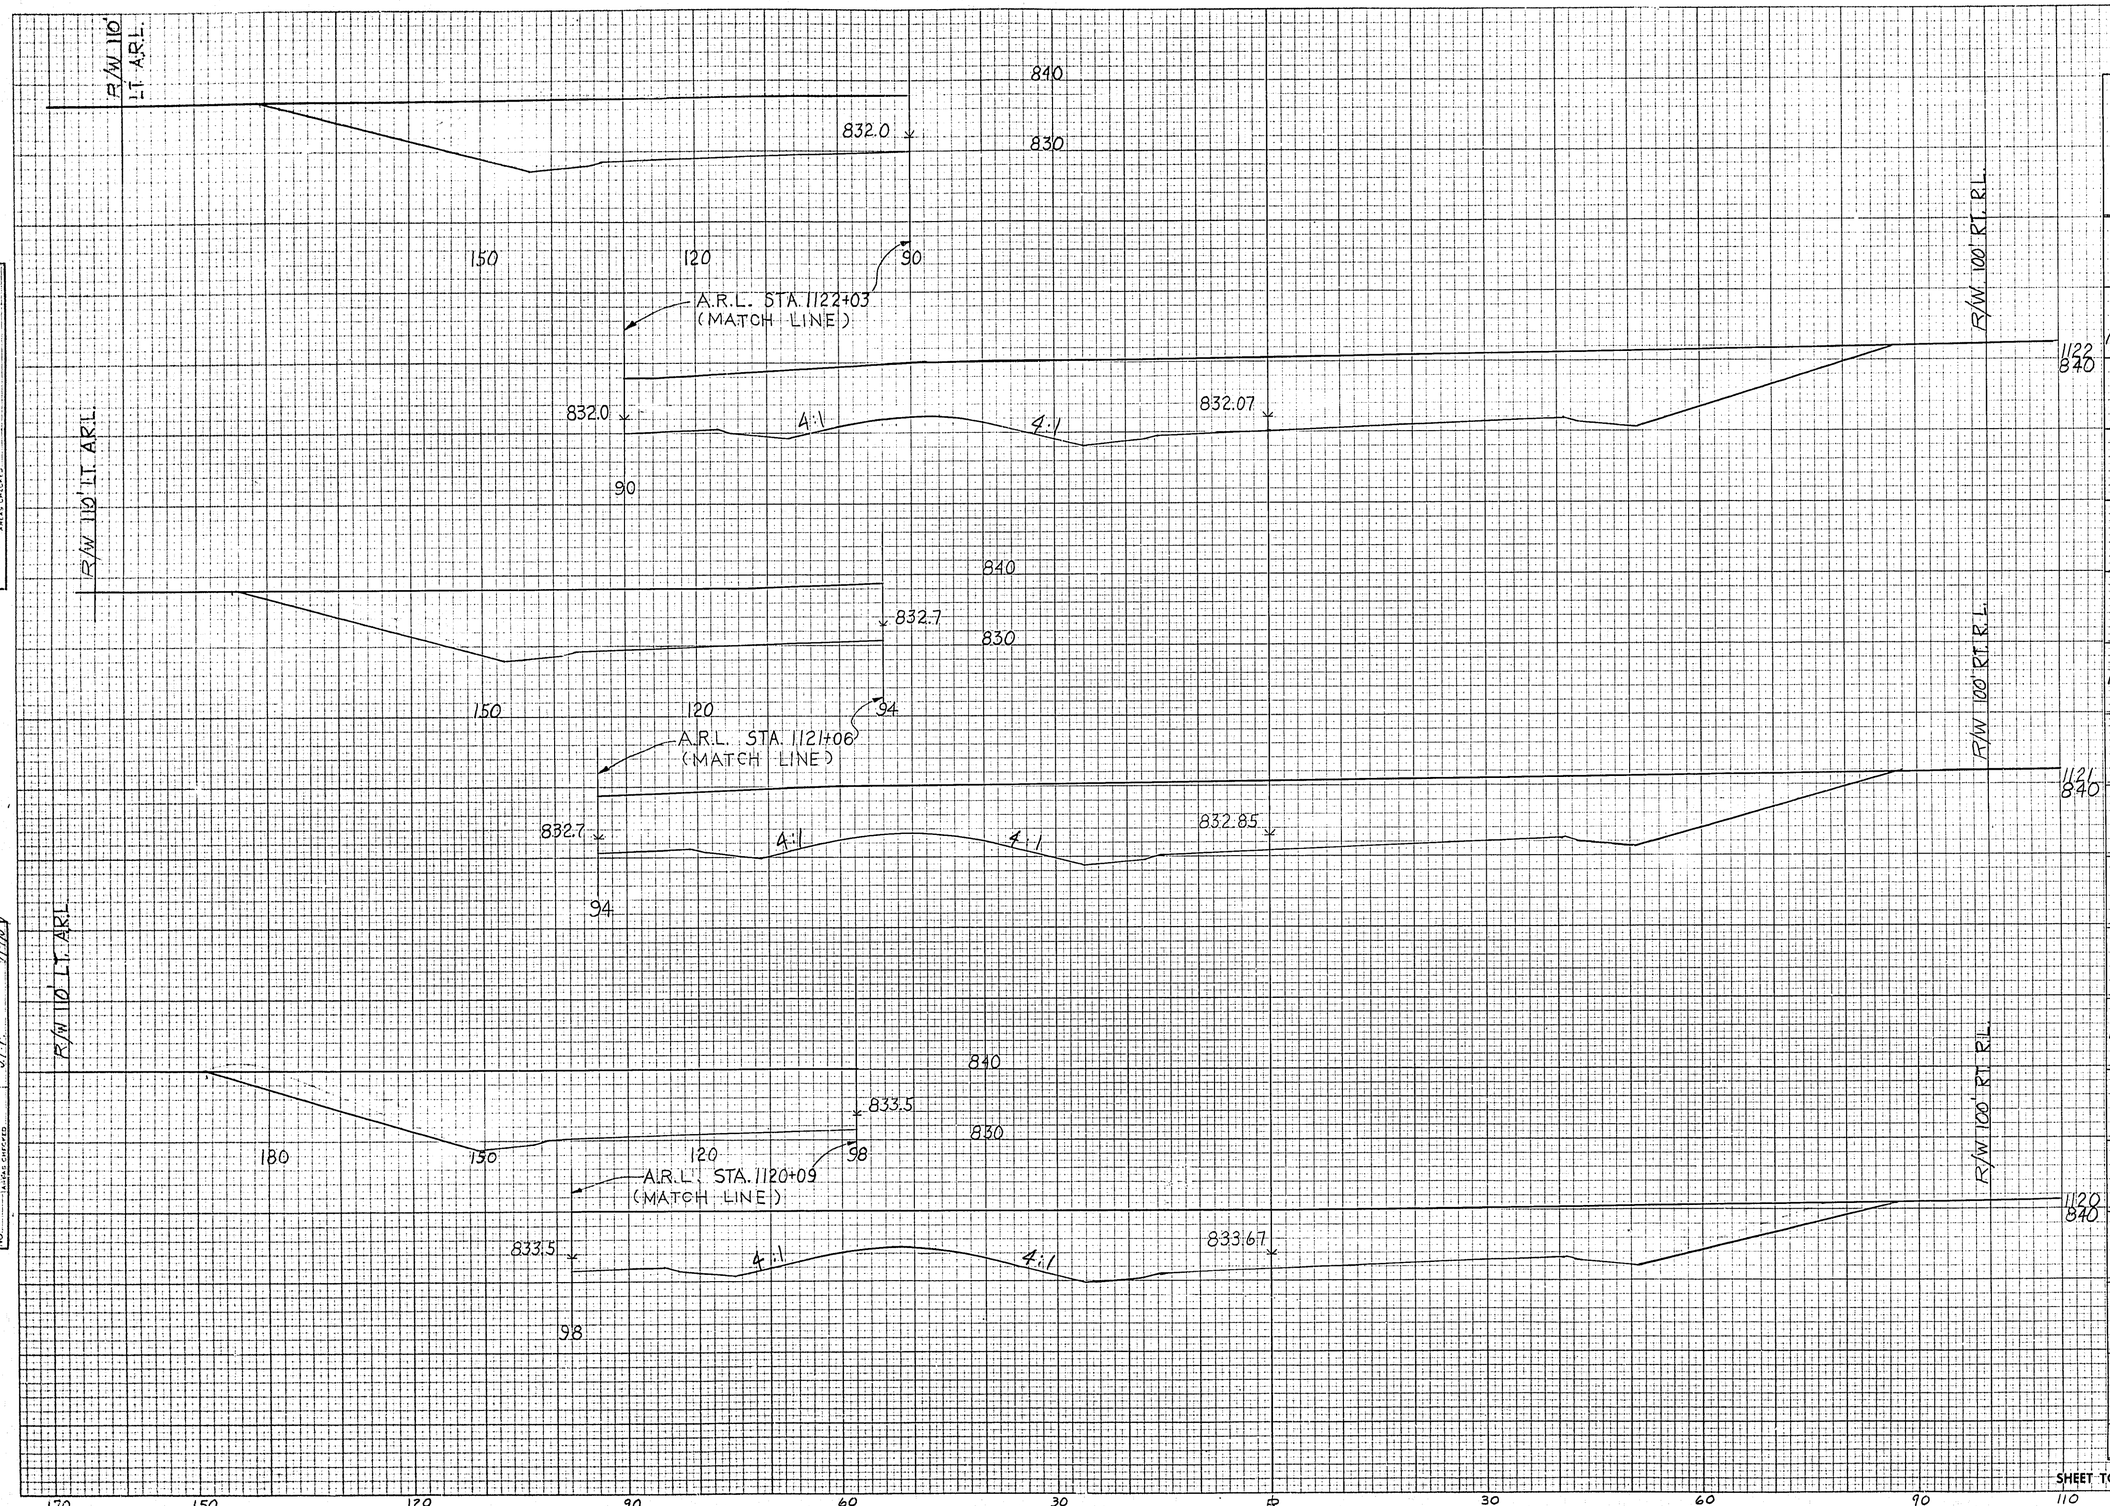

STATION	DISTANCE	YARDAGE EXCAVATION UNCL.	YARDAGE FILL
1122			
	100	7580	0
1121			
	100	7273	12
1120			
	100	6829	22
1119			
SHEET TOTAL		21682	34

FINAL SURVEY — PLOTTED — TRACED — TEMPLATE — AREAS — AREAS CHECKED — NOTE BOOK — NO. — BY — DATE

ORIGINAL SURVEY — SURVEYED — PLOTTED — TRACED — Troy 4-23-58 — TEMPLATE — Sidgy 7-11-58 — AREAS — J.T.M. 7/8/58 — NOTE BOOK — NO. — AREAS CHECKED


PLATE 3—CROSS SECTION O. P. R. & R. E. STANDARD
THE FREDERICK POST CO., CHICAGO

1120 - 1122

B.P.R. DISTRICT OFFICE	PROJECT	SHEET NUMBER	TOTAL SHEETS

FINAL SURVEY — SUBMITTED / PLOTTED / NOTE BOOK, TEMPLATE / AREAS / AREAS CHECKED / NO.

ORIGINAL SURVEY — SUBMITTED / PLOTTED / NOTE BOOK, TEMPLATE Subgr. T / AREAS / AREAS CHECKED / NO. 4917 — BY / DATE 7-21-58, 7-24-58

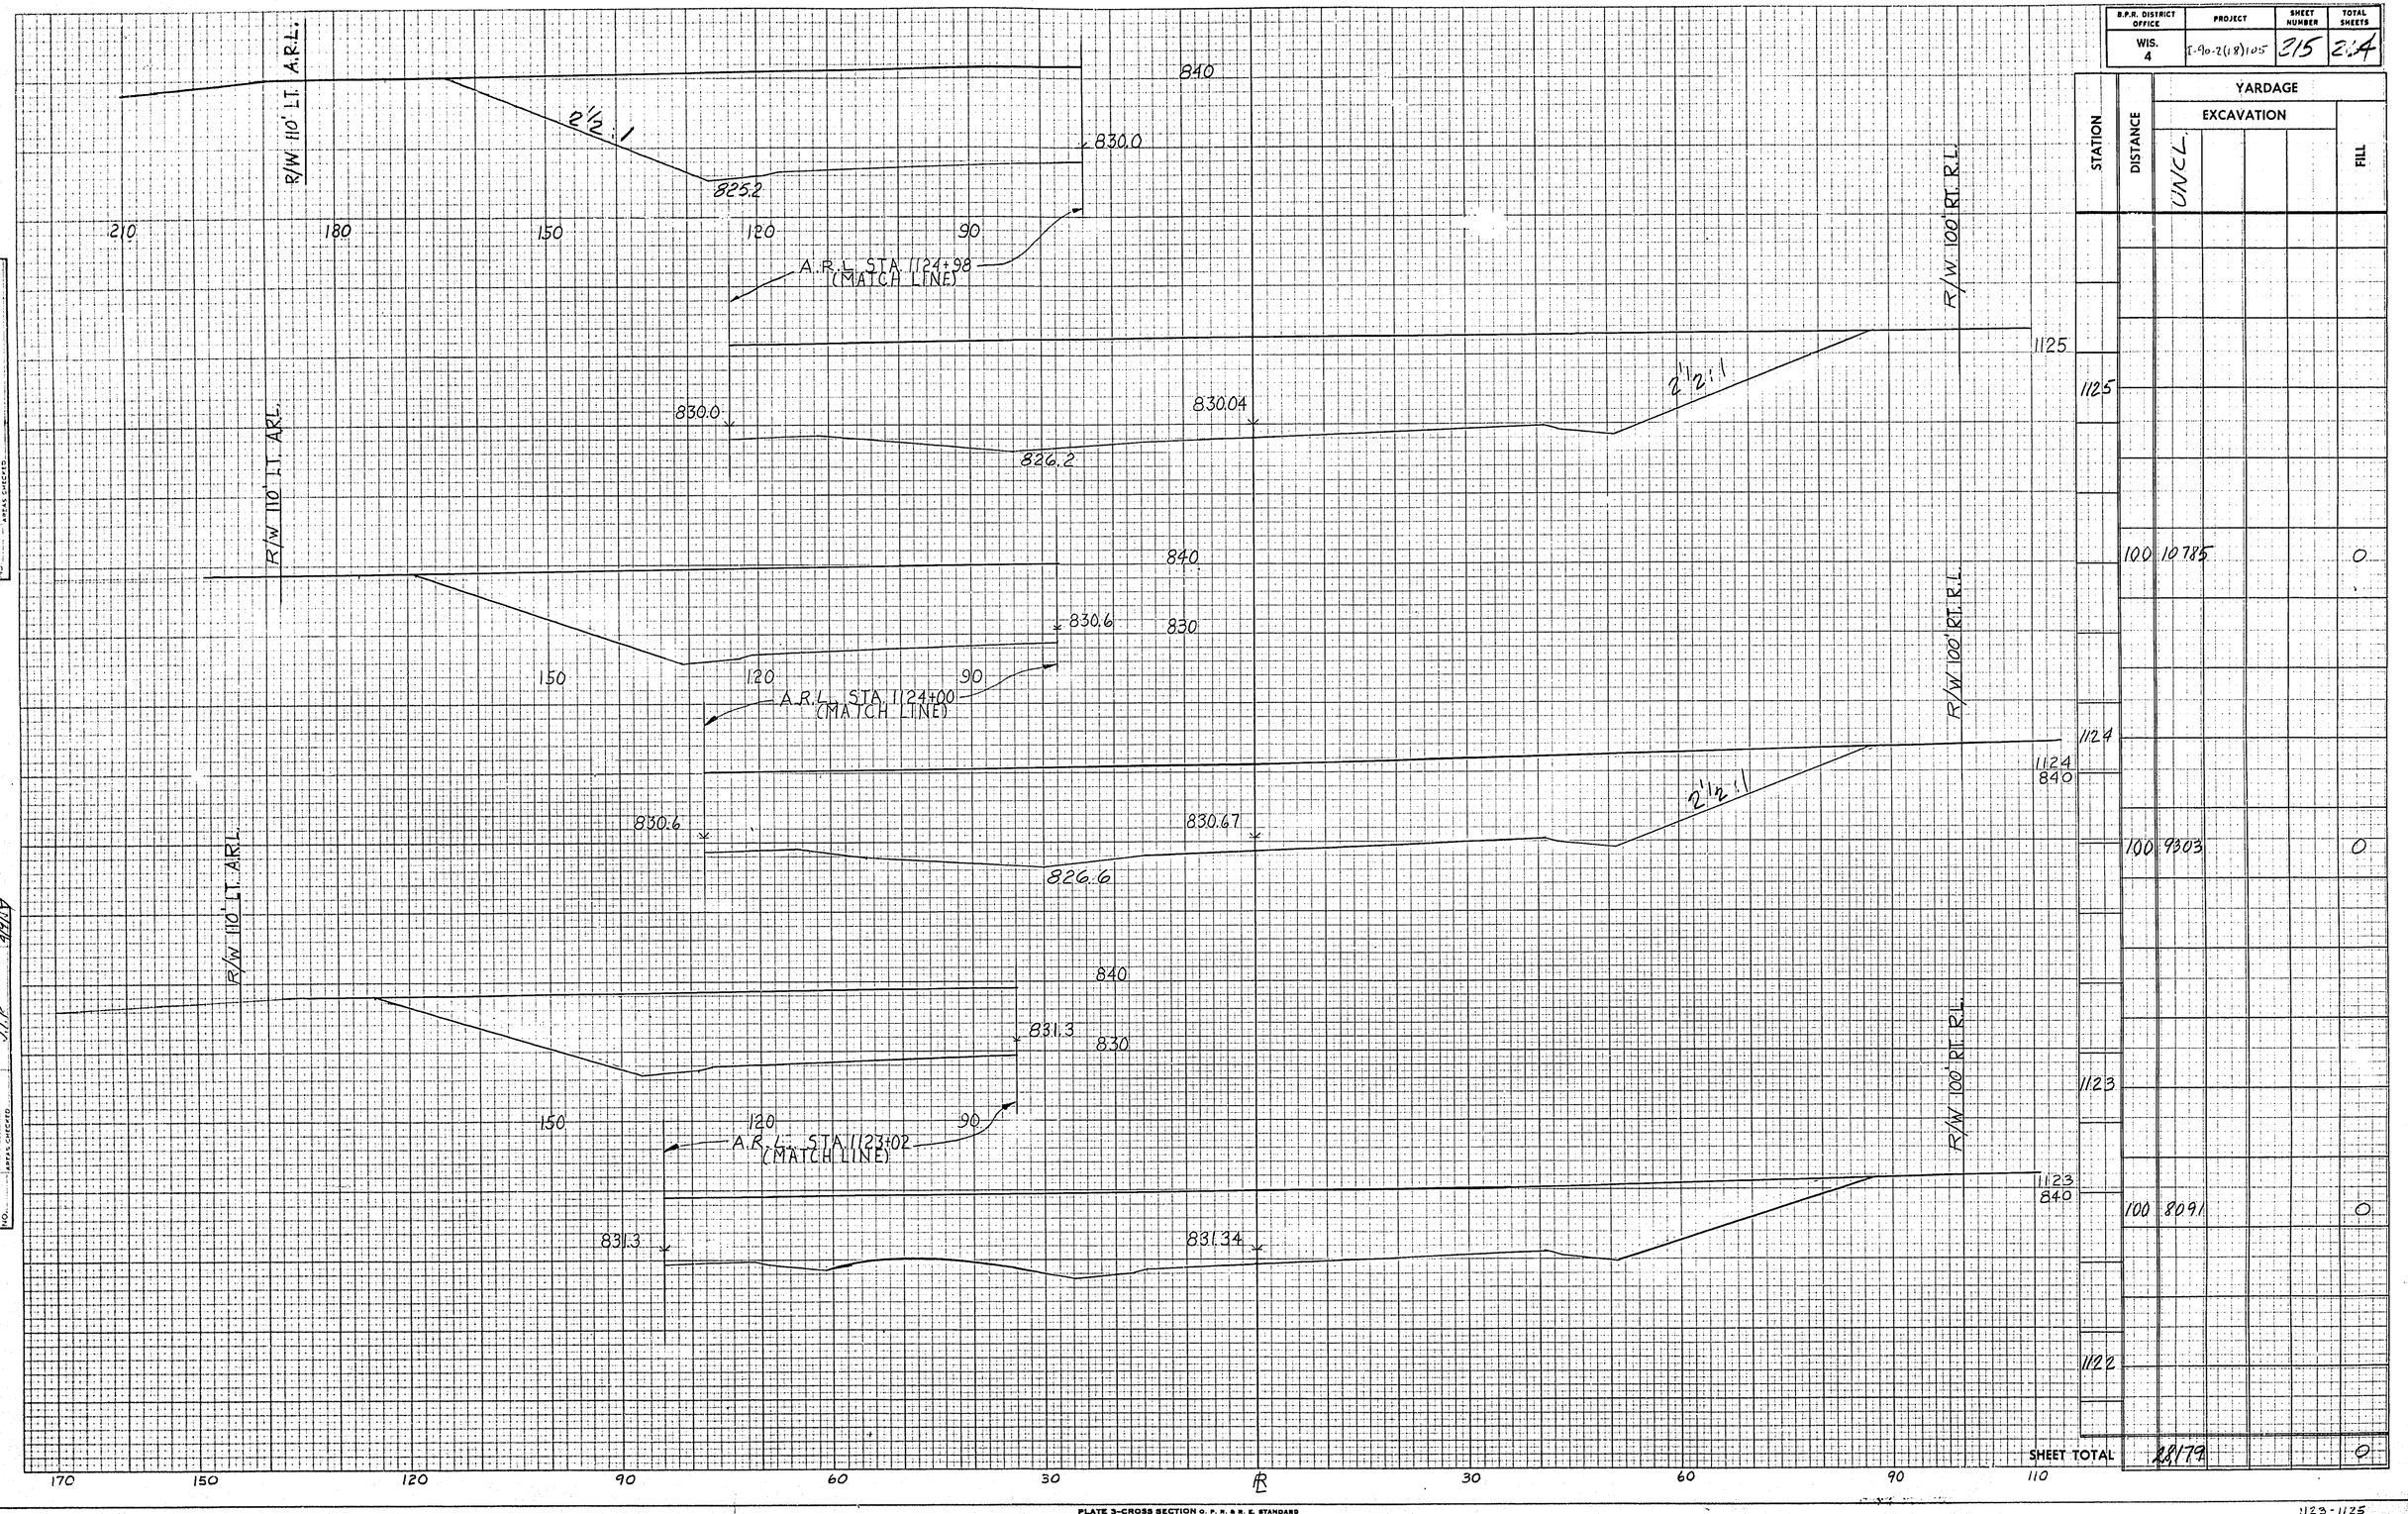


STATION	DISTANCE	YARDAGE EXCAVATION UNCL.	YARDAGE EXCAVATION	YARDAGE EXCAVATION	YARDAGE EXCAVATION	YARDAGE FILL
1125						
	100	10785				0
1124						
1124 840						
	100	9303				0
1123						
1123 840						
	100	8091				0
1122						
SHEET TOTAL		28179				0

B.P.R. DISTRICT OFFICE	PROJECT	SHEET NUMBER	TOTAL SHEETS

FINAL SURVEY — PLOTTED — CHECKED — NOTE BOOK — TEMPLATE — AREAS — CROSS SECTIONS


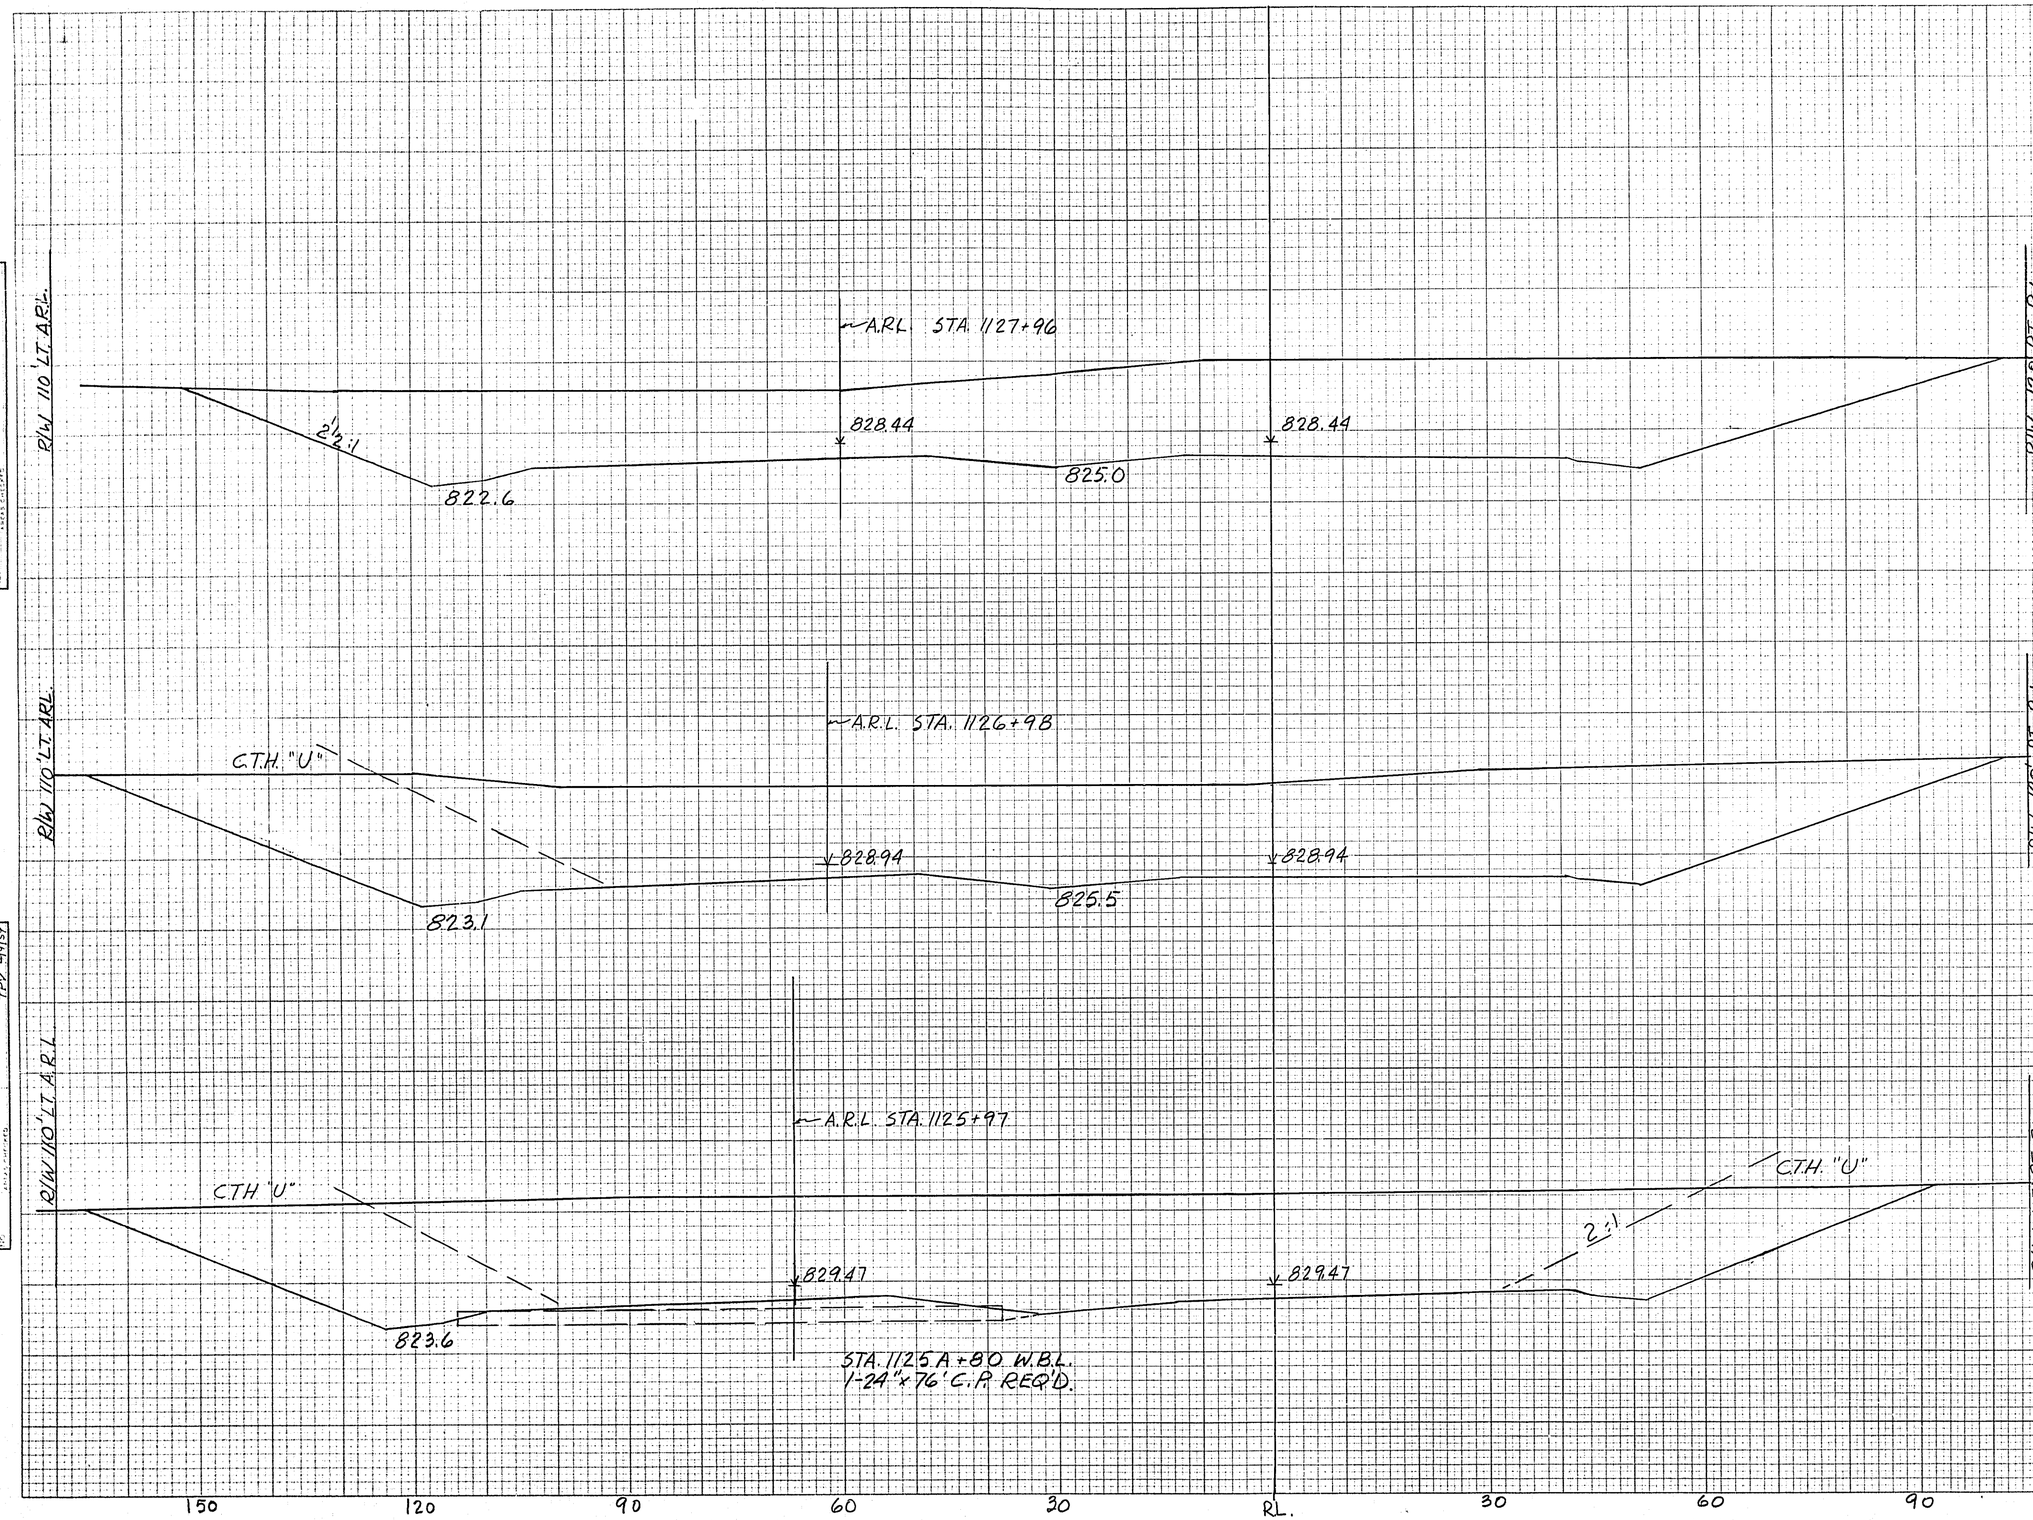

STATION	DISTANCE	YARDAGE EXCAVATION UNCL.	YARDAGE EXCAVATION	YARDAGE EXCAVATION	YARDAGE EXCAVATION	YARDAGE FILL
1128						
	100	10725				0
1127						
	100	12104				0
1126						
	100	11804				0
1125						
SHEET TOTAL		34638				0

PLATE 3—CROSS SECTION U. P. R. & R. E. STANDARD
THE FREDERICK POST CO., CHICAGO

B.P.R. DISTRICT OFFICE	PROJECT	SHEET NUMBER	TOTAL SHEETS
WIS. 4	I-94-2(18)105	217	264

FINAL SURVEY — SURVEYED / PLOTTED / TEMPLATE / AREAS / NOTE BOOK / AREAS COMPUTED / NO.

ORIGINAL SURVEY — SURVEYED / PLOTTED / TEMPLATE / AREAS / NOTE BOOK / AREAS COMPUTED / NO. — BY J.I.P. TRACED TFJ — DATE 4/1958 4/29/58

R/W 110' LT. A.R.L.

2½:1 — 822.9 — 826.94 — 826.94 — 6:1 — R/W 120' RT. R.L.

4:1 — 822.4 — 827.44 — 827.44 — R/W 120' RT. R.L.

SLOPE TO DRAIN 4:1 — 822.0 — 827.8 — 1129+30 830 — R/W 120' RT. R.L.

4:1 — 10:1 — 822.1 — 827.94 — 827.94 — 2½:1

150 120 90 60 30 R.L. 30 60 90 120

STATION	DISTANCE	YARDAGE EXCAVATION UNCL.	YARDAGE EXCAVATION	YARDAGE EXCAVATION	YARDAGE EXCAVATION	YARDAGE FILL
1131 840						
	1131					
	100	9898				0
1130 840	1130					
	100	8977				0
	1129					
1129 840						
	100	8632				0
	1128					
SHEET TOTAL		27,507				0

PLATE 3—CROSS SECTION O. P. R. & R. E. STANDARD
THE FREDERICK POST CO., CHICAGO

1129 - 1131

TRITZ RD.

B.P.R. DISTRICT OFFICE	PROJECT	SHEET NUMBER	TOTAL SHEETS
WIS. 4	I-90-2(18)105	218	264

FINAL SURVEY — SURVEYED, PLOTTED, NOTE BOOK, TEMPLATE, AREAS, AREAS CHECKED, NO., BY, DATE

ORIGINAL SURVEY — SURVEYED, PLOTTED, NOTE BOOK, TEMPLATE, AREAS, AREAS CHECKED, NO., BY, DATE

796.84
46"Z"+00
790

796.42
45"Z"+00
790

796.06
44"Z"+00
790

796.00
43"Z"+00
790
R/W
R/W

798.39
STA. 49"Z"+50
1-24"x56' C.P. REQ'D.
49"Z"+70
790

798.10
794.2
49"Z"+00
790

797.68
794.4
48"Z"+00
790

797.43
47"Z"+40
790

797.26
47"Z"+00
790

60 30 LR 30 60 60 30 LR 30 60

STATION	DISTANCE	YARDAGE EXCAVATION UNCL.	YARDAGE EXCAVATION	YARDAGE EXCAVATION	YARDAGE EXCAVATION	YARDAGE FILL
43+00						
	100					104
44+00						
	100					104
45+00						
	100					0
46+00						
	100					98
47+00						
	100					236
48+00						
	100					322
49+00						
	70					267
49+70						
SHEET TOTAL						1131

PLATE 3—CROSS SECTION O. P. R. & R. E. STANDARD
THE FREDERICK POST CO., CHICAGO

Access Rd "Z" at 320"L"+00


103

TRITZ RD.

B.P.R. DISTRICT OFFICE	PROJECT	SHEET NUMBER	TOTAL SHEETS
WIS. 4	I-90-2(18)105	219	264

FINAL SURVEY — SURVEYED / PLOTTED / TEMPLATE / NOTE BOOK / NO. / AREAS CHECKED / BY / DATE

ORIGINAL SURVEY — SURVEYED / PLOTTED / TEMPLATE / NOTE BOOK / NO. / AREAS CHECKED / BY J.H.P. / DATE 7/2/69

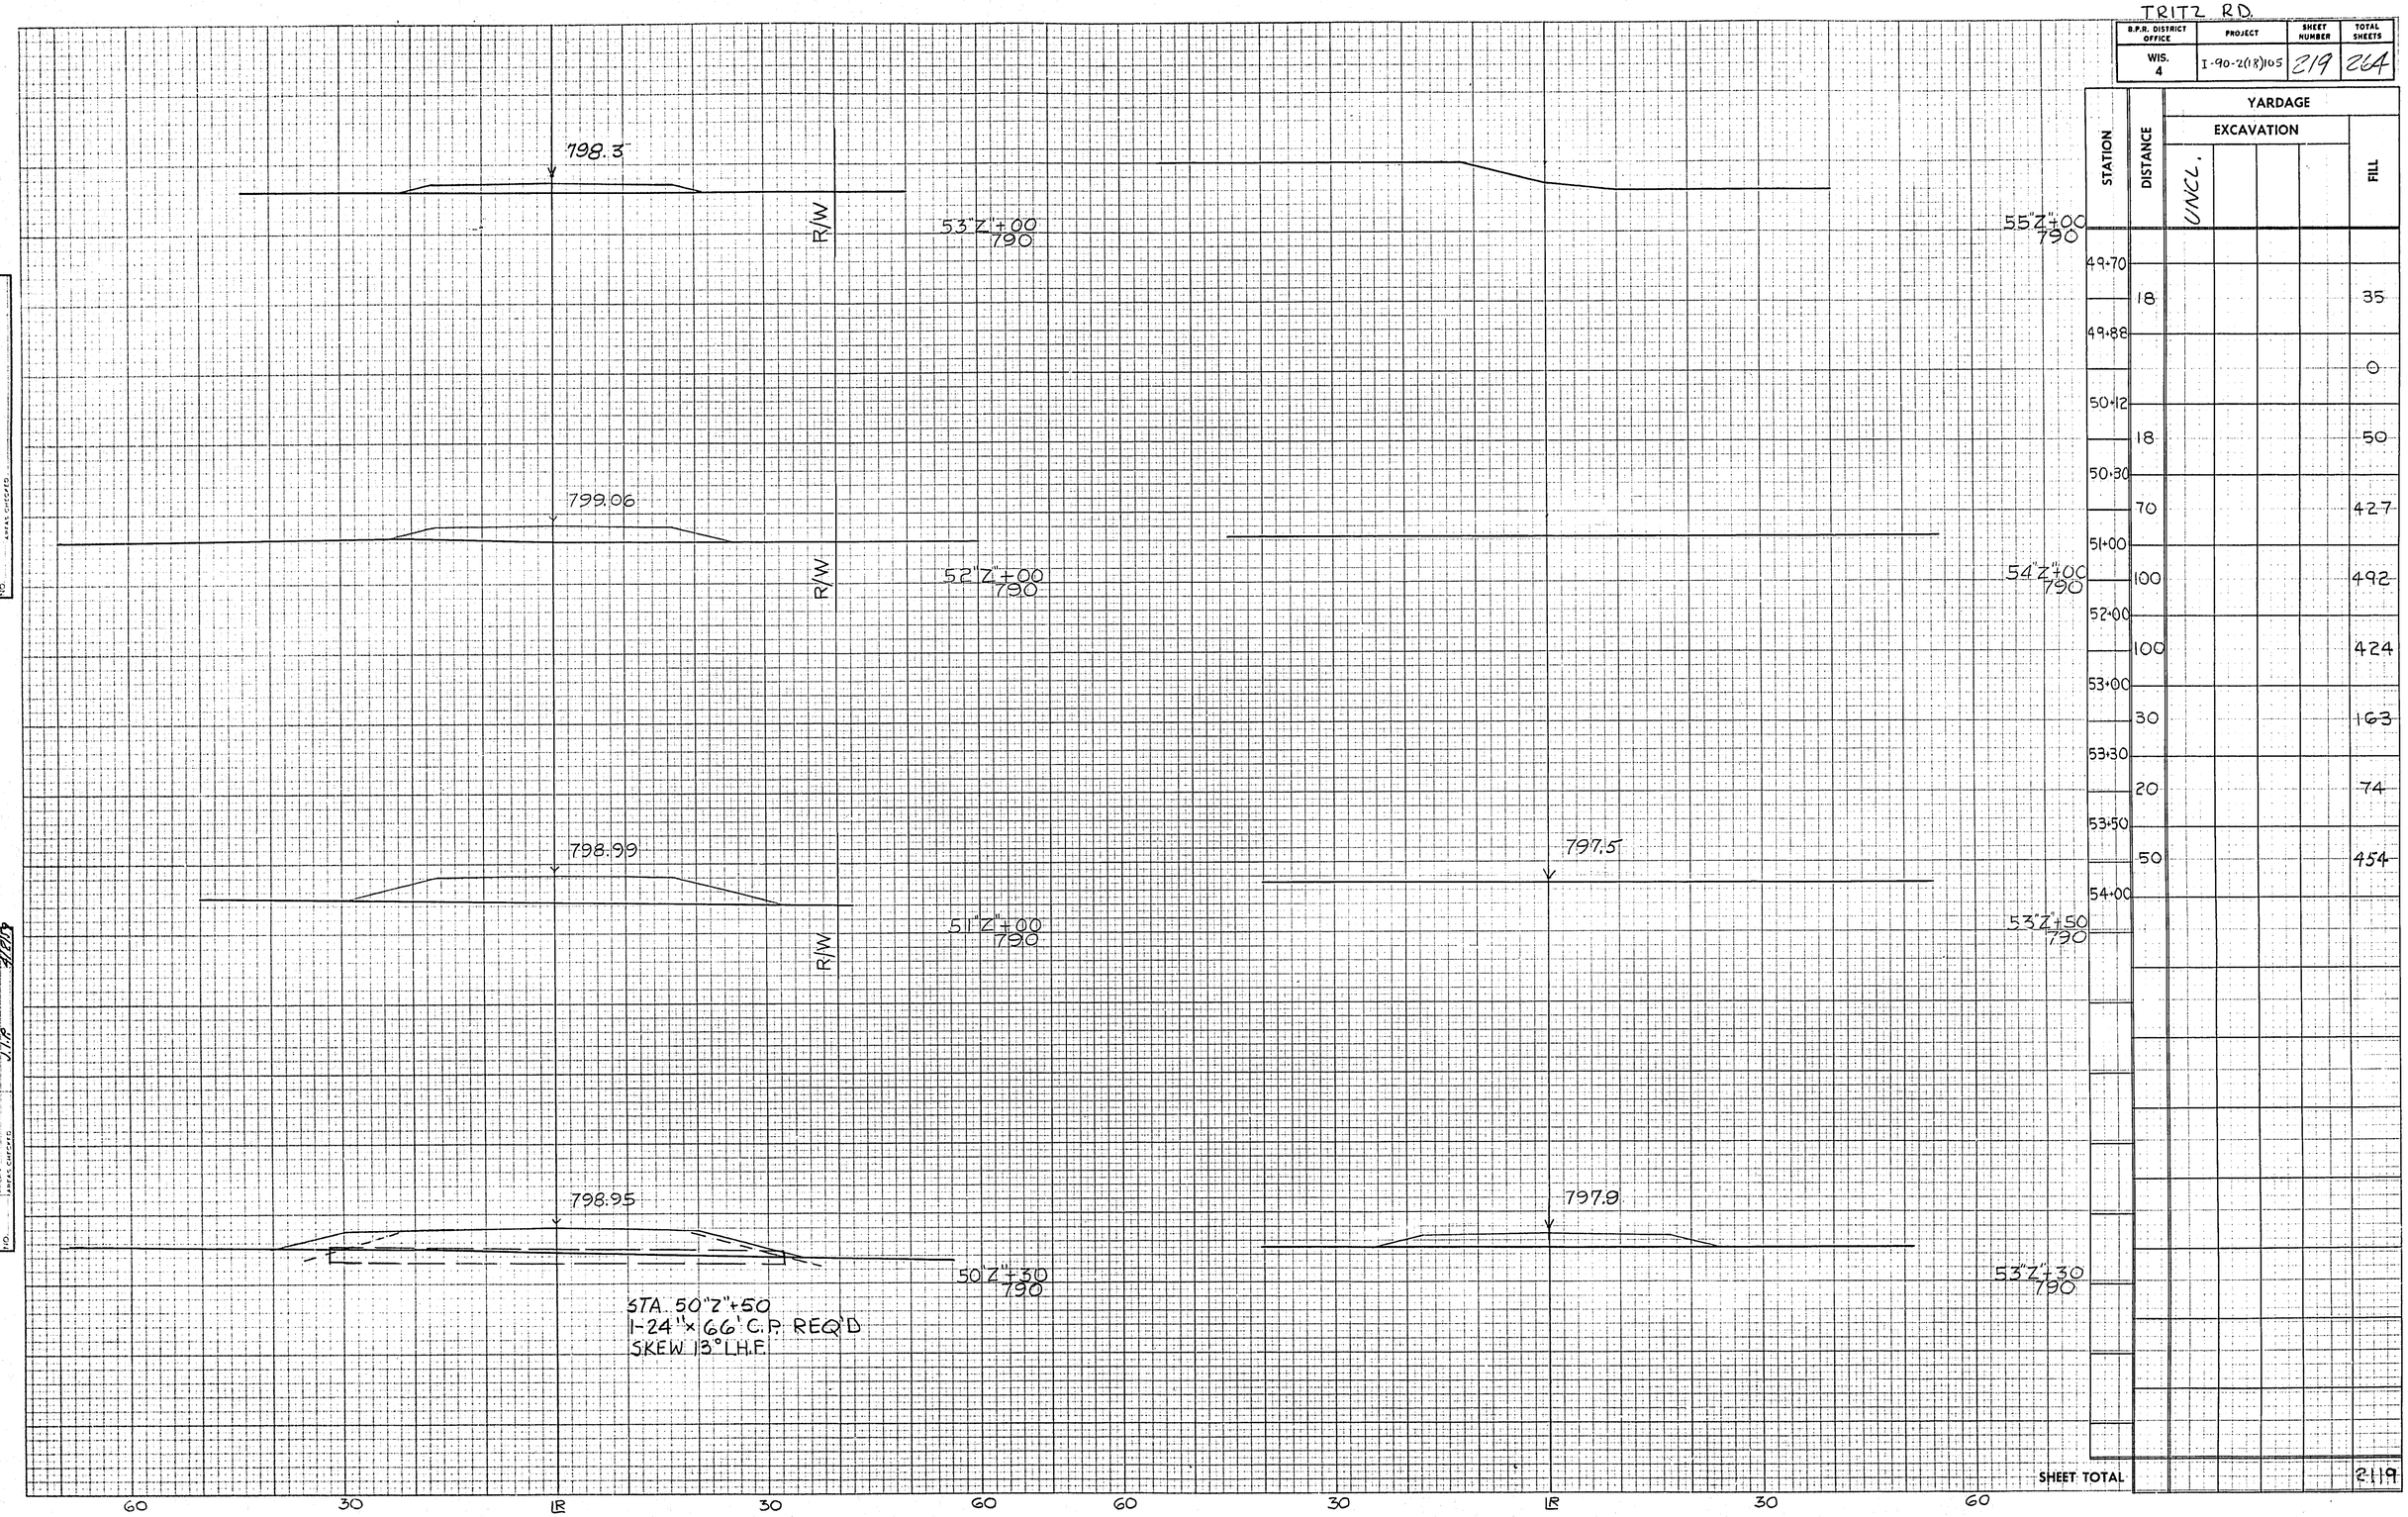

STATION	DISTANCE	YARDAGE EXCAVATION UNCL.	YARDAGE FILL
49+70			
	18		35
49+88			
			0
50+12			
	18		50
50+30			
	70		427
51+00			
	100		492
52+00			
	100		424
53+00			
	30		163
53+30			
	20		74
53+50			
	50		454
54+00			
SHEET TOTAL			2119

PLATE 3-CROSS SECTION O. P. R. & H. E. STANDARD
THE FREDERICK POST CO., CHICAGO


Access Rd. "Z" at 320"L"+00

ST.H. 33

B.P.R. DISTRICT OFFICE	PROJECT	SHEET NUMBER	TOTAL SHEETS
WIS. 4	I-90-2(18)105	220	264

FINAL SURVEY — SURVEYED / PLOTTED / NOTE BOOK / TEMPLATE / AREAS / VOLS. CHECKED / NO. / BY / DATE

ORIGINAL SURVEY — SURVEYED 5/8/19 / PLOTTED JJP / NOTE BOOK / TEMPLATE / AREAS / VOLS. CHECKED / NO. / BY / DATE

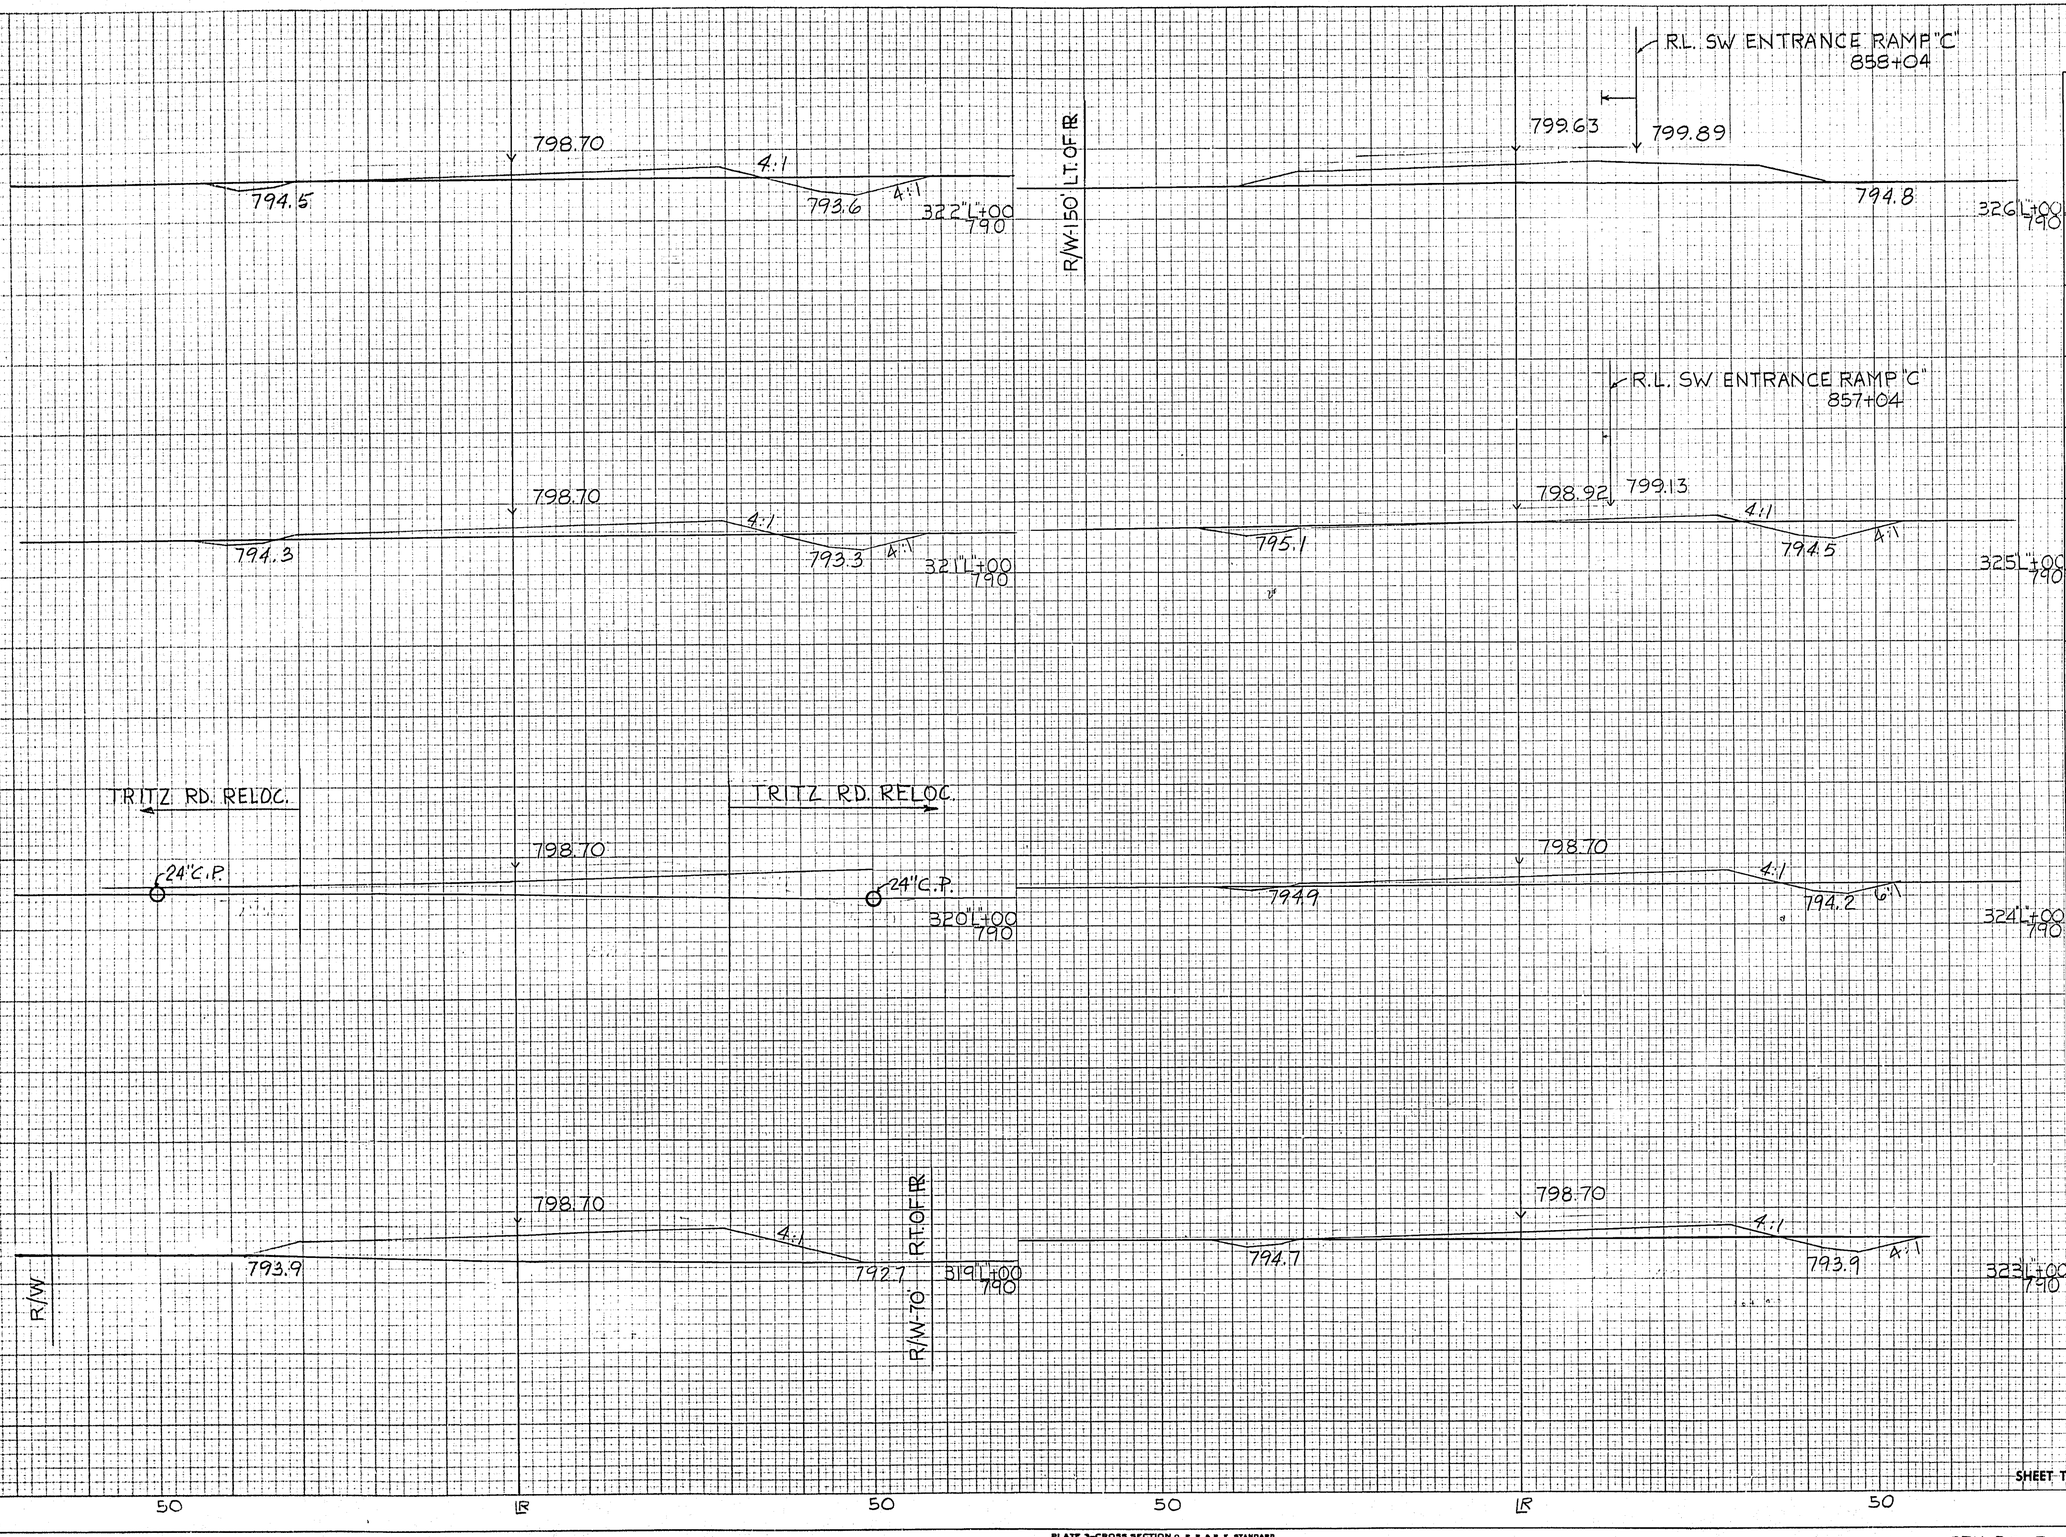

STATION	DISTANCE	YARDAGE EXCAVATION UNCL	YARDAGE EXCAVATION	YARDAGE EXCAVATION	YARDAGE EXCAVATION	YARDAGE FILL
	100	0				1185
326	100	102				907
325	100	154				315
324	100	163				482
323	100	189				302
322	100	142				339
321	100	65				463
320	100	0				704
319						
SHEET TOTAL		815				4197

PLATE 3—CROSS SECTION O. P. R. & R. E. STANDARD
THE FREDERICK POST CO., CHICAGO

STH 33 - ROAD "L" X-SEC 319+00 - 326+00

ST. H. 33

B.P.R. DISTRICT OFFICE	PROJECT	SHEET NUMBER	TOTAL SHEETS
WIS. 4	I-90-2(18)105	221	264

PASSING LANE

812.40

ACC. LANE

2½:1

2½:1

R/W-150' LT. OF ℄

331 L+00
790

PASSING LANE

ACC. LANE

809.43

2½:1

2½:1

R/W-150' LT. OF ℄

330 L+00
790

PASSING LANE

SW LOOP

806.43

329 L+00.95' Rt =
860 C + 50

3:1

R/W-150' LT. OF ℄

329 L+00
790

PASSING LANE

R.L. SW ENTRANCE RAMP "C"
860+22

803.50

802.00

4:1

4:1

R/W-150' LT. OF ℄

328 L+00
790

PASSING LANE

R.L. SW ENTRANCE RAMP "C"
859+06

801.19

800.68

4:1

4:1

745.1

R/W-150' LT. OF ℄

327 L+00
790

100 50 ℄ 50 100

STATION	DISTANCE	YARDAGE EXCAVATION UNCL.	YARDAGE EXCAVATION	YARDAGE EXCAVATION	YARDAGE EXCAVATION	YARDAGE FILL
331	100	0				6033
330	100	0				5033
329	100	0				5037
328	100	0				4019
327	100	0				2333
SHEET TOTAL		0				22,575

FINAL SURVEY — SURVEYED, PLOTTED, NOTE BOOK, NO. — TEMPLATE, AREAS, AREAS CHECKED — DATE

ORIGINAL SURVEY — SURVEYED, PLOTTED, NOTE BOOK, NO. — TEMPLATE, AREAS, AREAS CHECKED — BY JJS — DATE 4/8/75

PLATE 3—CROSS SECTION O. P. R. & R. E. STANDARD
THE FREDERICK POST CO., CHICAGO

STH 33 - ROAD 'L' X-SEC 327+00 - 331+00

STH 33

B.P.R. DISTRICT OFFICE	PROJECT	SHEET NUMBER	TOTAL SHEETS
WIS. 4	I-90-2(18)105	222	264

817.91

2½:1

2½:1

BRIDGE

R/W

817.91

2½:1

2½:1

817.81

2½:1

2½:1

R/W-150' LT. OF ℄

1120

816.68 ACC. LANE

2½:1

2½:1

R/W-150' LT. OF ℄

ACC. LANE

814.87

2½:1

2½:1

R/W-150' LT. OF ℄

100 50 ℄ 50 100

STATION	DISTANCE	YARDAGE EXCAVATION UNCL.	YARDAGE EXCAVATION	YARDAGE EXCAVATION	YARDAGE EXCAVATION	YARDAGE FILL
336"L"+28 790						
	72	0				5240
334 +28						
	216	structure				
334 +12						
	12	0				1078
334						
	100	0				7685
333						
334"L"+12 790	100	0				6778
332						
334"L"+00 790						
333"L"+00 790						
332"L"+00 790						
SHEET TOTAL		0				20781

FINAL SURVEY — NOTE BOOK — NO. — DATE — BY — SURVEYED — PLOTTED — TRACED — AREAS — AREAS CHECKED

ORIGINAL SURVEY — NOTE BOOK — NO. — DATE — BY — SURVEYED — PLOTTED — TRACED — AREAS — AREAS CHECKED — J.J.S. — 5/23/73

PLATE 3—CROSS SECTION O. P. R. & P. E. STANDARDS
THE FREDERICK POST CO., CHICAGO

STH 33 - ROAD 'L' X-SEC 332+00 - 336+28

ST. H. 33

B.P.R. DISTRICT OFFICE	PROJECT	SHEET NUMBER	TOTAL SHEETS
WIS. 4	E-90-2(18)105	223	264

ACC. LANE — PASSING LANE — 809.17

2½:1 — 2½:1

340 L +50 790 — R/W

STA. 340"L" +75
1-24"x160' C.P. REQ'D

ACC. LANE — PASSING LANE — 810.67

2½:1 — 2½:1

340 L +00 790 — R/W

ACC. LANE — 813.50

2½:1 — 2½:1

339 L +00 790 — R/W

ACC. LANE — 815.70

2½:1 — 2½:1

338 L +00 790 — R/W

ACC. LANE — 817.23

2½:1 — 2½:1

337 L +00 790 — R/W

100 — 50 — ℄ — 50 — 100

STATION	DISTANCE	YARDAGE EXCAVATION UNCL.				YARDAGE FILL
340 +50	50	0				2472
340	100	0				2630
339	100	0				6009
338	100	0				7213
337	100	0				7455
SHEET TOTAL		0				25779

FINAL SURVEY — COMPUTED — PLOTTED — TEMPLATE — AREAS — AREAS CHECKED — NOTE BOOK — NO. — BY — DATE


ORIGINAL SURVEY — COMPUTED — PLOTTED — TEMPLATE — AREAS — AREAS CHECKED — NOTE BOOK — NO. — BY — DATE — 4-6-73 — J.J.P.

PLATE 3—CROSS SECTION O. P. R. & R. E. STANDARD
THE FREDERICK POST CO., CHICAGO

STH 33 ROAD "L" X-SEC. 337+00 - 340+50

ST. H. 33

B.P.R. DISTRICT OFFICE	PROJECT	SHEET NUMBER	TOTAL SHEETS
WIS. 4	L-90-2(18)105	224	264

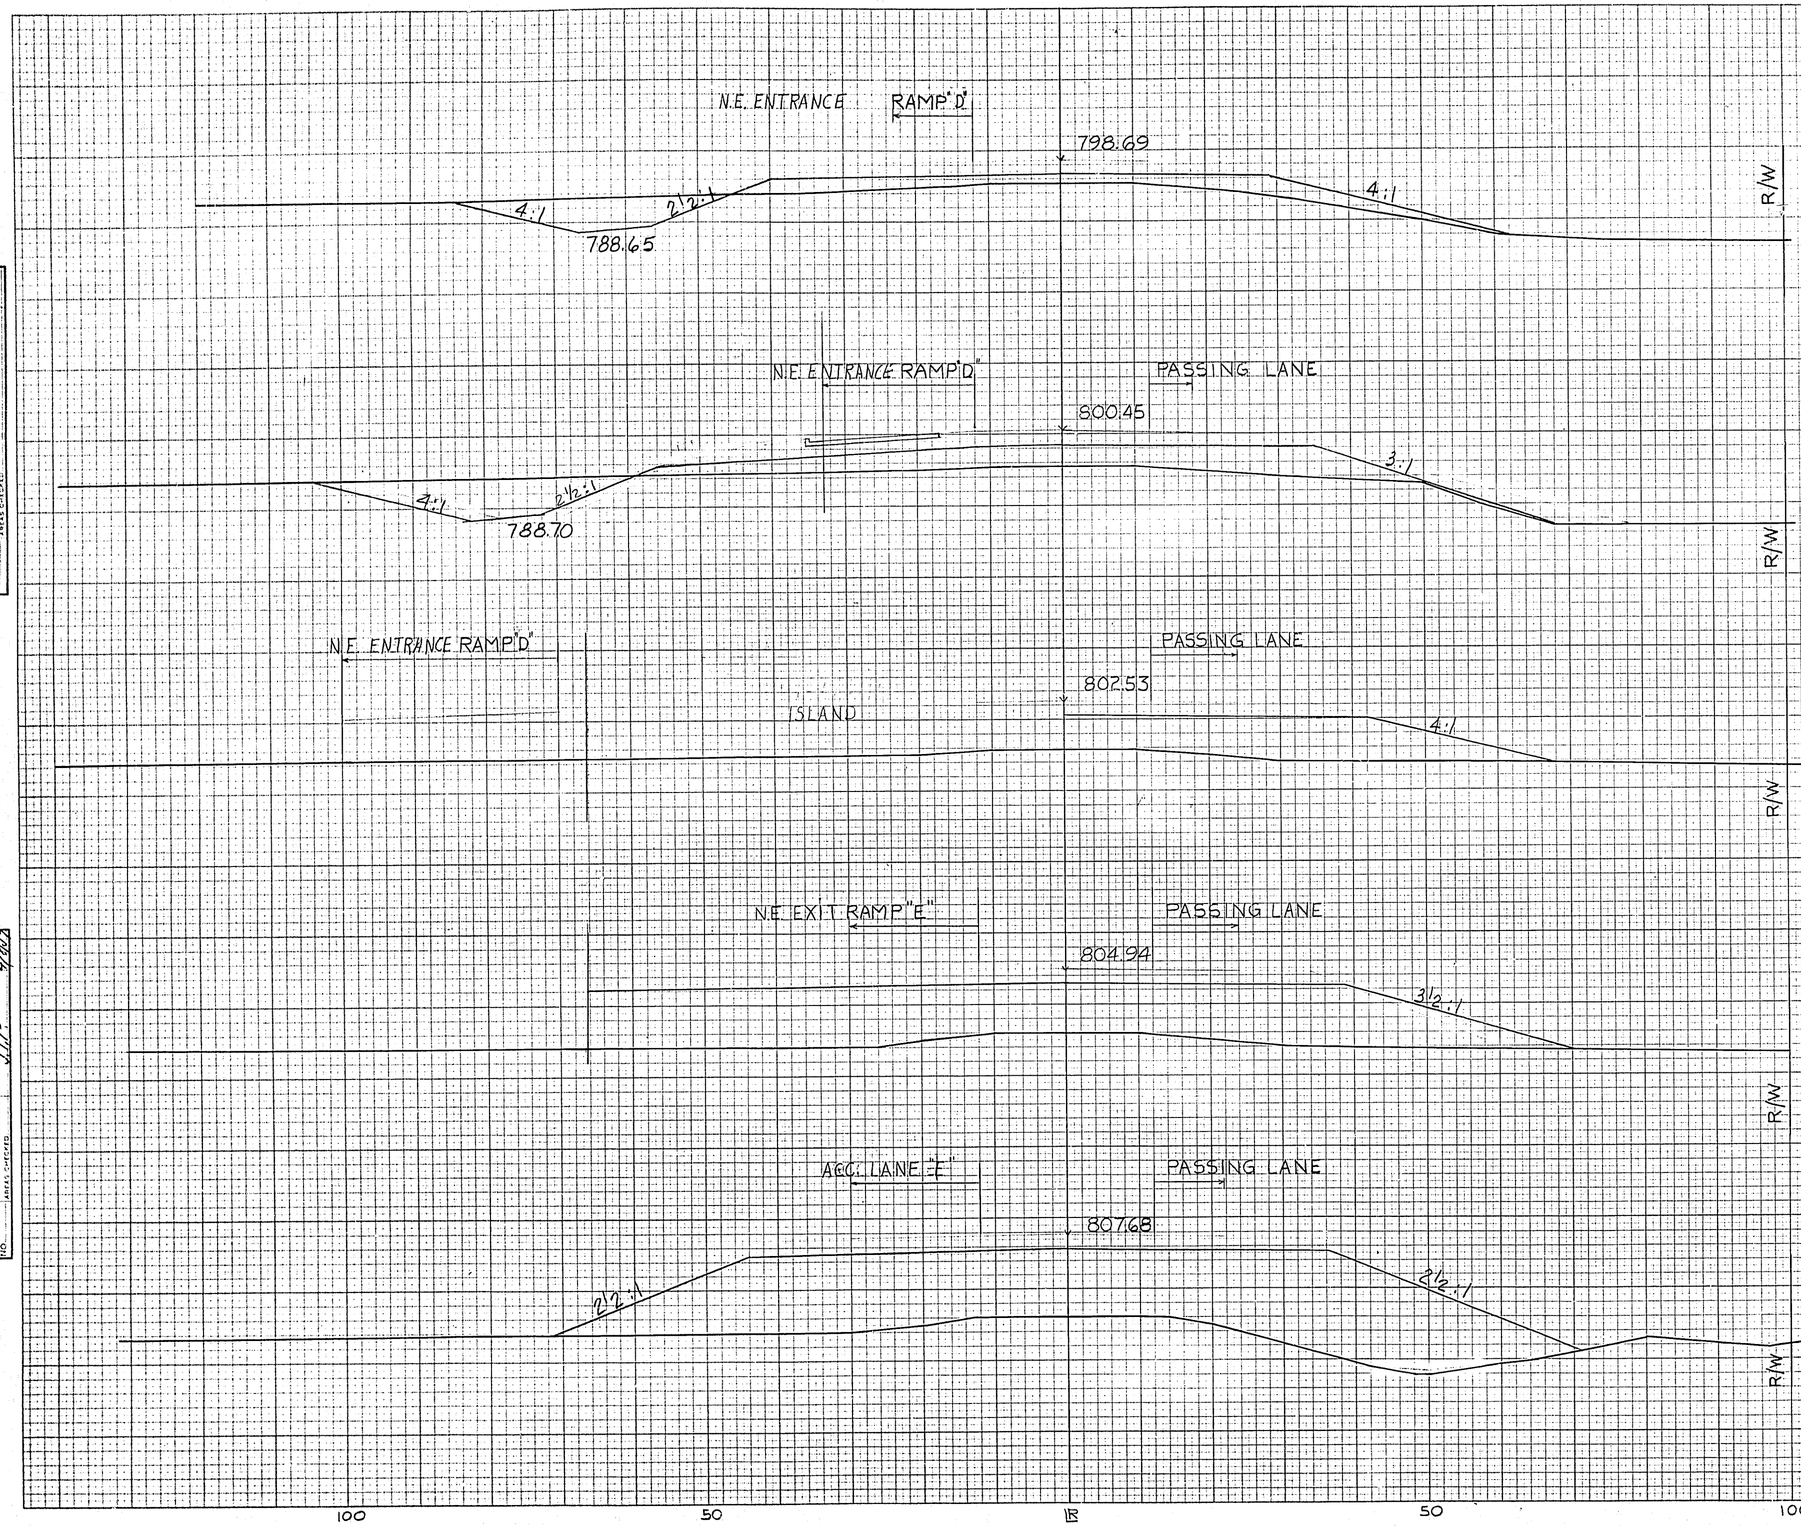


STATION	DISTANCE	YARDAGE EXCAVATION UNCL.			FILL
	100	370			454
345	100	432			796
344	100	278			1093
343	100	0			2333
342	100	0			4093
341					

STH 33

B.P.R. DISTRICT OFFICE	PROJECT	SHEET NUMBER	TOTAL SHEETS
WIS. 4	F-90-2(18)105	225	264

FINAL SURVEY — BY — DATE — SURVEYED — PLOTTED — TEMPLATE — NOTE BOOK — AREAS — NO. — AREAS CHECKED

ORIGINAL SURVEY — BY MLP — DATE 4-1948 — SURVEYED — PLOTTED — TEMPLATE — NOTE BOOK — AREAS — NO. — AREAS CHECKED

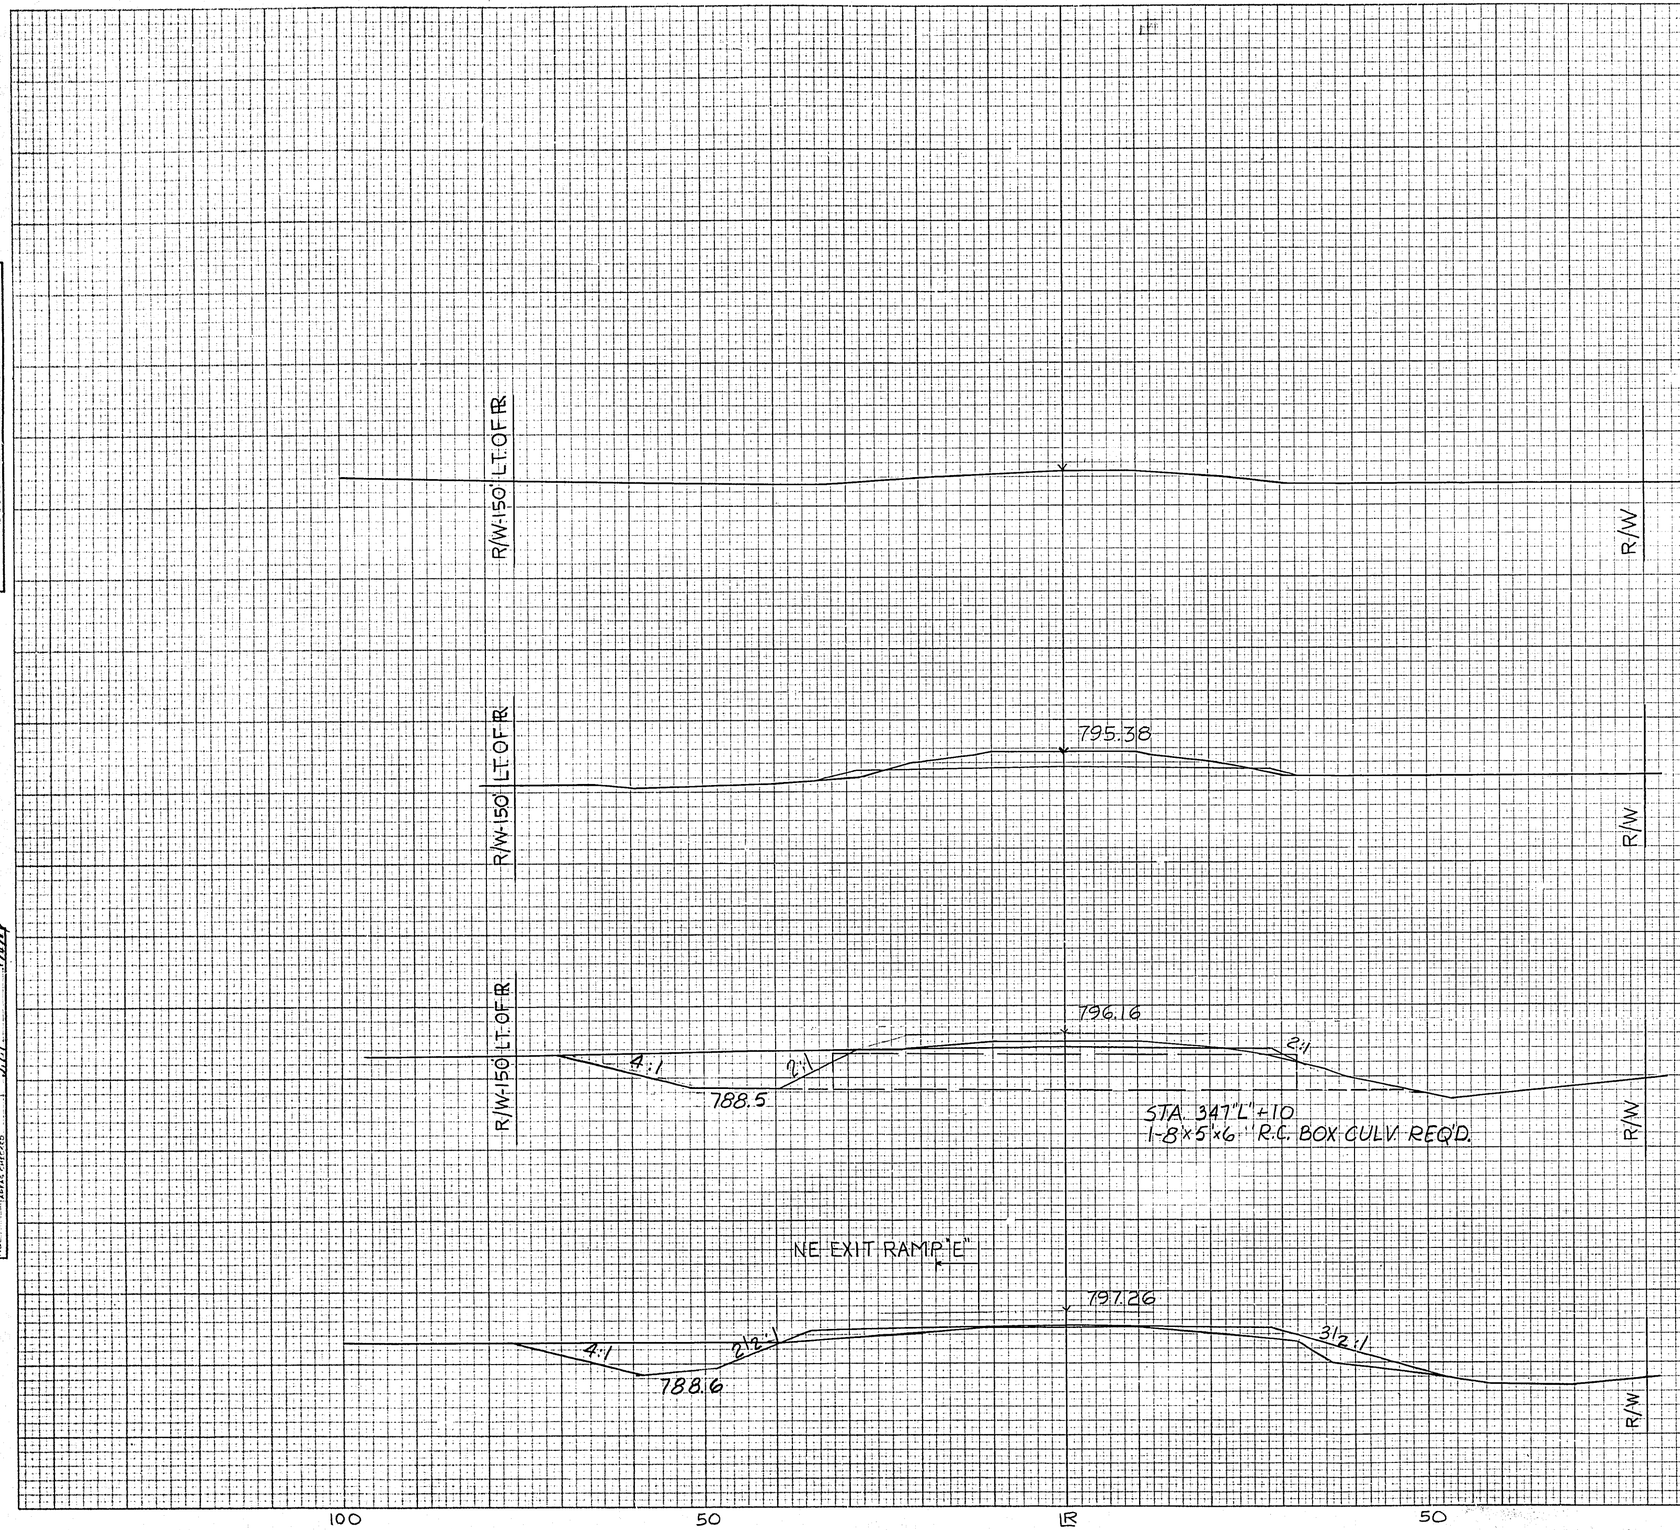

STATION	DISTANCE	YARDAGE EXCAVATION UNCL.			FILL
349					
	100	148			13
348					
	100	454			32
347					
	100	472			176
346					
SHEET TOTAL		1074			221

349"L"+00 790

348"L"+00 790

347"L"+00 790

346"L"+00 790

PLATE 3—CROSS SECTION O. P. R. & B. E. STANDARD
THE FREDERICK POST CO., CHICAGO

STH 33 ROAD 'L" X-SEC 346+00 - 349+00

SW. ENTRANCE RAMP - STH 33 INTERCHANGE

B.P.R. DISTRICT OFFICE	PROJECT	SHEET NUMBER	TOTAL SHEETS
WIS. 4	I-90-2 (18) 105	226	264

R.L. RAMP "B" 866+10
L.H. EDGE RAMP "B" 866+35
R.L. ENTRANCE RAMP "C"
797.50
798.90
798.77
4:1
4:1
4:1
789.4
866"C"+00 790

865"C"+00-144'LT. = STA. 330"L"+75-368'RT.
R.L. RAMP "B" 867+39
R.L. ENTRANCE RAMP "C"
AREA AHEAD
797.85
800.50
4:1
4:1
AREA BACK
865"C"+00 790

864"C"+00-144'LT. = STA. 330"L"+24-332'RT.
R.L. RAMP "B" 868+28
R.L. ENTRANCE RAMP "C"
802.69
799.02
4:1
4:1
STA. 864"C"+75
1-24"x124' C.P. REQ'D.
SKEW 12° RH.F.
864"C"+00 790

863"C"+00-148'LT. = STA. 330"L"+05-300'RT.
R.L. RAMP "B" 869+07
R.L. ENTRANCE RAMP "C"
800.62
804.06
4:1
4:1
863"C"+00 790

862"C"+00-148'LT. = STA. 330"L"+00-246'RT.
R.L. RAMP "B" 869+94
R.L. ENTRANCE RAMP "C"
802.73
804.29
4:1
4:1
862"C"+00 790

R.L. RAMP "B" 870+94
R.L. ENTRANCE RAMP "C"
4:1
ON TANGENT 861"C"+00 800

R.L. RAMP "B" 871"B"+44
R.L. ENTRANCE RAMP "C" 860"C"+50
805.00
ISLAND
802.81
4:1
4:1
ON TAN 860"C"+50 800

150 100 50 ℄R 50 100

STATION	DISTANCE	YARDAGE EXCAVATION UNCL.	YARDAGE FILL
866"C"+00			
866C + 00			
	100	165	1230
865"C"+00			
865C + 00			
	100	0	2394
864"C"+00			
864C + 00			
	100	137	2141
863"C"+00			
863C + 00			
	100	185	2178
862"C"+00			
862C + 00			
	100	43	2911
861"C"+00			
861C + 00			
	50	0	1393
860"C"+50			
860C + 50			
SHEET TOTAL		535	12692

FINAL SURVEY — SURVEYED, PLOTTED, TEMPLATE, NOTE BOOK, AREAS CHECKED, NO., BY, DATE

ORIGINAL SURVEY — SURVEYED, PLOTTED, TEMPLATE, NOTE BOOK, AREAS CHECKED, NO., BY, DATE

PLATE 3—CROSS SECTION O. P. R. & R. E. STANDARD
THE FREDERICK POST CO., CHICAGO

SW Ramp

B.P.R. DISTRICT OFFICE	PROJECT	SHEET NUMBER	TOTAL SHEETS
WIS. 4	I-90-2 (18) 105	327	24

FINAL SURVEY — SURVEYED, PLOTTED, TEMPLATE, NOTE BOOK, AREAS, AREAS CHECKED, NO., BY, DATE


ORIGINAL SURVEY — SURVEYED, PLOTTED, TEMPLATE, NOTE BOOK, AREAS CHECKED, NO., BY, DATE

FOR EARTHWORK AND SEE MAINLINE X-SECTIONS

868"C"+00-42 LT.=
868+00-50 RT.

867"C"+00-104 LT.=
R.L. 866+50-70 RT.

← R.L. ENTRANCE RAMP "C"

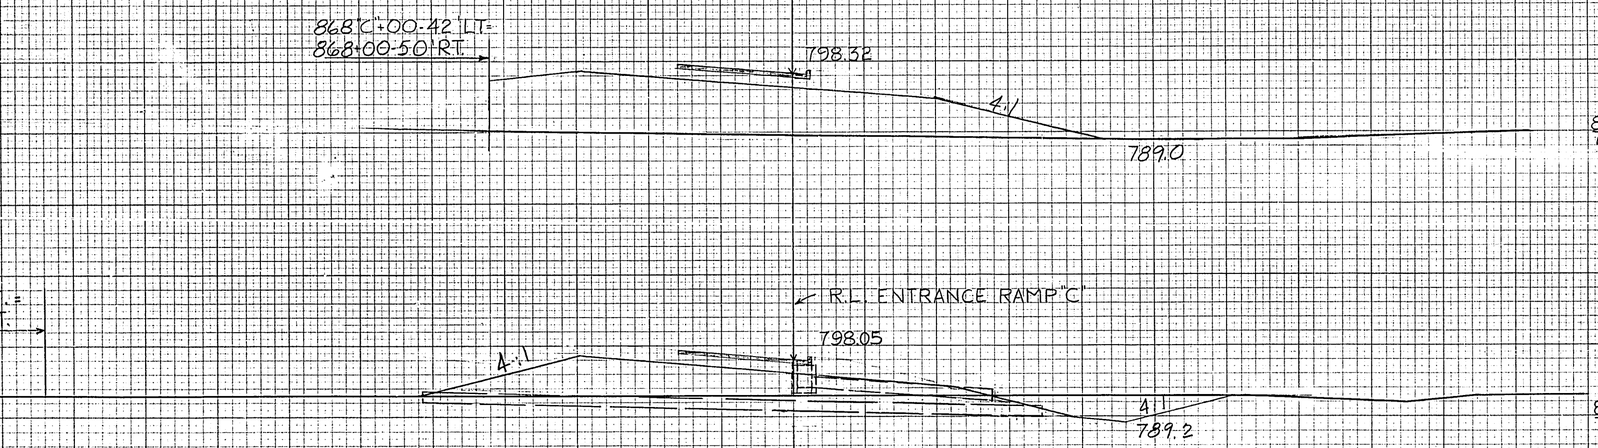

GRADE TO DRAIN

STA. 867"C"+00
1-18"x24' C.P. REQ'D.
1-INLET, TYPE I-N
1-PAVED FLUME, 18'x10'

STA. 867"C"+50
1-18"x84' C.P. REQ'D. LT.

STATION	DISTANCE	YARDAGE EXCAVATION UNCL.	YARDAGE EXCAVATION	YARDAGE EXCAVATION	YARDAGE EXCAVATION	YARDAGE FILL
868"C"+00						
790						
868 + 00						
	100	131				1289
867"C"+00						
790						
867 + 00						
	100	296				791
866 + 00						
SHEET TOTAL		427				2080

155 100 50 ℄ 50 100

PLATE 3-CROSS SECTION O. P. R. & R. E. STANDARD
THE FREDERICK POST CO., CHICAGO

B.P.R. DISTRICT OFFICE	PROJECT	SHEET NUMBER	TOTAL SHEETS
WIS. 4	I-90-2 (18) 105	138	204

FINAL SURVEY — DATE — BY — SURVEYED — PLOTTED — NOTE BOOK — TEMPLATE — AREAS — NO. — AREAS CHECKED

ORIGINAL SURVEY — DATE — BY — SURVEYED — PLOTTED — NOTE BOOK — TEMPLATE — AREAS — NO. — AREAS CHECKED

FOR END AREA AT 867+39
SEE RAMP C X-SECTIONS

R.L. ENTRANCE RAMP "C"
865+55

867"B"+00-100'RT=
330'L'+80-365'RT.

799.45

797.55

797.41

867"B"+00
790

FOR EARTHWORK LT. OF ℄
LINE, SEE RAMP "C"
X-SECTIONS

STA. 866B+50
1-18"x20' C.P. REQ'D
1-INLET, TYPE I-N, REQ'D

INV. 793.0

866B+50
790

866"B"+00-100'RT=
331'L'+25-365'RT.

866"B"+00-07'LT=
R.L. 866+50-118'RT.

797.50

866"B"+00
790

865"B"+00-129'LT=
R.L. 865+54-0'

865"B"+00-100'RT=
331'L'+75-338'RT.

797.92

865"B"+00
790


FOR EARTHWORK BACK,
SEE MAINLINE X-SECTIONS

150 100 50 ℄R 50 100

STATION	DISTANCE	YARDAGE EXCAVATION (UNCL.)	YARDAGE EXCAVATION	YARDAGE EXCAVATION	YARDAGE EXCAVATION	YARDAGE FILL
867B+39						
	39	38				240
867B+00						
	100	193				672
866B+00						
	100	100				1111
865B+00						
SHEET TOTAL		336				2023

PLATE 3—CROSS SECTION C. P. R. & R. E. STANDARD
THE FREDERICK POST CO., CHICAGO

B.P.R. DISTRICT OFFICE	PROJECT	SHEET NUMBER	TOTAL SHEETS
WIS. 4	I-90-2 (3)105	229	264

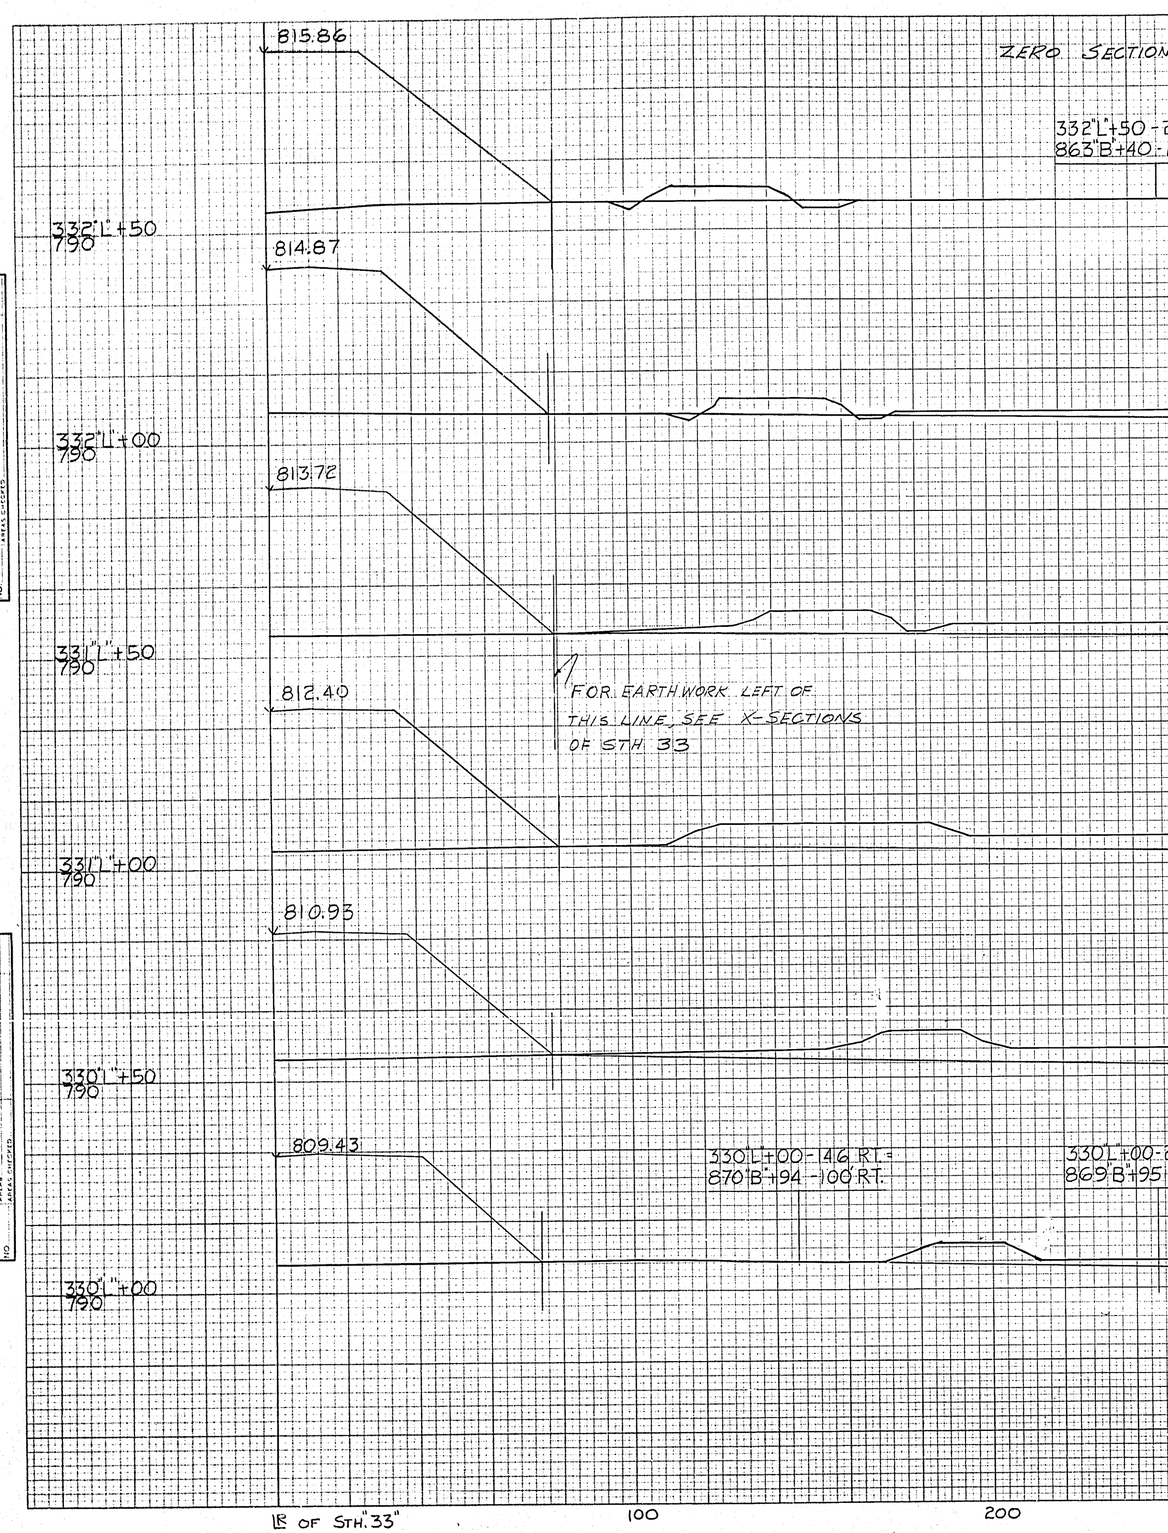

SCALE
VERT. 1" = 10'
HORIZ. 1" = 20'

STATION	DISTANCE	YARDAGE EXCAVATION UNCL.	YARDAGE EXCAVATION	YARDAGE EXCAVATION	YARDAGE EXCAVATION	YARDAGE FILL
332L+50						
	50	220				82
332L+00						
	50	412				219
331L+50						
	50	611				276
331L+00						
	50	696				206
330L+50						
	50	463				85
330L+00						
SHEET TOTAL		2402				868

FINAL SURVEY — SURVEYED, PLOTTED, TEMPLATE, AREAS, CHECKED — NOTE BOOK NO. — BY — DATE


ORIGINAL SURVEY — SURVEYED, PLOTTED, TEMPLATE, AREAS, CHECKED — NOTE BOOK NO. — BY — DATE

NE. ENTRANCE RAMP - STH 33 INTER.

B.P.R. DISTRICT OFFICE	PROJECT	SHEET NUMBER	TOTAL SHEETS
WIS. 4	I-90-2 (.8) 105	230	264

FINAL SURVEY — SURVEYED, PLOTTED, TEMPLATE, AREAS, AREAS CHECKED, NOTE BOOK, NO., DATE

ORIGINAL SURVEY — SURVEYED, PLOTTED, TEMPLATE, AREAS, AREAS CHECKED, NOTE BOOK, NO., BY, DATE

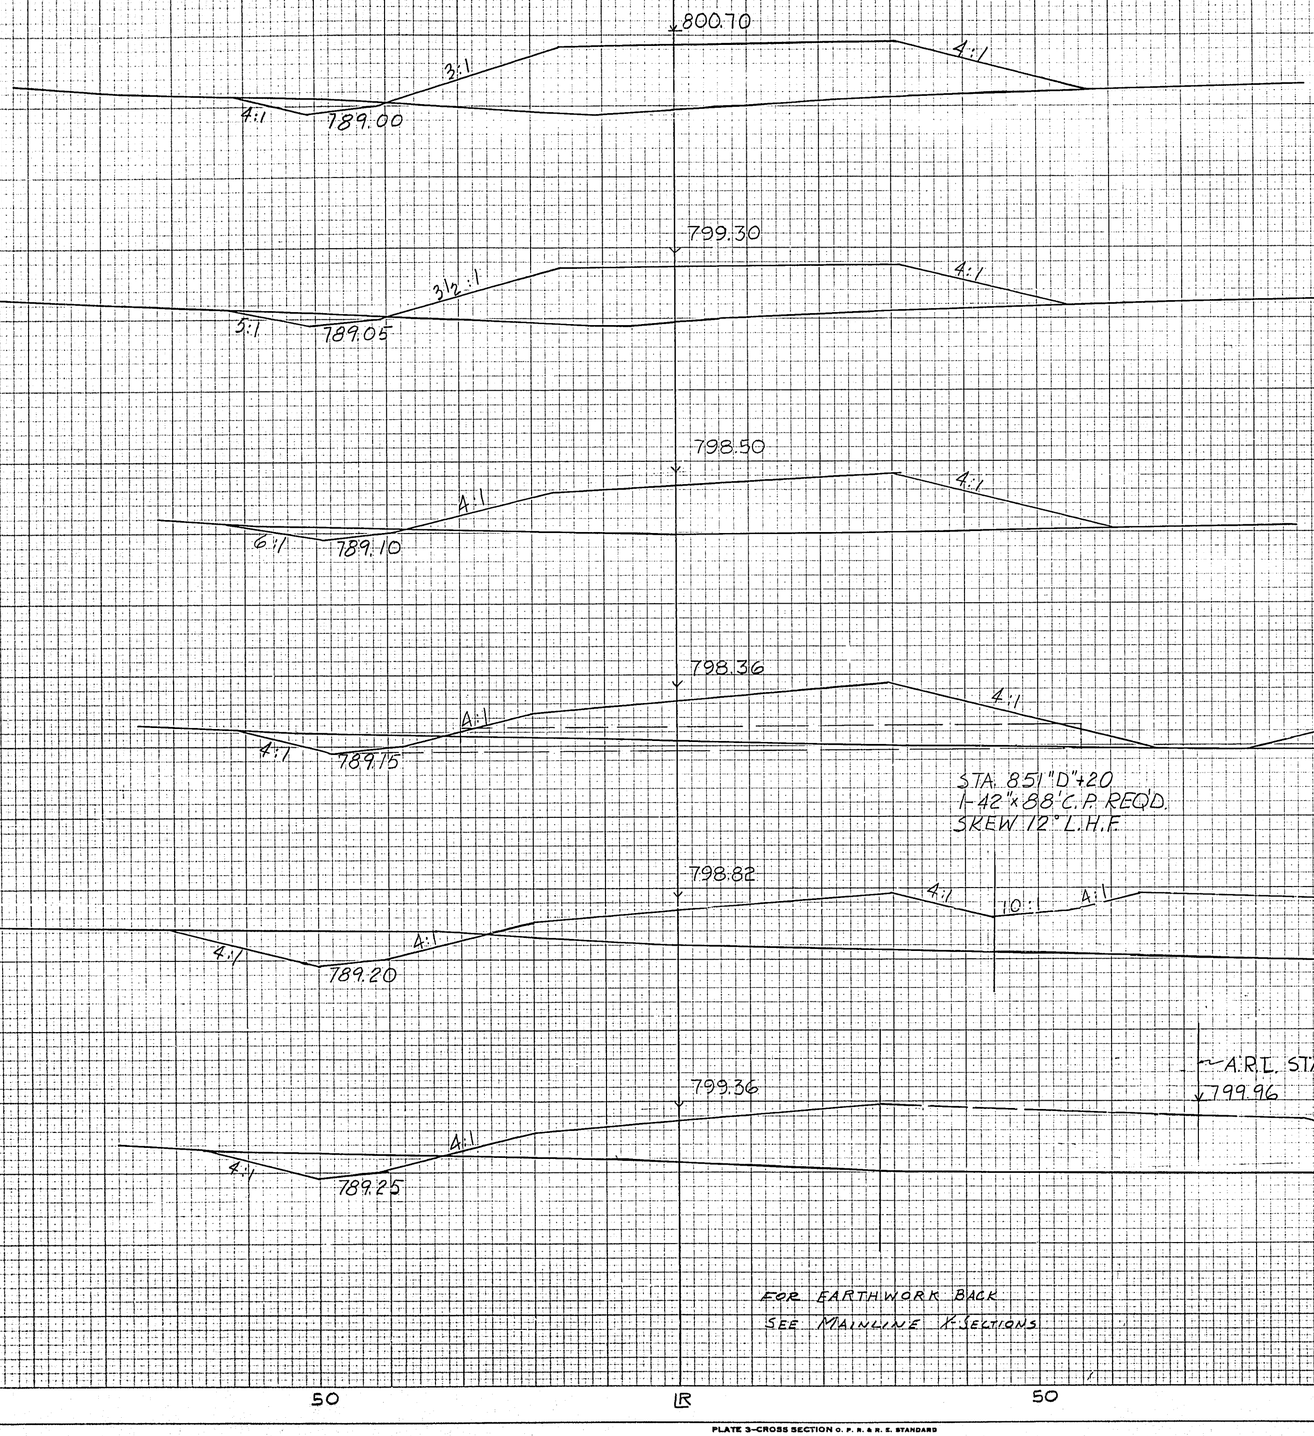

STATION	DISTANCE	YARDAGE EXCAVATION ROCK	YARDAGE EXCAVATION	YARDAGE EXCAVATION	YARDAGE EXCAVATION	YARDAGE FILL
854"D"+00 790						
854 + 00						
	100	81				2078
853"D"+00 790						
853 + 00						
	100	85				1856
852"D"+00 790						
852 + 00						
	100	141				1744
851"D"+00 790						
851 + 00						
	100	324				1496
850"D"+00 790						
850 + 00						
	100	350				1271
849"D"+00 790						
849 + 00						
SHEET TOTAL		981				8415

FOR EARTHWORK BACK SEE MAINLINE X SECTIONS

100 50 ℄ 50 100

115

PLATE 3—CROSS SECTION O. P. R. & R. E. STANDARD
THE FREDERICK POST CO., CHICAGO

N.E. ENTRANCE RAMP · STH 33 INTERCH.

B.P.R. DISTRICT OFFICE	PROJECT	SHEET NUMBER	TOTAL SHEETS
WIS. 4	I-90-2 (18) 105	231	264

FINAL SURVEY — SURVEYED, PLOTTED, TEMPLATE, NOTE BOOK, NO., AREAS, AREAS CHECKED, BY, DATE

ORIGINAL SURVEY — SURVEYED, PLOTTED, TEMPLATE, NOTE BOOK, NO., AREAS, AREAS CHECKED, BY, DATE

FOR EARTHWORK AHEAD
SEE RAMP 'E' X-SECTIONS

FOR EARTHWORK TO P.T. OF LINE
SEE RAMP E X-SECTIONS

R.L. NE EXIT RAMP "E" 850+80

802.18

799.44

788.95

4:1

4:1

4:1


855"D"+00
790

STATION	DISTANCE	YARDAGE EXCAVATION (EXCL.)				FILL
855"D"+00						
	100	131				2456
854"D"+00						
SHEET TOTAL		131				2456

100 50 ℄ 50 100

PLATE 3—CROSS SECTION O. P. R. & R. E. STANDARD
THE FREDERICK POST CO., CHICAGO

B.P.R. DISTRICT OFFICE	PROJECT	SHEET NUMBER	TOTAL SHEETS
WIS. 4	I-90-2 (18) 105	232	264

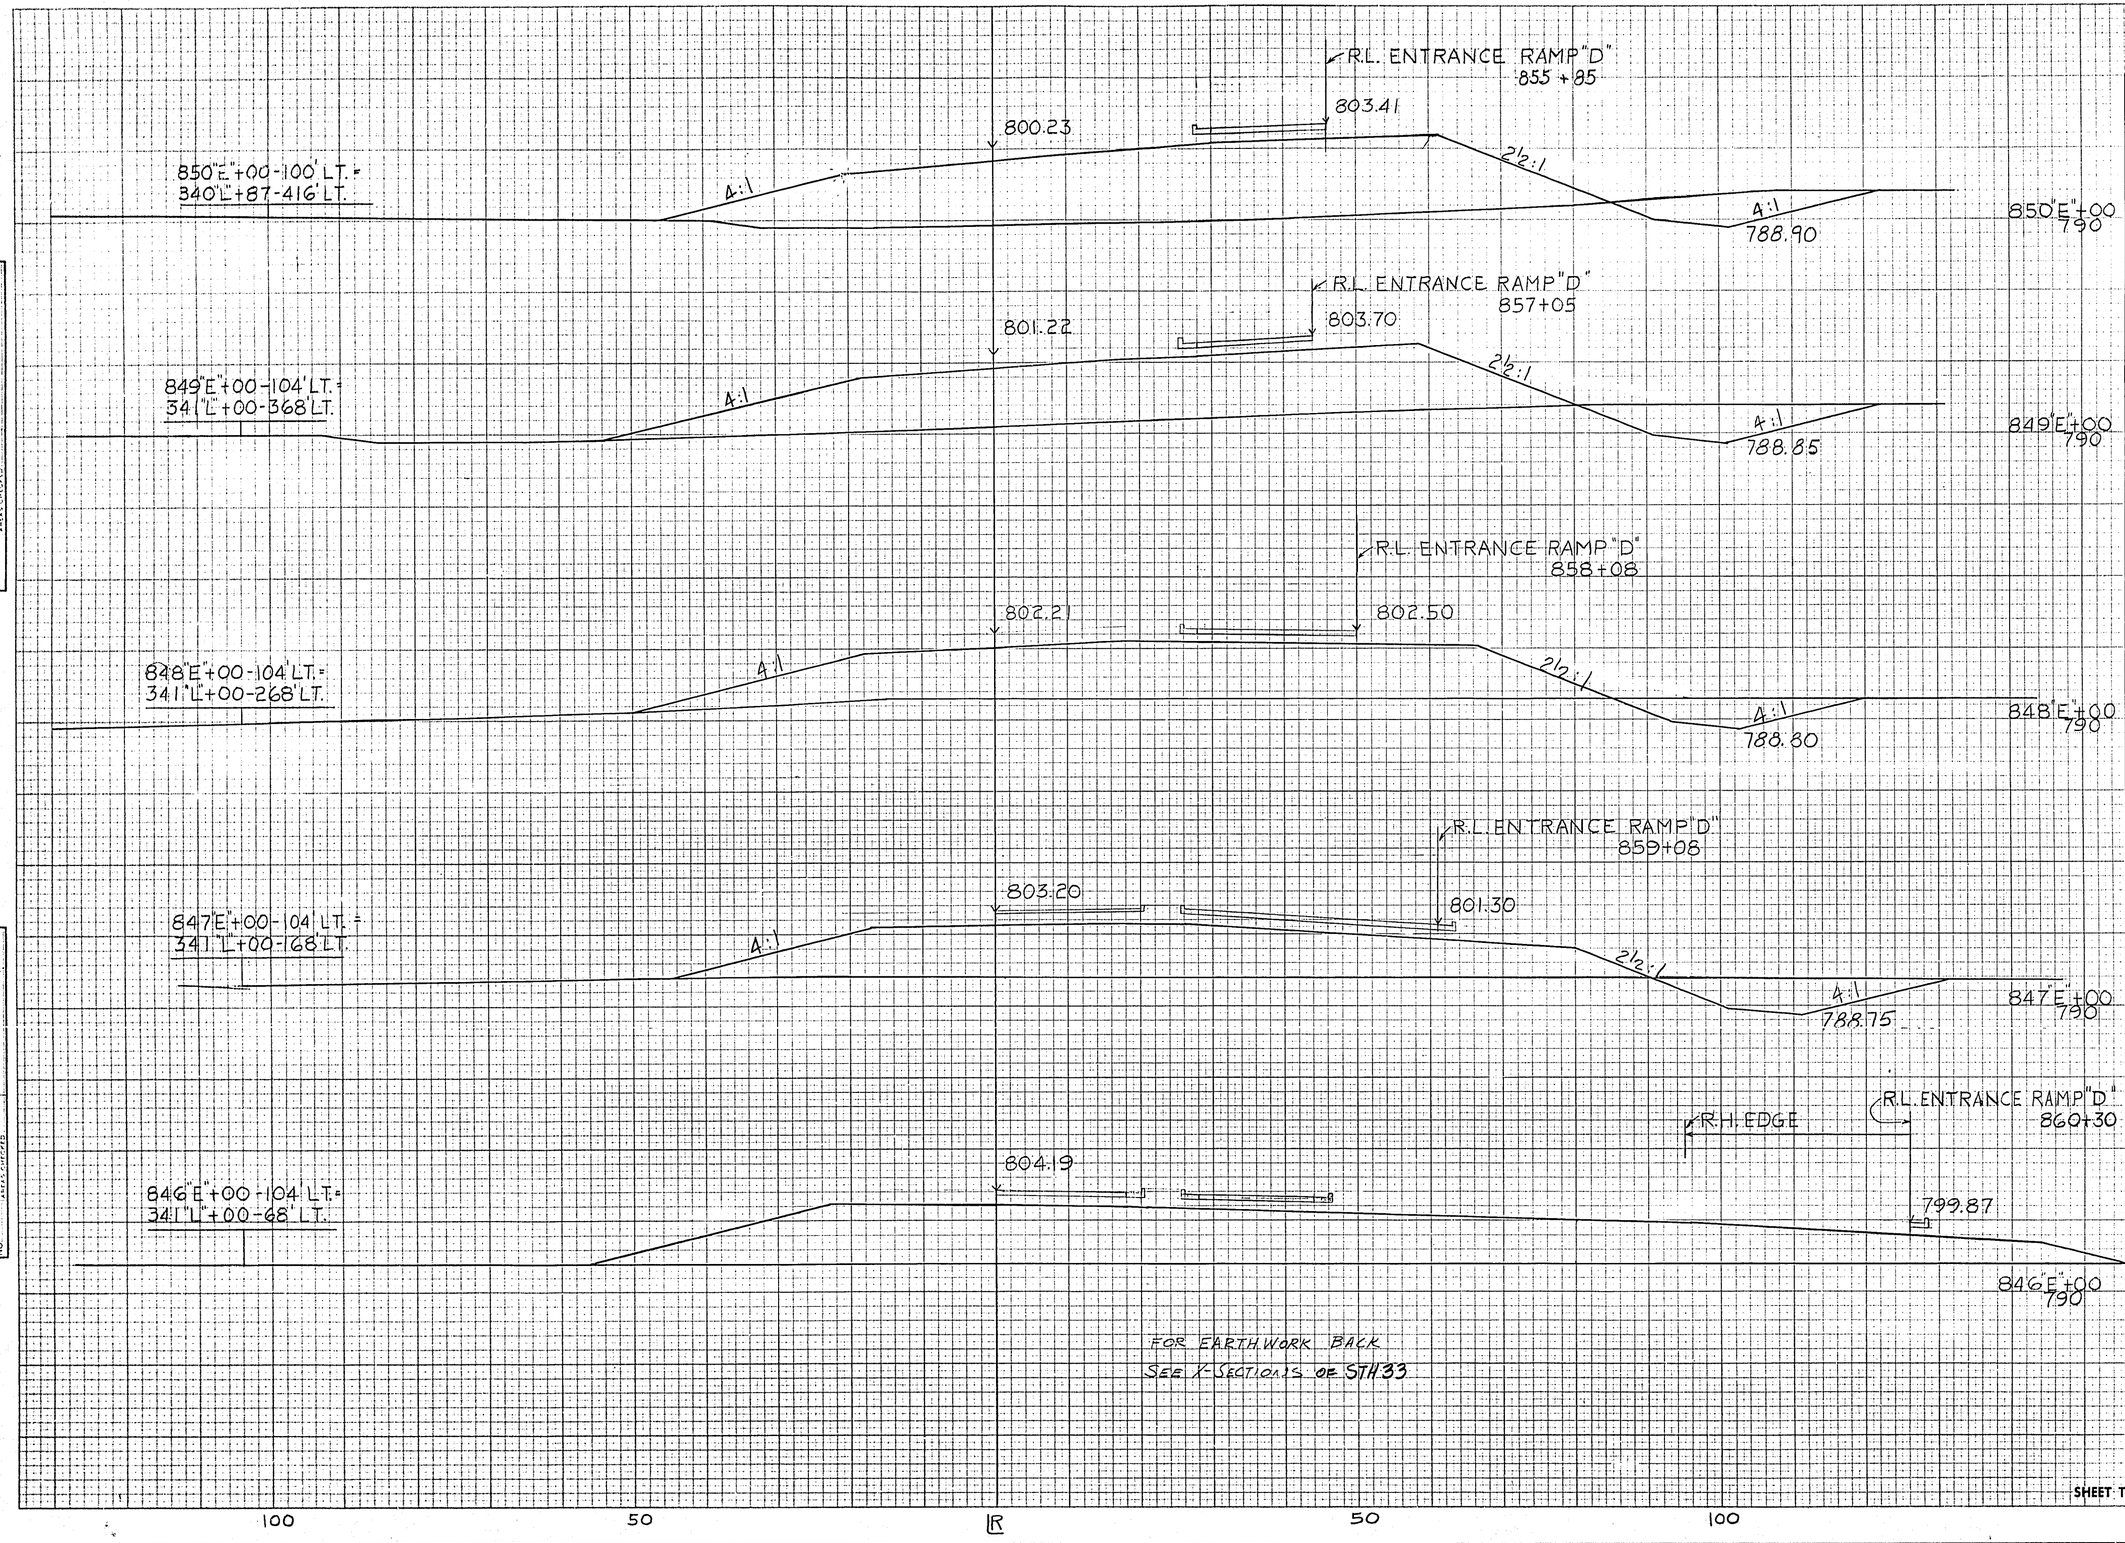

STATION	DISTANCE	YARDAGE EXCAVATION	YARDAGE FILL
850E + 00			
	100'	407	3507
849E + 00			
	100'	389	3096
848E + 00			
	100'	391	2811
847E + 00			
	100'	228	3631
846E + 00			
SHEET TOTAL		1413	13045

FINAL SURVEY — SURVEYED, PLOTTED, TEMPLATE, NOTE BOOK, AREAS CHECKED, NO., BY, DATE

ORIGINAL SURVEY — SURVEYED, PLOTTED, TEMPLATE, NOTE BOOK, AREAS CHECKED, NO., BY, DATE


1:7

PLATE 3—CROSS SECTION O. P. R. & R. E. STANDARD
THE FREDERICK POST CO., CHICAGO

B.P.R. DISTRICT OFFICE	PROJECT	SHEET NUMBER	TOTAL SHEETS
WIS. 4	I-90-2 (18) 105	233	264

FINAL SURVEY — DATE — BY — CHECKED — PLOTTED — TEMPLATE — AREAS — AREAS CHECKED — NOTE BOOK — NO.

ORIGINAL SURVEY — DATE — BY — CORRECTED — PLOTTED — TEMPLATE — AREAS — AREAS CHECKED — NOTE BOOK — NO.

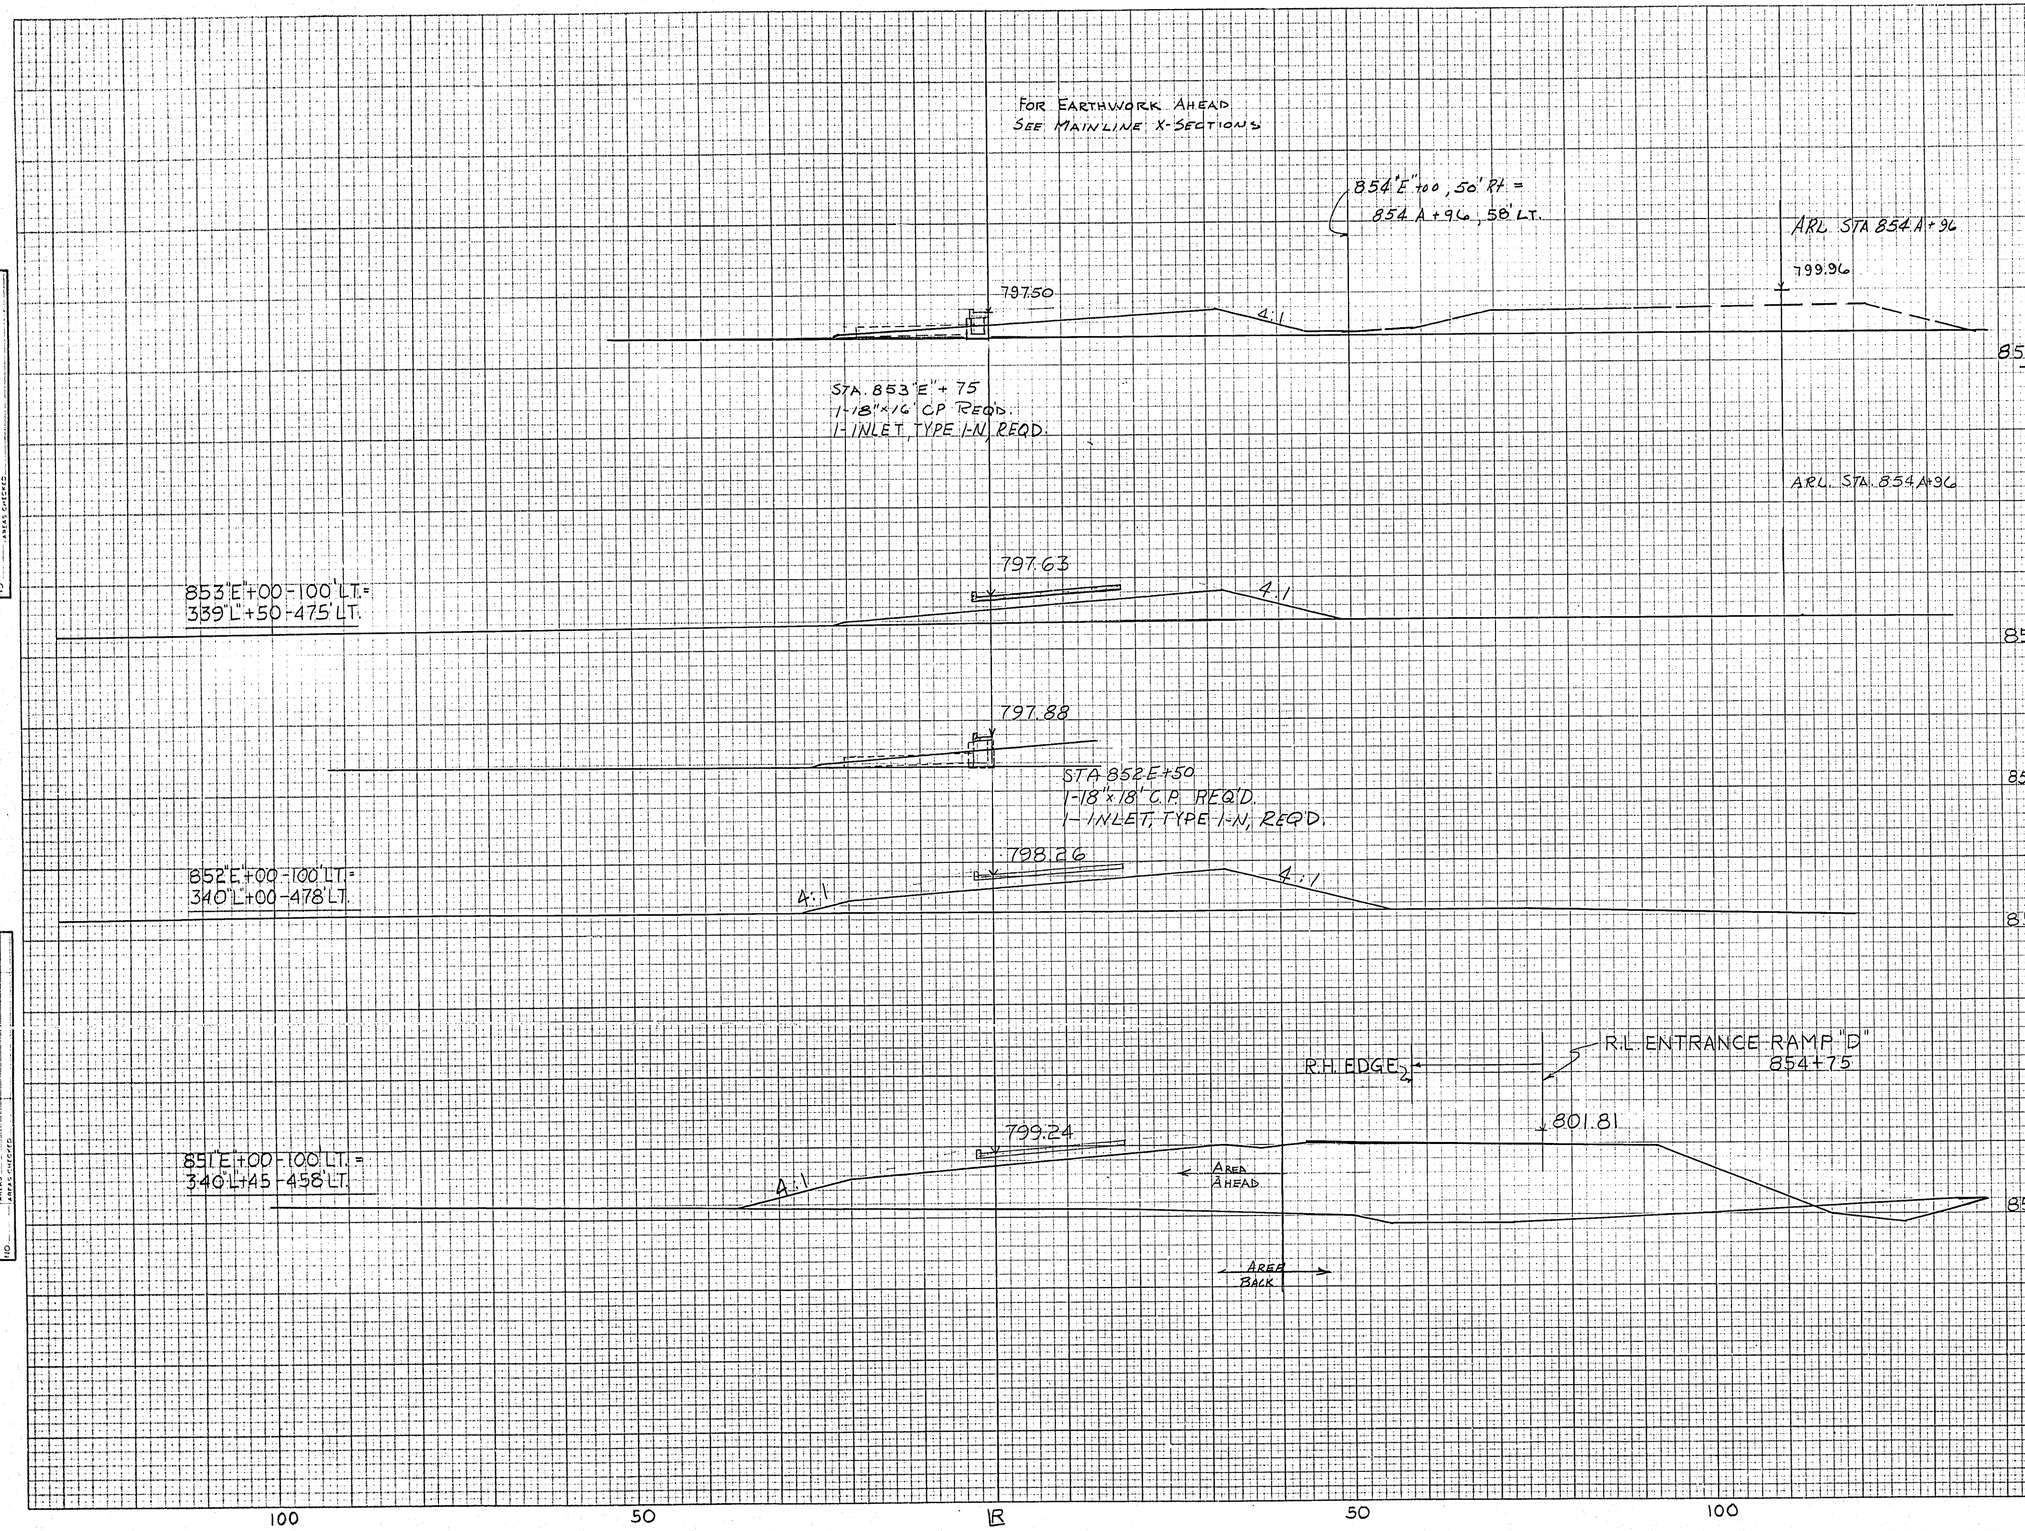


STATION	DISTANCE	YARDAGE EXCAVATION UNCL.	YARDAGE EXCAVATION	YARDAGE EXCAVATION	YARDAGE EXCAVATION	YARDAGE FILL
854E + 00						
	100	0				519
853E + 00						
	100	0				776
852E + 00						
	100	0				1374
851E + 00						
	150	261				3746
850E + 00						
SHEET TOTAL		261				6415

100 50 0 50 100

PLATE 3-CROSS SECTION O. P. R. & R. E. STANDARD
THE FREDERICK POST CO., CHICAGO

MEIKLE RD @ STA 887+10

B.P.R. DISTRICT OFFICE	PROJECT	SHEET NUMBER	TOTAL SHEETS
WIS. 4	I 90-2(18)105	234	264

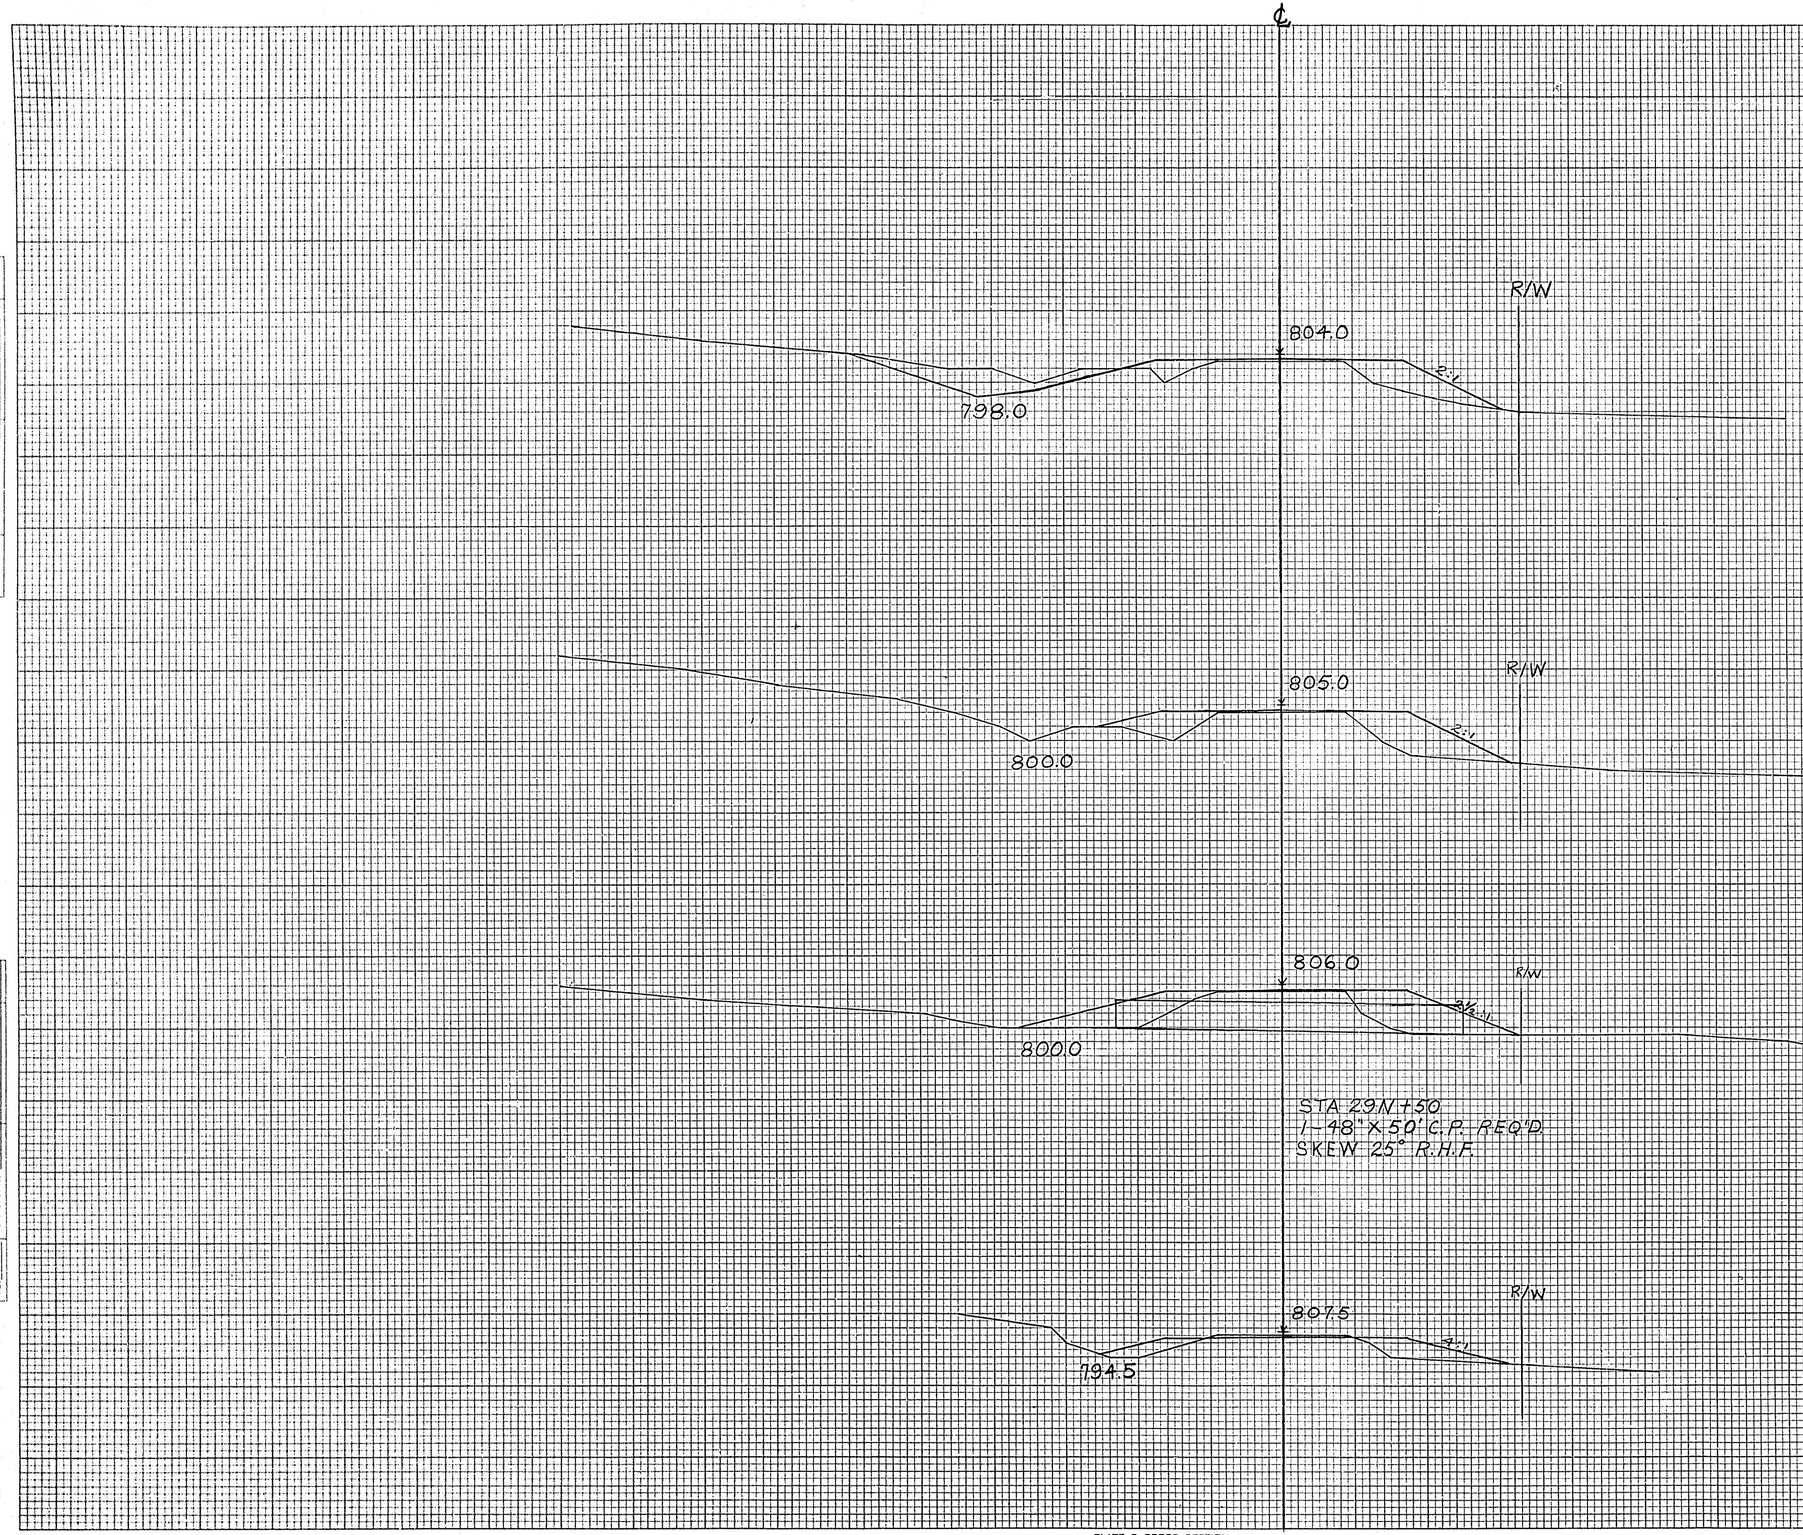

STATION	DISTANCE	YARDAGE EXCAVATION LEVEL				YARDAGE FILL
	50	23				65
32"N+00 800	32					
	100	0				331
31"N+00 800	31					
	100	0				469
30"N+00 800	30					
	100	0				350
29"N+00 810	29					
SHEET TOTAL		23				1215

FINAL SURVEY — SURVEYED / PLOTTED / TEMPLATE / AREAS CHECKED — NOTE BOOK — NO. — BY — DATE

ORIGINAL SURVEY — SURVEYED / PLOTTED / TEMPLATE / AREAS CHECKED — NOTE BOOK — NO. — BY — DATE


PLATE 3 CROSS SECTION O. P. R. & P. E. STANDARD
100% RAG PAPER-MADE AND PRINTED IN U. S. A.
EUGENE DIETZGEN CO.


MEIKLE RD. @ Sta. 887+10 @ STA. 955

B.P.R. DISTRICT OFFICE	PROJECT	SHEET NUMBER	TOTAL SHEETS
WIS. 4	I-90-2(13)105	235	264


FINAL SURVEY — SURVEYED / PLOTTED / TEMPLATE / NOTE BOOK / AREAS / NO — AREAS CHECKED


ORIGINAL SURVEY — SURVEYED / PLOTTED / TEMPLATE / NOTE BOOK / AREAS / NO — AREAS CHECKED — BY — DATE — 30 12-20-57 — 20 2-28-58

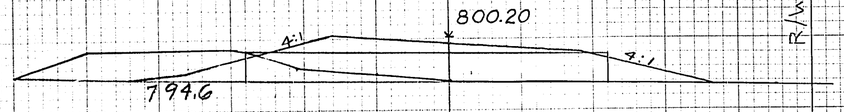

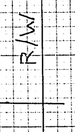

36"N+00
800

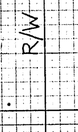


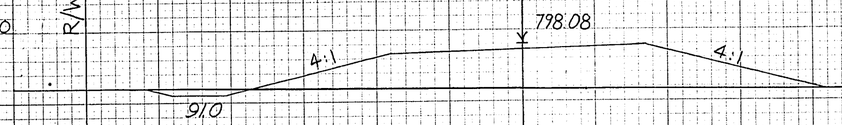





40"N+00
800


STA 35N+50
1-48"X 50'C.P. REQ'D.

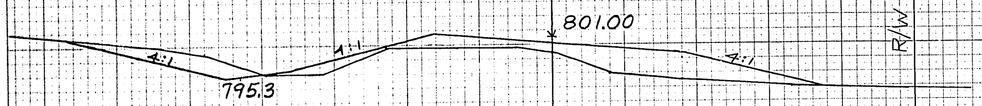

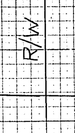


35"N+00
800

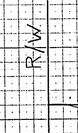

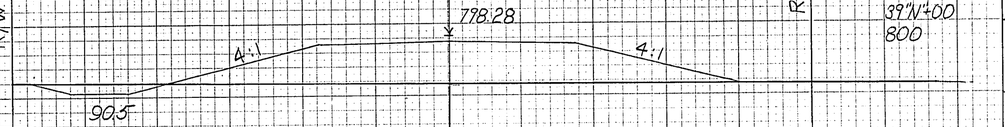





39"N+00
800

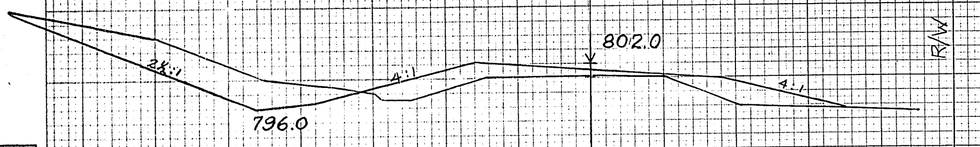

34"N+00
800

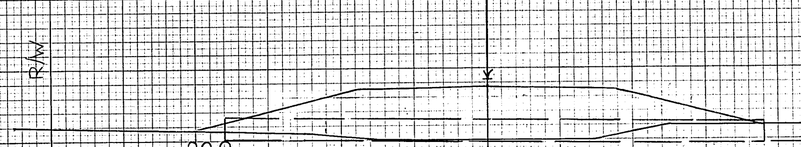

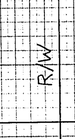

38"N+55
800

℄ DRAINAGE DITCH

STA. 38"N+60
1-36"X 78'C.P. REQ'D
SKEW 20° R.H.F.






33"N+00
800


STA 33N+60
1-54"X 58'C.P. REQ'D
SKEW 25° R.H.F.






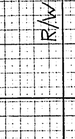


38"N+00
800

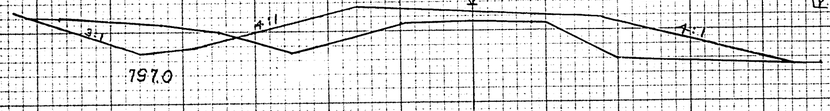

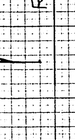

32"N+50
800



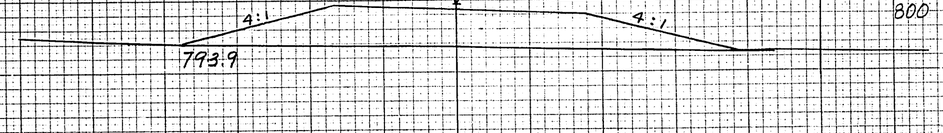



37"N+00
800

STATION	DISTANCE	YARDAGE EXCAVATION UNCL.	YARDAGE EXCAVATION	YARDAGE EXCAVATION	YARDAGE EXCAVATION	YARDAGE FILL
40						
	100	0				1215
39						
	45	0				601
+55						
	55	0				707
38						
	100	0				1018
37						
	100	167				797
36						
	100	204				431
35						
	100	129				1-3
34						
	100	185				141
33						
	50	23				47
+50						
32						
SHEET TOTAL		708				5075

50 50 50 50

MEIKLE RD STA 887+10

PLATE 3—CROSS SECTION O. P. R. & R. E. STANDARD
THE FREDERICK POST CO., CHICAGO


MEIKLE RD. @ Sta. 887+10

B.P.R. DISTRICT OFFICE	PROJECT	SHEET NUMBER	TOTAL SHEETS
WIS. 4	I-90-2(18)105	236	264

FINAL SURVEY — SURVEYED / PLOTTED / NOTE BOOK / TEMPLATE / AREAS / AREAS CHECKED / NO.

ORIGINAL SURVEY — SURVEYED / PLOTTED / NOTE BOOK / TEMPLATE / AREAS / AREAS CHECKED / NO.

BY	DATE
EO	3-25-53
EO	3-26-53

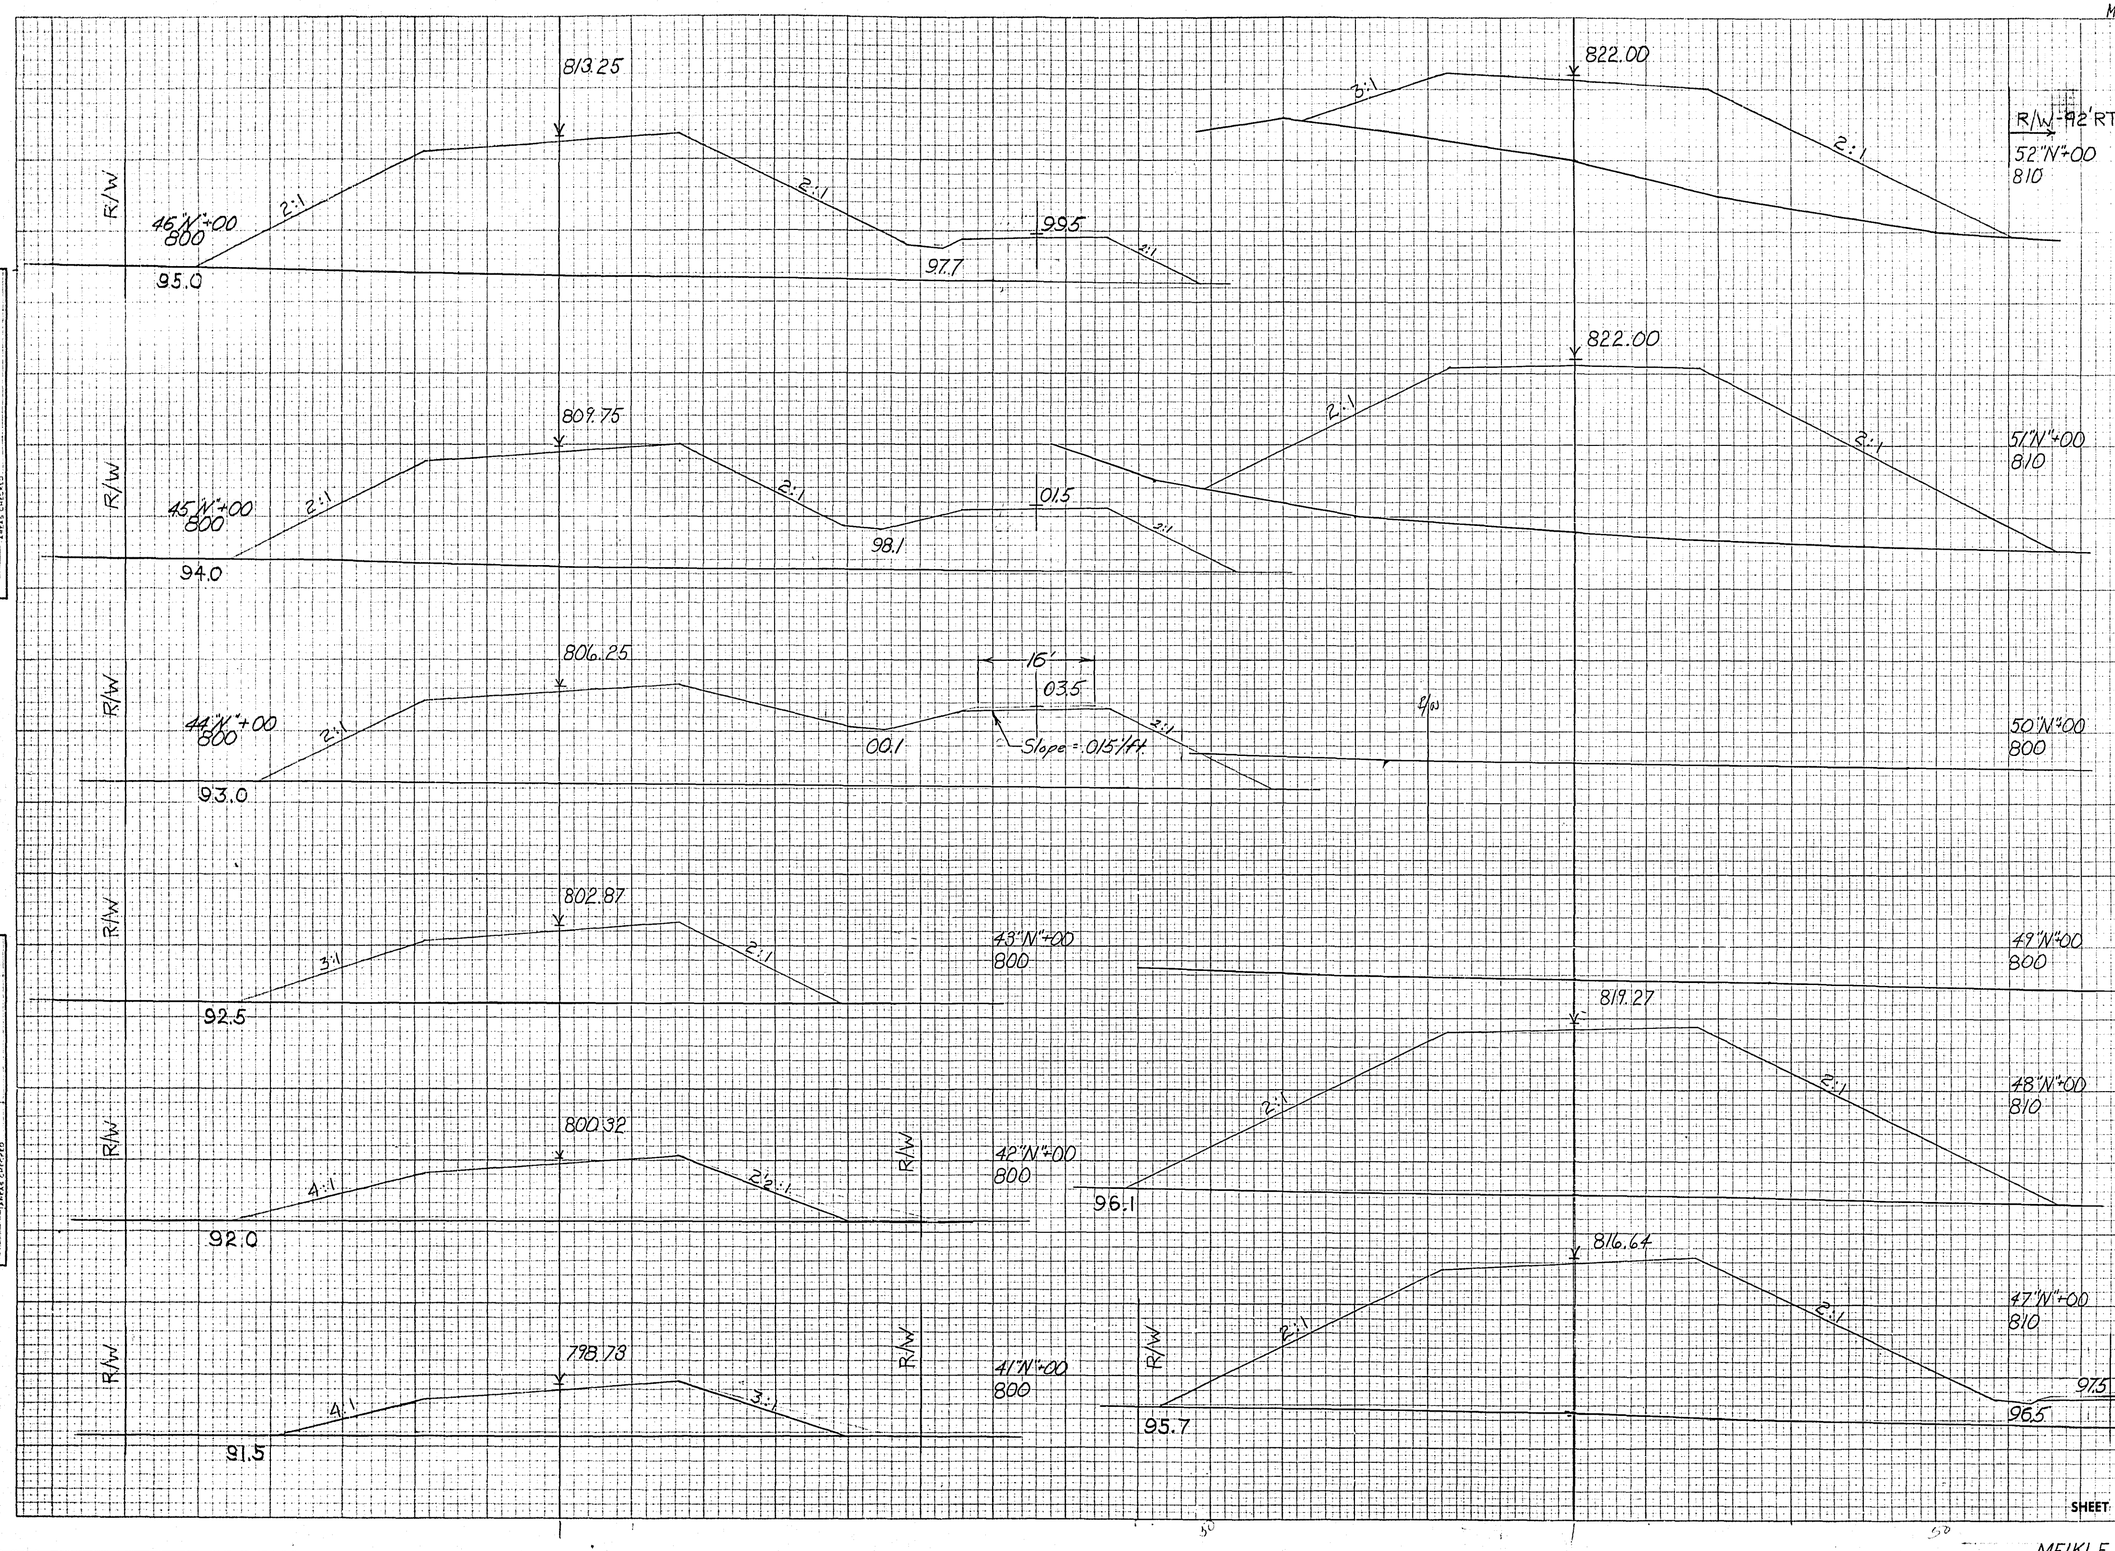

STATION	DISTANCE	YARDAGE EXCAVATION UNCL.	YARDAGE EXCAVATION	YARDAGE FILL
52				
	100	0		4882
51				
	10	0		664
50 +90				
	BRIDGE			
+30				
	30	0		2135
48				
	100	0		6671
47				
	100	0		5641
46				
	100	0		4466
45				
	100	0		3380
44				
	100	0		2566
43				
	100	0		2631
42				
	100	0		1671
41				
	100	0		1356
40				
SHEET TOTAL		0		35,451

120

PLATE 3—CROSS SECTION O. P. R. & R. E. STANDARD
THE FREDERICK POST CO., CHICAGO


MEIKLE RD STA 887+10

MEIKLE RD. @ Sta. 887+10

B.P.R. DISTRICT OFFICE	PROJECT	SHEET NUMBER	TOTAL SHEETS
WIS. 4	I-90-2(13)105	237	264

FINAL SURVEY
SURVEYED BY
PLOTTED DATE
CHECKED
NOTE BOOK TEMPLATE
NO. AREAS
AREAS CHECKED

ORIGINAL SURVEY
SURVEYED BY
PLOTTED 10-25-51
CHECKED 10-30-51
NOTE BOOK TEMPLATE
NO. AREAS
AREAS CHECKED

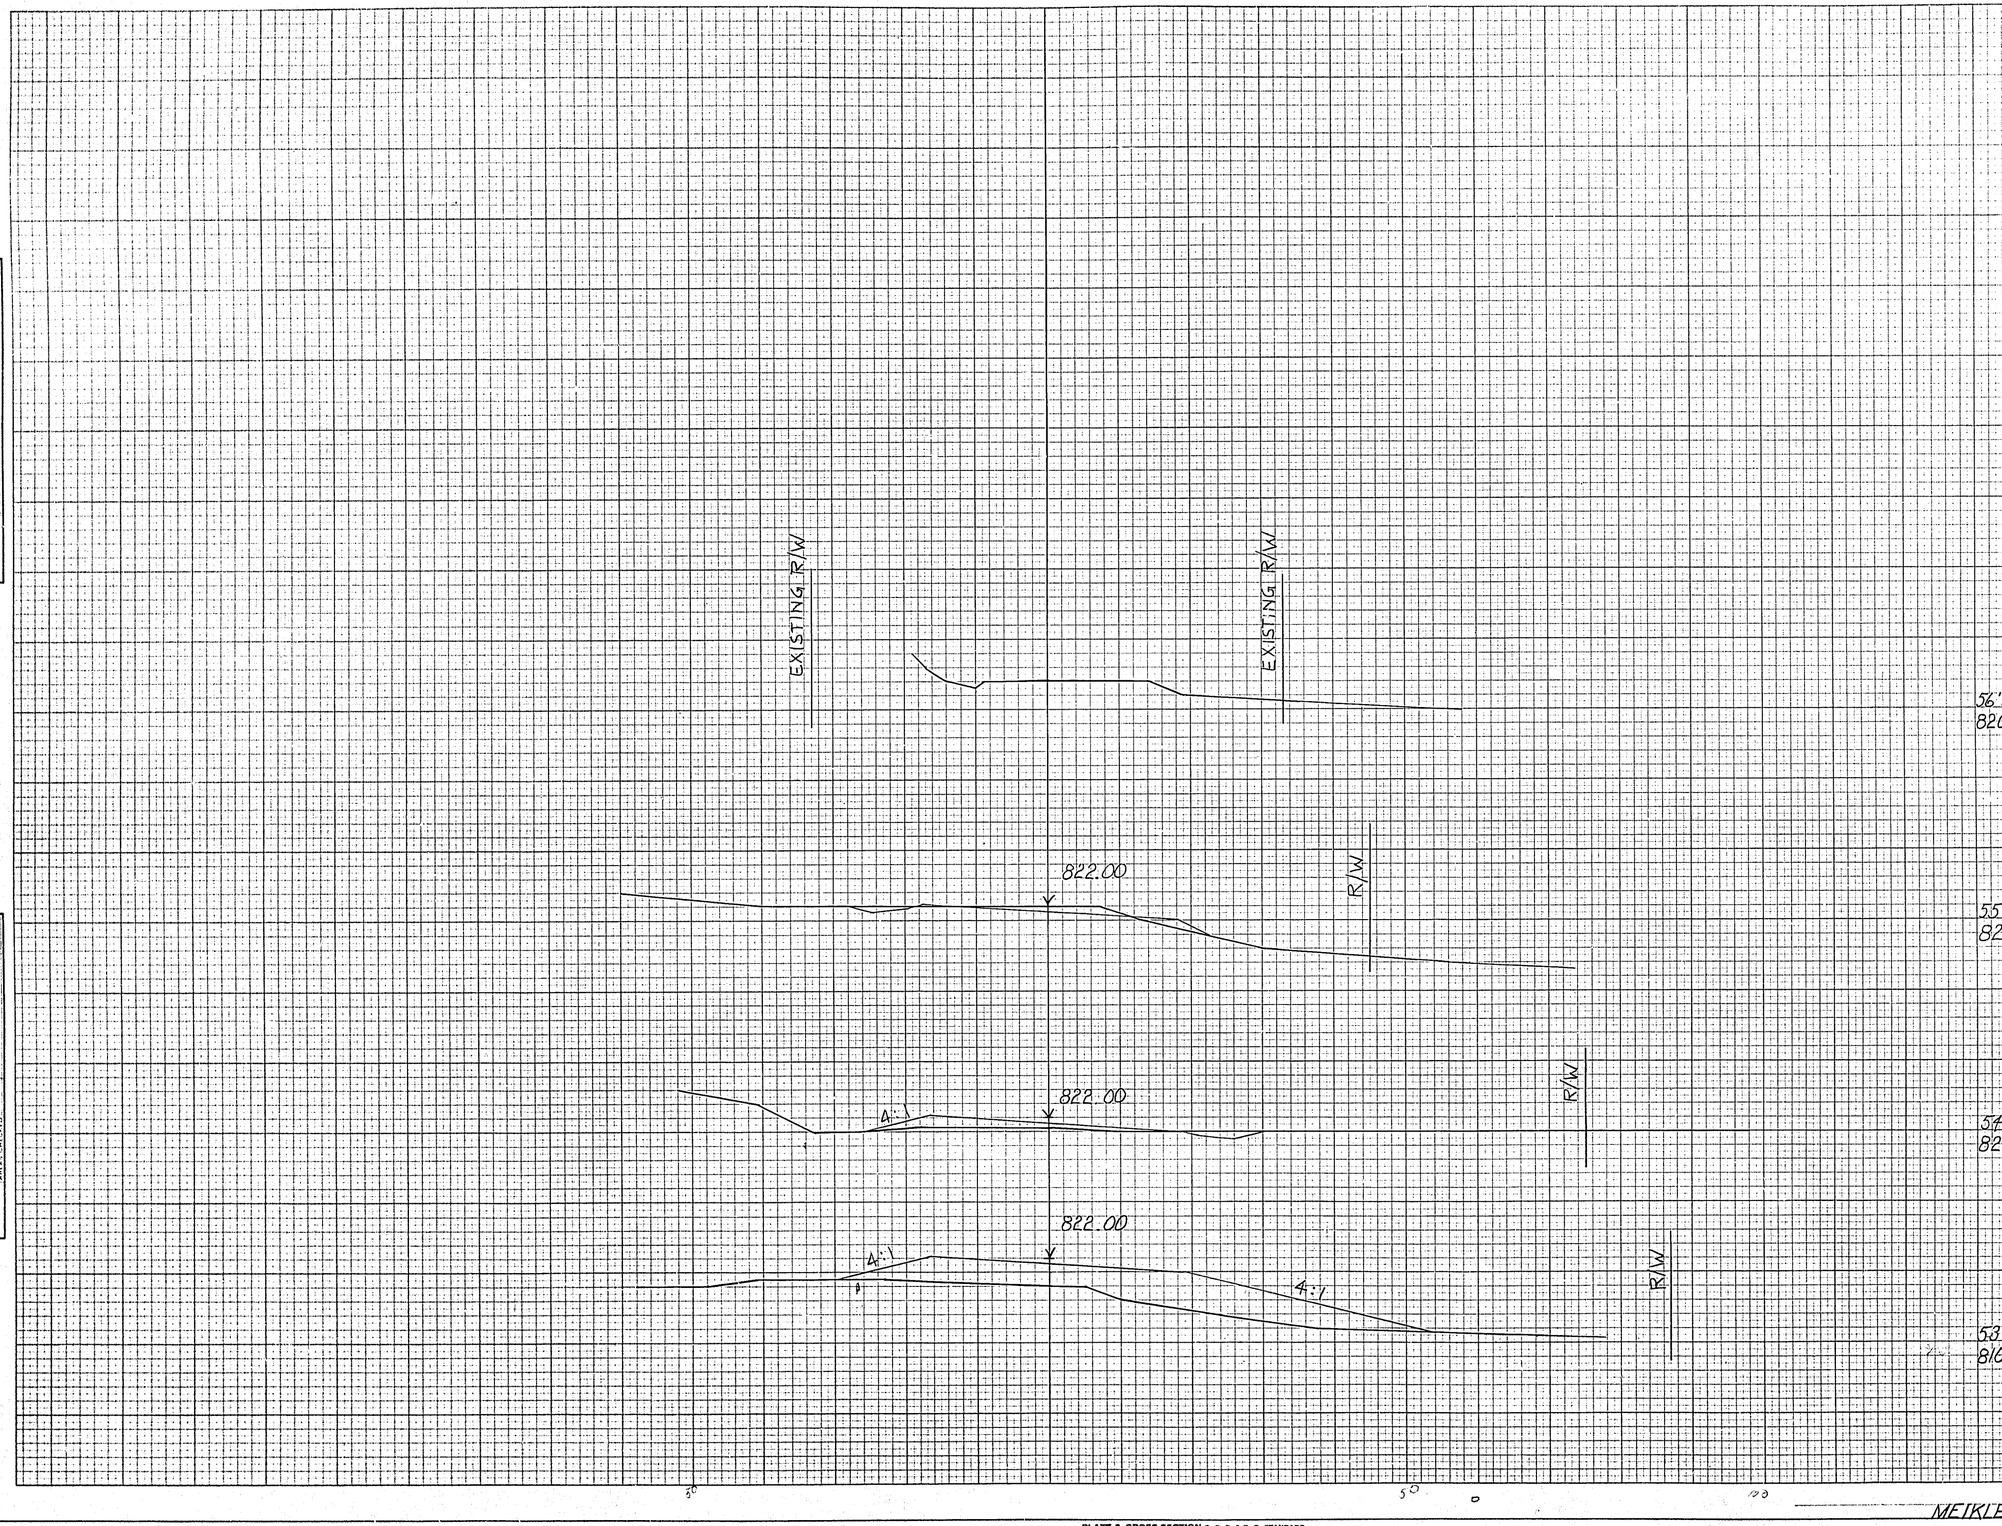


STATION	DISTANCE	YARDAGE EXCAVATION UNCL.			FILL
56					
	100	22			15
55					
	100	31			81
54					
	100	9			598
53					
	100	0			2094
52					
SHEET TOTAL		62			2788

MEIKLE RD STA 887+10

PLATE 3-CROSS SECTION O. P. R. & R. E. STANDARD
THE FREDERICK POST CO., CHICAGO

MEIKLE ROAD STA 921+00

B.P.R. DISTRICT OFFICE	PROJECT	SHEET NUMBER	TOTAL SHEETS
WIS. 4	I90-2(18)105	238	264

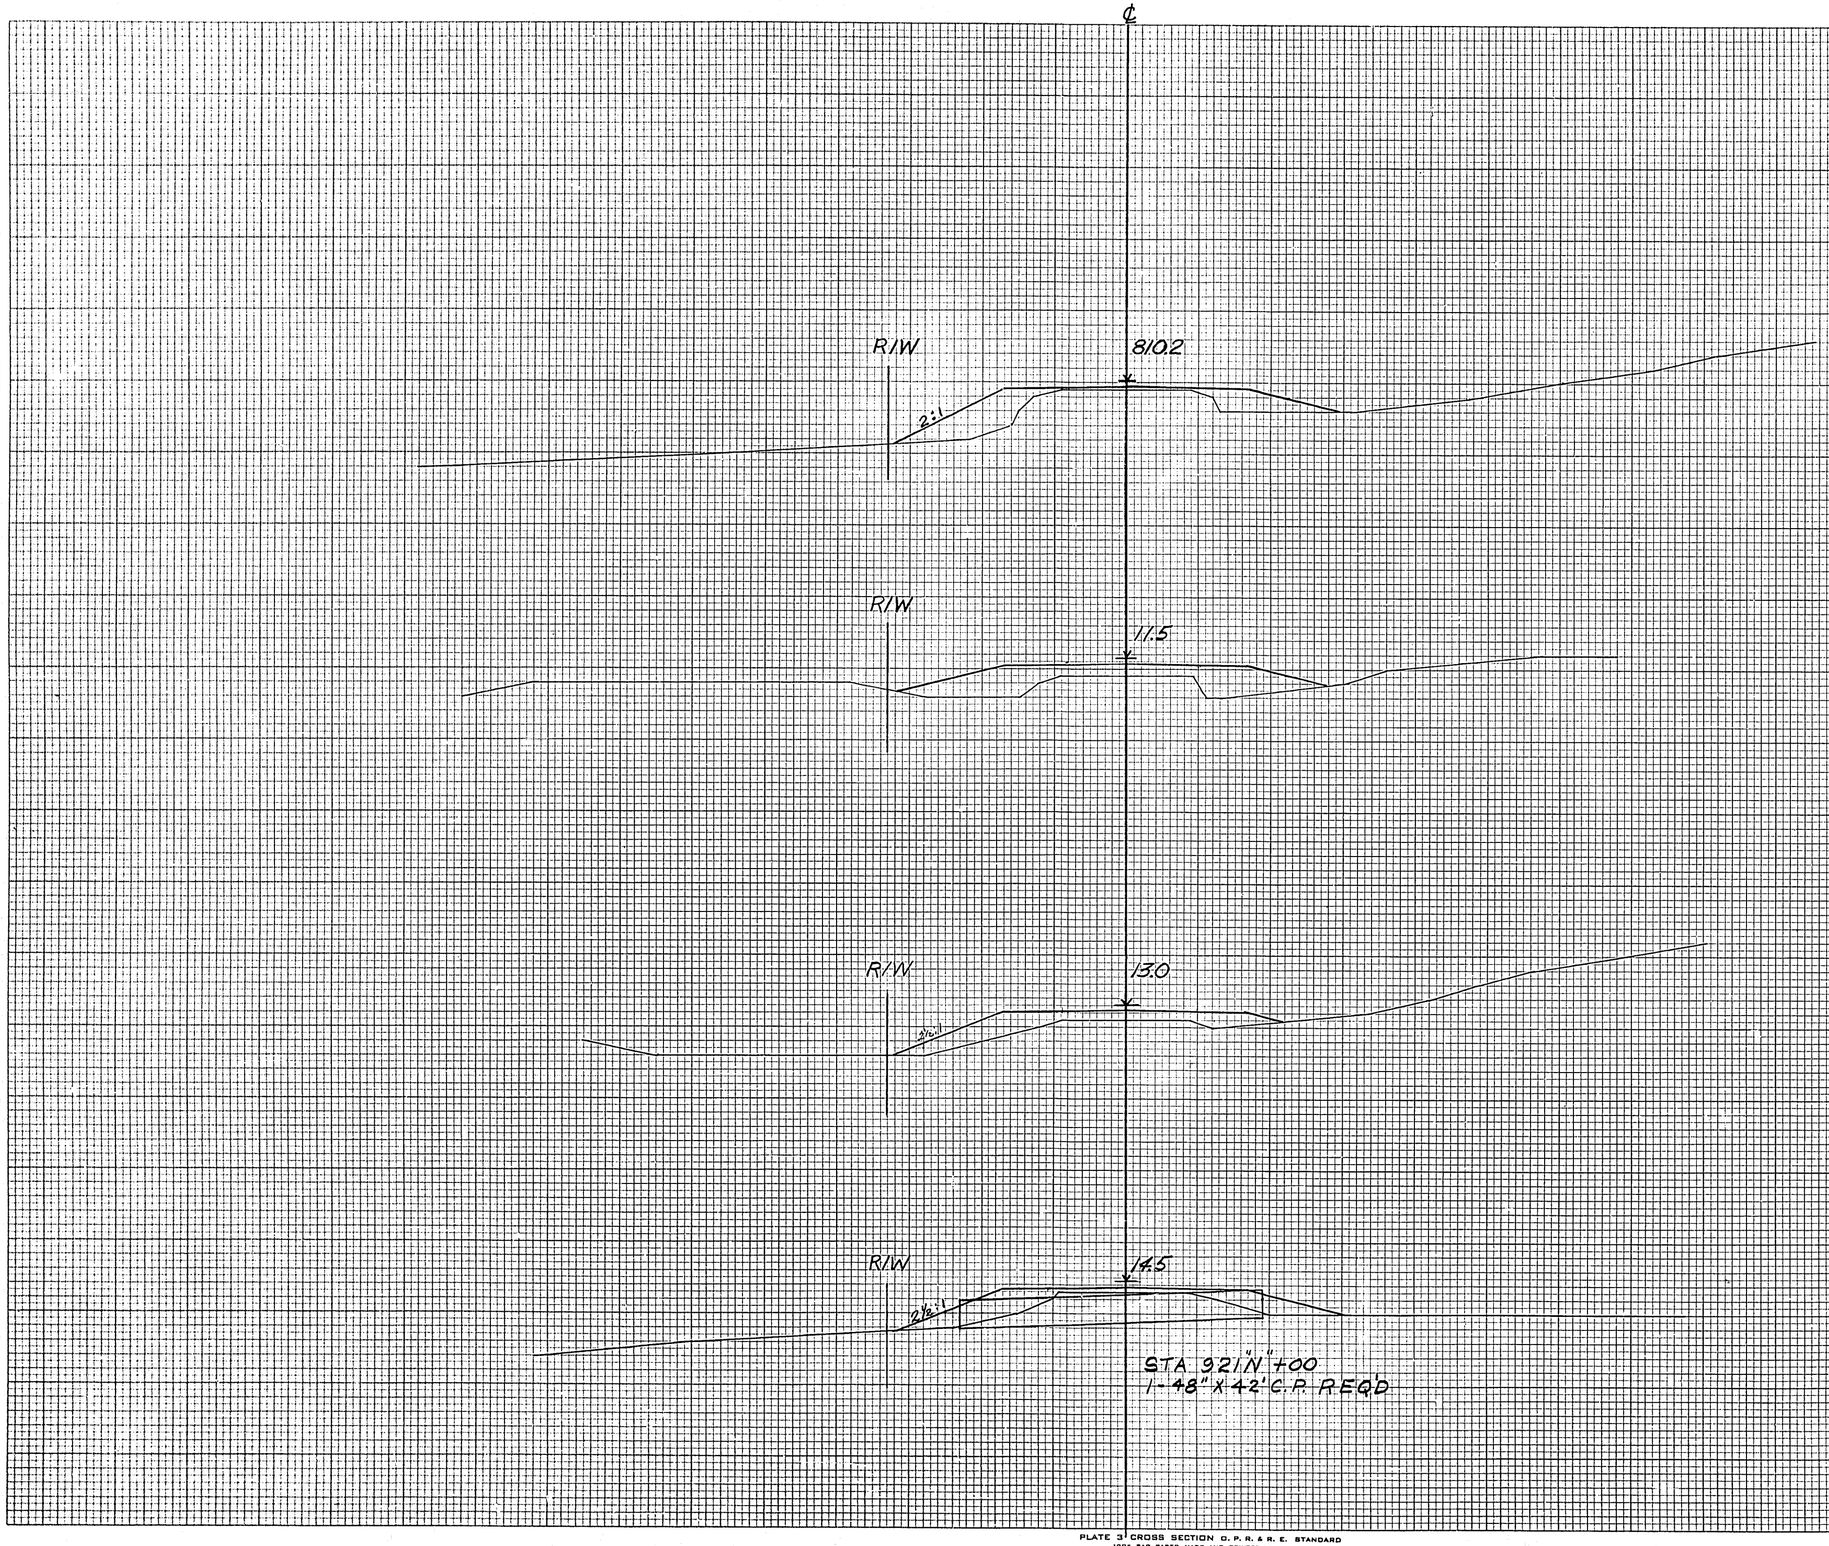

STATION	DISTANCE	YARDAGE EXCAVATION UNCL				FILL
925						
	100	0				233
924						
	100	0				530
923						
	100	0				493
922						
	100	0				404
921						
	100	0				208
920						
SHEET TOTAL		0				1868

ORIGINAL SURVEY — SURVEYED, PLOTTED, TRACED, CROSS SECTIONS CHECKED — BY — DATE


FINAL SURVEY — PLOTTED, TRACED, CROSS SECTIONS CHECKED — BY — DATE

NOTE BOOK _____ NO. _____

PLATE 3 CROSS SECTION O. P. R. & R. E. STANDARD
100% RAG PAPER-MADE AND PRINTED IN U. S. A.
EUGENE DIETZGEN CO.

Sta. 921+00 - 923"N"+00 Meikle Road

B.P.R. DISTRICT OFFICE	PROJECT	SHEET NUMBER	TOTAL SHEETS
WIS. 4	I-90-2(18)105	239	264

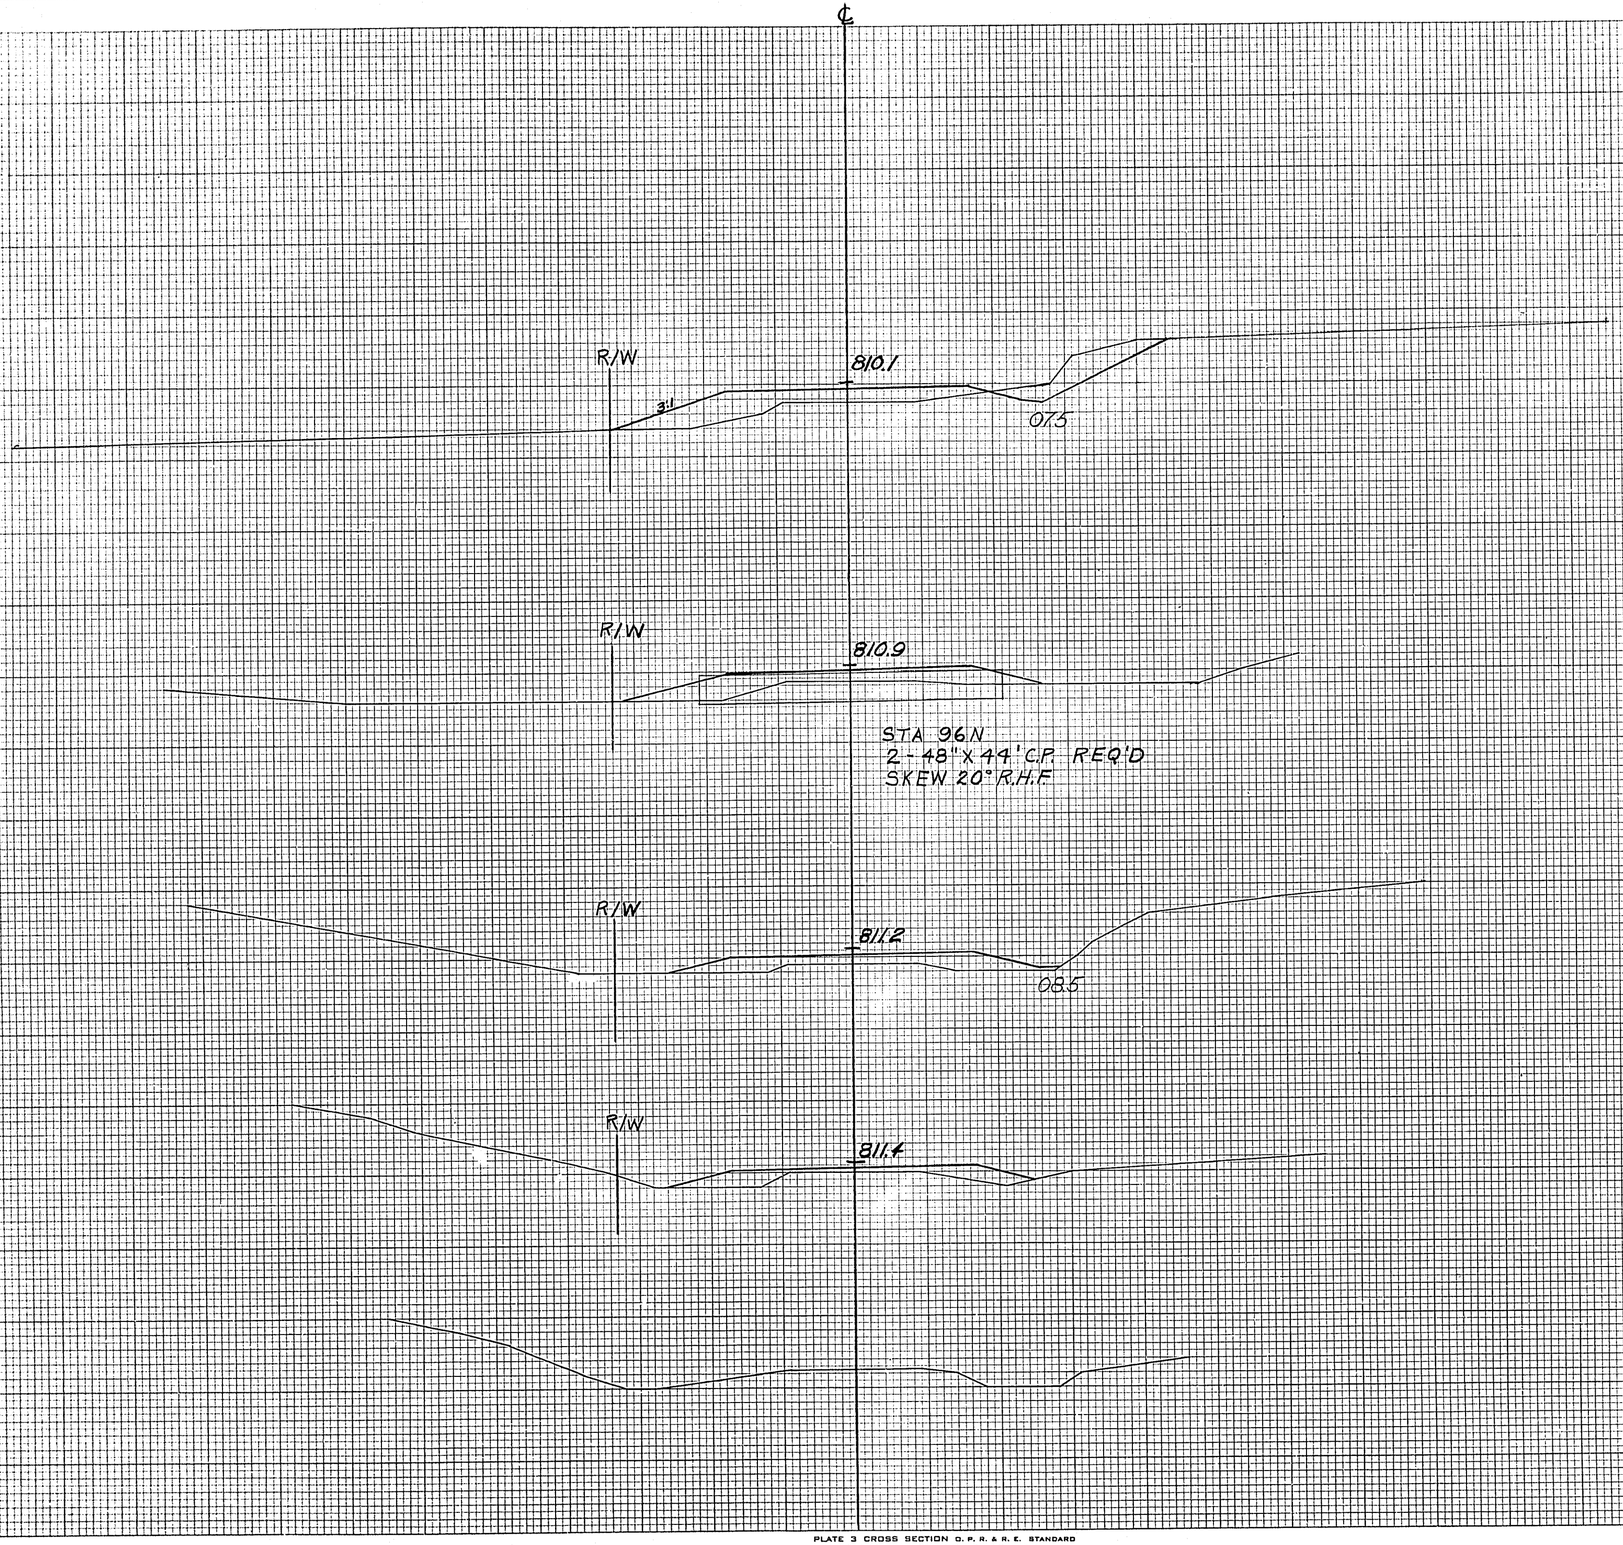

STATION	DISTANCE	YARDAGE EXCAVATION Unc.	FILL
97+00			
		0	641
96+00			
		0	378
95+00			
		0	300
94+00			
		0	141
93+00			
SHEET TOTAL		0	1460

97"N"+00
800

96"N"+00
800

95"N"+00
810

94"N"+00
810

93"N"+00
810

FINAL SURVEY
SURVEYED
PLOTTED
NOTE BOOK
NO.
TRACED
AREAS
AREAS CHECKED
DATE

ORIGINAL SURVEY
SURVEYED
PLOTTED
NOTE BOOK
TRACED
AREAS
AREAS CHECKED
BY
DATE

PLATE 3 CROSS SECTION O. P. R. & R. E. STANDARD
100% RAG PAPER-MADE AND PRINTED IN U. S. A.
EUGENE DIETZGEN CO.


Sh. 93"N"+00 - 97"N"+00 Meikle Road

MEIKLE RD. RELOCATED @ STA 955

B.P.R. DISTRICT OFFICE	PROJECT	SHEET NUMBER	TOTAL SHEETS
WIS. 4	I-90-2(18)105	240	264

FINAL SURVEY — SURVEYED, PLOTTED, NOTE BOOK, TEMPLATE, AREAS, AREAS CHECKED, BY, DATE, NO.

ORIGINAL SURVEY — SURVEYED, PLOTTED, NOTE BOOK, TEMPLATE, AREAS, AREAS CHECKED, BY, DATE, NO.

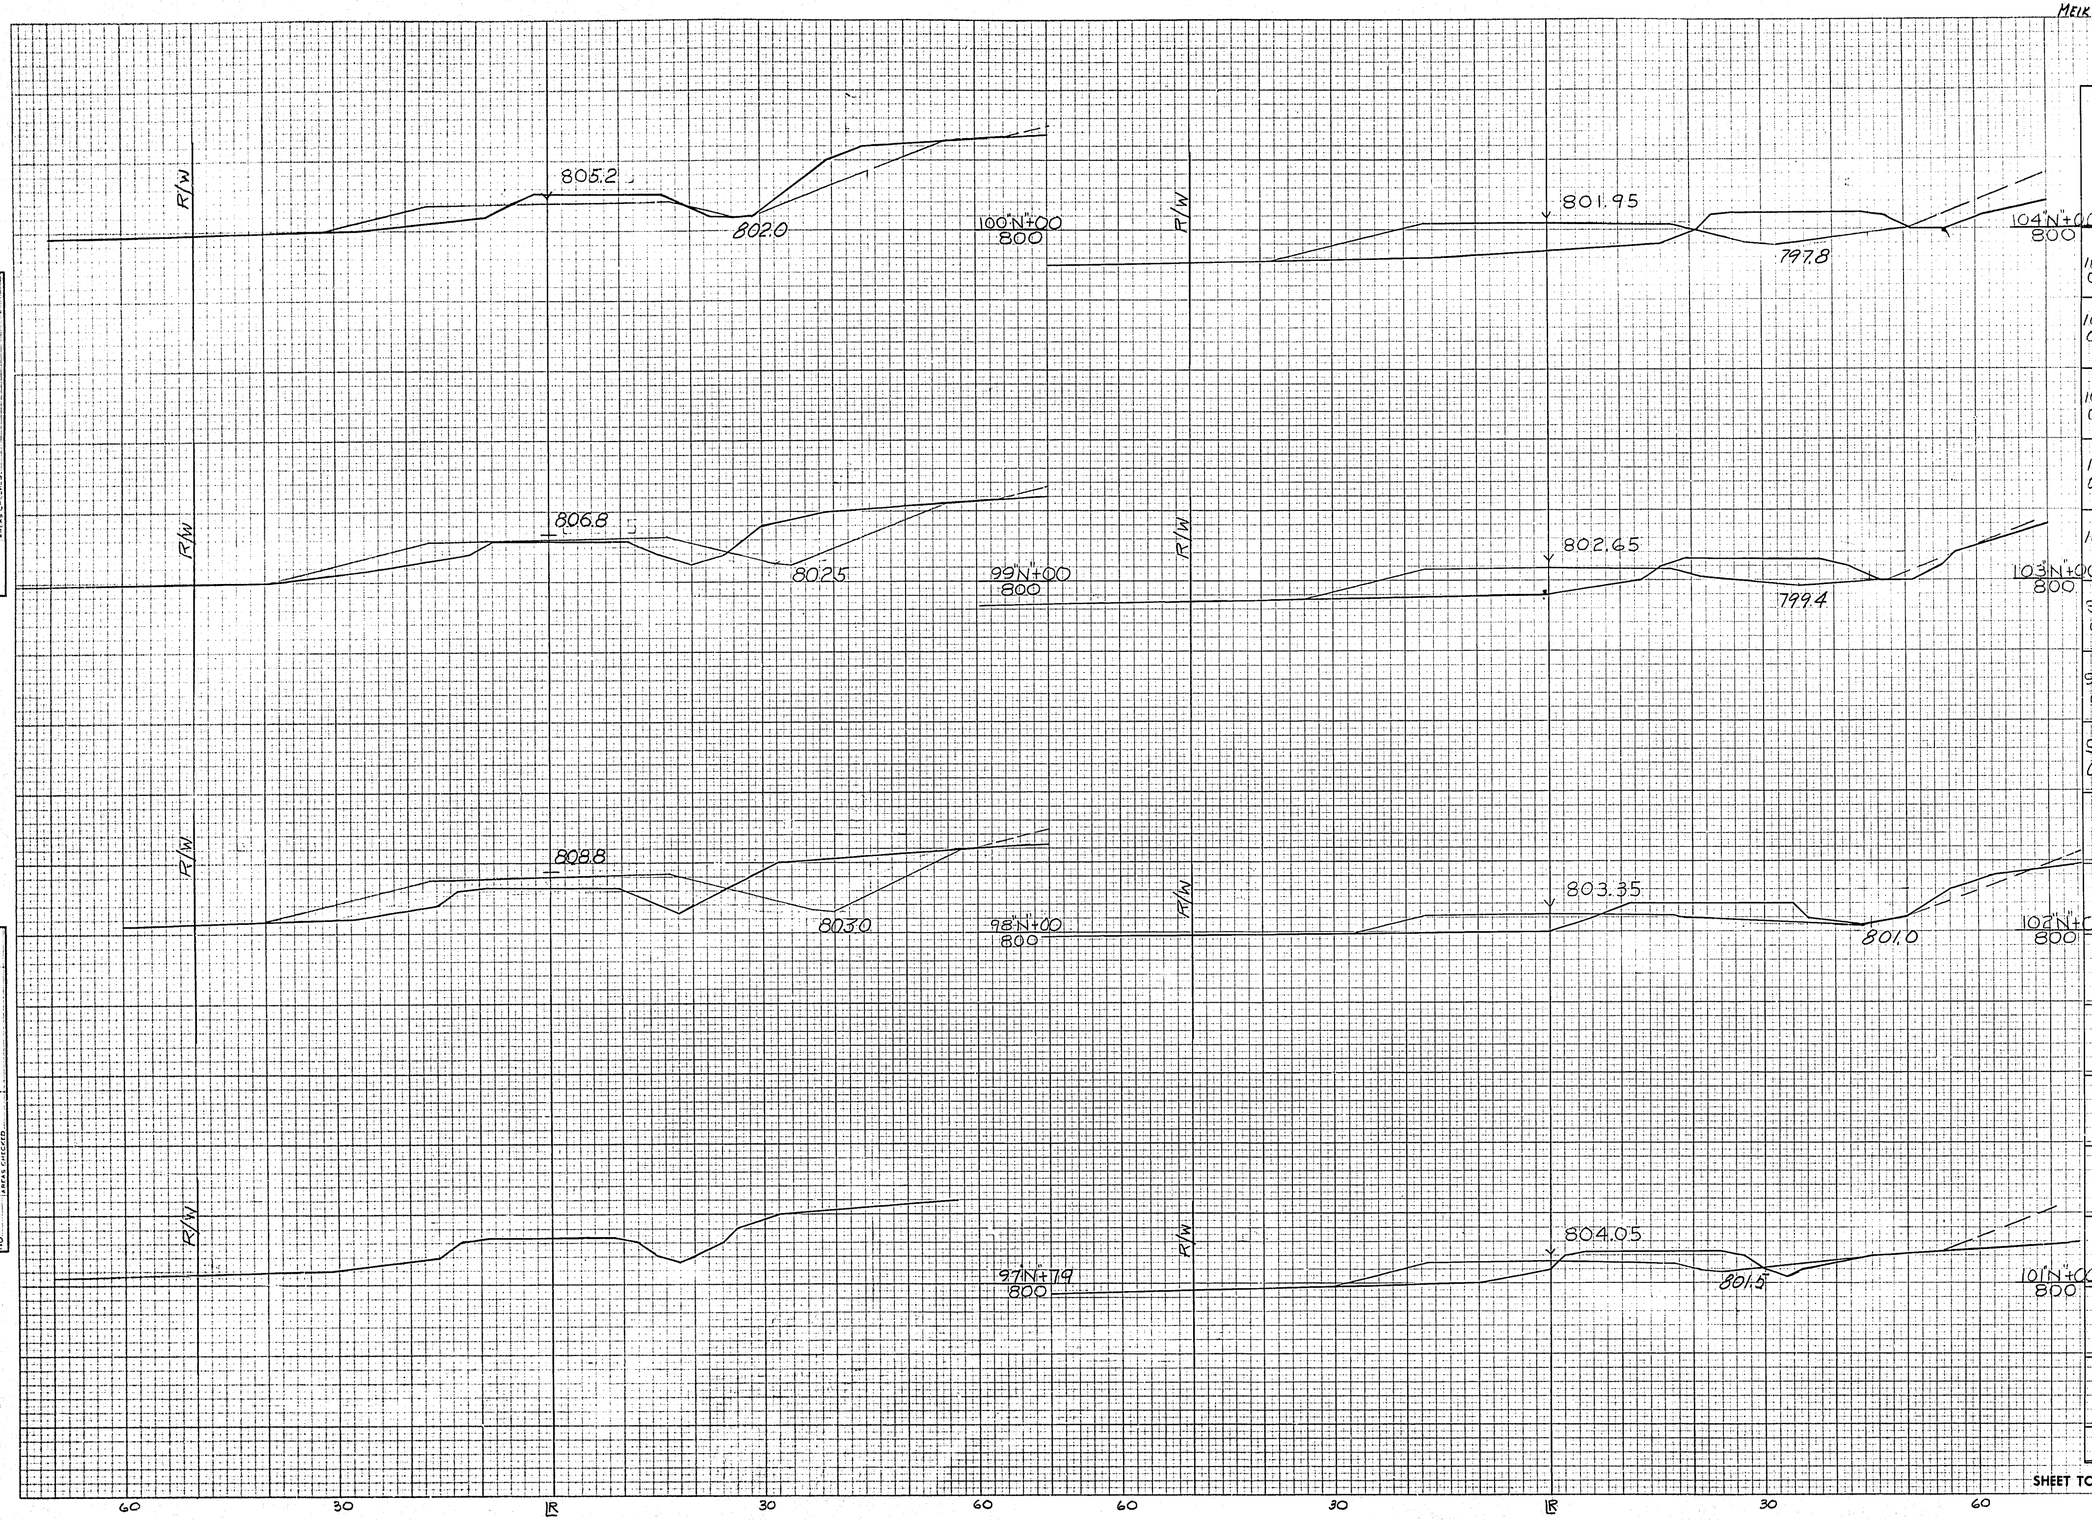

STATION	DISTANCE	YARDAGE EXCAVATION UNCL.				YARDAGE FILL
104N+00						
	100	226				603
103N+00						
	100	148				266
102N+00						
	100	100				143
101N+00						
	100	174				253
100N+00						
	100	211				129
99N+00						
	100	246				127
98N+00						
		45				519
97N+00						
SHEET TOTAL		1150				2091

12.2

PLATE 3—CROSS SECTION O. P. R. & B. E. STANDARD
THE FREDERICK POST CO., CHICAGO


STA. 97+79"N" - 104+00"N" MEIKLE RD RELOCATED

MEIKLE RD. RELOCATED @ STA. 965

B.P.R. DISTRICT OFFICE	PROJECT	SHEET NUMBER	TOTAL SHEETS
WIS. 4	I-90-2(18)1165	241	264

FINAL SURVEY — SURVEYED, PLOTTED, TEMPLATE, AREAS, CHECKED, NOTE BOOK, NO., BY, DATE

ORIGINAL SURVEY — PLOTTED, TEMPLATE, AREAS, CHECKED, NOTE BOOK, NO., BY, DATE

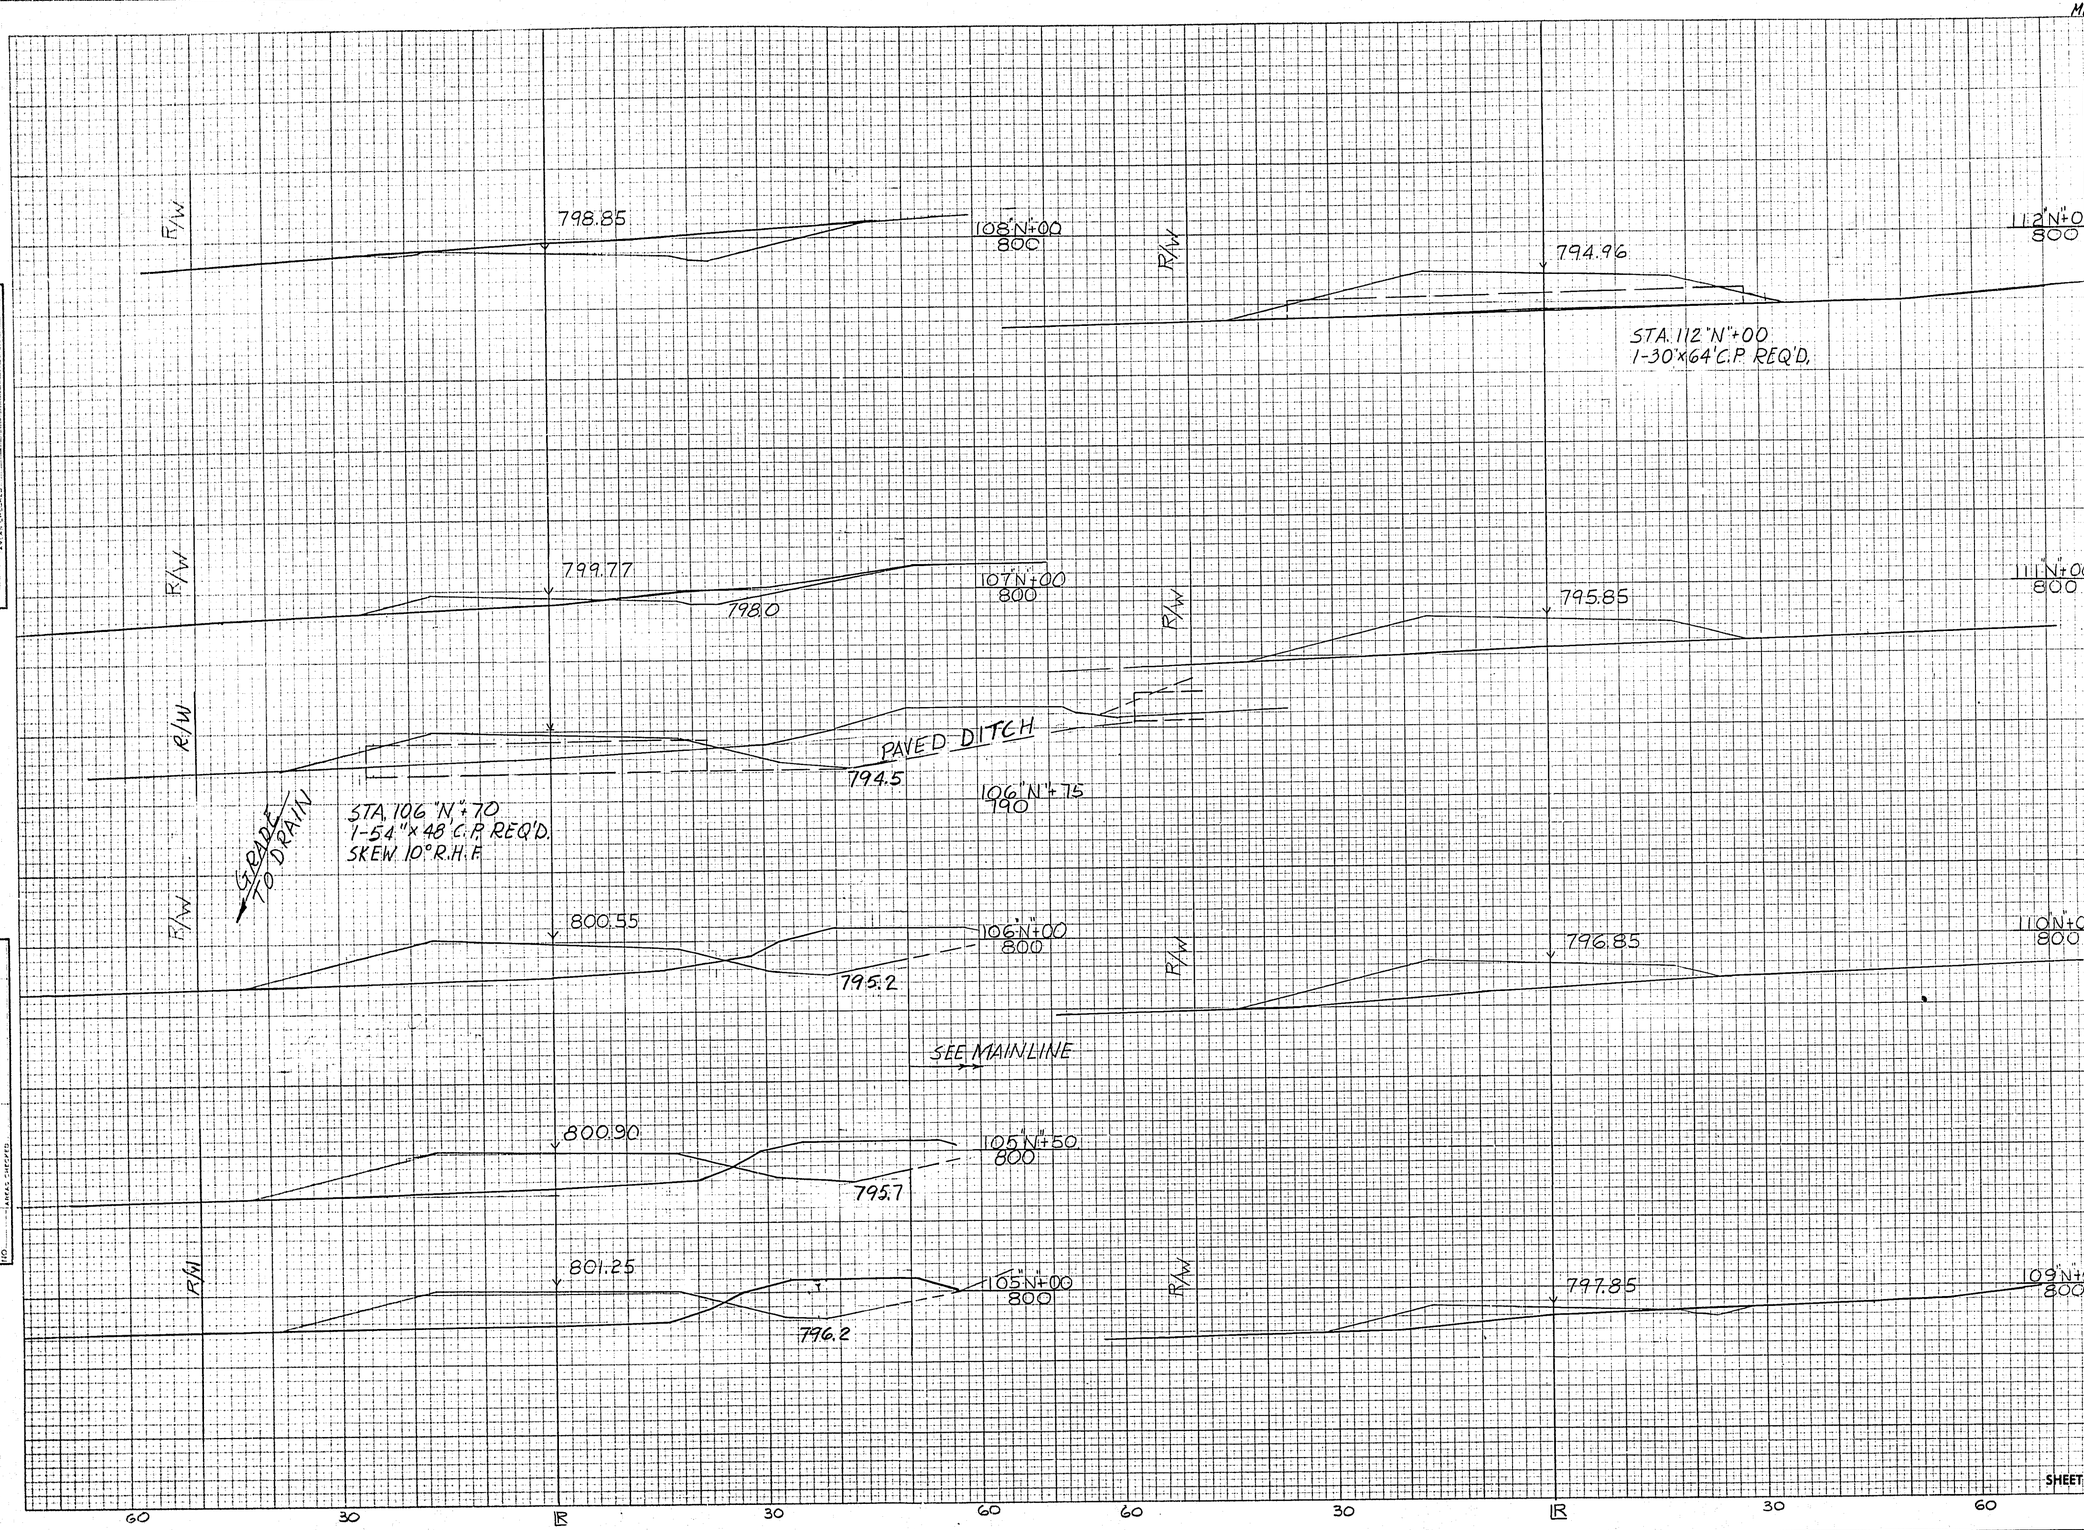

STATION	DISTANCE	YARDAGE EXCAVATION UNCL.	YARDAGE EXCAVATION	YARDAGE EXCAVATION	YARDAGE EXCAVATION	YARDAGE FILL
112N+00						
	100					875
111N+00						
	100					636
110N+00						
	100	17				383
109N+00						
	100	172				113
108N+00						
	100	235				81
107N+00						
	100	192				431
106N+00						
	50	126				368
105N+50						
	50	106				359
105N+00						
	100	285				781

PLATE 3–CROSS SECTION O. P. R. & R. E. STANDARD
THE FREDERICK POST CO., CHICAGO

STA. 105+00 N – 112+00 N" MEIKLE RD. RELOCATED

MEIKLE RD. RELOCATED @ STA. 955

B.P.R. DISTRICT OFFICE	PROJECT	SHEET NUMBER	TOTAL SHEETS
WIS. 4	I-90-2(8)105	242	264

FINAL SURVEY — SURVEYED, PLOTTED, NOTE BOOK, NO., DATE, BY, AREAS CHECKED

ORIGINAL SURVEY — SURVEYED, PLOTTED, NOTE BOOK, NO., DATE, BY, AREAS CHECKED

R/W 796.80 — 116"N"+00 800 — 799.18 — 795.4 — 120"N"+00 800

R/W 799.01 — 795.55 — 119"N"+50 800

R/W 796.10 — 115"N"+00 800 — 798.79 — 795.7 — 119"N"+00 800

R/W 795.49 — 114"N"+00 800 — 798.20 — 796.0 — 118"N"+00 800

R/W 794.81 — 113"N"+00 800 — 797.50 — 117"N"+00 800

30 — ℄ — 30 — 30 — ℄ — 30

STATION	DISTANCE	YARDAGE EXCAVATION UNCL.	YARDAGE EXCAVATION	YARDAGE EXCAVATION	YARDAGE EXCAVATION	YARDAGE FILL
120N +00						
	50					230
119N +50						
	50					213
119N +00						
	100					453
118N +00						
	100	85				232
117N +00						
	100	94				125
116N +00						
	100	9				477
115N +00						
	100					671
114N +00						
	100					705
113N +00						
	100					899
112N +00						
SHEET TOTAL		188				4025

PLATE 3—CROSS SECTION O. P. R. & R. E. STANDARD
THE FREDERICK POST CO., CHICAGO

STA. 113+00"N"-120+00"N" MEIKLE RD RELOCATED

MEIKLE RD RELOCATED @ STA 955

B.P.R. DISTRICT OFFICE	PROJECT	SHEET NUMBER	TOTAL SHEETS
WIS. 4	I-90-2(18)105	243	264

FINAL SURVEY — SURVEYED / PLOTTED / TRACED / AREAS / AREAS CHECKED / NOTE BOOK / NO. / BY / DATE

ORIGINAL SURVEY — SURVEYED / PLOTTED / TRACED / AREAS / AREAS CHECKED / NOTE BOOK / NO. / BY / DATE

R/W 800.80 124'N+00 800

R/W 805.30 126'N+00 800

R/W 800.02 123'N+00 800

R/W 802.54 127'N+00 800

SEE MAIN LINE

R/W 799.74 122'N+00 800

R/W 801.02 126'N+00 800

GRADE TO DRAIN

799.63 121'N'+60 800

799.9

STA 121'N'+60
TWIN 36"x52"C.P. REQ'D.
SKEW 7° R.H.F.

P/U

799.46 121'N+00 800

799.1

R/W 800.56 125'N+00 800

60 30 LR 30 60 60 30 LR 30

STATION	DISTANCE	YARDAGE EXCAVATION L.N.C.L.	YARDAGE EXCAVATION	YARDAGE EXCAVATION	YARDAGE EXCAVATION	YARDAGE FILL
123N +09						
	100	37				176
127N +00						
	100	111				24
126N +00						
	100	372				7
125N +00						
	100	348				176
124N +00						
	100					407
123N +00						
	100					540
122N +00						
	100					640
121N +00						
	100					512
120N +00						
SHEET TOTAL	868					2,482

PLATE 3—CROSS SECTION O. P. R. & R. E. STANDARD
THE FREDERICK POST CO., CHICAGO


STA 121+00'N' - 128+00'N' MEIKLE RD RELOCATED

MEIKLE RD. RELOCATED @ STA. 955

B.P.R. DISTRICT OFFICE	PROJECT	SHEET NUMBER	TOTAL SHEETS
WIS. 4	I-90-2(18)175	344	264

FINAL SURVEY — SURVEYED, PLOTTED, TEMPLATE, AREAS, AREAS CHECKED, BY, DATE, NOTE BOOK, NO.

ORIGINAL SURVEY — SURVEYED, PLOTTED, TEMPLATE, AREAS, AREAS CHECKED, BY, DATE, NOTE BOOK, NO.

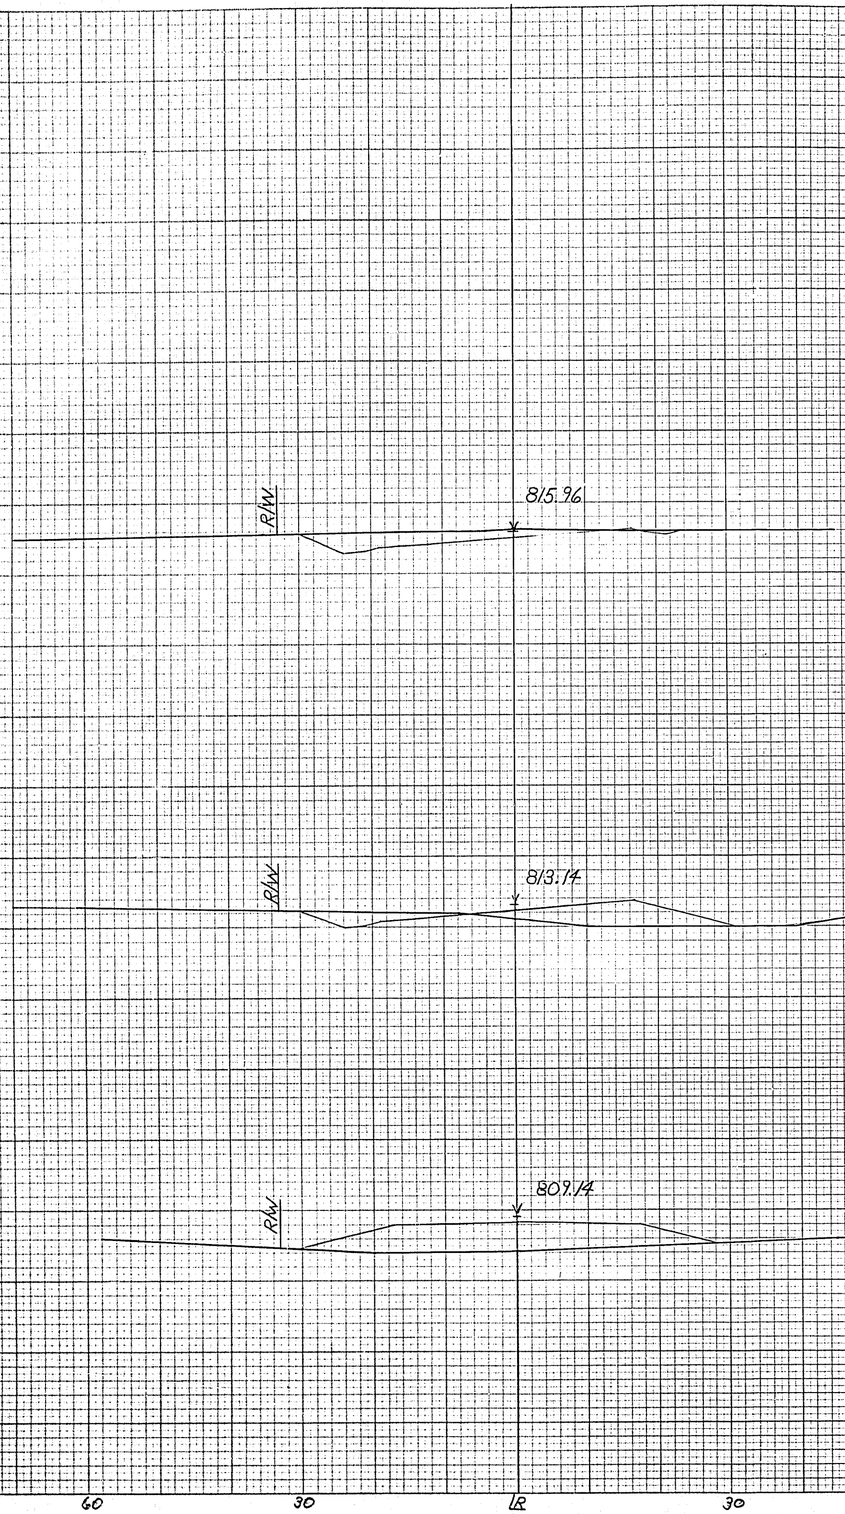

STATION	DISTANCE	YARDAGE EXCAVATION UNCL.				FILL
132N +50						
	50	9				22
132N +00						
	100	124				22
131N +00						
	100	165				320
130N +00						
	100	50				649
129N +00						
	100	0				488
128N +00						
SHEET TOTAL		348				1,501

126

PLATE 3—CROSS SECTION O. P. R. & R. E. STANDARD
THE FREDERICK POST CO., CHICAGO

STA 129'N+00 – 135'N+50 MEIKLE RD RELOCATED NEAR 955

ST.H. 78

B.P.R. DISTRICT OFFICE	PROJECT	SHEET NUMBER	TOTAL SHEETS
WIS. 4	I-90-2(13)105	245	264

FINAL SURVEY — SURVEYED, PLOTTED, NOTE BOOK, TEMPLATE, AREAS, QUANTITIES, NO. — BY, DATE

ORIGINAL SURVEY — SURVEYED, PLOTTED, NOTE BOOK, TEMPLATE, AREAS, QUANTITIES, NO. — BY, DATE — TY 11-18-58, TY 11-11-59

L.T. OF ℄ R/W-170

2:1

MATCH LINE

50

800.00

29"Q"+00 800

R/W-85' RT. OF ℄

L.T. OF ℄ R/W-134'

801.50

32"Q"+00 800

R/W-85' RT. OF ℄

799.50

28"Q"+00 800

6:1

801.00

31"Q"+00 800

R/W-85' RT. OF ℄

MATCH LINE

50

799.00

27"Q"+00 800

GRADE TO DRAIN

800.50

7:1

R/W-85' RT. OF ℄

30"Q"+00 800

MATCH LINE

70

R/W-132' LT. OF ℄

798.50

GRADE TO DRAIN

26"Q"+00 800

6:1

800.30

R/W-85' RT. OF ℄

29"Q"+60 800

50 50 50 50

STATION	DISTANCE	YARDAGE EXCAVATION UNCL.	YARDAGE EXCAVATION	YARDAGE EXCAVATION	YARDAGE EXCAVATION	YARDAGE FILL
26+00						
	100	922				
27+00						
	100	2311				
28+00						
	100	4218				
29+00						
	60	3063				
29+60						
	40	1984				
30+00						
	100	3448				
31+00						
	100	2693				
32+00						
SHEET TOTAL		18,639				

PLATE 3-CROSS SECTION O. P. R. & R. E. STANDARD
THE FREDERICK POST CO., CHICAGO

STH. 78 - ROAD "Q" X-SEC 26+00 - 32+00

ST. H. 78

B.P.R. DISTRICT OFFICE	PROJECT	SHEET NUMBER	TOTAL SHEETS
WIS. 4	I-90-2(18)105	346	364

R.L. SE EXIT RAMP "E"
875+26
802.94
803.50
LT. OF ℄
RT. OF ℄
R/W-125'
R/W-85'
GRADE TO DRAIN
36"Q"+00
800
STA. 40"Q"+00 - 55' LT. =
STA. 979"E"+08 - 57' RT.
805.75
2½:1
40"Q"+00
800
792.6

R.L. SE EXIT RAMP "E"
874+26
802.70
803.00
794.2
35"Q"+00
800
STA. 35"Q"+00
1-48" x 98' C.P. REQ'D
R.L. S.E. EXIT RAMP
STA. 39"Q"+00-33' LT. =
STA. 978"E"+16-33' RT.
805.00
39"Q"+00
800
792.3

R.L. SE EXIT RAMP "E"
873+26
802.35
802.50
A:1
34"Q"+00
800
R.L. SE EXIT RAMP
STA. 877"E"+25
802.8
804.50
38"Q"+00
800
792.0

802.00
33"Q"+00
800
R.L. SE EXIT RAMP
STA. 976"E"+27
802.8
804.00
3:1
37"Q"+00
800

50 50 50 50

STATION	DISTANCE	YARDAGE EXCAVATION LINCL.	YARDAGE EXCAVATION	YARDAGE EXCAVATION	YARDAGE EXCAVATION	YARDAGE FILL
32+00						
	100	148				463
33+00						
	100					1248
34+00						
	100					1824
35+00						
	100					2194
36+00						
	100					2532
37+00						
	100					2698
38+00						
	100					2509
39+00						
	100					2583
40+00						
SHEET TOTAL		148				16051

FINAL SURVEY — SURVEYED, PLOTTED, NOTE BOOK, TEMPLATE, AREAS, AREAS CHECKED, NO., BY, DATE

ORIGINAL SURVEY — SURVEYED, PLOTTED, NOTE BOOK, TEMPLATE, AREAS, AREAS CHECKED, NO., BY, DATE — TV 11-18-58, TV 11-20-58

PLATE 3-CROSS SECTION O. P. R. & R. E. STANDARD
THE FREDERICK POST CO., CHICAGO

STH 78 - ROAD "Q" X-SEC 33+00-40+00

ST. H. 78

B.P.R. DISTRICT OFFICE	PROJECT	SHEET NUMBER	TOTAL SHEETS
WIS. 4	I-90-2(18)105	247	264

DEACCELERATION LANE — 815.97 — PASSING LANE

2½:1 — 2½:1 — 796.3 — 794.1

45"Q"+00 800

R/W

DEACCELERATION LANE — PASSING LANE — 813.50

2½:1 — 2½:1 — 795.9 — 793.8

44"Q"+00 800

R/W

STA. 44"Q"+00
1-30"+148' C.P. REQ'D.

SE ENTRANCE RAMP "D" CONNECTION — PASSING LANE — 811.00

STA. 43"Q"+00 + 68' LT. =
STA. 1002"D"+00-03 LT.

2½:1 — 2½:1 — 793.5

NOTE AT 43"Q"+10 USE SAME SECT. AS 43"Q"+00

43"Q"+00 800

R/W

NOTE: AT 42"Q"+60 USE SAME SECT. AS 43"Q"+00

PASSING LANE — 808.75

4:1 — 2½:1 — 793.2

42"Q"+00 800

R/W

PASSING LANE — 807.00

4:1 — 2½:1 — 792.9

STA. 41"Q"+00
1-18"x 118' C.P. REQ'D.

41"Q"+00 800

R/W

100 50 50 100

STATION	DISTANCE	YARDAGE EXCAVATION UNCL.	YARDAGE EXCAVATION	YARDAGE EXCAVATION	YARDAGE EXCAVATION	YARDAGE FILL
40+00						
	100					3130
41+00						
	100					3735
42+00						
	60					3108
42+60						
	40					2489
43+00						
	10					622
43+10						
	90					5663
44+00						
	100	1185				6607
45+00						
SHEET TOTAL		1185				25,359

FINAL SURVEY — SUBMITTED — PLOTTED — NOTE BOOK — AREAS CHECKED — NO

ORIGINAL SURVEY — SUBMITTED TV 11/18/58 — PLOTTED TV 12/22/58 — NOTE BOOK — TEMPLATE — AREAS CHECKED — NO

PLATE 3-CROSS SECTION O. P. R. & R. E. STANDARD
THE FREDERICK POST CO., CHICAGO

STH 78 - ROAD "Q" X-SEC 41+00 - 45+00

ST. H. 78

B.P.R. DISTRICT OFFICE	PROJECT	SHEET NUMBER	TOTAL SHEETS
WIS. 4	I-90-2(18)105	248	264

FINAL SURVEY — DATE — BY — CHECKED — PLOTTED — TEMPLATE — NOTE BOOK — AREAS CHECKED — NO.

ORIGINAL SURVEY — DATE — BY — SURVEYED — PLOTTED — TEMPLATE — NOTE BOOK — AREAS CHECKED — NO.
TV 1-18-58
TV 1-30-58

BRIDGE

822.12
2½:1
2½:1
797.7
48"Q"+41
800

821.60
2½:1
2½:1
797.5
795.0
STRUCT. C-11-14
48"Q"+00
810

820.05
2½:1
2½:1
797.1
3:1
794.7
47"Q"+00
800

DECELERATION LANE

818.00
2½:1
4:1
796.7
794.4
46"Q"+00
800
R/W

100 50 ℄ 50 100

STATION	DISTANCE	YARDAGE EXCAVATION UNCL.				FILL
45+00						
	100	250				6759
46+00						
	100	470				6685
47+00						
	100	793				6685
48+00						
	41	254				2737
48+41						
SHEET TOTAL		1767				22366

PLATE 3-CROSS SECTION O. P. R. & R. E. STANDARD
THE FREDERICK POST CO., CHICAGO

130

ST.H 78-ROAD "Q" X-SEC 46+00-50+94

STH. 78

B.P.R. DISTRICT OFFICE	PROJECT	SHEET NUMBER	TOTAL SHEETS
WIS. 4	I-90-2(18)105	249	264

825.89 NW RAMP "B" TURN-OUT 968+66 824.69

R/W-155' LT. OF ℄

2½:1

2½:1

804.6

54"Q"+00
800

NW RAMP "B" TURN-OUT 967+68

825.36 824.87

R/W-155' LT. OF ℄

2½:1

2½:1

4:1

801.8

53"Q"+00
800

STA. 988+00
125' RT.

MATCH LINE

110

797.5

70

800

NW RAMP "B" TURN-OUT
966+68

824.83

2:1

2½:1

799.0

52"Q"+00
800

MATCH LINE

STA. 51"Q"+50 STRUCT. NO. C-11-16
1-8'x5'x160' R.C. BOX CULV. REQ'D.
SKEW 28° L.H.F.

824.30

2:1

2:1

2½:1

796.2

51"Q"+00
800

50 ℄ 50 100

STATION	DISTANCE	YARDAGE EXCAVATION LINCL.	YARDAGE EXCAVATION	YARDAGE EXCAVATION	YARDAGE EXCAVATION	YARDAGE FILL
48+41						
	37	41				1237
48+78						
	178	—				—
50+56						
	41	167				1173
50+97						
	103	1354				5865
52+00						
	100	1056				5667
53+00						
	100	241				5630
54+00						
SHEET TOTAL		2859				19572

FINAL SURVEY — SURVEYED, PLOTTED, NOTE BOOK, NOS., BY, DATE, AREAS CHECKED

ORIGINAL SURVEY — SURVEYED TV 11-8-58, PLOTTED TV 11-22-58, NOTE BOOK, NOS., BY, DATE, AREAS CHECKED

131

PLATE 3—CROSS SECTION O. P. R. & R. E. STANDARD
THE FREDERICK POST CO., CHICAGO

STH. 78 - ROAD "Q" X-SEC 51+00 - 54+00

ST.H. 78

R.P.R. DISTRICT OFFICE	PROJECT	SHEET NUMBER	TOTAL SHEETS
WIS. 4	I-90-2(18)105	250	364

PASSING LANE

TURN OUT LANE

828.01

2'2:1

R/W-155' LT. OF ℄

815.0

58"Q"+00
800

AREA @ 57"Q"+40 = AREA @ 57"Q"+00

PASSING LANE

NW RAMP-LOOP CONNECTION

827.48

2½:1

R/W-155' LT. OF ℄

814.5

57"Q"+00 - 85' RT. =
993"C"+00 - 35' LT.

570+00
800

56"Q"+00 - 85' RT. =
993"C"+00 - 135' LT.

PASSING LANE

826.95

ISLAND

L.H. EDGE

R.L. NW ENTRANCE RAMP "B"
970+80

824.30

2½:1

R/W-155' LT. OF ℄

814.0

56"Q"+00
800

FOR X-SECTIONS RIGHT OF THIS LINE, SEE X-SECTIONS OF RAMP "B"

826.42

L.H. EDGE

R.L. NW ENTRANCE RAMP "B"
969+66

824.51

AREA AHD

AREA BACK

2½:1

R/W-155' LT. OF ℄

813.5

307.4

55"Q"+00
800

50 ℄ 50 100

STATION	DISTANCE	YARDAGE EXCAVATION UNCL.	YARDAGE EXCAVATION	YARDAGE FILL
54+00				
	100	198		5870
55+00				
	100	54		5204
56+00				
	100			5954
57+00				
	40			2378
57+40				
	60			3117
58+00				
SHEET TOTAL		252		22523

FINAL SURVEY — DATE — BY — SURVEYED — PLOTTED — TRACED — NOTE BOOK — PAGES — NO. — PAGES CHECKED

ORIGINAL SURVEY — DATE 7-11-58 — BY — SURVEYED 7-10-58 — PLOTTED — TRACED — NOTE BOOK — PAGES — NO. — PAGES CHECKED

492

PLATE 3-CROSS SECTION O. P. R. & R. E. STANDARD
THE FREDERICK POST CO., CHICAGO


STH 78-ROAD "Q" X-SEC. 55+00 - 58+00

ST. H. 78

B.P.R. DISTRICT OFFICE	PROJECT	SHEET NUMBER	TOTAL SHEETS
WIS. 4	I-90 2(12)125	25	264

FINAL SURVEY — SURVEYED / PLOTTED / NOTE BOOK / AREAS — DATE / BY / NO. / AREAS CHECKED

ORIGINAL SURVEY — SURVEYED 1-19-58 / PLOTTED 1-V / NOTE BOOK 15-58 / AREAS 1-V / AREAS CHECKED

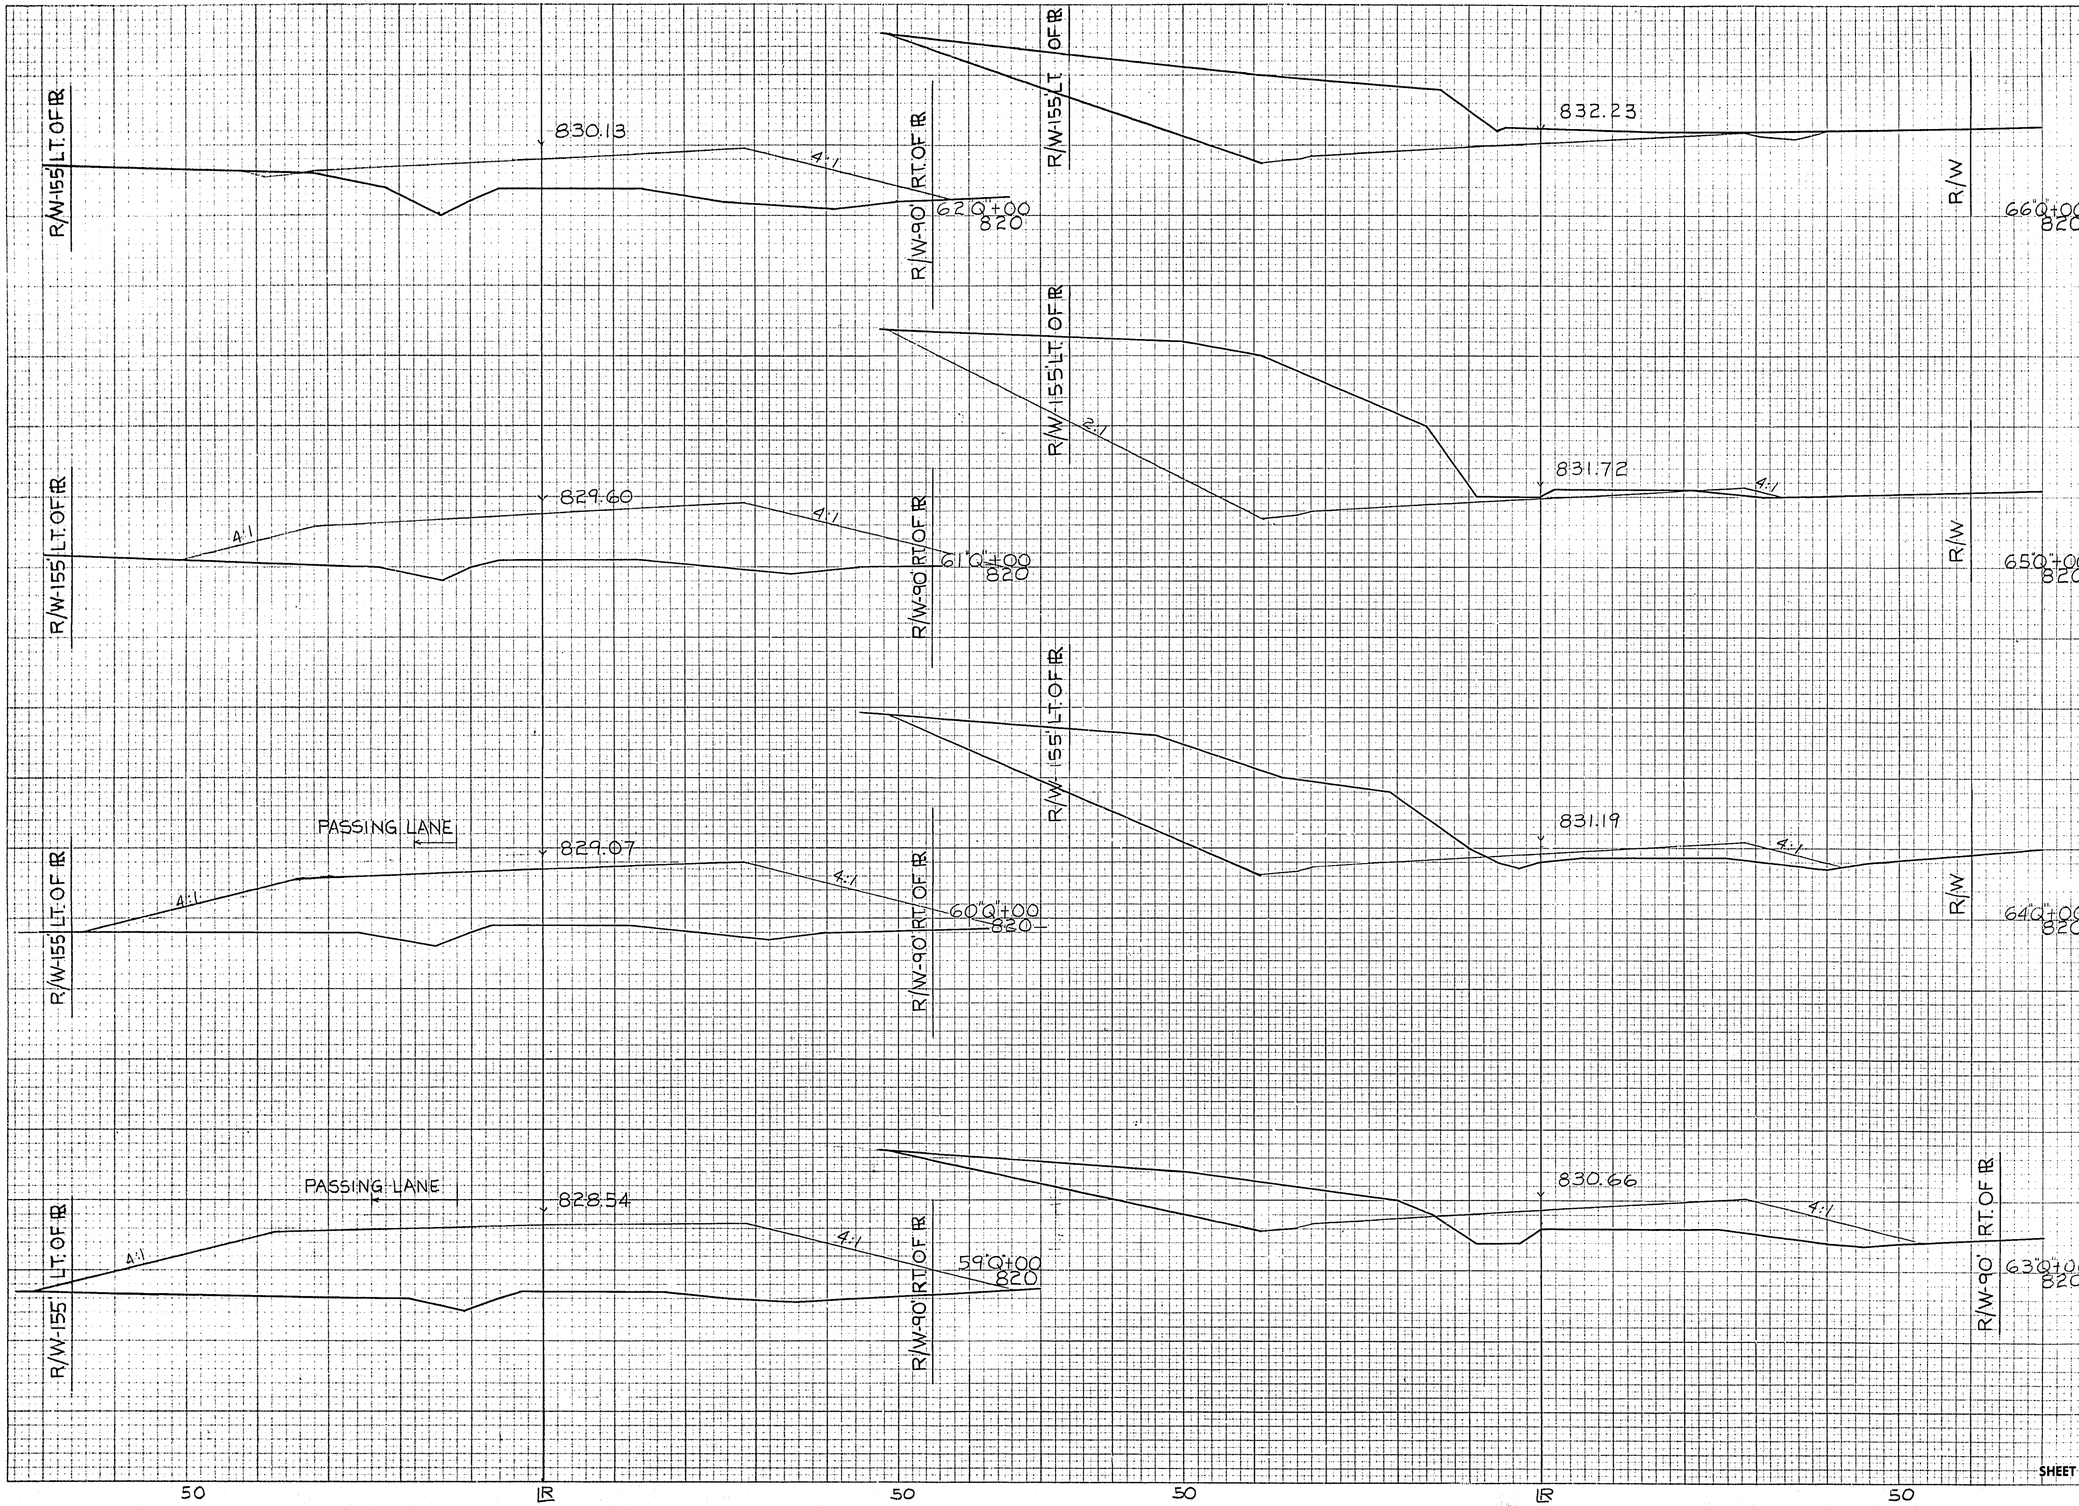


STATION	DISTANCE	YARDAGE EXCAVATION LINCL.	YARDAGE EXCAVATION	YARDAGE EXCAVATION	YARDAGE EXCAVATION	YARDAGE FILL
58+00						
	100					4046
59+00						
	100					3361
60+00						
	100					2713
61+00						
	100					1917
62+00						
	100					1130
63+00						
	100	1520				519
64+00						
	100	3067				157
65+00						
	100	2824				46
66+00						
SHEET TOTAL		7411				13889

PLATE 3—CROSS SECTION O. P. R. & R. E. STANDARD
THE FREDERICK POST CO., CHICAGO

ST. H. 78

B.P.R. DISTRICT OFFICE	PROJECT	SHEET NUMBER	TOTAL SHEETS
WIS. 4	I-90-2(12)103	252	264

STATION	DISTANCE	YARDAGE EXCAVATION UNCL.	EXCAVATION			FILL
66+00						
	100	1257				19
67+00						
	100	304				
68+00						

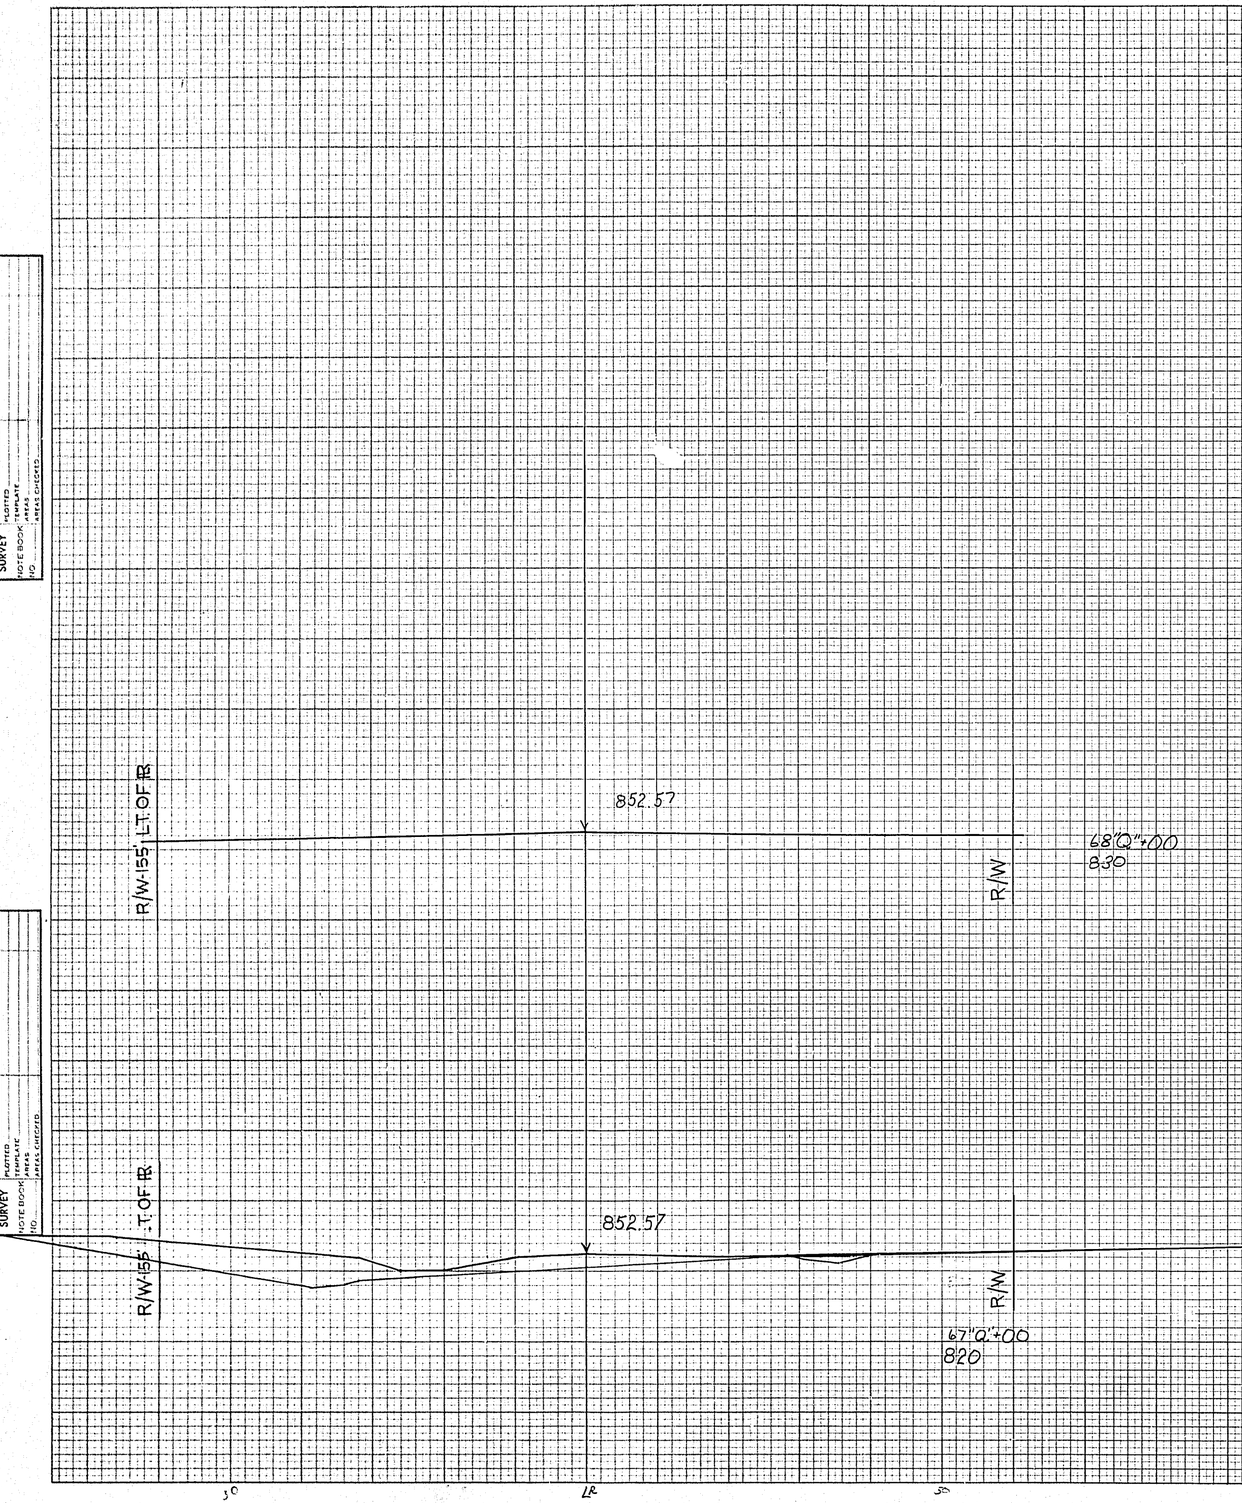

SHEET TOTAL 1561 19

STH 78 - ROAD 'Q' X-SEC. 67+00 - 68+00

PLATE 3—CROSS SECTION O. P. R. & B. E. STANDARD
THE FREDERICK POST CO., CHICAGO

S.E. EXIT RAMP STH "78" INTERCHANGE

B.P.R. DISTRICT OFFICE	PROJECT	SHEET NUMBER	TOTAL SHEETS
WIS. 4	1-90-2(18)165	253	264

FINAL SURVEY — SURVEYED / PLOTTED / NOTE BOOK / TEMPLATE / AREAS / CHECKED / NO. / DATE / BY

ORIGINAL SURVEY — SURVEYED / PLOTTED / NOTE BOOK / TEMPLATE / AREAS / CHECKED / NO. / DATE / BY

R.L. S.E. ENTRANCE RAMP
STA. 998"D"+90
807.85

809.80
4:1
801.7
802.0

983"E."
810

R.L. S.E. ENTRANCE RAMP
STA. 999"D"+32
807.90

809.48
4:1
801.3
801.8

450
810

STA. 982"E"+00-46'RT.
= STA. 999"D"+80-90'RT.

R.L. S.E. ENTRANCE RAMP
STA. 999+80

809.01
4:1
4:1
4:1
800.9

982"E"
810

STA 982"E"+10
1-18"×46'CP REQD
1-INLET, TYPE I-N, REQD

807.62
4:1
4:1
800.5

981"E"
800

805.93
4:1
4:1
800.1

980"E"
800

STA. 979"E"+00-55'RT. =
STA. 39"Q"+90-50'LT.

R.L. ST.H. 78

804.32
4:1
4:1
4:1

979"E"
800

STA. 978"E"+00-30'RT.
=STA. 38"Q"+82-30'RT.

R.L. ST.H. 78

803.24
4:1

978"E"
800

100 60 30 0 30 60 90 120

STATION	DISTANCE	YARDAGE EXCAVATION UNCL.	YARDAGE EXCAVATION	YARDAGE FILL
978+00				486
	100			1574
979+00				
	100			1458
980+00				
	100	26		1233
981+00				
	100	56		1340
982+00				
	50	55		918
982+50				
	50	82		975
983+00				
SHEET TOTAL		219		7934

PLATE 3-CROSS SECTION O. P. R. & R. E. STANDARD
THE FREDERICK POST CO., CHICAGO

B.P.R. DISTRICT OFFICE	PROJECT	SHEET NUMBER	TOTAL SHEETS
WIS. 4	I-90-2(18)105	254	264

FINAL SURVEY — SURVEYED BY ... DATE ... PLOTTED ... TRACED ... NOTE BOOK ... PAGE ... AREAS CHECKED ... NO ... INITIALS CHECKED

ORIGINAL SURVEY — SURVEYED BY ... DATE ... PLOTTED ... TRACED ... NOTE BOOK ... PAGES ... AREAS CHECKED ... NO ... INITIALS CHECKED

STA. 990"E"+00-45'RT. = STA. 992"D"+62-43'RT.

R.L. S.E. ENTRANCE RAMP STA. 992"D"+62

811.08 — 4:1 — 4:1 — 804.5 — 806.7 — 800.8

990"E" 810

R.L. S.E. ENTRANCE RAMP STA. 993"D"+57

810.82 — 4:1 — 804.1 — 807.06 — 801.2

989"E"+00-165'RT = 989"E" 47"Q"+73-510'LT. 810

STA. 994"D"+50

810.59 — 803.7 — 807.22 — 801.7

988"E"+00-148'RT. = 988"E" 46"Q"+70-515'LT. 810

R.L. S.E. ENTRANCE RAMP

STA. 995"D"+43

810.62 — 803.3 — 807.35 — 802.2

987"E"+00-145'RT. = 987"E" 45"Q"+94-506'RT. 810

STA. 987"E"+00
1-18"×46' CP REQD
1-INLET, TYPE 1-N, REQD.

STA. 996"D"+34

810.70 — 802.9 — 807.48 — 802.7

986"E"+00-150'RT. = 986"E" 45"Q"+25-470'LT. 810

STA. 997"D"+24

810.71 — 802.5 — 807.61 — 802.9

985"E"+00-145'RT. = 985"E" 44"Q"+63-430'LT. 810

R.L. S.E. ENTRANCE RAMP

STA. 998"D"+14

810.29 — 802.1 — 807.74 — 802.4

984"E"+00-130'RT. = 984"E" 44"Q"+00-390'LT. 810

100 60 30 0 30 60 100

STATION	DISTANCE	YARDAGE EXCAVATION UNCL.				FILL
983+00						
	100	287				1102
984+00						
	100	407				556
985+00						
	100	389				476
986+00						
	100	269				619
987+00						
	100	159				837
988+00						
	100	130				1065
989+00						
	100					1194
990+00						
SHEET TOTAL		1641				5844

PLATE 3-CROSS SECTION O. P. R. & R. E. STANDARD
THE FREDERICK POST CO., CHICAGO

B.P.R. DISTRICT OFFICE	PROJECT	SHEET NUMBER	TOTAL SHEETS
WIS. 4	I-90-2(18)105	255	264

FINAL SURVEY — SURVEYED / PLOTTED / TEMPLATE / NOTE BOOK / NO. / AREAS / AREAS CHECKED / BY / DATE

ORIGINAL SURVEY — SURVEYED / PLOTTED / TEMPLATE / NOTE BOOK / NO. / AREAS / AREAS CHECKED / BY / DATE

STA. 995"E" +00 - 35' RT. =
STA. 994A+95 - 50' LT.

813.43
808.5
W.B.L.
995 "E"
810

812.28
808.0
4:1
W.B.L.
994 "E"
810

811.89
4:1
4:1
993 "E"
810

811.63
4:1
4:1
992 "E"
810

811.36
4:1
4:1
991 "E"
810

90 80 30 0 30 60 90 120

STATION	DISTANCE	YARDAGE EXCAVATION UNCL.				FILL
990-00						
	100					1167
991-00						
	100					1120
992-00						
	100					1019
993-00						
	100					815
994-00						
	100					689
995-00						
	100					328
996-00						
SHEET TOTAL						5138

PLATE 3-CROSS SECTION O. P. R. & B. E. STANDARD
THE FREDERICK POST CO., CHICAGO

B.P.R. DISTRICT OFFICE	PROJECT	SHEET NUMBER	TOTAL SHEETS
WIS. 4	I-90-2(18)104	256	264

FINAL SURVEY — BY ____ DATE ____ SURVEYED ____ PLOTTED ____ NOTE BOOK ____ AREAS ____ TO ____ AREAS CHECKED ____

ORIGINAL SURVEY — BY ____ DATE ____ SURVEYED ____ PLOTTED ____ NOTE BOOK ____ AREAS ____ TO ____ AREAS CHECKED ____

992"D"+60-103'LT.=
48"Q"+20-502'LT.
806.65
800.8
STA. 992"D"+60-45'RT.=
STA. 990"E"+05-45'RT.
R.L. S.E. EXIT RAMP
811.1
992"D"+60
810

992"D"+00-103'LT.=
48"Q"+40-492'LT.
806.23
4:1
800.5
992 "D"
810

991"D"+00-73'LT.=
49"Q"+00-472'LT.
805.46
4:1
800.0
991 "D"
800

805.08
799.8
801.5
STA. 990"D"+50
1-18"x72' C.P. REQD.
990"D"+50
800

990"D"+00-97'LT.=
49"Q"+00-393'LT.
804.69
4:1
799.5
990 "D"
800

STA. 989"D"+00-42'RT.=
STA. 989A+10-50'LT.
A.R.L. STA. 989A+10
989 "D"
810

989"D"+00-103'LT.=
49"Q"+00-320'LT.
803.98
W.B.L.
798.8
STA. 989"D"+00
1-18"x20' C.P. REQ'D.
1-INLET, TYPE I-N, REQD.

STATION	DISTANCE	YARDAGE EXCAVATION UNCL.				YARDAGE FILL
989+00						
	100	94				306
990+00						
	100	87				380
991+00						
	100	120				352
992+00						
	60	67				250
992+60						
	97	45				252
993+57						
SHEET TOTAL		413				1540

30 60 30 0 30 60 90 120


PLATE 3-CROSS SECTION O. P. R. & H. E. STANDARD
THE FREDERICK POST CO., CHICAGO

SE Ramp Ent. "D"

B.P.R. DISTRICT OFFICE	PROJECT	SHEET NUMBER	TOTAL SHEETS
WIS. 4	I-90-2 (18) 105	257	264

FINAL SURVEY — SURVEYED / PLOTTED / NOTE BOOK / PAGE / NO. / AREAS CHECKED — BY / DATE

ORIGINAL SURVEY — CONNECTED / PLOTTED / NOTE BOOK / PAGE / NO. / AREAS CHECKED — BY / DATE — TV 1-2-51 — TV 12-50

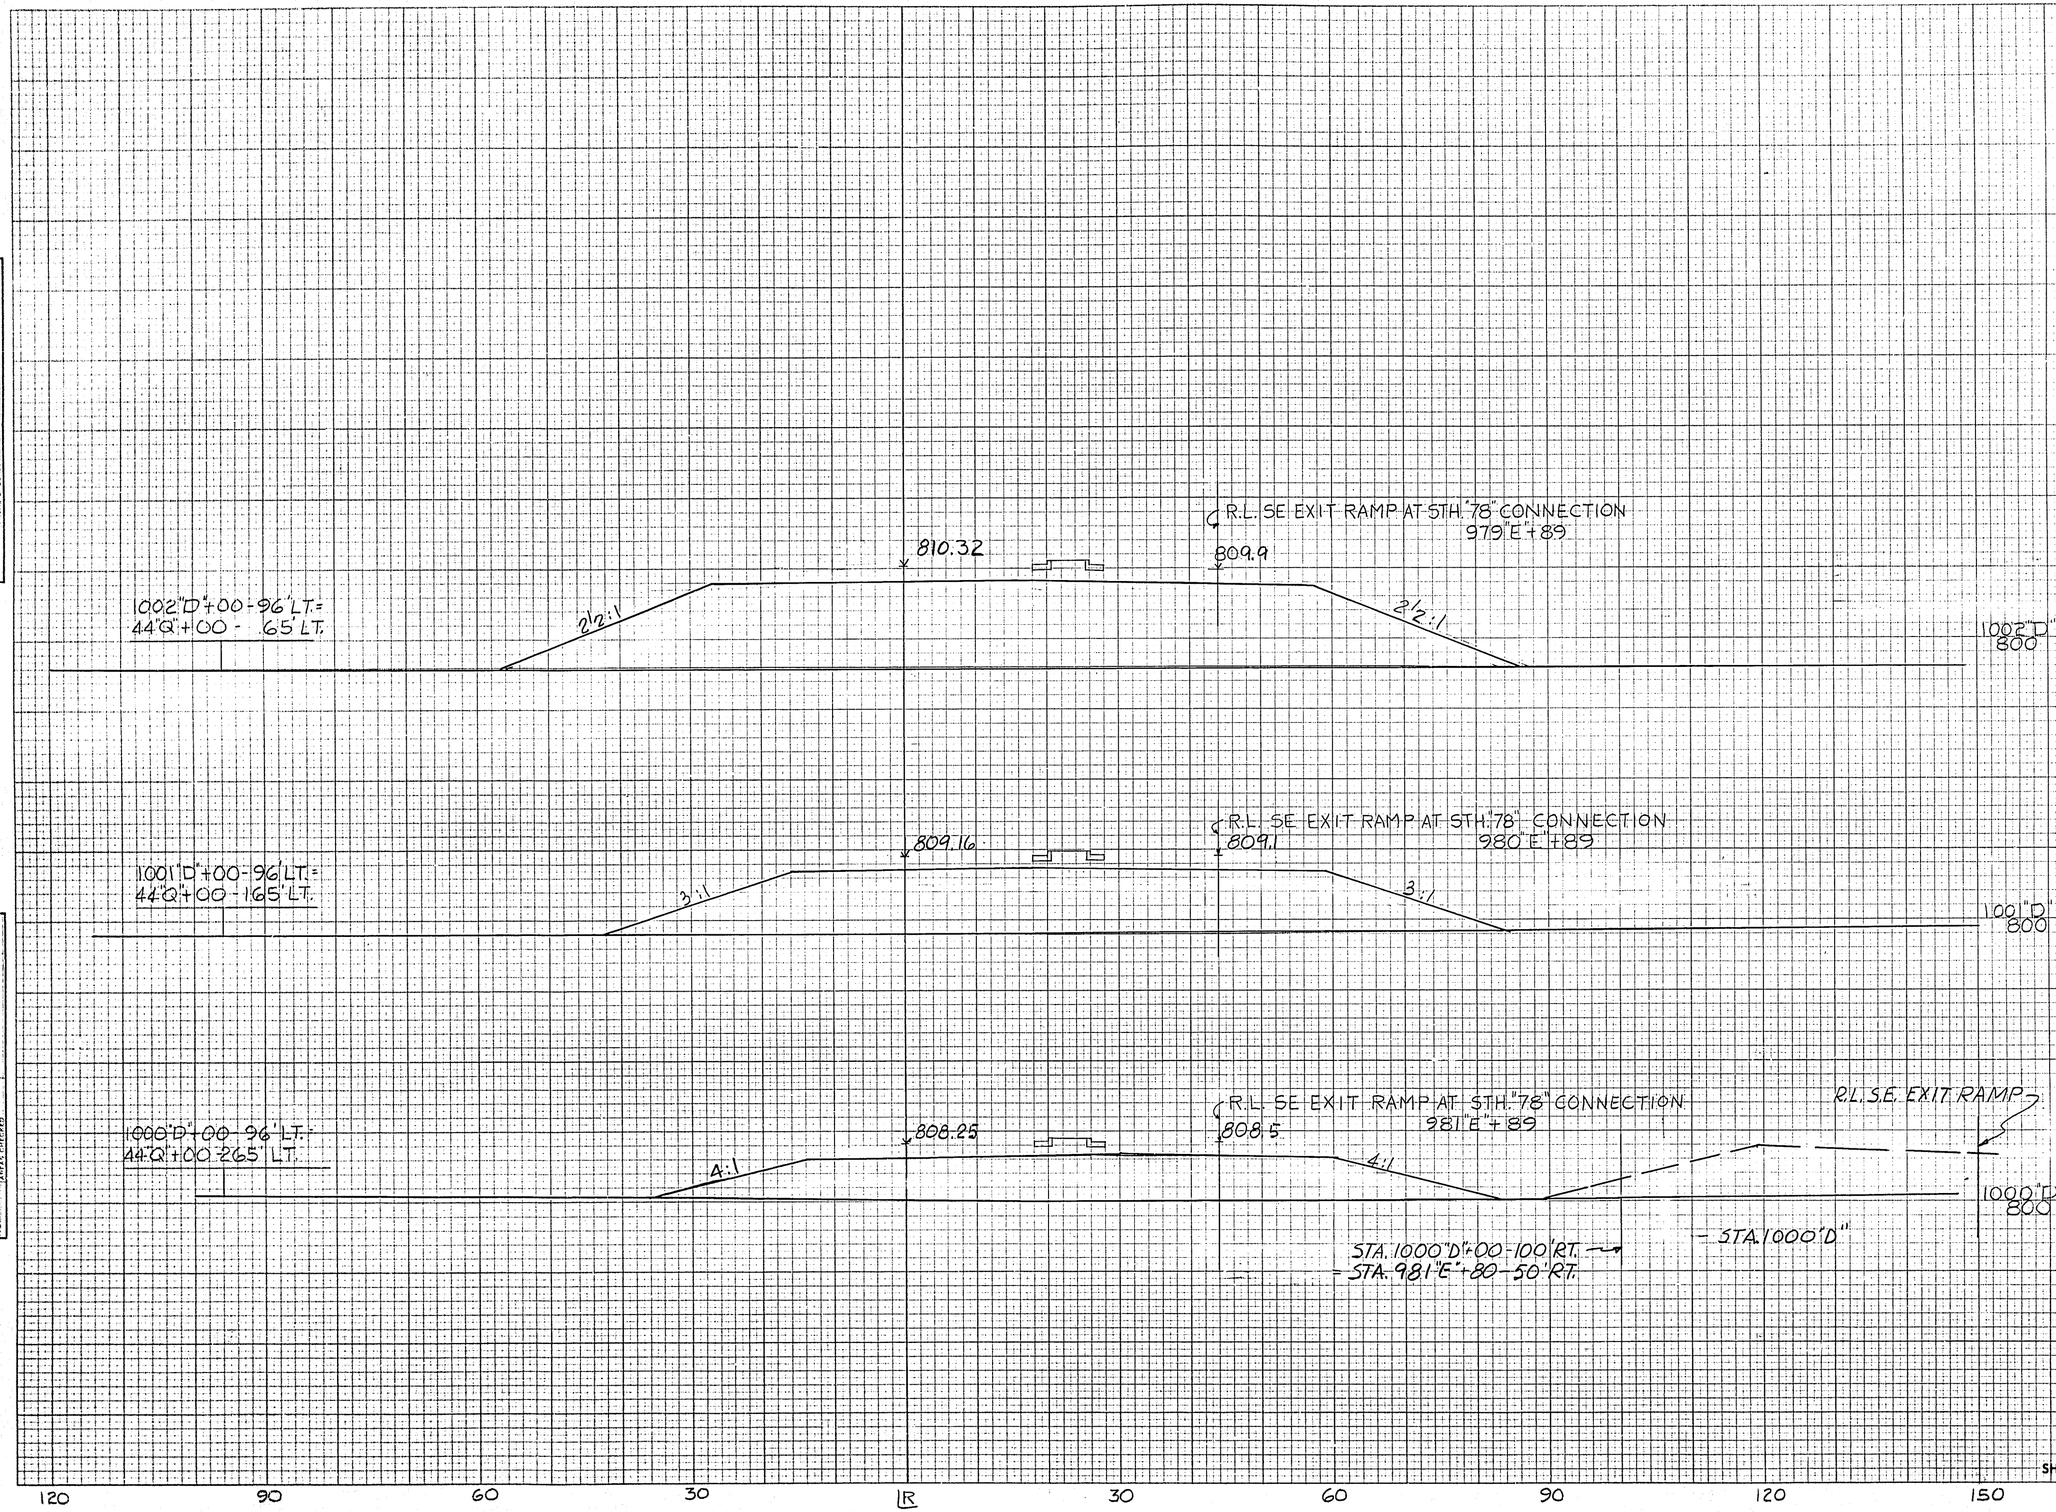

STATION	DISTANCE	YARDAGE EXCAVATION UNCL.	YARDAGE EXCAVATION	YARDAGE EXCAVATION	YARDAGE EXCAVATION	YARDAGE FILL
999+80						
	120					3250
1001+00						
	100					4065
1002+00						
SHEET TOTAL						7321

PLATE 3—CROSS SECTION O. P. R. & B. E. STANDARD
THE FREDERICK POST CO., CHICAGO

N.W. ENTRANCE RAMP B STH 78 INTERCHANGE

B.P.R. DISTRICT OFFICE	PROJECT	SHEET NUMBER	TOTAL SHEETS
WIS. 4	I-90-2 (18) 105	258	264

100' 50' ℄ 50'

RL N.W. EXIT RAMP "C" 991 "C" +00

826.44

823.08

1½:1

4:1

815.0

813.5

STA. 991 "C" +00
1-60" x 104' C.P. REQ'D.

972 "B" + 96
820

RL NW EXIT RAMP
STA 991 "C" +23

826.54

AREA AH0

823.25

2½:1

4:1

815.1

AREA BK

813.0

972 "B" + 77
820

823.87

STA 972 "B" +00 =
STA 992 "C" +00, -62 Lt.

972 "B" + 00
820

811.5

STA. 971 "B" + 82
1-18" x 25' C.P. REQ'D.
1-18" x 35' C.P. REQ'D.
1-INLET, TYPE 1-N, REQD
1-CATCH BASIN, TYPE 3-A, REQD.

TYPICAL DITCH PAVING IN THIS AREA

824.27

STA 971 "B" +00 =
STA 992 "C" +78 - 120 Lt

971 "B" + 00
820

809.5

824.45

STA 970 "B" +00 =
STA 55 "Q" + 56 - 70 Rt

970 "B" + 00
820

807.5

GRATE EL. 826.0

824.5

STA 969 "B" + 50
1-18" x 48" C.P. REQ'D.
1-INLET, TYPE 1-N, REQD.

1-PAVED FLUME REQ'D
STA 969 "B" + 50

969 "B" + 66
820

STA 969 "B" - 66 @ R.L. =
STA 55 "Q" +00, 52 Rt.

806.6

STATION	DISTANCE	YARDAGE EXCAVATION UNCL.			FILL
969-66					
	34	49			538
970-00					
	100	317			1152
971-00					
	100	512			689
972-00					
	77	341			248
972-77					
SHEET TOTAL		1219			2627

100' LT. 50' LT. ℄ 50' Rt. 100' Rt.

FINAL SURVEY — SURVEYED BY ____ DATE ____ NOTE BOOK ____ NO. ____ PLOTTED ____ TEMPLATE ____ AREAS ____ AREAS CHECKED ____

ORIGINAL SURVEY — SURVEYED BY ____ DATE ____ NOTE BOOK ____ NO. ____ PLOTTED ____ TEMPLATE ____ AREAS ____ AREAS CHECKED ____

PLATE 3-CROSS SECTION O. P. R. & R. E. STANDARD
THE FREDERICK POST CO., CHICAGO

NW ENTRANCE RAMP STA. "78"
INTERCHANGE

NW EXIT RAMP

B.P.R. DISTRICT OFFICE	PROJECT	SHEET NUMBER	TOTAL SHEETS
WIS. 4	I-90-2 (18) 105	259	264

RL NW. EXIT RAMP
STA. 986"C"+43

819.69

816.27

STA. 986"C"+43
1-18"×46' C.P. REQ'D.
1-INLET, TYPE I-N, REQD.

977 "B"
820

STA. 987"C"+48

821.60

818.18

976 "B"
820

STA. 988"C"+58

6:1

823.53

820.09

975 "B"
820

STA. 989"C"+72

825.30

821.78

6:1

974 "B"
820

STA. 974"B"+00
1-18"×26' C.P. REQD.
1-18"×20' C.P. REQD.
1-INLET, TYPE I-N-REQD.
1-C.B. TYPE 3-A, REQD.

STA. 990"C"+00

825.69

820.0

822.08

973 "B"+80
820

STA. 990"C"+95

12:1

4:1

1.0'

823.04

973 "B"
820

TYPICAL DITCH PAVING
IN THIS AREA.

STATION	DISTANCE	YARDAGE EXCAVATION UNCL.	FILL
972+77			
	23	149	214
973+00			
	80	185	892
973+80			
	20	15	145
974+00			
	100	1352	96
975+00			
	100	3398	37
976+00			
	100	4750	41
977+00			
SHEET TOTAL		9849	1425

FINAL SURVEY — STAKED, PLOTTED, TRIPLICATE, NOTE BOOK, NO., AREAS CHECKED, BY, DATE

ORIGINAL SURVEY — SURVEYED, PLOTTED, TRIPLICATE, NOTE BOOK, NO., AREAS CHECKED, BY, DATE

150 125 40 60 30 0 30 60 30

PLATE 3-CROSS SECTION O. P. R. & R. E. STANDARD
THE FREDERICK POST CO., CHICAGO

NW ENTRANCE RAMP STH "78" INTERCHANGE

B.P.R. DISTRICT OFFICE	PROJECT	SHEET NUMBER	TOTAL SHEETS
WIS. 4	I-30-2 (8) 105	260	264

FINAL SURVEY — SURVEYED, PLOTTED, NOTE BOOK, AREAS, SHEETS, NO., DATE, BY

ORIGINAL SURVEY — SURVEYED, PLOTTED, NOTE BOOK, AREAS, SHEETS, NO., DATE, BY

R.L. STA. 983+92

STA. 984"B"+00-32' LT. = R.L. STA. 983+92-38' RT.

803.81

INV. 799.0

INV. 800.7

STA. 984'B'+00
1-18"×22' C.P. REQD
1-INLET, TYPE I-N, REQD.

984 "B" 800

STA. 983"B"+00-52' LT. = R.L. STA. 982+84-70' RT.

804.91

STA. 982"B"+00-113' LT. = STA. 981"C"+00-109' LT. = R.L. STA. 981+50-103' RT.

STA. 983"B"+18
1-30"×66' C.P. REQ'D.

983 "B" 800

4:1

806.0

806.72

982 "B" 810

STA. 981"B"+00-38' LT. = STA. 982"C"+07-36' LT.

808.63

981 "B" 810

AREA AHD

AREA BACK

RL NW EXIT RAMP STA. 983'C'+15

813.97

810.54

STA. 983"C"+15
1-18"×48' C.P. REQ'D.
1-INLET, TYPE I-N, REQ'D.

980 "B" 810

RL NW EXIT RAMP STA. 984'C'+25

815.91

812.45

979 "B" 810

RL NW EXIT RAMP STA. 985'C'+33

817.83

814.36

2½:1

978 "B" 8.10

120 90 60 30 R.L. 30 60 90 120

STATION	DISTANCE	YARDAGE EXCAVATION UNCL.				FILL
977+00						
	100	5713				41
978+00						
	100	6894				37
979+00						
	100	6287				37
980+00						
	100	3046				
981+00						
	100	2648				
982+00						
	100	2426				
983+00						
	100	2037				
984+00						
	100					
SHEET TOTAL		28851				115

142

PLATE 3-CROSS SECTION O. P. R. & B. E. STANDARD
THE FREDERICK POST CO., CHICAGO

N.W. EXIT RAMP STH 78 INTERCHANGE

B.P.R. DISTRICT OFFICE	PROJECT	SHEET NUMBER	TOTAL SHEETS
WIS. 4	I-90-2 (18) 105	261	264

FINAL SURVEY — BY — DATE — SURVEYED — PLOTTED — TEMPLATE — NOTE BOOK — NO. — AREAS CHECKED

ORIGINAL SURVEY — BY — DATE — SURVEYED TV 12-8-59 — PLOTTED TV 12-22-59 — TEMPLATE — NOTE BOOK — NO. — AREAS CHECKED

STA. 983 "C" +00 - 18' LT. =
STA 980 "B" - 14 - 26' LT

810.2

813.71

983 "C"
820

STA. 982 "C" +00 - 35' LT. =
STA. 981 "B" +04 - 42' LT.

808.5

811.95

982 "C"
820

STA. 981 "C" +00 - 109' LT. =
R.L. STA 981+50 - 103' RT. =
STA. 982 "B" +00 - 113' LT.

810.19

805.2

981 "C"
820

STA. 980+20

STA. 980 "C" +00 - 52' LT. =
R.L. STA. 980+20 - 61' RT.

808.4

3½:1

808.62

803.1

980 "C"
820

STA. 980 "C" +00
1-30 x 68' C.P. REQ'D.

STATION	DISTANCE	YARDAGE EXCAVATION LINCL.	YARDAGE EXCAVATION	YARDAGE EXCAVATION	YARDAGE EXCAVATION	YARDAGE FILL
983+15						
	115	2630 ✓				43 ✓
982+00						
	100	3009 ✓				19 ✓
981+00						
		5824 ✓				
980+00						
SHEET TOTAL		11,463				62 ✓

150 120 90 60 30 ℄ 30 60 90

H-3

PLATE 3—CROSS SECTION O. P. R. & R. E. STANDARD
THE FREDERICK POST CO., CHICAGO

NW. EXIT RAMP 'C' - STH 78

B.P.R. DISTRICT OFFICE	PROJECT	SHEET NUMBER	TOTAL SHEETS
WIS. 4	I-90-2 (18) 105	252	264

FINAL SURVEY — SURVEYED — PLOTTED — NOTE BOOK — TEMPLATE — AREAS — AREAS CHECKED — NO. — BY — DATE

ORIGINAL SURVEY — SURVEYED — PLOTTED — NOTE BOOK — TEMPLATE — AREAS — AREAS CHECKED — NO. — BY — DATE — T.V. 12-2-71 — T.V. 12-2-71

993"C" +00 - 152' LT = 55"Q" +83' - 85' RT.

R.L. NW ENTRANCE RAMP "B" 970+62

L.H. EDGE — ISLAND

827.26

2½:1

4:1

993"C" 820

R.L. NW ENTRANCE RAMP "B" 972"B"+00

823.87

826.85

2½:1

4:1

6:1

992"C" 820

811.5

815.5

180 150 120 90 60 30 ℄ 30 60

STATION	DISTANCE	YARDAGE EXCAVATION UNCL				YARDAGE FILL
991+23						
	77	329'				1155
992+00						
	100	204'				4648
993+00						
SHEET TOTAL		533				5803

PLATE 3-CROSS SECTION O. P. R. & R. E. STANDARD
THE FREDERICK POST CO., CHICAGO

144

1945


STH NW CONN

FRONTAGE RD @ 1065

B.P.R. DISTRICT OFFICE	PROJECT	SHEET NUMBER	TOTAL SHEETS
WIS. 4	I-90-2(13)10	263	264

FINAL SURVEY — DATE — BY — SURVEYED — PLOTTED — NOTE BOOK — TRIPLET — AREAS — AREAS CHECKED — NO

ORIGINAL SURVEY — DATE — BY — SURVEYED — PLOTTED — NOTE BOOK — TRIPLET — AREAS — AREAS CHECKED — NO

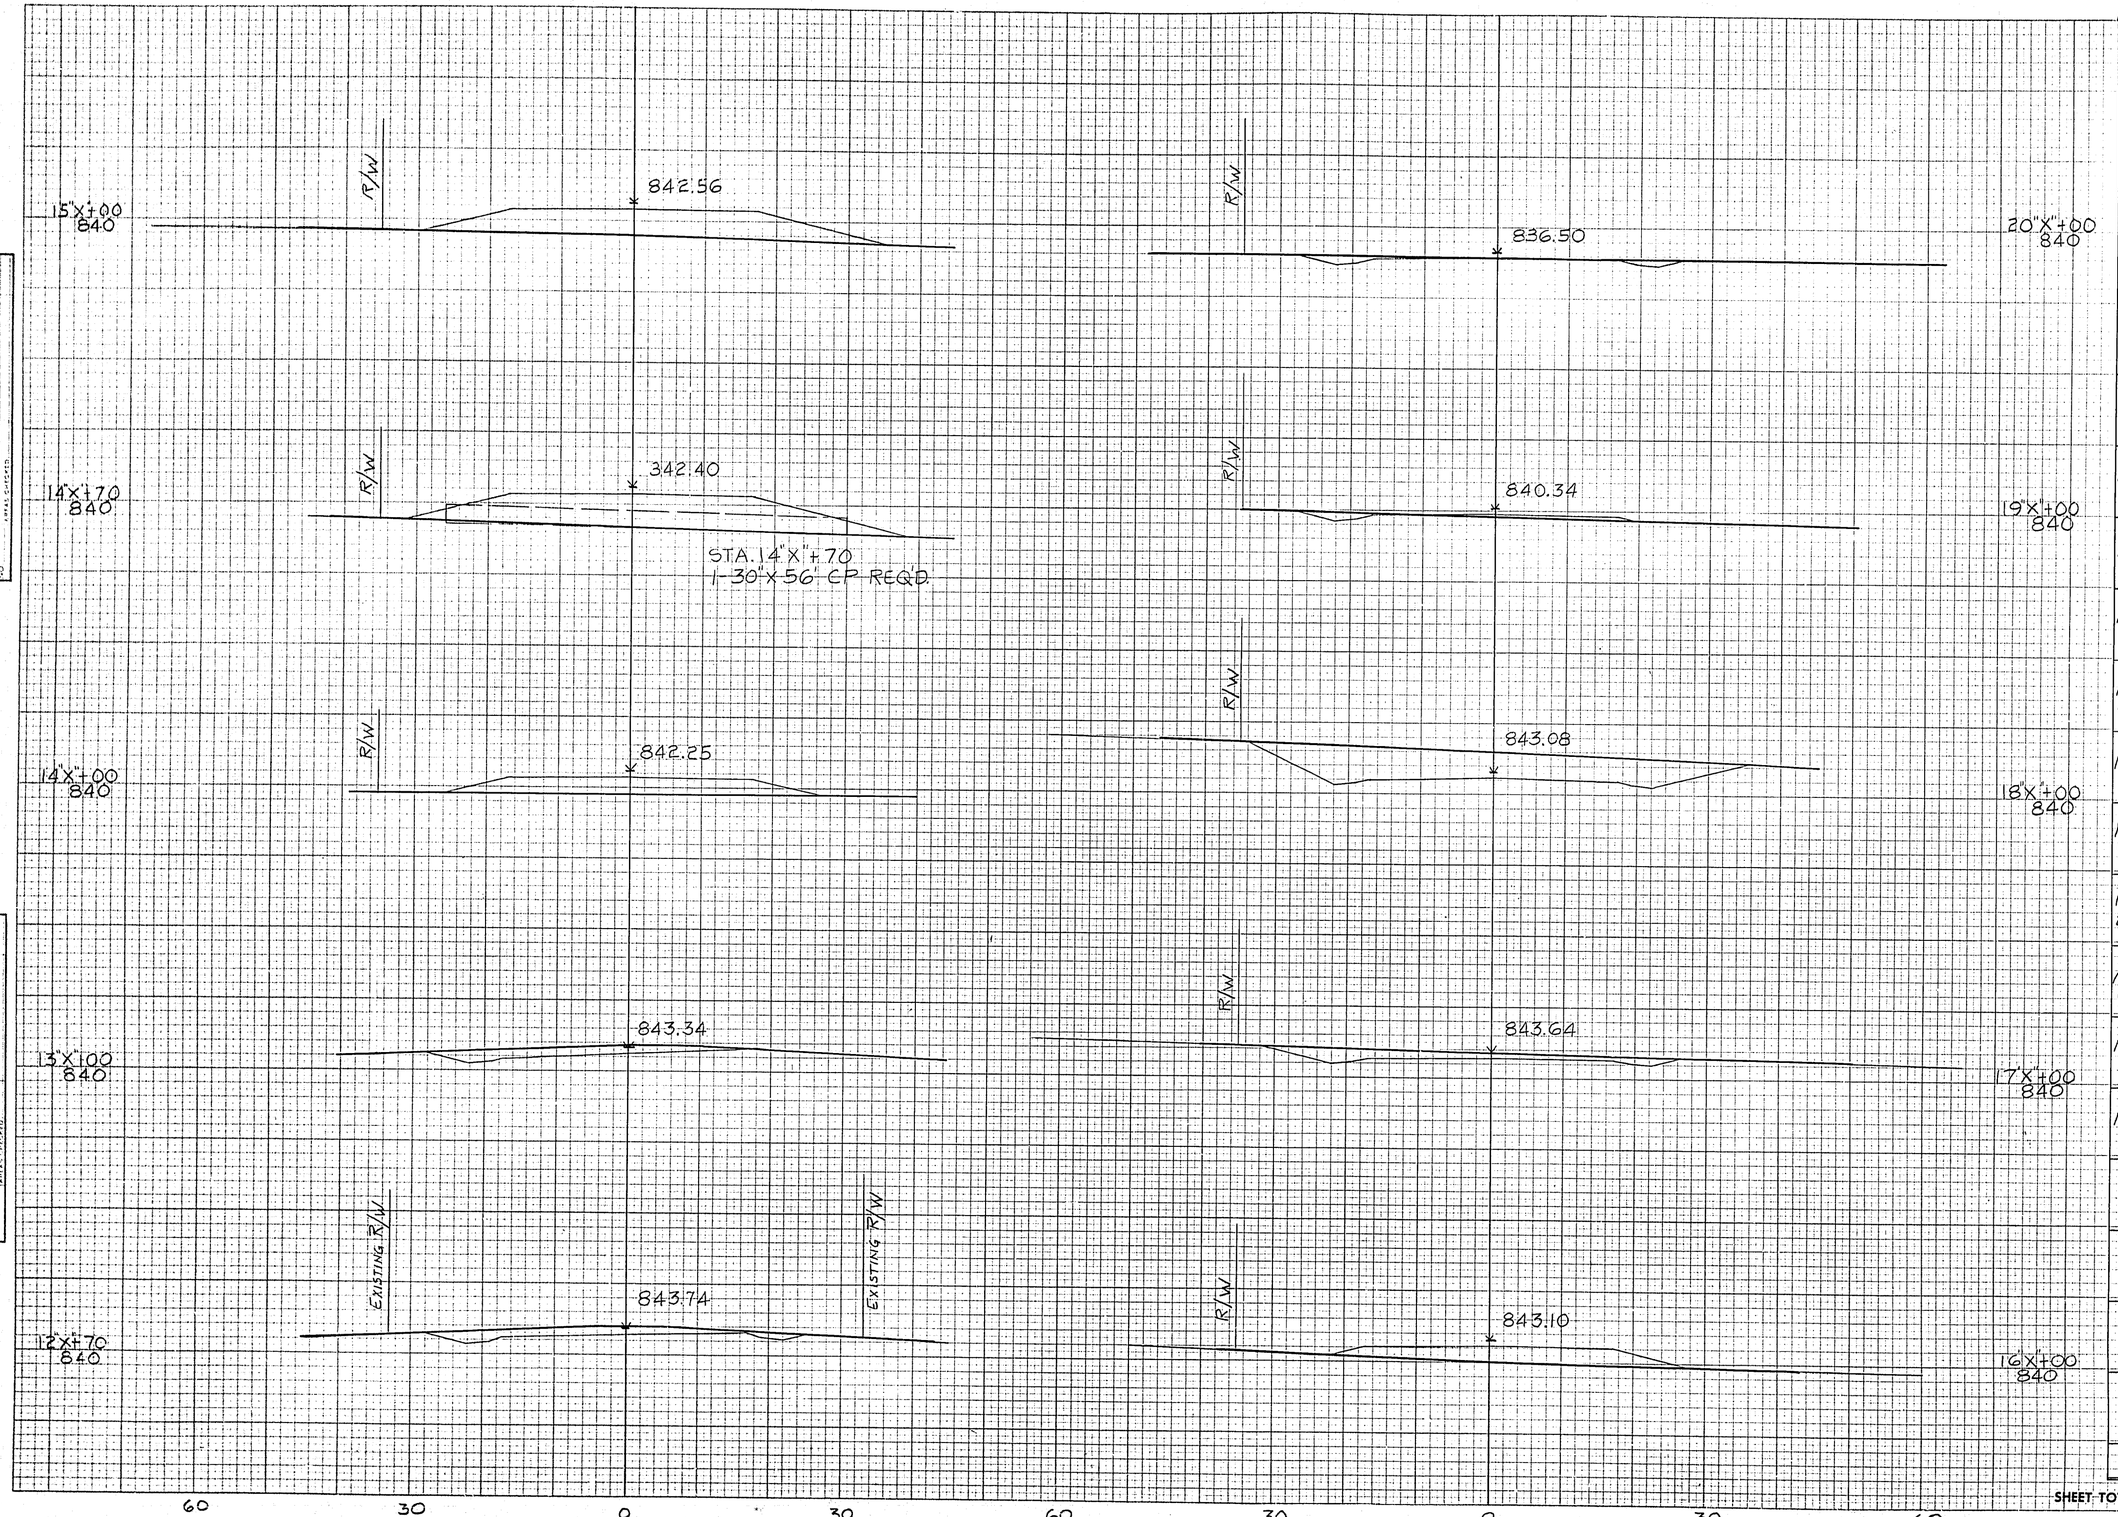

STATION	DISTANCE	YARDAGE EXCAVATION UNCL.				YARDAGE FILL
20X+00						
	100	19				
19X+00						
	100	455				
18X+00						
	100	533				
17X+00						
	28	27				
16X+72						
	72					131
16X+00						
	100					537
15X+00						
	30					240
14X+70						
	70					443
14X+00						
	78					144
13X+22						
	22	12				
13X+00						
	30	42				
12X+70						
	50	43				
12X+20						
SHEET TOTAL		1131				1492

PLATE 3—CROSS SECTION O. P. R. & R. E. STANDARD
THE FREDERICK POST CO., CHICAGO

FRONTAGE RD NEAR 1065+00

C.T.H. "U"

B.P.R. DISTRICT OFFICE	PROJECT	SHEET NUMBER	TOTAL SHEETS
WIS. 4	I-90-2(18)105	264	264

FINAL SURVEY — NOTEBOOK — NO. — DATE — BY — SURVEYED — PLOTTED — TRACED — AREAS CHECKED

ORIGINAL SURVEY — NOTE BOOK — NO. — DATE — BY — SURVEYED 6-10-58 — PLOTTED 6-20-58 — TRACED — AREAS CHECKED

849.81
17"R+69
840

850.00
16"R+69
840

STA 16"R"+40
1-30"x92' C.P. REQ'D

850.31
15"R+69
840

847.20
18"R+80
840

847.70
18"R+30
840

STA 18"R"+06
1-36"x96' C.P. REQ'D

STATION	DISTANCE	YARDAGE EXCAVATION	YARDAGE FILL
19R+17			
	37		205
18R+80			
	50		526
18R+30			
16R+19			
	19		262
16R+00			
	31		389
15R+69			
	31		178
15R+38			
SHEET TOTAL			1560

50 | R | 50 | 50 | R | 50

C.T.H. U

PLATE 3—CROSS SECTION O. P. R. & R. E. STANDARD
THE FREDERICK POST CO., CHICAGO