

FOR:	JOB NO:	SHEET NO:
MADE BY:	CHECKED BY:	BACKCHECKED BY:
DATE:	DATE:	DATE:



SAME SECTION AS HOLLAND ROAD

Minimum Vertical Clearance for Existing Bridges which are not Being Replaced and for Existing Bridges on which the Superstructure is not Being Replaced^{1, 2}

Overpass Facility →	Freeway, Expressway, or STH		Railroad ⁵ , CTH, Town Road, Local Road, or Street	Pedestrian or Shared-use Structures	Sign Structures ⁶
Underpass Facility ↓	Interchange	Grade Separation			
Non-arterial either STH, CTH, Town Road, Local Road, or Street	15'-3" min. or ES ³	If existing is < 14'-0" then increase to 14'-0" min. or ES ³	16'-3" min. or ES ³		18'-0" min. or ES ³ for existing sign structures on new construction projects or reconstruction projects;
		If existing is ≥ 14'-0", but < 14'-6" then maintain existing min. or ES ³			
		If existing is ≥ 14'-6" then 14'-6" min. or ES ³			
Arterial either CTH, Town Road, Local Road, or Street (excludes freeway and expressway; also excludes arterial STH)	If existing is < 15'-3" then increase to 15'-3" min. or ES ³	If existing is < 14'-0" then increase to 14'-0" min. or ES ³	17'-0" min. or ES ³		17'-0" or ES ³ for existing sign structures on 3R projects
	If existing is ≥ 15'-3", but < 16'-0" then maintain existing min. or ES ³	If existing is ≥ 14'-0", but < 14'-6" then maintain existing min. or ES ³			
	If existing is ≥ 16'-0" then 16'-0" min. or ES ³	If existing is ≥ 14'-6" then 14'-6" min. or ES ³			
Arterial STH (excludes freeway and expressway)	If existing is < 15'-3" then increase to 15'-3" min. or ES ³	If existing is < 14'-0" then increase to 14'-0" min. or ES ³	17'-0" min. or ES ³		
	If existing is ≥ 15'-3", but < 16'-0" then maintain existing min. or ES ³	If existing is ≥ 14'-0", but < 16'-0" then maintain existing min. or ES ³			
	If existing is ≥ 16'-0" then 16'-0" min. or ES ³	If existing is ≥ 16'-0" then 16'-0" min. or ES ³			
Freeway ⁴ or Expressway	16'-0" min. or ES ³				
Railroad ⁵	Maintain existing vertical clearance - if existing clearance is < 23'-0" then confer with BTLR Railroads and Harbors Section to determine the adequacy of the existing clearance.				

General notes:

- ¹ Vertical clearance is needed for the entire roadway width (critical point; to include traveled way, auxiliary lanes, turn lanes, and shoulders), according to the above table. Provide greater than minimum clearance if evaluation shows that greater clearance is needed because bridge superstructure is susceptible to being hit by under-passing vehicles.

Vertical clearance for railroads is measured from the top of rail and is required over an area 8 feet 6 inches from the track centerline on each side of a railroad track.

- ² Include a low clearance sign (W12-2), on structures if its use is in accordance with WisDOT MUTCD 2C.22.

- ³ ES = approved Exceptions To Standards Report required (see [FDM 11-1-2](#) and [FDM 11-1-4](#)).

- ⁴ See [FDM 11-44-1](#) for vertical clearance guidance specific to Interstate freeways.

- ⁵ Consult with the Region Railroad Coordinator if the over-passing or under-passing facility is either a railroad or a "rails-to-trails" trail; or if a structure is owned by a railroad company.

- ⁶ See LRFD Bridge Manual Chapter 39 for design considerations for vertical clearance on Sign Structures (http://on.dot.wi.gov/dtid_bos/extranet/structures/LRFD/LRFDManualIndex.htm).

Vertical Clearance for Construction of New Bridges, Replacement Bridges, and Bridges on which the Superstructure is being replaced¹

Overpass Facility →	Freeway, Expressway, or STH		Railroad ⁴ , CTH, Town Road, Local Road, or Street	Pedestrian or Shared-use Structures	Sign Structures ²
Underpass Facility ↓	Interchange	Grade Separation			
Non-arterial either STH, CTH, Town Road, Local Road, or Street	15'-9" Desirable	15'-3" Desirable		16'- 9" Desirable	18'-3" Minimum
	15'-3" Minimum	14'-9" Minimum		16'-3" Minimum	
Arterial either CTH, Town Road, Local Road, or Street (excludes freeway and expressway; also excludes arterial STH)	16'-9" Desirable	15'-3" Desirable		17'- 9" Desirable	
	16'-3" Minimum	14'-9" Minimum		17'-3" Minimum	
Freeway ³ or Expressway or arterial STH	16'-9" Desirable			17'- 9" Desirable	
	16'-4" Minimum			17'-4" Minimum	
Railroad ^{4,5,6,7}	23'-0" Minimum to 23'-3½" Maximum				

General notes:

- ¹ Vertical clearance is needed for the entire roadway width (critical point; to include traveled way, auxiliary lanes, turn lanes, and shoulders), according to the above table.

Vertical clearance for railroads is measured from the top of rail and is required over an area 8 feet 6 inches from the track centerline on each side of a railroad track.

Do not exceed the desirable vertical clearance shown unless justified. Depending on topography and other specific situations vertical clearance for any structure may be greater than that shown when justified. Some things to consider are: over height loads traveling on the roadway; the level of development in the area, the projected growth in traffic volume and importance of the roadway, and the possibility of reclassification.

- ² See LRFD Bridge Manual Chapter 39 (http://on.dot.wi.gov/dtid_bos/extranet/structures/LRFD/LRFDManualIndex.htm) and LRFD Standard Details 39.02 and 39.10 for design considerations and requirements for vertical clearance on new and replacement Sign Structures.
- ³ See FDM 11-44-1 for vertical clearance guidance specific to Interstate freeways.
- ⁴ Consult with the Region Railroad Coordinator if the over-passing or under-passing facility is either a railroad or a "rails-to-trails" trail; or if a structure is owned by a railroad company.
- ⁵ A vertical clearance <23'-0" requires both an approved Exception to Standards (see FDM 11-1-2 and FDM 11-1-4) and early coordination with BTLR R&H, Railroads and Harbors Section (RHS) through the Region Railroad Coordinator. The Exception to Standards shall contain documentation that the Office of the Commissioner of Railroads (OCR) has been petitioned.
- See Chapter 17 for additional information.
- ⁶ Provide justification for a vertical clearance >23'-3 ½" to the RHS.
- ⁷ Vertical clearance less than 23'-0" may be acceptable or desirable in certain situations, such as for spur tracks, lead tracks, some branch lines and even mainline tracks when other impediments to 23'-0" exist. Review such situations with the Railroad Project Coordination Engineer in RHS. Early coordination with RHS is required.

BRIDGE INSPECTION REPORT
Wisconsin Dept. of Transportation
DT2007 2003 s.84.17 Wis. Stats. Type = ROUTINE INSPECTION

page 1

Inventory Data

Feature On: CC		Maintainer: STATE HIGHWAY DEPT		Structure No: B-44-039
Feature Under: USH 41		Sect/Twn/Rng: S14 T21N R18E		
Location: 0.6M N JCT CTH 00		County: OUTAGAMI	Municipality: TOWN-VANDENBROEK (44040)	
Inv Rating: HS16	Rdwy Width (ft): 26.0	Deck Width (ft): 32.0	Existing Posting:	
Oper Rating: HS36	Total Length (ft): 210.0	Deck Area(ft2): 6720	ADT On: 760 Yr: 1980	ADT Under: 38950 Yr: 2003

Inspection Type (* = Supplemental Form Required)

	Routine Visual	Fracture Critical*	In-Depth*	UW-Dive*	UW-Surv*	UW-Probe/Visual*	Movable*
Last Insp.	10-21-11						
Frequency	24						
Recom. Freq.							
	Initial*	Damage	Interim	Load Posted	SI & A Field Review*		
Last Insp.							
Frequency	N/A						
Recom. Freq.	N/A				Item No. Needing Change		

Load Rating Information

Overburden	Measurement (in): 0.0	Date:	Deck Surface Type: CONCRETE	
Section Loss	File Meas. (%):	File Insp. Date: 10-15-09	Insp. Measurement (%):	Describe:
Re-rate for load capacity?	Reason:		Date Last Rated:	

Expansion Joints

		Temp:	35	55	Signing Condition			
Location	Type	File Insp. Date	File Insp. (in)	New Insp. (in)	Type of Marker	File	Y/N	Comments
SOUTH AB	SSE-400A		3.0	2.6	Bridge Markers	Y	Y	
NORTH AB	SSE-400A		3.0	2.5	Narrow Bridge			
					One Lane Road			
					Vertical Clearance			
					Weight Limit Post			
					Other(Addl. Sign)			

Clearances(Cardinal = N or E)

	File Meas. (ft.)	File Date	New Meas. (ft.)
Min. Vertical Clearance Under (Cardinal)	17.03		
Min. Vertical Clearance Under (non-Cardinal)	16.34		
Min. Vertical Clearance On			

Structure Type

Construction/Rehabilitation History

Material	Configuration	# of Spans	Overall Length (ft)	Year	Work Performed	Plan	Shop
PREST CONCRET	DECK GIRDER		38.0	1961	NEW STRUCTURE	P037	F046
CONT PREST CO	DECK GIRDER		68.0	1972	PAINTING		
CONT PREST CO	DECK GIRDER		68.0	1983	CONCRETE OVER	C226	C226
PREST CONCRET	DECK GIRDER		32.0	1985	BEARING - MIS	C275	
				1993	NEW DECK	PLAN	

Inspection Information

Special Requirements	Y/N	Comments				
Traffic Control	Y					
Access Equipment	Y					
Other	Y					

Inspector Information

Team Leader Name and No. Printed: Michaelson, Neil (3010)		Team Member(s) Name(s) Printed:	
Team Leader Signature:		Inspection Date: 10-21-11	Inspection Agency: STATE HIGHWAY DEPARTMENT (1)
District/Local Manager and No. Printed:		District/Local Manager Signature:	Review Date:

Element Inspection (X) Check Elements Inspected					Quantity in Condition States				
Ck	Elem./Env.	Description	Unit	Total QTY.	1	2	3	4	5
X	26 / 2	Conc Deck/Coatd Bars	SF	6720	6720				
X	109 / 3	P/S Conc Open Girder	LF	1079	1041	32	6		
		20 locations of old diaphragm attachments; 12" of spalls on girders in span 2 & 3; Also the ends of the girders are spalls with reinforcement showing							
X	172 / 3	Painted Steel Diaphr	EA	16	16				
X	205 / 4	R/Conc Column	EA	9	9				
X	215 / 3	R/Conc Abutment	LF	65	60	5			
		CS-2 (E Abut 3" & W Abut 2")							
X	234 / 4	R/Conc Cap	LF	91	56	35			
		Shallow spalls at pier 3, cracking on piers 1 & 2; bottom of reinforcement chairs showing							
X	250 / 3	Concrete Diaphragm	EA	15	15				
X	300 / 3	Strip Seal Exp Joint	LF	65		65			
		Filled with hot rubber							
X	310 / 4	Elastomeric Bearing	EA	8	5	2	1		
		Top plate of brg not painted.NE bearing are tipped							
X	322 / 4	Bituminous Approach	EA	2	2				
X	331 / 3	Conc Bridge Railing	LF	419	359	60			
		Light scaling							
X	342 / 4	RipRap Slope Protect	EA	2	2				
X	400 / 4	Concrete Wingwall	EA	4	4				

General Inspection/Maintenance Notes

--

Maintenance Recommendations (See standard code items & numbers)

Maintenance Item: Approach - Seal Approach to Paving Block
--

Amount:	Date(YYYY-MM-DD):
---------	-------------------

Maintenance item comment: Seal joints at the end of the deck
--

Maintenance Item:

Amount:	Date(MM-DD-YY):
---------	-----------------

Maintenance item comment:

NBI Ratings

NBI	File	New	NBI	File	New
Deck	8	8	Culvert	N	N
Superstructure	7	7	Channel	N	N
Substructure	7	7	Waterway	N	N

Maintenance Item:

Amount:	Date(MM-DD-YY):
---------	-----------------

Maintenance item comment:

STRUCTURE INVENTORY AND APPRAISAL FIELD REVIEW FORM

B-44-039
CC over USH 41

- (3) Municipality:
(16) Latitude(° ' "):
(17) Longitude(° ' "):

LOCATION	
TOWN-VANDENBROEK (44040)	
44°17'50.49"N	
88°17'16.14"W	

- (28A) Lanes On:
(28B) Lanes Under:
(102) Traffic Pattern On:
(102) Traffic Pattern Under:
(19) Detour Length(mi):

TRAFFIC SERVICE	
2	
4	
-NO TRAFFIC -ONE WAY TRAFFIC X-TWO WAY TRAFFIC	
-NO TRAFFIC -ONE WAY TRAFFIC X-TWO WAY TRAFFIC	
11	

- (49) Structure Length(ft):
(50) Sidewalk Width(ft):
(50) Curb Width(ft):
(52) Culvert Barrel Length(ft):
(34) Skew:

(51) Bridge Roadway(ft):
(52) Deck(ft):
(32) Approach Roadway(ft):

(47) Minimum Horizontal(ft):
(55) Minimum Right Lateral(ft):
(55) Minimum Left Lateral(ft):

GEOMETRY	
210.0	
Left:	Right:
0.0	
Angle(°): 0	Direction: -RIGHT FORWARD -LEFT FORWARD
Cardinal Width	Non-Cardinal Width
26.0	26.0
32.0	32.0
32	32
Cardinal Under Clearance	Non-Cardinal Under Clearance
48.0	58.0
10.0	10.0
14.0	24.0


- (36A) Bridge Rail Adequacy:
(36B) Transition Adequacy:
(36C) Approach Guardrail Adequacy:
(36D) Guardrail Termination Adequacy:
Outer Rail:

RAILING APPRAISAL		
-SUB-STANDARD	X-STANDARD	-NOT APPLICABLE
-SUB-STANDARD	X-STANDARD	-NOT APPLICABLE
-SUB-STANDARD	X-STANDARD	-NOT APPLICABLE
-SUB-STANDARD	X-STANDARD	-NOT APPLICABLE
Left	Right	Type
		TYPE F (TWO SQUARE TUBES) - STEEL(8)
		TYPE F (3 SQUARE TUBES) - STEEL(65)
		TYPE F (4 SQUARE TUBES) - STEEL(72)
		TYPE M-STEEL 3 SQUARE TUBES(93)
		SLOPED FACE PARAPET LF(91)
		SLOPED FACE PARAPET HF(92)
		VERTICAL FACE PARAPET TYPE A(74)
		TYPE W-THREE BEAM(79)
		TYPE H ON VERTICAL PARAPET(80)
		TIMBER(38)
X	X	OTHER(99) (Please specify) Left: NJ SLOPING PARAPET(61) Right: NJ SLOPING PARAPET(61)
Transition Type:		
		CONT GUARD RAIL
		NO APP GRDRL
		NO ATTACHMENT
5		22 MM(7/8") BOLT (Please enter quantity)
		25 MM(1") BOLT (Please enter quantity)
		OTHER (Please specify)
Guardrail Termination Type:		
X		(01) ENERGY ABSORBING TERMINAL/EAT
		(02) TURN DOWN
		(99) OTHER (Please specify)


- (72) Approach Alignment Appraisal:

ROADWAY ALIGNMENT APPRAISAL	
	(3) INTOLERABLE- Horizontal or Vertical curvature requires a substantial reduction in vehicle operating speed
	(6) FAIR- Horizontal or Vertical curvature requires a very minor speed reduction
X	(8) GOOD- No speed reduction required

COUNTY & HWY	ROUTE & SECTION	CLASS & AGREEMENT	STATE	FEDERAL	DIVISION	PROJECT	SHEET NO.	TOTAL SHEETS
44.1	3.2	21.28			4	FO3-2(61)	41	158

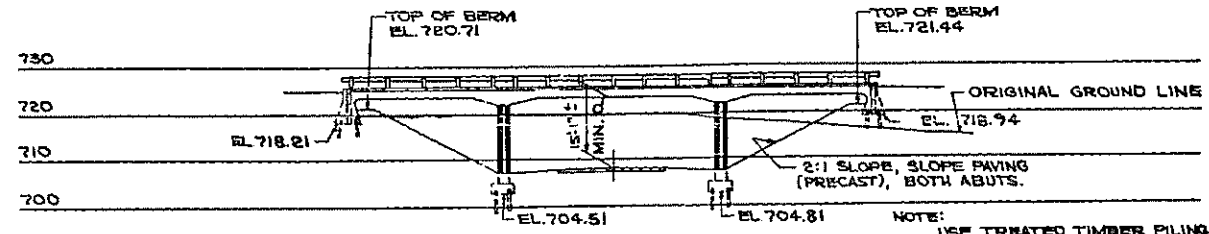


ELEVATION

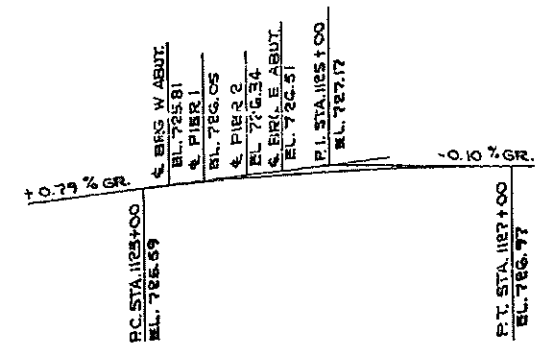

WEST LANE GRADE LINE ON MEDIAN EDGE

400'-0" VERTICAL CURVE

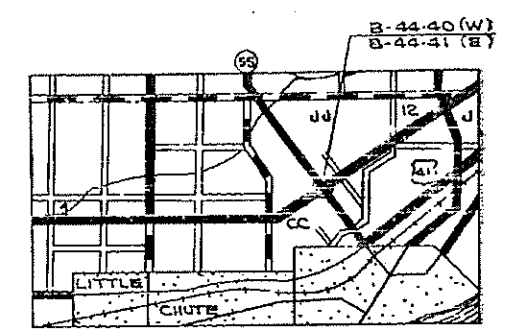


SCALE IN MILES


LOCALITY MAP

GENERAL NOTES

DRAWINGS SHALL NOT BE SCALED.
ALL CONCRETE MASONRY SHALL BE GRADE AA EXCEPT RAILING, POSTS AND WATER STOP WHICH SHALL BE GRADE X.
BEVEL ALL EXPOSED EDGES OF CONCRETE 1" UNLESS OTHERWISE SPECIFIED.
BAR STEEL REINFORCEMENT SHALL BE IMBEDDED 2" CLEAR UNLESS OTHERWISE SHOWN OR NOTED.
THE USE OF STRUCTURAL GRADE BAR STEEL REINFORCEMENT IS PROHIBITED.
PILING AT THE ABUTMENTS SHALL BE TREATED TIMBER PILING ESTIMATED 35'-0" LONG AND DRIVEN TO A MINIMUM BEARING VALUE OF 20 TONS PER PILE.
PILING AT THE PIERS SHALL BE TREATED TIMBER PILING ESTIMATED 25'-0" LONG AND DRIVEN TO A MINIMUM BEARING VALUE OF 20 TONS PER PILE.
THE TOP AND SLOPE OF THE FILL IN FRONT OF THE ABUTMENTS SHALL BE COVERED WITH SLOPE PAVING AS SHOWN IN SECTION THRU ABUTMENT ON SHEET X20772 AND AS SHOWN ON THIS SHEET.
ALL EXCAVATED VOLUME NOT OCCUPIED BY THE ABUTMENTS SHALL BE FILLED WITH GRANULAR BACKFILL TO THE ORIGINAL GROUND LINE. PAYMENT WILL BE ONLY FOR MATERIAL ACTUALLY PLACED WITHIN THE LIMITS SPECIFIED FOR EXCAVATION FOR STRUCTURES.

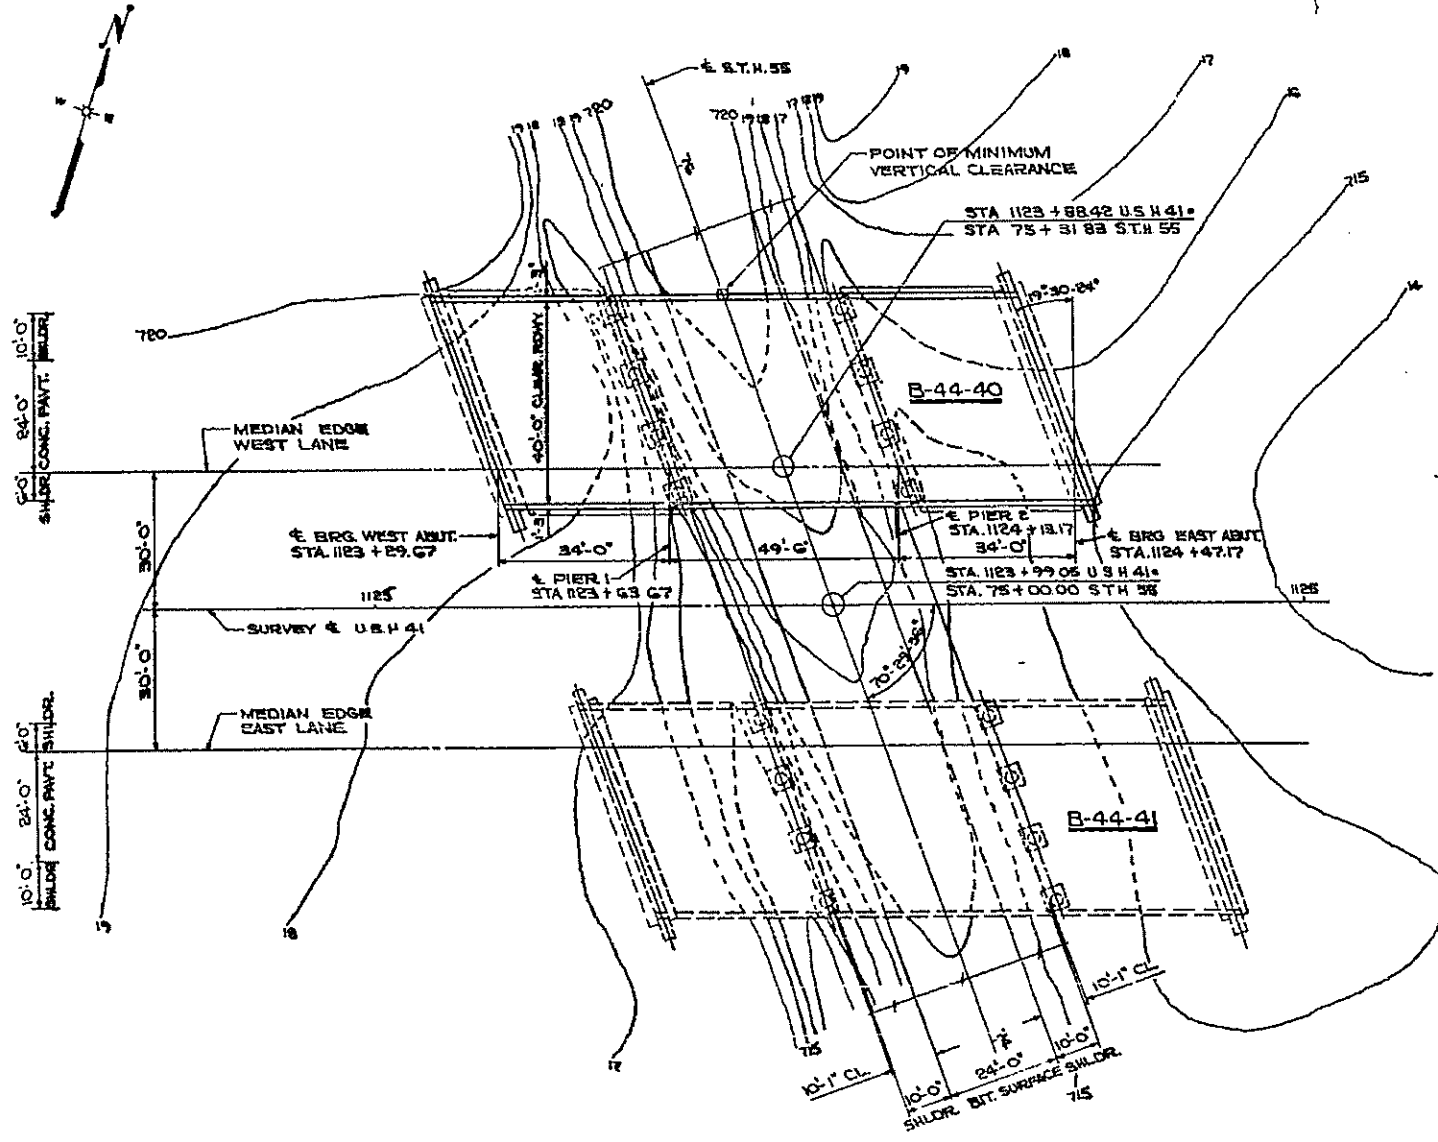

PLAN

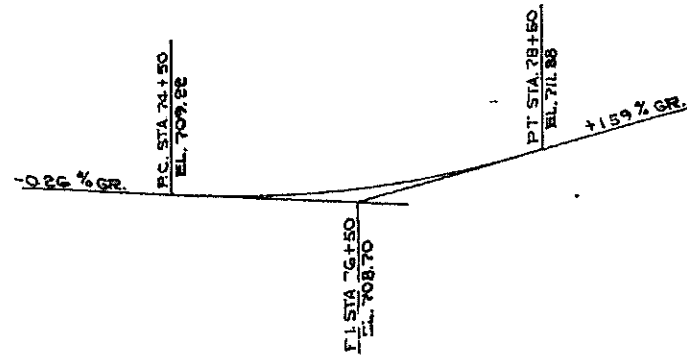

GRADE LINE ON S.T.H. 55

400'-0" VERTICAL CURVE

TOTAL ESTIMATED QUANTITIES

BID ITEMS	UNITS	SUPER.	W ABUT	PIER 1	PIER 2	E ABUT	TOTAL
EXCAVATION FOR STRUCTURES	C.Y.		35	100	150	35	380
GRANULAR BACKFILL	C.Y.		20	45	45	20	130
CONCRETE MASONRY GRADE AA	C.Y.	300.6	350	277	277	35.5	422.1
CONCRETE MASONRY GRADE X	C.Y.	78					78
BAR STEEL REINFORCEMENT	LB.	75,040	995	3,015	3,015	995	83,060
SHRETT ZINC	LB.		85			85	170
UNTREATED TIMBER TEST PILING (2"X6")	L.S.						1
TREATED TIMBER PILING - DEL.	L.F.		455	600	600	455	2,110
TREATED TIMBER PILING - DR.	L.F.		455	600	600	455	2,110
SLOPE PAVING, (CONC. BLOCK)	S.Y.		170			170	340
NON-BID ITEMS							
PREFORMED JOINT TYPE FILLER	SIZE		1/2" X 1/2"	1/2"	1/2"	1/2"	


* DRIVE ONE AT EAST ABUT. AND ONE AT PIER 1

LIST OF DRAWINGS

- 1. GENERAL PLAN X20770
- 2. SUPERSTRUCTURE X20771
- 3. SUPERSTRUCTURE X20772
- 4. ABUTMENTS X20773
- 5. PIERS X20774
- 6. SUBSURFACE EXPLORATION X20775

STATE HIGHWAY COMMISSION OF WISCONSIN	
GENERAL PLAN	
ON OUTAGAMIE	VANDENBROEK STA 1123+88.42
SECTION P.C. 53483+00	21N RANGE 18E
DESIGN SPEC AASHO 1957	LOADING HPS-316
DATE 9-21-59	DESIGN O.O. J. F. F.
APPROVED H.B. Schult	
APPROVED E.L. Rottman	
STRUCTURE B-44-40	SHEET 1 OF 6

X20770

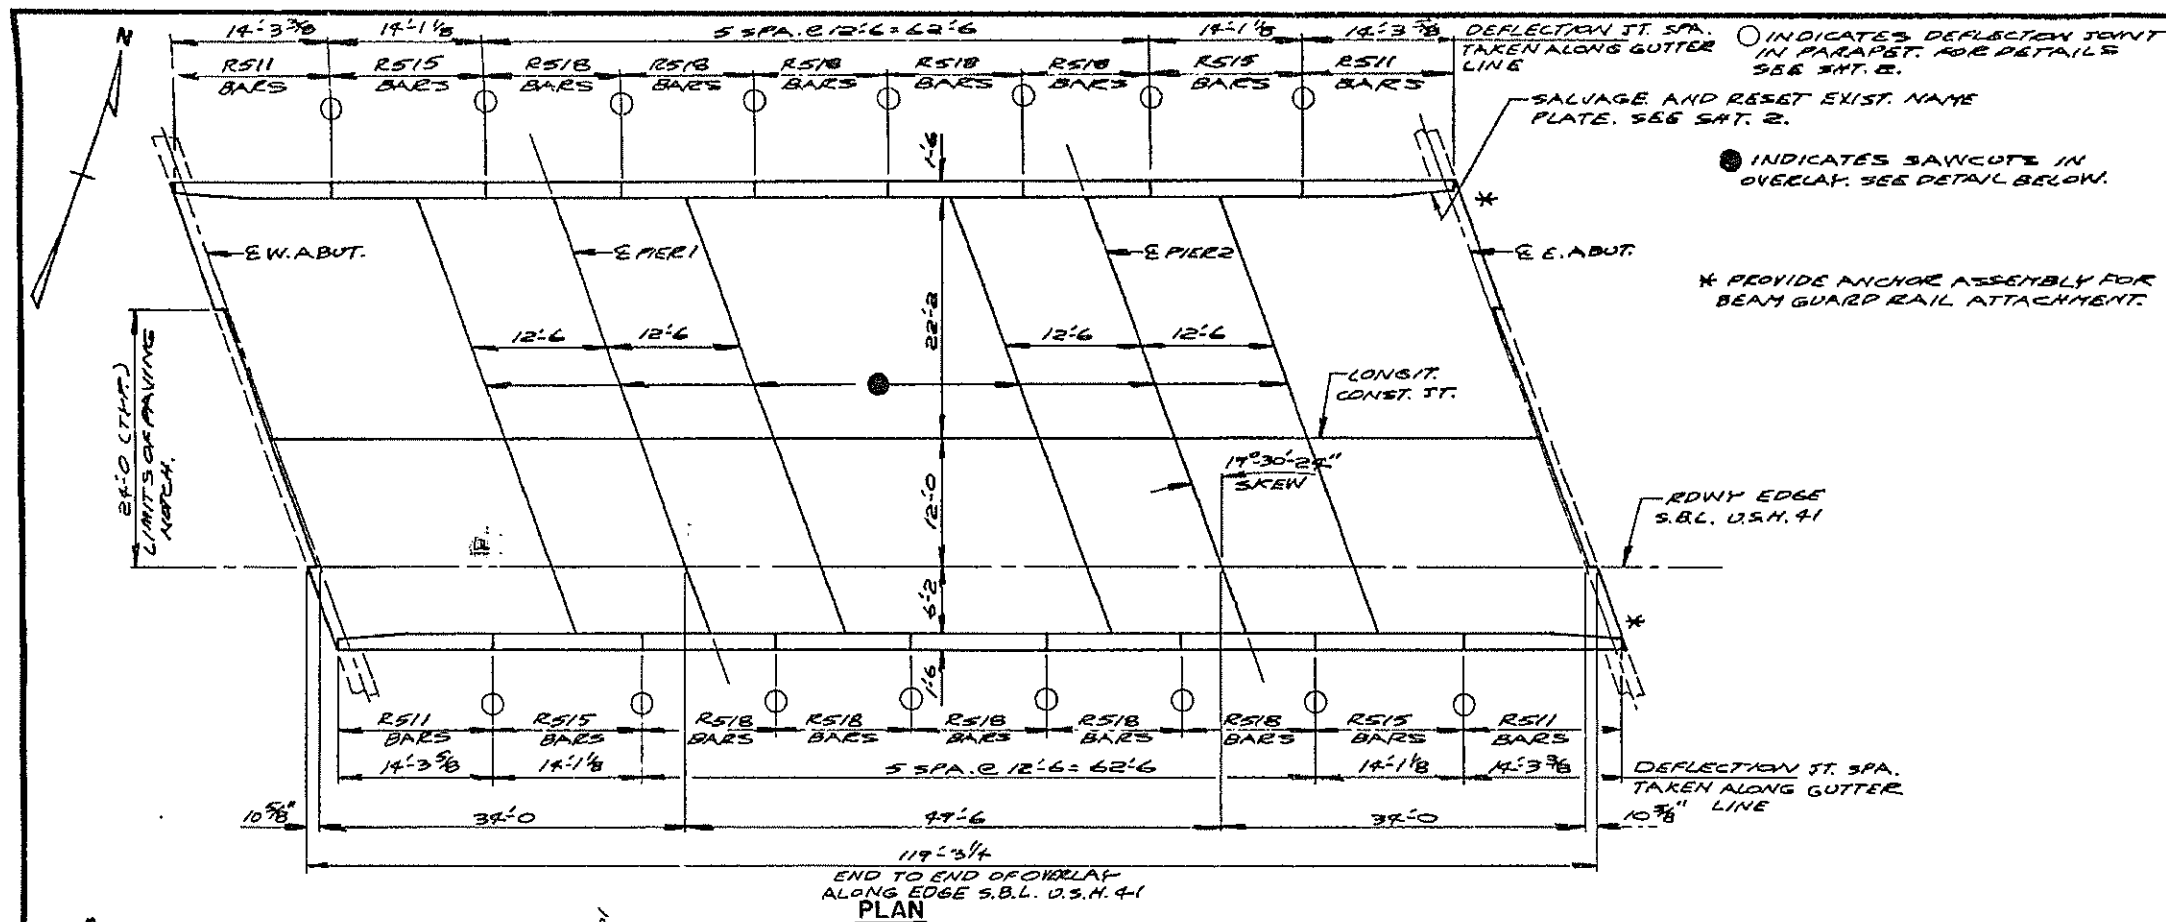


STATE PROJECT NUMBER	SHEET NO.
0044 - 64 - 10	8.2

GENERAL NOTES
 DRAWING SHALL NOT BE SCALED.
 BAR STEEL REIN. SHALL BE EMBEDDED 2" CLEAR UNLESS SHOWN OR NOTED OTHERWISE.
 PLAN DIMENS. ARE BASED ON ORIGINAL PLAN. FIELD VERIFY BEFORE ACCEPTING.

DESIGN DATA
 LIVELOAD:
 INVENTORY RATING — H-20
 OPERATIONAL RATING — H-37
 ALLOWABLE DESIGN STRESSES:
 CONCRETE — $f_c = 4,000$ P.S.I.
 MASONRY — $f_m = 9,000$ P.S.I.
 HIGH STRENGTH BAR STEEL REINFORCEMENT — $f_y = 60,000$ P.S.I.


NOTE: AVG OVERLAY THICKNESS = 1 3/8"
 TOP OF OVERLAY - ALONG LONGIT. CONST. JOINT + .670
 WEST END OF DECK STA 1123+25.33 EL. 725.88
 EAST END OF DECK STA 1128+33.01 EL. 726.59

PROPOSED GRADELINE
 BENCH MARK: BRASS DISC ON TOP OF N. EAST WINGWALL, EL. 726.60
 VARIATIONS TO THE NEW GRADE LINE OVER 1/4" MUST BE SUBMITTED FOR REVIEW BY BRIDGE SECTION.

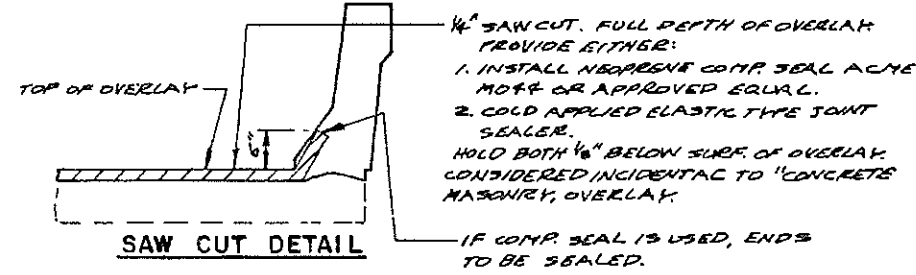

▲ CLEAN & SEAL EXIST. LONGIT. CONST. JT. WITH POURABLE EPOXY GROUT.

LIST OF DRAWINGS
 1. CONCRETE OVERLAY — X78641
 2. SLOPED FACE PARAPET — X78642

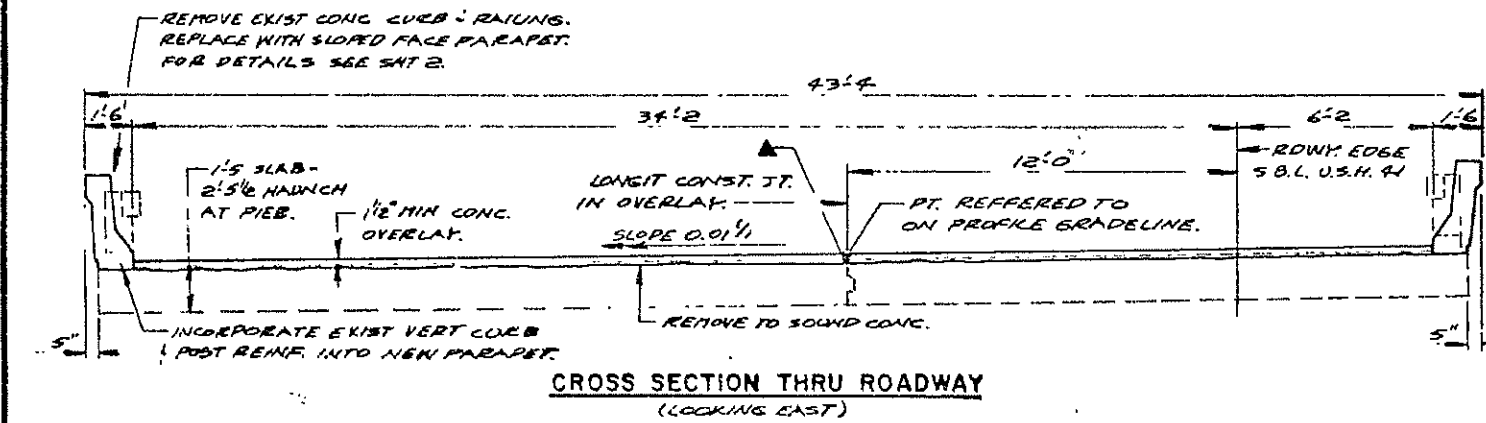


<u>TOTAL ESTIMATED QUANTITIES</u>		
BID ITEMS	UNIT	TOTAL
REMOVING OLD BRIDGE, B-44-40	L.S.	1
# CONCRETE MASONRY, BRIDGES	C.F.	20
PROTECTIVE SURFACE TREATMENT	GAL.	22
EPOXY CRACK SEALING	L.F.	118
DECK PREPARATION	S.F.	2
DECK CLEANING	S.F.	535
CONCRETE MASONRY OVERLAY	C.F.	32
3/4" EXPANSION ANCHORS	EA.	506
COATED HIGH STRENGTH BAR STEEL REINFORCEMENT	LB.	4,360
NON-BID ITEMS		
1/2" ALUMINUM OR ZINC PLATE	S.F.	33


INCLUDES CONC REQ'D IN PARAPETS ONLY.

* INCLUDES CONC. REQ'D IN PARAPETS ONLY.


Date	Revision	By
STRUCTURE B-44-40		
U.S.H. 41 (S.B.) OVER S.T.H. 35		
County	OUTAGAMIE	Township
Design	AAH TO 83	Drawn
Checked	K.A.B.	By
Approved	Stanley W. Wink	Date
CONCRETE OVERLAY		SHEET 1 OF 2
		X78641

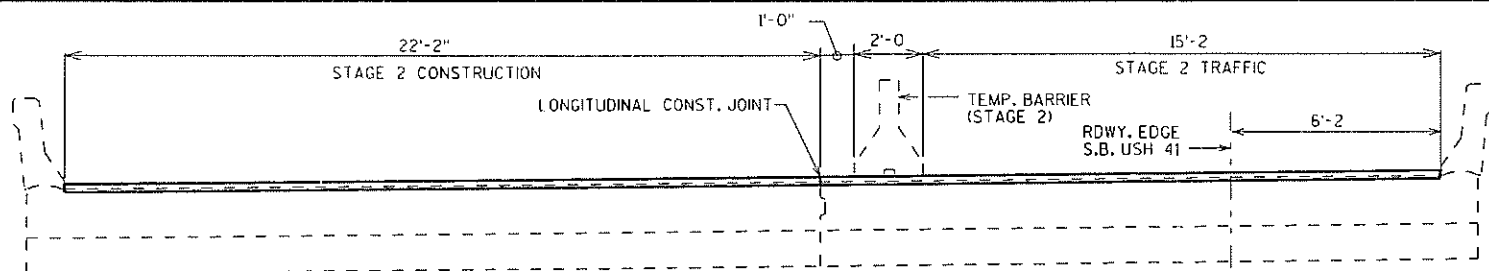


RDWY. CROSS SECT. (STAGE 2)

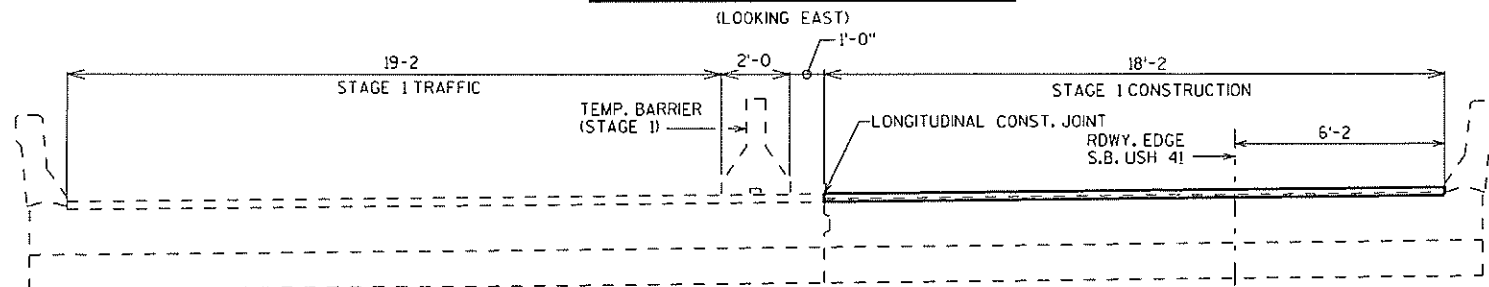

RDWY. CROSS SECT. (STAGE 1)

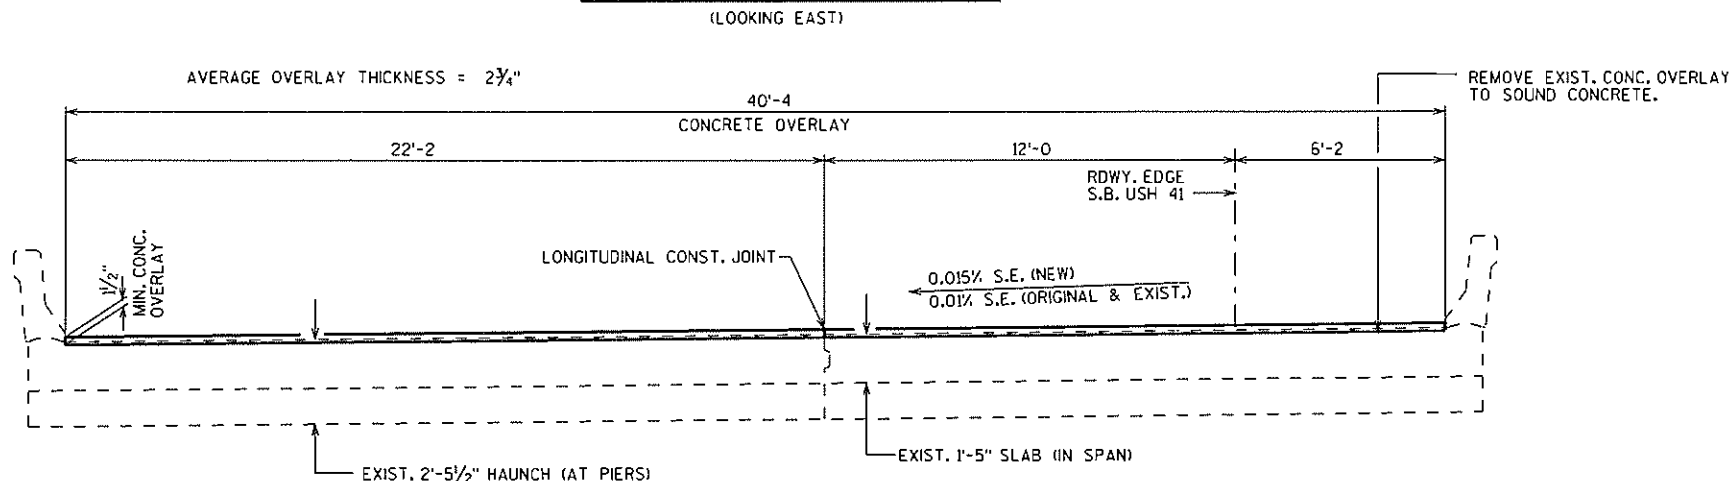

CROSS SECTION THRU RDWY. LOOKING EAST

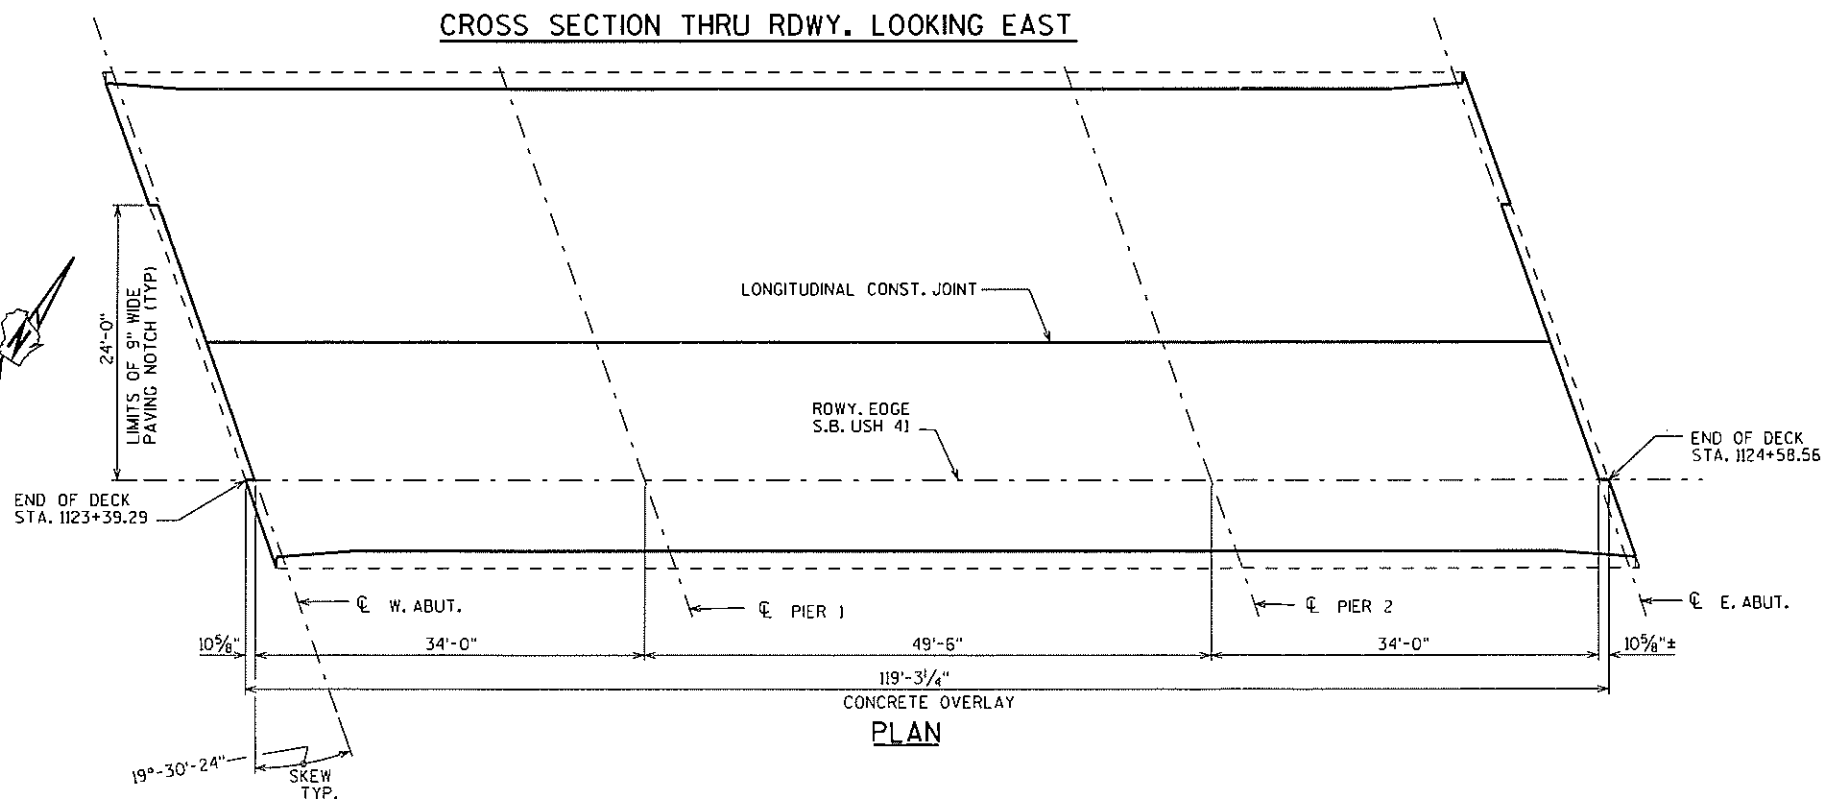

PLAN

DESIGN DATA

LIVE LOAD:
 INVENTORY RATING: HS-20
 OPERATIONAL RATING: HS-33
 MAXIMUM STANDARD PERMIT VEHICLE LOAD = 250 KIPS.

ULTIMATE DESIGN STRESSES:
 CONCRETE MASONRY OVERLAY DECKS $f'_c = 4,000$ P.S.I.
 BAR STEEL REINFORCEMENT $f_y = 60,000$ P.S.I.

GENERAL NOTES

DRAWINGS SHALL NOT BE SCALED.

ANY EXCAVATION NECESSARY TO COMPLETE THE OVERLAY AT THE ABUTMENTS IS TO BE CONSIDERED INCIDENTAL TO THE BID ITEM "CONCRETE MASONRY OVERLAY DECKS".

DIMENSIONS SHOWN ARE BASED ON EXISTING ORIGINAL STRUCTURE PLANS.

CONTACT THE BUREAU OF STRUCTURES DESIGN SECTION BEFORE PLACEMENT OF OVERLAY IF THE AVERAGE THICKNESS OF THE NEW OVERLAY WILL EXCEED 1/2" MORE THAN THE AVERAGE THICKNESS SHOWN ON THE PLANS.

"PROTECTIVE SURFACE TREATMENT" SHALL BE APPLIED TO THE ENTIRE TOP OF DECK SURFACE.

THERMOGRAPHY RESULT OF THE BRIDGE DECK ARE SHOWN ELSEWHERE IN THE PLANS.

TOTAL ESTIMATED QUANTITIES

REMOVING CONCRETE MASONRY OVERLAY DECKS	530 SY
CONCRETE MASONRY OVERLAY DECKS	54 CY
PROTECTIVE SURFACE TREATMENT	530 SY
PREPARATION DECKS TYPE 1	179 SY
PREPARATION DECKS TYPE 2	27 SY
FULL-DEPTH DECK REPAIR	5 SY
CONCRETE SURFACE REPAIR	12 SF

* REPAIRS SHALL BE DONE AT THE DIRECTION OF ENGINEER IN FIELD.


STRUCTURES DESIGN CONTACTS = DAVID R. GENSON (608) 266-8491
 DEAN SMITH (608) 266-5091

NO.	DATE	REVISION	BY
Plans Prepared By WISDOT BUREAU OF STRUCTURES APPROVED <i>William C. Duhon</i> SDR 1-13-09 CHIEF STRUCTURAL DESIGN ENGINEER DATE			
STRUCTURE B-44-40			
USH 41 S.B. OVER STH 55			
COUNTY	OUTAGAMIE	TOWN/CITY/VILLAGE	KAUKAUNA
DESIGN SPEC.	AASHTO STD. SPEC. 2003	LOAD	CONST. SPEC. 2003
DESIGNED BY	DRG. CK'D.	DRAWN BY	JHG CK'D. DDS
OVERLAY DETAILS			SHEET 1 OF 1
			34

FOR:	JOB NO:	SHEET NO:
MADE BY:	CHECKED BY:	BACKCHECKED BY:
DATE:	DATE:	DATE:

HNTB

SYMMETRICAL

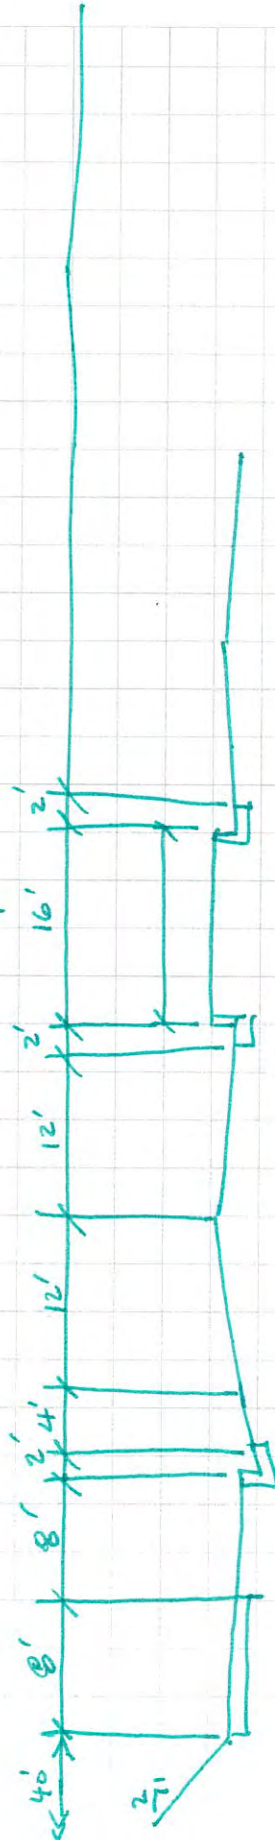

$$16.75 \times 2 = 33.50 + 2.5 + 4' = 40$$

$$\text{SPAN 1} = \text{SPAN 2}$$

$$\text{SPAN 1} = 40' + 16' + 32 + 8 = 96 / 0.942641 \approx 101.84'$$

$$\cos(51.66^\circ) = 0.6157$$

$$101.84 \times 2 = 203.68'$$

Less Abut to E.R.

$$\frac{2'}{0.942641} = 2.12'$$

$$101.84$$

$$2.12$$

$$99.72 < 100 \text{ use } 36W$$

Minimum Vertical Clearance for Existing Bridges which are not Being Replaced and for Existing Bridges on which the Superstructure is not Being Replaced^{1,2}

Overpass Facility →	Freeway, Expressway, or STH		Railroad ⁵ , CTH, Town Road, Local Road, or Street	Pedestrian or Shared-use Structures	Sign Structures ⁶
Underpass Facility ↓	Interchange	Grade Separation			
Non-arterial either STH, CTH, Town Road, Local Road, or Street	15'-3" min. or ES ³	If existing is < 14'-0" then increase to 14'-0" min. or ES ³	16'-3" min. or ES ³		18'-0" min. or ES ³ for existing sign structures on new construction projects or reconstruction projects;
		If existing is ≥ 14'-0", but < 14'-6" then maintain existing min. or ES ³			
		If existing is ≥ 14'-6" then 14'-6" min. or ES ³			
Arterial either CTH, Town Road, Local Road, or Street (excludes freeway and expressway; also excludes arterial STH)	If existing is < 15'-3" then increase to 15'-3" min. or ES ³	If existing is < 14'-0" then increase to 14'-0" min. or ES ³	17'-0" min. or ES ³		17'-0" or ES ³ for existing sign structures on 3R projects
	If existing is ≥ 15'-3", but < 16'-0" then maintain existing min. or ES ³	If existing is ≥ 14'-0", but < 14'-6" then maintain existing min. or ES ³			
	If existing is ≥ 16'-0" then 16'-0" min. or ES ³	If existing is ≥ 14'-6" then 14'-6" min. or ES ³			
Arterial STH (excludes freeway and expressway)	If existing is < 15'-3" then increase to 15'-3" min. or ES ³	If existing is < 14'-0" then increase to 14'-0" min. or ES ³	17'-0" min. or ES ³		
	If existing is ≥ 15'-3", but < 16'-0" then maintain existing min. or ES ³	If existing is ≥ 14'-0", but < 16'-0" then maintain existing min. or ES ³			
	If existing is ≥ 16'-0" then 16'-0" min. or ES ³	If existing is ≥ 16'-0" then 16'-0" min. or ES ³			
Freeway⁴ or Expressway	16'-0" min. or ES ³				
Railroad⁵	Maintain existing vertical clearance - if existing clearance is < 23'-0" then confer with BTLR Railroads and Harbors Section to determine the adequacy of the existing clearance.				

General notes:

- ¹ Vertical clearance is needed for the entire roadway width (critical point; to include traveled way, auxiliary lanes, turn lanes, and shoulders), according to the above table. Provide greater than minimum clearance if evaluation shows that greater clearance is needed because bridge superstructure is susceptible to being hit by under-passing vehicles.
Vertical clearance for railroads is measured from the top of rail and is required over an area 8 feet 6 inches from the track centerline on each side of a railroad track.
- ² Include a low clearance sign (W12-2), on structures if its use is in accordance with WisDOT MUTCD 2C.22.
- ³ ES = approved Exceptions To Standards Report required (see [FDM 11-1-2](#) and [FDM 11-1-4](#)).
- ⁴ See [FDM 11-44-1](#) for vertical clearance guidance specific to Interstate freeways.
- ⁵ Consult with the Region Railroad Coordinator if the over-passing or under-passing facility is either a railroad or a "rails-to-trails" trail; or if a structure is owned by a railroad company.
- ⁶ See LRFD Bridge Manual Chapter 39 for design considerations for vertical clearance on Sign Structures (http://on.dot.wi.gov/dtid_bos/extranet/structures/LRFD/LRFDManualIndex.htm).

Vertical Clearance for Construction of New Bridges, Replacement Bridges, and Bridges on which the Superstructure is being replaced¹

Overpass Facility →	Freeway, Expressway, or STH		Railroad ⁴ , CTH, Town Road, Local Road, or Street	Pedestrian or Shared-use Structures	Sign Structures ²
Underpass Facility ↓	Interchange	Grade Separation			
Non-arterial either STH, CTH, Town Road, Local Road, or Street	15'-9" Desirable	15'-3" Desirable	18'-3" Minimum	16'- 9" Desirable	
	15'-3" Minimum	14'-9" Minimum		16'-3" Minimum	
Arterial either CTH, Town Road, Local Road, or Street (excludes freeway and expressway; also excludes arterial STH)	16'-9" Desirable	15'-3" Desirable		17'- 9" Desirable	
	16'-3" Minimum	14'-9" Minimum		17'-3" Minimum	
Freeway³ or Expressway or arterial STH	16'-9" Desirable			17'- 9" Desirable	
	16'-4" Minimum			17'-4" Minimum	
Railroad ^{4,5,6,7}	23'-0" Minimum to 23'-3½" Maximum				

General notes:

- ¹ Vertical clearance is needed for the entire roadway width (critical point; to include traveled way, auxiliary lanes, turn lanes, and shoulders), according to the above table.

Vertical clearance for railroads is measured from the top of rail and is required over an area 8 feet 6 inches from the track centerline on each side of a railroad track.

Do not exceed the desirable vertical clearance shown unless justified. Depending on topography and other specific situations vertical clearance for any structure may be greater than that shown when justified. Some things to consider are: over height loads traveling on the roadway; the level of development in the area, the projected growth in traffic volume and importance of the roadway, and the possibility of reclassification.

- ² See LRFD Bridge Manual Chapter 39 (http://on.dot.wi.gov/dtid_bos/extranet/structures/LRFD/LRFDManualIndex.htm) and LRFD Standard Details 39.02 and 39.10 for design considerations and requirements for vertical clearance on new and replacement Sign Structures.
- ³ See FDM 11-44-1 for vertical clearance guidance specific to Interstate freeways.
- ⁴ Consult with the Region Railroad Coordinator if the over-passing or under-passing facility is either a railroad or a "rails-to-trails" trail; or if a structure is owned by a railroad company.
- ⁵ A vertical clearance <23'-0" requires both an approved Exception to Standards (see FDM 11-1-2 and FDM 11-1-4) and early coordination with BTLR R&H, Railroads and Harbors Section (RHS) through the Region Railroad Coordinator. The Exception to Standards shall contain documentation that the Office of the Commissioner of Railroads (OCR) has been petitioned.
- See Chapter 17 for additional information.
- ⁶ Provide justification for a vertical clearance >23'-3 ½" to the RHS.
- ⁷ Vertical clearance less than 23'-0" may be acceptable or desirable in certain situations, such as for spur tracks, lead tracks, some branch lines and even mainline tracks when other impediments to 23'-0" exist. Review such situations with the Railroad Project Coordination Engineer in RHS. Early coordination with RHS is required.

BRIDGE INSPECTION REPORT
Wisconsin Dept. of Transportation
DT2007 2003 s.84.17 Wis. Stats. Type = ROUTINE INSPECTION

page 1

Inventory Data

Feature On: USH 41 SB		Maintainer: STATE HIGHWAY DEPT		Structure No: B-44-040	
Feature Under: STH 55		Sect/Twn/Rng: S13 T21N R18E			
Location: 2.6M S JCT CTH JJ		County: OUTAGAMI		Municipality: CITY-KAUKAUNA (44241)	
Inv Rating: HS20	Rdwy Width (ft): 40.3	Deck Width (ft): 43.3	Existing Posting:		
Oper Rating: HS33	Total Length (ft): 119.3	Deck Area(ft2): 5165	ADT On: 19310 Yr: 2003	ADT Under: 4000 Yr: 2003	

Inspection Type (* = Supplemental Form Required)

	Routine Visual	Fracture Critical*	In-Depth*	UW-Dive*	UW-Surv*	UW-Probe/Visual*	Movable*
Last Insp.	10-18-11						
Frequency	24						
Recom. Freq.							
	Initial*	Damage	Interim	Load Posted	SI & A Field Review*		
Last Insp.							
Frequency	N/A						
Recom. Freq.	N/A				Item No. Needing Change		

Load Rating Information

Overburden	Measurement (in): 2.0	Date: 11-06-01	Deck Surface Type: CONCRETE		
Section Loss	File Meas. (%):	File Insp. Date: 10-15-09	Insp. Measurement (%):	Describe:	
Re-rate for load capacity?	Reason:			Date Last Rated: 01-13-09	

Expansion Joints

		Temp:		Signing Condition			
Location	Type	File Insp. Date	File Insp. (in)	New Insp. (in)	Type of Marker	File	Y/N
					Bridge Markers	Y	Y
					Narrow Bridge		
					One Lane Road		
					Vertical Clearance		
					Weight Limit Post		
					Other(Addl. Sign)		

Clearances(Cardinal = N or E)

	File Meas. (ft.)	File Date	New Meas. (ft.)
Min. Vertical Clearance Under (Cardinal)	15.05	10-17-11	
Min. Vertical Clearance Under (non-Cardinal)	14.93		
Min. Vertical Clearance On			

Structure Type

Construction/Rehabilitation History

Material	Configuration	# of Spans	Overall Length (ft)	Year	Work Performed	Plan	Shop
CONT CONCRETE	HAUNCHED SLAB		34.0	1961	NEW STRUCTURE	P038	F046
CONT CONCRETE	HAUNCHED SLAB		49.5	1986	CONCRETE OVER	C275	C275
CONT CONCRETE	HAUNCHED SLAB		34.0	2009	CONCRETE OVER		

Inspection Information

Special Requirements	Y/N	Comments				
Traffic Control	Y					
Access Equipment	Y					
Other	Y					

Inspector Information

Team Leader Name and No. Printed: Weber, Dale (3007)		Team Member(s) Name(s) Printed:			
Team Leader Signature:		Inspection Date: 10-18-11		Inspection Agency: STATE HIGHWAY DEPARTMENT (1)	
District/Local Manager and No. Printed:		District/Local Manager Signature:		Review Date:	

Element Inspection (X) Check Elements Inspected

					Quantity in Condition States				
Ck	Elem./Env.	Description	Unit	Total QTY.	1	2	3	4	5
X	48 / 4	Conc Slab/Conc Ov	SF	5096		5096			
		Areas of map cracking, const jt leaching							
X	205 / 4	R/Conc Column	EA	8	8				
X	215 / 4	R/Conc Abutment	LF	94	91	3			
		Leaching between haunch & floor							
X	322 / 4	Bituminous Approach	EA	2	2				
X	331 / 4	Conc Bridge Railing	LF	235	220	15			
X	343 / 3	Crushed Aggregate Sp	EA	2		2			
		Both settling							
X	358 / 4	Deck Cracking SmFlag	EA	1		1			
X	359 / 4	Und Dk Surf Sm Flag	EA	1			1		
		Leaching @ C/L joint							
X	400 / 4	Concrete Wingwall	EA	4	4				

General Inspection/Maintenance Notes

--

Maintenance Recommendations (See standard code items & numbers)

Maintenance Item: Approach - Seal Approach to Paving Block

Amount: Date(YYYY-MM-DD):

Maintenance item comment: w/rubber

Maintenance Item:

Amount: Date(MM-DD-YY):

Maintenance item comment:

NBI Ratings

NBI	File	New	NBI	File	New
Deck	7	7	Culvert	N	N
Superstructure	7	7	Channel	N	N
Substructure	8	8	Waterway	N	N

Maintenance Item:

Amount: Date(MM-DD-YY):

Maintenance item comment:

STRUCTURE INVENTORY AND APPRAISAL FIELD REVIEW FORM

B-44-040
USH 41 SB over STH 55

- (3) Municipality:
(16) Latitude(° ' "):
(17) Longitude(° ' "):

LOCATION	
CITY - KAUKAUNA (44241)	
44°17'58.58"N	
88°16'19.94"W	

- (28A) Lanes On:
(28B) Lanes Under:
(102) Traffic Pattern On:
(102) Traffic Pattern Under:
(19) Detour Length(mi):

TRAFFIC SERVICE	
2	
2	
-NO TRAFFIC X-ONE WAY TRAFFIC -TWO WAY TRAFFIC	
-NO TRAFFIC -ONE WAY TRAFFIC X-TWO WAY TRAFFIC	
1	

- (49) Structure Length(ft):
(50) Sidewalk Width(ft):
(50) Curb Width(ft):
(52) Culvert Barrel Length(ft):
(34) Skew:

GEOMETRY	
119.3	
Left: 0.0	Right: 0.0
Angle(°): 20	Direction: X-RIGHT FORWARD -LEFT FORWARD
Cardinal Width	Non-Cardinal Width
40.3	40.3
43.3	43.3
40	0
Cardinal Under Clearance	Non-Cardinal Under Clearance
39.0	39.0
6.0	6.0
9.0	9.0

- (51) Bridge Roadway(ft):
(52) Deck(ft):
(32) Approach Roadway(ft):
(47) Minimum Horizontal(ft):
(55) Minimum Right Lateral(ft):
(55) Minimum Left Lateral(ft):

- (36A) Bridge Rail Adequacy:
(36B) Transition Adequacy:
(36C) Approach Guardrail Adequacy:
(36D) Guardrail Termination Adequacy:
Outer Rail:

RAILING APPRAISAL		
-SUB-STANDARD	X-STANDARD	-NOT APPLICABLE
-SUB-STANDARD	X-STANDARD	-NOT APPLICABLE
-SUB-STANDARD	X-STANDARD	-NOT APPLICABLE
-SUB-STANDARD	X-STANDARD	-NOT APPLICABLE
Left	Right	Type
		TYPE F (TWO SQUARE TUBES) - STEEL(8)
		TYPE F (3 SQUARE TUBES) - STEEL(65)
		TYPE F (4 SQUARE TUBES) - STEEL(72)
		TYPE M-STEEL 3 SQUARE TUBES(93)
		SLOPED FACE PARAPET LF(91)
		SLOPED FACE PARAPET HF(92)
		VERTICAL FACE PARAPET TYPE A(74)
		TYPE W-THREE BEAM(79)
		TYPE H ON VERTICAL PARAPET(80)
		TIMBER(38)
X	X	OTHER(99) (Please specify) Left: NJ SLOPING PARAPET(61) Right: NJ SLOPING PARAPET(61)
Transition Type:		
		CONT GUARD RAIL
		NO APP GRDRL
		NO ATTACHMENT
5		22 MM(7/8") BOLT (Please enter quantity)
		25 MM(1") BOLT (Please enter quantity)
		OTHER (Please specify)
Guardrail Termination Type:		
X		(01) ENERGY ABSORBING TERMINAL/EAT
		(02) TURN DOWN
		(99) OTHER (Please specify)

- (72) Approach Alignment Appraisal:

ROADWAY ALIGNMENT APPRAISAL	
	(3) INTOLERABLE- Horizontal or Vertical curvature requires a substantial reduction in vehicle operating speed
	(6) FAIR- Horizontal or Vertical curvature requires a very minor speed reduction
X	(8) GOOD- No speed reduction required

This page intentionally left blank

BRIDGE INSPECTION REPORT
 Wisconsin Dept. of Transportation
 DT2007 2003 s.84.17 Wis. Stats. Type = ROUTINE INSPECTION

page 1

Inventory Data

Feature On: USH 41 NB		Maintainer: STATE HIGHWAY DEPT		Structure No: B-44-041
Feature Under: STH 55		Sect/Twn/Rng: S13 T21N R18E		
Location: 7.3M N JCT STH 47 TO		County: OUTAGAMI	Municipality: CITY-KAUKAUNA (44241)	
Inv Rating: HS21	Rdwy Width (ft): 40.0	Deck Width (ft): 43.0	Existing Posting:	
Oper Rating: HS35	Total Length (ft): 119.3	Deck Area(ft2): 5129	ADT On: 19475 Yr: 2003	ADT Under: 4000 Yr: 2003

Inspection Type (* = Supplemental Form Required)

	Routine Visual	Fracture Critical*	In-Depth*	UW-Dive*	UW-Surv*	UW-Probe/Visual*	Movable*
Last Insp.	10-18-11						
Frequency	24						
Recom. Freq.							
	Initial*	Damage	Interim	Load Posted	SI & A Field Review*		
Last Insp.							
Frequency	N/A						
Recom. Freq.	N/A				Item No. Needing Change		

Load Rating Information

Overburden	Measurement (in): 1.0	Date: 11-06-01	Deck Surface Type: CONCRETE	
Section Loss	File Meas. (%):	File Insp. Date: 10-15-09	Insp. Measurement (%):	Describe:
Re-rate for load capacity?	Reason:			Date Last Rated: 01-13-09

Expansion Joints

		Temp:			Signing Condition			
Location	Type	File Insp. Date	File Insp. (in)	New Insp. (in)	Type of Marker	File	Y/N	Comments
					Bridge Markers	Y	Y	
					Narrow Bridge			
					One Lane Road			
					Vertical Clearance			
					Weight Limit Post			
					Other(Addl. Sign)			

Clearances(Cardinal = N or E)

	File Meas. (ft.)	File Date	New Meas. (ft.)
Min. Vertical Clearance Under (Cardinal)	15.56	10-17-11	
Min. Vertical Clearance Under (non-Cardinal)	15.39		
Min. Vertical Clearance On			

Structure Type

Construction/Rehabilitation History

Material	Configuration	# of Spans	Overall Length (ft)	Year	Work Performed	Plan	Shop
CONT CONCRETE	HAUNCHED SLAB		34.0	1961	NEW STRUCTURE	P038	F046
CONT CONCRETE	HAUNCHED SLAB		49.5	1981	CONCRETE OVER	C226	C226
CONT CONCRETE	HAUNCHED SLAB		34.0	1994	REPAIR DECK		
				2009	CONCRETE OVER		

Inspection Information

Special Requirements	Y/N	Comments
Traffic Control	Y	
Access Equipment	Y	
Other	Y	

Inspector Information

Team Leader Name and No. Printed: Weber, Dale (3007)		Team Member(s) Name(s) Printed:	
Team Leader Signature:		Inspection Date: 10-18-11	Inspection Agency: STATE HIGHWAY DEPARTMENT (1)
District/Local Manager and No. Printed:		District/Local Manager Signature:	Review Date:

Element Inspection (X) Check Elements Inspected

Quantity in Condition States

Ck	Elem./Env.	Description	Unit	Total QTY.	1	2	3	4	5
X	48 / 4	Conc Slab/Conc Ov	SF	5061		5061			
		Shrinkage map cacking							
X	205 / 4	R/Conc Column	EA	8	8				
X	215 / 4	R/Conc Abutment	LF	94	91	3			
		CS-2 (N Abut 1" & S Abut 2"), Leaching between haunch & floor							
X	322 / 4	Bituminous Approach	EA	2	2				
X	331 / 4	Conc Bridge Railing	LF	236	200	36			
X	343 / 4	Crushed Aggregate Sp	EA	2		2			
		Both settling							
X	358 / 4	Deck Cracking SmFlag	EA	1		1			
X	359 / 4	Und Dk Surf Sm Flag	EA	1		1			
X	400 / 4	Concrete Wingwall	EA	4	4				

General Inspection/Maintenance Notes

Maintenance Recommendations (See standard code items & numbers)

Maintenance Item: Approach - Seal Approach to Paving Block
 Amount: Date(YYYY-MM-DD):
 Maintenance item comment: w/rubber

Maintenance Item:
 Amount: Date(MM-DD-YY):
 Maintenance item comment:

NBI Ratings

NBI	File	New	NBI	File	New
Deck	7	7	Culvert	N	N
Superstructure	7	7	Channel	N	N
Substructure	8	8	Waterway	N	N

Maintenance Item:
 Amount: Date(MM-DD-YY):
 Maintenance item comment:

STRUCTURE INVENTORY AND APPRAISAL FIELD REVIEW FORM

B-44-041
 USH 41 NB over STH 55

LOCATION

(3) Municipality:
 (16) Latitude(° ' "):
 (17) Longitude(° ' "):

CITY - KAUKAUNA (44241)
44°17'57.14"N
88°16'20.27"W

TRAFFIC SERVICE

(28A) Lanes On:
 (28B) Lanes Under:
 (102) Traffic Pattern On:
 (102) Traffic Pattern Under:
 (19) Detour Length(mi):

2
2
-NO TRAFFIC X-ONE WAY TRAFFIC -TWO WAY TRAFFIC
-NO TRAFFIC -ONE WAY TRAFFIC X-TWO WAY TRAFFIC
1

GEOMETRY

(49) Structure Length(ft):
 (50) Sidewalk Width(ft):
 (50) Curb Width(ft):
 (52) Culvert Barrel Length(ft):
 (34) Skew:
 (51) Bridge Roadway(ft):
 (52) Deck(ft):
 (32) Approach Roadway(ft):
 (47) Minimum Horizontal(ft):
 (55) Minimum Right Lateral(ft):
 (55) Minimum Left Lateral(ft):

119.3		
Left: 0.0		Right: 0.0
Angle(°): 20		Direction: X-RIGHT FORWARD -LEFT FORWARD
Cardinal Width		Non-Cardinal Width
40.0		40.0
43.0		43.0
40		0
Cardinal Under Clearance		Non-Cardinal Under Clearance
39.0		39.0
6.0		6.0
9.0		9.0

RAILING APPRAISAL

(36A) Bridge Rail Adequacy:
 (36B) Transition Adequacy:
 (36C) Approach Guardrail Adequacy:
 (36D) Guardrail Termination Adequacy:
 Outer Rail:

-SUB-STANDARD	X-STANDARD	-NOT APPLICABLE
-SUB-STANDARD	X-STANDARD	-NOT APPLICABLE
-SUB-STANDARD	X-STANDARD	-NOT APPLICABLE
-SUB-STANDARD	X-STANDARD	-NOT APPLICABLE
Left	Right	Type
		TYPE F (TWO SQUARE TUBES) - STEEL(8)
		TYPE F (3 SQUARE TUBES) - STEEL(65)
		TYPE F (4 SQUARE TUBES) - STEEL(72)
		TYPE M-STEEL 3 SQUARE TUBES(93)
		SLOPED FACE PARAPET LF(91)
		SLOPED FACE PARAPET HF(92)
		VERTICAL FACE PARAPET TYPE A(74)
		TYPE W-THRIE BEAM(79)
		TYPE H ON VERTICAL PARAPET(80)
		TIMBER(38)
X	X	OTHER(99) (Please specify) Left: NJ SLOPING PARAPET(61) Right: NJ SLOPING PARAPET(61)
		CONT GUARD RAIL
		NO APP GRDRL
		NO ATTACHMENT
5		22 MM(7/8") BOLT (Please enter quantity)
		25 MM(1") BOLT (Please enter quantity)
		OTHER (Please specify)
X		(01) ENERGY ABSORBING TERMINAL/EAT
		(02) TURN DOWN
		(99) OTHER (Please specify)

Transition Type:

Guardrail Termination Type:

ROADWAY ALIGNMENT APPRAISAL

(72) Approach Alignment Appraisal:

	(3) INTOLERABLE- Horizontal or Vertical curvature requires a substantial reduction in vehicle operating speed
	(6) FAIR- Horizontal or Vertical curvature requires a very minor speed reduction
X	(8) GOOD- No speed reduction required


This page intentionally left blank

13-AUG-1997 11:10
GREENSPAN


BENCH MARK			
NO	STATION	DESCRIPTION	ELEV
66	1188+70	SPIKE IN S MAPLE 150' LT	109.01

44.1	3.2	21.28	F03-2(4) 58 158
------	-----	-------	-----------------


730
720
710
700
690

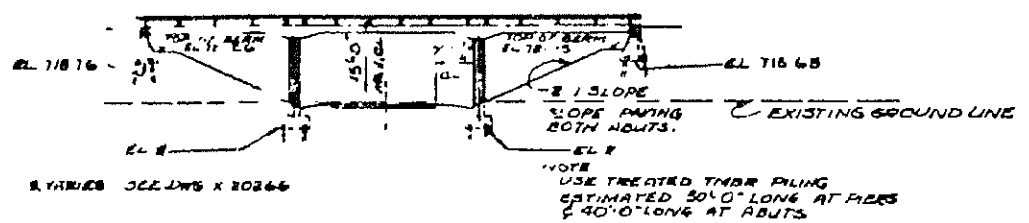


ELEVATION
(AT RT 4101.5 TO GERTRUDE ST)

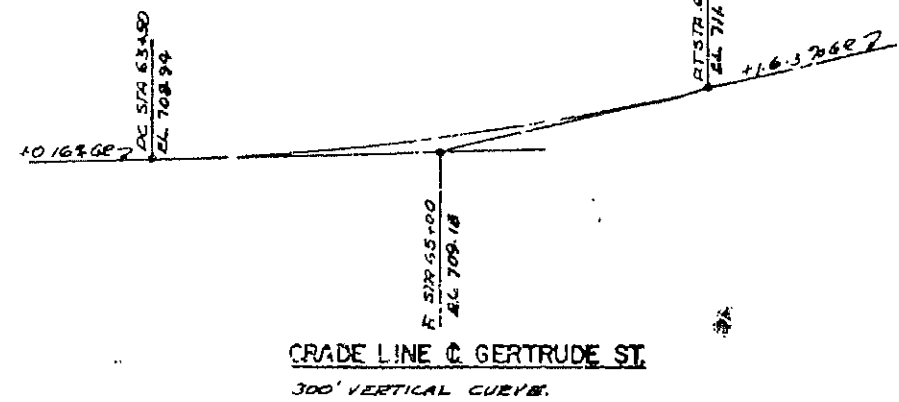

GRADE LINE @ GERTRUDE ST
300' VERTICAL CURVE

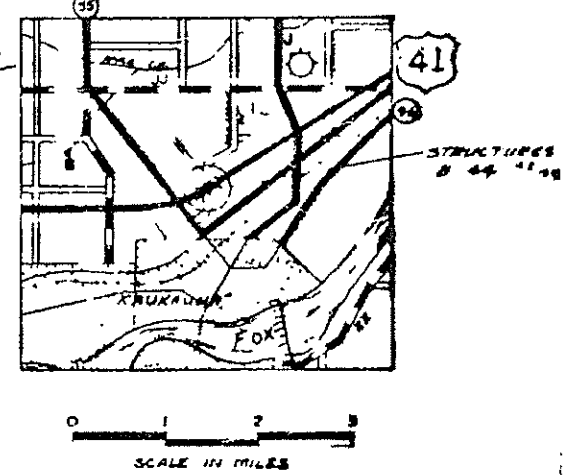

LOCALITY MAP

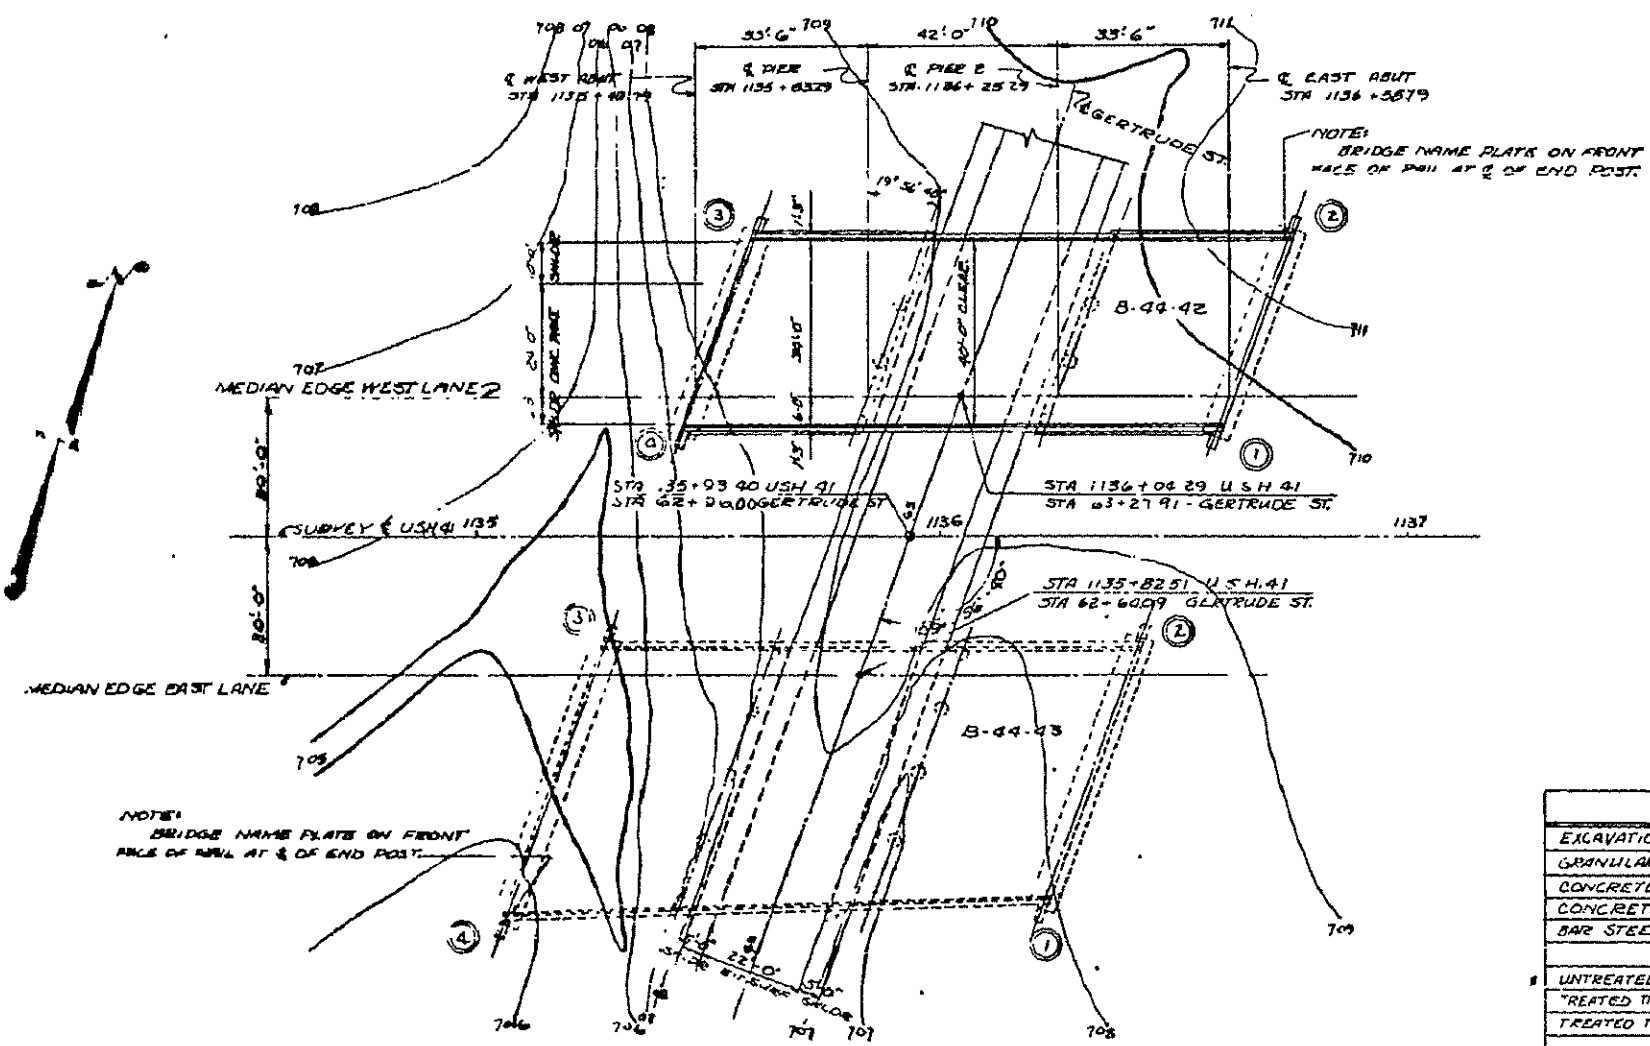

PLAN

3 SPAN (33.5'-02'-0, 33.5') RC CONCRETE SLAB SPAN
ABUTMENTS RC SILL TYPE ON TR TIMBER PILING
PIERS RC COLUMN TYPE ON TR TIMBER PILING

GENERAL NOTES

DRAWINGS SHALL NOT BE SCALED.
ALL CONCRETE MASONRY SHALL BE GRADE "A" EXCEPT FOR
RAILING WHICH SHALL BE GRADE "X"
BAR SILE. REINFORCEMENT SHALL BE INJECTED & CURED
UNLESS OTHERWISE SHOWN OR NOTED.
BEVEL ALL EXPOSED EDGES OF CONCRETE (UNLESS OTHERWISE
SPECIFIED).
THE USE OF STRUCTURAL GRADE BAR STEEL REINFORCEMENT IS
PROHIBITED.
THE TOP AND SLOPE OF THE FILL IN FRONT OF THE ABUTMENTS
SHALL BE COVERED WITH SLOPE PAVING AS SHOWN IN PLAN ON THIS
SHEET AND IN SECTION "A1" ON SHEET X20663
ALL EXCAVATED VOLUME NOT OCCUPIED BY THE ABUTMENTS SHALL
BE FILLED WITH GEN. 11AR BACKFILL TO THE GROUND LINE WHICH
EXISTED BEFORE EXCAVATION FOR ABUTMENTS BEGAN. PAYMENT WILL
BE MADE ONLY FOR MATERIAL ACTUALLY PLACED WITHIN THE LIMITS
SPECIFIED FOR "EXCAVATION FOR STRUCTURES"
PILING AT THE ABUTMENTS SHALL BE TREATED TIMBER PILING
ESTIMATED 40'-0" LONG AND DRIVEN TO A MINIMUM BLAKE
VALUE OF 20 TONS PER PILE.
PILING AT THE PIERS SHALL BE TREATED TIMBER PILING
ESTIMATED 30'-0" LONG AND DRIVEN TO A MINIMUM BLAKE
VALUE OF 20 TONS PER PILE.

MAX DESIGN STRESS
FC = 1400 P.S.I.

TOTAL ESTIMATED QUANTITIES

BID ITEMS	UNIT	SUPER- STRUCTURE	WEST ABUT	PIER 1	PIER 2	EAST ABUT	TOTAL
EXCAVATION FOR STRUCTURES	CY		40	60	70	40	210
GRANULAR BACKFILL	CY		25			25	50
CONCRETE MASONRY GRADE "A-A"	CY	245.3	35.5	30.2	30.2	35.5	376.7
CONCRETE MASONRY GRADE "X"	CY	7.3					7.3
BAR STEEL REINFORCEMENT	LB	60,940	940	2,730	2,730	940	68,290
UNTREATED TIMBER TEST PILE (29' 55' 0")	LOAD SPIN						1
TREATED TIMBER PILING - DELIVERED	LF		600	780	780	600	2,760
TREATED TIMBER PILING - DRIVEN	LF		600	780	780	600	2,760
SLOPE PAVING (CONC BLOCK)	SF		177			177	354
SHEET ZINC	LB	174					174
NON-BID ITEMS							
PRE FORMED FILLER	SF		1' x 1/4"	1/4"	1/4"	1' x 1/4"	1' x 1/4"

* DRIVE ONE AT LOCATION OF PIER 1 AND ONE AT EAST ABUTMENT

LIST OF DRAWINGS

1- GENERAL PLAN	X20662
2- SUPERSTRUCTURE	X20663
3- SUPERSTRUCTURE	X20664
4- ABUTMENTS	X20665
5- PIERS	X20666
6- SUB. INFACE EXPLORATION	X20667

STATE HIGHWAY COMMISSION OF WISCONSIN
GENERAL PLAN
TO OUTGAMIE IN VANDENBROOK
SECTION PC 38 TOTAL 21.28
DESIGN SPEC. AASHTO 1957 LATEST H20-44
DATE 8-20-59 DESIGNER J.B. LARSEN
DRAWN BY H.B. Sch...
CHECKED BY E.L. R...
STRUCTURE B 44 42 SHEET 1 OF 6
X20662

GENERAL NOTES

DRAWING SHALL NOT BE SCALED.
 BAR STEEL REINF. SHALL BE
 EMBEDDED 2" CLEAR UNLESS SHOWN
 OR NOTED OTHERWISE.
 PLAN DIMENS. ARE BASED ON
 ORIGINAL PLAN. FIELD VERIFY BEFORE
 ACCEPTING.

DESIGN DATA

LIVELOAD:
 INVENTORY RATING — H20
 OPERATIONAL RATING — H30

ALLOWABLE DESIGN STRESSES:
 CONCRETE — $f_c = 4,000$ P.S.I.
 HIGH STRENGTH BAR STEEL
 REINFORCEMENT — $f_y = 60,000$ P.S.I.

ADT=1700 (2004)
 $1700 (1.03)^{33} = 4500$

AS BUILT PLAN
 DATE 10/88 BY W.K.

LIST OF DRAWINGS


1. CONCRETE OVERLAY — X78643
 2. SLOPED FACE PARAPET — X78644

TOTAL ESTIMATED QUANTITIES

BID ITEMS	UNIT	TOTAL
REMOVING OLD BRIDGE	L.S.	1
CONCRETE MASONRY, BRIDGES	C.F.	18
PROTECTIVE SURFACE TREATMENT	GAL.	20
COATED HIGH STRENGTH BAR STEEL REINFORCEMENT	L.B.	4,050
DECK CLEANING	S.F.	497
CONCRETE MASONRY, OVERLAY	C.Y.	37
3/4" EXPANSION ANCHORS	E.A.	468
EPOXY CRACK SEALING	L.F.	110
NON-BID ITEMS		
1/2" ALUMINUM OR ZINC PLATE	S.F.	29


* INCLUDES CONC. REQ'D IN PARAPETS ONLY.

No.	Date	Revision	By
STATE OF WISCONSIN DEPARTMENT OF TRANSPORTATION DIVISION OF HIGHWAYS			
STRUCTURE B-44-42			
U.S.H. 41 (S.B.) OVER MALONEY RD.			
County	OUTAGAMIE	Town	VANDEBROEK
Design Spc.	AASHTO 93	Load	LCR 1981
Designer	K.A.B.	Drawn	By
By	Checked	By	Checked
Approved	Stanley W. Woods	3-7-86	DATE
CONCRETE OVERLAY		SHEET 1 OF 2 X78643	

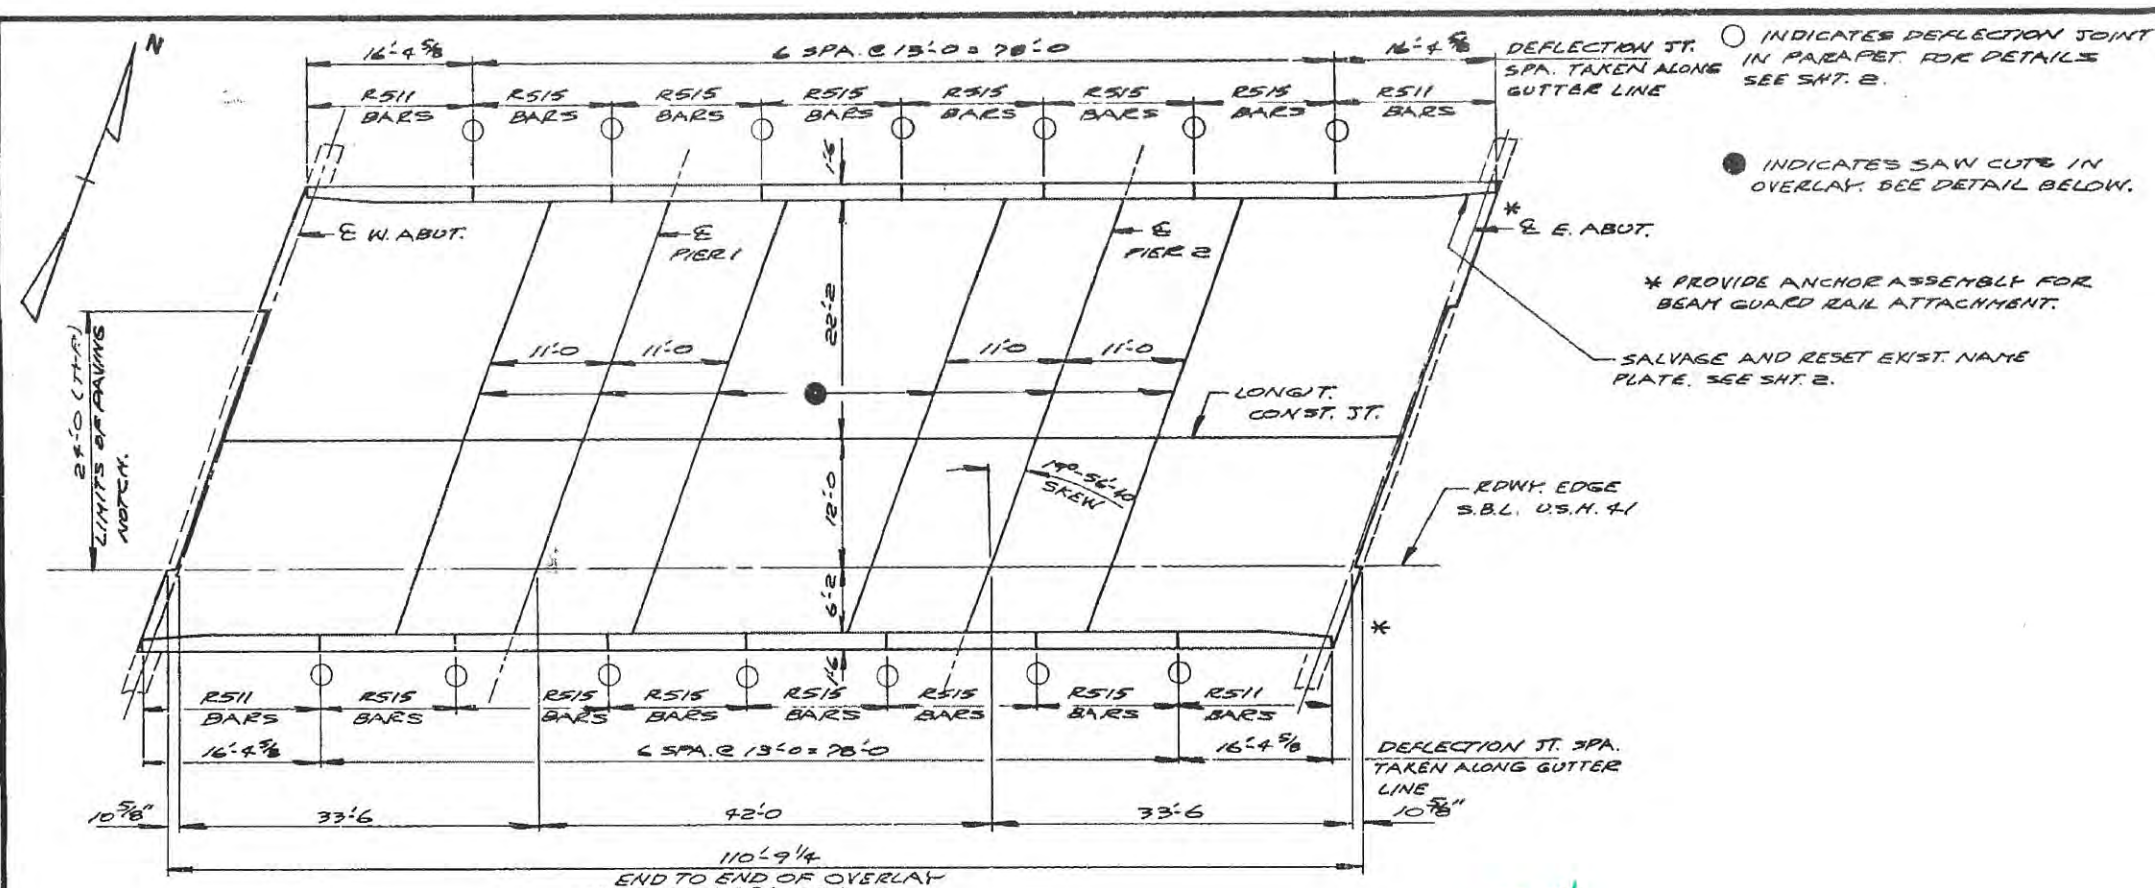


PLAN


NOTE: AVG. OVERLAY THICKNESS = 2"
 TOP OF OVERLAY - ALONG LONGIT. CONST. JT.
 - 0.1%
 WEST END OF DECK STA. 1135+59.95
 EAST END OF DECK STA. 1136+63.23
 EL. 726.16
 EL. 726.05

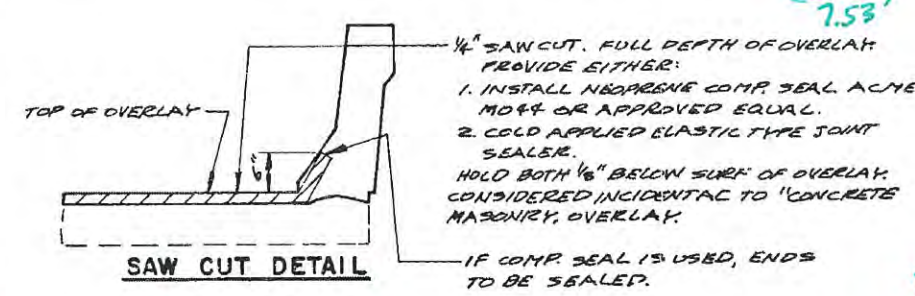


PROPOSED GRADELINE

BENCH MARK: PAINT MARK ON TOP OF WING SOUTHWEST CORNER OF BRIDGE NORTH BOUND. EL. 725.14
 VARIATIONS TO THE NEW GRADE LINE OVER 1/4" MUST BE SUBMITTED FOR REVIEW BY BRIDGE SECTION.
 REMOVE EXIST. CONC. CURB & RAILING. REPLACE WITH SLOPED FACE PARAPET. FOR DETAILS SEE SHT. 2.

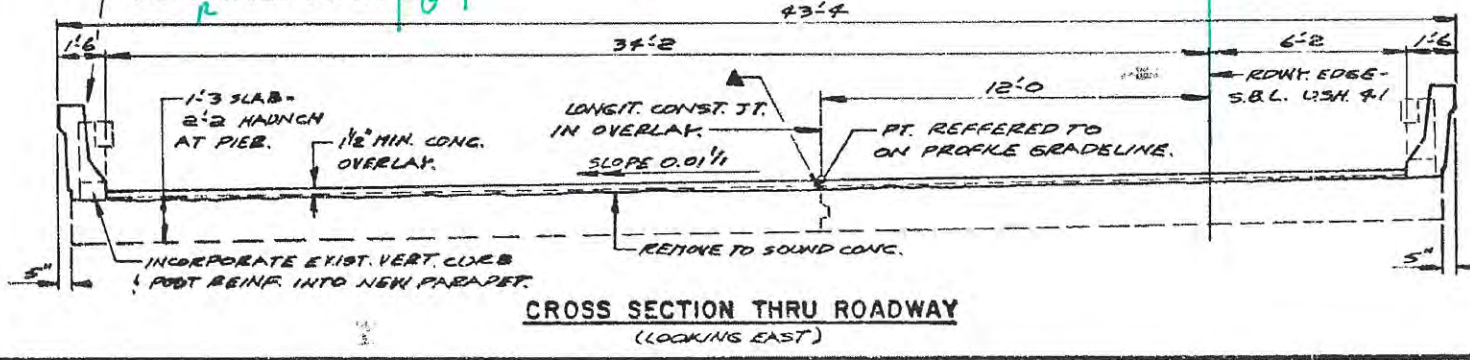


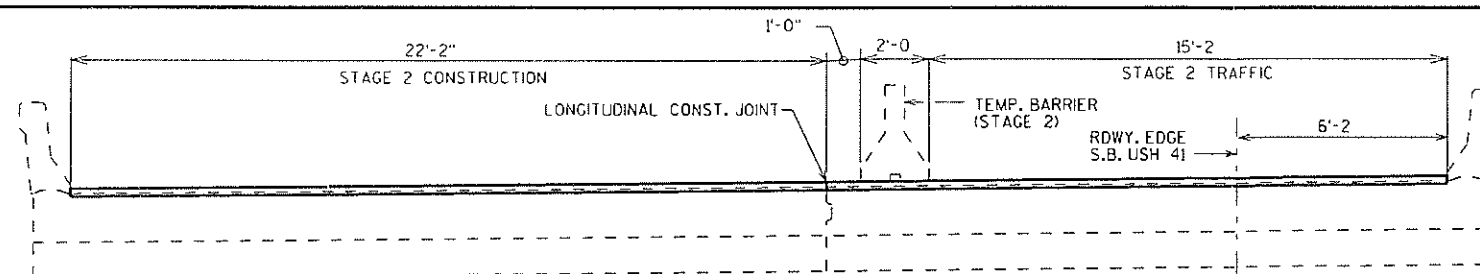


RDWY. CROSS SECT. (STAGE 2)

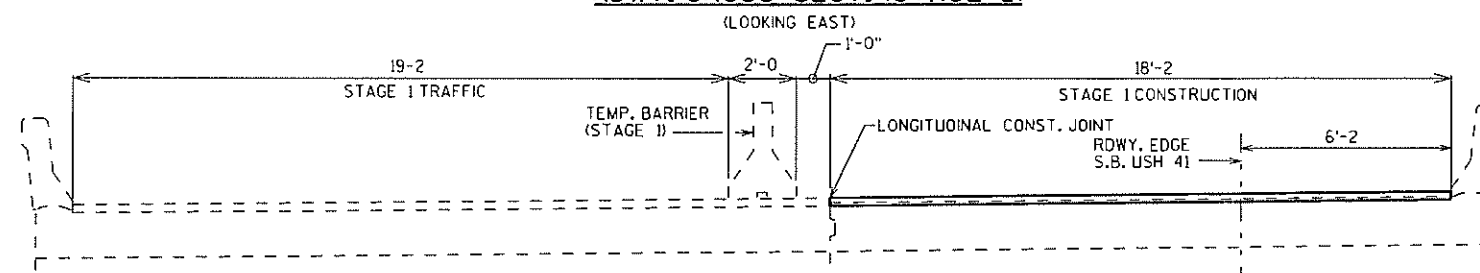

RDWY. CROSS SECT. (STAGE 1)

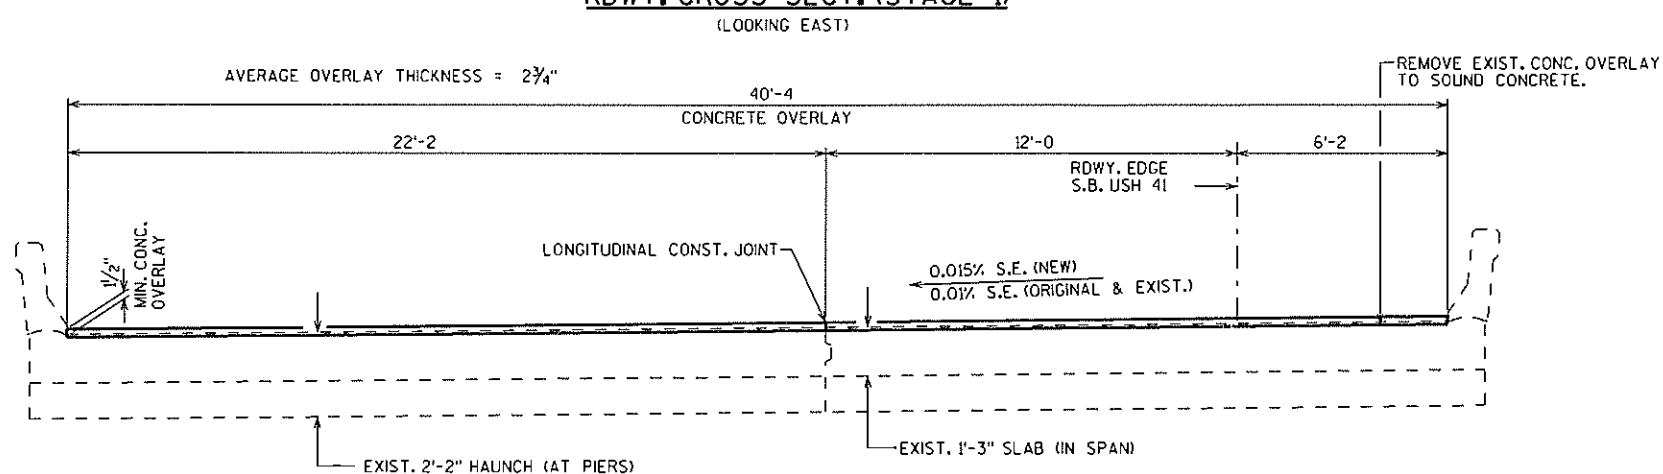

CROSS SECTION THRU RDWY. LOOKING EAST

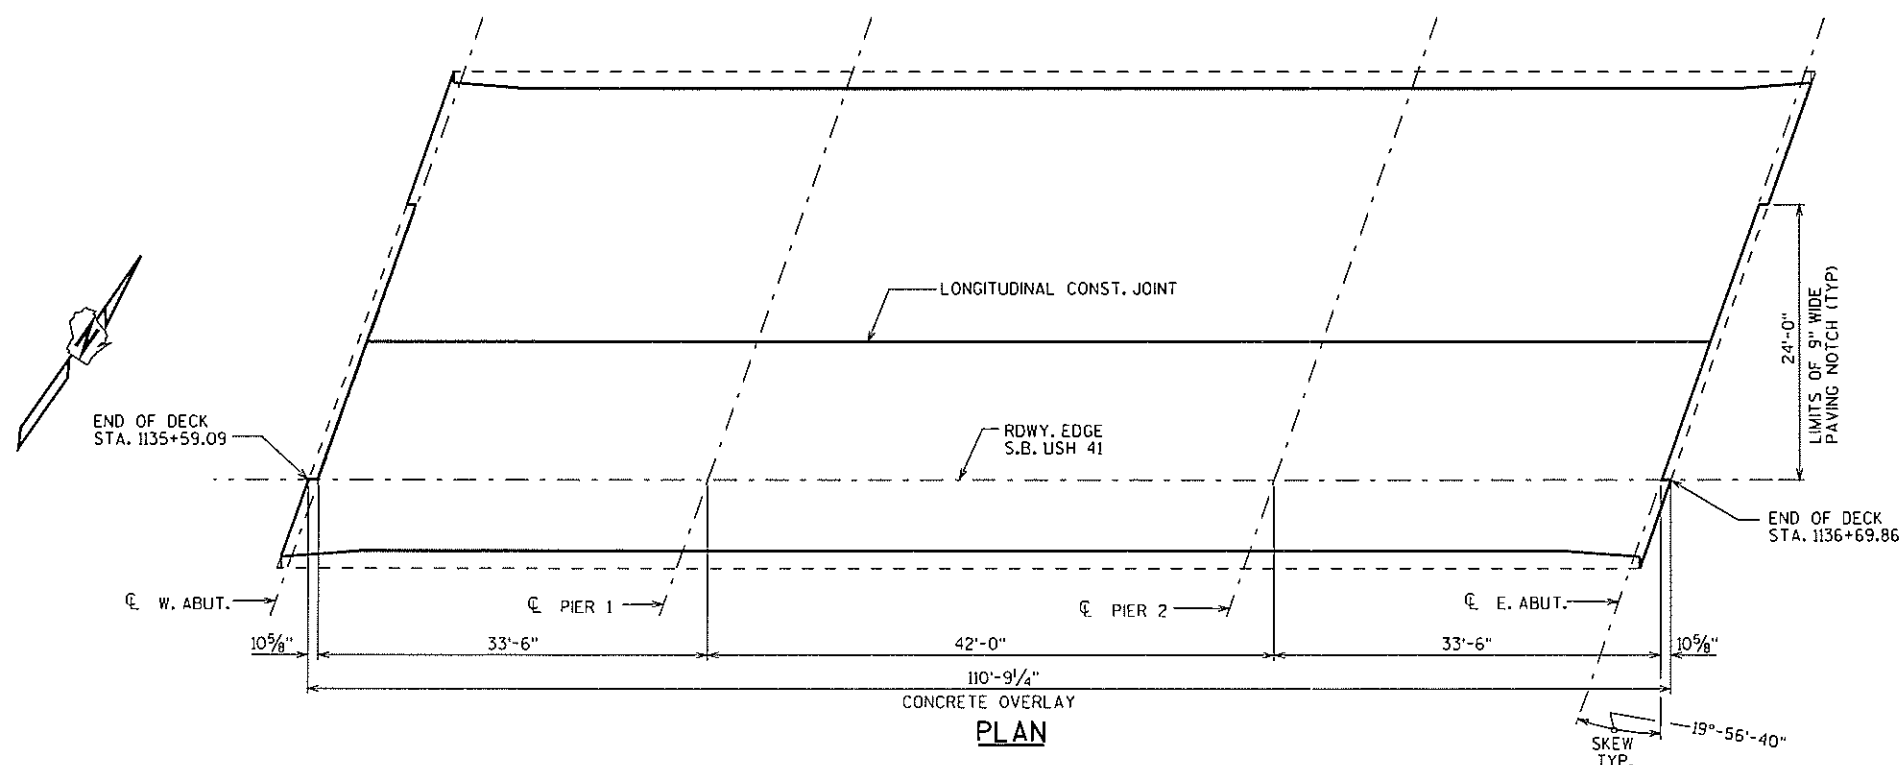

PLAN

DESIGN DATA

LIVE LOAD:

INVENTORY RATING: HS-16

OPERATIONAL RATING: HS-25

MAXIMUM STANDARD PERMIT VEHICLE LOAD = 250 KIPS.

ULTIMATE DESIGN STRESSES:

CONCRETE MASONRY OVERLAY DECKS $f'_c = 4,000$ P.S.I.BAR STEEL REINFORCEMENT $f_y = 60,000$ P.S.I.

GENERAL NOTES

DRAWINGS SHALL NOT BE SCALED.

ANY EXCAVATION NECESSARY TO COMPLETE THE OVERLAY AT THE ABUTMENTS IS TO BE CONSIDERED INCIDENTAL TO THE BID ITEM "CONCRETE MASONRY OVERLAY DECKS".

DIMENSIONS SHOWN ARE BASED ON EXISTING ORIGINAL STRUCTURE PLANS.

CONTACT THE BUREAU OF STRUCTURES DESIGN SECTION BEFORE PLACEMENT OF OVERLAY IF THE AVERAGE THICKNESS OF THE NEW OVERLAY WILL EXCEED 1/2" MORE THAN THE AVERAGE THICKNESS SHOWN ON THE PLANS.

"PROTECTIVE SURFACE TREATMENT" SHALL BE APPLIED TO THE ENTIRE TOP OF DECK SURFACE.

REMOVE EXISTING CONCRETE BLOCKS (USED FOR SLOPE PAVING) AS DIRECTED BY THE ENGINEER IN FIELD.

THERMOGRAPHY RESULT OF THE BRIDGE DECK ARE SHOWN ELSEWHERE IN THE PLAN.

TOTAL ESTIMATED QUANTITIES


REMOVING CONCRETE MASONRY OVERLAY DECKS	490 SY
REMOVING CONCRETE SLOPE PAVING	354 SY
CONCRETE MASONRY OVERLAY DECKS	42 CY
PROTECTIVE SURFACE TREATMENT	490 SY
PREPARATION DECKS TYPE 1	9 SY
PREPARATION DECKS TYPE 2	1 SY
SLOPE PAVING SELECT CRUSHED MATERIAL	354 SY
* CONCRETE SURFACE REPAIR	65 SF
* FULL DEPTH DECK REPAIR	9 SY

* REPAIRS SHALL BE DONE AT THE DIRECTION OF ENGINEER IN FIELD.

STRUCTURES DESIGN CONTACTS = DAVID R. GENSON (608) 266-8491
DEAN SMITH (608) 266-5091

NO.	DATE	REVISION	BY
Plans Prepared By WISDOT BUREAU OF STRUCTURES Approved: <i>William C. Doherty</i> SDR 1-13-09 CHIEF STRUCTURAL DESIGN ENGINEER DATE			
STRUCTURE B-44-42			
USH 41 S.B. OVER MALONEY RD.			
COUNTY	OUTAGAMIE	TOWN/CITY/VILLAGE	KAUKAUNA
DESIGN SPEC.	AASHTO STD. SPEC. 2003	LOAD	CONST. SPEC. 2003
DESIGNED BY	DRG	DESIGN CK'D.	BY JHG
OVERLAY DETAILS			SHEET 1 OF 1
			36

(1/8" grid, 64 squares per inch)

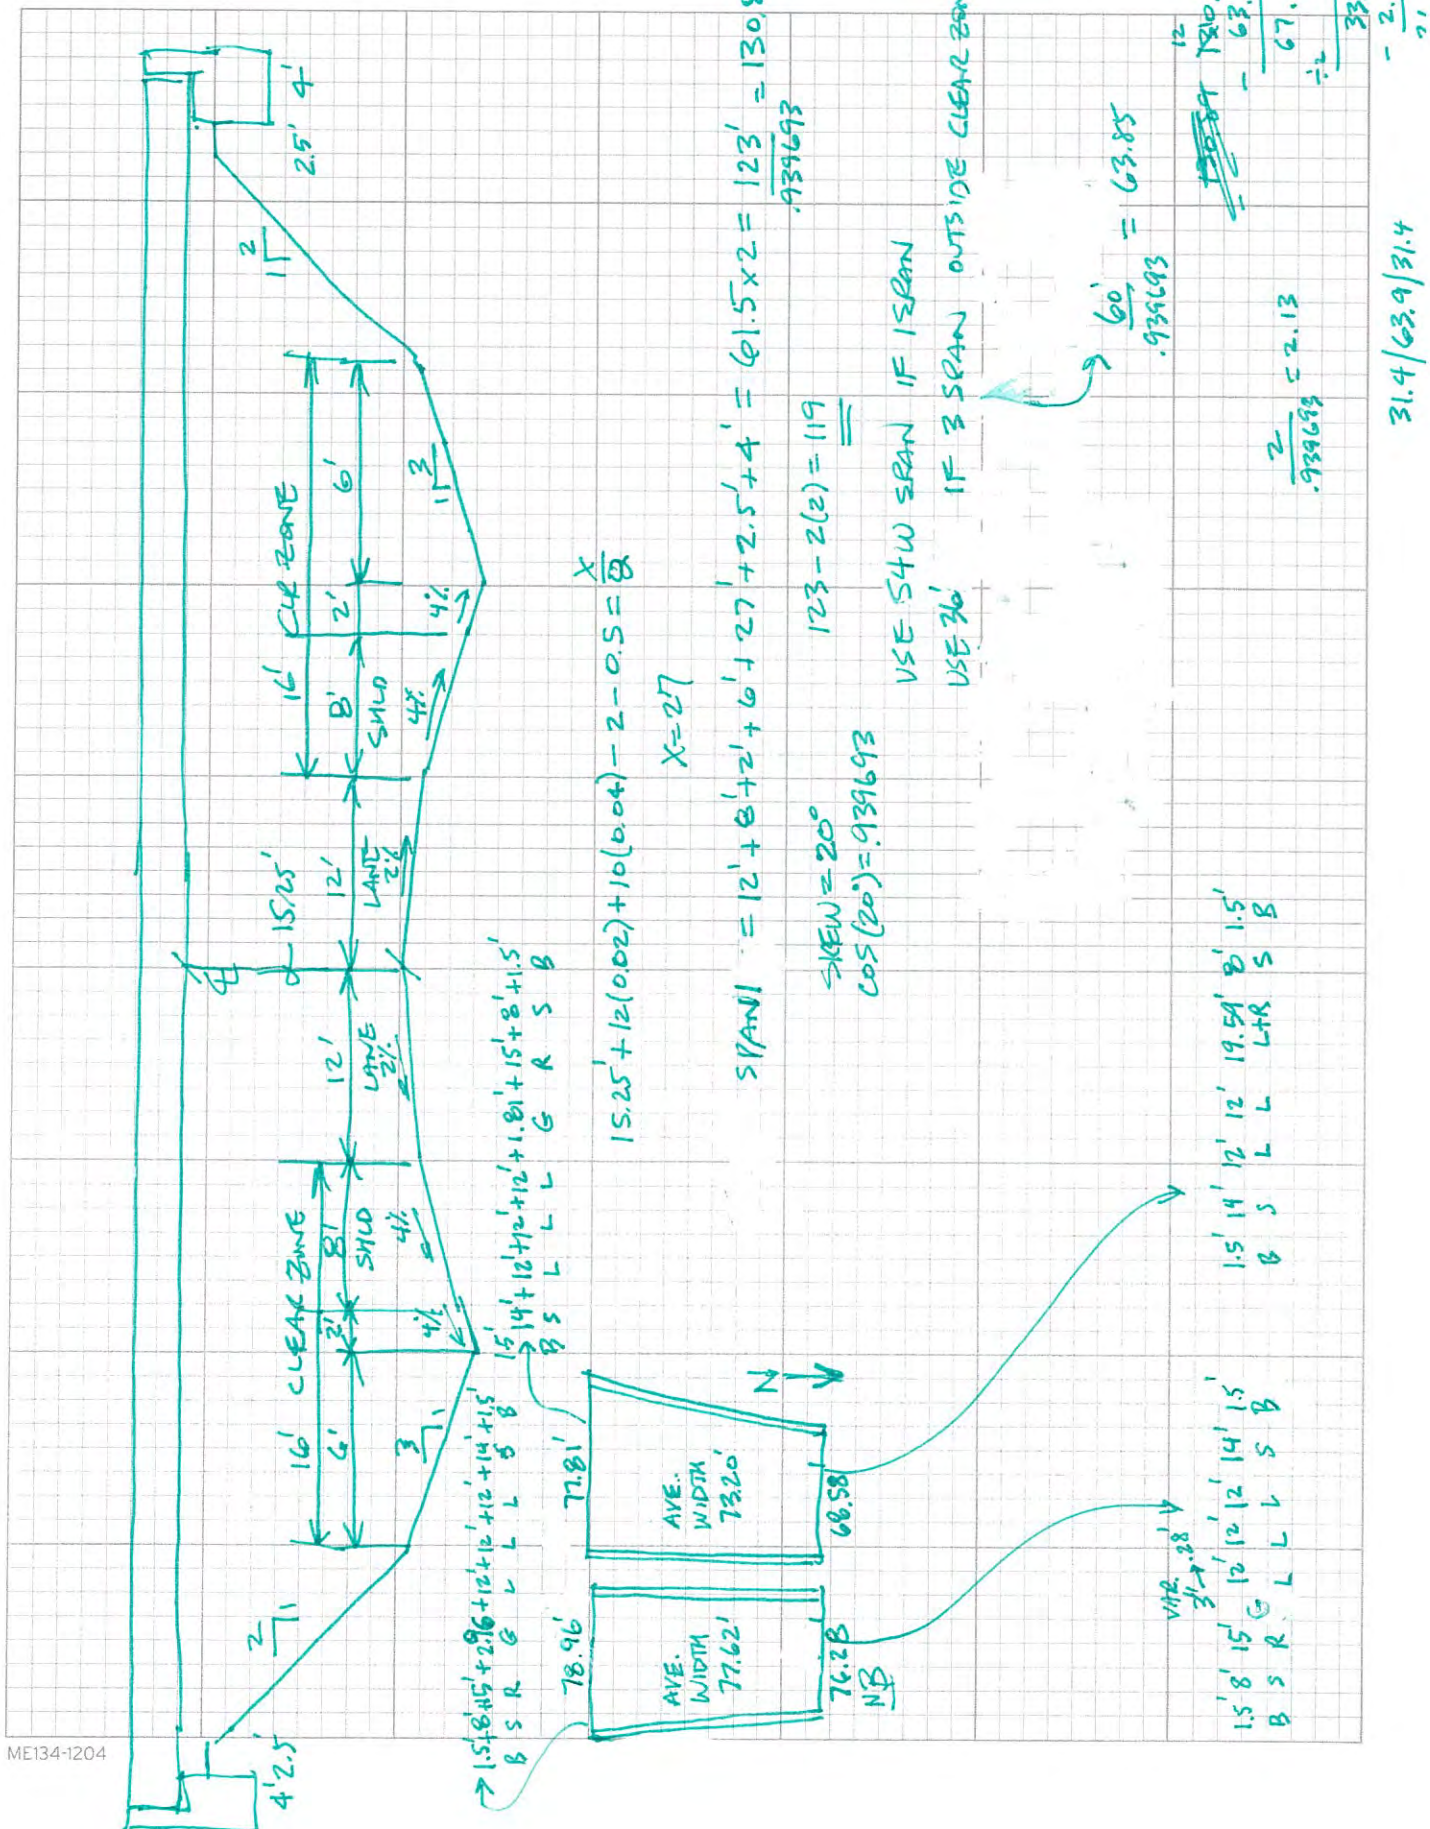

Minimum Vertical Clearance for Existing Bridges which are not Being Replaced and for Existing Bridges on which the Superstructure is not Being Replaced^{1,2}

Overpass Facility →	Freeway, Expressway, or STH		Railroad ⁵ , CTH, Town Road, Local Road, or Street	Pedestrian or Shared-use Structures	Sign Structures ⁶
Underpass Facility ↓	Interchange	Grade Separation			
Non-arterial either STH, CTH, Town Road, Local Road, or Street	15'-3" min. or ES ³	If existing is < 14'-0" then increase to 14'-0" min. or ES ³	16'-3" min. or ES ³		18'-0" min. or ES ³ for existing sign structures on new construction projects or reconstruction projects;
		If existing is ≥ 14'-0", but < 14'-6" then maintain existing min. or ES ³			
		If existing is ≥ 14'-6" then 14'-6" min. or ES ³			
Arterial either CTH, Town Road, Local Road, or Street (excludes freeway and expressway; also excludes arterial STH)	If existing is < 15'-3" then increase to 15'-3" min. or ES ³	If existing is < 14'-0" then increase to 14'-0" min. or ES ³	17'-0" min. or ES ³		17'-0" or ES ³ for existing sign structures on 3R projects
	If existing is ≥ 15'-3", but < 16'-0" then maintain existing min. or ES ³	If existing is ≥ 14'-0", but < 14'-6" then maintain existing min. or ES ³			
	If existing is ≥ 16' 0" then 16' 0" min. or ES ³	If existing is ≥ 14'-6" then 14'-6" min. or ES ³			
Arterial STH (excludes freeway and expressway)	If existing is < 15'-3" then increase to 15'-3" min. or ES ³	If existing is < 14'-0" then increase to 14'-0" min. or ES ³	17'-0" min. or ES ³		
	If existing is ≥ 15'-3", but < 16'-0" then maintain existing min. or ES ³	If existing is ≥ 14'-0", but < 16'-0" then maintain existing min. or ES ³			
	If existing is ≥ 16' 0" then 16' 0" min. or ES ³	If existing is ≥ 16' 0" then 16' 0" min. or ES ³			
Freeway ⁴ or Expressway	16'-0" min. or ES ³				
Railroad ⁵	Maintain existing vertical clearance - if existing clearance is < 23'-0" then confer with BTLR Railroads and Harbors Section to determine the adequacy of the existing clearance.				

General notes:

- ¹ Vertical clearance is needed for the entire roadway width (critical point; to include traveled way, auxiliary lanes, turn lanes, and shoulders), according to the above table. Provide greater than minimum clearance if evaluation shows that greater clearance is needed because bridge superstructure is susceptible to being hit by under-passing vehicles.
Vertical clearance for railroads is measured from the top of rail and is required over an area 8 feet 6 inches from the track centerline on each side of a railroad track.
- ² Include a low clearance sign (W12-2), on structures if its use is in accordance with WisDOT MUTCD 2C.22.
- ³ ES = approved Exceptions To Standards Report required (see [FDM 11-1-2](#) and [FDM 11-1-4](#)).
- ⁴ See [FDM 11-44-1](#) for vertical clearance guidance specific to Interstate freeways.
- ⁵ Consult with the Region Railroad Coordinator if the over-passing or under-passing facility is either a railroad or a "rails-to-trails" trail; or if a structure is owned by a railroad company.
- ⁶ See LRFD Bridge Manual Chapter 39 for design considerations for vertical clearance on Sign Structures (http://on.dot.wi.gov/dtid_bos/extranet/structures/LRFD/LRFDManualIndex.htm).

Vertical Clearance for Construction of New Bridges, Replacement Bridges, and Bridges on which the Superstructure is being replaced¹

Overpass Facility →	Freeway, Expressway, or STH		Railroad ⁴ , CTH, Town Road, Local Road, or Street	Pedestrian or Shared-use Structures	Sign Structures ²
Underpass Facility ↓	Interchange	Grade Separation			
Non-arterial either STH, CTH, Town Road, Local Road, or Street	15'-9" Desirable	15'-3" Desirable	16'- 9" Desirable	18'-3" Minimum	
	15'-3" Minimum	14'-9" Minimum	16'-3" Minimum		
Arterial either CTH, Town Road, Local Road, or Street (excludes freeway and expressway; also excludes arterial STH)	16'-9" Desirable	15'-3" Desirable	17'- 9" Desirable		
	16'-3" Minimum	14'-9" Minimum	17'-3" Minimum		
Freeway ³ or Expressway or arterial STH	16'-9" Desirable		17'- 9" Desirable		
	16'-4" Minimum		17'-4" Minimum		
Railroad ^{4,5,6,7}	23'-0" Minimum to 23'-3½" Maximum				

General notes:

- ¹ Vertical clearance is needed for the entire roadway width (critical point; to include traveled way, auxiliary lanes, turn lanes, and shoulders), according to the above table.

Vertical clearance for railroads is measured from the top of rail and is required over an area 8 feet 6 inches from the track centerline on each side of a railroad track.

Do not exceed the desirable vertical clearance shown unless justified. Depending on topography and other specific situations vertical clearance for any structure may be greater than that shown when justified. Some things to consider are: over height loads traveling on the roadway; the level of development in the area, the projected growth in traffic volume and importance of the roadway, and the possibility of reclassification.

- ² See LRFD Bridge Manual Chapter 39 (http://on.dot.wi.gov/dtid_bos/extranet/structures/LRFD/LRFDManualIndex.htm) and LRFD Standard Details 39.02 and 39.10 for design considerations and requirements for vertical clearance on new and replacement Sign Structures.
- ³ See FDM 11-44-1 for vertical clearance guidance specific to Interstate freeways.
- ⁴ Consult with the Region Railroad Coordinator if the over-passing or under-passing facility is either a railroad or a "rails-to-trails" trail; or if a structure is owned by a railroad company.
- ⁵ A vertical clearance <23'-0" requires both an approved Exception to Standards (see FDM 11-1-2 and FDM 11-1-4) and early coordination with BTLR R&H, Railroads and Harbors Section (RHS) through the Region Railroad Coordinator. The Exception to Standards shall contain documentation that the Office of the Commissioner of Railroads (OCR) has been petitioned.
- See Chapter 17 for additional information.
- ⁶ Provide justification for a vertical clearance >23'-3 ½" to the RHS.
- ⁷ Vertical clearance less than 23'-0" may be acceptable or desirable in certain situations, such as for spur tracks, lead tracks, some branch lines and even mainline tracks when other impediments to 23'-0" exist. Review such situations with the Railroad Project Coordination Engineer in RHS. Early coordination with RHS is required.

BRIDGE INSPECTION REPORT
 Wisconsin Dept. of Transportation
 DT2007 2003 s.84.17 Wis. Stats. Type = ROUTINE INSPECTION

page 1

Inventory Data

Feature On: USH 41 SB		Maintainer: STATE HIGHWAY DEPT		Structure No: B-44-042
Feature Under: MALONEY RD		Sect/Twn/Rng: S12 T21N R18E		
Location: 2.4M S JCT CTH JJ		County: OUTAGAMI	Municipality: CITY-KAUKAUNA (44241)	
Inv Rating: HS16	Rdwy Width (ft): 40.3	Deck Width (ft): 43.3	Existing Posting:	
Oper Rating: HS25	Total Length (ft): 110.8	Deck Area(ft2): 4797	ADT On: 23525 Yr: 1991	ADT Under: 500 Yr: 1980

Inspection Type (* = Supplemental Form Required)

	Routine Visual	Fracture Critical*	In-Depth*	UW-Dive*	UW-Surv*	UW-Probe/Visual*	Movable*
Last Insp.	10-17-11						
Frequency	24						
Recom. Freq.							
	Initial*	Damage	Interim	Load Posted	SI & A Field Review*		
Last Insp.							
Frequency	N/A						
Recom. Freq.	N/A				Item No. Needing Change		

Load Rating Information

Overburden	Measurement (in): 2.0	Date: 11-06-01	Deck Surface Type: CONCRETE	
Section Loss	File Meas. (%):	File Insp. Date: 10-15-09	Insp. Measurement (%):	Describe:
Re-rate for load capacity?	Reason:		Date Last Rated: 01-07-09	

Expansion Joints

Location	Type	Temp:	File Insp. (in)	New Insp. (in)	Signing Condition			Comments
		File Insp. Date			Type of Marker	File	Y/N	
					Bridge Markers	Y	Y	
					Narrow Bridge			
					One Lane Road			
					Vertical Clearance			
					Weight Limit Post			
					Other(Addl. Sign)			

Clearances(Cardinal = N or E)

	File Meas. (ft.)	File Date	New Meas. (ft.)
Min. Vertical Clearance Under (Cardinal)	15.33		
Min. Vertical Clearance Under (non-Cardinal)			
Min. Vertical Clearance On			

Structure Type

Material	Configuration	# of Spans	Overall Length (ft)	Construction/Rehabilitation History			
				Year	Work Performed	Plan	Shop
CONT CONCRETE	HAUNCHED SLAB		33.5	1961	NEW STRUCTURE	P037	
CONT CONCRETE	HAUNCHED SLAB		42.0	1986	CONCRETE OVER	C275	
CONT CONCRETE	HAUNCHED SLAB		33.5	1994	REPAIR DECK		
				2009	CONCRETE OVER		

Inspection Information

Special Requirements	Y/N	Comments				
Traffic Control	Y					
Access Equipment	Y					
Other	Y					

Inspector Information

Team Leader Name and No. Printed: Michaelson, Neil (3010)		Team Member(s) Name(s) Printed:	
Team Leader Signature:		Inspection Date: 10-17-11	Inspection Agency: STATE HIGHWAY DEPARTMENT (1)
District/Local Manager and No. Printed:		District/Local Manager Signature:	Review Date:

Element Inspection (X) Check Elements Inspected

					Quantity in Condition States				
Ck	Elem./Env.	Description	Unit	Total QTY.	1	2	3	4	5
X	48 / 4	Conc Slab/Conc Ov	SF	4728		4728			
		Areas of map cracking from shrinkage, const js leaching.							
X	205 / 3	R/Conc Column	EA	8	8				
X	215 / 4	R/Conc Abutment	LF	94	79	15			
		Leaching between floor & haunch; areas of delamination marked but never repair during last rehab							
X	322 / 4	Bituminous Approach	EA	2		2			
X	331 / 4	Conc Bridge Railing	LF	219	179	30	10		
		Rust staining coming through the surface of parapet							
X	340 / 3	Concrete Slope Prote	EA	2		2			
		slope protection has settled slightly							
X	358 / 4	Deck Cracking SmFlag	EA	1	1				
X	359 / 4	Und Dk Surf Sm Flag	EA	1		1			
		Construction joint has been repaired. Minor leaching occurring at the construction joint							
X	400 / 4	Concrete Wingwall	EA	4	4				

General Inspection/Maintenance Notes

--

Maintenance Recommendations (See standard code items & numbers)

Maintenance Item:
Amount: Date(YYYY-MM-DD):
Maintenance item comment:

Maintenance Item:
Amount: Date(MM-DD-YY):
Maintenance item comment:

NBI Ratings

NBI	File	New	NBI	File	New
Deck	7	7	Culvert	N	N
Superstructure	7	7	Channel	N	N
Substructure	8	7	Waterway	N	N

Maintenance Item:
Amount: Date(MM-DD-YY):
Maintenance item comment:

STRUCTURE INVENTORY AND APPRAISAL FIELD REVIEW FORM

B-44-042
USH 41 SB over MALONEY RD

- (3) Municipality:
(16) Latitude(" ' "):
(17) Longitude(" ' "):

LOCATION	
CITY - KAUKAUNA (44241)	
44°18'06.00"N	
88°16'06.00"W	

- (28A) Lanes On:
(28B) Lanes Under:
(102) Traffic Pattern On:
(102) Traffic Pattern Under:
(19) Detour Length(mi):

TRAFFIC SERVICE	
2	
2	
-NO TRAFFIC	X-ONE WAY TRAFFIC
-NO TRAFFIC	-ONE WAY TRAFFIC
-NO TRAFFIC	X-TWO WAY TRAFFIC
0	

- (49) Structure Length(ft):
(50) Sidewalk Width(ft):
(50) Curb Width(ft):
(52) Culvert Barrel Length(ft):
(34) Skew:
(51) Bridge Roadway(ft):
(52) Deck(ft):
(32) Approach Roadway(ft):
(47) Minimum Horizontal(ft):
(55) Minimum Right Lateral(ft):
(55) Minimum Left Lateral(ft):

GEOMETRY	
110.8	
Left: 0.0	Right: 0.0
0.0	
Angle(°): 20	Direction: -RIGHT FORWARD X-LEFT FORWARD
Cardinal Width	Non-Cardinal Width
40.3	40.3
43.3	43.3
40	0
Cardinal Under Clearance	Non-Cardinal Under Clearance
37.5	
7.5	
8.0	

- (36A) Bridge Rail Adequacy:
(36B) Transition Adequacy:
(36C) Approach Guardrail Adequacy:
(36D) Guardrail Termination Adequacy:
Outer Rail:

RAILING APPRAISAL		
-SUB-STANDARD	X-STANDARD	-NOT APPLICABLE
-SUB-STANDARD	X-STANDARD	-NOT APPLICABLE
-SUB-STANDARD	X-STANDARD	-NOT APPLICABLE
-SUB-STANDARD	X-STANDARD	-NOT APPLICABLE
Left	Right	Type
		TYPE F (TWO SQUARE TUBES) - STEEL(8)
		TYPE F (3 SQUARE TUBES) - STEEL(65)
		TYPE F (4 SQUARE TUBES) - STEEL(72)
		TYPE M-STEEL 3 SQUARE TUBES(93)
		SLOPED FACE PARAPET LF(91)
		SLOPED FACE PARAPET HF(92)
		VERTICAL FACE PARAPET TYPE A(74)
		TYPE W-THREE BEAM(79)
		TYPE H ON VERTICAL PARAPET(80)
		TIMBER(38)
X	X	OTHER(99) (Please specify) Left: NJ SLOPING PARAPET(61) Right: NJ SLOPING PARAPET(61)
Transition Type:		
CONT GUARD RAIL		
NO APP GRDRL		
NO ATTACHMENT		
4		22 MM(7/8") BOLT (Please enter quantity)
		25 MM(1") BOLT (Please enter quantity)
		OTHER (Please specify)
Guardrail Termination Type:		
X		(01) ENERGY ABSORBING TERMINAL/EAT
		(02) TURN DOWN
		(99) OTHER (Please specify)

- (72) Approach Alignment Appraisal:

ROADWAY ALIGNMENT APPRAISAL	
	(3) INTOLERABLE- Horizontal or Vertical curvature requires a substantial reduction in vehicle operating speed
	(6) FAIR- Horizontal or Vertical curvature requires a very minor speed reduction
X	(8) GOOD- No speed reduction required

This page intentionally left blank

BRIDGE INSPECTION REPORT
Wisconsin Dept. of Transportation
DT2007 2003 s.84.17 Wis. Stats. Type = ROUTINE INSPECTION

page 1

Inventory Data

Feature On: USH 41 NB		Maintainer: STATE HIGHWAY DEPT		Structure No: B-44-043	
Feature Under: MALONEY RD		Sect/Twn/Rng: S12 T12N R18E			
Location: 0.2M N JCT STH 55 TO		County: OUTAGAMI	Municipality: CITY-KAUKAUNA (44241)		
Inv Rating: HS16	Rdwy Width (ft): 53.8	Deck Width (ft): 60.1	Existing Posting:		
Oper Rating: HS25	Total Length (ft): 110.8	Deck Area(ft2): 6659	ADT On: 19475 Yr: 2003	ADT Under: 500 Yr: 1980	

Inspection Type (* = Supplemental Form Required)

	Routine Visual	Fracture Critical*	In-Depth*	UW-Dive*	UW-Surv*	UW-Probe/Visual*	Movable*
Last Insp.	10-17-11						
Frequency	24						
Recom. Freq.							
	Initial*	Damage	Interim	Load Posted	SI & A Field Review*		
Last Insp.							
Frequency	N/A						
Recom. Freq.	N/A				Item No. Needing Change		

Load Rating Information

Overburden	Measurement (in): 2.0	Date: 11-06-01	Deck Surface Type: CONCRETE		
Section Loss	File Meas. (%):	File Insp. Date: 10-15-09	Insp. Measurement (%):	Describe:	
Re-rate for load capacity?	Reason:			Date Last Rated: 01-07-09	

Expansion Joints

		Temp:			Signing Condition			
Location	Type	File Insp. Date	File Insp. (in)	New Insp. (in)	Type of Marker	File	Y/N	Comments
					Bridge Markers	Y	Y	
					Narrow Bridge			
					One Lane Road			
					Vertical Clearance			
					Weight Limit Post			
					Other(Addl. Sign)			

Clearances(Cardinal = N or E)

	File Meas. (ft.)	File Date	New Meas. (ft.)
Min. Vertical Clearance Under (Cardinal)	15.17		
Min. Vertical Clearance Under (non-Cardinal)			
Min. Vertical Clearance On			

Structure Type

Construction/Rehabilitation History

Material	Configuration	# of Spans	Overall Length (ft)	Year	Work Performed	Plan	Shop
CONT CONCRETE	HAUNCHED SLAB		33.5	1961	NEW STRUCTURE	P038	
CONT CONCRETE	HAUNCHED SLAB		42.0	1984	CONCRETE OVER	C226	C226
CONT CONCRETE	HAUNCHED SLAB		33.5	2009	CONCRETE OVER		

Inspection Information

Special Requirements	Y/N	Comments				
Traffic Control	Y					
Access Equipment	Y					
Other	Y					

Inspector Information

Team Leader Name and No. Printed: Michaelson, Neil (3010)		Team Member(s) Name(s) Printed:			
Team Leader Signature:		Inspection Date: 10-17-11		Inspection Agency: STATE HIGHWAY DEPARTMENT (1)	
District/Local Manager and No. Printed:		District/Local Manager Signature:		Review Date:	

Element Inspection (X) Check Elements Inspected

Quantity in Condition States

Ck	Elem./Env.	Description	Unit	Total QTY.	1	2	3	4	5
X	48 / 4	Conc Slab/Conc Ov	SF	6671		6671			
		Map cracking from shrinkage							
X	205 / 3	R/Conc Column	EA	10	10				
X	215 / 4	R/Conc Abutment	LF	130	111	19			
		CS-2 (N Abut 7" & S Abut 12"), Leaching between floor & haunch							
X	321 / 4	R/Conc Approach Slab	EA	2	2				
X	331 / 4	Conc Bridge Railing	LF	223	170	53			
X	340 / 4	Concrete Slope Prote	EA	2	1	1			
		Concrete block, Sliding down hill, some blocks missing on North abutment Missing concrete sections repaired with breaker run							
X	358 / 4	Deck Cracking SmFlag	EA	1	1				
X	359 / 4	Und Dk Surf Sm Flag	EA	1			1		
		Severe leaching at const. joint							
X	400 / 4	Concrete Wingwall	EA	4	4				

General Inspection/Maintenance Notes

Maintenance Recommendations (See standard code items & numbers)

Maintenance Item: Approach - Seal Approach to Paving Block
Amount: Date(YYYY-MM-DD):
Maintenance item comment: Seal joints at the end of the deck

Maintenance Item:
Amount: Date(MM-DD-YY):
Maintenance item comment:

Maintenance Item:
Amount: Date(MM-DD-YY):
Maintenance item comment:

NBI Ratings

NBI	File	New	NBI	File	New
Deck	7	7	Culvert	N	N
Superstructure	7	6	Channel	N	N
Substructure	7	7	Waterway	N	N

STRUCTURE INVENTORY AND APPRAISAL FIELD REVIEW FORM

B-44-043
 USH 41 NB over MALONEY RD

LOCATION

(3) Municipality:
 (16) Latitude(° ' "):
 (17) Longitude(° ' "):

CITY - KAUKAUNA (44241)
44°17'60.00"N
88°16'06.00"W

TRAFFIC SERVICE

(28A) Lanes On:
 (28B) Lanes Under:
 (102) Traffic Pattern On:
 (102) Traffic Pattern Under:
 (19) Detour Length(mi):

3
2
-NO TRAFFIC X-ONE WAY TRAFFIC -TWO WAY TRAFFIC
-NO TRAFFIC -ONE WAY TRAFFIC X-TWO WAY TRAFFIC
0

GEOMETRY

(49) Structure Length(ft):
 (50) Sidewalk Width(ft):
 (50) Curb Width(ft):
 (52) Culvert Barrel Length(ft):
 (34) Skew:
 (51) Bridge Roadway(ft):
 (52) Deck(ft):
 (32) Approach Roadway(ft):
 (47) Minimum Horizontal(ft):
 (55) Minimum Right Lateral(ft):
 (55) Minimum Left Lateral(ft):

110.8	
Left: 0.0	Right: 0.0
Angle(°): 20	Direction: -RIGHT FORWARD X-LEFT FORWARD
Cardinal Width	Non-Cardinal Width
53.8	57.1
60.1	60.1
40	0
Cardinal Under Clearance	Non-Cardinal Under Clearance
37.5	
8.0	
7.5	

RAILING APPRAISAL

(36A) Bridge Rail Adequacy:
 (36B) Transition Adequacy:
 (36C) Approach Guardrail Adequacy:
 (36D) Guardrail Termination Adequacy:
 Outer Rail:

-SUB-STANDARD X-STANDARD -NOT APPLICABLE		
-SUB-STANDARD X-STANDARD -NOT APPLICABLE		
-SUB-STANDARD X-STANDARD -NOT APPLICABLE		
-SUB-STANDARD X-STANDARD -NOT APPLICABLE		
Left	Right	Type
		TYPE F (TWO SQUARE TUBES) - STEEL(8)
		TYPE F (3 SQUARE TUBES) - STEEL(65)
		TYPE F (4 SQUARE TUBES) - STEEL(72)
		TYPE M-STEEL 3 SQUARE TUBES(93)
		SLOPED FACE PARAPET LF(91)
		SLOPED FACE PARAPET HF(92)
		VERTICAL FACE PARAPET TYPE A(74)
		TYPE W-THREE BEAM(79)
		TYPE H ON VERTICAL PARAPET(80)
		TIMBER(38)
X	X	OTHER(99) (Please specify) Left: NJ SLOPING PARAPET(61) Right: NJ SLOPING PARAPET(61)
		CONT GUARD RAIL
		NO APP GRDRL
		NO ATTACHMENT
4		22 MM(7/8") BOLT (Please enter quantity)
		25 MM(1") BOLT (Please enter quantity)
		OTHER (Please specify)
X		(01) ENERGY ABSORBING TERMINAL/EAT
		(02) TURN DOWN
		(99) OTHER (Please specify)

Transition Type:

Guardrail Termination Type:

ROADWAY ALIGNMENT APPRAISAL

(72) Approach Alignment Appraisal:

	(3) INTOLERABLE- Horizontal or Vertical curvature requires a substantial reduction in vehicle operating speed
	(6) FAIR- Horizontal or Vertical curvature requires a very minor speed reduction
X	(8) GOOD- No speed reduction required

This page intentionally left blank

0044-34-11

8.9

GENERAL NOTES

DRAWINGS ARE NOT TO BE SCALED.
CONTRACTOR SHALL VERIFY DIMENSIONS
IN THE FIELD.

BID ITEM "CONCRETE MASONRY" INCLUDES
PARAPET CONCRETE ONLY.

BAR STEEL REINF. SHALL BE IMBEDDED
2' CLEAR UNLESS OTHERWISE SHOWN OR NOTED.

VARIATIONS TO THE NEW GRADE LINE
OVER 1/4" MUST BE SUBMITTED BY THE FIELD
ENGINEER TO THE BRIDGE SECTION FOR APPROVAL.

CLEAN & SEAL EXIST. LONGIT. CONST. JOINTS
WITH PENETRATING EPOXY AS DIRECTED BY THE
ENGINEER.

TOTAL ESTIMATED QUANTITIES

BID ITEMS

REMOVING OLD BRIDGE	1	L. S.
CONCRETE MASONRY, OVERLAY	40	C. Y.
DECK CLEANING	675	S. Y.
DECK PREPARATION	34	S. Y.
CONCRETE MASONRY	19	C. Y.
HIGH STRENGTH		
BAR STEEL REINFORCEMENT	3,420	LBS.
STRUCTURAL CARBON STEEL	30	LBS.
EXPANSION ANCHORS, 3/4-INCH DIA.	416	EACH
EPOXY JOINT SEALING	220	L. F.

NON-BID ITEMS

1/2" ALUMINUM OR ZINC PLATE	33	S. F.
-----------------------------	----	-------

DESIGN DATA

LIVE LOAD:

INVENTORY RATING _____ H 18


OPERATING RATING _____ HS 26

ALLOWABLE DESIGN STRESSES:

CONCRETE MASONRY _____ $f'_c = 4,000$ psiHIGH STRENGTH BAR STEEL
REINFORCEMENT _____ $f_y = 60,000$ psi

1/4" SAW CUT, FULL DEPTH OF OVERLAY.

PROVIDE EITHER:

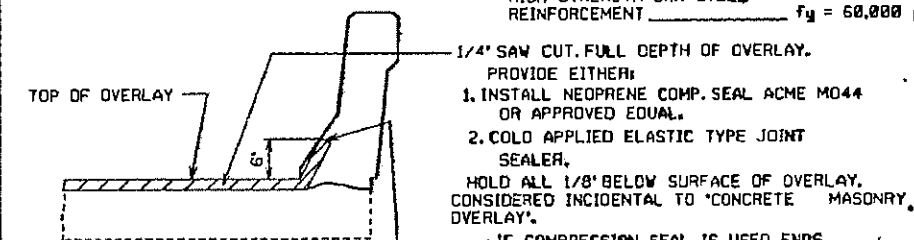1. INSTALL NEOPRENE COMP. SEAL ACME M044
OR APPROVED EQUAL.2. COLD APPLIED ELASTIC TYPE JOINT
SEALER.HOLD ALL 1/8" BELOW SURFACE OF OVERLAY.
CONSIDERED INCIDENTAL TO "CONCRETE MASONRY,
OVERLAY".IF COMPRESSION SEAL IS USED, ENDS
TO BE SEALED. SEAL TO BE PLACED
IN ONE CONTINUOUS PIECE.

SAW CUT DETAIL


LIST OF DRAWINGS

- OVERLAY _____ X72394
- SLOPED FACE PARAPET _____ X72395

AS BUILT PLAN


DATE 10-85 BY W.K.

* ANCHOR ASSEMBLY FOR
PLATE BEAM TYPE
GUARD RAIL @ THESE
LOCATIONS. SEE SHEET 2
FOR DETAILS.

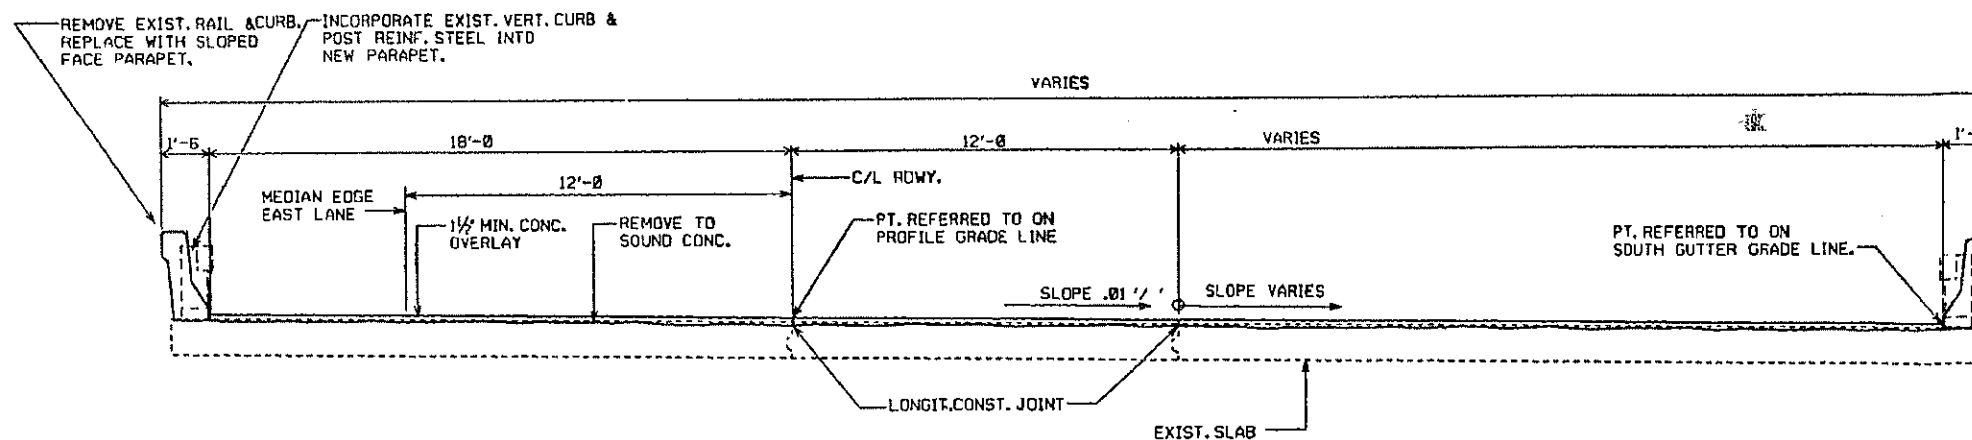


CROSS SECT. THRU ROWY.

(LOOKING EAST)

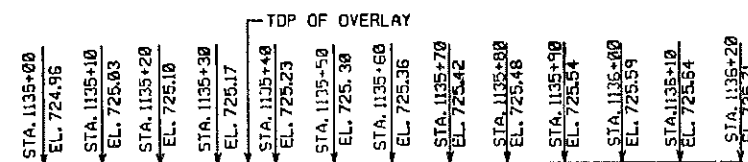


PROPOSED SOUTH GUTTER GRADE LINE

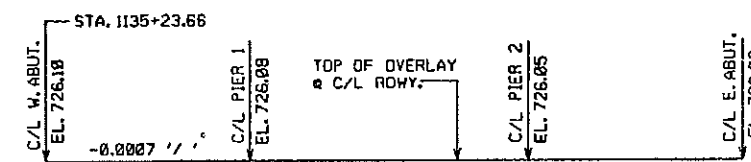

PROPOSED GRADE LINE

BENCH MARK - PAINT MK ON TOP OF WING
S.W. COR. OF BRIDGE - EL. 725.14

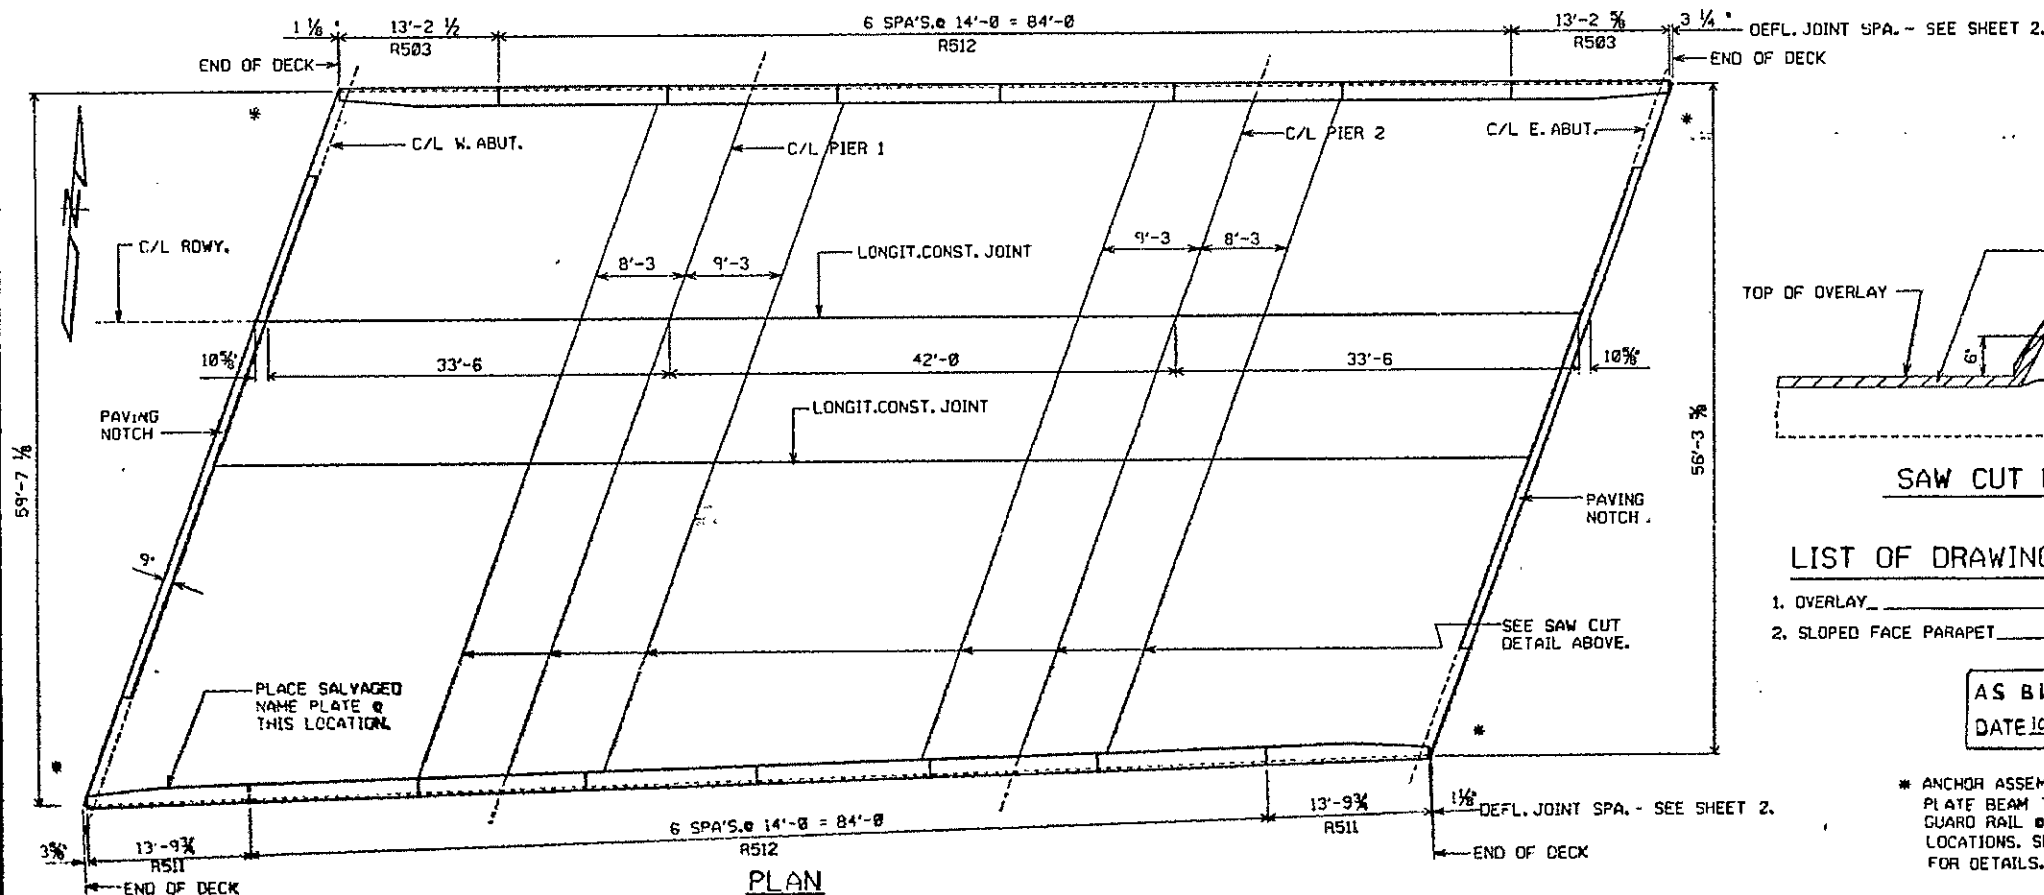



PLAN

NO.	DATE	REVISION	BY
STATE OF WISCONSIN DEPARTMENT OF TRANSPORTATION DIVISION OF HIGHWAYS			
STRUCTURE B-44-43			
US 41 N.B. OVER N. MALONEY RD.			
COUNTY	DOUTAGAMIE	TOWN/VILLAGE	VANDENBROEK
DESIGN SPEC	AASHTO 83	LOAD	CONST. SPEC. 1981
DESIGNED BY	WV	DESIGN CK'D	BA
DRAWN BY	JHG	PLANS CK'D	FWG
APPROVED	Stanley D. Woods	DATE	4-5-88
CHIEF BRIDGE ENGINEER			
OVERLAY			SHEET 1 OF 2
			X72394

12-11-11

FOR: SEGMENT 1	JOB NO:	SHEET NO:
MADE BY:	CHECKED BY:	BACKCHECKED BY:
DATE:	DATE:	DATE:

HNTB

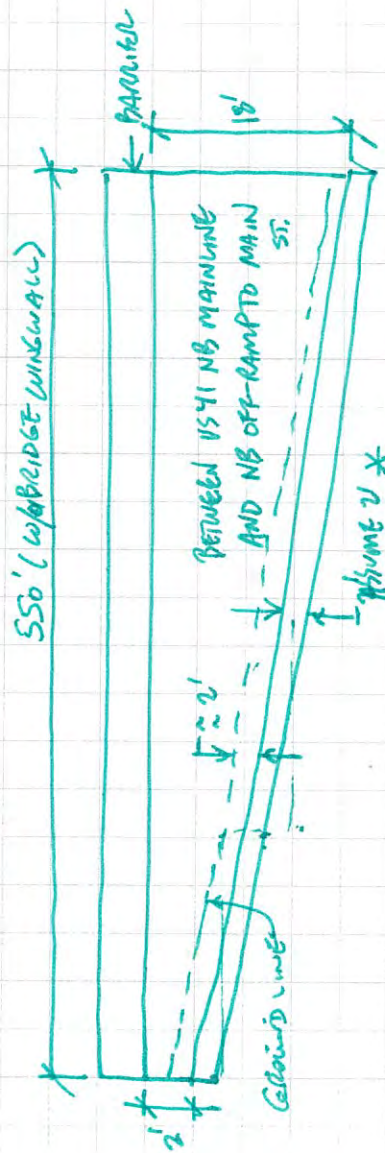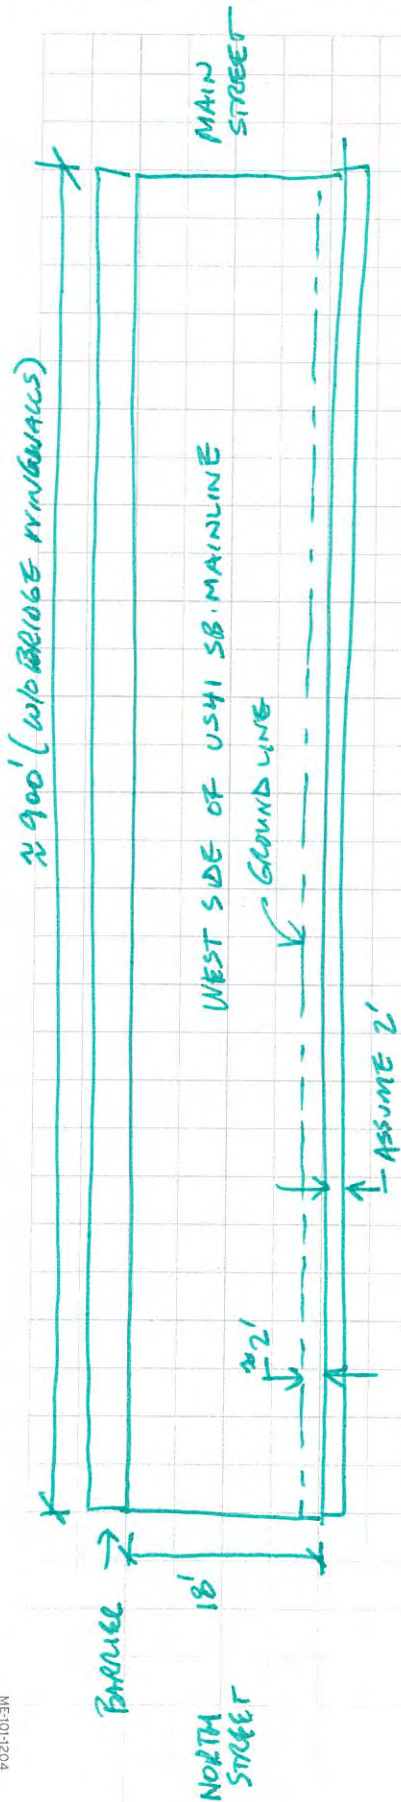


$$550' \times \left(\frac{20' + 20'}{2} \right) = 6,600 \text{ SF} \quad * = 7920 \text{ SF}$$

* ADD 20% FOR FOOTING
STAIR SIZED ALONG SLOPE

FOR: SEGMENT 1	JOB NO:	SHEET NO:
MADE BY:	CHECKED BY:	BACKCHECKED BY:
DATE:	DATE:	DATE:

HNTB

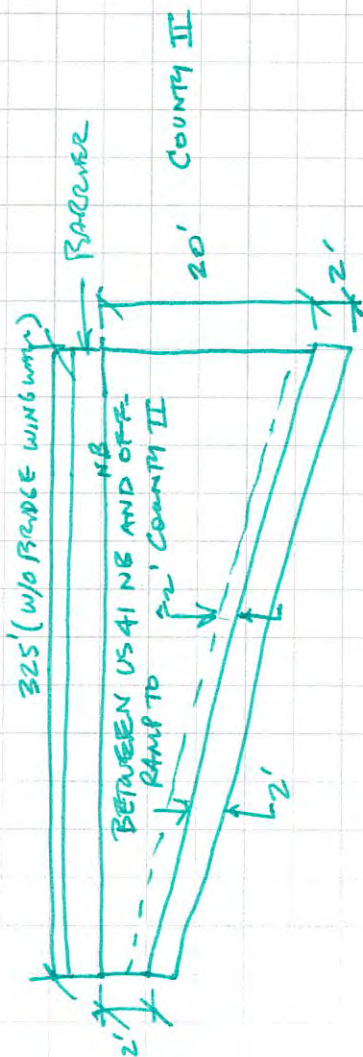

$$325' \times \left(\frac{4' + 22'}{2} \right) = 4225 (1.2) = 5070 \text{ SF}$$

RAMP BETWEEN US 41 NB AND ON-RAMP FROM COUNTY II IS SIMILAR.

$$\text{LENGTH} = 335'$$

$$335' \times \left(\frac{4' + 22'}{2} \right) = 4355 \text{ SF} \times 1.2 = 5226 \text{ SF}$$

RETAINING WALLS PLACED ^(W) ~~BEFORE~~ ALONG US 41 SB BETWEEN ON- AND OFF-RAMPS ARE PLACED WITH TRI-COUNTY RECONSTRUCTION PROJECT AND ARE ASSUMED PLACED IN POSITION TO COMPLEMENT US 41 RECONSTRUCTION PROJECT.

Vertical Clearance for Construction of New Bridges, Replacement Bridges, and Bridges on which the Superstructure is being replaced¹

Overpass Facility →	Freeway, Expressway, or STH		Railroad ⁴ , CTH, Town Road, Local Road, or Street	Pedestrian or Shared-use Structures	Sign Structures ²
Underpass Facility ↓	Interchange	Grade Separation			
Non-arterial either STH, CTH, Town Road, Local Road, or Street	15'-9" Desirable	15'-3" Desirable		16'- 9" Desirable	18'-3" Minimum
	15'-3" Minimum	14'-9" Minimum		16'-3" Minimum	
Arterial either CTH, Town Road, Local Road, or Street (excludes freeway and expressway; also excludes arterial STH)	16'-9" Desirable	15'-3" Desirable		17'- 9" Desirable	
	16'-3" Minimum	14'-9" Minimum		17'-3" Minimum	
Freeway ³ or Expressway or arterial STH	16'-9" Desirable			17'- 9" Desirable	
	16'-4" Minimum			17'-4" Minimum	
Railroad ^{4,5,6,7}	23'-0" Minimum to 23'-3½" Maximum				

General notes:

- ¹ Vertical clearance is needed for the entire roadway width (critical point; to include traveled way, auxiliary lanes, turn lanes, and shoulders), according to the above table.

Vertical clearance for railroads is measured from the top of rail and is required over an area 8 feet 6 inches from the track centerline on each side of a railroad track.

Do not exceed the desirable vertical clearance shown unless justified. Depending on topography and other specific situations vertical clearance for any structure may be greater than that shown when justified. Some things to consider are: over height loads traveling on the roadway; the level of development in the area, the projected growth in traffic volume and importance of the roadway, and the possibility of reclassification.

- ² See LRFD Bridge Manual Chapter 39 (http://on.dot.wi.gov/dtid_bos/extranet/structures/LRFD/LRFDManualIndex.htm) and LRFD Standard Details 39.02 and 39.10 for design considerations and requirements for vertical clearance on new and replacement Sign Structures.
- ³ See FDM 11-44-1 for vertical clearance guidance specific to Interstate freeways.
- ⁴ Consult with the Region Railroad Coordinator if the over-passing or under-passing facility is either a railroad or a "rails-to-trails" trail; or if a structure is owned by a railroad company.
- ⁵ A vertical clearance <23'-0" requires both an approved Exception to Standards (see FDM 11-1-2 and FDM 11-1-4) and early coordination with BTLR R&H, Railroads and Harbors Section (RHS) through the Region Railroad Coordinator. The Exception to Standards shall contain documentation that the Office of the Commissioner of Railroads (OCR) has been petitioned.
- See Chapter 17 for additional information.
- ⁶ Provide justification for a vertical clearance >23'-3 ½" to the RHS.
- ⁷ Vertical clearance less than 23'-0" may be acceptable or desirable in certain situations, such as for spur tracks, lead tracks, some branch lines and even mainline tracks when other impediments to 23'-0" exist. Review such situations with the Railroad Project Coordination Engineer in RHS. Early coordination with RHS is required.



DAAR
ENGINEERING, INC.

PROJECT: _____

DATE: _____


DESCRIPTION: CTH J Str over USH 41

SHEET _____ OF _____

B-44-44

CALC. BY: _____

CHECKED BY: _____

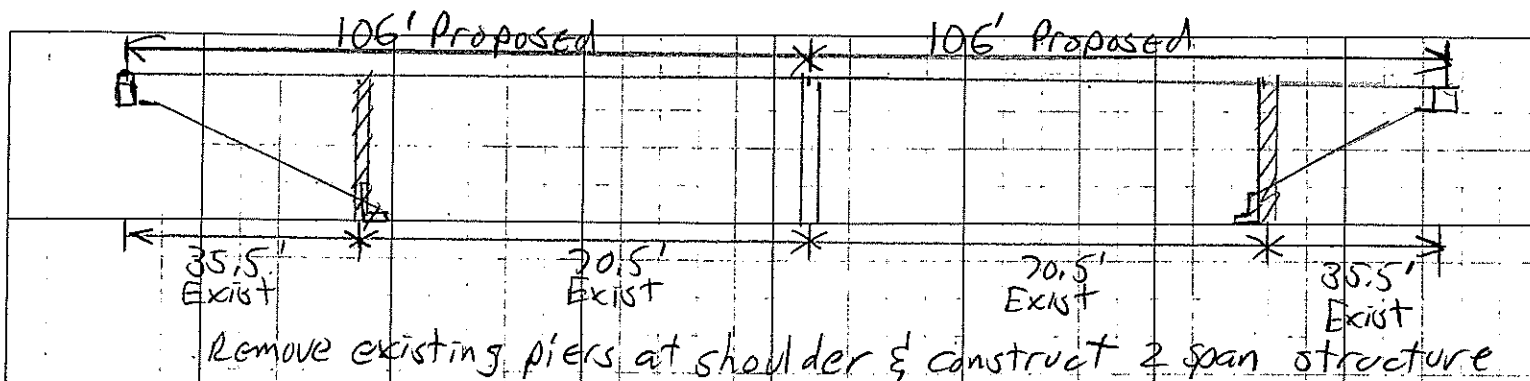

Existing 36" Girders & 8" Deck Proposed 45" Girders & 9" Deck
+0.83' diff.

Existing Rdway = 12' Lane & 5' Shldr Proposed = 2-12' lanes & 6' Shldr

13' Widening $\times .02 = +0.26'$

16' from edge of deck to $\phi = 16 \times .02 = 0.32'$

0.83
+ 0.26
+ 0.32
= 1.41'

USH 41 needs profile adjustment due to flat grades which are less than 0.4% -

Lower USH 41 by 0.6' at structure

Raise CTH J by 0.81' at ϕ

BRIDGE INSPECTION REPORT
Wisconsin Dept. of Transportation
DT2007 2003 s.84.17 Wis. Stats. Type = ROUTINE INSPECTION

page 1

Inventory Data

Feature On: CTH J		Maintainer: STATE HIGHWAY DEPT		Structure No: B-44-044
Feature Under: USH 41		Sect/Twn/Rng: S07 T21N R19E		
Location: 0.7M S JCT CTH JJ		County: OUTAGAMI	Municipality: TOWN-KAUKAUNA (44026)	
Inv Rating: HS20	Rdwy Width (ft): 34.0	Deck Width (ft): 36.8	Existing Posting:	
Oper Rating: HS34	Total Length (ft): 216.2	Deck Area(ft2): 7956	ADT On: 930 Yr: 2010	ADT Under: 23100 Yr: 2003

Inspection Type (* = Supplemental Form Required)

	Routine Visual	Fracture Critical*	In-Depth*	UW-Dive*	UW-Surv*	UW-Probe/Visual*	Movable*
Last Insp.	10-17-11						
Frequency	24						
Recom. Freq.							
	Initial*	Damage	Interim	Load Posted	SI & A Field Review*		
Last Insp.		07-20-11	08-29-11				
Frequency	N/A	00	00				
Recom. Freq.	N/A				Item No. Needing Change		

Load Rating Information

Overburden	Measurement (in):	Date:	Deck Surface Type: CONCRETE	
Section Loss	File Meas. (%):	File Insp. Date: 08-29-11	Insp. Measurement (%):	Describe:
Re-rate for load capacity?	Reason:			Date Last Rated: 12-17-09

Expansion Joints

		Temp:			Signing Condition			
Location	Type	File Insp. Date	File Insp. (in)	New Insp. (in)	Type of Marker	File	Y/N	Comments
					Bridge Markers			
					Narrow Bridge			
					One Lane Road			
					Vertical Clearance			
					Weight Limit Post			
					Other(Addl. Sign)			

Clearances(Cardinal = N or E)	File Meas. (ft.)	File Date	New Meas. (ft.)
Min. Vertical Clearance Under (Cardinal)	16.32	11-15-10	
Min. Vertical Clearance Under (non-Cardinal)	16.22	11-15-10	
Min. Vertical Clearance On			

Structure Type

Construction/Rehabilitation History

Material	Configuration	# of Spans	Overall Length (ft)	Year	Work Performed	Plan	Shop
PREST CONCRET	DECK GIRDER		35.5	1961	NEW STRUCTURE	P038	F046
PREST CONCRET	DECK GIRDER		70.5	1978	PAINTING		
PREST CONCRET	DECK GIRDER		70.5	1984	CONCRETE OVER	C226	C226
PREST CONCRET	DECK GIRDER		35.5	1985	BEARING - MIS	C275	

Inspection Information

Special Requirements	Y/N	Comments				
Traffic Control	Y					
Access Equipment	Y					
Other	Y					

Inspector Information

Team Leader Name and No. Printed: Michaelson, Neil (3010)		Team Member(s) Name(s) Printed:		
Team Leader Signature:		Inspection Date: 10-17-11	Inspection Agency: STATE HIGHWAY DEPARTMENT (1)	
District/Local Manager and No. Printed:		District/Local Manager Signature:	Review Date:	

Element Inspection (X) Check Elements Inspected

Element Inspection (X) Check Elements Inspected					Quantity in Condition States				
Ck	Elem./Env.	Description	Unit	Total QTY.	1	2	3	4	5
X	12 / 4	Conc Deck No Ovl	SF	7942	7942				
X	109 / 4	P/S Conc Open Girder	LF	1437	1432	5			
X	172 / 4	Painted Steel Diaphr	EA	36	36				
X	205 / 4	R/Conc Column	EA	9	8	1			
X	210 / 4	R/Conc Pier Wall	LF	78	69	9			
		At base of columns - including taper section. CS-2 (4" west 5" east) Large spall on east wall							
X	215 / 3	R/Conc Abutment	LF	74	64	10			
		CS-2 (6" east abut 4" west abut)							
X	234 / 3	R/Conc Cap	LF	111	105	6			
		Cracks on west cap							
X	250 / 4	Concrete Diaphragm	EA	21	21				
X	321 / 4	R/Conc Approach Slab	EA	2	2				
		North approach not installed for september 2010 interim inspection.							
X	333 / 4	Combin Bridge Railing	LF	435	354	81			
X	342 / 2	RipRap Slope Protect	EA	2	2				
X	358 / 4	Deck Cracking SmFlag	EA	1	1				
X	359 / 4	Und Dk Surf Sm Flag	EA	1		1			
X	400 / 3	Concrete Wingwall	EA	4	4				

General Inspection/Maintenance Notes

Maintenance Recommendations (See standard code items & numbers)

Maintenance Item:	
Amount:	Date(YYYY-MM-DD):
Maintenance item comment:	

Maintenance Item:	
Amount:	Date(MM-DD-YY):
Maintenance item comment:	

NBI Ratings

NBI	File	New	NBI	File	New
Deck	8	8	Culvert	N	N
Superstructure	7	7	Channel	N	N
Substructure	8	7	Waterway	N	N

Maintenance Item:	
Amount:	Date(MM-DD-YY):
Maintenance item comment:	

STRUCTURE INVENTORY AND APPRAISAL FIELD REVIEW FORM

B-44-044
CTH J over USH 41

- (3) Municipality:
(16) Latitude(" ' "):
(17) Longitude(" ' "):

LOCATION	
TOWN - KAUKAUNA (44026)	
44°18'18.93"N	
88°14'57.65"W	

- (28A) Lanes On:
(28B) Lanes Under:
(102) Traffic Pattern On:
(102) Traffic Pattern Under:
(19) Detour Length(mi):

TRAFFIC SERVICE	
2	
4	
-NO TRAFFIC X-ONE WAY TRAFFIC -TWO WAY TRAFFIC	
-NO TRAFFIC -ONE WAY TRAFFIC X-TWO WAY TRAFFIC	
1	

- (49) Structure Length(ft):
(50) Sidewalk Width(ft):
(50) Curb Width(ft):
(52) Culvert Barrel Length(ft):
(34) Skew:

GEOMETRY	
216.2	
Left:	Right:
0.0	
Angle("): 16	Direction: X-RIGHT FORWARD -LEFT FORWARD
Cardinal Width	Non-Cardinal Width
34.0	34.0
36.8	36.8
34	34
Cardinal Under Clearance	Non-Cardinal Under Clearance
64.8	64.8
12.2	12.2
28.6	28.6



- (51) Bridge Roadway(ft):
(52) Deck(ft):
(32) Approach Roadway(ft):
(47) Minimum Horizontal(ft):
(55) Minimum Right Lateral(ft):
(55) Minimum Left Lateral(ft):

- (36A) Bridge Rail Adequacy:
(36B) Transition Adequacy:
(36C) Approach Guardrail Adequacy:
(36D) Guardrail Termination Adequacy:
Outer Rail:

RAILING APPRAISAL		
-SUB-STANDARD	X-STANDARD	-NOT APPLICABLE
-SUB-STANDARD	X-STANDARD	-NOT APPLICABLE
-SUB-STANDARD	X-STANDARD	-NOT APPLICABLE
-SUB-STANDARD	X-STANDARD	-NOT APPLICABLE
Left	Right	Type
		TYPE F (TWO SQUARE TUBES) - STEEL(8)
		TYPE F (3 SQUARE TUBES) - STEEL(65)
		TYPE F (4 SQUARE TUBES) - STEEL(72)
		TYPE M-STEEL 3 SQUARE TUBES(93)
X	X	SLOPED FACE PARAPET LF(91)
		SLOPED FACE PARAPET HF(92)
		VERTICAL FACE PARAPET TYPE A(74)
		TYPE W-THREE BEAM(79)
		TYPE H ON VERTICAL PARAPET(80)
		TIMBER(38)
		OTHER(99) (Please specify)
Transition Type:		
		CONT GUARD RAIL
		NO APP GRDRL
		NO ATTACHMENT
5		22 MM(7/8") BOLT (Please enter quantity)
		25 MM(1") BOLT (Please enter quantity)
		OTHER (Please specify)
Guardrail Termination Type:		
X		(01) ENERGY ABSORBING TERMINAL/EAT
		(02) TURN DOWN
		(99) OTHER (Please specify)

- (72) Approach Alignment Appraisal:

ROADWAY ALIGNMENT APPRAISAL	
	(3) INTOLERABLE- Horizontal or Vertical curvature requires a substantial reduction in vehicle operating speed
	(6) FAIR- Horizontal or Vertical curvature requires a very minor speed reduction
X	(8) GOOD- No speed reduction required

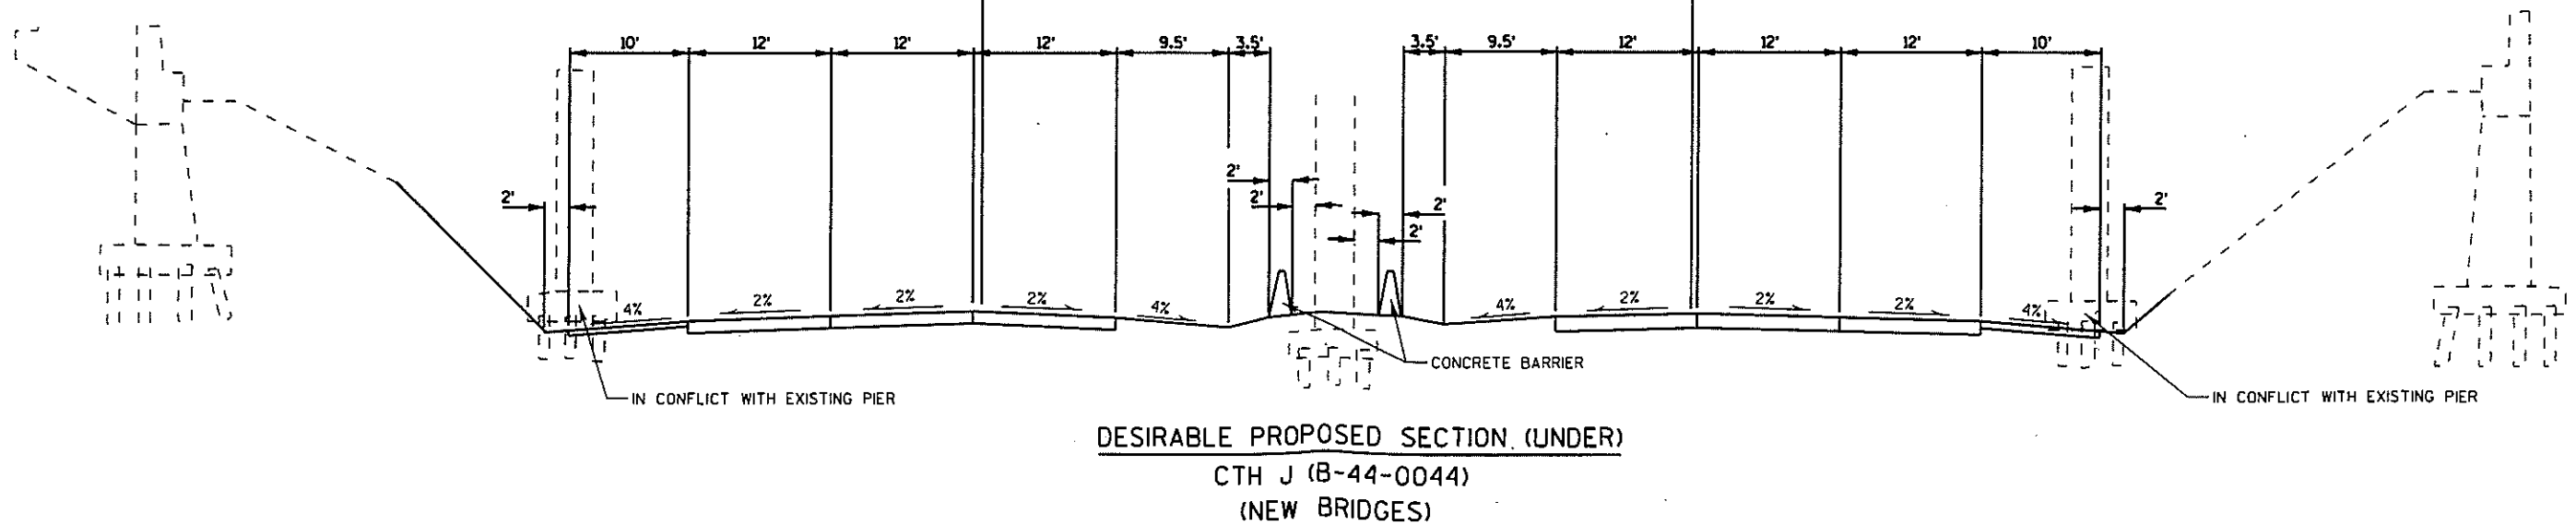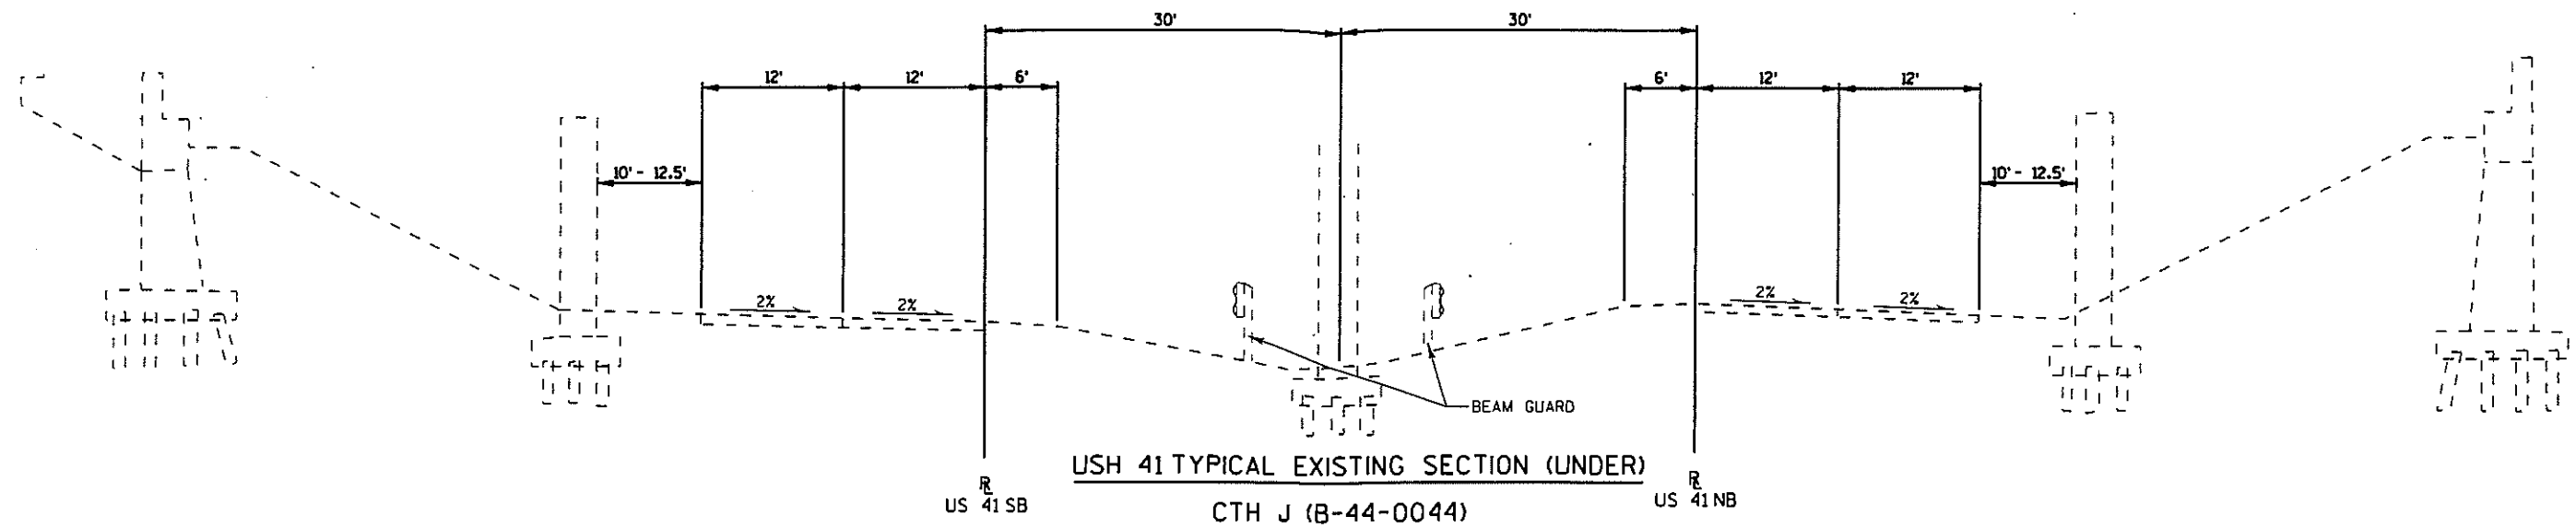



DESIGN DATA

LIVE LOAD:

INVENTORY RATING: HS-20
 OPERATIONAL RATING: HS-34
 MAXIMUM STANDARD PERMIT VEHICLE LOAD = 245 KIPS.

ULTIMATE DESIGN STRESSES:

CONCRETE MASONRY SLAB — $f'_c = 4,000$ P.S.I. ALL OTHER — $f'_c = 3,500$ P.S.I.
 BAR STEEL REINFORCEMENT, GRADE 60 — $f_y = 60,000$ P.S.I.
 36" PRESTRESSED GIRDERS, CONCRETE MASONRY — $f'_c = 6,000$ P.S.I.
 STRANDS — 0.5" DIA. WITH ULTIMATE TENSILE STRENGTH OF 270,000 P.S.I.

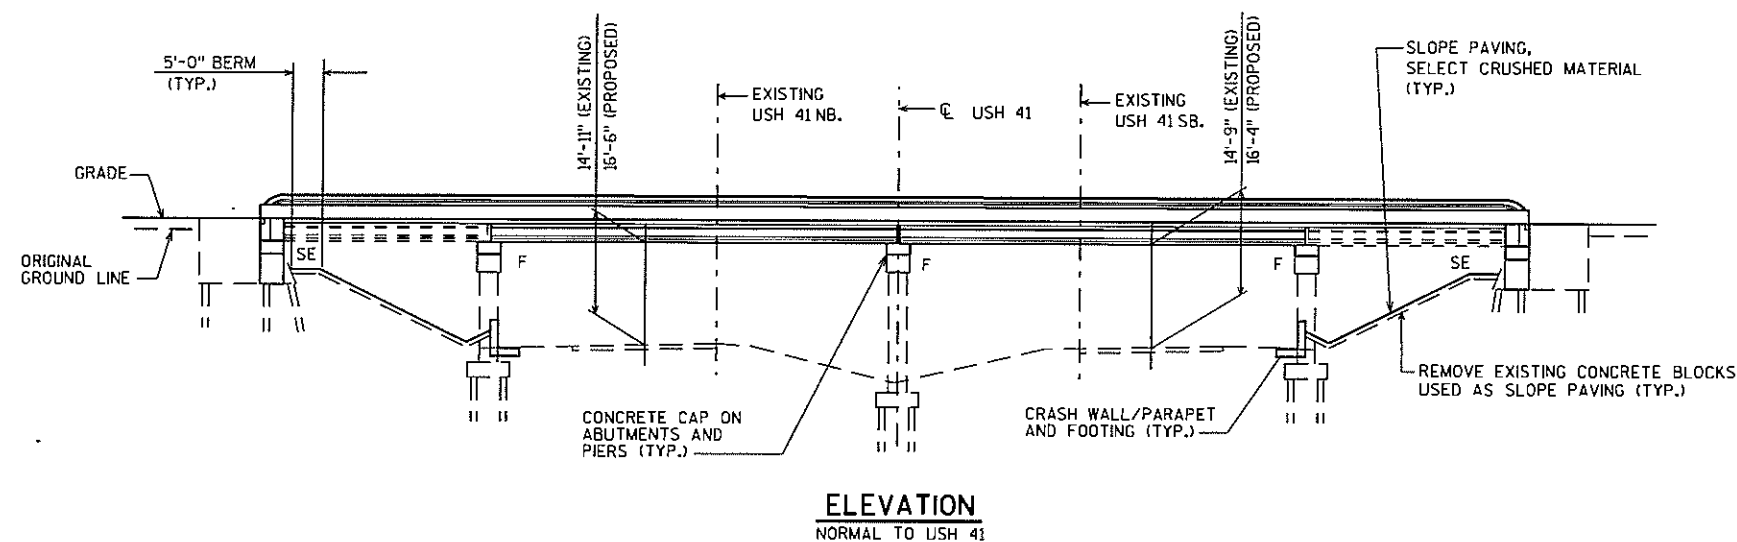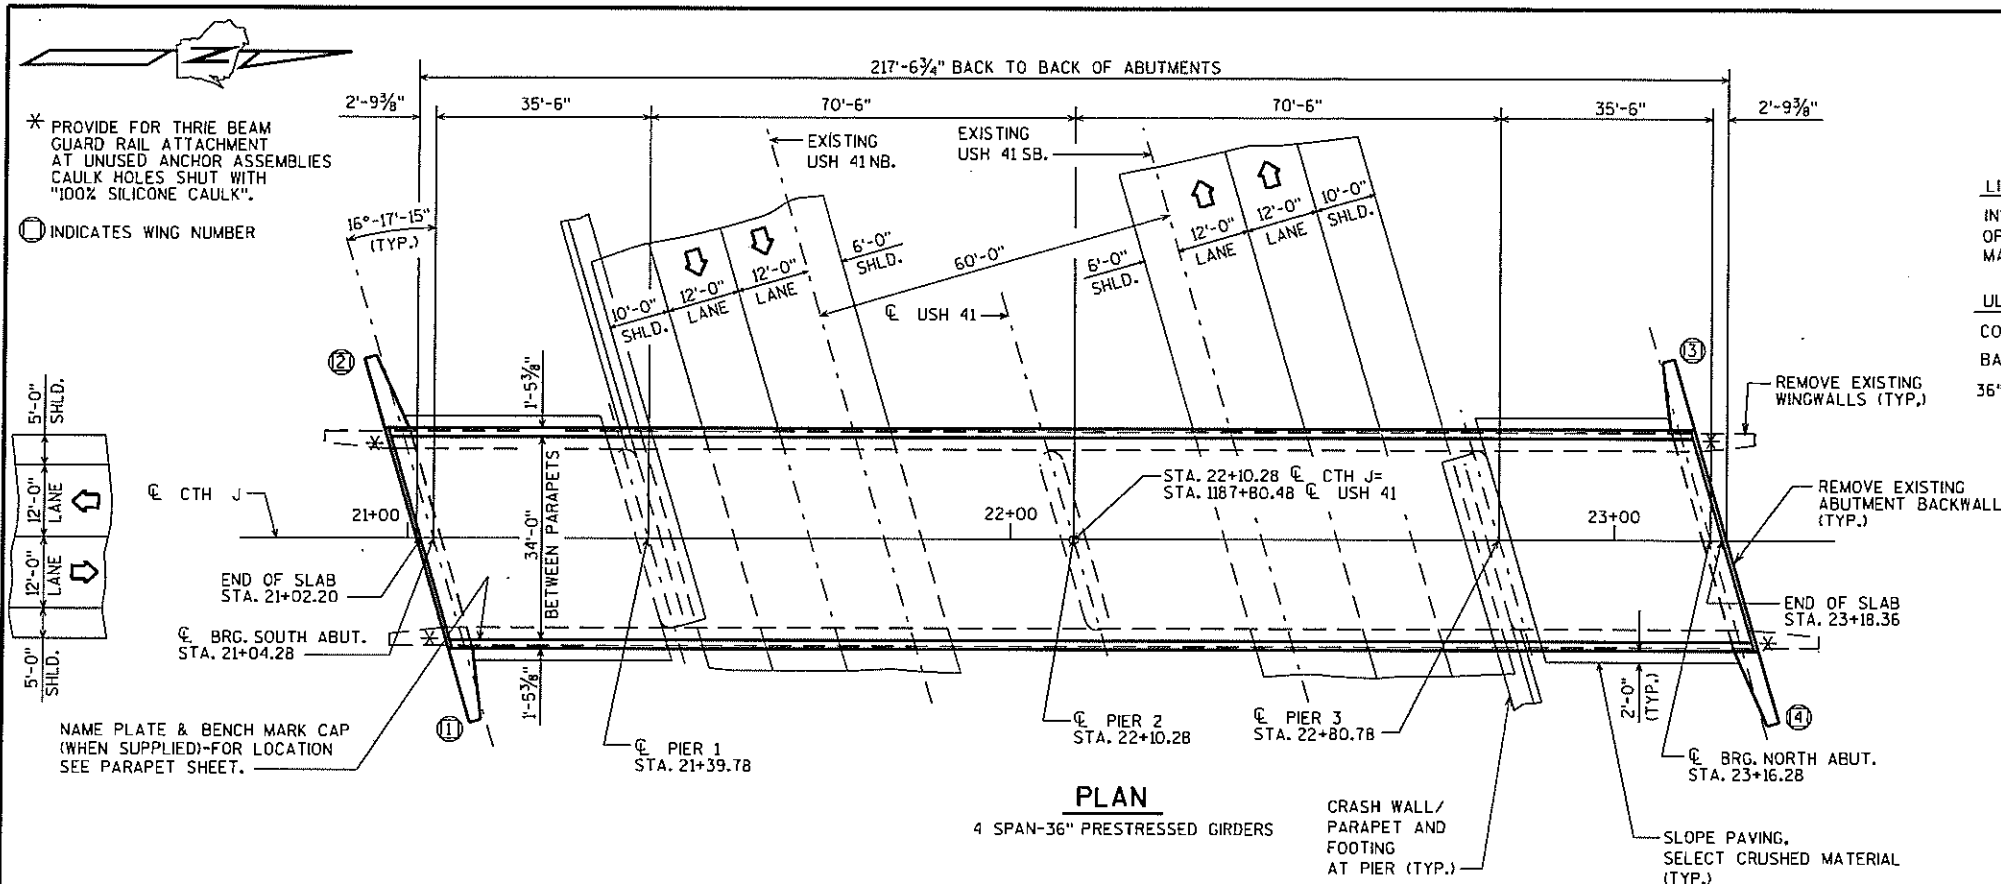

LIST OF DRAWINGS

1. DECK REPLACEMENT AND RAISING
2. CROSS SECTION & GENERAL NOTES
3. QUANTITIES & PROFILE
4. ABUTMENT REMOVAL DETAILS
5. SOUTH ABUTMENT
6. NORTH ABUTMENT
7. ABUTMENT DETAILS
8. PIER 1
9. PIER 2
10. PIER 3
11. PIER DETAILS
12. SUPERSTRUCTURE CROSS SECTIONS
13. SUPERSTRUCTURE
14. SUPERSTRUCTURE DETAILS
15. SUPERSTRUCTURE GIRDER REPLACEMENT
16. 36" PRESTRESSED GIRDER DETAILS
17. STEEL DIAPHRAGM
18. SLOPED FACE PARAPET LF
19. TUBULAR RAILING TYPE H (ALUM.)
20. TUBULAR RAILING TYPE H (STEEL)
21. SLOPE PAVING (SELECT CRUSHED MATERIAL)

STRUCTURE DESIGN CONTACT:

DAVE GENSON (608) 266-8491
 DEAN SMITH (608) 266-5091

NO.	DATE	REVISION	BY
Plans Prepared By WISDOT BUREAU OF STRUCTURES APPROVED <i>William C. Dehn</i> 12/17/09 CHIEF STRUCTURES DESIGN ENGINEER DATE STRUCTURE B-44-44 USH 41 OVER CTH J COUNTY OUTAGAMIE KAUKAUNA DESIGN SPEC. AASHTO STD. SPEC. 2003 LOAD DESIGNED BY DRG DESIGN CK'D. BY RIES PLANS CK'D. DRG DECK REPLACEMENT AND RAISING SHEET 1 OF 21 170			

GENERAL NOTES

DRAWINGS SHALL NOT BE SCALED.

BAR STEEL REINFORCEMENT SHALL BE EMBEDDED 2" CLEAR UNLESS OTHERWISE SHOWN OR NOTED.

THE FIRST OR FIRST TWO DIGITS OF THE BAR MARK SIGNIFIES THE BAR SIZE.

AT THE BACKFACE OF ABUTMENT ALL VOLUME WHICH CANNOT BE PLACED BEFORE ABUTMENT CONSTRUCTION AND IS NOT OCCUPIED BY THE NEW STRUCTURE SHALL BE BACKFILLED WITH STRUCTURE BACKFILL.

ELASTOMERIC BEARING PADS NEED NOT BE INDIVIDUALLY MOLDED PROVIDED THE CUT EDGES ARE SMOOTH AND TRUE.

CONCRETE FOR ABUTMENT AND PIER DIAPHRAGMS SHALL BE PLACED WITH THE DECK CONCRETE. NO OPTIONAL CONSTRUCTION JOINT WILL BE PERMITTED.

THE GRADATION OF THE STRUCTURE BACKFILL SHALL MEET THE REQUIREMENTS OF SECTION 209.2.2 OF THE STANDARD SPECIFICATIONS FOR GRADE 1 MATERIAL.

PROTECTIVE SURFACE TREATMENT TO BE APPLIED TO THE ENTIRE TOP OF DECK SURFACE AND THE FRONT FACE AND THE TOP OF THE PARAPET. PROTECTIVE SURFACE TREATMENT SHALL ALSO BE APPLIED TO PIERS 1 AND 3 FROM THE EXISTING GROUND LINE TO THE BOTTOM OF THE PIER CAP AFTER WATER BLAST CLEANING THE PIER COLUMNS.

THE EXISTING GROUND LINE SHALL BE USED AS THE UPPER LIMITS OF EXCAVATION.

THE SLOPE OF THE FILL IN FRONT OF THE ABUTMENTS SHALL BE COVERED WITH SLOPE PAVING MATERIAL TO THE EXTENT SHOWN ON SHEET 1 AND IN THE ABUTMENT DETAILS.

DIMENSIONS SHOWN ARE BASED ON THE ORIGINAL STRUCTURE PLANS.

CONTRACTOR SHALL VERIFY ALL DIMENSIONS PRIOR TO ANY FABRICATION AND CONSTRUCTION.

INFORMATION ON THESE DRAWINGS RELATED TO THE EXISTING BRIDGE IS BASED UPON AVAILABLE DRAWING FROM THE WISCONSIN DEPARTMENT OF TRANSPORTATION. NO GUARANTEE OR WARRANTY IS MADE THAT THE INFORMATION IS ALL INCLUSIVE OR TOTALLY ACCURATE. THEREFORE, THE CONTRACTOR SHALL MAKE ITS OWN DETERMINATION OF THE ACTUAL CONDITIONS TO BE ENCOUNTERED.

CONCRETE SURFACE REPAIR AS DIRECTED BY ENGINEER.

SOUTH ABUTMENT	15 S.F.
GIRDERS	45 S.F.
COLUMN 3 PIER 3	15 S.F.
NORTH ABUTMENT	45 S.F.


IN ADDITION TO THE STANDARD SPECIFICATIONS FOR THE BID ITEM "CONCRETE SURFACE REPAIR", THE FOLLOWING SHALL BE FOLLOWED FOR THE REPAIR: PRIOR TO THE PLACING OF THE CONCRETE MIXTURE ON THE DAMAGED AREAS OF THE PRESTRESSED GIRDER, THE REAR AXLES OF A 15 TON TRUCK, FULLY LOADED, SHALL BE PARKED OVER THE GIRDER BEING REPAIRED. THE LOADED TRUCK SHALL REMAIN IN PLACE DURING THE CURING PERIOD OF THE SURFACE REPAIR, OR FOR A MINIMUM PERIOD OF FOUR DAYS.

ALL CONCRETE REMOVAL SHALL BE DEFINED BY A 1" DEEP SAW CUT.


USE EXISTING BAR STEEL REINFORCEMENT WHERE SHOWN AND EXTEND 24 BAR DIAMETER INTO NEW WORK.

THE CONTRACTOR SHALL SUBMIT A REMOVAL AND BRIDGE JACKING PLAN TO THE ENGINEER FOR APPROVAL.

CONTRACTOR SHALL SUPPLY A NEW NAME PLATE IN ACCORDANCE WITH SECTION 502.3.11 OF THE STANDARD SPECIFICATIONS AND THE STANDARD DETAILED DRAWINGS. THE NEW NAME PLATE SHALL SHOW THE ORIGINAL CONSTRUCTION YEAR OF 1961.

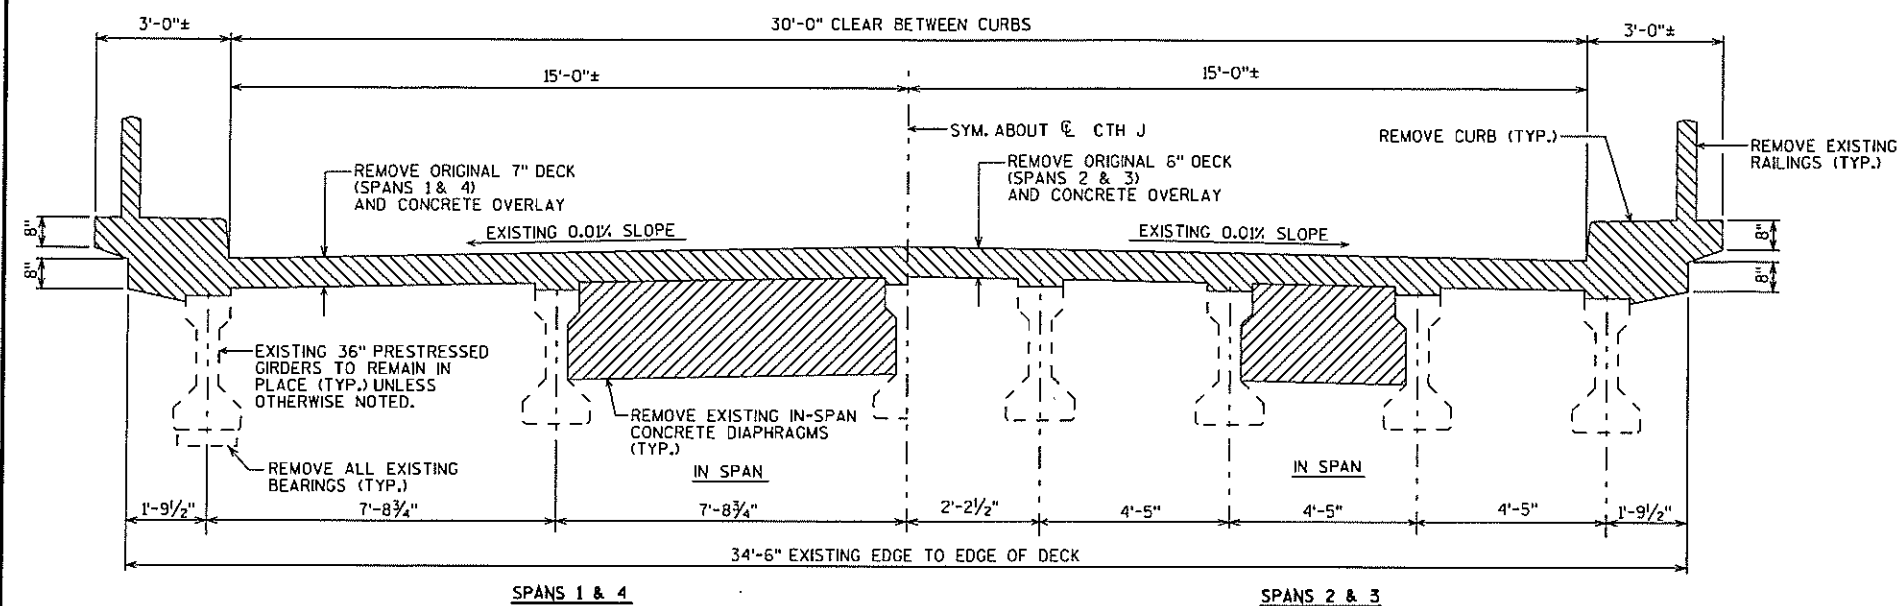

EXISTING CROSS SECTION THRU ROADWAY - LOOKING NORTH

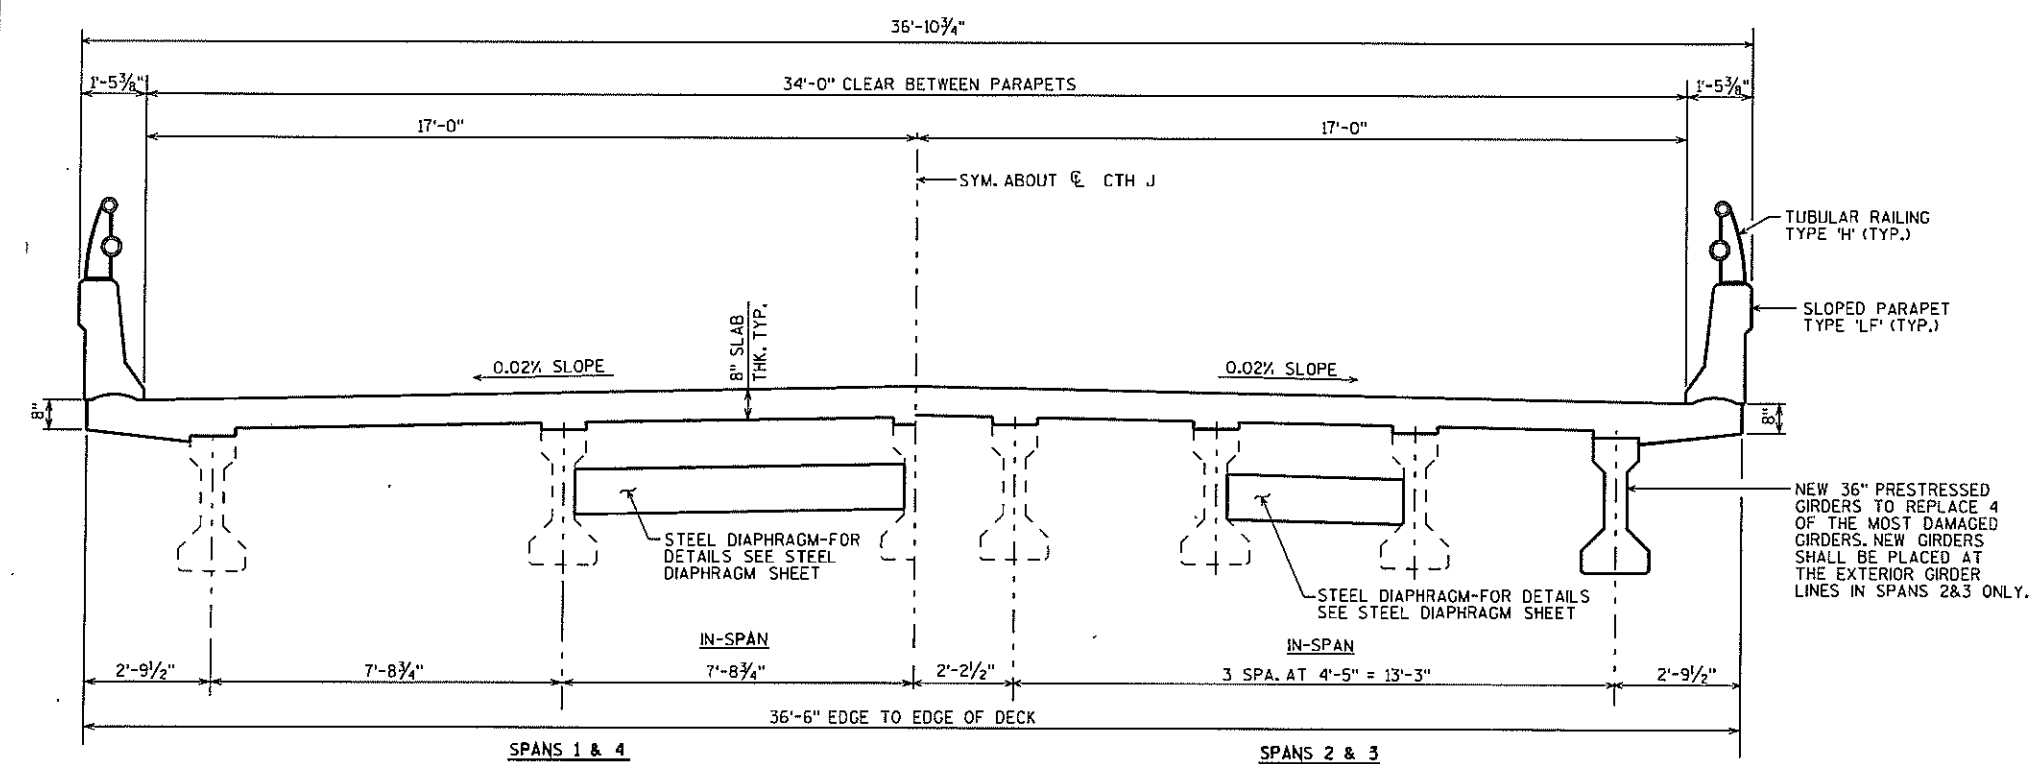


CROSS SECTION THRU ROADWAY - LOOKING NORTH

NO.	DATE	REVISION	BY
STATE OF WISCONSIN DEPARTMENT OF TRANSPORTATION STRUCTURES DESIGN SECTION			
STRUCTURE B-44-44			
DRAWN BY	RIES	PLANS CK'D.	DRG
CROSS SECTIONS AND GENERAL NOTES			SHEET 2
			171

TOTAL ESTIMATED QUANTITIES

BID ITEM NUMBER	BID ITEMS	UNIT	SUPER.	SOUTH ABUT.	NORTH ABUT.	PIER 1	PIER 2	PIER 3	TOTALS
203.0200	REMOVING OLD STRUCTURE STA. 22+10.28	LS							1
204.0175	REMOVING CONCRETE SLOPE PAVING	SY		150	150				300
206.1000	EXCAVATION FOR STRUCTURES BRIDGES B-44-44	LS							1
210.0100	BACKFILL STRUCTURE	CY		170	170				340
502.0100	CONCRETE MASONRY BRIDGES	CY	308	35	35	41	10	41	470
502.3200	PROTECTIVE SURFACE TREATMENT	SY	985			41		41	1,067
502.5020	MASONRY ANCHORS TYPE L NO. 8 BARS	EACH		14	14				28
502.6105	MASONRY ANCHORS TYPE S 5/8-INCH	EACH		90	90	76	76	76	408
502.6110	MASONRY ANCHORS TYPE S 3/4-INCH	EACH				30		30	60
503.0136	PRESTRESSED GIRDER TYPE I 36-INCH	LF	351						351
505.0405	BAR STEEL REINFORCEMENT HS BRIDGES	LB							
505.0605	BAR STEEL REINFORCEMENT HS COATED BRIDGES	LB	60,520	3485	3485	5365	1430	5365	79,650
506.2605	BEARING PADS ELASTOMERIC NON-LAMINATED	EACH		5	5	13	16	13	52
506.4000	STEEL DIAPHRADMS B-44-44	EACH	36						36
506.7050.S	REMOVING BEARINGS B-44-44	EACH		5	5	13	16	13	52
506.7060.S	BRIDGE JACKING B-44-44	LS							1
509.1500	CONCRETE SURFACE REPAIR	SF	45	15	45			15	120
513.4055	RAILING TUBULAR TYPE H B-44-44	LS							1
516.0500	RUBBERIZED MEMBRANE WATERPROOFING	SY		18	18				36
604.0600	SLOPE PAVING SELECT CRUSHED MATERIAL	SY		175	175				350
612.0406	PIPE UNDERDRAIN WRAPPED 6-INCH	LF		70	70				140
614.0150	ANCHOR ASSEMBLIES FOR STEEL PLATE BEAM GUARD	EACH	4			1		1	6
	NON-BID ITEMS								
	FILLER	SIZE							1/2" & 3/4"

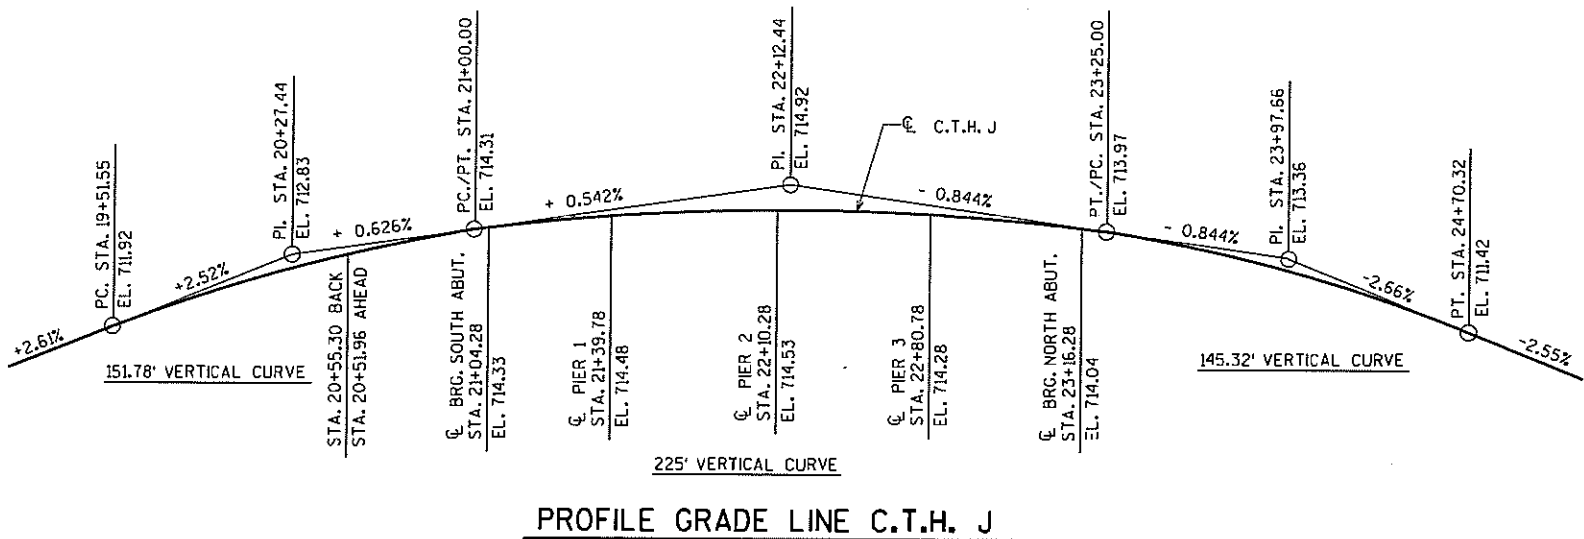

NO.	DATE	REVISION	BY
STATE OF WISCONSIN DEPARTMENT OF TRANSPORTATION STRUCTURES DESIGN SECTION			
STRUCTURE B-44-44			
DRAWN BY	RIES	PLANS CKD.	DRG
QUANTITIES & PROFILE		SHEET 3 172	

Vertical Clearance for Construction of New Bridges, Replacement Bridges, and Bridges on which the Superstructure is being replaced¹

Overpass Facility →	Freeway, Expressway, or STH		Railroad ⁴ , CTH, Town Road, Local Road, or Street	Pedestrian or Shared-use Structures	Sign Structures ²
Underpass Facility ↓	Interchange	Grade Separation			
Non-arterial either STH, CTH, Town Road, Local Road, or Street	15'-9" Desirable	15'-3" Desirable		16'-9" Desirable	18'-3" Minimum
	15'-3" Minimum	14'-9" Minimum		16'-3" Minimum	
Arterial either CTH, Town Road, Local Road, or Street (excludes freeway and expressway; also excludes arterial STH)	16'-9" Desirable	15'-3" Desirable		17'-9" Desirable	
	16'-3" Minimum	14'-9" Minimum		17'-3" Minimum	
Freeway³ or Expressway or arterial STH		16'-9" Desirable		17'-9" Desirable	
		16'-4" Minimum		17'-4" Minimum	
Railroad^{4,5,6,7}	23'-0" Minimum to 23'-3½" Maximum				

General notes:

- ¹ Vertical clearance is needed for the entire roadway width (critical point; to include traveled way, auxiliary lanes, turn lanes, and shoulders), according to the above table.

Vertical clearance for railroads is measured from the top of rail and is required over an area 8 feet 6 inches from the track centerline on each side of a railroad track.

Do not exceed the desirable vertical clearance shown unless justified. Depending on topography and other specific situations vertical clearance for any structure may be greater than that shown when justified. Some things to consider are: over height loads traveling on the roadway; the level of development in the area, the projected growth in traffic volume and importance of the roadway, and the possibility of reclassification.

- ² See LRFD Bridge Manual Chapter 39 (http://on.dot.wi.gov/dtid_bos/extranet/structures/LRFD/LRFDManualIndex.htm) and LRFD Standard Details 39.02 and 39.10 for design considerations and requirements for vertical clearance on new and replacement Sign Structures.
- ³ See FDM 11-44-1 for vertical clearance guidance specific to Interstate freeways.
- ⁴ Consult with the Region Railroad Coordinator if the over-passing or under-passing facility is either a railroad or a "rails-to-trails" trail; or if a structure is owned by a railroad company.
- ⁵ A vertical clearance <23'-0" requires both an approved Exception to Standards (see FDM 11-1-2 and FDM 11-1-4) and early coordination with BTLR R&H, Railroads and Harbors Section (RHS) through the Region Railroad Coordinator. The Exception to Standards shall contain documentation that the Office of the Commissioner of Railroads (OCR) has been petitioned.
- See Chapter 17 for additional information.
- ⁶ Provide justification for a vertical clearance >23'-3 ½" to the RHS.
- ⁷ Vertical clearance less than 23'-0" may be acceptable or desirable in certain situations, such as for spur tracks, lead tracks, some branch lines and even mainline tracks when other impediments to 23'-0" exist. Review such situations with the Railroad Project Coordination Engineer in RHS. Early coordination with RHS is required.



DAAR
ENGINEERING, INC.

PROJECT: _____

DATE: _____


DESCRIPTION: CTH J Str over USH 41

SHEET _____ OF _____

B-44-44

CALC. BY: _____

CHECKED BY: _____

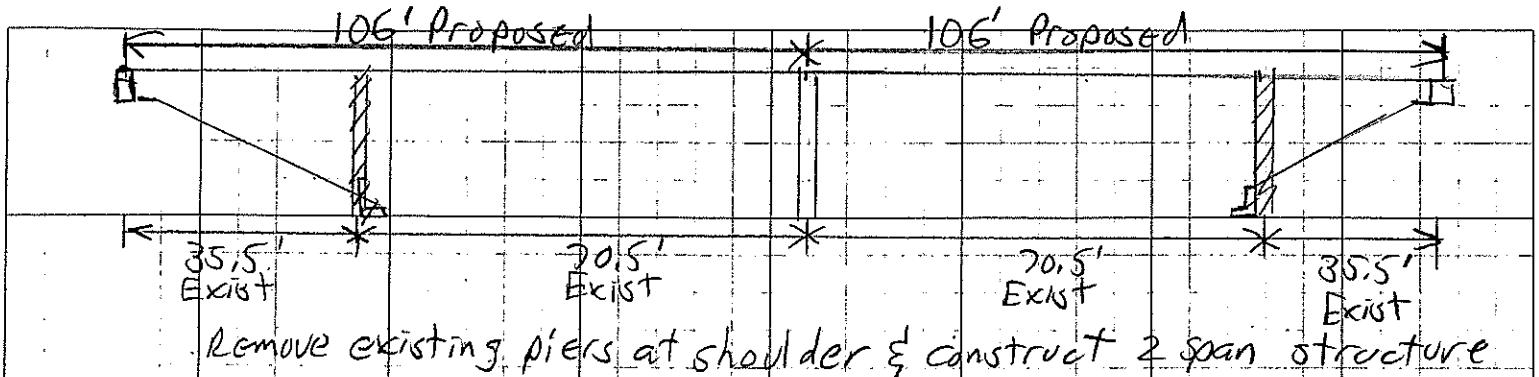

Existing 36" Girders & 8" Deck Proposed 45" Girders & 9" Deck
+0.83' diff.

Existing Rdway = 12' Lane & 5' Shldr Proposed = 2-12' lanes & 6' Shldr

13' Widening $\times .02 = +0.26'$

16' from edge of deck to $\phi = 16 \times .02 = 0.32'$

0.83
+ 0.26
+ 0.32

1.41'

USH 41 needs profile adjustment due to flat grades which are less than 0.4% -

Lower USH 41 by 0.6' at structure

Raise CTH J by 0.81' at ϕ

BRIDGE INSPECTION REPORT
Wisconsin Dept. of Transportation
DT2007 2003 s.84.17 Wis. Stats. Type = ROUTINE INSPECTION

page 1

Inventory Data

Feature On: CTH J		Maintainer: STATE HIGHWAY DEPT		Structure No: B-44-044
Feature Under: USH 41		Sect/Twn/Rng: S07 T21N R19E		
Location: 0.7M S JCT CTH JJ		County: OUTAGAMI	Municipality: TOWN-KAUKAUNA (44026)	
Inv Rating: HS20	Rdwy Width (ft): 34.0	Deck Width (ft): 36.8	Existing Posting:	
Oper Rating: HS34	Total Length (ft): 216.2	Deck Area(ft2): 7956	ADT On: 930 Yr: 2010	ADT Under: 23100 Yr: 2003

Inspection Type (* = Supplemental Form Required)

	Routine Visual	Fracture Critical*	In-Depth*	UW-Dive*	UW-Surv*	UW-Probe/Visual*	Movable*
Last Insp.	10-17-11						
Frequency	24						
Recom. Freq.							
	Initial*	Damage	Interim	Load Posted	SI & A Field Review*		
Last Insp.		07-20-11	08-29-11				
Frequency	N/A	00	00				
Recom. Freq.	N/A				Item No. Needing Change		

Load Rating Information

Overburden	Measurement (in):	Date:	Deck Surface Type: CONCRETE	
Section Loss	File Meas. (%):	File Insp. Date: 08-29-11	Insp. Measurement (%):	Describe:
Re-rate for load capacity?	Reason:			Date Last Rated: 12-17-09

Expansion Joints

Location	Type	Temp:			Signing Condition			
		File Insp. Date	File Insp. (in)	New Insp. (in)	Type of Marker	File	Y/N	Comments
					Bridge Markers			
					Narrow Bridge			
					One Lane Road			
					Vertical Clearance			
					Weight Limit Post			
					Other(Addl. Sign)			

Clearances(Cardinal = N or E)

	File Meas. (ft.)	File Date	New Meas. (ft.)
Min. Vertical Clearance Under (Cardinal)	16.32	11-15-10	
Min. Vertical Clearance Under (non-Cardinal)	16.22	11-15-10	
Min. Vertical Clearance On			

Structure Type

Material	Configuration	# of Spans	Overall Length (ft)	Year	Work Performed	Plan	Shop
PREST CONCRET	DECK GIRDER		35.5	1961	NEW STRUCTURE	P038	F046
PREST CONCRET	DECK GIRDER		70.5	1978	PAINTING		
PREST CONCRET	DECK GIRDER		70.5	1984	CONCRETE OVER	C226	C226
PREST CONCRET	DECK GIRDER		35.5	1985	BEARING - MIS	C275	

Construction/Rehabilitation History

				1995	REPAIR SUPERS		
				2000	REPAIR SUPERS		
				2010	NEW DECK		

Inspection Information

Special Requirements	Y/N	Comments				
Traffic Control	Y					
Access Equipment	Y					
Other	Y					

Inspector Information

Team Leader Name and No. Printed: Michaelson, Neil (3010)		Team Member(s) Name(s) Printed:	
Team Leader Signature:		Inspection Date: 10-17-11	Inspection Agency: STATE HIGHWAY DEPARTMENT (1)
District/Local Manager and No. Printed:		District/Local Manager Signature:	Review Date:

Element Inspection (X) Check Elements Inspected					Quantity in Condition States				
Ck	Elem./Env.	Description	Unit	Total QTY.	1	2	3	4	5
X	12 / 4	Conc Deck No Ovl	SF	7942	7942				
X	109 / 4	P/S Conc Open Girder	LF	1437	1432	5			
X	172 / 4	Painted Steel Diaphr	EA	36	36				
X	205 / 4	R/Conc Column	EA	9	8	1			
X	210 / 4	R/Conc Pier Wall	LF	78	69	9			
		At base of columns - including taper section. CS-2 (4" west 5" east) Large spall on east wall							
X	215 / 3	R/Conc Abutment	LF	74	64	10			
		CS-2 (6" east abut 4" west abut)							
X	234 / 3	R/Conc Cap	LF	111	105	6			
		Cracks on west cap							
X	250 / 4	Concrete Diaphragm	EA	21	21				
X	321 / 4	R/Conc Approach Slab	EA	2	2				
		North approach not installed for september 2010 interim inspection.							
X	333 / 4	Combin Bridge Railing	LF	435	354	81			
X	342 / 2	RipRap Slope Protect	EA	2	2				
X	358 / 4	Deck Cracking SmFlag	EA	1	1				
X	359 / 4	Und Dk Surf Sm Flag	EA	1		1			
X	400 / 3	Concrete Wingwall	EA	4	4				

General Inspection/Maintenance Notes

Maintenance Recommendations (See standard code items & numbers)

Maintenance Item:	
Amount:	Date(YYYY-MM-DD):
Maintenance item comment:	

Maintenance Item:	
Amount:	Date(MM-DD-YY):
Maintenance item comment:	

NBI Ratings

NBI	File	New	NBI	File	New
Deck	8	8	Culvert	N	N
Superstructure	7	7	Channel	N	N
Substructure	8	7	Waterway	N	N

Maintenance Item:	
Amount:	Date(MM-DD-YY):
Maintenance item comment:	

STRUCTURE INVENTORY AND APPRAISAL FIELD REVIEW FORM

B-44-044
CTH J over USH 41

- (3) Municipality:
(16) Latitude(° ' "):
(17) Longitude(° ' "):

LOCATION	
TOWN-KAUKAUNA (44026)	
44°18'18.93"N	
88°14'57.65"W	

- (28A) Lanes On:
(28B) Lanes Under:
(102) Traffic Pattern On:
(102) Traffic Pattern Under:
(19) Detour Length(mi):

TRAFFIC SERVICE	
2	
4	
-NO TRAFFIC	X-ONE WAY TRAFFIC -TWO WAY TRAFFIC
-NO TRAFFIC	-ONE WAY TRAFFIC X-TWO WAY TRAFFIC
1	

- (49) Structure Length(ft):
(50) Sidewalk Width(ft):
(50) Curb Width(ft):
(52) Culvert Barrel Length(ft):
(34) Skew:

GEOMETRY	
216.2	
Left:	Right:
0.0	
Angle(°): 16	Direction: X-RIGHT FORWARD -LEFT FORWARD
Cardinal Width	Non-Cardinal Width
34.0	34.0
36.8	36.8
34	34
Cardinal Under Clearance	Non-Cardinal Under Clearance
64.8	64.8
12.2	12.2
28.6	28.6



- (51) Bridge Roadway(ft):
(52) Deck(ft):
(32) Approach Roadway(ft):
(47) Minimum Horizontal(ft):
(55) Minimum Right Lateral(ft):
(55) Minimum Left Lateral(ft):

- (36A) Bridge Rail Adequacy:
(36B) Transition Adequacy:
(36C) Approach Guardrail Adequacy:
(36D) Guardrail Termination Adequacy:
Outer Rail:


RAILING APPRAISAL		
-SUB-STANDARD	X-STANDARD	-NOT APPLICABLE
-SUB-STANDARD	X-STANDARD	-NOT APPLICABLE
-SUB-STANDARD	X-STANDARD	-NOT APPLICABLE
-SUB-STANDARD	X-STANDARD	-NOT APPLICABLE
Left	Right	Type
		TYPE F (TWO SQUARE TUBES) - STEEL(8)
		TYPE F (3 SQUARE TUBES) - STEEL(65)
		TYPE F (4 SQUARE TUBES) - STEEL(72)
		TYPE M-STEEL 3 SQUARE TUBES(93)
X	X	SLOPED FACE PARAPET LF(91)
		SLOPED FACE PARAPET HF(92)
		VERTICAL FACE PARAPET TYPE A(74)
		TYPE W-THRIE BEAM(79)
		TYPE H ON VERTICAL PARAPET(80)
		TIMBER(38)
		OTHER(99) (Please specify)
Transition Type:		
		CONT GUARD RAIL
		NO APP GRDRL
		NO ATTACHMENT
5		22 MM(7/8") BOLT (Please enter quantity)
		25 MM(1") BOLT (Please enter quantity)
		OTHER (Please specify)
Guardrail Termination Type:		
X		(01) ENERGY ABSORBING TERMINAL/EAT
		(02) TURN DOWN
		(99) OTHER (Please specify)

- (72) Approach Alignment Appraisal:

ROADWAY ALIGNMENT APPRAISAL	
	(3) INTOLERABLE- Horizontal or Vertical curvature requires a substantial reduction in vehicle operating speed
	(6) FAIR- Horizontal or Vertical curvature requires a very minor speed reduction
X	(8) GOOD- No speed reduction required

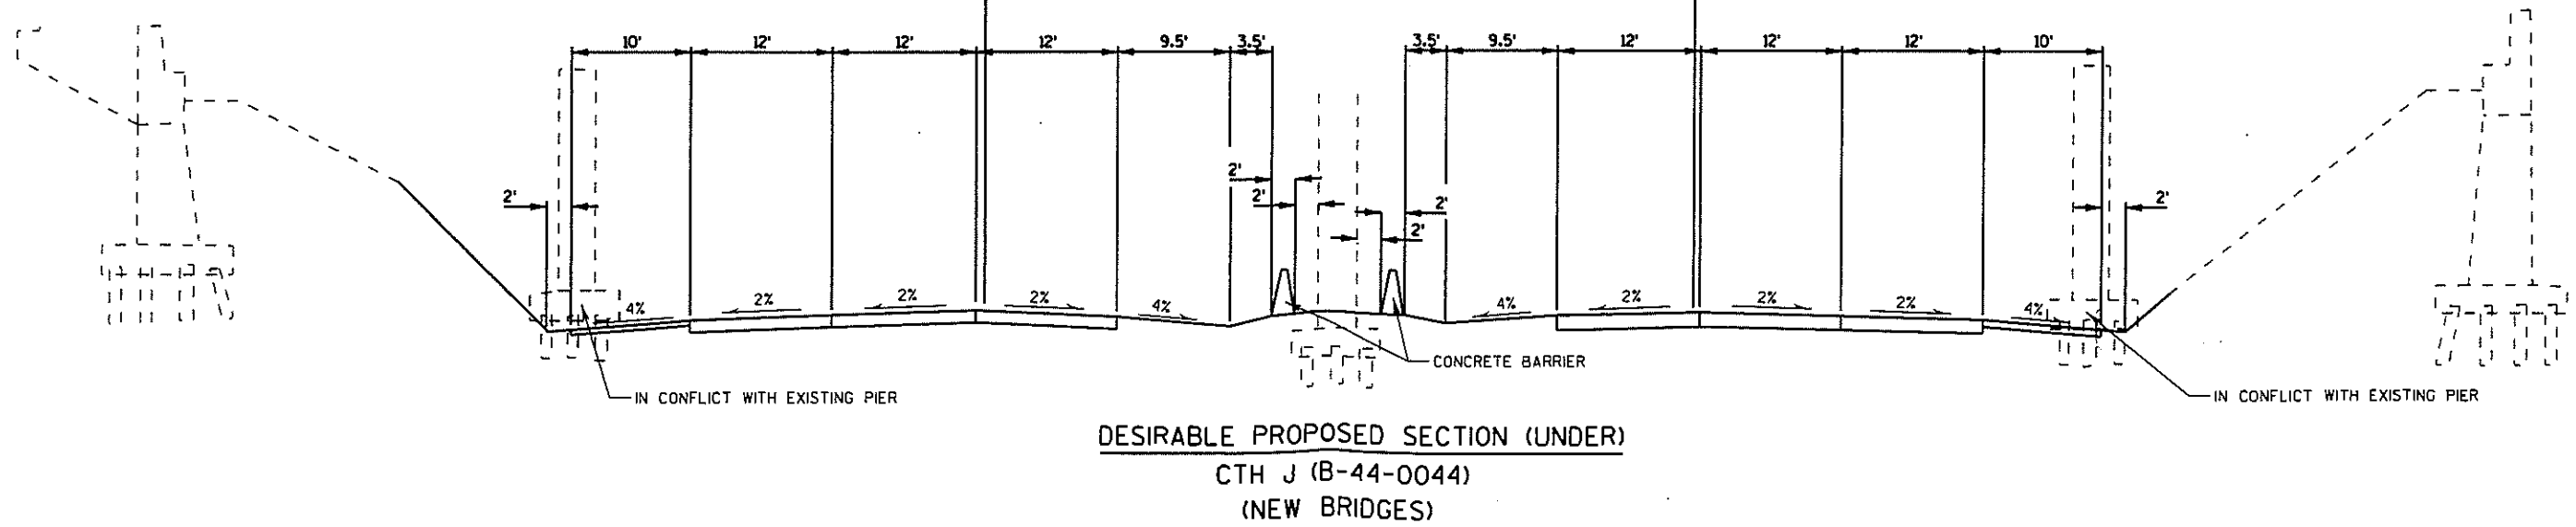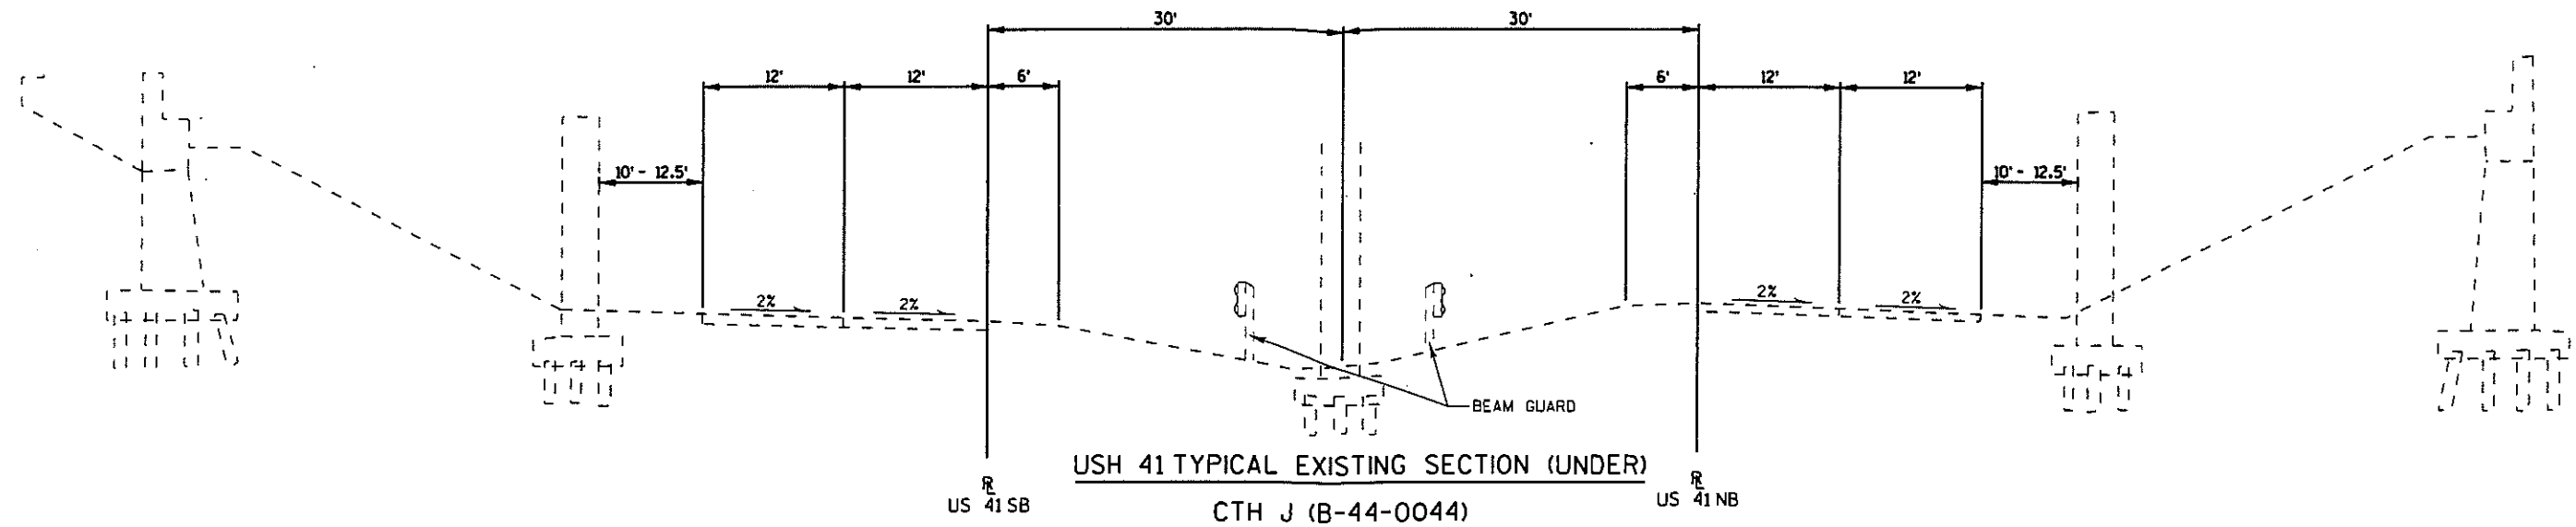

CONCRETE MASONRY SLAB — $f'c = 4,000$ P.S.I. ALL OTHER — $f'c = 3,500$ P.S.I.
 BAR STEEL REINFORCEMENT, GRADE 60 — $f_y = 60,000$ P.S.I.
 36" PRESTRESSED GIRDERS, CONCRETE MASONRY — $f'c = 6,000$ P.S.I.
 STRANDS - 0.5" DIA. WITH ULTIMATE TENSILE STRENGTH OF 270,000 P.S.I.

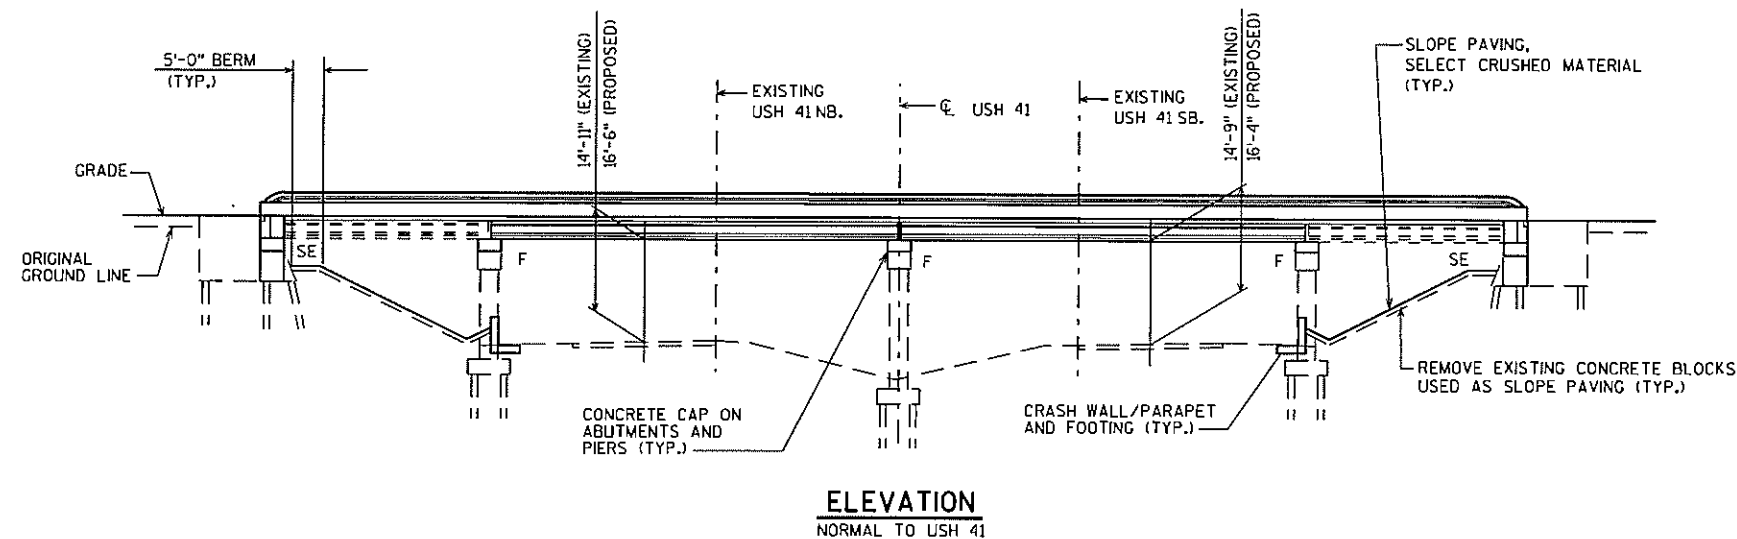

1. DECK REPLACEMENT AND RAISING
2. CROSS SECTION & GENERAL NOTES
3. QUANTITIES & PROFILE
4. ABUTMENT REMOVAL DETAILS
5. SOUTH ABUTMENT
6. NORTH ABUTMENT
7. ABUTMENT DETAILS
8. PIER 1
9. PIER 2
10. PIER 3
11. PIER DETAILS
12. SUPERSTRUCTURE CROSS SECTIONS
13. SUPERSTRUCTURE
14. SUPERSTRUCTURE DETAILS
15. SUPERSTRUCTURE GIRDER REPLACEMENT
16. 36" PRESTRESSED GIRDER DETAILS
17. STEEL DIAPHRAGM
18. SLOPED FACE PARAPET L/F
19. TUBULAR RAILING TYPE H (ALUM.)
20. TUBULAR RAILING TYPE H (STEEL)
21. SLOPE PAVING (SELECT CRUSHED MATERIAL)

STRUCTURE DESIGN CONTACT:
DAVE GENSON (608) 266-8491
DEAN SMITH (608) 266-5091

NO.	DATE	REVISION	BY

	Plans Prepared By	WISDOT
	BUREAU OF STRUCTURES	
APPROVED	<i>William C. Decker</i> ^{HIGH}	12/17/09
CHIEF STRUCTURES DESIGN ENGINEER		DATE

STRUCTURE B-44-44	
USH 41 OVER CTH J	

COUNTY	OUTAGAMIE	TOWNSHIP CITY	LAKE KAUKAUNA
DESIGN SPEC. AASHTO	STD. SPEC. 403	LOAD	
DESIGNED BY	DRG CK'D. <u> </u>	DRAWN BY	RIES PLANS CK'D. DRG

DECK REPLACEMENT AND RAISING	SHEET 1 OF 21 170
---	--

GENERAL NOTES

DRAWINGS SHALL NOT BE SCALED.

BAR STEEL REINFORCEMENT SHALL BE EMBEDDED 2" CLEAR UNLESS OTHERWISE SHOWN OR NOTED.

THE FIRST OR FIRST TWO DIGITS OF THE BAR MARK SIGNIFIES THE BAR SIZE.

AT THE BACKFACE OF ABUTMENT ALL VOLUME WHICH CANNOT BE PLACED BEFORE ABUTMENT CONSTRUCTION AND IS NOT OCCUPIED BY THE NEW STRUCTURE SHALL BE BACKFILLED WITH STRUCTURE BACKFILL.

ELASTOMERIC BEARING PADS NEED NOT BE INDIVIDUALLY MOLDED PROVIDED THE CUT EDGES ARE SMOOTH AND TRUE.

CONCRETE FOR ABUTMENT AND PIER DIAPHRAGMS SHALL BE PLACED WITH THE DECK CONCRETE. NO OPTIONAL CONSTRUCTION JOINT WILL BE PERMITTED.

THE GRADATION OF THE STRUCTURE BACKFILL SHALL MEET THE REQUIREMENTS OF SECTION 209.2.2 OF THE STANDARD SPECIFICATIONS FOR GRADE 1 MATERIAL.

PROTECTIVE SURFACE TREATMENT TO BE APPLIED TO THE ENTIRE TOP OF DECK SURFACE AND THE FRONT FACE AND THE TOP OF THE PARAPET. PROTECTIVE SURFACE TREATMENT SHALL ALSO BE APPLIED TO PIERS 1 AND 3 FROM THE EXISTING GROUND LINE TO THE BOTTOM OF THE PIER CAP AFTER WATER BLAST CLEANING THE PIER COLUMNS.

THE EXISTING GROUND LINE SHALL BE USED AS THE UPPER LIMITS OF EXCAVATION.

THE SLOPE OF THE FILL IN FRONT OF THE ABUTMENTS SHALL BE COVERED WITH SLOPE PAVING MATERIAL TO THE EXTENT SHOWN ON SHEET 1 AND IN THE ABUTMENT DETAILS.

DIMENSIONS SHOWN ARE BASED ON THE ORIGINAL STRUCTURE PLANS.

CONTRACTOR SHALL VERIFY ALL DIMENSIONS PRIOR TO ANY FABRICATION AND CONSTRUCTION.

INFORMATION ON THESE DRAWINGS RELATED TO THE EXISTING BRIDGE IS BASED UPON AVAILABLE DRAWING FROM THE WISCONSIN DEPARTMENT OF TRANSPORTATION. NO GUARANTEE OR WARRANTY IS MADE THAT THE INFORMATION IS ALL INCLUSIVE OR TOTALLY ACCURATE. THEREFORE, THE CONTRACTOR SHALL MAKE ITS OWN DETERMINATION OF THE ACTUAL CONDITIONS TO BE ENCOUNTERED.

CONCRETE SURFACE REPAIR AS DIRECTED BY ENGINEER.

SOUTH ABUTMENT	15 S.F.
GIRDERS	45 S.F.
COLUMN 3 PIER 3	15 S.F.
NORTH ABUTMENT	45 S.F.


IN ADDITION TO THE STANDARD SPECIFICATIONS FOR THE BID ITEM "CONCRETE SURFACE REPAIR", THE FOLLOWING SHALL BE FOLLOWED FOR THE REPAIR: PRIOR TO THE PLACING OF THE CONCRETE MIXTURE ON THE DAMAGED AREAS OF THE PRESTRESSED GIRDER, THE REAR AXLES OF A 15 TON TRUCK, FULLY LOADED, SHALL BE PARKED OVER THE GIRDER BEING REPAIRED. THE LOADED TRUCK SHALL REMAIN IN PLACE DURING THE CURING PERIOD OF THE SURFACE REPAIR, OR FOR A MINIMUM PERIOD OF FOUR DAYS.

ALL CONCRETE REMOVAL SHALL BE DEFINED BY A 1" DEEP SAW CUT.


USE EXISTING BAR STEEL REINFORCEMENT WHERE SHOWN AND EXTEND 24 BAR DIAMETER INTO NEW WORK.

THE CONTRACTOR SHALL SUBMIT A REMOVAL AND BRIDGE JACKING PLAN TO THE ENGINEER FOR APPROVAL.

CONTRACTOR SHALL SUPPLY A NEW NAME PLATE IN ACCORDANCE WITH SECTION 502.3.11 OF THE STANDARD SPECIFICATIONS AND THE STANDARD DETAILED DRAWINGS. THE NEW NAME PLATE SHALL SHOW THE ORIGINAL CONSTRUCTION YEAR OF 1961.

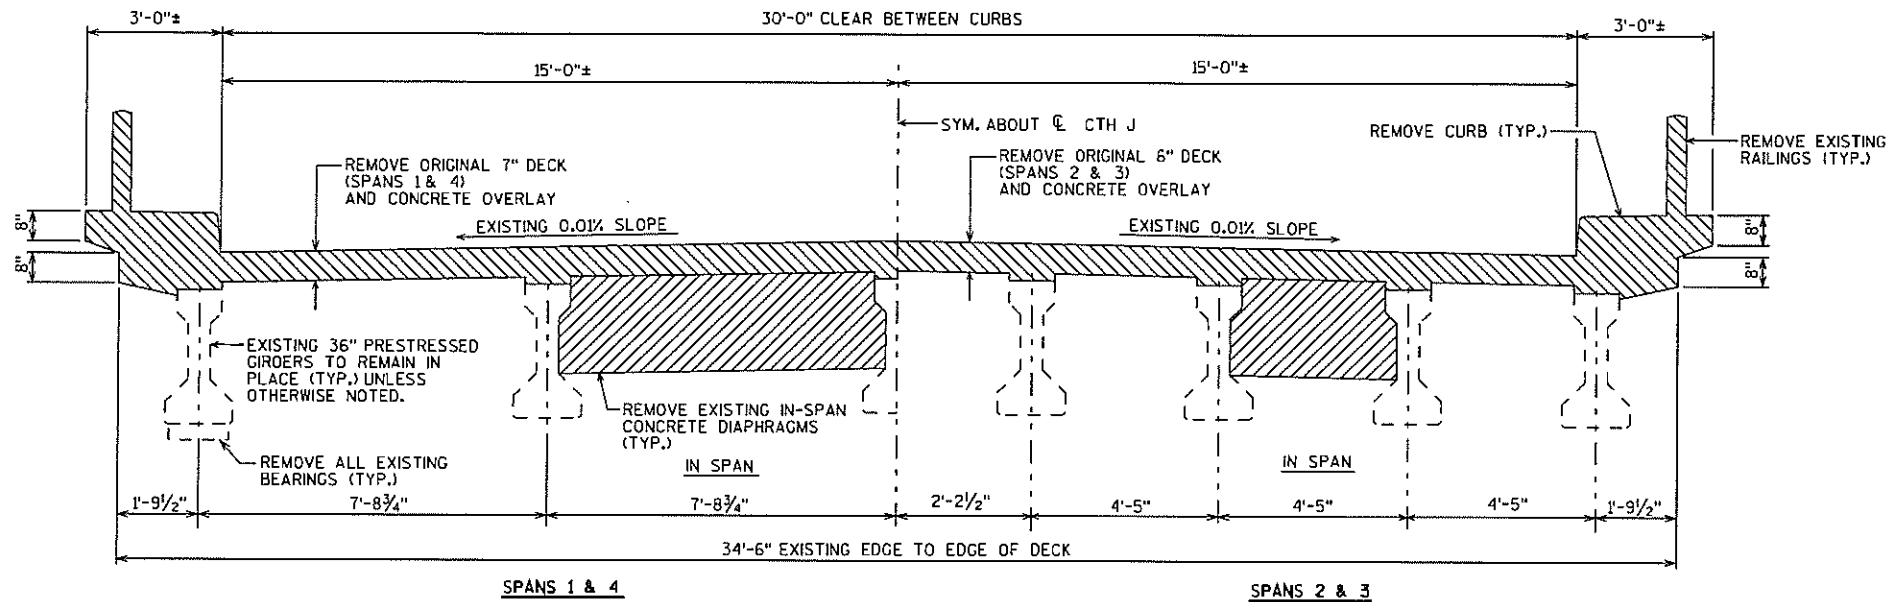

EXISTING CROSS SECTION THRU ROADWAY - LOOKING NORTH

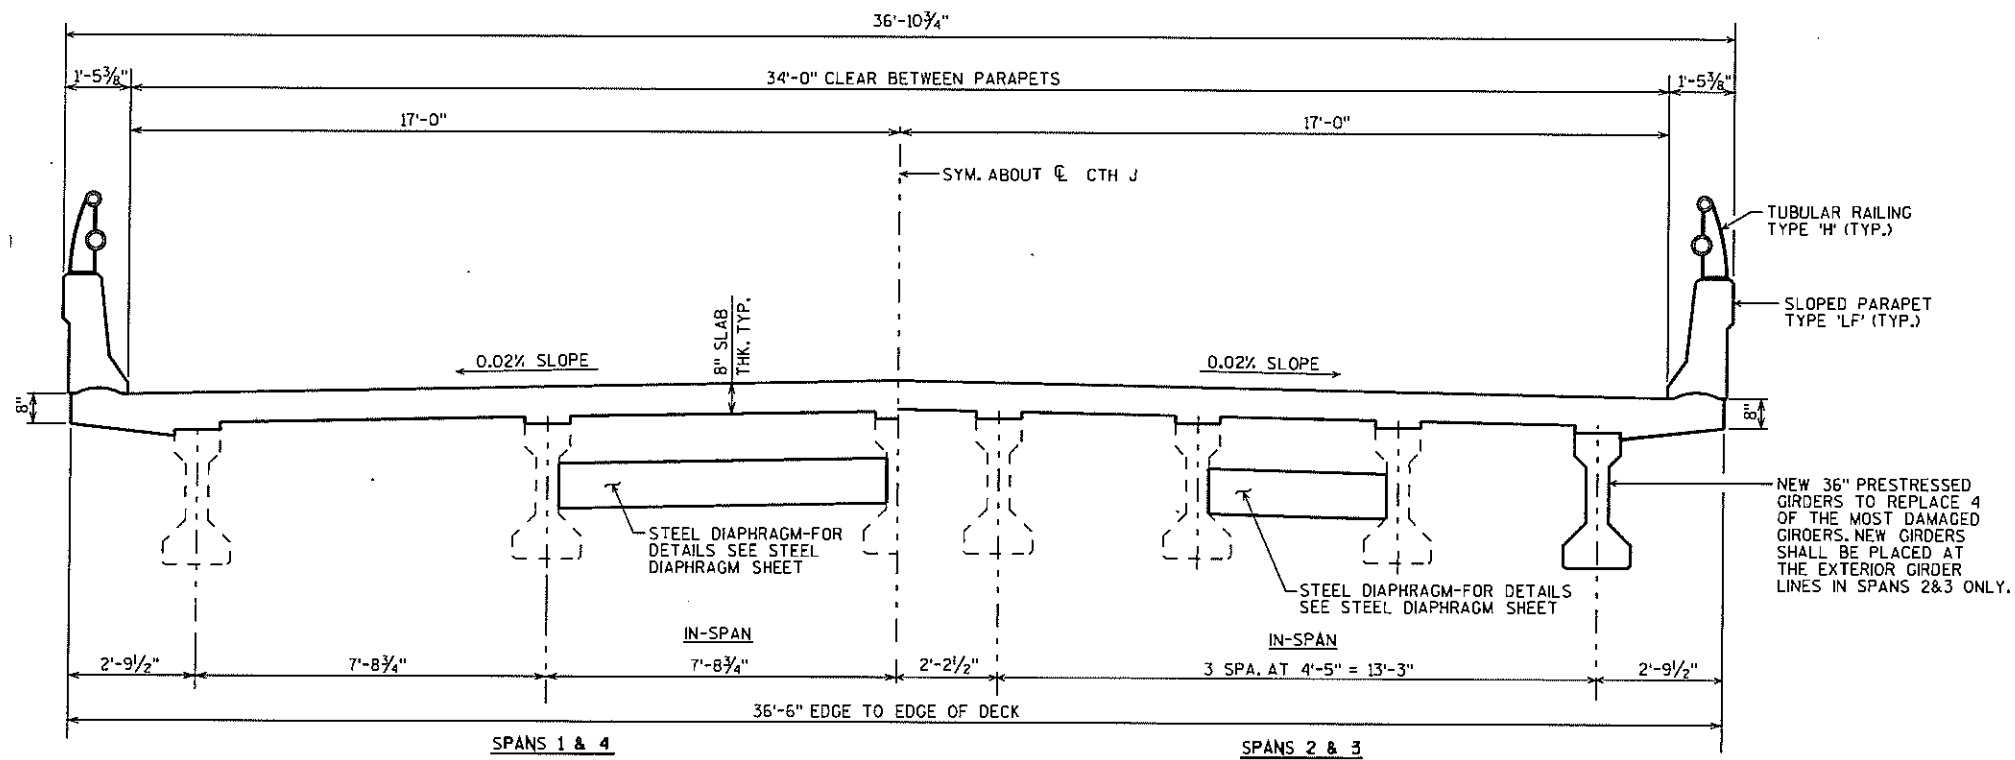


CROSS SECTION THRU ROADWAY - LOOKING NORTH

NO.	DATE	REVISION	BY
STATE OF WISCONSIN DEPARTMENT OF TRANSPORTATION STRUCTURES DESIGN SECTION			
STRUCTURE B-44-44			
DRAWN BY		RIES	PLANS CKD. DRG
CROSS SECTIONS AND GENERAL NOTES			SHEET 2
			171

TOTAL ESTIMATED QUANTITIES

BID ITEM NUMBER	BID ITEMS	UNIT	SUPER.	SOUTH ABUT.	NORTH ABUT.	PIER 1	PIER 2	PIER 3	TOTALS
203.0200	REMOVING OLD STRUCTURE STA. 22+10.28	LS	---	---	---	---	---	---	1
204.0175	REMOVING CONCRETE SLOPE PAVING	SY	---	150	150	---	---	---	300
206.1000	EXCAVATION FOR STRUCTURES BRIDGES B-44-44	LS	---	---	---	---	---	---	1
210.0100	BACKFILL STRUCTURE	CY	---	170	170	---	---	---	340
502.0100	CONCRETE MASONRY BRIDGES	CY	308	35	35	41	10	41	470
502.3200	PROTECTIVE SURFACE TREATMENT	SY	985	---	---	41	---	41	1,067
502.5020	MASONRY ANCHORS TYPE L NO. 8 BARS	EACH	---	14	14	---	---	---	28
502.6105	MASONRY ANCHORS TYPE S 5/8-INCH	EACH	---	90	90	76	76	76	408
502.6110	MASONRY ANCHORS TYPE S 3/4-INCH	EACH	---	---	---	30	---	30	60
503.0136	PRESTRESSED GIRDER TYPE I 36-INCH	LF	351	---	---	---	---	---	351
505.0405	BAR STEEL REINFORCEMENT HS BRIDGES	LB	---	---	---	---	---	---	---
505.0605	BAR STEEL REINFORCEMENT HS COATED BRIDGES	LB	60,520	3485	3485	5365	1430	5365	79,650
505.2605	BEARING PADS ELASTOMERIC NON-LAMINATED	EACH	---	5	5	13	16	13	52
506.4000	STEEL DIAPHRAGMS B-44-44	EACH	36	---	---	---	---	---	36
506.7050.S	REMOVING BEARINGS B-44-44	EACH	---	5	5	13	16	13	52
506.7060.S	BRIDGE JACKING B-44-44	LS	---	---	---	---	---	---	1
509.1500	CONCRETE SURFACE REPAIR	SF	45	15	45	---	---	15	120
513.4055	RAILING TUBULAR TYPE H B-44-44	LS	---	---	---	---	---	---	1
516.0500	RUBBERIZED MEMBRANE WATERPROOFING	SY	---	18	18	---	---	---	36
604.0600	SLOPE PAVING SELECT CRUSHED MATERIAL	SY	---	175	175	---	---	---	350
612.0406	PIPE UNDERDRAIN WRAPPED 6-INCH	LF	---	70	70	---	---	---	140
614.0150	ANCHOR ASSEMBLIES FOR STEEL PLATE BEAM GUARD	EACH	4	---	---	1	---	1	6
	NON-BID ITEMS								
	FILLER	SIZE	---	---	---	---	---	---	1/2" & 3/4"

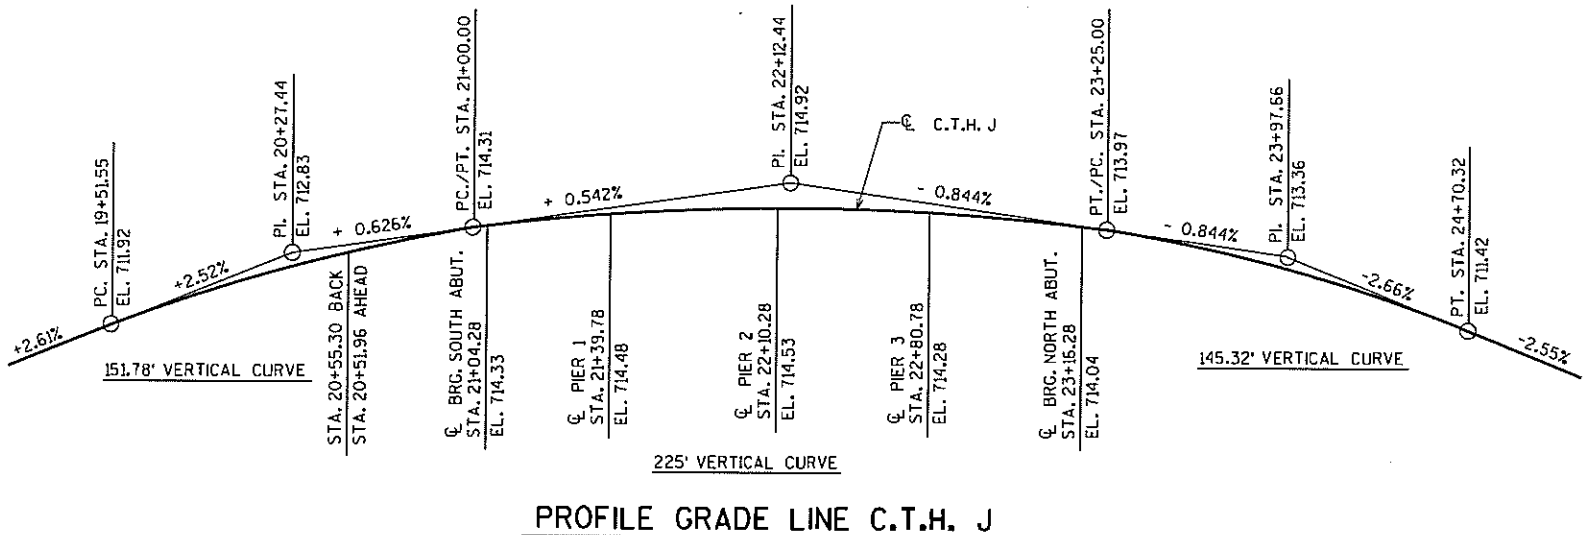

NO.	DATE	REVISION	BY
STATE OF WISCONSIN DEPARTMENT OF TRANSPORTATION STRUCTURES DESIGN SECTION			
STRUCTURE B-44-44			
	DRAWN BY	RIES	PLANS DRG
QUANTITIES & PROFILE		SHEET 3	
		172	

Vertical Clearance for Construction of New Bridges, Replacement Bridges, and Bridges on which the Superstructure is being replaced¹

Overpass Facility →	Freeway, Expressway, or STH		Railroad ⁴ , CTH, Town Road, Local Road, or Street	Pedestrian or Shared-use Structures	Sign Structures ²
Underpass Facility ↓	Interchange	Grade Separation			
Non-arterial either STH, CTH, Town Road, Local Road, or Street	15'-9" Desirable	15'-3" Desirable	16'-9" Desirable	16'-3" Minimum	18'-3" Minimum
	15'-3" Minimum	14'-9" Minimum			
Arterial either CTH, Town Road, Local Road, or Street (excludes freeway and expressway; also excludes arterial STH)	16'-9" Desirable	15'-3" Desirable	17'-9" Desirable	17'-3" Minimum	
	16'-3" Minimum	14'-9" Minimum			
Freeway ³ or Expressway or arterial STH	16'-9" Desirable		17'-9" Desirable	17'-4" Minimum	
	16'-4" Minimum				
Railroad ^{4,5,6,7}	23'-0" Minimum to 23'-3½" Maximum				

General notes:

- ¹ Vertical clearance is needed for the entire roadway width (critical point; to include traveled way, auxiliary lanes, turn lanes, and shoulders), according to the above table.

Vertical clearance for railroads is measured from the top of rail and is required over an area 8 feet 6 inches from the track centerline on each side of a railroad track.

Do not exceed the desirable vertical clearance shown unless justified. Depending on topography and other specific situations vertical clearance for any structure may be greater than that shown when justified. Some things to consider are: over height loads traveling on the roadway; the level of development in the area, the projected growth in traffic volume and importance of the roadway, and the possibility of reclassification.

- ² See LRFD Bridge Manual Chapter 39 (http://on.dot.wi.gov/dtid_bos/extranet/structures/LRFD/LRFDManualIndex.htm) and LRFD Standard Details 39.02 and 39.10 for design considerations and requirements for vertical clearance on new and replacement Sign Structures.
- ³ See FDM 11-44-1 for vertical clearance guidance specific to Interstate freeways.
- ⁴ Consult with the Region Railroad Coordinator if the over-passing or under-passing facility is either a railroad or a "rails-to-trails" trail; or if a structure is owned by a railroad company.
- ⁵ A vertical clearance <23'-0" requires both an approved Exception to Standards (see FDM 11-1-2 and FDM 11-1-4) and early coordination with BTLR R&H, Railroads and Harbors Section (RHS) through the Region Railroad Coordinator. The Exception to Standards shall contain documentation that the Office of the Commissioner of Railroads (OCR) has been petitioned.
- See Chapter 17 for additional information.
- ⁶ Provide justification for a vertical clearance >23'-3½" to the RHS.
- ⁷ Vertical clearance less than 23'-0" may be acceptable or desirable in certain situations, such as for spur tracks, lead tracks, some branch lines and even mainline tracks when other impediments to 23'-0" exist. Review such situations with the Railroad Project Coordination Engineer in RHS. Early coordination with RHS is required.



DAAR
ENGINEERING, INC.

PROJECT: _____

DESCRIPTION: US 41 over CTH JJ

B-44-71(SB) & 72(NB)

DATE: _____

SHEET ____ OF ____

CALC. BY: _____

CHECKED BY: _____

Existing structures are 40' x 99' 1-95' span with 54" Girders
V.C. = 15.32' SB & 15.03' NB Need 16.75'


Existing CTH JJ is 2-12' lanes & 6' shldr. Expand CTH JJ to

4-12' lanes & 6' shldr. → 4-12' lanes = 48'
2-14' clear zone = 28' (includes shldr)
Slope Paving 2 x 34' = 68'
12' @ 2:1 = 34'
Abutment (28' + 4') x 2 = 13'

157' span = 72" Girders

Raise US 41 by 18" - No

Proposed Typical half section on JJ

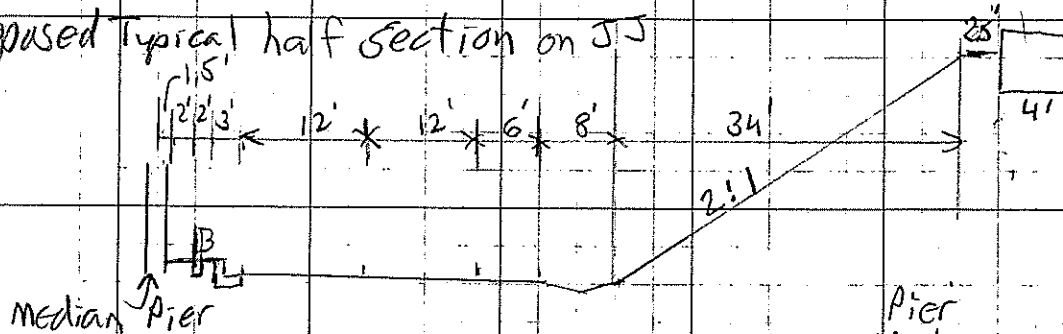

20' widening in median
= 20' x .02 = 0.4'

Pier offset 1.5'
Beam Guard 2.0'
C & G 2.0'
2-12' lanes 3.0'
14' clear zone 24.0'
Slope Paving 14.0'
Abutment 34.0'
2.8'
4.0'

B-71(SB) 15.32' - at & JJ

+ 1.5'
16.82'

- 0.4'
16.42' → raise 41 0.33'

87.0' span = 36" Girders

1.5' difference in girders

B-72(NB) 15.03' - at & JJ

+ 1.5'
16.53'
- 0.4'
16.13'

raise US 41 0.62'

Note: Profile raise on US 41

will be required to correct deficient grades,

BRIDGE INSPECTION REPORT
Wisconsin Dept. of Transportation
DT2007 2003 s.84.17 Wis. Stats. Type = ROUTINE INSPECTION

page 1

Inventory Data

Feature On: USH 41	Maintainer: STATE HIGHWAY DEPT	Structure No: B-44-071
Feature Under: JJ (SB)	Sect/Twn/Rng: S08 T21N R19E	
Location: 3.2M S JCT CTH U	County: OUTAGAMI	Municipality: TOWN-KAUKAUNA (44026)
Inv Rating: HS22.2	Rdwy Width (ft): 39.4	Deck Width (ft): 42.0
Oper Rating: HS43.3	Total Length (ft): 99.5	Deck Area(ft2): 4179
	ADT On: 19000 Yr: 1998	ADT Under: 0 Yr: 2000

Inspection Type (* = Supplemental Form Required)

	Routine Visual	Fracture Critical*	In-Depth*	UW-Dive*	UW-Surv*	UW-Probe/Visual*	Movable*
Last Insp.	10-17-11						
Frequency	24						
Recom. Freq.							
	Initial*	Damage	Interim	Load Posted	SI & A Field Review*		
Last Insp.							
Frequency	N/A						
Recom. Freq.	N/A						
					Item No. Needing Change		

Load Rating Information

Overburden	Measurement (in): 0.0	Date:	Deck Surface Type: CONCRETE
Section Loss	File Meas. (%):	File Insp. Date: 10-19-09	Insp. Measurement (%):
Re-rate for load capacity?	Reason:		Date Last Rated: 03-14-00

Expansion Joints

		Temp:			Signing Condition			
Location	Type	File Insp. Date	File Insp. (in)	New Insp. (in)	Type of Marker	File	Y/N	Comments
					Bridge Markers			
					Narrow Bridge			
					One Lane Road			
					Vertical Clearance			
					Weight Limit Post			
					Other(Addl. Sign)			

Clearances(Cardinal = N or E)

	File Meas. (ft.)	File Date	New Meas. (ft.)
Min. Vertical Clearance Under (Cardinal)	15.32	11-28-00	
Min. Vertical Clearance Under (non-Cardinal)			
Min. Vertical Clearance On			

Structure Type

Construction/Rehabilitation History

Material	Configuration	# of Spans	Overall Length (ft)	Year	Work Performed	Plan	Shop
PREST CONCRET	DECK GIRDER		95.5	2000	NEW STRUCTURE		

Inspection Information

Special Requirements	Y/N	Comments
Traffic Control	Y	
Access Equipment	Y	
Other	Y	

Inspector Information

Team Leader Name and No. Printed: Michaelson, Neil (3010)	Team Member(s) Name(s) Printed:	
Team Leader Signature:	Inspection Date: 10-17-11	Inspection Agency: STATE HIGHWAY DEPARTMENT (1)
District/Local Manager and No. Printed:	District/Local Manager Signature:	Review Date:

Element Inspection (X) Check Elements Inspected

					Quantity in Condition States				
Ck	Elem./Env.	Description	Unit	Total QTY.	1	2	3	4	5
X	26 / 4	Conc Deck/Coatd Bars	SF	4179	4179				
		Dia. cracks.							
X	109 / 3	P/S Conc Open Girder	LF	482	482				
X	172 / 3	Painted Steel Diaphr	EA	8	8				
X	215 / 4	R/Conc Abutment	LF	85	76	7	2		
		Spall at center of south abut; North abut has 5 cracks							
X	322 / 4	Bituminous Approach	EA	2		2			
		Both approaches are deteriorating at the egde of the deck and need sealing							
X	331 / 4	Conc Bridge Railing	LF	291	246	45			
		cracks and popouts							
X	342 / 2	RipRap Slope Protect	EA	2	2				
X	358 / 4	Deck Cracking SmFlag	EA	1	1				
X	359 / 4	Und Dk Surf Sm Flag	EA	1	1				
X	400 / 4	Concrete Wingwall	EA	4	4				

General Inspection/Maintenance Notes

Maintenance Recommendations (See standard code items & numbers)

Maintenance Item: Approach - Seal Approach to Paving Block

Amount: Date(YYYY-MM-DD):

Maintenance item comment: Seal joints at the end of deck

Maintenance Item:

Amount: Date(MM-DD-YY):

Maintenance item comment:

NBI Ratings

NBI	File	New	NBI	File	New
Deck	7	7	Culvert	N	N
Superstructure	7	8	Channel	N	N
Substructure	7	7	Waterway	N	N

Maintenance Item:

Amount: Date(MM-DD-YY):

Maintenance item comment:

STRUCTURE INVENTORY AND APPRAISAL FIELD REVIEW FORM

B-44-071
USH 41 over JJ (SB)

- (3) Municipality:
 (16) Latitude(° ' ") :
 (17) Longitude(° ' ") :

LOCATION

TOWN - KAUKAUNA (44026)
44°18'51.62"N
88°13'43.85"W

- (28A) Lanes On:
 (28B) Lanes Under:
 (102) Traffic Pattern On:
 (102) Traffic Pattern Under:
 (19) Detour Length(mi):

TRAFFIC SERVICE

2
2
-NO TRAFFIC X-ONE WAY TRAFFIC -TWO WAY TRAFFIC
-NO TRAFFIC -ONE WAY TRAFFIC X-TWO WAY TRAFFIC
3

- (49) Structure Length(ft):
 (50) Sidewalk Width(ft):
 (50) Curb Width(ft):
 (52) Culvert Barrel Length(ft):
 (34) Skew:

GEOMETRY

99.5	
Left: 0.0	Right: 0.0
Angle(°): 23	Direction: X-RIGHT FORWARD -LEFT FORWARD
Cardinal Width	Non-Cardinal Width
39.4	39.4
42.0	42.0
39	0
Cardinal Under Clearance	Non-Cardinal Under Clearance
48.5	
16.0	
8.5	

- (51) Bridge Roadway(ft):
 (52) Deck(ft):
 (32) Approach Roadway(ft):
 (47) Minimum Horizontal(ft):
 (55) Minimum Right Lateral(ft):
 (55) Minimum Left Lateral(ft):

RAILING APPRAISAL

- (36A) Bridge Rail Adequacy:
 (36B) Transition Adequacy:
 (36C) Approach Guardrail Adequacy:
 (36D) Guardrail Termination Adequacy:
 Outer Rail:

-SUB-STANDARD	X-STANDARD	-NOT APPLICABLE
-SUB-STANDARD	X-STANDARD	-NOT APPLICABLE
-SUB-STANDARD	X-STANDARD	-NOT APPLICABLE
-SUB-STANDARD	X-STANDARD	-NOT APPLICABLE
Left	Right	Type
		TYPE F (TWO SQUARE TUBES) - STEEL(8)
		TYPE F (3 SQUARE TUBES) - STEEL(65)
		TYPE F (4 SQUARE TUBES) - STEEL(72)
		TYPE M-STEEL 3 SQUARE TUBES(93)
X	X	SLOPED FACE PARAPET LF(91)
		SLOPED FACE PARAPET HF(92)
		VERTICAL FACE PARAPET TYPE A(74)
		TYPE W-THREE BEAM(79)
		TYPE H ON VERTICAL PARAPET(80)
		TIMBER(38)
		OTHER(99) (Please specify)

Transition Type:

	CONT GUARD RAIL
	NO APP GRDRL
	NO ATTACHMENT
5	22 MM(7/8") BOLT (Please enter quantity)
	25 MM(1") BOLT (Please enter quantity)
	OTHER (Please specify)

Guardrail Termination Type:

X	(01) ENERGY ABSORBING TERMINAL/EAT
	(02) TURN DOWN
	(99) OTHER (Please specify)

(72) Approach Alignment Appraisal:

ROADWAY ALIGNMENT APPRAISAL

	(3) INTOLERABLE- Horizontal or Vertical curvature requires a substantial reduction in vehicle operating speed
	(6) FAIR- Horizontal or Vertical curvature requires a very minor speed reduction
X	(8) GOOD- No speed reduction required

This page intentionally left blank

BRIDGE INSPECTION REPORT
Wisconsin Dept. of Transportation
DT2007 2003 s.84.17 Wis. Stats. Type = ROUTINE INSPECTION

page 1

Inventory Data

Feature On: USH 41		Maintainer: STATE HIGHWAY DEPT		Structure No: B-44-072
Feature Under: JJ		Sect/Twn/Rng: S08 T21N R19E		
Location: 1.2M N JCT CTH J		County: OUTAGAMI	Municipality: TOWN-KAUKAUNA (44026)	
Inv Rating: HS21.1	Rdwy Width (ft): 39.4	Deck Width (ft): 42.3	Existing Posting:	
Oper Rating: HS43.3	Total Length (ft): 99.4	Deck Area(ft2): 4204	ADT On: 23100 Yr: 2003	ADT Under: 0 Yr: 2000

Inspection Type (* = Supplemental Form Required)

	Routine Visual	Fracture Critical*	In-Depth*	UW-Dive*	UW-Surv*	UW-Probe/Visual*	Movable*
Last Insp.	10-17-11						
Frequency	24						
Recom. Freq.							
	Initial*	Damage	Interim	Load Posted	SI & A Field Review*		
Last Insp.							
Frequency	N/A						
Recom. Freq.	N/A				Item No. Needing Change		

Load Rating Information

Overburden	Measurement (in): 0.0	Date:	Deck Surface Type: CONCRETE	
Section Loss	File Meas. (%):	File Insp. Date: 10-19-09	Insp. Measurement (%):	Describe:
Re-rate for load capacity?	Reason:		Date Last Rated: 07-20-99	

Expansion Joints

		Temp:			Signing Condition			
Location	Type	File Insp. Date	File Insp. (in)	New Insp. (in)	Type of Marker	File	Y/N	Comments
					Bridge Markers			
					Narrow Bridge			
					One Lane Road			
					Vertical Clearance			
					Weight Limit Post			
					Other(Addl. Sign)			

Clearances(Cardinal = N or E)

	File Meas. (ft.)	File Date	New Meas. (ft.)
Min. Vertical Clearance Under (Cardinal)	15.03	11-28-00	
Min. Vertical Clearance Under (non-Cardinal)			
Min. Vertical Clearance On			

Structure Type

Construction/Rehabilitation History

Material	Configuration	# of Spans	Overall Length (ft)	Year	Work Performed	Plan	Shop
PREST CONCRET	DECK GIRDER		95.5	1999	NEW STRUCTURE	PLAN	

Inspection Information

Special Requirements	Y/N	Comments
Traffic Control	Y	
Access Equipment	Y	
Other	Y	

Inspector Information

Team Leader Name and No. Printed: Michaelson, Neil (3010)		Team Member(s) Name(s) Printed:	
Team Leader Signature:		Inspection Date: 10-17-11	Inspection Agency: STATE HIGHWAY DEPARTMENT (1)
District/Local Manager and No. Printed:		District/Local Manager Signature:	Review Date:

Element Inspection (X) Check Elements Inspected

Element Inspection (X) Check Elements Inspected					Quantity in Condition States				
Ck	Elem./Env.	Description	Unit	Total QTY.	1	2	3	4	5
X	26 / 4	Conc Deck/Coatd Bars	SF	4204	4204				
		Diagonal cracks at abut, longitudinal at center							
X	109 / 3	P/S Conc Open Girder	LF	482	482				
X	172 / 3	Painted Steel Diaphr	EA	8	8				
X	215 / 4	R/Conc Abutment	LF	72	63	9			
		CS-2 (S Abut 4" & N Abut 5")							
X	322 / 4	Bituminous Approach	EA	2	1	1			
		North approach slightly settled							
X	331 / 4	Conc Bridge Railing	LF	269	219	50			
X	342 / 2	RipRap Slope Protect	EA	2	2				
X	358 / 4	Deck Cracking SmFlag	EA	1	1				
X	359 / 4	Und Dk Surf Sm Flag	EA	1	1				
X	400 / 4	Concrete Wingwall	EA	4	4				

General Inspection/Maintenance Notes

--

Maintenance Recommendations (See standard code items & numbers)

Maintenance Item: Approach - Seal Approach to Paving Block

Amount: Date(YYYY-MM-DD):

Maintenance item comment: Seal joints at the ends of the deck

Maintenance Item:

Amount: Date(MM-DD-YY):

Maintenance item comment:

NBI Ratings

NBI	File	New	NBI	File	New
Deck	7	7	Culvert	N	N
Superstructure	8	8	Channel	N	N
Substructure	8	7	Waterway	N	N

Maintenance Item:

Amount: Date(MM-DD-YY):

Maintenance item comment:

STRUCTURE INVENTORY AND APPRAISAL FIELD REVIEW FORM

B-44-072
USH 41 over JJ

(3) Municipality:
(16) Latitude(° ' "):
(17) Longitude(° ' "):

LOCATION	
TOWN- KAUKAUNA (44026)	
44°18'50.08"N	
88°13'43.58"W	

(28A) Lanes On:
(28B) Lanes Under:
(102) Traffic Pattern On:
(102) Traffic Pattern Under:
(19) Detour Length(mi):

TRAFFIC SERVICE	
2	
2	
-NO TRAFFIC	X-ONE WAY TRAFFIC -TWO WAY TRAFFIC
-NO TRAFFIC	-ONE WAY TRAFFIC X-TWO WAY TRAFFIC
3	

(49) Structure Length(ft):
(50) Sidewalk Width(ft):
(50) Curb Width(ft):
(52) Culvert Barrel Length(ft):
(34) Skew:

GEOMETRY	
99.4	
Left: 0.0	Right: 0.0
Angle(°): 13	Direction: X-RIGHT FORWARD -LEFT FORWARD
Cardinal Width	Non-Cardinal Width
39.4	39.4
42.3	42.3
39	0
Cardinal Under Clearance	Non-Cardinal Under Clearance
48.0	
15.5	
8.5	

(51) Bridge Roadway(ft):
(52) Deck(ft):
(32) Approach Roadway(ft):
(47) Minimum Horizontal(ft):
(55) Minimum Right Lateral(ft):
(55) Minimum Left Lateral(ft):

(36A) Bridge Rail Adequacy:
(36B) Transition Adequacy:
(36C) Approach Guardrail Adequacy:
(36D) Guardrail Termination Adequacy:
Outer Rail:

RAILING APPRAISAL		
-SUB-STANDARD	X-STANDARD	-NOT APPLICABLE
-SUB-STANDARD	X-STANDARD	-NOT APPLICABLE
-SUB-STANDARD	X-STANDARD	-NOT APPLICABLE
-SUB-STANDARD	X-STANDARD	-NOT APPLICABLE
Left	Right	Type
		TYPE F (TWO SQUARE TUBES) - STEEL(8)
		TYPE F (3 SQUARE TUBES) - STEEL(65)
		TYPE F (4 SQUARE TUBES) - STEEL(72)
		TYPE M-STEEL 3 SQUARE TUBES(93)
X	X	SLOPED FACE PARAPET LF(91)
		SLOPED FACE PARAPET HF(92)
		VERTICAL FACE PARAPET TYPE A(74)
		TYPE W-THREE BEAM(79)
		TYPE H ON VERTICAL PARAPET(80)
		TIMBER(38)
		OTHER(99) (Please specify)
Transition Type:		
		CONT GUARD RAIL
		NO APP GRDRL
		NO ATTACHMENT
5		22 MM(7/8") BOLT (Please enter quantity)
		25 MM(1") BOLT (Please enter quantity)
		OTHER (Please specify)
Guardrail Termination Type:		
X		(01) ENERGY ABSORBING TERMINAL/EAT
		(02) TURN DOWN
		(99) OTHER (Please specify)


Transition Type:

Guardrail Termination Type:

(72) Approach Alignment Appraisal:

ROADWAY ALIGNMENT APPRAISAL	
	(3) INTOLERABLE- Horizontal or Vertical curvature requires a substantial reduction in vehicle operating speed
	(6) FAIR- Horizontal or Vertical curvature requires a very minor speed reduction
X	(8) GOOD- No speed reduction required

This page intentionally left blank

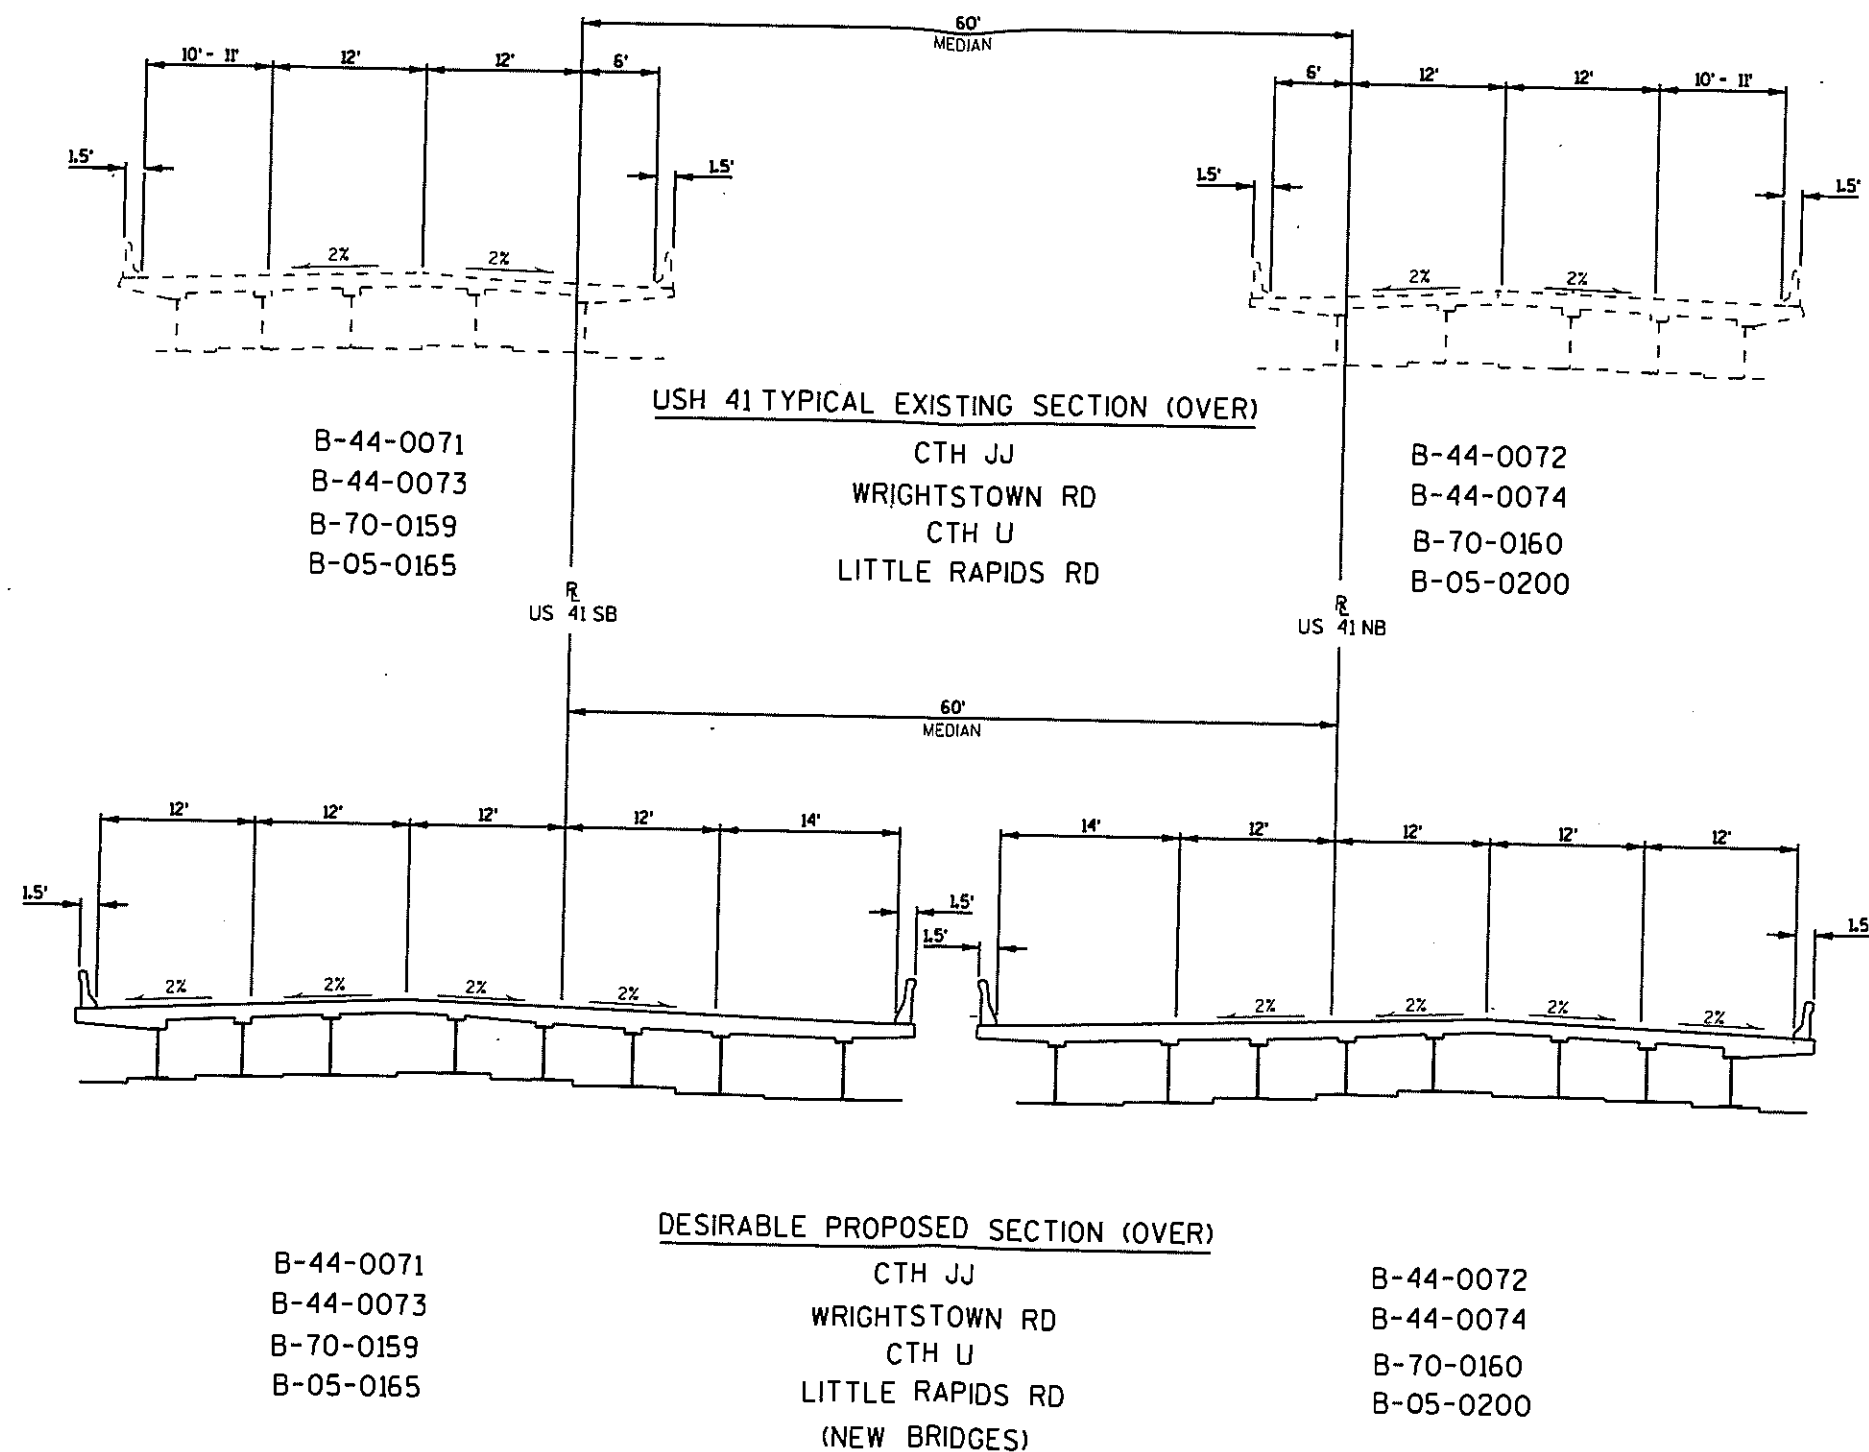

DESIGN DATA

LIVE LOAD:

DESIGN RATING: MS-18
 INVENTORY RATING: MS-20
 OPERATIONAL RATING: MS-39
 MAXIMUM STANDARD PERMIT VEHICLE LOAD = 1110 kN.
 STRUCTURE IS DESIGNED FOR A FUTURE WEARING SURFACE OF 10 kN/m².

ULTIMATE DESIGN STRESSES:


CONCRETE MASONRY SLAB — $f'_c = 28 \text{ MPa}$ ALL OTHER — $f'_c = 24 \text{ MPa}$
 BAR STEEL REINFORCEMENT, AASHTO M-31M, GRADE 420 — $f_y = 420 \text{ MPa}$
 1370mm PRESTRESSED GIRDERS, CONCRETE MASONRY — $f'_c = 42 \text{ MPa}$
 STRANDS - 13mm DIA. WITH ULTIMATE TENSILE STRENGTH OF 1860 MPa

FOUNDATION DATA

ABUTMENTS TO BE SUPPORTED ON HP 250 X 62 STEEL PILING
 DRIVEN TO A MINIMUM BEARING VALUE OF 490 kN PER PILE.
 ESTIMATED 29m LONG.


TRAFFIC VOLUME

U.S.H. 41 C.T.H. JJ
 A.D.T.=37,000 (2018) A.D.T.=1,620 (2018)
 R.O.S.=110 km/h R.O.S.=70 km/h

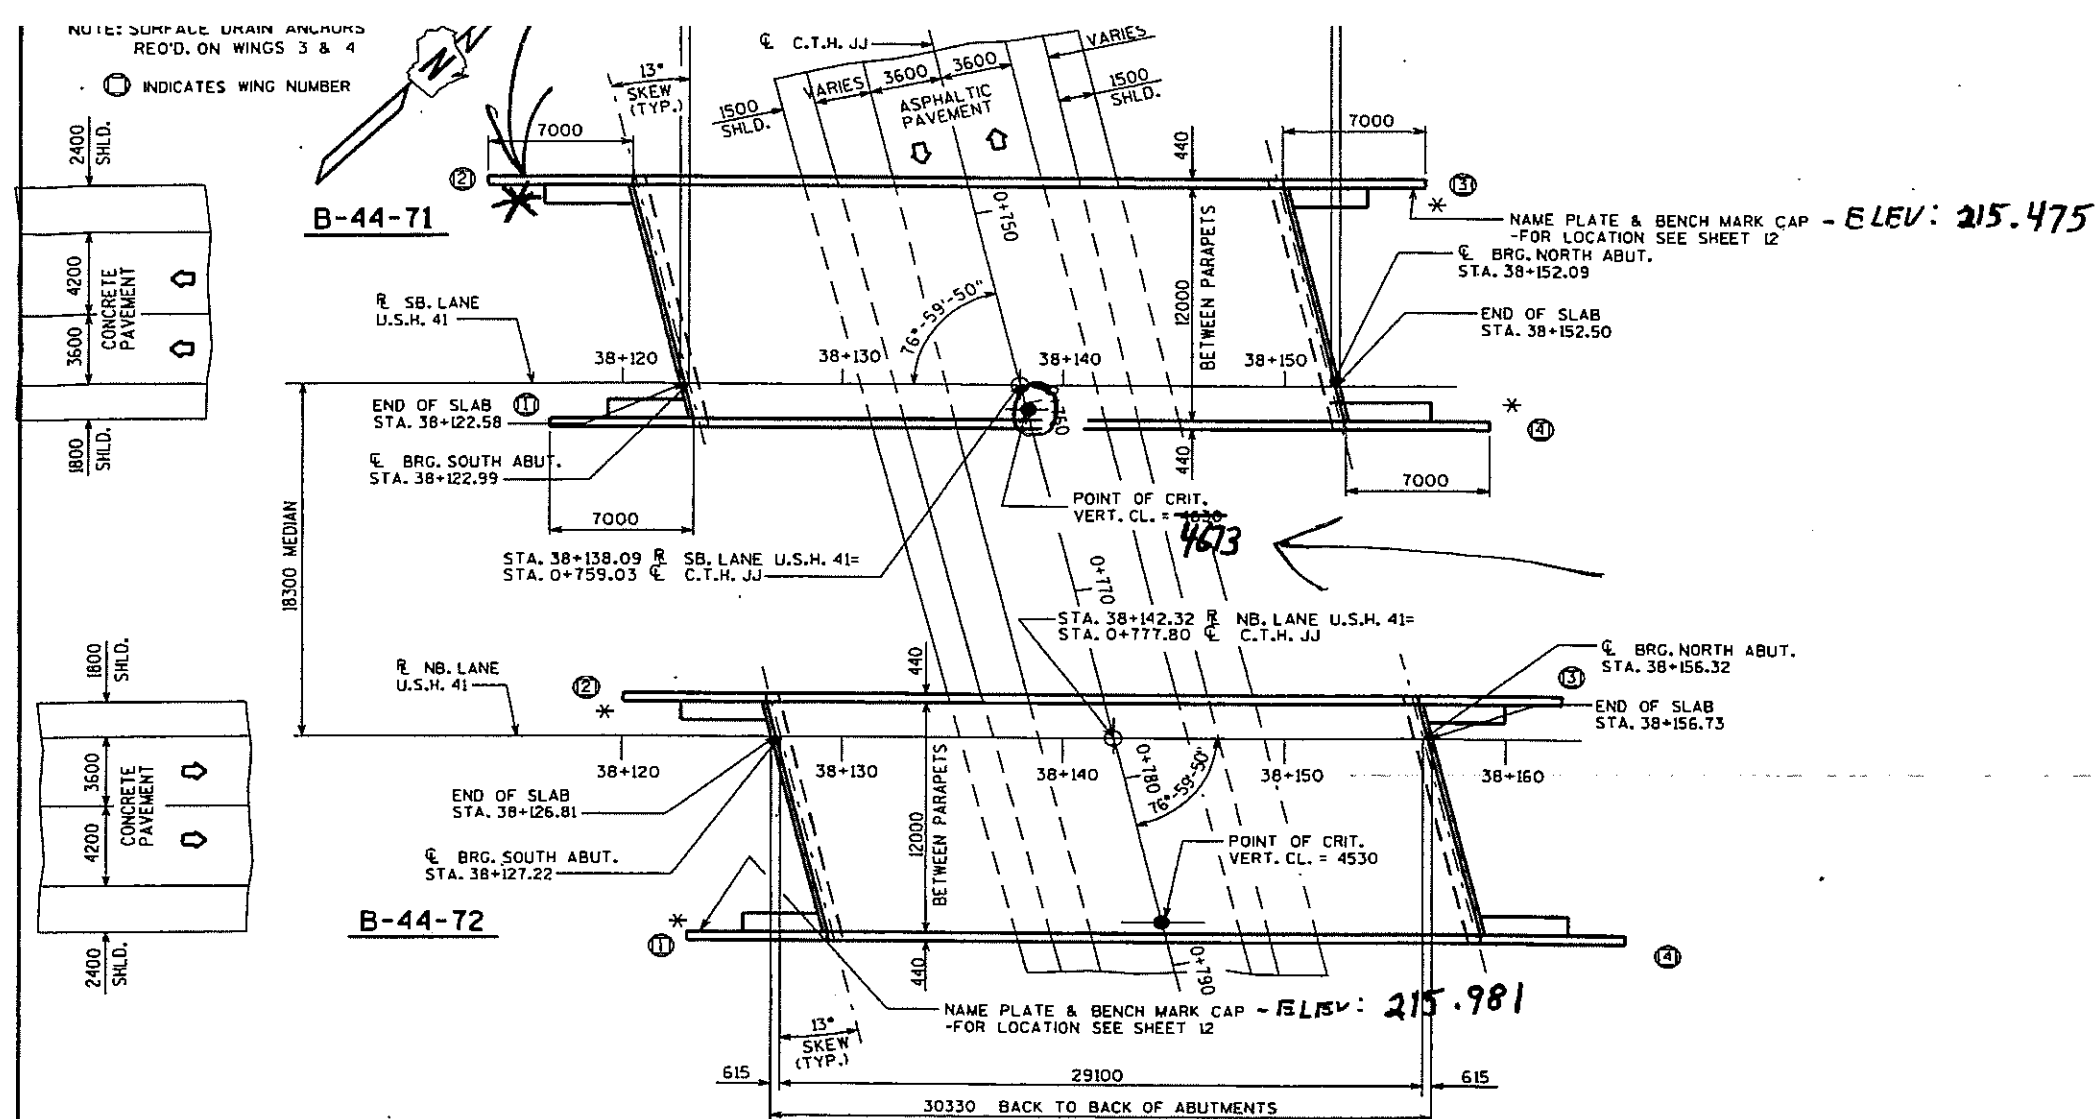


PLAN

SINGLE SPAN - 1370mm PRESTRESSED GIRDERS

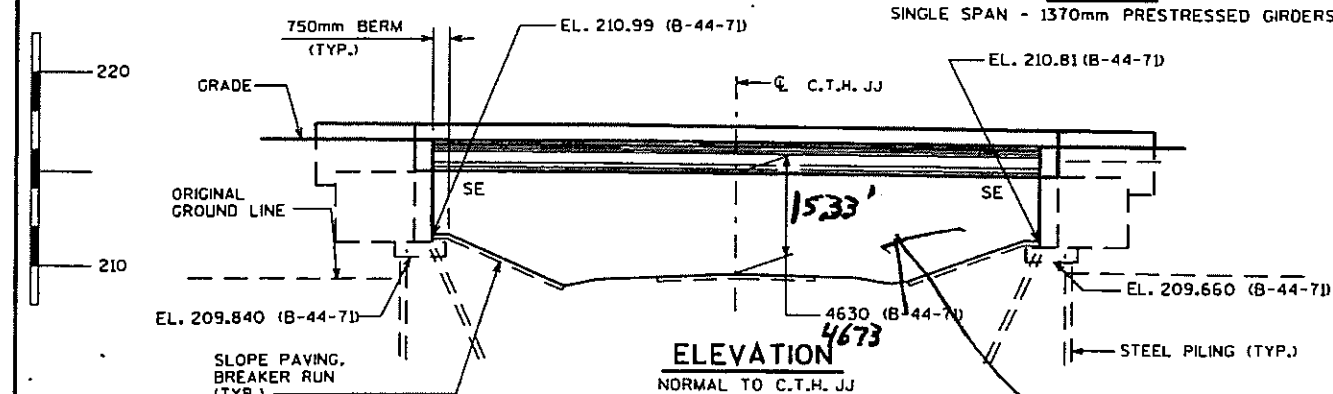

ELEVATION

NORMAL TO C.T.H. JJ

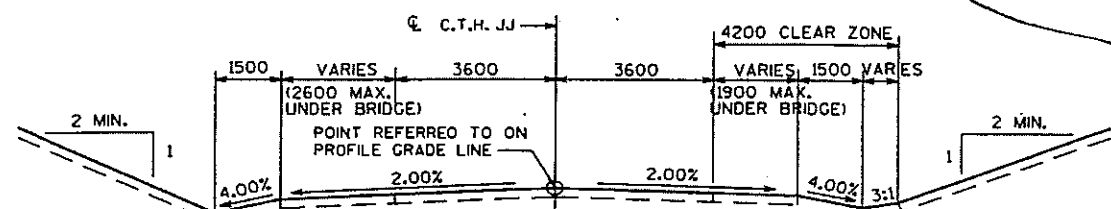

TYPICAL SECTION THRU C.T.H. JJ

LIST OF DRAWINGS

1. GENERAL PLAN
2. CROSS SECTION & QUANTITIES
3. SUBSURFACE EXPLORATION
4. SOUTH ABUTMENT
5. SOUTH ABUTMENT DETAILS
6. NORTH ABUTMENT
7. NORTH ABUTMENT DETAILS
8. SUPERSTRUCTURE
9. SUPERSTRUCTURE DETAILS
10. 1370 mm PRESTRESSED GIRDER DETAILS
11. STEEL DIAPHRAGM
12. SLOPED FACE PARAPET LF




BRIDGE OFFICE CONTACT:

FINN HUBBARD -----(608) 266-8489
 JERRY ZIRK----- (608) 266-5163

NO.	DATE	REVISION	BY
STATE OF WISCONSIN DEPARTMENT OF TRANSPORTATION DIVISION OF HIGHWAYS			
STRUCTURE B-44-71			
U.S.H. 41 OVER C.T.H. JJ			
COUNTY	OUTAGAMIE	TOWN/VILLAGE	KAUKAUNA
DESIGN SPEC.	AASHTO 1996	LOAD	MS-18
DESIGNED BY	CIHA	DESIGN CK'D	KTN
DRAWN BY	JHG	PLANS CK'D	ZRK
APPROVED	01-18-00		DATE
CHIEF BRIDGE DESIGN ENGINEER			
GENERAL PLAN		SHEET 1 OF 12	
		DATE: MAR'98	

I.D. 1131-08-00F

FILE: TGP.DGN
 SCALE: 1/75

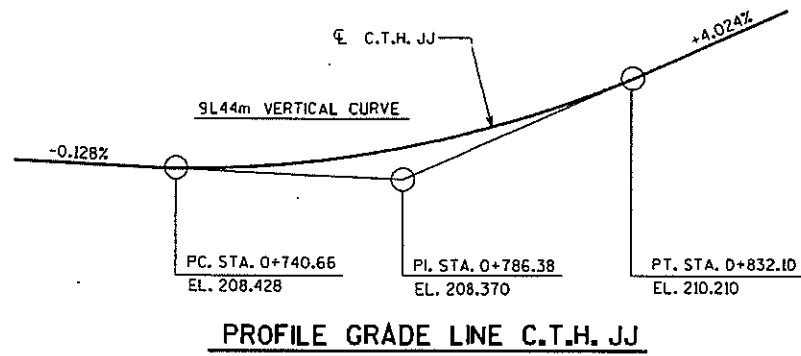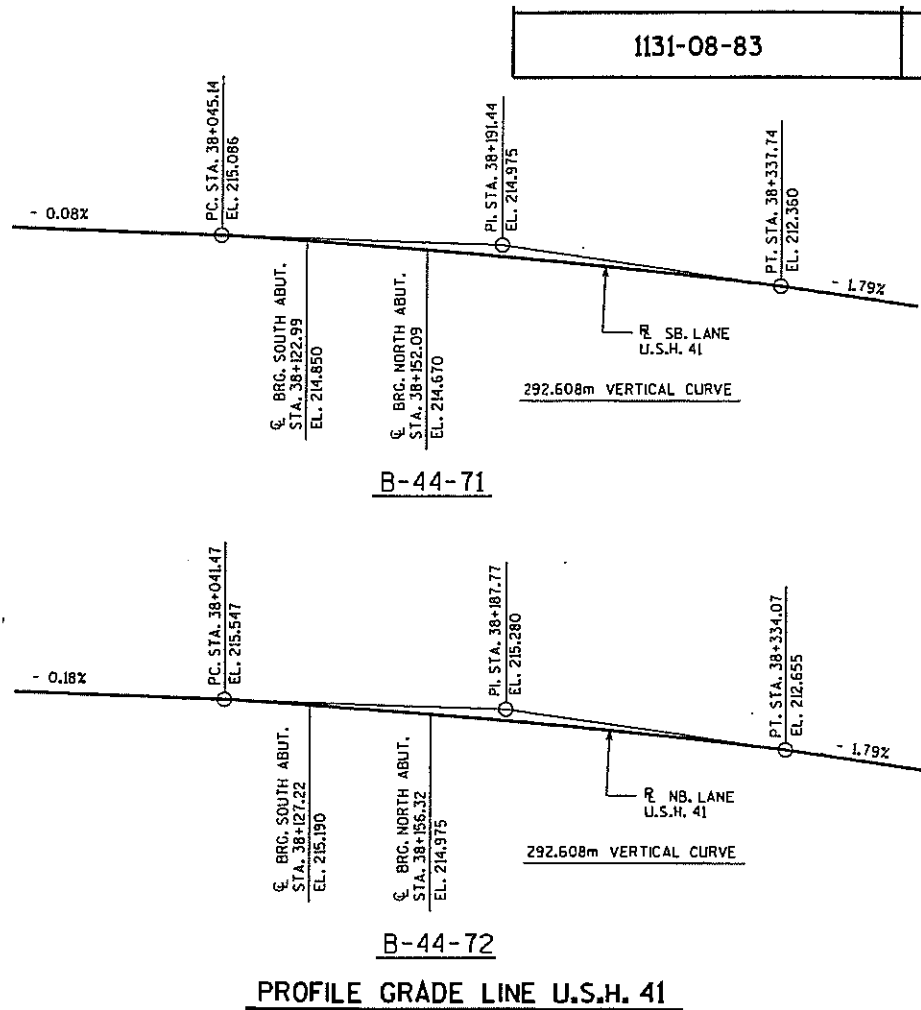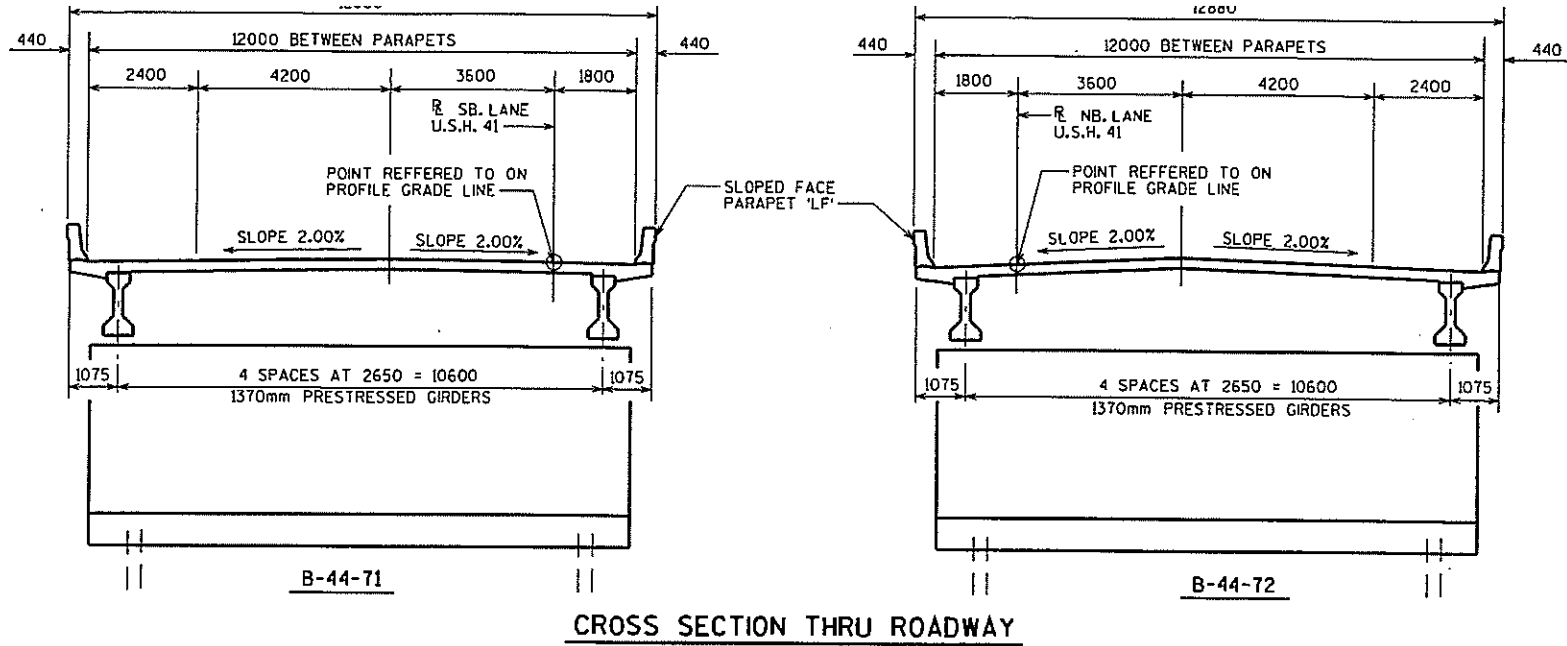

TOTAL ESTIMATED QUANTITIES

BID ITEMS	UNIT	SUPER.	SOUTH ABUT.	NORTH ABUT.	TOTALS
EXCAVATION FOR STRUCTURES, BRIDGES, B-44-71	L.S.	—	—	—	1
STRUCTURE BACKFILL	m³	—	570	570	1140
CONCRETE MASONRY, BRIDGES	m³	126	108	108	342
PROTECTIVE SURFACE TREATMENT	m²	430	—	—	430
PRESTRESSED GIRDER, TYPE, 1370 mm	m	147	—	—	147
HIGH-STRENGTH BAR STEEL REINFORCEMENT, BRIDGES	kg	—	3770	3800	7570
COATED HIGH-STRENGTH BAR STEEL REINFORCEMENT, BRIDGES	kg	14090	480	480	15050
NON-LAMINATED ELASTOMERIC BEARING PADS	EACH	10	—	—	10
STEEL PILING, DELIVERED AND DRIVEN, HP250mm X 62kg/m	m	—	493	493	986
RUBBERIZED MEMBRANE WATERPROOFING	m²	—	7	7	14
SLOPE PAVING, BREAKER RUN	m²	—	98	132	230
PIPE UNDERDRAIN, 150 mm	m	—	10	10	20
PIPE UNDERDRAIN, UNPERFORATED, 150 mm	m	—	10	10	20
GEOTEXTILE FABRIC, TYPE DF	m²	—	23	23	46
ANCHOR ASSEMBLIES FOR STEEL PLATE BEAM GUARD	EACH	2	—	—	2
STEEL DIAPHRAGMS, STRUCTURE B-44-71	EACH	8	—	—	8
NON-BID ITEMS					
FILLER	SIZE	—	—	—	13 & 19

GENERAL NOTES

DRAWINGS SHALL NOT BE SCALED.
BAR STEEL REINFORCEMENT SHALL BE EMBEDDED 50 mm CLEAR UNLESS OTHERWISE SHOWN OR NOTED.
ALL REINFORCING BARS ARE METRIC AND THE FIRST TWO DIGITS OF THE BAR MARK SIGNIFIES THE BAR SIZE
ALL DIMENSIONS MILLIMETERS (mm) UNLESS OTHERWISE NOTED.
ALL STATIONS AND ALL ELEVATIONS ARE METERS (m).
ELASTOMERIC BEARING PADS NEED NOT BE INDIVIDUALLY MOLDED PROVIDED THE CUT EDGES ARE SMOOTH AND TRUE.
AT THE BACKFACE OF ABUTMENT ALL VOLUME WHICH CANNOT BE IN PLACE BEFORE ABUTMENT CONSTRUCTION AND NOT OCCUPIED BY THE NEW STRUCTURE SHALL BE BACKFILLED WITH STRUCTURE BACKFILL.
THE GRADATION OF THE STRUCTURE BACKFILL SHALL MEET THE REQUIREMENTS OF SECT. 209.2.2 OF THE STD. SPEC'S. FOR GRADE 1 MATERIAL.

NO.	DATE	REVISION	BY
STATE OF WISCONSIN DEPARTMENT OF TRANSPORTATION DIVISION OF HIGHWAYS			
STRUCTURE B-44-71			
CONST. SPEC.	1996	DRAWN BY JHG	PLANS CKD. ZIRK
CROSS SECTION & QUANTITIES			SHEET 2

FILE= 710P.DGN
SCALE = 75

1131-08-78

8.1

DESIGN DATA

LIVE LOAD:

DESIGN RATING: MS-18
 INVENTORY RATING: MS-20
 OPERATIONAL RATING: MS-39
 MAXIMUM STANDARD PERMIT VEHICLE LOAD = 1110 kN.
 STRUCTURE IS DESIGNED FOR A FUTURE WEARING
 SURFACE OF 10 kN/m².

ULTIMATE DESIGN STRESSES:

CONCRETE MASONRY SLAB — $f'_c = 28$ MPa ALL OTHER — $f'_c = 24$ MPa
 BAR STEEL REINFORCEMENT, AASHTO M-31M, GRADE 420 — $f_y = 420$ MPa
 1370mm PRESTRESSED GIRDERS, CONCRETE MASONRY — $f'_c = 42$ MPa
 STRANDS — 13mm DIA. WITH ULTIMATE TENSILE STRENGTH OF 1860 MPa

FOUNDATION DATA

ABUTMENTS TO BE SUPPORTED ON HP 250 X 62 STEEL PILING
 DRIVEN TO A MINIMUM BEARING VALUE OF 490 kN PER PILE.
 ESTIMATED 29m LONG.

TRAFFIC VOLUME

U.S.H. 41 C.T.H. JJ
 A.D.T. = 37,000 (2018) A.D.T. = 1,620 (2018)
 R.D.S. = 110 km/h R.D.S. = 70 km/h

BRIDGE OFFICE CONTACT:


FINN HUBBARD -----(608) 266-8489
 JERRY ZIRK -----(608) 266-5163


LIST OF DRAWINGS

1. GENERAL PLAN
2. CROSS SECTION & QUANTITIES
3. SUBSURFACE EXPLORATION
4. SOUTH ABUTMENT
5. SOUTH ABUTMENT DETAILS
6. NORTH ABUTMENT
7. NORTH ABUTMENT DETAILS
8. SUPERSTRUCTURE
9. SUPERSTRUCTURE DETAILS
10. 1370 mm PRESTRESSED GIRDER DETAILS
11. STEEL DIAPHRAGM
12. SLOPED FACE PARAPET "LF"

NO.	DATE	REVISION	BY
STATE OF WISCONSIN DEPARTMENT OF TRANSPORTATION DIVISION OF HIGHWAYS			
STRUCTURE B-44-72			
U.S.H. 41 OVER C.T.H. JJ			
COUNTY	OUTAGAMIE	TOWNSHIP/VILLAGE	KAUKAUNA
DESIGN SPEC.	AASHTO 1996	LOAD	MS-18
DESIGNED BY	CHIA	DESIGN CK'D.	KTN
DRAWN BY	JHC	PLANS CK'D.	ZIRK
APPROVED	[Signature] 04-28-99		
CHIEF BRIDGE DESIGN ENGINEER			DATE
GENERAL PLAN			SHEET 1 OF 12
			DATE: FEB'98

I.D. 1131-08-00F

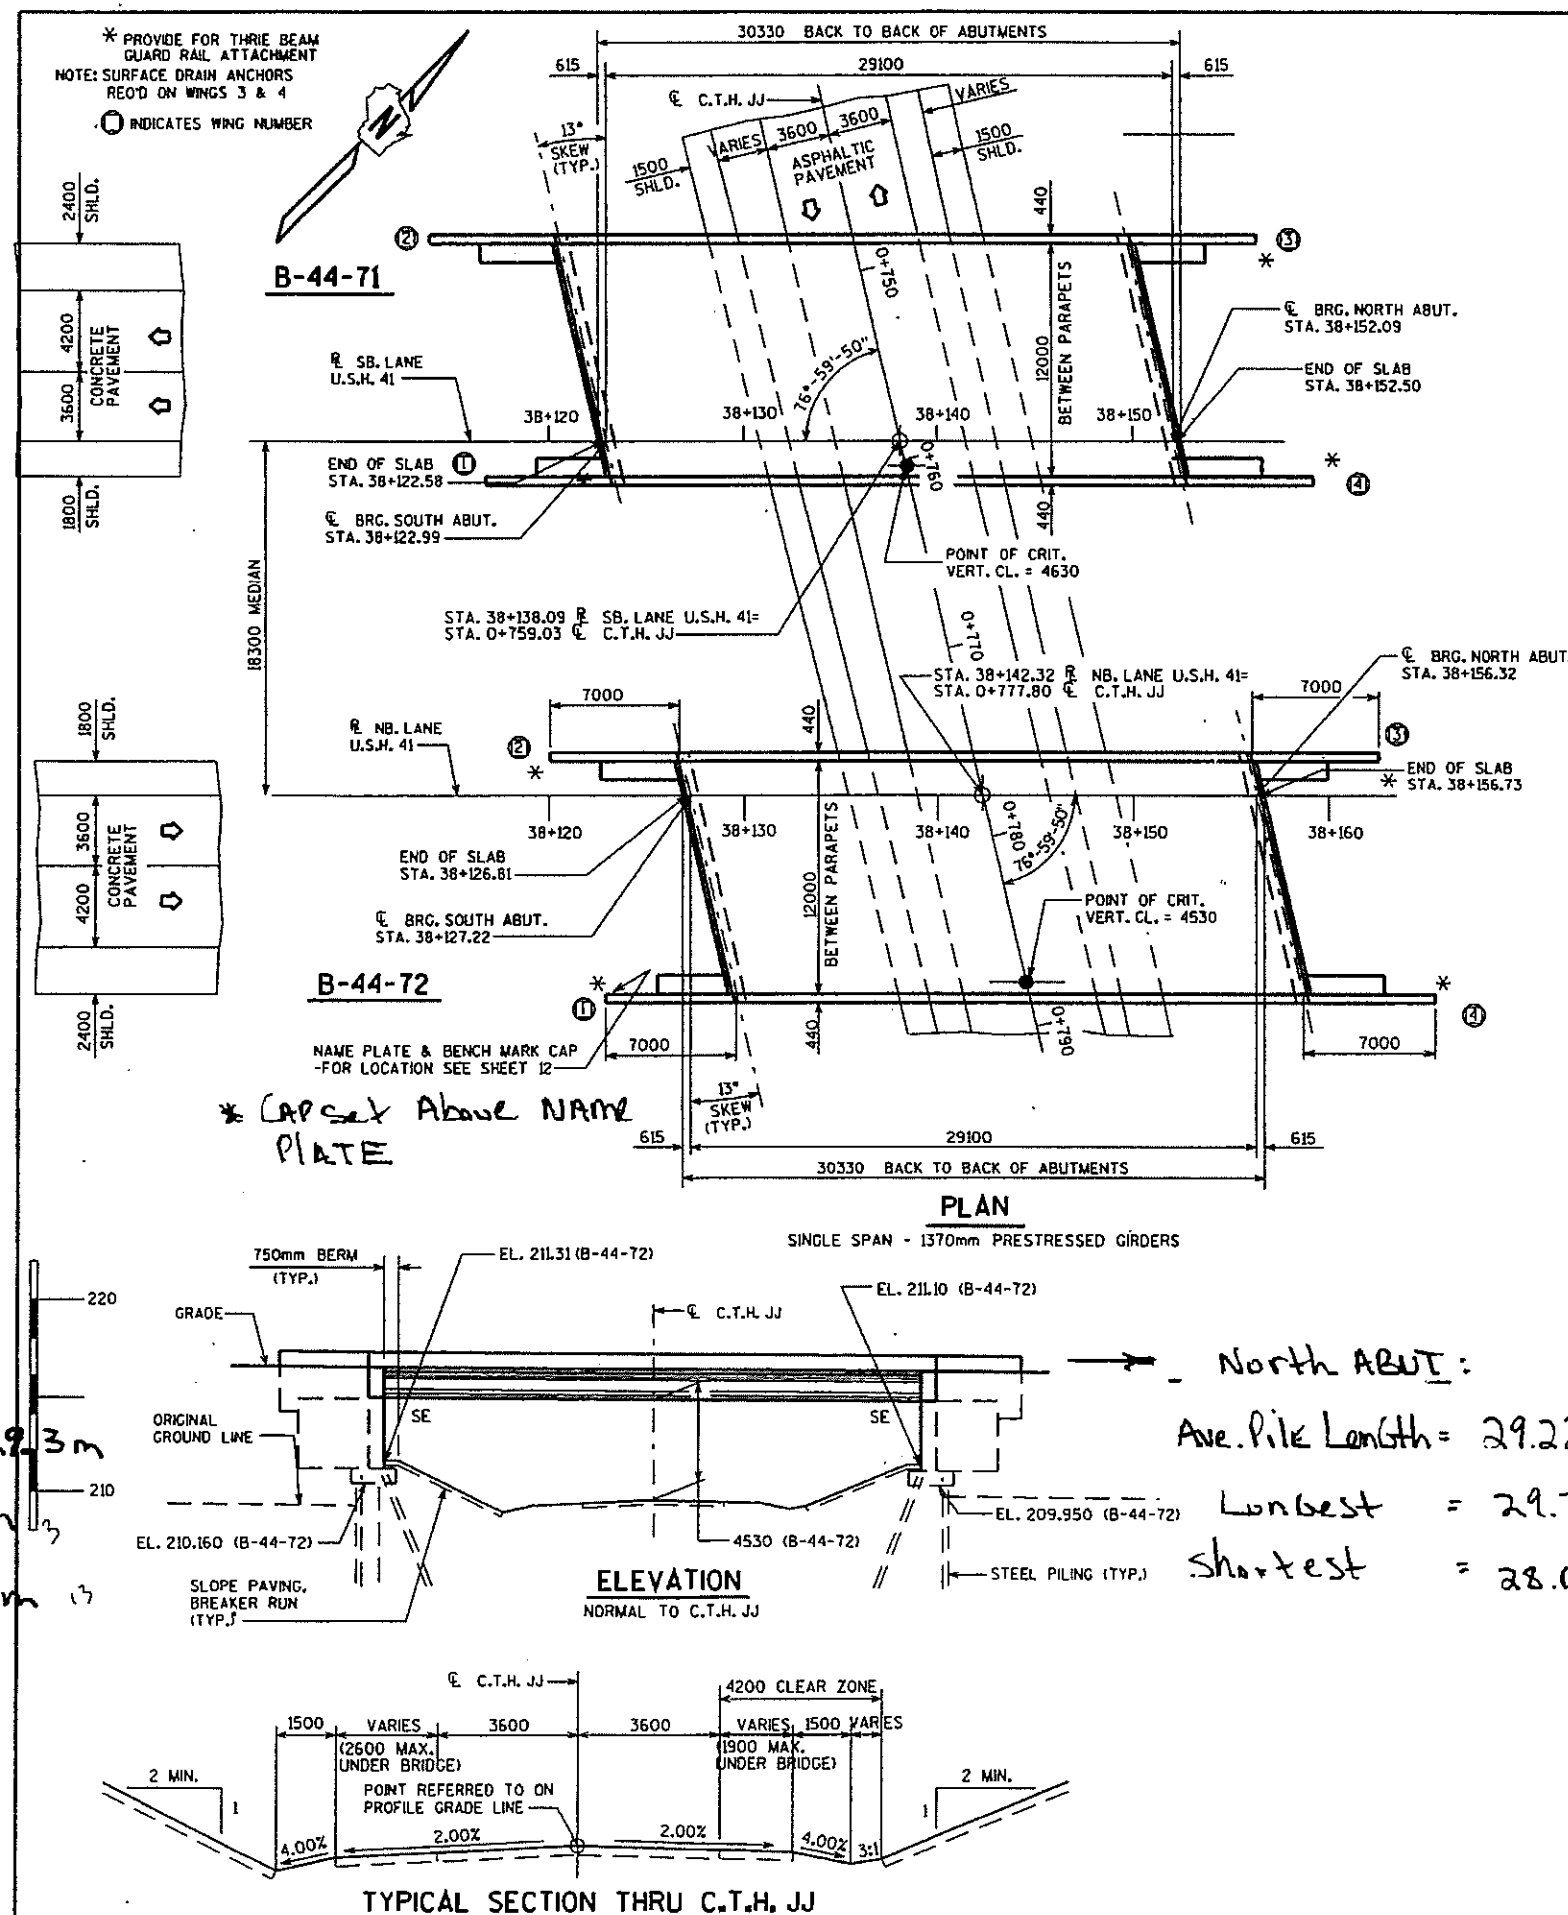FILE = 72GP.DGN
SCALE = 1/75

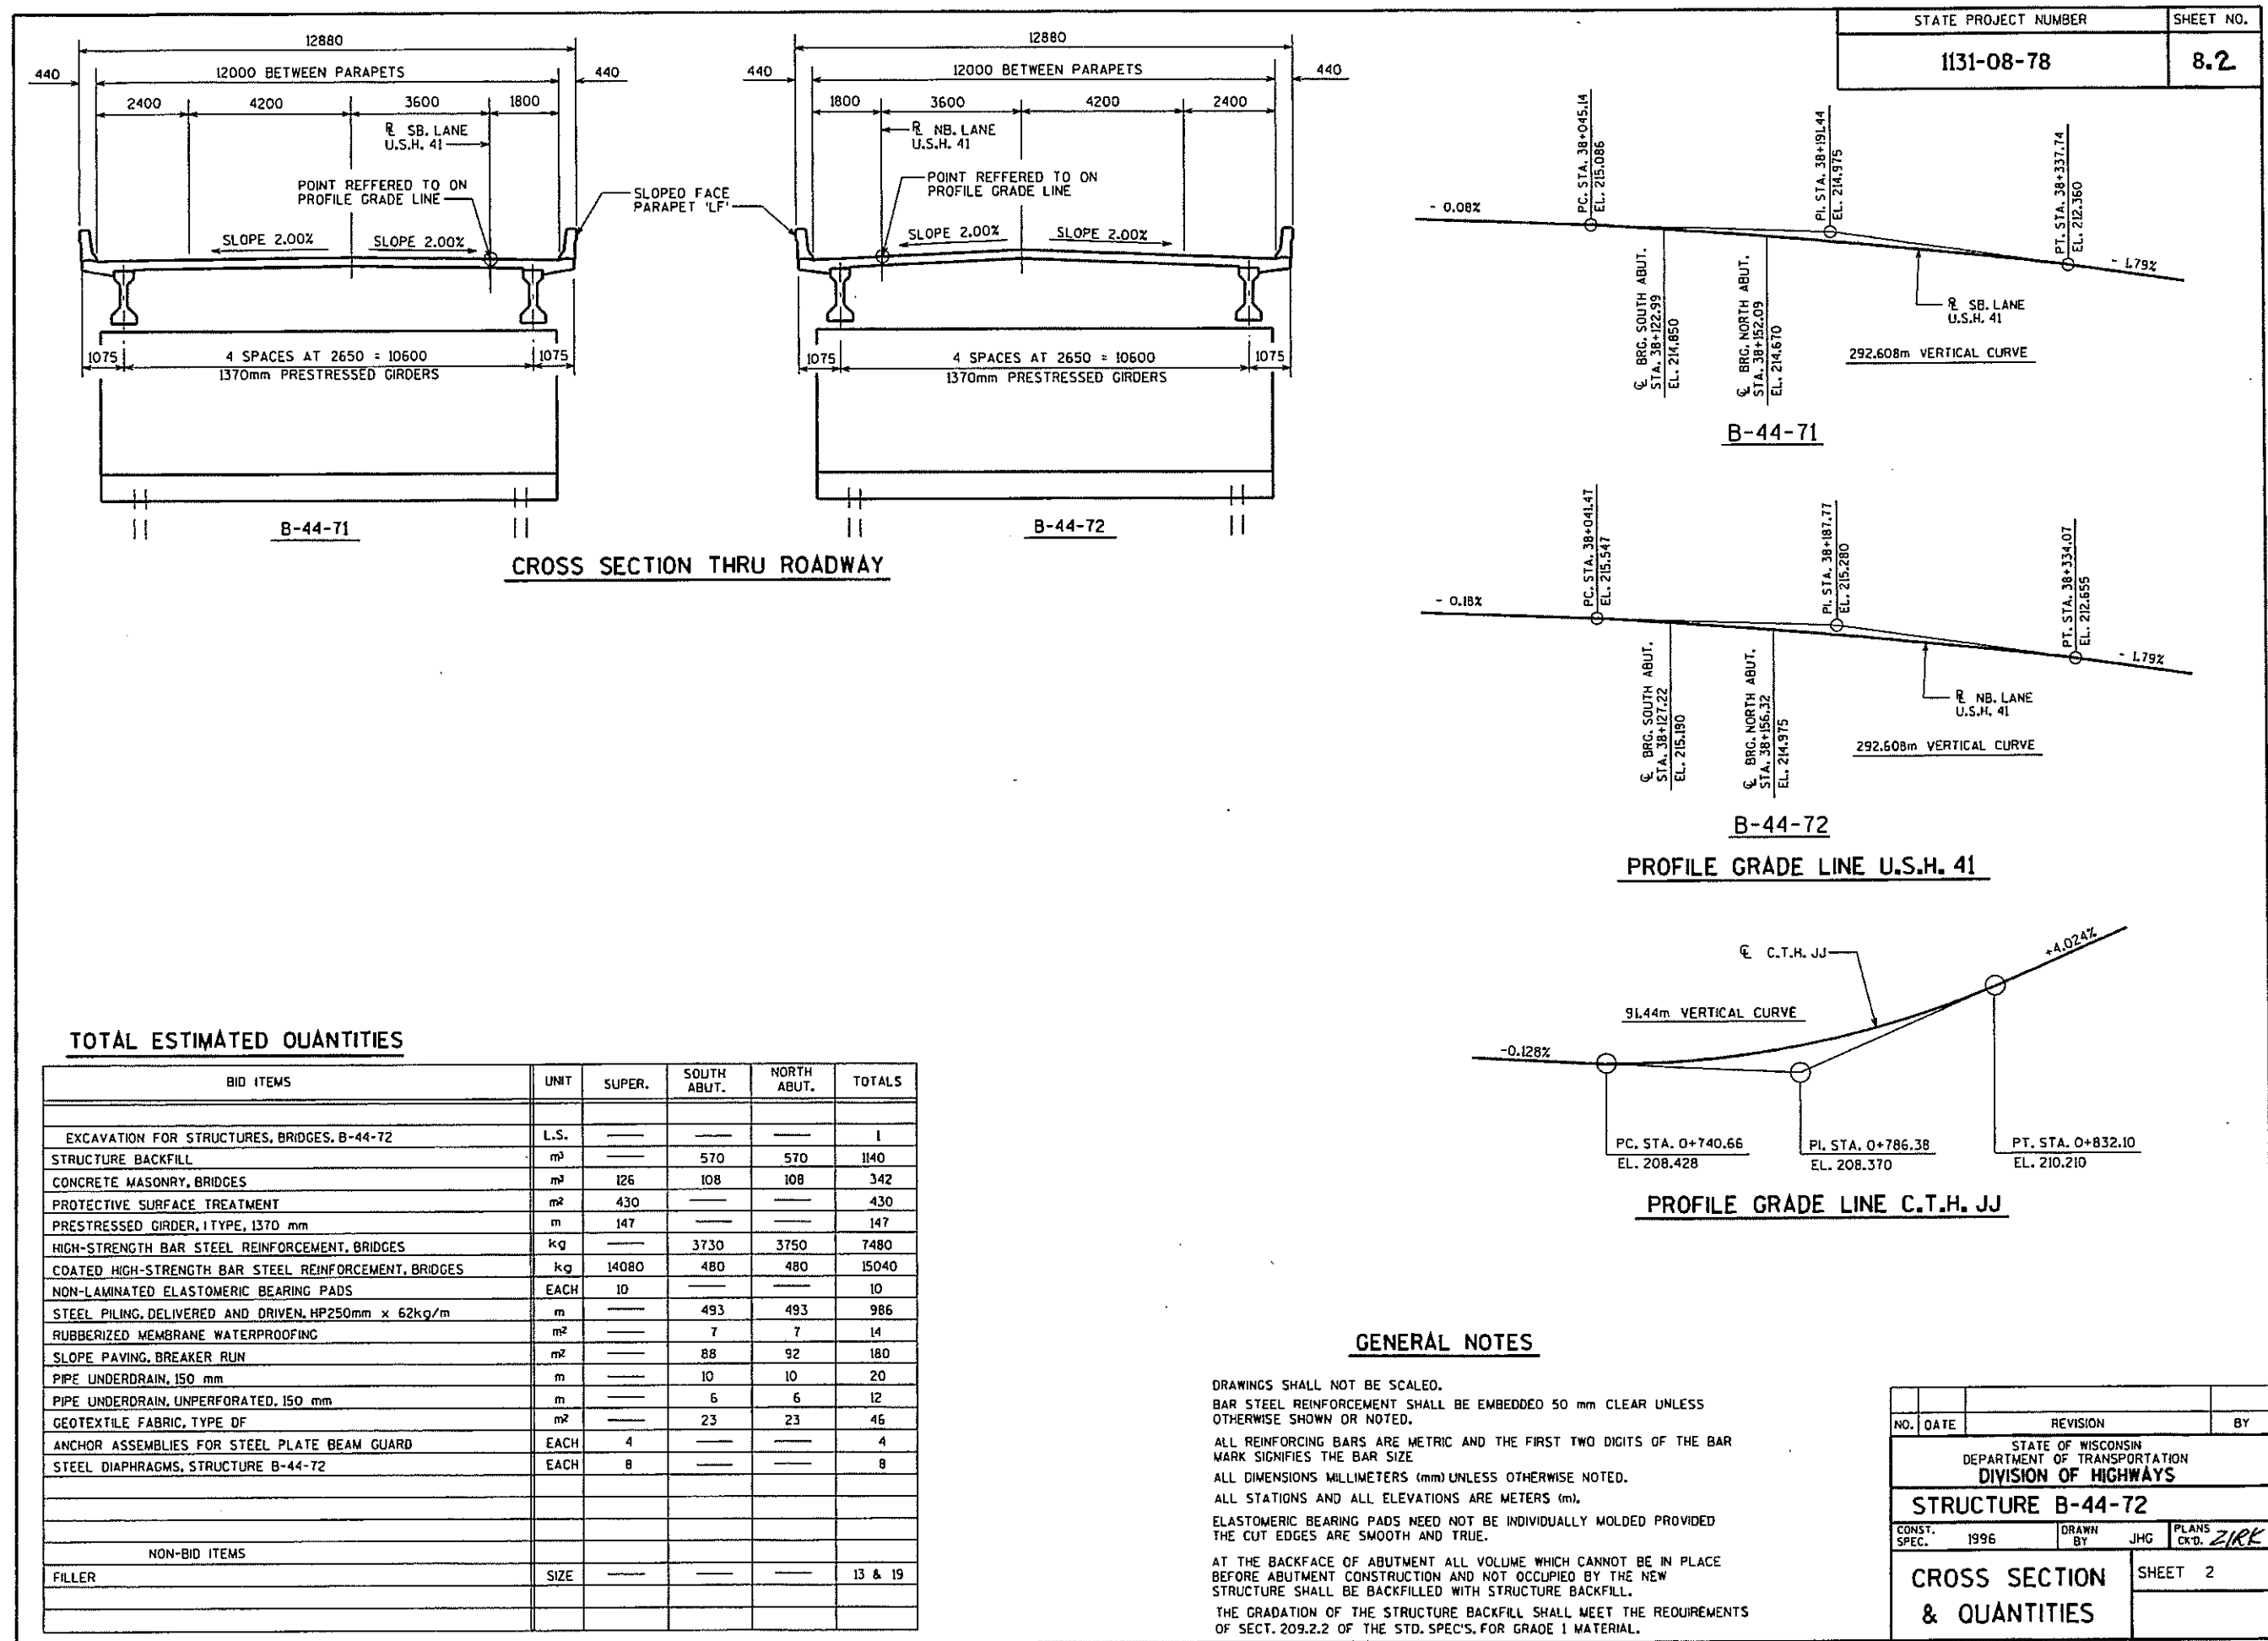

Vertical Clearance for Construction of New Bridges, Replacement Bridges, and Bridges on which the Superstructure is being replaced¹

Overpass Facility →	Freeway, Expressway, or STH		Railroad ⁴ , CTH, Town Road, Local Road, or Street	Pedestrian or Shared-use Structures	Sign Structures ²
Underpass Facility ↓	Interchange	Grade Separation			
Non-arterial either STH, CTH, Town Road, Local Road, or Street	15'-9" Desirable	15'-3" Desirable		16'-9" Desirable	18'-3" Minimum
	15'-3" Minimum	14'-9" Minimum		16'-3" Minimum	
Arterial either CTH, Town Road, Local Road, or Street (excludes freeway and expressway; also excludes arterial STH)	16'-9" Desirable	15'-3" Desirable		17'-9" Desirable	
	16'-3" Minimum	14'-9" Minimum		17'-3" Minimum	
Freeway ³ or Expressway or arterial STH	16'-9" Desirable			17'-9" Desirable	
	16'-4" Minimum			17'-4" Minimum	
Railroad ^{4,5,6,7}	23'-0" Minimum to 23'-3½" Maximum				

General notes:

- ¹ Vertical clearance is needed for the entire roadway width (critical point; to include traveled way, auxiliary lanes, turn lanes, and shoulders), according to the above table.

Vertical clearance for railroads is measured from the top of rail and is required over an area 8 feet 6 inches from the track centerline on each side of a railroad track.

Do not exceed the desirable vertical clearance shown unless justified. Depending on topography and other specific situations vertical clearance for any structure may be greater than that shown when justified. Some things to consider are: over height loads traveling on the roadway; the level of development in the area, the projected growth in traffic volume and importance of the roadway, and the possibility of reclassification.

- ² See LRFD Bridge Manual Chapter 39 (http://on.dot.wi.gov/dtid_bos/extranet/structures/LRFD/LRFDManualIndex.htm) and LRFD Standard Details 39.02 and 39.10 for design considerations and requirements for vertical clearance on new and replacement Sign Structures.
- ³ See FDM 11-44-1 for vertical clearance guidance specific to Interstate freeways.
- ⁴ Consult with the Region Railroad Coordinator if the over-passing or under-passing facility is either a railroad or a "rails-to-trails" trail; or if a structure is owned by a railroad company.
- ⁵ A vertical clearance <23'-0" requires both an approved Exception to Standards (see FDM 11-1-2 and FDM 11-1-4) and early coordination with BTLR R&H, Railroads and Harbors Section (RHS) through the Region Railroad Coordinator. The Exception to Standards shall contain documentation that the Office of the Commissioner of Railroads (OCR) has been petitioned.
- See Chapter 17 for additional information.
- ⁶ Provide justification for a vertical clearance >23'-3 ½" to the RHS.
- ⁷ Vertical clearance less than 23'-0" may be acceptable or desirable in certain situations, such as for spur tracks, lead tracks, some branch lines and even mainline tracks when other impediments to 23'-0" exist. Review such situations with the Railroad Project Coordination Engineer in RHS. Early coordination with RHS is required.



DAAR
ENGINEERING, INC.

PROJECT: _____

DATE: _____

DESCRIPTION: US 41 over CTH JJ

SHEET _____ OF _____

B-44-71(SB) & 72(NB)

CALC. BY: _____

CHECKED BY: _____

Existing structures are 40' x 99', 1-95' span with 54" Girders
V.C. = 15.32' SB & 15.03' NB Need 16.75'


Existing CTH JJ is 2-12' lanes & 6' shldr, Expand CTH JJ to

4-12' lanes & 6' shldr → 4-12' lanes = 48'
2-14' clear zone = 28' (includes shldr)
Slope paving 2 x 34 = 68'
17' @ 2:1 = 34'
Abutment (25' + 4') x 2 = 18'

157' span = 72" Girders

Raise US 41 by 18" - No

Proposed Typical half section on JJ

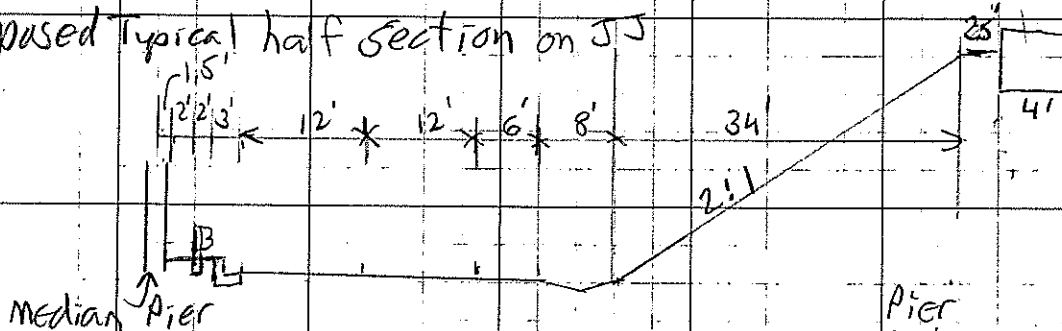

20' widening in median
= 20' x .02 = 0.4'

Pier offset 1.5'
Beam Guard 2.0'
C & G 2.0'
2-12' lanes 3.0'
14' clear zone 24.0'
Slope paving 14.0'
Abutment 38.0'
2.8'
4.0'

B-71(SB) 15.32' - at & JJ

+ 1.5'
16.82'

- 0.4'
16.42' → raise 41 0.33'

87.0' span = 36" Girders

1.5' difference in girders

B-72(NB) 15.03' - at & JJ

+ 1.5'

16.53'
- 0.4'
16.13' raise US 41 0.62'

Note: Profile raise on US 41

Will be required to correct deficient grades,

BRIDGE INSPECTION REPORT
Wisconsin Dept. of Transportation
DT2007 2003 s.84.17 Wis. Stats. Type = ROUTINE INSPECTION

page 1

Inventory Data

Feature On: USH 41		Maintainer: STATE HIGHWAY DEPT		Structure No: B-44-071
Feature Under: JJ (SB)		Sect/Twn/Rng: S08 T21N R19E		
Location: 3.2M S JCT CTH U		County: OUTAGAMI	Municipality: TOWN-KAUKAUNA (44026)	
Inv Rating: HS22.2	Rdwy Width (ft): 39.4	Deck Width (ft): 42.0	Existing Posting:	
Oper Rating: HS43.3	Total Length (ft): 99.5	Deck Area(ft2): 4179	ADT On: 19000 Yr: 1998	ADT Under: 0 Yr: 2000

Inspection Type (* = Supplemental Form Required)

	Routine Visual	Fracture Critical*	In-Depth*	UW-Dive*	UW-Surv*	UW-Probe/Visual*	Movable*
Last Insp.	10-17-11						
Frequency	24						
Recom. Freq.							
	Initial*	Damage	Interim	Load Posted	SI & A Field Review*		
Last Insp.							
Frequency	N/A						
Recom. Freq.	N/A				Item No. Needing Change		

Load Rating Information

Overburden	Measurement (in): 0.0	Date:	Deck Surface Type: CONCRETE	
Section Loss	File Meas. (%):	File Insp. Date: 10-19-09	Insp. Measurement (%):	Describe:
Re-rate for load capacity?	Reason:		Date Last Rated: 03-14-00	

Expansion Joints

Location	Type	Temp:			Signing Condition			
		File Insp. Date	File Insp. (in)	New Insp. (in)	Type of Marker	File	Y/N	Comments
					Bridge Markers			
					Narrow Bridge			
					One Lane Road			
					Vertical Clearance			
					Weight Limit Post			
					Other(Addl. Sign)			

Clearances(Cardinal = N or E)

	File Meas. (ft.)	File Date	New Meas. (ft.)
Min. Vertical Clearance Under (Cardinal)	15.32	11-28-00	
Min. Vertical Clearance Under (non-Cardinal)			
Min. Vertical Clearance On			

Structure Type

Construction/Rehabilitation History

Material	Configuration	# of Spans	Overall Length (ft)	Year	Work Performed	Plan	Shop
PREST CONCRET	DECK GIRDER		95.5	2000	NEW STRUCTURE		

Inspection Information

Special Requirements	Y/N	Comments				
Traffic Control	Y					
Access Equipment	Y					
Other	Y					

Inspector Information

Team Leader Name and No. Printed: Michaelson, Neil (3010)		Team Member(s) Name(s) Printed:	
Team Leader Signature:		Inspection Date: 10-17-11	Inspection Agency: STATE HIGHWAY DEPARTMENT (1)
District/Local Manager and No. Printed:		District/Local Manager Signature:	Review Date:

Element Inspection (X) Check Elements Inspected					Quantity in Condition States				
Ck	Elem./Env.	Description	Unit	Total QTY.	1	2	3	4	5
X	26 / 4	Conc Deck/Coatd Bars	SF	4179	4179				
		Dia. cracks.							
X	109 / 3	P/S Conc Open Girder	LF	482	482				
X	172 / 3	Painted Steel Diaphr	EA	8	8				
X	215 / 4	R/Conc Abutment	LF	85	76	7	2		
		Spall at center of south abut; North abut has 5 cracks							
X	322 / 4	Bituminous Approach	EA	2		2			
		Both approaches are deteriorating at the egde of the deck and need sealing							
X	331 / 4	Conc Bridge Railing	LF	291	246	45			
		cracks and popouts							
X	342 / 2	RipRap Slope Protect	EA	2	2				
X	358 / 4	Deck Cracking SmFlag	EA	1	1				
X	359 / 4	Und Dk Surf Sm Flag	EA	1	1				
X	400 / 4	Concrete Wingwall	EA	4	4				

General Inspection/Maintenance Notes

--

Maintenance Recommendations (See standard code items & numbers)

Maintenance Item: Approach - Seal Approach to Paving Block
--

Amount: Date(YYYY-MM-DD):

Maintenance item comment: Seal joints at the end of deck
--

Maintenance Item:

Amount: Date(MM-DD-YY):

Maintenance item comment:

NBI Ratings

NBI	File	New	NBI	File	New
Deck	7	7	Culvert	N	N
Superstructure	7	8	Channel	N	N
Substructure	7	7	Waterway	N	N

Maintenance Item:

Amount: Date(MM-DD-YY):

Maintenance item comment:

STRUCTURE INVENTORY AND APPRAISAL FIELD REVIEW FORM

B-44-071
USH 41 over JJ (SB)

LOCATION

- (3) Municipality:
 (16) Latitude("° ' "):
 (17) Longitude("° ' "):

TOWN - KAUKAUNA (44026)
44°18'51.62"N
88°13'43.85"W

TRAFFIC SERVICE

- (28A) Lanes On:
 (28B) Lanes Under:
 (102) Traffic Pattern On:
 (102) Traffic Pattern Under:
 (19) Detour Length(mi):

2
2
-NO TRAFFIC X-ONE WAY TRAFFIC -TWO WAY TRAFFIC
-NO TRAFFIC -ONE WAY TRAFFIC X-TWO WAY TRAFFIC
3

GEOMETRY

- (49) Structure Length(ft):
 (50) Sidewalk Width(ft):
 (50) Curb Width(ft):
 (52) Culvert Barrel Length(ft):
 (34) Skew:
 (51) Bridge Roadway(ft):
 (52) Deck(ft):
 (32) Approach Roadway(ft):
 (47) Minimum Horizontal(ft):
 (55) Minimum Right Lateral(ft):
 (55) Minimum Left Lateral(ft):

99.5	
Left: 0.0	Right: 0.0
Angle(°): 23	Direction: X-RIGHT FORWARD -LEFT FORWARD
Cardinal Width	Non-Cardinal Width
39.4	39.4
42.0	42.0
39	0
Cardinal Under Clearance	Non-Cardinal Under Clearance
48.5	
16.0	
8.5	

RAILING APPRAISAL

- (36A) Bridge Rail Adequacy:
 (36B) Transition Adequacy:
 (36C) Approach Guardrail Adequacy:
 (36D) Guardrail Termination Adequacy:
 Outer Rail:

-SUB-STANDARD	X-STANDARD	-NOT APPLICABLE
-SUB-STANDARD	X-STANDARD	-NOT APPLICABLE
-SUB-STANDARD	X-STANDARD	-NOT APPLICABLE
-SUB-STANDARD	X-STANDARD	-NOT APPLICABLE
Left	Right	Type
		TYPE F (TWO SQUARE TUBES) - STEEL(8)
		TYPE F (3 SQUARE TUBES) - STEEL(65)
		TYPE F (4 SQUARE TUBES) - STEEL(72)
		TYPE M-STEEL 3 SQUARE TUBES(93)
X	X	SLOPED FACE PARAPET LF(91)
		SLOPED FACE PARAPET HF(92)
		VERTICAL FACE PARAPET TYPE A(74)
		TYPE W-THREE BEAM(79)
		TYPE H ON VERTICAL PARAPET(80)
		TIMBER(38)
		OTHER(99) (Please specify)
Transition Type:		
		CONT GUARD RAIL
		NO APP GRDRL
		NO ATTACHMENT
5		22 MM(7/8") BOLT (Please enter quantity)
		25 MM(1") BOLT (Please enter quantity)
		OTHER (Please specify)
Guardrail Termination Type:		
X		(01) ENERGY ABSORBING TERMINAL/EAT
		(02) TURN DOWN
		(99) OTHER (Please specify)

ROADWAY ALIGNMENT APPRAISAL

- (72) Approach Alignment Appraisal:

	(3) INTOLERABLE- Horizontal or Vertical curvature requires a substantial reduction in vehicle operating speed
	(6) FAIR- Horizontal or Vertical curvature requires a very minor speed reduction
X	(8) GOOD- No speed reduction required

This page intentionally left blank

BRIDGE INSPECTION REPORT
Wisconsin Dept. of Transportation
DT2007 2003 s.84.17 Wis. Stats. Type = ROUTINE INSPECTION

page 1

Inventory Data

Feature On: USH 41	Maintainer: STATE HIGHWAY DEPT	Structure No: B-44-072
Feature Under: JJ	Sect/Twn/Rng: S08 T21N R19E	
Location: 1.2M N JCT CTH J	County: OUTAGAMI	Municipality: TOWN-KAUKAUNA (44026)
Inv Rating: HS21.1	Rdwy Width (ft): 39.4	Deck Width (ft): 42.3
Oper Rating: HS43.3	Total Length (ft): 99.4	Existing Posting:
	Deck Area(ft2): 4204	ADT On: 23100 Yr: 2003
		ADT Under: 0 Yr: 2000

Inspection Type (* = Supplemental Form Required)

	Routine Visual	Fracture Critical*	In-Depth*	UW-Dive*	UW-Surv*	UW-Probe/Visual*	Movable*
Last Insp.	10-17-11						
Frequency	24						
Recom. Freq.							
	Initial*	Damage	Interim	Load Posted	SI & A Field Review*		
Last Insp.							
Frequency	N/A						
Recom. Freq.	N/A						
					Item No. Needing Change		

Load Rating Information

Overburden	Measurement (in): 0.0	Date:	Deck Surface Type: CONCRETE
Section Loss	File Meas. (%):	File Insp. Date: 10-19-09	Insp. Measurement (%):
Re-rate for load capacity?	Reason:		Describe:
			Date Last Rated: 07-20-99

Expansion Joints

Location	Type	Temp:	File Insp. Date	File Insp. (in)	New Insp. (in)	Signing Condition	File	Y/N	Comments
						Type of Marker			
						Bridge Markers			
						Narrow Bridge			
						One Lane Road			
						Vertical Clearance			
						Weight Limit Post			
						Other(Addl. Sign)			

Clearances(Cardinal = N or E)

	File Meas. (ft.)	File Date	New Meas. (ft.)
Min. Vertical Clearance Under (Cardinal)	15.03	11-28-00	
Min. Vertical Clearance Under (non-Cardinal)			
Min. Vertical Clearance On			

Structure Type

Construction/Rehabilitation History

Material	Configuration	# of Spans	Overall Length (ft)	Year	Work Performed	Plan	Shop
PREST CONCRET	DECK GIRDER		95.5	1999	NEW STRUCTURE	PLAN	

Inspection Information

Special Requirements	Y/N	Comments				
Traffic Control	Y					
Access Equipment	Y					
Other	Y					

Inspector Information

Team Leader Name and No. Printed: Michaelson, Neil (3010)	Team Member(s) Name(s) Printed:
Team Leader Signature:	Inspection Date: 10-17-11
	Inspection Agency: STATE HIGHWAY DEPARTMENT (1)
District/Local Manager and No. Printed:	District/Local Manager Signature:
	Review Date:

Element Inspection (X) Check Elements Inspected					Quantity in Condition States				
Ck	Elem./Env.	Description	Unit	Total QTY.	1	2	3	4	5
X	26 / 4	Conc Deck/Coatd Bars	SF	4204	4204				
		Diagonal cracks at abut, longitudinal at center							
X	109 / 3	P/S Conc Open Girder	LF	482	482				
X	172 / 3	Painted Steel Diaphr	EA	8	8				
X	215 / 4	R/Conc Abutment	LF	72	63	9			
		CS-2 (S Abut 4" & N Abut 5")							
X	322 / 4	Bituminous Approach	EA	2	1	1			
		North approach slightly settled							
X	331 / 4	Conc Bridge Railing	LF	269	219	50			
X	342 / 2	RipRap Slope Protect	EA	2	2				
X	358 / 4	Deck Cracking SmFlag	EA	1	1				
X	359 / 4	Und Dk Surf Sm Flag	EA	1	1				
X	400 / 4	Concrete Wingwall	EA	4	4				

General Inspection/Maintenance Notes

--

Maintenance Recommendations (See standard code items & numbers)

Maintenance Item: Approach - Seal Approach to Paving Block

Amount: Date(YYYY-MM-DD):

Maintenance item comment: Seal joints at the ends of the deck

Maintenance Item:

Amount: Date(MM-DD-YY):

Maintenance item comment:

NBI Ratings

NBI	File	New	NBI	File	New
Deck	7	7	Culvert	N	N
Superstructure	8	8	Channel	N	N
Substructure	8	7	Waterway	N	N

Maintenance Item:

Amount: Date(MM-DD-YY):

Maintenance item comment:

STRUCTURE INVENTORY AND APPRAISAL FIELD REVIEW FORM

B-44-072
USH 41 over JJ

- (3) Municipality:
(16) Latitude(° ' "):
(17) Longitude(° ' "):

LOCATION	
TOWN - KAUKAUNA (44026)	
44°18'50.08"N	
88°13'43.58"W	

- (28A) Lanes On:
(28B) Lanes Under:
(102) Traffic Pattern On:
(102) Traffic Pattern Under:
(19) Detour Length(mi):

TRAFFIC SERVICE	
2	
2	
-NO TRAFFIC	X-ONE WAY TRAFFIC -TWO WAY TRAFFIC
-NO TRAFFIC	-ONE WAY TRAFFIC X-TWO WAY TRAFFIC
3	

- (49) Structure Length(ft):
(50) Sidewalk Width(ft):
(50) Curb Width(ft):
(52) Culvert Barrel Length(ft):
(34) Skew:
(51) Bridge Roadway(ft):
(52) Deck(ft):
(32) Approach Roadway(ft):
(47) Minimum Horizontal(ft):
(55) Minimum Right Lateral(ft):
(55) Minimum Left Lateral(ft):

GEOMETRY	
99.4	
Left: 0.0	Right: 0.0
Angle(°): 13	Direction: X-RIGHT FORWARD -LEFT FORWARD
Cardinal Width	Non-Cardinal Width
39.4	39.4
42.3	42.3
39	0
Cardinal Under Clearance	Non-Cardinal Under Clearance
48.0	
15.5	
8.5	


- (36A) Bridge Rail Adequacy:
(36B) Transition Adequacy:
(36C) Approach Guardrail Adequacy:
(36D) Guardrail Termination Adequacy:
Outer Rail:

RAILING APPRAISAL	
-SUB-STANDARD	X-STANDARD -NOT APPLICABLE
-SUB-STANDARD	X-STANDARD -NOT APPLICABLE
-SUB-STANDARD	X-STANDARD -NOT APPLICABLE
-SUB-STANDARD	X-STANDARD -NOT APPLICABLE
Left	Right Type
	TYPE F (TWO SQUARE TUBES) - STEEL(8)
	TYPE F (3 SQUARE TUBES) - STEEL(65)
	TYPE F (4 SQUARE TUBES) - STEEL(72)
	TYPE M-STEEL 3 SQUARE TUBES(93)
X	X SLOPED FACE PARAPET LF(91)
	SLOPED FACE PARAPET HF(92)
	VERTICAL FACE PARAPET TYPE A(74)
	TYPE W-THREE BEAM(79)
	TYPE H ON VERTICAL PARAPET(80)
	TIMBER(38)
	OTHER(99) (Please specify)
Transition Type:	
	CONT GUARD RAIL
	NO APP GRDRL
	NO ATTACHMENT
5	22 MM(7/8") BOLT (Please enter quantity)
	25 MM(1") BOLT (Please enter quantity)
	OTHER (Please specify)
Guardrail Termination Type:	
X	(01) ENERGY ABSORBING TERMINAL/EAT
	(02) TURN DOWN
	(99) OTHER (Please specify)

- (72) Approach Alignment Appraisal:

ROADWAY ALIGNMENT APPRAISAL	
	(3) INTOLERABLE- Horizontal or Vertical curvature requires a substantial reduction in vehicle operating speed
	(6) FAIR- Horizontal or Vertical curvature requires a very minor speed reduction
X	(8) GOOD- No speed reduction required

This page intentionally left blank

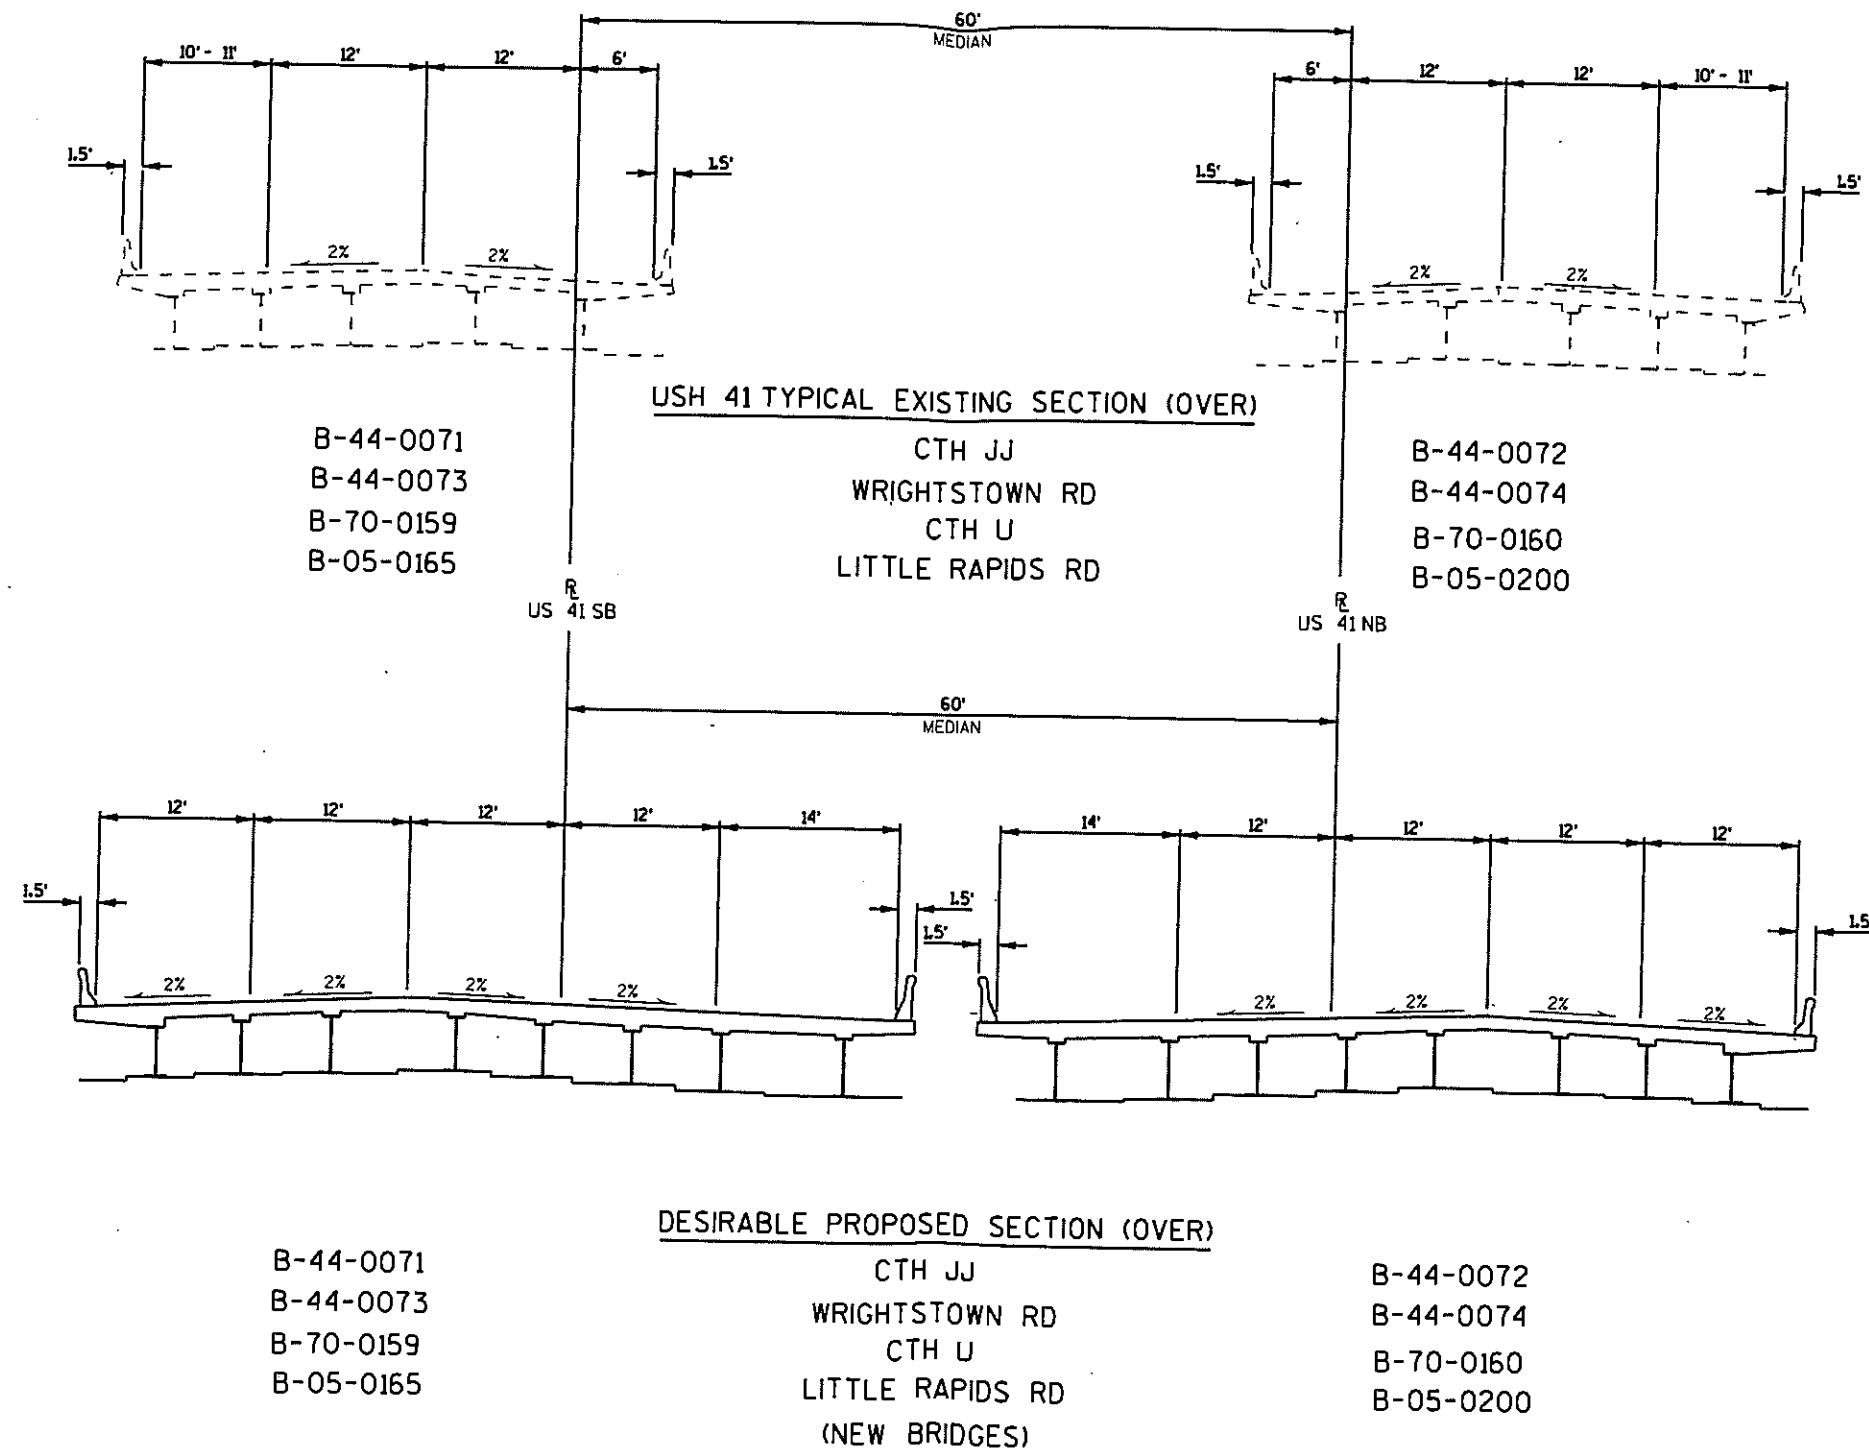

DESIGN DATA

LIVE LOAD:

DESIGN RATING: MS-18
 INVENTORY RATING: MS-20
 OPERATIONAL RATING: MS-39
 MAXIMUM STANDARD PERMIT VEHICLE LOAD = 1110 kN.
 STRUCTURE IS DESIGNED FOR A FUTURE WEARING SURFACE OF 10 kN/m².

ULTIMATE DESIGN STRESSES:

CONCRETE MASONRY SLAB — $f'_c = 28$ MPa ALL OTHER — $f'_c = 24$ MPa
 BAR STEEL REINFORCEMENT, AASHTO M-31M, GRADE 420 — $f_y = 420$ MPa
 1370mm PRESTRESSED GIRDERS, CONCRETE MASONRY — $f'_c = 42$ MPa
 STRANDS - 13mm OIA, WITH ULTIMATE TENSILE STRENGTH OF 1860 MPa

FOUNDATION DATA

ABUTMENTS TO BE SUPPORTED ON HP 250 X 62 STEEL PILING DRIVEN TO A MINIMUM BEARING VALUE OF 490 kN PER PILE. ESTIMATED 29m LONG.

TRAFFIC VOLUME

U.S.H. 41 C.T.H. JJ
 A.D.T.=37,000 (2018) A.D.T.=1620 (2018)
 R.O.S.=110 km/h R.O.S.=70 km/h

PLAN

SINGLE SPAN - 1370mm PRESTRESSED GIRDERS

ELEVATION

NORMAL TO C.T.H. JJ

TYPICAL SECTION THRU C.T.H. JJ

LIST OF DRAWINGS

1. GENERAL PLAN
2. CROSS SECTION & QUANTITIES
3. SUBSURFACE EXPLORATION
4. SOUTH ABUTMENT
5. SOUTH ABUTMENT DETAILS
6. NORTH ABUTMENT
7. NORTH ABUTMENT DETAILS
8. SUPERSTRUCTURE
9. SUPERSTRUCTURE DETAILS
10. 1370 mm PRESTRESSED GIRDER DETAILS
11. STEEL DIAPHRAGM
12. SLOPED FACE PARAPET LF


BRIDGE OFFICE CONTACT:

FINN HUBBARD -----(608) 266-8489
 JERRY ZIRK -----(608) 266-5163


NO.	DATE	REVISION	BY
STATE OF WISCONSIN DEPARTMENT OF TRANSPORTATION DIVISION OF HIGHWAYS			
STRUCTURE B-44-71			
U.S.H. 41 OVER C.T.H. JJ			
COUNTY	OUTAGAMIE	TOWNSHIP/VILLAGE	KAUKAUNA
DESIGN SPEC.	AASHTO 1996	LOAD	MS-18
DESIGNED BY	CIHA	DESIGN CK'D.	KTN
DRAWN BY	JHG	PLANS CK'D.	ZRK
APPROVED	[Signature]		01-18-00
CHIEF BRIDGE DESIGN ENGINEER		DATE	
GENERAL PLAN		SHEET 1 OF 12	
		DATE: MAR'98	

I.D. 1131-08-00F


FILE: TIGP.DGN
 SCALE: 1/15

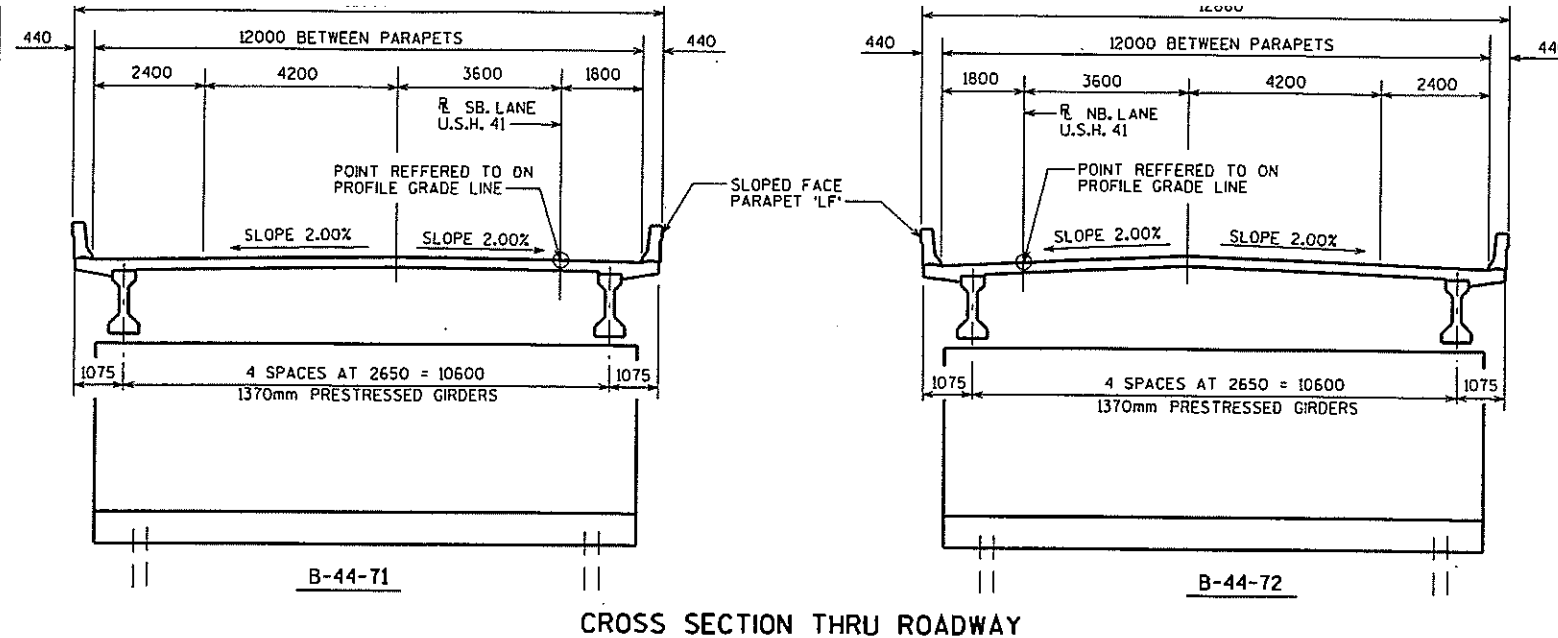

CROSS SECTION THRU ROADWAY

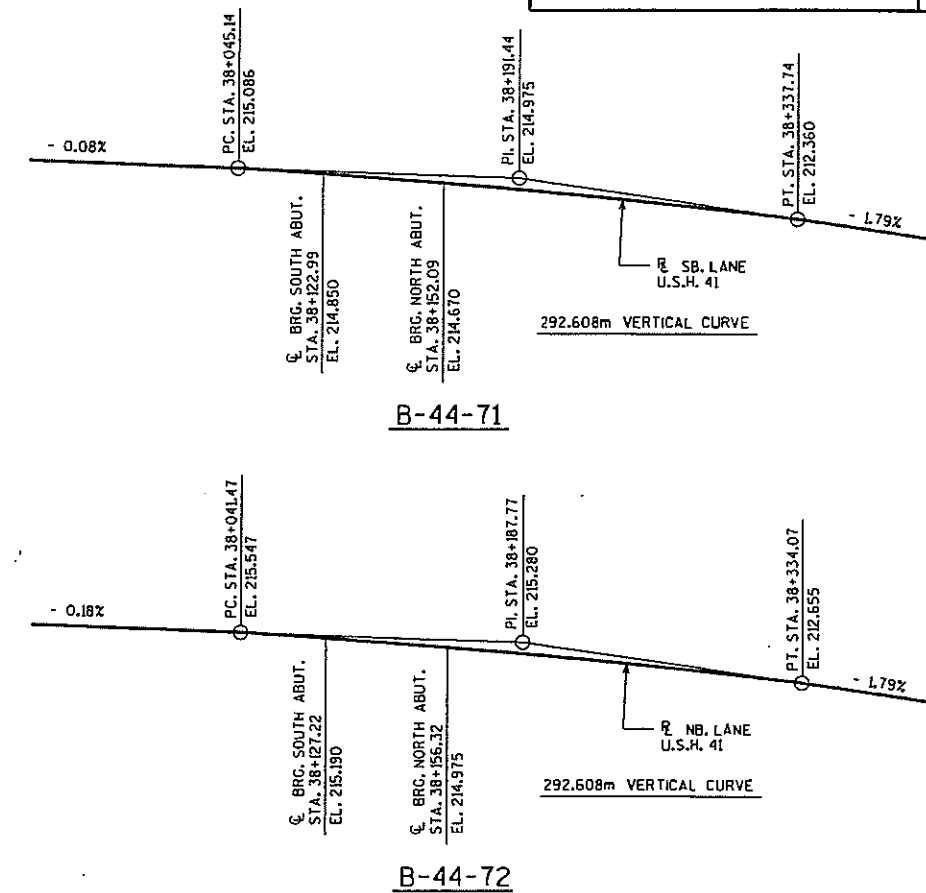

PROFILE GRADE LINE U.S.H. 41

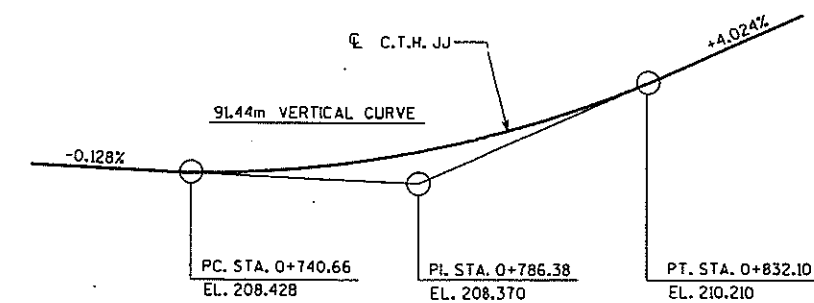

PROFILE GRADE LINE C.T.H. JJ

TOTAL ESTIMATED QUANTITIES

BID ITEMS	UNIT	SUPER.	SOUTH ABUT.	NORTH ABUT.	TOTALS
EXCAVATION FOR STRUCTURES, BRIDGES, B-44-71	L.S.	---	---	---	1
STRUCTURE BACKFILL	m ³	---	570	570	1140
CONCRETE MASONRY, BRIDGES	m ³	126	108	108	342
PROTECTIVE SURFACE TREATMENT	m ²	430	---	---	430
PRESTRESSED GIRDER, I TYPE, 1370 mm	m	147	---	---	147
HIGH-STRENGTH BAR STEEL REINFORCEMENT, BRIDGES	kg	---	3770	3800	7570
COATED HIGH-STRENGTH BAR STEEL REINFORCEMENT, BRIDGES	kg	14090	480	480	15050
NON-LAMINATED ELASTOMERIC BEARING PADS	EACH	10	---	---	10
STEEL PILING, DELIVERED AND DRIVEN, HP250mm X 62kg/m	m	---	493	493	986
RUBBERIZED MEMBRANE WATERPROOFING	m ²	---	7	7	14
SLOPE PAVING, BREAKER RUN	m ²	---	98	132	230
PIPE UNDERDRAIN, 150 mm	m	---	10	10	20
PIPE UNDERDRAIN, UNPERFORATED, 150 mm	m	---	10	10	20
GEOTEXTILE FABRIC, TYPE DF	m ²	---	23	23	46
ANCHOR ASSEMBLIES FOR STEEL PLATE BEAM GUARD	EACH	2	---	---	2
STEEL DIAPHRAGMS, STRUCTURE B-44-71	EACH	8	---	---	8
NON-BID ITEMS					
FILLER	SIZE	---	---	---	13 & 19

GENERAL NOTES

DRAWINGS SHALL NOT BE SCALED.
 BAR STEEL REINFORCEMENT SHALL BE EMBEDDED 50 mm CLEAR UNLESS OTHERWISE SHOWN OR NOTED.
 ALL REINFORCING BARS ARE METRIC AND THE FIRST TWO DIGITS OF THE BAR MARK SIGNIFIES THE BAR SIZE.
 ALL DIMENSIONS MILLIMETERS (mm) UNLESS OTHERWISE NOTED.
 ALL STATIONS AND ALL ELEVATIONS ARE METERS (m).
 ELASTOMERIC BEARING PADS NEED NOT BE INDIVIDUALLY MOLDED PROVIDED THE CUT EDGES ARE SMOOTH AND TRUE.
 AT THE BACKFACE OF ABUTMENT ALL VOLUME WHICH CANNOT BE IN PLACE BEFORE ABUTMENT CONSTRUCTION AND NOT OCCUPIED BY THE NEW STRUCTURE SHALL BE BACKFILLED WITH STRUCTURE BACKFILL.
 THE GRADATION OF THE STRUCTURE BACKFILL SHALL MEET THE REQUIREMENTS OF SECT. 209.2.2 OF THE STD. SPEC'S. FOR GRADE 1 MATERIAL.

NO.	DATE	REVISION	BY
STATE OF WISCONSIN DEPARTMENT OF TRANSPORTATION DIVISION OF HIGHWAYS			
STRUCTURE B-44-71			
CONST. SPEC.	1996	DRAWN BY JHG	PLANE CKD. ZIRK
CROSS SECTION & QUANTITIES			SHEET 2

 FILE= 710P.DGN
 SCALE = 75

1131-08-78

8.1

DESIGN DATA

LIVE LOAD:

DESIGN RATING: MS-18
 INVENTORY RATING: MS-20
 OPERATIONAL RATING: MS-39
 MAXIMUM STANDARD PERMIT VEHICLE LOAD = 1110 KN.
 STRUCTURE IS DESIGNED FOR A FUTURE WEARING
 SURFACE OF 1.0 KN/m².

ULTIMATE DESIGN STRESSES:

CONCRETE MASONRY SLAB — $f'_c = 28$ MPa ALL OTHER — $f'_c = 24$ MPa
 BAR STEEL REINFORCEMENT, AASHTO M-31M, GRADE 420 — $f_y = 420$ MPa
 1370mm PRESTRESSED GIRDERS, CONCRETE MASONRY — $f'_c = 42$ MPa
 STRANDS - 13mm DIA. WITH ULTIMATE TENSILE STRENGTH OF 1860 MPa

FOUNDATION DATA

ABUTMENTS TO BE SUPPORTED ON HP 250 X 62 STEEL PILING
 DRIVEN TO A MINIMUM BEARING VALUE OF 490 KN PER PILE.
 ESTIMATED 29m LONG.

TRAFFIC VOLUME

U.S.H. 41 C.T.H. JJ
 A.D.T. = 37,000 (2018) A.D.T. = 1,620 (2018)
 R.D.S. = 110 km/h R.D.S. = 70 km/h

BRIDGE OFFICE CONTACT:



FRANK HUBBARD -----(608) 266-8489
 JERRY ZIRK -----(608) 266-5163

LIST OF DRAWINGS

1. GENERAL PLAN
2. CROSS SECTION & QUANTITIES
3. SUBSURFACE EXPLORATION
4. SOUTH ABUTMENT
5. SOUTH ABUTMENT DETAILS
6. NORTH ABUTMENT
7. NORTH ABUTMENT DETAILS
8. SUPERSTRUCTURE
9. SUPERSTRUCTURE DETAILS
10. 1370 mm PRESTRESSED GIRDER DETAILS
11. STEEL DIAPHRAGM
12. SLOPED FACE PARAPET "LF"

NO.	DATE	REVISION	BY
STATE OF WISCONSIN DEPARTMENT OF TRANSPORTATION DIVISION OF HIGHWAYS			
STRUCTURE B-44-72			
U.S.H. 41 OVER C.T.H. JJ			
COUNTY	OUTAGAMIE	TOWNSHIP/VILLAGE	KAUKAUNA
DESIGN SPEC.	AASHTO 1996	LOAD	MS-18
DESIGNED BY	CHIA	DESIGN CK'D.	KTN
DRAWN BY	JHC	PLANS CK'D.	ZIRK
APPROVED	[Signature] 04-23-99		
CHIEF BRIDGE DESIGN ENGINEER			DATE
GENERAL PLAN			SHEET 1 OF 12
			DATE: FEB'98

I.D. 1131-08-00F

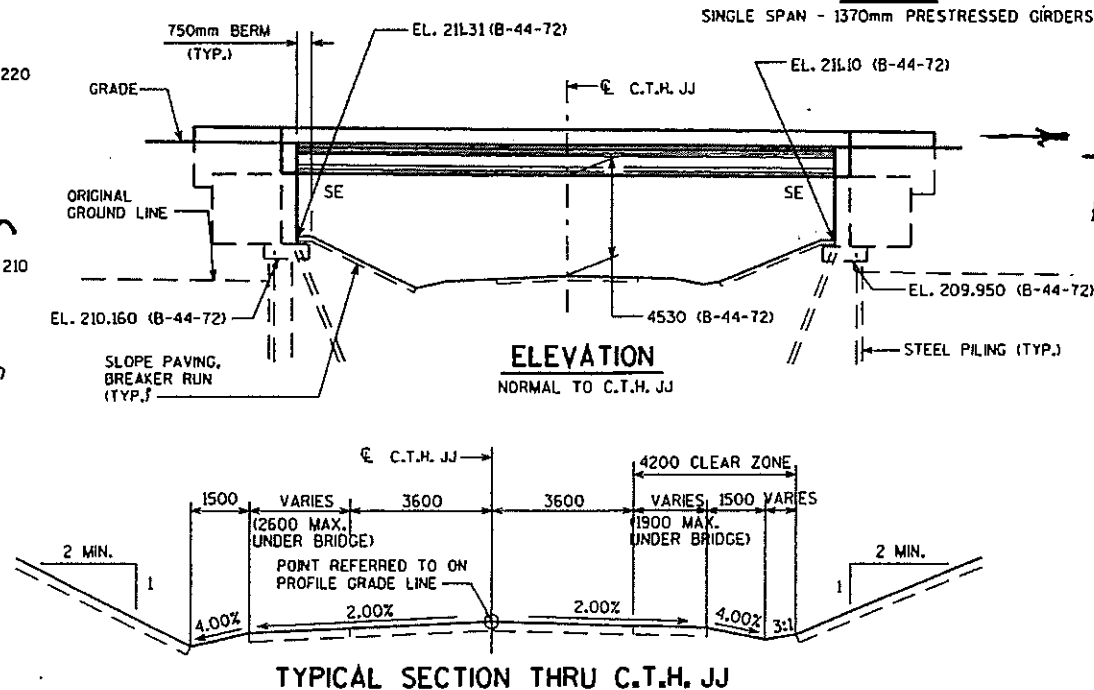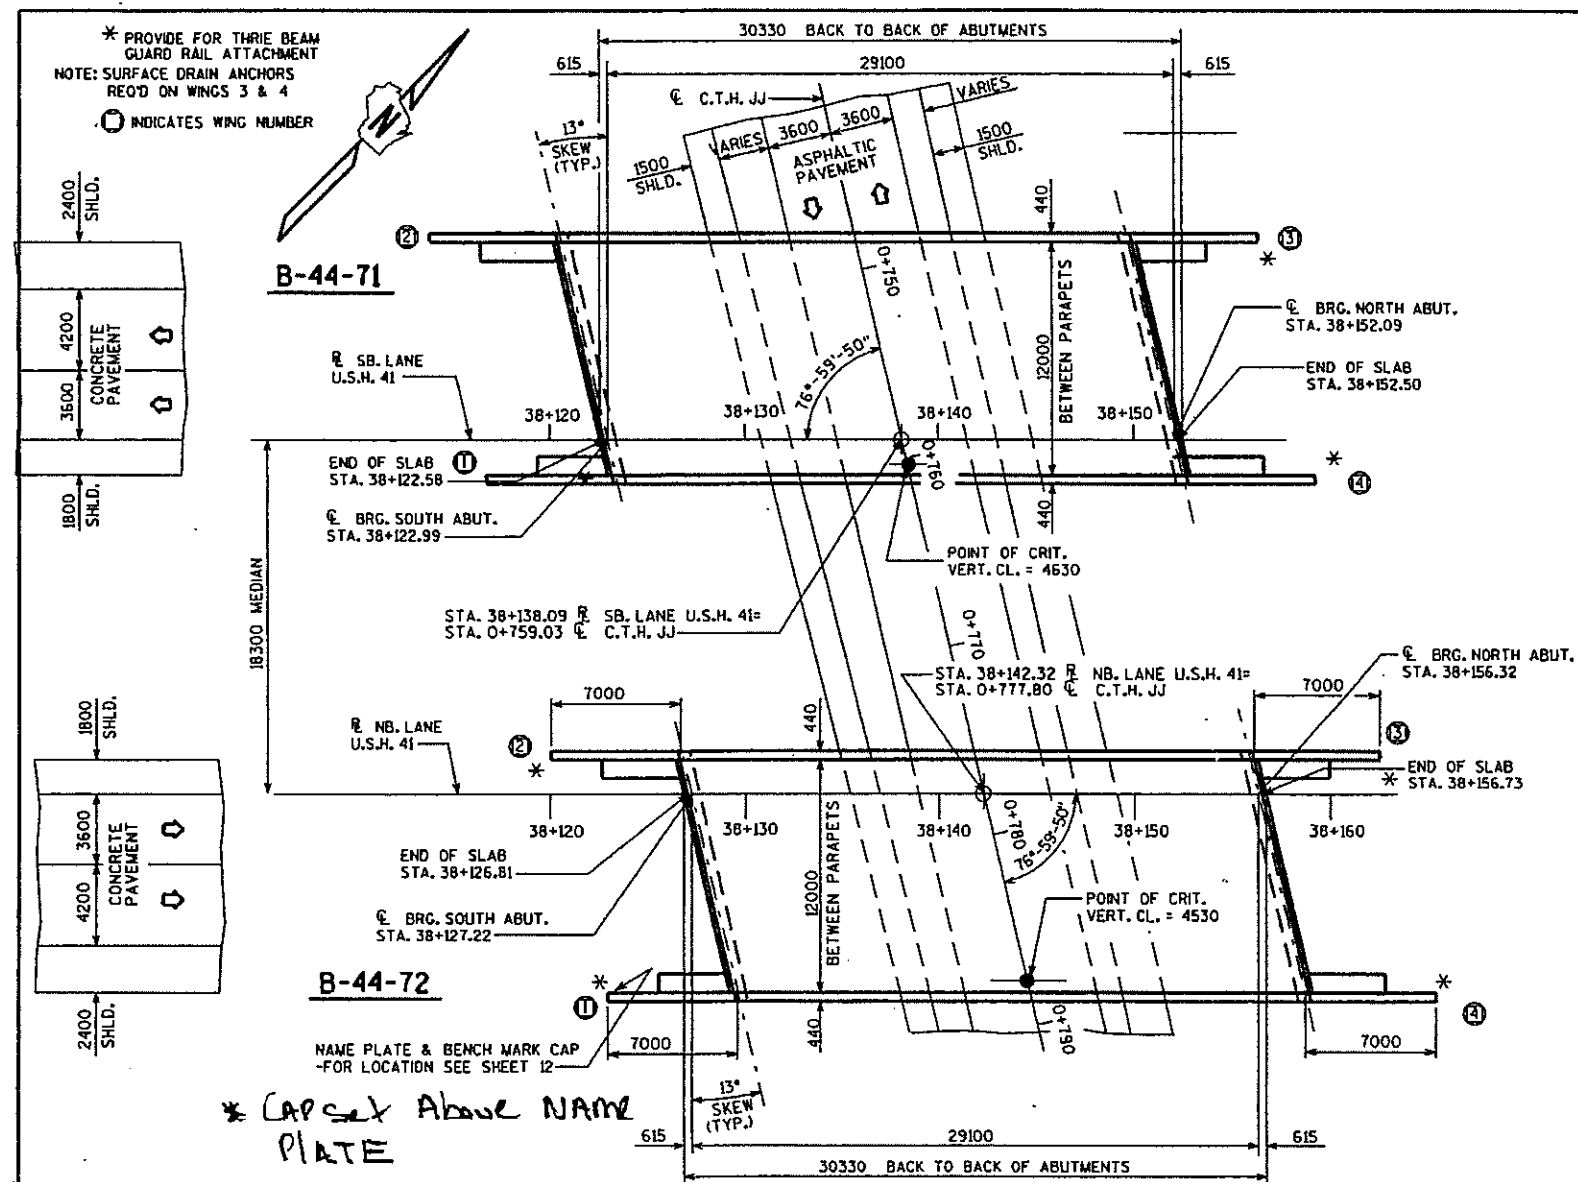

North ABUT:


Ave. Pile Length = 29.22m

Longest = 29.7m

Shortest = 28.6m

TYPICAL SECTION THRU C.T.H. JJ

FILE: 1131-08-00F
SCALE: 1/15

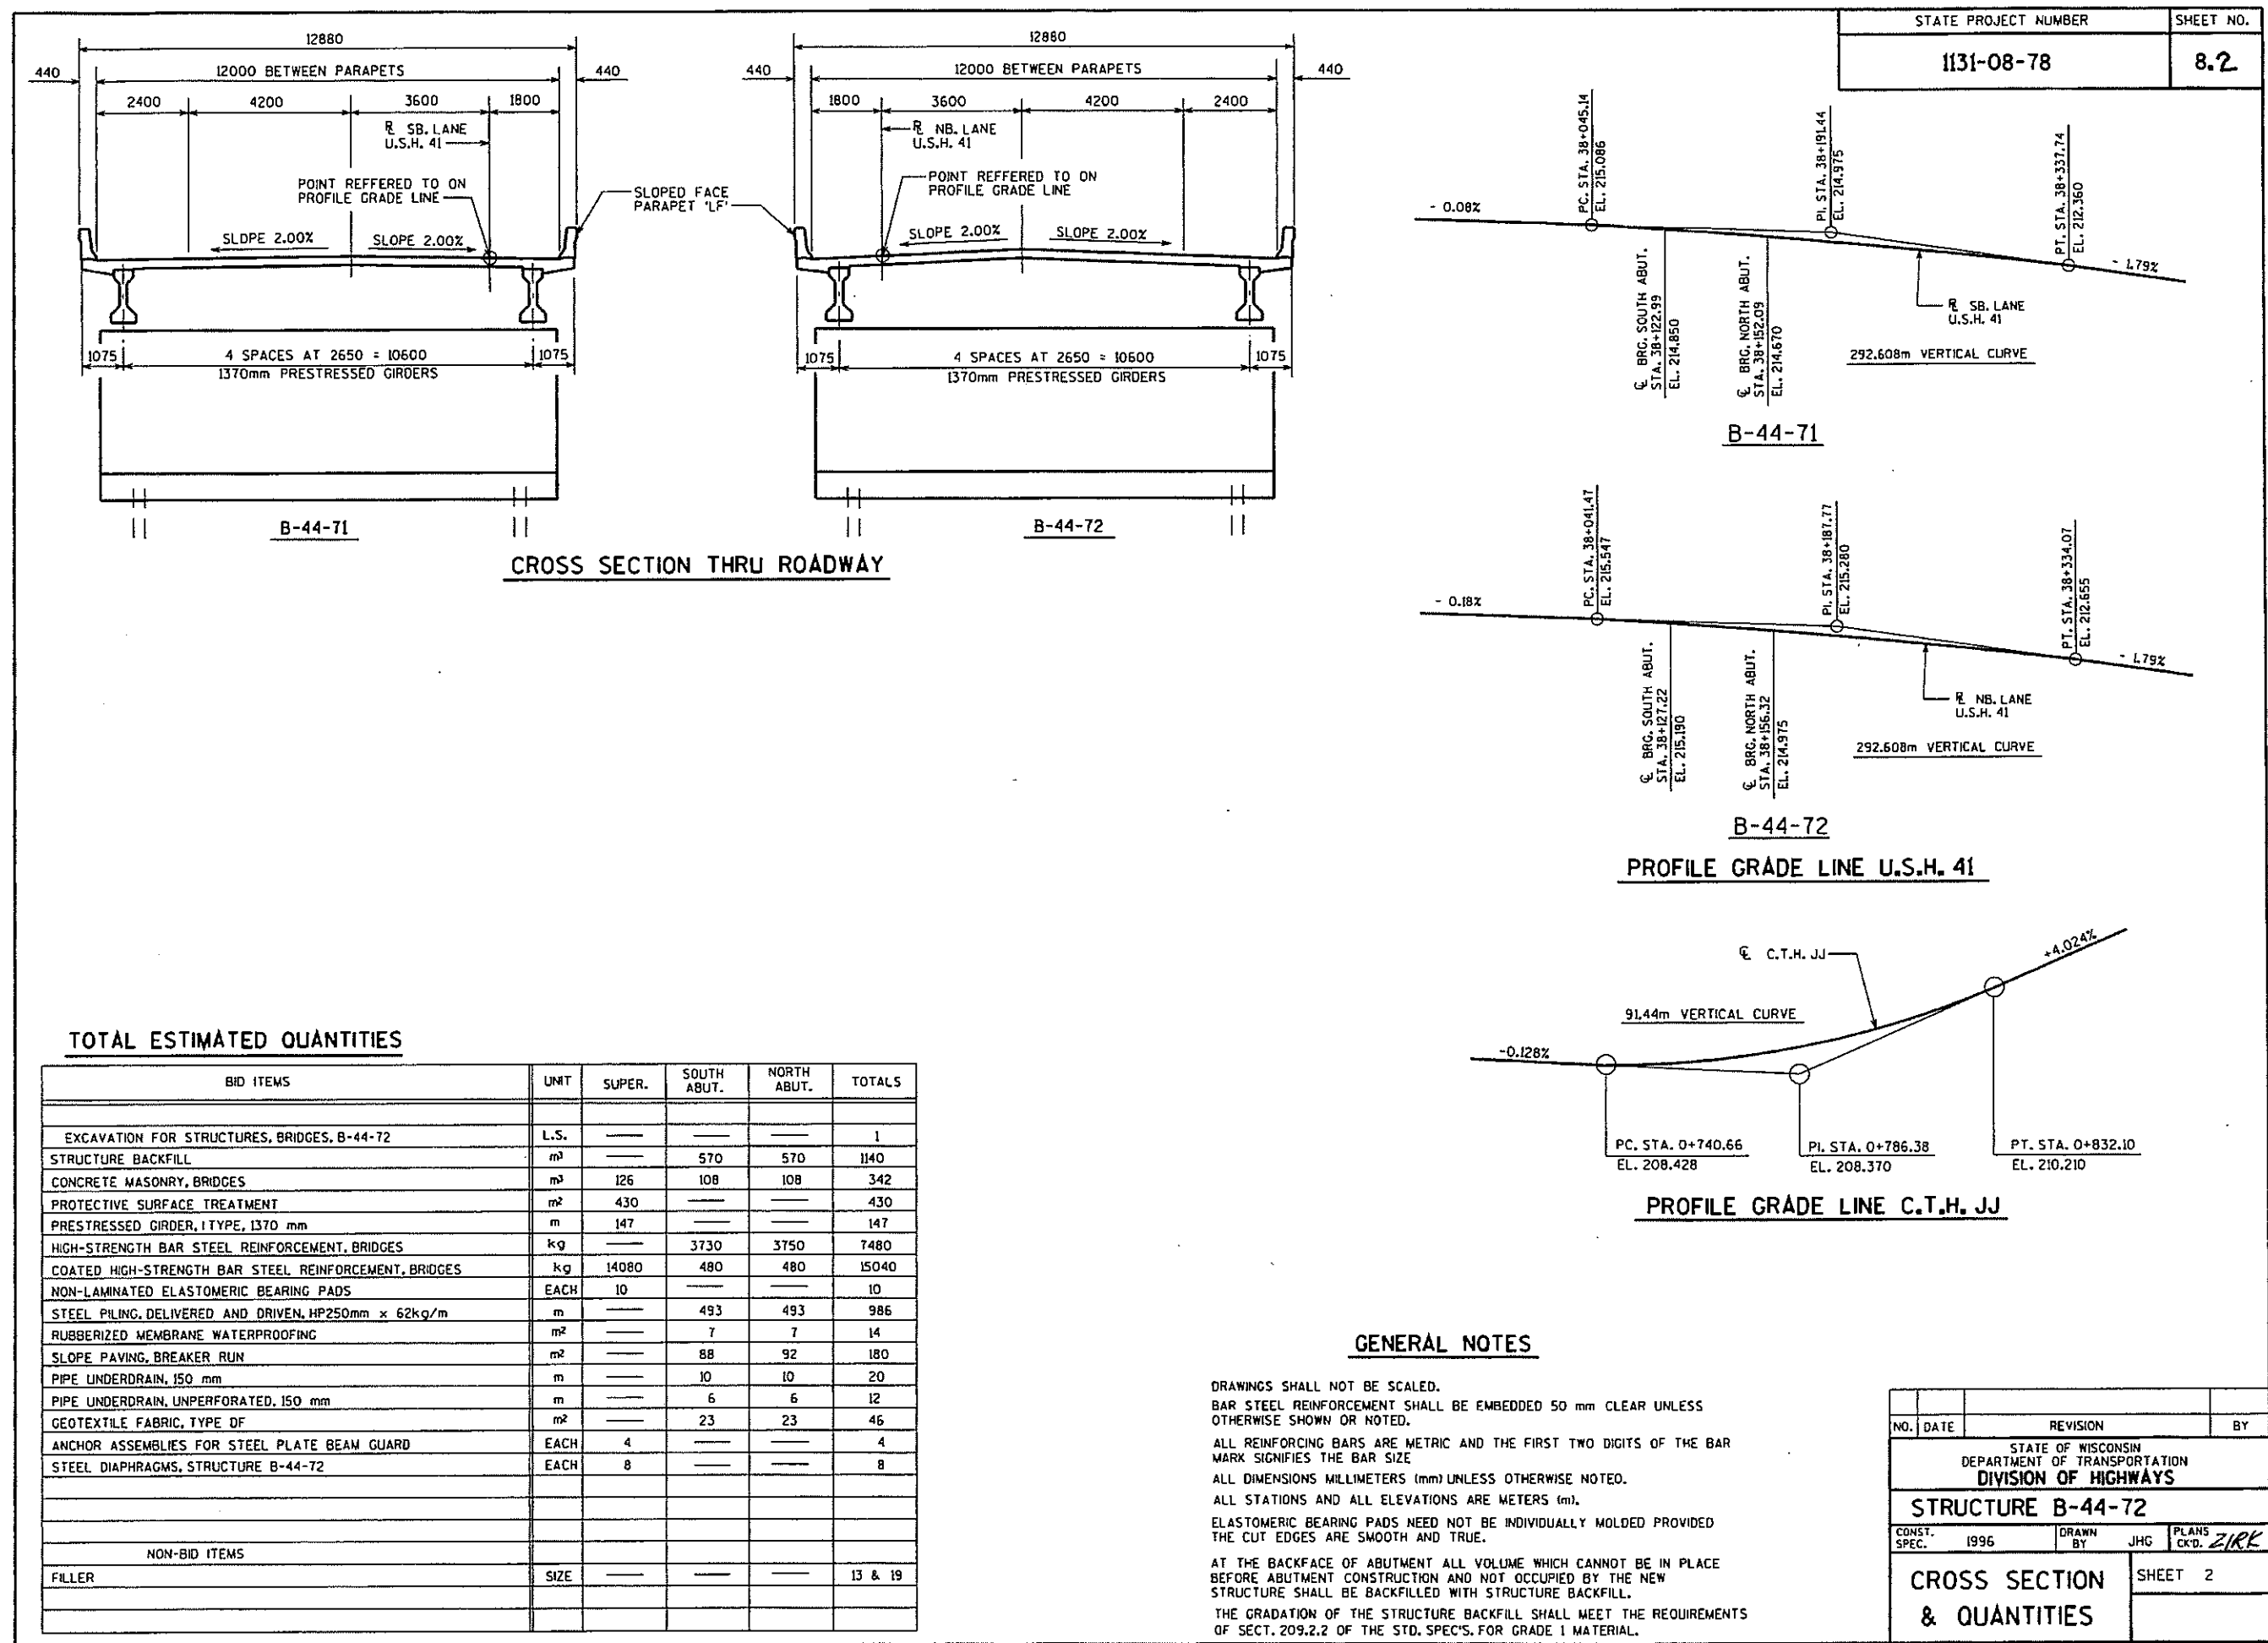

Vertical Clearance for Construction of New Bridges, Replacement Bridges, and Bridges on which the Superstructure is being replaced¹

Overpass Facility →	Freeway, Expressway, or STH		Railroad ⁴ , CTH, Town Road, Local Road, or Street	Pedestrian or Shared-use Structures	Sign Structures ²
Underpass Facility ↓	Interchange	Grade Separation			
Non-arterial either STH, CTH, Town Road, Local Road, or Street	15'-9" Desirable	15'-3" Desirable	16'- 9" Desirable	18'-3" Minimum	
	15'-3" Minimum	14'-9" Minimum	16'-3" Minimum		
Arterial either CTH, Town Road, Local Road, or Street (excludes freeway and expressway; also excludes arterial STH)	16'-9" Desirable	15'-3" Desirable	17'- 9" Desirable		
	16'-3" Minimum	14'-9" Minimum	17'-3" Minimum		
Freeway ³ or Expressway or arterial STH	16'-9" Desirable		17'- 9" Desirable		
	16'-4" Minimum		17'-4" Minimum		
Railroad ^{4,5,6,7}	23'-0" Minimum to 23'-3½" Maximum				

General notes:

- ¹ Vertical clearance is needed for the entire roadway width (critical point; to include traveled way, auxiliary lanes, turn lanes, and shoulders), according to the above table.

Vertical clearance for railroads is measured from the top of rail and is required over an area 8 feet 6 inches from the track centerline on each side of a railroad track.

Do not exceed the desirable vertical clearance shown unless justified. Depending on topography and other specific situations vertical clearance for any structure may be greater than that shown when justified. Some things to consider are: over height loads traveling on the roadway; the level of development in the area, the projected growth in traffic volume and importance of the roadway, and the possibility of reclassification.

- ² See LRFD Bridge Manual Chapter 39 (http://on.dot.wi.gov/dtid_bos/extranet/structures/LRFD/LRFDManualIndex.htm) and LRFD Standard Details 39.02 and 39.10 for design considerations and requirements for vertical clearance on new and replacement Sign Structures.
- ³ See FDM 11-44-1 for vertical clearance guidance specific to Interstate freeways.
- ⁴ Consult with the Region Railroad Coordinator if the over-passing or under-passing facility is either a railroad or a "rails-to-trails" trail; or if a structure is owned by a railroad company.
- ⁵ A vertical clearance <23'-0" requires both an approved Exception to Standards (see FDM 11-1-2 and FDM 11-1-4) and early coordination with BTLR R&H, Railroads and Harbors Section (RHS) through the Region Railroad Coordinator. The Exception to Standards shall contain documentation that the Office of the Commissioner of Railroads (OCR) has been petitioned.
- See Chapter 17 for additional information.
- ⁶ Provide justification for a vertical clearance >23'-3 ½" to the RHS.
- ⁷ Vertical clearance less than 23'-0" may be acceptable or desirable in certain situations, such as for spur tracks, lead tracks, some branch lines and even mainline tracks when other impediments to 23'-0" exist. Review such situations with the Railroad Project Coordination Engineer in RHS. Early coordination with RHS is required.



DAAR
ENGINEERING, INC.

PROJECT: _____

DATE: _____

DESCRIPTION: US 41 over Wrightstown
Road B-44-73(SB) & 74(NB)

SHEET _____ OF _____

CALC. BY: _____


CHECKED BY: _____

Existing Structures are 40'x102' 54" Girders 1 span
VC = 15.12' SB & 15.03' NB Need 16.75'
Existing Wrightstown is 2-12' lanes & 5' shldrs. Expand to 4-12' lanes & 6' shldr

4-12' lanes = 48'
2-14' Clear Zones = 28'
Slope Paving 17@2.1 x 2 = 68'
Abutments (2.5'+4') x 2 = 13'

157' span = 72" Girders → raise us 41 18" - No

Proposed Typical Half Section (Wrightstown)

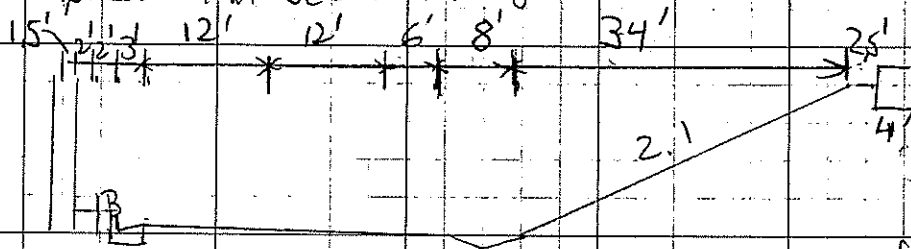

Pier offset 1.5'
Beam Guard 2.0'
C & G 2.0'
2-12' lanes 3.0'
14' clear zone 24.0'
Slope Paving 14.0'
Abutment 34.0'
2.5'
4.0'

20' Widening In Median 20' x .02 = 0.4'

B-73(SB)
15.12 at CL
+ 1.50
16.62
- 0.4
16.22

Raise SB 41 0.63'

+1.5' difference in girders

87' span
36" Girders

B-74(NB)
15.03 at CL
+ 1.50
16.53
- 0.4
16.13

Raise NB 41 0.62'

BRIDGE INSPECTION REPORT
Wisconsin Dept. of Transportation
DT2007 2003 s.84.17 Wis. Stats. Type = ROUTINE INSPECTION

page 1

Inventory Data

Feature On: USH 41		Maintainer: STATE HIGHWAY DEPT		Structure No: B-44-073
Feature Under: WRIGHTSTOWN RD		Sect/Twn/Rng: S33 T22N R19E		
Location: 1.9M S JCT CTH U		County: OUTAGAMI	Municipality: TOWN-KAUKAUNA (44026)	
Inv Rating: HS22.2	Rdwy Width (ft): 39.4	Deck Width (ft): 42.3	Existing Posting:	
Oper Rating: HS50	Total Length (ft): 106.1	Deck Area(ft2): 4488	ADT On: 19000 Yr: 1998	ADT Under: Yr:

Inspection Type (* = Supplemental Form Required)

	Routine Visual	Fracture Critical*	In-Depth*	UW-Dive*	UW-Surv*	UW-Probe/Visual*	Movable*
Last Insp.	10-17-11						
Frequency	24						
Recom. Freq.							
	Initial*	Damage	Interim	Load Posted	SI & A Field Review*		
Last Insp.							
Frequency	N/A						
Recom. Freq.	N/A				Item No. Needing Change		

Load Rating Information

Overburden	Measurement (in): 0.0	Date:	Deck Surface Type: CONCRETE	
Section Loss	File Meas. (%):	File Insp. Date: 10-19-09	Insp. Measurement (%):	Describe:
Re-rate for load capacity?	Reason:		Date Last Rated: 03-14-00	

Expansion Joints

Location	Type	Temp:			Signing Condition			
		File Insp. Date	File Insp. (in)	New Insp. (in)	Type of Marker	File	Y/N	Comments
					Bridge Markers			
					Narrow Bridge			
					One Lane Road			
					Vertical Clearance			
					Weight Limit Post			
					Other(Addl. Sign)			

Clearances(Cardinal = N or E)

	File Meas. (ft.)	File Date	New Meas. (ft.)
Min. Vertical Clearance Under (Cardinal)	15.12	11-28-00	
Min. Vertical Clearance Under (non-Cardinal)			
Min. Vertical Clearance On			

Structure Type

Construction/Rehabilitation History

Material	Configuration	# of Spans	Overall Length (ft)	Year	Work Performed	Plan	Shop
PREST CONCRET	DECK GIRDER		101.7	2000	NEW STRUCTURE		

Inspection Information

Special Requirements	Y/N	Comments				
Traffic Control	Y					
Access Equipment	Y					
Other	Y					

Inspector Information

Team Leader Name and No. Printed: Michaelson, Neil (3010)		Team Member(s) Name(s) Printed:		
Team Leader Signature:		Inspection Date: 10-17-11	Inspection Agency: STATE HIGHWAY DEPARTMENT (1)	
District/Local Manager and No. Printed:		District/Local Manager Signature:	Review Date:	

Element Inspection (X) Check Elements Inspected

					Quantity in Condition States				
Ck	Elem./Env.	Description	Unit	Total QTY.	1	2	3	4	5
X	26 / 4	Conc Deck/Coatd Bars	SF	4488	4488				
	Dia. cracks.								
X	109 / 3	P/S Conc Open Girder	LF	515	515				
X	172 / 3	Painted Steel Diaphr	EA	8	8				
X	215 / 4	R/Conc Abutment	LF	95	79	16			
	South abut spalling under girders CS-2 (north 6" south 10")								
X	321 / 4	R/Conc Approach Slab	EA	2	1	1			
	South approach has settled slightly								
X	331 / 4	Conc Bridge Railing	LF	311	249	62			
X	342 / 2	RipRap Slope Protect	EA	2	1	1			
	South slope protection has settled								
X	358 / 4	Deck Cracking SmFlag	EA	1	1				
X	359 / 4	Und Dk Surf Sm Flag	EA	1	1				
X	400 / 4	Concrete Wingwall	EA	4	4				

General Inspection/Maintenance Notes

--

Maintenance Recommendations (See standard code items & numbers)

Maintenance Item: Approach - Seal Approach to Paving Block
Amount: Date(YYYY-MM-DD):
Maintenance item comment: Seal joints at end of deck

Maintenance Item:
Amount: Date(MM-DD-YY):
Maintenance item comment:

NBI Ratings

NBI	File	New	NBI	File	New
Deck	7	7	Culvert	N	N
Superstructure	7	7	Channel	N	N
Substructure	7	7	Waterway	N	N

Maintenance Item:
Amount: Date(MM-DD-YY):
Maintenance item comment:

STRUCTURE INVENTORY AND APPRAISAL FIELD REVIEW FORM

B-44-073
USH 41 over WRIGHTSTOWN RD

LOCATION

- (3) Municipality:
 (16) Latitude(° ' ") :
 (17) Longitude(° ' ") :

TOWN - KAUKAUNA (44026)
44° 19' 43.66" N
88° 12' 38.79" W

TRAFFIC SERVICE

- (28A) Lanes On:
 (28B) Lanes Under:
 (102) Traffic Pattern On:
 (102) Traffic Pattern Under:
 (19) Detour Length(mi):

2
2
-NO TRAFFIC X-ONE WAY TRAFFIC -TWO WAY TRAFFIC
-NO TRAFFIC -ONE WAY TRAFFIC X-TWO WAY TRAFFIC
3

GEOMETRY

- (49) Structure Length(ft):
 (50) Sidewalk Width(ft):
 (50) Curb Width(ft):
 (52) Culvert Barrel Length(ft):
 (34) Skew:
 (51) Bridge Roadway(ft):
 (52) Deck(ft):
 (32) Approach Roadway(ft):
 (47) Minimum Horizontal(ft):
 (55) Minimum Right Lateral(ft):
 (55) Minimum Left Lateral(ft):

106.1		
Left: 0.0		Right: 0.0
Angle(°): 27		Direction: X-RIGHT FORWARD -LEFT FORWARD
Cardinal Width		Non-Cardinal Width
39.4		39.4
42.3		42.3
39		0
Cardinal Under Clearance		Non-Cardinal Under Clearance
49.0		
10.0		
15.0		

RAILING APPRAISAL

- (36A) Bridge Rail Adequacy:
 (36B) Transition Adequacy:
 (36C) Approach Guardrail Adequacy:
 (36D) Guardrail Termination Adequacy:
 Outer Rail:

-SUB-STANDARD	X-STANDARD	-NOT APPLICABLE
-SUB-STANDARD	X-STANDARD	-NOT APPLICABLE
-SUB-STANDARD	X-STANDARD	-NOT APPLICABLE
-SUB-STANDARD	X-STANDARD	-NOT APPLICABLE
Left	Right	Type
		TYPE F (TWO SQUARE TUBES) - STEEL(8)
		TYPE F (3 SQUARE TUBES) - STEEL(65)
		TYPE F (4 SQUARE TUBES) - STEEL(72)
		TYPE M-STEEL 3 SQUARE TUBES(93)
X	X	SLOPED FACE PARAPET LF(91)
		SLOPED FACE PARAPET HF(92)
		VERTICAL FACE PARAPET TYPE A(74)
		TYPE W-THREE BEAM(79)
		TYPE H ON VERTICAL PARAPET(80)
		TIMBER(38)
		OTHER(99) (Please specify)

Transition Type:

	CONT GUARD RAIL
	NO APP GRDRL
	NO ATTACHMENT
5	22 MM(7/8") BOLT (Please enter quantity)
	25 MM(1") BOLT (Please enter quantity)
	OTHER (Please specify)

Guardrail Termination Type:

X	(01) ENERGY ABSORBING TERMINAL/EAT
	(02) TURN DOWN
	(99) OTHER (Please specify)

ROADWAY ALIGNMENT APPRAISAL

(72) Approach Alignment Appraisal:

	(3) INTOLERABLE- Horizontal or Vertical curvature requires a substantial reduction in vehicle operating speed
	(6) FAIR- Horizontal or Vertical curvature requires a very minor speed reduction
X	(8) GOOD- No speed reduction required

This page intentionally left blank

BRIDGE INSPECTION REPORT
Wisconsin Dept. of Transportation
DT2007 2003 s.84.17 Wis. Stats. Type = ROUTINE INSPECTION

page 1

Inventory Data

Feature On: USH 41		Maintainer: STATE HIGHWAY DEPT		Structure No: B-44-074
Feature Under: WRIGHTSTOWN RD NB		Sect/Twn/Rng: S33 T22N R19E		
Location: 1.3M N JCT CTH JJ		County: OUTAGAMI	Municipality: TOWN-KAUKAUNA (44026)	
Inv Rating: HS22.2	Rdwy Width (ft): 39.4	Deck Width (ft): 39.4, 42.3	Existing Posting:	
Oper Rating: HS50	Total Length (ft): 106.1	Deck Area(ft2): 4334	ADT On: 23100 Yr: 2003	ADT Under: Yr:

Inspection Type (* = Supplemental Form Required)

	Routine Visual	Fracture Critical*	In-Depth*	UW-Dive*	UW-Surv*	UW-Probe/Visual*	Movable*
Last Insp.	10-17-11						
Frequency	24						
Recom. Freq.							
	Initial*	Damage	Interim	Load Posted	SI & A Field Review*		
Last Insp.							
Frequency	N/A						
Recom. Freq.	N/A				Item No. Needing Change		

Load Rating Information

Overburden	Measurement (in): 0.0	Date:	Deck Surface Type: CONCRETE	
Section Loss	File Meas. (%):	File Insp. Date: 10-19-09	Insp. Measurement (%):	Describe:
Re-rate for load capacity?	Reason:	Date Last Rated: 03-14-00		

Expansion Joints

		Temp:			Signing Condition			
Location	Type	File Insp. Date	File Insp. (in)	New Insp. (in)	Type of Marker	File	Y/N	Comments
					Bridge Markers			
					Narrow Bridge			
					One Lane Road			
					Vertical Clearance			
					Weight Limit Post			
					Other(Addl. Sign)			

Clearances(Cardinal = N or E)

	File Meas. (ft.)	File Date	New Meas. (ft.)
Min. Vertical Clearance Under (Cardinal)	15.03	11-28-00	
Min. Vertical Clearance Under (non-Cardinal)			
Min. Vertical Clearance On			

Structure Type

Construction/Rehabilitation History

Material	Configuration	# of Spans	Overall Length (ft)	Year	Work Performed	Plan	Shop
PREST CONCRET	DECK GIRDER		101.7	2000	NEW STRUCTURE		

Inspection Information

Special Requirements	Y/N	Comments
Traffic Control	Y	
Access Equipment	Y	
Other	Y	

Inspector Information

Team Leader Name and No. Printed: Michaelson, Neil (3010)		Team Member(s) Name(s) Printed:	
Team Leader Signature:		Inspection Date: 10-17-11	Inspection Agency: STATE HIGHWAY DEPARTMENT (1)
District/Local Manager and No. Printed:		District/Local Manager Signature:	Review Date:

Element Inspection (X) Check Elements Inspected

Element Inspection (X) Check Elements Inspected					Quantity in Condition States				
Ck	Elem./Env.	Description	Unit	Total QTY.	1	2	3	4	5
X	26 / 4	Conc Deck/Coatd Bars	SF	4334	4334				
		Dia. cracks.							
X	109 / 3	P/S Conc Open Girder	LF	515	515				
X	172 / 3	Painted Steel Diaphr	EA	8	8				
X	215 / 4	R/Conc Abutment	LF	95	84	9	2		
		CS-2 (S Abut 7" & N Abut 2") CS-3 N Abut 2"							
X	321 / 4	R/Conc Approach Slab	EA	2	1	1			
		North approach settled slightly							
X	331 / 4	Conc Bridge Railing	LF	311	246	65			
X	342 / 2	RipRap Slope Protect	EA	2	1	1			
		South slope protection is settling							
X	358 / 4	Deck Cracking SmFlag	EA	1	1				
X	359 / 4	Und Dk Surf Sm Flag	EA	1	1				
		Diagonal cracking at ends of deck							
X	400 / 4	Concrete Wingwall	EA	4	4				

General Inspection/Maintenance Notes

Maintenance Recommendations (See standard code items & numbers)

Maintenance Item: Approach - Seal Approach to Paving Block

Amount: Date(YYYY-MM-DD):

Maintenance item comment: Seal jts at the end of the deck

Maintenance Item:

Amount: Date(MM-DD-YY):

Maintenance item comment:

NBI Ratings

NBI	File	New	NBI	File	New
Deck	8	8	Culvert	N	N
Superstructure	8	8	Channel	N	N
Substructure	8	7	Waterway	N	N

Maintenance Item:

Amount: Date(MM-DD-YY):

Maintenance item comment:

STRUCTURE INVENTORY AND APPRAISAL FIELD REVIEW FORM

B-44-074
USH 41 over WRIGHTSTOWN RD NB

- (3) Municipality:
 (16) Latitude(° ' "):
 (17) Longitude(° ' "):

LOCATION	
TOWN - KAUKAUNA (44026)	
44°19'42.61"N	
88°12'37.69"W	

- (28A) Lanes On:
 (28B) Lanes Under:
 (102) Traffic Pattern On:
 (102) Traffic Pattern Under:
 (19) Detour Length(mi):

TRAFFIC SERVICE	
2	
2	
-NO TRAFFIC X-ONE WAY TRAFFIC -TWO WAY TRAFFIC	
-NO TRAFFIC -ONE WAY TRAFFIC X-TWO WAY TRAFFIC	
3	

- (49) Structure Length(ft):
 (50) Sidewalk Width(ft):
 (50) Curb Width(ft):
 (52) Culvert Barrel Length(ft):
 (34) Skew:
 (51) Bridge Roadway(ft):
 (52) Deck(ft):
 (32) Approach Roadway(ft):
 (47) Minimum Horizontal(ft):
 (55) Minimum Right Lateral(ft):
 (55) Minimum Left Lateral(ft):

GEOMETRY	
106.1	
Left: 0.0	Right: 0.0
Angle(°): 27	Direction: X-RIGHT FORWARD -LEFT FORWARD
Cardinal Width	Non-Cardinal Width
39.4	39.4
39.4	42.3
39	0
Cardinal Under Clearance	Non-Cardinal Under Clearance
46.3	
12.8	
9.8	

- (36A) Bridge Rail Adequacy:
 (36B) Transition Adequacy:
 (36C) Approach Guardrail Adequacy:
 (36D) Guardrail Termination Adequacy:
 Outer Rail:

RAILING APPRAISAL		
-SUB-STANDARD	X-STANDARD	-NOT APPLICABLE
-SUB-STANDARD	X-STANDARD	-NOT APPLICABLE
-SUB-STANDARD	X-STANDARD	-NOT APPLICABLE
-SUB-STANDARD	X-STANDARD	-NOT APPLICABLE
Left	Right	Type
		TYPE F (TWO SQUARE TUBES) - STEEL(8)
		TYPE F (3 SQUARE TUBES) - STEEL(66)
		TYPE F (4 SQUARE TUBES) - STEEL(72)
		TYPE M-STEEL 3 SQUARE TUBES(93)
X	X	SLOPED FACE PARAPET LF(91)
		SLOPED FACE PARAPET HF(92)
		VERTICAL FACE PARAPET TYPE A(74)
		TYPE W-THREE BEAM(79)
		TYPE H ON VERTICAL PARAPET(80)
		TIMBER(38)
		OTHER(99) (Please specify)

Transition Type:

	CONT GUARD RAIL
	NO APP GRDRL
	NO ATTACHMENT
5	22 MM(7/8") BOLT (Please enter quantity)
	25 MM(1") BOLT (Please enter quantity)
	OTHER (Please specify)


Guardrail Termination Type:

	(01) ENERGY ABSORBING TERMINAL/EAT
	(02) TURN DOWN
	(99) OTHER (Please specify)

(72) Approach Alignment Appraisal:

ROADWAY ALIGNMENT APPRAISAL	
	(3) INTOLERABLE- Horizontal or Vertical curvature requires a substantial reduction in vehicle operating speed
	(6) FAIR- Horizontal or Vertical curvature requires a very minor speed reduction
X	(8) GOOD- No speed reduction required

This page intentionally left blank

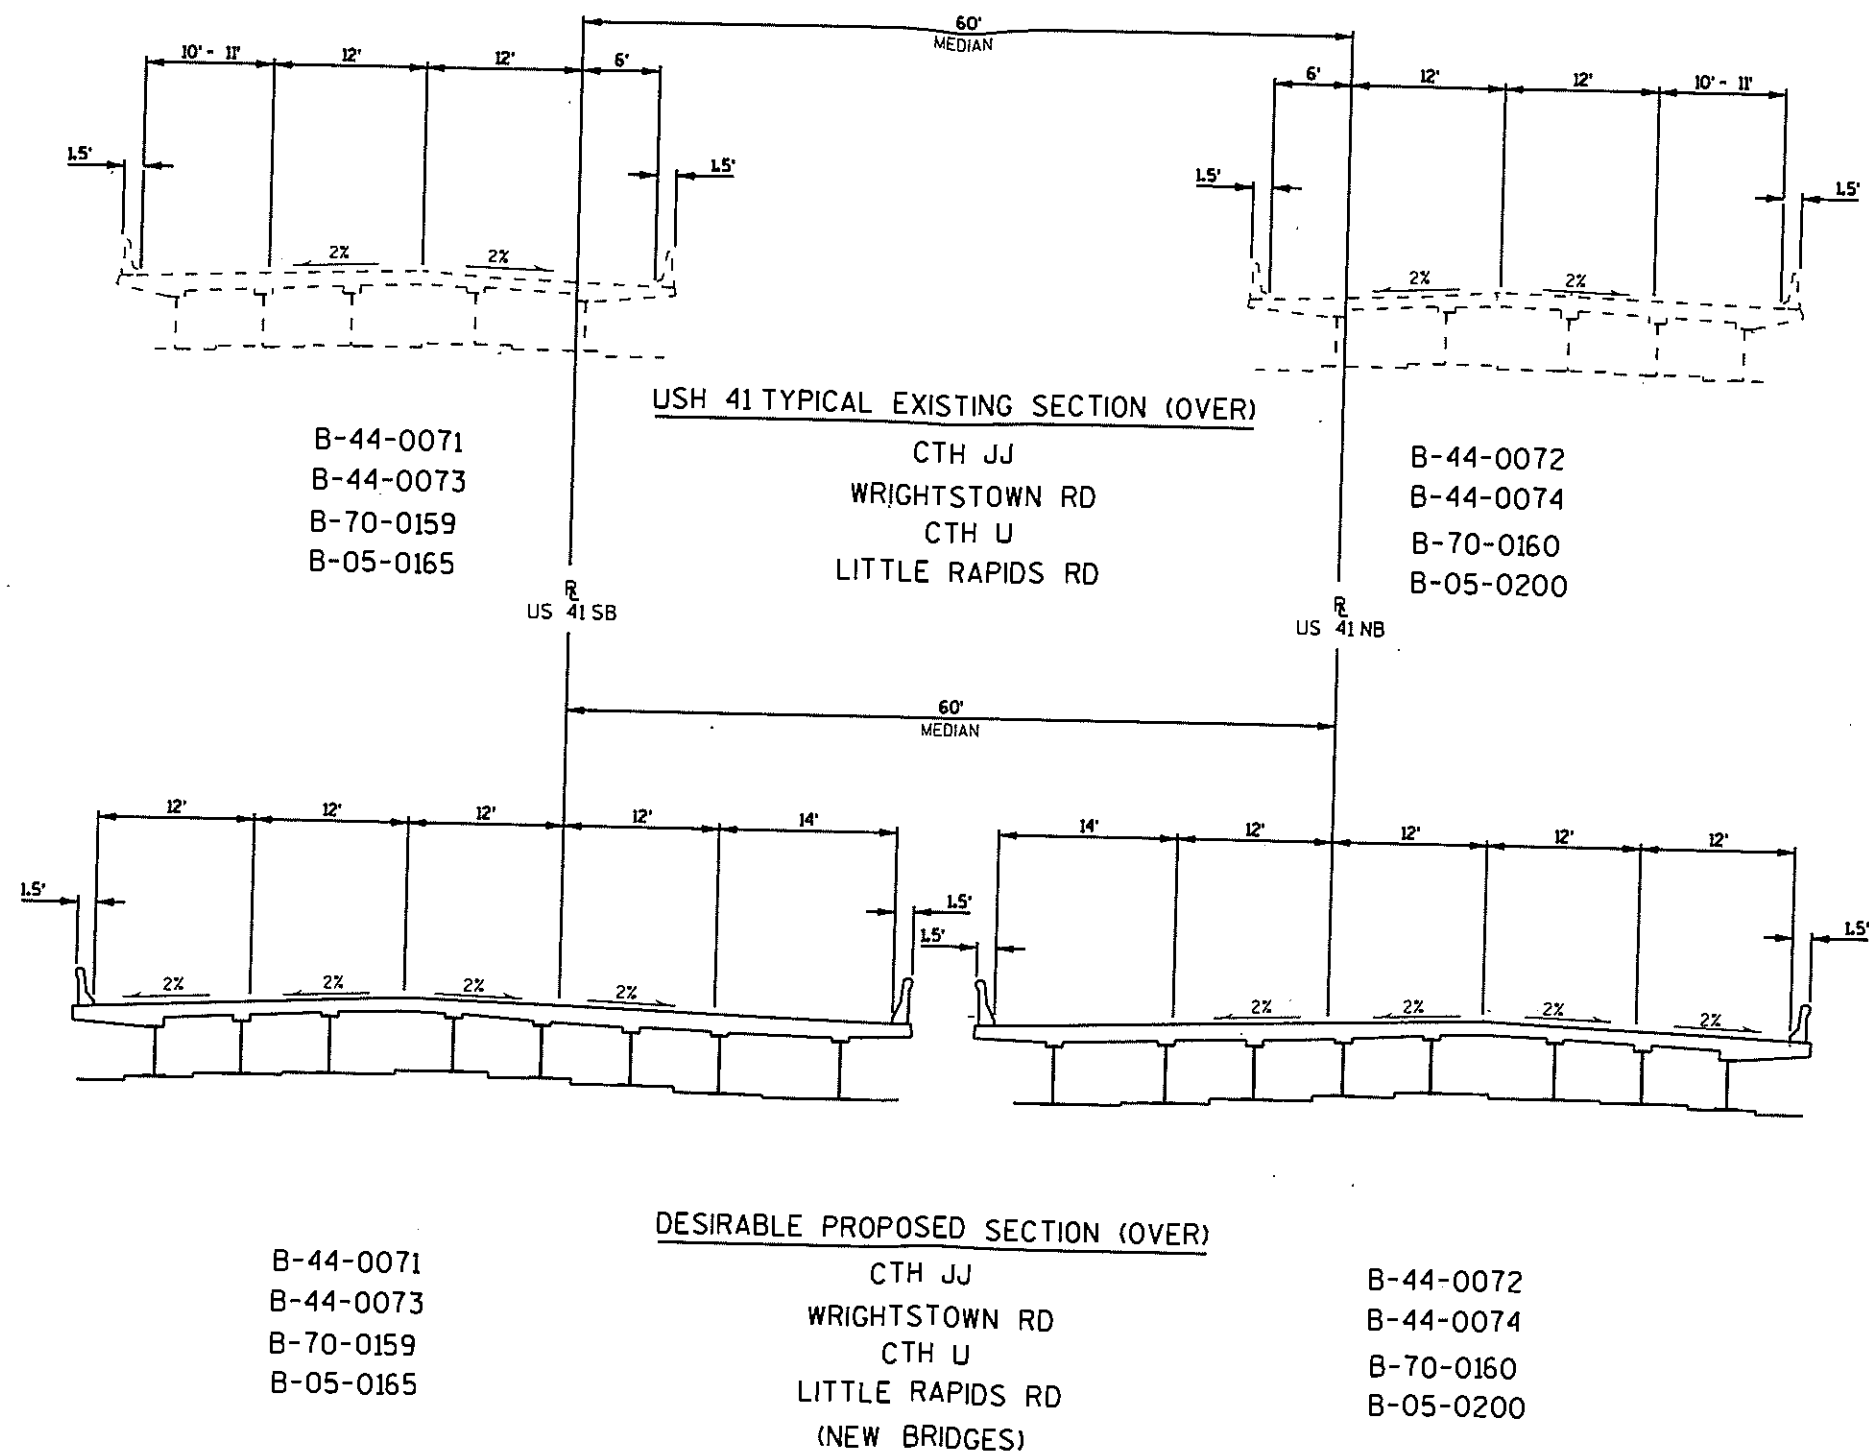

INDICATES WING NUMBER

DESIGN DATA

LIVE LOAD:

DESIGN RATING: MS-18
 INVENTORY RATING: MS-20
 OPERATIONAL RATING: MS-45
 MAXIMUM STANDARD PERMIT VEHICLE LOAD = 1110 kN
 STRUCTURE IS DESIGNED FOR A FUTURE WEARING SURFACE OF 1.0 kN/m².

ULTIMATE DESIGN STRESSES:


CONCRETE MASONRY SLAB — $f'_c = 28 \text{ MPa}$ ALL OTHER — $f'_c = 24 \text{ MPa}$
 BAR STEEL REINFORCEMENT, AASHTO M-318, GRADE 420 — $f_y = 420 \text{ MPa}$
 1370mm PRESTRESSED GIRDERS, CONCRETE MASONRY — $f'_c = 45 \text{ MPa}$
 STRANDS — 13mm DIA. WITH ULTIMATE TENSILE STRENGTH OF 1860 MPa

FOUNDATION DATA

ABUTMENTS TO BE SUPPORTED ON HP 250 X 62 STEEL PILING DRIVEN TO A MINIMUM BEARING VALUE OF 490 kN PER PILE. ESTIMATED 26m LONG @ S. ABUT. & 25m LONG @ N. ABUT.

TRAFFIC VOLUME

U.S.H. 41	WRIGHTSTOWN ROAD
A.D.T.=37,000 (2018)	A.D.T.=600 (2018)
R.O.S.=110 km/h	R.O.S.=70 km/h

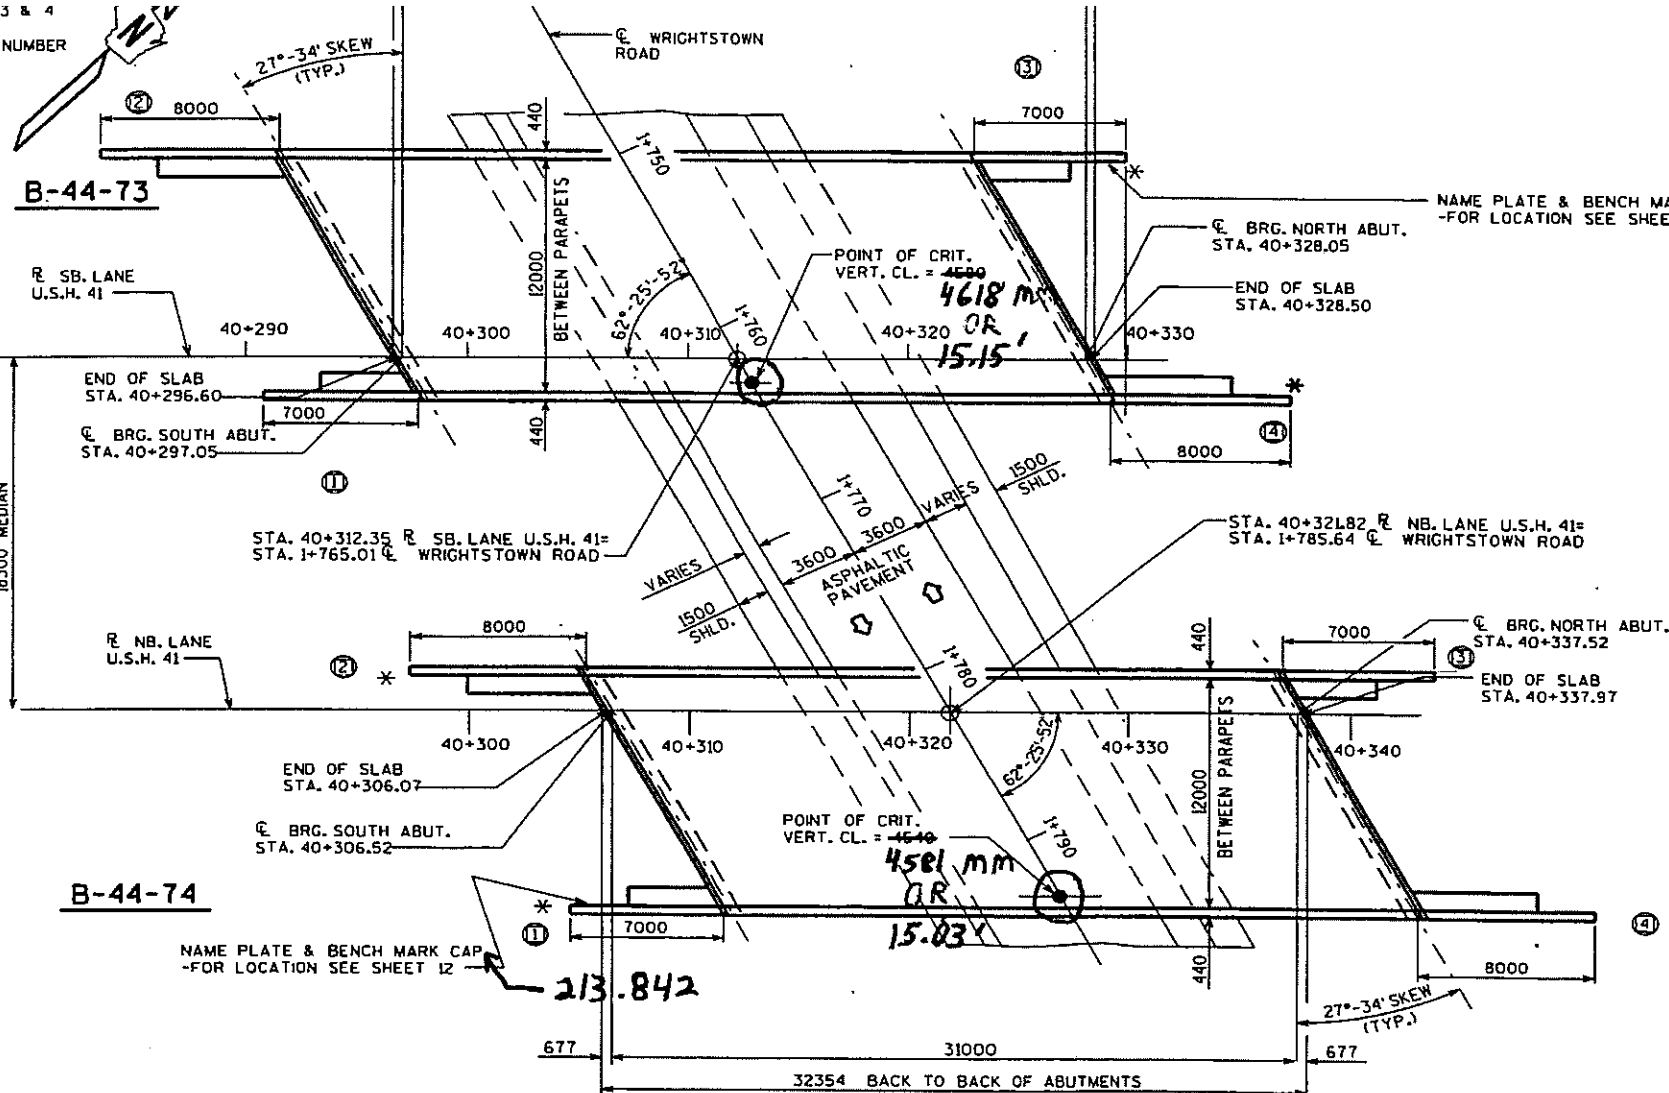


PLAN

SINGLE SPAN - 1370mm PRESTRESSED GIRDERS

ELEVATION

NORMAL TO WRIGHTSTOWN ROAD

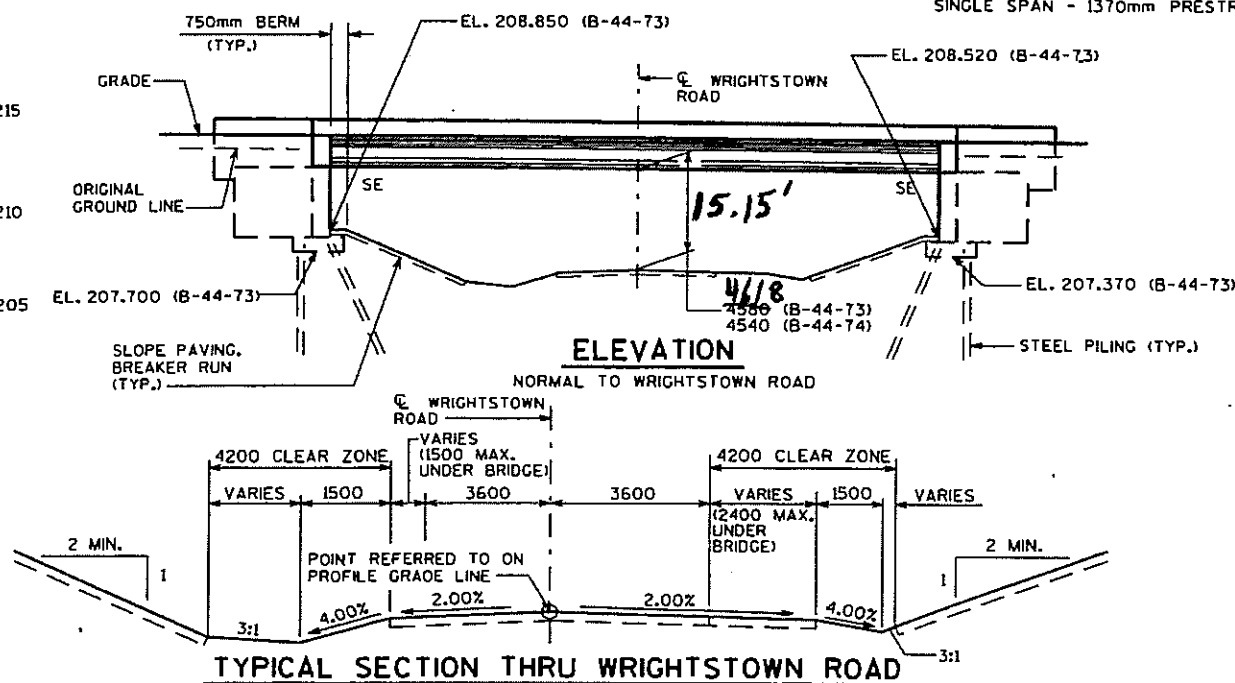

TYPICAL SECTION THRU WRIGHTSTOWN ROAD

LIST OF DRAWINGS

1. GENERAL PLAN
2. CROSS SECTION & QUANTITIES
3. SUBSURFACE EXPLORATION
4. SOUTH ABUTMENT
5. SOUTH ABUT. DETAILS
6. NORTH ABUTMENT
7. NORTH ABUT. DETAILS
8. SUPERSTRUCTURE
9. SUPERSTRUCTURE DETAILS
10. 1370mm PRESTRESSED GIRDER DETAILS
11. STEEL DIAPHRAGM
12. SLOPE FACE PARAPET "LF"


BRIDGE OFFICE CONTACT :
 JERRY ZIRK (608) 266-5153
 FINN HUBBARD (608) 266-8489

NO.	DATE	REVISION	BY
STATE OF WISCONSIN DEPARTMENT OF TRANSPORTATION DIVISION OF HIGHWAYS			
STRUCTURE B-44-73			
U.S.H. 41 OVER WRIGHTSTOWN ROAD			
COUNTY	OUTAGAMIE	TOWN/VILLAGE	KAUKAUNA
DESIGN SPEC.	AASHTO 1996	LOAD	MS-18
DESIGNED BY	CIHA	DESIGN CK'D.	KTN
BY	CIHA	DRAWN BY	JHG
APPROVED	[Signature]		DATE
CHIEF BRIDGE DESIGN ENGINEER		01-18-00	
GENERAL PLAN			SHEET 1 OF 12
			DATE: FEB'98


I.D. 1131-08-00G

DISTRICT CONTACT


FILE: 730P.DGN
SCALE: 1/16"

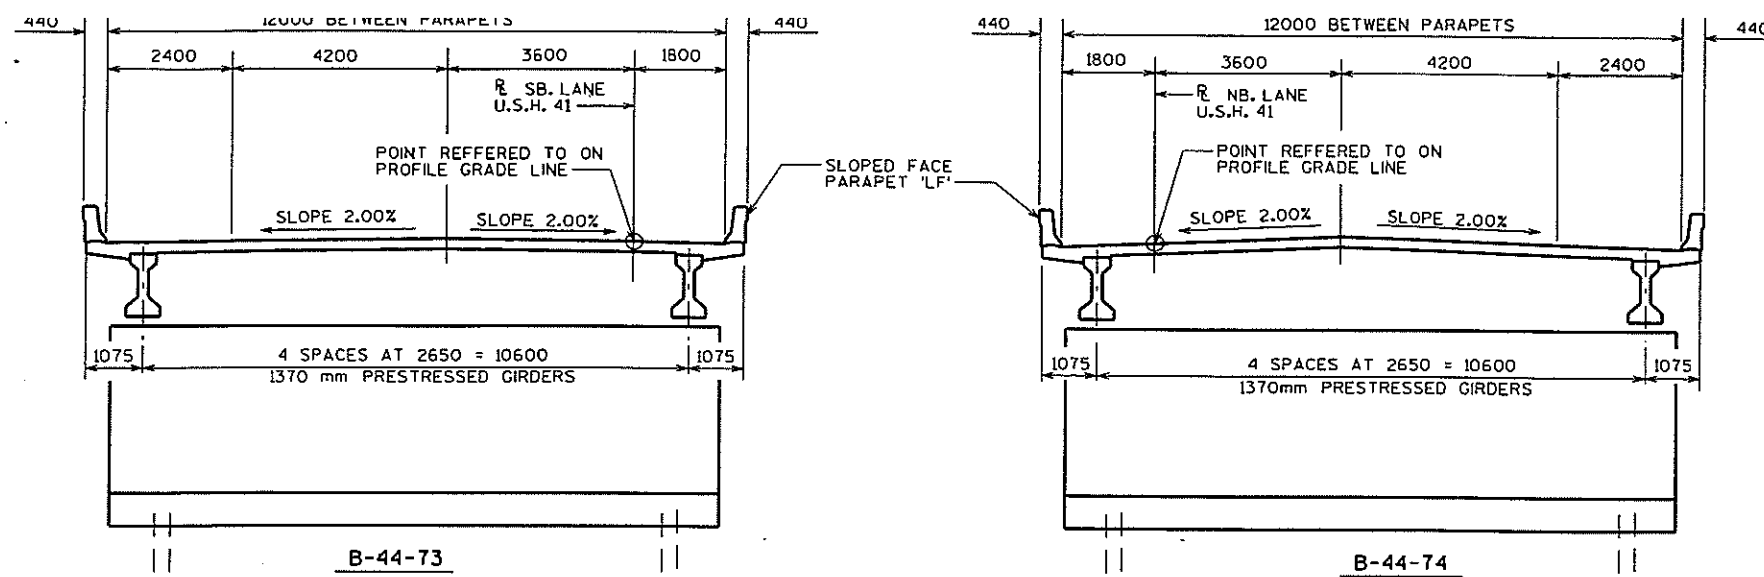

CROSS SECTION THRU ROADWAY

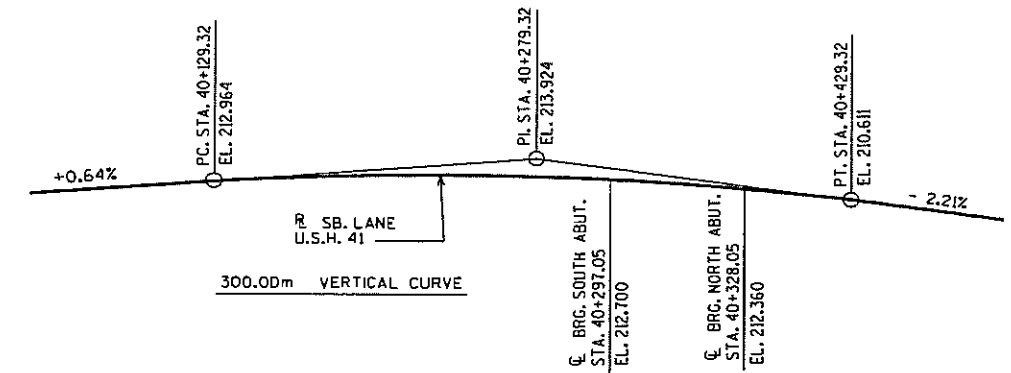


B-44-73

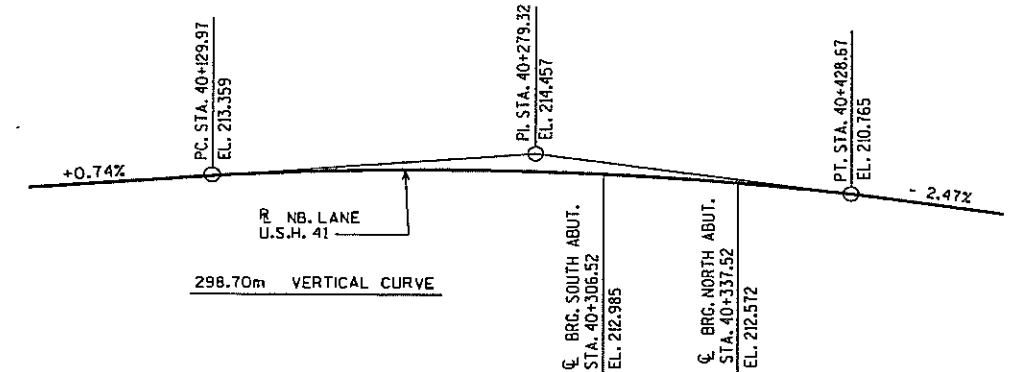

B-44-74

PROFILE GRADE LINE U.S.H. 41

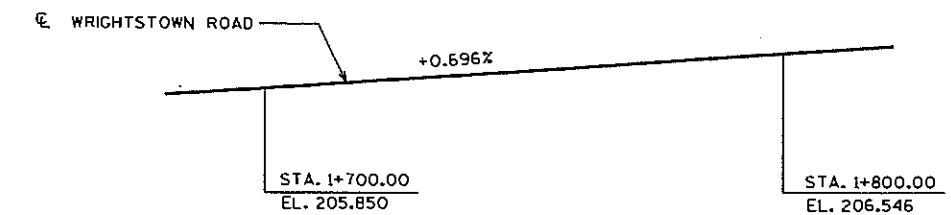

PROFILE GRADE LINE WRIGHTSTOWN ROAD

TOTAL ESTIMATED QUANTITIES

BID ITEMS	UNIT	SUPER.	SOUTH ABUT.	NORTH ABUT.	TOTALS
EXCAVATION FOR STRUCTURES, BRIDGES, B-44-73	L.S.	—	—	—	1
STRUCTURE BACKFILL	m ³	—	650	650	1300
CONCRETE MASONRY, BRIDGES	m ³	141	118	118	377
PROTECTIVE SURFACE TREATMENT	m ²	460	—	—	460
PRESTRESSED GIRDER, 1 TYPE, 1370 mm	m	157	—	—	157
HIGH-STRENGTH BAR STEEL REINFORCEMENT, BRIDGES	kg	—	4210	4150	8360
COATED HIGH-STRENGTH BAR STEEL REINFORCEMENT, BRIDGES	kg	14800	530	530	15860
NON-LAMINATED ELASTOMERIC BEARING PADS	EACH	10	—	—	10
STEEL PILING, DELIVERED AND DRIVEN, HP 250 X 62 kg/m	m	—	442	425	867
RUBBERIZED MEMBRANE WATERPROOFING	m ²	—	7	7	14
SLOPE PAVING, BREAKER RUN	m ²	—	70	70	140
PIPE UNDERDRAIN, 150 mm	m	—	11	11	22
PIPE UNDERDRAIN, UNPERFORATED, 150 mm	m	—	6	6	12
GEOTEXTILE FABRIC, TYPE DF	m ²	—	20	20	40
ANCHOR ASSEMBLIES FOR STEEL PLATE BEAM GUARD	EACH	2	—	—	2
STEEL DIAPHRAGMS, STRUCTURE B-44-73	EACH	8	—	—	8
NON-BID ITEMS					
FILLER	SIZE	—	—	—	13 & 19

GENERAL NOTES

DRAWINGS SHALL NOT BE SCALED.

BAR STEEL REINFORCEMENT SHALL BE EMBEDDED 50 mm CLEAR UNLESS OTHERWISE SHOWN OR NOTED.

ALL REINFORCING BARS ARE METRIC AND THE FIRST TWO DIGITS OF THE BAR MARK SIGNIFIES THE BAR SIZE

ALL DIMENSIONS MILLIMETERS (mm) UNLESS OTHERWISE NOTED.

ALL STATIONS AND ALL ELEVATIONS ARE METERS (m).



ELASTOMERIC BEARING PADS NEED NOT BE INDIVIDUALLY MOLDED PROVIDED THE CUT EDGES ARE SMOOTH AND TRUE.

AT THE BACKFACE OF ABUTMENT ALL VOLUME WHICH CANNOT BE IN PLACE BEFORE ABUTMENT CONSTRUCTION AND NOT OCCUPIED BY THE NEW STRUCTURE SHALL BE BACKFILLED WITH STRUCTURE BACKFILL.

THE GRADATION OF THE STRUCTURE BACKFILL SHALL MEET THE REQUIREMENTS OF SECT. 209.2.2 OF THE STD. SPEC'S. FOR GRADE 1 MATERIAL.

NO.	DATE	REVISION	BY
STATE OF WISCONSIN DEPARTMENT OF TRANSPORTATION DIVISION OF HIGHWAYS			
STRUCTURE B-44-73			
CONST. SPEC.	1996	DRAWN BY JHG	PLANS CKD. ZIRK
CROSS SECTION & QUANTITIES			SHEET 2

FILE= 73GP.DGN
SCALE = 75

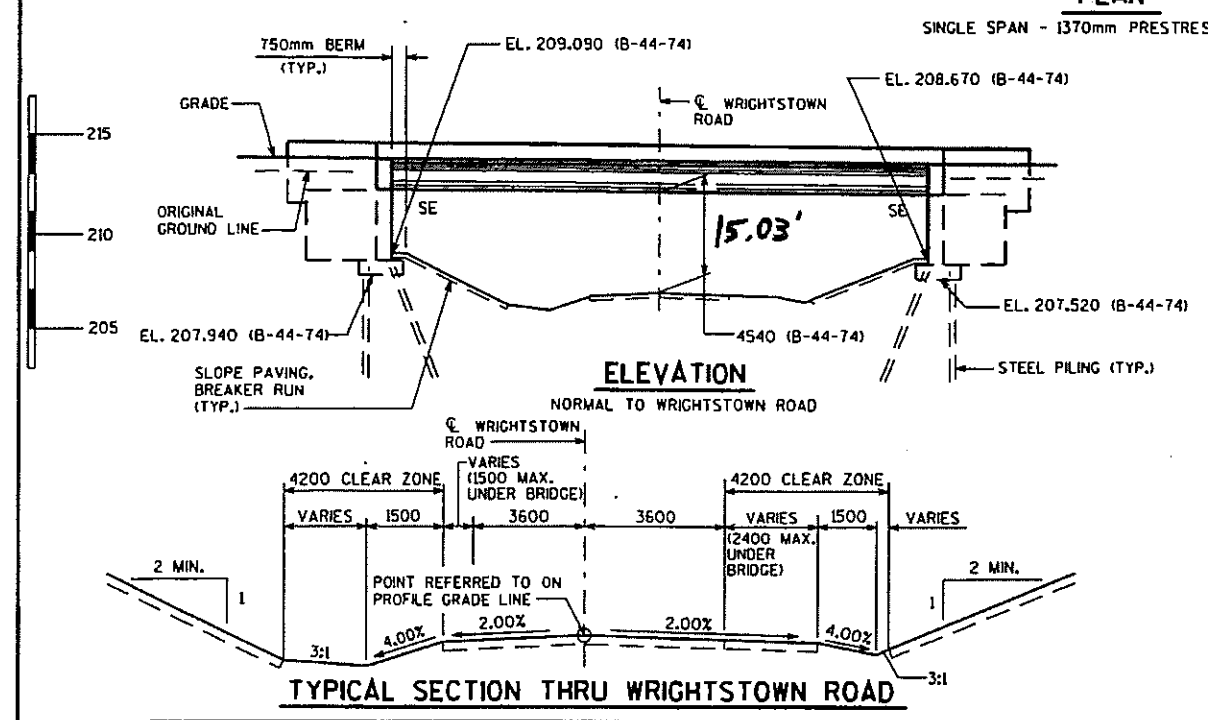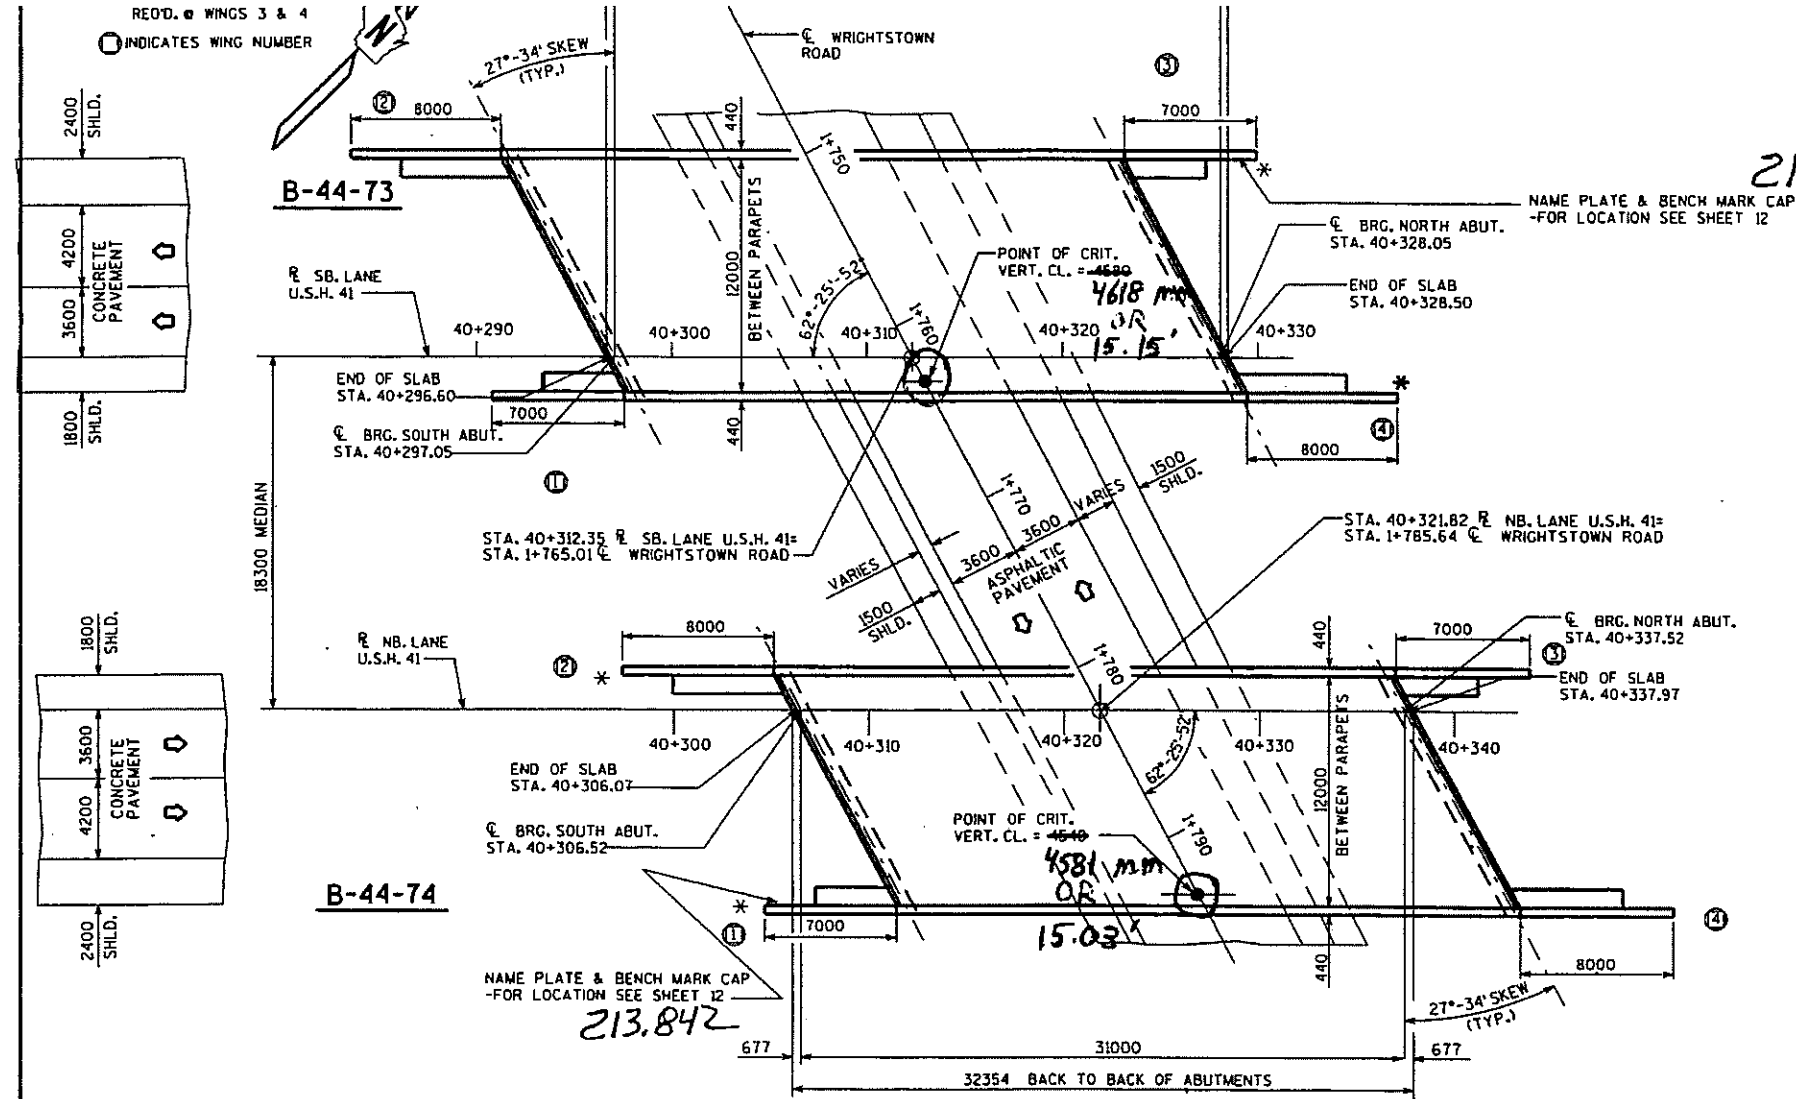

DESIGN DATA

LIVE LOAD:
 DESIGN RATING: MS-18
 INVENTORY RATING: MS-20
 OPERATIONAL RATING: MS-45
 MAXIMUM STANDARD PERMIT VEHICLE LOAD = 110 KN.
 STRUCTURE IS DESIGNED FOR A FUTURE WEARING SURFACE OF 1.0 KN/m².

ULTIMATE DESIGN STRESSES:
 CONCRETE MASONRY SLAB— $f'_c = 28 \text{ MPa}$ ALL OTHER— $f'_c = 24 \text{ MPa}$
 BAR STEEL REINFORCEMENT, AASHTO M-31M, GRADE 420 $f_y = 420 \text{ MPa}$
 1370mm PRESTRESSED GIRDERS, CONCRETE MASONRY $f'_c = 45 \text{ MPa}$
 STRANDS - 13mm DIA. WITH ULTIMATE TENSILE STRENGTH OF 1860 MPa

FOUNDATION DATA

ABUTMENTS TO BE SUPPORTED ON HP 250 X 62 STEEL PILING DRIVEN TO A MINIMUM BEARING VALUE OF 450 KN PER PILE. ESTIMATED 26m LONG AT S. ABUT. AND 25m LONG AT N. ABUT.

TRAFFIC VOLUME

U.S.H. 41	WRIGHTSTOWN ROAD
A.D.T.=37,000 (2018)	A.D.T.=600 (2018)
R.D.S.=110 km/h	R.D.S.=70 km/h

LIST OF DRAWINGS

1. GENERAL PLAN
2. CROSS SECTION & QUANTITIES
3. SUBSURFACE EXPLORATION
4. SOUTH ABUTMENT
5. SOUTH ABUT. DETAILS
6. NORTH ABUTMENT
7. NORTH ABUT. DETAILS
8. SUPERSTRUCTURE
9. SUPERSTRUCTURE DETAILS
10. 1370mm PRESTRESSED GIRDER DETAILS
11. STEEL DIAPHRAGM
12. SLOPED FACE PARAPET "LF"




BRIDGE OFFICE CONTACT :
 JERRY ZIRK (608) 266-5163
 FINN HUBBARD (608) 266-8489

NO.	DATE	REVISION	BY
STATE OF WISCONSIN DEPARTMENT OF TRANSPORTATION DIVISION OF HIGHWAYS			
STRUCTURE B-44-74			
U.S.H. 41 OVER WRIGHTSTOWN ROAD			
COUNTY	OUTAGAMIE	TOWN/AGENCY/VILLAGE	KAUKAUNA
DESIGN SPEC.	AASHTO 1996	LOAD	MS-18
DESIGNED BY	CIHA	CONST. SPEC.	1996
CK'D.	KTN	PLANS CK'D.	ZIRK
APPROVED	01-18-00		
CHIEF BRIDGE DESIGN ENGINEER	DATE		
GENERAL PLAN		SHEET 1 OF 12	
		DATE: FEB'98	


I.D. 1131-08-00G

DISTRICT CONTACT

FILE= 74gp.dgn
SCALE= 175

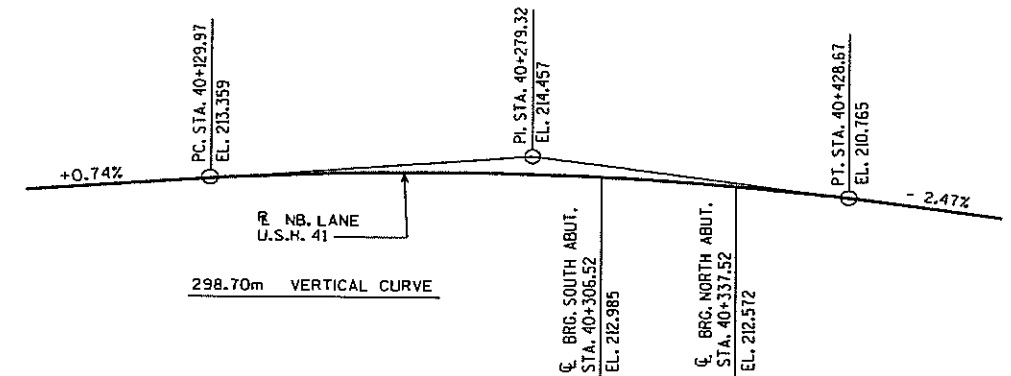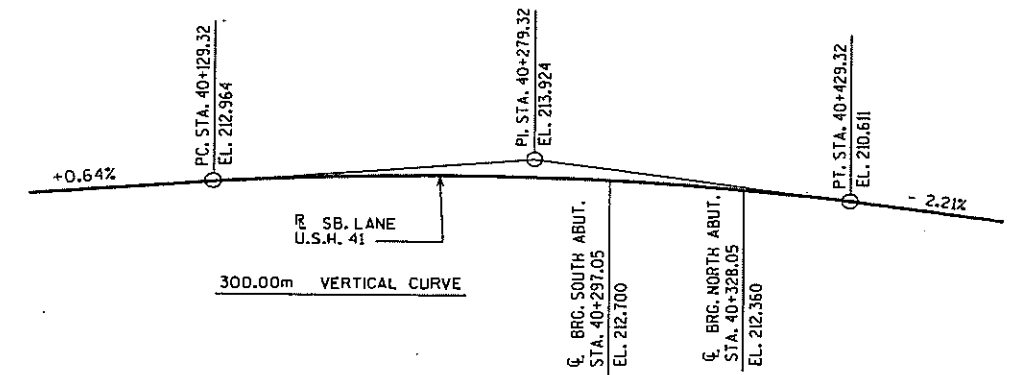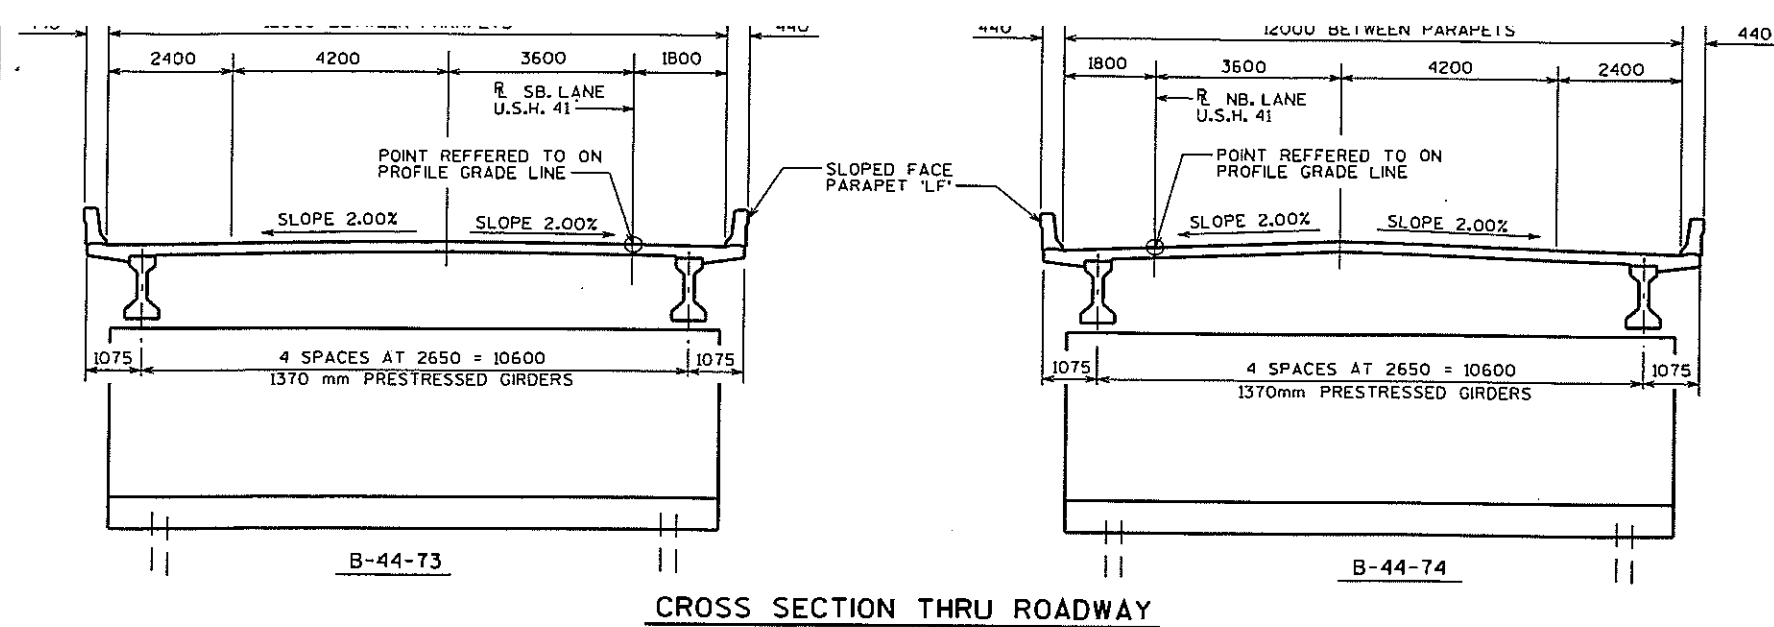

PROFILE GRADE LINE U.S.H. 41

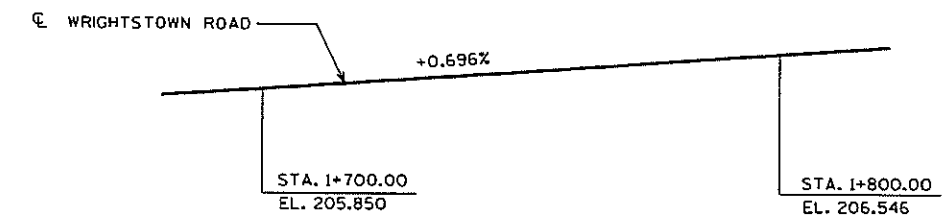

TOTAL ESTIMATED QUANTITIES

BID ITEMS	UNIT	SUPER.	SOUTH ABUT.	NORTH ABUT.	TOTALS
EXCAVATION FOR STRUCTURES, BRIDGES, B-44-74	L.S.	---	---	---	1
STRUCTURE BACKFILL	m ³	---	650	650	1300
CONCRETE MASONRY, BRIDGES	m ³	141	118	118	377
PROTECTIVE SURFACE TREATMENT	m ²	460	---	---	460
PRESTRESSED GIRDER, TYPE 1370 mm	m	157	---	---	157
HIGH-STRENGTH BAR STEEL REINFORCEMENT, BRIDGES	kg	---	4230	4220	8450
COATED HIGH-STRENGTH BAR STEEL REINFORCEMENT, BRIDGES	kg	14800	530	530	15860
NON-LAMINATED ELASTOMERIC BEARING PADS	EACH	10	---	---	10
STEEL PILING DELIVERED AND DRIVEN, HP250 x 62kg/m	m	---	442	425	867
RUBBERIZED MEMBRANE WATERPROOFING	m ²	---	7	7	14
SLOPE PAVING, BREAKER RUN	m ²	---	70	70	140
PIPE UNDERDRAIN, 150 mm	m	---	11	11	22
PIPE UNDERDRAIN, UNPERFORATED, 150 mm	m	---	6	6	12
GEOTEXTILE FABRIC, TYPE DF	m ²	---	20	20	40
ANCHOR ASSEMBLIES FOR STEEL PLATE BEAM GUARD	EACH	2	---	---	2
STEEL DIAPHRAGMS, STRUCTURE B-44-74	EACH	8	---	---	8
NON-BID ITEMS					
FILLER	SIZE	---	---	---	13 & 19

GENERAL NOTES

DRAWINGS SHALL NOT BE SCALED.

BAR STEEL REINFORCEMENT SHALL BE EMBEDDED 50 mm CLEAR UNLESS OTHERWISE SHOWN OR NOTED.

ALL REINFORCING BARS ARE METRIC AND THE FIRST TWO DIGITS OF THE BAR MARK SIGNIFIES THE BAR SIZE

ALL DIMENSIONS MILLIMETERS (mm) UNLESS OTHERWISE NOTED.

ALL STATIONS AND ALL ELEVATIONS ARE METERS (m).

ELASTOMERIC BEARING PADS NEED NOT BE INDIVIDUALLY MOLDED PROVIDED THE CUT EDGES ARE SMOOTH AND TRUE.

AT THE BACKFACE OF ABUTMENT ALL VOLUME WHICH CANNOT BE IN PLACE BEFORE ABUTMENT CONSTRUCTION AND NOT OCCUPIED BY THE NEW STRUCTURE SHALL BE BACKFILLED WITH STRUCTURE BACKFILL.

THE GRADATION OF THE STRUCTURE BACKFILL SHALL MEET THE REQUIREMENTS OF SECT. 209.2.2 OF THE STD. SPEC'S. FOR GRADE 1 MATERIAL.

NO.	DATE	REVISION	BY
STATE OF WISCONSIN DEPARTMENT OF TRANSPORTATION DIVISION OF HIGHWAYS			
STRUCTURE B-44-74			
CONST. SPEC.	1996	DRAWN BY JHG	PLANS CKD. ZIRK
CROSS SECTION & QUANTITIES			SHEET 2

Vertical Clearance for Construction of New Bridges, Replacement Bridges, and Bridges on which the Superstructure is being replaced¹

Overpass Facility →	Freeway, Expressway, or STH		Railroad ⁴ , CTH, Town Road, Local Road, or Street	Pedestrian or Shared-use Structures	Sign Structures ²
Underpass Facility ↓	Interchange	Grade Separation			
Non-arterial either STH, CTH, Town Road, Local Road, or Street	15'-9" Desirable	15'-3" Desirable		16'-9" Desirable	18'-3" Minimum
	15'-3" Minimum	14'-9" Minimum		16'-3" Minimum	
Arterial either CTH, Town Road, Local Road, or Street (excludes freeway and expressway; also excludes arterial STH)	16'-9" Desirable	15'-3" Desirable		17'-9" Desirable	
	16'-3" Minimum	14'-9" Minimum		17'-3" Minimum	
Freeway ³ or Expressway or arterial STH	16'-9" Desirable			17'-9" Desirable	
	16'-4" Minimum			17'-4" Minimum	
Railroad ^{4,5,6,7}	23'-0" Minimum to 23'-3½" Maximum				

General notes:

- ¹ Vertical clearance is needed for the entire roadway width (critical point; to include traveled way, auxiliary lanes, turn lanes, and shoulders), according to the above table.

Vertical clearance for railroads is measured from the top of rail and is required over an area 8 feet 6 inches from the track centerline on each side of a railroad track.

Do not exceed the desirable vertical clearance shown unless justified. Depending on topography and other specific situations vertical clearance for any structure may be greater than that shown when justified. Some things to consider are: over height loads traveling on the roadway; the level of development in the area, the projected growth in traffic volume and importance of the roadway, and the possibility of reclassification.

- ² See LRFD Bridge Manual Chapter 39 (http://on.dot.wi.gov/dtid_bos/extranet/structures/LRFD/LRFDManualIndex.htm) and LRFD Standard Details 39.02 and 39.10 for design considerations and requirements for vertical clearance on new and replacement Sign Structures.
- ³ See FDM 11-44-1 for vertical clearance guidance specific to Interstate freeways.
- ⁴ Consult with the Region Railroad Coordinator if the over-passing or under-passing facility is either a railroad or a "rails-to-trails" trail; or if a structure is owned by a railroad company.
- ⁵ A vertical clearance <23'-0" requires both an approved Exception to Standards (see FDM 11-1-2 and FDM 11-1-4) and early coordination with BTLR R&H, Railroads and Harbors Section (RHS) through the Region Railroad Coordinator. The Exception to Standards shall contain documentation that the Office of the Commissioner of Railroads (OCR) has been petitioned.
- See Chapter 17 for additional information.
- ⁶ Provide justification for a vertical clearance >23'-3 ½" to the RHS.
- ⁷ Vertical clearance less than 23'-0" may be acceptable or desirable in certain situations, such as for spur tracks, lead tracks, some branch lines and even mainline tracks when other impediments to 23'-0" exist. Review such situations with the Railroad Project Coordination Engineer in RHS. Early coordination with RHS is required.



DAAR
ENGINEERING, INC.

PROJECT: _____

DATE: _____

DESCRIPTION: US 41 over Wrightstown
Road B-44-73(SB) & 74 (NB)

SHEET _____ OF _____

CALC. BY: _____

CHECKED BY: _____

Existing Structures are 40'x102' 54" Girders 1 span


VC = 15.12' SB & 15.03' NB Need 16.75'

Existing Wrightstown is 2-12' lanes & 5' shldrs. Expand to 4-12' lanes & 6' shldrs

4-12' lanes = 48'
2-14' Clear Zones = 28'
Slope Paving 17' @ 2:1 x 2 = 68'
Abutments (2.5' + 4') x 2 = 13'

157' span = 72" Girders → raise US 41 18" No

Proposed Typical Half Section (Wrightstown)

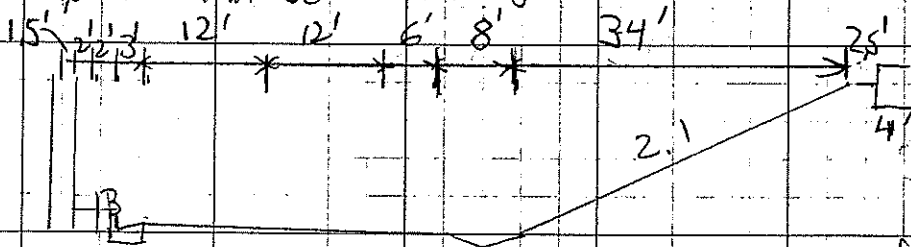

Pier offset 1.5'
Begin Guard 2.0'
C & G 3.0'
2-12' lanes 24.0'
14' clear zone 14.0'
Slope Paving 34.0'
Abutment 2.5'
4.0'

20' Widening In Median 20' x .02 = 0.4'

B-73(SB)

15.12
+ 1.50

16.62
- 0.4

16.22

at C

Raise SB 41 0.63'

+ 1.5' difference
in girders

87' span
36" Girders

B-74 (NB)

15.03
+ 1.50

16.53
- 0.4

16.13

at C

Raise NB 41 0.62

BRIDGE INSPECTION REPORT
Wisconsin Dept. of Transportation
DT2007 2003 s.84.17 Wis. Stats. Type = ROUTINE INSPECTION

page 1

Inventory Data

Feature On: USH 41		Maintainer: STATE HIGHWAY DEPT		Structure No: B-44-073
Feature Under: WRIGHTSTOWN RD		Sect/Twn/Rng: S33 T22N R19E		
Location: 1.9M S JCT CTH U		County: OUTAGAMI	Municipality: TOWN-KAUKAUNA (44026)	
Inv Rating: HS22.2	Rdwy Width (ft): 39.4	Deck Width (ft): 42.3	Existing Posting:	
Oper Rating: HS50	Total Length (ft): 106.1	Deck Area(ft2): 4488	ADT On: 19000 Yr: 1998	ADT Under: Yr:

Inspection Type (* = Supplemental Form Required)

	Routine Visual	Fracture Critical*	In-Depth*	UW-Dive*	UW-Surv*	UW-Probe/Visual*	Movable*
Last Insp.	10-17-11						
Frequency	24						
Recom. Freq.							
	Initial*	Damage	Interim	Load Posted	SI & A Field Review*		
Last Insp.							
Frequency	N/A						
Recom. Freq.	N/A				Item No. Needing Change		

Load Rating Information

Overburden	Measurement (in): 0.0	Date:	Deck Surface Type: CONCRETE	
Section Loss	File Meas. (%):	File Insp. Date: 10-19-09	Insp. Measurement (%):	Describe:
Re-rate for load capacity?	Reason:		Date Last Rated: 03-14-00	

Expansion Joints

Location	Type	Temp:		Signing Condition				
		File Insp. Date	File Insp. (in)	New Insp. (in)	Type of Marker	File	Y/N	Comments
					Bridge Markers			
					Narrow Bridge			
					One Lane Road			
					Vertical Clearance			
					Weight Limit Post			
					Other(Addl. Sign)			

Clearances(Cardinal = N or E)

	File Meas. (ft.)	File Date	New Meas. (ft.)
Min. Vertical Clearance Under (Cardinal)	15.12	11-28-00	
Min. Vertical Clearance Under (non-Cardinal)			
Min. Vertical Clearance On			

Structure Type

Construction/Rehabilitation History

Material	Configuration	# of Spans	Overall Length (ft)	Year	Work Performed	Plan	Shop
PREST CONCRET	DECK GIRDER		101.7	2000	NEW STRUCTURE		

Inspection Information

Special Requirements	Y/N	Comments				
Traffic Control	Y					
Access Equipment	Y					
Other	Y					

Inspector Information

Team Leader Name and No. Printed: Michaelson, Neil (3010)		Team Member(s) Name(s) Printed:	
Team Leader Signature:		Inspection Date: 10-17-11	Inspection Agency: STATE HIGHWAY DEPARTMENT (1)
District/Local Manager and No. Printed:		District/Local Manager Signature:	Review Date:

Element Inspection (X) Check Elements Inspected

					Quantity in Condition States				
Ck	Elem./Env.	Description	Unit	Total QTY.	1	2	3	4	5
X	26 / 4	Conc Deck/Coatd Bars	SF	4488	4488				
		Dia. cracks.							
X	109 / 3	P/S Conc Open Girder	LF	515	515				
X	172 / 3	Painted Steel Diaphr	EA	8	8				
X	215 / 4	R/Conc Abutment	LF	95	79	16			
		South abut spalling under girders CS-2 (north 6" south 10")							
X	321 / 4	R/Conc Approach Slab	EA	2	1	1			
		South approach has settled slightly							
X	331 / 4	Conc Bridge Railing	LF	311	249	62			
X	342 / 2	RipRap Slope Protect	EA	2	1	1			
		South slope protection has settled							
X	358 / 4	Deck Cracking SmFlag	EA	1	1				
X	359 / 4	Und Dk Surf Sm Flag	EA	1	1				
X	400 / 4	Concrete Wingwall	EA	4	4				

General Inspection/Maintenance Notes

Maintenance Recommendations (See standard code items & numbers)

Maintenance Item: Approach - Seal Approach to Paving Block

Amount: Date(YYYY-MM-DD):

Maintenance item comment: Seal joints at end of deck

Maintenance Item:

Amount: Date(MM-DD-YY):

Maintenance item comment:

NBI Ratings

NBI	File	New	NBI	File	New
Deck	7	7	Culvert	N	N
Superstructure	7	7	Channel	N	N
Substructure	7	7	Waterway	N	N

Maintenance Item:

Amount: Date(MM-DD-YY):

Maintenance item comment:

STRUCTURE INVENTORY AND APPRAISAL FIELD REVIEW FORM

B-44-073
USH 41 over WRIGHTSTOWN RD

(3) Municipality:
 (16) Latitude(° ' ")
 (17) Longitude(° ' ")

LOCATION

TOWN - KAUKAUNA (44026)
44°19'43.66"N
88°12'38.79"W

(28A) Lanes On:
 (28B) Lanes Under:
 (102) Traffic Pattern On:
 (102) Traffic Pattern Under:
 (19) Detour Length(mi):

TRAFFIC SERVICE

2
2
-NO TRAFFIC X-ONE WAY TRAFFIC -TWO WAY TRAFFIC
-NO TRAFFIC -ONE WAY TRAFFIC X-TWO WAY TRAFFIC
3

(49) Structure Length(ft):
 (50) Sidewalk Width(ft):
 (50) Curb Width(ft):
 (52) Culvert Barrel Length(ft):
 (34) Skew:

GEOMETRY

106.1	
Left: 0.0	Right: 0.0
Angle(°): 27	Direction: X-RIGHT FORWARD -LEFT FORWARD
Cardinal Width	Non-Cardinal Width
39.4	39.4
42.3	42.3
39	0
Cardinal Under Clearance	Non-Cardinal Under Clearance
49.0	
10.0	
15.0	

(51) Bridge Roadway(ft):
 (52) Deck(ft):
 (32) Approach Roadway(ft):
 (47) Minimum Horizontal(ft):
 (55) Minimum Right Lateral(ft):
 (55) Minimum Left Lateral(ft):

RAILING APPRAISAL

(36A) Bridge Rail Adequacy:
 (36B) Transition Adequacy:
 (36C) Approach Guardrail Adequacy:
 (36D) Guardrail Termination Adequacy:
 Outer Rail:

-SUB-STANDARD	X-STANDARD	-NOT APPLICABLE
-SUB-STANDARD	X-STANDARD	-NOT APPLICABLE
-SUB-STANDARD	X-STANDARD	-NOT APPLICABLE
-SUB-STANDARD	X-STANDARD	-NOT APPLICABLE
Left	Right	Type
		TYPE F (TWO SQUARE TUBES) - STEEL(8)
		TYPE F (3 SQUARE TUBES) - STEEL(65)
		TYPE F (4 SQUARE TUBES) - STEEL(72)
		TYPE M-STEEL 3 SQUARE TUBES(93)
X	X	SLOPED FACE PARAPET LF(91)
		SLOPED FACE PARAPET HF(92)
		VERTICAL FACE PARAPET TYPE A(74)
		TYPE W-THREE BEAM(79)
		TYPE H ON VERTICAL PARAPET(80)
		TIMBER(38)
		OTHER(99) (Please specify)

Transition Type:

	CONT GUARD RAIL
	NO APP GRDRL
	NO ATTACHMENT
5	22 MM(7/8") BOLT (Please enter quantity)
	25 MM(1") BOLT (Please enter quantity)
	OTHER (Please specify)

Guardrail Termination Type:

X	(01) ENERGY ABSORBING TERMINAL/EAT
	(02) TURN DOWN
	(99) OTHER (Please specify)

ROADWAY ALIGNMENT APPRAISAL

(72) Approach Alignment Appraisal:

	(3) INTOLERABLE- Horizontal or Vertical curvature requires a substantial reduction in vehicle operating speed
	(6) FAIR- Horizontal or Vertical curvature requires a very minor speed reduction
X	(8) GOOD- No speed reduction required

This page intentionally left blank

BRIDGE INSPECTION REPORT
Wisconsin Dept. of Transportation
DT2007 2003 s.84.17 Wis. Stats. Type = ROUTINE INSPECTION

page 1

Inventory Data

Feature On: USH 41		Maintainer: STATE HIGHWAY DEPT		Structure No: B-44-074
Feature Under: WRIGHTSTOWN RD NB		Sect/Twn/Rng: S33 T22N R19E		
Location: 1.3M N JCT CTH JJ		County: OUTAGAMI	Municipality: TOWN-KAUKAUNA (44026)	
Inv Rating: HS22.2	Rdwy Width (ft): 39.4	Deck Width (ft): 39.4, 42.3	Existing Posting:	
Oper Rating: HS50	Total Length (ft): 106.1	Deck Area(ft2): 4334	ADT On: 23100 Yr: 2003	ADT Under: Yr:

Inspection Type (* = Supplemental Form Required)

	Routine Visual	Fracture Critical*	In-Depth*	UW-Dive*	UW-Surv*	UW-Probe/Visual*	Movable*
Last Insp.	10-17-11						
Frequency	24						
Recom. Freq.							
	Initial*	Damage	Interim	Load Posted	SI & A Field Review*		
Last Insp.							
Frequency	N/A						
Recom. Freq.	N/A				Item No. Needing Change		

Load Rating Information

Overburden	Measurement (in): 0.0	Date:	Deck Surface Type: CONCRETE	
Section Loss	File Meas. (%):	File Insp. Date: 10-19-09	Insp. Measurement (%):	Describe:
Re-rate for load capacity?	Reason:	Date Last Rated: 03-14-00		

Expansion Joints

		Temp:			Signing Condition			
Location	Type	File Insp. Date	File Insp. (in)	New Insp. (in)	Type of Marker	File	Y/N	Comments
					Bridge Markers			
					Narrow Bridge			
					One Lane Road			
					Vertical Clearance			
					Weight Limit Post			
					Other(Addl. Sign)			

Clearances(Cardinal = N or E)

	File Meas. (ft.)	File Date	New Meas. (ft.)
Min. Vertical Clearance Under (Cardinal)	15.03	11-28-00	
Min. Vertical Clearance Under (non-Cardinal)			
Min. Vertical Clearance On			

Structure Type

Construction/Rehabilitation History

Material	Configuration	# of Spans	Overall Length (ft)	Year	Work Performed	Plan	Shop
PREST CONCRET	DECK GIRDER		101.7	2000	NEW STRUCTURE		

Inspection Information

Special Requirements	Y/N	Comments				
Traffic Control	Y					
Access Equipment	Y					
Other	Y					

Inspector Information

Team Leader Name and No. Printed: Michaelson, Neil (3010)		Team Member(s) Name(s) Printed:	
Team Leader Signature:		Inspection Date: 10-17-11	Inspection Agency: STATE HIGHWAY DEPARTMENT (1)
District/Local Manager and No. Printed:		District/Local Manager Signature:	Review Date:

Element Inspection (X) Check Elements Inspected

Element Inspection (X) Check Elements Inspected					Quantity in Condition States				
Ck	Elem./Env.	Description	Unit	Total QTY.	1	2	3	4	5
X	26 / 4	Conc Deck/Coatd Bars	SF	4334	4334				
	Dia. cracks.								
X	109 / 3	P/S Conc Open Girder	LF	515	515				
X	172 / 3	Painted Steel Diaphr	EA	8	8				
X	215 / 4	R/Conc Abutment	LF	95	84	9	2		
	CS-2 (S Abut 7" & N Abut 2") CS-3 N Abut 2"								
X	321 / 4	R/Conc Approach Slab	EA	2	1	1			
	North approach settled slightly								
X	331 / 4	Conc Bridge Railing	LF	311	246	65			
X	342 / 2	RipRap Slope Protect	EA	2	1	1			
	South slope protection is settling								
X	358 / 4	Deck Cracking SmFlag	EA	1	1				
X	359 / 4	Und Dk Surf Sm Flag	EA	1	1				
	Diagonal cracking at ends of deck								
X	400 / 4	Concrete Wingwall	EA	4	4				

General Inspection/Maintenance Notes

--

Maintenance Recommendations (See standard code items & numbers)

Maintenance Item: Approach - Seal Approach to Paving Block
Amount: Date(YYYY-MM-DD):
Maintenance item comment: Seal jts at the end of the deck

Maintenance Item:

Amount: Date(MM-DD-YY):

Maintenance item comment:

NBI Ratings

NBI	File	New	NBI	File	New
Deck	8	8	Culvert	N	N
Superstructure	8	8	Channel	N	N
Substructure	8	7	Waterway	N	N

Maintenance Item:

Amount: Date(MM-DD-YY):

Maintenance item comment:

STRUCTURE INVENTORY AND APPRAISAL FIELD REVIEW FORM

B-44-074
USH 41 over WRIGHTSTOWN RD NB

- (3) Municipality:
 (16) Latitude(° ' "):
 (17) Longitude(° ' "):

LOCATION	
TOWN - KAUKAUNA (44026)	
44°19'42.61"N	
88°12'37.69"W	

- (28A) Lanes On:
 (28B) Lanes Under:
 (102) Traffic Pattern On:
 (102) Traffic Pattern Under:
 (19) Detour Length(mi):

TRAFFIC SERVICE	
2	
2	
-NO TRAFFIC X-ONE WAY TRAFFIC -TWO WAY TRAFFIC	
-NO TRAFFIC -ONE WAY TRAFFIC X-TWO WAY TRAFFIC	
3	

- (49) Structure Length(ft):
 (50) Sidewalk Width(ft):
 (50) Curb Width(ft):
 (52) Culvert Barrel Length(ft):
 (34) Skew:
 (51) Bridge Roadway(ft):
 (52) Deck(ft):
 (32) Approach Roadway(ft):
 (47) Minimum Horizontal(ft):
 (55) Minimum Right Lateral(ft):
 (55) Minimum Left Lateral(ft):

GEOMETRY	
106.1	
Left: 0.0	Right: 0.0
Angle(°): 27	Direction: X-RIGHT FORWARD -LEFT FORWARD
Cardinal Width	Non-Cardinal Width
39.4	39.4
39.4	42.3
39	0
Cardinal Under Clearance	Non-Cardinal Under Clearance
46.3	
12.8	
9.8	


- (36A) Bridge Rail Adequacy:
 (36B) Transition Adequacy:
 (36C) Approach Guardrail Adequacy:
 (36D) Guardrail Termination Adequacy:
 Outer Rail:

RAILING APPRAISAL		
-SUB-STANDARD	X-STANDARD	-NOT APPLICABLE
-SUB-STANDARD	X-STANDARD	-NOT APPLICABLE
-SUB-STANDARD	X-STANDARD	-NOT APPLICABLE
-SUB-STANDARD	X-STANDARD	-NOT APPLICABLE
Left	Right	Type
		TYPE F (TWO SQUARE TUBES) - STEEL(8)
		TYPE F (3 SQUARE TUBES) - STEEL(65)
		TYPE F (4 SQUARE TUBES) - STEEL(72)
		TYPE M-STEEL 3 SQUARE TUBES(93)
X	X	SLOPED FACE PARAPET LF(91)
		SLOPED FACE PARAPET HF(92)
		VERTICAL FACE PARAPET TYPE A(74)
		TYPE W-THREE BEAM(79)
		TYPE H ON VERTICAL PARAPET(80)
		TIMBER(38)
		OTHER(99) (Please specify)
Transition Type:		
		CONT GUARD RAIL
		NO APP GRDRL
		NO ATTACHMENT
5		22 MM(7/8") BOLT (Please enter quantity)
		25 MM(1") BOLT (Please enter quantity)
		OTHER (Please specify)
Guardrail Termination Type:		
		(01) ENERGY ABSORBING TERMINAL/EAT
		(02) TURN DOWN
		(99) OTHER (Please specify)

- (72) Approach Alignment Appraisal:

ROADWAY ALIGNMENT APPRAISAL	
	(3) INTOLERABLE- Horizontal or Vertical curvature requires a substantial reduction in vehicle operating speed
	(6) FAIR- Horizontal or Vertical curvature requires a very minor speed reduction
X	(8) GOOD- No speed reduction required

This page intentionally left blank

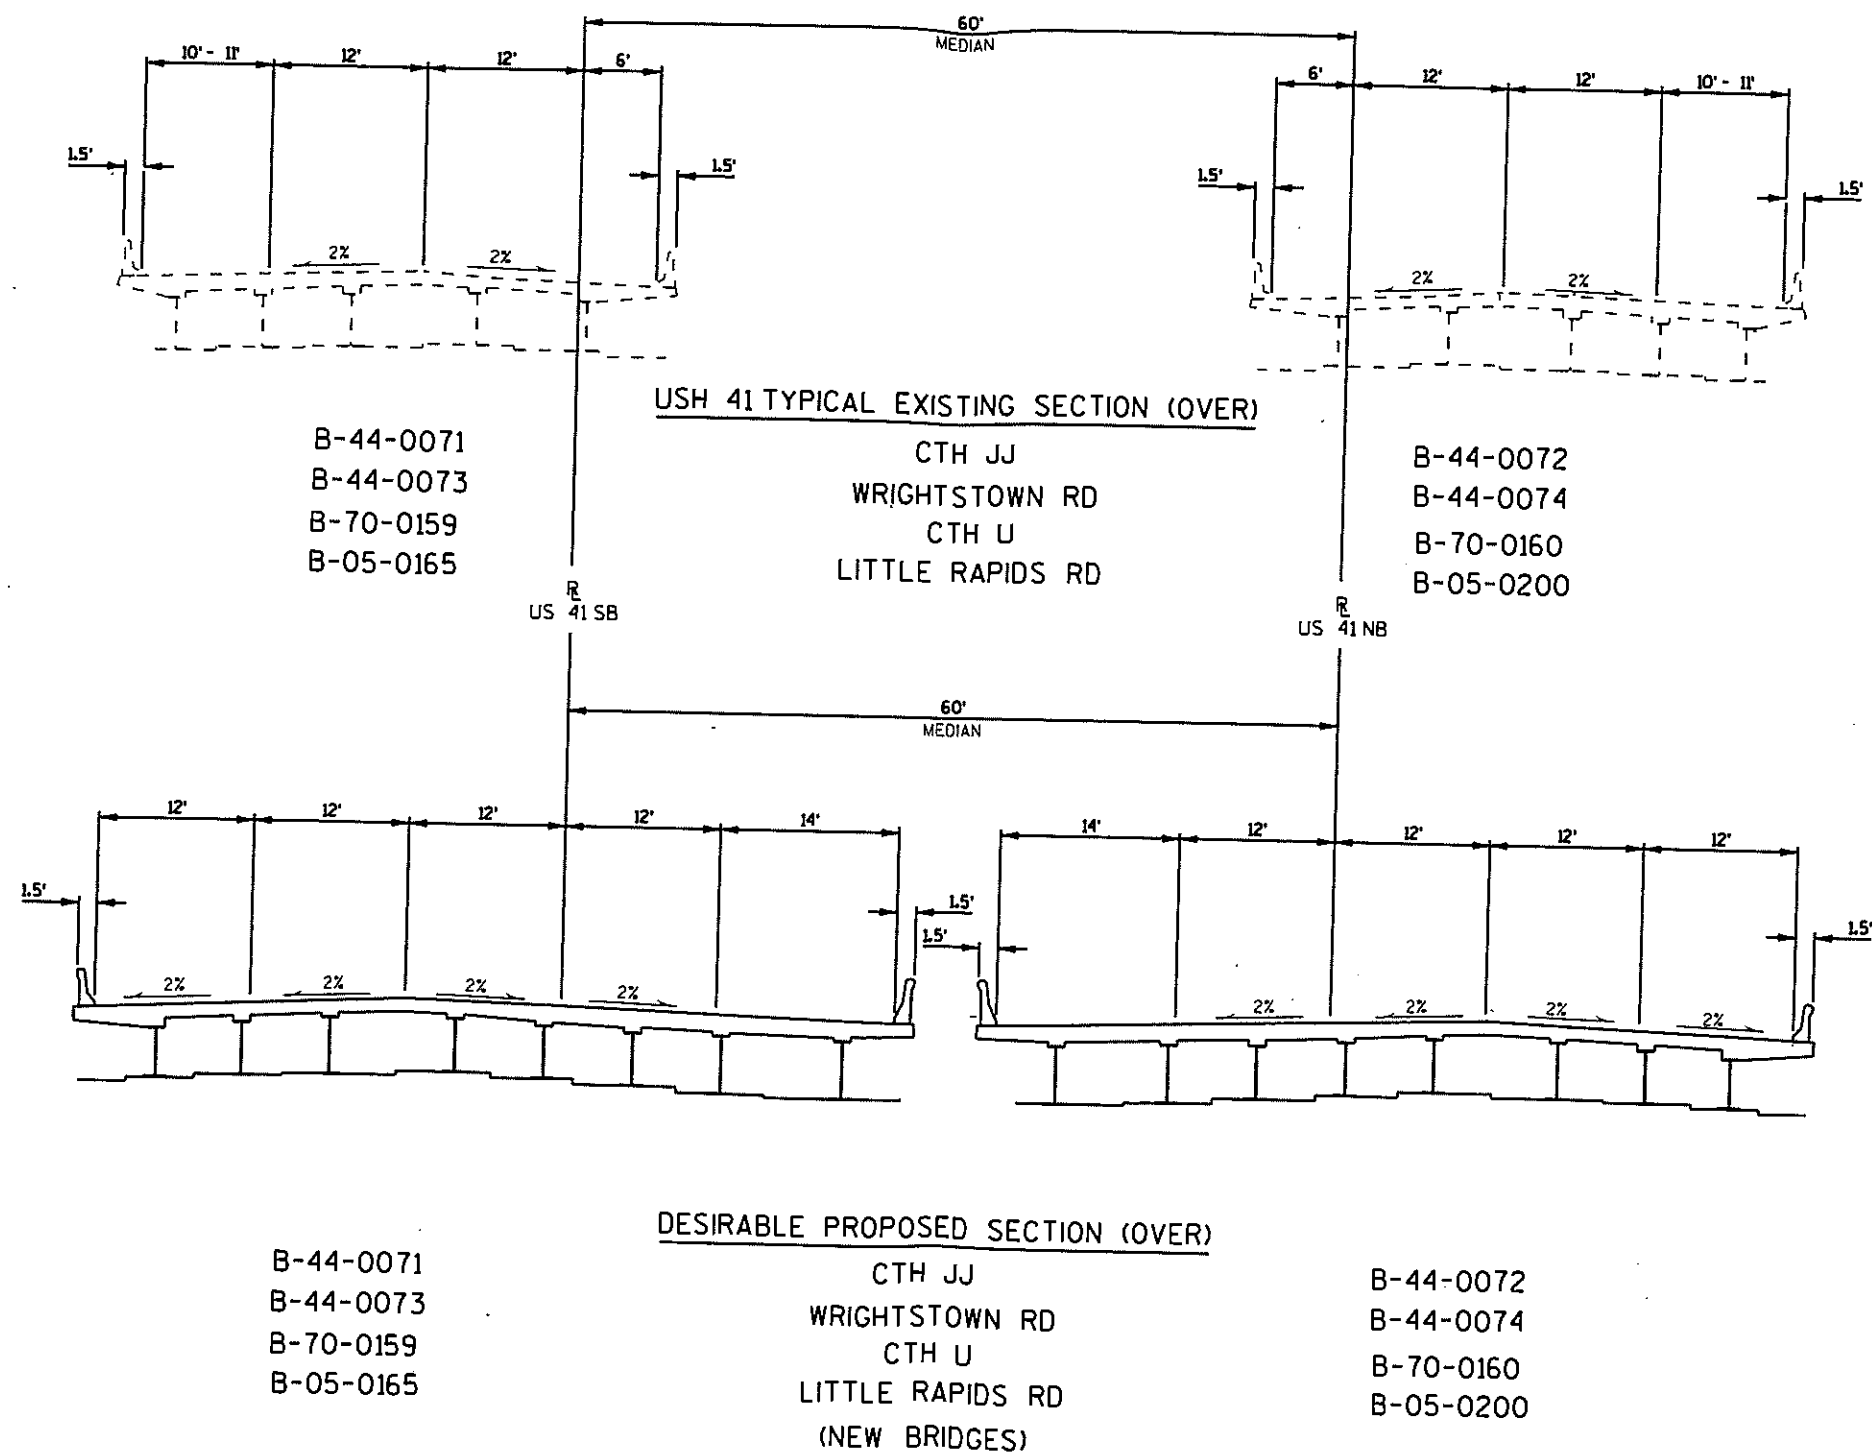

INDICATES WING NUMBER

DESIGN DATA

LIVE LOAD:

DESIGN RATING: MS-18
 INVENTORY RATING: MS-20
 OPERATIONAL RATING: MS-45
 MAXIMUM STANDARD PERMIT VEHICLE LOAD = 110 KN.
 STRUCTURE IS DESIGNED FOR A FUTURE WEARING SURFACE OF 10 KN/m².

ULTIMATE DESIGN STRESSES:


CONCRETE MASONRY SLAB — $f'_c = 28 \text{ MPa}$ ALL OTHER — $f'_c = 24 \text{ MPa}$
 BAR STEEL REINFORCEMENT, AASHTO M-31M, GRADE 420 — $f_y = 420 \text{ MPa}$
 1370mm PRESTRESSED GIRDERS, CONCRETE MASONRY — $f'_c = 45 \text{ MPa}$
 STRANDS - 13mm DIA. WITH ULTIMATE TENSILE STRENGTH OF 1860 MPa

FOUNDATION DATA

ABUTMENTS TO BE SUPPORTED ON HP 250 X 62 STEEL PILING DRIVEN TO A MINIMUM BEARING VALUE OF 490 KN PER PILE. ESTIMATED 26m LONG @ S. ABUT. & 25m LONG @ N. ABUT.


TRAFFIC VOLUME

U.S.H. 41	WRIGHTSTOWN ROAD
A.D.T.=37,000 (2018)	A.D.T.=600 (2018)
R.O.S.=110 km/h	R.O.S.=70 km/h

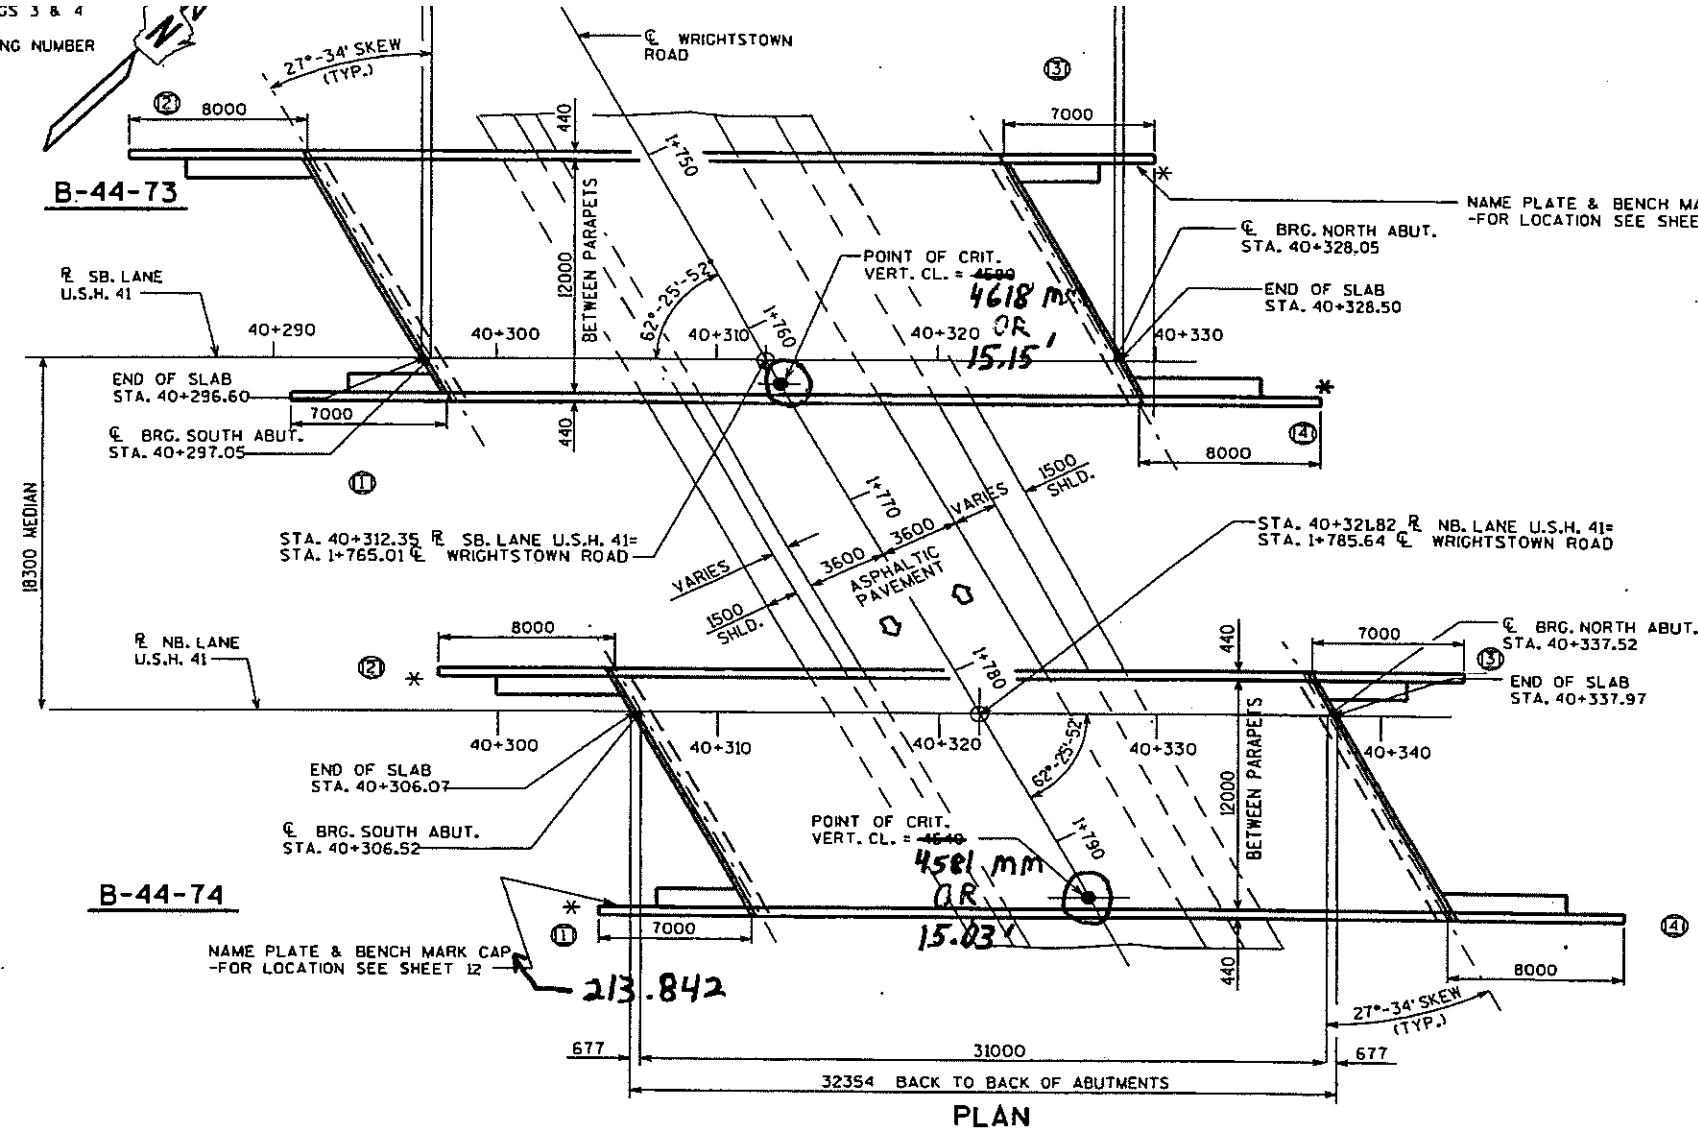

PLAN

SINGLE SPAN - 1370mm PRESTRESSED GIRDERS

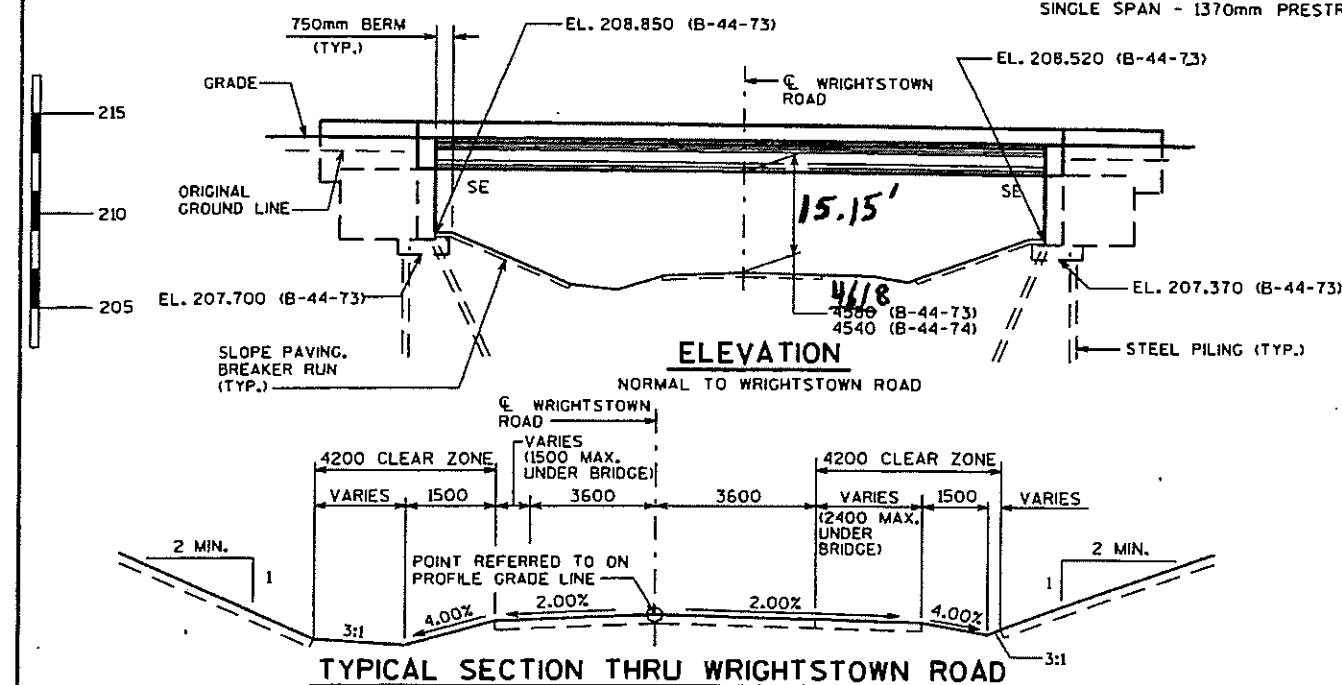

ELEVATION

TYPICAL SECTION THRU WRIGHTSTOWN ROAD

LIST OF DRAWINGS

1. GENERAL PLAN
2. CROSS SECTION & QUANTITIES
3. SUBSURFACE EXPLORATION
4. SOUTH ABUTMENT
5. SOUTH ABUT. DETAILS
6. NORTH ABUTMENT
7. NORTH ABUT. DETAILS
8. SUPERSTRUCTURE
9. SUPERSTRUCTURE DETAILS
10. 1370mm PRESTRESSED GIRDER DETAILS
11. STEEL DIAPHRAGM
12. SLOPED FACE PARAPET "LF"


BRIDGE OFFICE CONTACT:
 JERRY ZIRK (608) 266-5163
 FINN HUBBARD (608) 266-8489

NO.	DATE	REVISION	BY
STATE OF WISCONSIN DEPARTMENT OF TRANSPORTATION DIVISION OF HIGHWAYS			
STRUCTURE B-44-73			
U.S.H. 41 OVER WRIGHTSTOWN ROAD			
COUNTY	OUTAGAMIE	TOWN/SHIP/VILLAGE	KAUKAUNA
DESIGN SPEC.	AASHTO 1996	LOAD	MS-18
DESIGNED BY	CIHA	CONST. SPEC.	1996
DESIGN CK'D.	KTN	DRAWN BY	JHC
APPROVED	[Signature]		DATE
CHIEF BRIDGE DESIGN ENGINEER		01-18-00	
GENERAL PLAN		SHEET 1 OF 12	
		DATE: FEB'98	


I.D. 1131-08-00G

DISTRICT CONTACT


FILE: 73GP.DGN
SCALE: 1"=175'

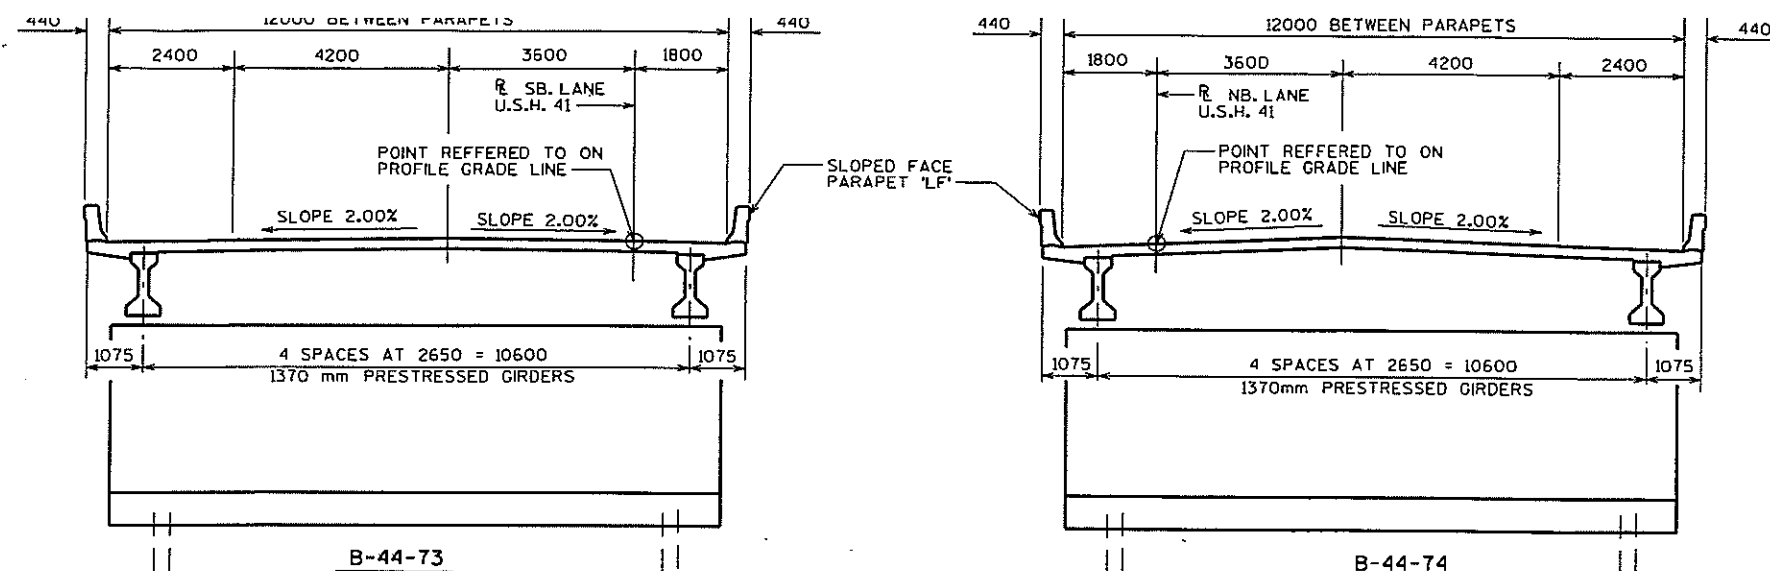

CROSS SECTION THRU ROADWAY

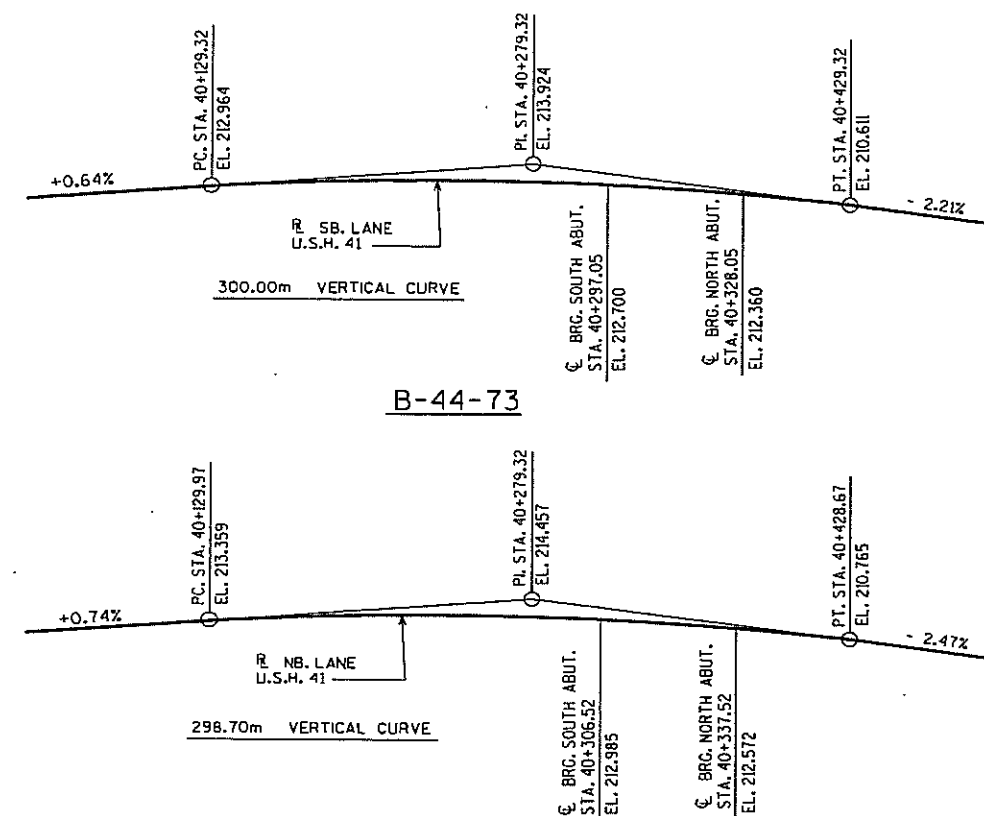

PROFILE GRADE LINE U.S.H. 41

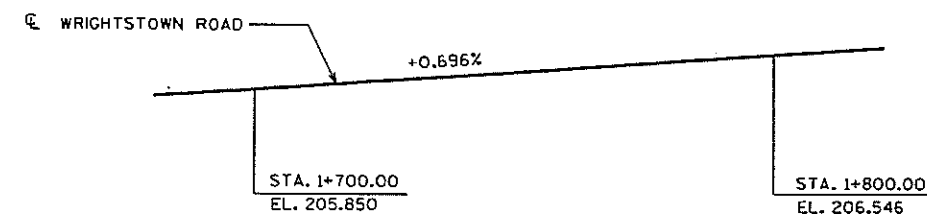

PROFILE GRADE LINE WRIGHTSTOWN ROAD

TOTAL ESTIMATED QUANTITIES


BID ITEMS	UNIT	SUPER.	SOUTH ABUT.	NORTH ABUT.	TOTALS
EXCAVATION FOR STRUCTURES, BRIDGES, B-44-73	L.S.	---	---	---	1
STRUCTURE BACKFILL	m ³	---	650	650	1300
CONCRETE MASONRY, BRIDGES	m ³	141	118	118	377
PROTECTIVE SURFACE TREATMENT	m ²	460	---	---	460
PRESTRESSED GIRDER, 1 TYPE, 1370 mm	m	157	---	---	157
HIGH-STRENGTH BAR STEEL REINFORCEMENT, BRIDGES	kg	---	4210	4150	8360
COATED HIGH-STRENGTH BAR STEEL REINFORCEMENT, BRIDGES	kg	14800	530	530	15860
NON-LAMINATED ELASTOMERIC BEARING PADS	EACH	10	---	---	10
STEEL PILING, DELIVERED AND DRIVEN, HP 250 X 62 kg/m	m	---	442	425	867
RUBBERIZED MEMBRANE WATERPROOFING	m ²	---	7	7	14
SLOPE PAVING, BREAKER RUN	m ²	---	70	70	140
PIPE UNDERDRAIN, 150 mm	m	---	11	11	22
PIPE UNDERDRAIN, UNPERFORATED, 150 mm	m	---	6	6	12
GEOTEXTILE FABRIC, TYPE DF	m ²	---	20	20	40
ANCHOR ASSEMBLIES FOR STEEL PLATE BEAM GUARD	EACH	2	---	---	2
STEEL DIAPHRAGMS, STRUCTURE B-44-73	EACH	8	---	---	8
NON-BID ITEMS					
FILLER	SIZE	---	---	---	13 & 19

GENERAL NOTES

DRAWINGS SHALL NOT BE SCALED.
 BAR STEEL REINFORCEMENT SHALL BE EMBEDDED 50 mm CLEAR UNLESS OTHERWISE SHOWN OR NOTED.
 ALL REINFORCING BARS ARE METRIC AND THE FIRST TWO DIGITS OF THE BAR MARK SIGNIFIES THE BAR SIZE
 ALL DIMENSIONS MILLIMETERS (mm) UNLESS OTHERWISE NOTED.
 ALL STATIONS AND ALL ELEVATIONS ARE METERS (m).
 ELASTOMERIC BEARING PADS NEED NOT BE INDIVIDUALLY MOLDED PROVIDED THE CUT EDGES ARE SMOOTH AND TRUE.
 AT THE BACKFACE OF ABUTMENT ALL VOLUME WHICH CANNOT BE IN PLACE BEFORE ABUTMENT CONSTRUCTION AND NOT OCCUPIED BY THE NEW STRUCTURE SHALL BE BACKFILLED WITH STRUCTURE BACKFILL.
 THE GRADATION OF THE STRUCTURE BACKFILL SHALL MEET THE REQUIREMENTS OF SECT. 209.2.2 OF THE STD. SPEC'S. FOR GRADE 1 MATERIAL.

NO.	DATE	REVISION	BY
STATE OF WISCONSIN DEPARTMENT OF TRANSPORTATION DIVISION OF HIGHWAYS			
STRUCTURE B-44-73			
CONST. SPEC.	1996	DRAWN BY JHC	PLANS CKD. ZIRIK
CROSS SECTION & QUANTITIES			SHEET 2

 FILE= 73GP.DGN
 SCALE = 75

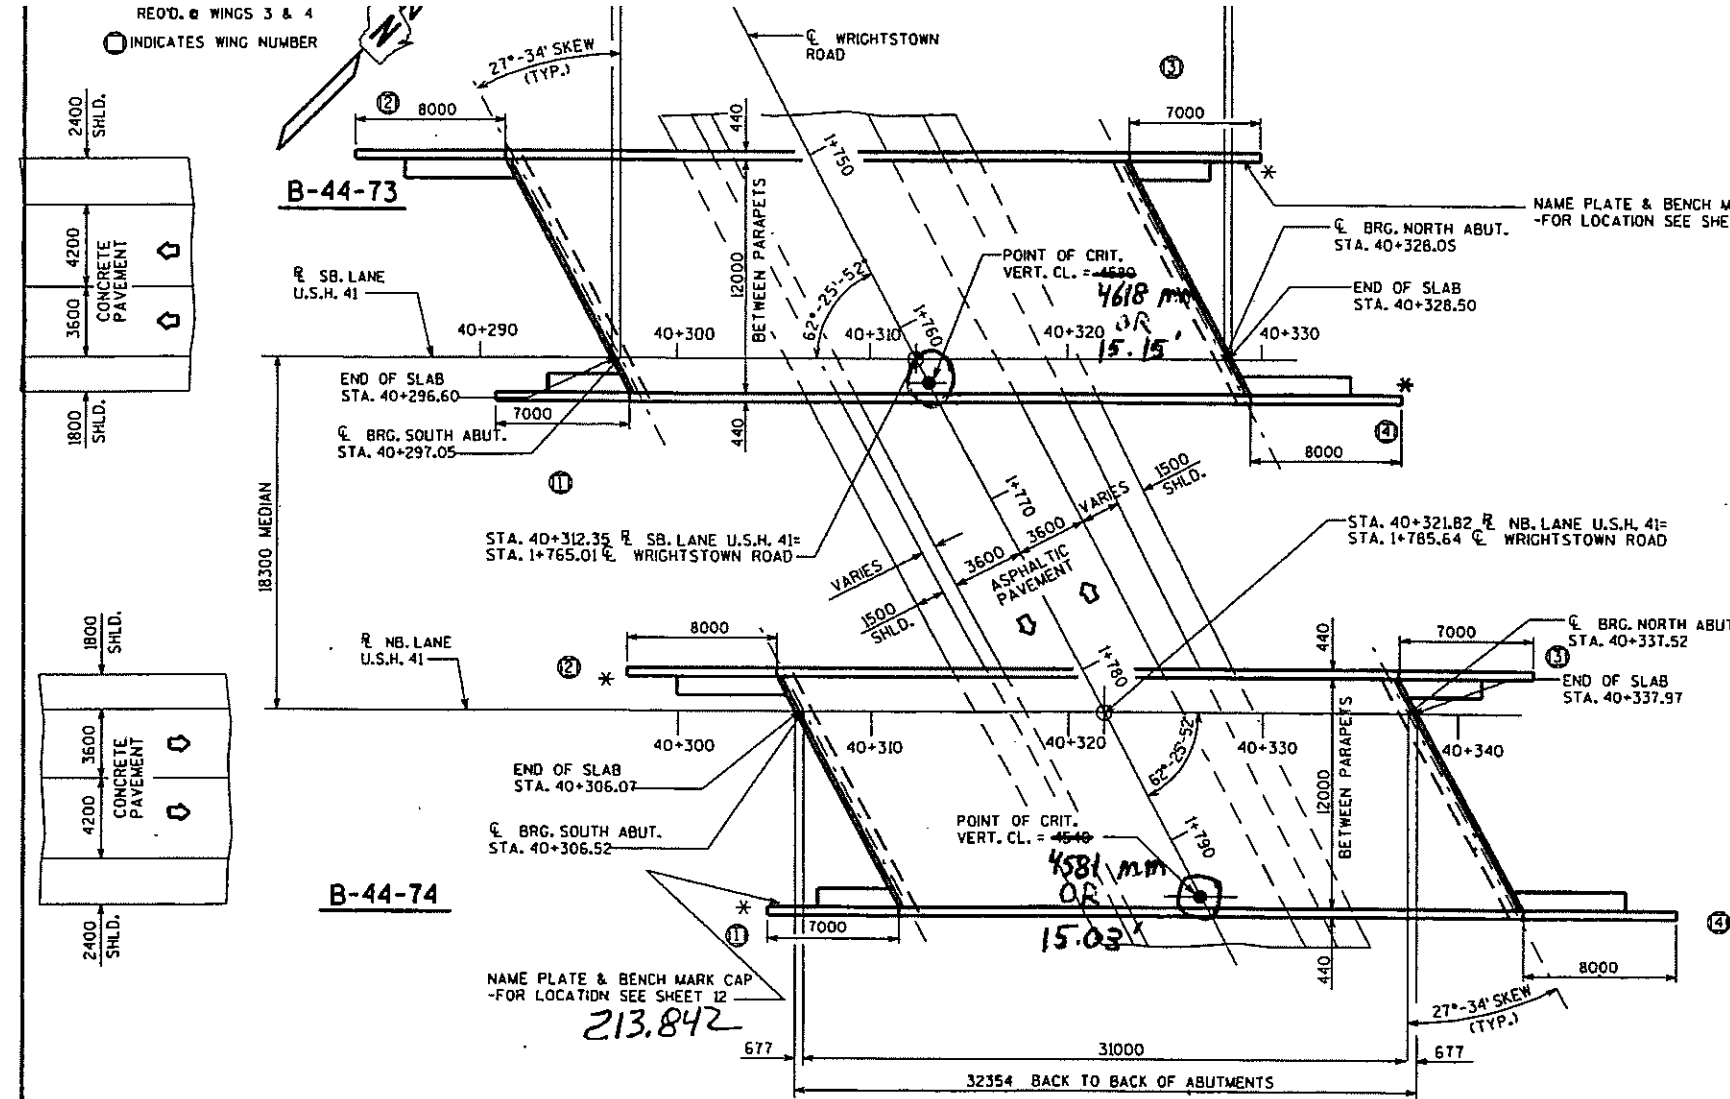

DESIGN DATA

LIVE LOAD:
 DESIGN RATING: MS-18
 INVENTORY RATING: MS-20
 OPERATIONAL RATING: MS-45
 MAXIMUM STANDARD PERMIT VEHICLE LOAD = 110 KN.
 STRUCTURE IS DESIGNED FOR A FUTURE WEARING SURFACE OF 10 kN/m².

ULTIMATE DESIGN STRESSES:
 CONCRETE MASONRY SLAB — $f'_c = 28 \text{ MPa}$ ALL OTHER — $f'_c = 24 \text{ MPa}$
 BAR STEEL REINFORCEMENT, AASHTO M-31M, GRADE 420 — $f_y = 420 \text{ MPa}$
 1370mm PRESTRESSED GIRDERS, CONCRETE MASONRY — $f'_c = 45 \text{ MPa}$
 STRANDS — 13mm DIA. WITH ULTIMATE TENSILE STRENGTH OF 1860 MPa

FOUNDATION DATA


ABUTMENTS TO BE SUPPORTED ON HP 250 X 62 STEEL PILING DRIVEN TO A MINIMUM BEARING VALUE OF 490 kN PER PILE. ESTIMATED 26m LONG AT S. ABUT. AND 25m LONG AT N. ABUT.

TRAFFIC VOLUME

U.S.H. 41	WRIGHTSTOWN ROAD
A.D.T.=37,000 (2018)	A.D.T.=600 (2018)
R.D.S.=110 km/h	R.D.S.=70 km/h

PLAN

SINGLE SPAN - 1370mm PRESTRESSED GIRDERS

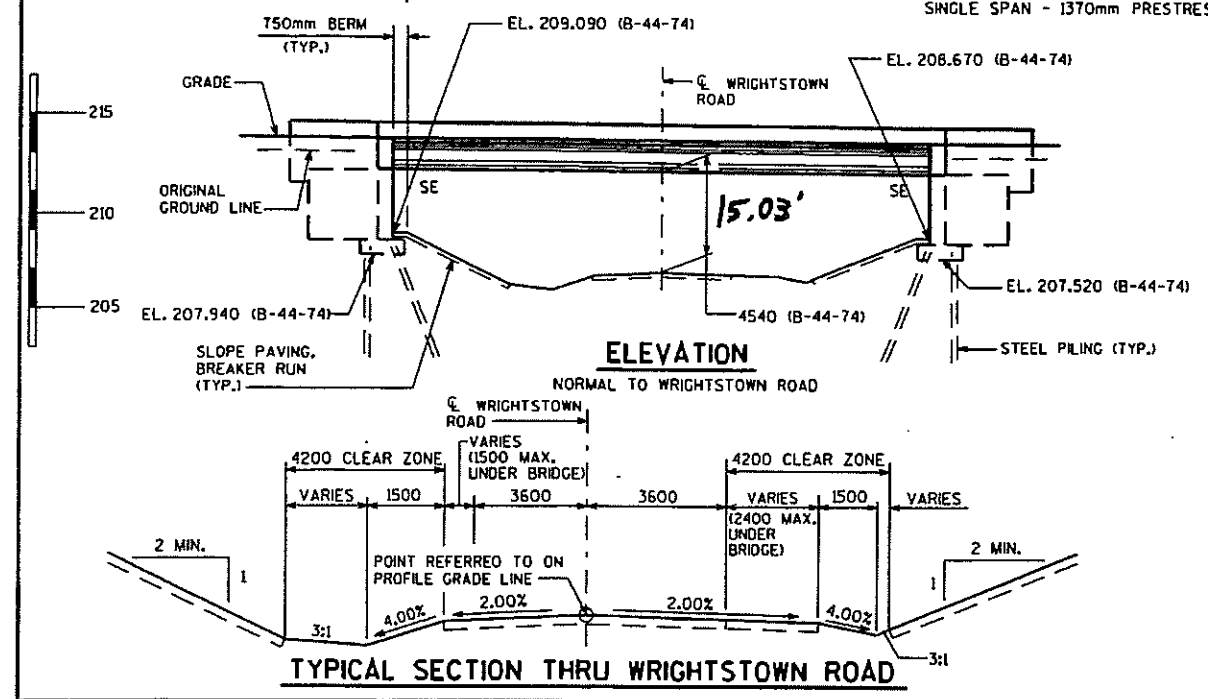

ELEVATION

LIST OF DRAWINGS

1. GENERAL PLAN
2. CROSS SECTION & QUANTITIES
3. SUBSURFACE EXPLORATION
4. SOUTH ABUTMENT
5. SOUTH ABUT. DETAILS
6. NORTH ABUTMENT
7. NORTH ABUT. DETAILS
8. SUPERSTRUCTURE
9. SUPERSTRUCTURE DETAILS
10. 1370mm PRESTRESSED GIRDER DETAILS
11. STEEL DIAPHRAGM
12. SLOPED FACE PARAPET 'LF'


BRIDGE OFFICE CONTACT :
 JERRY ZIRK (608) 266-5163
 FINN HUBBARD (608) 266-8489

NO.	DATE	REVISION	BY
STATE OF WISCONSIN DEPARTMENT OF TRANSPORTATION DIVISION OF HIGHWAYS			
STRUCTURE B-44-74			
U.S.H. 41 OVER WRIGHTSTOWN ROAD			
COUNTY	OUTAGAMIE	TOWN/VILLAGE	KAUKAUNA
DESIGN SPEC.	AASHTO 1996	LOAD MS-18	CONST. SPEC. 1996
DESIGNED BY	CIHA	DESIGN CK'D. KTN	DRAWN BY JHG
			PLANS CK'D. ZIRK
APPROVED	<i>William J. Smith</i> CHIEF BRIDGE DESIGN ENGINEER		01-18-00 DATE
GENERAL PLAN			SHEET 1 OF 12
			DATE: FEB'98


I.D. 1131-08-00G

DISTRICT CONTACT


FILE= 749p.dgn
SCALE= 1/75

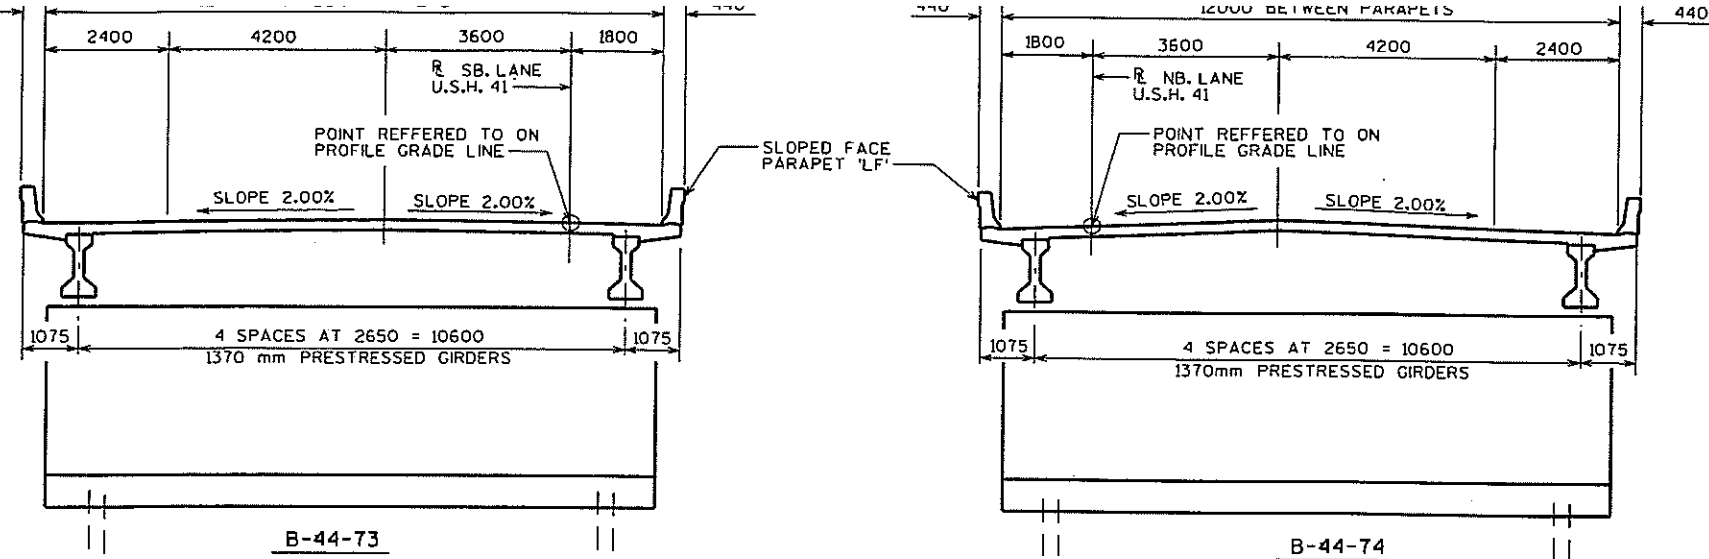

CROSS SECTION THRU ROADWAY

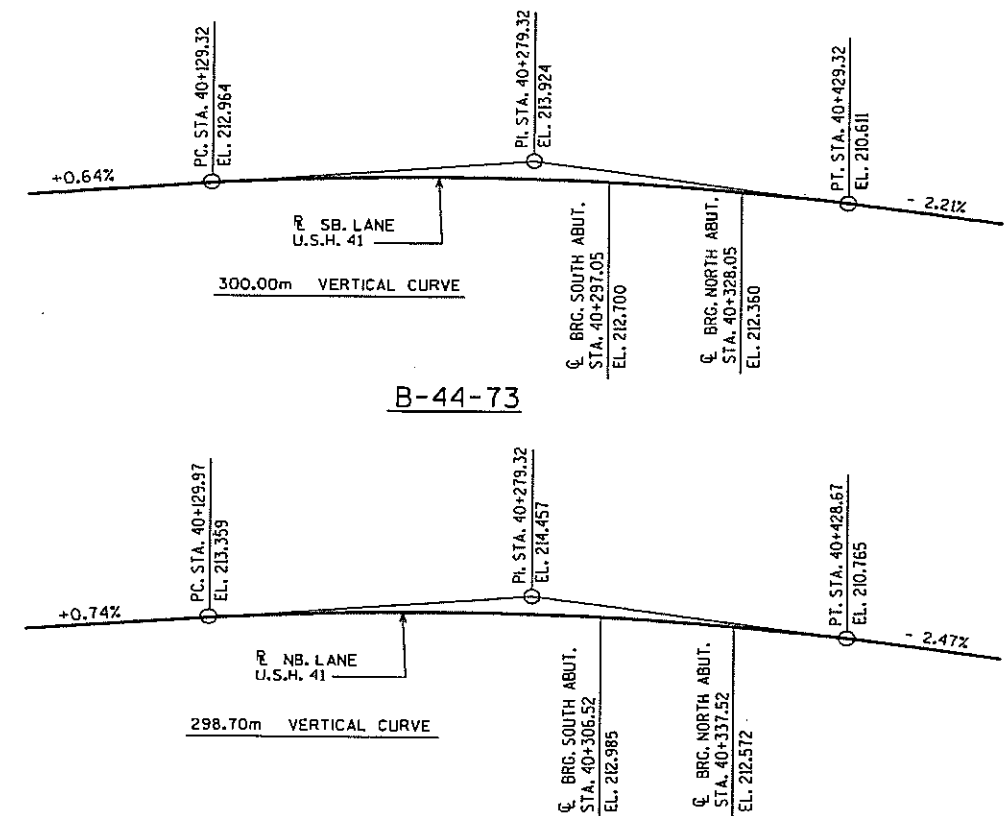

PROFILE GRADE LINE U.S.H. 41

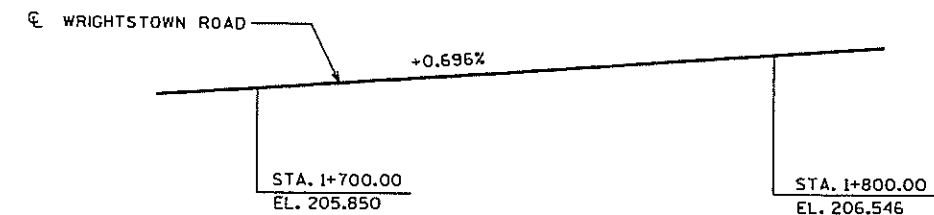

PROFILE GRADE LINE WRIGHTSTOWN ROAD

TOTAL ESTIMATED QUANTITIES

BID ITEMS	UNIT	SUPER.	SOUTH ABUT.	NORTH ABUT.	TOTALS
EXCAVATION FOR STRUCTURES, BRIDGES, B-44-74	L.S.	---	---	---	1
STRUCTURE BACKFILL	m ³	---	650	650	1300
CONCRETE MASONRY, BRIDGES	m ³	141	118	118	377
PROTECTIVE SURFACE TREATMENT	m ²	460	---	---	460
PRESTRESSED GIRDER, TYPE, 1370 mm	m	157	---	---	157
HIGH-STRENGTH BAR STEEL REINFORCEMENT, BRIDGES	kg	---	4230	4220	8450
COATED HIGH-STRENGTH BAR STEEL REINFORCEMENT, BRIDGES	kg	14800	530	530	15860
NON-LAMINATED ELASTOMERIC BEARING PADS	EACH	10	---	---	10
STEEL PILING DELIVERED AND DRIVEN, HP250 x 62kg/m	m	---	442	425	867
RUBBERIZED MEMBRANE WATERPROOFING	m ²	---	7	7	14
SLOPE PAVING, BREAKER RUN	m ²	---	70	70	140
PIPE UNDERDRAIN, 150 mm	m	---	11	11	22
PIPE UNDERDRAIN, UNPERFORATED, 150 mm	m	---	6	6	12
GEOTEXTILE FABRIC, TYPE DF	m ²	---	20	20	40
ANCHOR ASSEMBLIES FOR STEEL PLATE BEAM GUARD	EACH	2	---	---	2
STEEL DIAPHRAGMS, STRUCTURE B-44-74	EACH	8	---	---	8
NON-BID ITEMS					
FILLER	SIZE	---	---	---	13 & 19

GENERAL NOTES

DRAWINGS SHALL NOT BE SCALED.
 BAR STEEL REINFORCEMENT SHALL BE EMBEDDED 50 mm CLEAR UNLESS OTHERWISE SHOWN OR NOTED.
 ALL REINFORCING BARS ARE METRIC AND THE FIRST TWO DIGITS OF THE BAR MARK SIGNIFIES THE BAR SIZE
 ALL DIMENSIONS MILLIMETERS (mm) UNLESS OTHERWISE NOTED.
 ALL STATIONS AND ALL ELEVATIONS ARE METERS (m).
 ELASTOMERIC BEARING PADS NEED NOT BE INDIVIDUALLY MOLDED PROVIDED THE CUT EDGES ARE SMOOTH AND TRUE.
 AT THE BACKFACE OF ABUTMENT ALL VOLUME WHICH CANNOT BE IN PLACE BEFORE ABUTMENT CONSTRUCTION AND NOT OCCUPIED BY THE NEW STRUCTURE SHALL BE BACKFILLED WITH STRUCTURE BACKFILL.
 THE GRADATION OF THE STRUCTURE BACKFILL SHALL MEET THE REQUIREMENTS OF SECT. 209.2.2 OF THE STD. SPEC'S. FOR GRADE 1 MATERIAL.

NO.	DATE	REVISION	BY
STATE OF WISCONSIN DEPARTMENT OF TRANSPORTATION DIVISION OF HIGHWAYS			
STRUCTURE B-44-74			
CONST. SPEC.	1996	DRAWN BY JHG	PLANS CKD. ZIRK
CROSS SECTION & QUANTITIES			SHEET 2

FILE= 749p.dgn
 SCALE = 75

Vertical Clearance for Construction of New Bridges, Replacement Bridges, and Bridges on which the Superstructure is being replaced¹

Overpass Facility →	Freeway, Expressway, or STH		Railroad ⁴ , CTH, Town Road, Local Road, or Street	Pedestrian or Shared-use Structures	Sign Structures ²
Underpass Facility ↓	Interchange	Grade Separation			
Non-arterial either STH, CTH, Town Road, Local Road, or Street	15'-9" Desirable	15'-3" Desirable		16'- 9" Desirable	18'-3" Minimum
	15'-3" Minimum	14'-9" Minimum		16'-3" Minimum	
Arterial either CTH, Town Road, Local Road, or Street (excludes freeway and expressway; also excludes arterial STH)	16'-9" Desirable	15'-3" Desirable		17'- 9" Desirable	
	16'-3" Minimum	14'-9" Minimum		17'-3" Minimum	
Freeway ³ or Expressway or arterial STH	16'-9" Desirable			17'- 9" Desirable	
	16'-4" Minimum			17'-4" Minimum	
Railroad ^{4,5,6,7}	23'-0" Minimum to 23'-3½" Maximum				

General notes:

¹ Vertical clearance is needed for the entire roadway width (critical point; to include traveled way, auxiliary lanes, turn lanes, and shoulders), according to the above table.

Vertical clearance for railroads is measured from the top of rail and is required over an area 8 feet 6 inches from the track centerline on each side of a railroad track.

Do not exceed the desirable vertical clearance shown unless justified. Depending on topography and other specific situations vertical clearance for any structure may be greater than that shown when justified. Some things to consider are: over height loads traveling on the roadway; the level of development in the area, the projected growth in traffic volume and importance of the roadway, and the possibility of reclassification.

² See LRFD Bridge Manual Chapter 39 (http://on.dot.wi.gov/dtid_bos/extranet/structures/LRFD/LRFDManualIndex.htm) and LRFD Standard Details 39.02 and 39.10 for design considerations and requirements for vertical clearance on new and replacement Sign Structures.

³ See FDM 11-44-1 for vertical clearance guidance specific to Interstate freeways.

⁴ Consult with the Region Railroad Coordinator if the over-passing or under-passing facility is either a railroad or a "rails-to-trails" trail; or if a structure is owned by a railroad company.

⁵ A vertical clearance <23'-0" requires both an approved Exception to Standards (see FDM 11-1-2 and FDM 11-1-4) and early coordination with BTLR R&H, Railroads and Harbors Section (RHS) through the Region Railroad Coordinator. The Exception to Standards shall contain documentation that the Office of the Commissioner of Railroads (OCR) has been petitioned.

See Chapter 17 for additional information.

⁶ Provide justification for a vertical clearance >23'-3 ½" to the RHS.

⁷ Vertical clearance less than 23'-0" may be acceptable or desirable in certain situations, such as for spur tracks, lead tracks, some branch lines and even mainline tracks when other impediments to 23'-0" exist. Review such situations with the Railroad Project Coordination Engineer in RHS. Early coordination with RHS is required.



DAAR
ENGINEERING, INC.

PROJECT: _____

DATE: _____

DESCRIPTION: USH 41 over CTH U

SHEET ____ OF ____

B-44-159 (SB) & 160 (NB)


CALC. BY: _____

CHECKED BY: _____

Existing Structures are 40' x 141', 2-68' spans & 36" Girders
VC = 17.68' (SB) & 17.45' (NB) Retaining walls R-44-10 & 11

Existing Retaining walls are failing, so it is proposed to
remove them & build a longer structure, Salvage existing Median
pier?

Proposed Typical Half Section on CTH U

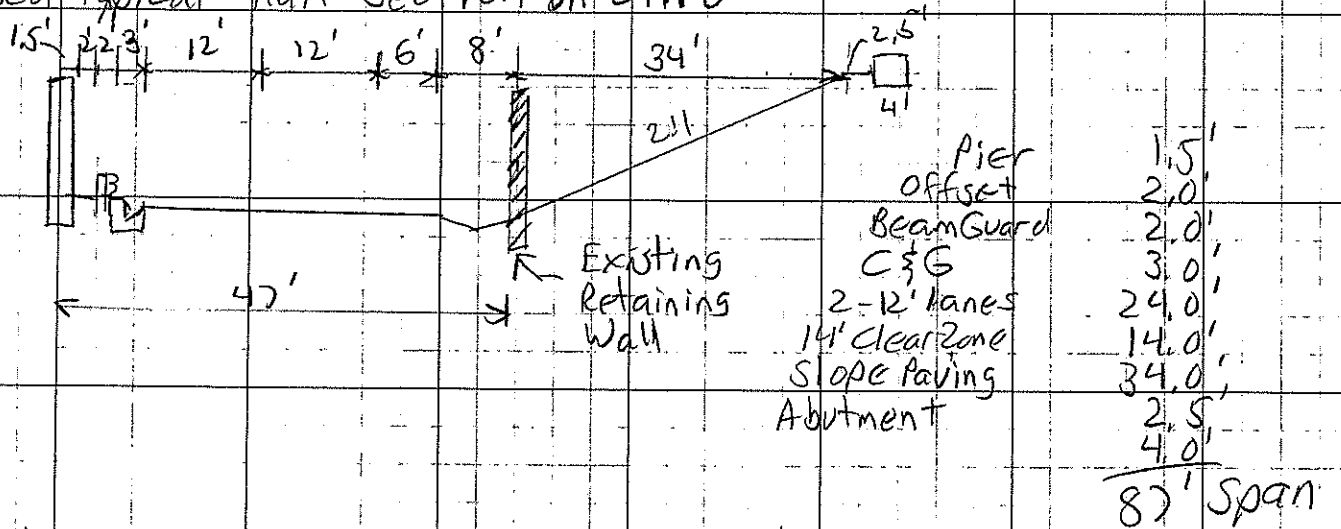

Widening in Median = $20' \times .02 = 0.4'$

36" Girders

$$\begin{array}{r} VC \text{ SB} = 17.68' \\ - 0.40' \\ \hline 17.28' \end{array}$$

$$\begin{array}{r} VC \text{ NB} = 17.45' \\ - 0.40' \\ \hline 17.05' \end{array}$$

Meets Desirability with no change to profiles

BRIDGE INSPECTION REPORT
Wisconsin Dept. of Transportation
DT2007 2003 s.84.17 Wis. Stats. Type = ROUTINE INSPECTION

page 1

Inventory Data

Feature On: USH 41		Maintainer: STATE HIGHWAY DEPT		Structure No: B-44-159	
Feature Under: U		Sect/Twn/Rng: S27 T22N R19E			
Location: 2.7M S JCT CTH S		County: OUTAGAMI	Municipality: TOWN-KAUKAUNA (44026)		
Inv Rating: HS22.2	Rdwy Width (ft): 39.4	Deck Width (ft): 42.3	Existing Posting:		
Oper Rating: HS48.9	Total Length (ft): 141.0	Deck Area(ft2): 5964	ADT On: 18090 Yr: 2003	ADT Under: 0 Yr: 2000	

Inspection Type (* = Supplemental Form Required)

	Routine Visual	Fracture Critical*	In-Depth*	UW-Dive*	UW-Surv*	UW-Probe/Visual*	Movable*
Last Insp.	10-17-11						
Frequency	24						
Recom. Freq.							
	Initial*	Damage	Interim	Load Posted	SI & A Field Review*		
Last Insp.							
Frequency	N/A						
Recom. Freq.	N/A				Item No. Needing Change		

Load Rating Information

Overburden	Measurement (in): 0.0	Date:	Deck Surface Type: CONCRETE		
Section Loss	File Meas. (%):	File Insp. Date: 10-19-09	Insp. Measurement (%):	Describe:	
Re-rate for load capacity?	Reason:				Date Last Rated: 02-16-99

Expansion Joints

Location	Type	Temp:			Signing Condition			
		File Insp. Date	File Insp. (in)	New Insp. (in)	Type of Marker	File	Y/N	Comments
					Bridge Markers			
					Narrow Bridge			
					One Lane Road			
					Vertical Clearance			
					Weight Limit Post			
					Other(Addl. Sign)			

Clearances(Cardinal = N or E)

	File Meas. (ft.)	File Date	New Meas. (ft.)
Min. Vertical Clearance Under (Cardinal)	17.68	02-17-00	
Min. Vertical Clearance Under (non-Cardinal)	17.45	02-17-00	
Min. Vertical Clearance On			

Structure Type

Construction/Rehabilitation History

Material	Configuration	# of Spans	Overall Length (ft)	Year	Work Performed	Plan	Shop
CONT PREST CO	DECK GIRDER		67.9	1999	NEW STRUCTURE	PLAN	
CONT PREST CO	DECK GIRDER		67.9				

Inspection Information

Special Requirements	Y/N	Comments				
Traffic Control	Y					
Access Equipment	Y					
Other	Y					

Inspector Information

Team Leader Name and No. Printed: Michaelson, Neil (3010)		Team Member(s) Name(s) Printed:			
Team Leader Signature:		Inspection Date: 10-17-11		Inspection Agency: STATE HIGHWAY DEPARTMENT (1)	
District/Local Manager and No. Printed:		District/Local Manager Signature:		Review Date:	

Element Inspection (X) Check Elements Inspected

Quantity in Condition States

Ck	Elem./Env.	Description	Unit	Total QTY.	1	2	3	4	5
X	26 / 4	Conc Deck/Coatd Bars	SF	5964	5964				
X	109 / 3	P/S Conc Open Girder	LF	820	820				
X	172 / 3	Painted Steel Diaphr	EA	10	10				
X	205 / 3	R/Conc Column	EA	3	3				
X	215 / 4	R/Conc Abutment	LF	91	87	4			
		Cracks on south abutment							
X	234 / 4	R/Conc Cap	LF	42	42				
X	250 / 3	Concrete Diaphragm	EA	5	5				
X	321 / 4	R/Conc Approach Slab	EA	2		2			
		End of approaches at edge of deck are deteriorating and settling							
X	331 / 4	Conc Bridge Railing	LF	314	254	60			
X	342 / 2	RipRap Slope Protect	EA	2	2				
X	358 / 4	Deck Cracking SmFlag	EA	1	1				
X	359 / 4	Und Dk Surf Sm Flag	EA	1	1				
		Diagonal cracking at the ends of the deck, some tranverse cracking							
X	400 / 4	Concrete Wingwall	EA	4	2		2		
		SW wingwall has moved approximately 2-3 inches; Also experiencing spalling at modular joints and differential settling of modular panels.							
		NW wingwall has moved approximately 1 inch west on the bottom of the precast panel located at the back of abutment face.							

General Inspection/Maintenance Notes

Maintenance Recommendations (See standard code items & numbers)

Maintenance Item: Approach - Seal Joint along Parapet/Wing	
Amount:	Date(YYYY-MM-DD):
Maintenance item comment: Seal open joint at the junction between parapet and end of deck at the pavement surface.	

Maintenance Item:	
Amount:	Date(MM-DD-YY):
Maintenance item comment:	

NBI Ratings

NBI	File	New	NBI	File	New
Deck	8	8	Culvert	N	N
Superstructure	8	8	Channel	N	N
Substructure	7	7	Waterway	N	N

Maintenance Item:	
Amount:	Date(MM-DD-YY):
Maintenance item comment:	

STRUCTURE INVENTORY AND APPRAISAL FIELD REVIEW FORM

B-44-159
USH 41 over U

- (3) Municipality:
(16) Latitude(° ' ") :
(17) Longitude(° ' ") :

LOCATION	
TOWN-KAUKAUNA (44026)	
44°20'59.57"N	
88°11'35.53"W	

- (28A) Lanes On:
(28B) Lanes Under:
(102) Traffic Pattern On:
(102) Traffic Pattern Under:
(19) Detour Length(mi):

TRAFFIC SERVICE	
2	
2	
-NO TRAFFIC X-ONE WAY TRAFFIC -TWO WAY TRAFFIC	
-NO TRAFFIC -ONE WAY TRAFFIC X-TWO WAY TRAFFIC	
0	

- (49) Structure Length(ft):
(50) Sidewalk Width(ft):
(50) Curb Width(ft):
(52) Culvert Barrel Length(ft):
(34) Skew:

GEOMETRY	
141.0	
Left: 0.0	Right: 0.0
Angle(°): 40	Direction: -RIGHT FORWARD X-LEFT FORWARD
Cardinal Width	Non-Cardinal Width
39.4	39.4
42.3	42.3
39	0
Cardinal Under Clearance	Non-Cardinal Under Clearance
32.2	32.2
11.8	11.8
8.5	8.5

- (51) Bridge Roadway(ft):
(52) Deck(ft):
(32) Approach Roadway(ft):
(47) Minimum Horizontal(ft):
(55) Minimum Right Lateral(ft):
(55) Minimum Left Lateral(ft):

- (36A) Bridge Rail Adequacy:
(36B) Transition Adequacy:
(36C) Approach Guardrail Adequacy:
(36D) Guardrail Termination Adequacy:
Outer Rail:

RAILING APPRAISAL		
-SUB-STANDARD X-STANDARD -NOT APPLICABLE		
-SUB-STANDARD X-STANDARD -NOT APPLICABLE		
-SUB-STANDARD X-STANDARD -NOT APPLICABLE		
-SUB-STANDARD X-STANDARD -NOT APPLICABLE		
Left	Right	Type
		TYPE F (TWO SQUARE TUBES) - STEEL(8)
		TYPE F (3 SQUARE TUBES) - STEEL(65)
		TYPE F (4 SQUARE TUBES) - STEEL(72)
		TYPE M-STEEL 3 SQUARE TUBES(93)
	X	SLOPED FACE PARAPET LF(91)
		SLOPED FACE PARAPET HF(92)
		VERTICAL FACE PARAPET TYPE A(74)
		TYPE W-THREE BEAM(79)
		TYPE H ON VERTICAL PARAPET(80)
		TIMBER(38)
X		OTHER(99) (Please specify)
		Left:
Transition Type:		
		CONT GUARD RAIL
		NO APP GRDRL
		NO ATTACHMENT
5		22 MM(7/8") BOLT (Please enter quantity)
		25 MM(1") BOLT (Please enter quantity)
		OTHER (Please specify)
Guardrail Termination Type:		
		(01) ENERGY ABSORBING TERMINAL/EAT
		(02) TURN DOWN
		(99) OTHER (Please specify)

- (72) Approach Alignment Appraisal:

ROADWAY ALIGNMENT APPRAISAL	
	(3) INTOLERABLE- Horizontal or Vertical curvature requires a substantial reduction in vehicle operating speed
	(6) FAIR- Horizontal or Vertical curvature requires a very minor speed reduction
X	(8) GOOD- No speed reduction required

BRIDGE INSPECTION REPORT
Wisconsin Dept. of Transportation
DT2007 2003 s.84.17 Wis. Stats. Type = ROUTINE INSPECTION

page 1

Inventory Data

Feature On: USH41 NB	Maintainer: STATE HIGHWAY DEPT	Structure No: B-44-160
Feature Under: U	Sect/Twn/Rng: S27 T22N R19E	
Location: 3.2M N JCT JJ	County: OUTAGAMI	Municipality: TOWN-KAUKAUNA (44026)
Inv Rating: HS22.2	Rdwy Width (ft): 39.4	Deck Width (ft): 42.3
Oper Rating: HS48.9	Total Length (ft): 141.0	Deck Area(ft2): 5964
	ADT On: 18460 Yr: 2003	ADT Under: 0 Yr: 2000

Inspection Type (* = Supplemental Form Required)

	Routine Visual	Fracture Critical*	In-Depth*	UW-Dive*	UW-Surv*	UW-Probe/Visual*	Movable*
Last Insp.	10-17-11						
Frequency	24						
Recom. Freq.							
	Initial*	Damage	Interim	Load Posted	SI & A Field Review*		
Last Insp.							
Frequency	N/A						
Recom. Freq.	N/A						
					Item No. Needing Change		

Load Rating Information

Overburden	Measurement (in): 0.0	Date:	Deck Surface Type: CONCRETE
Section Loss	File Meas. (%):	File Insp. Date: 10-19-09	Insp. Measurement (%):
Re-rate for load capacity?	Reason:		Date Last Rated: 02-16-99

Expansion Joints

Location	Type	Temp:	File Insp. Date	File Insp. (in)	New Insp. (in)	Signing Condition	File	Y/N	Comments
						Bridge Markers			
						Narrow Bridge			
						One Lane Road			
						Vertical Clearance			
						Weight Limit Post			
						Other(Addl. Sign)			

Clearances(Cardinal = N or E)

	File Meas. (ft.)	File Date	New Meas. (ft.)
Min. Vertical Clearance Under (Cardinal)	17.68	02-17-00	
Min. Vertical Clearance Under (non-Cardinal)	17.68	02-17-00	
Min. Vertical Clearance On			

Structure Type

Construction/Rehabilitation History

Material	Configuration	# of Spans	Overall Length (ft)	Year	Work Performed	Plan	Shop
CONT PREST CO	DECK GIRDER		67.9	1999	NEW STRUCTURE	PLAN	
CONT PREST CO	DECK GIRDER		67.9				

Inspection Information

Special Requirements	Y/N	Comments				
Traffic Control	Y					
Access Equipment	Y					
Other	Y					

Inspector Information

Team Leader Name and No. Printed: Michaelson, Neil (3010)	Team Member(s) Name(s) Printed:					
Team Leader Signature:	Inspection Date: 10-17-11	Inspection Agency: STATE HIGHWAY DEPARTMENT (1)				
District/Local Manager and No. Printed:	District/Local Manager Signature:	Review Date:				

Element Inspection (X) Check Elements Inspected

					Quantity in Condition States				
Ck	Elem./Env.	Description	Unit	Total QTY.	1	2	3	4	5
X	26 / 4	Conc Deck/Coatd Bars	SF	5964	5964				
		Diagonal cracking at abutments							
X	109 / 3	P/S Conc Open Girder	LF	820	820				
X	172 / 3	Painted Steel Diaphr	EA	10	10				
X	205 / 3	R/Conc Column	EA	3	3				
X	215 / 4	R/Conc Abutment	LF	91	85	6			
		CS-2 (N Abut 3" & S Abut 3"), Leaking at joint East support keyway (?) appears to have moved out							
X	234 / 4	R/Conc Cap	LF	42	42				
X	250 / 3	Concrete Diaphragm	EA	5	5				
X	321 / 4	R/Conc Approach Slab	EA	2		2			
		Spalled and cracked on South end							
X	331 / 4	Conc Bridge Railing	LF	314	254	60			
X	342 / 2	RipRap Slope Protect	EA	2	1	1			
X	358 / 4	Deck Cracking SmFlag	EA	1	1				
X	359 / 4	Und Dk Surf Sm Flag	EA	1	1				
X	400 / 4	Concrete Wingwall	EA	4	2	2			
		NE & SE wing settled 1" Tipped out 1-1/2" at the top on NE corner.							

General Inspection/Maintenance Notes

MSE walls at NE & SE corners of abutments settling, cracking, spalling, and leaking.

Maintenance Recommendations (See standard code items & numbers)

Maintenance Item: Approach - Seal Approach to Paving Block

Amount: **Date(YYYY-MM-DD):**

Maintenance item comment: Seal hole in pavement at the junction between the parapet and the wingwall

Maintenance Item:

Amount: **Date(MM-DD-YY):**

Maintenance item comment:

NBI Ratings

NBI	File	New	NBI	File	New
Deck	8	8	Culvert	N	N
Superstructure	8	8	Channel	N	N
Substructure	7	7	Waterway	N	N

Maintenance Item:

Amount: **Date(MM-DD-YY):**

Maintenance item comment:

STRUCTURE INVENTORY AND APPRAISAL FIELD REVIEW FORM

B-44-160
USH41 NB over U

- (3) Municipality:
 (16) Latitude(" ' "):
 (17) Longitude(" ' "):

LOCATION	
TOWN - KAUKAUNA (44026)	
44°20'56.86"N	
88°11'35.91"W	

- (28A) Lanes On:
 (28B) Lanes Under:
 (102) Traffic Pattern On:
 (102) Traffic Pattern Under:
 (19) Detour Length(mi):

TRAFFIC SERVICE	
2	
2	
-NO TRAFFIC X-ONE WAY TRAFFIC -TWO WAY TRAFFIC	
-NO TRAFFIC -ONE WAY TRAFFIC X-TWO WAY TRAFFIC	
0	

- (49) Structure Length(ft):
 (50) Sidewalk Width(ft):
 (50) Curb Width(ft):
 (52) Culvert Barrel Length(ft):
 (34) Skew:

GEOMETRY	
141.0	
Left: 0.0	Right: 0.0
Angle("): 40	Direction: -RIGHT FORWARD X-LEFT FORWARD
Cardinal Width	Non-Cardinal Width
39.4	39.4
42.3	42.3
39	0
Cardinal Under Clearance	Non-Cardinal Under Clearance
34.0	34.5
14.0	14.0
8.0	8.5






- (51) Bridge Roadway(ft):
 (52) Deck(ft):
 (32) Approach Roadway(ft):
 (47) Minimum Horizontal(ft):
 (55) Minimum Right Lateral(ft):
 (55) Minimum Left Lateral(ft):

- (36A) Bridge Rail Adequacy:
 (36B) Transition Adequacy:
 (36C) Approach Guardrail Adequacy:
 (36D) Guardrail Termination Adequacy:
 Outer Rail:

RAILING APPRAISAL		
-SUB-STANDARD	X-STANDARD	-NOT APPLICABLE
-SUB-STANDARD	X-STANDARD	-NOT APPLICABLE
-SUB-STANDARD	X-STANDARD	-NOT APPLICABLE
-SUB-STANDARD	X-STANDARD	-NOT APPLICABLE
Left	Right	Type
		TYPE F (TWO SQUARE TUBES) - STEEL(8)
		TYPE F (3 SQUARE TUBES) - STEEL(65)
		TYPE F (4 SQUARE TUBES) - STEEL(72)
		TYPE M-STEEL 3 SQUARE TUBES(93)
X	X	SLOPED FACE PARAPET LF(91)
		SLOPED FACE PARAPET HF(92)
		VERTICAL FACE PARAPET TYPE A(74)
		TYPE W-THREE BEAM(79)
		TYPE H ON VERTICAL PARAPET(80)
		TIMBER(38)
		OTHER(99) (Please specify)
Transition Type:		
		CONT GUARD RAIL
		NO APP GRORL
		NO ATTACHMENT
5		22 MM(7/8") BOLT (Please enter quantity)
		25 MM(1") BOLT (Please enter quantity)
		OTHER (Please specify)
Guardrail Termination Type:		
X		(01) ENERGY ABSORBING TERMINAL/EAT
		(02) TURN DOWN
		(99) OTHER (Please specify)

- (72) Approach Alignment Appraisal:

ROADWAY ALIGNMENT APPRAISAL	
	(3) INTOLERABLE- Horizontal or Vertical curvature requires a substantial reduction in vehicle operating speed
	(6) FAIR- Horizontal or Vertical curvature requires a very minor speed reduction
X	(8) GOOD- No speed reduction required

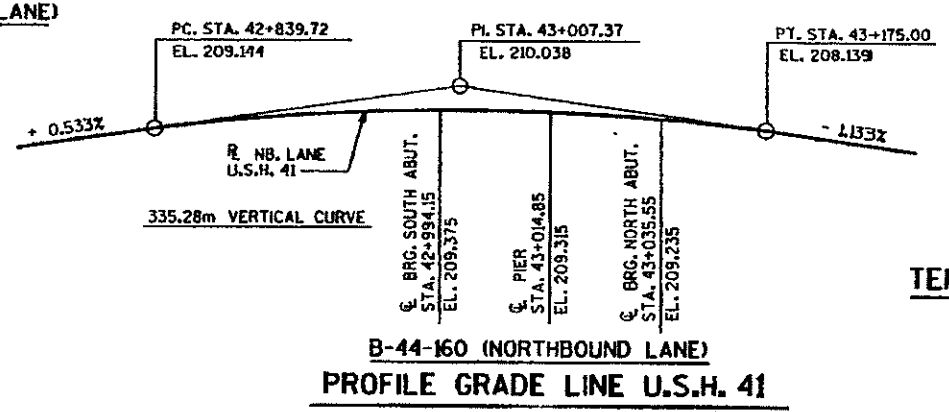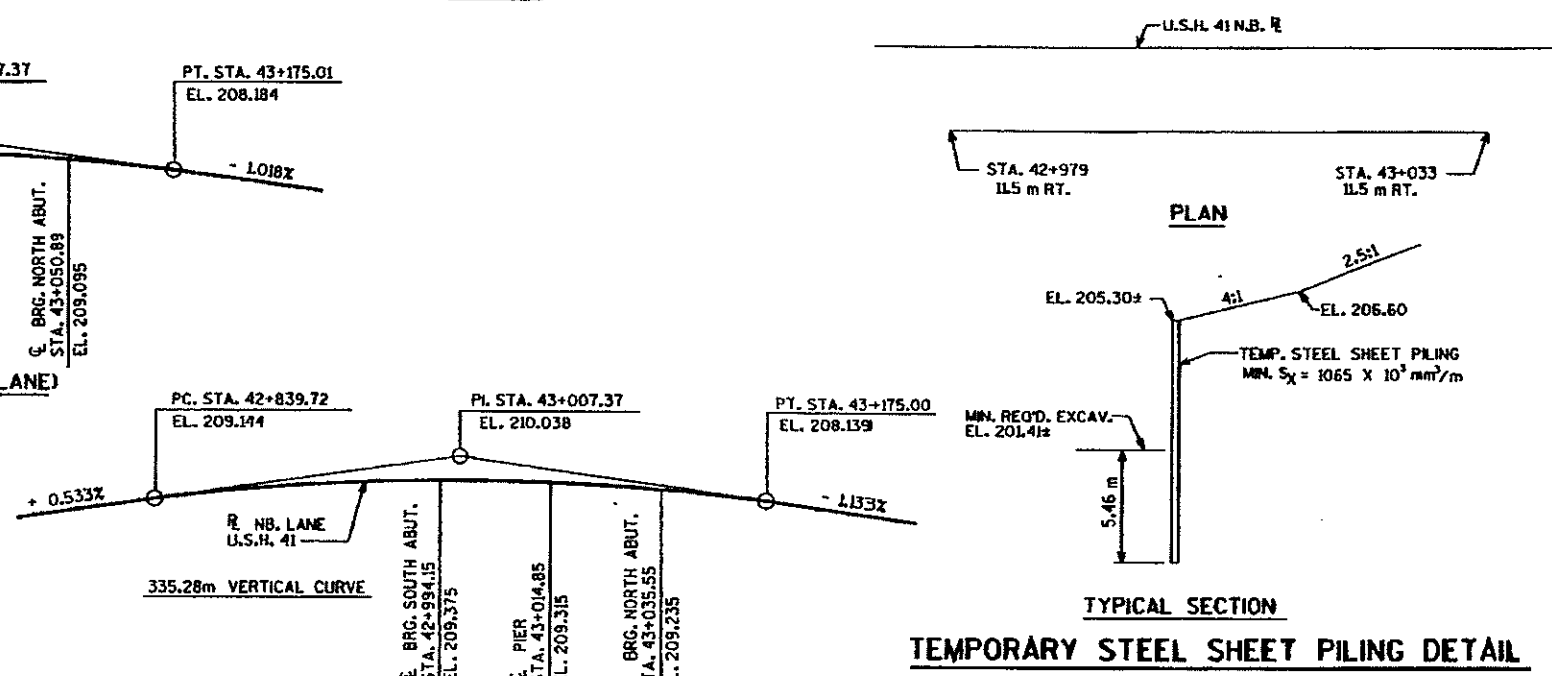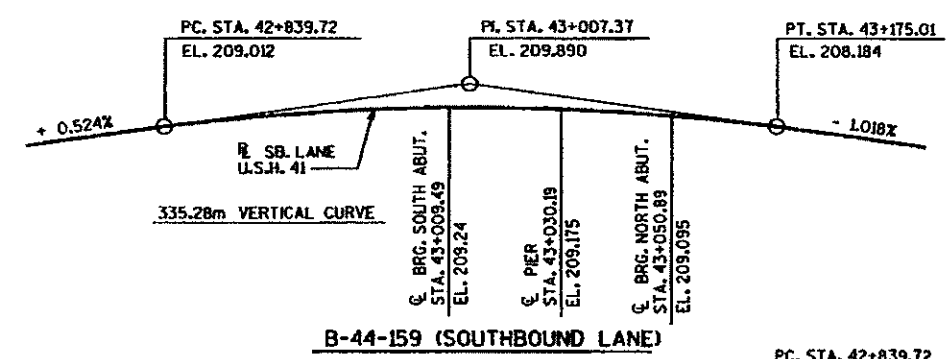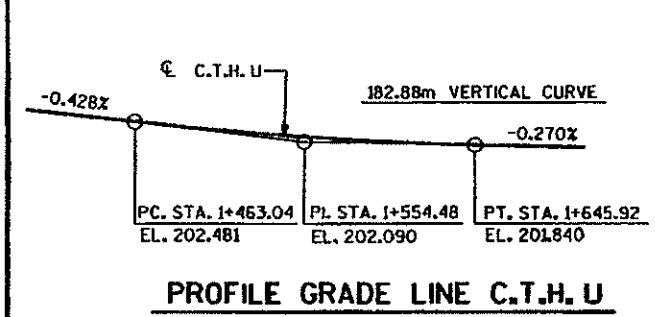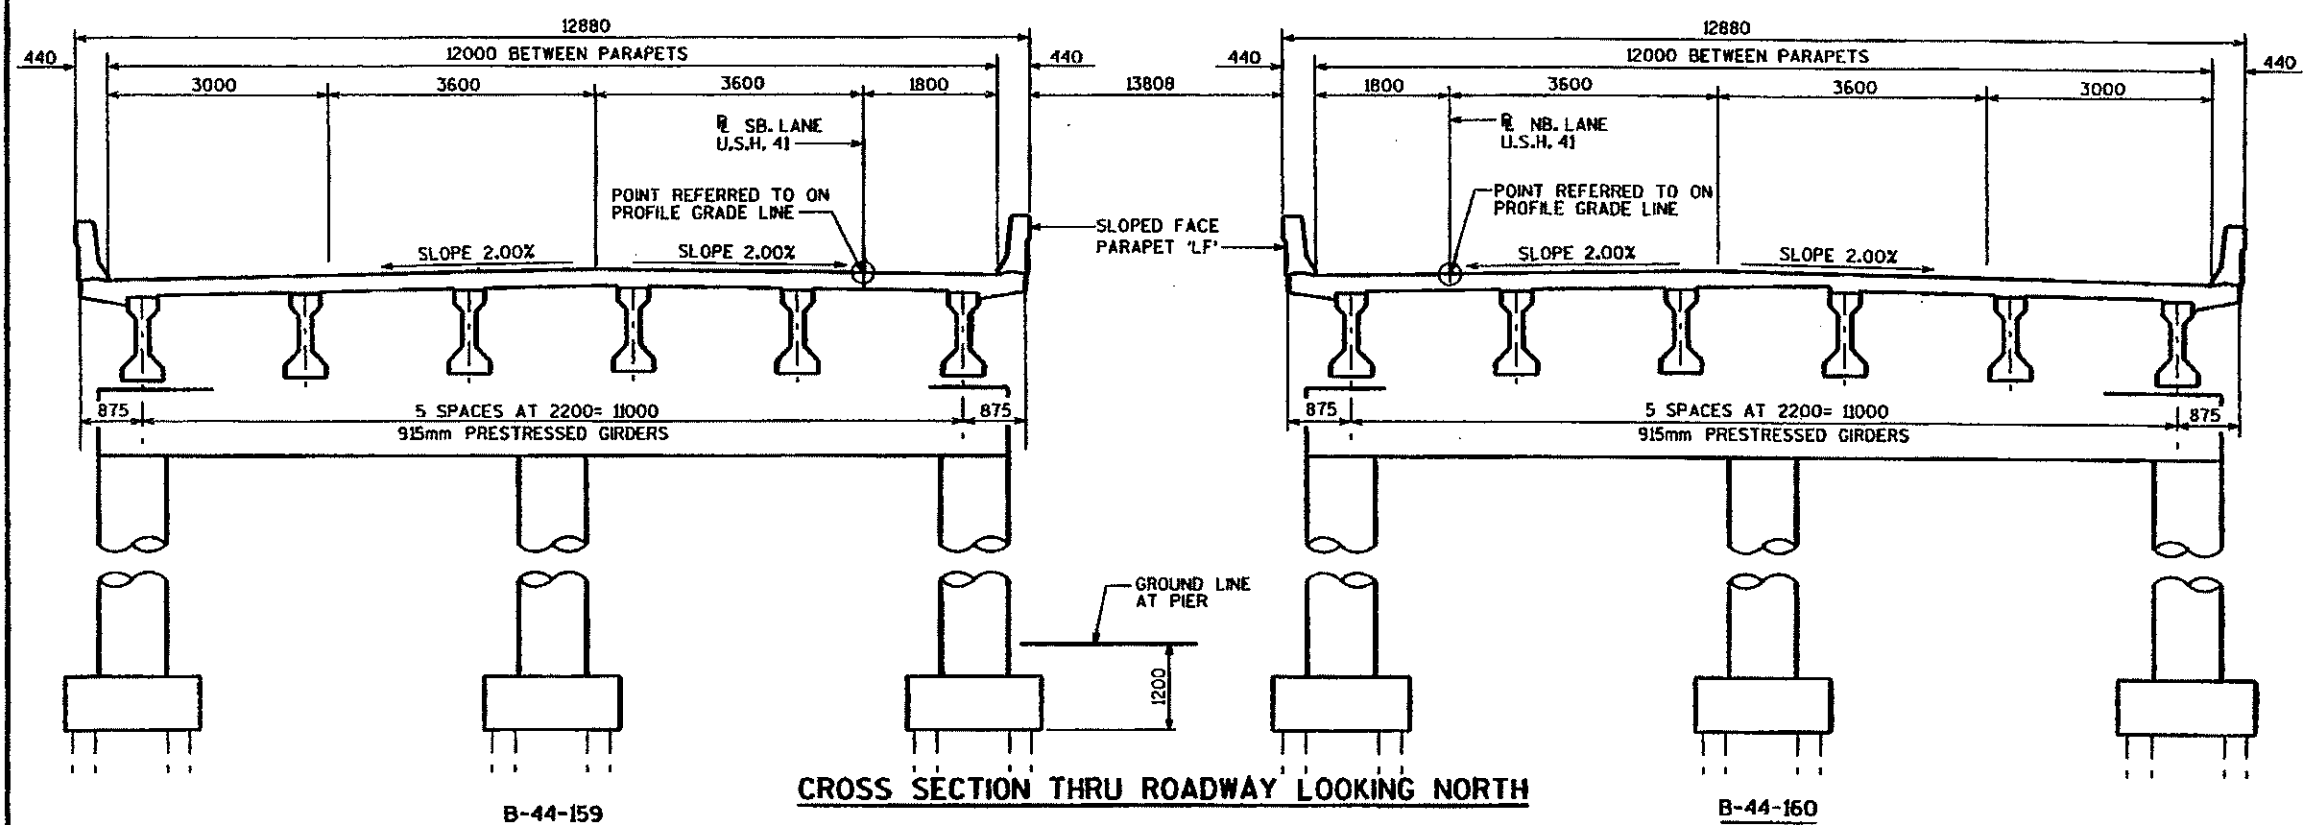

TOTAL ESTIMATED QUANTITIES

BID ITEMS	UNIT	SUPER.	SOUTH ABUT.	NORTH ABUT.	PIER 1	TOTALS
EXCAVATION FOR STRUCTURES, BRIDGES, B-44-160	L.S.					1
STRUCTURE BACKFILL	m³		91	91		182
CONCRETE MASONRY, BRIDGES	m³	179	34	32	33	278
PROTECTIVE SURFACE TREATMENT	m²	608				608
PRESTRESSED GIRDER, I TYPE, 915 mm	m	250				250
HIGH-STRENGTH BAR STEEL REINFORCEMENT, BRIDGES	Kg		1710	1740	170	3620
COATED HIGH-STRENGTH BAR STEEL REINFORCEMENT, BRIDGES	Kg	20435	237	298	2560	23530
NON-LAMINATED ELASTOMERIC BEARING PADS	EACH		6	6	6	18
STEEL PILING, DELIVERED AND DRIVEN, HP 250 X 62	m		216	216	264	696
RUBBERIZED MEMBRANE WATERPROOFING	m²		8	8		16
SLOPE PAVING, CRUSHED AGGREGATE BREAKER RUN	m²		84	84		168
ANCHOR ASSEMBLIES FOR STEEL PLATE BEAM GUARD	EACH		1	1		2
STEEL DIAPHRAGMS, STRUCTURE B-44-160	EACH	10				10
TEMPORARY STEEL SHEET PILING	m²					505
NON-BID ITEMS						
FILLER	SIZE					13 & 19

GENERAL NOTES

DRAWINGS SHALL NOT BE SCALED.
BAR STEEL REINFORCEMENT SHALL BE EMBEDDED 50 mm CLEAR UNLESS OTHERWISE SHOWN OR NOTED.
ALL REINFORCING BARS ARE METRIC AND THE FIRST TWO DIGITS OF THE BAR MARK SIGNIFIES THE BAR SIZE
ALL DIMENSIONS MILLIMETERS (mm) UNLESS OTHERWISE NOTED.
ALL STATIONS AND ALL ELEVATIONS ARE METERS (m).
ELASTOMERIC BEARING PADS NEED NOT BE INDIVIDUALLY MOLDED PROVIDED THE CUT EDGES ARE SMOOTH AND TRUE.
THE EXISTING GROUND LINE SHALL BE USED AS THE UPPER LIMITS OF EXCAVATION AT THE PIERS.
AT THE BACKFACE OF ABUTMENT ALL EXCAVATED VOLUME NOT OCCUPIED BY THE NEW STRUCTURE SHALL BE BACKFILLED WITH STRUCTURE BACKFILL.

NO.	DATE	REVISION	BY
STATE OF WISCONSIN DEPARTMENT OF TRANSPORTATION DIVISION OF HIGHWAYS			
STRUCTURE B-44-160			
CONST. SPEC.	1996	DRAWN BY RIES	PLANS CK'D. KTN
CROSS SECTION & QUANTITIES		SHEET 2	

FILE: BR.B44160160GP.GPJ
SCALE = 50

1131-08-72

8.14

DESIGN DATA

LIVE LOAD:

DESIGN RATING: MS-18
 INVENTORY RATING: MS-20
 OPERATIONAL RATING: MS-44
 MAXIMUM STANDARD PERMIT VEHICLE LOAD = 1110 KN.
 STRUCTURE IS DESIGNED FOR A FUTURE WEARING SURFACE OF 1.0 KN/m².

ULTIMATE DESIGN STRESSES:

CONCRETE MASONRY SLAB — $f'_c = 28 \text{ MPa}$ ALL OTHER — $f'_c = 24 \text{ MPa}$
 BAR STEEL REINFORCEMENT, AASHTO M-42M, GRADE 420 — $f_y = 420 \text{ MPa}$
 915mm PRESTRESSED GIRDERS, CONCRETE MASONRY — $f'_c = 45 \text{ MPa}$
 STRANDS - 13mm DIA. WITH ULTIMATE TENSILE STRENGTH OF 1860 MPa
 TEMP. STEEL SHEET PILING — MIN. $S_x = 1065 \times 10^3 \text{ mm}^4/\text{m}$


FOUNDATION DATA

ABUTMENTS TO BE SUPPORTED ON HP 250 X 62 STEEL PILING DRIVEN TO A MINIMUM BEARING VALUE OF 490 KN PER PILE. ESTIMATED 27 M LONG.

PIER TO BE SUPPORTED ON HP 250 X 62 STEEL PILING DRIVEN TO A MINIMUM BEARING VALUE OF 490 KN PER PILE. ESTIMATED 22 M LONG.

TRAFFIC VOLUME


U.S.H. 41	C.T.H. U
A.D.T.=36,505 (2018)	A.D.T.=1,650 (2018)
R.D.S.=110 km/h	R.D.S.=70 km/h

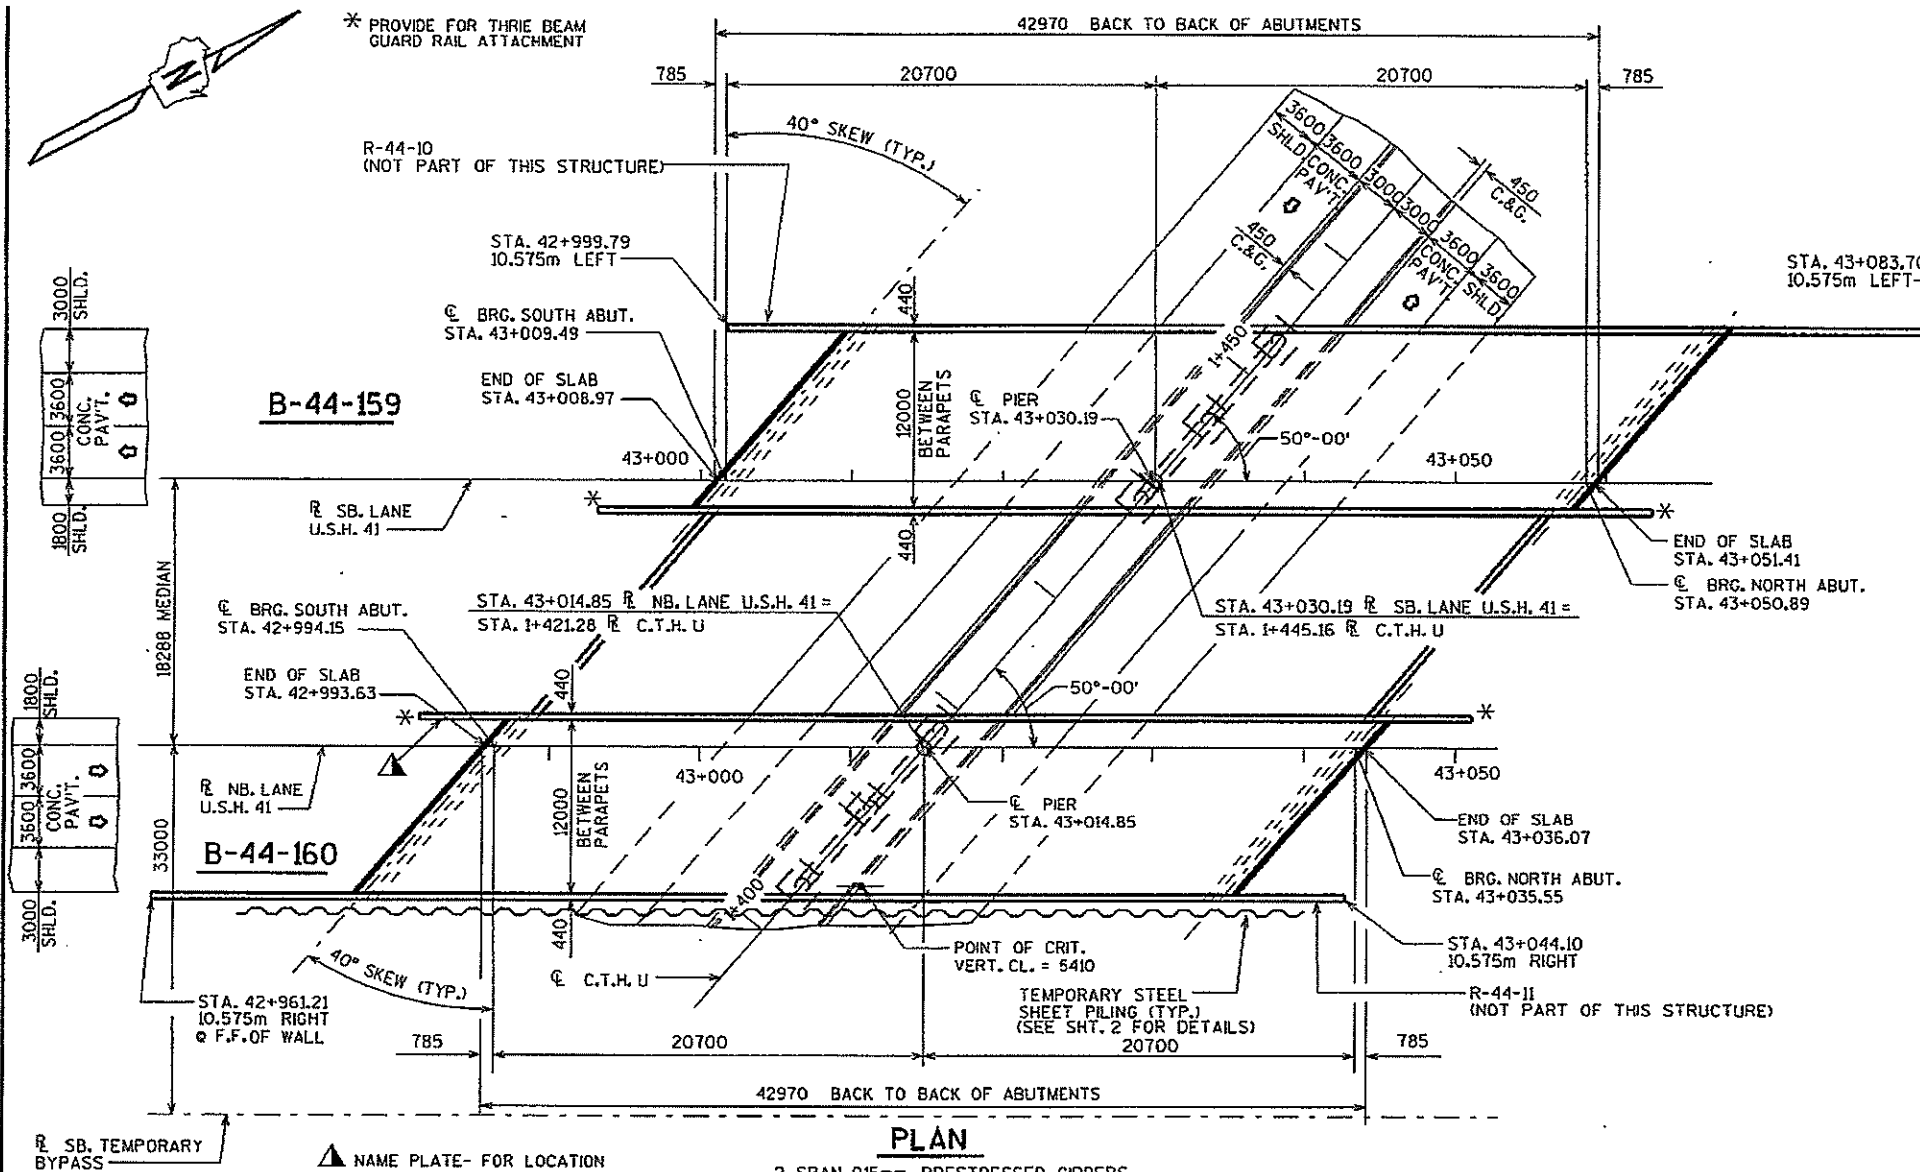

PLAN


NAME PLATE- FOR LOCATION
 SEE SLOPE FACE PARAPET SHT.

2 SPAN-915mm PRESTRESSED GIRDERS

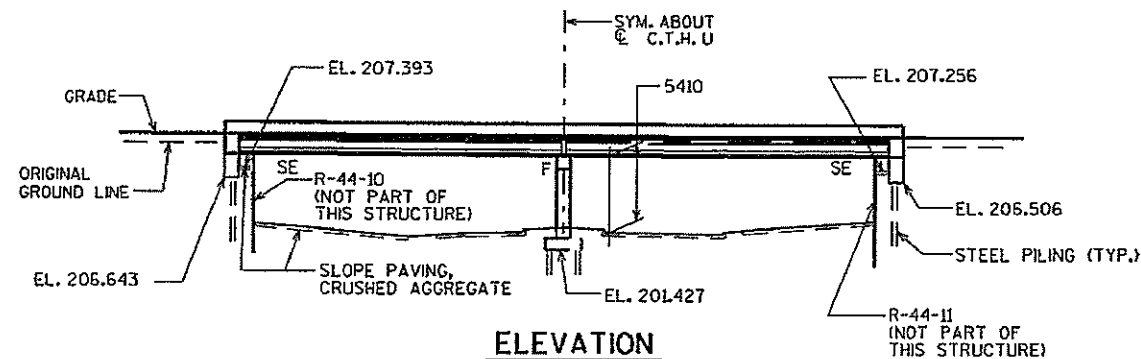

ELEVATION

NORMAL TO C.T.H. U

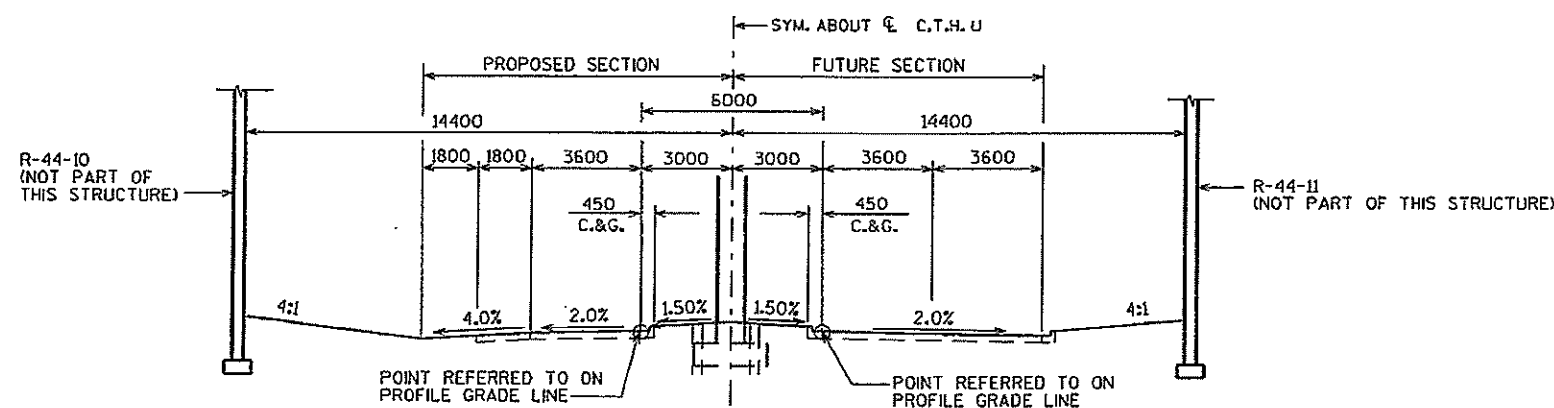

TYPICAL SECTION THRU C.T.H. U

LIST OF DRAWINGS

1. GENERAL PLAN
2. CROSS SECTION & QUANTITIES
3. SUBSURFACE EXPLORATION
4. SOUTH ABUTMENT
5. SOUTH ABUTMENT DETAILS
6. NORTH ABUTMENT
7. NORTH ABUTMENT DETAILS
8. PIER
9. SUPERSTRUCTURE
10. SUPERSTRUCTURE DETAILS
11. 915mm PRESTRESSED GIRDER DETAILS
12. STEEL DIAPHRAGM
13. SLOPED FACE PARAPET "LF"

BRIDGE OFFICE CONTACT :



FINN HUBBARD (608) 266-8489
 KEITH NELSON (608) 266-5083

NO.	DATE	REVISION	BY
STATE OF WISCONSIN DEPARTMENT OF TRANSPORTATION DIVISION OF HIGHWAYS			
STRUCTURE B-44-160			
U.S.H. 41 OVER C.T.H. U			
COUNTY	OUTAGAMIE	TOWN/CITY/VILLAGE	KAUKAUNA
DESIGN SPEC.	AASHTO 1996	LOAD	MS-18
DESIGNED BY	KTN	DRAWN BY	COMP/CMF
APPROVED	CHIEF BRIDGE DESIGN ENGINEER		DATE
GENERAL PLAN			SHEET 1 OF 13
			DATE: JULY '98

FILE= BR.B44160:160GP.GPN
 SCALE= 250


1131-08-72

8.2

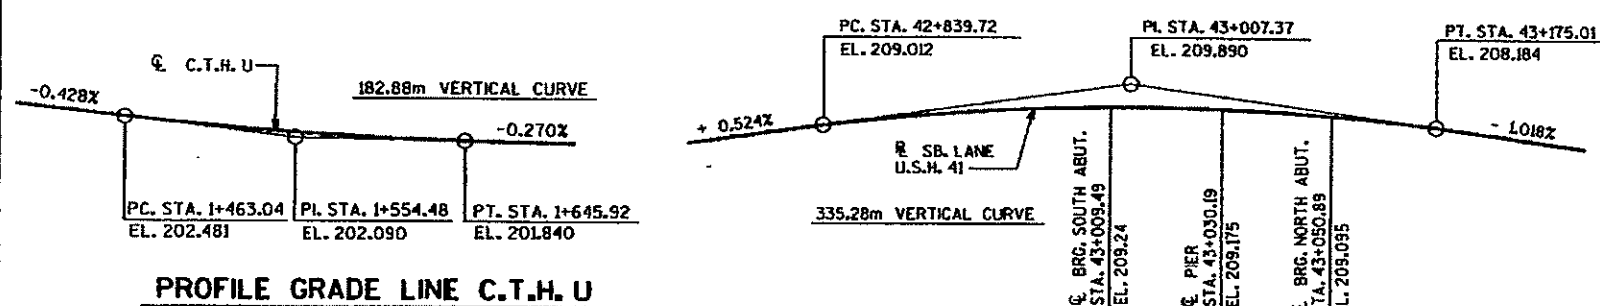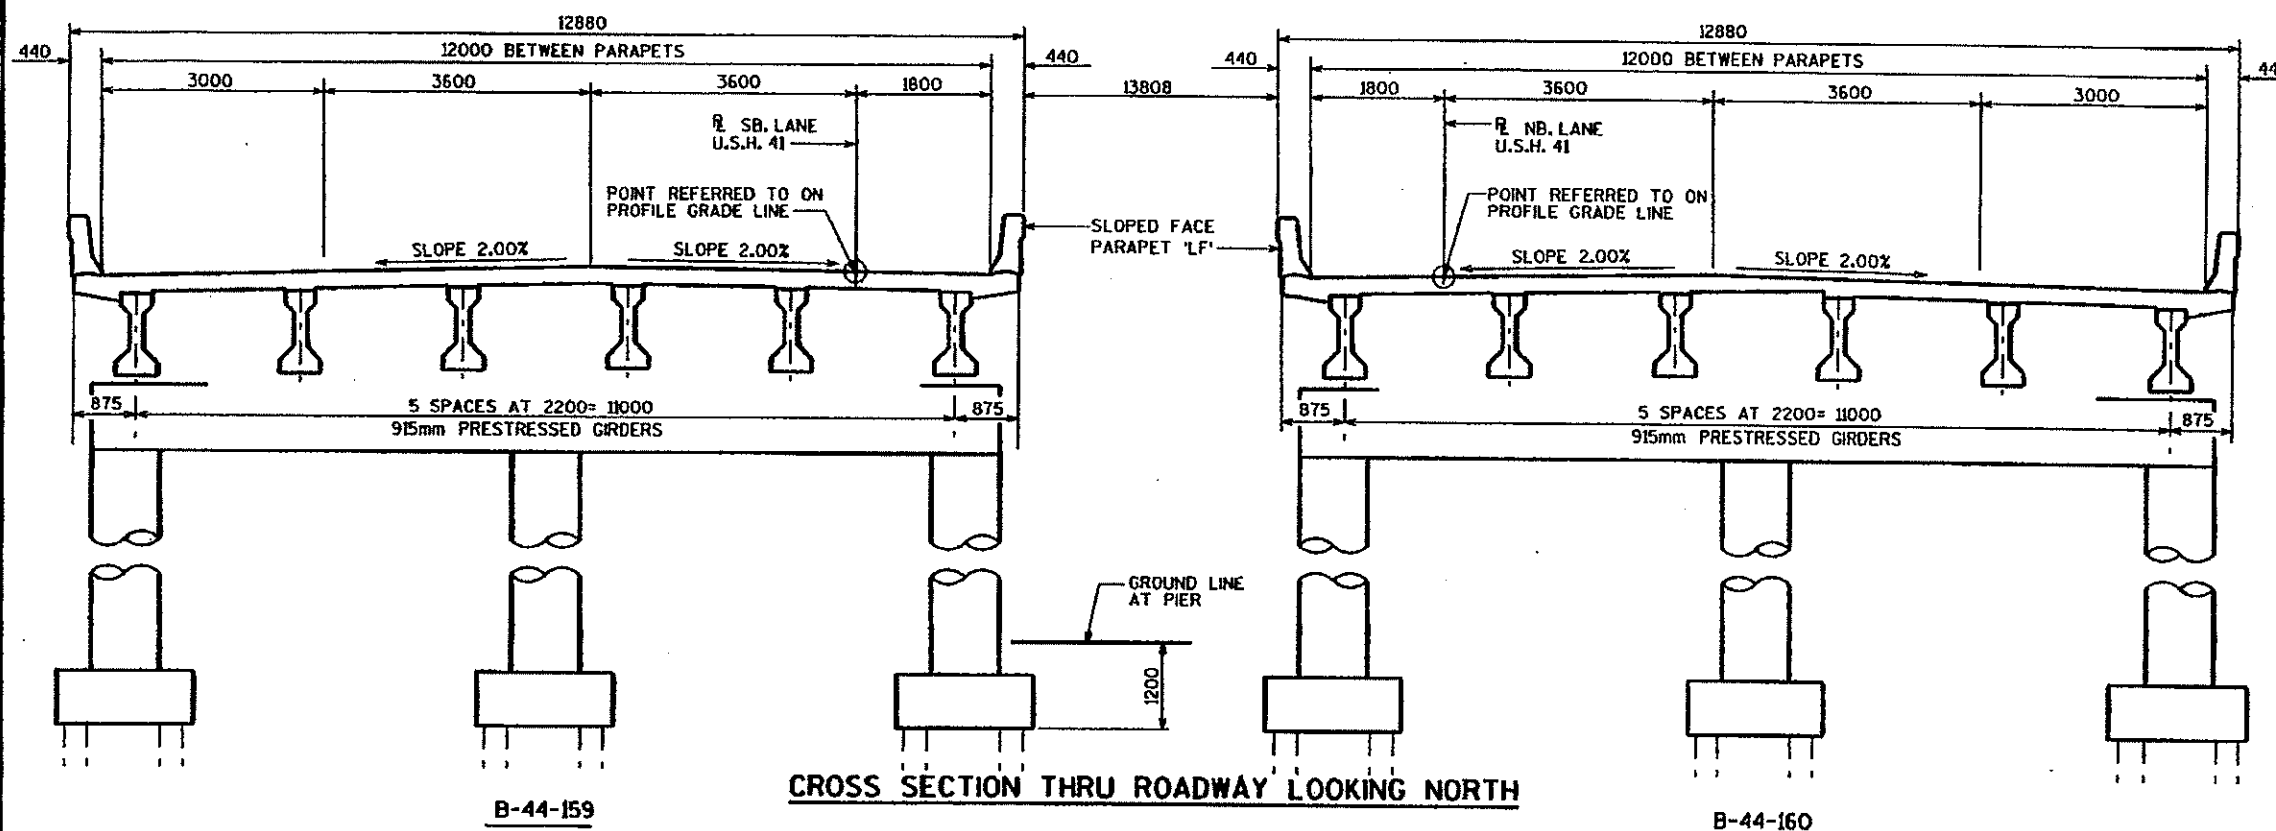

TOTAL ESTIMATED QUANTITIES

BID ITEMS	UNIT	SUPER.	SOUTH ABUT.	NORTH ABUT.	PIER 1	TOTALS
EXCAVATION FOR STRUCTURES, BRIDGES, B-44-159	L.S.					1
STRUCTURE BACKFILL	m ³		91	91		182
CONCRETE MASONRY, BRIDGES	m ³	179	34	32	33	278
PROTECTIVE SURFACE TREATMENT	m ²	608				608
PRESTRESSED GIRDER, I-TYPE, 915 mm	m	250				250
HIGH-STRENGTH BAR STEEL REINFORCEMENT, BRIDGES	kg		1740	1710	170	3620
COATED HIGH-STRENGTH BAR STEEL REINFORCEMENT, BRIDGES	kg	20435	298	237	2583	23550
NON-LAMINATED ELASTOMERIC BEARING PADS	EACH		6	6	6	18
STEEL PILING, DELIVERED AND DRIVEN, HP 250 X 62	m		216	216	264	696
RUBBERIZED MEMBRANE WATERPROOFING	m ²		8	8		16
SLOPE PAVING, CRUSHED AGGREGATE <i>Breaker Run</i>	m ²		84	84		168
ANCHOR ASSEMBLIES FOR STEEL PLATE BEAM GUARD	EACH		1	1		2
STEEL DIAPHRAGMS, STRUCTURE B-44-159	EACH	10				10
NON-BID ITEMS						
FILLER	SIZE					13 & 19

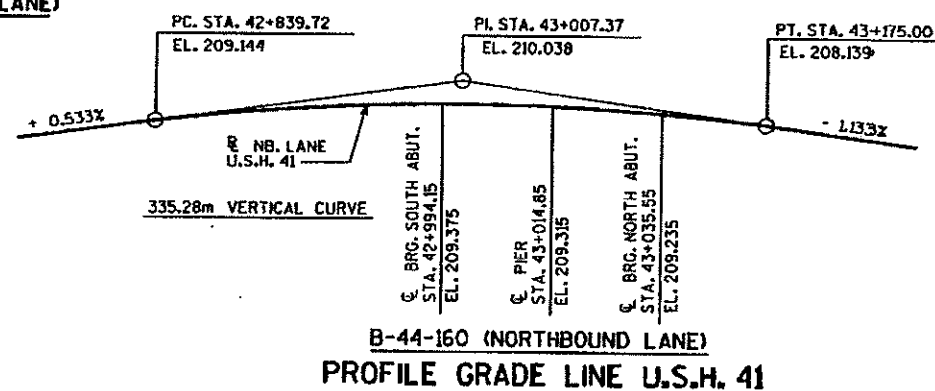

GENERAL NOTES

DRAWINGS SHALL NOT BE SCALED.
BAR STEEL REINFORCEMENT SHALL BE EMBEDDED 50 mm CLEAR UNLESS OTHERWISE SHOWN OR NOTED.
ALL REINFORCING BARS ARE METRIC AND THE FIRST TWO DIGITS OF THE BAR MARK SIGNIFIES THE BAR SIZE
ALL DIMENSIONS MILLIMETERS (mm) UNLESS OTHERWISE NOTED.
ALL STATIONS AND ALL ELEVATIONS ARE METERS (m).
ELASTOMERIC BEARING PADS NEED NOT BE INDIVIDUALLY MOLDED PROVIDED THE CUT EDGES ARE SMOOTH AND TRUE.
THE EXISTING GROUND LINE SHALL BE USED AS THE UPPER LIMITS OF EXCAVATION AT THE PIERS.
AT THE BACKFACE OF ABUTMENT ALL EXCAVATED VOLUME NOT OCCUPIED BY THE NEW STRUCTURE SHALL BE BACKFILLED WITH STRUCTURE BACKFILL.

NO.	DATE	REVISION	BY
STATE OF WISCONSIN DEPARTMENT OF TRANSPORTATION DIVISION OF HIGHWAYS			
STRUCTURE B-44-159			
CONST. SPEC.	1996	DRAWN BY	RIES
		PLANS C.D.	KTN
CROSS SECTION & QUANTITIES			SHEET 2

: br44 b159:159gd.dgn

1131-08-72

8.1

DESIGN DATA

LIVE LOAD:

DESIGN RATING: MS-18
 INVENTORY RATING: MS-20
 OPERATIONAL RATING: MS-44
 MAXIMUM STANDARD PERMIT VEHICLE LOAD = 1110 kN.
 STRUCTURE IS DESIGNED FOR A FUTURE WEARING SURFACE OF 1.0 kN/m².

ULTIMATE DESIGN STRESSES:

CONCRETE MASONRY SLAB — $f'_c = 28 \text{ MPa}$ ALL OTHER — $f'_c = 24 \text{ MPa}$
 BAR STEEL REINFORCEMENT, AASHTO M-42M, GRADE 420 — $f_y = 420 \text{ MPa}$
 915mm PRESTRESSED GIRDERS, CONCRETE MASONRY — $f'_c = 45 \text{ MPa}$
 STRANDS - 13mm DIA. WITH ULTIMATE TENSILE STRENGTH OF 1860 MPa


FOUNDATION DATA

ABUTMENTS TO BE SUPPORTED ON HP 250 X 62 STEEL PILING DRIVEN TO A MINIMUM BEARING VALUE OF 490 kN PER PILE. ESTIMATED 27 M LONG.

PIER TO BE SUPPORTED ON HP 250 X 62 STEEL PILING DRIVEN TO A MINIMUM BEARING VALUE OF 490 kN PER PILE. ESTIMATED 22 M LONG.


TRAFFIC VOLUME

U.S.H. 41 C.T.H. U
 A.D.T.=36,505 (2018) A.D.T.=1,650 (2018)
 R.D.S.=110 km/h R.D.S.=70 km/h

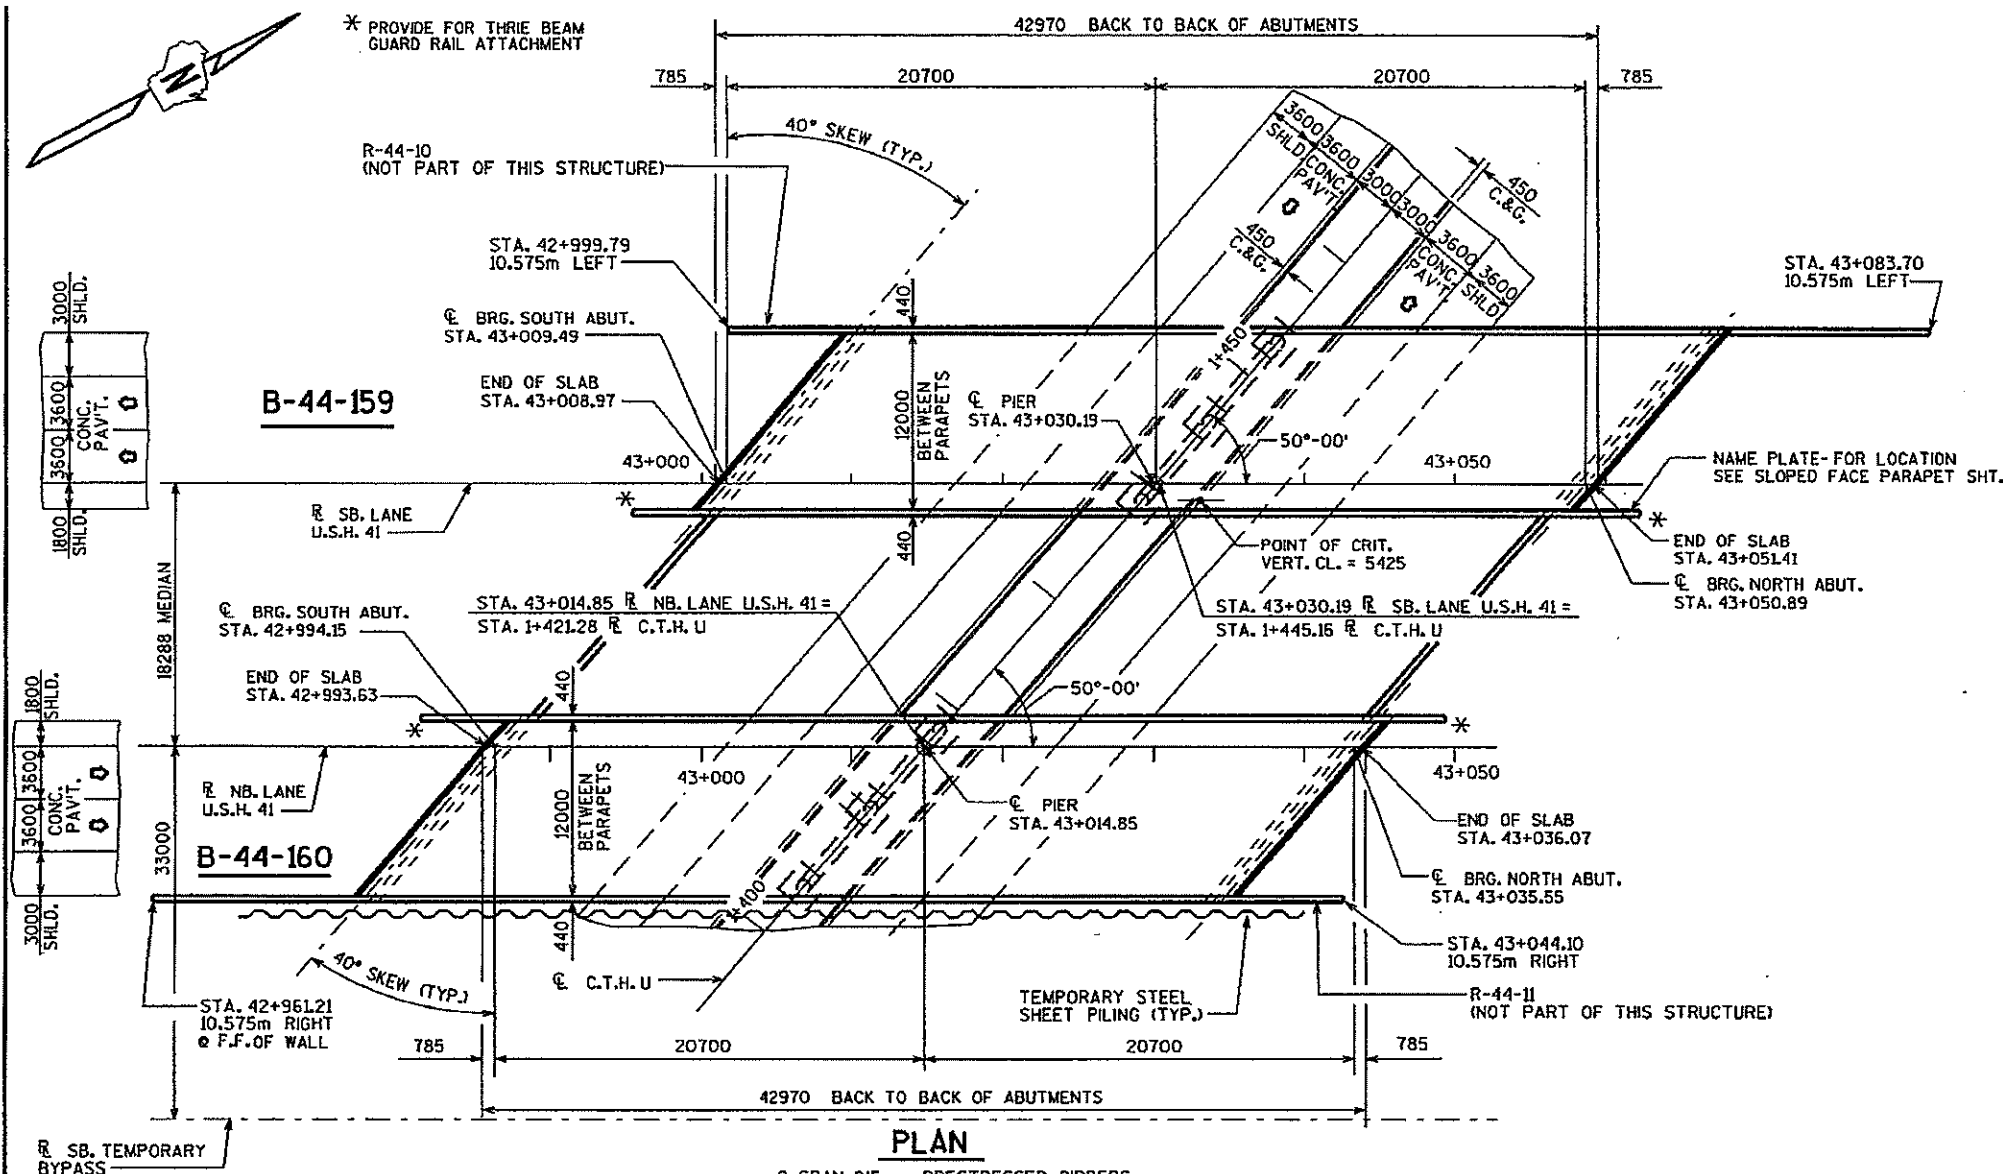


PLAN

2 SPAN-915mm PRESTRESSED GIRDERS

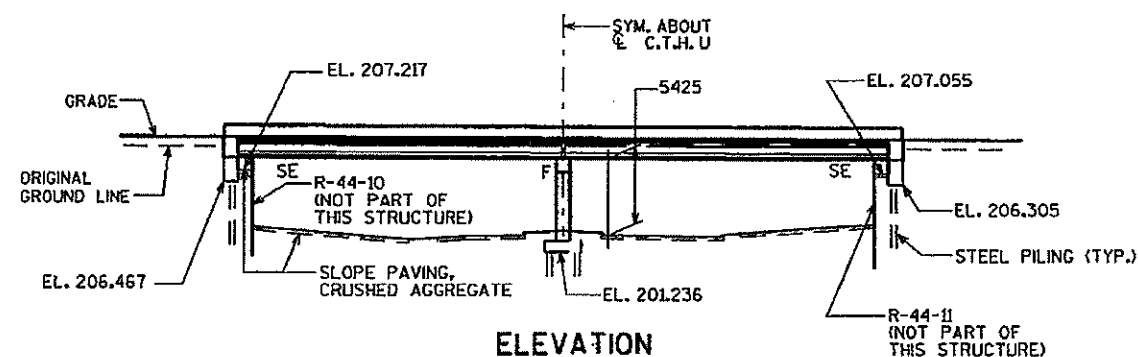

ELEVATION

NORMAL TO C.T.H. U

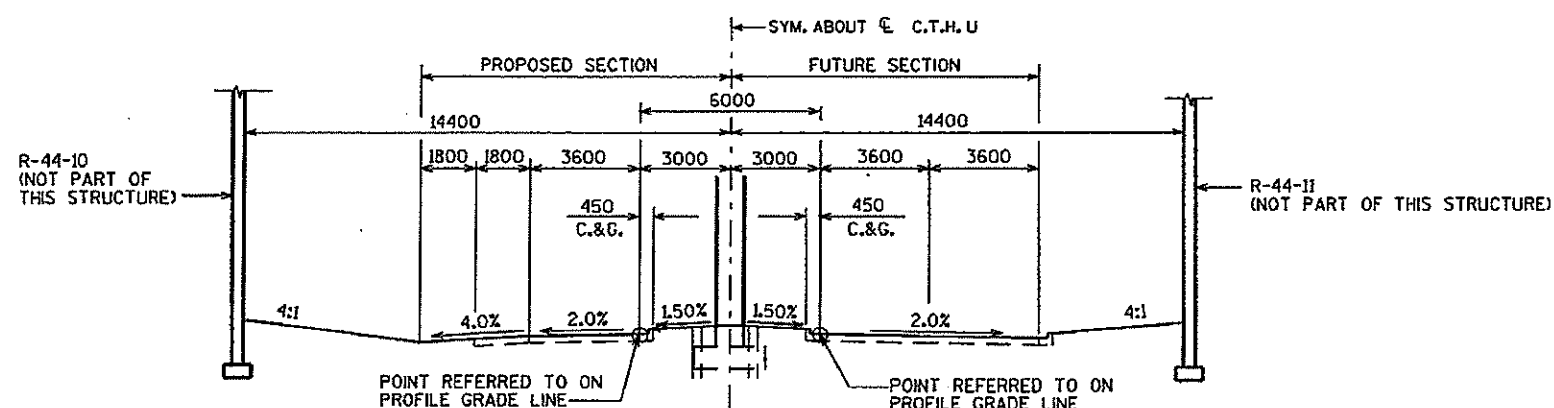

TYPICAL SECTION THRU C.T.H. U

LIST OF DRAWINGS

1. GENERAL PLAN
2. CROSS SECTION & QUANTITIES
3. SUBSURFACE EXPLORATION
4. SOUTH ABUTMENT
5. SOUTH ABUTMENT DETAILS
6. NORTH ABUTMENT
7. NORTH ABUTMENT DETAILS
8. PIER
9. SUPERSTRUCTURE
10. SUPERSTRUCTURE DETAILS
11. 915mm PRESTRESSED GIRDER DETAILS
12. STEEL DIAPHRAGM
13. SLOPED FACE PARAPET "LF"

BRIDGE OFFICE CONTACT :
 FINN HUBBARD (608) 266-8489
 KEITH NELSON (608) 266-5083

NO.	DATE	REVISION	BY
STATE OF WISCONSIN DEPARTMENT OF TRANSPORTATION DIVISION OF HIGHWAYS			
STRUCTURE B-44-159			
U.S.H. 41 OVER C.T.H. U			
COUNTY	OUTAGAMIE	TOWN/CITY/VILLAGE	KAUKAUNA
DESIGN SPEC.	AASHTO 1996	LOAD MS-18	CONST. SPEC. 1996
DESIGNED BY	KTN	DESIGN CK'D. DJK	DRAWN BY COMP/CMF
			PLANS CK'D. KTN
APPROVED	<i>H.A. Anderson</i> CHIEF BRIDGE DESIGN ENGINEER		11-17-98 DATE
GENERAL PLAN			SHEET 1 OF 1
			DATE: JULY '98

FILE= b441591599p.dgn
 SCALE= 250

Vertical Clearance for Construction of New Bridges, Replacement Bridges, and Bridges on which the Superstructure is being replaced¹

Overpass Facility →	Freeway, Expressway, or STH		Railroad ⁴ , CTH, Town Road, Local Road, or Street	Pedestrian or Shared-use Structures	Sign Structures ²
Underpass Facility ↓	Interchange	Grade Separation			
Non-arterial either STH, CTH, Town Road, Local Road, or Street	15'-9" Desirable	15'-3" Desirable	16'- 9" Desirable	18'-3" Minimum	
	15'-3" Minimum	14'-9" Minimum	16'-3" Minimum		
Arterial either CTH, Town Road, Local Road, or Street (excludes freeway and expressway; also excludes arterial STH)	16'-9" Desirable	15'-3" Desirable	17'- 9" Desirable		
	16'-3" Minimum	14'-9" Minimum	17'-3" Minimum		
Freeway ³ or Expressway or arterial STH	16'-9" Desirable		17'- 9" Desirable		
	16'-4" Minimum		17'-4" Minimum		
Railroad ^{4,5,6,7}	23'-0" Minimum to 23'-3½" Maximum				

General notes:

¹ Vertical clearance is needed for the entire roadway width (critical point; to include traveled way, auxiliary lanes, turn lanes, and shoulders), according to the above table.

Vertical clearance for railroads is measured from the top of rail and is required over an area 8 feet 6 inches from the track centerline on each side of a railroad track.

Do not exceed the desirable vertical clearance shown unless justified. Depending on topography and other specific situations vertical clearance for any structure may be greater than that shown when justified. Some things to consider are: over height loads traveling on the roadway; the level of development in the area, the projected growth in traffic volume and importance of the roadway, and the possibility of reclassification.

² See LRFD Bridge Manual Chapter 39 (http://on.dot.wi.gov/dtid_bos/extranet/structures/LRFD/LRFDManualIndex.htm) and LRFD Standard Details 39.02 and 39.10 for design considerations and requirements for vertical clearance on new and replacement Sign Structures.

³ See FDM 11-44-1 for vertical clearance guidance specific to Interstate freeways.

⁴ Consult with the Region Railroad Coordinator if the over-passing or under-passing facility is either a railroad or a "rails-to-trails" trail; or if a structure is owned by a railroad company.

⁵ A vertical clearance <23'-0" requires both an approved Exception to Standards (see FDM 11-1-2 and FDM 11-1-4) and early coordination with BTLR R&H, Railroads and Harbors Section (RHS) through the Region Railroad Coordinator. The Exception to Standards shall contain documentation that the Office of the Commissioner of Railroads (OCR) has been petitioned.

See Chapter 17 for additional information.

⁶ Provide justification for a vertical clearance >23'-3 ½" to the RHS.

⁷ Vertical clearance less than 23'-0" may be acceptable or desirable in certain situations, such as for spur tracks, lead tracks, some branch lines and even mainline tracks when other impediments to 23'-0" exist. Review such situations with the Railroad Project Coordination Engineer in RHS. Early coordination with RHS is required.



DAAR
ENGINEERING, INC.

PROJECT: _____

DATE: _____

DESCRIPTION: USH 41 over CTH U

SHEET _____ OF _____

B-44-159 (SB) & 160 (NB)


CALC. BY: _____

CHECKED BY: _____

Existing Structures are 40' x 141', 2-68' spans & 36" Girders
VC = 17.68' (SB) & 17.45' (NB) Retaining walls R-44-10 & 11

Existing Retaining walls are failing, so it is proposed to
remove them & build a longer structure, Salvage existing Median
pier?

Proposed Typical Half Section on CTH U

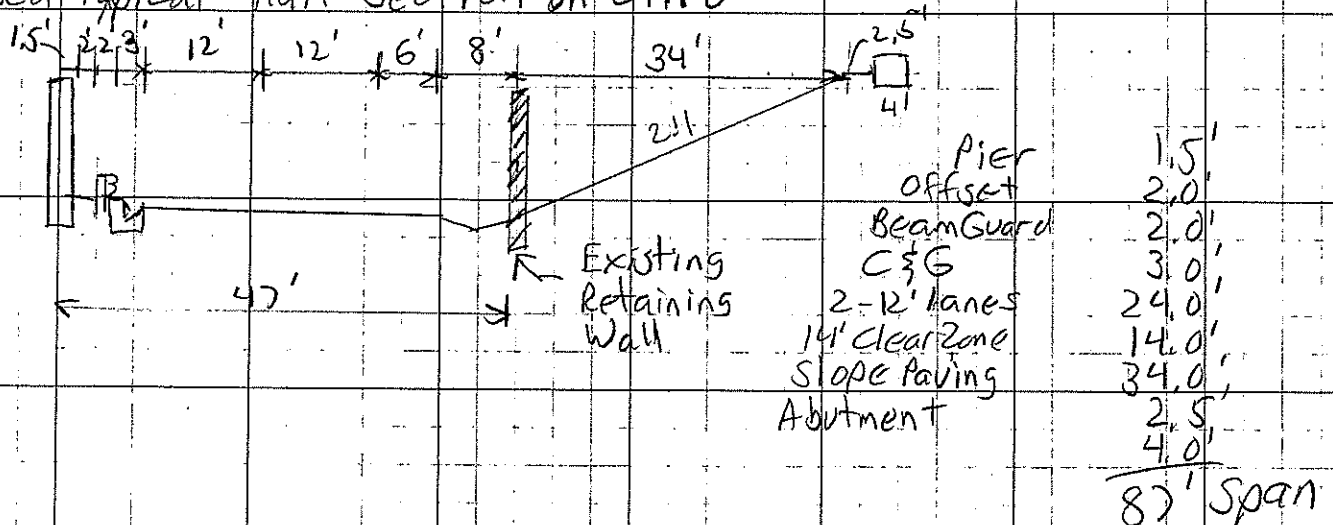

Widening in Median = $20' \times .02 = 0.4'$

$$\begin{array}{r} VC \text{ SB} = 17.68' \\ - 0.40' \\ \hline 17.28' \end{array}$$

$$\begin{array}{r} VC \text{ NB} = 17.45' \\ - 0.40' \\ \hline 17.05' \end{array}$$

Meets Desirable with no change to profiles

BRIDGE INSPECTION REPORT
Wisconsin Dept. of Transportation
DT2007 2003 s.84.17 Wis. Stats. Type = ROUTINE INSPECTION

page 1

Inventory Data

Feature On: USH 41		Maintainer: STATE HIGHWAY DEPT		Structure No: B-44-159
Feature Under: U		Sect/Twn/Rng: S27 T22N R19E		
Location: 2.7M S JCT CTH S		County: OUTAGAMI	Municipality: TOWN-KAUKAUNA (44026)	
Inv Rating: HS22.2	Rdwy Width (ft): 39.4	Deck Width (ft): 42.3	Existing Posting:	
Oper Rating: HS48.9	Total Length (ft): 141.0	Deck Area(ft2): 5964	ADT On: 18090 Yr: 2003	ADT Under: 0 Yr: 2000

Inspection Type (* = Supplemental Form Required)

	Routine Visual	Fracture Critical*	In-Depth*	UW-Dive*	UW-Surv*	UW-Probe/Visual*	Movable*
Last Insp.	10-17-11						
Frequency	24						
Recom. Freq.							
	Initial*	Damage	Interim	Load Posted	SI & A Field Review*		
Last Insp.							
Frequency	N/A						
Recom. Freq.	N/A				Item No. Needing Change		

Load Rating Information

Overburden	Measurement (in): 0.0	Date:	Deck Surface Type: CONCRETE	
Section Loss	File Meas. (%):	File Insp. Date: 10-19-09	Insp. Measurement (%):	Describe:
Re-rate for load capacity?	Reason:		Date Last Rated: 02-16-99	

Expansion Joints

Location	Type	Temp:		Signing Condition				
		File Insp. Date	File Insp. (in)	New Insp. (in)	Type of Marker	File	Y/N	Comments
					Bridge Markers			
					Narrow Bridge			
					One Lane Road			
					Vertical Clearance			
					Weight Limit Post			
					Other(Addl. Sign)			

Clearances(Cardinal = N or E)

	File Meas. (ft.)	File Date	New Meas. (ft.)
Min. Vertical Clearance Under (Cardinal)	17.68	02-17-00	
Min. Vertical Clearance Under (non-Cardinal)	17.45	02-17-00	
Min. Vertical Clearance On			

Structure Type

Construction/Rehabilitation History

Material	Configuration	# of Spans	Overall Length (ft)	Year	Work Performed	Plan	Shop
CONT PREST CO	DECK GIRDER		67.9	1999	NEW STRUCTURE	PLAN	
CONT PREST CO	DECK GIRDER		67.9				

Inspection Information

Special Requirements	Y/N	Comments				
Traffic Control	Y					
Access Equipment	Y					
Other	Y					

Inspector Information

Team Leader Name and No. Printed: Michaelson, Neil (3010)		Team Member(s) Name(s) Printed:	
Team Leader Signature:		Inspection Date: 10-17-11	Inspection Agency: STATE HIGHWAY DEPARTMENT (1)
District/Local Manager and No. Printed:		District/Local Manager Signature:	Review Date:

Element Inspection (X) Check Elements Inspected

Quantity in Condition States

Ck	Elem./Env.	Description	Unit	Total QTY.	1	2	3	4	5
X	26 / 4	Conc Deck/Coatd Bars	SF	5964	5964				
X	109 / 3	P/S Conc Open Girder	LF	820	820				
X	172 / 3	Painted Steel Diaphr	EA	10	10				
X	205 / 3	R/Conc Column	EA	3	3				
X	215 / 4	R/Conc Abutment	LF	91	87	4			
		Cracks on south abutment							
X	234 / 4	R/Conc Cap	LF	42	42				
X	250 / 3	Concrete Diaphragm	EA	5	5				
X	321 / 4	R/Conc Approach Slab	EA	2		2			
		End of approaches at edge of deck are deteriorating and settling							
X	331 / 4	Conc Bridge Railing	LF	314	254	60			
X	342 / 2	RipRap Slope Protect	EA	2	2				
X	358 / 4	Deck Cracking SmFlag	EA	1	1				
X	359 / 4	Und Dk Surf Sm Flag	EA	1	1				
		Diagonal cracking at the ends of the deck, some tranverse cracking							
X	400 / 4	Concrete Wingwall	EA	4	2		2		
		SW wingwall has moved approximately 2-3 inches; Also experiencing spalling at modular joints and differential settling of modular panels.							
		NW wingwall has moved approximately 1 inch west on the bottom of the precast panel located at the back of abutment face.							

General Inspection/Maintenance Notes

--

Maintenance Recommendations (See standard code items & numbers)

Maintenance Item: Approach - Seal Joint along Parapet/Wing	
Amount:	Date(YYYY-MM-DD):
Maintenance item comment: Seal open joint at the junction between parapet and end of deck at the pavement surface.	

Maintenance Item:	
Amount:	Date(MM-DD-YY):
Maintenance item comment:	

NBI Ratings

NBI	File	New	NBI	File	New
Deck	8	8	Culvert	N	N
Superstructure	8	8	Channel	N	N
Substructure	7	7	Waterway	N	N

Maintenance Item:	
Amount:	Date(MM-DD-YY):
Maintenance item comment:	

STRUCTURE INVENTORY AND APPRAISAL FIELD REVIEW FORM

B-44-159
USH 41 over U

(3) Municipality:
(16) Latitude(° ' "):
(17) Longitude(° ' "):

LOCATION	
TOWN-KAUKAUNA (44026)	
44°20'59.57"N	
88°11'35.53"W	

(28A) Lanes On:
(28B) Lanes Under:
(102) Traffic Pattern On:
(102) Traffic Pattern Under:
(19) Detour Length(mi):

TRAFFIC SERVICE	
2	
2	
-NO TRAFFIC X-ONE WAY TRAFFIC -TWO WAY TRAFFIC	
-NO TRAFFIC -ONE WAY TRAFFIC X-TWO WAY TRAFFIC	
0	

(49) Structure Length(ft):
(50) Sidewalk Width(ft):
(50) Curb Width(ft):
(52) Culvert Barrel Length(ft):
(34) Skew:

GEOMETRY	
141.0	
Left: 0.0	Right: 0.0
Angle(°): 40	Direction: -RIGHT FORWARD X-LEFT FORWARD
Cardinal Width	Non-Cardinal Width
39.4	39.4
42.3	42.3
39	0
Cardinal Under Clearance	Non-Cardinal Under Clearance
32.2	32.2
11.8	11.8
8.5	8.5

(51) Bridge Roadway(ft):
(52) Deck(ft):
(32) Approach Roadway(ft):
(47) Minimum Horizontal(ft):
(55) Minimum Right Lateral(ft):
(55) Minimum Left Lateral(ft):

(36A) Bridge Rail Adequacy:
(36B) Transition Adequacy:
(36C) Approach Guardrail Adequacy:
(36D) Guardrail Termination Adequacy:
Outer Rail:

RAILING APPRAISAL		
-SUB-STANDARD	X-STANDARD	-NOT APPLICABLE
-SUB-STANDARD	X-STANDARD	-NOT APPLICABLE
-SUB-STANDARD	X-STANDARD	-NOT APPLICABLE
-SUB-STANDARD	X-STANDARD	-NOT APPLICABLE
Left	Right	Type
		TYPE F (TWO SQUARE TUBES) - STEEL(8)
		TYPE F (3 SQUARE TUBES) - STEEL(65)
		TYPE F (4 SQUARE TUBES) - STEEL(72)
		TYPE M-STEEL 3 SQUARE TUBES(93)
	X	SLOPED FACE PARAPET LF(91)
		SLOPED FACE PARAPET HF(92)
		VERTICAL FACE PARAPET TYPE A(74)
		TYPE W-THREE BEAM(79)
		TYPE H ON VERTICAL PARAPET(80)
		TIMBER(38)
X		OTHER(99) (Please specify)
		Left:
Transition Type:		
		CONT GUARD RAIL
		NO APP GRDRL
		NO ATTACHMENT
5		22 MM(7/8") BOLT (Please enter quantity)
		25 MM(1") BOLT (Please enter quantity)
		OTHER (Please specify)
Guardrail Termination Type:		
		(01) ENERGY ABSORBING TERMINAL/EAT
		(02) TURN DOWN
		(99) OTHER (Please specify)

(72) Approach Alignment Appraisal:

ROADWAY ALIGNMENT APPRAISAL	
	(3) INTOLERABLE- Horizontal or Vertical curvature requires a substantial reduction in vehicle operating speed
	(6) FAIR- Horizontal or Vertical curvature requires a very minor speed reduction
X	(8) GOOD- No speed reduction required

BRIDGE INSPECTION REPORT
Wisconsin Dept. of Transportation
DT2007 2003 s.84.17 Wis. Stats. Type = ROUTINE INSPECTION

page 1

Inventory Data

Feature On: USH41 NB		Maintainer: STATE HIGHWAY DEPT		Structure No: B-44-160
Feature Under: U		Sect/Twn/Rng: S27 T22N R19E		
Location: 3.2M N JCT JJ		County: OUTAGAMI	Municipality: TOWN-KAUKAUNA (44026)	
Inv Rating: HS22.2	Rdwy Width (ft): 39.4	Deck Width (ft): 42.3	Existing Posting:	
Oper Rating: HS48.9	Total Length (ft): 141.0	Deck Area(ft2): 5964	ADT On: 18460 Yr: 2003	ADT Under: 0 Yr: 2000

Inspection Type (* = Supplemental Form Required)

	Routine Visual	Fracture Critical*	In-Depth*	UW-Dive*	UW-Surv*	UW-Probe/Visual*	Movable*
Last Insp.	10-17-11						
Frequency	24						
Recom. Freq.							
	Initial*	Damage	Interim	Load Posted	SI & A Field Review*		
Last Insp.							
Frequency	N/A						
Recom. Freq.	N/A				Item No. Needing Change		

Load Rating Information

Overburden	Measurement (in): 0.0	Date:	Deck Surface Type: CONCRETE	
Section Loss	File Meas. (%):	File Insp. Date: 10-19-09	Insp. Measurement (%):	Describe:
Re-rate for load capacity?	Reason:		Date Last Rated: 02-16-99	

Expansion Joints

Location	Type	Temp:		Signing Condition			
		File Insp. Date	File Insp. (in)	New Insp. (in)	Type of Marker	File	Y/N
					Bridge Markers		
					Narrow Bridge		
					One Lane Road		
					Vertical Clearance		
					Weight Limit Post		
					Other(Addl. Sign)		

Clearances(Cardinal = N or E)

	File Meas. (ft.)	File Date	New Meas. (ft.)
Min. Vertical Clearance Under (Cardinal)	17.68	02-17-00	
Min. Vertical Clearance Under (non-Cardinal)	17.68	02-17-00	
Min. Vertical Clearance On			

Structure Type

Construction/Rehabilitation History

Material	Configuration	# of Spans	Overall Length (ft)	Year	Work Performed	Plan	Shop
CONT PREST CO	DECK GIRDER		67.9	1999	NEW STRUCTURE	PLAN	
CONT PREST CO	DECK GIRDER		67.9				

Inspection Information

Special Requirements	Y/N	Comments				
Traffic Control	Y					
Access Equipment	Y					
Other	Y					

Inspector Information

Team Leader Name and No. Printed: Michaelson, Neil (3010)		Team Member(s) Name(s) Printed:	
Team Leader Signature:		Inspection Date: 10-17-11	Inspection Agency: STATE HIGHWAY DEPARTMENT (1)
District/Local Manager and No. Printed:		District/Local Manager Signature:	Review Date:

Element Inspection (X) Check Elements Inspected

					Quantity in Condition States				
Ck	Elem./Env.	Description	Unit	Total QTY.	1	2	3	4	5
X	26 / 4	Conc Deck/Coatd Bars	SF	5964	5964				
		Diagonal cracking at abutments							
X	109 / 3	P/S Conc Open Girder	LF	820	820				
X	172 / 3	Painted Steel Diaphr	EA	10	10				
X	205 / 3	R/Conc Column	EA	3	3				
X	215 / 4	R/Conc Abutment	LF	91	85	6			
		CS-2 (N Abut 3" & S Abut 3"), Leaking at joint East support keyway (?) appears to have moved out							
X	234 / 4	R/Conc Cap	LF	42	42				
X	250 / 3	Concrete Diaphragm	EA	5	5				
X	321 / 4	R/Conc Approach Slab	EA	2		2			
		Spalled and cracked on South end							
X	331 / 4	Conc Bridge Railing	LF	314	254	60			
X	342 / 2	RipRap Slope Protect	EA	2	1	1			
X	358 / 4	Deck Cracking SmFlag	EA	1	1				
X	359 / 4	Und Dk Surf Sm Flag	EA	1	1				
X	400 / 4	Concrete Wingwall	EA	4	2	2			
		NE & SE wing settled 1" Tipped out 1-1/2" at the top on NE corner.							

General Inspection/Maintenance Notes

MSE walls at NE & SE corners of abutments settling, cracking, spalling, and leaking.

Maintenance Recommendations (See standard code items & numbers)

Maintenance Item: Approach - Seal Approach to Paving Block

Amount: **Date(YYYY-MM-DD):**

Maintenance item comment: Seal hole in pavement at the junction between the parapet and the wingwall

Maintenance Item:

Amount: **Date(MM-DD-YY):**

Maintenance item comment:

NBI Ratings

NBI	File	New	NBI	File	New
Deck	8	8	Culvert	N	N
Superstructure	8	8	Channel	N	N
Substructure	7	7	Waterway	N	N

Maintenance Item:

Amount: **Date(MM-DD-YY):**

Maintenance item comment:

STRUCTURE INVENTORY AND APPRAISAL FIELD REVIEW FORM

B-44-160
USH41 NB over U

- (3) Municipality:
(16) Latitude(" ' "):
(17) Longitude(" ' "):

LOCATION	
TOWN-KAUKAUNA (44026)	
44°20'56.86"N	
88°11'35.91"W	

- (28A) Lanes On:
(28B) Lanes Under:
(102) Traffic Pattern On:
(102) Traffic Pattern Under:
(19) Detour Length(mi):

TRAFFIC SERVICE	
2	
2	
-NO TRAFFIC X-ONE WAY TRAFFIC -TWO WAY TRAFFIC	
-NO TRAFFIC -ONE WAY TRAFFIC X-TWO WAY TRAFFIC	
0	

- (49) Structure Length(ft):
(50) Sidewalk Width(ft):
(50) Curb Width(ft):
(52) Culvert Barrel Length(ft):
(34) Skew:

(51) Bridge Roadway(ft):
(52) Deck(ft):
(32) Approach Roadway(ft):

(47) Minimum Horizontal(ft):
(55) Minimum Right Lateral(ft):
(55) Minimum Left Lateral(ft):


GEOMETRY	
141.0	
Left: 0.0	Right: 0.0
Angle(°): 40	Direction: -RIGHT FORWARD X-LEFT FORWARD
Cardinal Width	Non-Cardinal Width
39.4	39.4
42.3	42.3
39	0
Cardinal Under Clearance	Non-Cardinal Under Clearance
34.0	34.5
14.0	14.0
8.0	8.5

- (36A) Bridge Rail Adequacy:
(36B) Transition Adequacy:
(36C) Approach Guardrail Adequacy:
(36D) Guardrail Termination Adequacy:
Outer Rail:


RAILING APPRAISAL	
-SUB-STANDARD X-STANDARD -NOT APPLICABLE	
-SUB-STANDARD X-STANDARD -NOT APPLICABLE	
-SUB-STANDARD X-STANDARD -NOT APPLICABLE	
-SUB-STANDARD X-STANDARD -NOT APPLICABLE	
Left	Right Type
	TYPE F (TWO SQUARE TUBES) - STEEL(8)
	TYPE F (3 SQUARE TUBES) - STEEL(65)
	TYPE F (4 SQUARE TUBES) - STEEL(72)
	TYPE M-STEEL 3 SQUARE TUBES(93)
X	X SLOPED FACE PARAPET LF(91)
	SLOPED FACE PARAPET HF(92)
	VERTICAL FACE PARAPET TYPE A(74)
	TYPE W-THREE BEAM(79)
	TYPE H ON VERTICAL PARAPET(80)
	TIMBER(38)
	OTHER(99) (Please specify)
Transition Type:	
	CONT GUARD RAIL
	NO APP GRDRL
	NO ATTACHMENT
5	22 MM(7/8") BOLT (Please enter quantity)
	25 MM(1") BOLT (Please enter quantity)
	OTHER (Please specify)
Guardrail Termination Type:	
X	(01) ENERGY ABSORBING TERMINAL/EAT
	(02) TURN DOWN
	(99) OTHER (Please specify)

- (72) Approach Alignment Appraisal:


ROADWAY ALIGNMENT APPRAISAL	
	(3) INTOLERABLE- Horizontal or Vertical curvature requires a substantial reduction in vehicle operating speed
	(6) FAIR- Horizontal or Vertical curvature requires a very minor speed reduction
X	(8) GOOD- No speed reduction required

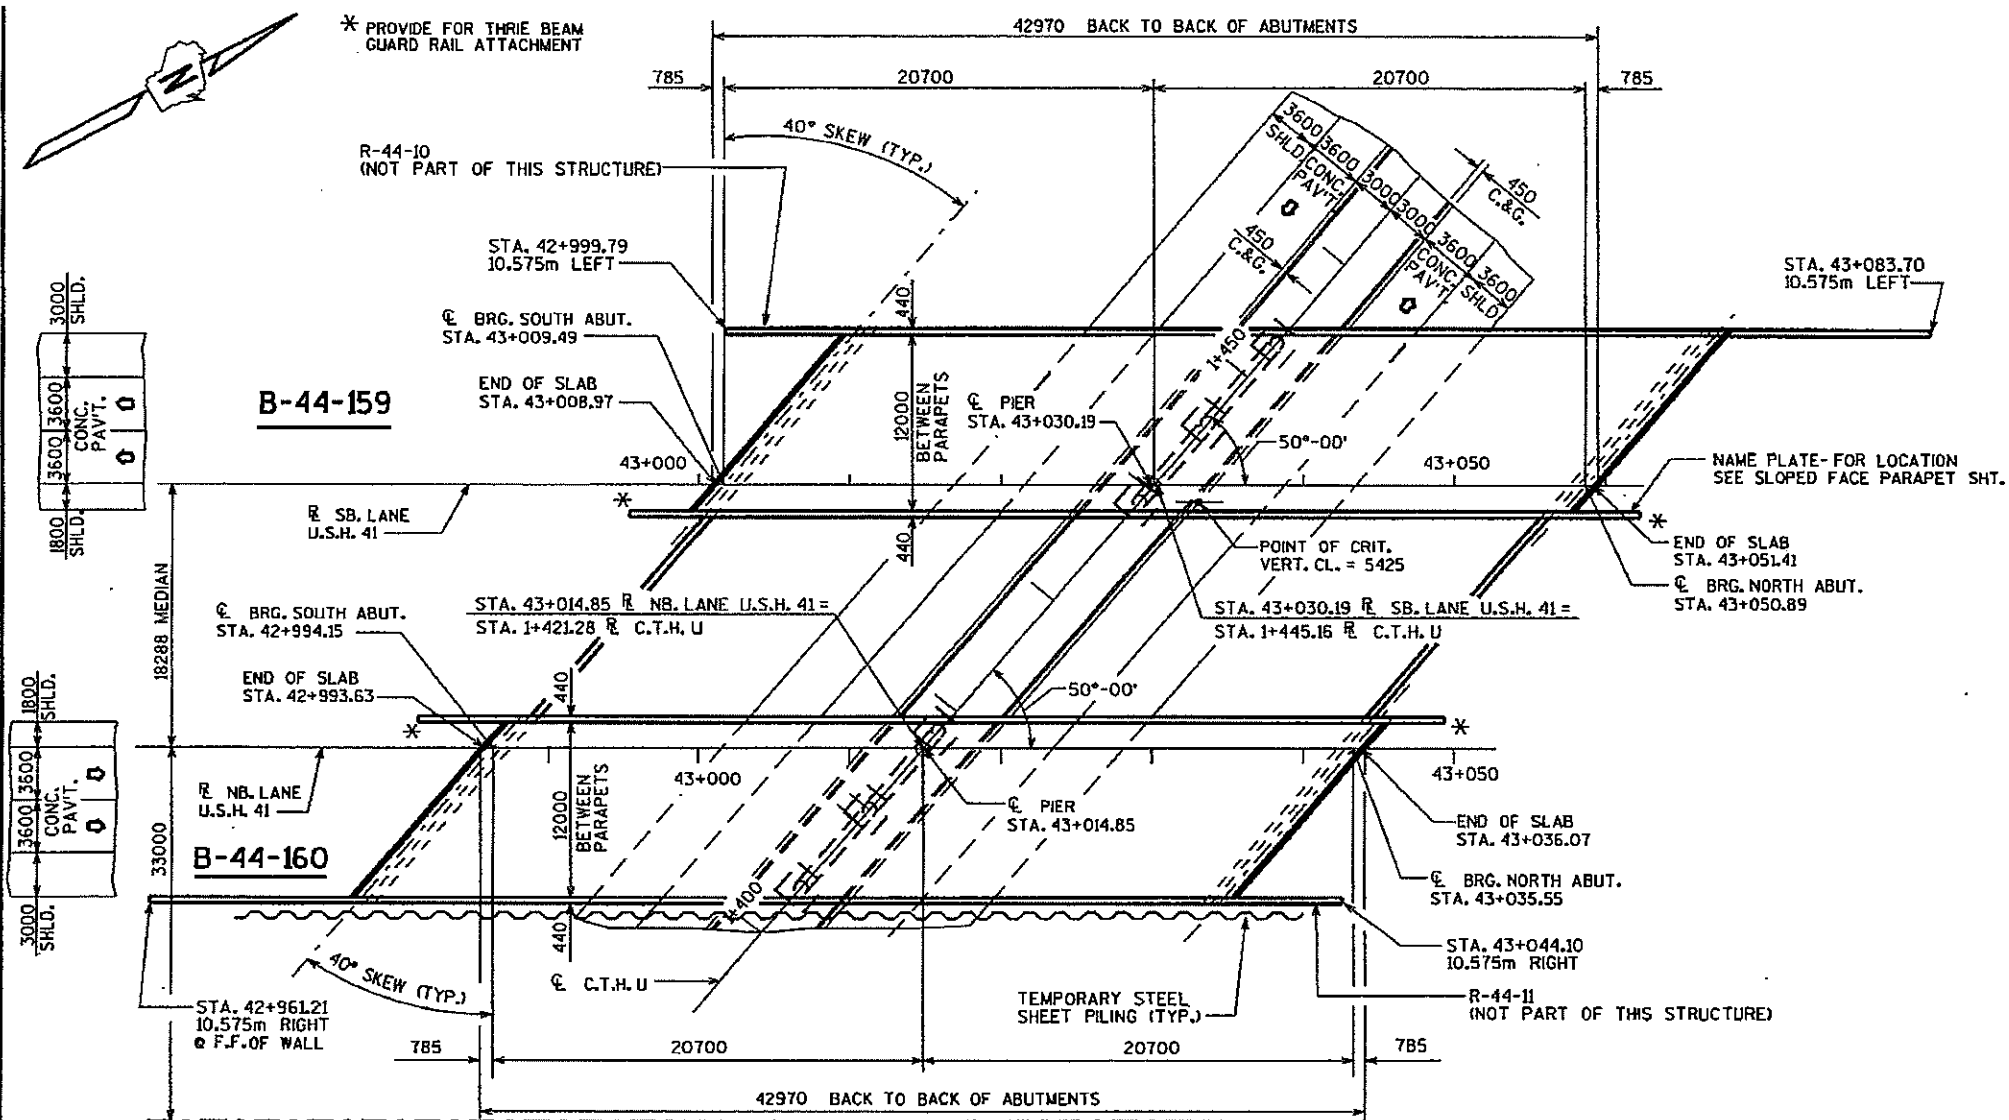

PLAN

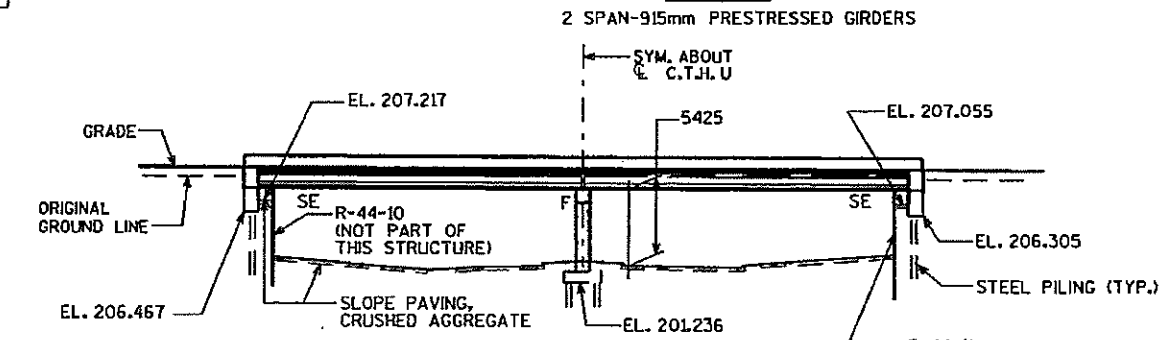

ELEVATION

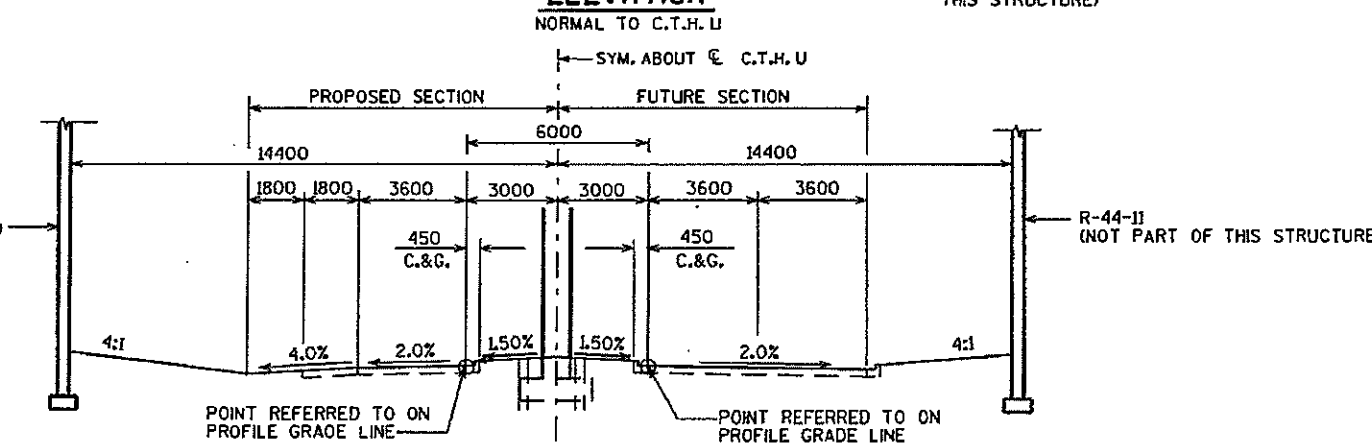

TYPICAL SECTION THRU C.T.H.U.

DESIGN DATA

LIVE LOAD:
 DESIGN RATING: MS-18
 INVENTORY RATING: MS-20
 OPERATIONAL RATING: MS-44
 MAXIMUM STANDARD PERMIT VEHICLE LOAD = 110 kN.
 STRUCTURE IS DESIGNED FOR A FUTURE WEARING SURFACE OF 1.0 kN/m².

ULTIMATE DESIGN STRESSES:
 CONCRETE MASONRY SLAB — $f'_c = 28 \text{ MPa}$ ALL OTHER — $f'_c = 24 \text{ MPa}$
 BAR STEEL REINFORCEMENT, AASHTO M-42M, GRADE 420 — $f_y = 420 \text{ MPa}$
 915mm PRESTRESSED GIRDERS, CONCRETE MASONRY — $f'_c = 45 \text{ MPa}$
 STRANDS - 13mm DIA. WITH ULTIMATE TENSILE STRENGTH OF 1860 MPa

FOUNDATION DATA

ABUTMENTS TO BE SUPPORTED ON HP 250 X 62 STEEL PILING DRIVEN TO A MINIMUM BEARING VALUE OF 490 kN PER PILE. ESTIMATED 27 M LONG.

PIER TO BE SUPPORTED ON HP 250 X 62 STEEL PILING DRIVEN TO A MINIMUM BEARING VALUE OF 490 kN PER PILE. ESTIMATED 22 M LONG.

TRAFFIC VOLUME

U.S.H. 41	C.T.H.U.
A.D.T.=36,505 (2018)	A.D.T.=1,650 (2018)
R.O.S.=110 km/h	R.O.S.=70 km/h

LIST OF DRAWINGS

1. GENERAL PLAN
2. CROSS SECTION & QUANTITIES
3. SUBSURFACE EXPLORATION
4. SOUTH ABUTMENT
5. SOUTH ABUTMENT DETAILS
6. NORTH ABUTMENT
7. NORTH ABUTMENT DETAILS
8. PIER
9. SUPERSTRUCTURE
10. SUPERSTRUCTURE DETAILS
11. 915 mm PRESTRESSED GIRDER DETAILS
12. STEEL DIAPHRAGM
13. SLOPED FACE PARAPET "LF"


BRIDGE OFFICE CONTACT :
 FINN HUBBARD (608) 266-8489
 KEITH NELSON (608) 266-5083

NO.	DATE	REVISION	BY
STATE OF WISCONSIN DEPARTMENT OF TRANSPORTATION DIVISION OF HIGHWAYS			
STRUCTURE B-44-159			
U.S.H. 41 OVER C.T.H.U.			
COUNTY	OUTAGAMIE	TOWN/CITY/VILLAGE	KAUKAUNA
DESIGN SPEC.	AASHTO 1996	LOAD	MS-18
DESIGNED BY	KTN	CONST. SPEC.	1996
DESIGN CK'D.	DJK	PLANS CK'D.	KTN
APPROVED	CHIEF BRIDGE DESIGN ENGINEER		DATE
GENERAL PLAN			SHEET 1 OF 13
			DATE: JULY '98


FILE= br b441591599p.dgn
 SCALE= 250

1131-08-72

8.2

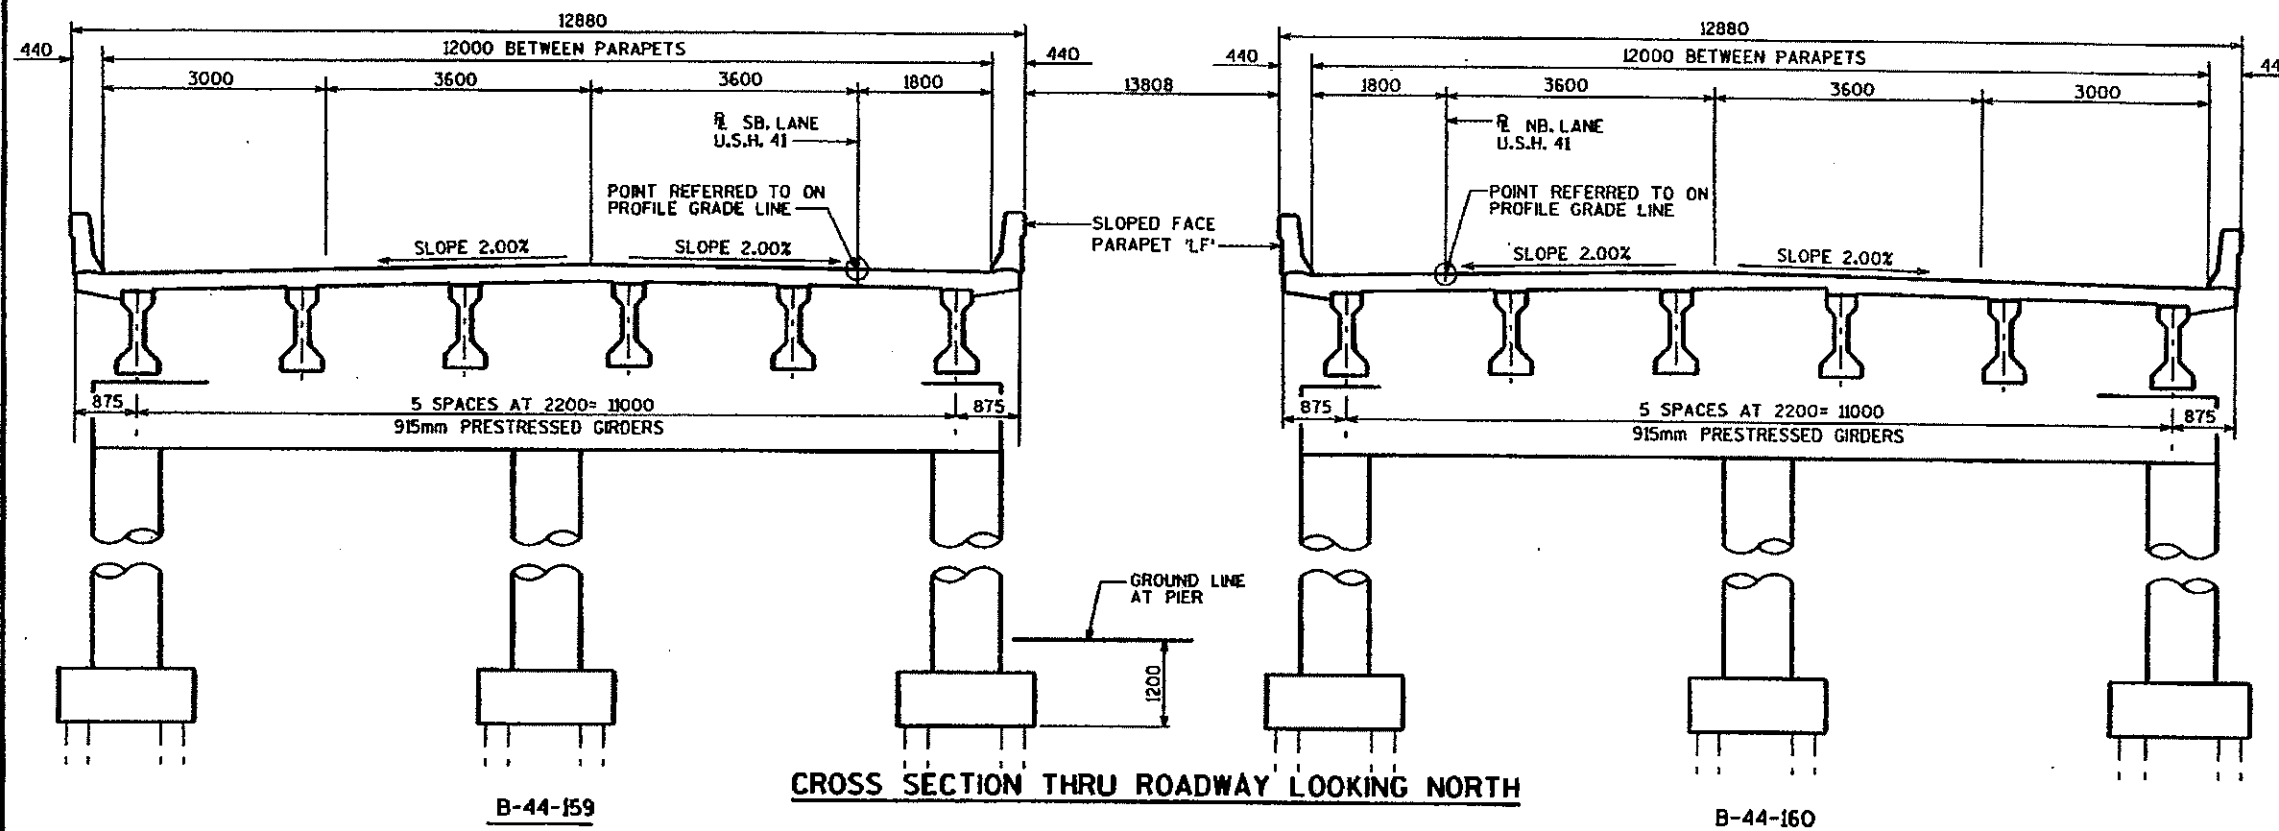


CROSS SECTION THRU ROADWAY LOOKING NORTH

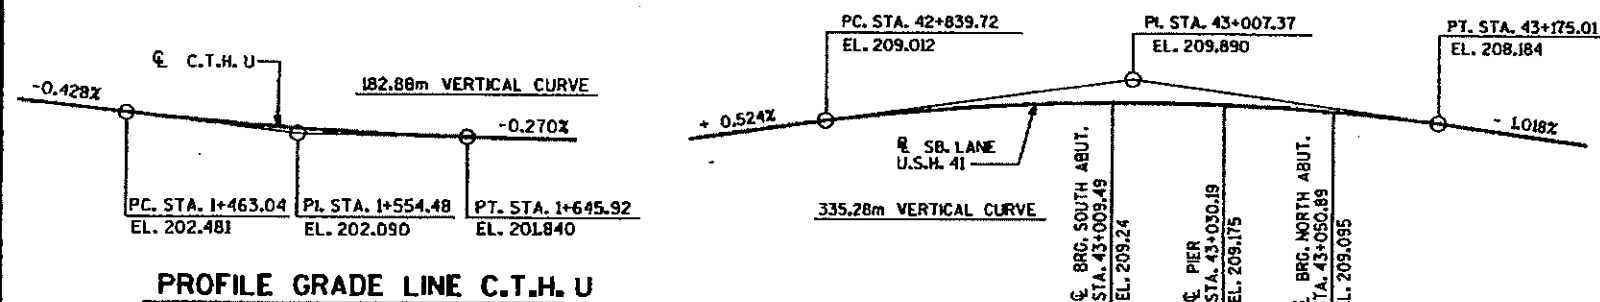

PROFILE GRADE LINE C.T.H. U

TOTAL ESTIMATED QUANTITIES

BID ITEMS	UNIT	SUPER.	SOUTH ABUT.	NORTH ABUT.	PIER 1	TOTALS
EXCAVATION FOR STRUCTURES, BRIDGES, B-44-159	L.S.					1
STRUCTURE BACKFILL	m ³		91	91		182
CONCRETE MASONRY, BRIDGES	m ³	179	34	32	33	278
PROTECTIVE SURFACE TREATMENT	m ²	608				608
PRESTRESSED GIRDER, TYPE, 915 mm	m	250				250
HIGH-STRENGTH BAR STEEL REINFORCEMENT, BRIDGES	kg		1740	1710	170	3620
COATED HIGH-STRENGTH BAR STEEL REINFORCEMENT, BRIDGES	kg	20435	298	237	2583	23550
NON-LAMINATED ELASTOMERIC BEARING PADS	EACH		6	6	6	18
STEEL PILING, DELIVERED AND DRIVEN, HP 250 X 62	m		216	216	264	696
RUBBERIZED MEMBRANE WATERPROOFING	m ²		8	8		16
SLOPE PAVING, GRAVELLED AGGREGATE BREAKER RUN	m ²		84	84		168
ANCHOR ASSEMBLIES FOR STEEL PLATE BEAM GUARD	EACH		1	1		2
STEEL DIAPHRAGMS, STRUCTURE B-44-159	EACH	10				10
NON-BID ITEMS						
FILLER	SIZE					13 & 19

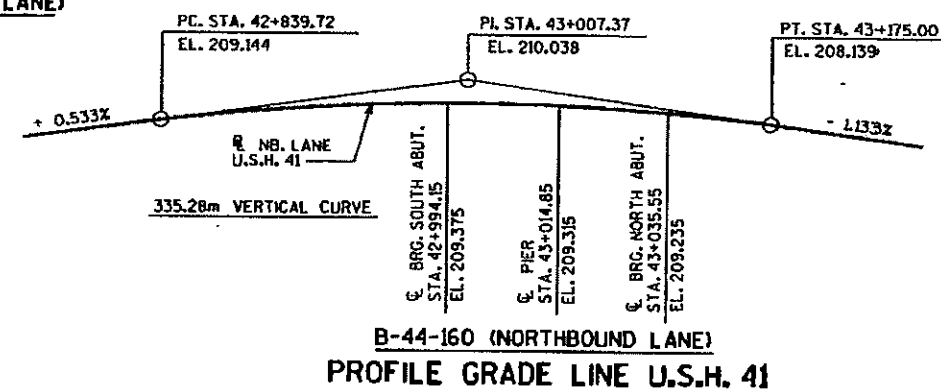B-44-160 (NORTHBOUND LANE)
PROFILE GRADE LINE U.S.H. 41

GENERAL NOTES

DRAWINGS SHALL NOT BE SCALED.
BAR STEEL REINFORCEMENT SHALL BE EMBEDDED 50 mm CLEAR UNLESS OTHERWISE SHOWN OR NOTED.
ALL REINFORCING BARS ARE METRIC AND THE FIRST TWO DIGITS OF THE BAR MARK SIGNIFIES THE BAR SIZE
ALL DIMENSIONS MILLIMETERS (mm) UNLESS OTHERWISE NOTED.
ALL STATIONS AND ALL ELEVATIONS ARE METERS (m).
ELASTOMERIC BEARING PADS NEED NOT BE INDIVIDUALLY MOLDED PROVIDED THE CUT EDGES ARE SMOOTH AND TRUE.
THE EXISTING GROUND LINE SHALL BE USED AS THE UPPER LIMITS OF EXCAVATION AT THE PIERS.
AT THE BACKFACE OF ABUTMENT ALL EXCAVATED VOLUME NOT OCCUPIED BY THE NEW STRUCTURE SHALL BE BACKFILLED WITH STRUCTURE BACKFILL.

NO.	DATE	REVISION	BY
STATE OF WISCONSIN DEPARTMENT OF TRANSPORTATION DIVISION OF HIGHWAYS			
STRUCTURE B-44-159			
CONST. SPEC.	1996	DRAWN BY	RIES
		PLANS Ckd.	KTN
CROSS SECTION & QUANTITIES			SHEET 2

br44 b159:159gd.dgn

1131-08-72

8.14

DESIGN DATA

LIVE LOAD:

DESIGN RATING: MS-18
 INVENTORY RATING: MS-20
 OPERATIONAL RATING: MS-44
 MAXIMUM STANDARD PERMIT VEHICLE LOAD = 110 KN.
 STRUCTURE IS DESIGNED FOR A FUTURE WEARING SURFACE OF 10 KN/m².

ULTIMATE DESIGN STRESSES:

CONCRETE MASONRY SLAB $f'_c = 28 \text{ MPa}$ ALL OTHER $f'_c = 24 \text{ MPa}$
 BAR STEEL REINFORCEMENT, AASHTO M-42M, GRADE 420 $f_y = 420 \text{ MPa}$
 915mm PRESTRESSED GIRDERS, CONCRETE MASONRY $f'_c = 45 \text{ MPa}$
 STRANDS - 13mm DIA. WITH ULTIMATE TENSILE STRENGTH OF 1860 MPa
 TEMP. STEEL SHEET PILING $\text{MIN. } S_x = 1065 \times 10^3 \text{ mm}^4/\text{m}$


FOUNDATION DATA

ABUTMENTS TO BE SUPPORTED ON HP 250 X 62 STEEL PILING DRIVEN TO A MINIMUM BEARING VALUE OF 490 KN PER PILE. ESTIMATED 27 M LONG.

PIER TO BE SUPPORTED ON HP 250 X 62 STEEL PILING DRIVEN TO A MINIMUM BEARING VALUE OF 490 KN PER PILE. ESTIMATED 22 M LONG.


TRAFFIC VOLUME

U.S.H. 41 C.T.H. U
 A.D.T.=36,505 (2018) A.D.T.=1,650 (2018)
 R.D.S.=110 km/h R.D.S.=70 km/h

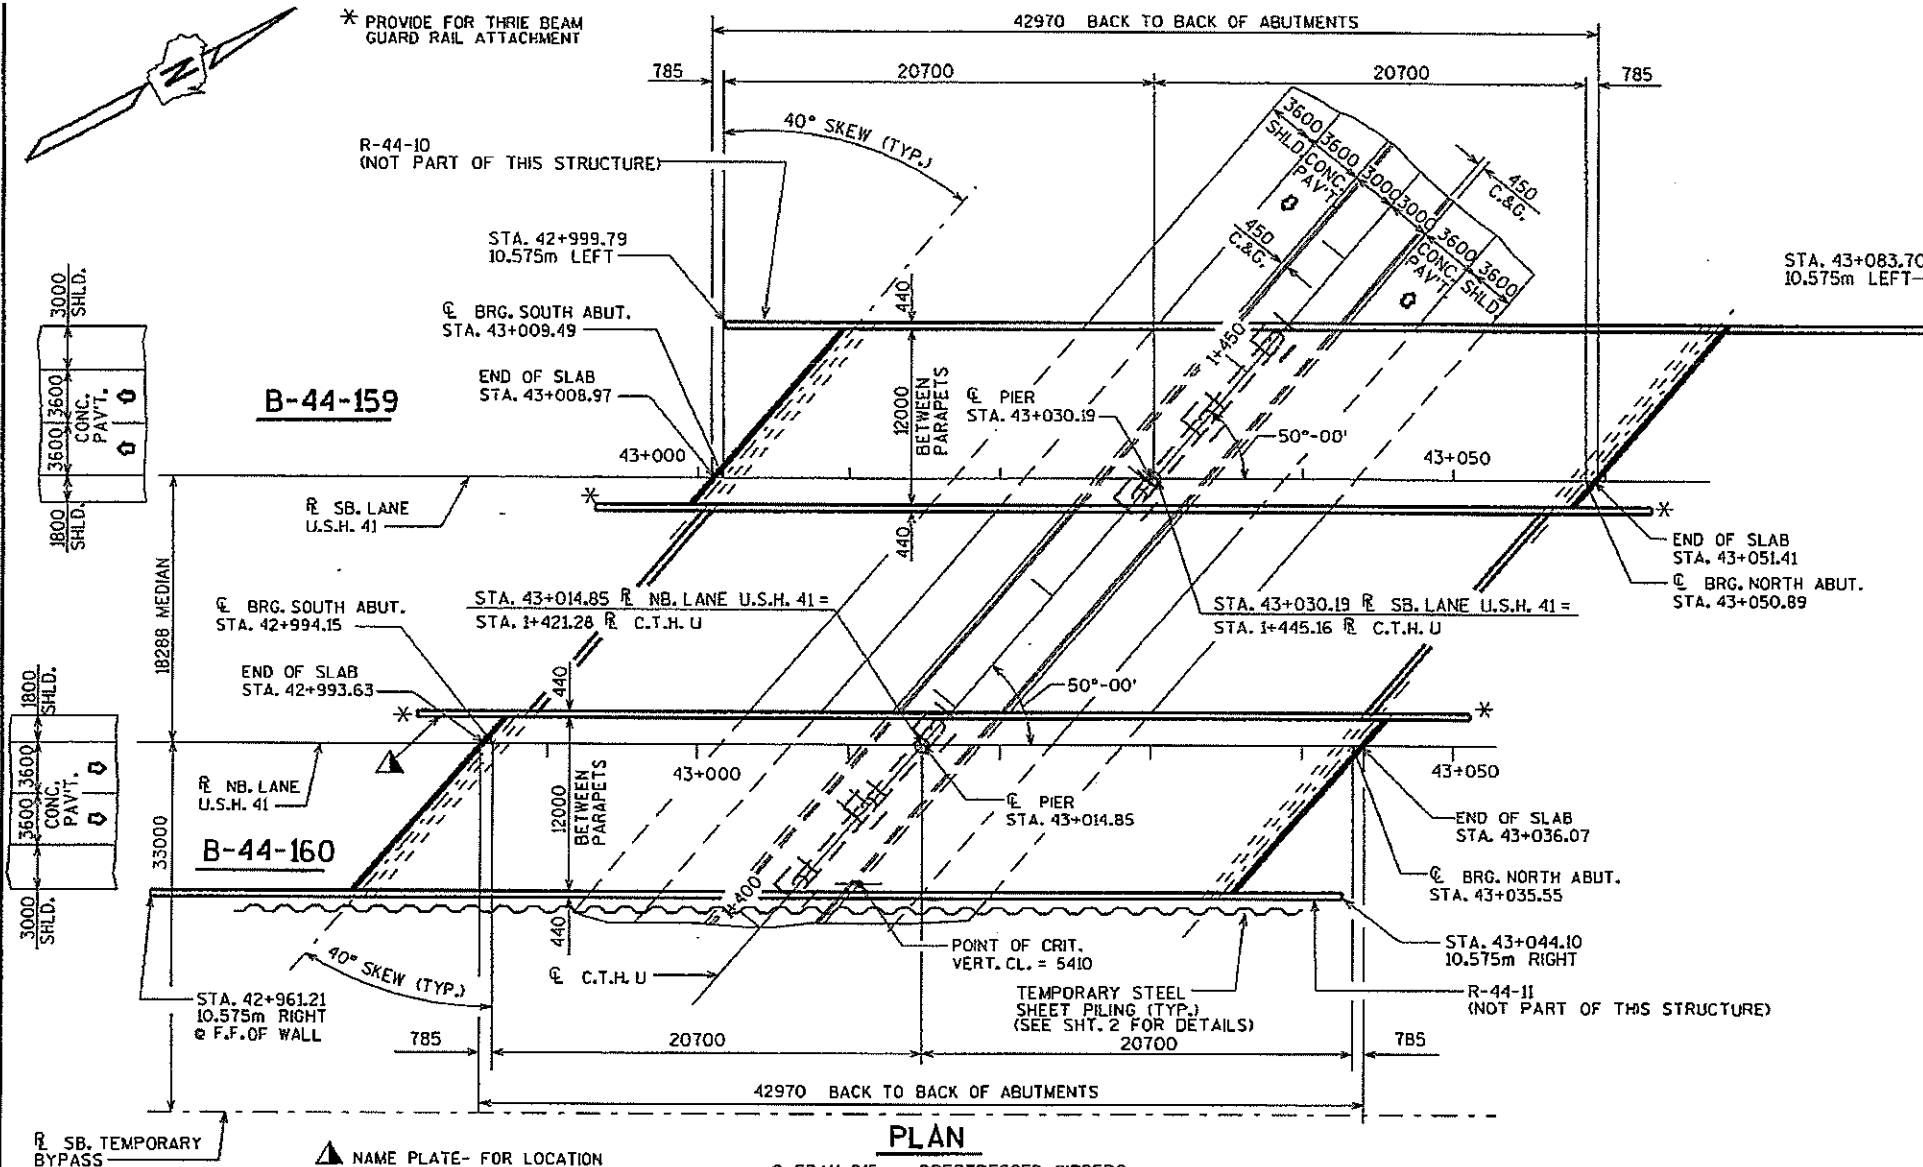

PLAN

2 SPAN-915mm PRESTRESSED GIRDERS

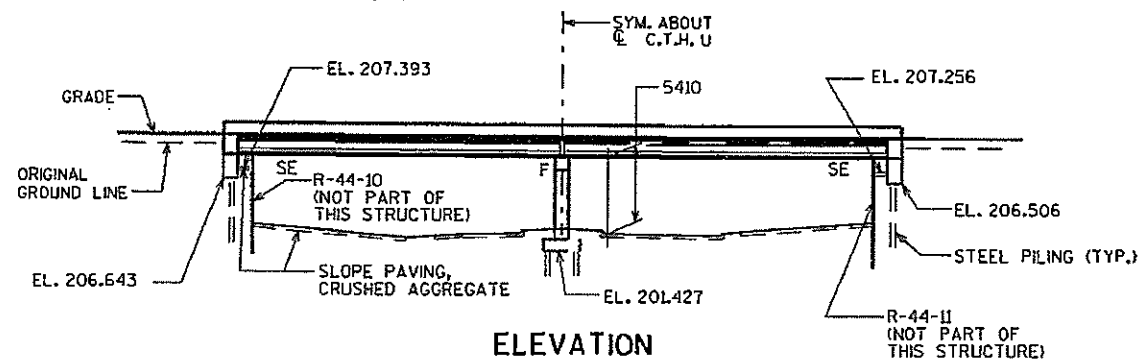

ELEVATION


NORMAL TO C.T.H.U

LIST OF DRAWINGS

1. GENERAL PLAN
2. CROSS SECTION & QUANTITIES
3. SUBSURFACE EXPLORATION
4. SOUTH ABUTMENT
5. SOUTH ABUTMENT DETAILS
6. NORTH ABUTMENT
7. NORTH ABUTMENT DETAILS
8. PIER
9. SUPERSTRUCTURE
10. SUPERSTRUCTURE DETAILS
11. 915mm PRESTRESSED GIRDER DETAILS
12. STEEL DIAPHRAGM
13. SLOPED FACE PARAPET "LF"

BRIDGE OFFICE CONTACT :

FINN HUBBARD (608) 266-8489
 KEITH NELSON (608) 266-5083

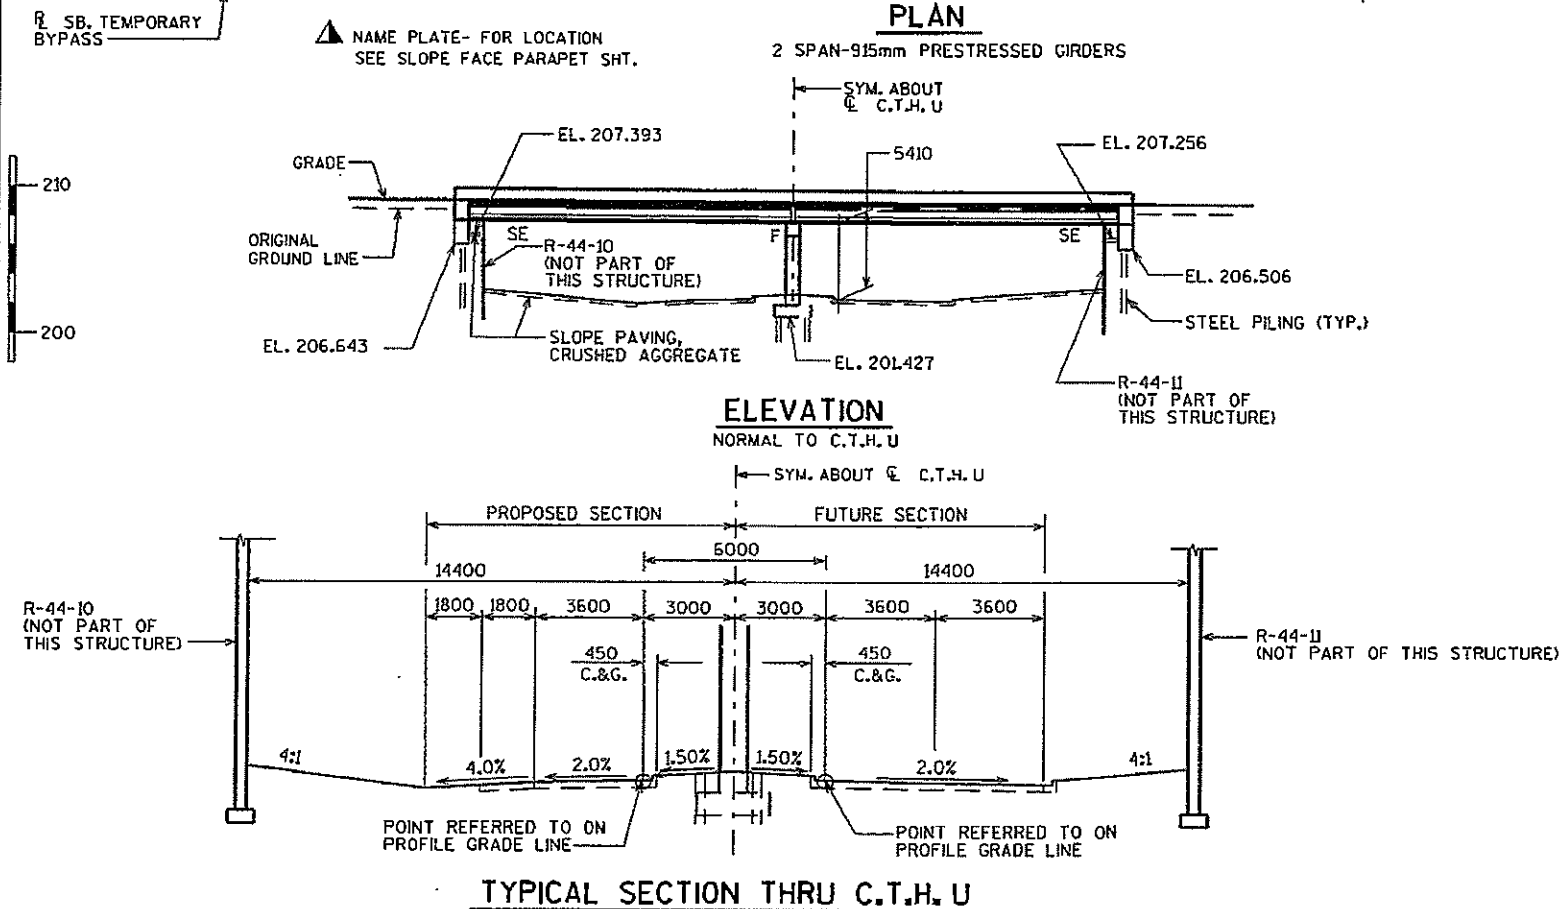






TYPICAL SECTION THRU C.T.H.U

GENERAL PLAN

SHEET 1 OF 13

DATE: JULY '98

FILE= BR-B44160:160CP.GPJ
 SCALE= 250

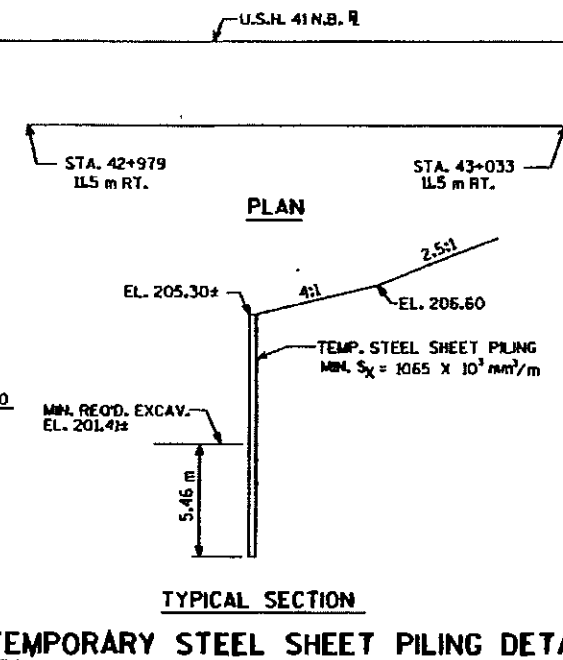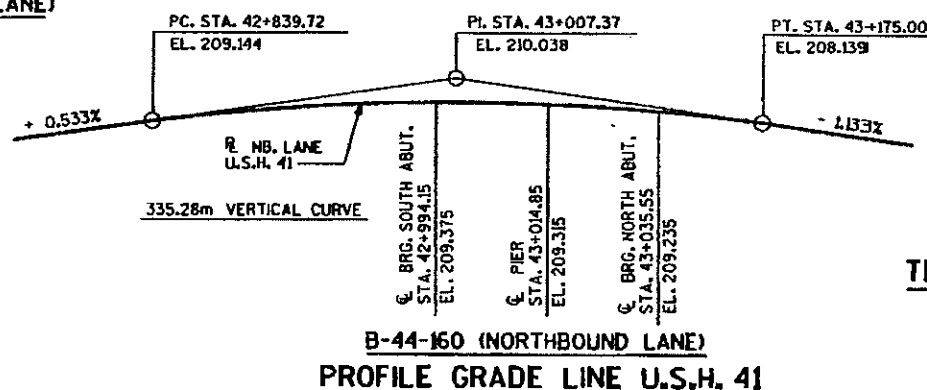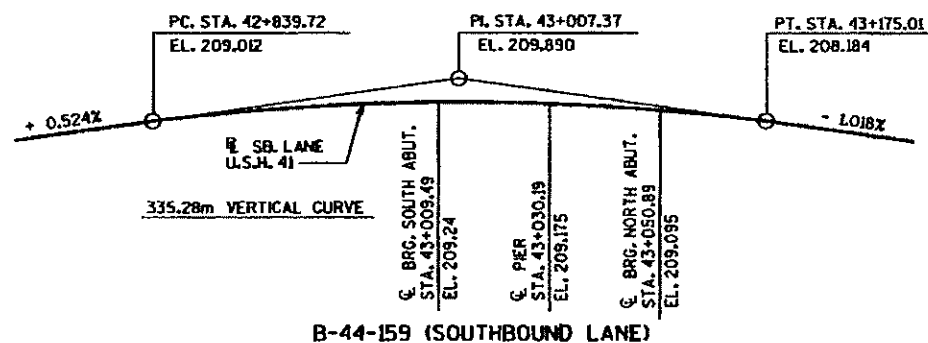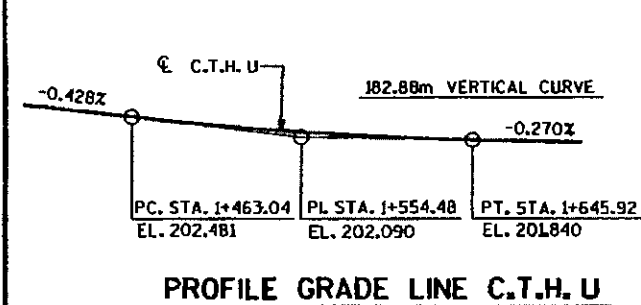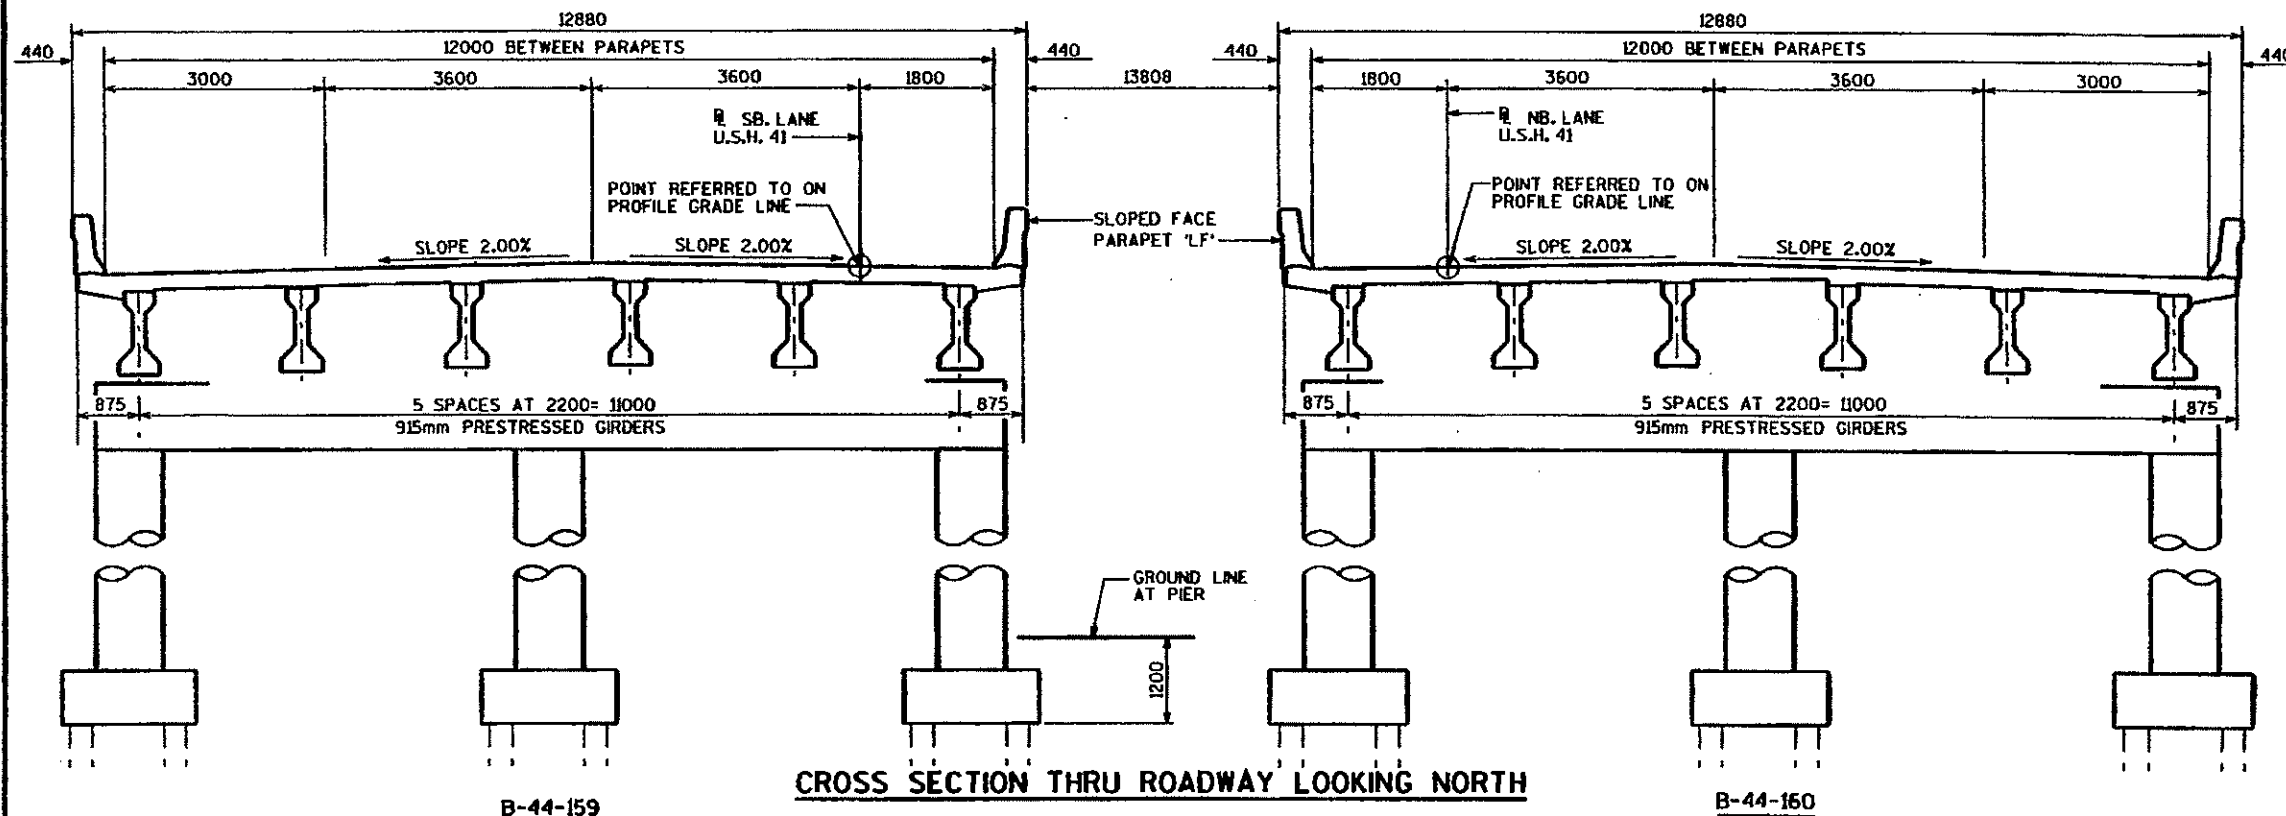

TOTAL ESTIMATED QUANTITIES

BID ITEMS	UNIT	SUPER.	SOUTH ABUT.	NORTH ABUT.	PIER 1	TOTALS
EXCAVATION FOR STRUCTURES, BRIDGES, B-44-160	L.S.					1
STRUCTURE BACKFILL	m ³		91	91		182
CONCRETE MASONRY, BRIDGES	m ³	179	34	32	33	278
PROTECTIVE SURFACE TREATMENT	m ²	608				608
PRESTRESSED GIRDER, I TYPE, 915 mm	m	250				250
HIGH-STRENGTH BAR STEEL REINFORCEMENT, BRIDGES	Kg		1710	1740	170	3620
COATED HIGH-STRENGTH BAR STEEL REINFORCEMENT, BRIDGES	Kg	20435	237	298	2560	23530
NON-LAMINATED ELASTOMERIC BEARING PADS	EACH		6	6	6	18
STEEL PILING, DELIVERED AND DRIVEN, HP 250 X 62	m		216	216	264	696
RUBBERIZED MEMBRANE WATERPROOFING	m ²		8	8		16
SLOPE PAVING, CRUSHED AGGREGATE BREAKER RUN	m ²		84	84		168
ANCHOR ASSEMBLIES FOR STEEL PLATE BEAM GUARD	EACH		1	1		2
STEEL DIAPHRAGMS, STRUCTURE B-44-160	EACH	10				10
TEMPORARY STEEL SHEET PILING	m ²					505
NON-BID ITEMS						
FILLER	SIZE					13 & 19

GENERAL NOTES

DRAWINGS SHALL NOT BE SCALED.
BAR STEEL REINFORCEMENT SHALL BE EMBEDDED 50 mm CLEAR UNLESS OTHERWISE SHOWN OR NOTED.
ALL REINFORCING BARS ARE METRIC AND THE FIRST TWO DIGITS OF THE BAR MARK SIGNIFIES THE BAR SIZE
ALL DIMENSIONS MILLIMETERS (mm) UNLESS OTHERWISE NOTED.
ALL STATIONS AND ALL ELEVATIONS ARE METERS (m).
ELASTOMERIC BEARING PADS NEED NOT BE INDIVIDUALLY MOLDED PROVIDED THE CUT EDGES ARE SMOOTH AND TRUE.
THE EXISTING GROUND LINE SHALL BE USED AS THE UPPER LIMITS OF EXCAVATION AT THE PIERS.
AT THE BACKFACE OF ABUTMENT ALL EXCAVATED VOLUME NOT OCCUPIED BY THE NEW STRUCTURE SHALL BE BACKFILLED WITH STRUCTURE BACKFILL.

NO.	DATE	REVISION	BY
STATE OF WISCONSIN DEPARTMENT OF TRANSPORTATION DIVISION OF HIGHWAYS			
STRUCTURE B-44-160			
CONSTR. SPEC.	1996	DRAWN BY RIES	PLANS CKD. KTN
CROSS SECTION & QUANTITIES		SHEET 2	

E= BR. B44160160GP.GPJ
SCALE = 50