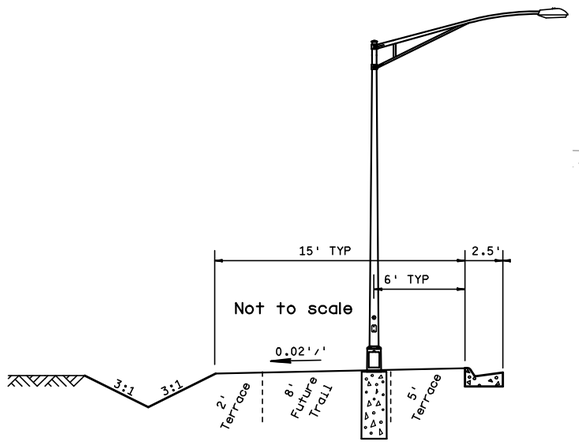

LEGEND

- LIGHTING CONTROL CABINET (Type 10) WITH METER BREAKER PEDESTAL
- 2" CONDUIT, NON-METALLIC (UNLESS OTHERWISE NOTED)
- 250 WATT LUMINAIRE,TYPE 5 POLE, TYPE 5 CONCRETE BASE, TRUSS TYPE - 4½" CLAMP - 12FT WITH TRANSFORMER BASE
- PULL BOX 24" X 42"
- POWER POLE
- SERVICE POLE
- ELECTRIC, UNDERGROUND
- ELECTRIC, OVERHEAD
- SIGN BRIDGE
- LUMINAIRE (Private)

Changed to LED B

ENTERTAINMENT DRIVE

STH 172 (AIRPORT DR)

AUSTIN STRAUBEL AIRPORT

III-250-12-5-C-1
III-250-12-5-D-3
III-250-12-5-D-2
III-250-12-5-D-1
III-250-12-5-B-2
III-250-12-5-B-3
III-250-12-5-B-1
III-250-12-5-A-2
III-250-12-5-A-1

LB1 LB2 LB3 LB5 LB6 LB7 LB8 LB9 LB10 CB1

3"

NOTES:

THE LOCATION OF EXISTING AND PROPOSED UTILITIES AS SHOWN ON THE PLANS ARE APPROXIMATE. IN ADDITION, THERE MAY BE OTHER UTILITIES WITHIN THE PROJECT AREA WHICH ARE NOT SHOWN. THE CONTRACTOR SHALL VERIFY THE LOCATIONS OF ALL UTILITIES PRIOR TO CONSTRUCTION.

III -150-12-5-A-4
- LIGHT UNIT NUMBER IN CIRCUIT
- CIRCUIT NUMBER
- BASE TYPE
- MAST ARM LENGTH (in feet)
- LAMP WATTAGE
- DISTRIBUTION TYPE

240 VOLT SYSTEM

120/240 VOLT ELECTRIC SERVICE

As-Built 7-14-2011

STH 172 & AIRPORT ENT/ENTERTAINMENT DR
VILLAGE OF ASHWAUBENON
BROWN COUNTY

LIGHTING NO. 764

DESIGNER: WISDOT NE Region Traffic Unit

DATE: 11-1-2010 SHEET NO. 1 OF 1

PROJECT NO: 9280-04-72	HWY: STH 172	COUNTY: BROWN	ROUNDABOUT LIGHTING	SHEET	E