2

LEGEND

- LIGHTING CONTROL CABINET WITH METER BREAKER PEDESTAL
- 2" CONDUIT, NON-METALLIC (UNLESS OTHERWISE NOTED)
- 150 WATT LUMINAIRE, TYPE 5 POLE, TYPE 5 CONCRETE BASE, TRUSS TYPE - 4½" CLAMP - 12FT WITH TRANSFORMER BASE
- PULL BOX 24" X 42"
- POWER POLE
- SERVICE POLE
- ELECTRIC, UNDERGROUND — E
- ELECTRIC, OVERHEAD — OH
- SIGN

III -150-12-5-A-4

- LIGHT UNIT NUMBER IN CIRCUIT
- CIRCUIT NUMBER
- BASE TYPE
- MAST ARM LENGTH (in feet)
- LAMP WATTAGE
- DISTRIBUTION TYPE

240 VOLT SYSTEM

120/240 VOLT ELECTRIC SERVICE

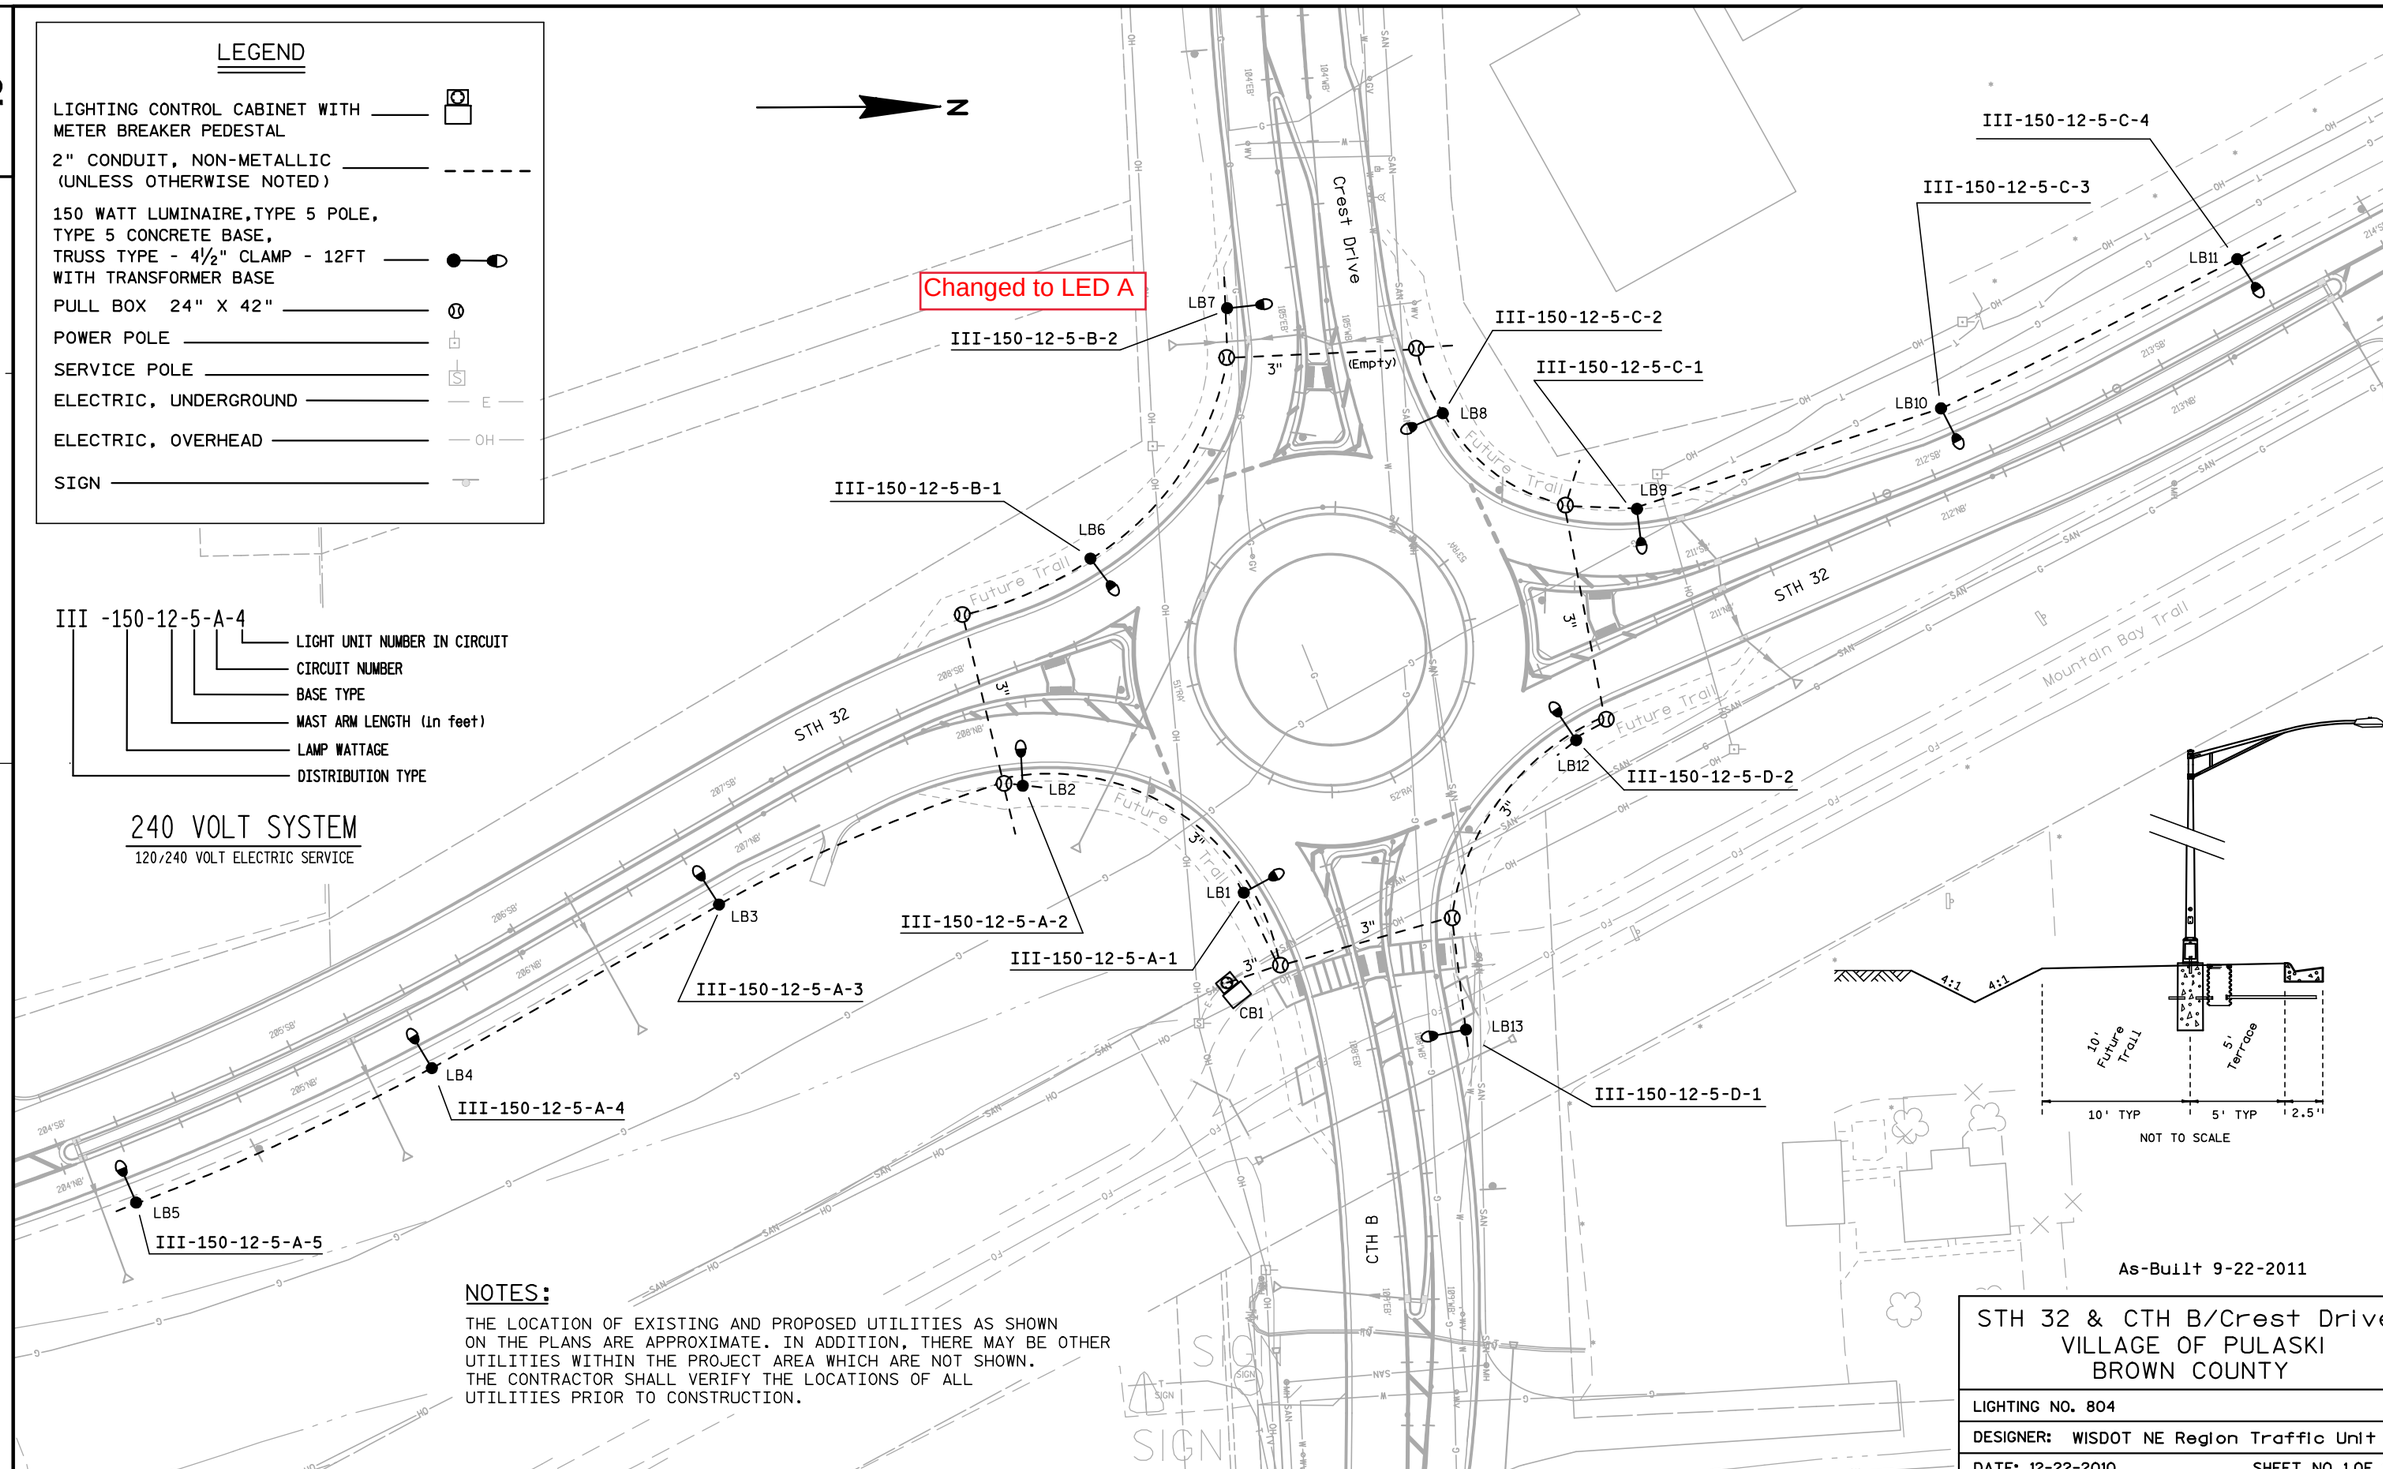

NOTES:

THE LOCATION OF EXISTING AND PROPOSED UTILITIES AS SHOWN ON THE PLANS ARE APPROXIMATE. IN ADDITION, THERE MAY BE OTHER UTILITIES WITHIN THE PROJECT AREA WHICH ARE NOT SHOWN. THE CONTRACTOR SHALL VERIFY THE LOCATIONS OF ALL UTILITIES PRIOR TO CONSTRUCTION.

As-Built 9-22-2011

STH 32 & CTH B/Crest Drive
VILLAGE OF PULASKI
BROWN COUNTY

LIGHTING NO. 804

DESIGNER: WISDOT NE Region Traffic Unit

DATE: 12-22-2010 SHEET NO. 1 OF 1

PROJECT NO: 9190-21-71	HWY: STH 32	COUNTY: BROWN	ROUNDABOUT LIGHTING L-804	SHEET	E