2

III -150-12-5-A-4

- LIGHT UNIT NUMBER IN CIRCUIT
- CIRCUIT NUMBER
- BASE TYPE
- MAST ARM LENGTH (in feet)
- LAMP WATTAGE
- DISTRIBUTION TYPE

240 VOLT SYSTEM

120/240 VOLT ELECTRIC SERVICE

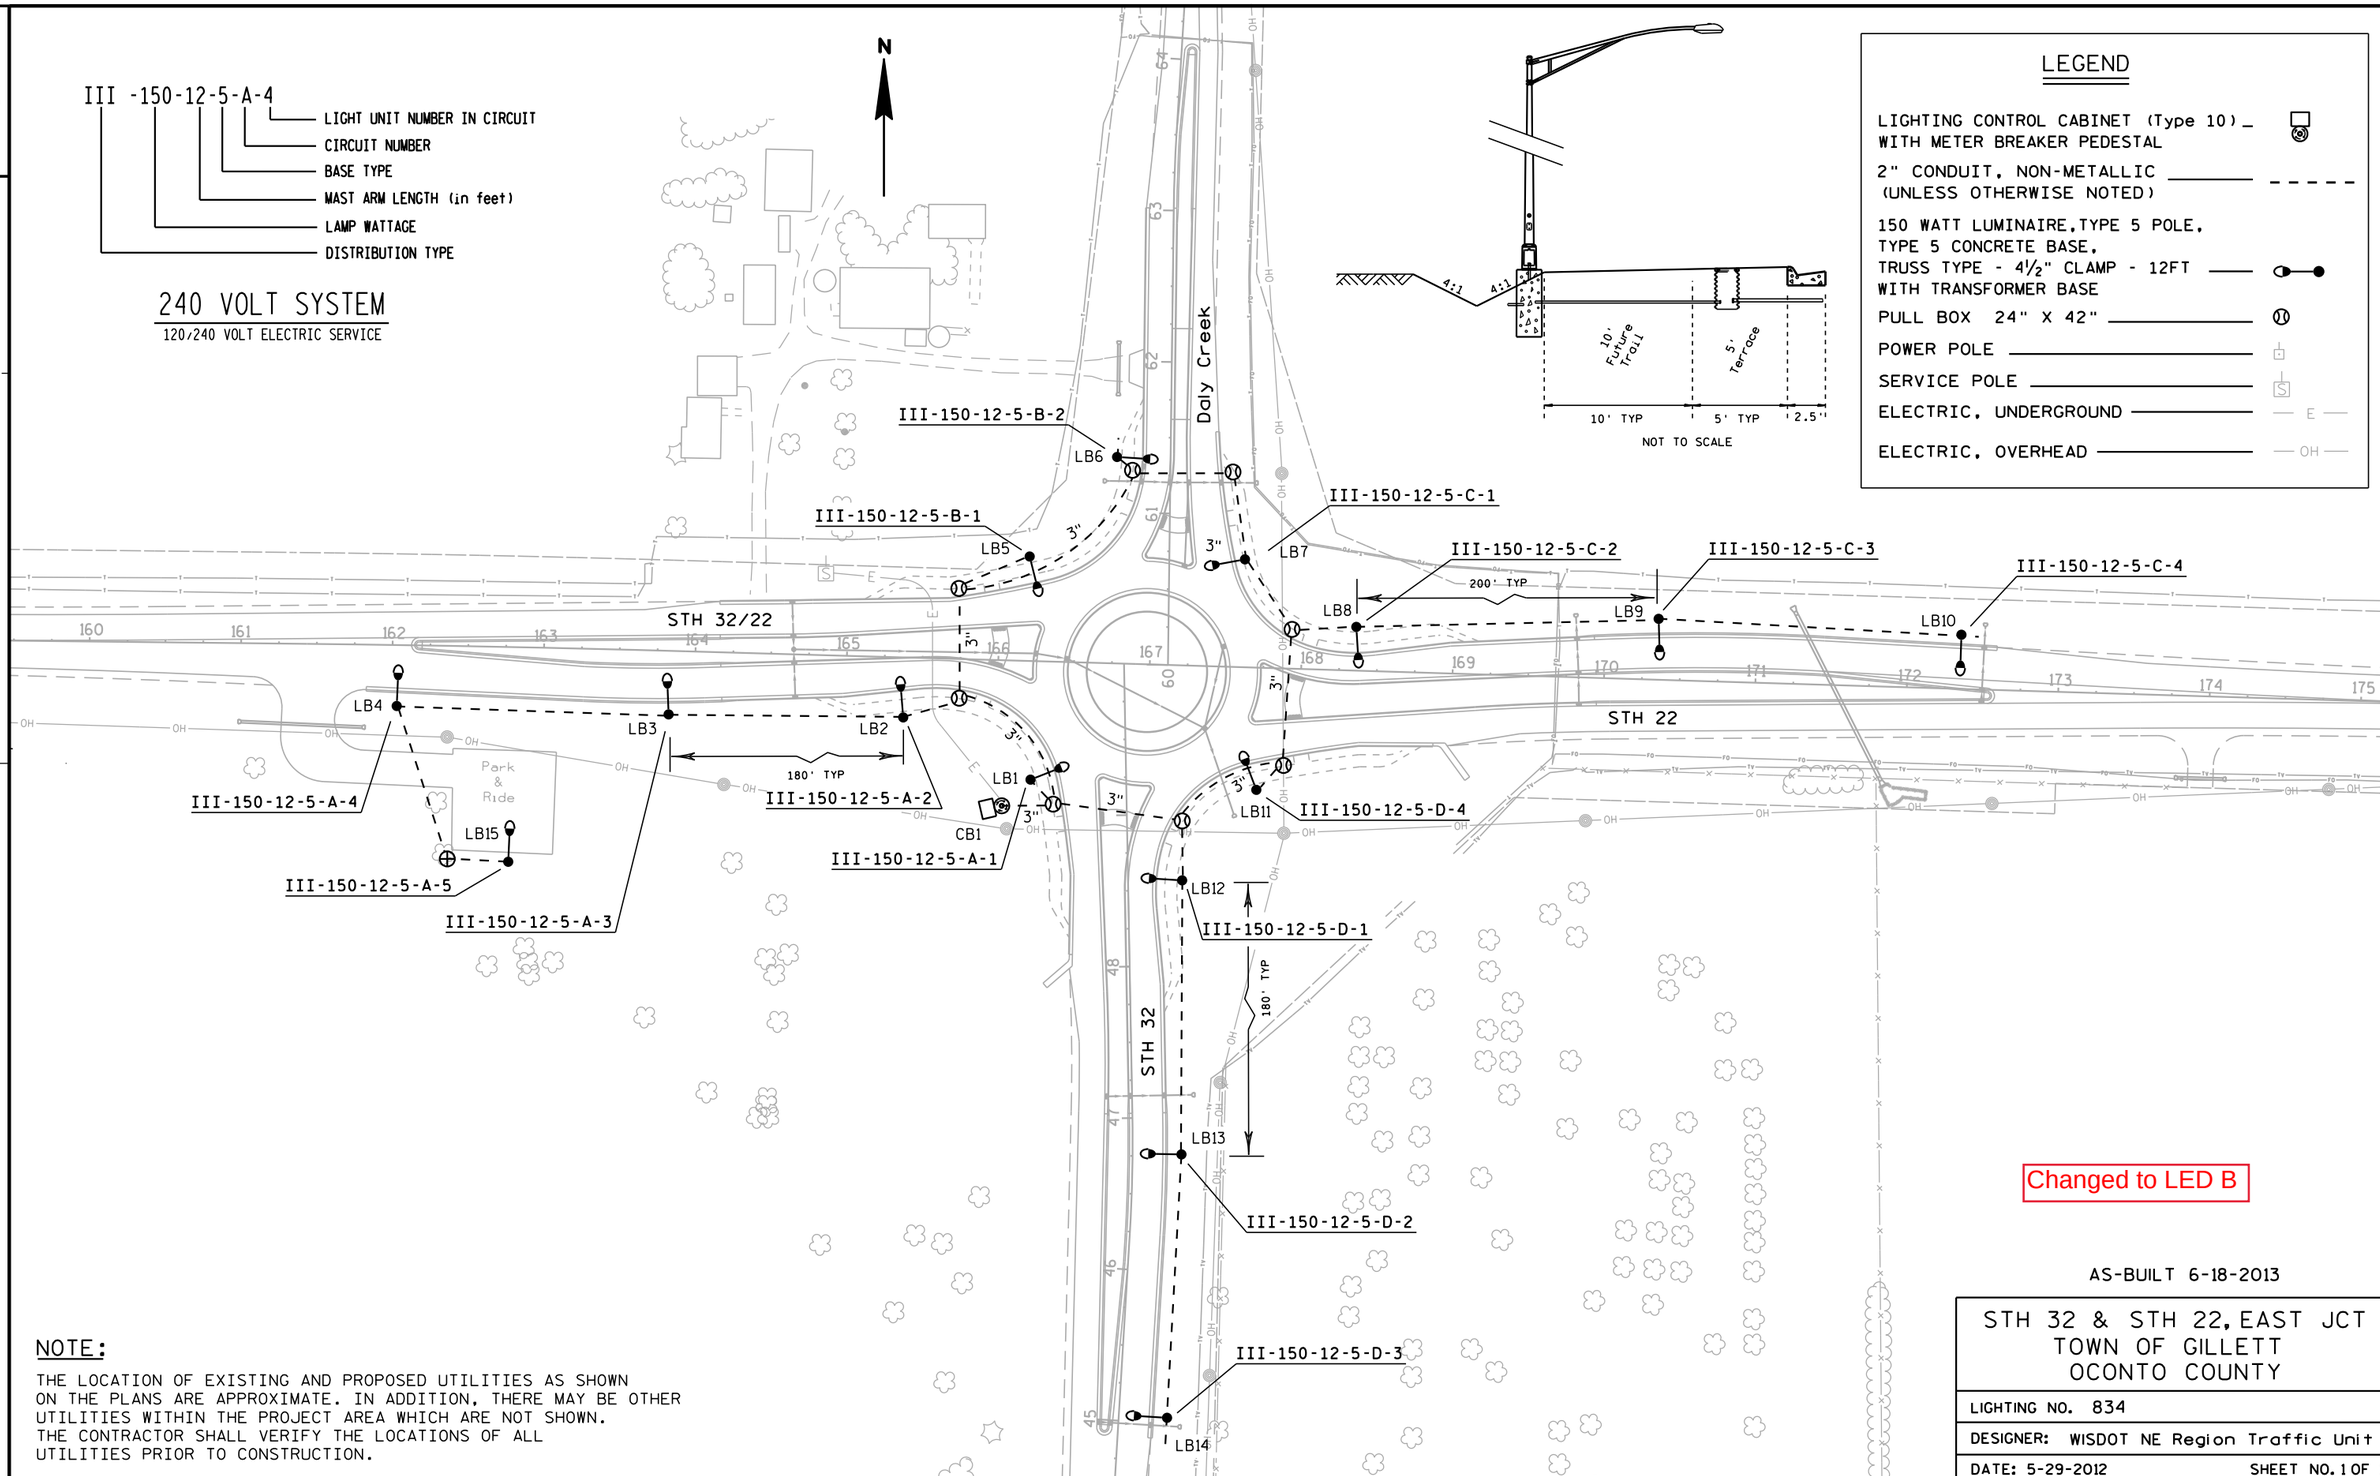

AS-BUILT 6-18-2013

NOTE:

THE LOCATION OF EXISTING AND PROPOSED UTILITIES AS SHOWN ON THE PLANS ARE APPROXIMATE. IN ADDITION, THERE MAY BE OTHER UTILITIES WITHIN THE PROJECT AREA WHICH ARE NOT SHOWN. THE CONTRACTOR SHALL VERIFY THE LOCATIONS OF ALL UTILITIES PRIOR TO CONSTRUCTION.

STH 32 & STH 22, EAST JCT
TOWN OF GILLETT
OCONTO COUNTY

LIGHTING NO. 834

DESIGNER: WISDOT NE Region Traffic Unit

DATE: 5-29-2012 SHEET NO. 1 OF 1

PROJECT NO: 9180-18-71	HWY: STH 22	COUNTY: OCONTO	CONSTRUCTION LIGHTING - ROUNDABOUT LIGHTING	SHEET	E