STATE PROJECT	FEDERAL PROJECT	
	PROJECT	CONTRACT
1131-08-82	HPP 2000 (222)	1

STATE OF WISCONSIN
DEPARTMENT OF TRANSPORTATION

KAUKAUNA - DE PERE

CTH OO - CTH S (FRONTAGE ROADS)
USH 41
BROWN & OUTAGAMIE COUNTIES

AS BUILT

1733

AS BUILT PLAN
NO.
SUPERVISOR Jill Michaelson
RESIDENT Mike Leitzke
CONTRACTOR Mashuda
COMPLETED 4-18-2001

STATE PROJECT NUMBER
1131-08-82

INDEX OF SHEETS

Sheet No. | Title
Sheet No. 2.1-2.12 Typical Sections and Details
Sheet No. 3.1-3.3 Estimate of Quantities
Sheet No. 3A-3H Miscellaneous Quantities
Sheet No. 4.1-4.27 Right of Way Plat
Sheet No. 5.1-5.39 Plan and Profile
Sheet No. 6.1-6.22 Standard Detail Drawings
Sheet No. ——— Sign Plates
Sheet No. ——— Structure Plans
Sheet No. 9.1-9.4 Computer Earthwork Data
Sheet No. 9.5-9.36 Cross Sections

TOTAL SHEETS = 148

CTH U INTERCHANGE
STA 43+022.60 USH 41 MED ℄
X = 753 658.284
Y = 58 958.128

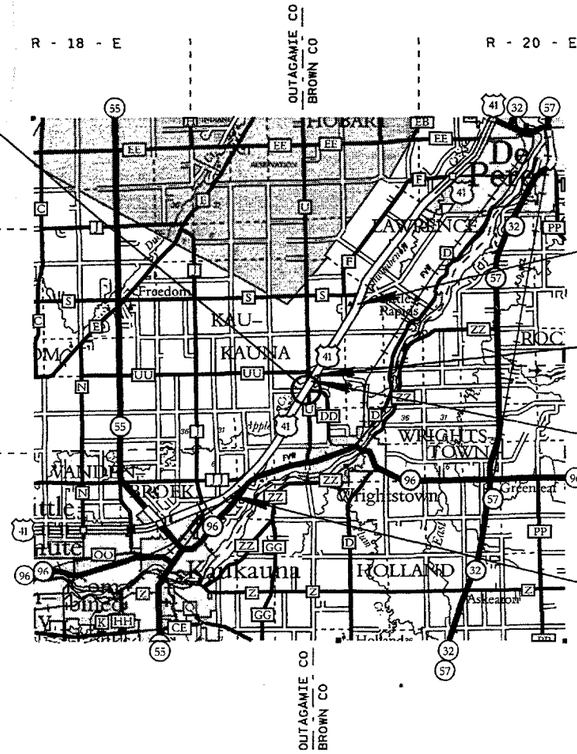

END PROJECT
STA 43+620 W FRT RD ℄

EXCEPTION TO NET ℄ LENGTH
STA 40+441.80 TO 40+482.60 W FRT RD ℄
STRUCTURE B-5-305

EQUATION
STA 39+802.16 W FRT RD ℄ AH=
STA 43+198.92 W FRT RD ℄ BK

BEGIN PROJECT
STA 37+360 W FRT RD ℄
X = 750 094.911
Y = 54 345.759

DESIGN DESIGNATION

		USH 41	E FRT RD	W FRT RD
A.D.T. 1998	=	28 665	1 565	995
A.D.T. 2018	=	37 050	2 350	1 285
D.H.V. 2018	=	2 425	170	93
D.	=	60-40	60-40	60-40
T.	=	13.9%	8.4%	8.4%
V.	=	110 KPH	70-90 KPH	90 KPH
ESALS	=	N/A	299 300	167 900

CONVENTIONAL SYMBOLS

COUNTY LINE
CORPORATE LIMITS
PROPERTY LINE (P.L. + 58.1)
LOT LINE
LIMITED EASEMENT
EXISTING RIGHT OF WAY
PROPOSED OR NEW R/W LINE
SURVEY LINE
SLOPE INTERCEPT
ORIGINAL GROUND
MARSH OR ROCK PROFILE
EXISTING CULVERT
PROPOSED CULVERT (Box or Pipe)
CULVERT (Profile View)

COMBUSTIBLE FLUIDS (CAUTION)
UNDERGROUND UTILITIES
GAS (G)
ELECTRIC (E)
TELEPHONE OR TELEGRAPH (T)
SERVICE PEDESTAL
CABLE MARKER (P)
POWER POLE
TELEPHONE POLE
RAILROAD
MARSH AREA
WOODED OR SHRUB AREA

LAYOUT
SCALE 0 — 5 km

TOTAL NET LENGTH OF CENTERLINE = 9.616 km

ALL COORDINATES ON THIS PLAN ARE REFERENCED TO THE WISCONSIN COORDINATE SYSTEM SOUTH ZONE.

SURVEY BOOK NO. 1480 & 1480A

STATE OF WISCONSIN
DEPARTMENT OF TRANSPORTATION

PREPARED BY
Surveyor DISTRICT 3
Designer J. S. BOADO
District Examiner G. STOIBER & E. L. VANN
District Supervisor M. J. BERG
Proj. Dev. Engineer
C.O. Examiner N.R. AFFELDT

APPROVED FOR DISTRICT OFFICE
DATE: 10/29/99 (Signature) P.E.

AUTHORIZED FOR BUREAU OF HIGHWAY DEVELOPMENT
DATE: 12/3/99 (Signature)

M

WISDOT: MSHT10

BROWN & OUTAGAMIE
PLOT SCALE: 10:560
PLOT NAME: 105
REV. DATE: 10-11-99
ORIGINATOR: DIST. 3
FILE NAME: D3_03 1131081105.dgn

1131-08-82

22

Feb 2002

(1131-08-82)

1-full
T25-D