P.R.A. DISTRICT OFFICE	PROJECT	SHEET NUMBER	TOTAL SHEETS
WIS. 5N	T-0387(7)	18	24

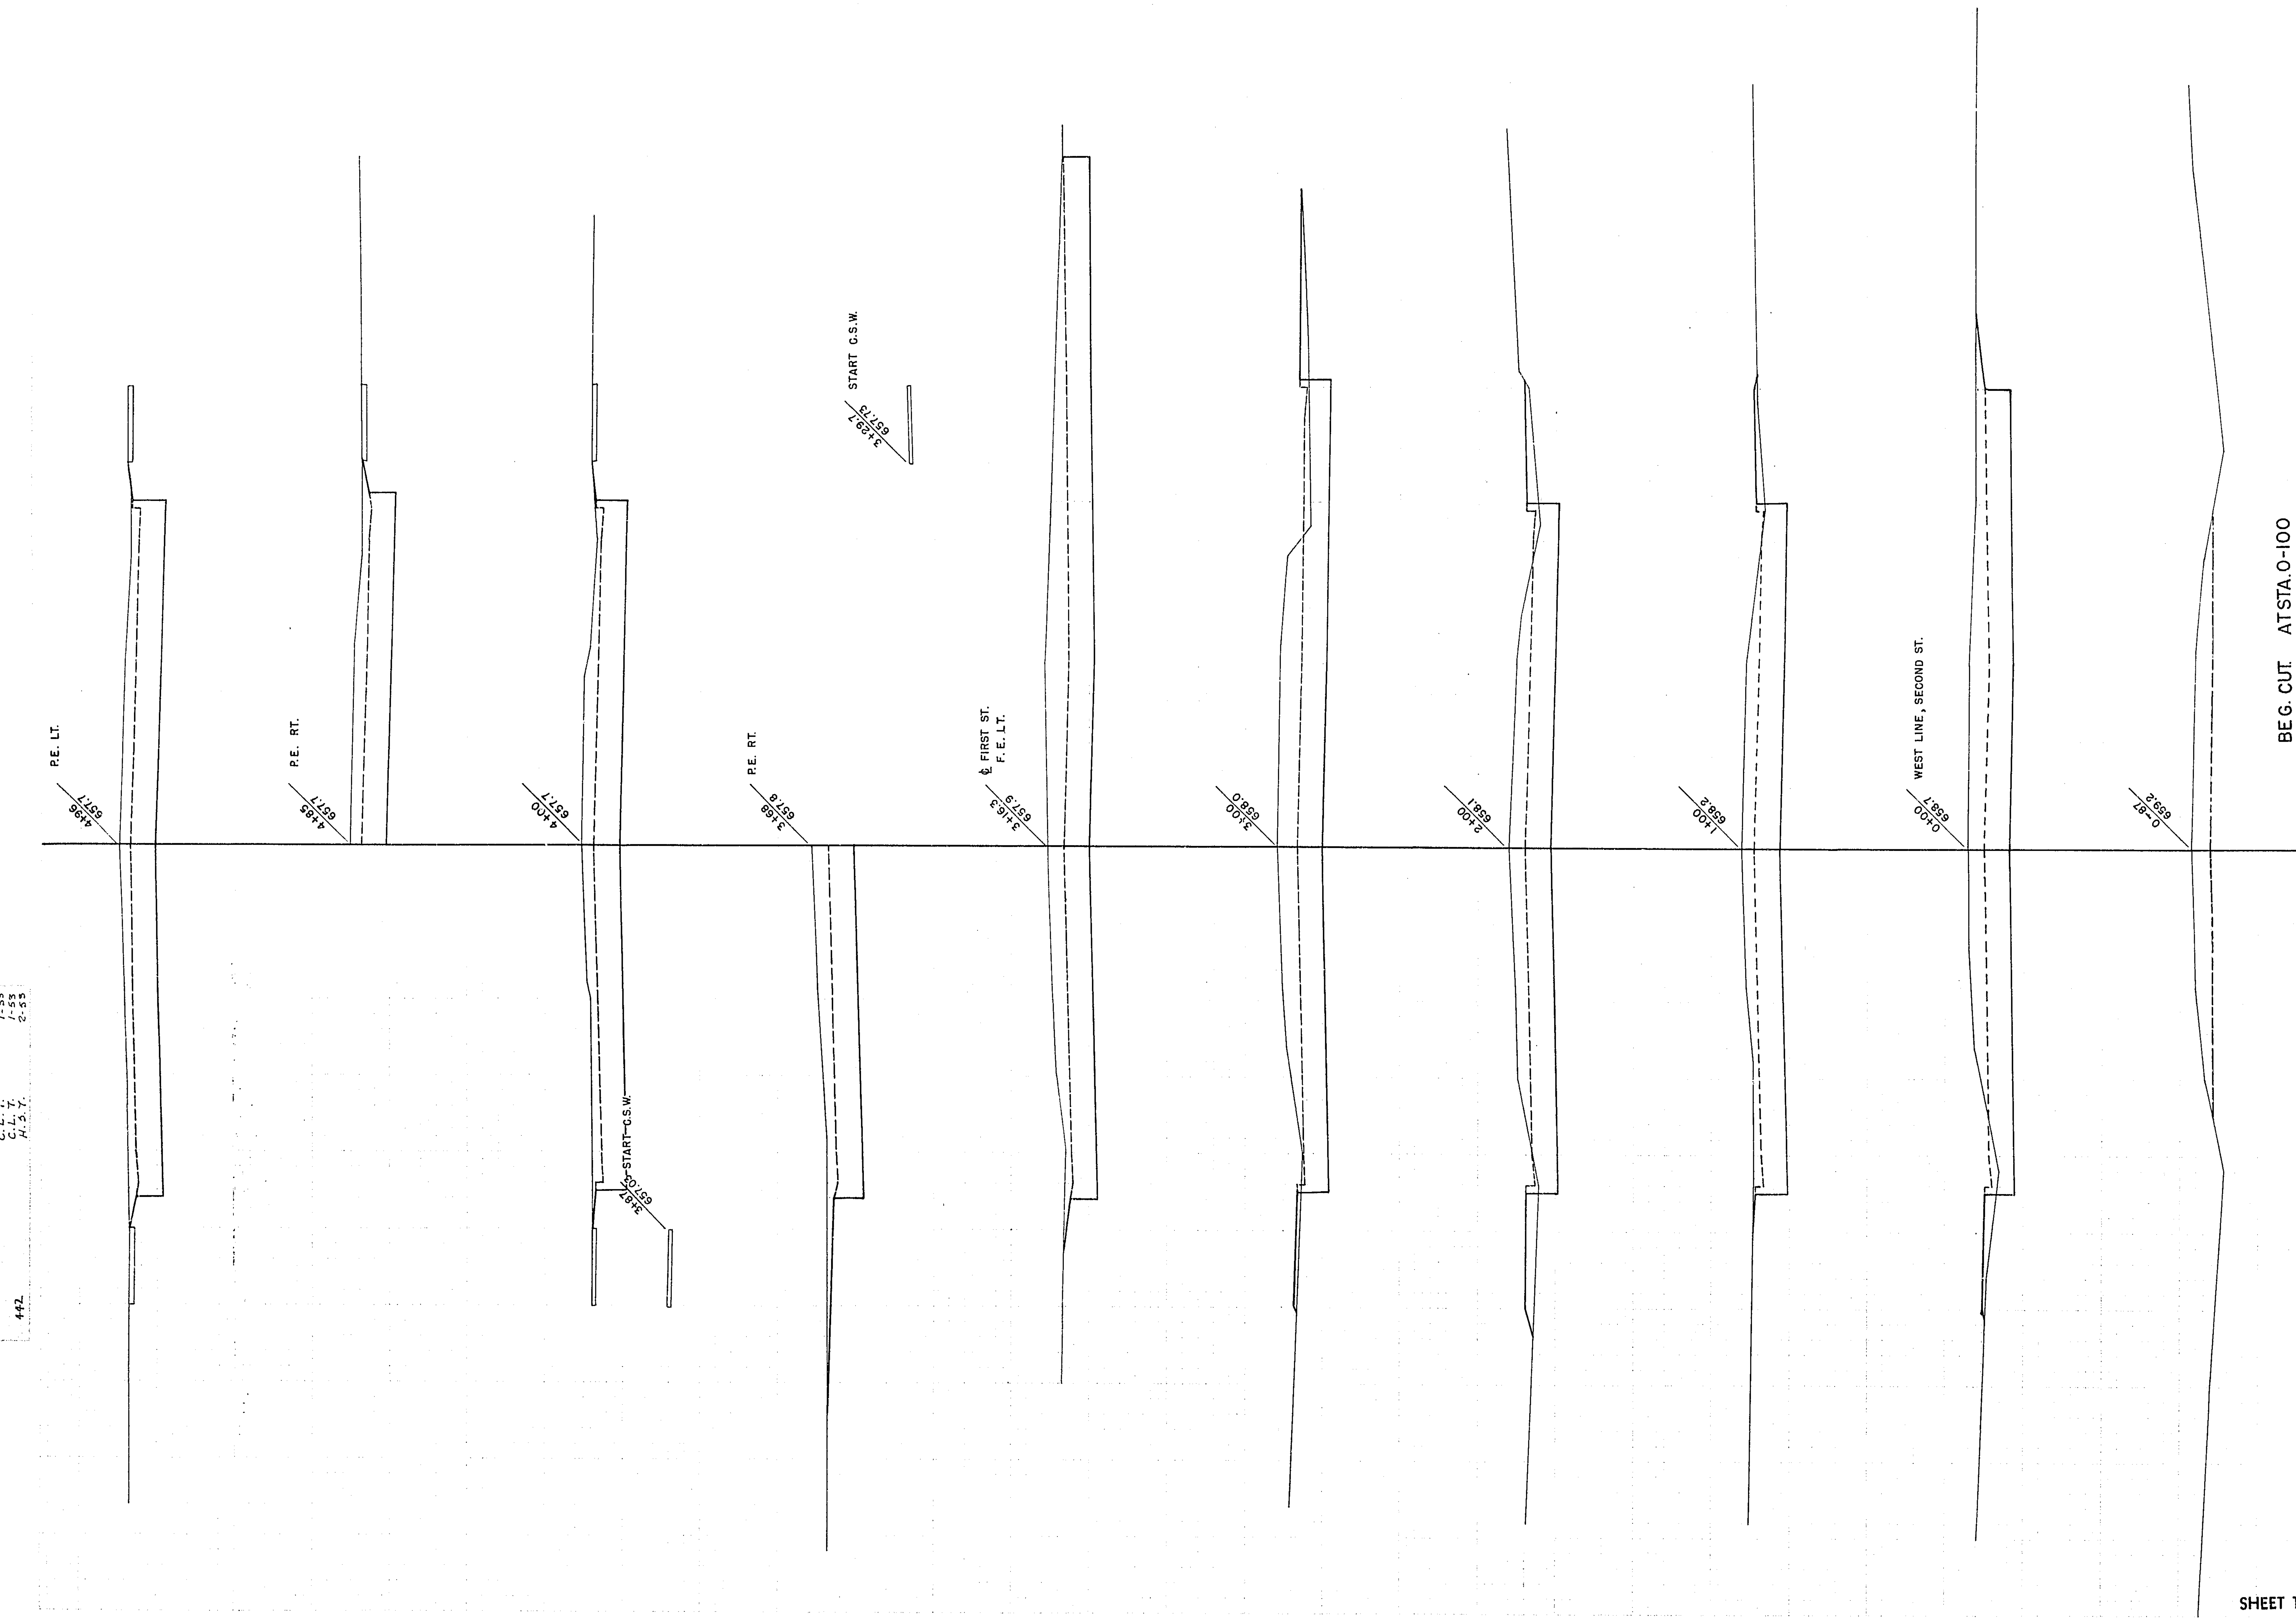

STATION	DISTANCE	YARDAGE EXCAVATION UNCL				FILL
0-100						
		7				0
0-87						
		250				4
0						
		411				9
1						
		367				30
2						
		424				43
3						
		88				4
+16.3						
		404				0
4						
		354				0
+96						
SHEET TOTAL		2305				90

P.R.A. DISTRICT OFFICE	PROJECT	SHEET NUMBER	TOTAL SHEETS
WIS. 5N	T-0387(7)	19	24

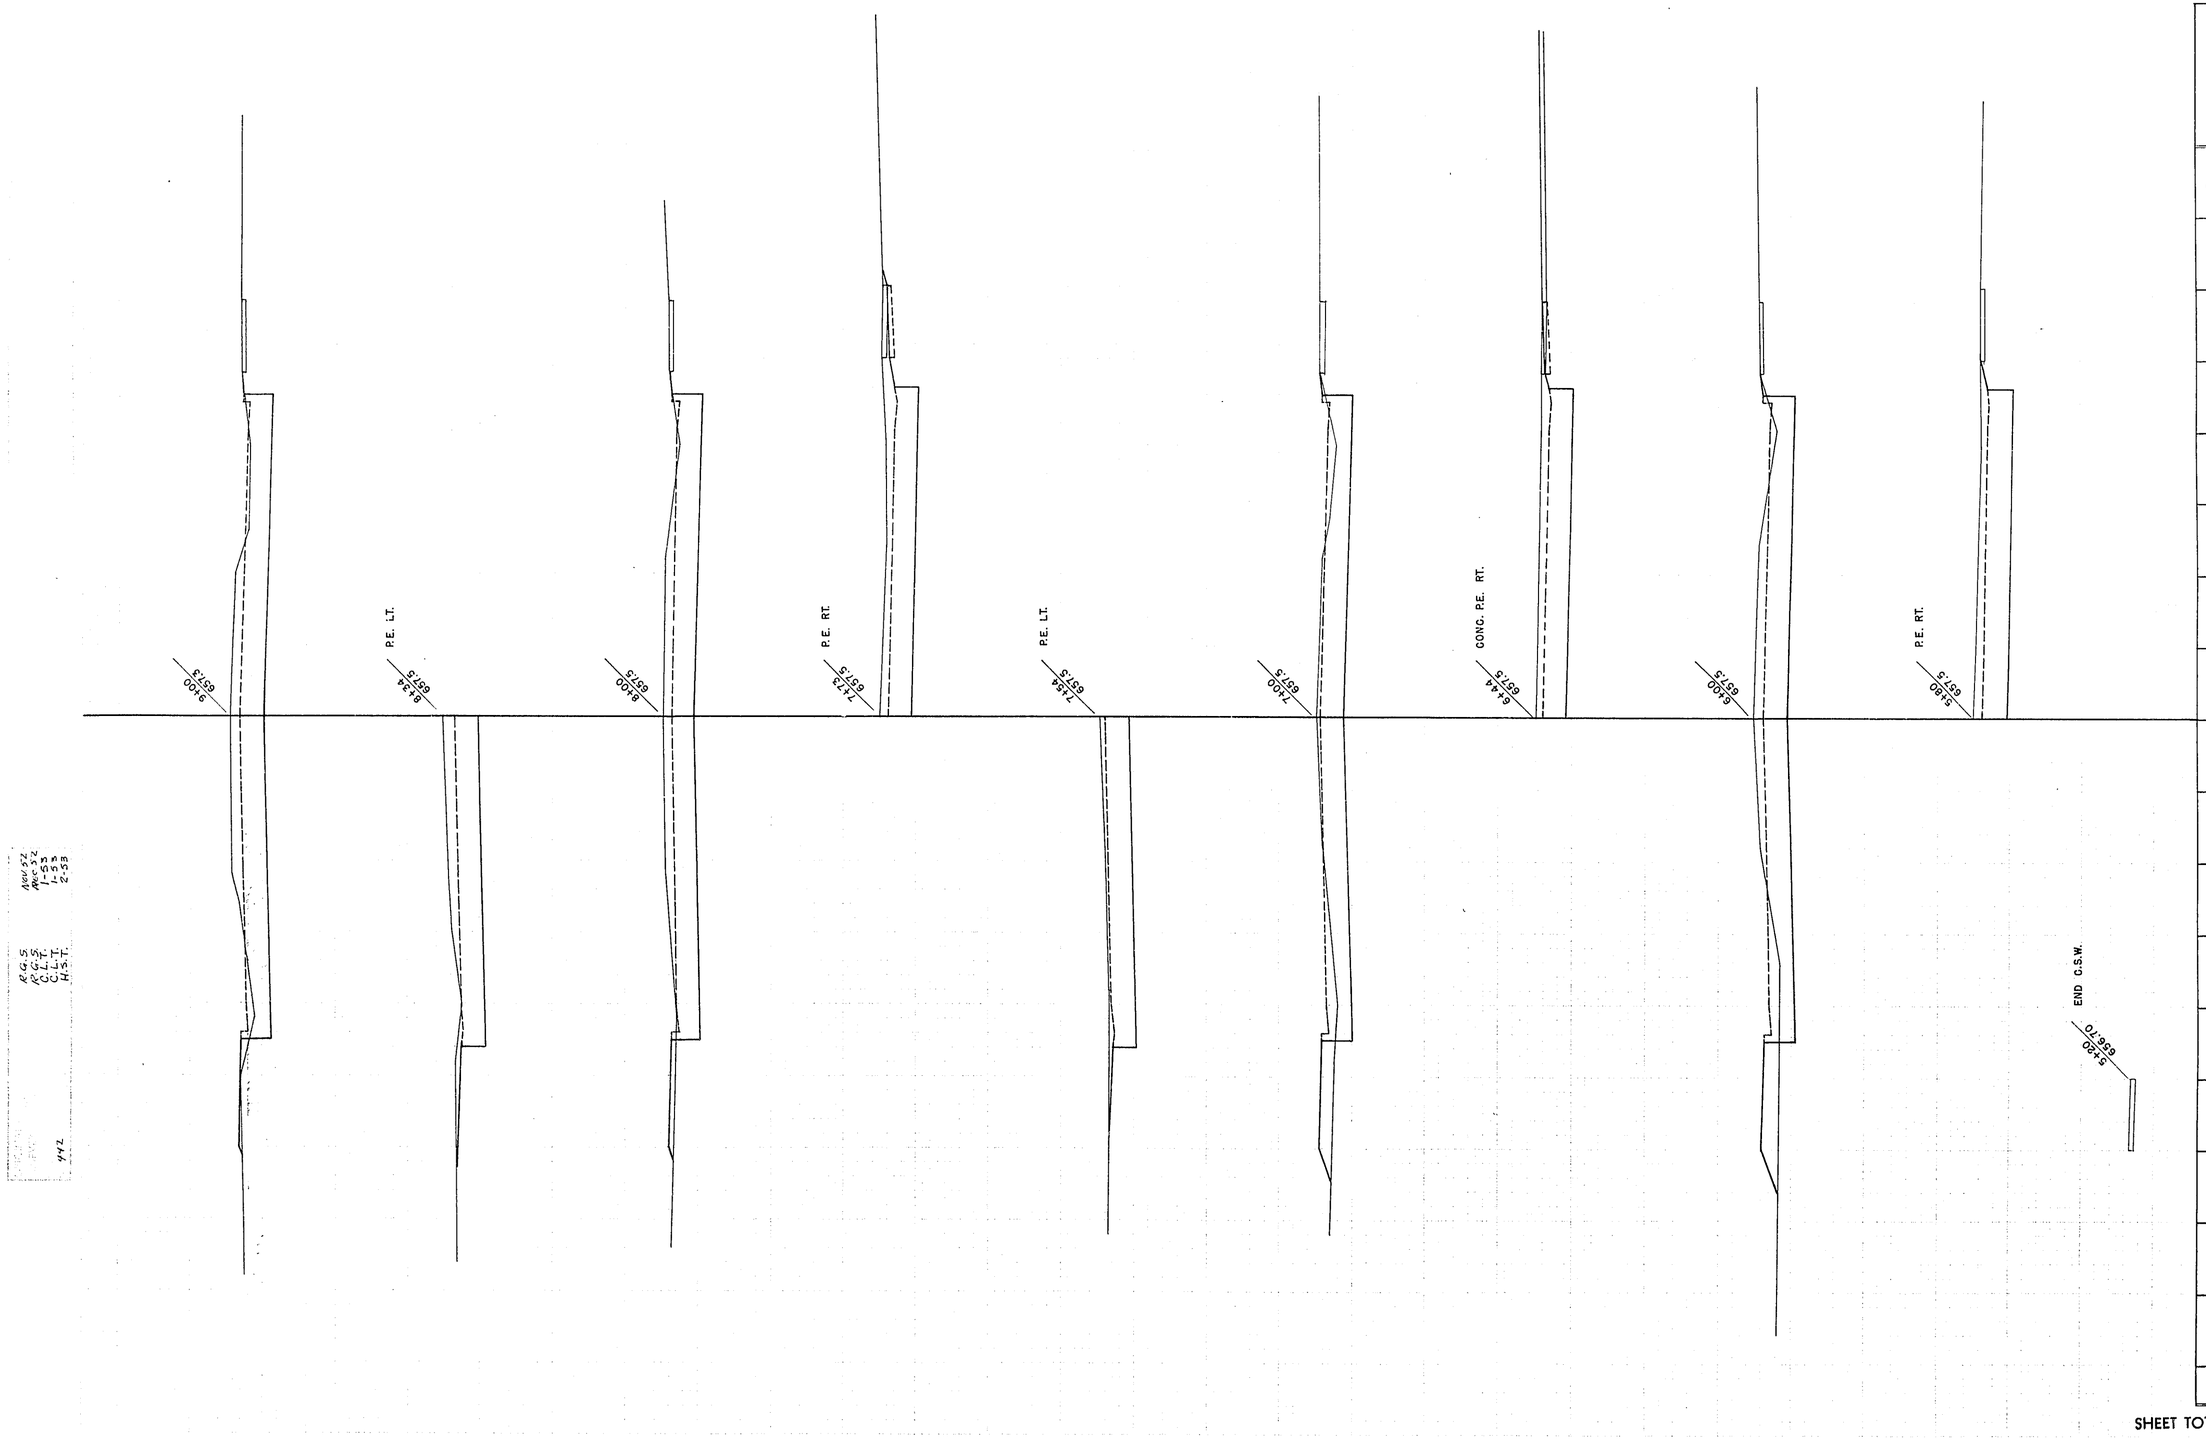

STATION	DISTANCE	YARDAGE EXCAVATION UNCL				FILL
4+96						
		361				24
6						
		285				39
7						
		300				39
8						
		320				13
9						
SHEET TOTAL		1266				115

P.R.A. DISTRICT OFFICE	PROJECT	SHEET NUMBER	TOTAL SHEETS
WIS. 5N	T-0387(7)	20	24

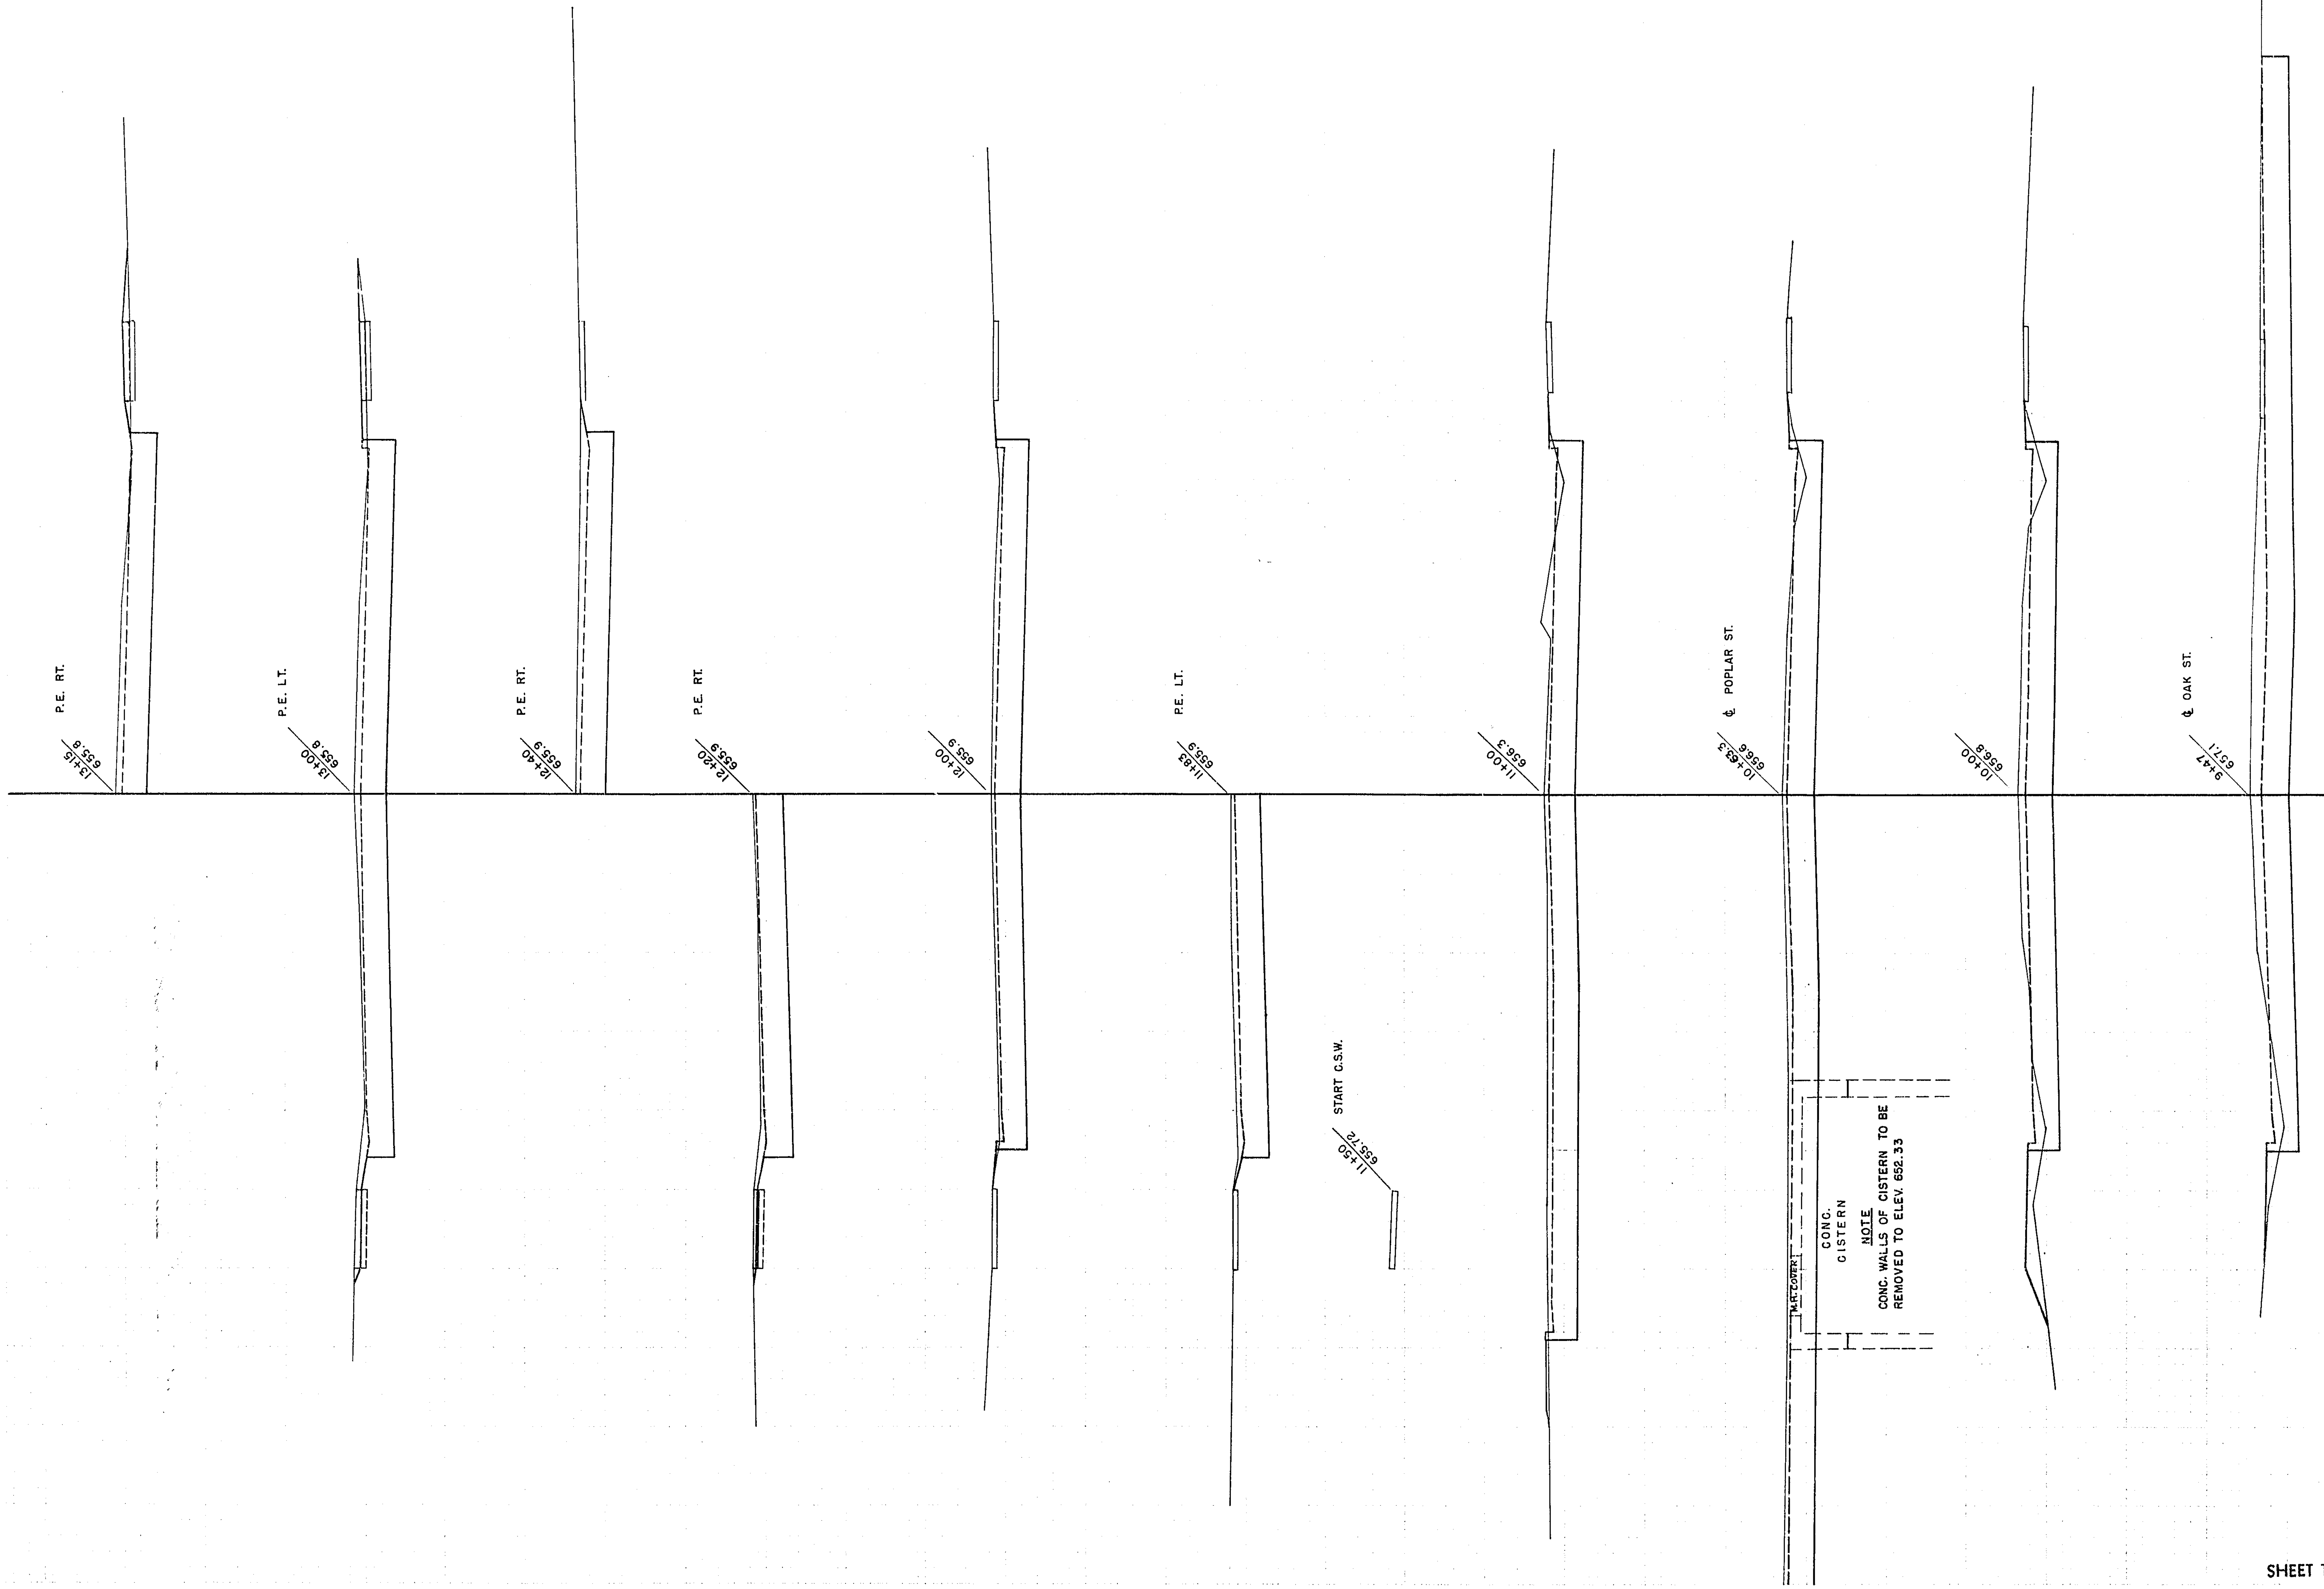

STATION	DISTANCE	YARDAGE EXCAVATION UNCL.				FILL
9						
		182				6
+47						
		206				9
10						
		273				11
+63.3						
		179				2
11						
		363				0
12						
		309				2
13						
SHEET TOTAL		1512				30

P.R.A. DISTRICT OFFICE	PROJECT	SHEET NUMBER	TOTAL SHEETS
WIS. 5N	T-0387(7)	21	24

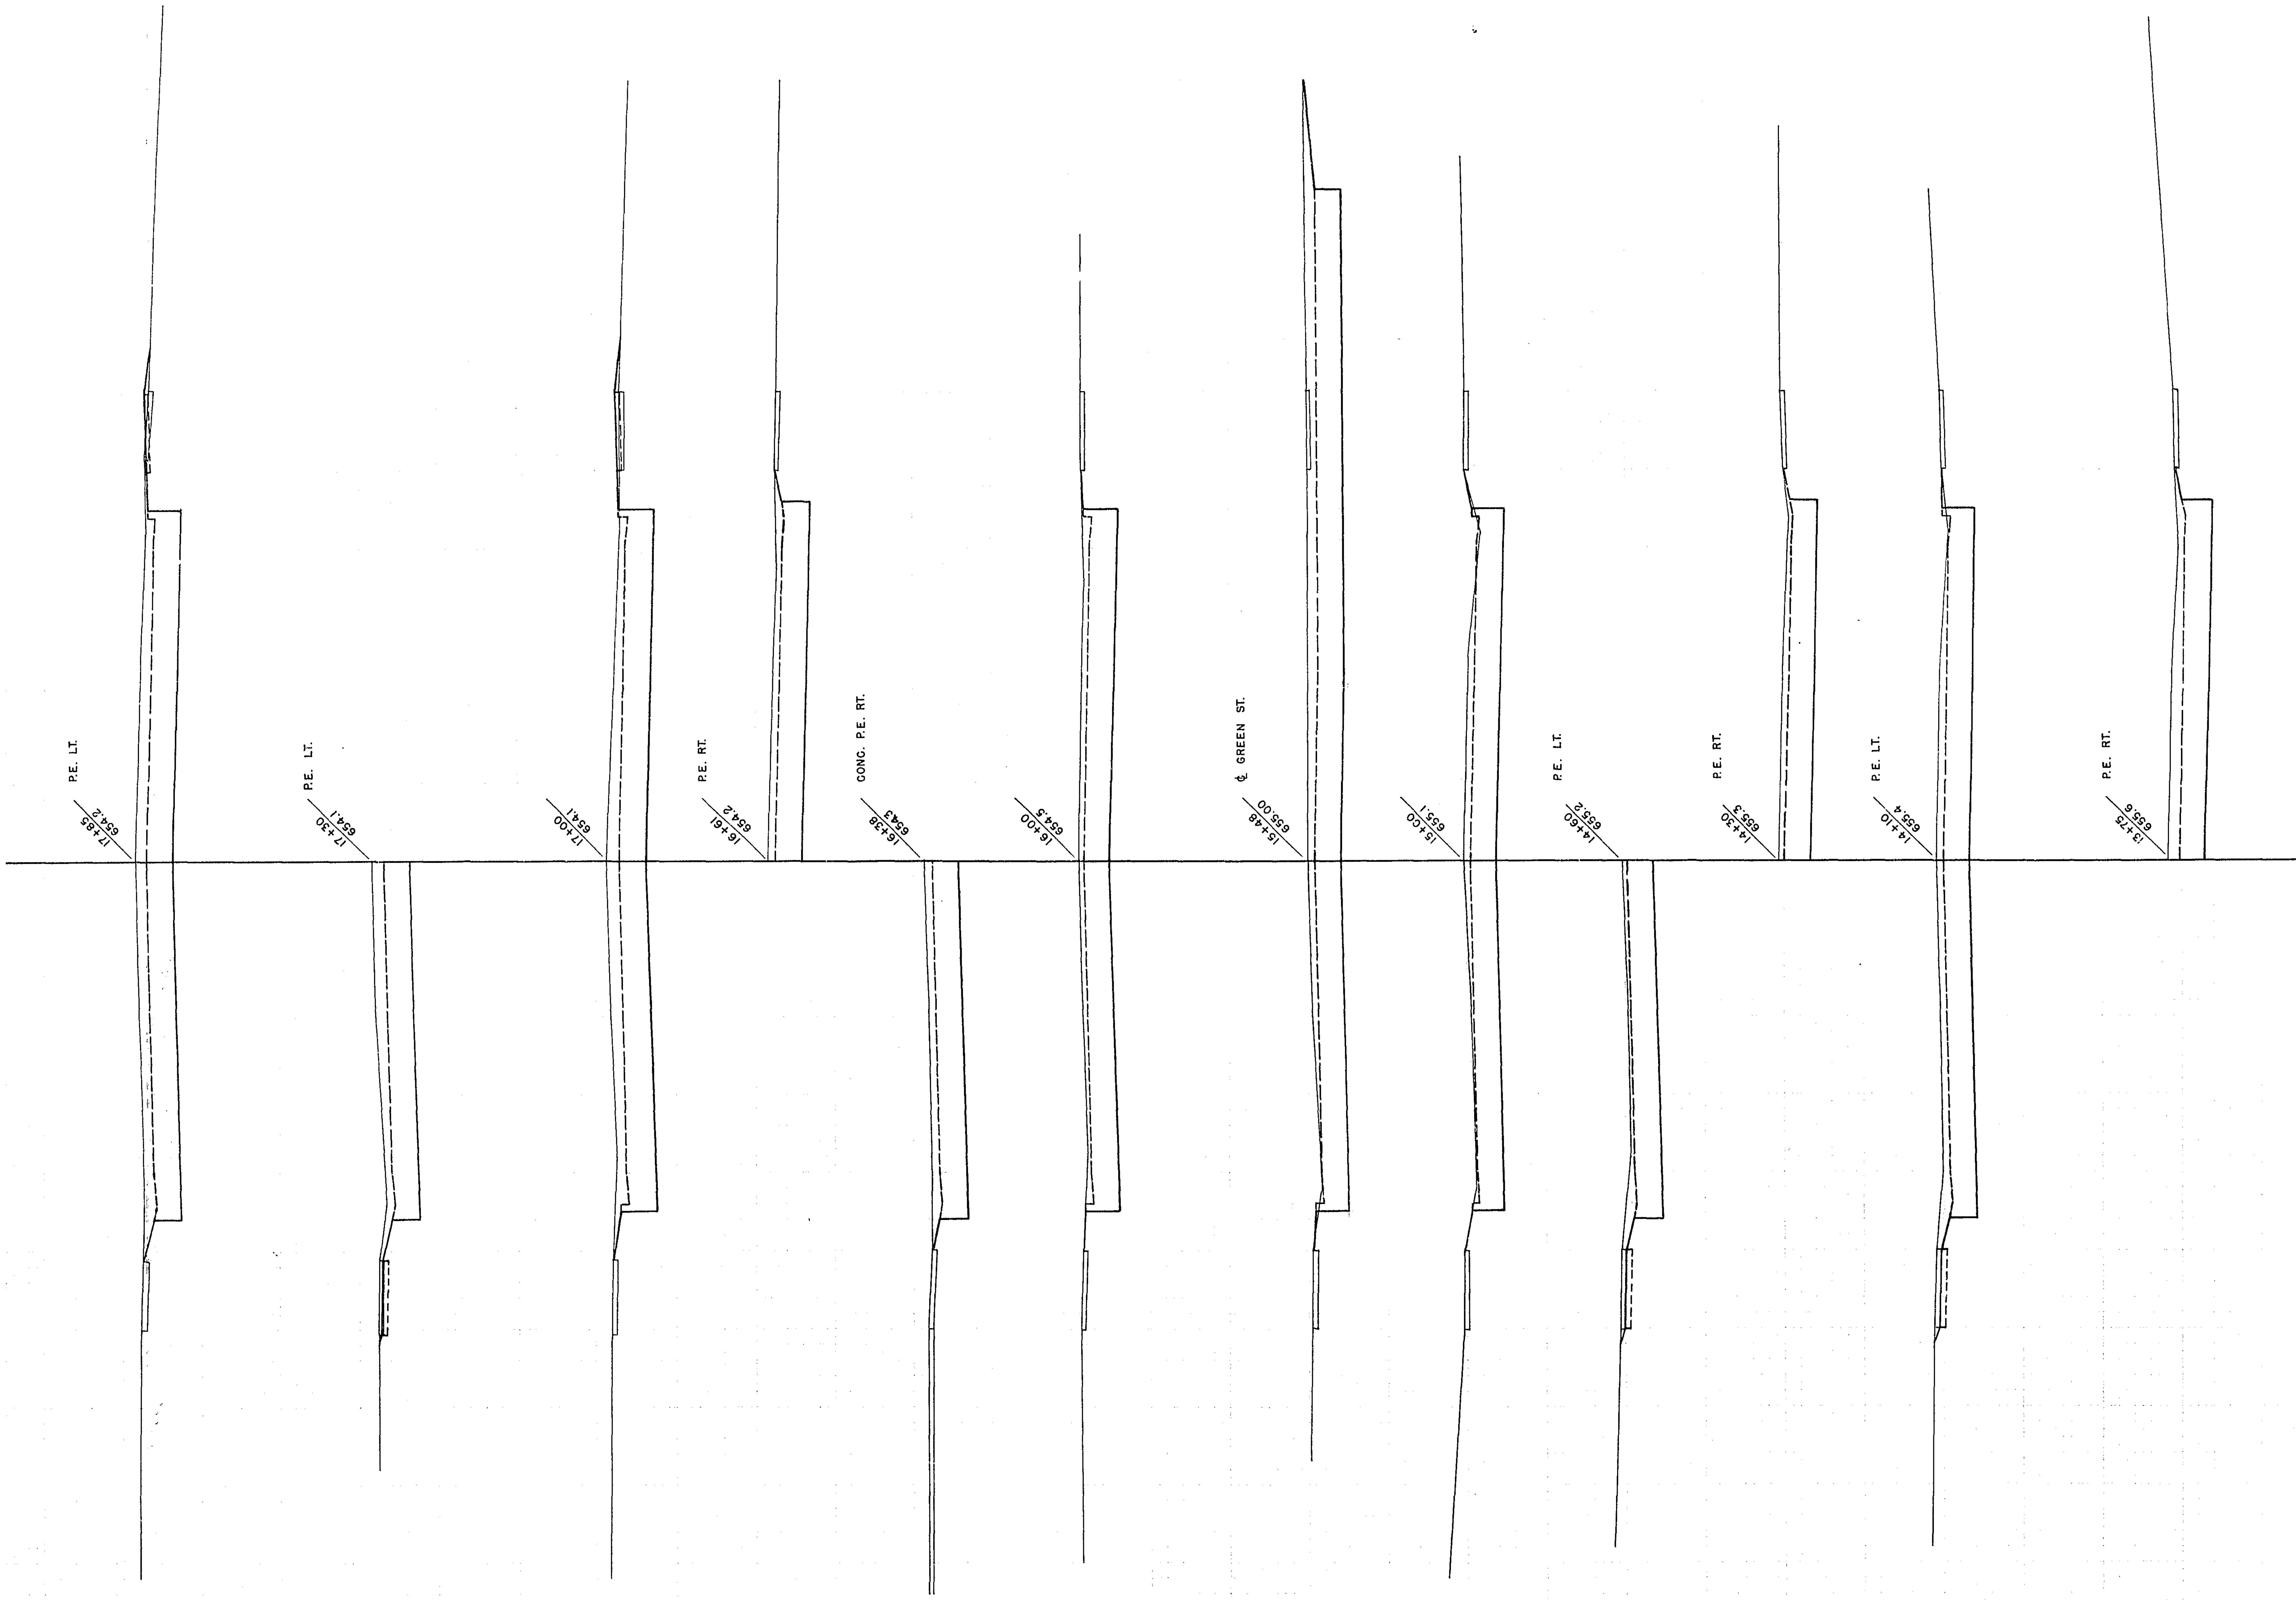

R.G.S. AUG 52
R.G.S. DEC 52
C.L.T. 1-53
W.S.T. 2-53
442

STATION	DISTANCE	YARDAGE				
		EXCAVATION				FILL
		UNCL.				
13						
		359				4
14+10						
		296				2
15						
		197				0
+48						
		220				0
16						
		365				2
17						
		338				2
+85						
SHEET TOTAL		1775				10

P.R.A. DISTRICT OFFICE	PROJECT	SHEET NUMBER	TOTAL SHEETS
WIS. 5N	T-0387(7)	22	24

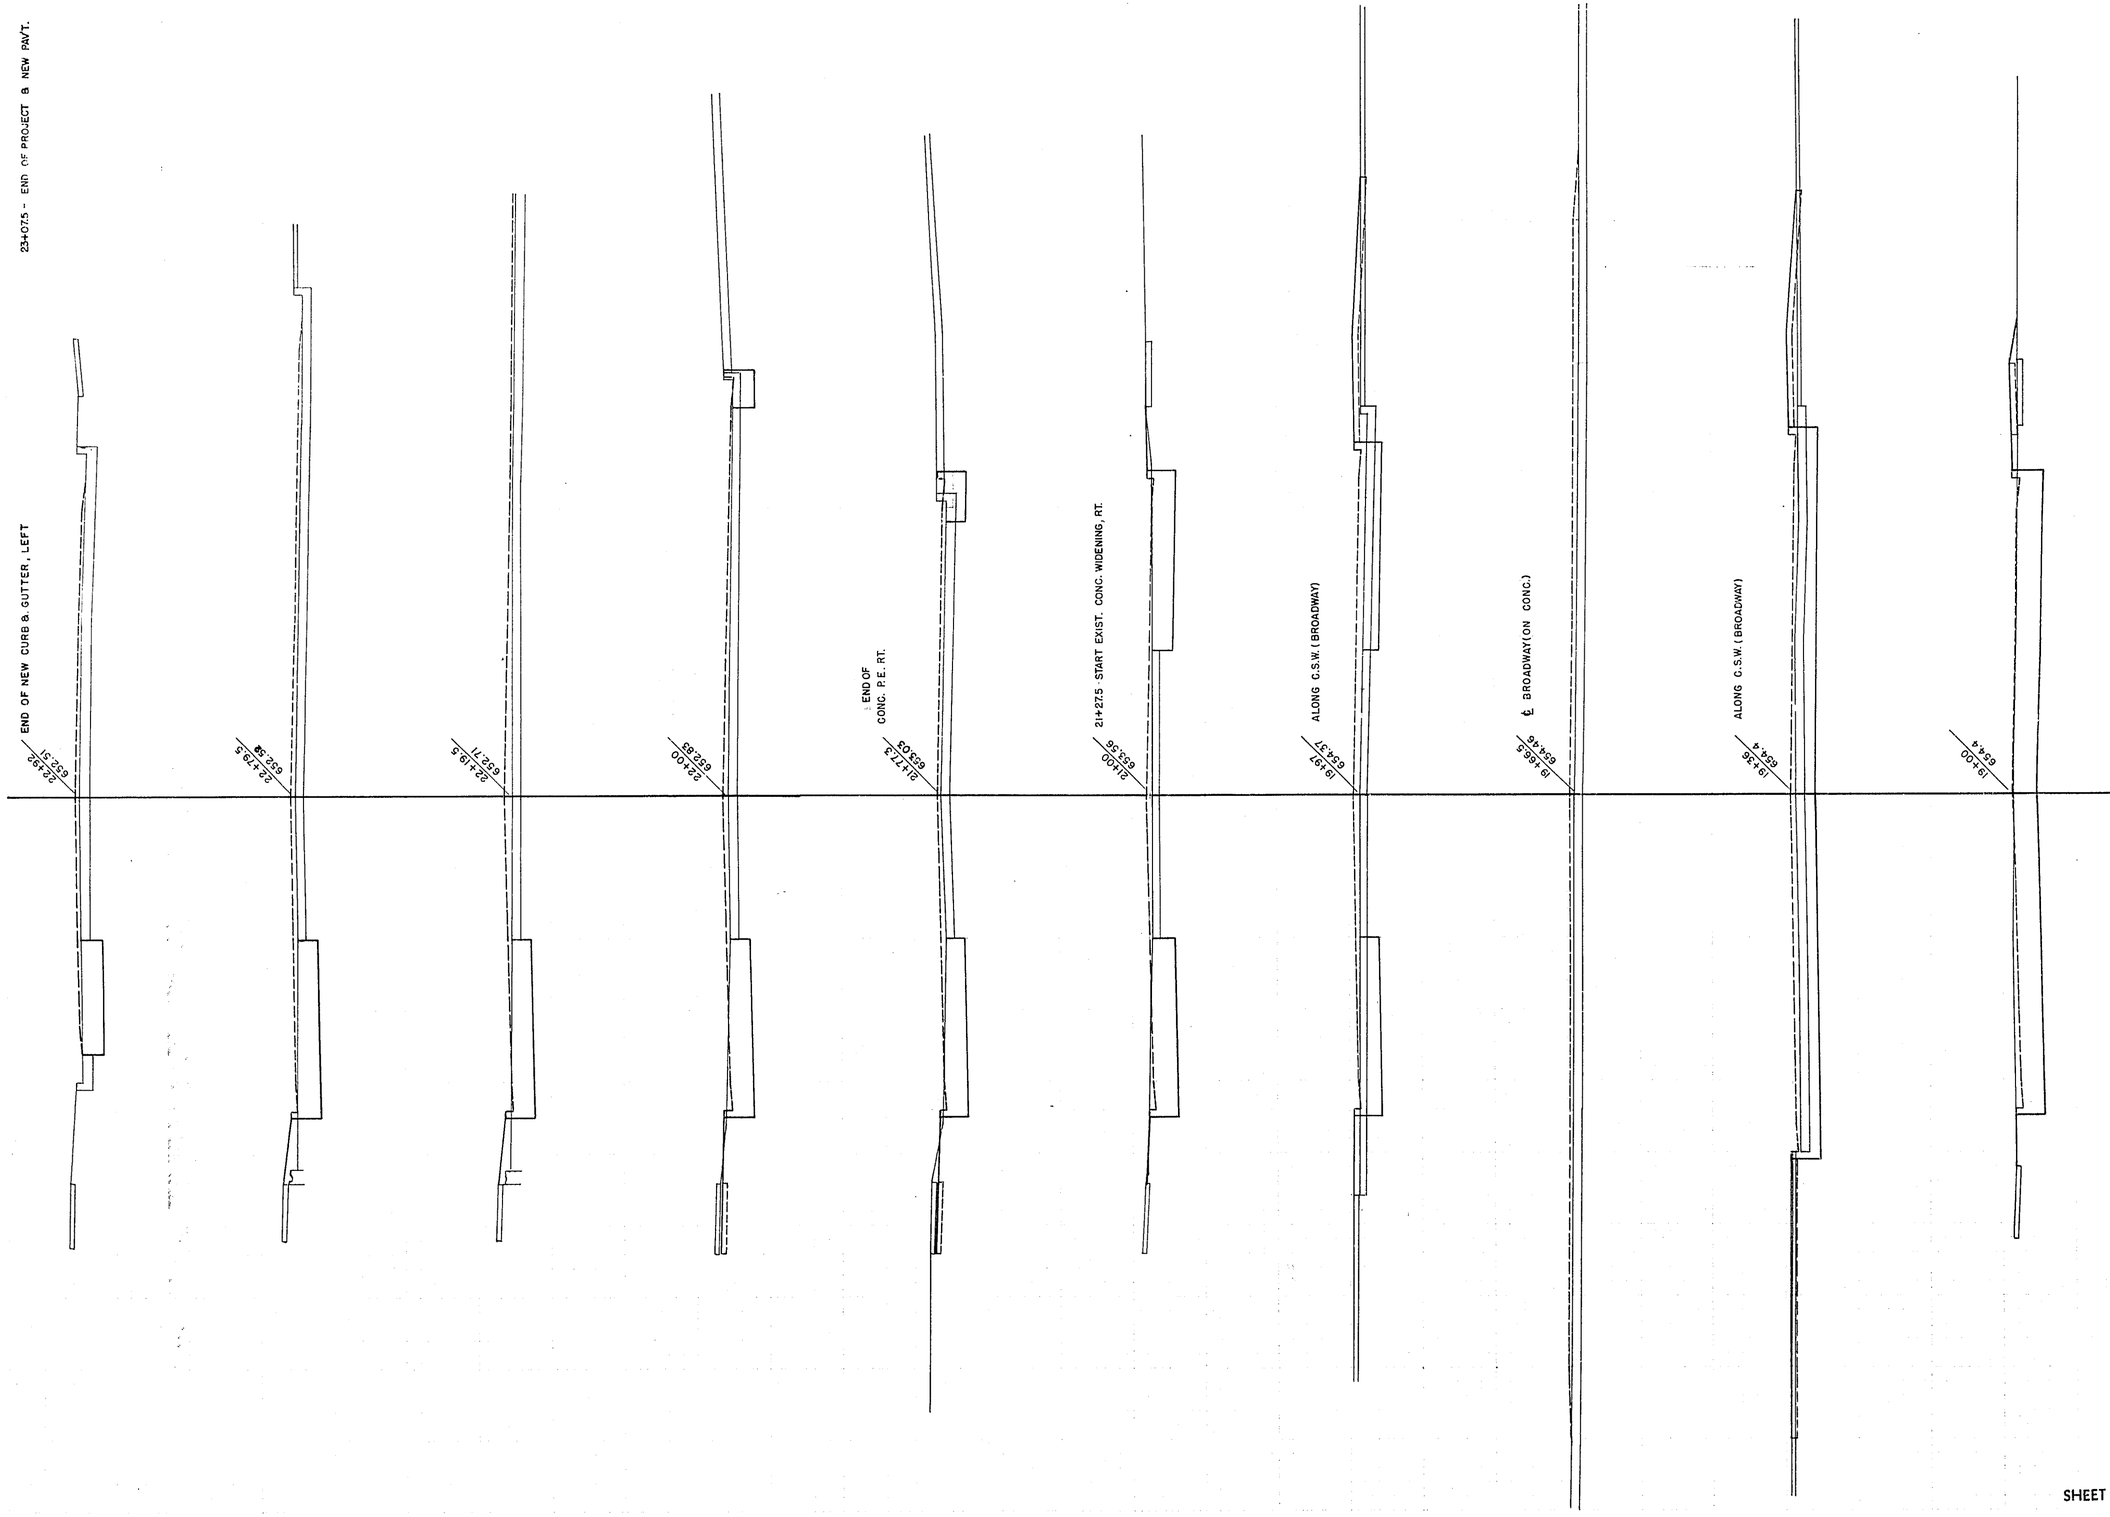

STATION	DISTANCE	YARDAGE EXCAVATION UNCL.				FILL
17+85						
		394				2
19						
		96				1
+36 BACK						
+97 AHEAD						
		151				8
21						
		43				1
+27.5						
		37				2
+77.3						
		17				1
22						
		15				1
+19.5						
		44				0
+79.5						
		9				0
+92						
SHEET TOTAL		806				16

NO. 299-3 - 60M - 12-7-51

P.R.A. DISTRICT OFFICE	PROJECT	SHEET NUMBER	TOTAL SHEETS
WIS. 5N	T-0387(7)	23	24

STATION	DISTANCE	YARDAGE				
		EXCAVATION				FILL
		UNCL.				
0						
2+80.6		NO EXC.	OR	FILL	REQD.	
SHEET TOTAL		0				0

P.R.A. DISTRICT OFFICE	PROJECT	SHEET NUMBER	TOTAL SHEETS
WIS. 5N	T-0387(7)	24	24

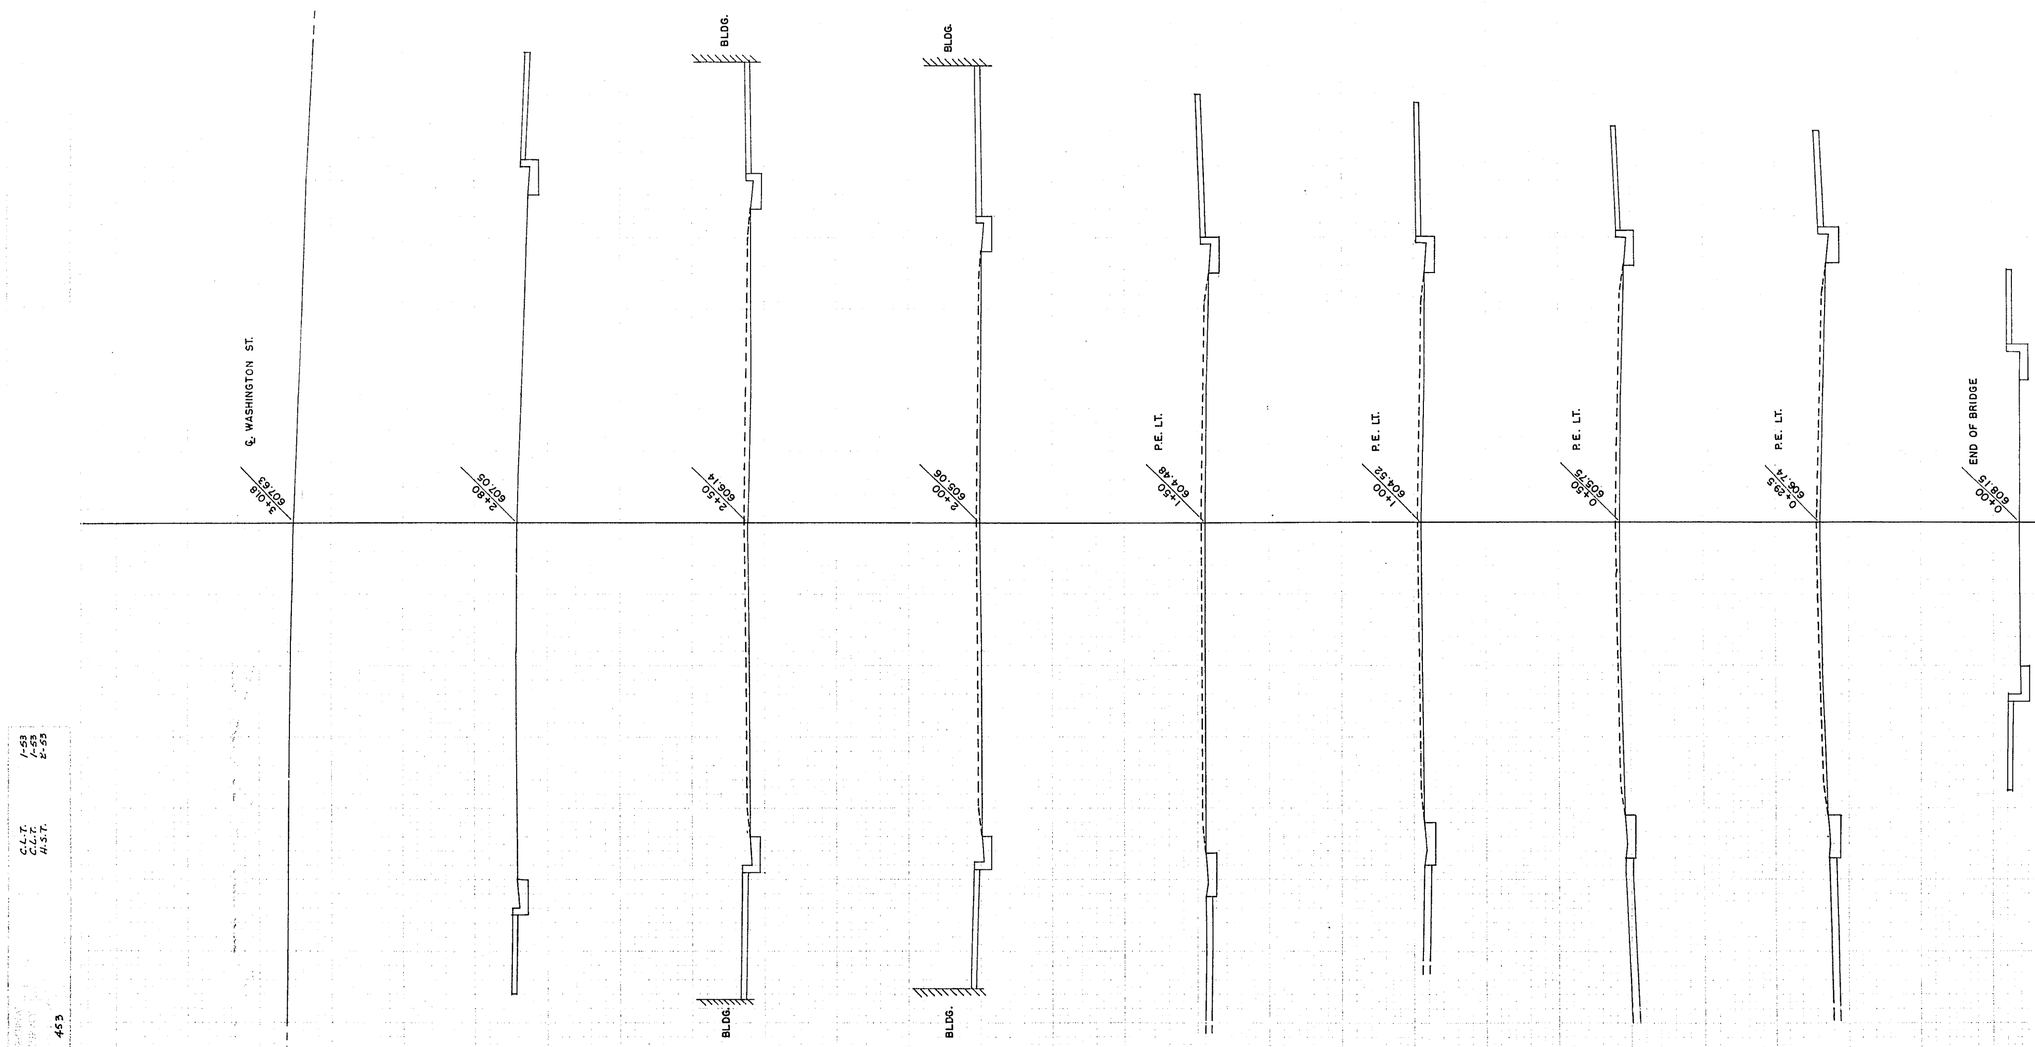

STATION	DISTANCE	YARDAGE EXCAVATION UNCL.				FILL
0						
2+80		NO. EXC. OR FILL REQD.				
SHEET TOTAL		0				0
TOTAL - PROJ. T-0387 (7)		7664				261