

UTILITY WORKSHEET

DT2236 6/2009 s.84.063 Wis. Stats.

Wisconsin Department of Transportation

Utility Company Name Village of Casco - Water Sanitary Sewer	PLEASE RETURN THIS WORKSHEET BY December 15, 2021
Project Description Design Project ID: 4130-11-00 Construction Project ID: 4130-11-71 LUXEMBURG - ALGOMA VALLEY ROAD - SUNSET AVENUE STH 54, Kewaunee County	RETURN TO Becky Reese Division of Transportation System Development Northeast Region 944 Vanderperren Way Green Bay WI 54304

1. Describe your proposed relocation plan for the above project, as requested in the enclosed letter, using highway stationing whenever possible. Attach extra sheets if needed.
2. Conflicting utility facilities will need to be relocated prior to construction. If this is not feasible, provide an explanation and an indication of what work will require coordination with the highway contractor during construction.
3. Anticipated Start Date
4. Estimated construction time required (In working days)
5. List the approvals required and the expected time schedule to obtain those approvals.
6. Include a list of the real estate parcels that the Wisconsin Department of Transportation (DOT) must have acquired to enable your company to complete the necessary facility installations and relocations prior to construction.
7. Review the enclosed plans for the above project. Are your facilities correct as shown? If not, list the errors. In some cases, it may be easier to return a marked up copy of the plan. **It is very important that your facilities are shown correctly because all construction field personnel will use this information. Uncorrected location errors could create construction delays or damage to utility facilities.**
8. Is this work dependent on work by other utilities? If so, which other utilities, and what time schedule has been coordinated with them?
9. Please provide the name, address, and telephone number of the field contact person for this project, so that we may place this information on the highway plan

ROAD 2/22 PH 12:27:06
WISDOT ME

Name KELLY PINCHART	
Address 407 MAPLE ST. CASCO, WIS.	
City, State, ZIP Code CASCO, WIS. 54205	
Area Code - Telephone Number 920-837-2143	Area Code - Telephone Number (Mobile) 920-676-7703
E-mail Address pinchie@centurytel.net	

10. List any other relevant information that may impact the ultimate goal of preventing construction delay due to uncertain scheduling of utility facility relocations.

11.

Yes	No	
<input type="checkbox"/>	<input type="checkbox"/>	Do you have any facilities that are no longer in use but have been left in place in the project area? If "Yes", approximately where are the facilities located and what type and size of facility is involved?
<input type="checkbox"/>	<input type="checkbox"/>	Does the line have any remaining product?
<input type="checkbox"/>	<input type="checkbox"/>	Does the line have any asbestos wrap or any other hazardous materials associated with it?
<input type="checkbox"/>	<input type="checkbox"/>	Does any part of the line conflict directly with the proposed highway project? If so, what arrangements have been made to remove those portions? This should be mentioned as part of your work plan in question number 1 on this form.
<input type="checkbox"/>	<input type="checkbox"/>	Is there any reason the highway contractor cannot remove portions of the line left in place?

If you answered "Yes" to any of the questions above, please attach additional pages.

Preparer Area Code - Telephone #, Ext. 920-837-2143	Preparer E-Mail Address pinchie@centurytel.net	
920-676-7703 CAL	KELLY PINCHART	01/09/2022
	(Name of Person Who Prepared this Worksheet) (If completed electronically, Brush Script Font)	(Date)

NOTE: DOT will be sending to you a Trans 220 Work Plan Approval letter and a Start Work Notice after we complete the review of your Work Plan.

Ms. Reese

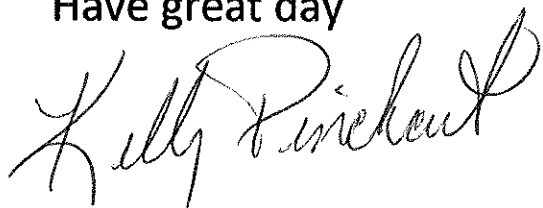
Hello, my name is Kelly Pinchart (Casco Village President), and have received the enclosed document from my clerk/treasurer this week.

This is in response to the Highway "54" project running thru our Village in "projected 2023". All Village residents have their own wells for water supply so the only "pipes" that would come into question in the "54" right of way would be our sanitary sewer system piping which would be considerably beneath the surface for your "milling" process.

However, there are 16 manhole covers that will have to be "milled" around. The Village intends to upgrade these manholes this coming spring in anticipation of your project in 2023.

If you have any questions, feel free to contact me @920-837-2143 HOME OR 920-676-7703 CELL.

Have great day

A handwritten signature in cursive script that reads "Kelly Pinchart". The signature is written in dark ink and is positioned below the text "Have great day".

Kelly Pinchart

Casco Village President