

Utility Company Name CenturyLink - Communication Line	PLEASE RETURN THIS WORKSHEET BY December 15, 2021
Project Description Design Project ID: 4130-11-00 Construction Project ID: 4130-11-71 LUXEMBURG - ALGOMA VALLEY ROAD - SUNSET AVENUE STH 54, Kewaunee County	RETURN TO Becky Reese Division of Transportation System Development Northeast Region 944 Vanderperren Way Green Bay WI 54304

1. Describe your proposed relocation plan for the above project, as requested in the enclosed letter, using highway stationing whenever possible. Attach extra sheets if needed.
NO Conflicts, attached are appx locates with approximate depth readings of LUMEN (CenturyLink) facilities in the areas.
2. Conflicting utility facilities will need to be relocated prior to construction. If this is not feasible, provide an explanation and an indication of what work will require coordination with the highway contractor during construction.
NA
3. Anticipated Start Date
NA
4. Estimated construction time required (In working days)
NA
5. List the approvals required and the expected time schedule to obtain those approvals.
NA
6. Include a list of the real estate parcels that the Wisconsin Department of Transportation (DOT) must have acquired to enable your company to complete the necessary facility installations and relocations prior to construction.
NA
7. Review the enclosed plans for the above project. Are your facilities correct as shown? If not, list the errors. In some cases, it may be easier to return a marked up copy of the plan. It is very important that your facilities are shown correctly because all construction field personnel will use this information. Uncorrected location errors could create construction delays or damage to utility facilities.
File attached with approximate locates and depths.
8. Is this work dependent on work by other utilities? If so, which other utilities, and what time schedule has been coordinated with them?
NA
9. Please provide the name, address, and telephone number of the field contact person for this project, so that we may place this information on the highway plan

Name Steven Bishop	
Address 130 4 th St	
City, State, ZIP Code Baraboo, WI 53913	
Area Code - Telephone Number 608-355-7501	Area Code - Telephone Number (Mobile) 608-963-8594
E-mail Address Steven.bishop@lumen.com	

10. List any other relevant information that may impact the ultimate goal of preventing construction delay due to uncertain scheduling of utility facility relocations.
At Station 293+81 existing telephone cable is in area, DOT plans show fill in profiles. Culvert work in area? Use caution

11.

Yes	No
☐	☒

 Do you have any facilities that are no longer in use but have been left in place in the project area? If "Yes", approximately where are the facilities located and what type and size of facility is involved?

☐	☐
--------------------------	--------------------------

 Does the line have any remaining product?

☐	☐
--------------------------	--------------------------

 Does the line have any asbestos wrap or any other hazardous materials associated with it?

☐	☐
--------------------------	--------------------------

 Does any part of the line conflict directly with the proposed highway project? If so, what arrangements have been made to remove those portions? This should be mentioned as part of your work plan in question number 1 on this form.

☐	☐
--------------------------	--------------------------

 Is there any reason the highway contractor cannot remove portions of the line left in place?

If you answered "Yes" to any of the questions above, please attach additional pages.

Preparer Area Code - Telephone #, Ext. 319-423-5242	Preparer E-Mail Address dshea@terratechllc.net	
Daniel R. Shea	Daniel R. Shea	01/19/2022
	(Name of Person Who Prepared this Worksheet) (If completed electronically, Brush Script Font)	(Date)

NOTE: DOT will be sending to you a Trans 220 Work Plan Approval letter and a Start Work Notice after we complete the review of your Work Plan.

PROJECT ID: 4130-11-71

COUNTY: KEWAUNEE

WITH: N/A

ORDER OF SHEETS

Section No.	1	Title
Section No.	2	Typical Sections and Details
Section No.	3	Estimate of Quantities
Section No.	3	Miscellaneous Quantities
Section No.	4	Right of Way Plat
Section No.	5	Plan and Profile
Section No.	6	Standard Detail Drawings
Section No.	7	Sign Plates
Section No.	8	Structure Plans
Section No.	9	Computer Earthwork Data
Section No.	9	Cross Sections

TOTAL SHEETS =



DESIGN DESIGNATION 4130-11-00

A.A.D.T.	2024	=	4820
A.A.D.T.	2044	=	4820
D.H.V.		=	289
D.D.		=	50/50
T.		=	11%
DESIGN SPEED		=	55 MPH
ESALS		=	1,140,000

CONVENTIONAL SYMBOLS

PLAN


CORPORATE LIMITS	
PROPERTY LINE	
LOT LINE	
LIMITED HIGHWAY EASEMENT	
EXISTING RIGHT OF WAY	
PROPOSED OR NEW R/W LINE	
SLOPE INTERCEPT	
REFERENCE LINE	
EXISTING CULVERT	
PROPOSED CULVERT (Box or Pipe)	
COMBUSTIBLE FLUIDS	
MARSH AREA	
WOODED OR SHRUB AREA	

PROFILE

GRADE LINE	
ORIGINAL GROUND	
MARSH OR ROCK PROFILE (To be noted as such)	
SPECIAL DITCH	
GRADE ELEVATION	
CULVERT (Profile View)	
UTILITIES	
ELECTRIC	
FIBER OPTIC	
GAS	
SANITARY SEWER	
STORM SEWER	
TELEPHONE	
WATER	
UTILITY PEDESTAL	
POWER POLE	
TELEPHONE POLE	

EXCEPTION TO NET & LENGTH
STA 334+99 TO STA 336+37
EXISTING STRUCTURE B-31-71

BEGIN PROJECT
STA 241+06.81
Y= 466,915.592
X= 224,803.371

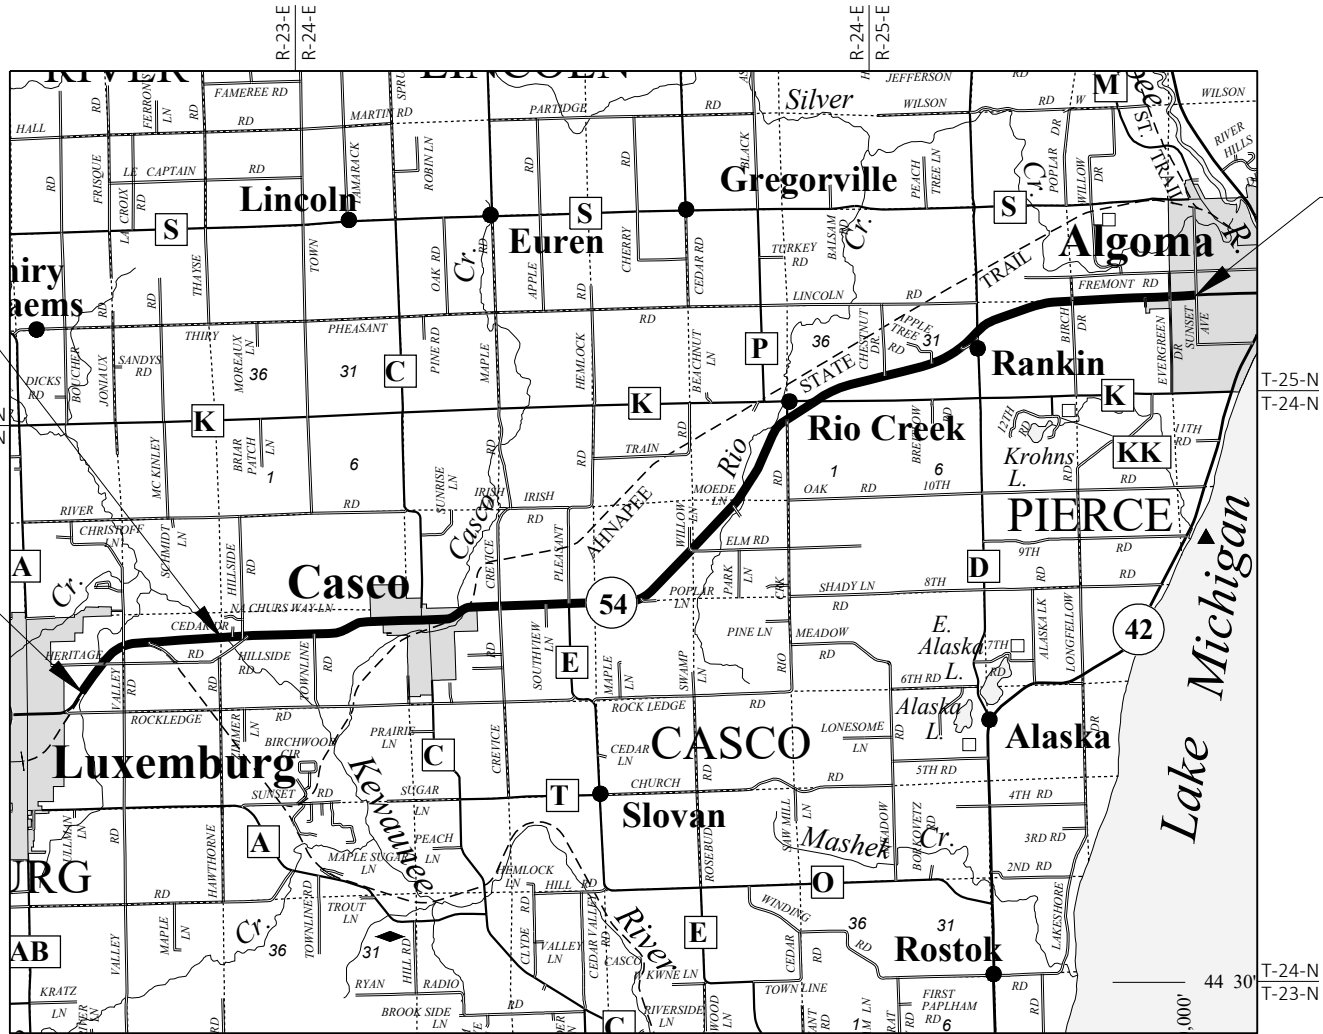

LAYOUT
SCALE 0 2 MI
TOTAL NET LENGTH OF CENTERLINE = 13.203 MI

HORIZONTAL POSITIONS SHOWN ON THIS PLAN ARE WISCONSIN COORDINATE REFERENCE SYSTEM (WISCRS), KEWAUNEE COUNTY, NAD83 (2011), IN U.S. SURVEY FEET. POSITIONS SHOWN ARE GRID COORDINATES, GRID BEARINGS, AND GRID DISTANCES. GRID DISTANCES ARE THE SAME AS GROUND DISTANCES. ELEVATIONS ARE REFERENCED TO NAVD 88 (2012). GPS DERIVED ELEVATIONS ARE BASED ON GEOID 2012A.

END PROJECT
STA 938+90.00
Y= 487,240.981
X= 286,927.405

STATE OF WISCONSIN
DEPARTMENT OF TRANSPORTATION

PLAN OF PROPOSED IMPROVEMENT

LUXEMBURG - ALGOMA

VALLEY ROAD - SUNSET AVENUE

STH 54

KEWAUNEE COUNTY

STATE PROJECT NUMBER
4130-11-71

STATE PROJECT	FEDERAL PROJECT	
	PROJECT	CONTRACT
4130-11-71		

TRANS 220
PROJECT PLAN
FOR
DESIGN OF UTILITY FACILITY
ALTERATIONS OR RELOCATIONS


Date: 09/16/2021

STATE OF WISCONSIN
DEPARTMENT OF TRANSPORTATION

PREPARED BY	NE REGION
Surveyor	
Designer	D. KIRST
Project Manager	P. BRAUER
Regional Examiner	
Regional Supervisor	D. SEGERSTROM

APPROVED FOR THE DEPARTMENT
DATE: (Signature)


E

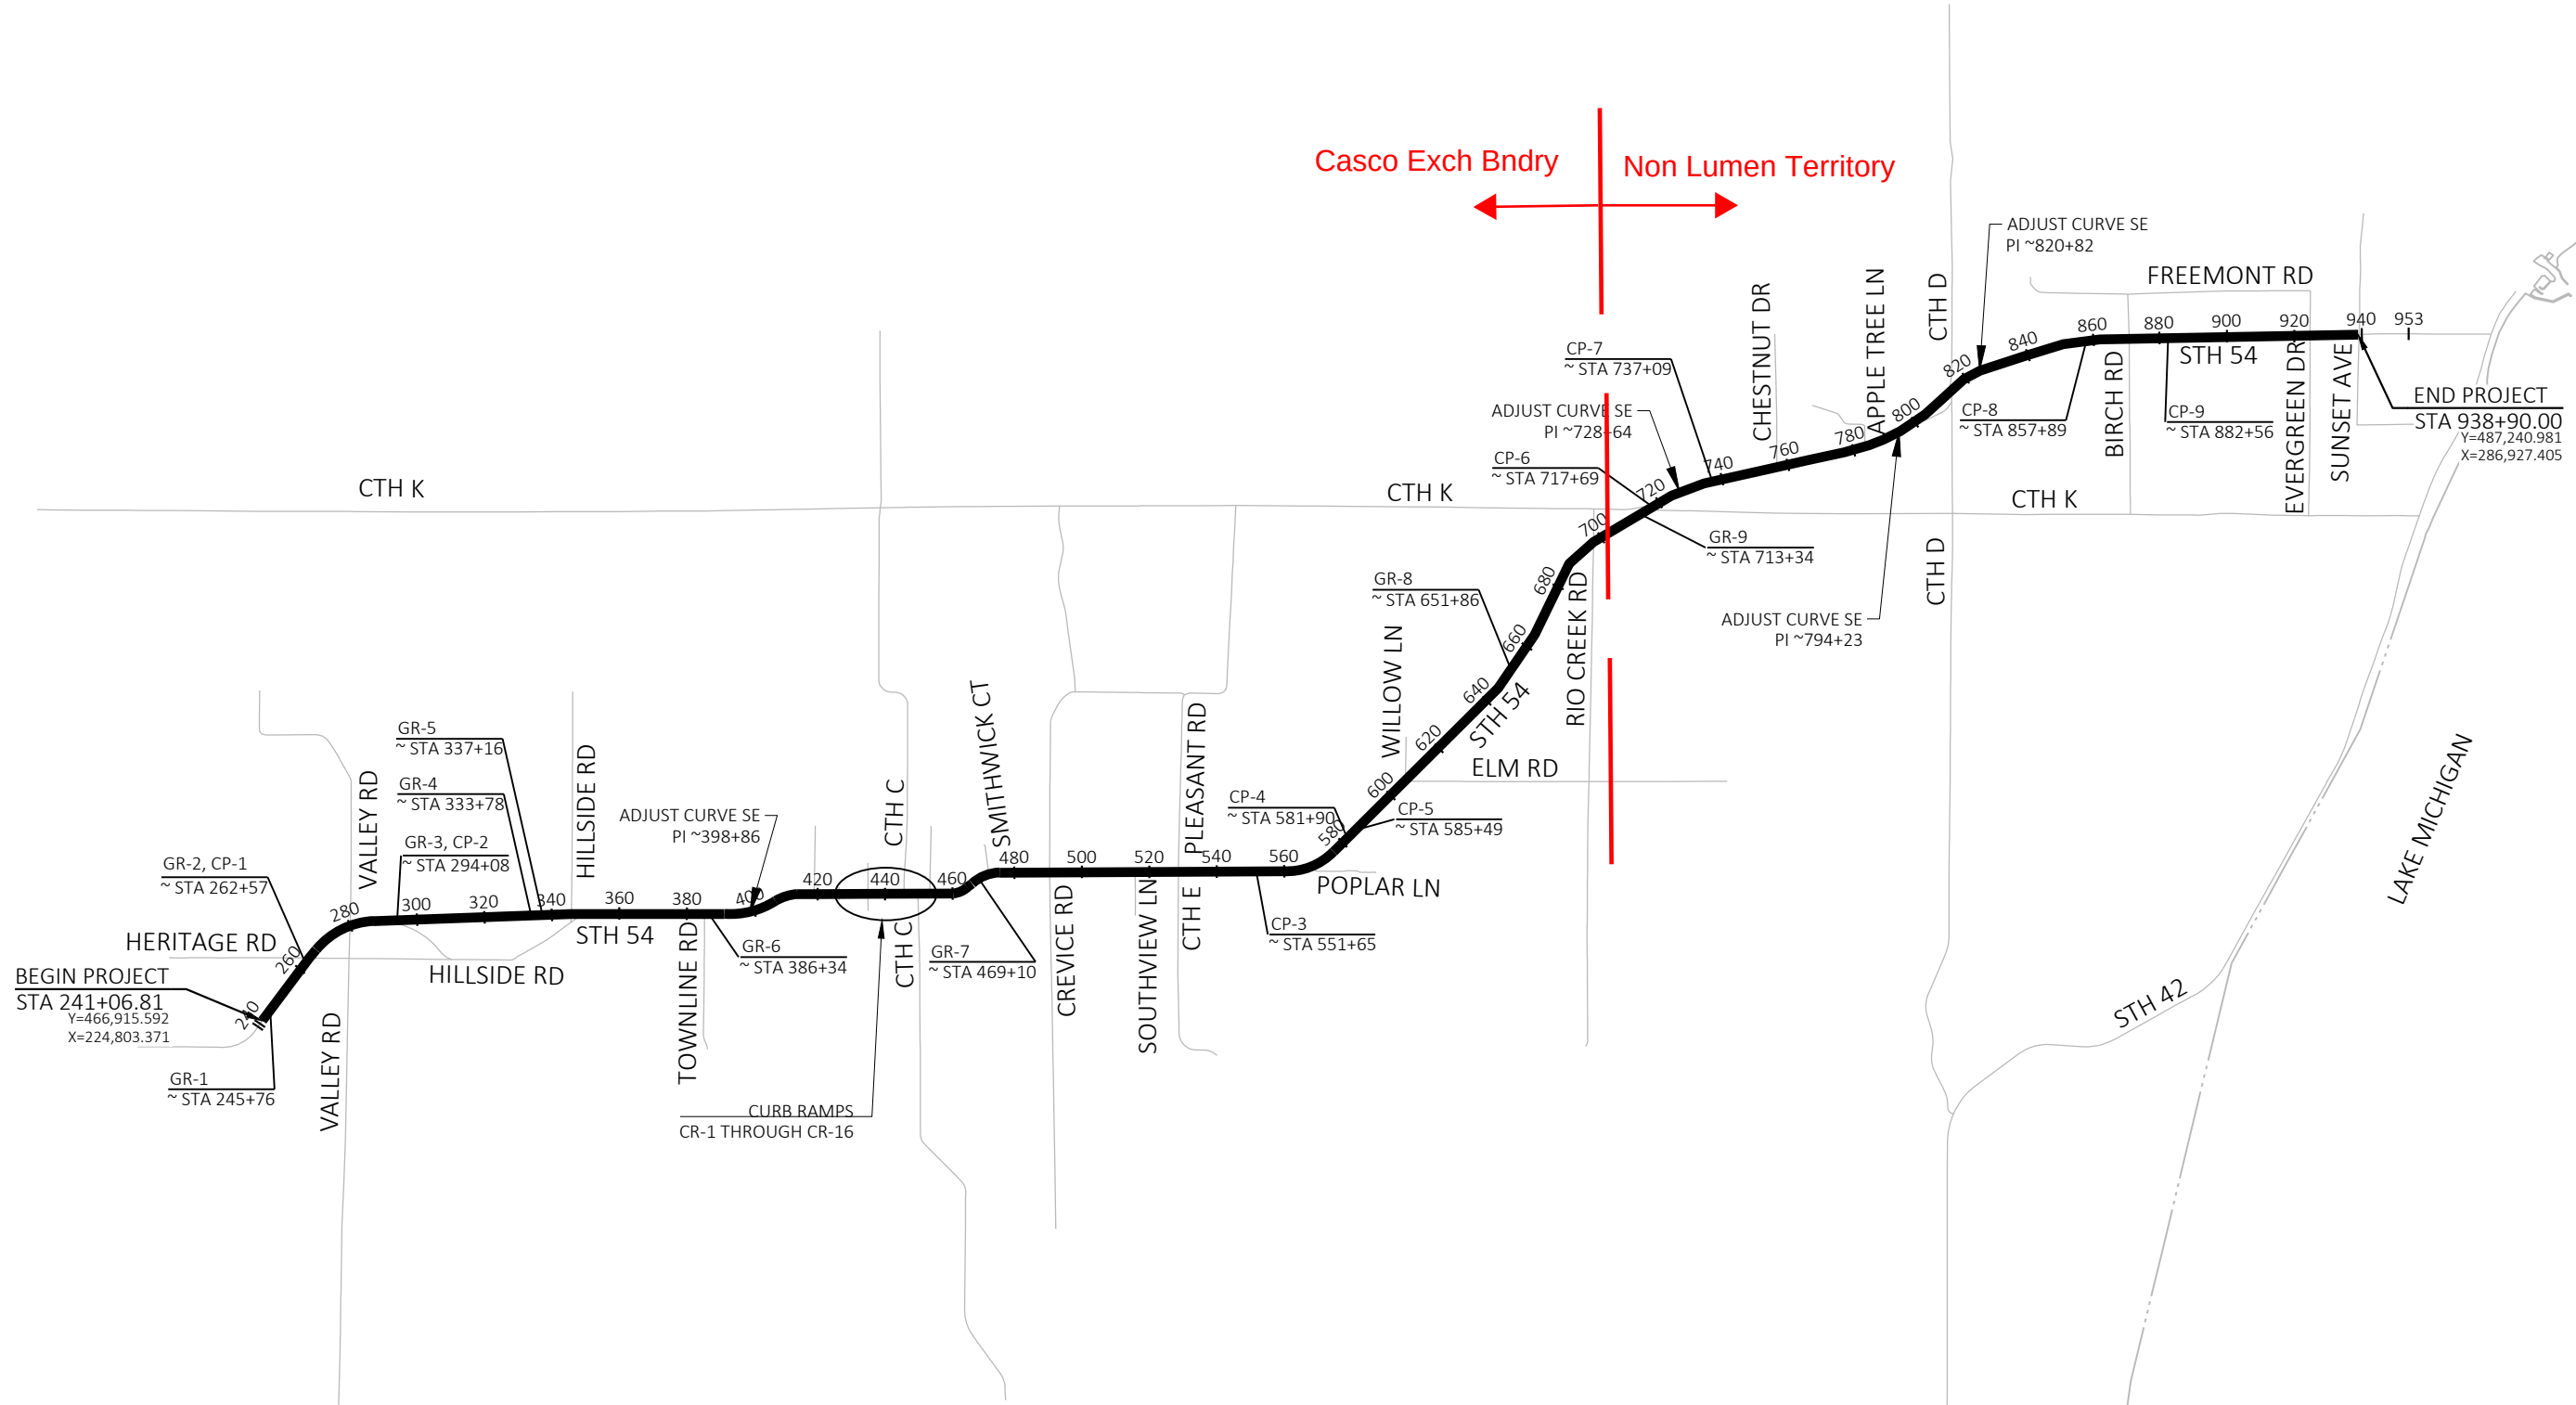

CP = CULVERT PIPE WORK - LOCATION #
CR = CURB RAMP WORK - LOCATION #
GR = GUARDRAIL WORK - LOCATION #

PROJECT NO: 4130-11-71	HWY: STH 54	COUNTY: KEWAUNEE	PROJECT OVERVIEW	SHEET	E
------------------------	-------------	------------------	------------------	-------	---

NO CONFLICT

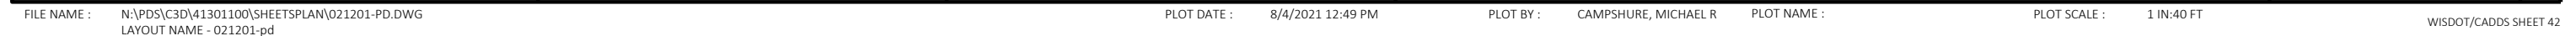



Lumen Markups


NO CONFLICT

Lumen Markups
FIBER IS 6-10' OFF EXISTING EOP, NO
CONFLICTS-USE CAUTION

CenturyLink facilities are approximate only and
have not been potholed.
FOR REFERENCE ONLY

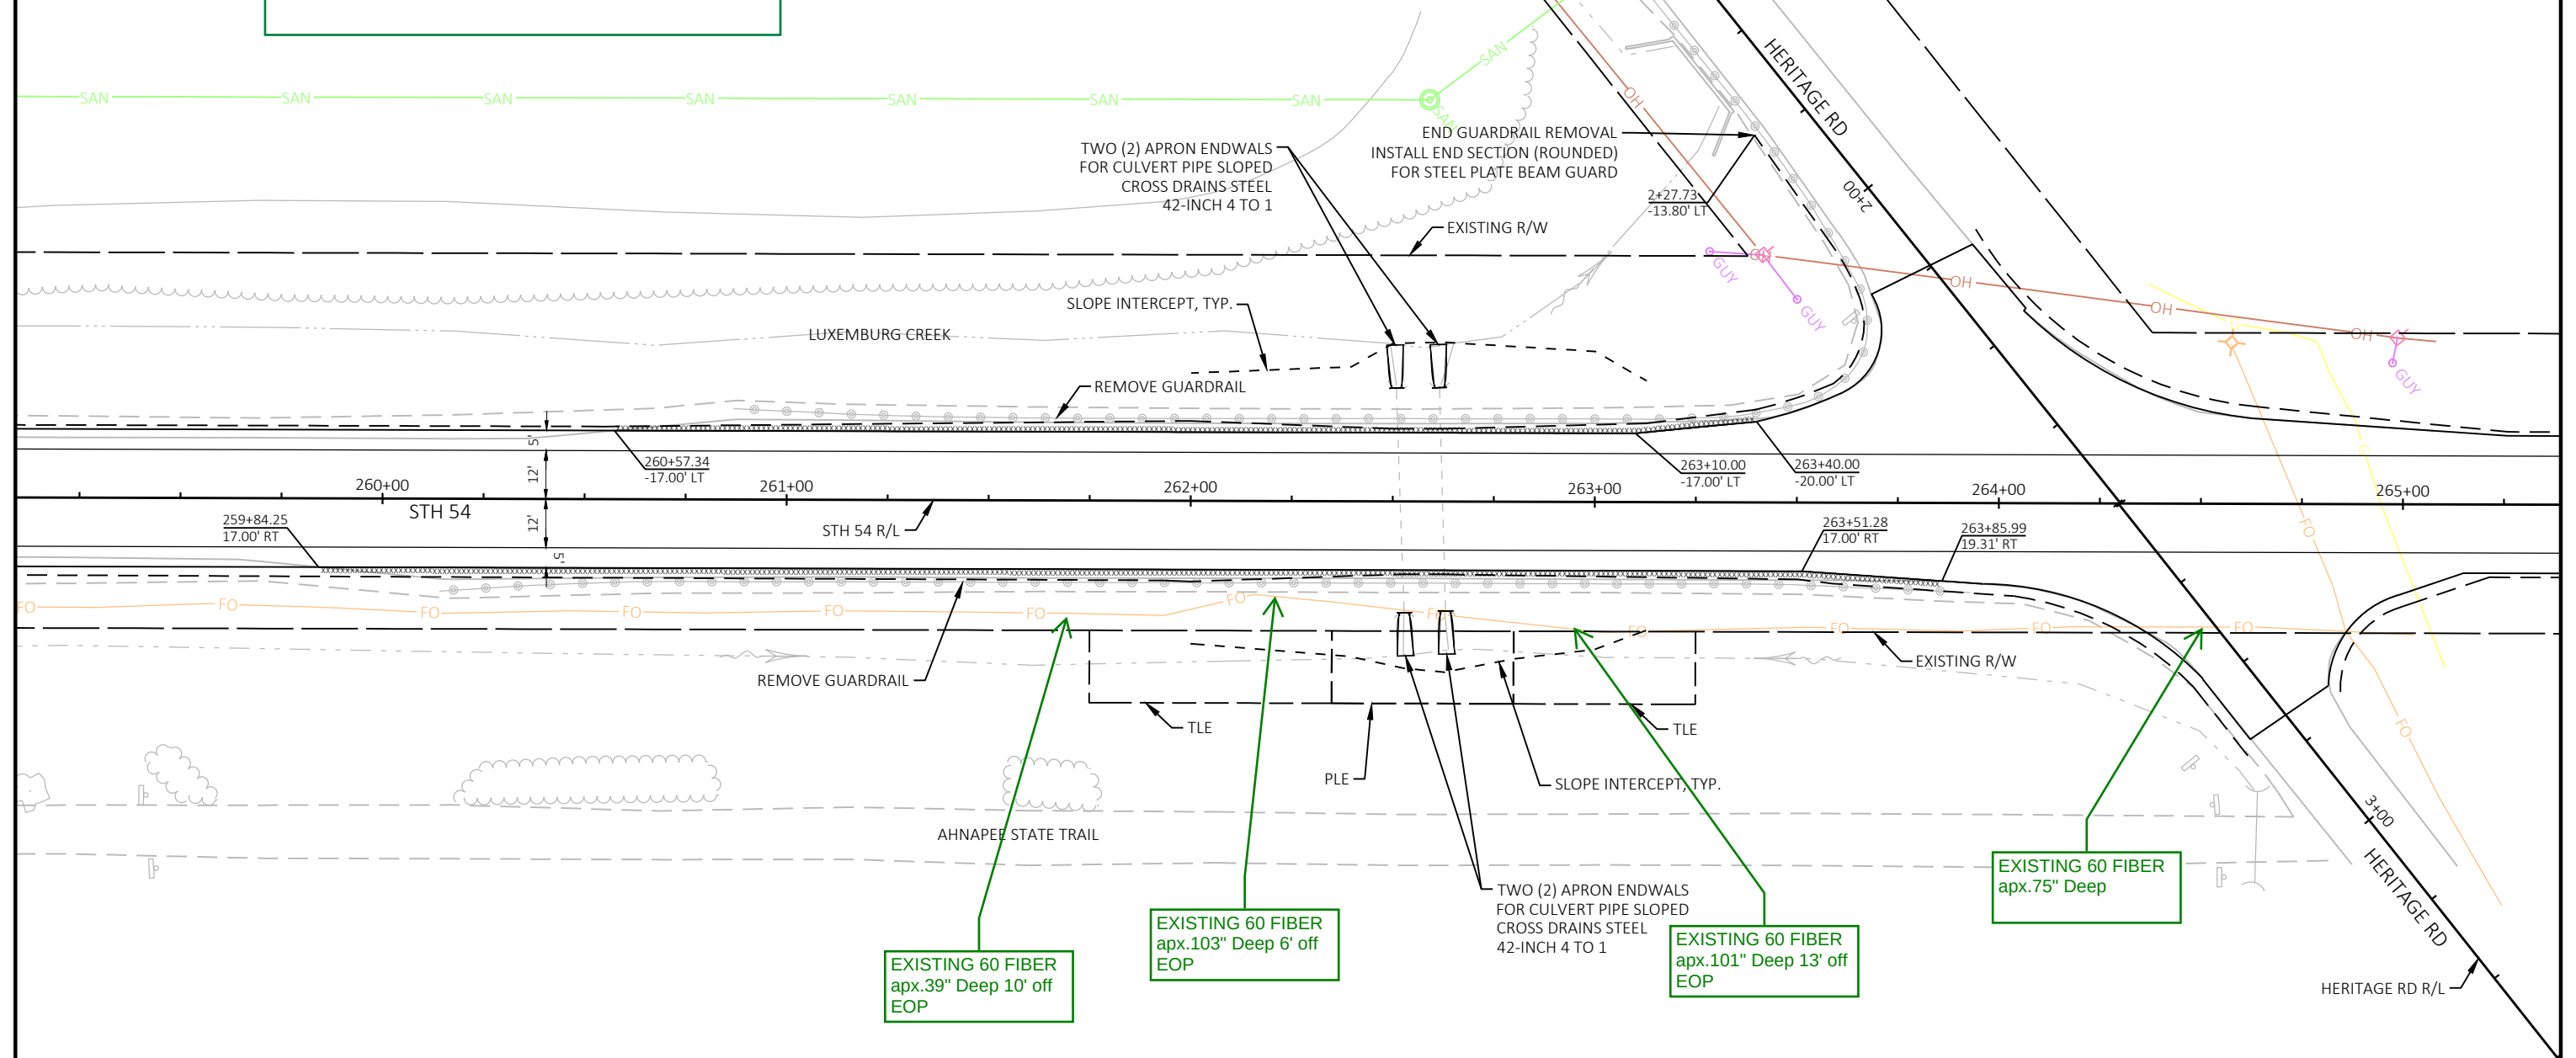

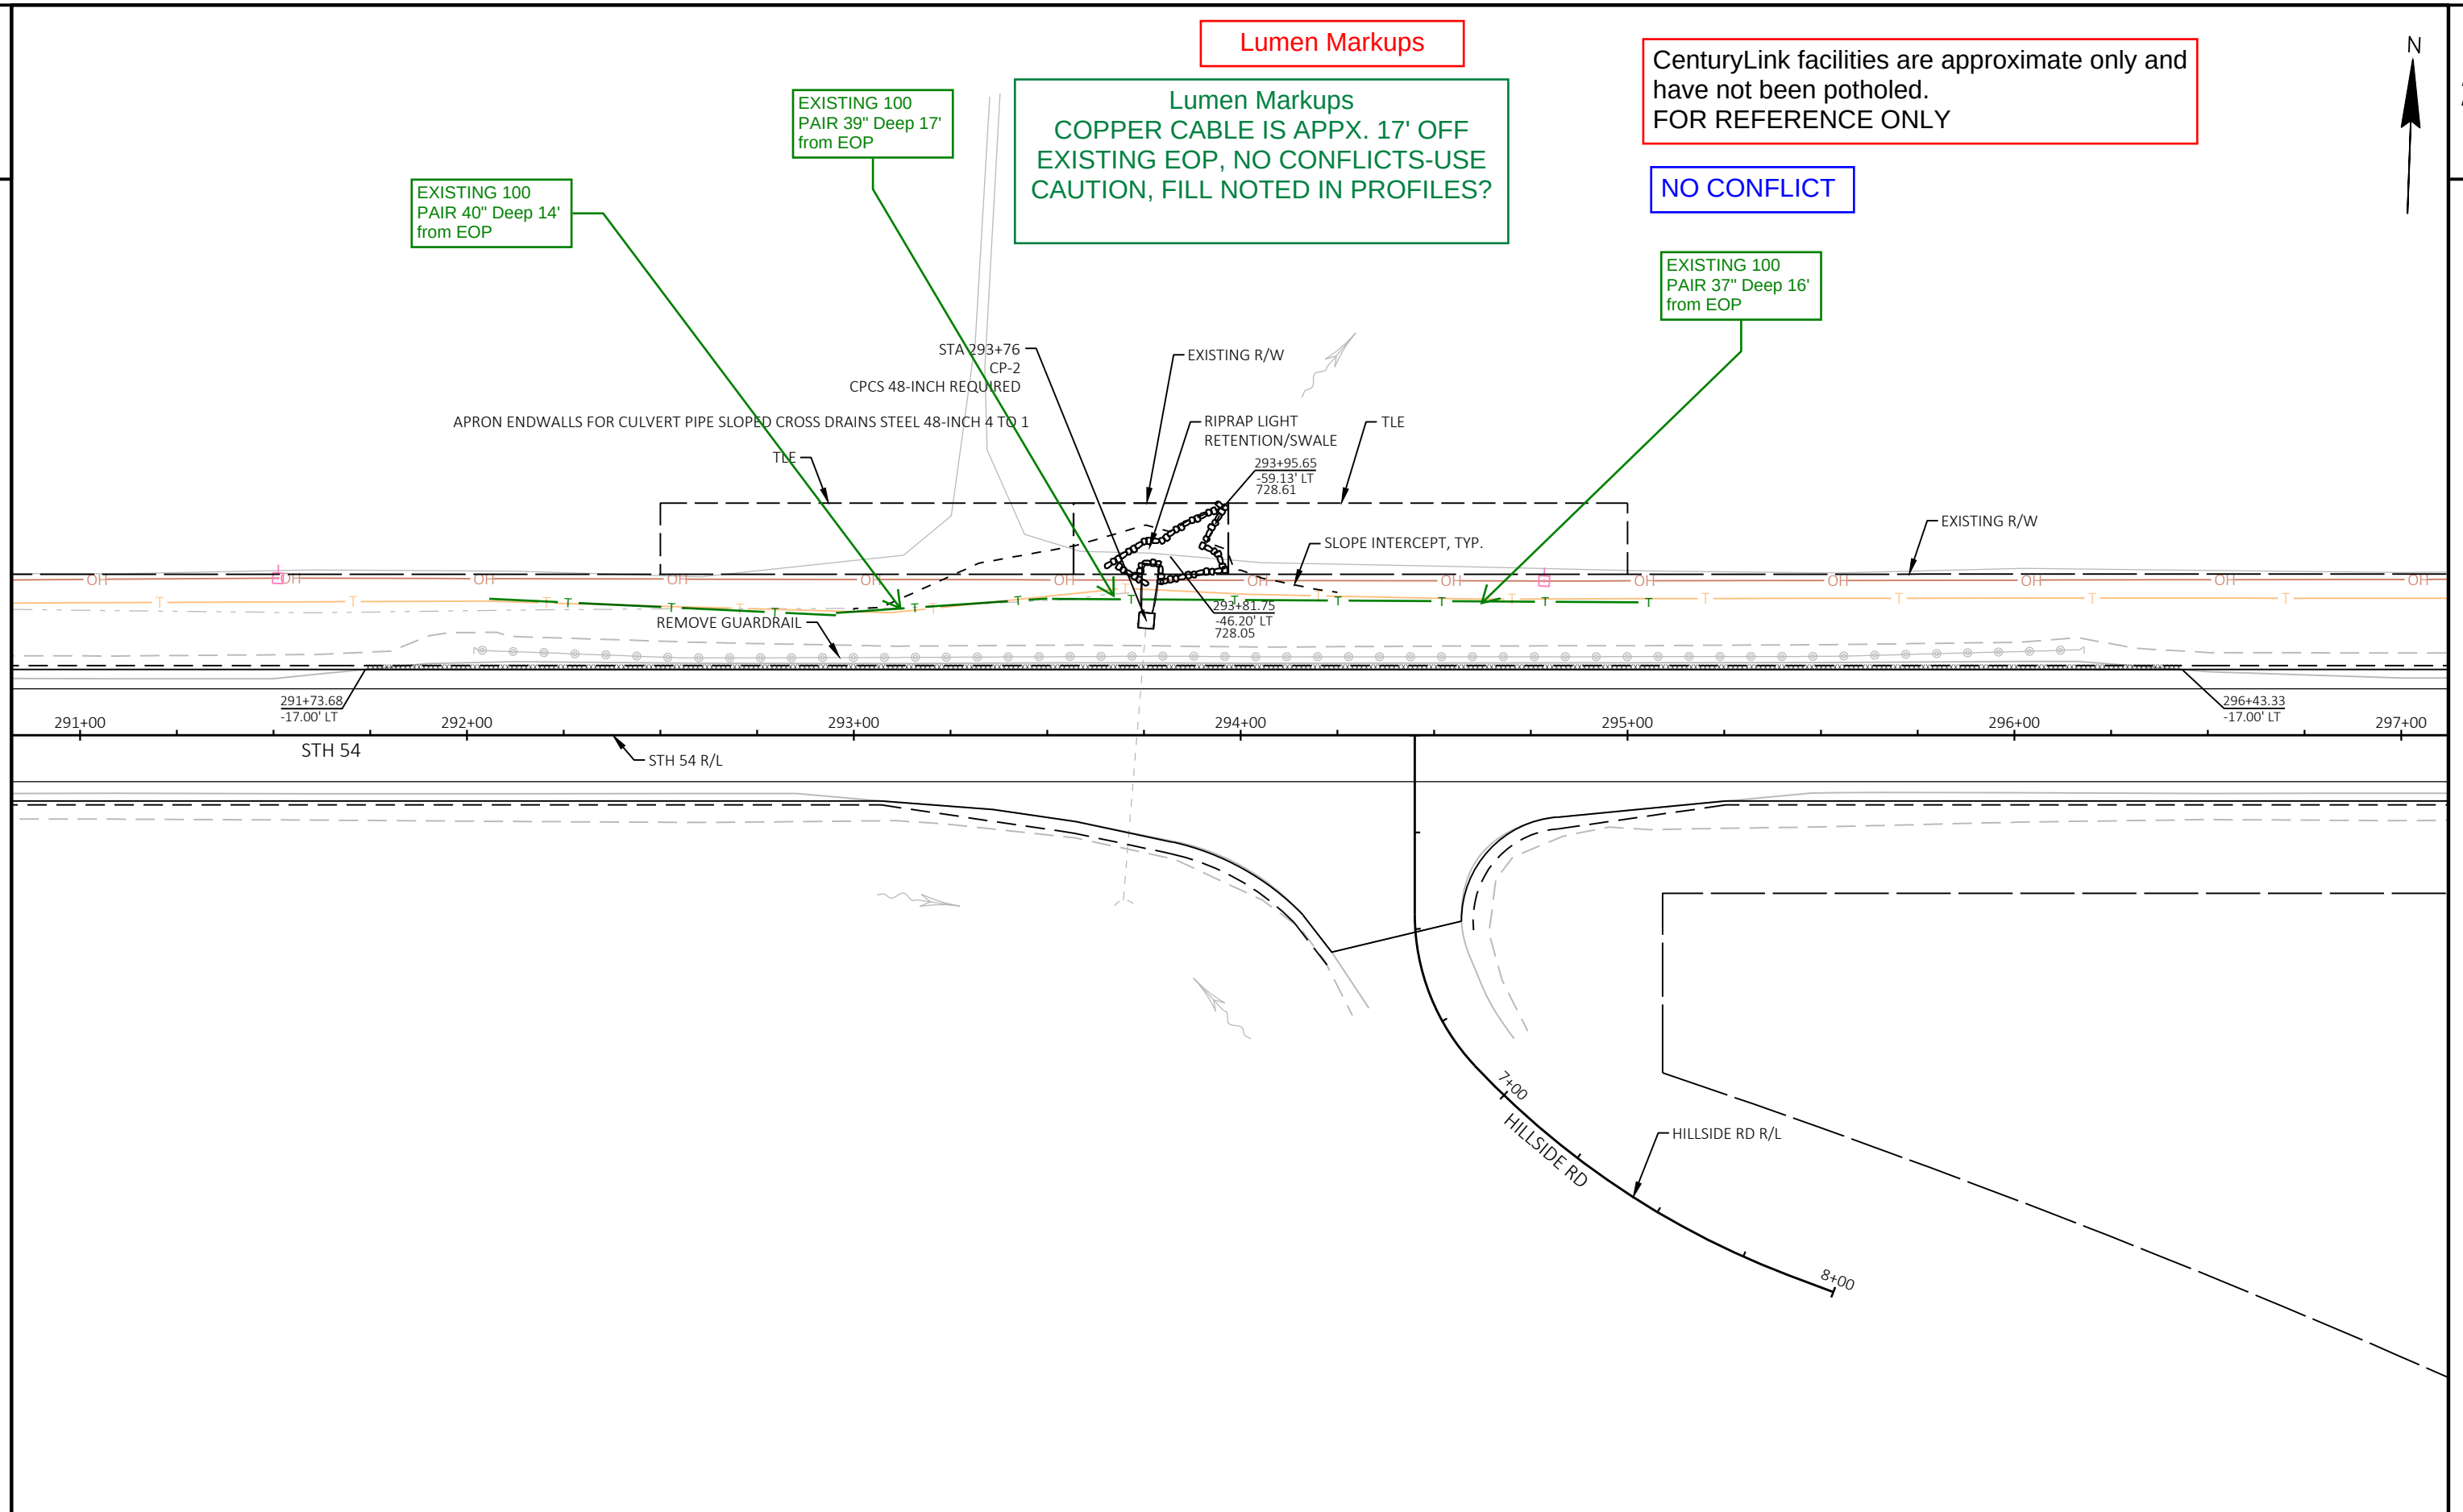


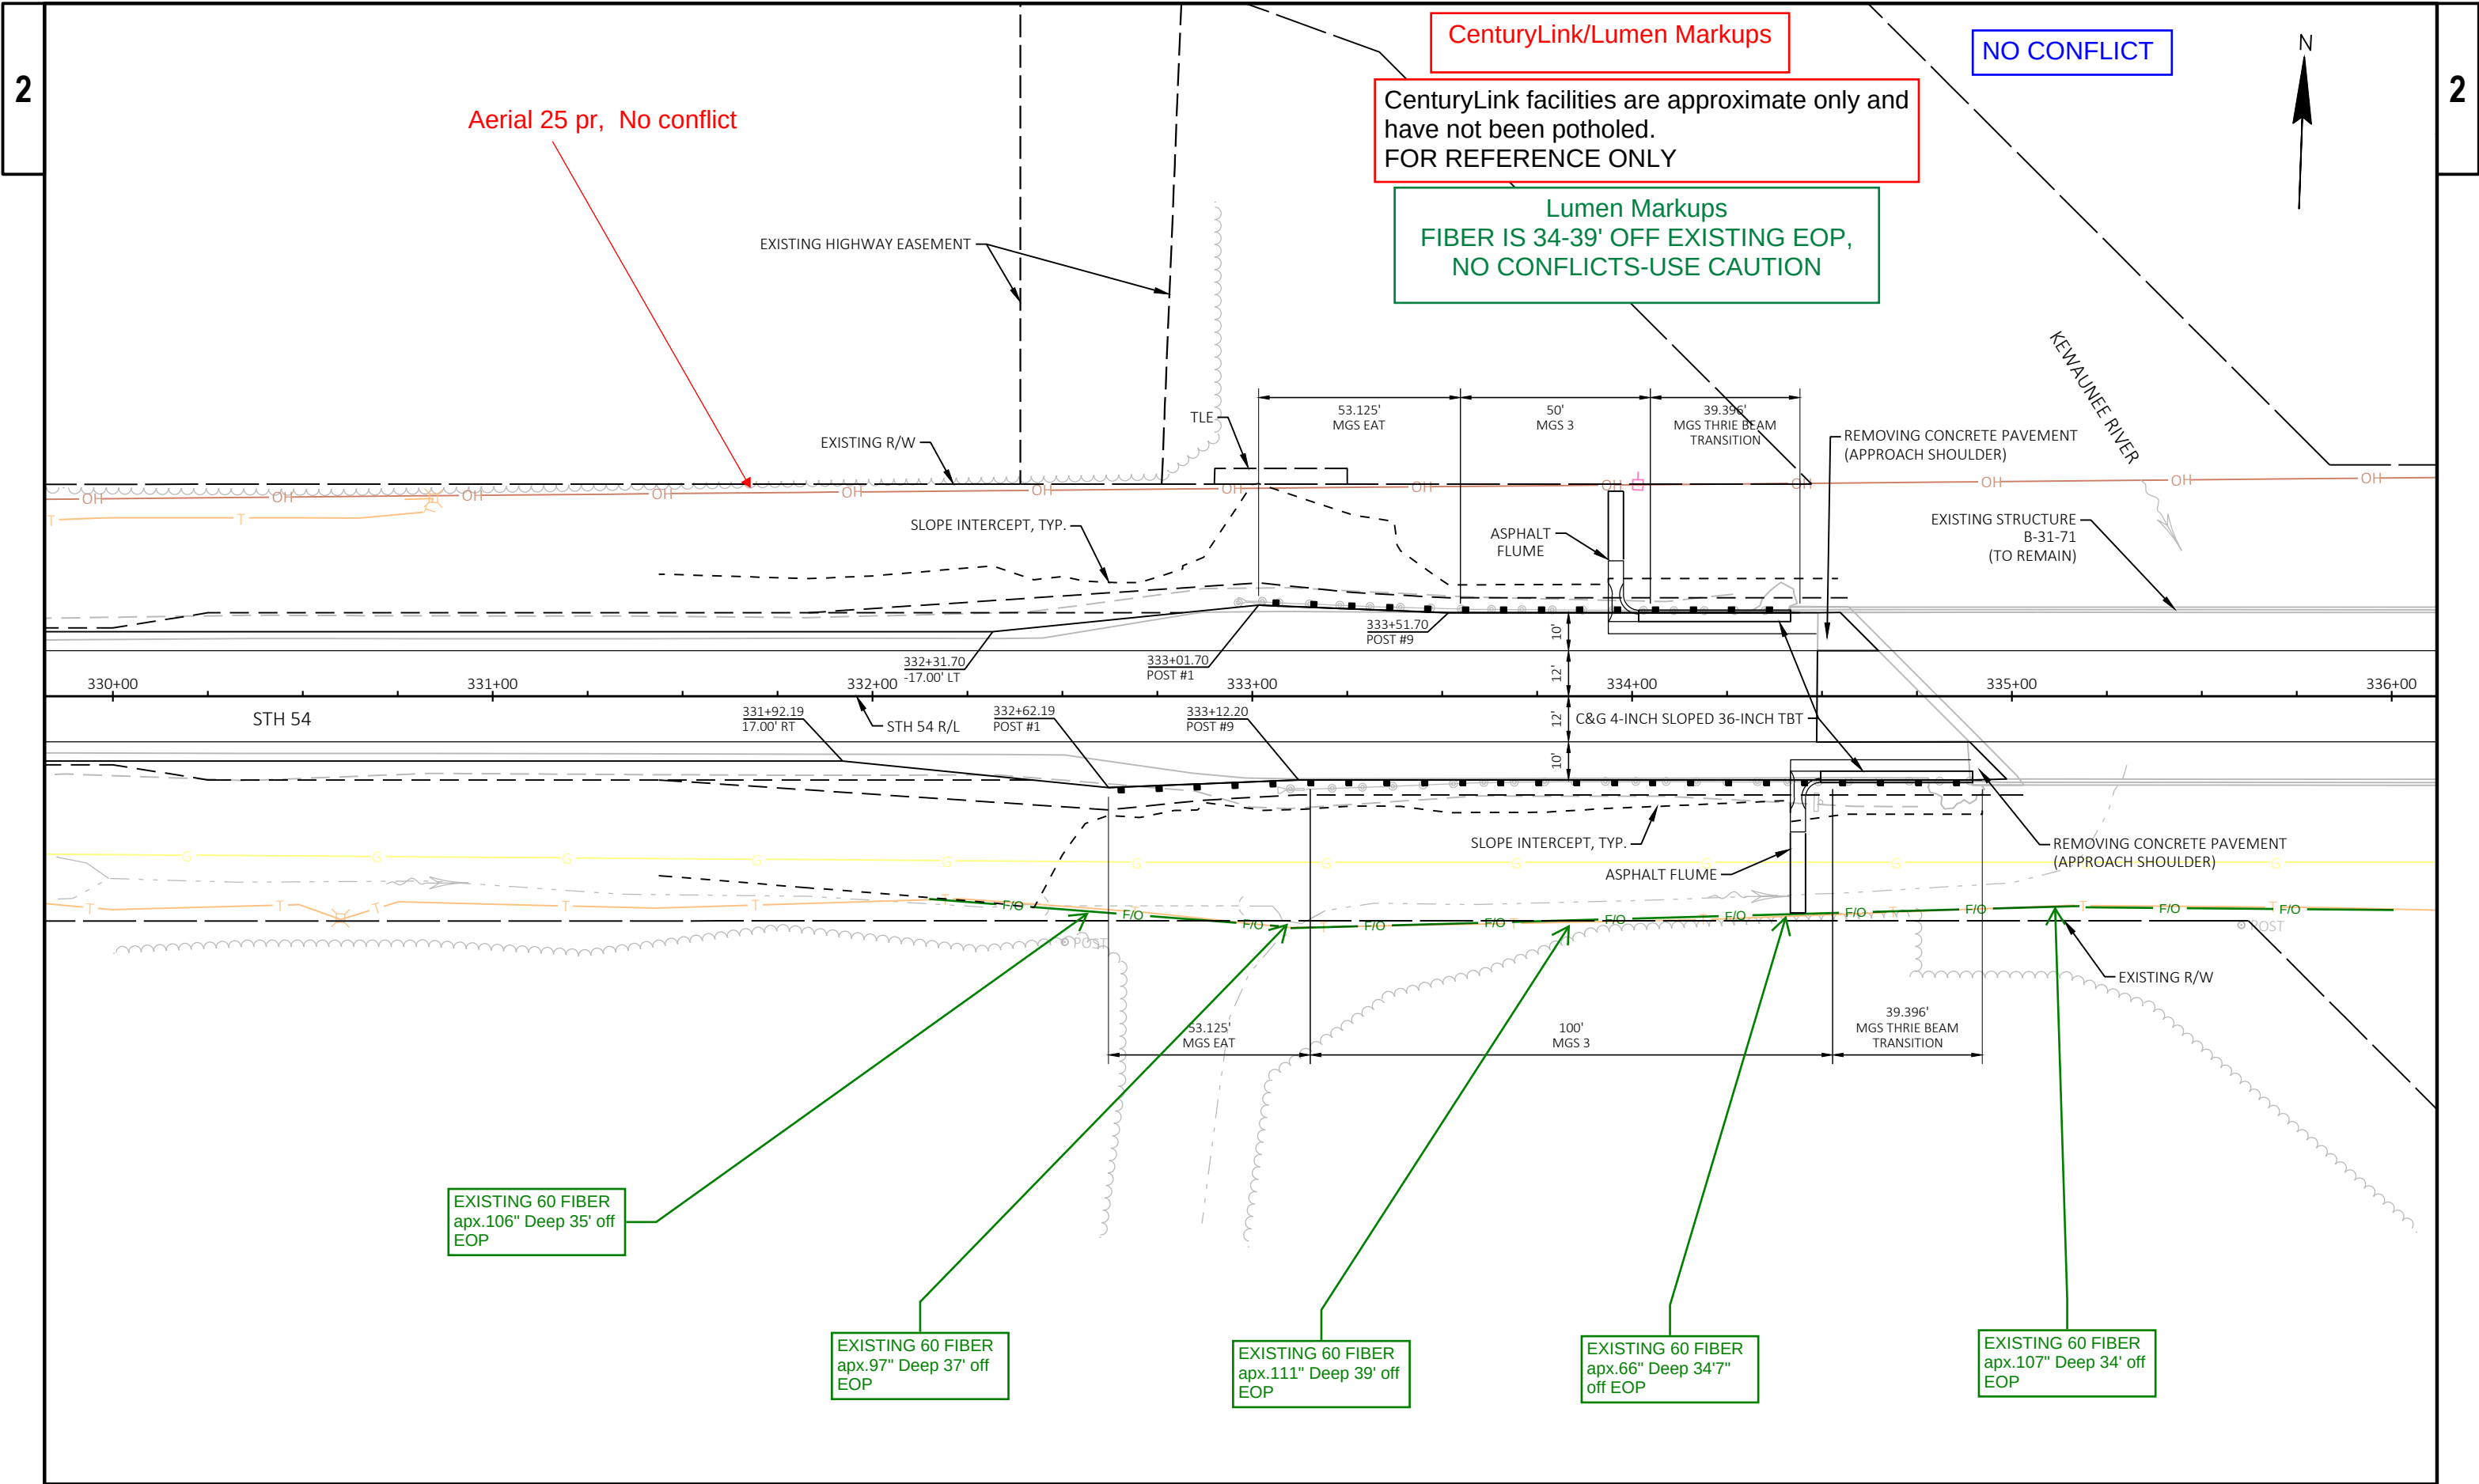

CenturyLink/Lumen Markups

CenturyLink facilities are approximate only and have not been potholed.
FOR REFERENCE ONLY

NO CONFLICT

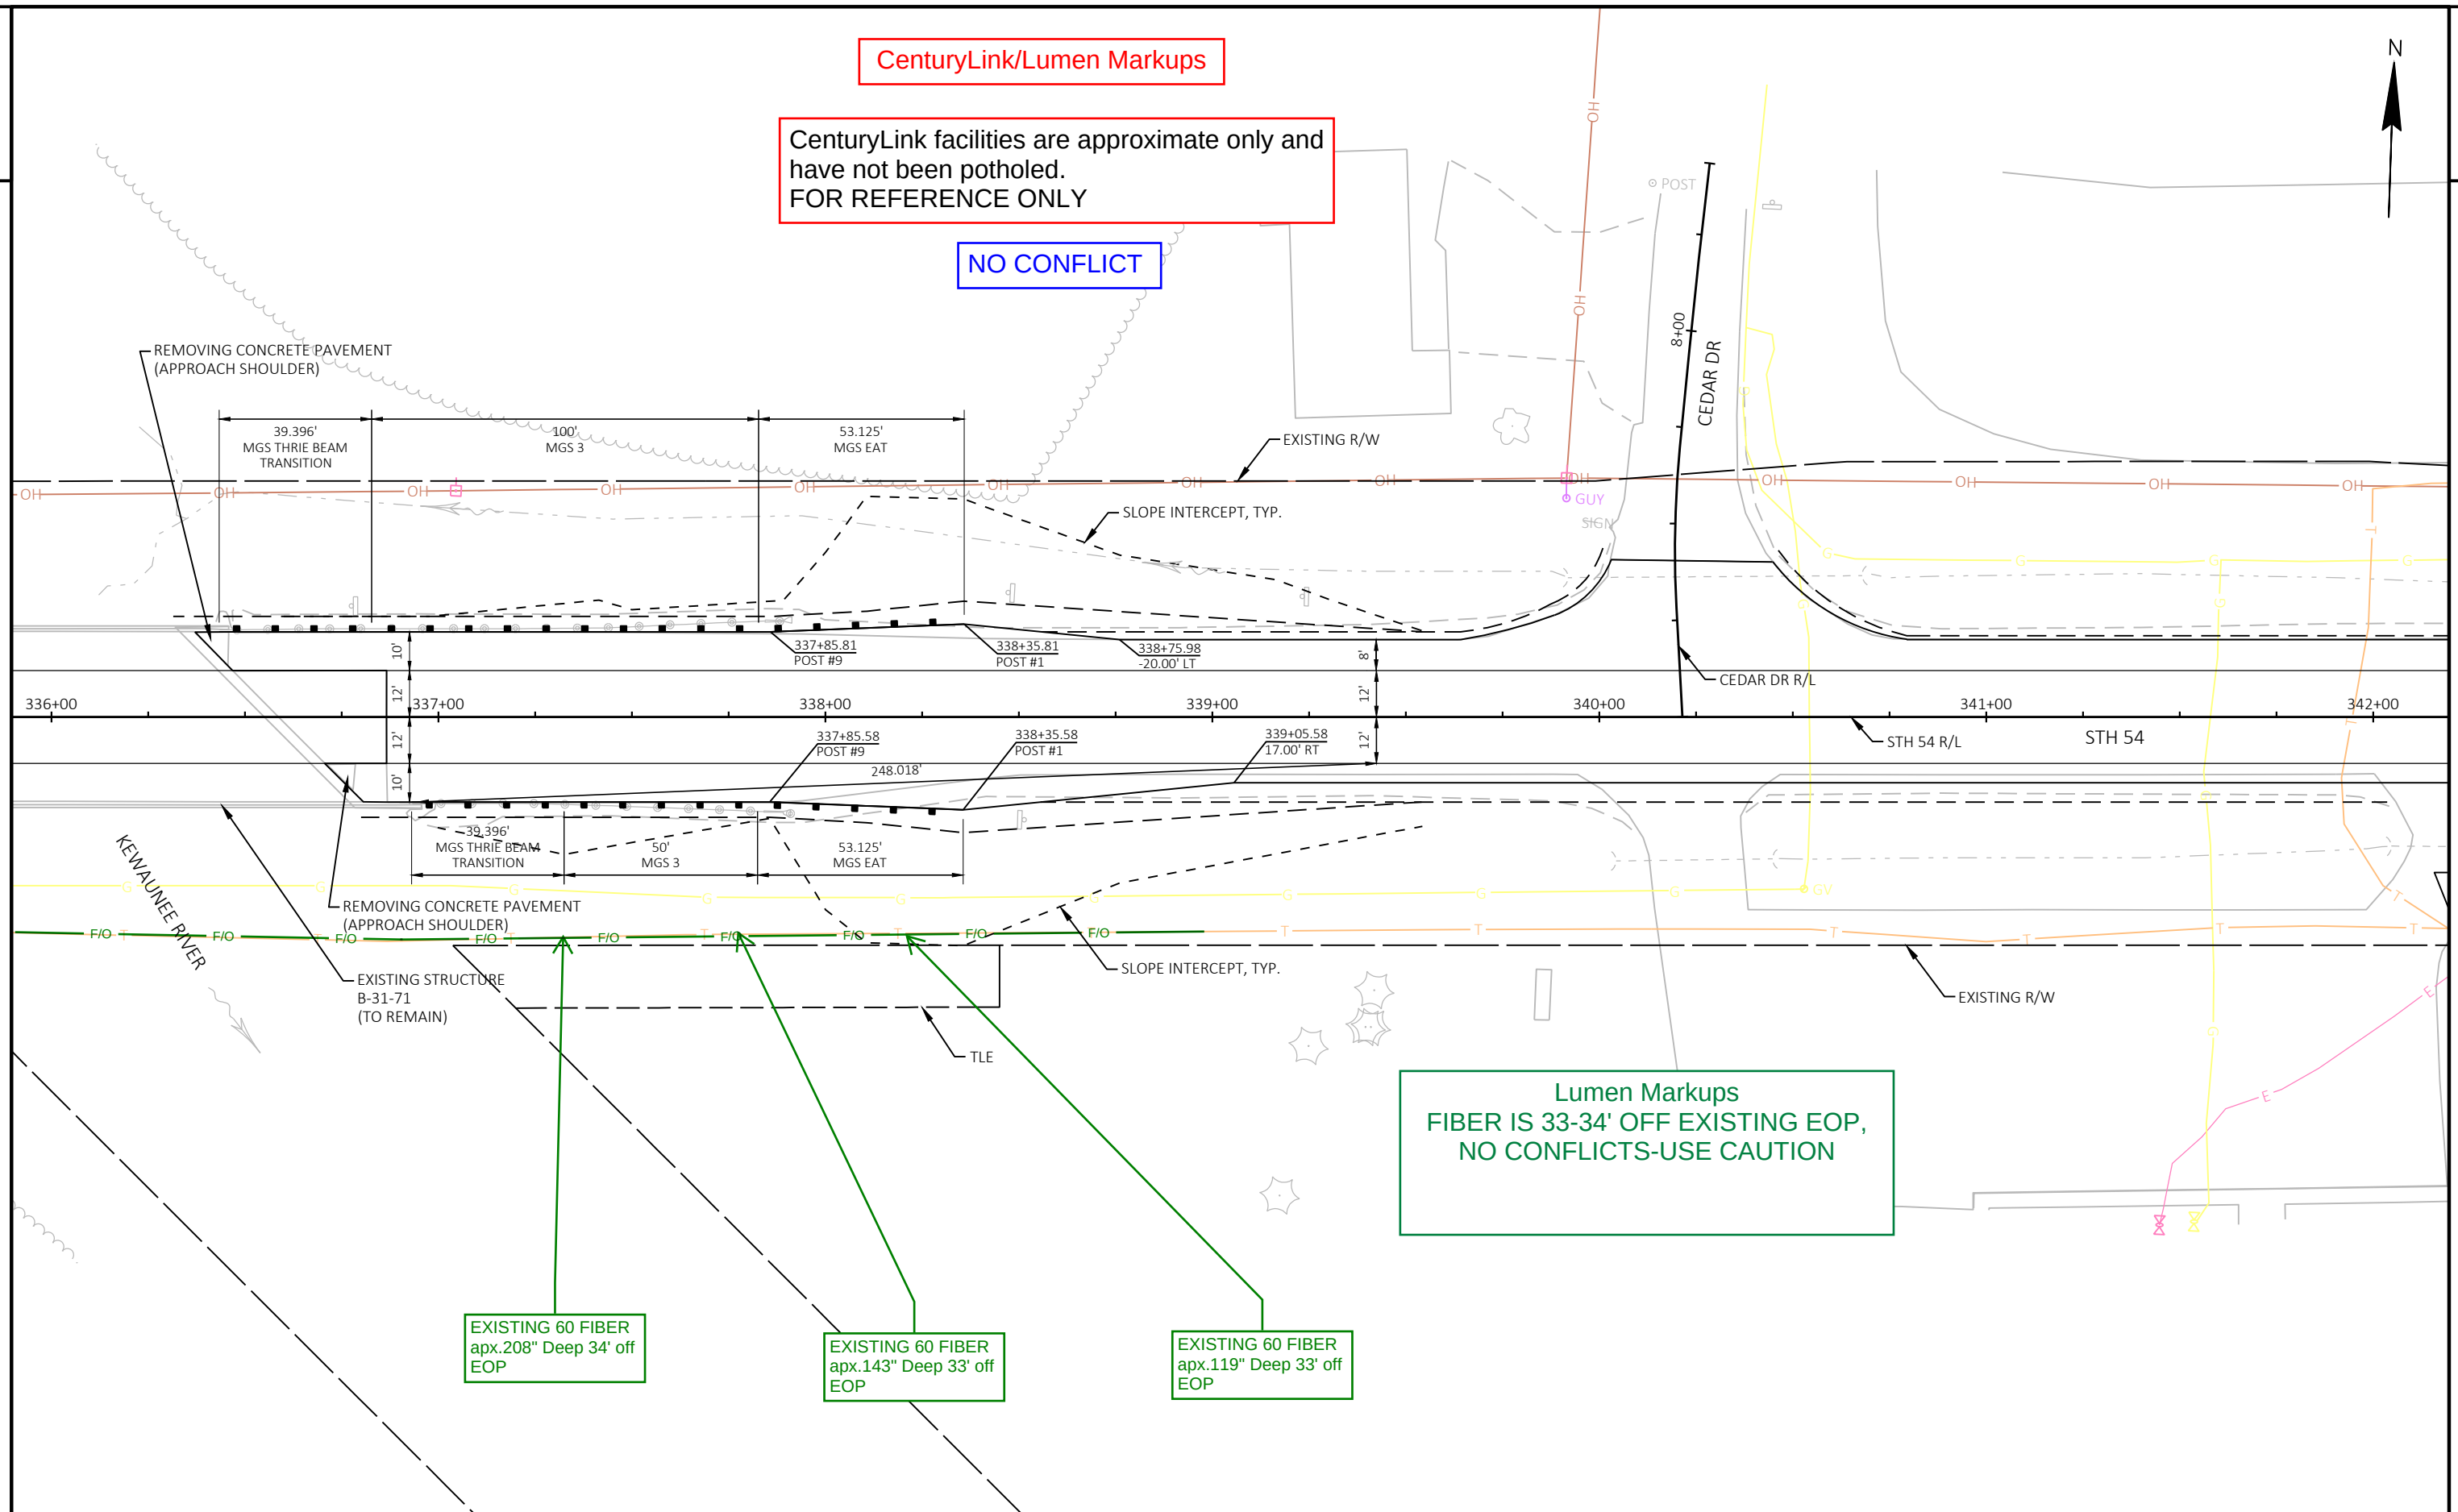


CenturyLink/Lumen Markups

NO CONFLICT


CenturyLink facilities are approximate only and
have not been potholed.
FOR REFERENCE ONLY

Lumen Markups
NO CONFLICTS, LOCATES REQUIRED
AT TOWNLINE RD, USE CAUTION

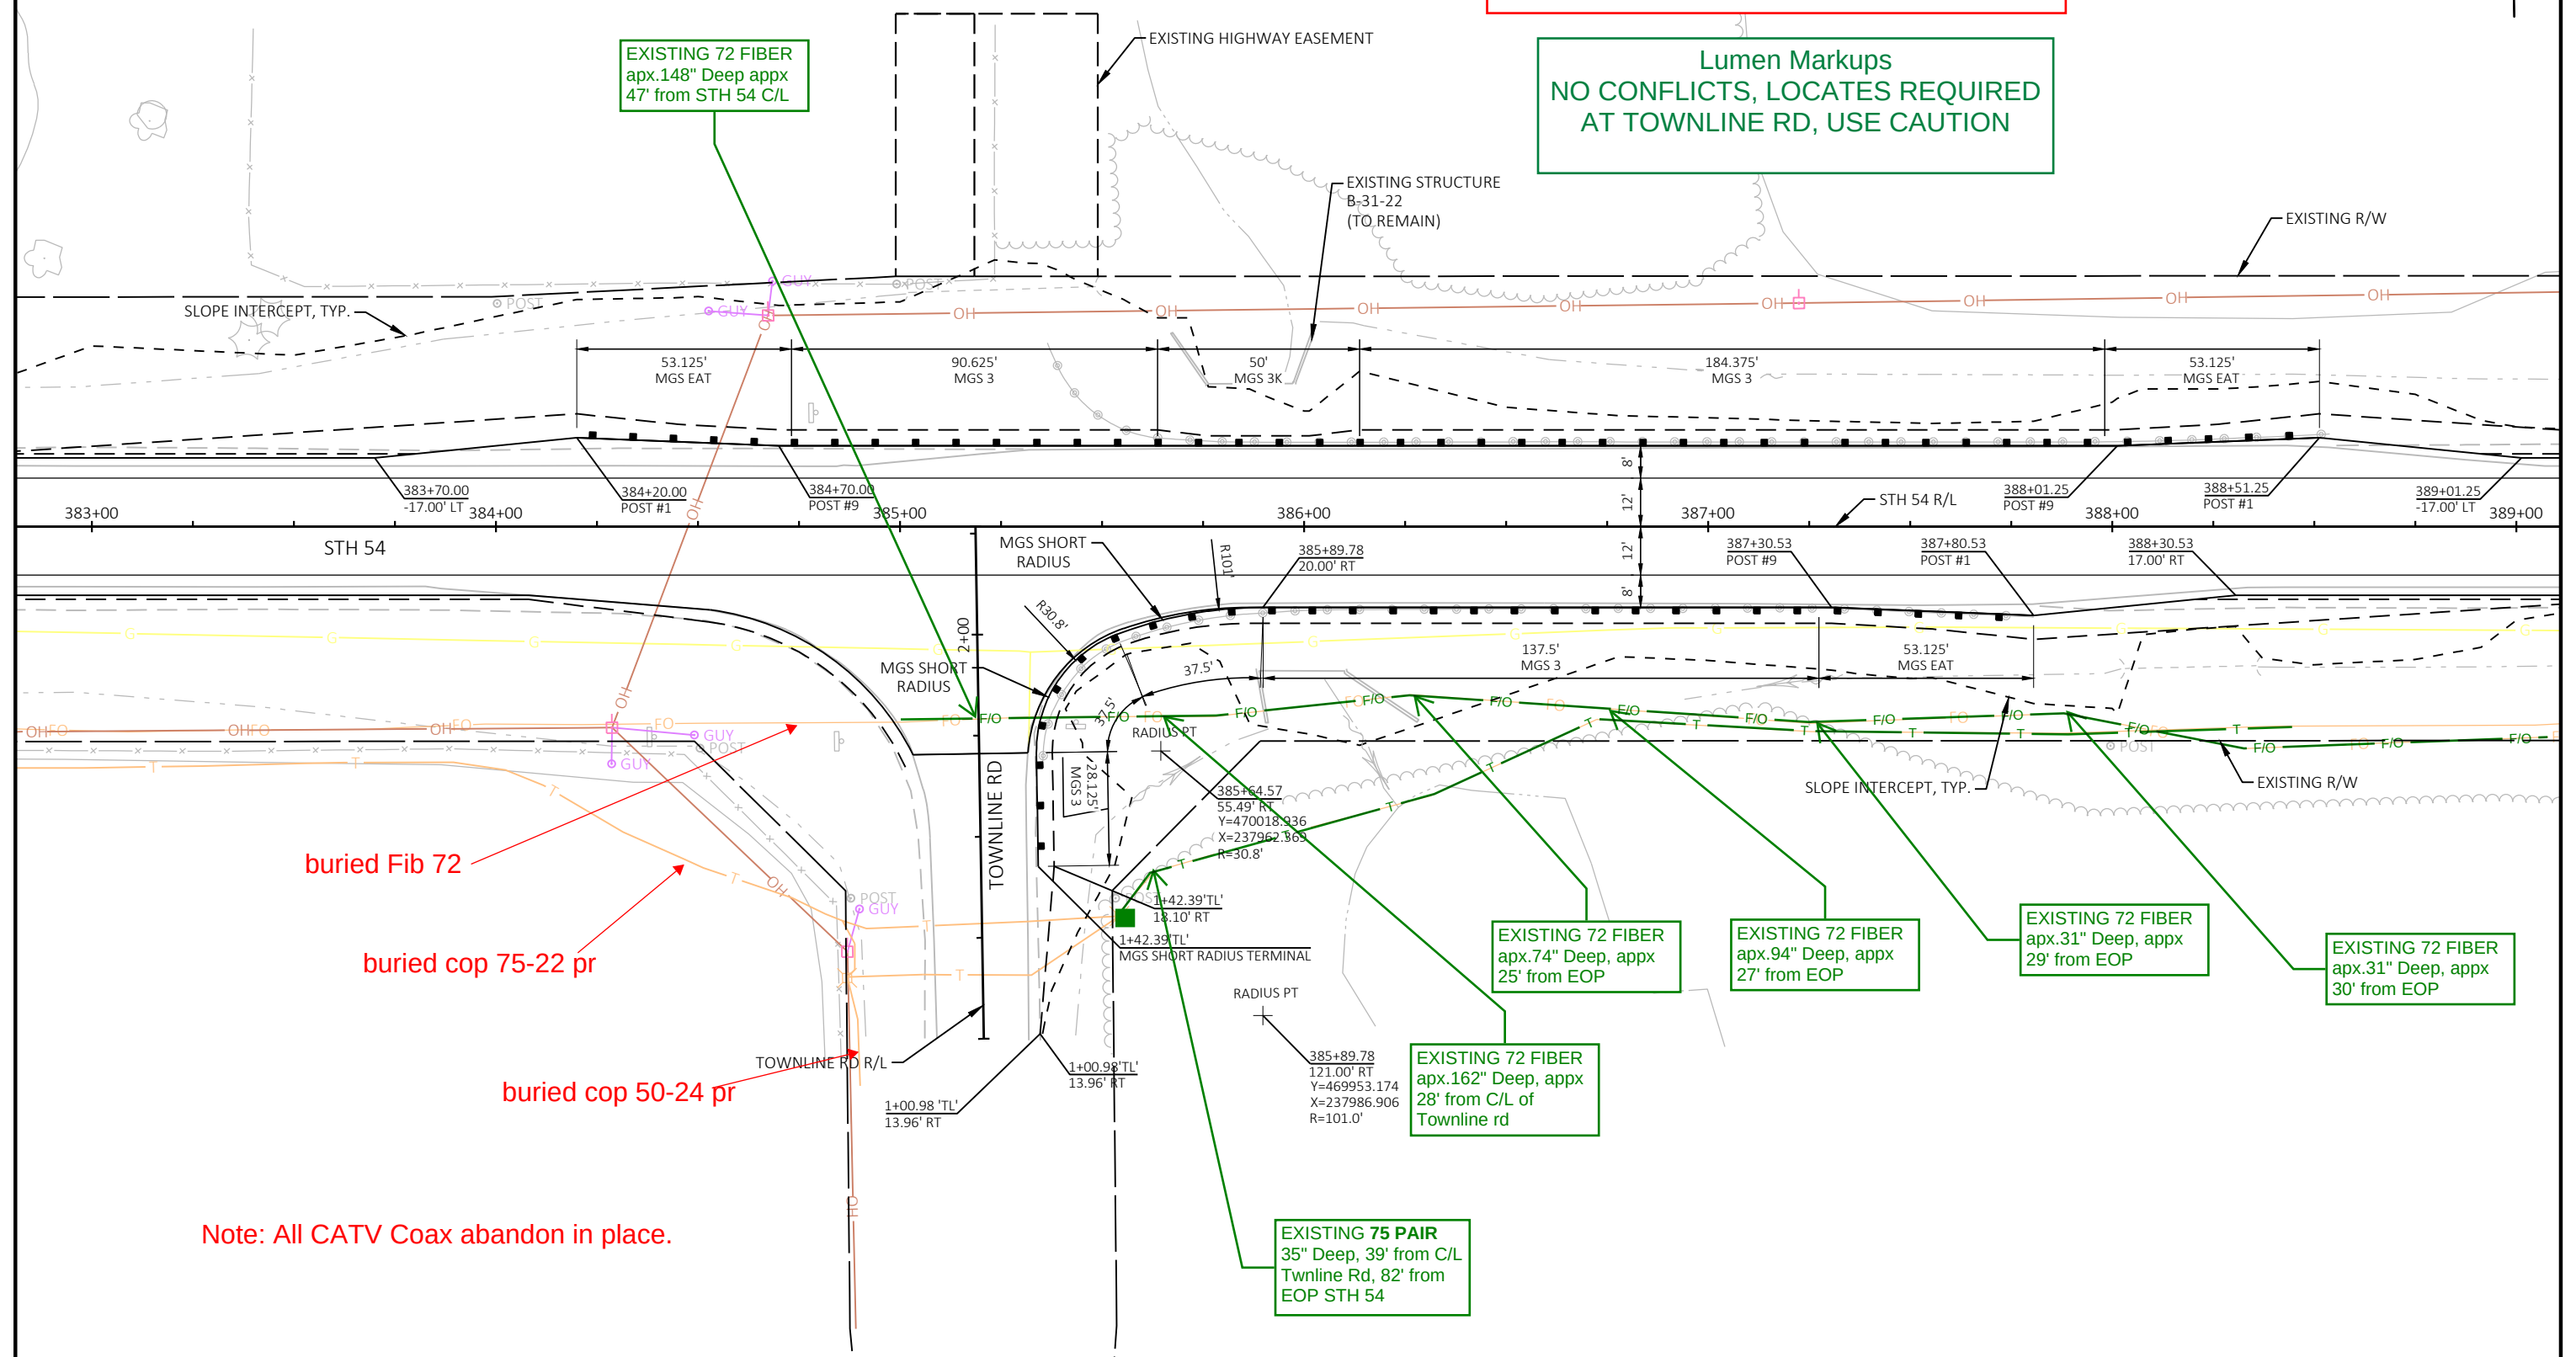

2

EXISTING 75 PAIR
68" Deep, 35' from
EOP STH 54

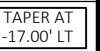

E

WISDOT/CADDS SHEET 42

