GRE

PROJECT ID: 6200-11-71

WITH: N/A

COUNTY: WINNEBAGO

08

AUG 07

ORDER OF SHEETS

Section No.	1	Title
Section No.	2	Typical Sections and Details
Section No.	3	Estimate of Quantities
Section No.	3	Miscellaneous Quantities
Section No.	4	Right of Way Plat
Section No.	5	Plan and Profile
Section No.	6	Standard Detail Drawings
Section No.	7	Sign Plates
Section No.	8	Structure Plans
Section No.	9	Computer Earthwork Data
Section No.	9	Cross Sections

TOTAL SHEETS = 306

STATE OF WISCONSIN
DEPARTMENT OF TRANSPORTATION

PLAN OF PROPOSED IMPROVEMENT

CTH G - CTH II / WINCHESTER

OLD STH 110

USH 45

WINNEBAGO COUNTY

STATE PROJECT	FEDERAL PROJECT	
	PROJECT	CONTRACT
6200-11-71	DEM 2007452	1

AS BUILT PLAN

NO.

SUPERVISOR JILL MICHAELSON

RESIDENT TAMMY RABE / BRIAN HAEN

CONTRACTOR MICHELS MATERIALS

COMPLETED 9-5-2008

AS-BUILT PLAN

STATE PROJECT NUMBER

6200-11-71

N

DESIGN DESIGNATION

A.D.T.	2006	=	11,400
A.D.T.	2026	=	16,300
D.H.V.		=	728
D.D.		=	62/38
T.		=	8.4
DESIGN SPEED		=	70 MPH

CONVENTIONAL SYMBOLS

PLAN

CORPORATE LIMITS

PROPERTY LINE — PL + 58.1

LOT LINE

LIMITED HIGHWAY EASEMENT

EXISTING RIGHT OF WAY

PROPOSED OR NEW R/W LINE

SLOPE INTERCEPT

REFERENCE LINE

EXISTING CULVERT

PROPOSED CULVERT (Box or Pipe)

COMBUSTIBLE FLUIDS — CAUTION

MARSH AREA

WOODED OR SHRUB AREA

PROFILE

GRADE LINE

ORIGINAL GROUND

MARSH OR ROCK PROFILE (To be noted as such) — ROCK

SPECIAL DITCH — LABEL

GRADE ELEVATION — 95.36

CULVERT (Profile View)

UTILITIES

ELECTRIC — E

FIBER OPTIC — FO

GAS — G

SANITARY SEWER — SAN

STORM SEWER — SS

TELEPHONE — T

WATER — W

UTILITY PEDESTAL

POWER POLE

TELEPHONE POLE

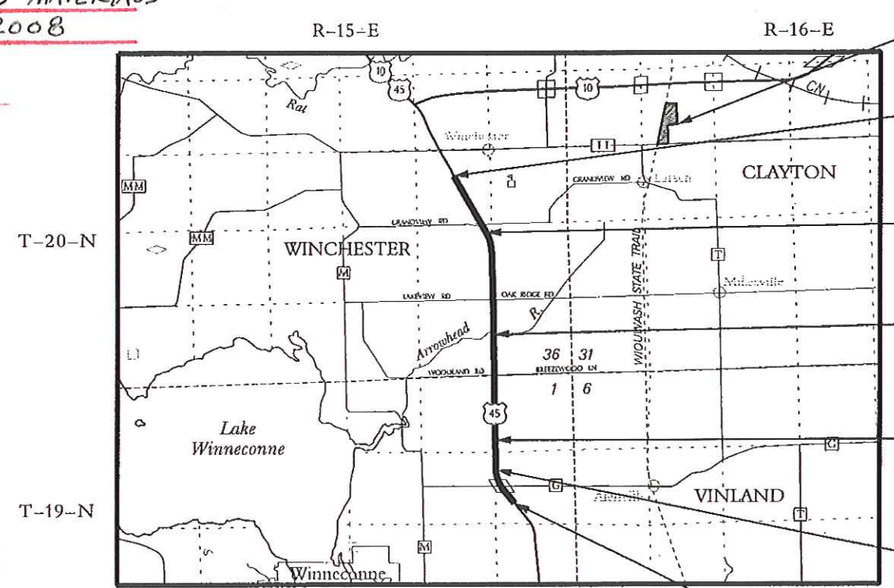

WETLAND MITIGATION SITE

END PROJECT 6200-11-71

STA. 414+54.86 USH 45 NB ℞

STATION EQUATION
STA. 374+10.78 USH 45 NB BK=
STA. 373+75.97 USH 45 NB AH

STRUCTURE B-70-244
STA. 302+25.62 - STA. 303+24.38

STATION EQUATION
STA. 494+99.99 USH 45 NB BK=
STA. 228+14.10 USH 45 NB AH

STATION EQUATION
STA. 474+31.73 USH 45 NB BK=
STA. 474+38.83 USH 45 NB AH

BEGIN PROJECT 6200-11-71

STA. 453+00.00 USH 45 NB ℞

Y = 514,941.65

X = 760,781.91

LAYOUT SCALE 0 — 1 MI.

TOTAL NET LENGTH OF CENTERLINE = 4.331 MI.

"Coordinates on this plan are referenced to the Wisconsin County Coordinate System (WCCS), Winnebago County."

FINAL PLANS PREPARED BY

TN & Associates, Inc.
Engineering and Science

WISCONSIN
LISA MARIE DREIFUERST
35006
MADISON, WI
PROFESSIONAL ENGINEER

1/29/07 (Date) (Signature)

STATE OF WISCONSIN
DEPARTMENT OF TRANSPORTATION

PREPARED BY

Surveyor	NE REGION
Designer	J A HILBERT & TN & ASSOCIATES
Project Manager	W R BERTRAND
District Examiner	
District Supervisor	J E MICHAELSON
C.O. Examiner	Carl Wanganovski

APPROVED FOR DISTRICT OFFICE

DATE: 1-29-07 William R. Bertrand (Signature)

E