Jan '03

AS-BUILT PLAN

PROJECT ID: 9040-05-70
WITH:

COUNTY: ONEIDA

+25D

0057-07-00

INDEX OF SHEETS

Sheet No.	1	Title
Sheet No.		Typical Sections and Details
Sheet No.		Estimate of Quantities
Sheet No.		Miscellaneous Quantities
Sheet No.		Right of Way Plat
Sheet No.		Plan and Profile
Sheet No.		Standard Detail Drawings
Sheet No.		Sign Plates
Sheet No.	✓	Structure Plans
Sheet No.		Computer Earthwork Data
Sheet No.		Cross Sections

TOTAL SHEETS = 489

STATE OF WISCONSIN
DEPARTMENT OF TRANSPORTATION

PLAN OF PROPOSED IMPROVEMENT

U.S.H. 8 - BIRCHWOOD DRIVE

(S.T.H. 17 RELOCATION)

S.T.H. 17

ONEIDA COUNTY

STATE PROJECT	FEDERAL PROJECT	
	PROJECT	CONTRACT
9040-05-70	TCSP 2003046	1

PRIME CONTRACTOR: HOFFMAN CONST. CO.
SUBCONTRACTORS:
- AMERICAN ASPHALT
- CENTURY FENCE CO.
- DUFFEK SAND & GRAVEL
- FAHRNER ASPHALT SEALERS
- INTERSTATE SAWING
- LUNDA CONSTRUCTION CO.
- RDLW, LLC
- RENT-A-FLASH OF WISCONSIN
- STRAIGHT ARROW CONSTRUCTION
- VAN ERT ELECTRIC CO.
- WOORSTER LAND SURVEYING CO.

PROJECT ENGINEER:
- CHERYL SIMON (2003)
- MICHAEL GRANGE (2004)

PROJECT START: 4/28/03
SUSPENDED: 11/21/03
RESUMED: 4/13/04
PROJECT COMPLETE: 9/07/04

STATE PROJECT NUMBER
9040-05-70

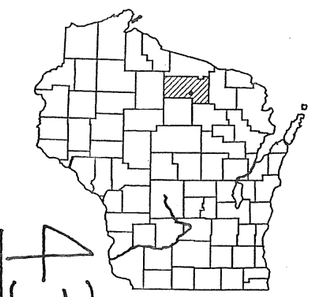

43

END PROJECT
STATION ~~175+00.00~~
176+50

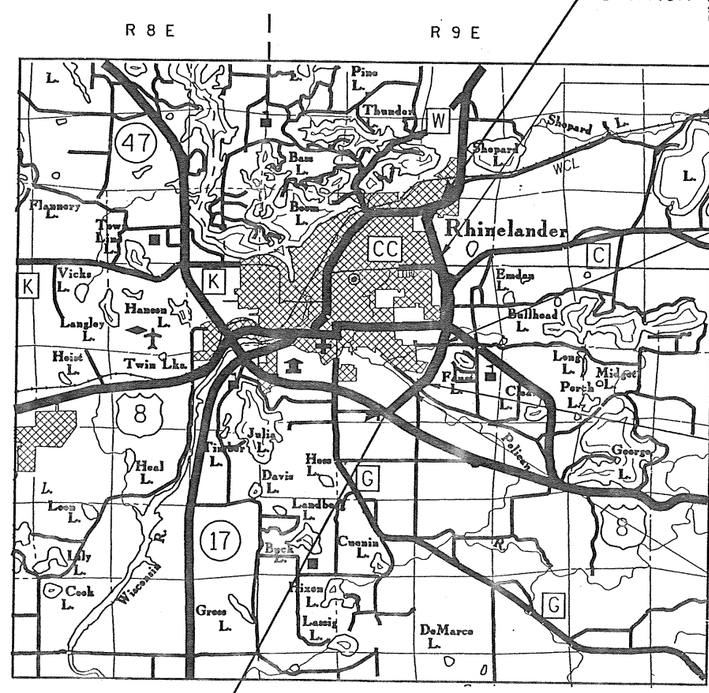

STA. 125+46.07 BACK=
STA. 125+20.05 AHEAD
EQUATION

STA. 85+72.12 BACK=
STA. 84+91.41 AHEAD
EQUATION

STA. 28+34.78 BACK=
STA. 28+19.45 AHEAD
EQUATION

STRUCTURE B-43-47

GN

BEGIN PROJECT
STA. 3+39.33
X = 2,155,427.499
Y = 165,509.317

LAYOUT
SCALE 0 1 MI.

DESIGN DESIGNATION

		RURAL	URBAN
A.D.T. (2003)	=	3,610	10,200
A.D.T. (2023)	=	6,100	12,500
D.H.V. 2-WAY (2023)	=	715	1,450
D.	=	60	60
T.	=	8%	8%
V.	=	45 M.P.H.	35 M.P.H.
ESALS	=	1,284,800	1,803,100

CONVENTIONAL SIGNS

COUNTY LINE	COMBUSTIBLE FLUIDS (UNDER PRESSURE)
CORPORATE LIMITS	UNDERGROUND UTILITIES
PROPERTY LINE	GAS
LOT LINE	ELECTRIC
LIMITED HIGHWAY EASEMENT	TELEPHONE
EXISTING RIGHT OF WAY	SERVICE PEDESTAL
NEW RIGHT OF WAY	CABLE MARKER
REFERENCE LINE	POWER POLE
SLOPE INTERCEPT	TELEPHONE POLE
ORIGINAL GROUND	RAILROADS
MARSH OR ROCK PROFILE	MARSH
CULVERT IN PLACE	WOODED AREA
CULVERT REQUIRED	SILT FENCE
CULVERT REQUIRED (Profile)	EROSION MAT
	EROSION BALES

TOTAL NET LENGTH OF CENTERLINE = 1.075 MI. (RURAL)
2.226 = ~~2.198~~ MI. (URBAN)
3.301 = ~~3.273~~ MI. TOTAL

"Coordinates on this plan are referenced to the Wisconsin State Plane Coordinate System (WSPCS), 'North' Zone."

ORIGNAL PLANS PREPARED BY
AYRES ASSOCIATES
Engineers/Scientists Surveyors
916 Willard Dr., Suite #200
Green Bay, Wisconsin 54304

WISCONSIN PROFESSIONAL ENGINEER
MARK S. SCHUSTER
E-23976
GREEN BAY, WIS.

10/3/02 (Date) (Signature)

STATE OF WISCONSIN
DEPARTMENT OF TRANSPORTATION

PREPARED BY

Surveyor	STATE OF WISCONSIN AND AYRES ASSOCIATES
Designer	AYRES ASSOCIATES
District Examiner	MIKE VENDT
District Supervisor	ROBIN STAFFORD
C.O. Examiner	Jane E. Englebrecht

APPROVED FOR DISTRICT OFFICE
DATE: 10-4-02 (Signature)

FILE NAME: TITLE.DGN

WISDOT/CADDS SHEET 10