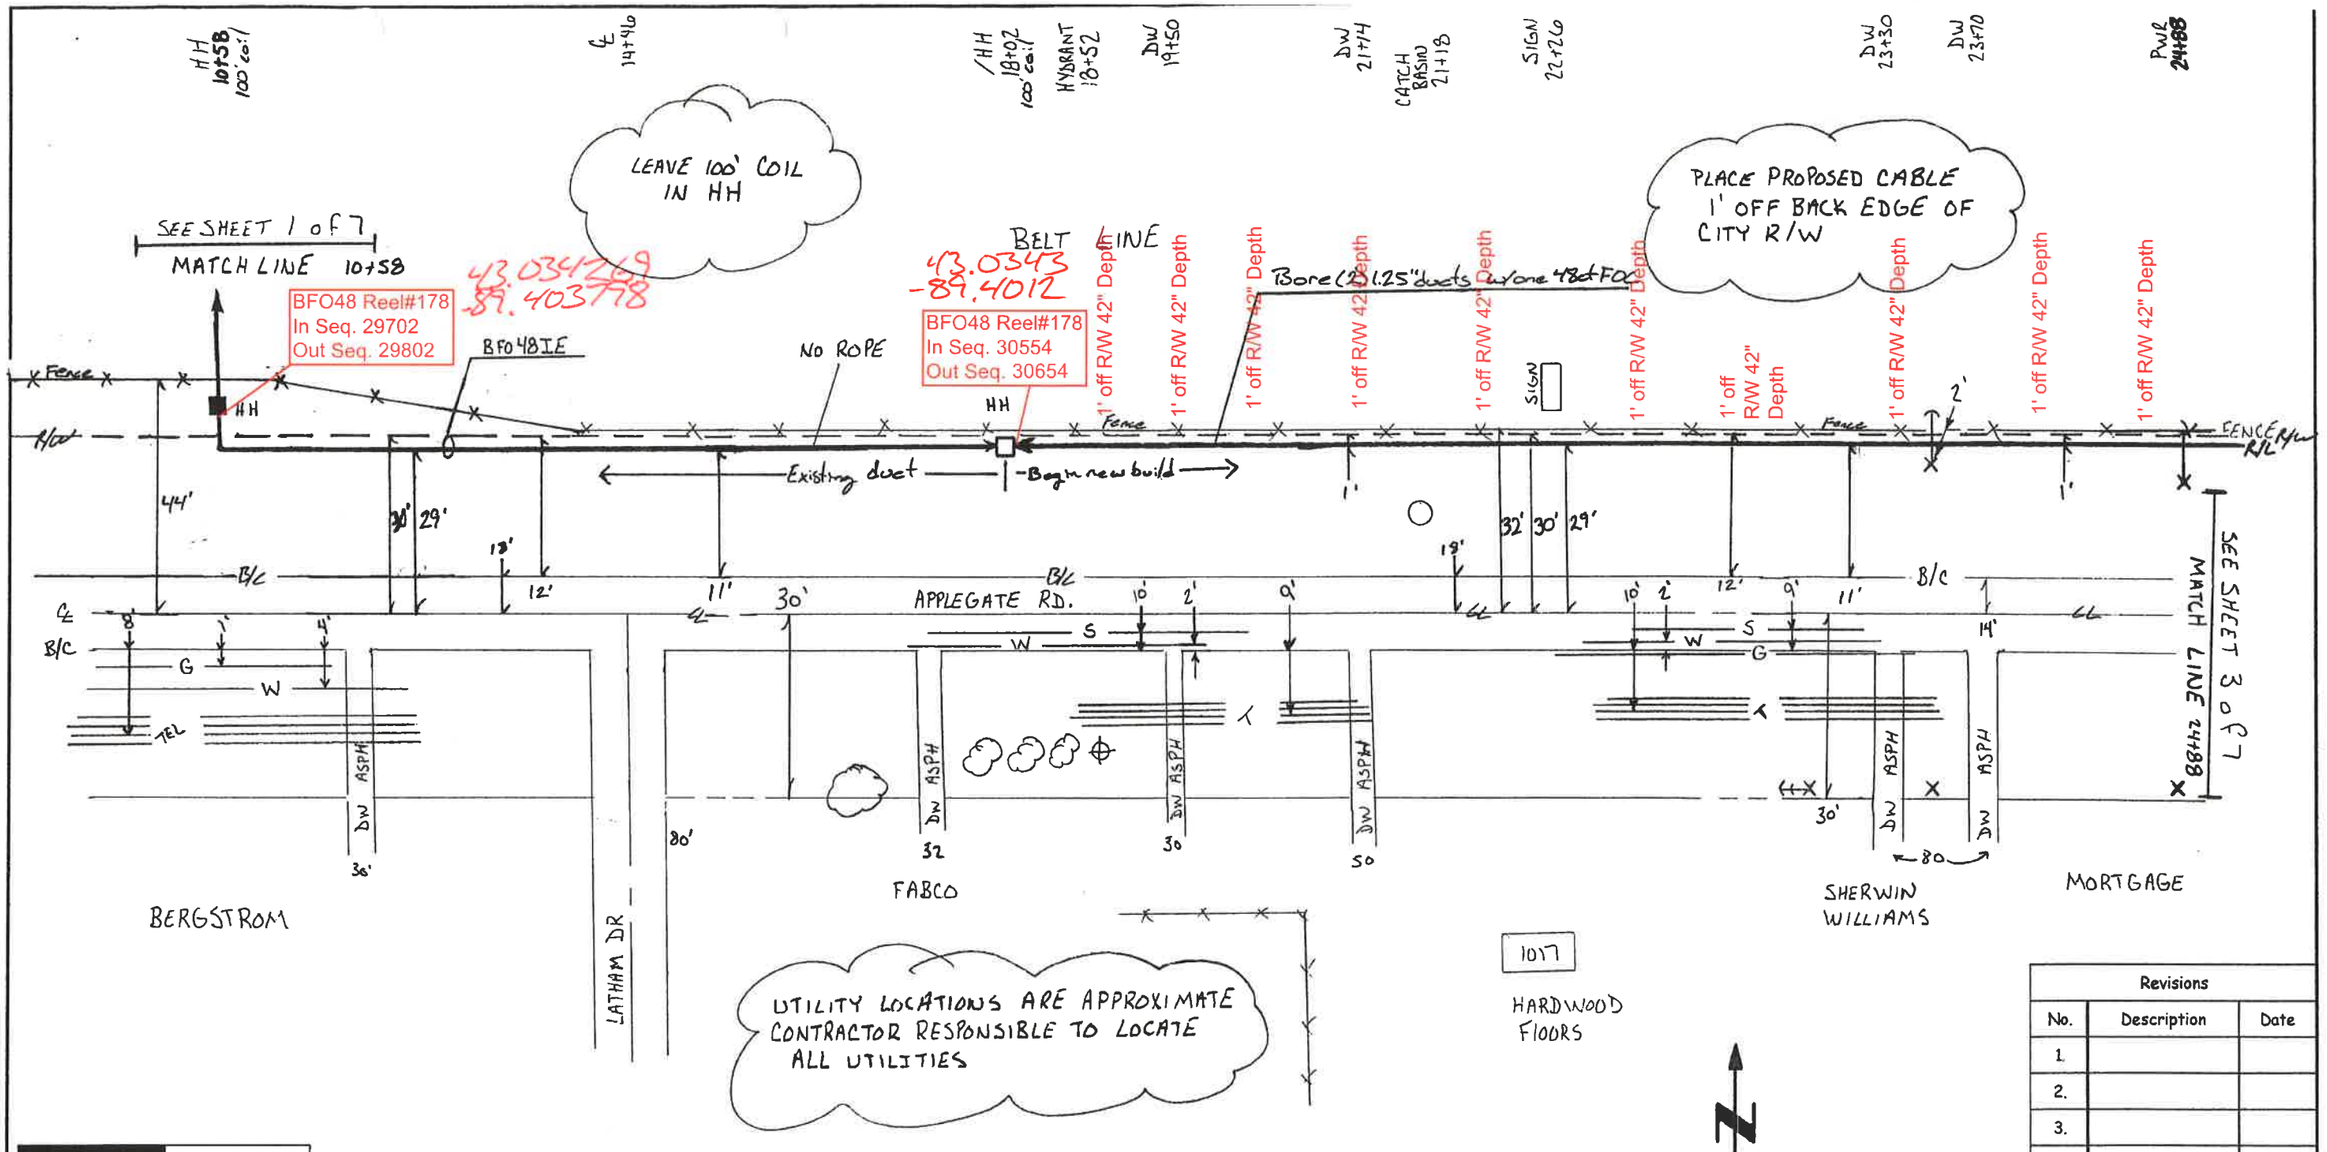

Assembly Units	Quantity	As-built	Assembly Units	Quantity	As-built	Assembly Units	Quantity	As-built
WTBHF	1	1 ✓						
BFO 48 IE	1630	~~752'~~ 852						
BM60(1.25)2PD	686	~~686'~~						
BMS3P(8)	1	1 ✓						

CenturyLink
1151 CenturyTel Dr Bldg A
Wentzville, MO 63385
Main Office No: 636-887-4747
Network Ops Cntr: 800 604-6688
Main Fax No: 636-887-4960

TITLE: PLACE FACILITIES TO MERITER BLDG.

DRAWING DESCRIPTION: EXTEND 48 FIBER TO 2650 NOVATION PKWY

NOTICE
INFORMATION ON THIS DOCUMENT IS PROPRIETARY AND SHALL NOT BE USED, COPIED, REPRODUCED OR DISCLOSED IN WHOLE OR IN PART WITHOUT WRITTEN CONSENT OF LIGHTCORE

Revisions		
No.	Description	Date
1.		
2.		
3.		
4.		
5.		

DATE: 6/2011	PJNO: E.255771
SCALE: NTS	City / State: MADISON, WI
DRAWN BY: TO	SHEET: 3 OF: 8
CHECKED BY: JDB	DRAWING: 2
APPROVED BY:	