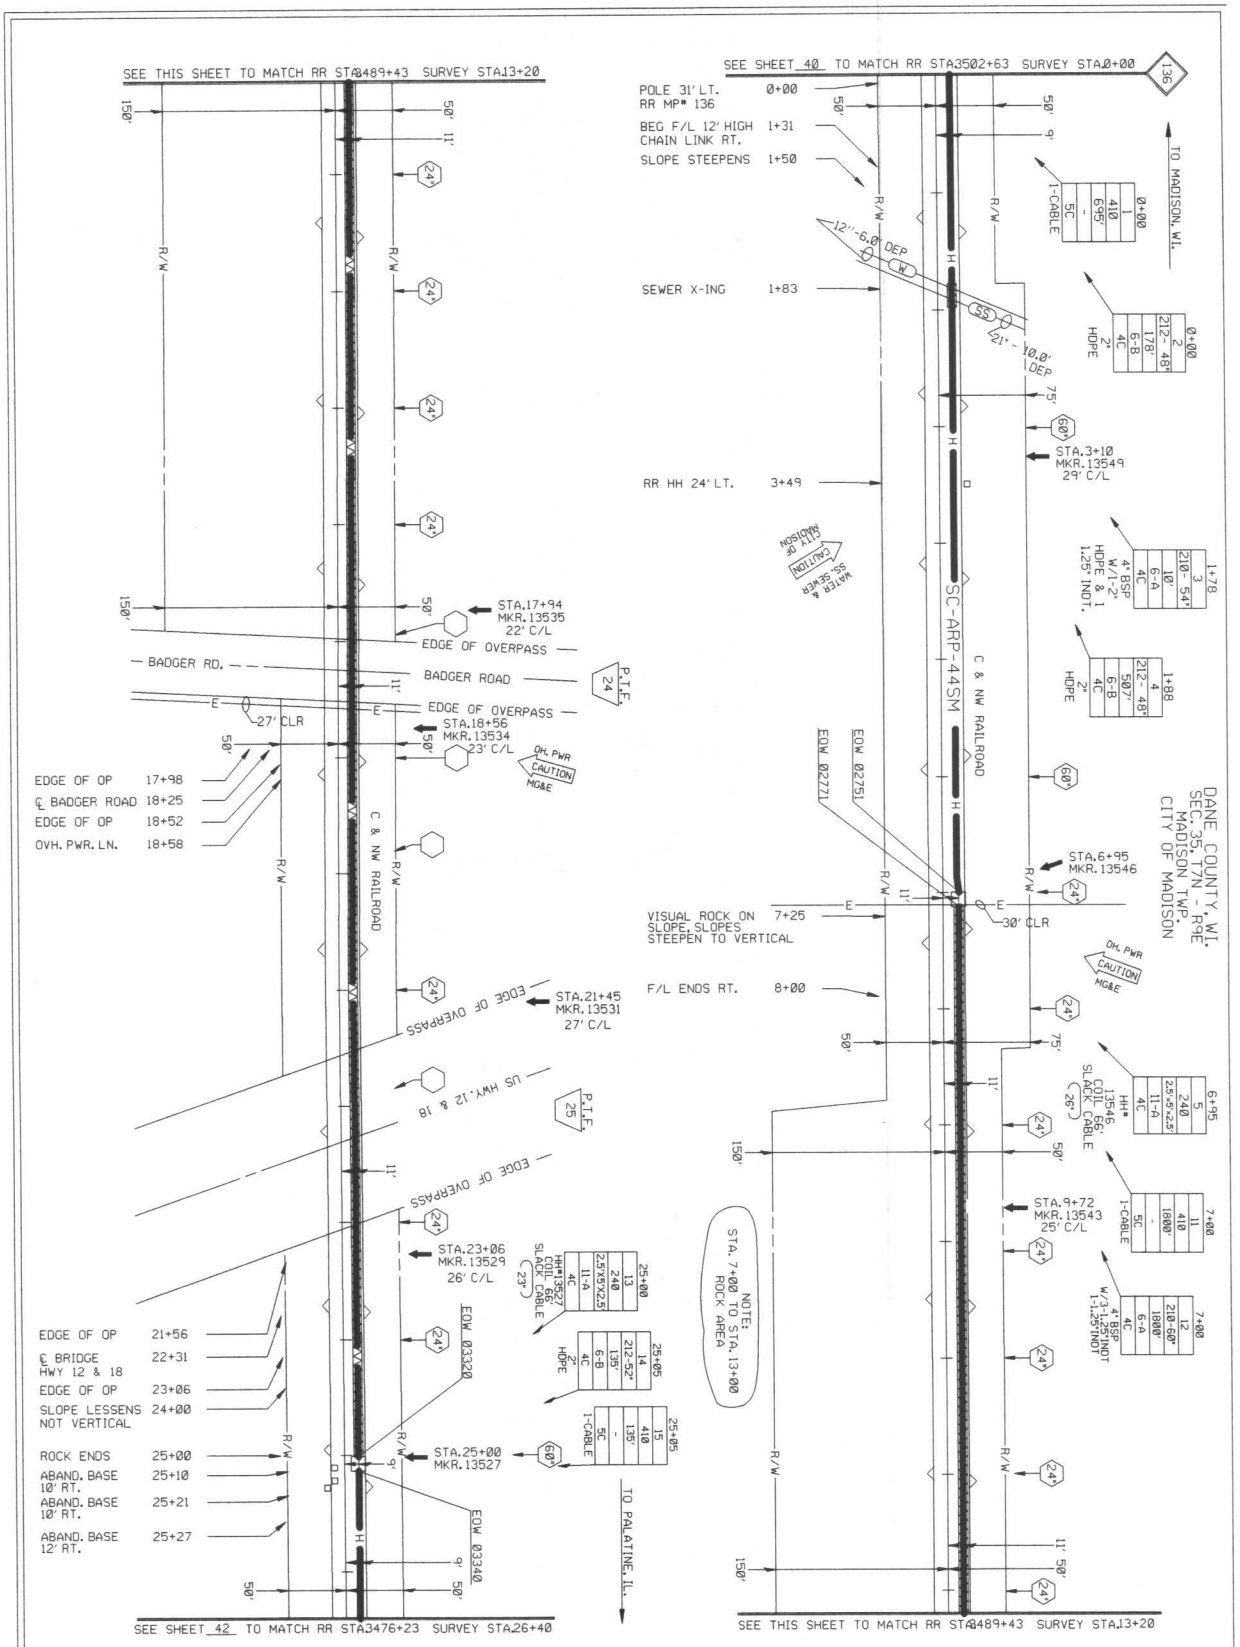

MCI

TELECOMMUNICATIONS CORPORATION

LIGHTWAVE SYSTEMS

TITLE: FIBER OPTIC CABLE ROUTE

MADISON, WI. TO PALATINE, IL.

DATE: 4-20-93

ENGINEER SMS

REVISIONS

DATE	DESCRIPTION	INITIAL
02/98	AS-BUILTS	K.E.M.

EXCEPT AS MAY BE OTHERWISE PROVIDED BY CONTRACT, THIS DRAWING AND ALL INFORMATION THEREON SHALL REMAIN THE PROPERTY OF MCI TELECOMMUNICATIONS CORPORATION AND BEING ISSUED IN STRICT CONFIDENCE AND SHALL NOT BE REPRODUCED, COPIED OR USED FOR ANY PURPOSE WITHOUT SPECIFIC WRITTEN PERMISSION.

TOLERANCES: UNLESS OTHERWISE SPECIFIED
XX± .02 XXX± .010 FRACTIONAL ± 1/32"
ANGLES ± 30'

SCALE
HORIZONTAL: 1"=50'
VERTICAL: 1"=50'

DEPT.ID024 LOC.ID.041

MP 136 TO MP 135

SHEET 41 OF 380

DWG. NO. 1128604I.02A

1.25" INDT	5410'	
HH 2.5"x5"x2.5'	1	
4" BSP	1810'	
2" HDPE	830'	
10"STEEL CASING		
10M STRAND		
BUR. CA. MKRS.	8	
MH 4' X 4' X 4'		
HH 3' X 5' X 4'		
4" SPLIT PVC		
4" SPLIT GIP		
CORR. INDT.		
4" PVC		
4" GIP		
CABLE	2762'	

MATERIAL LIST QUANTITY

RAILROAD 2640 LF

SURVEY 2640 LF

MAP FOOTAGE

MADISON, WI

TO

SHARON, WI

SPAN: B

PROJECT:# 011286