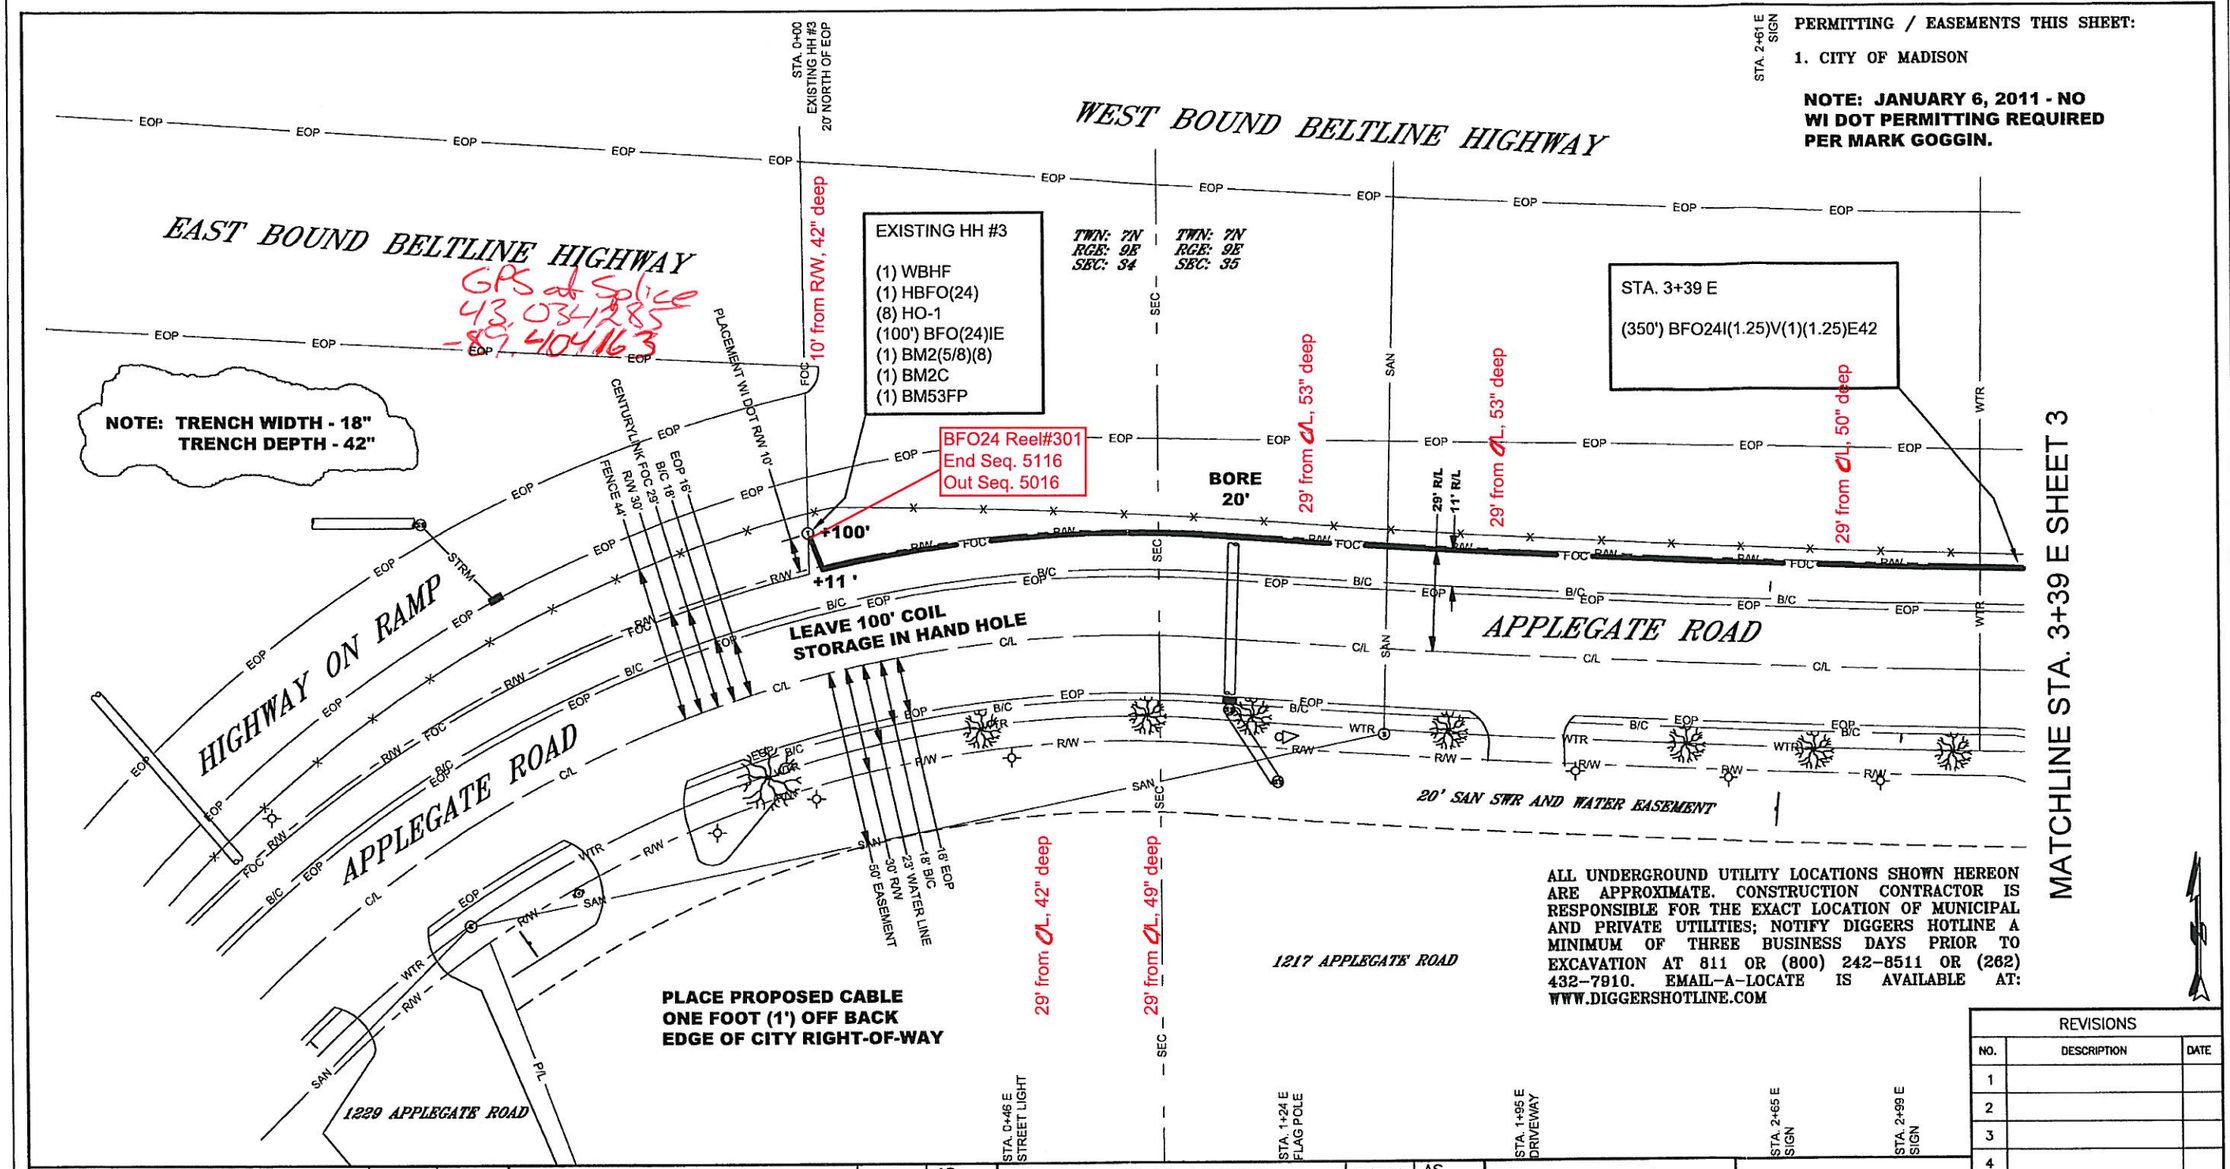

PERMITTING / EASEMENTS THIS SHEET:

1. CITY OF MADISON

NOTE: JANUARY 6, 2011 - NO WI DOT PERMITTING REQUIRED PER MARK GOGGIN.

ALL UNDERGROUND UTILITY LOCATIONS SHOWN HEREON ARE APPROXIMATE. CONSTRUCTION CONTRACTOR IS RESPONSIBLE FOR THE EXACT LOCATION OF MUNICIPAL AND PRIVATE UTILITIES; NOTIFY DIGGERS HOTLINE A MINIMUM OF THREE BUSINESS DAYS PRIOR TO EXCAVATION AT 811 OR (800) 242-8511 OR (262) 432-7910. EMAIL-A-LOCATE IS AVAILABLE AT: WWW.DIGGERSHOTLINE.COM

ASSEMBLY UNITS	QTY	AS BUILT	ASSEMBLY UNITS	QTY	AS BUILT	ASSEMBLY UNITS	QTY	AS BUILT
WBHF	1	1 ✓	WHBFO	1	1			
~~HBFO(24)~~ HBFO(~~144~~) 60ct	1	1	BM60(1.25)2PD	298	298			
BFO24I(1.25)V(1)(1.25)E42	52	52 ✓	147 BFO(24)		1			
BM53FP	1	1 ✓						
HO-1	8	8						
BFO(24)IE	398	~~398~~						
BM2(5/8)(8)	1	1 ✓						
BM2C	1	2						

REVISIONS		
NO.	DESCRIPTION	DATE
1		
2		
3		
4		
5		
6		

Link

14567 N. Outer Forty Rd Suite 500
Chesterfield Missouri, 63017

Main Office No.: 314-880-1000
Network Ops Cntr.: 800-604-6688
Main Fax No.: 314-880-1999

TITLE
PLACE FACILITIES TO FABCO EQUIPMENT

DRAWING DESCRIPTION
EXTEND FIBER TO 1111 APPLEGATE ROAD MADISON, WISCONSIN

****NOTICE****
INFORMATION ON THIS DOCUMENT IS PROPRIETARY AND SHALL NOT BE USED, COPIED, REPRODUCED OR DISCLOSED IN WHOLE OR IN PART WITHOUT WRITTEN CONSENT OF LIGHTCORE

DATE 12/2010	PJ NO. E.229228
SCALE NTS	CNTY:DANE STATE:WISCONSIN
DRAWN BY K.WHITING	SHEET 2 OF 7
CHECKED BY	DRAWING NO. 1
APPROVED BY:	