PROJECT ID: 5145-00-60
WITH: N/A

COUNTY: DANE

ORDER OF SHEETS

Section No.	1	Title
Section No.	2	Typical Sections and Details
Section No.	3	Estimate of Quantities
Section No.	3	Miscellaneous Quantities
Section No.	4	Right of Way Plat
Section No.	5	Plan and Profile
Section No.	6	Standard Detail Drawings
Section No.	7	Sign Plates
Section No.	8	Structure Plans
Section No.	9	Computer Earthwork Data
Section No.	9	Cross Sections

TOTAL SHEETS = 71

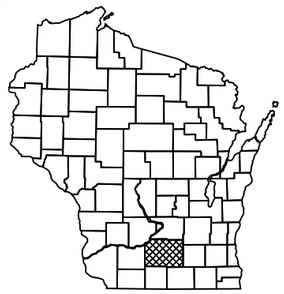

N

BEGIN PROJECT
STA. 0+72.86
Y=522,547.92
X=721,212.49

STATE OF WISCONSIN
DEPARTMENT OF TRANSPORTATION

PLAN OF PROPOSED IMPROVEMENT

MAZOMANIE - USH 12

STH 78 TO USH 12

STH 19

DANE COUNTY

STATE PROJECT NUMBER
5145-00-71

STATE PROJECT	FEDERAL PROJECT	
	PROJECT	CONTRACT
5145-00-71		

30% PLAN
6/7/2018

No comments -
Michelle Brokaw

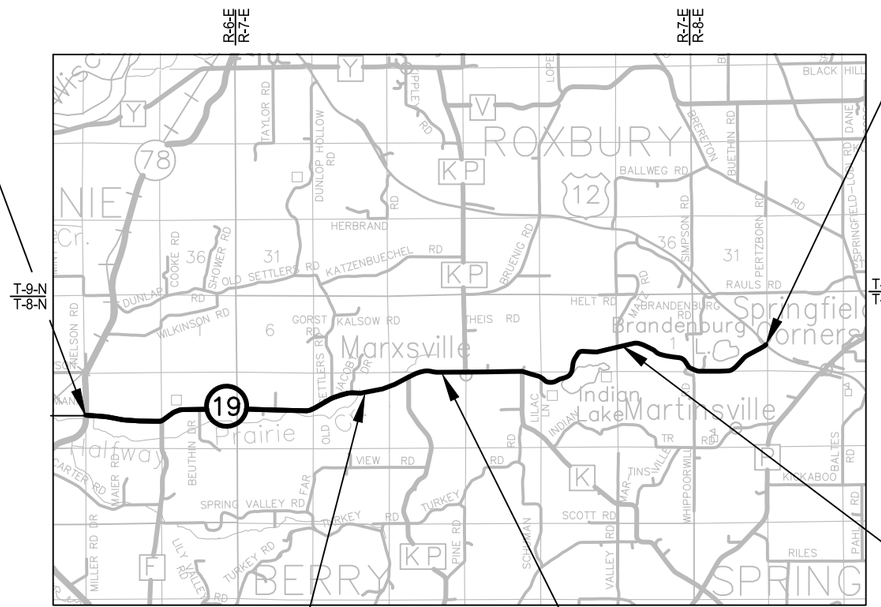

DESIGN DESIGNATION

A.A.D.T.	2022	= 2,500
A.A.D.T.	2042	= 3,000
D.H.V.	(10.7%)	= 321
D.D.		= 60/40
T.		= 15.3%
DESIGN SPEED		= 55 MPH - STH 78 TO CTH KP (SOUTH)
		= 45 MPH - CTH KP (SOUTH) TO CTH KP (NORTH)
		= 55 MPH - CTH KP (NORTH) TO USH 12
ESALS		= ----

CONVENTIONAL SYMBOLS

PLAN
- CORPORATE LIMITS
- PROPERTY LINE
- LOT LINE
- LIMITED HIGHWAY EASEMENT
- EXISTING RIGHT OF WAY
- PROPOSED OR NEW R/W LINE
- SLOPE INTERCEPT
- REFERENCE LINE
- EXISTING CULVERT
- PROPOSED CULVERT (Box or Pipe)
- COMBUSTIBLE FLUIDS (CAUTION)
- MARSH AREA
- WOODED OR SHRUB AREA

PROFILE
- GRADE LINE
- ORIGINAL GROUND
- MARSH OR ROCK PROFILE (To be noted as such) (ROCK)
- SPECIAL DITCH (LABEL)
- GRADE ELEVATION (95.36)
- CULVERT (Profile View)

UTILITIES
- ELECTRIC (E)
- FIBER OPTIC (FO)
- GAS (G)
- SANITARY SEWER (SAN)
- STORM SEWER (SS)
- TELEPHONE (T)
- WATER (W)
- UTILITY PEDESTAL
- POWER POLE
- TELEPHONE POLE

LAYOUT
SCALE 0 1 MI

TOTAL NET LENGTH OF CENTERLINE = 9.618 MI.

COORDINATES ON THIS PLAN ARE REFERENCED TO THE WISCONSIN COUNTY COORDINATE SYSTEM (WCCS), DANE COUNTY, NAD83 (91).

ELEVATIONS ON THIS PLAN ARE REFERENCED TO THE NORTH AMERICAN DATUM OF NGVD 88.

STATE OF WISCONSIN
DEPARTMENT OF TRANSPORTATION

PREPARED BY

Surveyor	WISDOT / JT ENGINEERING
Designer	GREGORY PAYNE, P.E.
Project Manager	LALITHA BALACHANDRAN, P.E.
Regional Examiner	SW REGION
Regional Supervisor	WILLIAM STROBEL, P.E.

APPROVED FOR THE DEPARTMENT

DATE: _____ _____ (Signature)

E

GENERAL NOTES

PAVING LIMITS AT INTERSECTIONS ARE TO BE DETERMINED IN THE FIELD BY THE ENGINEER.

THE LOCATION OF STOP LINES SHALL BE DETERMINED IN THE FIELD BY THE ENGINEER.

THE CENTERLINE OF STH 19 IS APPROXIMATELY THE MAINLINE REFERENCE LINE IN THE REHABILITATION AREAS.

NO TREES OR SHRUBS ARE TO BE REMOVED WITHOUT APPROVAL OF THE ENGINEER.

DISTURBED AREAS WITHIN THE RIGHT OF WAY SHALL BE RESTORED AS DIRECTED BY THE ENGINEER

WHEN THE QUANTITY OF BASE AGGREGATE DENSE IS MEASURED FOR PAYMENT IN TONS, THE DEPTH OR THICKNESS AS SHOWN ON THE PLAN IS APPROXIMATE AND THE ACTUAL THICKNESS WILL DEPEND UPON THE DISTRIBUTION OF THE MATERIAL AS DIRECTED BY THE ENGINEER IN THE FIELD.

EROSION CONTROL FEATURES WILL BE DETERMINED BY THE EROSION CONTROL IMPLEMENTATION PLAN (ECIP). ALL EROSION CONTROL MEASURES SHALL BE MAINTAINED UNTIL SUCH A TIME AS THE ENGINEER DETERMINES THE MEASURE IS NO LONGER NECESSARY.

PRIOR TO THE PLACEMENT OF MGS GUARDRAIL, THE SHOULDERS SHALL BE IN PLACE, SHAPED, AND COMPACTED UNLESS SHOWN OTHERWISE.

LIMI NS OF BEAM GUARD REPLACEMENTS AND ADJUSTMENTS MAY BE ADJUSTED BY THE RDINATE EXACT LOCATIONS WITH THE ENGINEER IN THE FIELD.

locations

EXACT LOCATIONS AND WIDTHS OF DRIVEWAYS AND PRIVATE FIELD ENTRANCES SHALL BE DETERMINED BY THE ENGINEER IN THE FIELD.

THE ~~LOCATION~~ OF ~~THE~~ EXISTING AND PROPOSED UTILITY INSTALLATIONS AS the THE PLANS ARE APPROXIMATE.

THERE ARE UTILITY FACILITIES WITHIN THE PROJECT AREA THAT ARE NOT SHOWN ON THE PLANS. THE CONTRACTOR SHALL COORDINATE HIS CONSTRUCTION ACTIVITIES WITH A CALL TO DIGGERS HOTLINE AND/OR A DIRECT CALL TO THE UTILITIES THAT HAVE FACILITIES IN ~~THAT~~ AREA. NOT ALL UTILITIES ARE MEMBERS OF DIGGERS HOTLINE.

ADJUST THE LOCATIONS OF CONTRACT ITEMS UNDER THIS CONTRACT TO AVOID CONFLICT WITH THE EXISTING UTILITY FACILITIES, UNLESS OTHERWISE SPECIFIED IN THE CONTRACT SPECIAL PROVISIONS.

HMA PAVEMENT WEIGHT CALCULATIONS ARE BASED ON 112 LB/SY/IN.

THE CONTRACTOR'S PAVING OPERATIONS SHALL BE CONSISTENT WITH THE PLAN TYPICAL SECTIONS AND BE CONSTRUCTED TO PREVENT HMA LONGITUDINAL JOINTS FROM BEING LOCATION WITHIN A DRIVING OR TURNING LANE.

DO NOT STORE EQUIPMENT OR MATERIAL IN ENVIRONMENTALLY SENSITIVE AREAS, WETLANDS OR WATERWAYS.

ALL EXISTING SIGNS SHALL REMAIN IN PLACE UNTIL CONSTRUCTION OPERATIONS REQUIRE THEIR REMOVAL OR UNLESS ENGINEER APPROVES THEIR REMOVAL.

DISTURBED AREAS WITHIN THE PROJECT LIMITS ARE TO BE TOPSOILED, FERTILIZED, SEEDED, AND MULCHED OR E-MATTED AS DIRECTED BY THE ENGINEER IN THE FIELD.

ABBREVIATIONS

AADT	AVERAGE ANNUAL DAILY TRAFFIC
ASPH	
ENTRA	
CE	
CP	
CPCS	
CPRC	
DHV	
D	
DIA	
E	
EAT	BING
TERMINAL	
EL	ELEVATION
ESALS	
EOP	
EXIST	
F.E.	
G	
H	
HES	
IP	
L	
LHF	
LC	LONG CHORD
NOM	NOMINAL
N	NORTH
PCC	POINT OF COMPOUND CURVATURE
PE	PRIVATE ENTRANCE
PL	PROPERTY LINE
RCPA	REINFORCED CONCRETE PIPE ARCH
RHF	RIGHT HAND FORWARD
RD	ROAD
RT	RIGHT
R/W	RIGHT OF WAY
SDD	STANDARD DETAIL DRAWING
SHR	SHRINKAGE
SE	SUPERELEVATION
T	PERCENT TRUCKS
TEL	TELEPHONE
TN	TOWN
TC	TOP OF CURB
TRANS	TRANSITION
VOL	VOLUME
W	WEST
V	DESIGN SPEED

Change to:
Ryan Niemeier
same address
zip 54601
(608) 796-5190
ryan.niemeier@centurylink.com

Change to:
Jane Rossing
same address
(608) 252-7099
add email:
grossing@mge.com

UTILITY CONTACTS

MICHAEL BROLIN
ALLIANT ENERGY - ELECTRICITY ~~AND GAS/PETROLEUM~~
4902 NORTH BILTMORE LN
MADISON, WI 53713
(608) 458-4871
MICHAEL BROLIN@ALLIANTENERGY.COM

~~STEVE BISHOP~~
CENTURYLINK - COMMUNICATION LINE
333 N FRONT ST.
LA CROSSE, WI ~~54602~~
~~(608) 796-5543~~
~~STEVEN.BISHOP@CENTURYLINK.COM~~

~~TIM STATZ~~
MADISON GAS AND ELECTRIC - ELECTRICITY
PO BOX 1231
MADISON, WI 53701-1231
~~(608) 252-4727~~

~~CAROL ANASON - COMMUNICATION LINE~~
~~AT&T WISCONSIN~~
~~316 W WASHINGTON AVE~~
~~MADISON, 53703~~
~~(608) 252-2385~~
~~CA2624@ATT.COM~~

JERRY MYERS
TDS TELECOM - COMMUNICATION LINE
525 JUNCTION RD
MADISON, WI 53717
(608)664-4404
JERRY.MYERS@TDSTELECOM.COM

SECTION 2 ORDER OF SHEETS

GENERAL NOTES
PROJECT OVERVIEW
TYPICAL SECTIONS
TRAFFIC CONTROL - ADVANCED WARNING SIGNING
TRAFFIC CONTROL - DETOUR PLAN

WISDOT PROJECT MANAGER

LALITHA BALACHANDRAN, P.E.
WISDOT SW REGION
2101 WRIGHT STREET
MADISON, WI 53704
(608) 243-3382
LALITHA.BALACHANDRAN@DOT.WI.GOV

WISDOT PROJECT LEADER

GREGORY PAYNE, P.E.
WISDOT SW REGION
2101 WRIGHT STREET
MADISON, WI 53704
(608) 242-8058
GREGORY.PAYNE@DOT.WI.GOV

DNR LIAISON

ERIC HEGGELUND
DNR SOUTH CENTRAL REGION HQ
3911 FISH HATCHERY ROAD
FITCHBURG, WI 53711
(608) 275-3301
ERIC.HEGGELUND@WISCONSIN.GOV

DIGGERS HOTLINE
Dial 811 or (800)242-8511
www.DiggersHotline.com

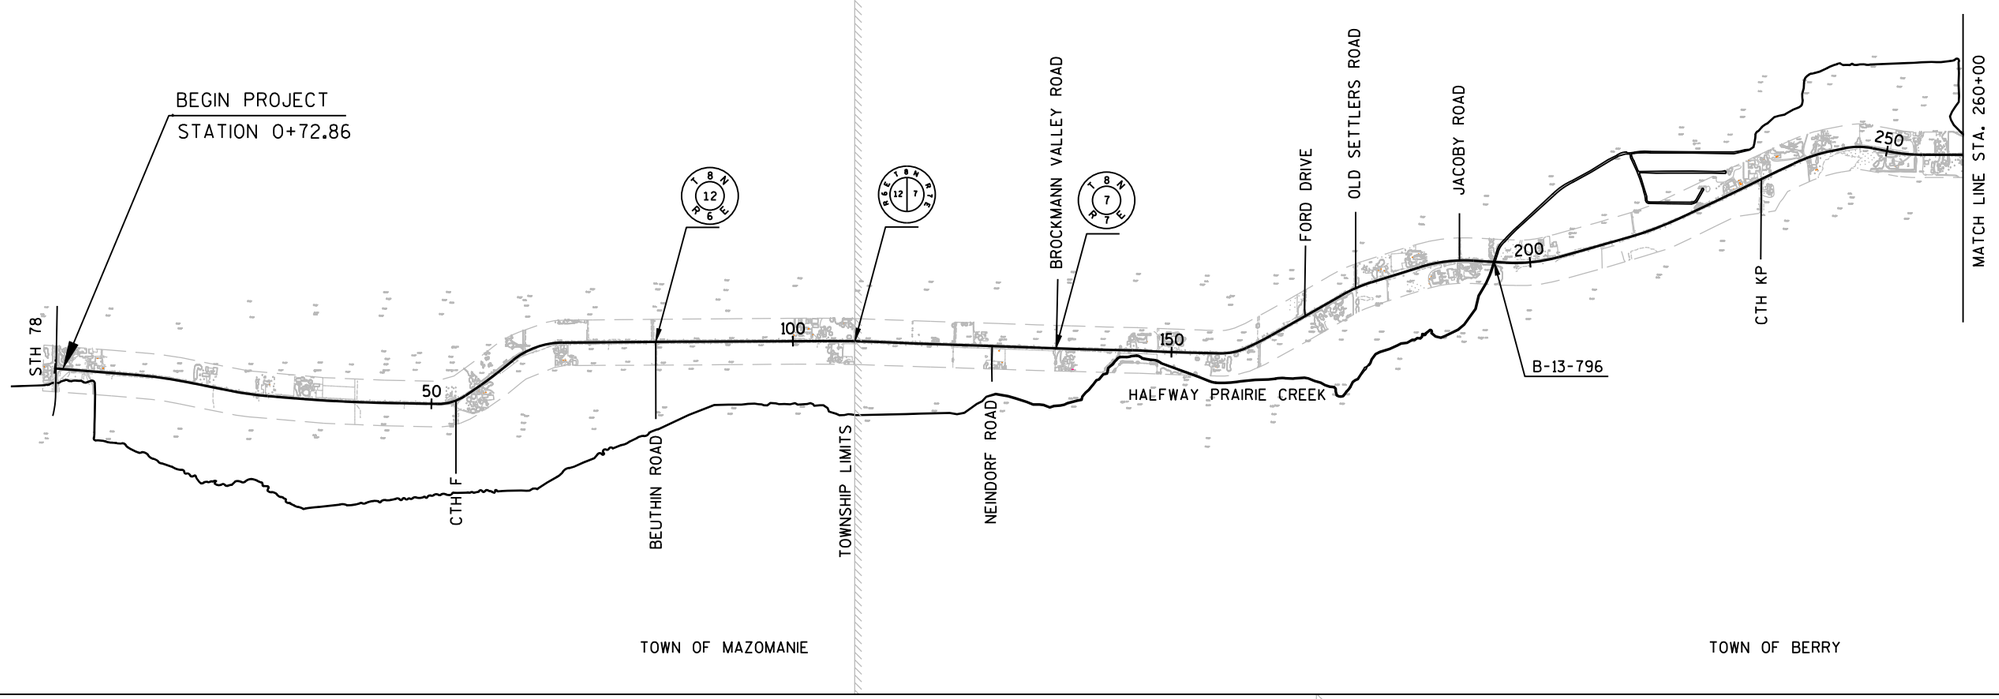

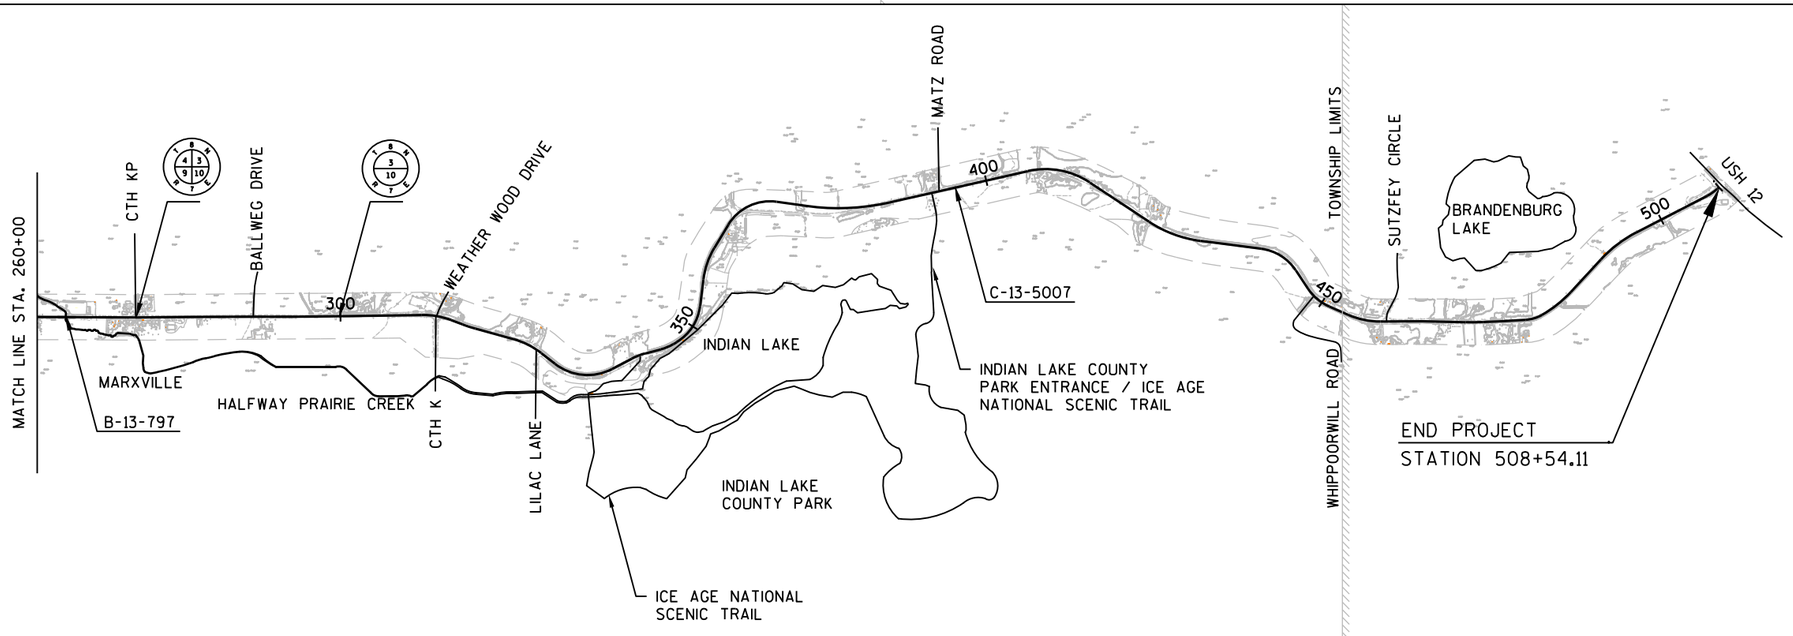

PROJECT NO: 5145-00-71	HWY: STH 19	COUNTY: DANE	PROJECT OVERVIEW	SHEET 2	E

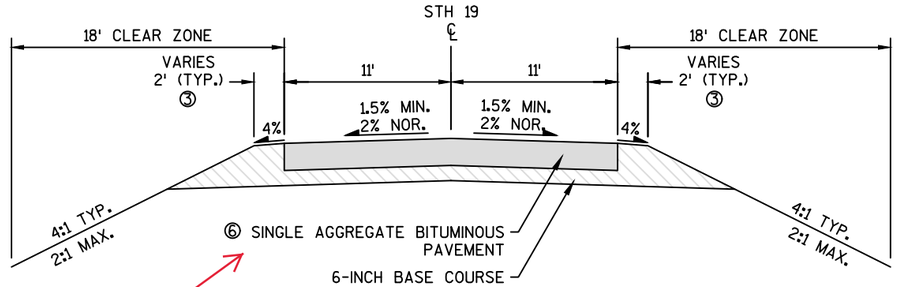

Provide the thickness ranges of the material layers from the Roadway Boring information. Include the roadway boring information in the plan.

EXISTING TYPICAL SECTION - STH 19

STA. 0+72.86 TO STA. 508+54.11

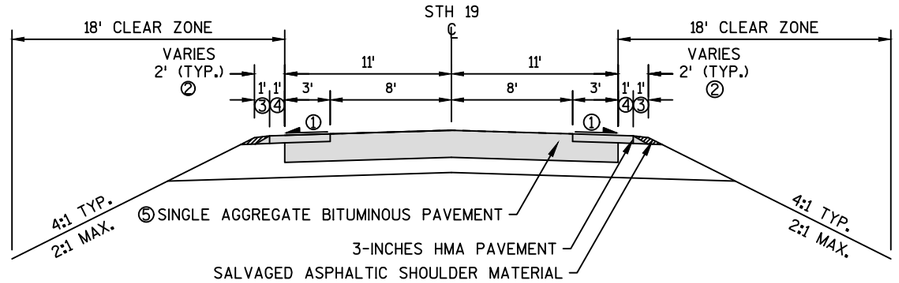

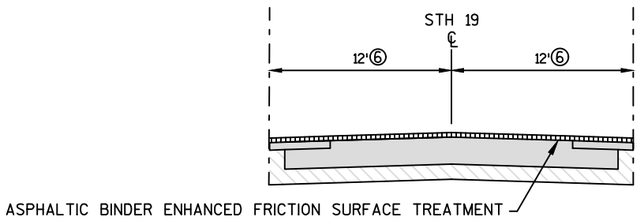

EXISTING TYPICAL SECTION - STH 19

STA. 49+25 TO STA. 56+25
STA. 363+50 TO STA. 369+75
STA. 403+75 TO STA. 414+00

Distinguish which station ranges apply to typical above and which apply to partial typical shown below.

① EXISTING SUPERELEVATION AND SUPERELVATION RATES VARY

② 5' SHOULDER FROM STA 180+00 TO 206+00 LT AND RT
5' SHOULDER FROM STA 259+30 TO 268+30 LT AND RT

③ AGGREGATE SHOULDER WIDTH VARIATION

STATION LEFT
0.5' FROM STA. 85+00 TO STA. 86+50
0.5' FROM STA. 130+50 TO STA. 132+00
0.5' FROM STA. 173+00 TO STA. 175+00
0.5' FROM STA. 178+00 TO STA. 179+00
0.5' FROM STA. 211+25 TO STA. 211+75
0.5' FROM STA. 237+25 TO STA. 273+75
0.5' FROM STA. 244+50 TO STA. 245+00
0.5' FROM STA. 286+00 TO STA. 287+50
0.5' FROM STA. 296+00 TO STA. 299+00
0.5' FROM STA. 317+50 TO STA. 325+00
0.5' FROM STA. 353+00 TO STA. 364+00
0.5' FROM STA. 368+00 TO STA. 369+00
0.5' FROM STA. 374+00 TO STA. 375+00
0.5' FROM STA. 394+00 TO STA. 395+00
0.5' FROM STA. 416+50 TO STA. 419+00
0.5' FROM STA. 430+00 TO STA. 435+00
0.5' FROM STA. 435+00 TO STA 441+50
0.5' FROM STA. 441+50 TO STA. 446+50
0.5' FROM STA. 462+00 TO STA. 465+50
0.5' FROM STA. 485+50 TO STA. 501+50

STATION RIGHT
0.5' FROM STA. 65+50 TO STA. 66+50
0.5' FROM STA. 73+00 TO STA. 80+00
0.5' FROM STA. 88+50 TO STA. 94+00
0.5' FROM STA. 94+00 TO STA. 104+00
0.5' FROM STA. 122+50 TO STA. 131+00
0.5' FROM STA. 144+00 TO STA. 147+50
0.5' FROM STA. 151+50 TO STA. 153+50
0.5' FROM STA. 240+50 TO STA. 247+00
0.5' FROM STA. 276+50 TO STA. 277+50
0.5' FROM STA. 276+50 TO STA. 277+50
0.5' FROM STA. 282+00 TO STA. 282+50
0.5' FROM STA. 292+50 TO STA. 293+00
0.5' FROM STA. 300+50 TO STA. 306+50
0.5' FROM STA. 306+50 TO STA. 308+00
0.5' FROM STA. 363+00 TO STA. 364+50
0.5' FROM STA. 376+50 TO STA. 377+50
0.5' FROM STA. 384+50 TO STA. 385+00
0.5' FROM STA. 397+00 TO STA. 398+50
0.5' FROM STA. 408+50 TO STA. 409+50
0.5' FROM STA. 414+50 TO STA. 417+50
0.5' FROM STA. 462+00 TO STA. 465+50
0.5' FROM STA. 483+00 TO STA. 484+50
0.5' FROM STA. 490+50 TO STA. 492+50
0.5' FROM STA. 494+50 TO STA. 500+00
0.5' FROM STA. 500+00 TO STA. 501+50
0.5' FROM STA. 503+00 TO STA. 504+00

④ ASPHALT SHOULDER WIDTH VARIATION
3.0' FROM STA. 192+90 RT TO STA 196+60 RT
3.0' FROM STA. 193+70 LT TO STA. 197+40 LT
5.0' FROM STA. 261+30 RT TO STA. 265+65 RT
5.0' FROM STA, 261+75 LT TO STA. 266+15 LT
3.0' FROM STA. 392+90 RT TO STA. 394+63 RT
3.0' FROM STA. 396+27 RT TO STA 396+95 RT
3.0' FROM STA. 394+35 LT TO STA. 394+63 LT
3.0' FROM STA. 396+27 LT TO STA. 397+35 LT
0.5' FROM STA. 494+50 LT TO STA. 500+00 LT
2.0' WIDTH ON THE INSIDE OF CURVES FROM PC TO PT

⑤ 10¾-INCH: STH 78 TO CTH KP (NORTH)
8¾-INCH: CTH KP (NORTH) TO USH 12

⑥ 24' (TYP.) ASPHALTIC BINDER ENHANCED FRICTION SURFACE TREATMENT WIDTH THROUGH INTERSECTIONS

PROJECT NO: 5145-00-71	HWY: STH 19	COUNTY: DANE	TYPICAL SECTIONS	SHEET 3	E

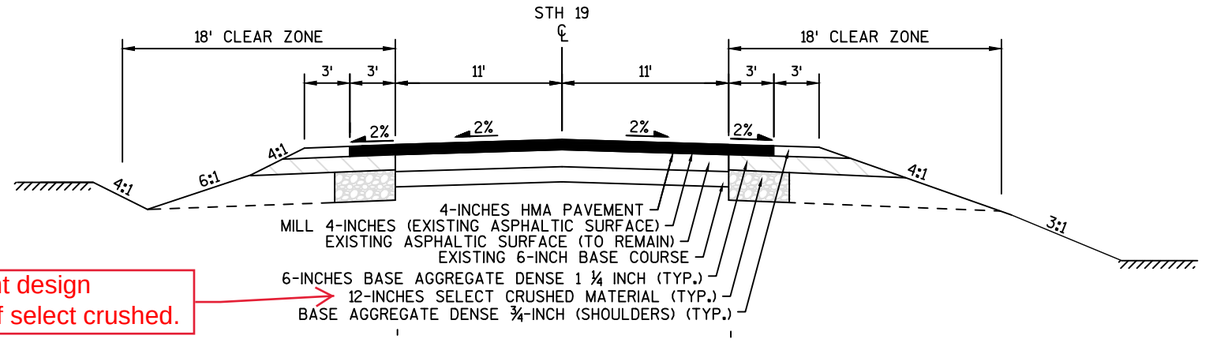

Preliminary pavement design specifies using 16" of select crushed.

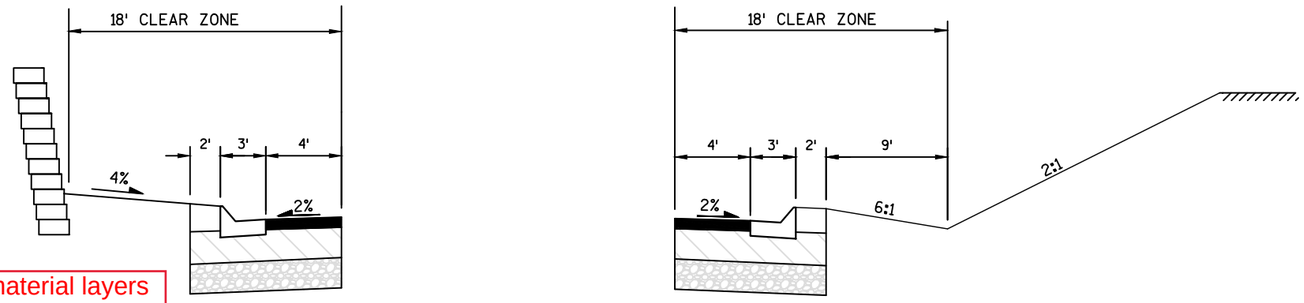

Label material layers with thicknesses.

PROPOSED TYPICAL SECTION - STH 19

Project starts at 0+72.86

STA 0+35.86 TO STA 56+00
STA 71+00 TO STA 270+00
STA 277+00 TO STA 304+75
STA 463+50 TO STA 508+54.11

Distinguish which station ranges apply to typical above and which apply to partial typical shown below.

PROJECT NO: 5145-00-71	HWY: STH 19	COUNTY: DANE	TYPICAL SECTIONS	SHEET 4	E

FILE NAME : N:\PDS\C3D\51450001\SHEETSPLAN\020301-TS.DWG PLOT DATE : 6/5/2018 10:48 AM PLOT BY : RACH, JEREMY PAUL PLOT NAME : PLOT SCALE : 1 IN:10 FT
WISDOT/CADDS SHEET 42

2

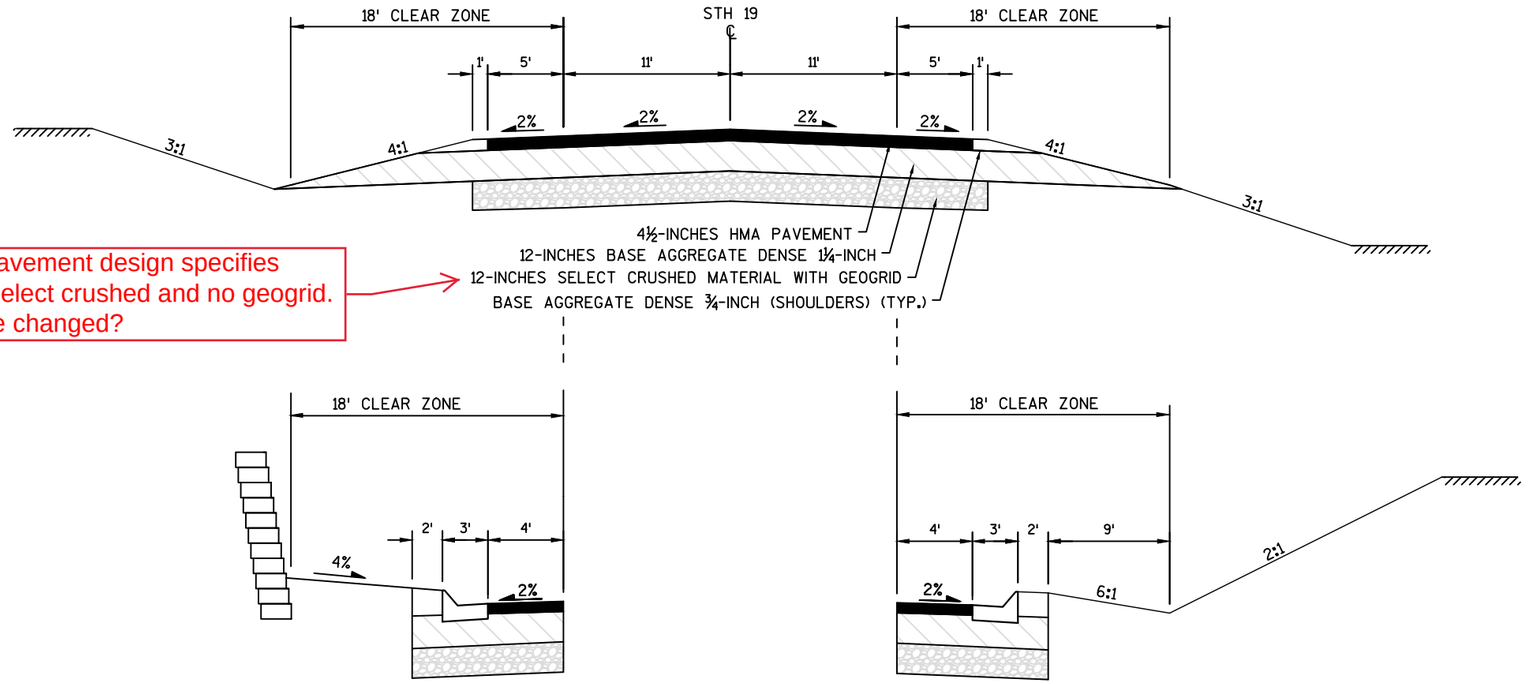

Preliminary pavement design specifies using 16" of select crushed and no geogrid. Has this since changed?

Label material layers with thicknesses.

PROPOSED TYPICAL SECTION STH - 19

STA 56+00 TO STA 71+00
STA 270+00 TO STA 277+00
STA 304+75 TO STA 463+50

Distinguish which station ranges apply to typical above and which apply to partial typical shown below.

Include existing and proposed typicals for sideroads where needed (i.e. CTH KP).

PROJECT NO: 5145-00-71	HWY: STH 19	COUNTY: DANE	TYPICAL SECTIONS	SHEET 5	E

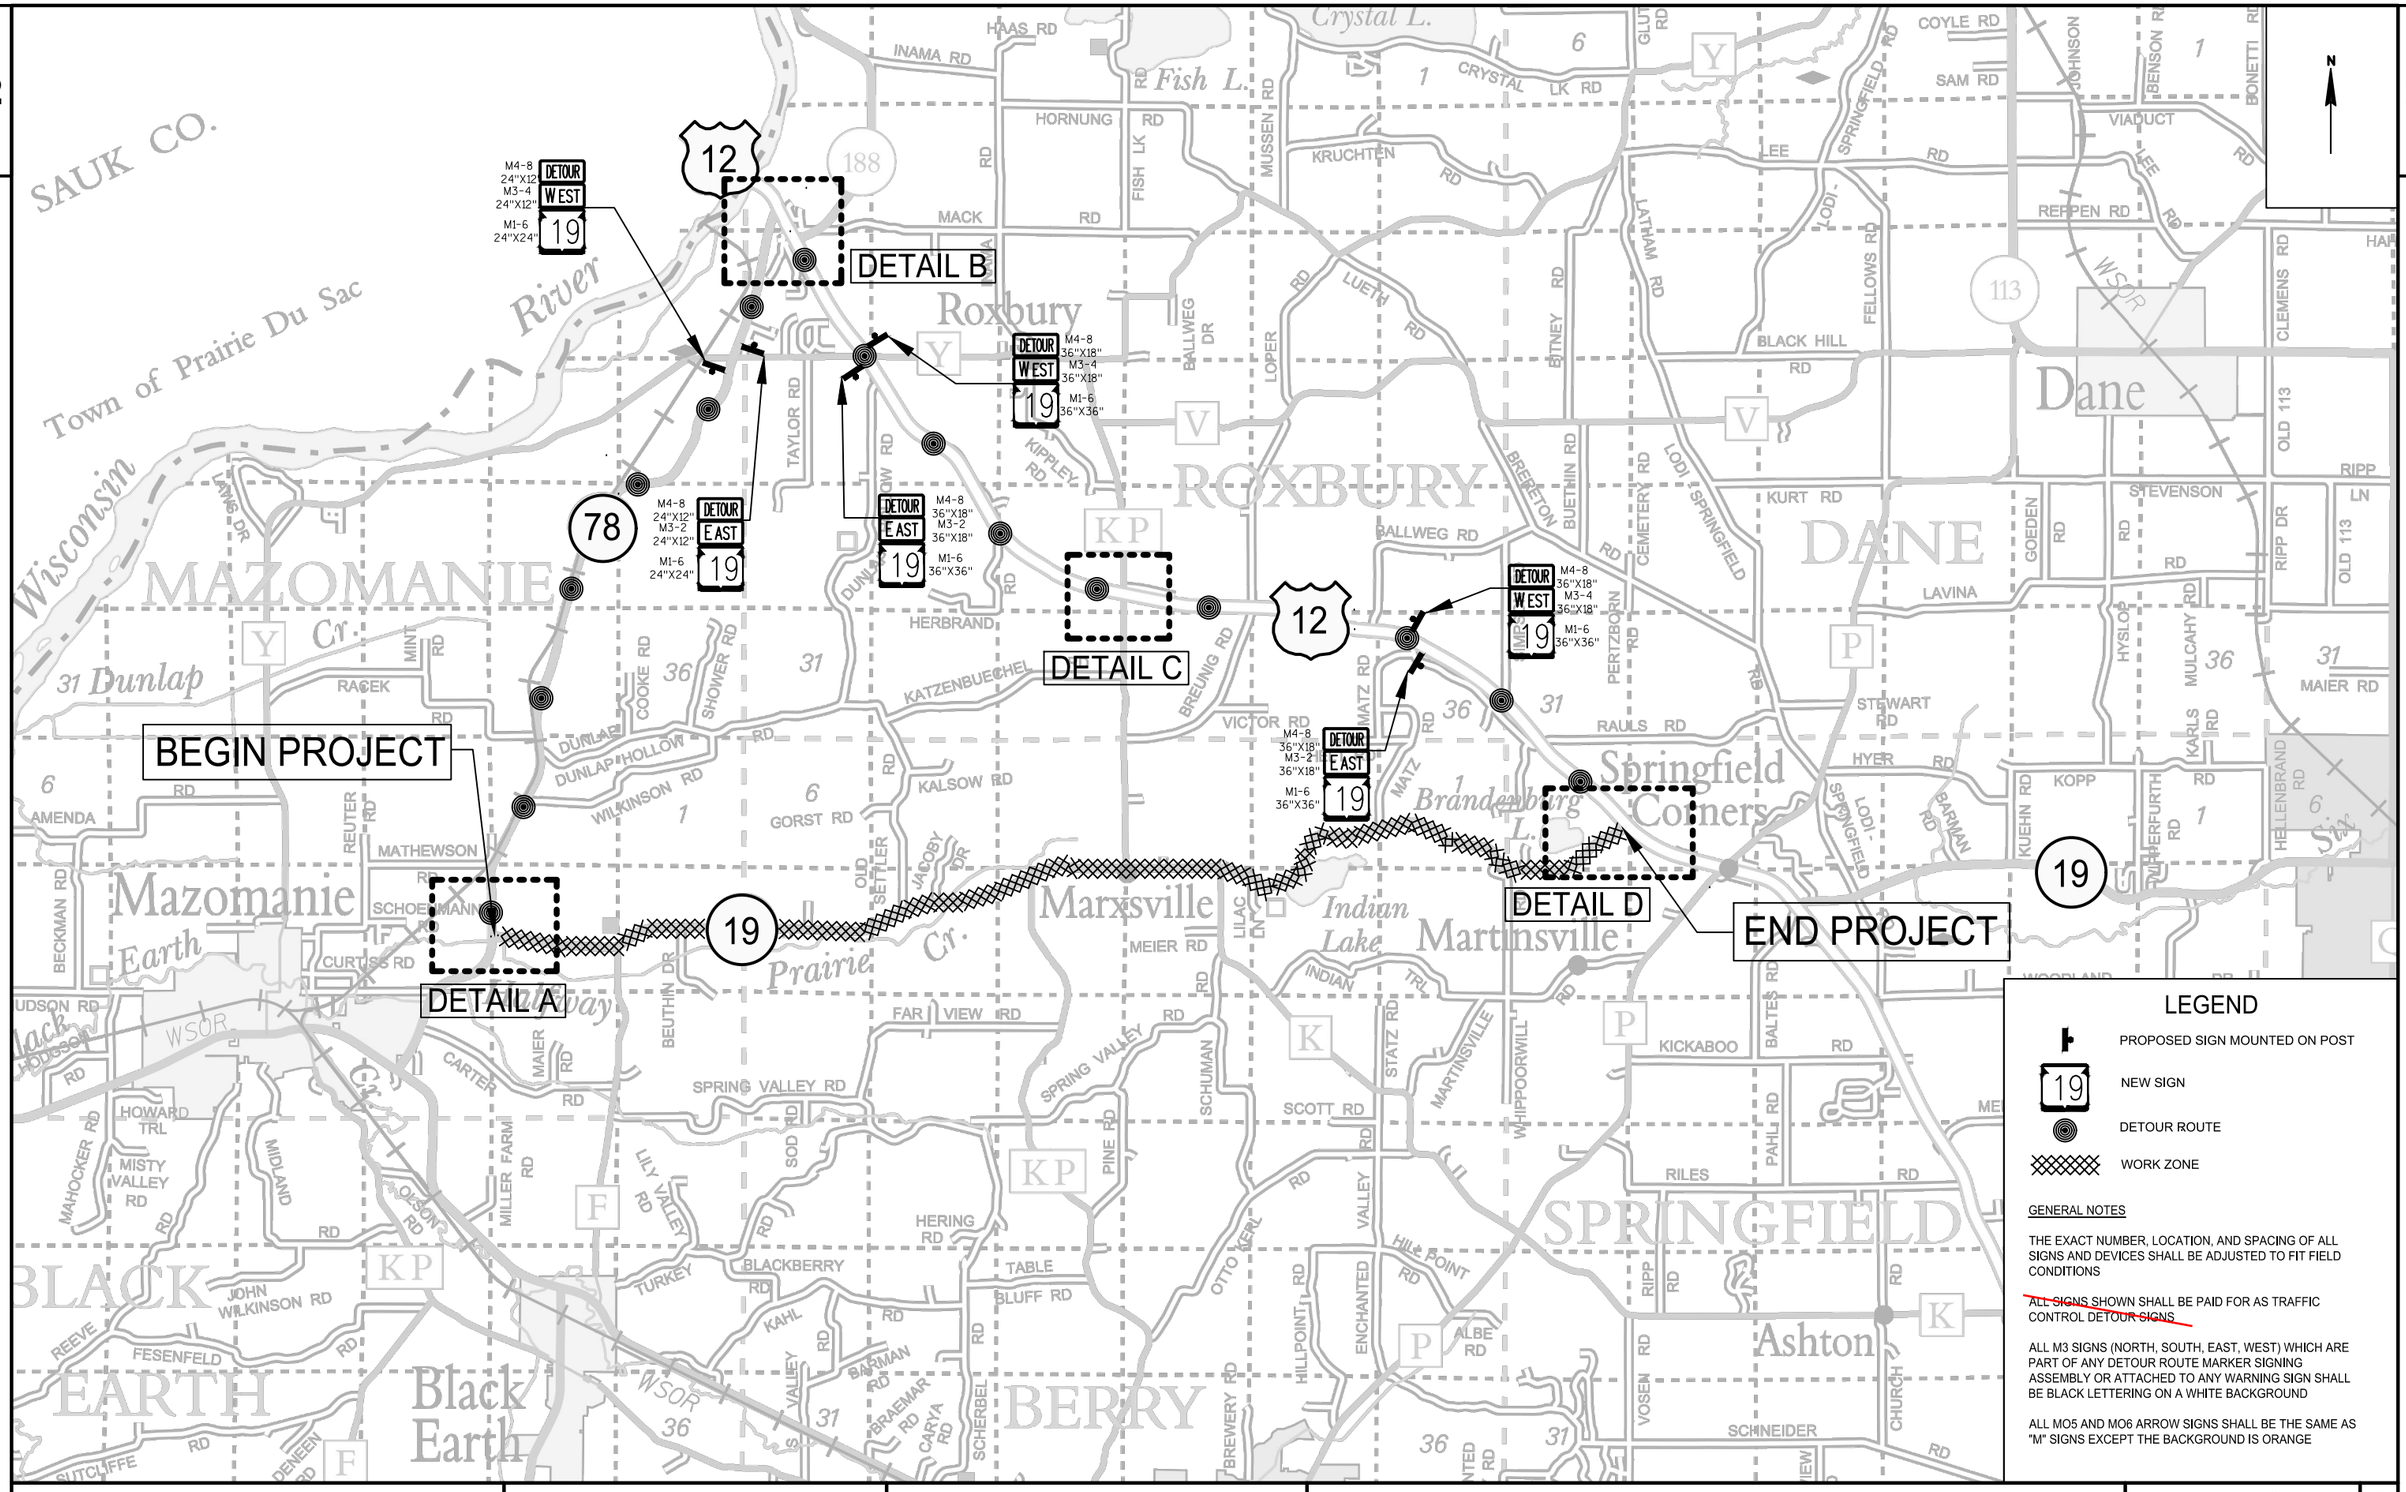

PROJECT NO: 5145-00-71	HWY: STH 19	COUNTY: DANE	TRAFFIC CONTROL DETOUR PLAN (STH 19)	SHEET 6	E

FILE NAME : N:\PDS\C3D\51450001\SHEETSPLAN\027101-DT.DWG
LAYOUT NAME - ****
PLOT DATE : 4/3/2018 9:00 AM
PLOT BY : RACH, JEREMY PAUL
PLOT NAME :
PLOT SCALE :
WISDOT/CADDS SHEET 42

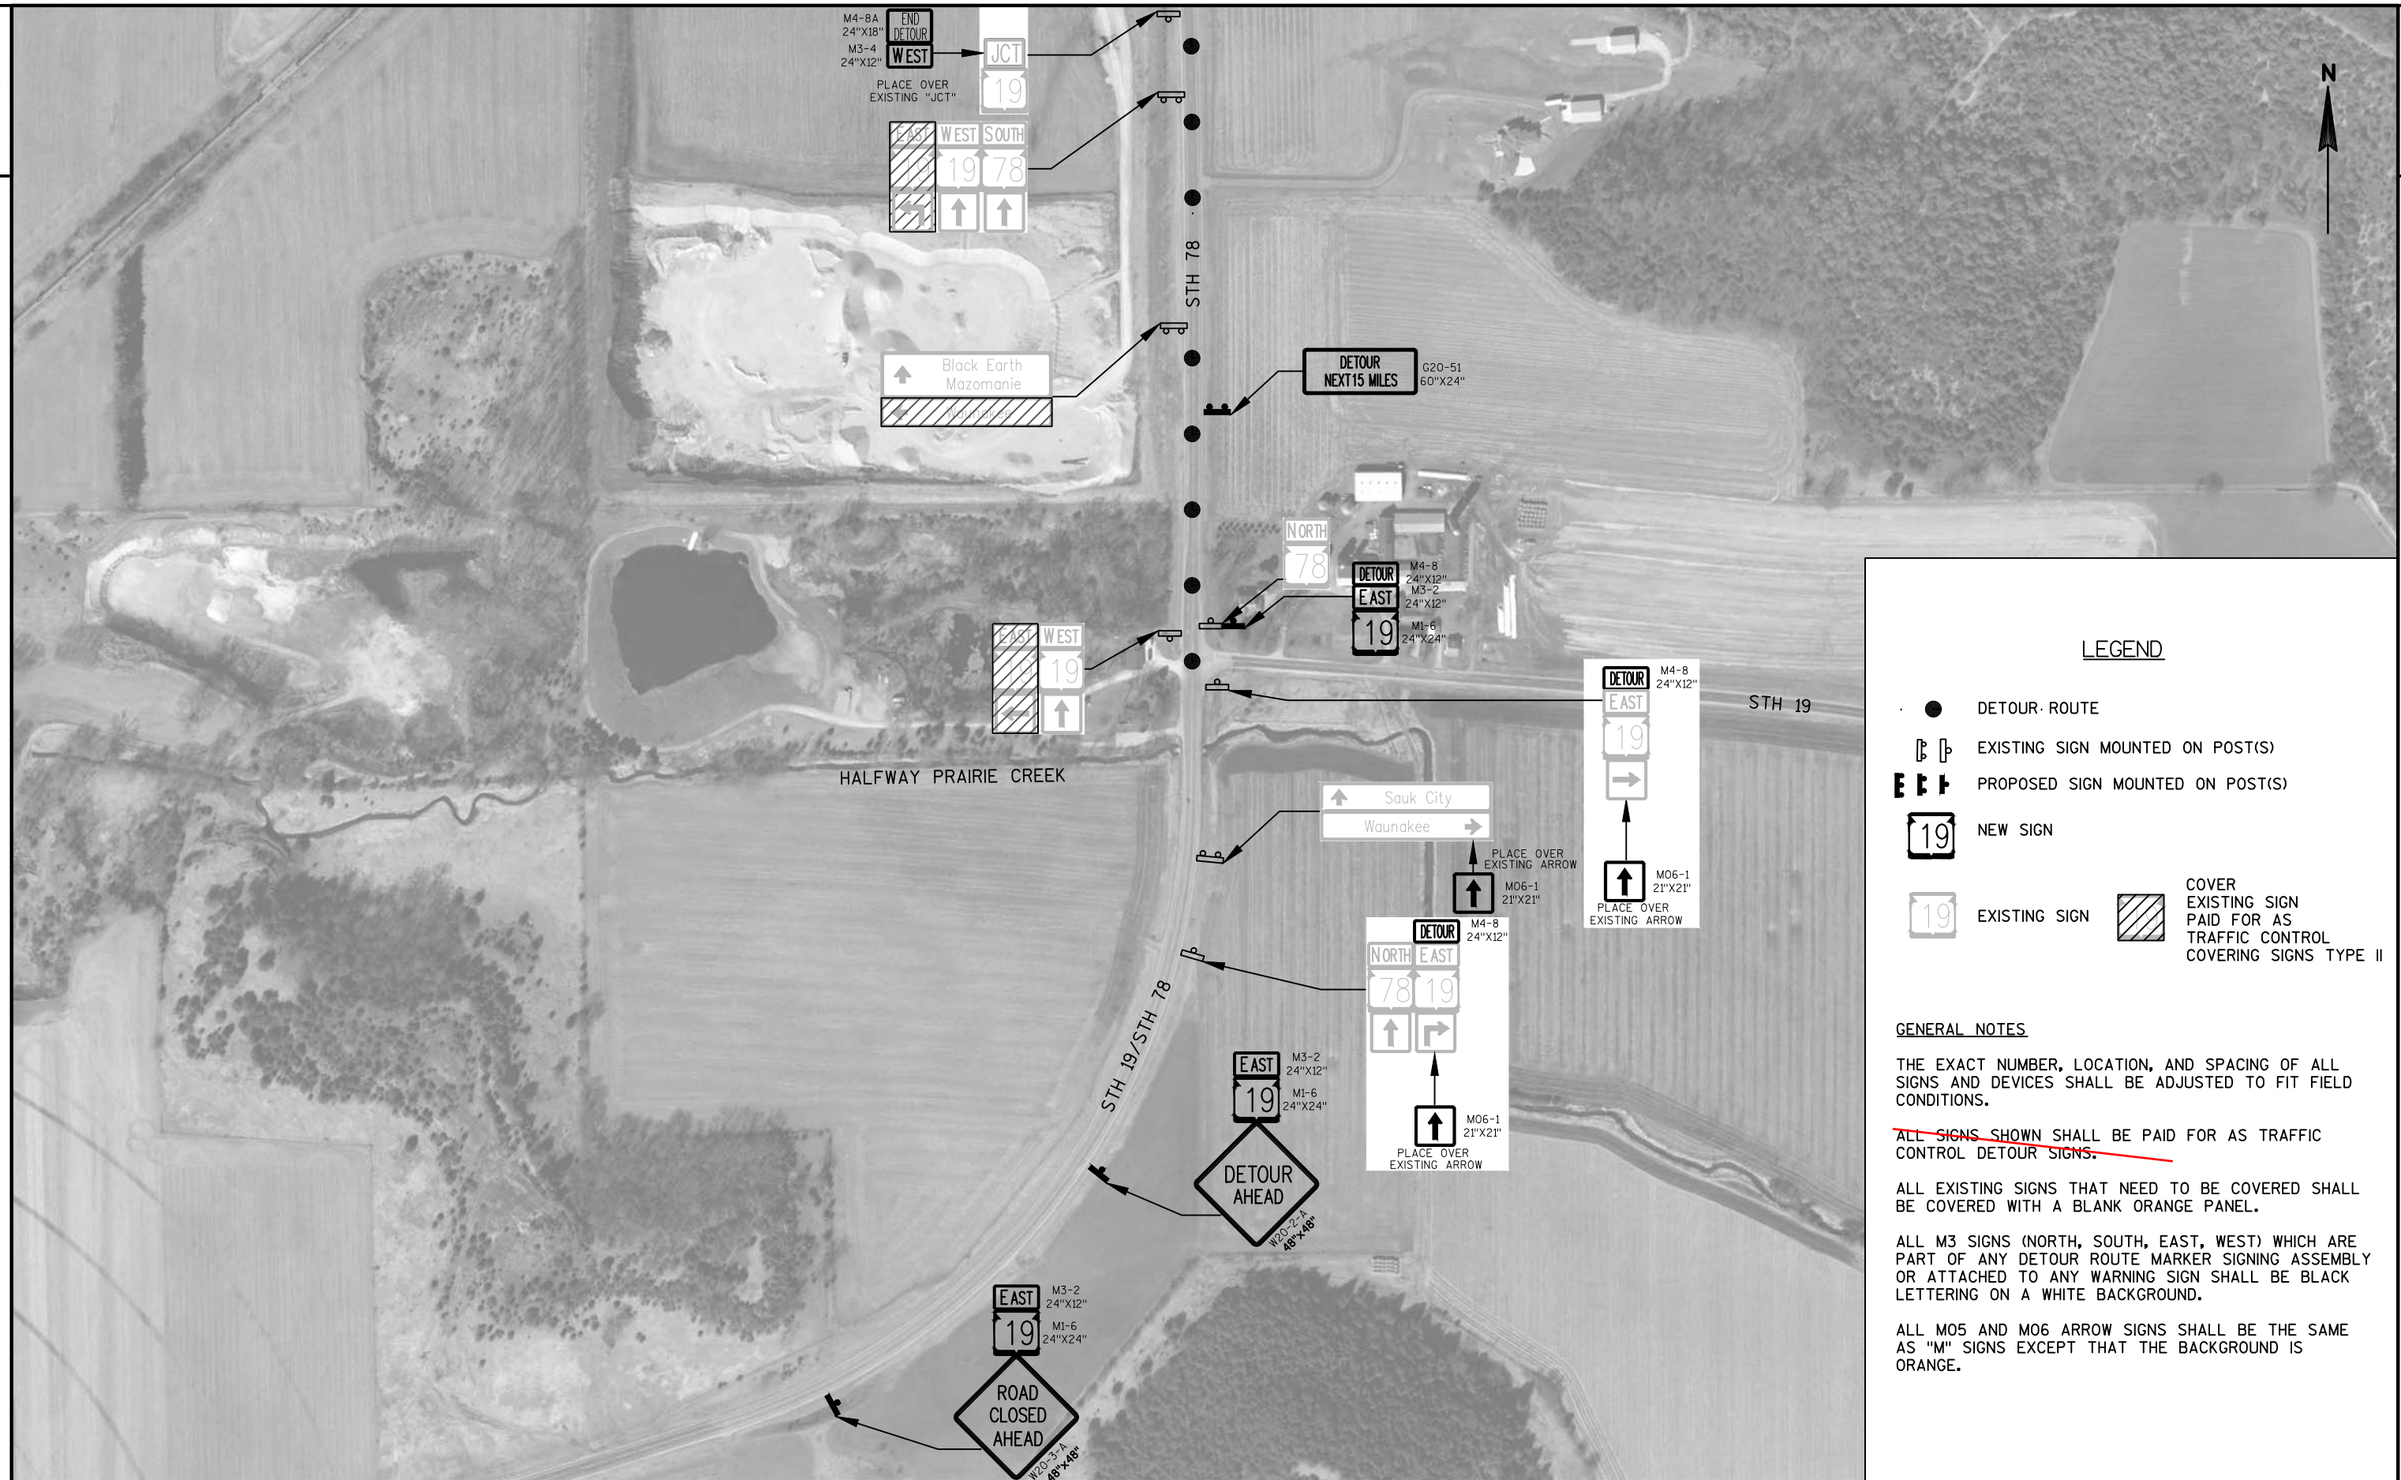

LEGEND

- DETOUR ROUTE
- EXISTING SIGN MOUNTED ON POST(S)
- PROPOSED SIGN MOUNTED ON POST(S)
- 19 — NEW SIGN
- 19 — EXISTING SIGN
- COVER EXISTING SIGN PAID FOR AS TRAFFIC CONTROL COVERING SIGNS TYPE II

GENERAL NOTES

THE EXACT NUMBER, LOCATION, AND SPACING OF ALL SIGNS AND DEVICES SHALL BE ADJUSTED TO FIT FIELD CONDITIONS.

ALL SIGNS SHOWN SHALL BE PAID FOR AS TRAFFIC CONTROL DETOUR SIGNS.

ALL EXISTING SIGNS THAT NEED TO BE COVERED SHALL BE COVERED WITH A BLANK ORANGE PANEL.

ALL M3 SIGNS (NORTH, SOUTH, EAST, WEST) WHICH ARE PART OF ANY DETOUR ROUTE MARKER SIGNING ASSEMBLY OR ATTACHED TO ANY WARNING SIGN SHALL BE BLACK LETTERING ON A WHITE BACKGROUND.

ALL M05 AND M06 ARROW SIGNS SHALL BE THE SAME AS "M" SIGNS EXCEPT THAT THE BACKGROUND IS ORANGE.

PROJECT NO: 5145-00-71	HWY: STH 19	COUNTY: DANE	DETOUR - DETAIL A	SHEET 7	E

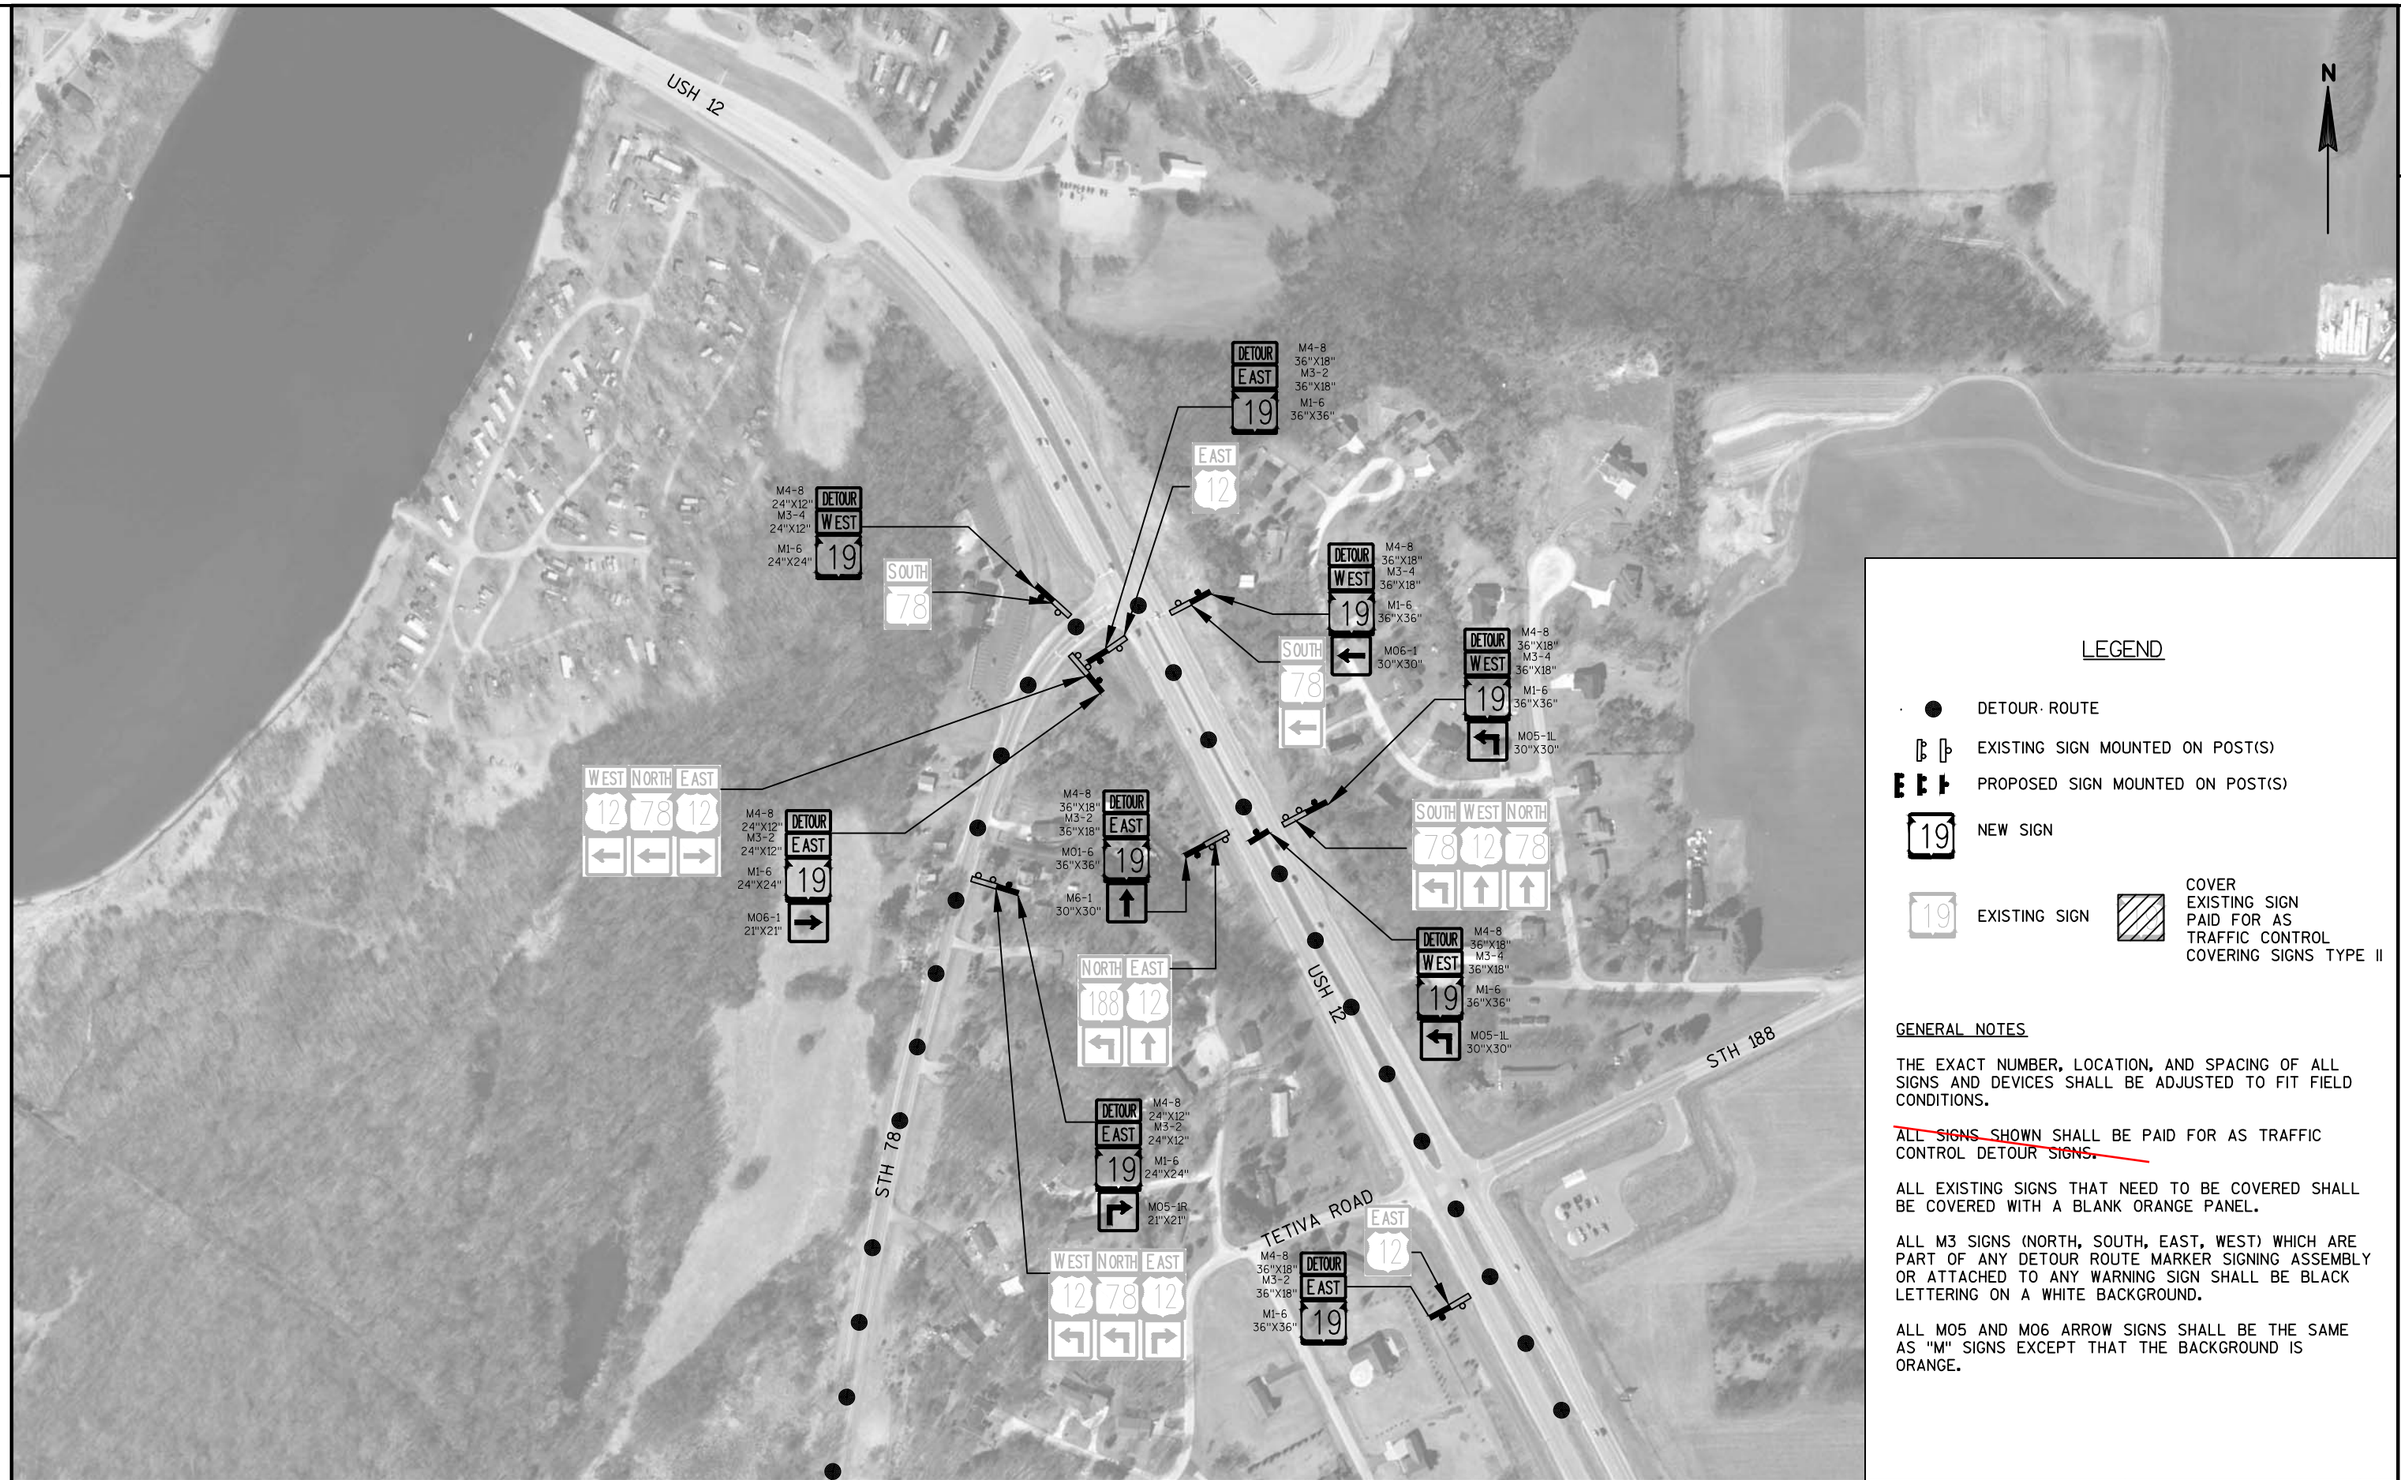

LEGEND

- DETOUR ROUTE
- EXISTING SIGN MOUNTED ON POST(S)
- PROPOSED SIGN MOUNTED ON POST(S)
- 19 NEW SIGN
- 19 EXISTING SIGN
- COVER EXISTING SIGN PAID FOR AS TRAFFIC CONTROL COVERING SIGNS TYPE II

GENERAL NOTES

THE EXACT NUMBER, LOCATION, AND SPACING OF ALL SIGNS AND DEVICES SHALL BE ADJUSTED TO FIT FIELD CONDITIONS.

~~ALL SIGNS SHOWN SHALL BE PAID FOR AS TRAFFIC CONTROL DETOUR SIGNS.~~

ALL EXISTING SIGNS THAT NEED TO BE COVERED SHALL BE COVERED WITH A BLANK ORANGE PANEL.

ALL M3 SIGNS (NORTH, SOUTH, EAST, WEST) WHICH ARE PART OF ANY DETOUR ROUTE MARKER SIGNING ASSEMBLY OR ATTACHED TO ANY WARNING SIGN SHALL BE BLACK LETTERING ON A WHITE BACKGROUND.

ALL M05 AND M06 ARROW SIGNS SHALL BE THE SAME AS "M" SIGNS EXCEPT THAT THE BACKGROUND IS ORANGE.

PROJECT NO: 5145-00-71	HWY: STH 19	COUNTY: DANE	DETOUR - DETAIL B	SHEET 8	E

2

LEGEND

- DETOUR ROUTE
- EXISTING SIGN MOUNTED ON POST(S)
- PROPOSED SIGN MOUNTED ON POST(S)
- 19 NEW SIGN
- 19 EXISTING SIGN
- COVER EXISTING SIGN PAID FOR AS TRAFFIC CONTROL COVERING SIGNS TYPE II

GENERAL NOTES

THE EXACT NUMBER, LOCATION, AND SPACING OF ALL SIGNS AND DEVICES SHALL BE ADJUSTED TO FIT FIELD CONDITIONS.

~~ALL SIGNS SHOWN SHALL BE PAID FOR AS TRAFFIC CONTROL DETOUR SIGNS.~~

ALL EXISTING SIGNS THAT NEED TO BE COVERED SHALL BE COVERED WITH A BLANK ORANGE PANEL.

ALL M3 SIGNS (NORTH, SOUTH, EAST, WEST) WHICH ARE PART OF ANY DETOUR ROUTE MARKER SIGNING ASSEMBLY OR ATTACHED TO ANY WARNING SIGN SHALL BE BLACK LETTERING ON A WHITE BACKGROUND.

ALL M05 AND M06 ARROW SIGNS SHALL BE THE SAME AS "M" SIGNS EXCEPT THAT THE BACKGROUND IS ORANGE.

PROJECT NO: 5145-00-71	HWY: STH 19	COUNTY: DANE	DETOUR - DETAIL C	SHEET 9	E

2

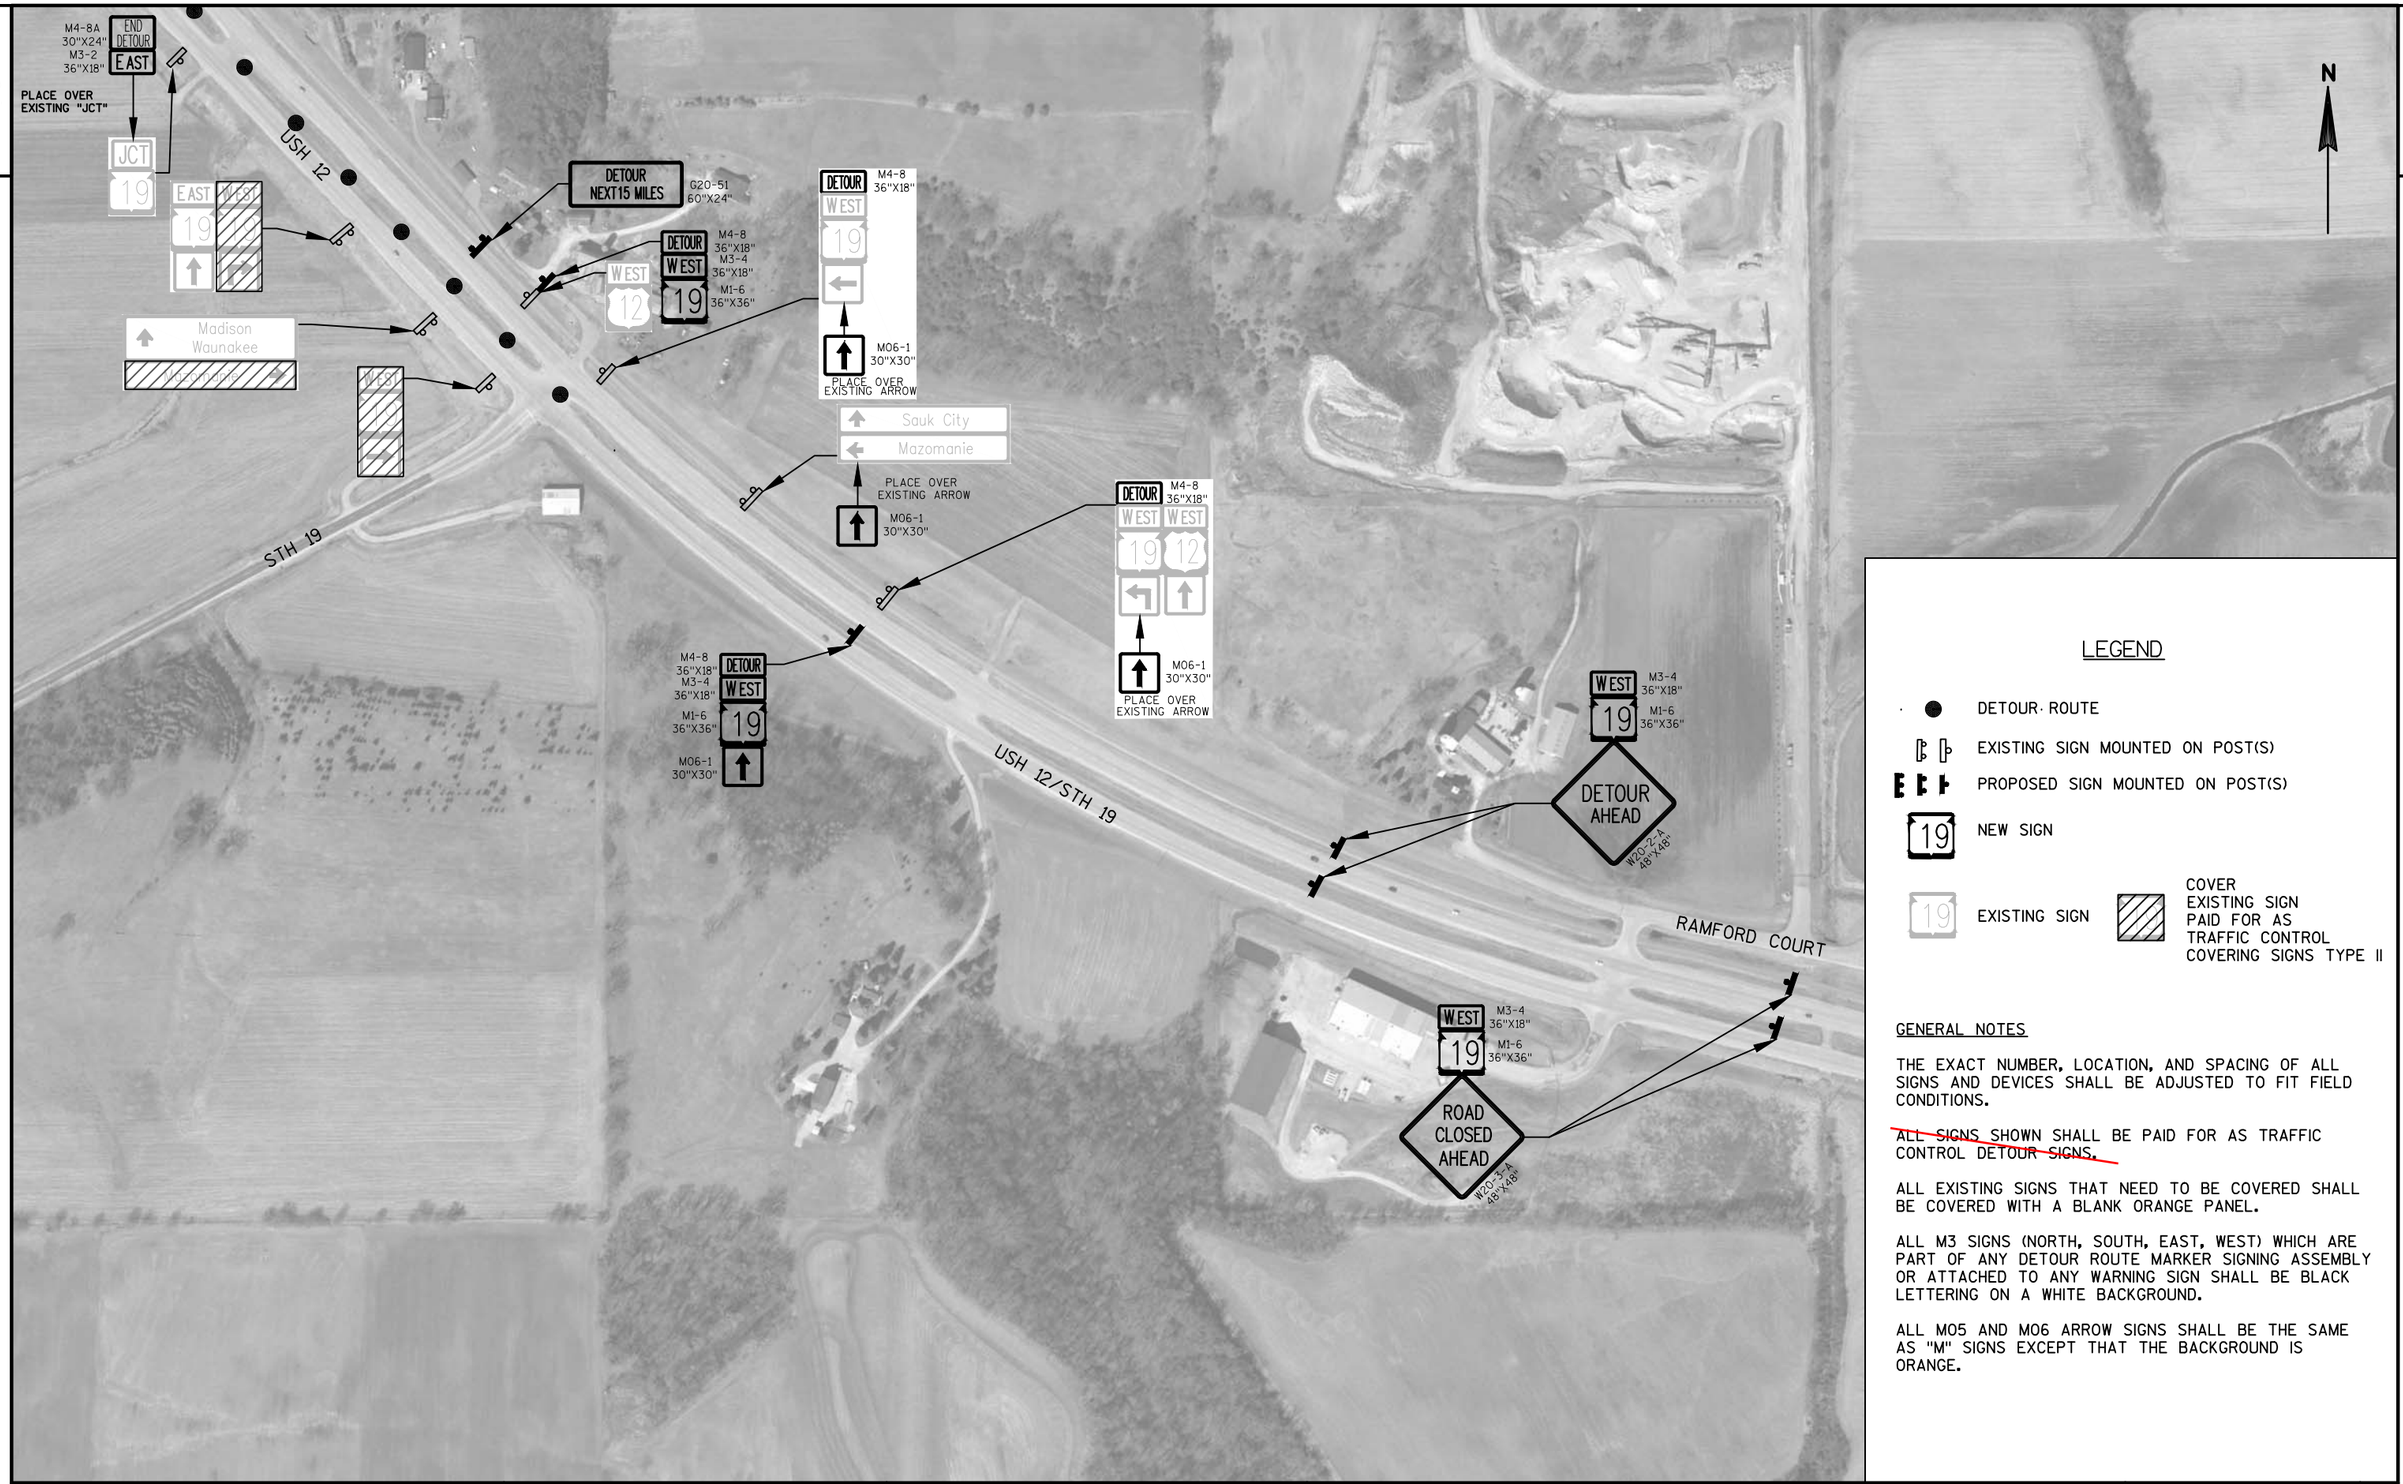

LEGEND

- DETOUR ROUTE
- EXISTING SIGN MOUNTED ON POST(S)
- PROPOSED SIGN MOUNTED ON POST(S)
- 19 — NEW SIGN
- 19 — EXISTING SIGN
- COVER EXISTING SIGN PAID FOR AS TRAFFIC CONTROL COVERING SIGNS TYPE II

GENERAL NOTES

THE EXACT NUMBER, LOCATION, AND SPACING OF ALL SIGNS AND DEVICES SHALL BE ADJUSTED TO FIT FIELD CONDITIONS.

ALL SIGNS SHOWN SHALL BE PAID FOR AS TRAFFIC CONTROL DETOUR SIGNS.

ALL EXISTING SIGNS THAT NEED TO BE COVERED SHALL BE COVERED WITH A BLANK ORANGE PANEL.

ALL M3 SIGNS (NORTH, SOUTH, EAST, WEST) WHICH ARE PART OF ANY DETOUR ROUTE MARKER SIGNING ASSEMBLY OR ATTACHED TO ANY WARNING SIGN SHALL BE BLACK LETTERING ON A WHITE BACKGROUND.

ALL M05 AND M06 ARROW SIGNS SHALL BE THE SAME AS "M" SIGNS EXCEPT THAT THE BACKGROUND IS ORANGE.

PROJECT NO: 5145-00-71	HWY: STH 19	COUNTY: DANE	DETOUR - DETAIL D	SHEET 10	E

Make sure what's shown in plan sheets corresponds to what's shown in typicals and cross sections.

Show edge of paved shoulder and edge of base course shoulder and remove other lines.

Guardrail req'd anywhere?

Show and label retaining wall locations.

Matchline

MINOR LOT LINE (TYP.)

SLOPE INTERCEPTS (TYP.)

EXISTING R/W (TYP.)

BEGIN PROJECT
BEGIN REHABILITATION
STA 0+72.86

BP: 0+00.00

PC: 10+83.07

14+00.00

STH 19/78

STH 19

N

5

5

VCL = 150.00
K = 310.67

VCL = 150.00
K = 383.77

VCL = 550.00
K = 343.11

VCL = 175.00
K = 265.04

-0.05%
-0.71%
-0.23%
0.16%

VPC STA 0+55.50
VPC EL 810.46

VPI STA 1+43.00
VPI EL 810.41

VPT STA 2+30.50
VPT EL 809.78

STA 0+43.32
EL 810.46

VPC STA 2+90.00
VPC EL 809.36

VPI STA 3+65.00
VPI EL 808.83

VPT STA 4+40.00
VPT EL 808.65

VPC STA 6+09.00
VPC EL 808.26

VPI STA 6+84.00
VPI EL 808.09

VPT STA 7+59.00
VPT EL 808.21

VPC STA 10+63.00
VPC EL 808.70

VPI STA 13+38.00
VPI EL 809.14

| | | |

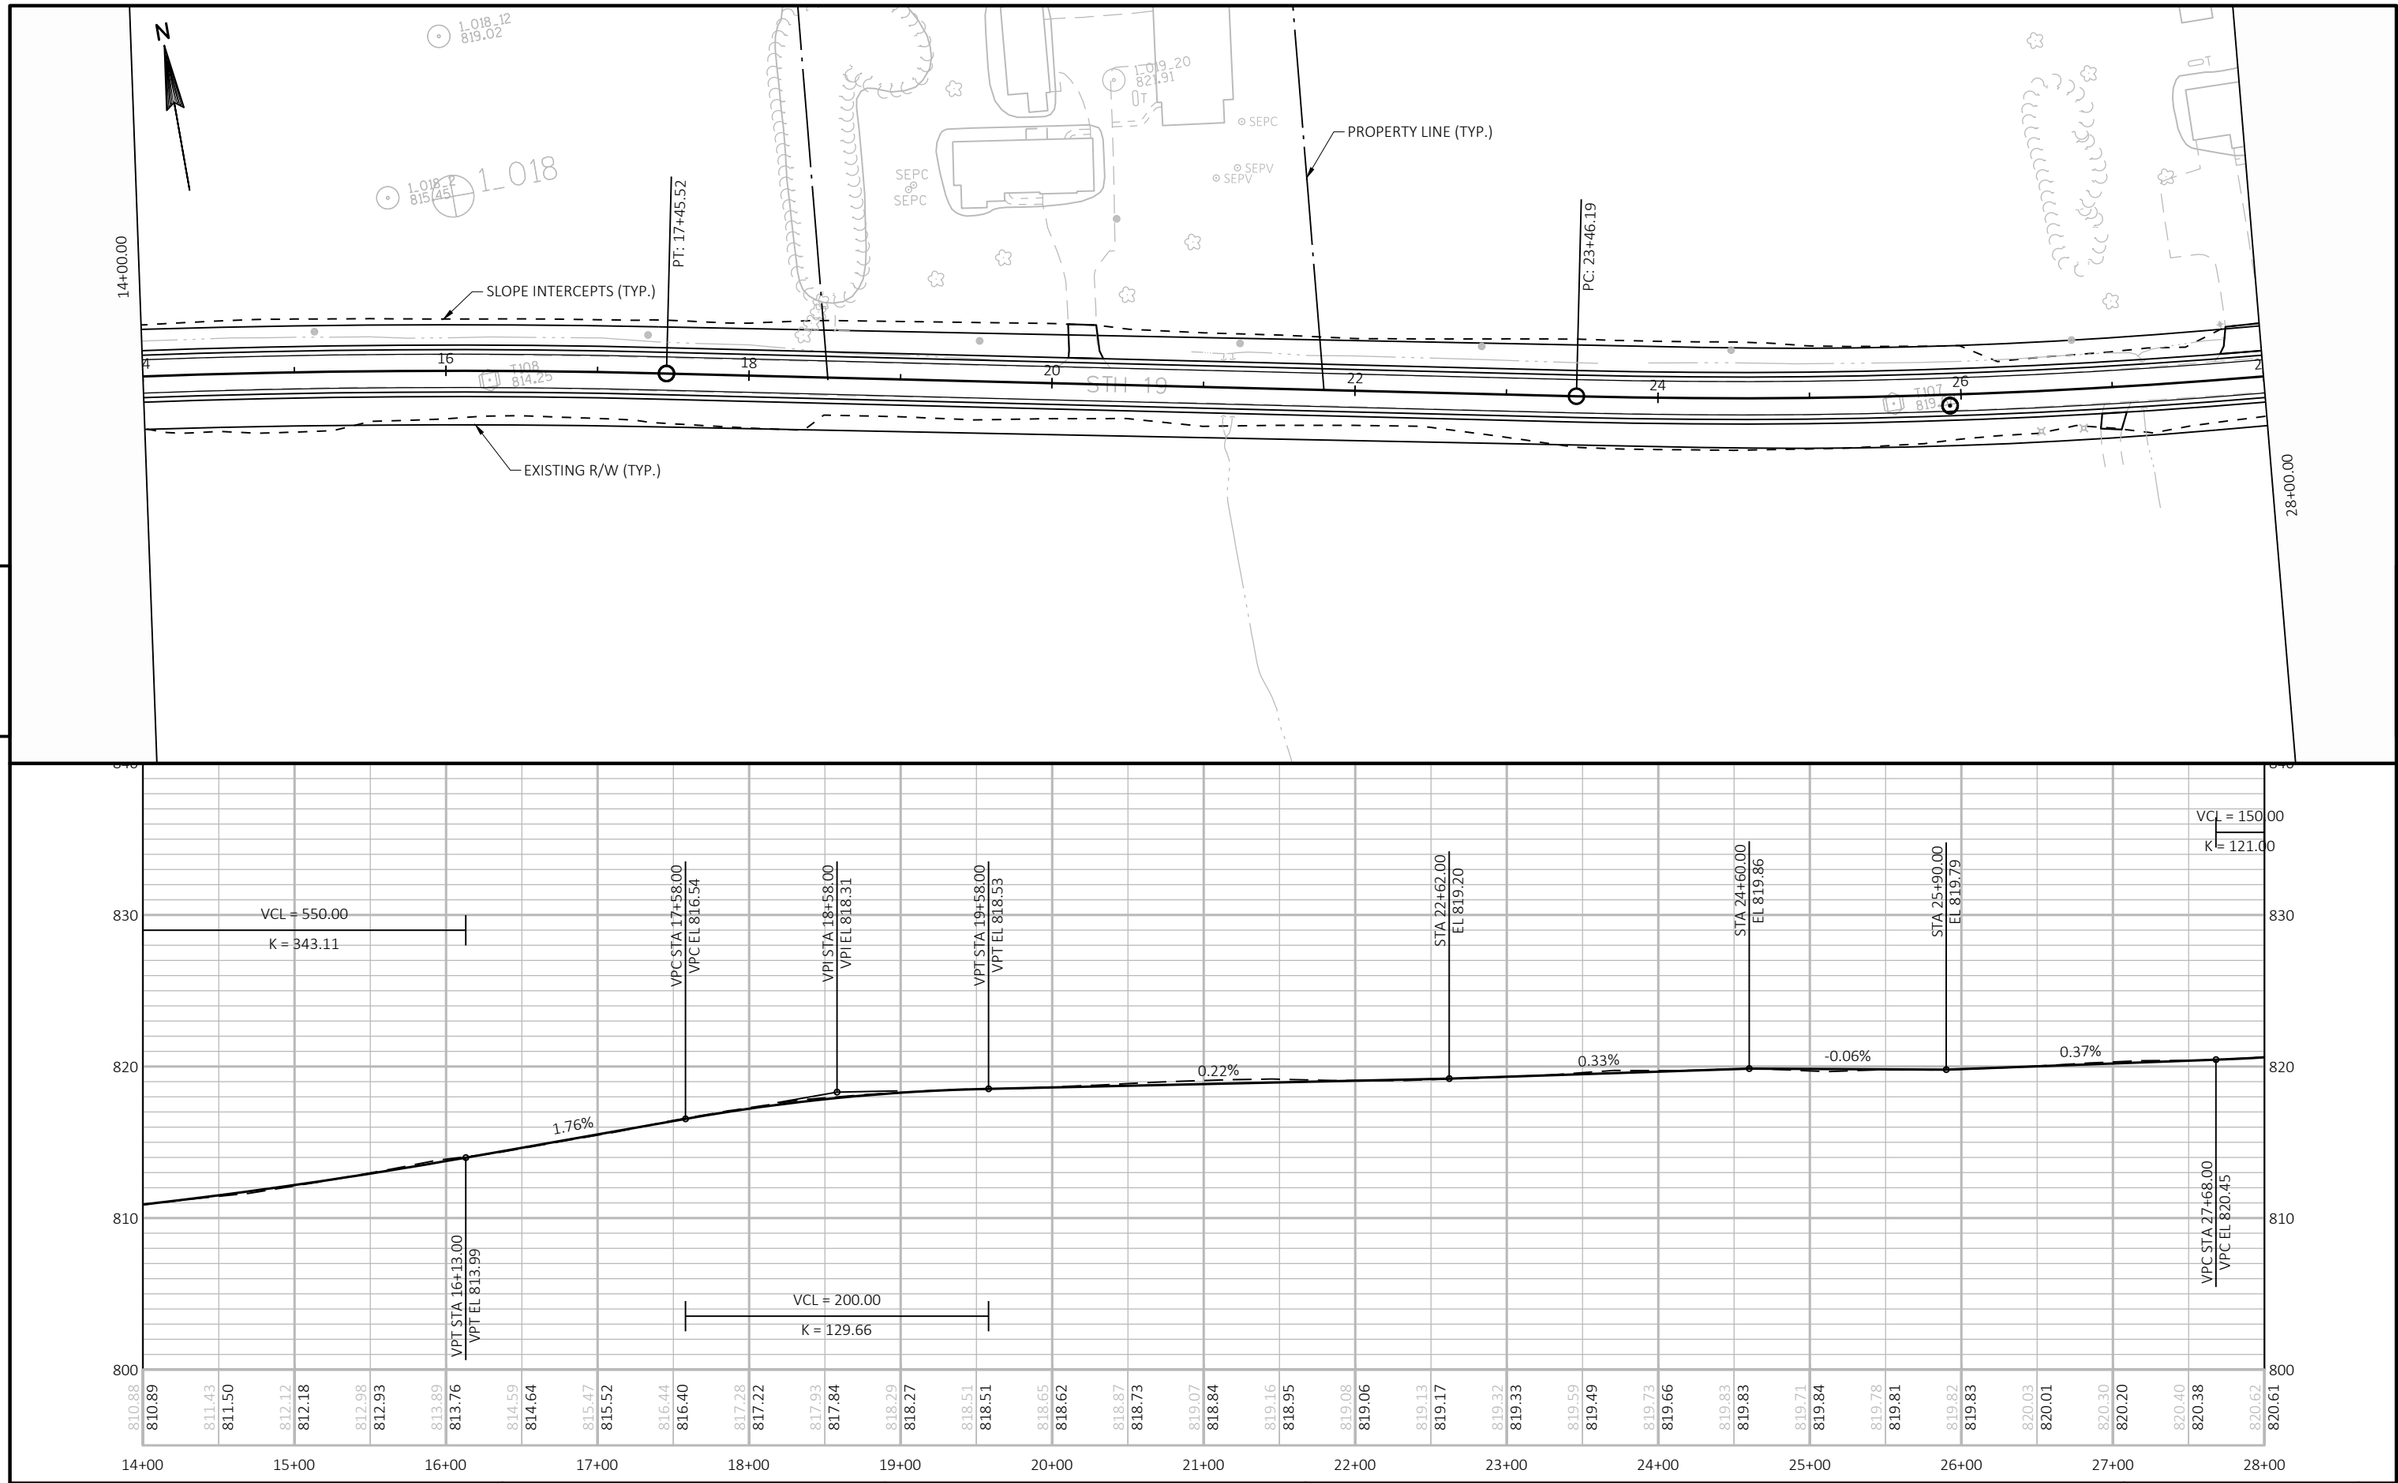

PROJECT NO: 5145-00-71	HWY: STH 19	COUNTY: DANE	PLAN AND PROFILE:	SHEET 12	E

FILE NAME : N:\PDS\C3D\51450001\SHEETSPLAN\050101_PP.DWG
LAYOUT NAME - 050102-pp

PLOT DATE : 6/7/2018 7:30 AM PLOT BY : RACH, JEREMY PAUL PLOT NAME : PLOT SCALE : 1 IN:100 FT

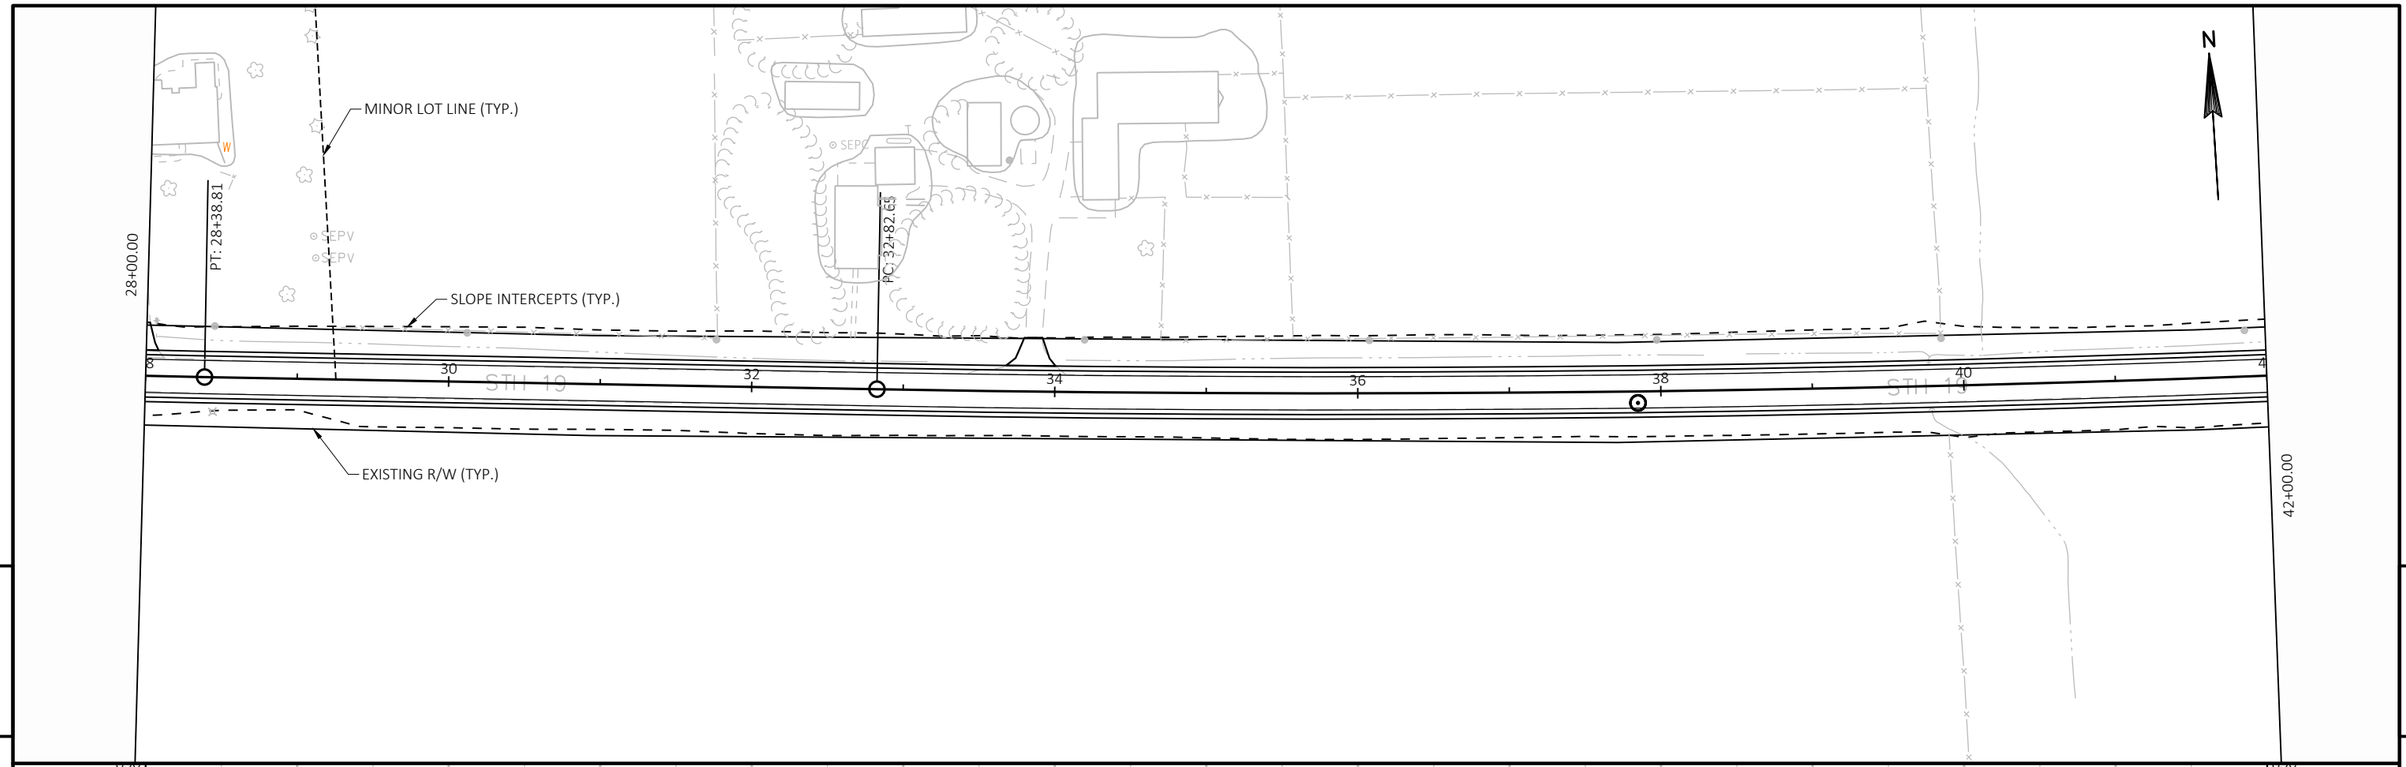

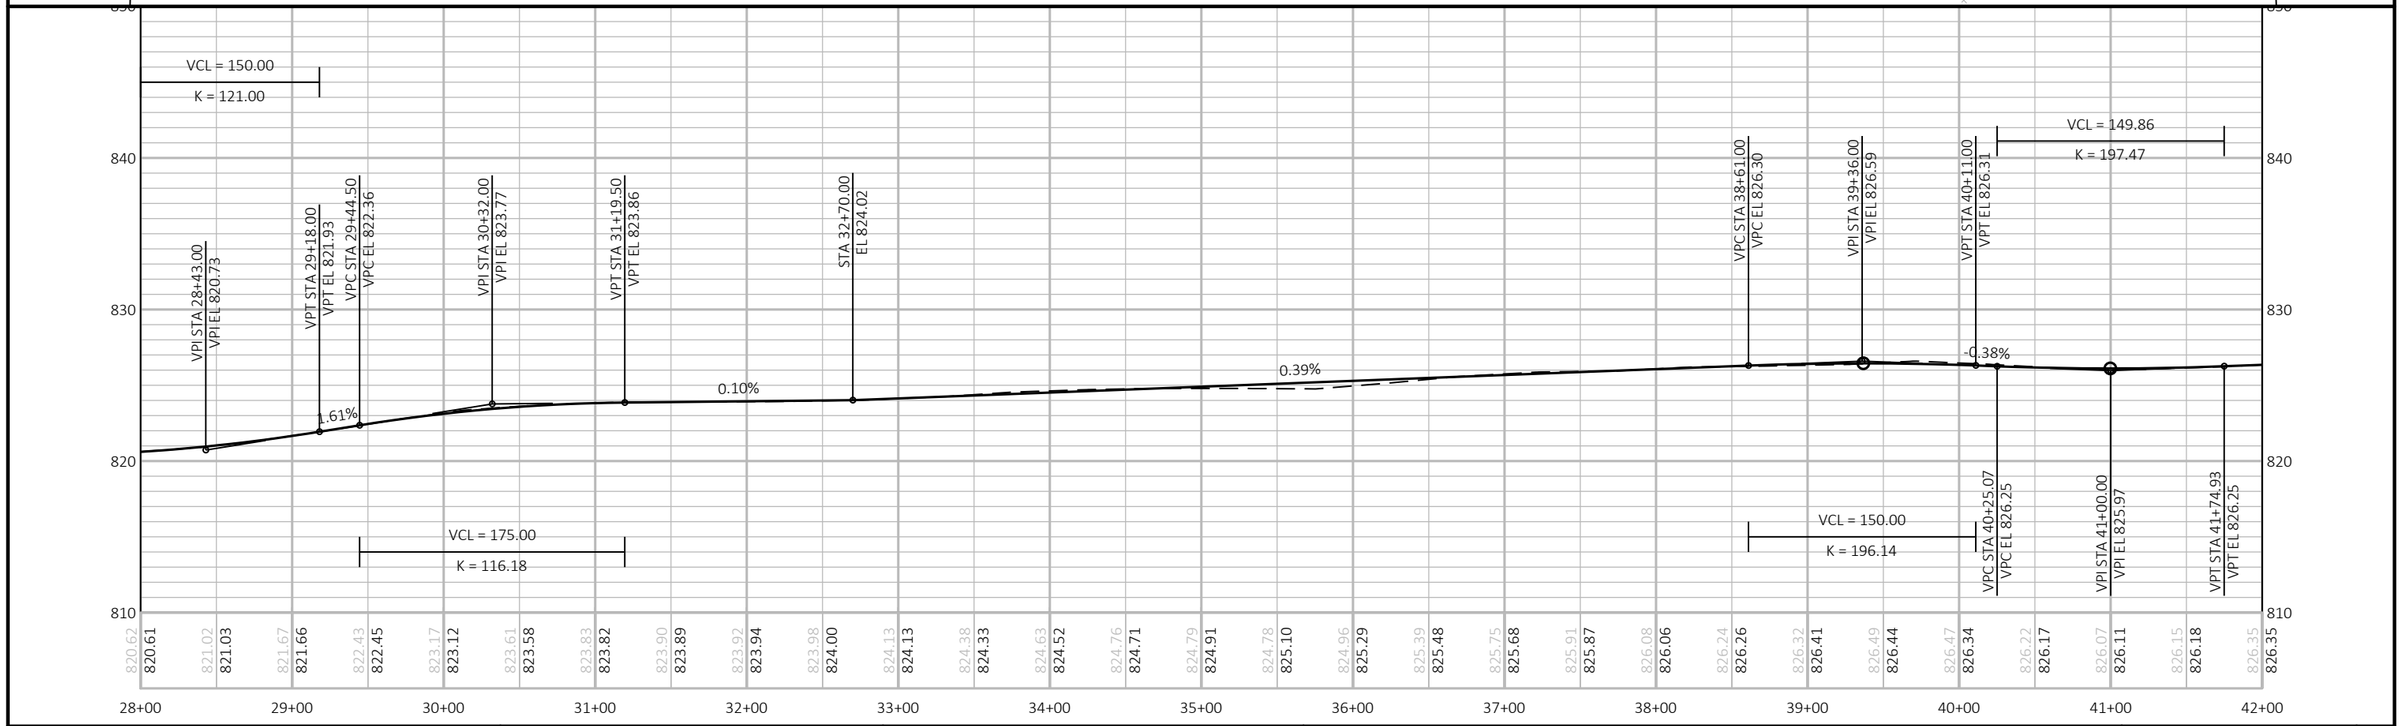

PROJECT NO: 5145-00-71	HWY: STH 19	COUNTY: DANE	PLAN AND PROFILE:	SHEET 13	E

FILE NAME : N:\PDS\C3D\51450001\SHEETSPLAN\050101_PP.DWG
LAYOUT NAME - 050103-pp

PLOT DATE : 6/7/2018 7:30 AM PLOT BY : RACH, JEREMY PAUL PLOT NAME : PLOT SCALE : 1 IN:100 FT

WISDOT/CADDS SHEET 44

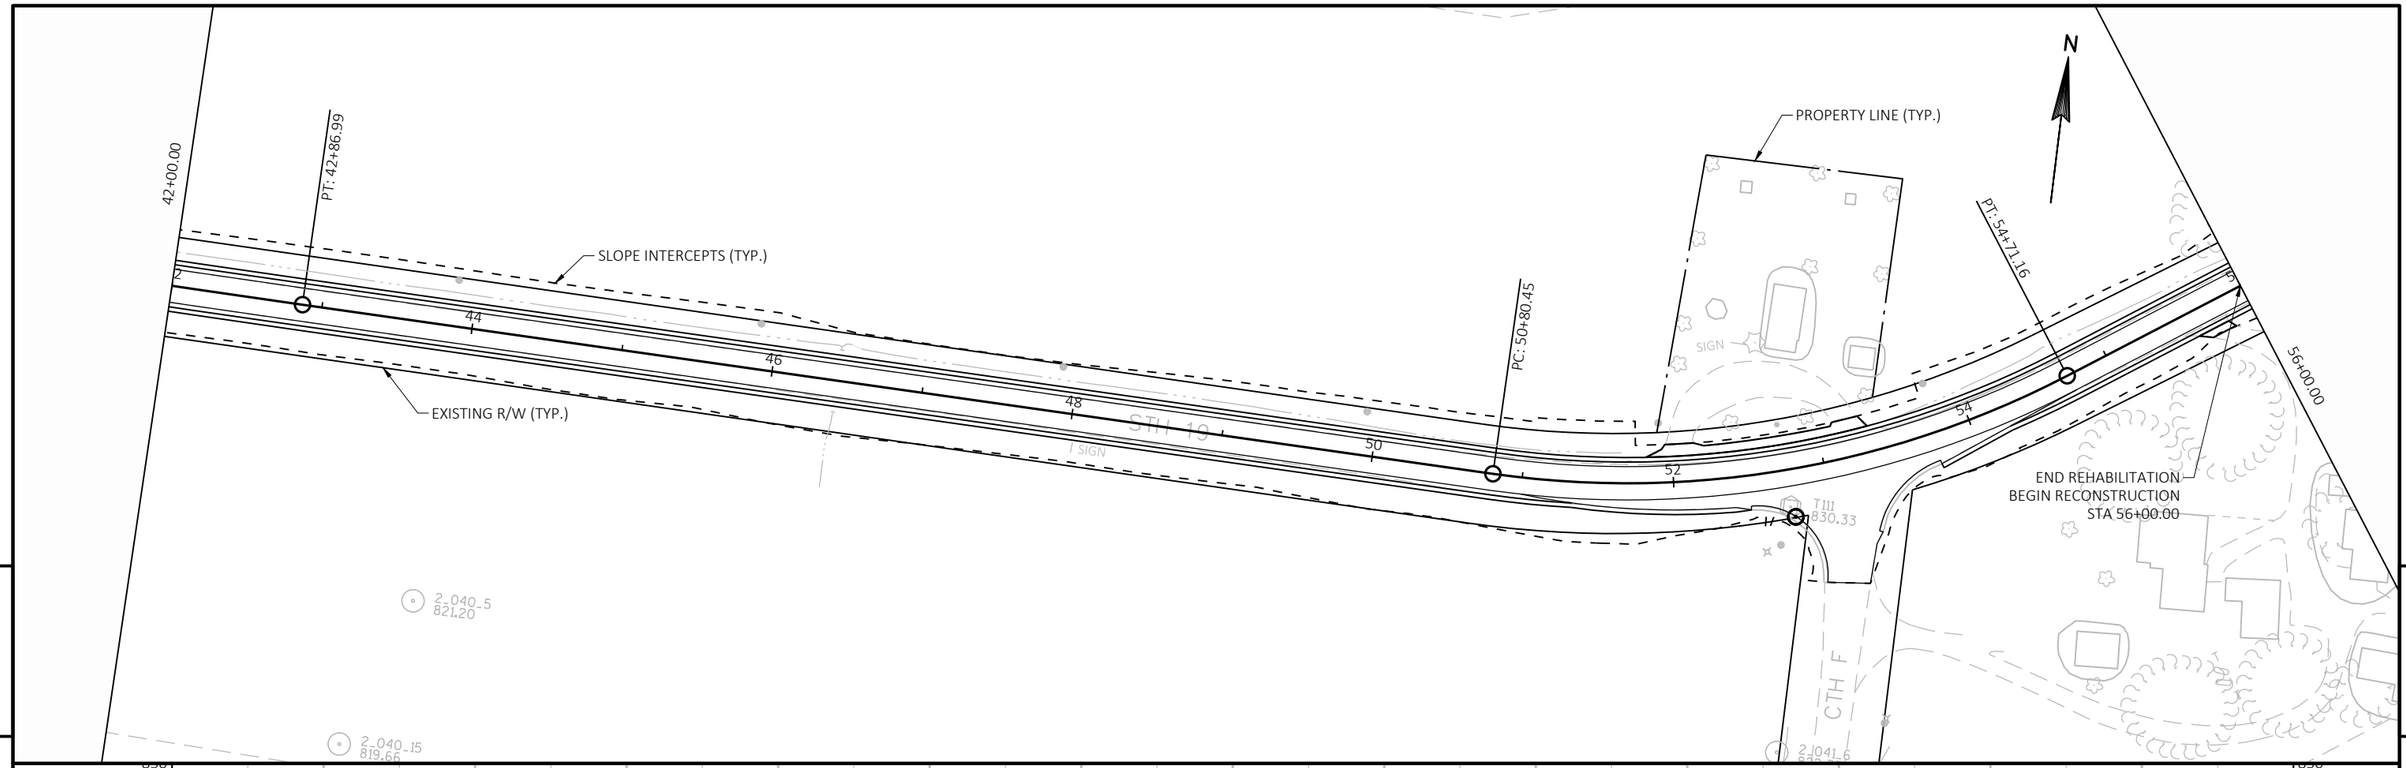

PROJECT NO: 5145-00-71	HWY: STH 19	COUNTY: DANE	PLAN AND PROFILE:	SHEET 14	E

FILE NAME : N:\PDS\C3D\51450001\SHEETSPLAN\050101_PP.DWG
LAYOUT NAME - 050104-pp

PLOT DATE : 6/7/2018 7:30 AM PLOT BY : RACH, JEREMY PAUL PLOT NAME : PLOT SCALE : 1 IN:100 FT

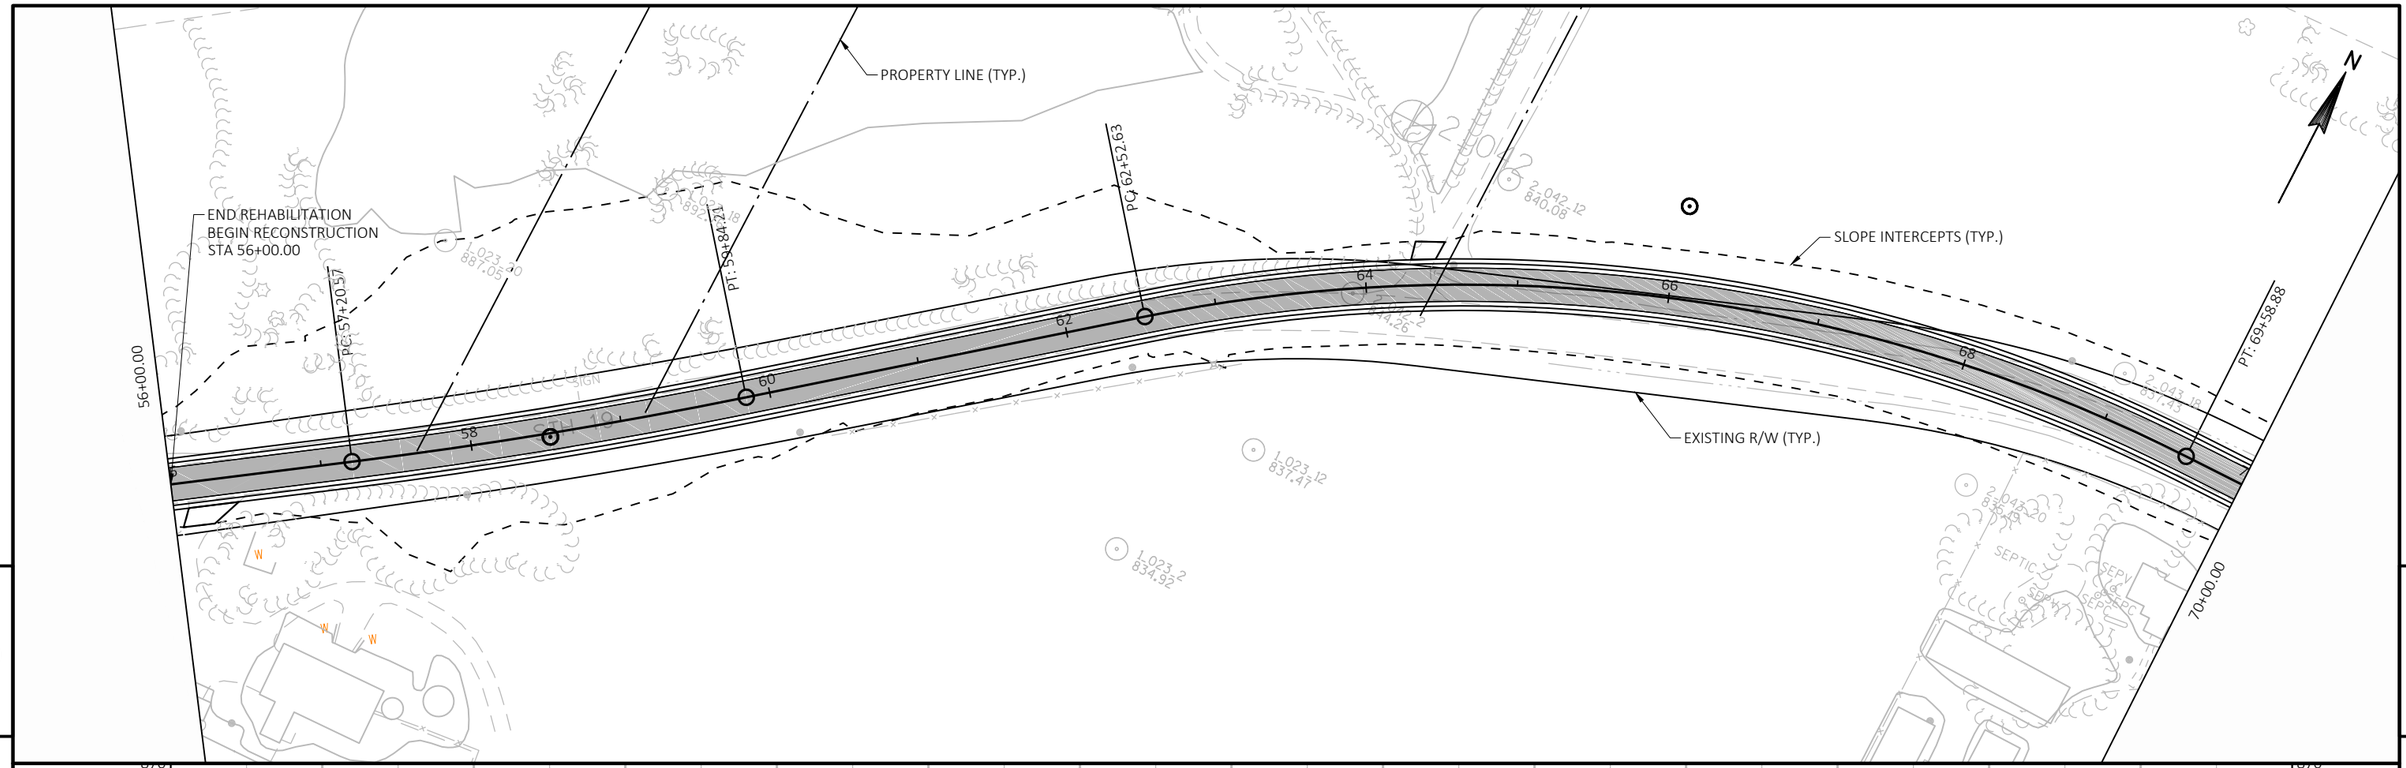

5 5

PROJECT NO: 5145-00-71	HWY: STH 19	COUNTY: DANE	PLAN AND PROFILE:	SHEET 15	E

FILE NAME : N:\PDS\C3D\51450001\SHEETSPLAN\050101_PP.DWG
LAYOUT NAME - 050105-pp
PLOT DATE : 6/7/2018 7:30 AM
PLOT BY : RACH, JEREMY PAUL
PLOT NAME :
PLOT SCALE : 1 IN:100 FT
WISDOT/CADDS SHEET 44

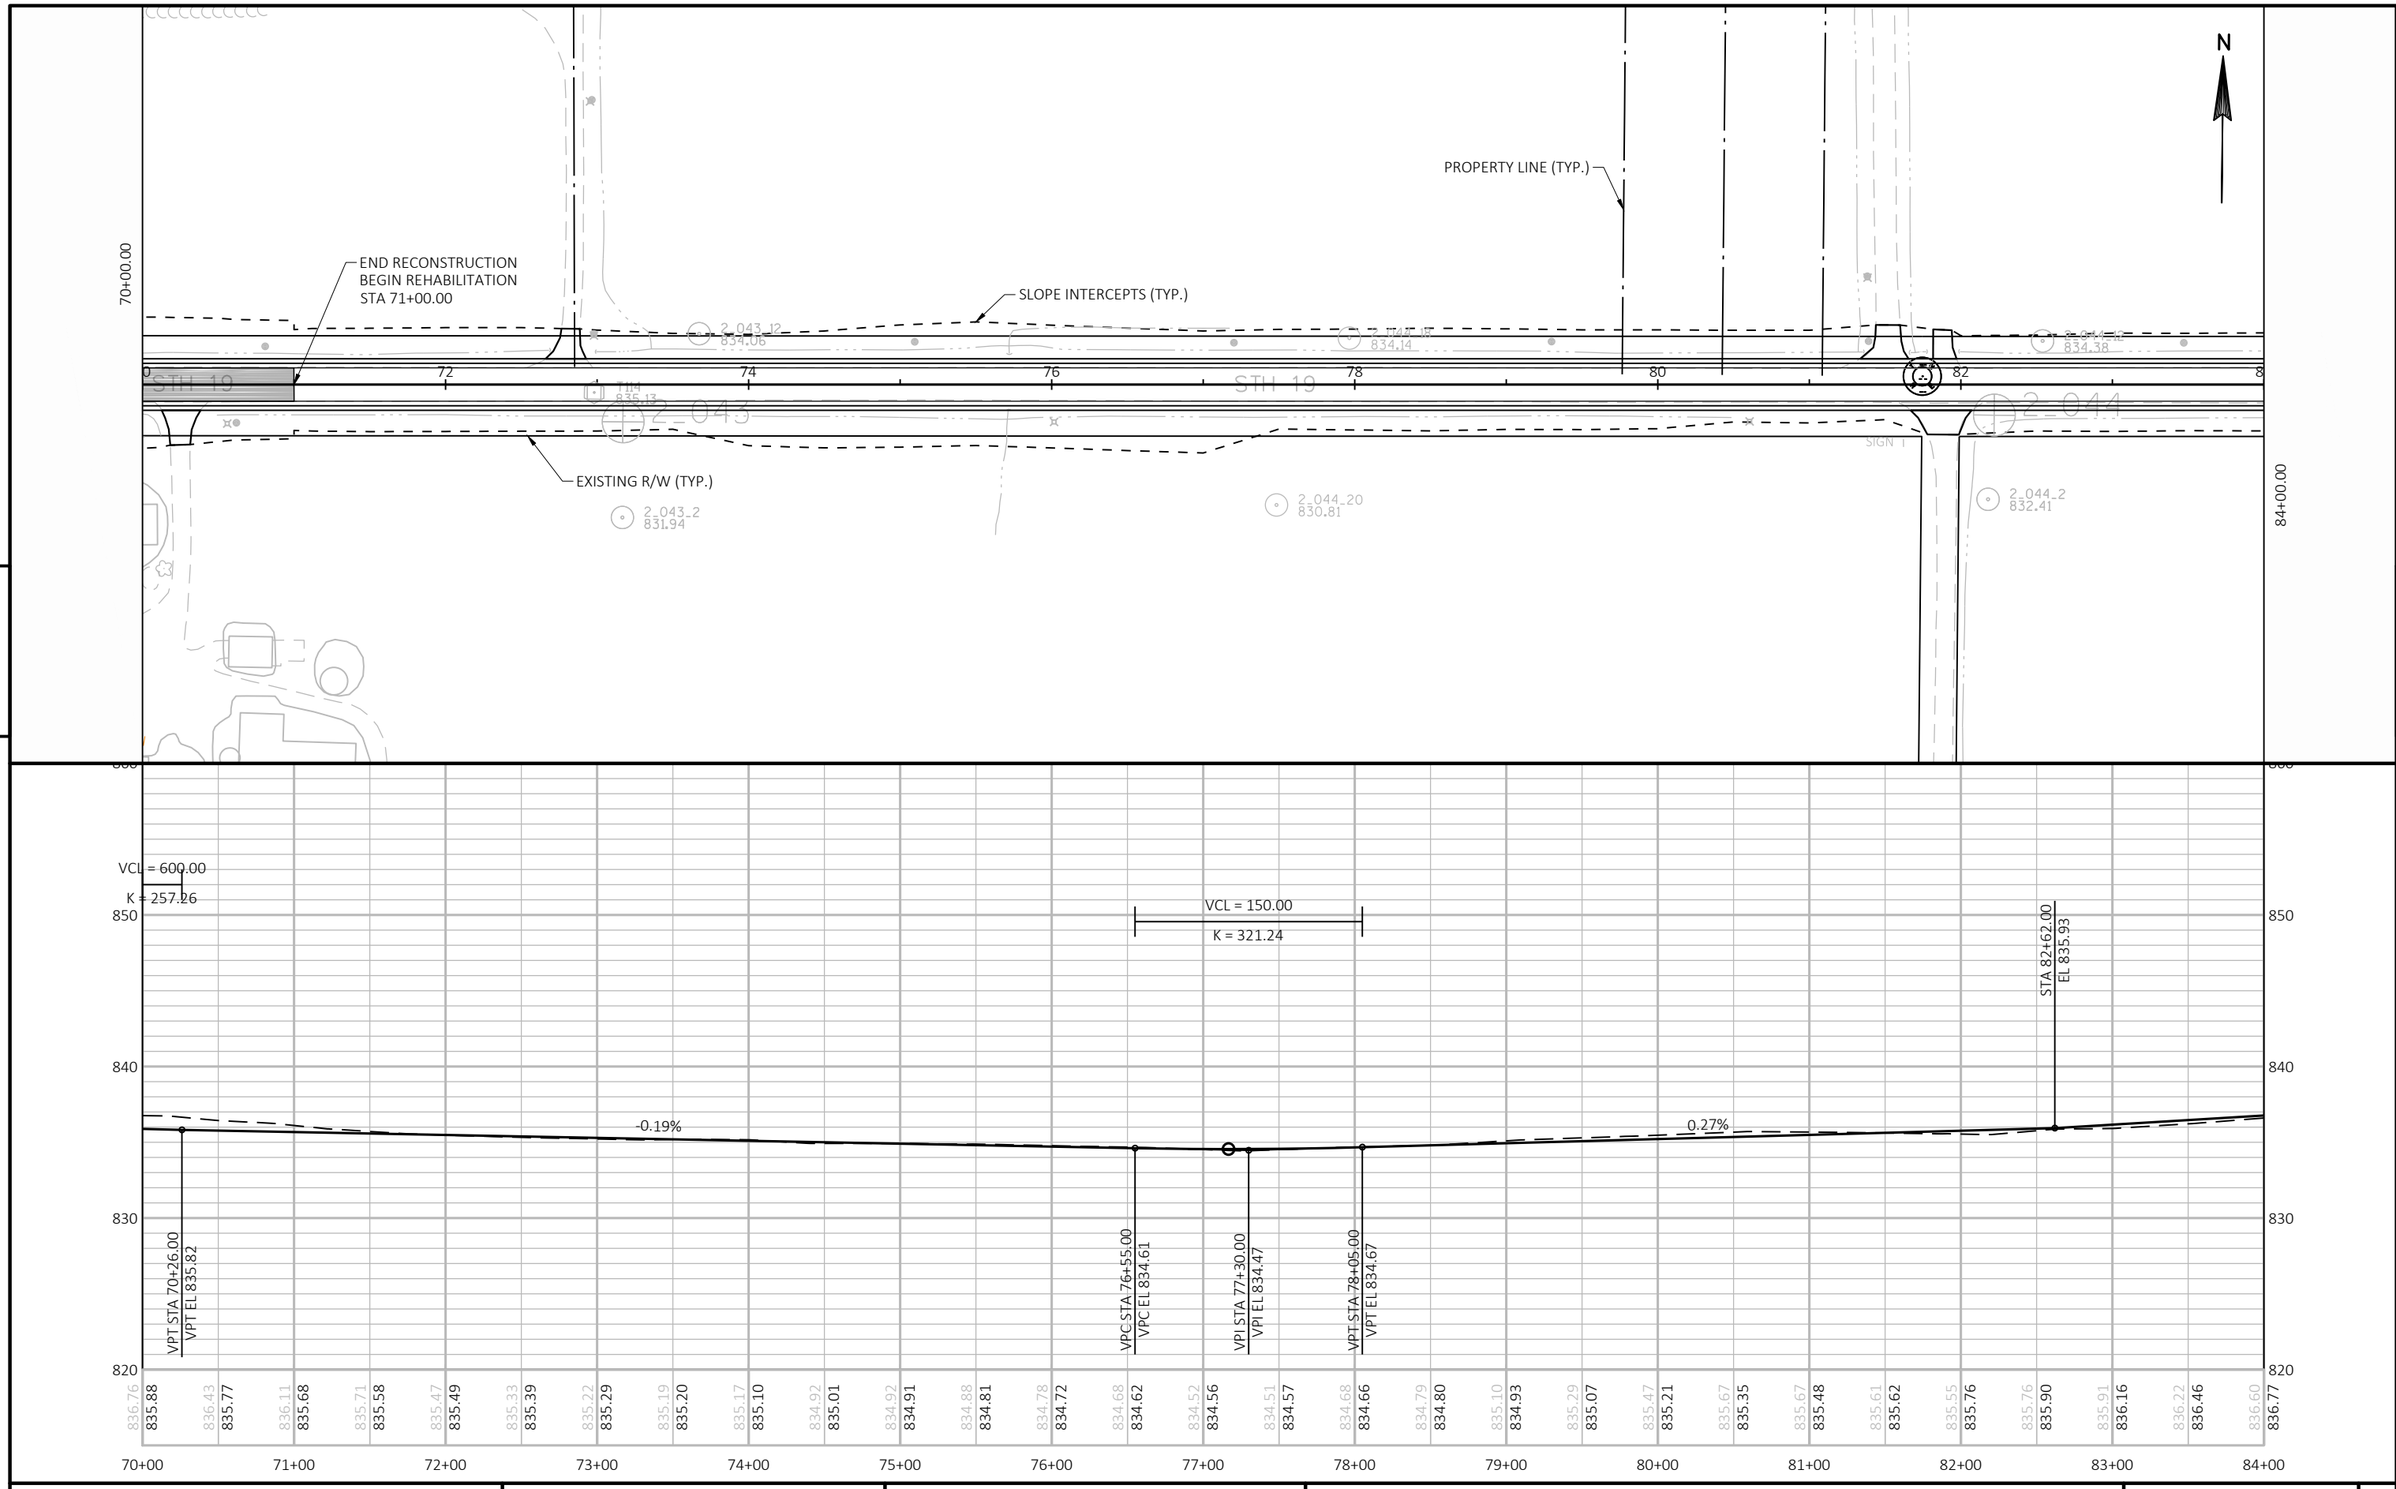

PROJECT NO: 5145-00-71	HWY: STH 19	COUNTY: DANE	PLAN AND PROFILE:	SHEET 16	E

FILE NAME : N:\PDS\C3D\51450001\SHEETSPLAN\050101_PP.DWG
LAYOUT NAME - 050106-pp

PLOT DATE : 6/7/2018 7:31 AM PLOT BY : RACH, JEREMY PAUL PLOT NAME : PLOT SCALE : 1 IN:100 FT

WISDOT/CADDS SHEET 44

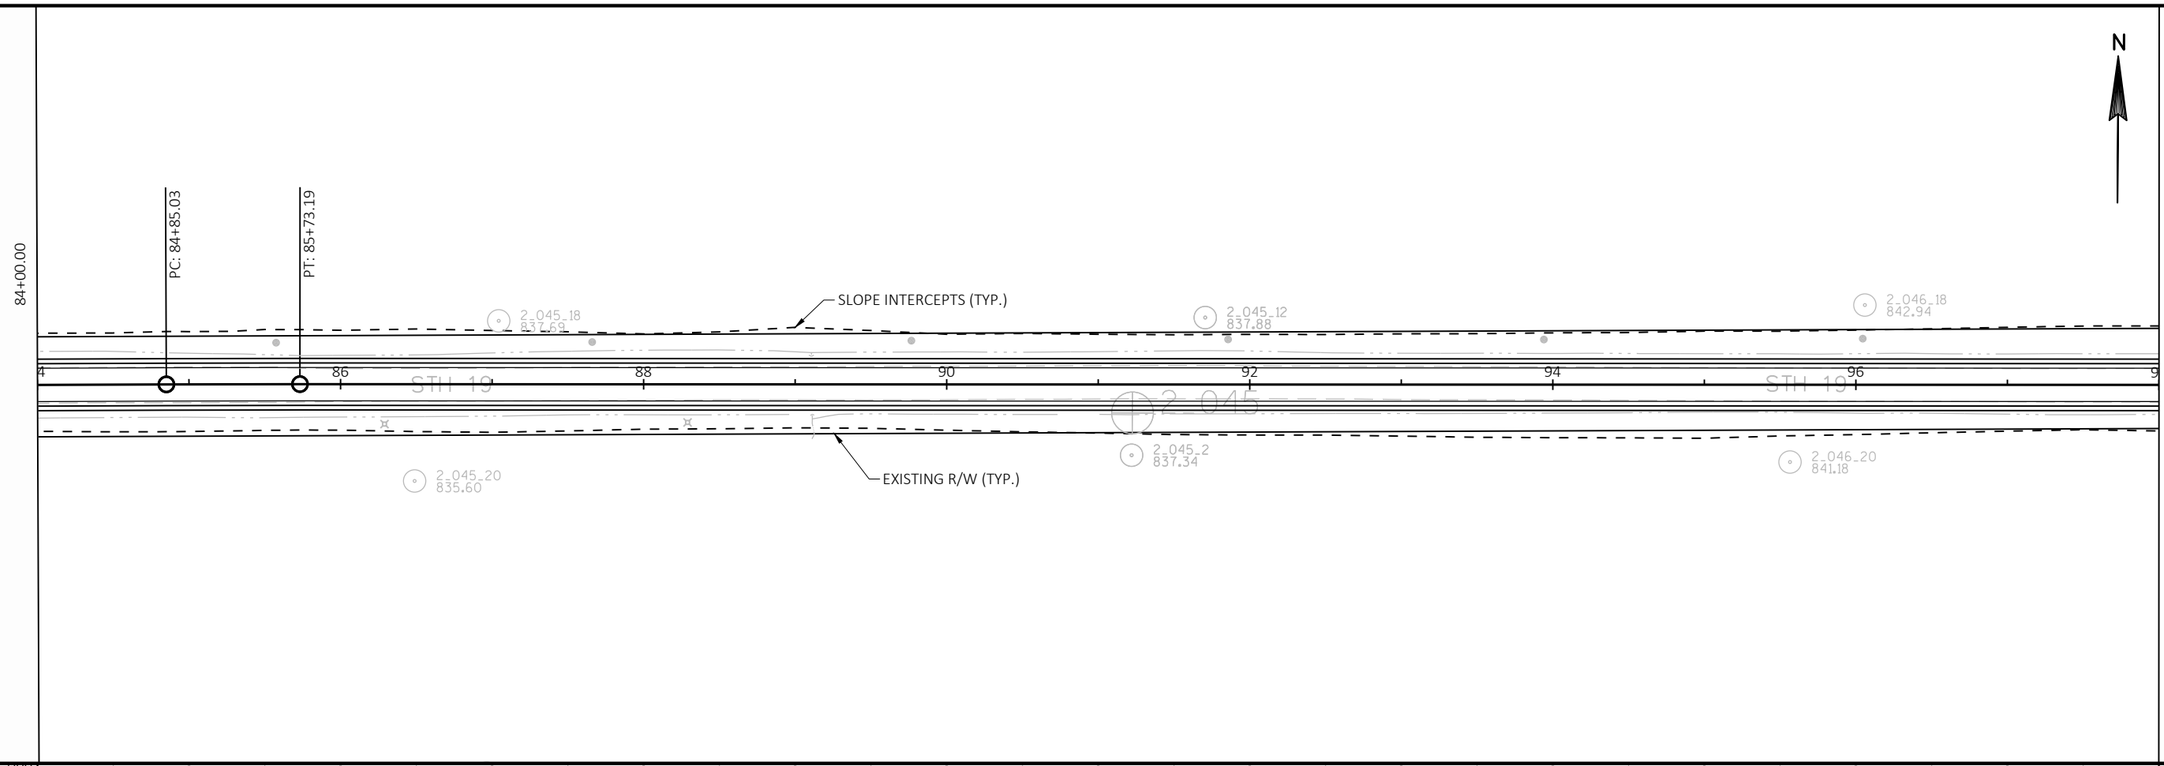

PROJECT NO: 5145-00-71	HWY: STH 19	COUNTY: DANE	PLAN AND PROFILE:	SHEET 17	E

FILE NAME : N:\PDS\C3D\51450001\SHEETSPLAN\050101_PP.DWG
LAYOUT NAME - 050107-pp

PLOT DATE : 6/7/2018 7:31 AM PLOT BY : RACH, JEREMY PAUL PLOT NAME : PLOT SCALE : 1 IN:100 FT

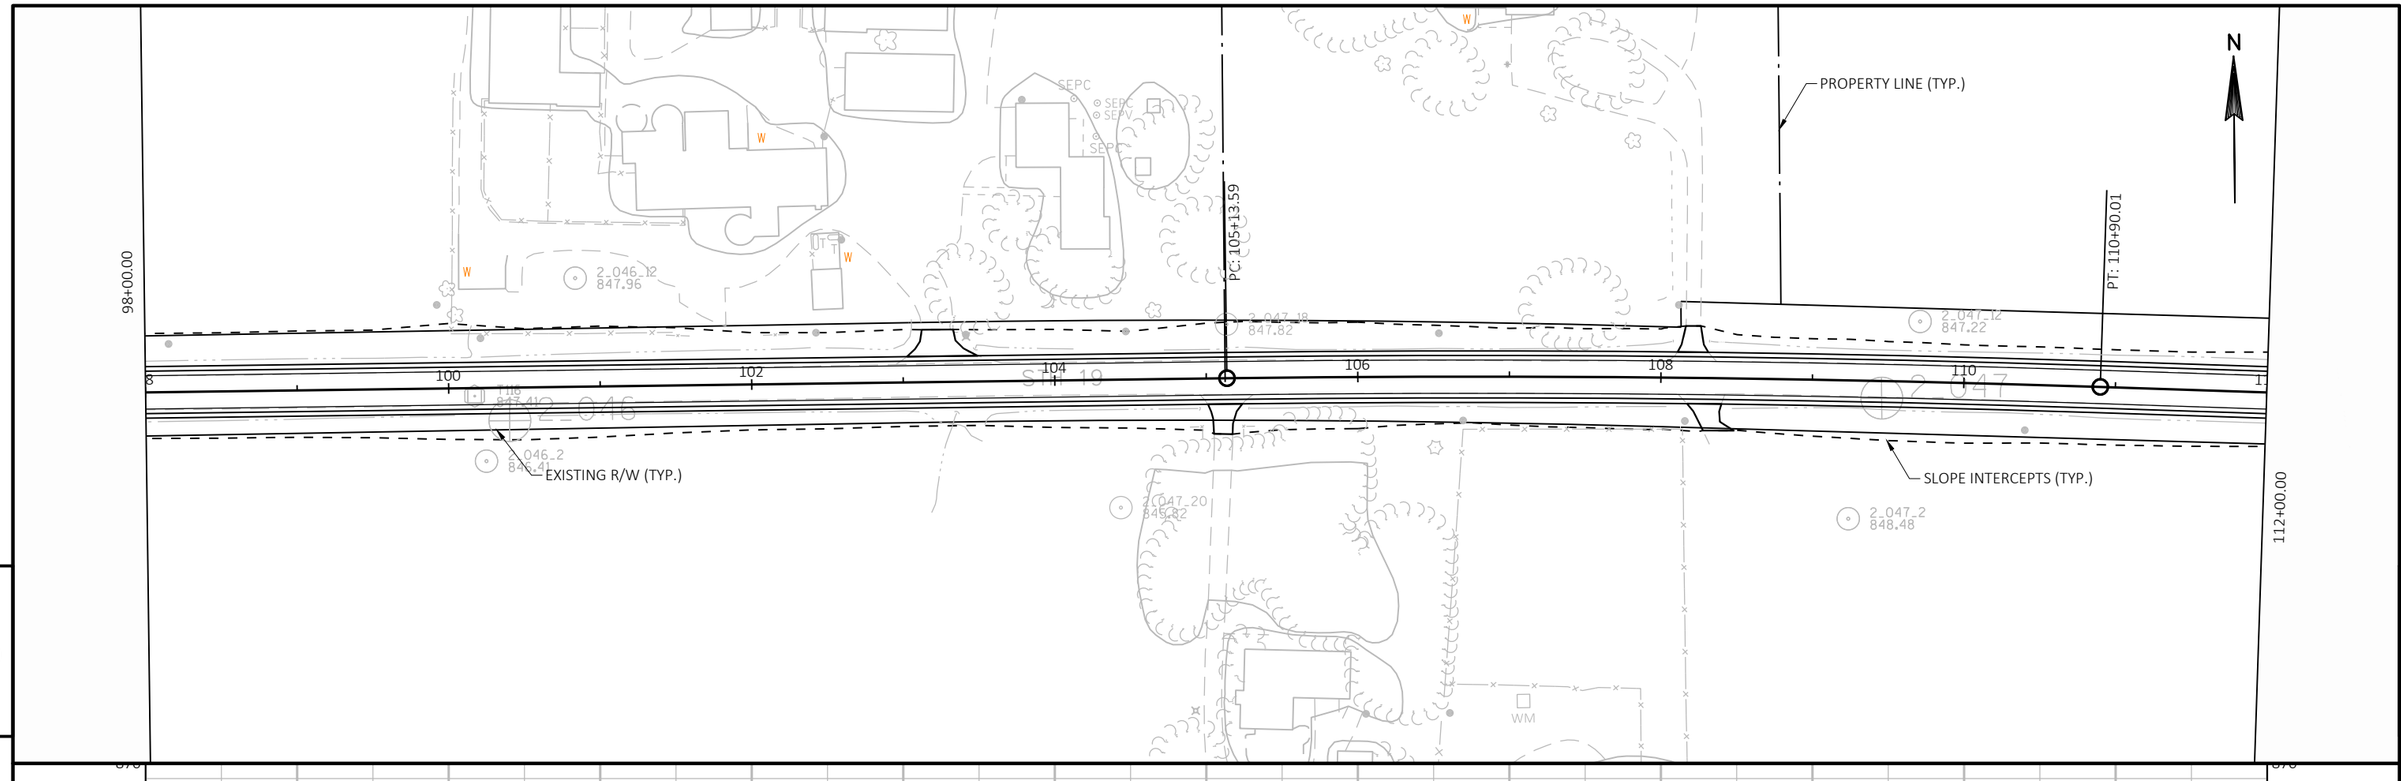

PROJECT NO: 5145-00-71	HWY: STH 19	COUNTY: DANE	PLAN AND PROFILE:	SHEET 18	E

FILE NAME : N:\PDS\C3D\51450001\SHEETSPLAN\050101_PP.DWG
LAYOUT NAME - 050108-pp
PLOT DATE : 6/7/2018 7:31 AM
PLOT BY : RACH, JEREMY PAUL
PLOT NAME :
PLOT SCALE : 1 IN:100 FT
WISDOT/CADDS SHEET 44

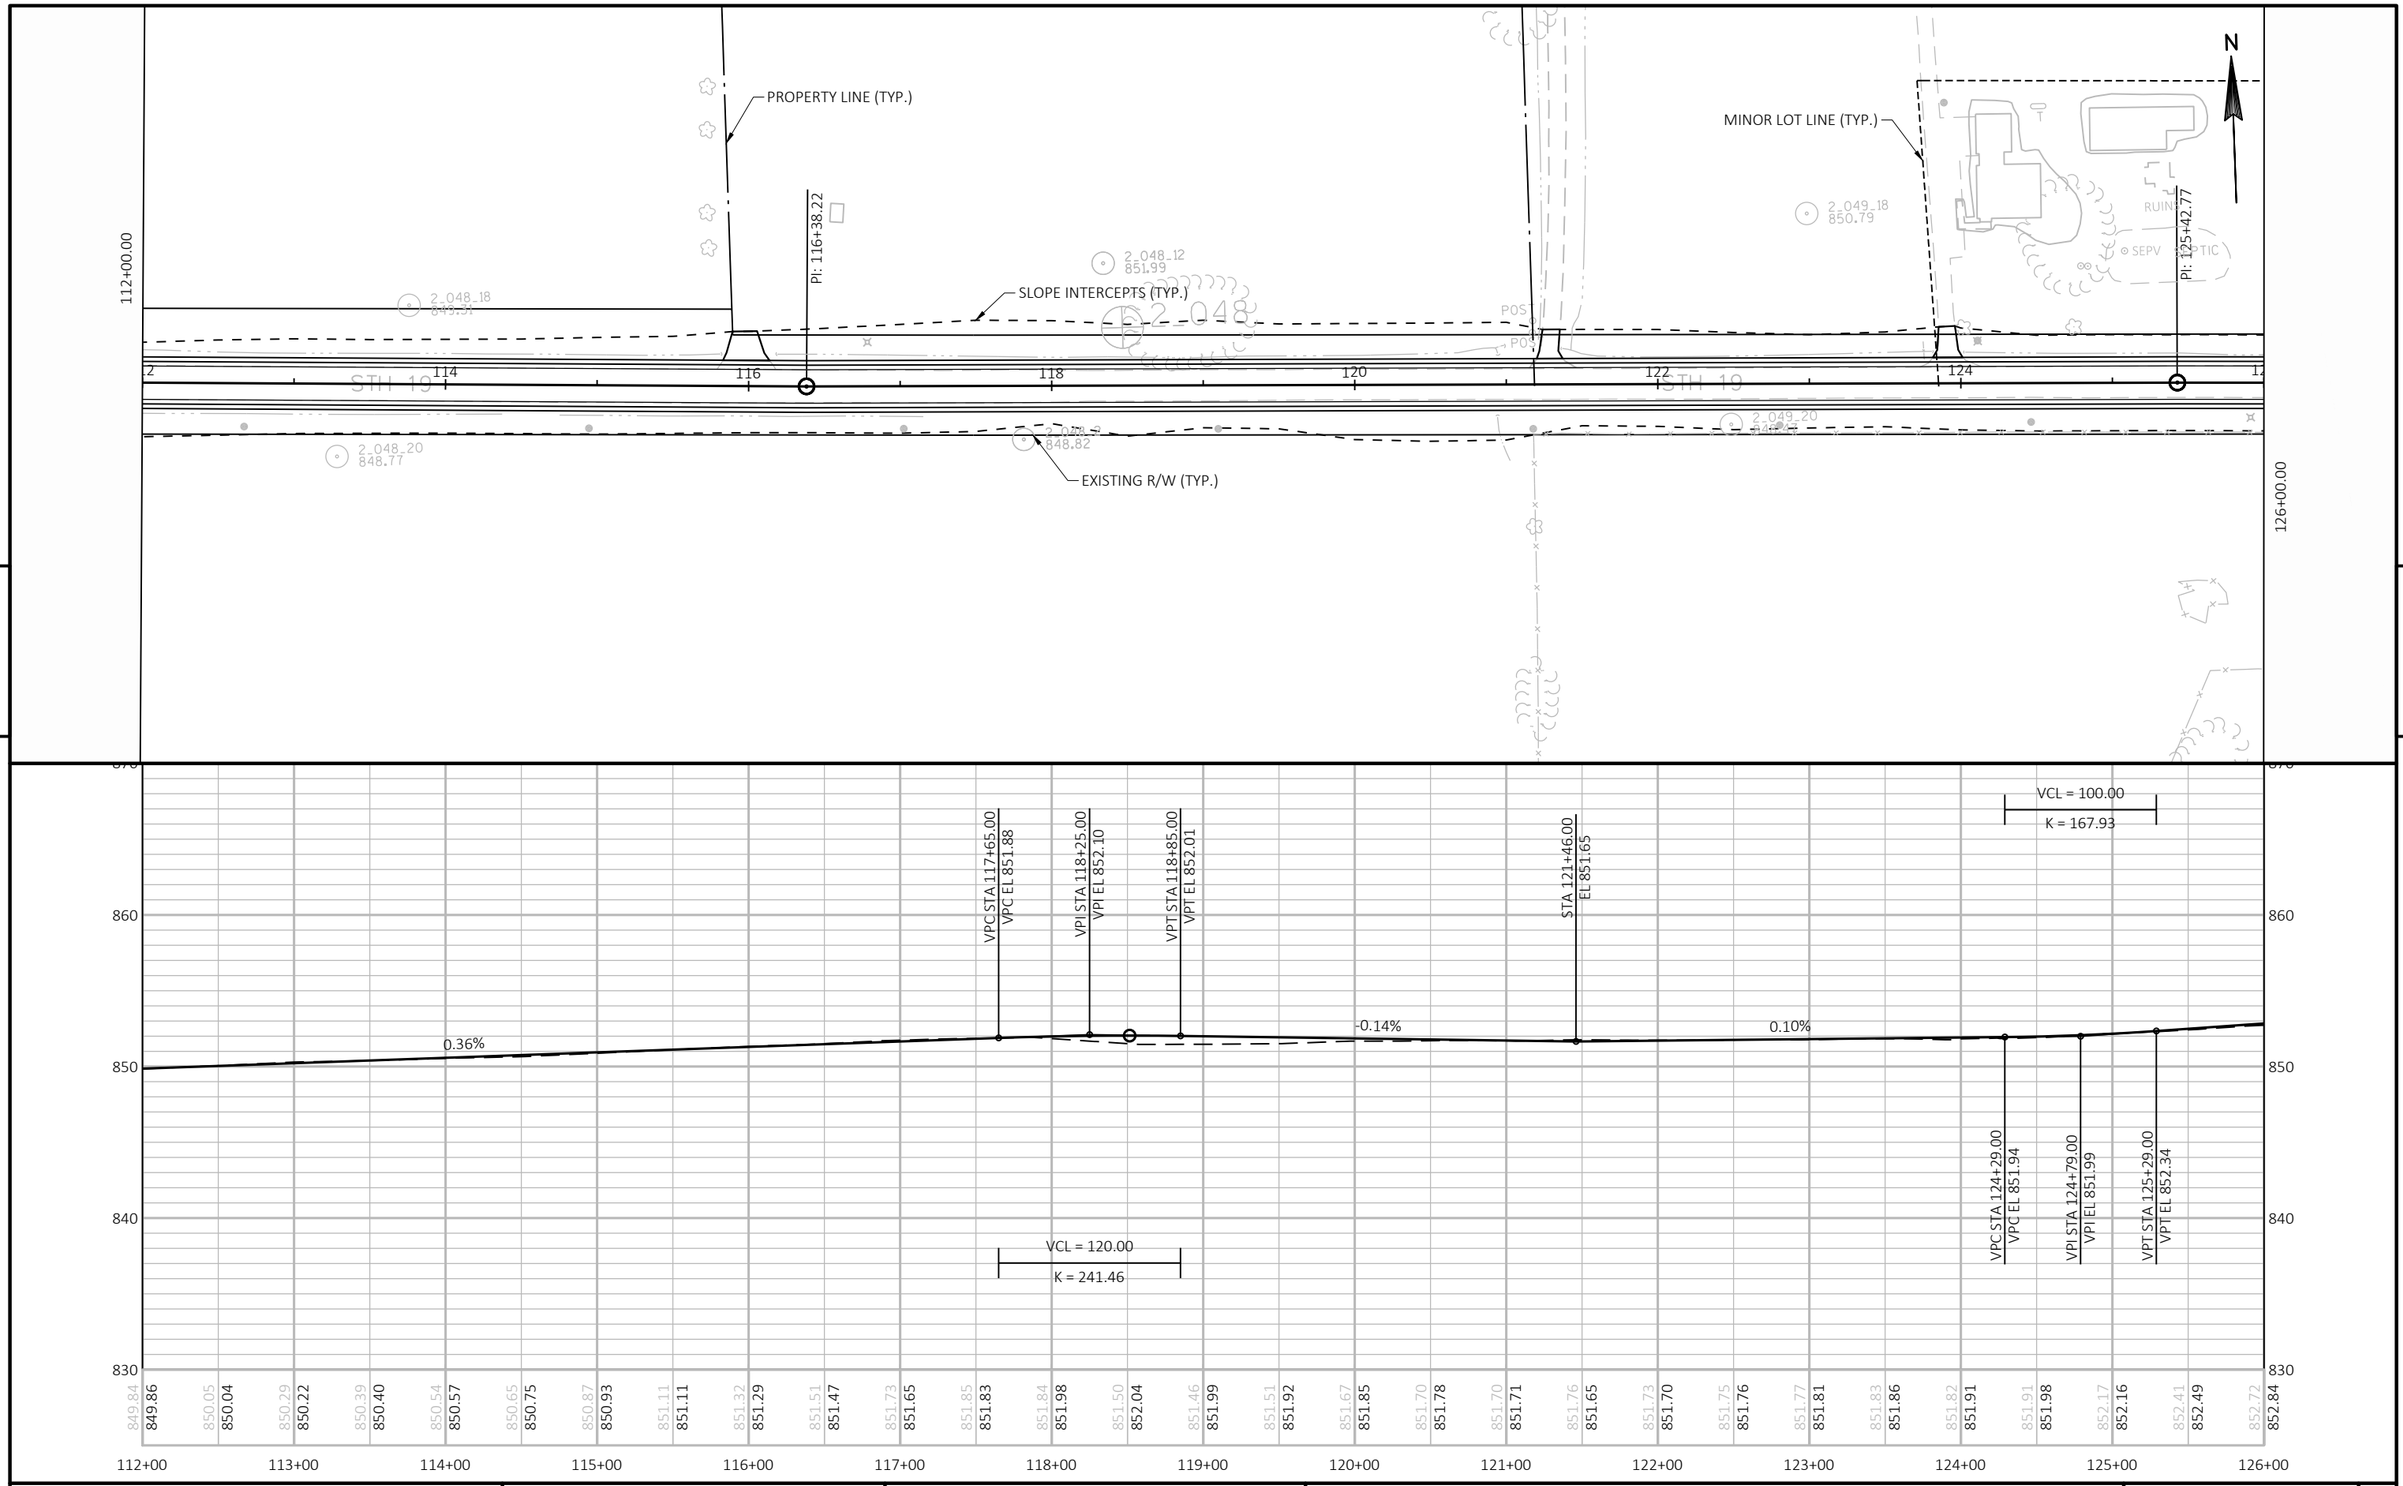

PROJECT NO: 5145-00-71	HWY: STH 19	COUNTY: DANE	PLAN AND PROFILE:	SHEET 19	E

FILE NAME : N:\PDS\C3D\51450001\SHEETSPLAN\050101_PP.DWG
LAYOUT NAME - 050109-pp

PLOT DATE : 6/7/2018 7:31 AM PLOT BY : RACH, JEREMY PAUL PLOT NAME : PLOT SCALE : 1 IN:100 FT

WISDOT/CADDS SHEET 44

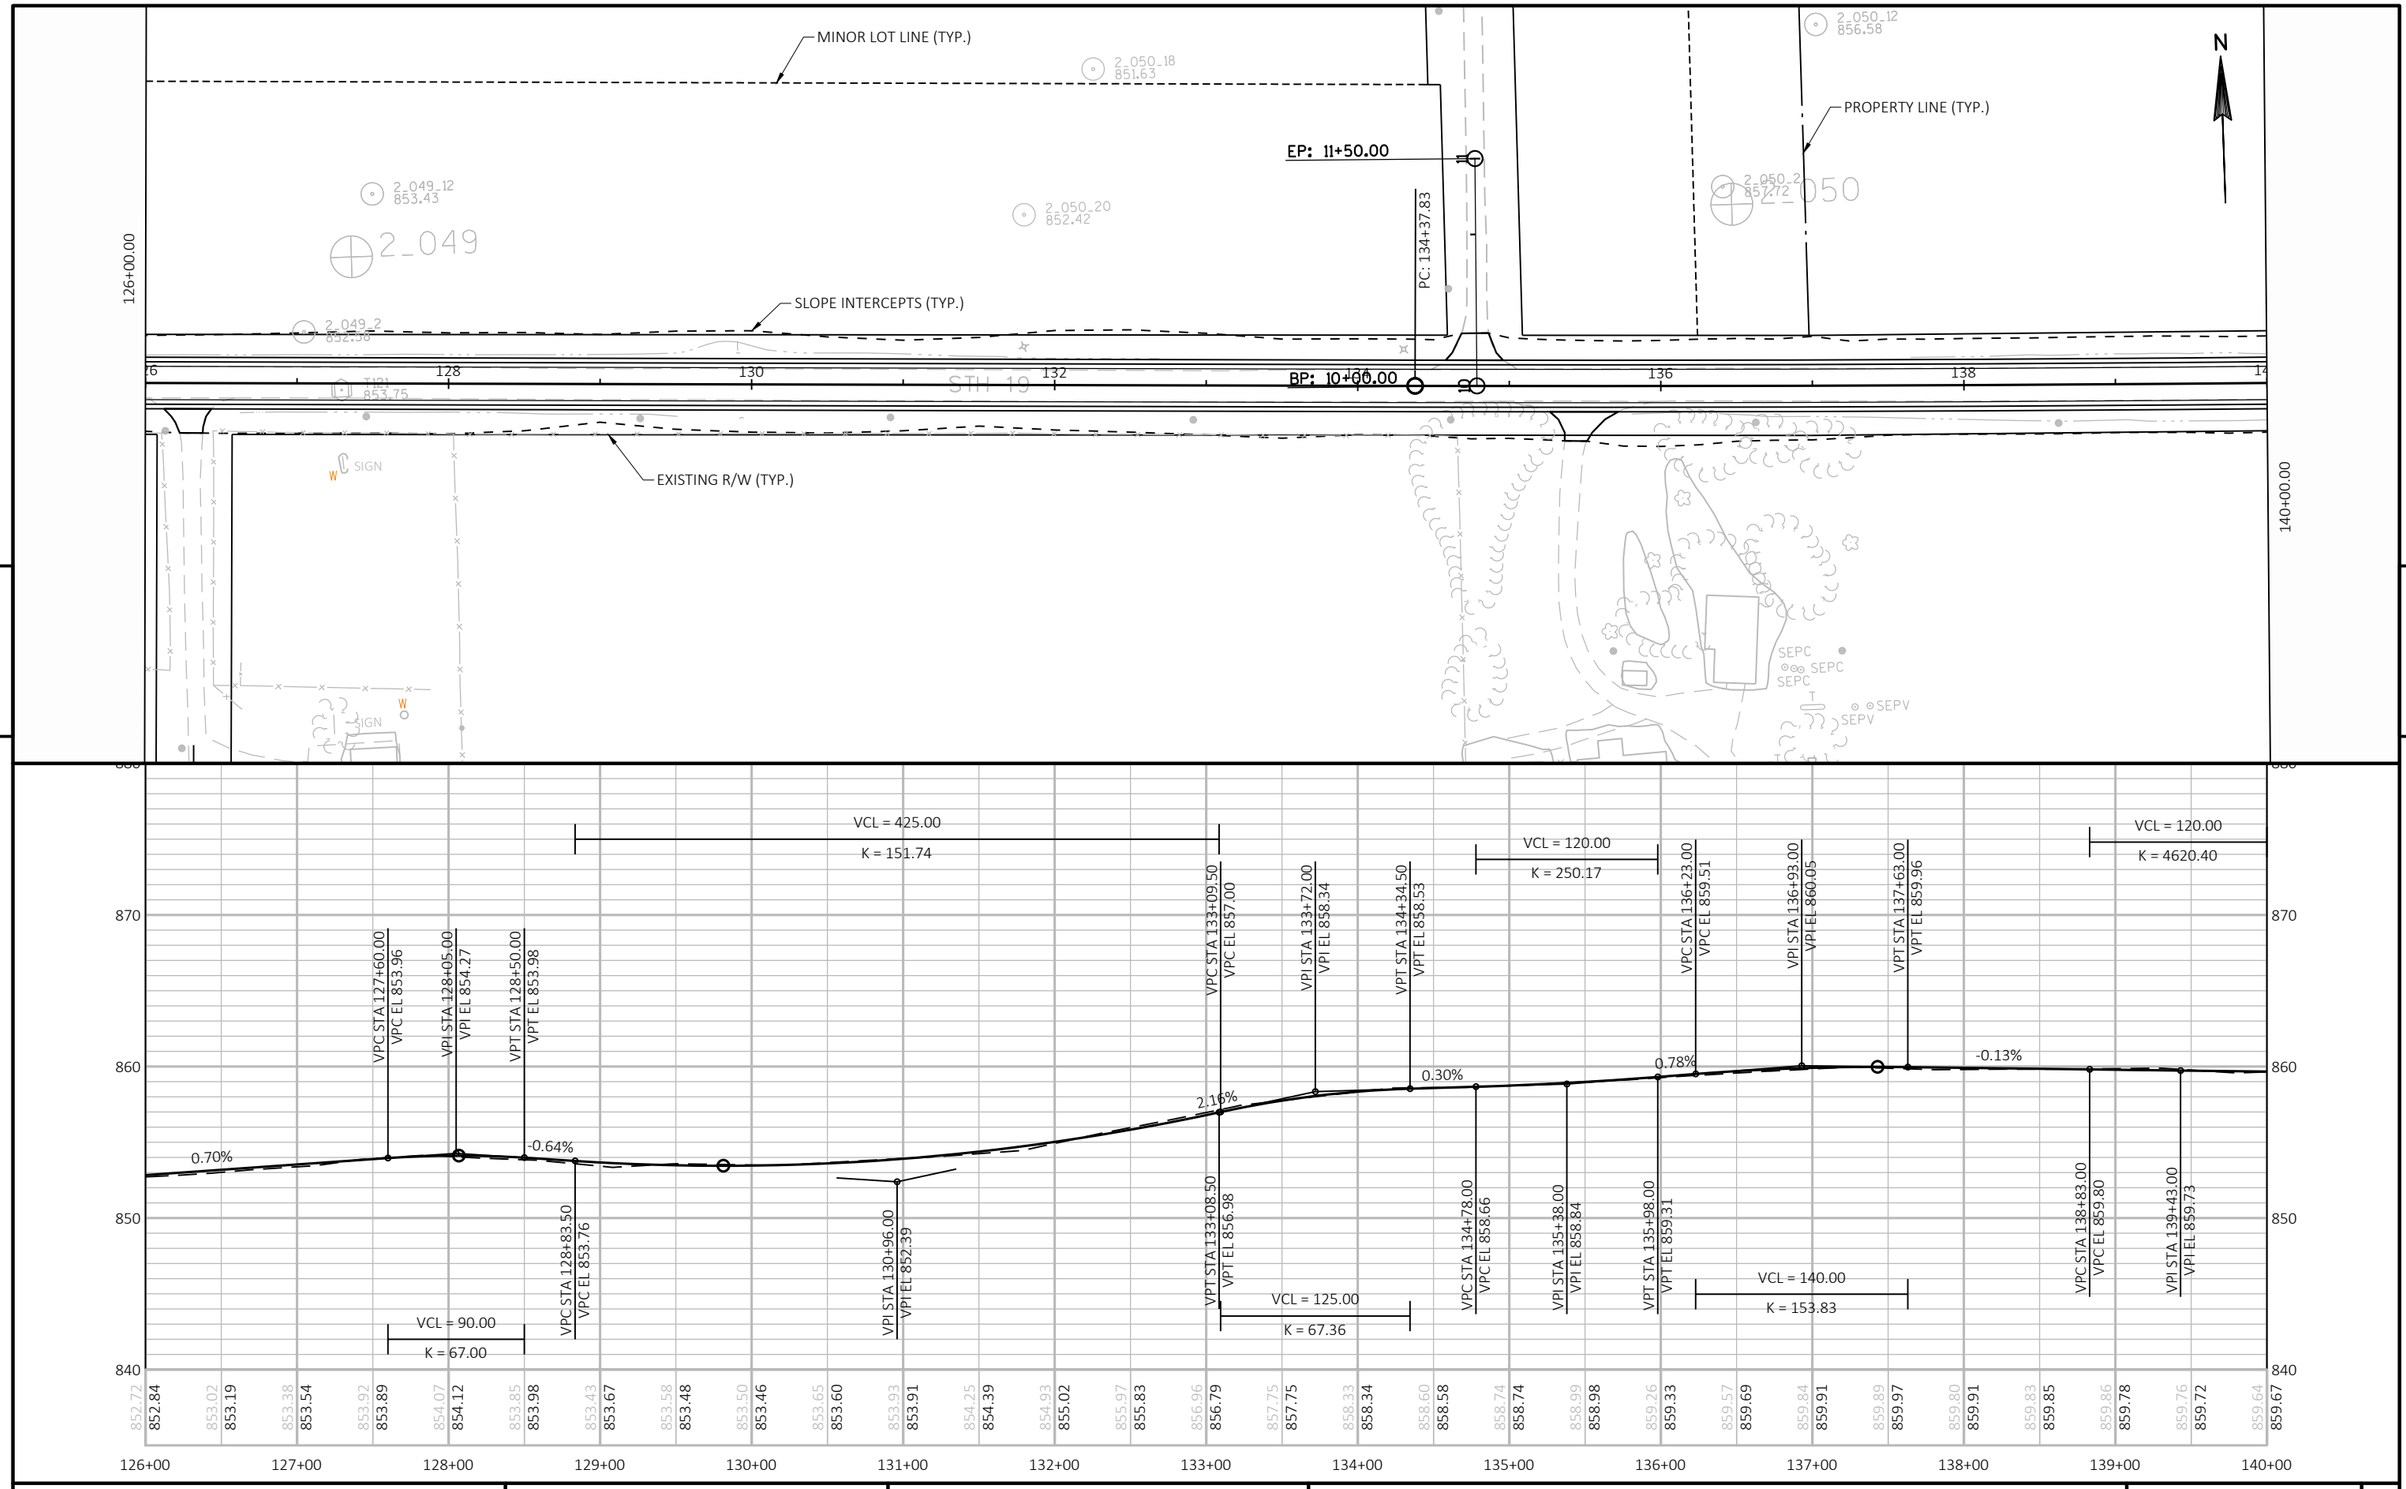

PROJECT NO: 5145-00-71	HWY: STH 19	COUNTY: DANE	PLAN AND PROFILE:	SHEET 20	E

FILE NAME : N:\PDS\C3D\51450001\SHEETSPLAN\050101_PP.DWG
LAYOUT NAME - 050110-pp

PLOT DATE : 6/7/2018 7:32 AM PLOT BY : RACH, JEREMY PAUL PLOT NAME : PLOT SCALE : 1 IN:100 FT

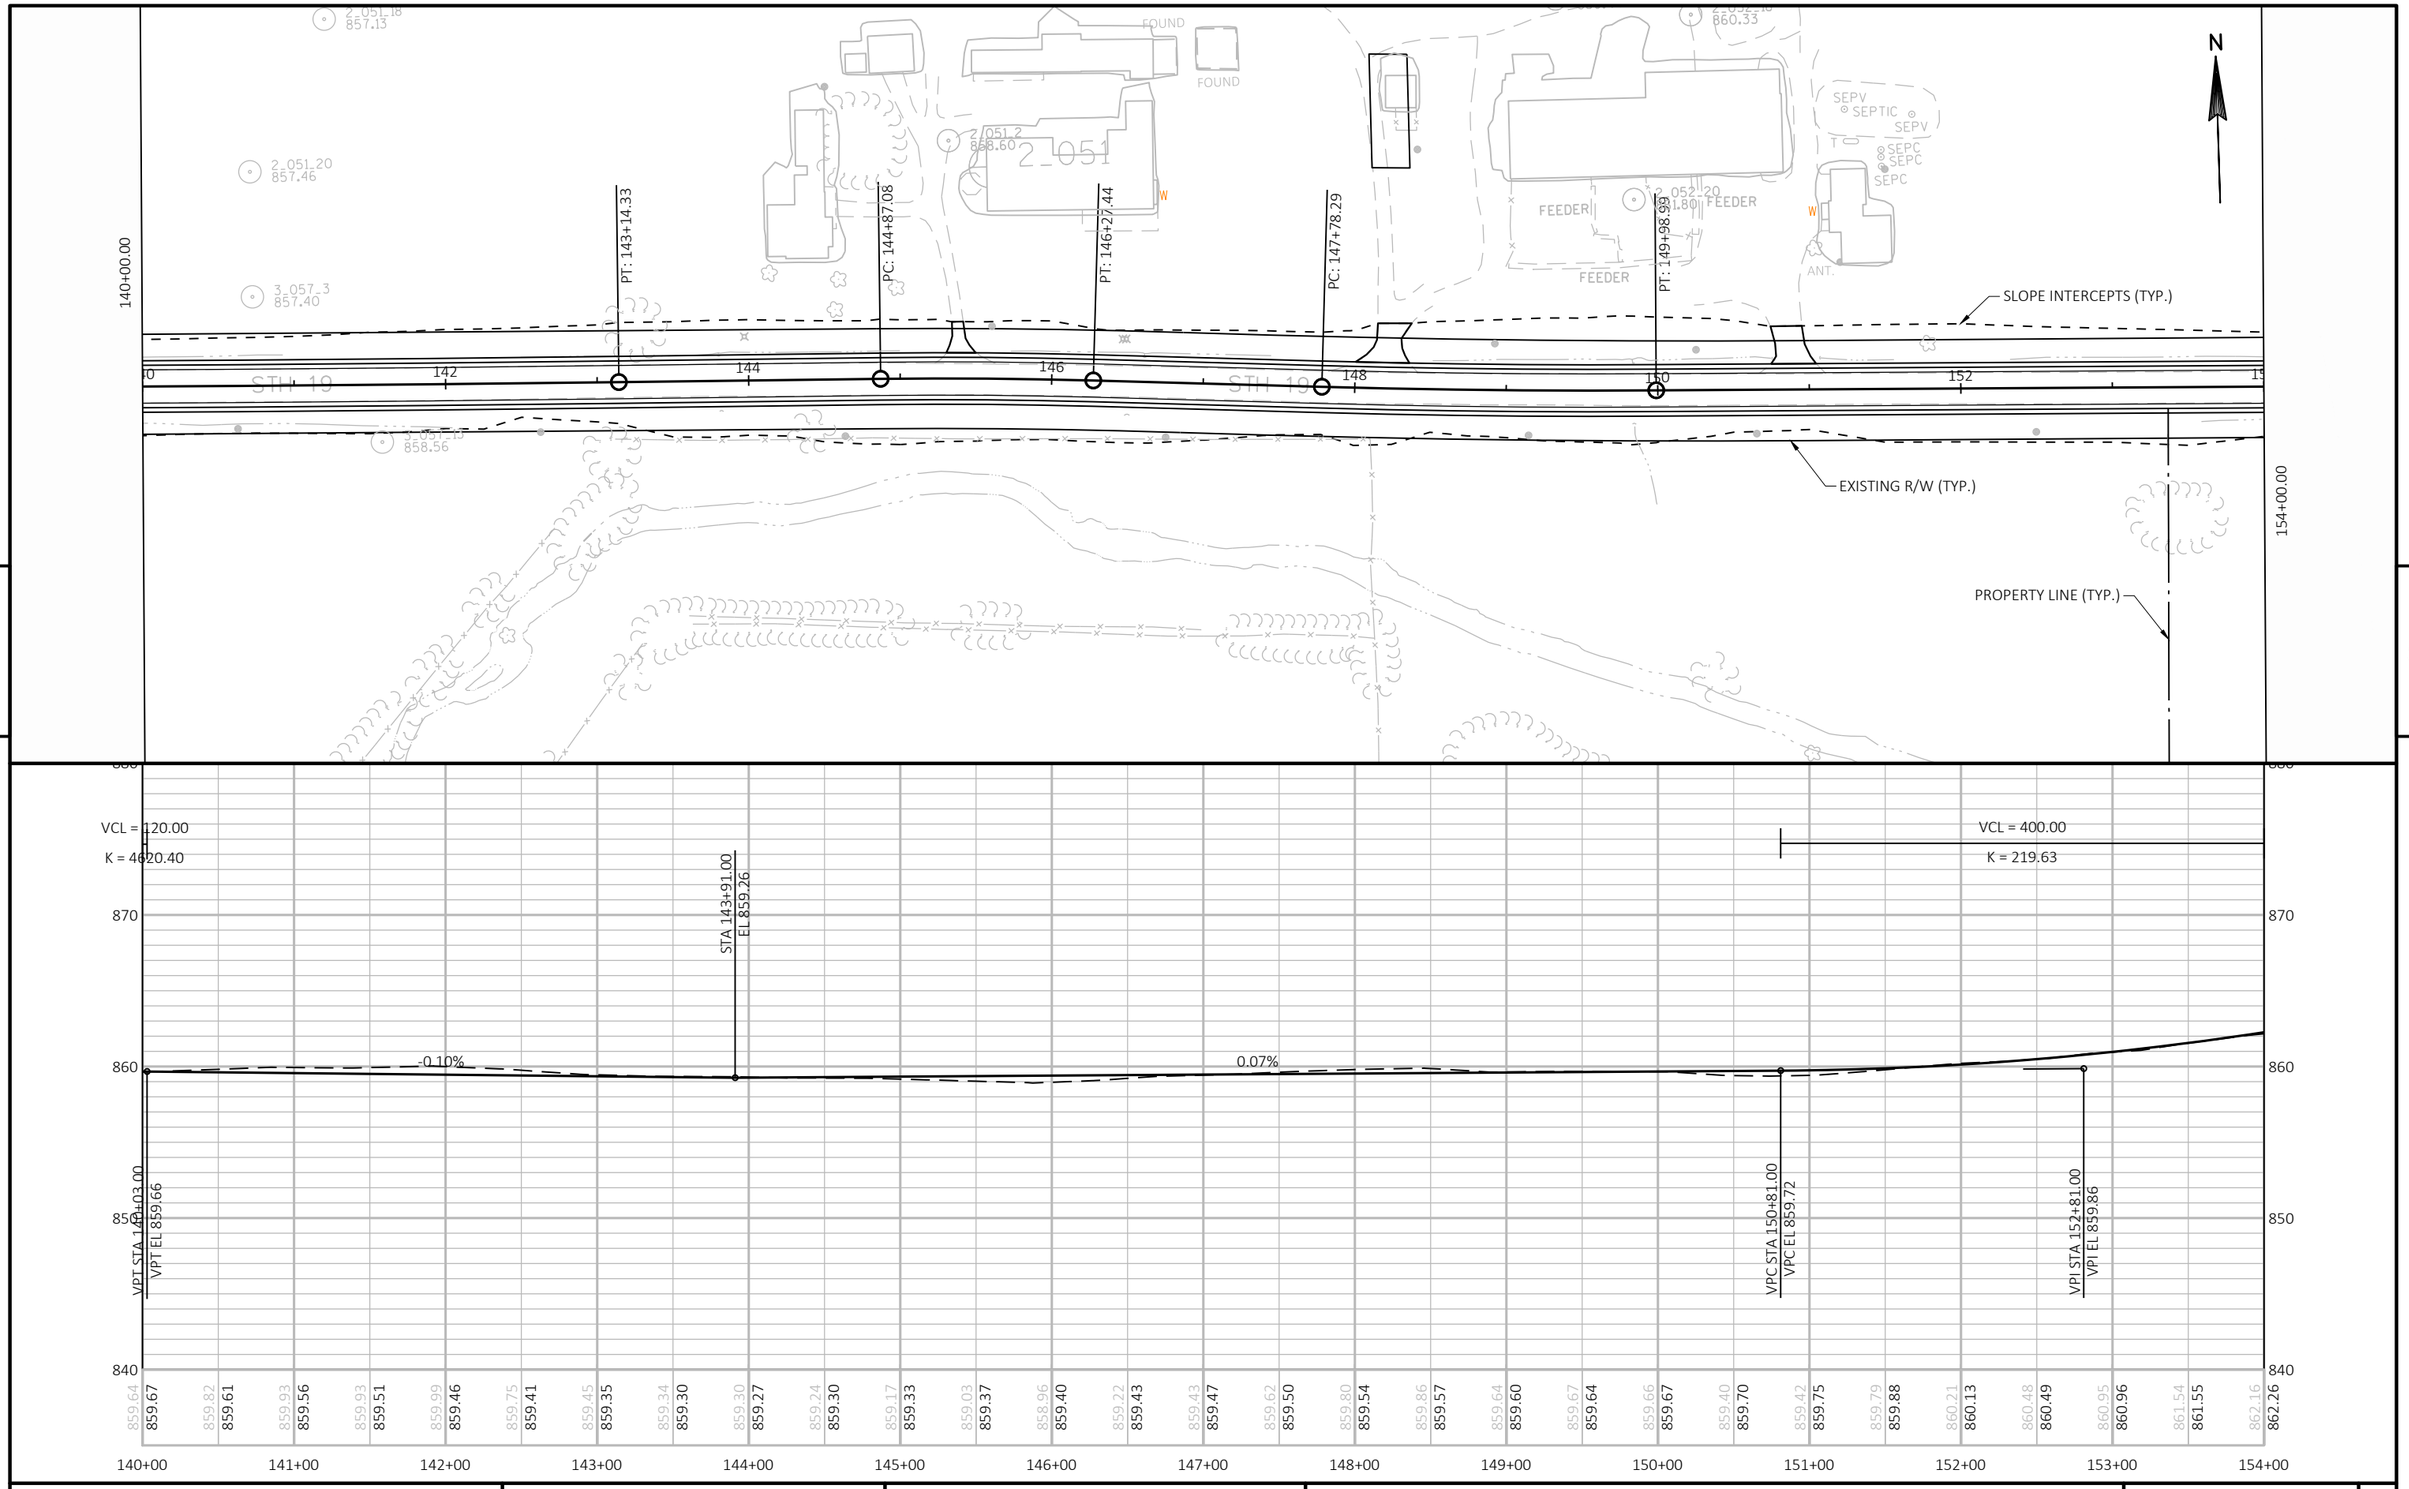

PROJECT NO: 5145-00-71	HWY: STH 19	COUNTY: DANE	PLAN AND PROFILE:	SHEET 21	E

FILE NAME : N:\PDS\C3D\51450001\SHEETSPLAN\050101_PP.DWG
LAYOUT NAME - 050111-pp

PLOT DATE : 6/7/2018 7:32 AM PLOT BY : RACH, JEREMY PAUL PLOT NAME : PLOT SCALE : 1 IN:100 FT

WISDOT/CADDS SHEET 44

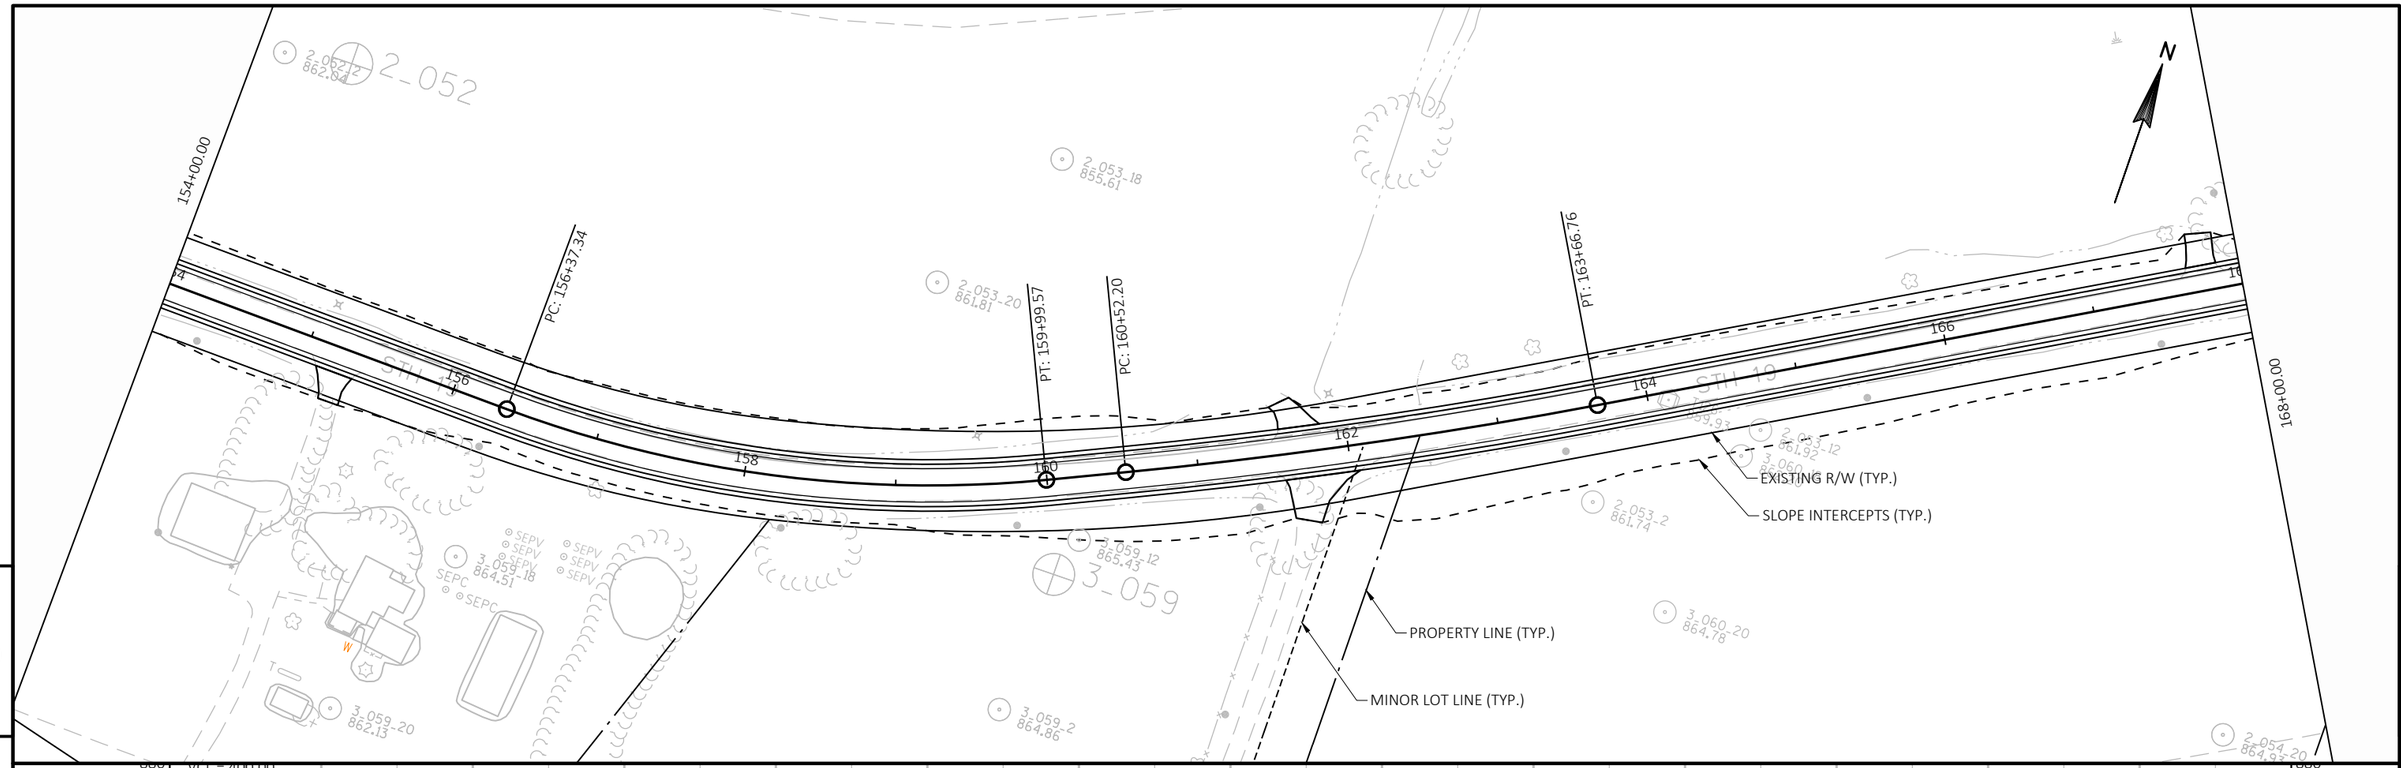

PROJECT NO: 5145-00-71	HWY: STH 19	COUNTY: DANE	PLAN AND PROFILE:	SHEET 22	E

FILE NAME : N:\PDS\C3D\51450001\SHEETSPLAN\050101_PP.DWG
LAYOUT NAME - 050112-pp

PLOT DATE : 6/7/2018 7:32 AM PLOT BY : RACH, JEREMY PAUL PLOT NAME : PLOT SCALE : 1 IN:100 FT

WISDOT/CADDS SHEET 44

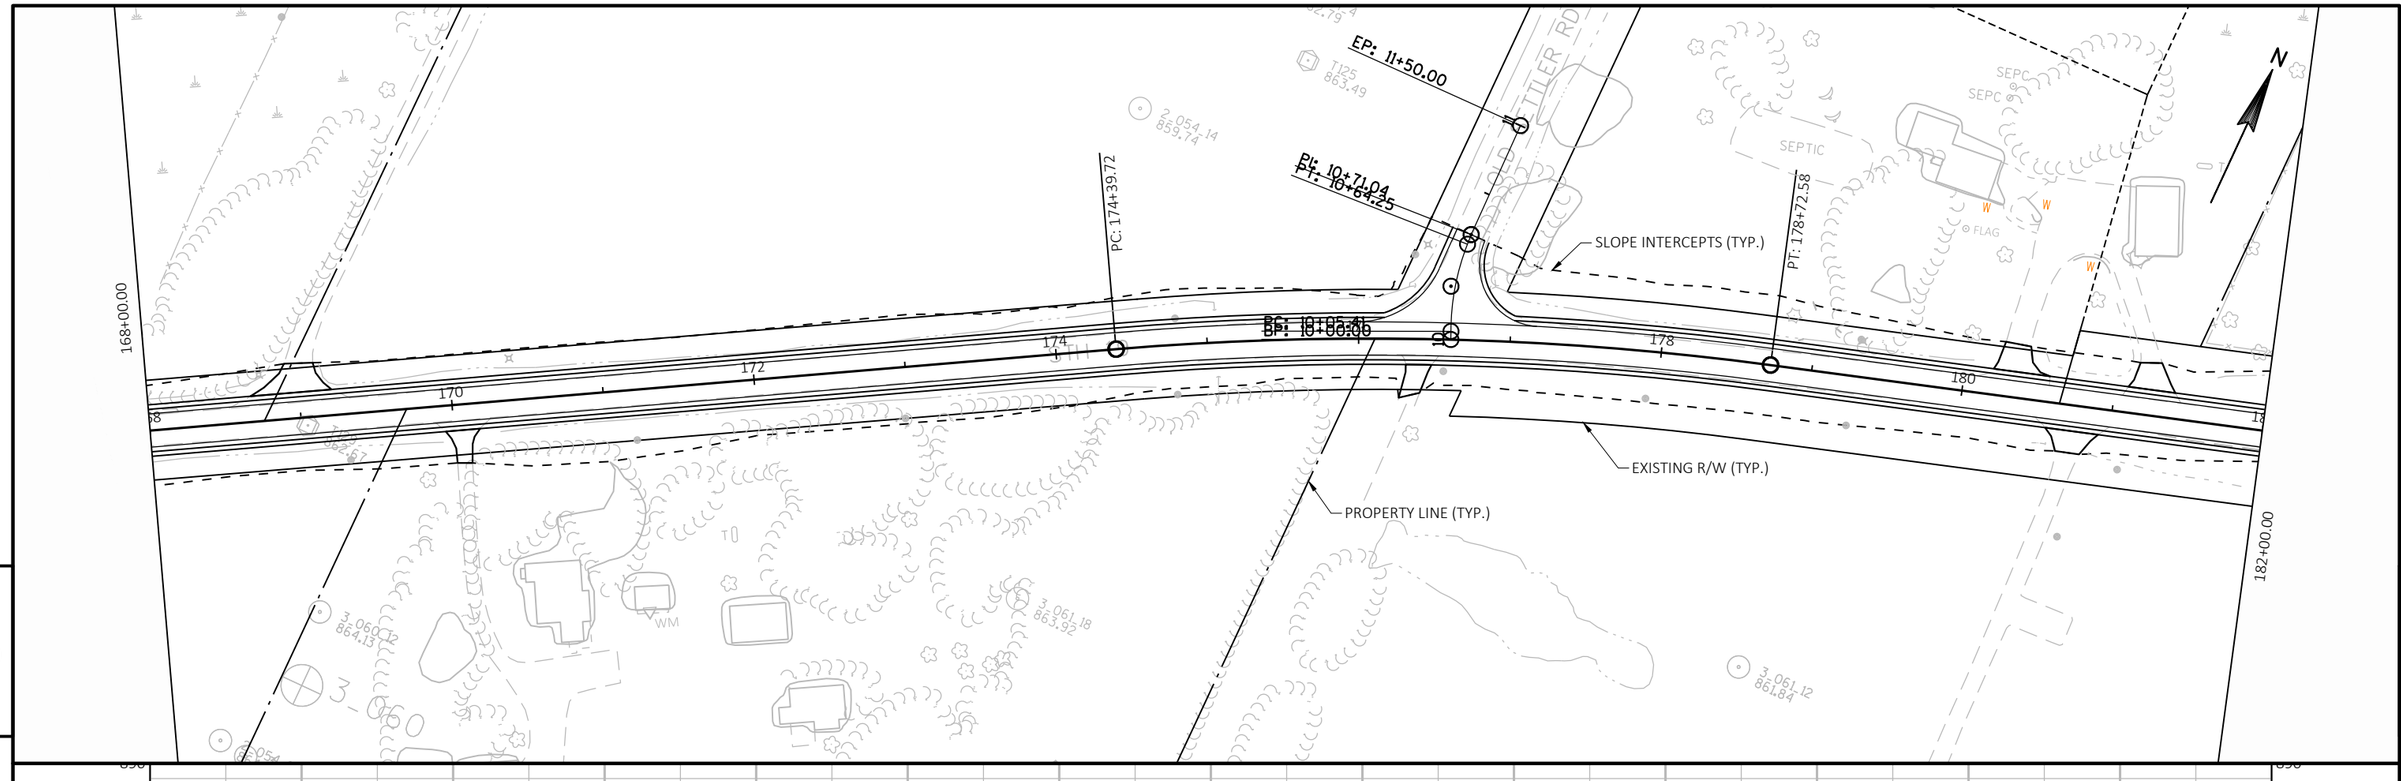

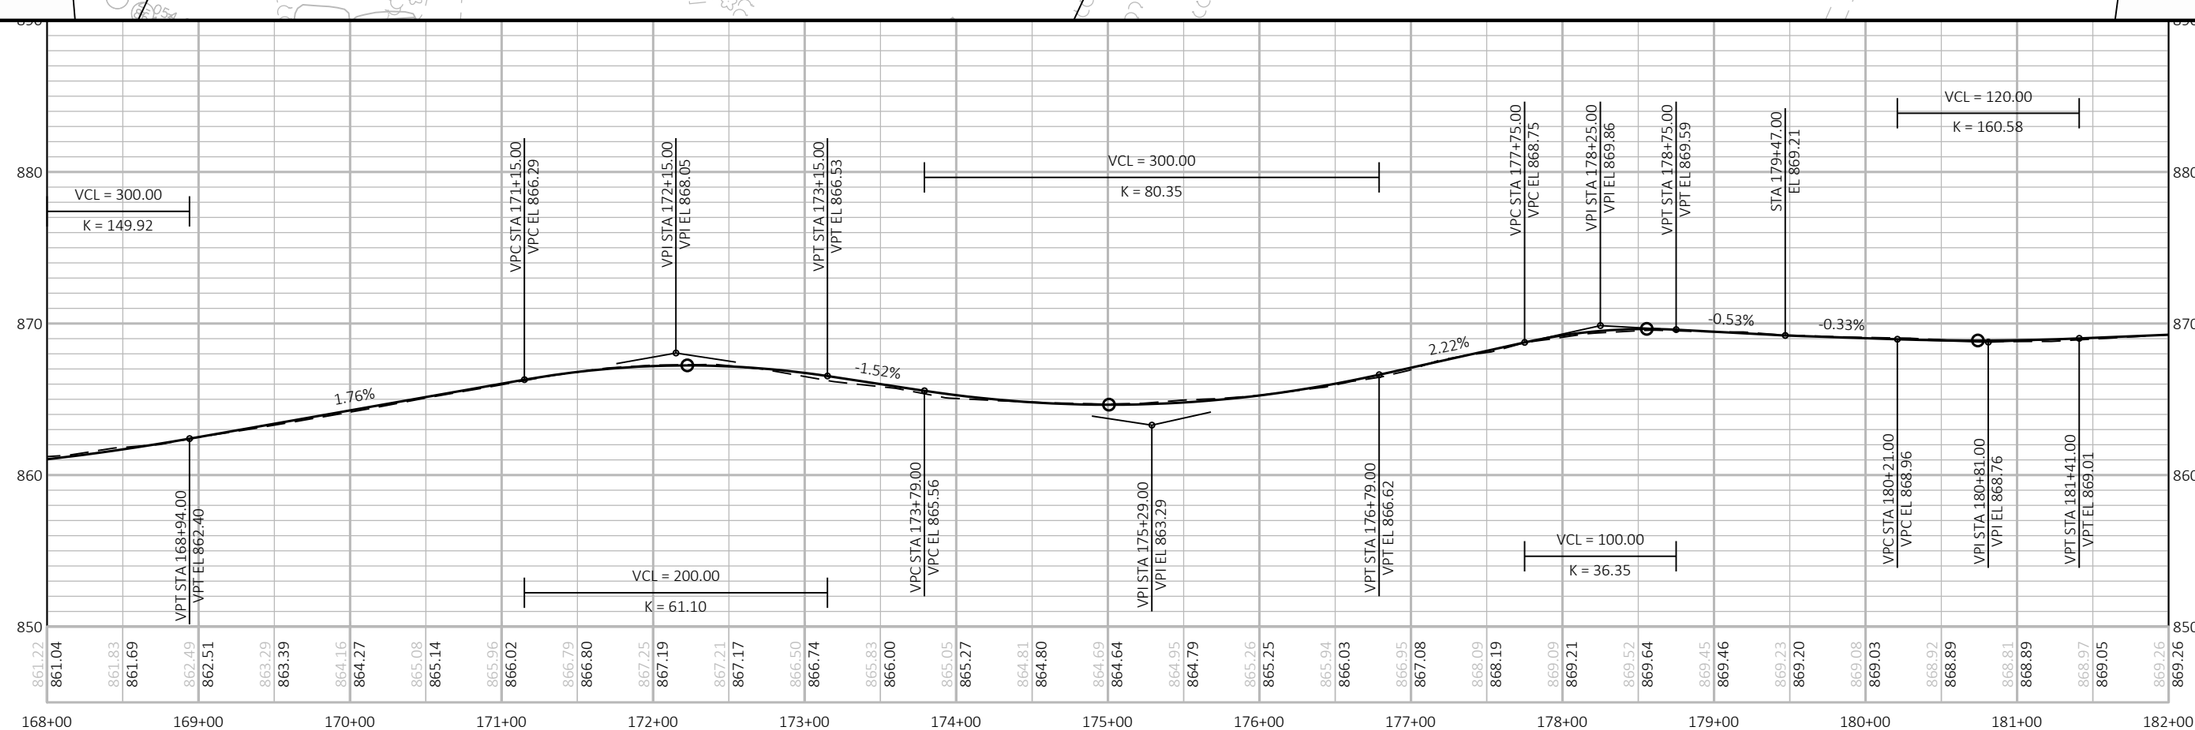

PROJECT NO: 5145-00-71	HWY: STH 19	COUNTY: DANE	PLAN AND PROFILE:	SHEET 23	E

FILE NAME : N:\PDS\C3D\51450001\SHEETSPLAN\050101_PP.DWG
LAYOUT NAME - 050113-pp

PLOT DATE : 6/7/2018 7:32 AM PLOT BY : RACH, JEREMY PAUL PLOT NAME : PLOT SCALE : 1 IN:100 FT

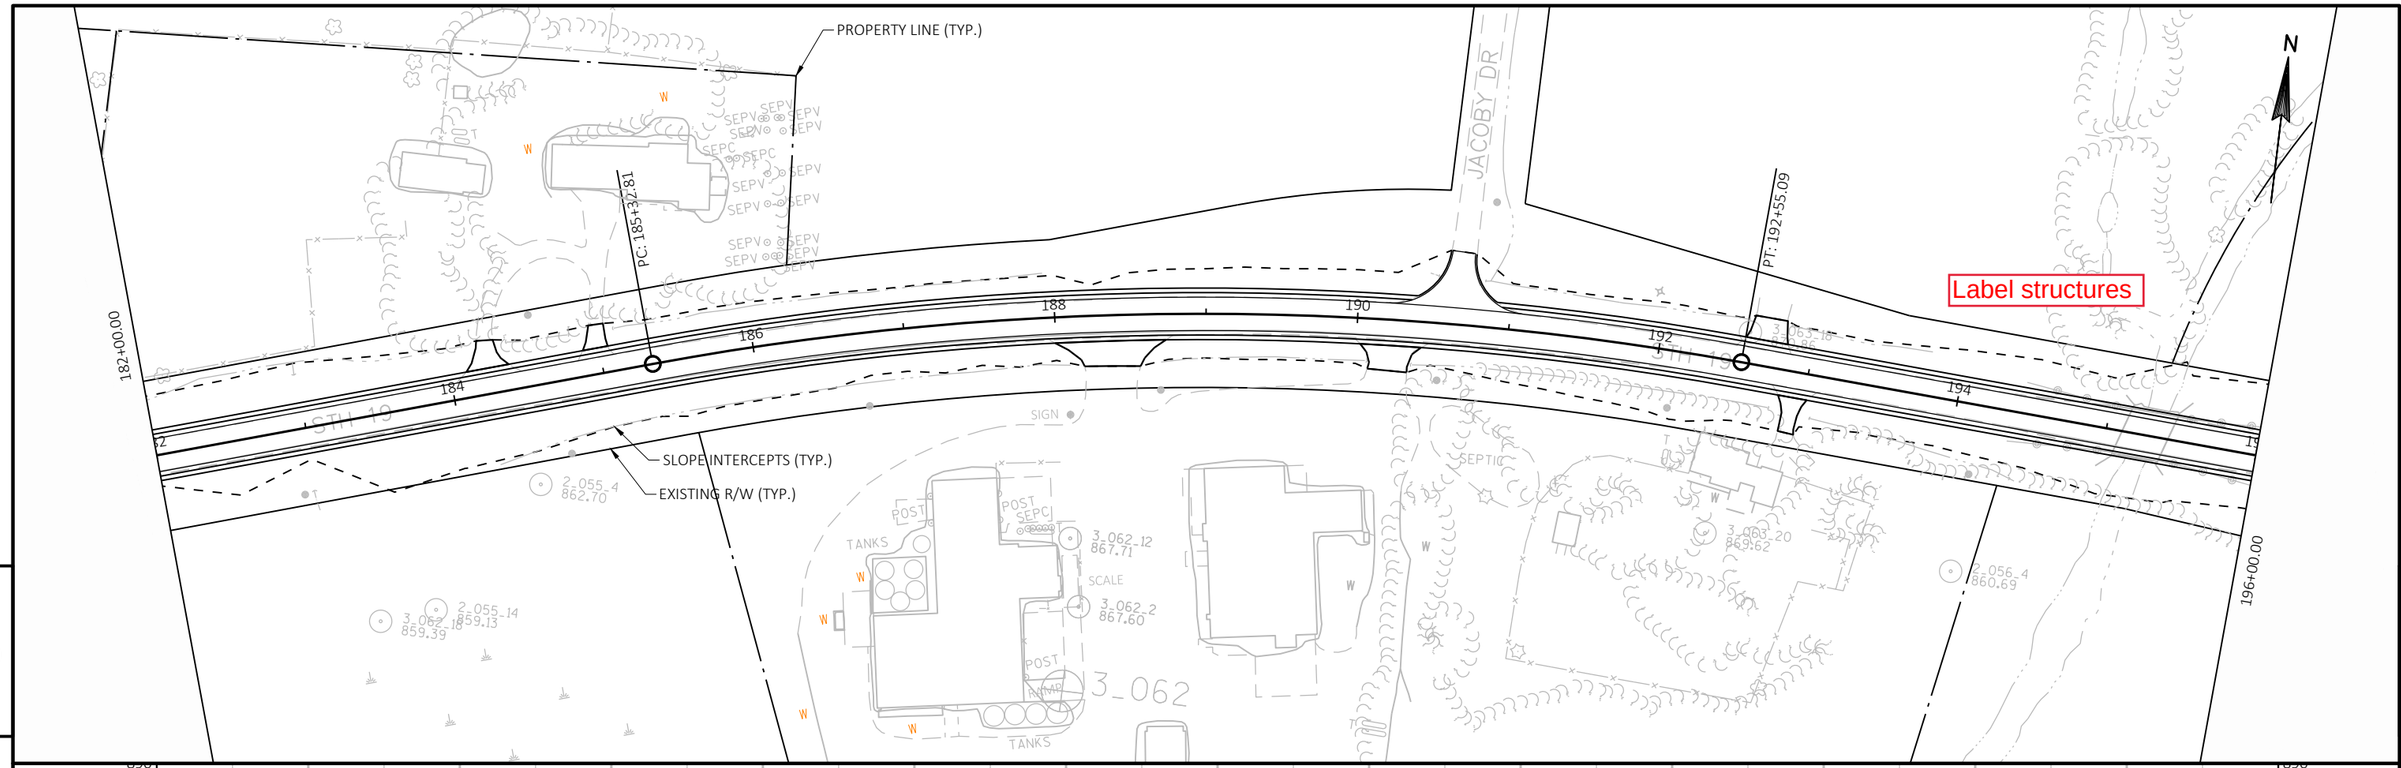

PROJECT NO: 5145-00-71	HWY: STH 19	COUNTY: DANE	PLAN AND PROFILE:	SHEET 24	E

FILE NAME : N:\PDS\C3D\51450001\SHEETSPLAN\050101_PP.DWG
LAYOUT NAME - 050114-pp

PLOT DATE : 6/7/2018 7:33 AM PLOT BY : RACH, JEREMY PAUL PLOT NAME : PLOT SCALE : 1 IN:100 FT

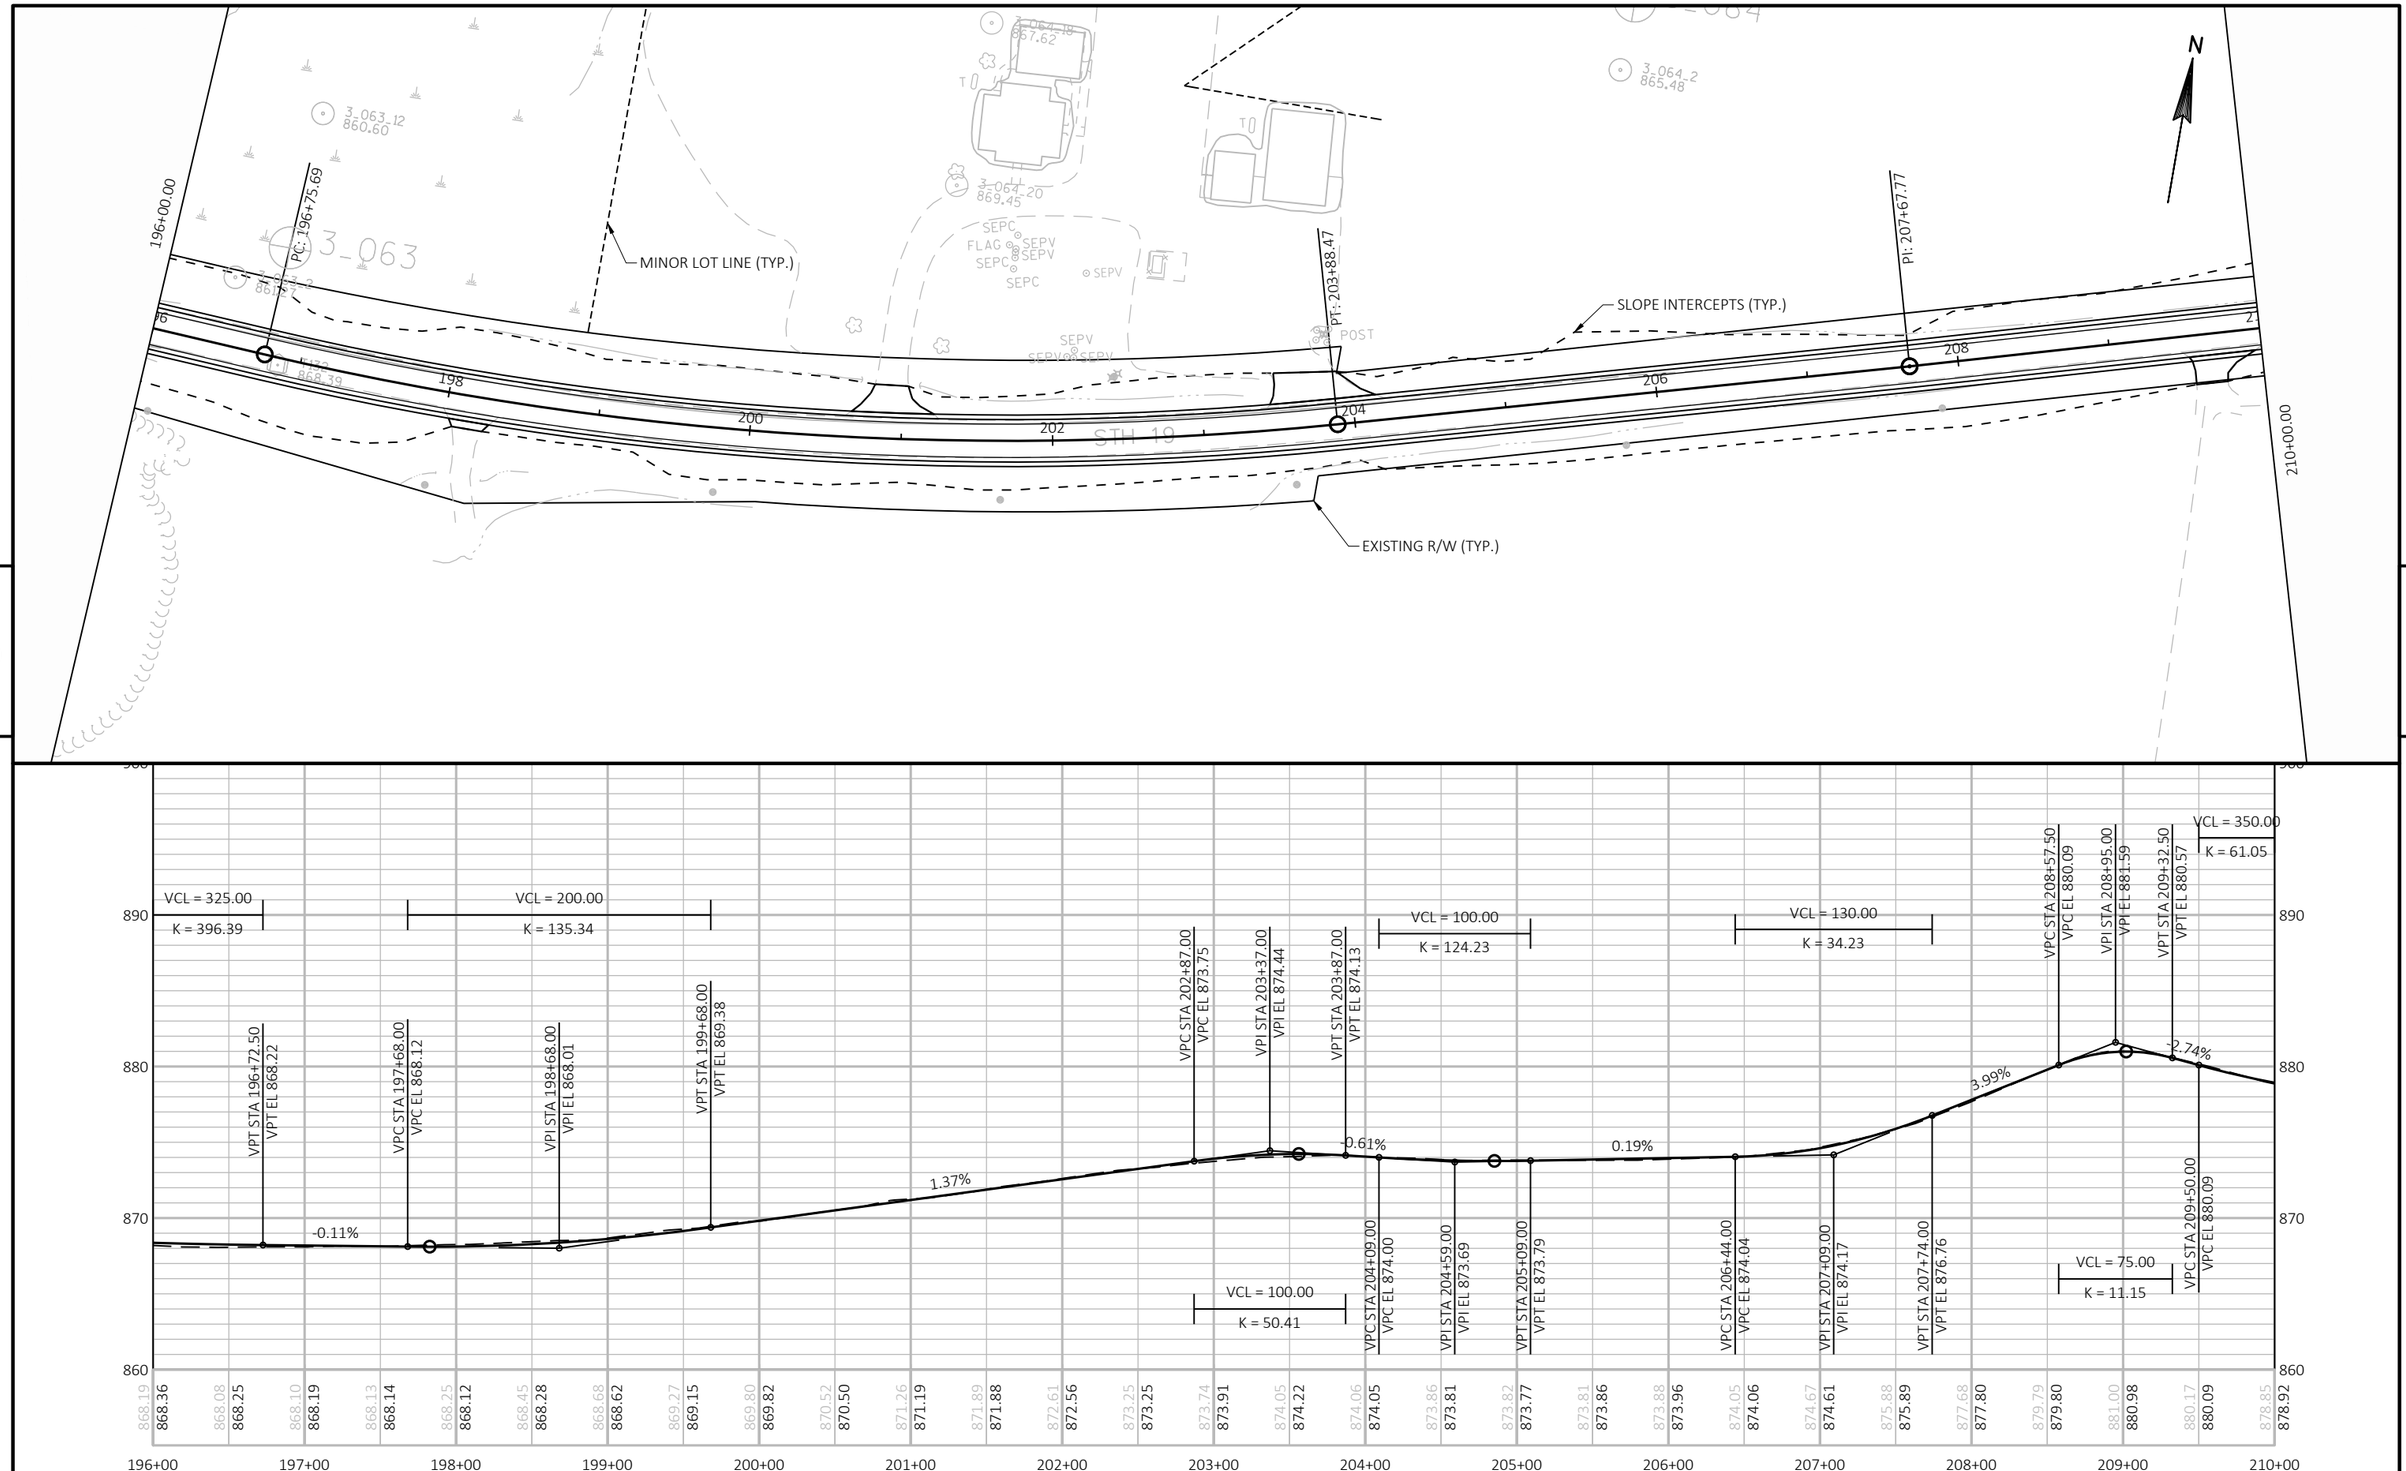

PROJECT NO: 5145-00-71	HWY: STH 19	COUNTY: DANE	PLAN AND PROFILE:	SHEET 25	E

FILE NAME : N:\PDS\C3D\51450001\SHEETSPLAN\050101_PP.DWG
LAYOUT NAME - 050115-pp

PLOT DATE : 6/7/2018 7:33 AM PLOT BY : RACH, JEREMY PAUL PLOT NAME : PLOT SCALE : 1 IN:100 FT

WISDOT/CADDS SHEET 44

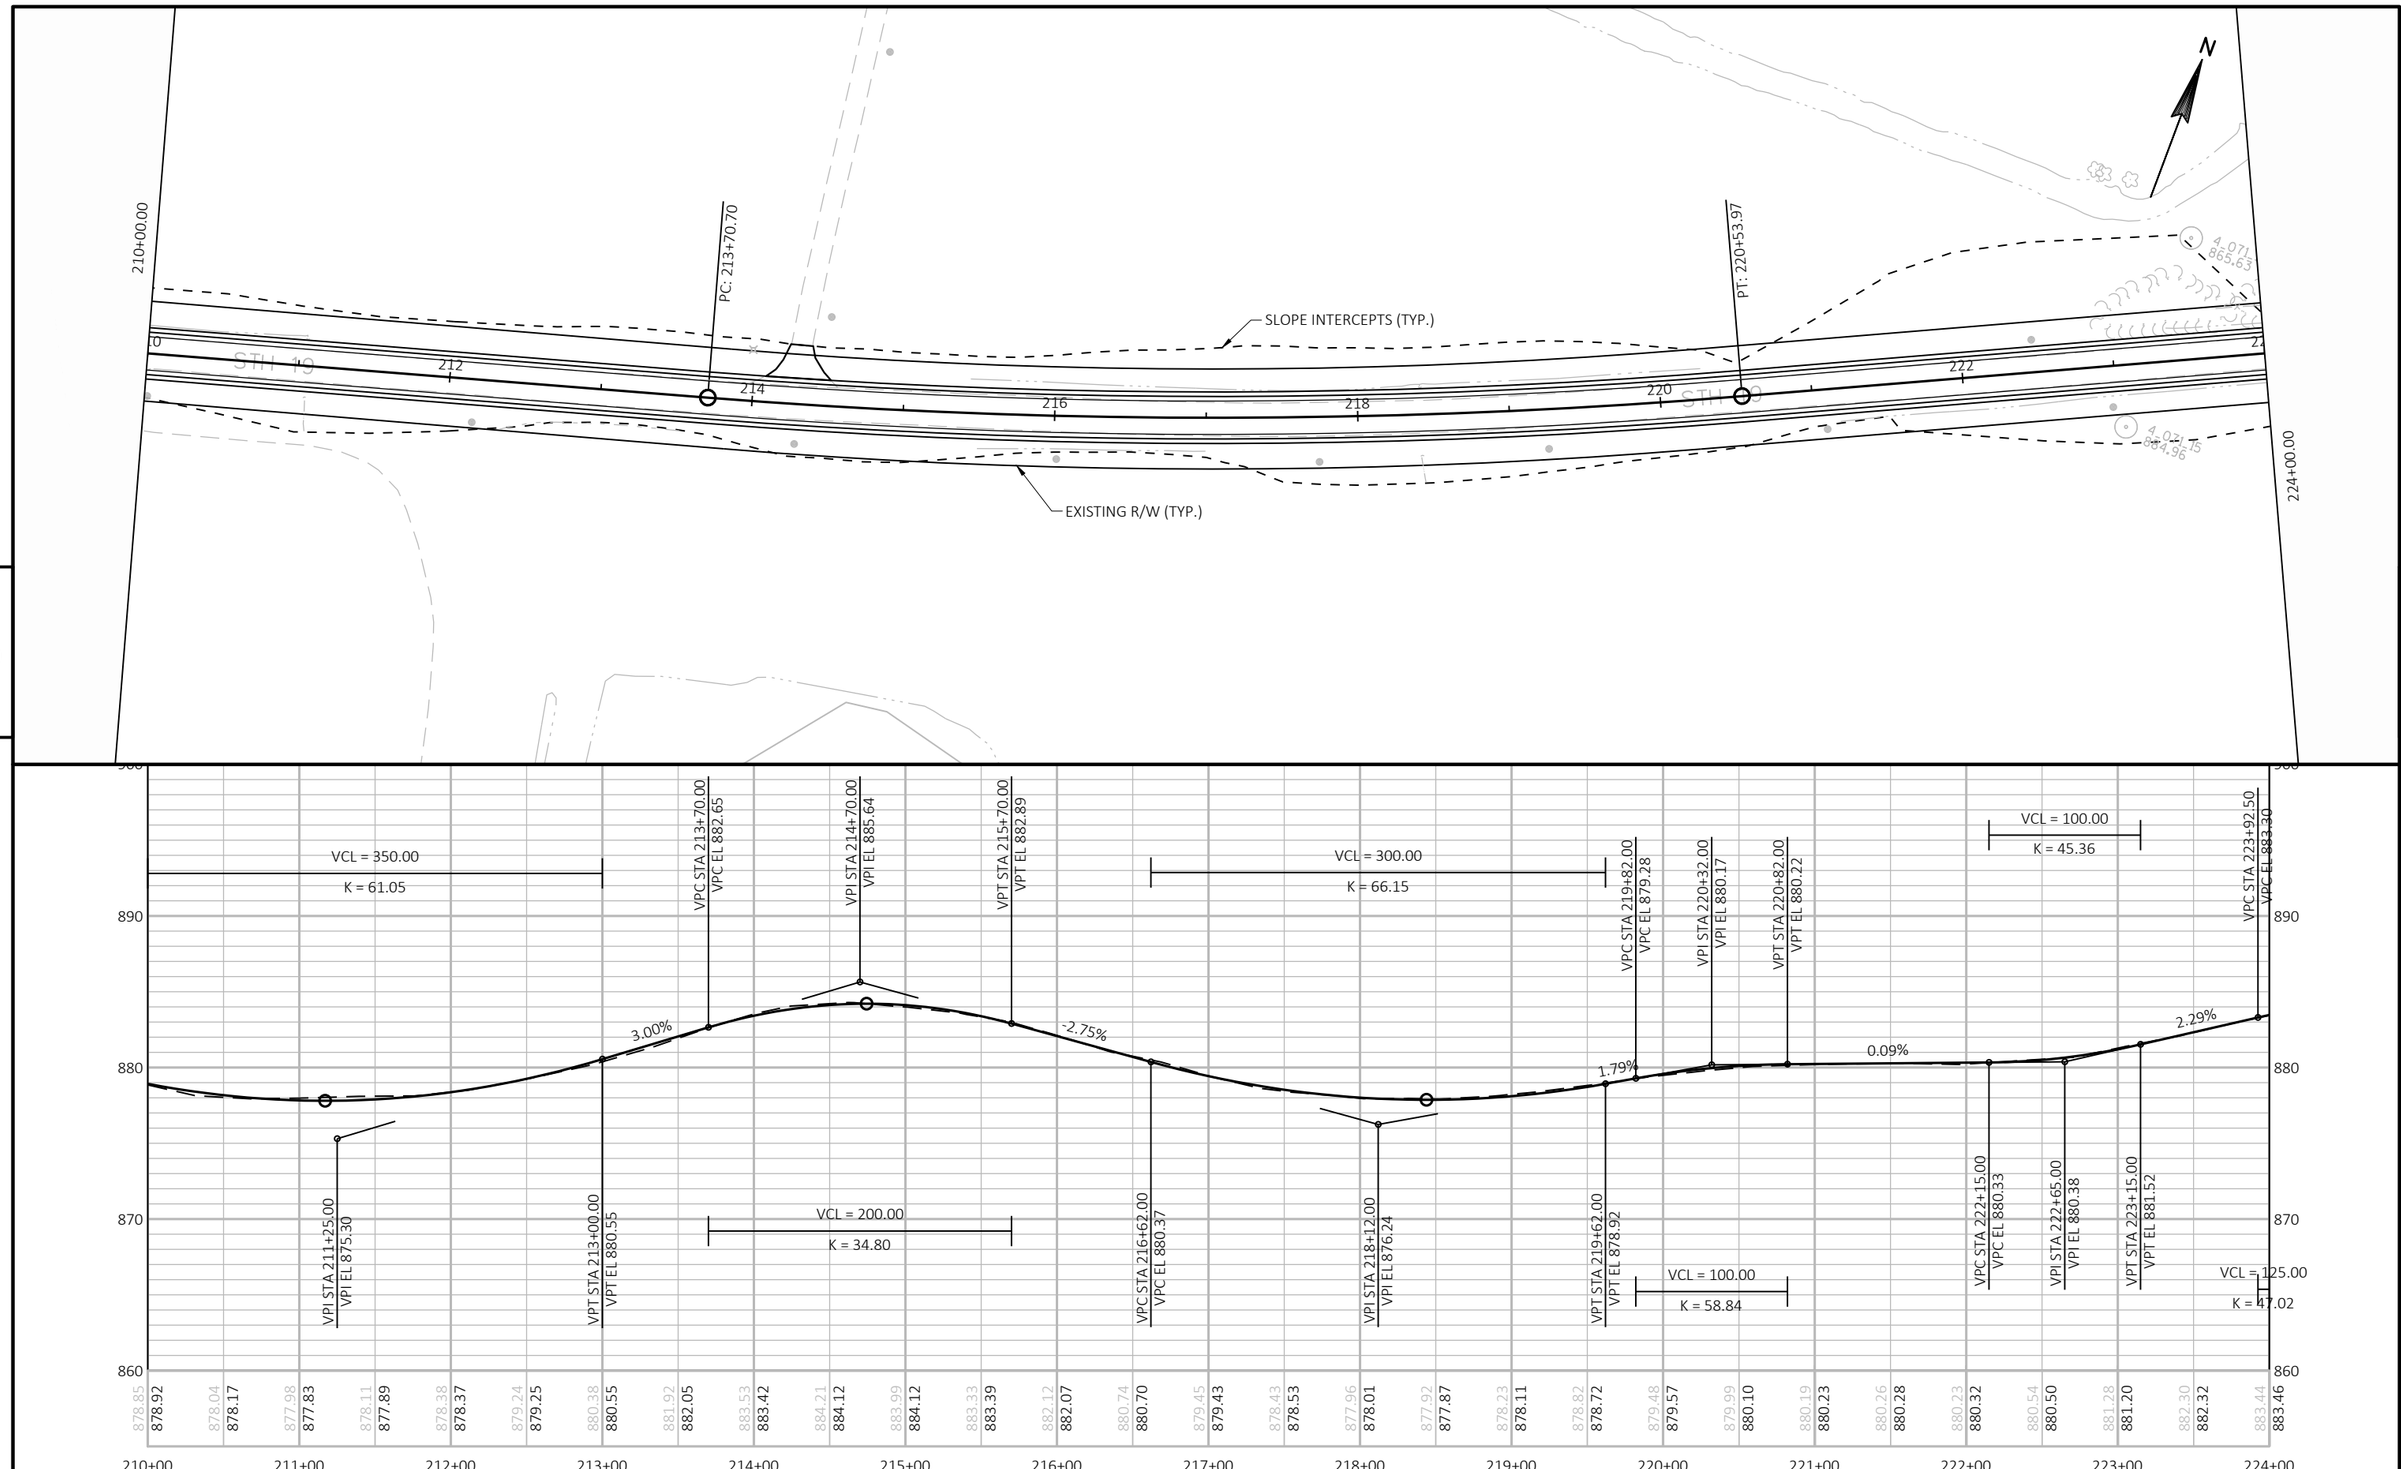

PROJECT NO: 5145-00-71	HWY: STH 19	COUNTY: DANE	PLAN AND PROFILE:	SHEET 26	E

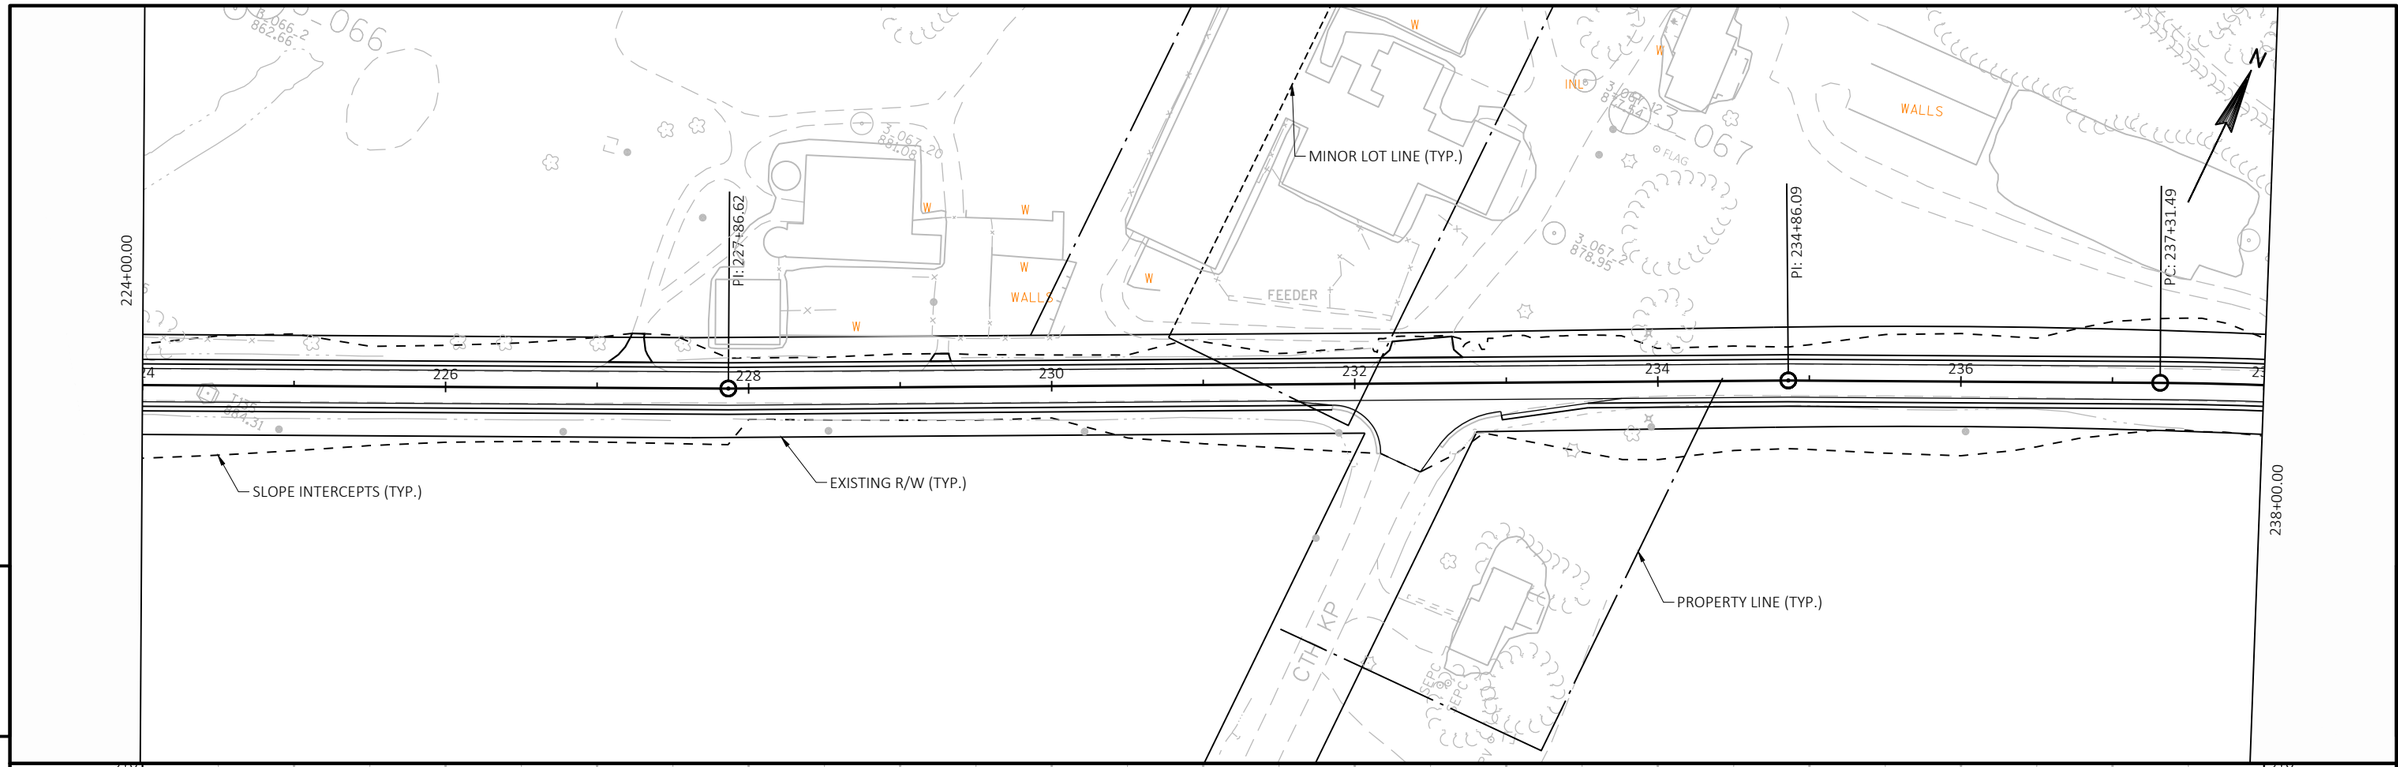

PROJECT NO: 5145-00-71	HWY: STH 19	COUNTY: DANE	PLAN AND PROFILE:	SHEET 27	E

FILE NAME : N:\PDS\C3D\51450001\SHEETSPLAN\050101_PP.DWG
LAYOUT NAME - 050117-pp

PLOT DATE : 6/7/2018 7:33 AM PLOT BY : RACH, JEREMY PAUL PLOT NAME : PLOT SCALE : 1 IN:100 FT

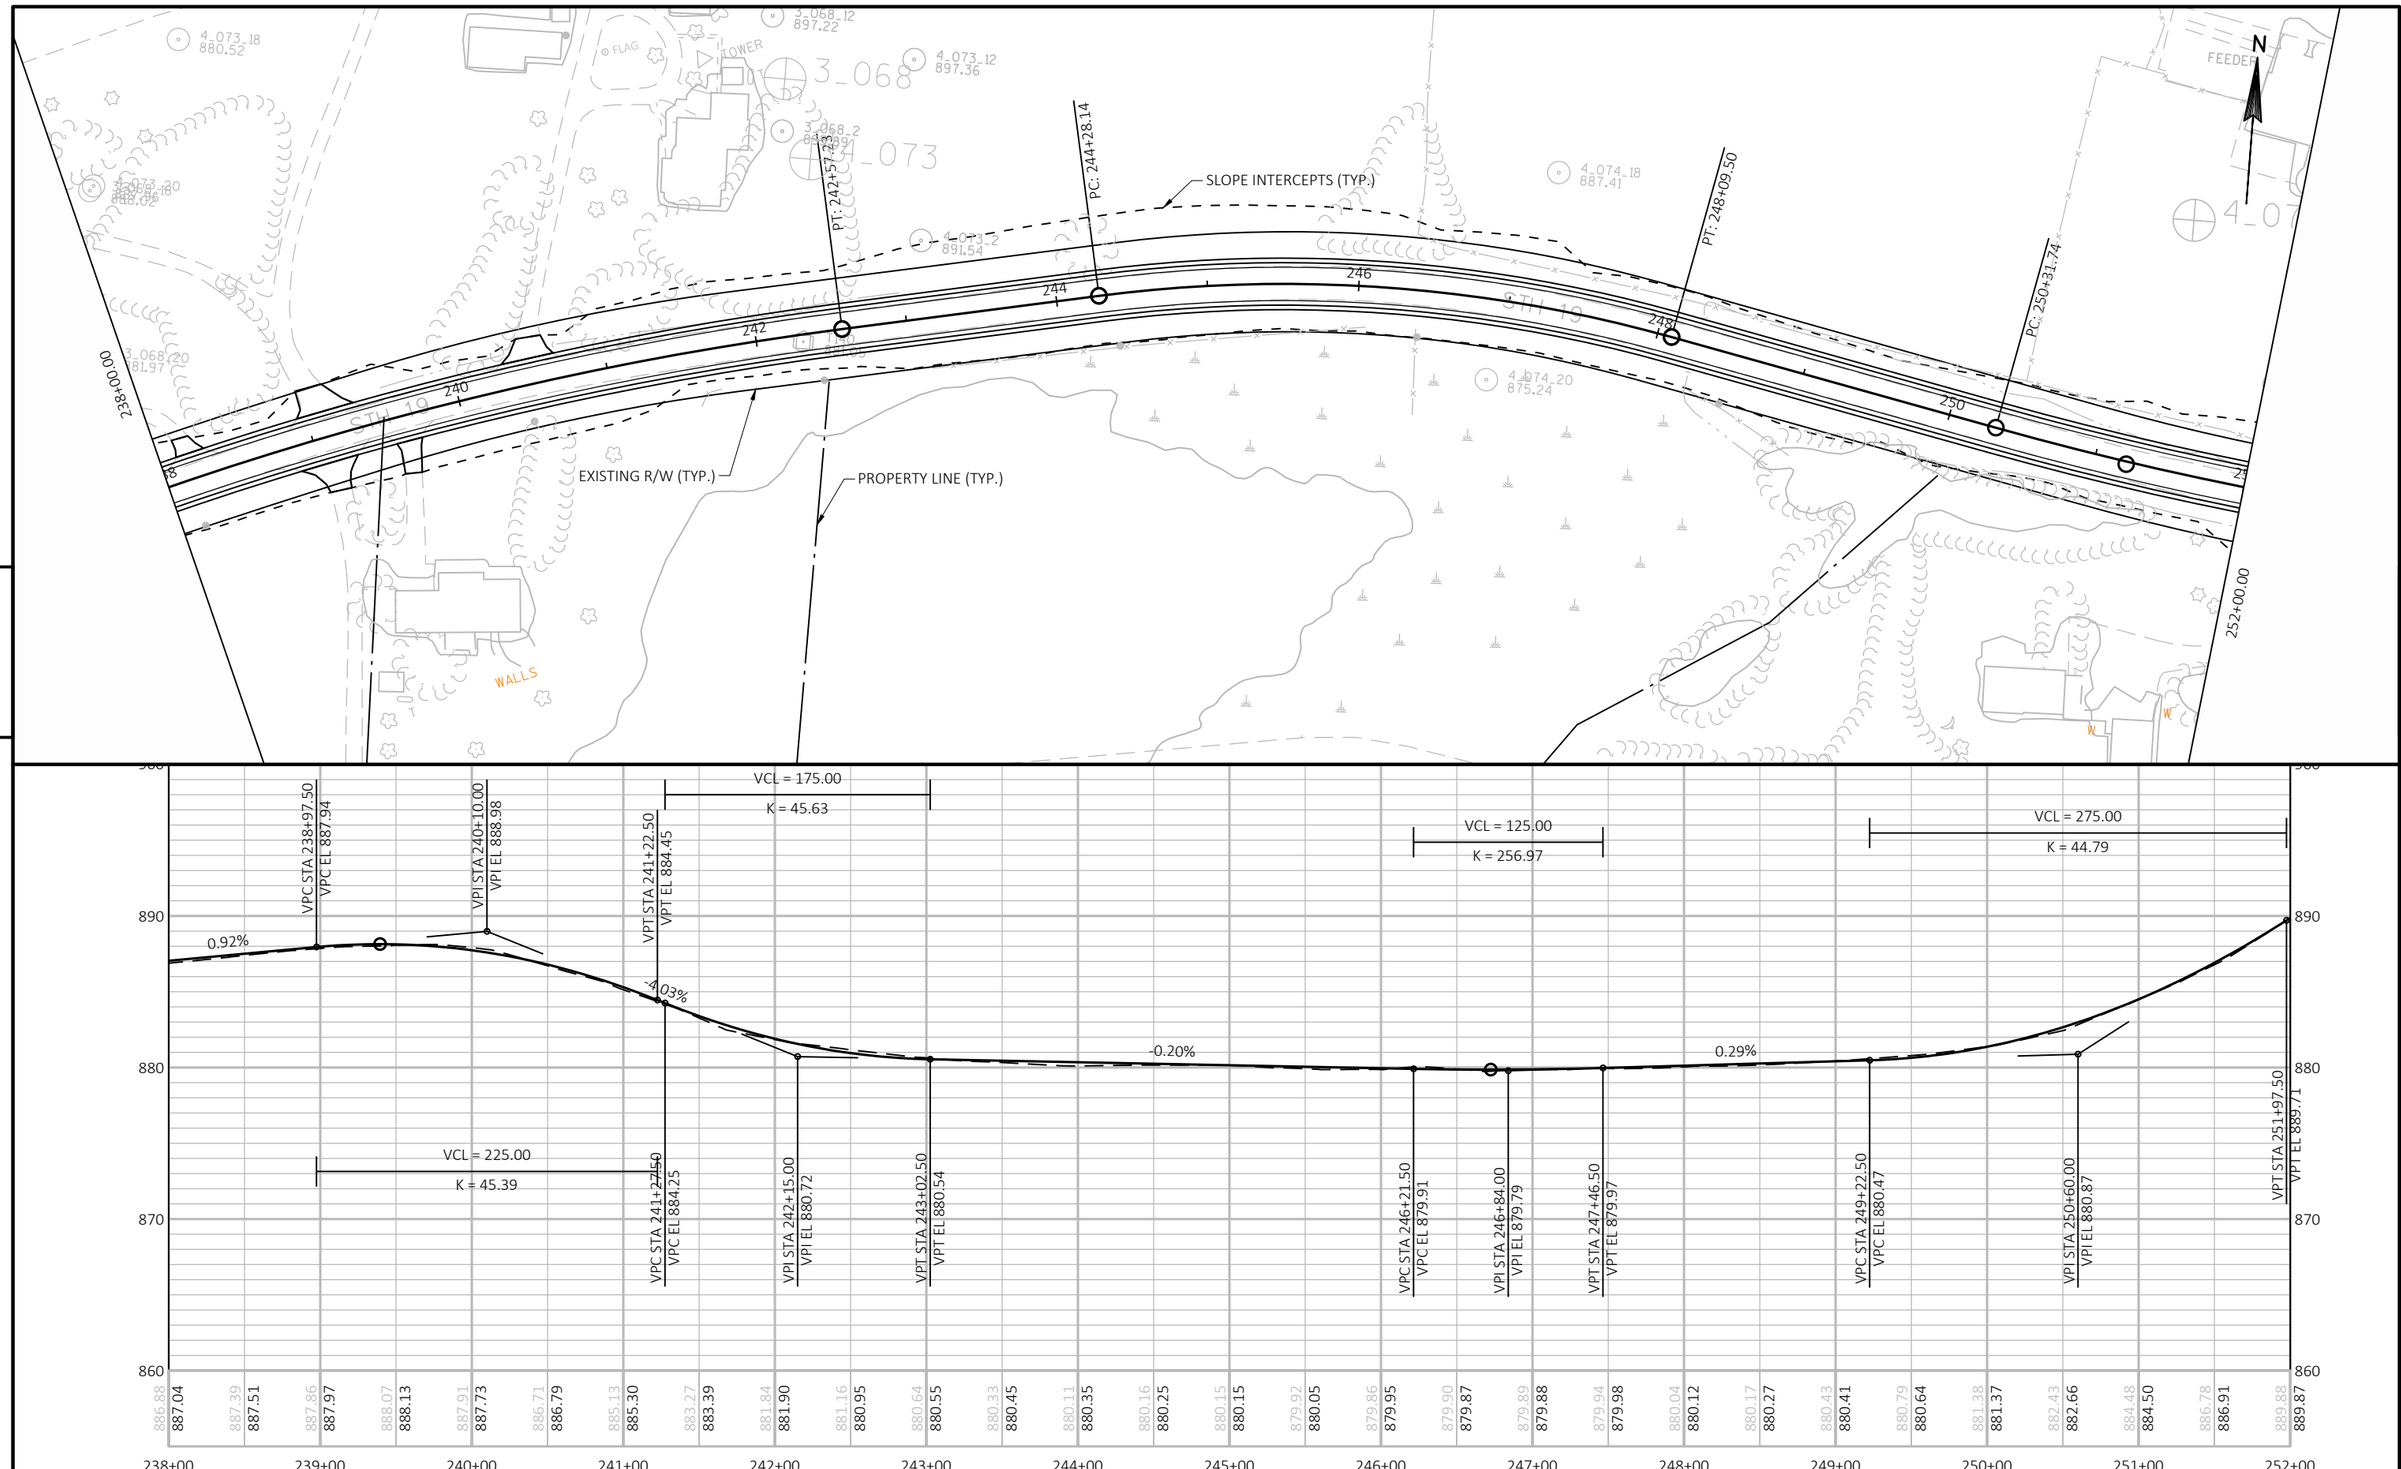

PROJECT NO: 5145-00-71	HWY: STH 19	COUNTY: DANE	PLAN AND PROFILE:	SHEET 28	E

FILE NAME : N:\PDS\C3D\51450001\SHEETSPLAN\050101_PP.DWG
LAYOUT NAME - 050118-pp
PLOT DATE : 6/7/2018 7:33 AM
PLOT BY : RACH, JEREMY PAUL
PLOT NAME :
PLOT SCALE : 1 IN:100 FT
WISDOT/CADDS SHEET 44

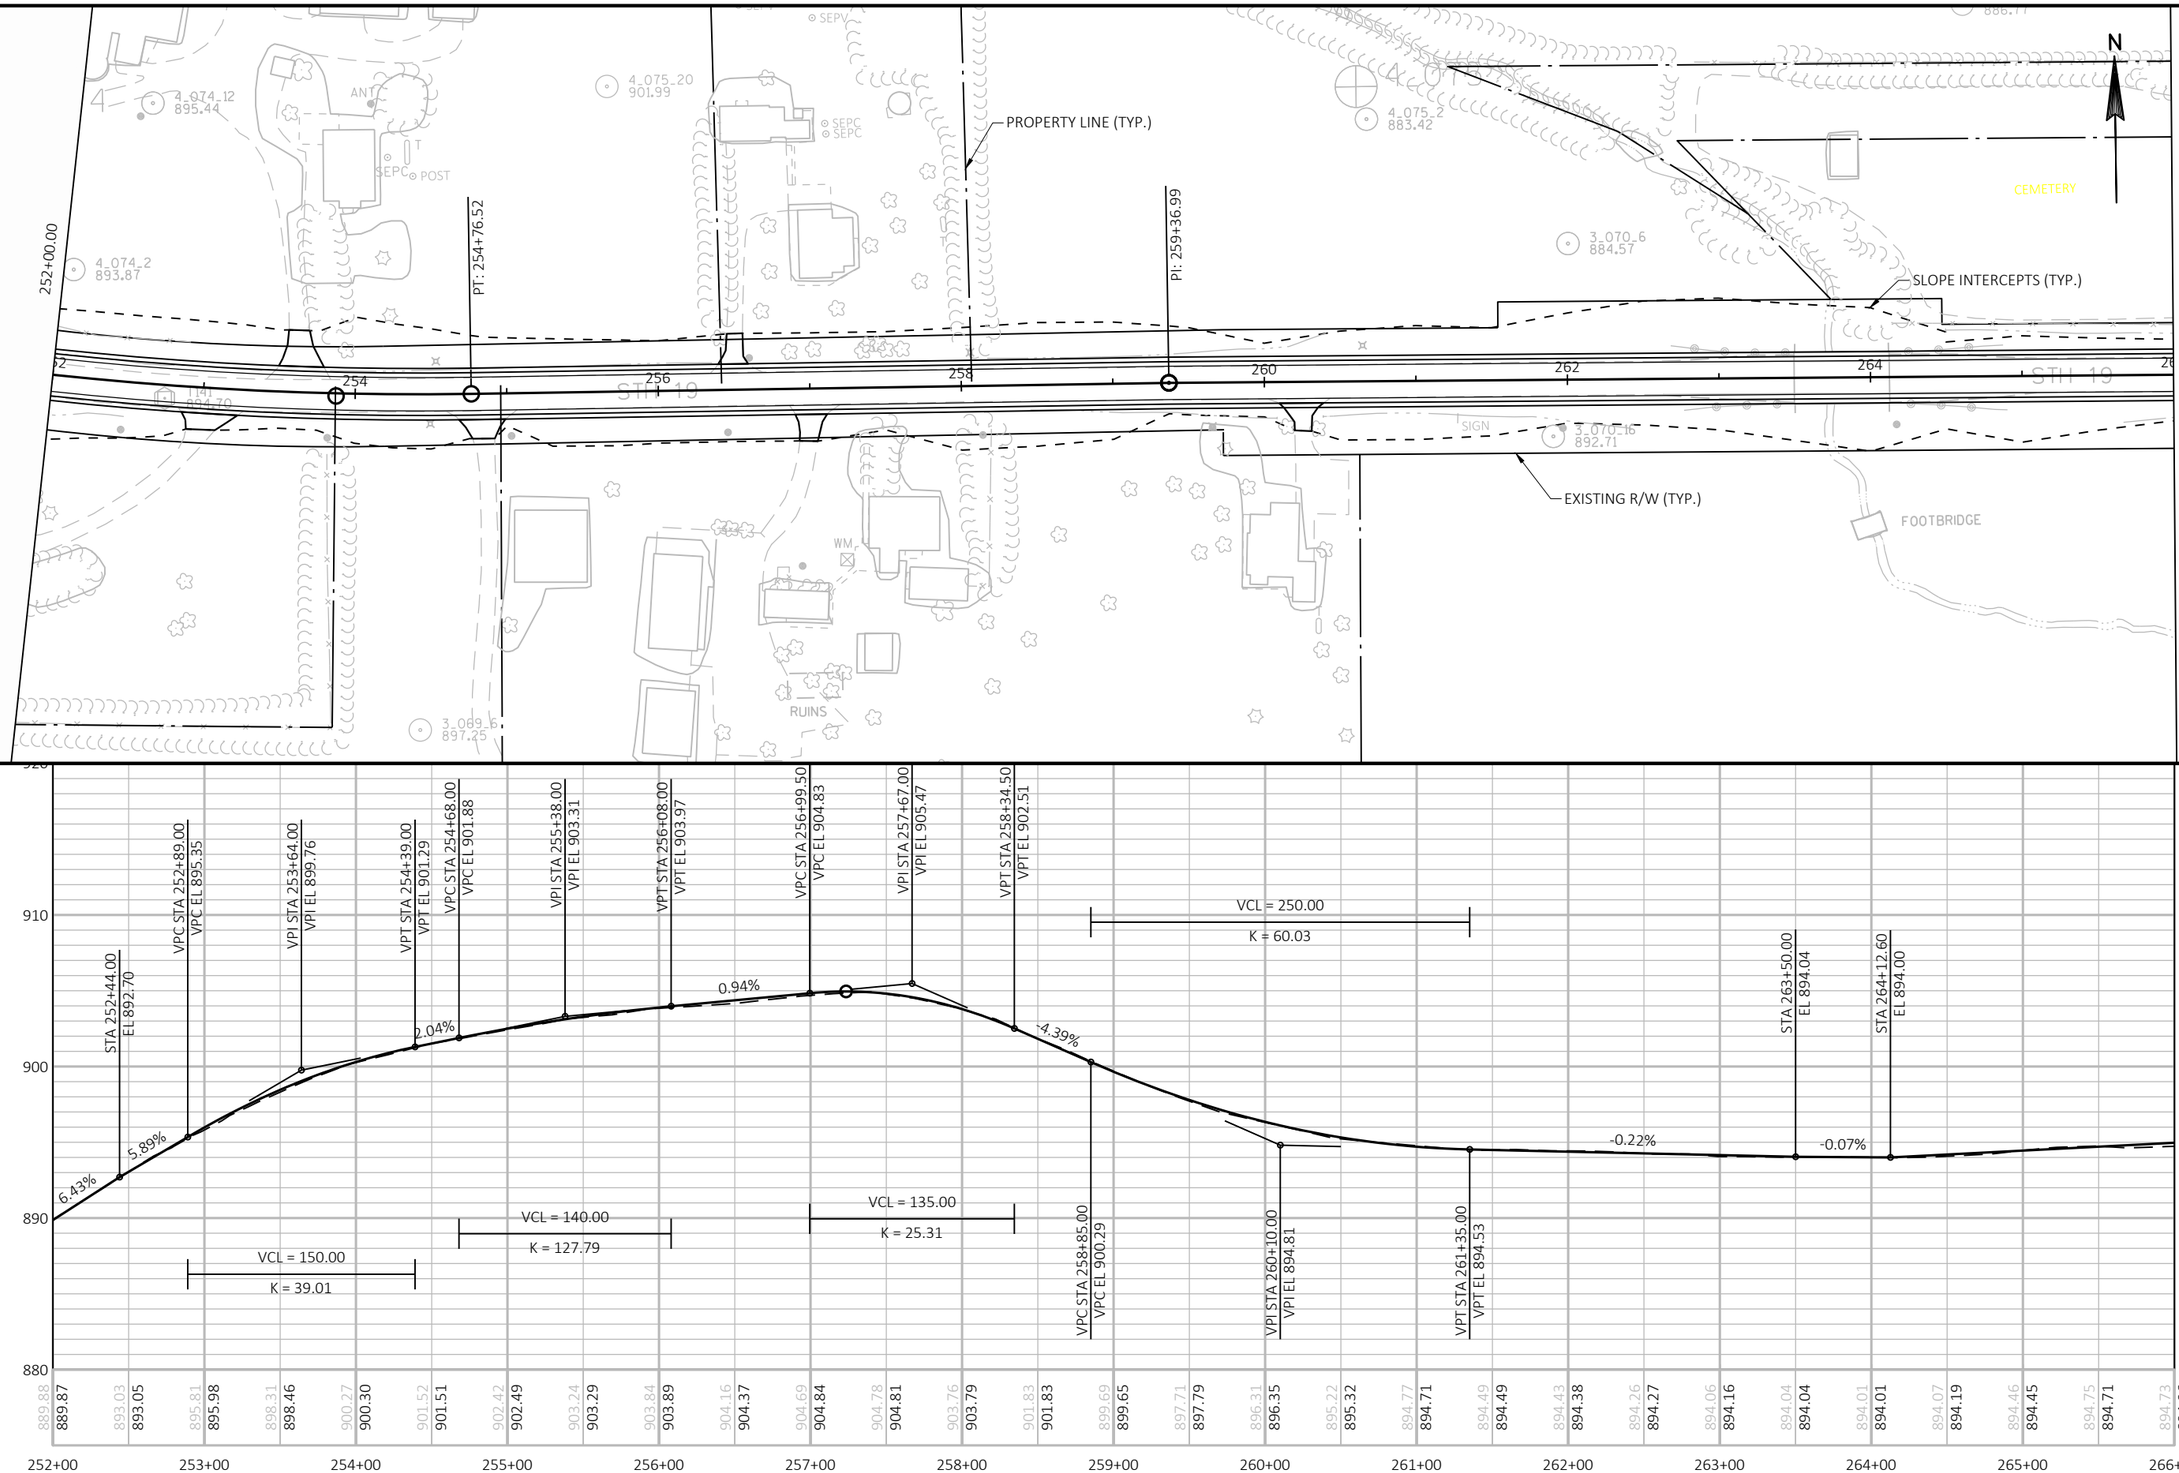

PROJECT NO: 5145-00-71	HWY: STH 19	COUNTY: DANE	PLAN AND PROFILE:	SHEET 29	E

FILE NAME : N:\PDS\C3D\51450001\SHEETSPLAN\050101_PP.DWG
LAYOUT NAME - 050119-pp

PLOT DATE : 6/7/2018 7:34 AM PLOT BY : RACH, JEREMY PAUL PLOT NAME : PLOT SCALE : 1 IN:100 FT

Add suffix to all sideroad alignments to distinguish them from the mainline.

Plan/profile needed for CTH KP.

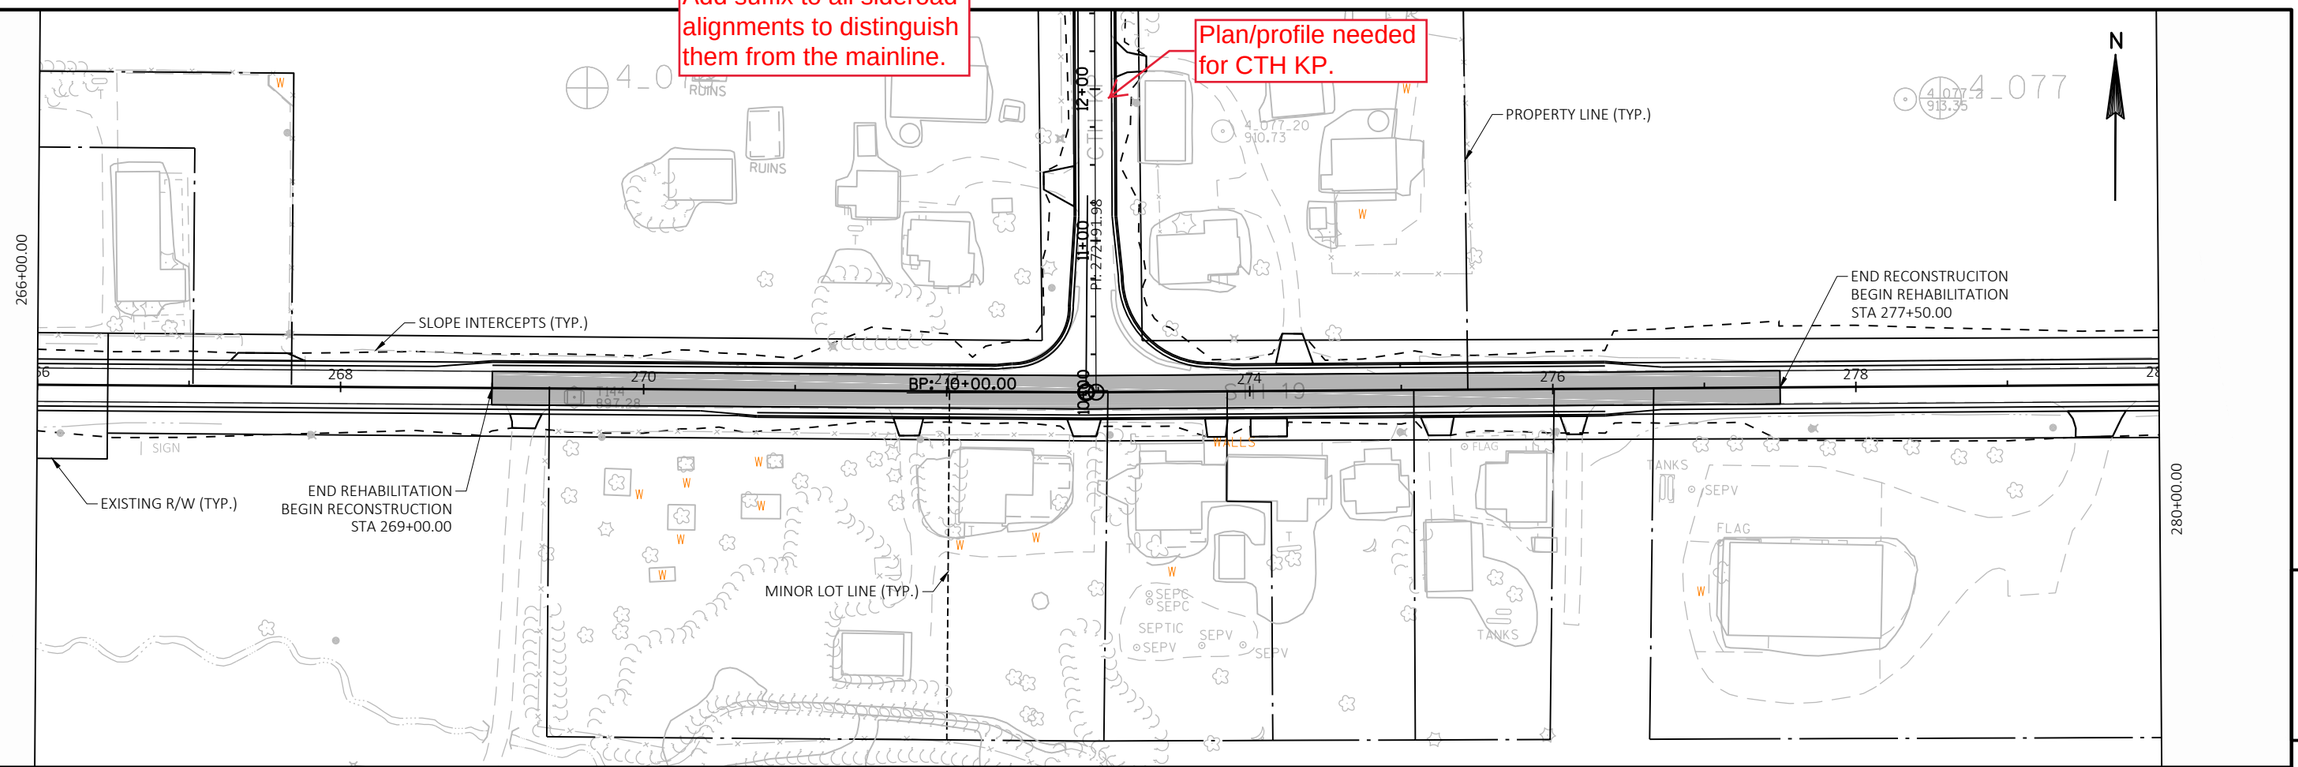

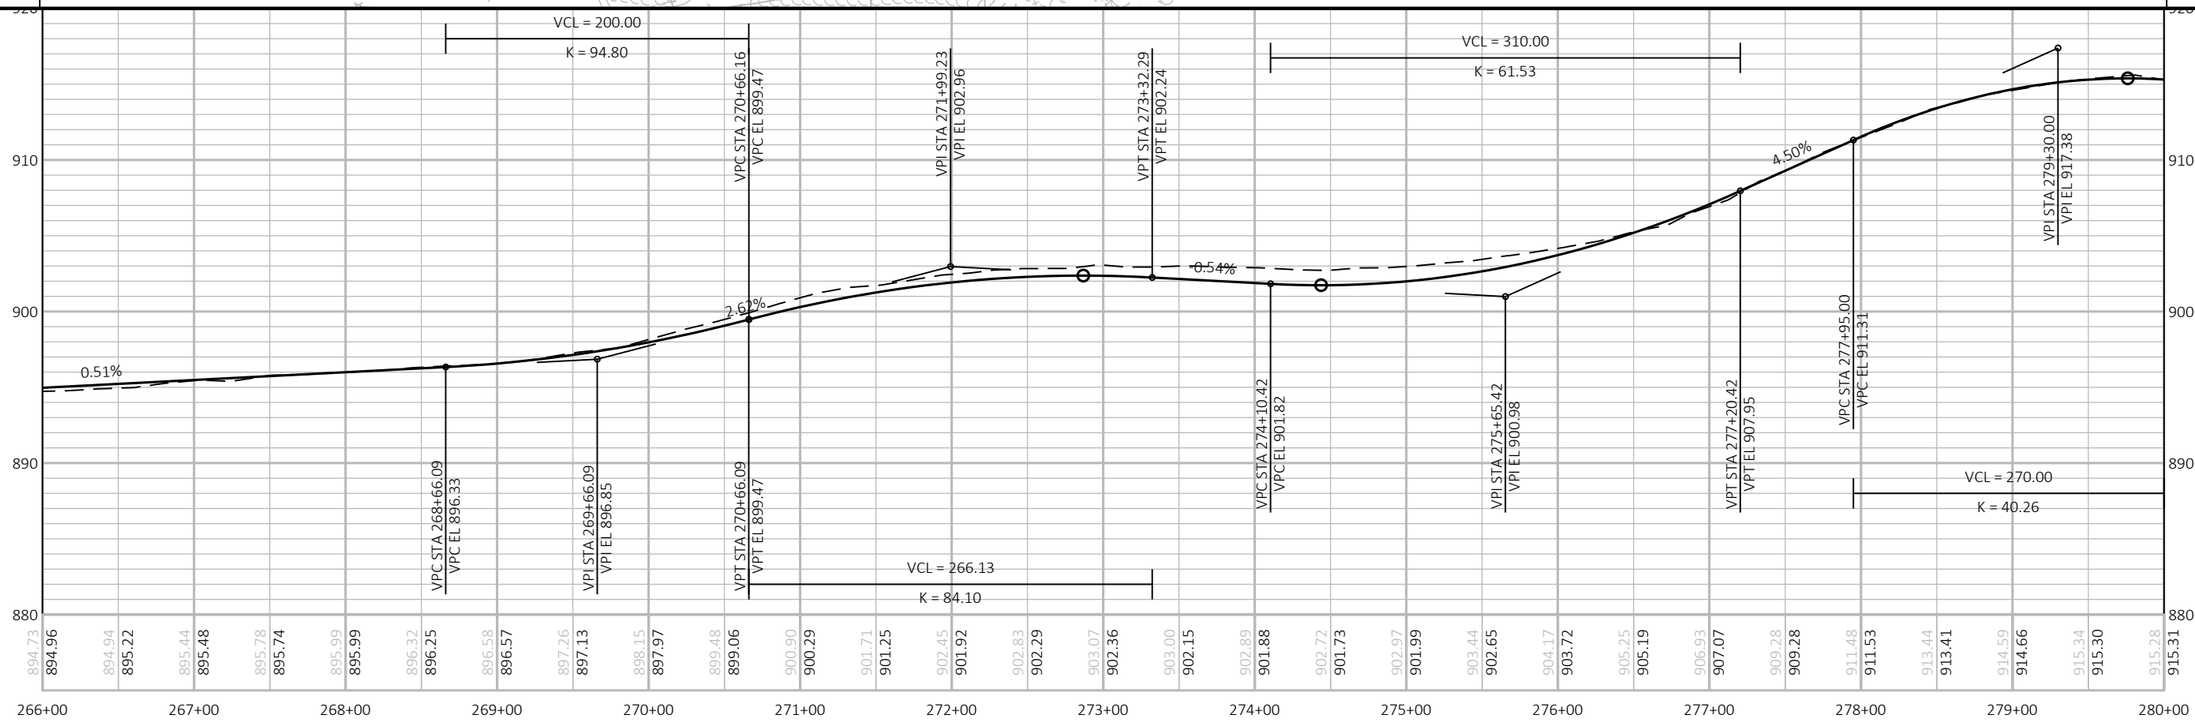

PROJECT NO: 5145-00-71	HWY: STH 19	COUNTY: DANE	PLAN AND PROFILE:	SHEET 30	E

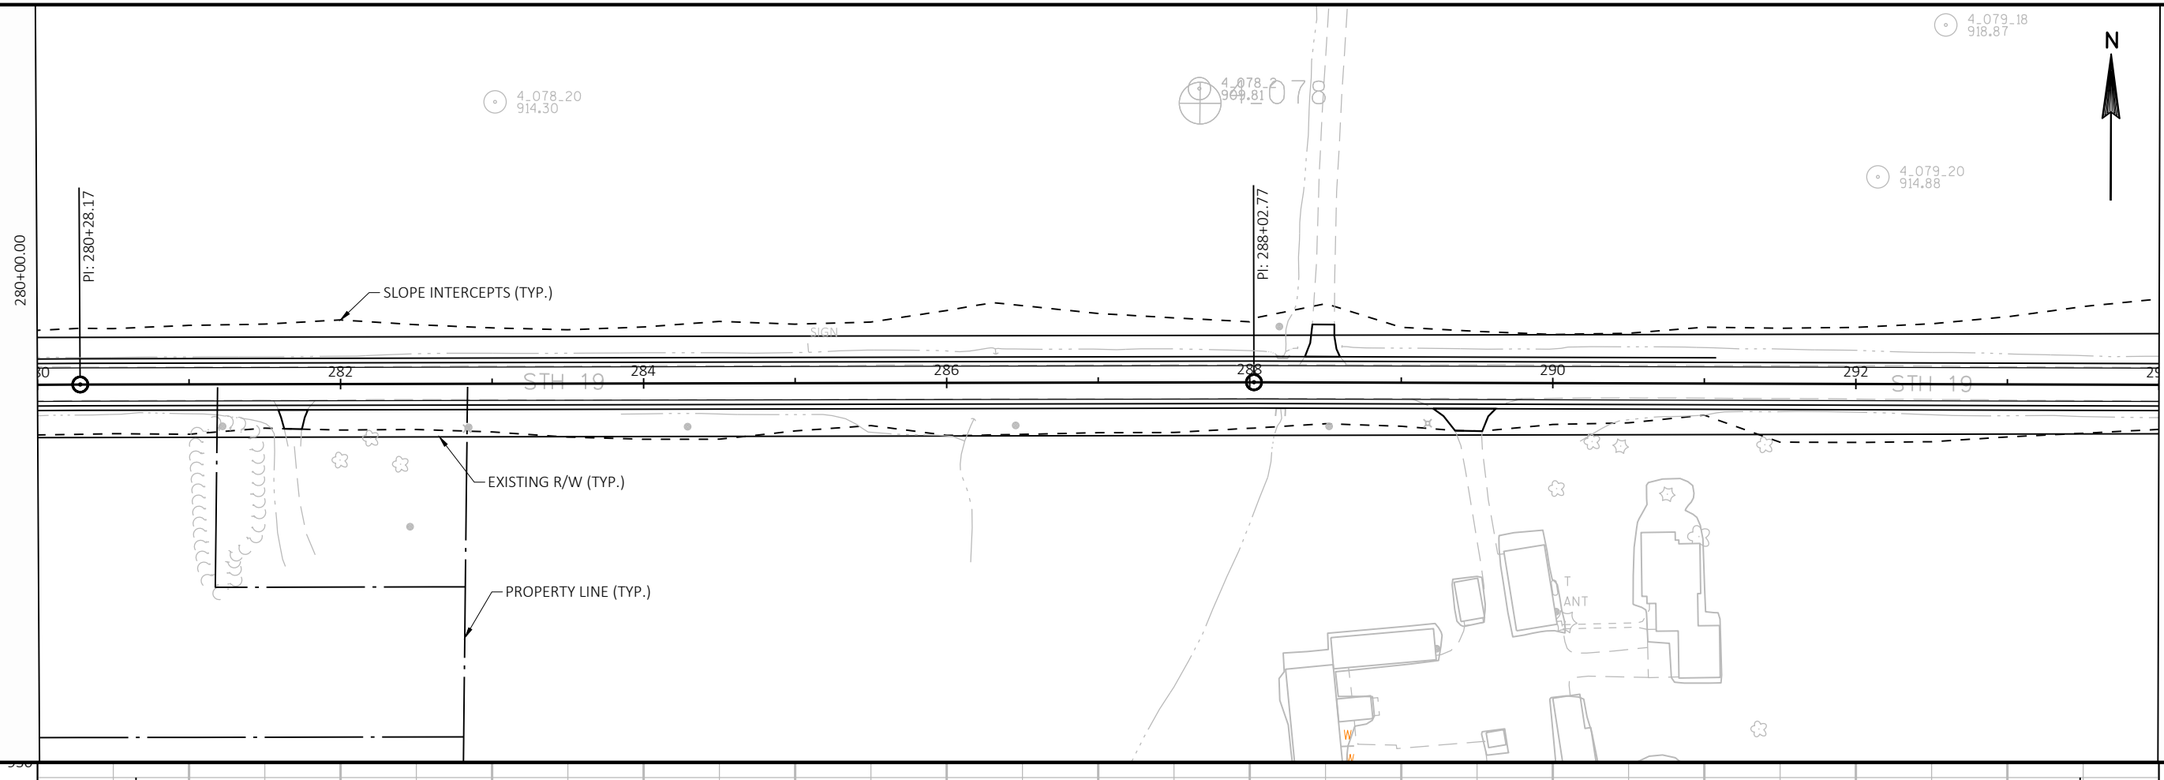

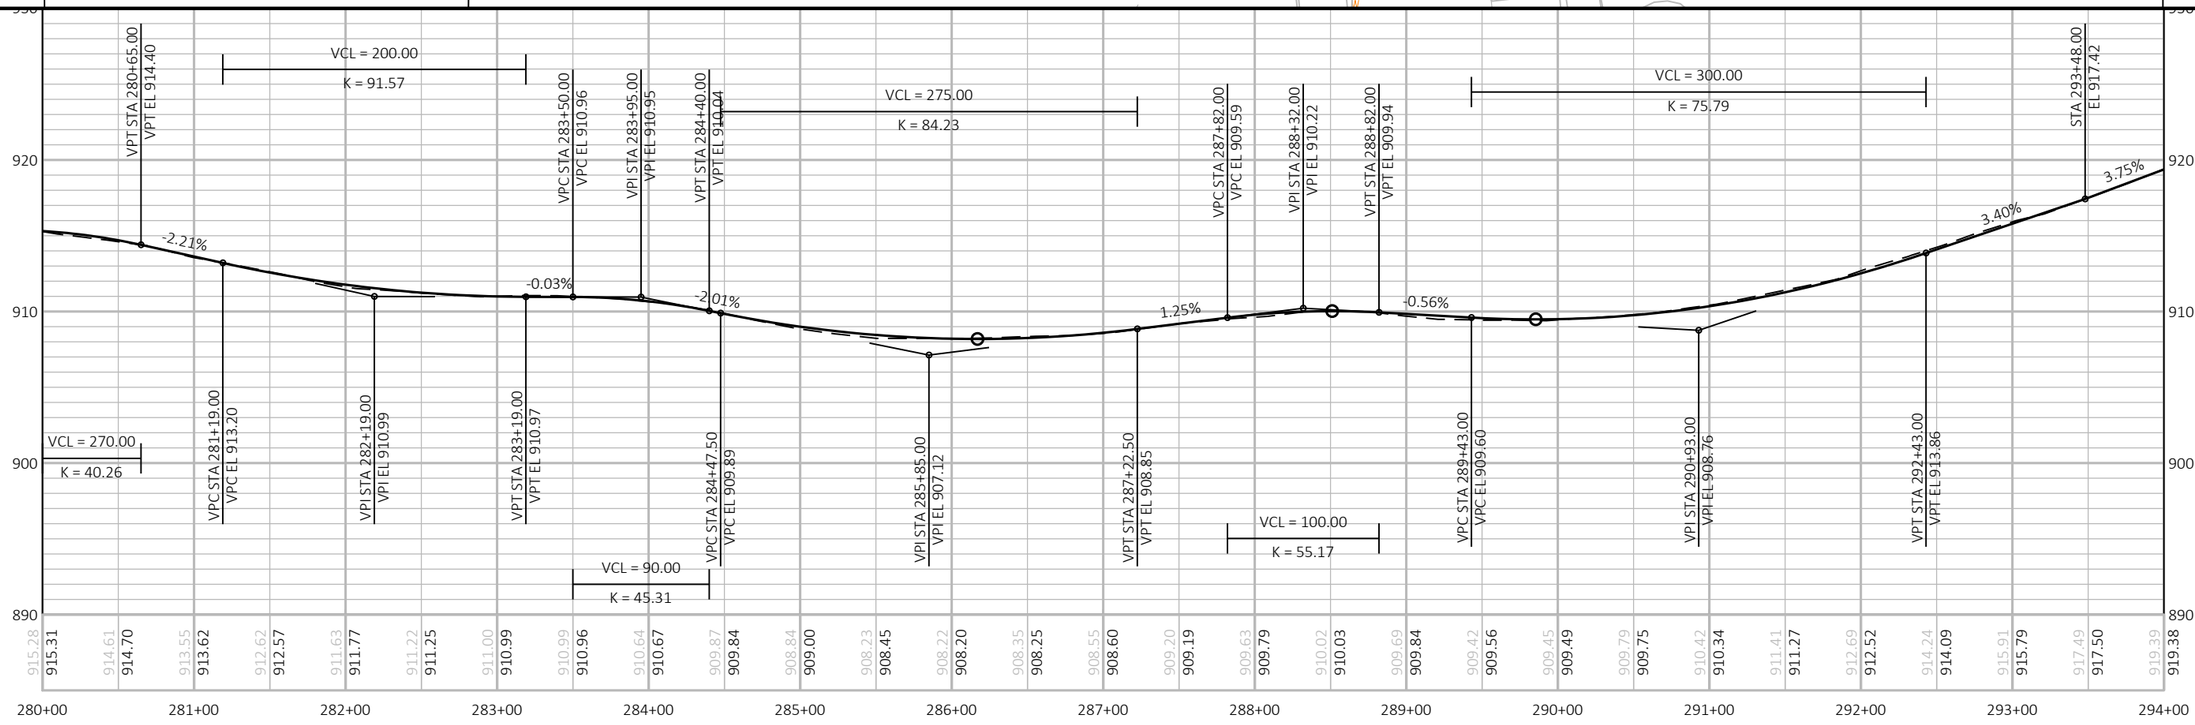

PROJECT NO: 5145-00-71	HWY: STH 19	COUNTY: DANE	PLAN AND PROFILE:	SHEET 31	E

FILE NAME : N:\PDS\C3D\51450001\SHEETSPLAN\050101_PP.DWG
LAYOUT NAME - 050121-pp

PLOT DATE : 6/7/2018 7:34 AM PLOT BY : RACH, JEREMY PAUL PLOT NAME : PLOT SCALE : 1 IN:100 FT

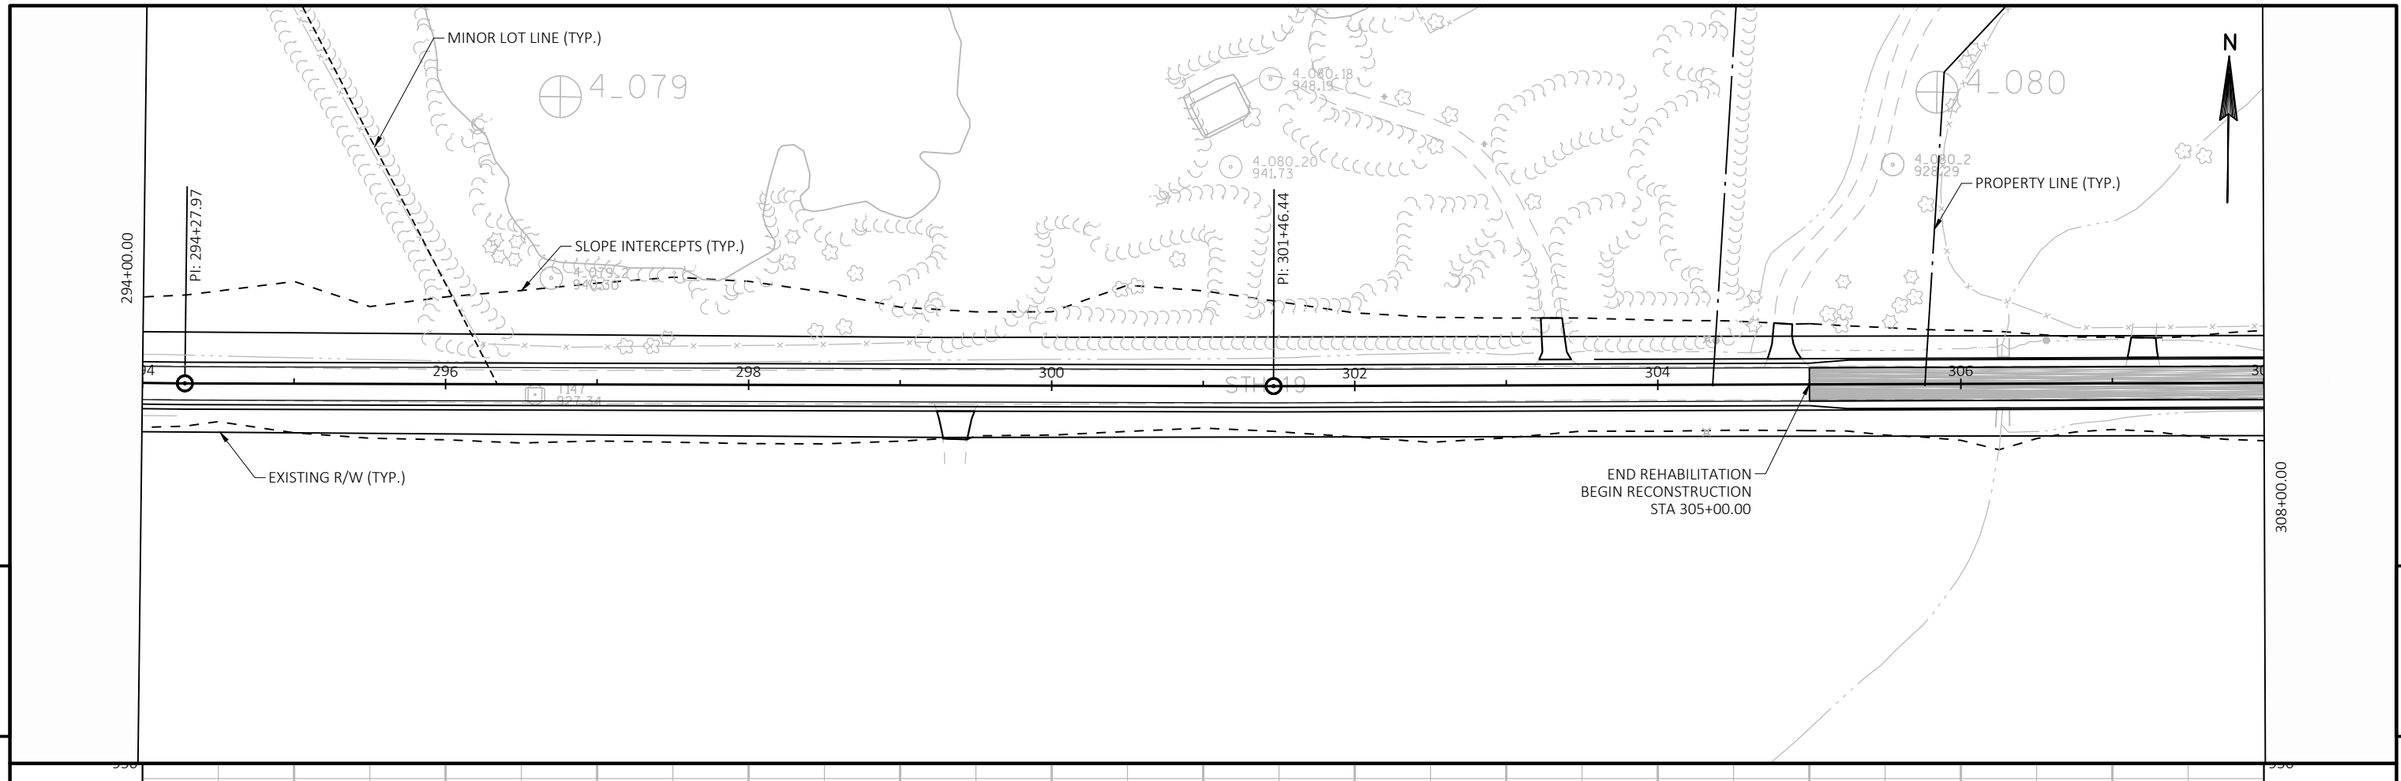

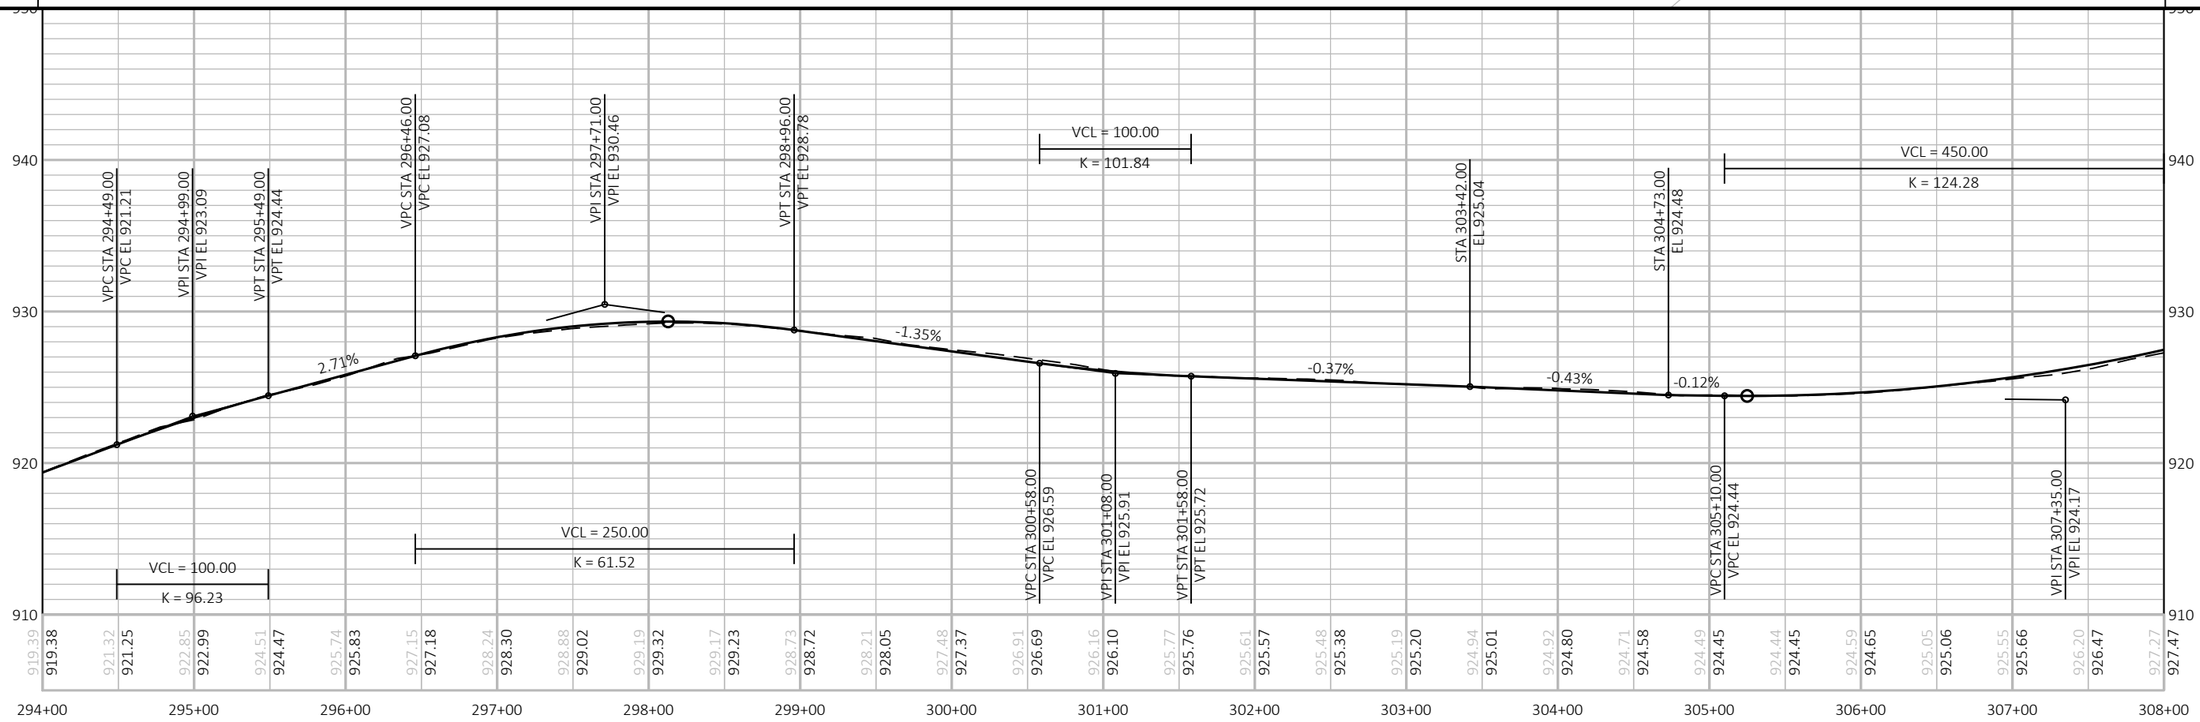

PROJECT NO: 5145-00-71	HWY: STH 19	COUNTY: DANE	PLAN AND PROFILE:	SHEET 32	E

FILE NAME : N:\PDS\C3D\51450001\SHEETSPLAN\050101_PP.DWG
LAYOUT NAME - 050122-pp
PLOT DATE : 6/7/2018 7:34 AM
PLOT BY : RACH, JEREMY PAUL
PLOT NAME :
PLOT SCALE : 1 IN:100 FT

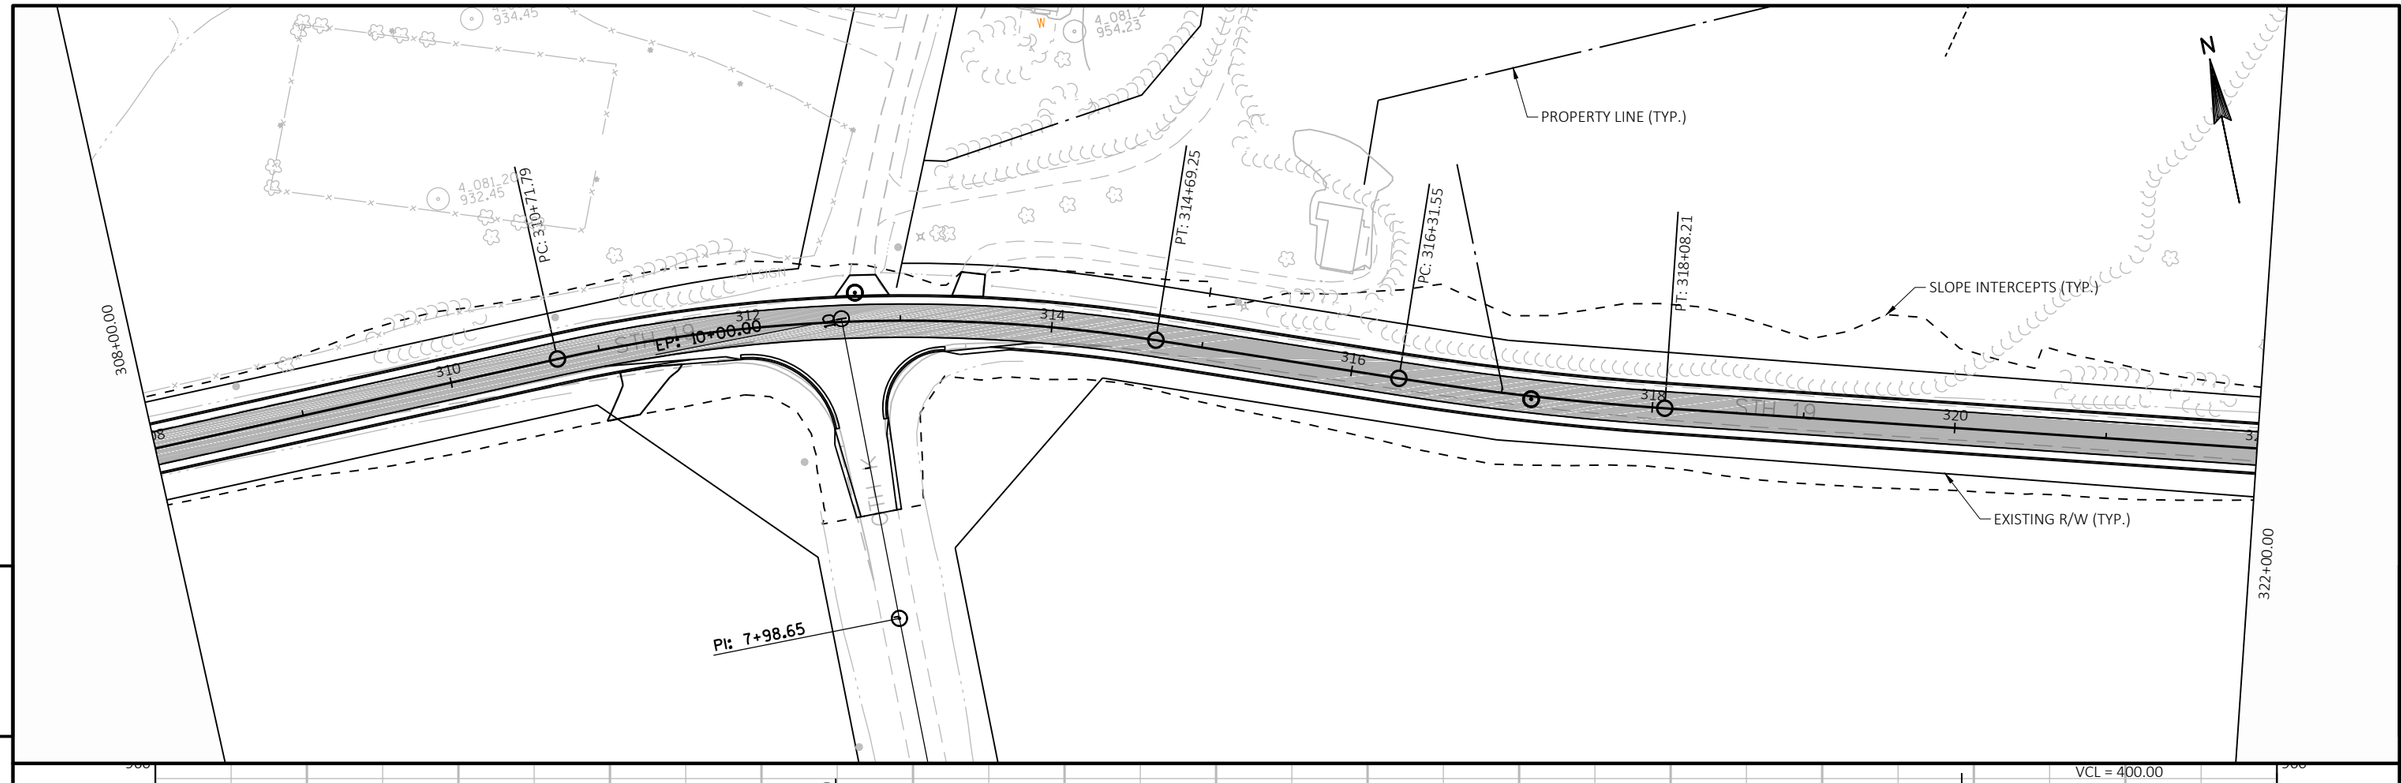

PROJECT NO: 5145-00-71	HWY: STH 19	COUNTY: DANE	PLAN AND PROFILE:	SHEET 33	E

FILE NAME : N:\PDS\C3D\51450001\SHEETSPLAN\050101_PP.DWG
LAYOUT NAME - 050123-pp

PLOT DATE : 6/7/2018 7:35 AM PLOT BY : RACH, JEREMY PAUL PLOT NAME : PLOT SCALE : 1 IN:100 FT

WISDOT/CADDS SHEET 44

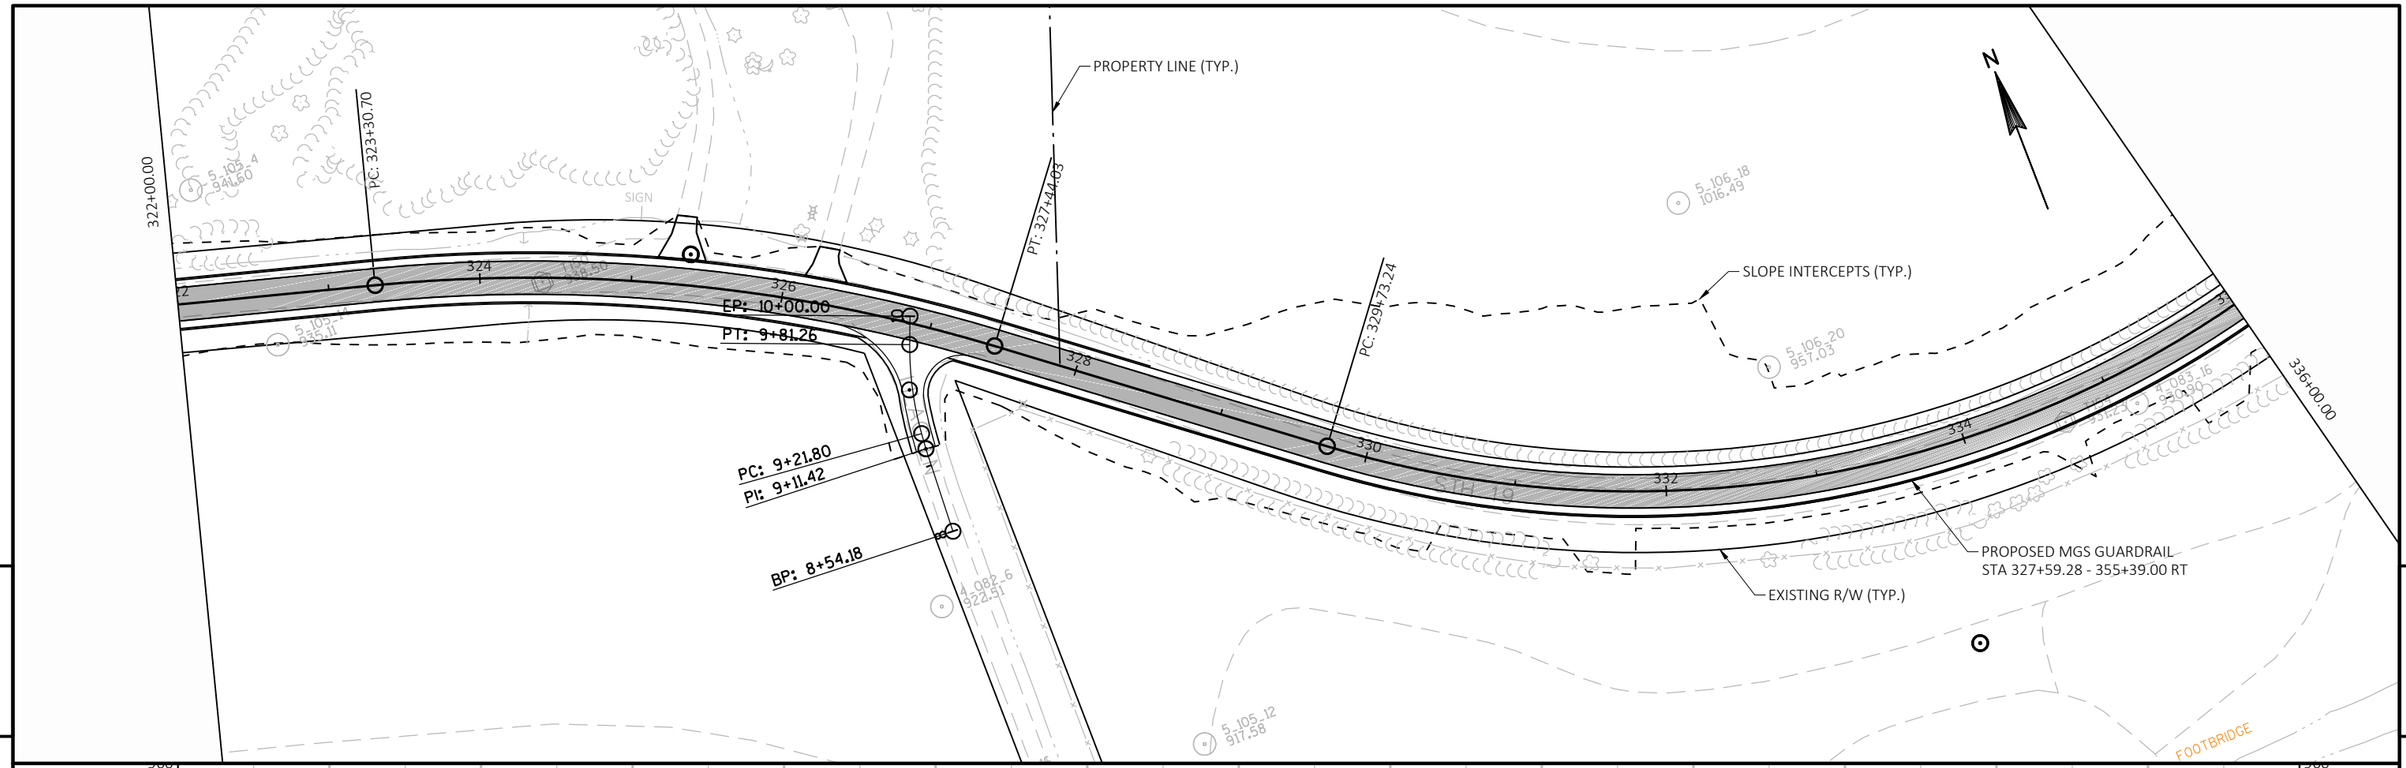

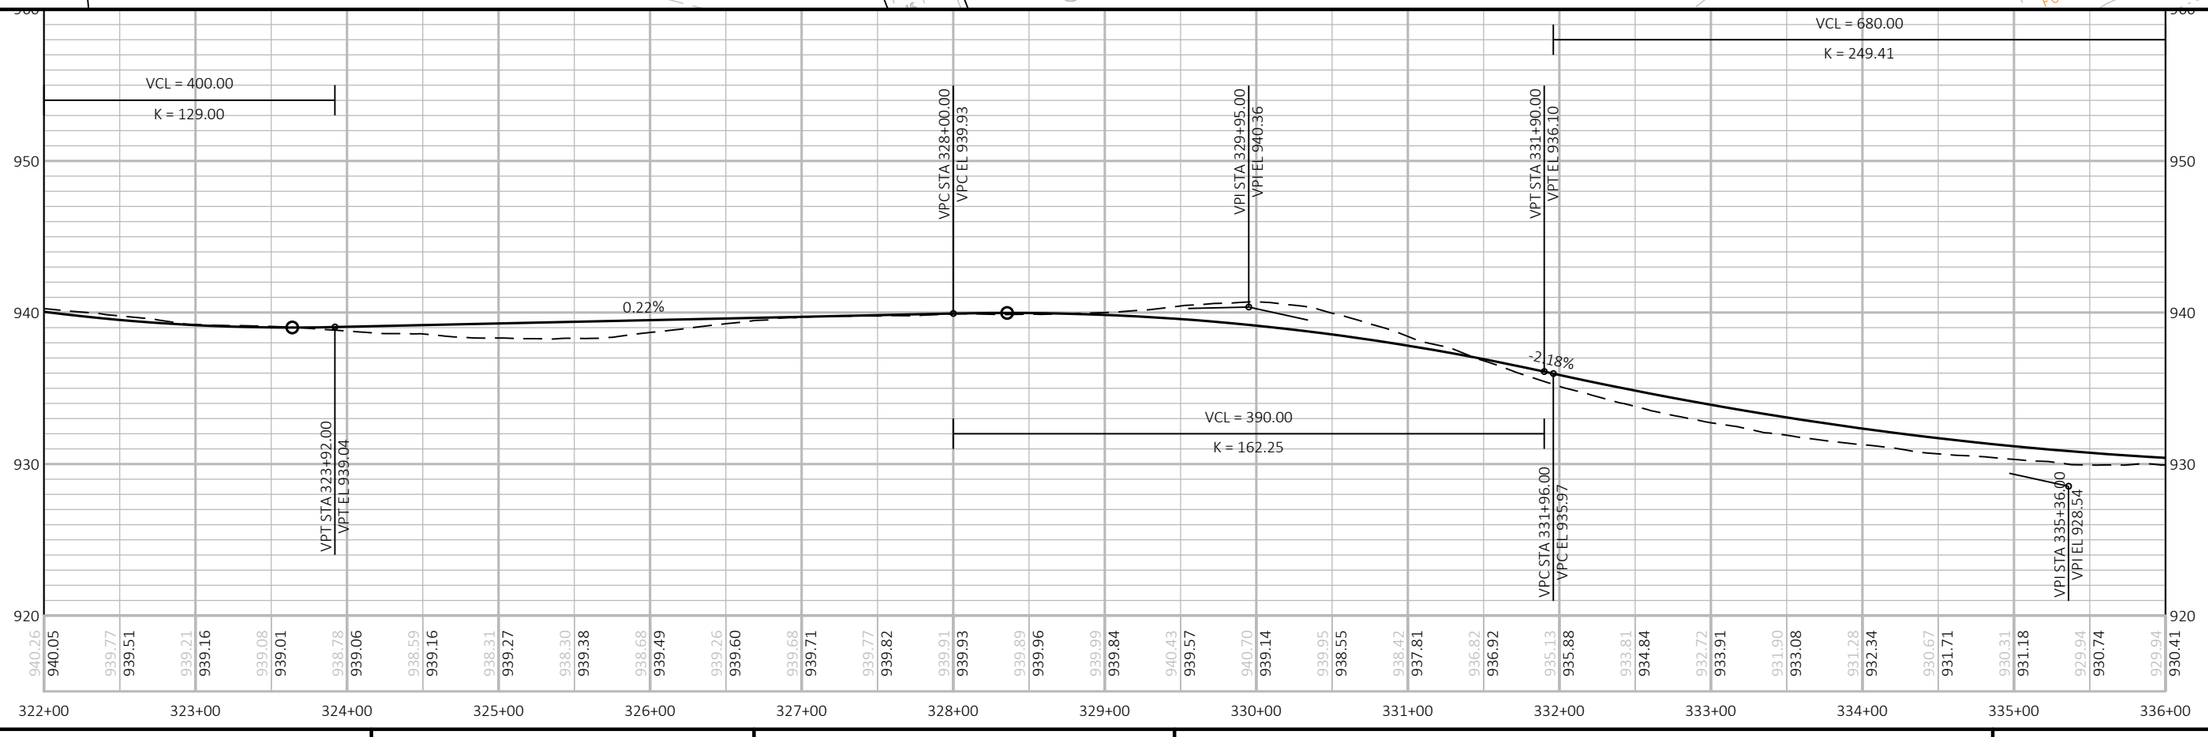

PROJECT NO: 5145-00-71	HWY: STH 19	COUNTY: DANE	PLAN AND PROFILE:	SHEET 34	E

FILE NAME : N:\PDS\C3D\51450001\SHEETSPLAN\050101_PP.DWG
LAYOUT NAME - 050124-pp
PLOT DATE : 6/7/2018 7:35 AM
PLOT BY : RACH, JEREMY PAUL
PLOT NAME :
PLOT SCALE : 1 IN:100 FT

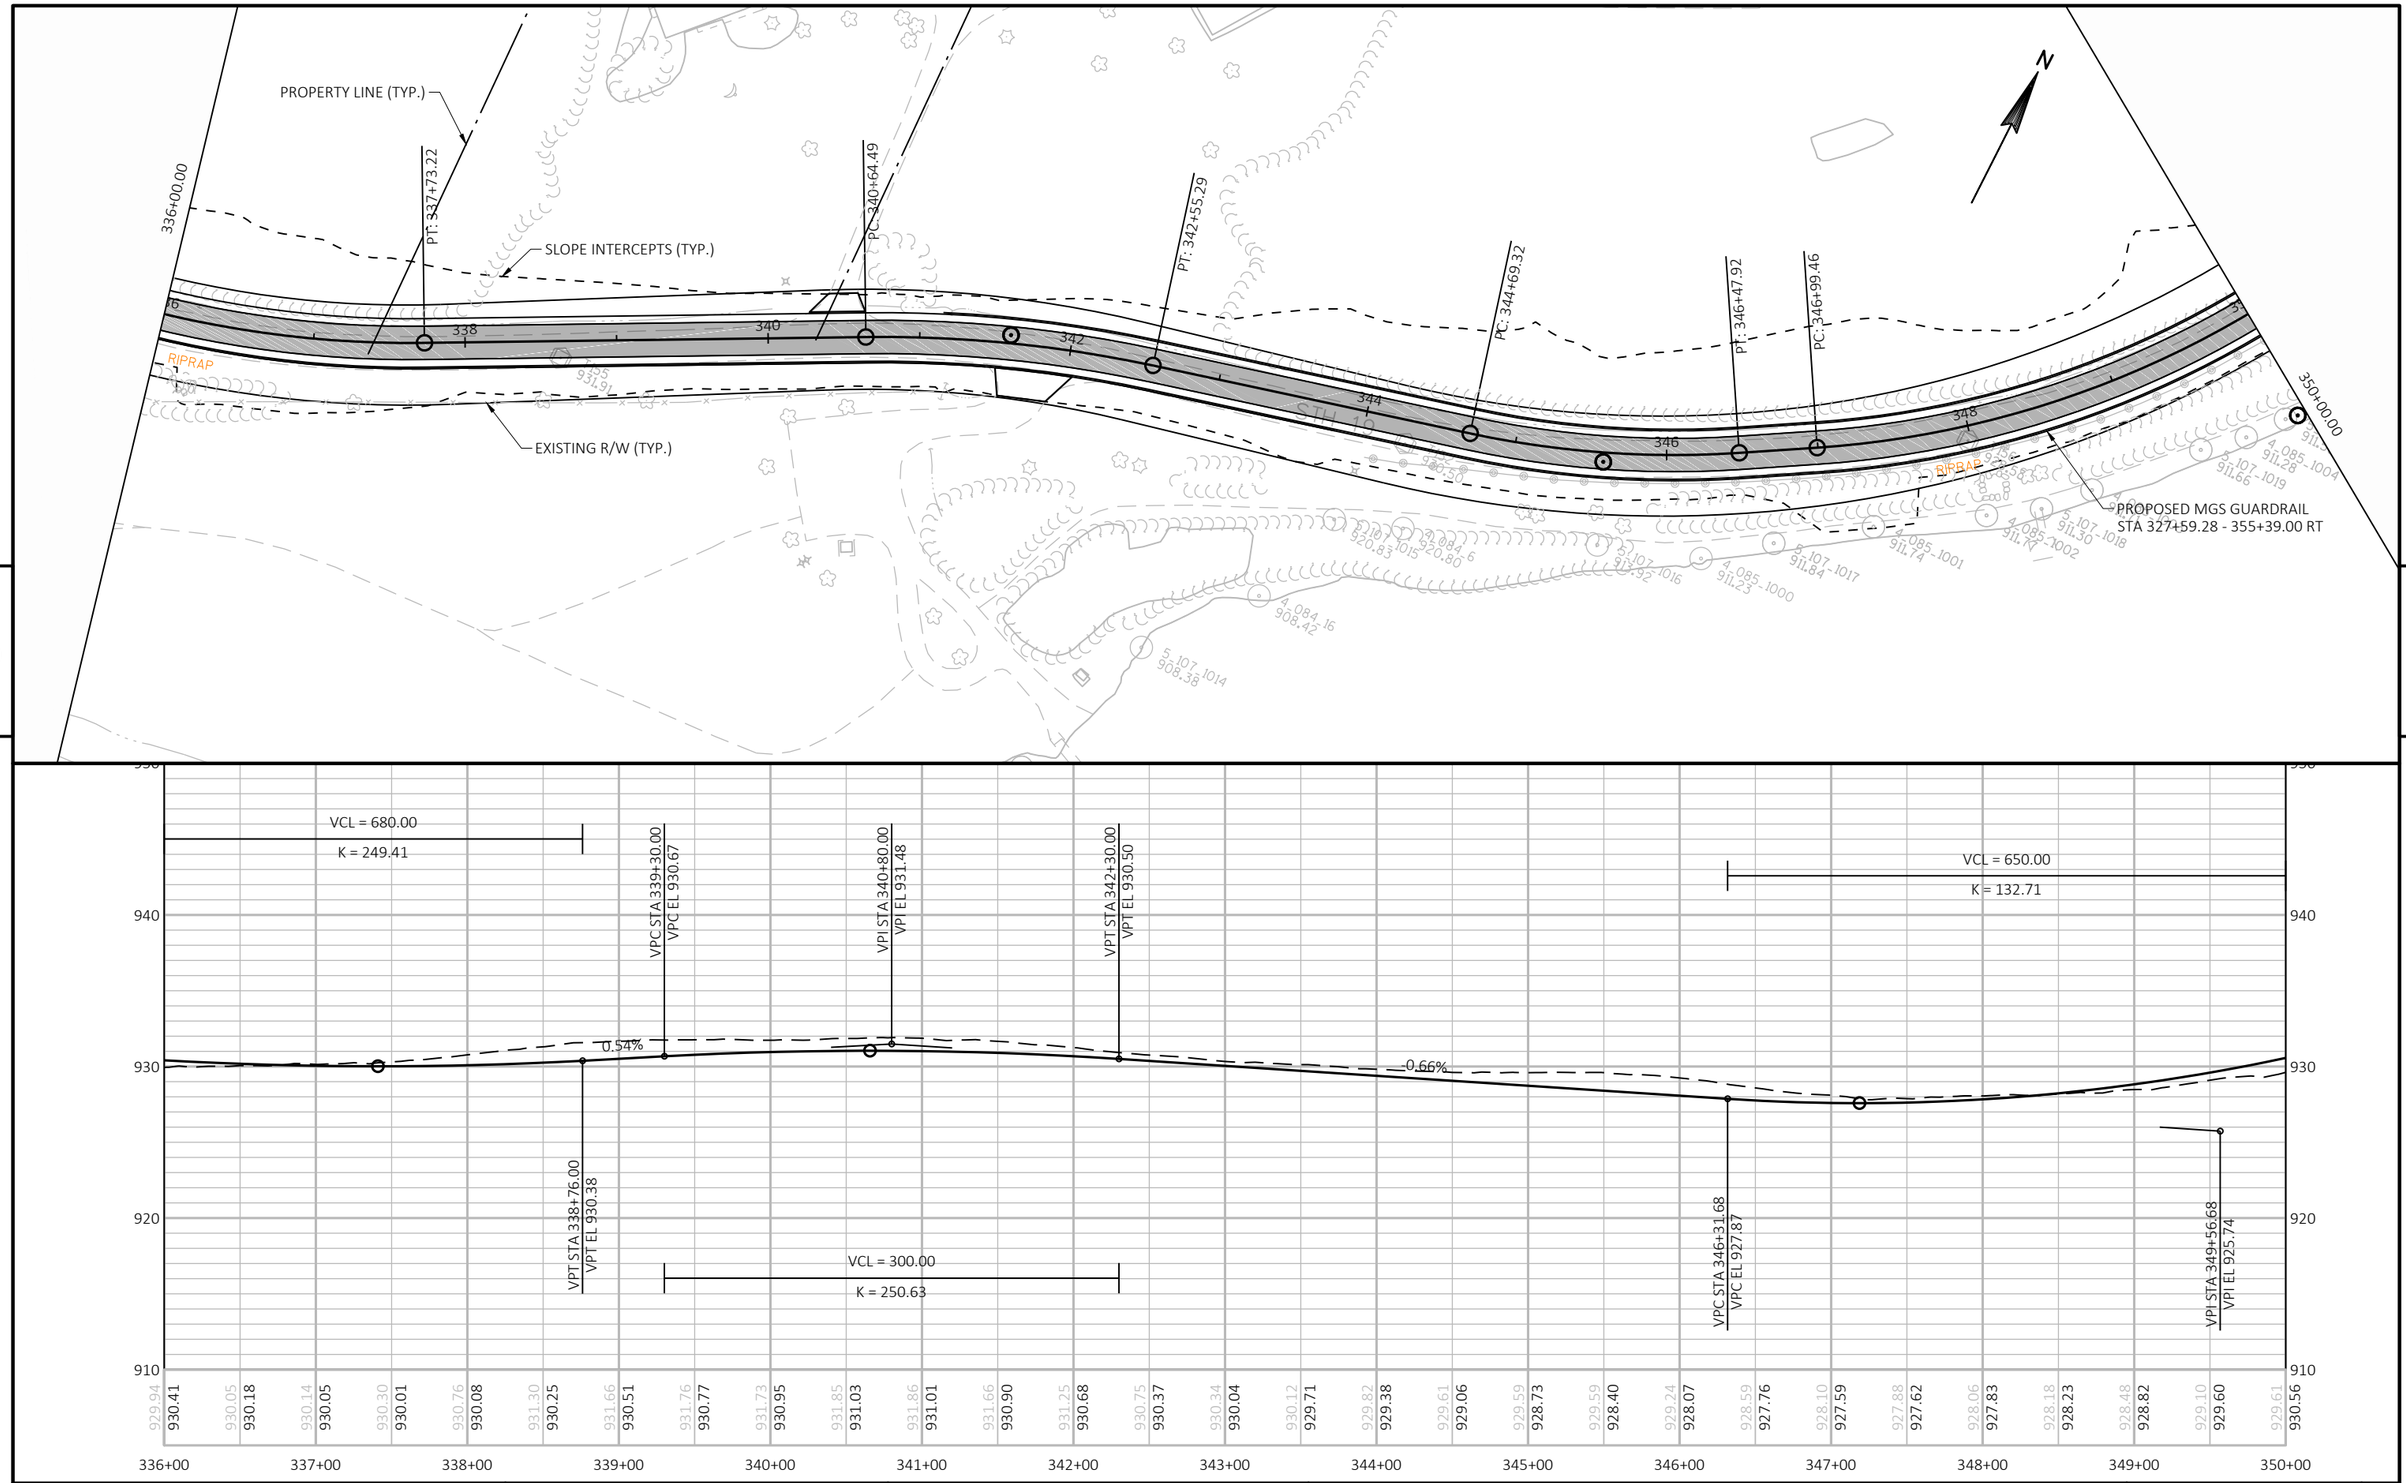

PROJECT NO: 5145-00-71	HWY: STH 19	COUNTY: DANE	PLAN AND PROFILE:	SHEET 35	E

FILE NAME : N:\PDS\C3D\51450001\SHEETSPLAN\050101_PP.DWG
LAYOUT NAME - 050125-pp

PLOT DATE : 6/7/2018 7:35 AM PLOT BY : RACH, JEREMY PAUL PLOT NAME : PLOT SCALE : 1 IN:100 FT

WISDOT/CADDS SHEET 44

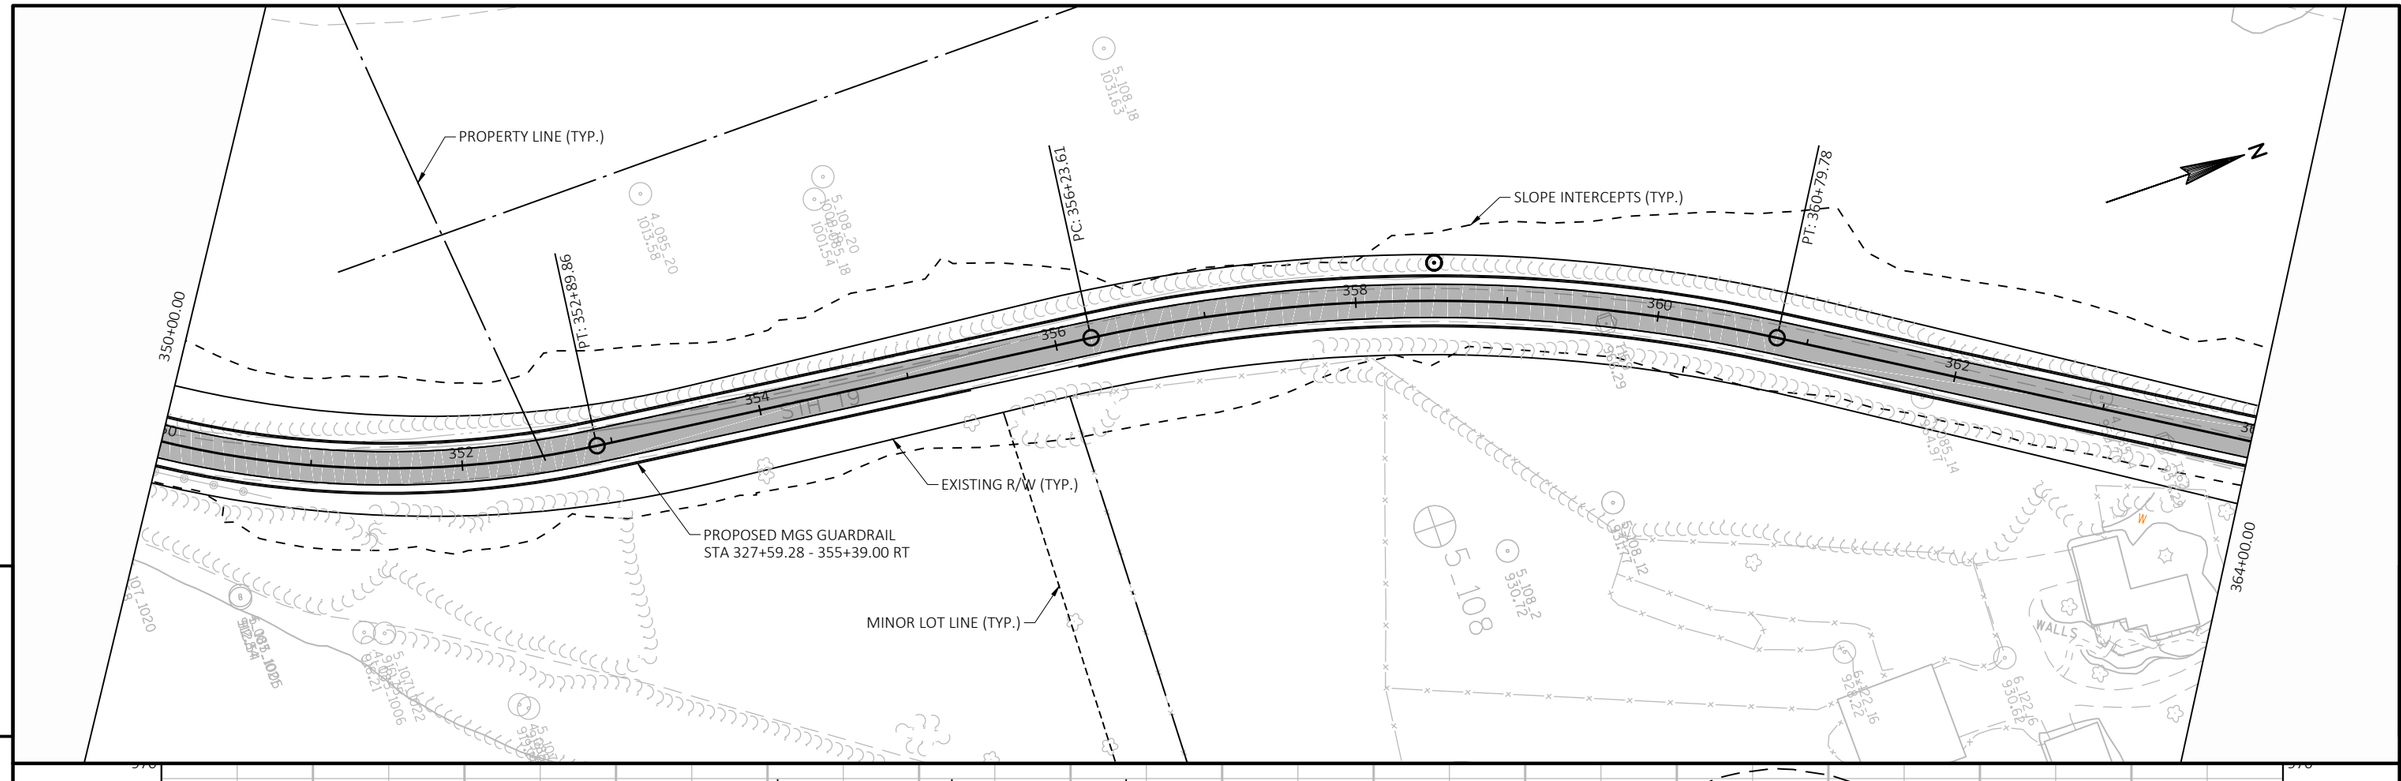

PROJECT NO: 5145-00-71	HWY: STH 19	COUNTY: DANE	PLAN AND PROFILE:	SHEET 36	E

FILE NAME : N:\PDS\C3D\51450001\SHEETSPLAN\050101_PP.DWG
LAYOUT NAME - 050126-pp

PLOT DATE : 6/7/2018 7:35 AM PLOT BY : RACH, JEREMY PAUL PLOT NAME : PLOT SCALE : 1 IN:100 FT

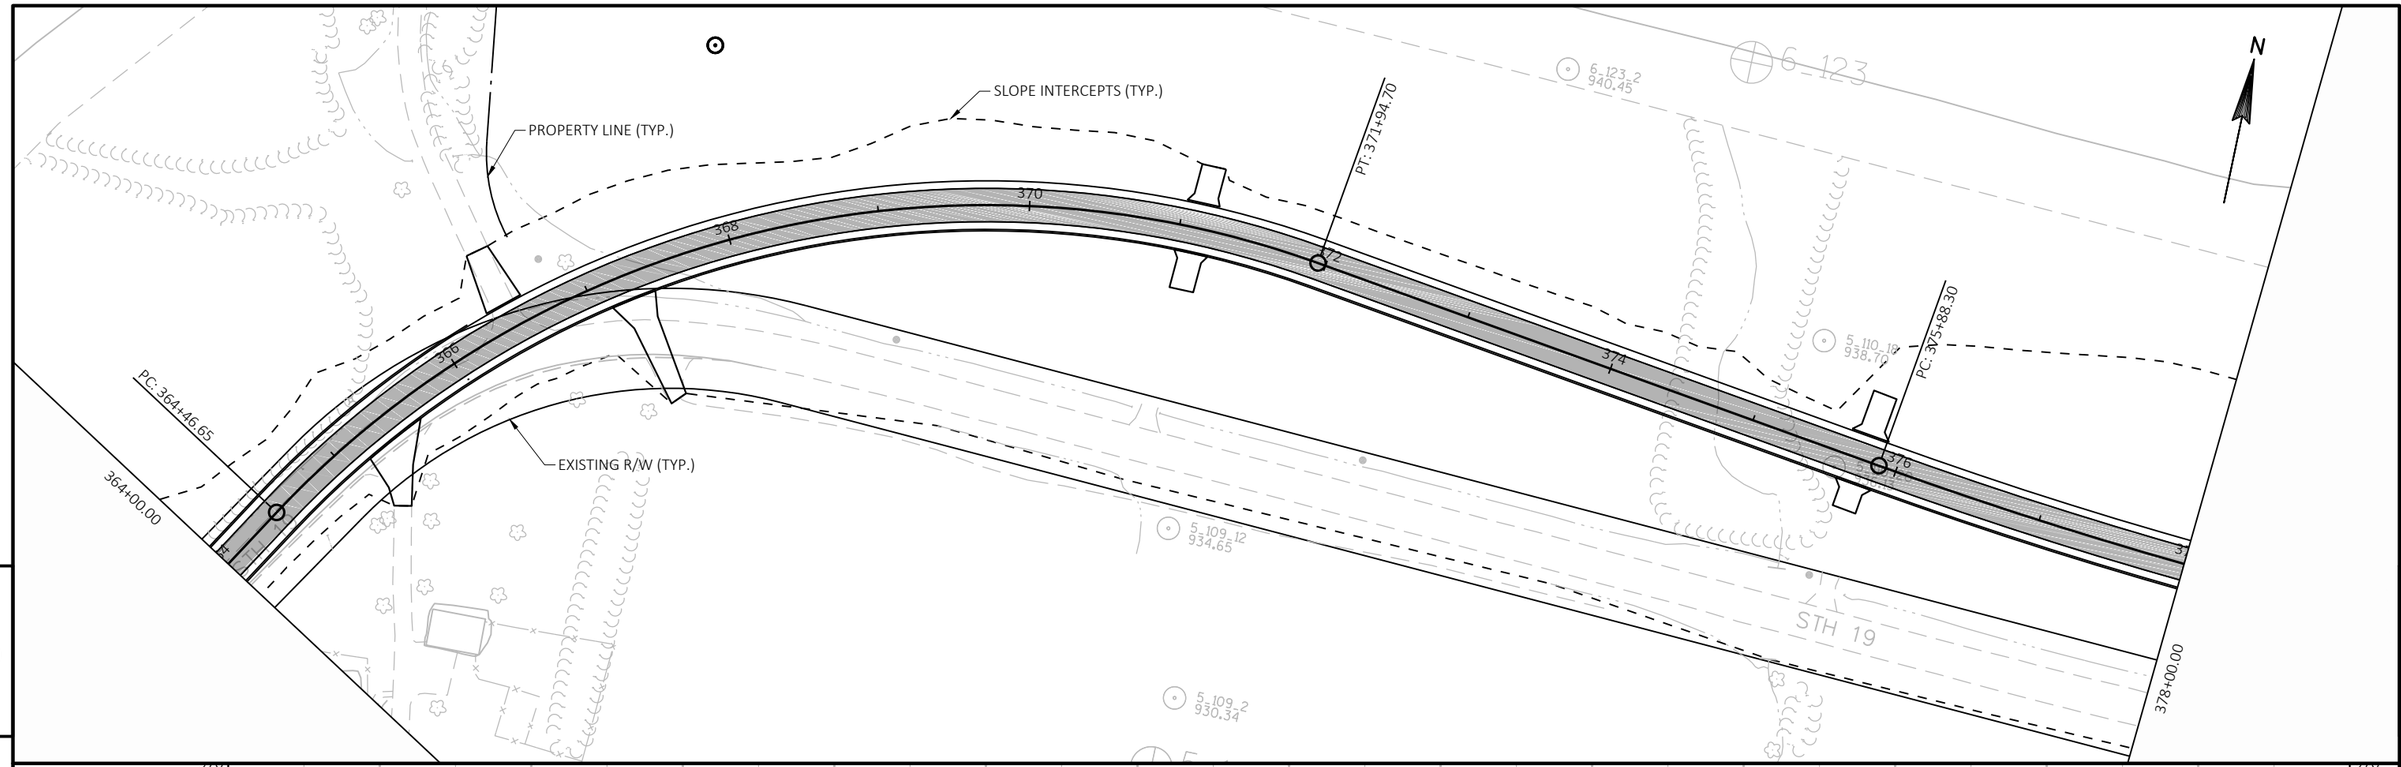

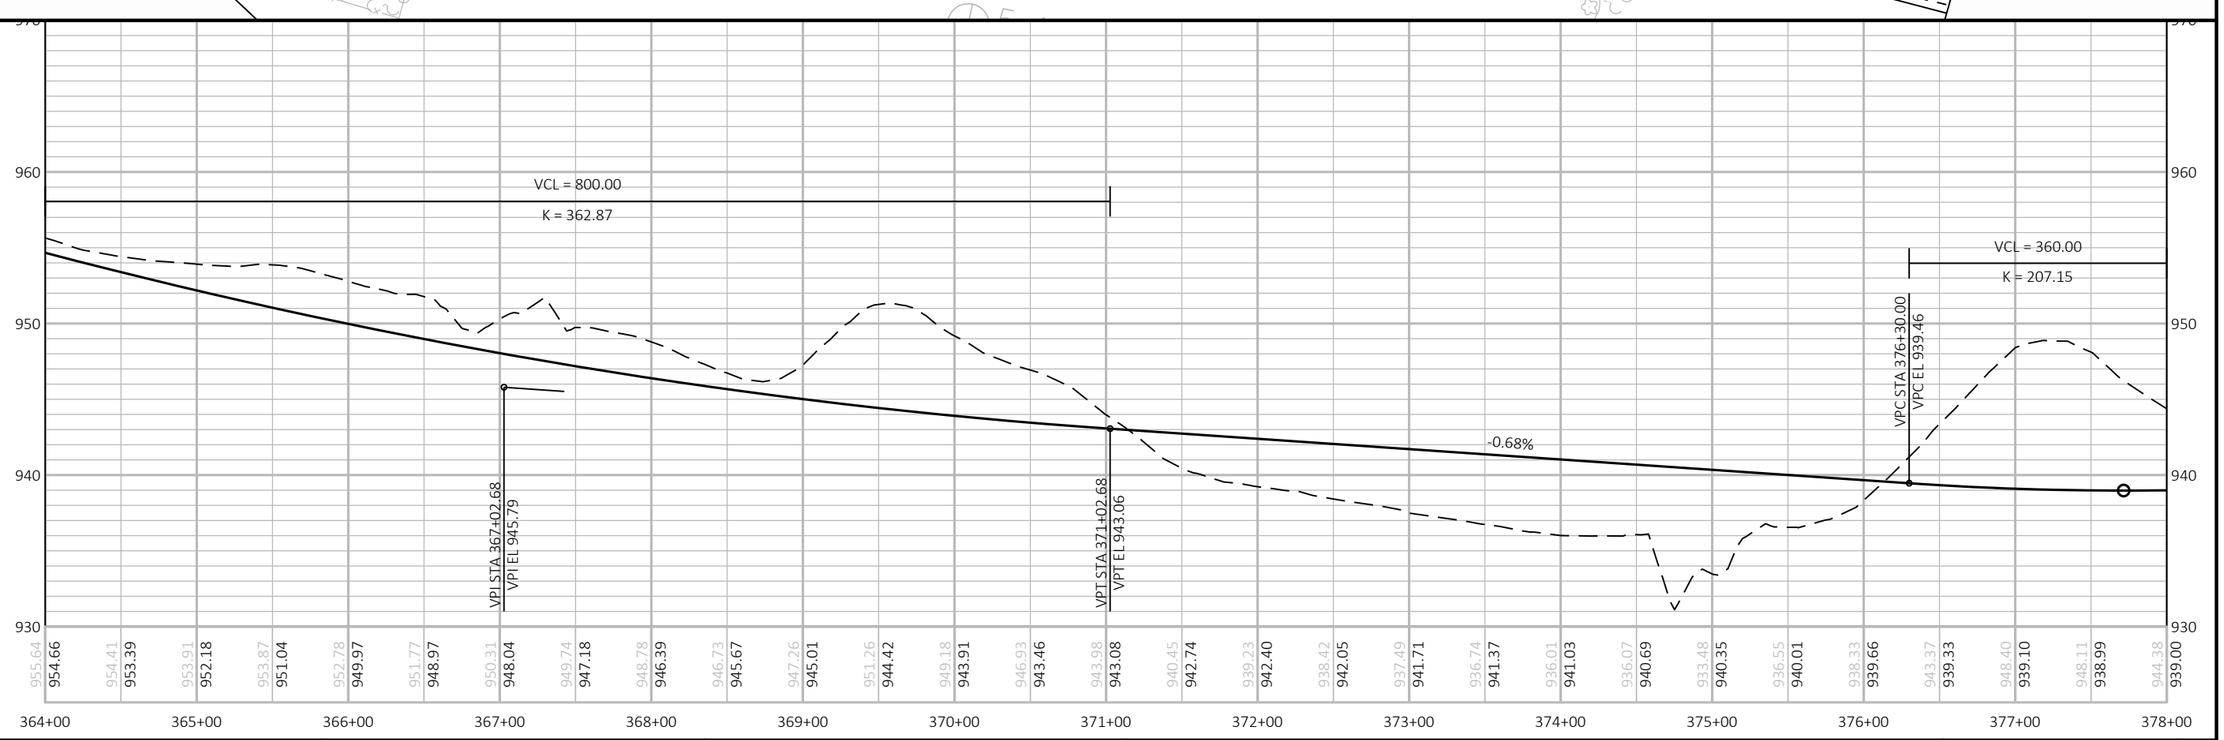

PROJECT NO: 5145-00-71	HWY: STH 19	COUNTY: DANE	PLAN AND PROFILE:	SHEET 37	E

FILE NAME : N:\PDS\C3D\51450001\SHEETSPLAN\050101_PP.DWG
LAYOUT NAME - 050127-pp

PLOT DATE : 6/7/2018 7:36 AM PLOT BY : RACH, JEREMY PAUL PLOT NAME : PLOT SCALE : 1 IN:100 FT

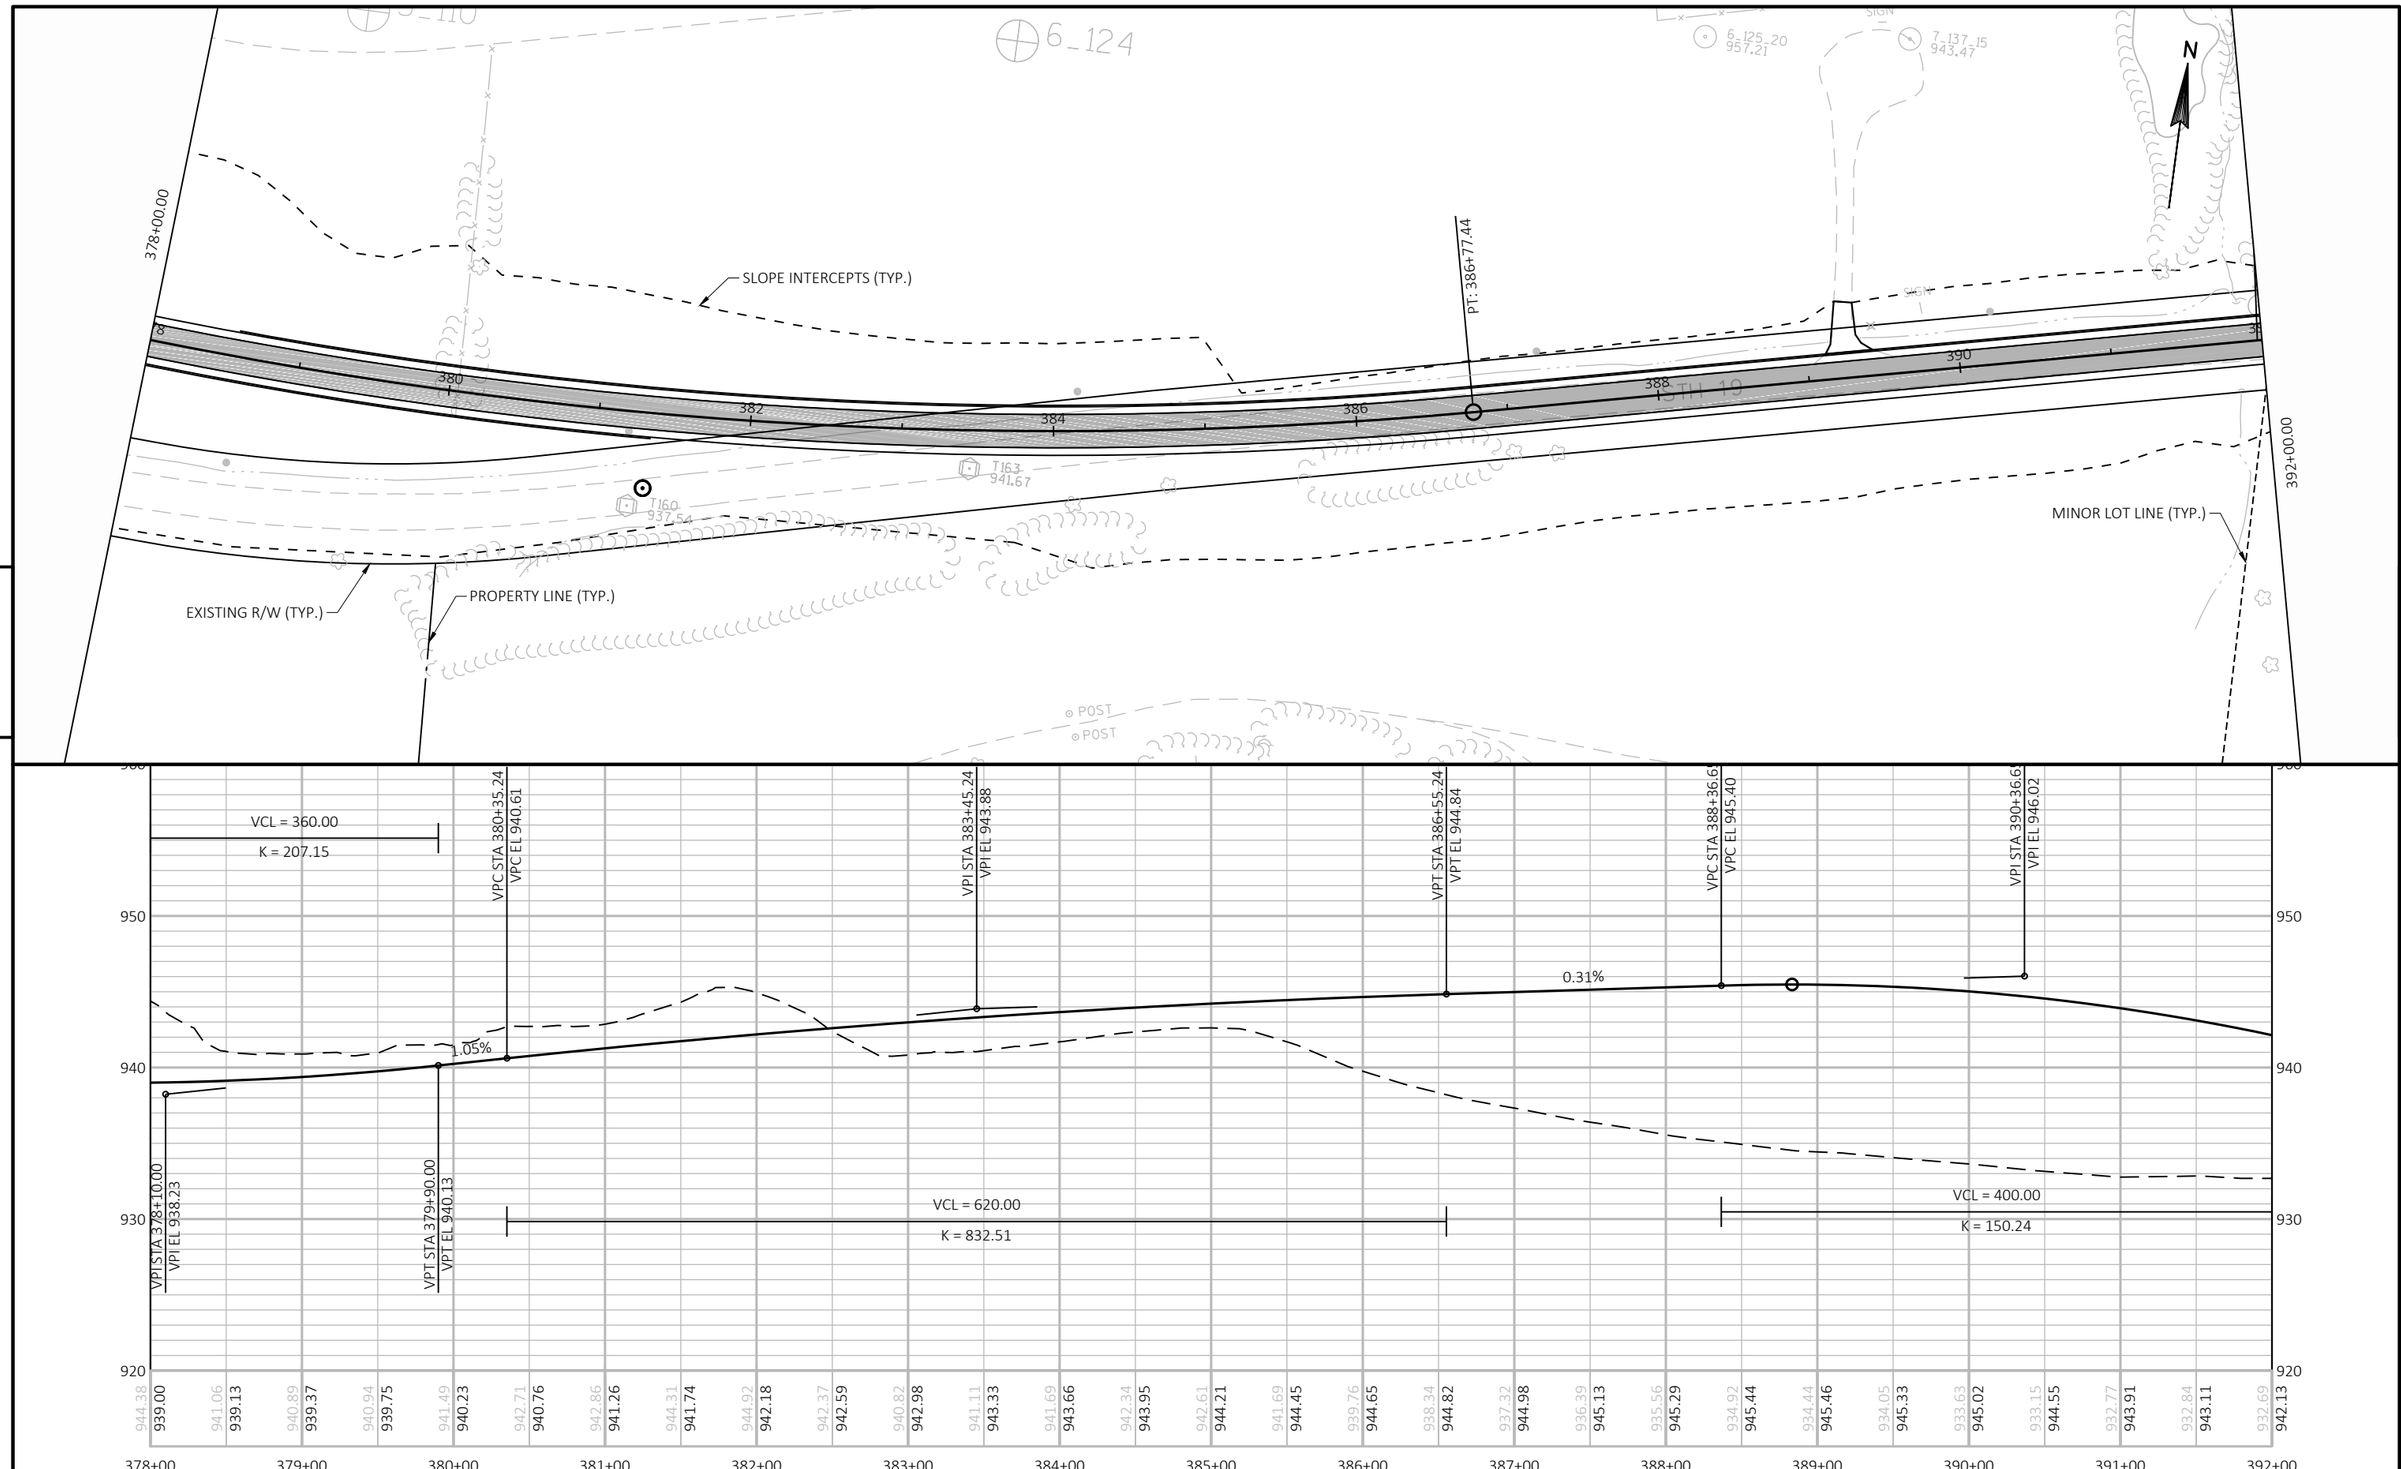

PROJECT NO: 5145-00-71	HWY: STH 19	COUNTY: DANE	PLAN AND PROFILE:	SHEET 38	E

FILE NAME : N:\PDS\C3D\51450001\SHEETSPLAN\050101_PP.DWG
LAYOUT NAME - 050128-pp
PLOT DATE : 6/7/2018 7:36 AM
PLOT BY : RACH, JEREMY PAUL
PLOT NAME :
PLOT SCALE : 1 IN:100 FT
WISDOT/CADDS SHEET 44

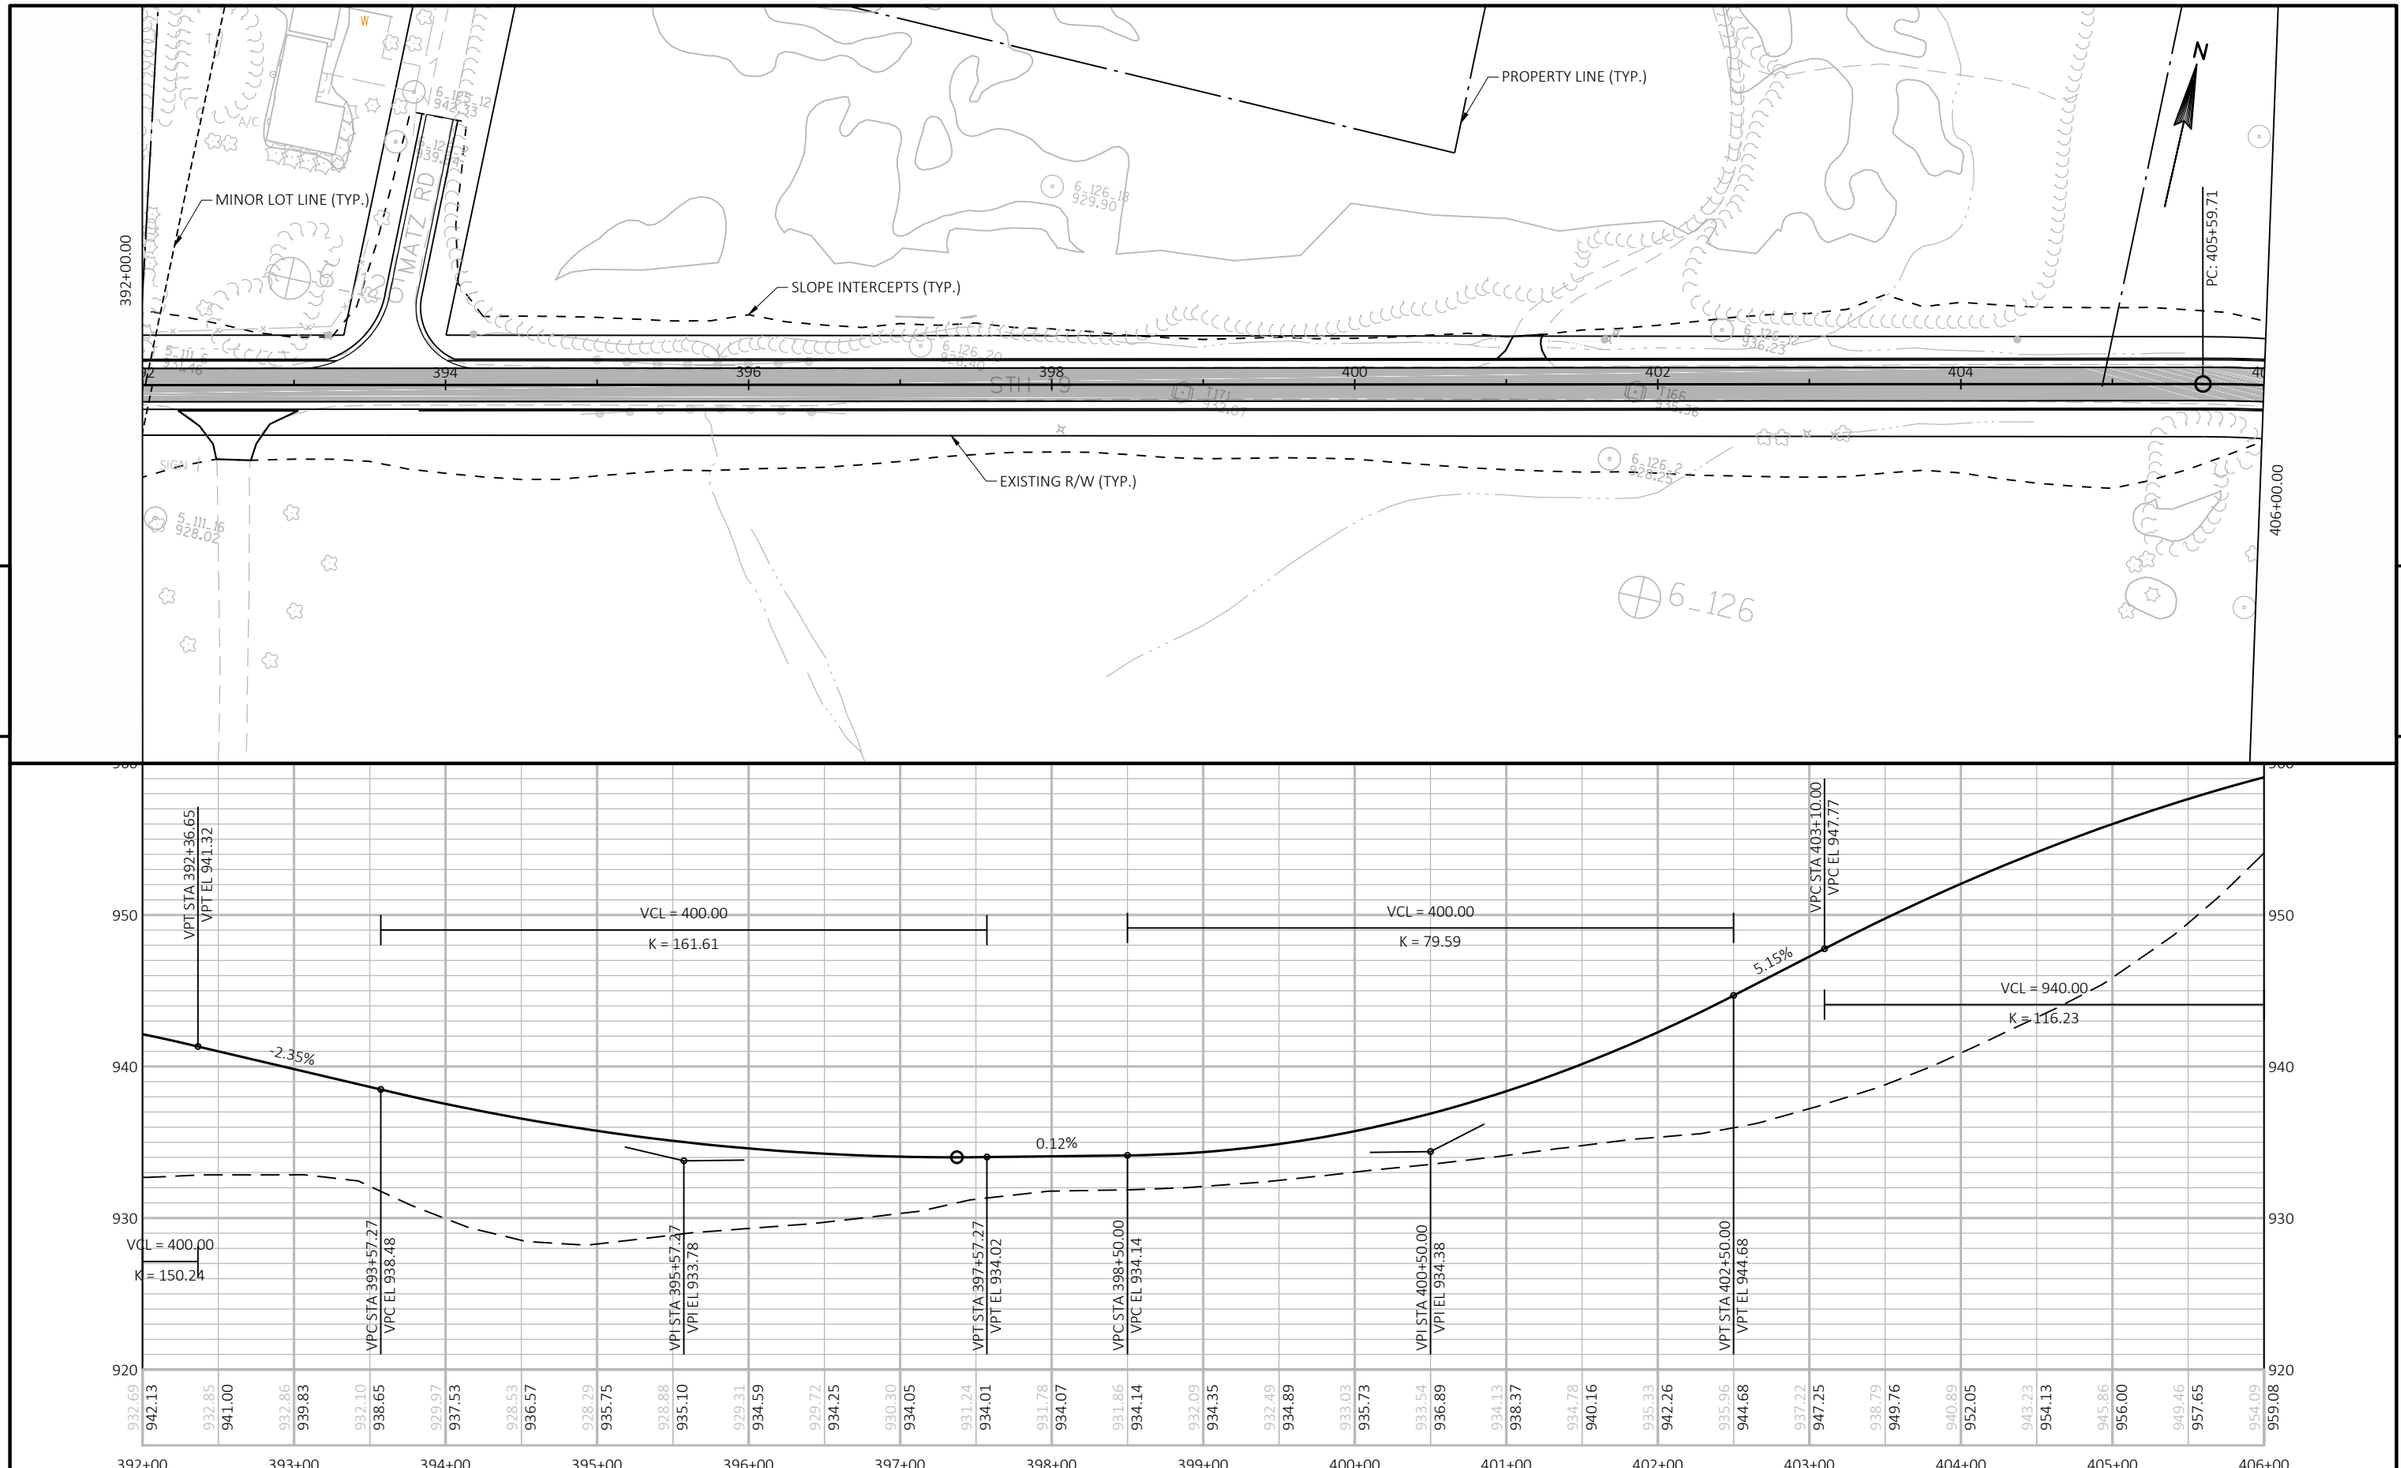

PROJECT NO: 5145-00-71	HWY: STH 19	COUNTY: DANE	PLAN AND PROFILE:	SHEET 39	E

FILE NAME : N:\PDS\C3D\51450001\SHEETSPLAN\050101_PP.DWG
LAYOUT NAME - 050129-pp

PLOT DATE : 6/7/2018 7:36 AM PLOT BY : RACH, JEREMY PAUL PLOT NAME : PLOT SCALE : 1 IN:100 FT

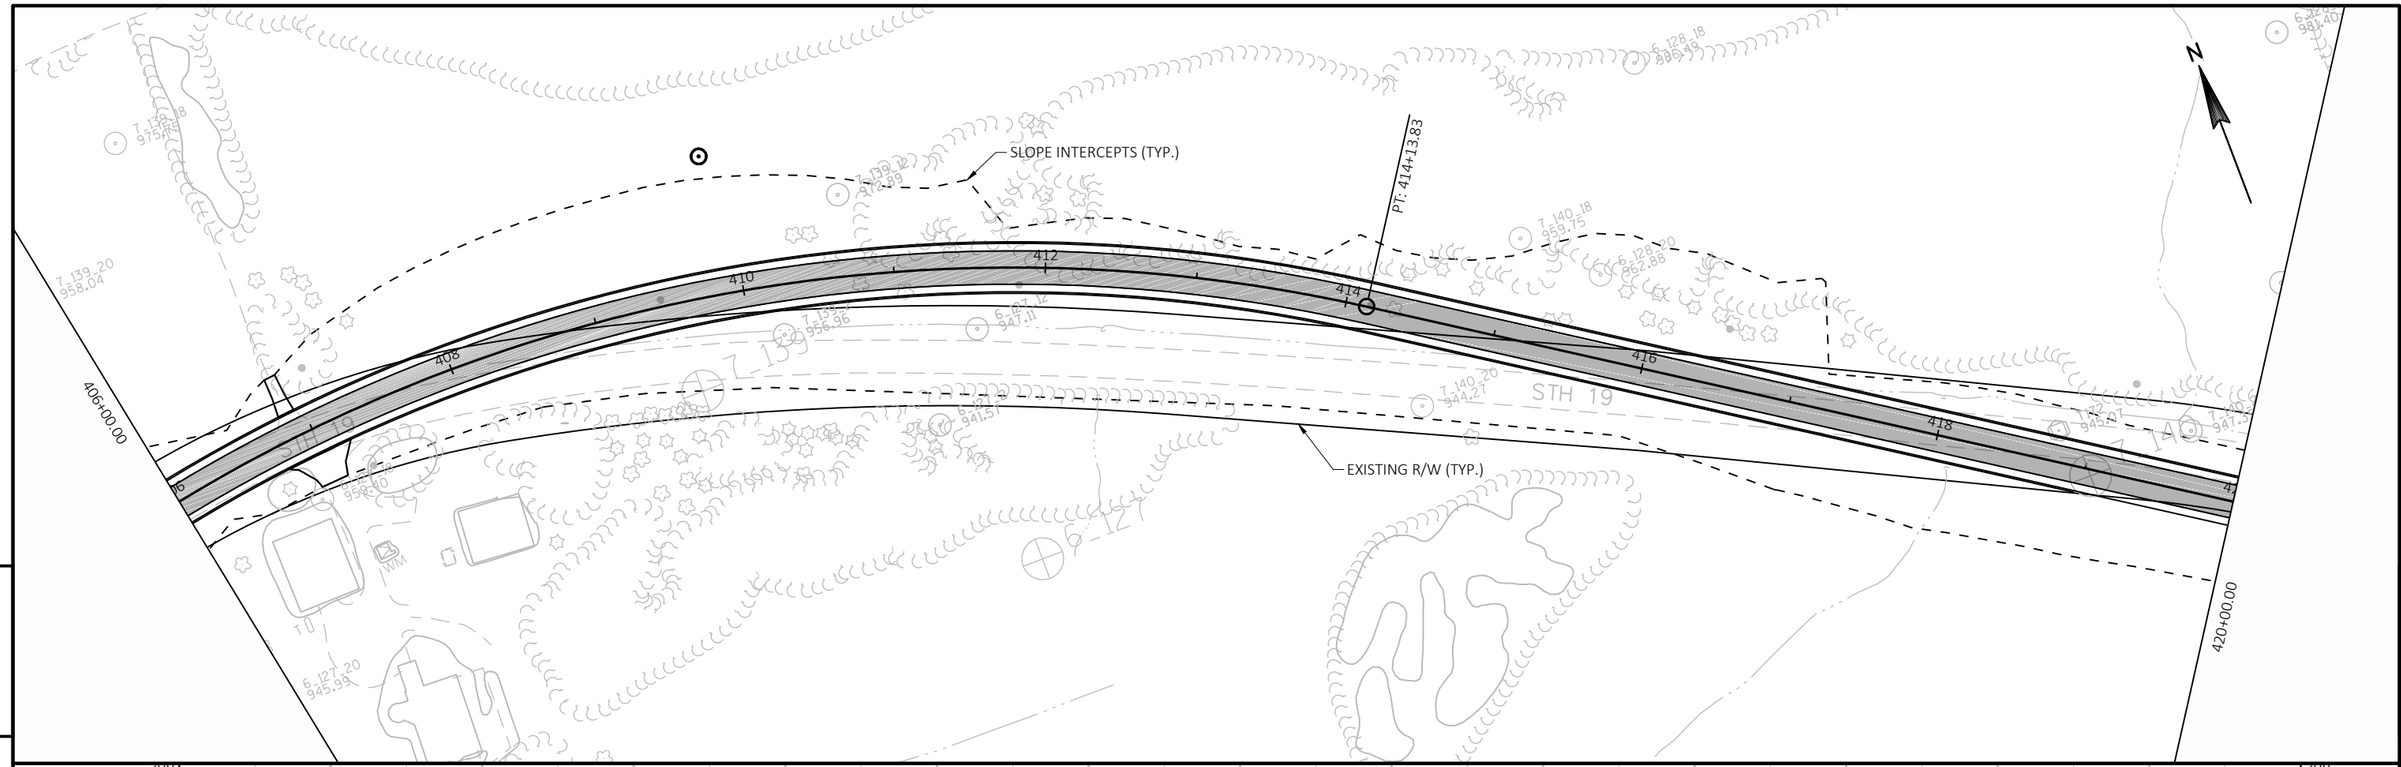

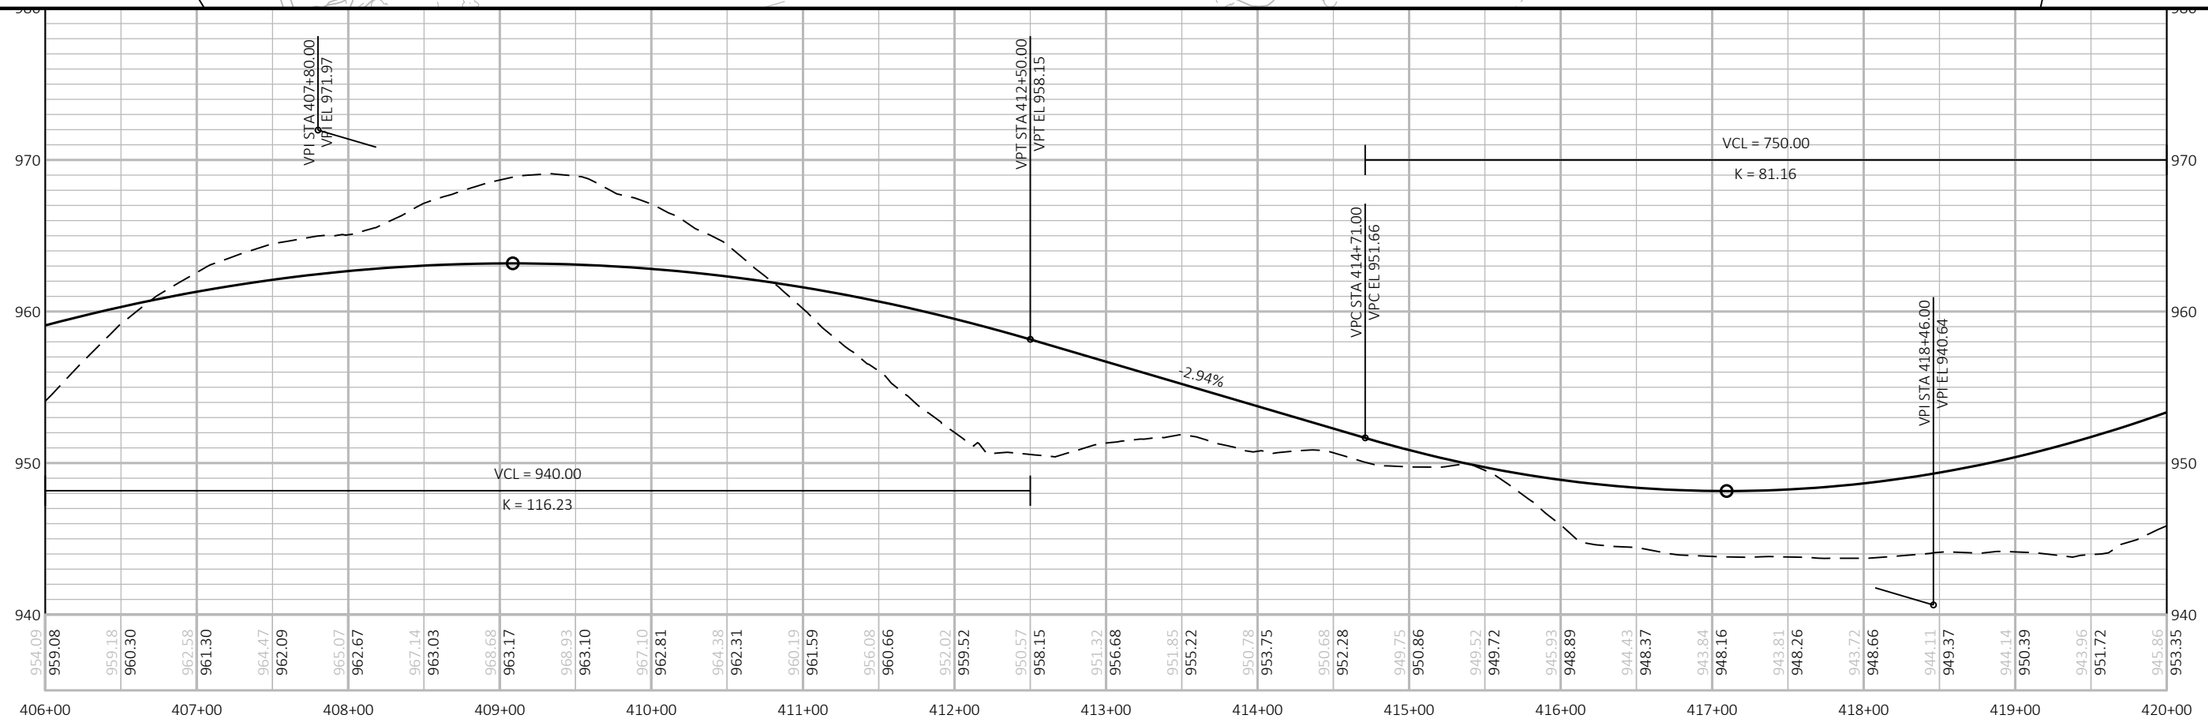

PROJECT NO: 5145-00-71	HWY: STH 19	COUNTY: DANE	PLAN AND PROFILE:	SHEET 40	E

FILE NAME : N:\PDS\C3D\51450001\SHEETSPLAN\050101_PP.DWG
LAYOUT NAME - 050130-pp

PLOT DATE : 6/7/2018 7:36 AM PLOT BY : RACH, JEREMY PAUL PLOT NAME : PLOT SCALE : 1 IN:100 FT

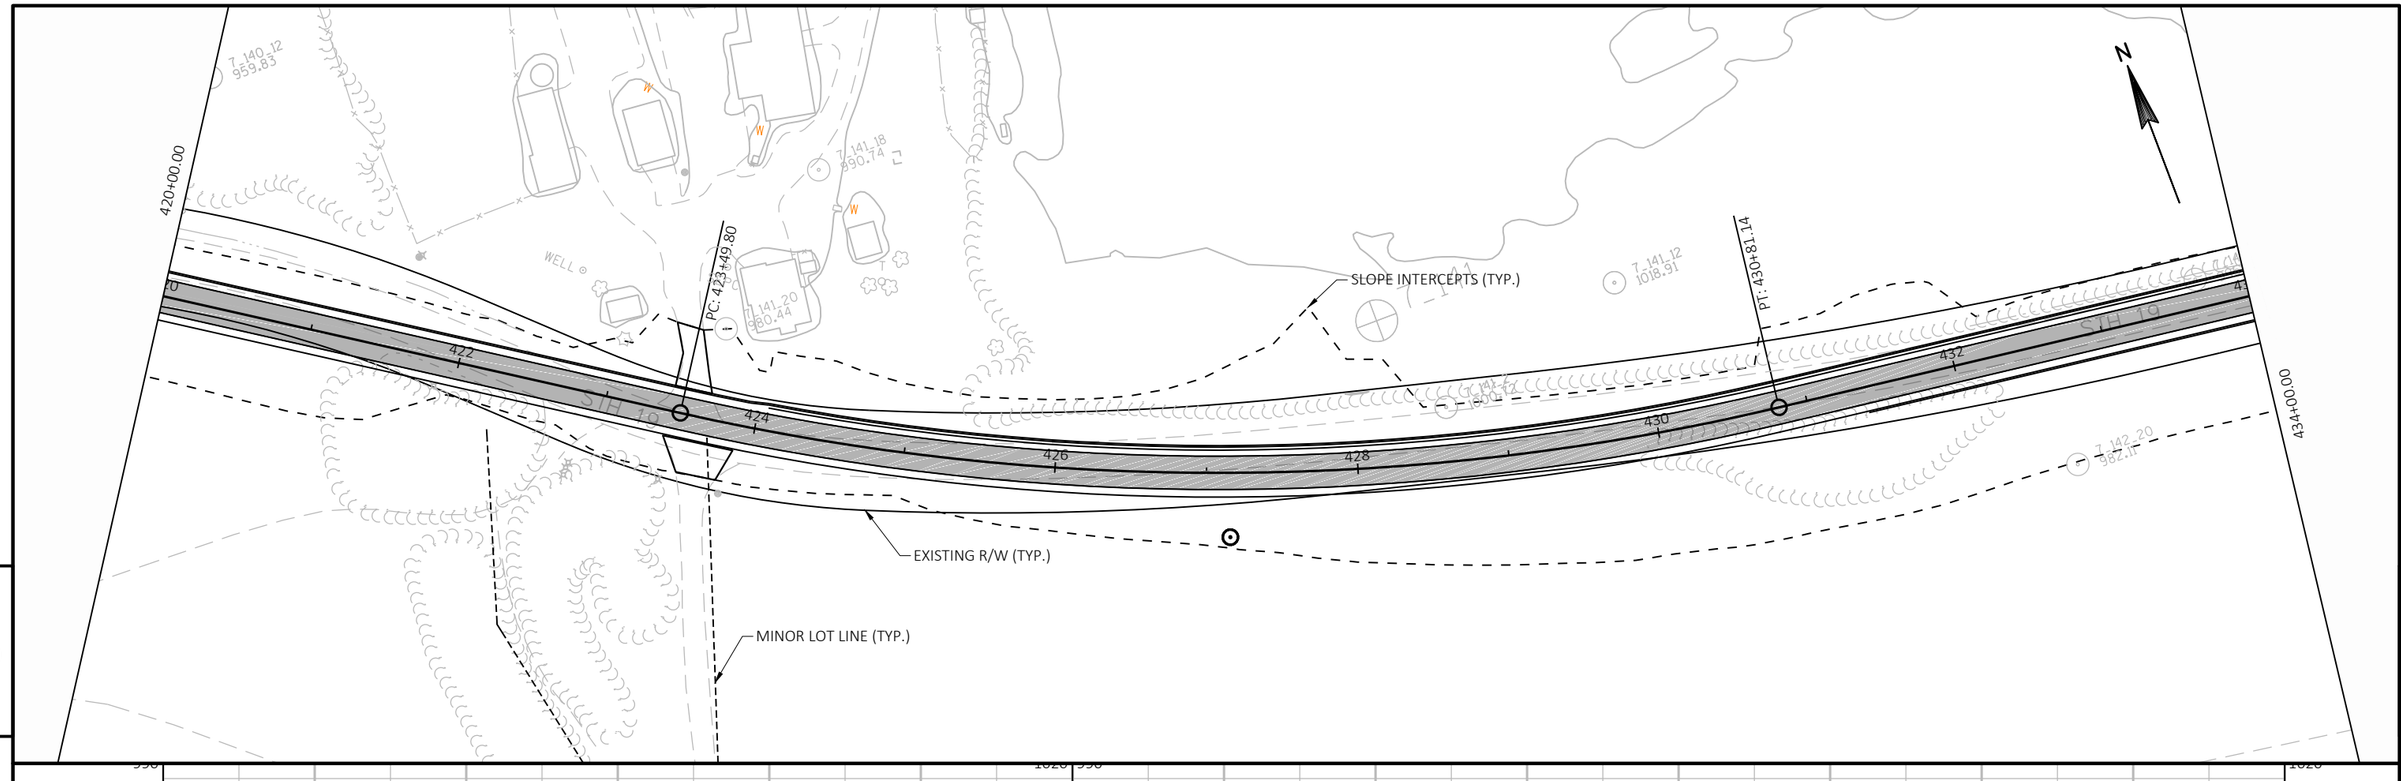

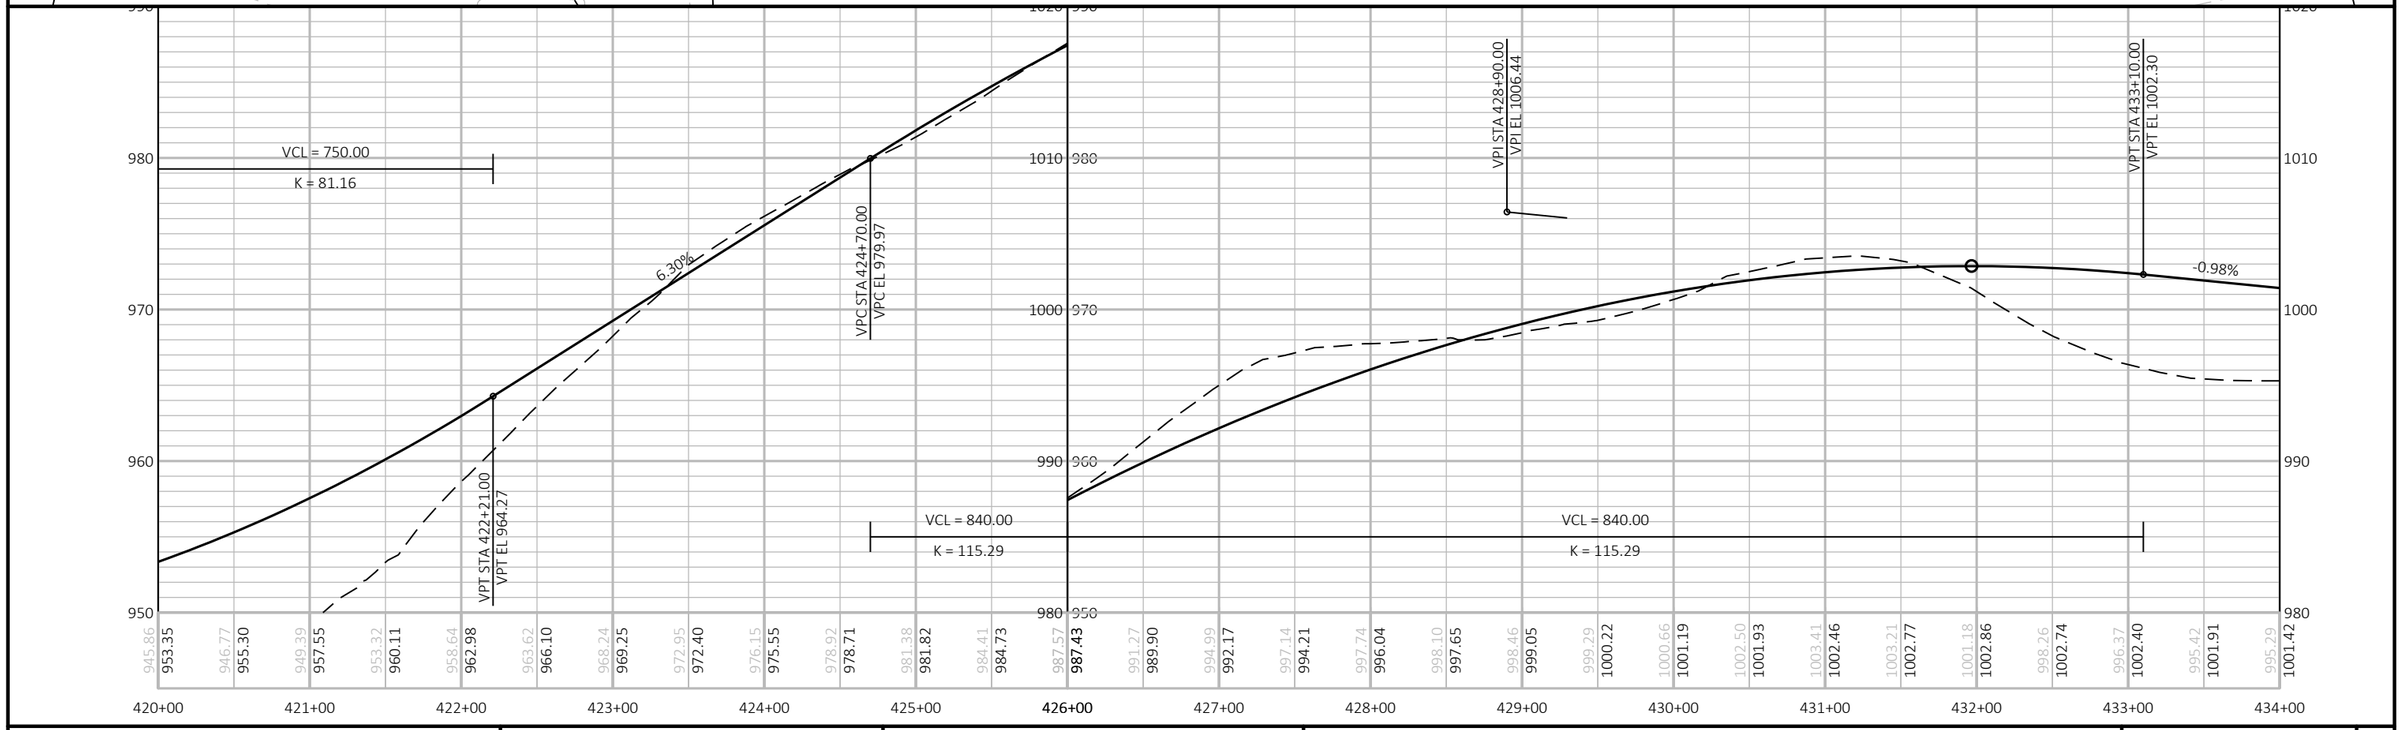

PROJECT NO: 5145-00-71	HWY: STH 19	COUNTY: DANE	PLAN AND PROFILE:	SHEET 41	E

FILE NAME : N:\PDS\C3D\51450001\SHEETSPLAN\050101_PP.DWG
LAYOUT NAME - 050131-pp
PLOT DATE : 6/7/2018 7:37 AM
PLOT BY : RACH, JEREMY PAUL
PLOT NAME :
PLOT SCALE : 1 IN:100 FT
WISDOT/CADDS SHEET 44

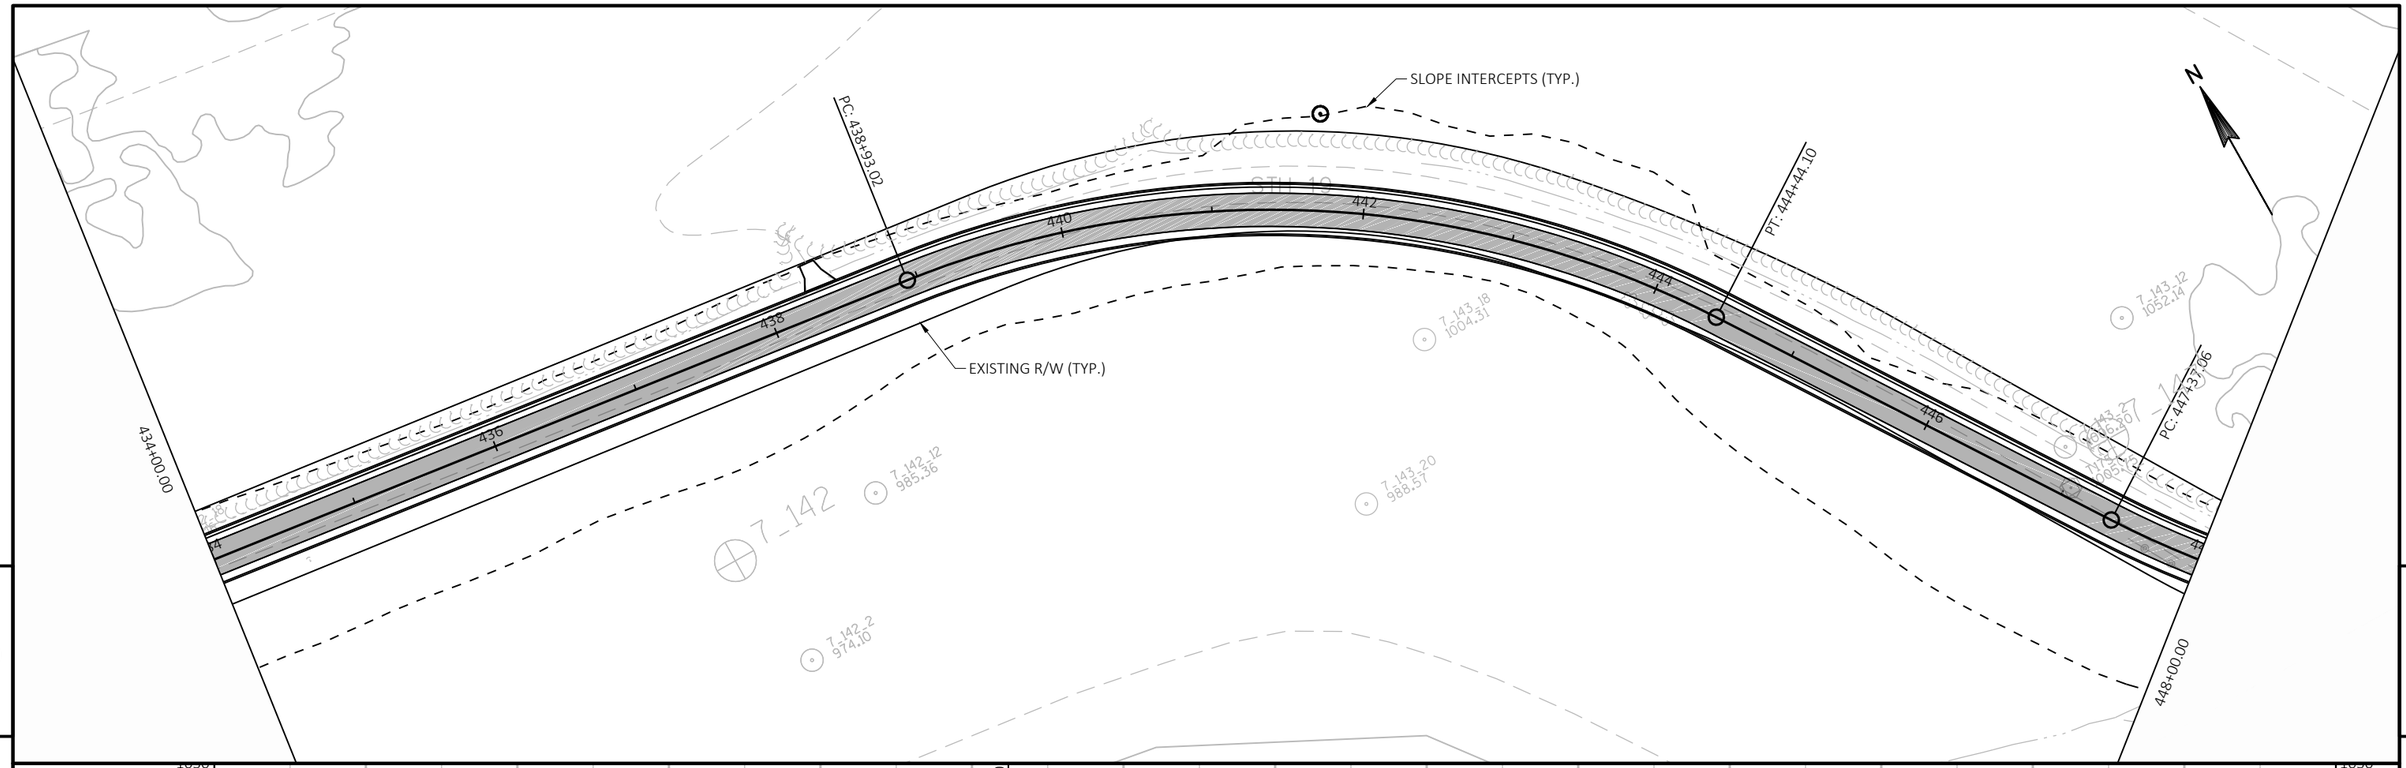

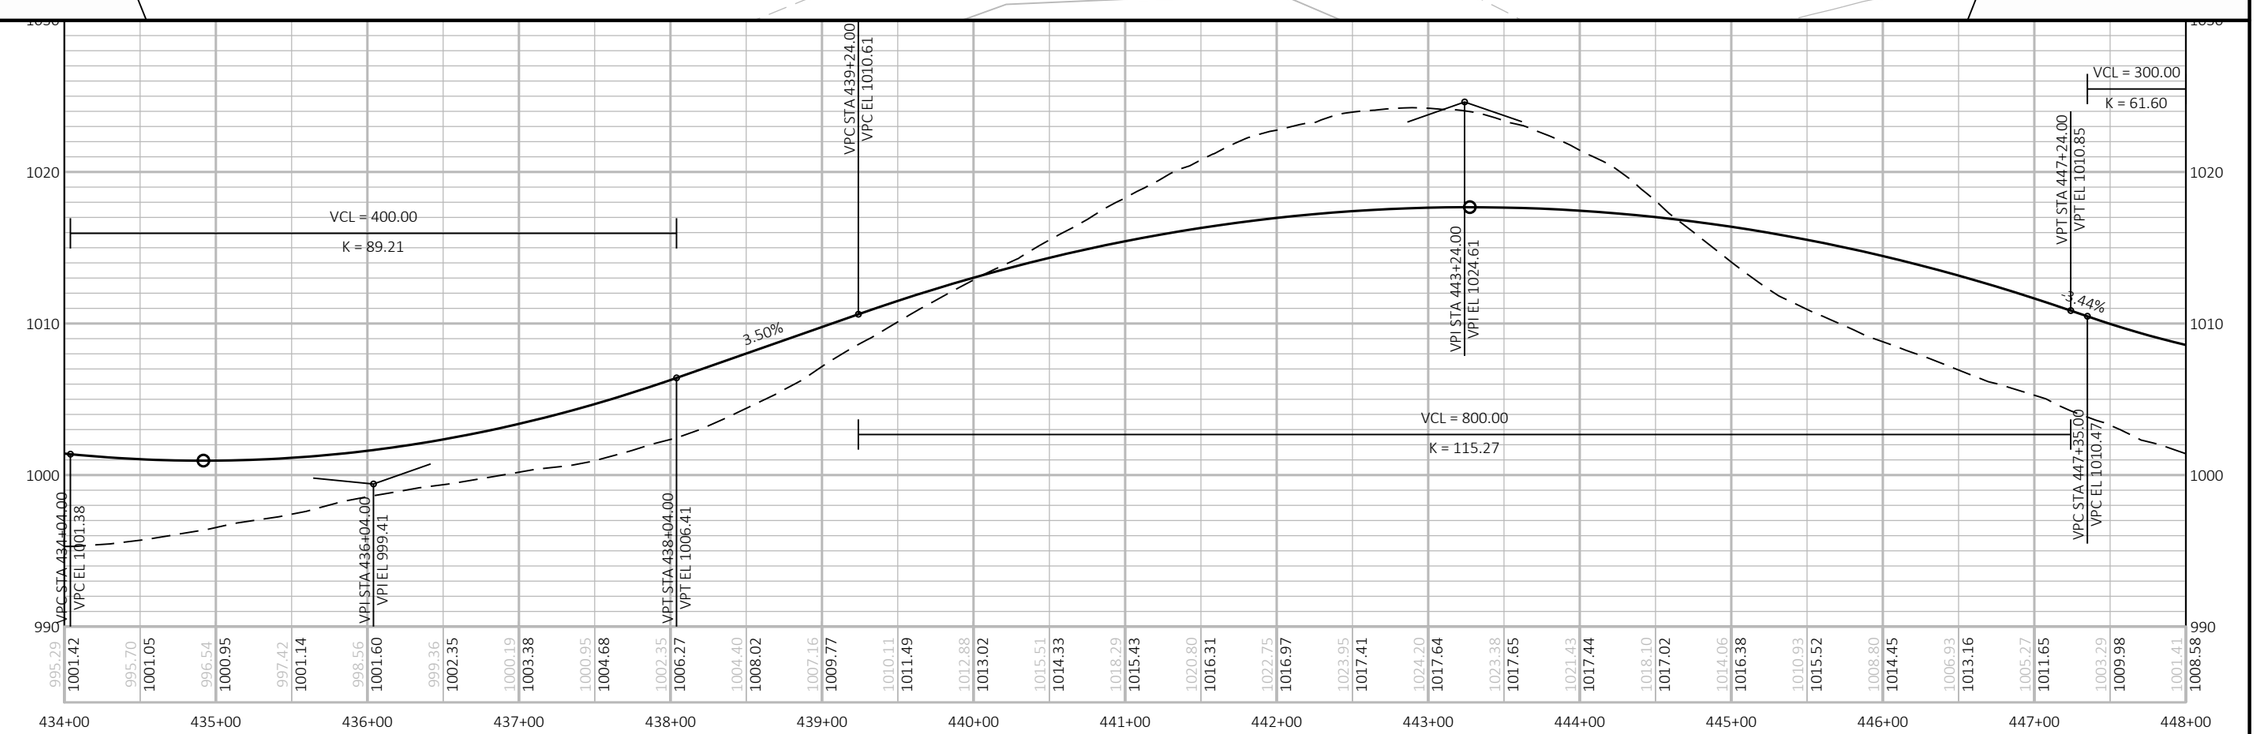

PROJECT NO: 5145-00-71	HWY: STH 19	COUNTY: DANE	PLAN AND PROFILE:	SHEET 42	E

FILE NAME : N:\PDS\C3D\51450001\SHEETSPLAN\050101_PP.DWG
LAYOUT NAME - 050132-pp

PLOT DATE : 6/7/2018 7:37 AM PLOT BY : RACH, JEREMY PAUL PLOT NAME : PLOT SCALE : 1 IN:100 FT

WISDOT/CADDS SHEET 44

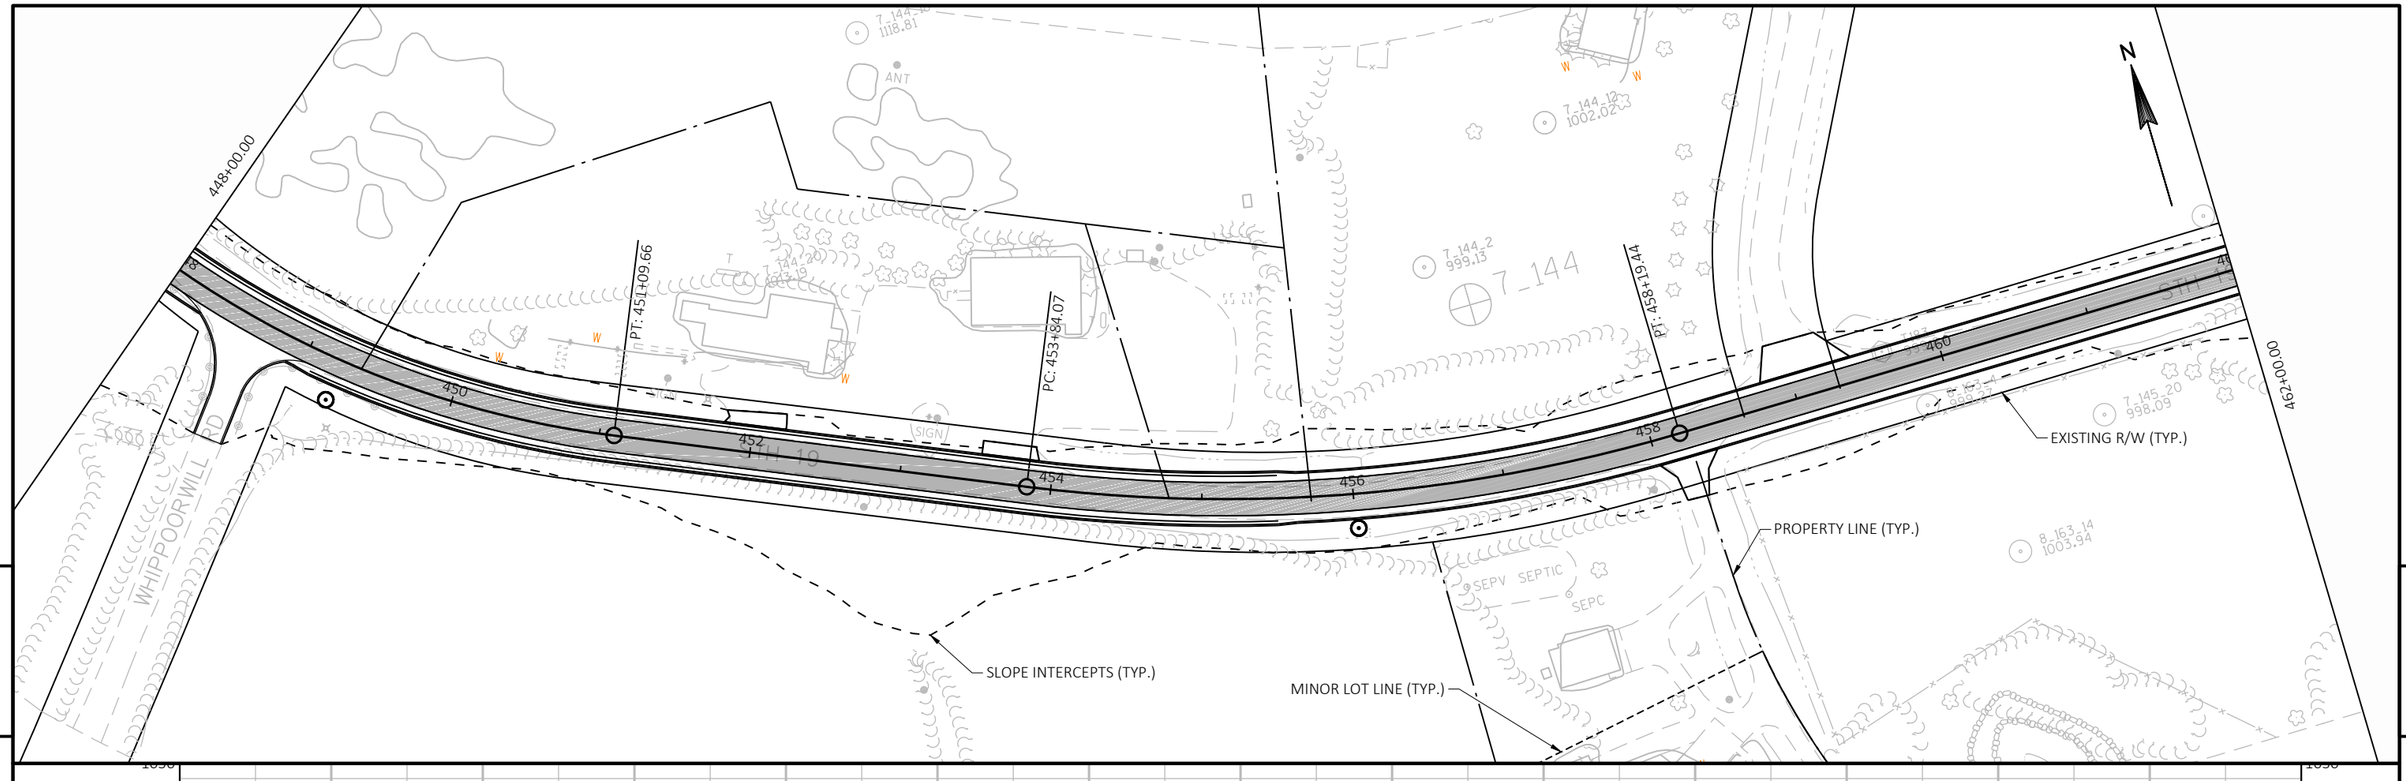

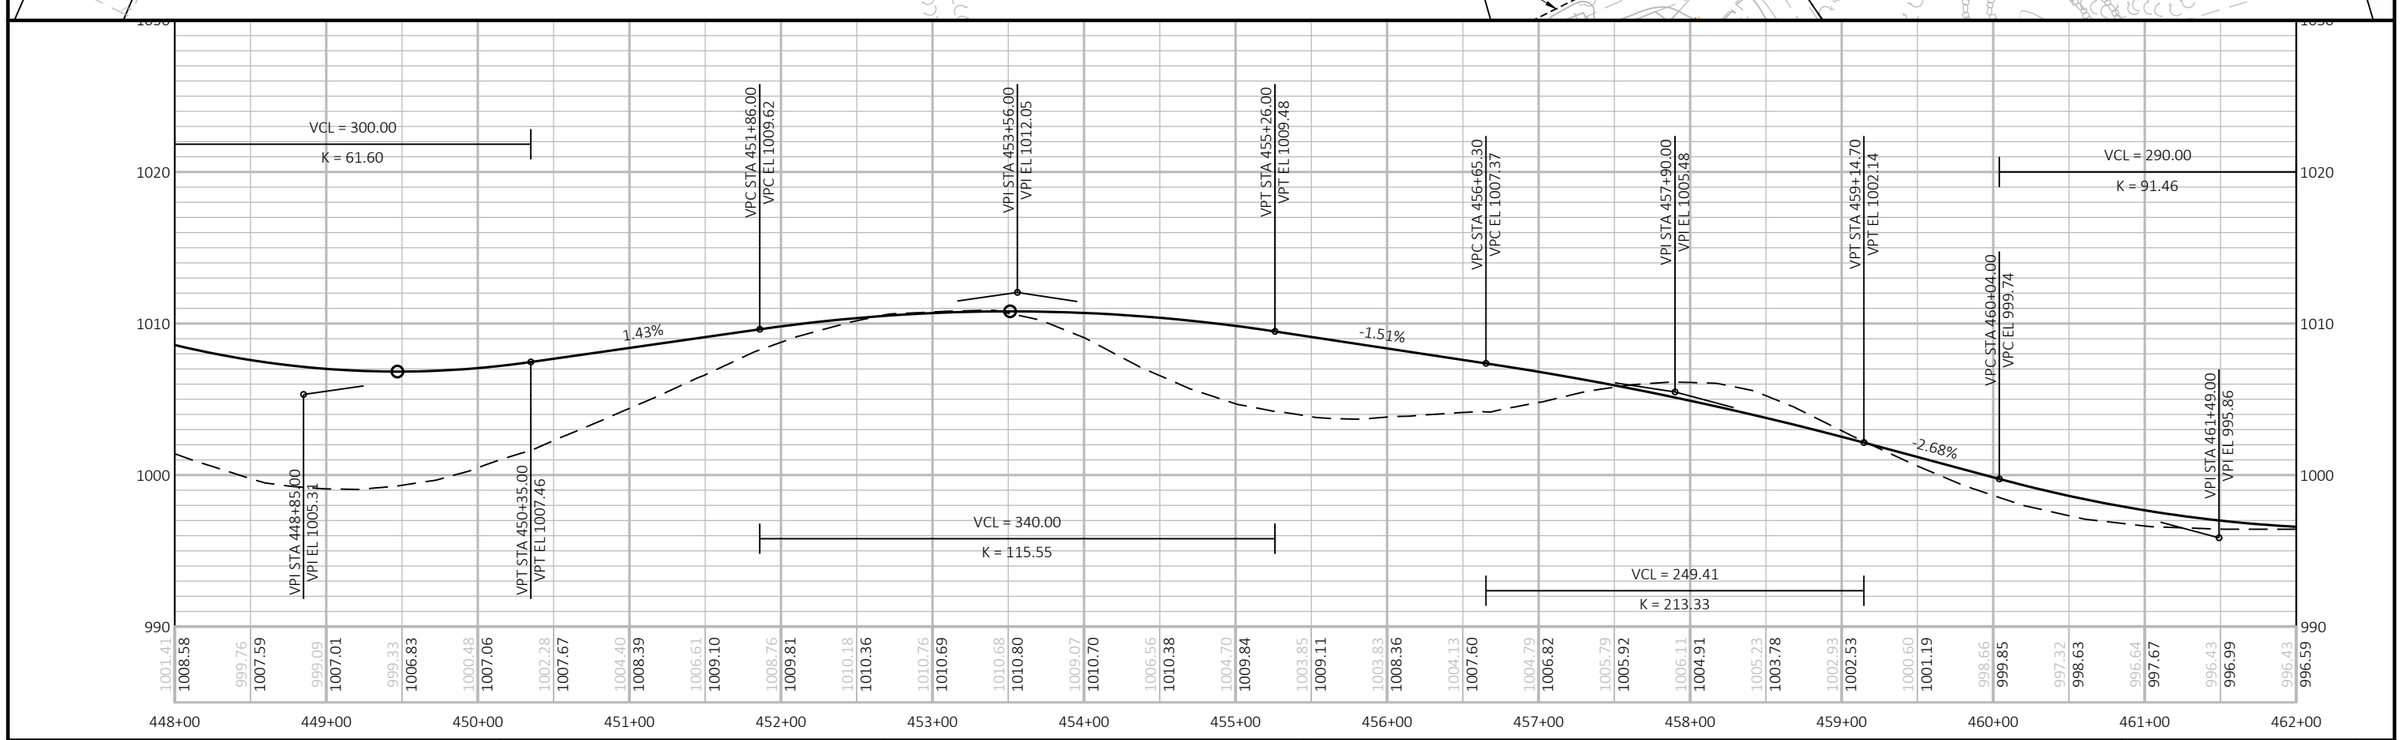

PROJECT NO: 5145-00-71	HWY: STH 19	COUNTY: DANE	PLAN AND PROFILE:	SHEET 43	E

FILE NAME : N:\PDS\C3D\51450001\SHEETSPLAN\050101_PP.DWG
LAYOUT NAME - 050133-pp

PLOT DATE : 6/7/2018 7:37 AM PLOT BY : RACH, JEREMY PAUL PLOT NAME : PLOT SCALE : 1 IN:100 FT

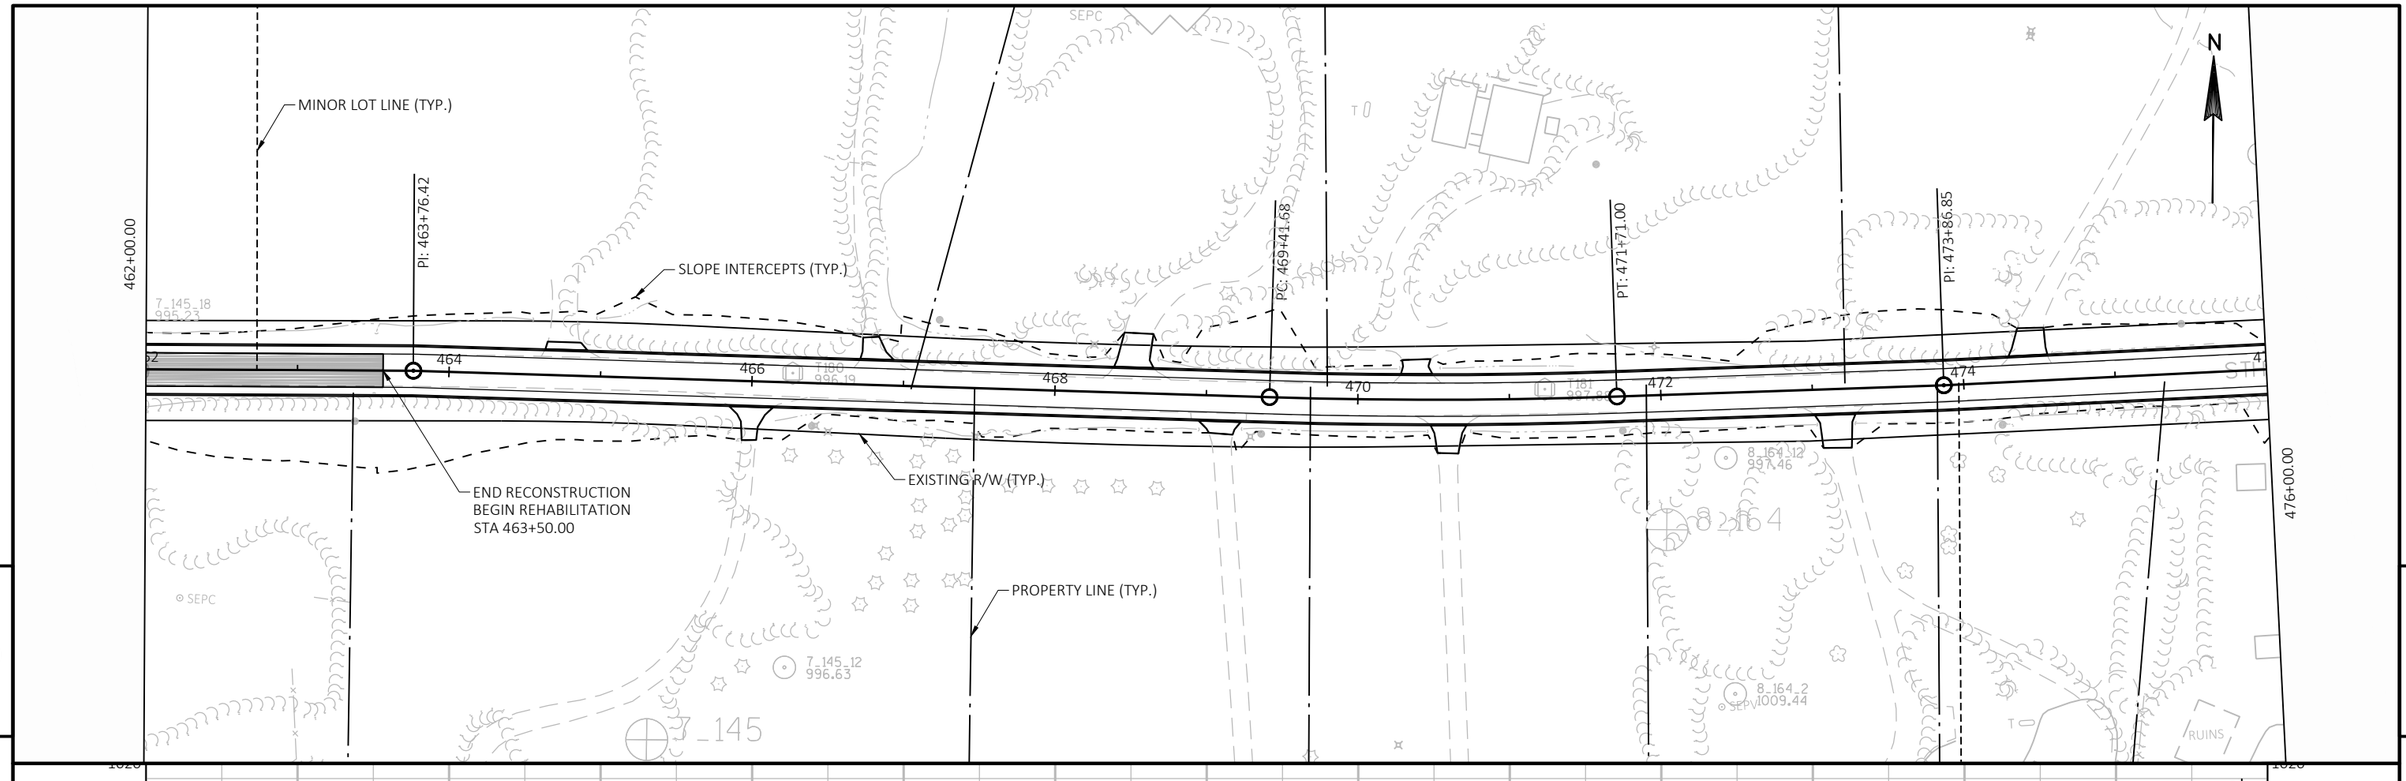

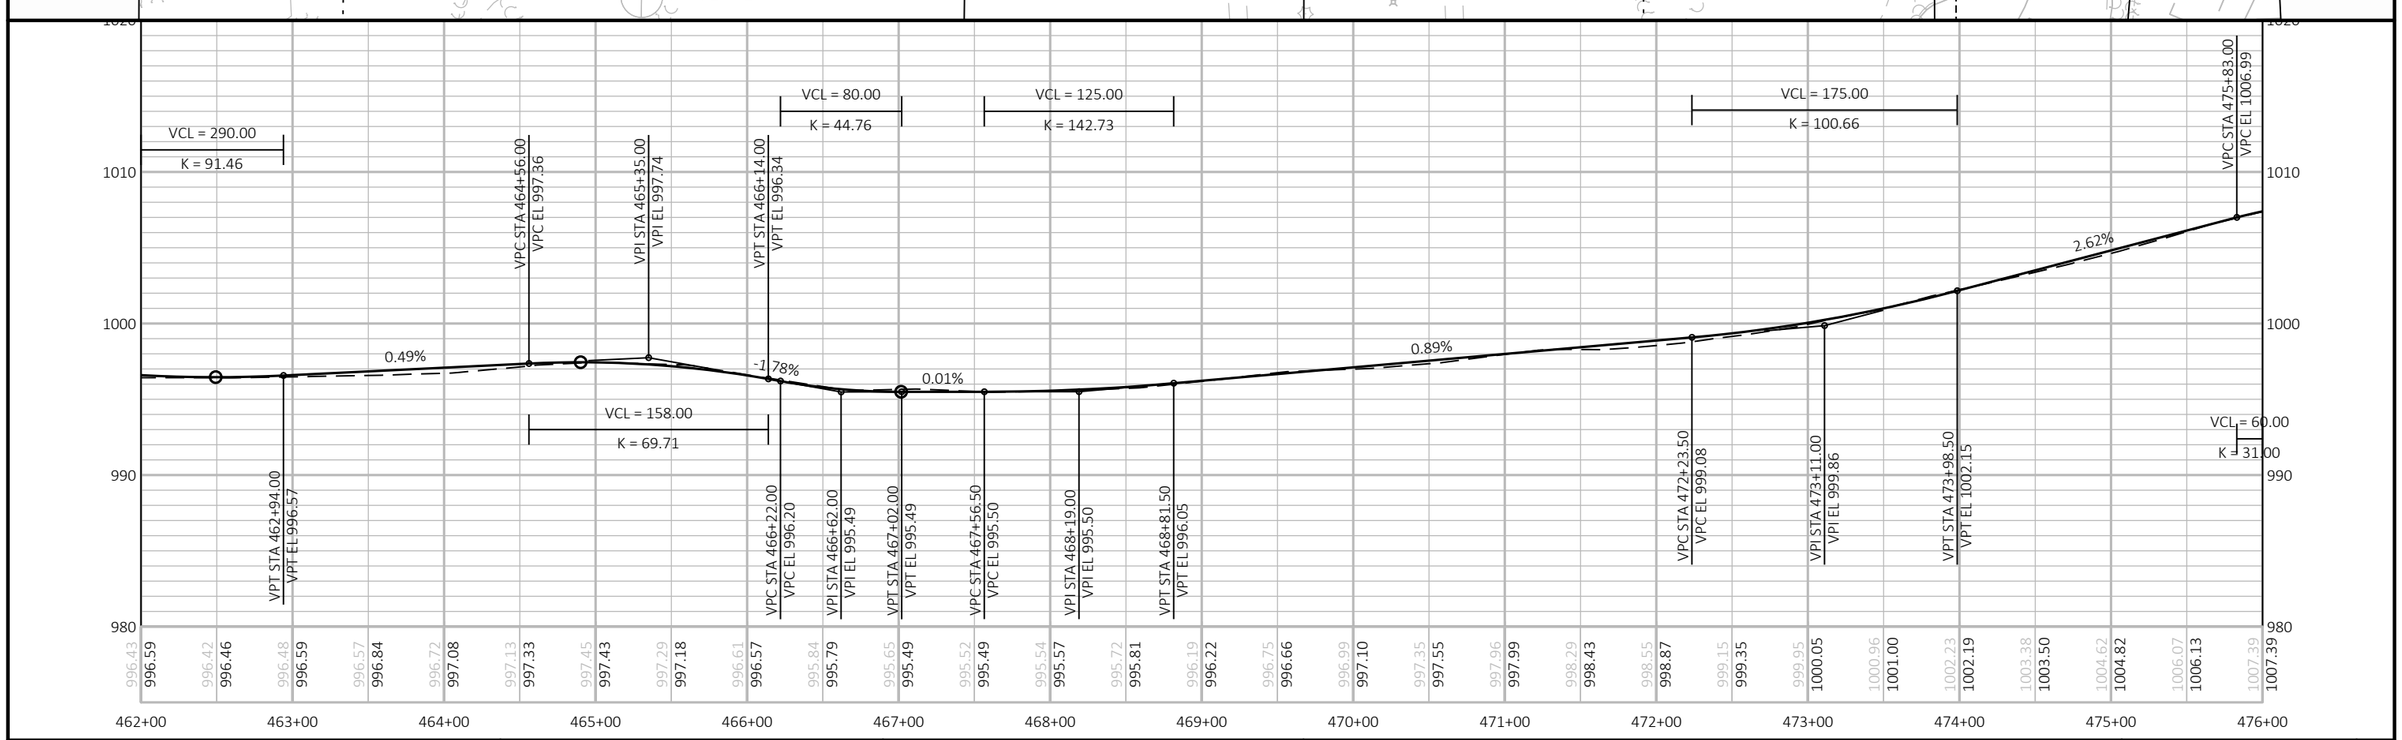

PROJECT NO: 5145-00-71	HWY: STH 19	COUNTY: DANE	PLAN AND PROFILE:	SHEET 44	E

FILE NAME : N:\PDS\C3D\51450001\SHEETSPLAN\050101_PP.DWG
LAYOUT NAME - 050134-pp

PLOT DATE : 6/7/2018 7:37 AM PLOT BY : RACH, JEREMY PAUL PLOT NAME : PLOT SCALE : 1 IN:100 FT

WISDOT/CADDS SHEET 44

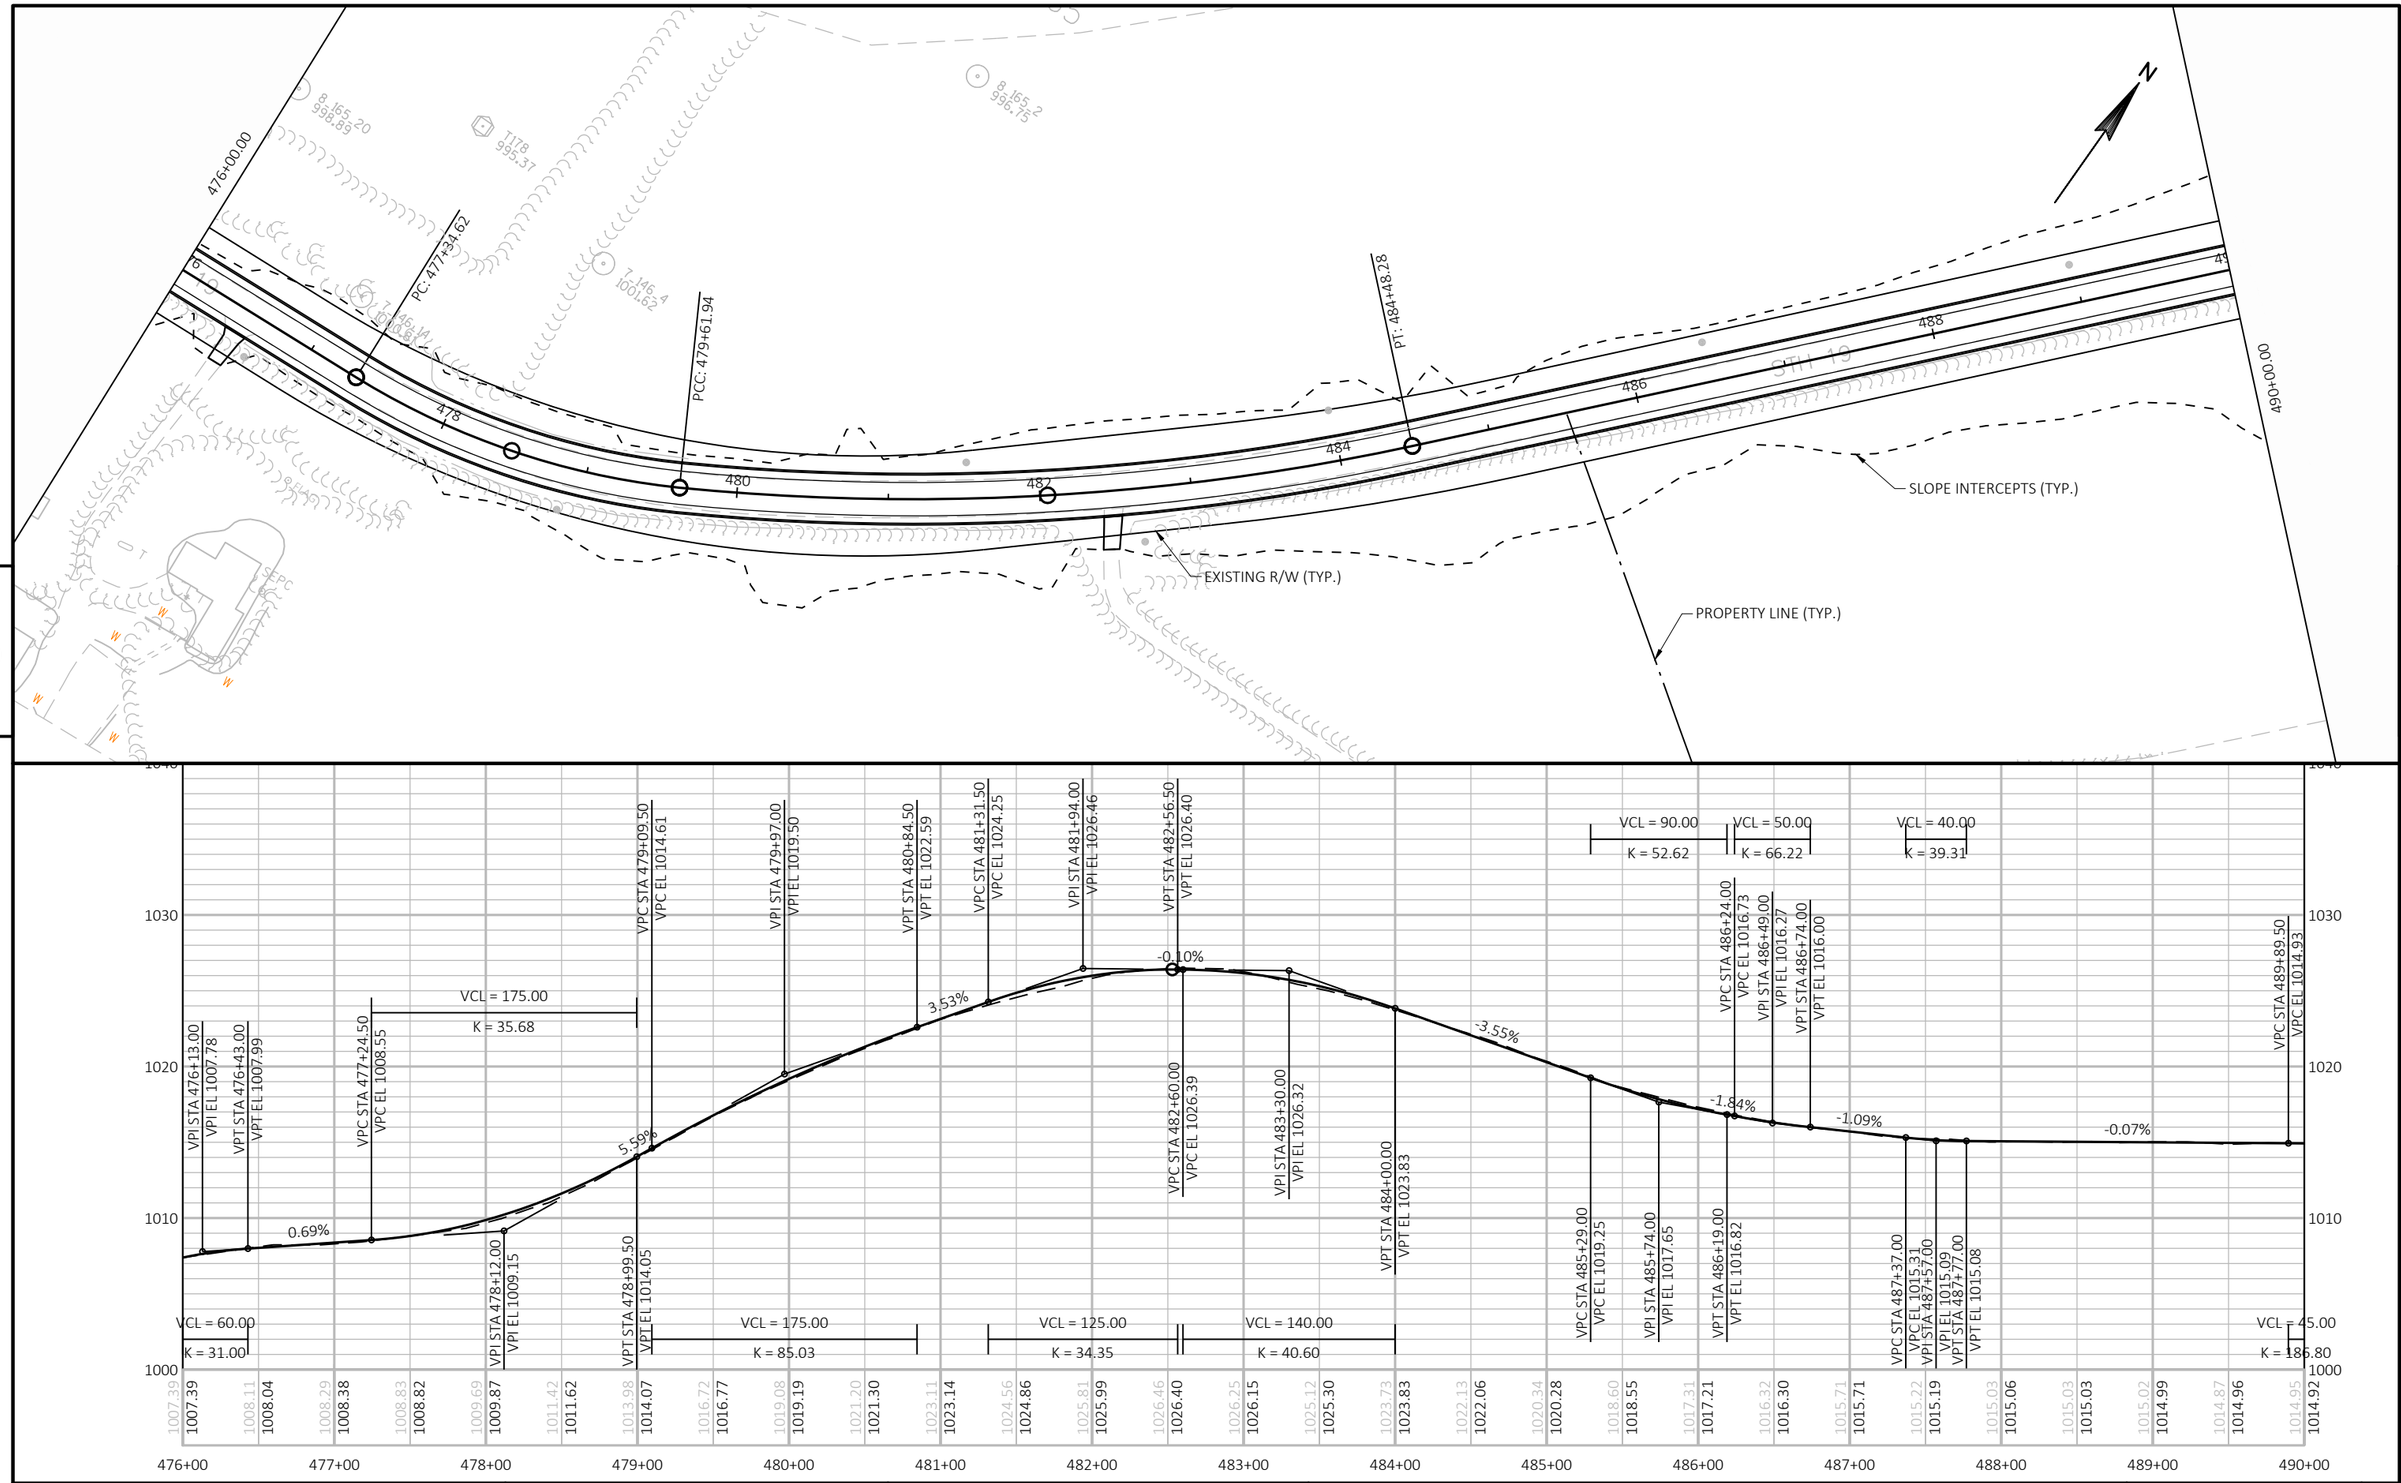

PROJECT NO: 5145-00-71	HWY: STH 19	COUNTY: DANE	PLAN AND PROFILE:	SHEET 45	E

FILE NAME : N:\PDS\C3D\51450001\SHEETSPLAN\050101_PP.DWG
LAYOUT NAME - 050135-pp

PLOT DATE : 6/7/2018 7:38 AM PLOT BY : RACH, JEREMY PAUL PLOT NAME : PLOT SCALE : 1 IN:100 FT

WISDOT/CADDS SHEET 44

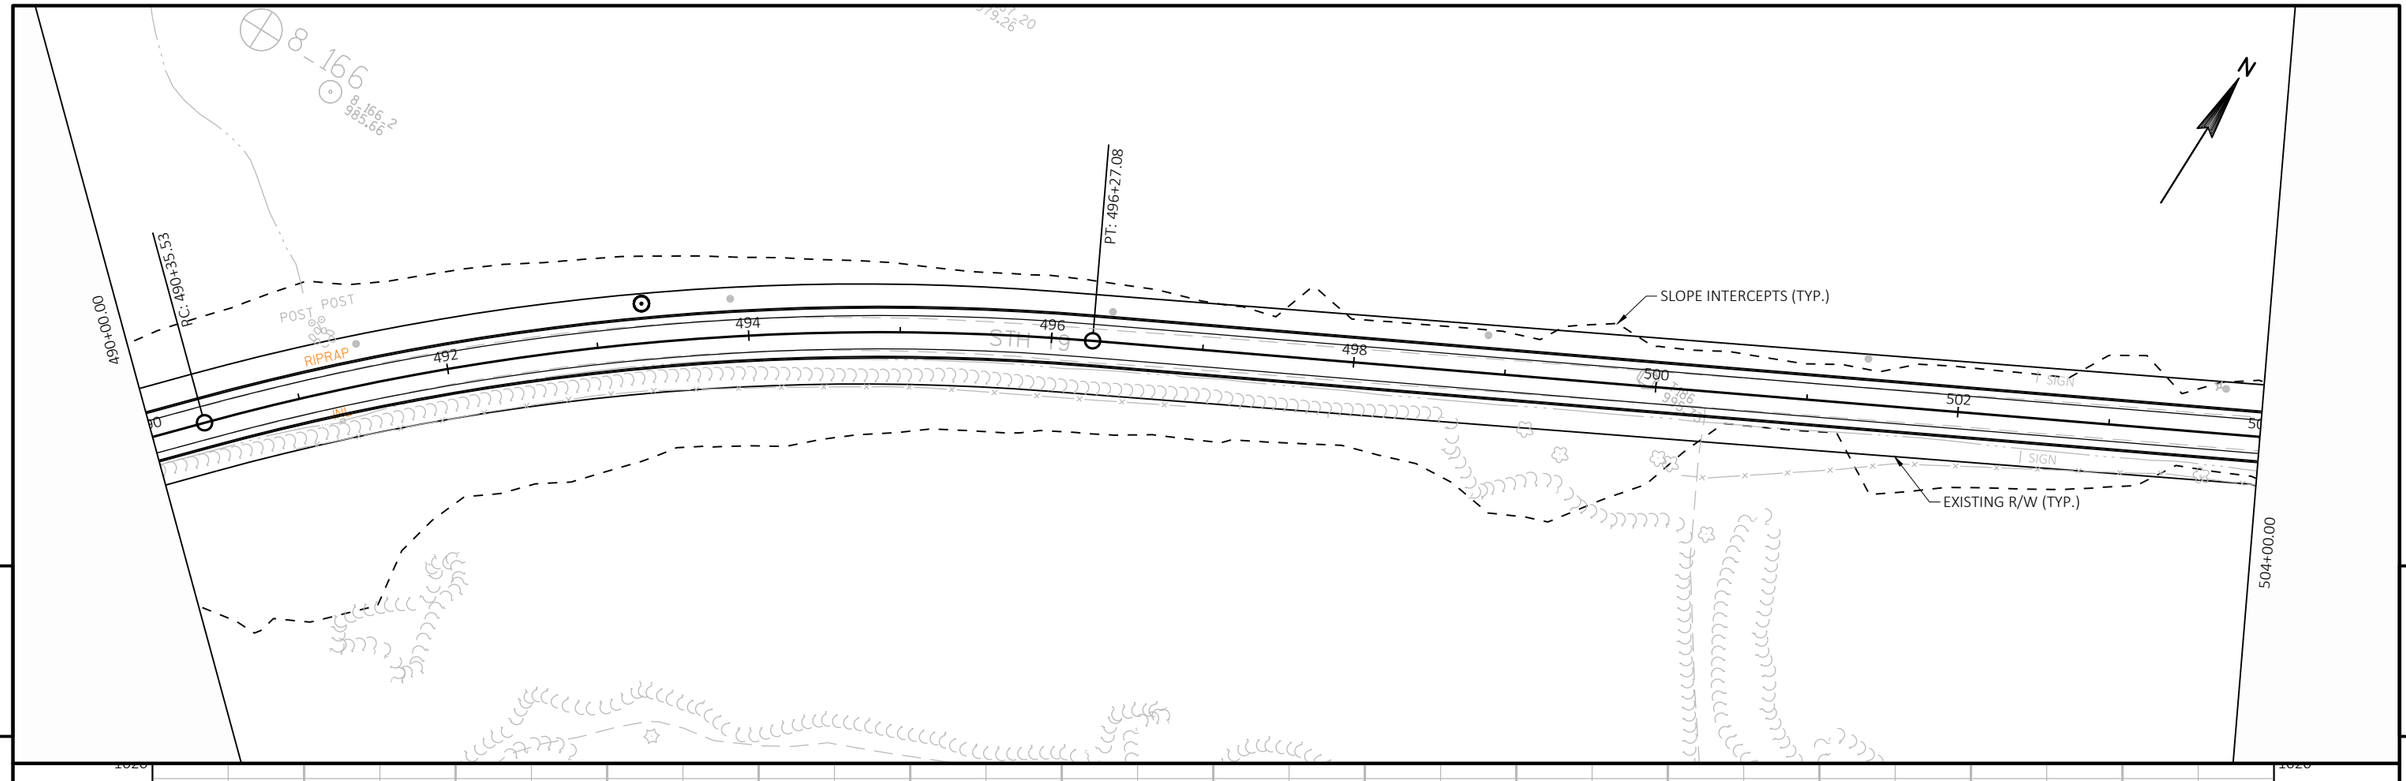

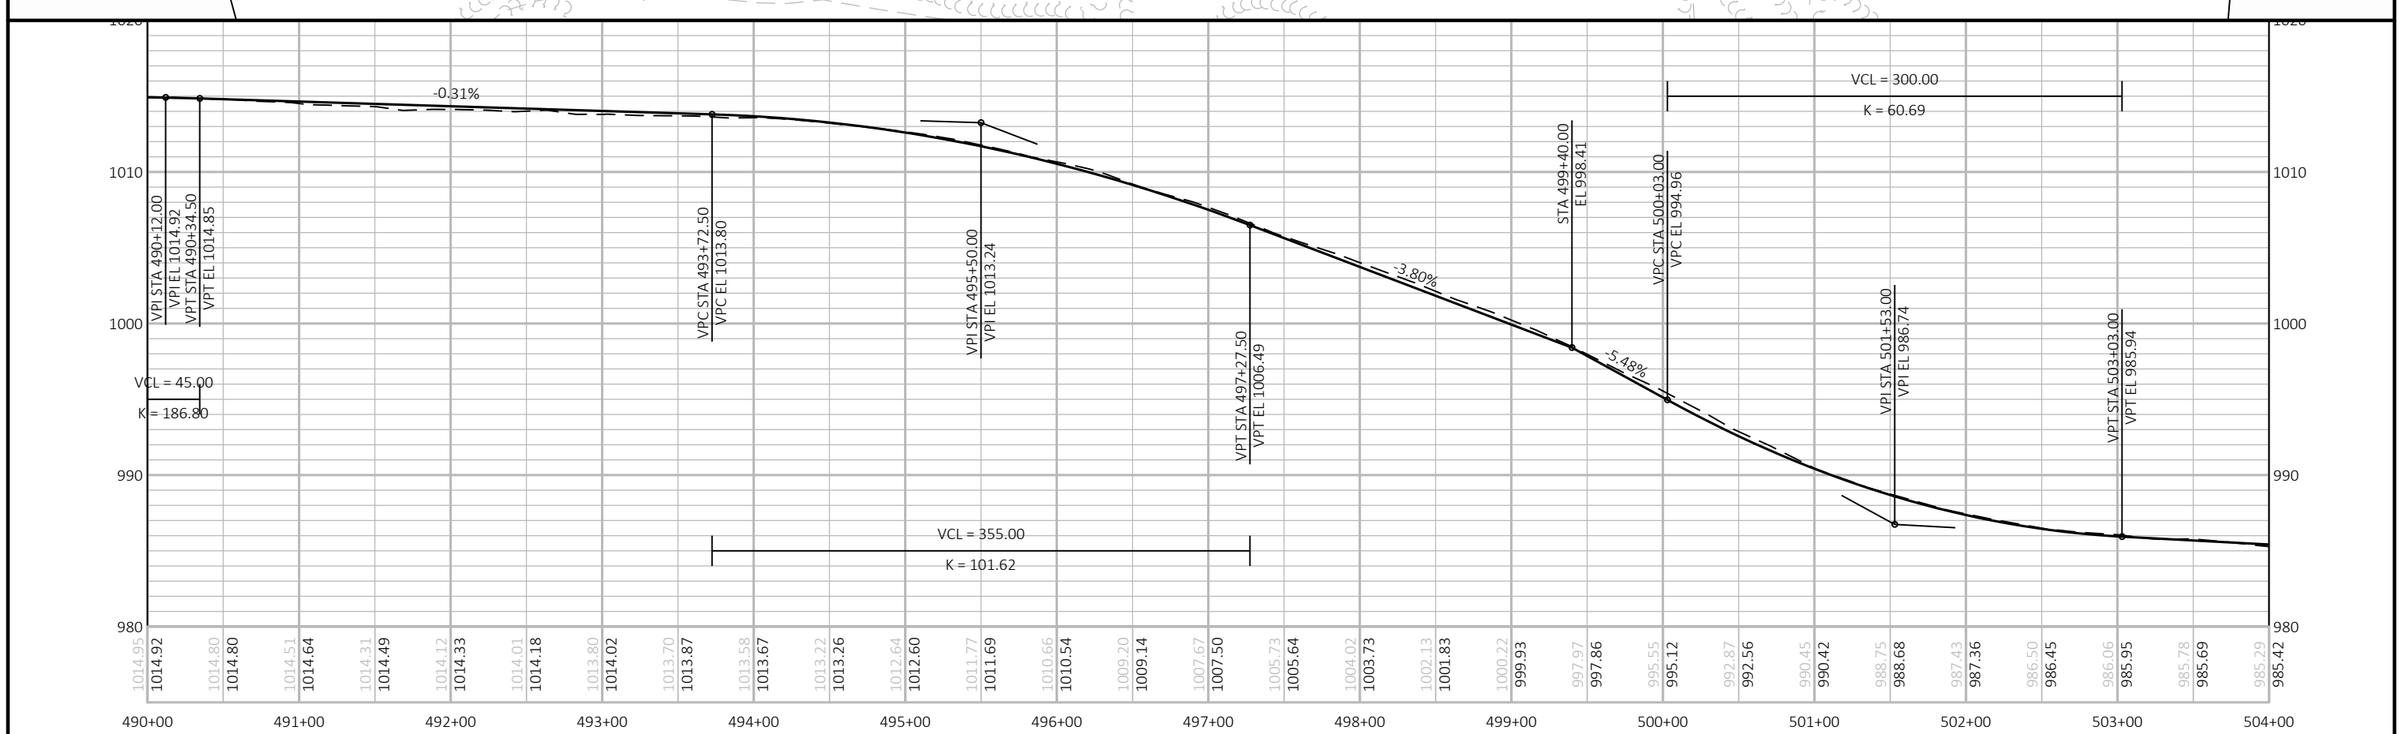

PROJECT NO: 5145-00-71	HWY: STH 19	COUNTY: DANE	PLAN AND PROFILE:	SHEET 46	E

FILE NAME : N:\PDS\C3D\51450001\SHEETSPLAN\050101_PP.DWG
LAYOUT NAME - 050136-pp
PLOT DATE : 6/7/2018 7:38 AM
PLOT BY : RACH, JEREMY PAUL
PLOT NAME :
PLOT SCALE : 1 IN:100 FT
WISDOT/CADDS SHEET 44

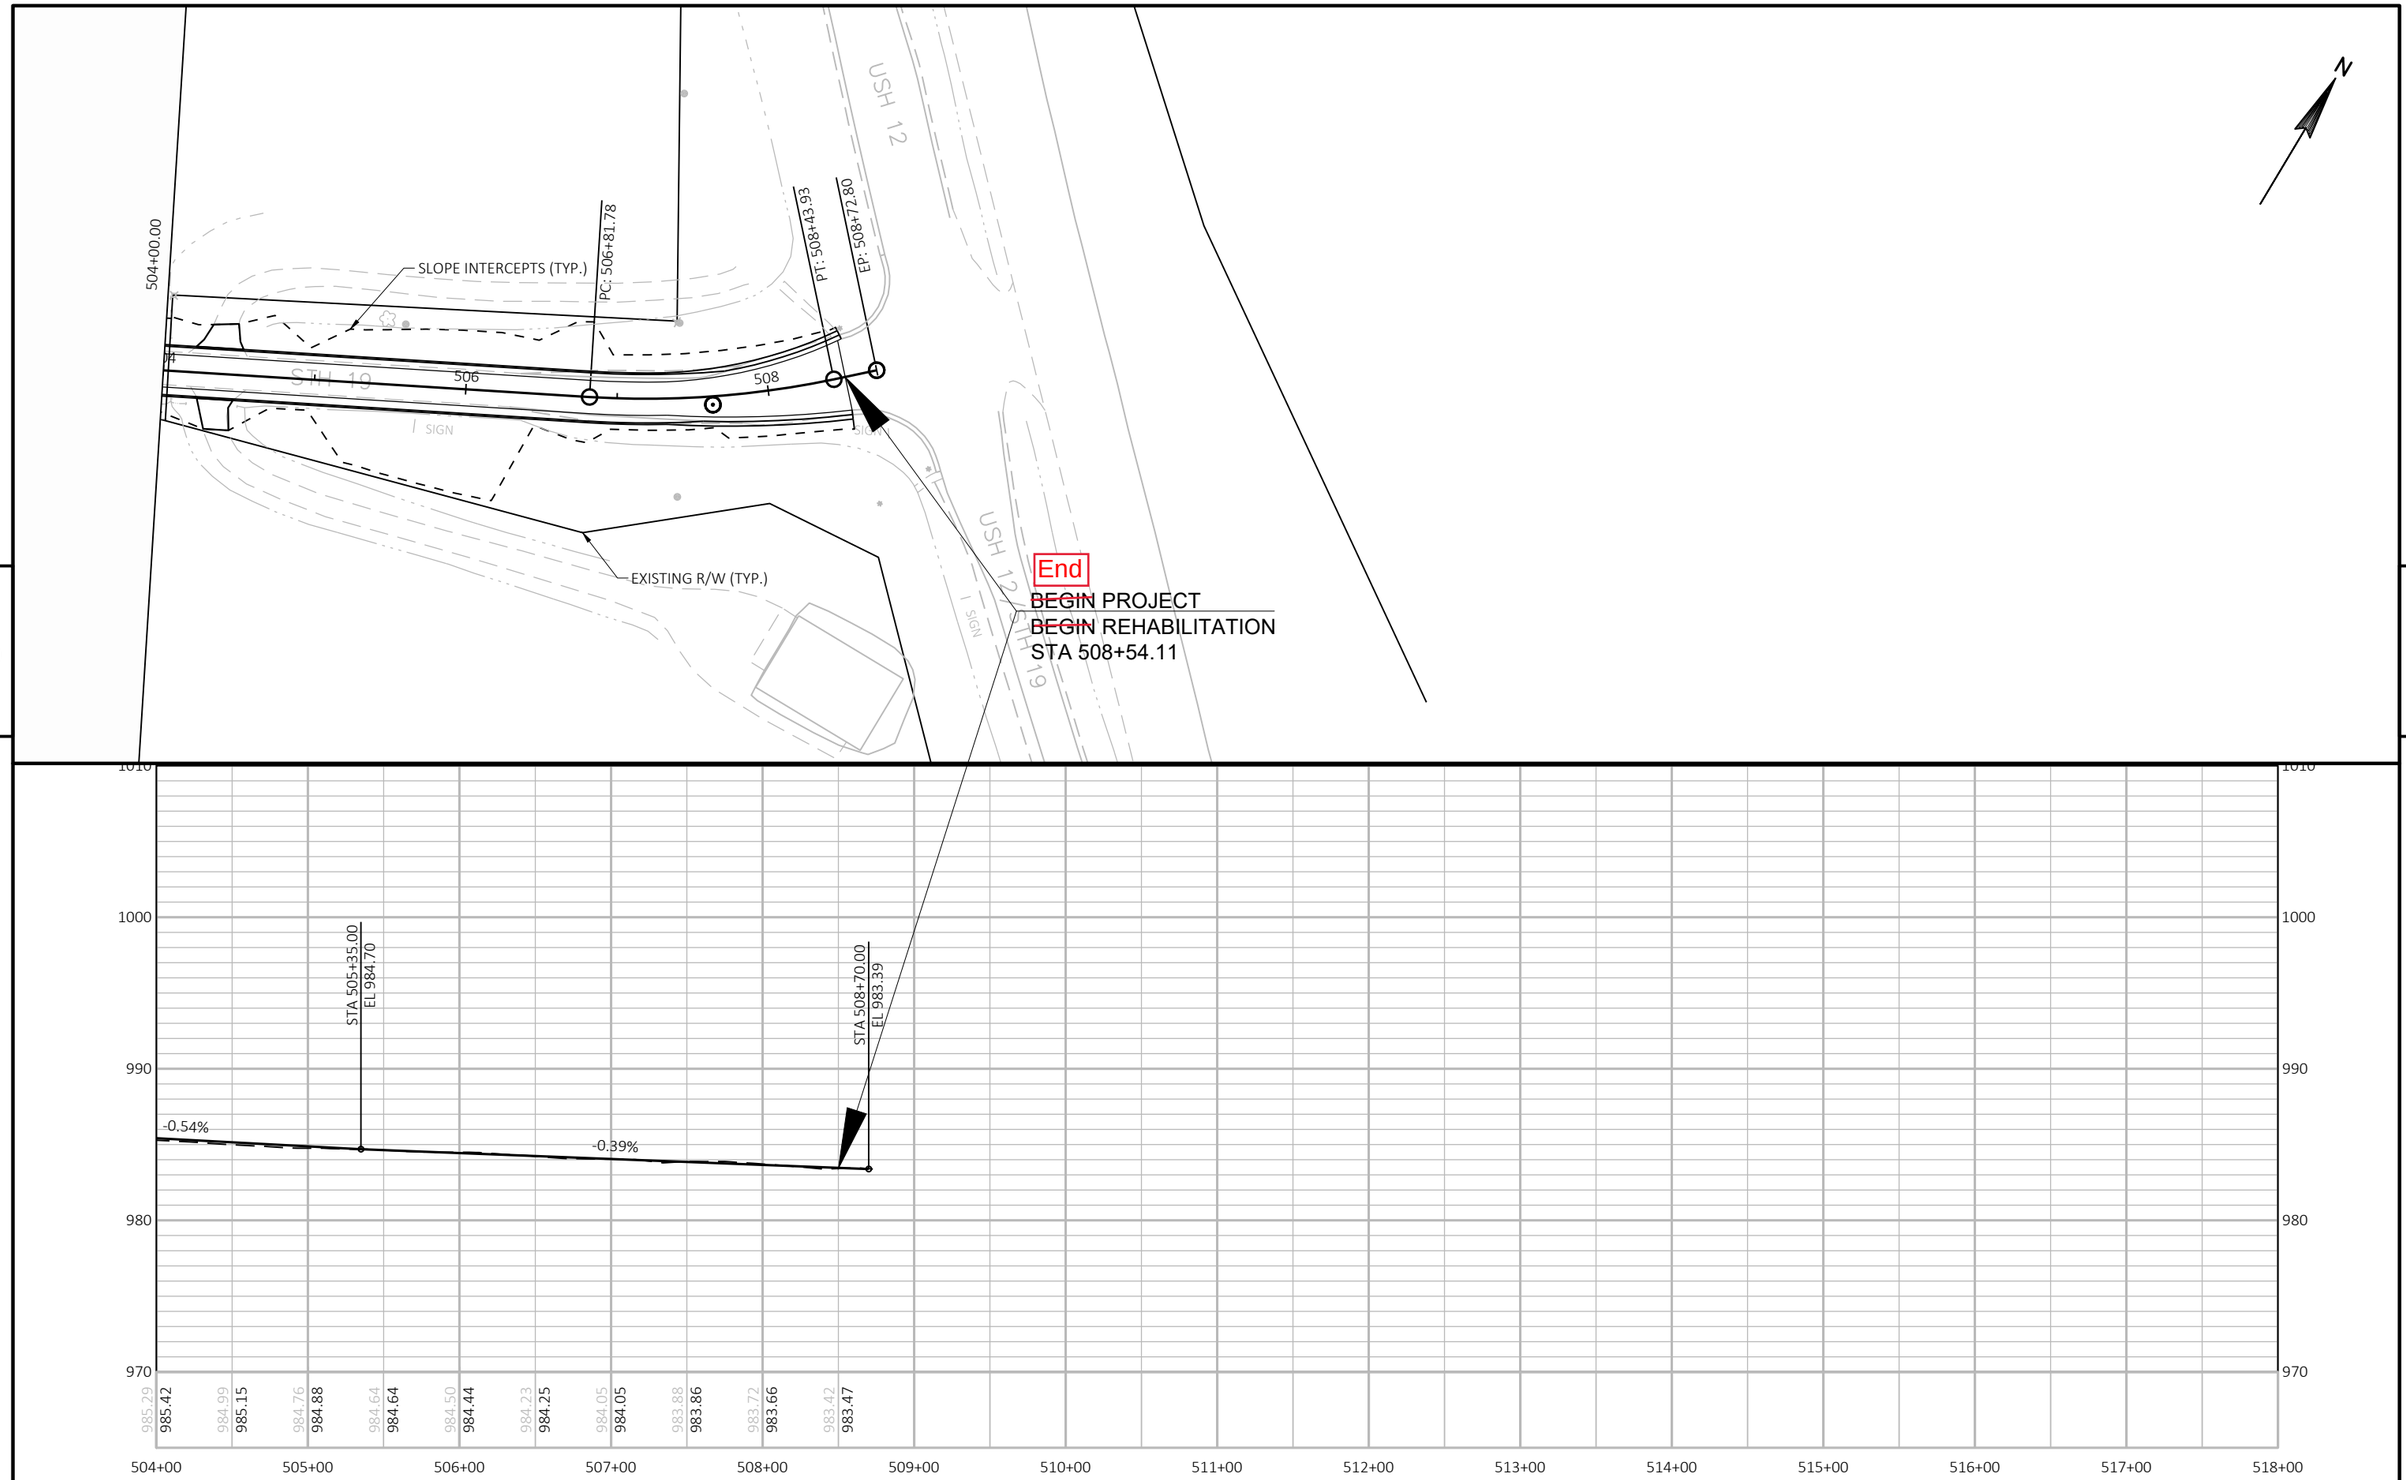

PROJECT NO: 5145-00-71	HWY: STH 19	COUNTY: DANE	PLAN AND PROFILE:	SHEET 47	E

FILE NAME : N:\PDS\C3D\51450001\SHEETSPLAN\050101_PP.DWG
LAYOUT NAME - 050137-pp

PLOT DATE : 6/7/2018 7:38 AM PLOT BY : RACH, JEREMY PAUL PLOT NAME : PLOT SCALE : 1 IN:100 FT

Add tick marks indicating locations of existing utilities.

Darken.

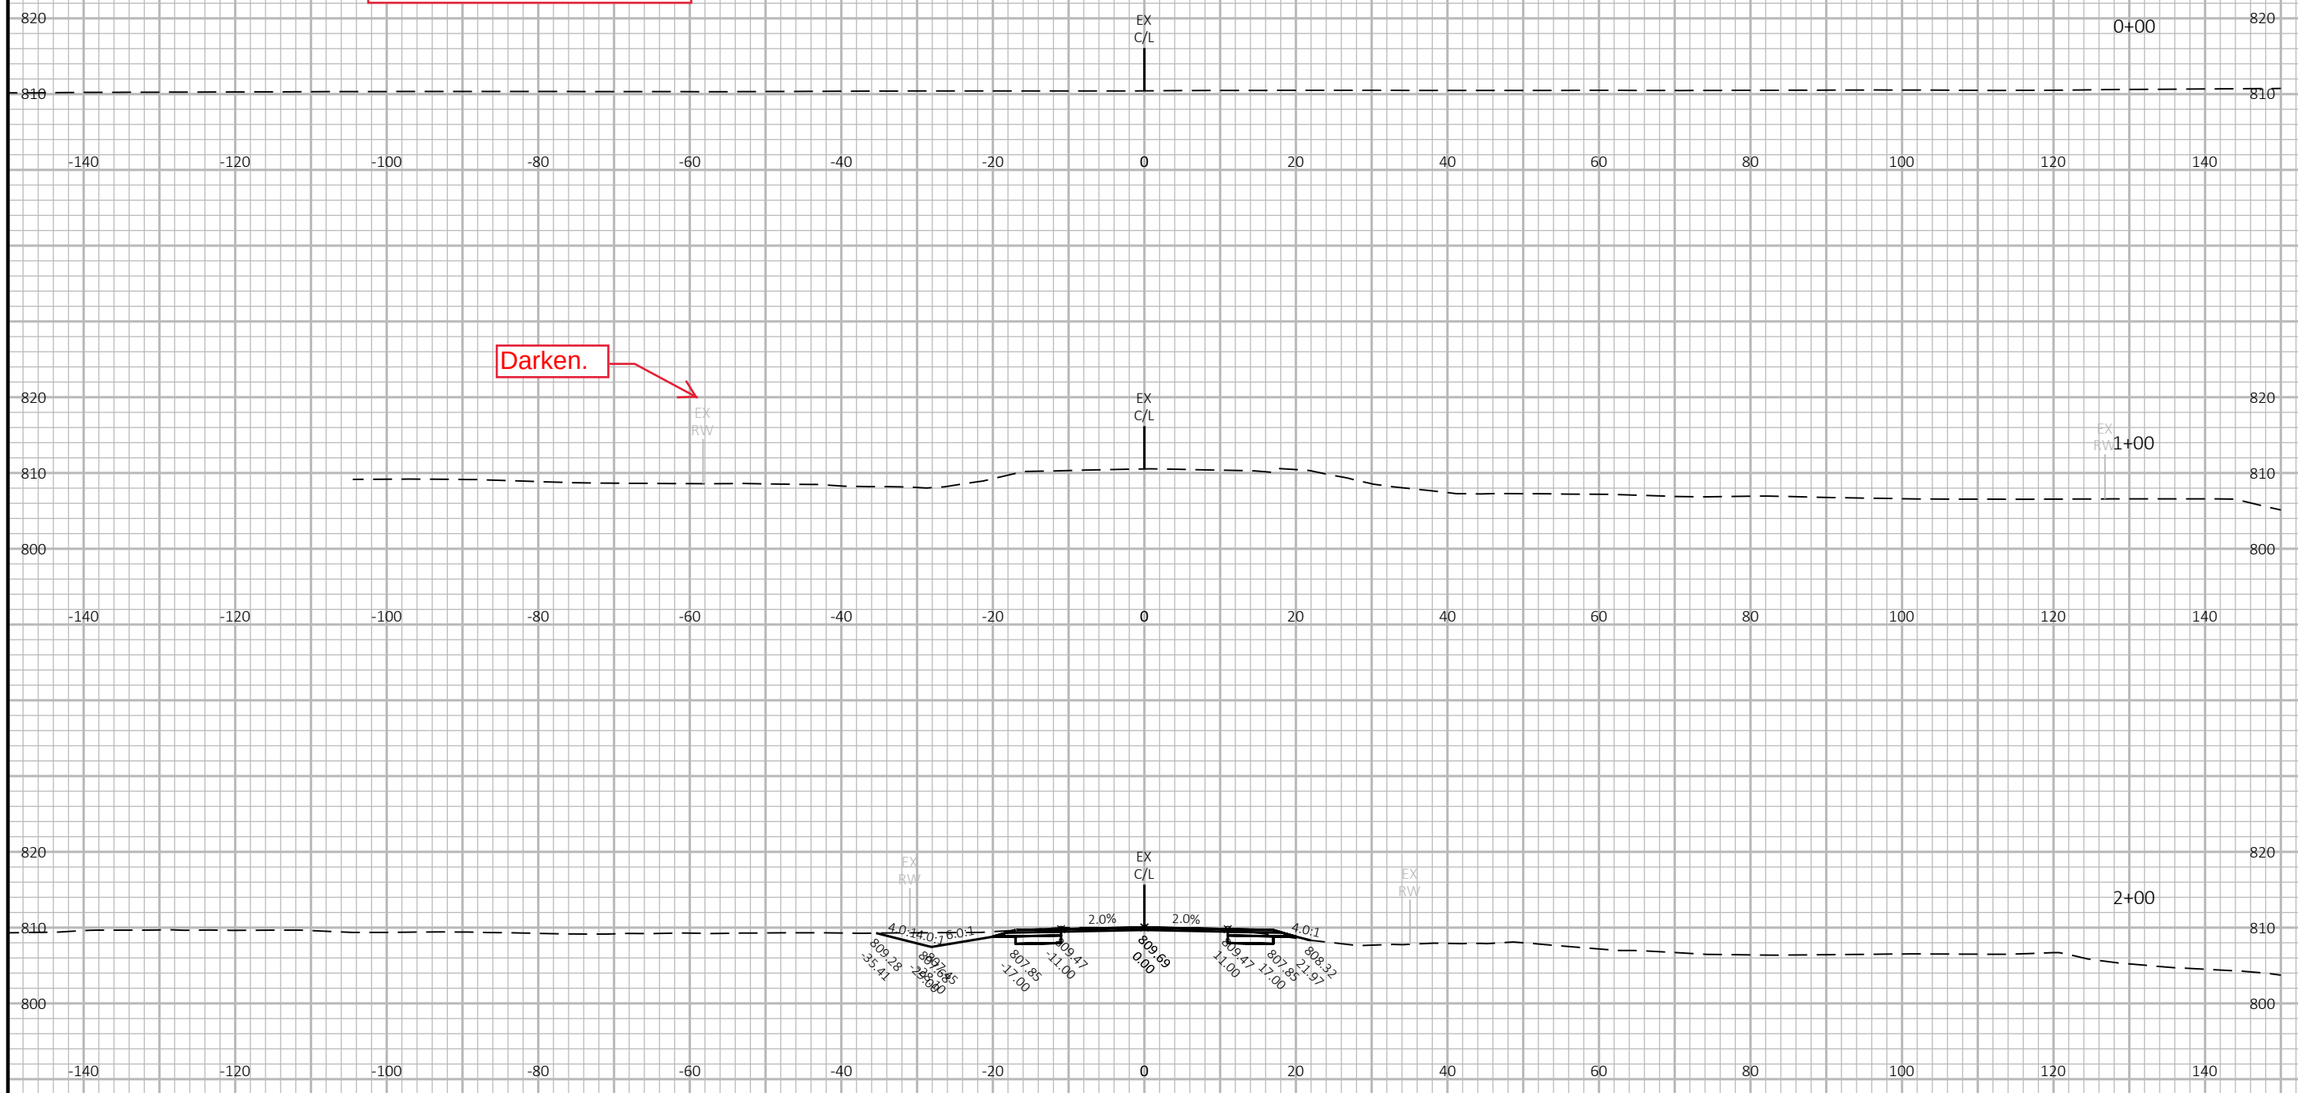

9

9

PROJECT NO: 5145-00-71	HWY: STH 19	COUNTY: DANE COUNTY	CROSS SECTIONS: Mainline ###########	SHEET 48	E

FILE NAME : N:\PDS\C3D\51450001\SHEETSPLAN\090201_XS.DWG
LAYOUT NAME - 090201-xs

PLOT DATE : 6/6/2018 4:34 PM PLOT BY : RACH, JEREMY PAUL PLOT NAME : PLOT SCALE : 1 IN:20 FT HORZ. / 1 IN:20 FT VERT.

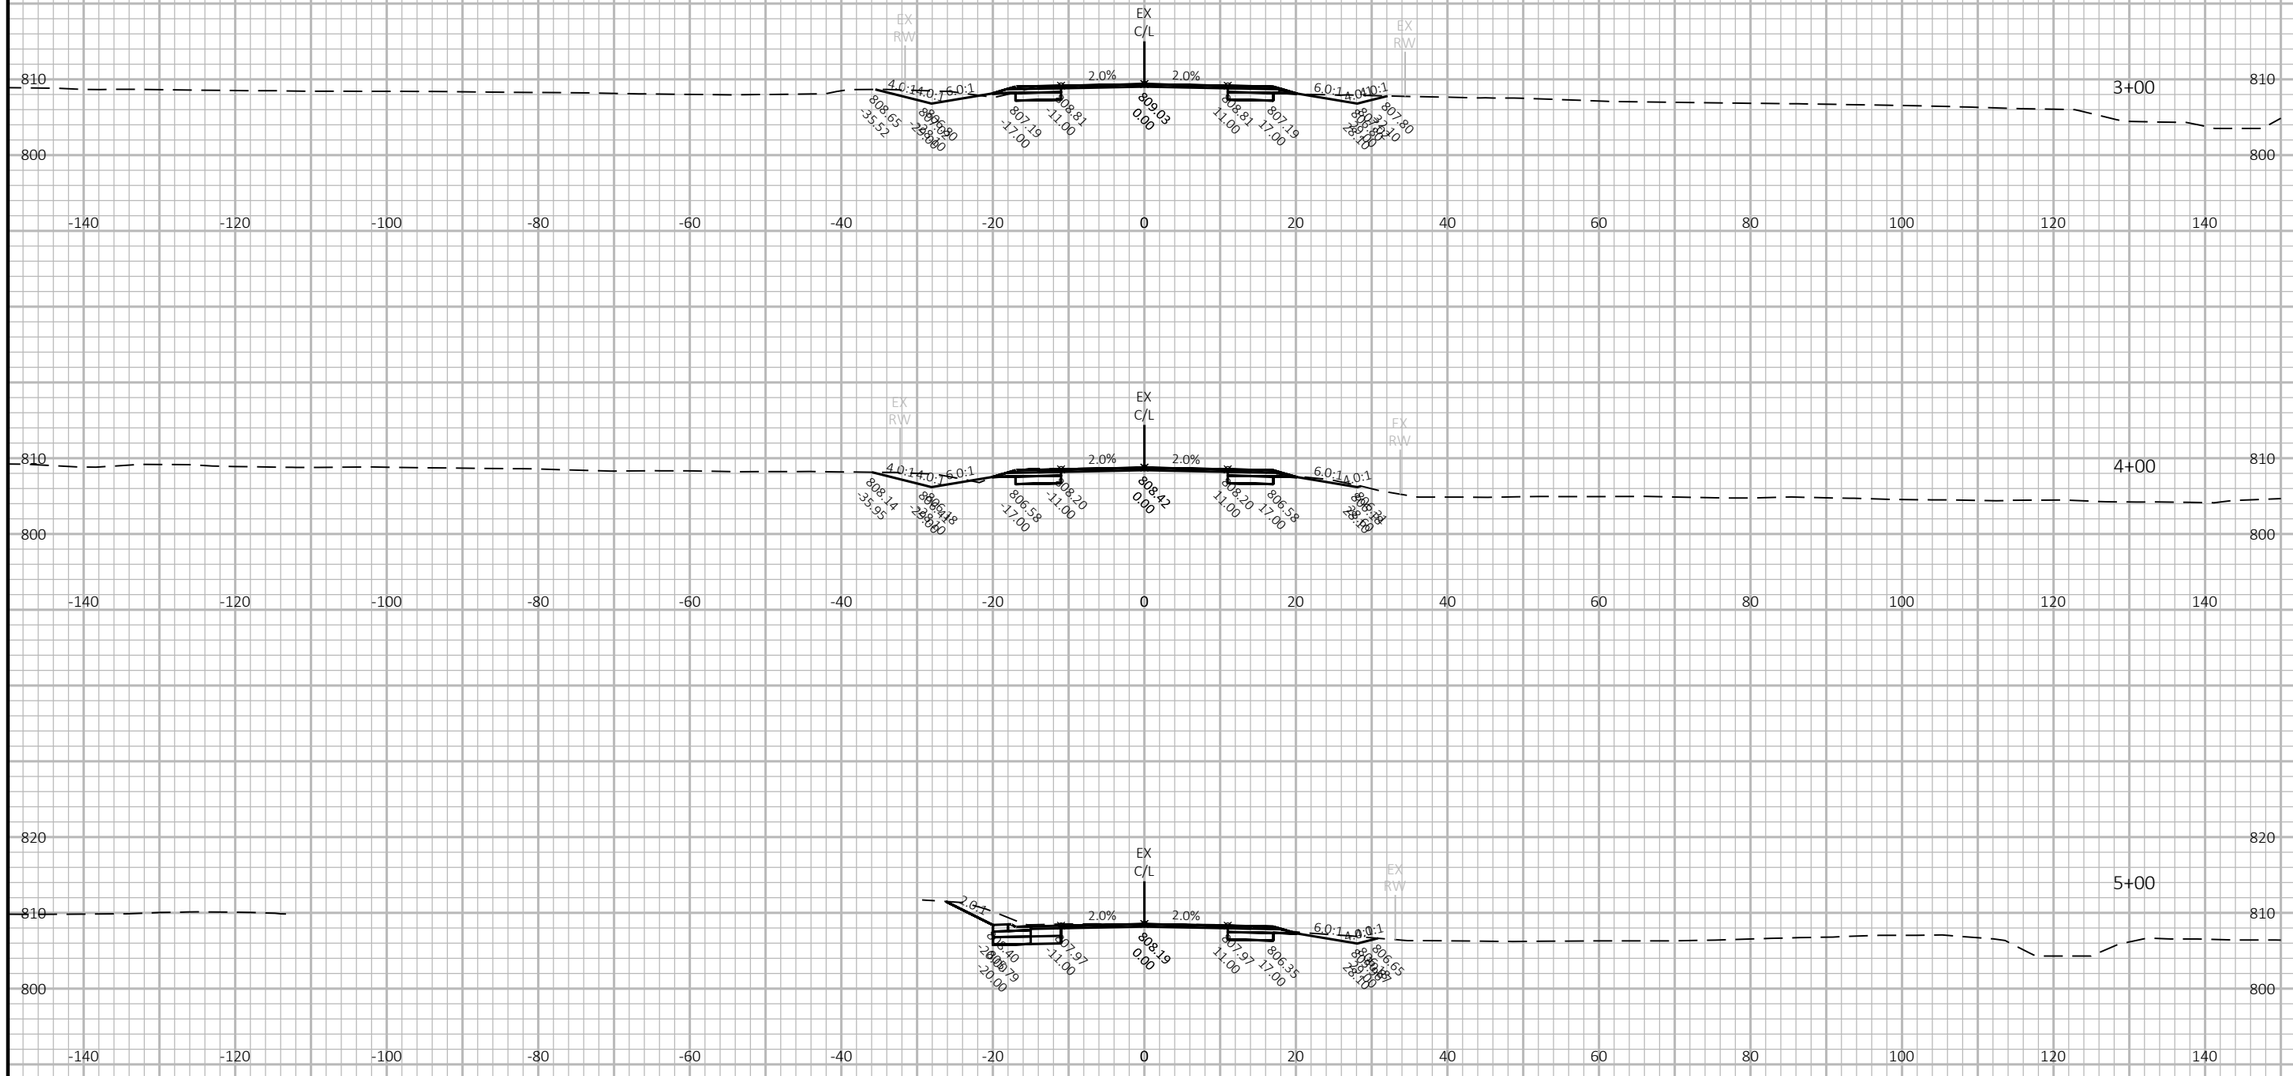

9

9

PROJECT NO: 5145-00-71	HWY: STH 19	COUNTY: DANE COUNTY	CROSS SECTIONS: ##########################	SHEET 49	E

FILE NAME : N:\PDS\C3D\51450001\SHEETSPLAN\090201_XS.DWG
LAYOUT NAME - 090202-xs

PLOT DATE : 6/6/2018 4:35 PM PLOT BY : RACH, JEREMY PAUL PLOT NAME : PLOT SCALE : 1 IN:20 FT HORZ. / 1 IN:20 FT VERT.

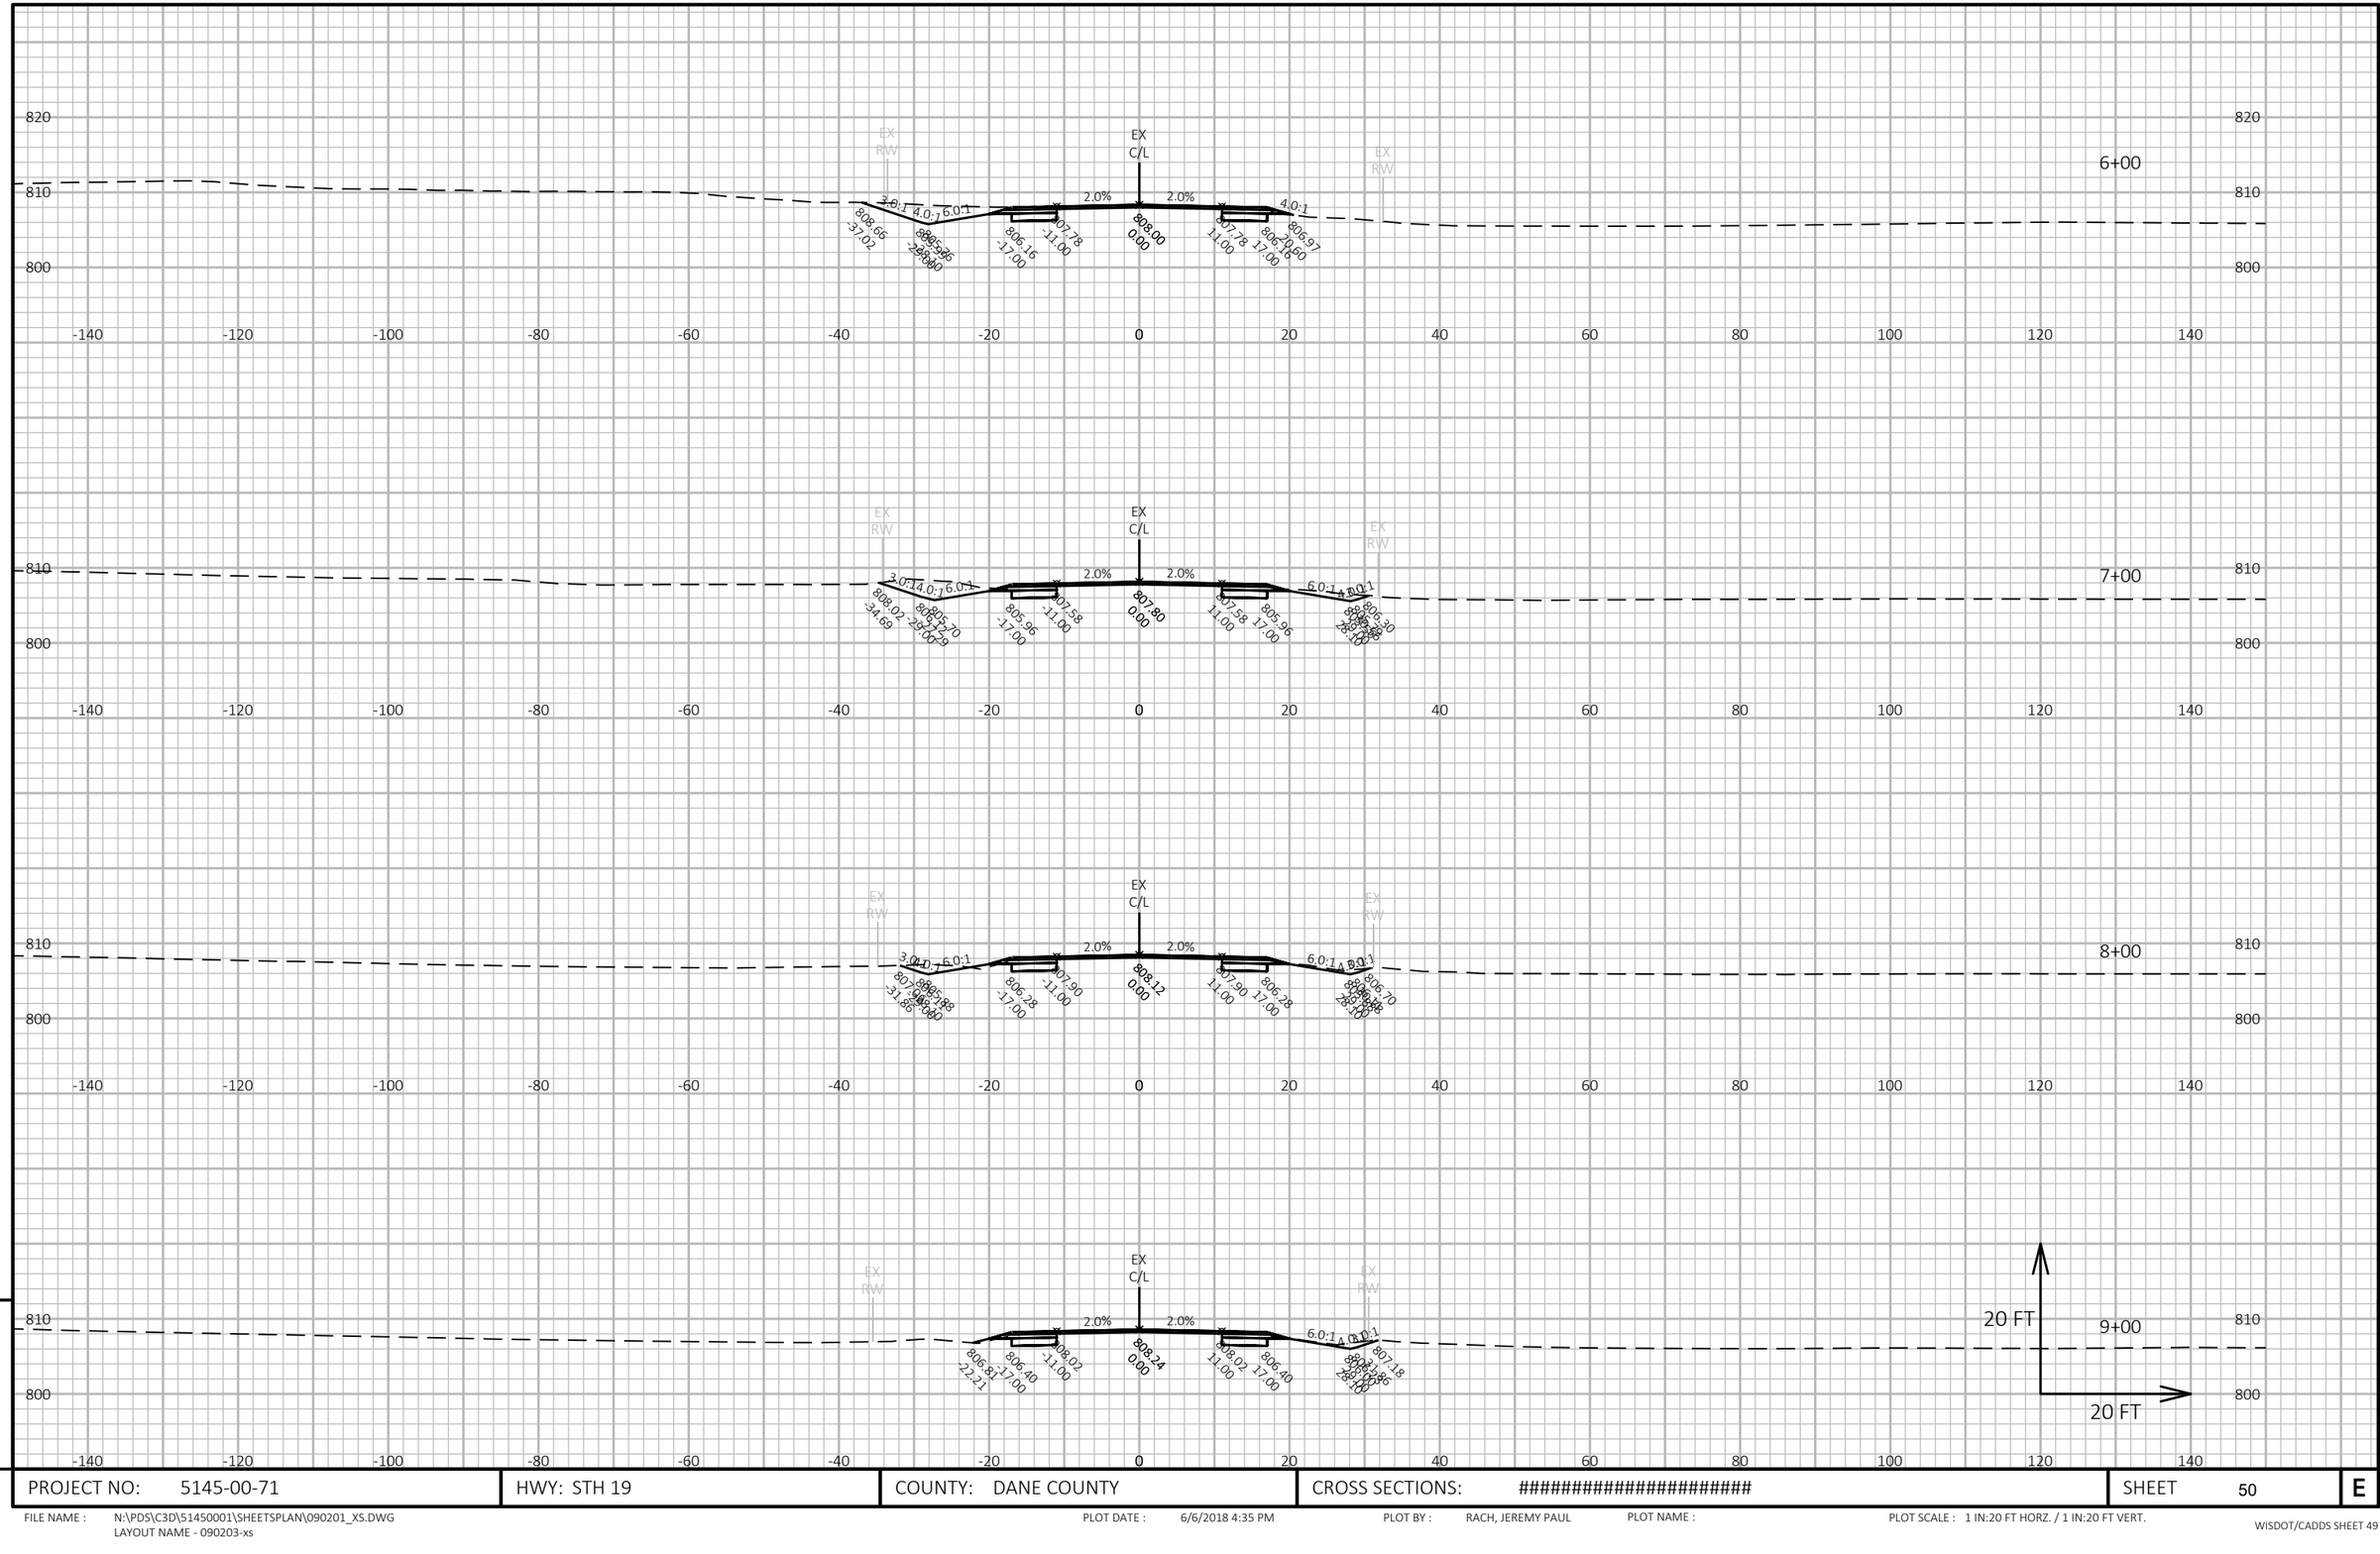

9

PROJECT NO: 5145-00-71	HWY: STH 19	COUNTY: DANE COUNTY	CROSS SECTIONS: ##########################	SHEET 50	E

FILE NAME : N:\PDS\C3D\51450001\SHEETSPLAN\090201_XS.DWG
LAYOUT NAME - 090203-xs

PLOT DATE : 6/6/2018 4:35 PM PLOT BY : RACH, JEREMY PAUL PLOT NAME : PLOT SCALE : 1 IN:20 FT HORZ. / 1 IN:20 FT VERT.

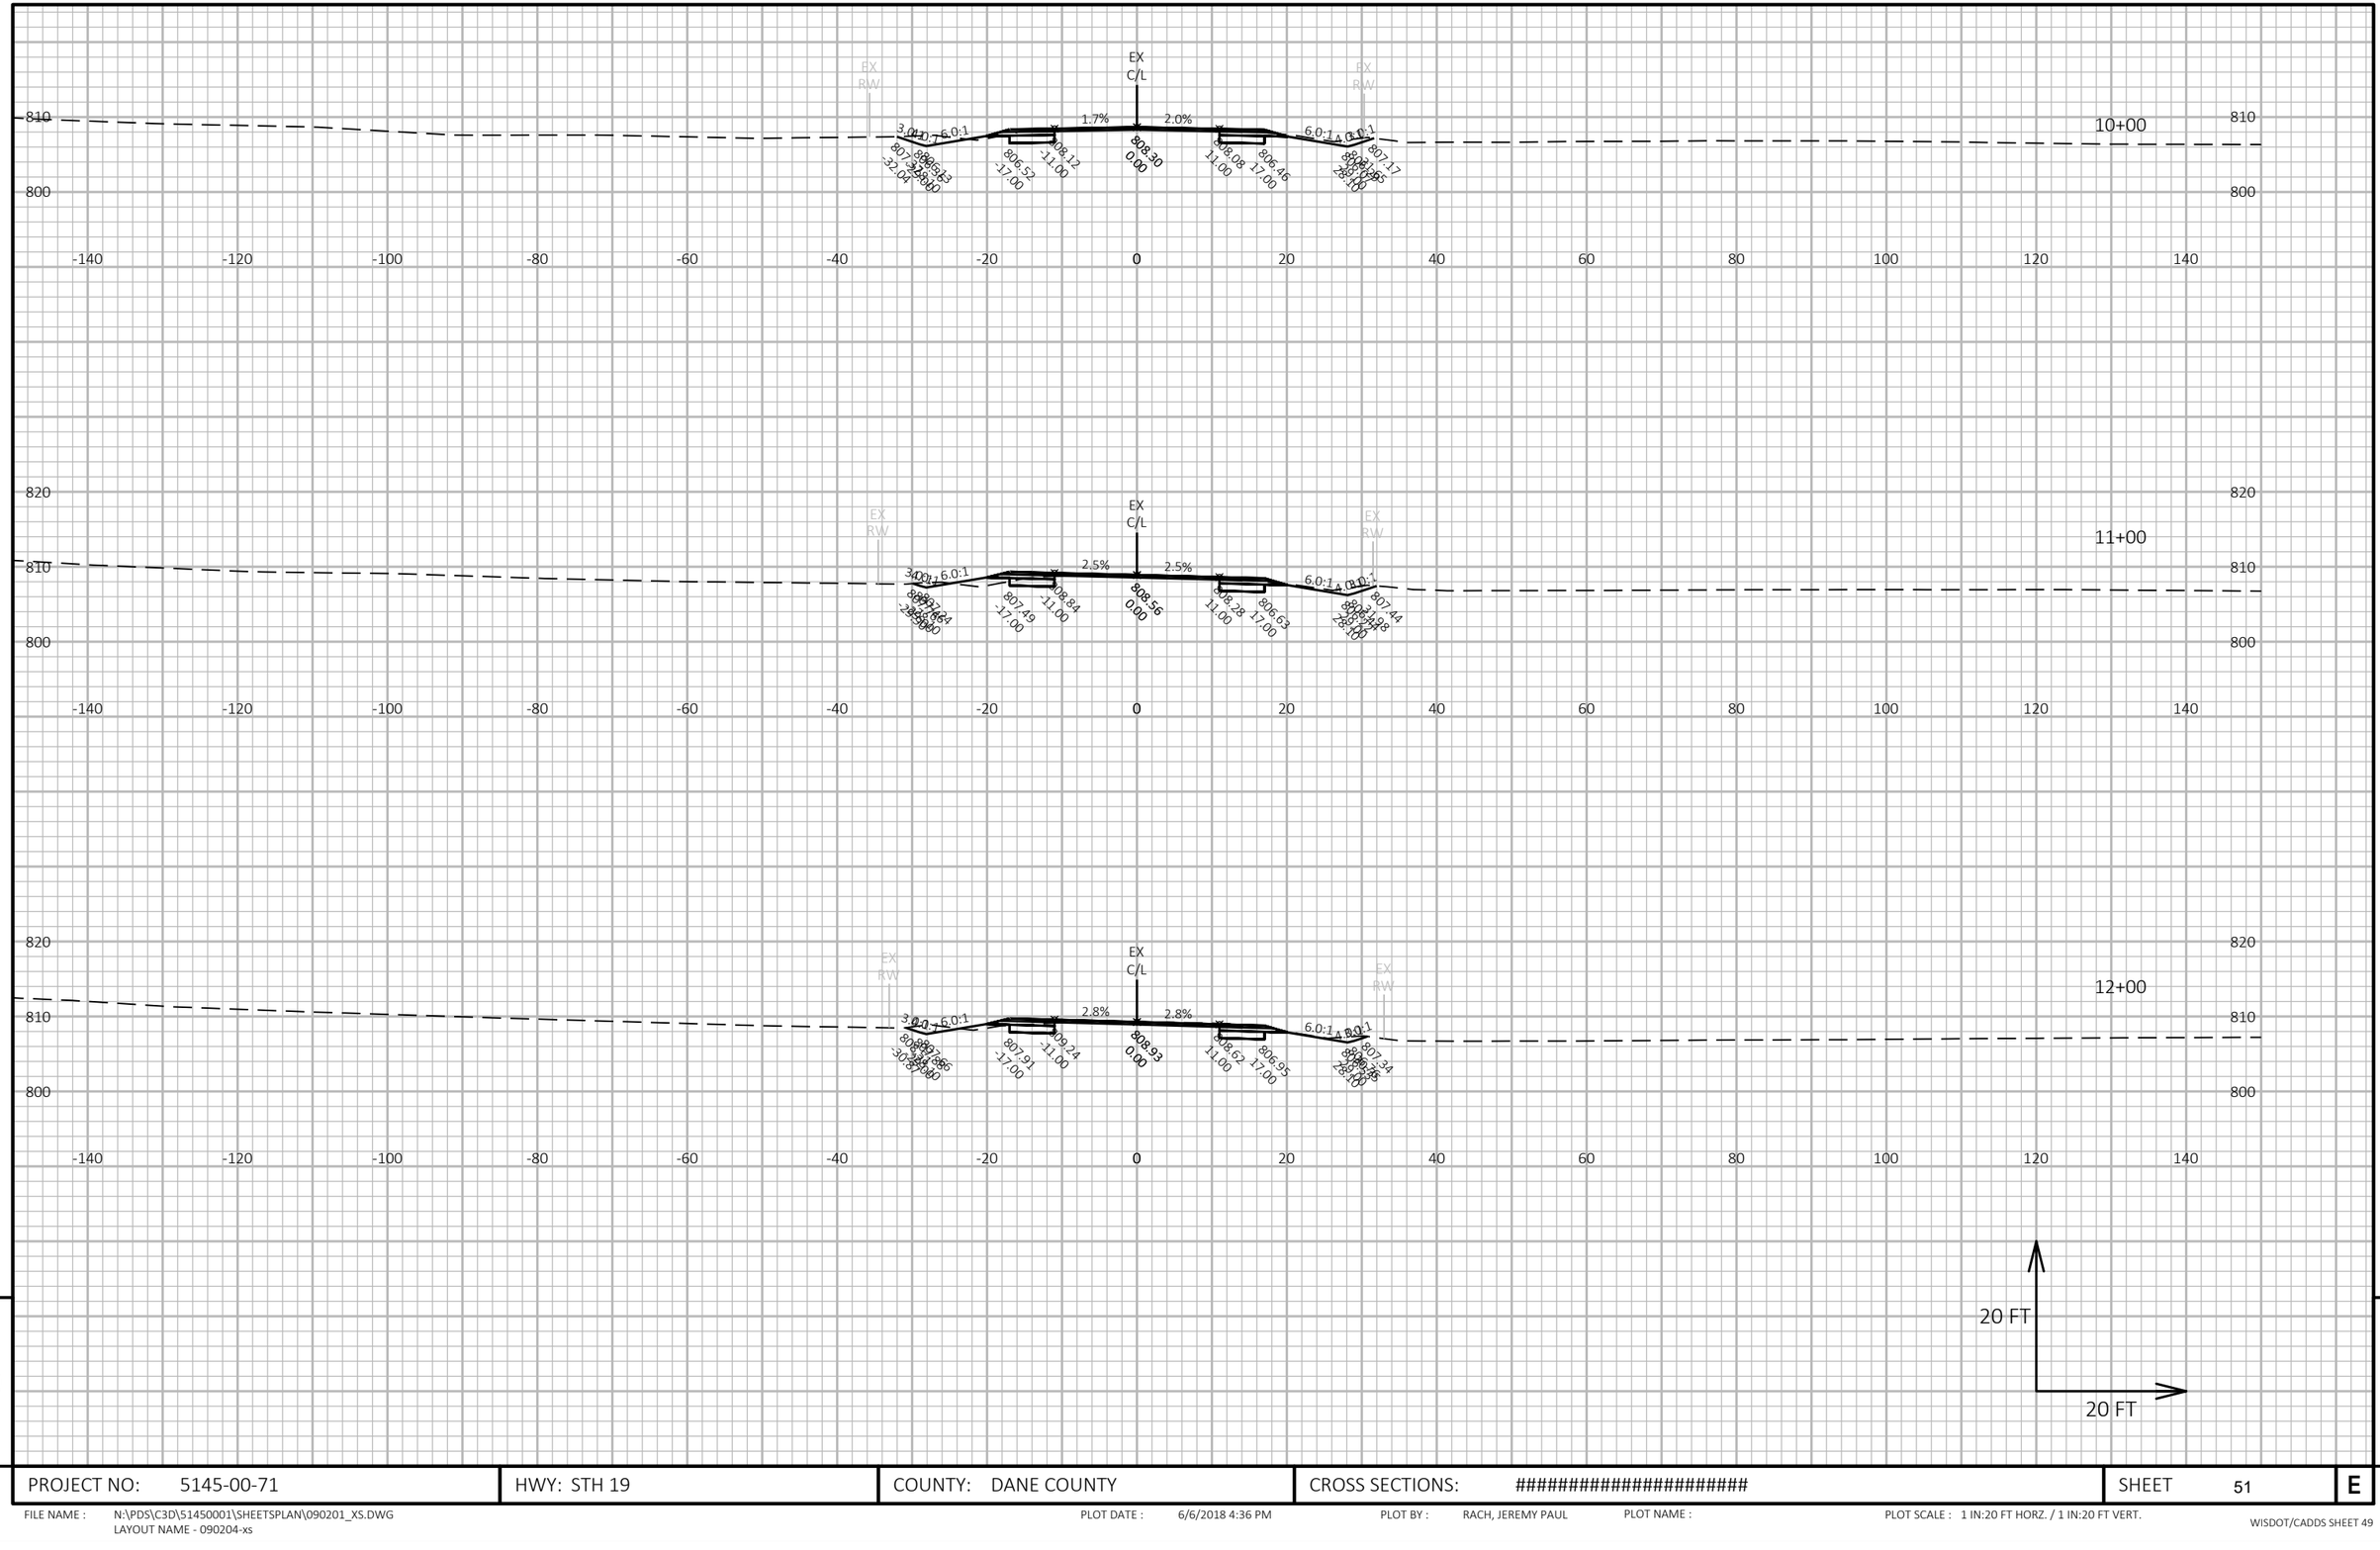

9

9

PROJECT NO: 5145-00-71	HWY: STH 19	COUNTY: DANE COUNTY	CROSS SECTIONS: ##########################	SHEET 51	E

FILE NAME : N:\PDS\C3D\51450001\SHEETSPLAN\090201_XS.DWG
LAYOUT NAME - 090204-xs
PLOT DATE : 6/6/2018 4:36 PM
PLOT BY : RACH, JEREMY PAUL
PLOT NAME :
PLOT SCALE : 1 IN:20 FT HORZ. / 1 IN:20 FT VERT.

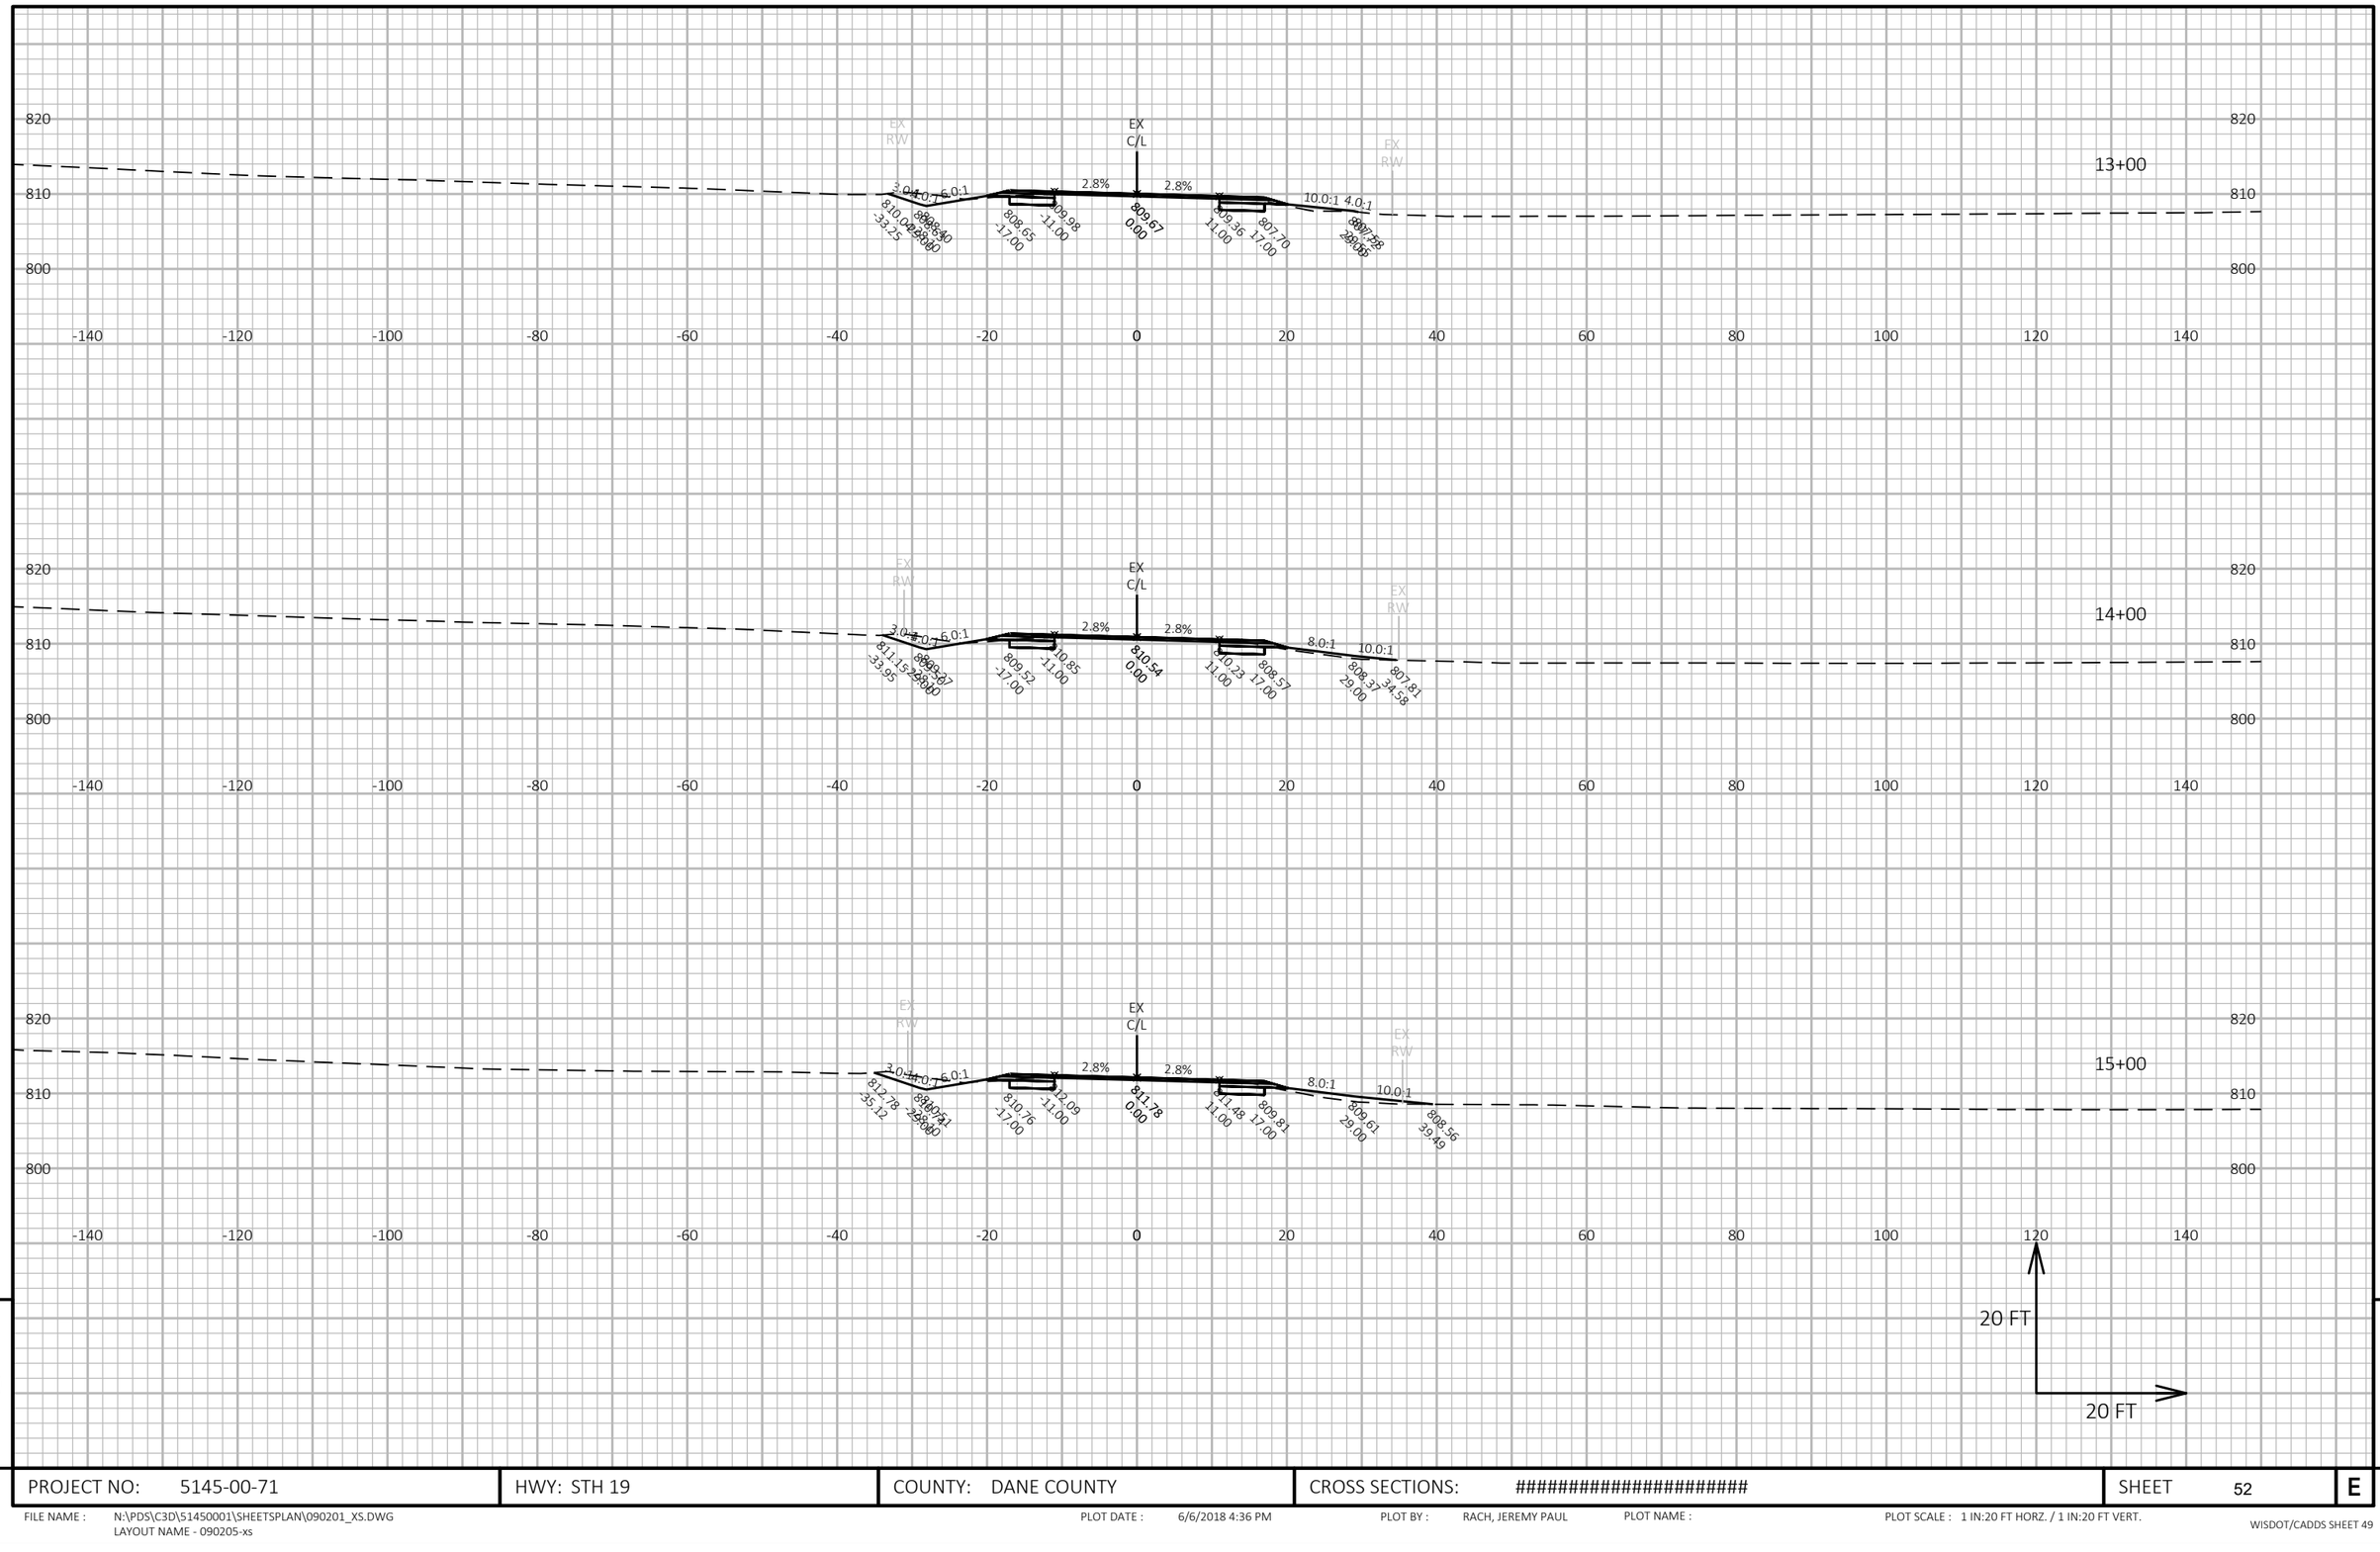

PROJECT NO: 5145-00-71	HWY: STH 19	COUNTY: DANE COUNTY	CROSS SECTIONS: ##########################	SHEET 52

FILE NAME : N:\PDS\C3D\51450001\SHEETSPLAN\090201_XS.DWG
LAYOUT NAME - 090205-xs

PLOT DATE : 6/6/2018 4:36 PM PLOT BY : RACH, JEREMY PAUL PLOT NAME : PLOT SCALE : 1 IN:20 FT HORZ. / 1 IN:20 FT VERT.

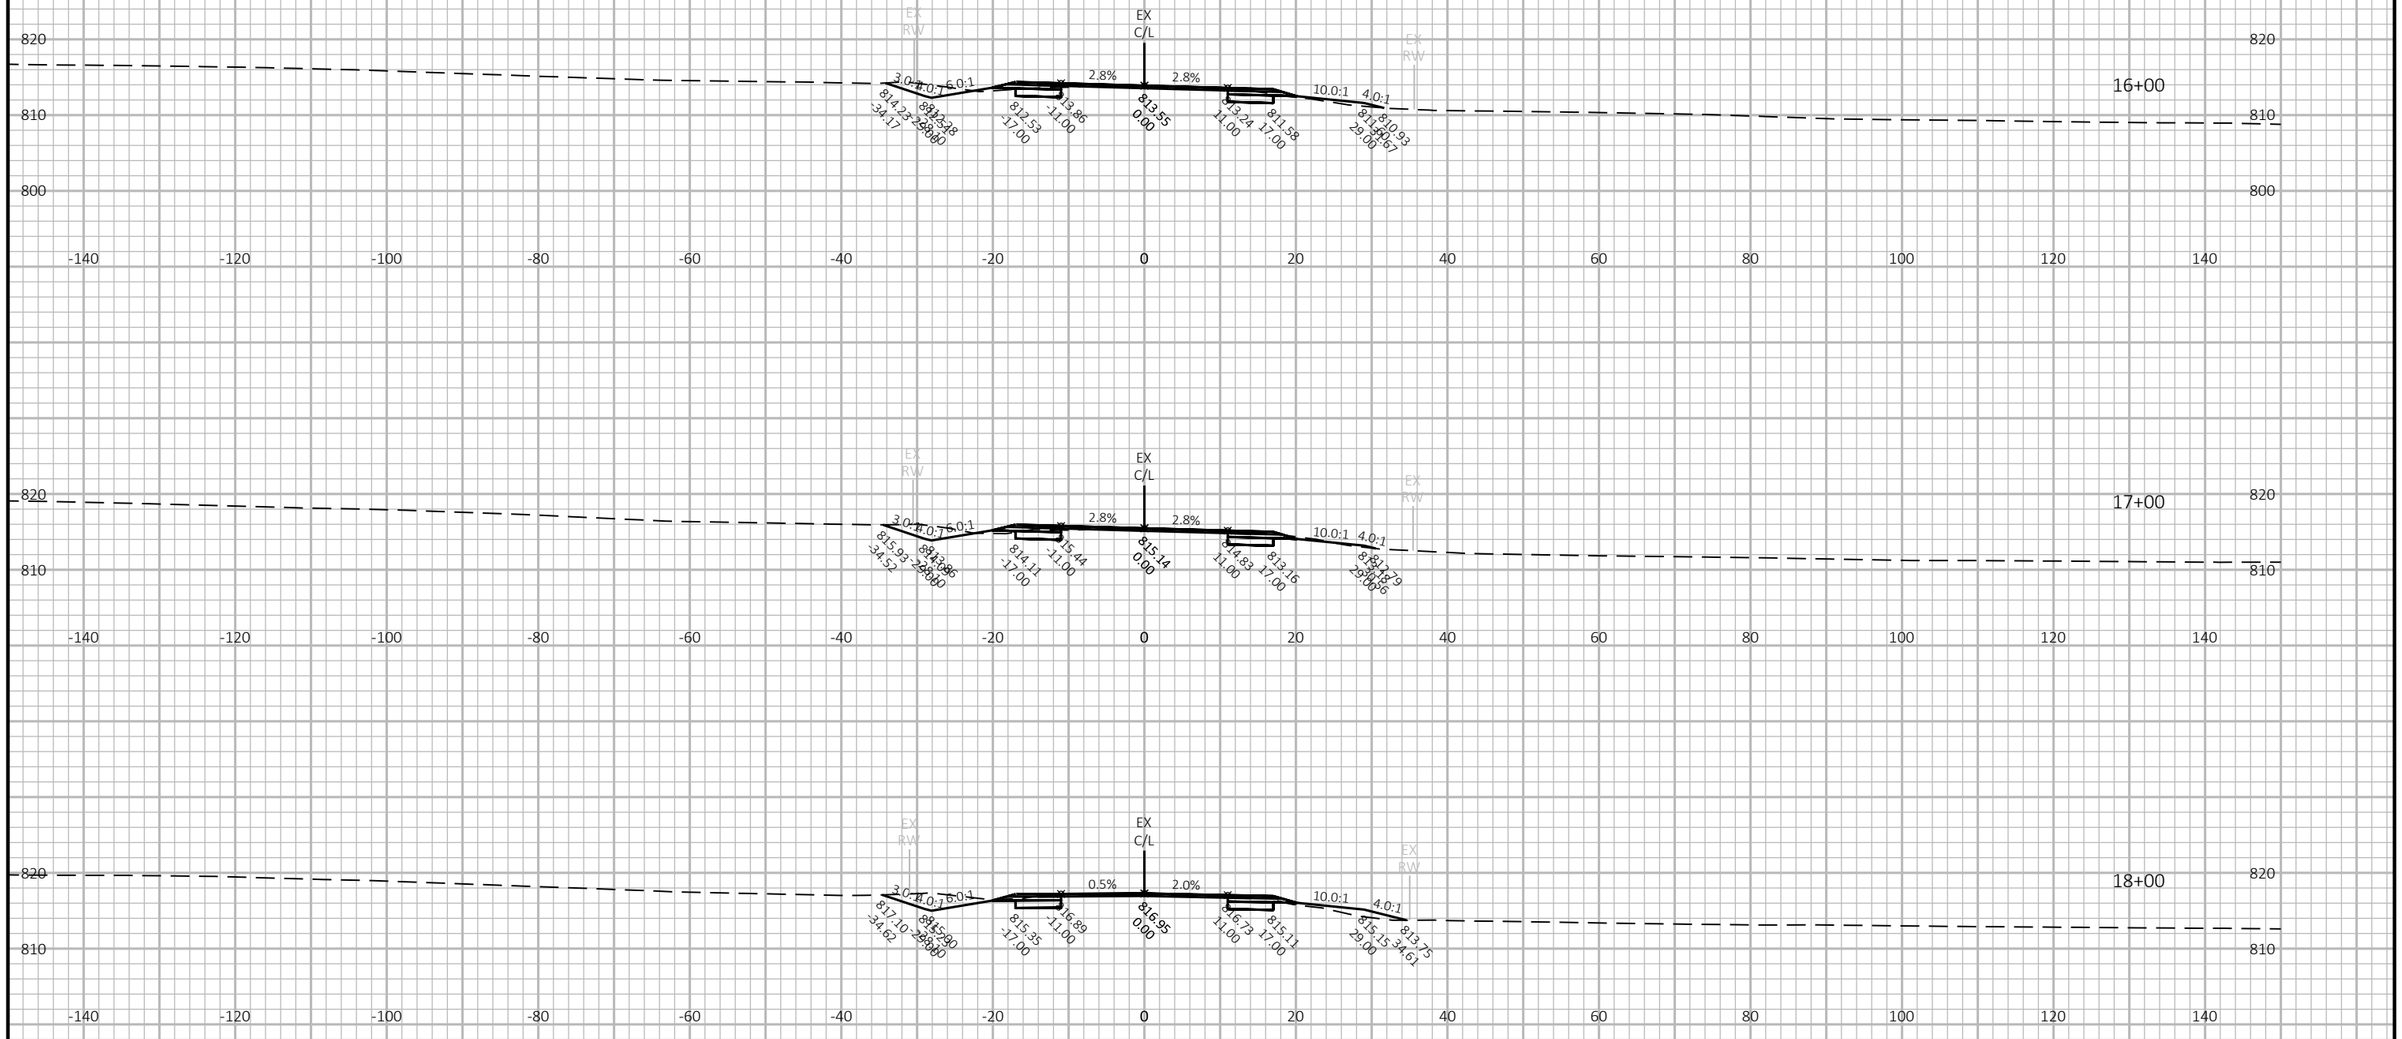

9

9

PROJECT NO: 5145-00-71	HWY: STH 19	COUNTY: DANE COUNTY	CROSS SECTIONS: ##########################	SHEET 53	E

FILE NAME : N:\PDS\C3D\51450001\SHEETSPLAN\090201_XS.DWG
LAYOUT NAME - 090206-xs

PLOT DATE : 6/6/2018 4:37 PM PLOT BY : RACH, JEREMY PAUL PLOT NAME : PLOT SCALE : 1 IN:20 FT HORZ. / 1 IN:20 FT VERT.

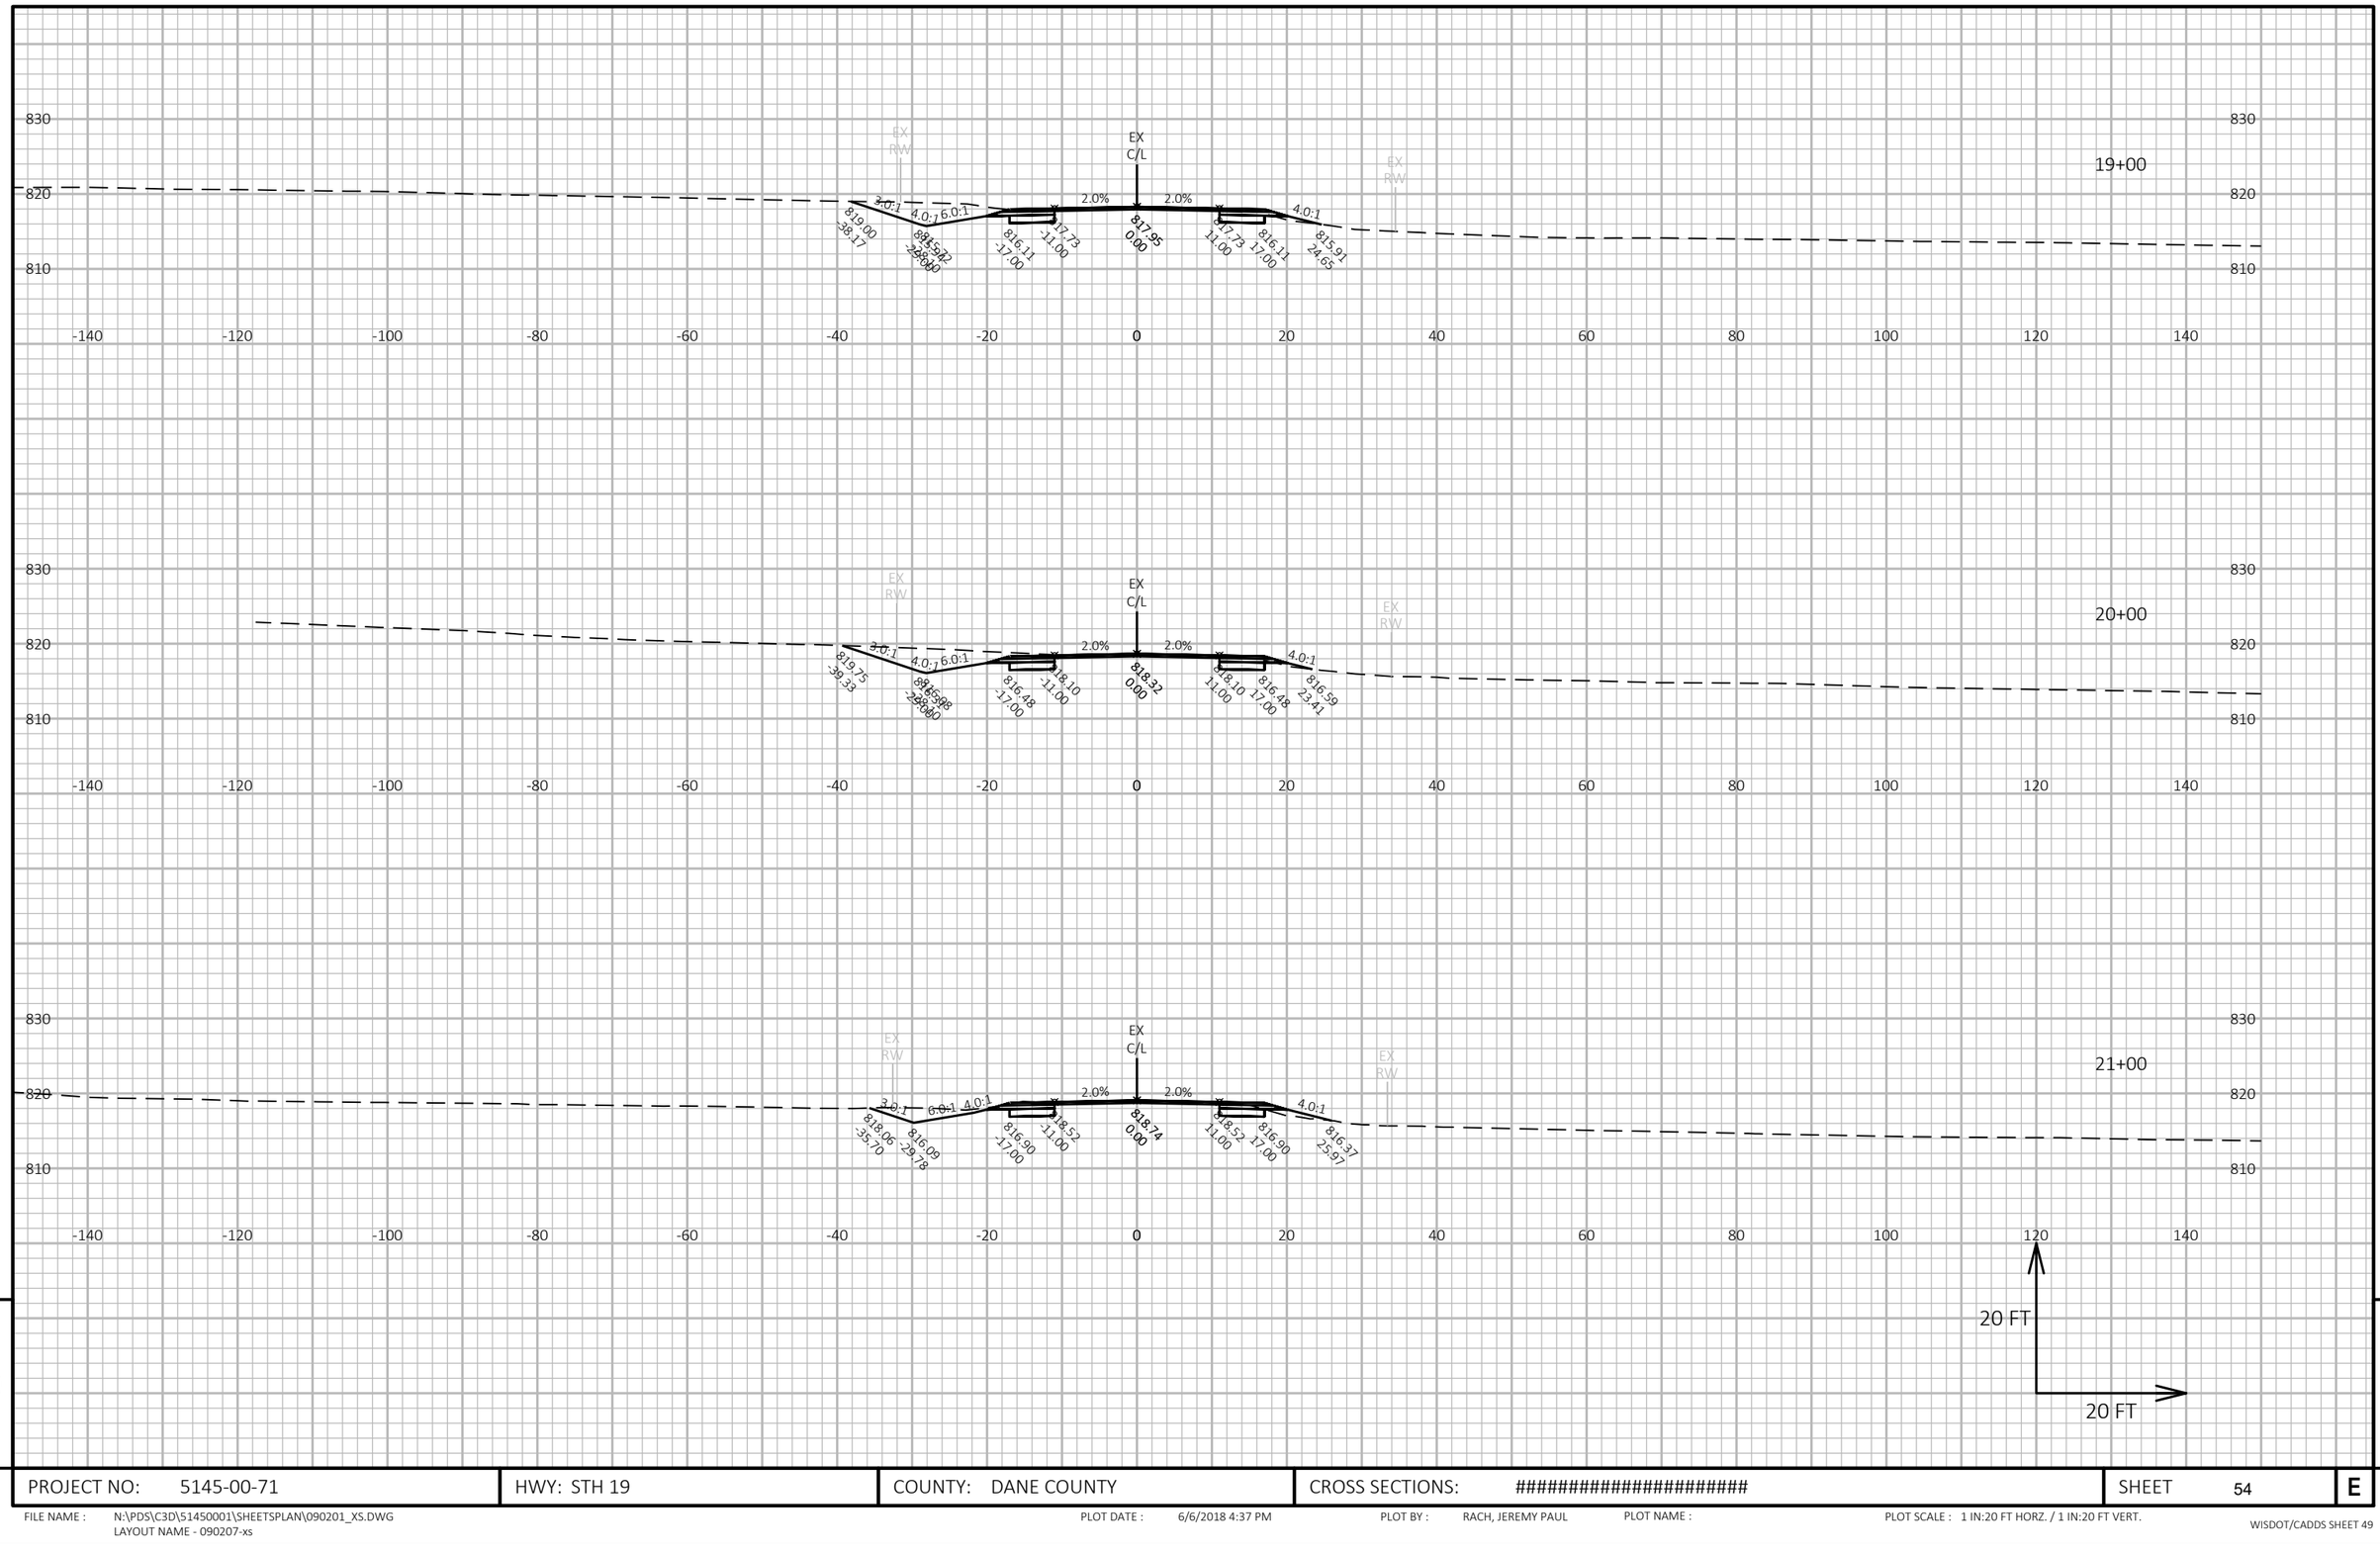

9

9

PROJECT NO: 5145-00-71	HWY: STH 19	COUNTY: DANE COUNTY	CROSS SECTIONS: ##########################	SHEET 54	E

FILE NAME : N:\PDS\C3D\51450001\SHEETSPLAN\090201_XS.DWG
LAYOUT NAME - 090207-xs

PLOT DATE : 6/6/2018 4:37 PM PLOT BY : RACH, JEREMY PAUL PLOT NAME : PLOT SCALE : 1 IN:20 FT HORZ. / 1 IN:20 FT VERT.

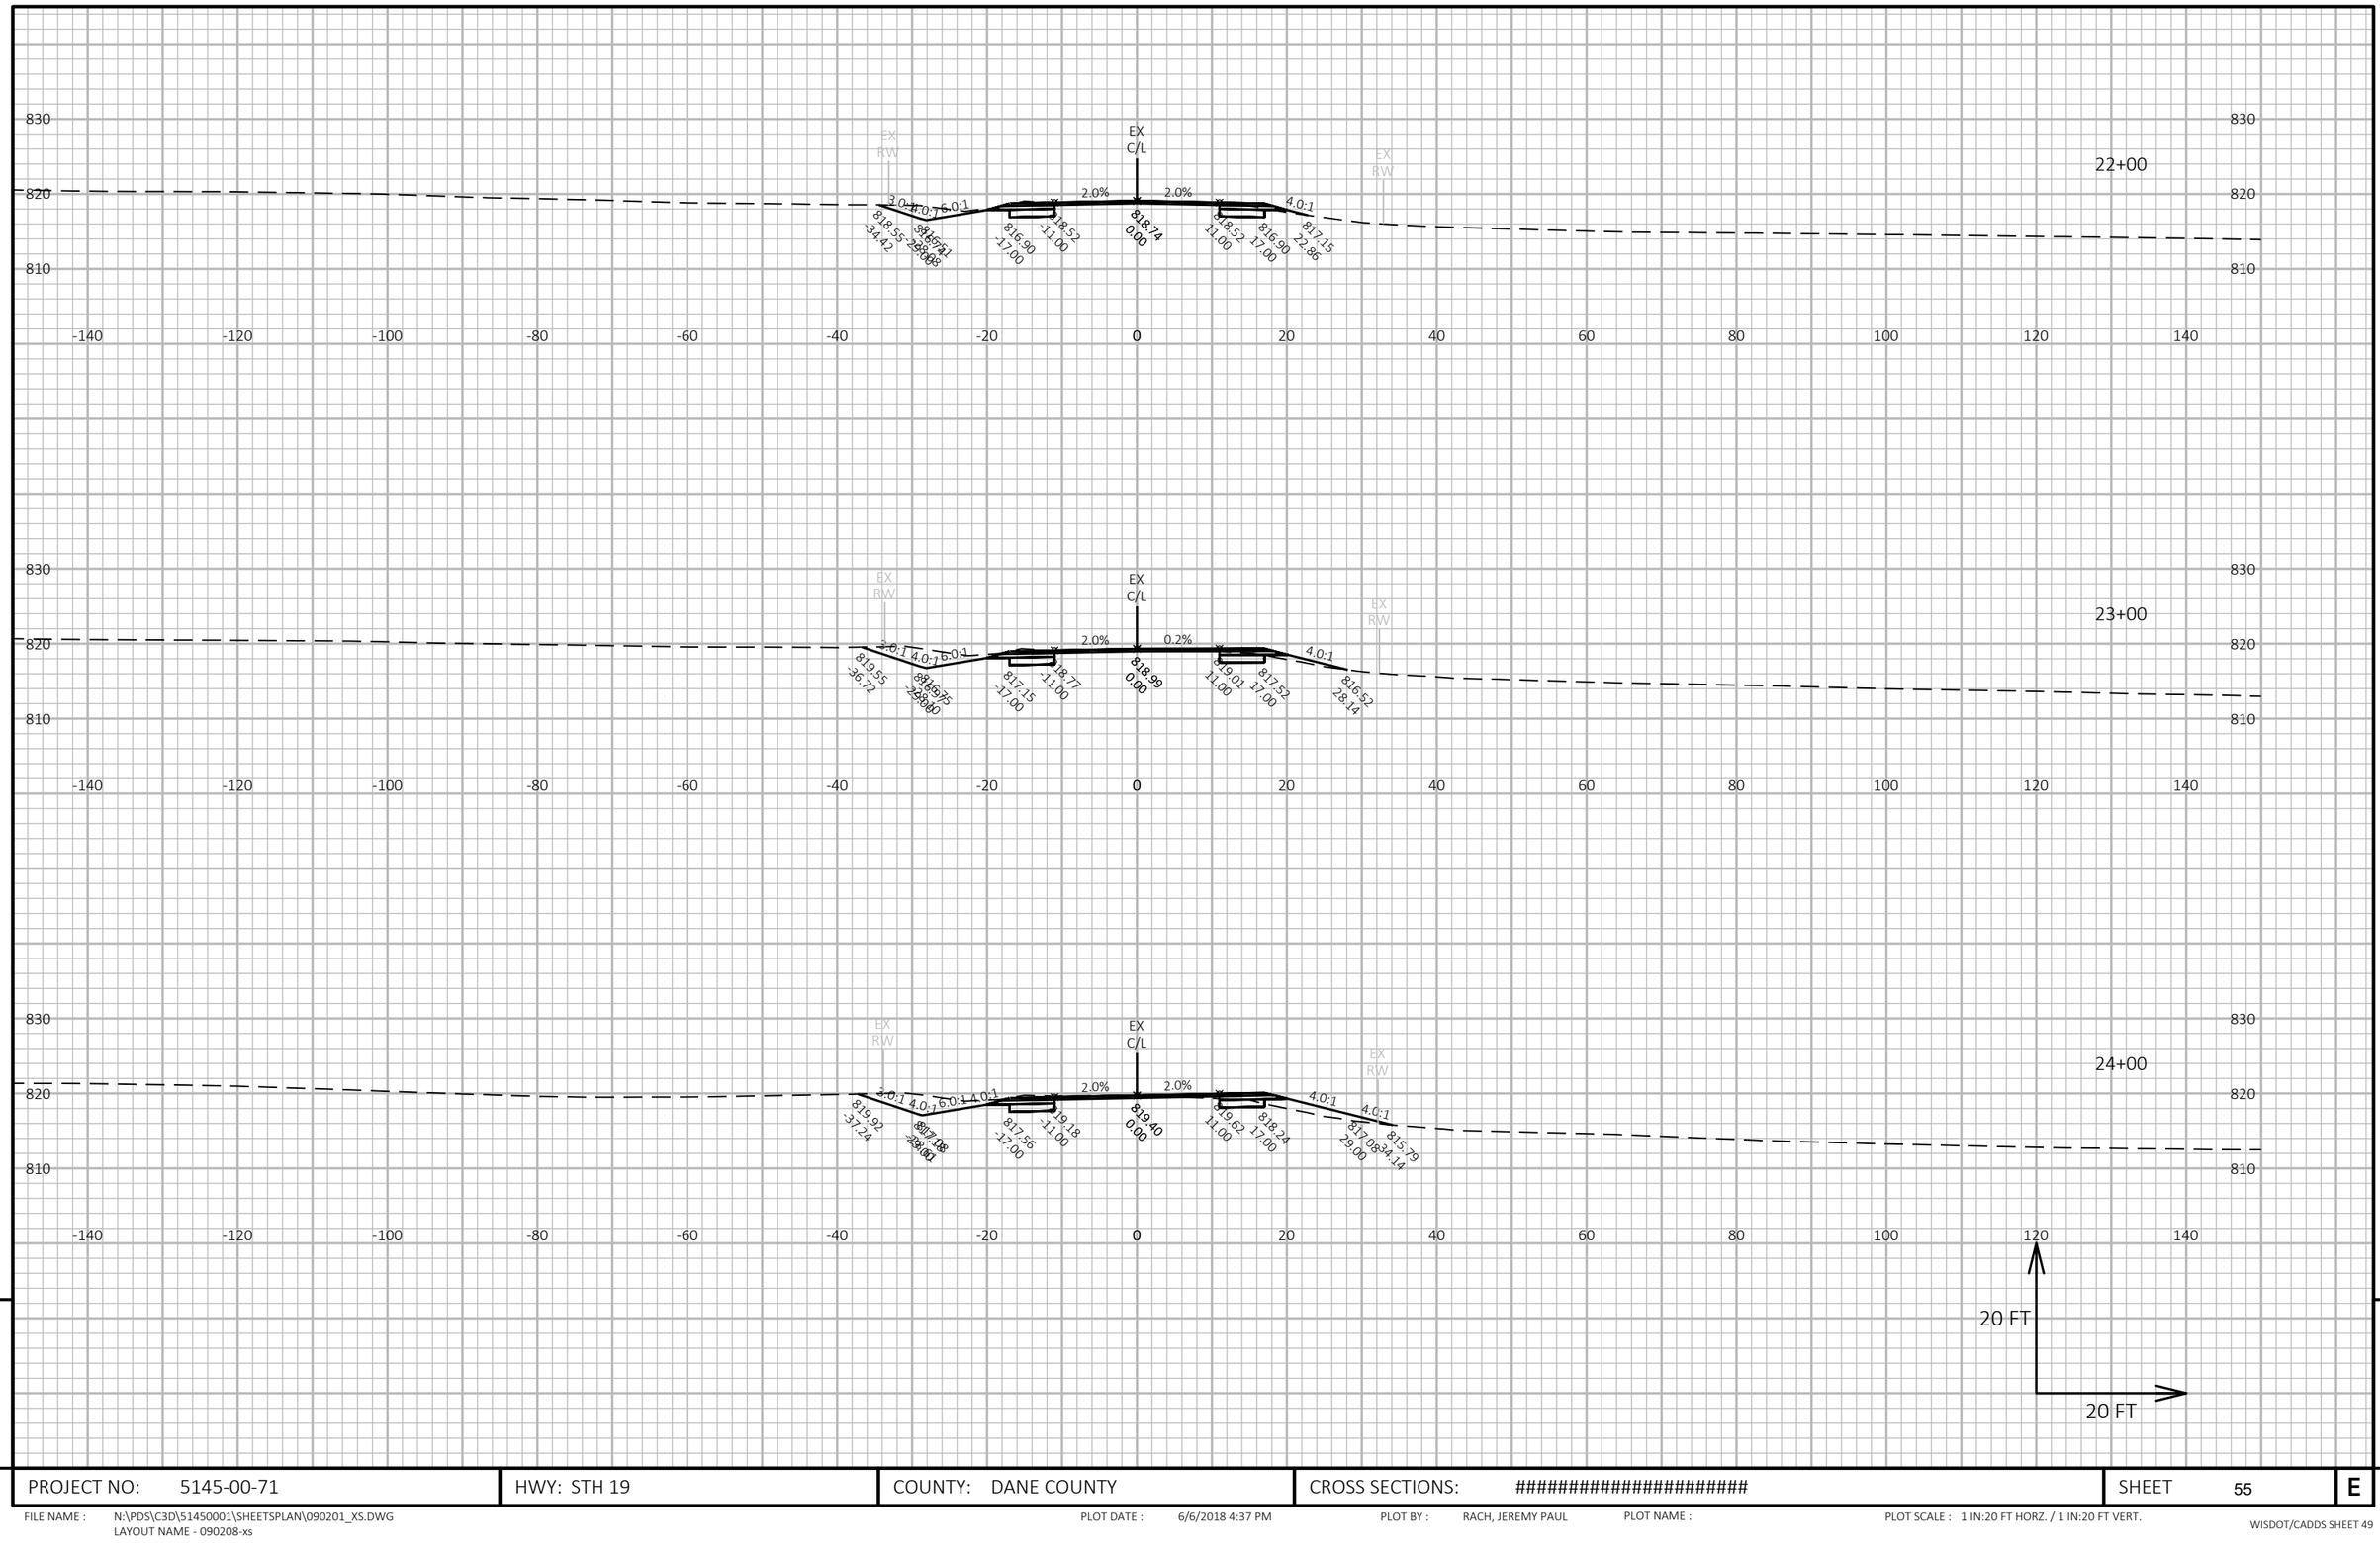

9

9

PROJECT NO: 5145-00-71	HWY: STH 19	COUNTY: DANE COUNTY	CROSS SECTIONS: ##########################	SHEET 55	E

FILE NAME : N:\PDS\C3D\51450001\SHEETSPLAN\090201_XS.DWG
LAYOUT NAME - 090208-xs

PLOT DATE : 6/6/2018 4:37 PM PLOT BY : RACH, JEREMY PAUL PLOT NAME : PLOT SCALE : 1 IN:20 FT HORZ. / 1 IN:20 FT VERT.

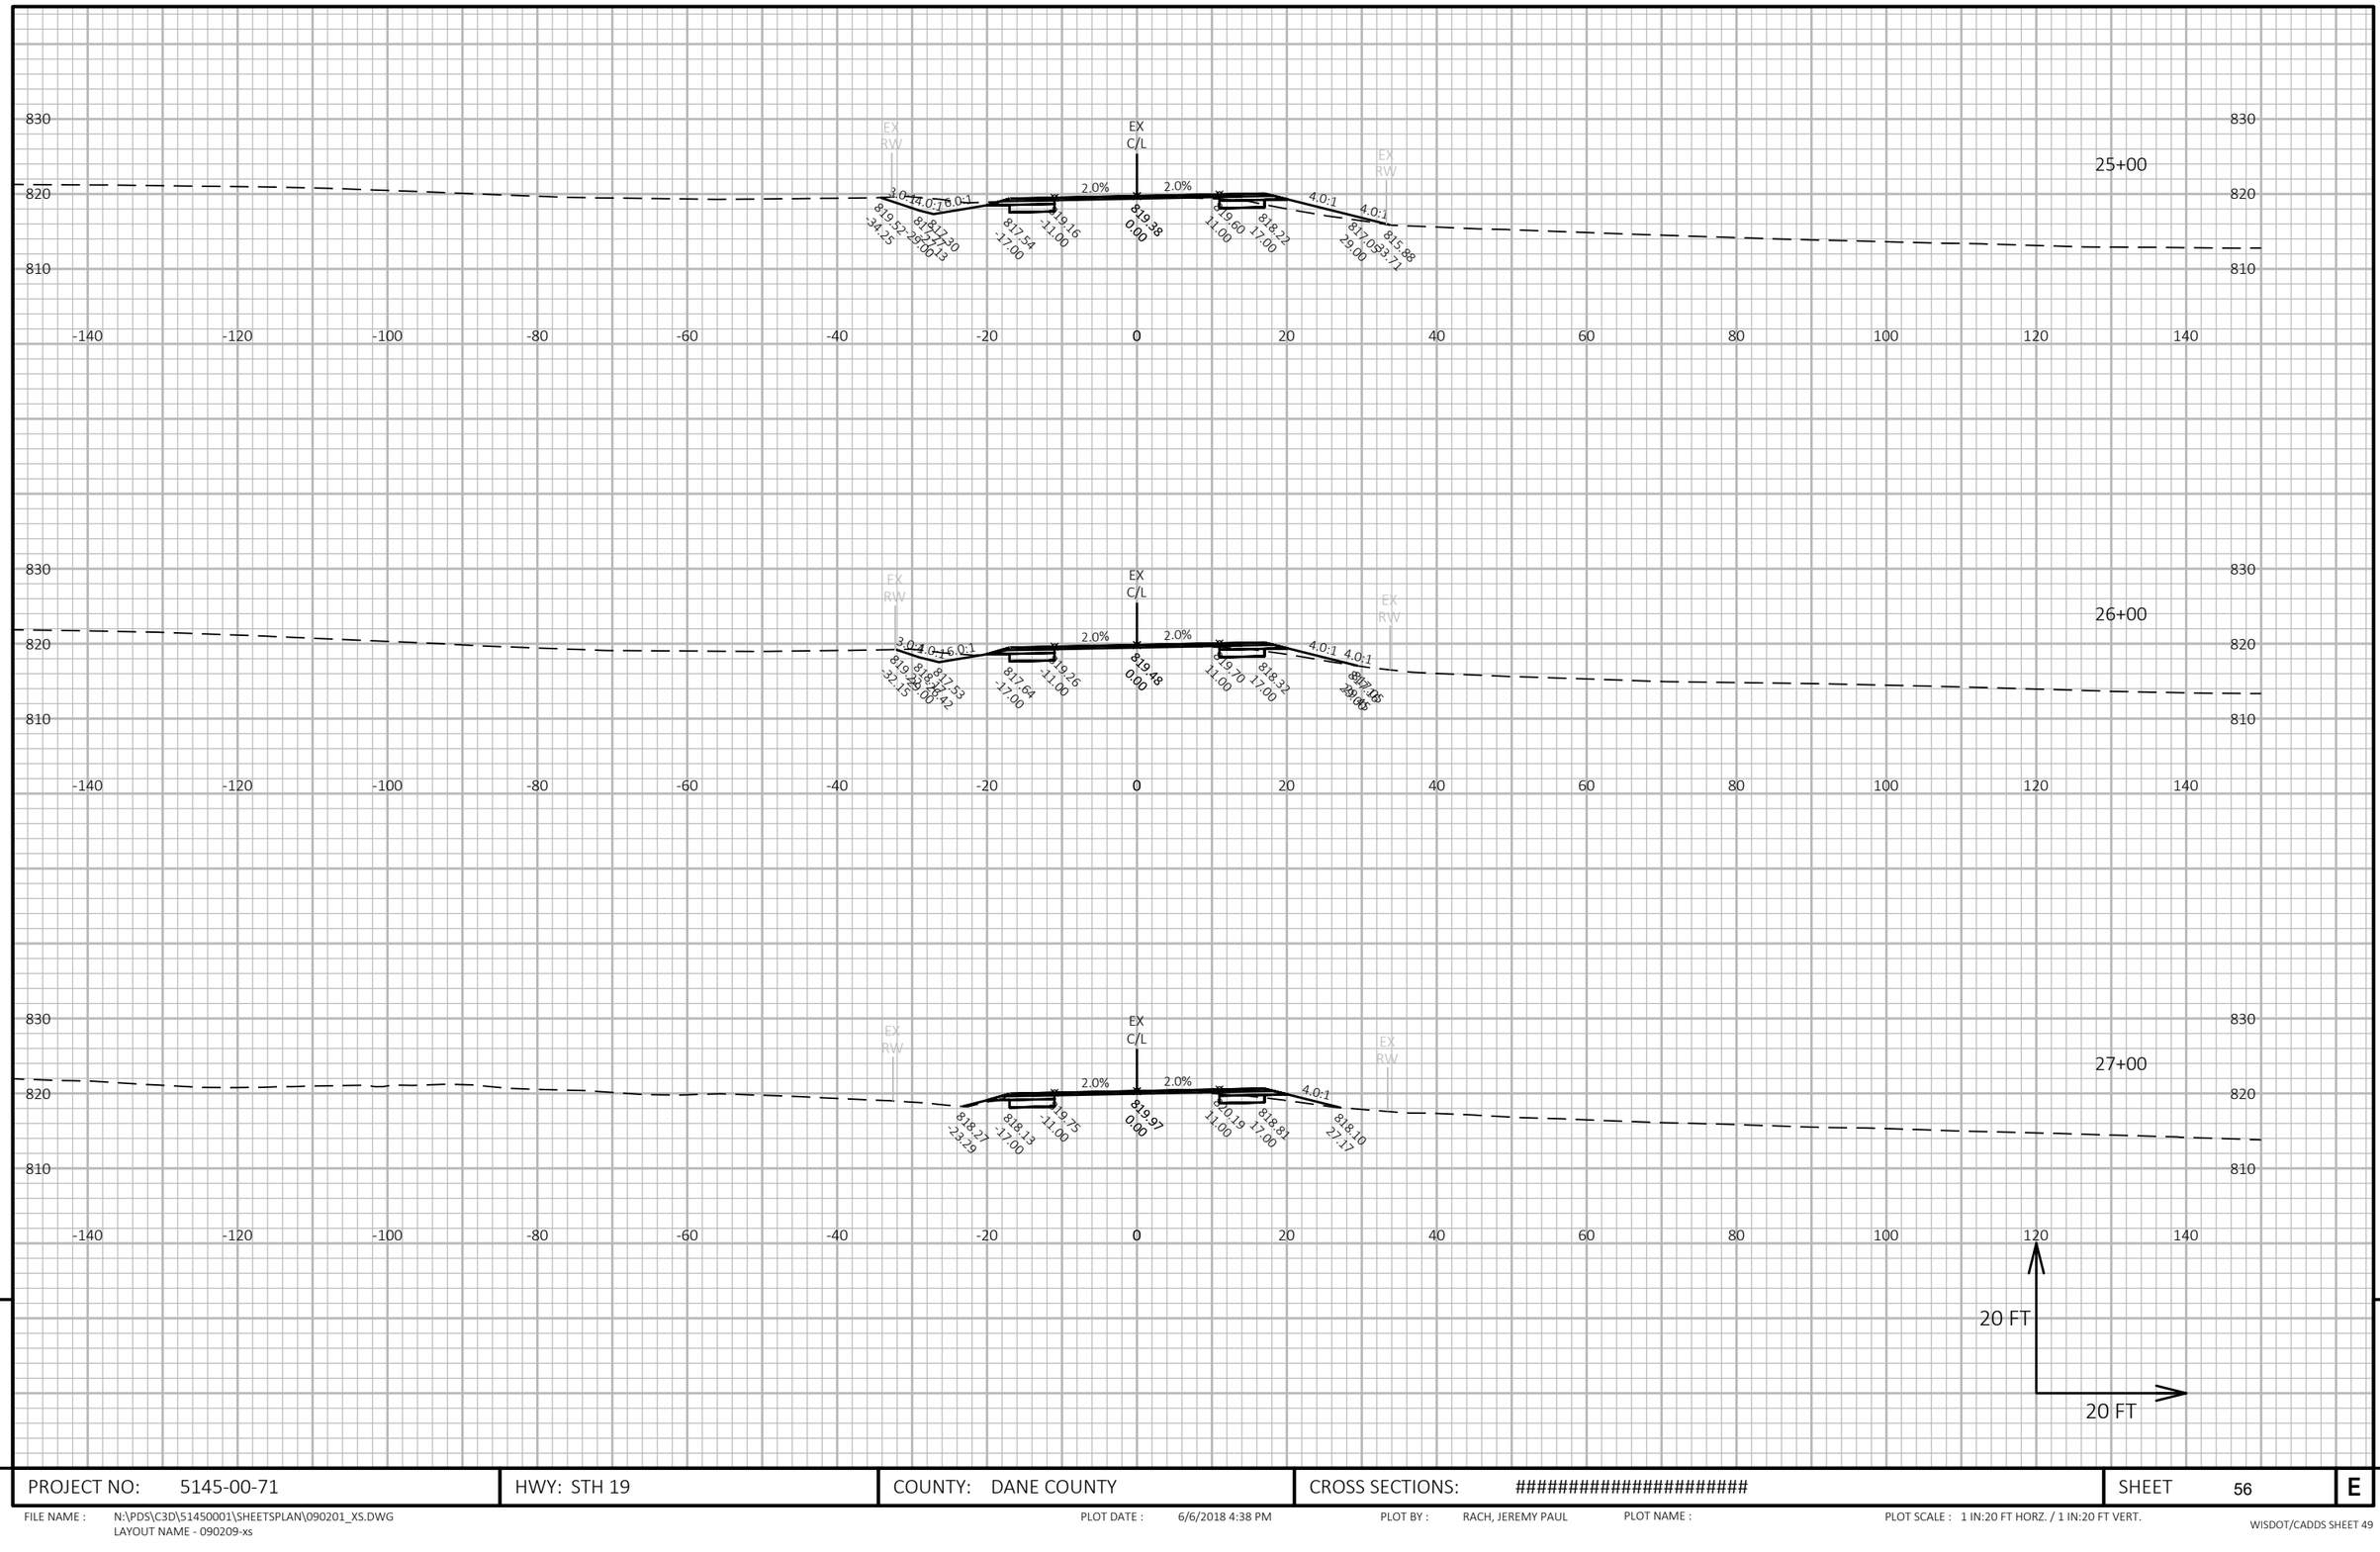

PROJECT NO: 5145-00-71	HWY: STH 19	COUNTY: DANE COUNTY	CROSS SECTIONS: ##########################	SHEET 56 E

FILE NAME : N:\PDS\C3D\51450001\SHEETSPLAN\090201_XS.DWG
LAYOUT NAME - 090209-xs

PLOT DATE : 6/6/2018 4:38 PM PLOT BY : RACH, JEREMY PAUL PLOT NAME : PLOT SCALE : 1 IN:20 FT HORZ. / 1 IN:20 FT VERT.

WISDOT/CADDS SHEET 49

9

9

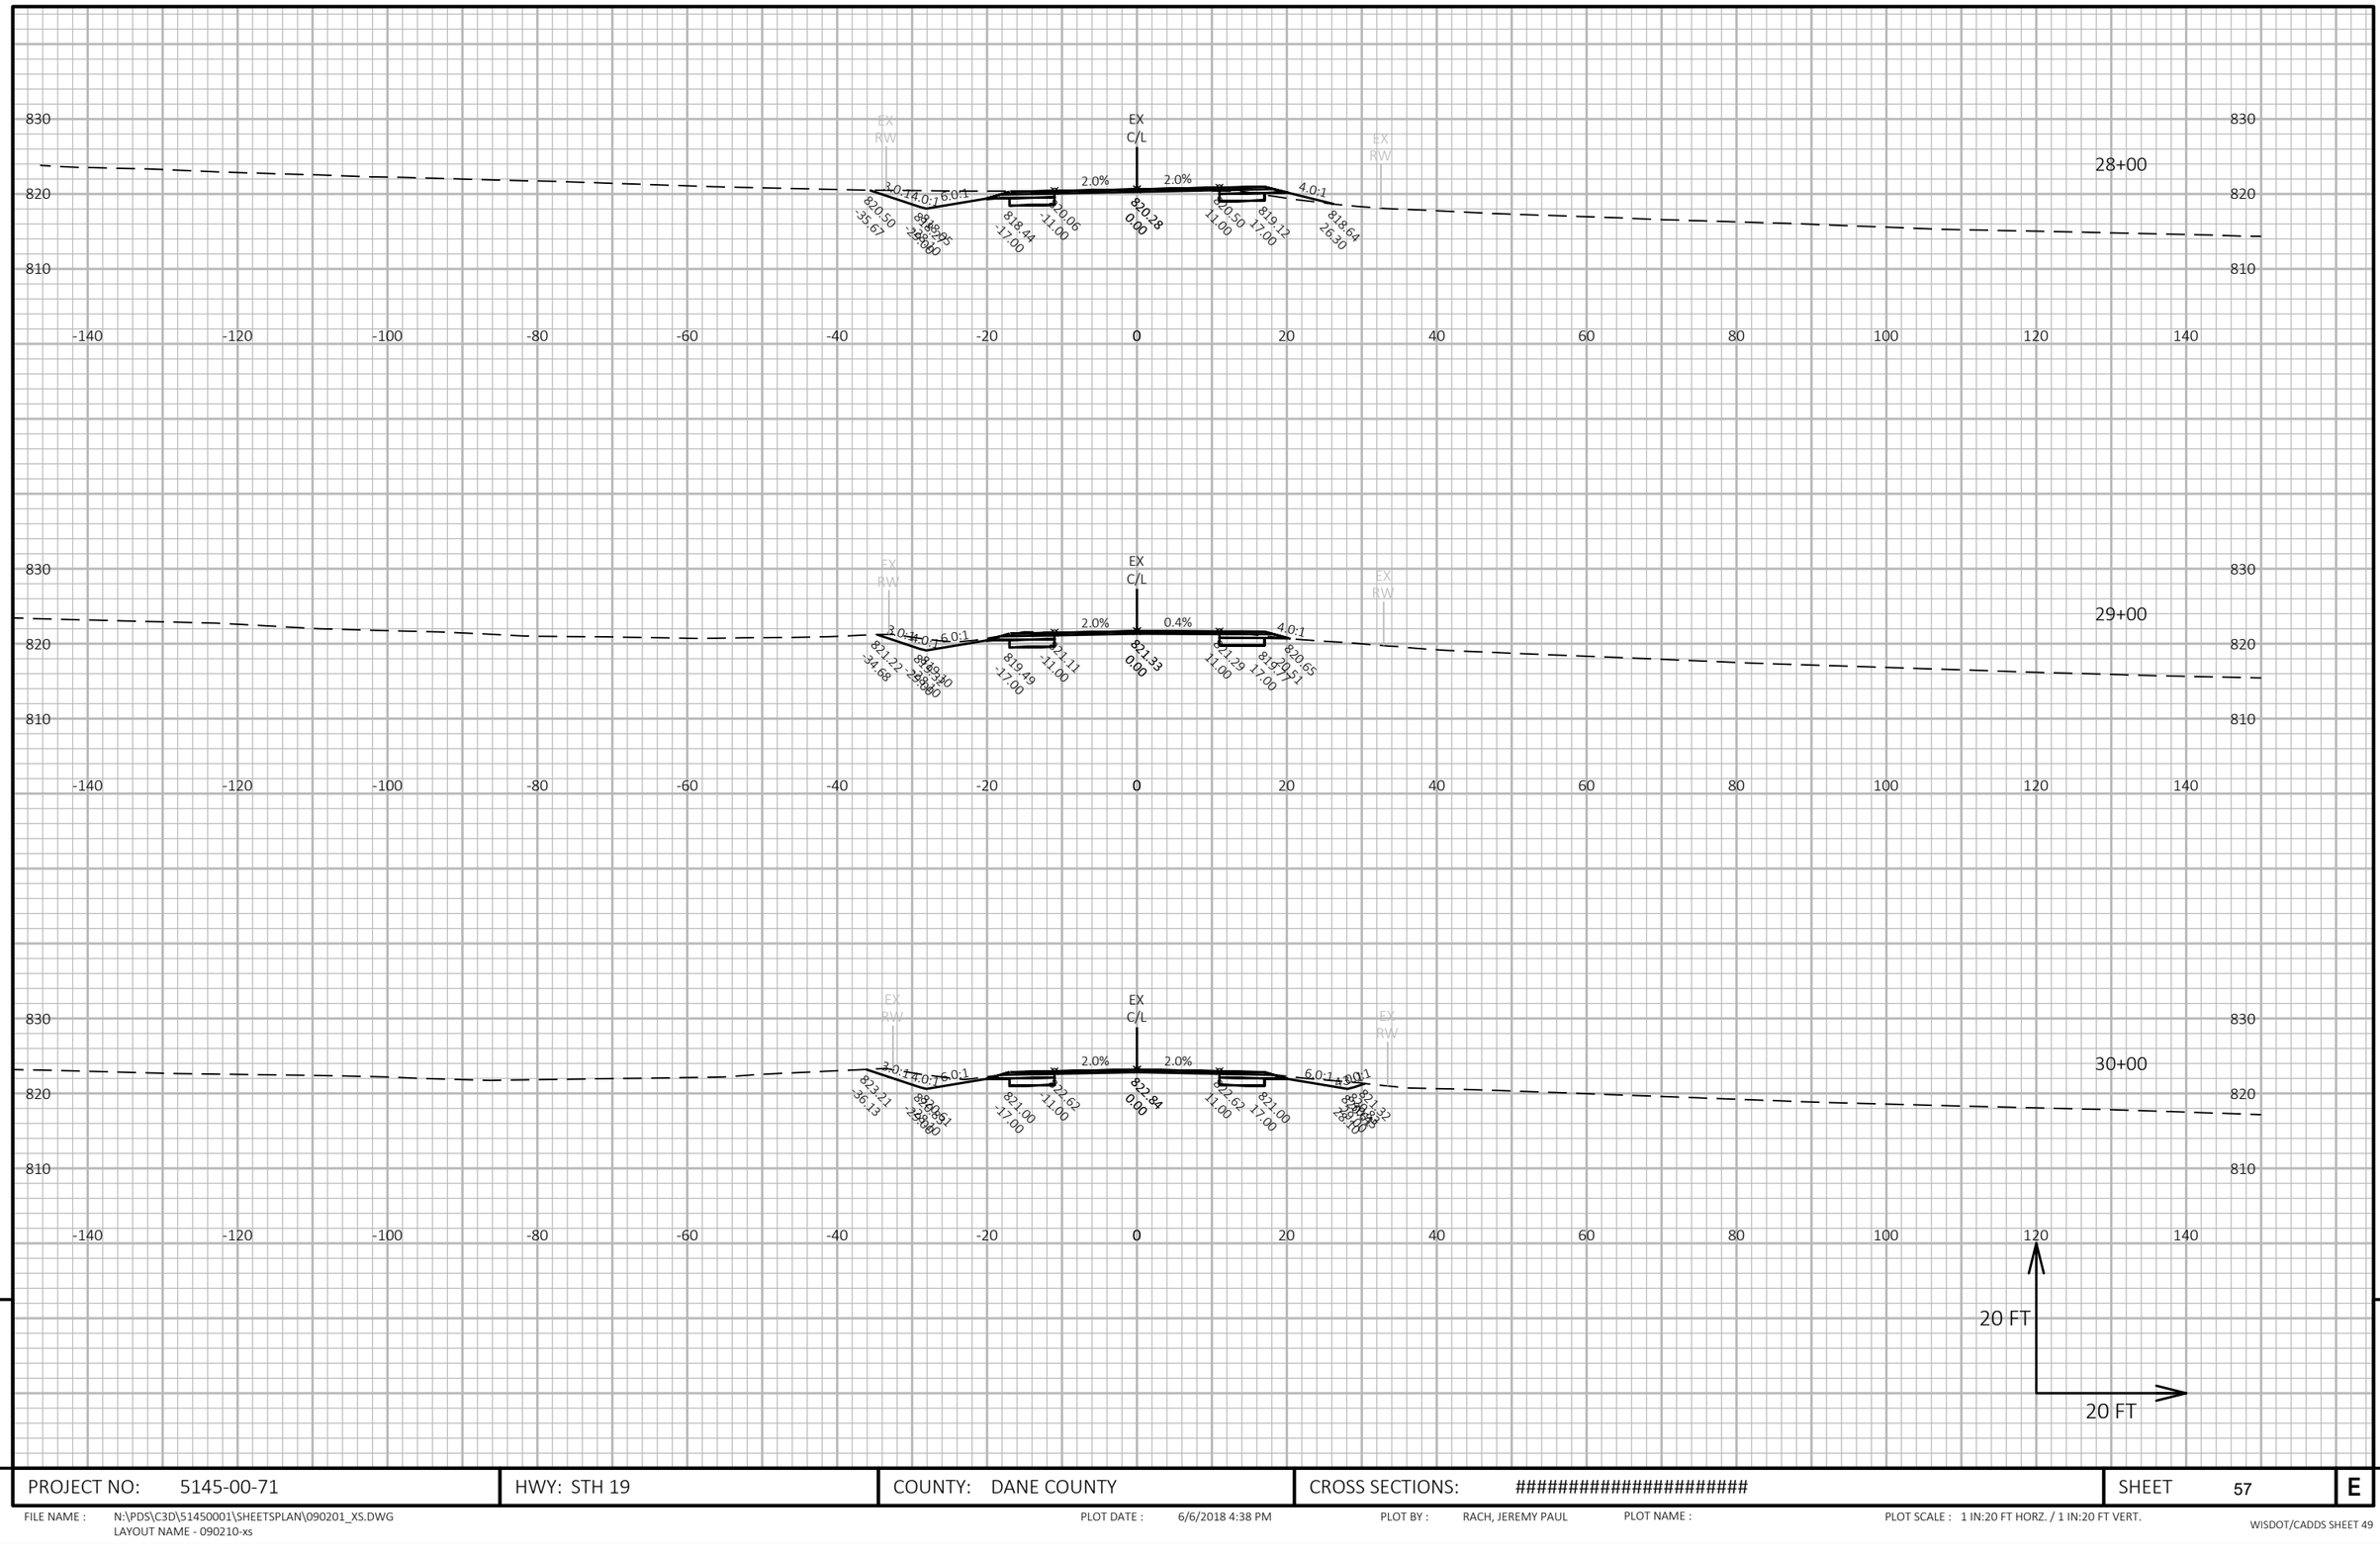

9

9

PROJECT NO: 5145-00-71	HWY: STH 19	COUNTY: DANE COUNTY	CROSS SECTIONS: ##########################	SHEET 57	E

FILE NAME : N:\PDS\C3D\51450001\SHEETSPLAN\090201_XS.DWG
LAYOUT NAME - 090210-xs

PLOT DATE : 6/6/2018 4:38 PM PLOT BY : RACH, JEREMY PAUL PLOT NAME : PLOT SCALE : 1 IN:20 FT HORZ. / 1 IN:20 FT VERT.

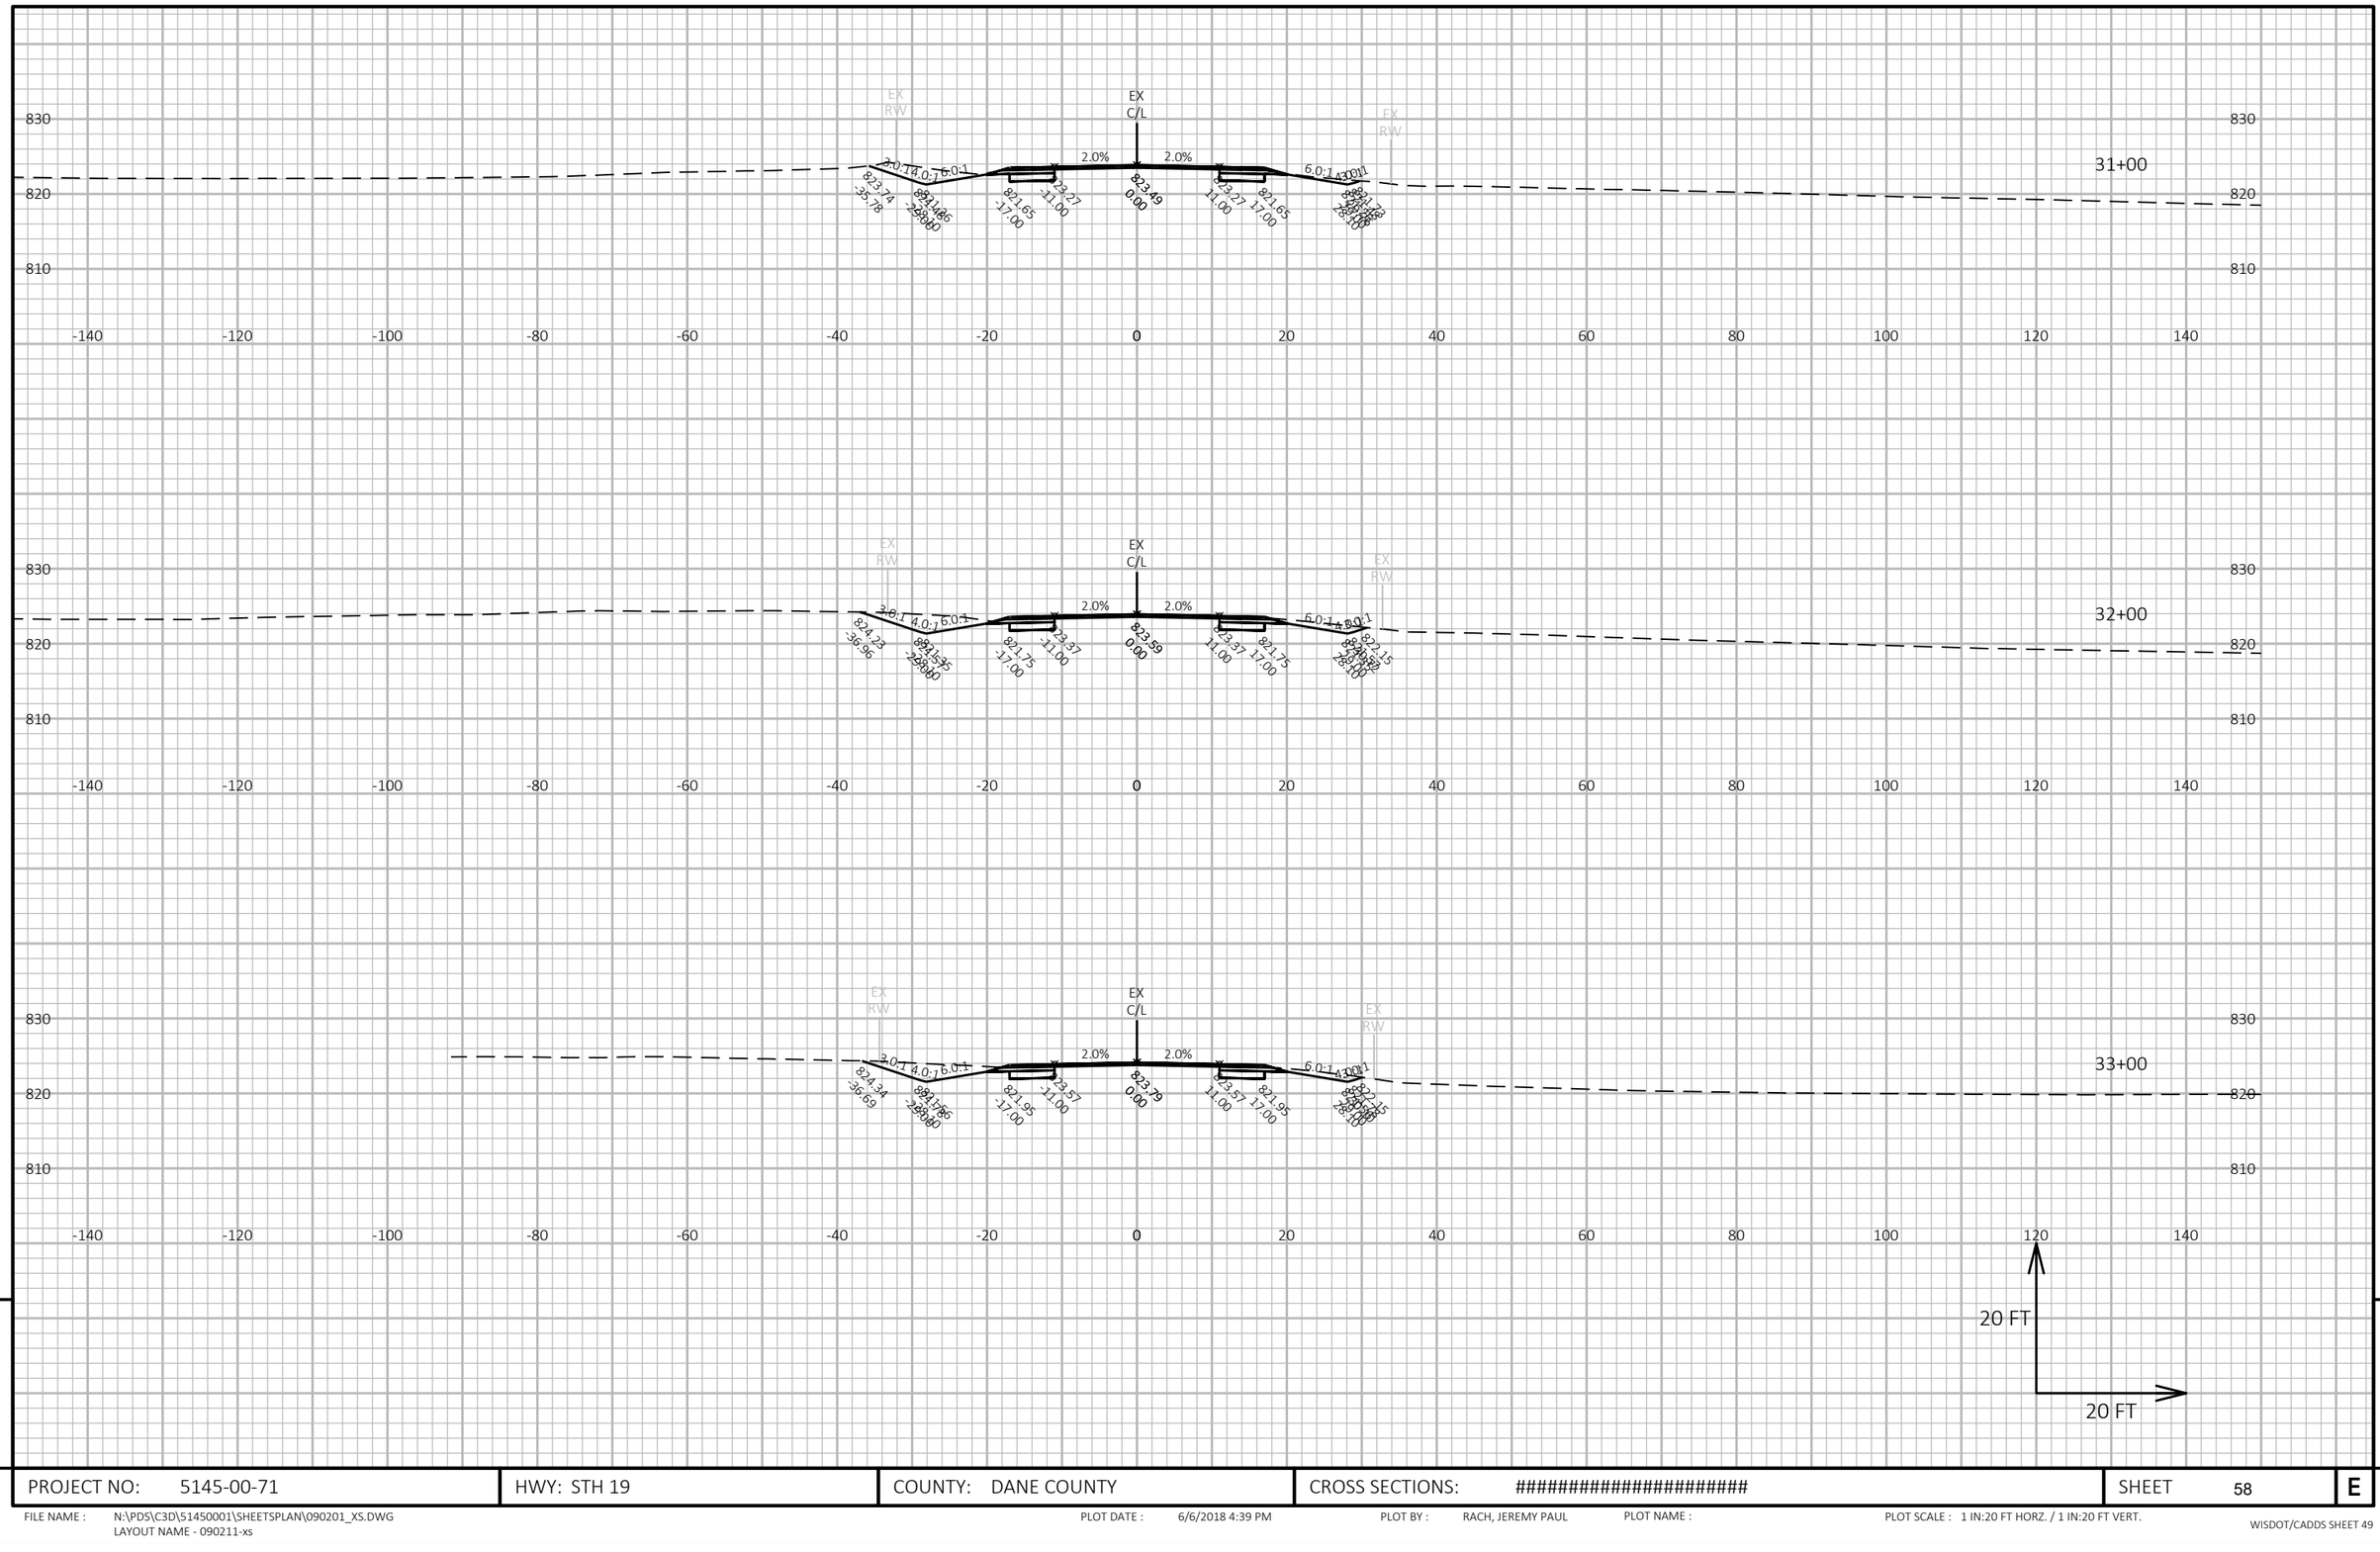

9

9

PROJECT NO: 5145-00-71	HWY: STH 19	COUNTY: DANE COUNTY	CROSS SECTIONS: ##########################	SHEET 58	E

FILE NAME : N:\PDS\C3D\51450001\SHEETSPLAN\090201_XS.DWG
LAYOUT NAME - 090211-xs

PLOT DATE : 6/6/2018 4:39 PM PLOT BY : RACH, JEREMY PAUL PLOT NAME : PLOT SCALE : 1 IN:20 FT HORZ. / 1 IN:20 FT VERT.

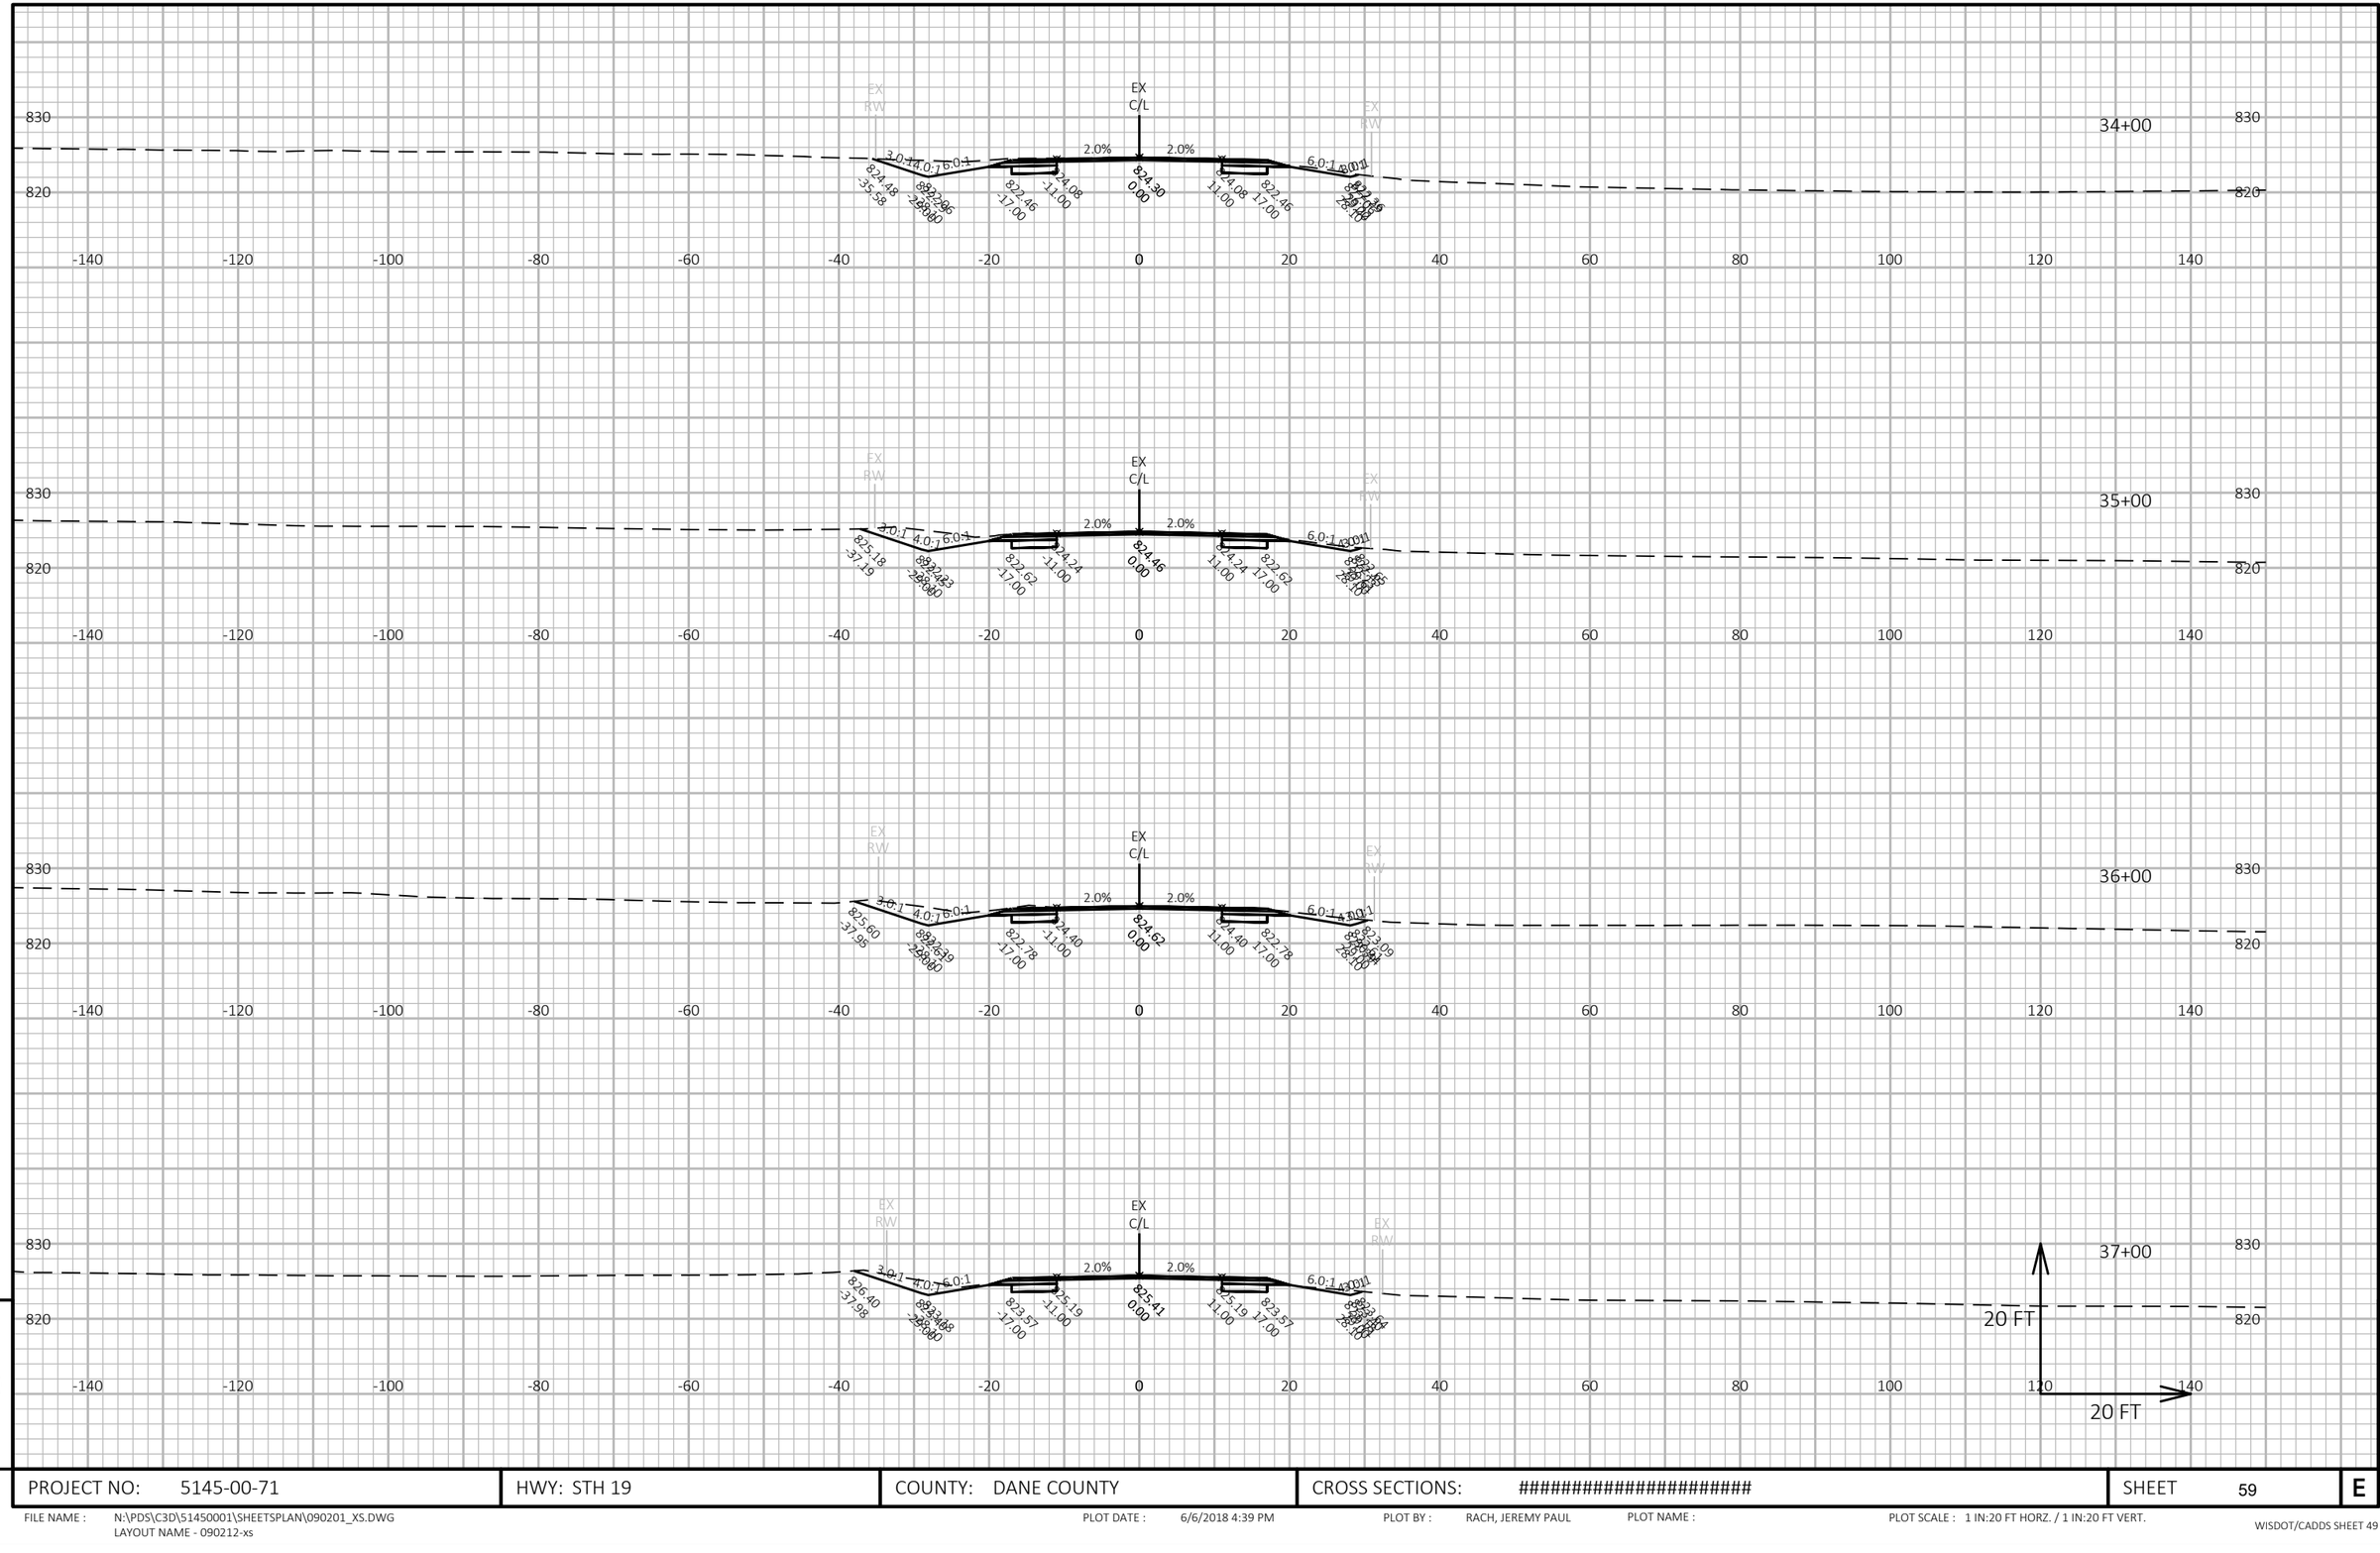

PROJECT NO: 5145-00-71	HWY: STH 19	COUNTY: DANE COUNTY	CROSS SECTIONS: ##########################	SHEET 59 E

FILE NAME : N:\PDS\C3D\51450001\SHEETSPLAN\090201_XS.DWG
LAYOUT NAME - 090212-xs

PLOT DATE : 6/6/2018 4:39 PM PLOT BY : RACH, JEREMY PAUL PLOT NAME : PLOT SCALE : 1 IN:20 FT HORZ. / 1 IN:20 FT VERT.

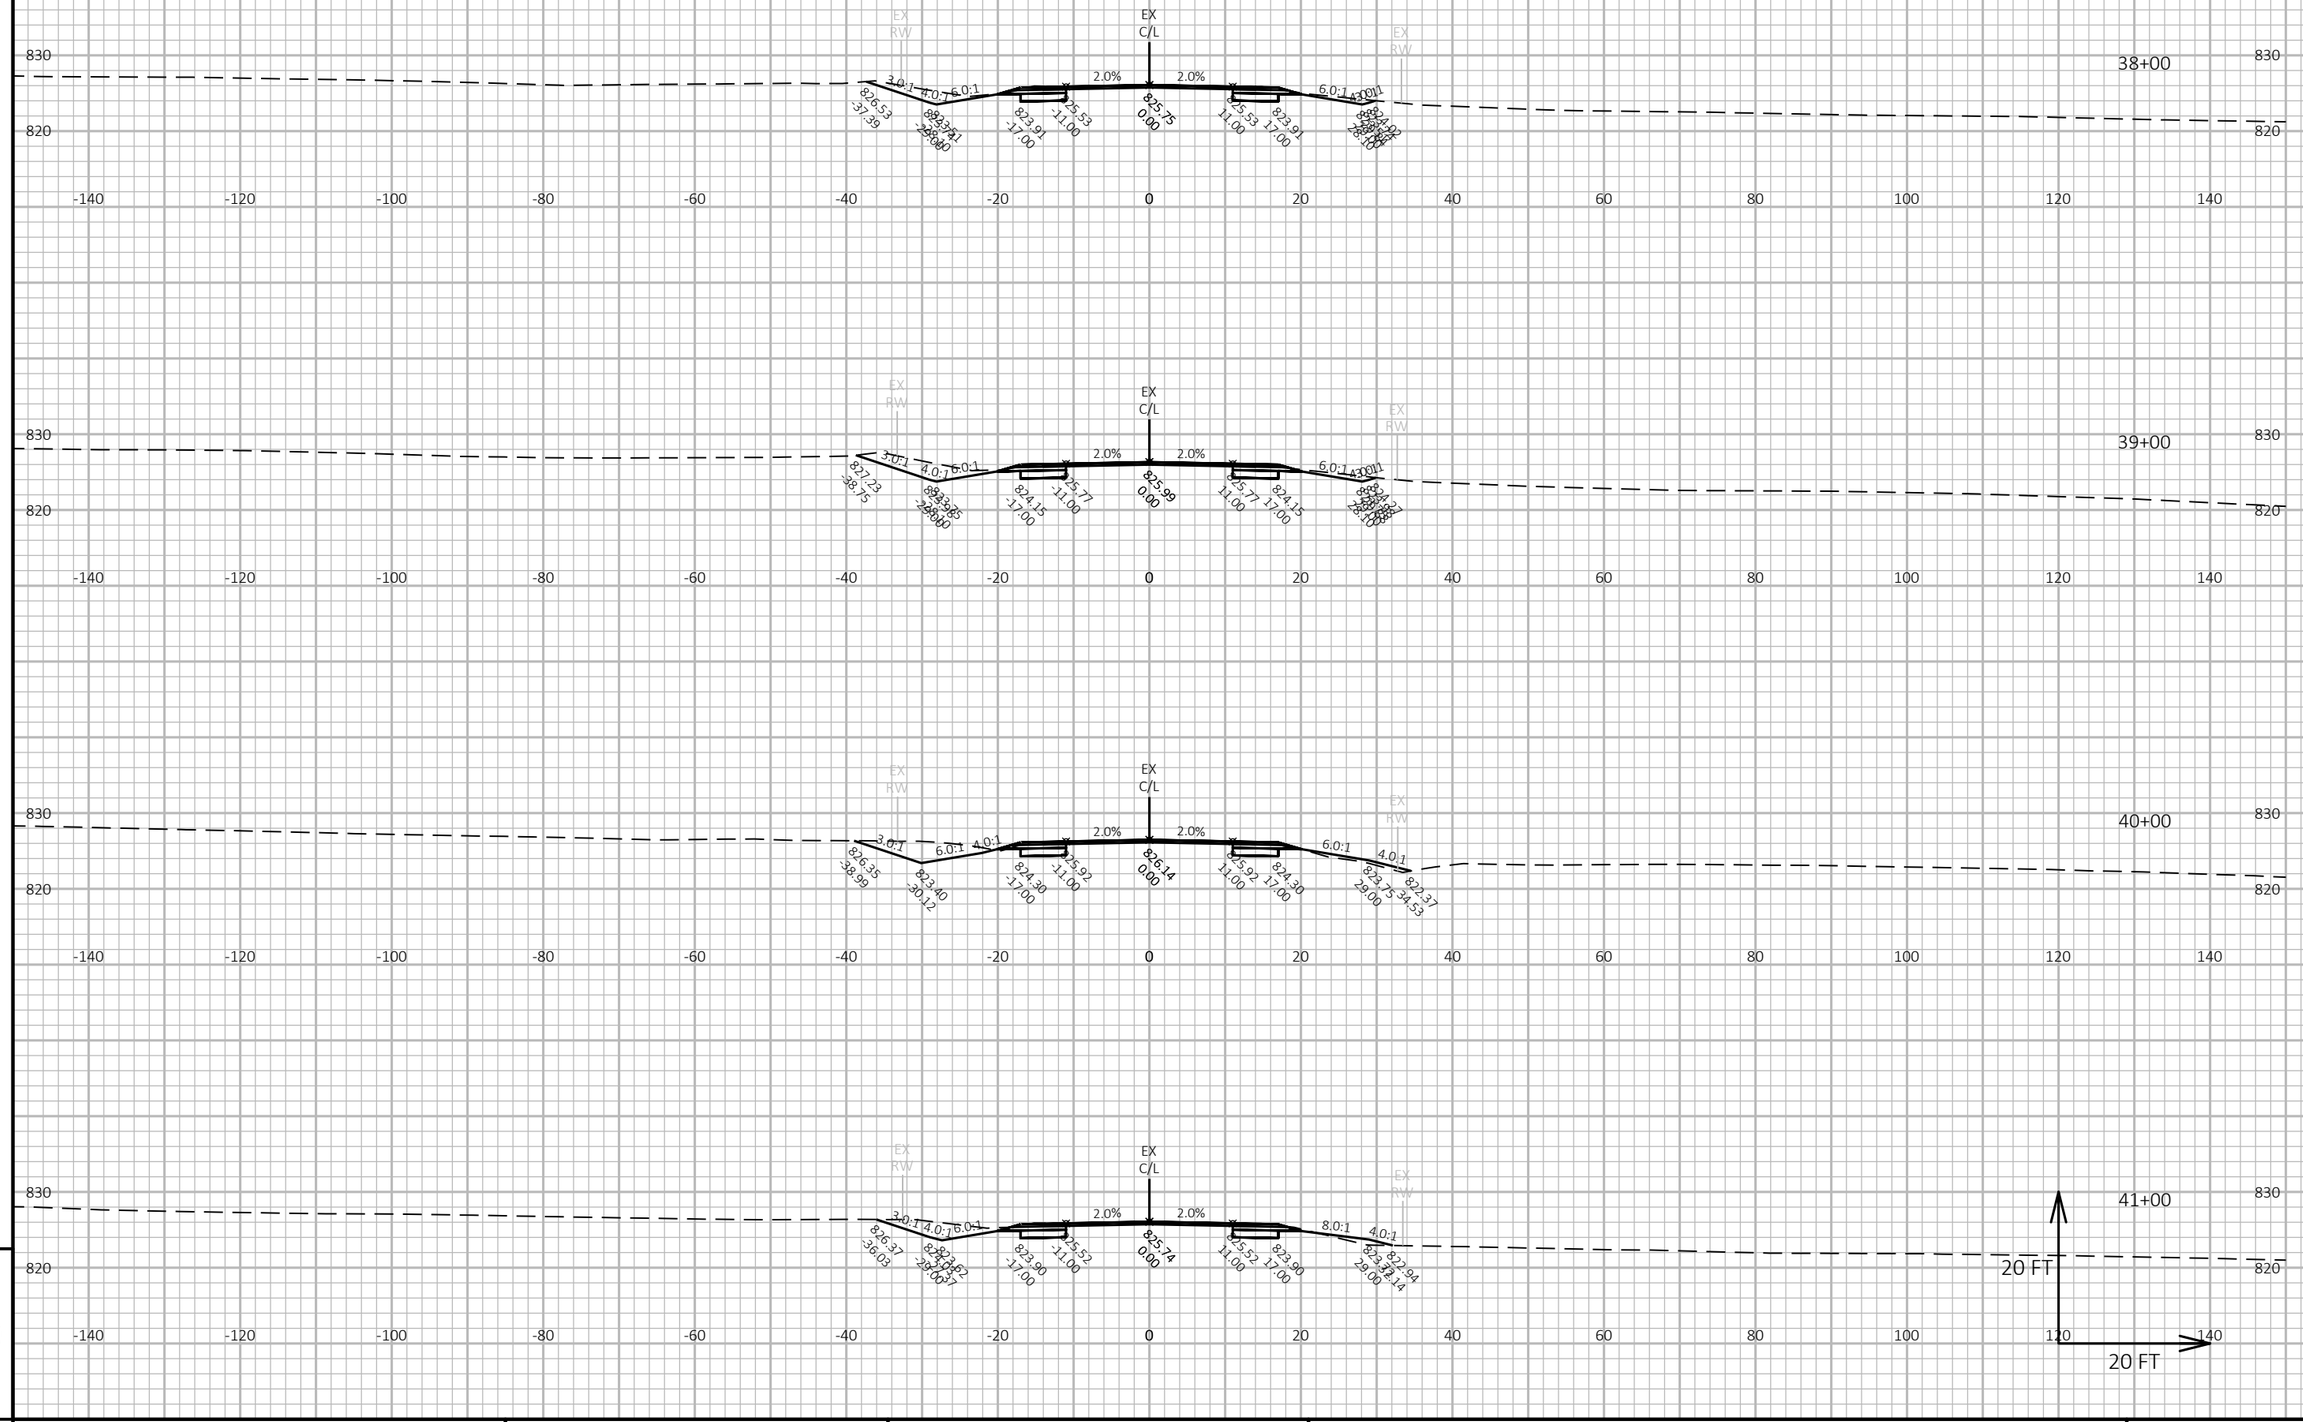

9

9

PROJECT NO: 5145-00-71	HWY: STH 19	COUNTY: DANE COUNTY	CROSS SECTIONS: ##########################	SHEET 60	E

FILE NAME : N:\PDS\C3D\51450001\SHEETSPLAN\090201_XS.DWG
LAYOUT NAME - 090213-xs
PLOT DATE : 6/6/2018 4:39 PM
PLOT BY : RACH, JEREMY PAUL
PLOT NAME :
PLOT SCALE : 1 IN:20 FT HORZ. / 1 IN:20 FT VERT.

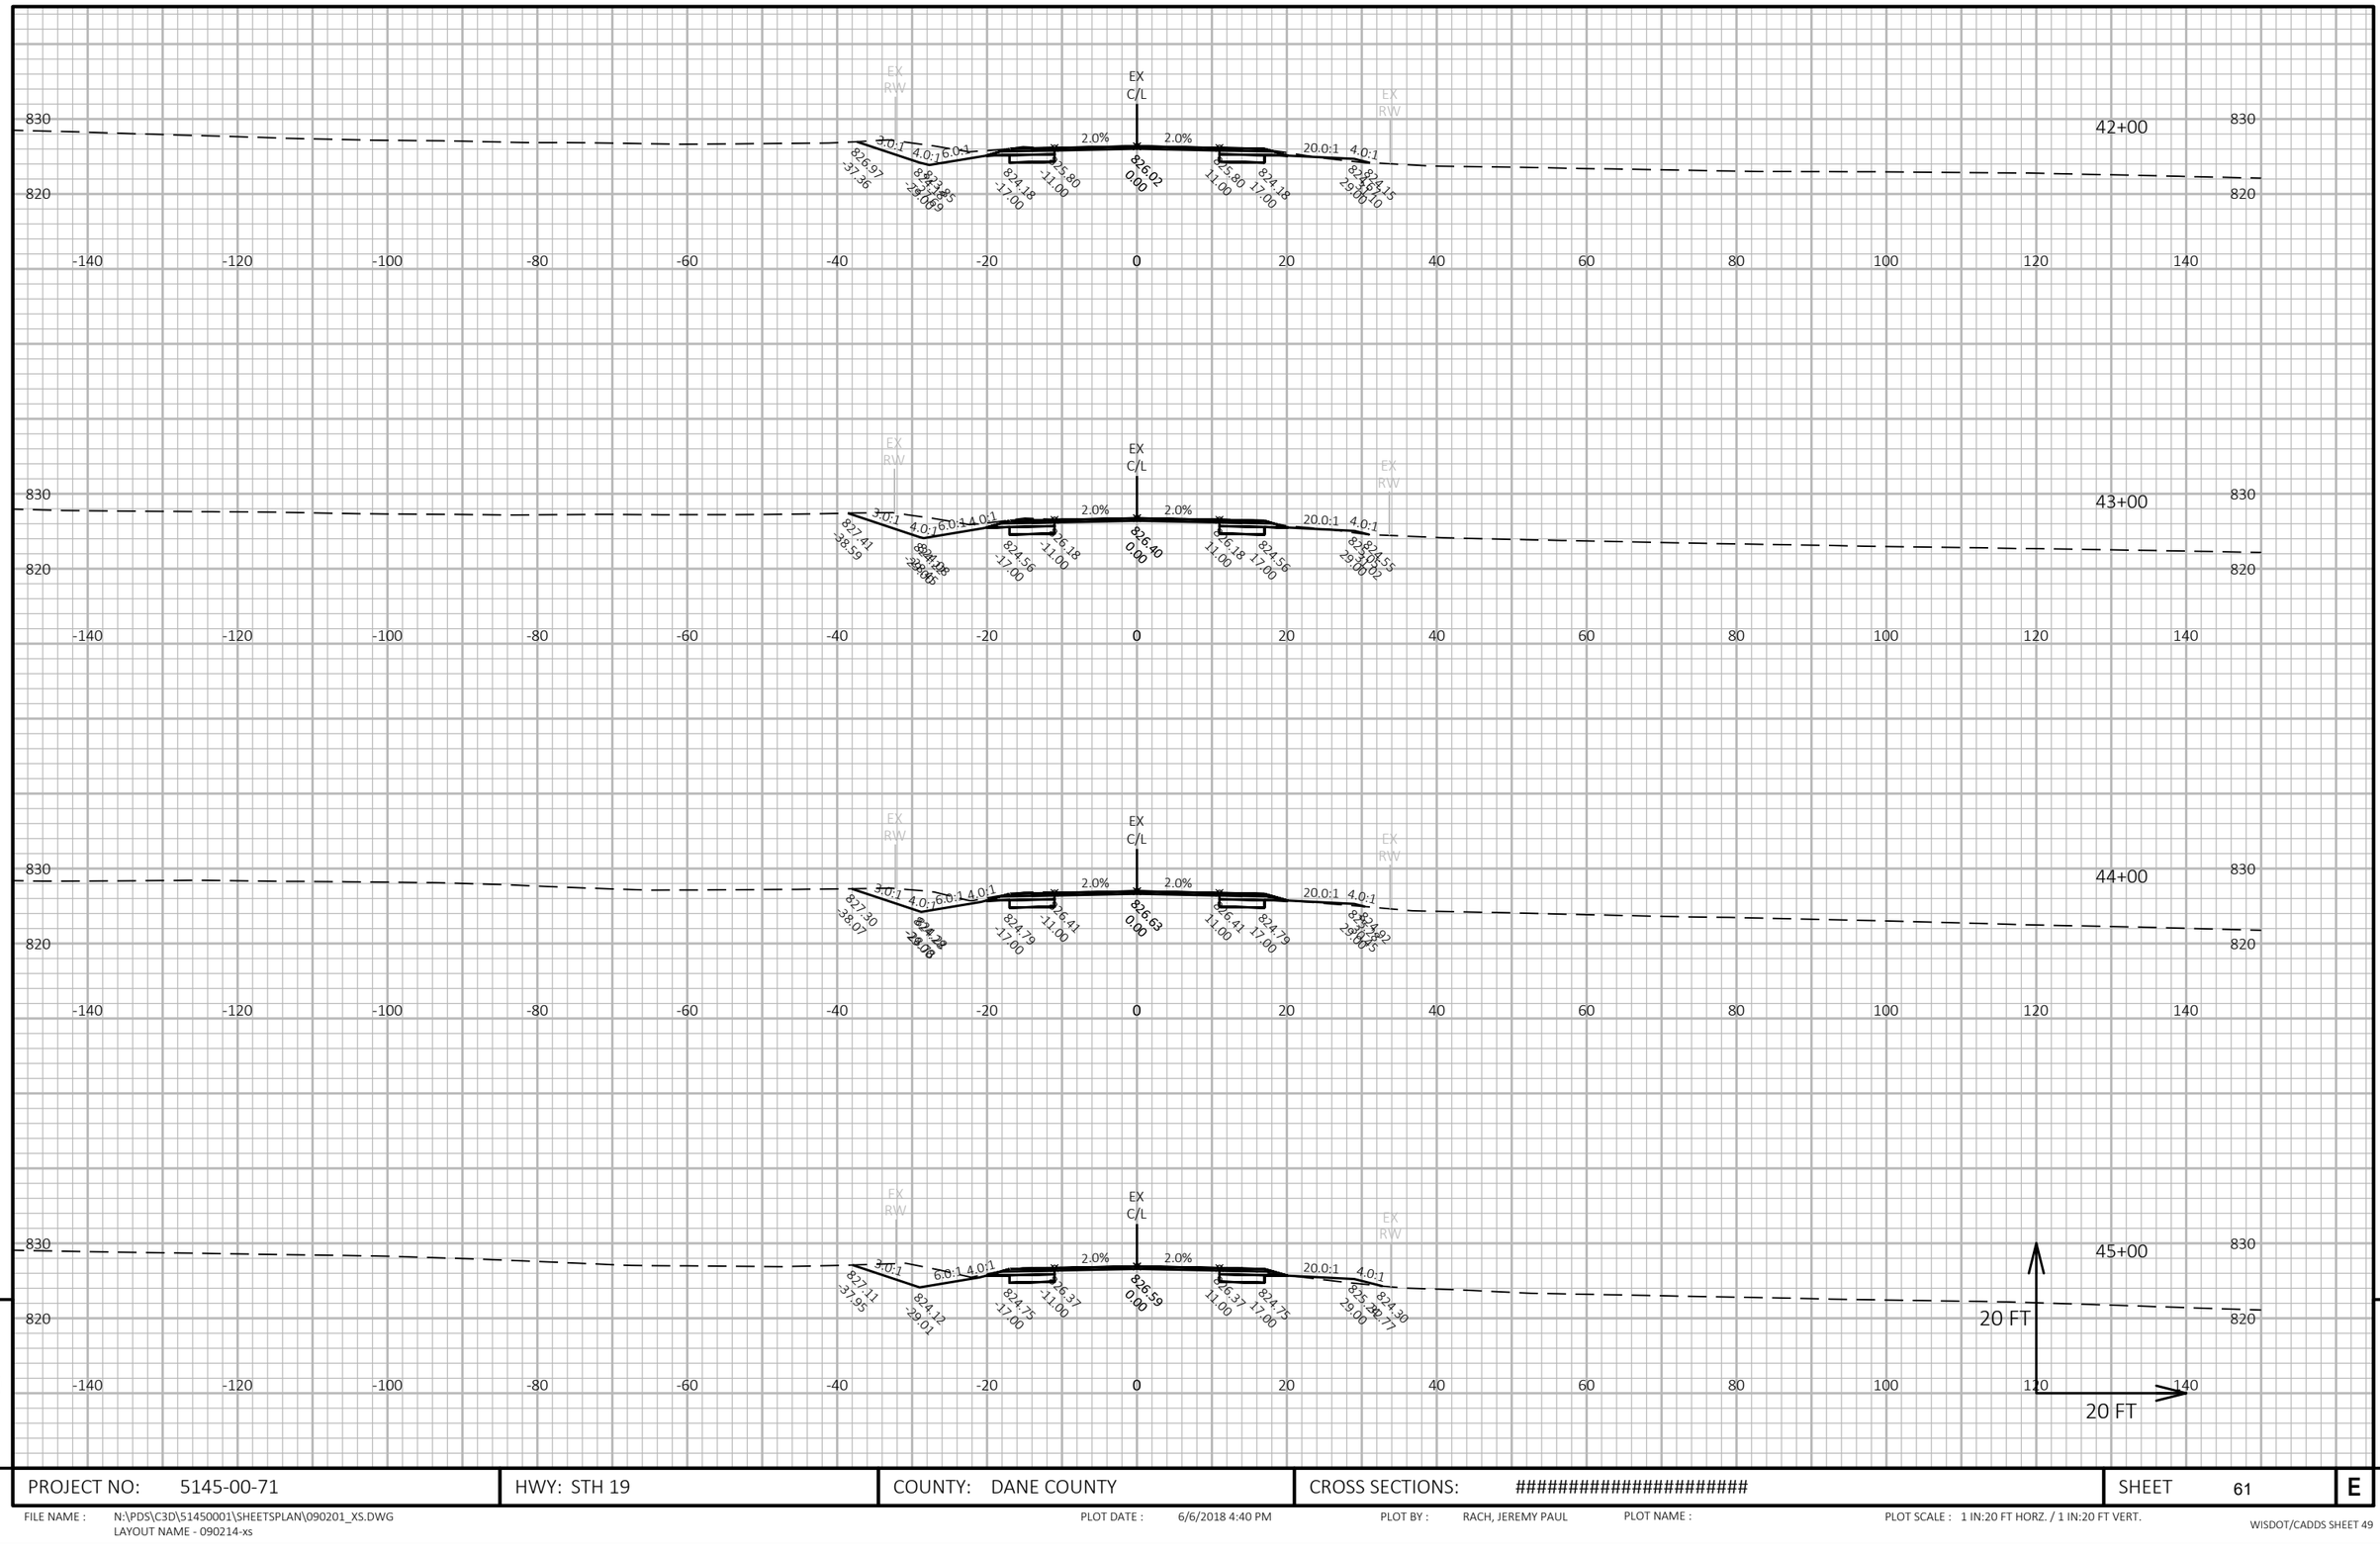

9

PROJECT NO: 5145-00-71	HWY: STH 19	COUNTY: DANE COUNTY	CROSS SECTIONS: ##########################	SHEET 61	E

FILE NAME : N:\PDS\C3D\51450001\SHEETSPLAN\090201_XS.DWG
LAYOUT NAME - 090214-xs

PLOT DATE : 6/6/2018 4:40 PM PLOT BY : RACH, JEREMY PAUL PLOT NAME : PLOT SCALE : 1 IN:20 FT HORZ. / 1 IN:20 FT VERT.

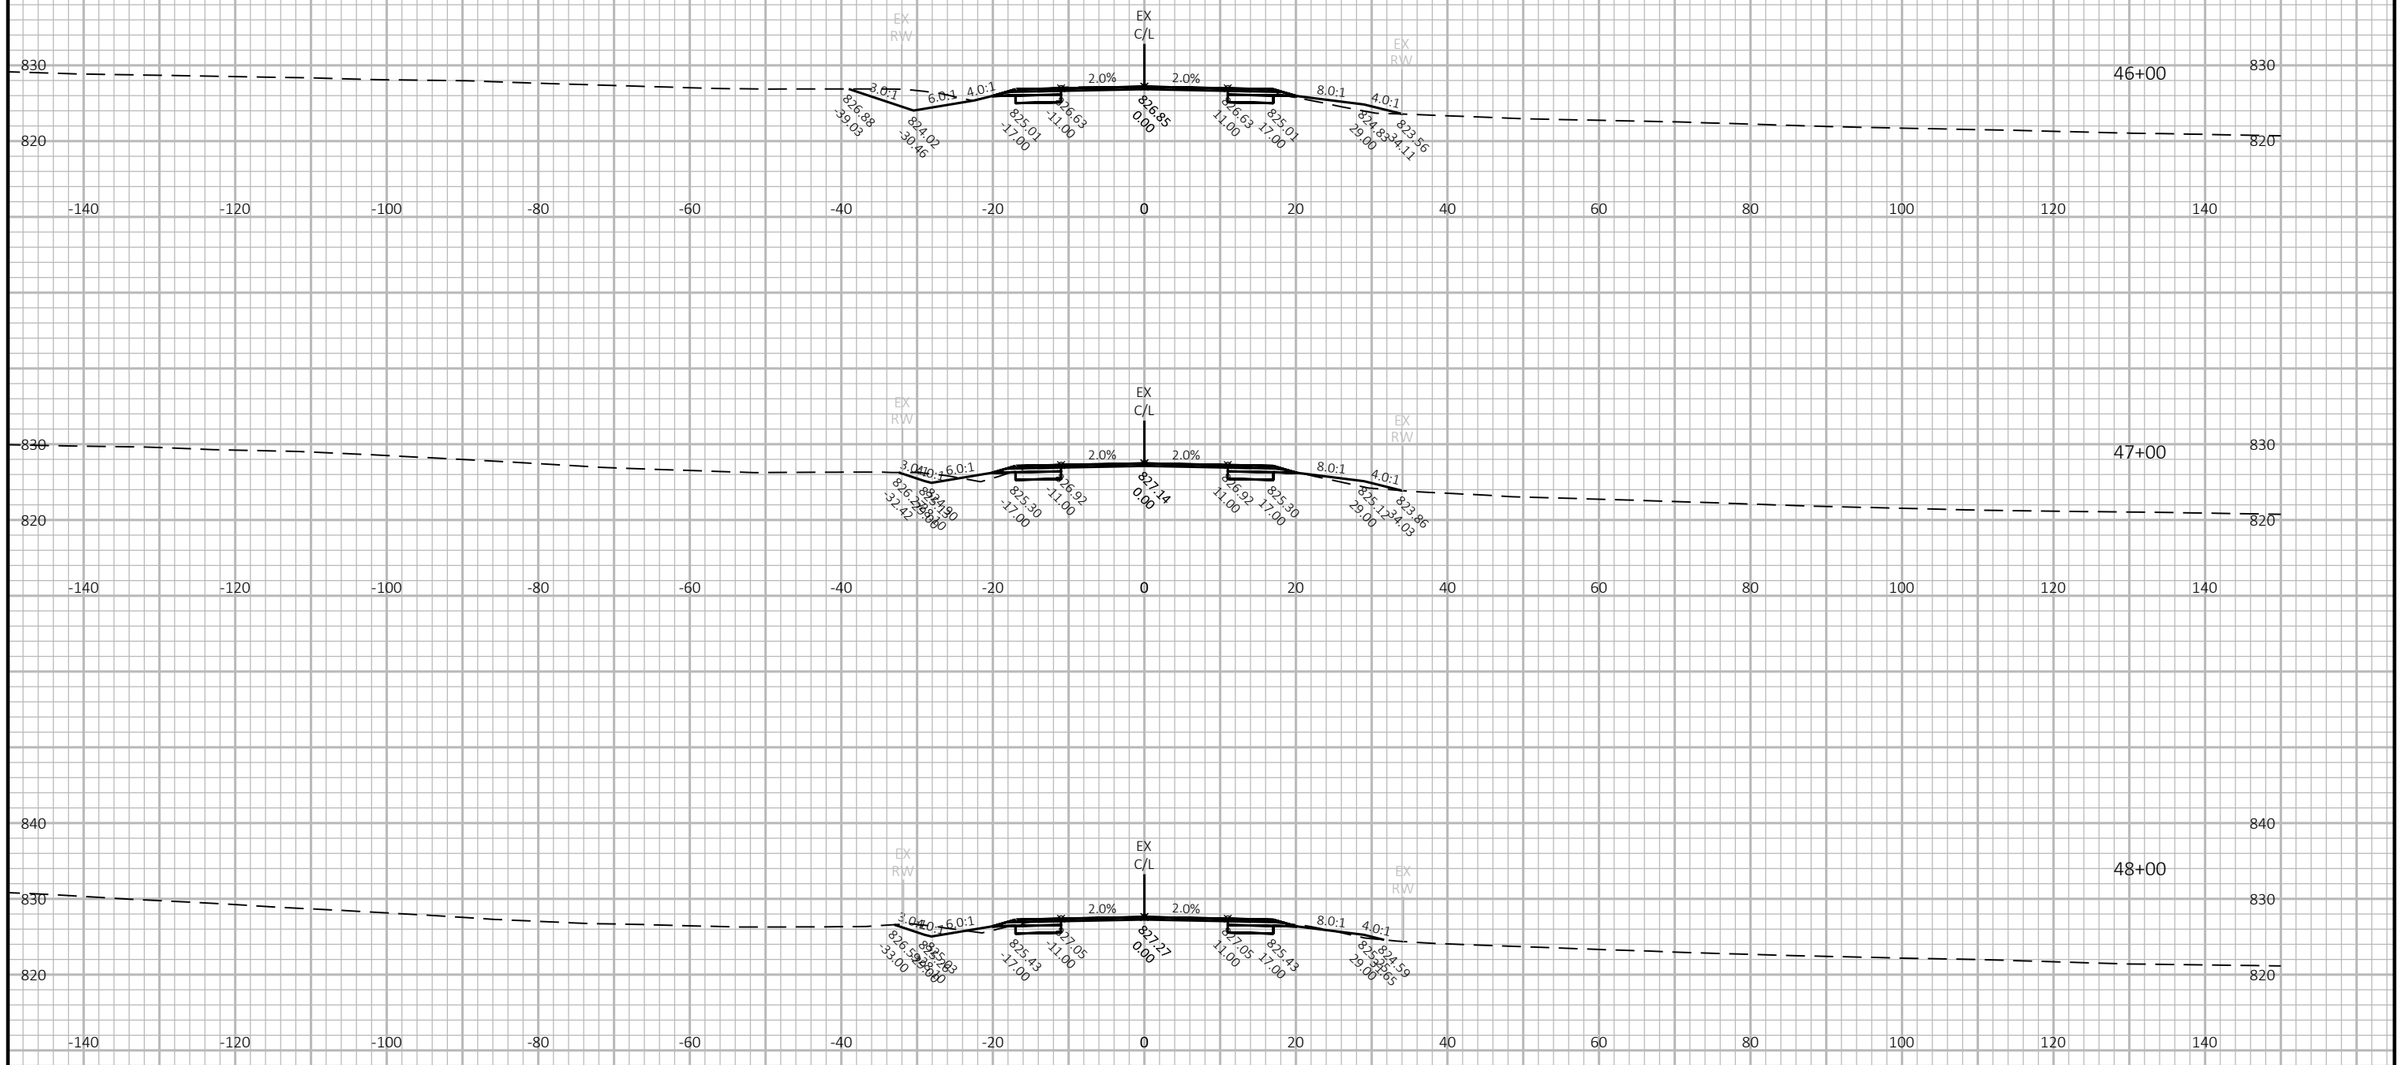

9

9

PROJECT NO: 5145-00-71	HWY: STH 19	COUNTY: DANE COUNTY	CROSS SECTIONS: ##########################	SHEET 62	E

FILE NAME : N:\PDS\C3D\51450001\SHEETSPLAN\090201_XS.DWG
LAYOUT NAME - 090215-xs

PLOT DATE : 6/6/2018 4:40 PM PLOT BY : RACH, JEREMY PAUL PLOT NAME : PLOT SCALE : 1 IN:20 FT HORZ. / 1 IN:20 FT VERT.

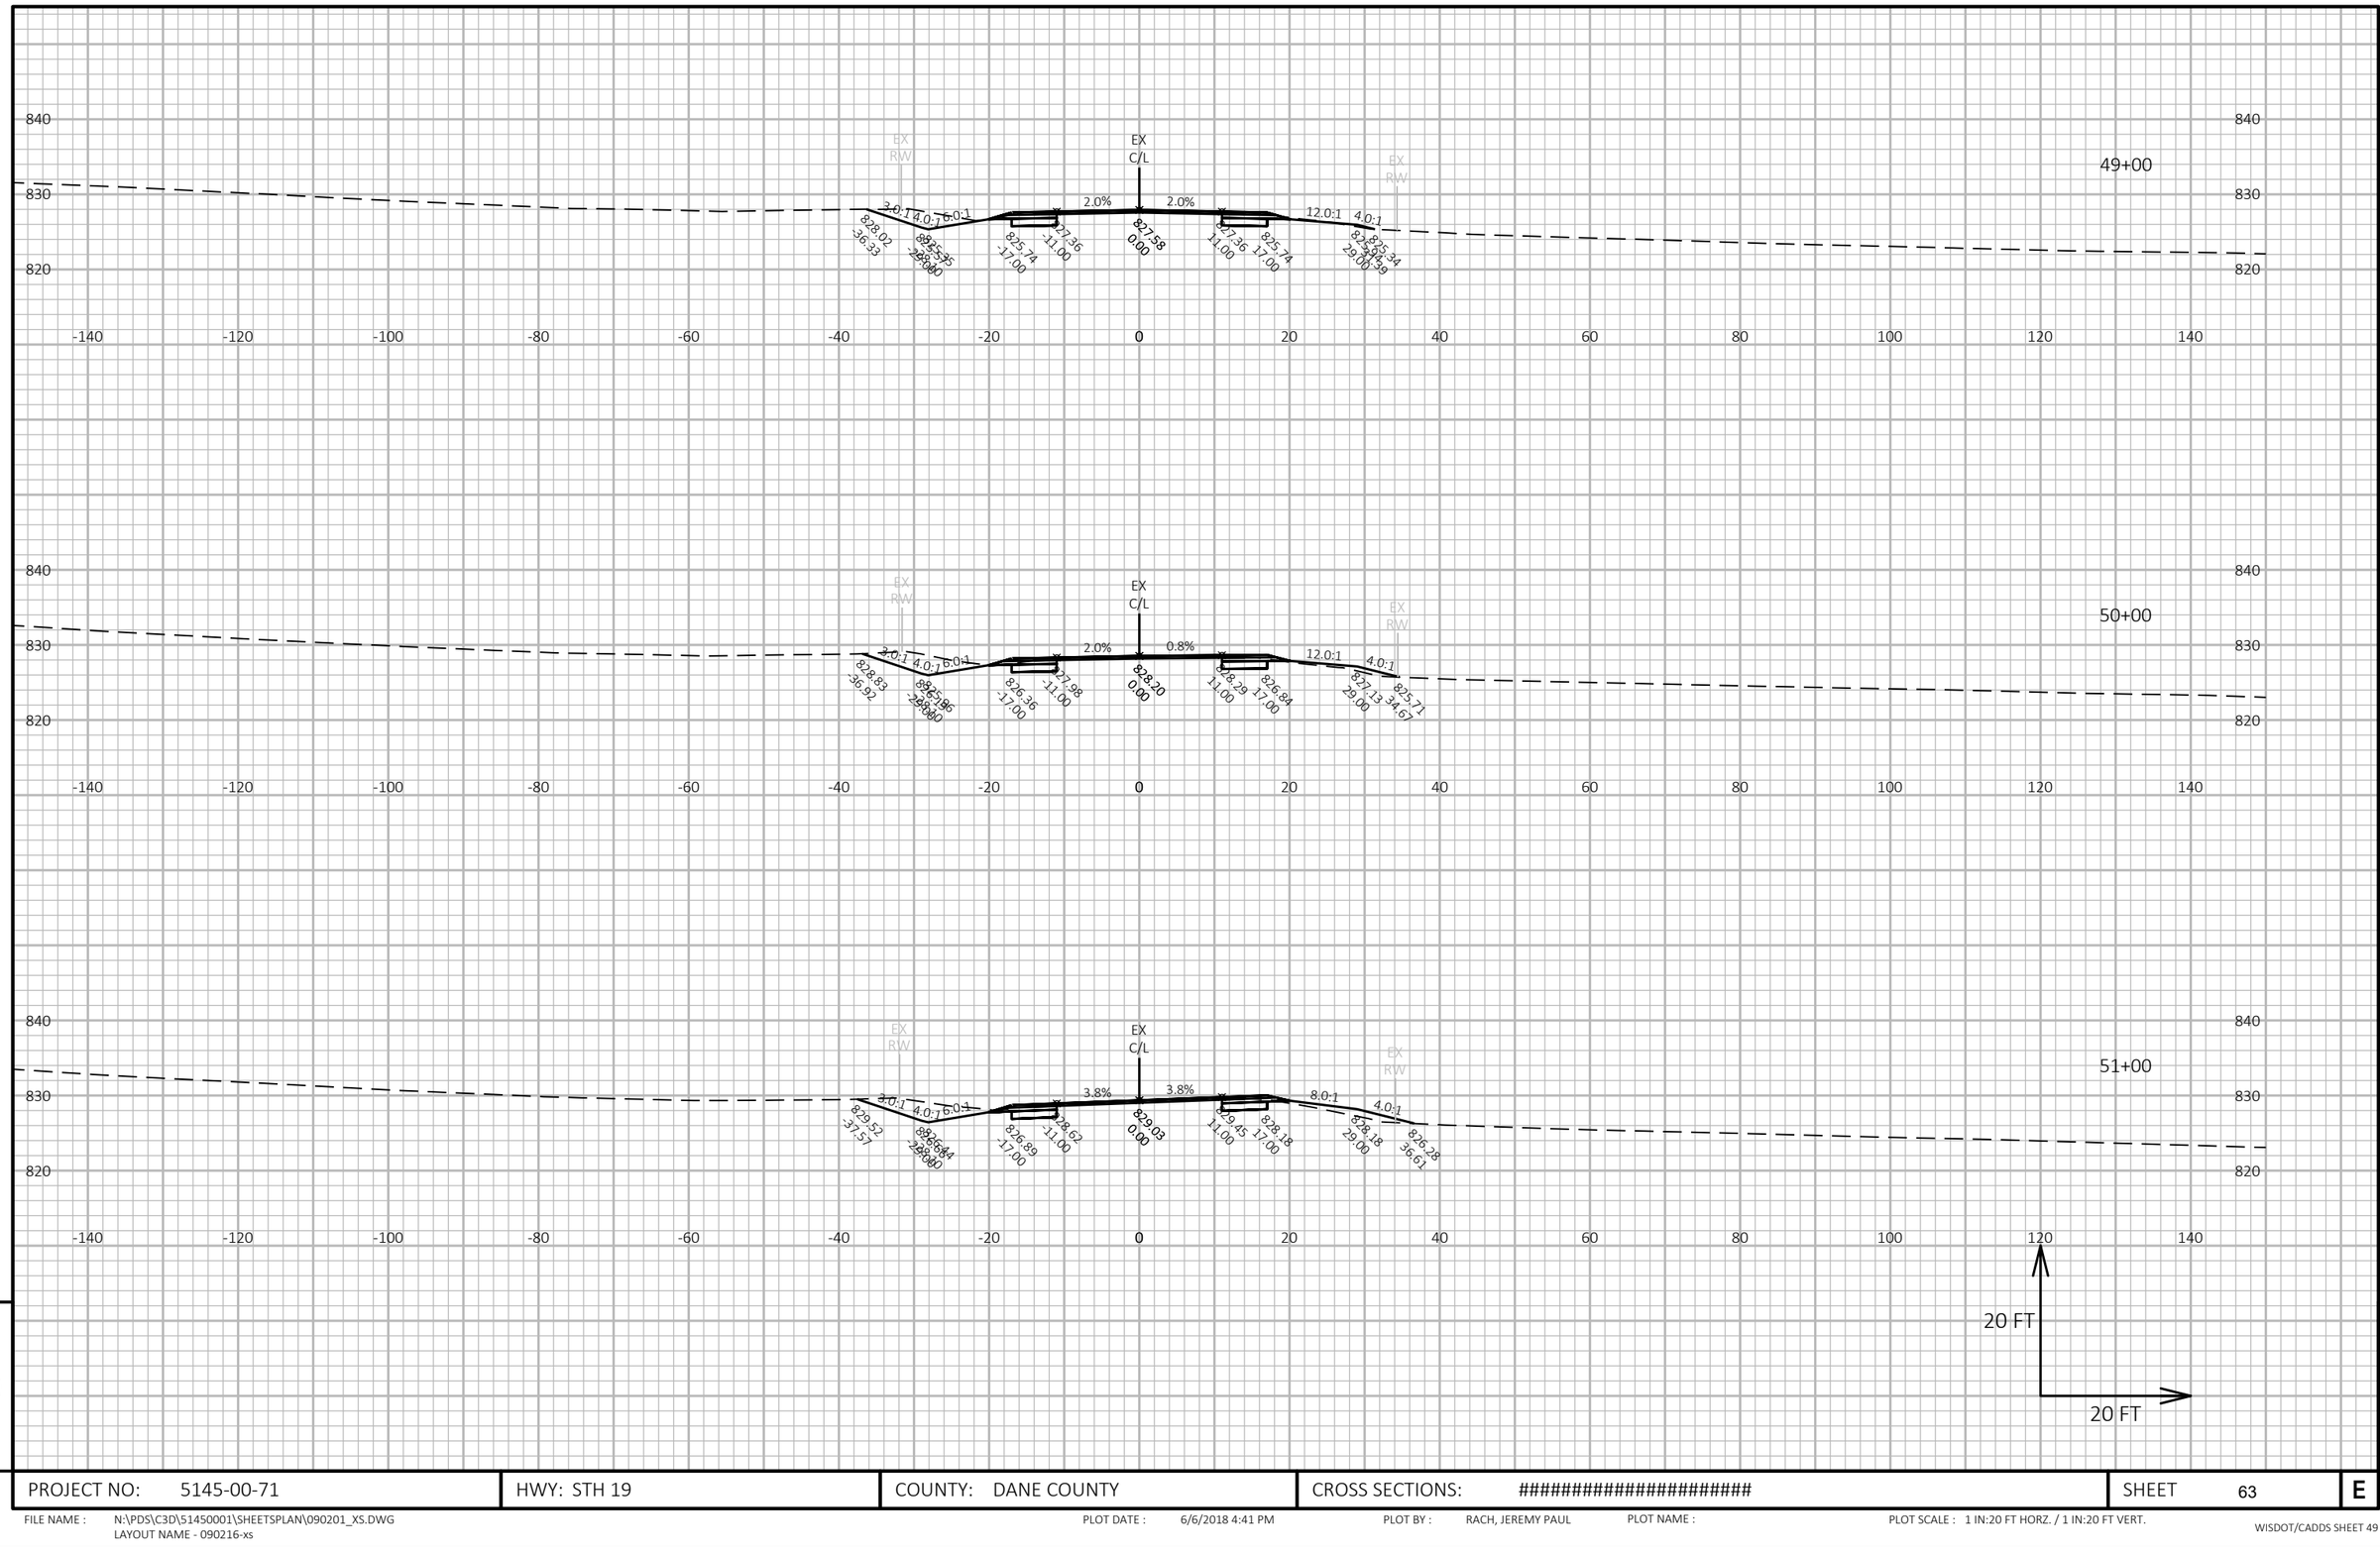

9

9

PROJECT NO: 5145-00-71	HWY: STH 19	COUNTY: DANE COUNTY	CROSS SECTIONS: ##########################	SHEET 63	E

FILE NAME : N:\PDS\C3D\51450001\SHEETSPLAN\090201_XS.DWG
LAYOUT NAME - 090216-xs

PLOT DATE : 6/6/2018 4:41 PM PLOT BY : RACH, JEREMY PAUL PLOT NAME : PLOT SCALE : 1 IN:20 FT HORZ. / 1 IN:20 FT VERT.

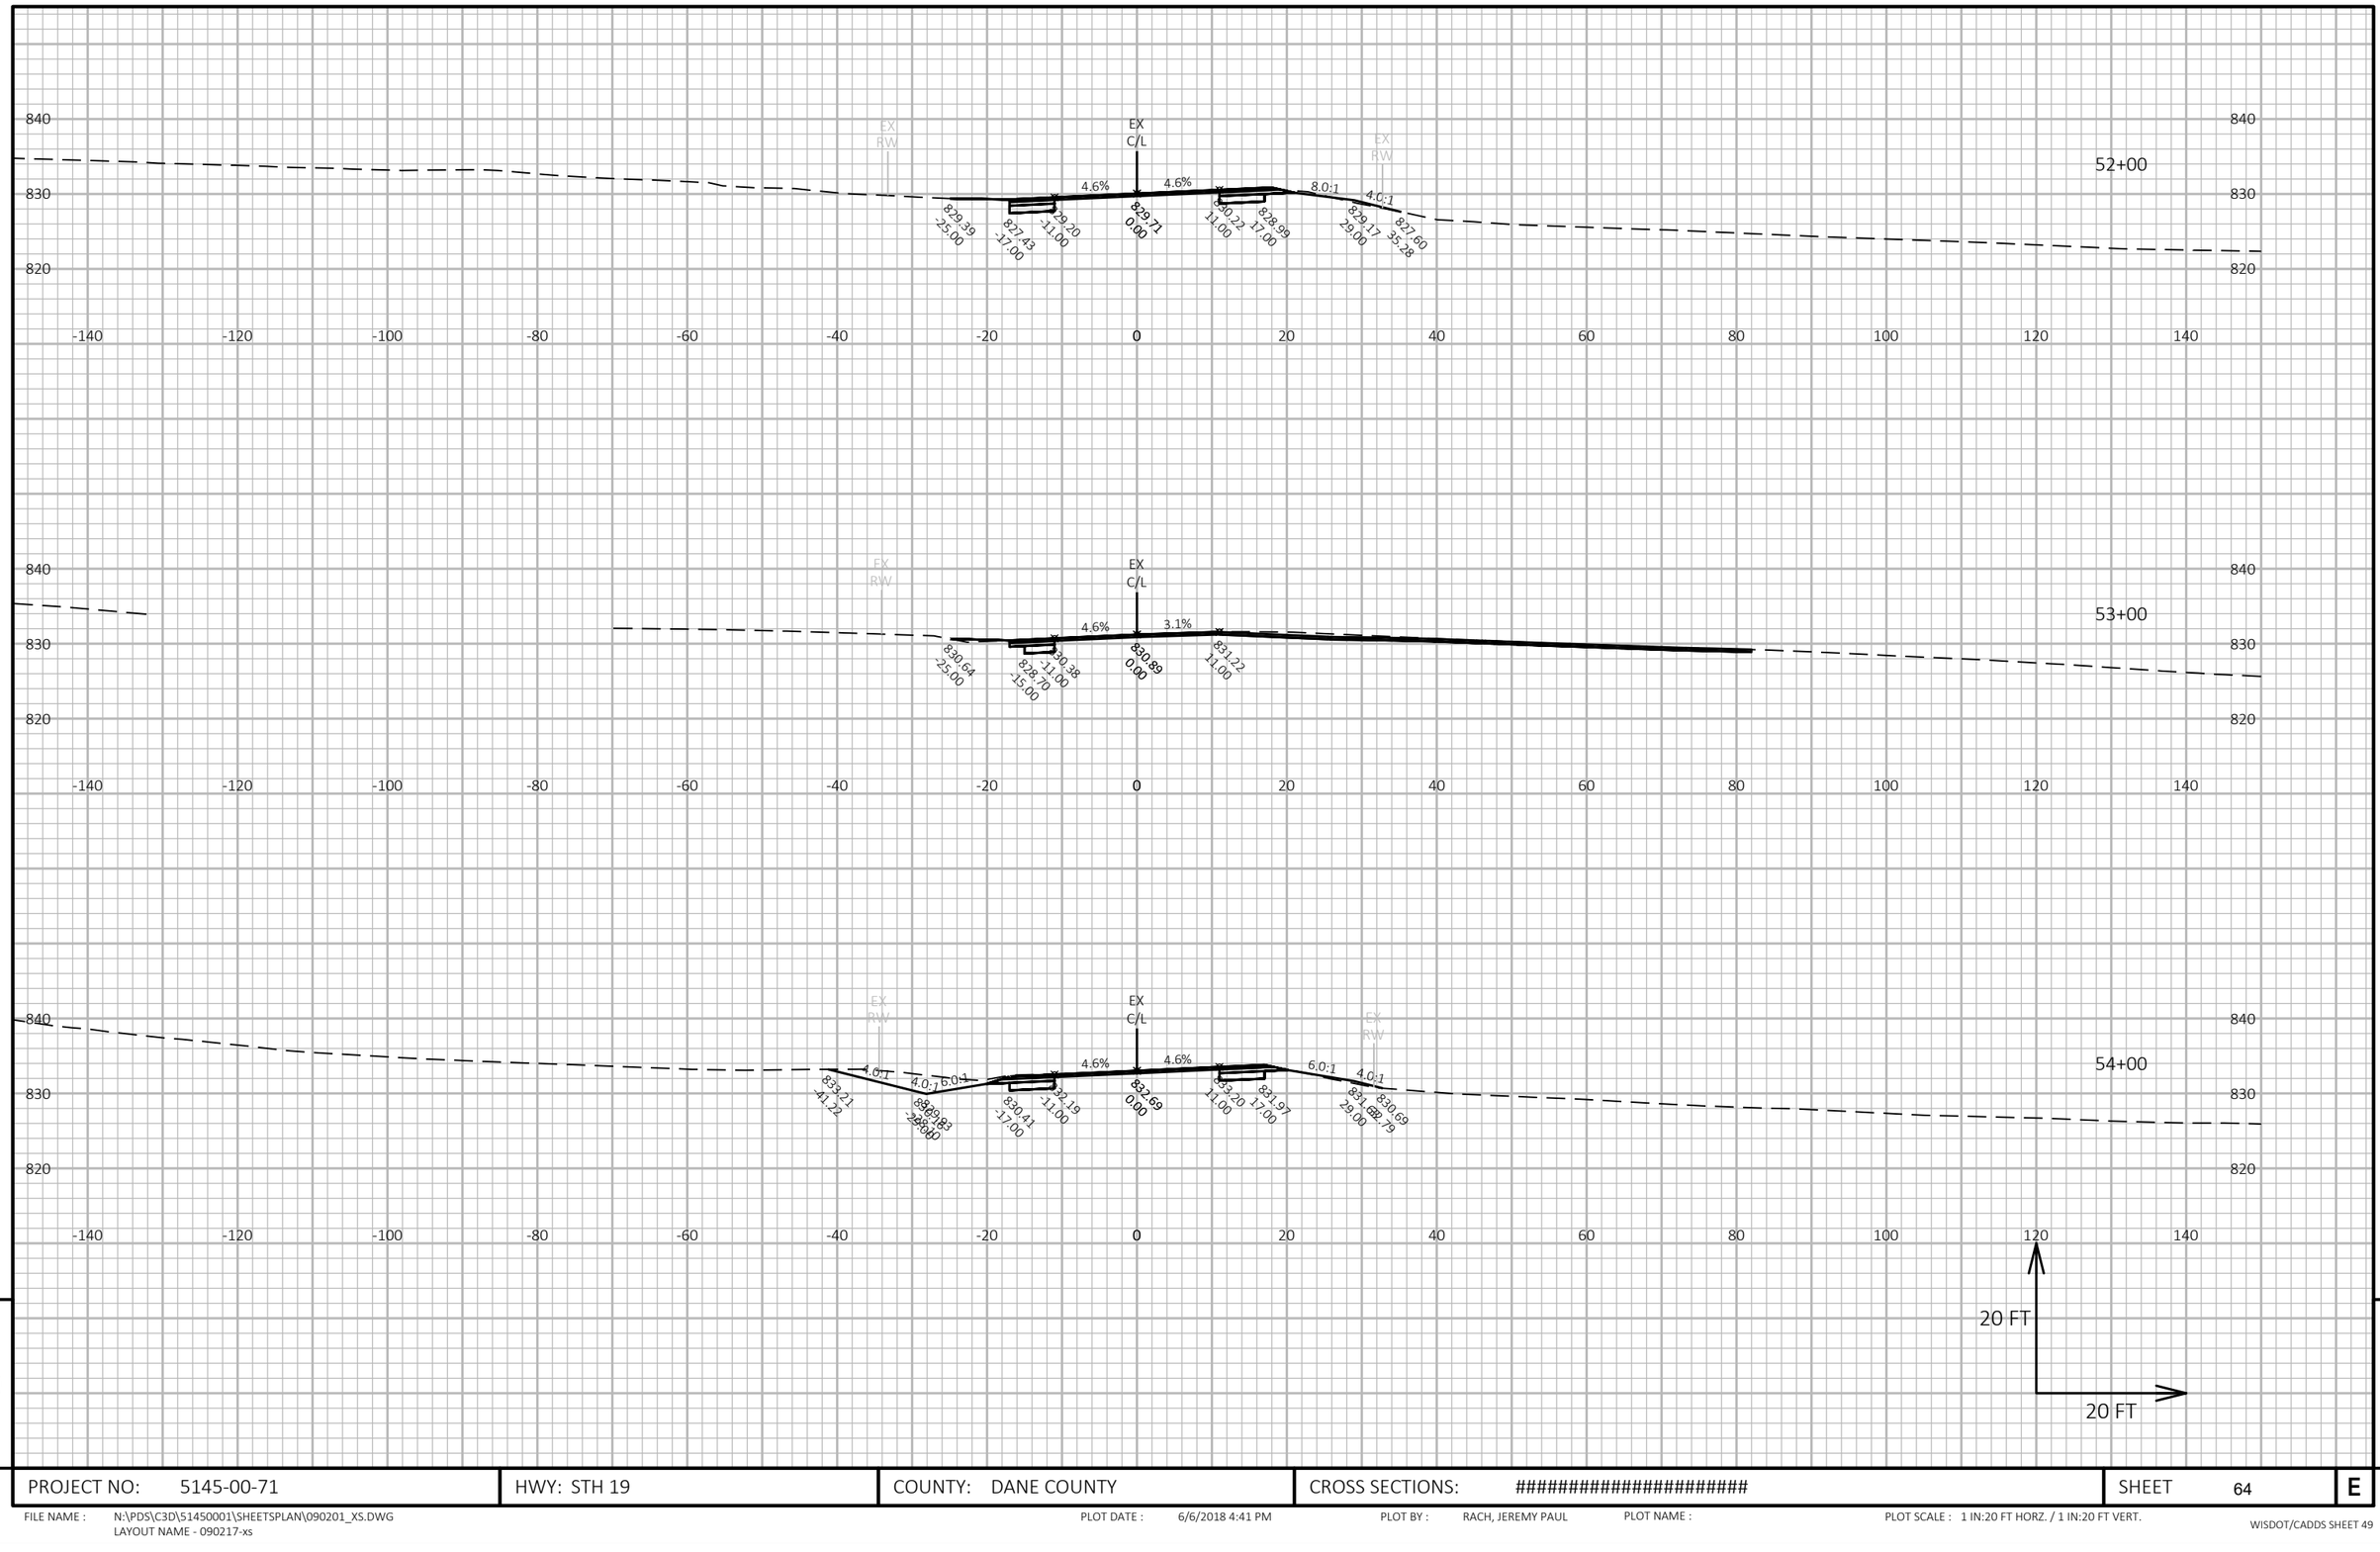

9

9

PROJECT NO: 5145-00-71	HWY: STH 19	COUNTY: DANE COUNTY	CROSS SECTIONS: ##########################	SHEET 64	E

FILE NAME : N:\PDS\C3D\51450001\SHEETSPLAN\090201_XS.DWG
LAYOUT NAME - 090217-xs

PLOT DATE : 6/6/2018 4:41 PM PLOT BY : RACH, JEREMY PAUL PLOT NAME : PLOT SCALE : 1 IN:20 FT HORZ. / 1 IN:20 FT VERT.

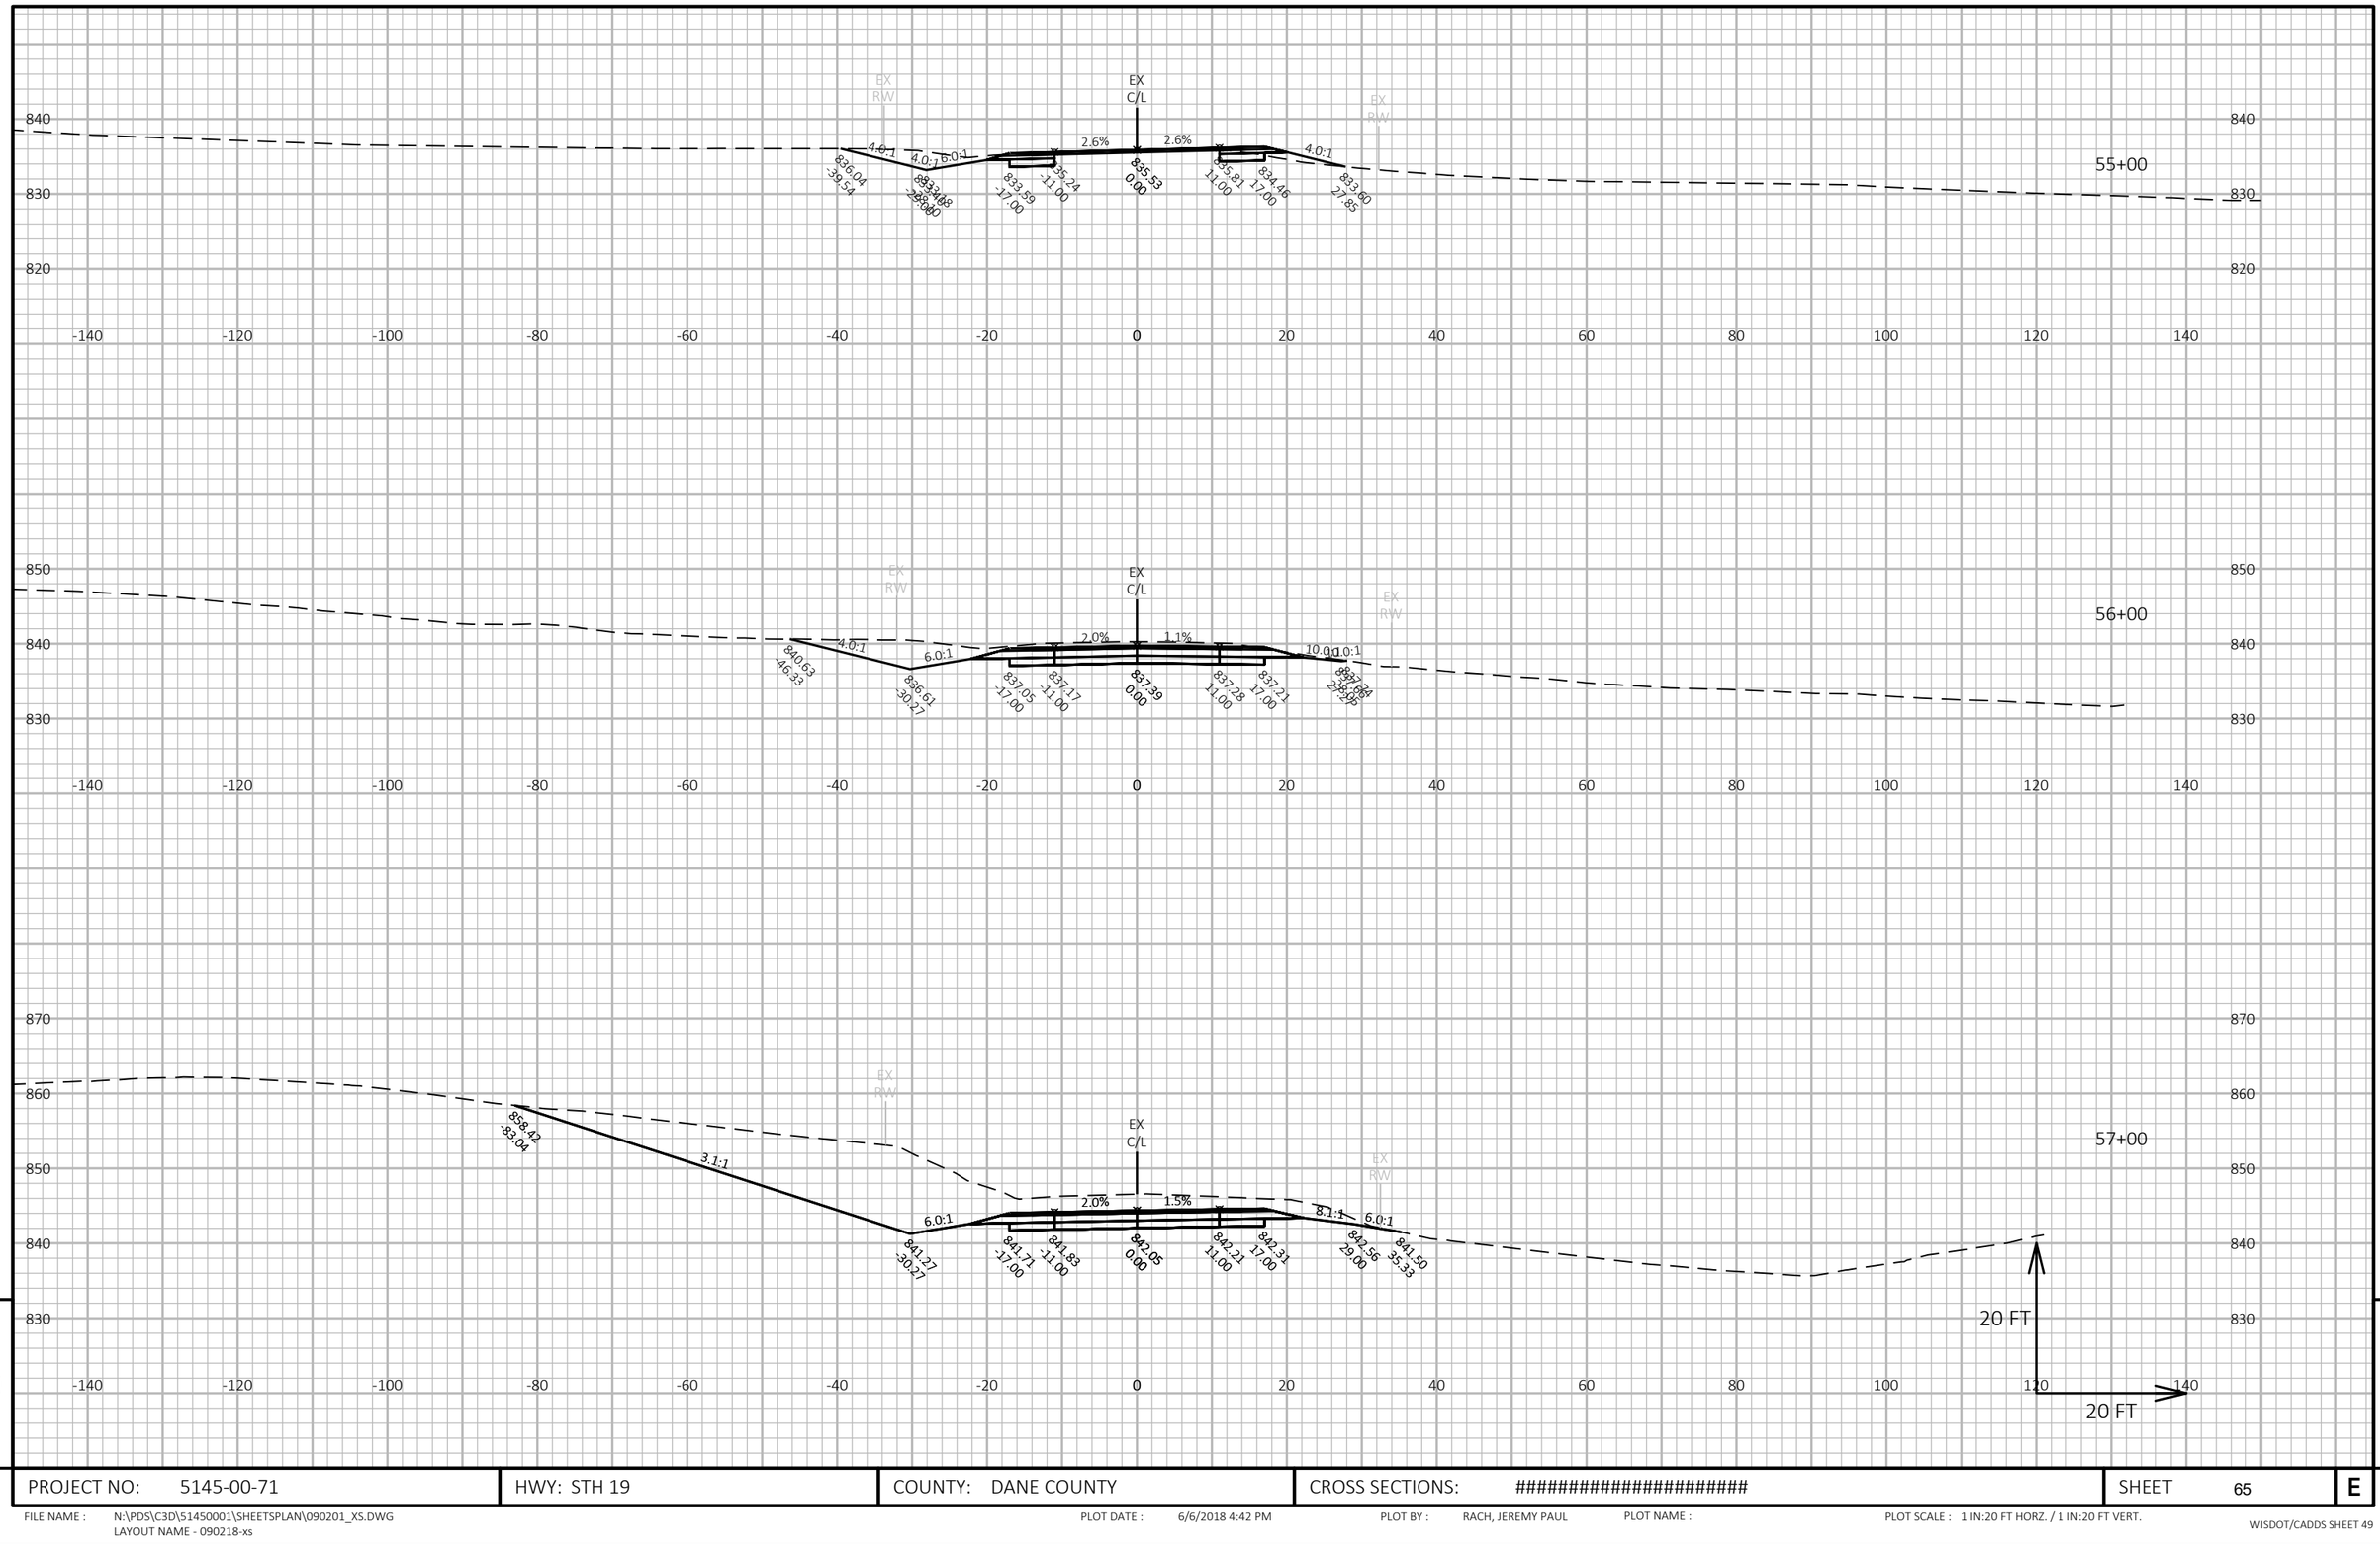

9

9

PROJECT NO: 5145-00-71	HWY: STH 19	COUNTY: DANE COUNTY	CROSS SECTIONS: ##########################	SHEET 65	E

FILE NAME : N:\PDS\C3D\51450001\SHEETSPLAN\090201_XS.DWG
LAYOUT NAME - 090218-xs

PLOT DATE : 6/6/2018 4:42 PM PLOT BY : RACH, JEREMY PAUL PLOT NAME : PLOT SCALE : 1 IN:20 FT HORZ. / 1 IN:20 FT VERT.

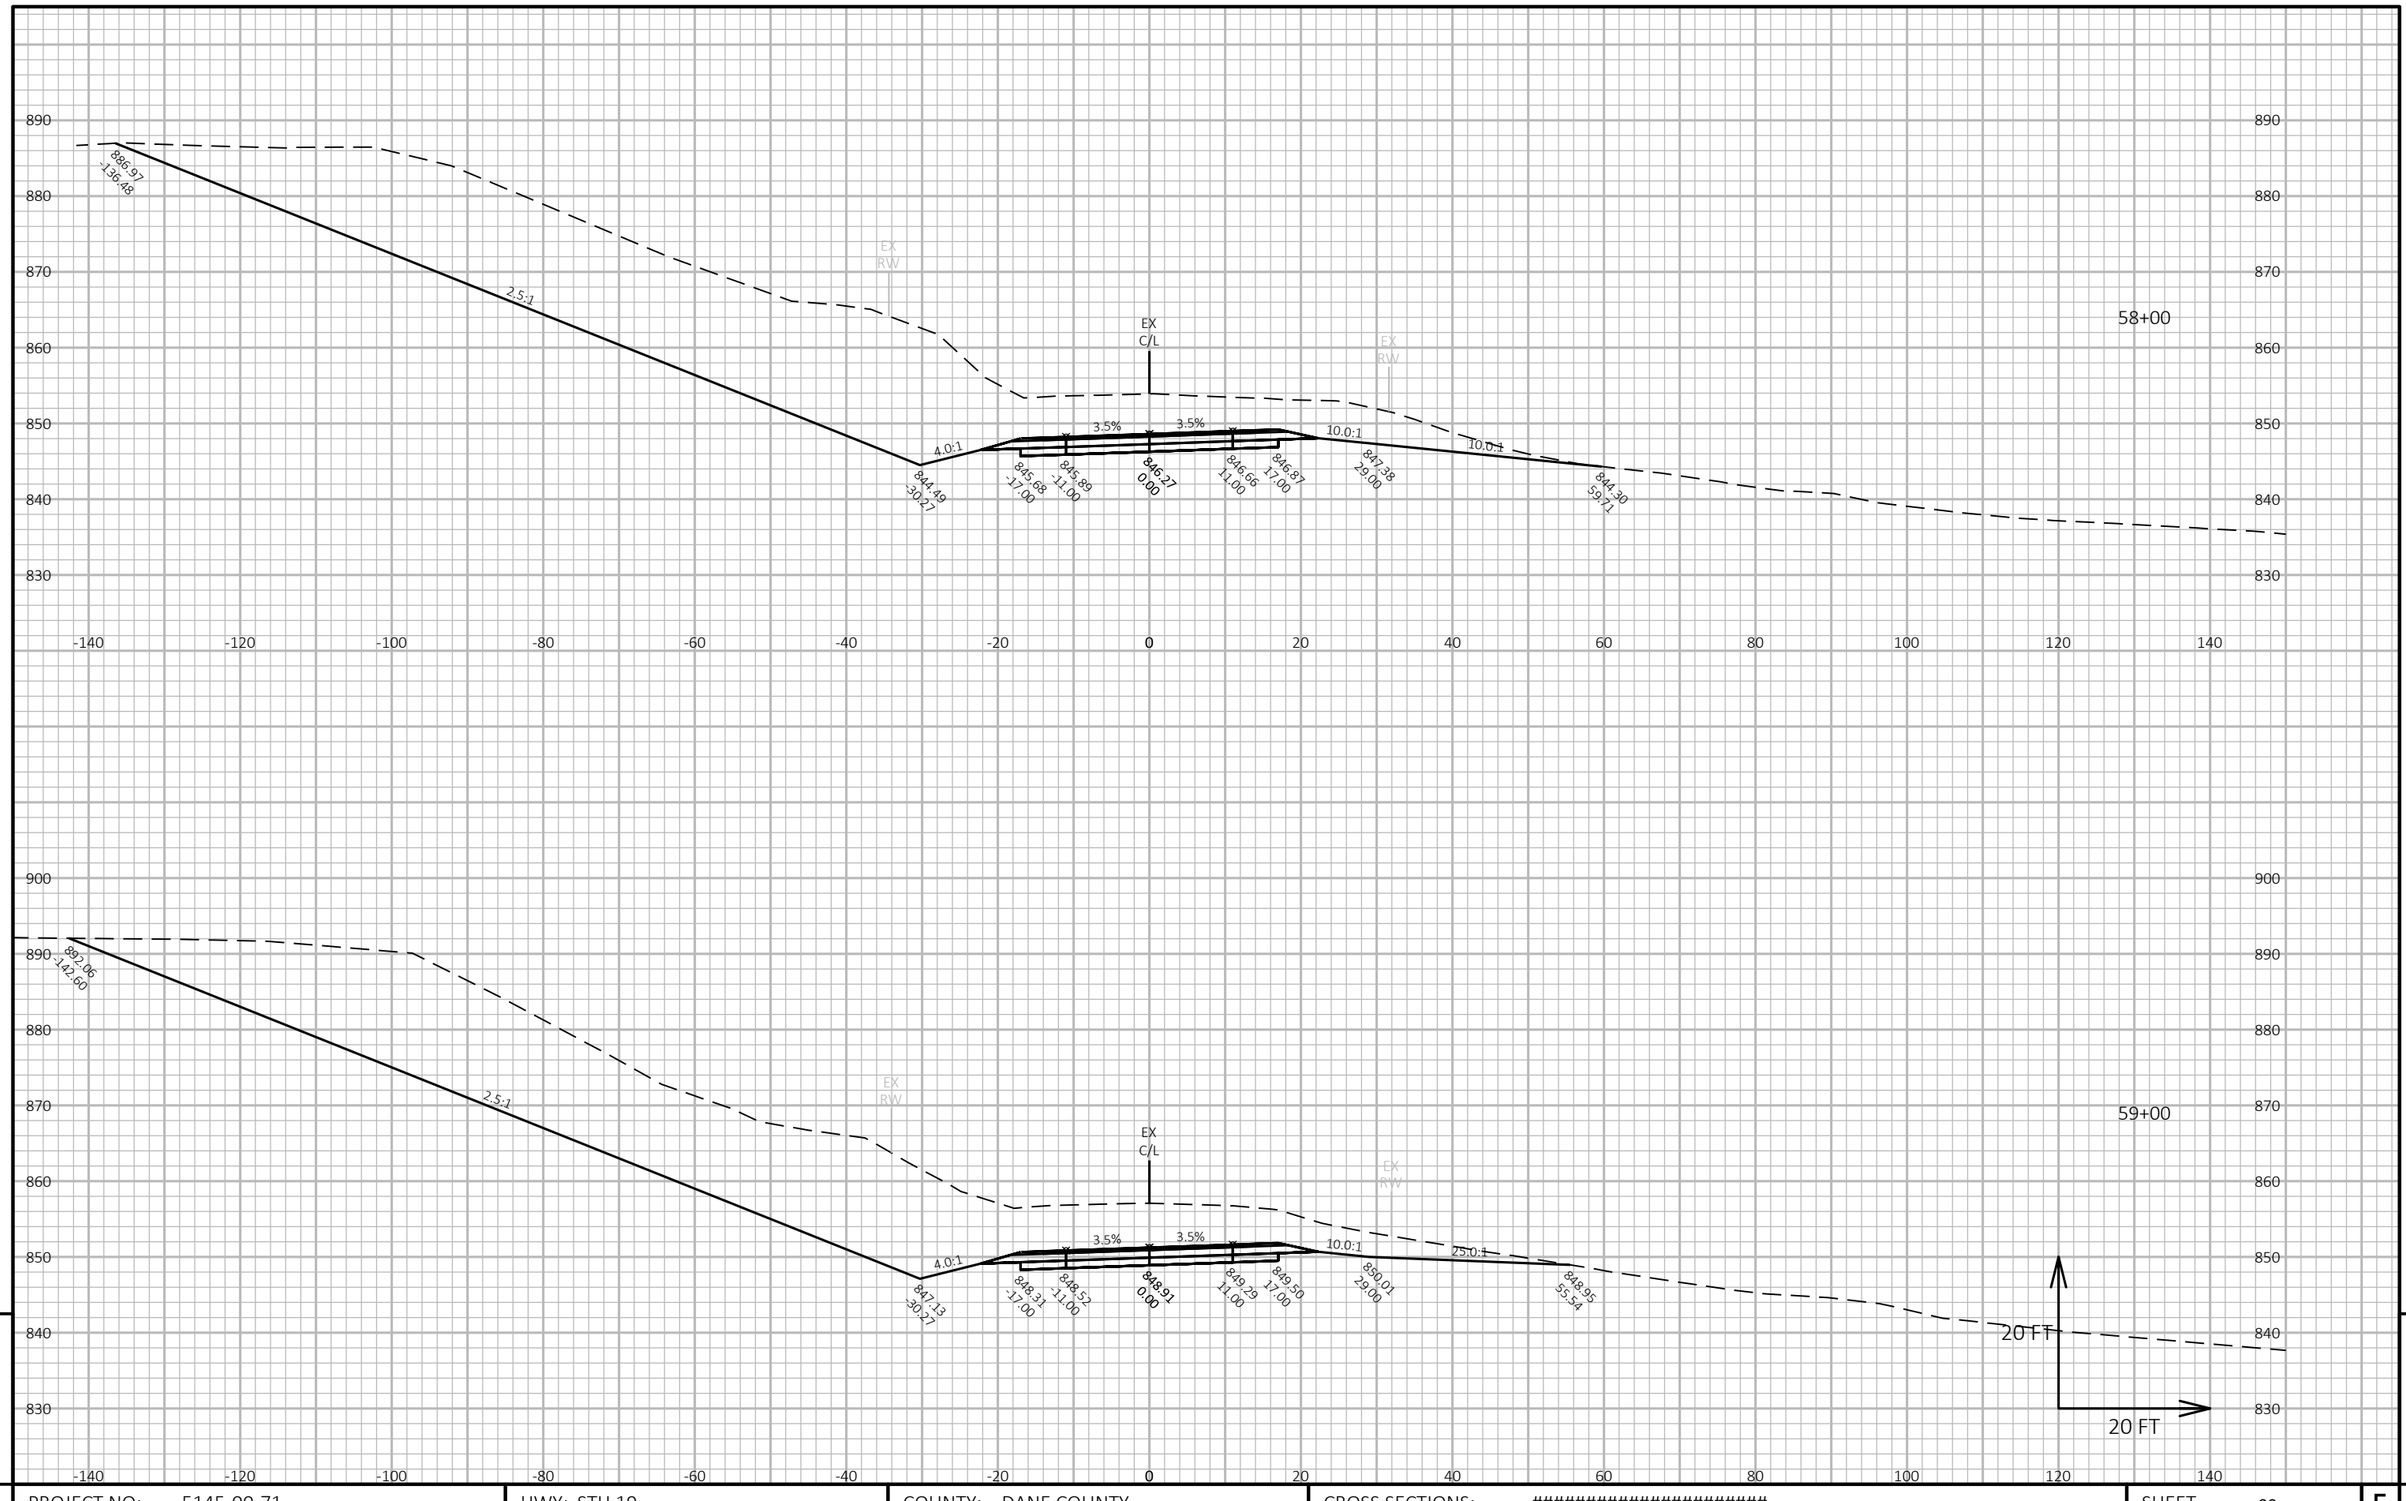

PROJECT NO: 5145-00-71	HWY: STH 19	COUNTY: DANE COUNTY	CROSS SECTIONS: ##########################	SHEET 66

FILE NAME : N:\PDS\C3D\51450001\SHEETSPLAN\090201_XS.DWG
LAYOUT NAME - 090219-xs

PLOT DATE : 6/6/2018 4:42 PM PLOT BY : RACH, JEREMY PAUL PLOT NAME : PLOT SCALE : 1 IN:20 FT HORZ. / 1 IN:20 FT VERT.

WISDOT/CADDS SHEET 49

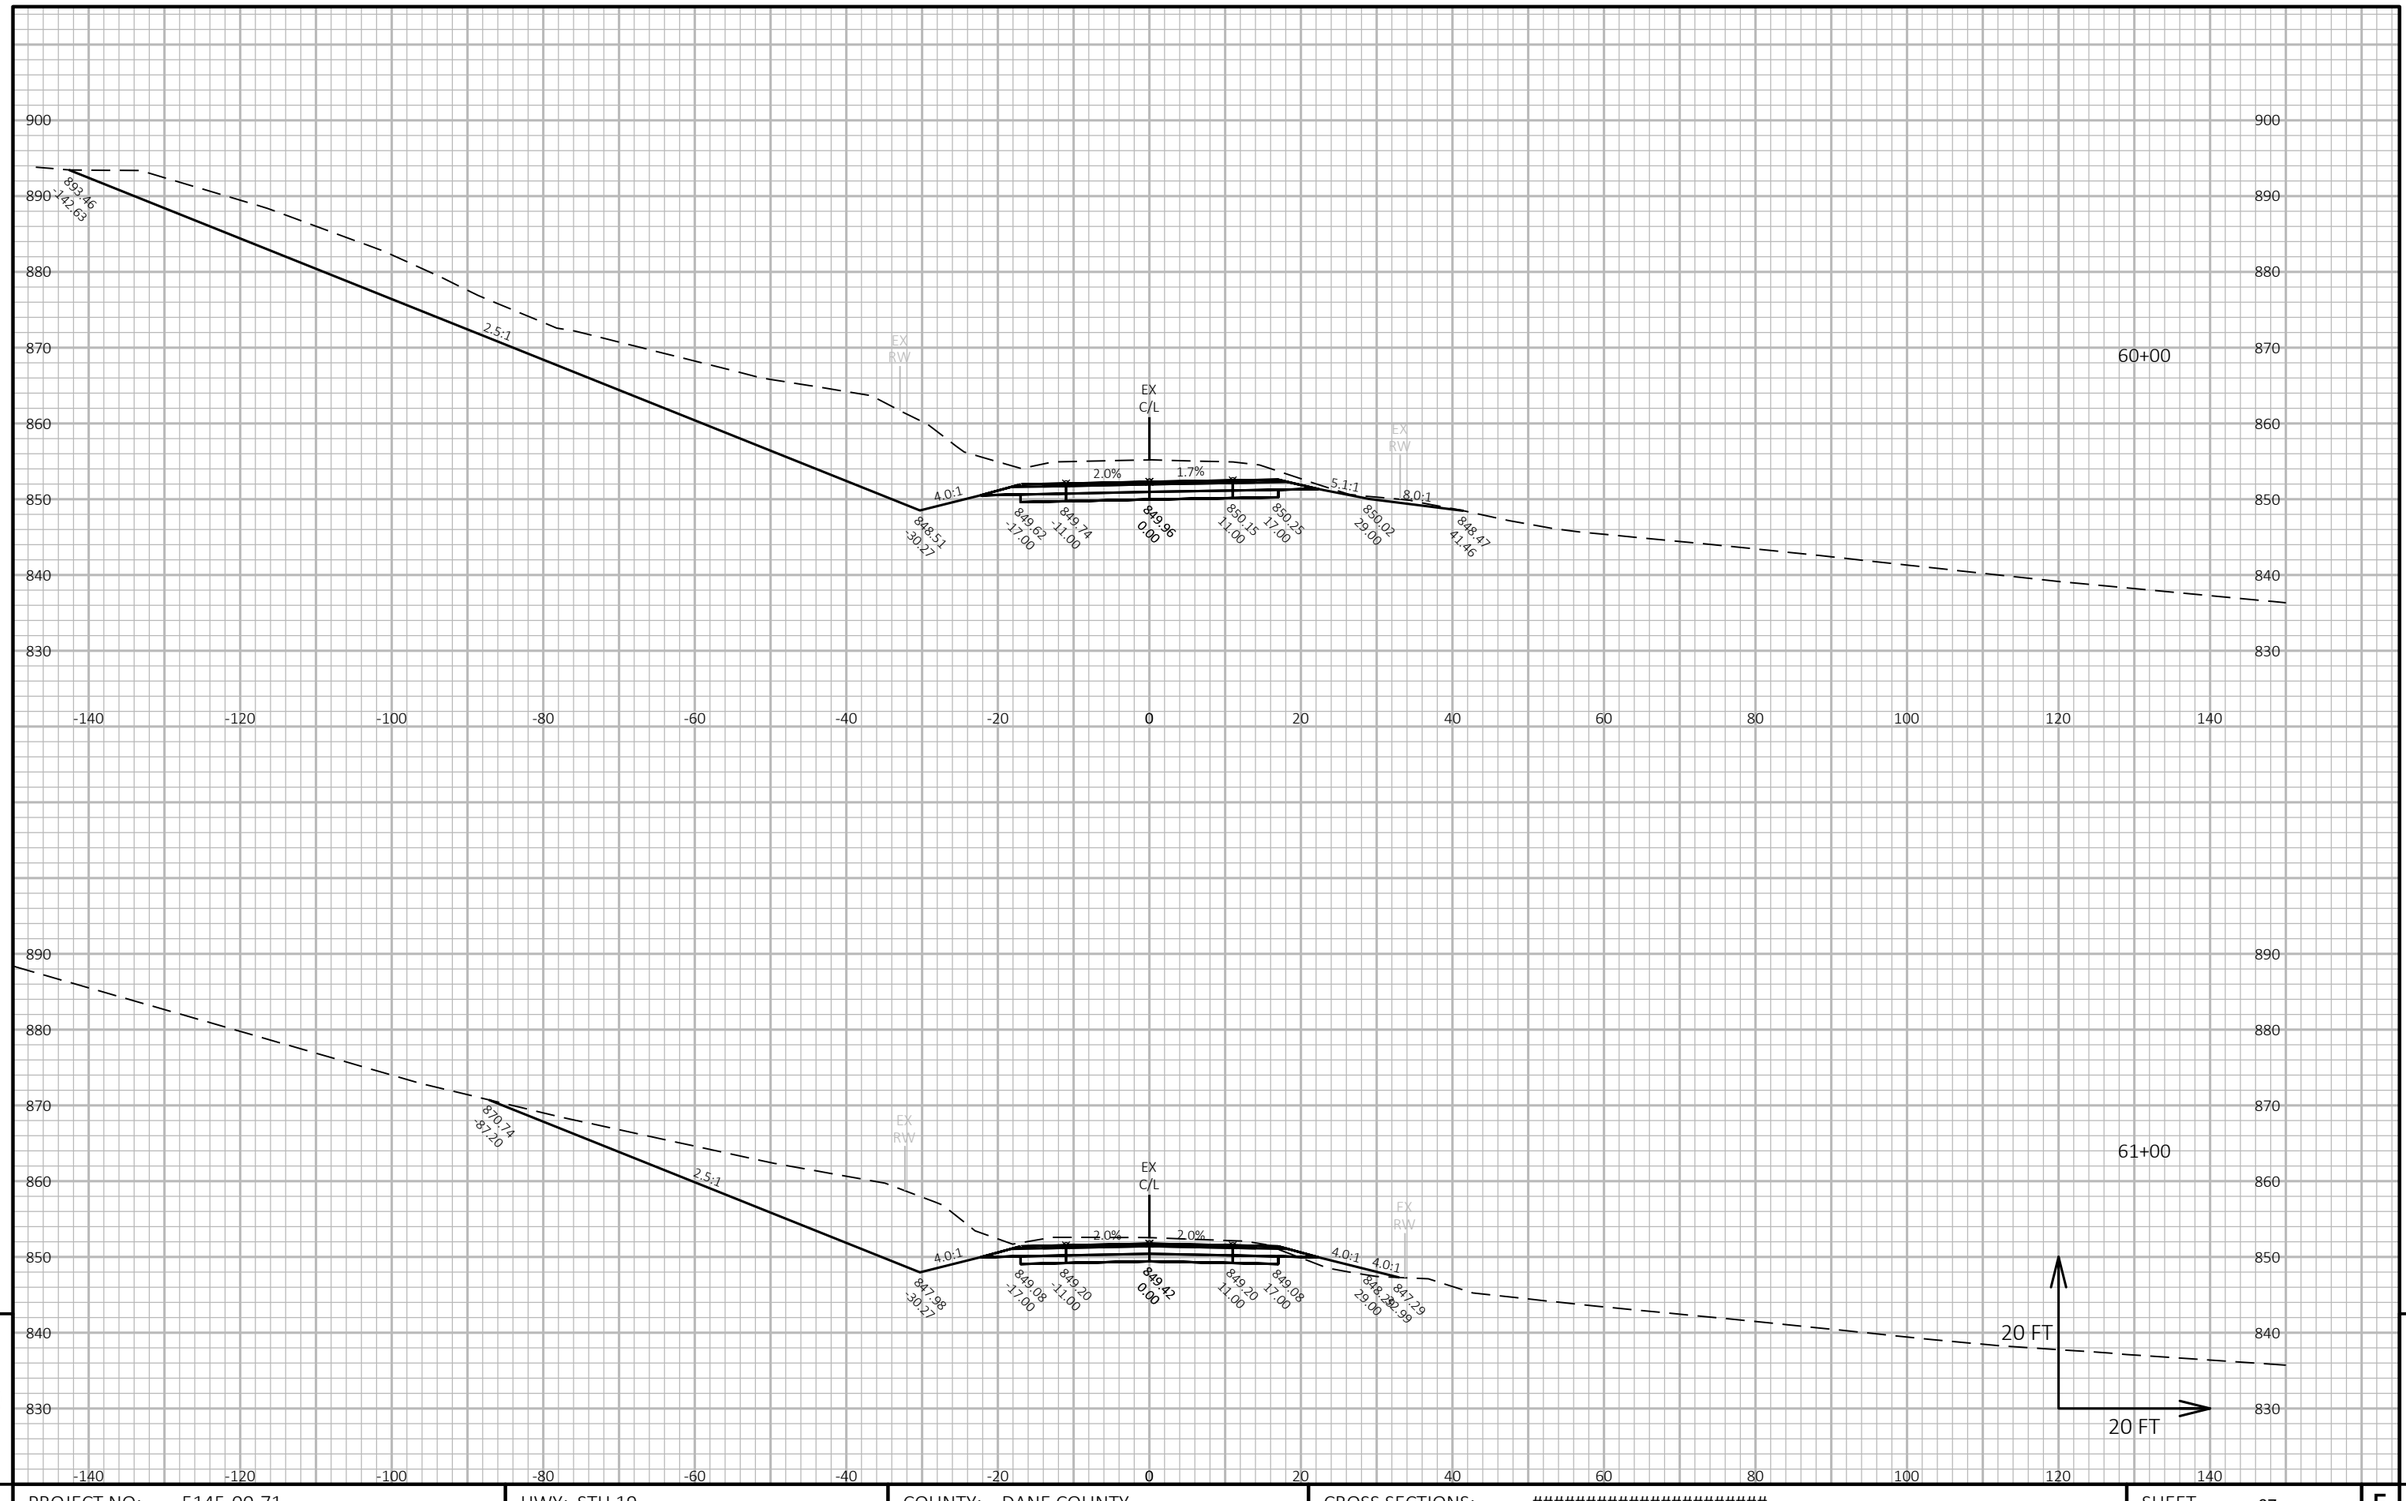

9

9

PROJECT NO: 5145-00-71	HWY: STH 19	COUNTY: DANE COUNTY	CROSS SECTIONS: ##########################	SHEET 67	E

FILE NAME : N:\PDS\C3D\51450001\SHEETSPLAN\090201_XS.DWG
LAYOUT NAME - 090220-xs

PLOT DATE : 6/6/2018 4:42 PM PLOT BY : RACH, JEREMY PAUL PLOT NAME : PLOT SCALE : 1 IN:20 FT HORZ. / 1 IN:20 FT VERT.

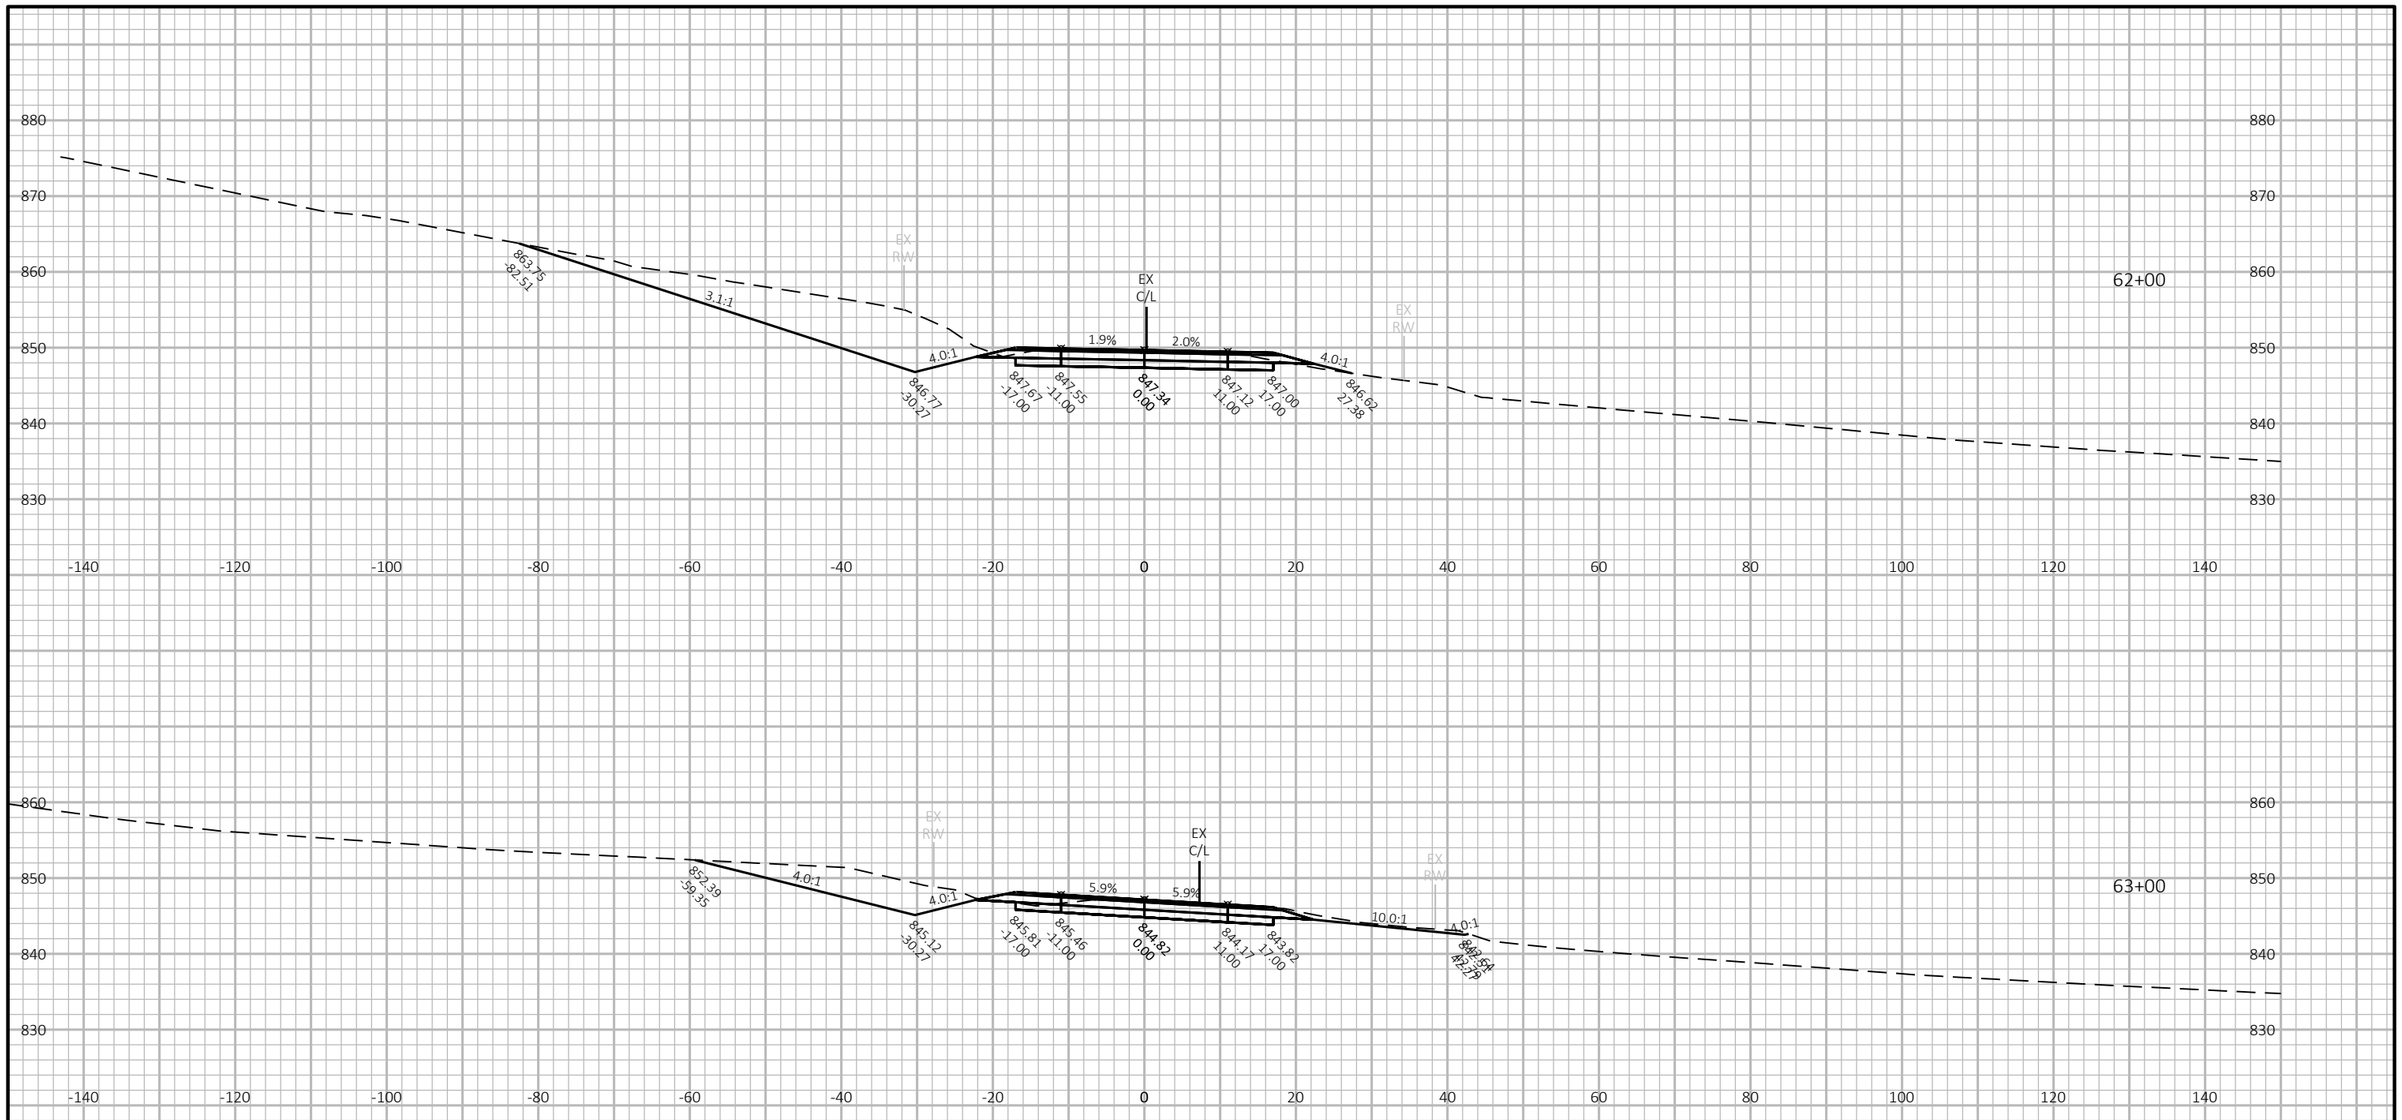

PROJECT NO: 5145-00-71	HWY: STH 19	COUNTY: DANE COUNTY	CROSS SECTIONS: ##########################	SHEET 68	E

FILE NAME : N:\PDS\C3D\51450001\SHEETSPLAN\090201_XS.DWG
LAYOUT NAME - 090221-xs

PLOT DATE : 6/6/2018 4:43 PM PLOT BY : RACH, JEREMY PAUL PLOT NAME : PLOT SCALE : 1 IN:20 FT HORZ. / 1 IN:20 FT VERT.

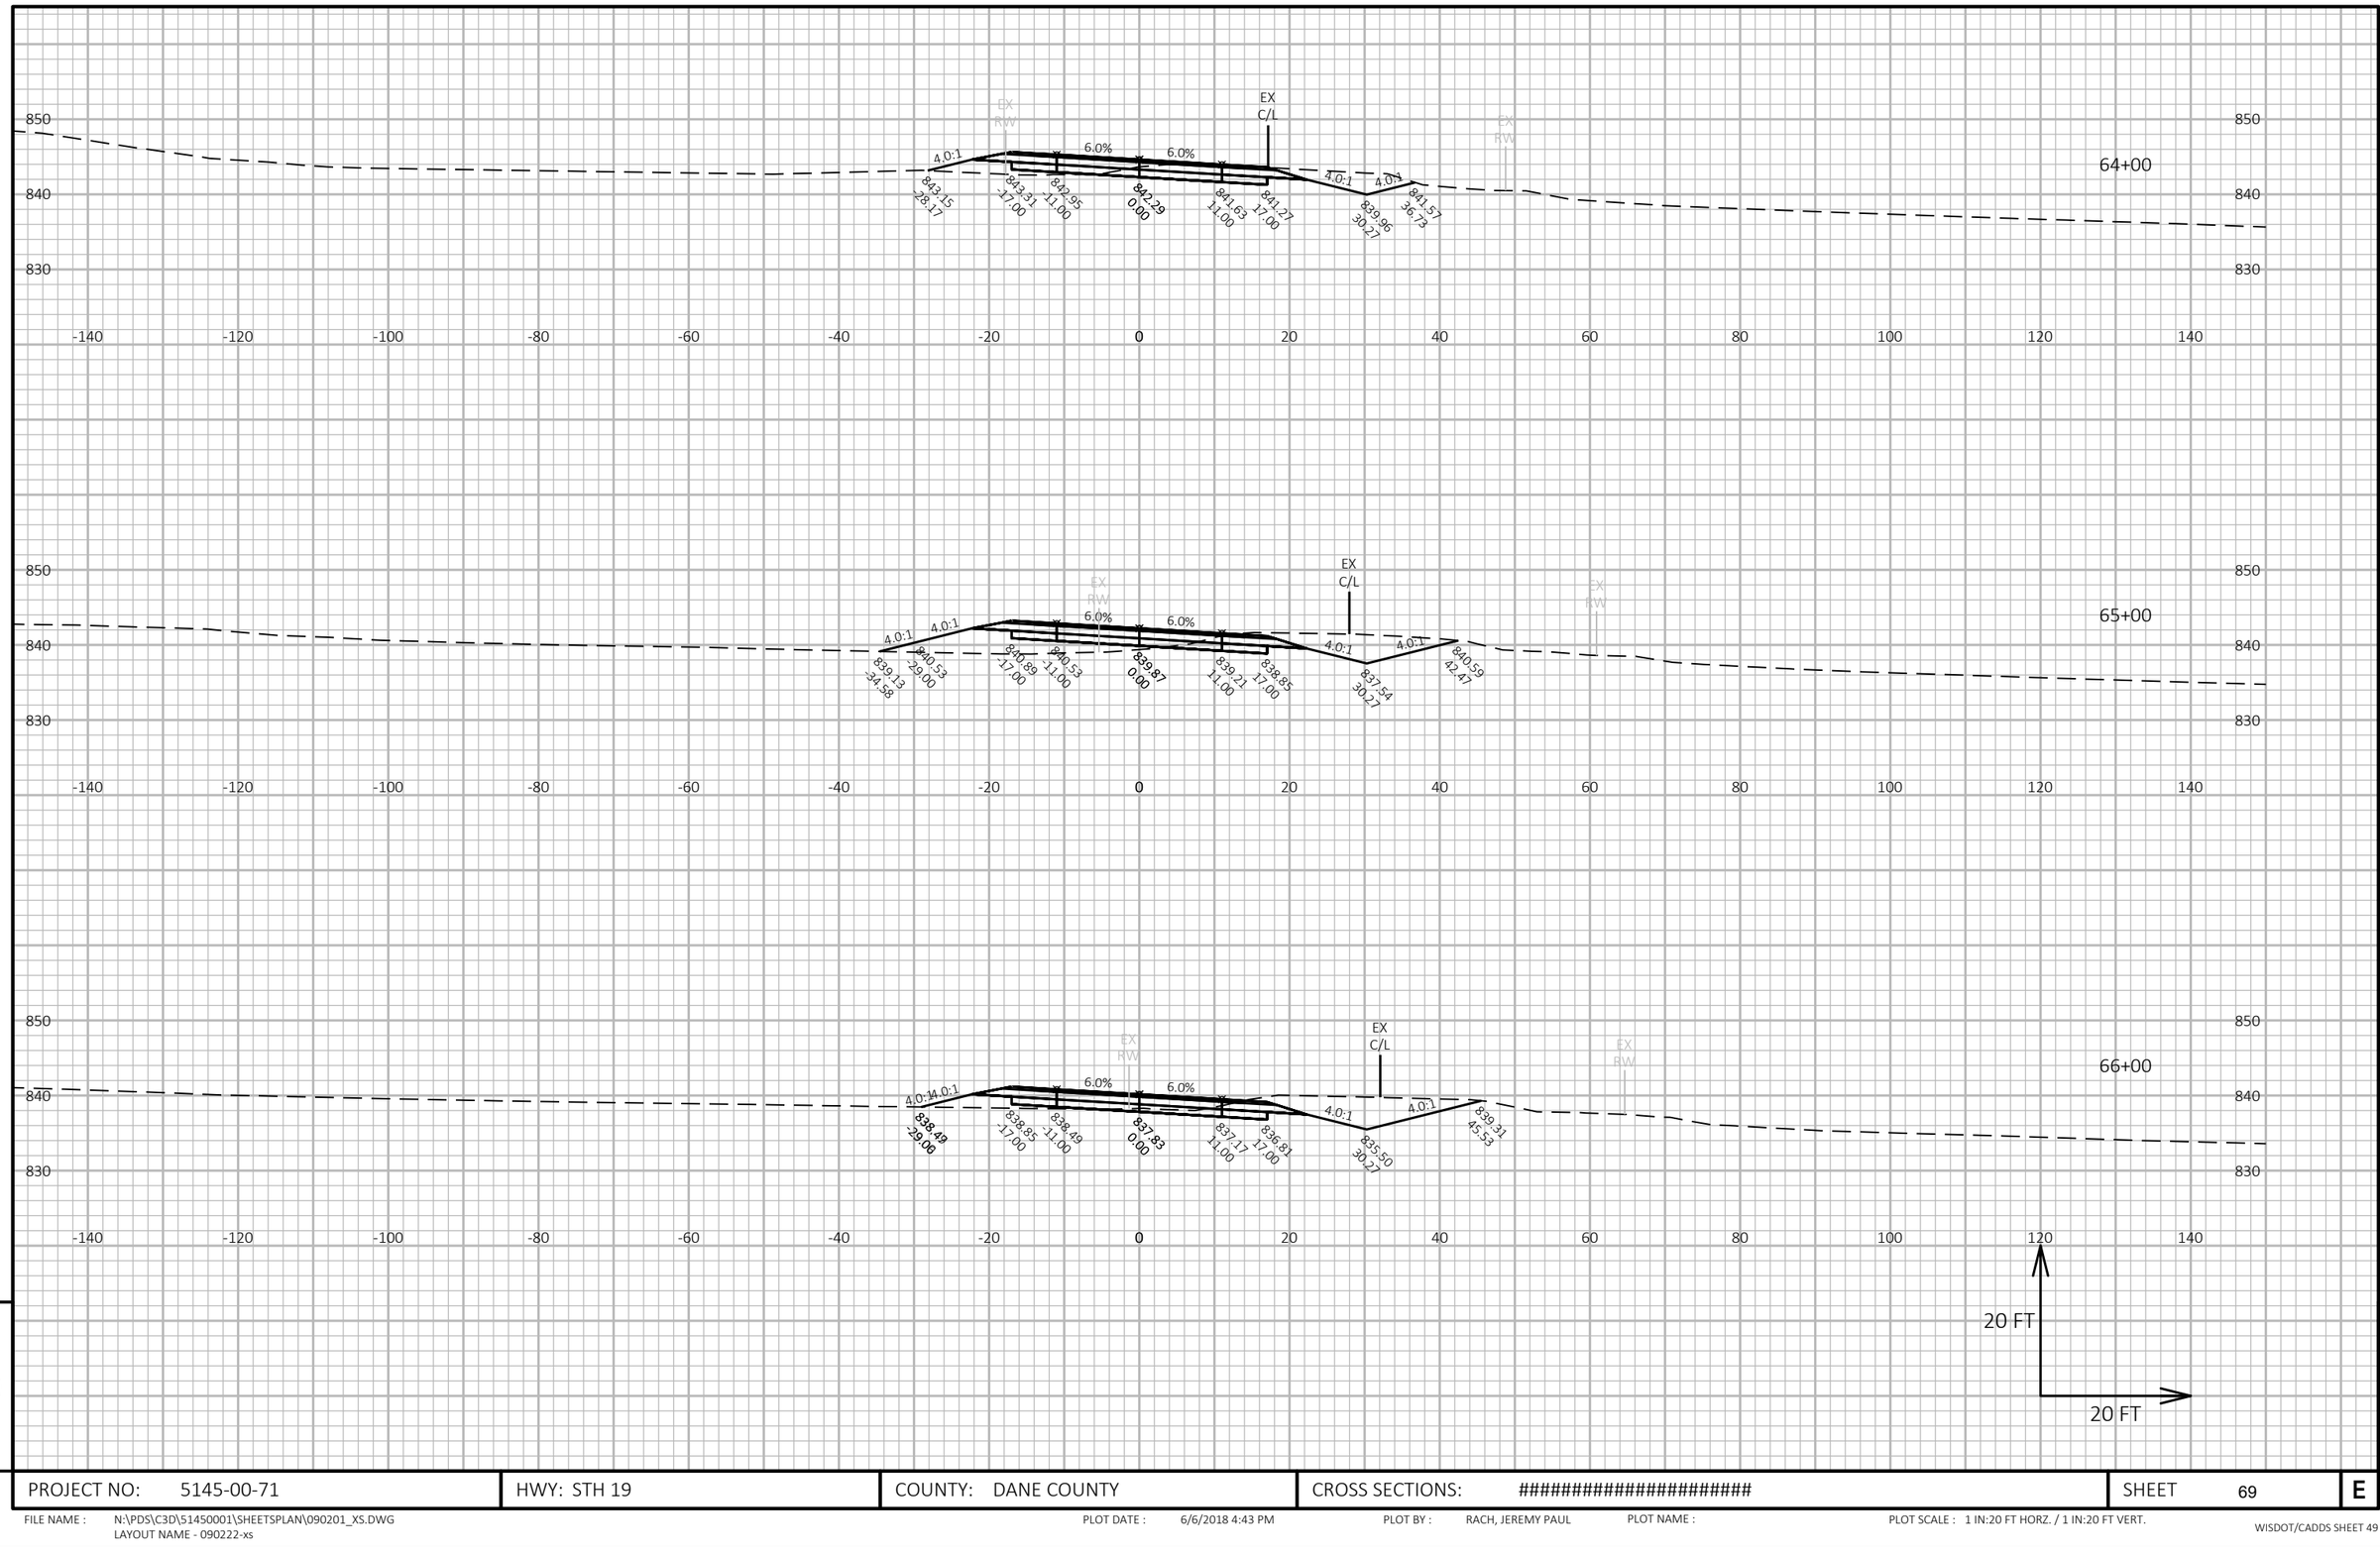

9

9

PROJECT NO: 5145-00-71	HWY: STH 19	COUNTY: DANE COUNTY	CROSS SECTIONS: ##########################	SHEET 69	E

FILE NAME : N:\PDS\C3D\51450001\SHEETSPLAN\090201_XS.DWG
LAYOUT NAME - 090222-xs

PLOT DATE : 6/6/2018 4:43 PM PLOT BY : RACH, JEREMY PAUL PLOT NAME : PLOT SCALE : 1 IN:20 FT HORZ. / 1 IN:20 FT VERT.

9

9

PROJECT NO: 5145-00-71	HWY: STH 19	COUNTY: DANE COUNTY	CROSS SECTIONS: ##########################	SHEET 70	E

FILE NAME : N:\PDS\C3D\51450001\SHEETSPLAN\090201_XS.DWG
LAYOUT NAME - 090223-xs

PLOT DATE : 6/6/2018 4:44 PM PLOT BY : RACH, JEREMY PAUL PLOT NAME : PLOT SCALE : 1 IN:20 FT HORZ. / 1 IN:20 FT VERT.

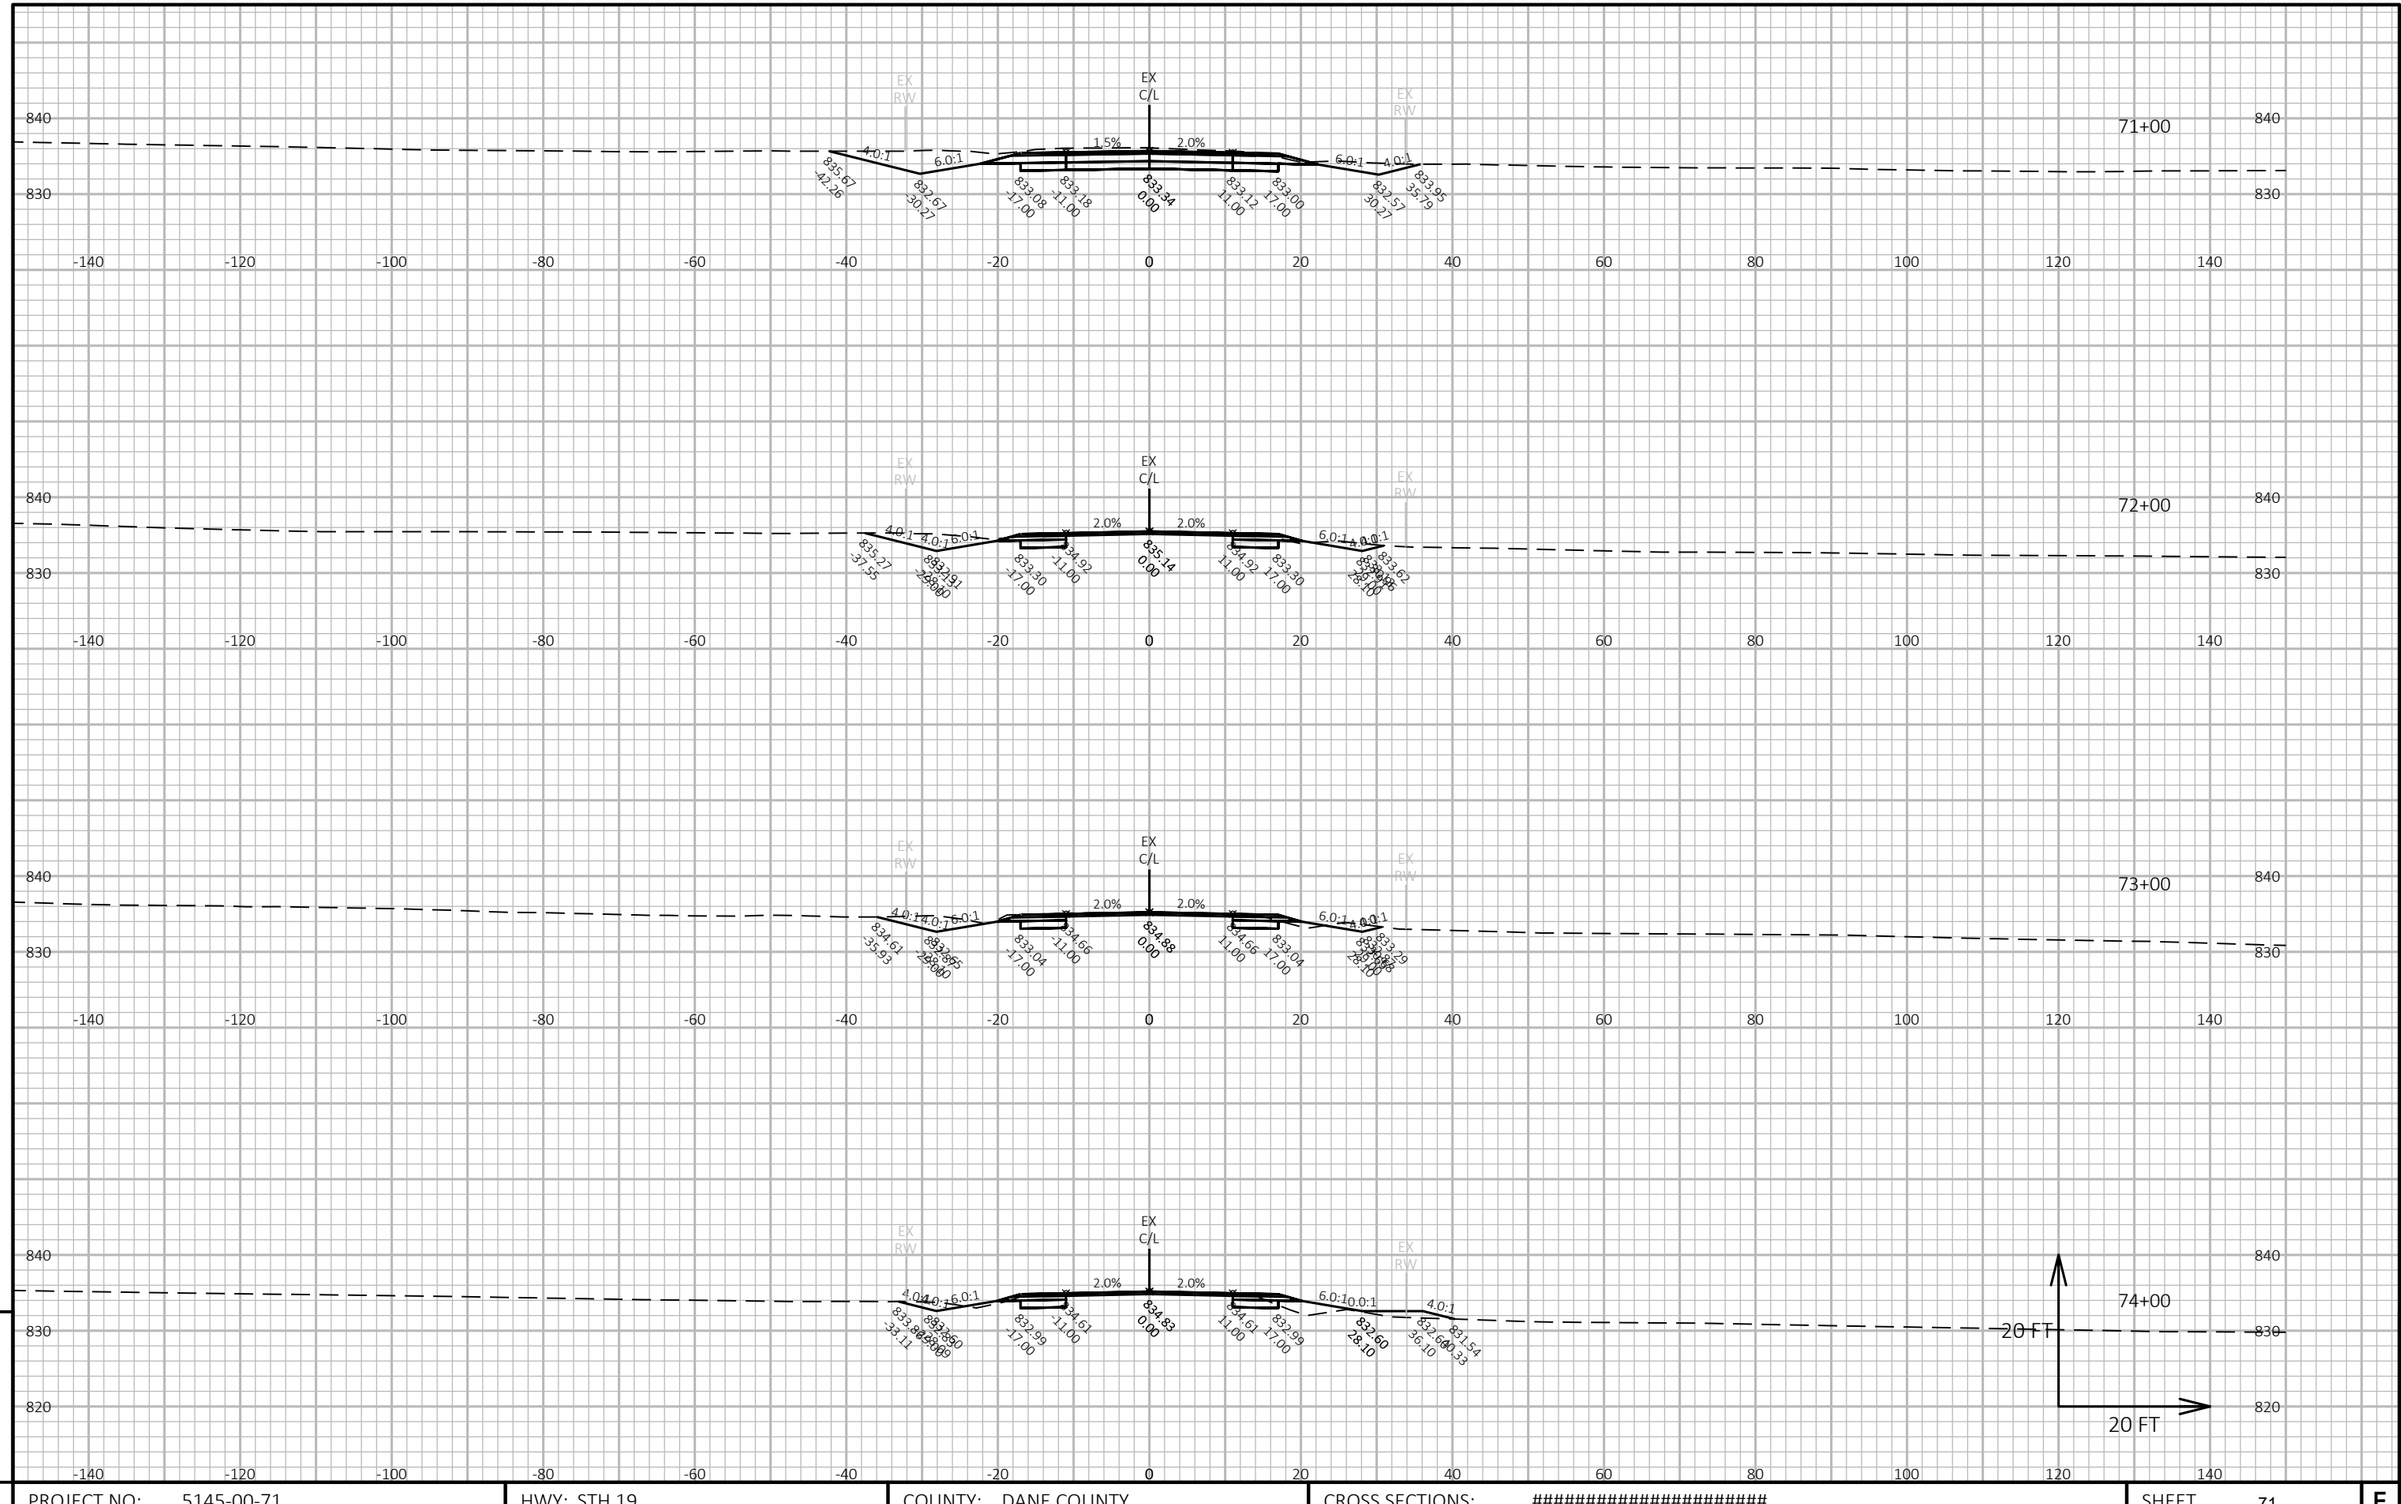

9

PROJECT NO: 5145-00-71	HWY: STH 19	COUNTY: DANE COUNTY	CROSS SECTIONS: ##########################	SHEET 71	E

9

FILE NAME : N:\PDS\C3D\51450001\SHEETSPLAN\090201_XS.DWG
LAYOUT NAME - 090224-xs

PLOT DATE : 6/6/2018 4:44 PM PLOT BY : RACH, JEREMY PAUL PLOT NAME : PLOT SCALE : 1 IN:20 FT HORZ. / 1 IN:20 FT VERT.

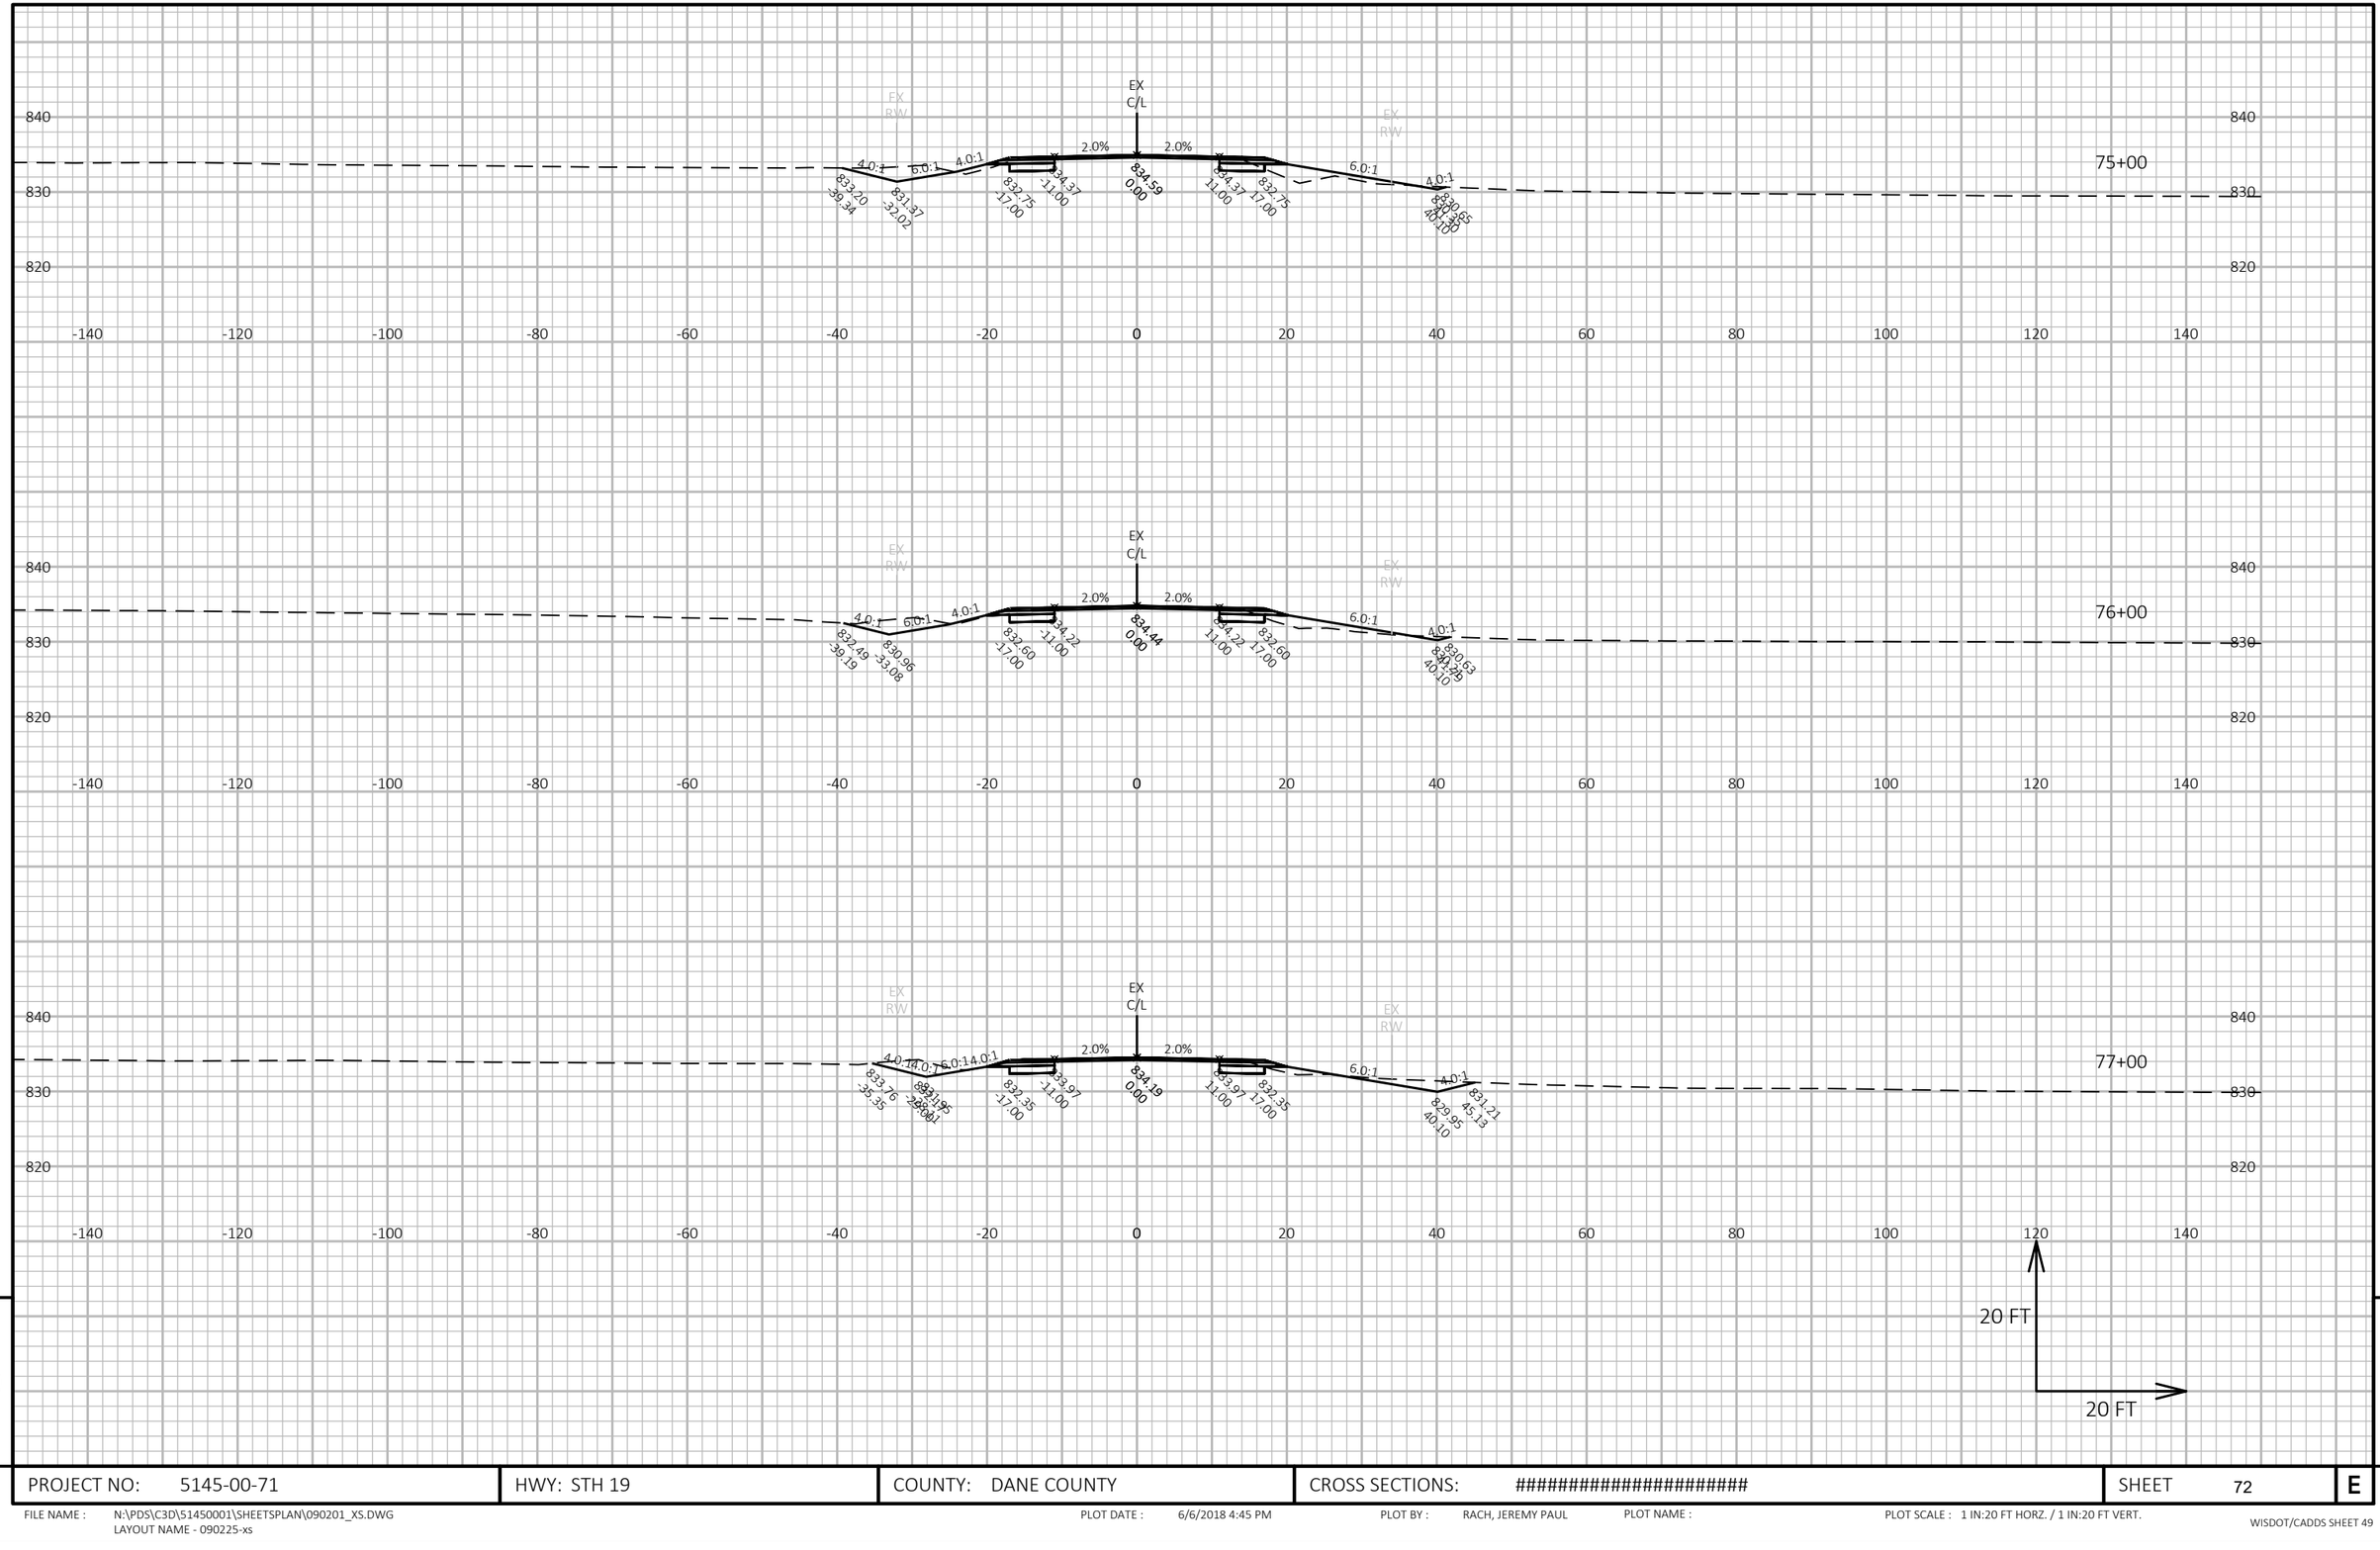
75+00
76+00
77+00
EX C/L
EX RW
EX RW
2.0%
2.0%
4.0:1
6.0:1
4.0:1
6.0:1
4.0:1
6.0:1

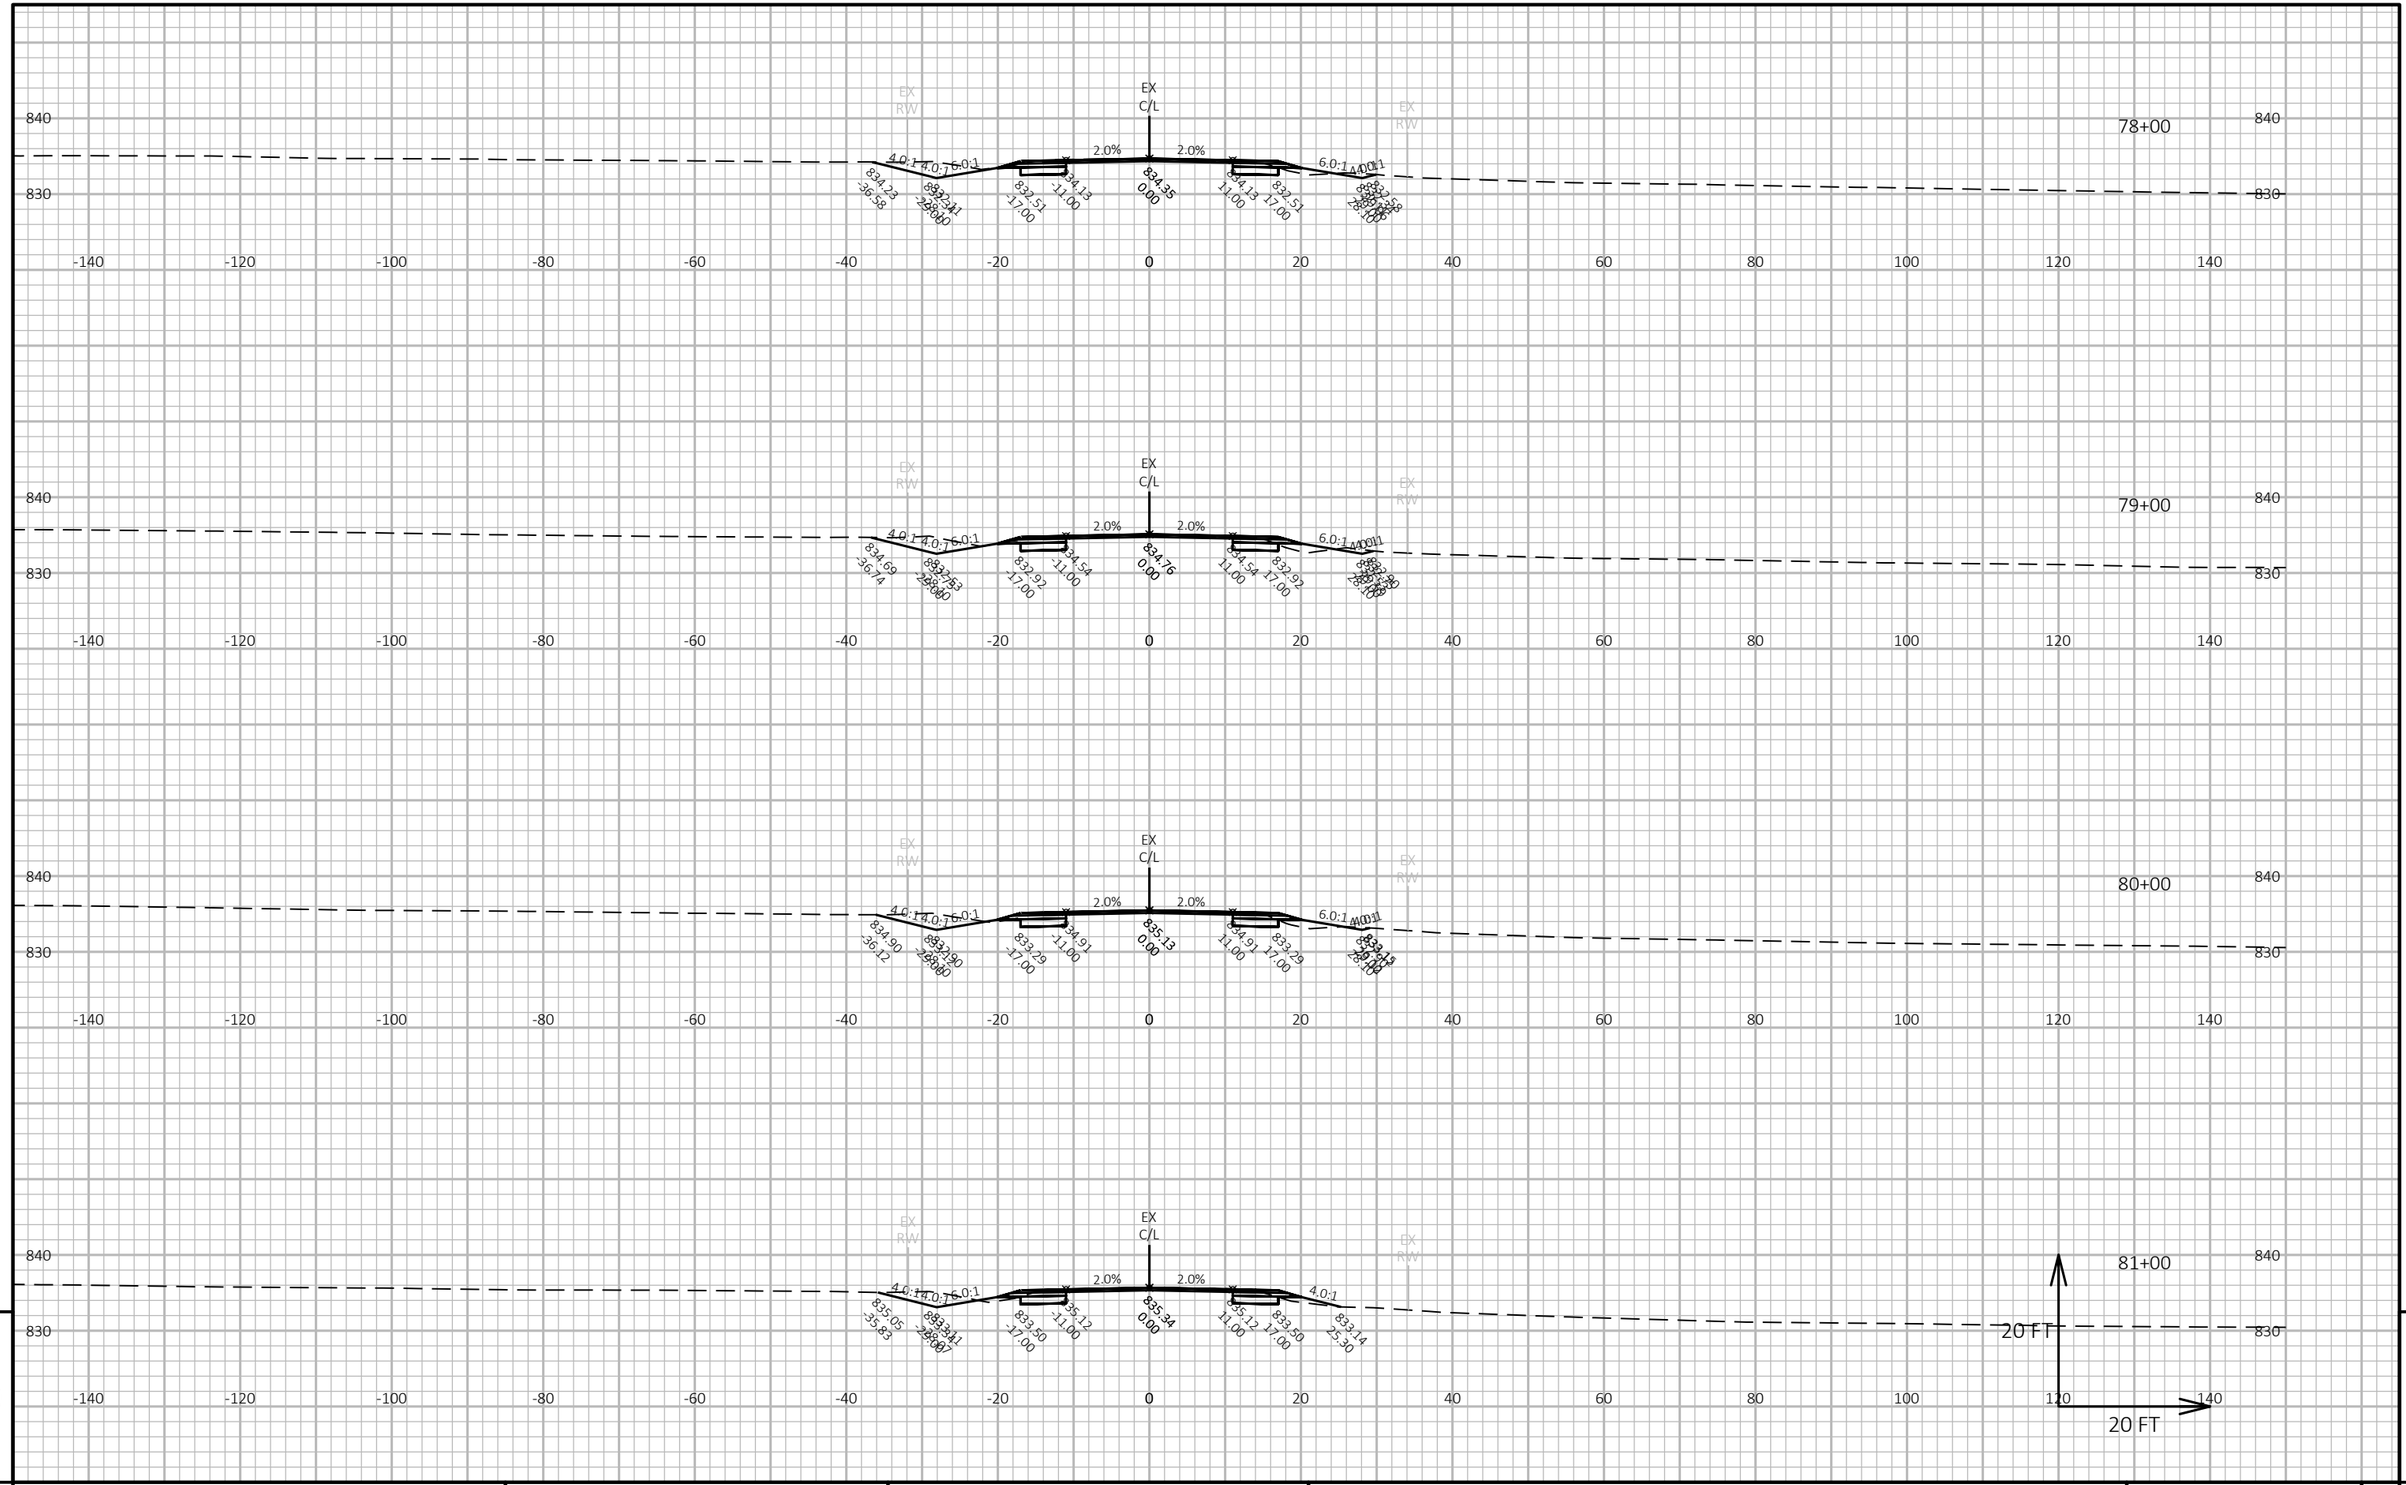

9

9

PROJECT NO: 5145-00-71	HWY: STH 19	COUNTY: DANE COUNTY	CROSS SECTIONS: ##########################	SHEET 73	E

FILE NAME : N:\PDS\C3D\51450001\SHEETSPLAN\090201_XS.DWG
LAYOUT NAME - 090226-xs

PLOT DATE : 6/6/2018 4:45 PM PLOT BY : RACH, JEREMY PAUL PLOT NAME : PLOT SCALE : 1 IN:20 FT HORZ. / 1 IN:20 FT VERT.

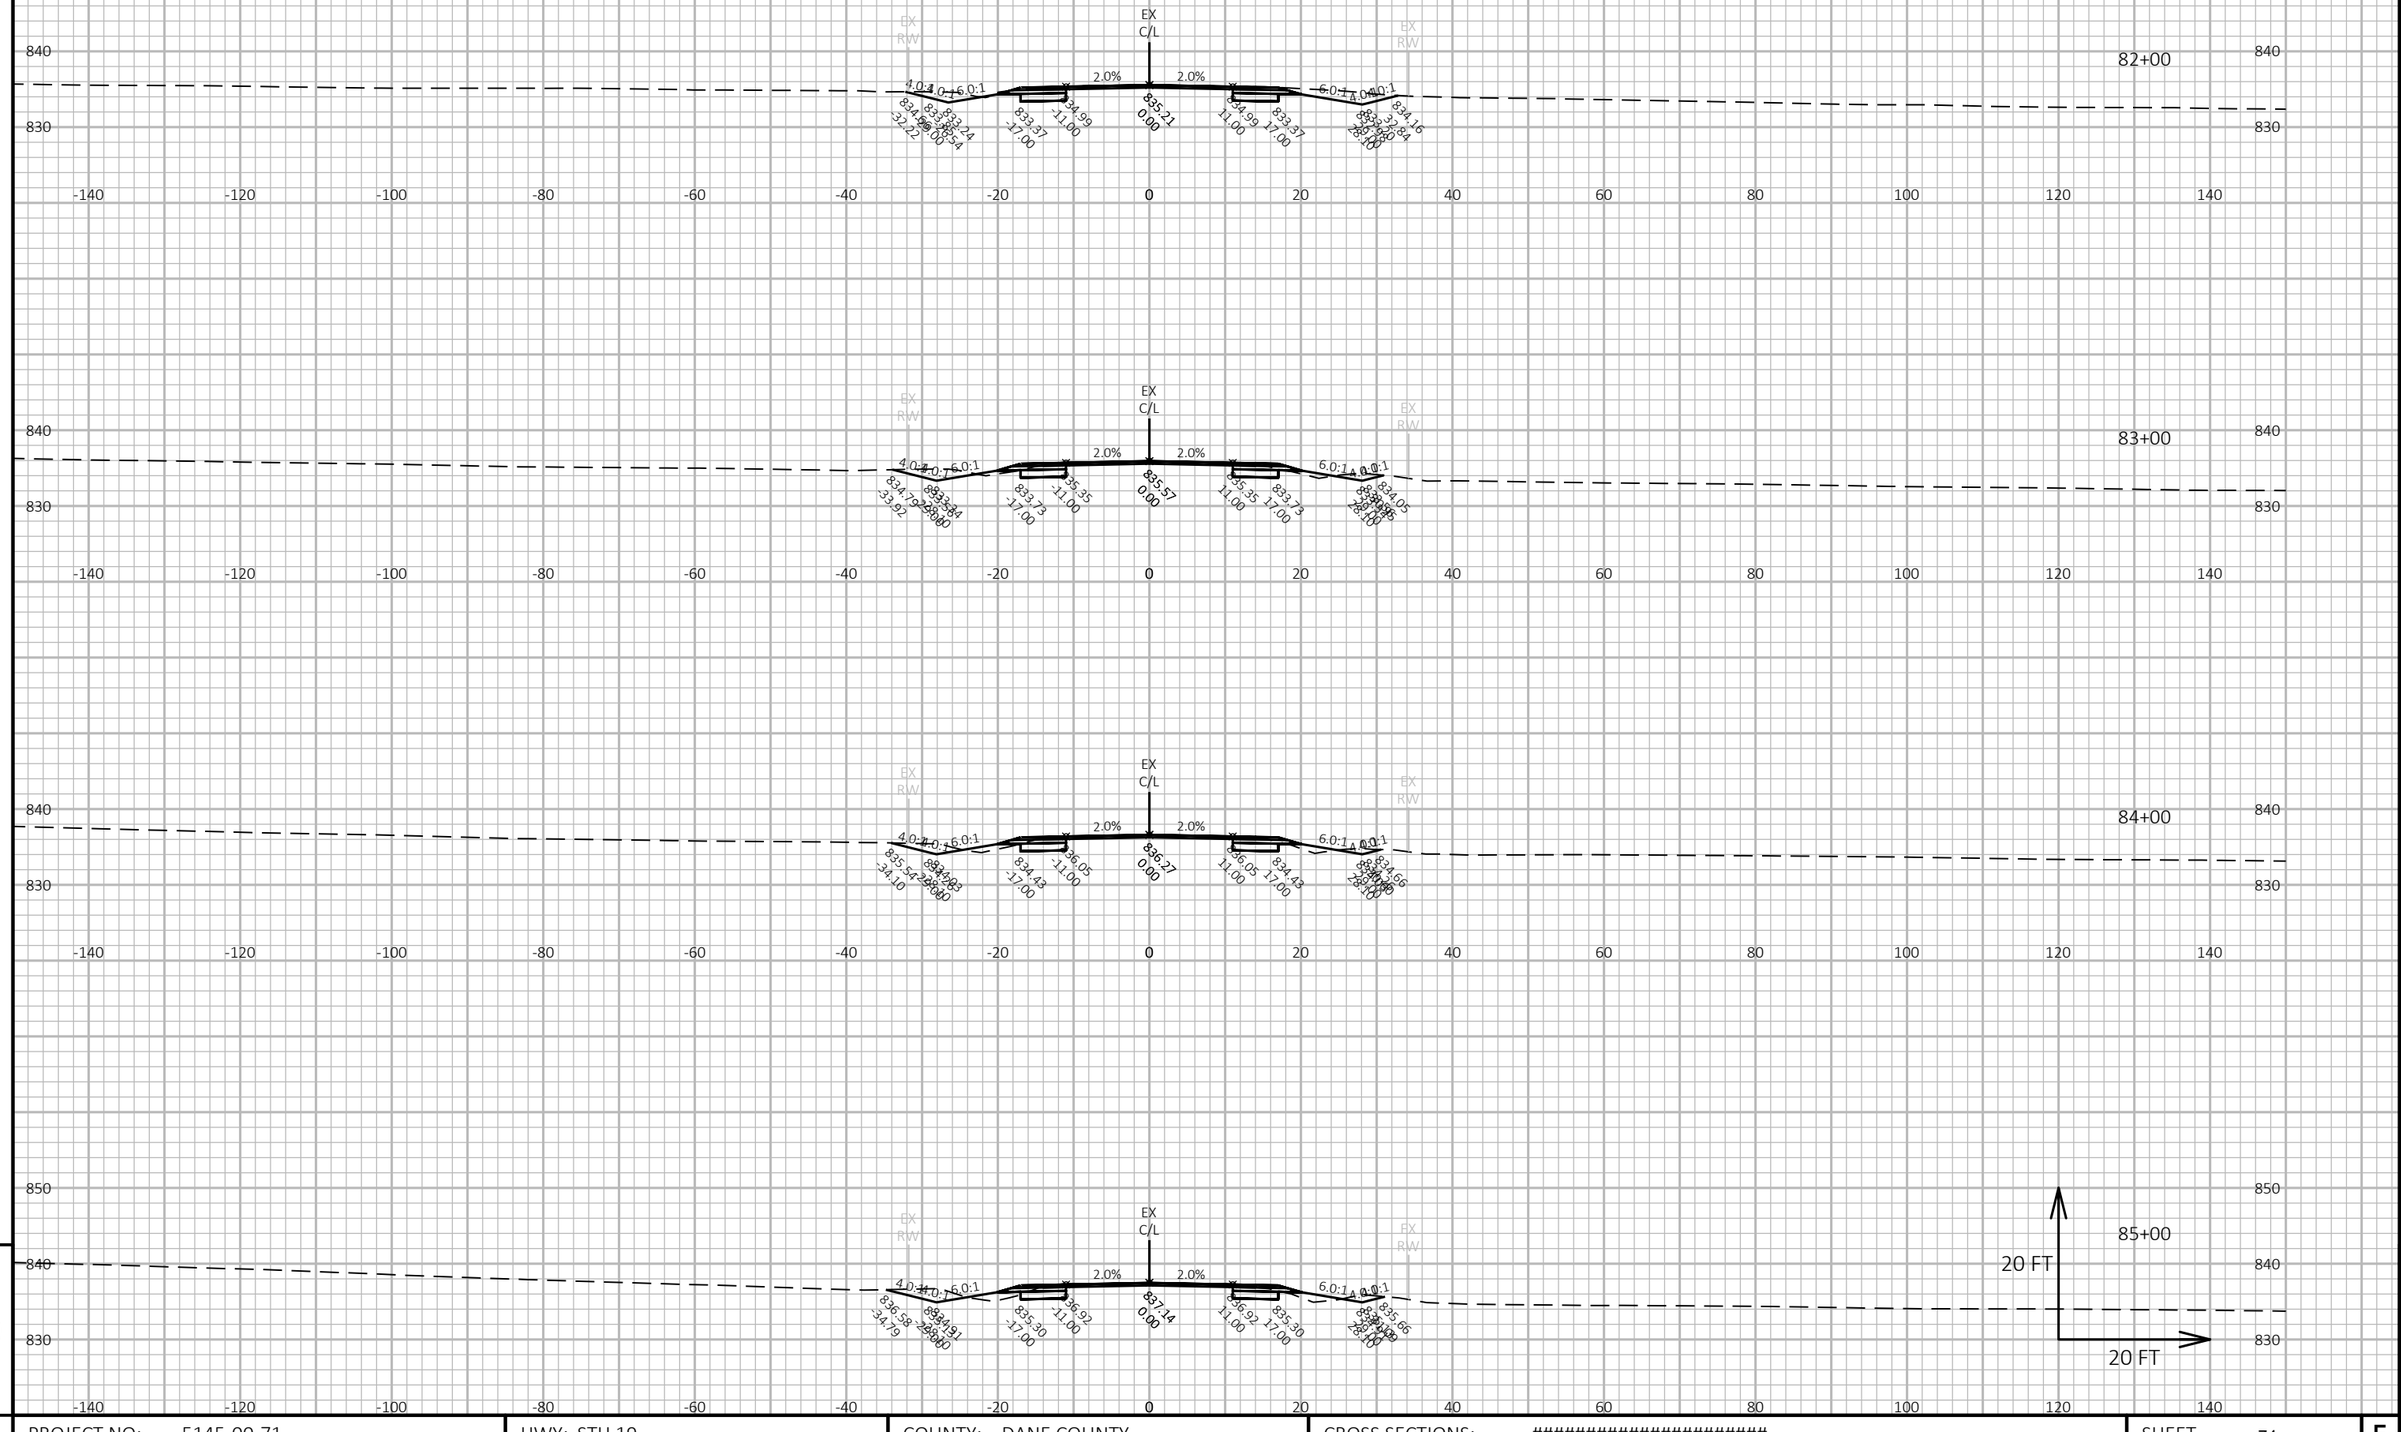

9

PROJECT NO: 5145-00-71	HWY: STH 19	COUNTY: DANE COUNTY	CROSS SECTIONS: ##########################	SHEET 74	E

9

FILE NAME : N:\PDS\C3D\51450001\SHEETSPLAN\090201_XS.DWG
LAYOUT NAME - 090227-xs

PLOT DATE : 6/6/2018 4:45 PM PLOT BY : RACH, JEREMY PAUL PLOT NAME : PLOT SCALE : 1 IN:20 FT HORZ. / 1 IN:20 FT VERT.

WISDOT/CADDS SHEET 49

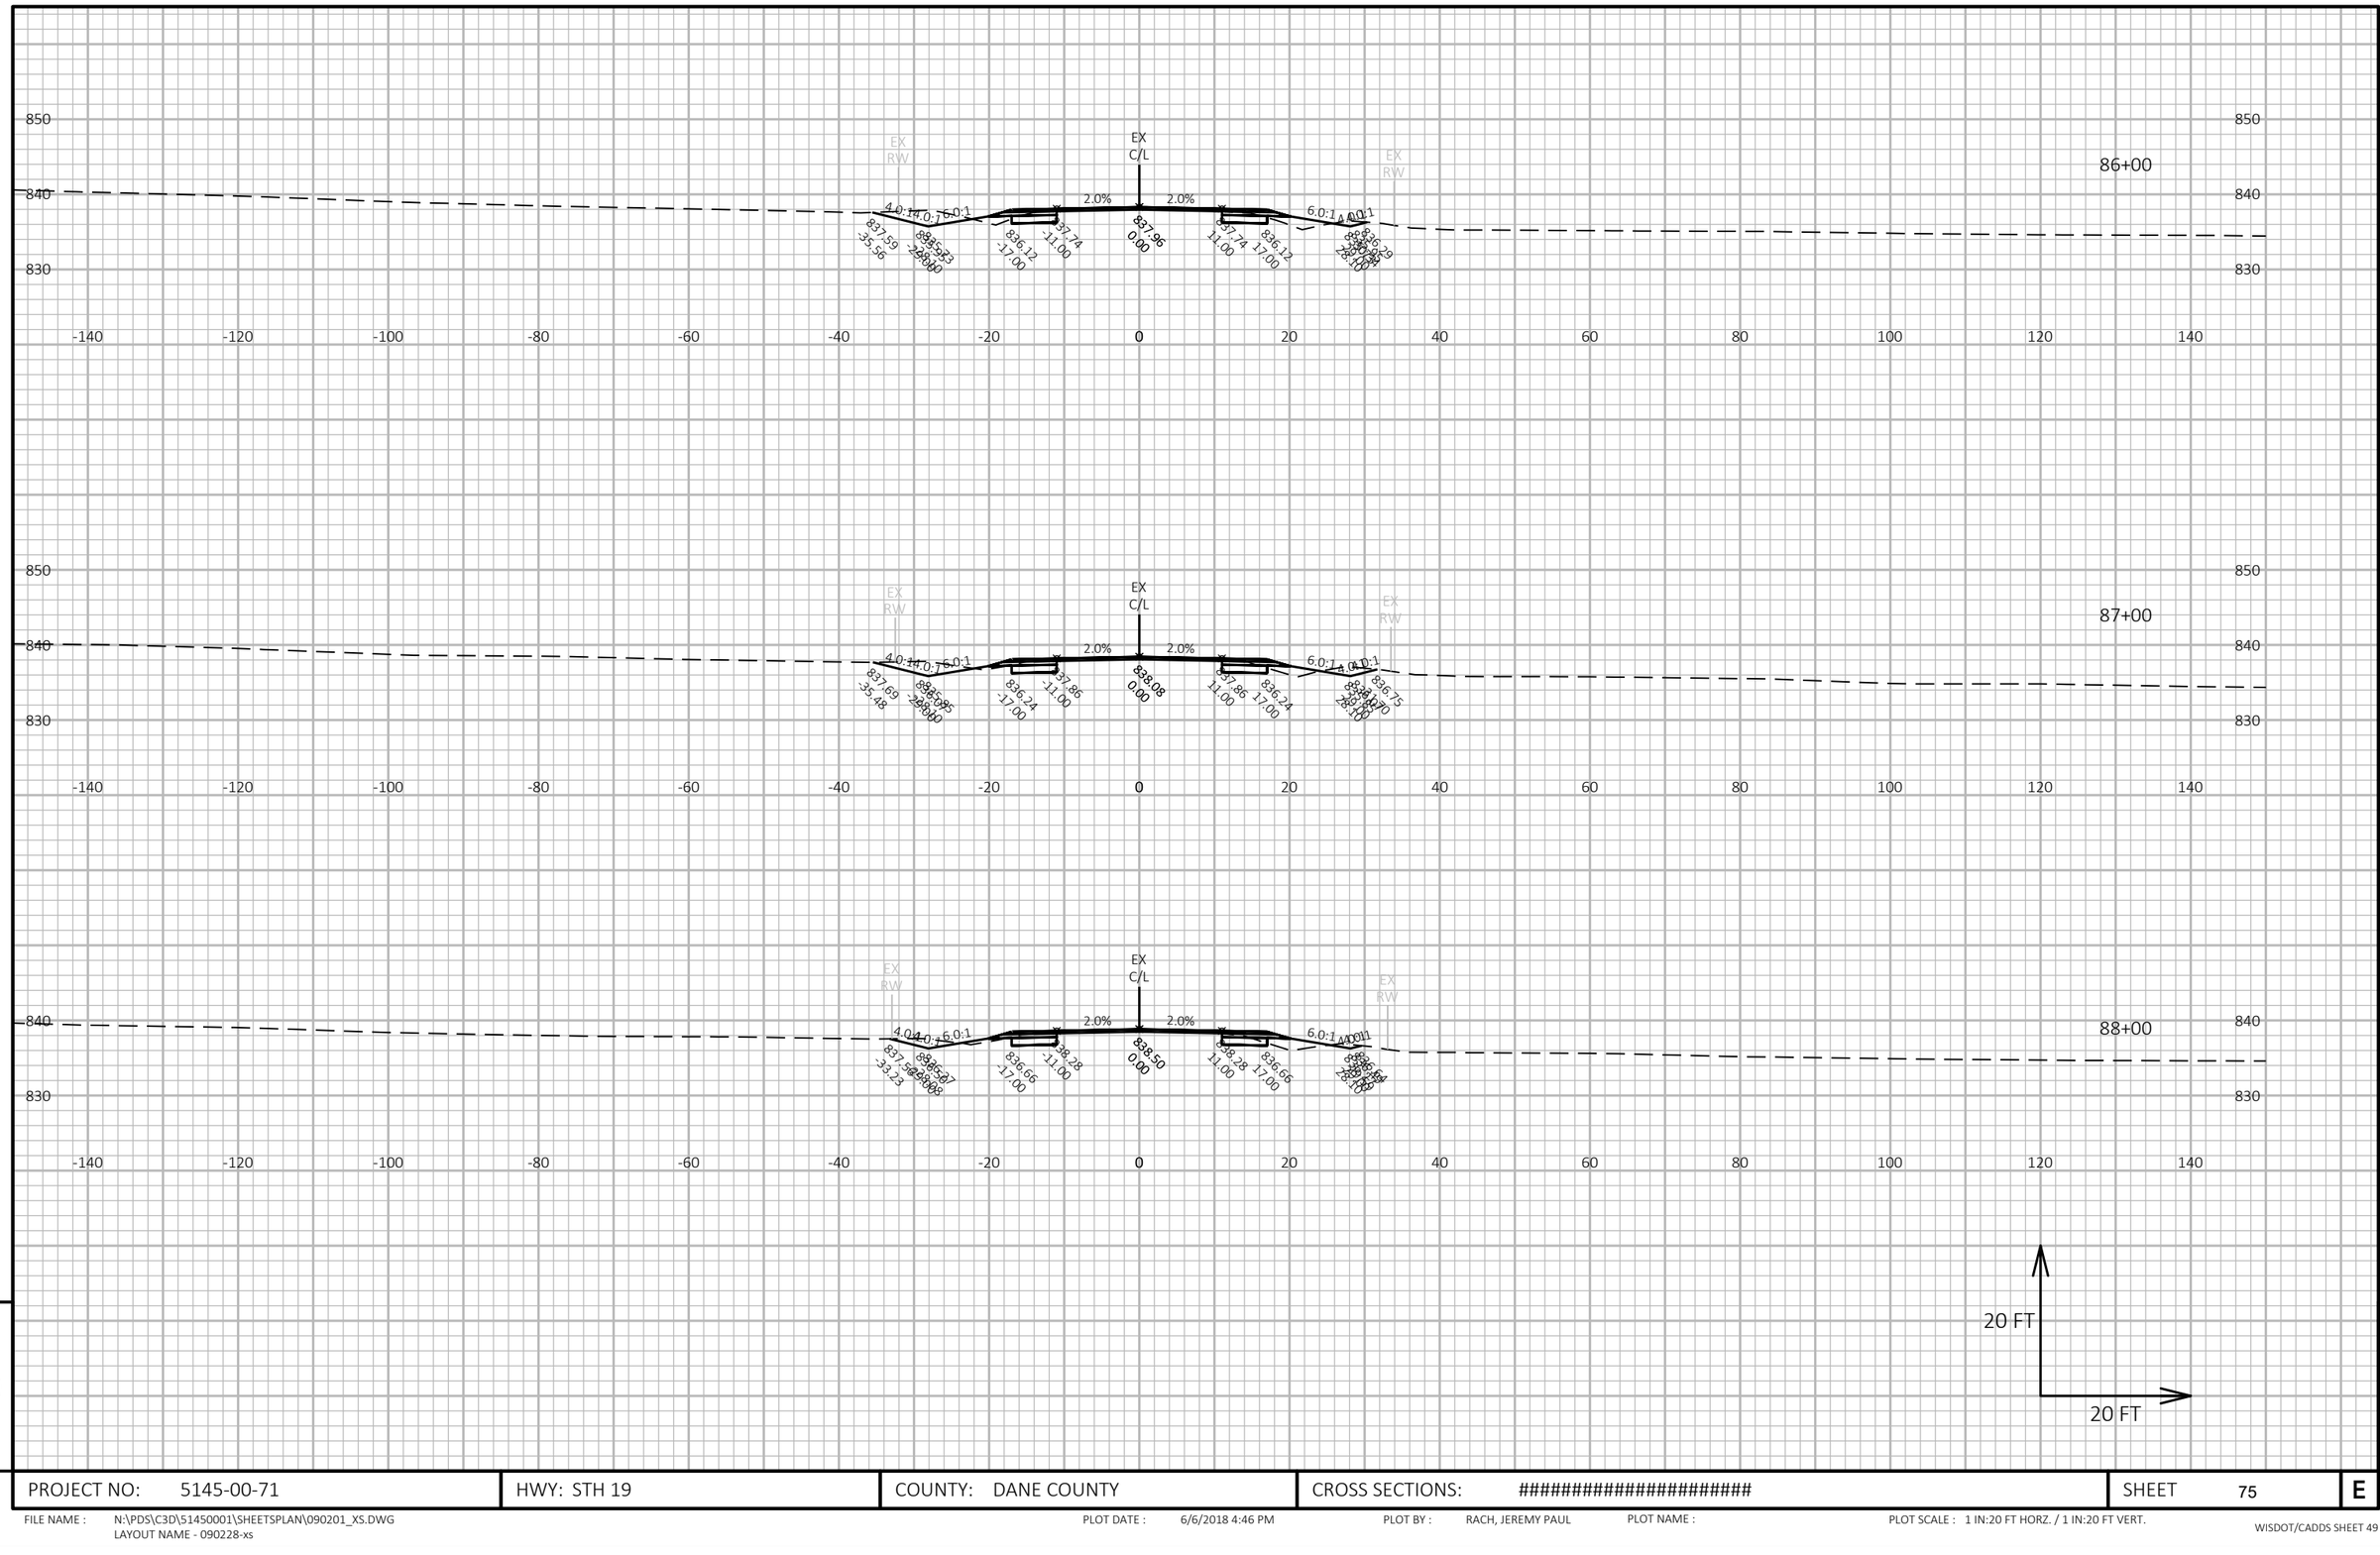

9

9

PROJECT NO: 5145-00-71	HWY: STH 19	COUNTY: DANE COUNTY	CROSS SECTIONS: ##########################	SHEET 75	E

FILE NAME : N:\PDS\C3D\51450001\SHEETSPLAN\090201_XS.DWG
LAYOUT NAME - 090228-xs

PLOT DATE : 6/6/2018 4:46 PM

PLOT BY : RACH, JEREMY PAUL

PLOT NAME :

PLOT SCALE : 1 IN:20 FT HORZ. / 1 IN:20 FT VERT.

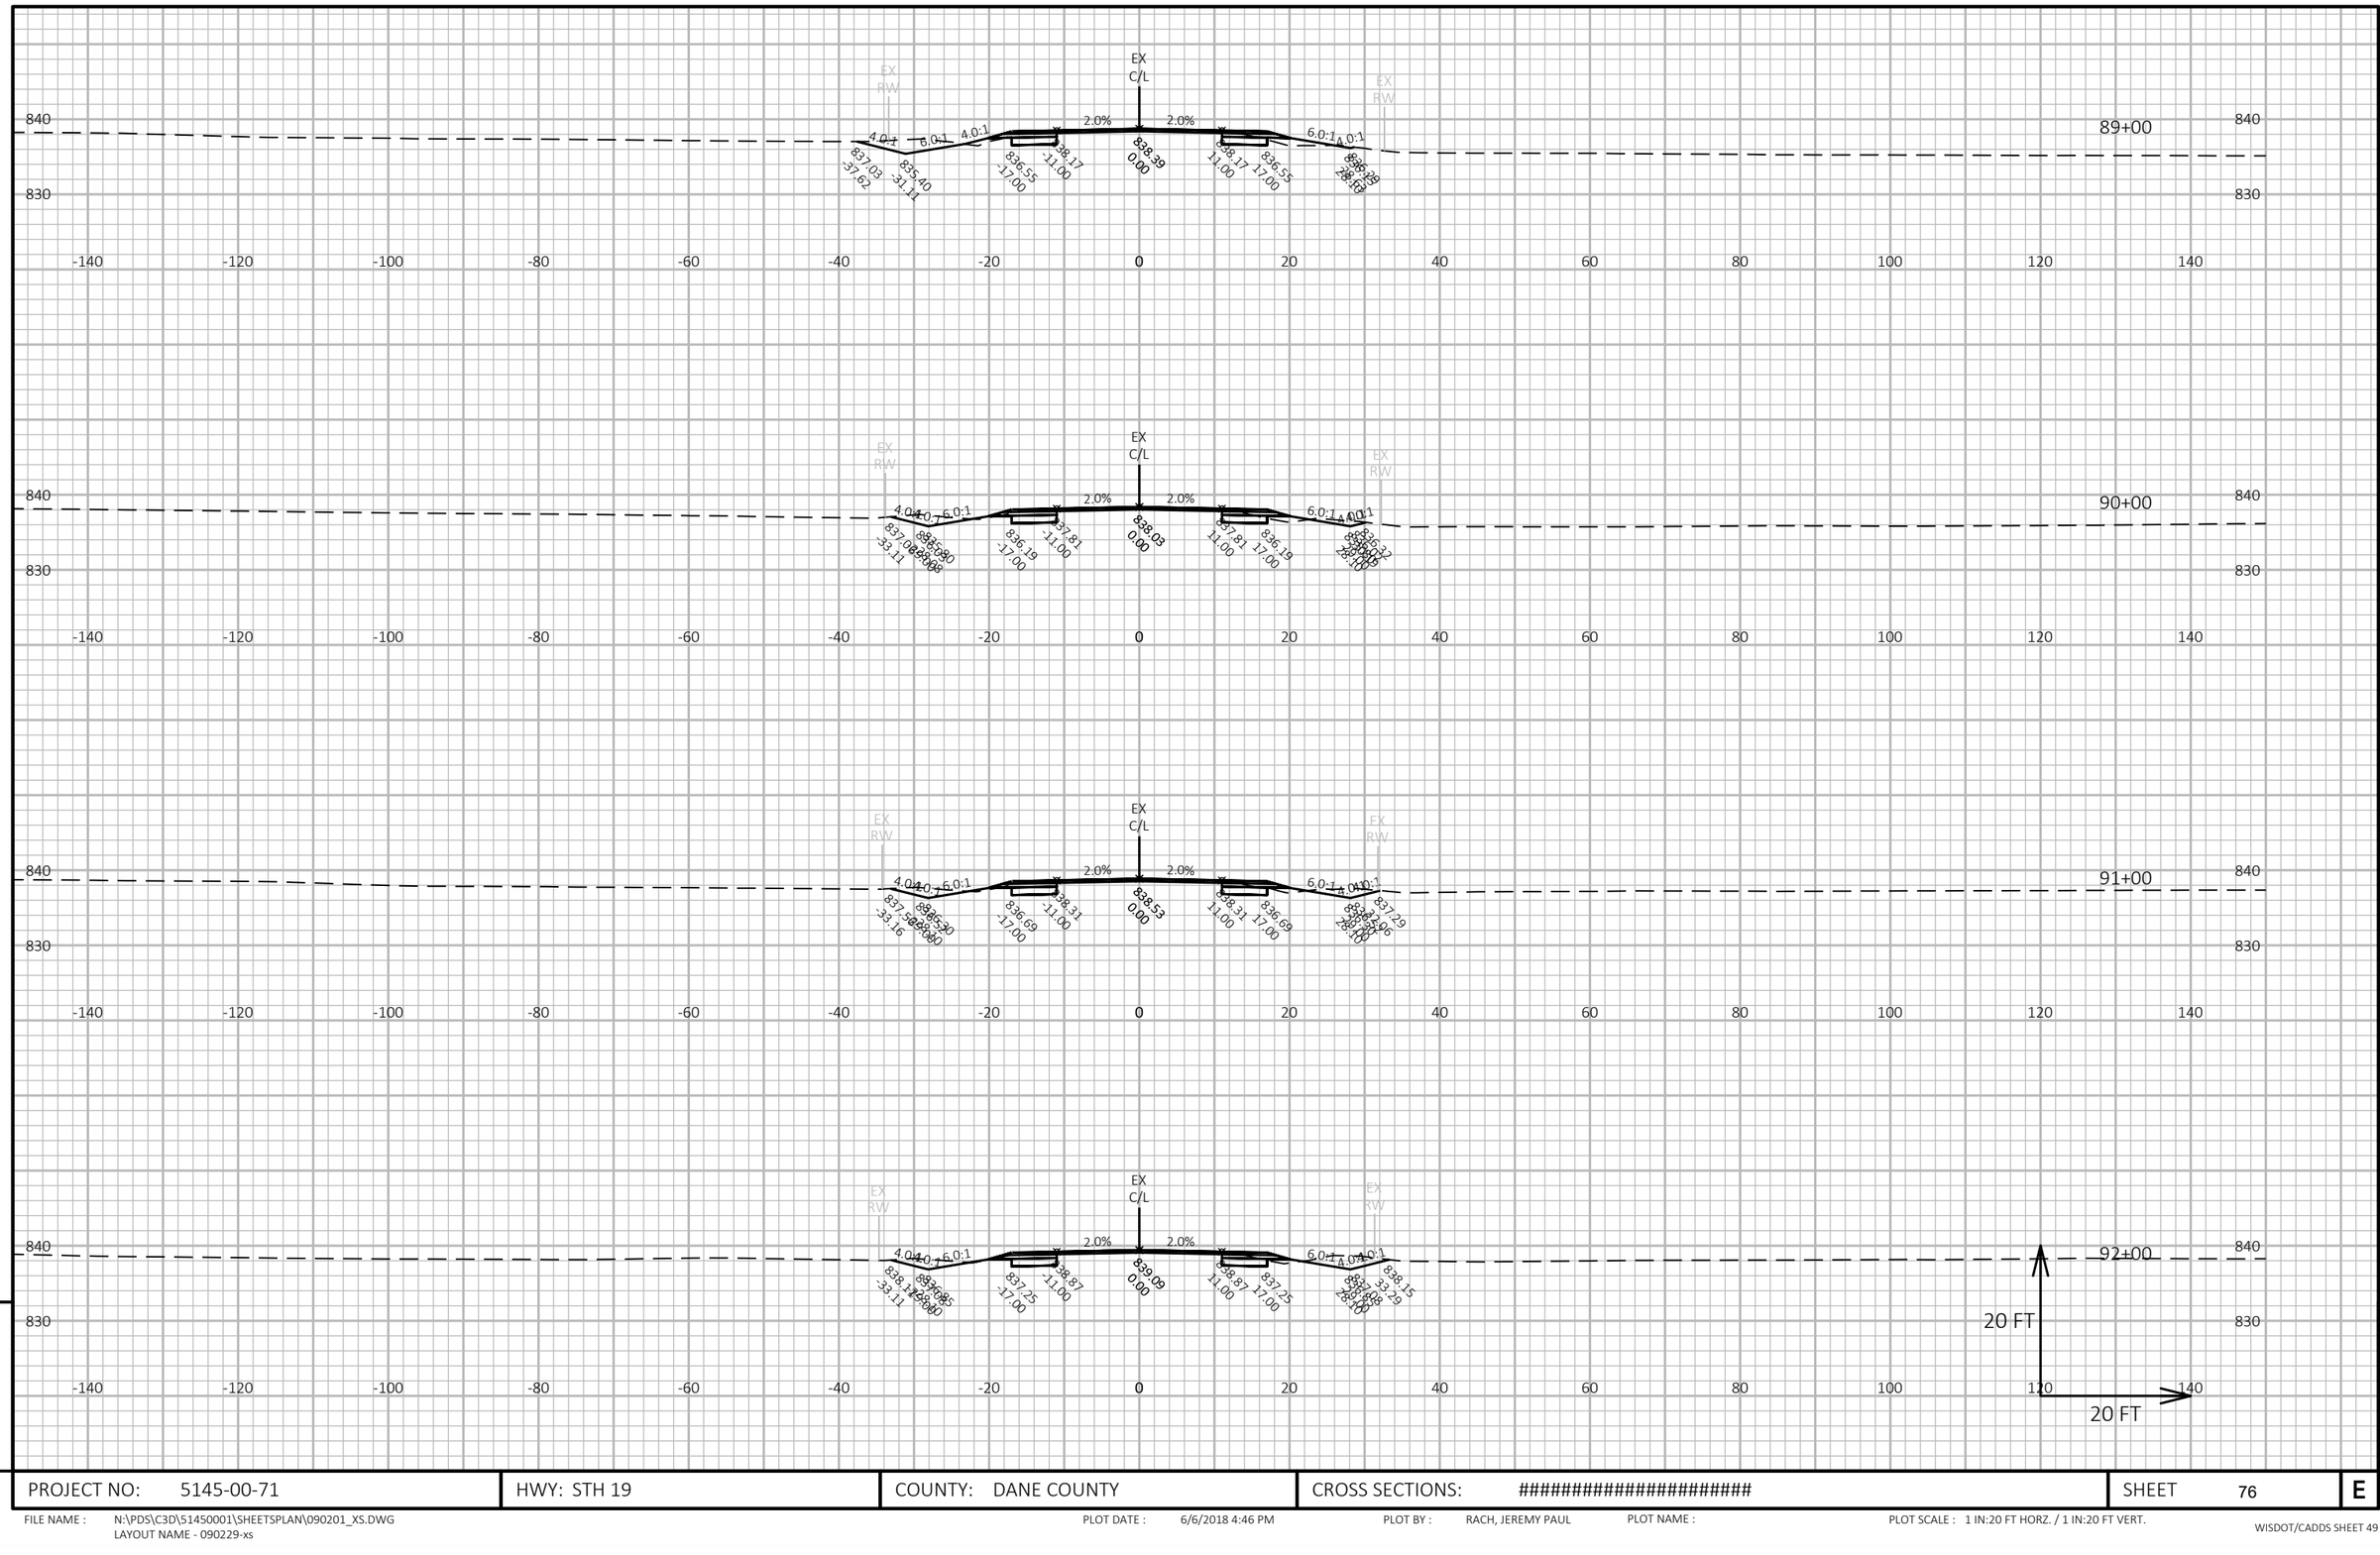

PROJECT NO: 5145-00-71	HWY: STH 19	COUNTY: DANE COUNTY	CROSS SECTIONS: ##########################	SHEET 76

FILE NAME : N:\PDS\C3D\51450001\SHEETSPLAN\090201_XS.DWG
LAYOUT NAME - 090229-xs

PLOT DATE : 6/6/2018 4:46 PM PLOT BY : RACH, JEREMY PAUL PLOT NAME : PLOT SCALE : 1 IN:20 FT HORZ. / 1 IN:20 FT VERT.

WISDOT/CADDS SHEET 49

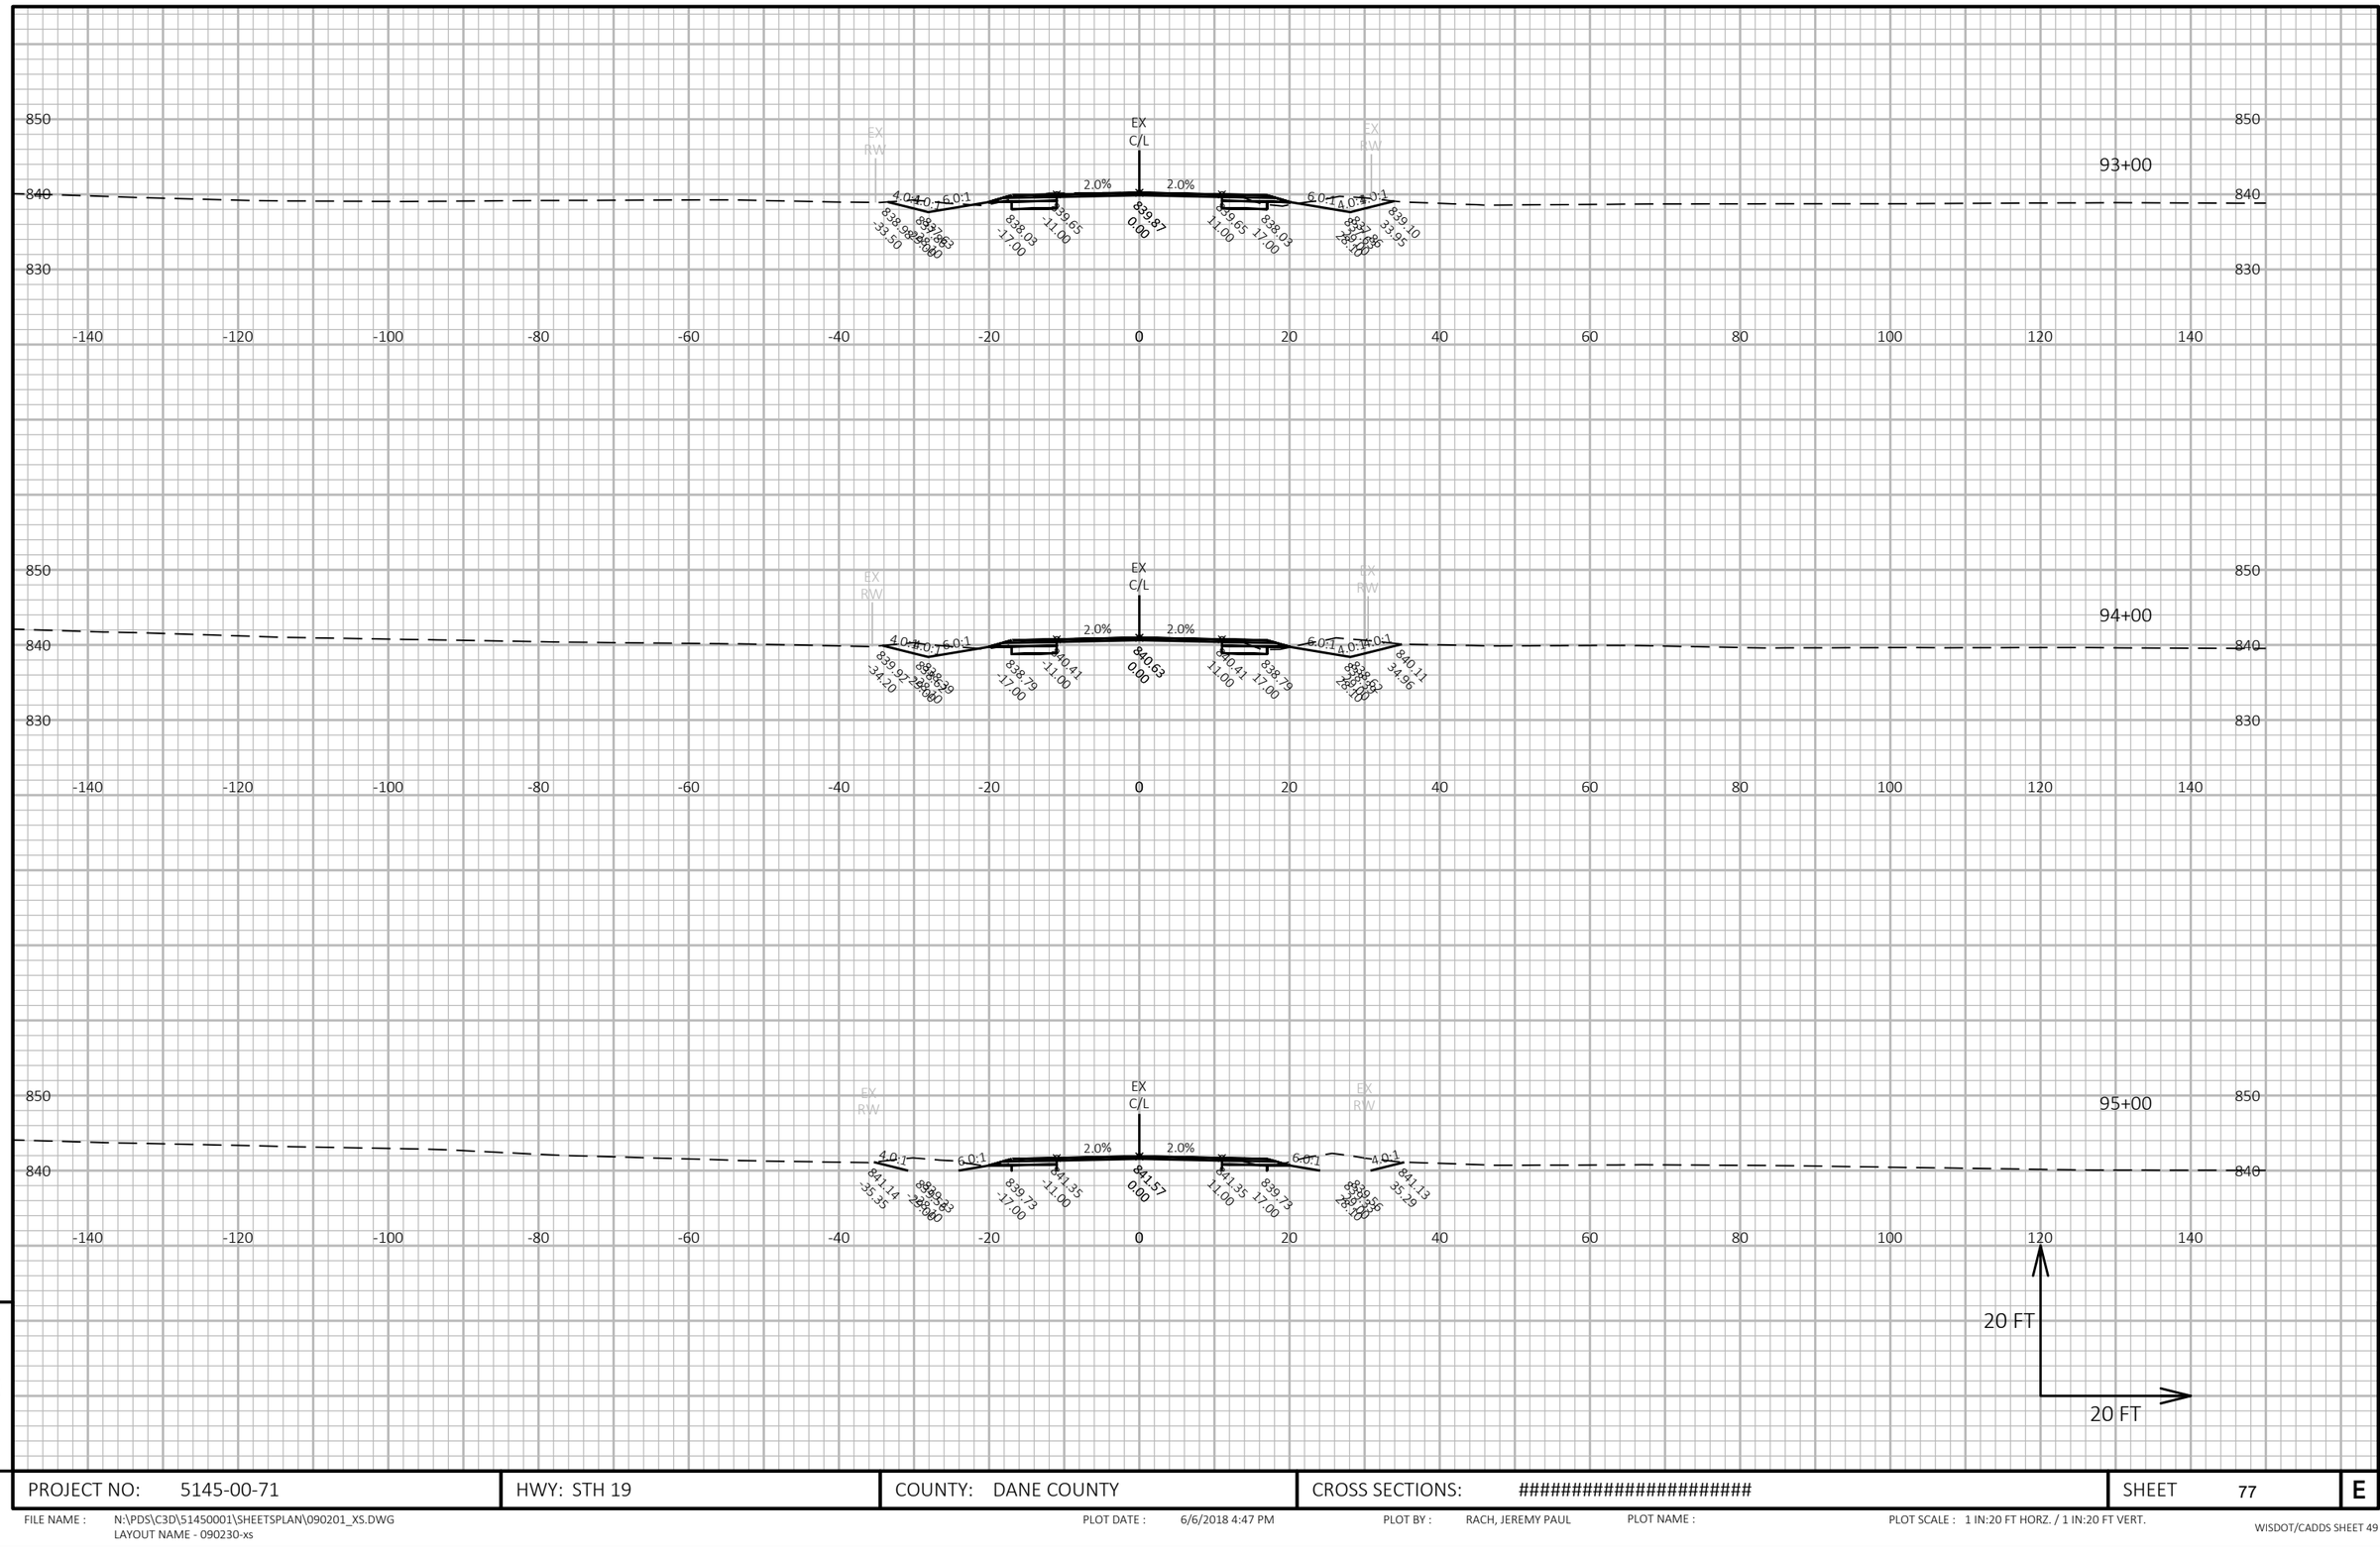

PROJECT NO: 5145-00-71	HWY: STH 19	COUNTY: DANE COUNTY	CROSS SECTIONS: ##########################	SHEET 77 E

FILE NAME : N:\PDS\C3D\51450001\SHEETSPLAN\090201_XS.DWG
LAYOUT NAME - 090230-xs

PLOT DATE : 6/6/2018 4:47 PM PLOT BY : RACH, JEREMY PAUL PLOT NAME : PLOT SCALE : 1 IN:20 FT HORZ. / 1 IN:20 FT VERT.

WISDOT/CADDS SHEET 49

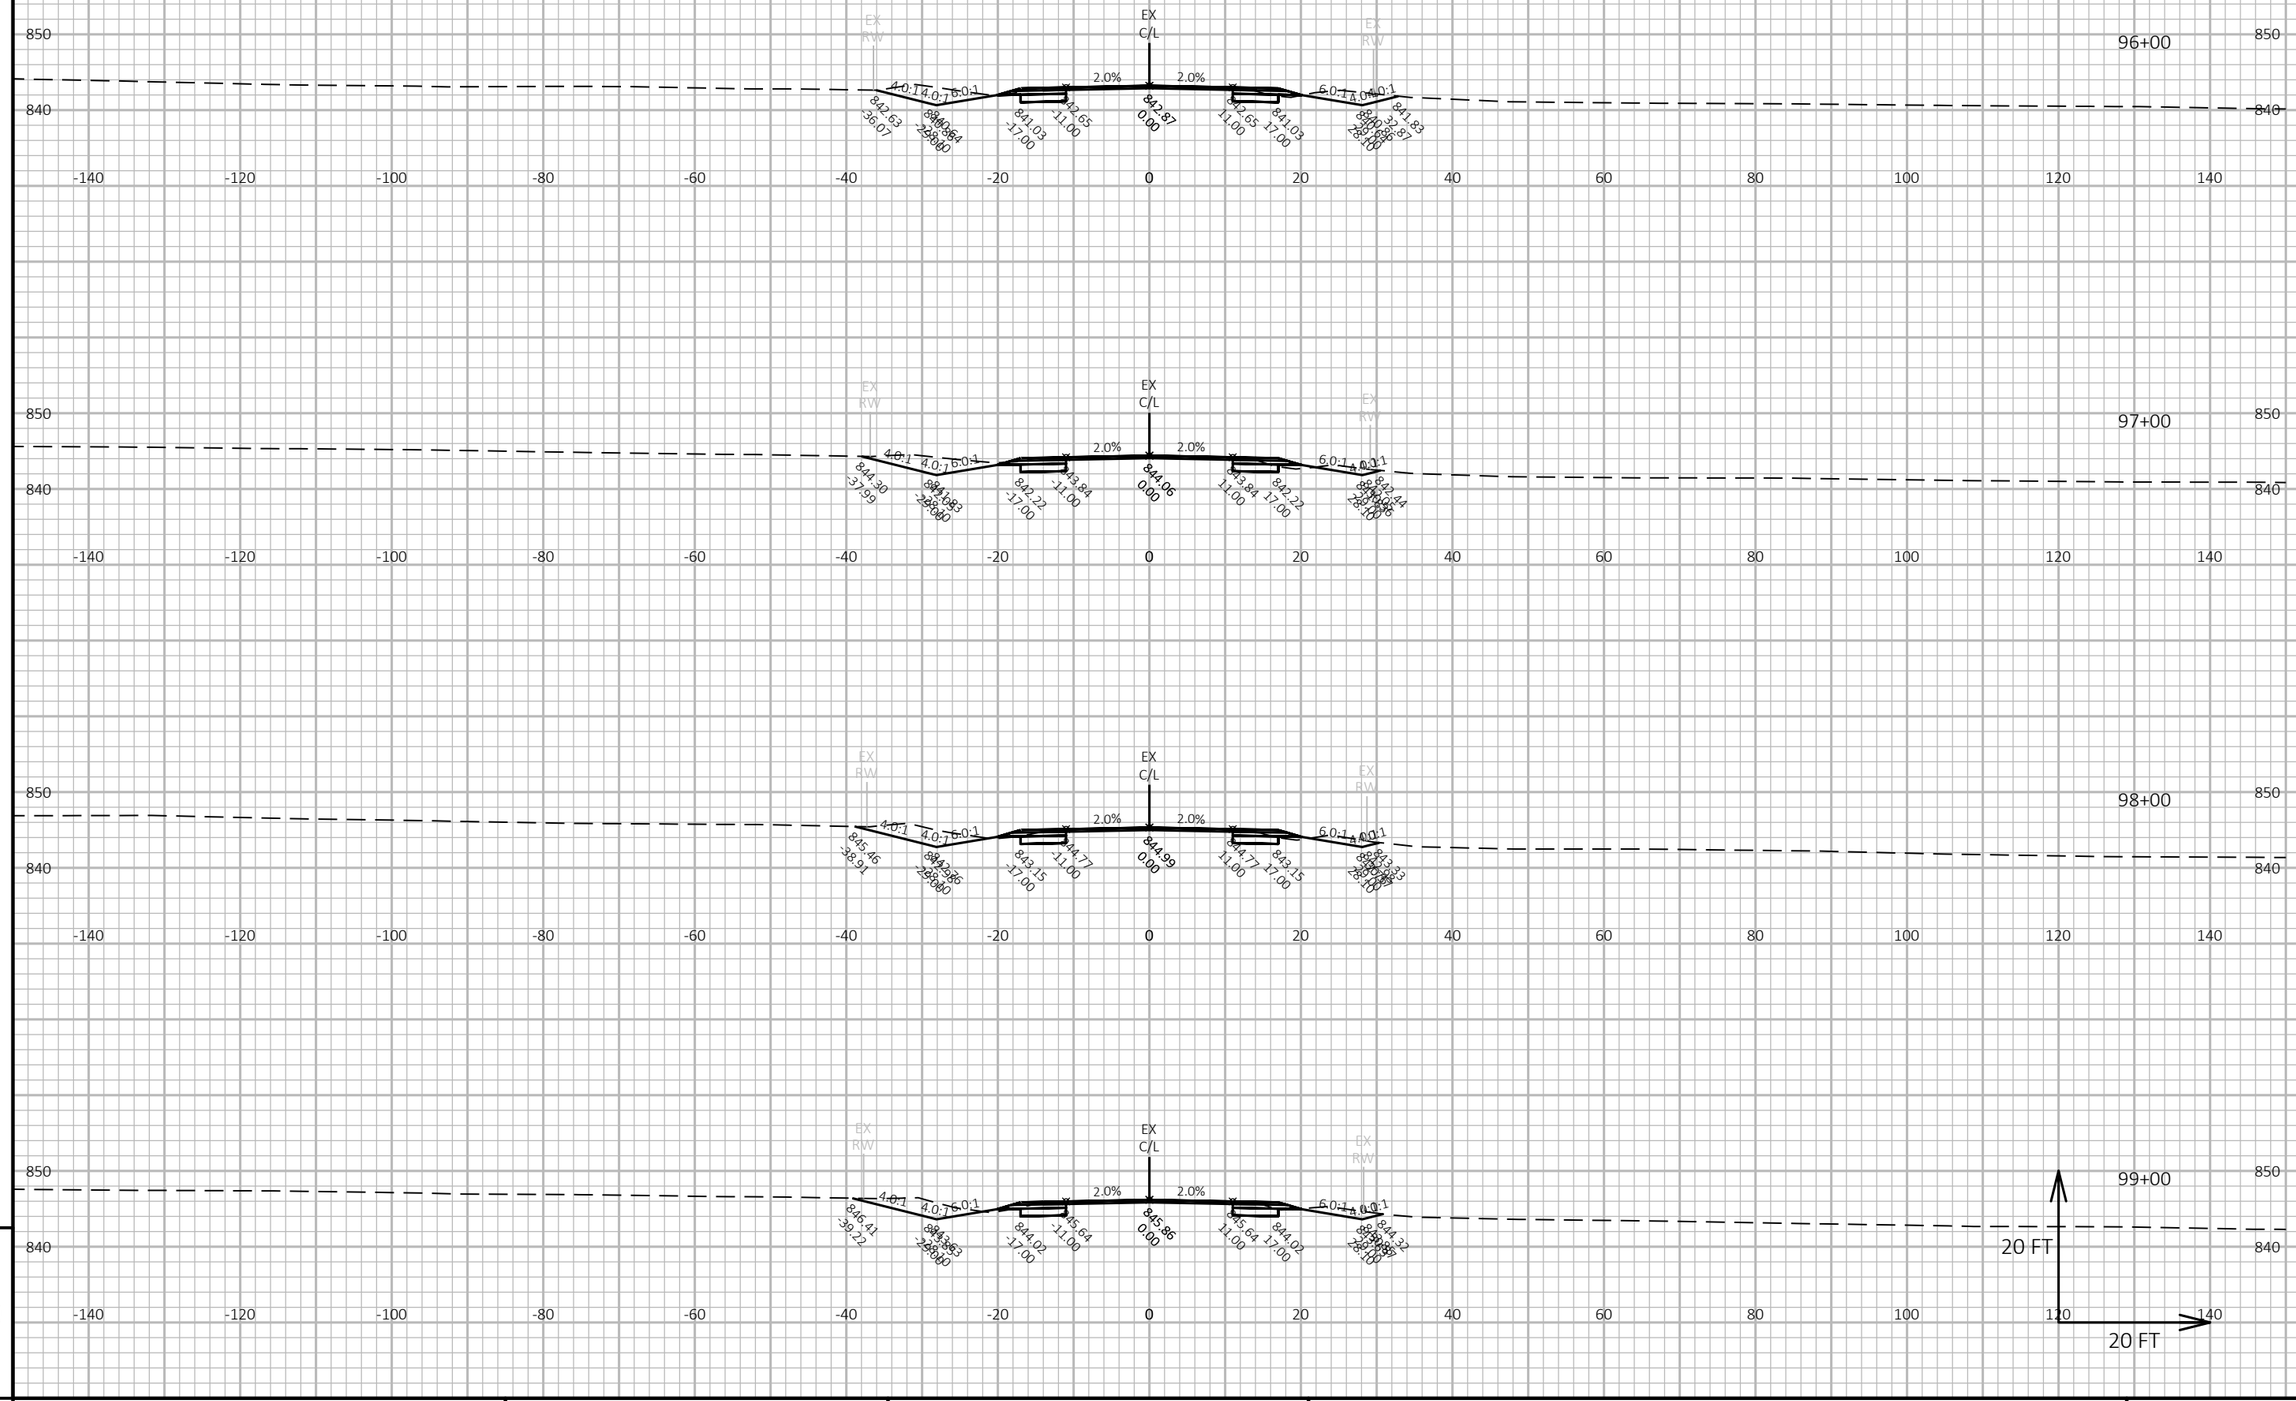

9

9

PROJECT NO: 5145-00-71	HWY: STH 19	COUNTY: DANE COUNTY	CROSS SECTIONS: ##########################	SHEET 78	E

FILE NAME : N:\PDS\C3D\51450001\SHEETSPLAN\090201_XS.DWG
LAYOUT NAME - 090231-xs
PLOT DATE : 6/6/2018 4:47 PM
PLOT BY : RACH, JEREMY PAUL
PLOT NAME :
PLOT SCALE : 1 IN:20 FT HORZ. / 1 IN:20 FT VERT.
WISDOT/CADDS SHEET 49

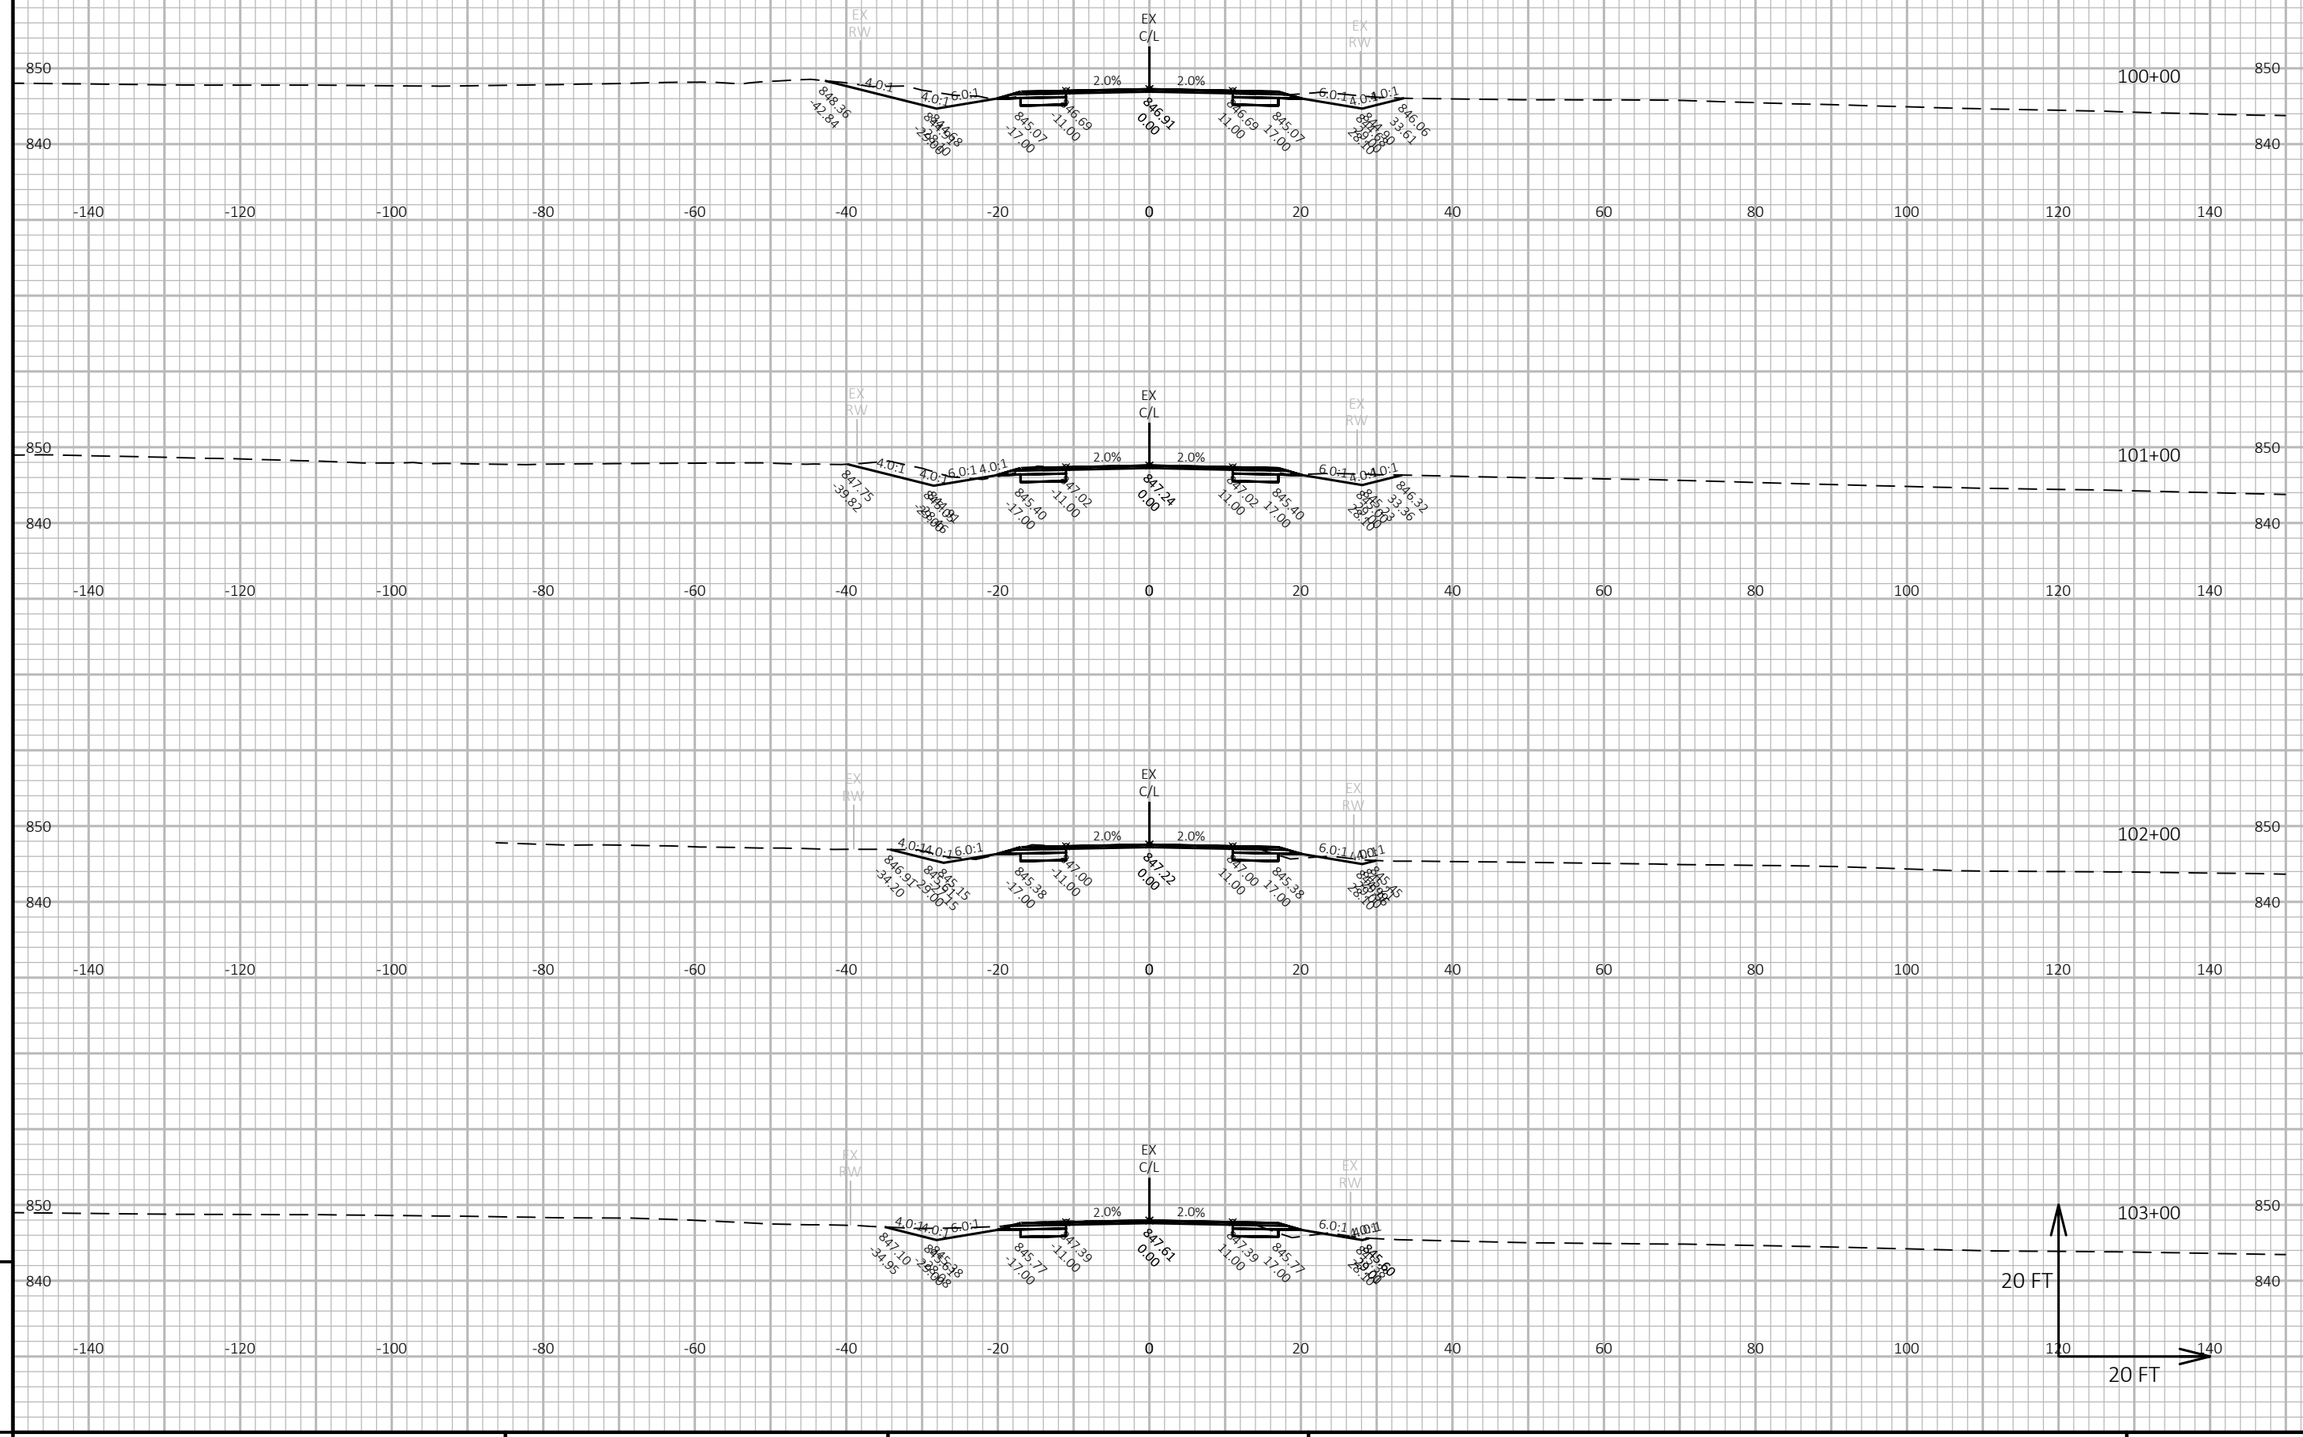

9

9

PROJECT NO: 5145-00-71	HWY: STH 19	COUNTY: DANE COUNTY	CROSS SECTIONS: ##########################	SHEET 79	E

FILE NAME : N:\PDS\C3D\51450001\SHEETSPLAN\090201_XS.DWG
LAYOUT NAME - 090232-xs

PLOT DATE : 6/6/2018 4:48 PM PLOT BY : RACH, JEREMY PAUL PLOT NAME : PLOT SCALE : 1 IN:20 FT HORZ. / 1 IN:20 FT VERT.

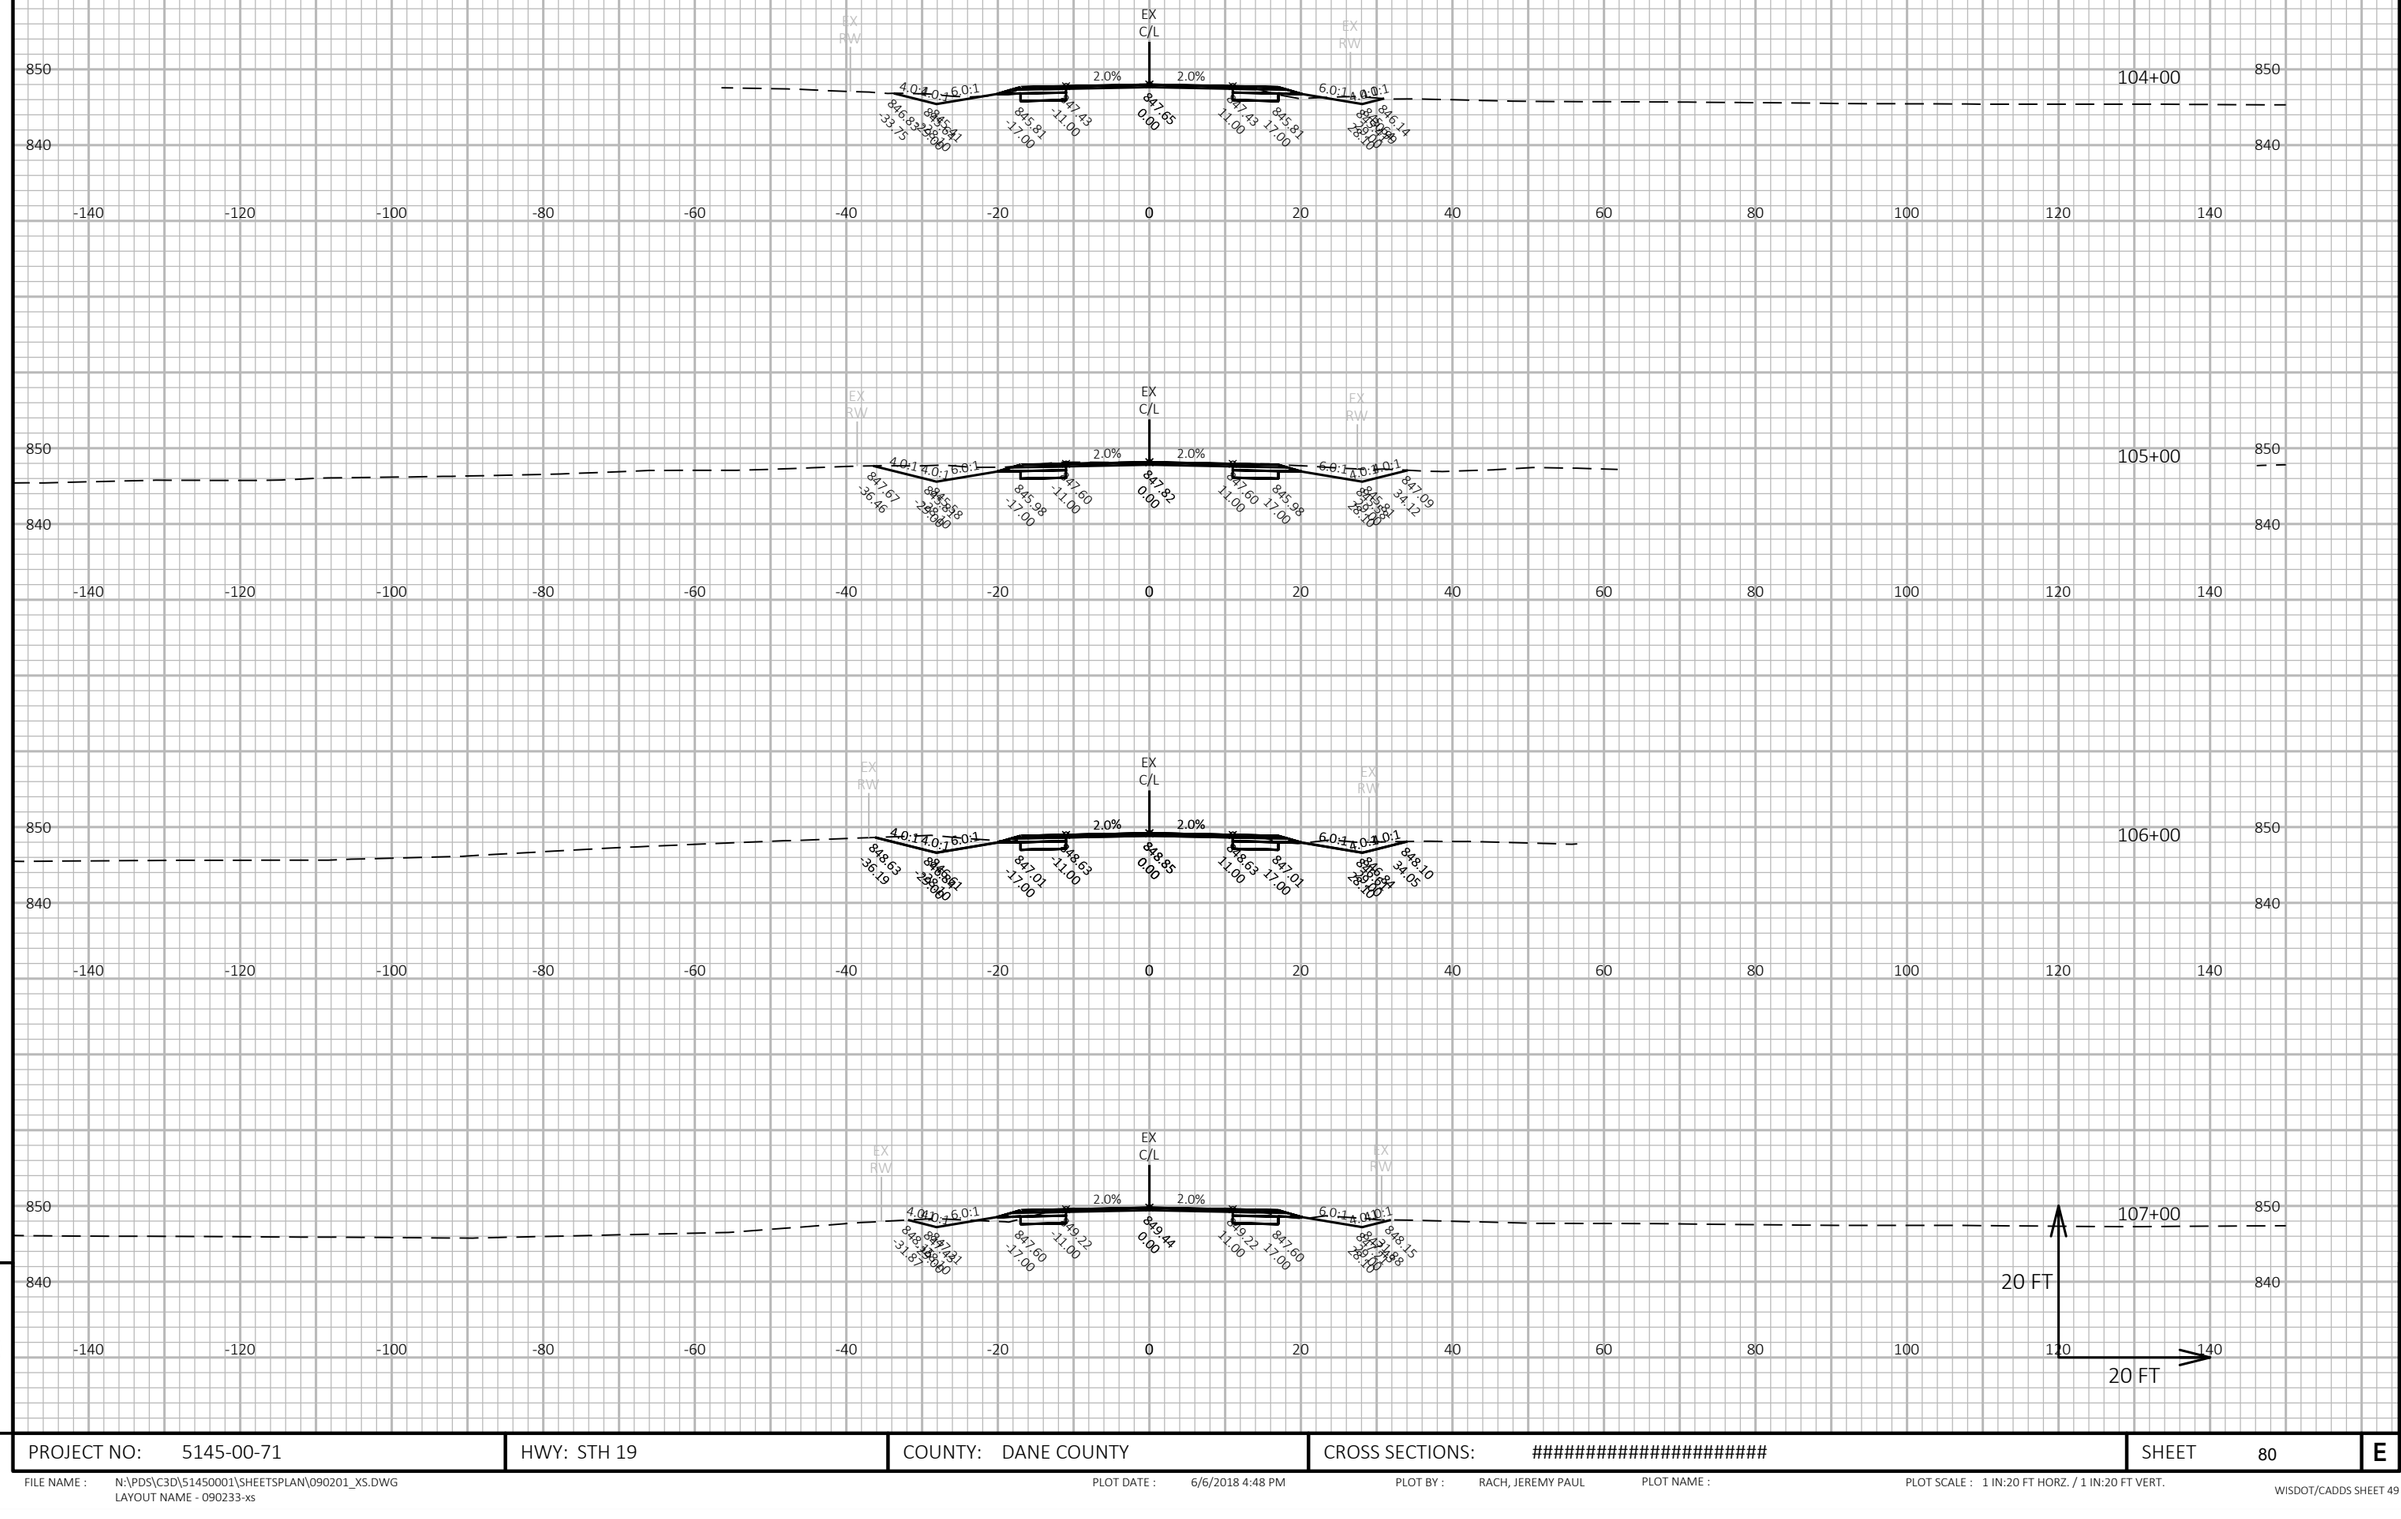

9

9

PROJECT NO: 5145-00-71	HWY: STH 19	COUNTY: DANE COUNTY	CROSS SECTIONS: ##########################	SHEET 80	E

FILE NAME : N:\PDS\C3D\51450001\SHEETSPLAN\090201_XS.DWG
LAYOUT NAME - 090233-xs

PLOT DATE : 6/6/2018 4:48 PM PLOT BY : RACH, JEREMY PAUL PLOT NAME : PLOT SCALE : 1 IN:20 FT HORZ. / 1 IN:20 FT VERT.

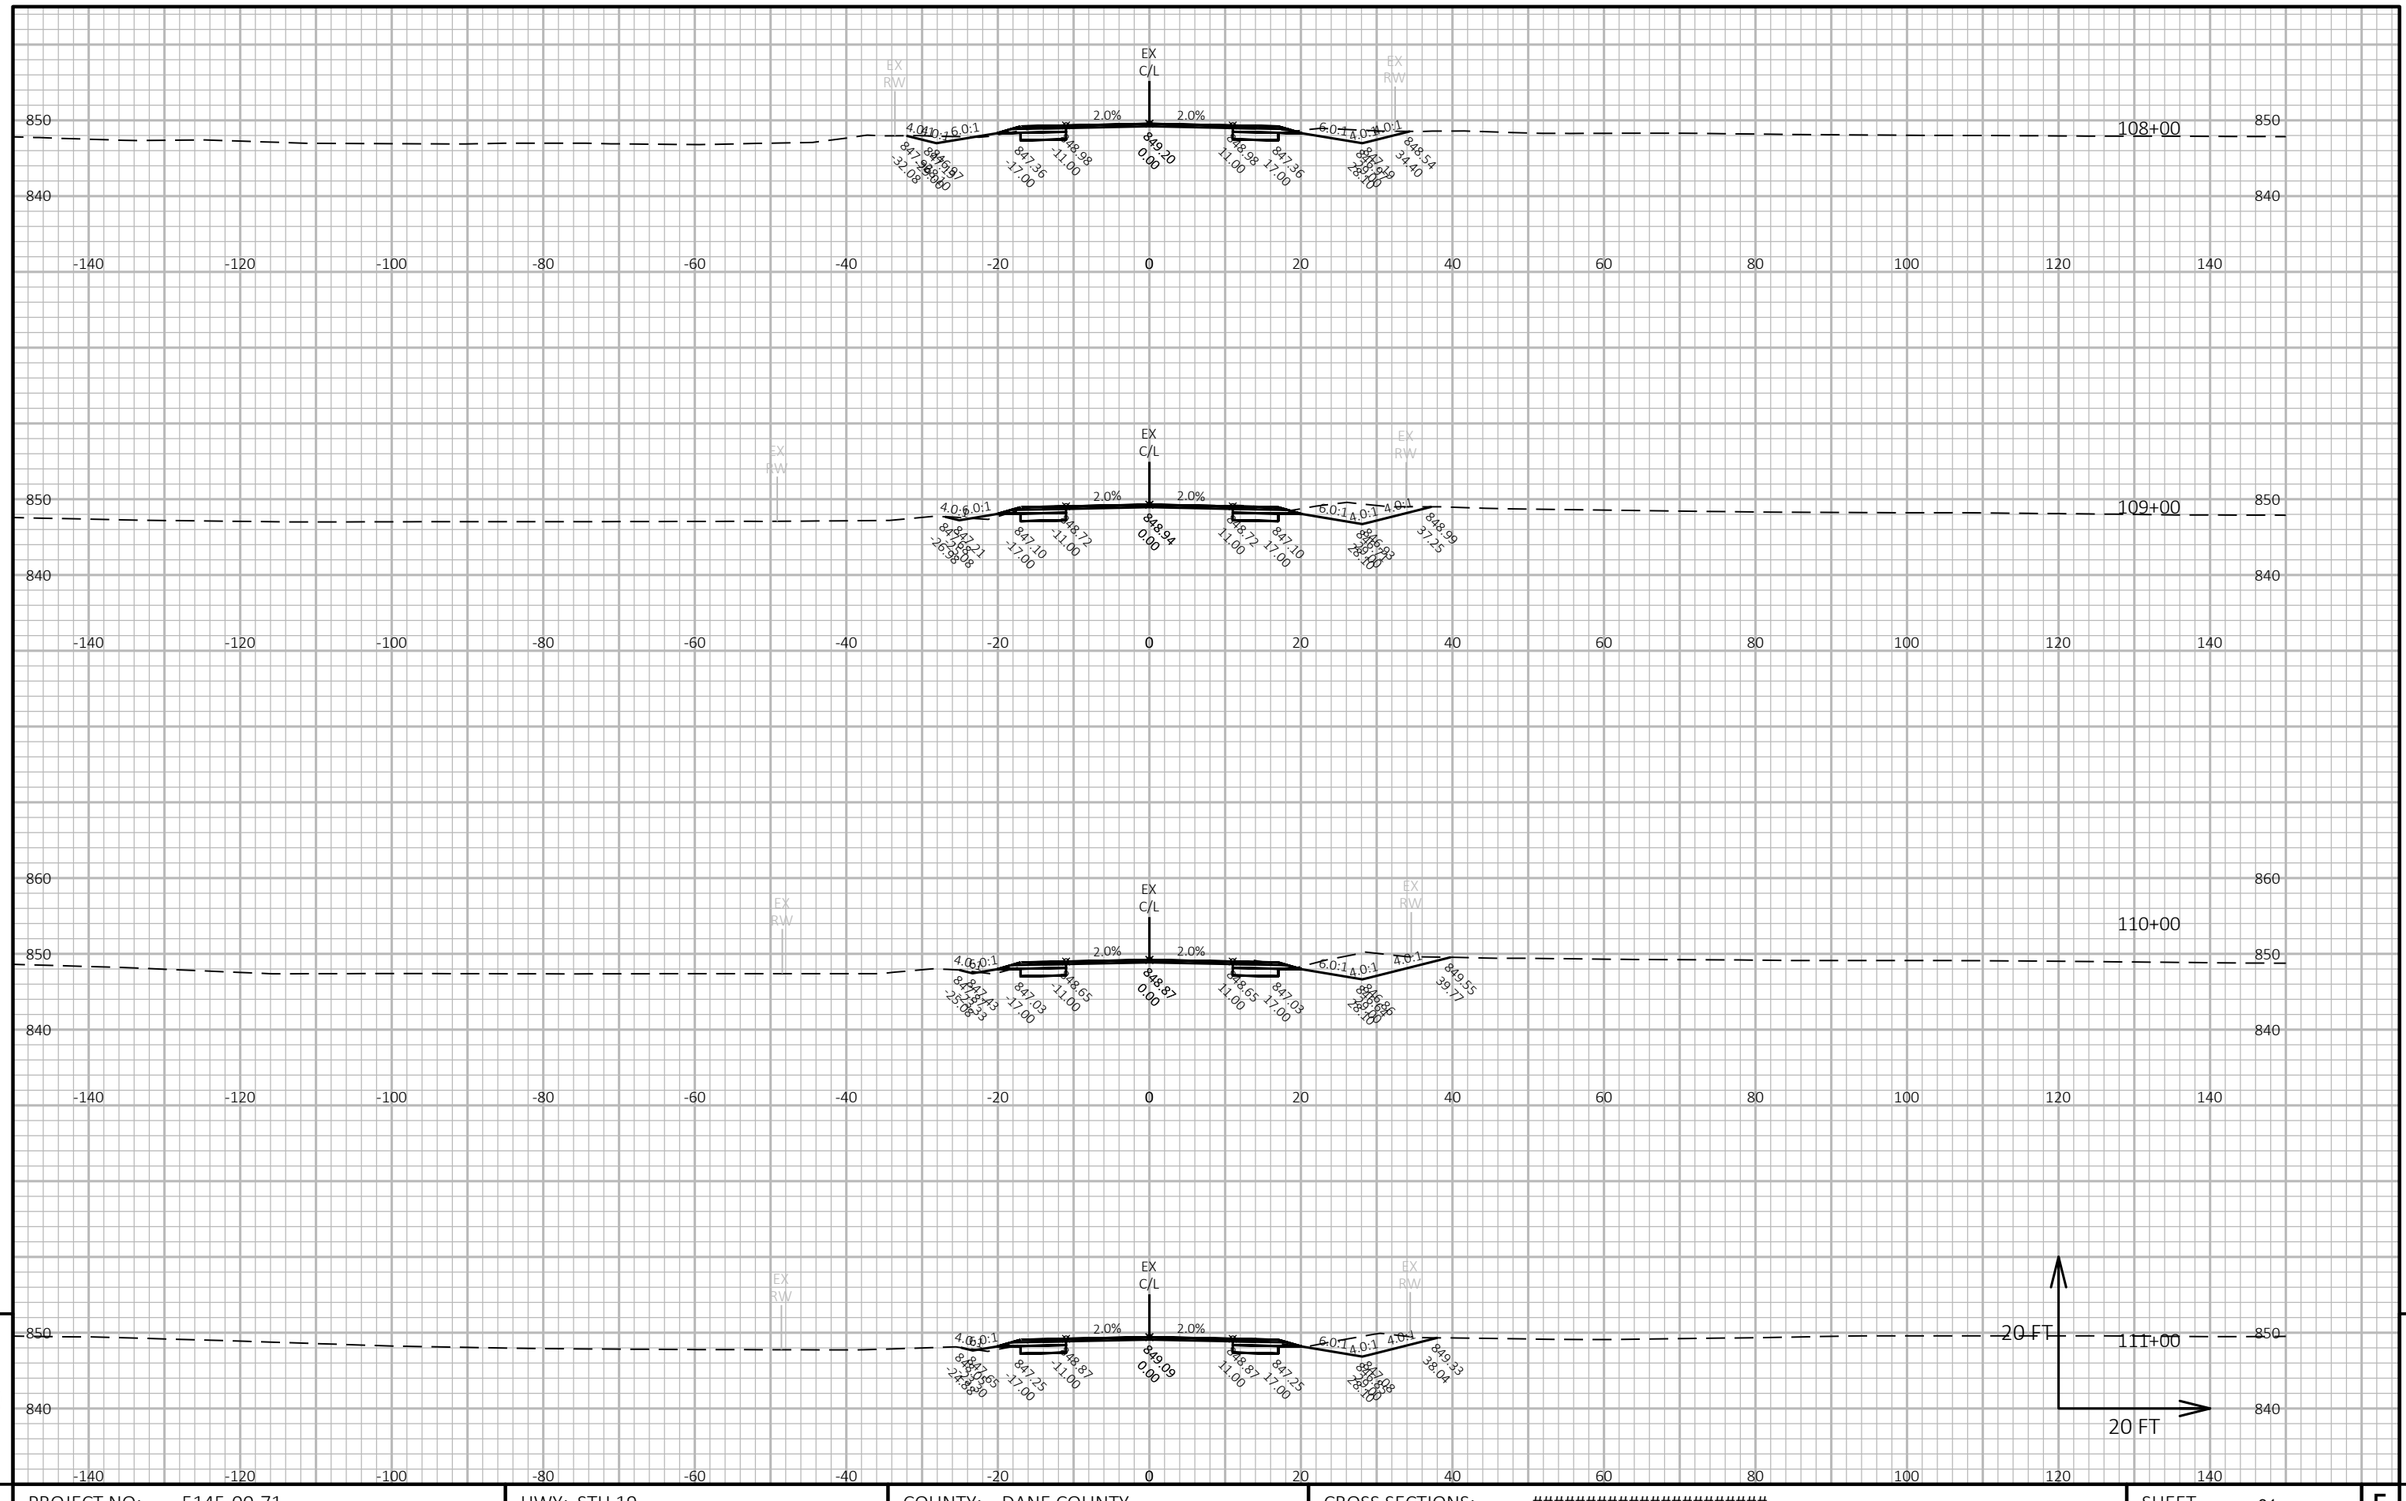

9

9

PROJECT NO: 5145-00-71	HWY: STH 19	COUNTY: DANE COUNTY	CROSS SECTIONS: ##########################	SHEET 81	E

FILE NAME : N:\PDS\C3D\51450001\SHEETSPLAN\090201_XS.DWG
LAYOUT NAME - 090234-xs

PLOT DATE : 6/6/2018 4:49 PM PLOT BY : RACH, JEREMY PAUL PLOT NAME : PLOT SCALE : 1 IN:20 FT HORZ. / 1 IN:20 FT VERT.

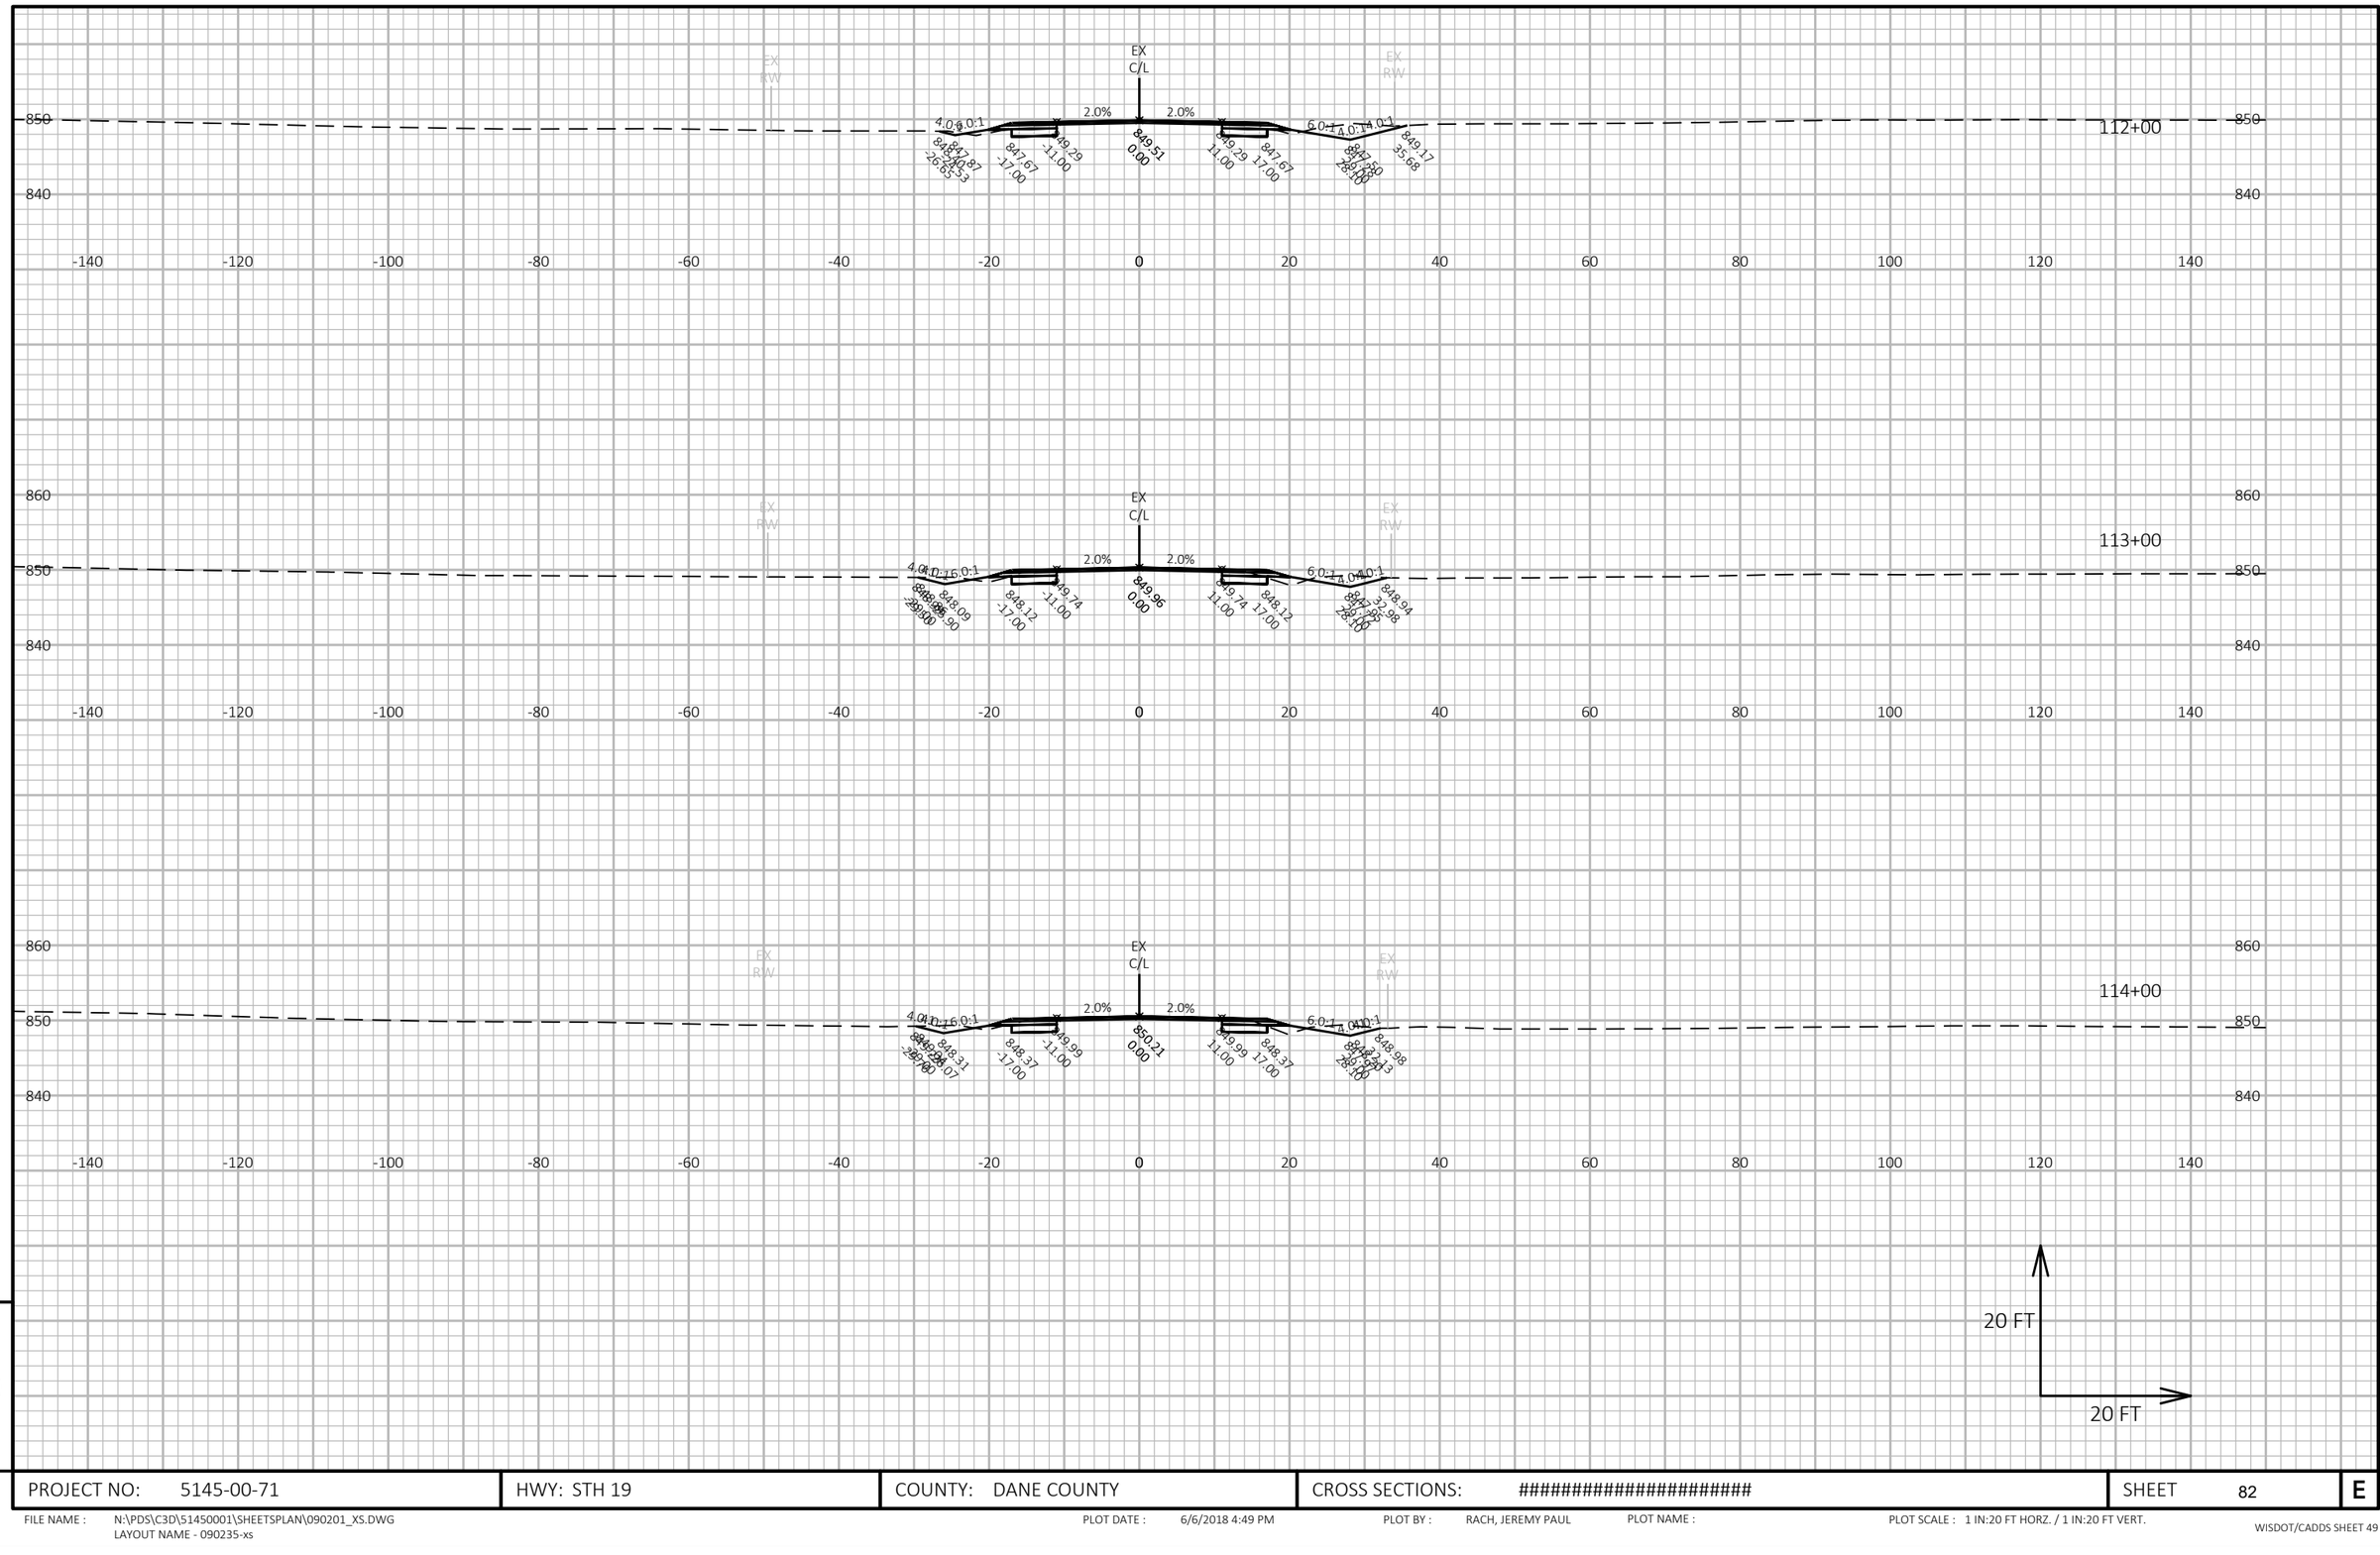

9

9

PROJECT NO: 5145-00-71	HWY: STH 19	COUNTY: DANE COUNTY	CROSS SECTIONS: ##########################	SHEET 82	E

FILE NAME : N:\PDS\C3D\51450001\SHEETSPLAN\090201_XS.DWG
LAYOUT NAME - 090235-xs

PLOT DATE : 6/6/2018 4:49 PM PLOT BY : RACH, JEREMY PAUL PLOT NAME : PLOT SCALE : 1 IN:20 FT HORZ. / 1 IN:20 FT VERT.

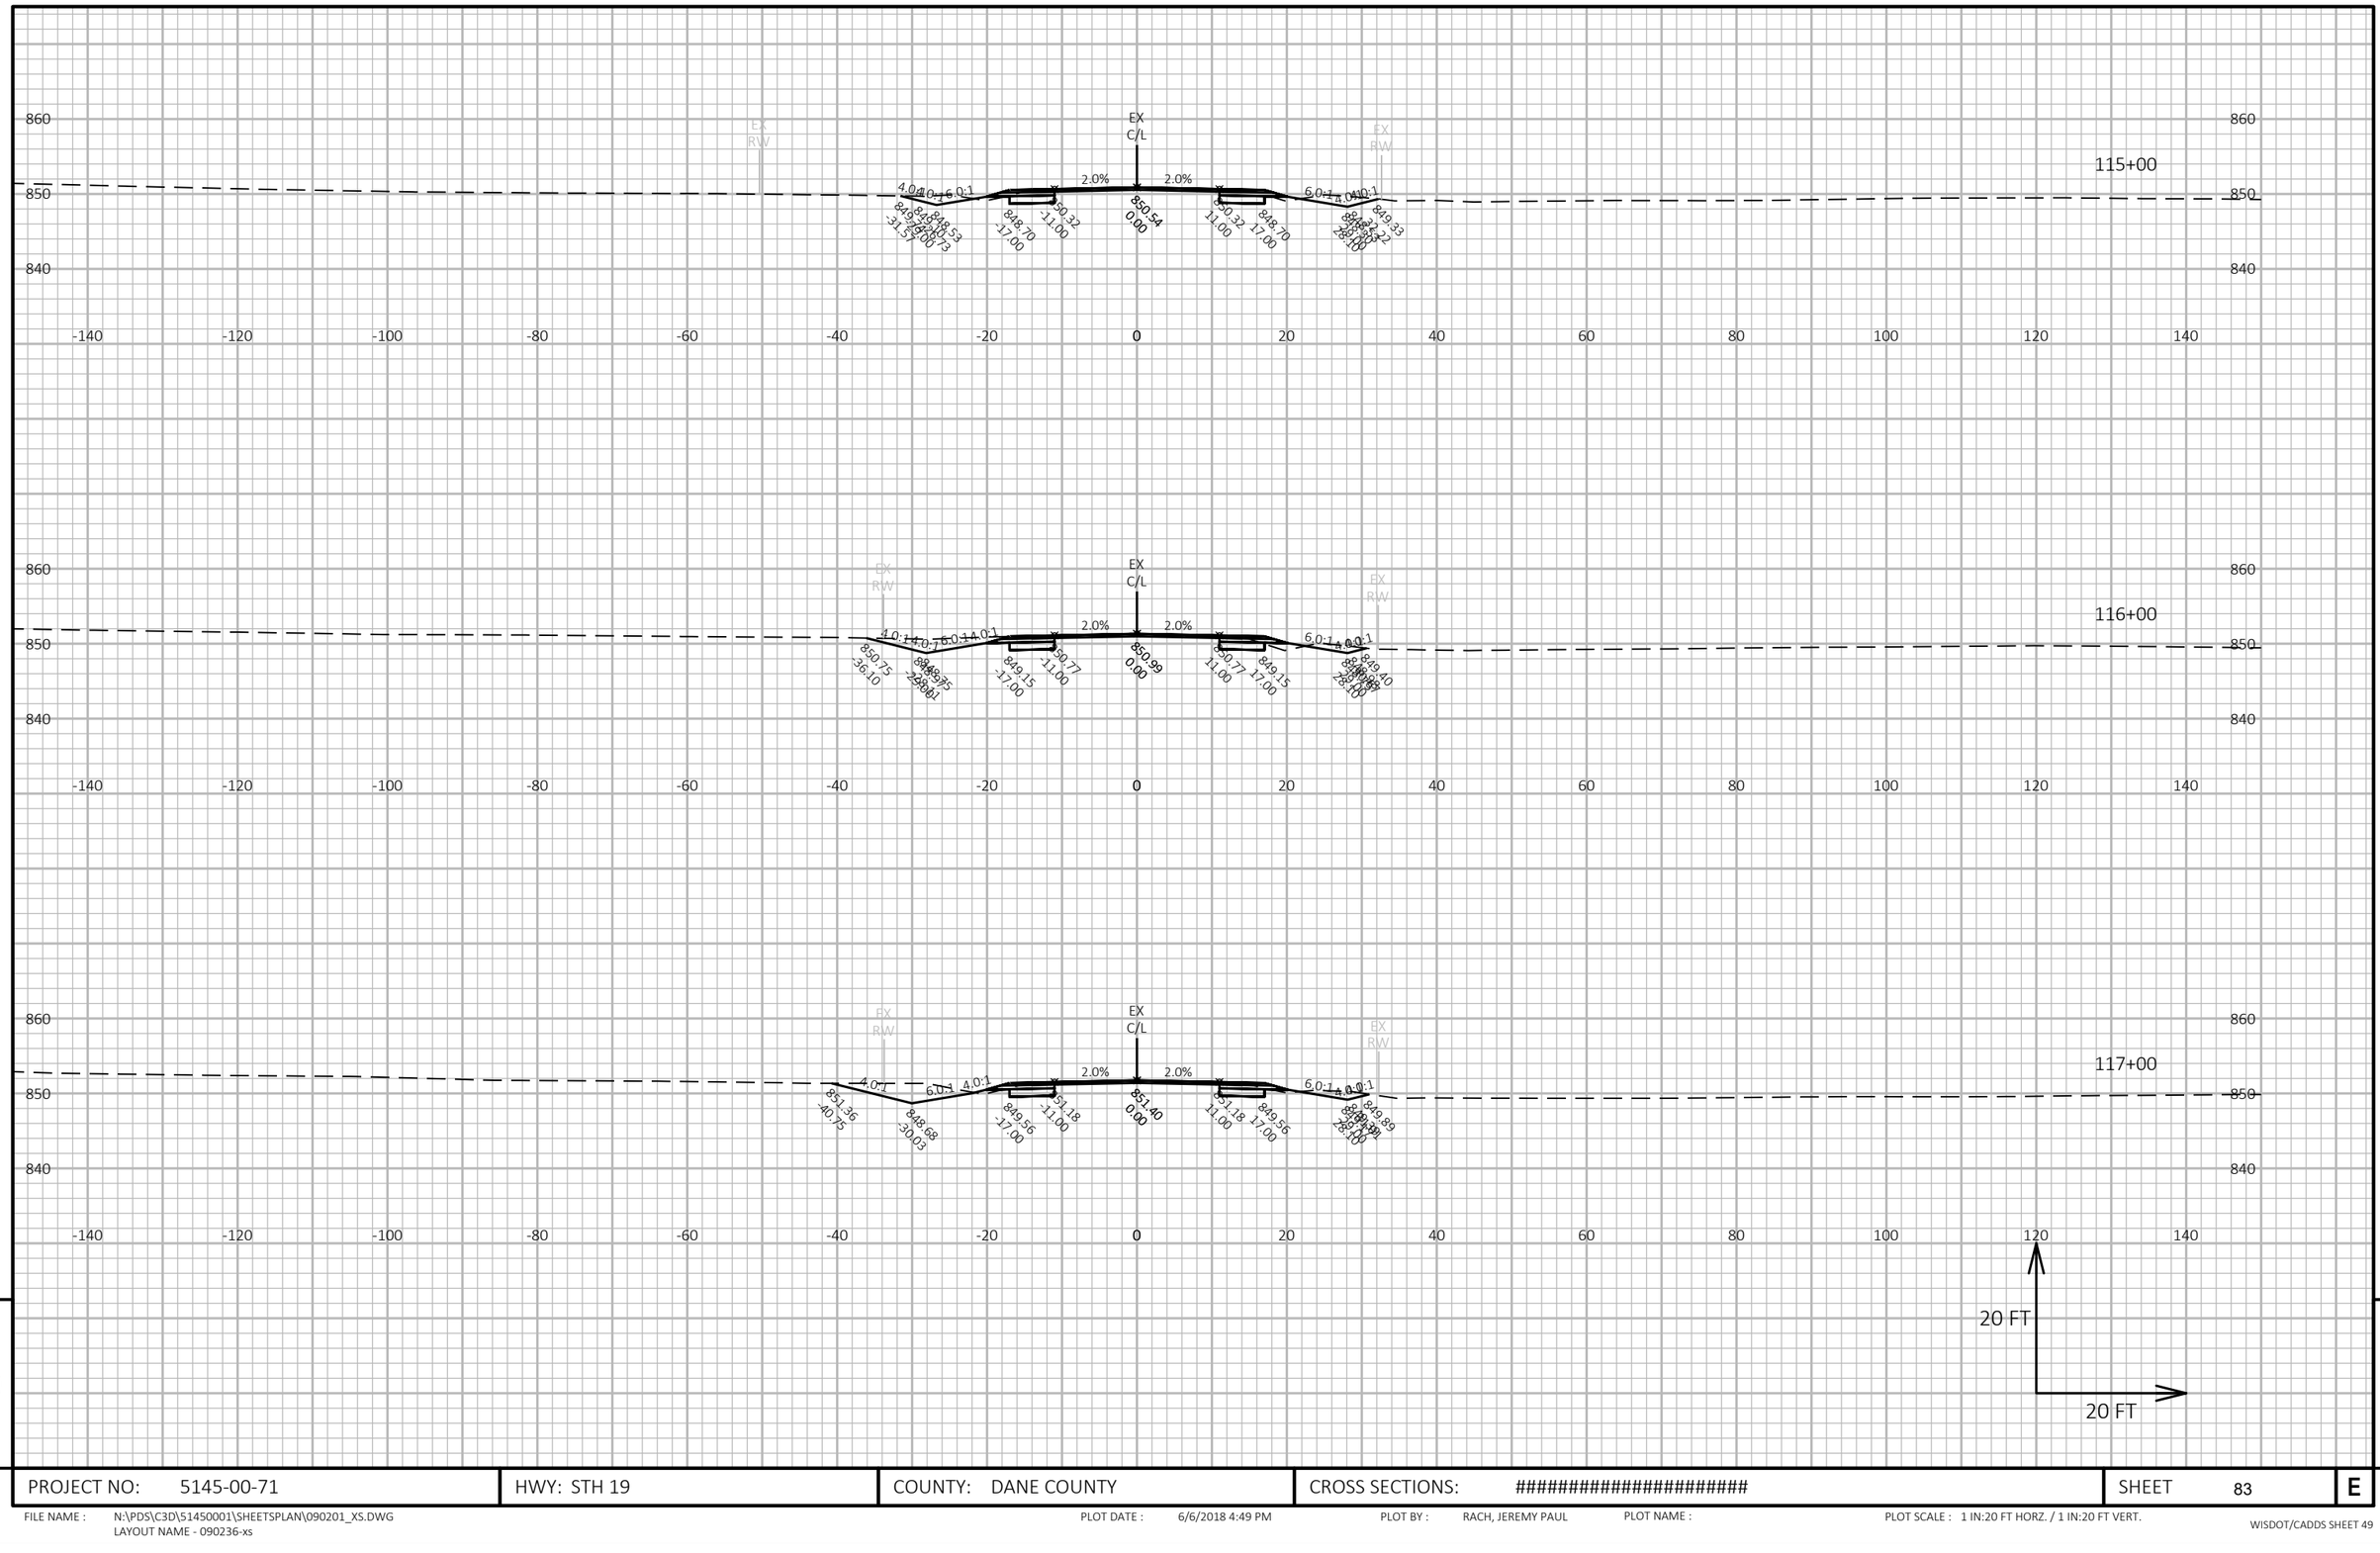

9

9

PROJECT NO: 5145-00-71	HWY: STH 19	COUNTY: DANE COUNTY	CROSS SECTIONS: ##########################	SHEET 83	E

FILE NAME : N:\PDS\C3D\51450001\SHEETSPLAN\090201_XS.DWG
LAYOUT NAME - 090236-xs

PLOT DATE : 6/6/2018 4:49 PM PLOT BY : RACH, JEREMY PAUL PLOT NAME : PLOT SCALE : 1 IN:20 FT HORZ. / 1 IN:20 FT VERT.

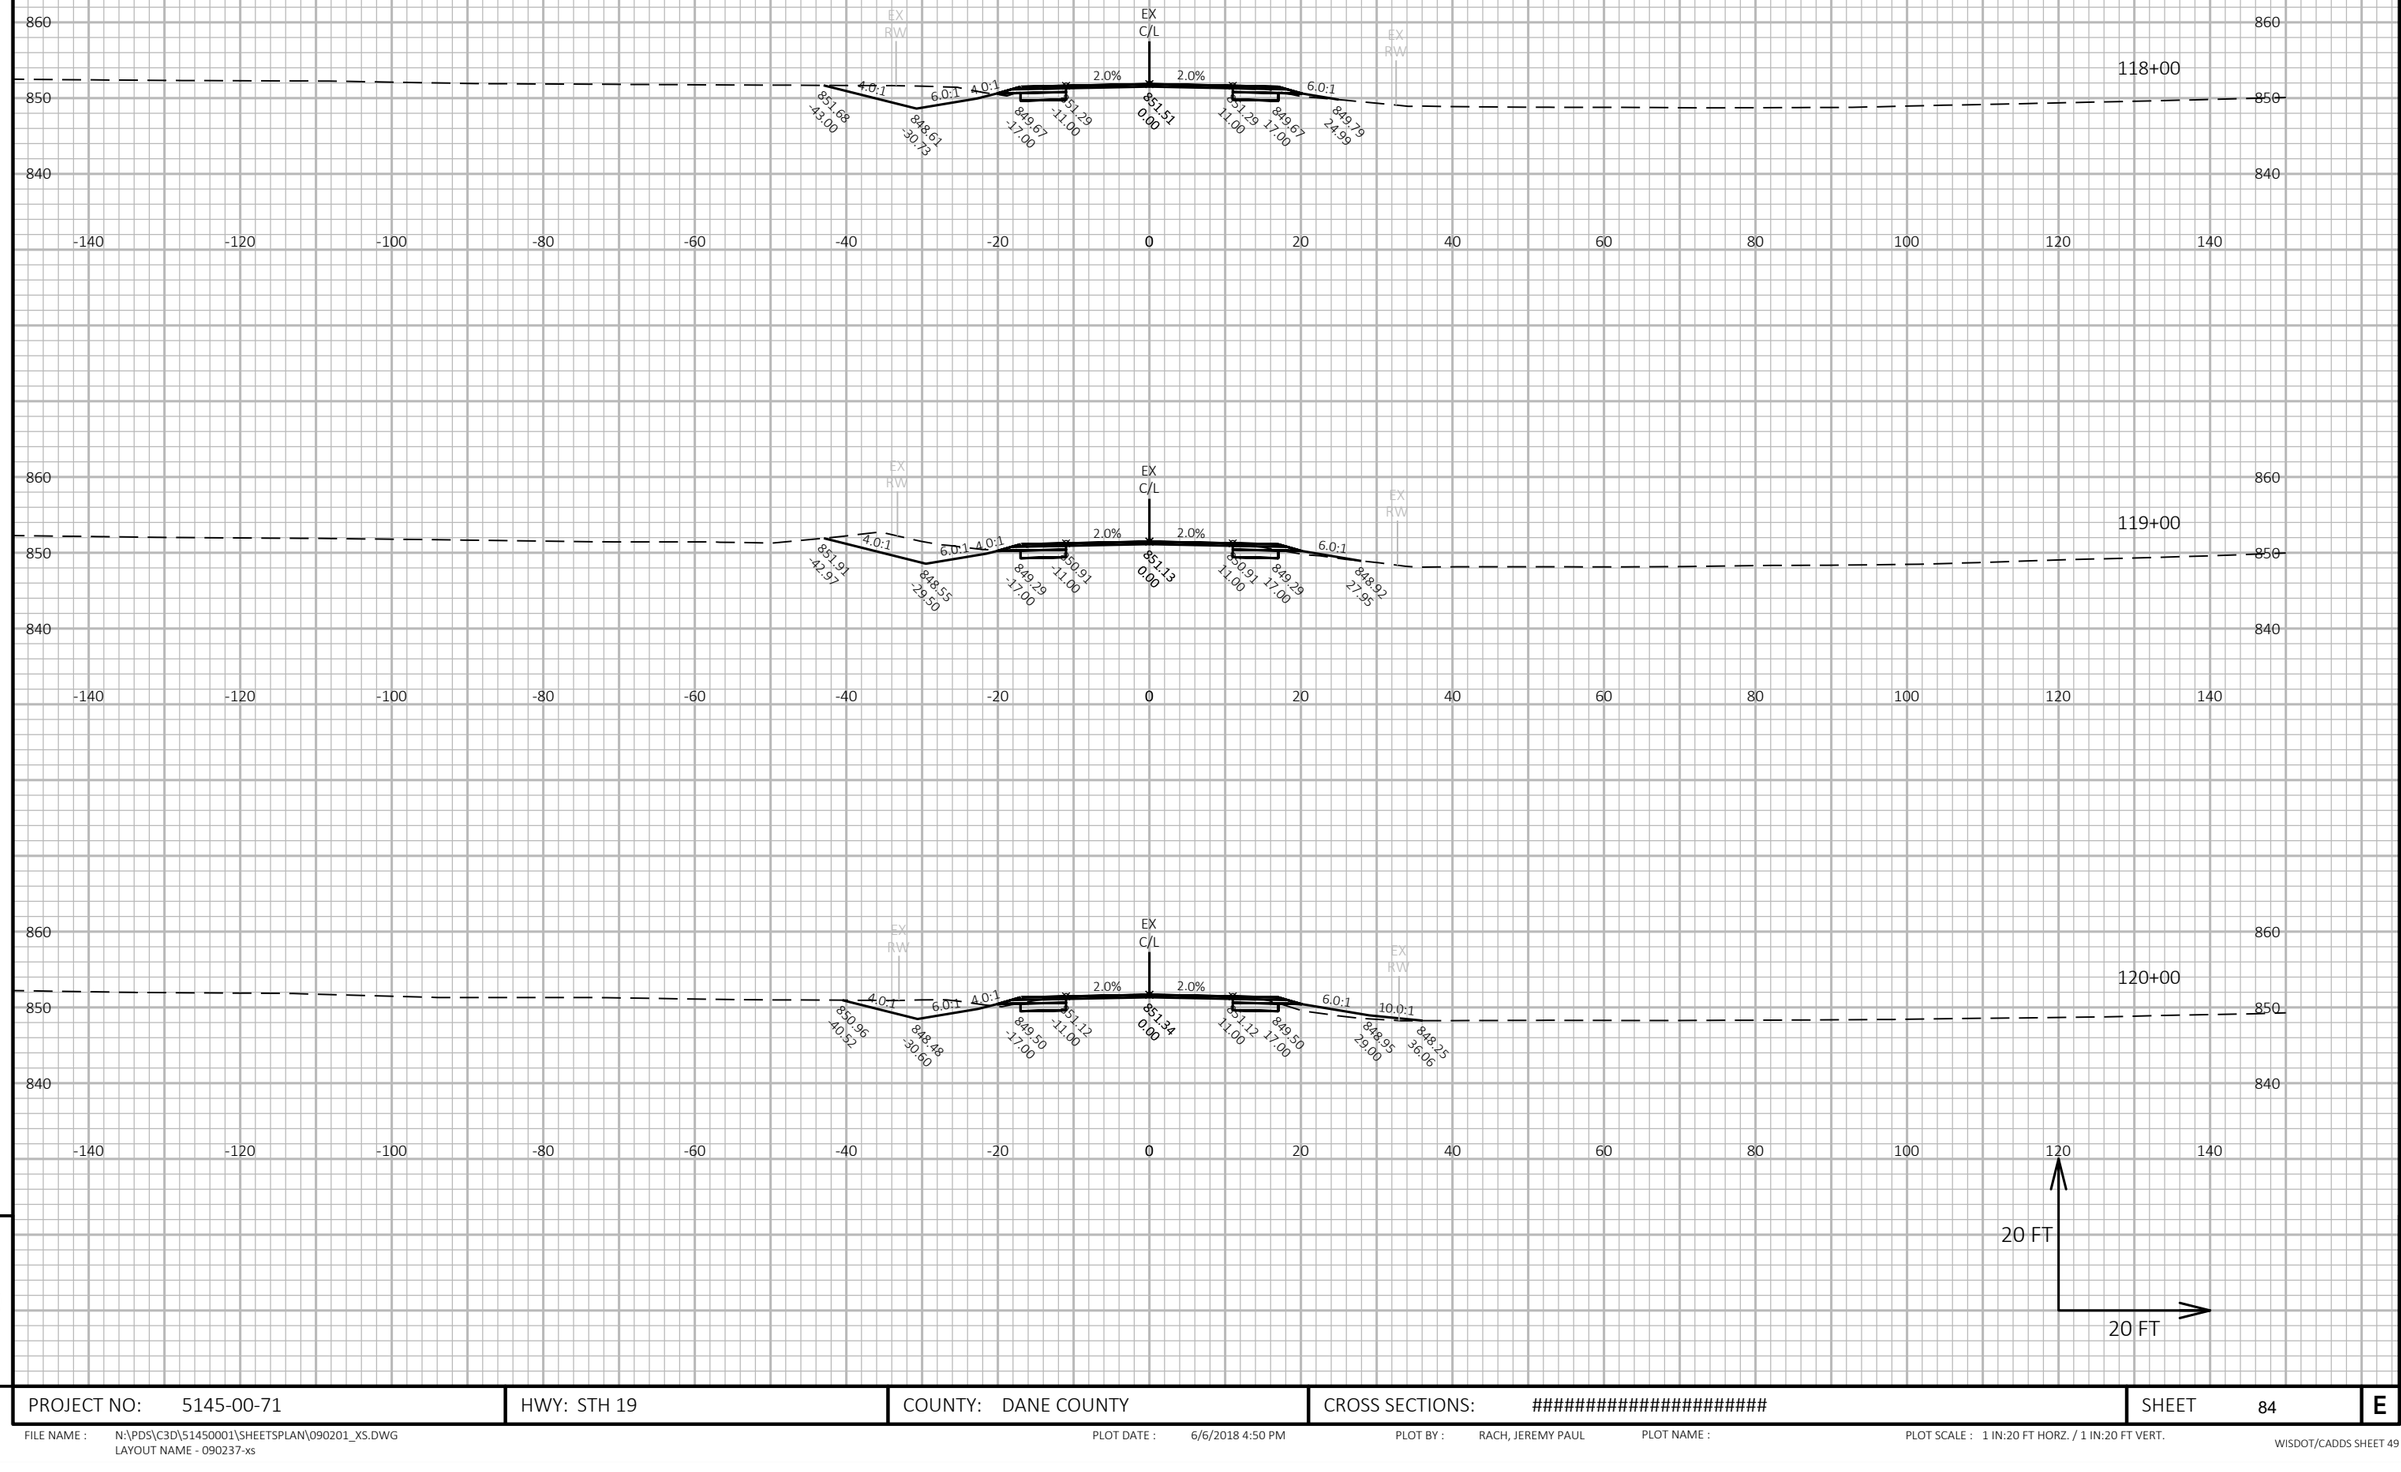

9

9

PROJECT NO: 5145-00-71	HWY: STH 19	COUNTY: DANE COUNTY	CROSS SECTIONS: ##########################	SHEET 84	E

FILE NAME : N:\PDS\C3D\51450001\SHEETSPLAN\090201_XS.DWG
LAYOUT NAME - 090237-xs

PLOT DATE : 6/6/2018 4:50 PM PLOT BY : RACH, JEREMY PAUL PLOT NAME : PLOT SCALE : 1 IN:20 FT HORZ. / 1 IN:20 FT VERT.

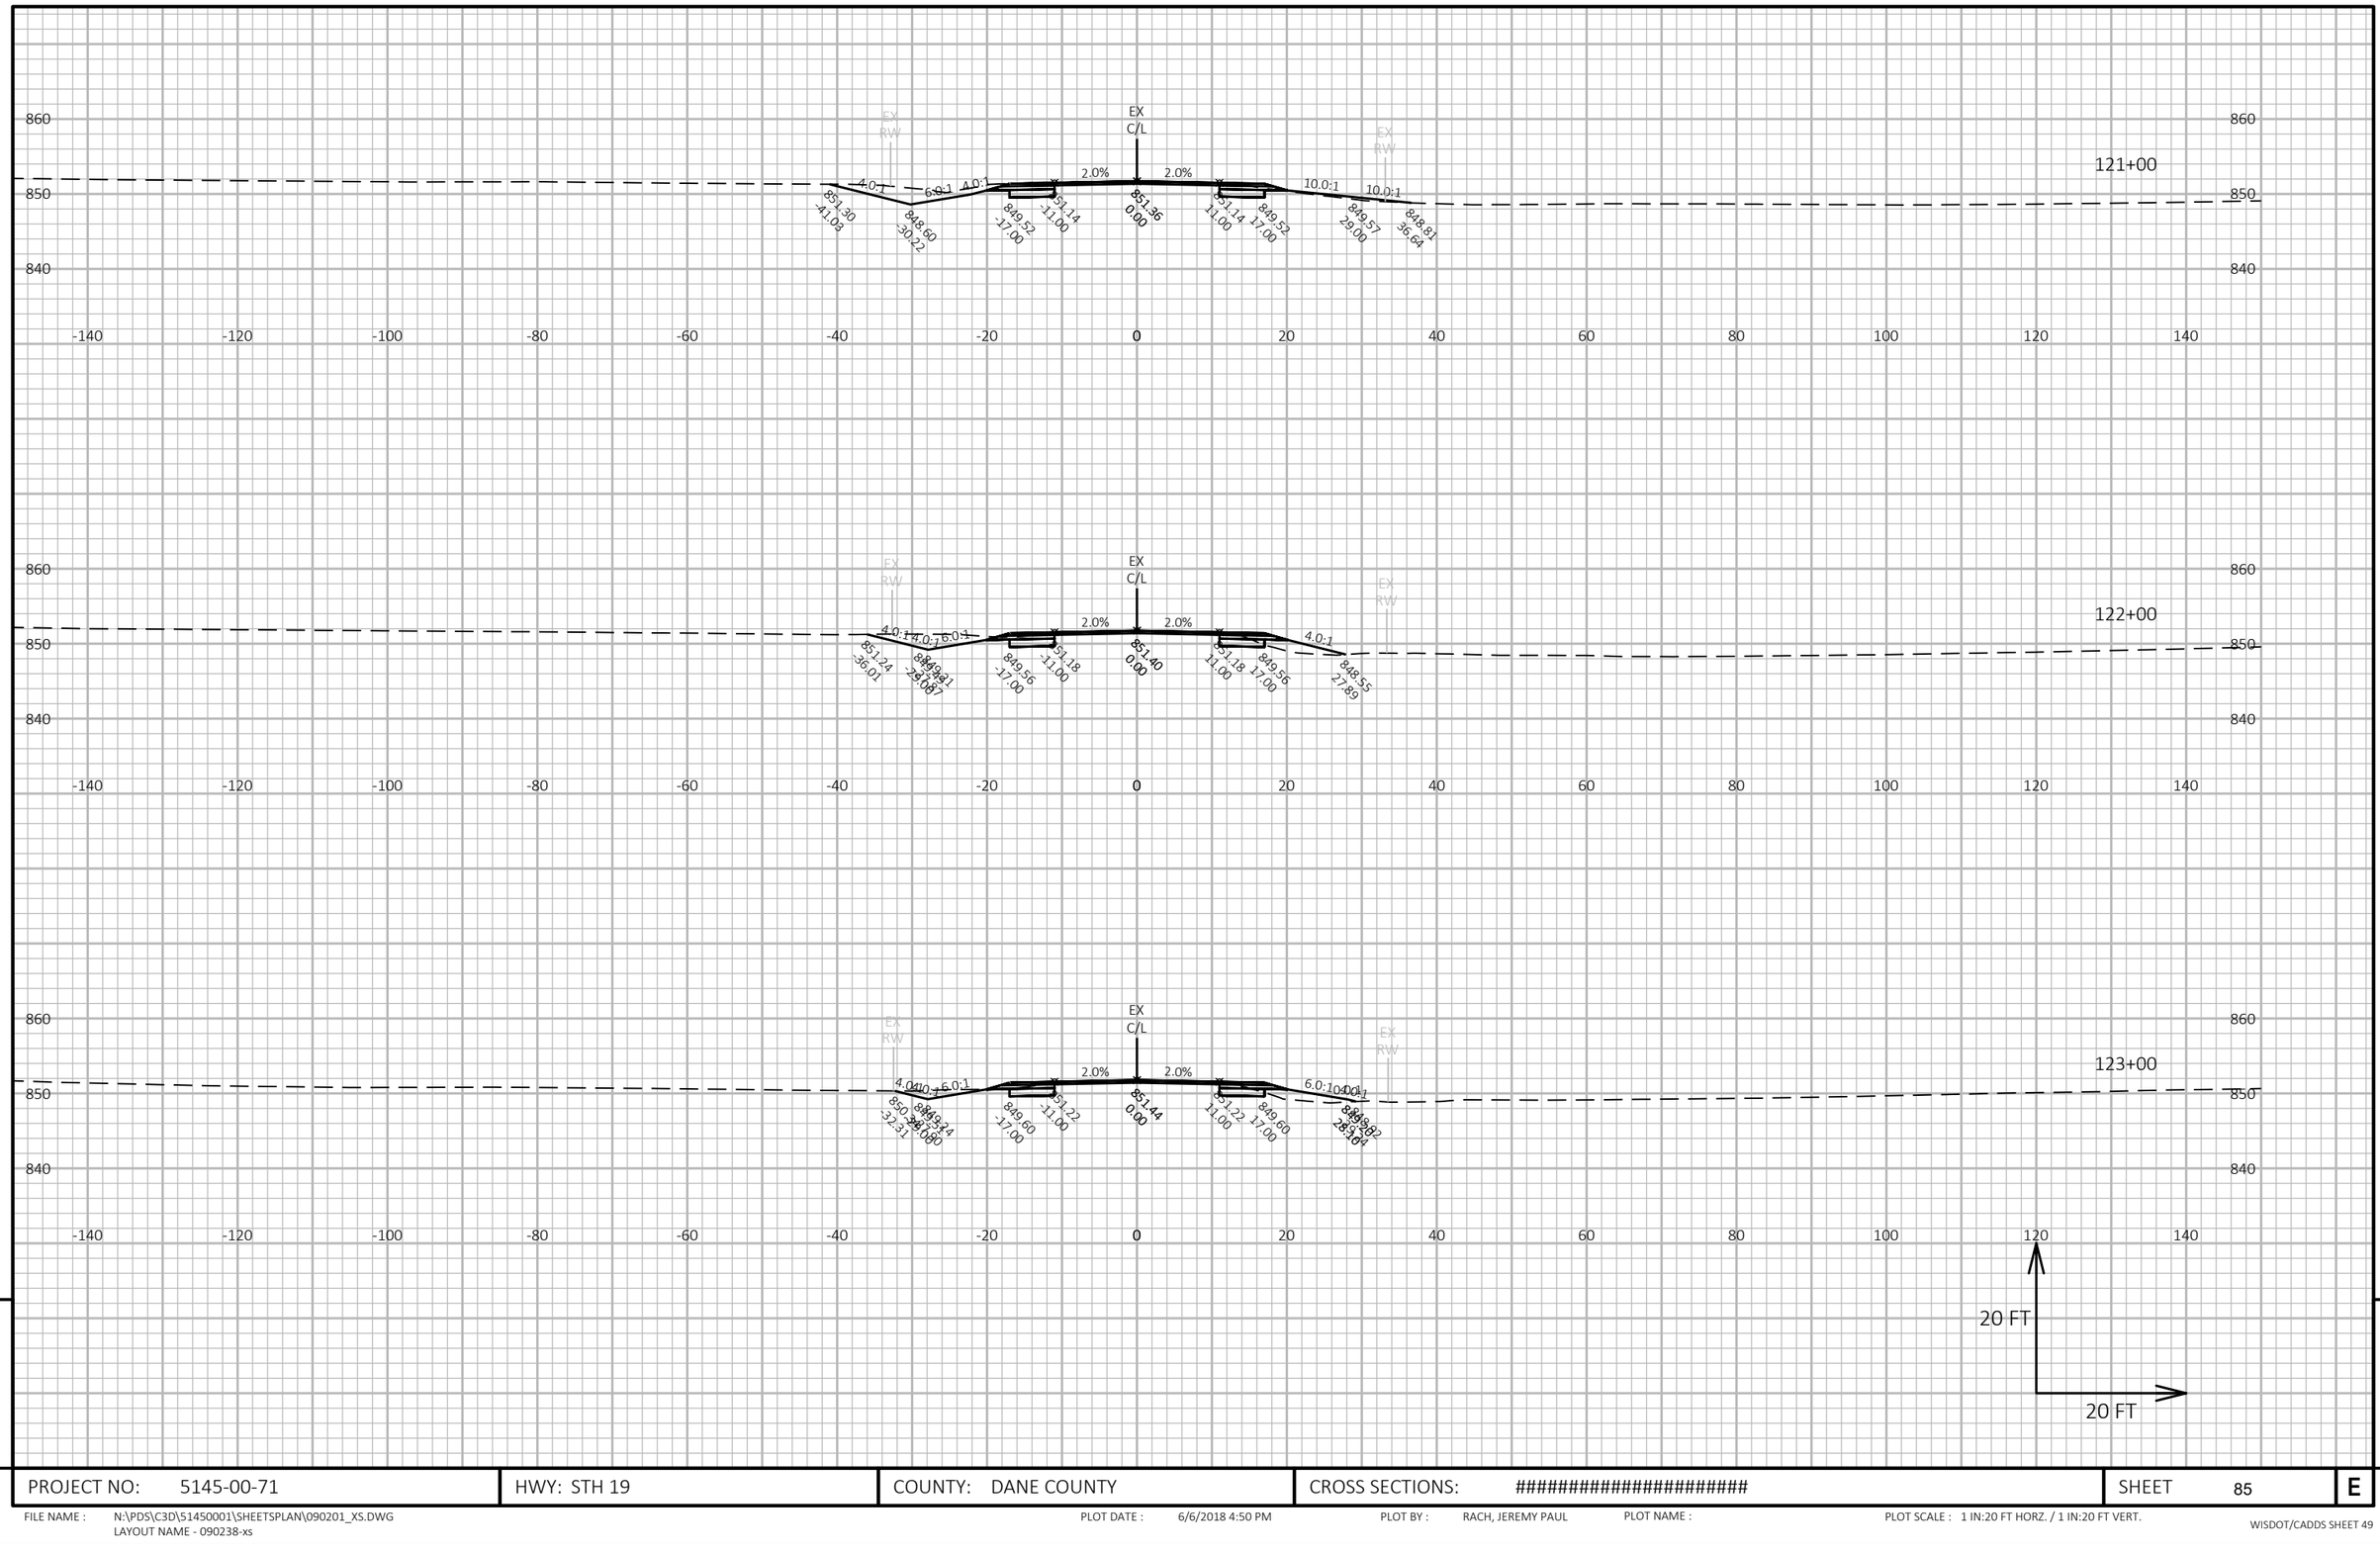

PROJECT NO: 5145-00-71	HWY: STH 19	COUNTY: DANE COUNTY	CROSS SECTIONS: ##########################	SHEET 85 E

FILE NAME : N:\PDS\C3D\51450001\SHEETSPLAN\090201_XS.DWG
LAYOUT NAME - 090238-xs

PLOT DATE : 6/6/2018 4:50 PM PLOT BY : RACH, JEREMY PAUL PLOT NAME : PLOT SCALE : 1 IN:20 FT HORZ. / 1 IN:20 FT VERT.

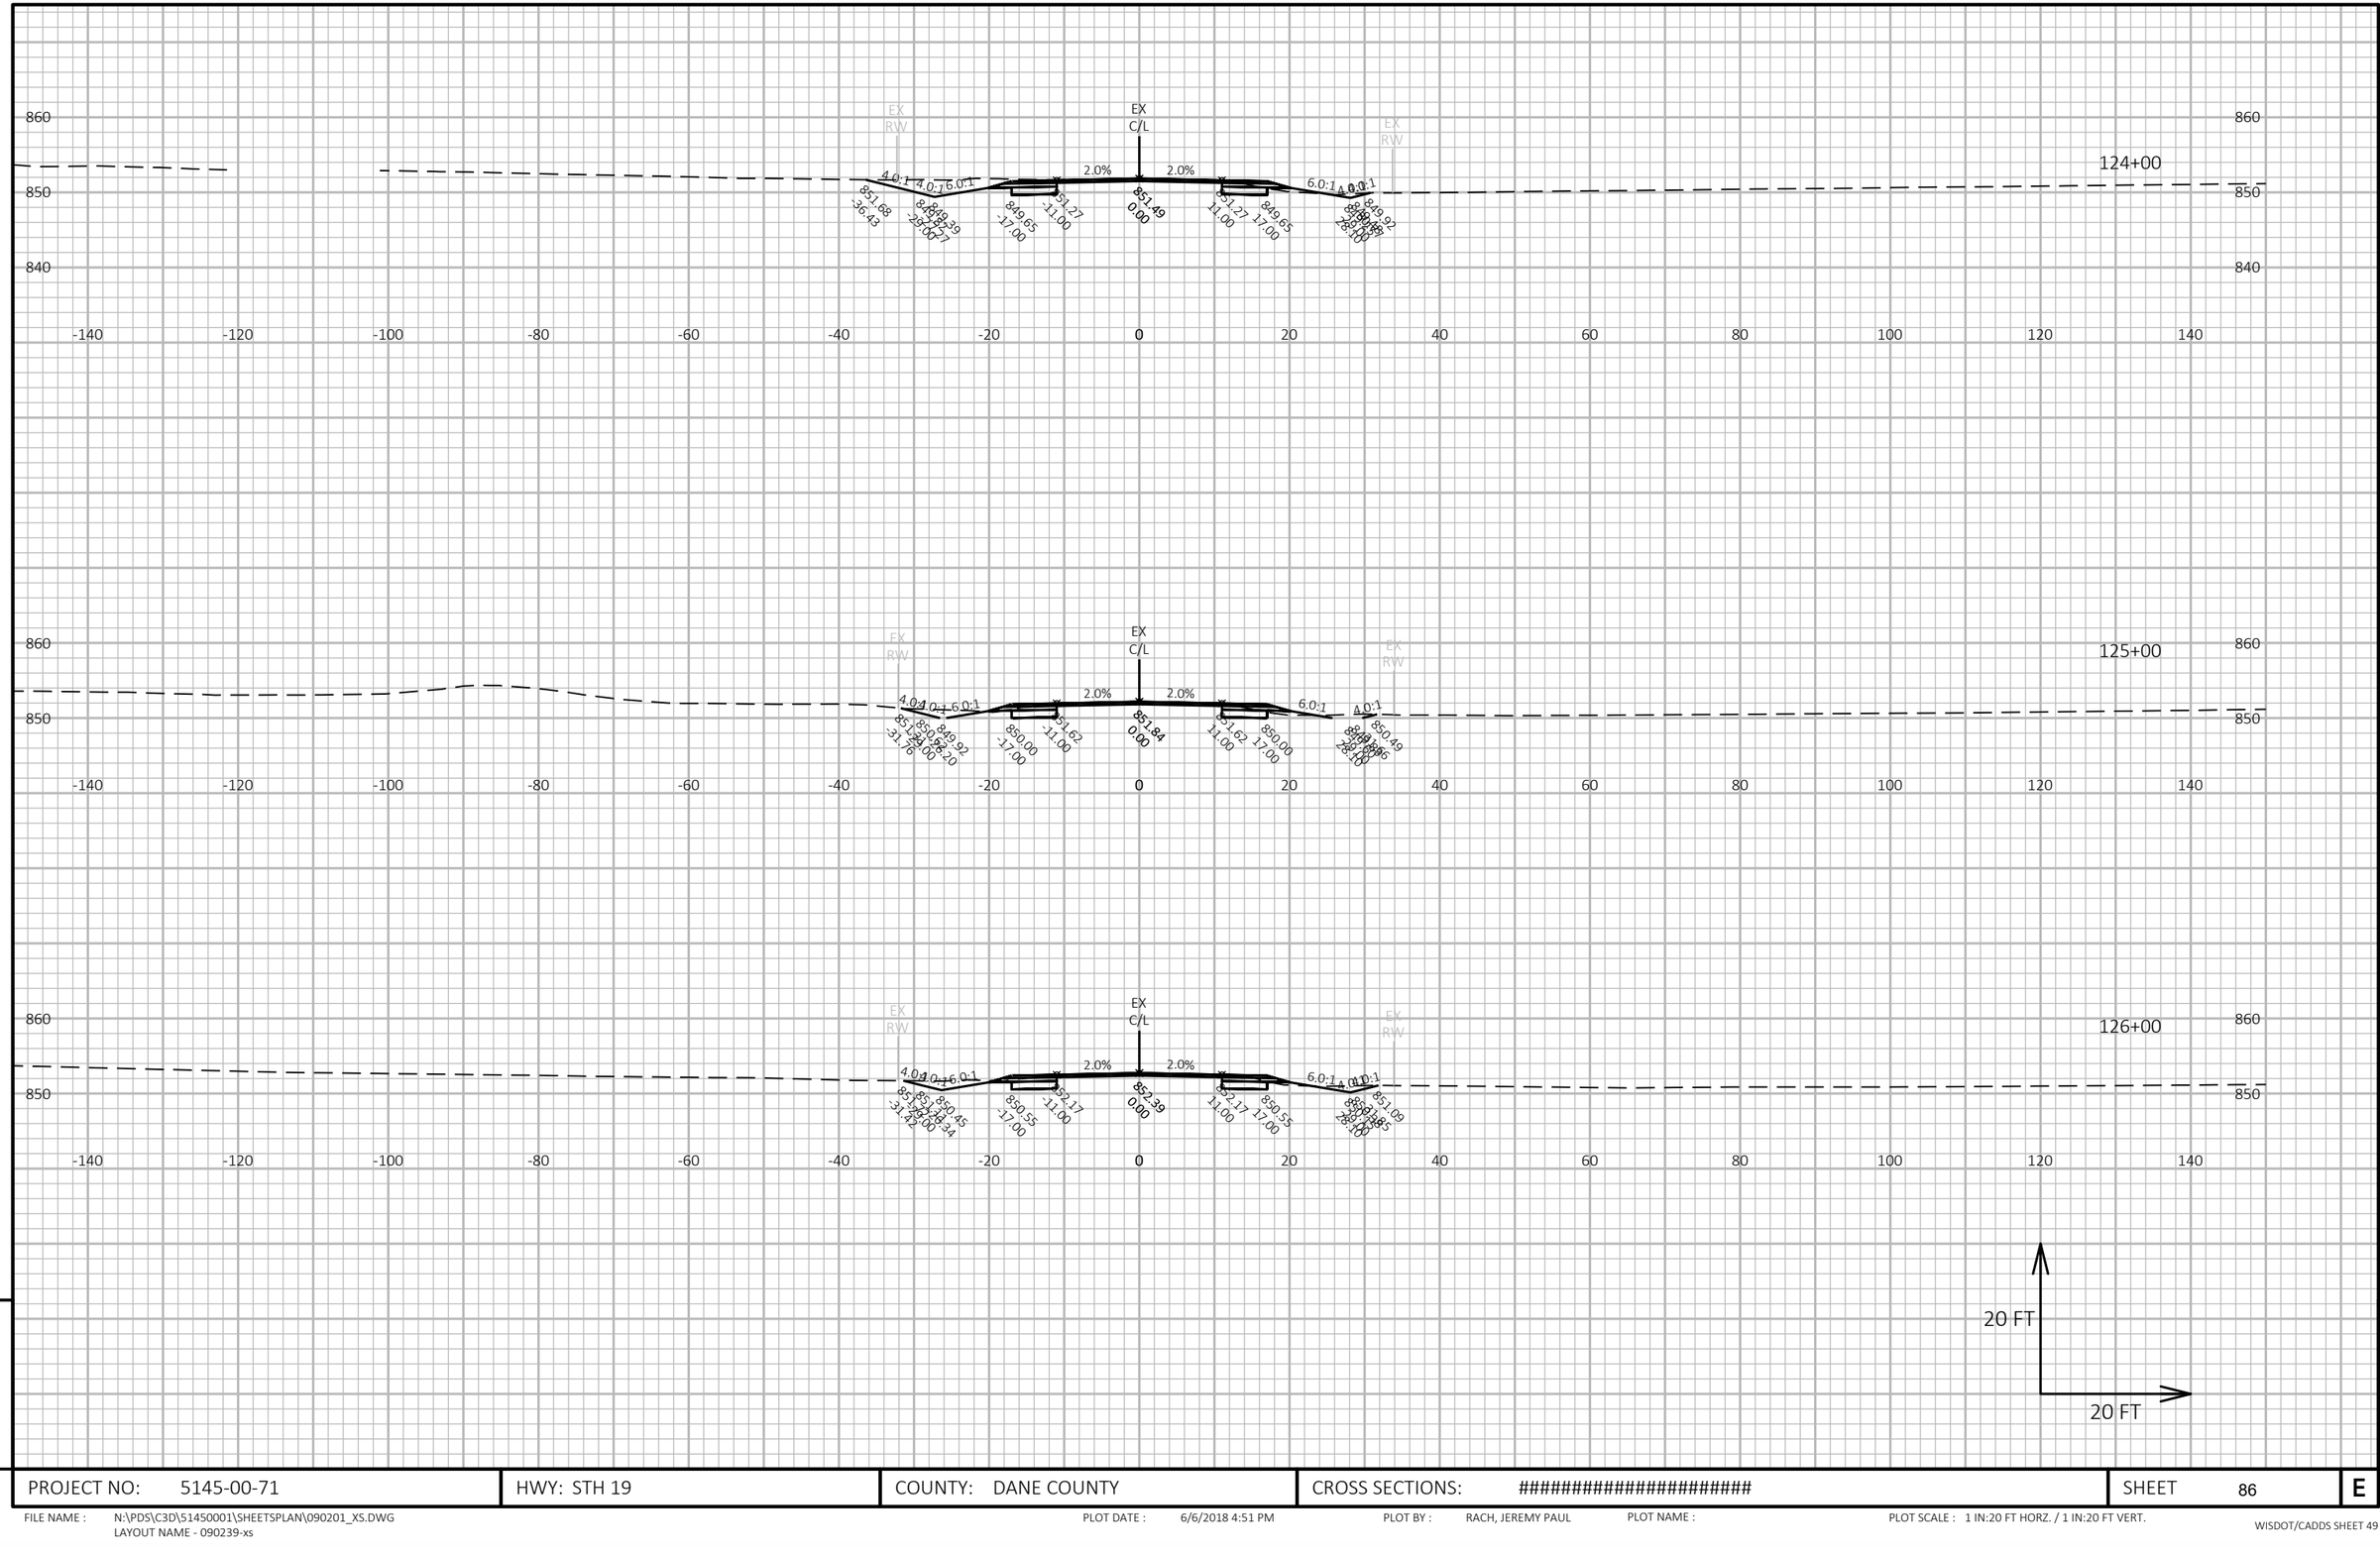

PROJECT NO: 5145-00-71	HWY: STH 19	COUNTY: DANE COUNTY	CROSS SECTIONS: ##########################	SHEET 86	E

FILE NAME : N:\PDS\C3D\51450001\SHEETSPLAN\090201_XS.DWG
LAYOUT NAME - 090239-xs

PLOT DATE : 6/6/2018 4:51 PM PLOT BY : RACH, JEREMY PAUL PLOT NAME : PLOT SCALE : 1 IN:20 FT HORZ. / 1 IN:20 FT VERT.

WISDOT/CADDS SHEET 49

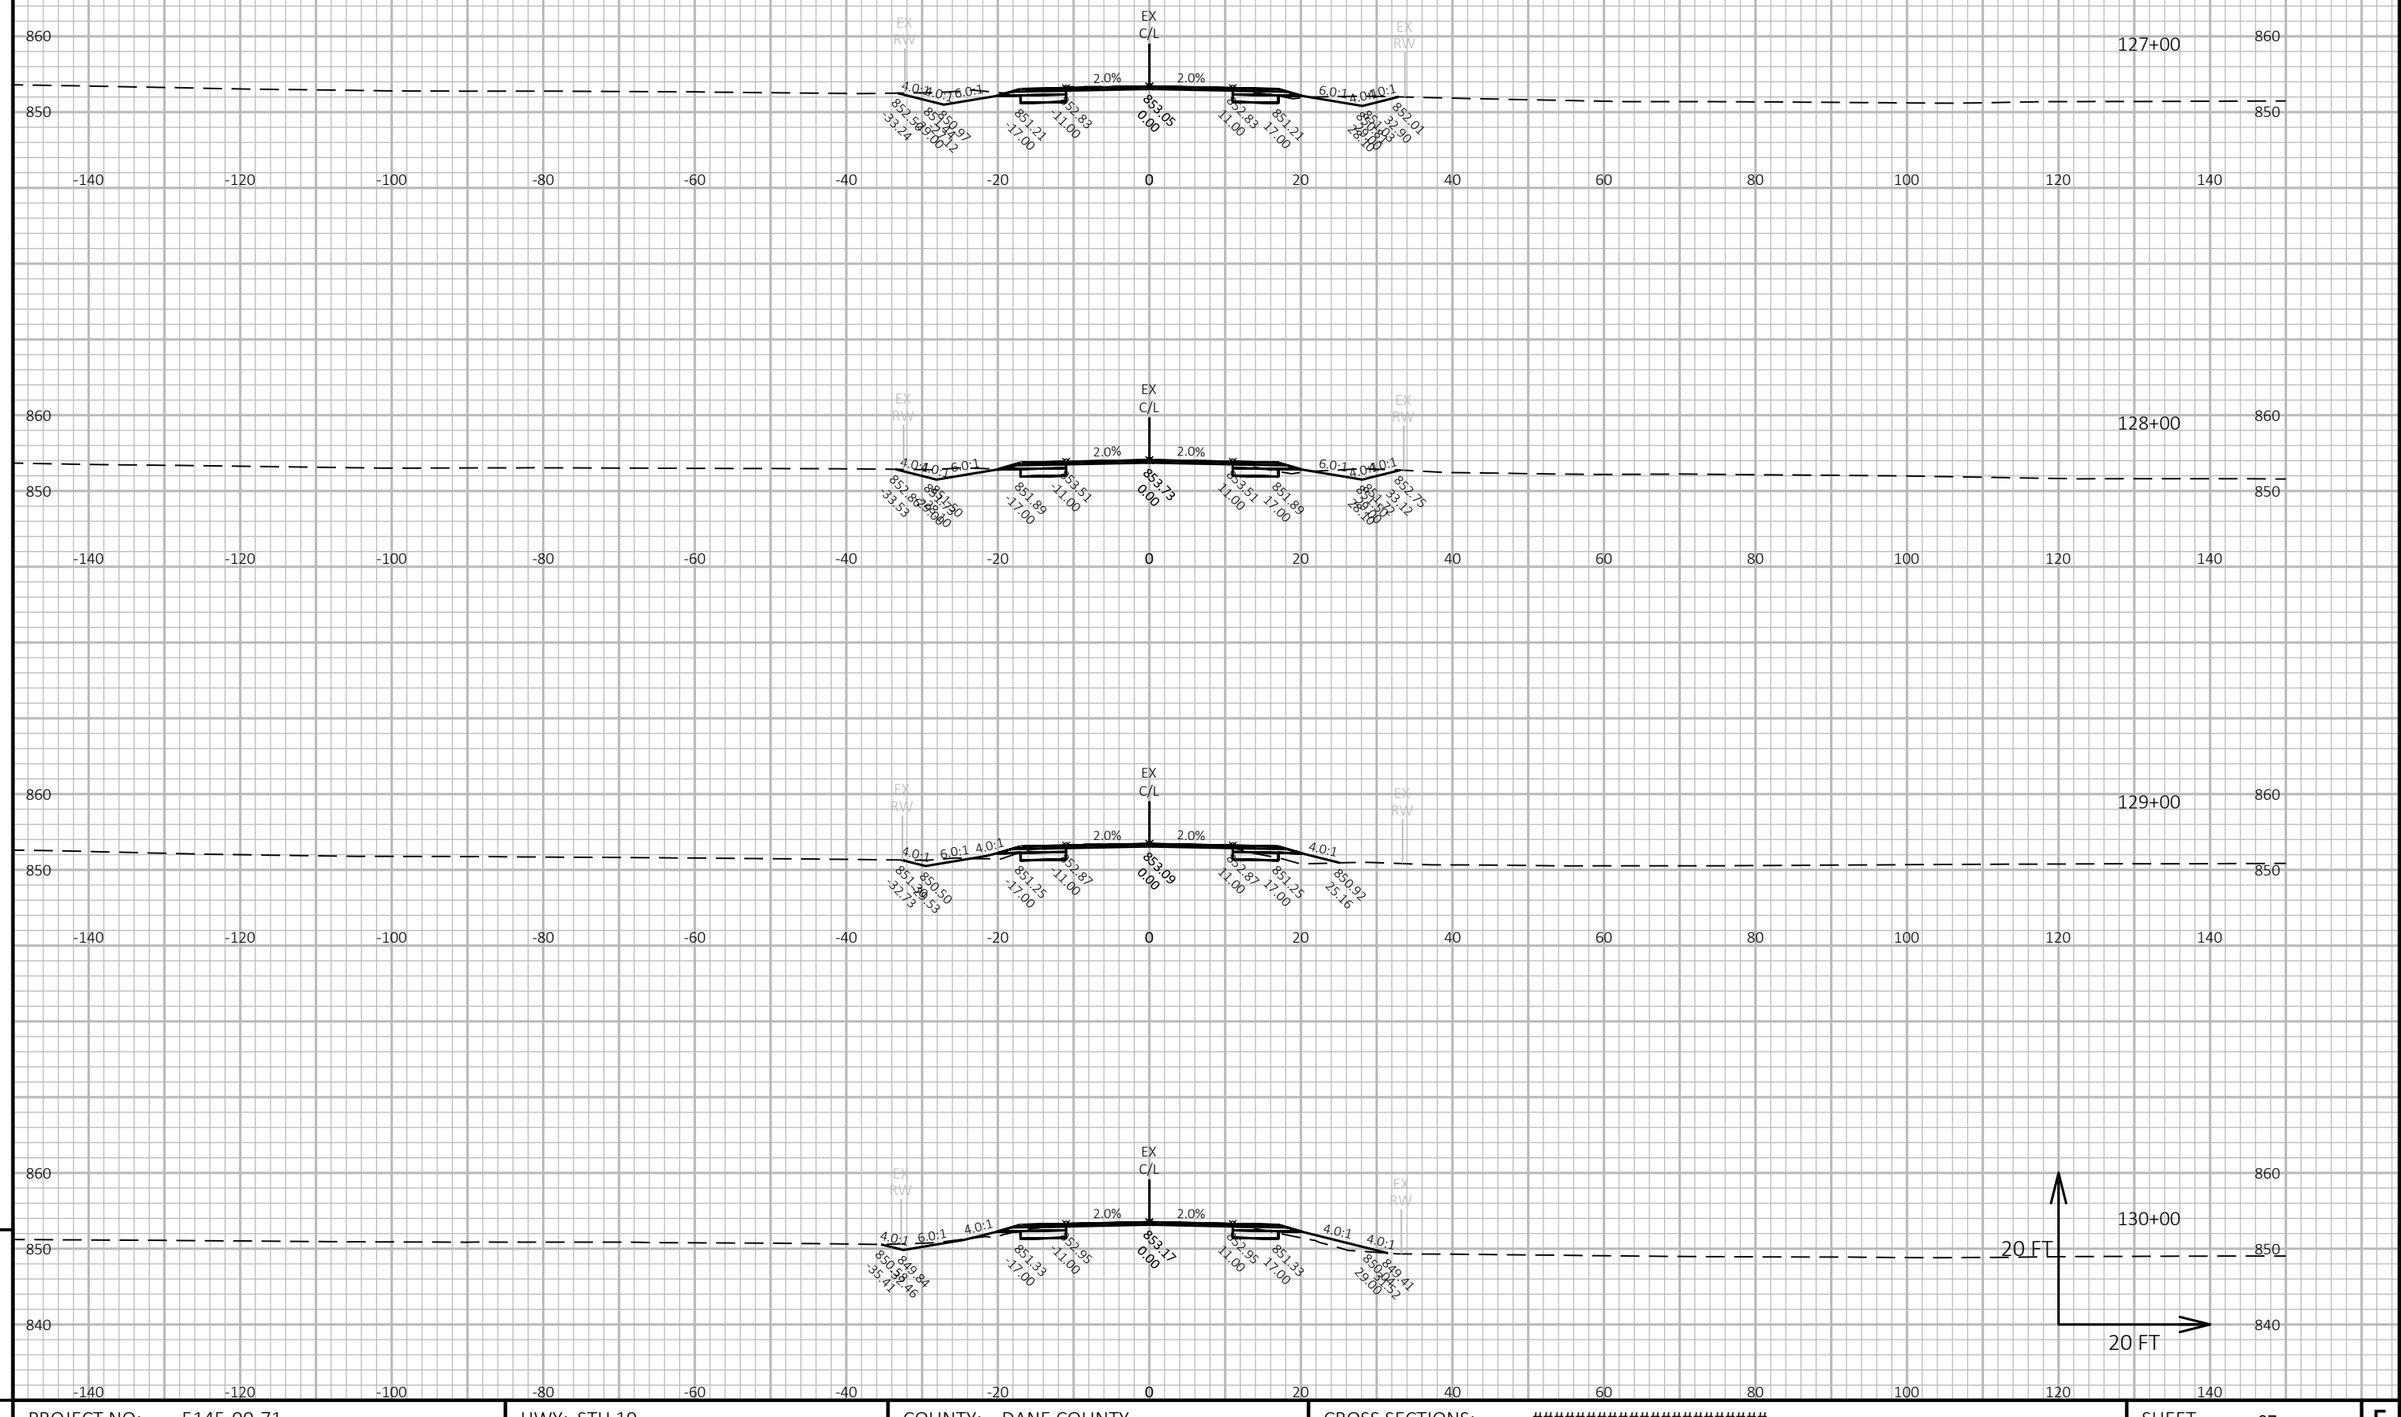

9

PROJECT NO: 5145-00-71	HWY: STH 19	COUNTY: DANE COUNTY	CROSS SECTIONS: ##########################	SHEET 87	E

FILE NAME : N:\PDS\C3D\51450001\SHEETSPLAN\090201_XS.DWG
LAYOUT NAME - 090240-xs

PLOT DATE : 6/6/2018 4:51 PM PLOT BY : RACH, JEREMY PAUL PLOT NAME : PLOT SCALE : 1 IN:20 FT HORZ. / 1 IN:20 FT VERT.

WISDOT/CADDS SHEET 49

9

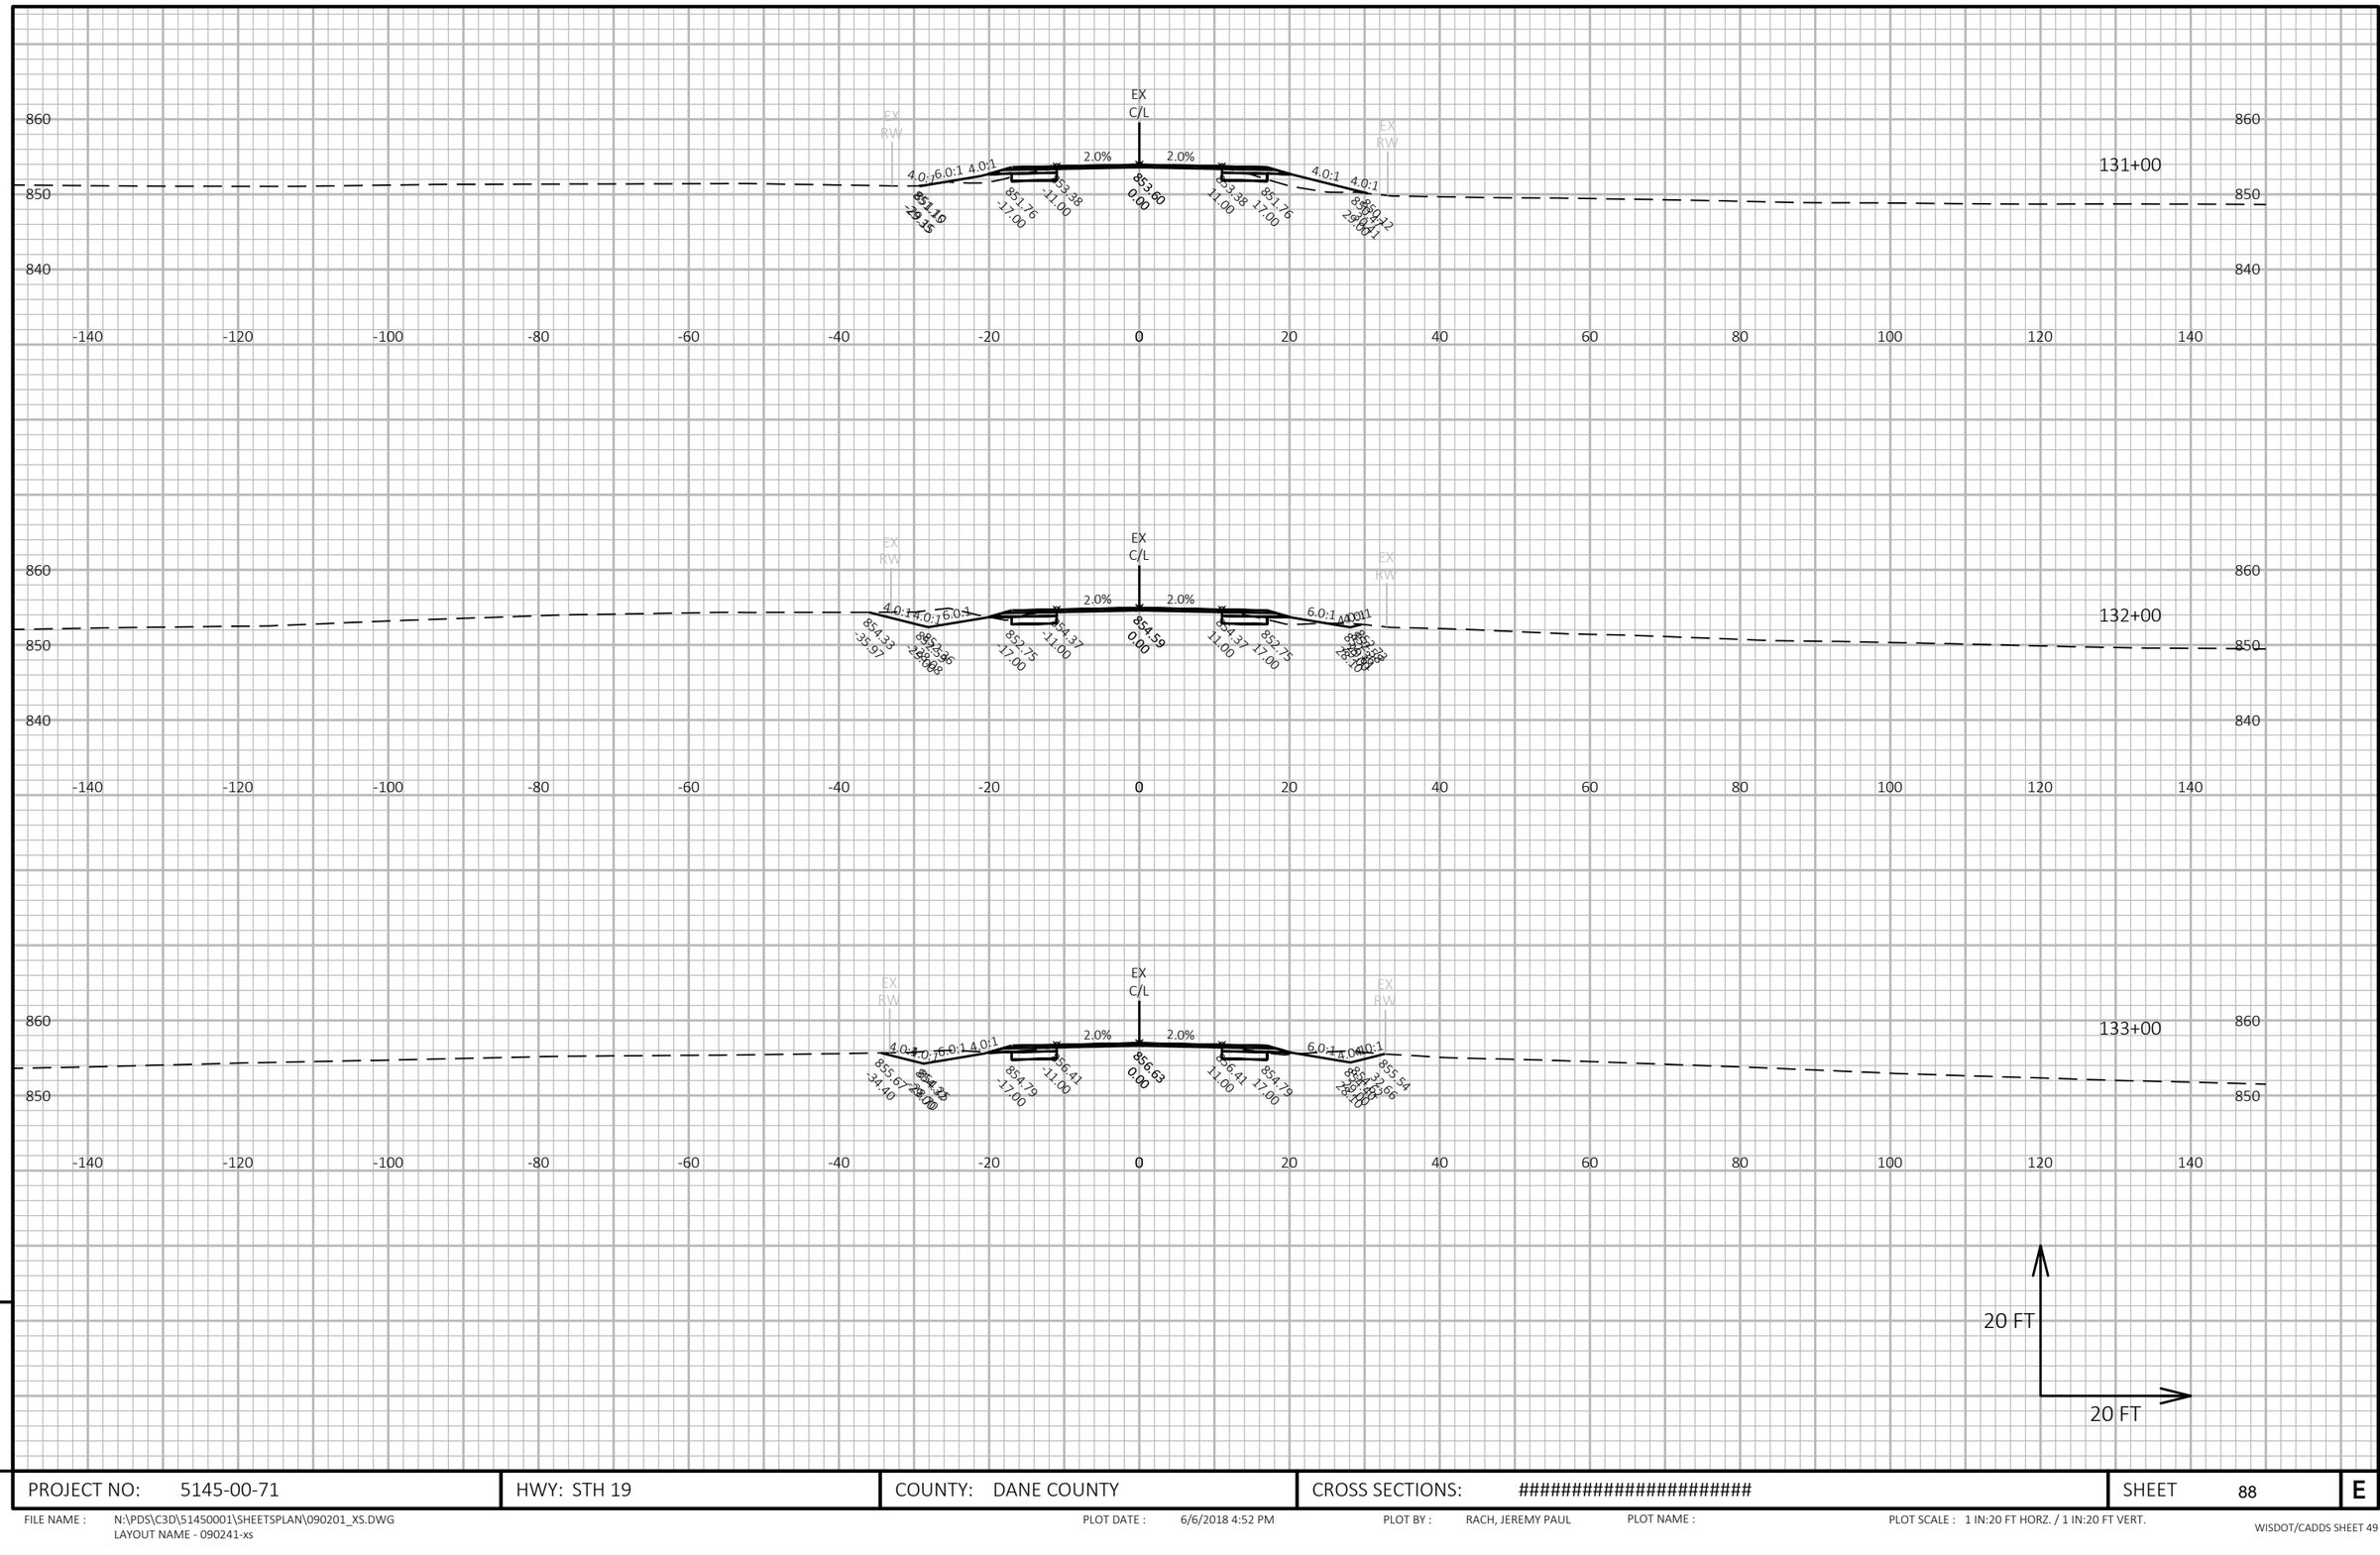

9

9

PROJECT NO: 5145-00-71	HWY: STH 19	COUNTY: DANE COUNTY	CROSS SECTIONS: ##########################	SHEET 88	E

FILE NAME : N:\PDS\C3D\51450001\SHEETSPLAN\090201_XS.DWG
LAYOUT NAME - 090241-xs

PLOT DATE : 6/6/2018 4:52 PM

PLOT BY : RACH, JEREMY PAUL

PLOT NAME :

PLOT SCALE : 1 IN:20 FT HORZ. / 1 IN:20 FT VERT.

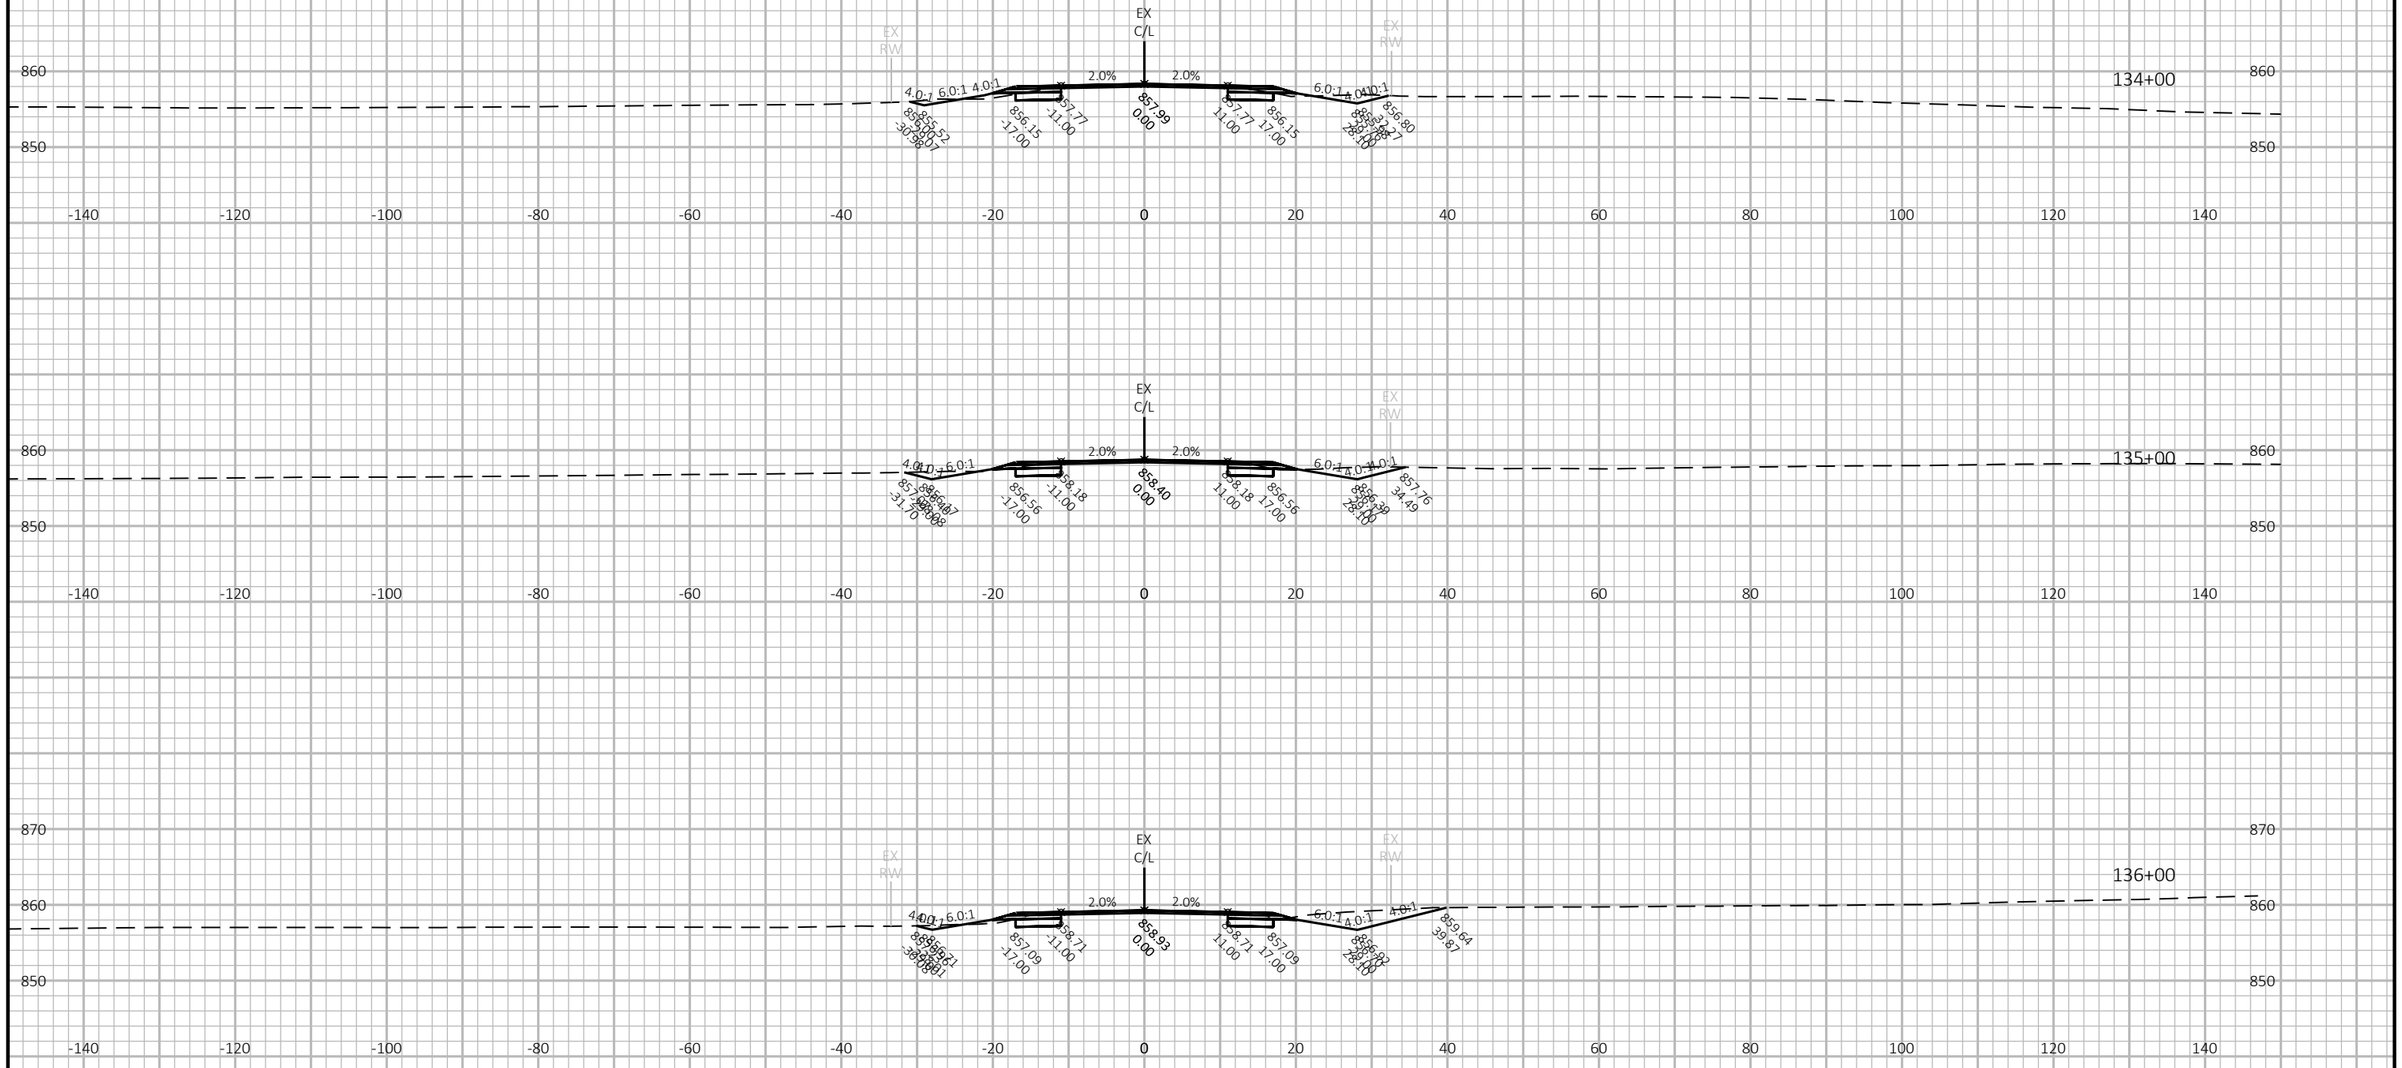

9

9

PROJECT NO: 5145-00-71	HWY: STH 19	COUNTY: DANE COUNTY	CROSS SECTIONS: ##########################	SHEET 89	E

FILE NAME : N:\PDS\C3D\51450001\SHEETSPLAN\090201_XS.DWG
LAYOUT NAME - 090242-xs

PLOT DATE : 6/6/2018 4:52 PM PLOT BY : RACH, JEREMY PAUL PLOT NAME : PLOT SCALE : 1 IN:20 FT HORZ. / 1 IN:20 FT VERT.

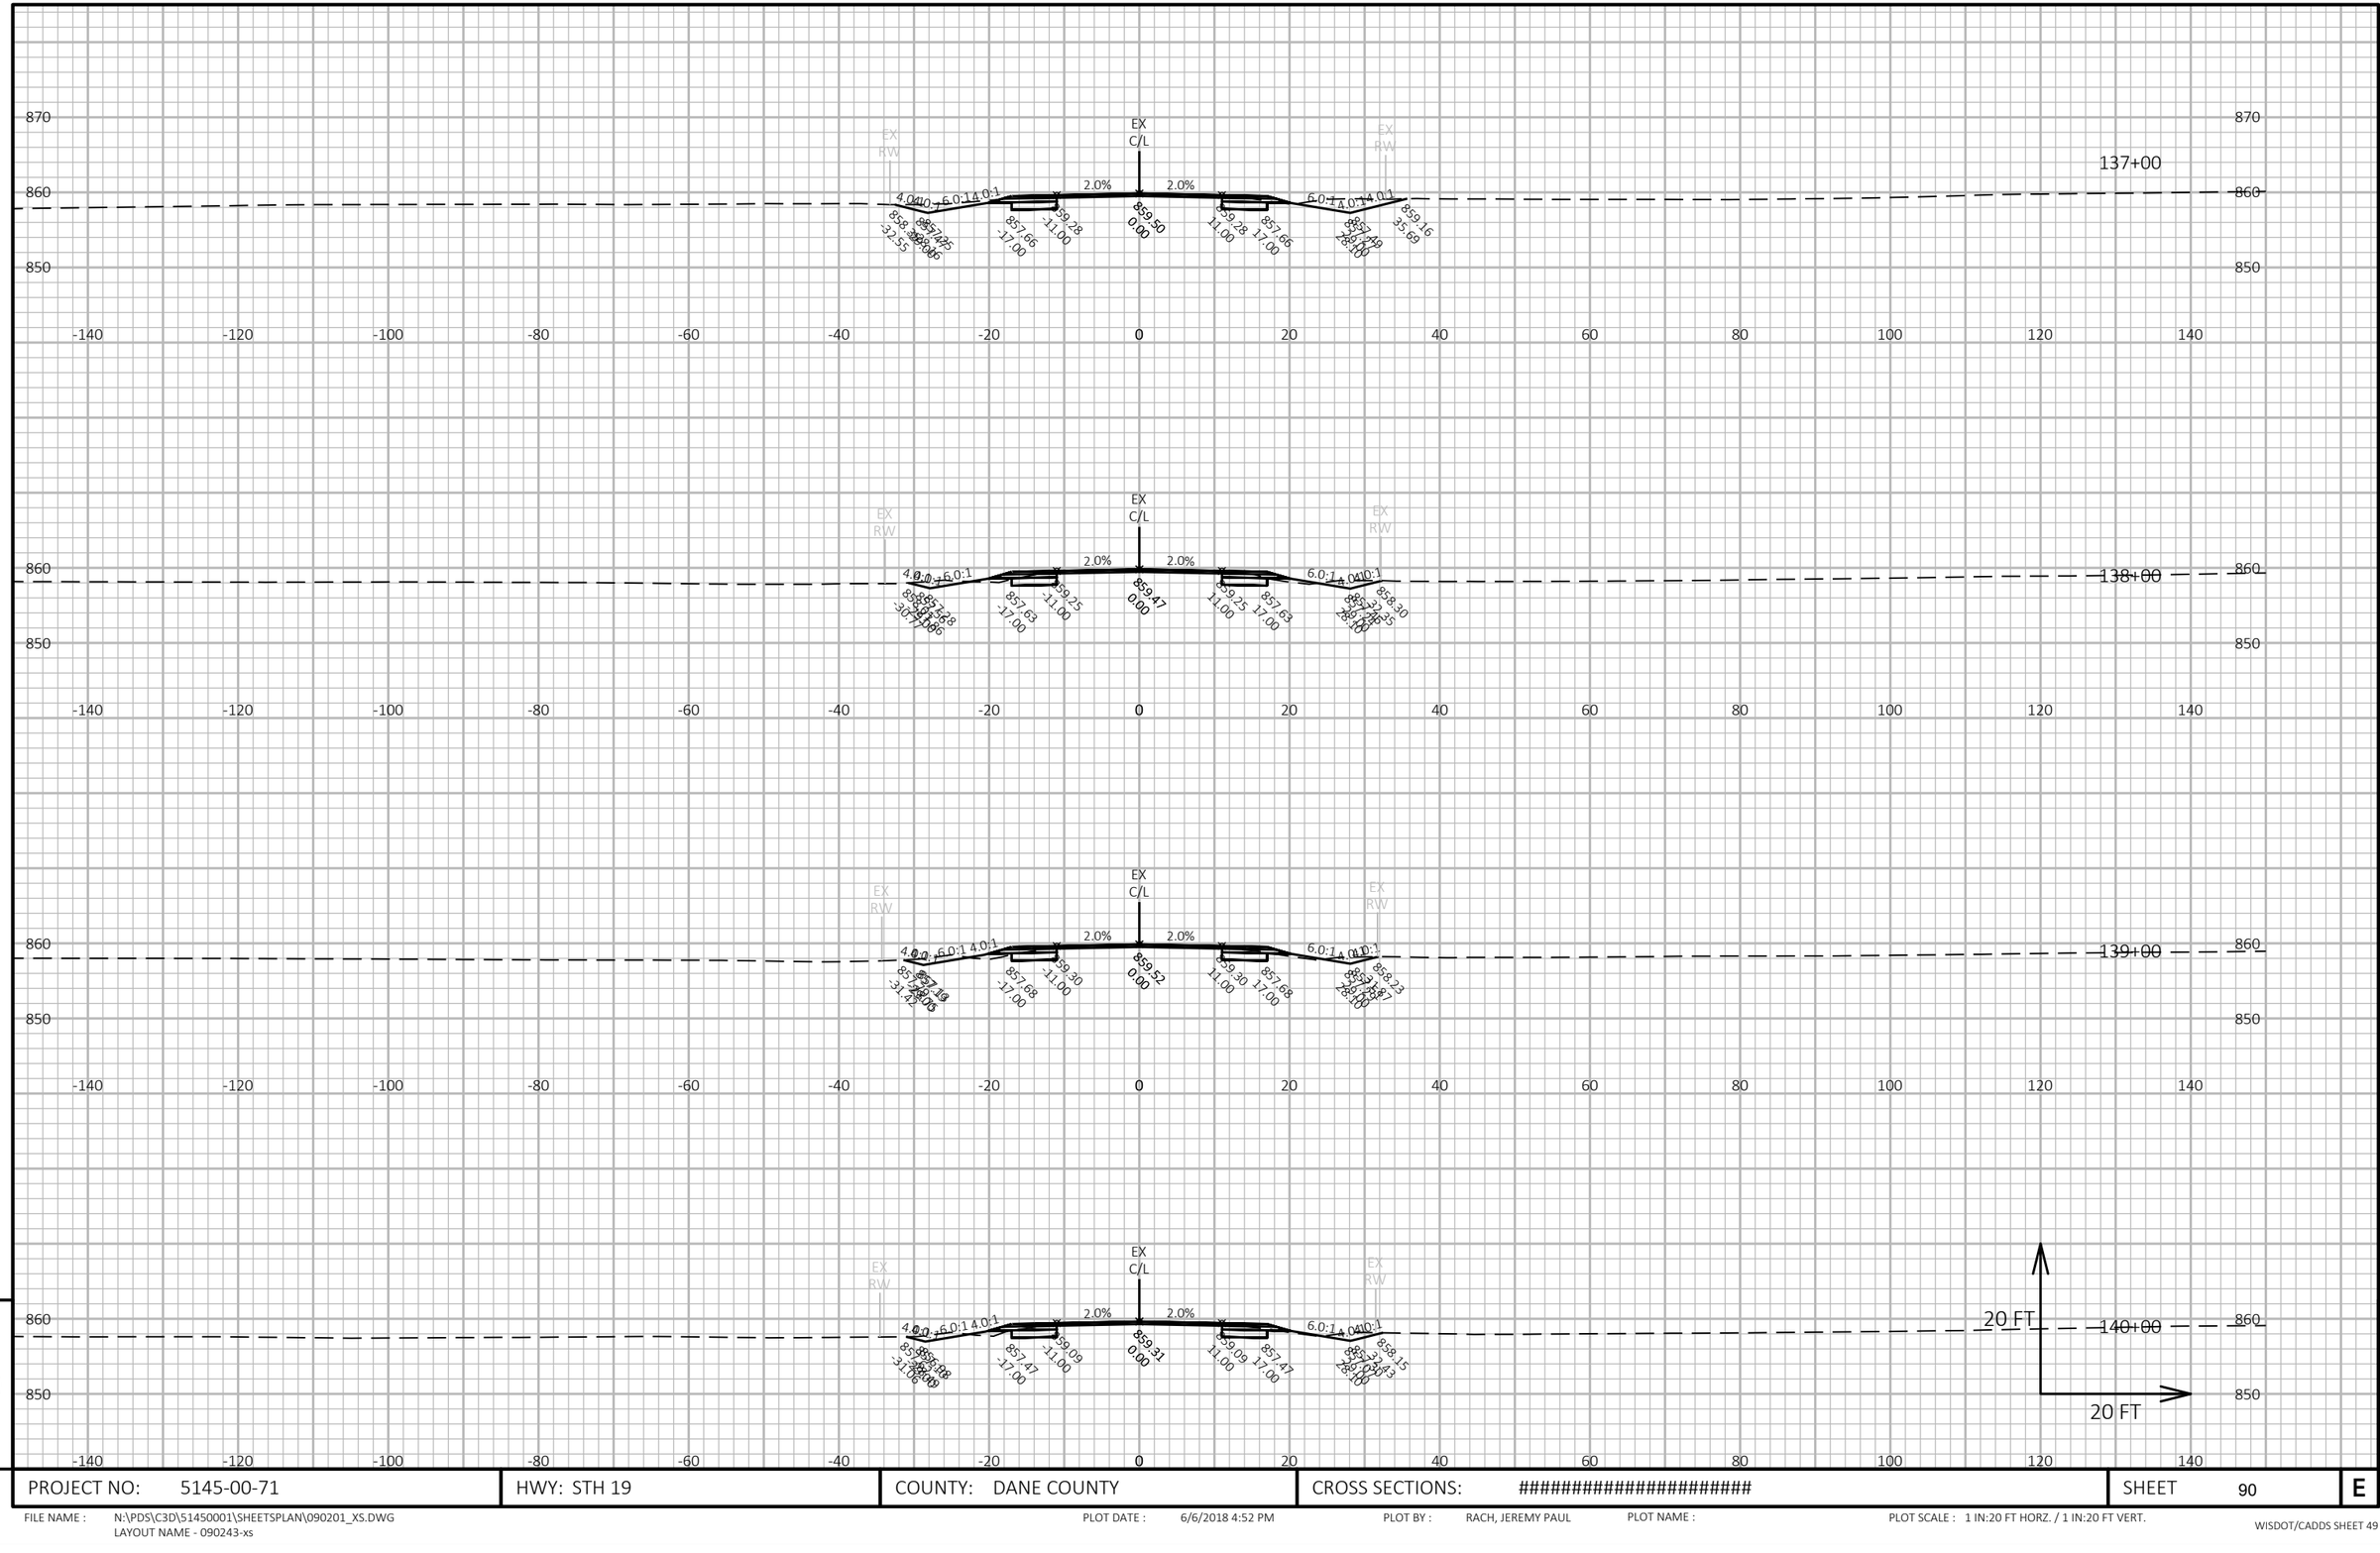
137+00
138+00
139+00
140+00
EX C/L
EX R/W
2.0%
4.0:1
6.0:1
859.50
859.47
859.52
859.31
857.66
857.63
857.68
857.47
859.28
859.25
859.30
859.09
859.16
858.30
858.23
858.15
857.49
857.43
857.47
857.41
857.05
857.00
857.03
857.00
857.01
857.00
857.00
857.00

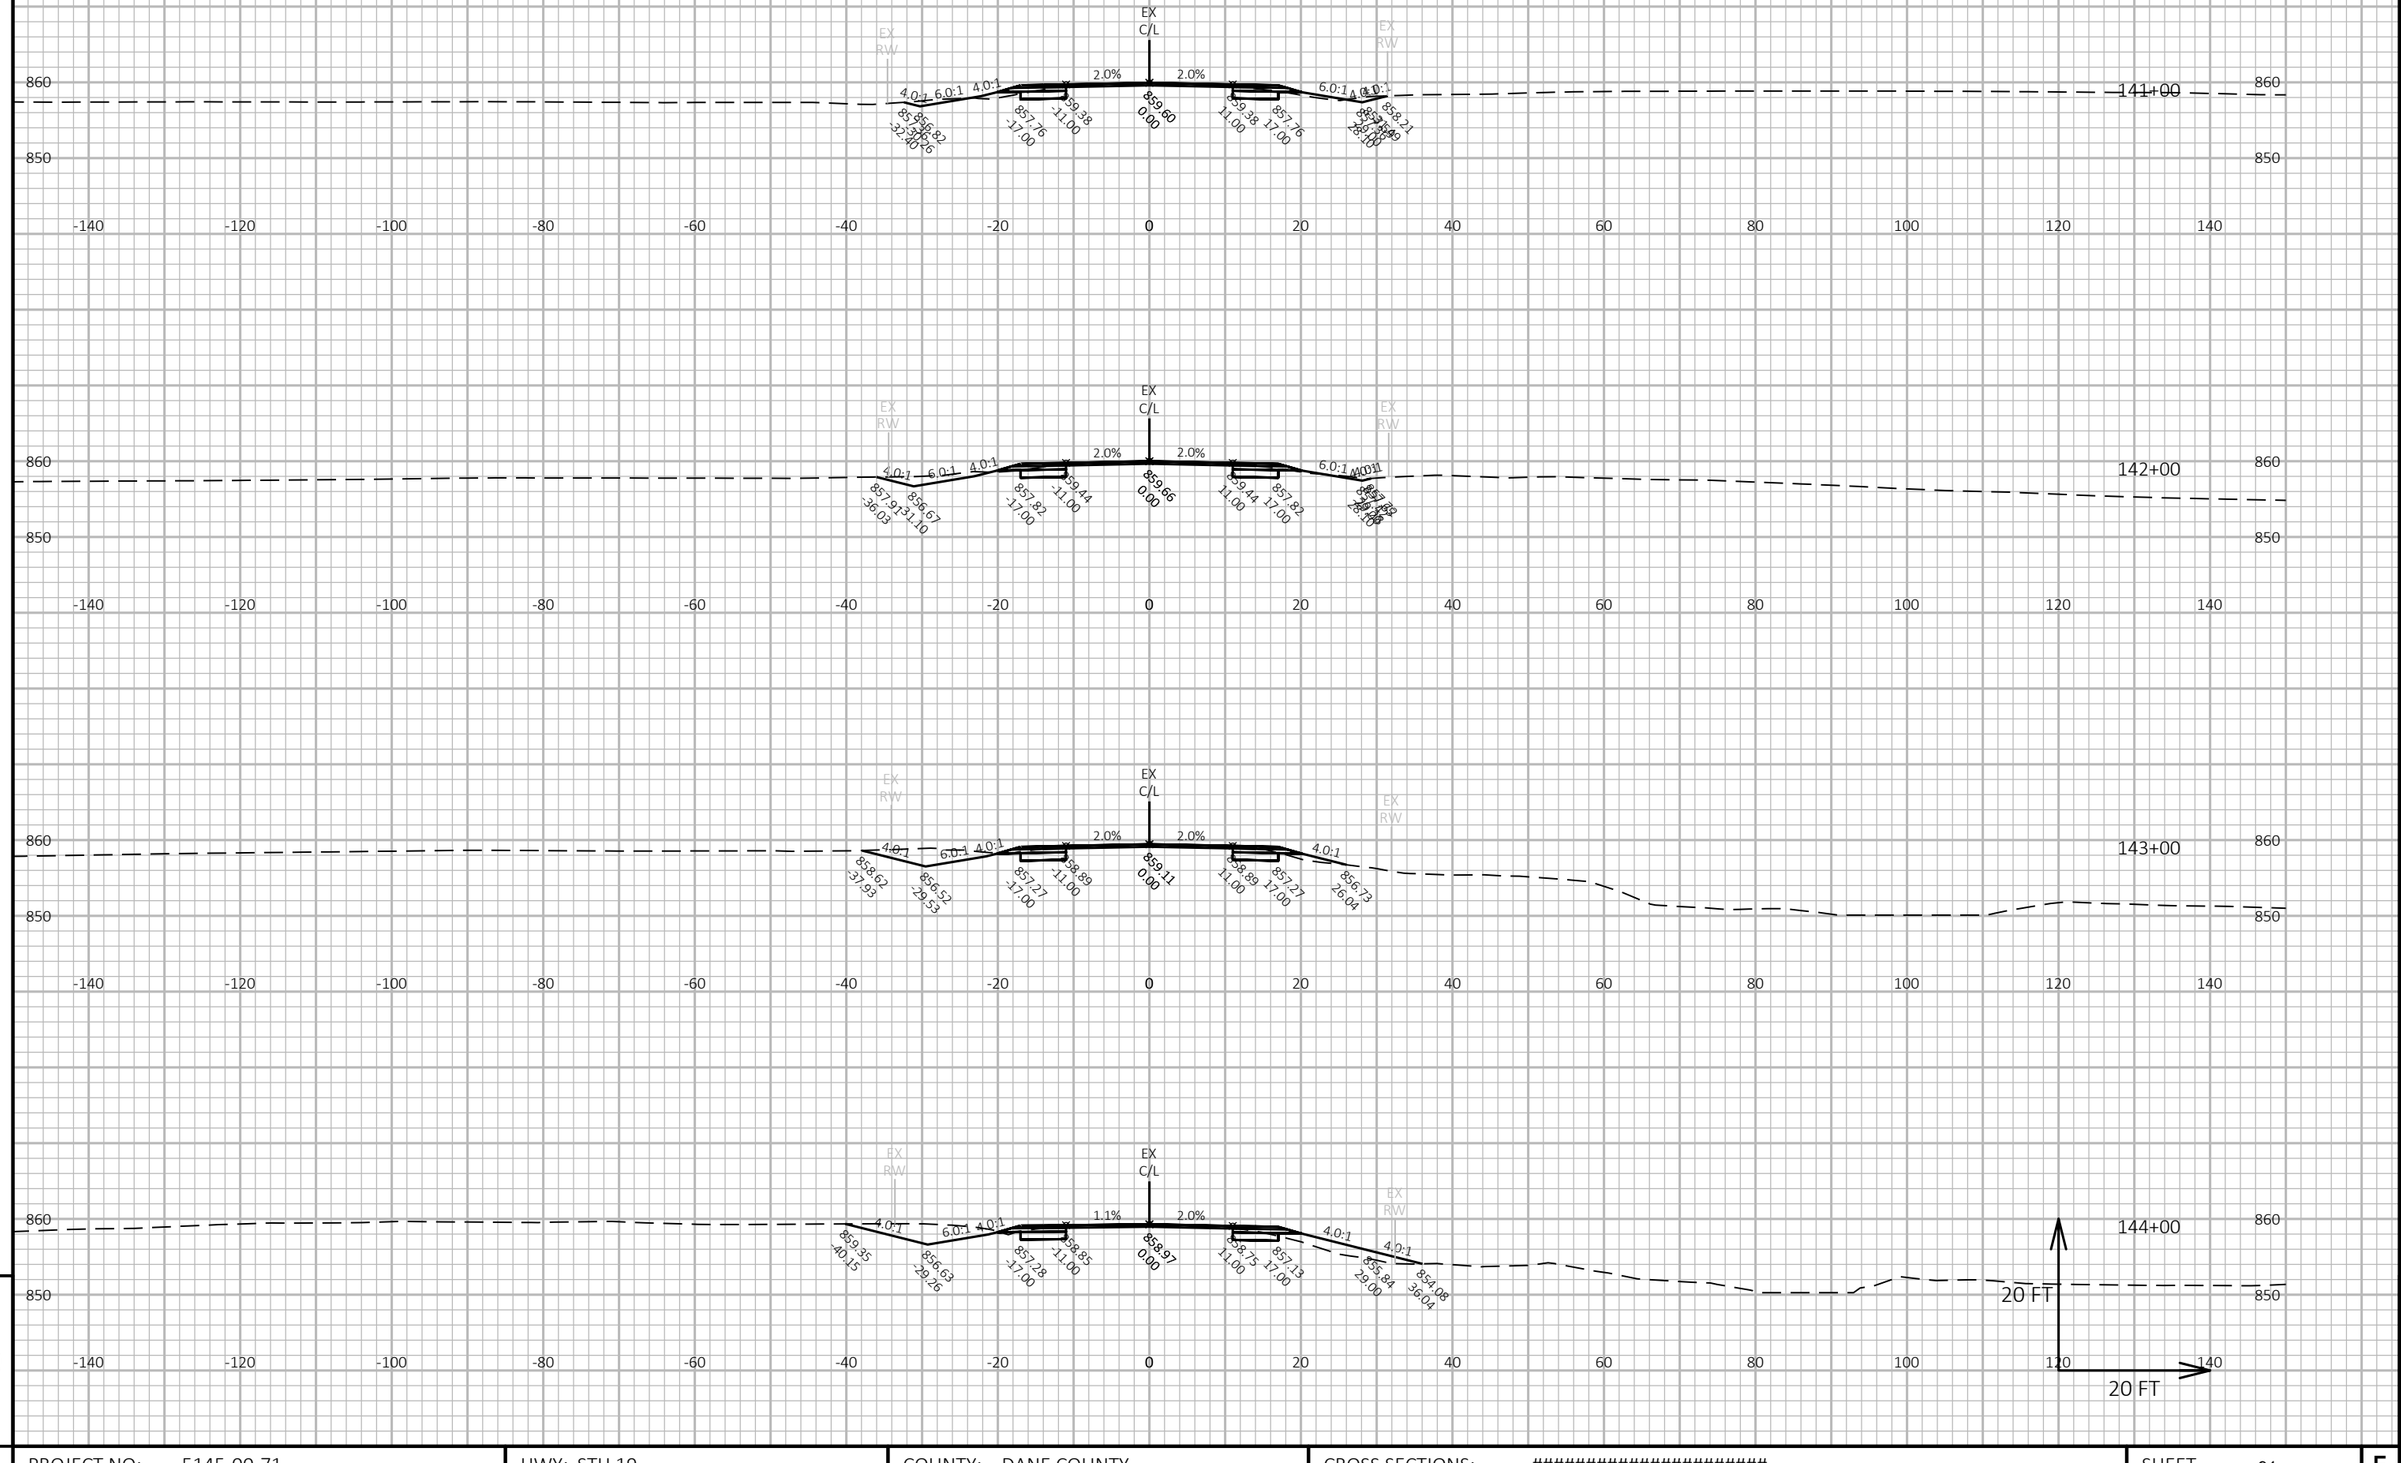

9

PROJECT NO: 5145-00-71	HWY: STH 19	COUNTY: DANE COUNTY	CROSS SECTIONS: ##########################	SHEET 91	E

FILE NAME : N:\PDS\C3D\51450001\SHEETSPLAN\090201_XS.DWG
LAYOUT NAME - 090244-xs

PLOT DATE : 6/6/2018 4:53 PM PLOT BY : RACH, JEREMY PAUL PLOT NAME : PLOT SCALE : 1 IN:20 FT HORZ. / 1 IN:20 FT VERT.

9

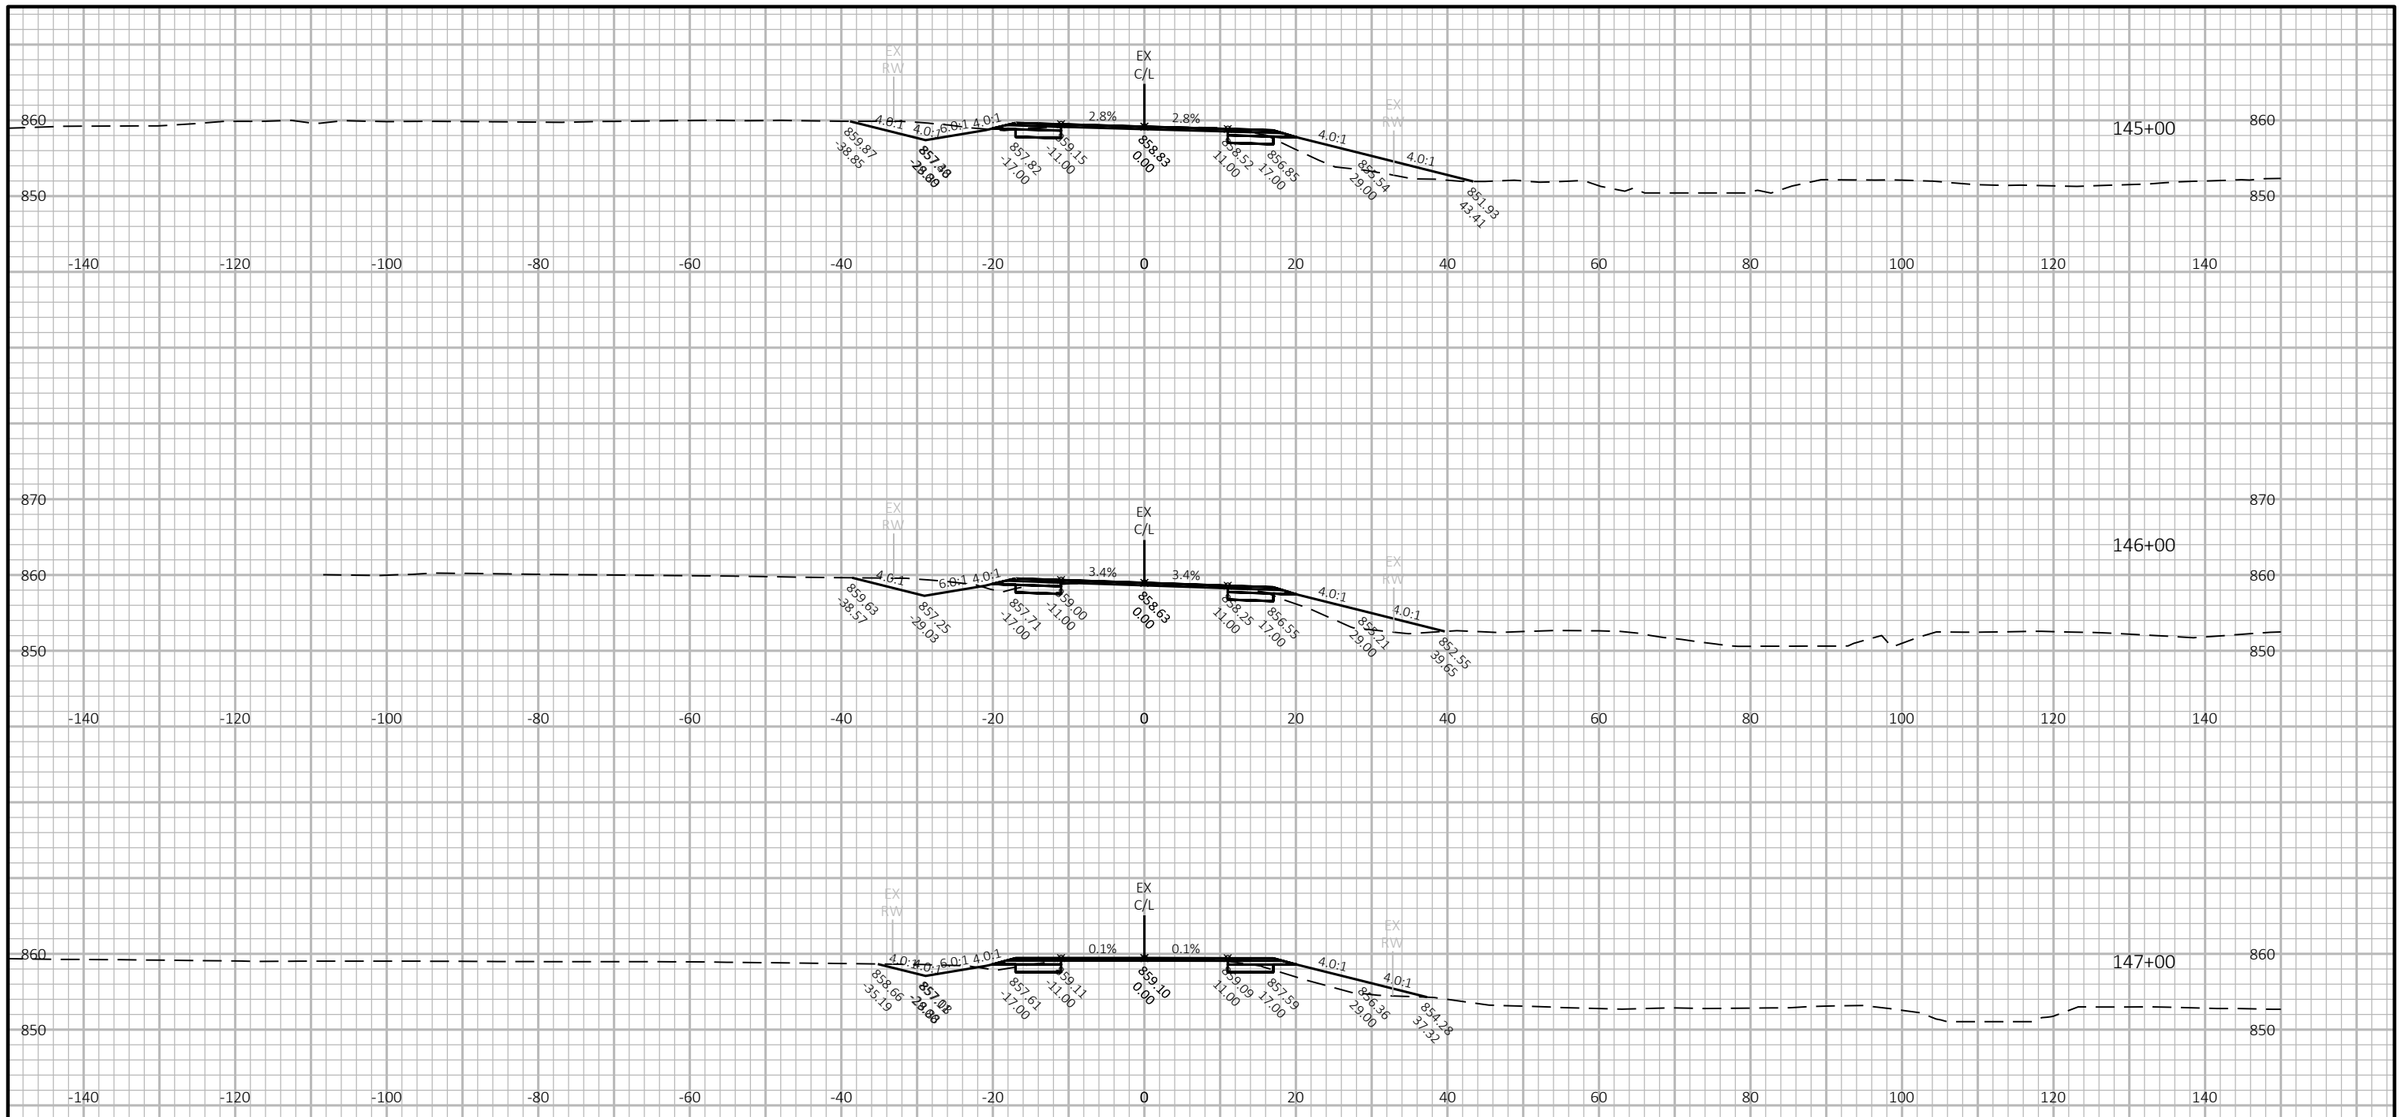

9

9

PROJECT NO: 5145-00-71	HWY: STH 19	COUNTY: DANE COUNTY	CROSS SECTIONS: ##########################	SHEET 92	E

FILE NAME : N:\PDS\C3D\51450001\SHEETSPLAN\090201_XS.DWG
LAYOUT NAME - 090245-xs

PLOT DATE : 6/6/2018 4:53 PM

PLOT BY : RACH, JEREMY PAUL

PLOT NAME :

PLOT SCALE : 1 IN:20 FT HORZ. / 1 IN:20 FT VERT.

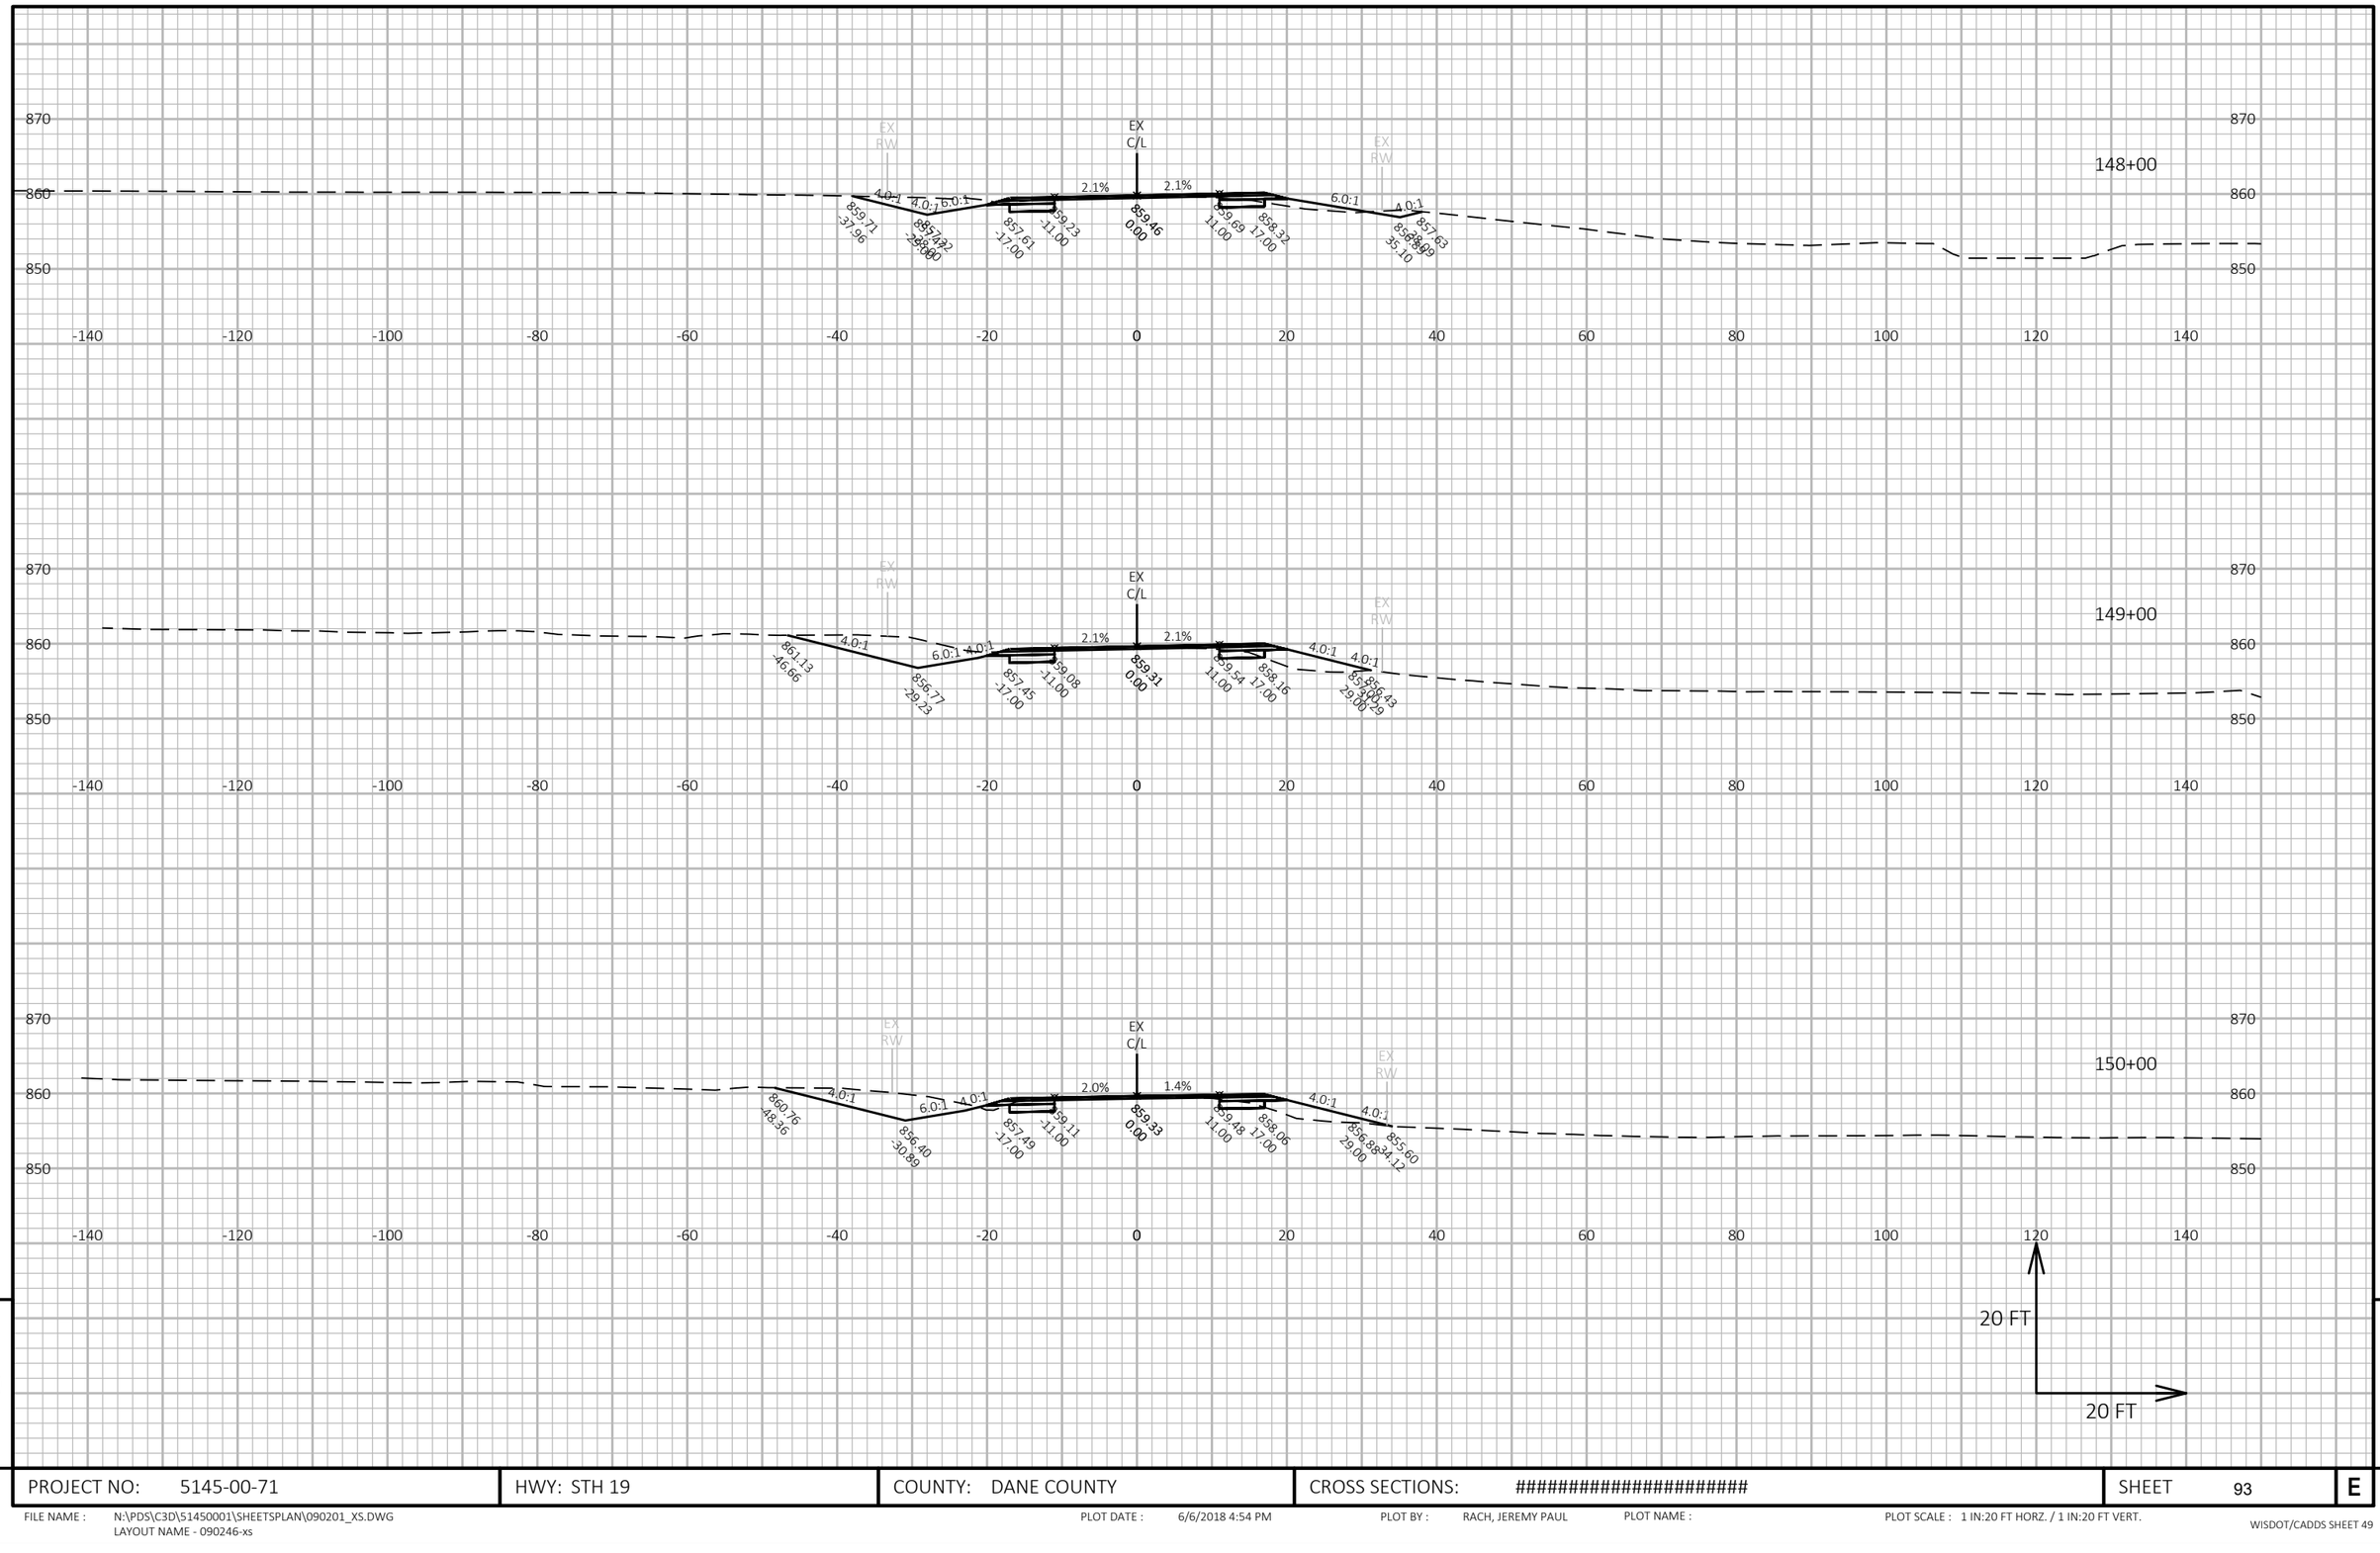

9

9

PROJECT NO: 5145-00-71	HWY: STH 19	COUNTY: DANE COUNTY	CROSS SECTIONS: ##########################	SHEET 93	E

FILE NAME : N:\PDS\C3D\51450001\SHEETSPLAN\090201_XS.DWG
LAYOUT NAME - 090246-xs

PLOT DATE : 6/6/2018 4:54 PM PLOT BY : RACH, JEREMY PAUL PLOT NAME : PLOT SCALE : 1 IN:20 FT HORZ. / 1 IN:20 FT VERT.

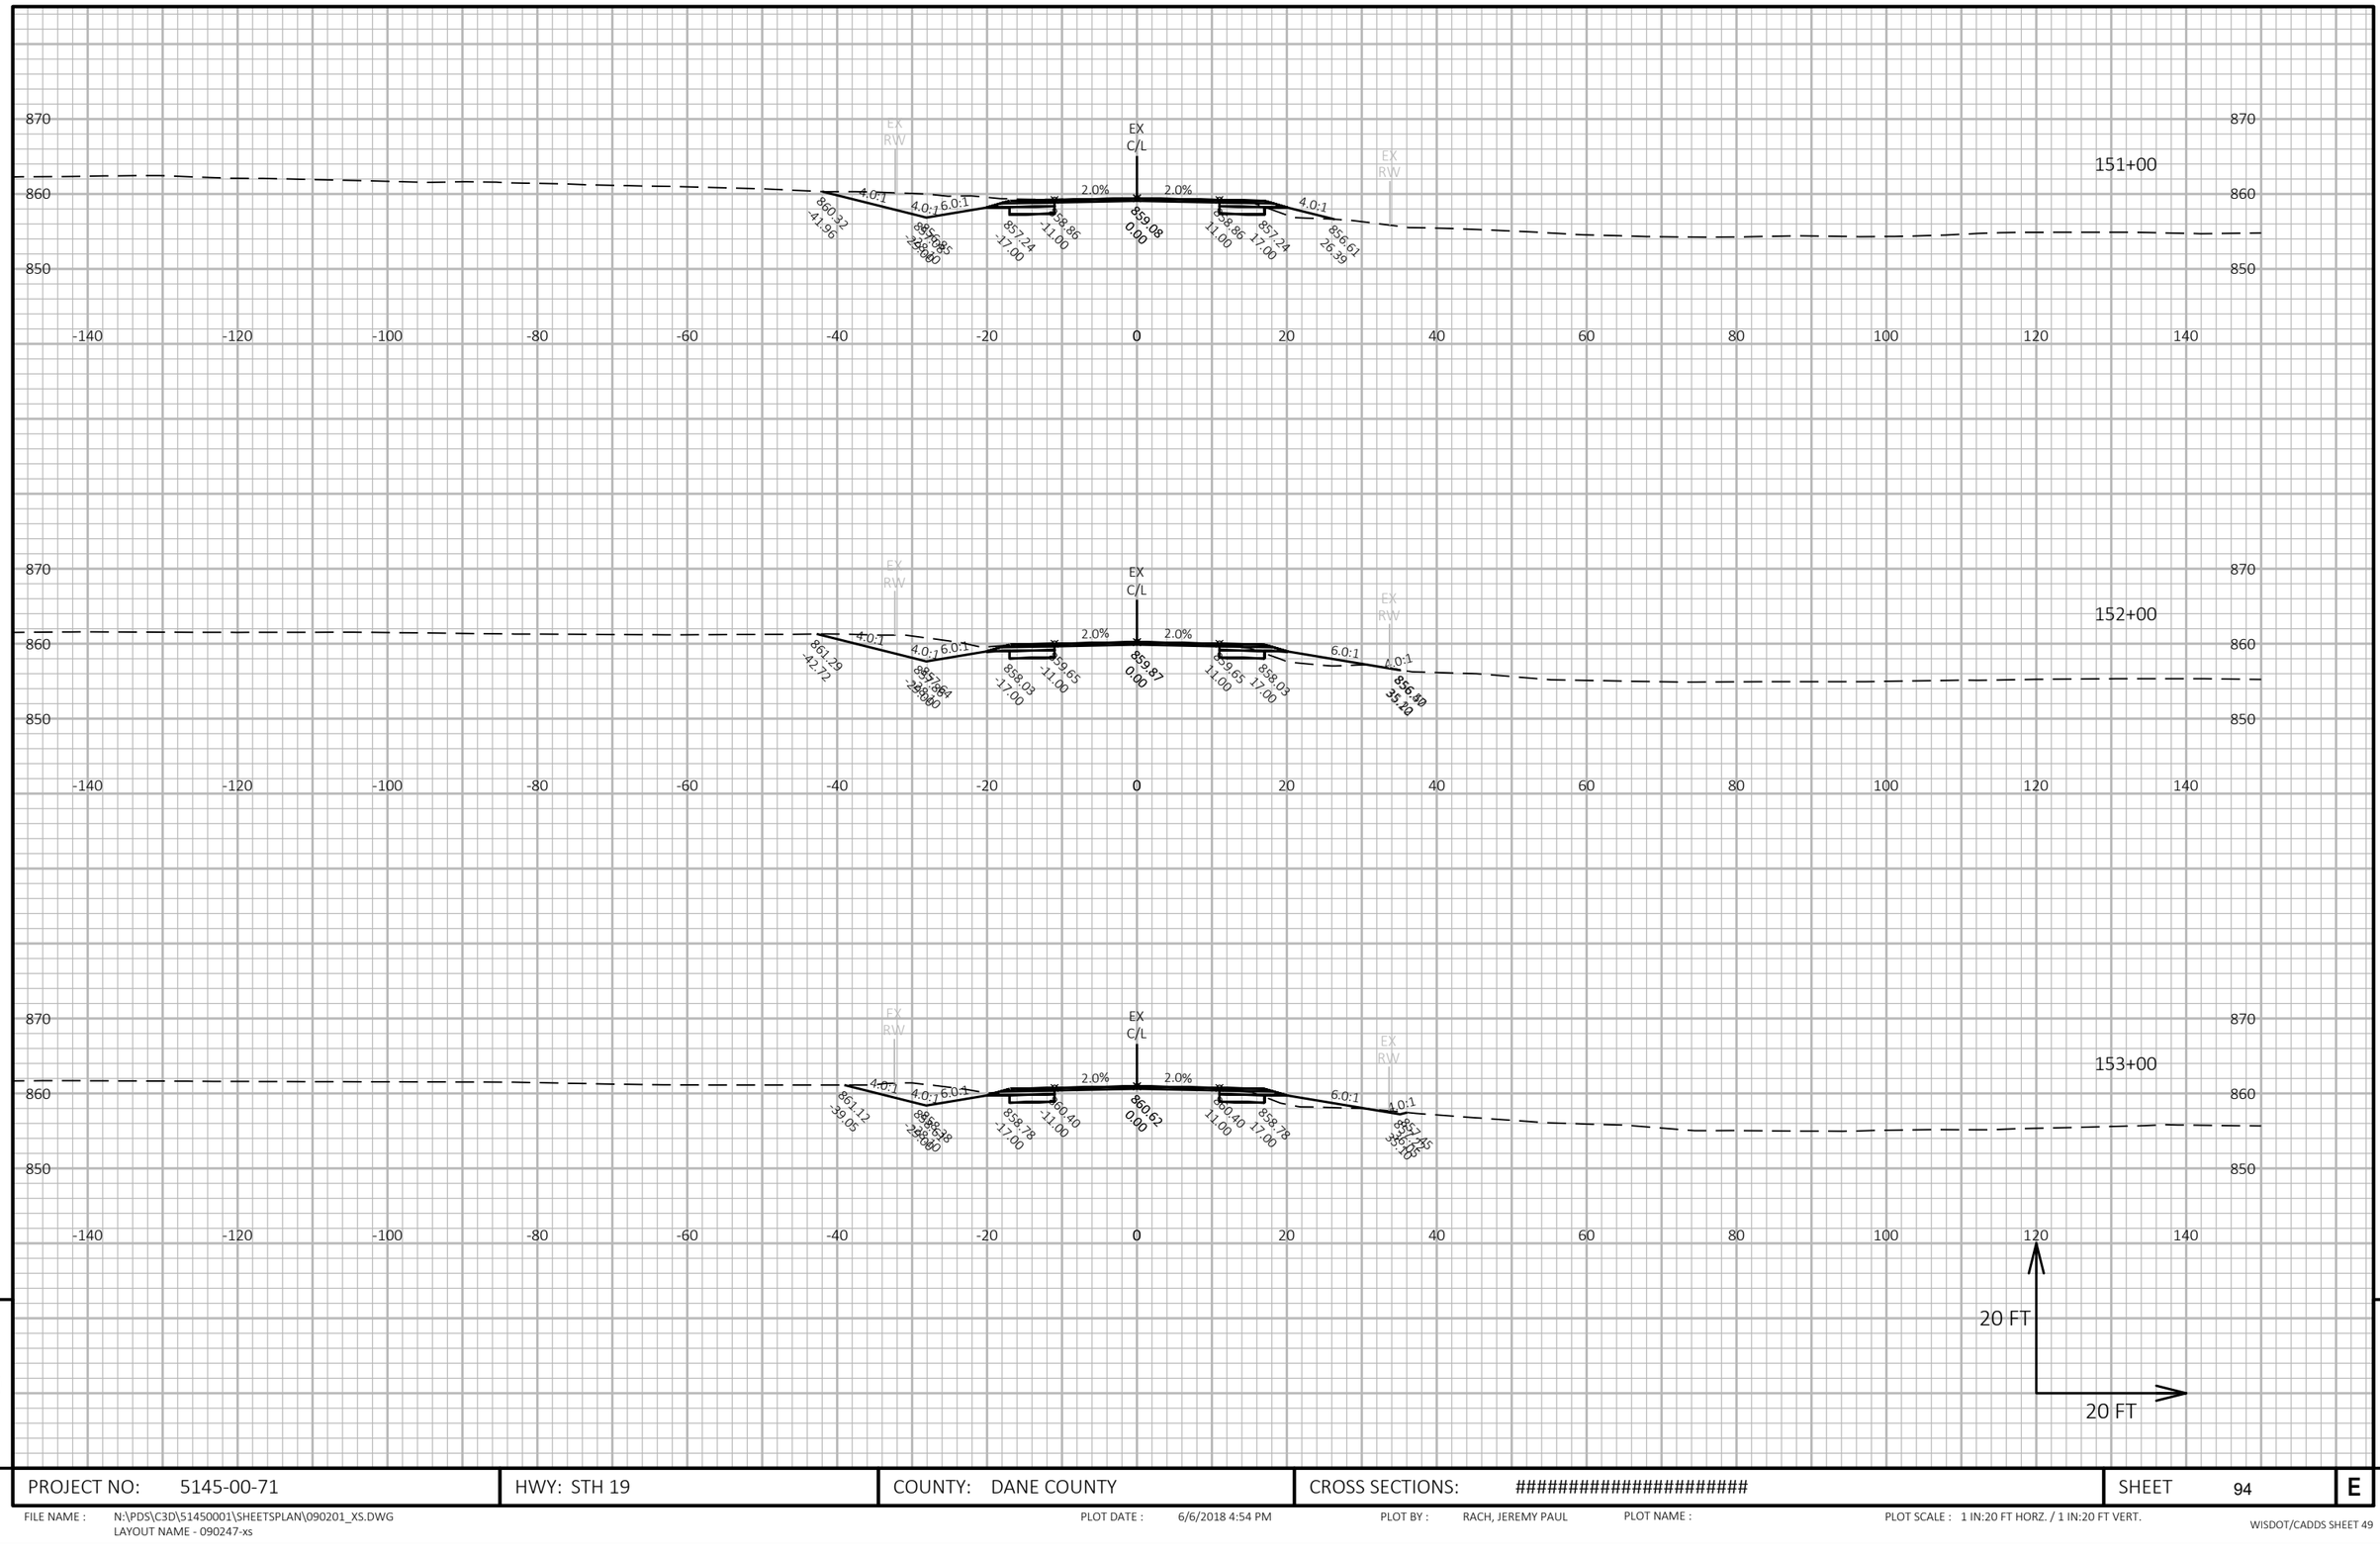

9

9

PROJECT NO: 5145-00-71	HWY: STH 19	COUNTY: DANE COUNTY	CROSS SECTIONS: ##########################	SHEET 94	E

FILE NAME : N:\PDS\C3D\51450001\SHEETSPLAN\090201_XS.DWG
LAYOUT NAME - 090247-xs

PLOT DATE : 6/6/2018 4:54 PM

PLOT BY : RACH, JEREMY PAUL

PLOT NAME :

PLOT SCALE : 1 IN:20 FT HORZ. / 1 IN:20 FT VERT.

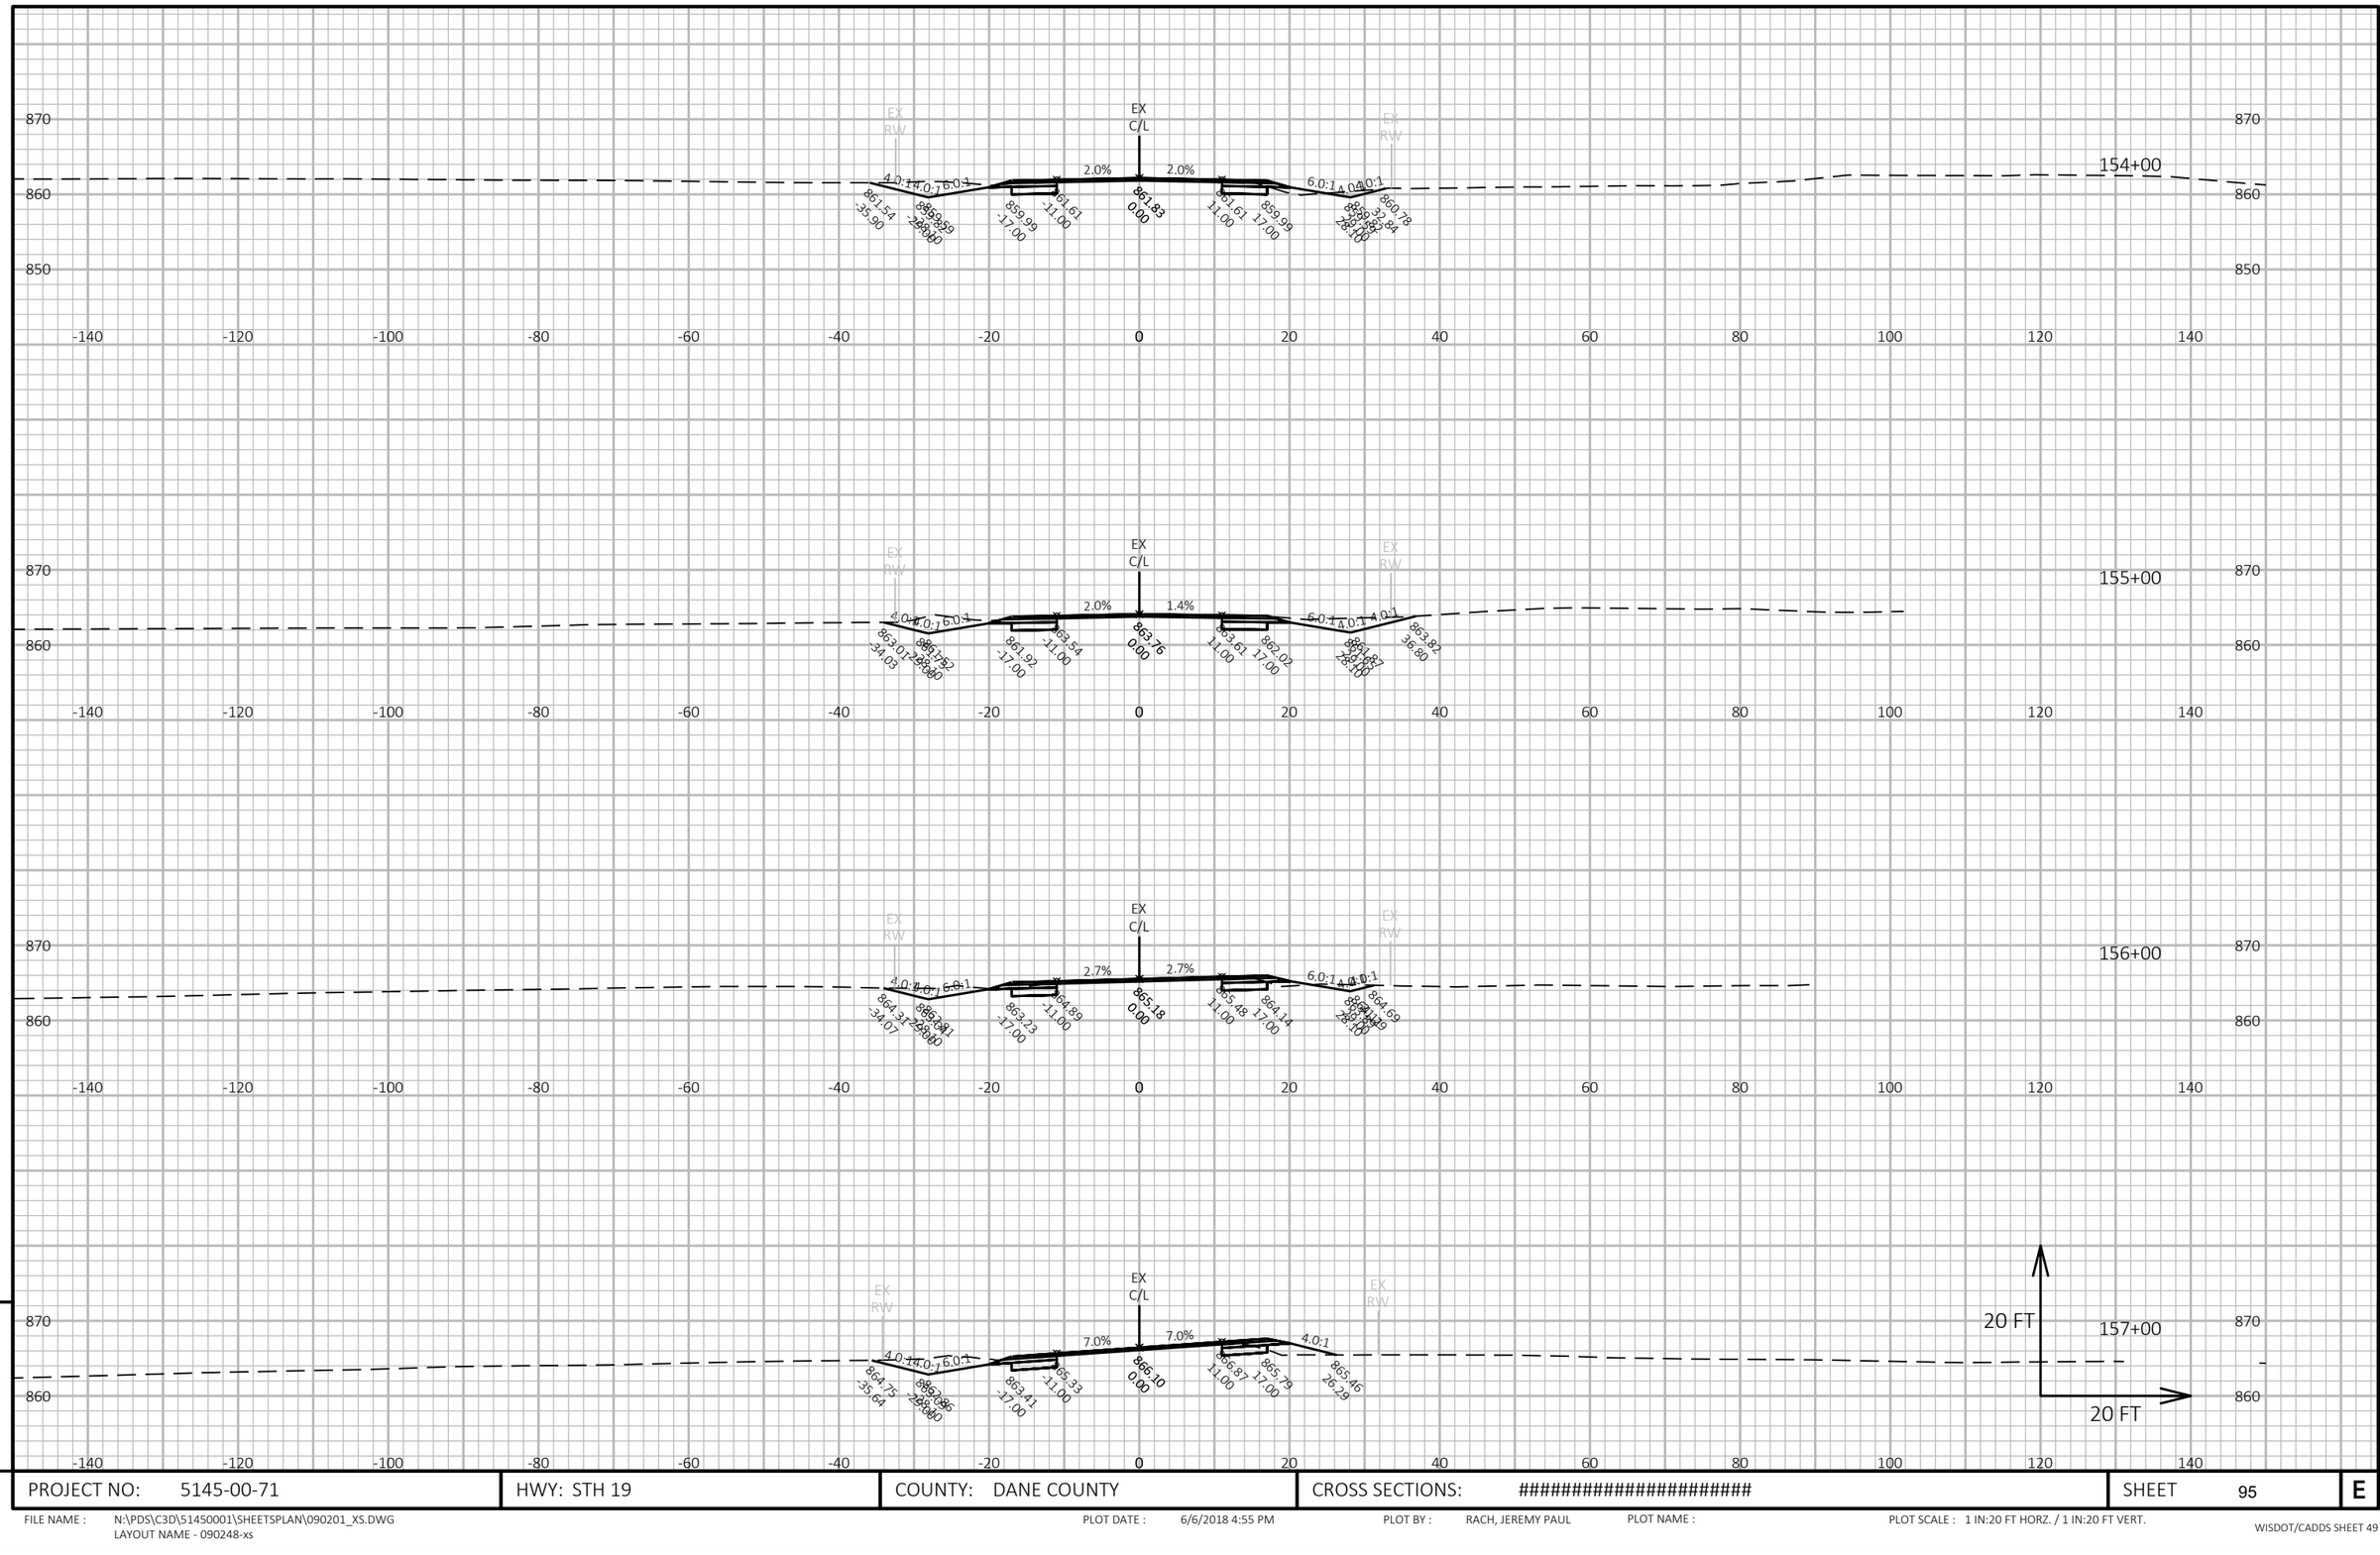

9

PROJECT NO: 5145-00-71	HWY: STH 19	COUNTY: DANE COUNTY	CROSS SECTIONS: ##########################	SHEET 95	E

FILE NAME : N:\PDS\C3D\51450001\SHEETSPLAN\090201_XS.DWG
LAYOUT NAME - 090248-xs
PLOT DATE : 6/6/2018 4:55 PM
PLOT BY : RACH, JEREMY PAUL
PLOT NAME :
PLOT SCALE : 1 IN:20 FT HORZ. / 1 IN:20 FT VERT.
WISDOT/CADDS SHEET 49

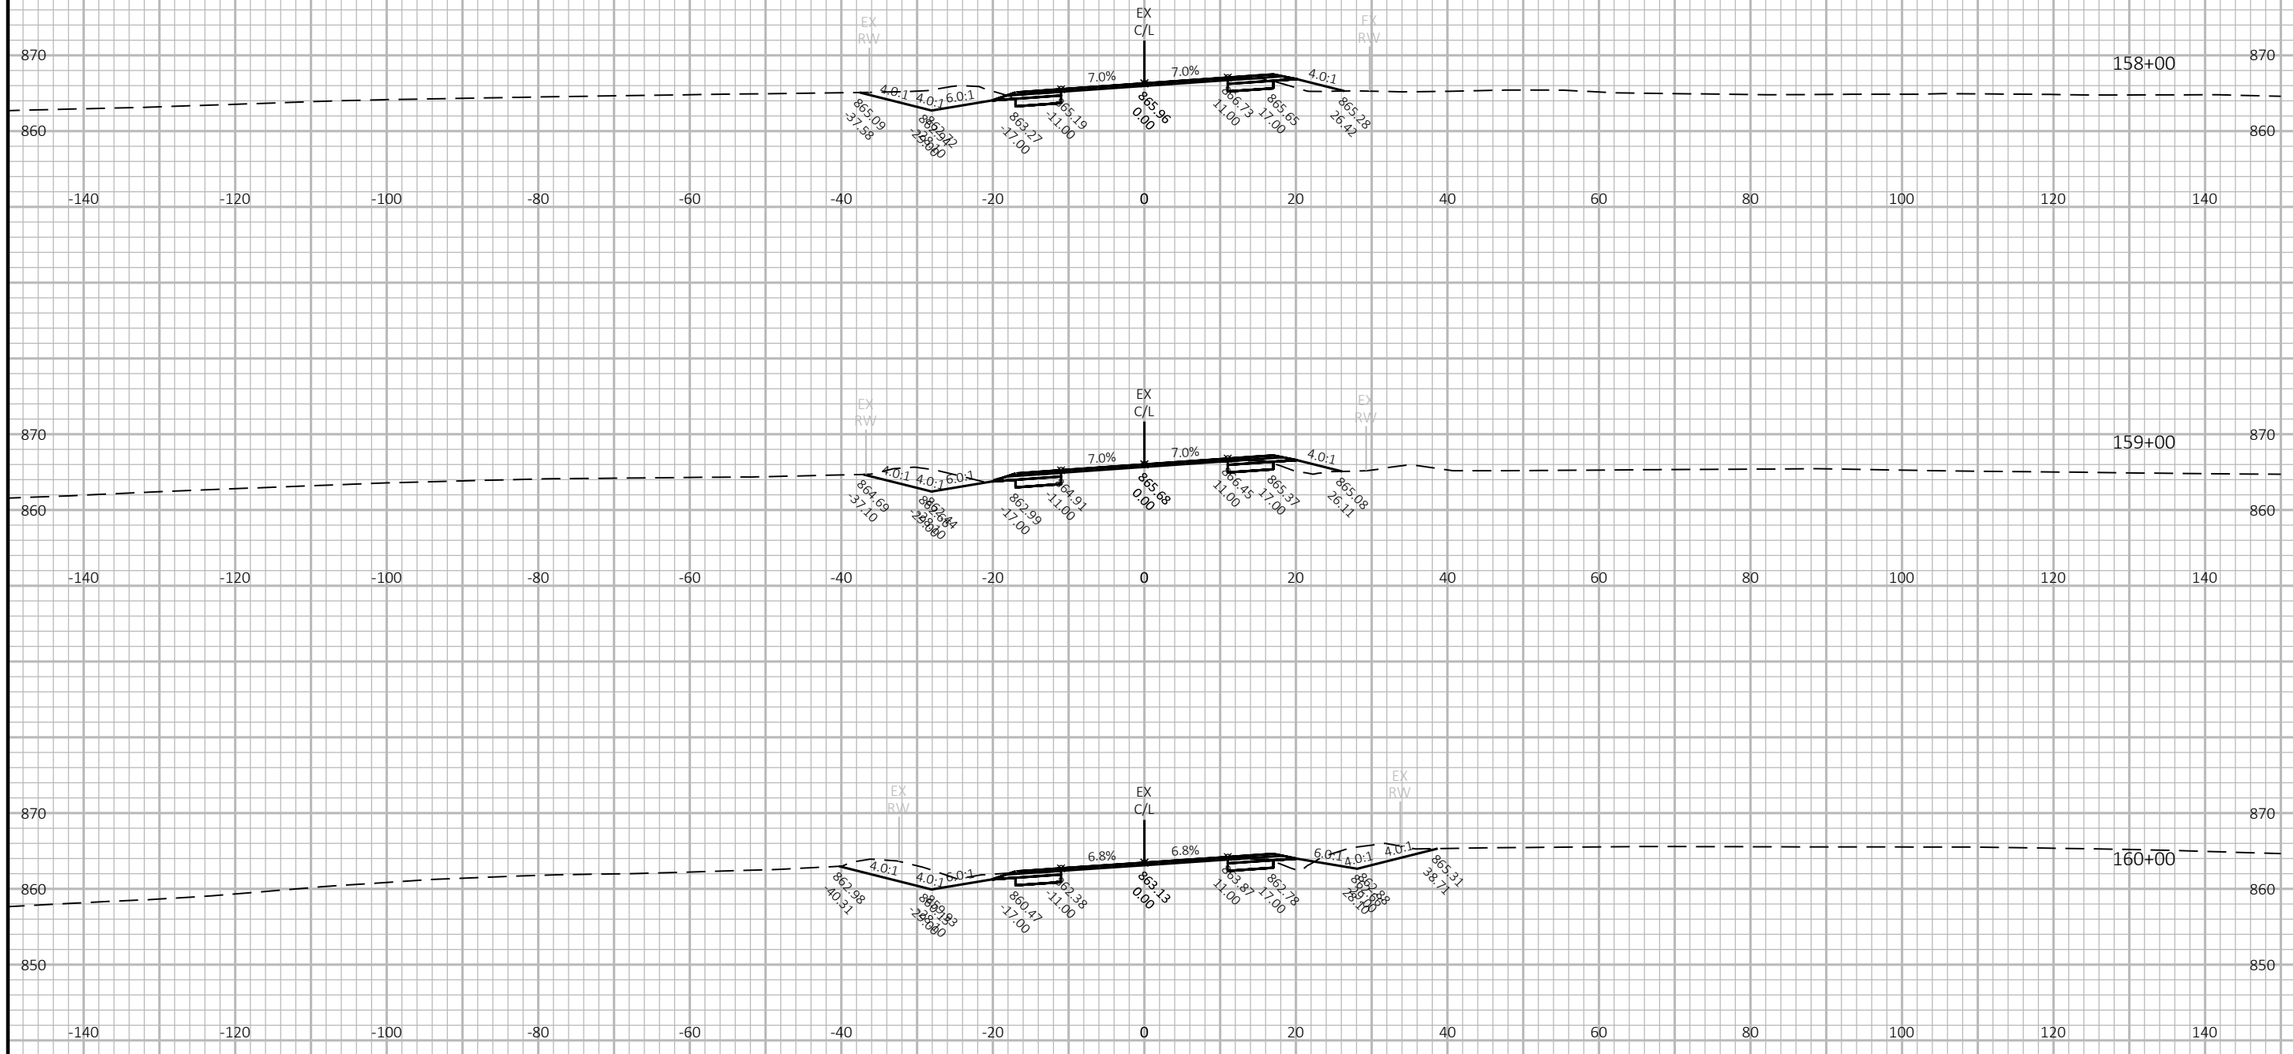

9

9

PROJECT NO: 5145-00-71	HWY: STH 19	COUNTY: DANE COUNTY	CROSS SECTIONS: ##########################	SHEET 96	E

FILE NAME : N:\PDS\C3D\51450001\SHEETSPLAN\090201_XS.DWG
LAYOUT NAME - 090249-xs

PLOT DATE : 6/6/2018 4:55 PM PLOT BY : RACH, JEREMY PAUL PLOT NAME : PLOT SCALE : 1 IN:20 FT HORZ. / 1 IN:20 FT VERT.

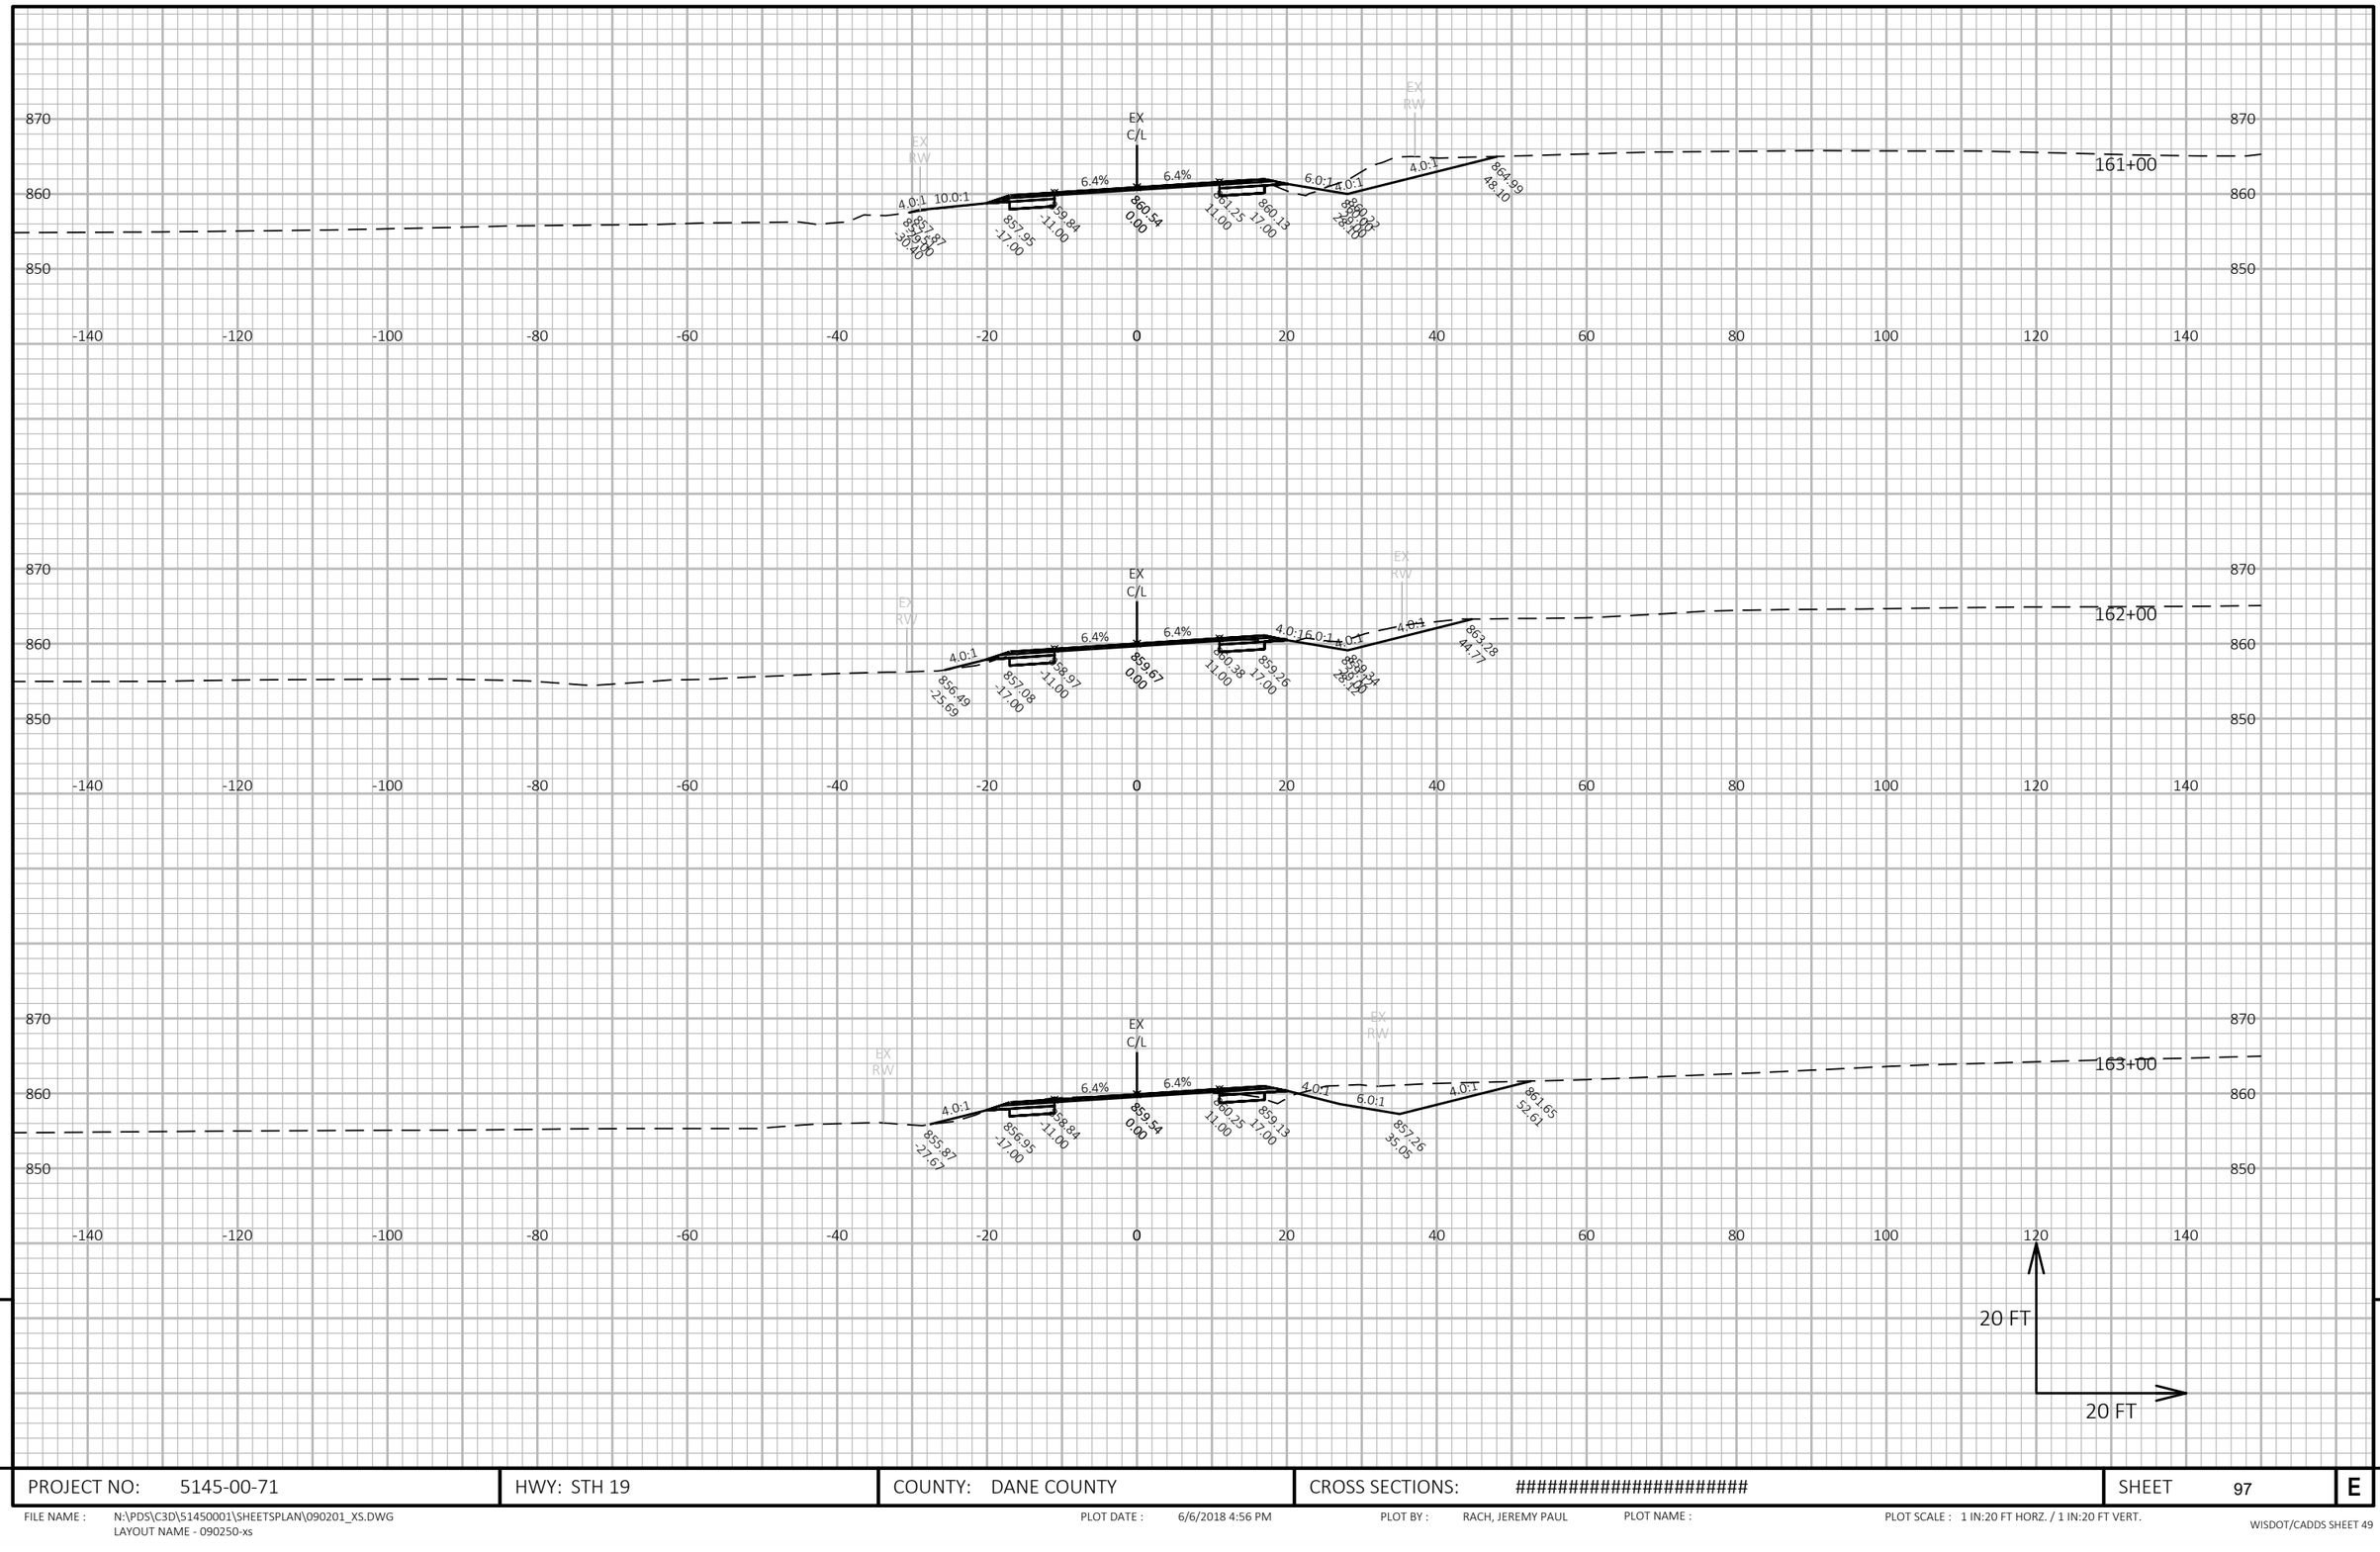

PROJECT NO: 5145-00-71	HWY: STH 19	COUNTY: DANE COUNTY	CROSS SECTIONS: ##########################	SHEET 97 E

FILE NAME : N:\PDS\C3D\51450001\SHEETSPLAN\090201_XS.DWG
LAYOUT NAME - 090250-xs

PLOT DATE : 6/6/2018 4:56 PM PLOT BY : RACH, JEREMY PAUL PLOT NAME : PLOT SCALE : 1 IN:20 FT HORZ. / 1 IN:20 FT VERT.

WISDOT/CADDS SHEET 49

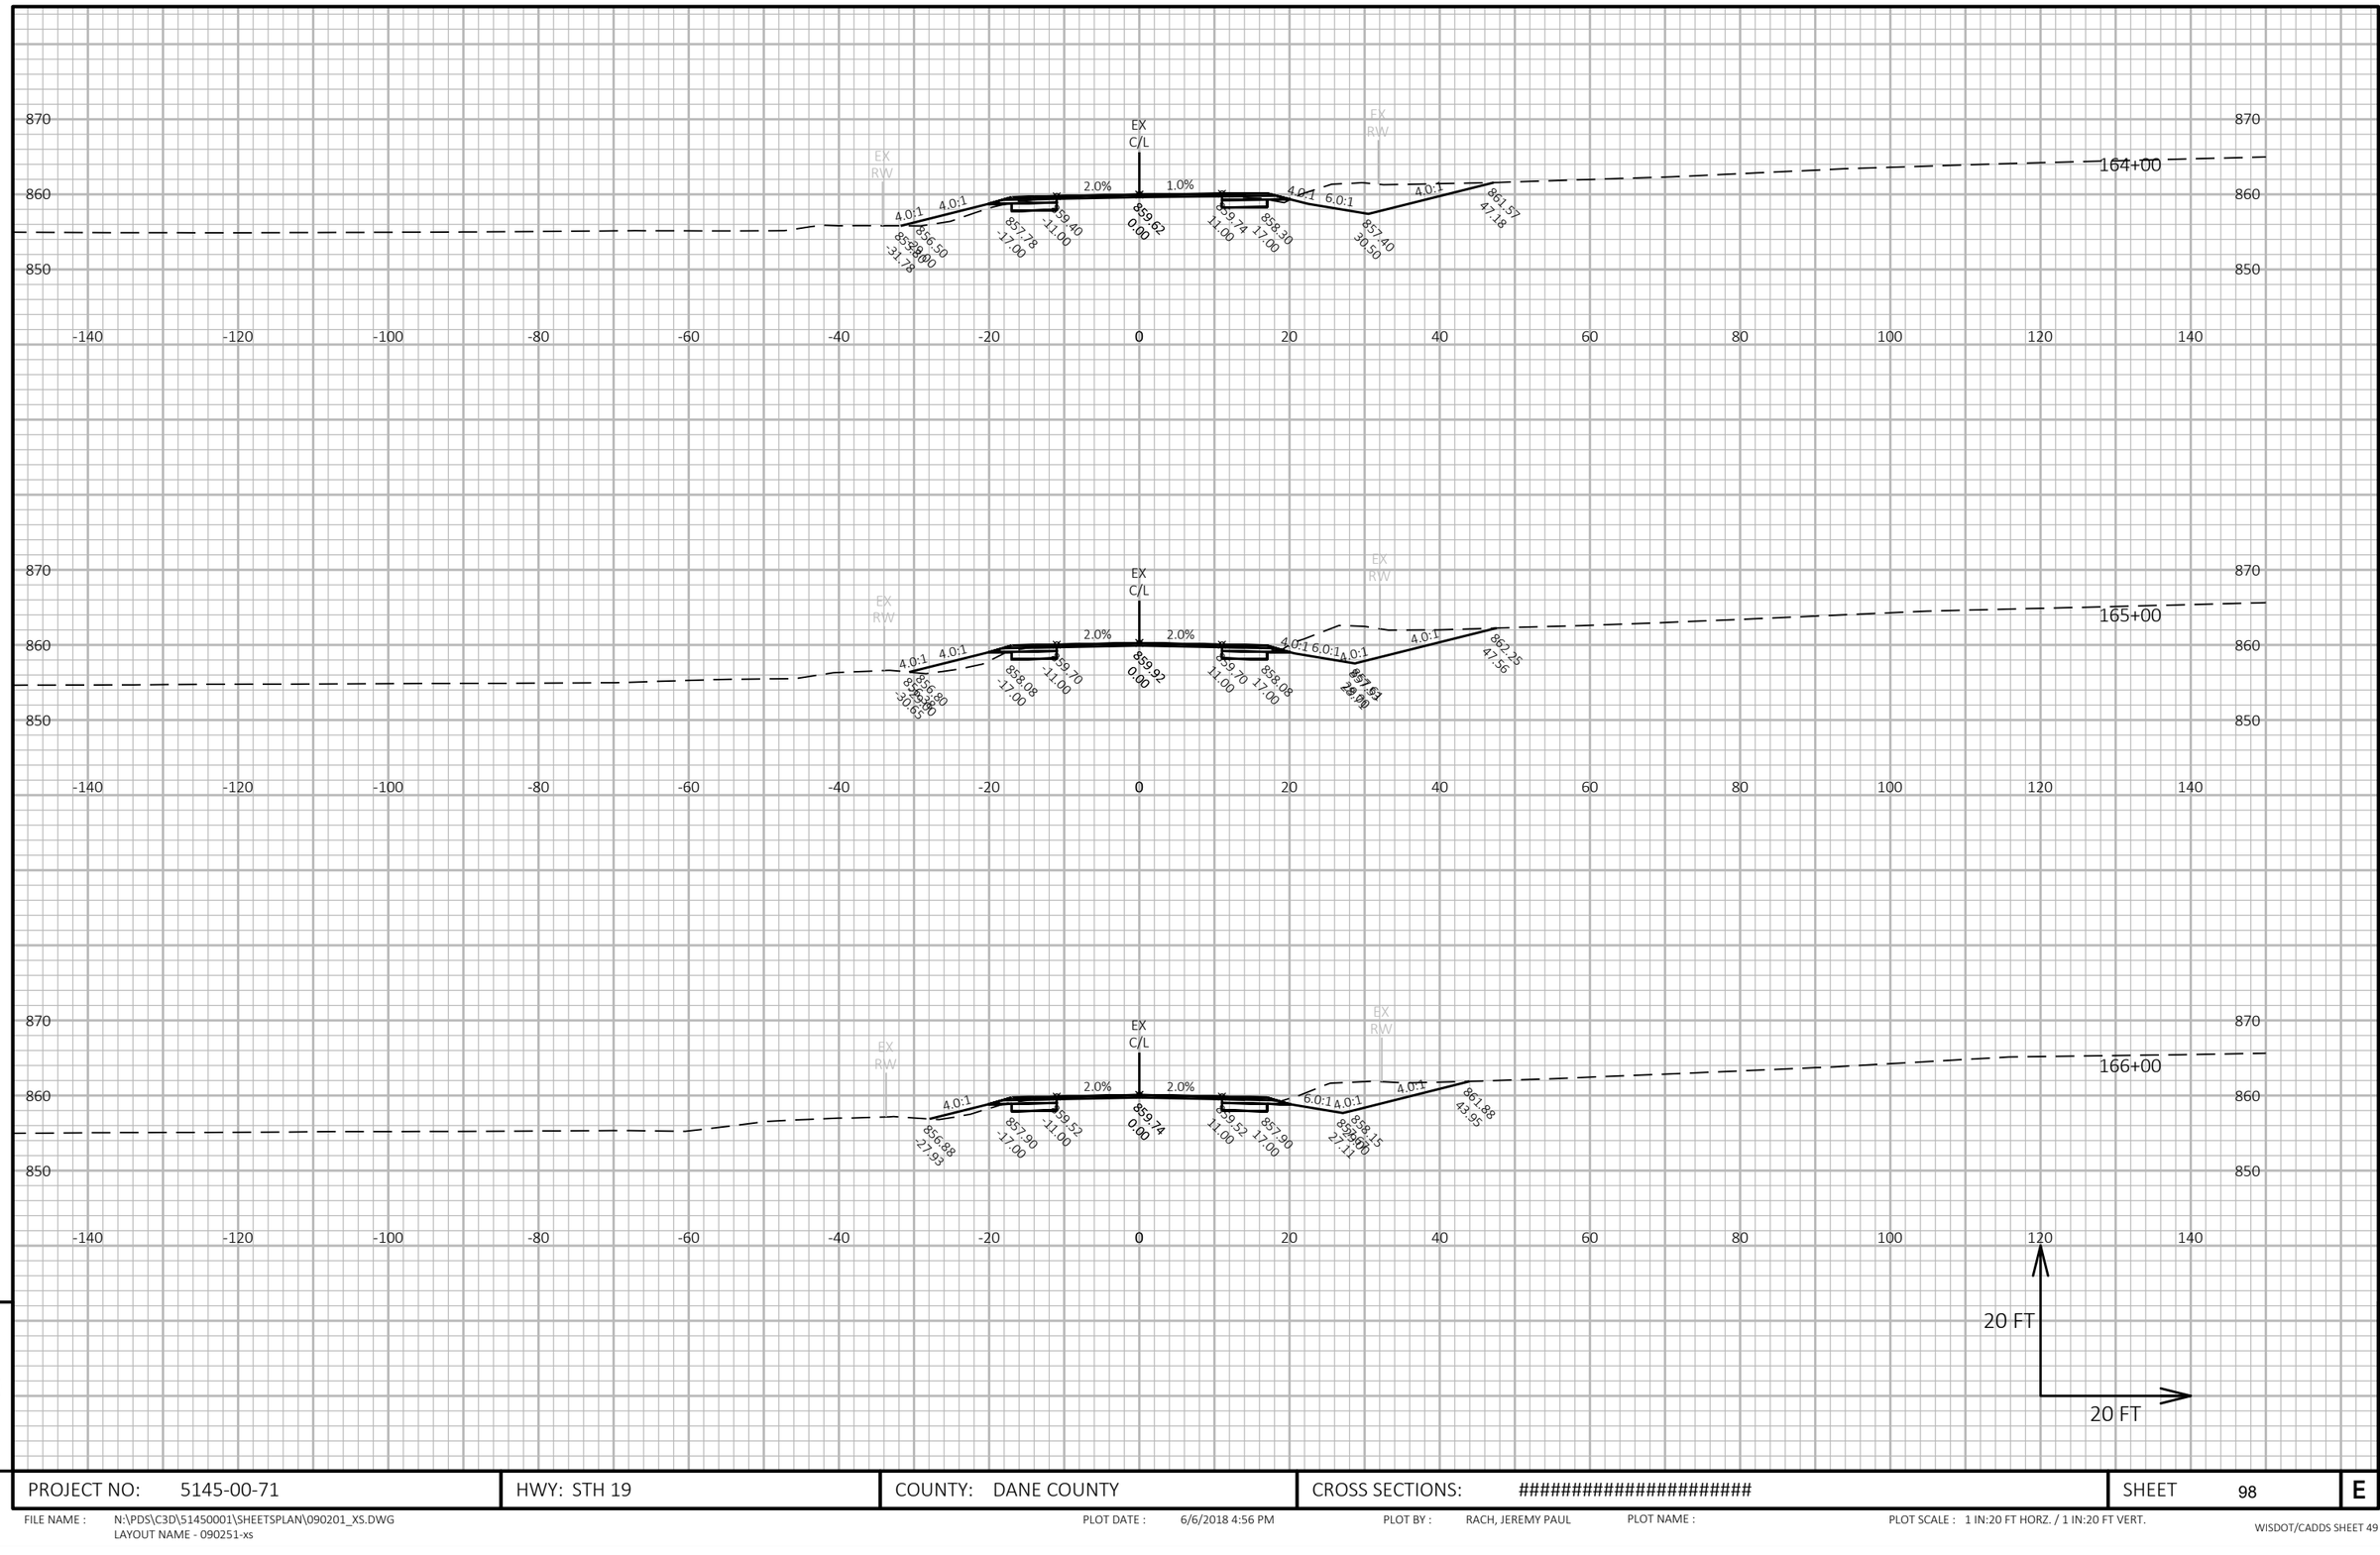

PROJECT NO: 5145-00-71	HWY: STH 19	COUNTY: DANE COUNTY	CROSS SECTIONS: ##########################	SHEET 98	E

FILE NAME : N:\PDS\C3D\51450001\SHEETSPLAN\090201_XS.DWG
LAYOUT NAME - 090251-xs

PLOT DATE : 6/6/2018 4:56 PM PLOT BY : RACH, JEREMY PAUL PLOT NAME : PLOT SCALE : 1 IN:20 FT HORZ. / 1 IN:20 FT VERT.

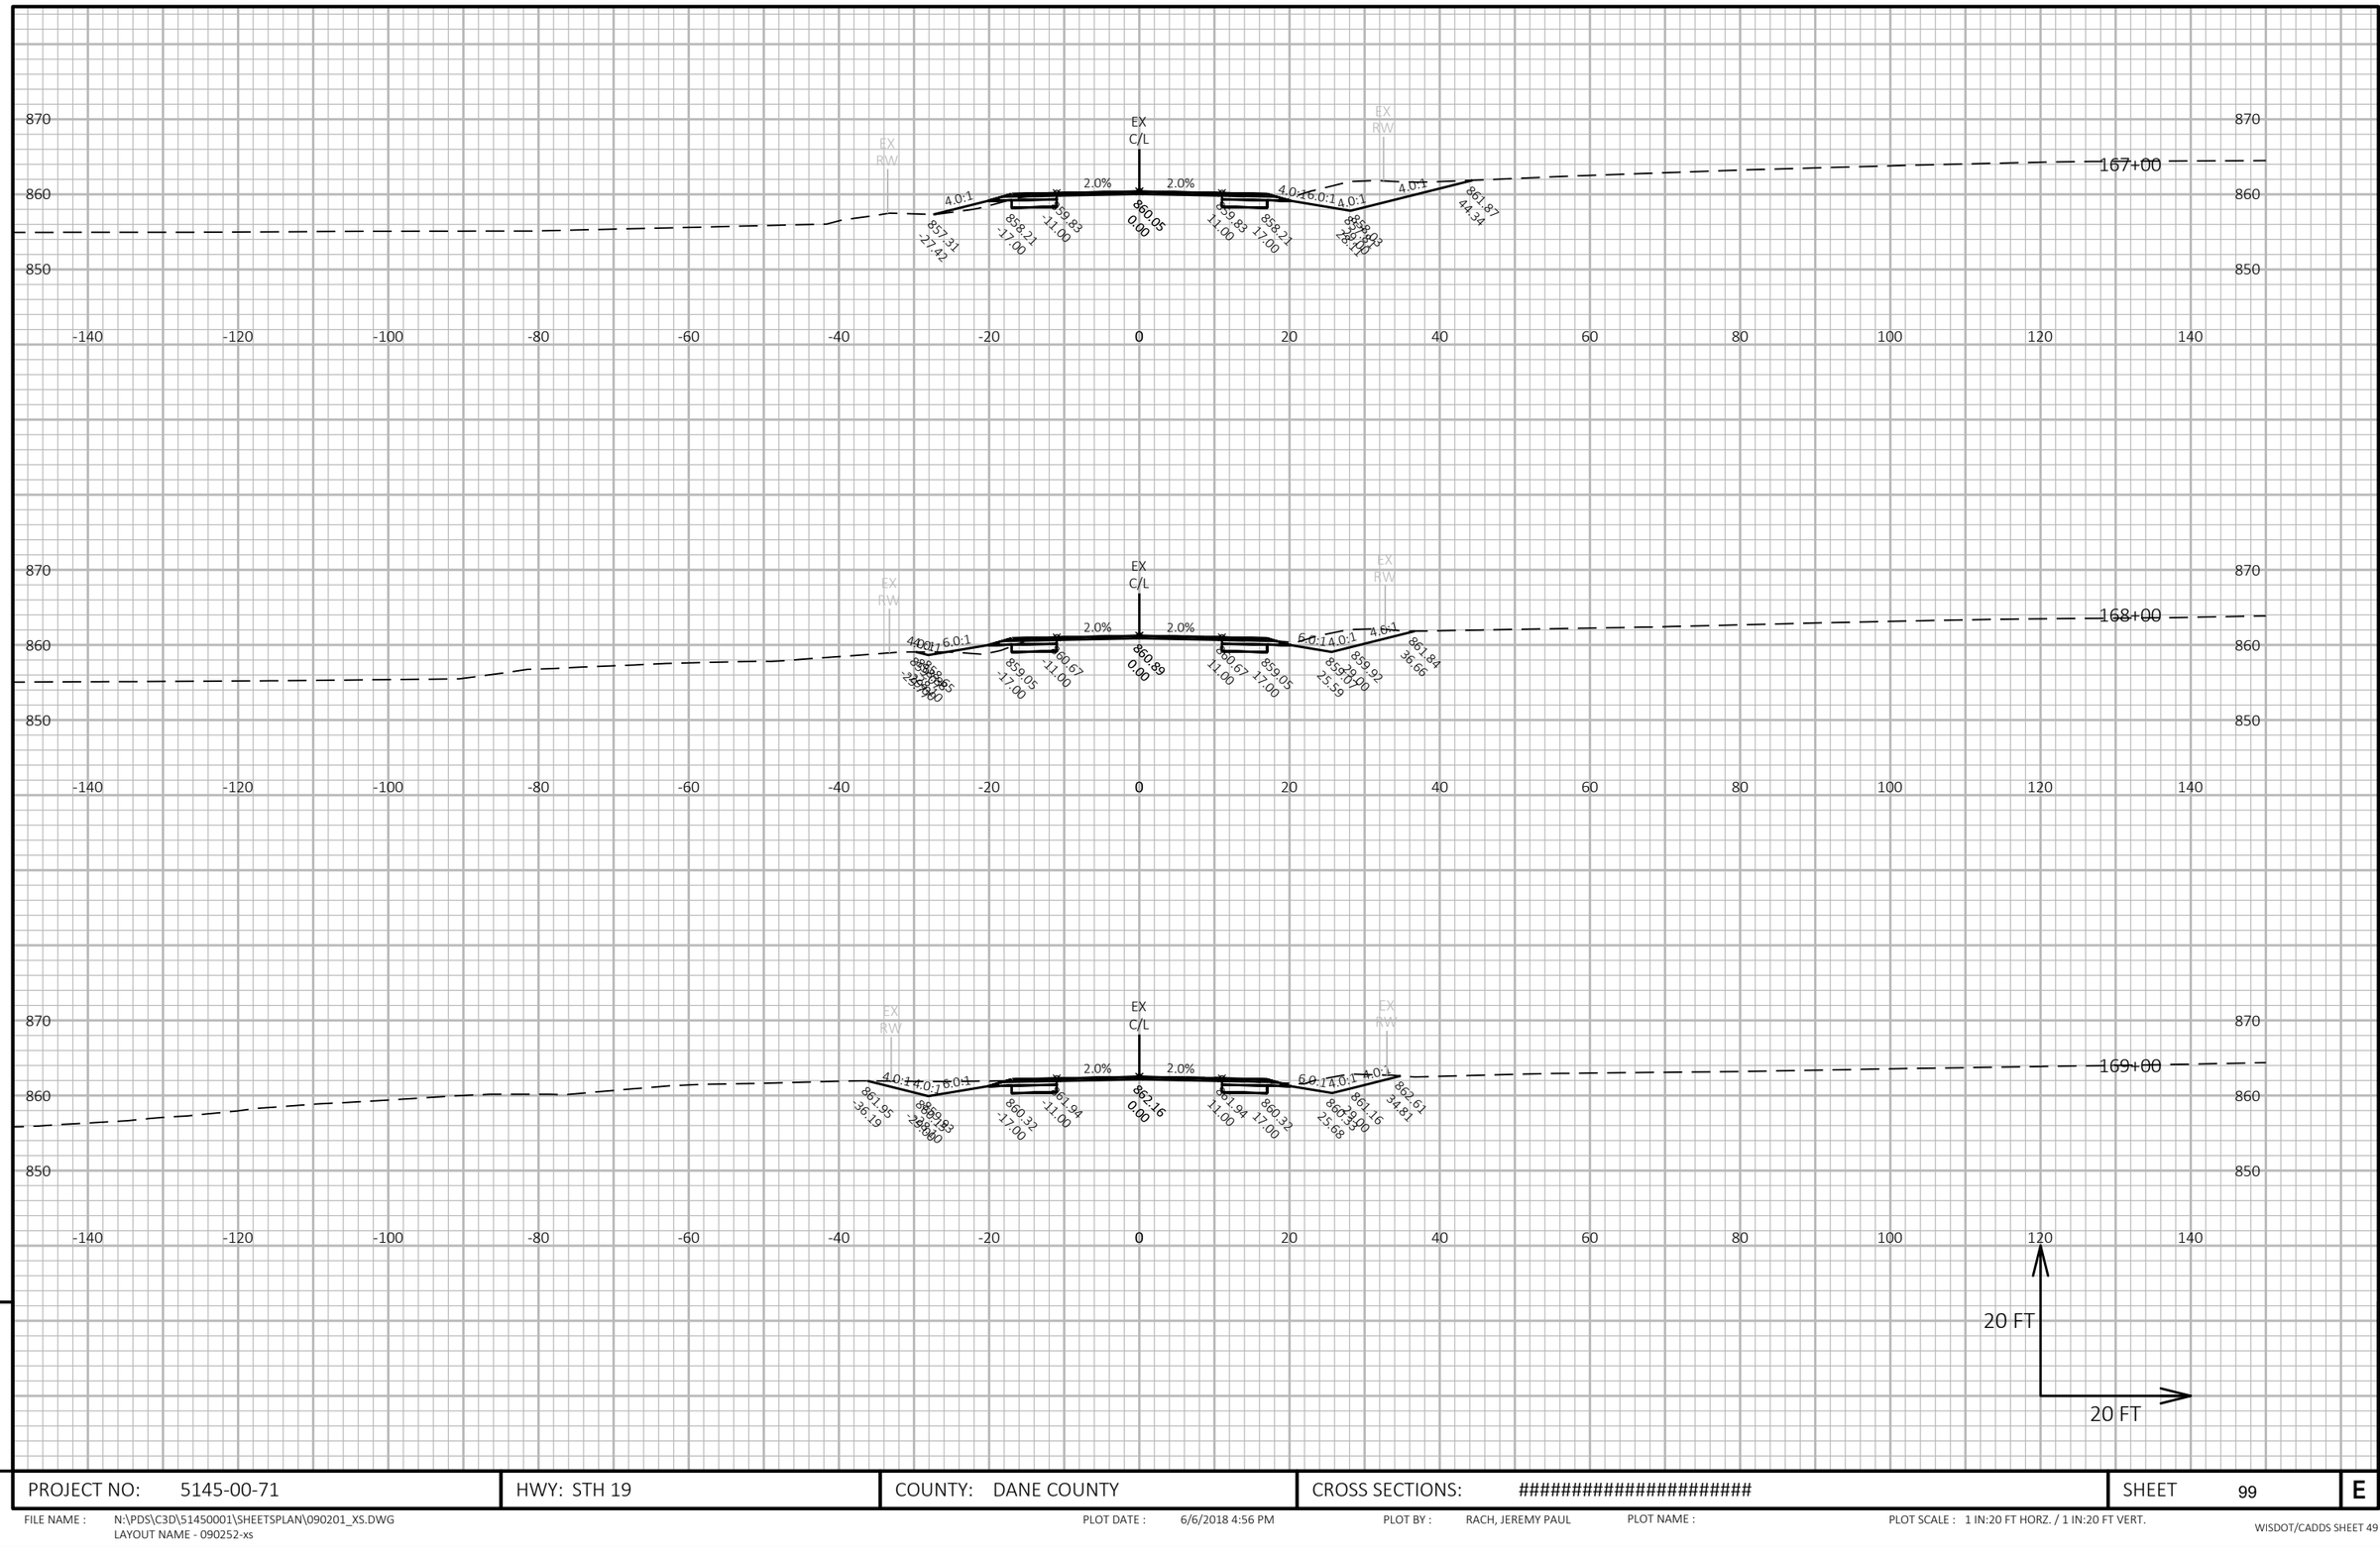

9

9

PROJECT NO: 5145-00-71	HWY: STH 19	COUNTY: DANE COUNTY	CROSS SECTIONS: ##########################	SHEET 99	E

FILE NAME : N:\PDS\C3D\51450001\SHEETSPLAN\090201_XS.DWG
LAYOUT NAME - 090252-xs

PLOT DATE : 6/6/2018 4:56 PM

PLOT BY : RACH, JEREMY PAUL

PLOT NAME :

PLOT SCALE : 1 IN:20 FT HORZ. / 1 IN:20 FT VERT.

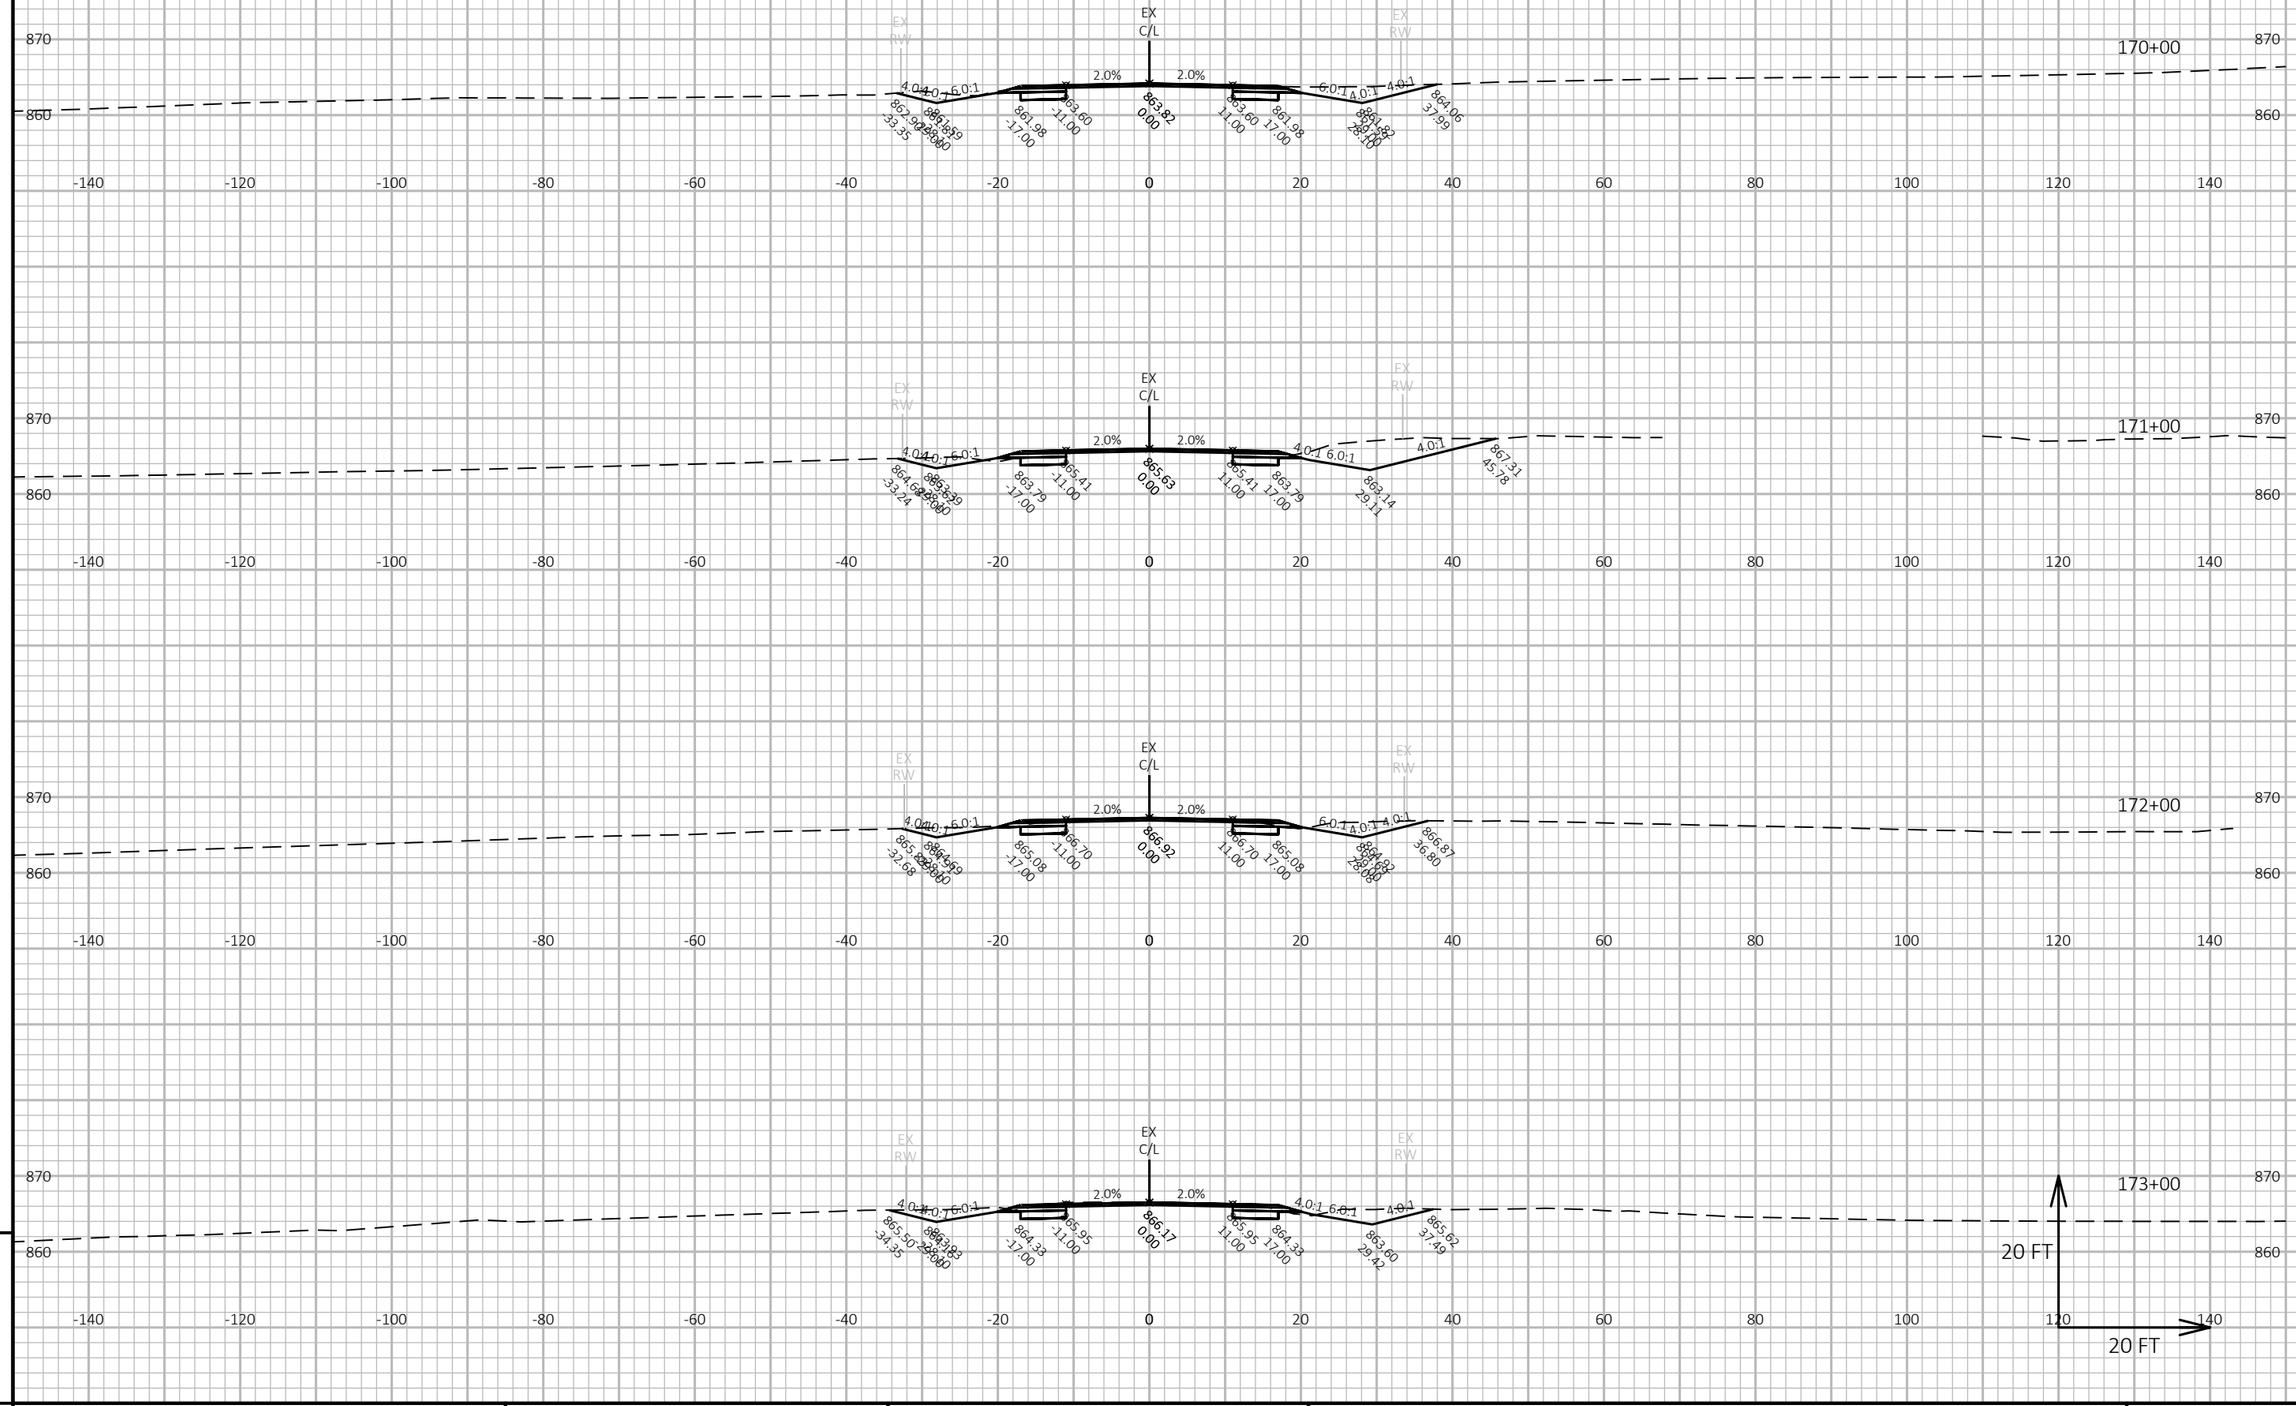

PROJECT NO: 5145-00-71	HWY: STH 19	COUNTY: DANE COUNTY	CROSS SECTIONS: ##########################	SHEET 100	E

FILE NAME : N:\PDS\C3D\51450001\SHEETSPLAN\090201_XS.DWG
LAYOUT NAME - 090253-xs
PLOT DATE : 6/6/2018 4:57 PM
PLOT BY : RACH, JEREMY PAUL
PLOT NAME :
PLOT SCALE : 1 IN:20 FT HORZ. / 1 IN:20 FT VERT.
WISDOT/CADDS SHEET 49

9

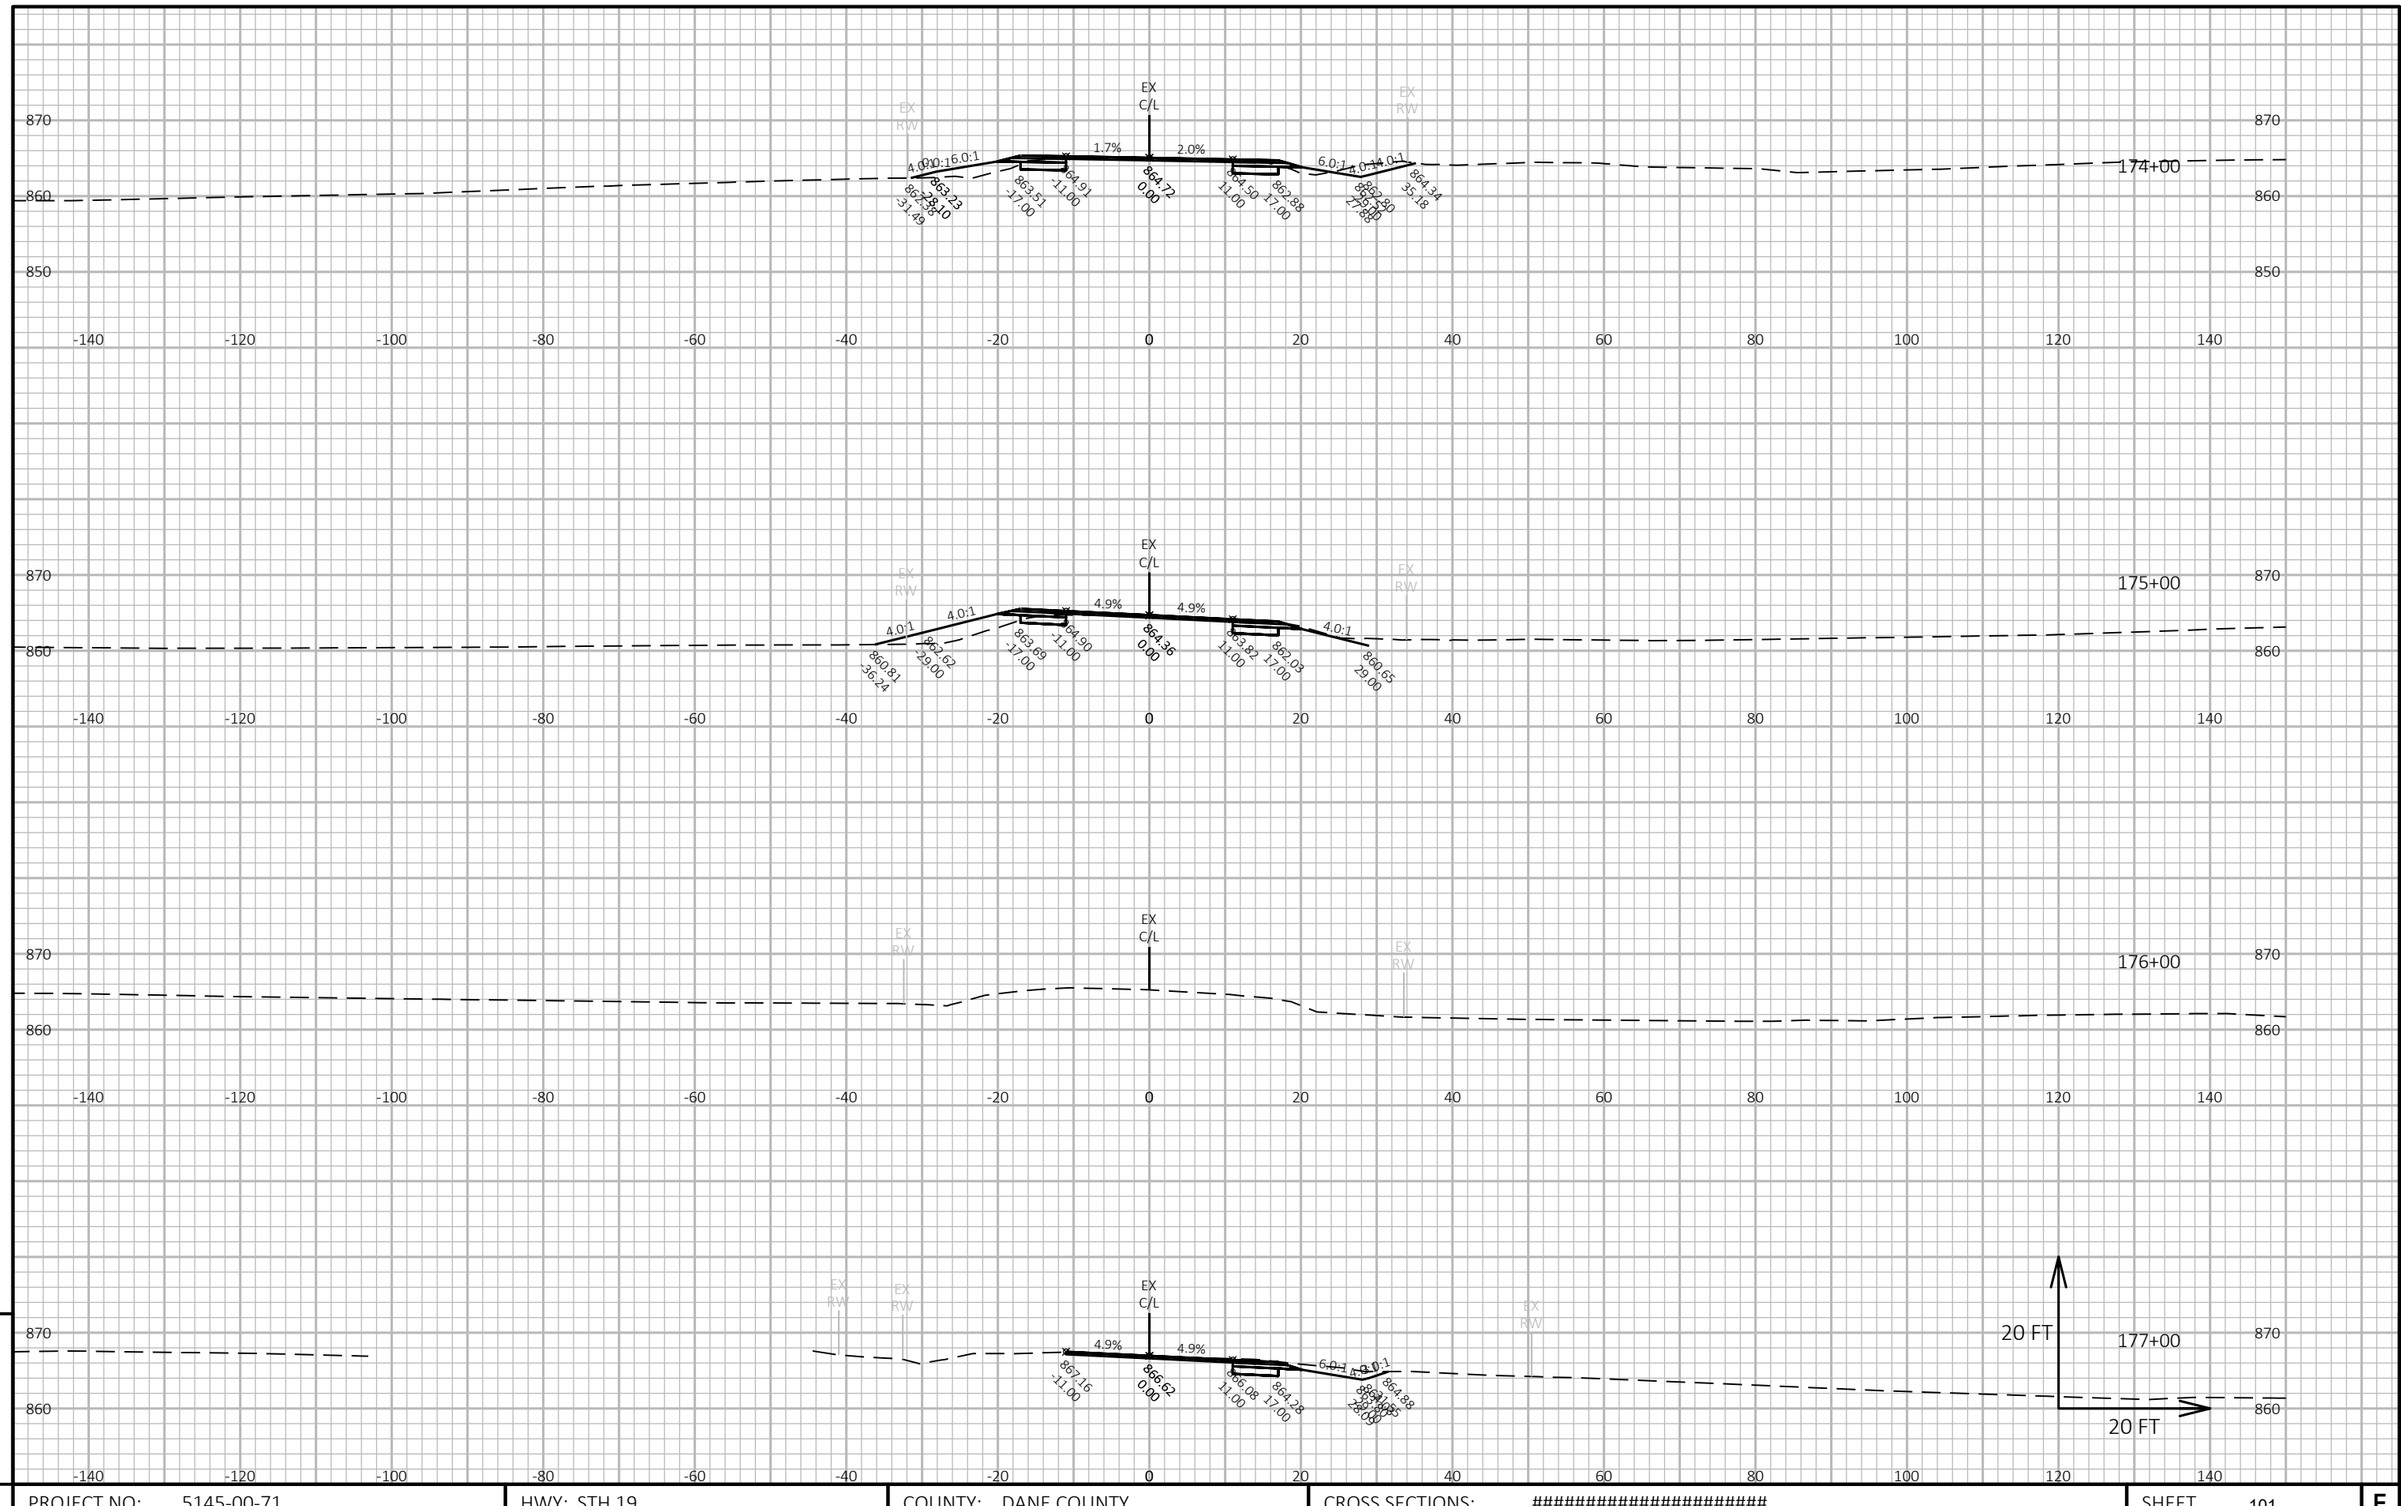

9

9

PROJECT NO: 5145-00-71	HWY: STH 19	COUNTY: DANE COUNTY	CROSS SECTIONS: ##########################	SHEET 101	E

FILE NAME : N:\PDS\C3D\51450001\SHEETSPLAN\090201_XS.DWG
LAYOUT NAME - 090254-xs

PLOT DATE : 6/6/2018 4:57 PM PLOT BY : RACH, JEREMY PAUL PLOT NAME : PLOT SCALE : 1 IN:20 FT HORZ. / 1 IN:20 FT VERT.

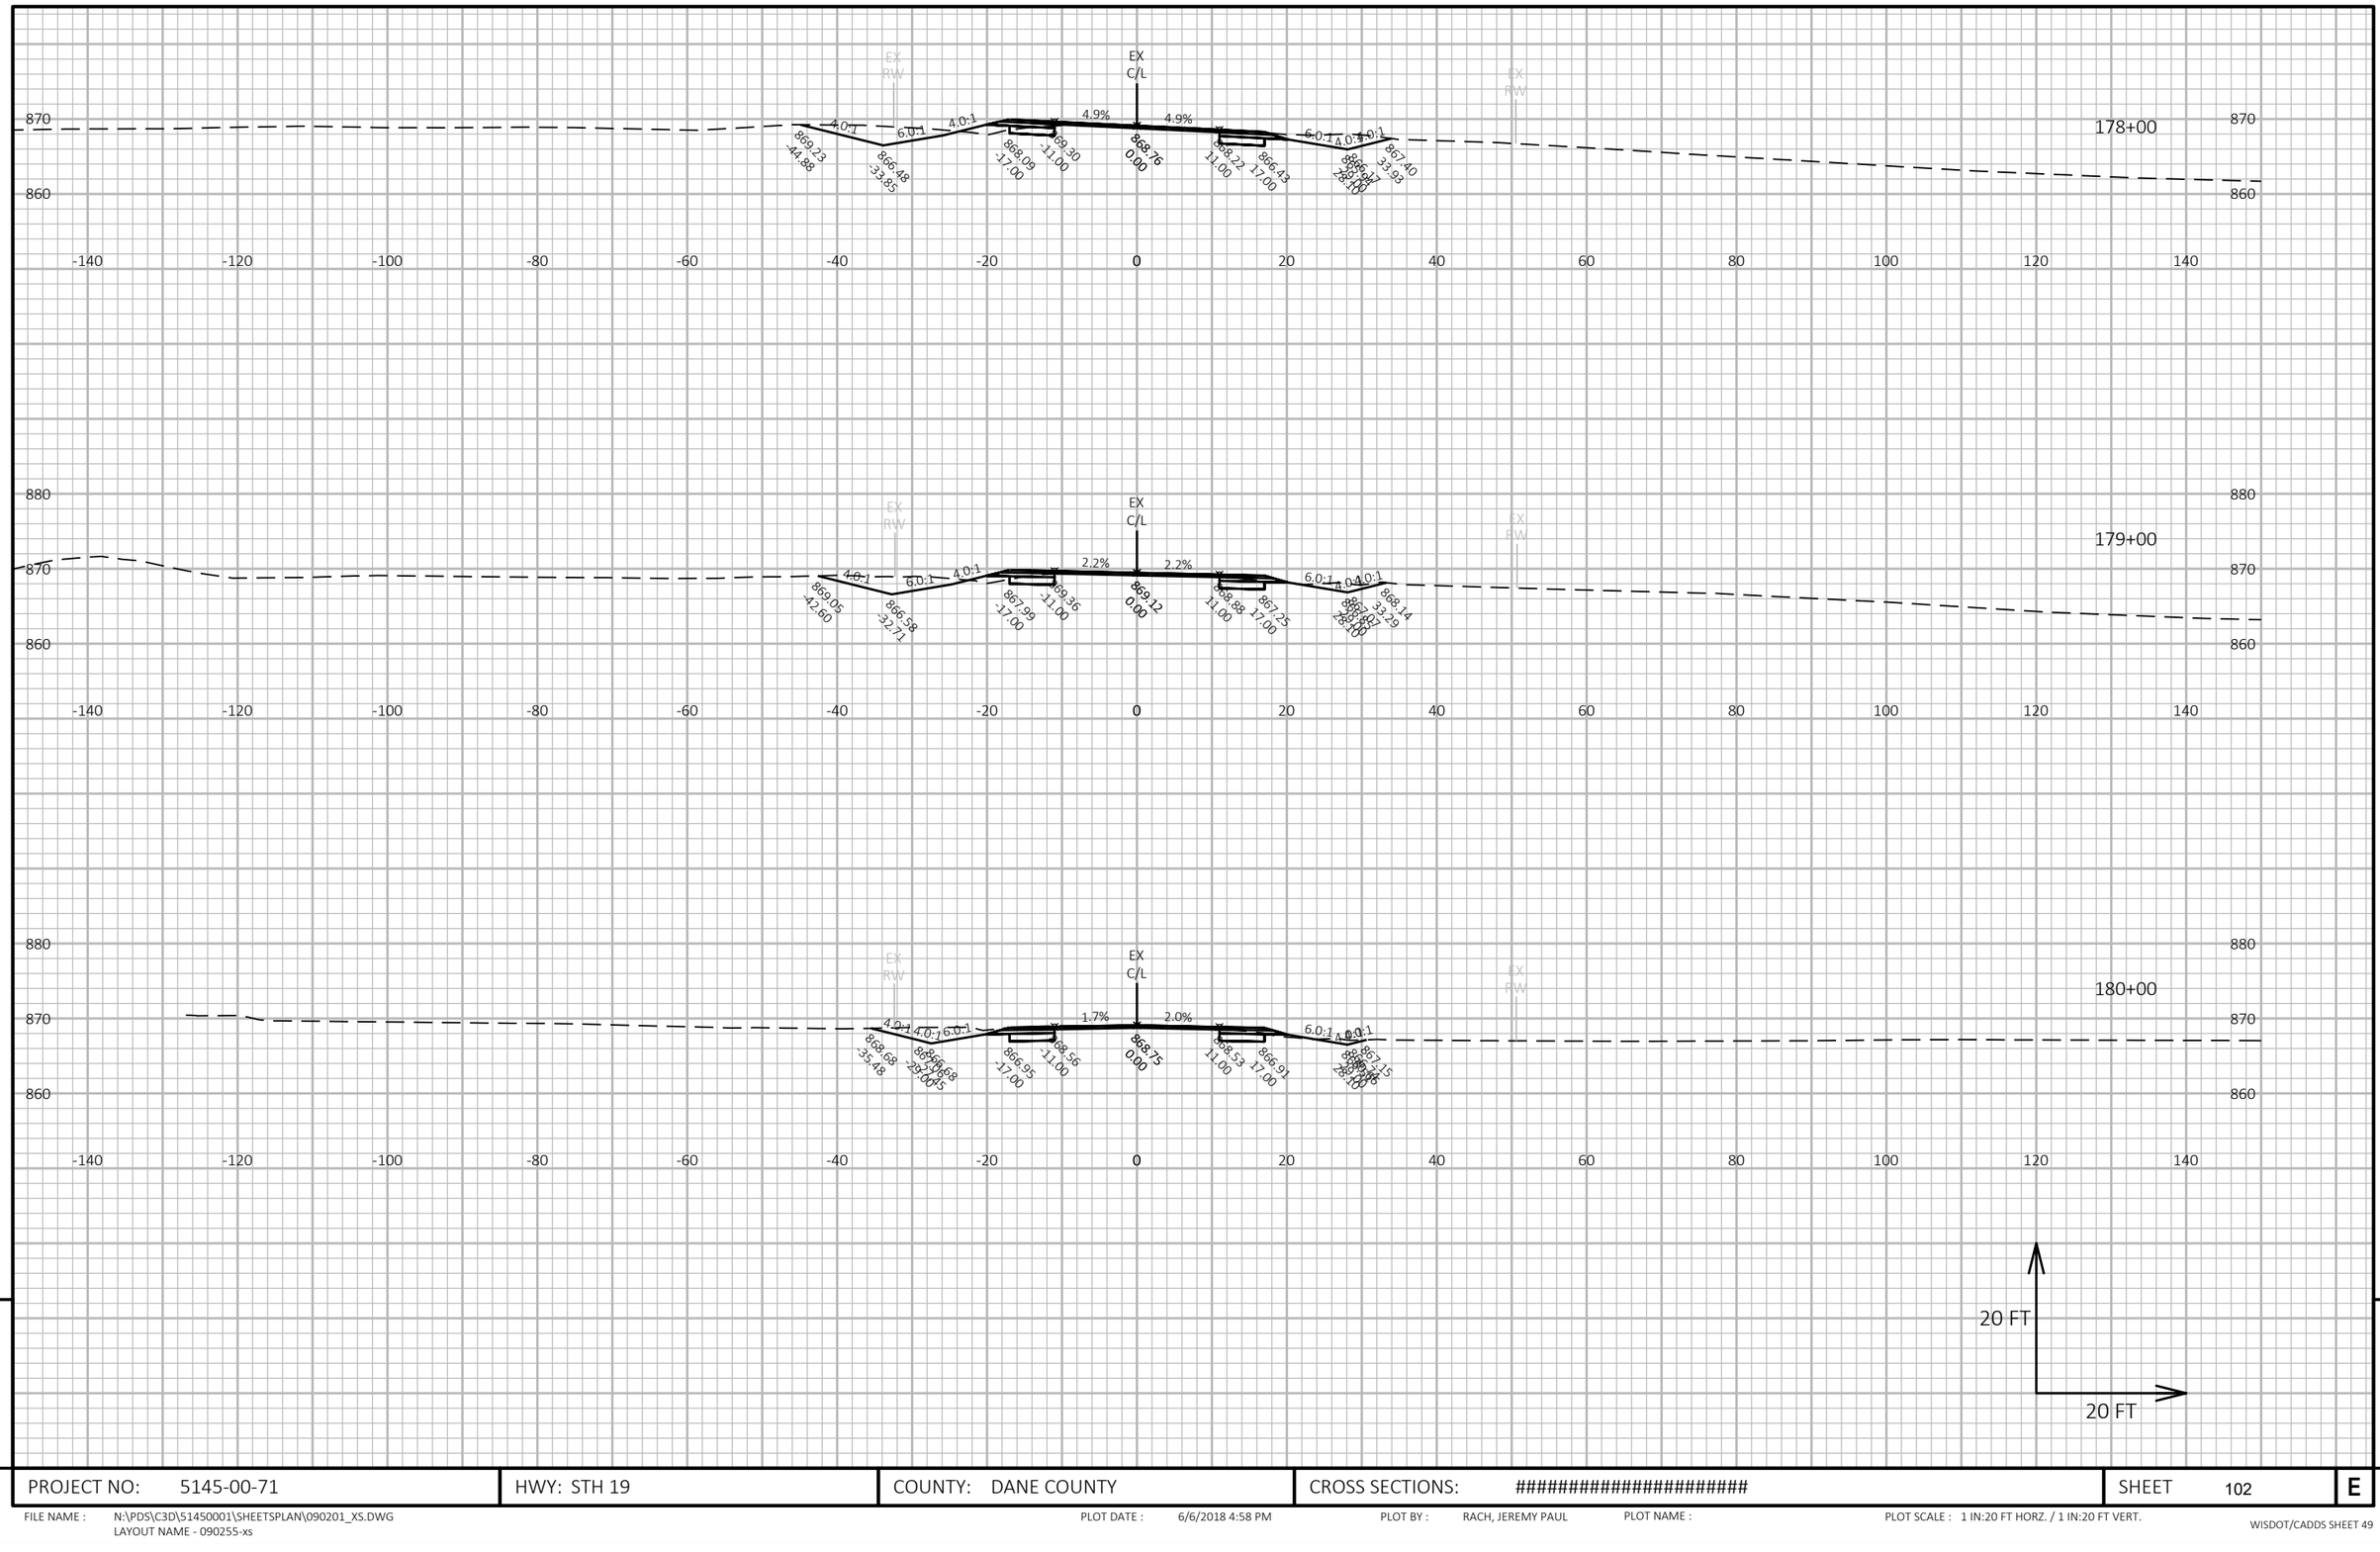

9

9

PROJECT NO: 5145-00-71	HWY: STH 19	COUNTY: DANE COUNTY	CROSS SECTIONS: ##########################	SHEET 102	E

FILE NAME : N:\PDS\C3D\51450001\SHEETSPLAN\090201_XS.DWG
LAYOUT NAME - 090255-xs
PLOT DATE : 6/6/2018 4:58 PM
PLOT BY : RACH, JEREMY PAUL
PLOT NAME :
PLOT SCALE : 1 IN:20 FT HORZ. / 1 IN:20 FT VERT.
WISDOT/CADDS SHEET 49

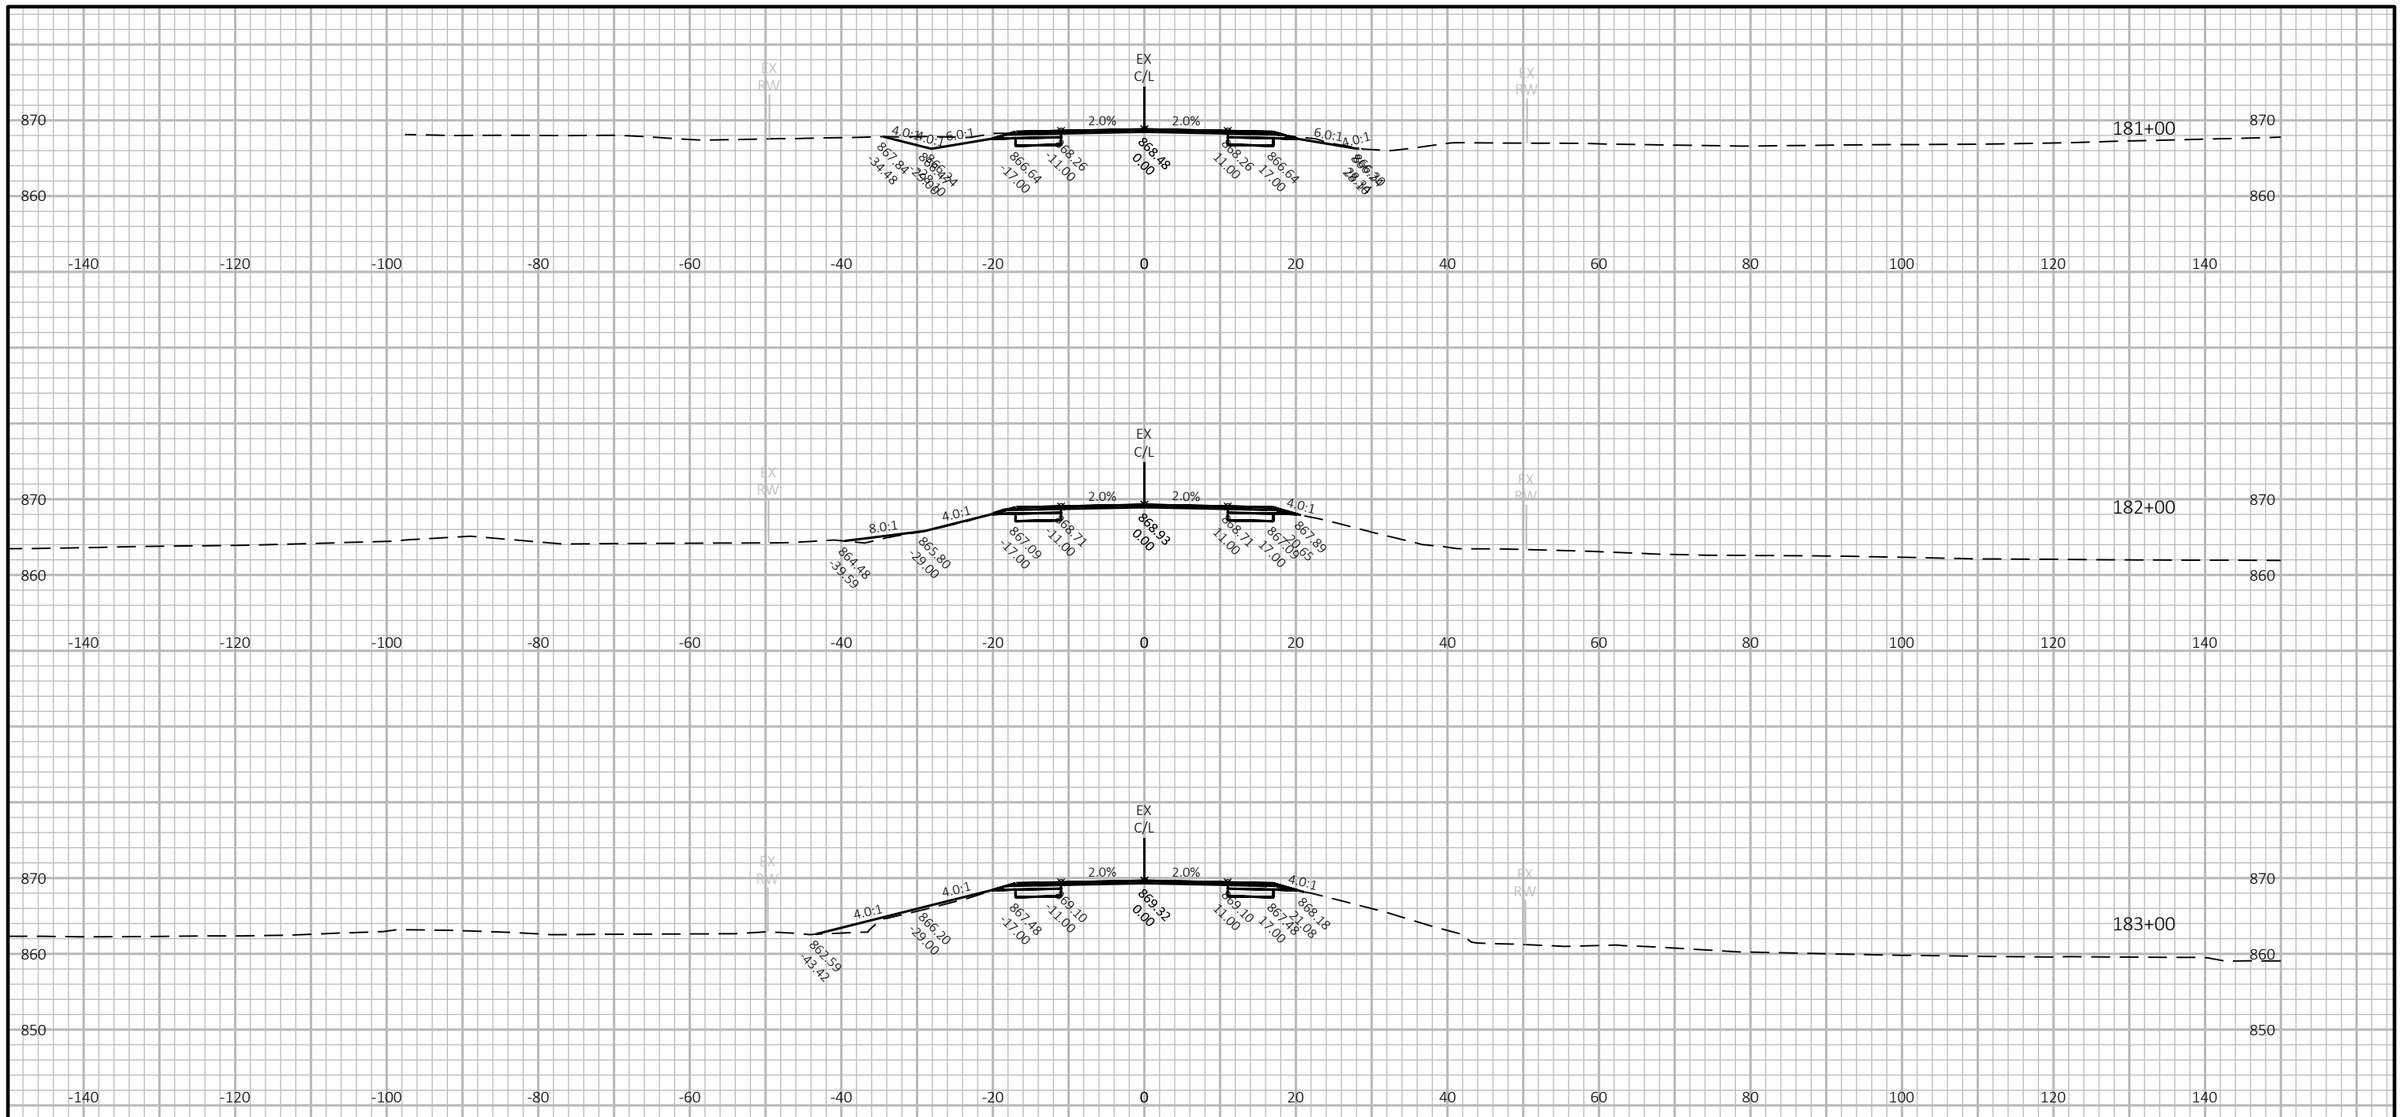

9

9

PROJECT NO: 5145-00-71	HWY: STH 19	COUNTY: DANE COUNTY	CROSS SECTIONS: ##########################	SHEET 103	E

FILE NAME : N:\PDS\C3D\51450001\SHEETSPLAN\090201_XS.DWG
LAYOUT NAME - 090256-xs

PLOT DATE : 6/6/2018 4:58 PM PLOT BY : RACH, JEREMY PAUL PLOT NAME : PLOT SCALE : 1 IN:20 FT HORZ. / 1 IN:20 FT VERT.

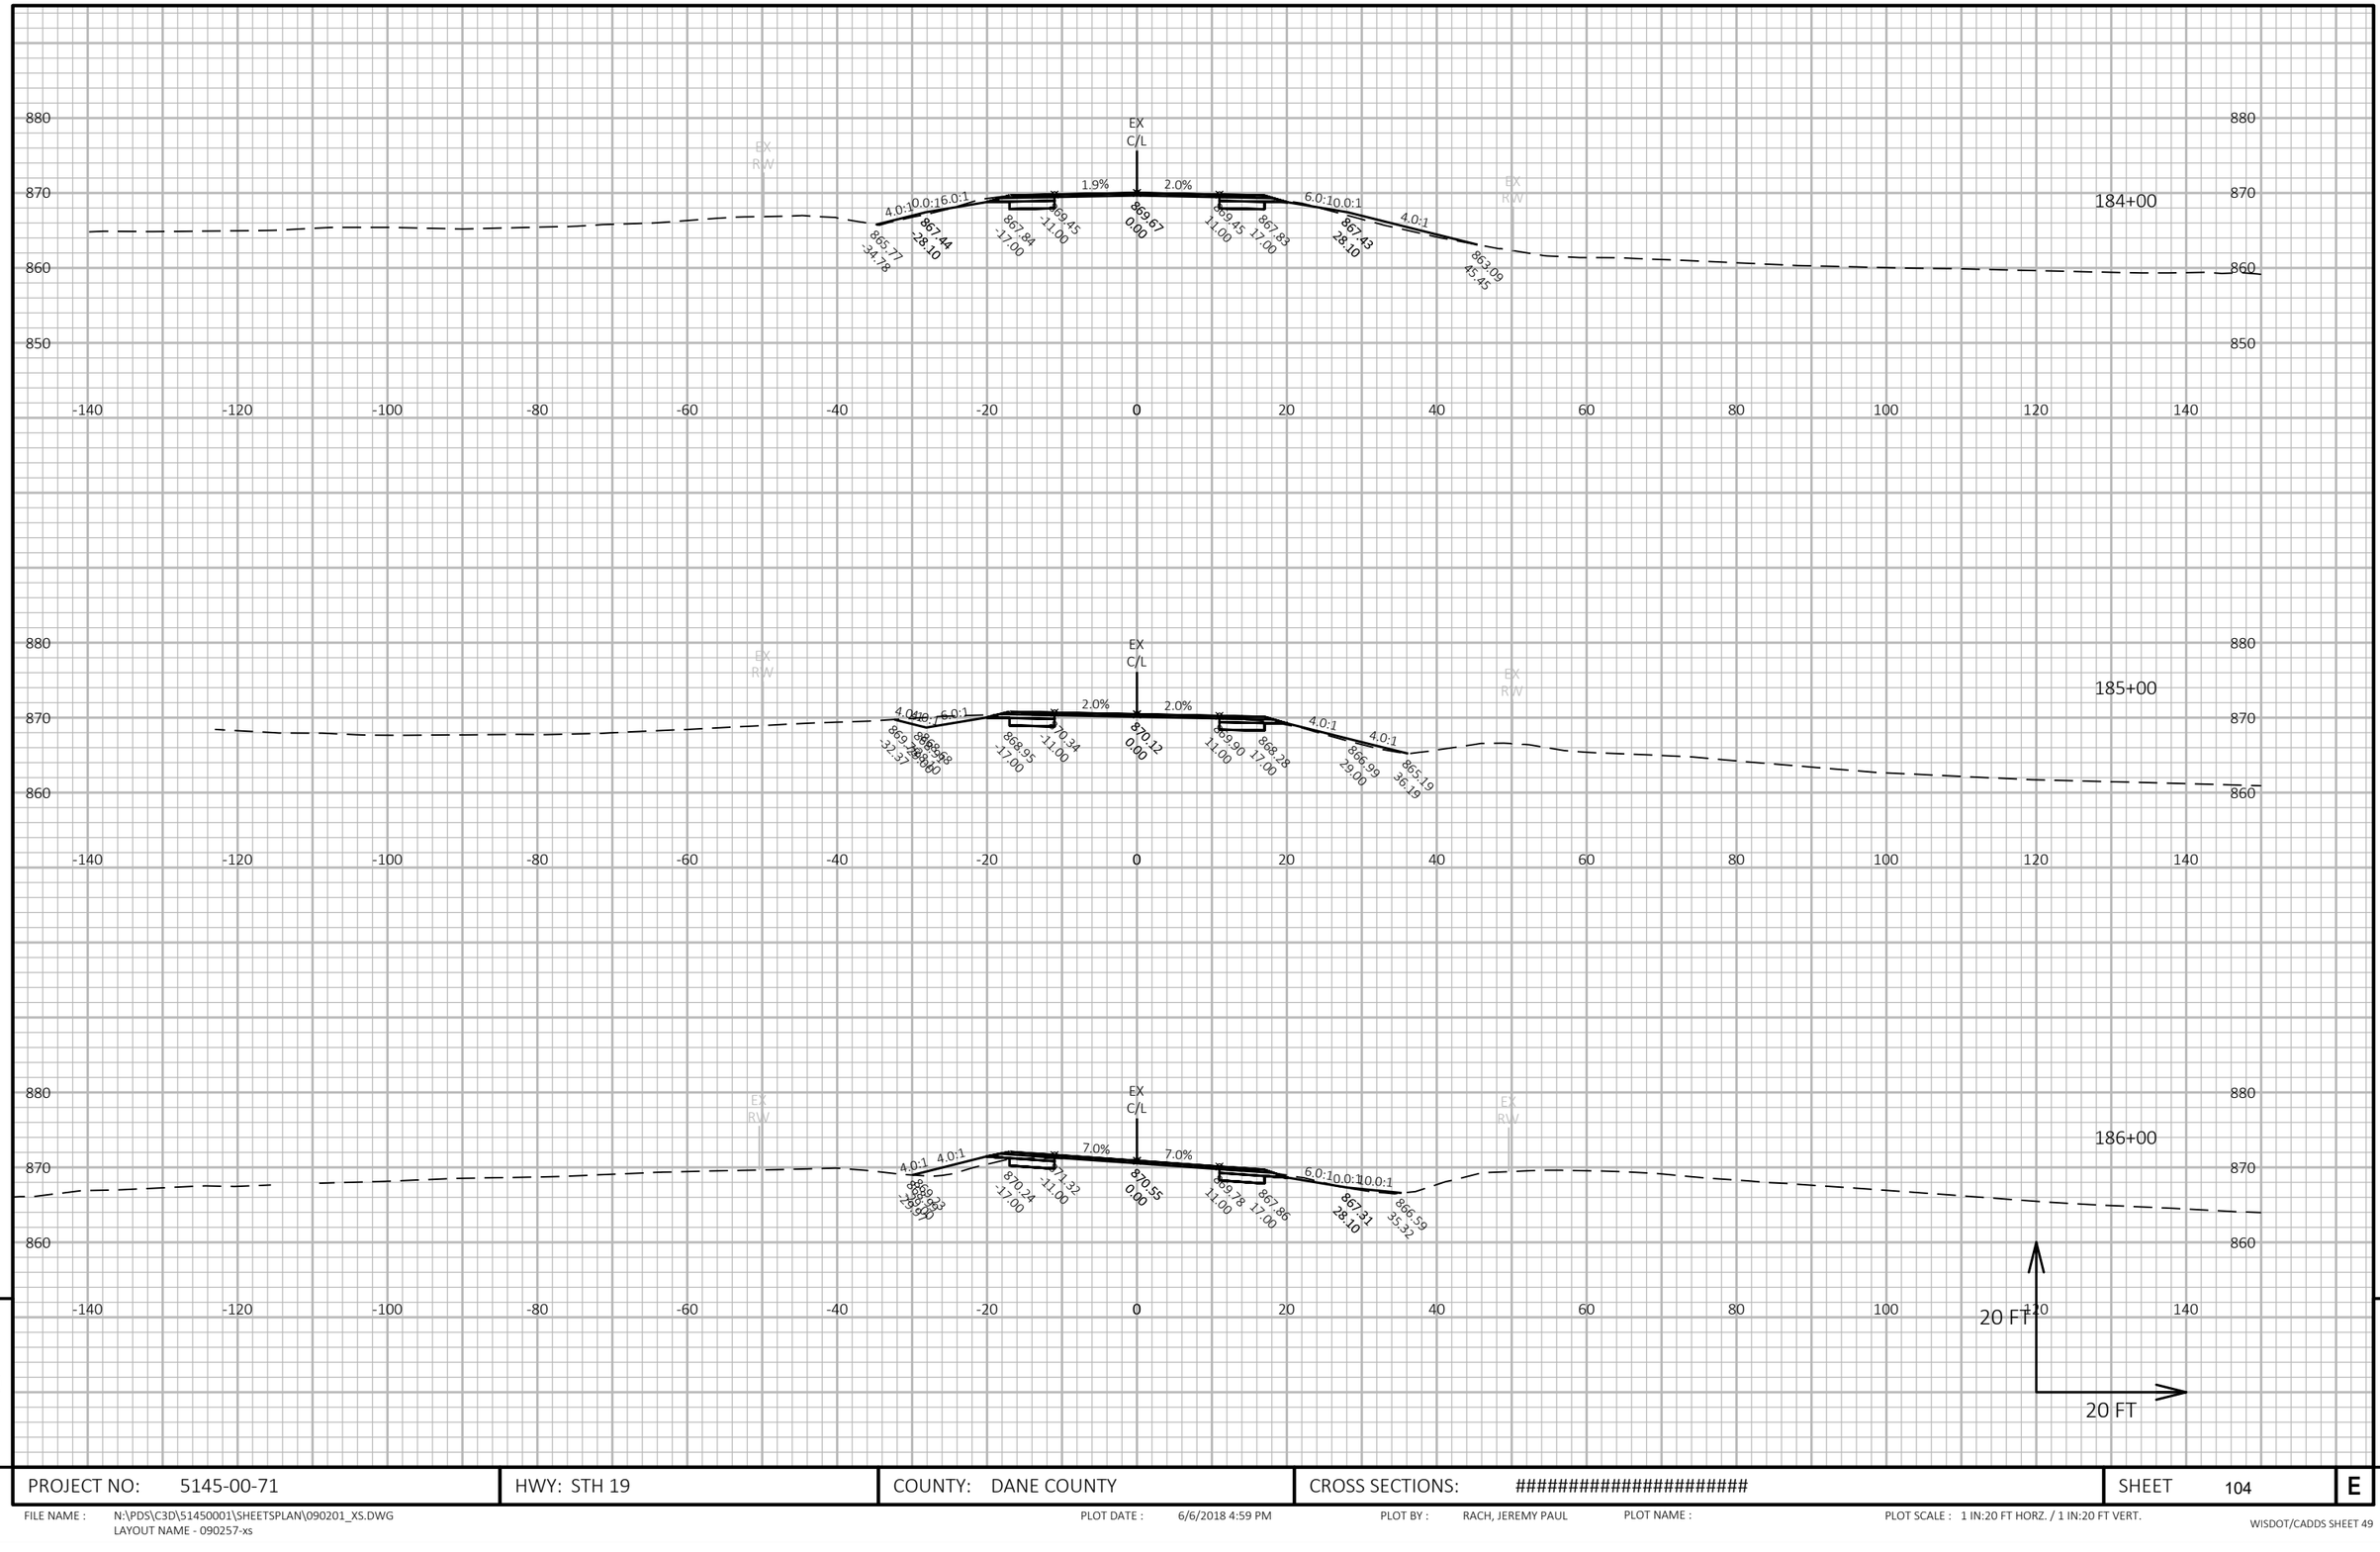

9

9

PROJECT NO: 5145-00-71	HWY: STH 19	COUNTY: DANE COUNTY	CROSS SECTIONS: ##########################	SHEET 104	E

FILE NAME : N:\PDS\C3D\51450001\SHEETSPLAN\090201_XS.DWG
LAYOUT NAME - 090257-xs

PLOT DATE : 6/6/2018 4:59 PM PLOT BY : RACH, JEREMY PAUL PLOT NAME : PLOT SCALE : 1 IN:20 FT HORZ. / 1 IN:20 FT VERT.

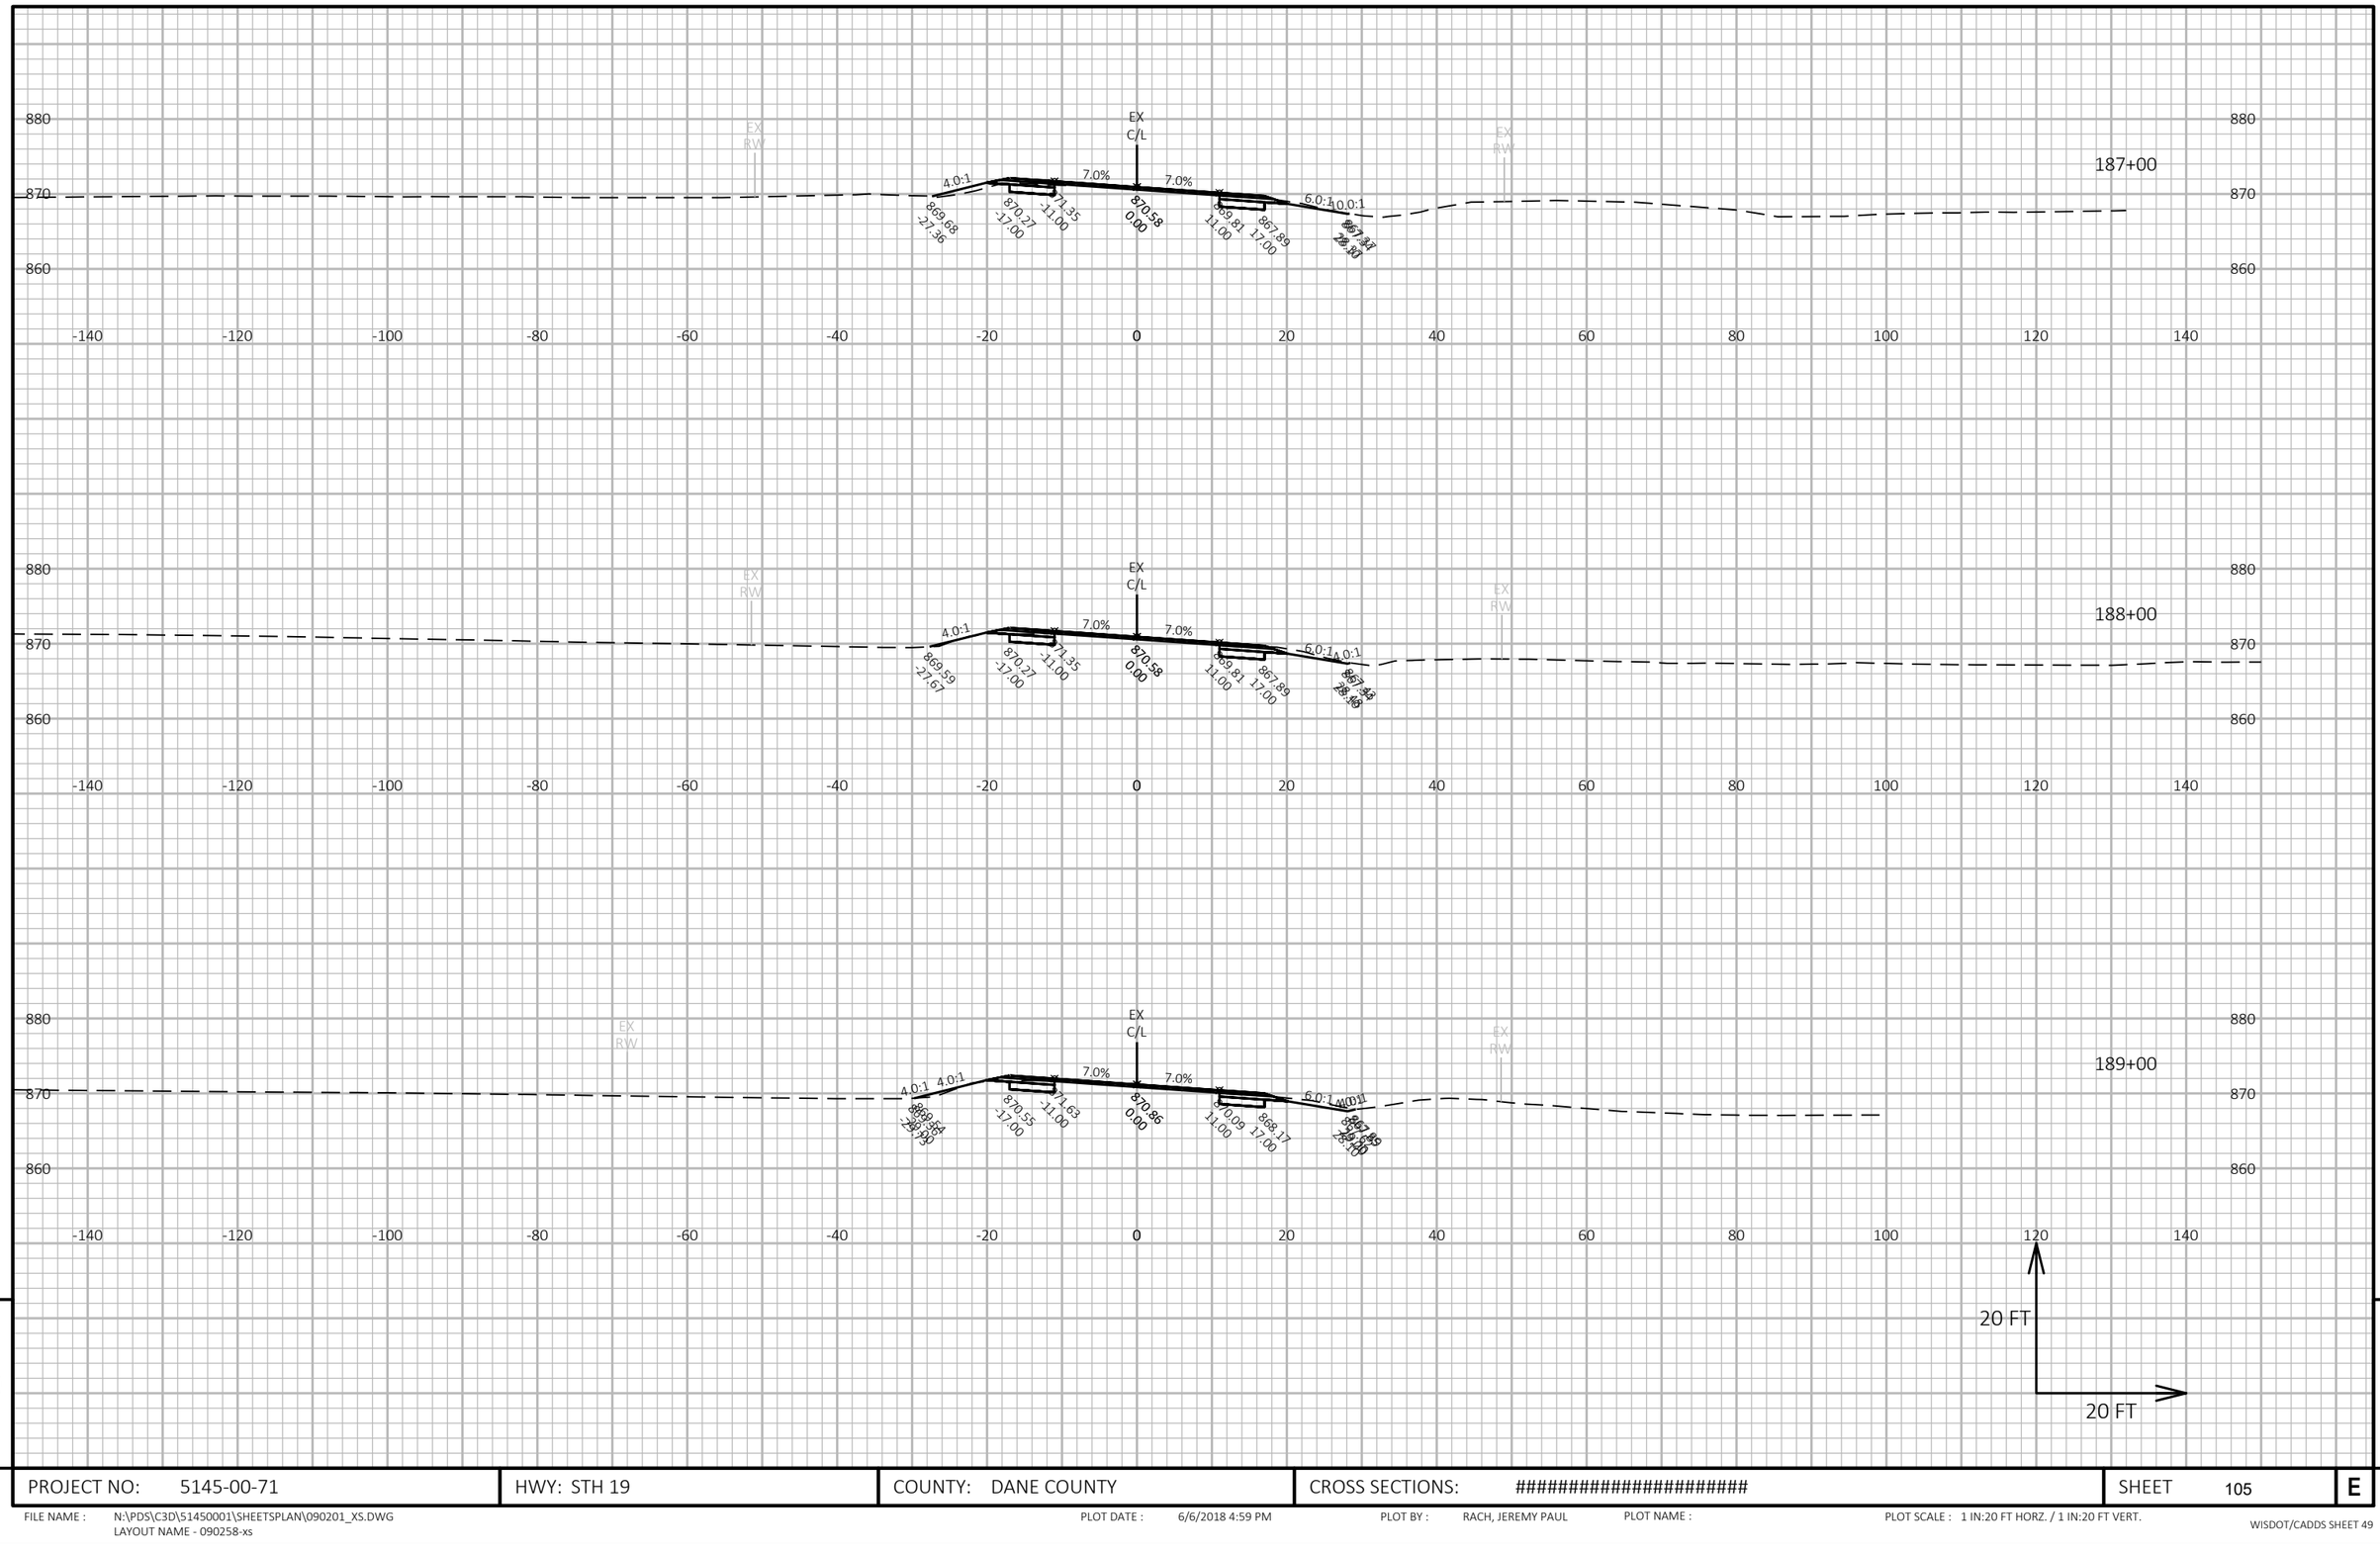

9

9

PROJECT NO: 5145-00-71	HWY: STH 19	COUNTY: DANE COUNTY	CROSS SECTIONS: ##########################	SHEET 105	E

FILE NAME : N:\PDS\C3D\51450001\SHEETSPLAN\090201_XS.DWG
LAYOUT NAME - 090258-xs

PLOT DATE : 6/6/2018 4:59 PM PLOT BY : RACH, JEREMY PAUL PLOT NAME : PLOT SCALE : 1 IN:20 FT HORZ. / 1 IN:20 FT VERT.

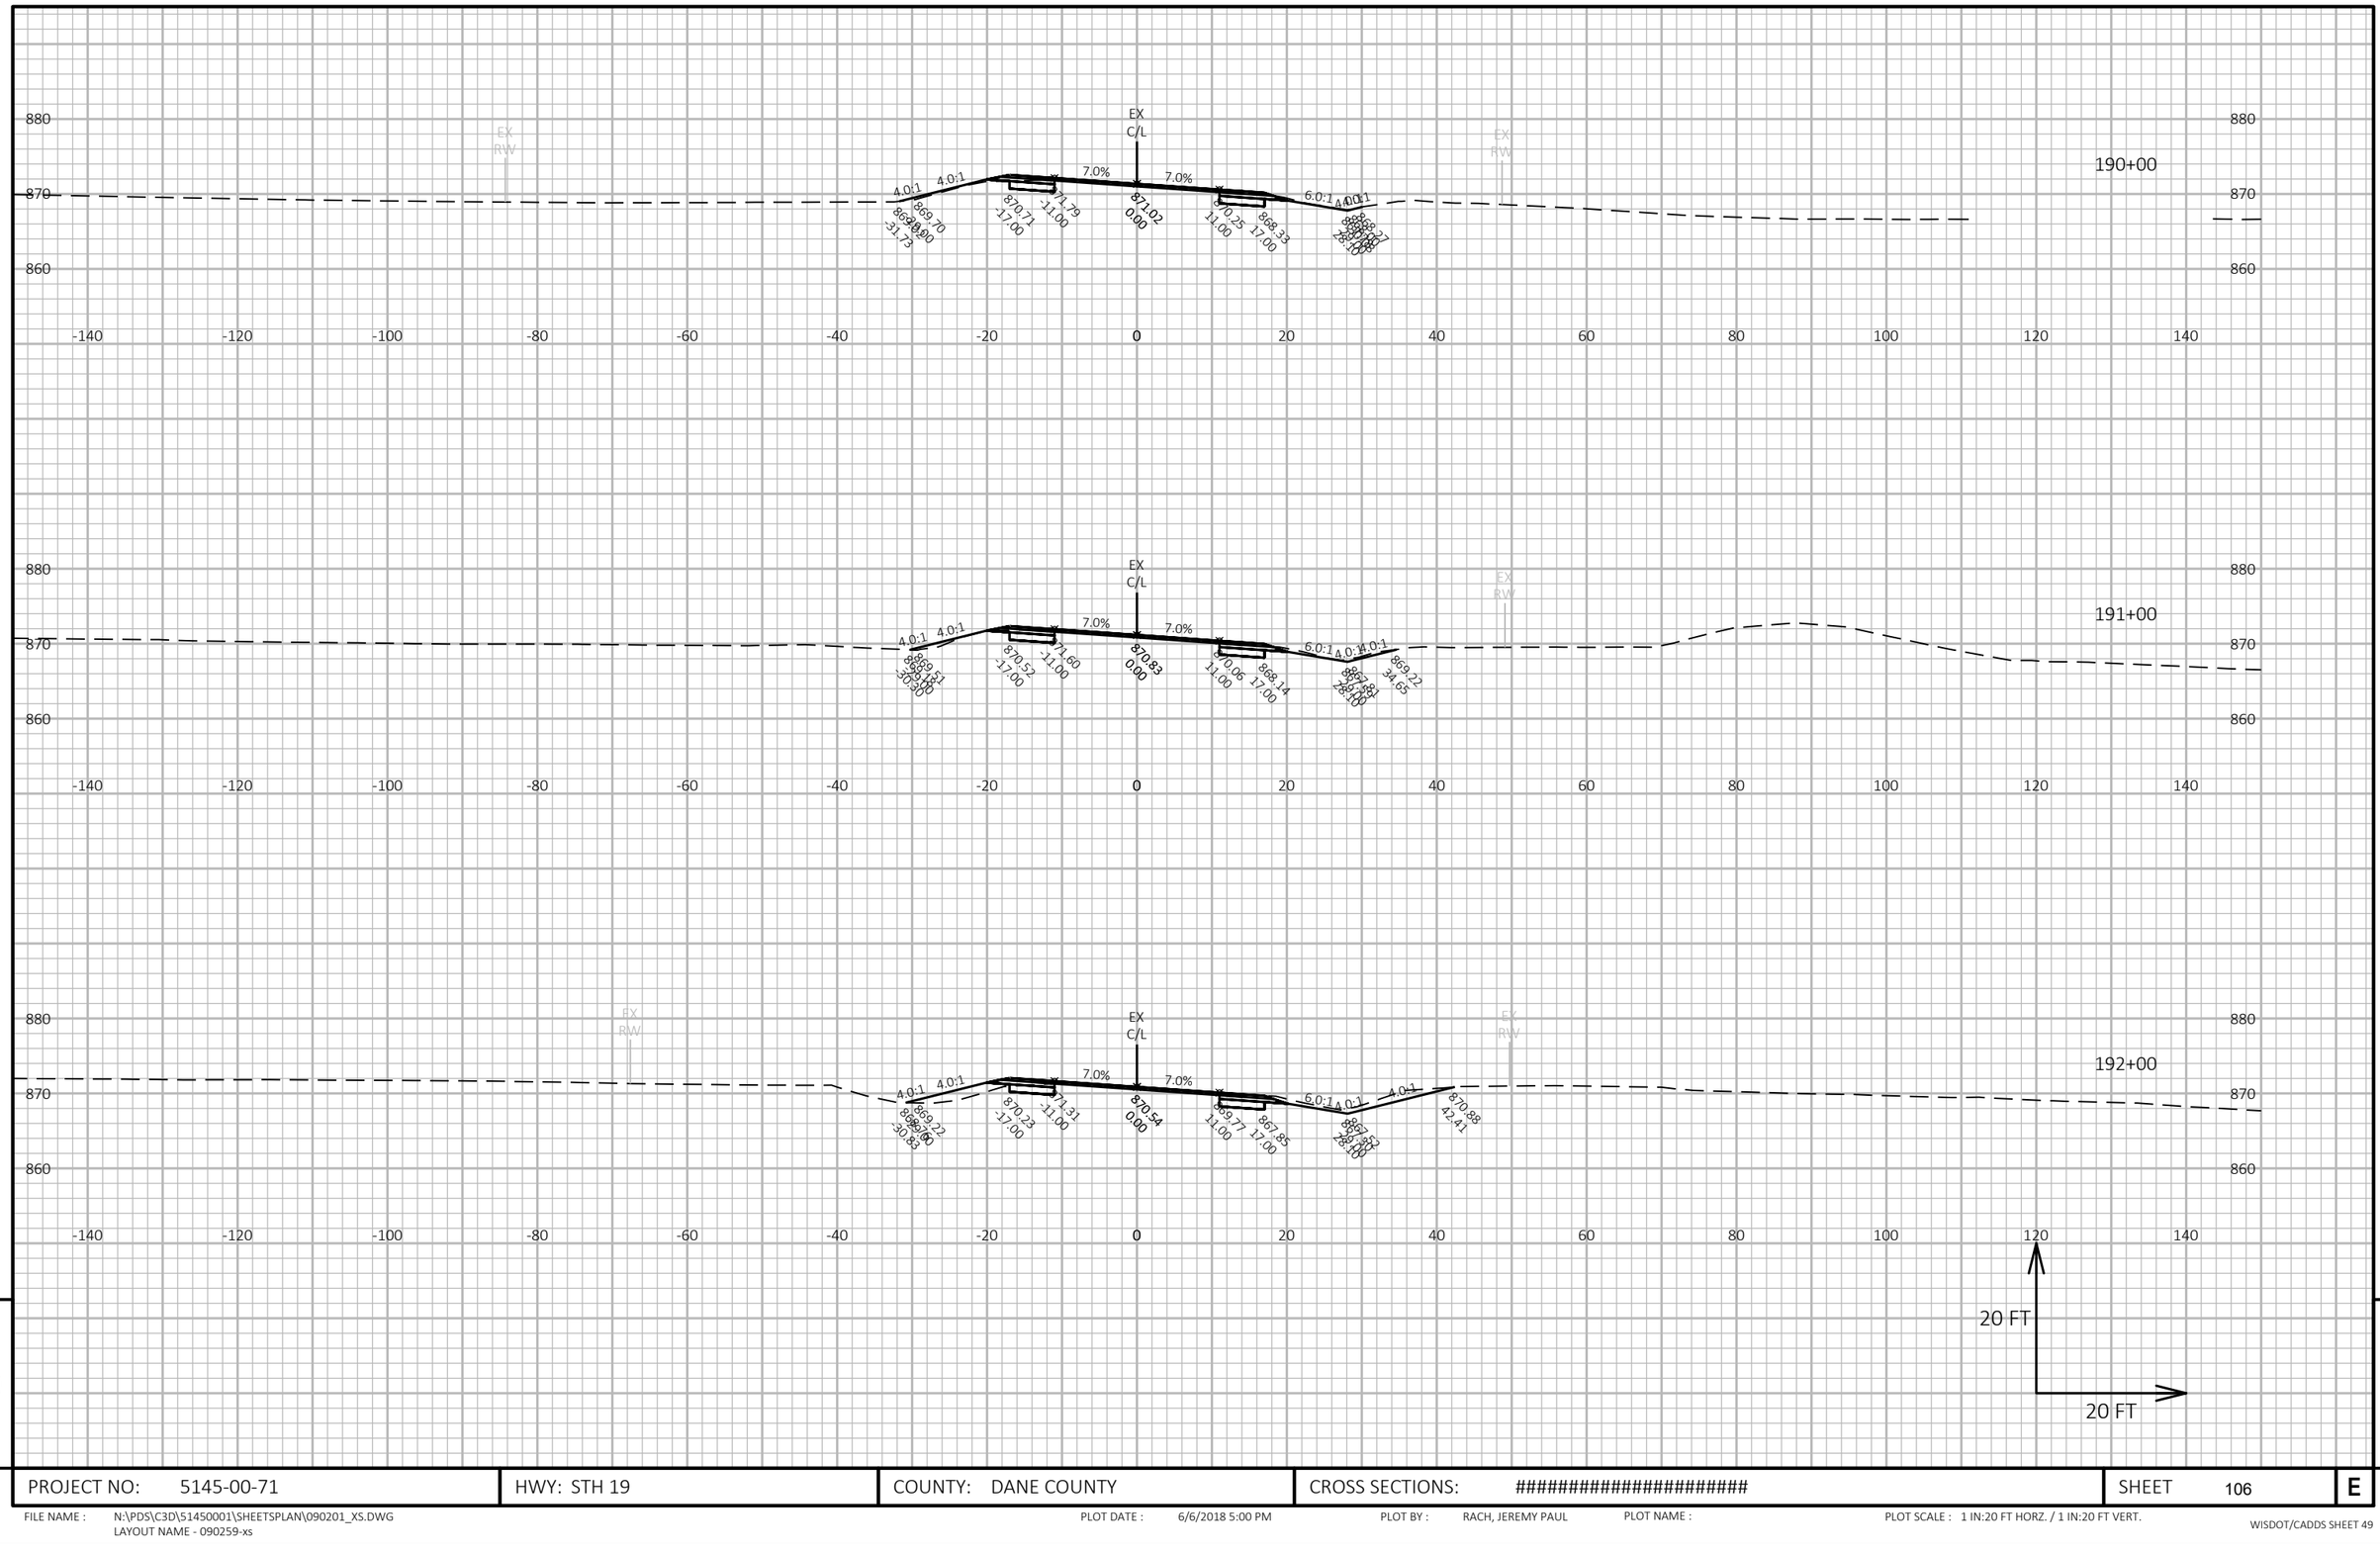

9

9

PROJECT NO: 5145-00-71	HWY: STH 19	COUNTY: DANE COUNTY	CROSS SECTIONS: ##########################	SHEET 106	E

FILE NAME : N:\PDS\C3D\51450001\SHEETSPLAN\090201_XS.DWG
LAYOUT NAME - 090259-xs

PLOT DATE : 6/6/2018 5:00 PM PLOT BY : RACH, JEREMY PAUL PLOT NAME : PLOT SCALE : 1 IN:20 FT HORZ. / 1 IN:20 FT VERT.

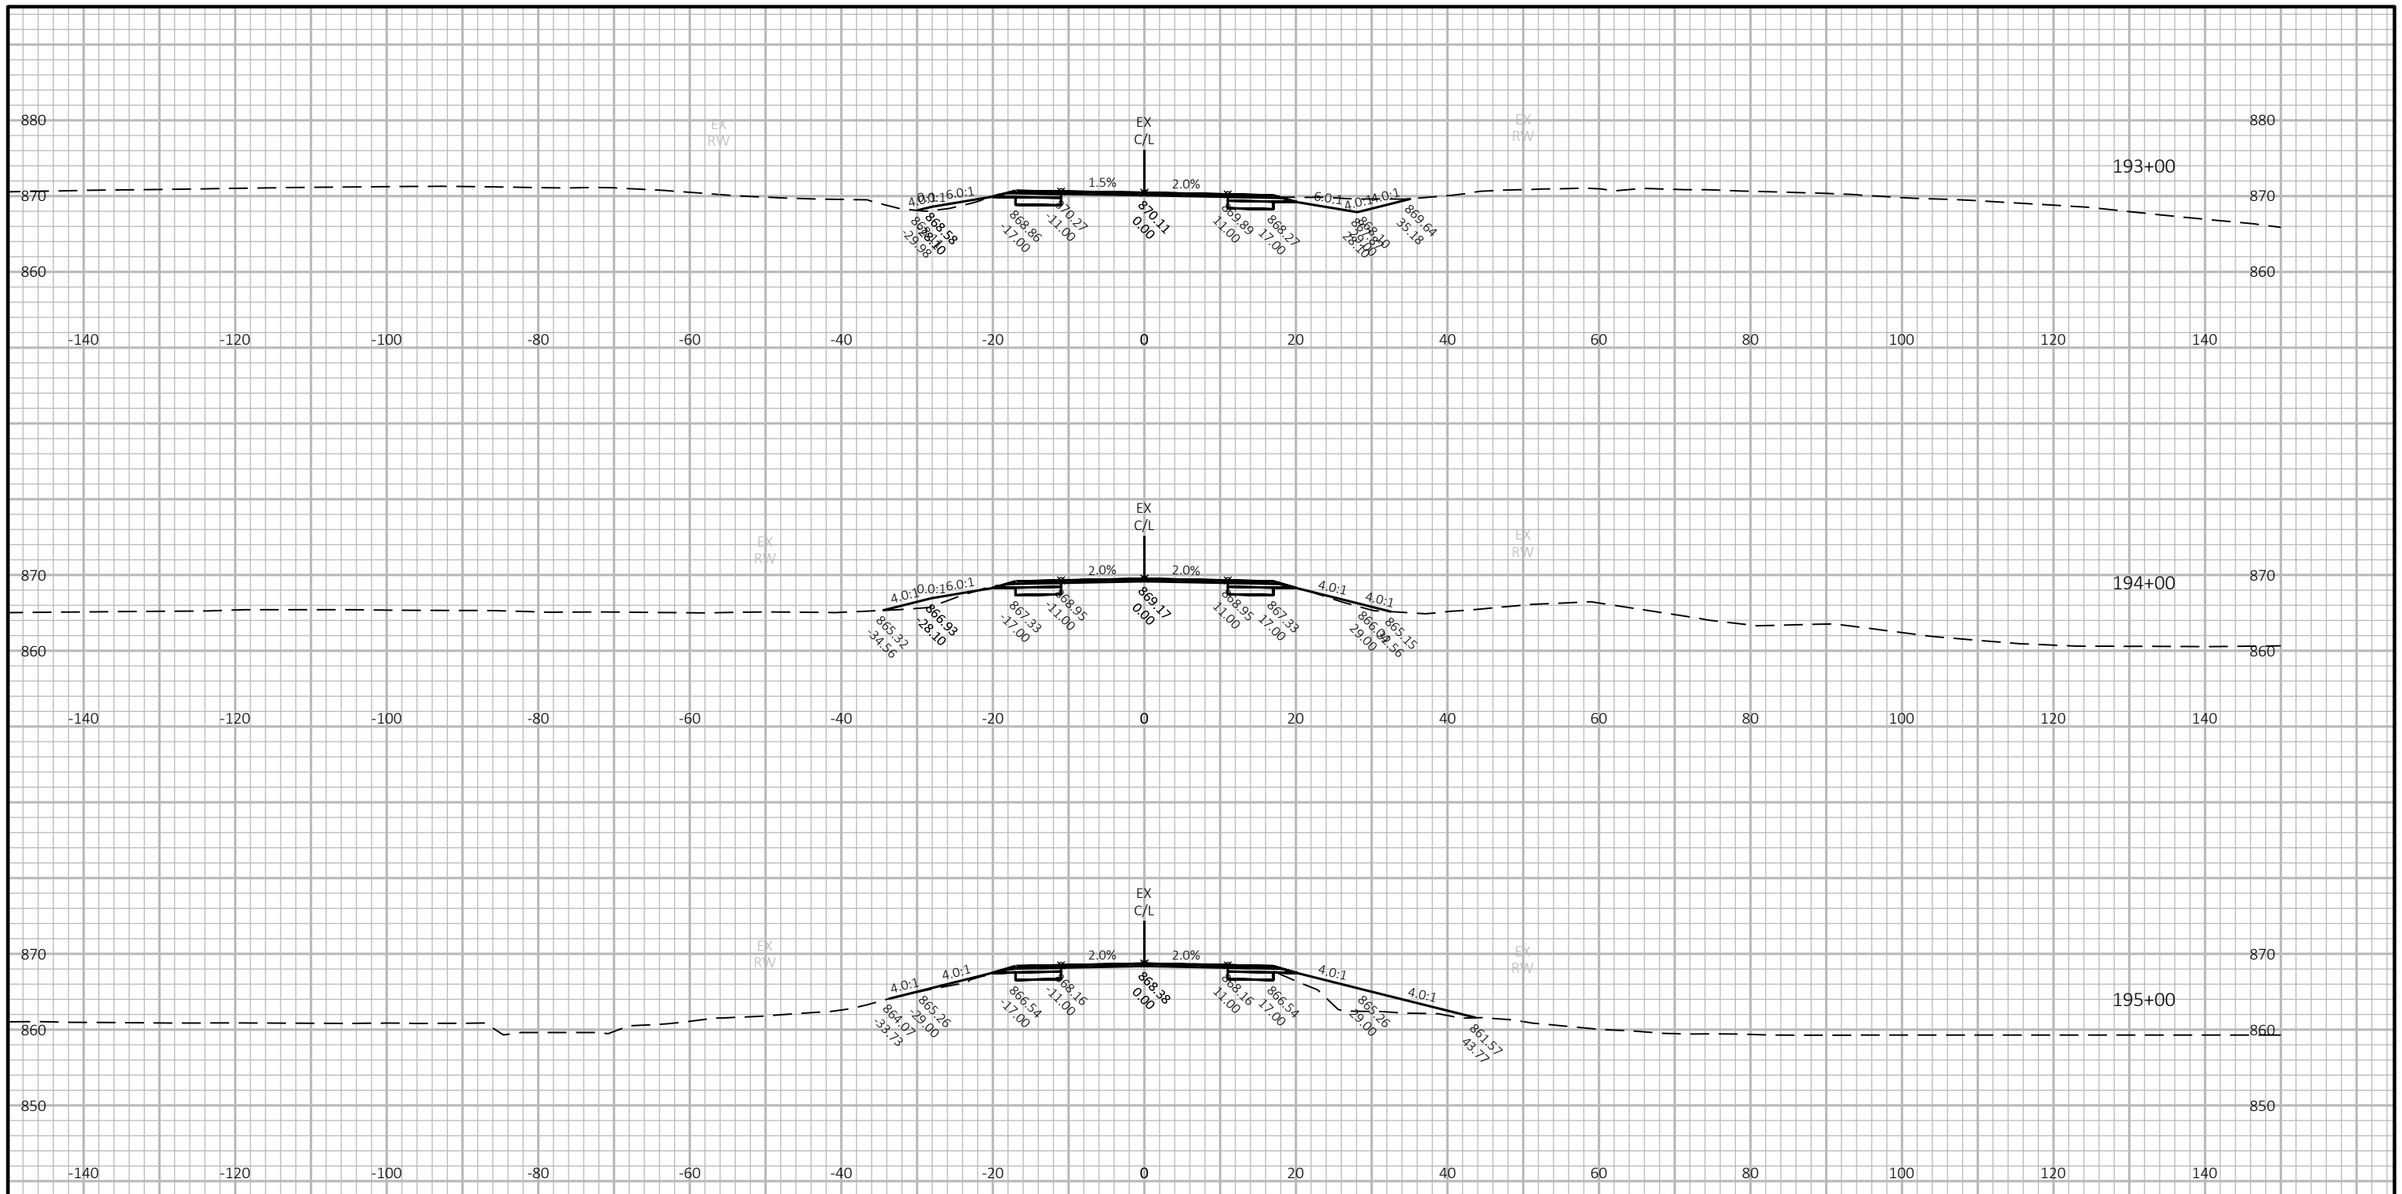

9

9

PROJECT NO: 5145-00-71	HWY: STH 19	COUNTY: DANE COUNTY	CROSS SECTIONS: ##########################	SHEET 107	E

FILE NAME : N:\PDS\C3D\51450001\SHEETSPLAN\090201_XS.DWG
LAYOUT NAME - 090260-xs

PLOT DATE : 6/6/2018 5:00 PM PLOT BY : RACH, JEREMY PAUL PLOT NAME : PLOT SCALE : 1 IN:20 FT HORZ. / 1 IN:20 FT VERT.

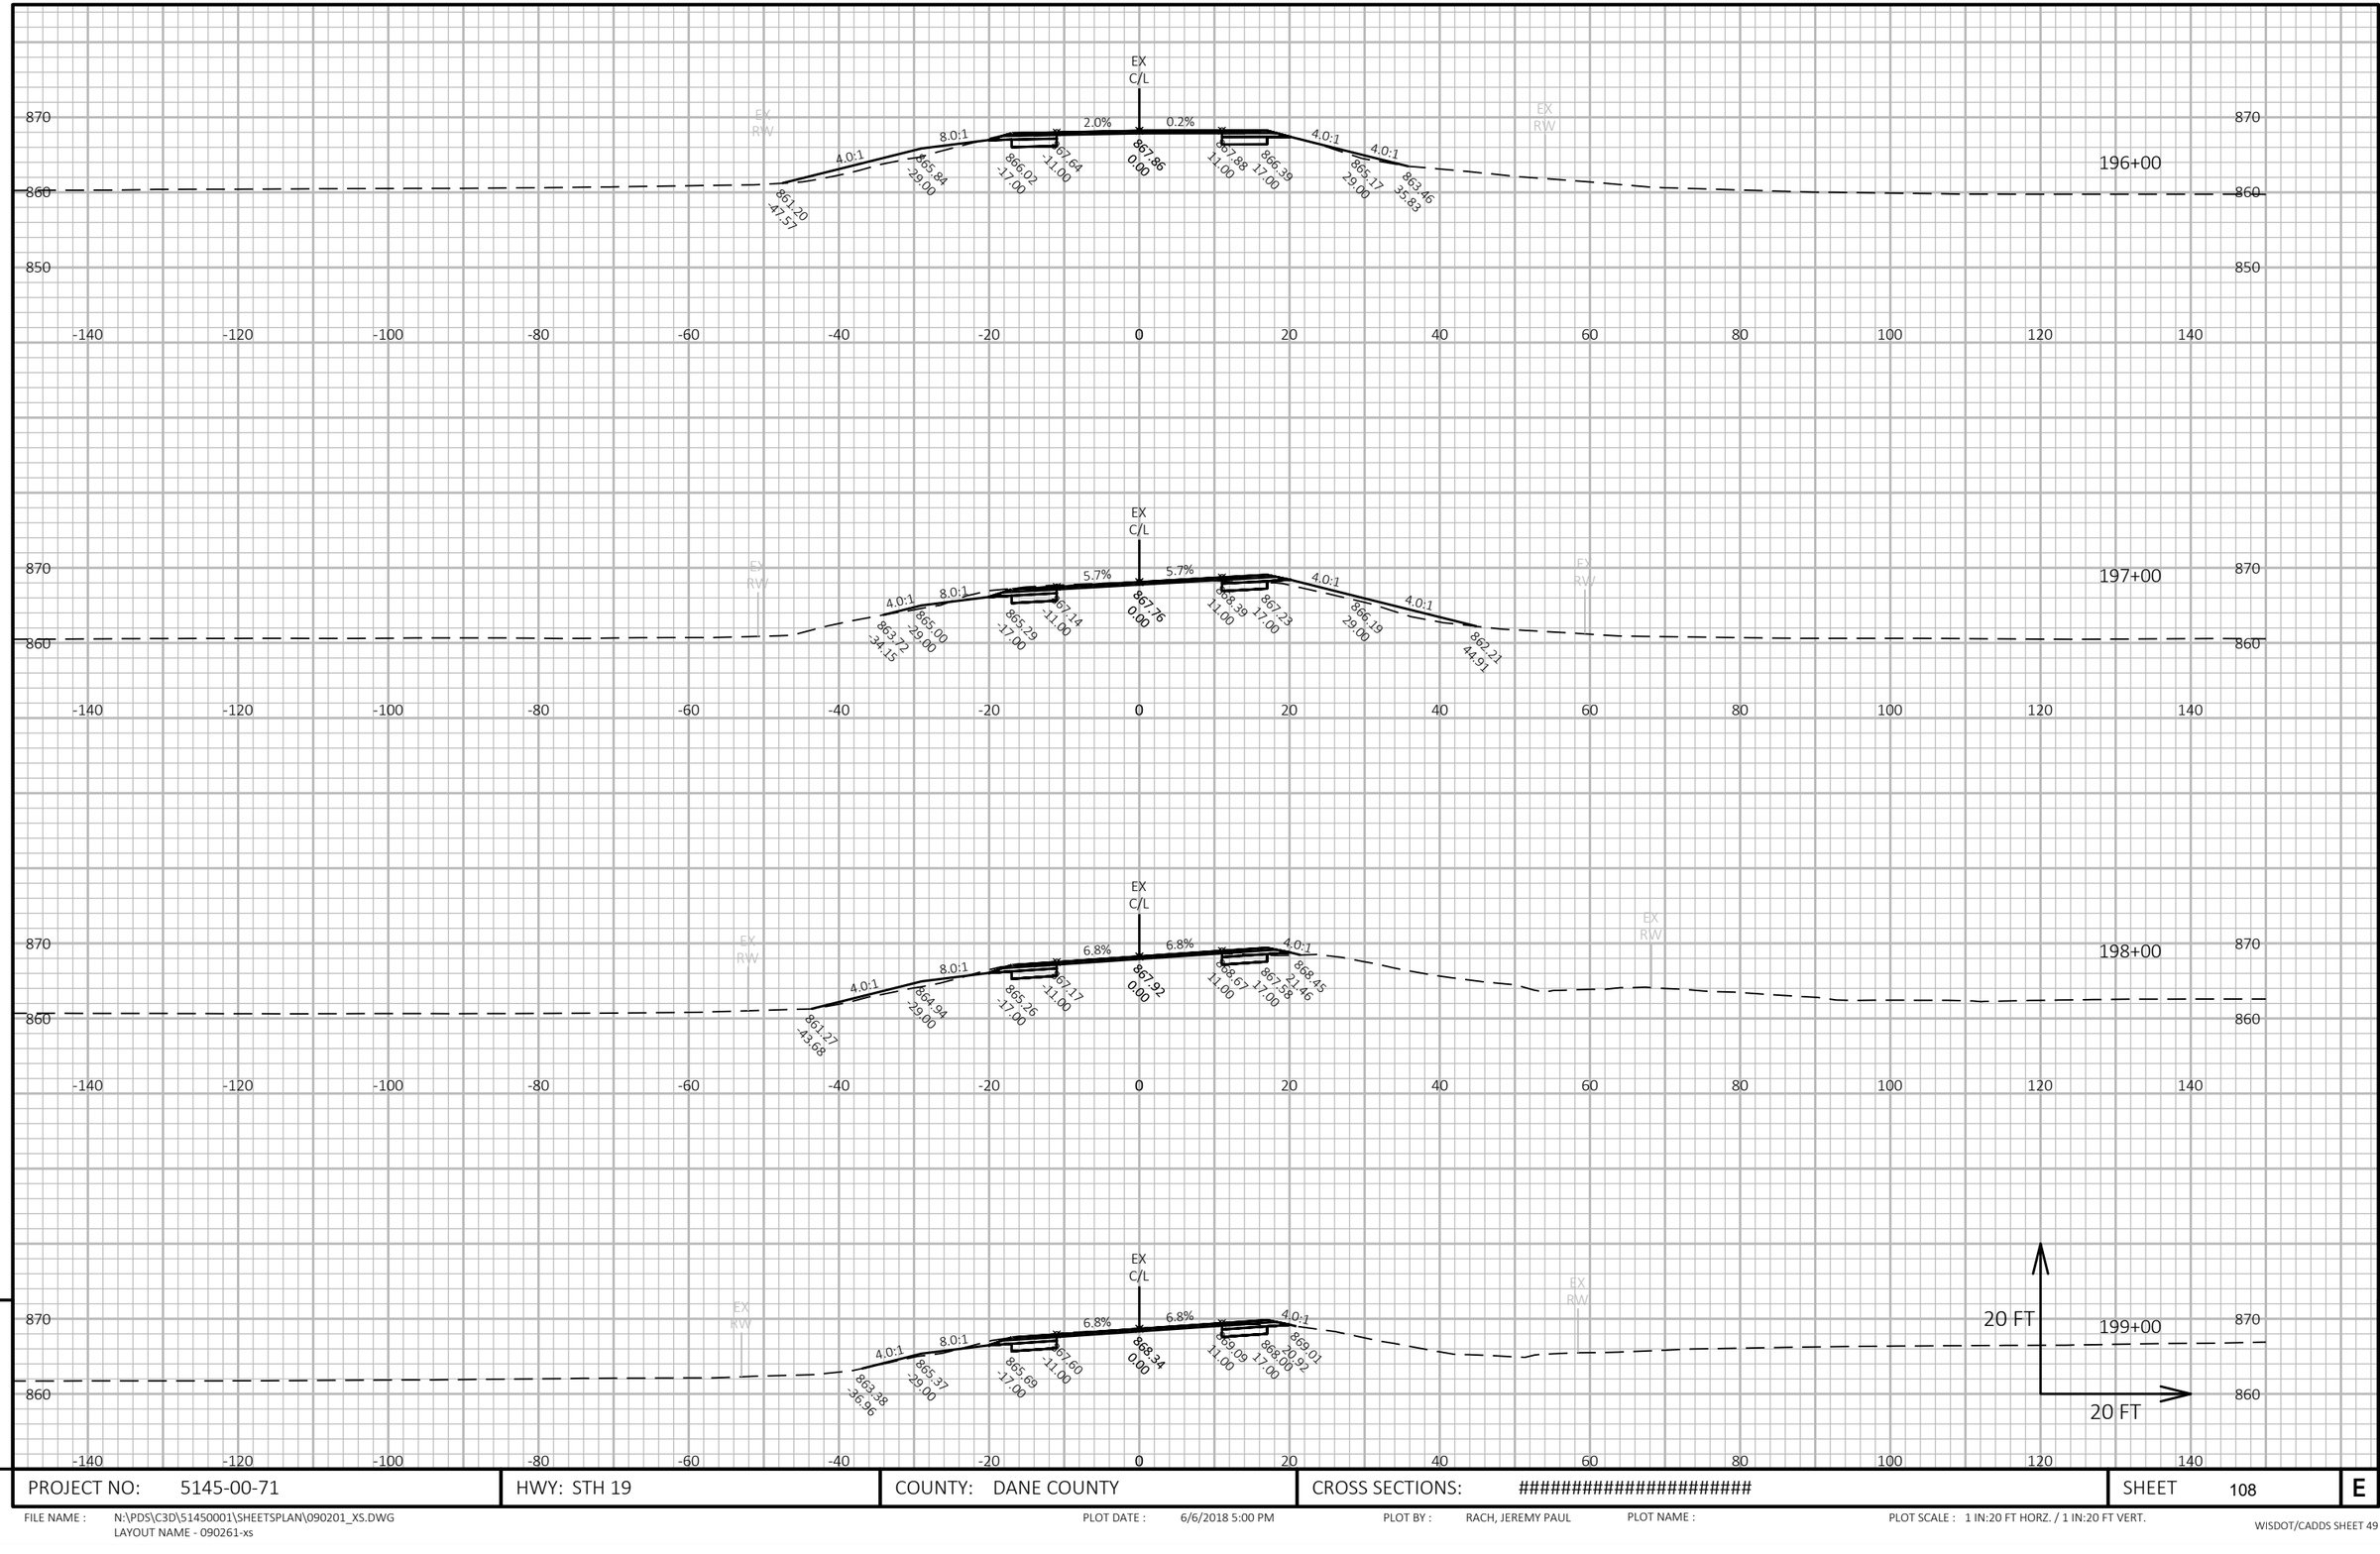

9

9

PROJECT NO: 5145-00-71	HWY: STH 19	COUNTY: DANE COUNTY	CROSS SECTIONS: ##########################	SHEET 108	E

FILE NAME : N:\PDS\C3D\51450001\SHEETSPLAN\090201_XS.DWG
LAYOUT NAME - 090261-xs

PLOT DATE : 6/6/2018 5:00 PM PLOT BY : RACH, JEREMY PAUL PLOT NAME : PLOT SCALE : 1 IN:20 FT HORZ. / 1 IN:20 FT VERT.

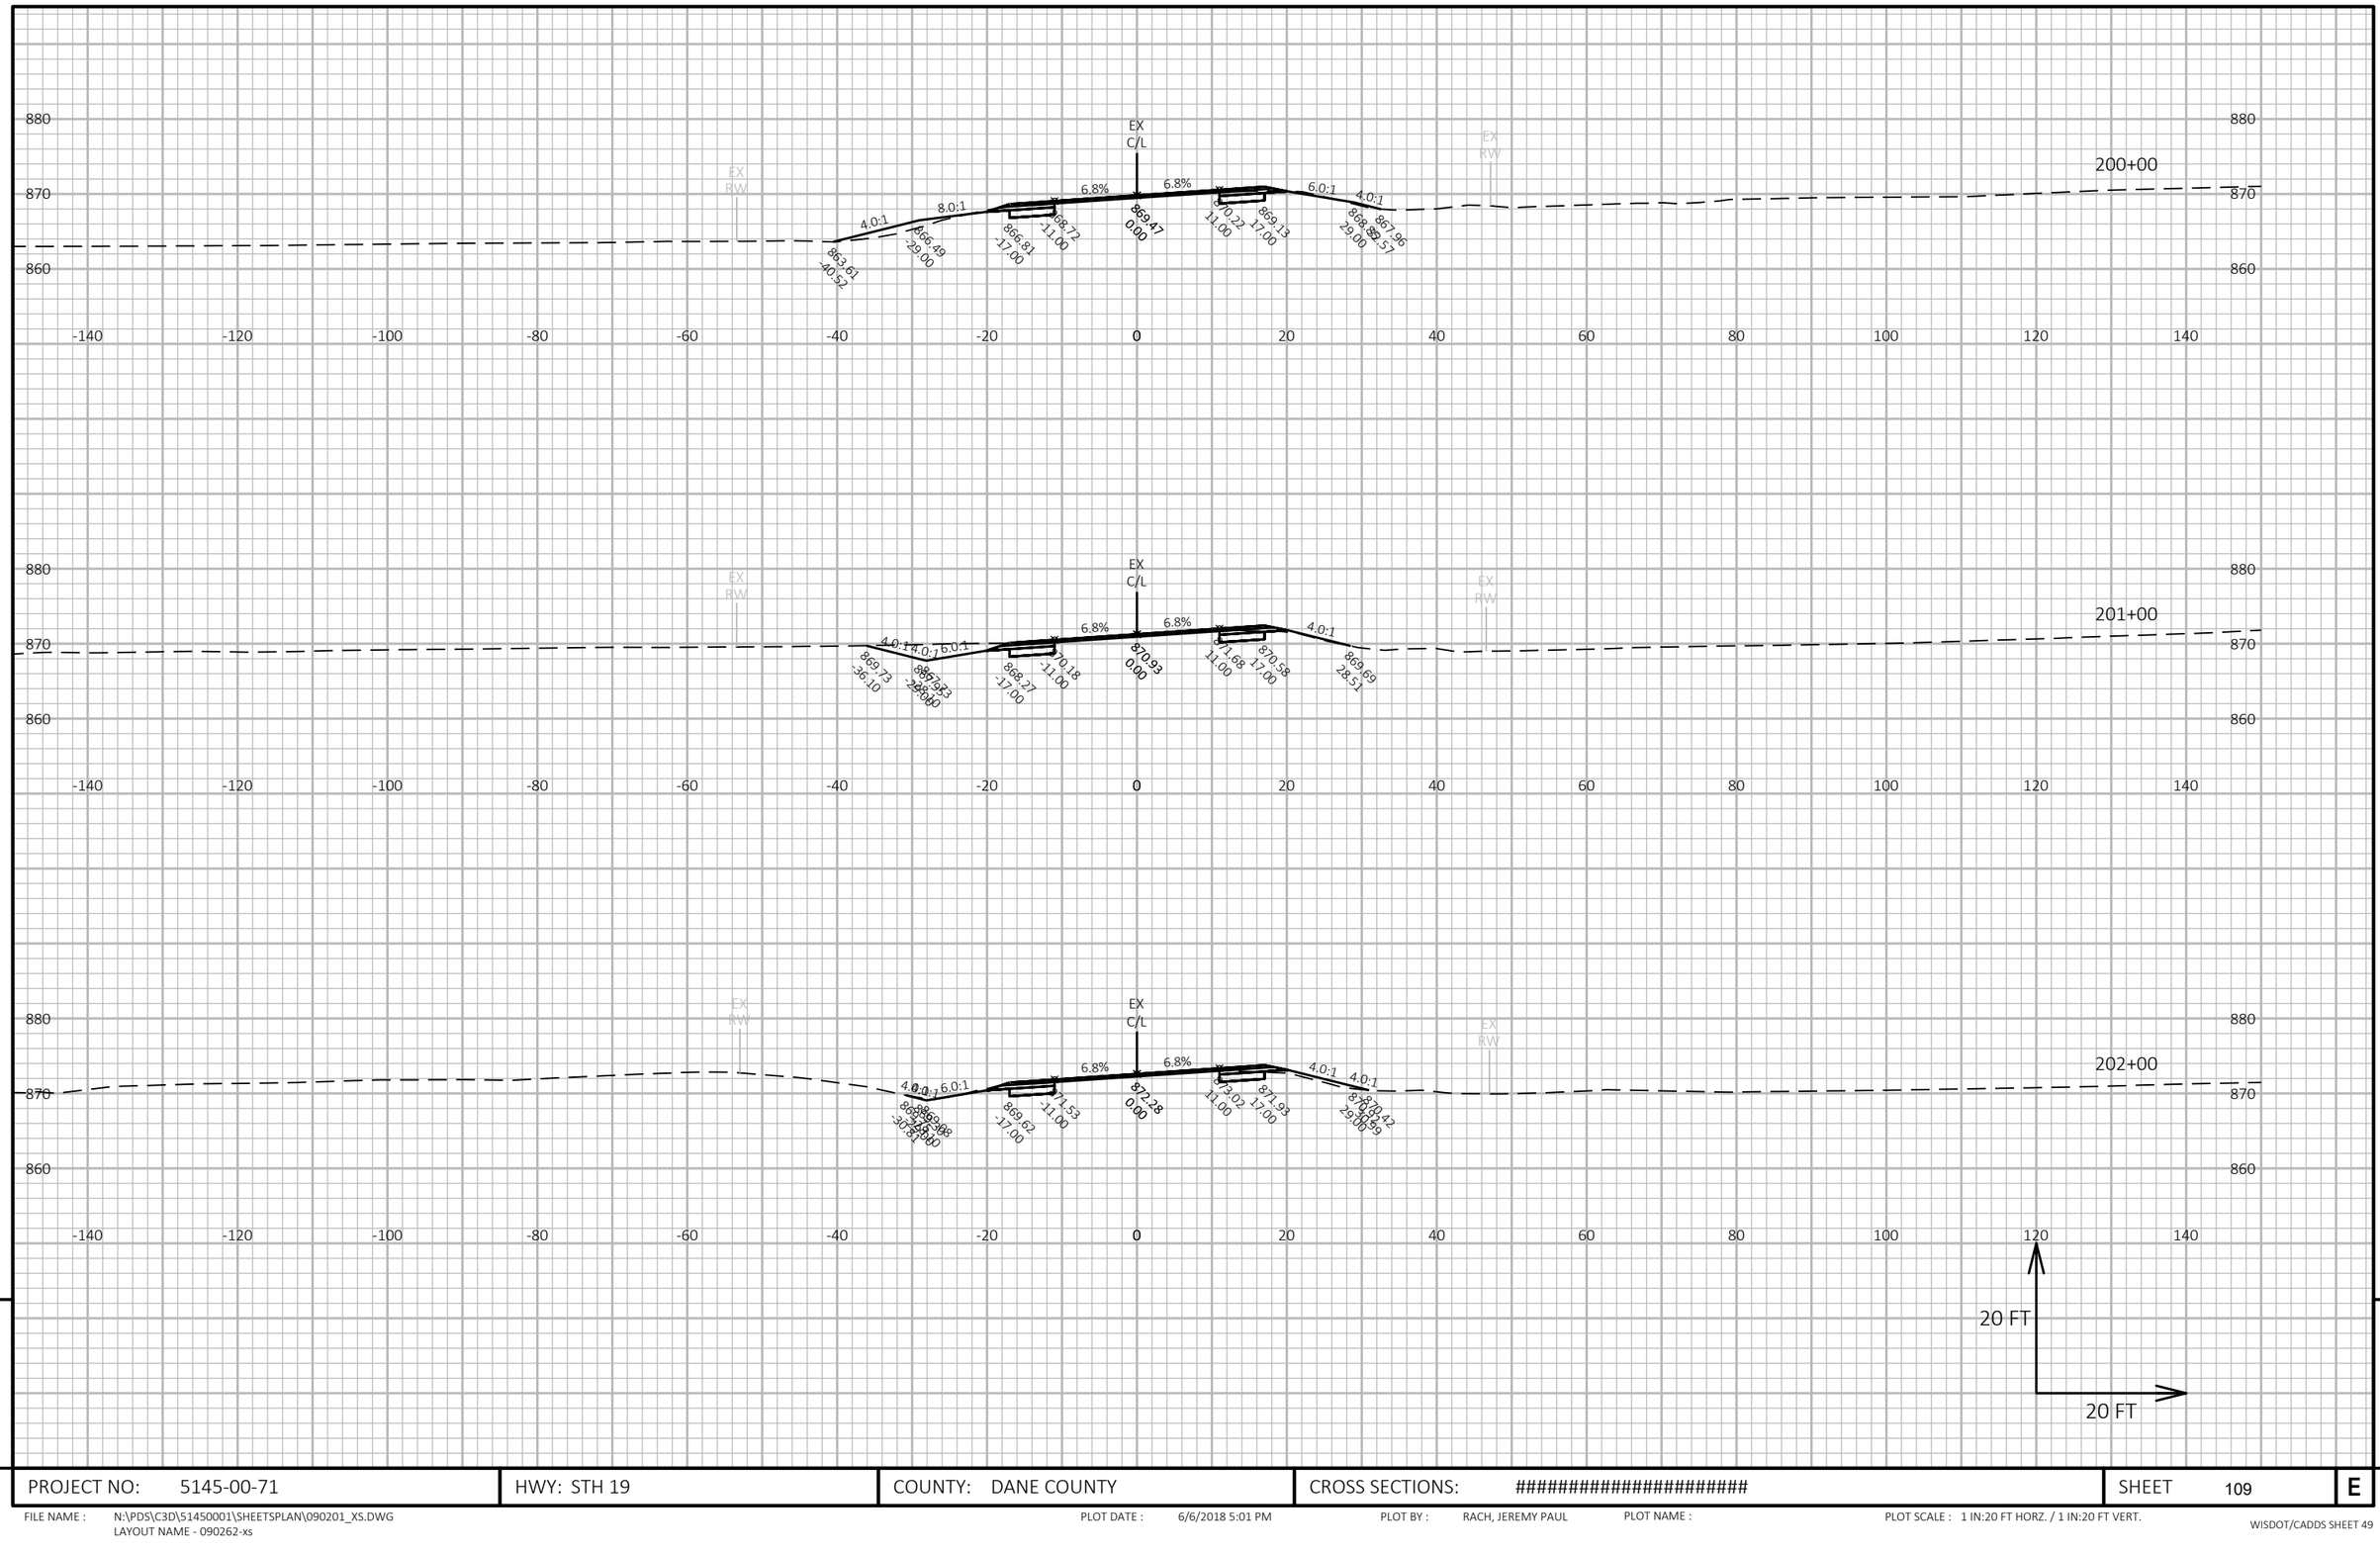

9

9

PROJECT NO: 5145-00-71	HWY: STH 19	COUNTY: DANE COUNTY	CROSS SECTIONS: ##########################	SHEET 109	E

FILE NAME : N:\PDS\C3D\51450001\SHEETSPLAN\090201_XS.DWG
LAYOUT NAME - 090262-xs

PLOT DATE : 6/6/2018 5:01 PM PLOT BY : RACH, JEREMY PAUL PLOT NAME : PLOT SCALE : 1 IN:20 FT HORZ. / 1 IN:20 FT VERT.

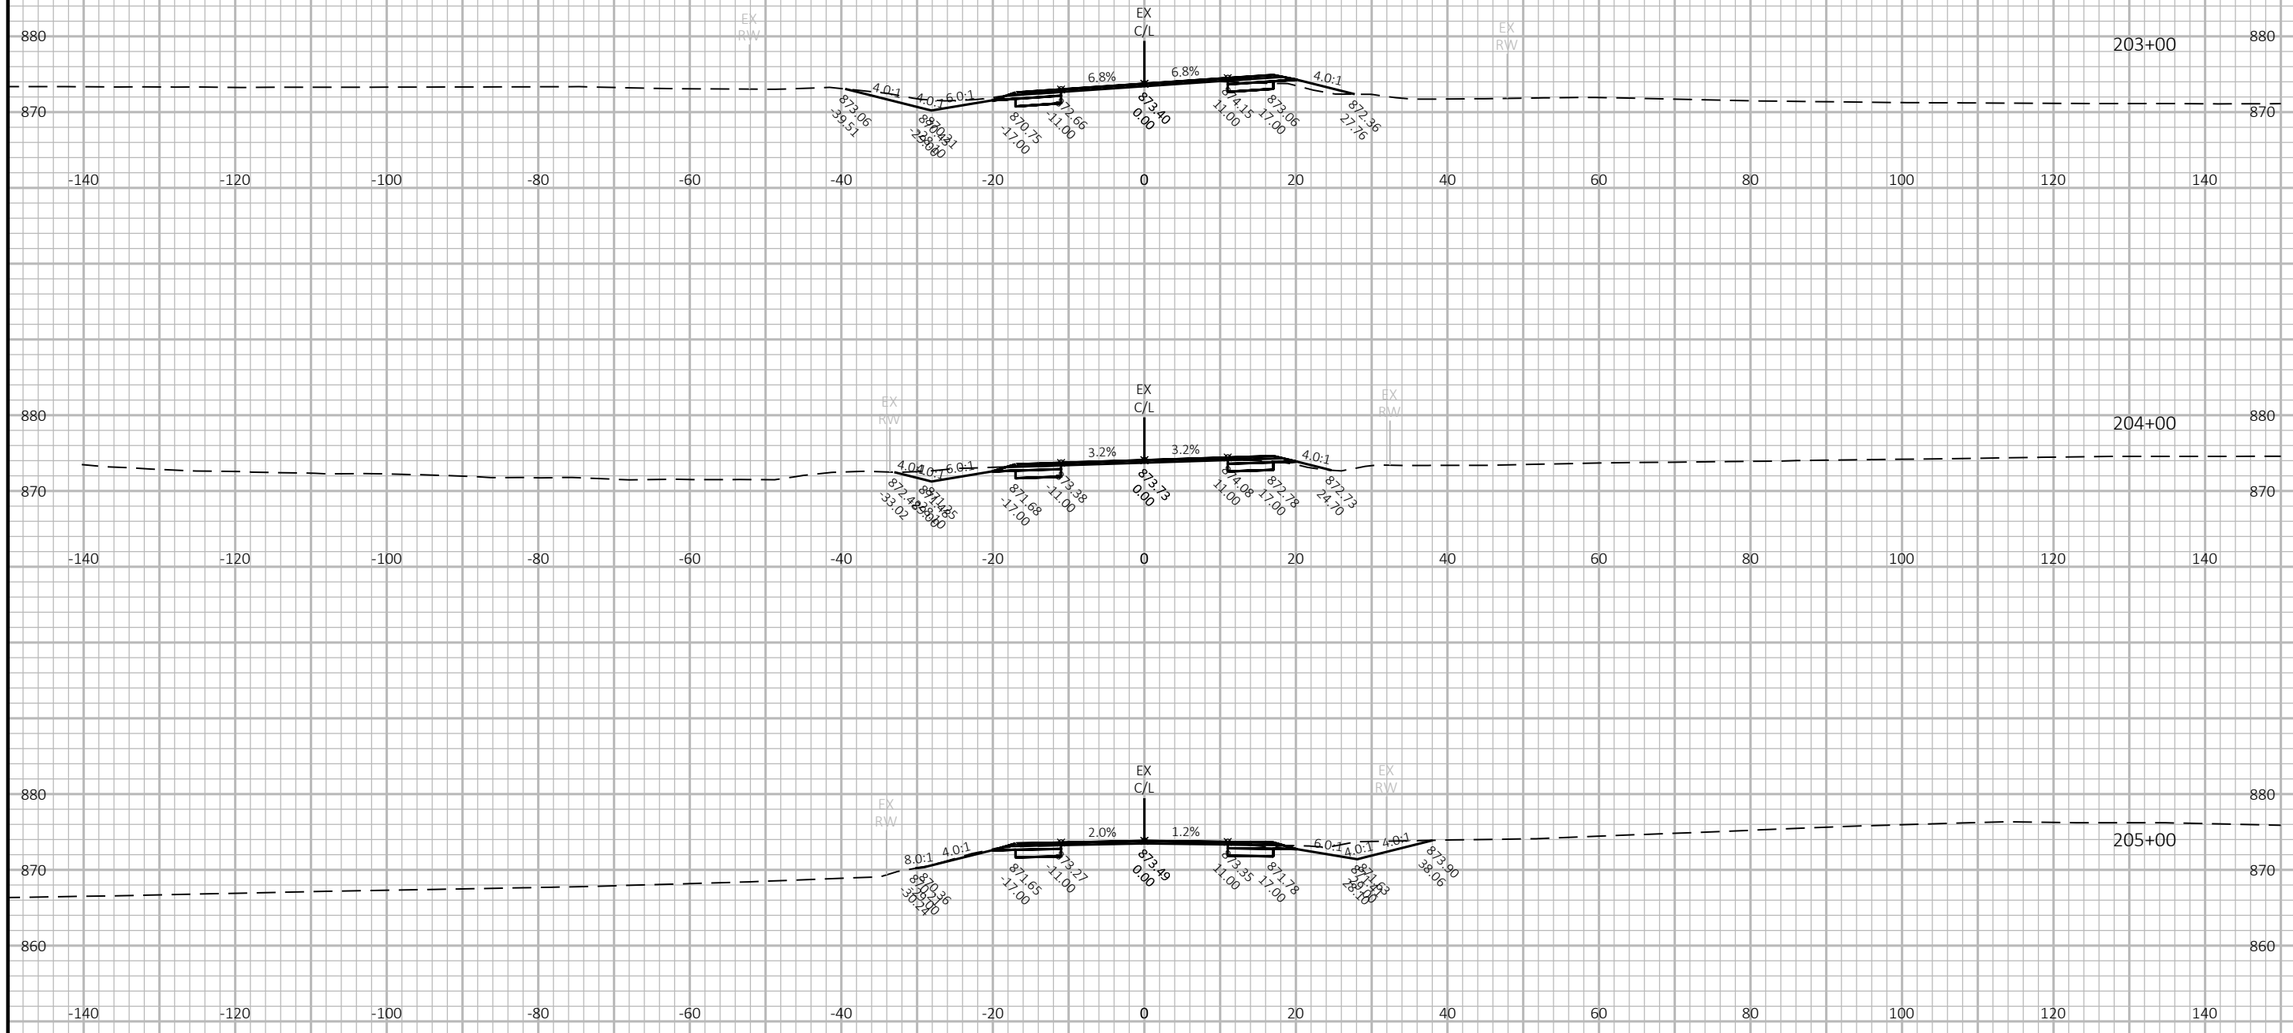

9

9

PROJECT NO: 5145-00-71	HWY: STH 19	COUNTY: DANE COUNTY	CROSS SECTIONS: ##########################	SHEET 110	E

FILE NAME : N:\PDS\C3D\51450001\SHEETSPLAN\090201_XS.DWG
LAYOUT NAME - 090263-xs

PLOT DATE : 6/6/2018 5:01 PM PLOT BY : RACH, JEREMY PAUL PLOT NAME : PLOT SCALE : 1 IN:20 FT HORZ. / 1 IN:20 FT VERT.

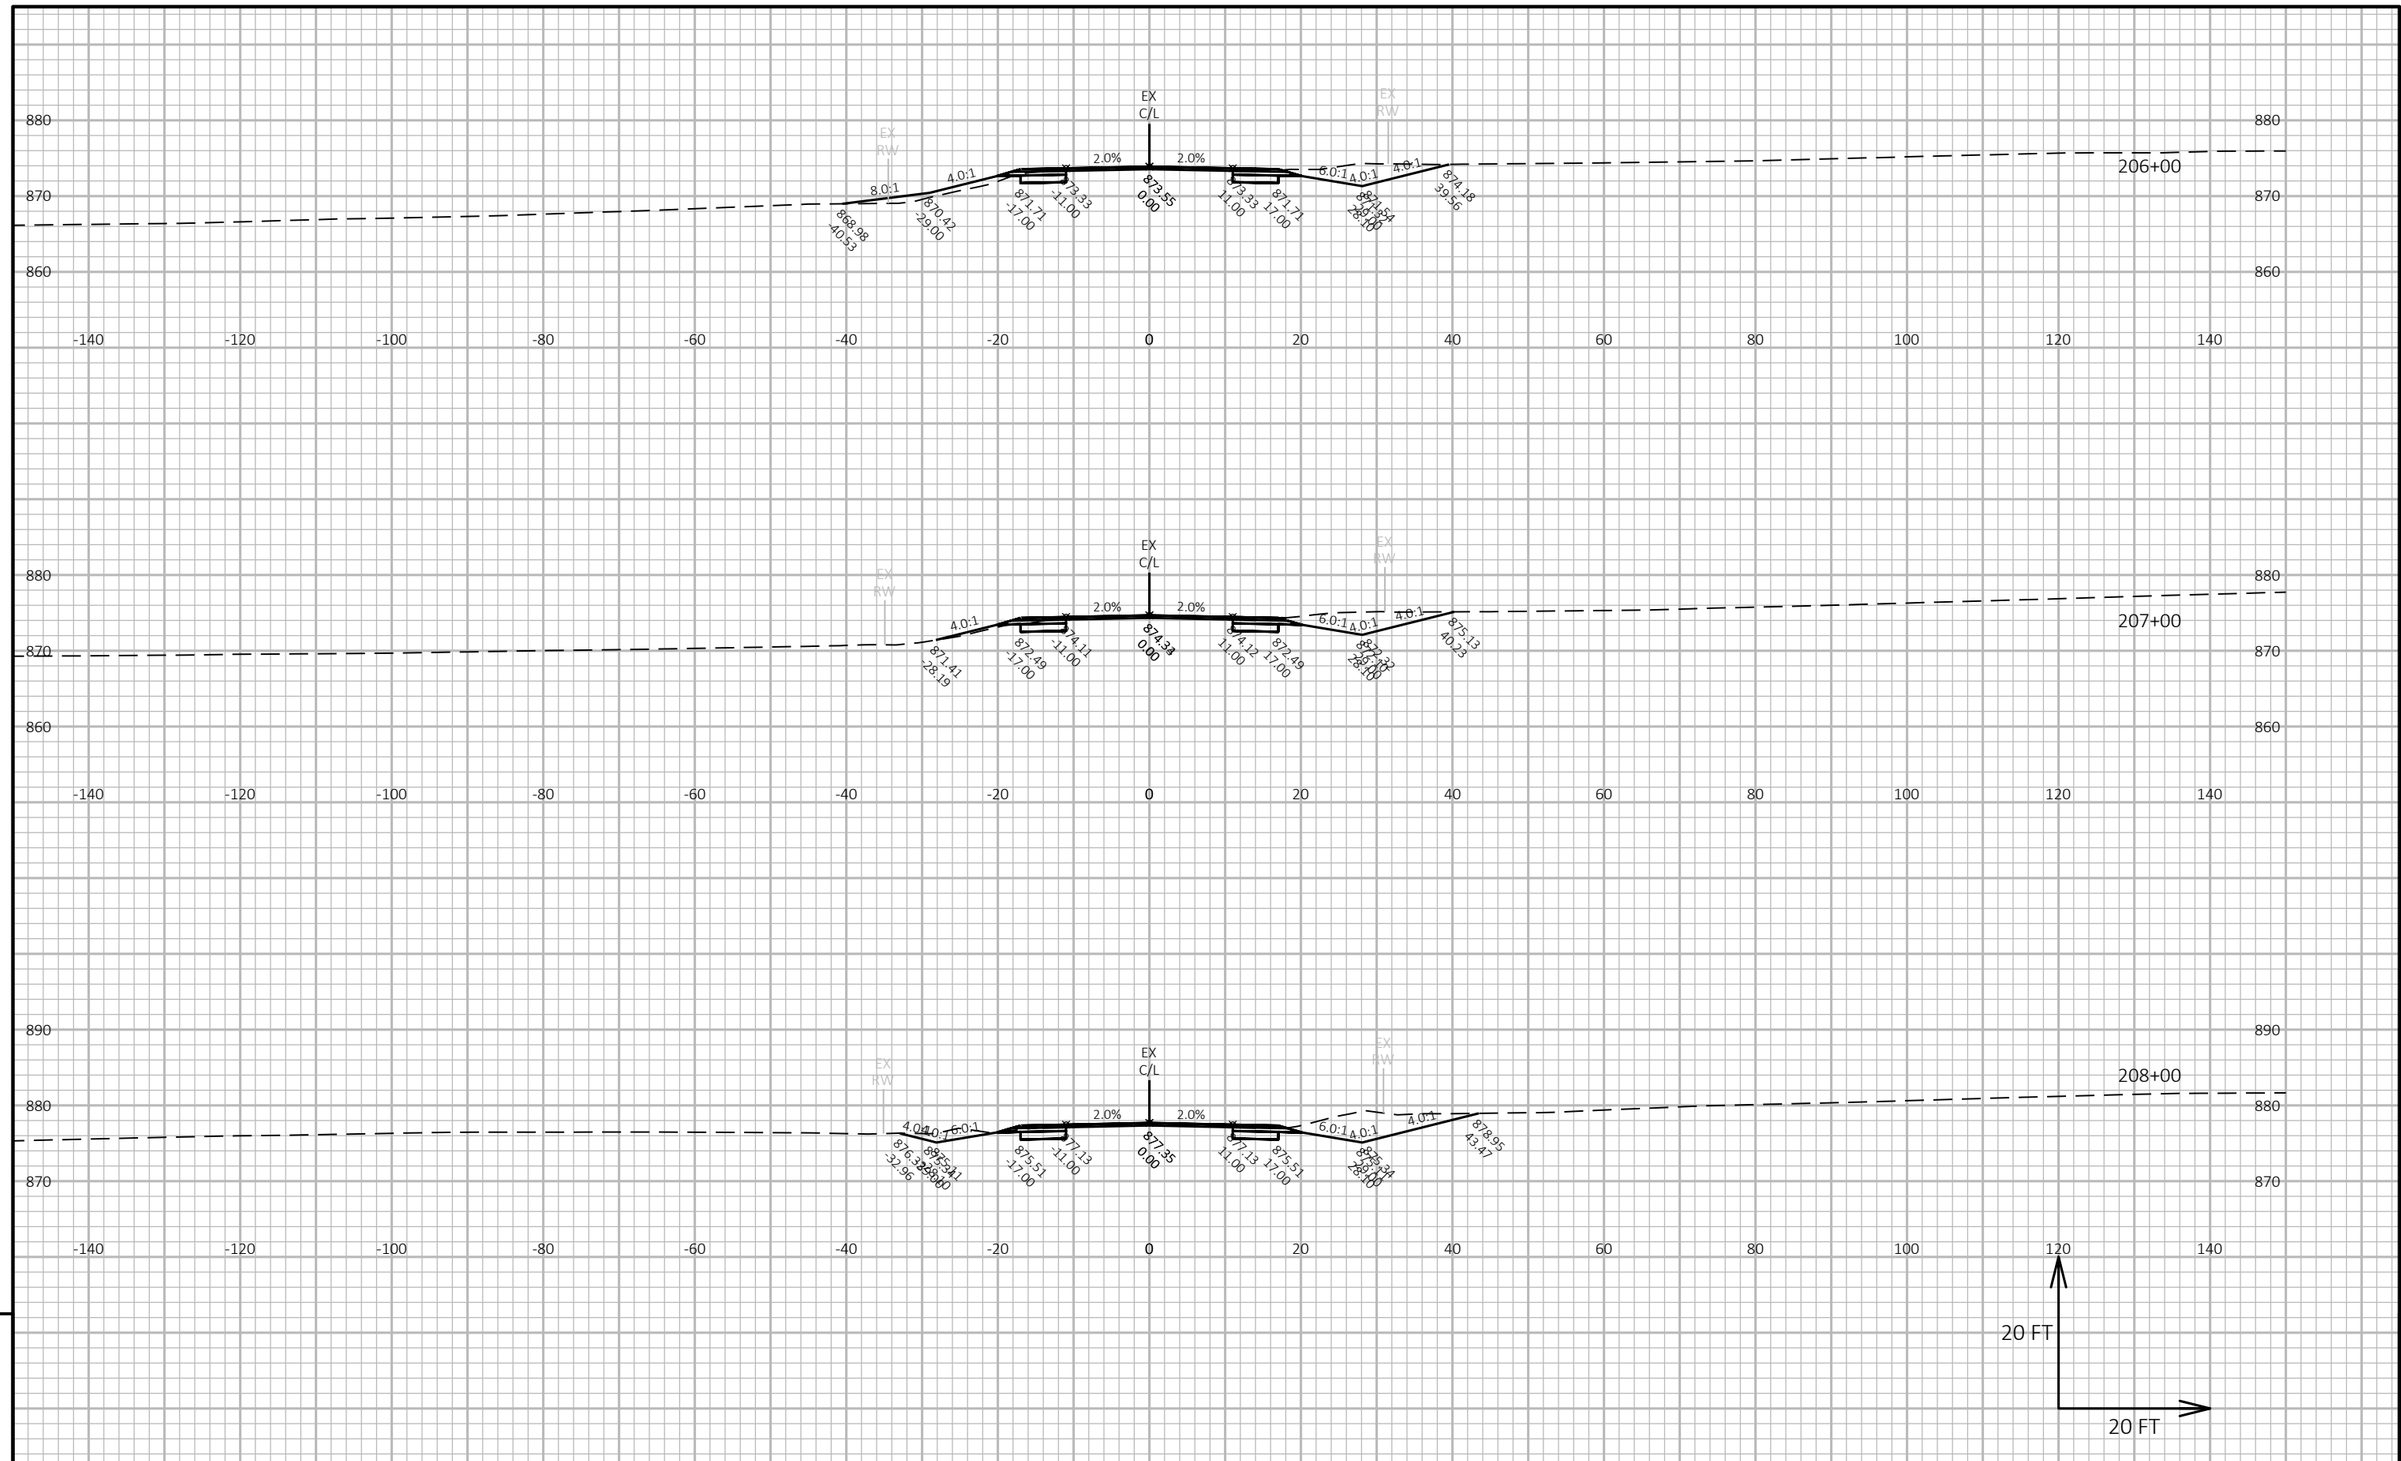

PROJECT NO: 5145-00-71	HWY: STH 19	COUNTY: DANE COUNTY	CROSS SECTIONS: ##########################	SHEET 111

FILE NAME : N:\PDS\C3D\51450001\SHEETSPLAN\090201_XS.DWG
LAYOUT NAME - 090264-xs

PLOT DATE : 6/6/2018 5:02 PM PLOT BY : RACH, JEREMY PAUL PLOT NAME : PLOT SCALE : 1 IN:20 FT HORZ. / 1 IN:20 FT VERT.

WISDOT/CADDS SHEET 49

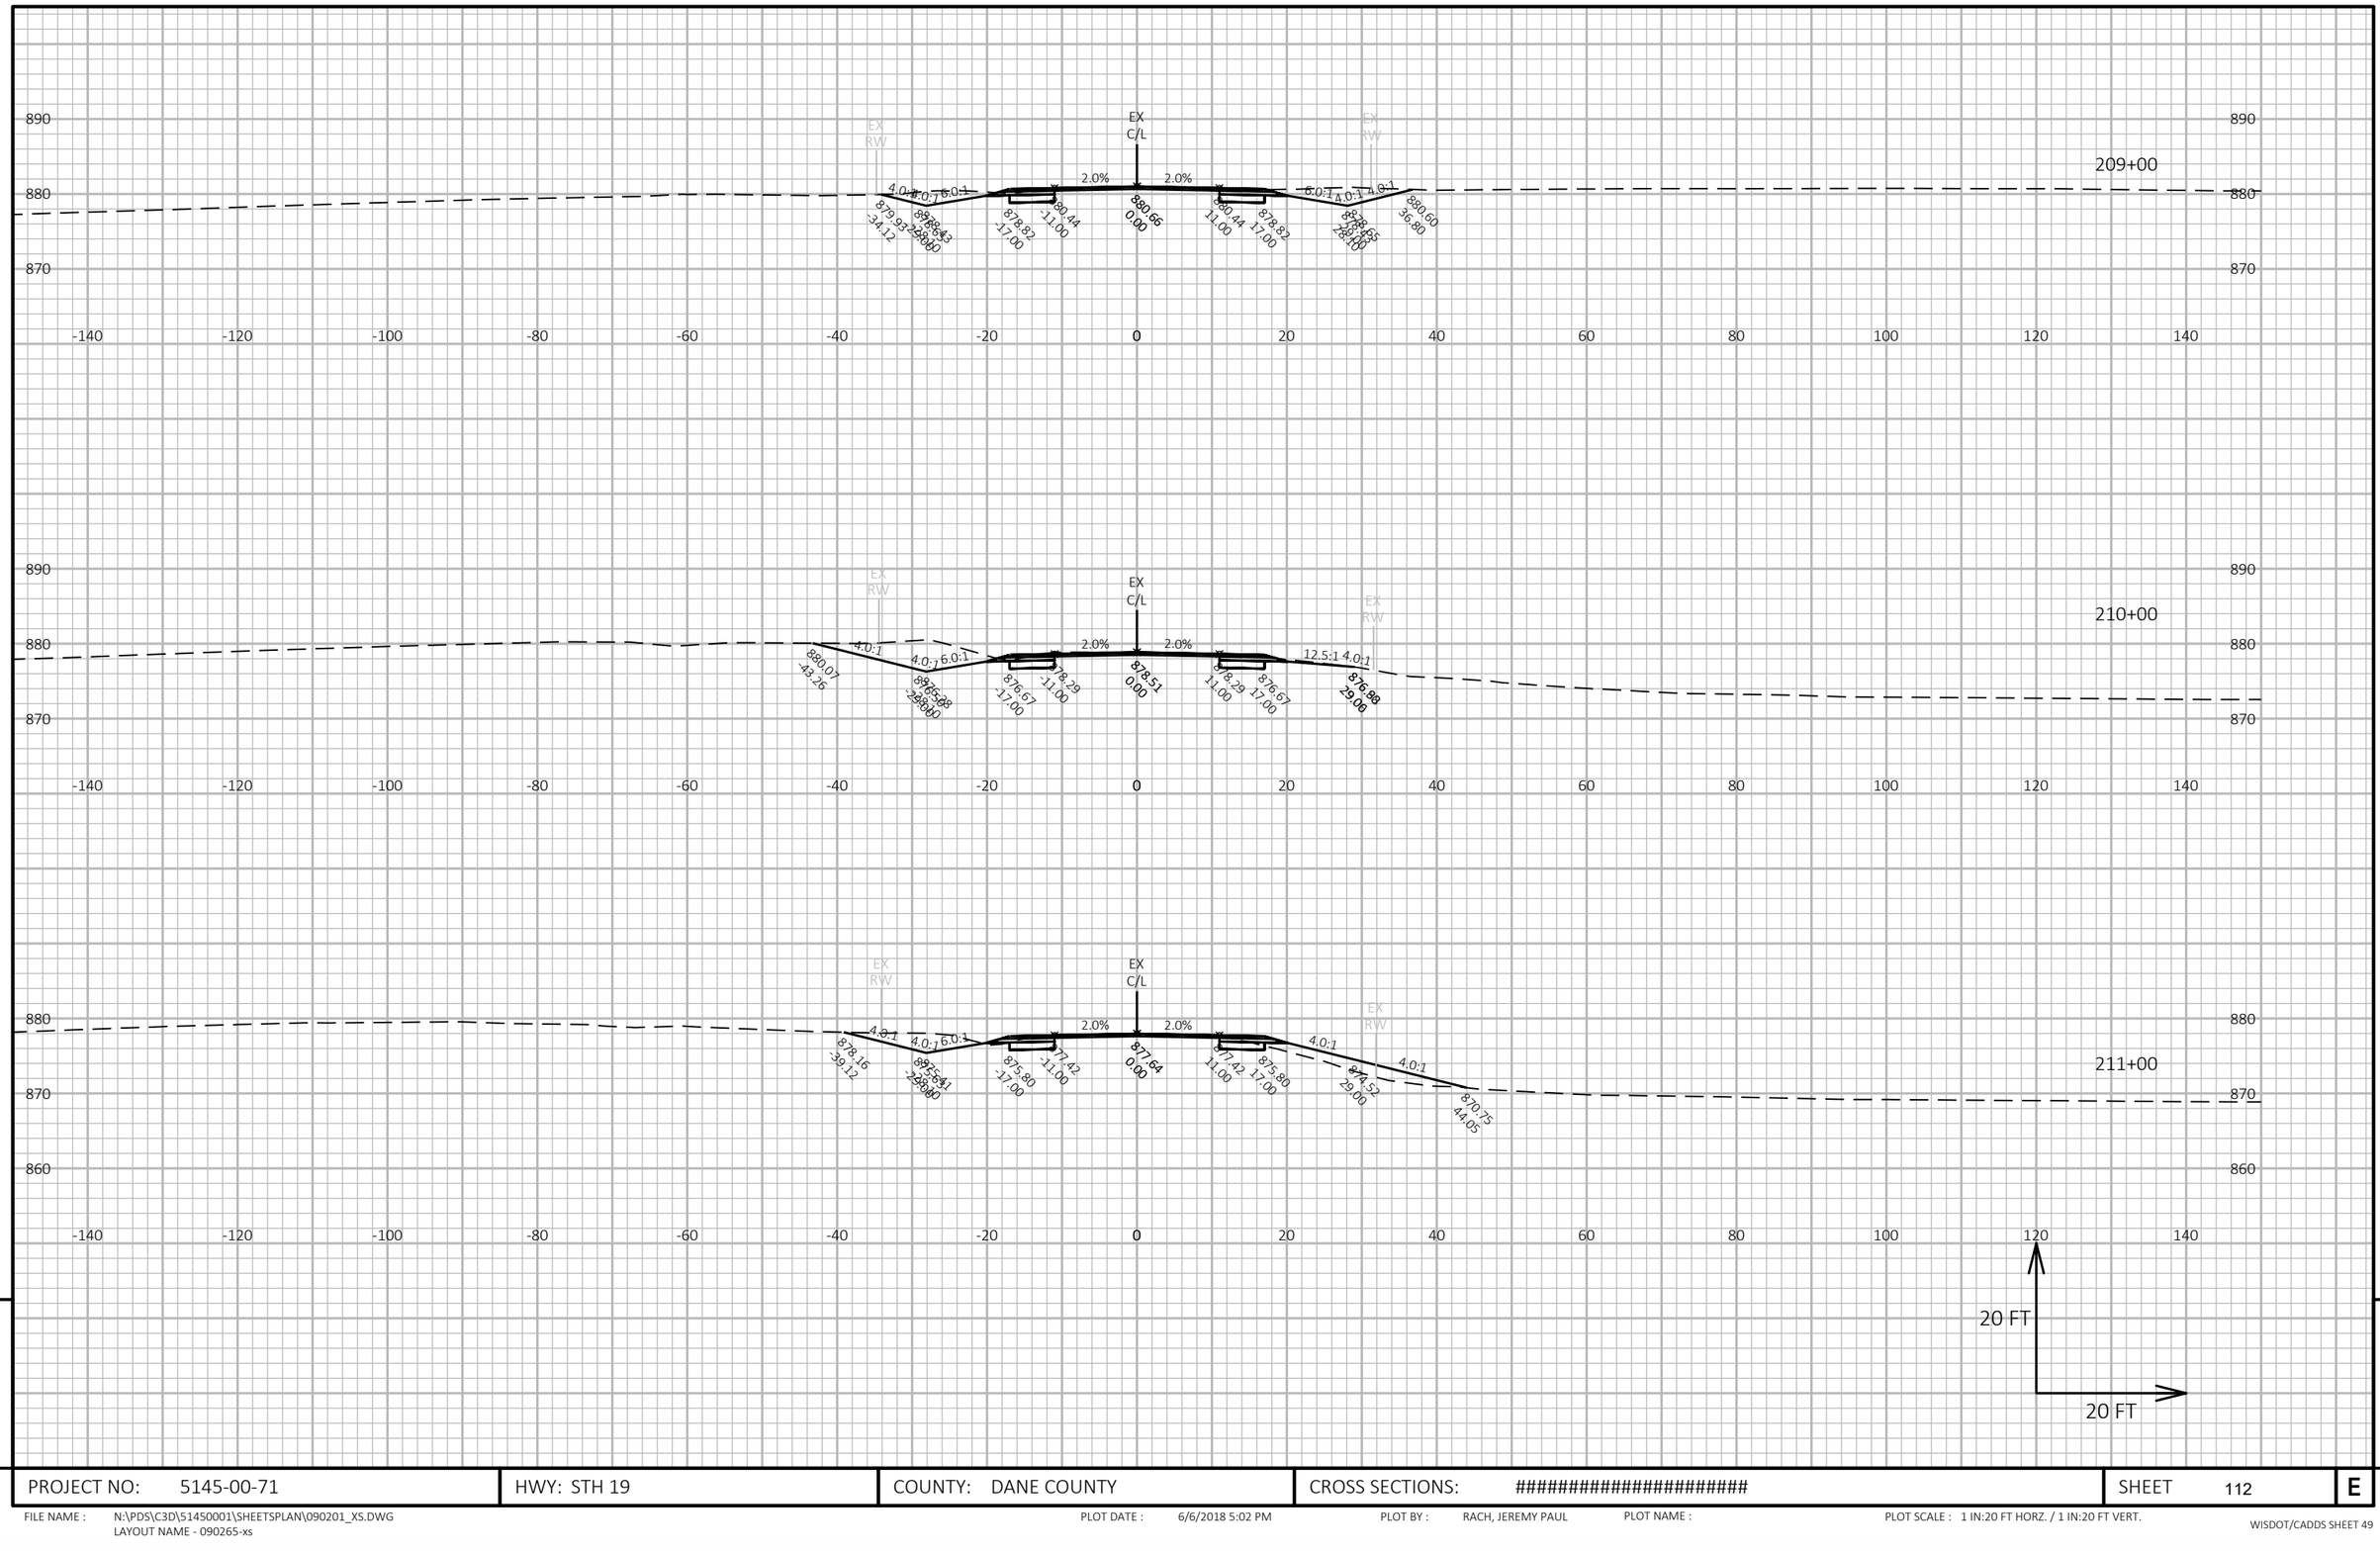

PROJECT NO: 5145-00-71	HWY: STH 19	COUNTY: DANE COUNTY	CROSS SECTIONS: ##########################	SHEET 112	E

FILE NAME : N:\PDS\C3D\51450001\SHEETSPLAN\090201_XS.DWG
LAYOUT NAME - 090265-xs

PLOT DATE : 6/6/2018 5:02 PM PLOT BY : RACH, JEREMY PAUL PLOT NAME : PLOT SCALE : 1 IN:20 FT HORZ. / 1 IN:20 FT VERT.

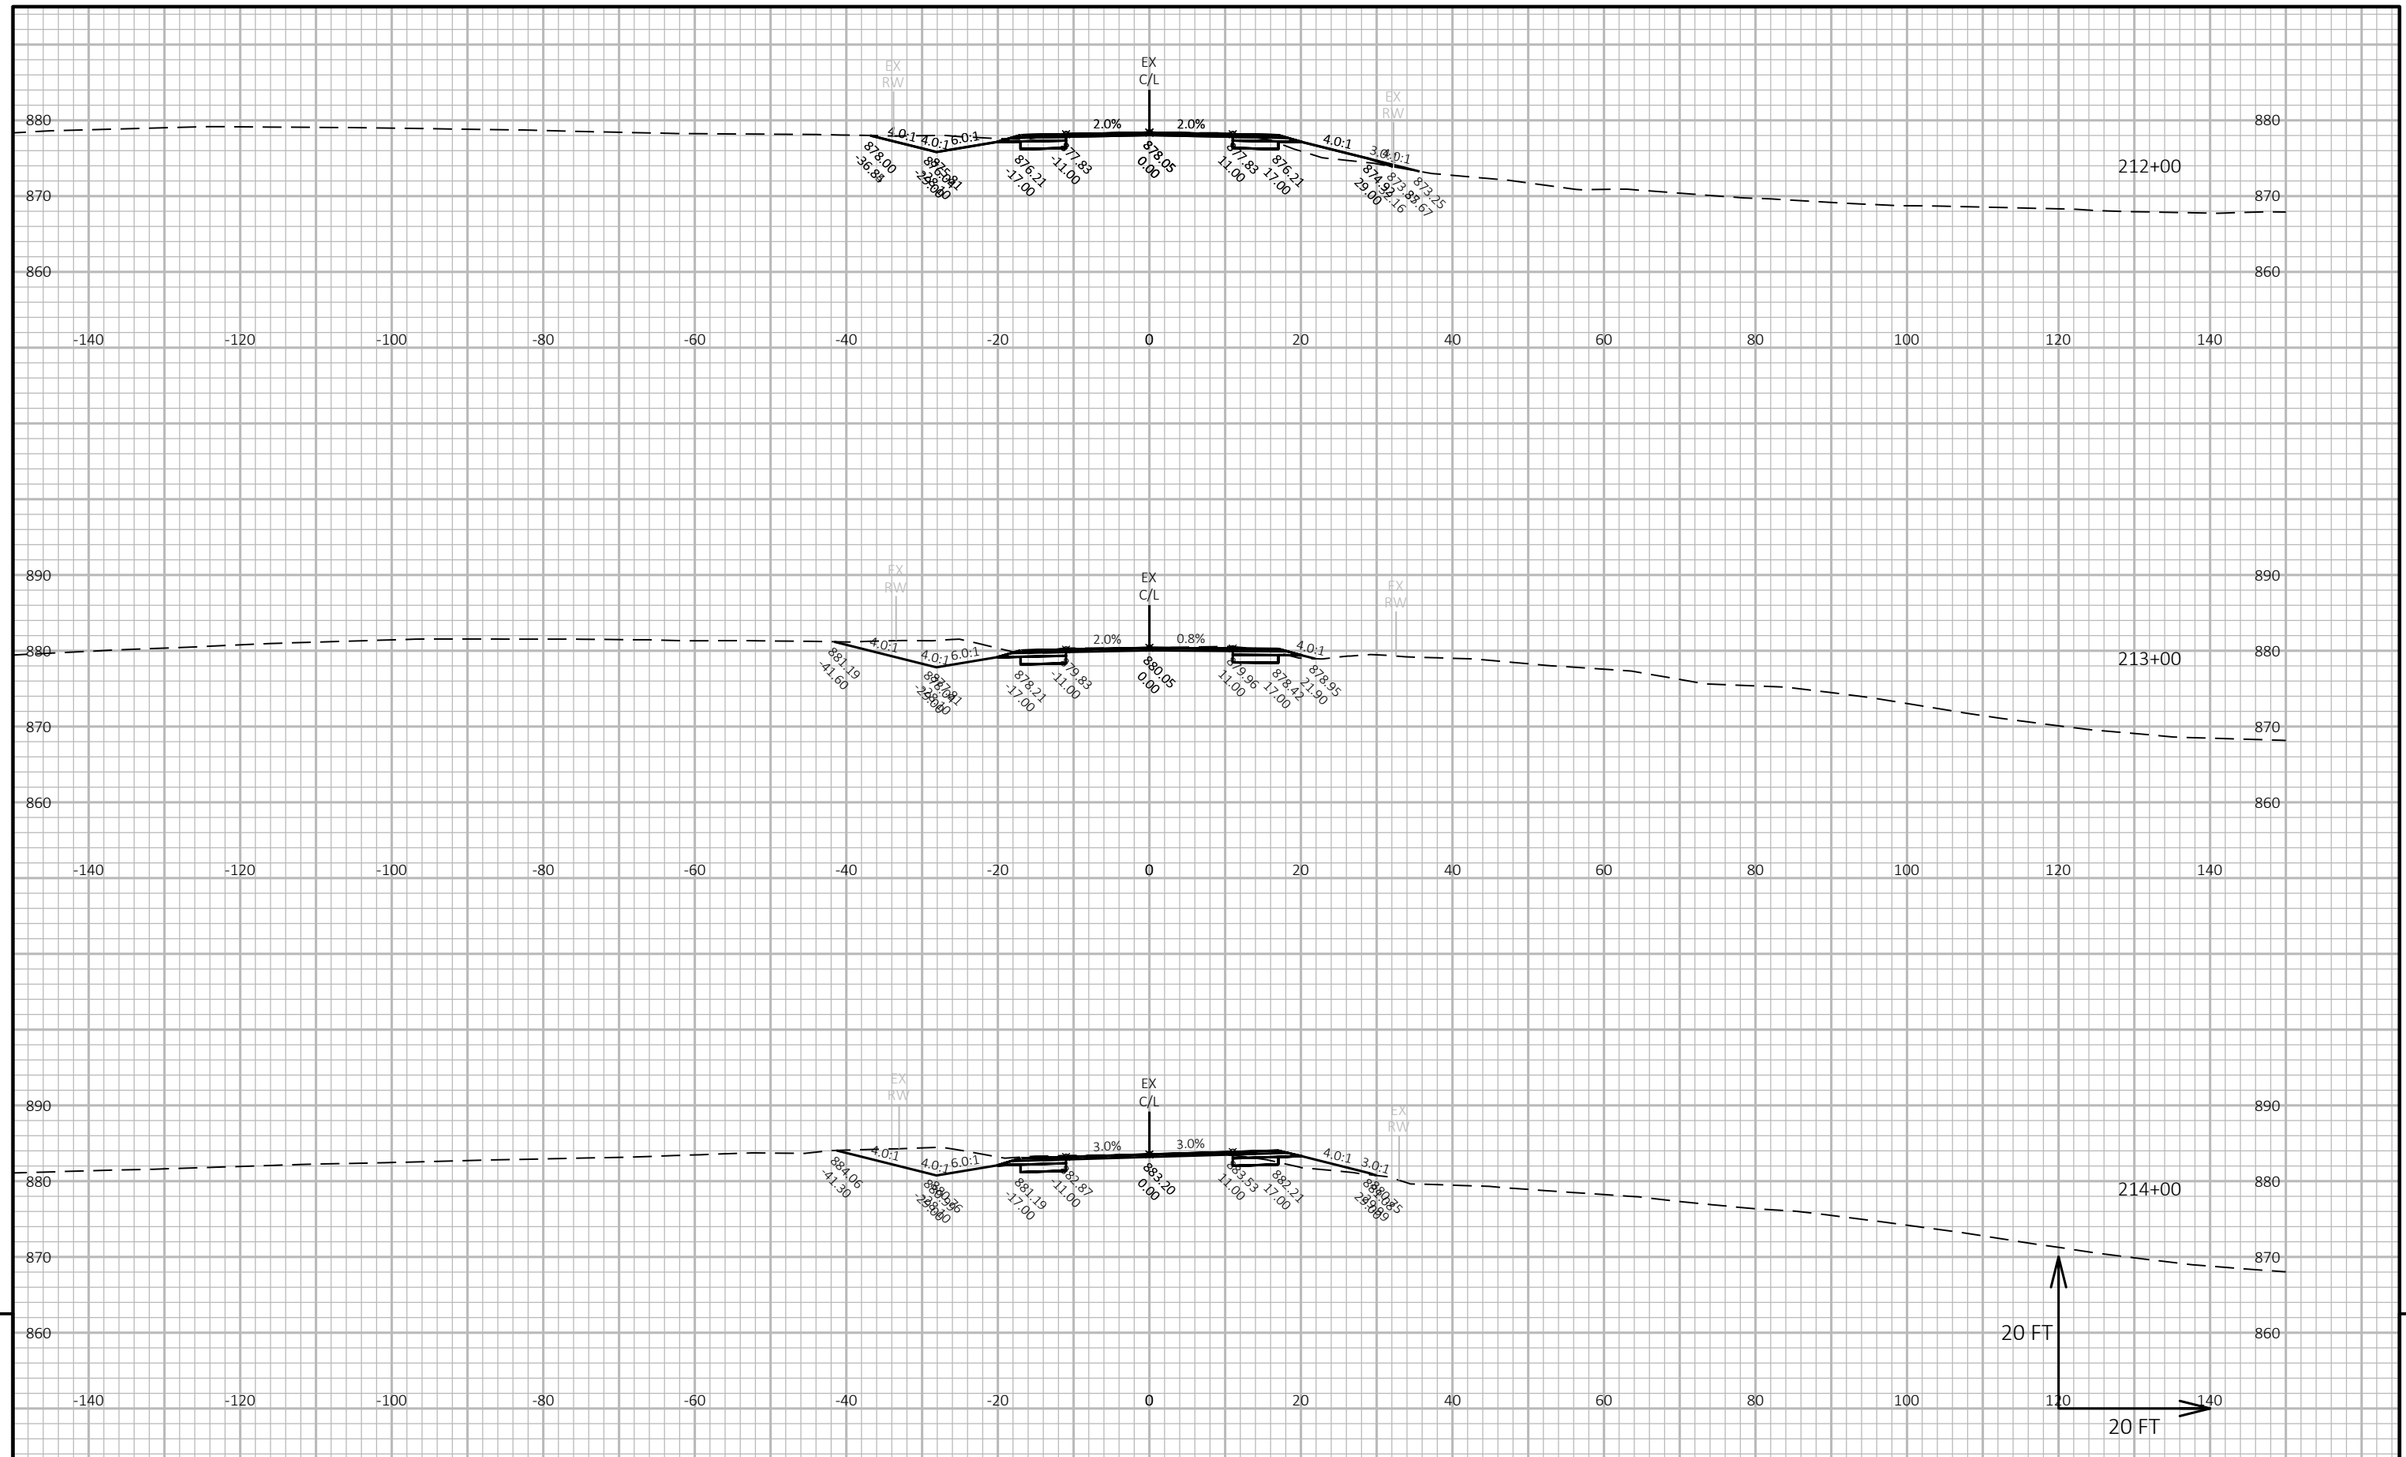

PROJECT NO: 5145-00-71	HWY: STH 19	COUNTY: DANE COUNTY	CROSS SECTIONS: ##########################	SHEET 113	E

FILE NAME : N:\PDS\C3D\51450001\SHEETSPLAN\090201_XS.DWG
LAYOUT NAME - 090266-xs

PLOT DATE : 6/6/2018 5:03 PM PLOT BY : RACH, JEREMY PAUL PLOT NAME : PLOT SCALE : 1 IN:20 FT HORZ. / 1 IN:20 FT VERT.

WISDOT/CADDS SHEET 49

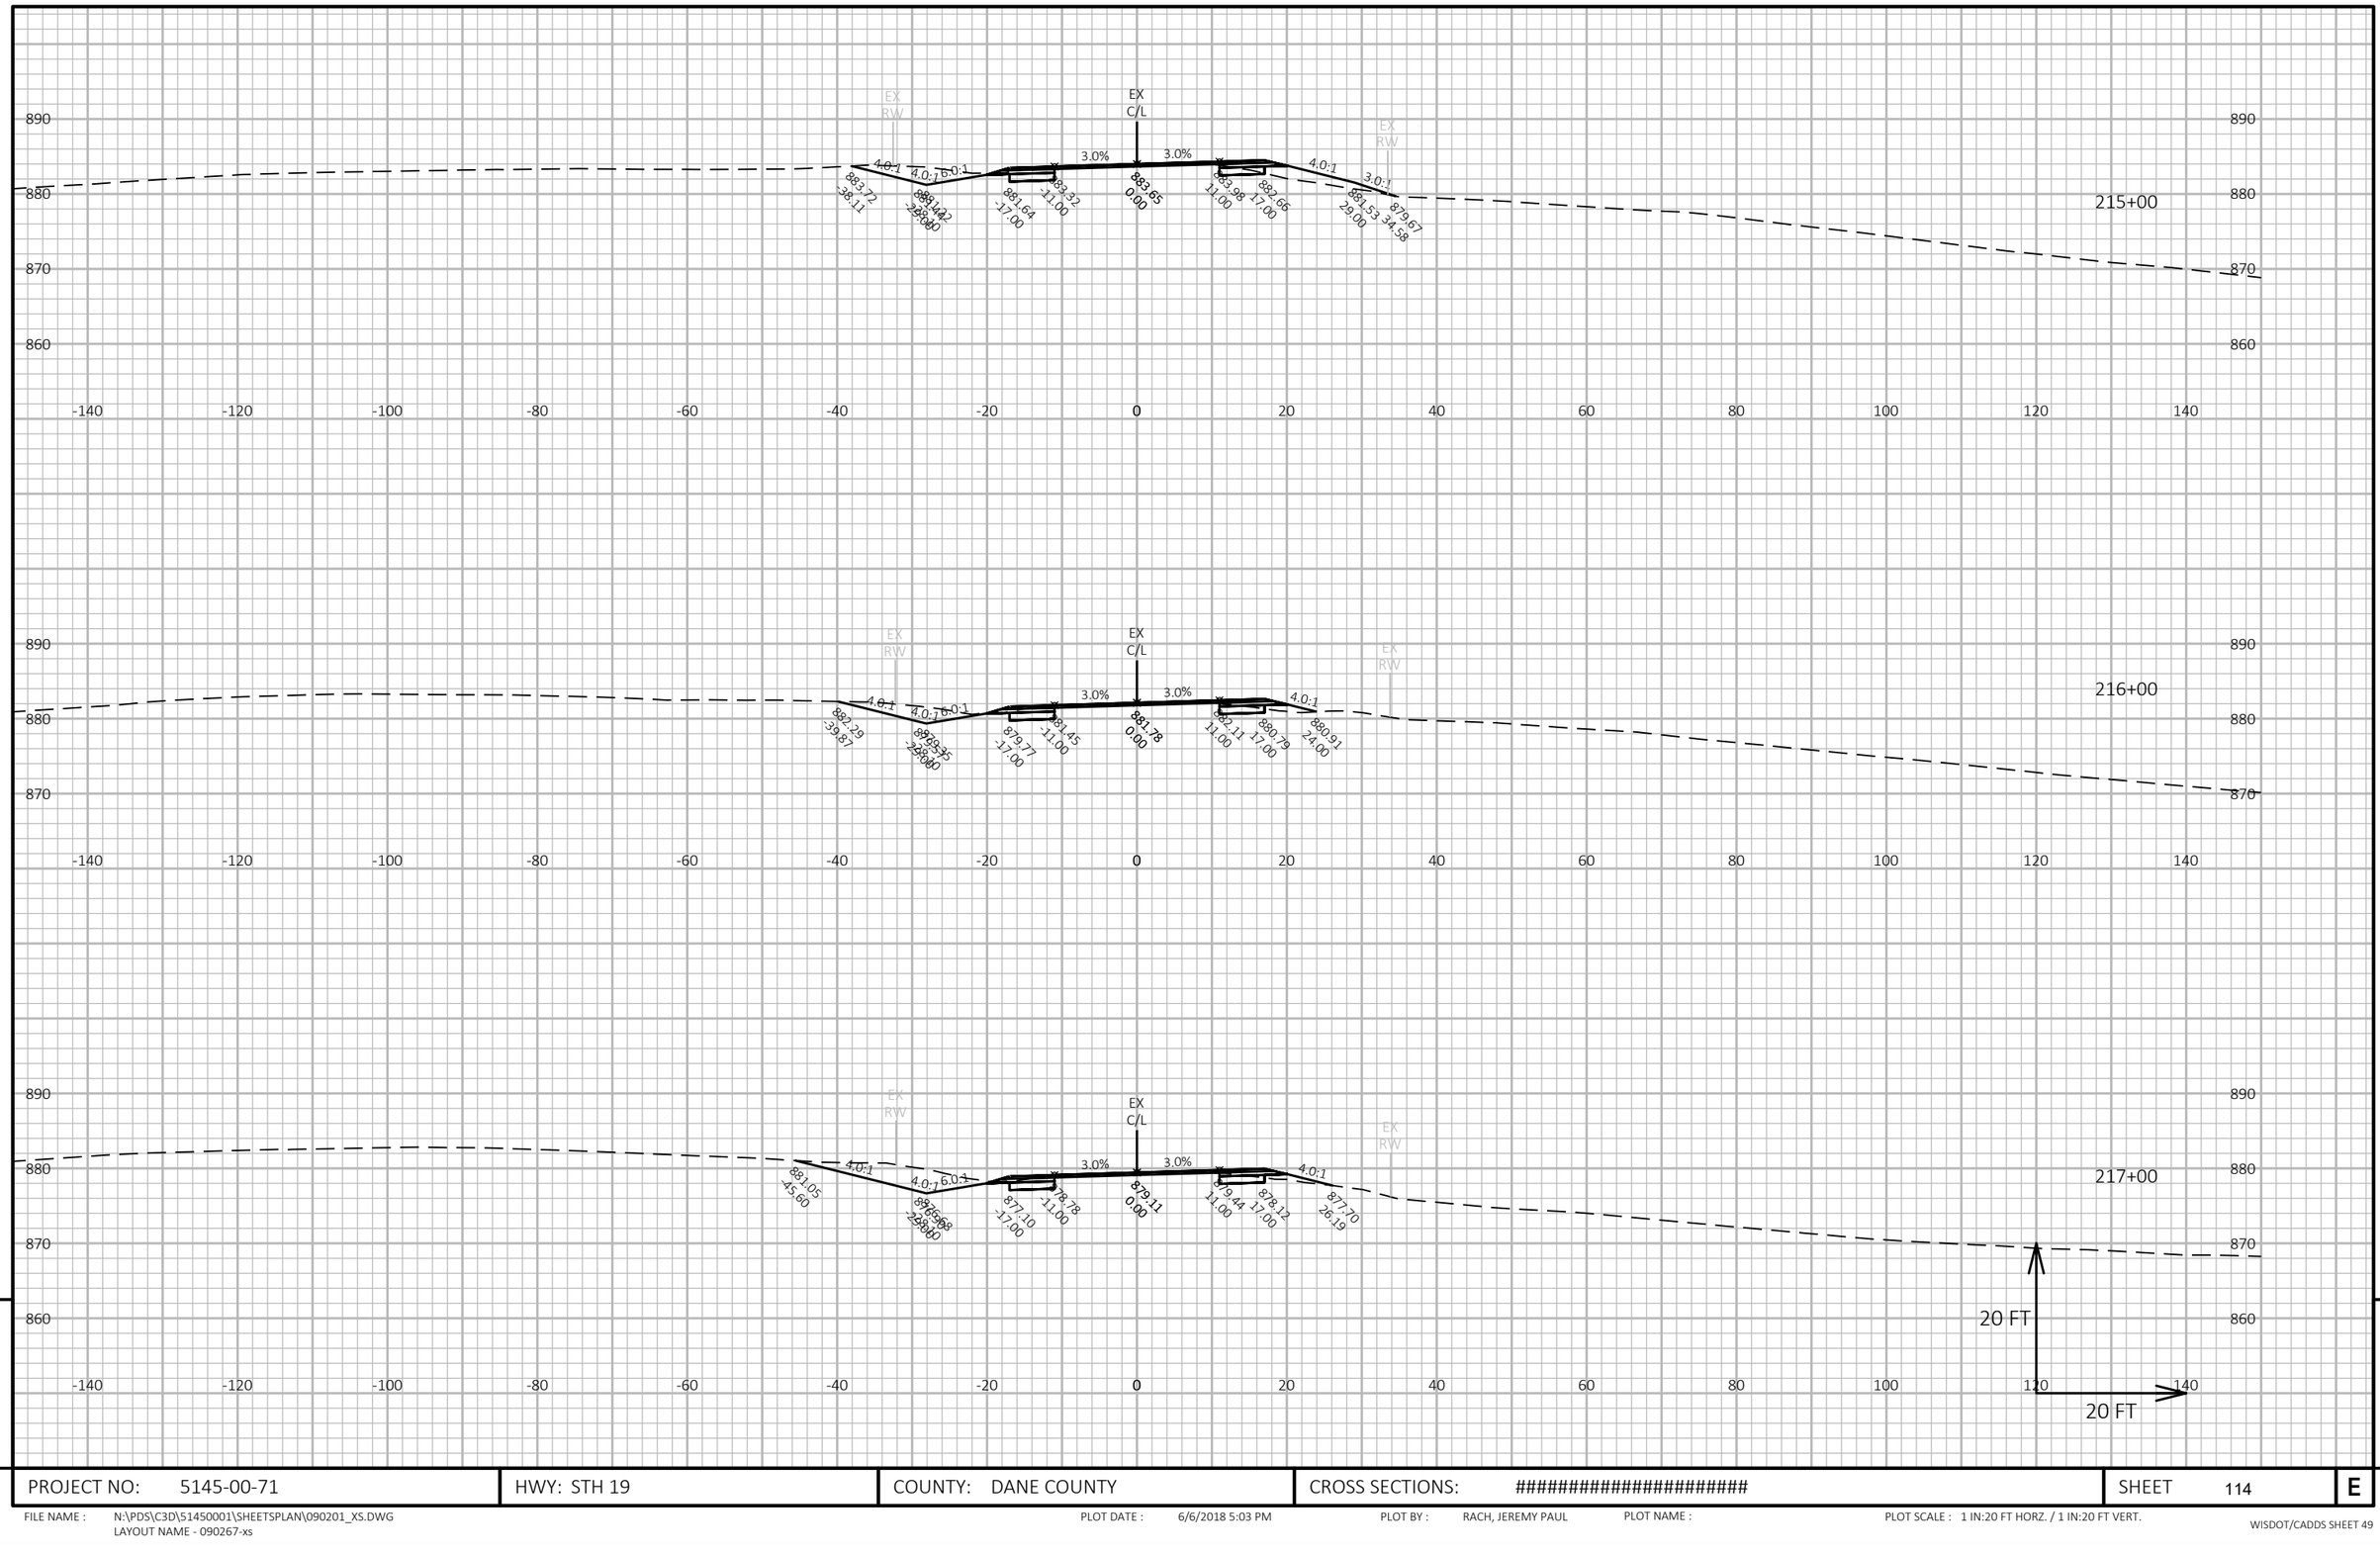

9

9

PROJECT NO: 5145-00-71	HWY: STH 19	COUNTY: DANE COUNTY	CROSS SECTIONS: ##########################	SHEET 114	E

FILE NAME : N:\PDS\C3D\51450001\SHEETSPLAN\090201_XS.DWG
LAYOUT NAME - 090267-xs

PLOT DATE : 6/6/2018 5:03 PM PLOT BY : RACH, JEREMY PAUL PLOT NAME : PLOT SCALE : 1 IN:20 FT HORZ. / 1 IN:20 FT VERT.

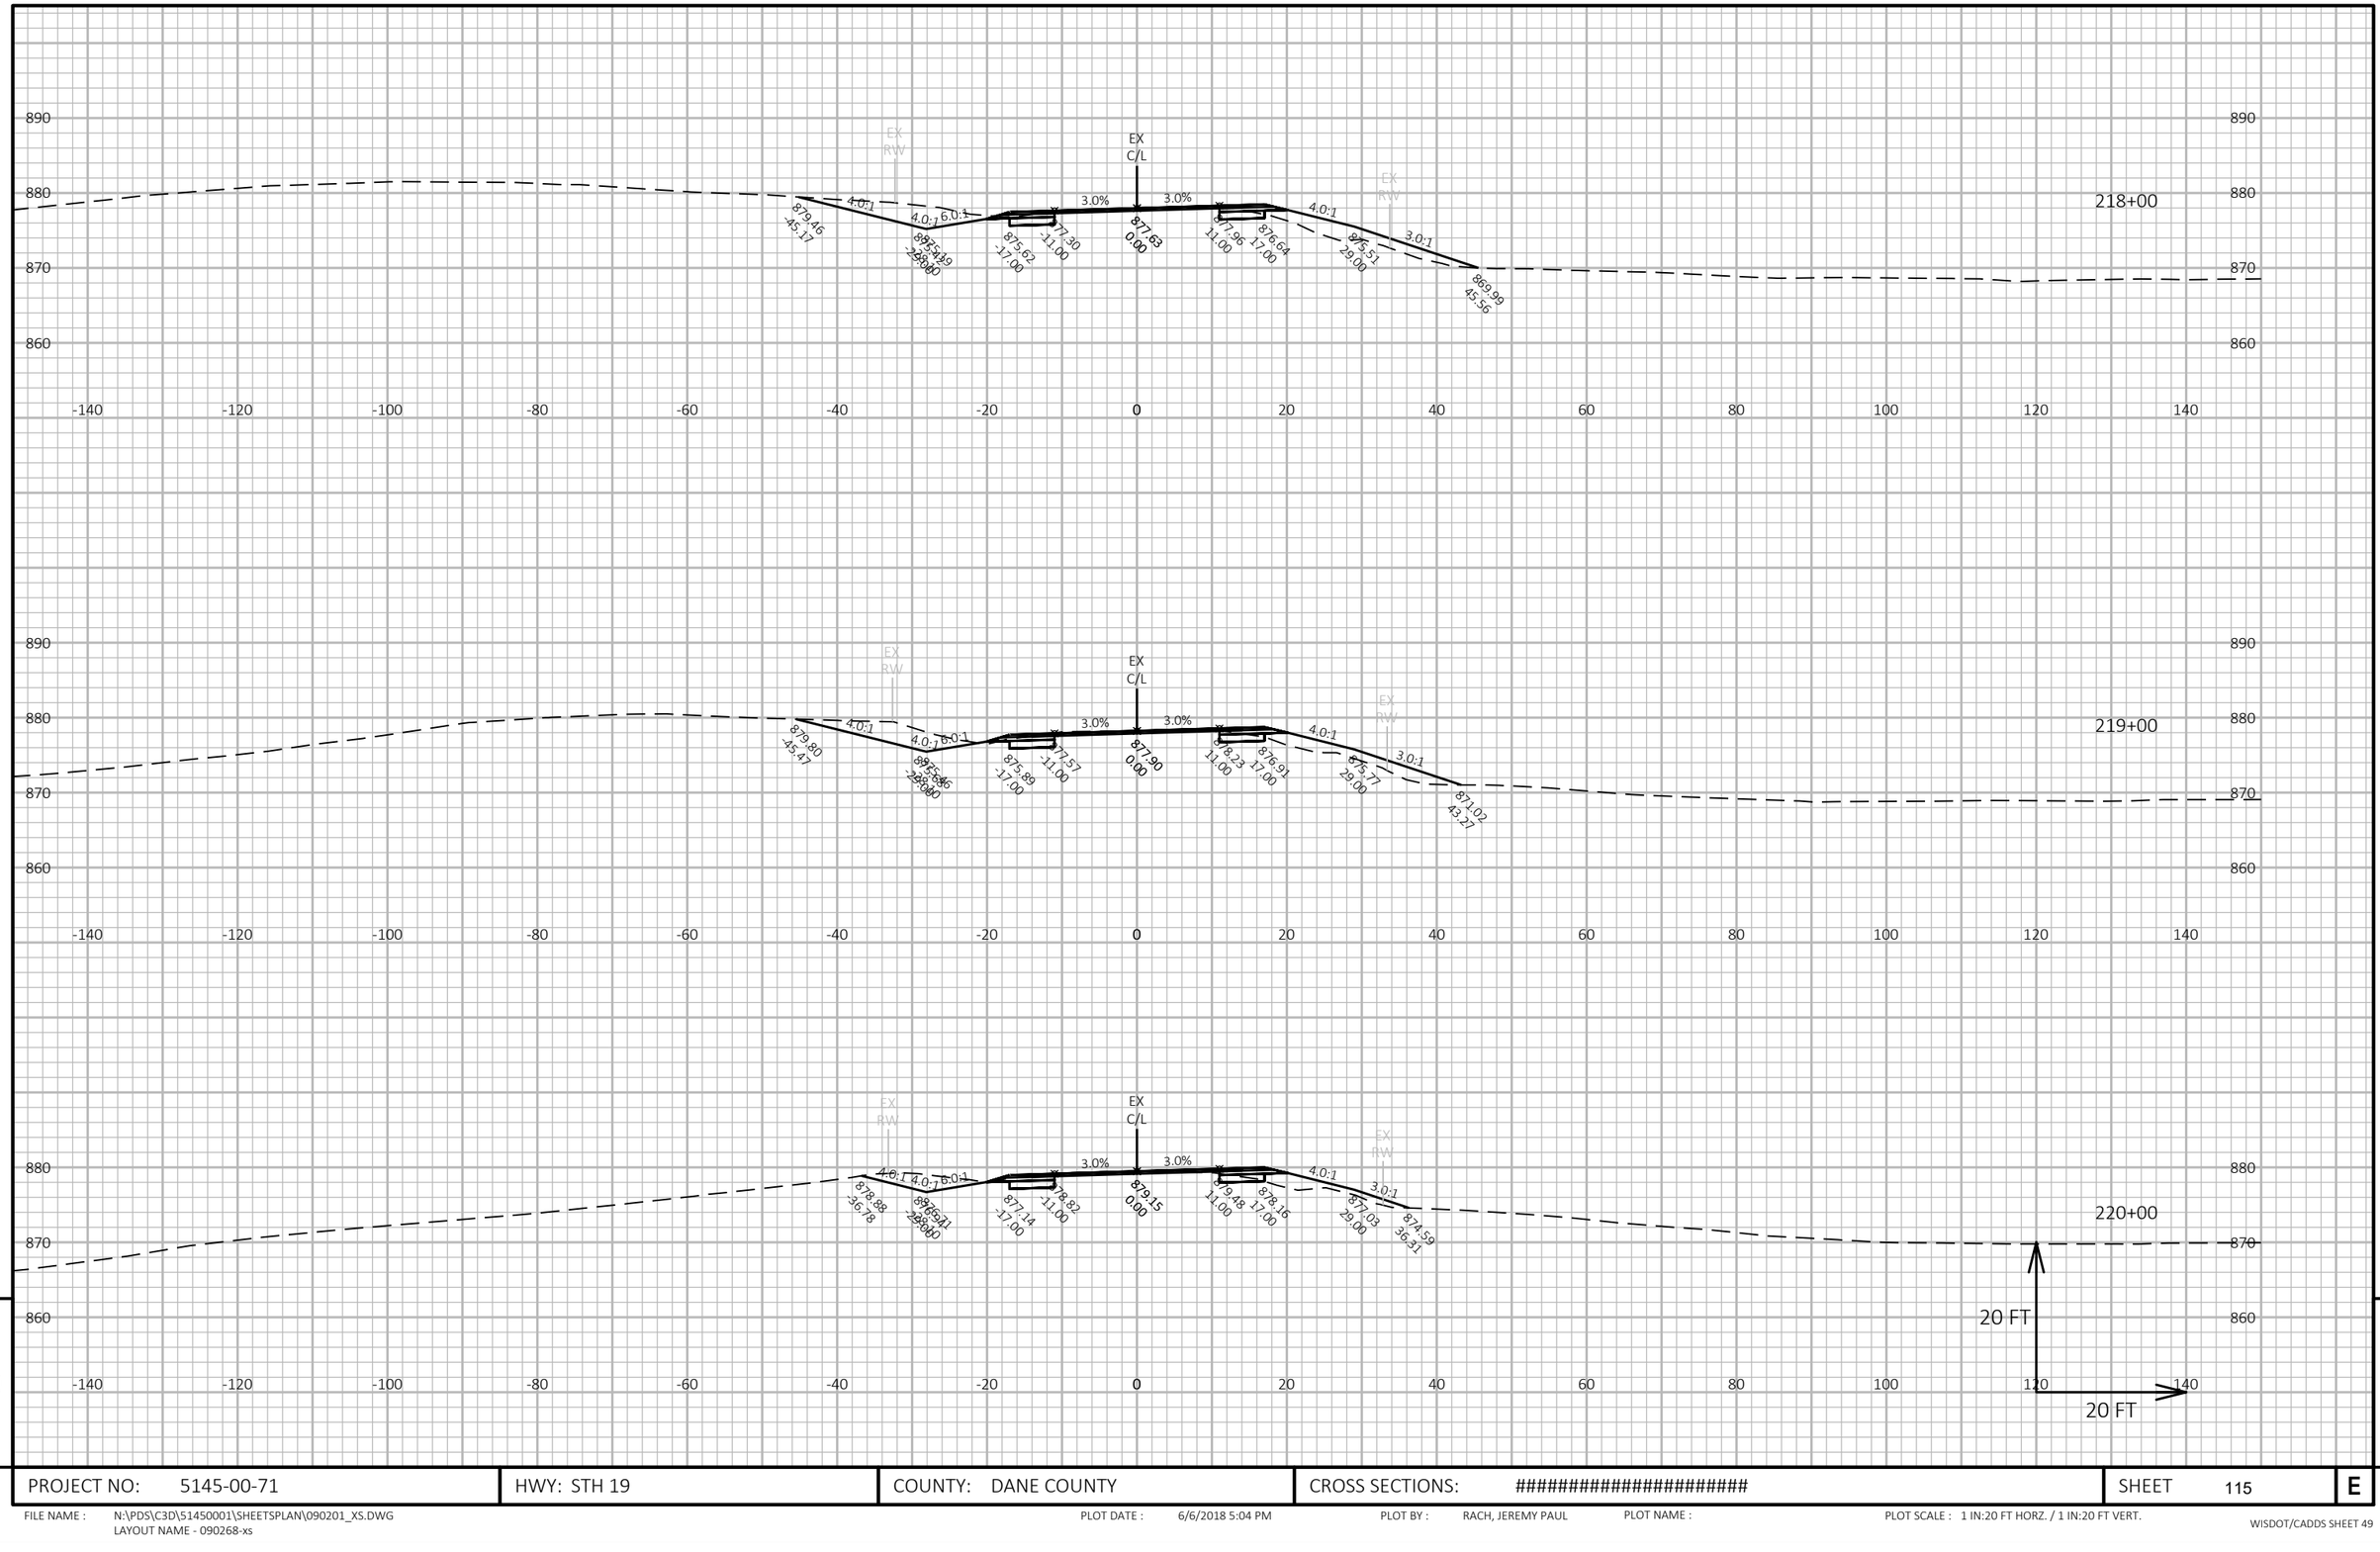

PROJECT NO: 5145-00-71	HWY: STH 19	COUNTY: DANE COUNTY	CROSS SECTIONS: ##########################	SHEET 115	E

FILE NAME : N:\PDS\C3D\51450001\SHEETSPLAN\090201_XS.DWG
LAYOUT NAME - 090268-xs

PLOT DATE : 6/6/2018 5:04 PM PLOT BY : RACH, JEREMY PAUL PLOT NAME : PLOT SCALE : 1 IN:20 FT HORZ. / 1 IN:20 FT VERT.

WISDOT/CADDS SHEET 49

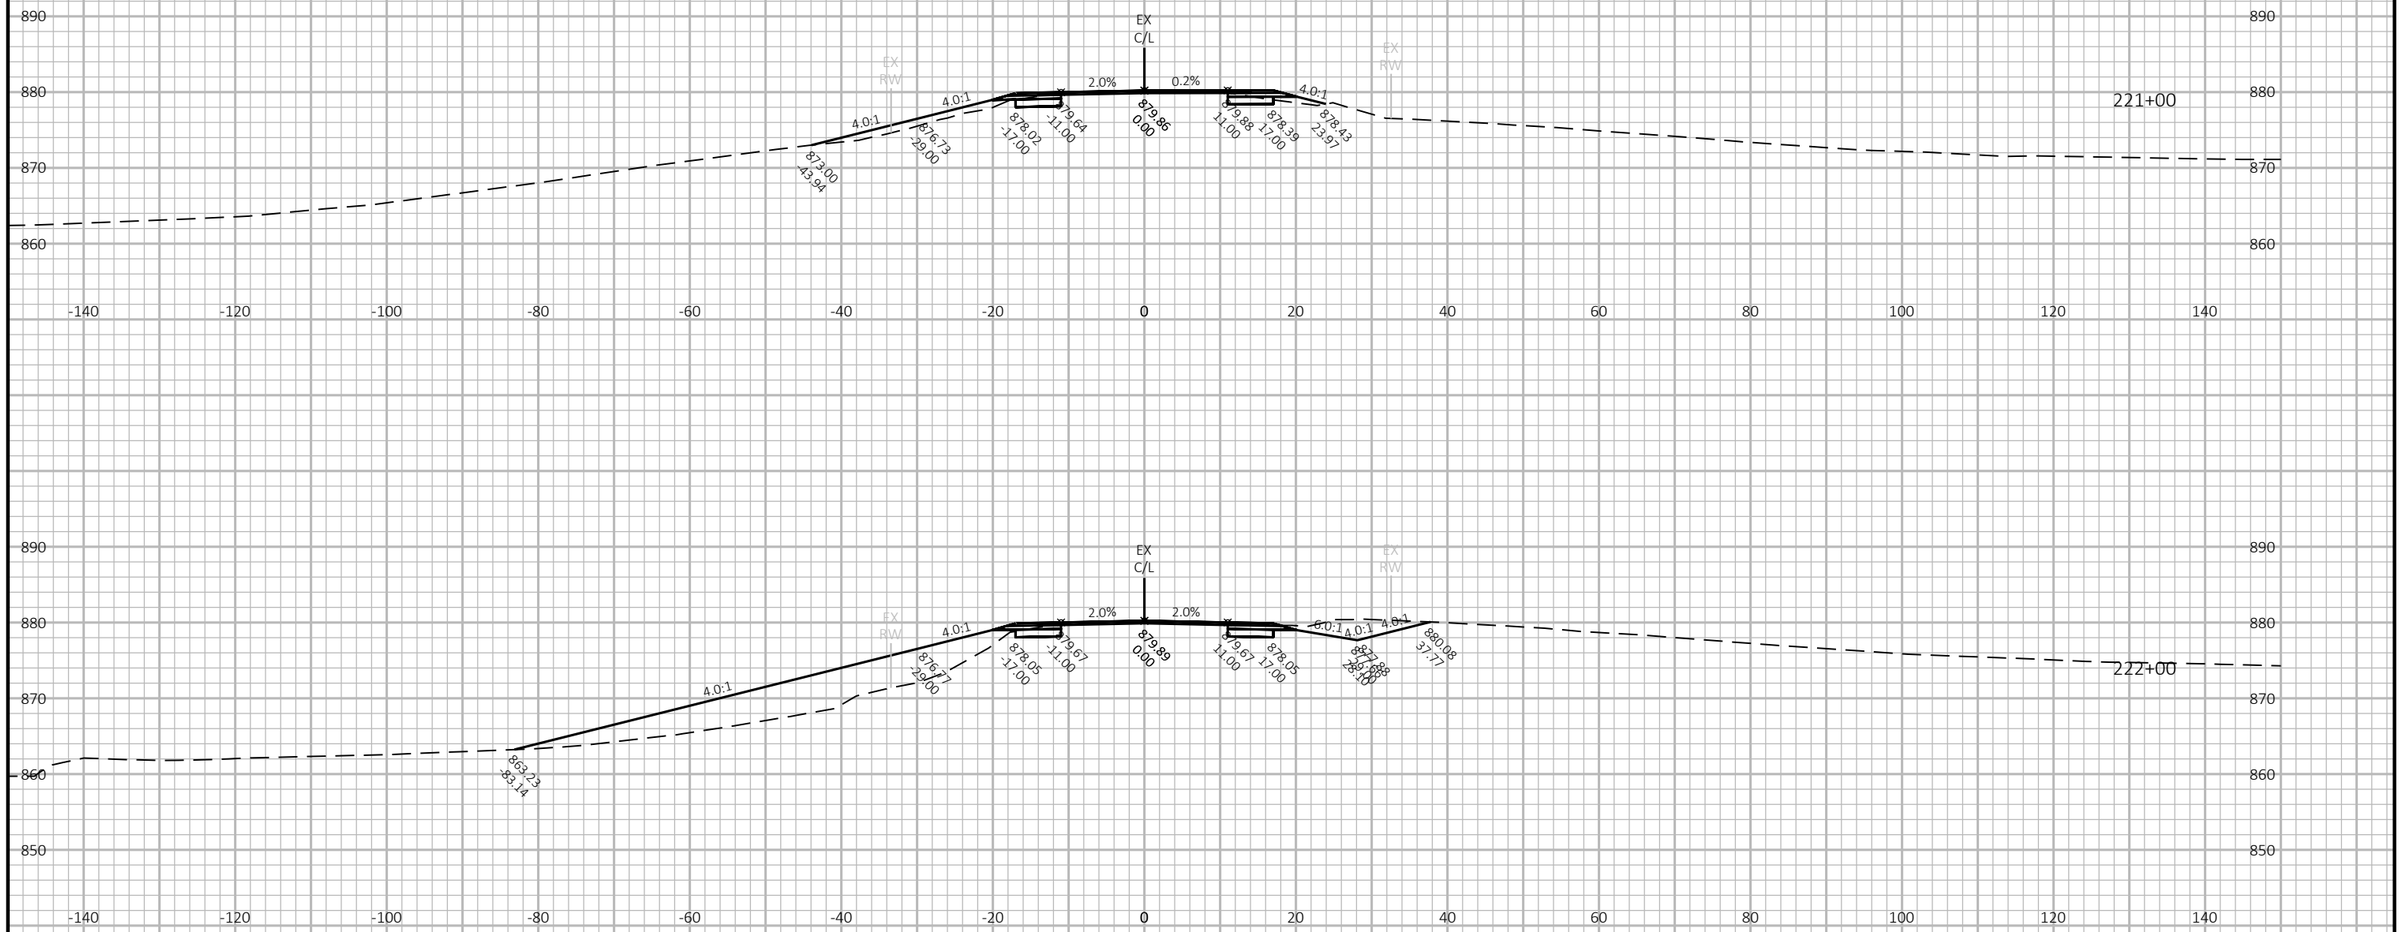

9

9

PROJECT NO: 5145-00-71	HWY: STH 19	COUNTY: DANE COUNTY	CROSS SECTIONS: ##########################	SHEET 116	E

FILE NAME : N:\PDS\C3D\51450001\SHEETSPLAN\090201_XS.DWG
LAYOUT NAME - 090269-xs

PLOT DATE : 6/6/2018 5:04 PM PLOT BY : RACH, JEREMY PAUL PLOT NAME : PLOT SCALE : 1 IN:20 FT HORZ. / 1 IN:20 FT VERT.

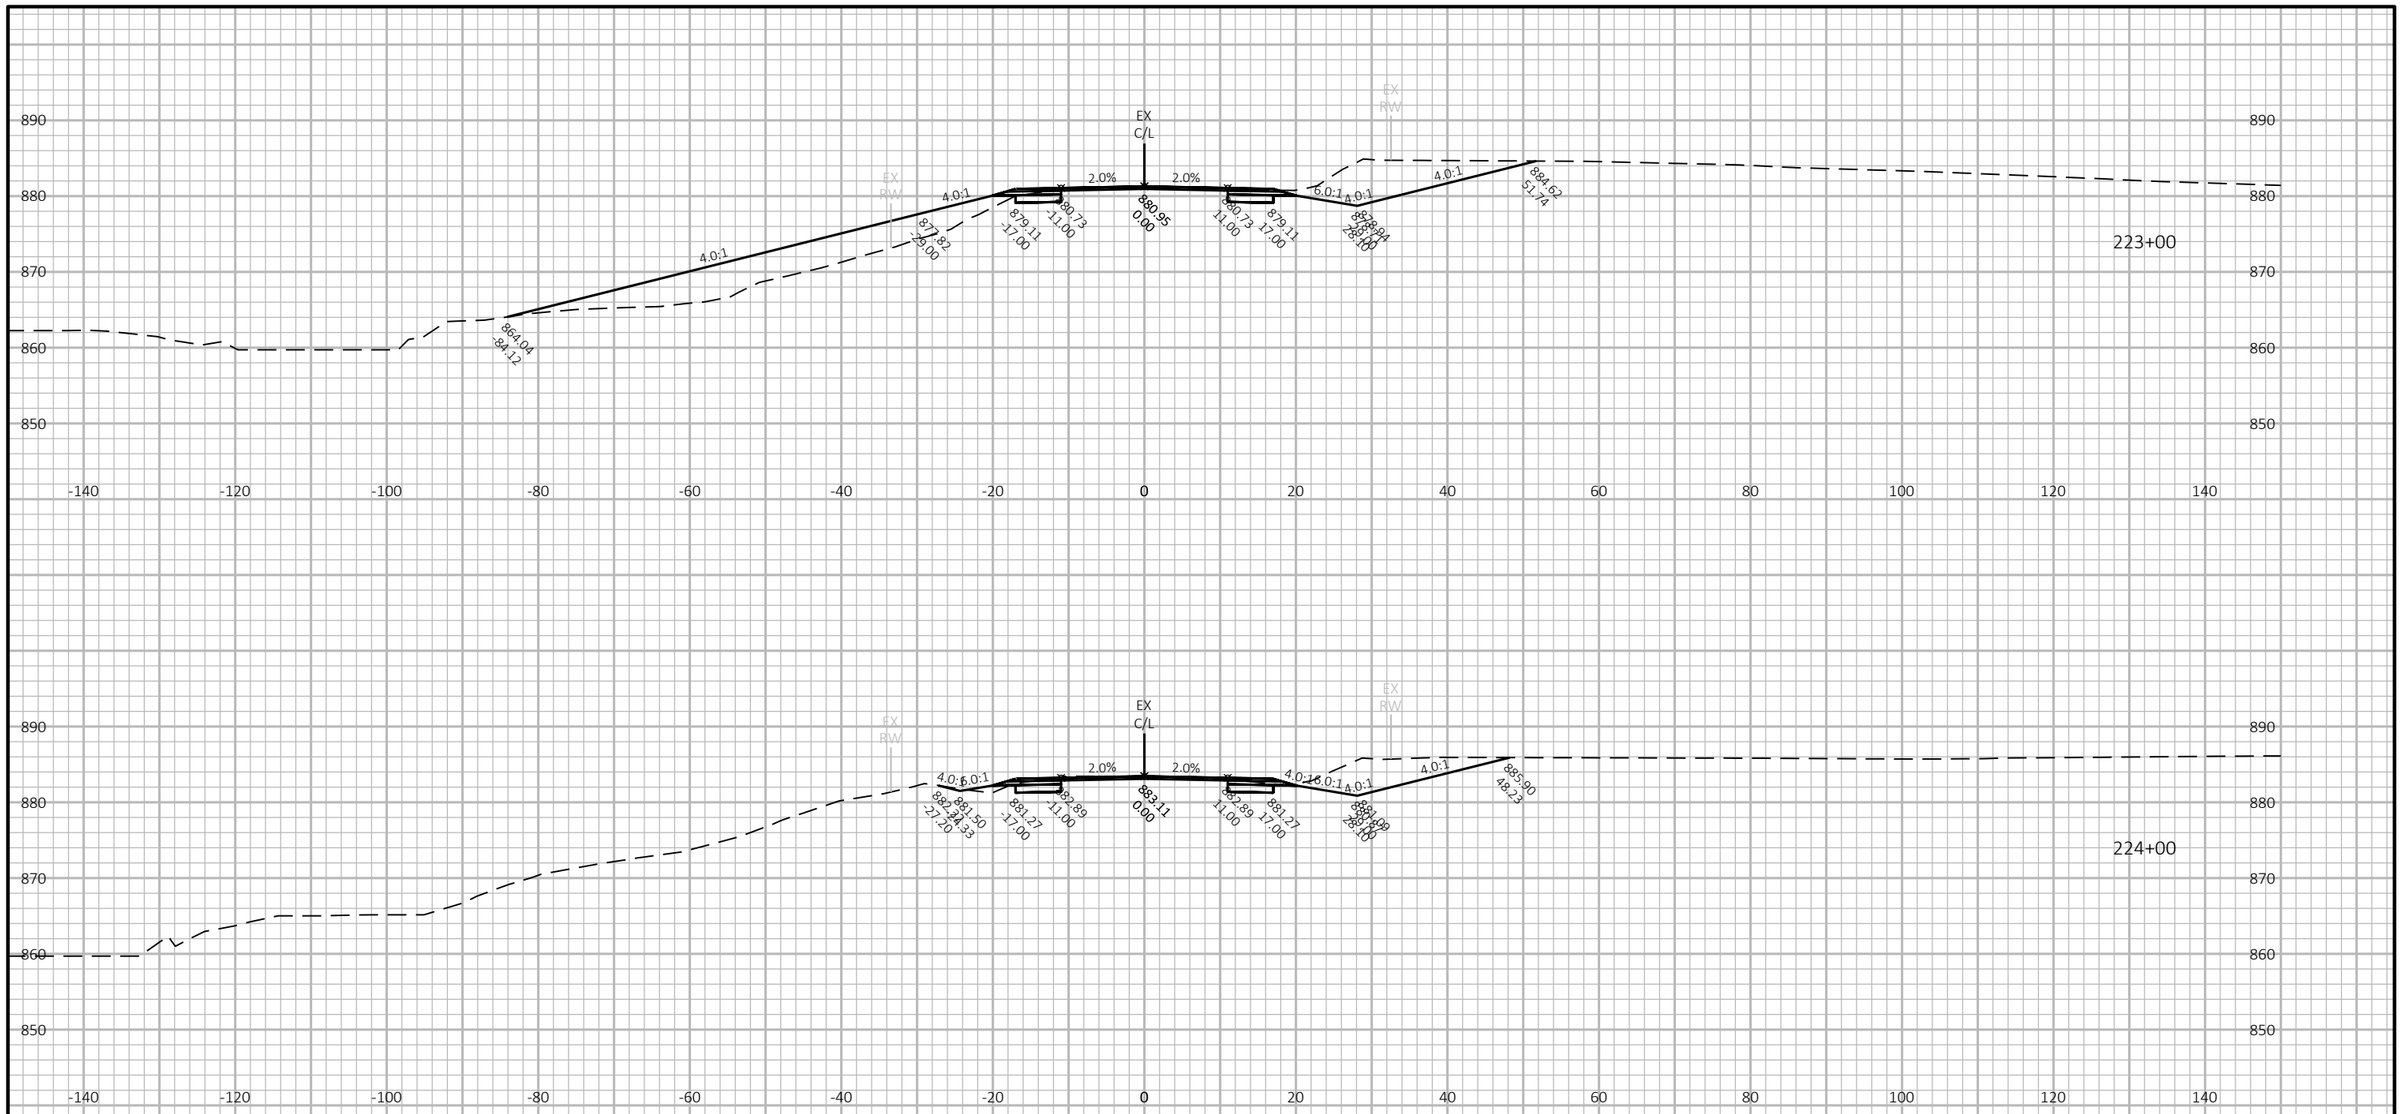

PROJECT NO: 5145-00-71	HWY: STH 19	COUNTY: DANE COUNTY	CROSS SECTIONS: ##########################	SHEET 117	E

FILE NAME : N:\PDS\C3D\51450001\SHEETSPLAN\090201_XS.DWG
LAYOUT NAME - 090270-xs

PLOT DATE : 6/6/2018 5:05 PM PLOT BY : RACH, JEREMY PAUL PLOT NAME : PLOT SCALE : 1 IN:20 FT HORZ. / 1 IN:20 FT VERT.

WISDOT/CADDS SHEET 49

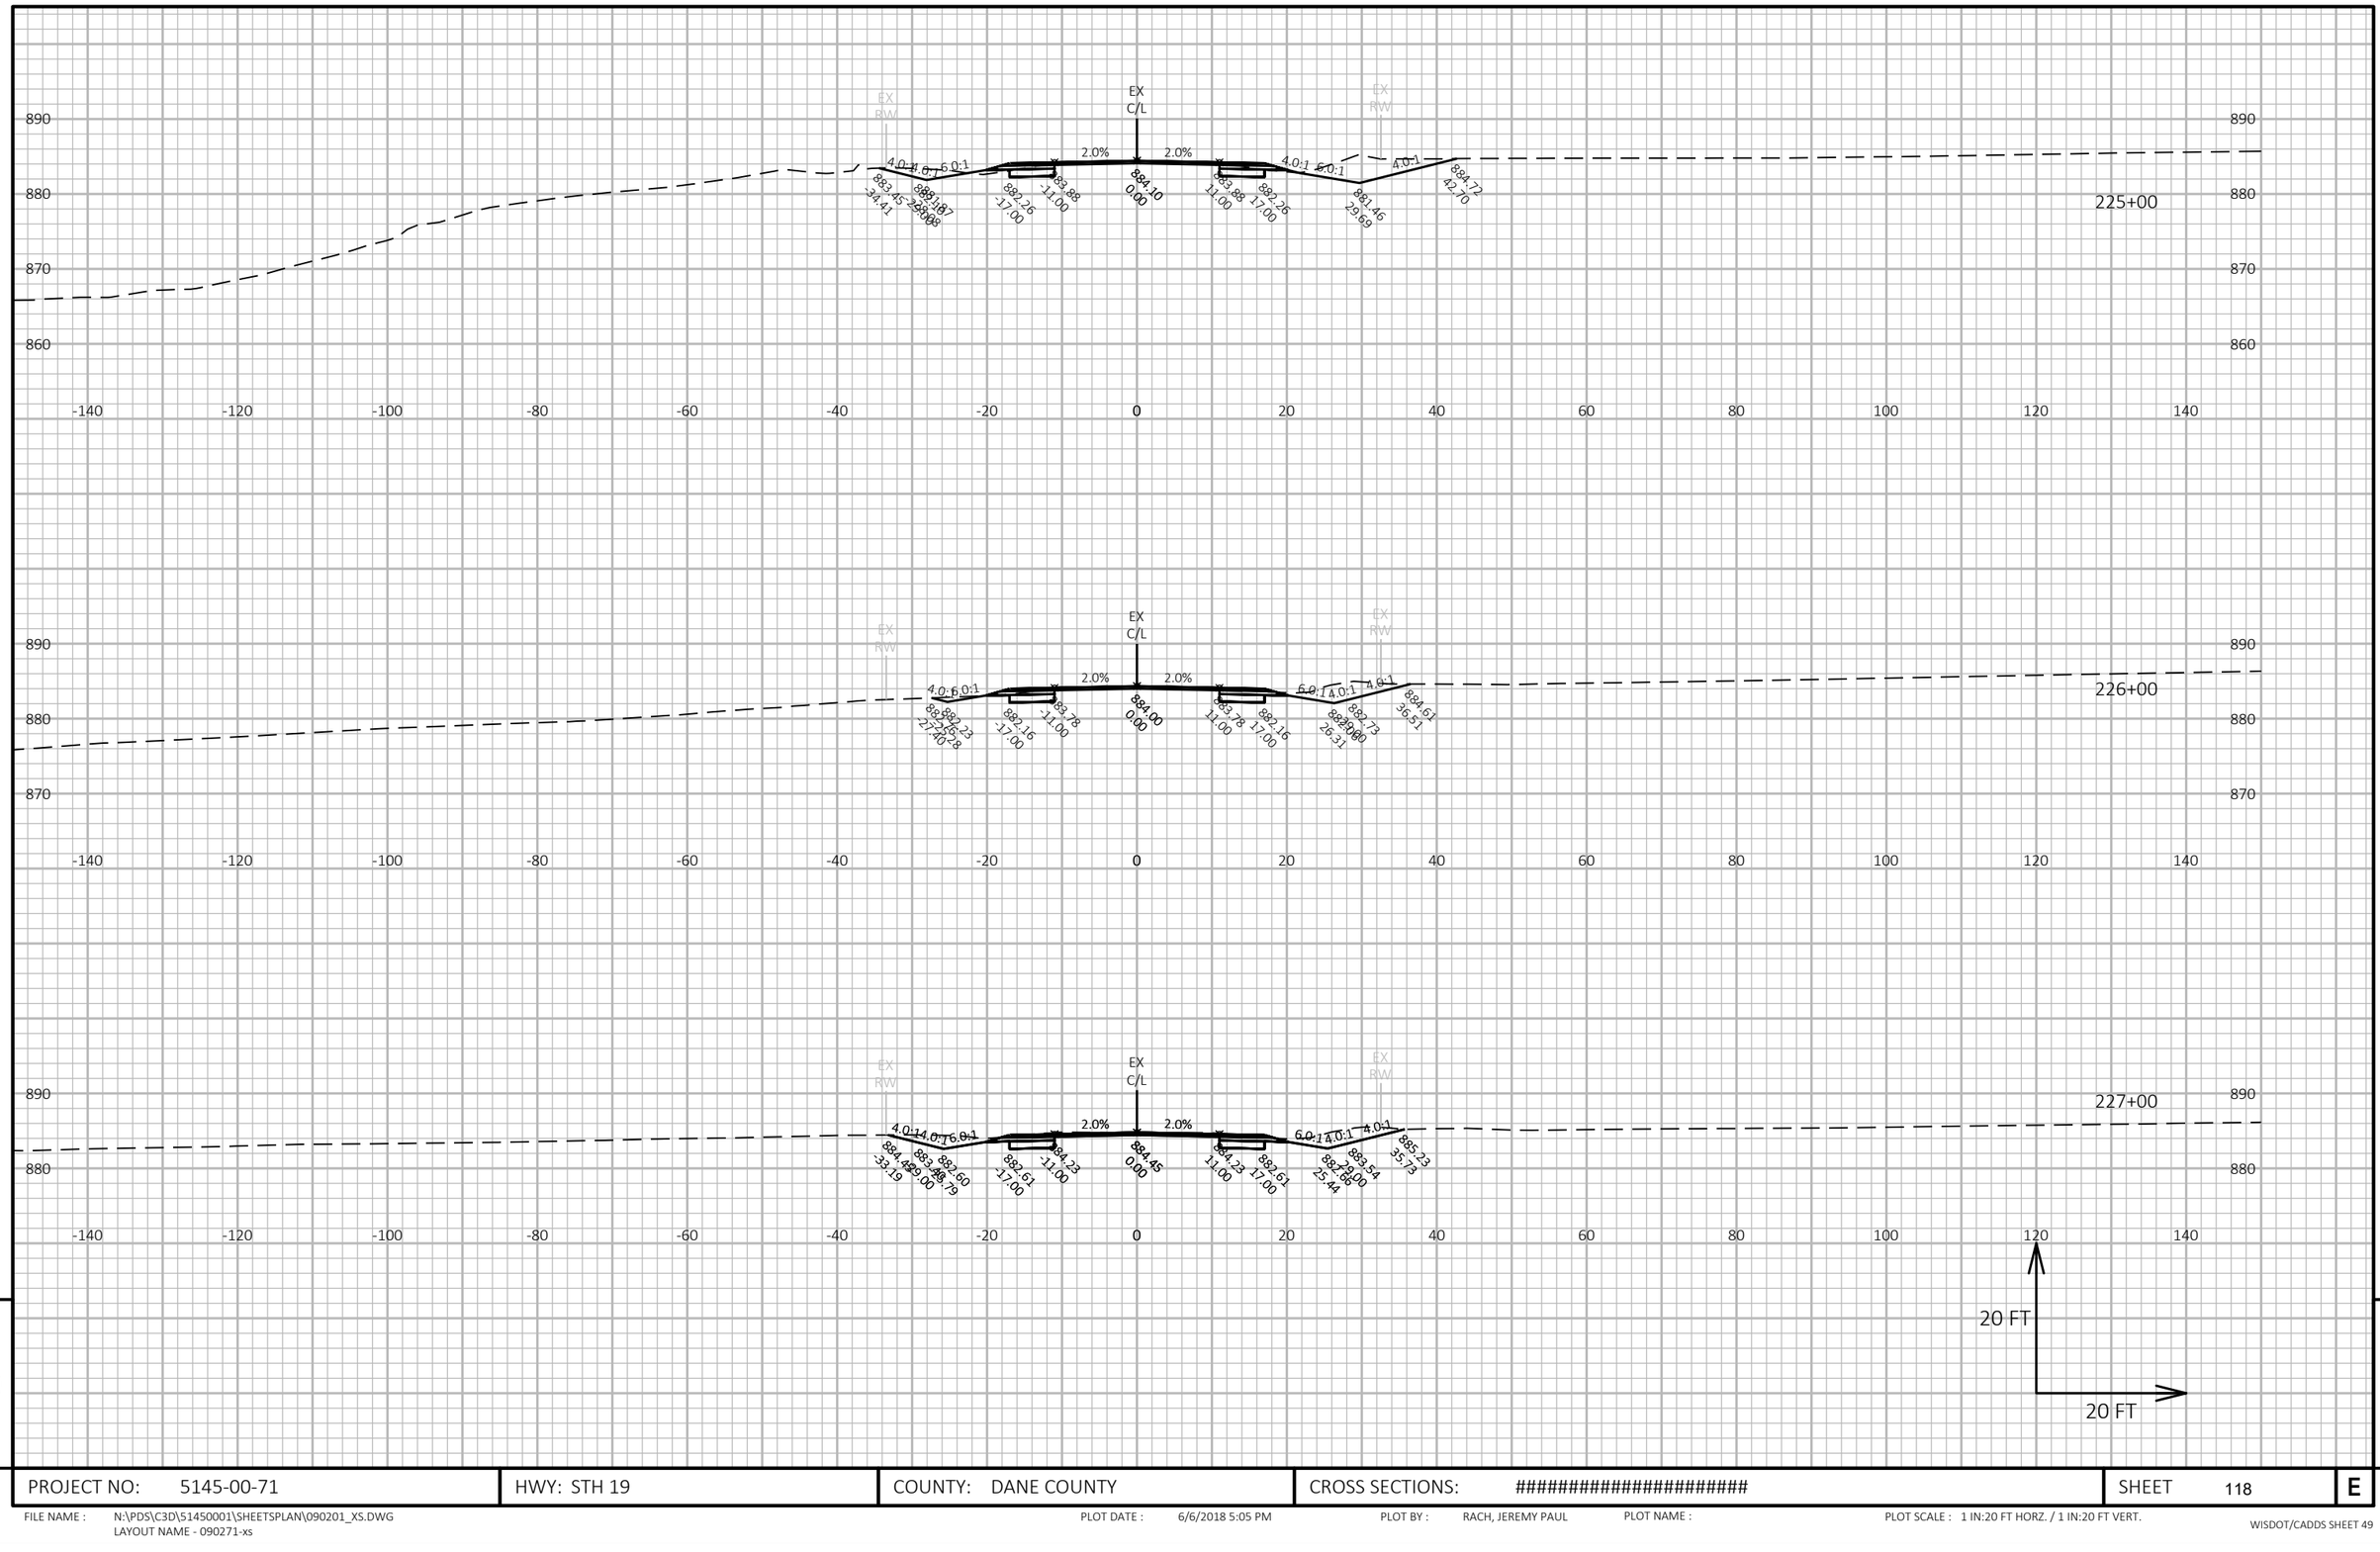

9

9

PROJECT NO: 5145-00-71	HWY: STH 19	COUNTY: DANE COUNTY	CROSS SECTIONS: ##########################	SHEET 118	E

FILE NAME : N:\PDS\C3D\51450001\SHEETSPLAN\090201_XS.DWG
LAYOUT NAME - 090271-xs

PLOT DATE : 6/6/2018 5:05 PM PLOT BY : RACH, JEREMY PAUL PLOT NAME : PLOT SCALE : 1 IN:20 FT HORZ. / 1 IN:20 FT VERT.

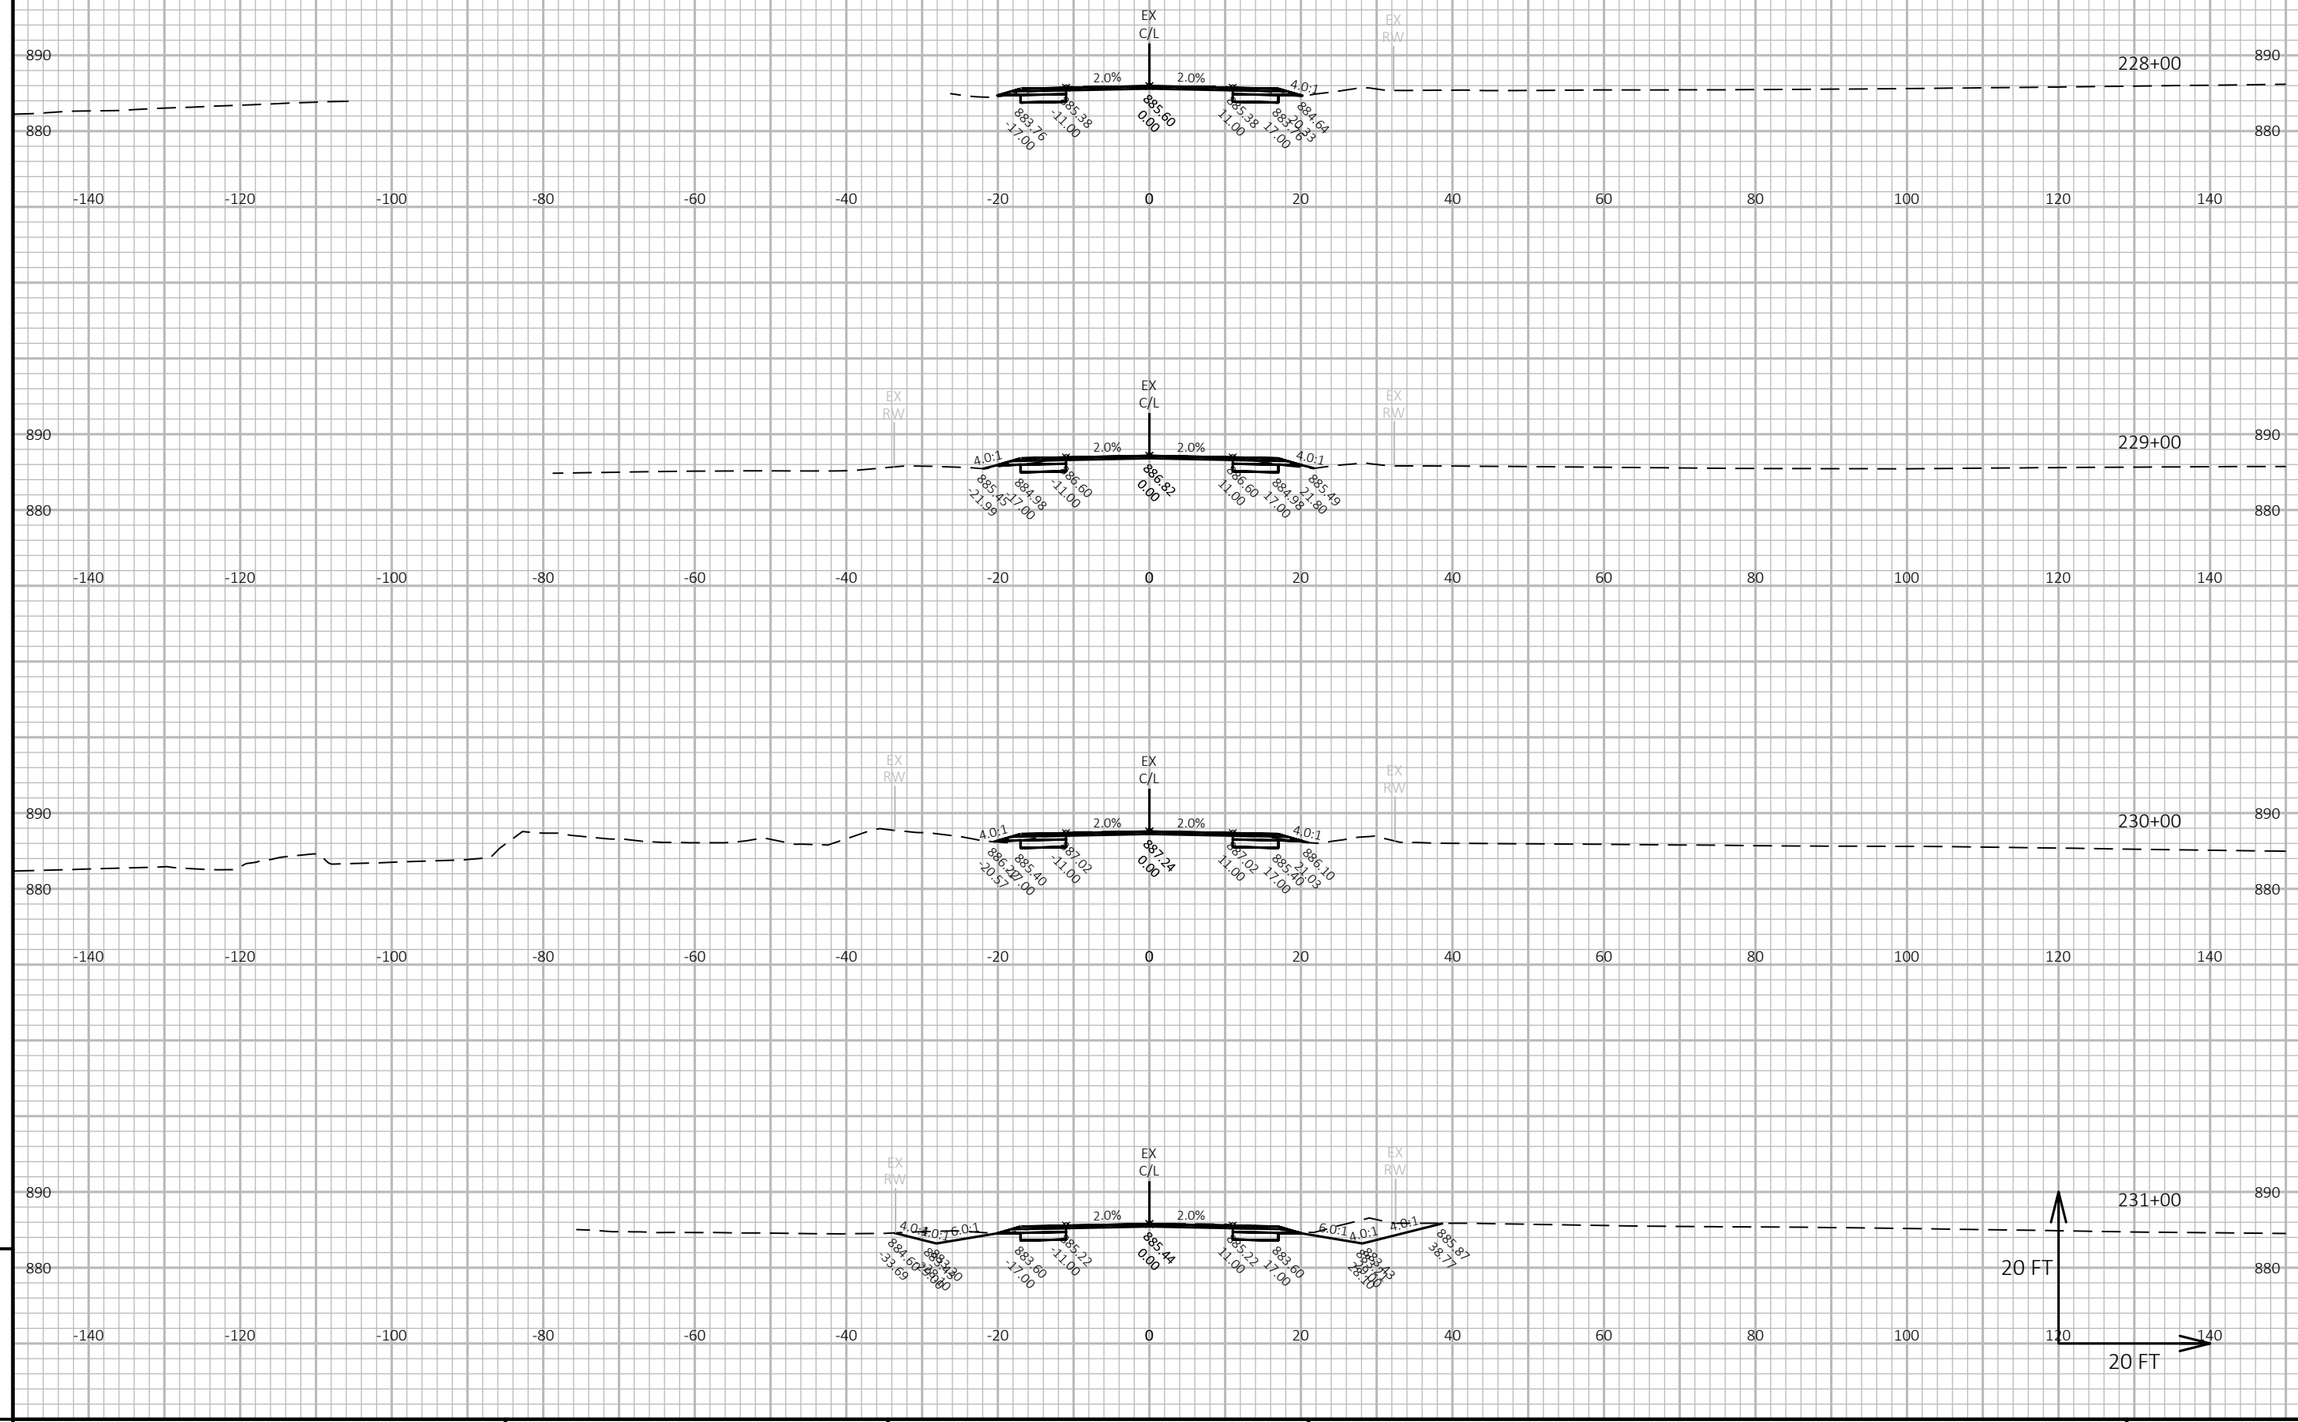

PROJECT NO: 5145-00-71	HWY: STH 19	COUNTY: DANE COUNTY	CROSS SECTIONS: ##########################	SHEET 119

E

FILE NAME : N:\PDS\C3D\51450001\SHEETSPLAN\090201_XS.DWG
LAYOUT NAME - 090272-xs

PLOT DATE : 6/6/2018 5:05 PM PLOT BY : RACH, JEREMY PAUL PLOT NAME : PLOT SCALE : 1 IN:20 FT HORZ. / 1 IN:20 FT VERT.

WISDOT/CADDS SHEET 49

9

9

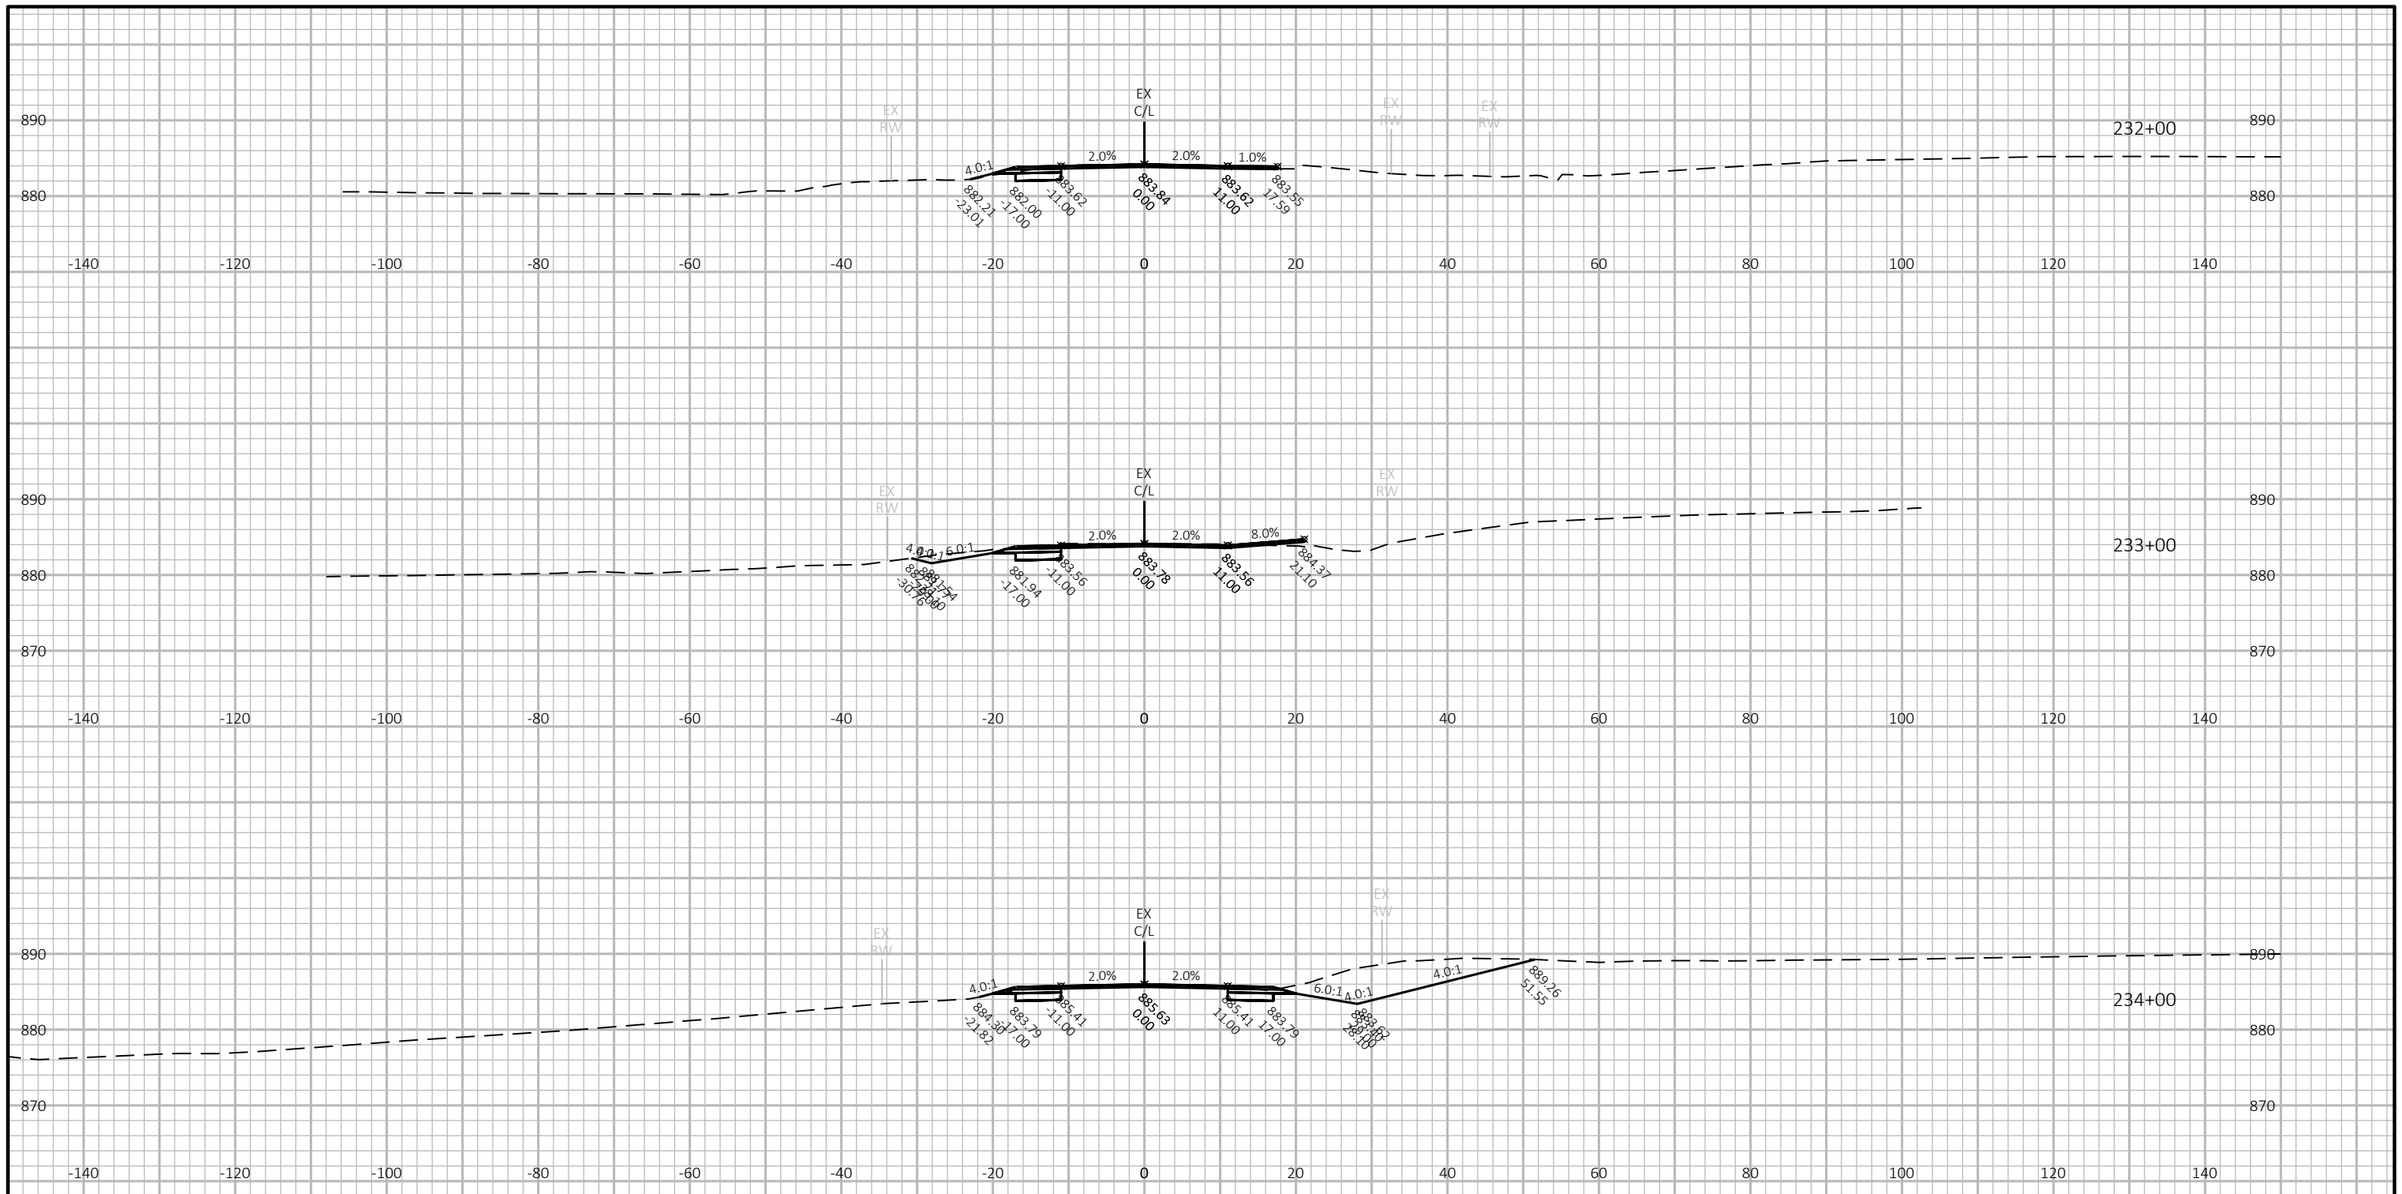

9

9

PROJECT NO: 5145-00-71	HWY: STH 19	COUNTY: DANE COUNTY	CROSS SECTIONS: ##########################	SHEET 120	E

FILE NAME : N:\PDS\C3D\51450001\SHEETSPLAN\090201_XS.DWG
LAYOUT NAME - 090273-xs
PLOT DATE : 6/6/2018 5:06 PM
PLOT BY : RACH, JEREMY PAUL
PLOT NAME :
PLOT SCALE : 1 IN:20 FT HORZ. / 1 IN:20 FT VERT.
WISDOT/CADDS SHEET 49

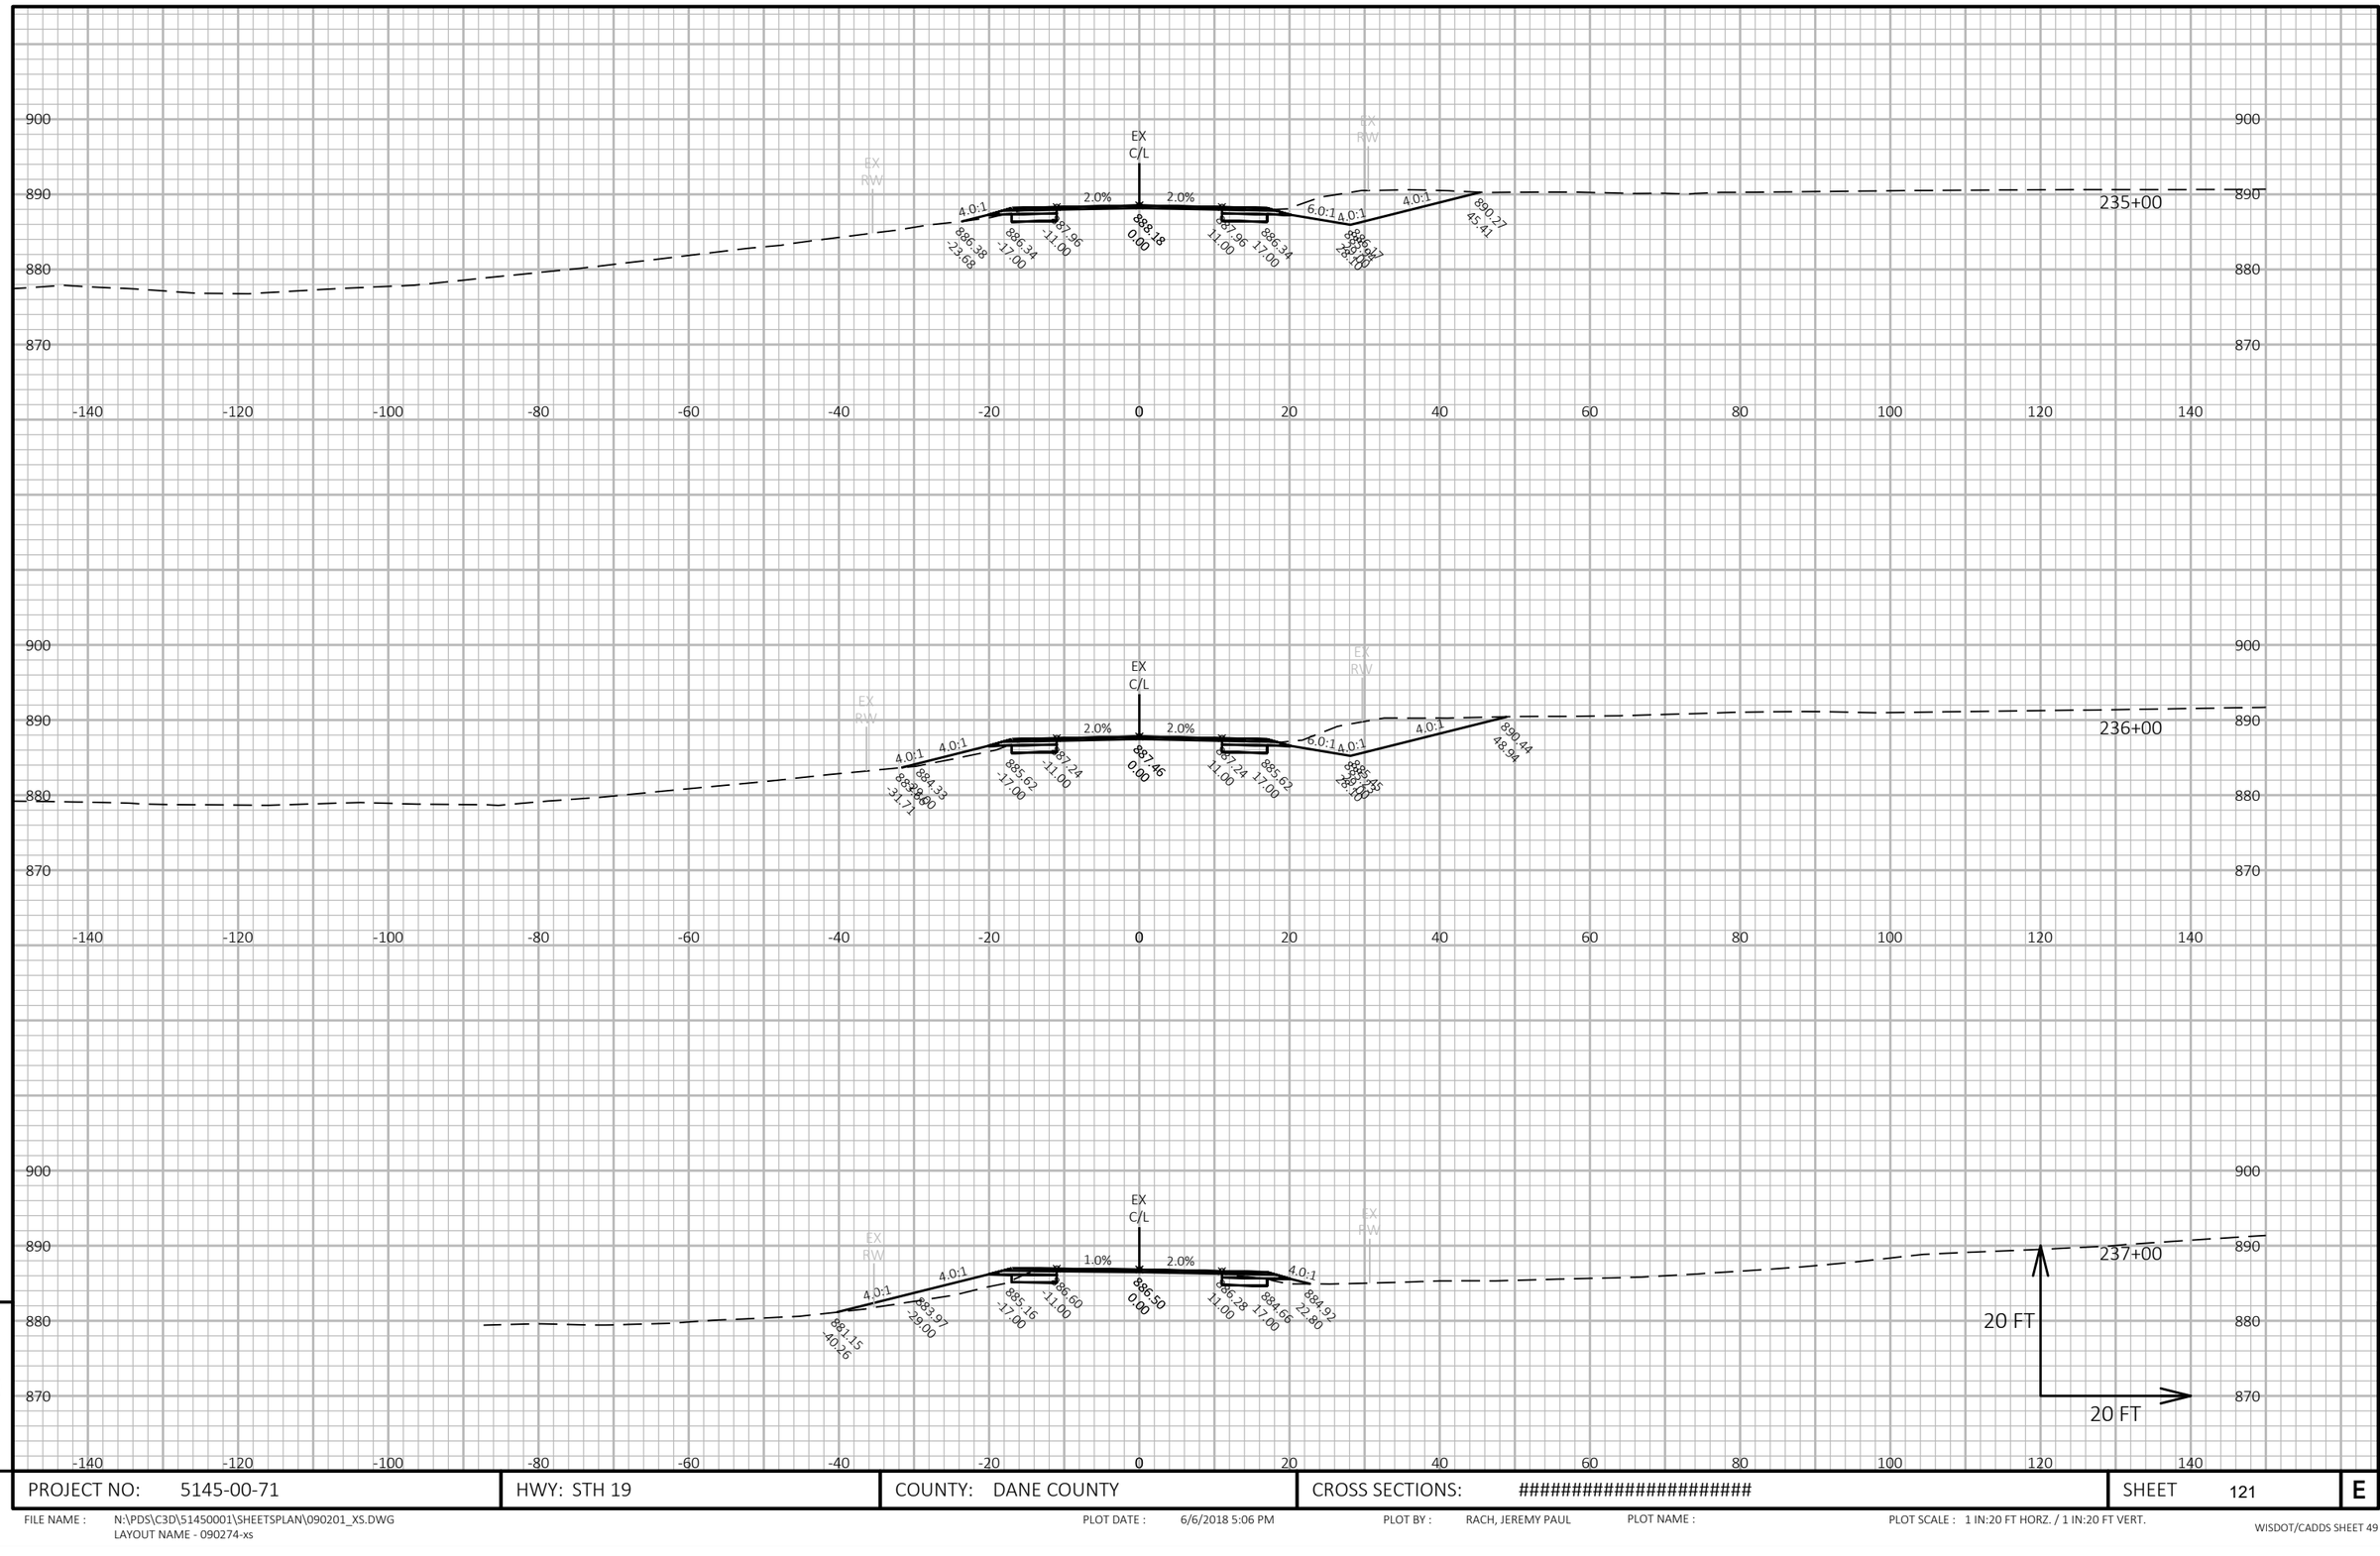

9

PROJECT NO: 5145-00-71	HWY: STH 19	COUNTY: DANE COUNTY	CROSS SECTIONS: ##########################	SHEET 121	E

9

FILE NAME : N:\PDS\C3D\51450001\SHEETSPLAN\090201_XS.DWG
LAYOUT NAME - 090274-xs
PLOT DATE : 6/6/2018 5:06 PM
PLOT BY : RACH, JEREMY PAUL
PLOT NAME :
PLOT SCALE : 1 IN:20 FT HORZ. / 1 IN:20 FT VERT.

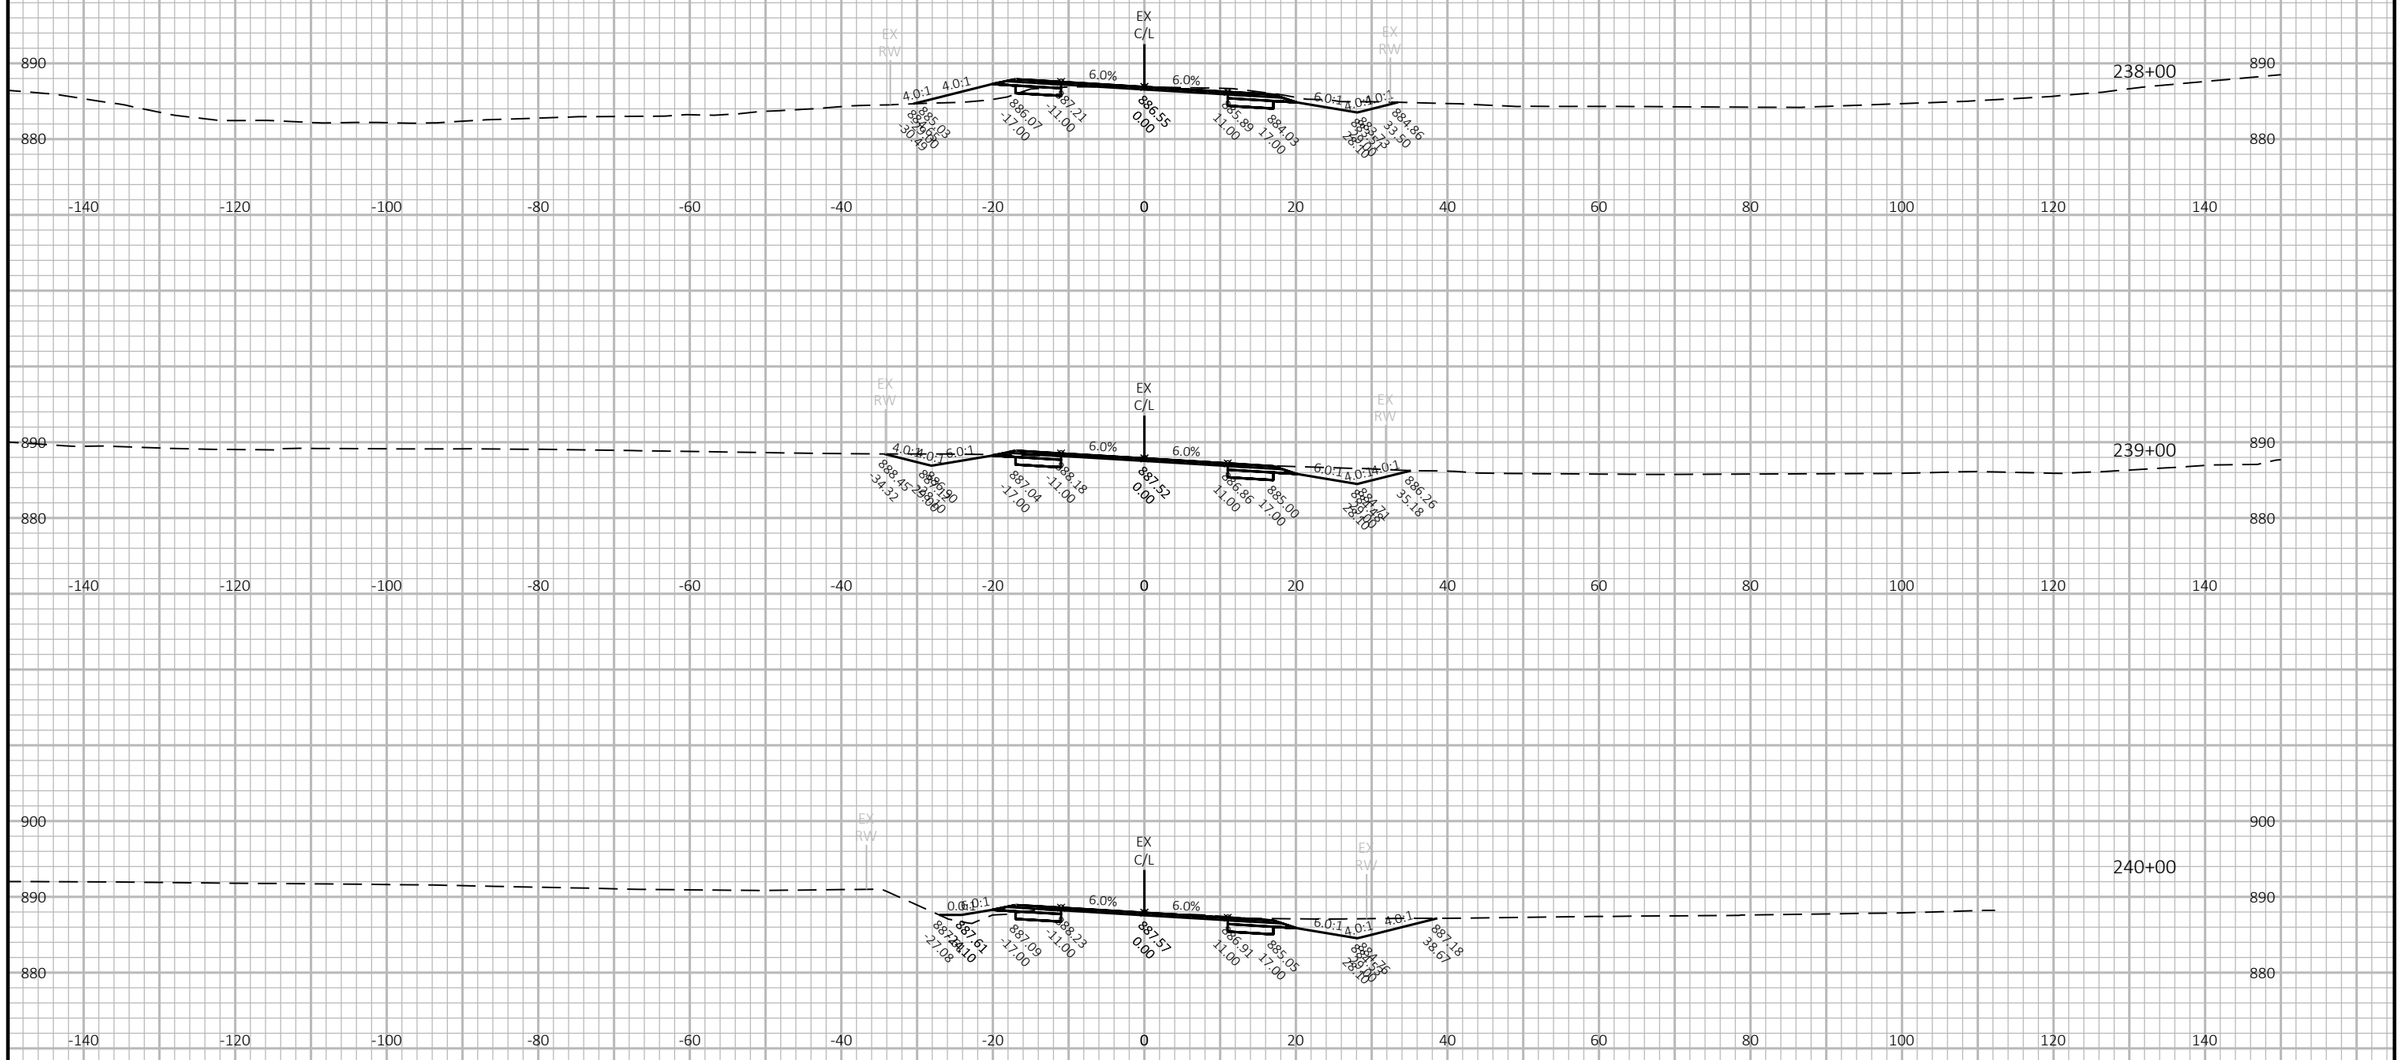

9

9

PROJECT NO: 5145-00-71	HWY: STH 19	COUNTY: DANE COUNTY	CROSS SECTIONS: ##########################	SHEET 122	E

FILE NAME : N:\PDS\C3D\51450001\SHEETSPLAN\090201_XS.DWG
LAYOUT NAME - 090275-xs

PLOT DATE : 6/6/2018 5:07 PM PLOT BY : RACH, JEREMY PAUL PLOT NAME : PLOT SCALE : 1 IN:20 FT HORZ. / 1 IN:20 FT VERT.

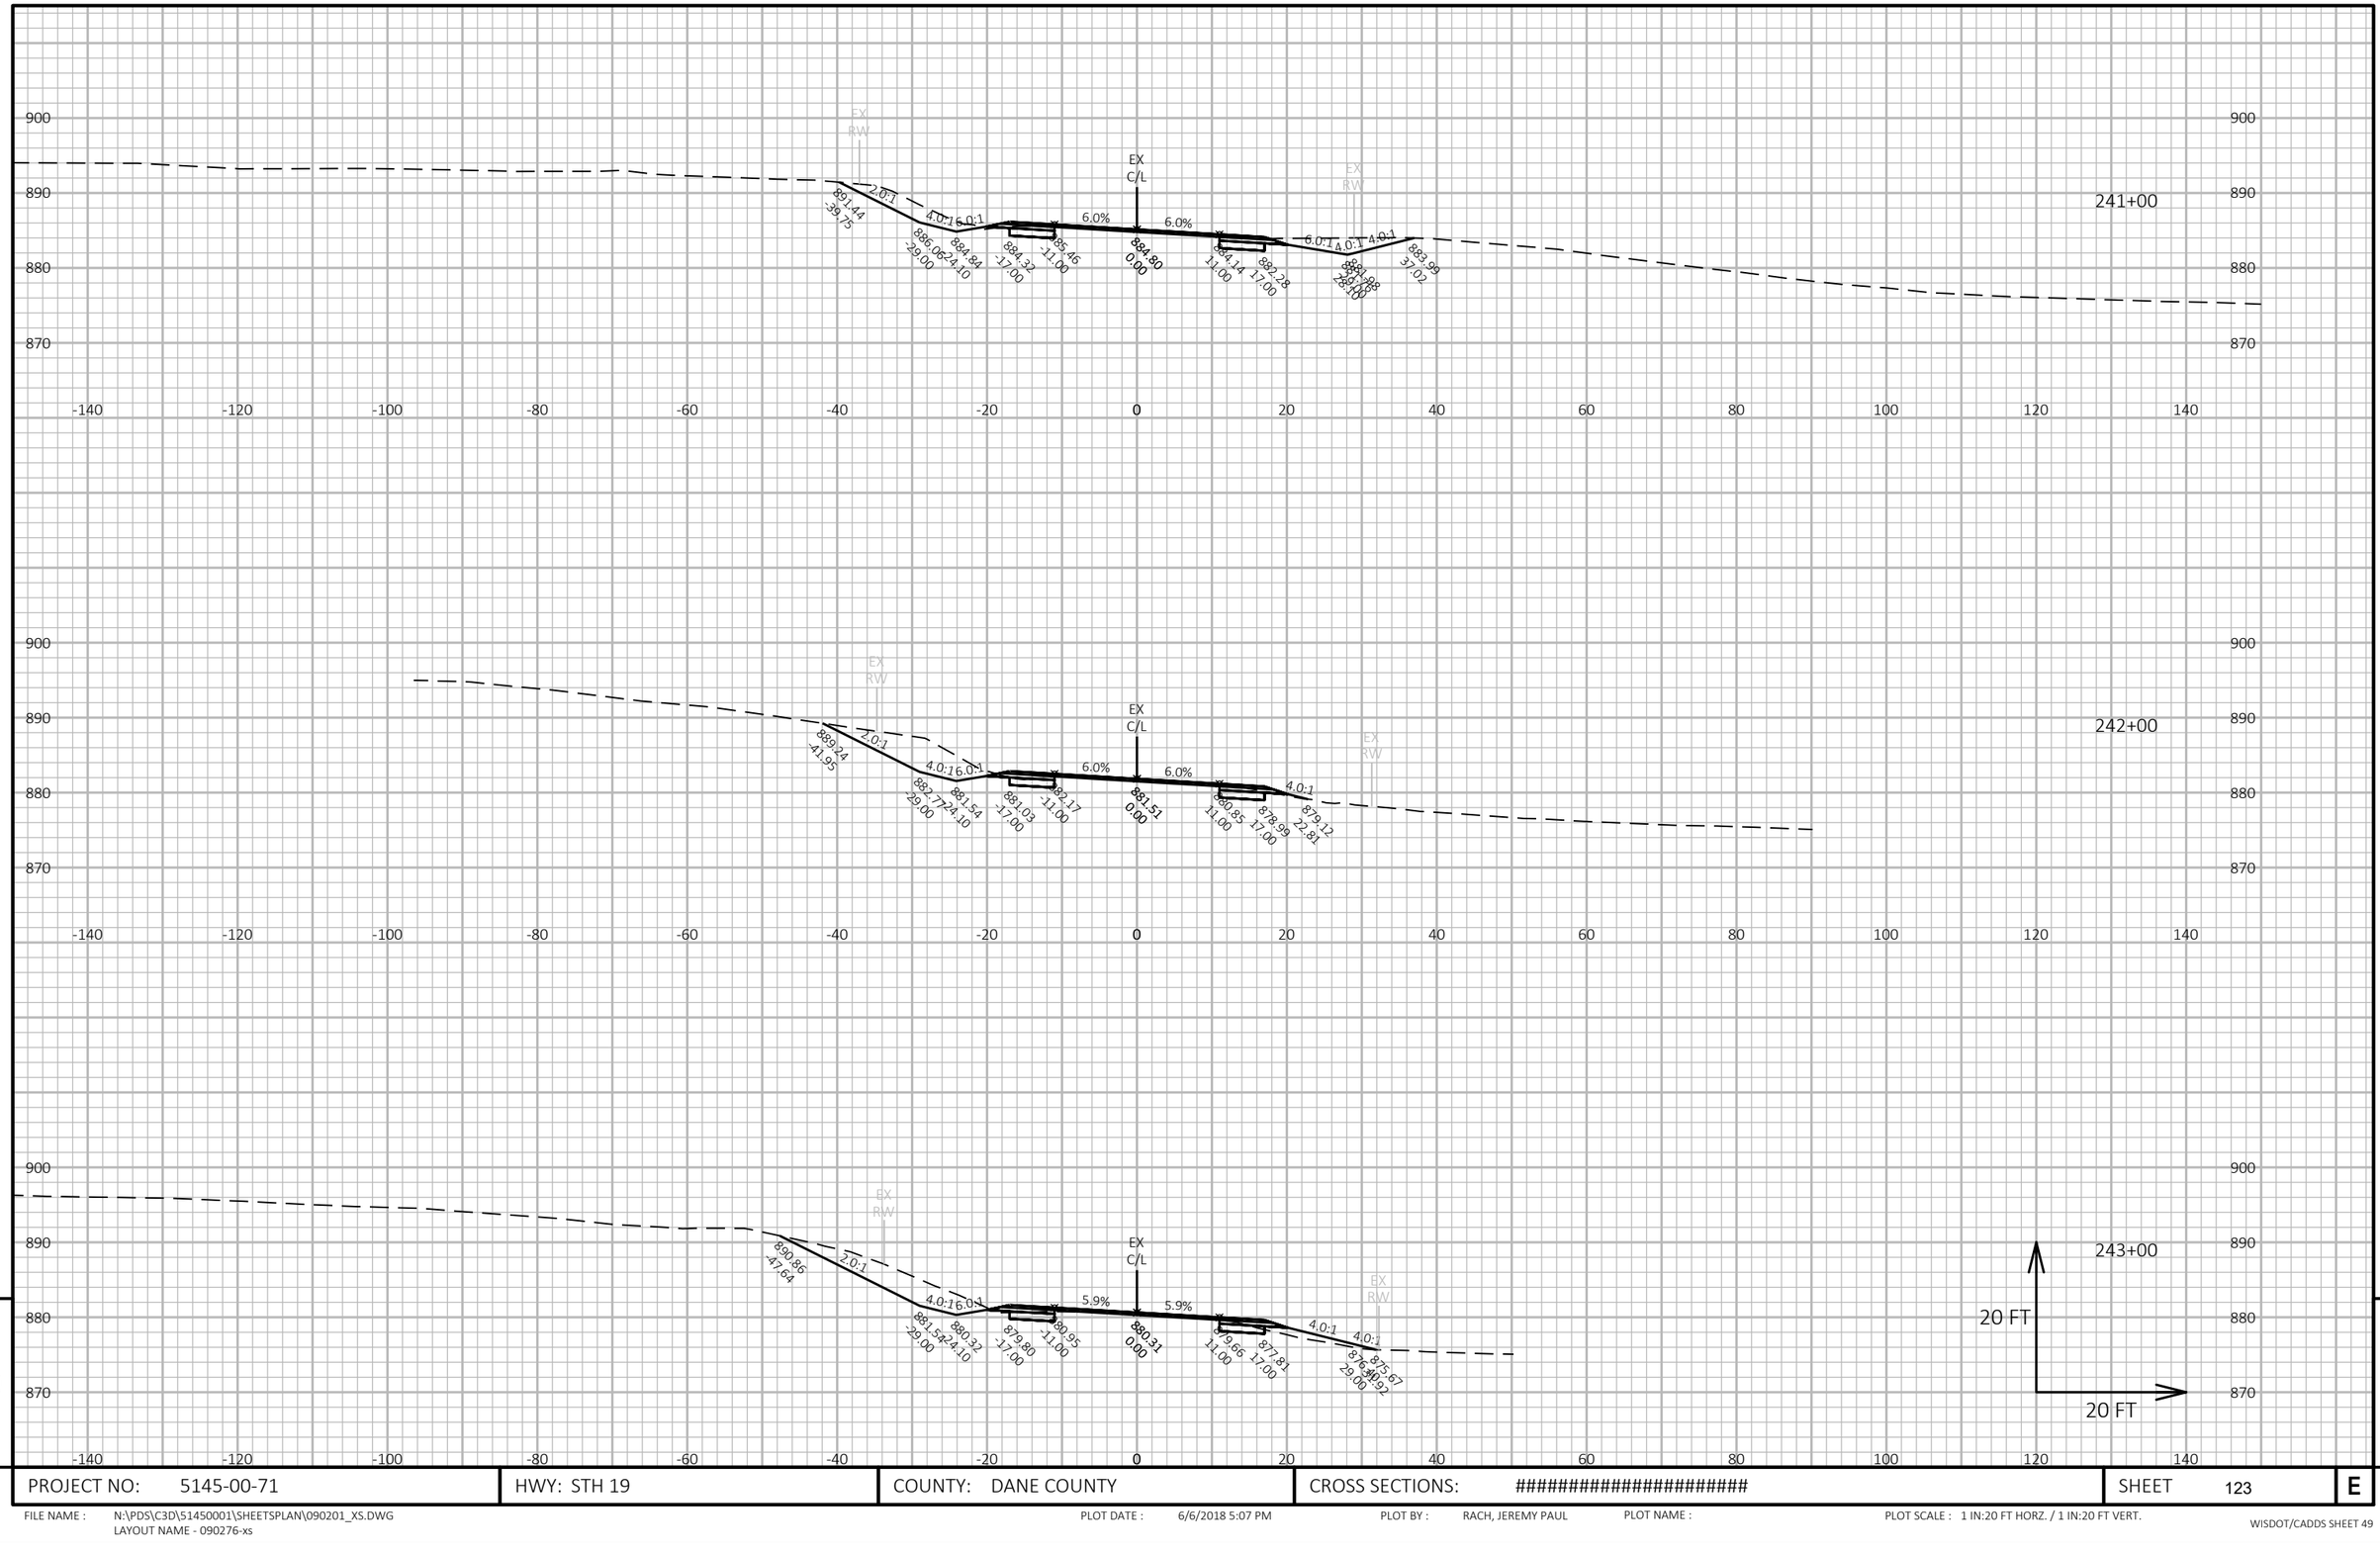

PROJECT NO: 5145-00-71	HWY: STH 19	COUNTY: DANE COUNTY	CROSS SECTIONS: ##########################	SHEET 123	E

FILE NAME : N:\PDS\C3D\51450001\SHEETSPLAN\090201_XS.DWG
LAYOUT NAME - 090276-xs

PLOT DATE : 6/6/2018 5:07 PM PLOT BY : RACH, JEREMY PAUL PLOT NAME : PLOT SCALE : 1 IN:20 FT HORZ. / 1 IN:20 FT VERT.

WISDOT/CADDS SHEET 49

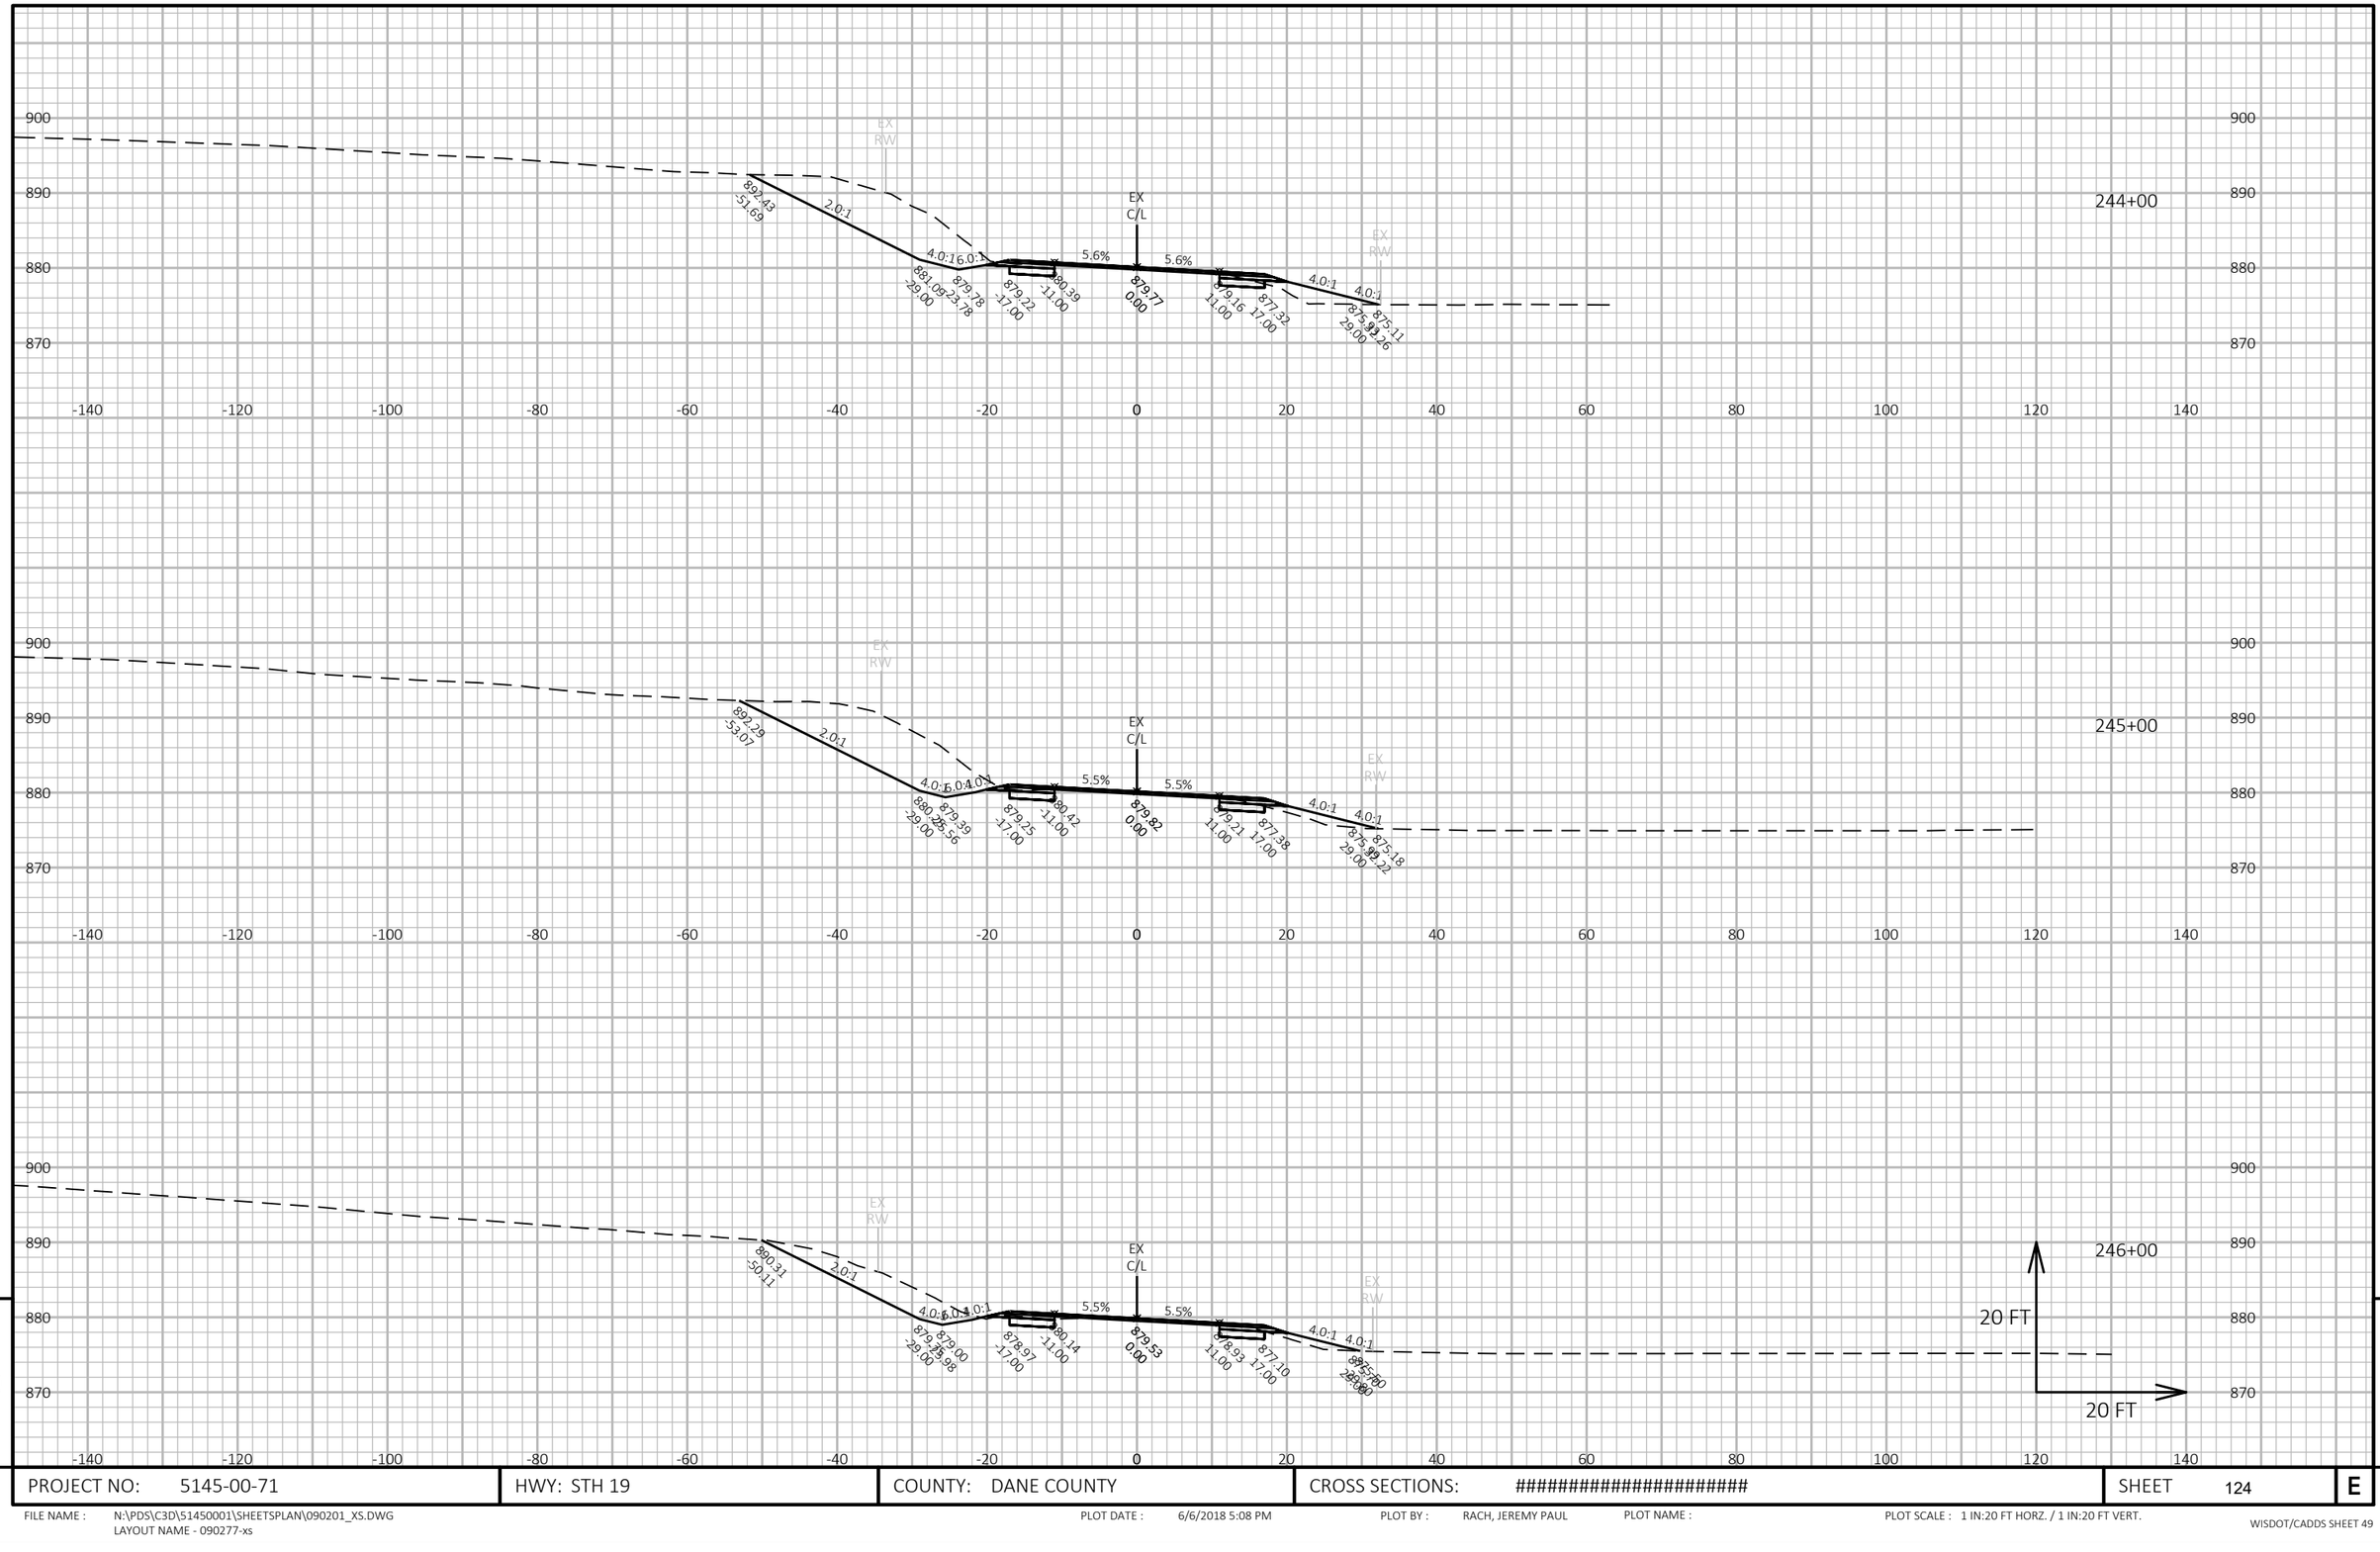

9

9

PROJECT NO: 5145-00-71	HWY: STH 19	COUNTY: DANE COUNTY	CROSS SECTIONS: ##########################	SHEET 124	E

FILE NAME : N:\PDS\C3D\51450001\SHEETSPLAN\090201_XS.DWG
LAYOUT NAME - 090277-xs

PLOT DATE : 6/6/2018 5:08 PM PLOT BY : RACH, JEREMY PAUL PLOT NAME : PLOT SCALE : 1 IN:20 FT HORZ. / 1 IN:20 FT VERT.

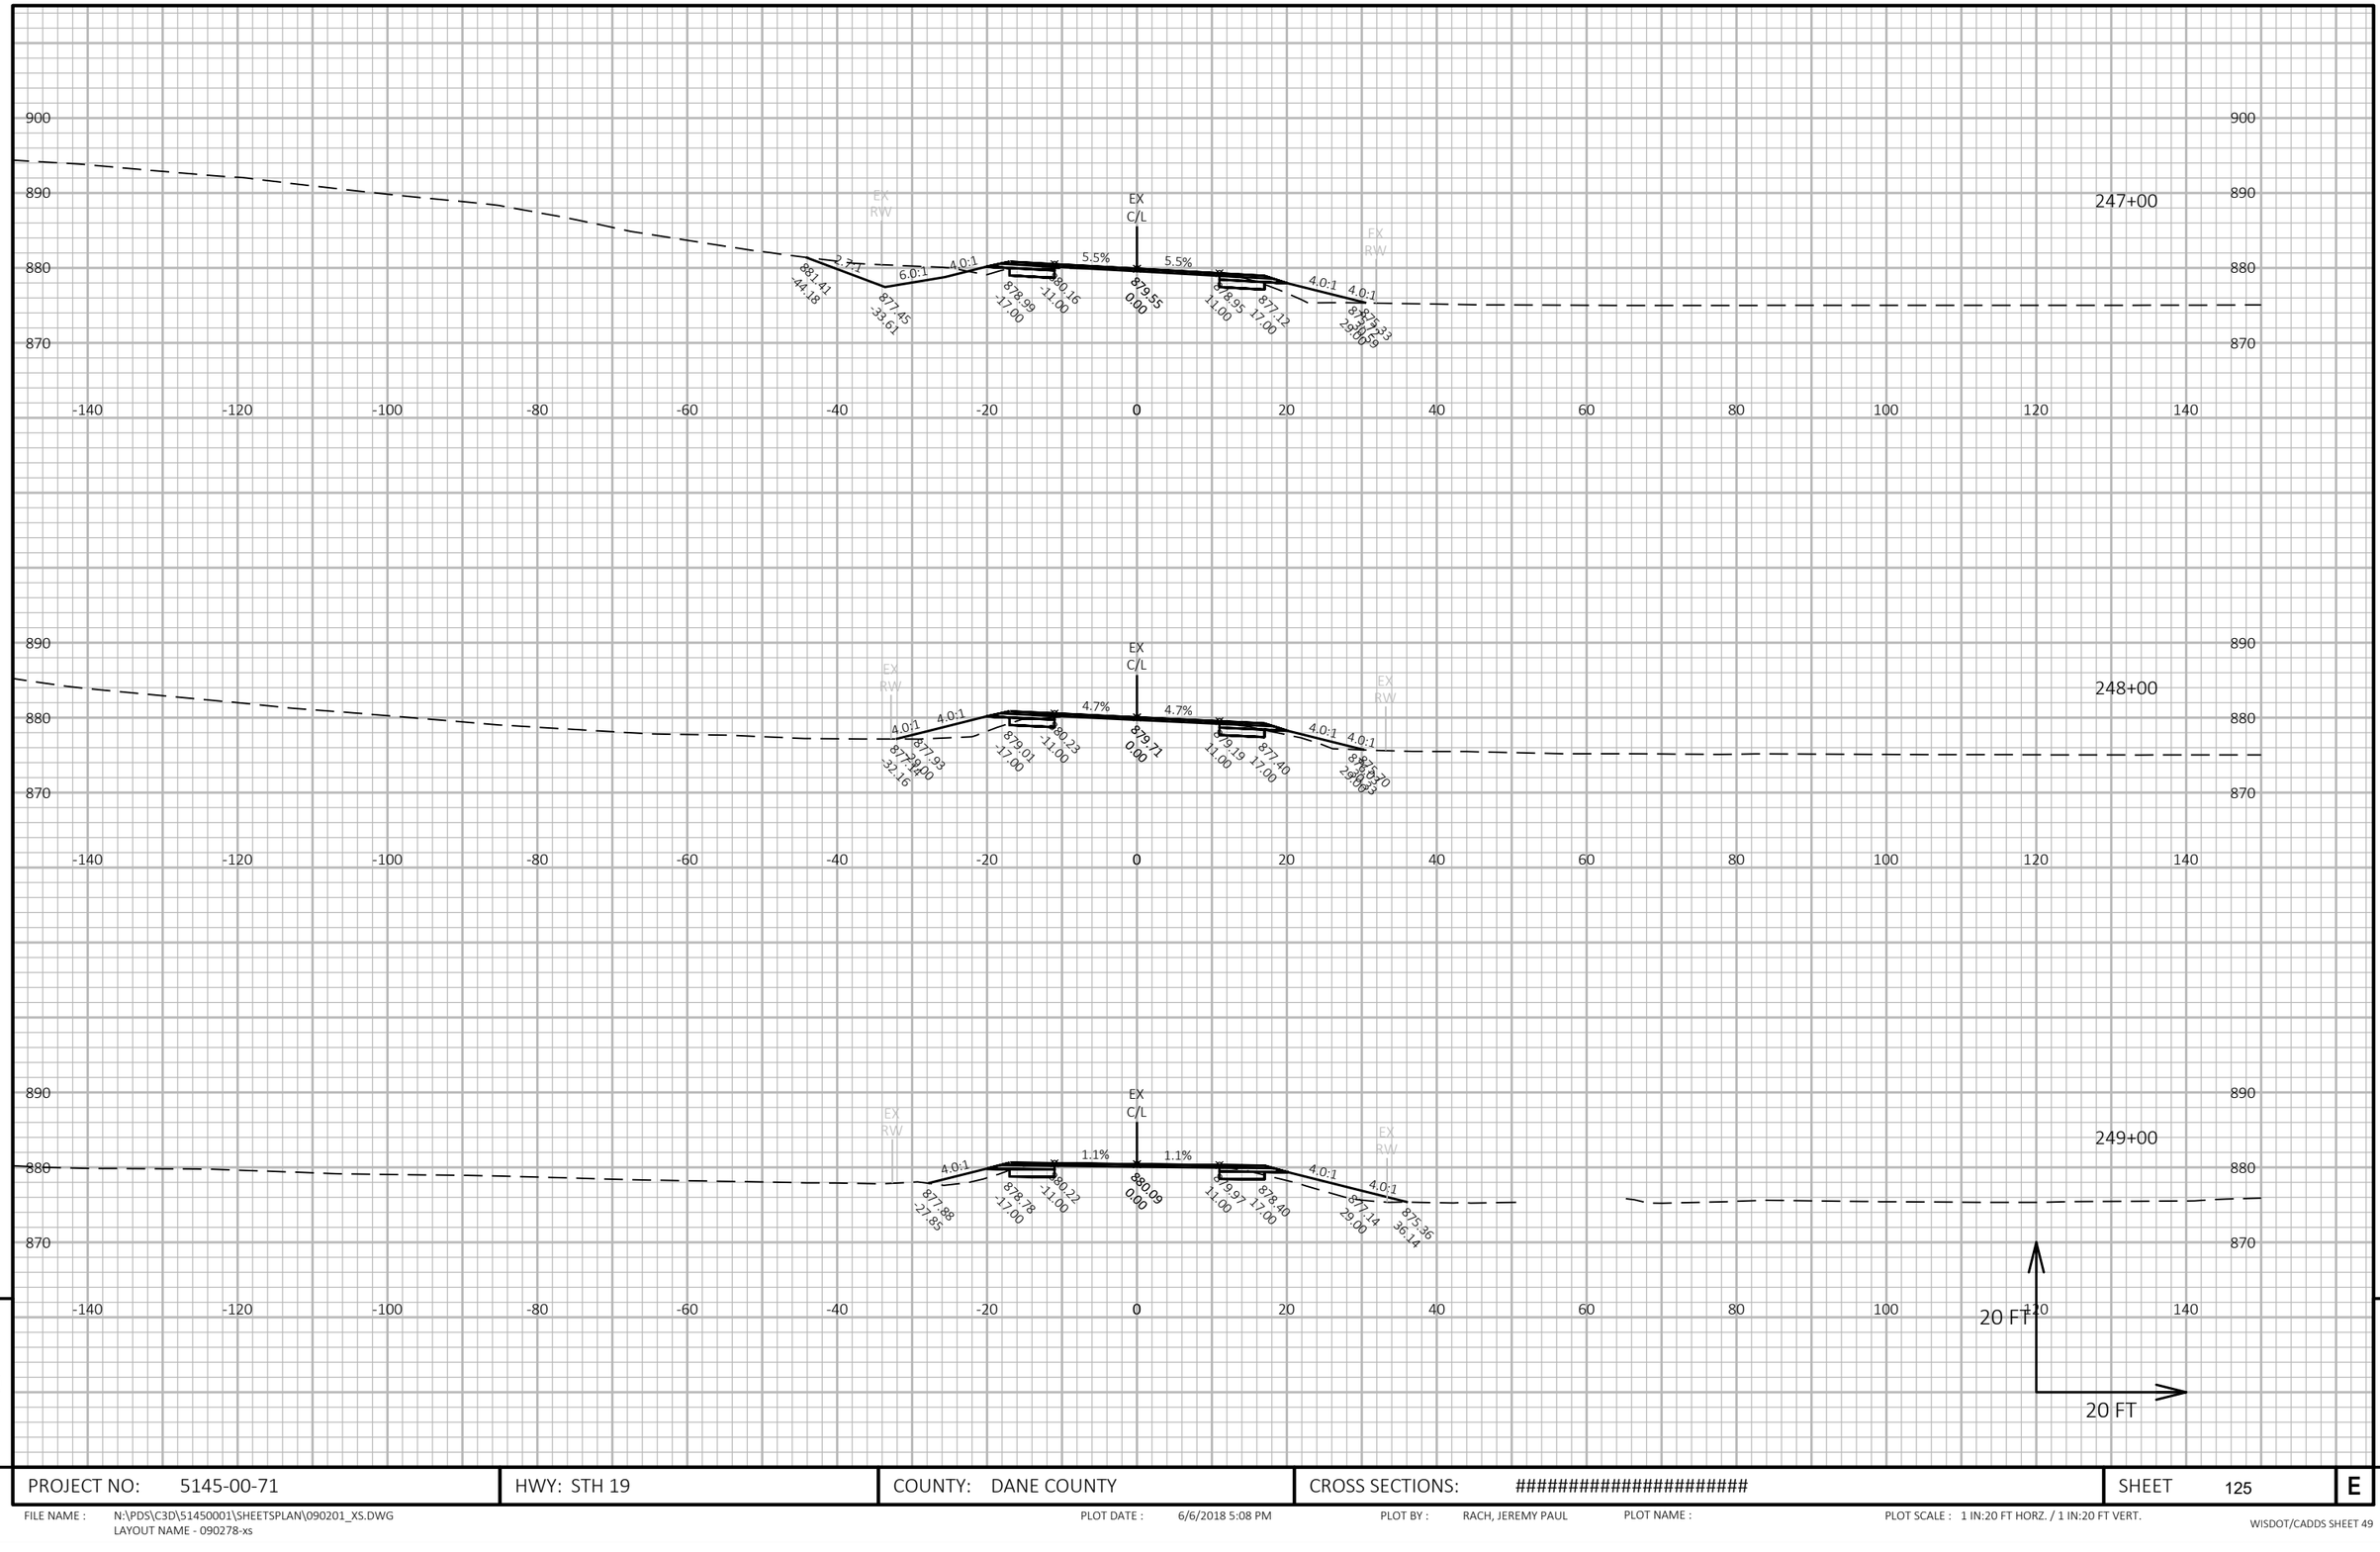

9

9

PROJECT NO: 5145-00-71	HWY: STH 19	COUNTY: DANE COUNTY	CROSS SECTIONS: ##########################	SHEET 125	E

FILE NAME : N:\PDS\C3D\51450001\SHEETSPLAN\090201_XS.DWG
LAYOUT NAME - 090278-xs
PLOT DATE : 6/6/2018 5:08 PM
PLOT BY : RACH, JEREMY PAUL
PLOT NAME :
PLOT SCALE : 1 IN:20 FT HORZ. / 1 IN:20 FT VERT.

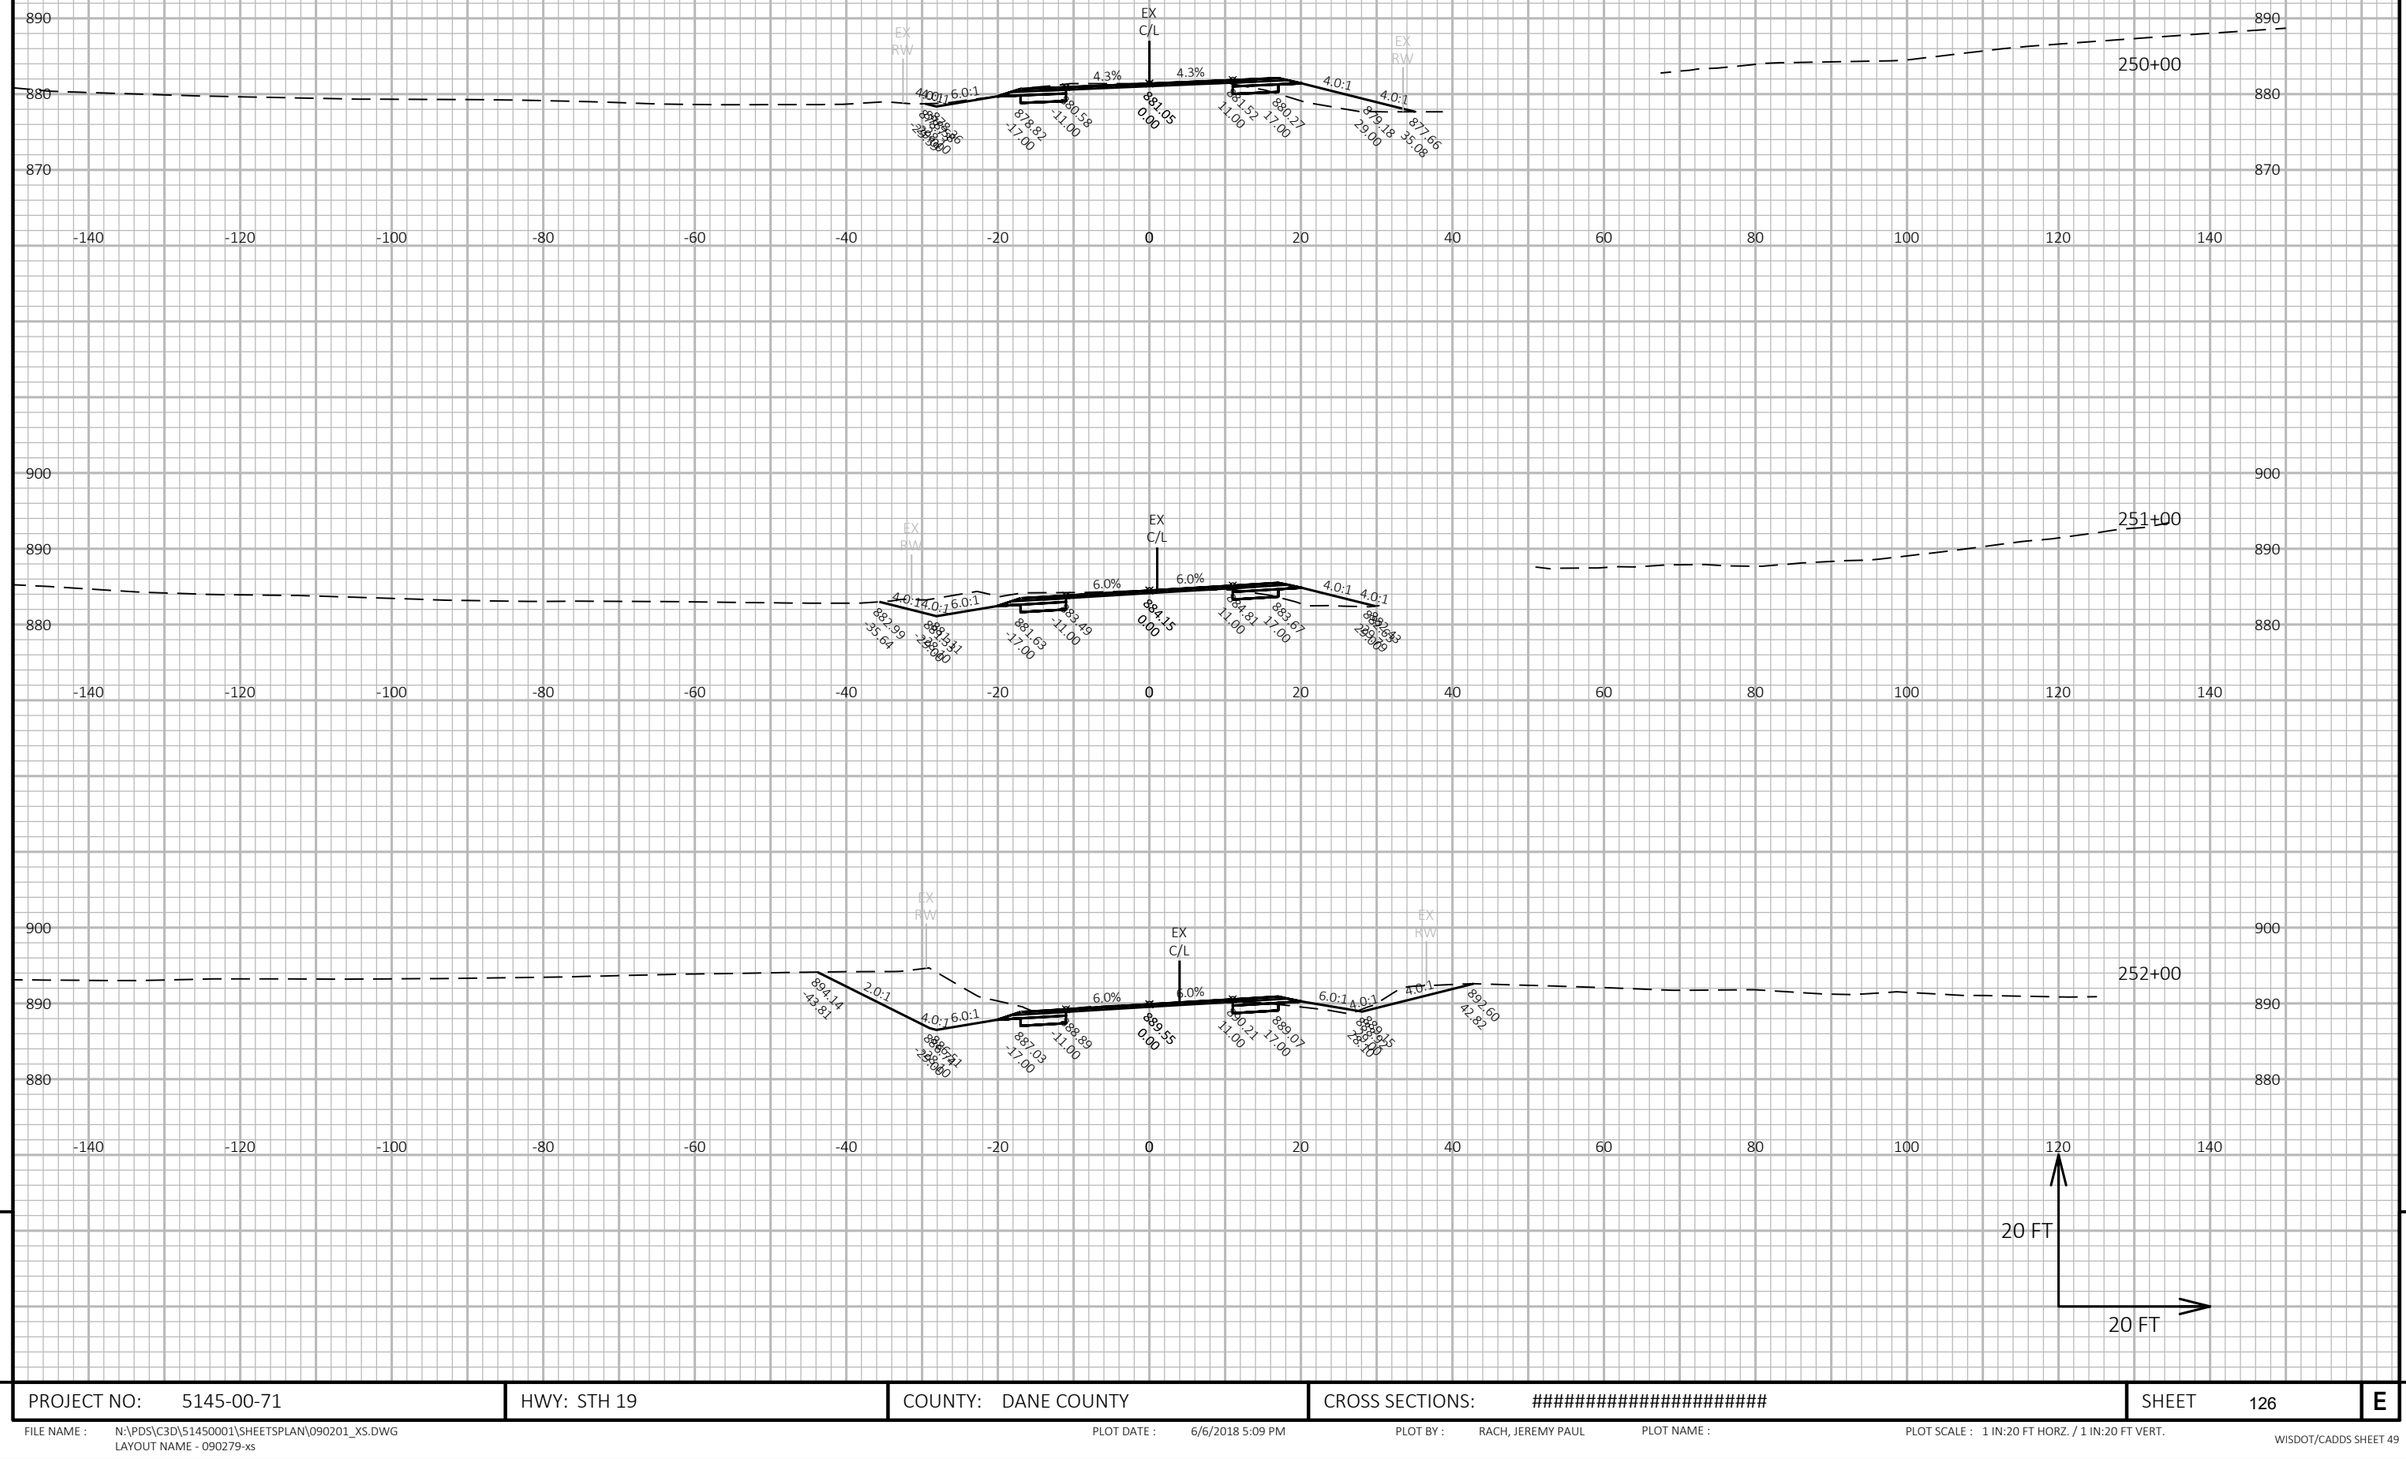

PROJECT NO: 5145-00-71	HWY: STH 19	COUNTY: DANE COUNTY	CROSS SECTIONS: ##########################	SHEET 126	E

FILE NAME : N:\PDS\C3D\51450001\SHEETSPLAN\090201_XS.DWG
LAYOUT NAME - 090279-xs

PLOT DATE : 6/6/2018 5:09 PM PLOT BY : RACH, JEREMY PAUL PLOT NAME : PLOT SCALE : 1 IN:20 FT HORZ. / 1 IN:20 FT VERT.

WISDOT/CADDS SHEET 49

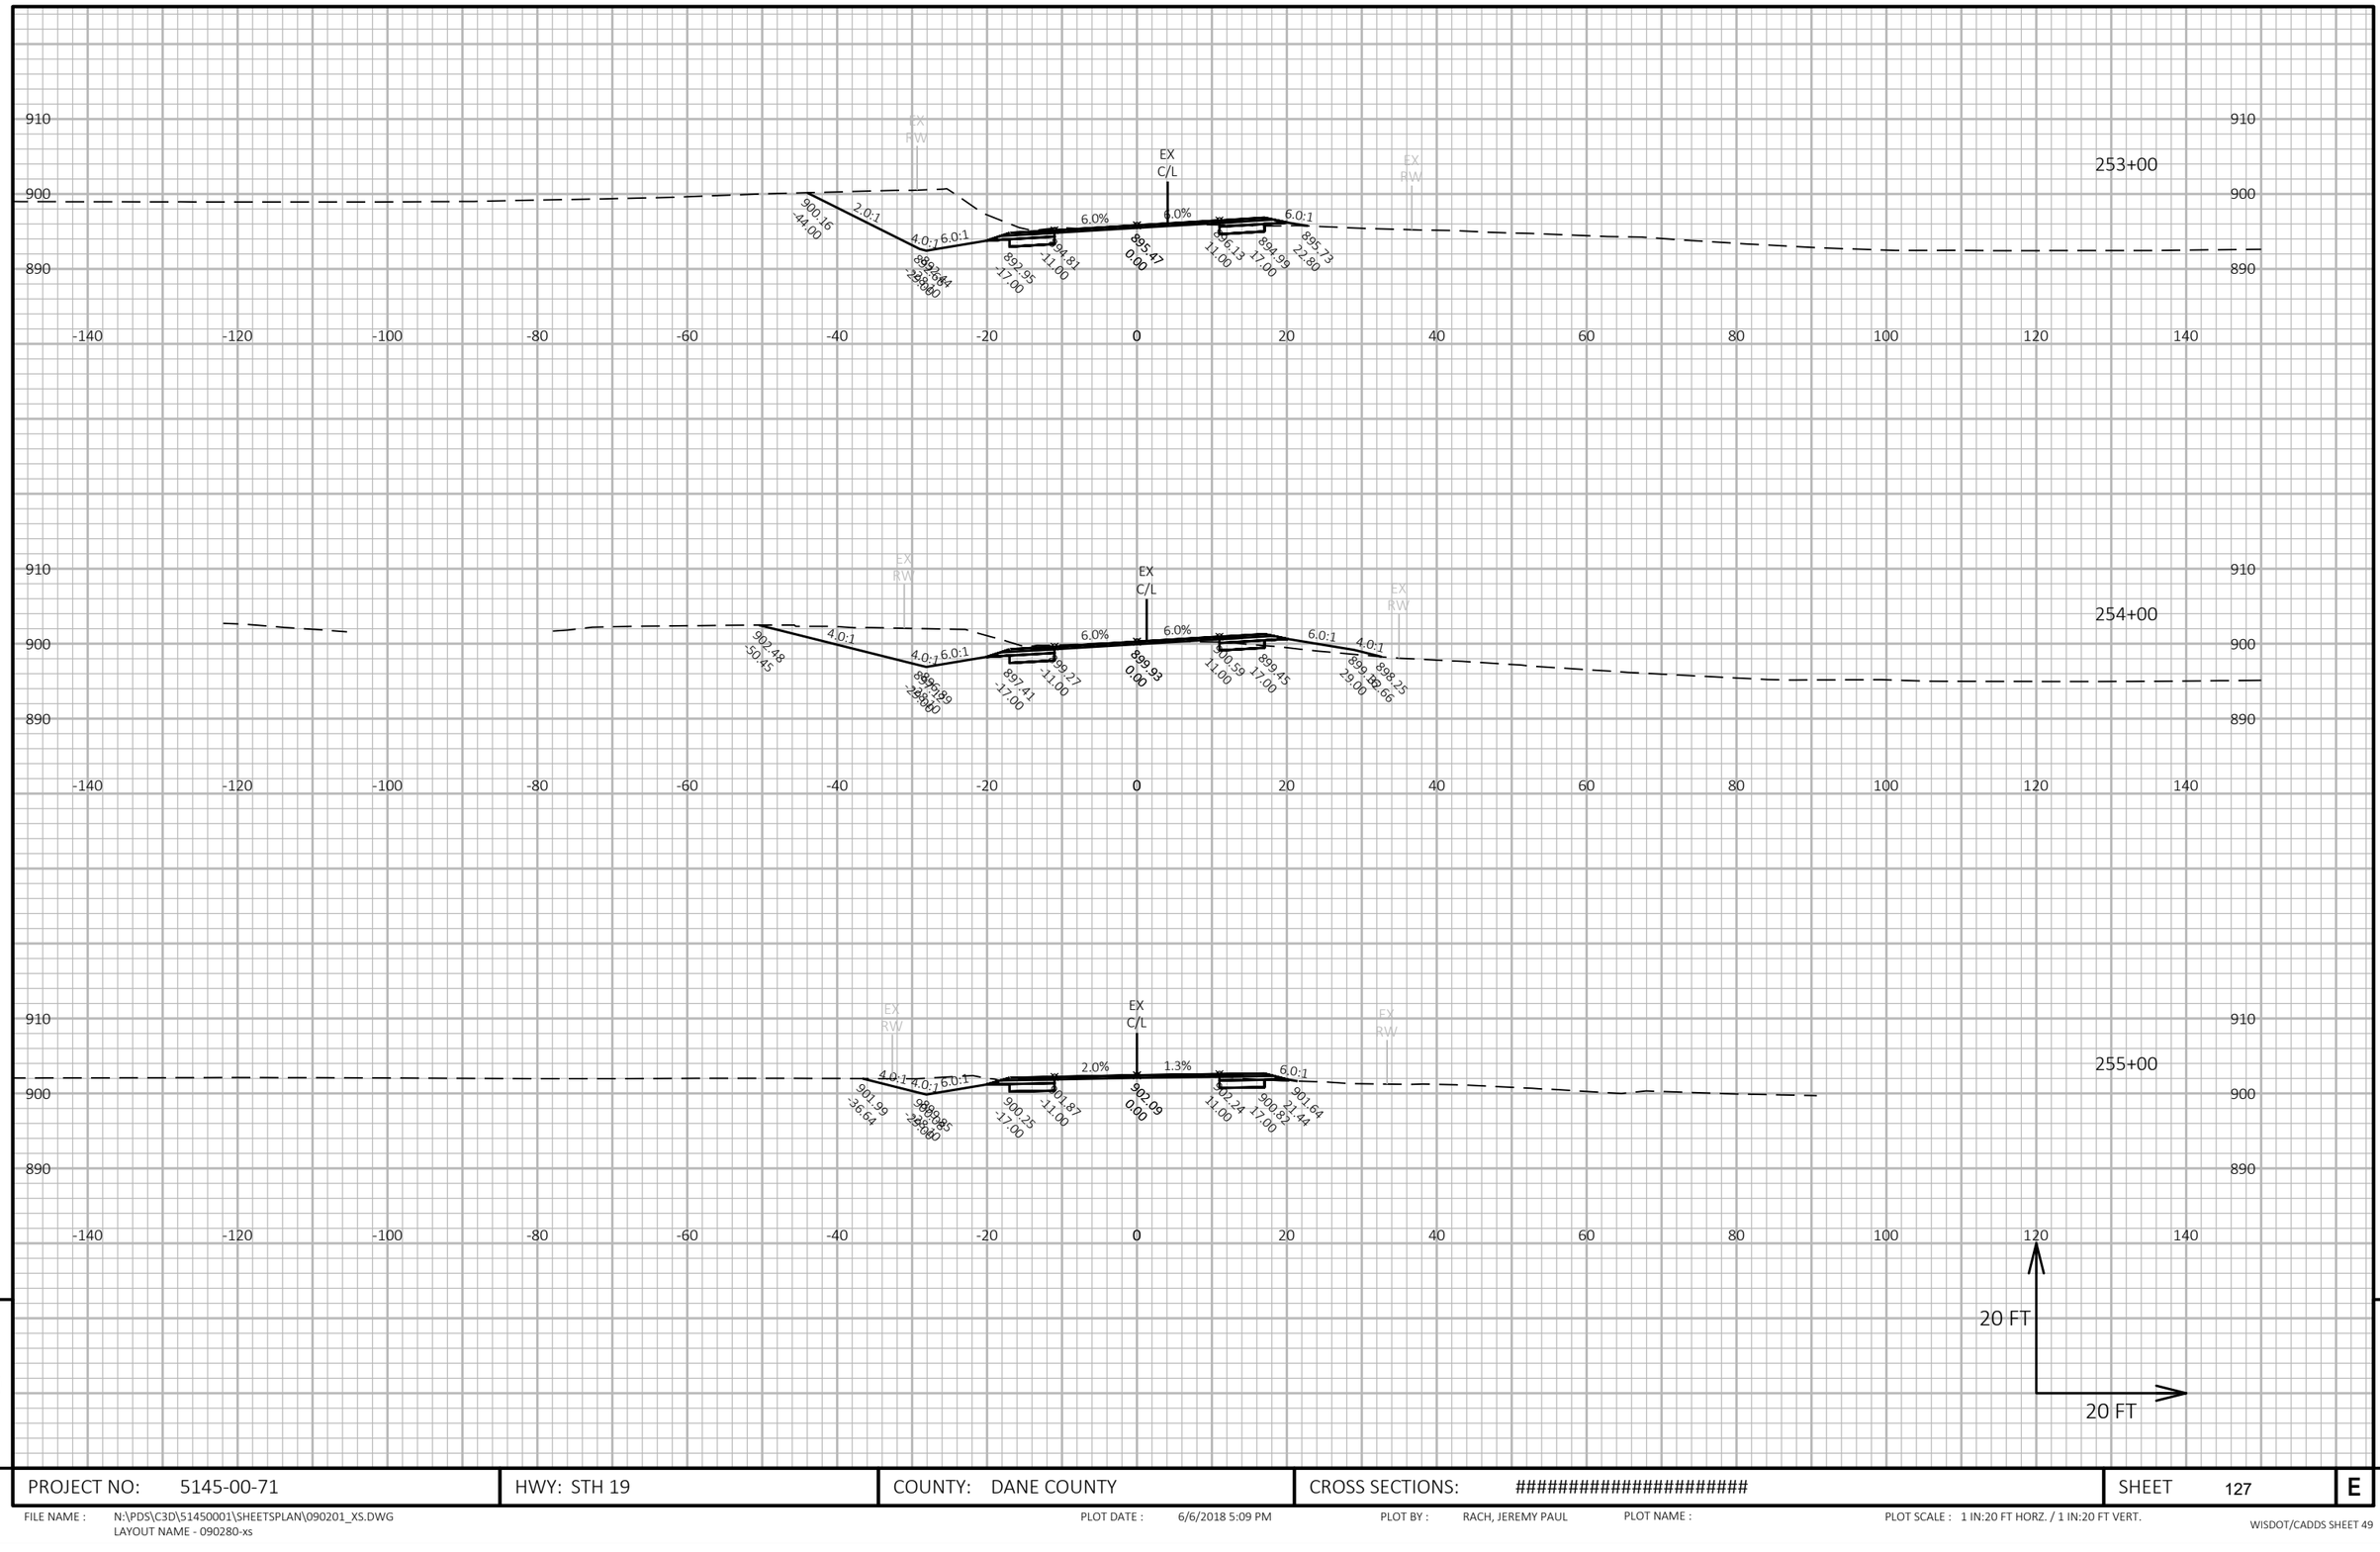

9

9

PROJECT NO: 5145-00-71	HWY: STH 19	COUNTY: DANE COUNTY	CROSS SECTIONS: ##########################	SHEET 127	E

FILE NAME : N:\PDS\C3D\51450001\SHEETSPLAN\090201_XS.DWG
LAYOUT NAME - 090280-xs

PLOT DATE : 6/6/2018 5:09 PM PLOT BY : RACH, JEREMY PAUL PLOT NAME : PLOT SCALE : 1 IN:20 FT HORZ. / 1 IN:20 FT VERT.

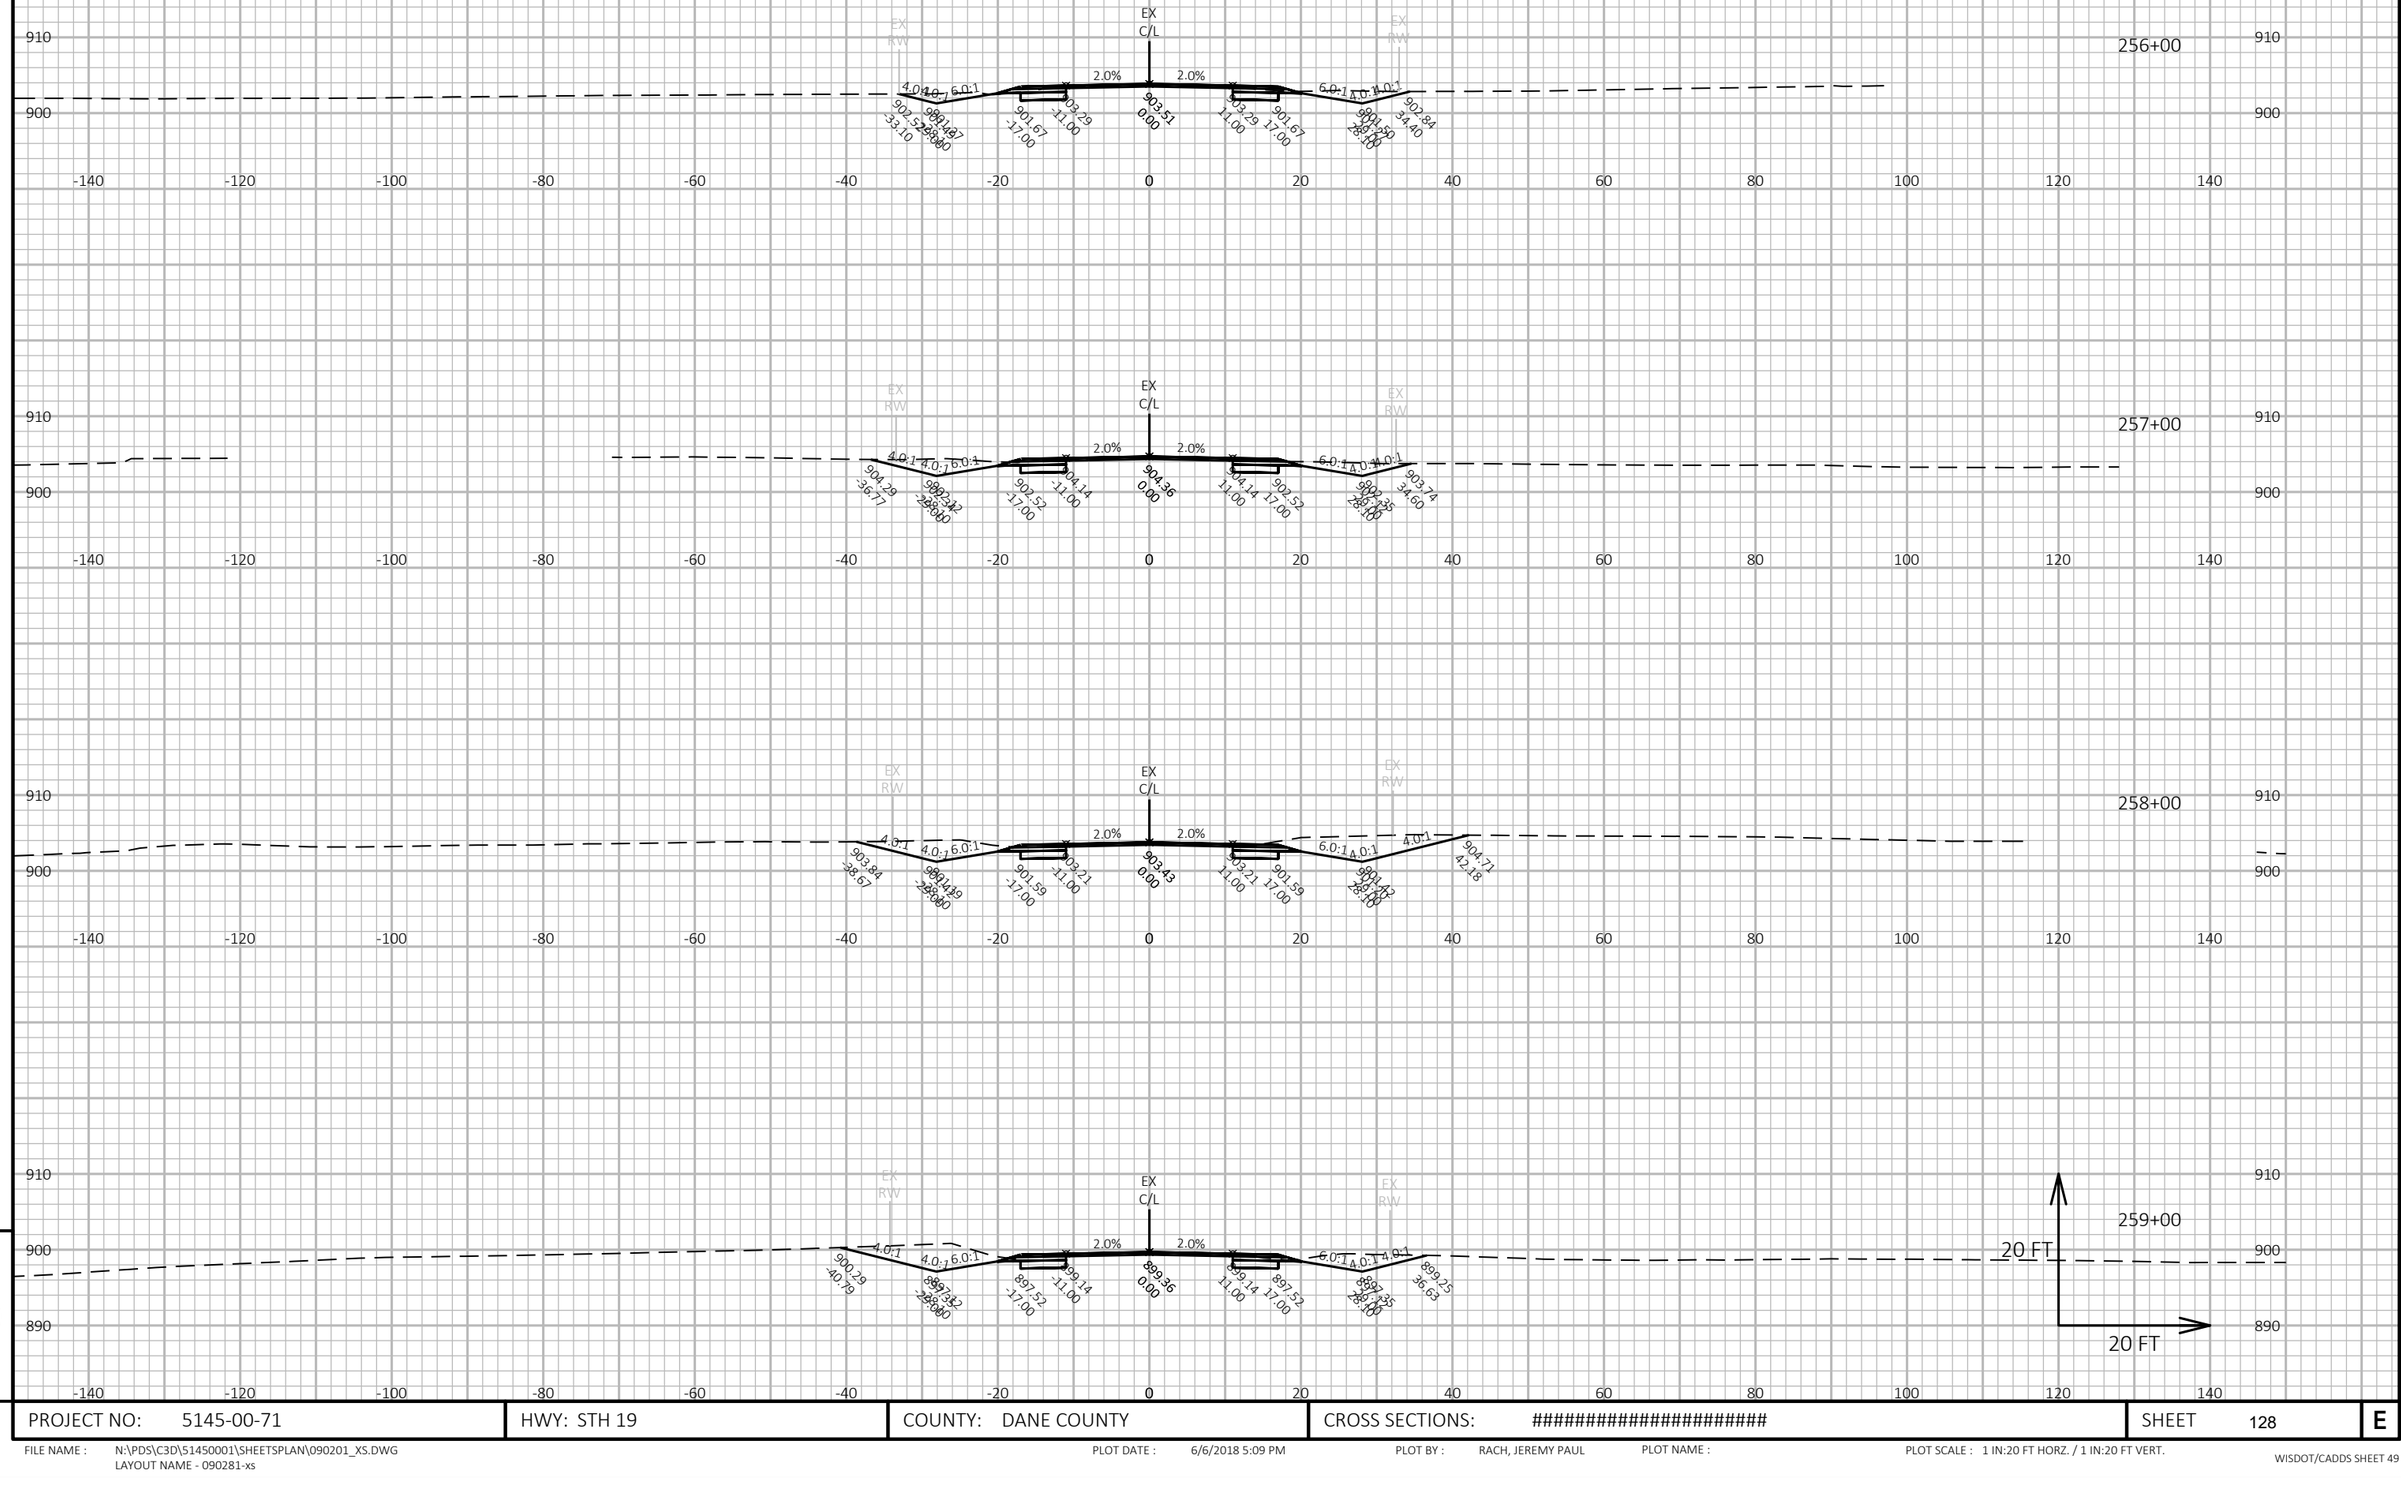

9

PROJECT NO: 5145-00-71	HWY: STH 19	COUNTY: DANE COUNTY	CROSS SECTIONS: ##########################	SHEET 128	E

FILE NAME : N:\PDS\C3D\51450001\SHEETSPLAN\090201_XS.DWG
LAYOUT NAME - 090281-xs
PLOT DATE : 6/6/2018 5:09 PM
PLOT BY : RACH, JEREMY PAUL
PLOT NAME :
PLOT SCALE : 1 IN:20 FT HORZ. / 1 IN:20 FT VERT.
WISDOT/CADDS SHEET 49

9

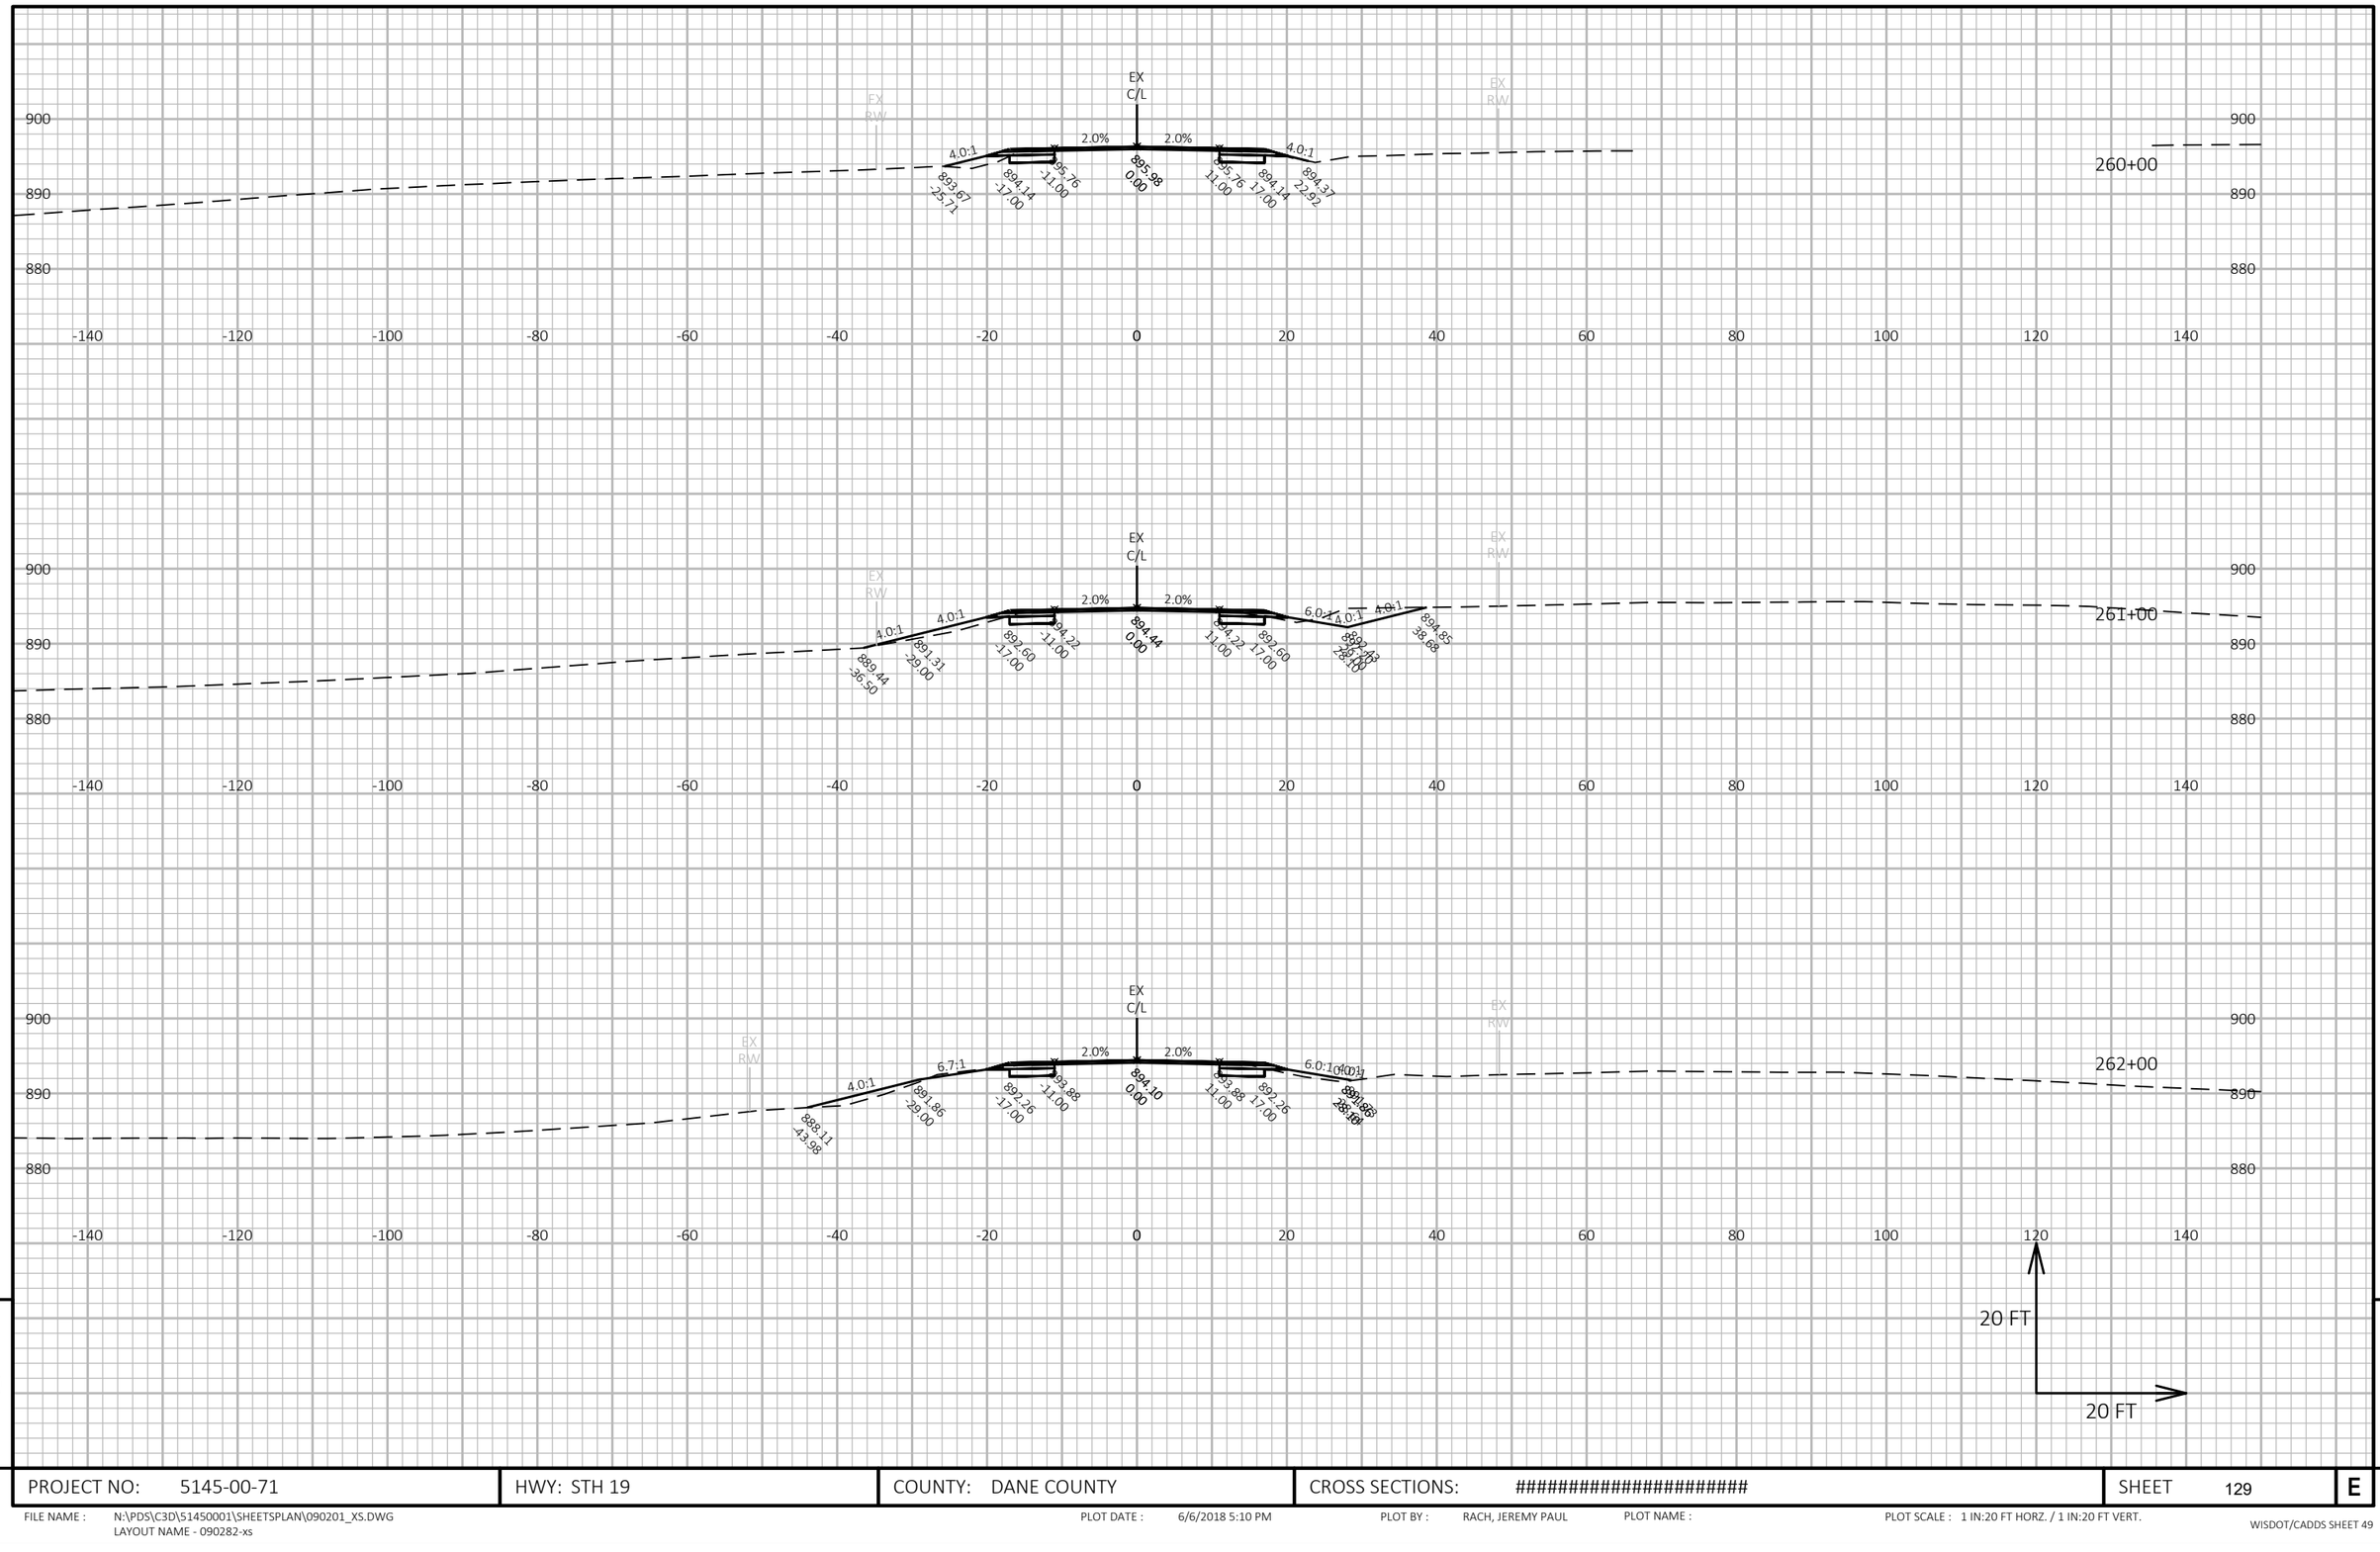

9

9

PROJECT NO: 5145-00-71	HWY: STH 19	COUNTY: DANE COUNTY	CROSS SECTIONS: ##########################	SHEET 129	E

FILE NAME : N:\PDS\C3D\51450001\SHEETSPLAN\090201_XS.DWG
LAYOUT NAME - 090282-xs

PLOT DATE : 6/6/2018 5:10 PM PLOT BY : RACH, JEREMY PAUL PLOT NAME : PLOT SCALE : 1 IN:20 FT HORZ. / 1 IN:20 FT VERT.

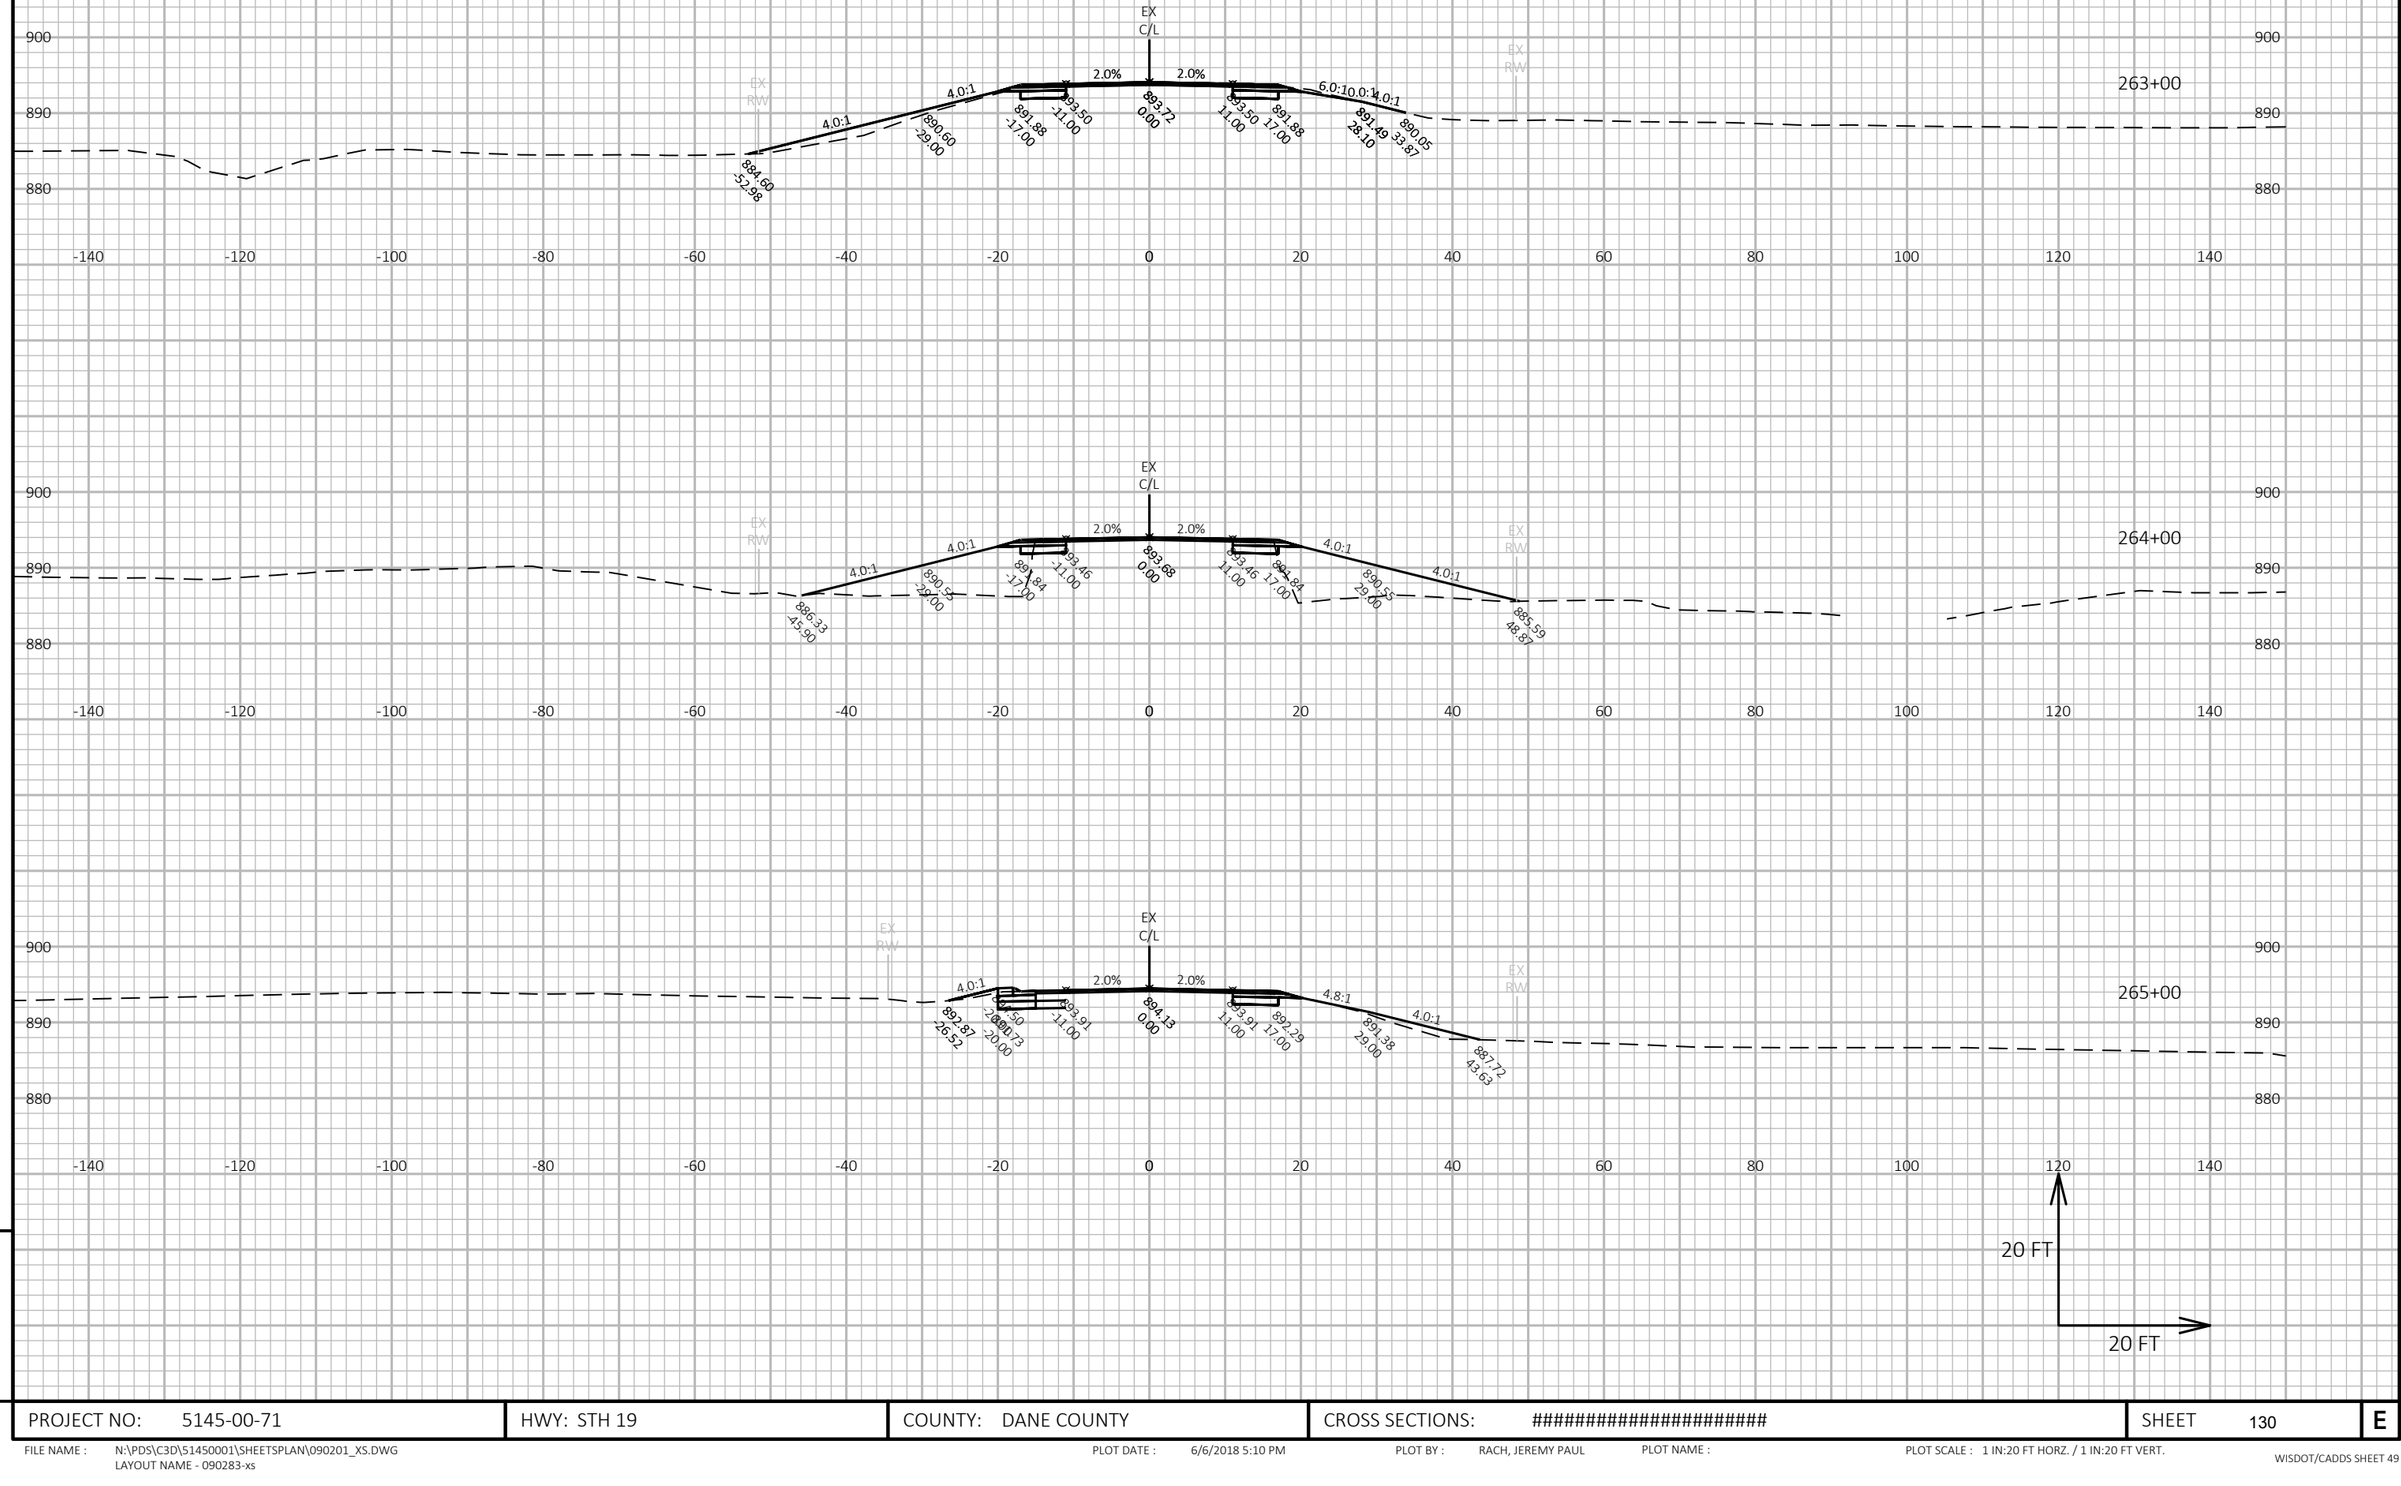

PROJECT NO: 5145-00-71	HWY: STH 19	COUNTY: DANE COUNTY	CROSS SECTIONS: ##########################	SHEET 130 E

FILE NAME : N:\PDS\C3D\51450001\SHEETSPLAN\090201_XS.DWG
LAYOUT NAME - 090283-xs

PLOT DATE : 6/6/2018 5:10 PM PLOT BY : RACH, JEREMY PAUL PLOT NAME : PLOT SCALE : 1 IN:20 FT HORZ. / 1 IN:20 FT VERT.

9

9

PROJECT NO: 5145-00-71	HWY: STH 19	COUNTY: DANE COUNTY	CROSS SECTIONS: ##########################	SHEET 131	E

FILE NAME : N:\PDS\C3D\51450001\SHEETSPLAN\090201_XS.DWG
LAYOUT NAME - 090284-xs

PLOT DATE : 6/6/2018 5:11 PM

PLOT BY : RACH, JEREMY PAUL

PLOT NAME :

PLOT SCALE : 1 IN:20 FT HORZ. / 1 IN:20 FT VERT.

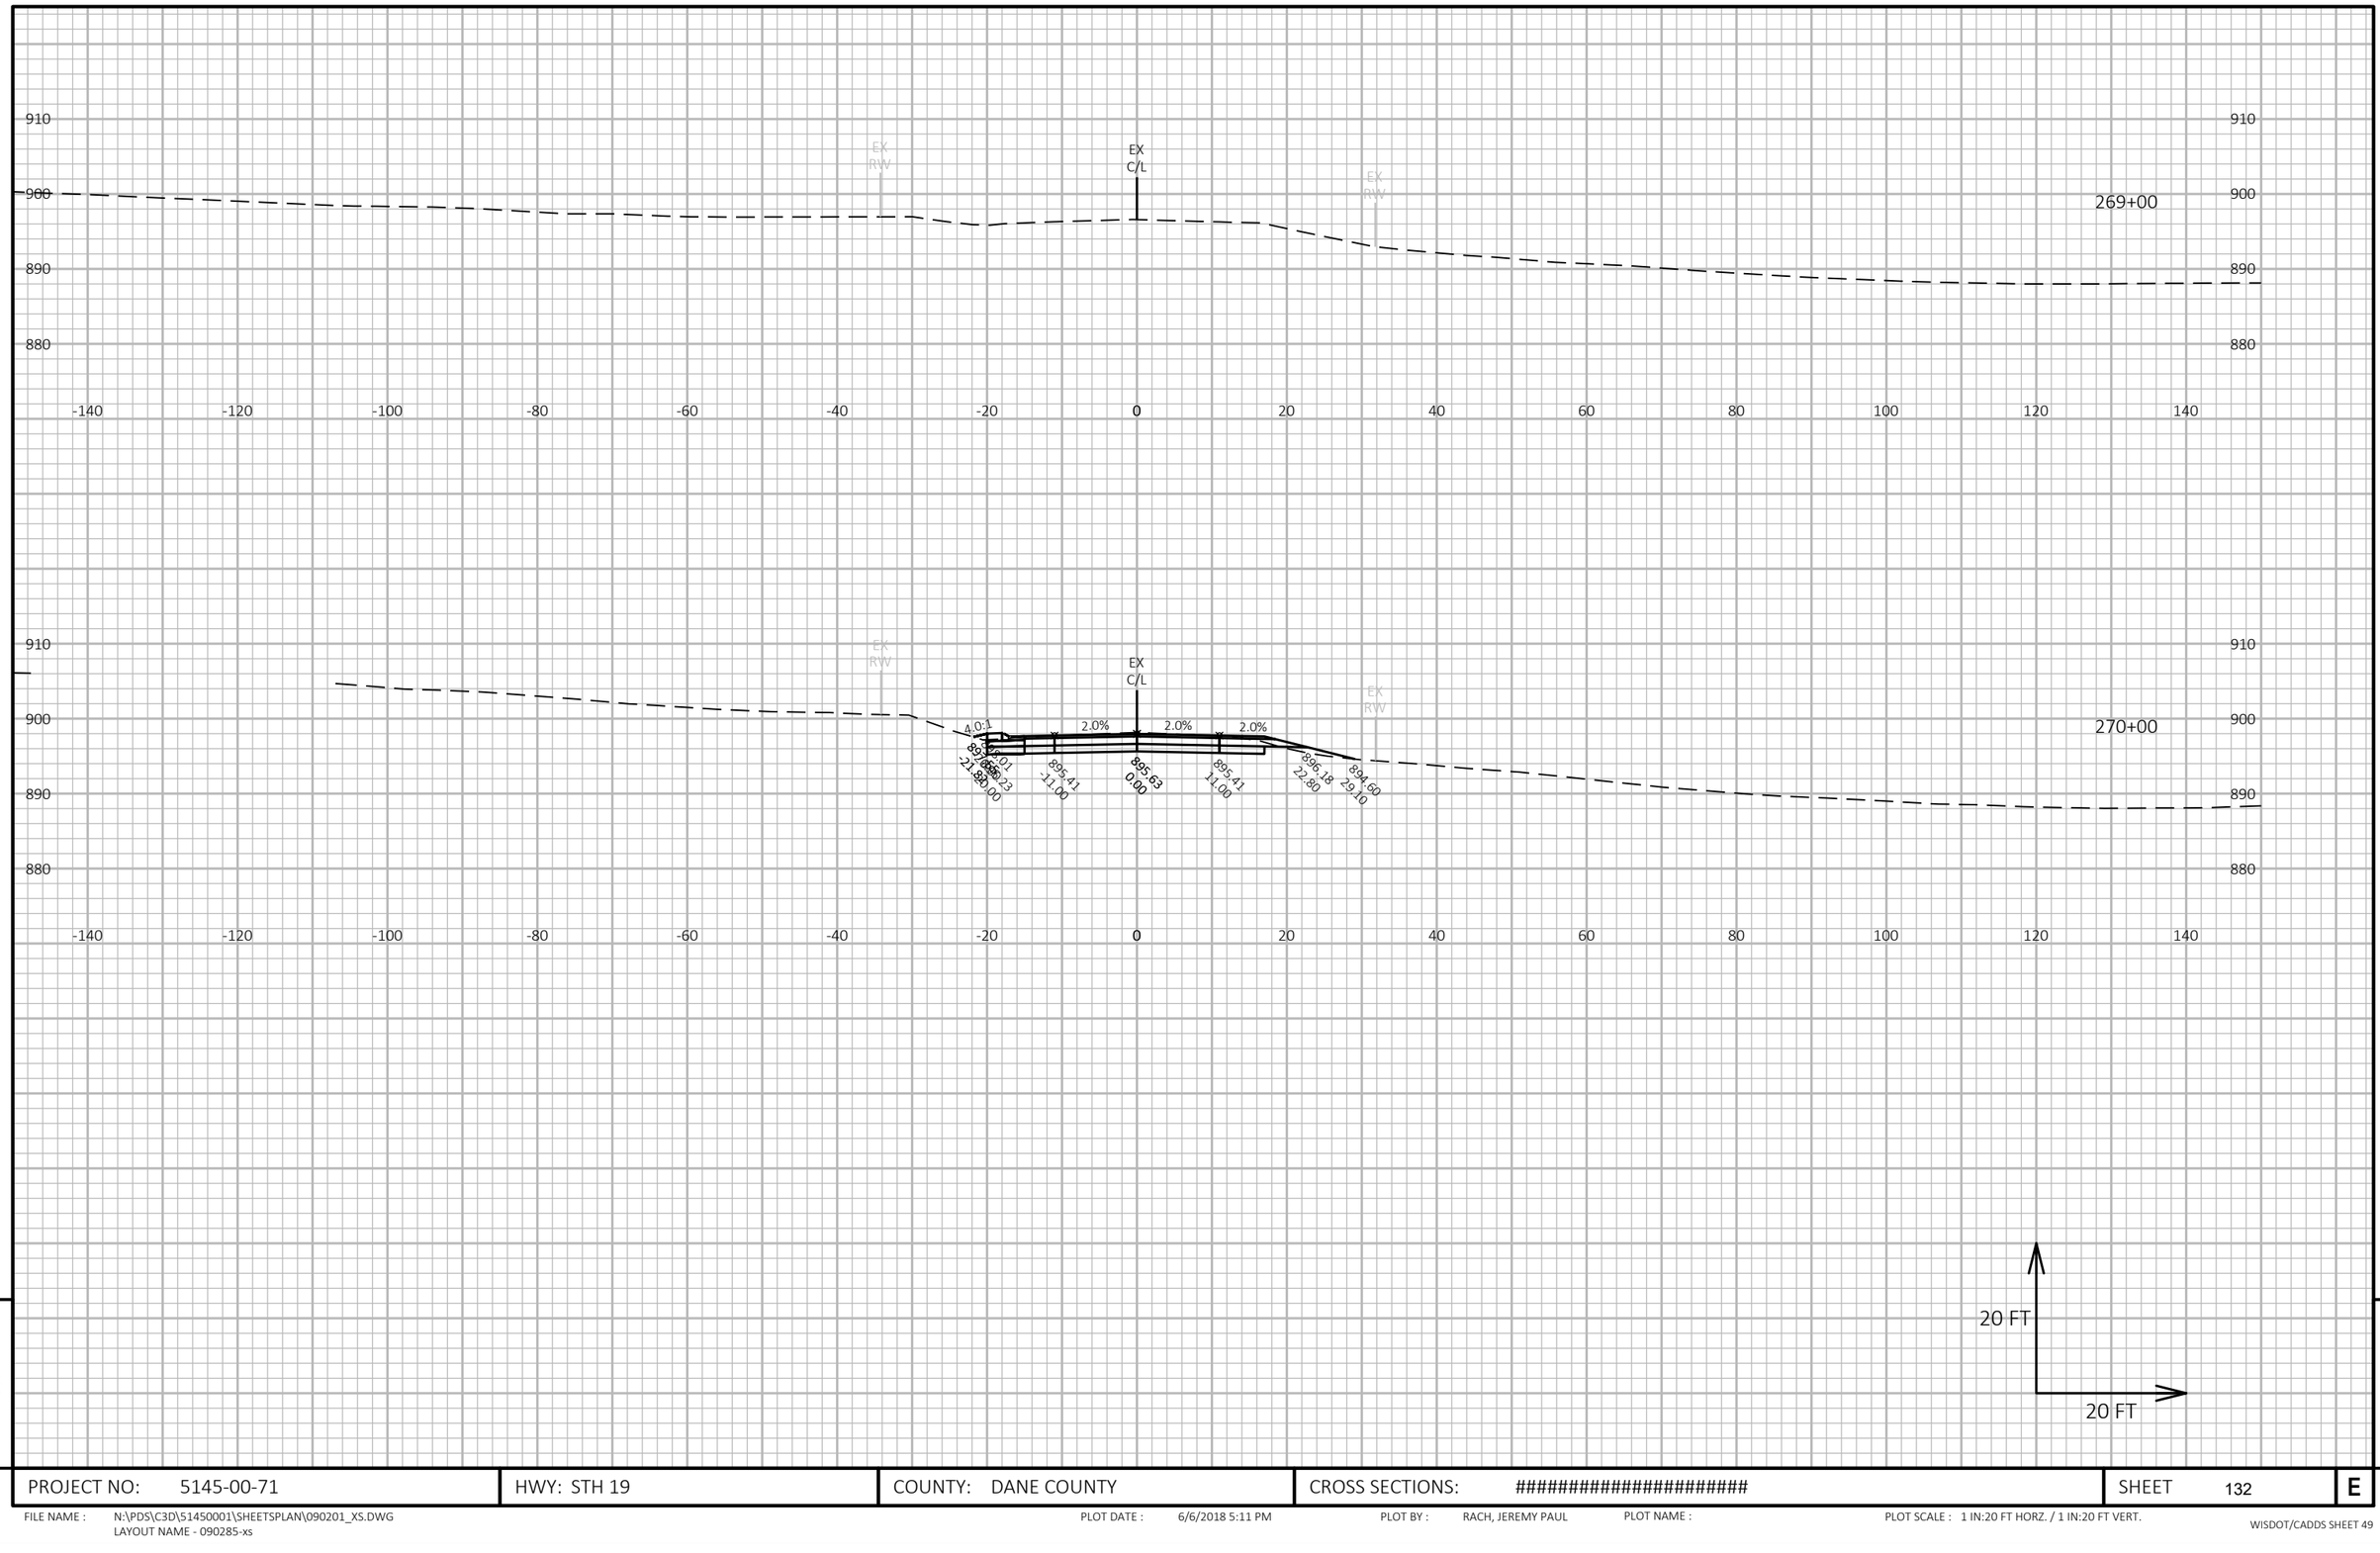

9

9

PROJECT NO: 5145-00-71	HWY: STH 19	COUNTY: DANE COUNTY	CROSS SECTIONS: ##########################	SHEET 132	E

FILE NAME : N:\PDS\C3D\51450001\SHEETSPLAN\090201_XS.DWG
LAYOUT NAME - 090285-xs

PLOT DATE : 6/6/2018 5:11 PM PLOT BY : RACH, JEREMY PAUL PLOT NAME : PLOT SCALE : 1 IN:20 FT HORZ. / 1 IN:20 FT VERT.

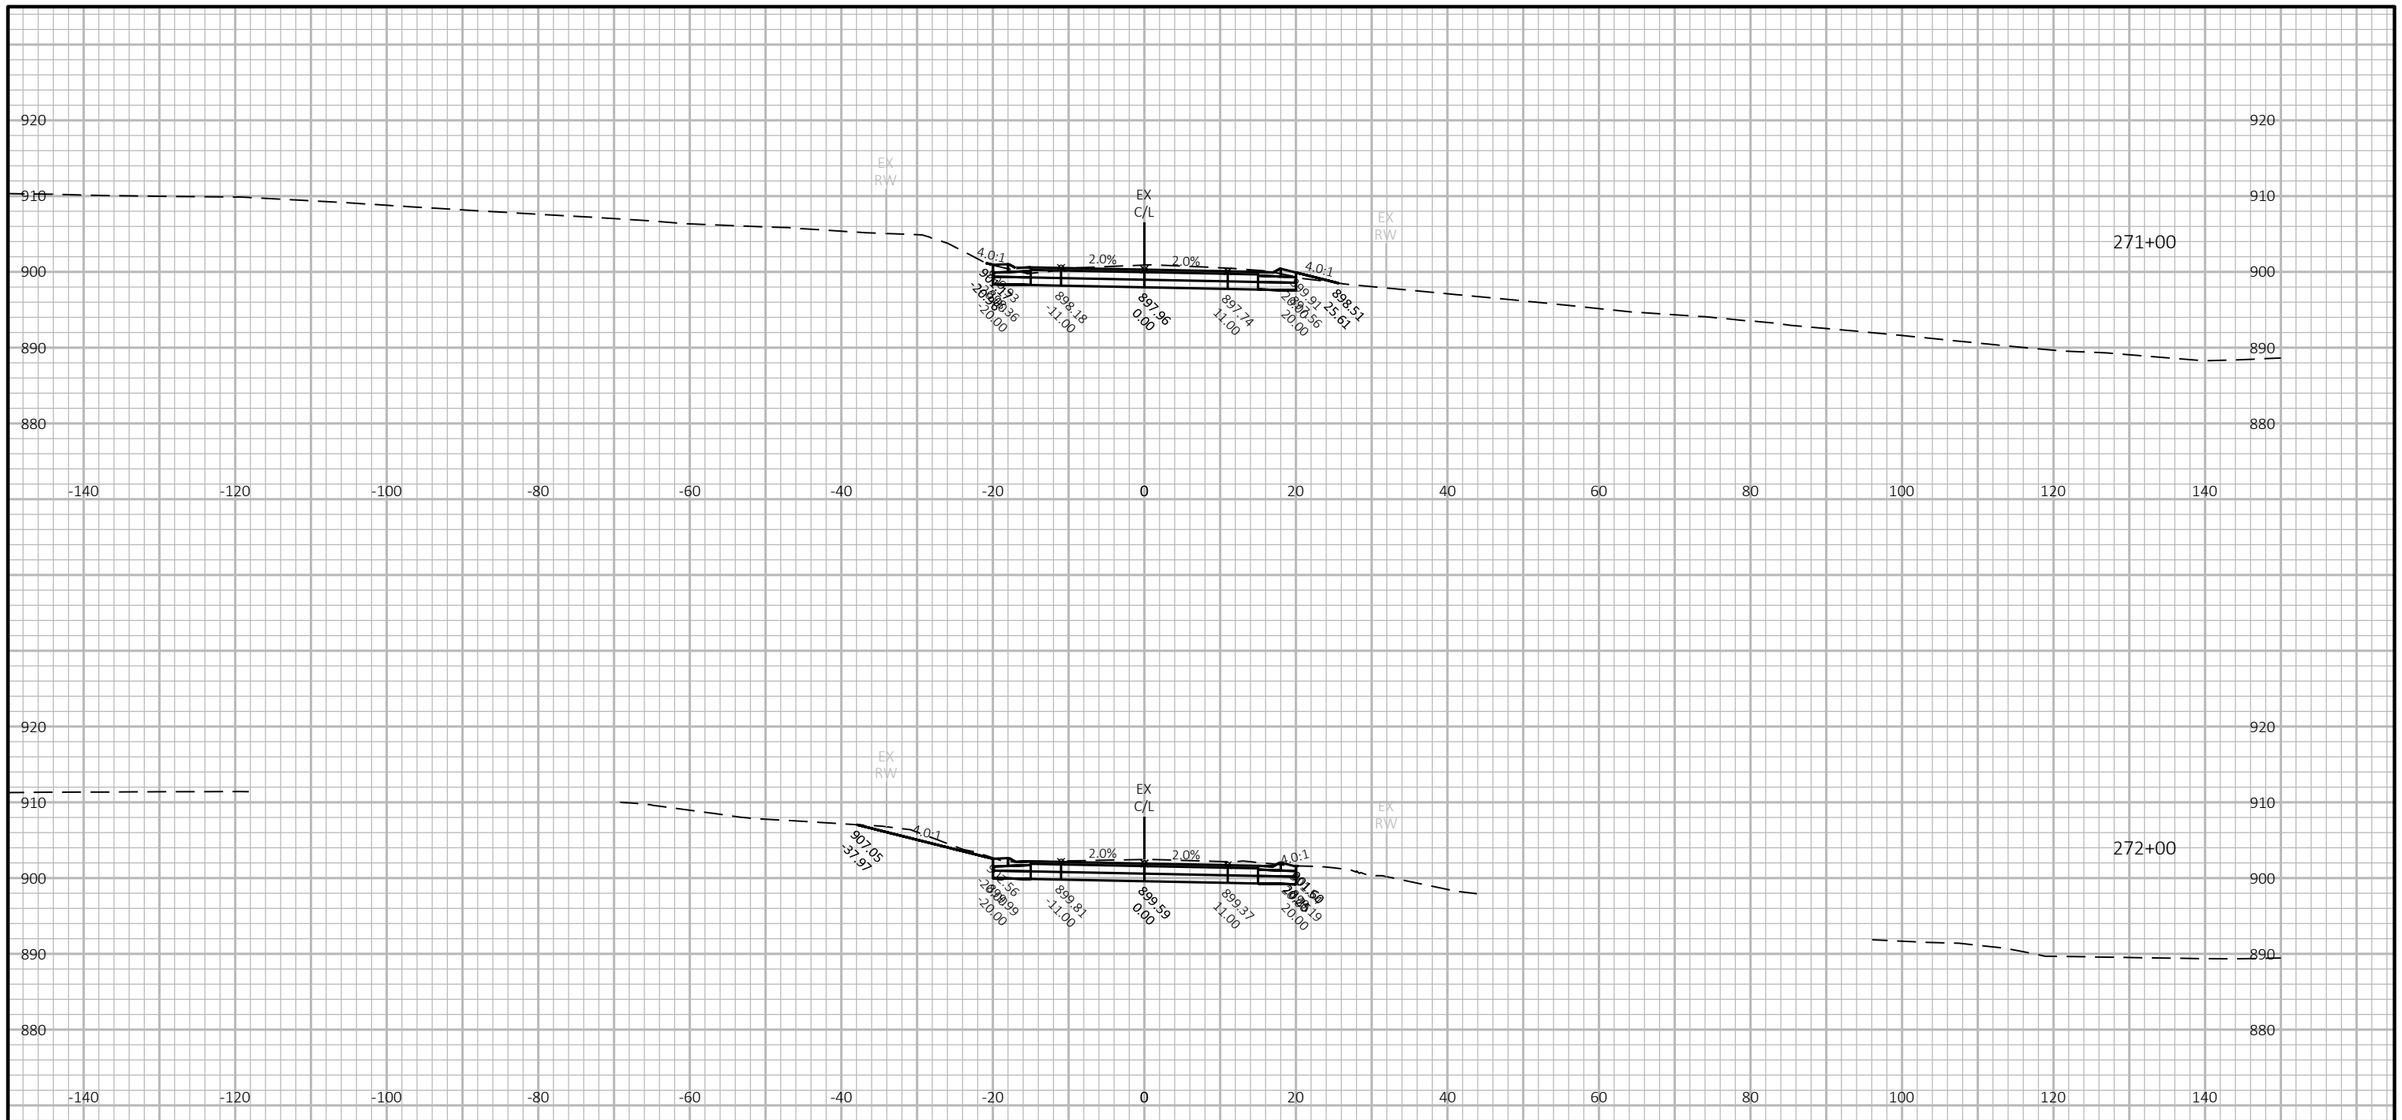

9

9

PROJECT NO: 5145-00-71	HWY: STH 19	COUNTY: DANE COUNTY	CROSS SECTIONS: ##########################	SHEET 133	E

FILE NAME : N:\PDS\C3D\51450001\SHEETSPLAN\090201_XS.DWG
LAYOUT NAME - 090286-xs

PLOT DATE : 6/6/2018 5:12 PM PLOT BY : RACH, JEREMY PAUL PLOT NAME : PLOT SCALE : 1 IN:20 FT HORZ. / 1 IN:20 FT VERT.

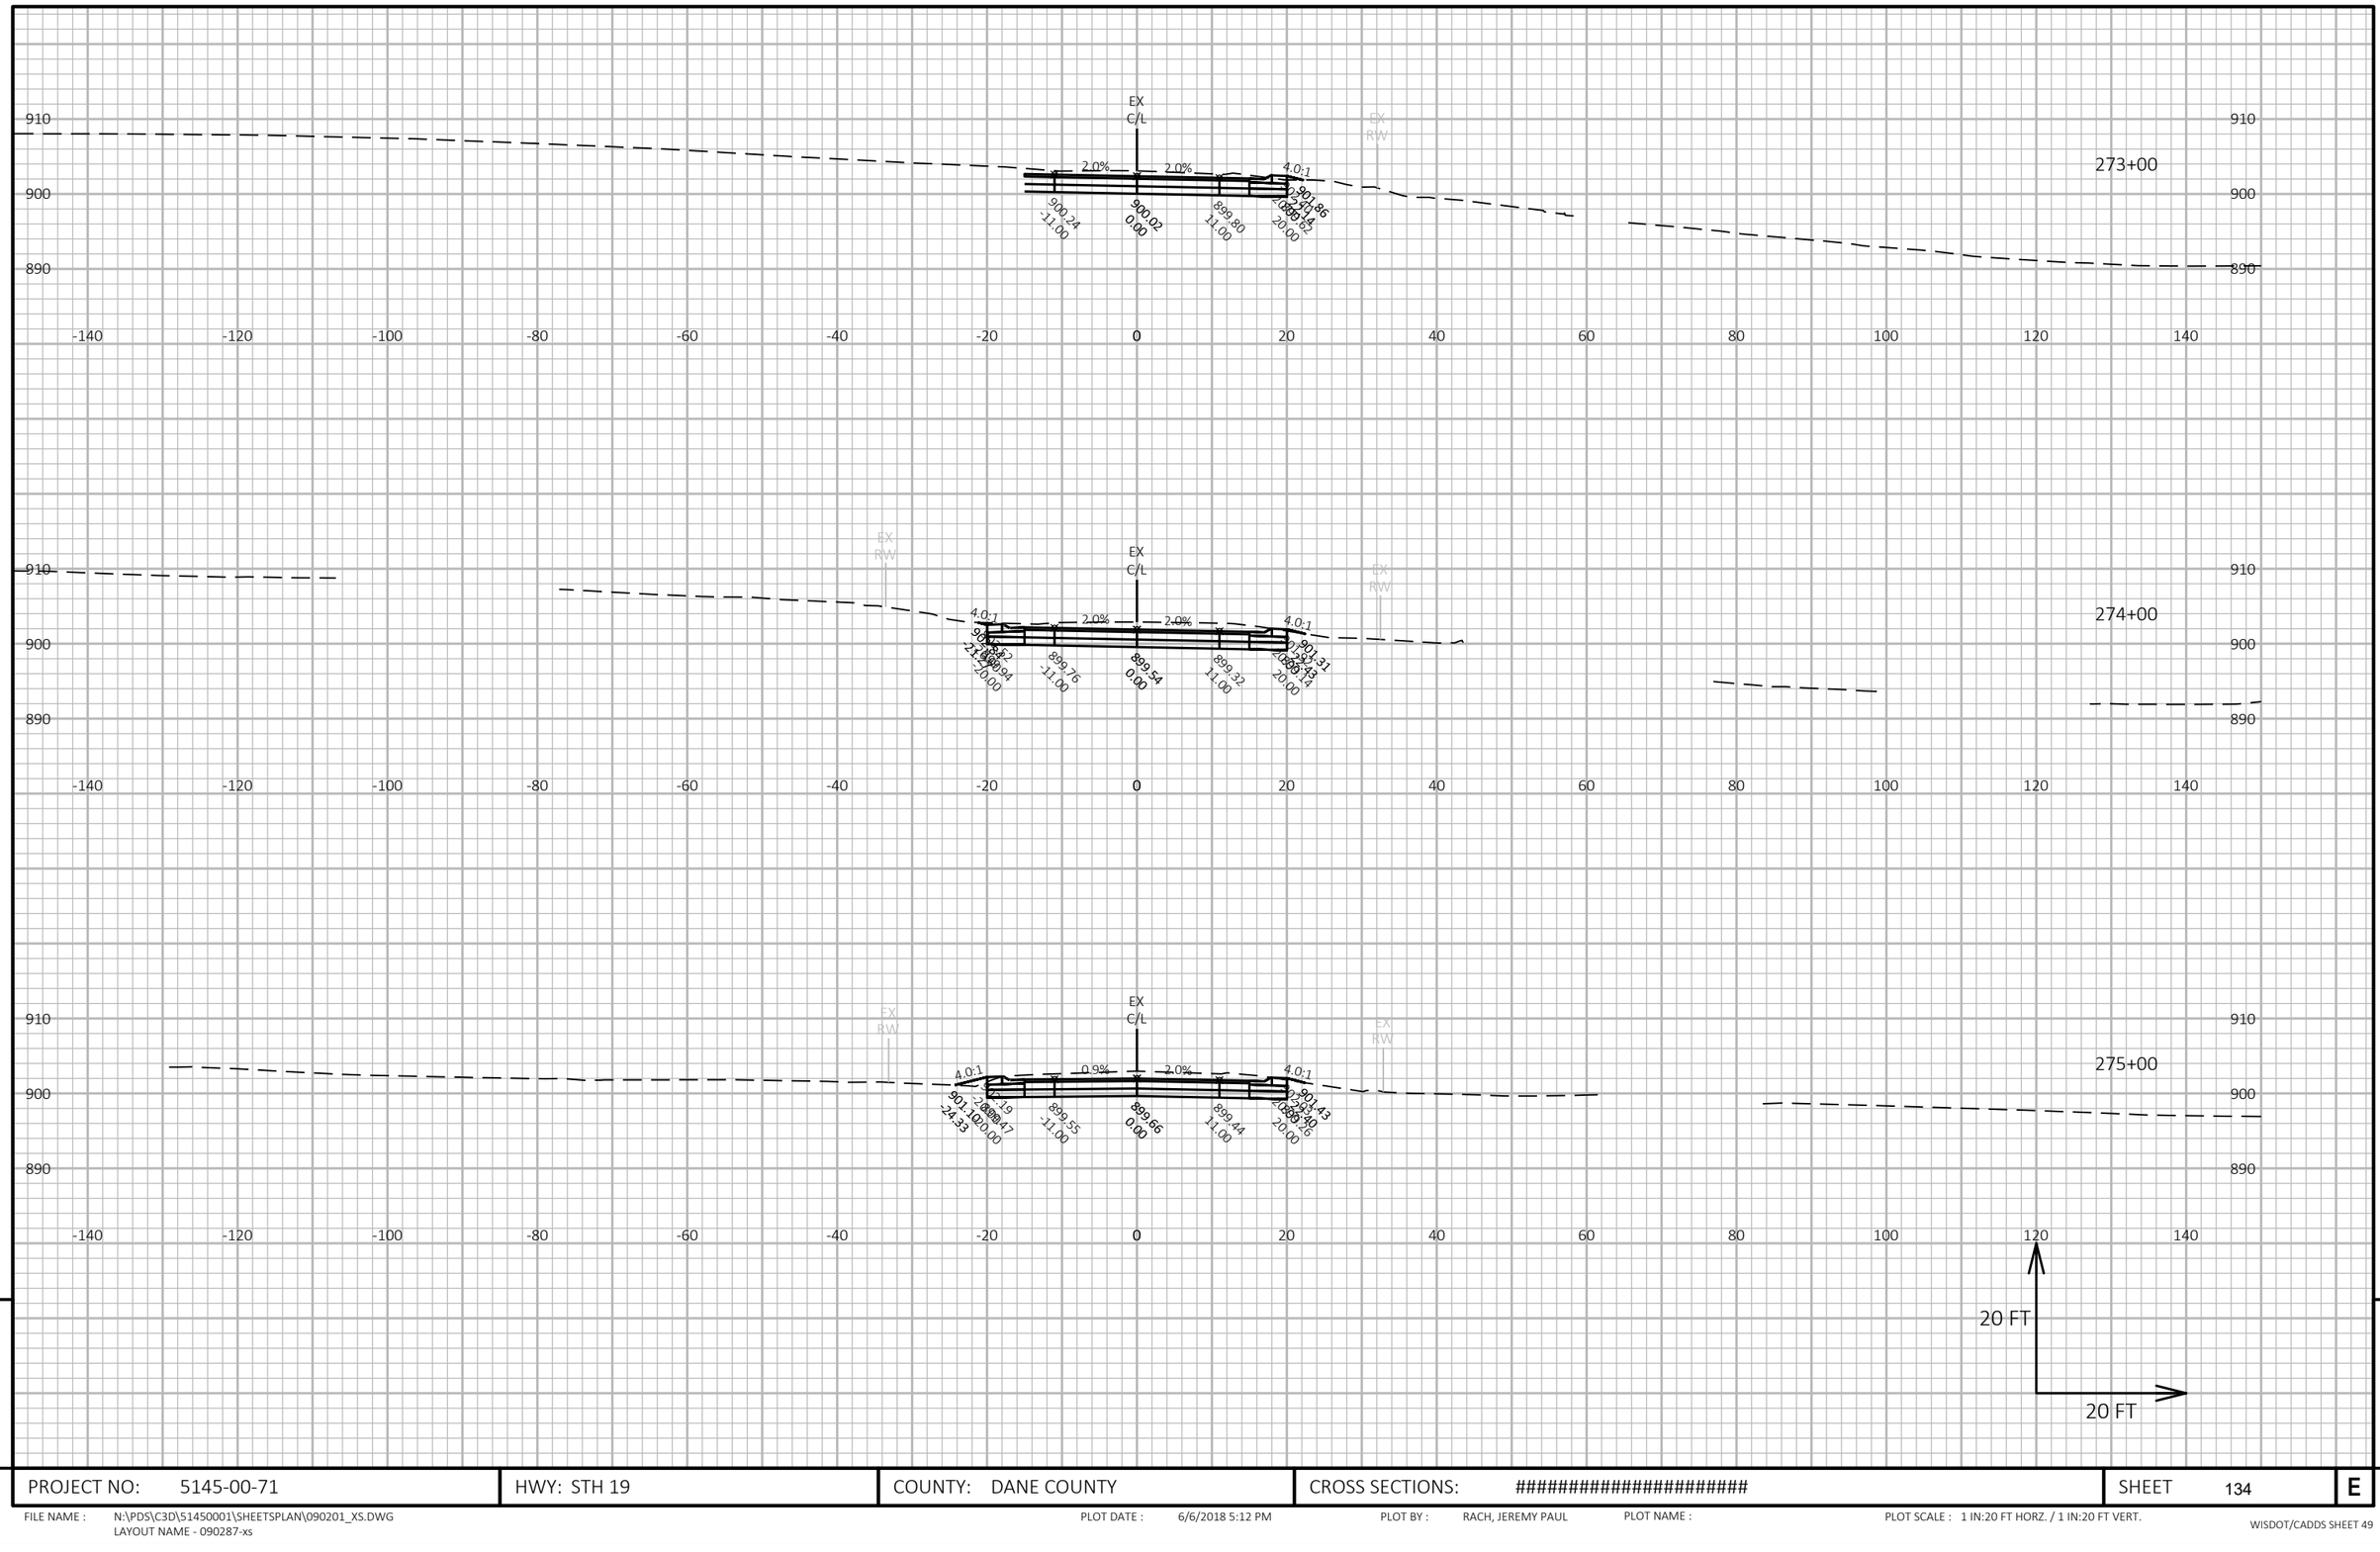

9

9

PROJECT NO: 5145-00-71	HWY: STH 19	COUNTY: DANE COUNTY	CROSS SECTIONS: ##########################	SHEET 134	E

FILE NAME : N:\PDS\C3D\51450001\SHEETSPLAN\090201_XS.DWG
LAYOUT NAME - 090287-xs
PLOT DATE : 6/6/2018 5:12 PM
PLOT BY : RACH, JEREMY PAUL
PLOT NAME :
PLOT SCALE : 1 IN:20 FT HORZ. / 1 IN:20 FT VERT.
WISDOT/CADDS SHEET 49

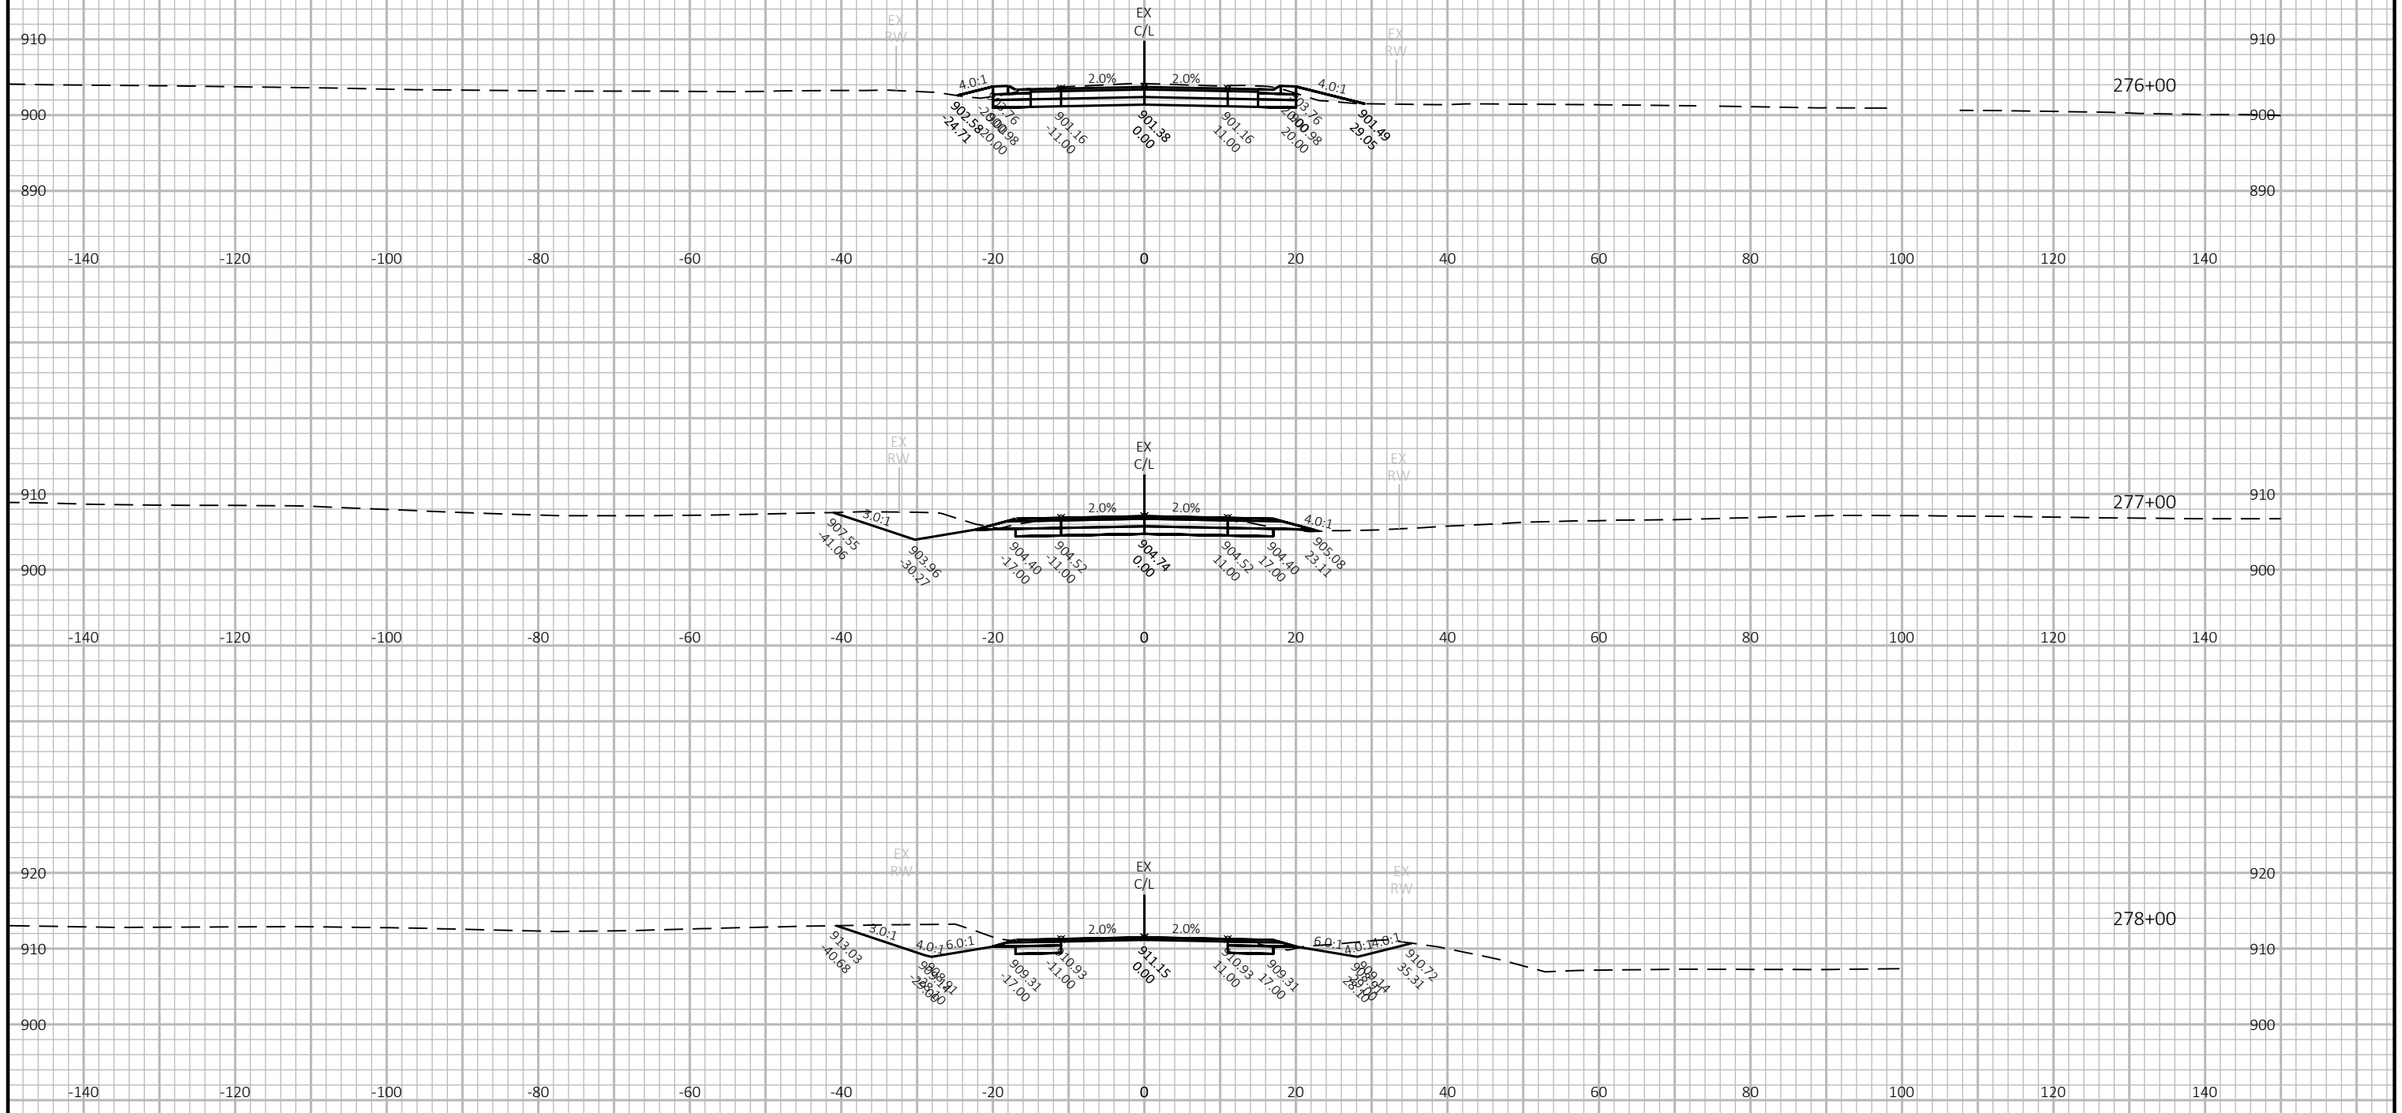

9

9

PROJECT NO: 5145-00-71	HWY: STH 19	COUNTY: DANE COUNTY	CROSS SECTIONS: ##########################	SHEET 135	E

FILE NAME : N:\PDS\C3D\51450001\SHEETSPLAN\090201_XS.DWG
LAYOUT NAME - 090288-xs

PLOT DATE : 6/6/2018 5:13 PM PLOT BY : RACH, JEREMY PAUL PLOT NAME : PLOT SCALE : 1 IN:20 FT HORZ. / 1 IN:20 FT VERT.

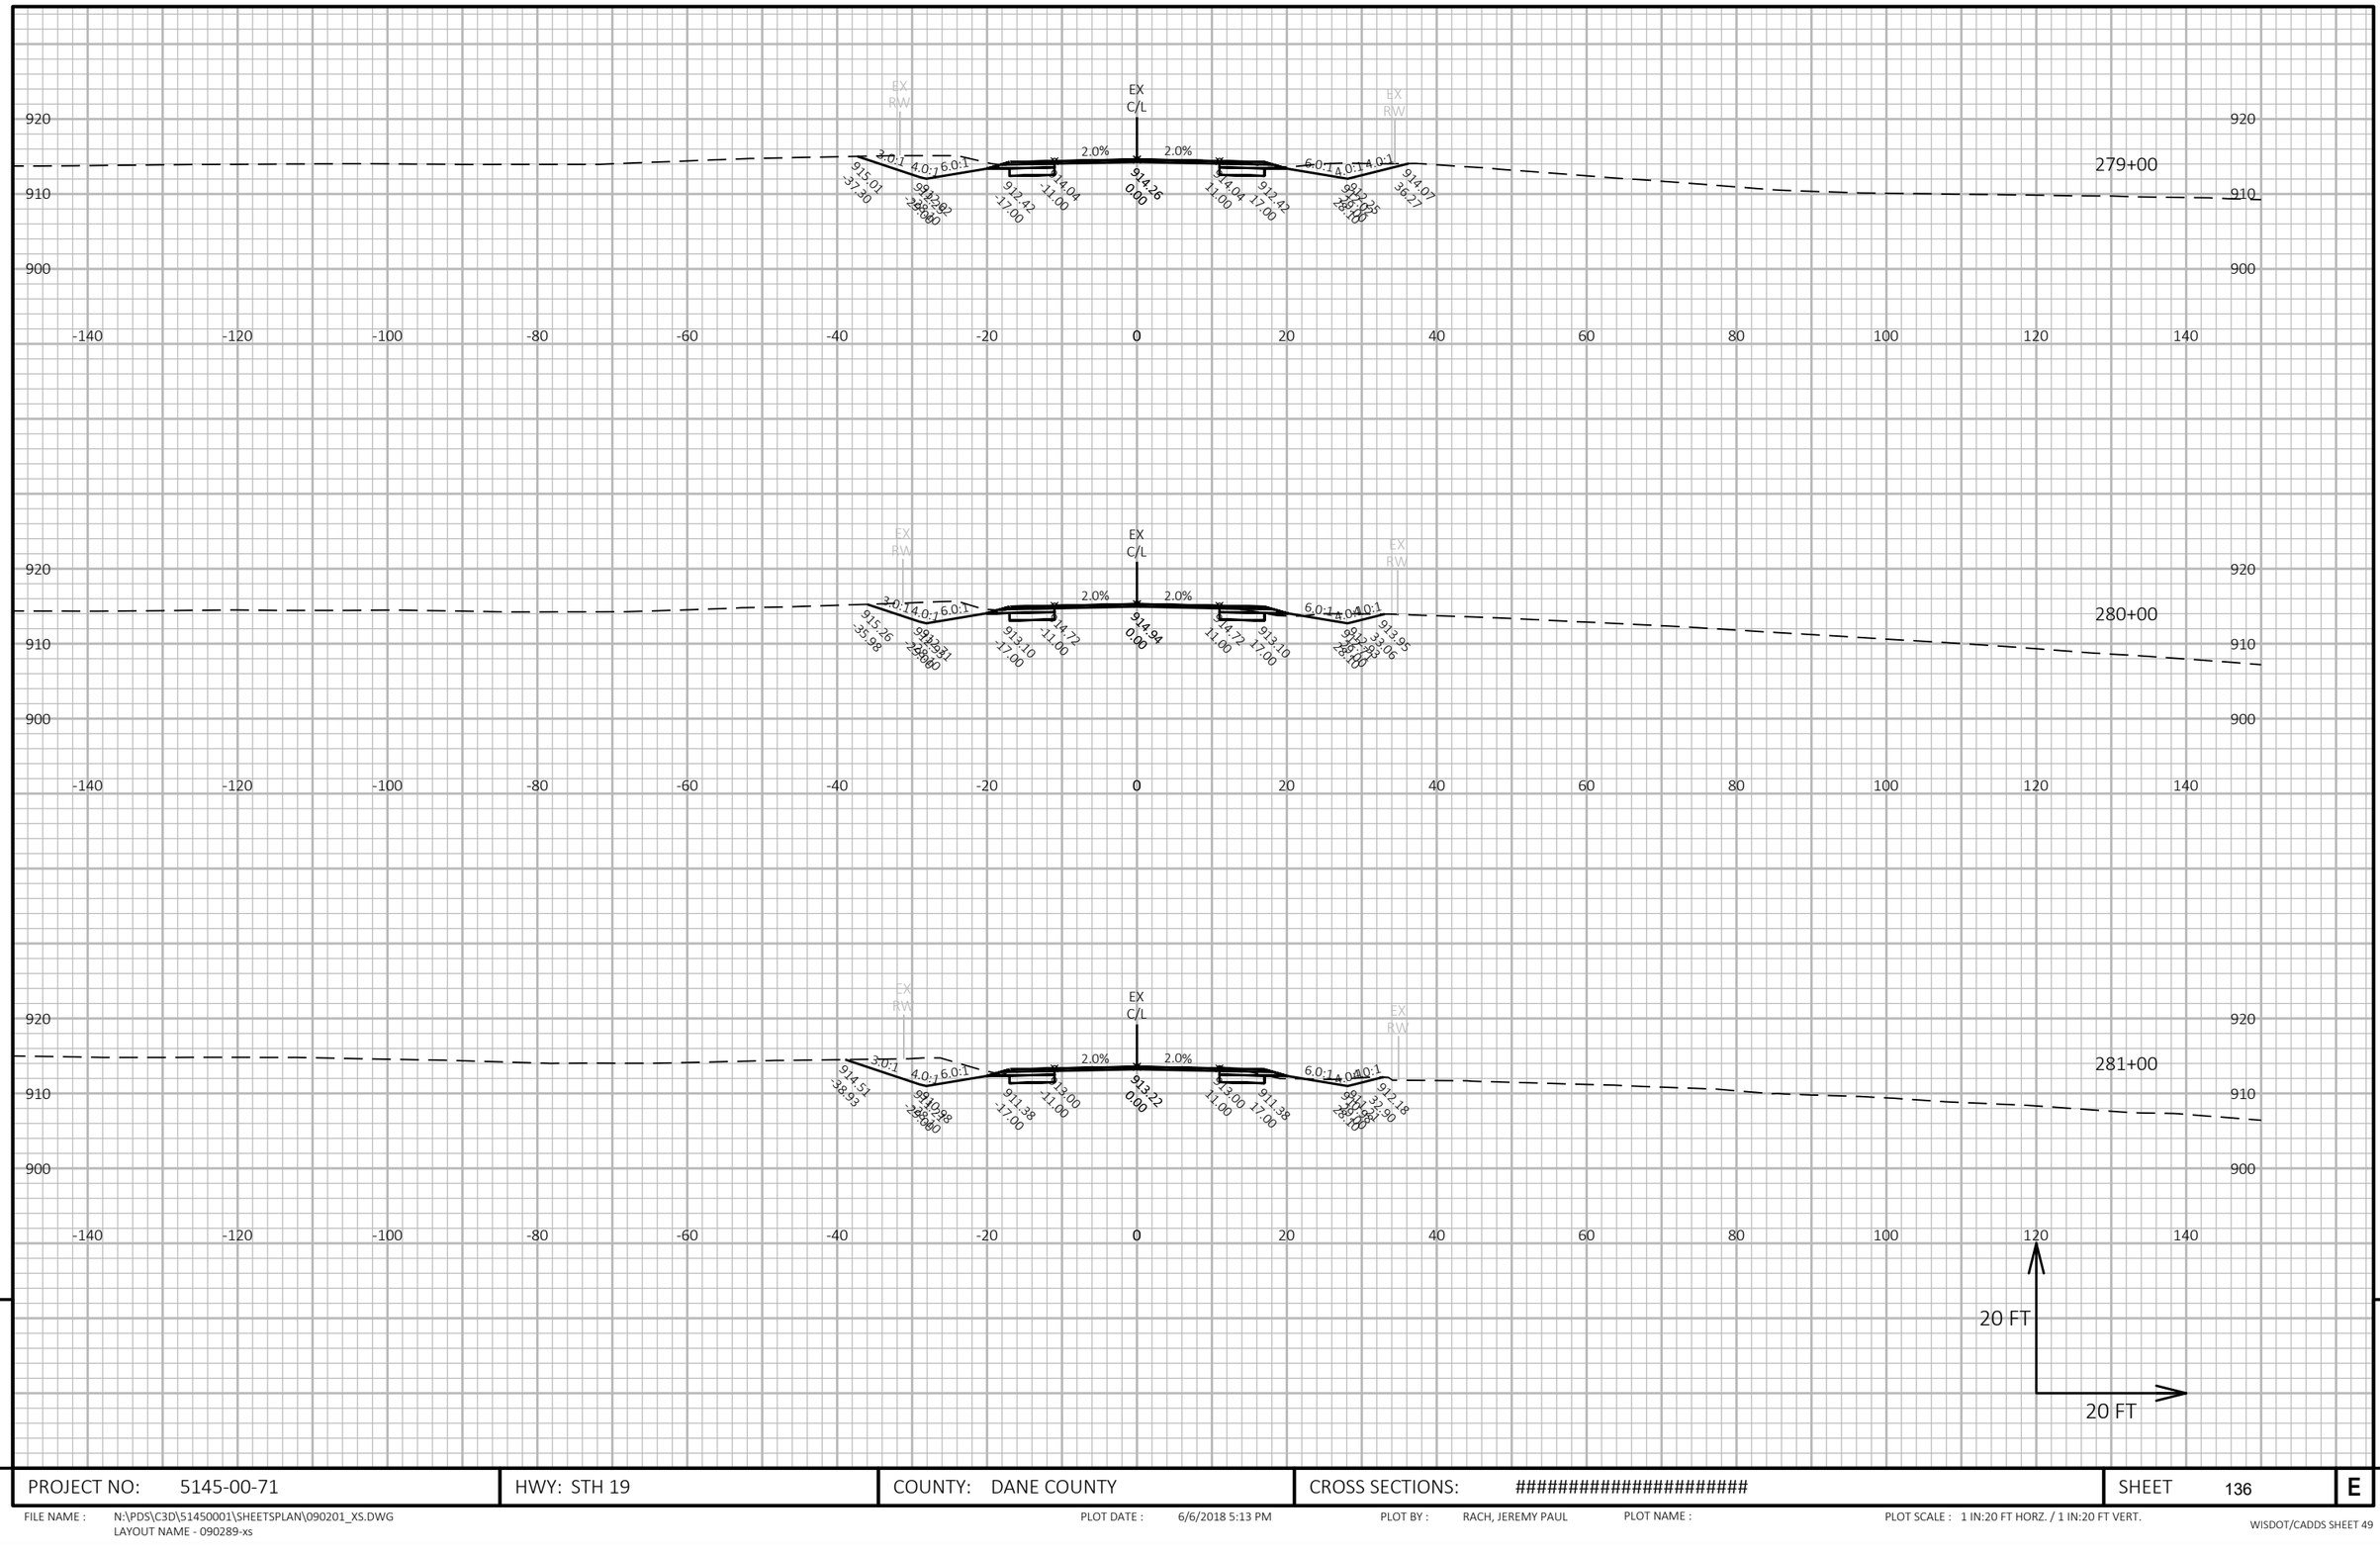

9

9

PROJECT NO: 5145-00-71	HWY: STH 19	COUNTY: DANE COUNTY	CROSS SECTIONS: ##########################	SHEET 136	E

FILE NAME : N:\PDS\C3D\51450001\SHEETSPLAN\090201_XS.DWG
LAYOUT NAME - 090289-xs

PLOT DATE : 6/6/2018 5:13 PM

PLOT BY : RACH, JEREMY PAUL

PLOT NAME :

PLOT SCALE : 1 IN:20 FT HORZ. / 1 IN:20 FT VERT.

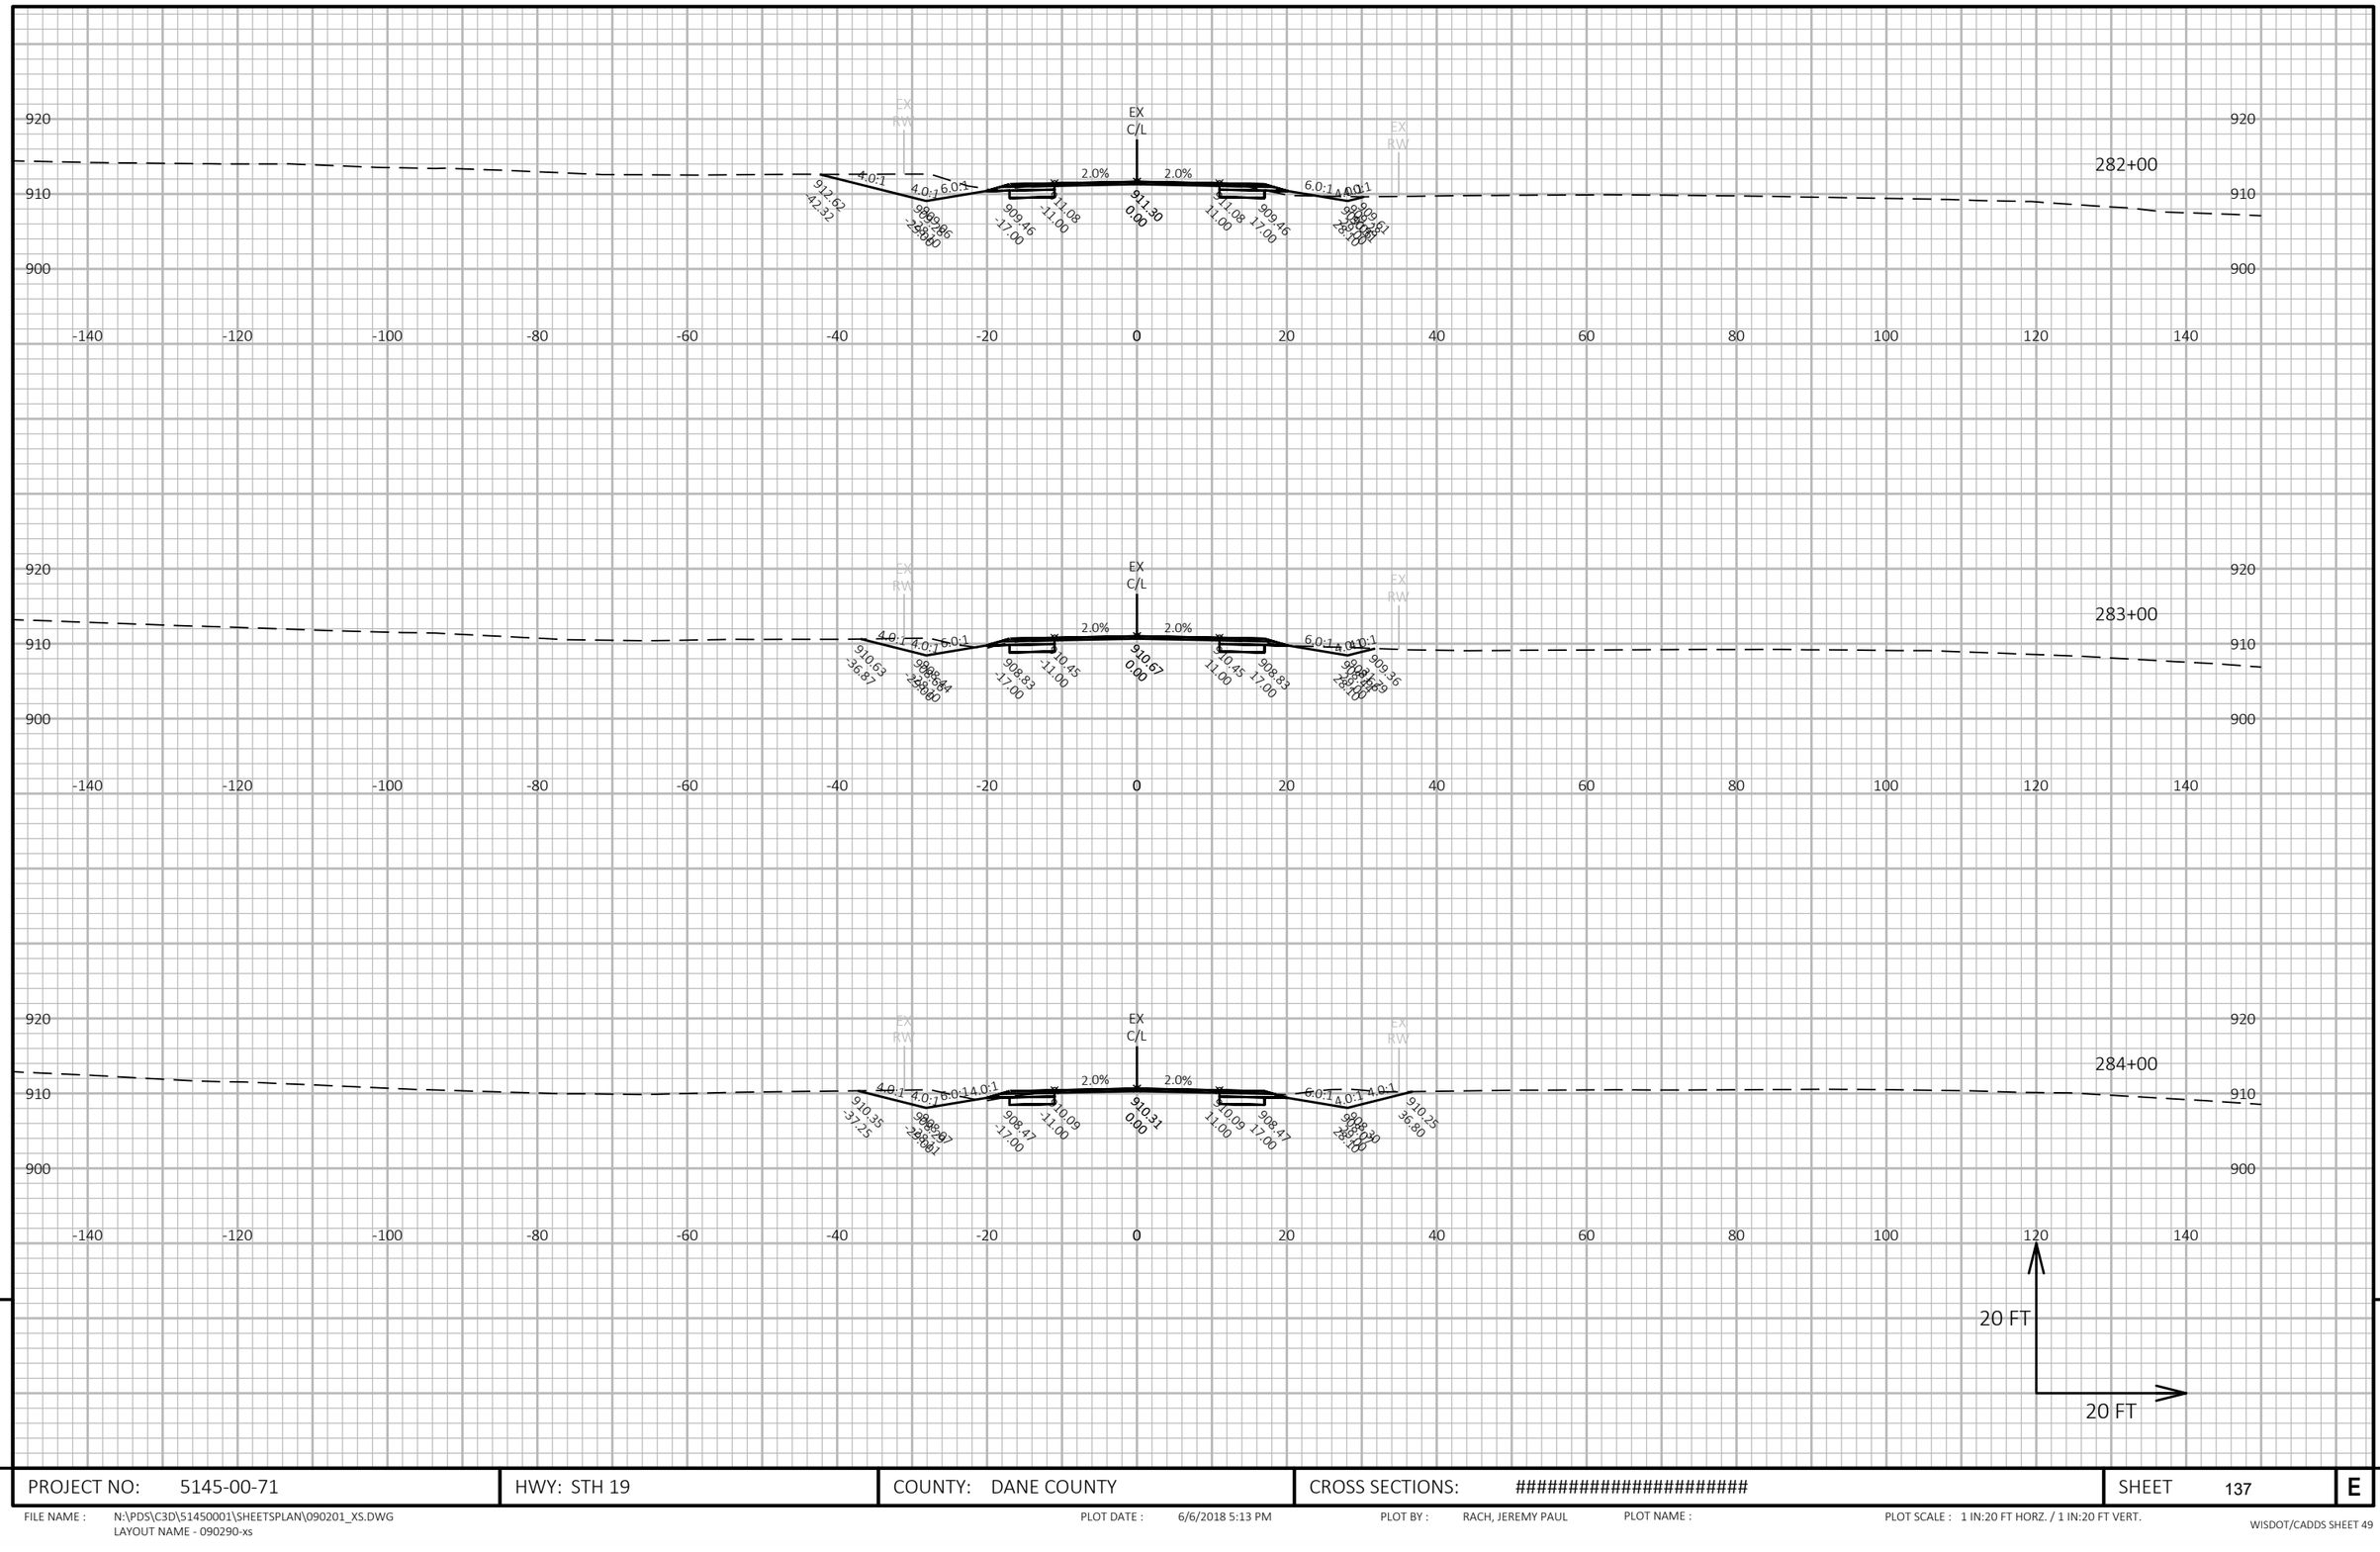

9

9

PROJECT NO: 5145-00-71	HWY: STH 19	COUNTY: DANE COUNTY	CROSS SECTIONS: ##########################	SHEET 137	E

FILE NAME : N:\PDS\C3D\51450001\SHEETSPLAN\090201_XS.DWG
LAYOUT NAME - 090290-xs

PLOT DATE : 6/6/2018 5:13 PM PLOT BY : RACH, JEREMY PAUL PLOT NAME : PLOT SCALE : 1 IN:20 FT HORZ. / 1 IN:20 FT VERT.

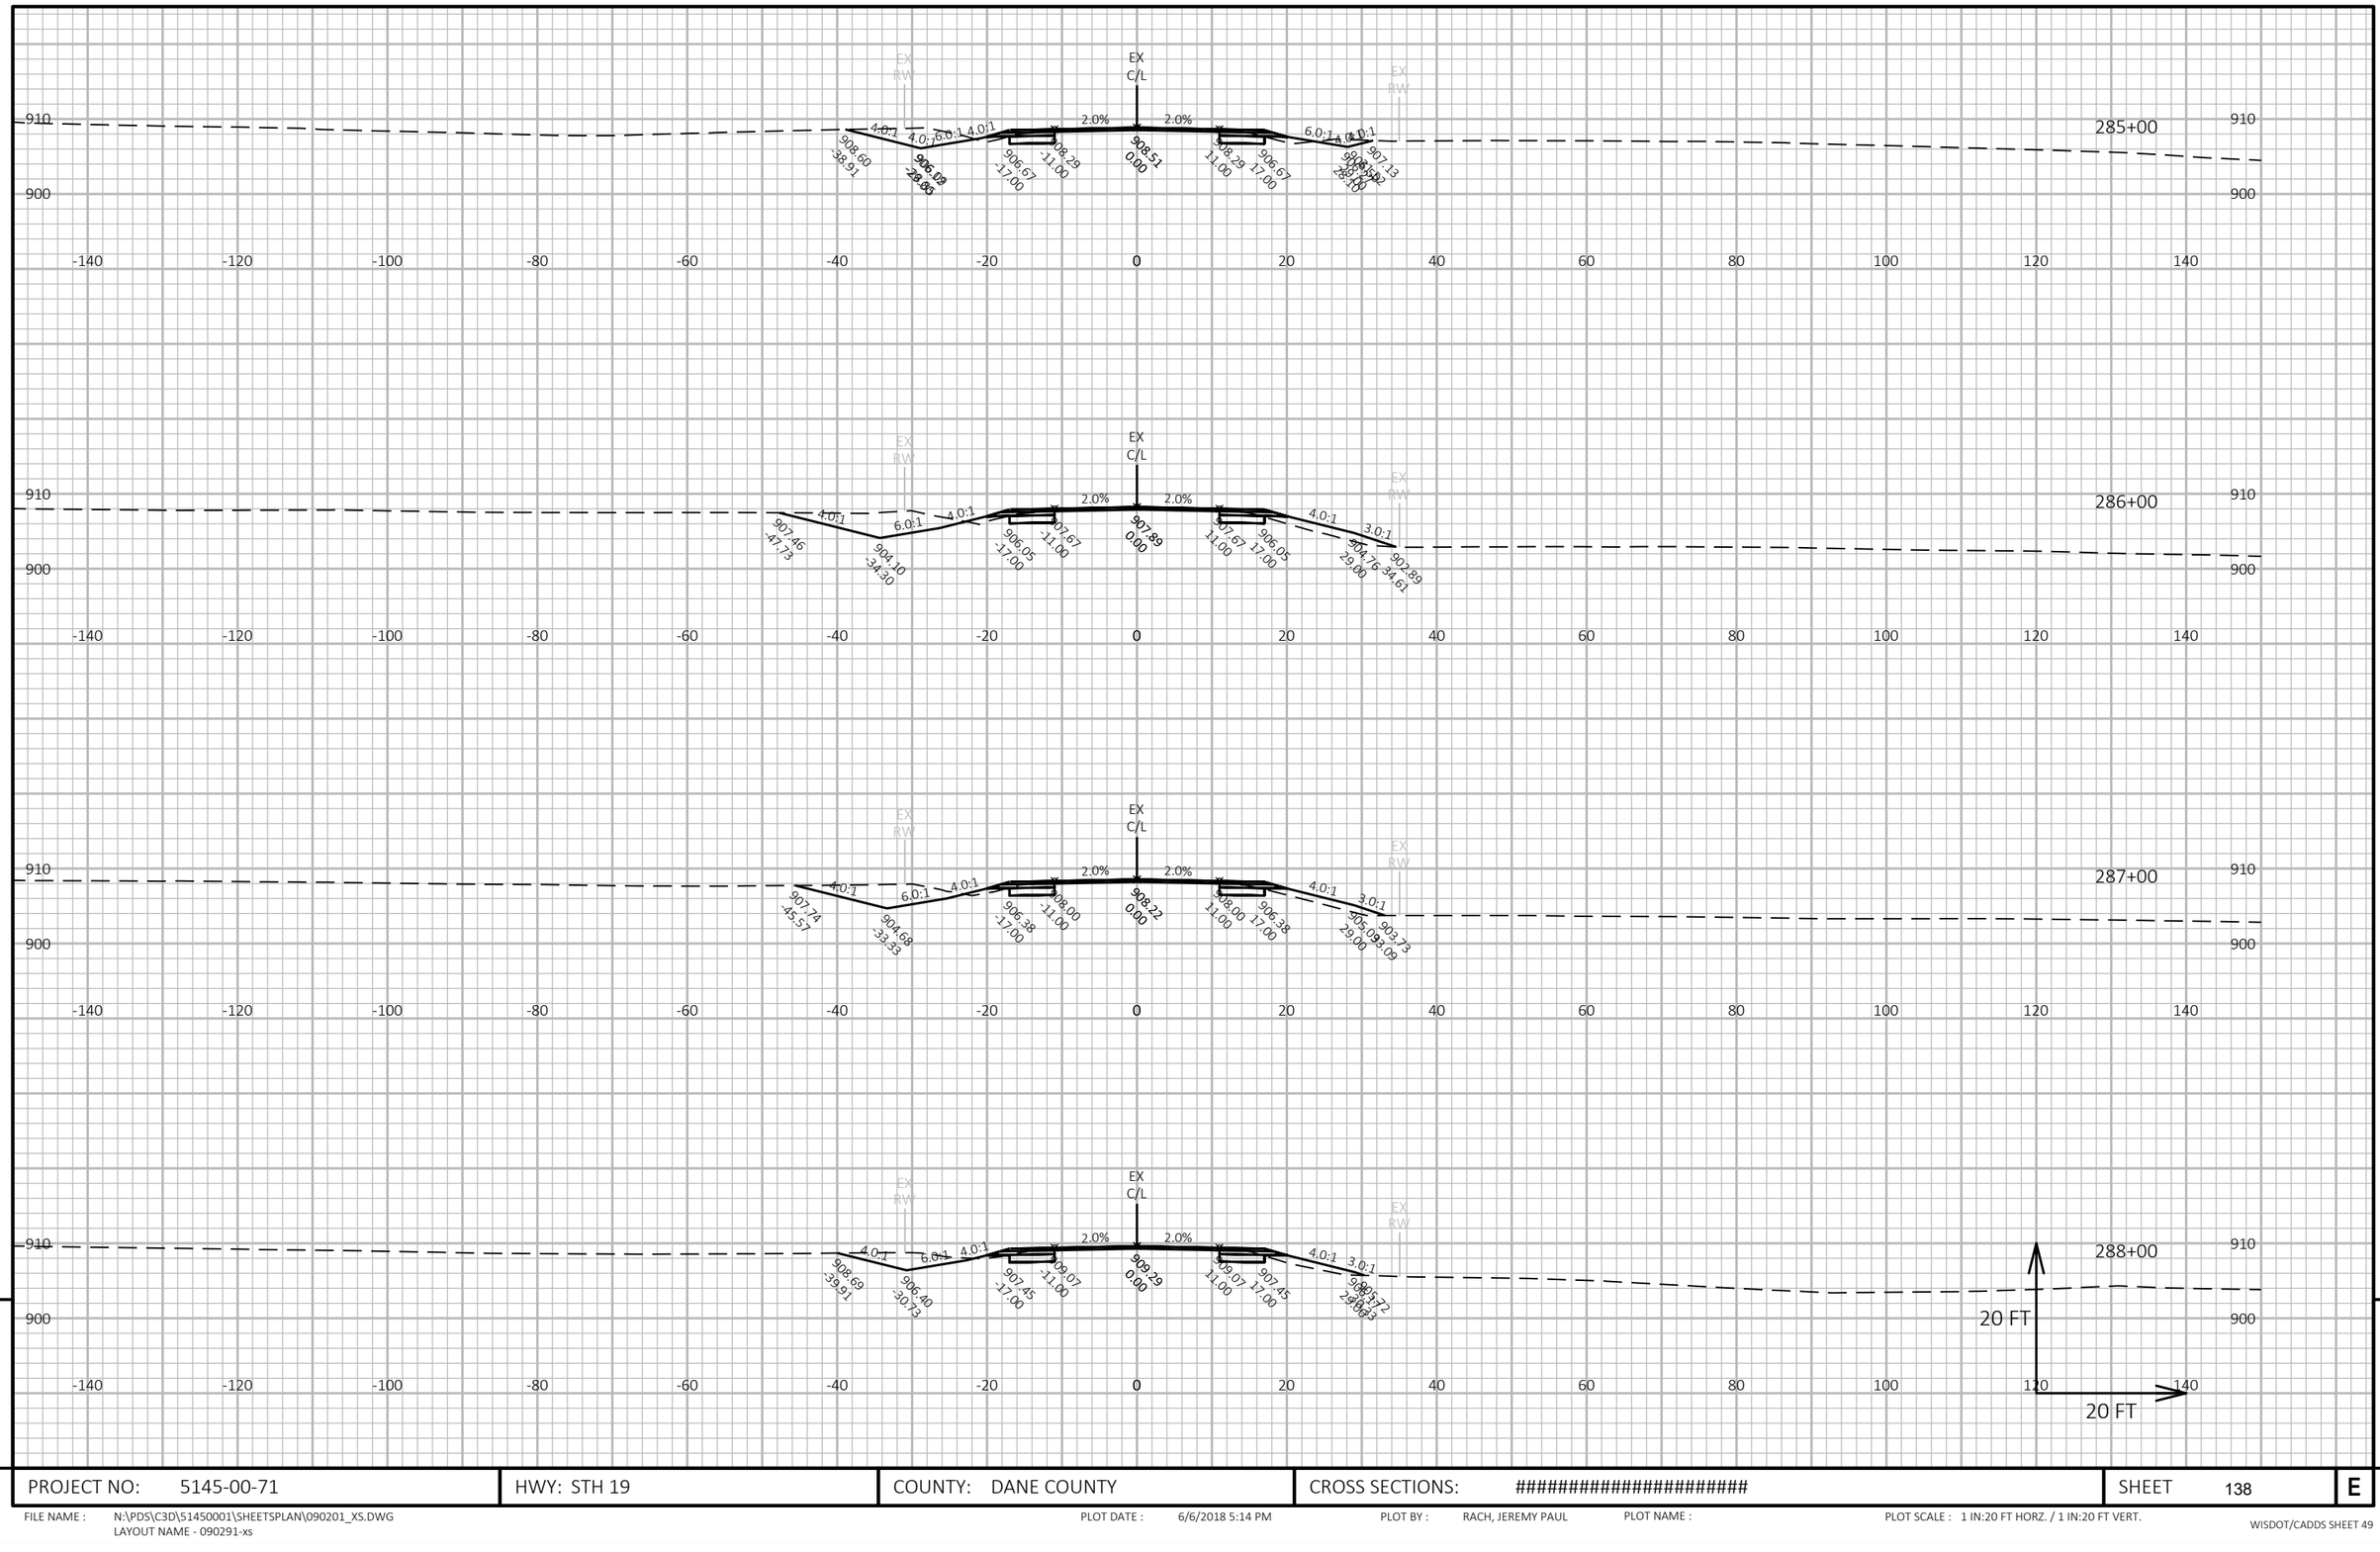

PROJECT NO: 5145-00-71	HWY: STH 19	COUNTY: DANE COUNTY	CROSS SECTIONS: ##########################	SHEET 138	E

FILE NAME : N:\PDS\C3D\51450001\SHEETSPLAN\090201_XS.DWG
LAYOUT NAME - 090291-xs

PLOT DATE : 6/6/2018 5:14 PM PLOT BY : RACH, JEREMY PAUL PLOT NAME : PLOT SCALE : 1 IN:20 FT HORZ. / 1 IN:20 FT VERT.

WISDOT/CADDS SHEET 49

9

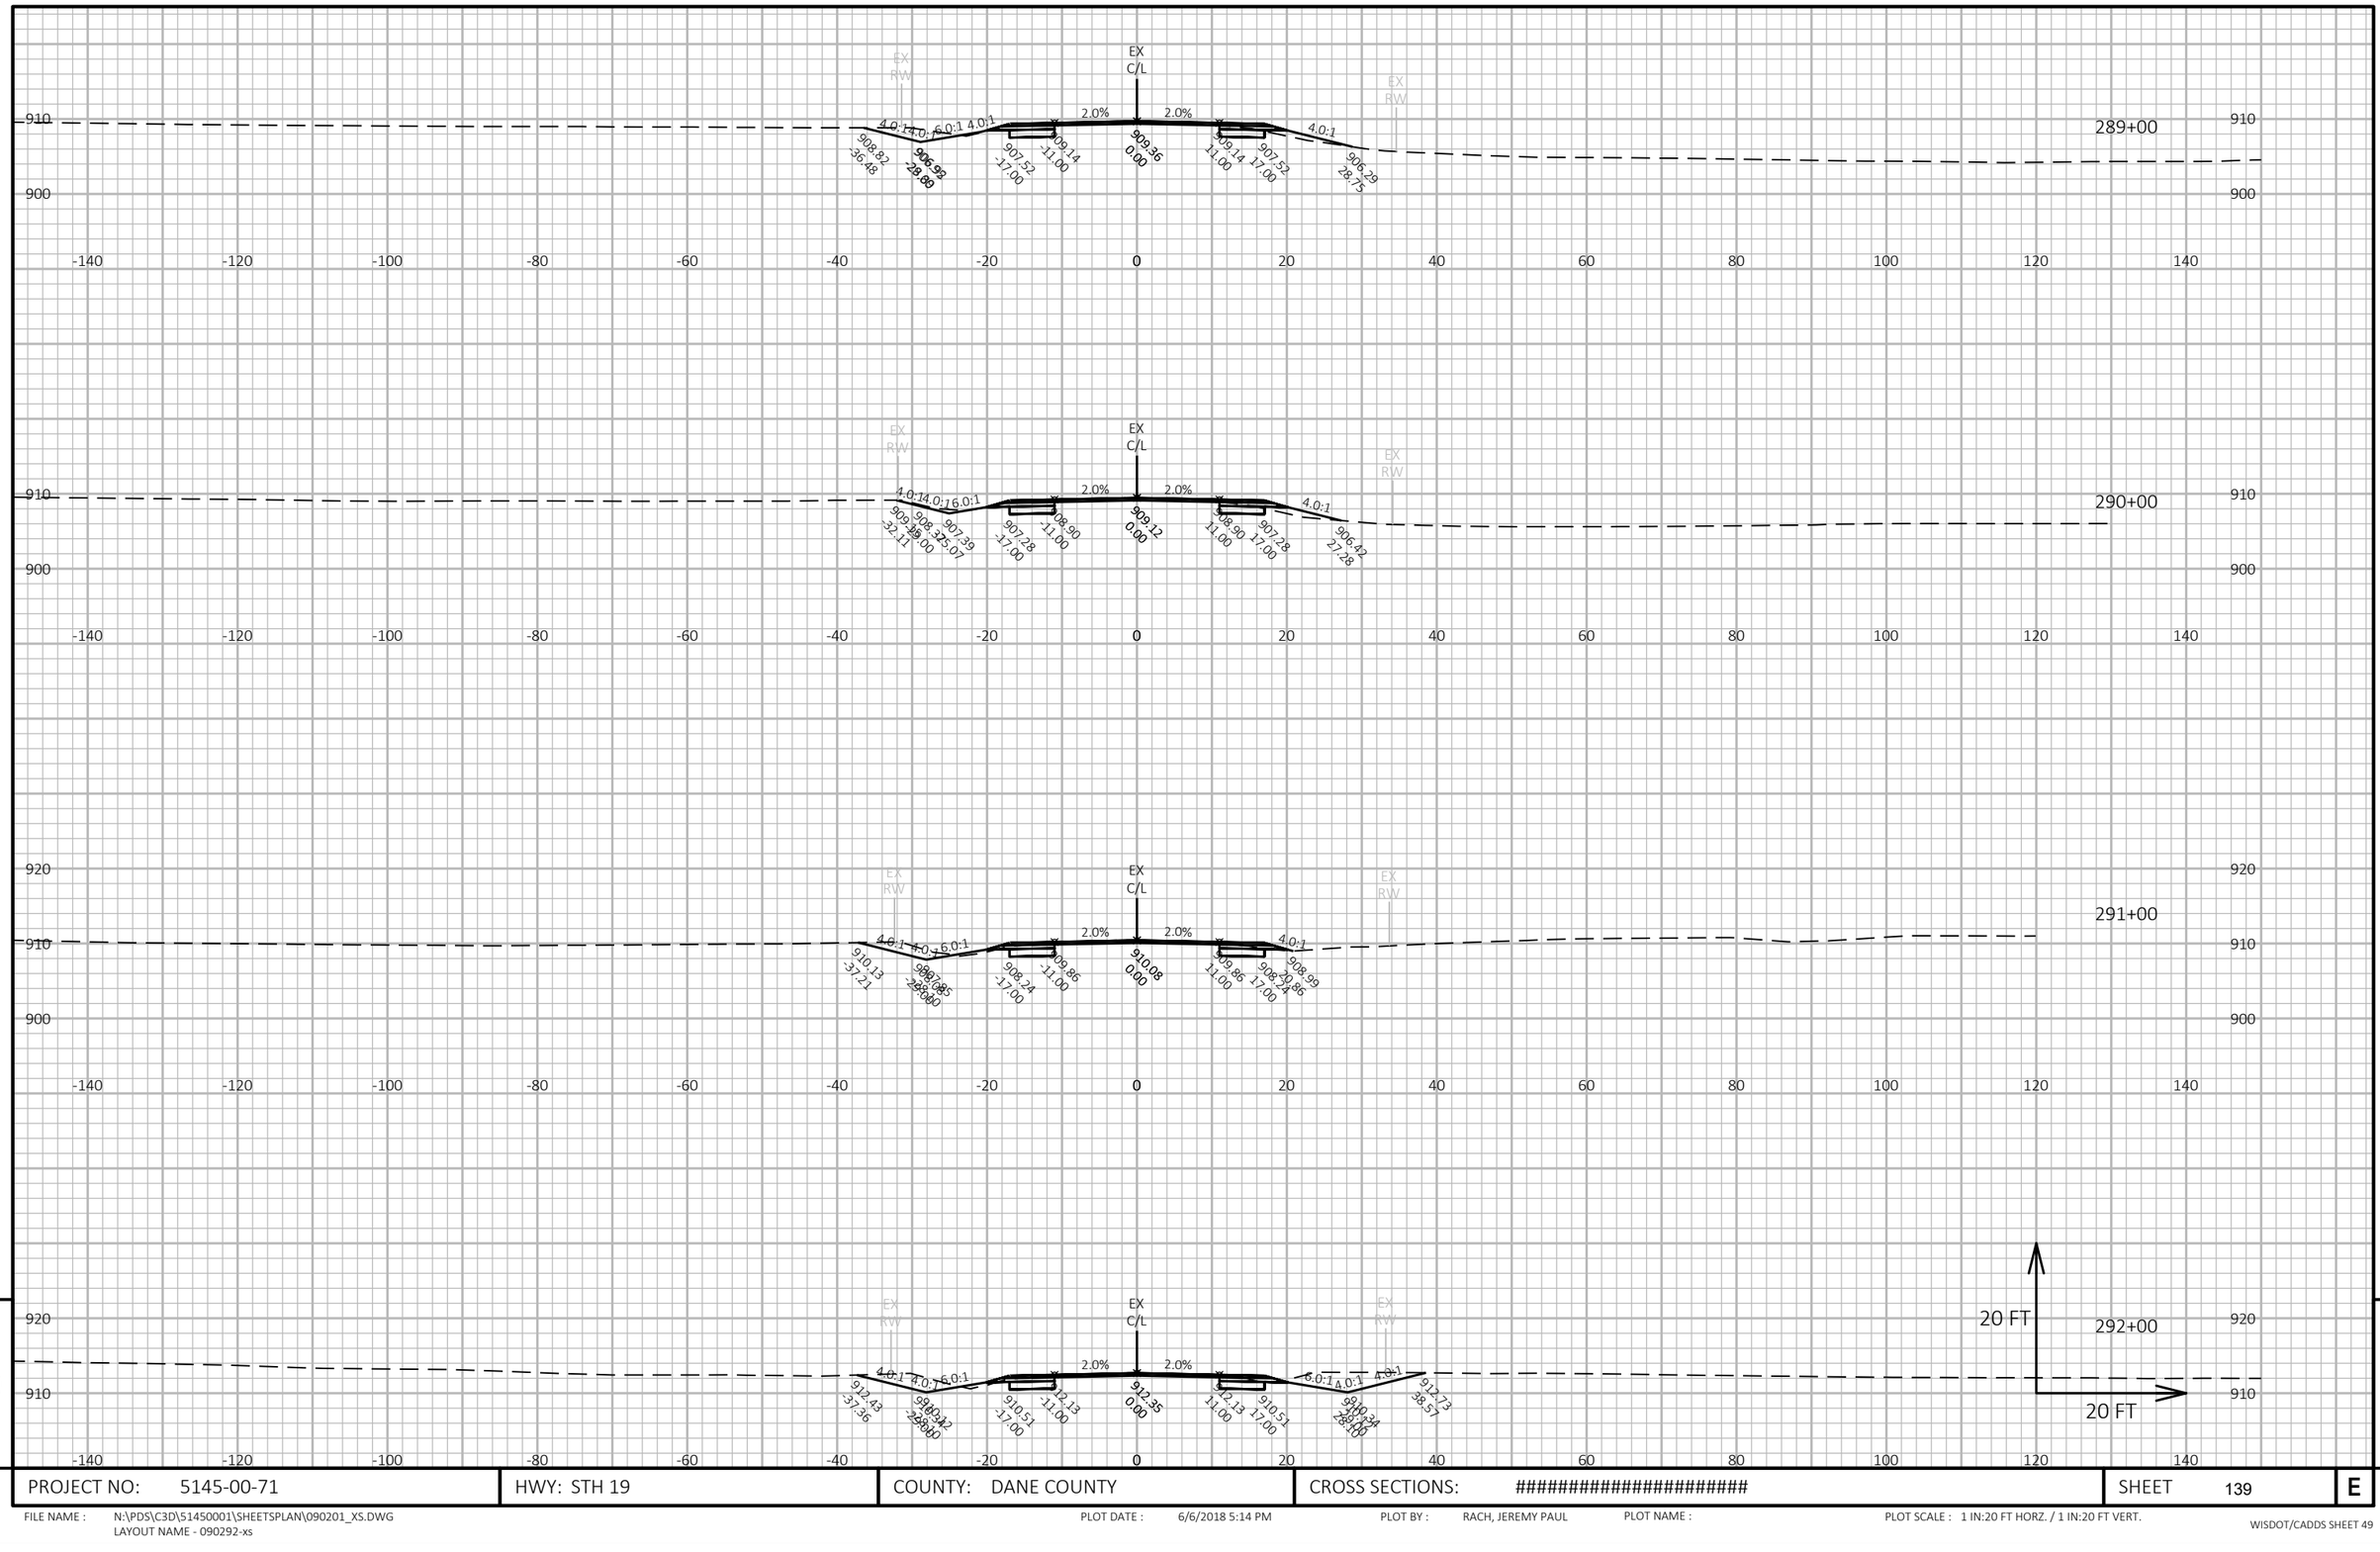

9

PROJECT NO: 5145-00-71	HWY: STH 19	COUNTY: DANE COUNTY	CROSS SECTIONS: ##########################	SHEET 139	E

9

FILE NAME : N:\PDS\C3D\51450001\SHEETSPLAN\090201_XS.DWG
LAYOUT NAME - 090292-xs

PLOT DATE : 6/6/2018 5:14 PM

PLOT BY : RACH, JEREMY PAUL

PLOT NAME :

PLOT SCALE : 1 IN:20 FT HORZ. / 1 IN:20 FT VERT.

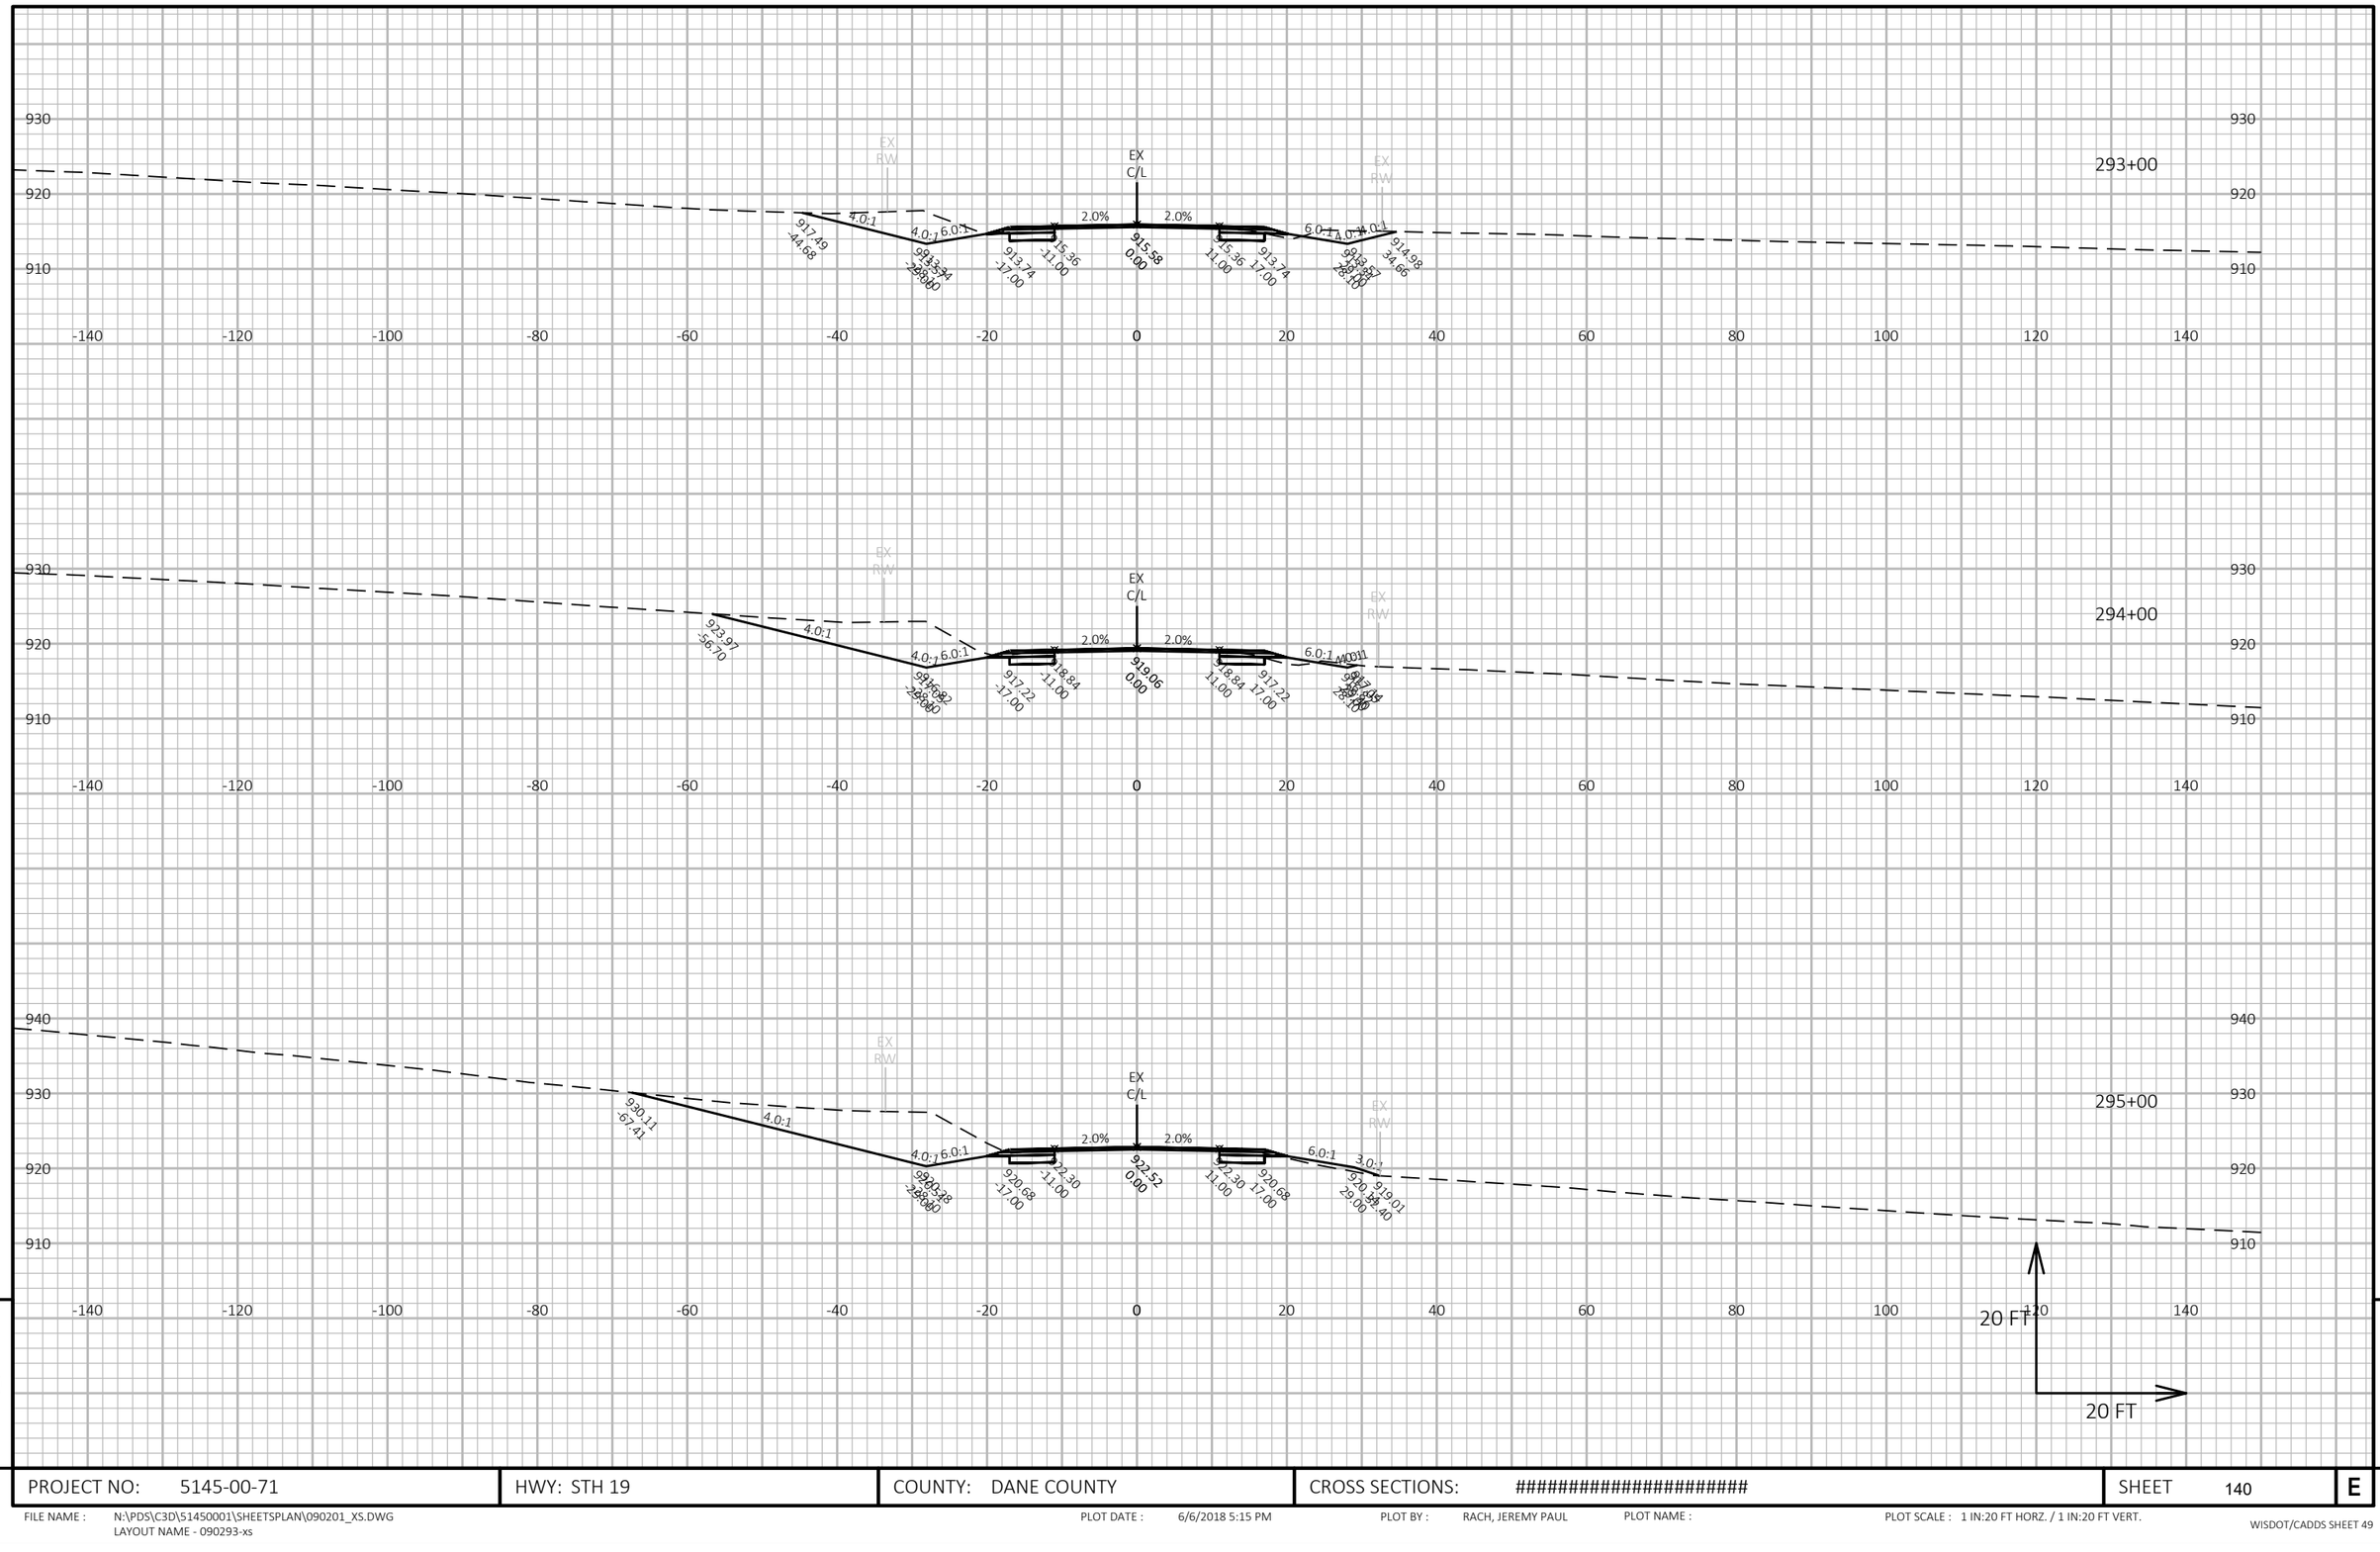

9

9

PROJECT NO: 5145-00-71	HWY: STH 19	COUNTY: DANE COUNTY	CROSS SECTIONS: ##########################	SHEET 140	E

FILE NAME : N:\PDS\C3D\51450001\SHEETSPLAN\090201_XS.DWG
LAYOUT NAME - 090293-xs

PLOT DATE : 6/6/2018 5:15 PM PLOT BY : RACH, JEREMY PAUL PLOT NAME : PLOT SCALE : 1 IN:20 FT HORZ. / 1 IN:20 FT VERT.

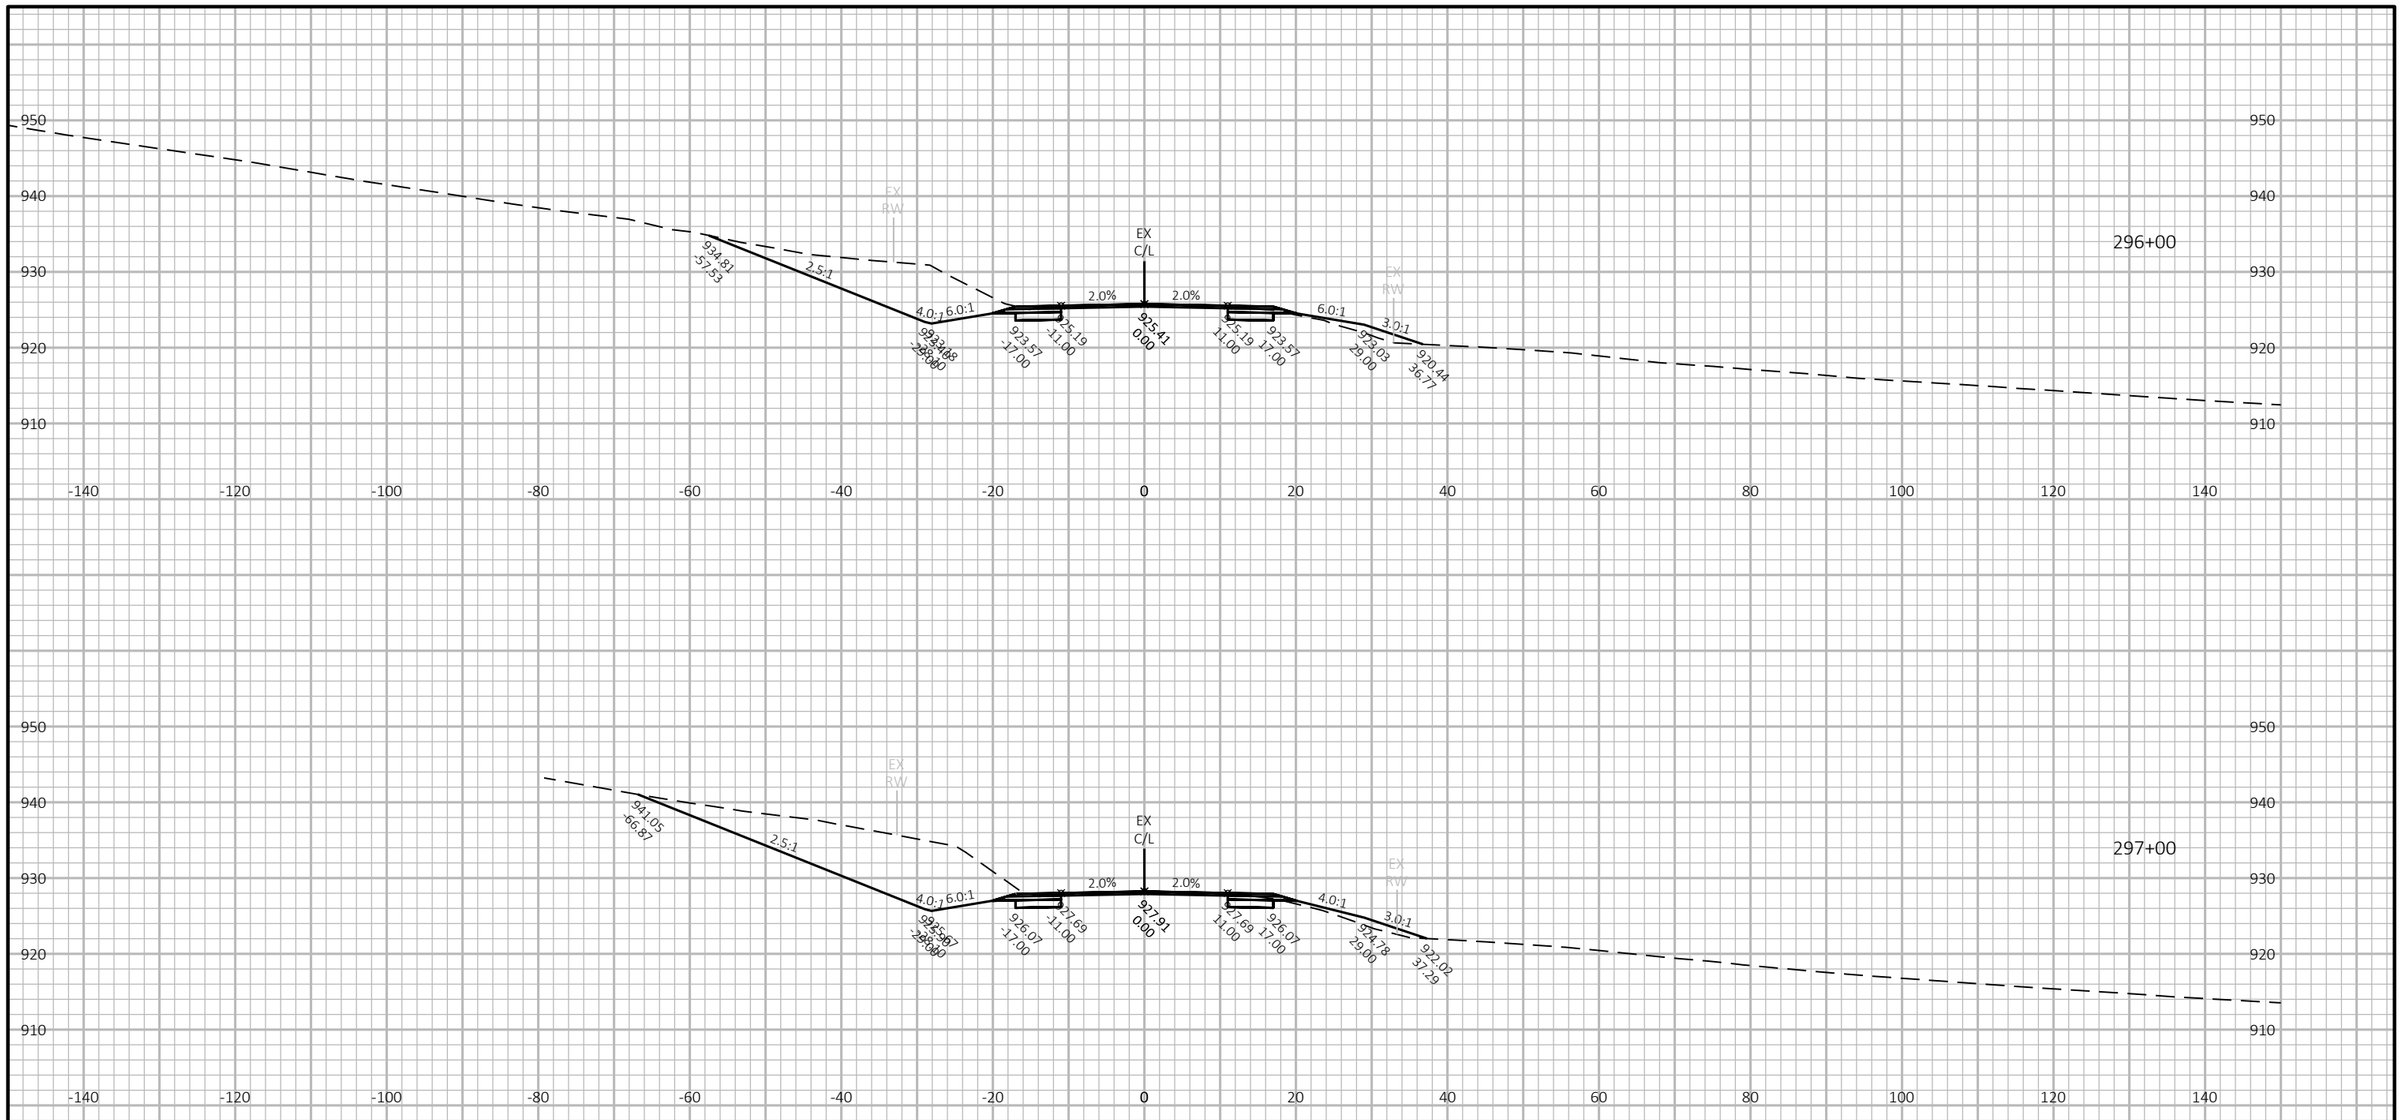

9

9

PROJECT NO: 5145-00-71	HWY: STH 19	COUNTY: DANE COUNTY	CROSS SECTIONS: ##########################	SHEET 141	E

FILE NAME : N:\PDS\C3D\51450001\SHEETSPLAN\090201_XS.DWG
LAYOUT NAME - 090294-xs

PLOT DATE : 6/6/2018 5:15 PM PLOT BY : RACH, JEREMY PAUL PLOT NAME : PLOT SCALE : 1 IN:20 FT HORZ. / 1 IN:20 FT VERT.

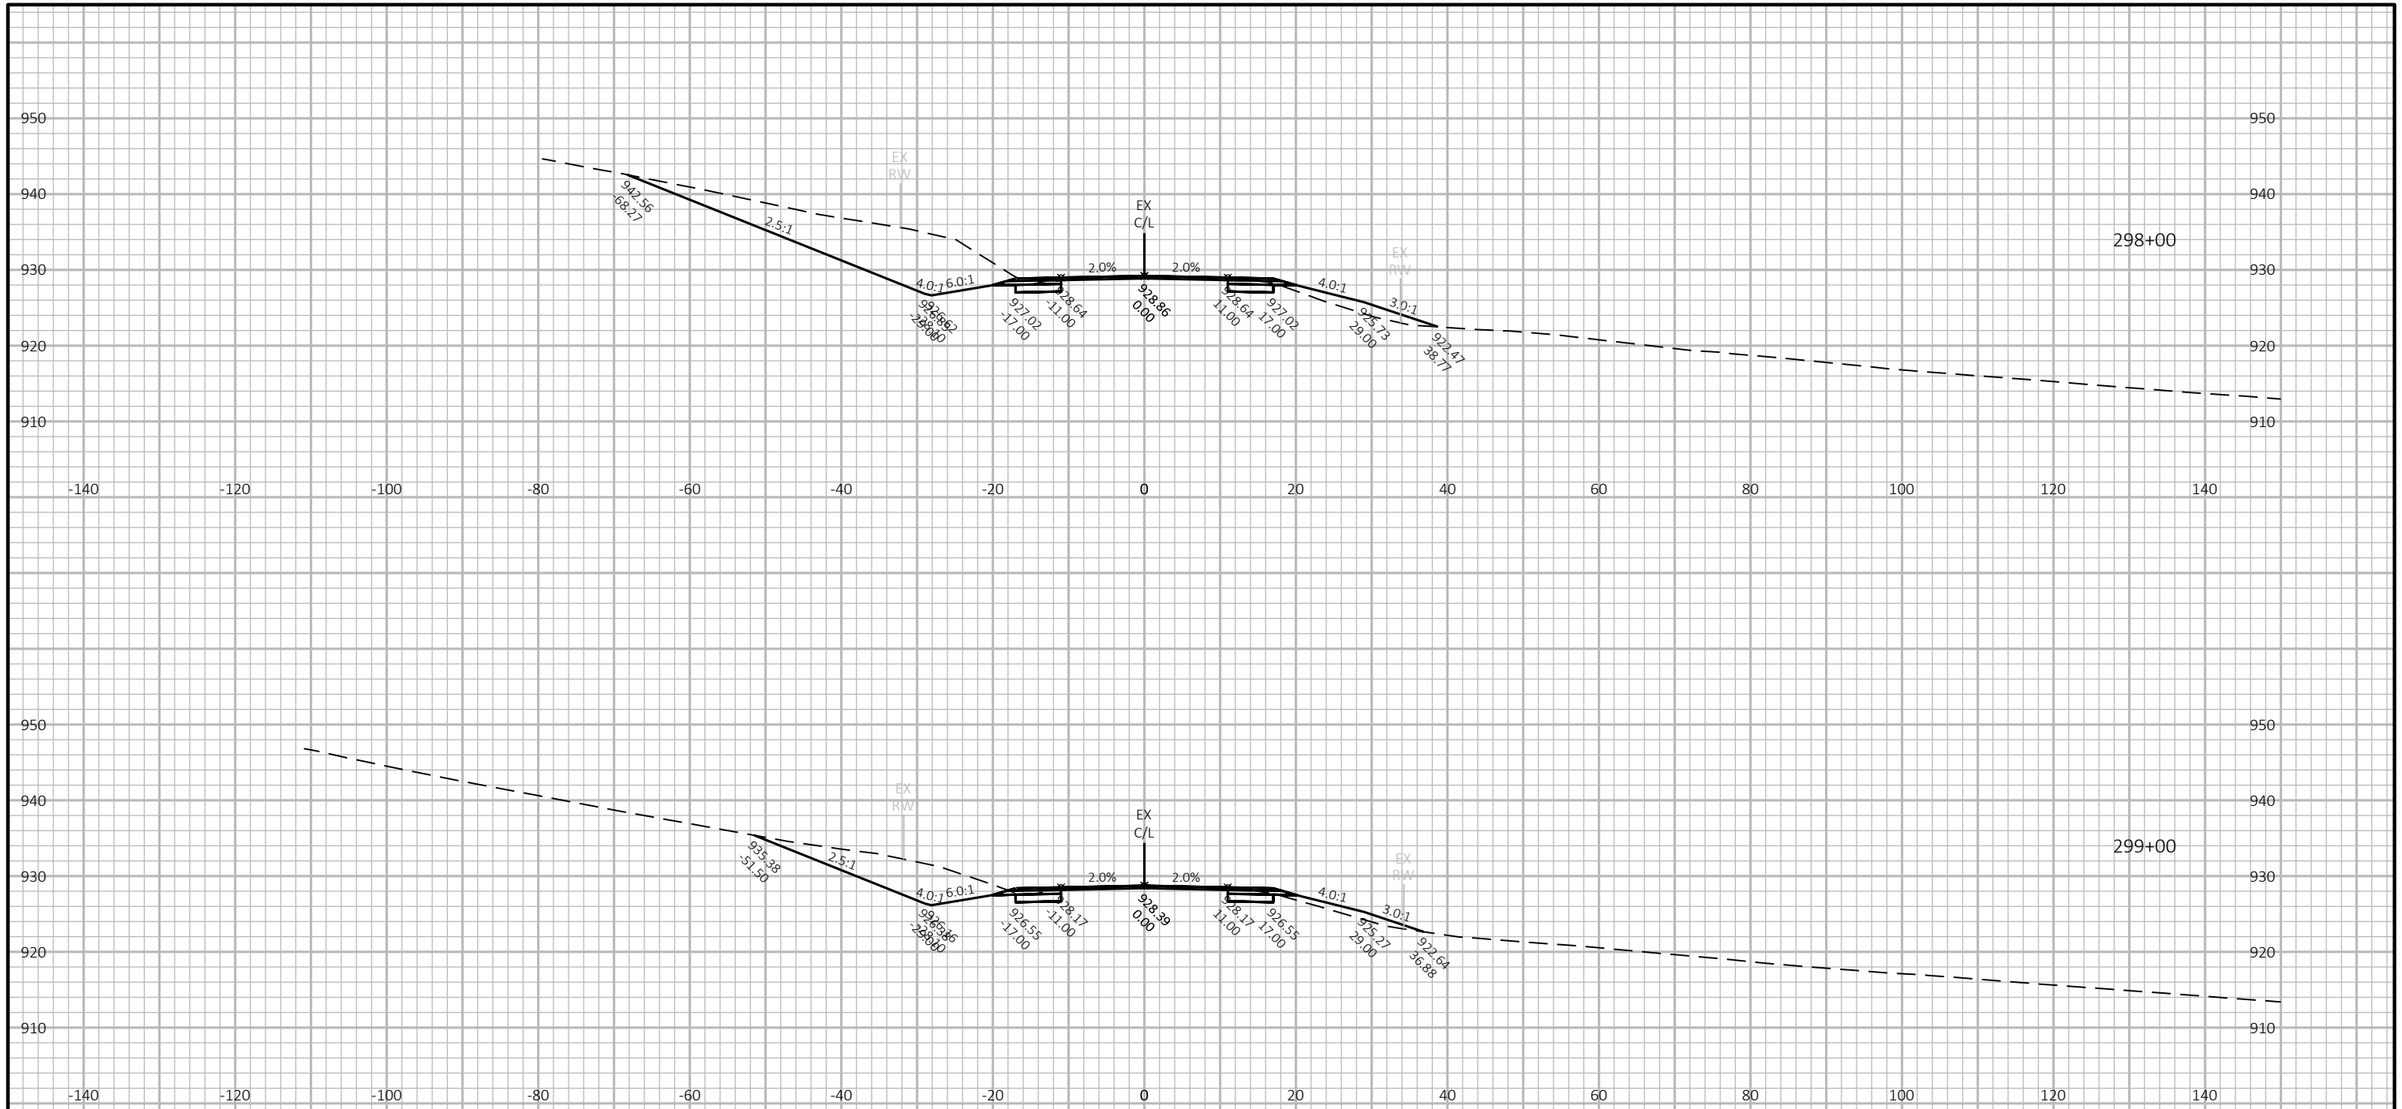

9

9

PROJECT NO: 5145-00-71	HWY: STH 19	COUNTY: DANE COUNTY	CROSS SECTIONS: ##########################	SHEET 142	E

FILE NAME : N:\PDS\C3D\51450001\SHEETSPLAN\090201_XS.DWG
LAYOUT NAME - 090295-xs

PLOT DATE : 6/6/2018 5:16 PM PLOT BY : RACH, JEREMY PAUL PLOT NAME : PLOT SCALE : 1 IN:20 FT HORZ. / 1 IN:20 FT VERT.

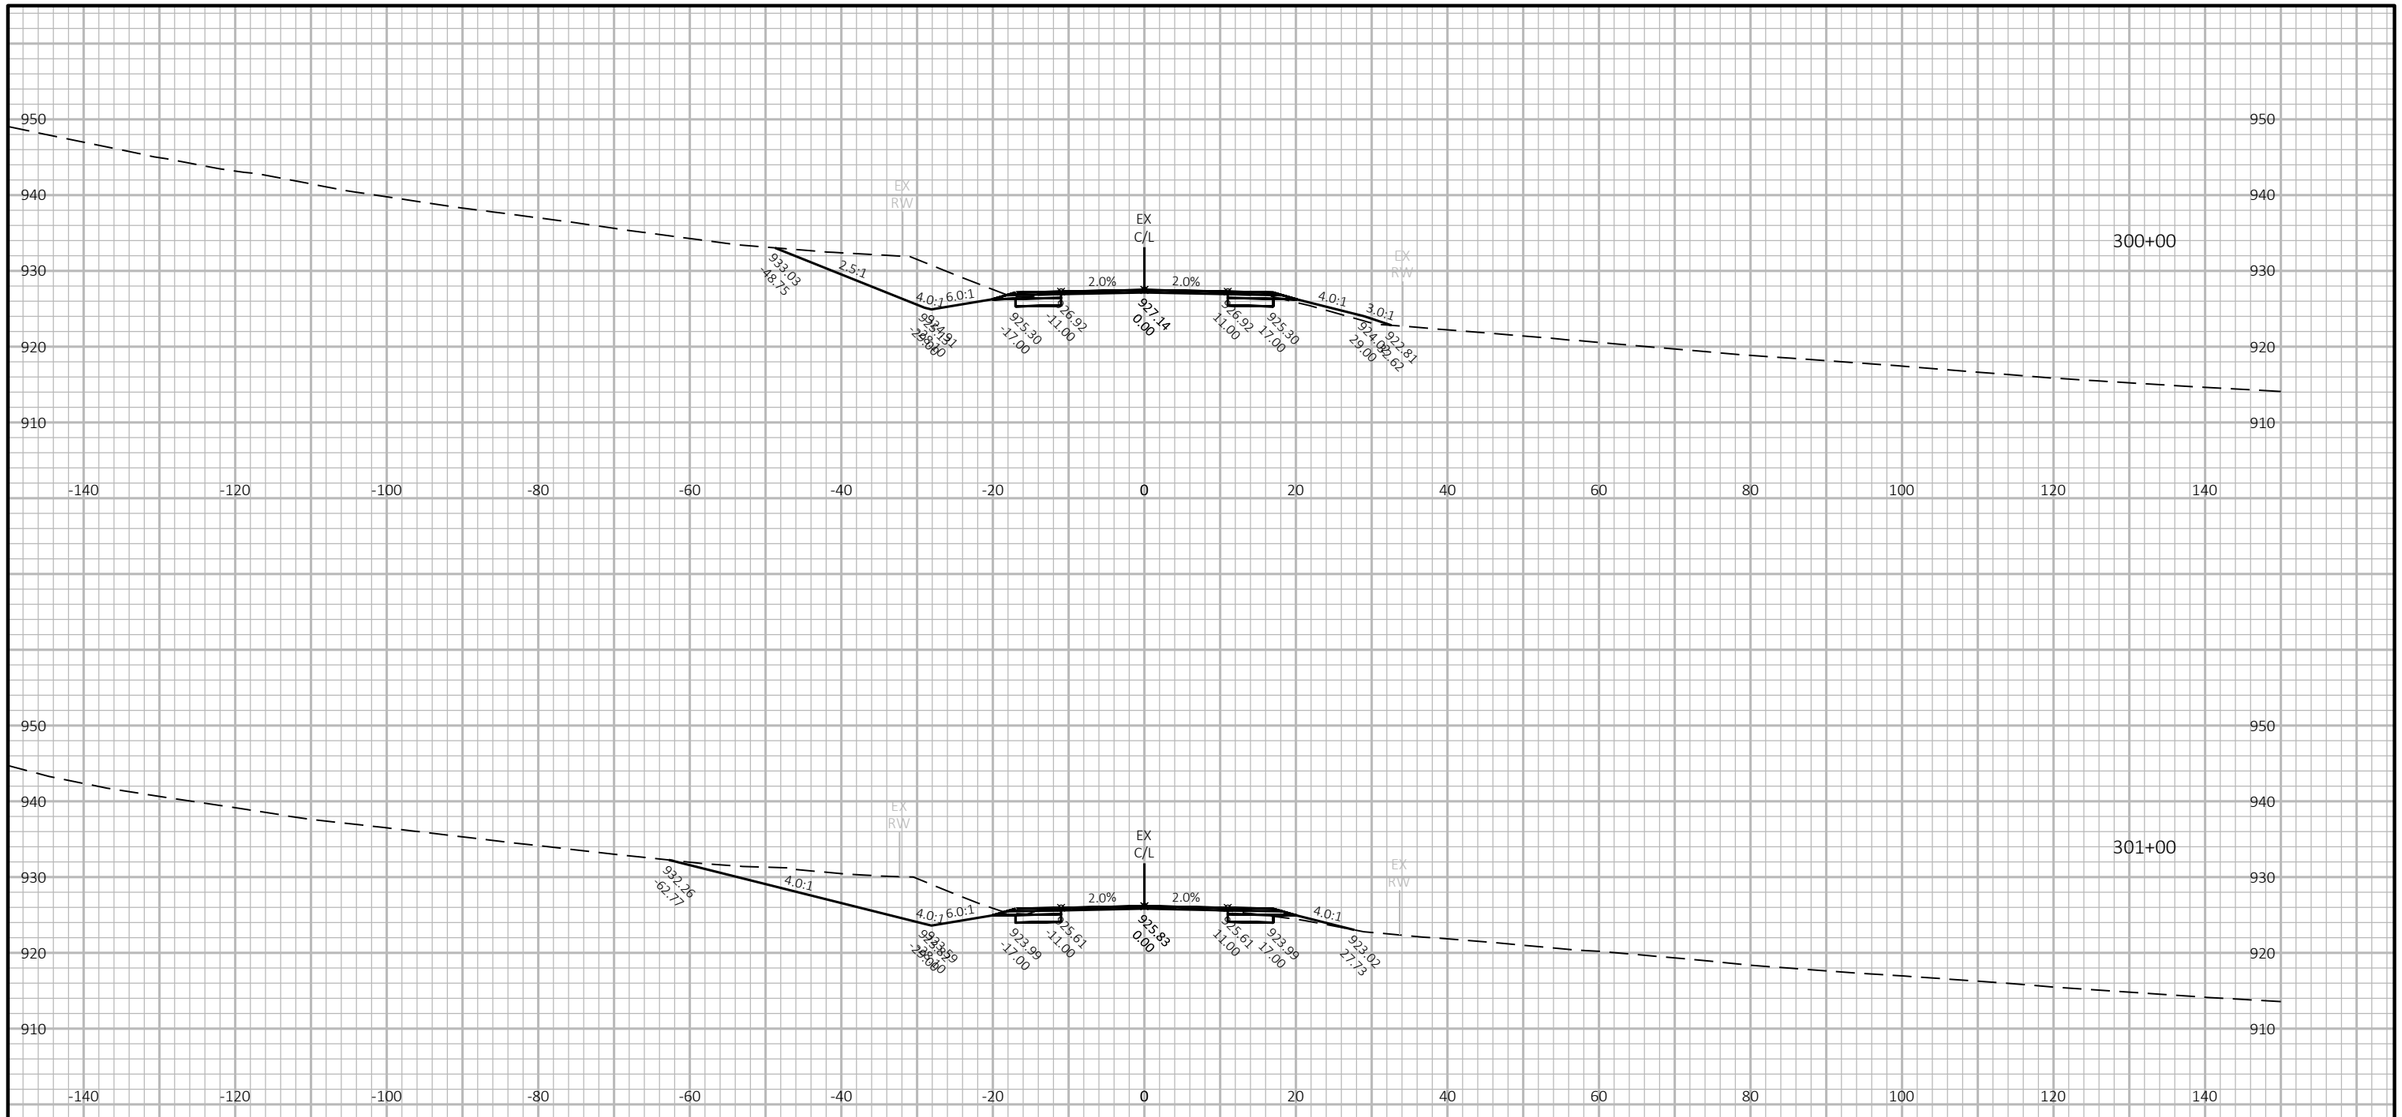

9

9

PROJECT NO: 5145-00-71	HWY: STH 19	COUNTY: DANE COUNTY	CROSS SECTIONS: ##########################	SHEET 143	E

FILE NAME : N:\PDS\C3D\51450001\SHEETSPLAN\090201_XS.DWG
LAYOUT NAME - 090296-xs

PLOT DATE : 6/6/2018 5:16 PM PLOT BY : RACH, JEREMY PAUL PLOT NAME : PLOT SCALE : 1 IN:20 FT HORZ. / 1 IN:20 FT VERT.

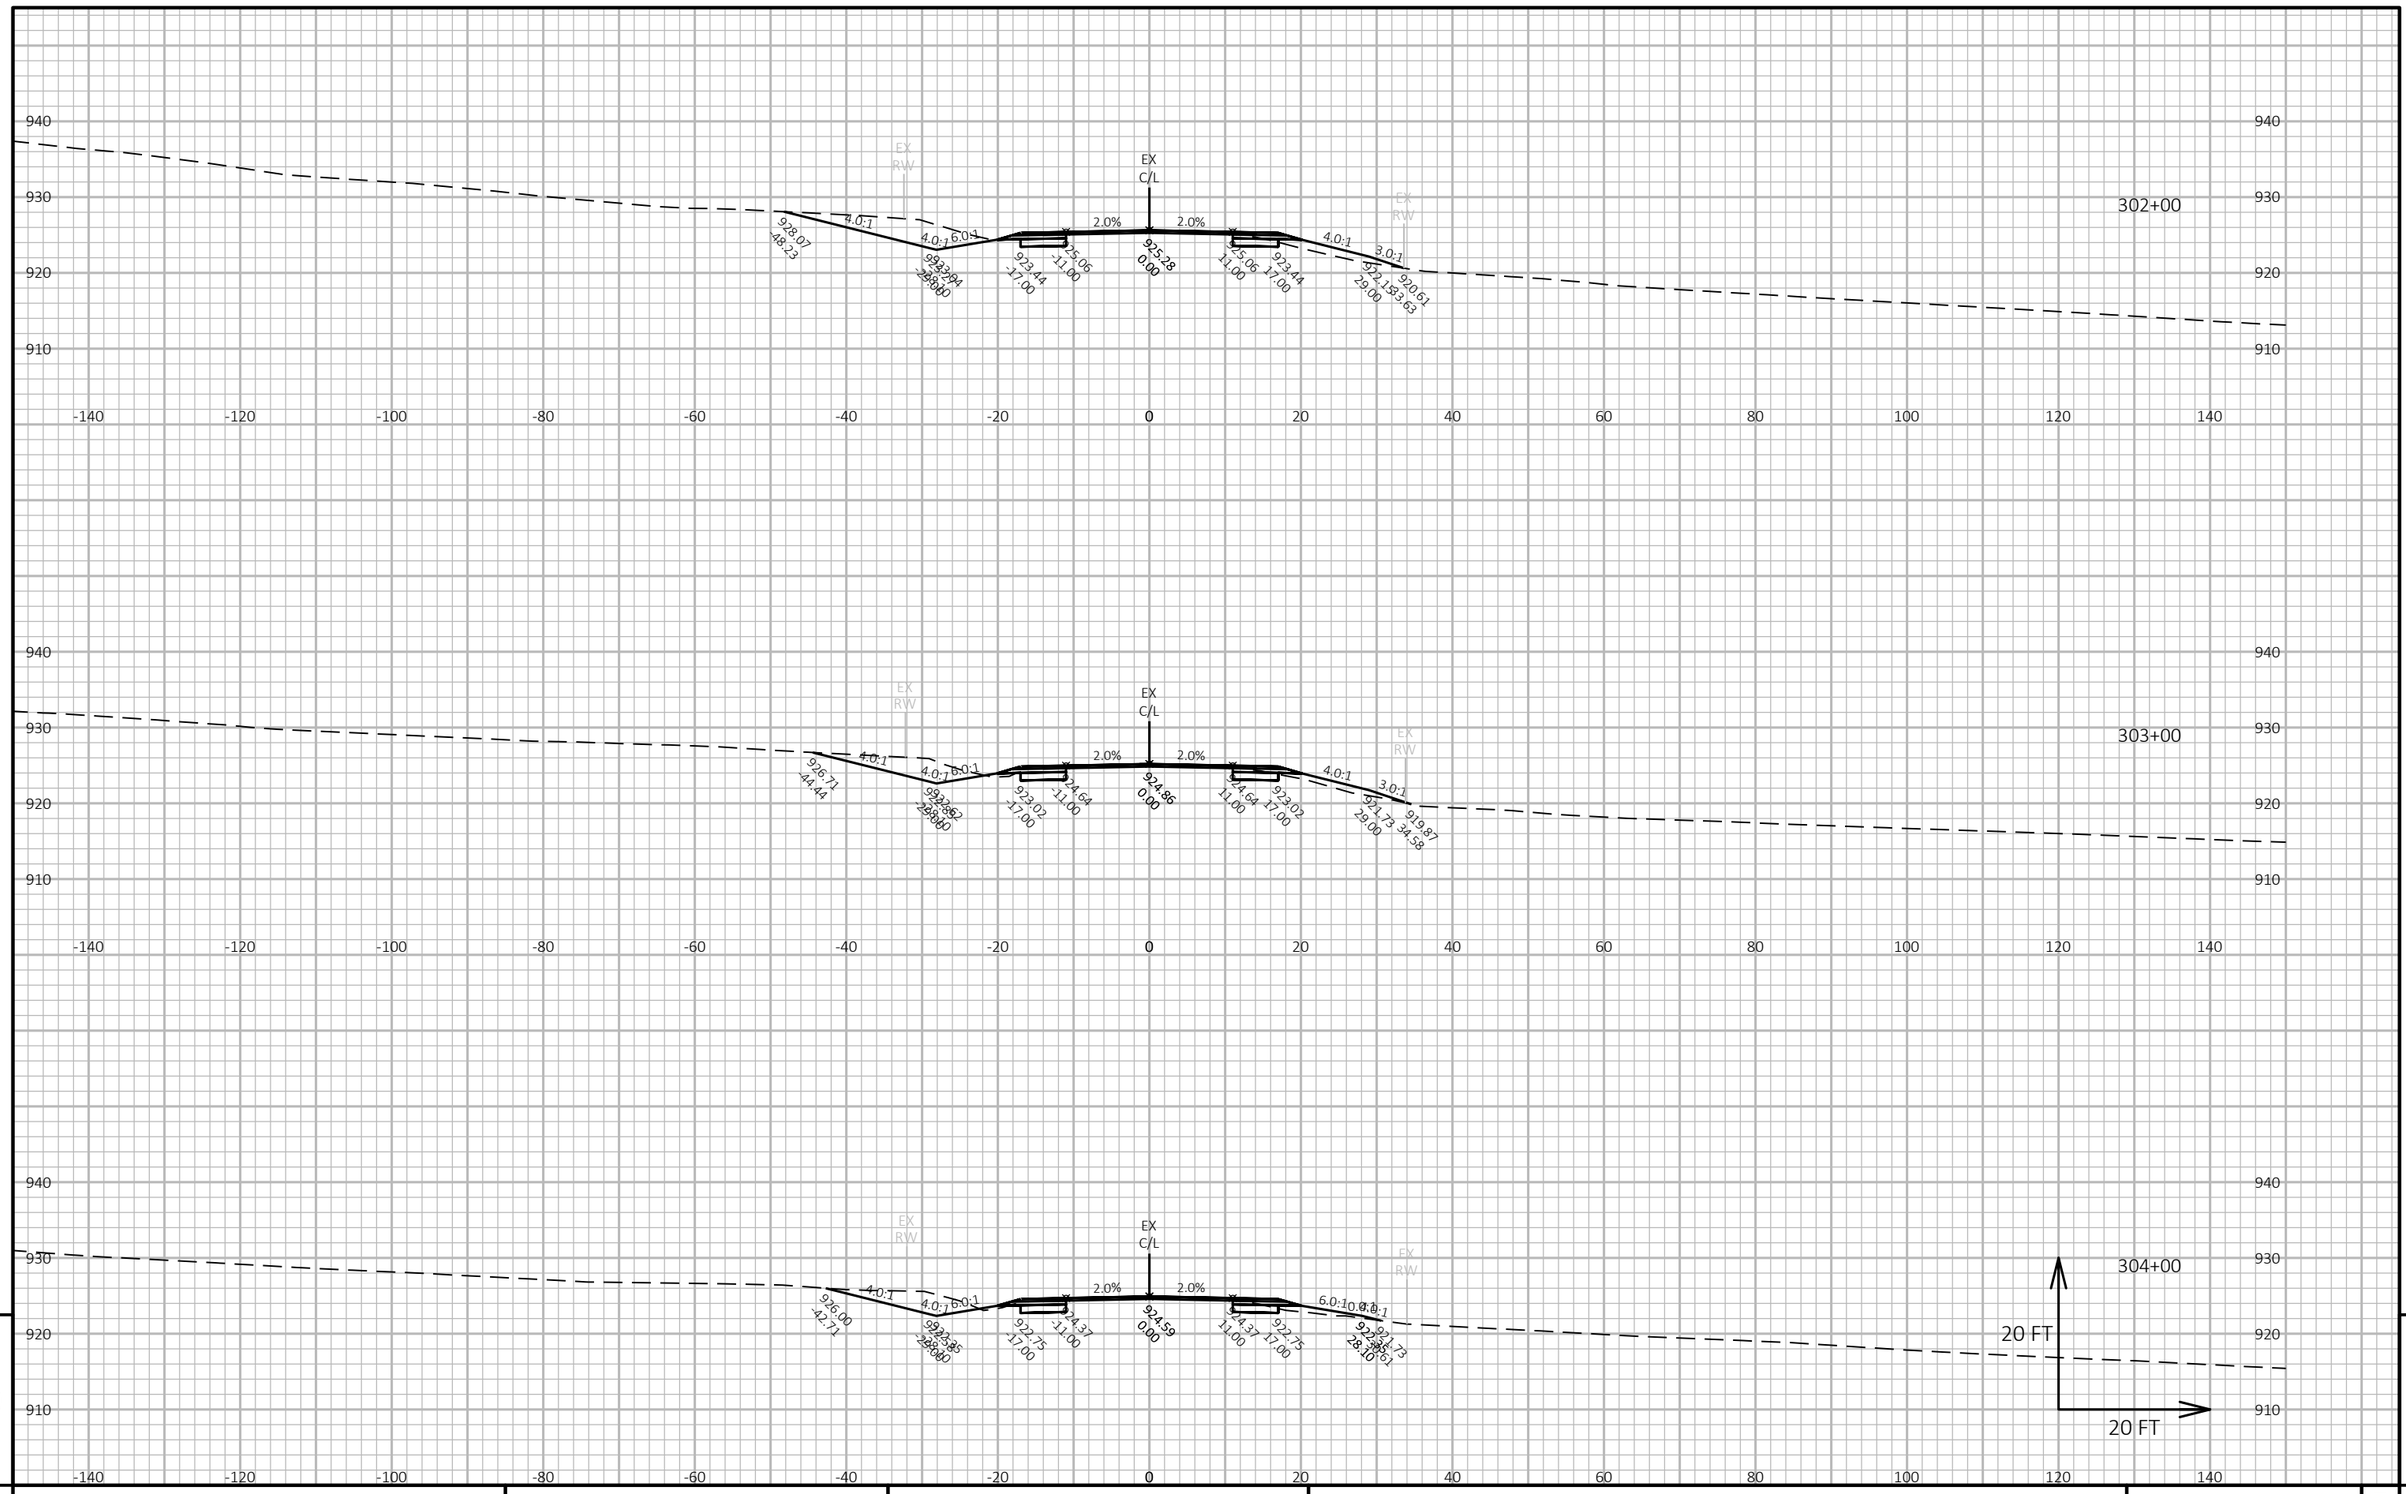

9

PROJECT NO: 5145-00-71	HWY: STH 19	COUNTY: DANE COUNTY	CROSS SECTIONS: ##########################	SHEET 144	E

9

FILE NAME : N:\PDS\C3D\51450001\SHEETSPLAN\090201_XS.DWG
LAYOUT NAME - 090297-xs

PLOT DATE : 6/6/2018 5:17 PM PLOT BY : RACH, JEREMY PAUL PLOT NAME : PLOT SCALE : 1 IN:20 FT HORZ. / 1 IN:20 FT VERT.

WISDOT/CADDS SHEET 49

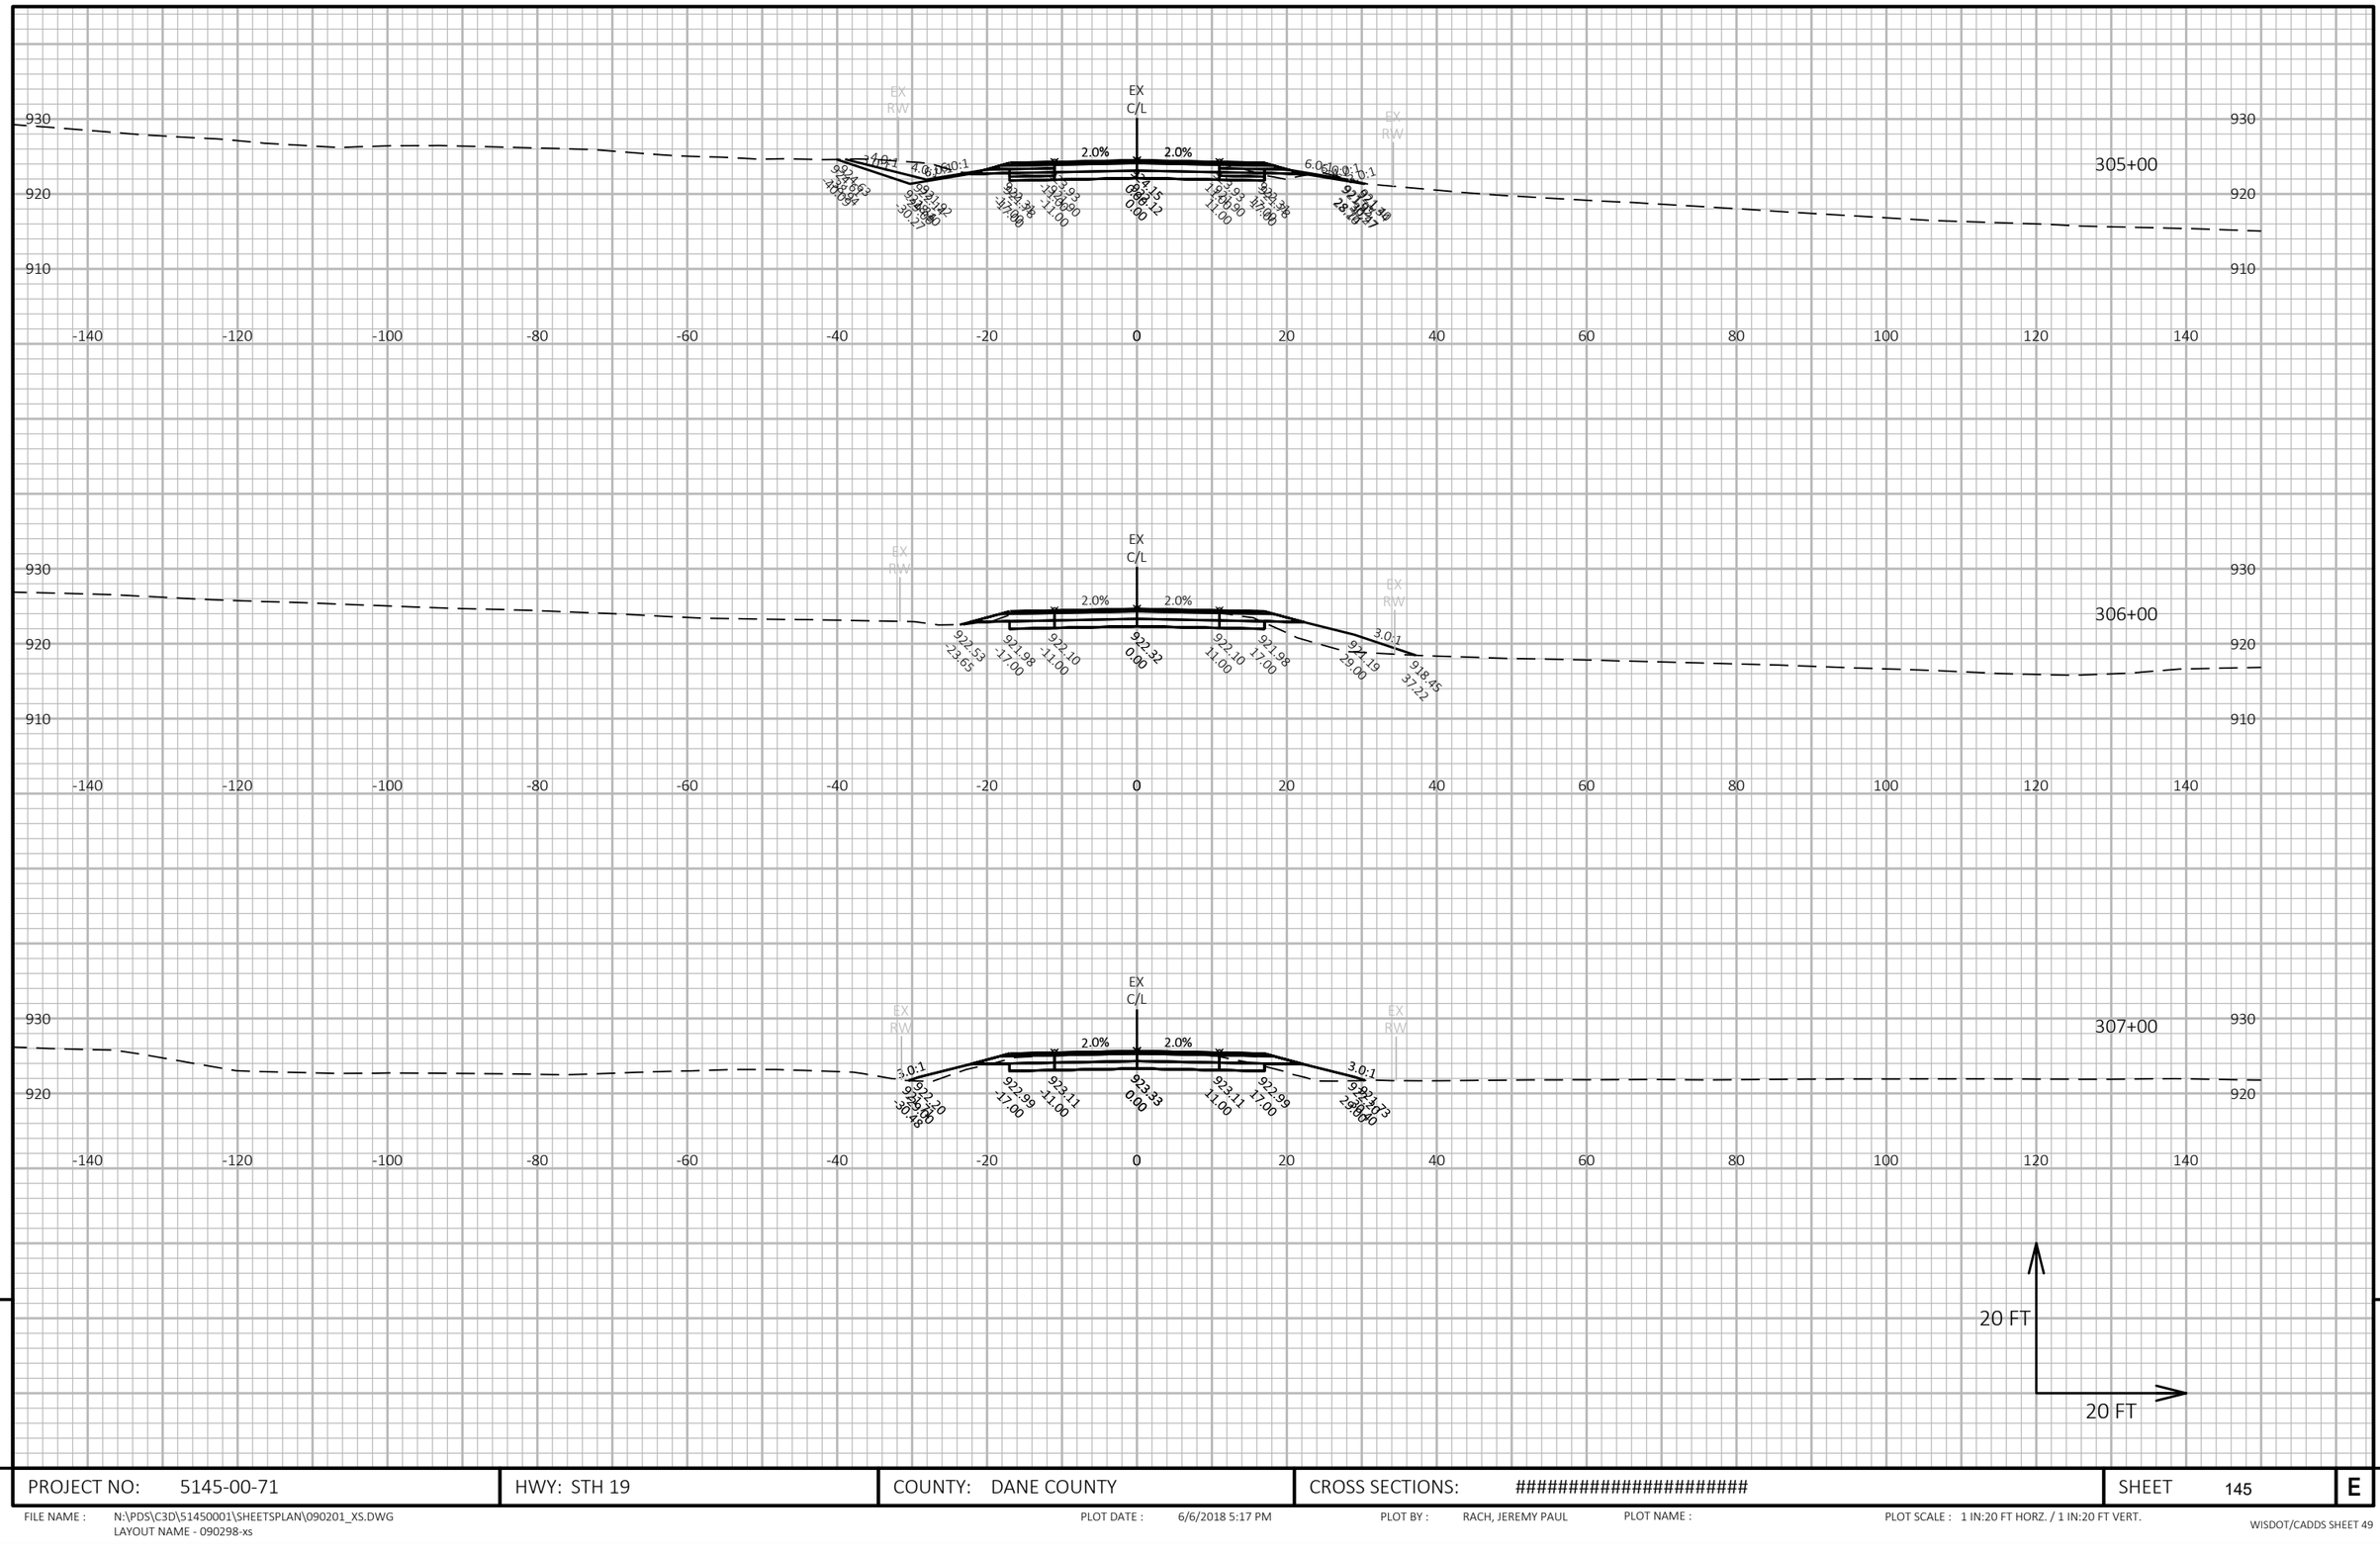

9

9

PROJECT NO: 5145-00-71	HWY: STH 19	COUNTY: DANE COUNTY	CROSS SECTIONS: ##########################	SHEET 145	E

FILE NAME : N:\PDS\C3D\51450001\SHEETSPLAN\090201_XS.DWG
LAYOUT NAME - 090298-xs

PLOT DATE : 6/6/2018 5:17 PM PLOT BY : RACH, JEREMY PAUL PLOT NAME : PLOT SCALE : 1 IN:20 FT HORZ. / 1 IN:20 FT VERT.

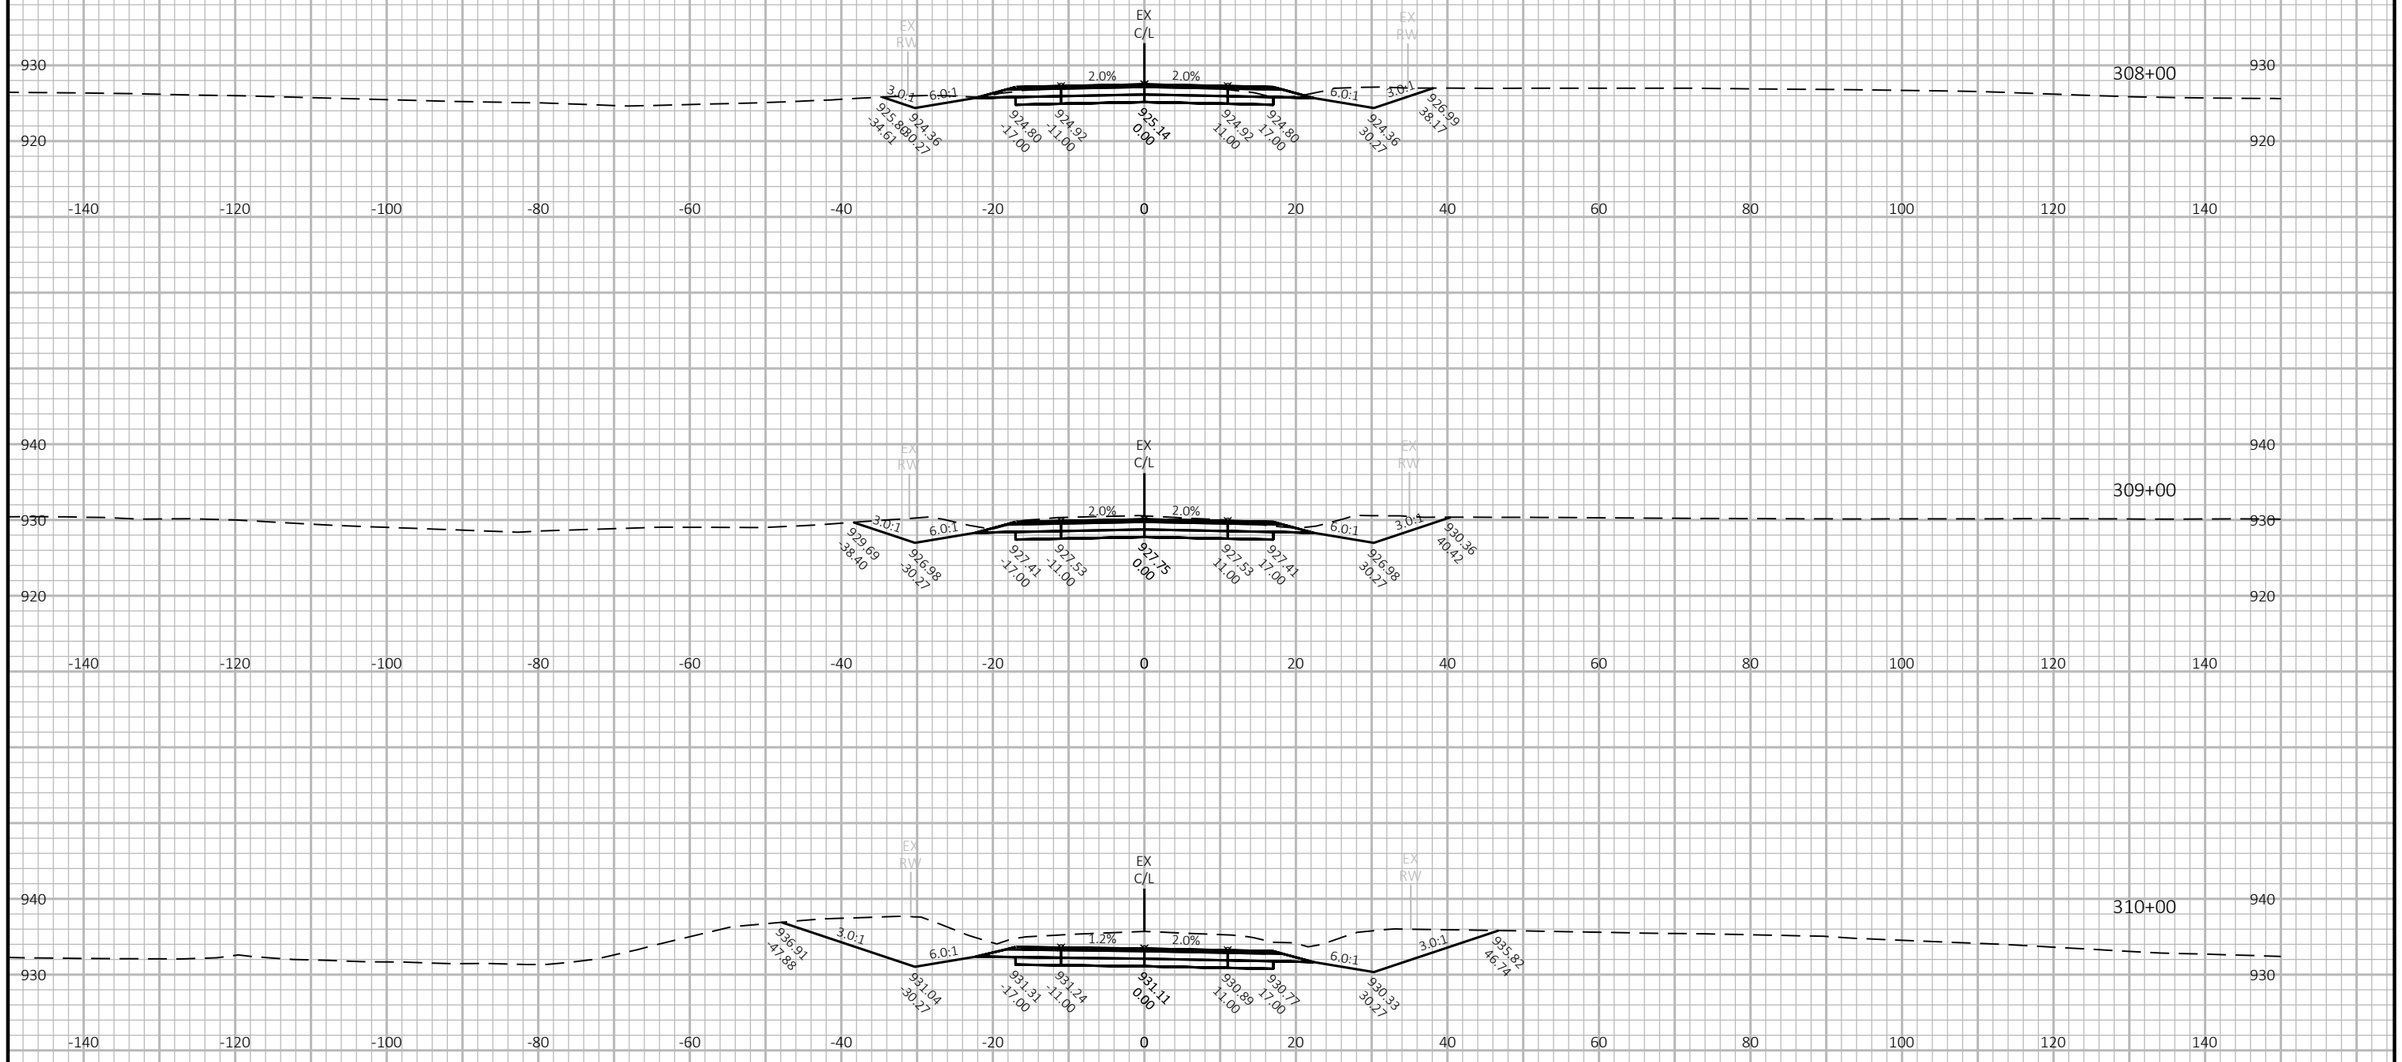

9

PROJECT NO: 5145-00-71	HWY: STH 19	COUNTY: DANE COUNTY	CROSS SECTIONS: ##########################	SHEET 146	E

FILE NAME : N:\PDS\C3D\51450001\SHEETSPLAN\090201_XS.DWG
LAYOUT NAME - 090299-xs

PLOT DATE : 6/6/2018 5:18 PM PLOT BY : RACH, JEREMY PAUL PLOT NAME : PLOT SCALE : 1 IN:20 FT HORZ. / 1 IN:20 FT VERT.

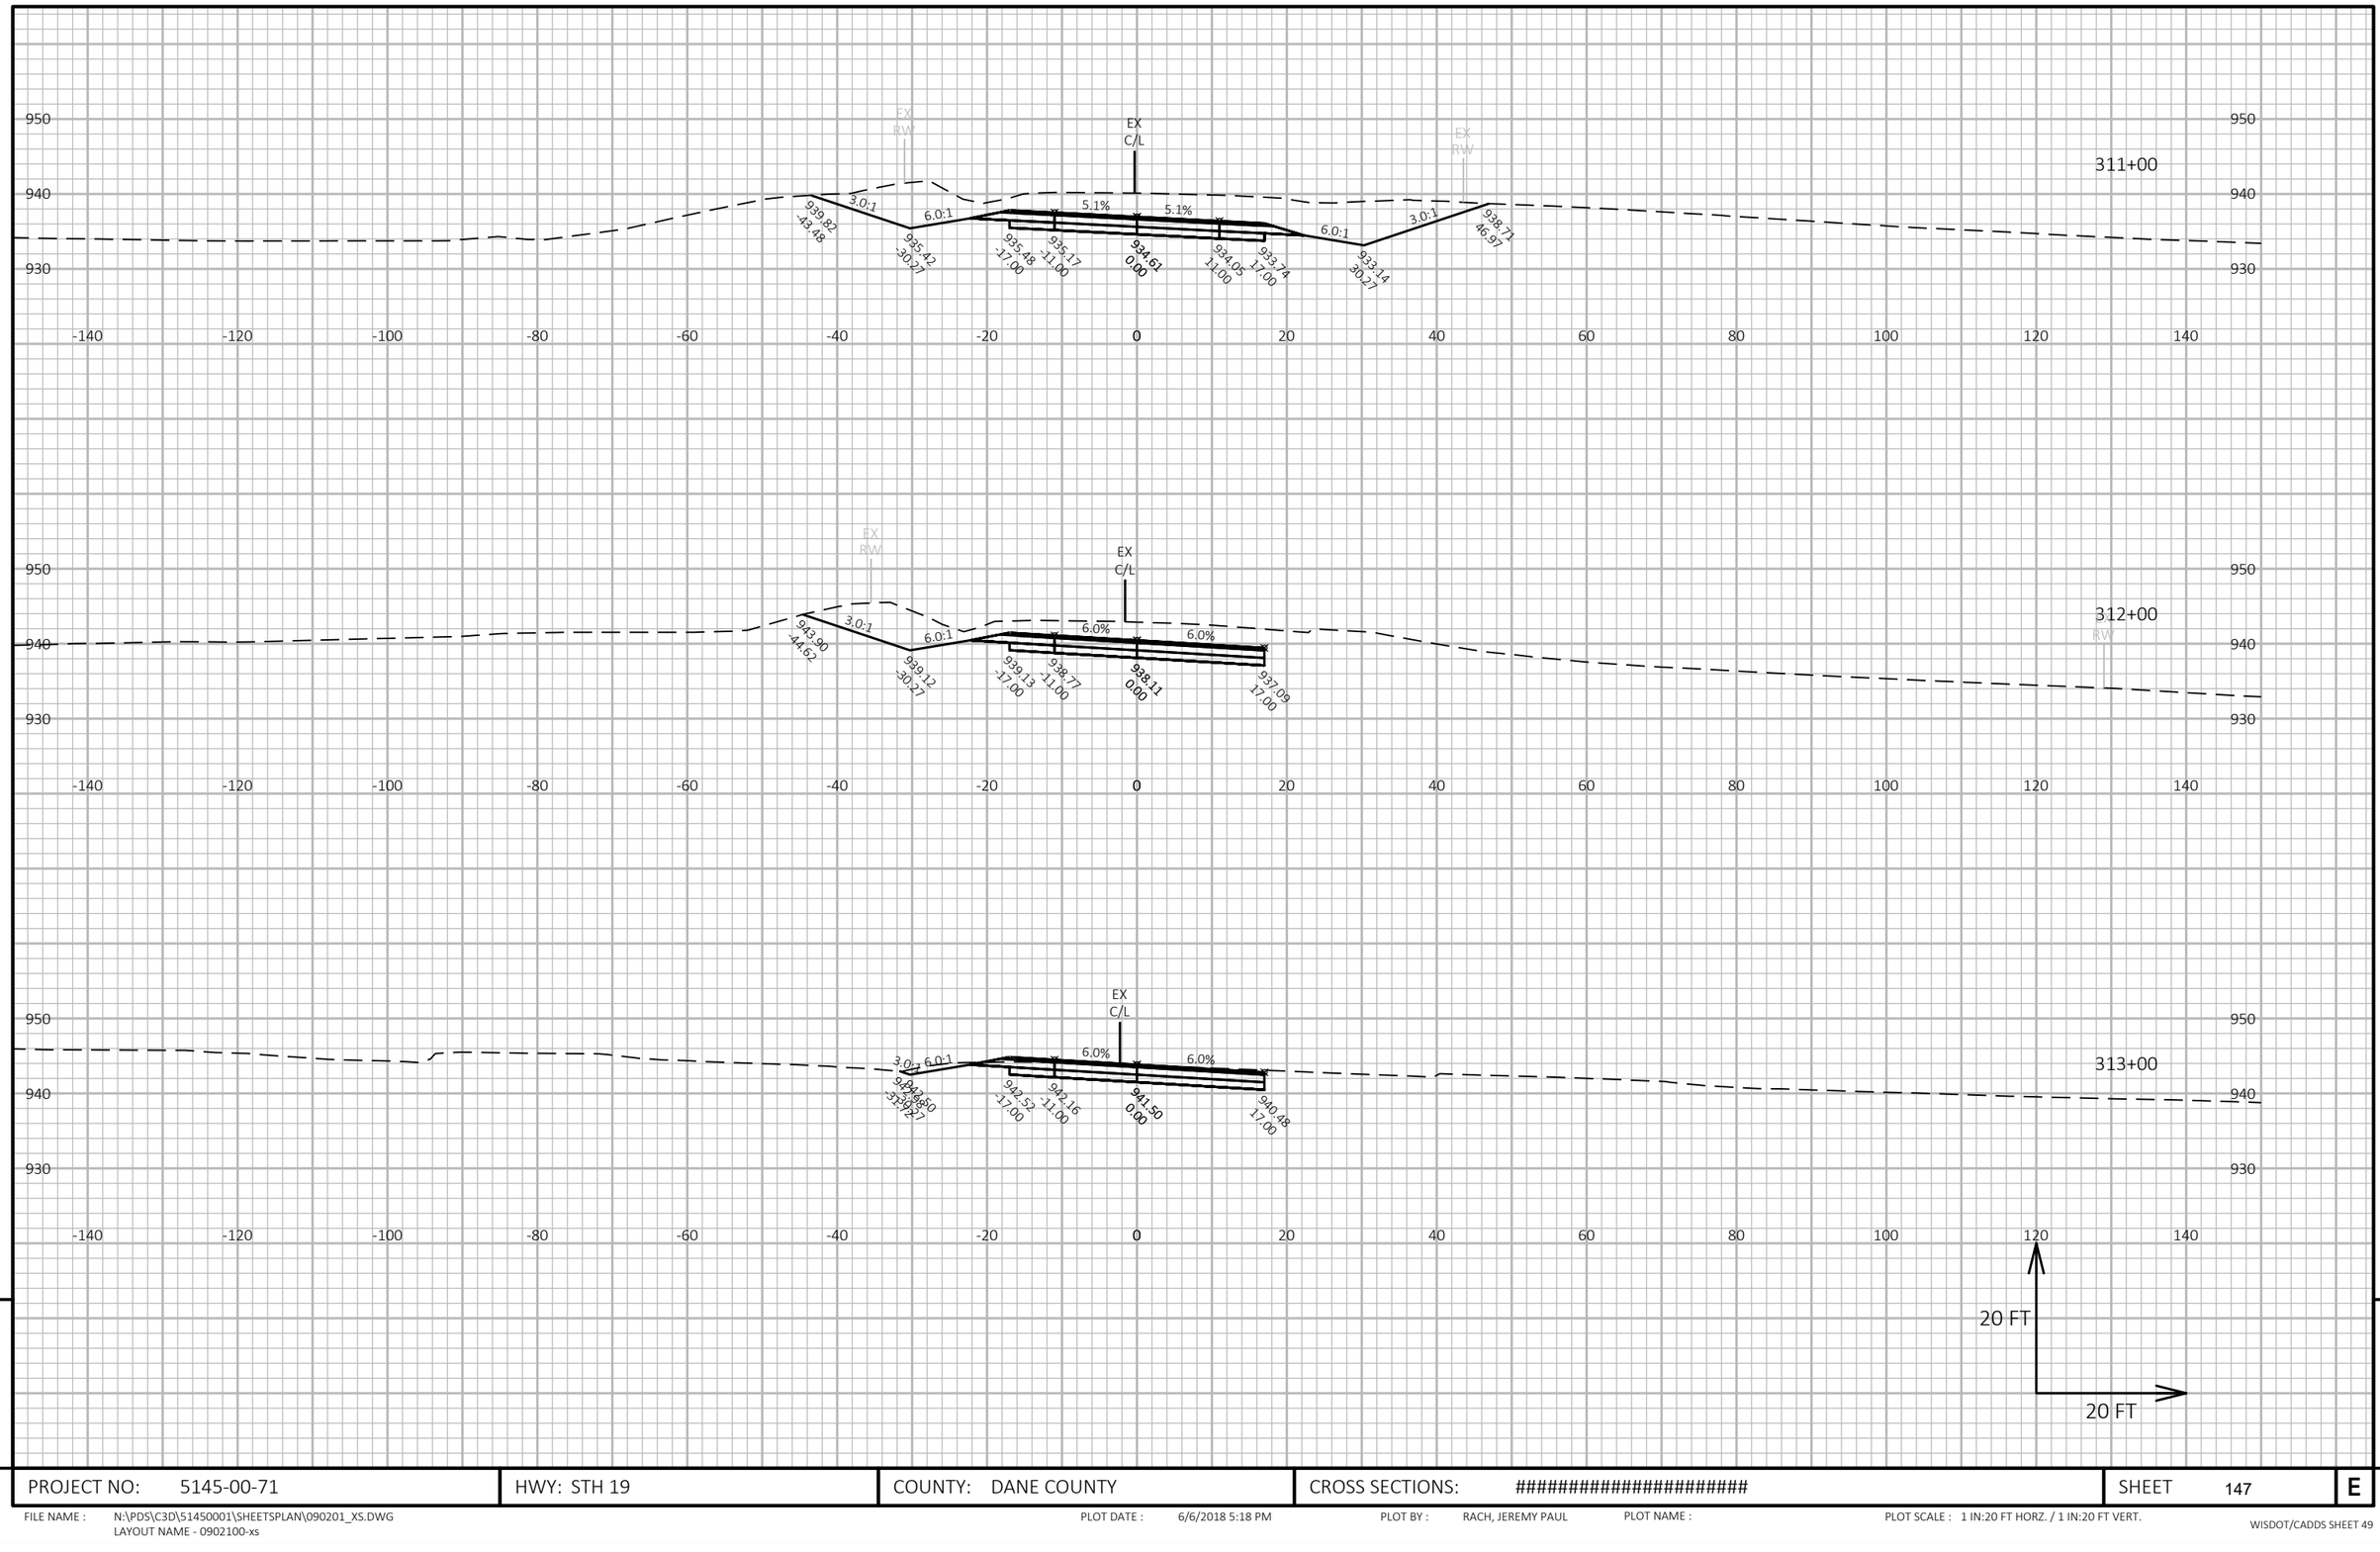

9

9

PROJECT NO: 5145-00-71	HWY: STH 19	COUNTY: DANE COUNTY	CROSS SECTIONS: ##########################	SHEET 147	E

FILE NAME : N:\PDS\C3D\51450001\SHEETSPLAN\090201_XS.DWG
LAYOUT NAME - 0902100-xs

PLOT DATE : 6/6/2018 5:18 PM PLOT BY : RACH, JEREMY PAUL PLOT NAME : PLOT SCALE : 1 IN:20 FT HORZ. / 1 IN:20 FT VERT.

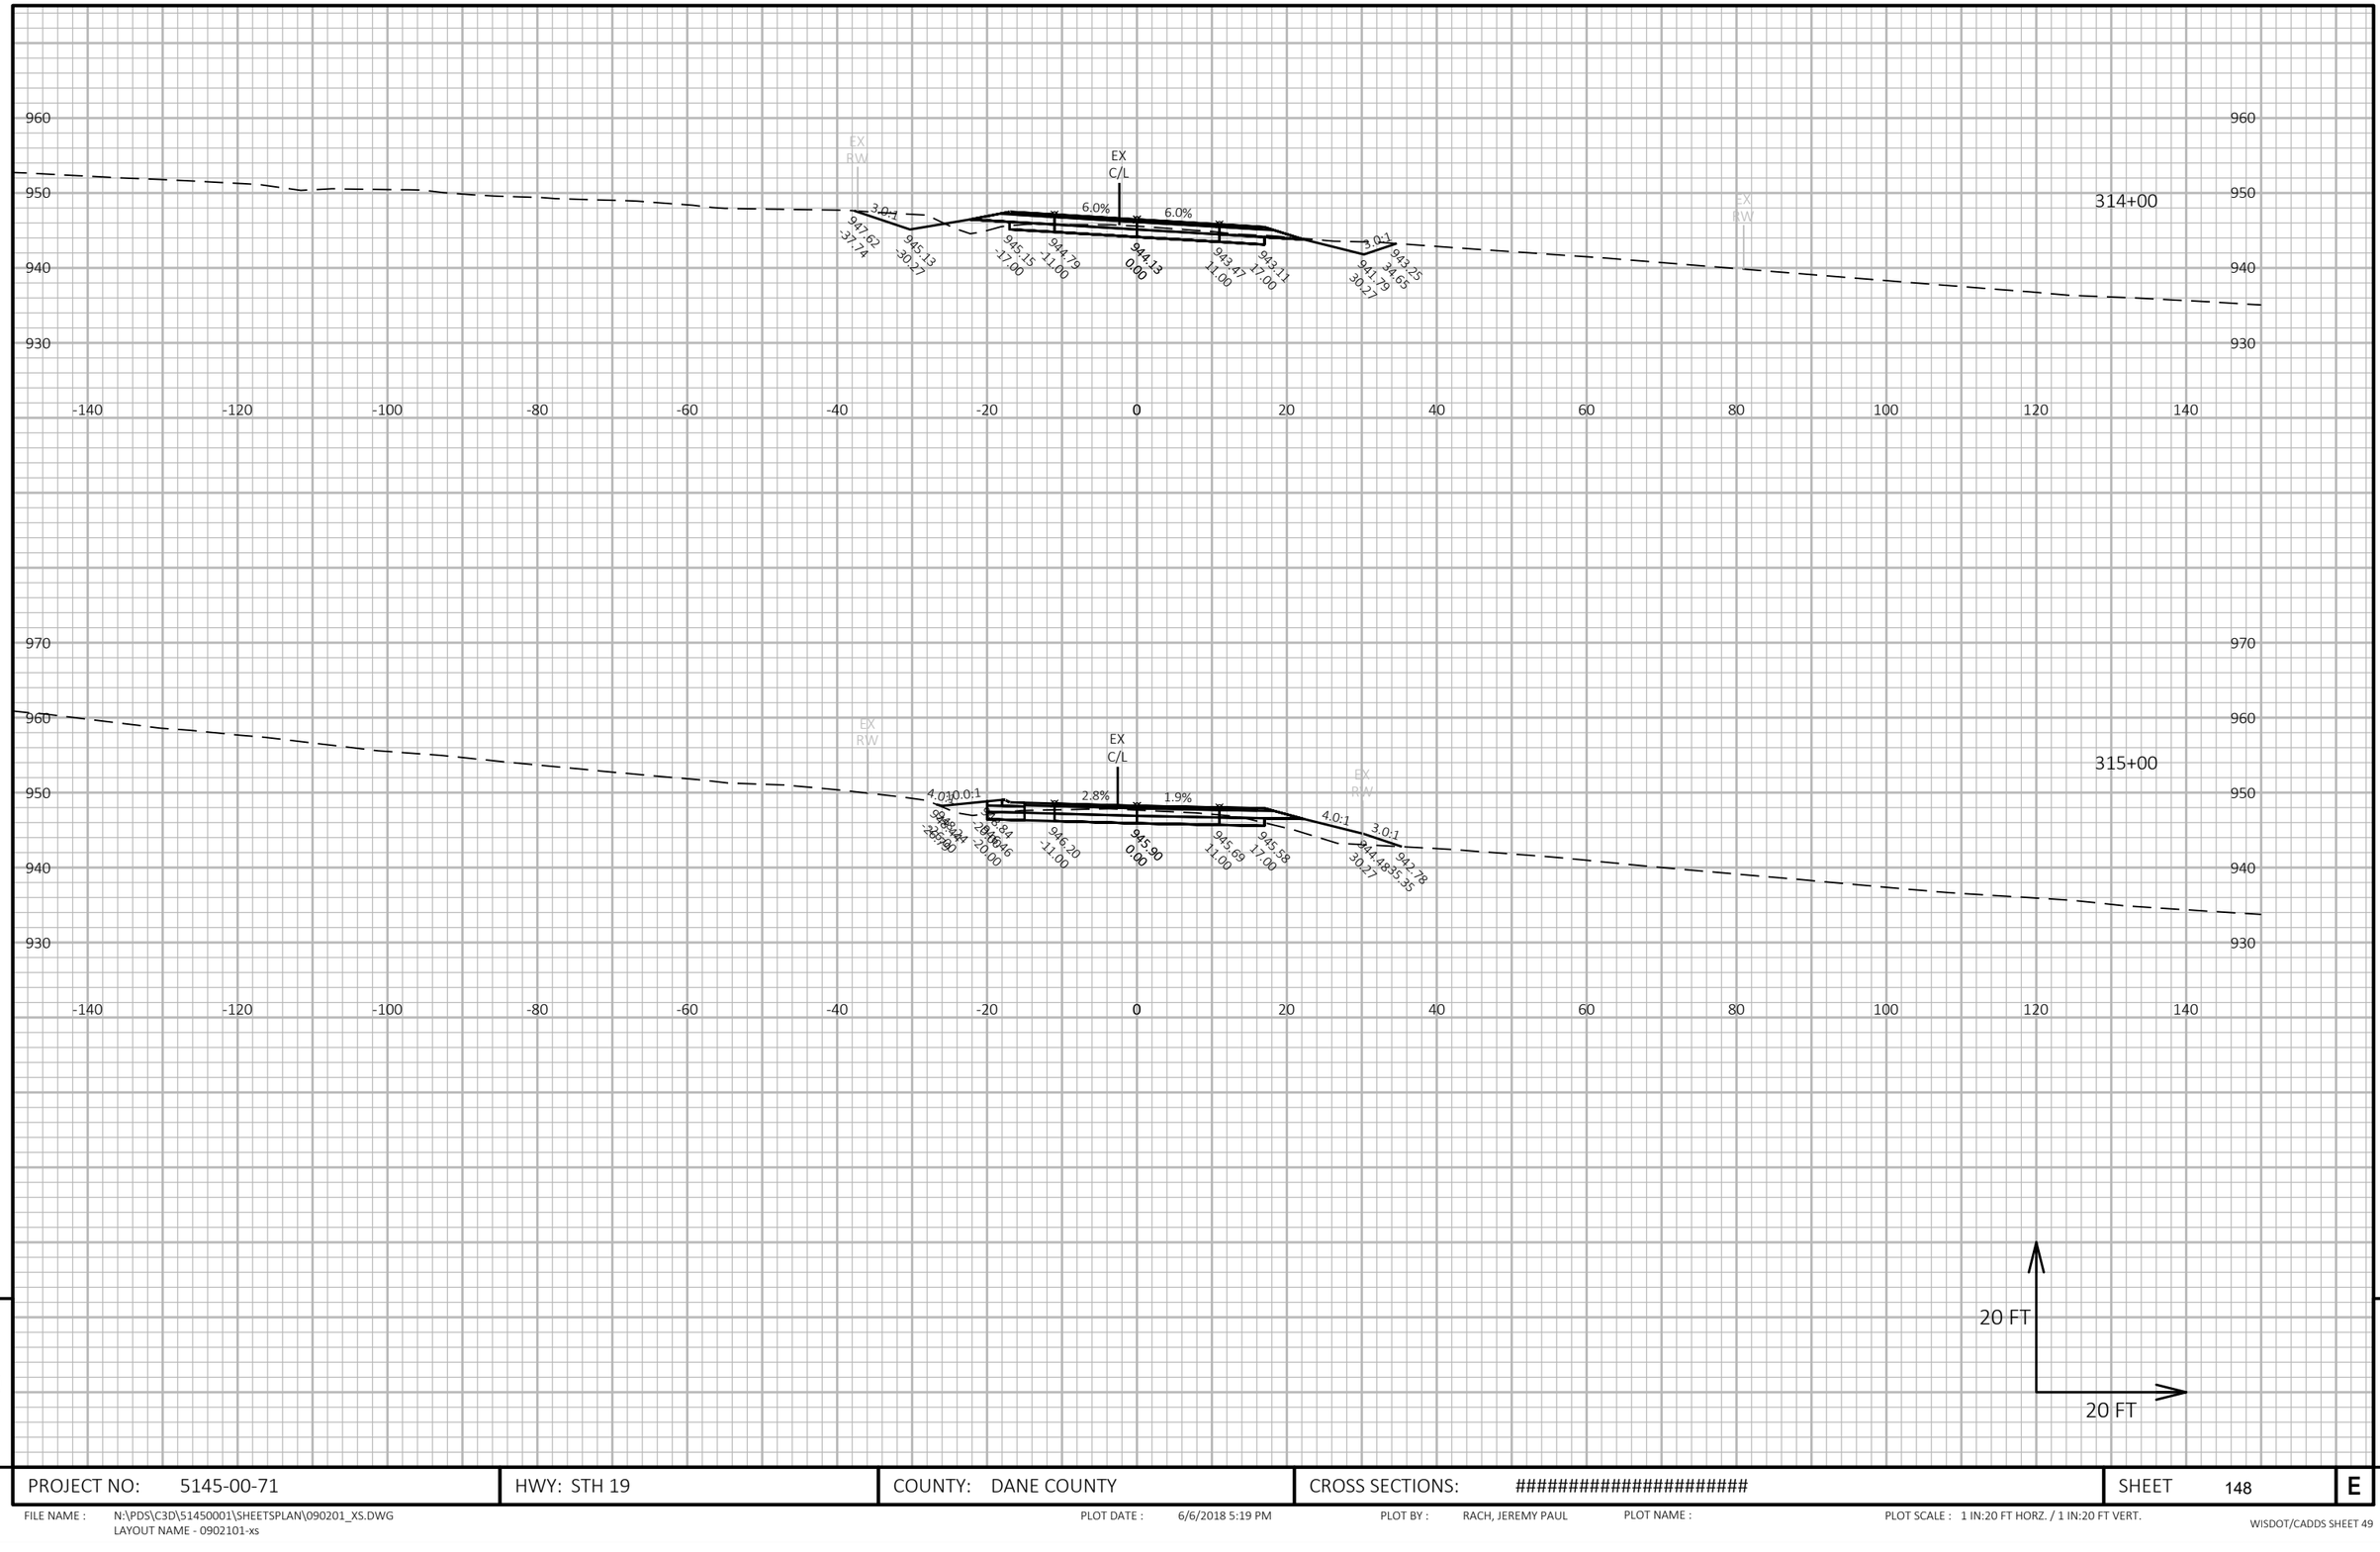

9

9

PROJECT NO: 5145-00-71	HWY: STH 19	COUNTY: DANE COUNTY	CROSS SECTIONS: ##########################	SHEET 148	E

FILE NAME : N:\PDS\C3D\51450001\SHEETSPLAN\090201_XS.DWG
LAYOUT NAME - 0902101-xs
PLOT DATE : 6/6/2018 5:19 PM
PLOT BY : RACH, JEREMY PAUL
PLOT NAME :
PLOT SCALE : 1 IN:20 FT HORZ. / 1 IN:20 FT VERT.
WISDOT/CADDS SHEET 49

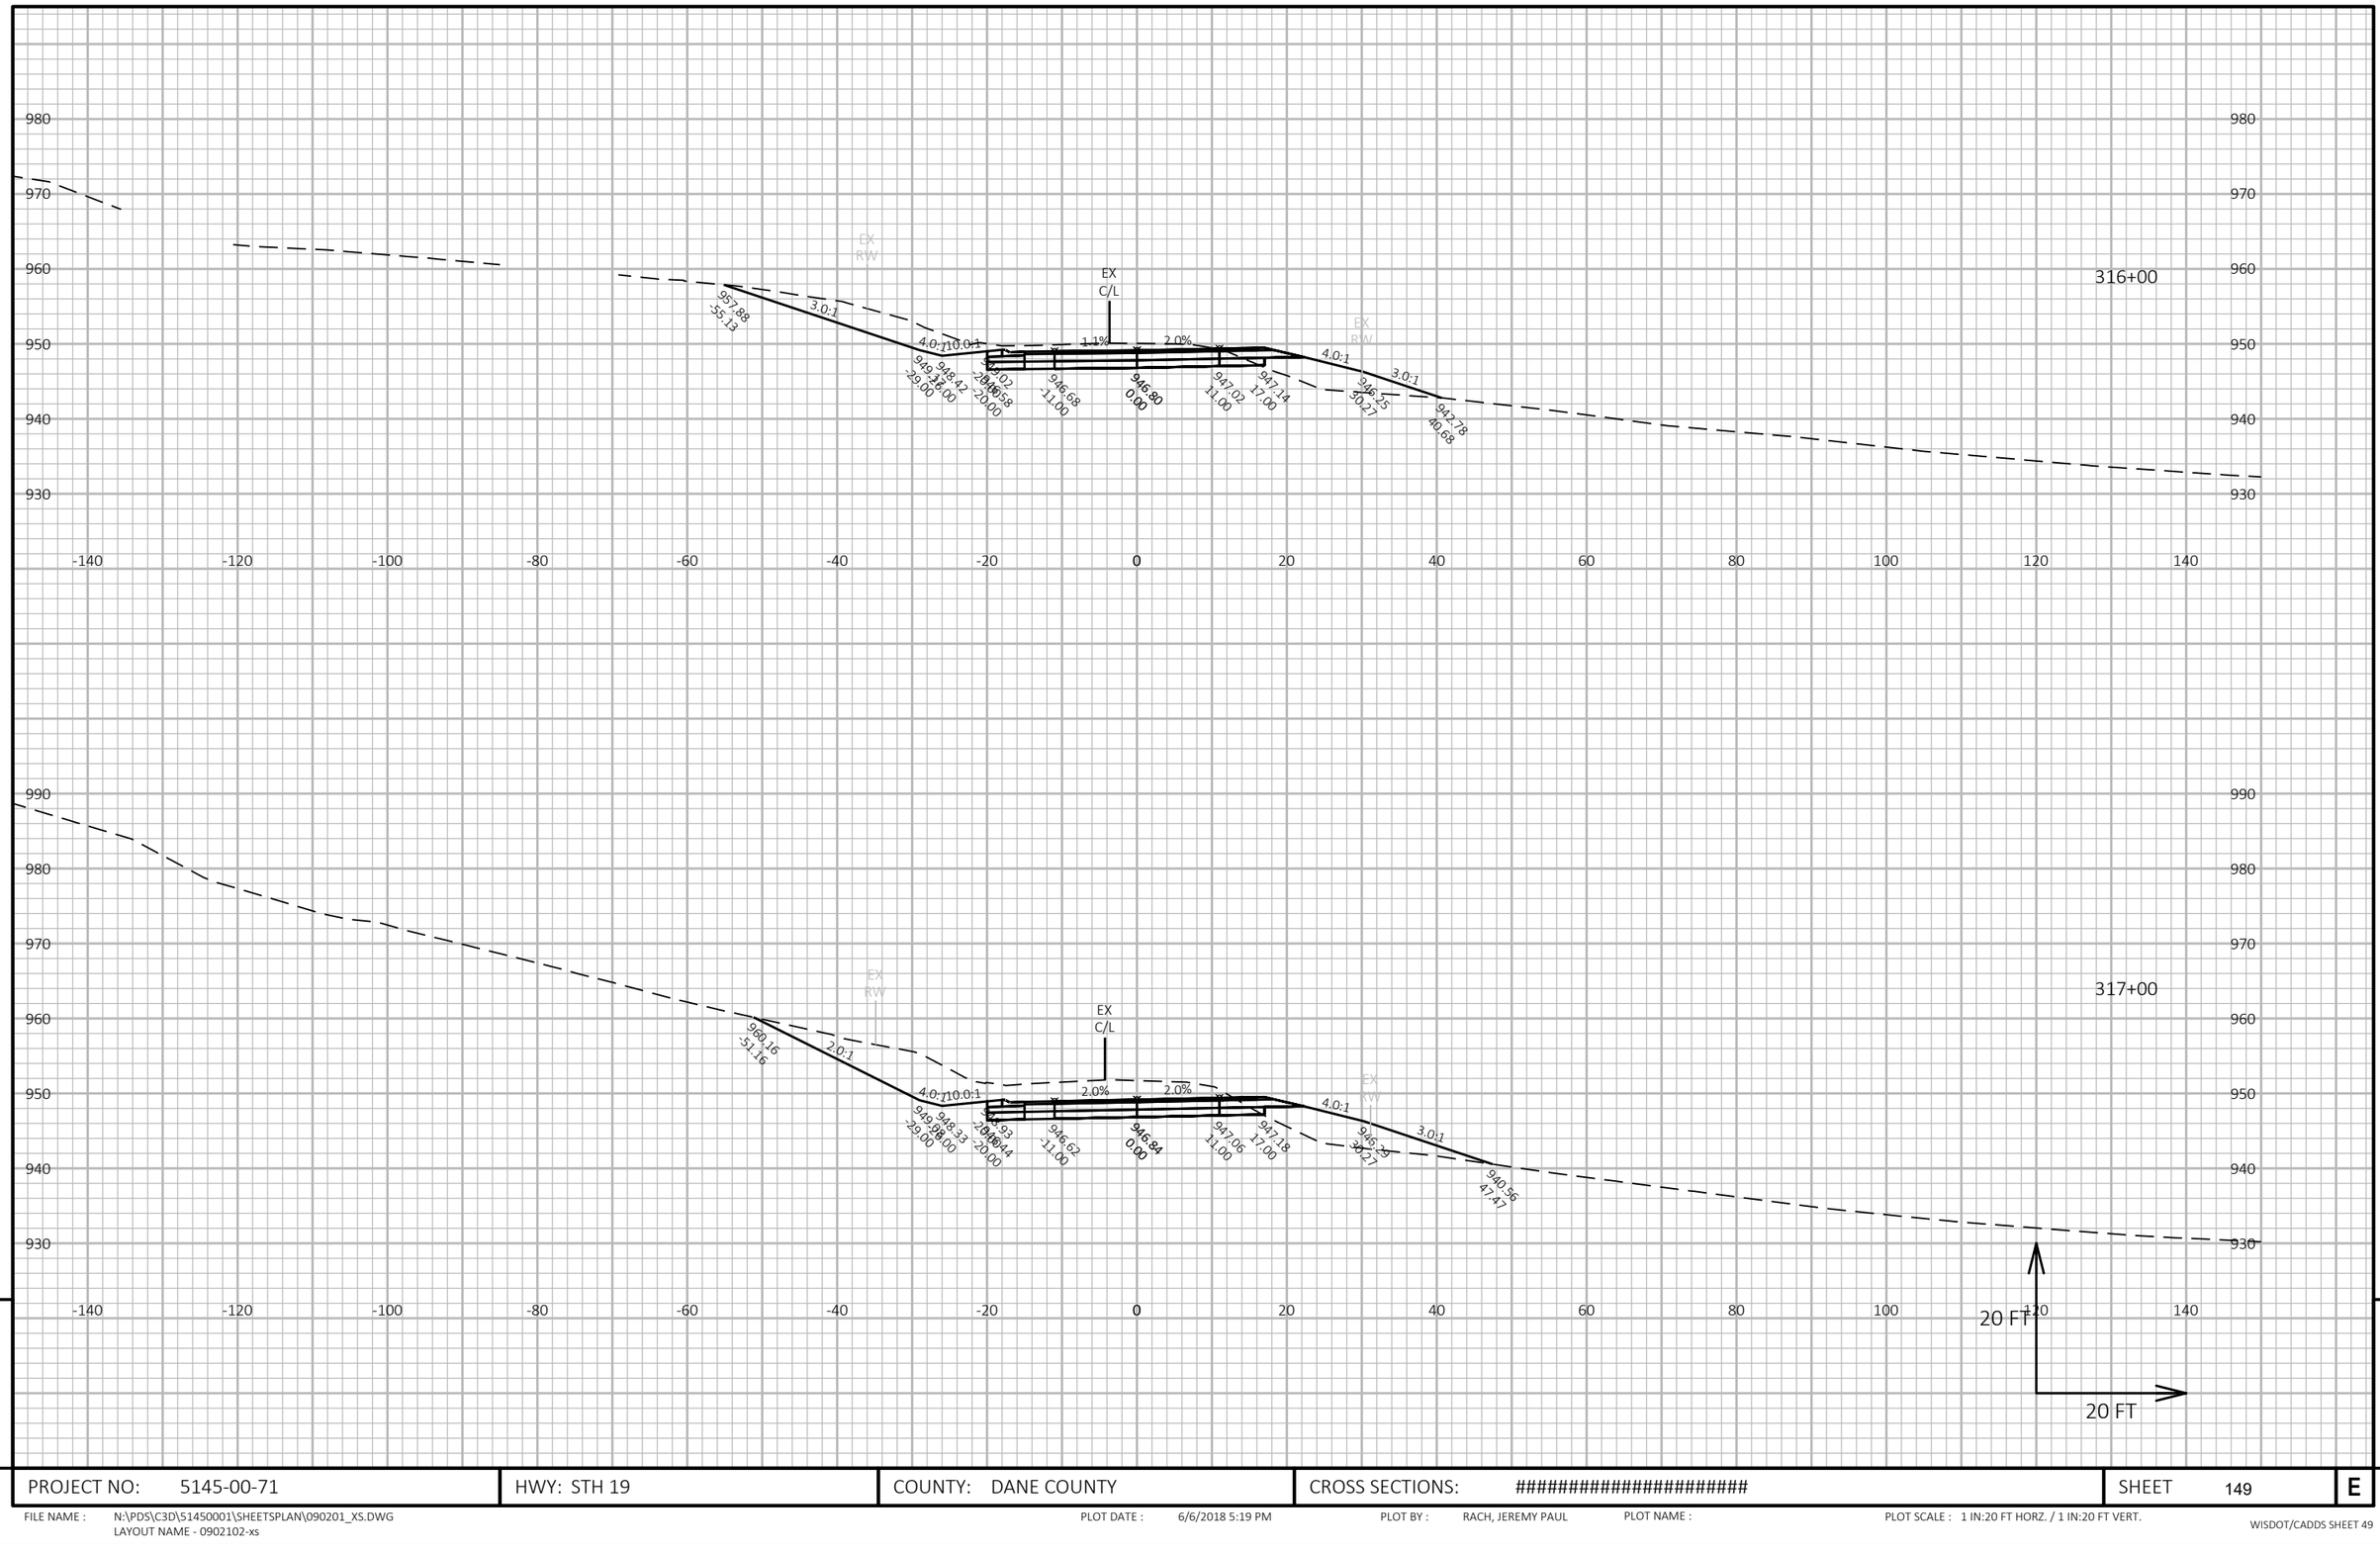

PROJECT NO: 5145-00-71	HWY: STH 19	COUNTY: DANE COUNTY	CROSS SECTIONS: ##########################	SHEET 149

FILE NAME : N:\PDS\C3D\51450001\SHEETSPLAN\090201_XS.DWG
LAYOUT NAME - 0902102-xs

PLOT DATE : 6/6/2018 5:19 PM PLOT BY : RACH, JEREMY PAUL PLOT NAME : PLOT SCALE : 1 IN:20 FT HORZ. / 1 IN:20 FT VERT.

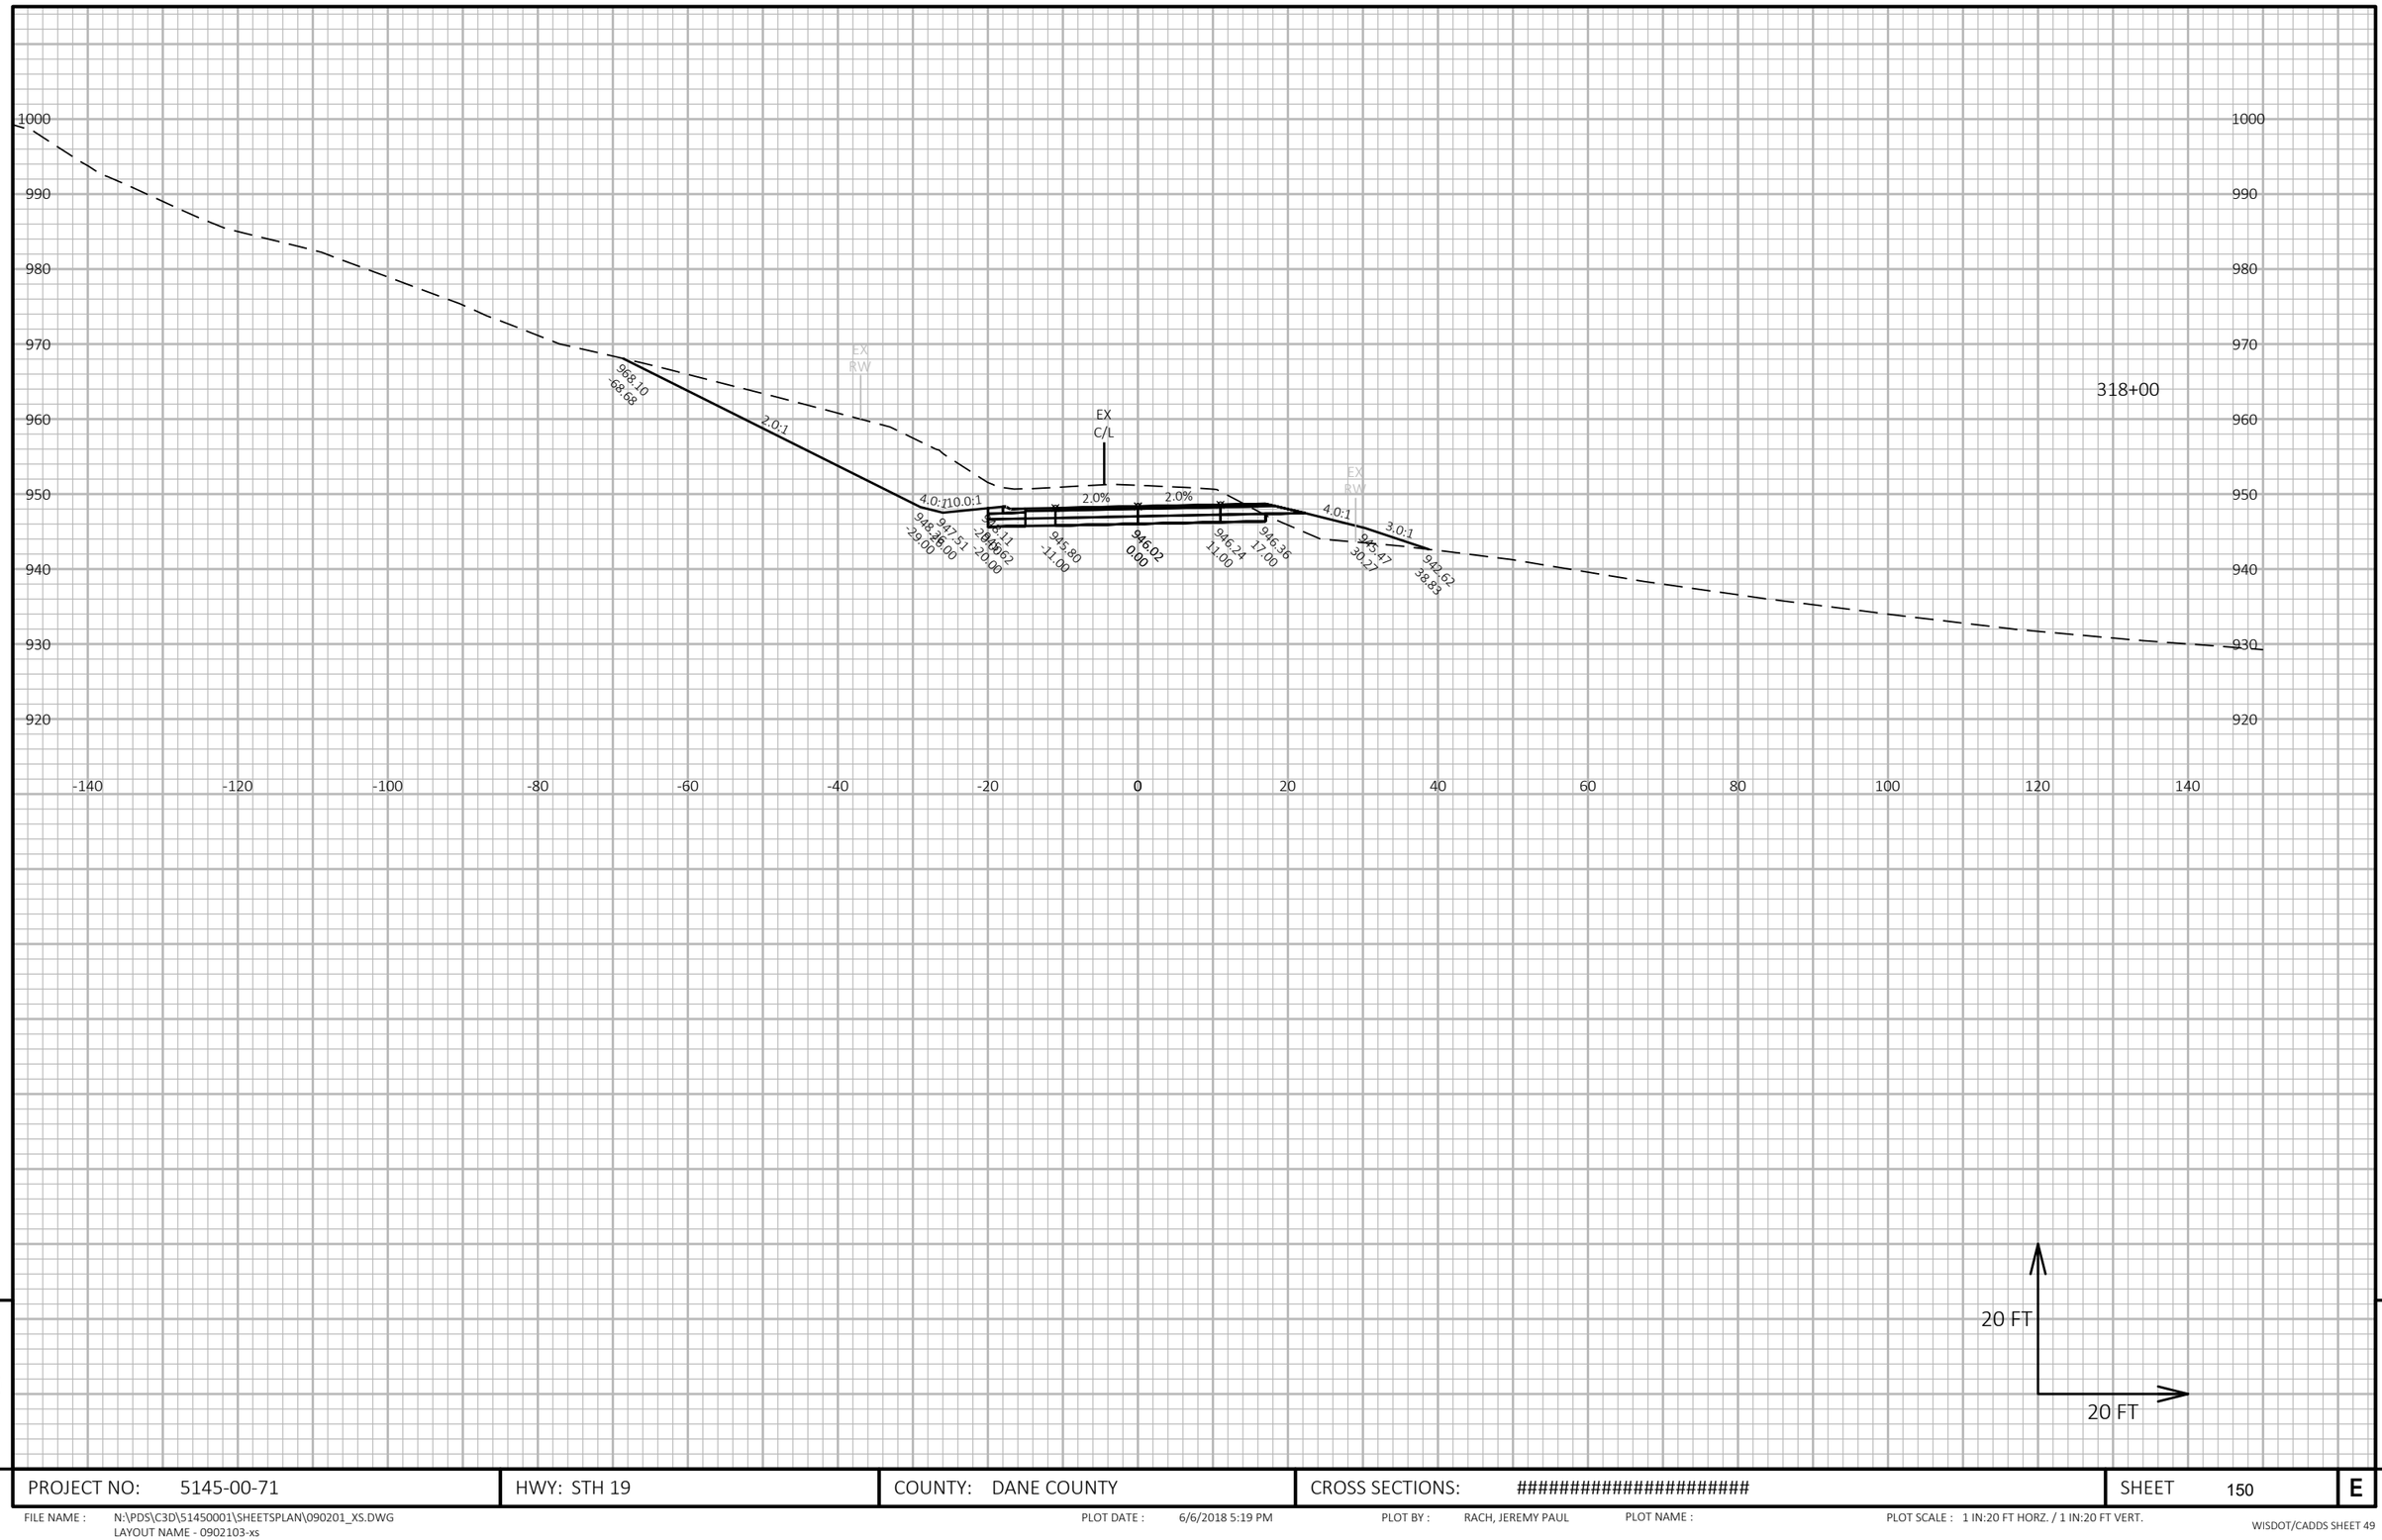

9

9

PROJECT NO: 5145-00-71	HWY: STH 19	COUNTY: DANE COUNTY	CROSS SECTIONS: ##########################	SHEET 150	E

FILE NAME : N:\PDS\C3D\51450001\SHEETSPLAN\090201_XS.DWG
LAYOUT NAME - 0902103-xs

PLOT DATE : 6/6/2018 5:19 PM PLOT BY : RACH, JEREMY PAUL PLOT NAME : PLOT SCALE : 1 IN:20 FT HORZ. / 1 IN:20 FT VERT.

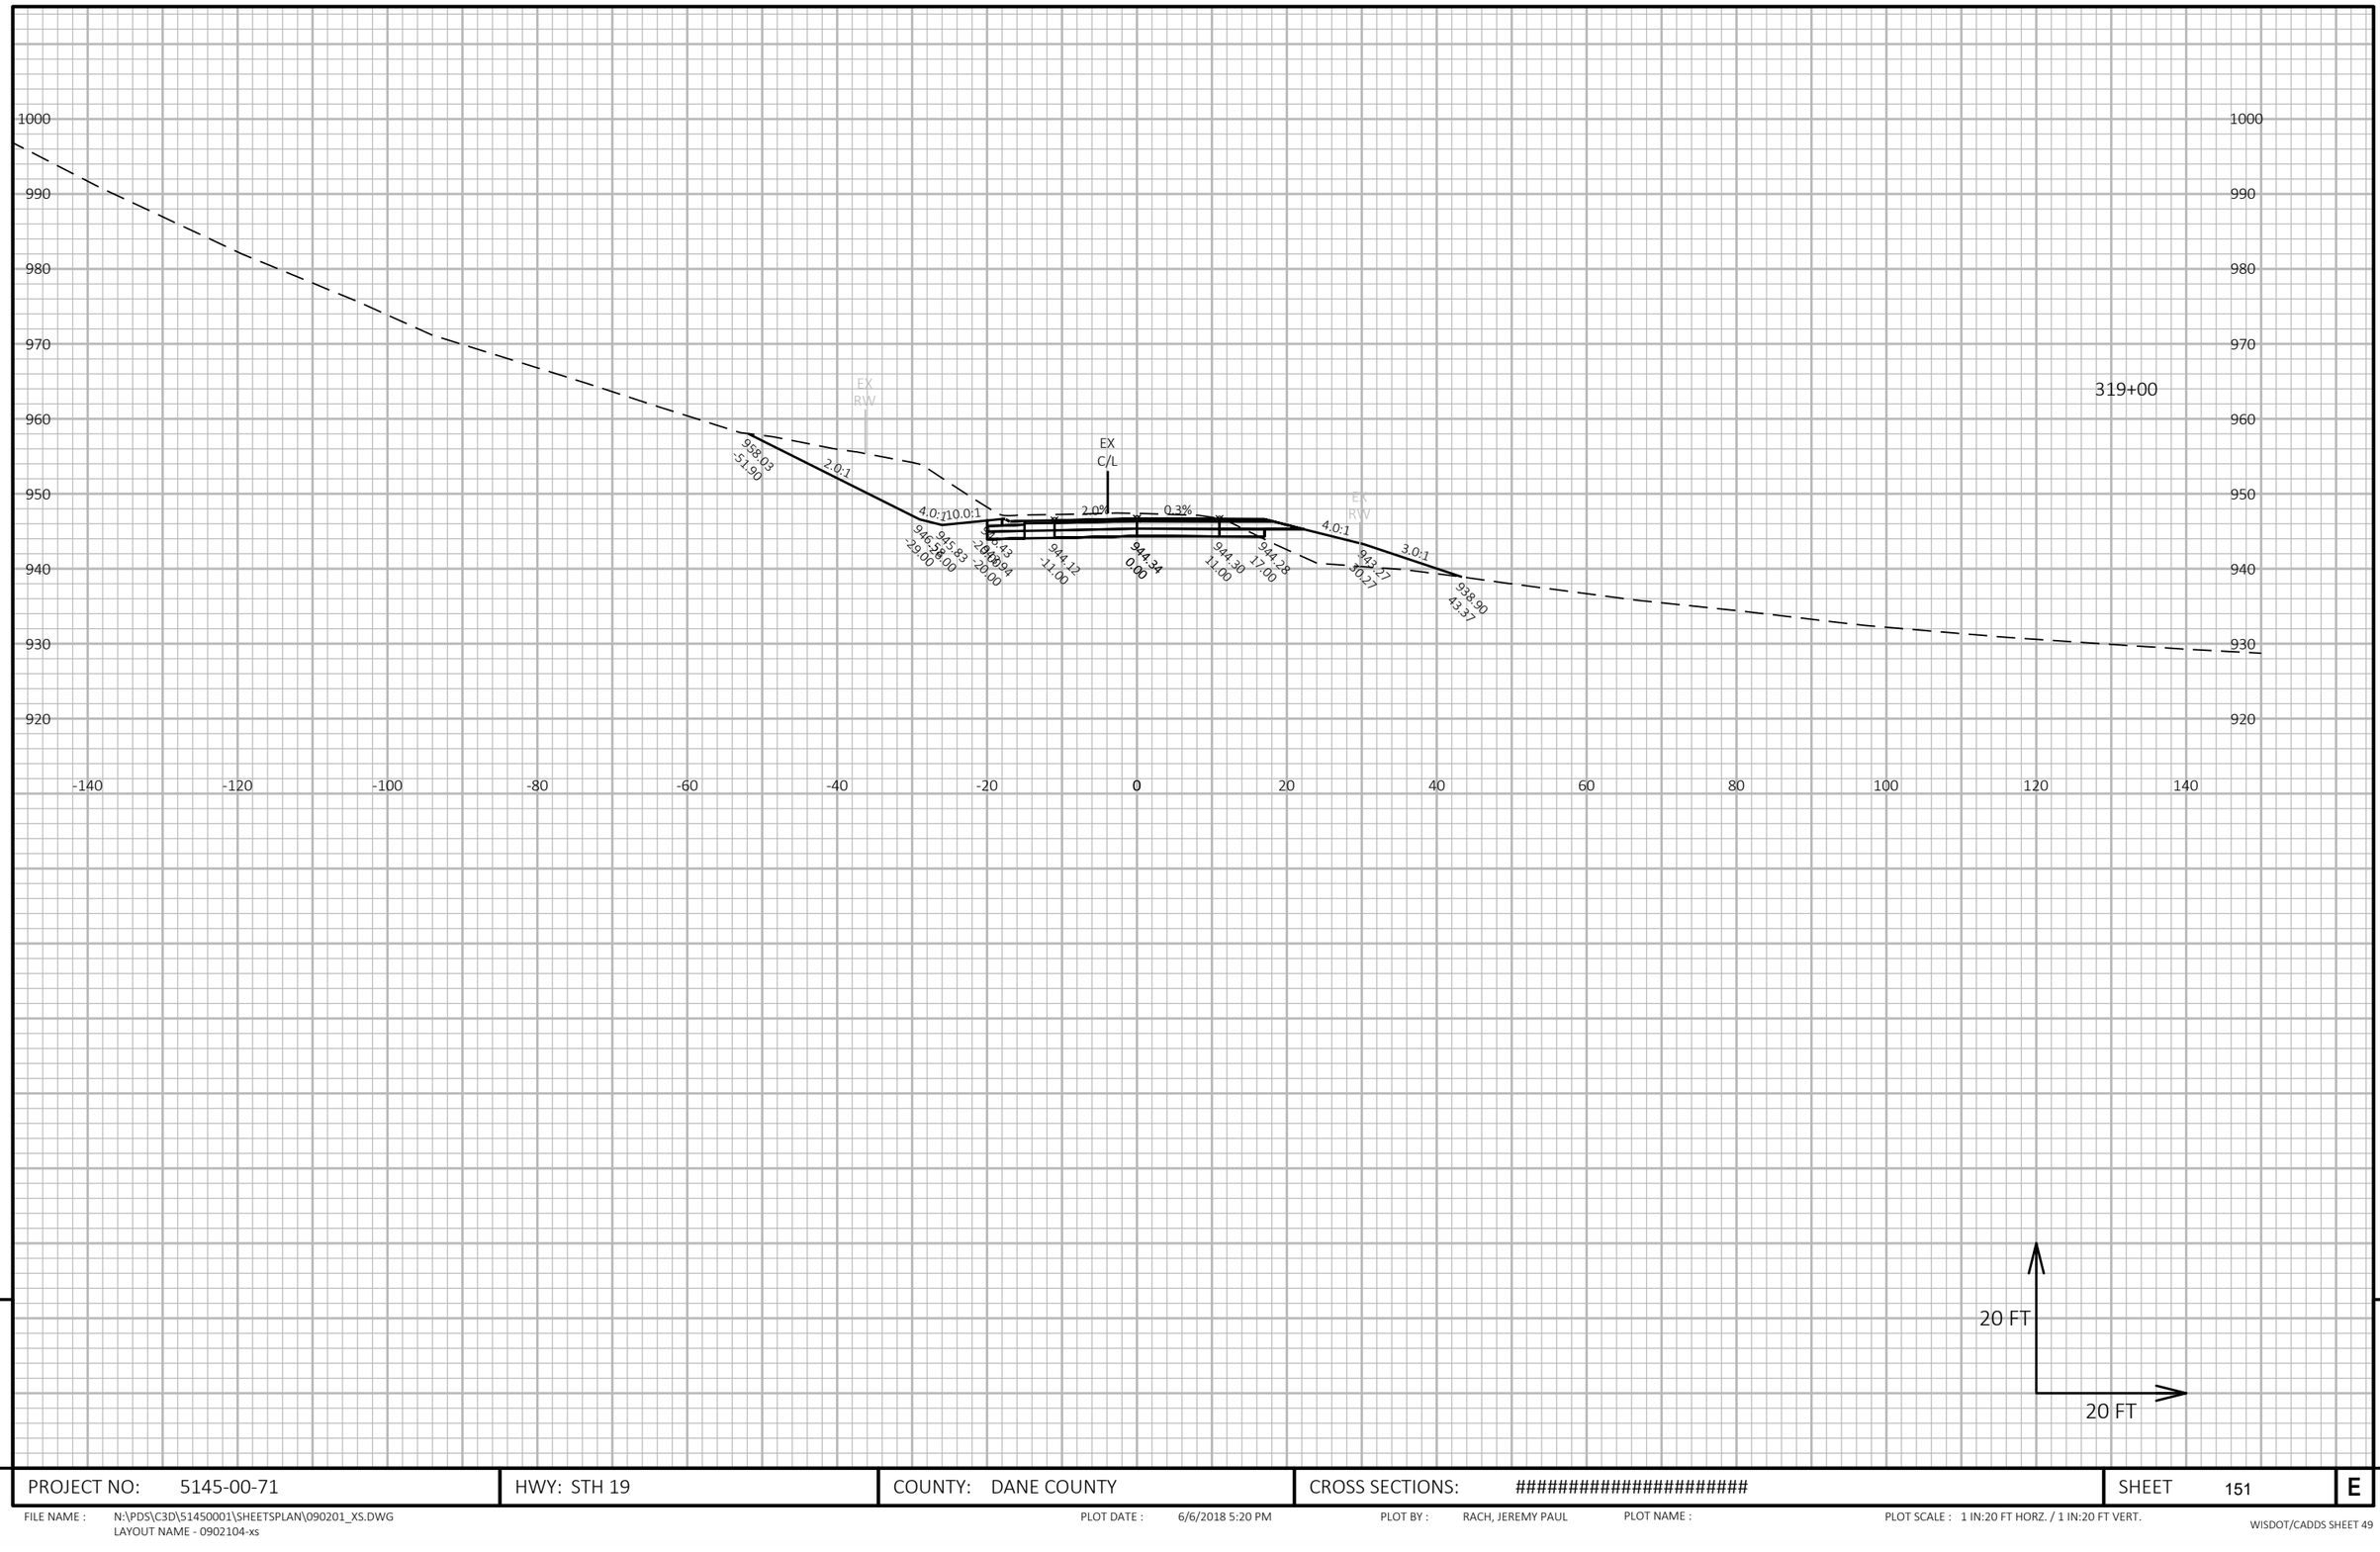

9

9

PROJECT NO: 5145-00-71	HWY: STH 19	COUNTY: DANE COUNTY	CROSS SECTIONS: ##########################	SHEET 151	E

FILE NAME : N:\PDS\C3D\51450001\SHEETSPLAN\090201_XS.DWG
LAYOUT NAME - 0902104-xs

PLOT DATE : 6/6/2018 5:20 PM PLOT BY : RACH, JEREMY PAUL PLOT NAME : PLOT SCALE : 1 IN:20 FT HORZ. / 1 IN:20 FT VERT.

WISDOT/CADDS SHEET 49

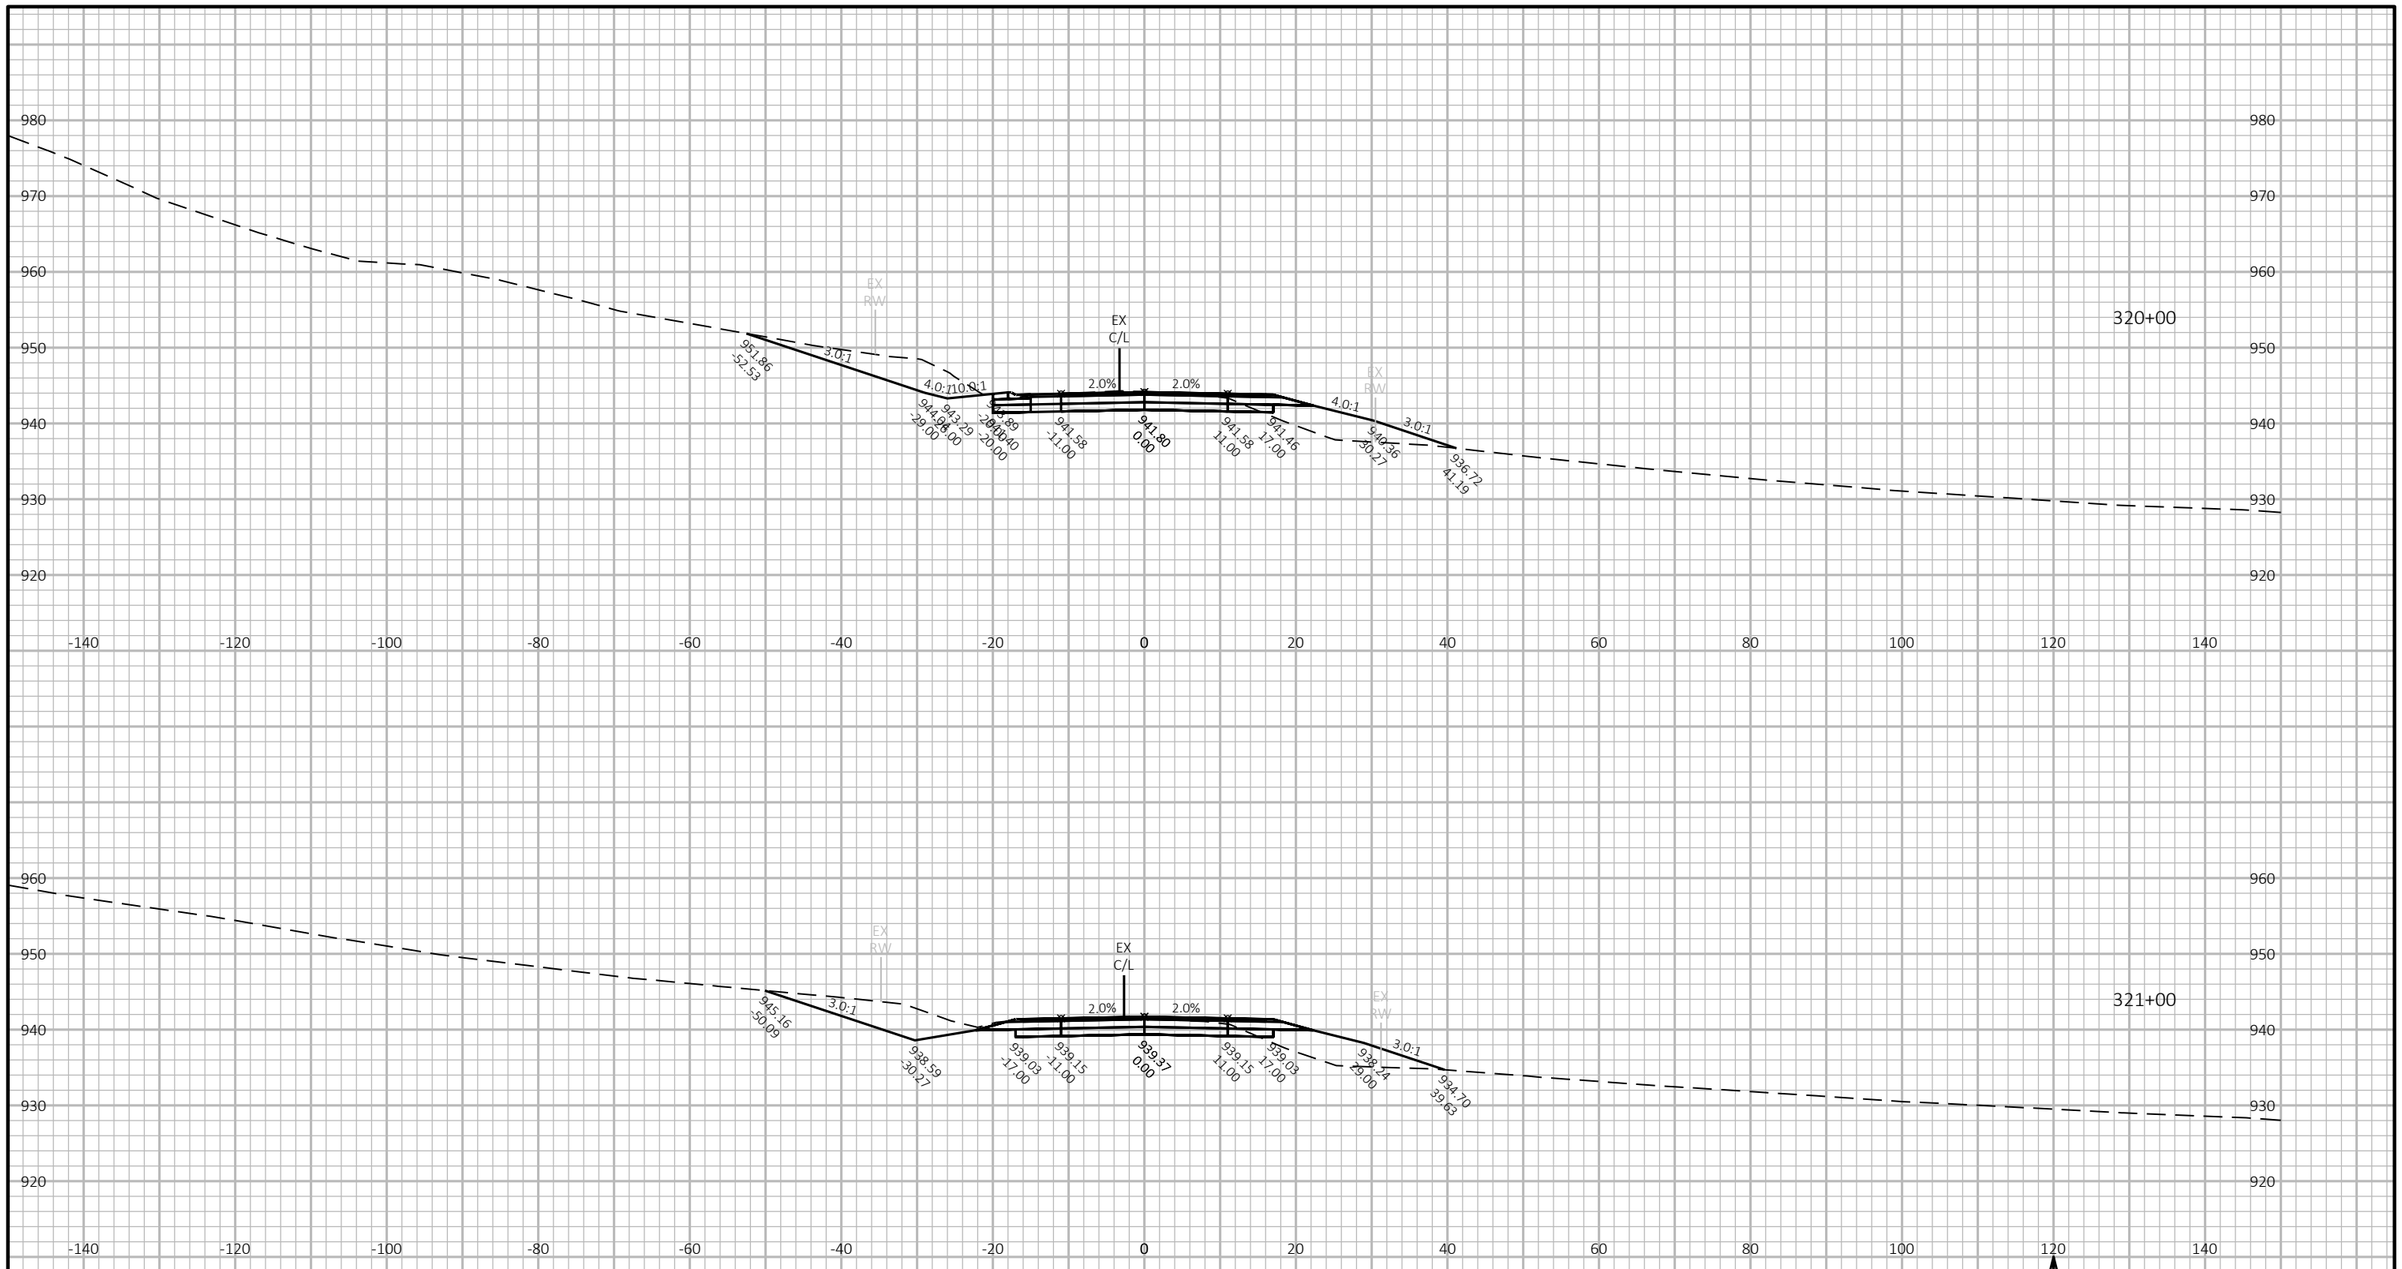

9

9

PROJECT NO: 5145-00-71	HWY: STH 19	COUNTY: DANE COUNTY	CROSS SECTIONS: ##########################	SHEET 152	E

FILE NAME : N:\PDS\C3D\51450001\SHEETSPLAN\090201_XS.DWG
LAYOUT NAME - 0902105-xs

PLOT DATE : 6/6/2018 5:20 PM

PLOT BY : RACH, JEREMY PAUL

PLOT NAME :

PLOT SCALE : 1 IN:20 FT HORZ. / 1 IN:20 FT VERT.

WISDOT/CADDS SHEET 49

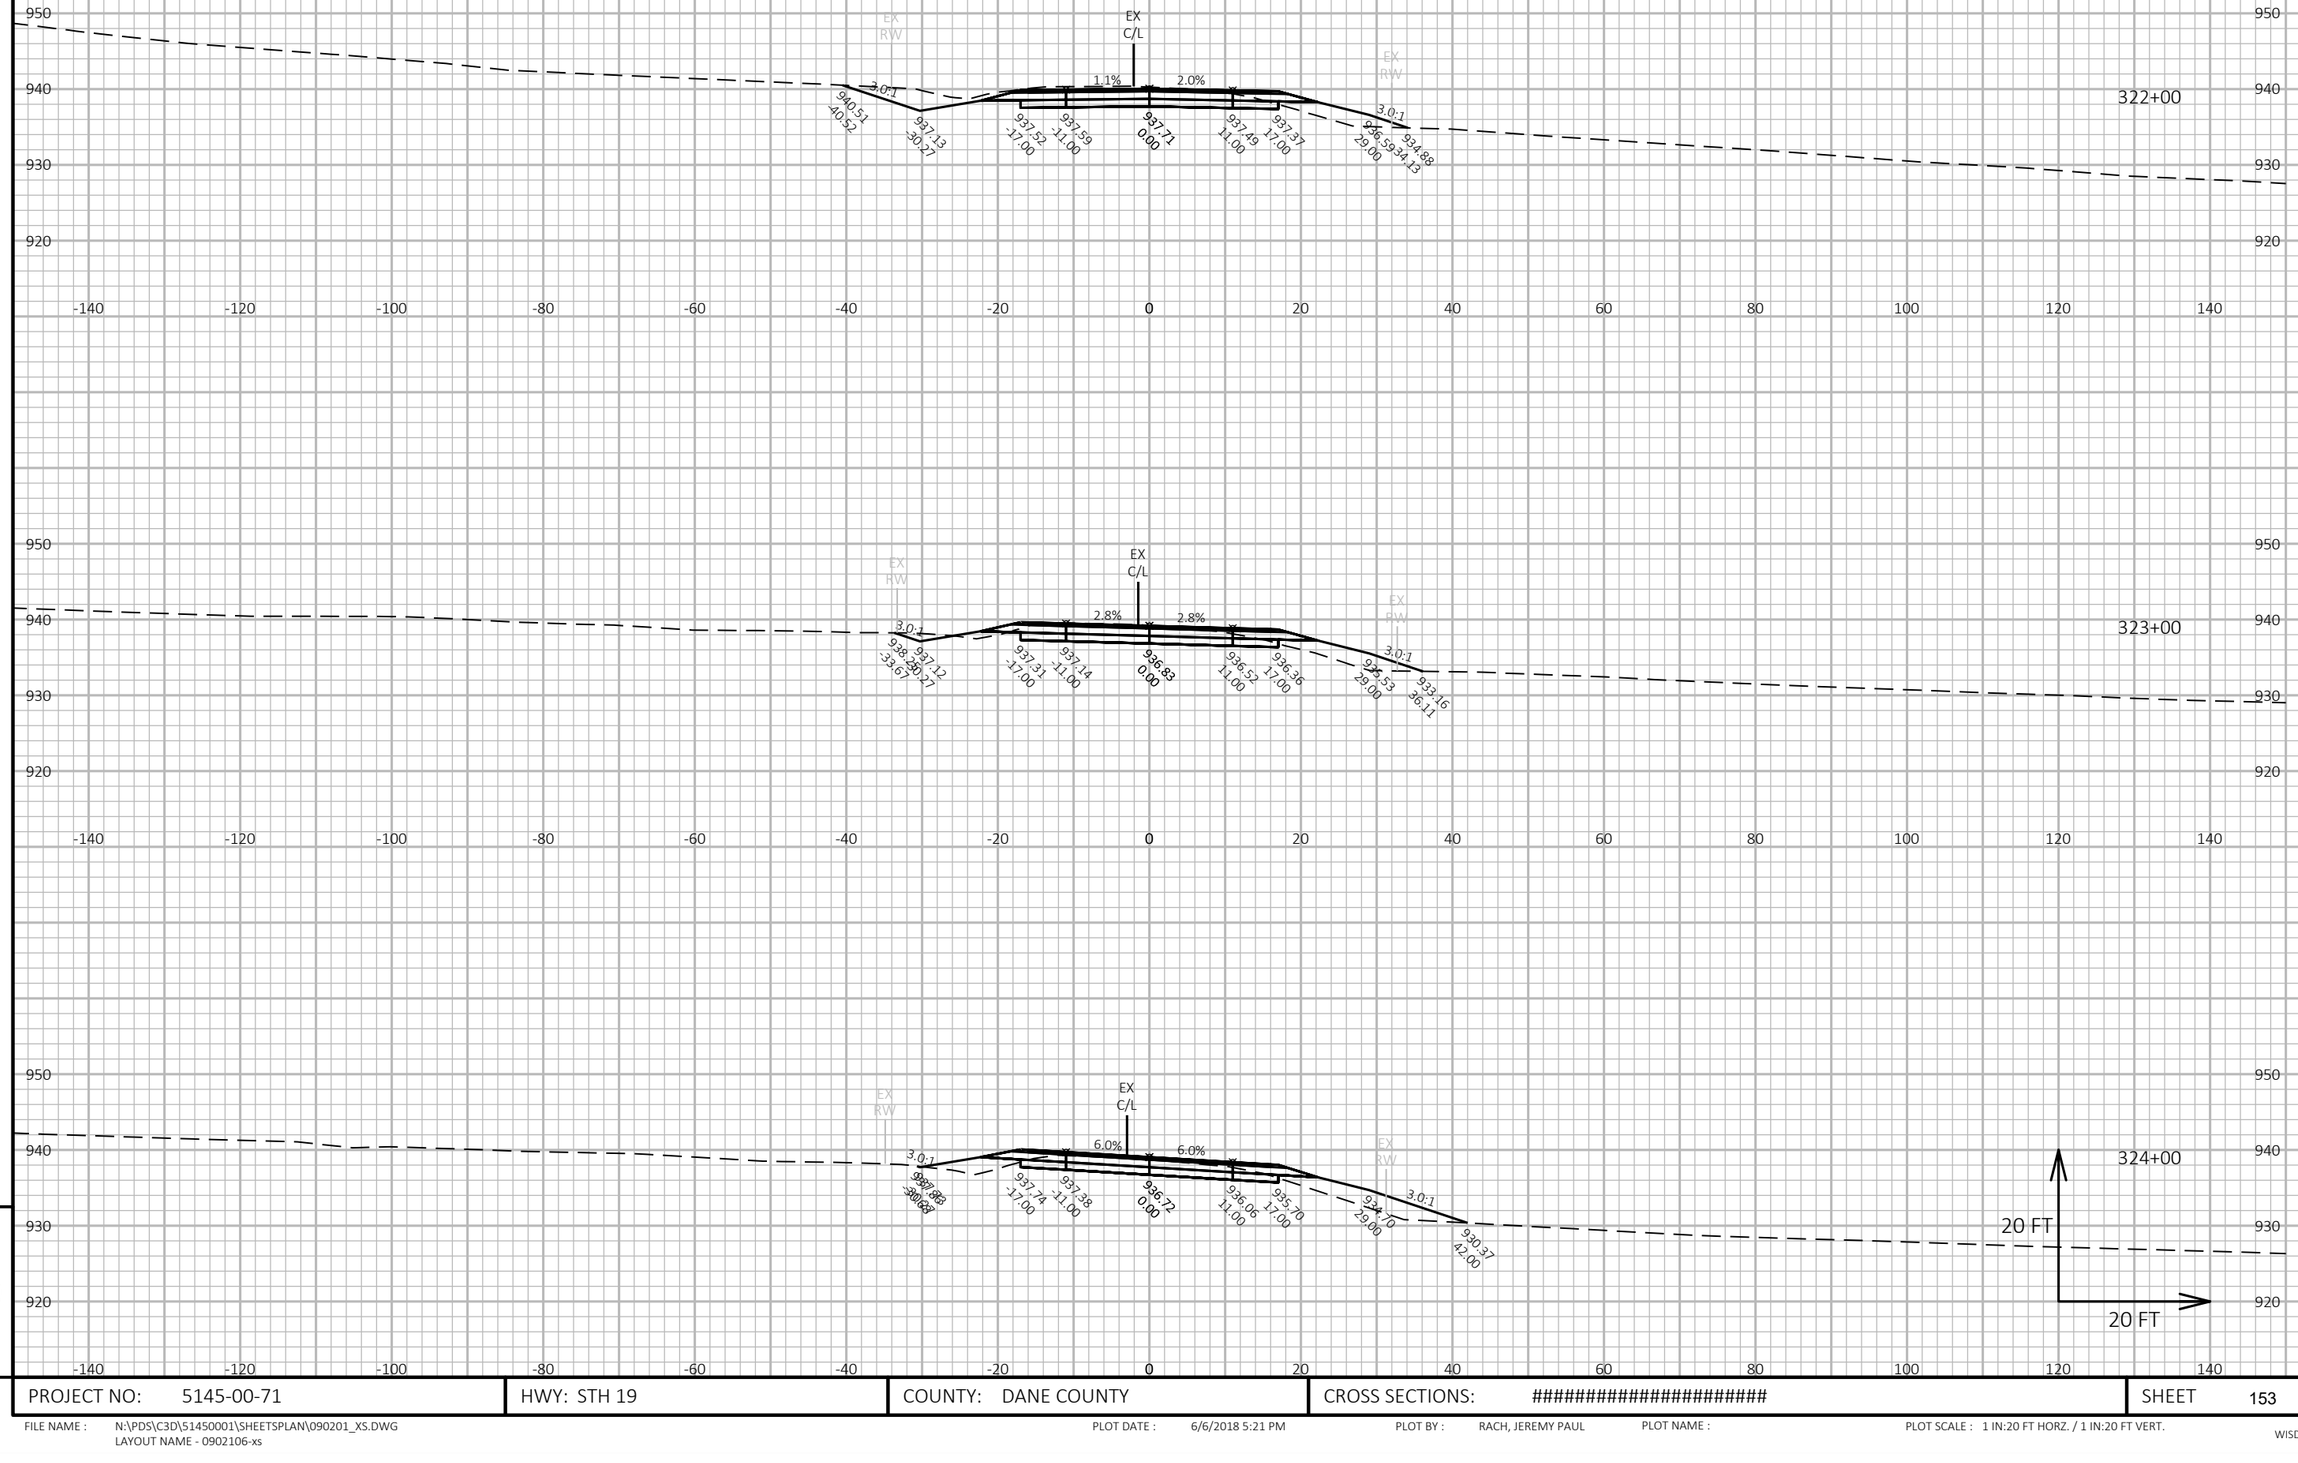

9

9

PROJECT NO: 5145-00-71	HWY: STH 19	COUNTY: DANE COUNTY	CROSS SECTIONS: ##########################	SHEET 153	E

FILE NAME : N:\PDS\C3D\51450001\SHEETSPLAN\090201_XS.DWG
LAYOUT NAME - 0902106-xs

PLOT DATE : 6/6/2018 5:21 PM PLOT BY : RACH, JEREMY PAUL PLOT NAME : PLOT SCALE : 1 IN:20 FT HORZ. / 1 IN:20 FT VERT.

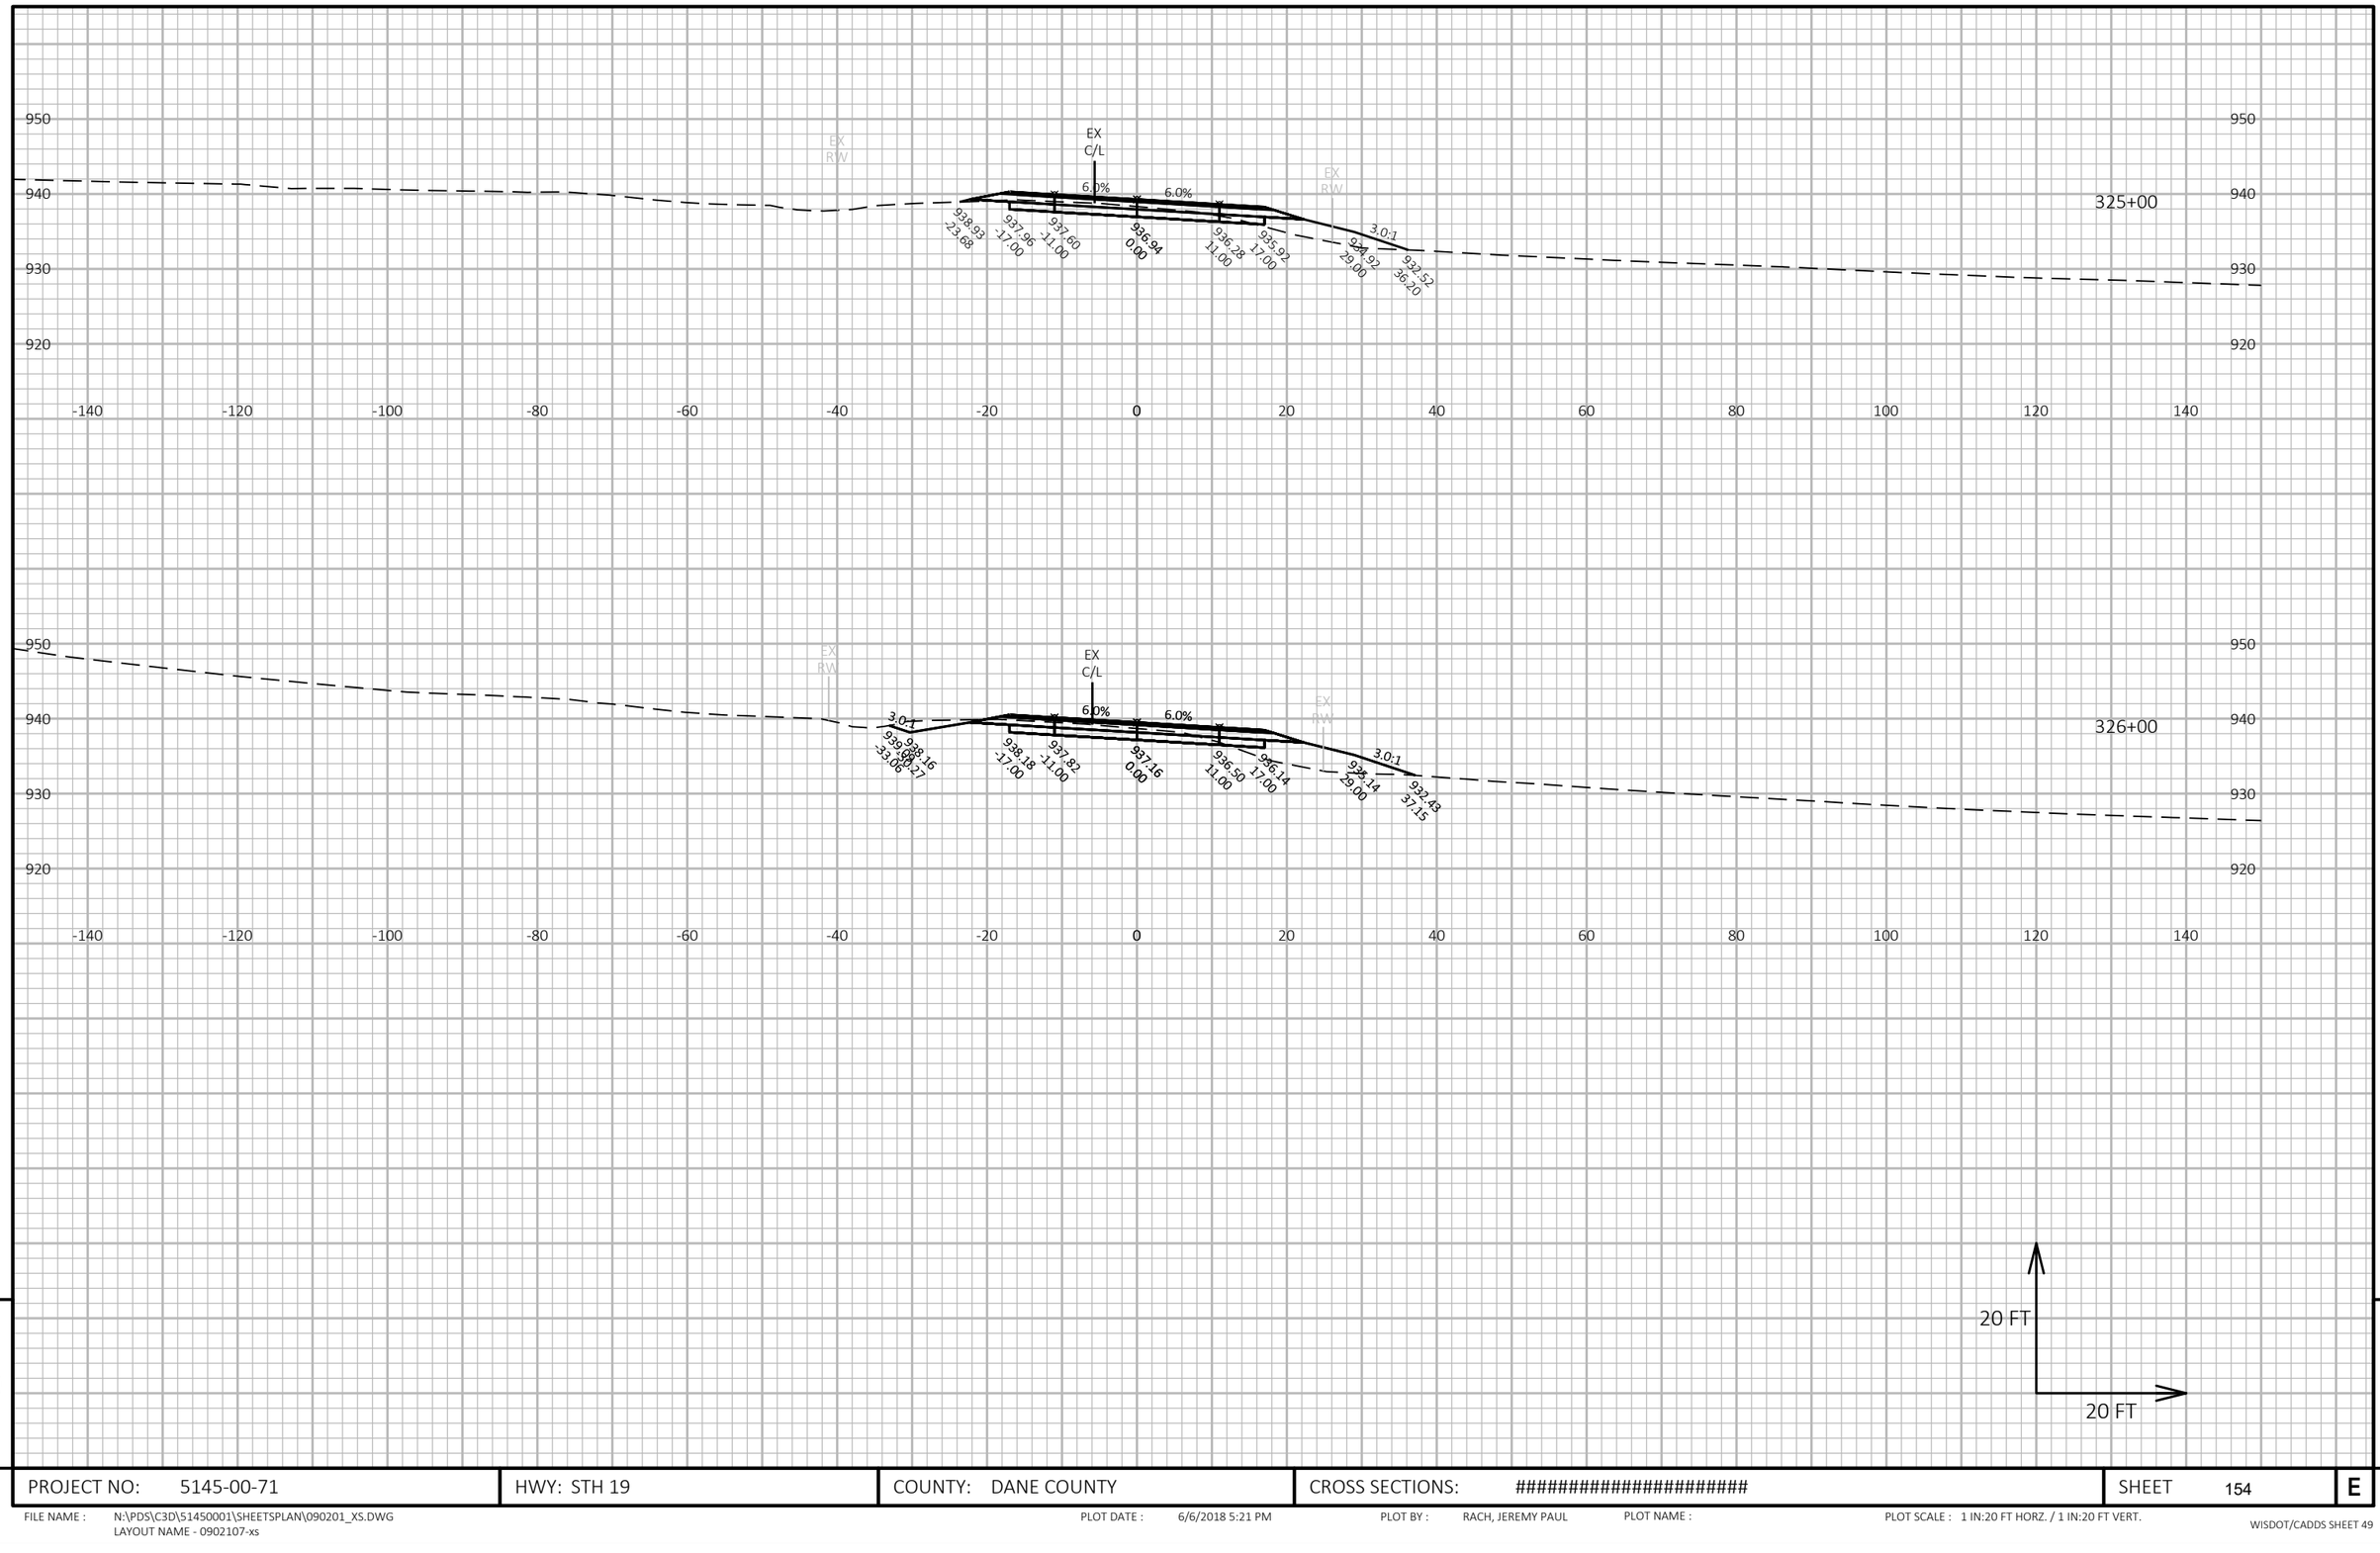

9

9

PROJECT NO: 5145-00-71	HWY: STH 19	COUNTY: DANE COUNTY	CROSS SECTIONS: ##########################	SHEET 154	E

FILE NAME : N:\PDS\C3D\51450001\SHEETSPLAN\090201_XS.DWG
LAYOUT NAME - 0902107-xs

PLOT DATE : 6/6/2018 5:21 PM

PLOT BY : RACH, JEREMY PAUL

PLOT NAME :

PLOT SCALE : 1 IN:20 FT HORZ. / 1 IN:20 FT VERT.

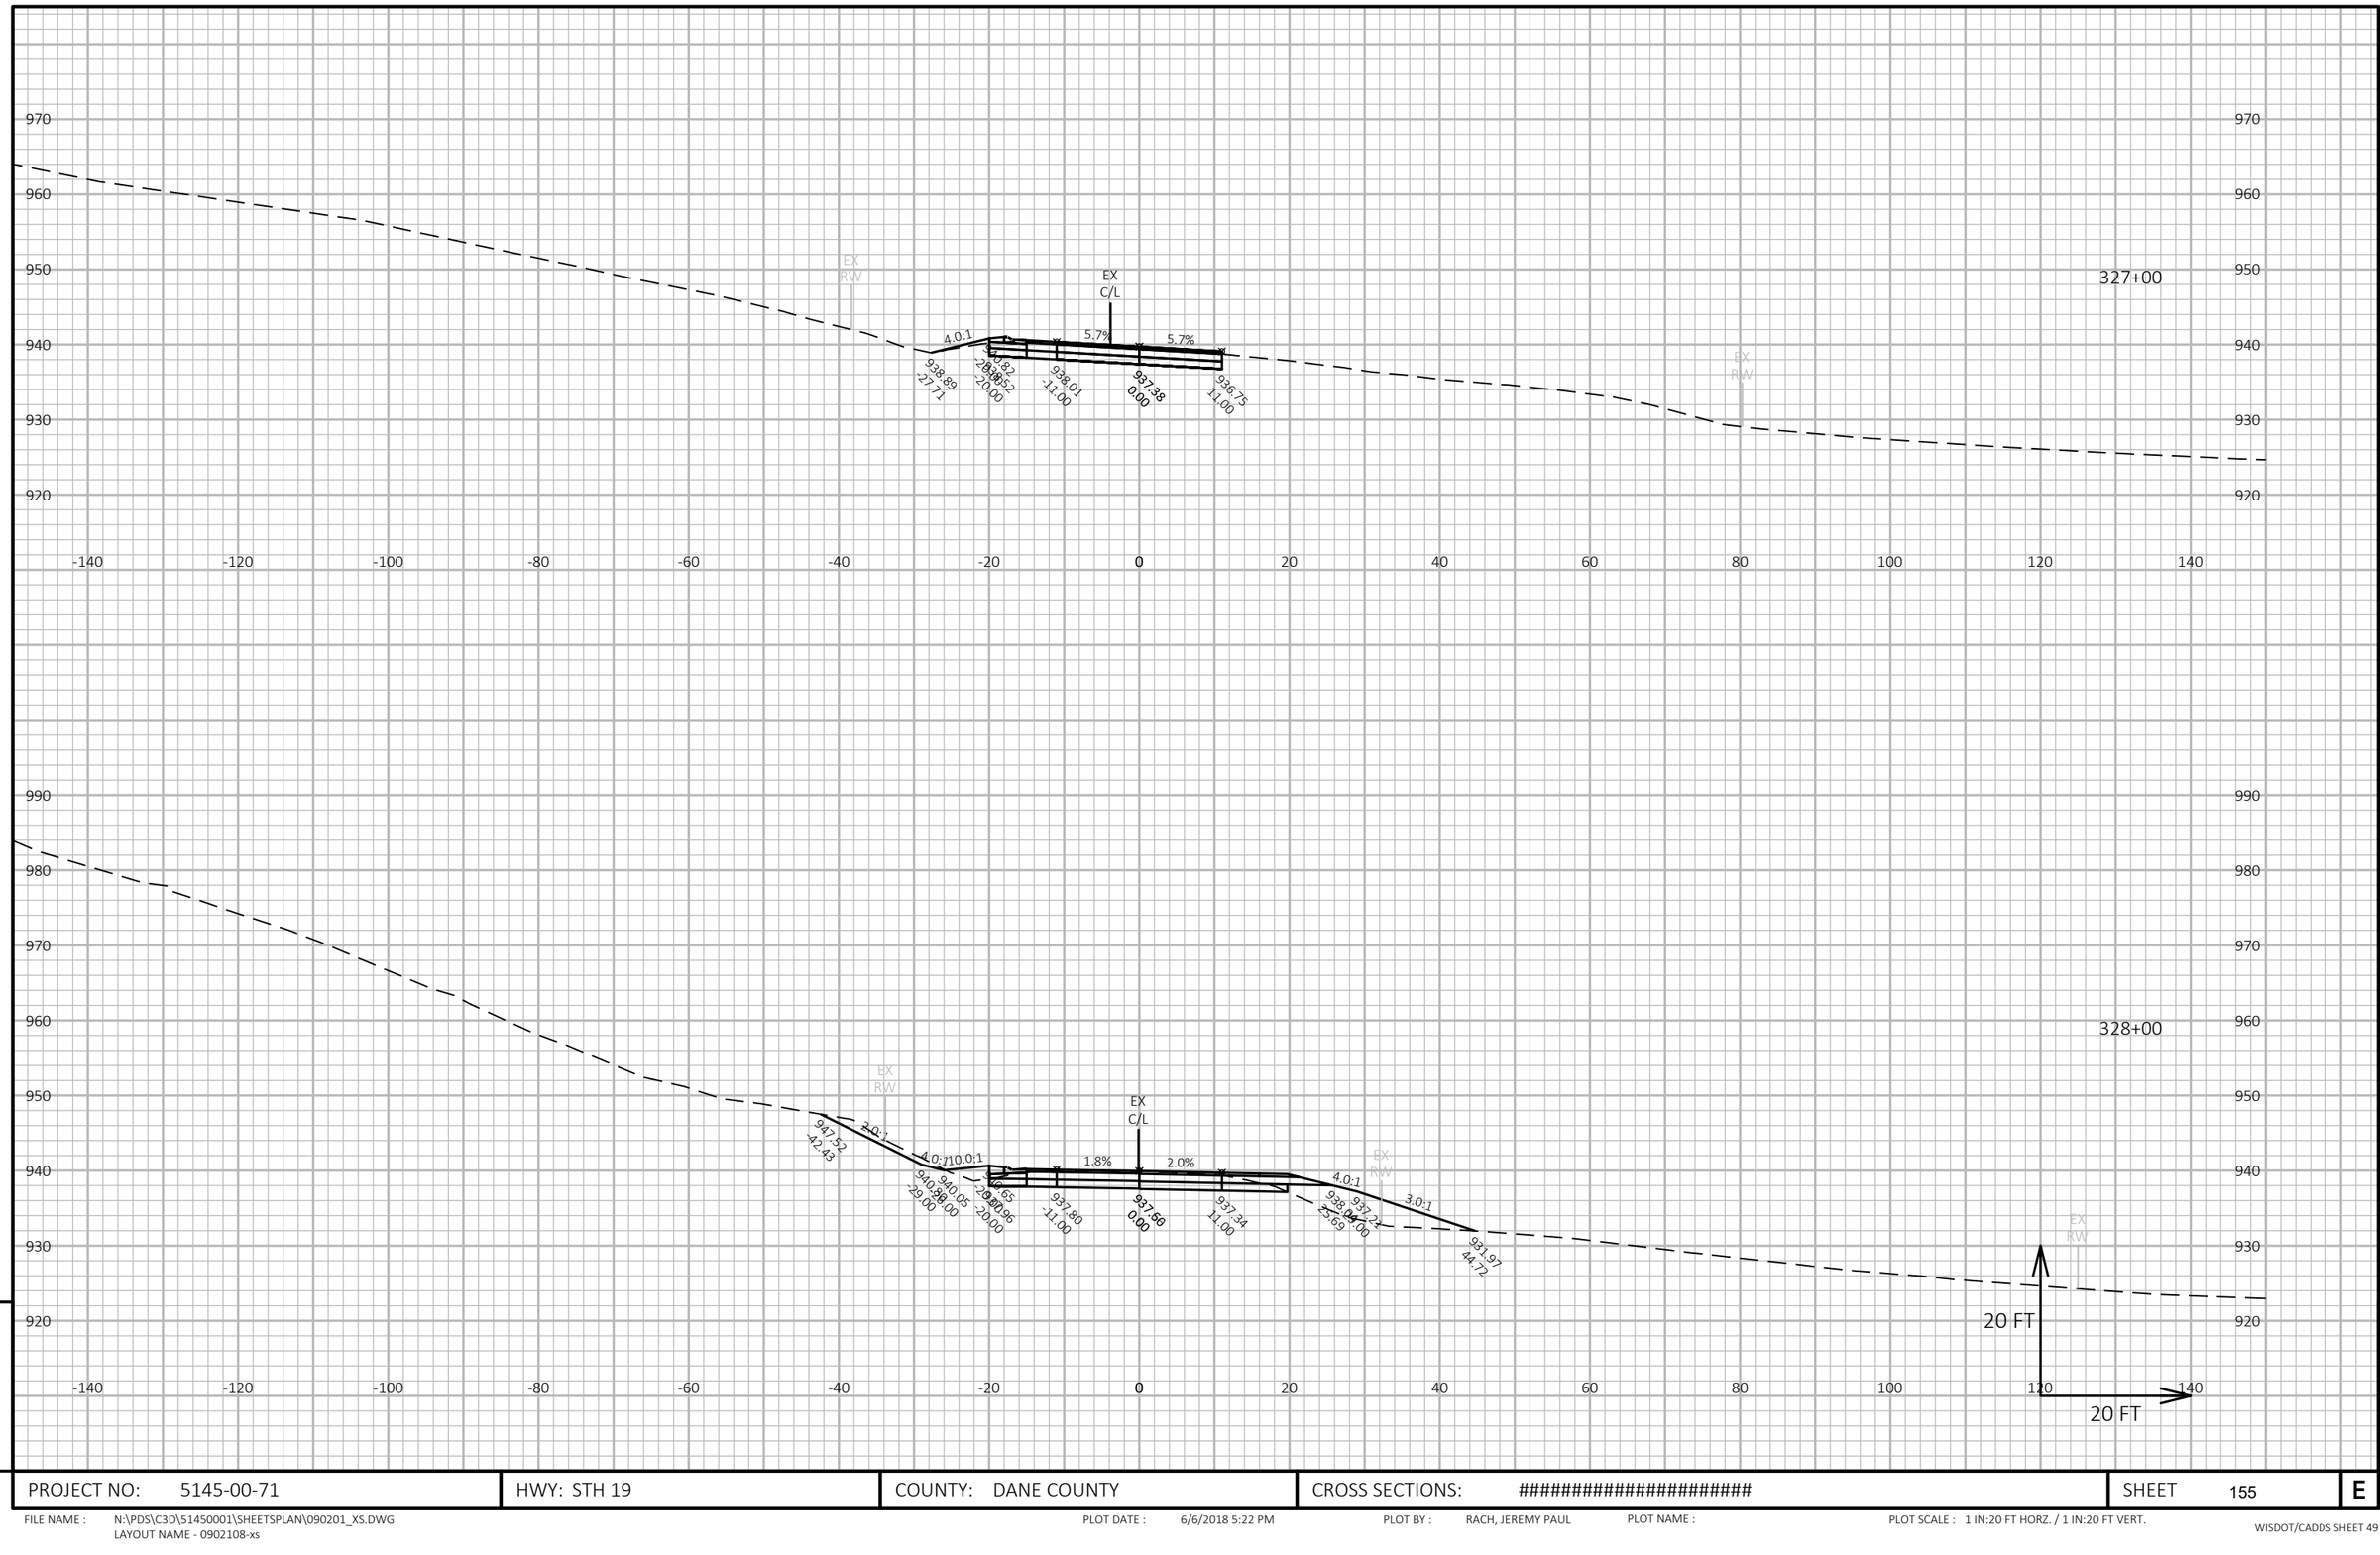

9

PROJECT NO: 5145-00-71	HWY: STH 19	COUNTY: DANE COUNTY	CROSS SECTIONS: ##########################	SHEET 155	E

FILE NAME : N:\PDS\C3D\51450001\SHEETSPLAN\090201_XS.DWG
LAYOUT NAME - 0902108-xs

PLOT DATE : 6/6/2018 5:22 PM PLOT BY : RACH, JEREMY PAUL PLOT NAME : PLOT SCALE : 1 IN:20 FT HORZ. / 1 IN:20 FT VERT.

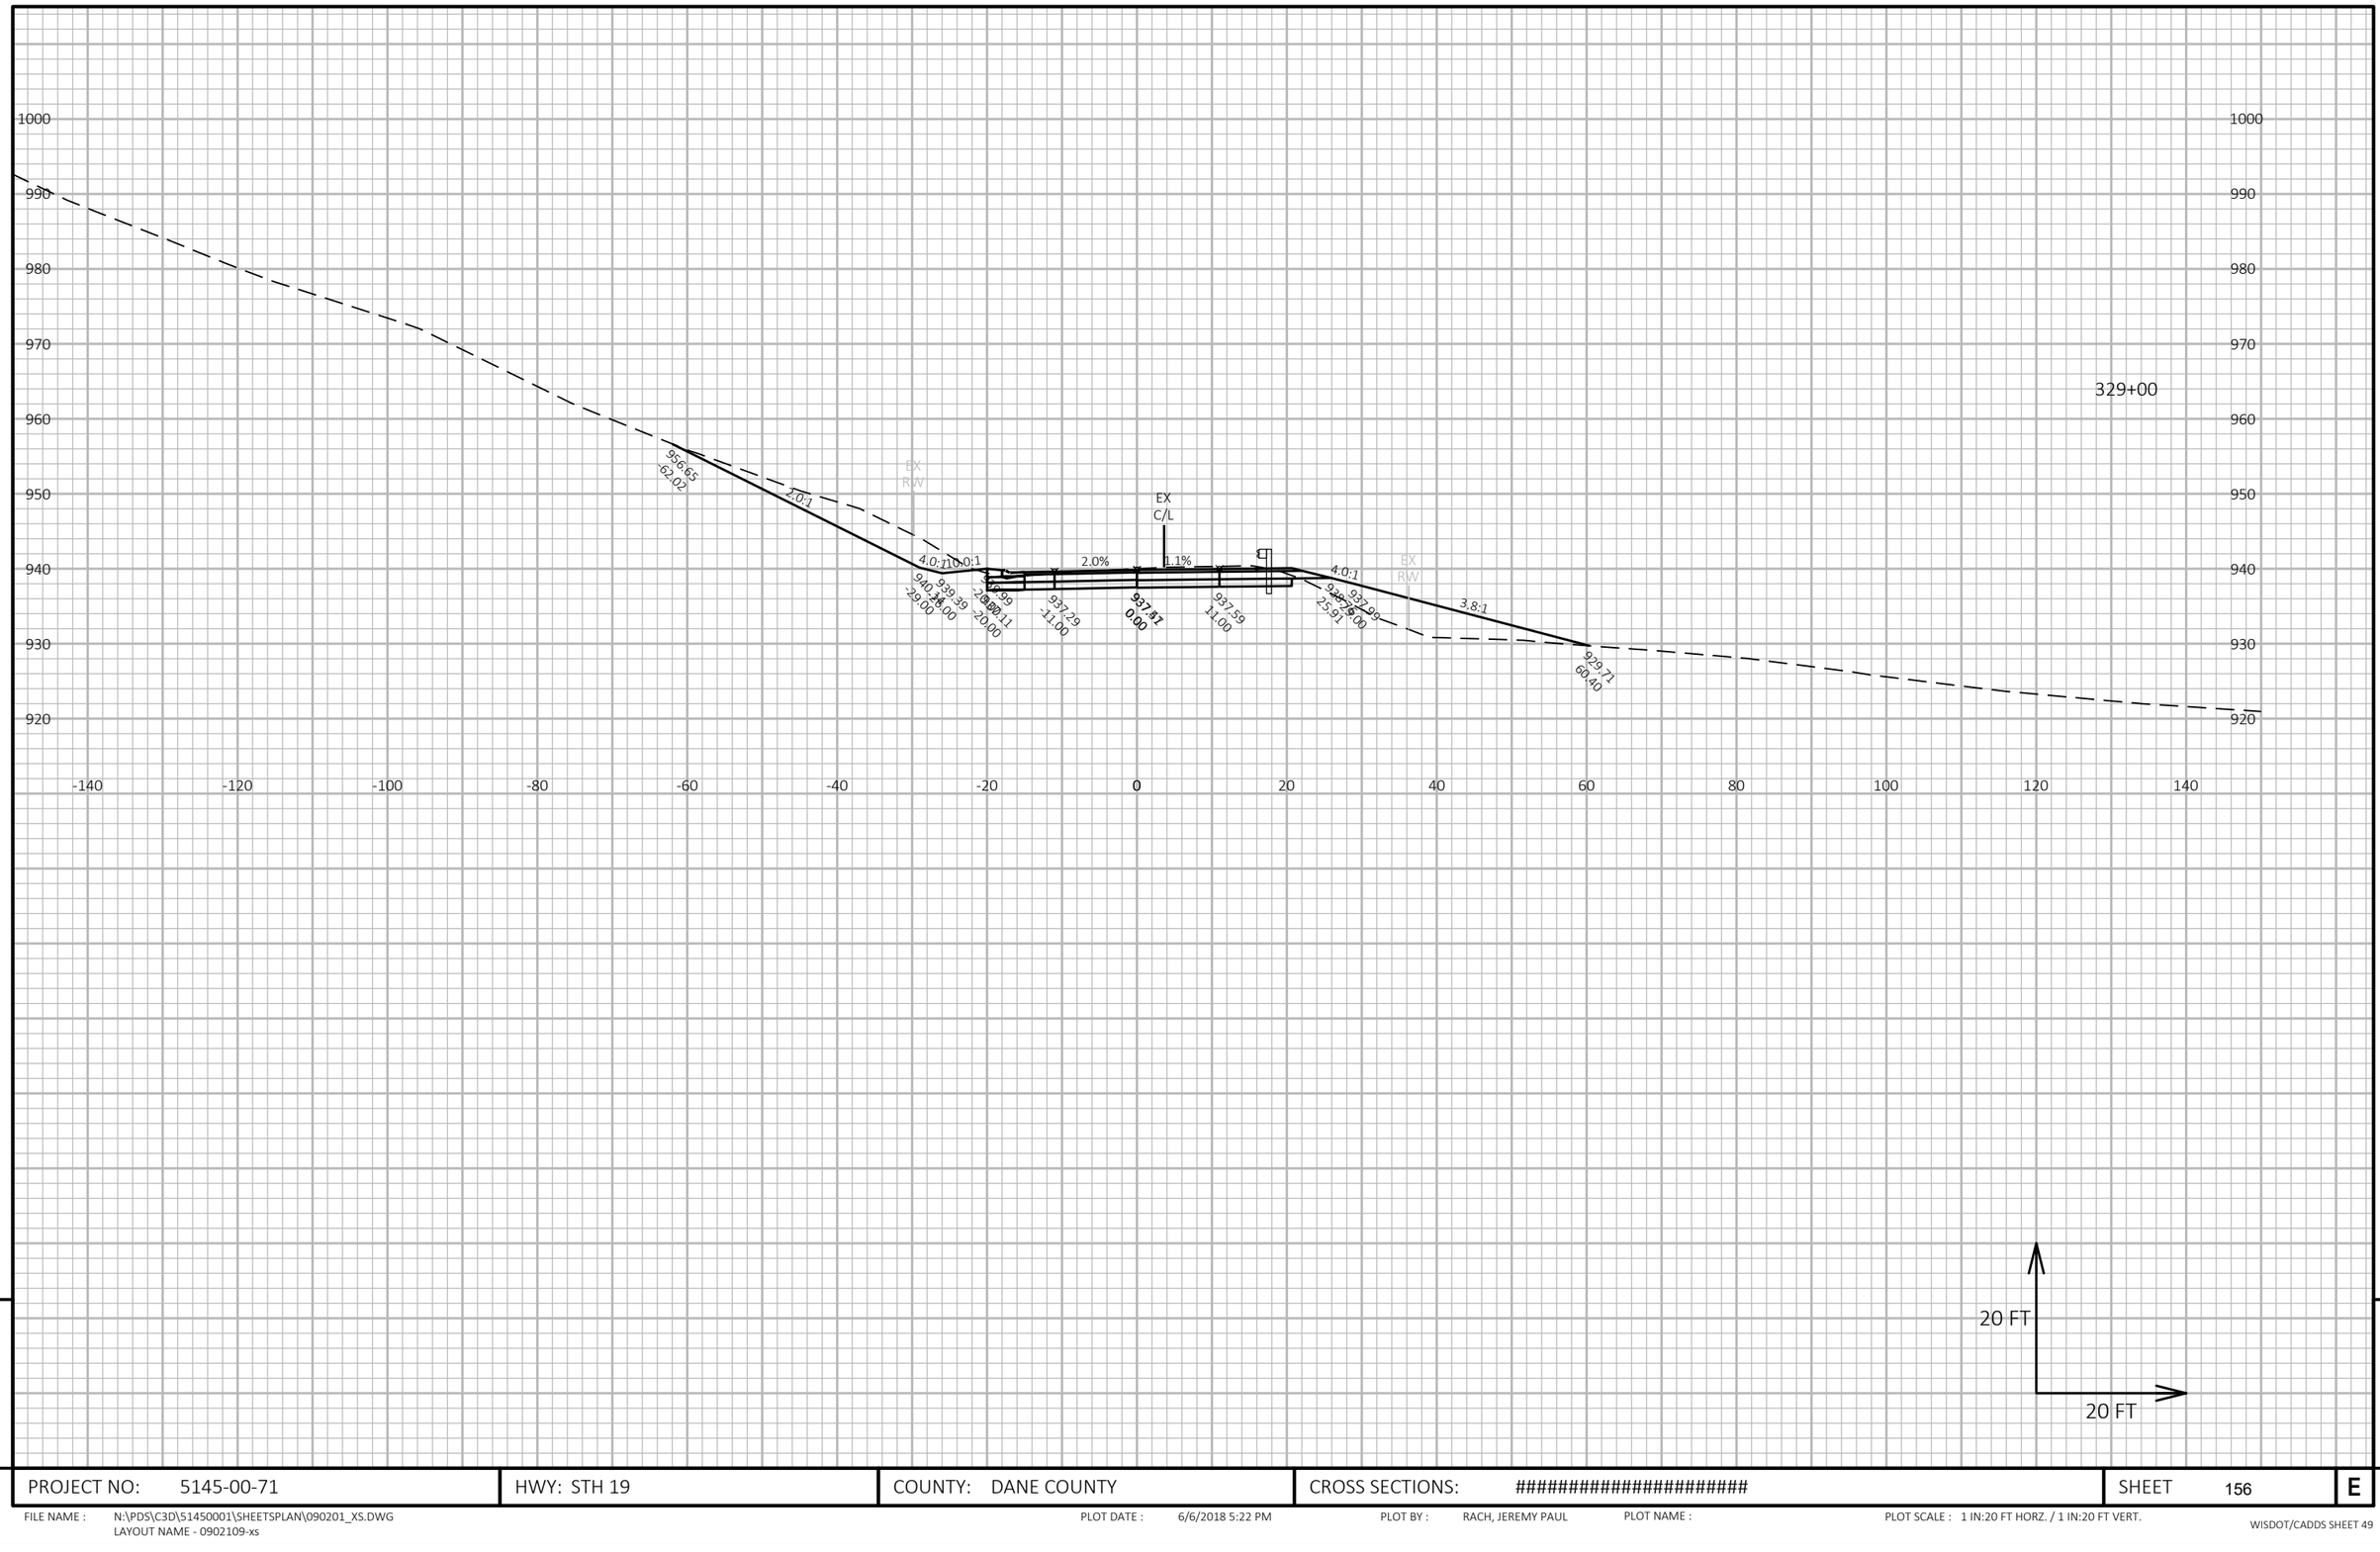

9

9

PROJECT NO: 5145-00-71	HWY: STH 19	COUNTY: DANE COUNTY	CROSS SECTIONS: ##########################	SHEET 156	E

FILE NAME : N:\PDS\C3D\51450001\SHEETSPLAN\090201_XS.DWG
LAYOUT NAME - 0902109-xs

PLOT DATE : 6/6/2018 5:22 PM

PLOT BY : RACH, JEREMY PAUL

PLOT NAME :

PLOT SCALE : 1 IN:20 FT HORZ. / 1 IN:20 FT VERT.

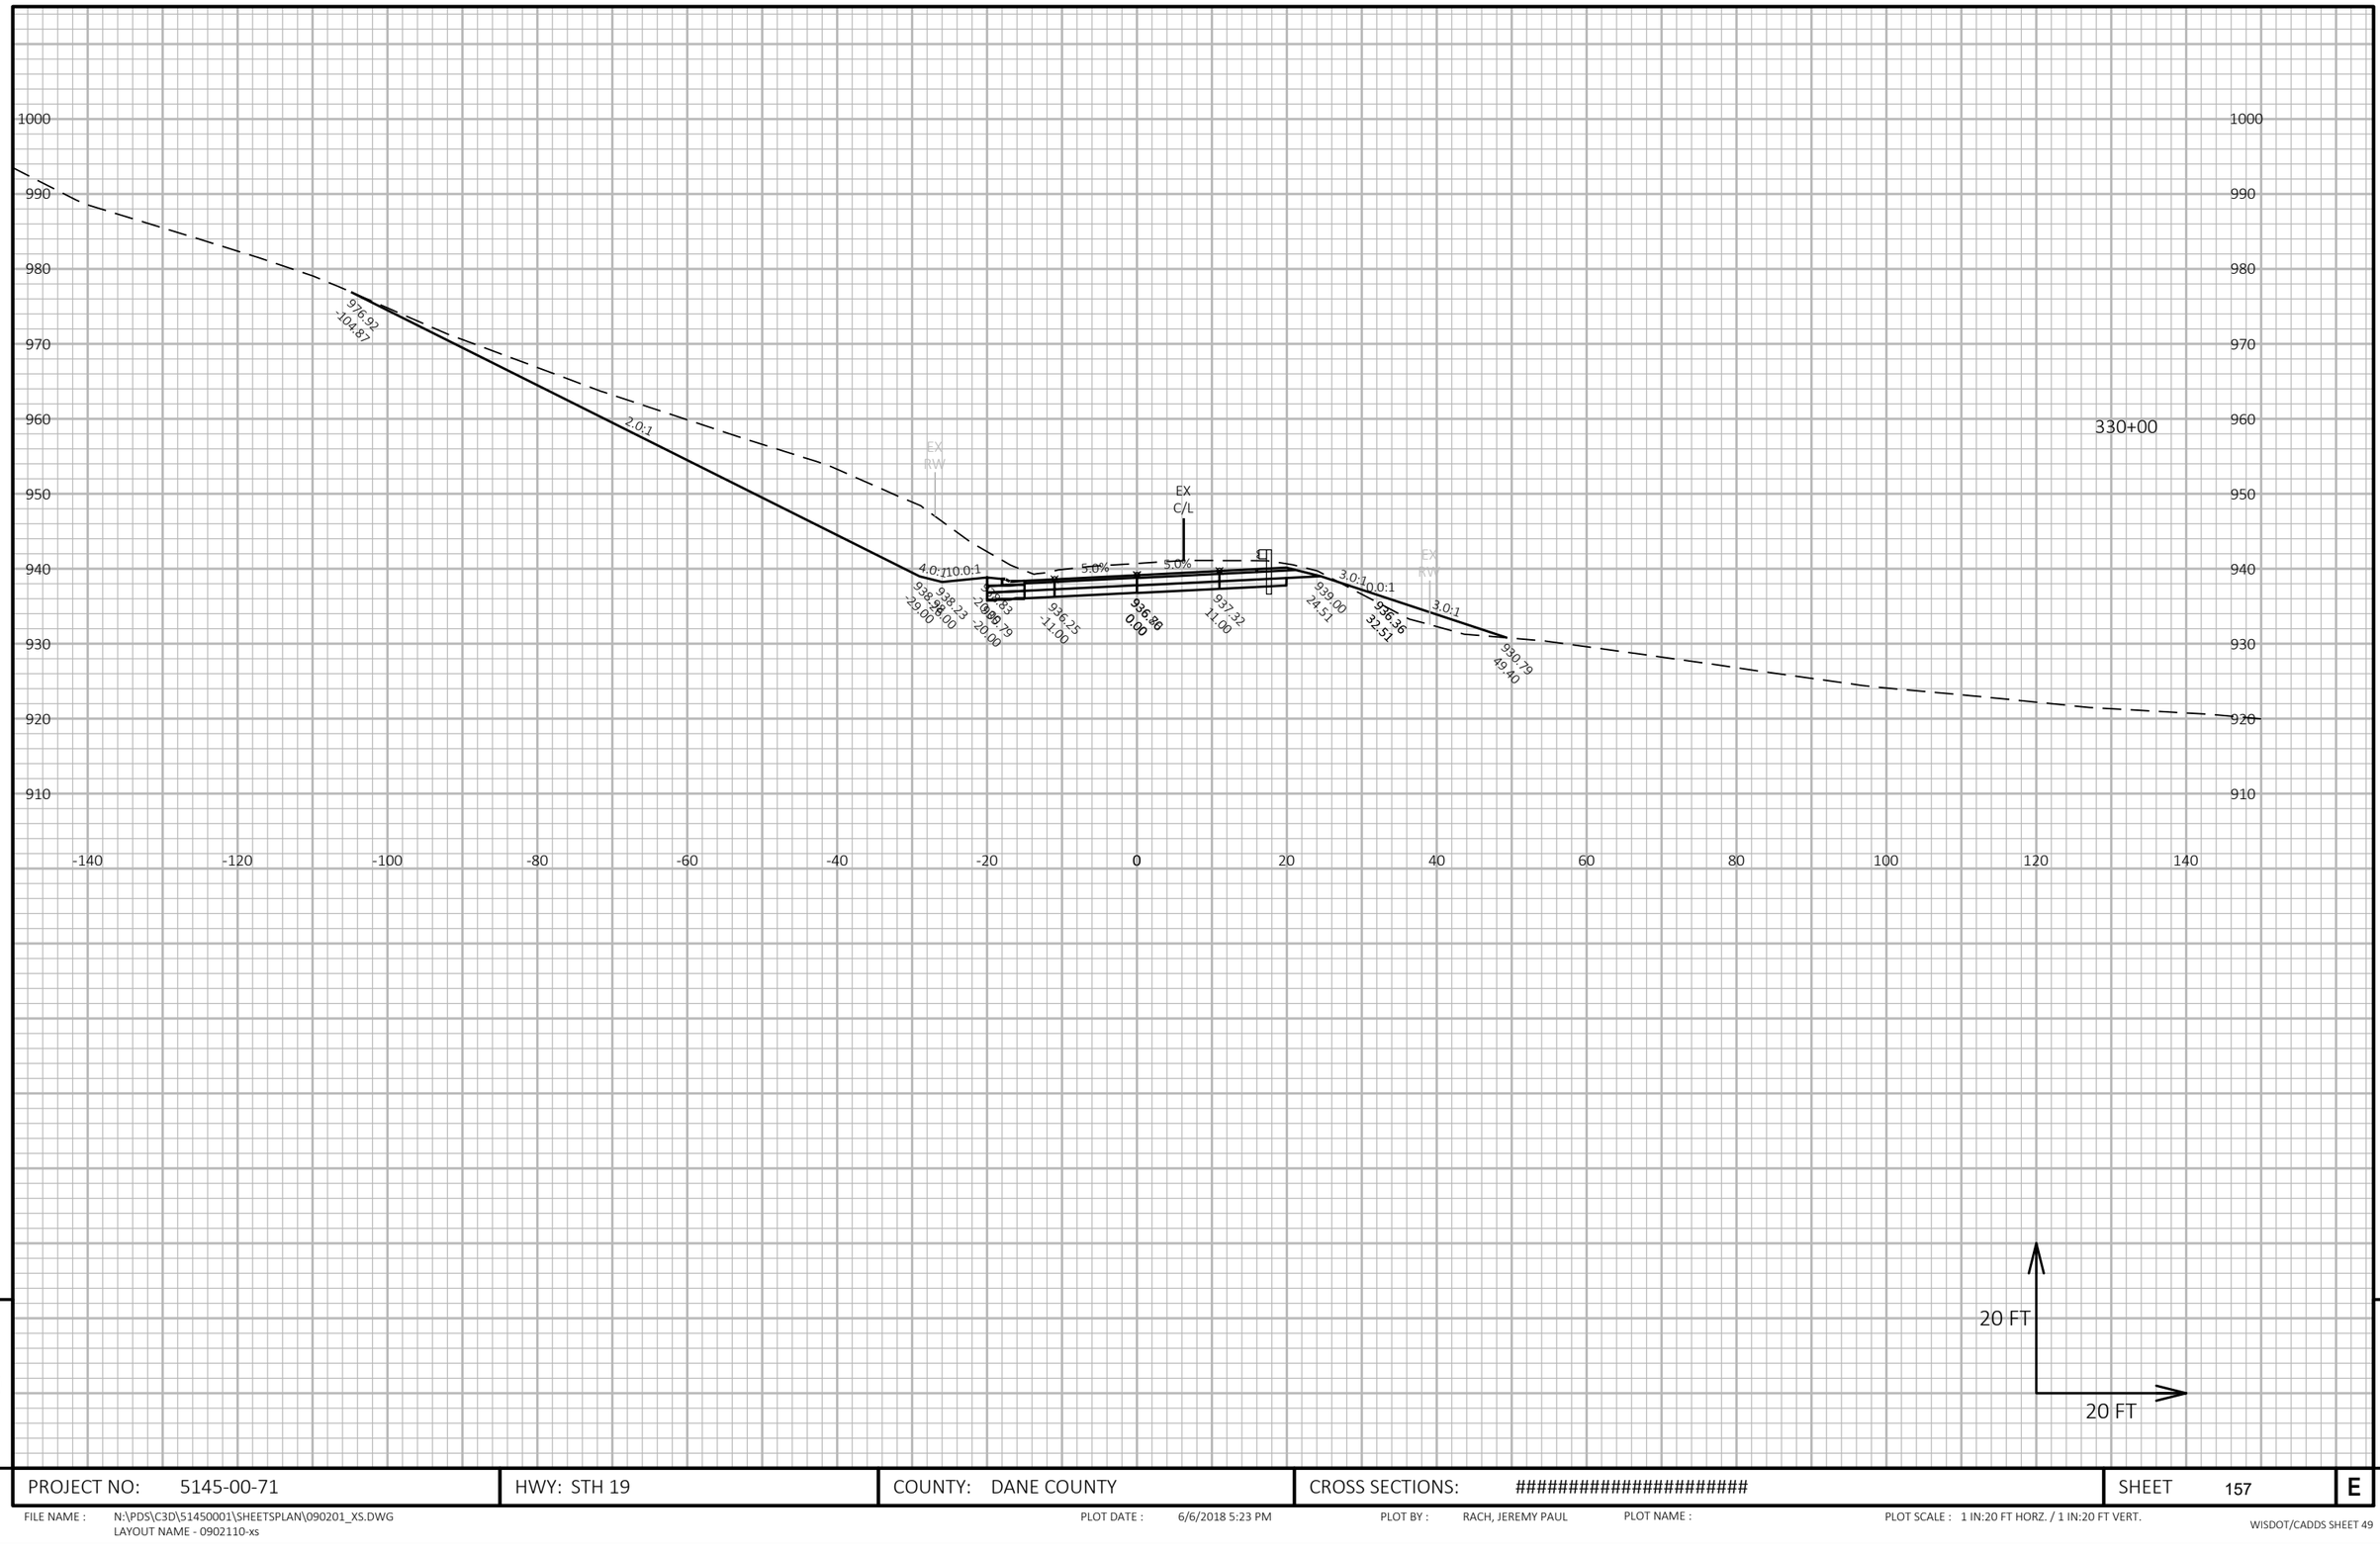

9

9

PROJECT NO: 5145-00-71	HWY: STH 19	COUNTY: DANE COUNTY	CROSS SECTIONS: ##########################	SHEET 157	E

FILE NAME : N:\PDS\C3D\51450001\SHEETSPLAN\090201_XS.DWG
LAYOUT NAME - 0902110-xs

PLOT DATE : 6/6/2018 5:23 PM PLOT BY : RACH, JEREMY PAUL PLOT NAME : PLOT SCALE : 1 IN:20 FT HORZ. / 1 IN:20 FT VERT.

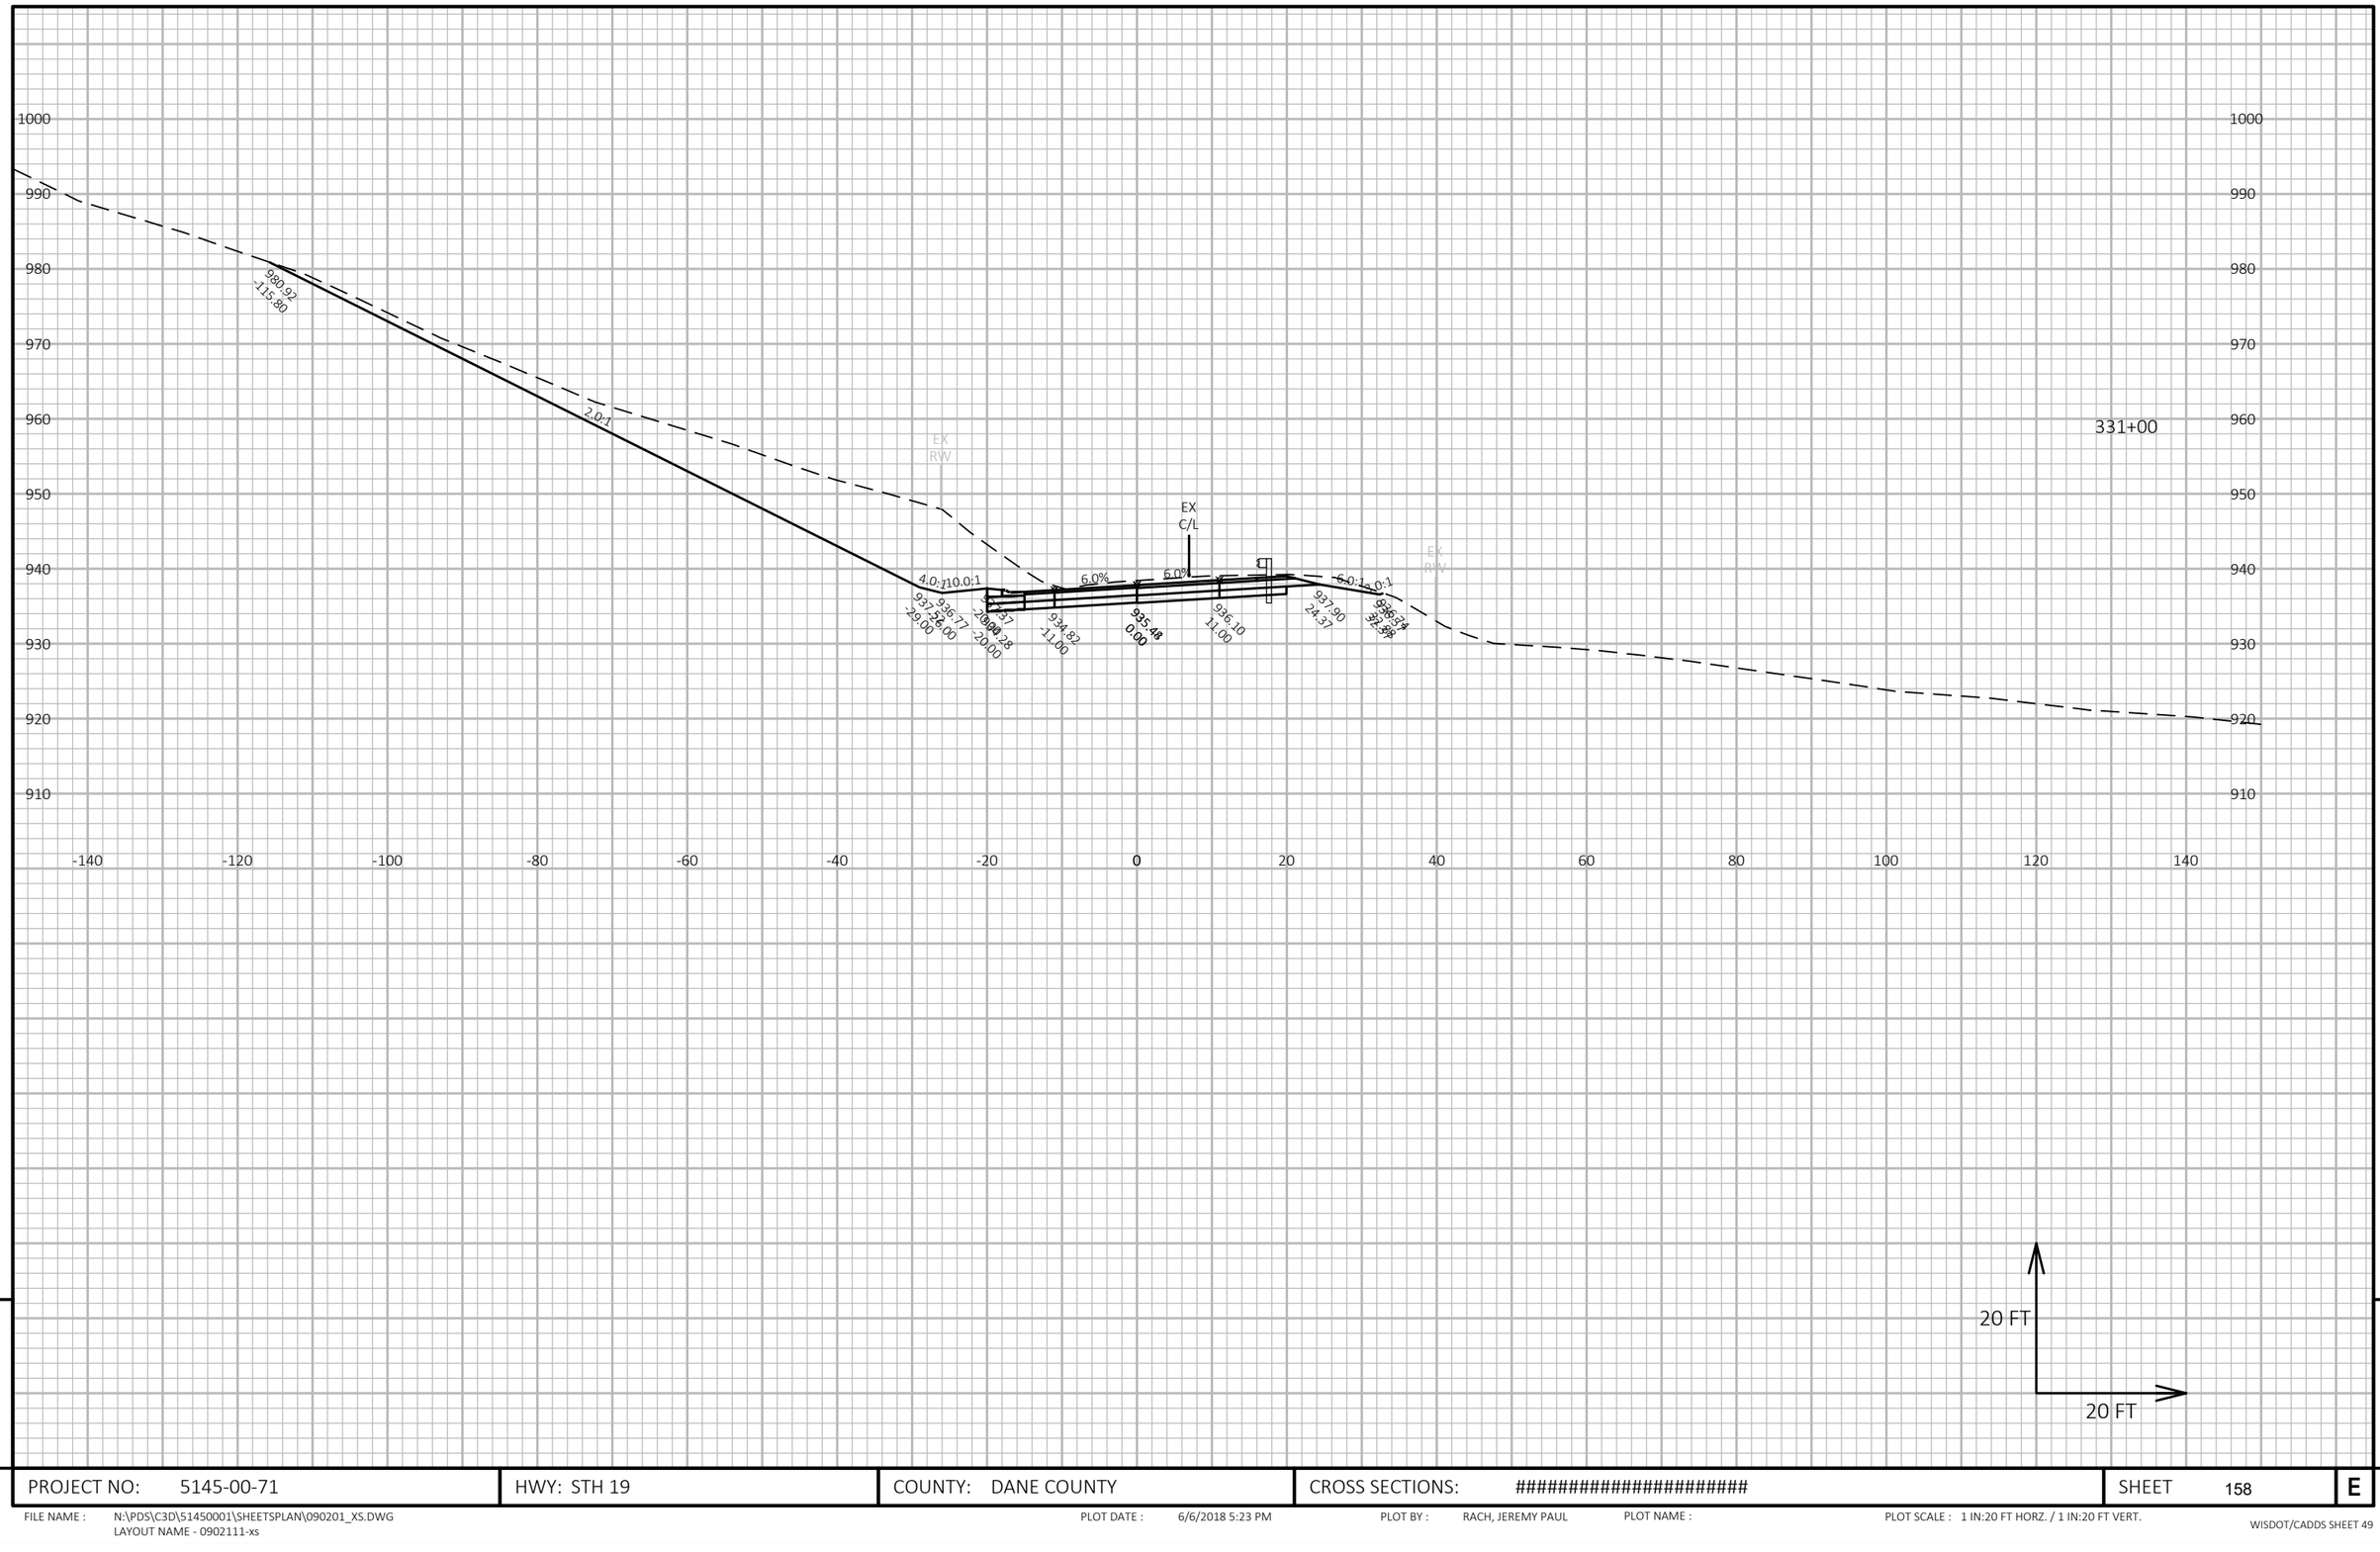

9

9

PROJECT NO: 5145-00-71	HWY: STH 19	COUNTY: DANE COUNTY	CROSS SECTIONS: ##########################	SHEET 158	E

FILE NAME : N:\PDS\C3D\51450001\SHEETSPLAN\090201_XS.DWG
LAYOUT NAME - 0902111-xs

PLOT DATE : 6/6/2018 5:23 PM PLOT BY : RACH, JEREMY PAUL PLOT NAME : PLOT SCALE : 1 IN:20 FT HORZ. / 1 IN:20 FT VERT.

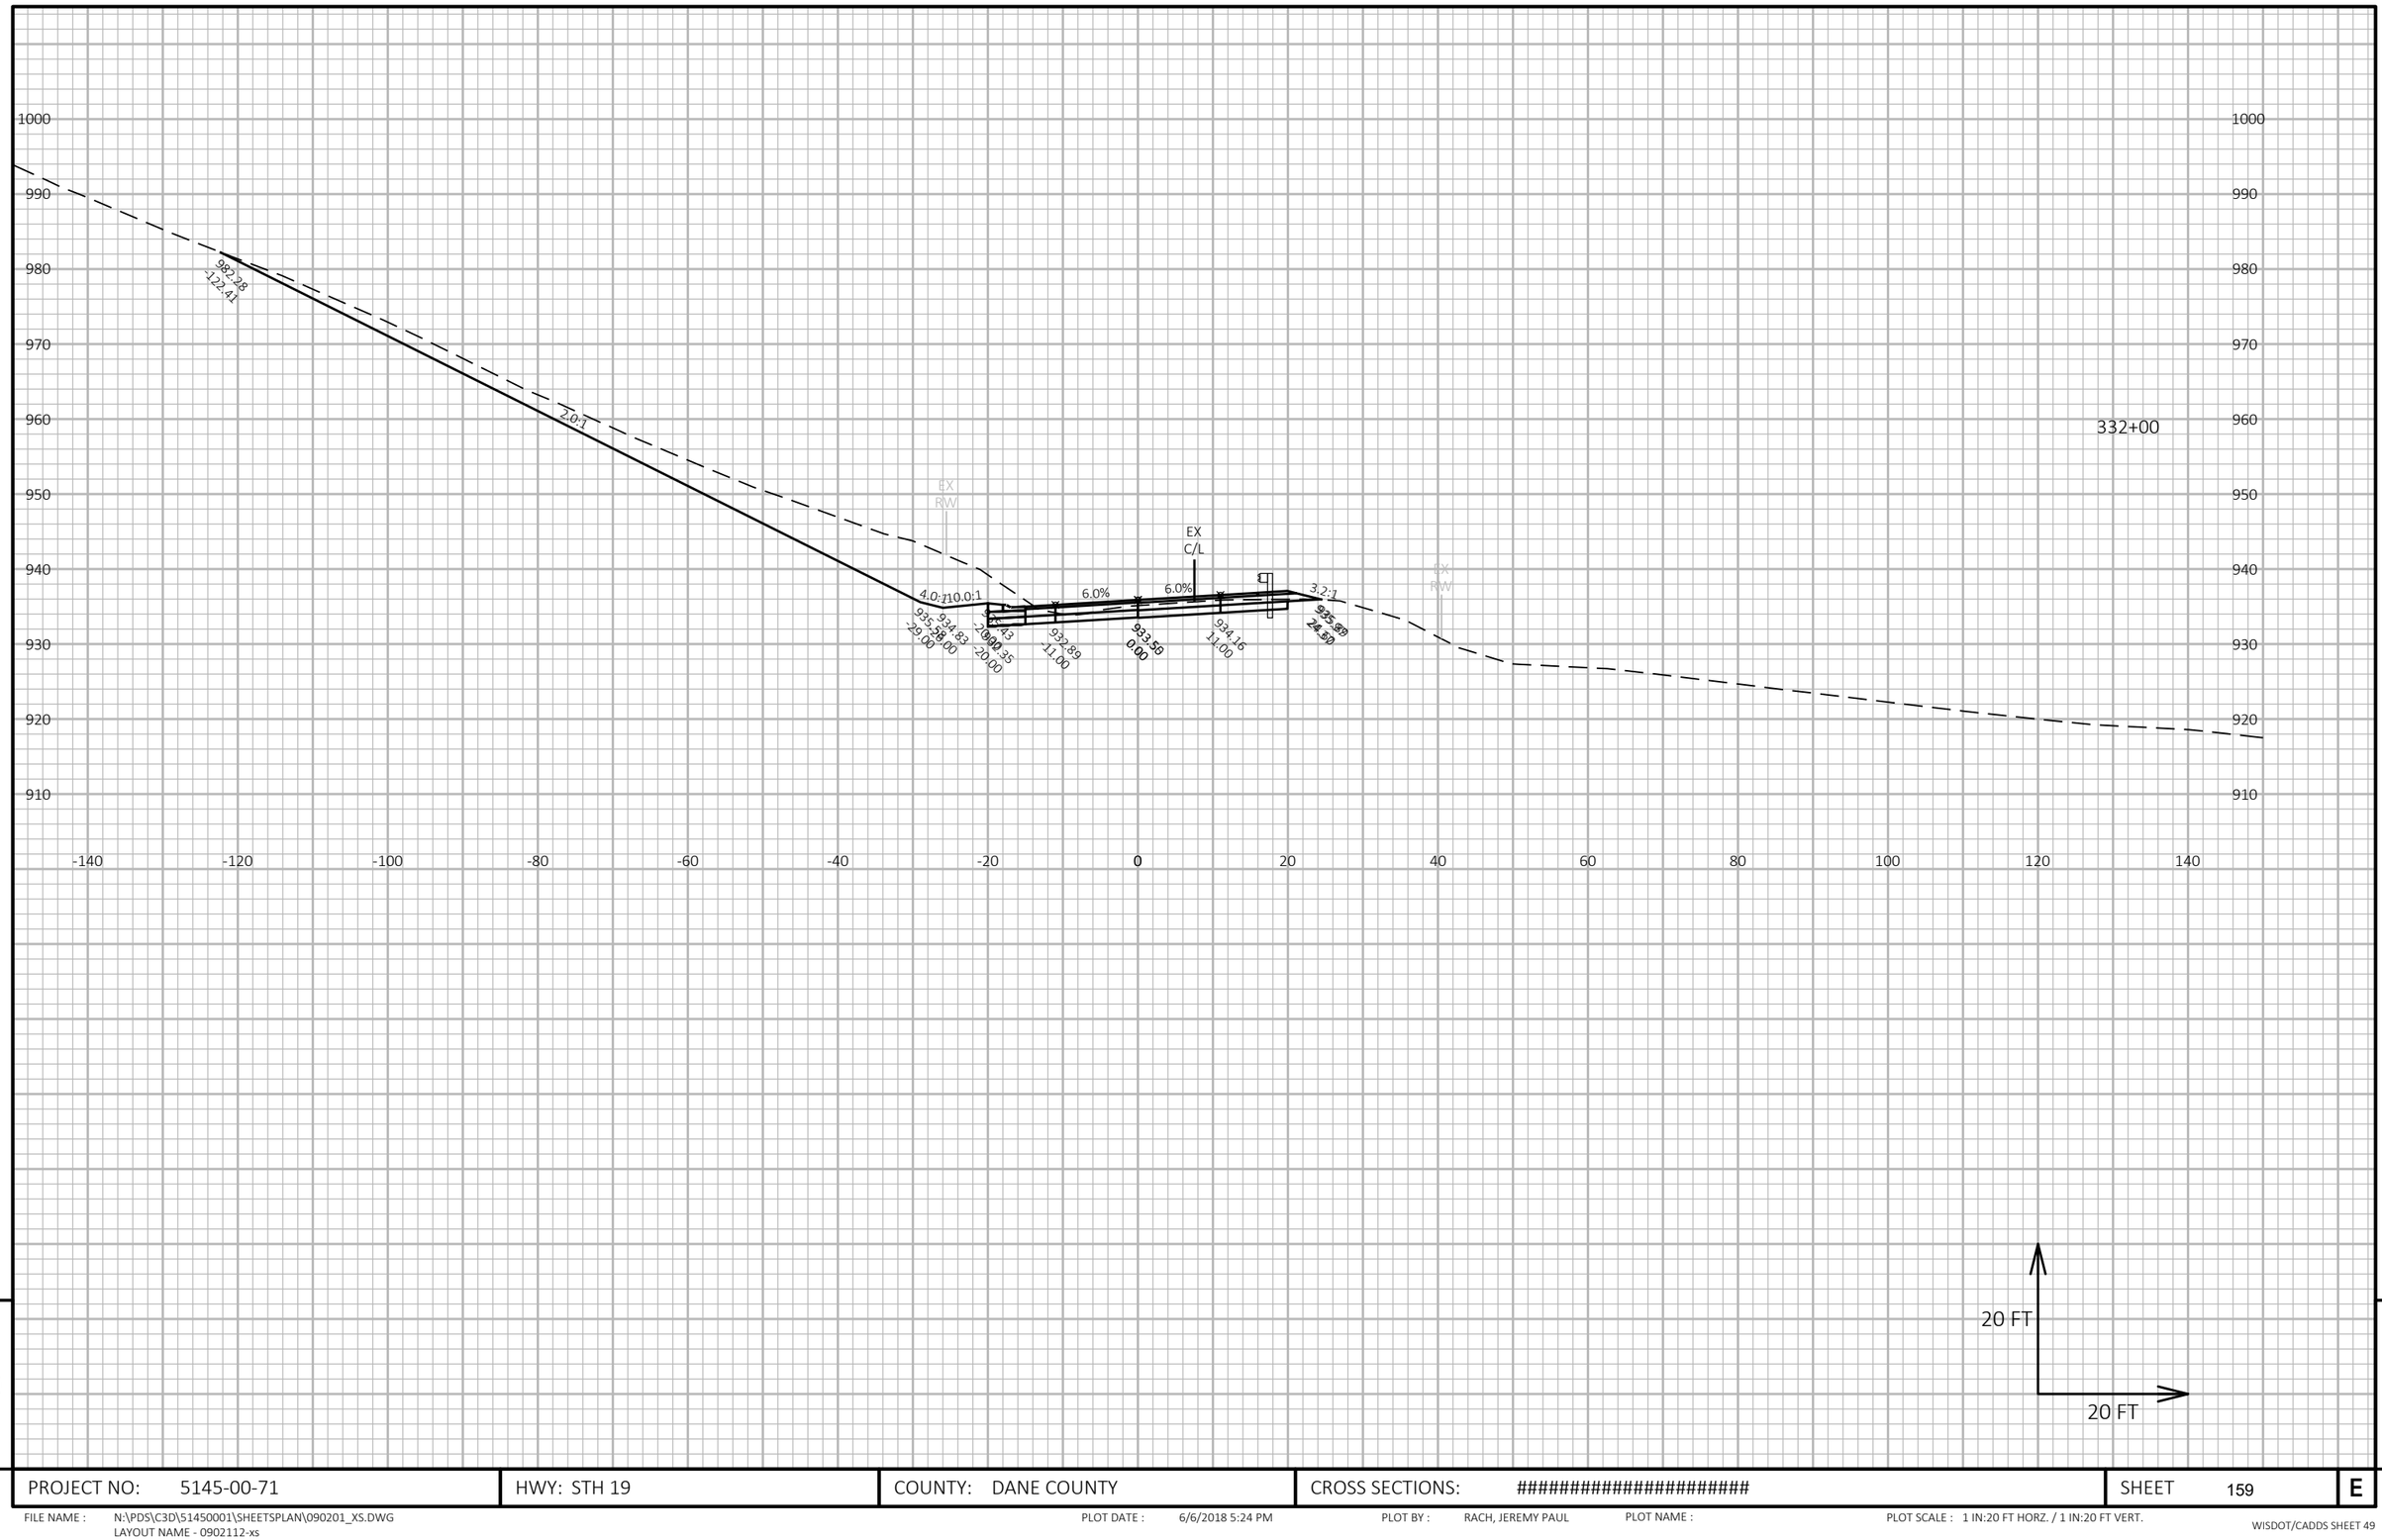

9

PROJECT NO: 5145-00-71	HWY: STH 19	COUNTY: DANE COUNTY	CROSS SECTIONS: ##########################	SHEET 159	E

9

FILE NAME : N:\PDS\C3D\51450001\SHEETSPLAN\090201_XS.DWG
LAYOUT NAME - 0902112-xs

PLOT DATE : 6/6/2018 5:24 PM PLOT BY : RACH, JEREMY PAUL PLOT NAME : PLOT SCALE : 1 IN:20 FT HORZ. / 1 IN:20 FT VERT.

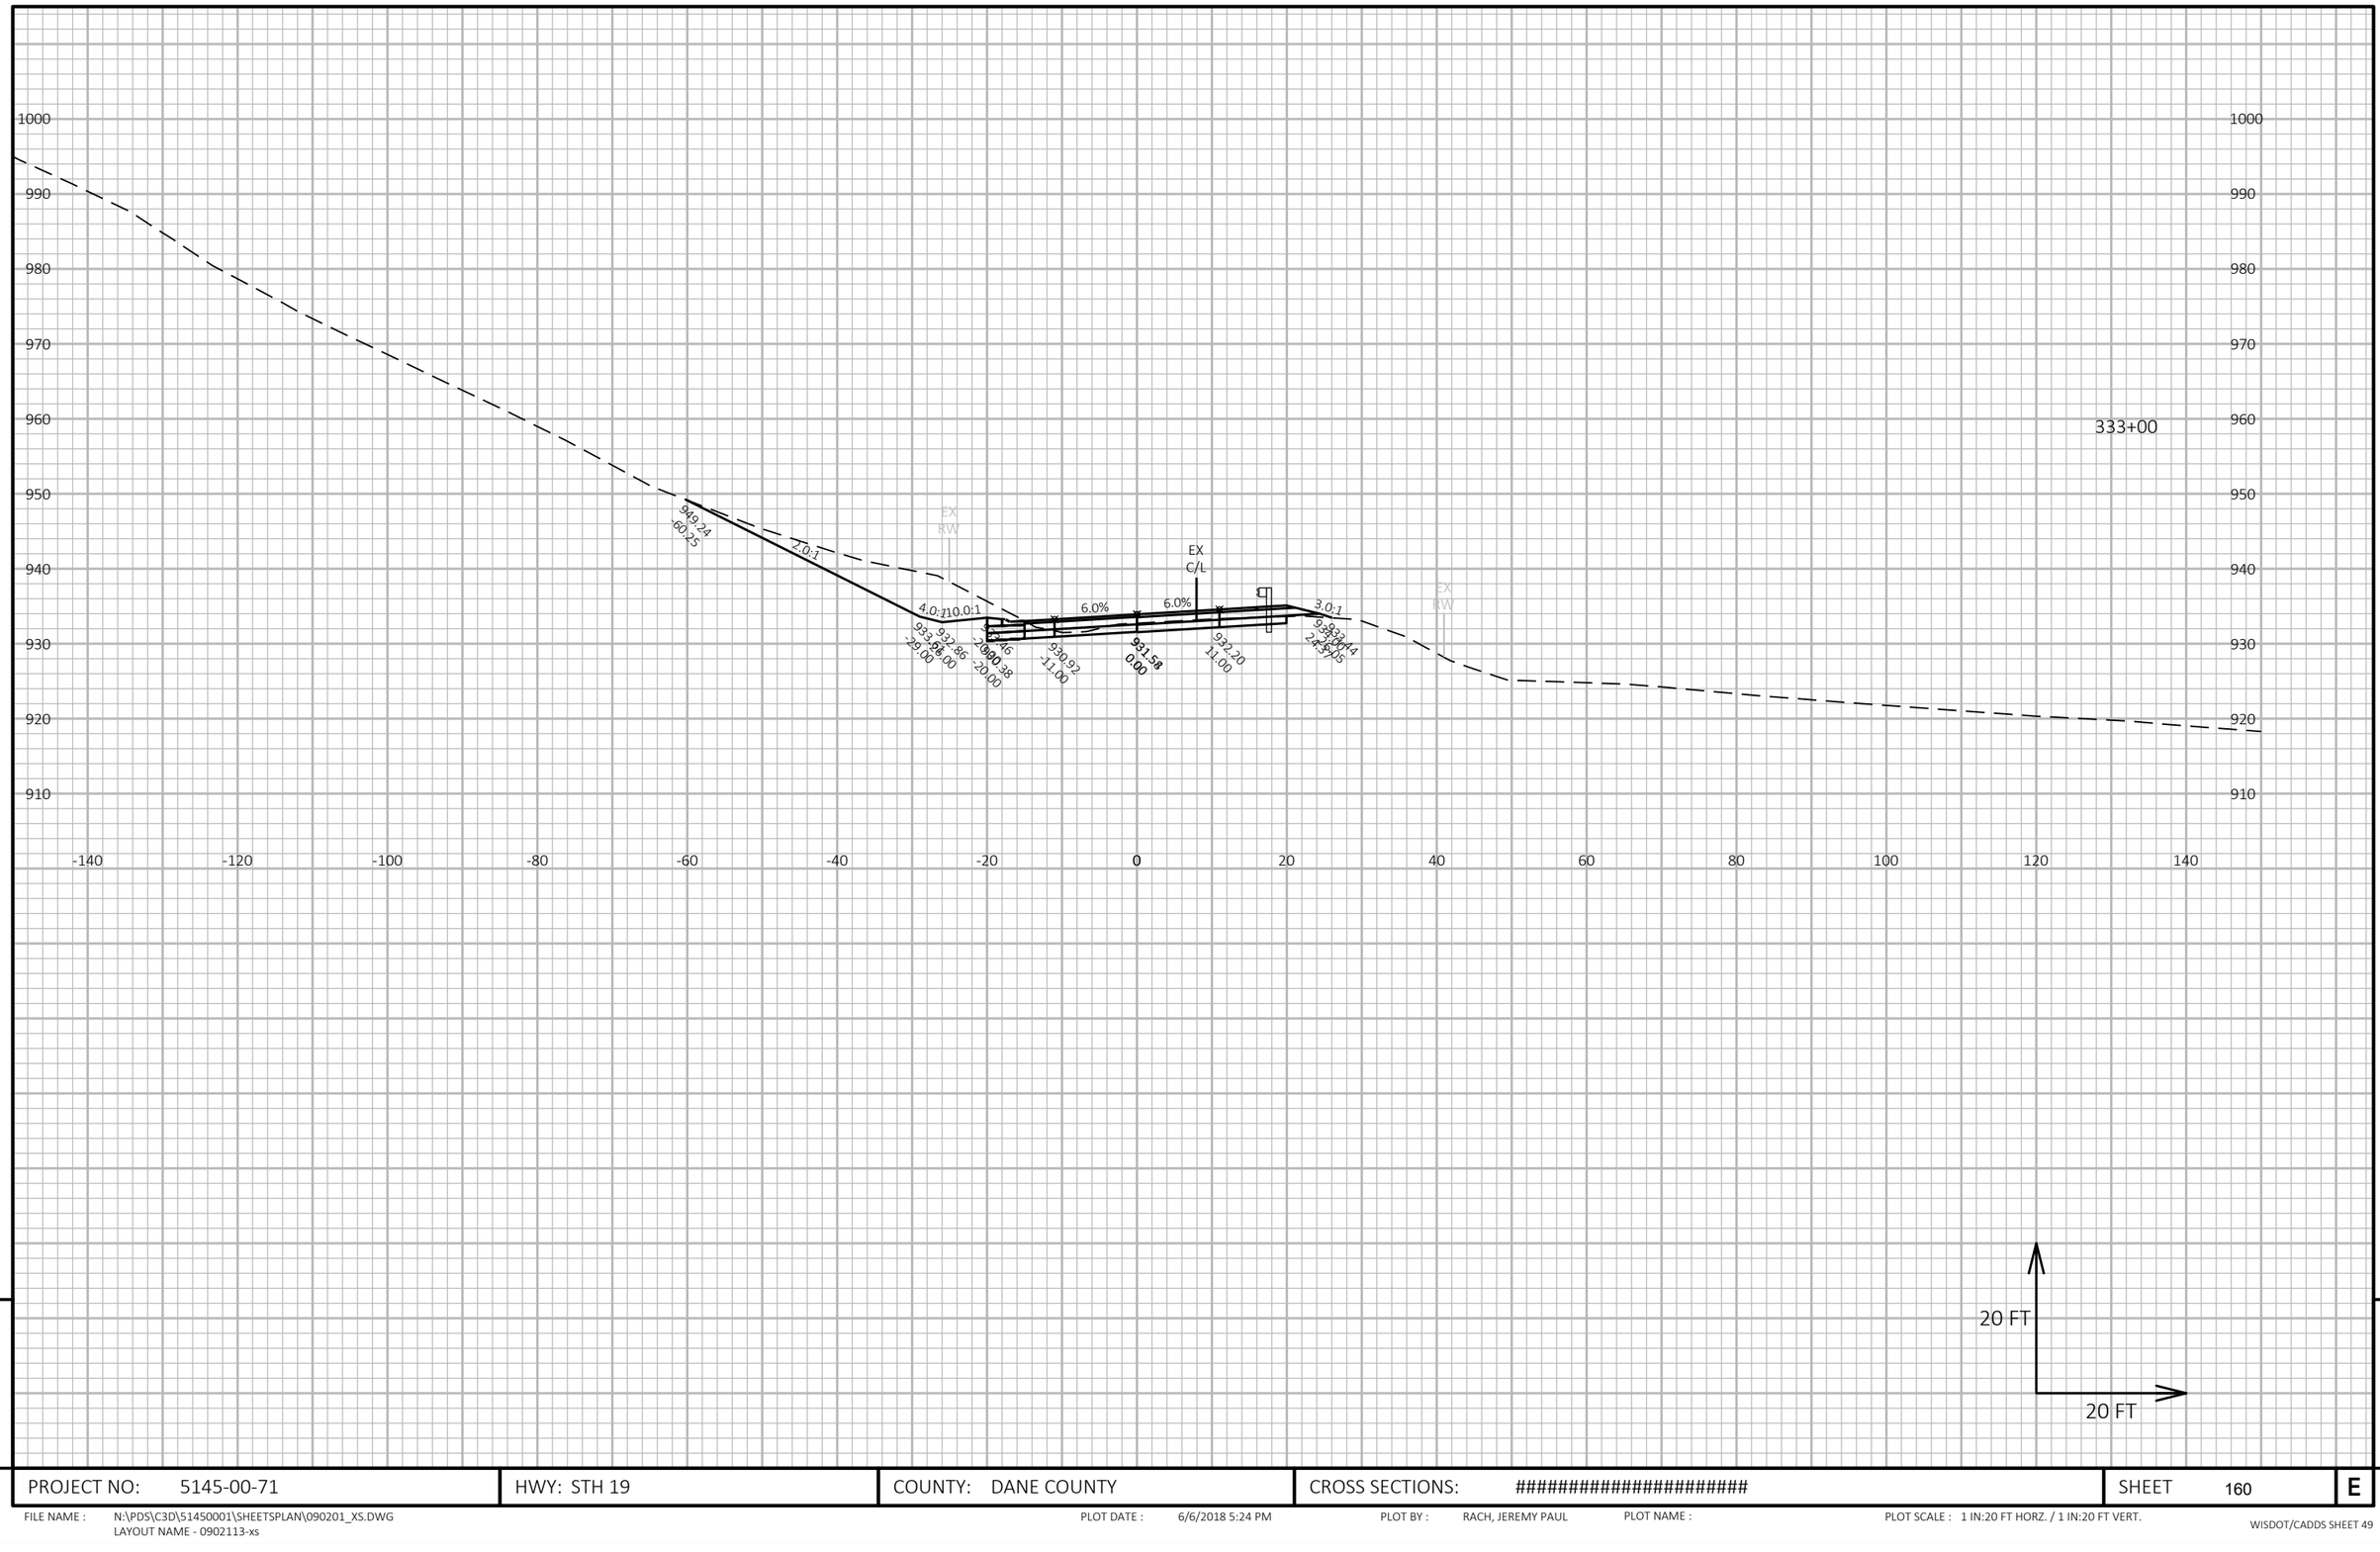

9

9

PROJECT NO: 5145-00-71	HWY: STH 19	COUNTY: DANE COUNTY	CROSS SECTIONS: ##########################	SHEET 160	E

FILE NAME : N:\PDS\C3D\51450001\SHEETSPLAN\090201_XS.DWG
LAYOUT NAME - 0902113-xs

PLOT DATE : 6/6/2018 5:24 PM PLOT BY : RACH, JEREMY PAUL PLOT NAME : PLOT SCALE : 1 IN:20 FT HORZ. / 1 IN:20 FT VERT.

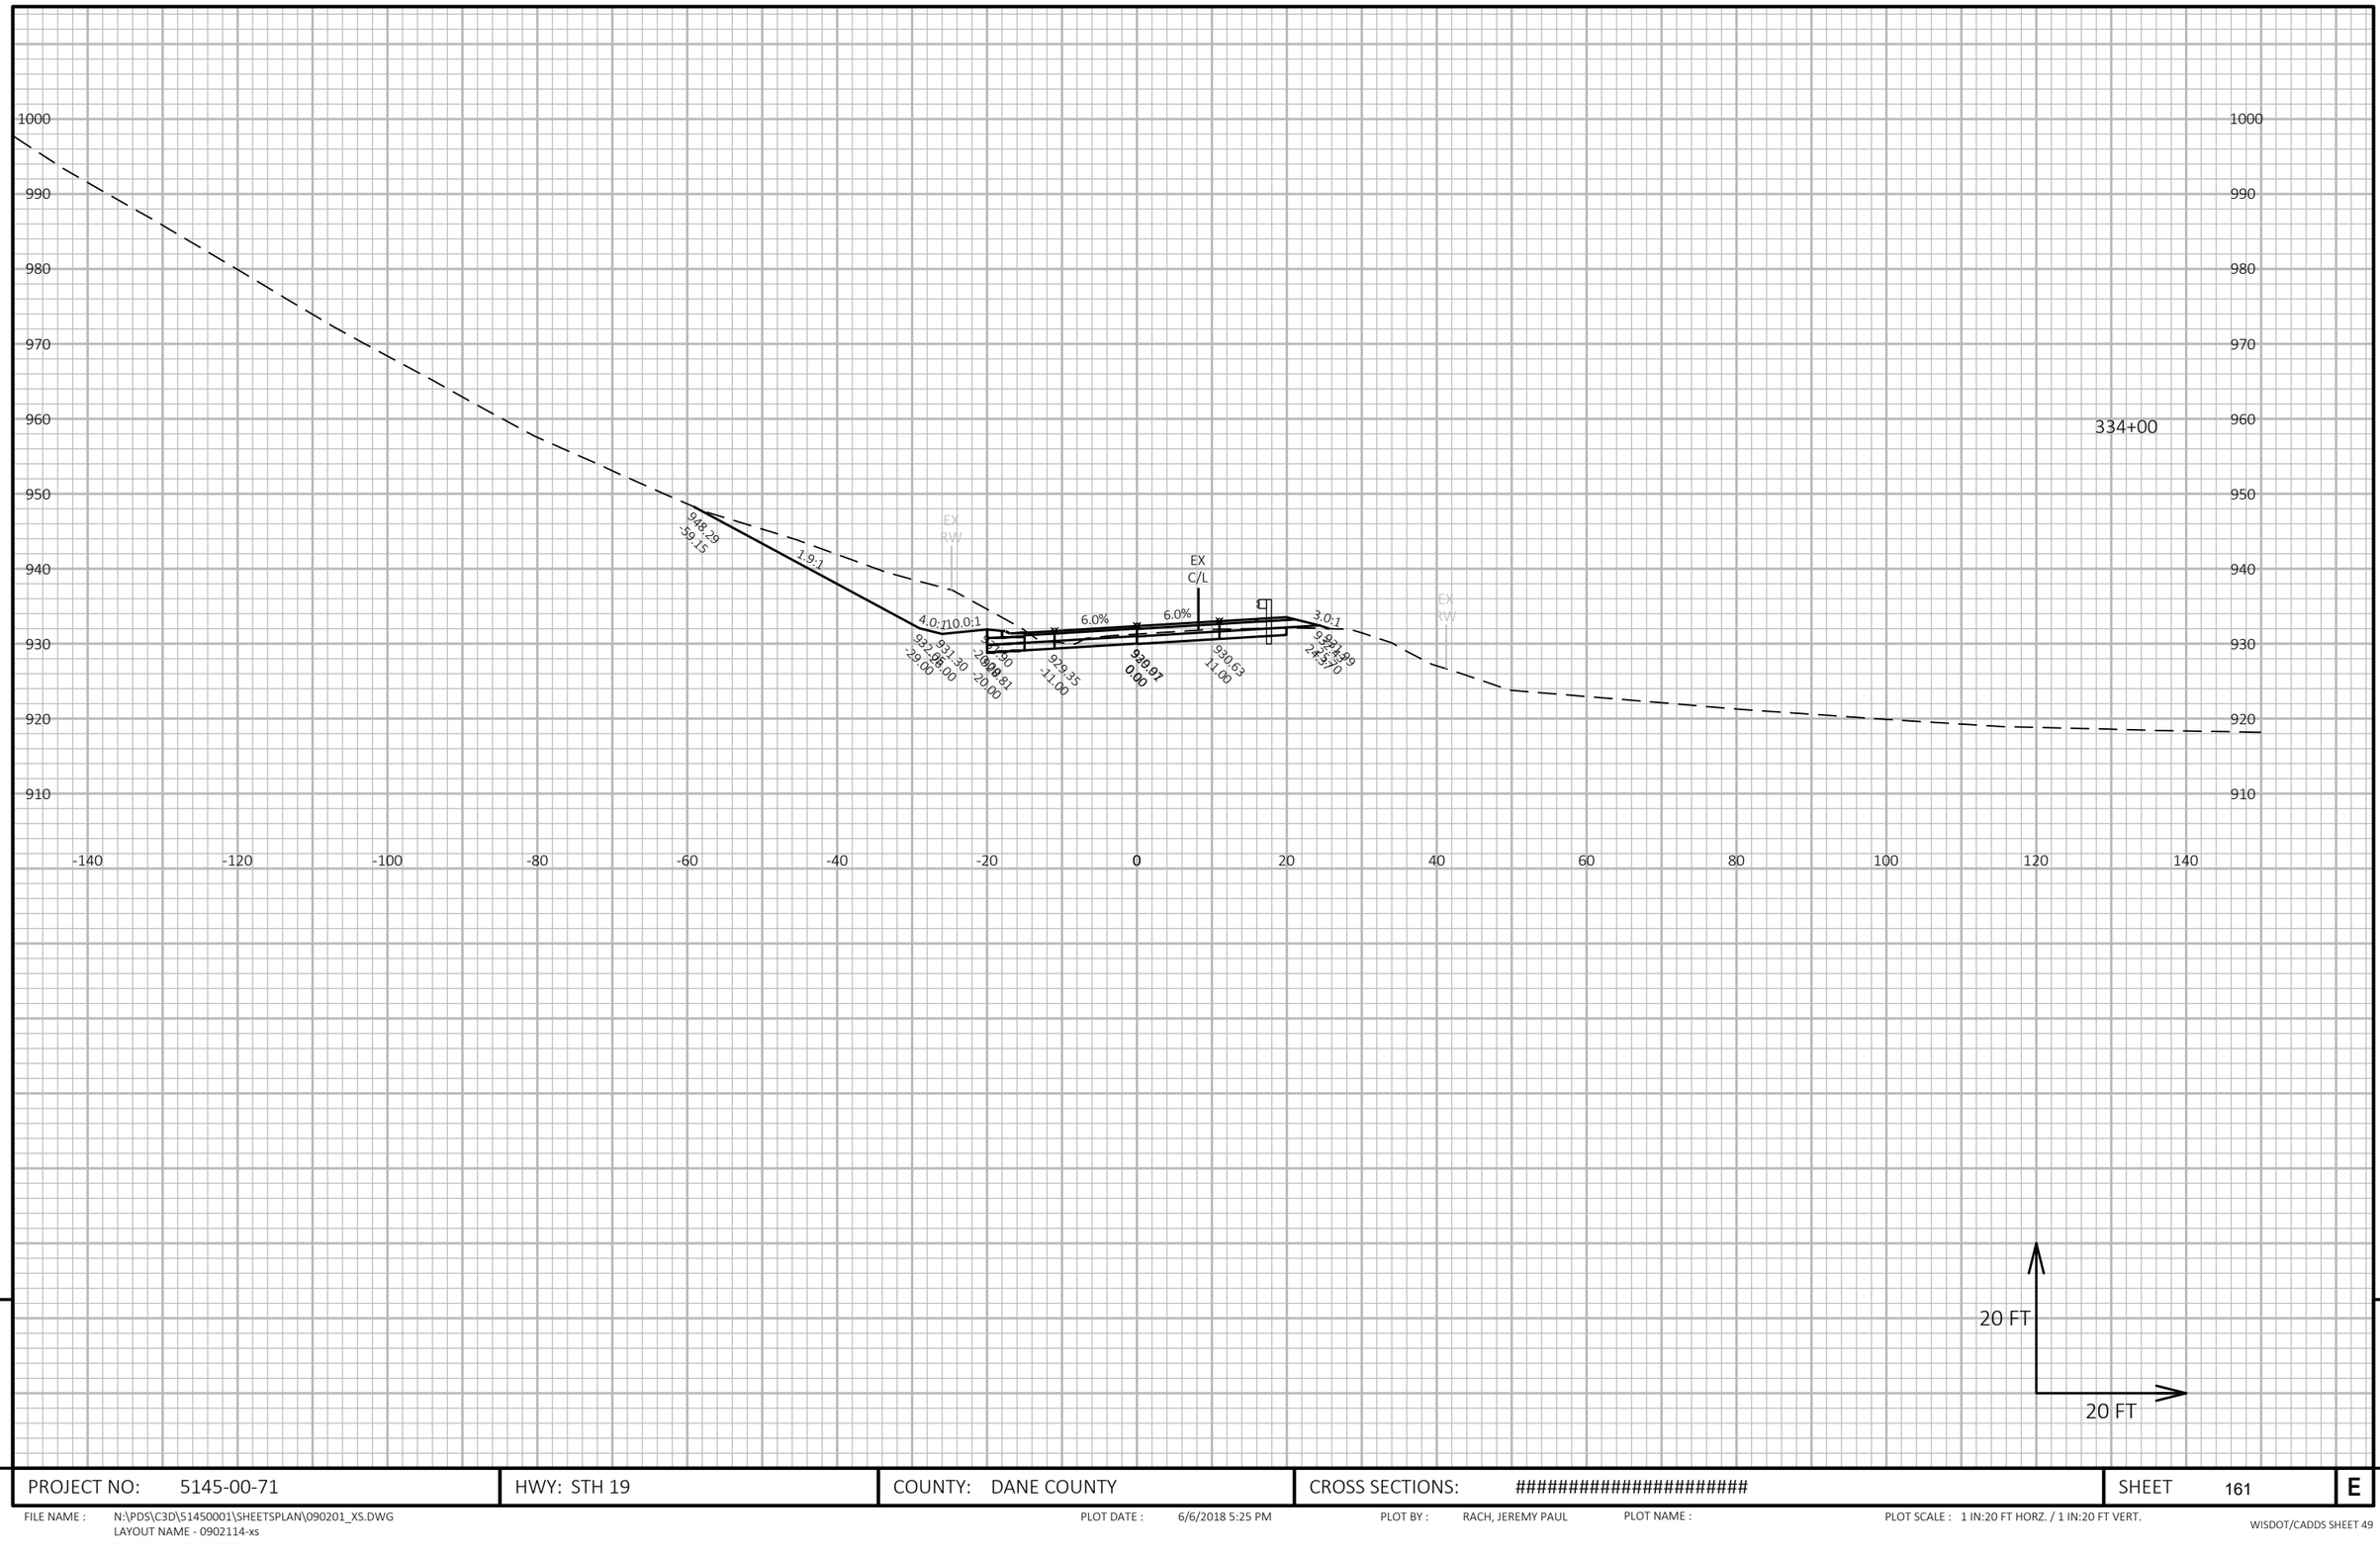

9

9

PROJECT NO: 5145-00-71	HWY: STH 19	COUNTY: DANE COUNTY	CROSS SECTIONS: ##########################	SHEET 161	E

FILE NAME : N:\PDS\C3D\51450001\SHEETSPLAN\090201_XS.DWG
LAYOUT NAME - 0902114-xs

PLOT DATE : 6/6/2018 5:25 PM PLOT BY : RACH, JEREMY PAUL PLOT NAME : PLOT SCALE : 1 IN:20 FT HORZ. / 1 IN:20 FT VERT.

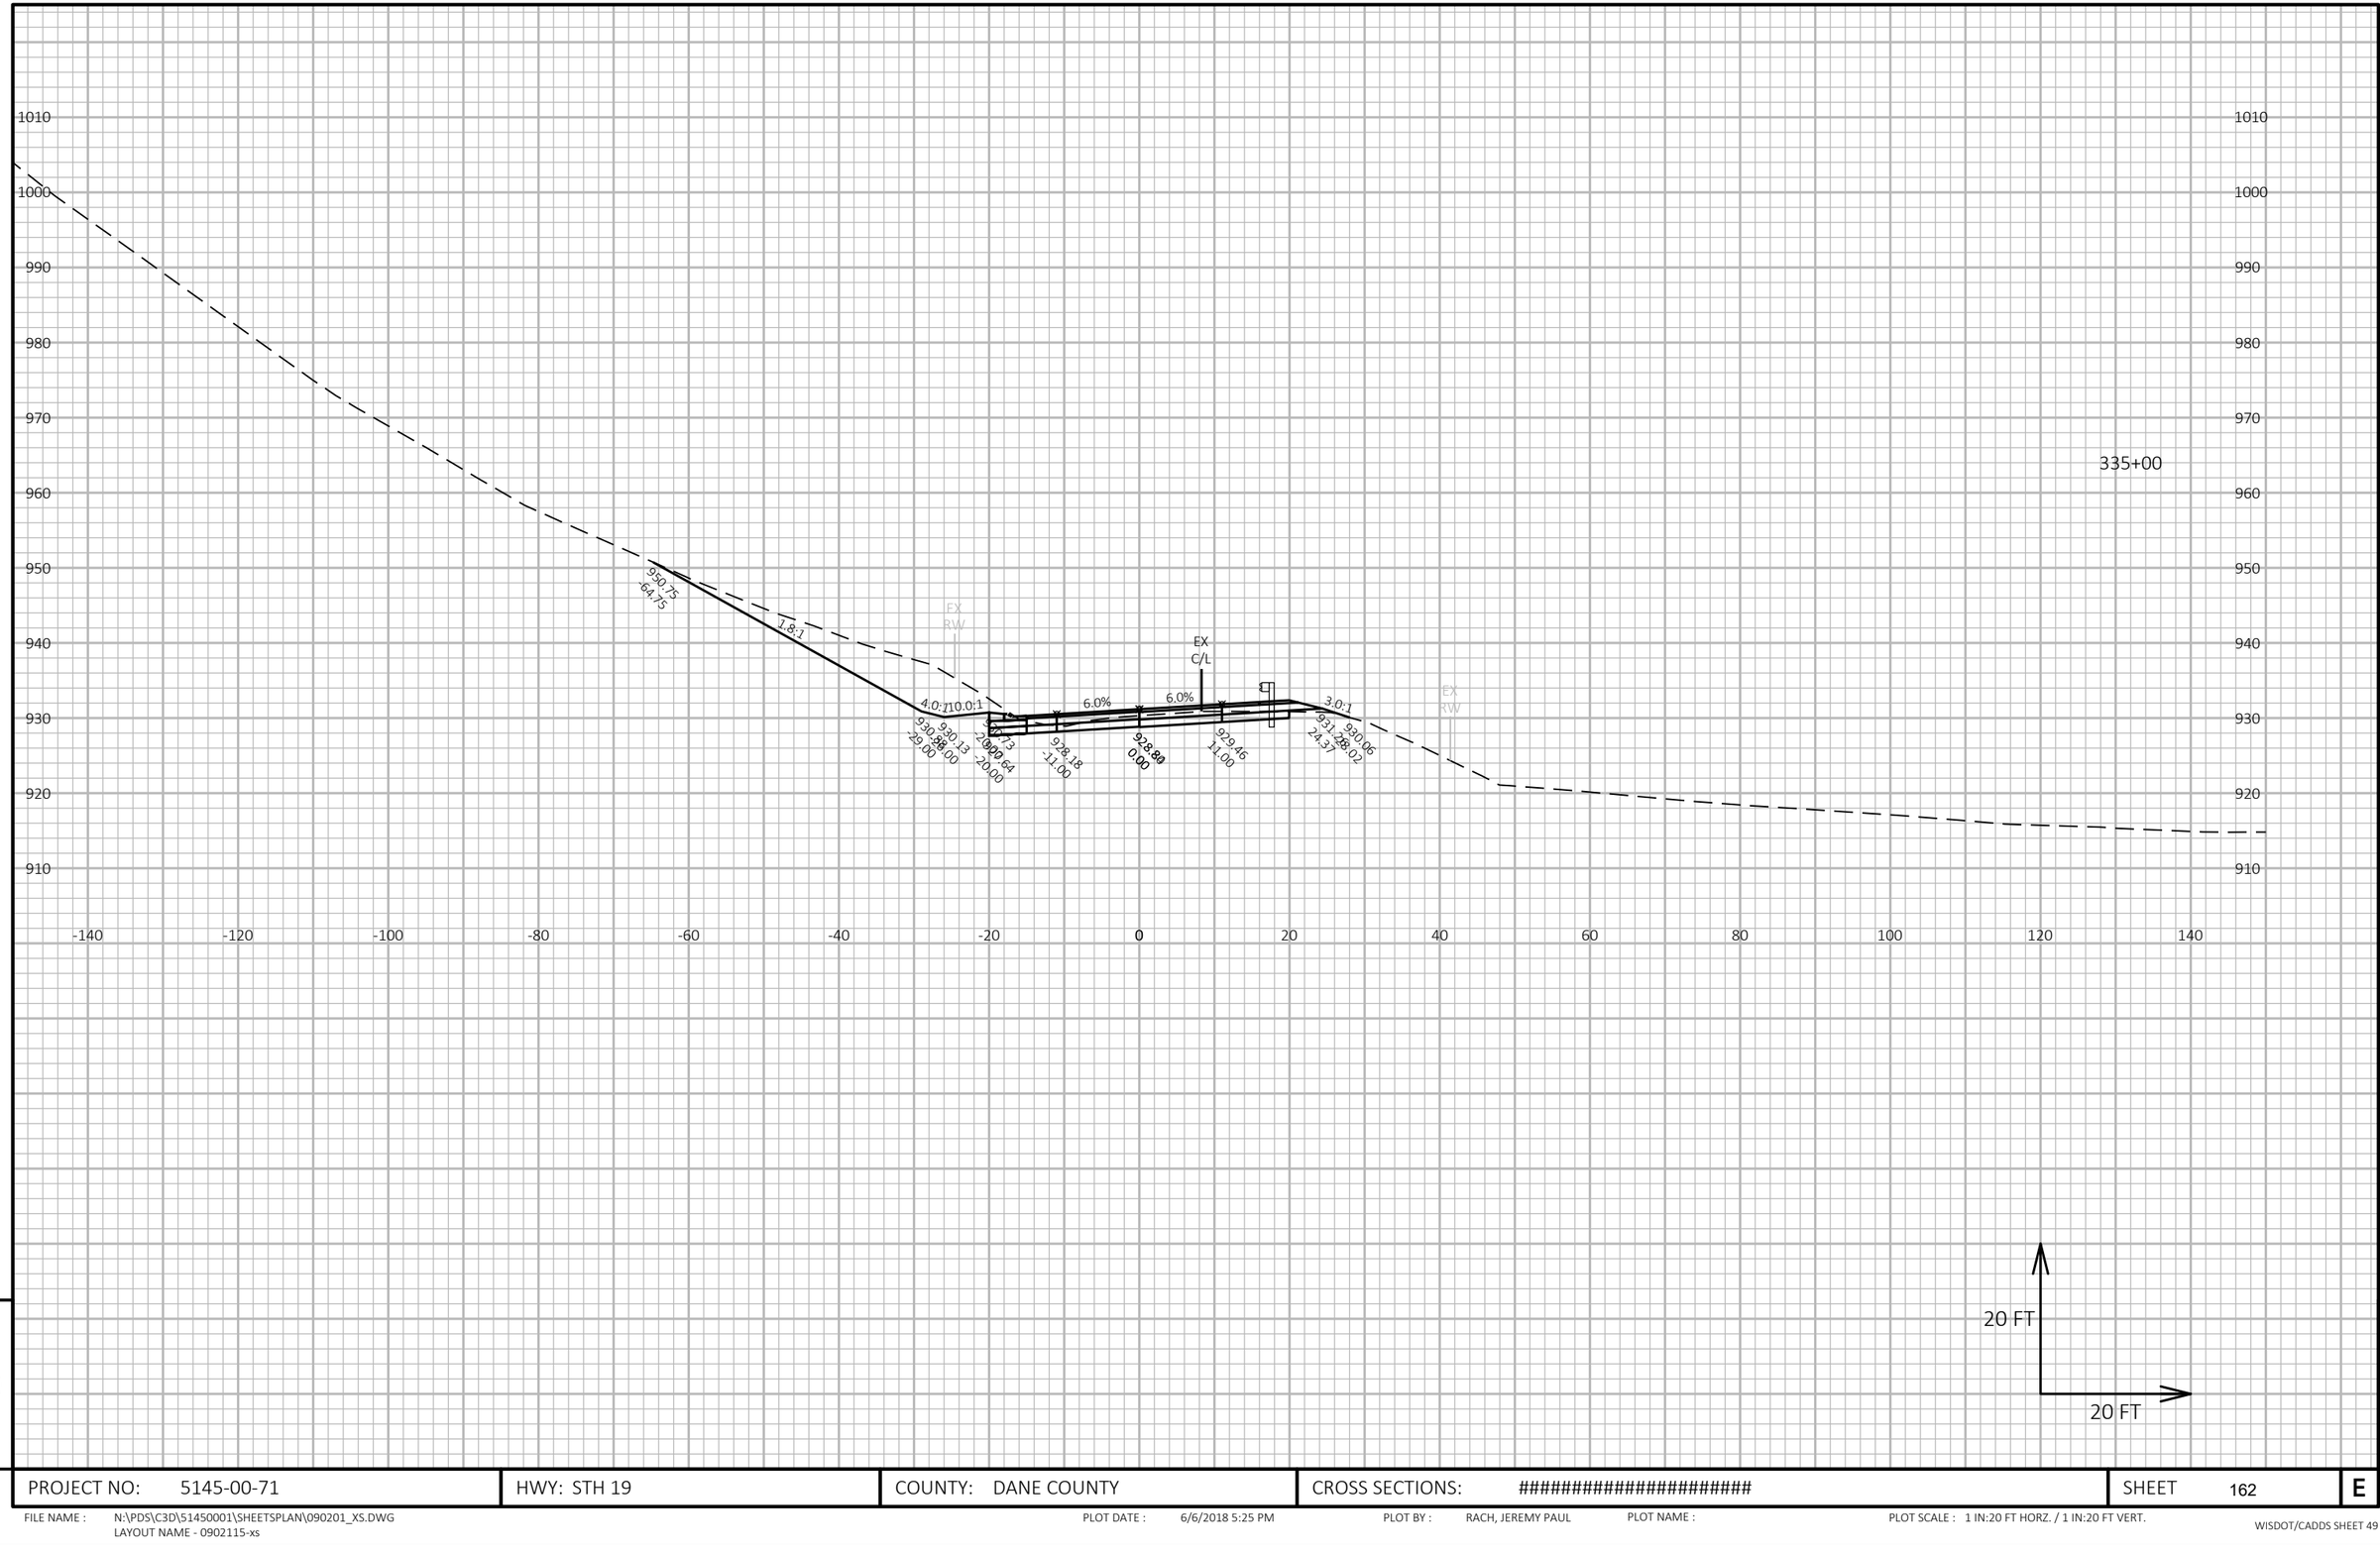

9

9

PROJECT NO: 5145-00-71	HWY: STH 19	COUNTY: DANE COUNTY	CROSS SECTIONS: ##########################	SHEET 162	E

FILE NAME : N:\PDS\C3D\51450001\SHEETSPLAN\090201_XS.DWG
LAYOUT NAME - 0902115-xs

PLOT DATE : 6/6/2018 5:25 PM PLOT BY : RACH, JEREMY PAUL PLOT NAME : PLOT SCALE : 1 IN:20 FT HORZ. / 1 IN:20 FT VERT.

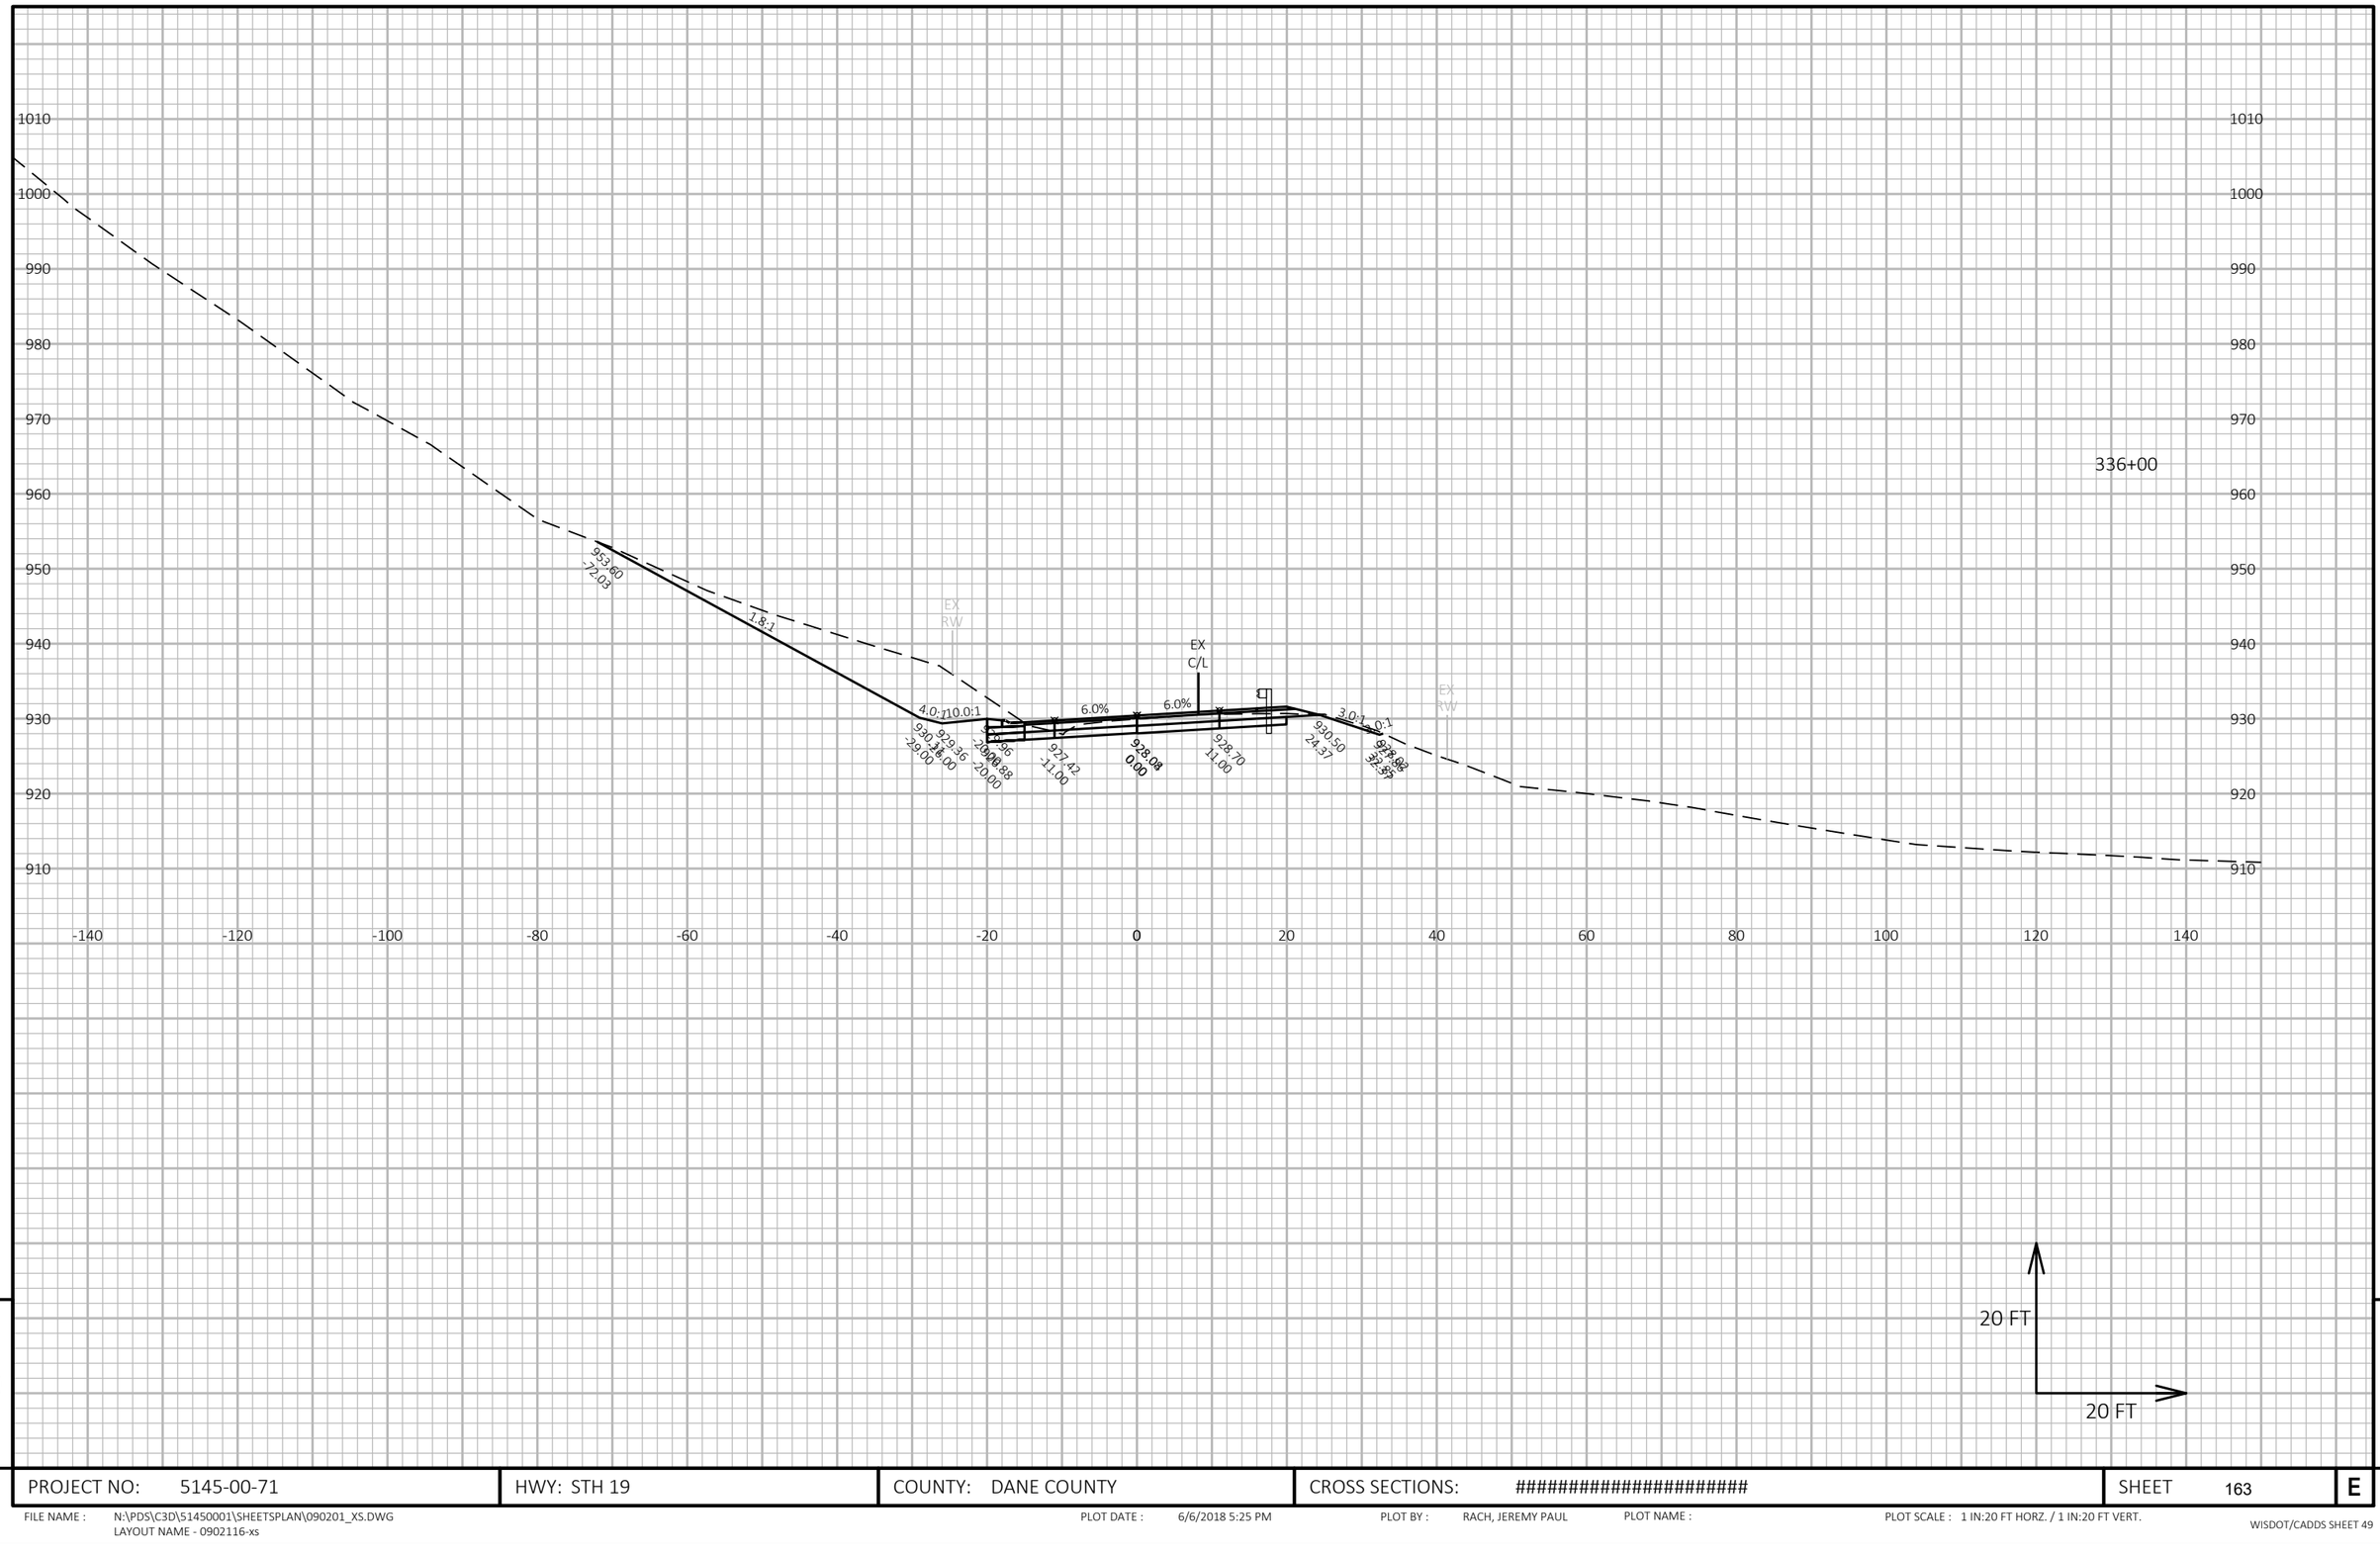

9

9

PROJECT NO: 5145-00-71	HWY: STH 19	COUNTY: DANE COUNTY	CROSS SECTIONS: ##########################	SHEET 163	E

FILE NAME : N:\PDS\C3D\51450001\SHEETSPLAN\090201_XS.DWG
LAYOUT NAME - 0902116-xs

PLOT DATE : 6/6/2018 5:25 PM PLOT BY : RACH, JEREMY PAUL PLOT NAME : PLOT SCALE : 1 IN:20 FT HORZ. / 1 IN:20 FT VERT.

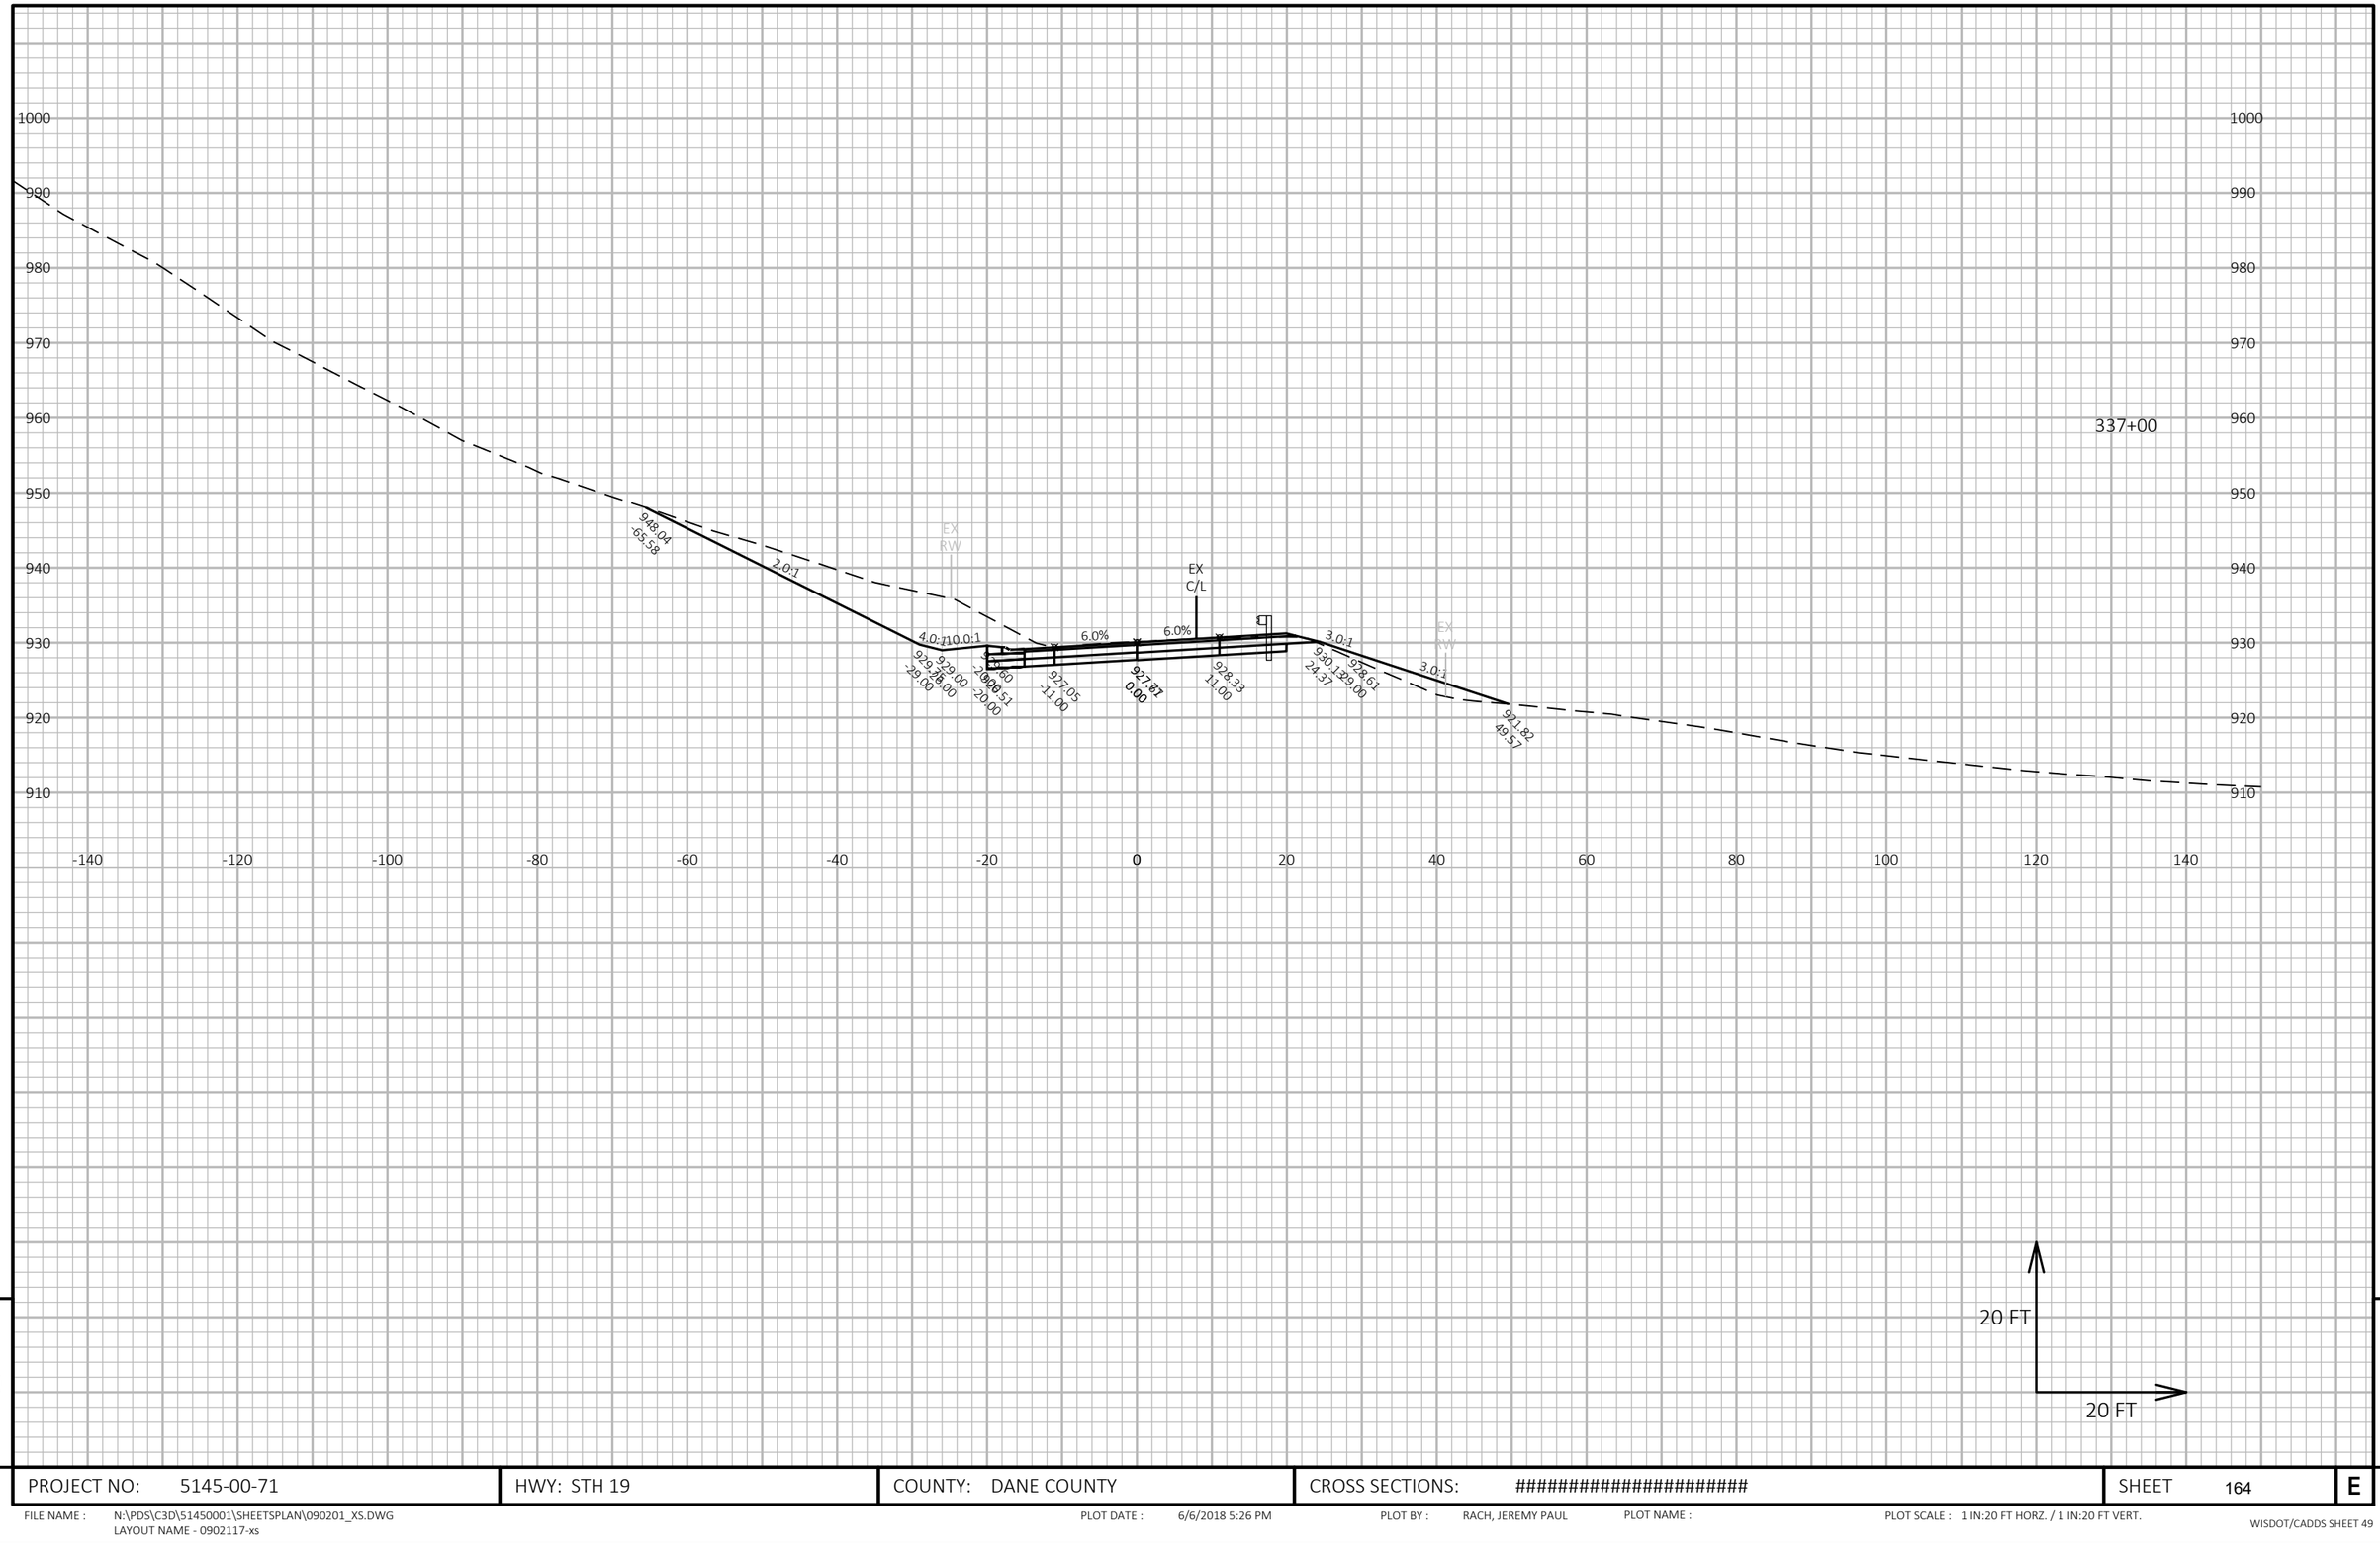

9

9

PROJECT NO: 5145-00-71	HWY: STH 19	COUNTY: DANE COUNTY	CROSS SECTIONS: ##########################	SHEET 164	E

FILE NAME : N:\PDS\C3D\51450001\SHEETSPLAN\090201_XS.DWG
LAYOUT NAME - 0902117-xs

PLOT DATE : 6/6/2018 5:26 PM PLOT BY : RACH, JEREMY PAUL PLOT NAME : PLOT SCALE : 1 IN:20 FT HORZ. / 1 IN:20 FT VERT.

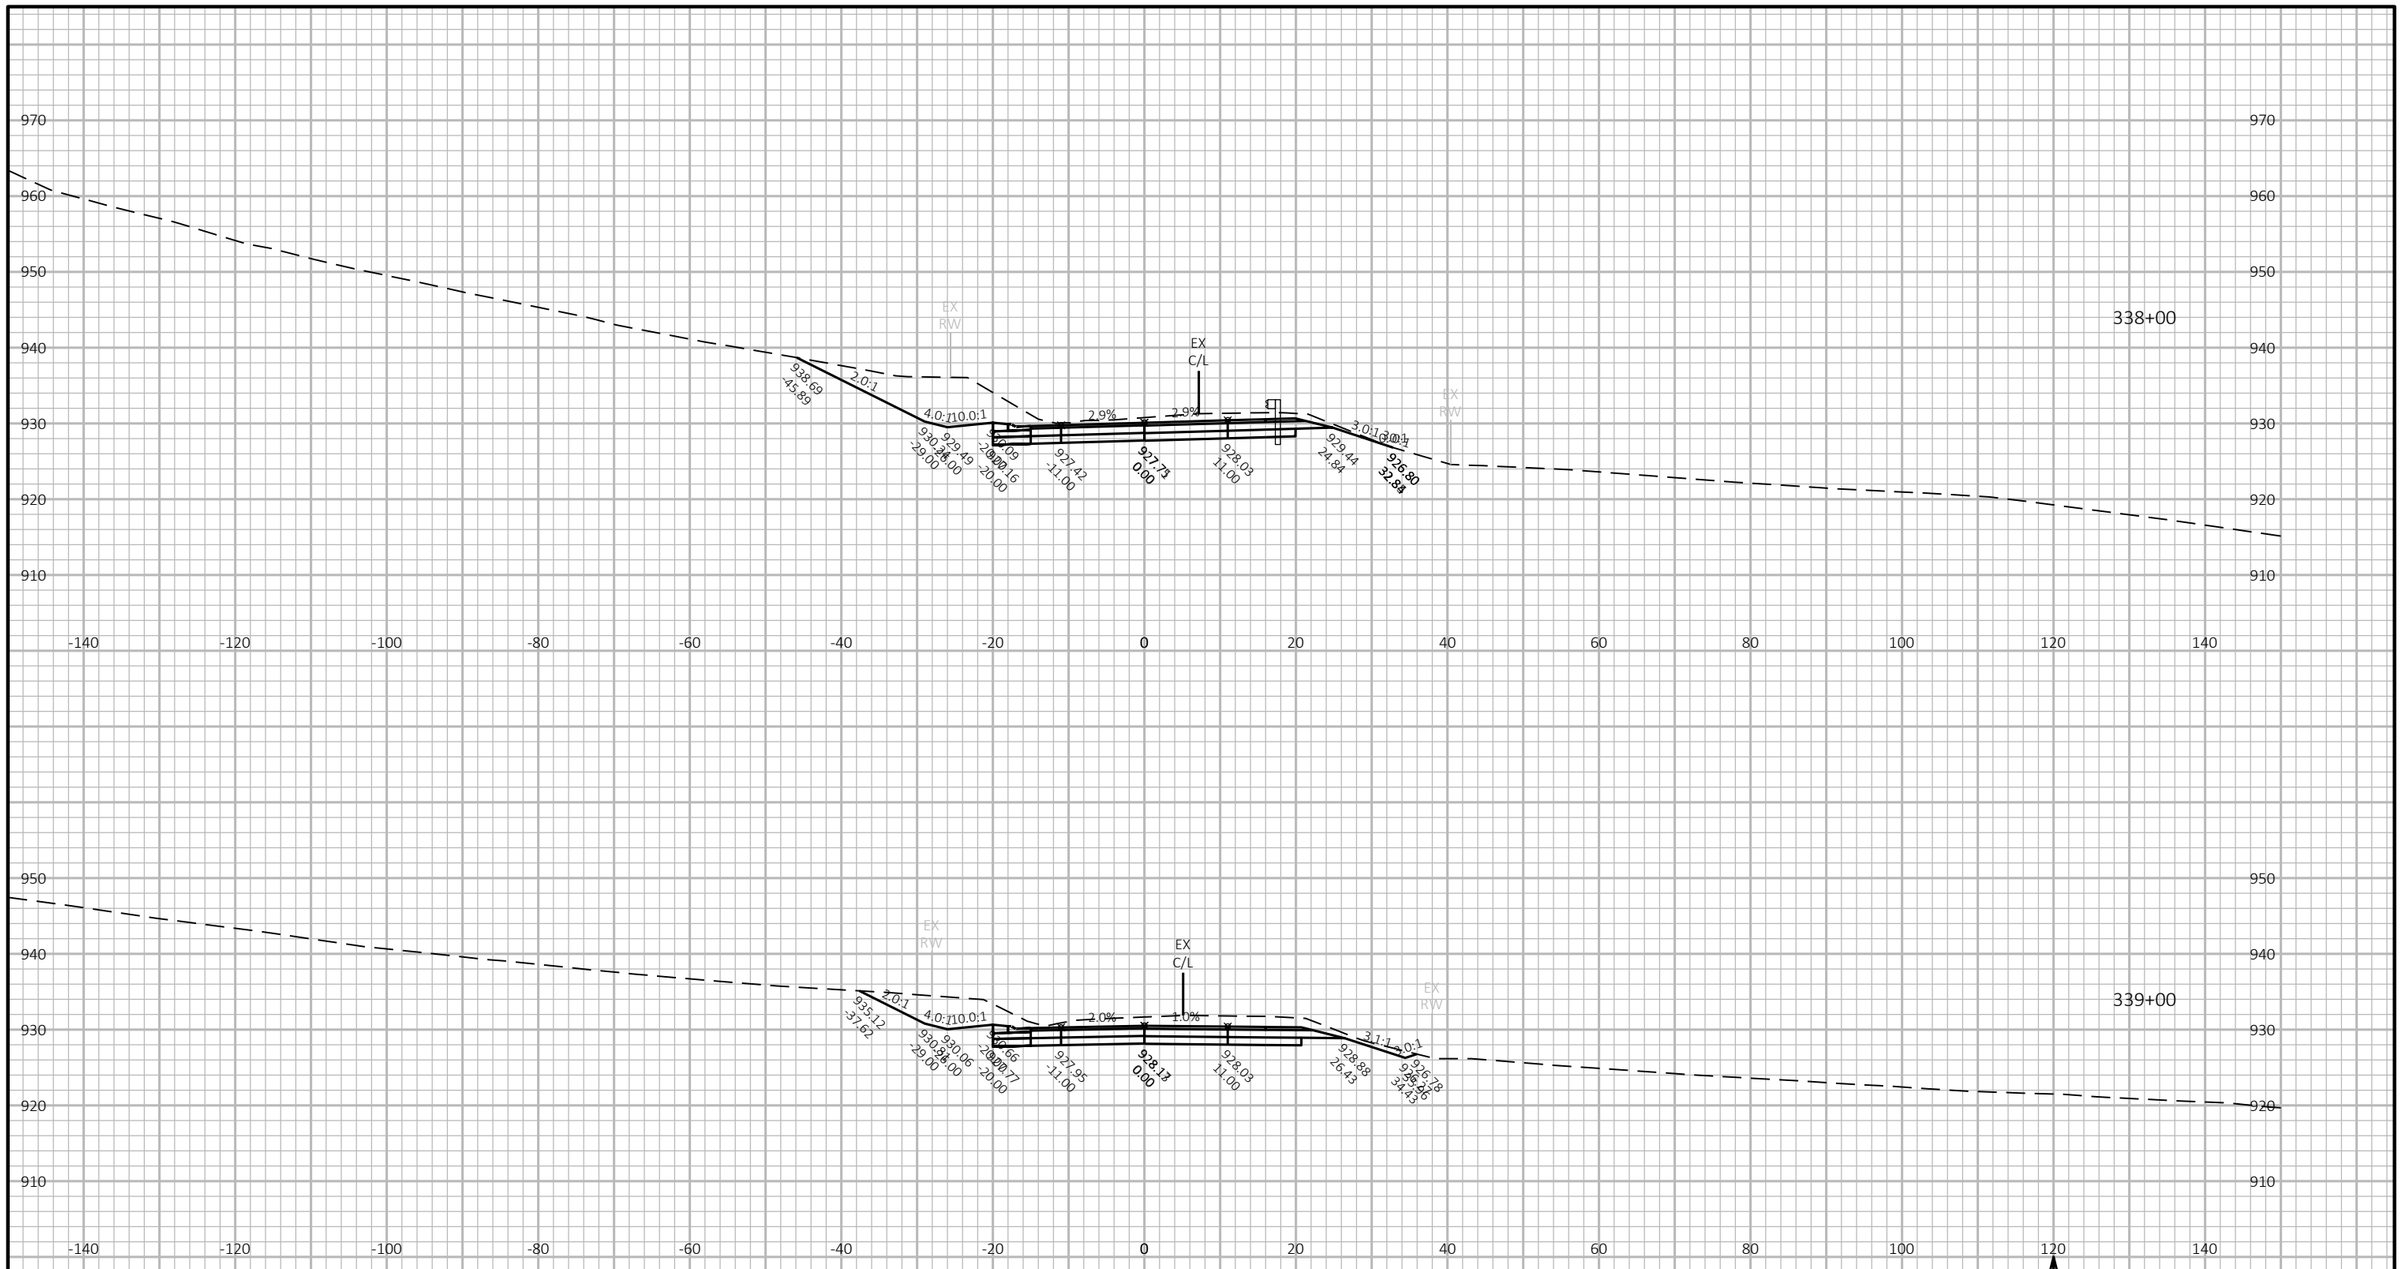

9

9

PROJECT NO: 5145-00-71	HWY: STH 19	COUNTY: DANE COUNTY	CROSS SECTIONS: ##########################	SHEET 165	E

FILE NAME : N:\PDS\C3D\51450001\SHEETSPLAN\090201_XS.DWG
LAYOUT NAME - 0902118-xs

PLOT DATE : 6/6/2018 5:26 PM PLOT BY : RACH, JEREMY PAUL PLOT NAME : PLOT SCALE : 1 IN:20 FT HORZ. / 1 IN:20 FT VERT.

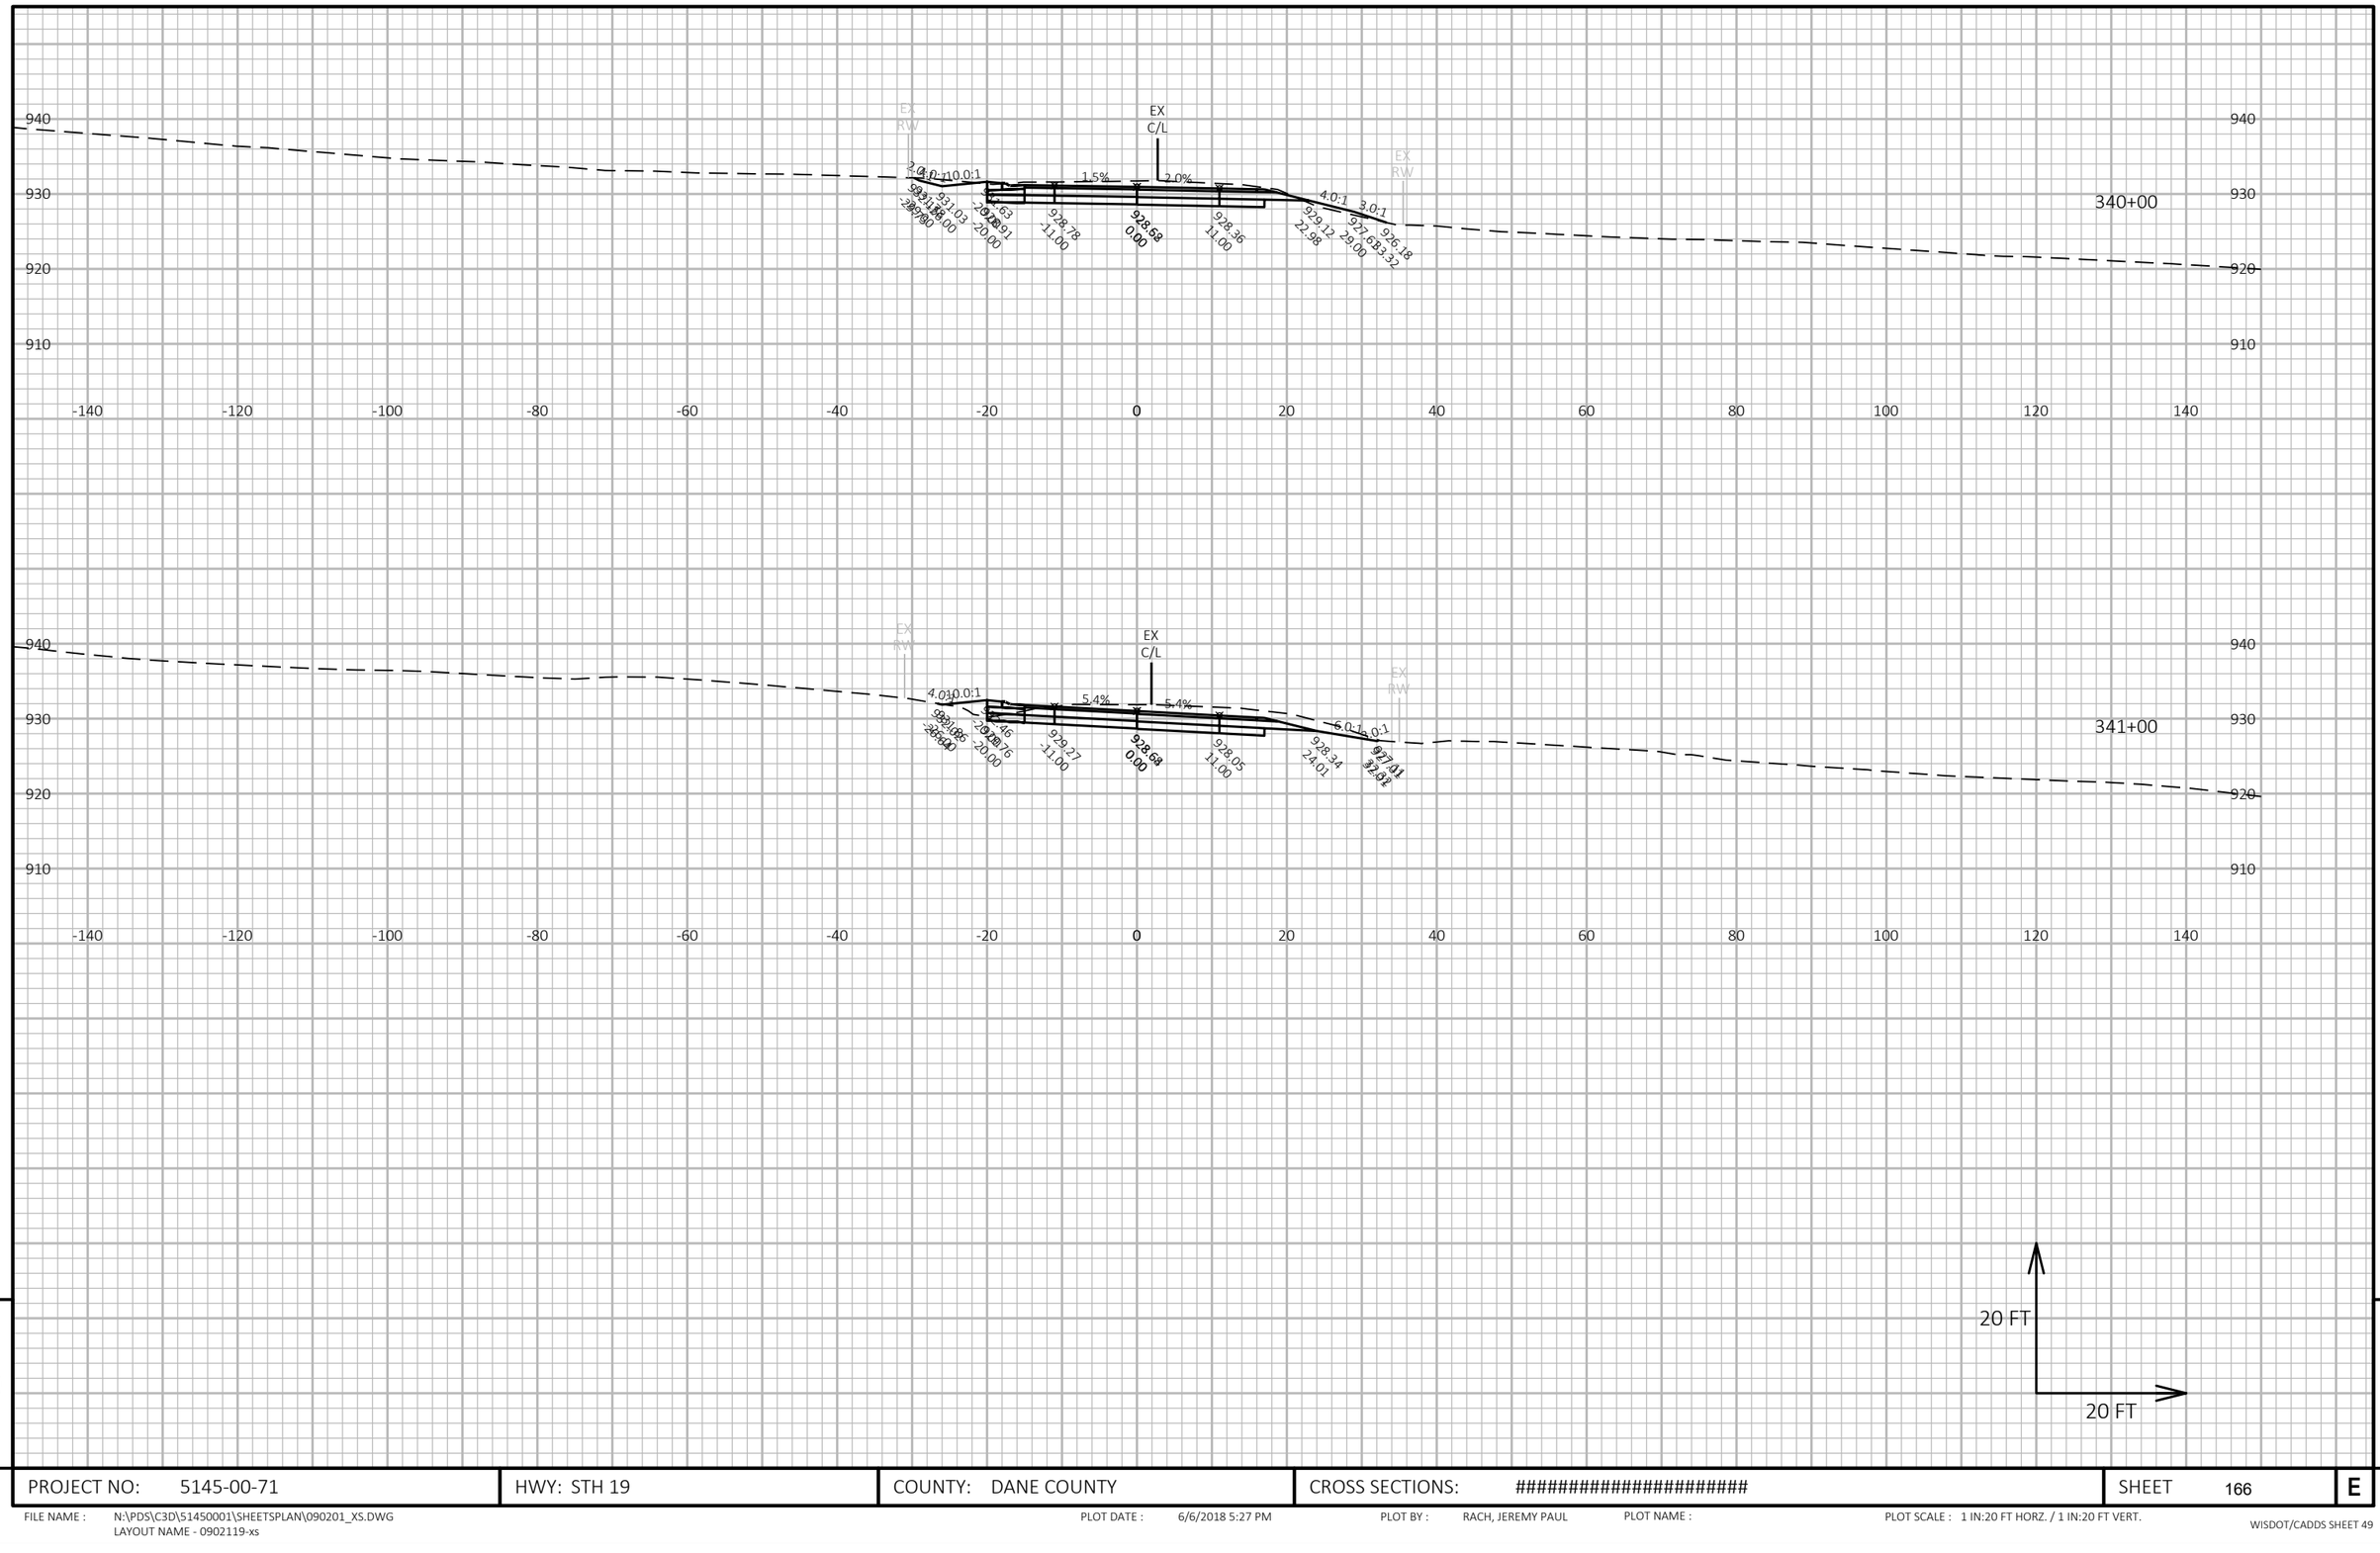

9

9

PROJECT NO: 5145-00-71	HWY: STH 19	COUNTY: DANE COUNTY	CROSS SECTIONS: ##########################	SHEET 166	E

FILE NAME : N:\PDS\C3D\51450001\SHEETSPLAN\090201_XS.DWG
LAYOUT NAME - 0902119-xs

PLOT DATE : 6/6/2018 5:27 PM PLOT BY : RACH, JEREMY PAUL PLOT NAME : PLOT SCALE : 1 IN:20 FT HORZ. / 1 IN:20 FT VERT.

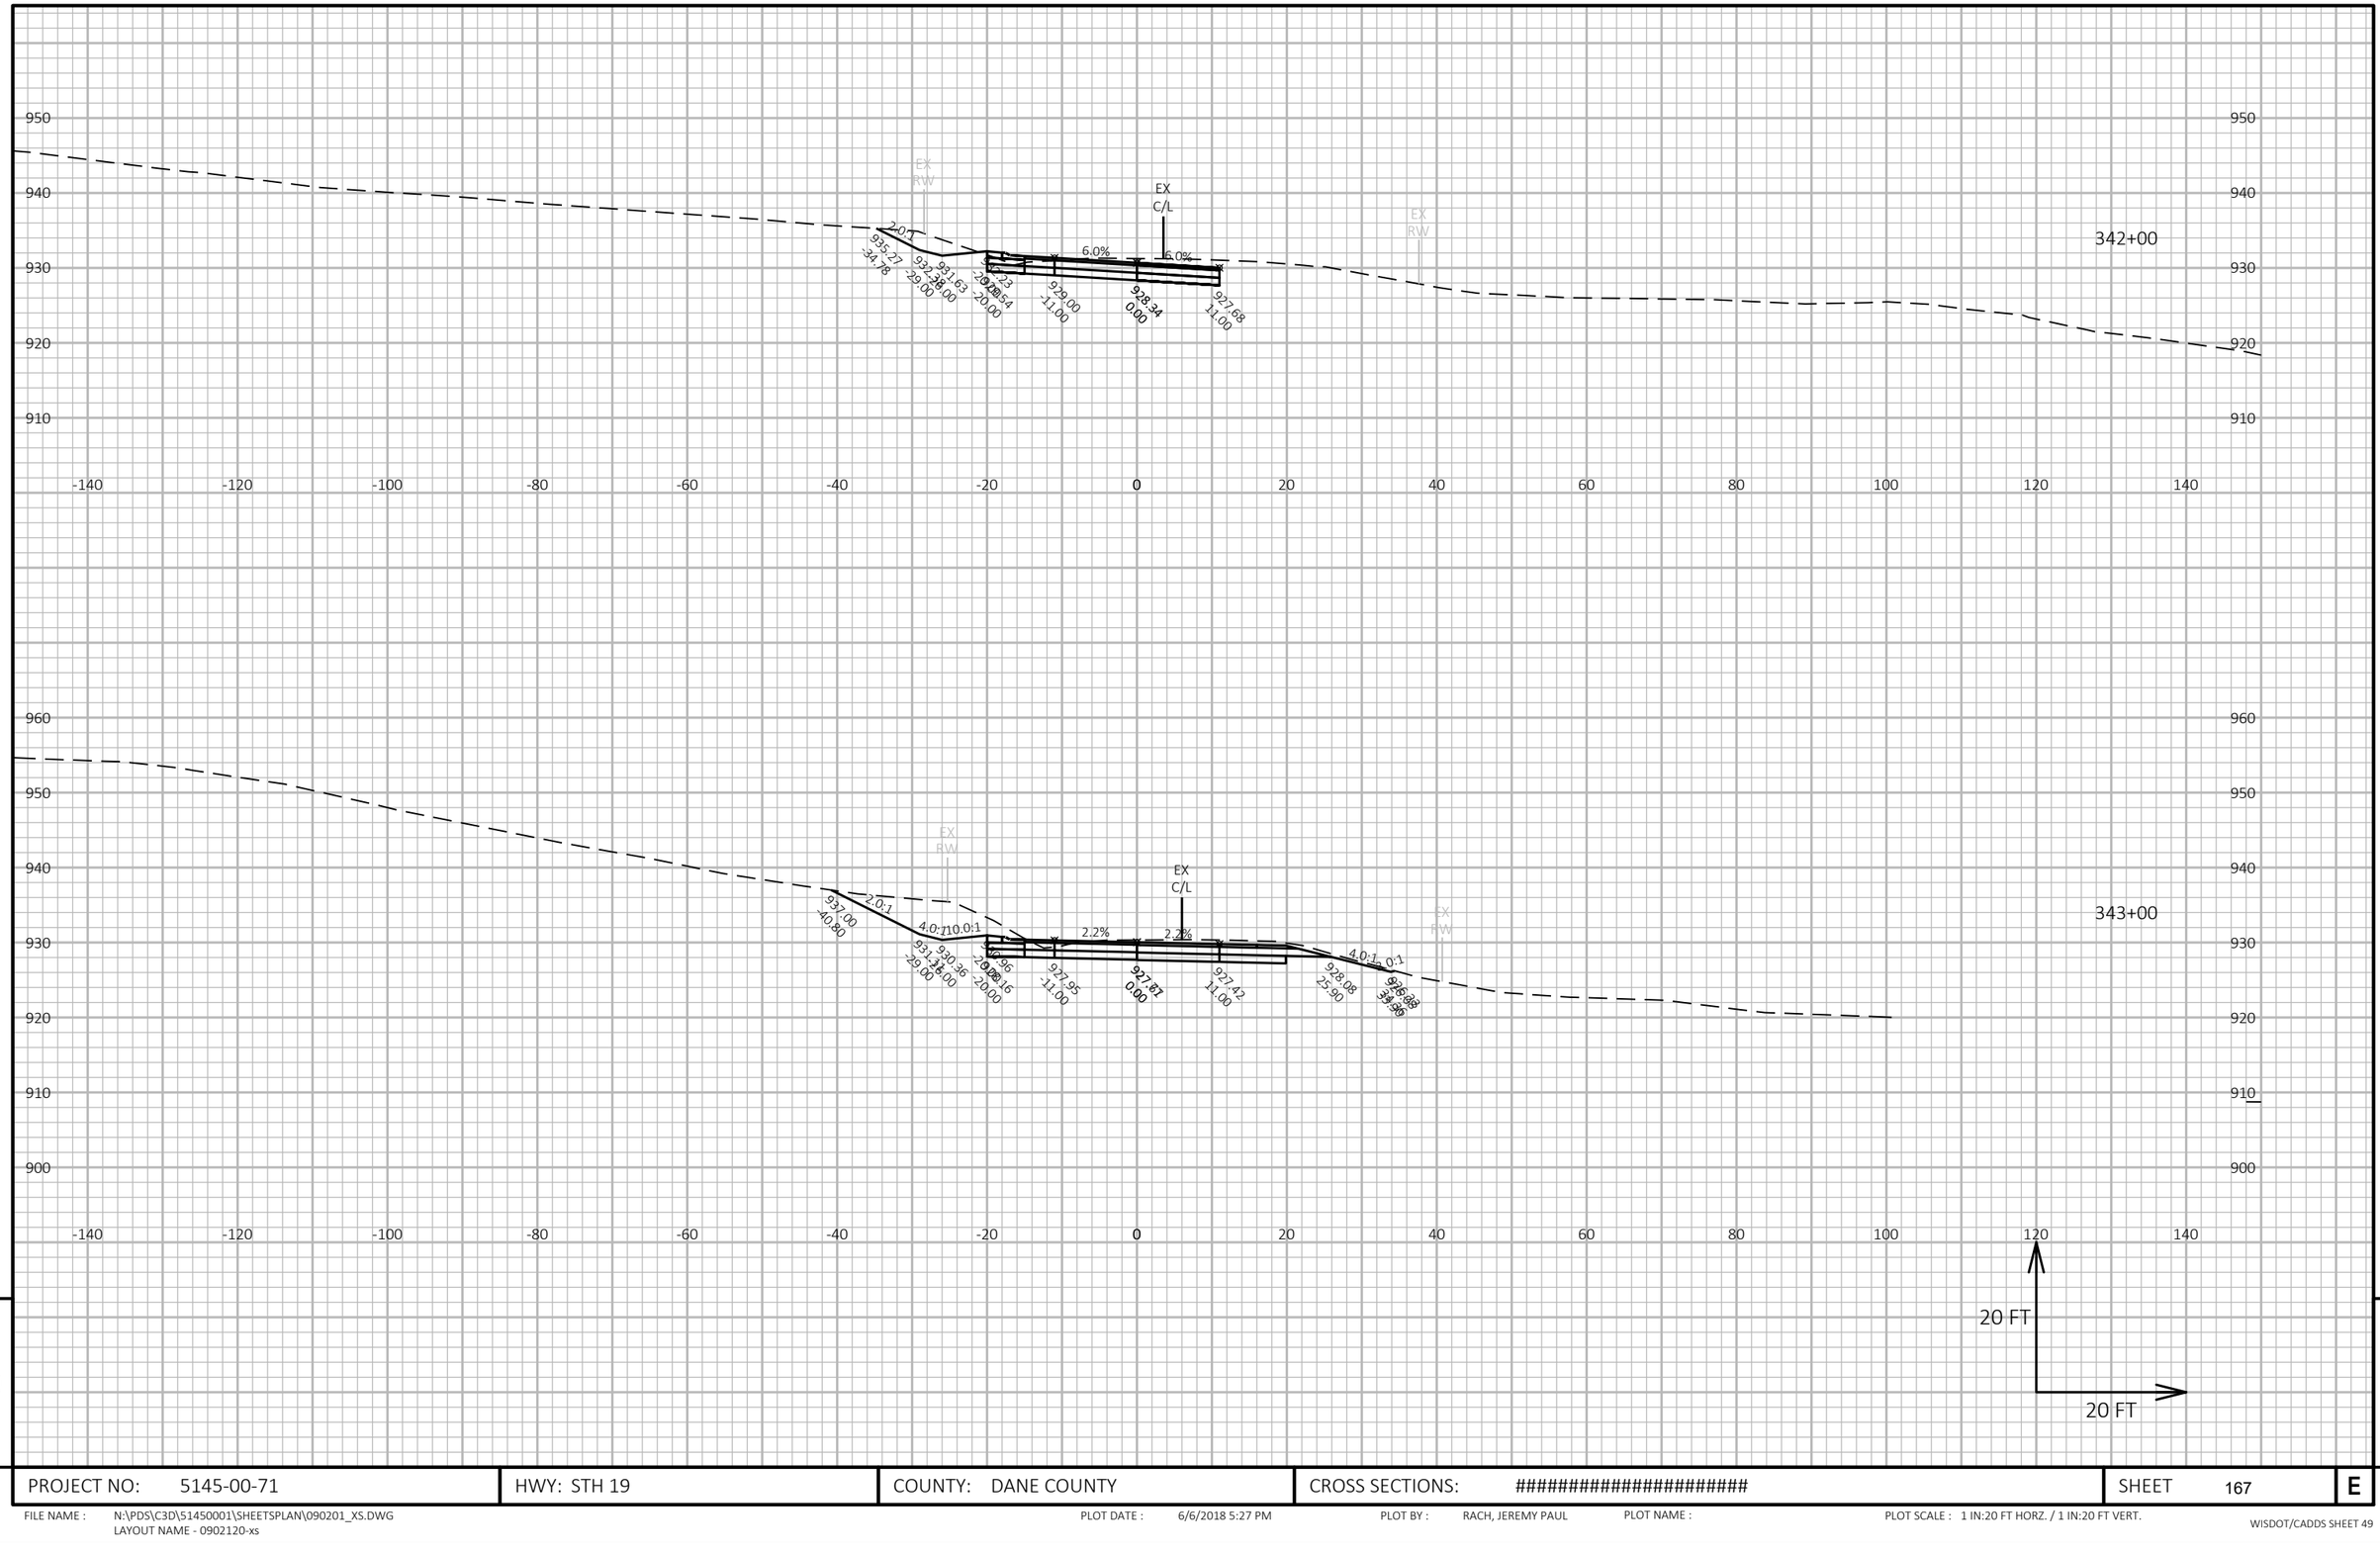

9

9

PROJECT NO: 5145-00-71	HWY: STH 19	COUNTY: DANE COUNTY	CROSS SECTIONS: ##########################	SHEET 167	E

FILE NAME : N:\PDS\C3D\51450001\SHEETSPLAN\090201_XS.DWG
LAYOUT NAME - 0902120-xs

PLOT DATE : 6/6/2018 5:27 PM PLOT BY : RACH, JEREMY PAUL PLOT NAME : PLOT SCALE : 1 IN:20 FT HORZ. / 1 IN:20 FT VERT.

WISDOT/CADDS SHEET 49

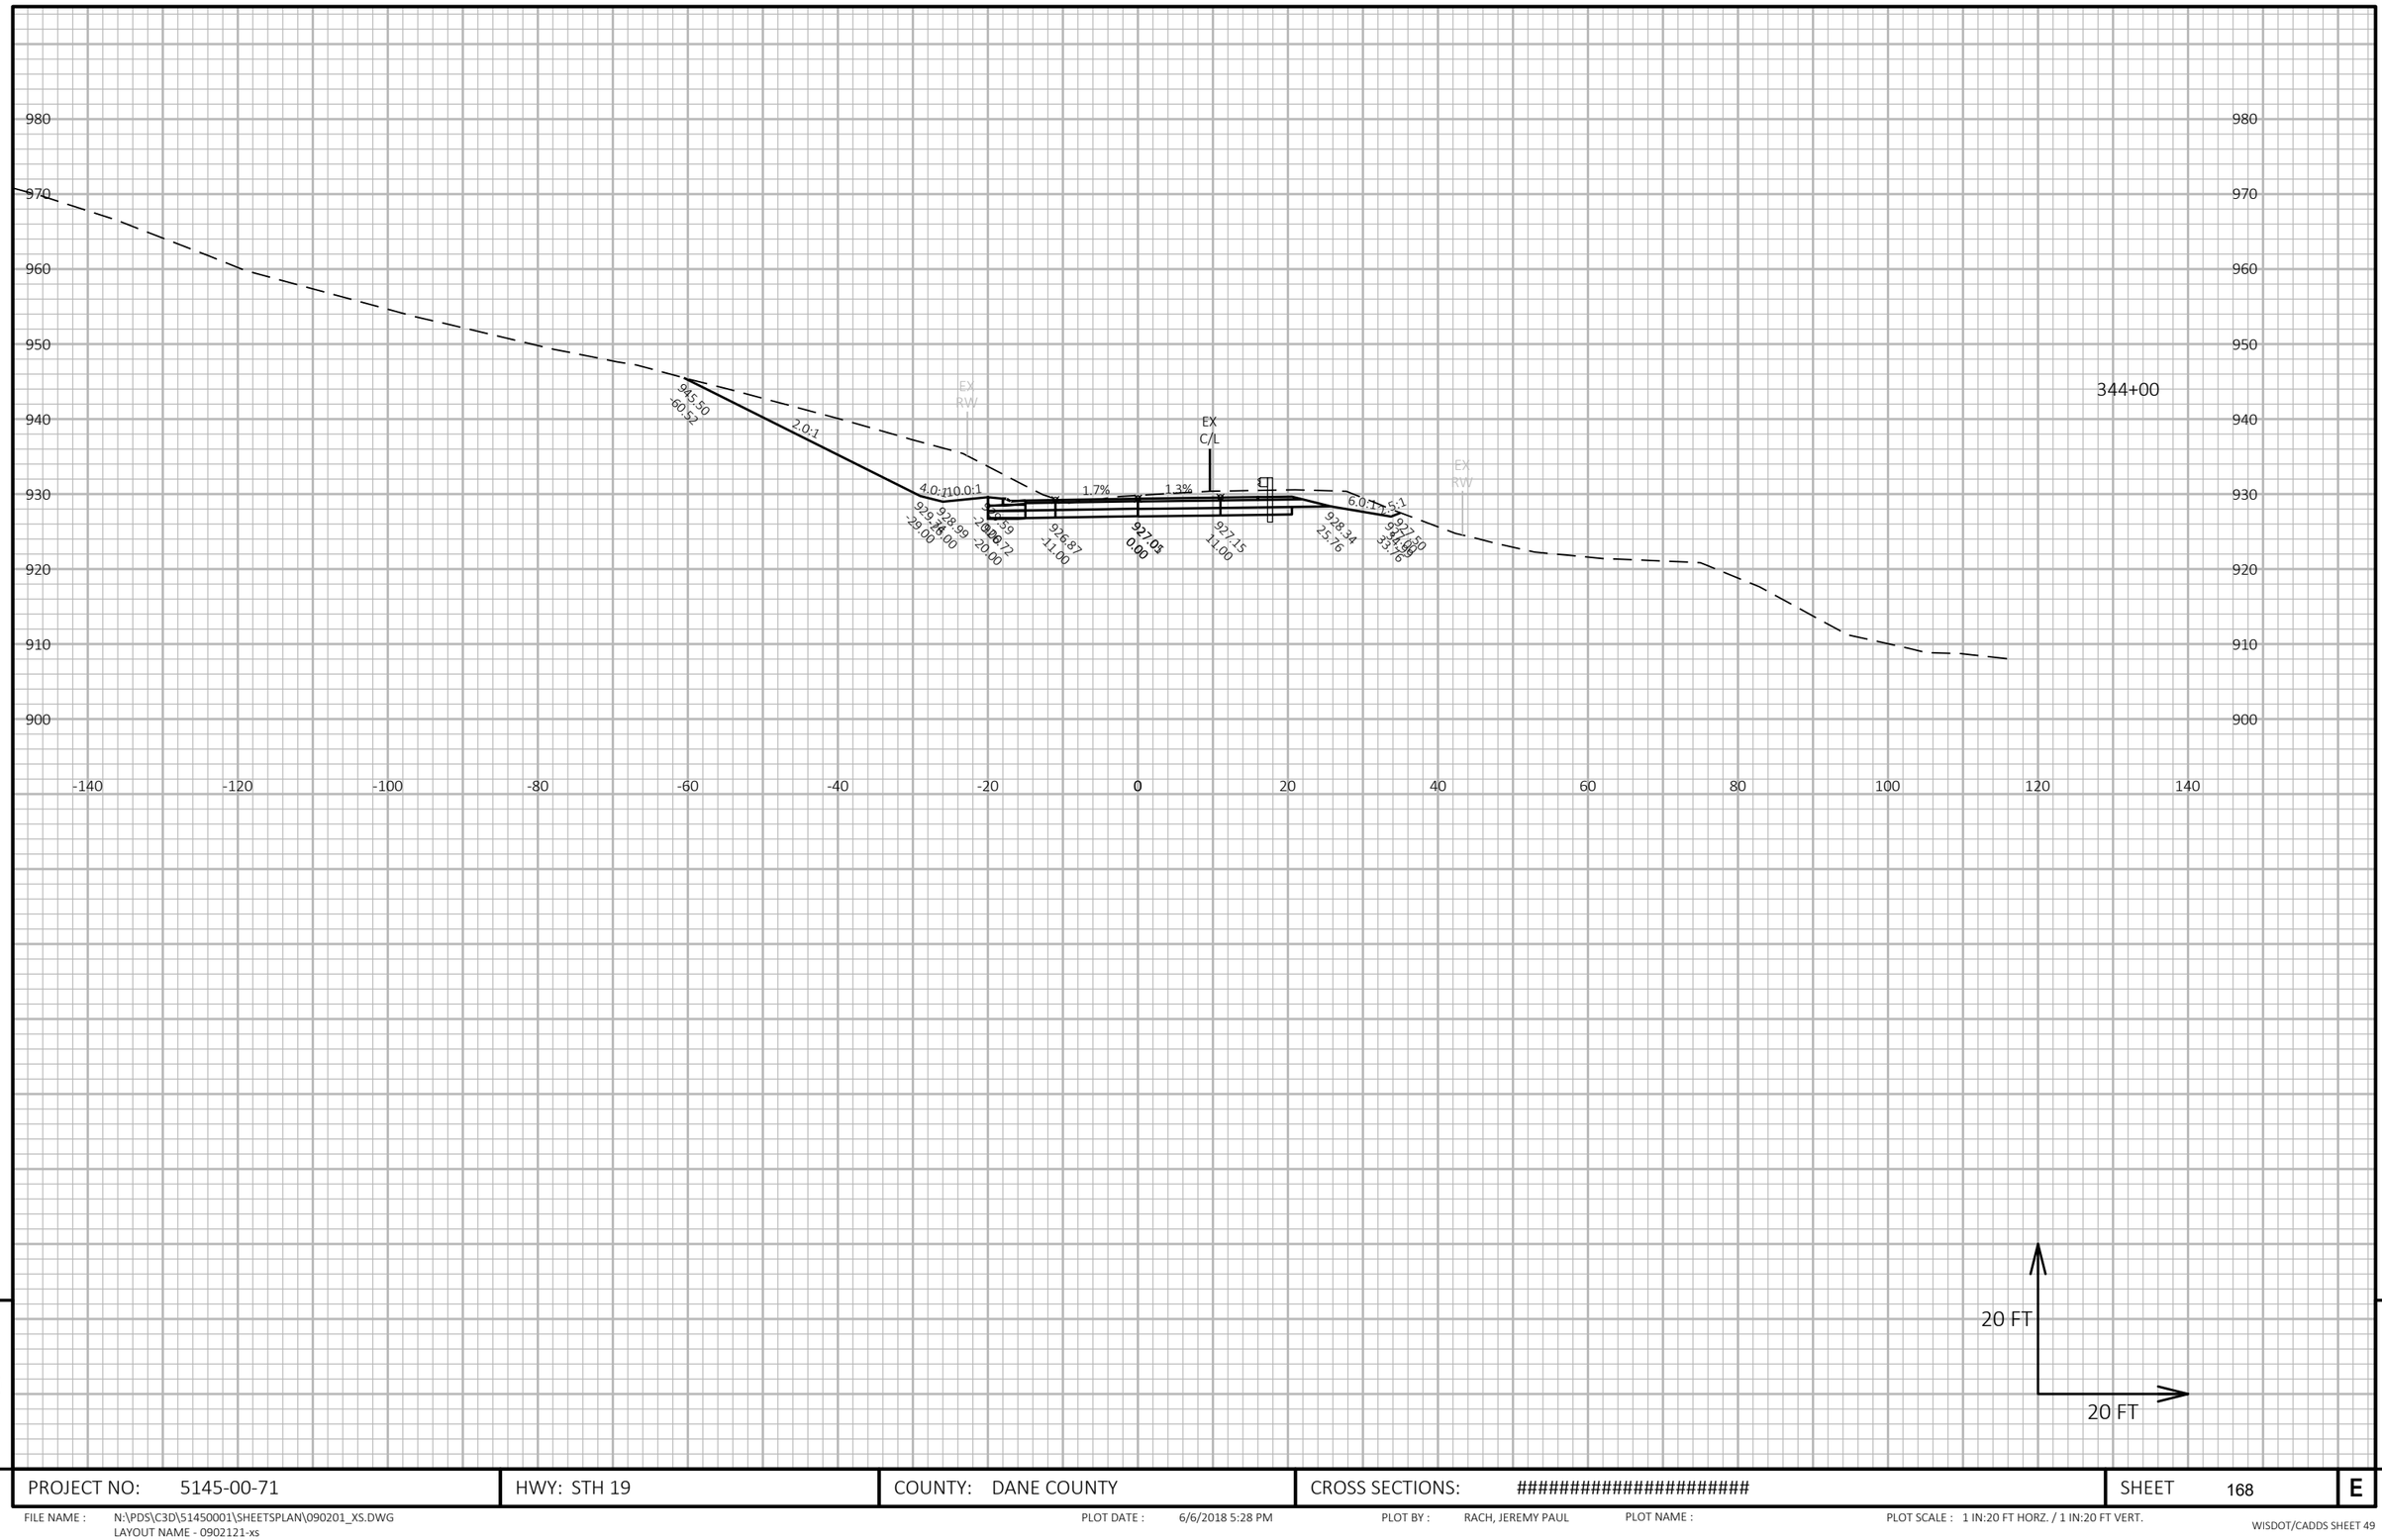

9

9

PROJECT NO: 5145-00-71	HWY: STH 19	COUNTY: DANE COUNTY	CROSS SECTIONS: ##########################	SHEET 168	E

FILE NAME : N:\PDS\C3D\51450001\SHEETSPLAN\090201_XS.DWG
LAYOUT NAME - 0902121-xs

PLOT DATE : 6/6/2018 5:28 PM PLOT BY : RACH, JEREMY PAUL PLOT NAME : PLOT SCALE : 1 IN:20 FT HORZ. / 1 IN:20 FT VERT.

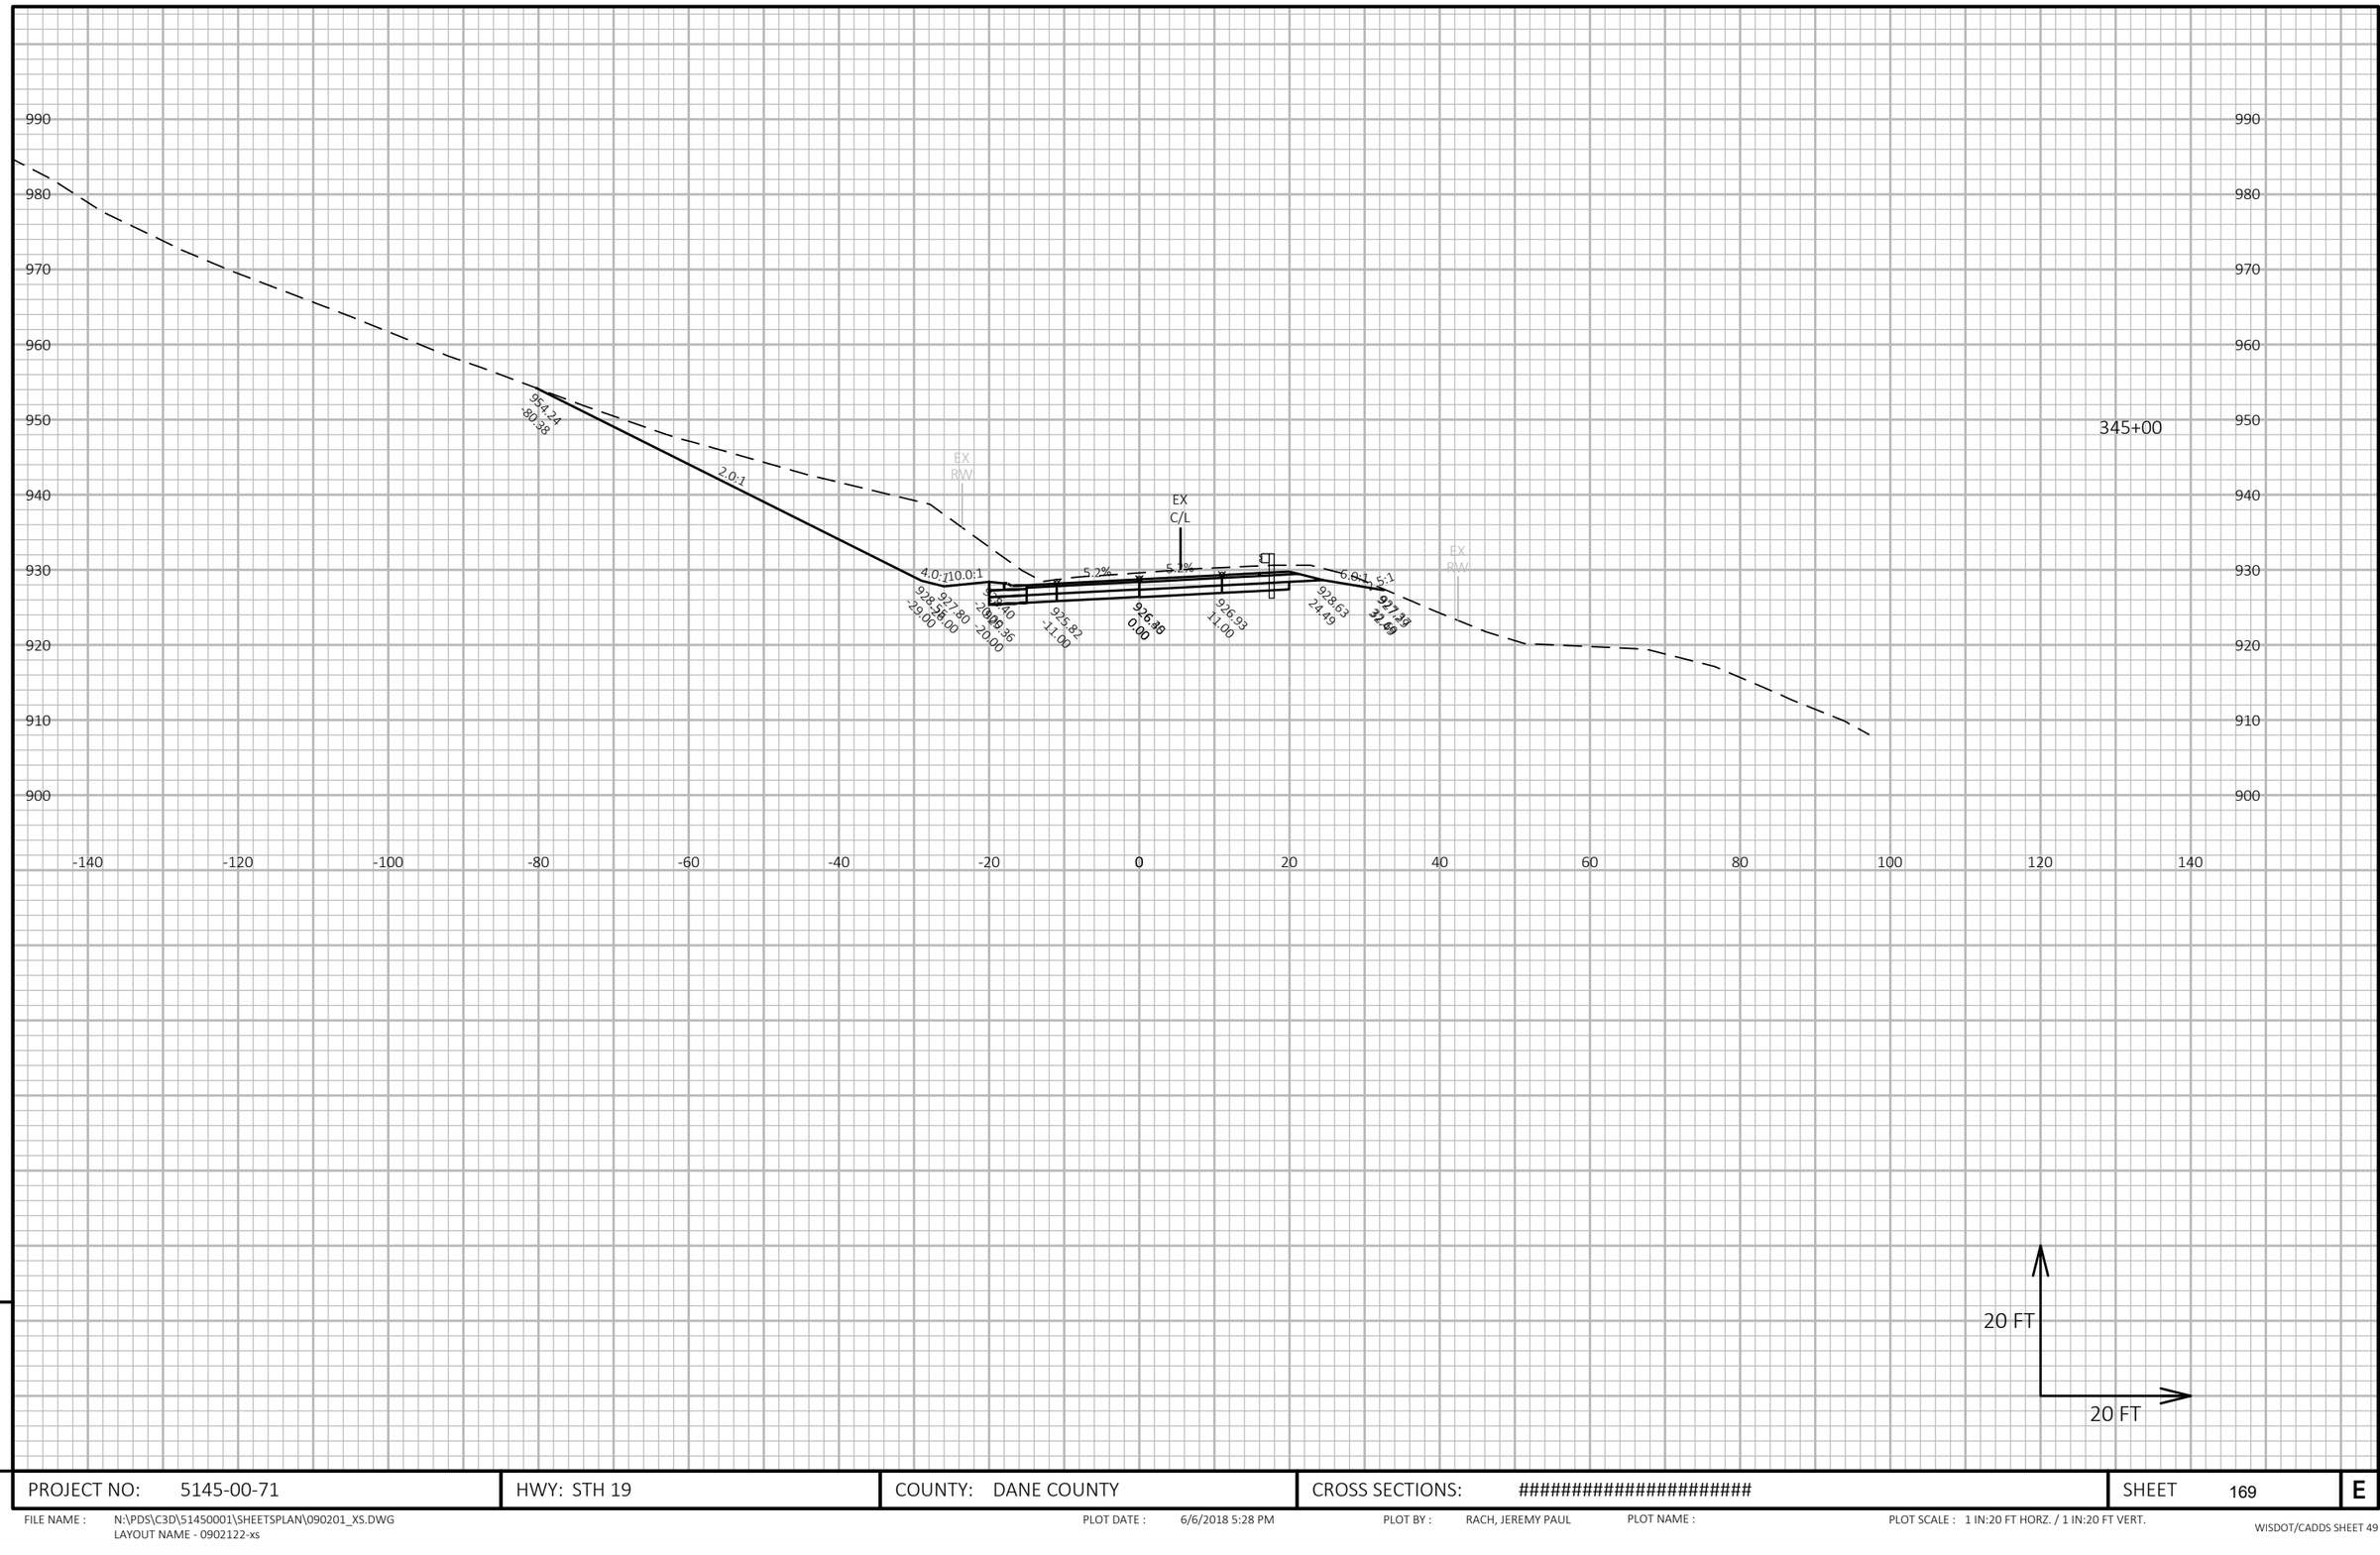

9

9

PROJECT NO: 5145-00-71	HWY: STH 19	COUNTY: DANE COUNTY	CROSS SECTIONS: ##########################	SHEET 169	E

FILE NAME : N:\PDS\C3D\51450001\SHEETSPLAN\090201_XS.DWG
LAYOUT NAME - 0902122-xs

PLOT DATE : 6/6/2018 5:28 PM PLOT BY : RACH, JEREMY PAUL PLOT NAME : PLOT SCALE : 1 IN:20 FT HORZ. / 1 IN:20 FT VERT.

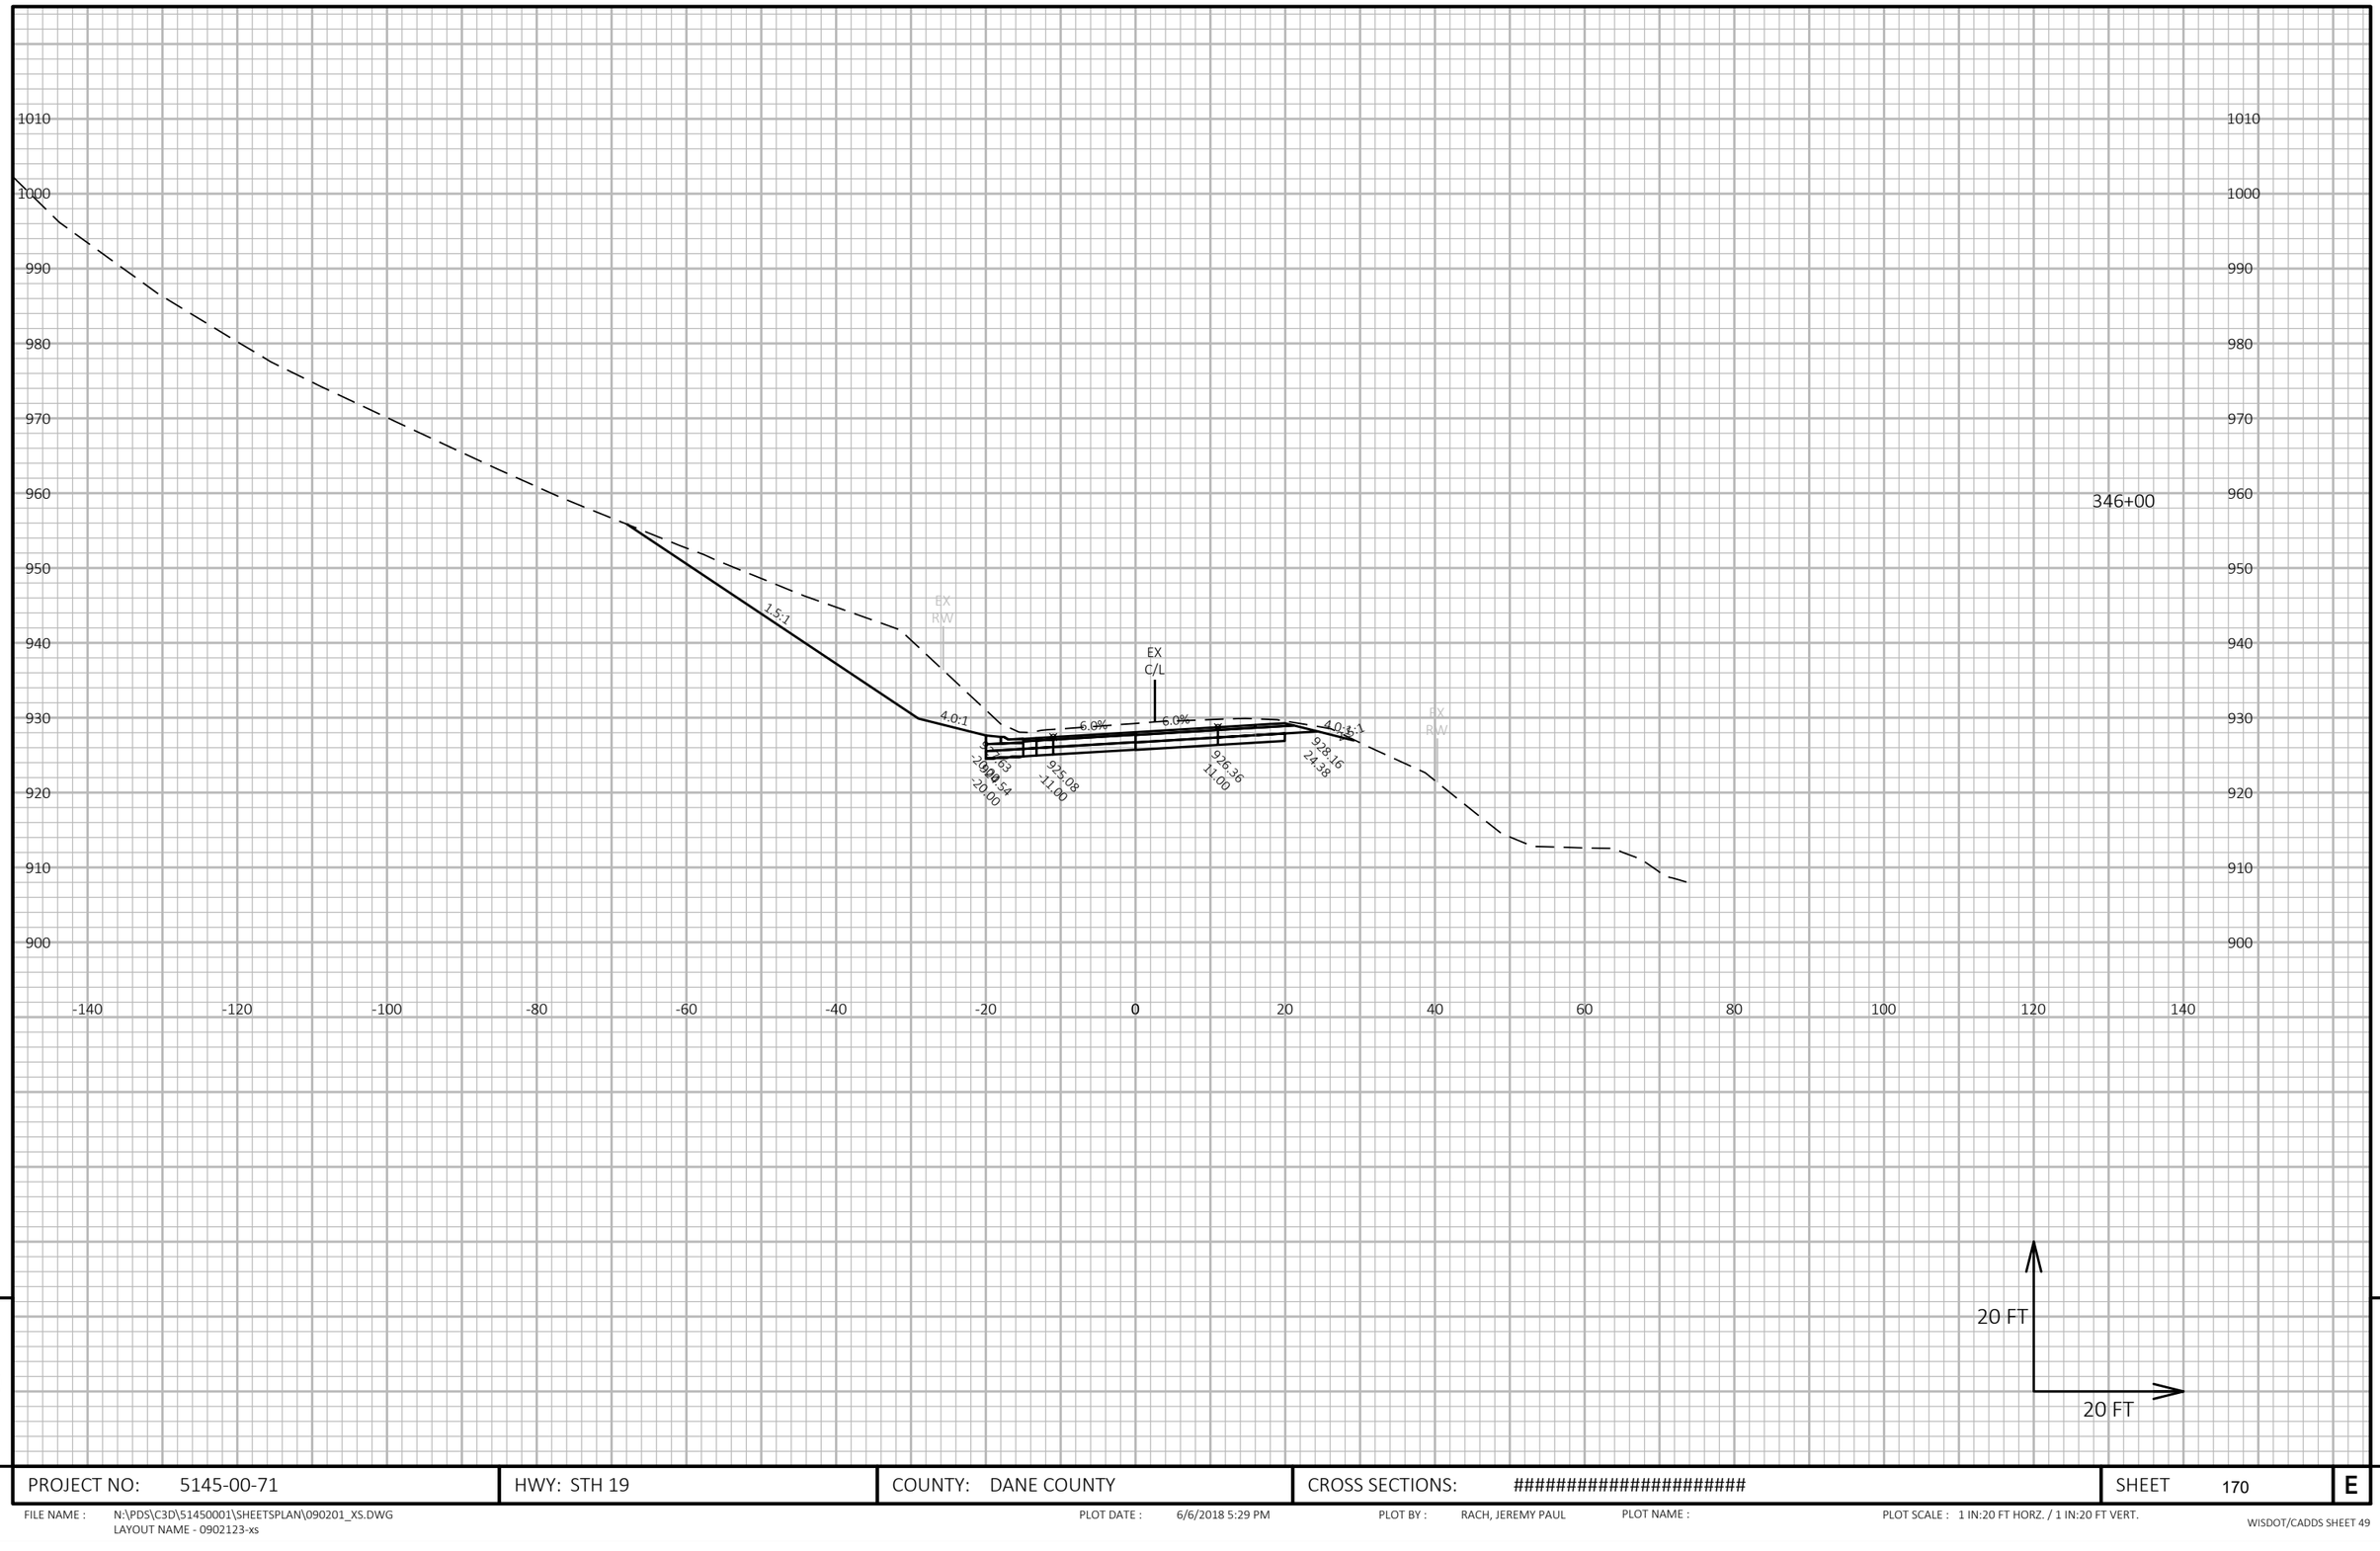

9

9

PROJECT NO: 5145-00-71	HWY: STH 19	COUNTY: DANE COUNTY	CROSS SECTIONS: ##########################	SHEET 170	E

FILE NAME : N:\PDS\C3D\51450001\SHEETSPLAN\090201_XS.DWG
LAYOUT NAME - 0902123-xs

PLOT DATE : 6/6/2018 5:29 PM PLOT BY : RACH, JEREMY PAUL PLOT NAME : PLOT SCALE : 1 IN:20 FT HORZ. / 1 IN:20 FT VERT.

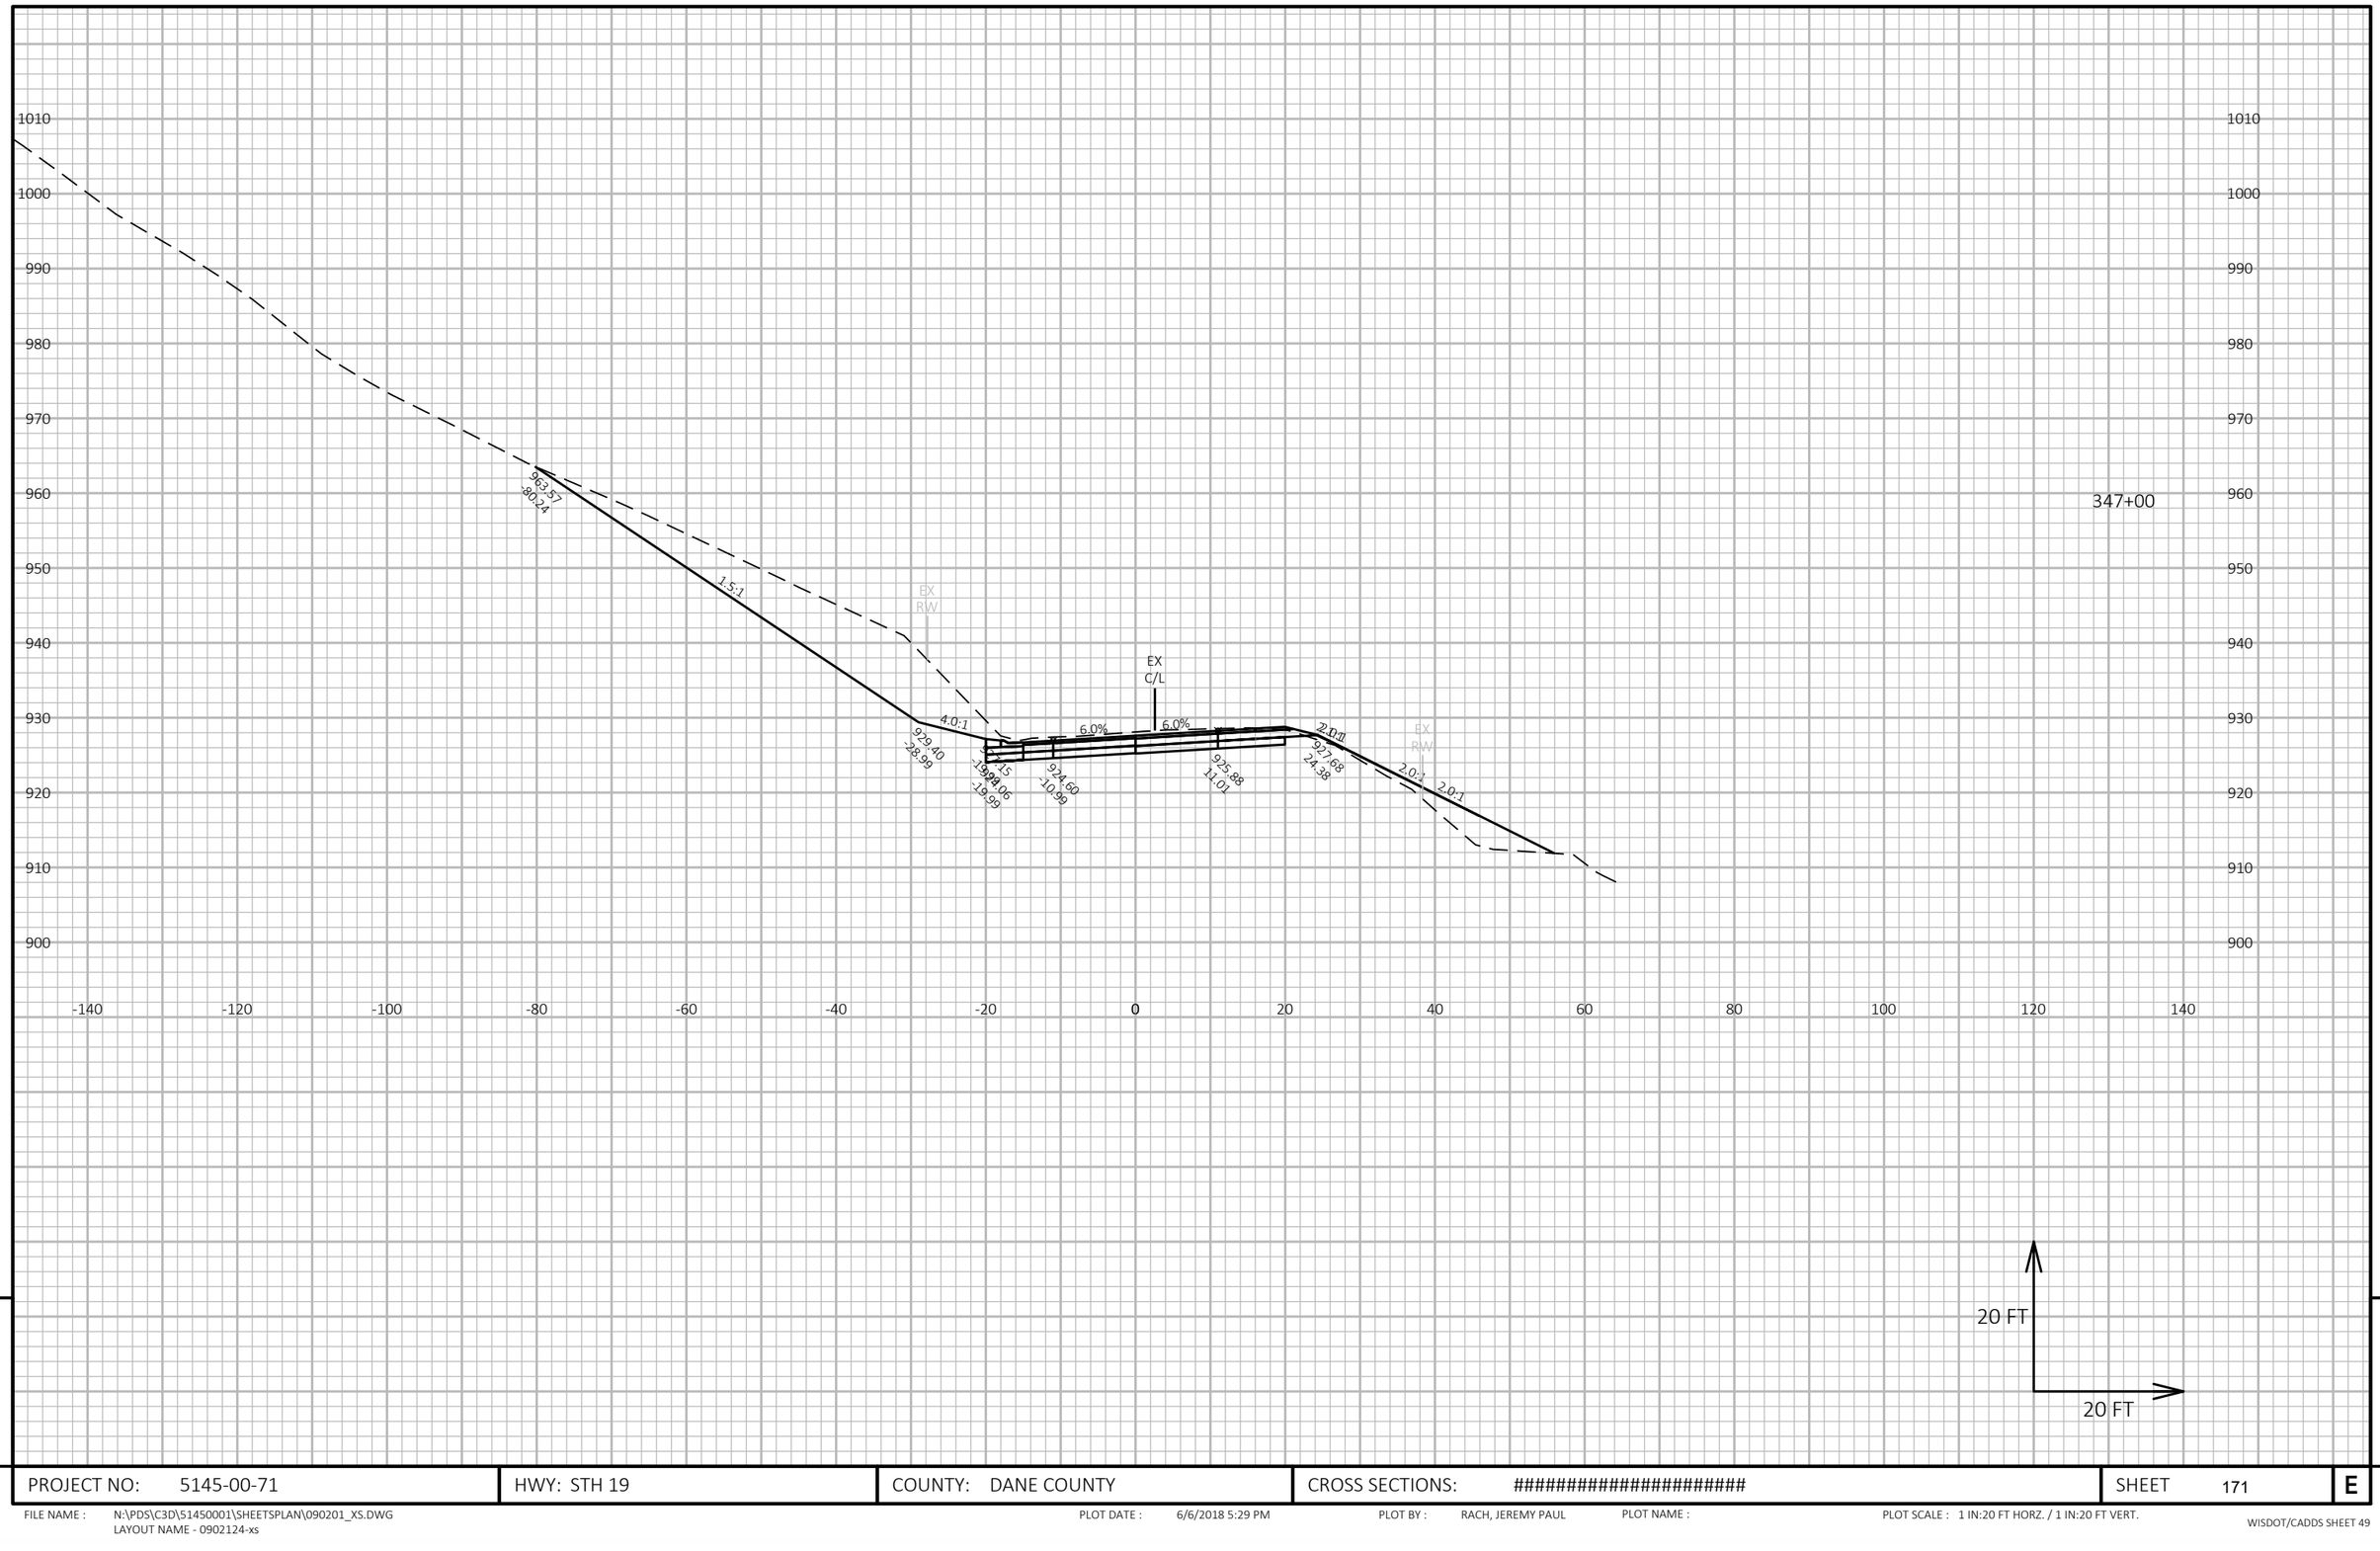

9

9

PROJECT NO: 5145-00-71	HWY: STH 19	COUNTY: DANE COUNTY	CROSS SECTIONS: ##########################	SHEET 171	E

FILE NAME : N:\PDS\C3D\51450001\SHEETSPLAN\090201_XS.DWG
LAYOUT NAME - 0902124-xs

PLOT DATE : 6/6/2018 5:29 PM

PLOT BY : RACH, JEREMY PAUL

PLOT NAME :

PLOT SCALE : 1 IN:20 FT HORZ. / 1 IN:20 FT VERT.

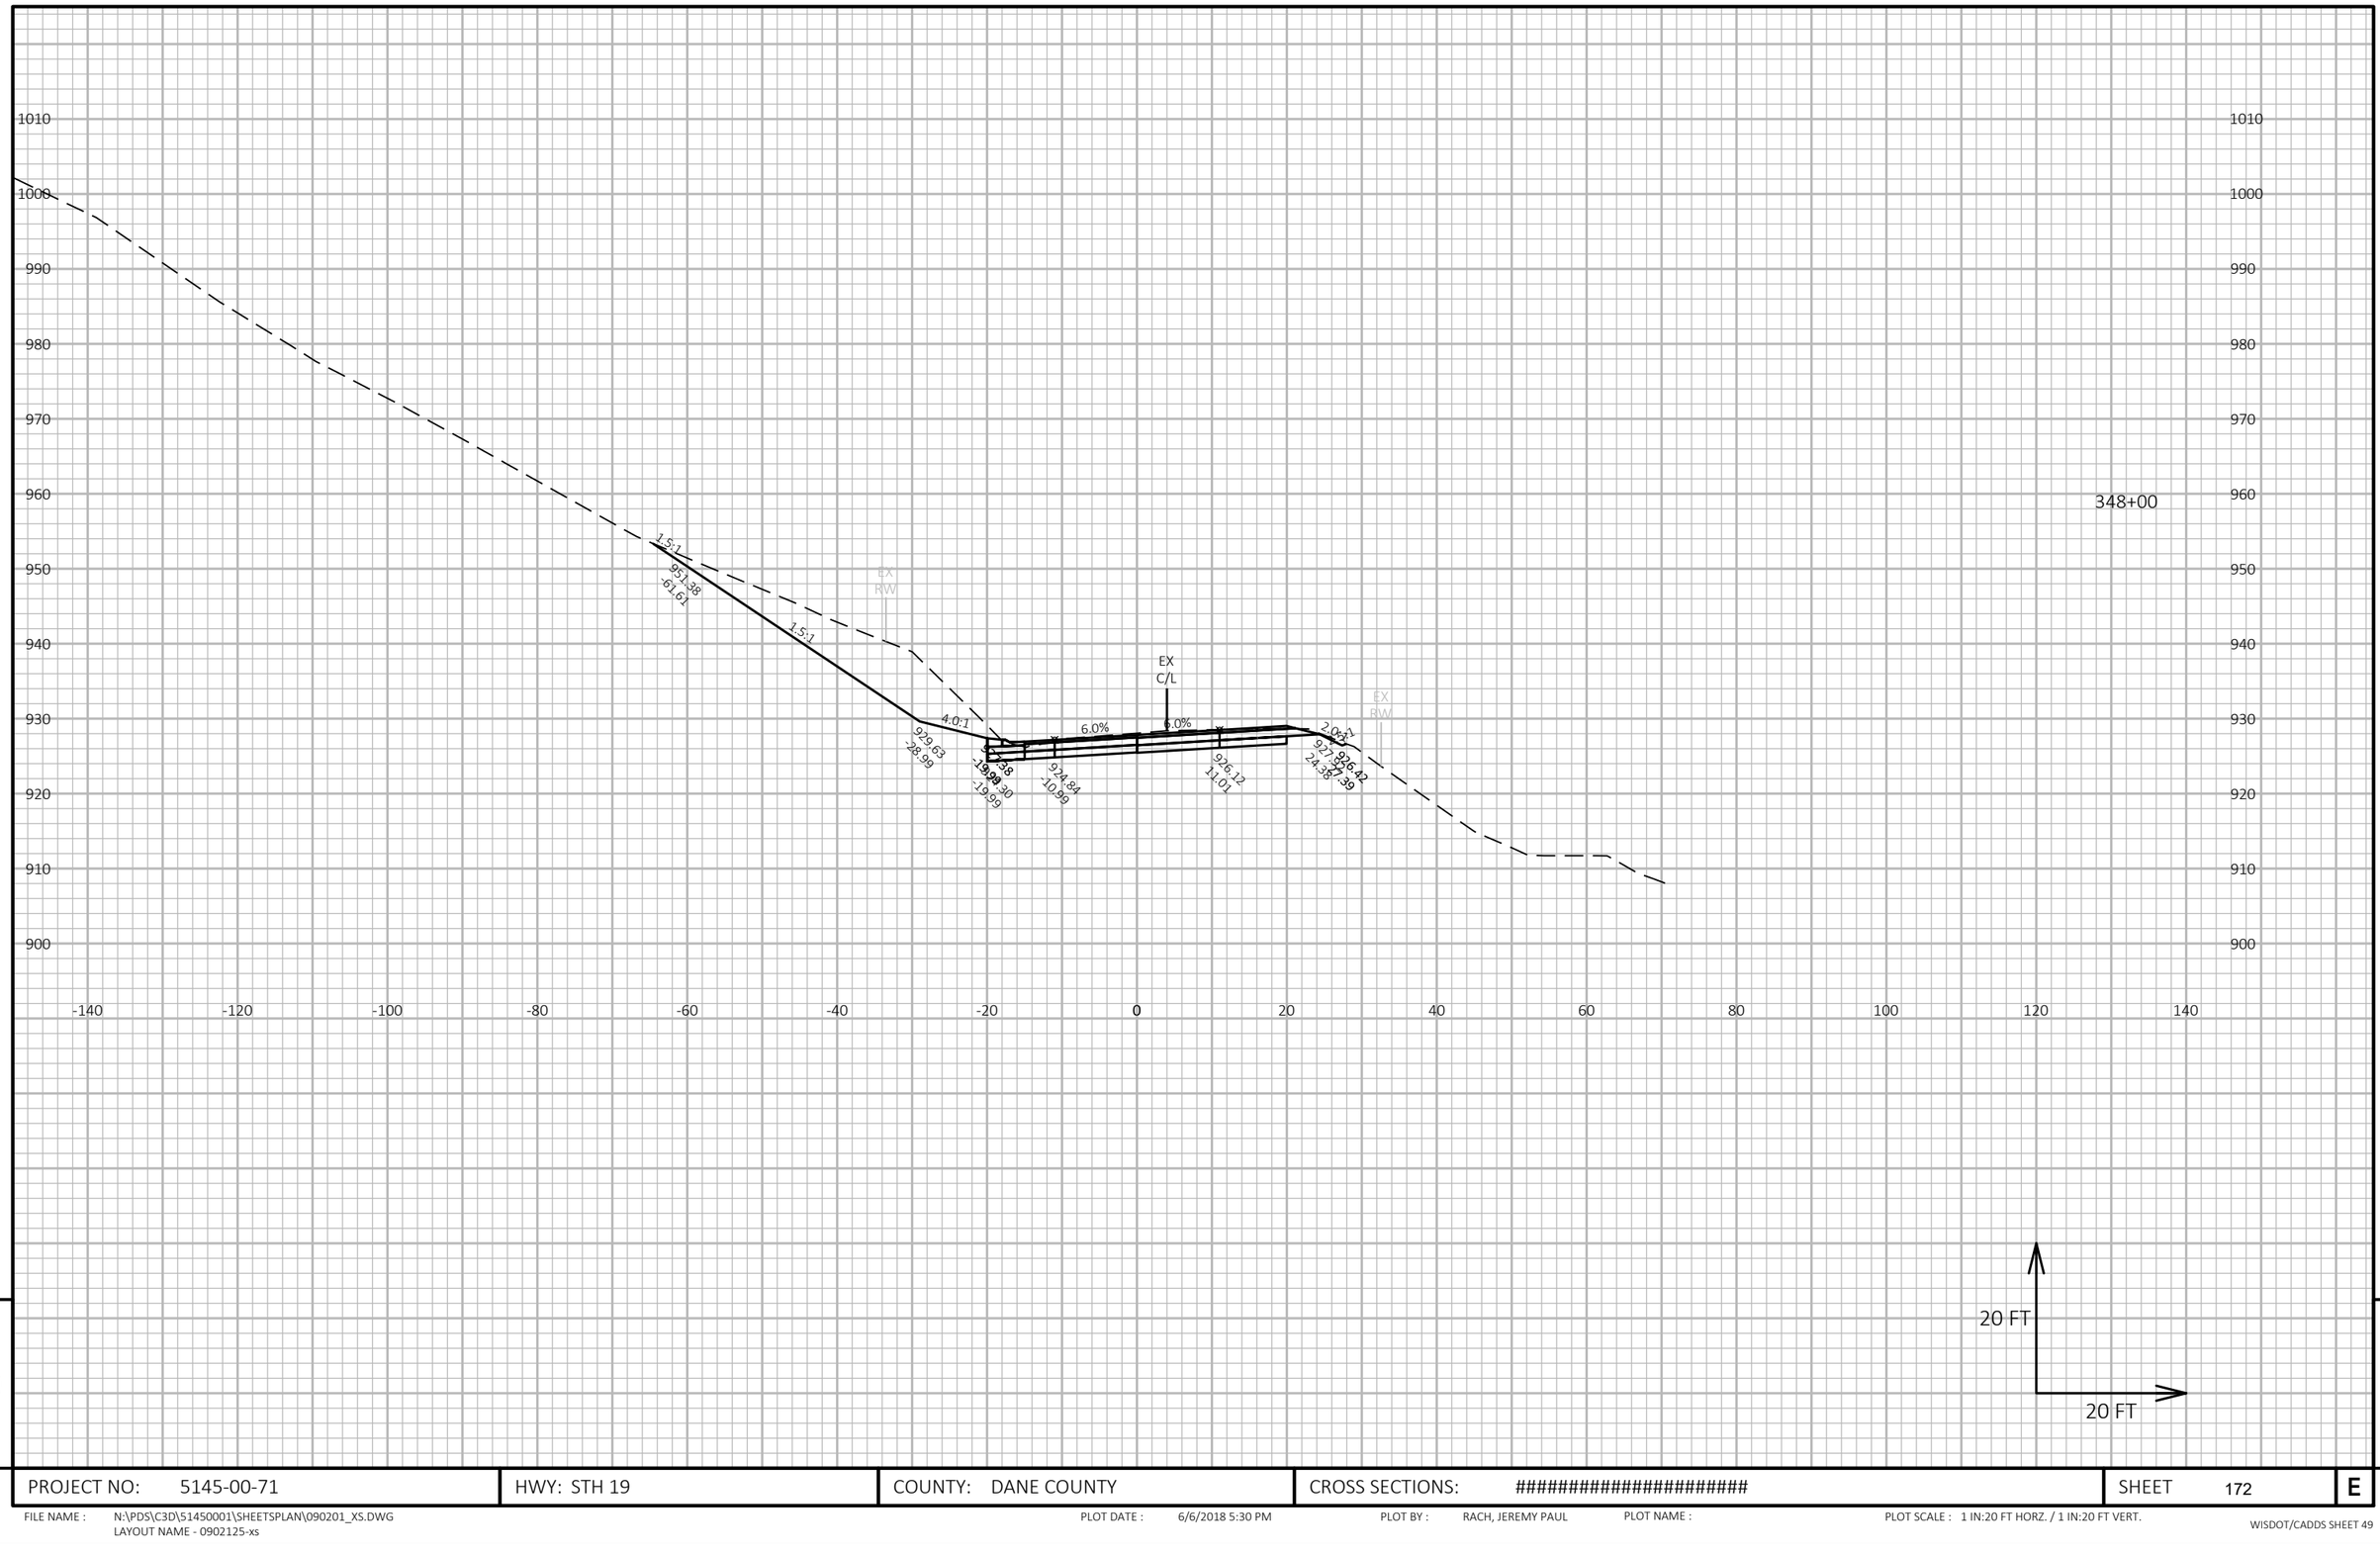

9

9

PROJECT NO: 5145-00-71	HWY: STH 19	COUNTY: DANE COUNTY	CROSS SECTIONS: ##########################	SHEET 172	E

FILE NAME : N:\PDS\C3D\51450001\SHEETSPLAN\090201_XS.DWG
LAYOUT NAME - 0902125-xs

PLOT DATE : 6/6/2018 5:30 PM PLOT BY : RACH, JEREMY PAUL PLOT NAME : PLOT SCALE : 1 IN:20 FT HORZ. / 1 IN:20 FT VERT.

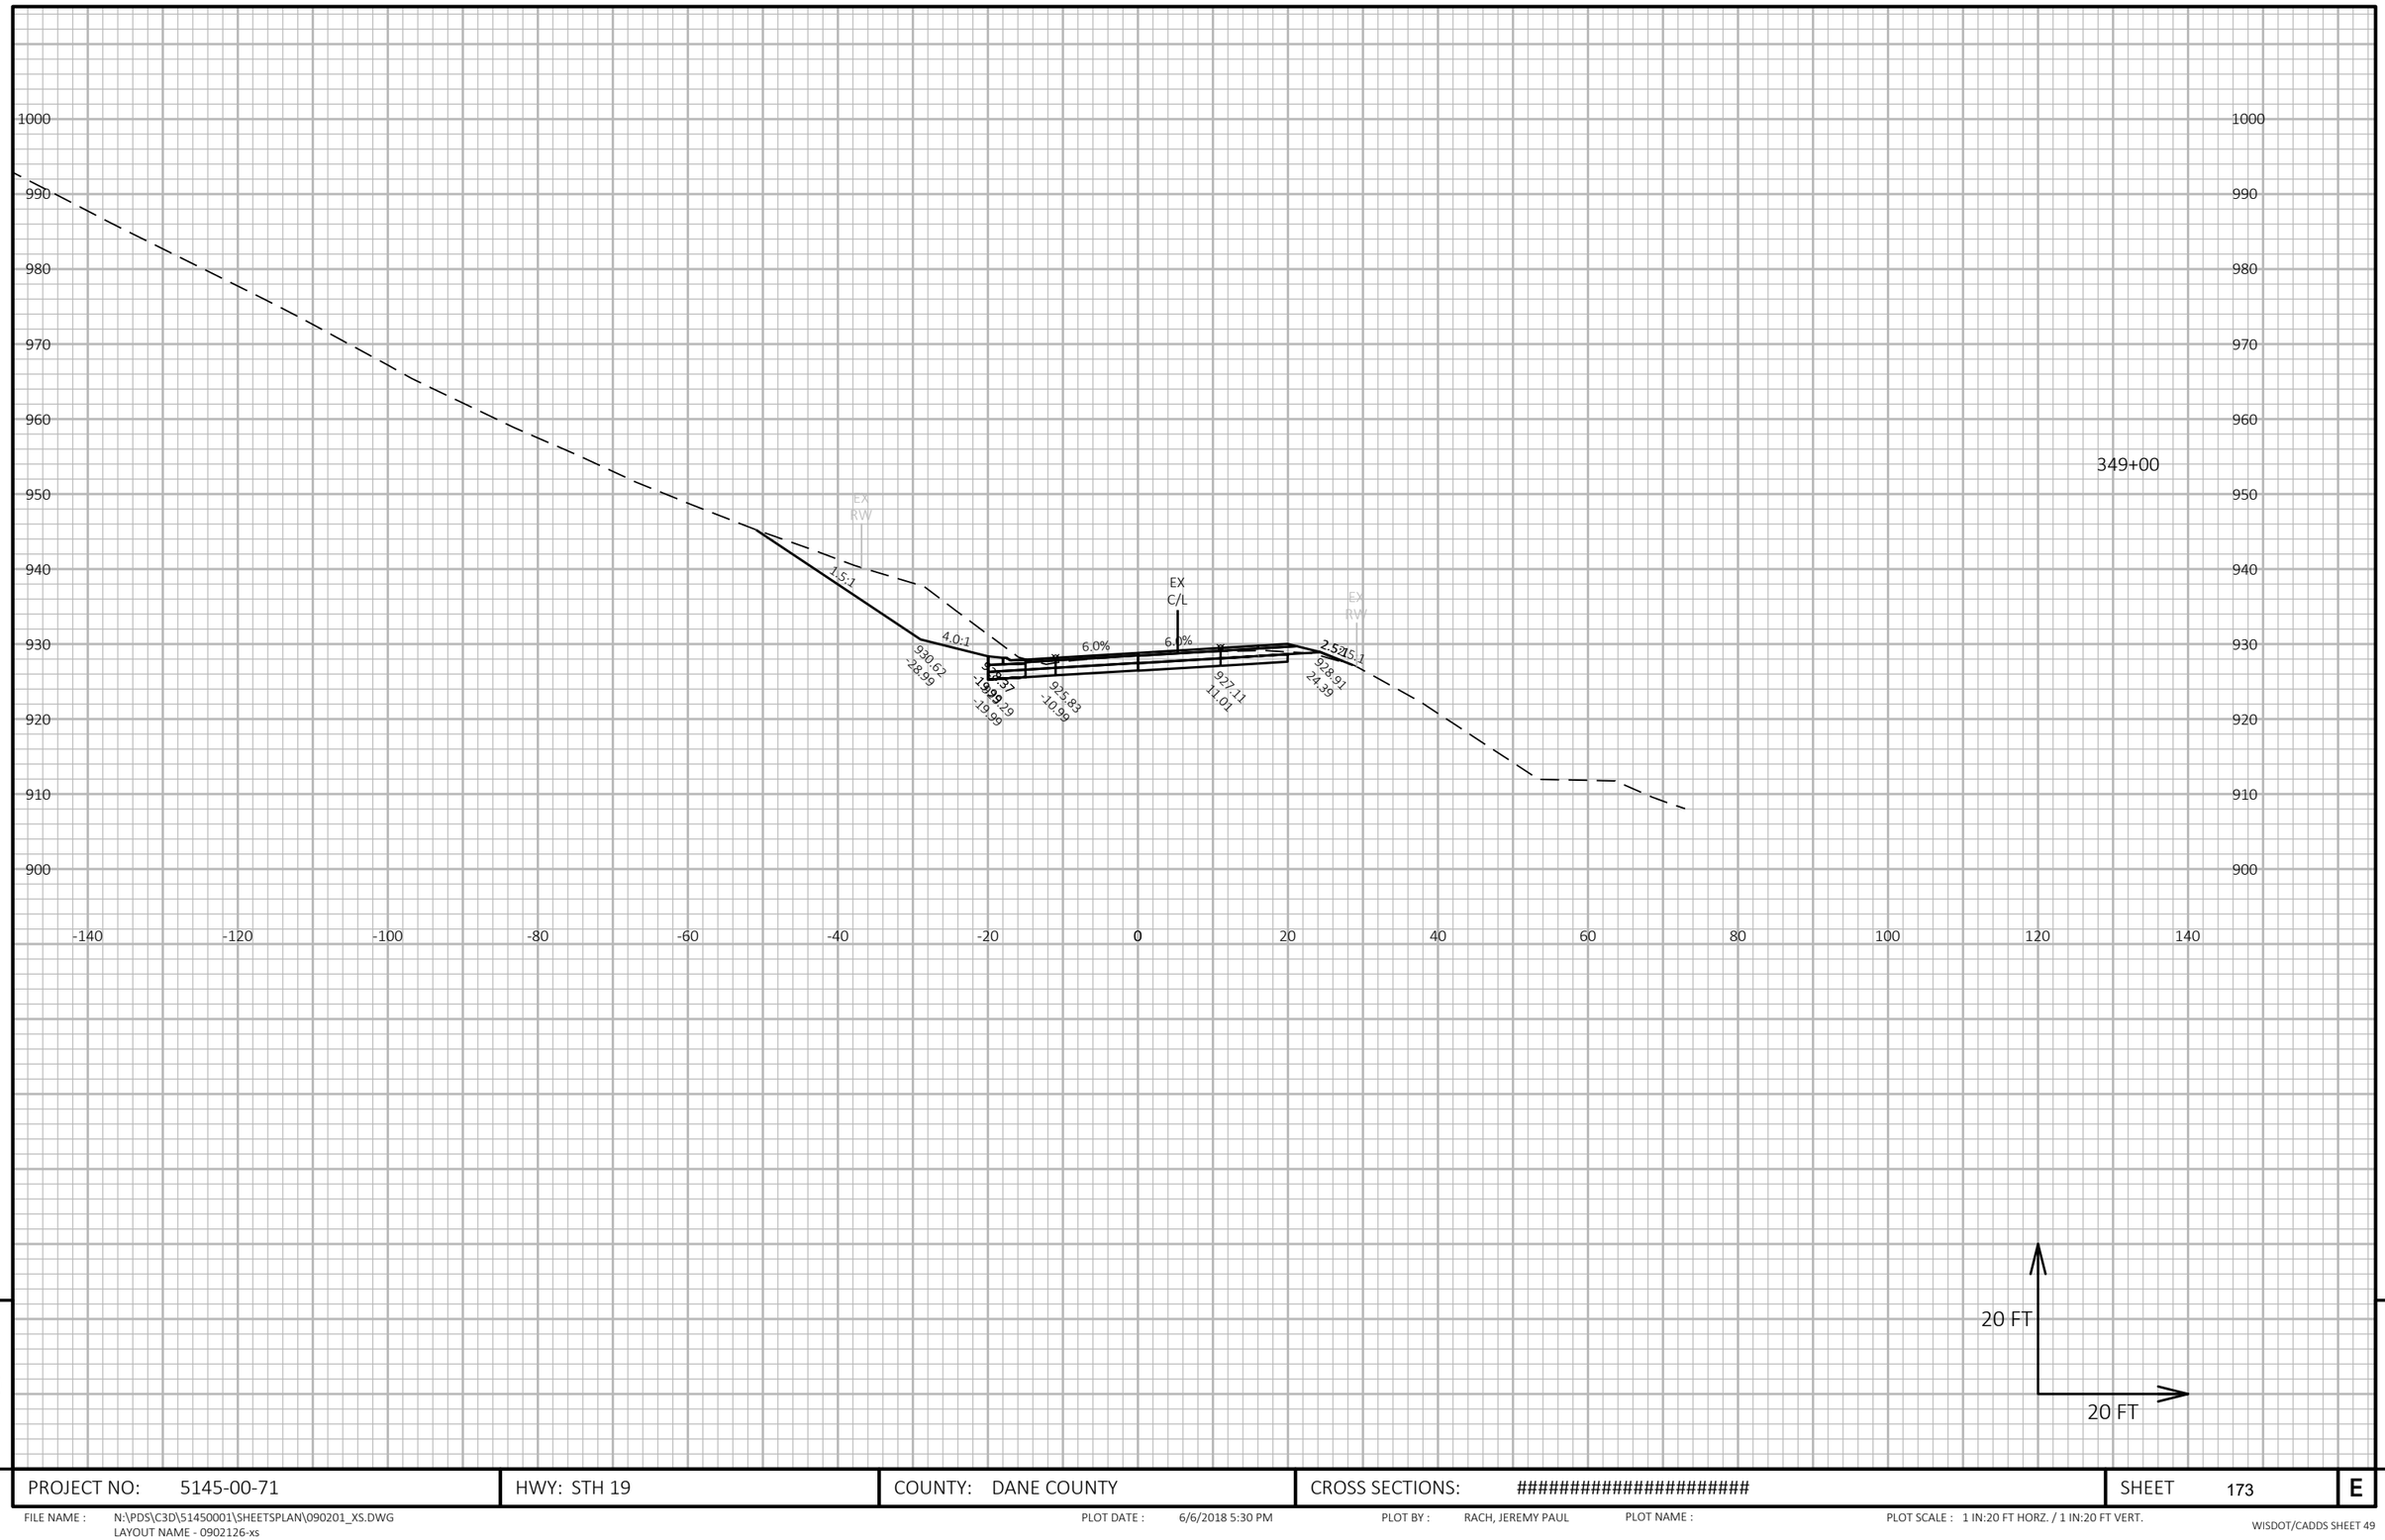

9

9

PROJECT NO: 5145-00-71	HWY: STH 19	COUNTY: DANE COUNTY	CROSS SECTIONS: ##########################	SHEET 173	E

FILE NAME : N:\PDS\C3D\51450001\SHEETSPLAN\090201_XS.DWG
LAYOUT NAME - 0902126-xs

PLOT DATE : 6/6/2018 5:30 PM PLOT BY : RACH, JEREMY PAUL PLOT NAME : PLOT SCALE : 1 IN:20 FT HORZ. / 1 IN:20 FT VERT.

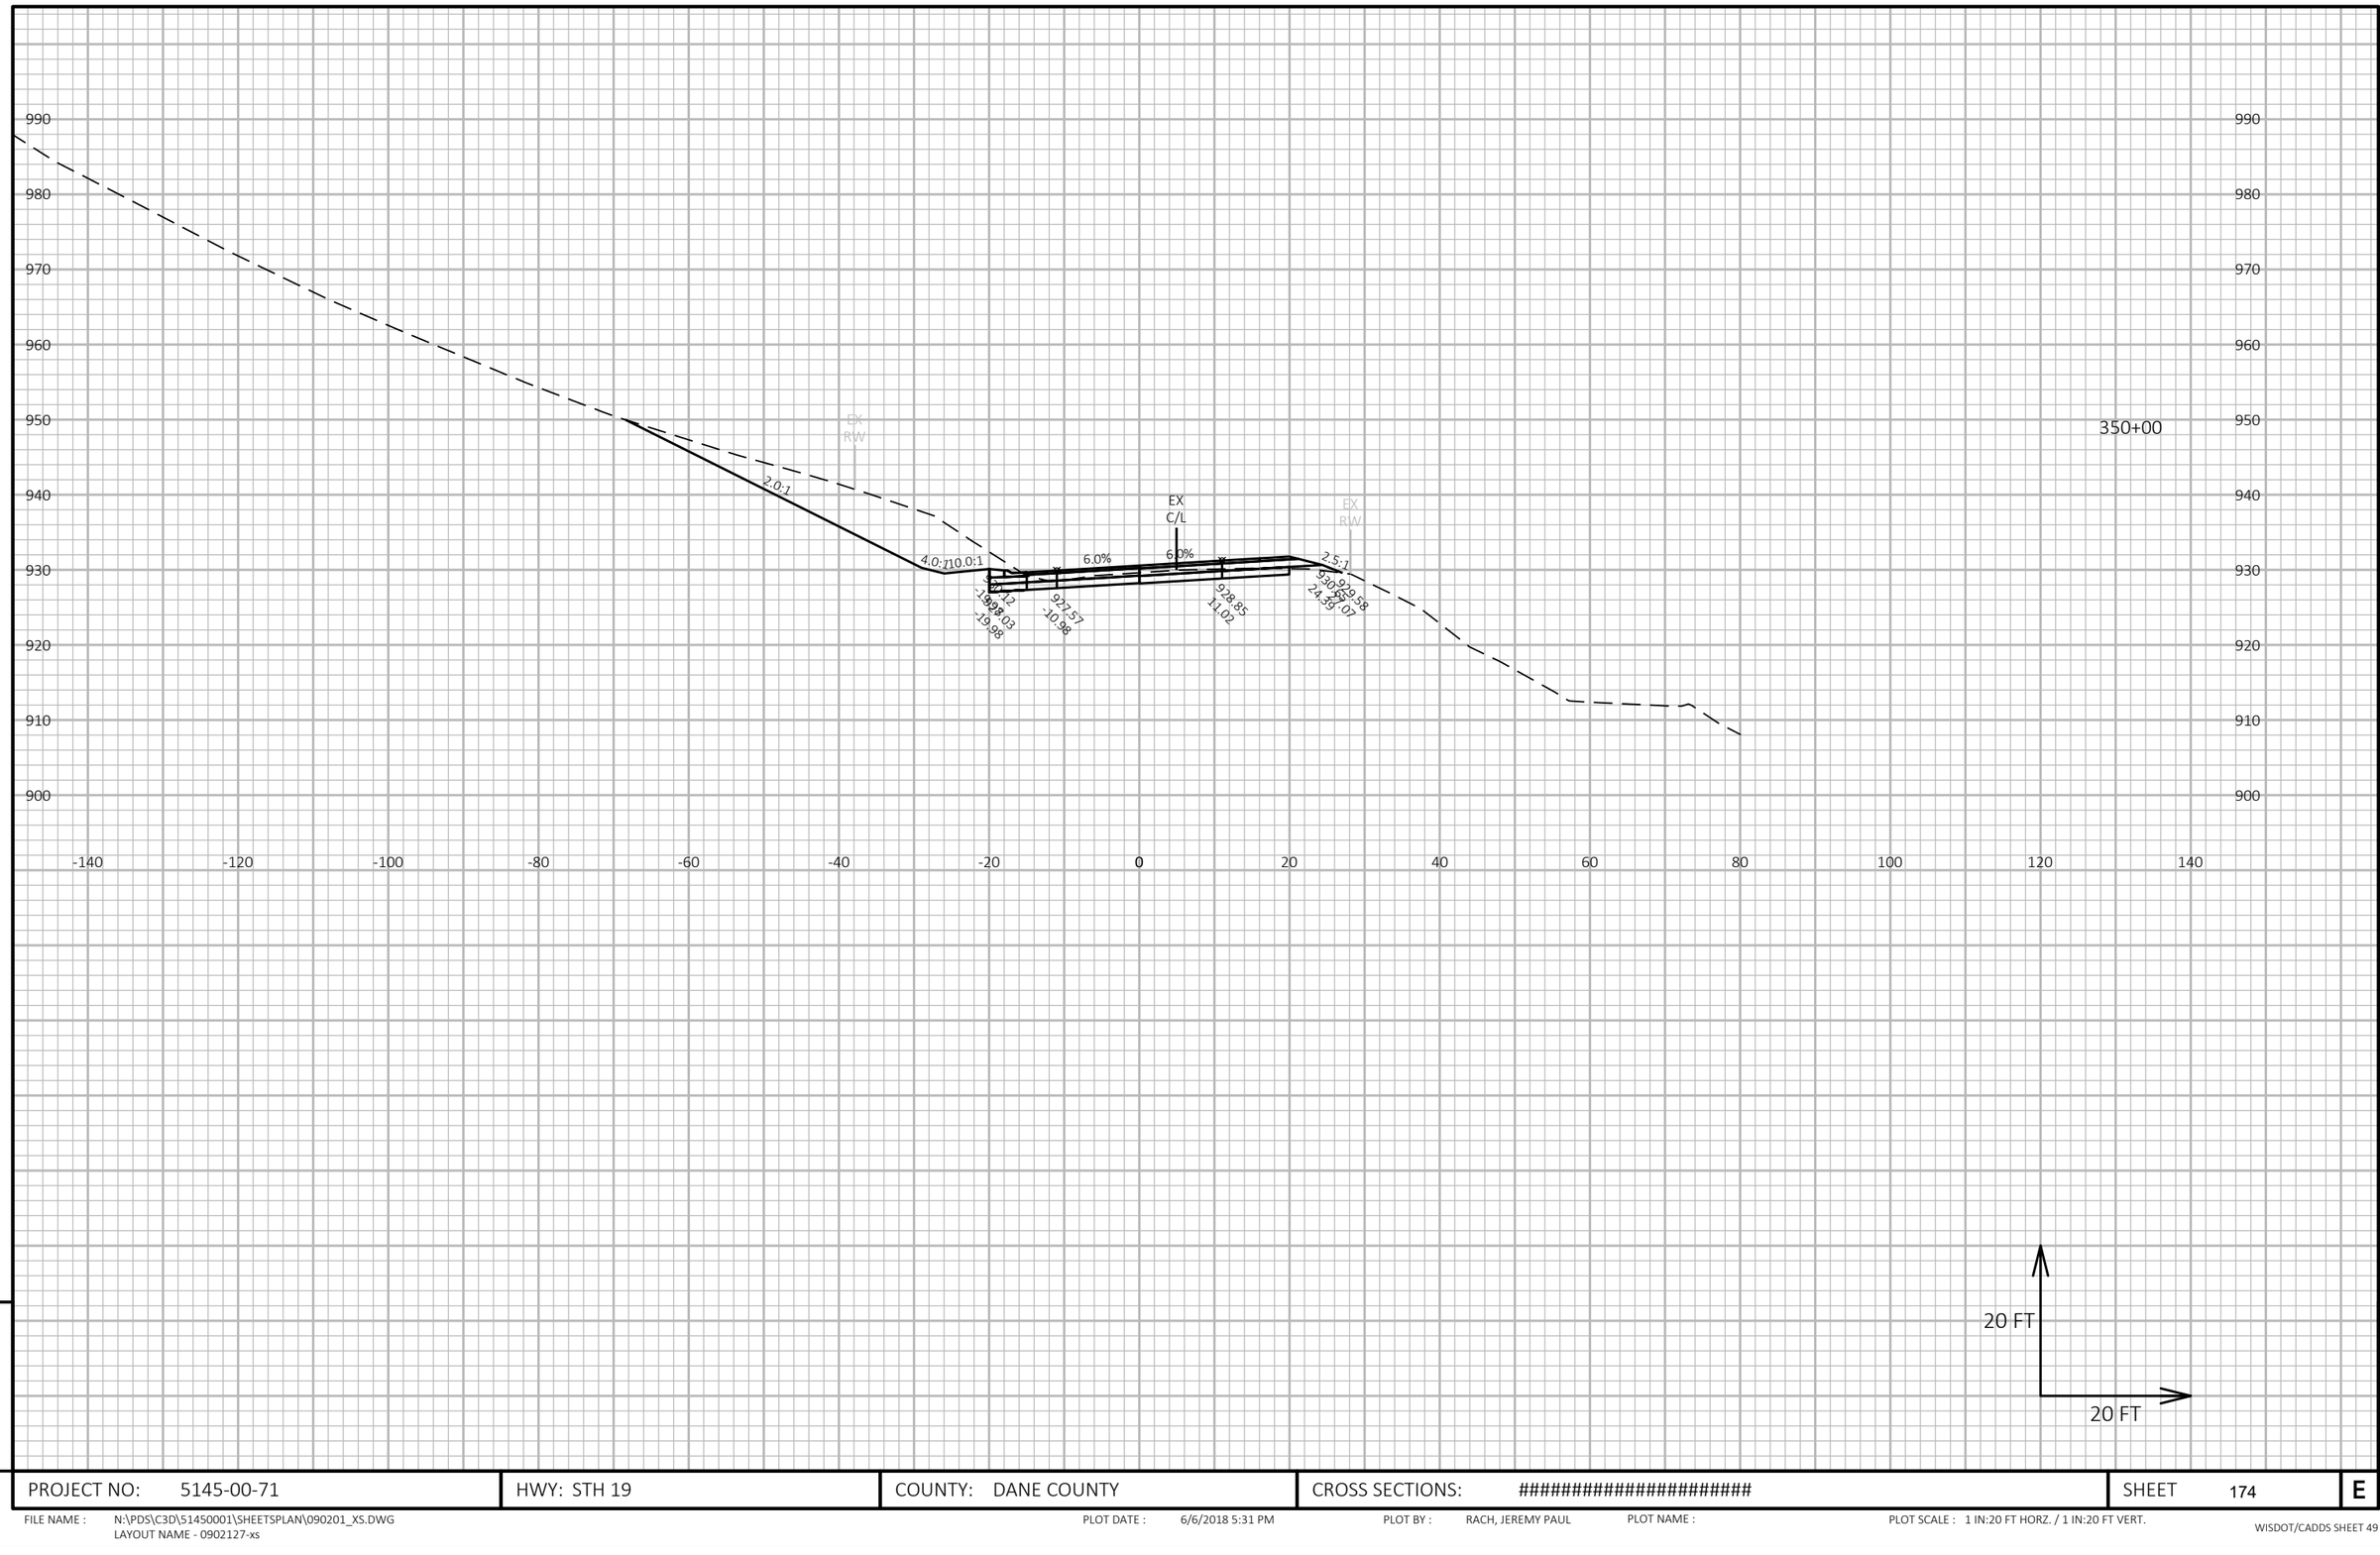

9

9

PROJECT NO: 5145-00-71	HWY: STH 19	COUNTY: DANE COUNTY	CROSS SECTIONS: ##########################	SHEET 174	E

FILE NAME : N:\PDS\C3D\51450001\SHEETSPLAN\090201_XS.DWG
LAYOUT NAME - 0902127-xs

PLOT DATE : 6/6/2018 5:31 PM PLOT BY : RACH, JEREMY PAUL PLOT NAME : PLOT SCALE : 1 IN:20 FT HORZ. / 1 IN:20 FT VERT.

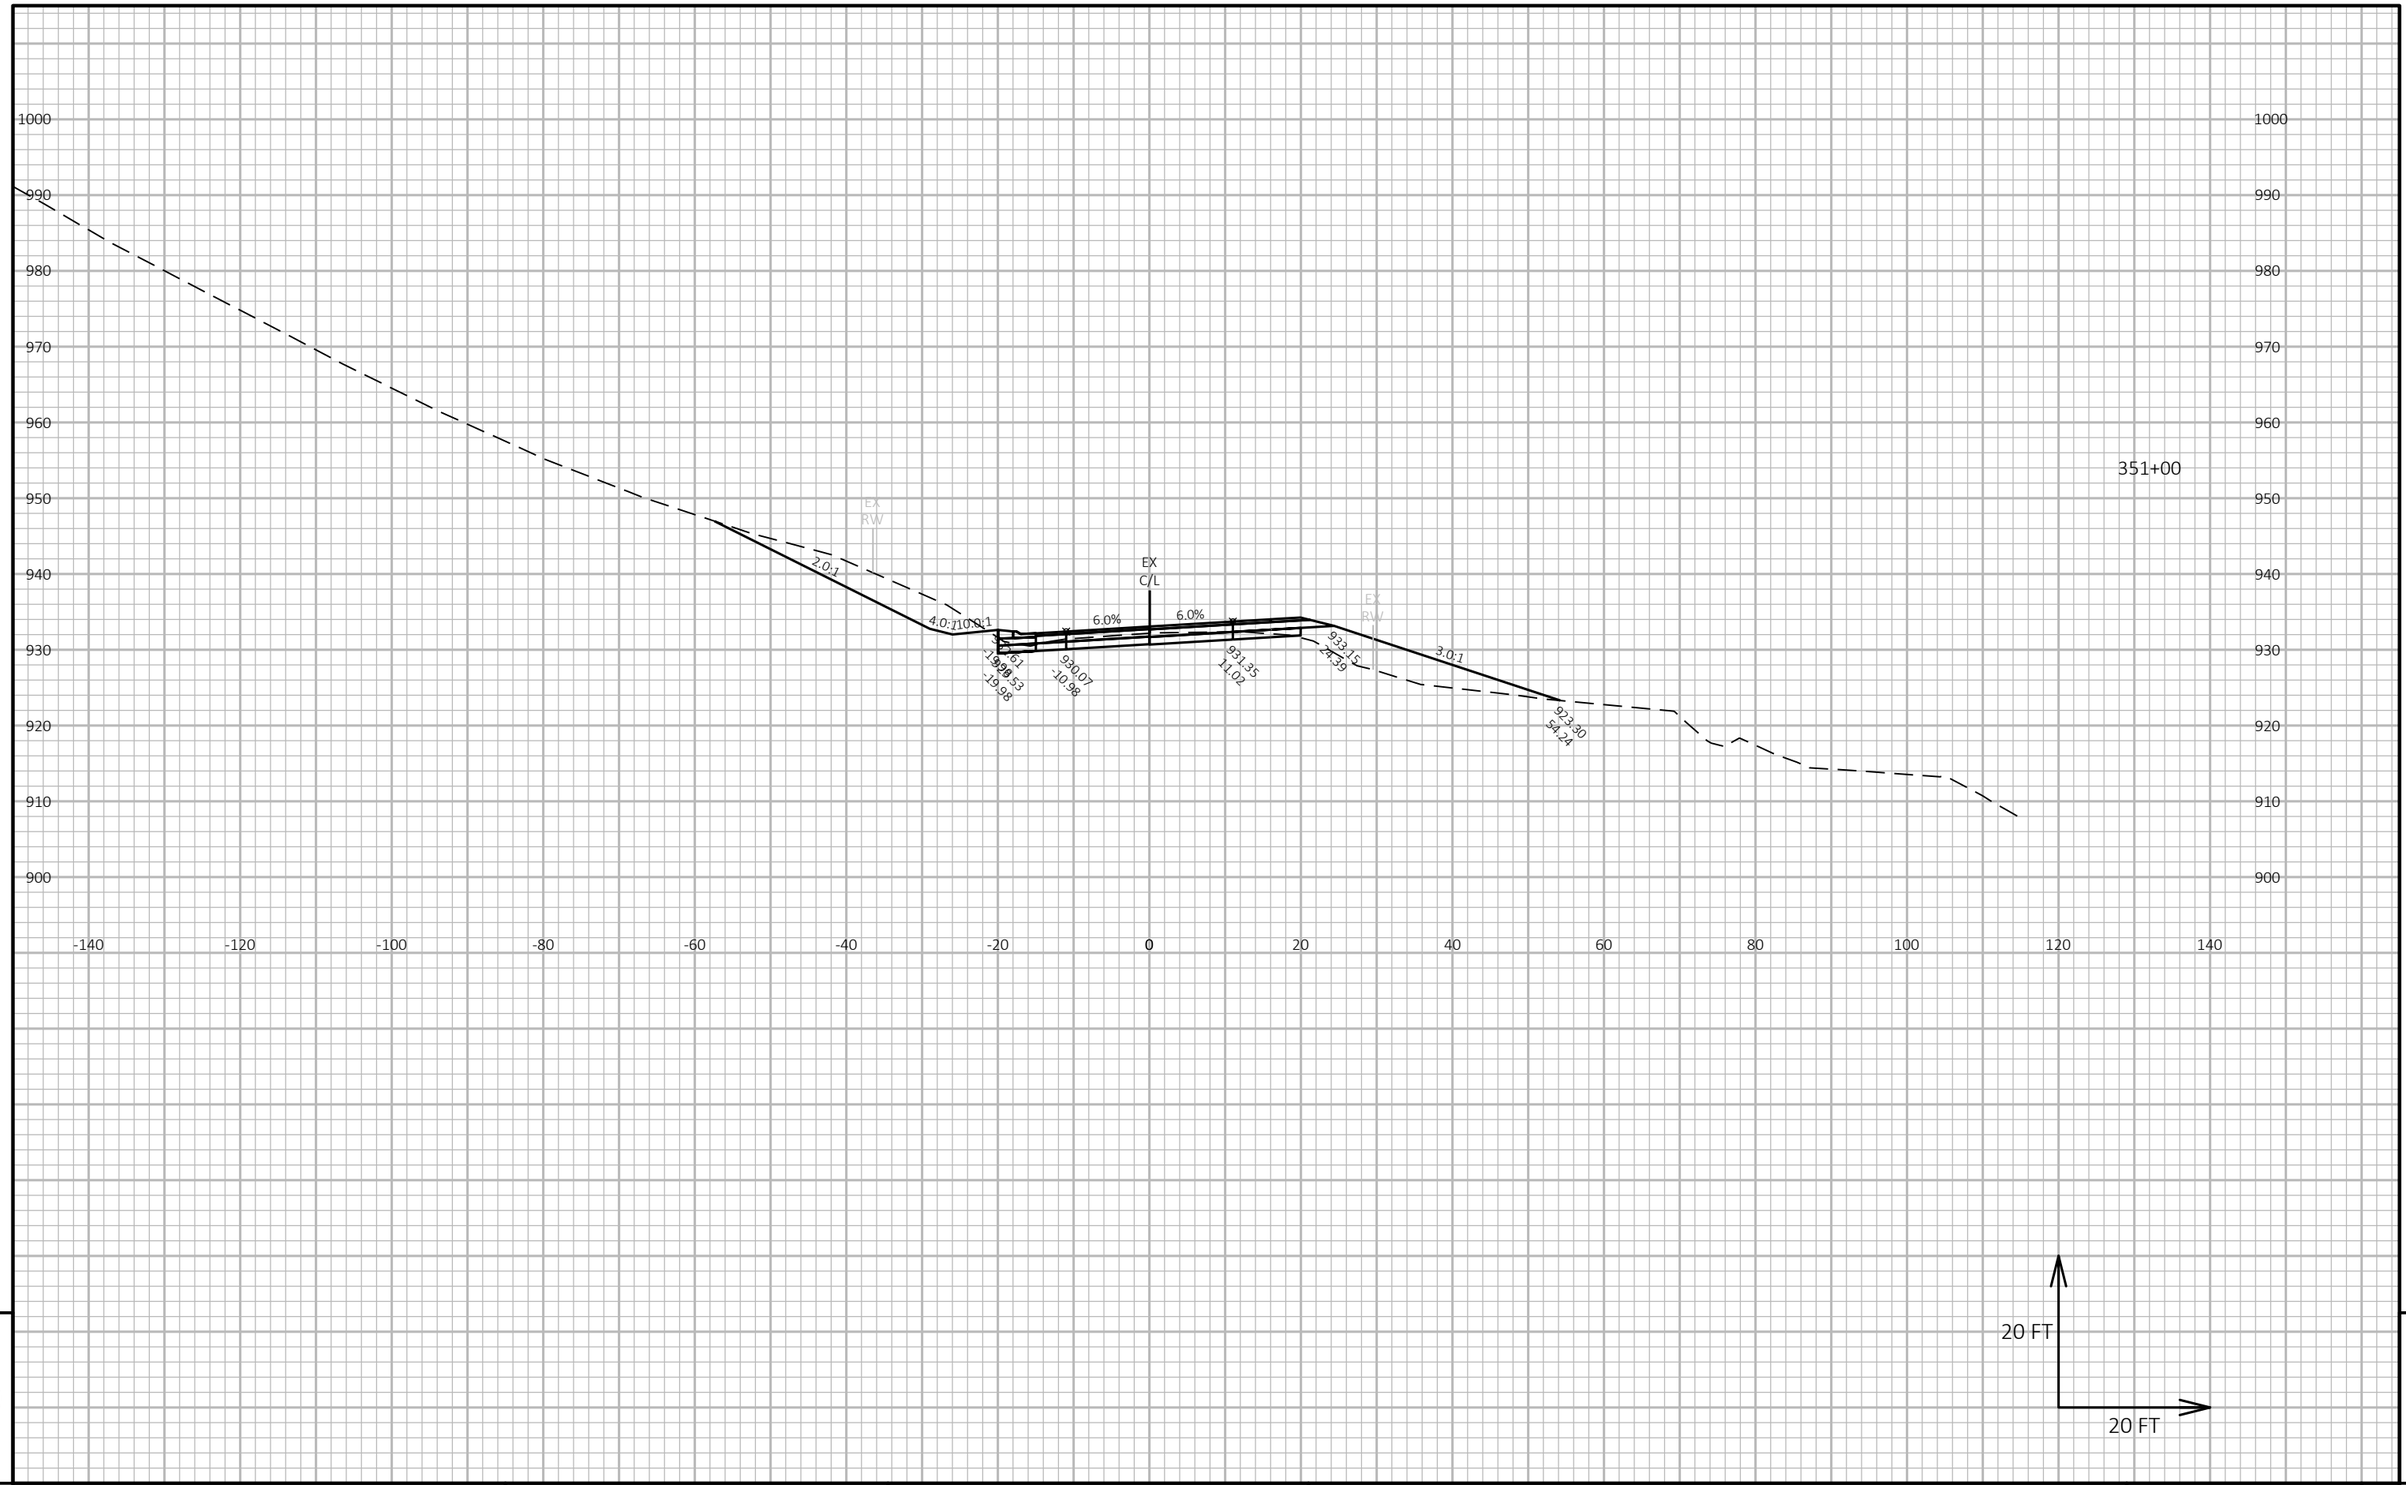

9

9

PROJECT NO: 5145-00-71	HWY: STH 19	COUNTY: DANE COUNTY	CROSS SECTIONS: ##########################	SHEET 175	E

FILE NAME : N:\PDS\C3D\51450001\SHEETSPLAN\090201_XS.DWG
LAYOUT NAME - 0902128-xs

PLOT DATE : 6/6/2018 5:31 PM PLOT BY : RACH, JEREMY PAUL PLOT NAME : PLOT SCALE : 1 IN:20 FT HORZ. / 1 IN:20 FT VERT.

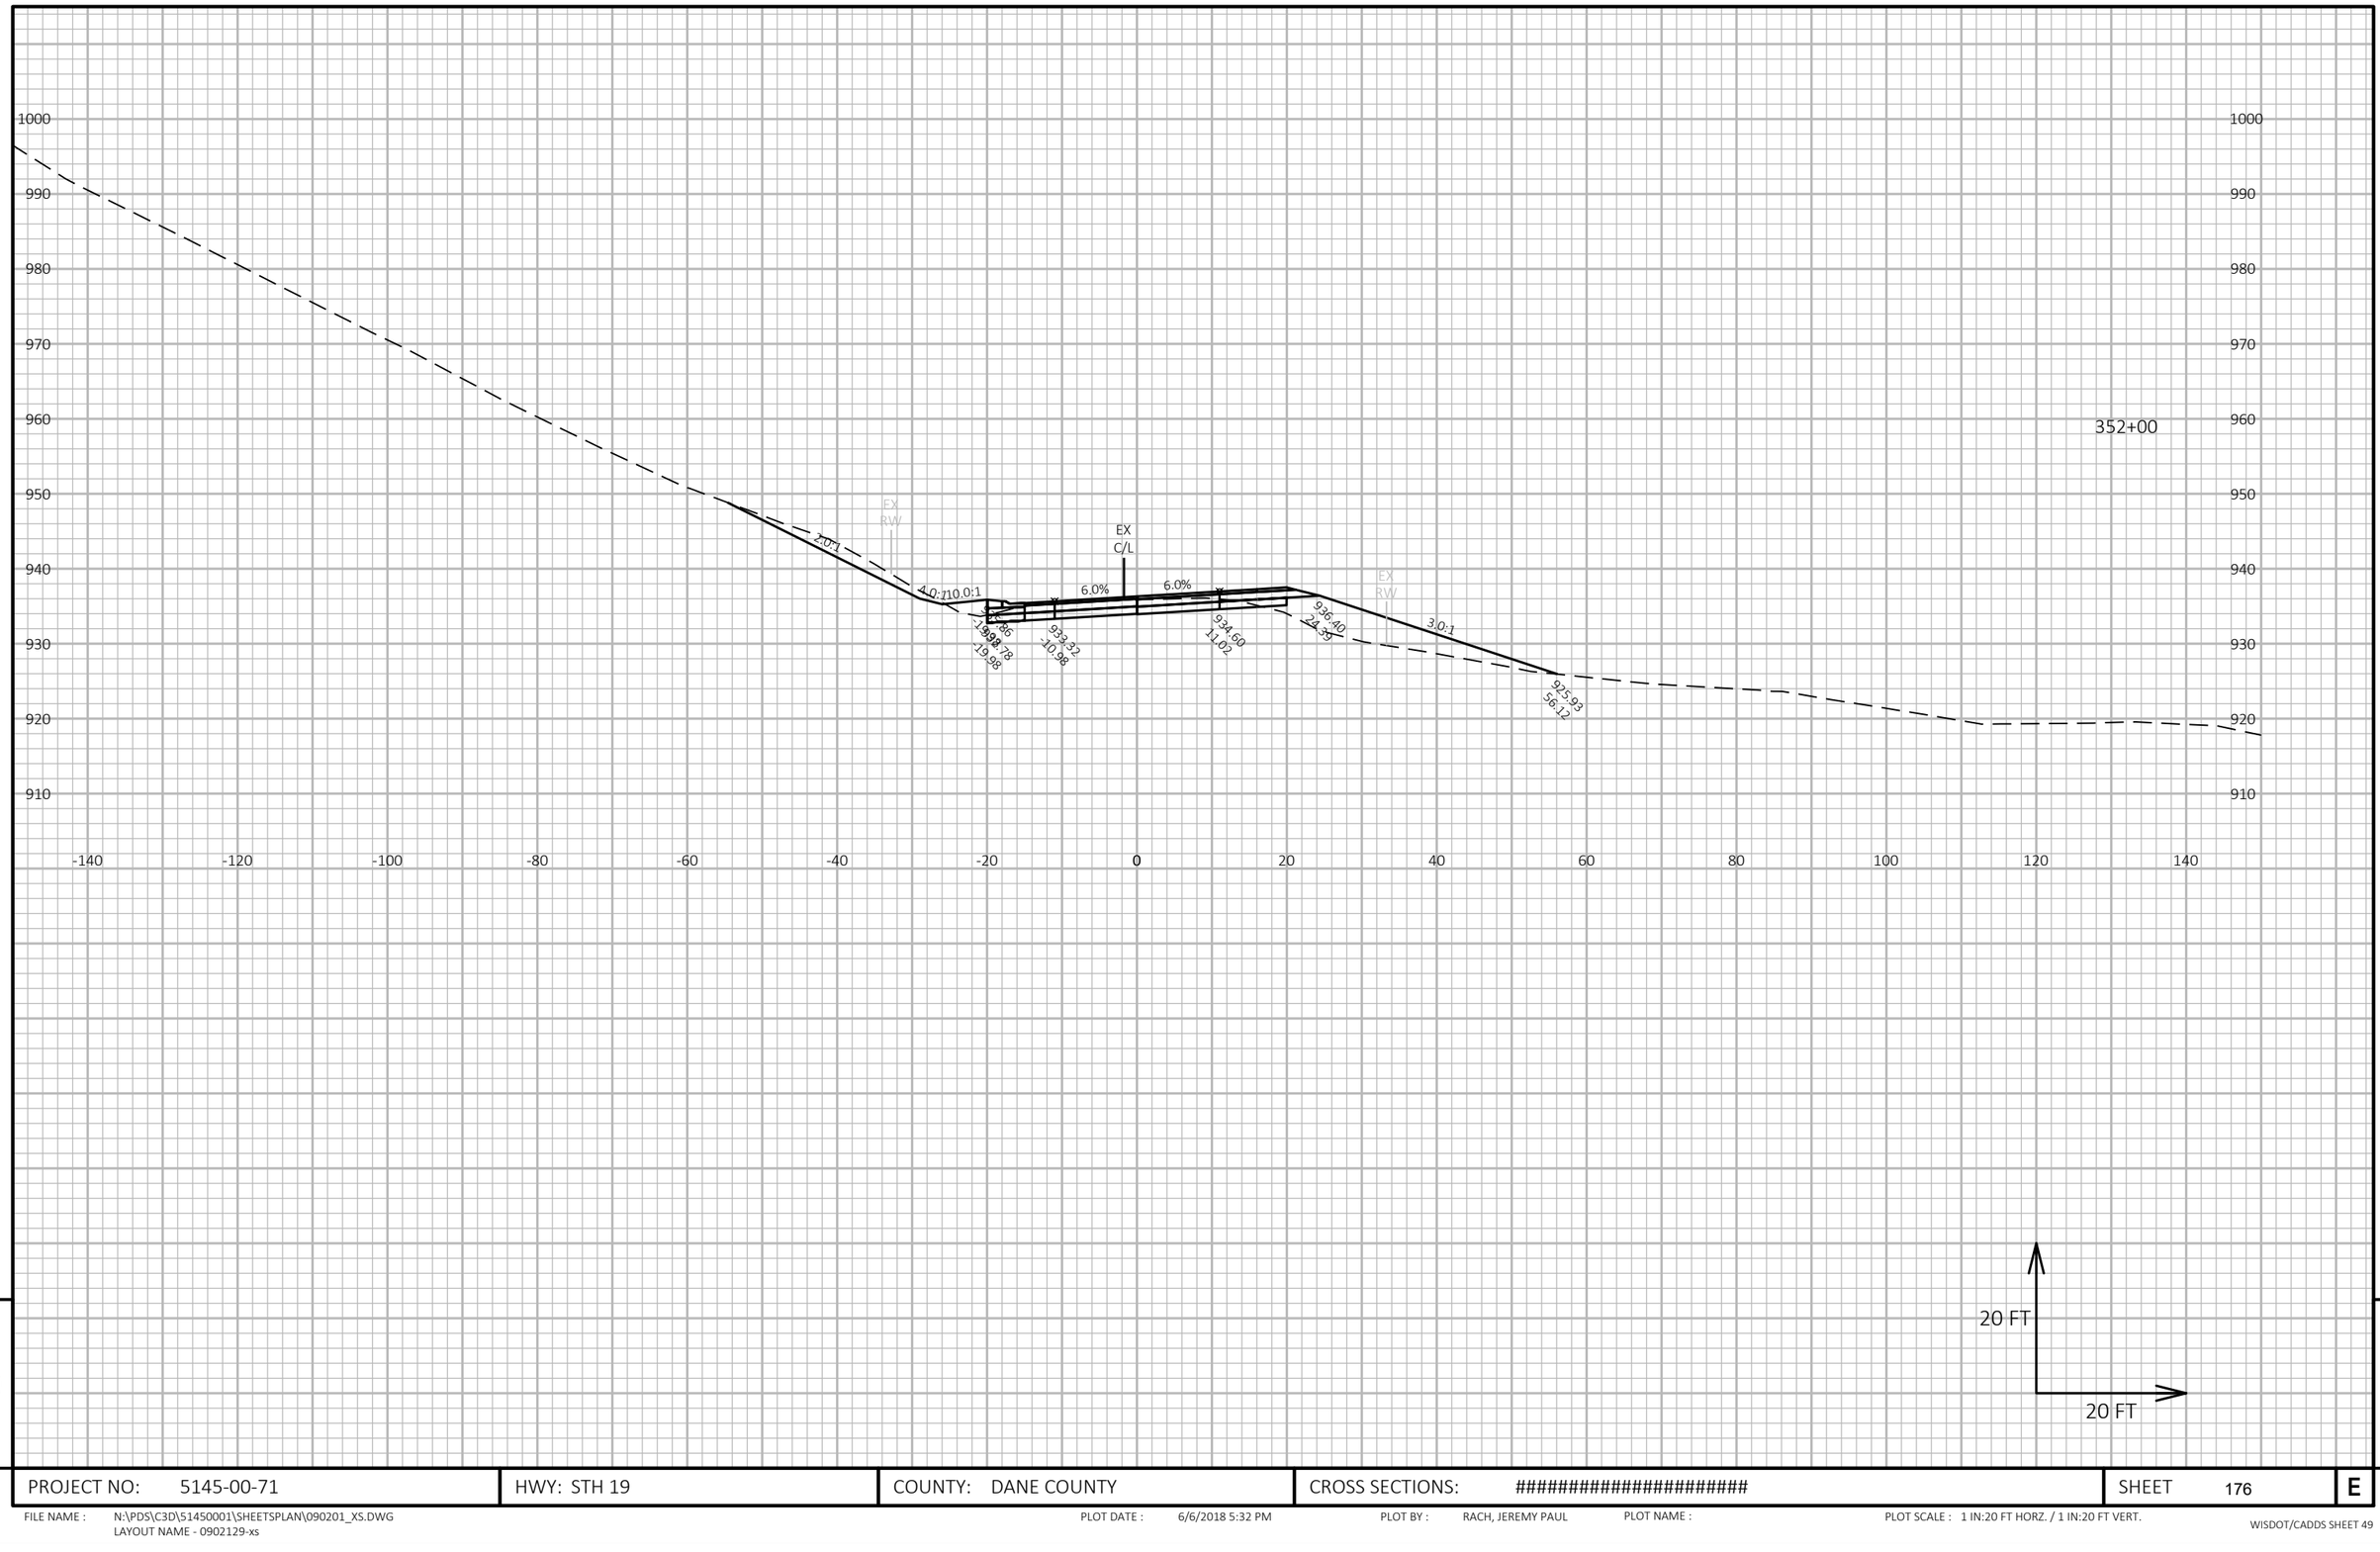

9

9

PROJECT NO: 5145-00-71	HWY: STH 19	COUNTY: DANE COUNTY	CROSS SECTIONS: ##########################	SHEET 176	E

FILE NAME : N:\PDS\C3D\51450001\SHEETSPLAN\090201_XS.DWG
LAYOUT NAME - 0902129-xs

PLOT DATE : 6/6/2018 5:32 PM PLOT BY : RACH, JEREMY PAUL PLOT NAME : PLOT SCALE : 1 IN:20 FT HORZ. / 1 IN:20 FT VERT.

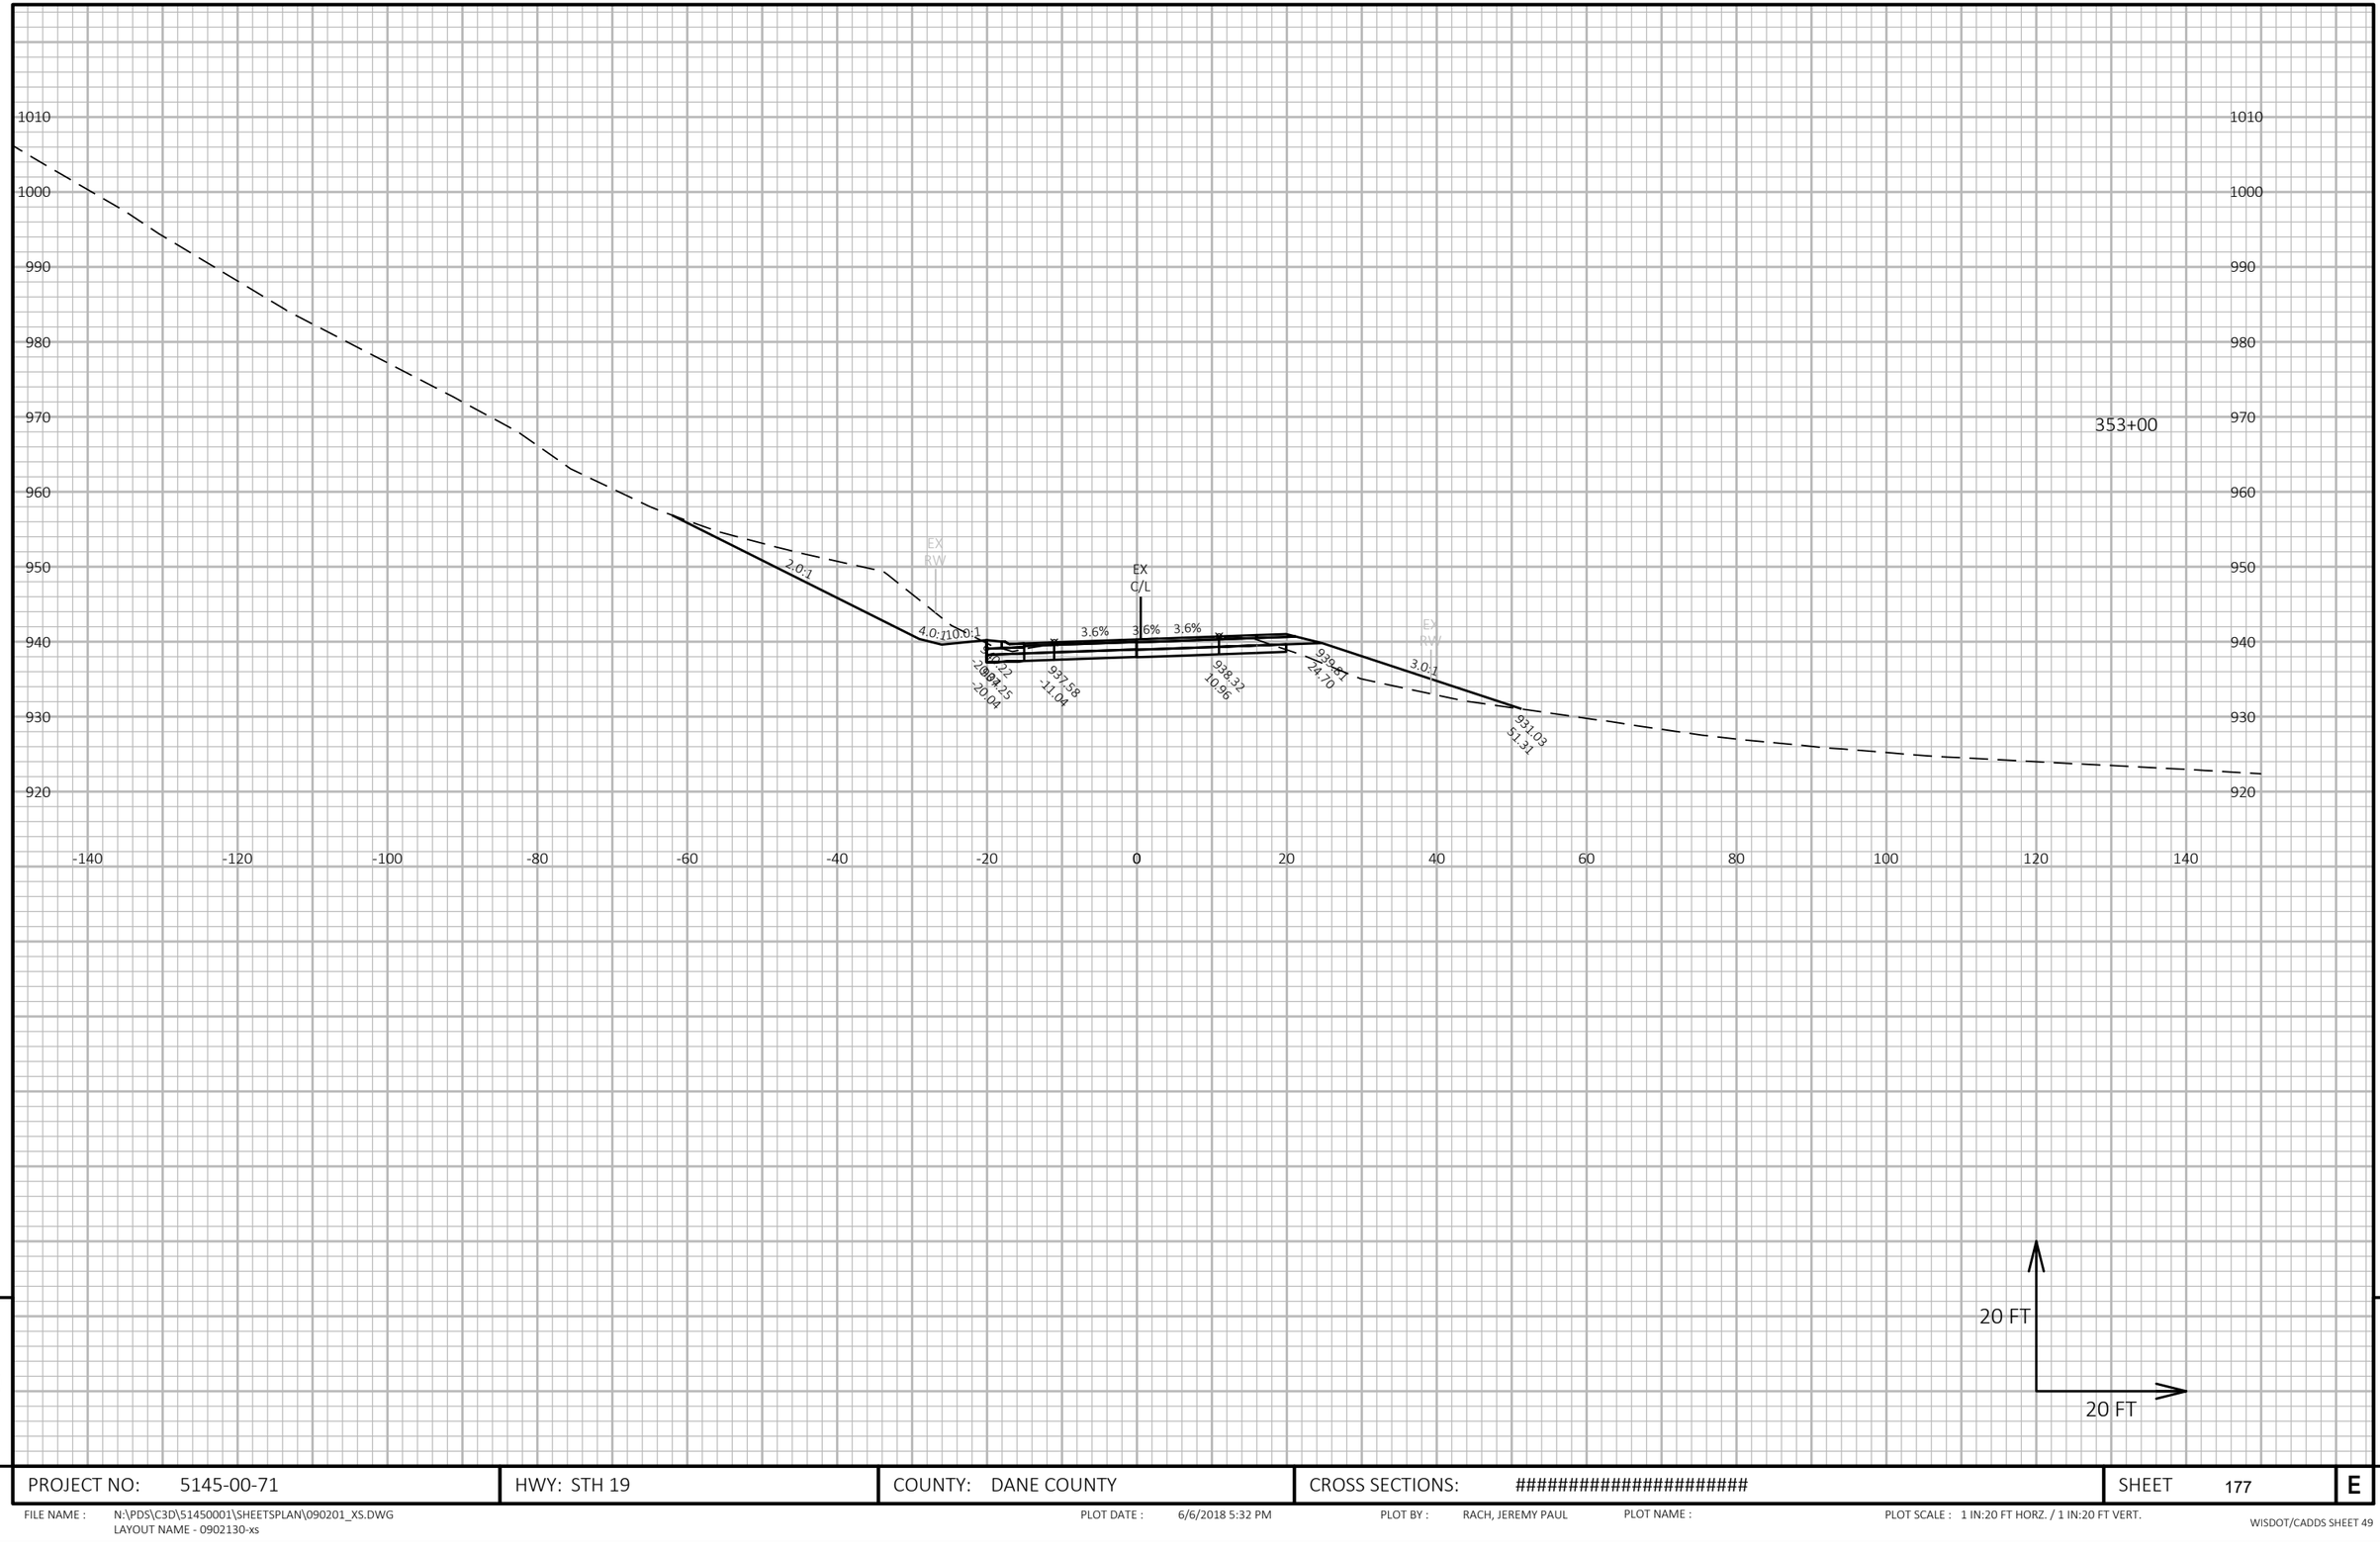

9

9

PROJECT NO: 5145-00-71	HWY: STH 19	COUNTY: DANE COUNTY	CROSS SECTIONS: ##########################	SHEET 177	E

FILE NAME : N:\PDS\C3D\51450001\SHEETSPLAN\090201_XS.DWG
LAYOUT NAME - 0902130-xs

PLOT DATE : 6/6/2018 5:32 PM PLOT BY : RACH, JEREMY PAUL PLOT NAME : PLOT SCALE : 1 IN:20 FT HORZ. / 1 IN:20 FT VERT.

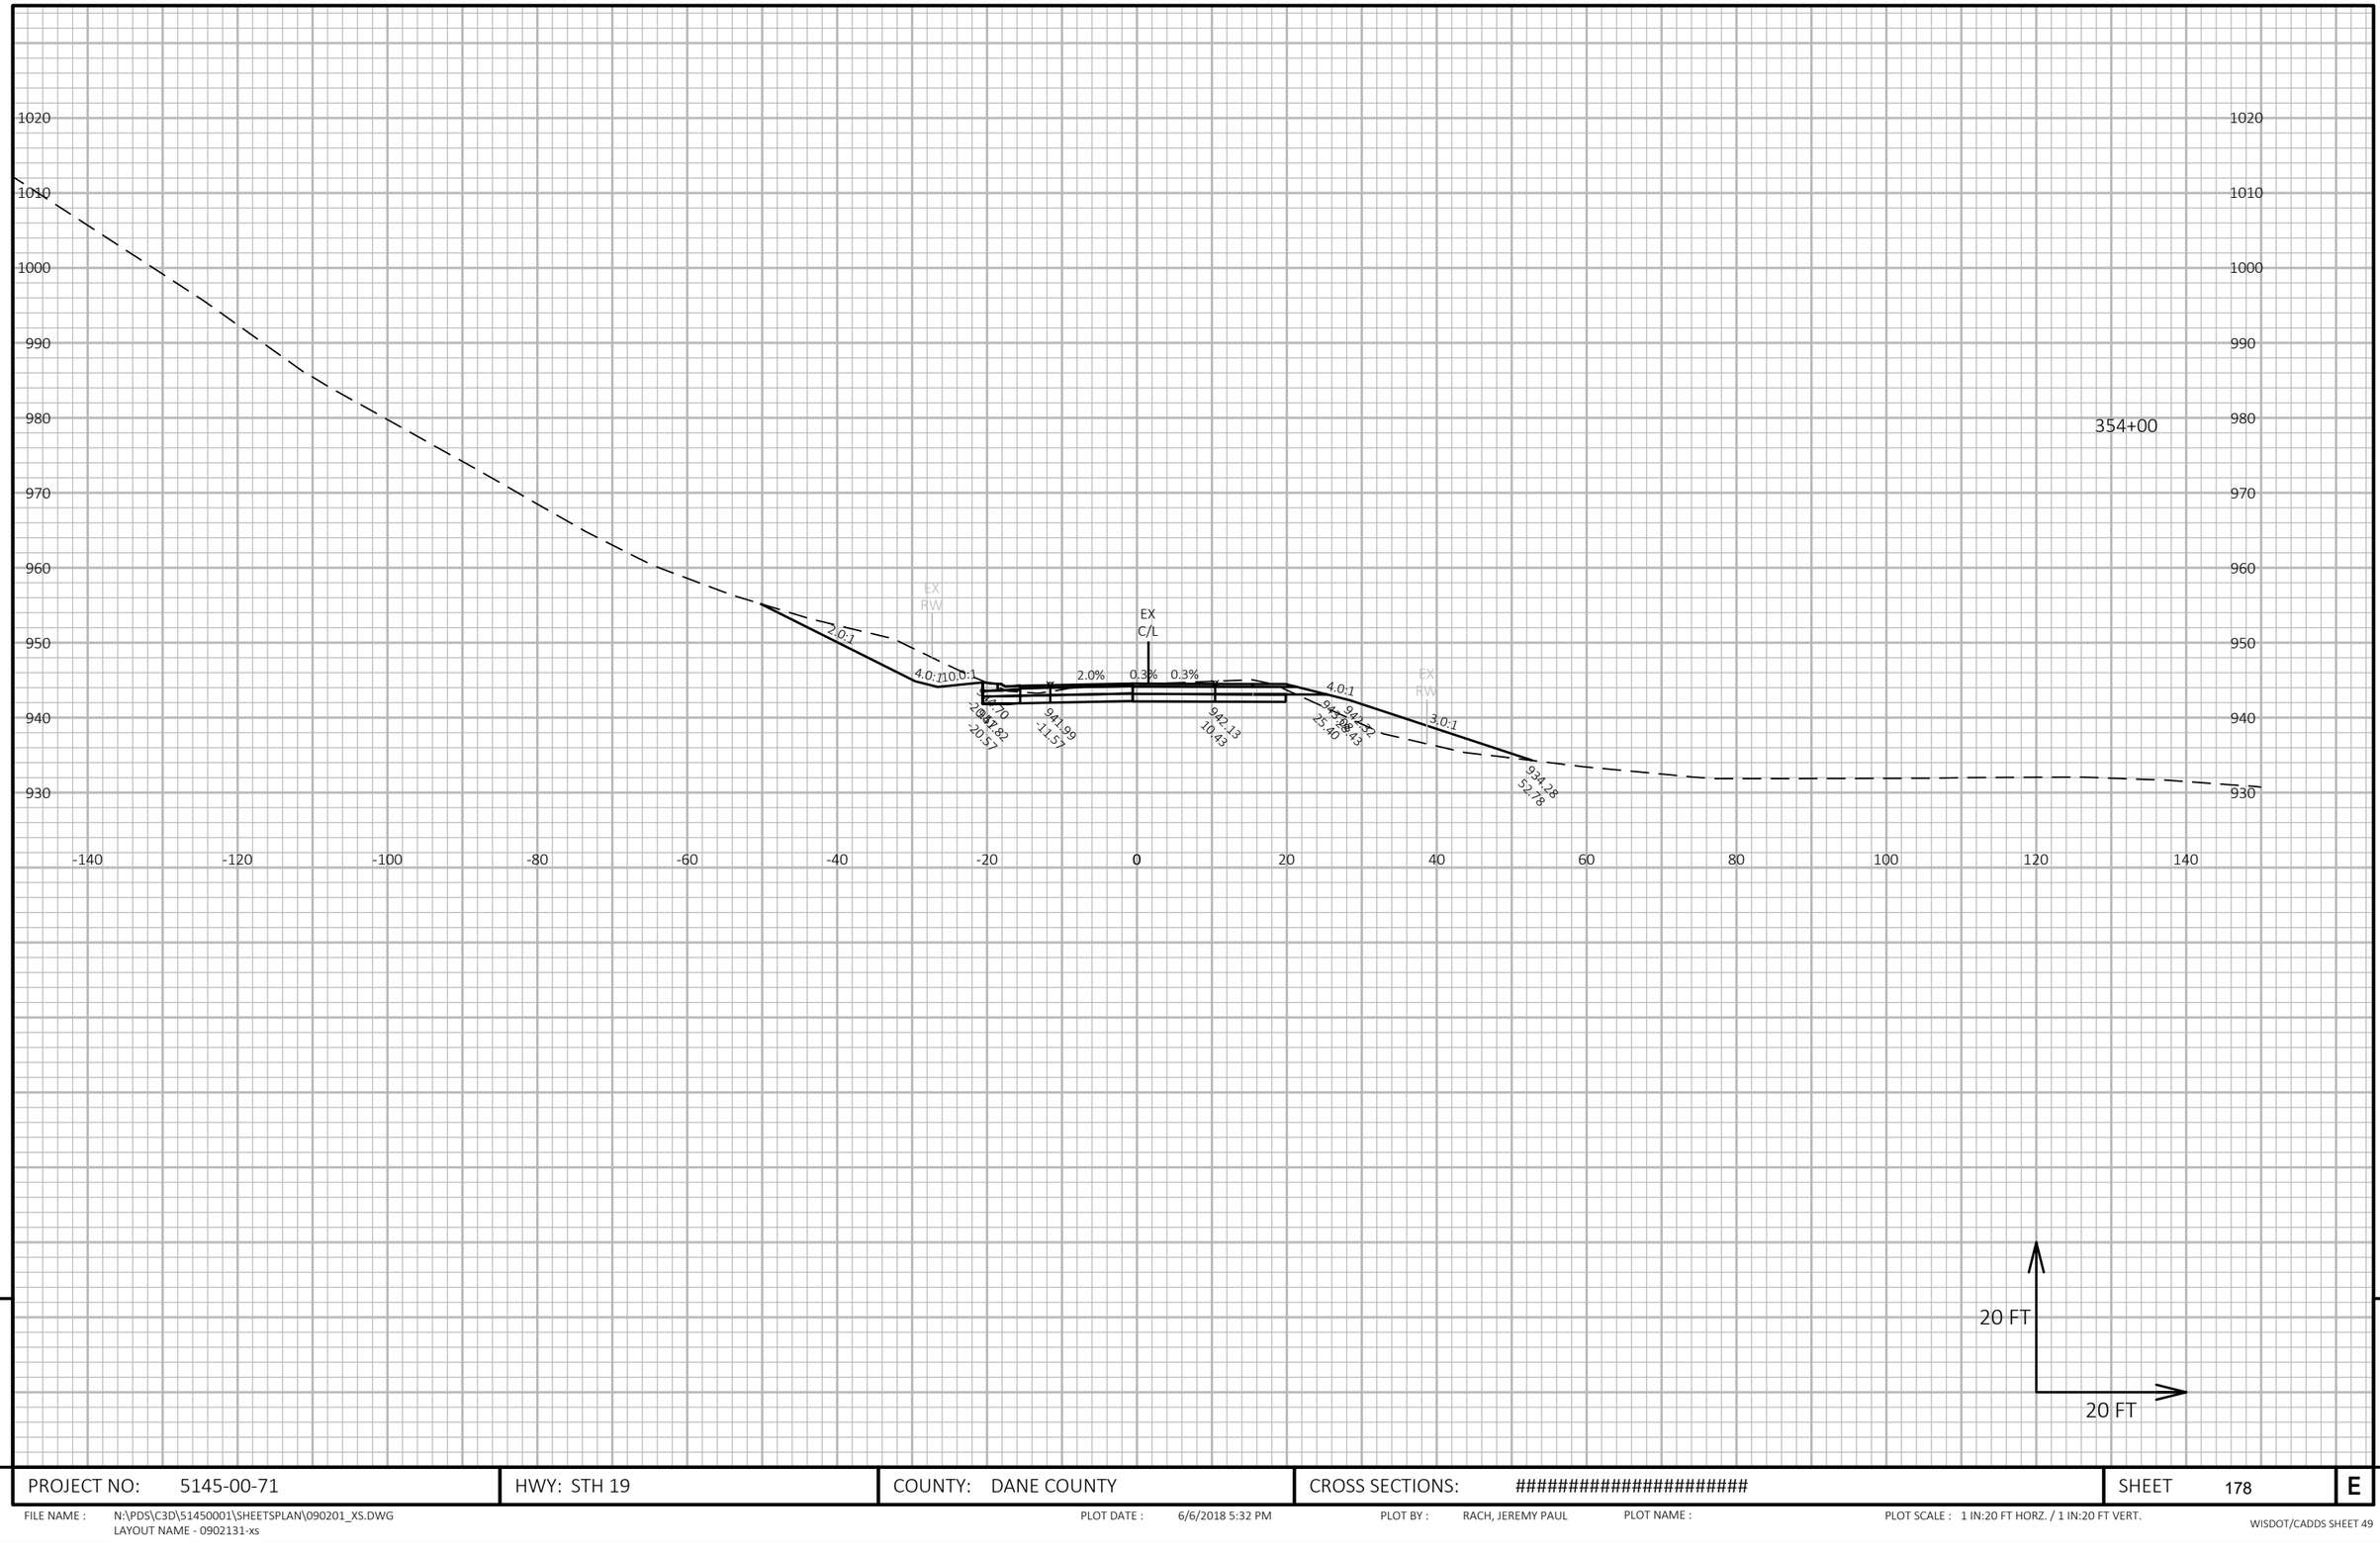

9

9

PROJECT NO: 5145-00-71	HWY: STH 19	COUNTY: DANE COUNTY	CROSS SECTIONS: ##########################	SHEET 178	E

FILE NAME : N:\PDS\C3D\51450001\SHEETSPLAN\090201_XS.DWG
LAYOUT NAME - 0902131-xs

PLOT DATE : 6/6/2018 5:32 PM PLOT BY : RACH, JEREMY PAUL PLOT NAME : PLOT SCALE : 1 IN:20 FT HORZ. / 1 IN:20 FT VERT.

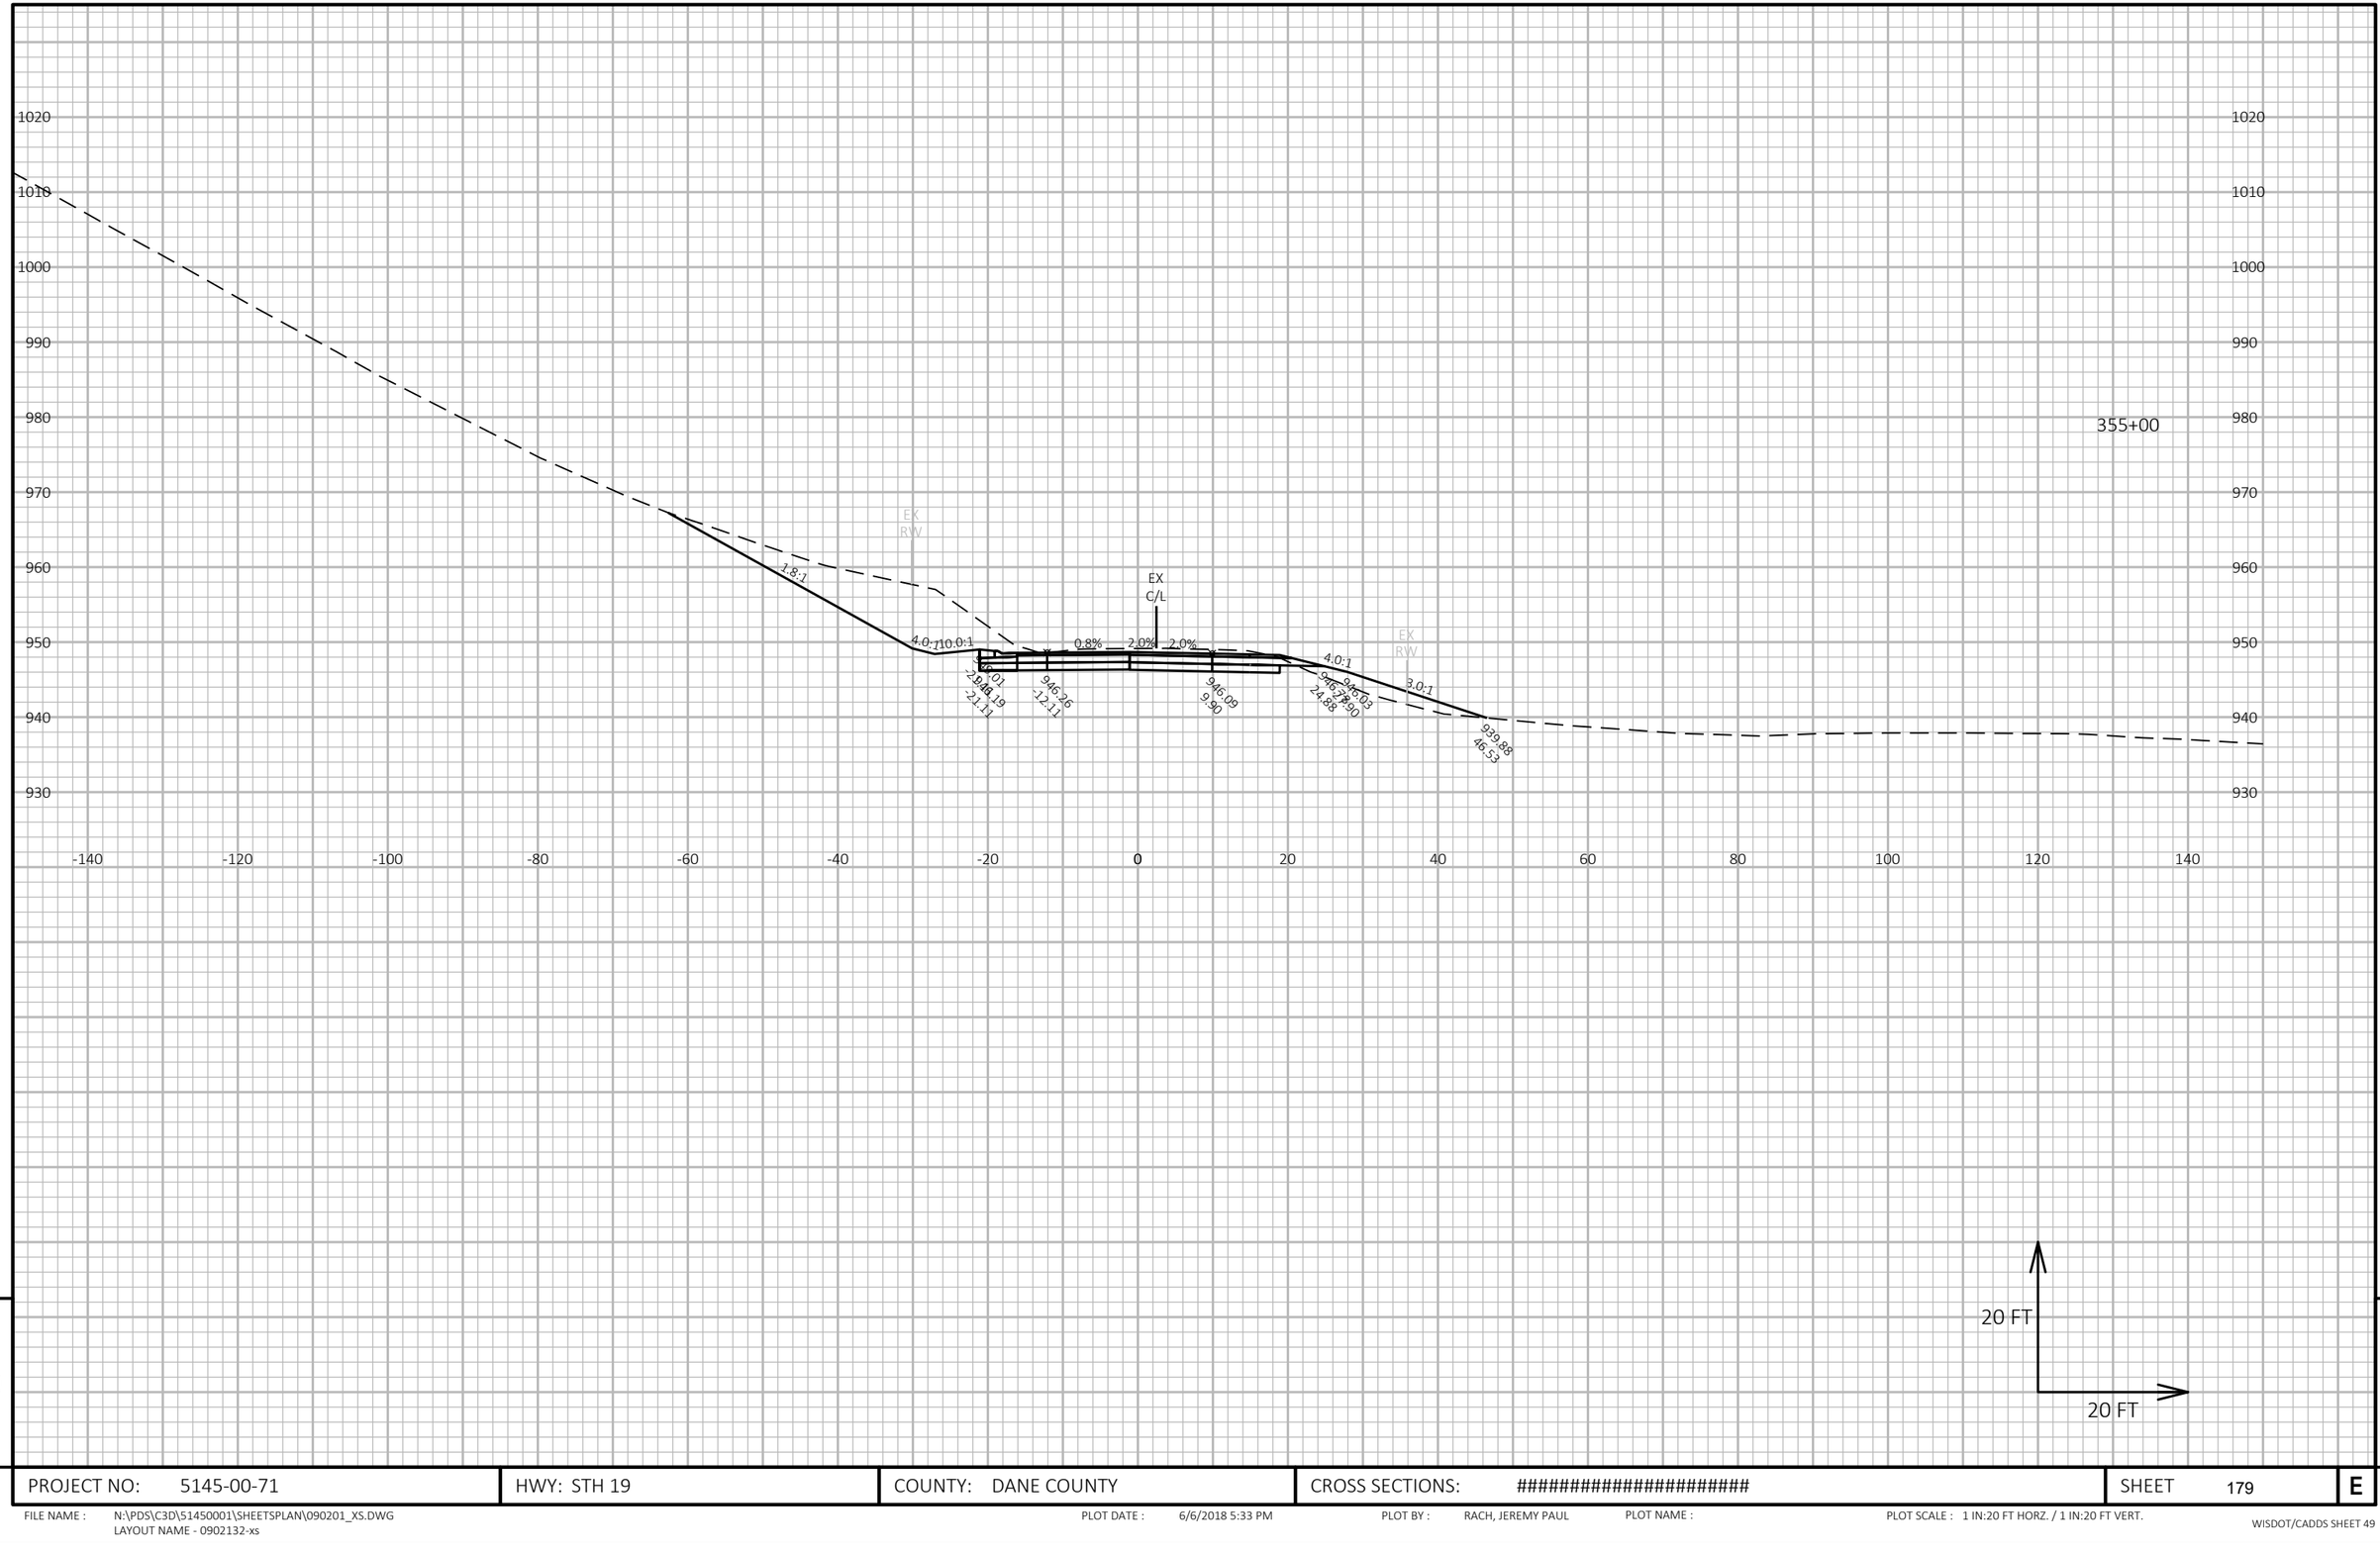

9

9

PROJECT NO: 5145-00-71	HWY: STH 19	COUNTY: DANE COUNTY	CROSS SECTIONS: ##########################	SHEET 179	E

FILE NAME : N:\PDS\C3D\51450001\SHEETSPLAN\090201_XS.DWG
LAYOUT NAME - 0902132-xs

PLOT DATE : 6/6/2018 5:33 PM PLOT BY : RACH, JEREMY PAUL PLOT NAME : PLOT SCALE : 1 IN:20 FT HORZ. / 1 IN:20 FT VERT.

WISDOT/CADDS SHEET 49

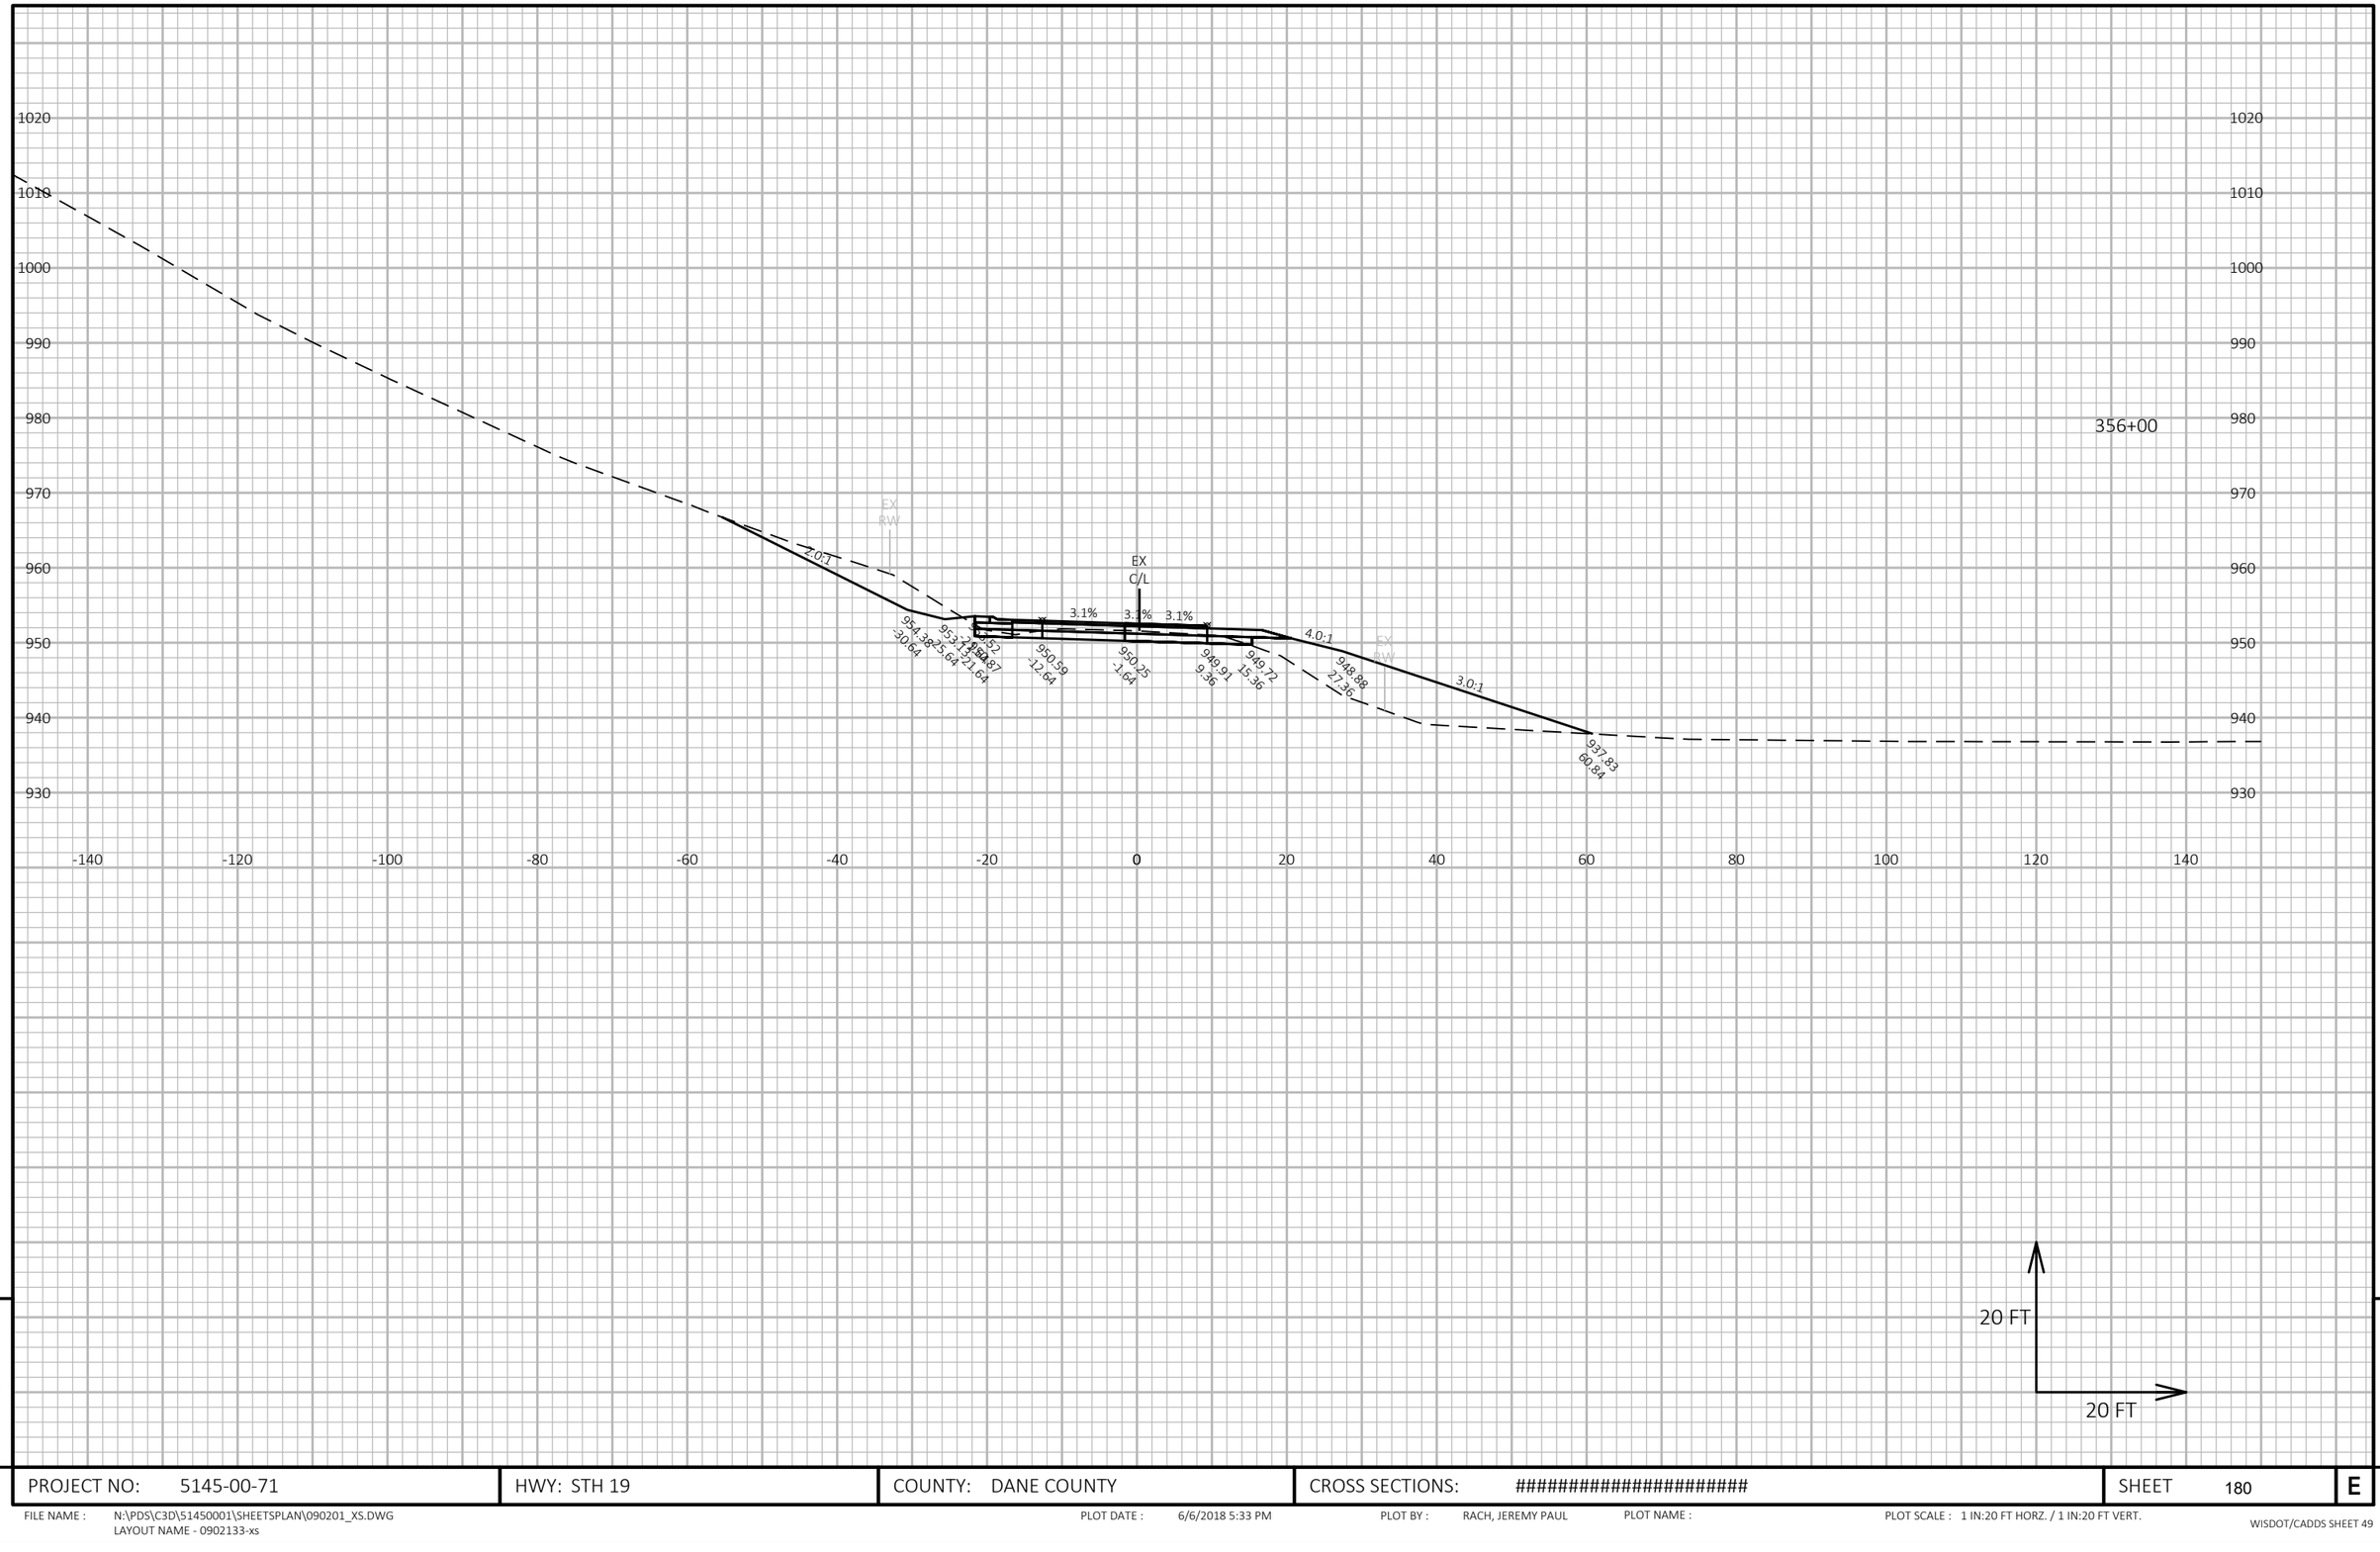

9

9

PROJECT NO: 5145-00-71	HWY: STH 19	COUNTY: DANE COUNTY	CROSS SECTIONS: ##########################	SHEET 180	E

FILE NAME : N:\PDS\C3D\51450001\SHEETSPLAN\090201_XS.DWG
LAYOUT NAME - 0902133-xs

PLOT DATE : 6/6/2018 5:33 PM PLOT BY : RACH, JEREMY PAUL PLOT NAME : PLOT SCALE : 1 IN:20 FT HORZ. / 1 IN:20 FT VERT.

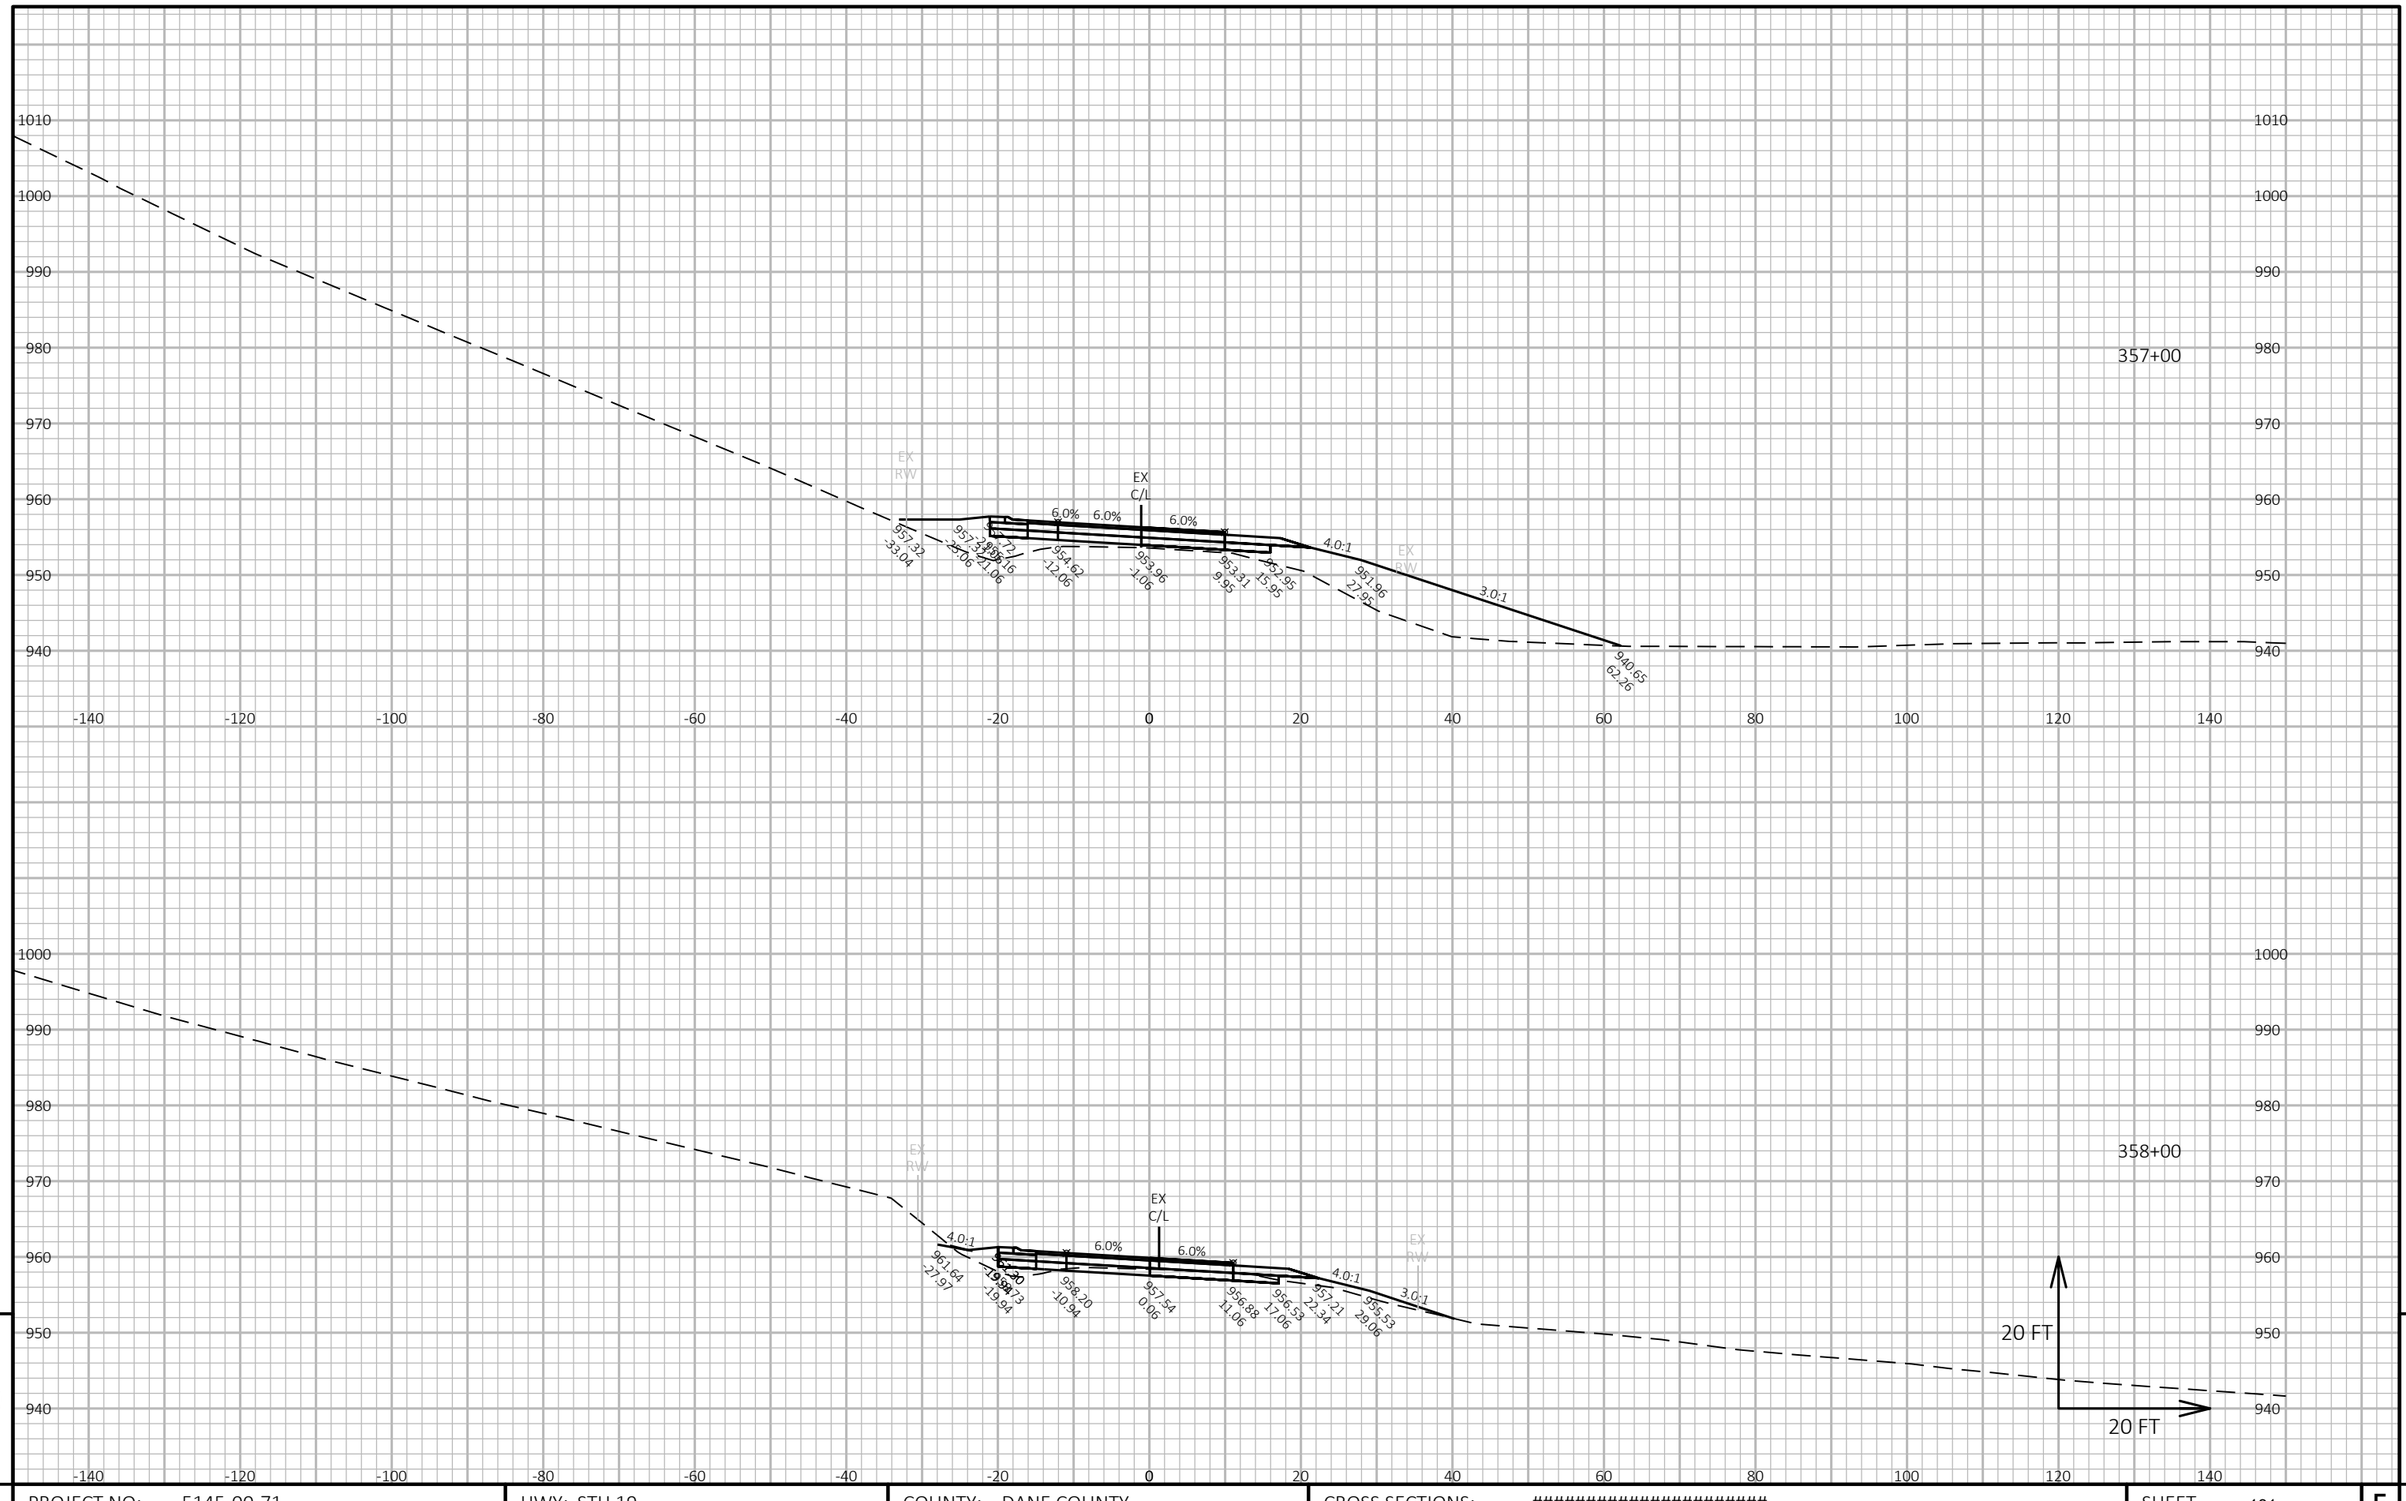

PROJECT NO: 5145-00-71	HWY: STH 19	COUNTY: DANE COUNTY	CROSS SECTIONS: ##########################	SHEET 181	E

FILE NAME : N:\PDS\C3D\51450001\SHEETSPLAN\090201_XS.DWG
LAYOUT NAME - 0902134-xs

PLOT DATE : 6/6/2018 5:34 PM PLOT BY : RACH, JEREMY PAUL PLOT NAME : PLOT SCALE : 1 IN:20 FT HORZ. / 1 IN:20 FT VERT.

WISDOT/CADDS SHEET 49

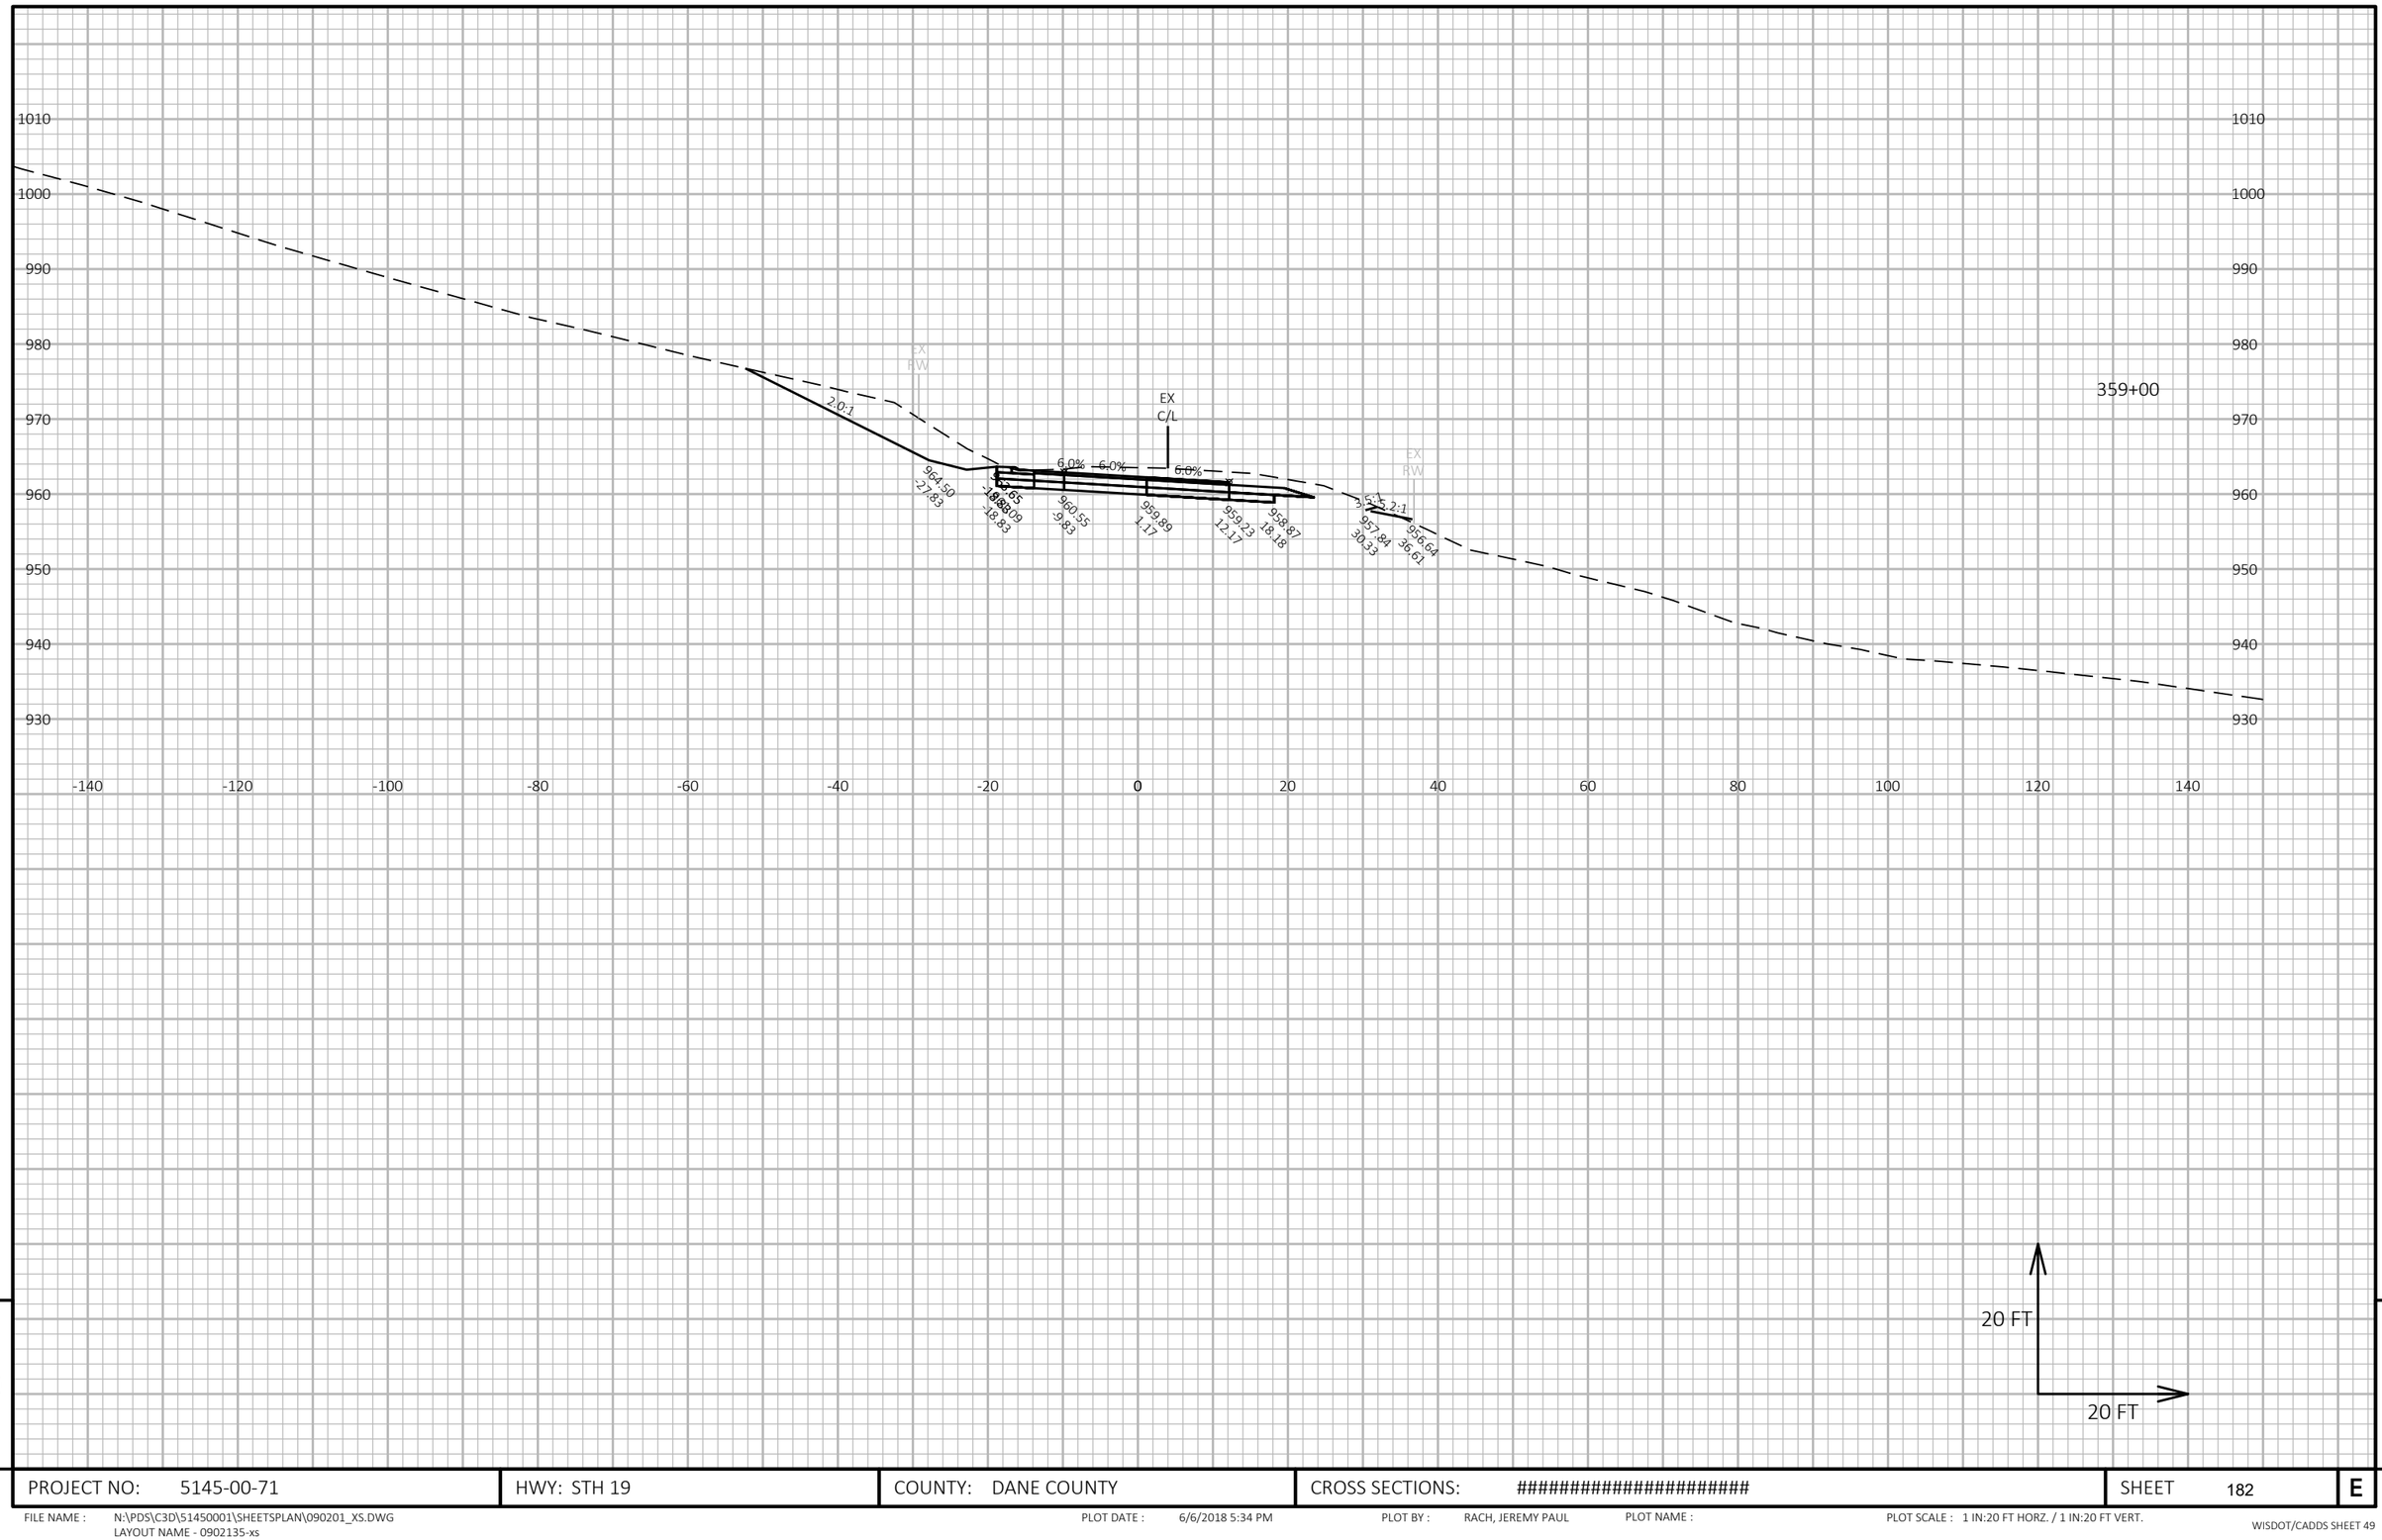

9

9

PROJECT NO: 5145-00-71	HWY: STH 19	COUNTY: DANE COUNTY	CROSS SECTIONS: ##########################	SHEET 182	E

FILE NAME : N:\PDS\C3D\51450001\SHEETSPLAN\090201_XS.DWG
LAYOUT NAME - 0902135-xs

PLOT DATE : 6/6/2018 5:34 PM PLOT BY : RACH, JEREMY PAUL PLOT NAME : PLOT SCALE : 1 IN:20 FT HORZ. / 1 IN:20 FT VERT.

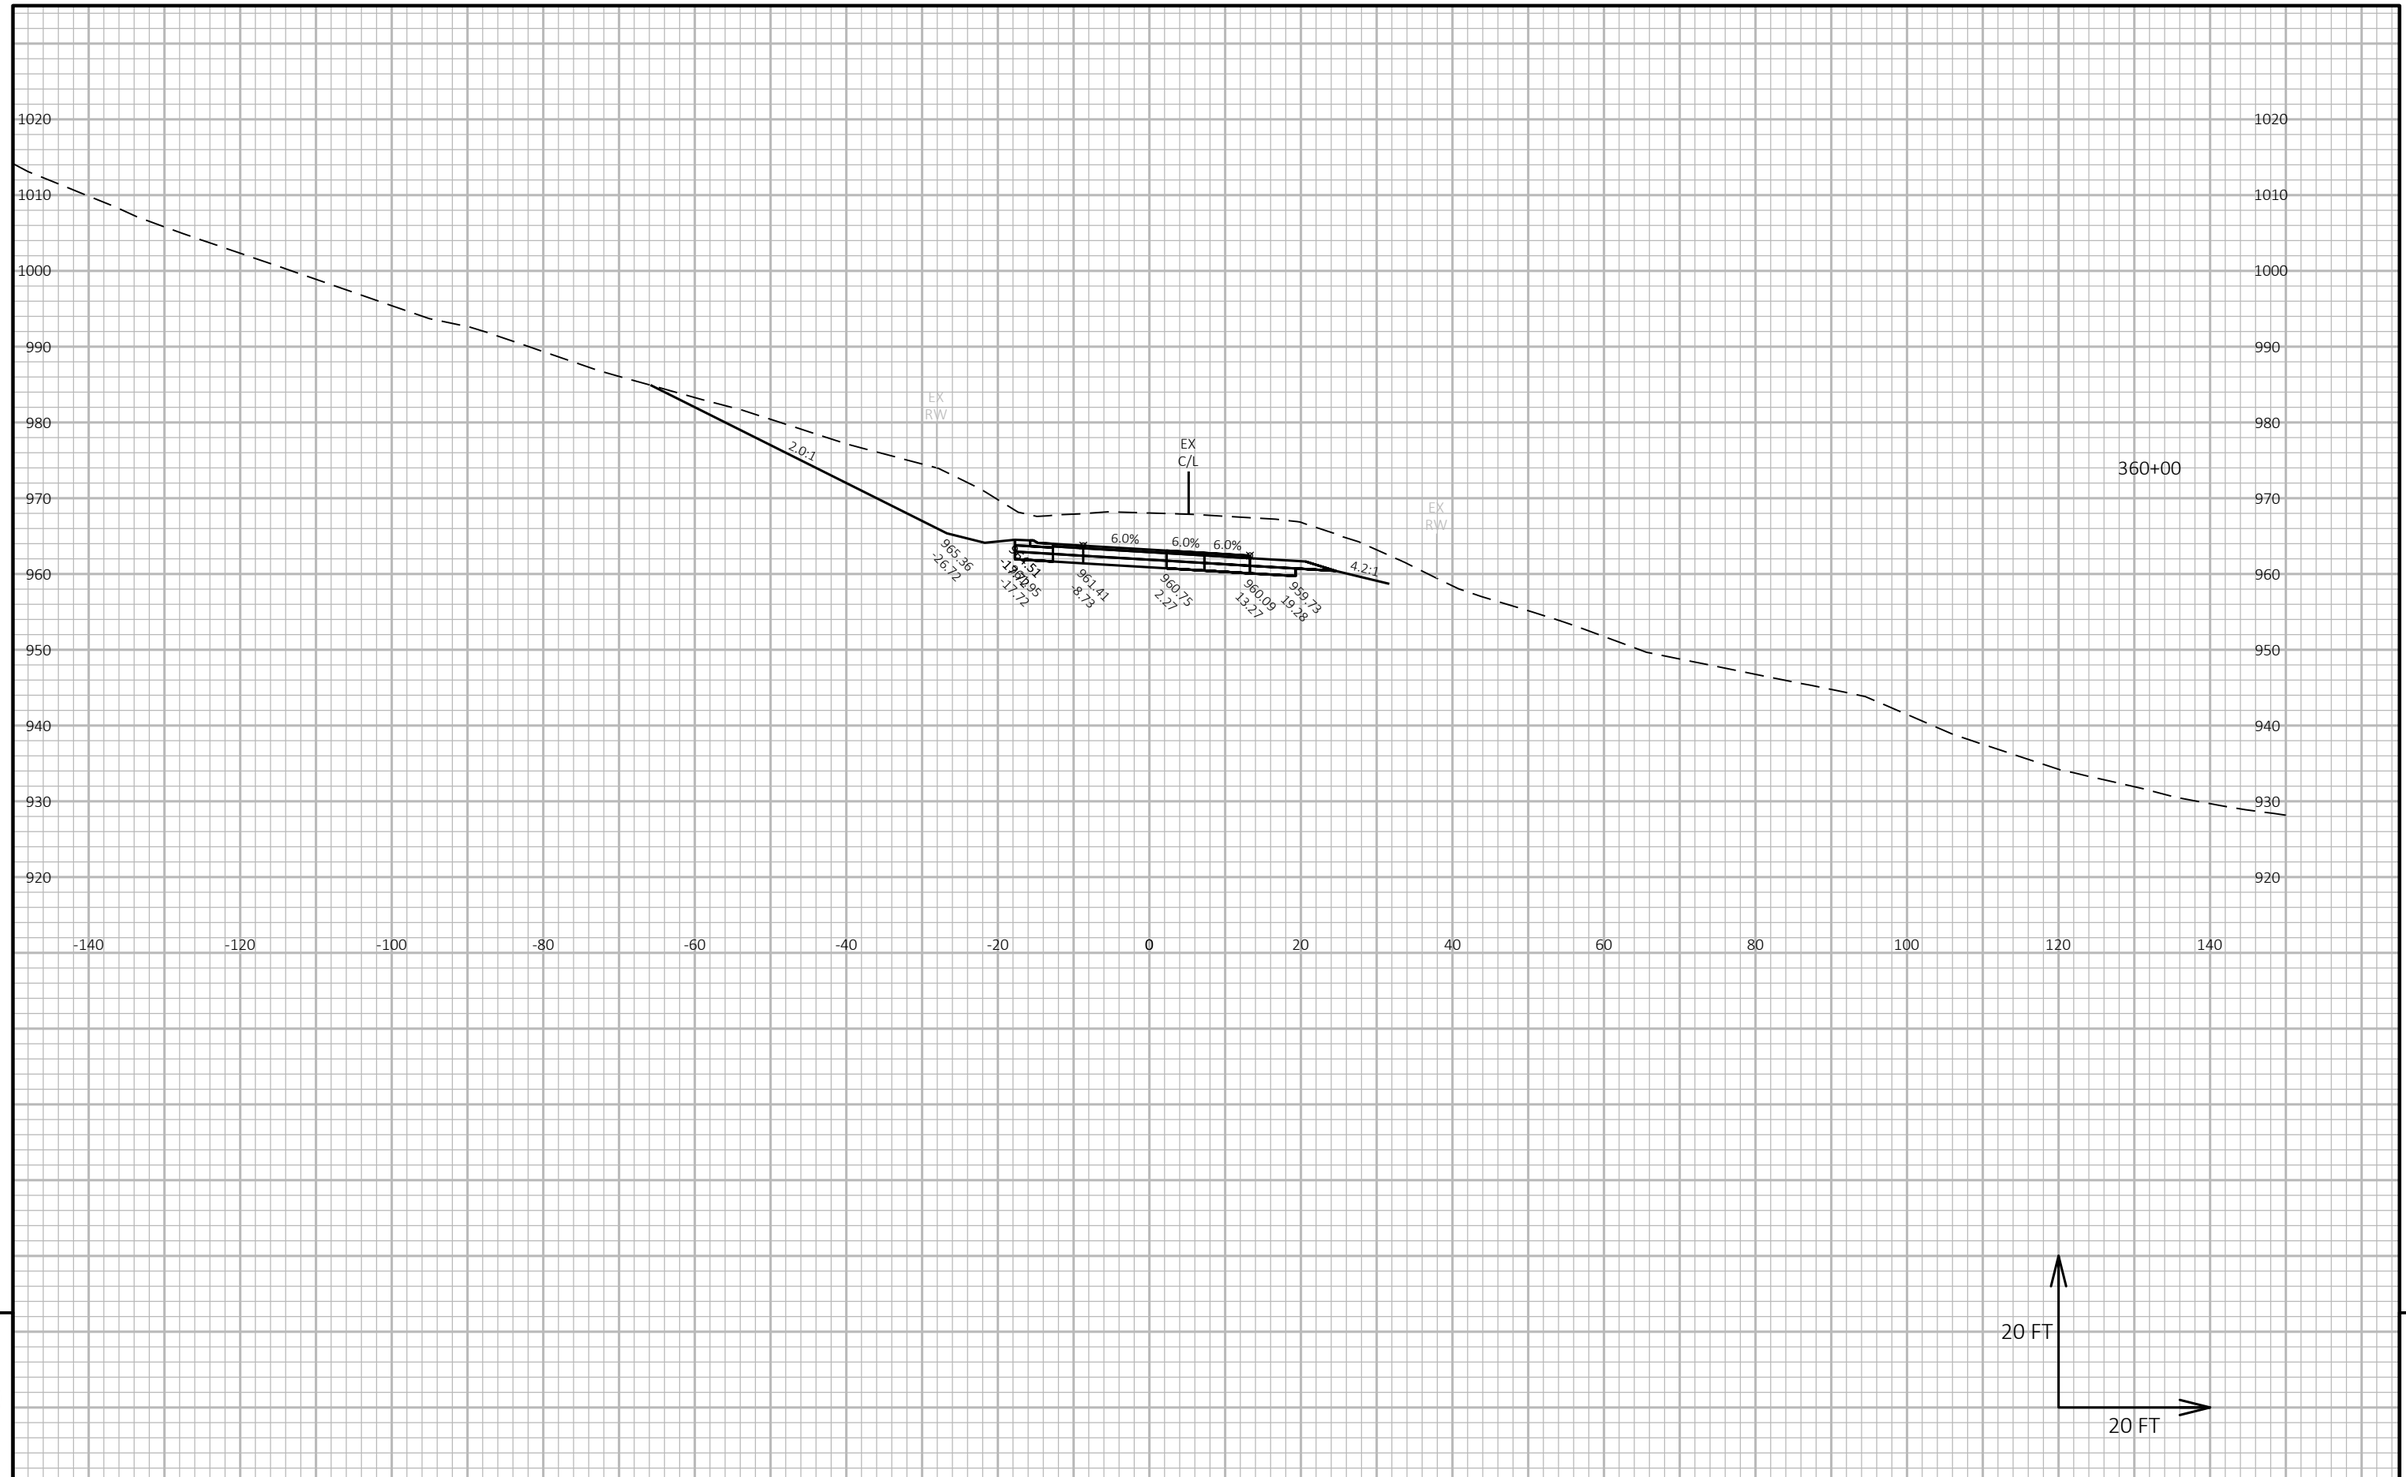

9

9

PROJECT NO: 5145-00-71	HWY: STH 19	COUNTY: DANE COUNTY	CROSS SECTIONS: ##########################	SHEET 183	E

FILE NAME : N:\PDS\C3D\51450001\SHEETSPLAN\090201_XS.DWG
LAYOUT NAME - 0902136-xs

PLOT DATE : 6/6/2018 5:35 PM PLOT BY : RACH, JEREMY PAUL PLOT NAME : PLOT SCALE : 1 IN:20 FT HORZ. / 1 IN:20 FT VERT.

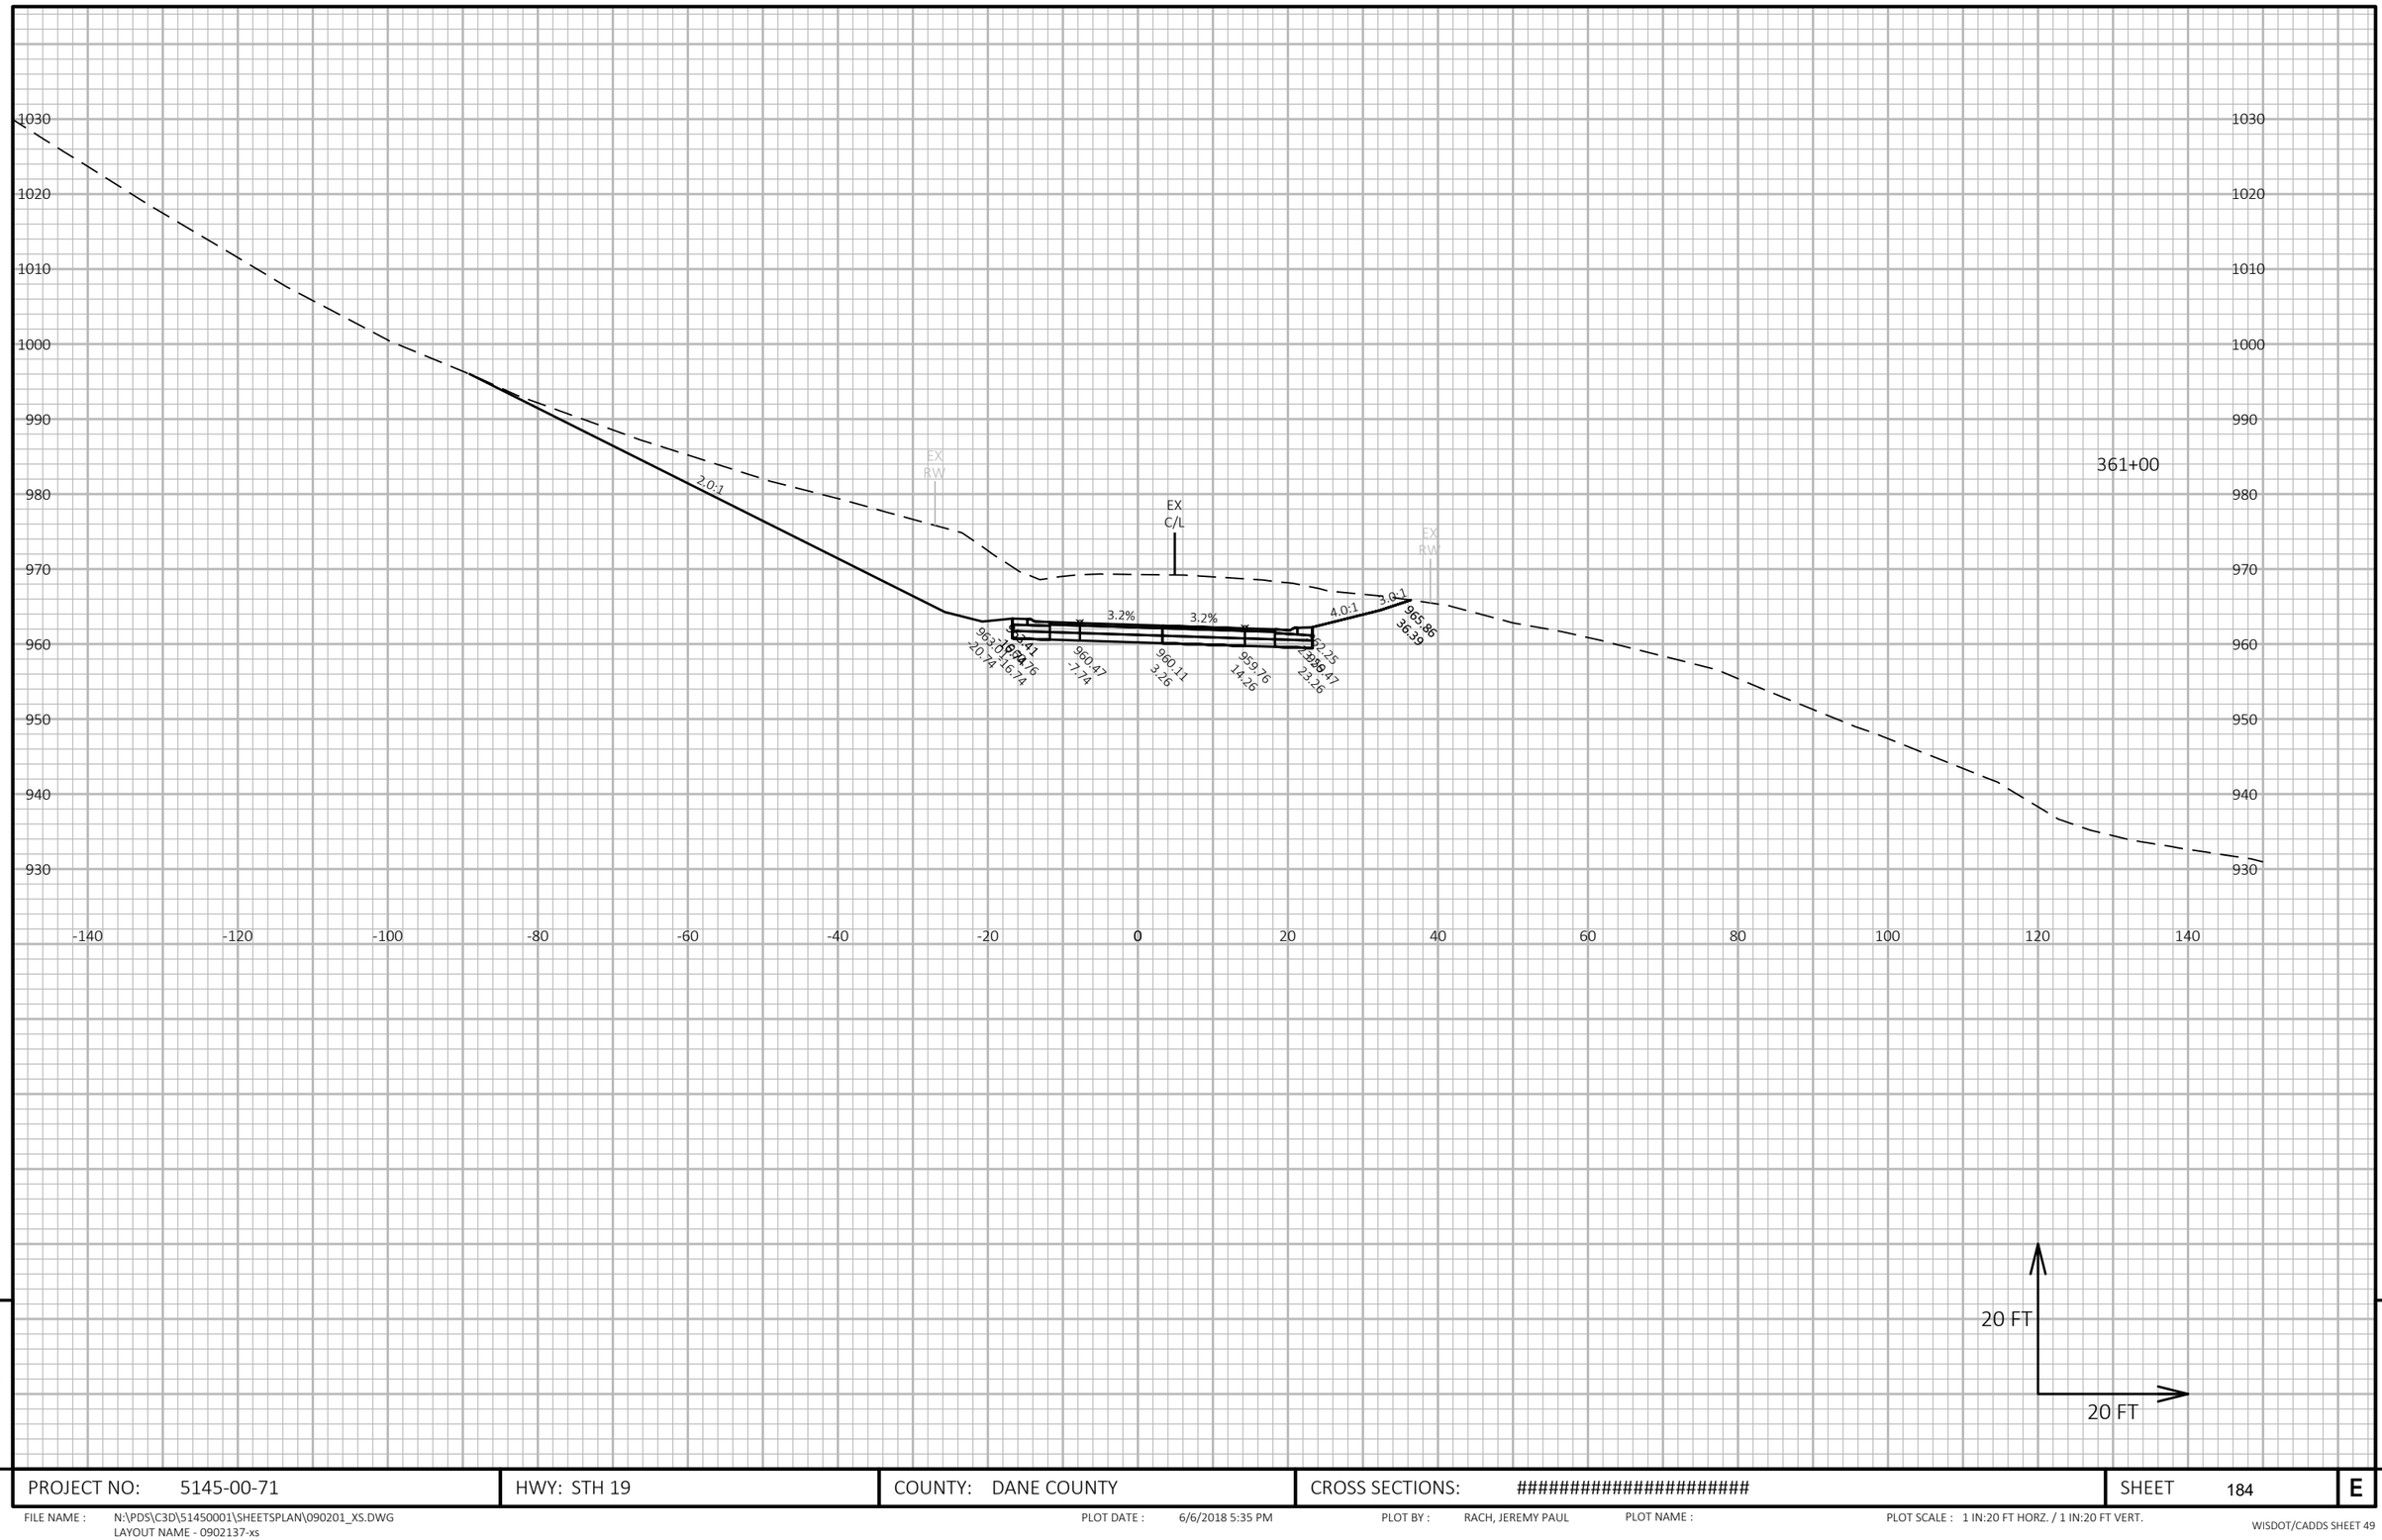

9

9

PROJECT NO: 5145-00-71	HWY: STH 19	COUNTY: DANE COUNTY	CROSS SECTIONS: ##########################	SHEET 184	E

FILE NAME : N:\PDS\C3D\51450001\SHEETSPLAN\090201_XS.DWG
LAYOUT NAME - 0902137-xs

PLOT DATE : 6/6/2018 5:35 PM PLOT BY : RACH, JEREMY PAUL PLOT NAME : PLOT SCALE : 1 IN:20 FT HORZ. / 1 IN:20 FT VERT.

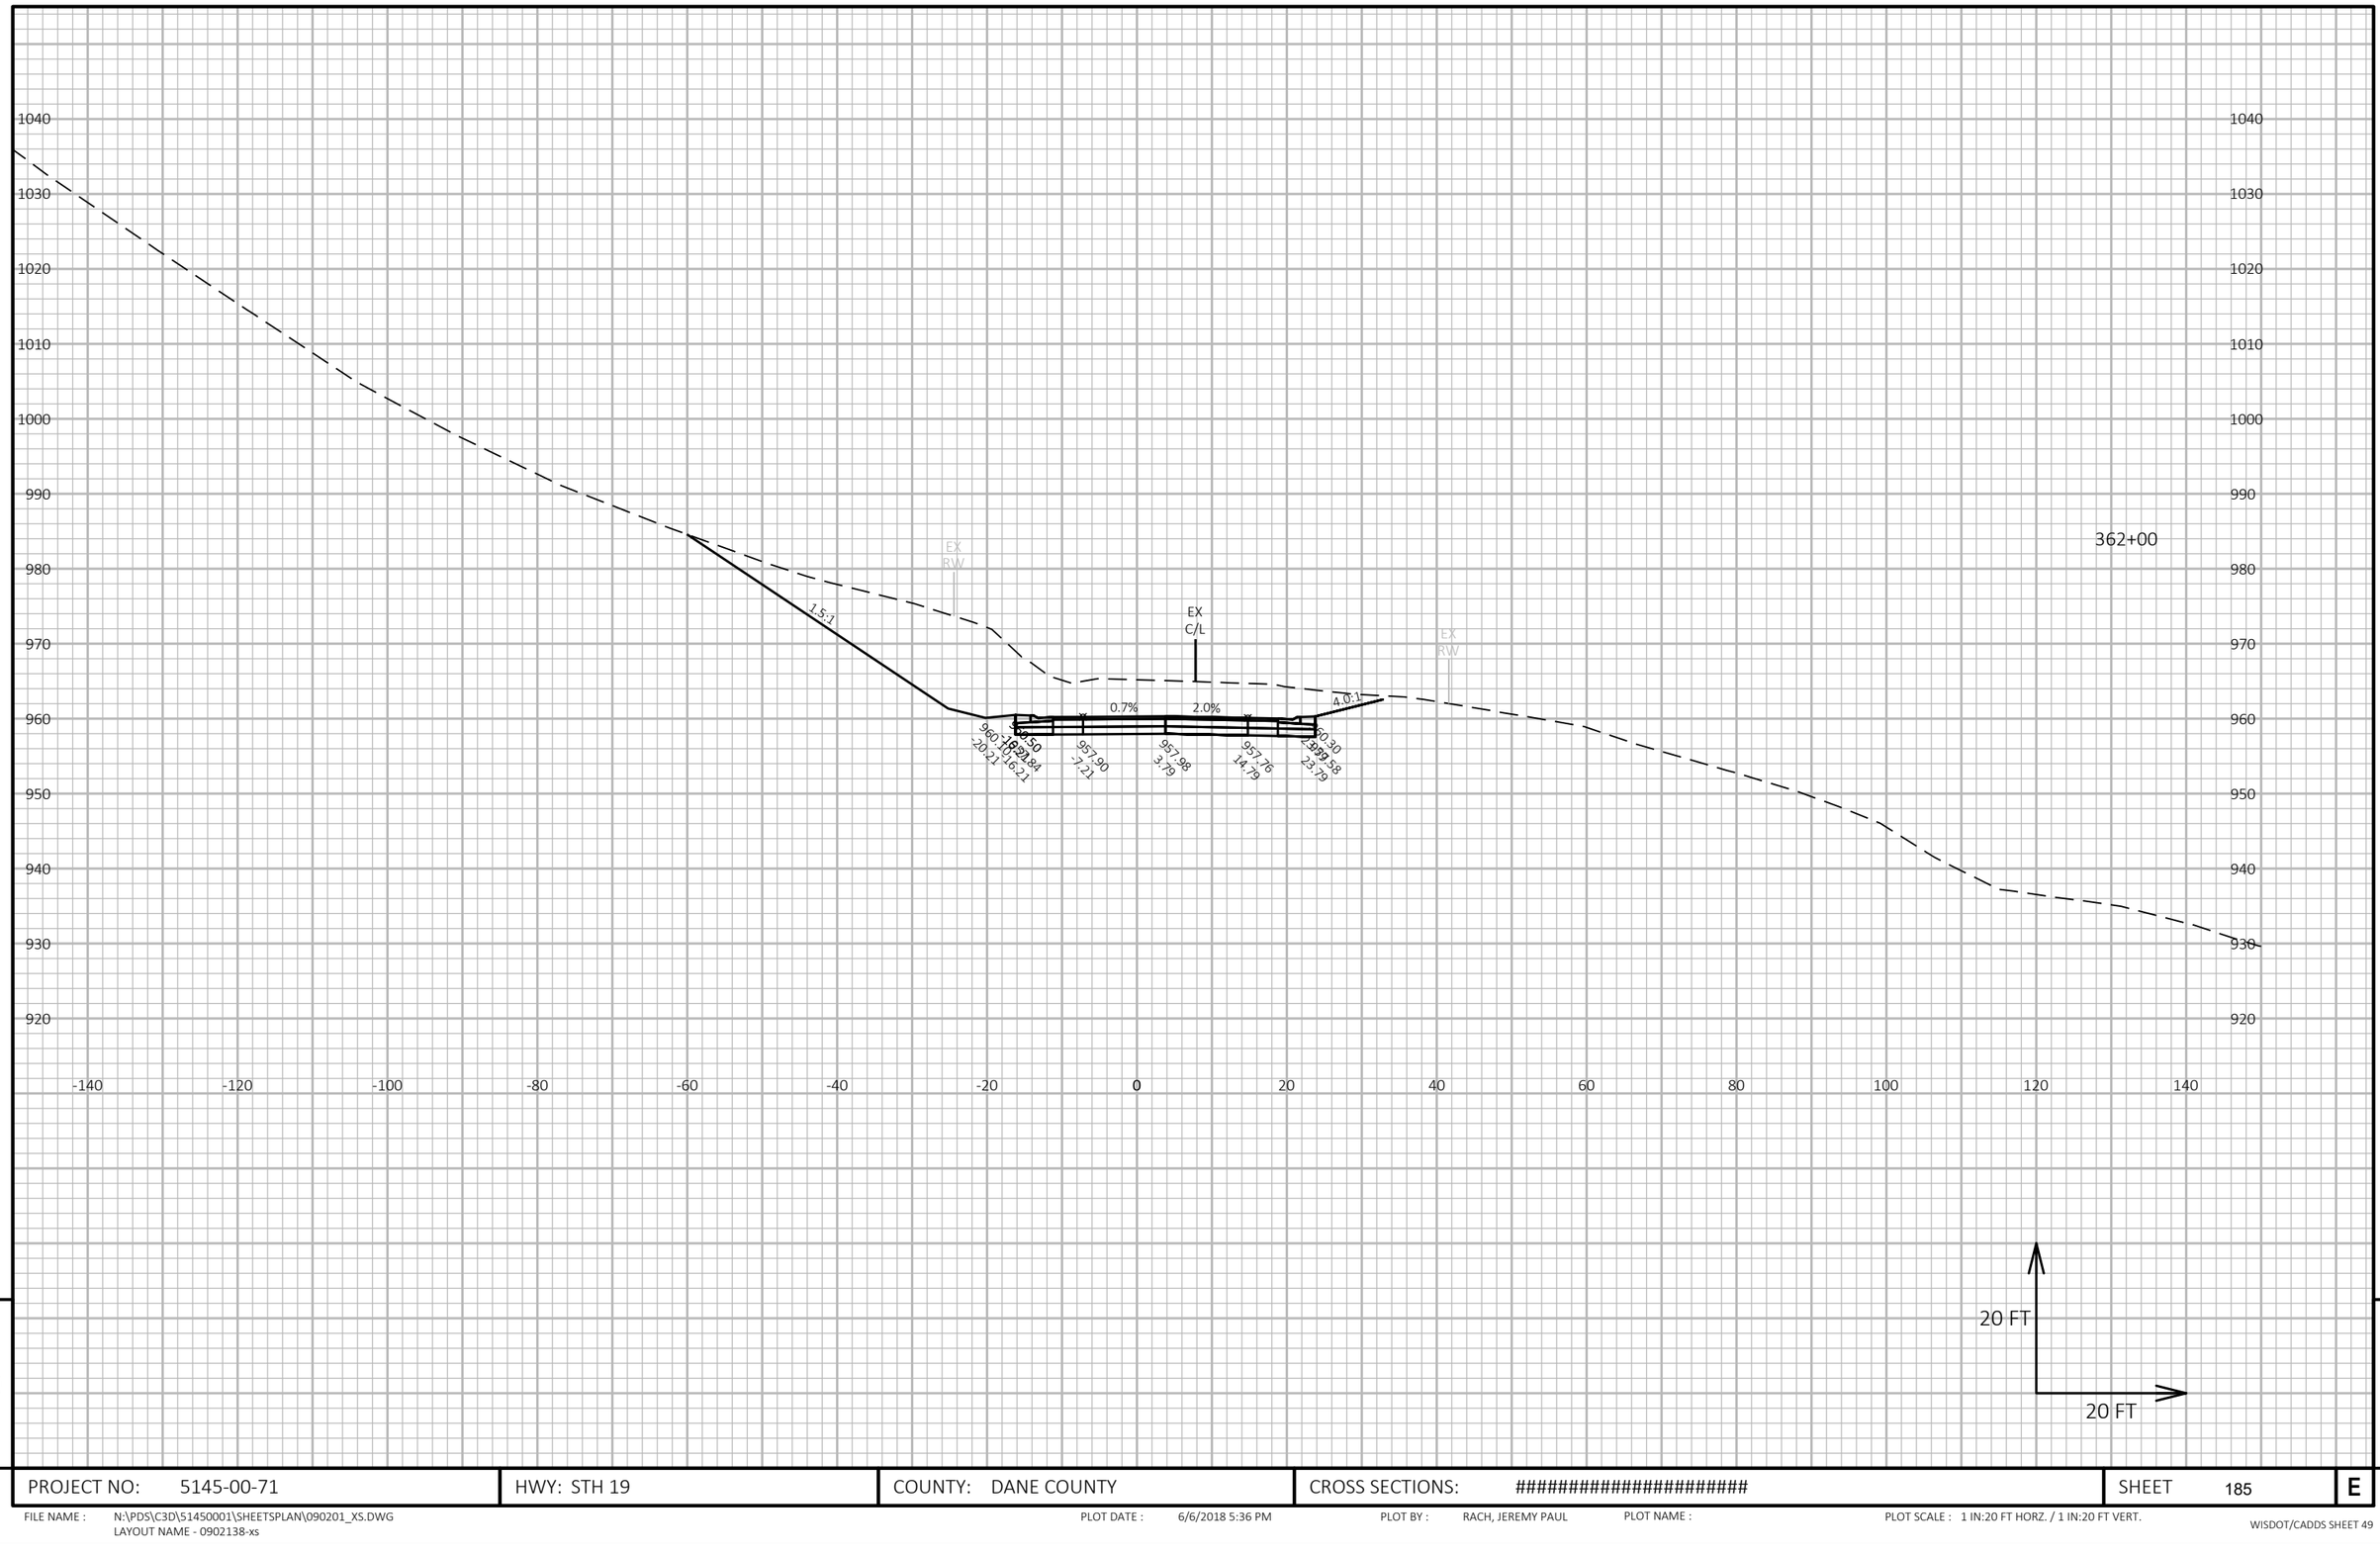

9

9

PROJECT NO: 5145-00-71	HWY: STH 19	COUNTY: DANE COUNTY	CROSS SECTIONS: ##########################	SHEET 185	E

FILE NAME : N:\PDS\C3D\51450001\SHEETSPLAN\090201_XS.DWG
LAYOUT NAME - 0902138-xs

PLOT DATE : 6/6/2018 5:36 PM PLOT BY : RACH, JEREMY PAUL PLOT NAME : PLOT SCALE : 1 IN:20 FT HORZ. / 1 IN:20 FT VERT.

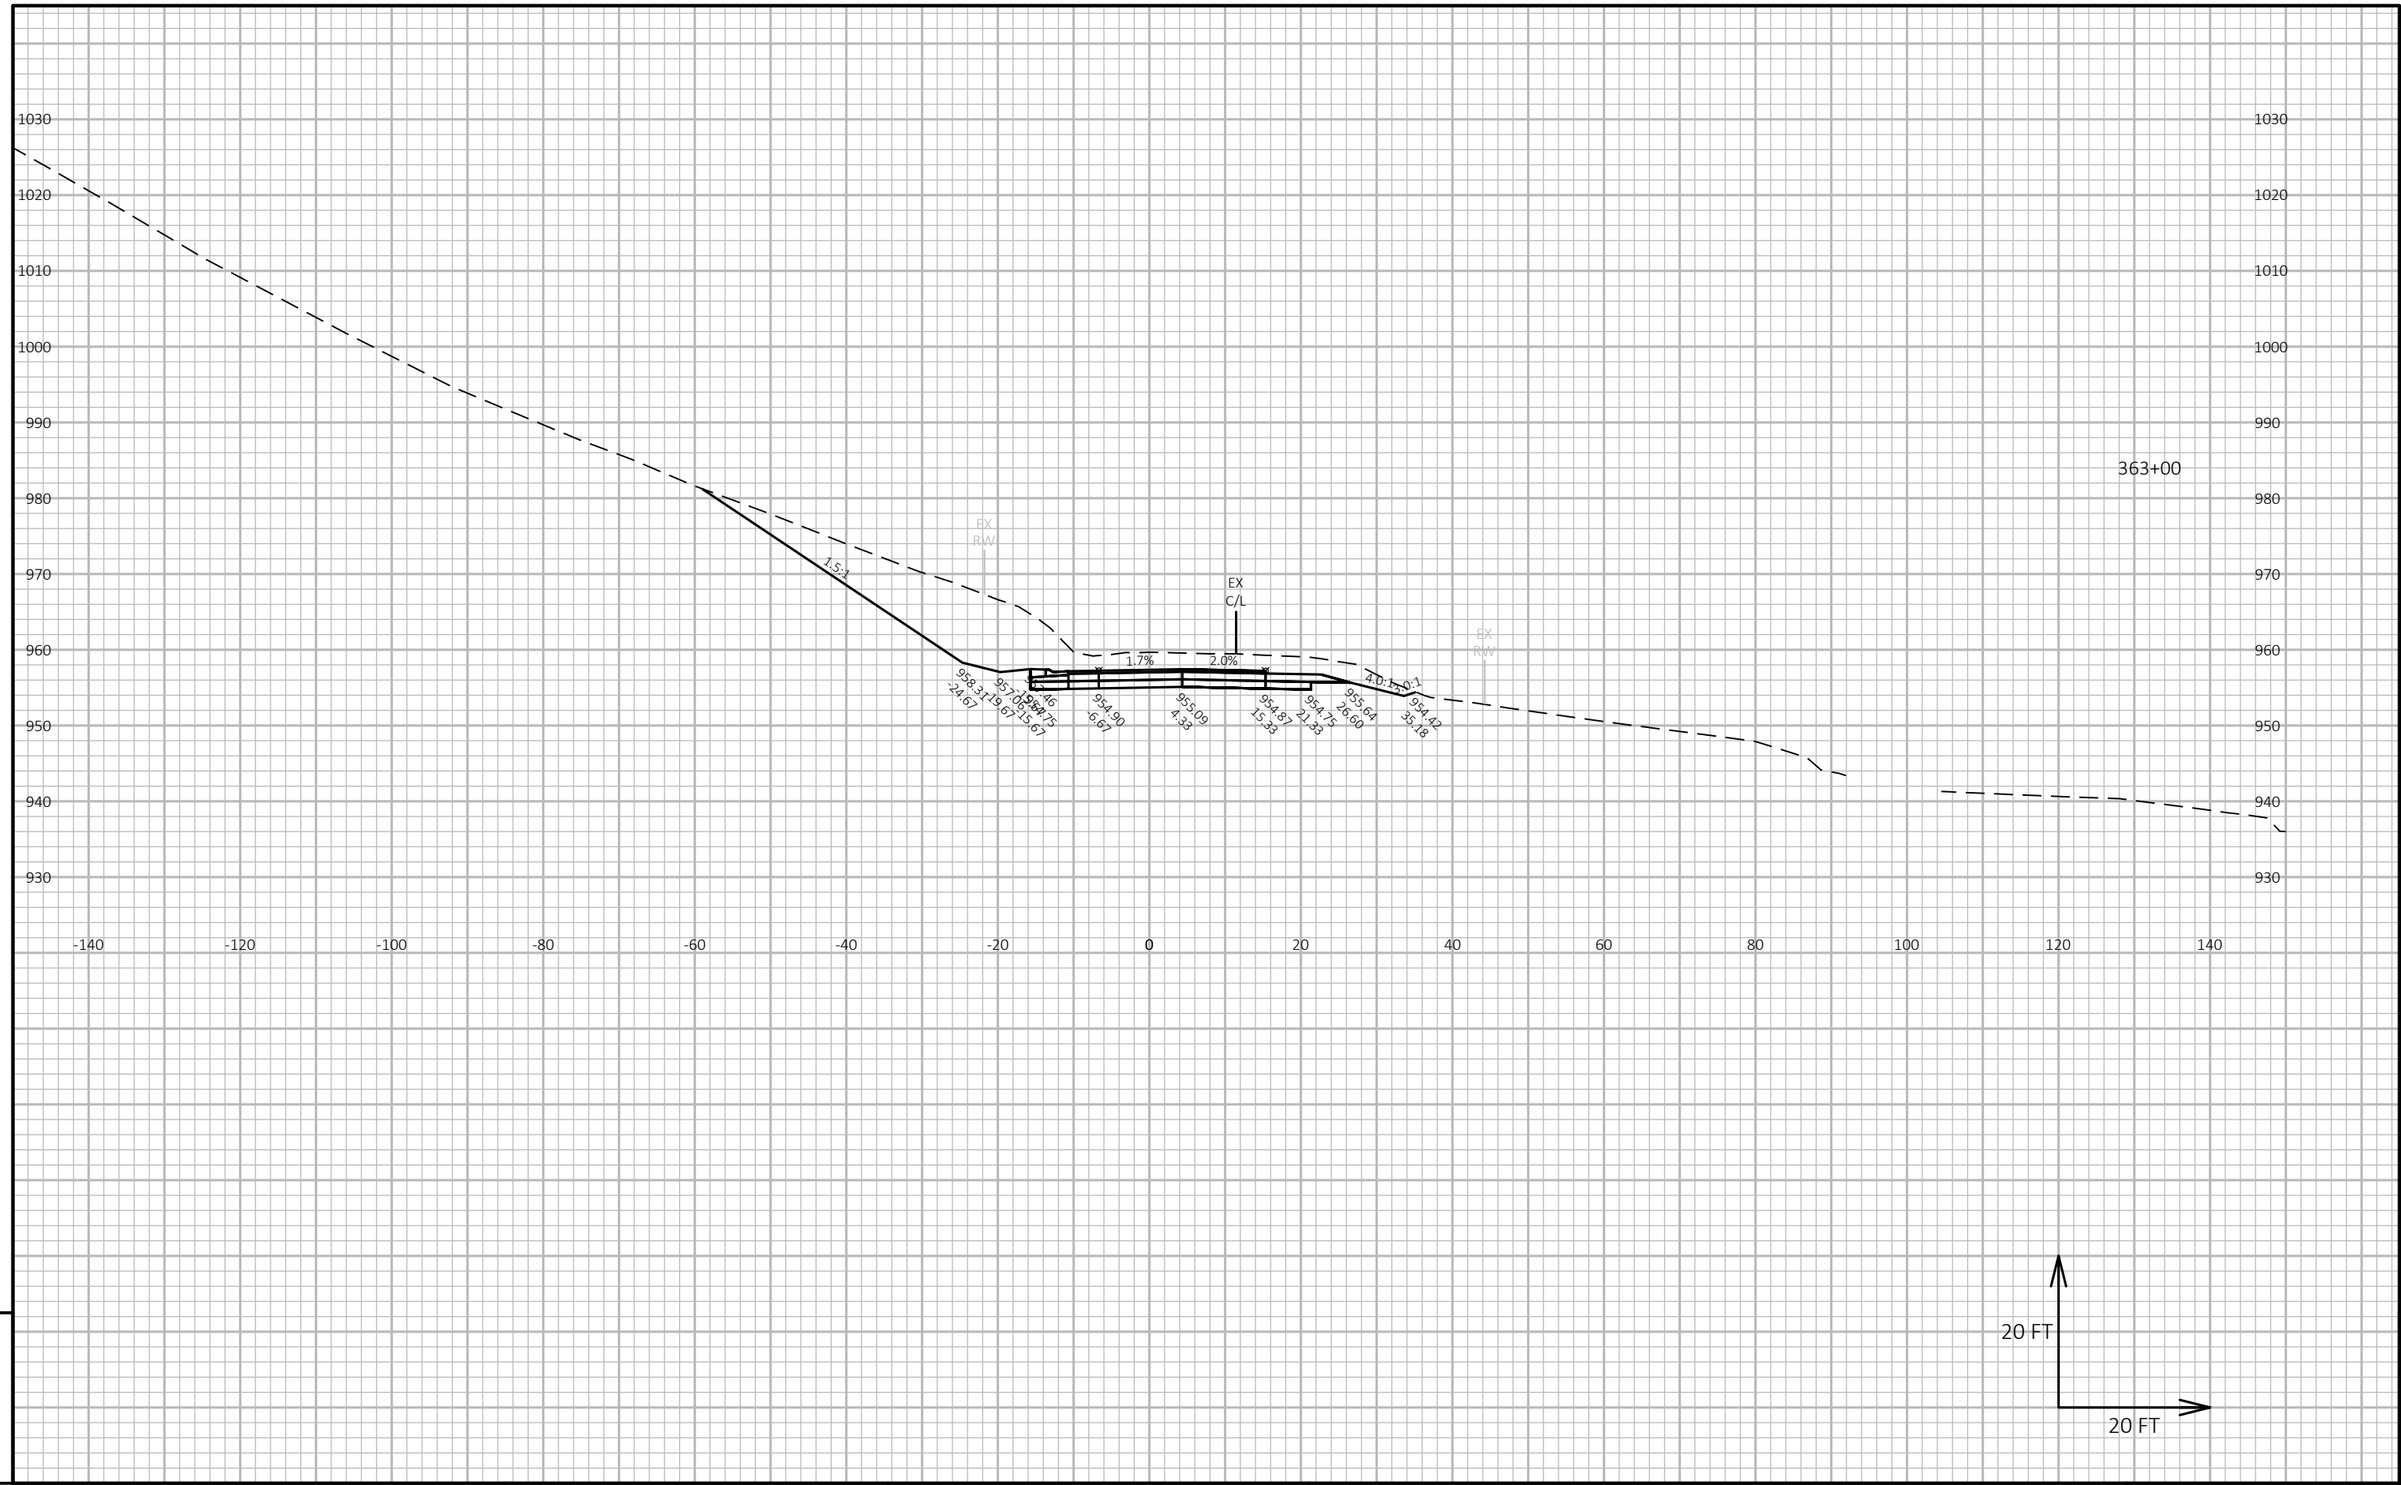

9

9

PROJECT NO: 5145-00-71	HWY: STH 19	COUNTY: DANE COUNTY	CROSS SECTIONS: ##########################	SHEET 186	E

FILE NAME : N:\PDS\C3D\51450001\SHEETSPLAN\090201_XS.DWG
LAYOUT NAME - 0902139-xs

PLOT DATE : 6/6/2018 5:36 PM PLOT BY : RACH, JEREMY PAUL PLOT NAME : PLOT SCALE : 1 IN:20 FT HORZ. / 1 IN:20 FT VERT.

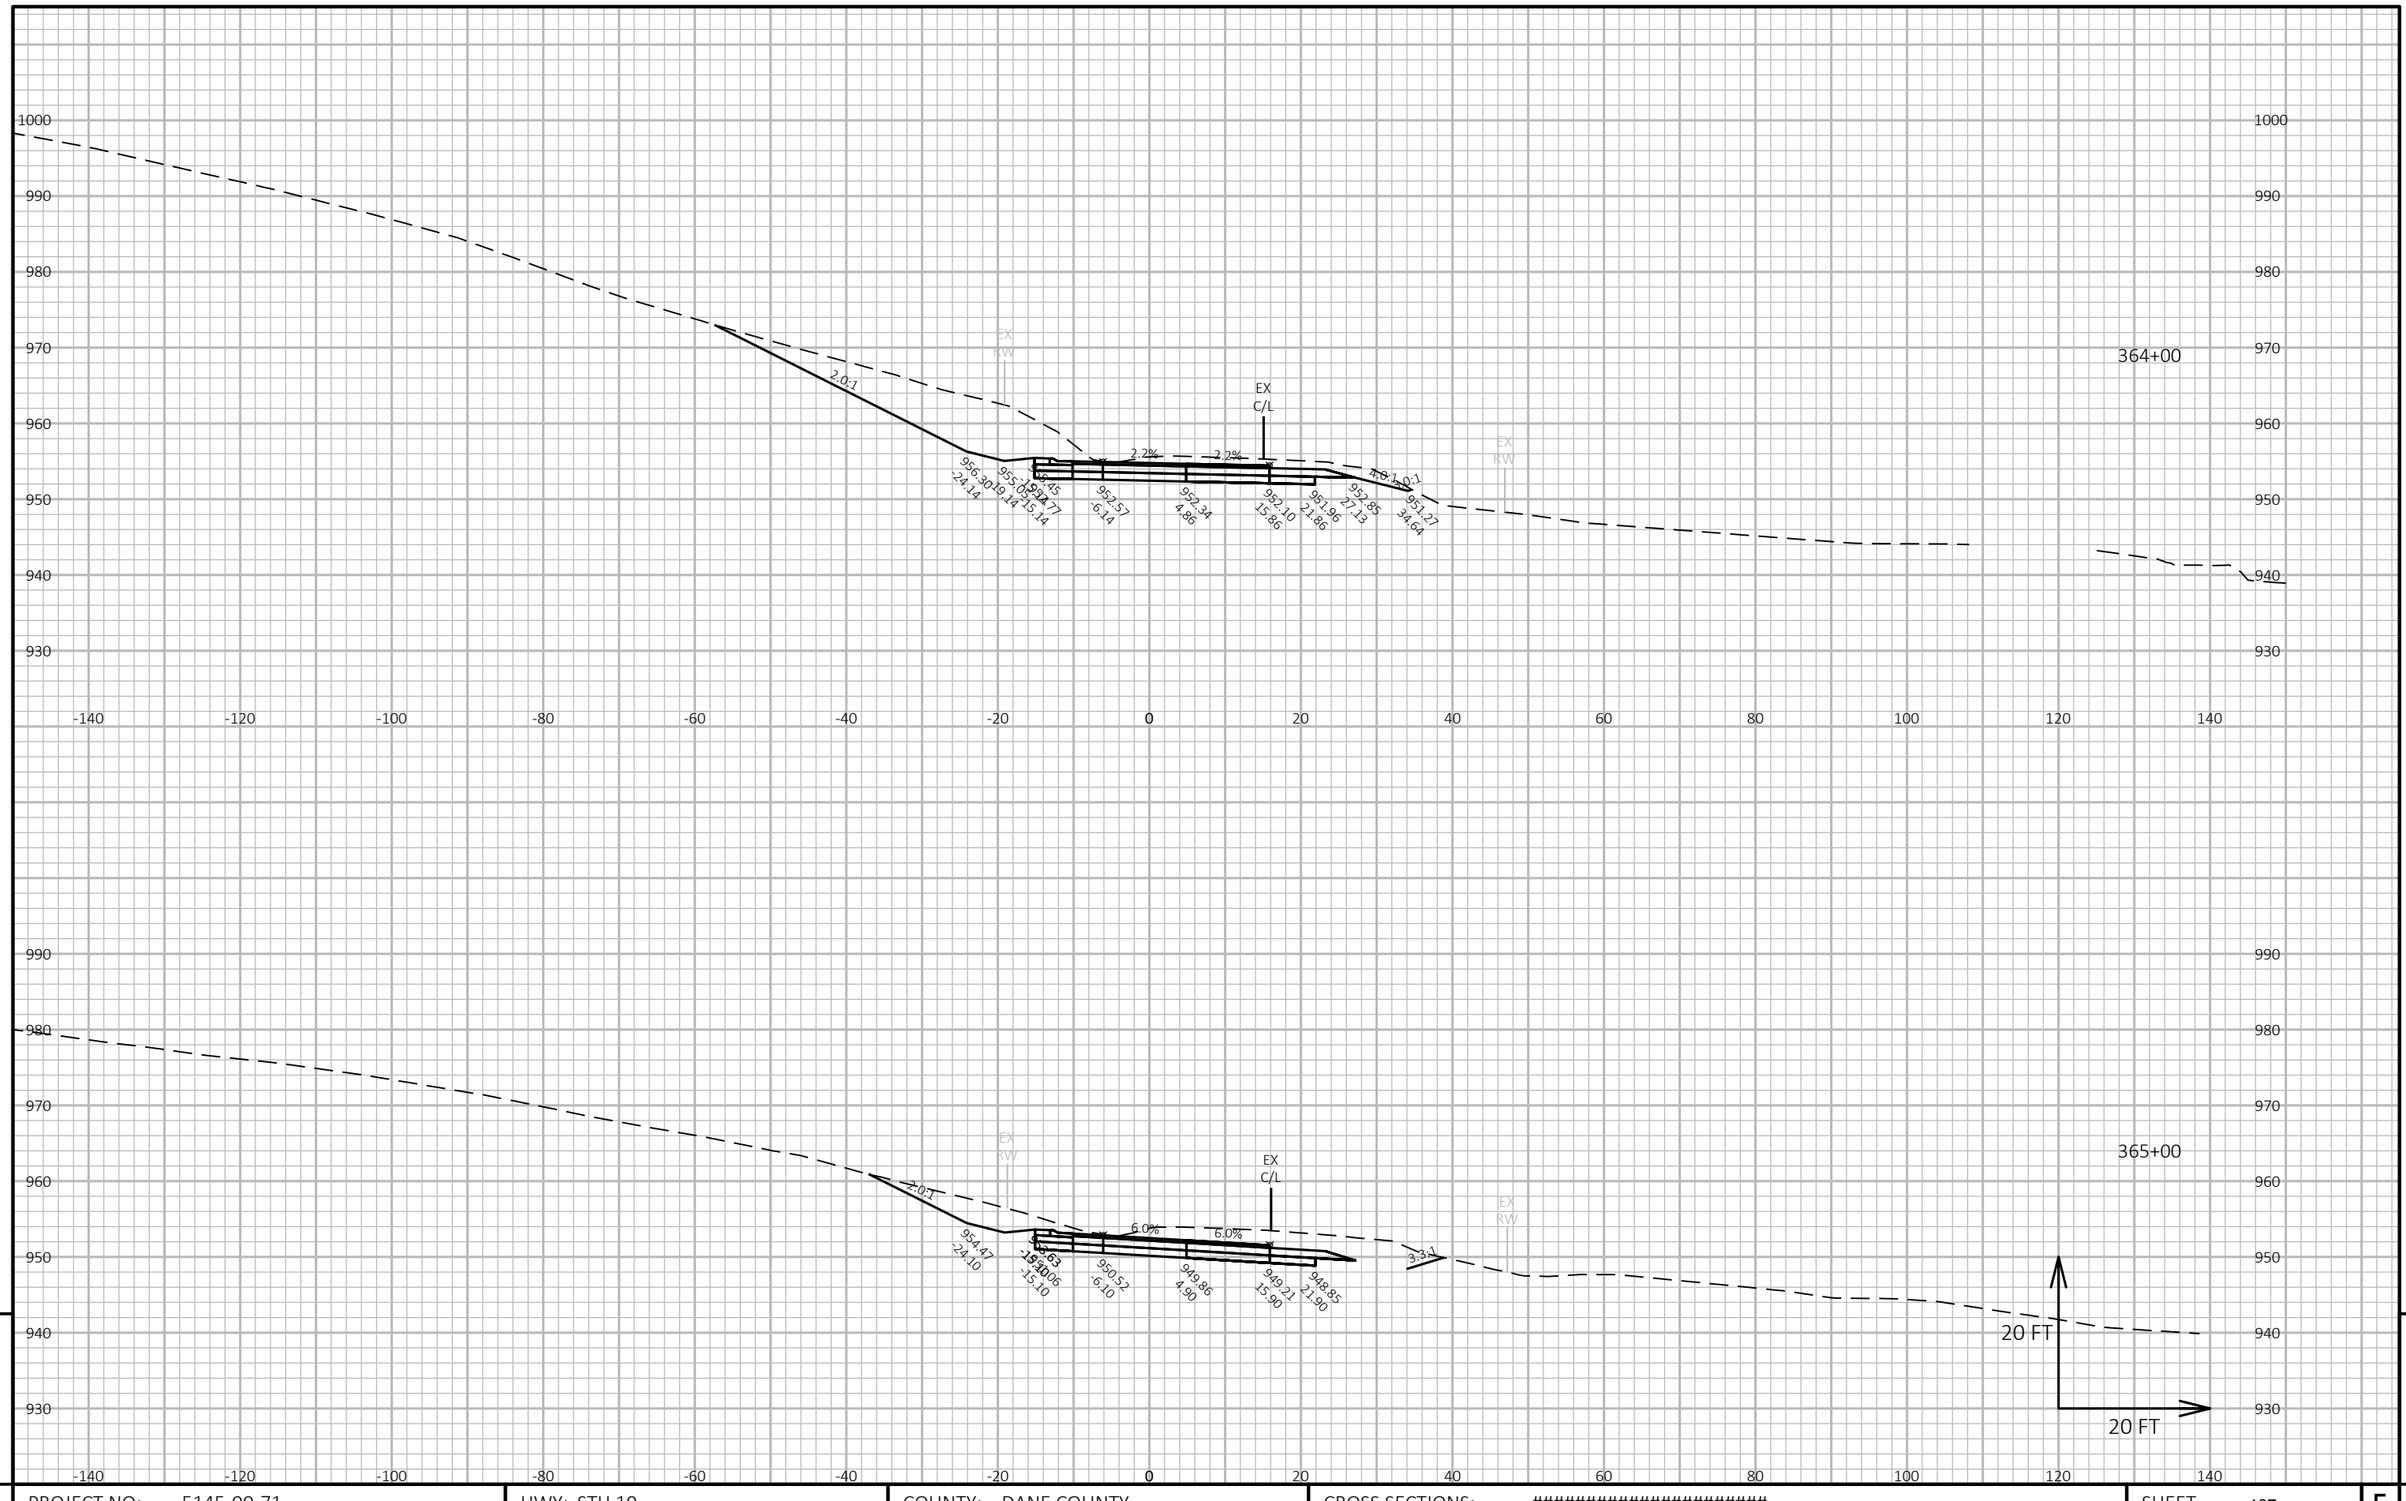

PROJECT NO: 5145-00-71	HWY: STH 19	COUNTY: DANE COUNTY	CROSS SECTIONS: ##########################	SHEET 187	E

FILE NAME : N:\PDS\C3D\51450001\SHEETSPLAN\090201_XS.DWG
LAYOUT NAME - 0902140-xs

PLOT DATE : 6/6/2018 5:37 PM PLOT BY : RACH, JEREMY PAUL PLOT NAME : PLOT SCALE : 1 IN:20 FT HORZ. / 1 IN:20 FT VERT.

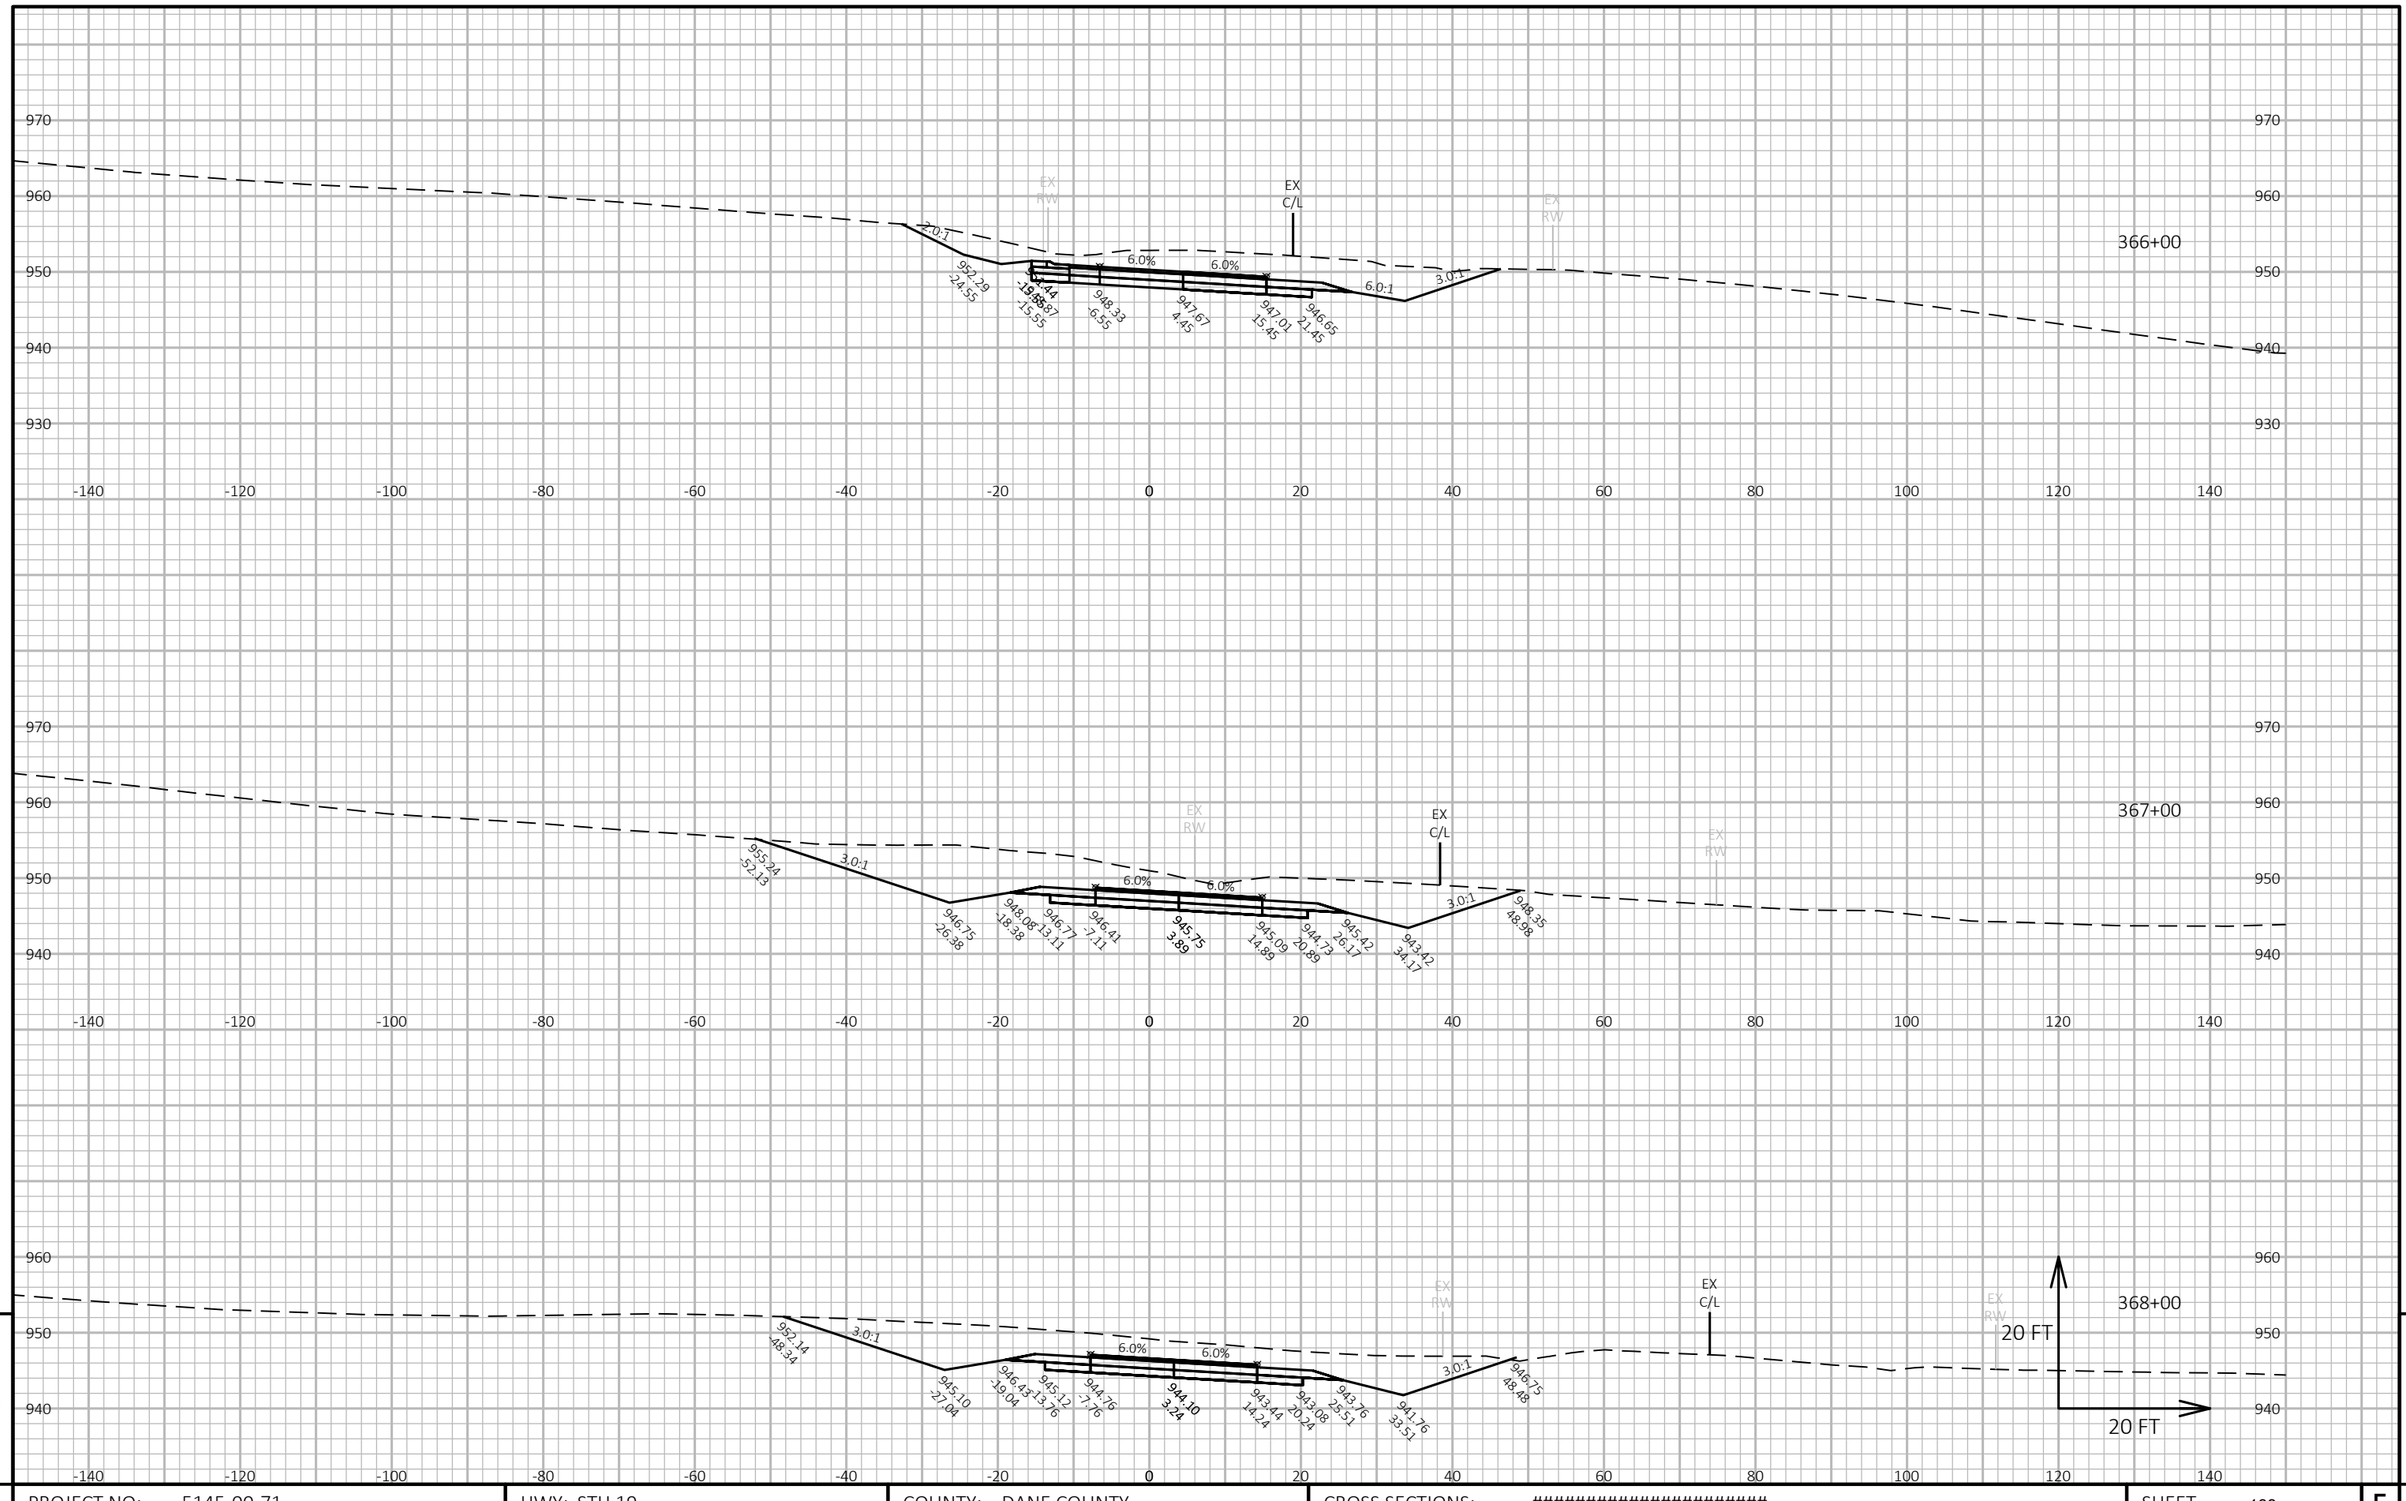

PROJECT NO: 5145-00-71	HWY: STH 19	COUNTY: DANE COUNTY	CROSS SECTIONS: ##########################	SHEET 188 E

FILE NAME : N:\PDS\C3D\51450001\SHEETSPLAN\090201_XS.DWG
LAYOUT NAME - 0902141-xs

PLOT DATE : 6/6/2018 5:37 PM PLOT BY : RACH, JEREMY PAUL PLOT NAME : PLOT SCALE : 1 IN:20 FT HORZ. / 1 IN:20 FT VERT.

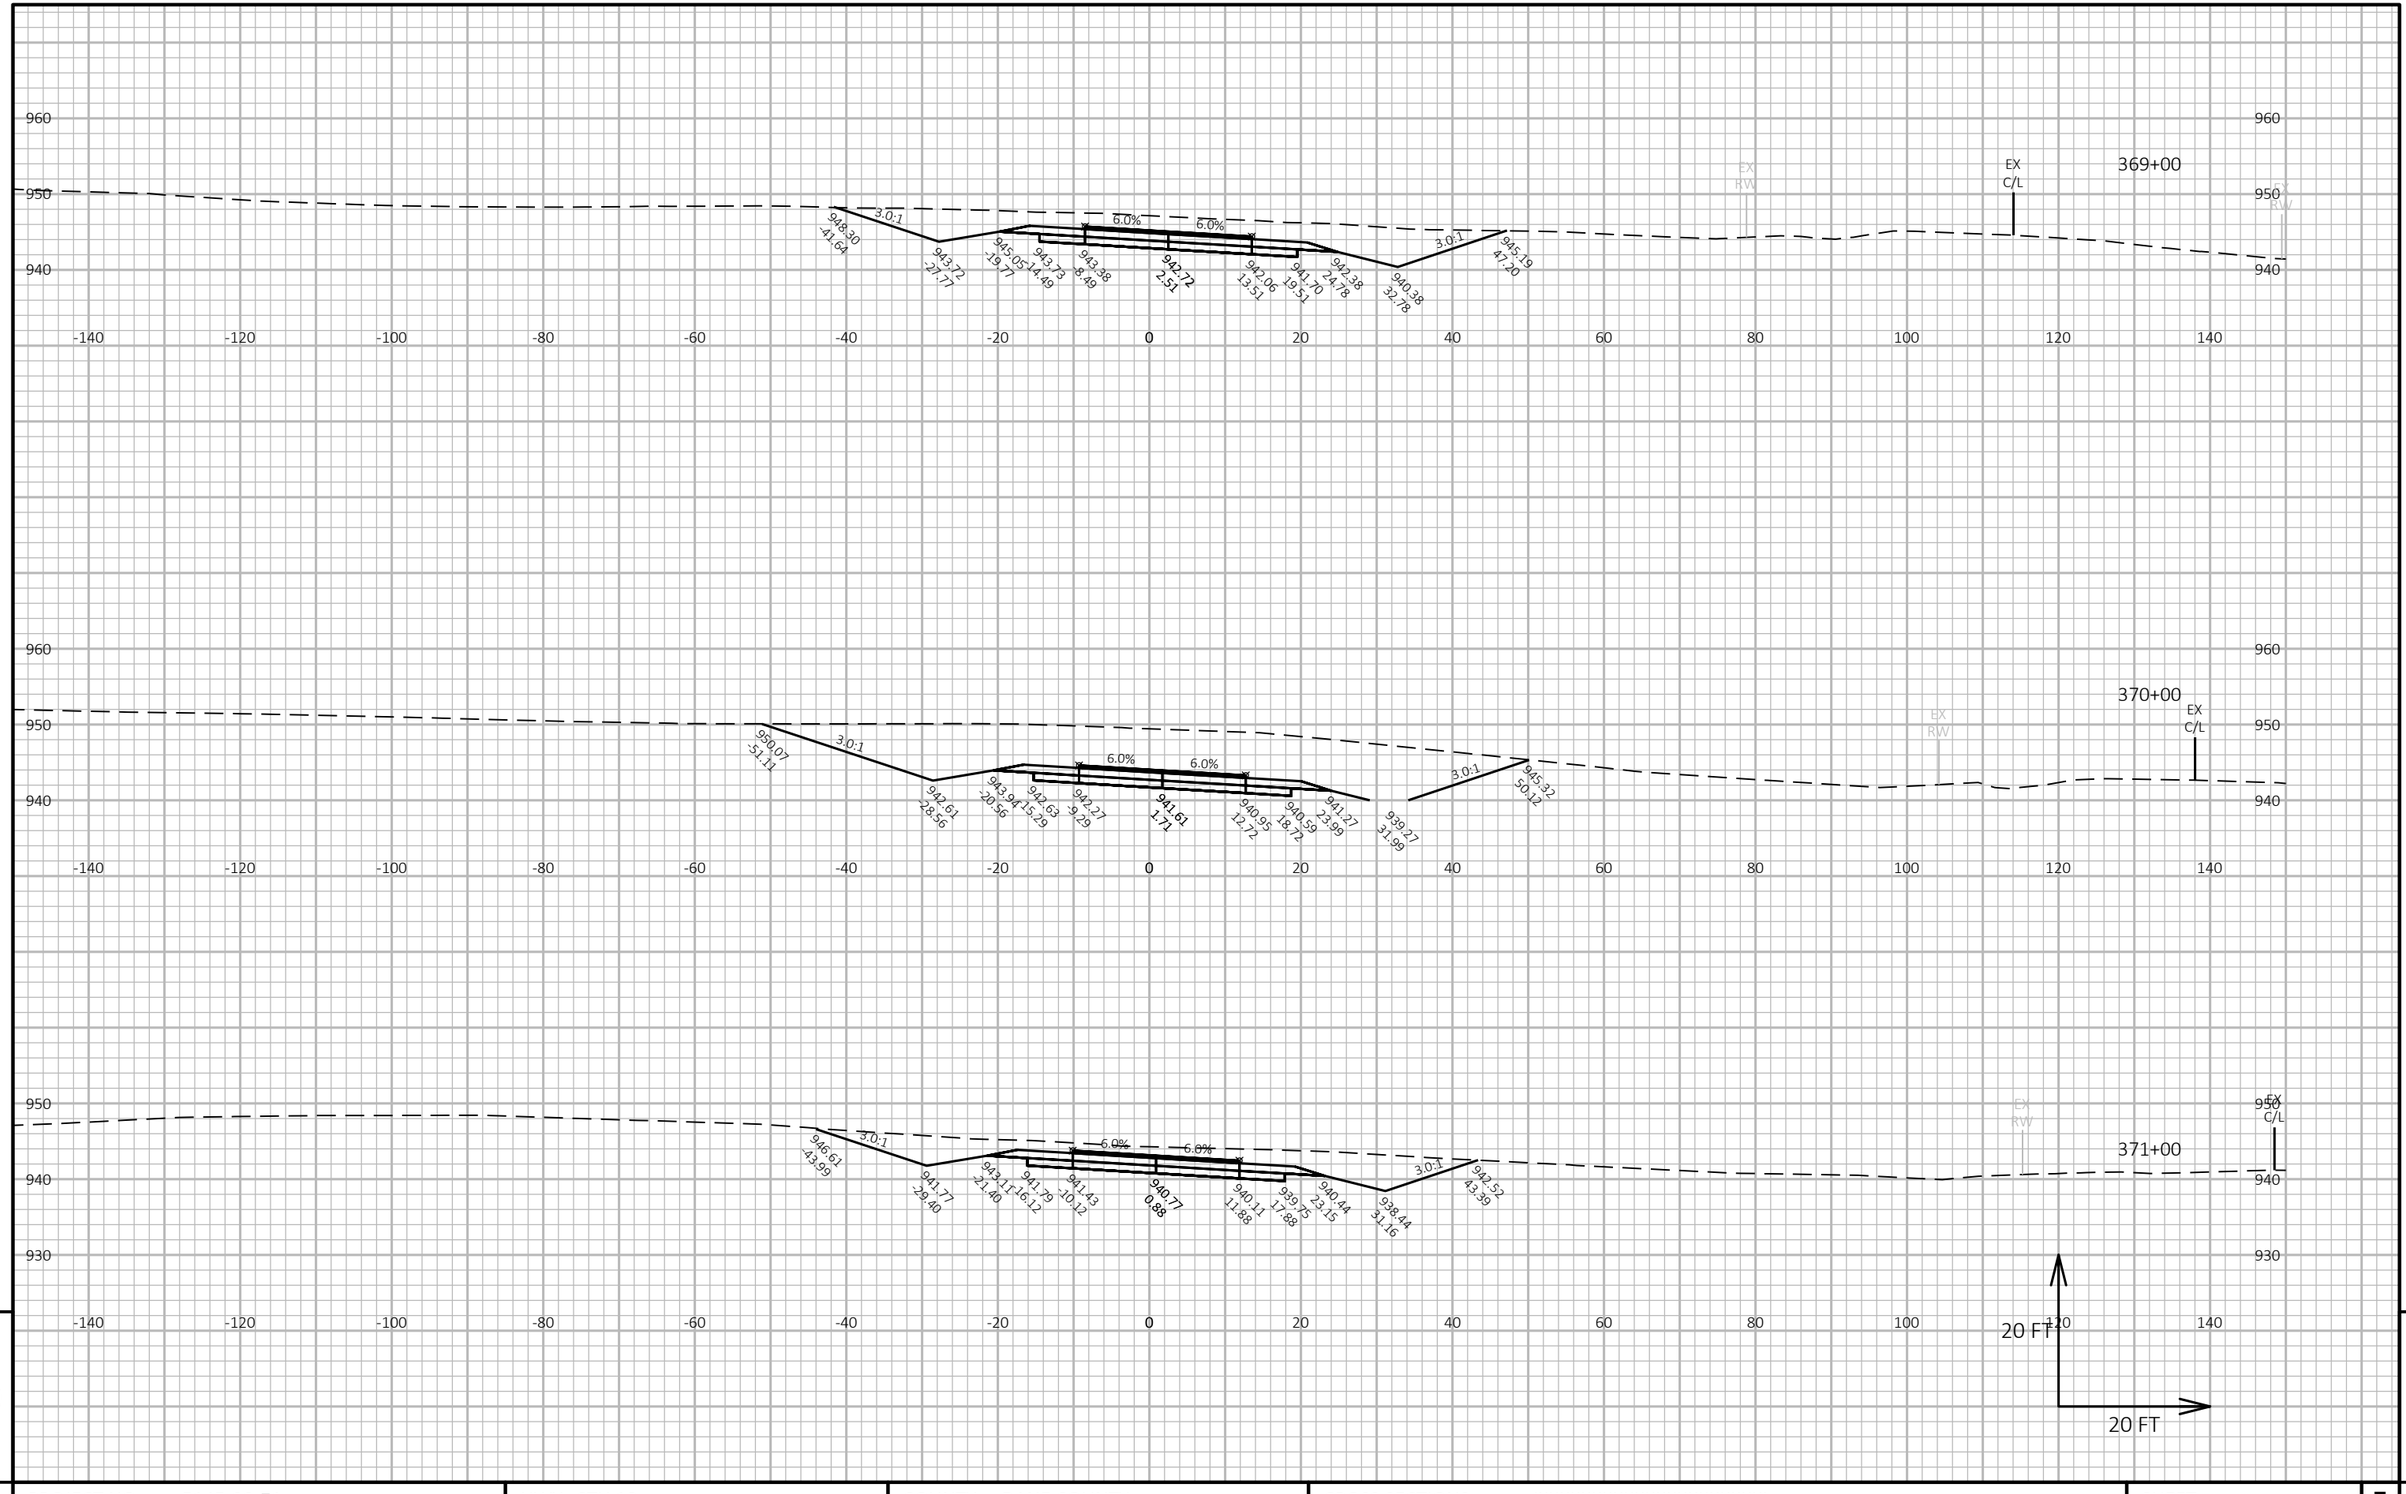

9

9

PROJECT NO: 5145-00-71	HWY: STH 19	COUNTY: DANE COUNTY	CROSS SECTIONS: ##########################	SHEET 189	E

FILE NAME : N:\PDS\C3D\51450001\SHEETSPLAN\090201_XS.DWG
LAYOUT NAME - 0902142-xs

PLOT DATE : 6/6/2018 5:38 PM

PLOT BY : RACH, JEREMY PAUL

PLOT NAME :

PLOT SCALE : 1 IN:20 FT HORZ. / 1 IN:20 FT VERT.

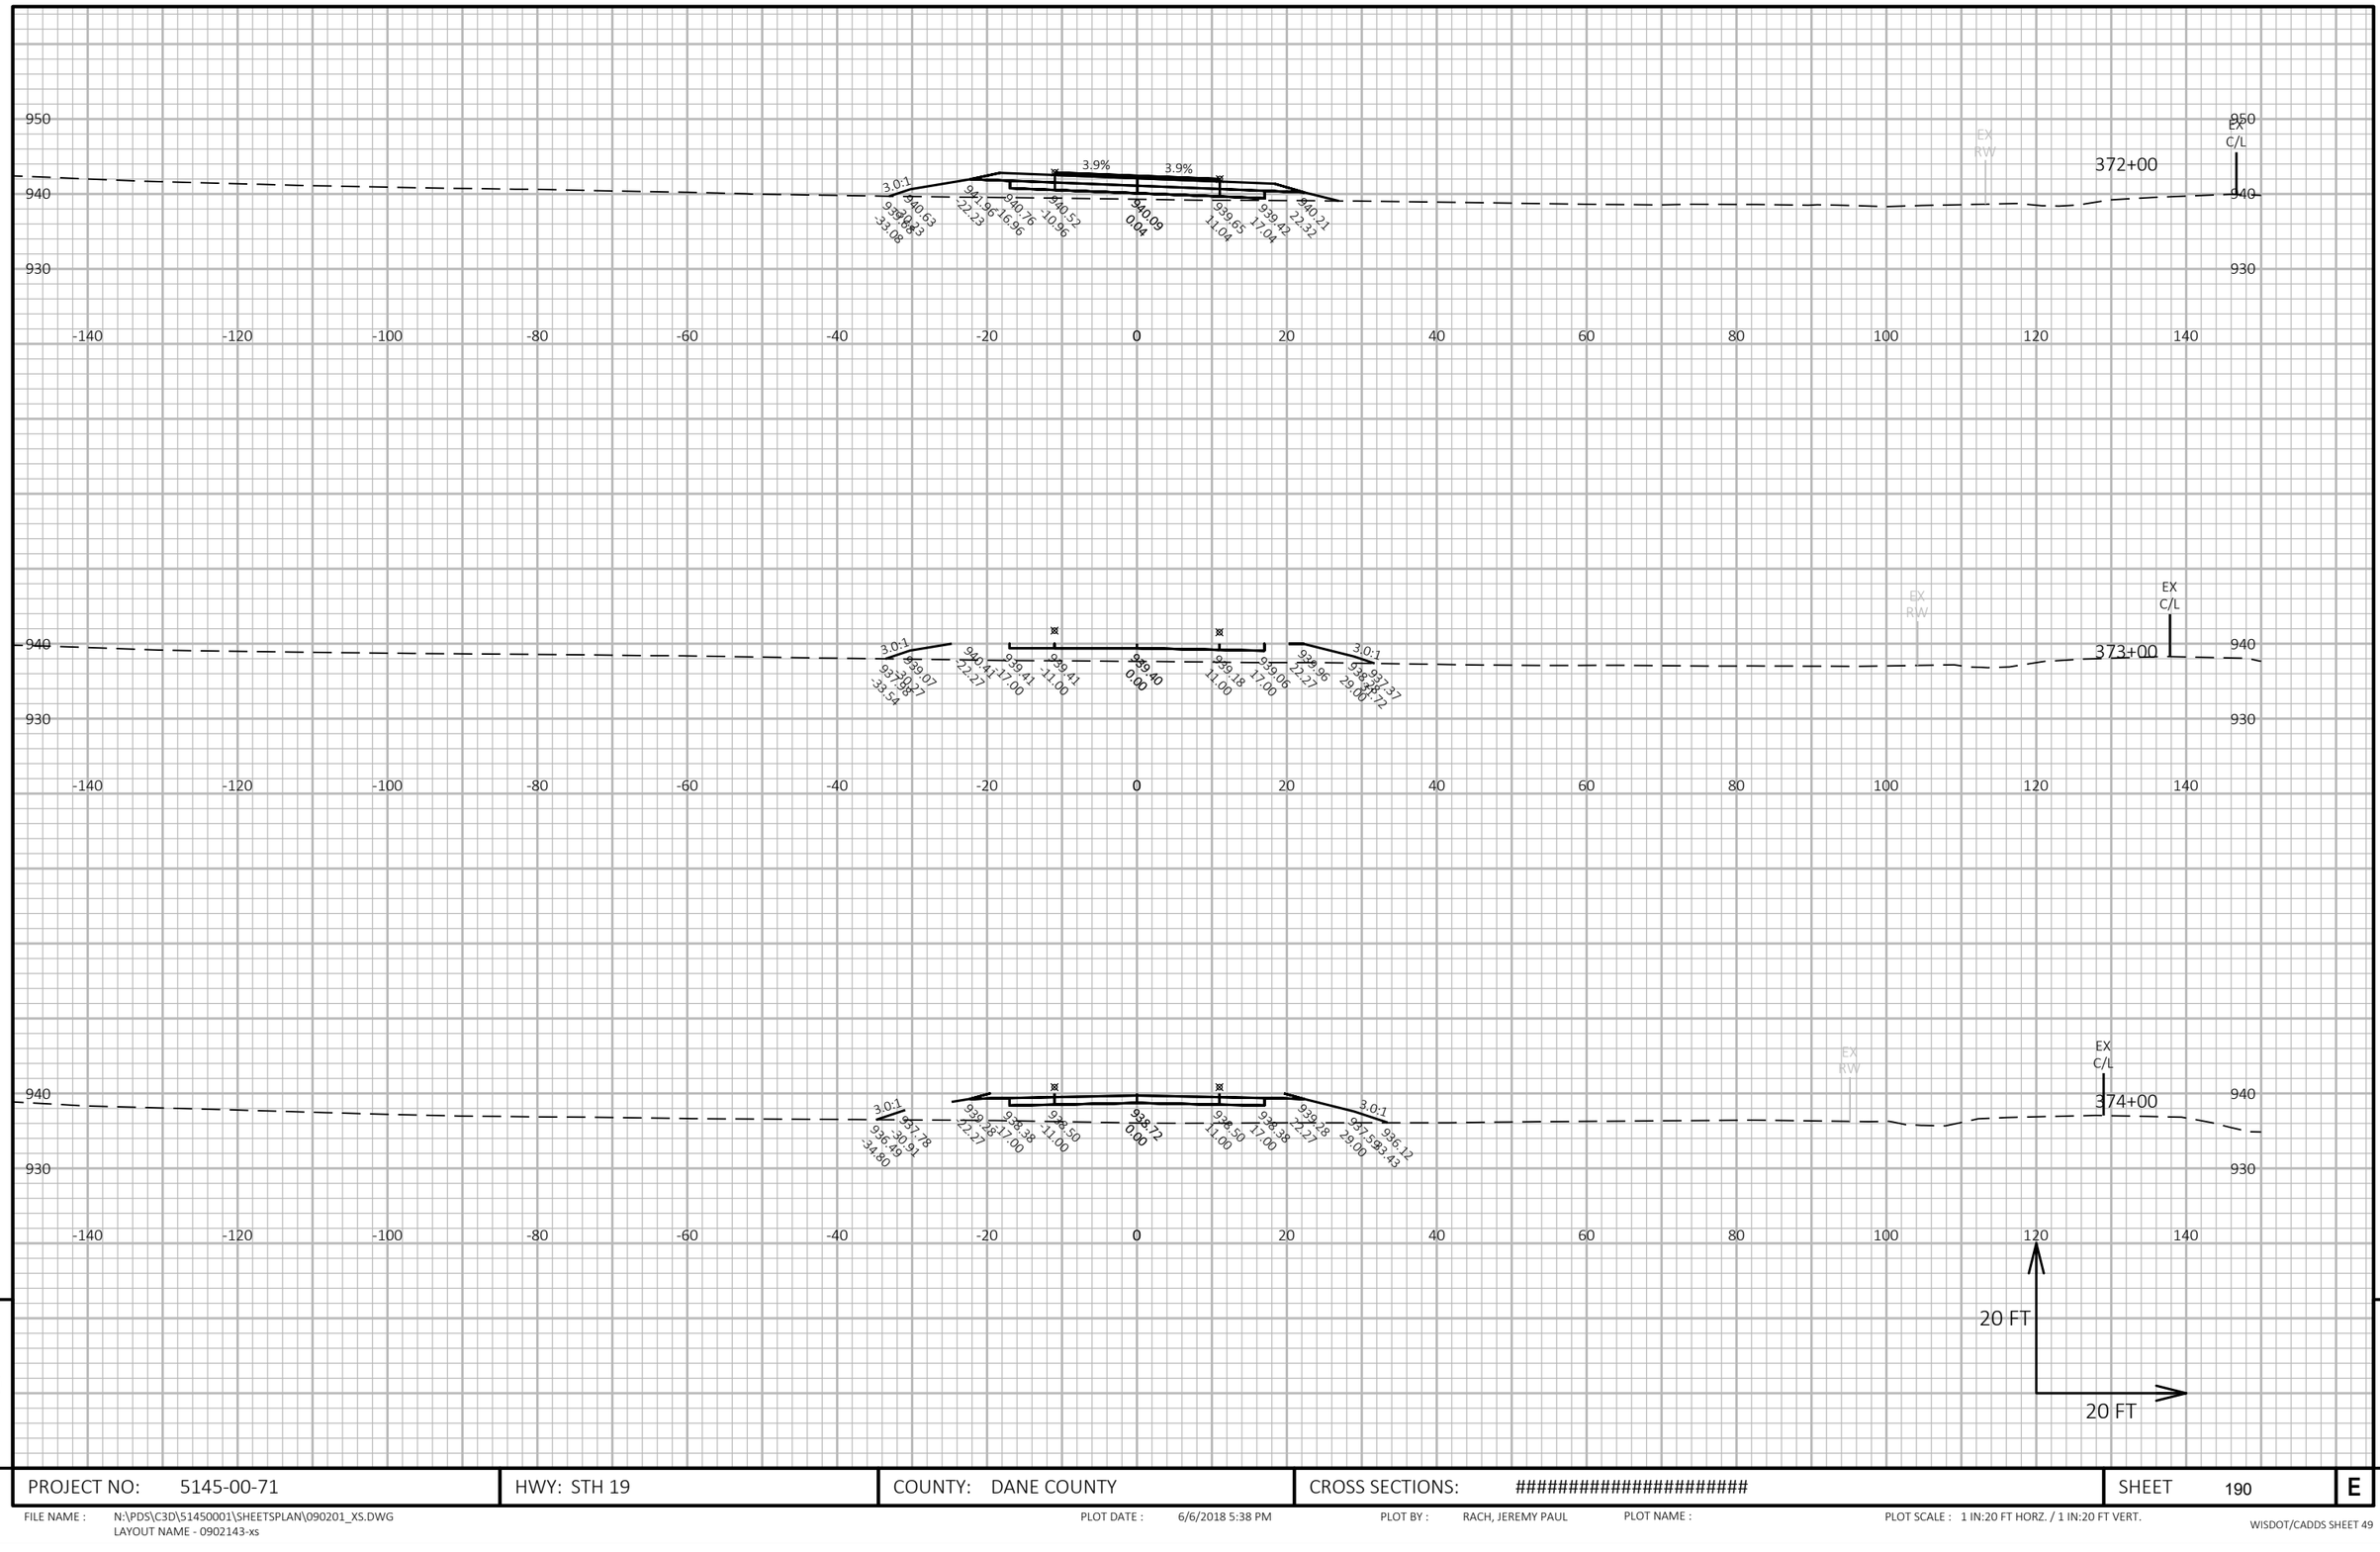

PROJECT NO: 5145-00-71	HWY: STH 19	COUNTY: DANE COUNTY	CROSS SECTIONS: ##########################	SHEET 190	E

FILE NAME : N:\PDS\C3D\51450001\SHEETSPLAN\090201_XS.DWG
LAYOUT NAME - 0902143-xs

PLOT DATE : 6/6/2018 5:38 PM PLOT BY : RACH, JEREMY PAUL PLOT NAME : PLOT SCALE : 1 IN:20 FT HORZ. / 1 IN:20 FT VERT.

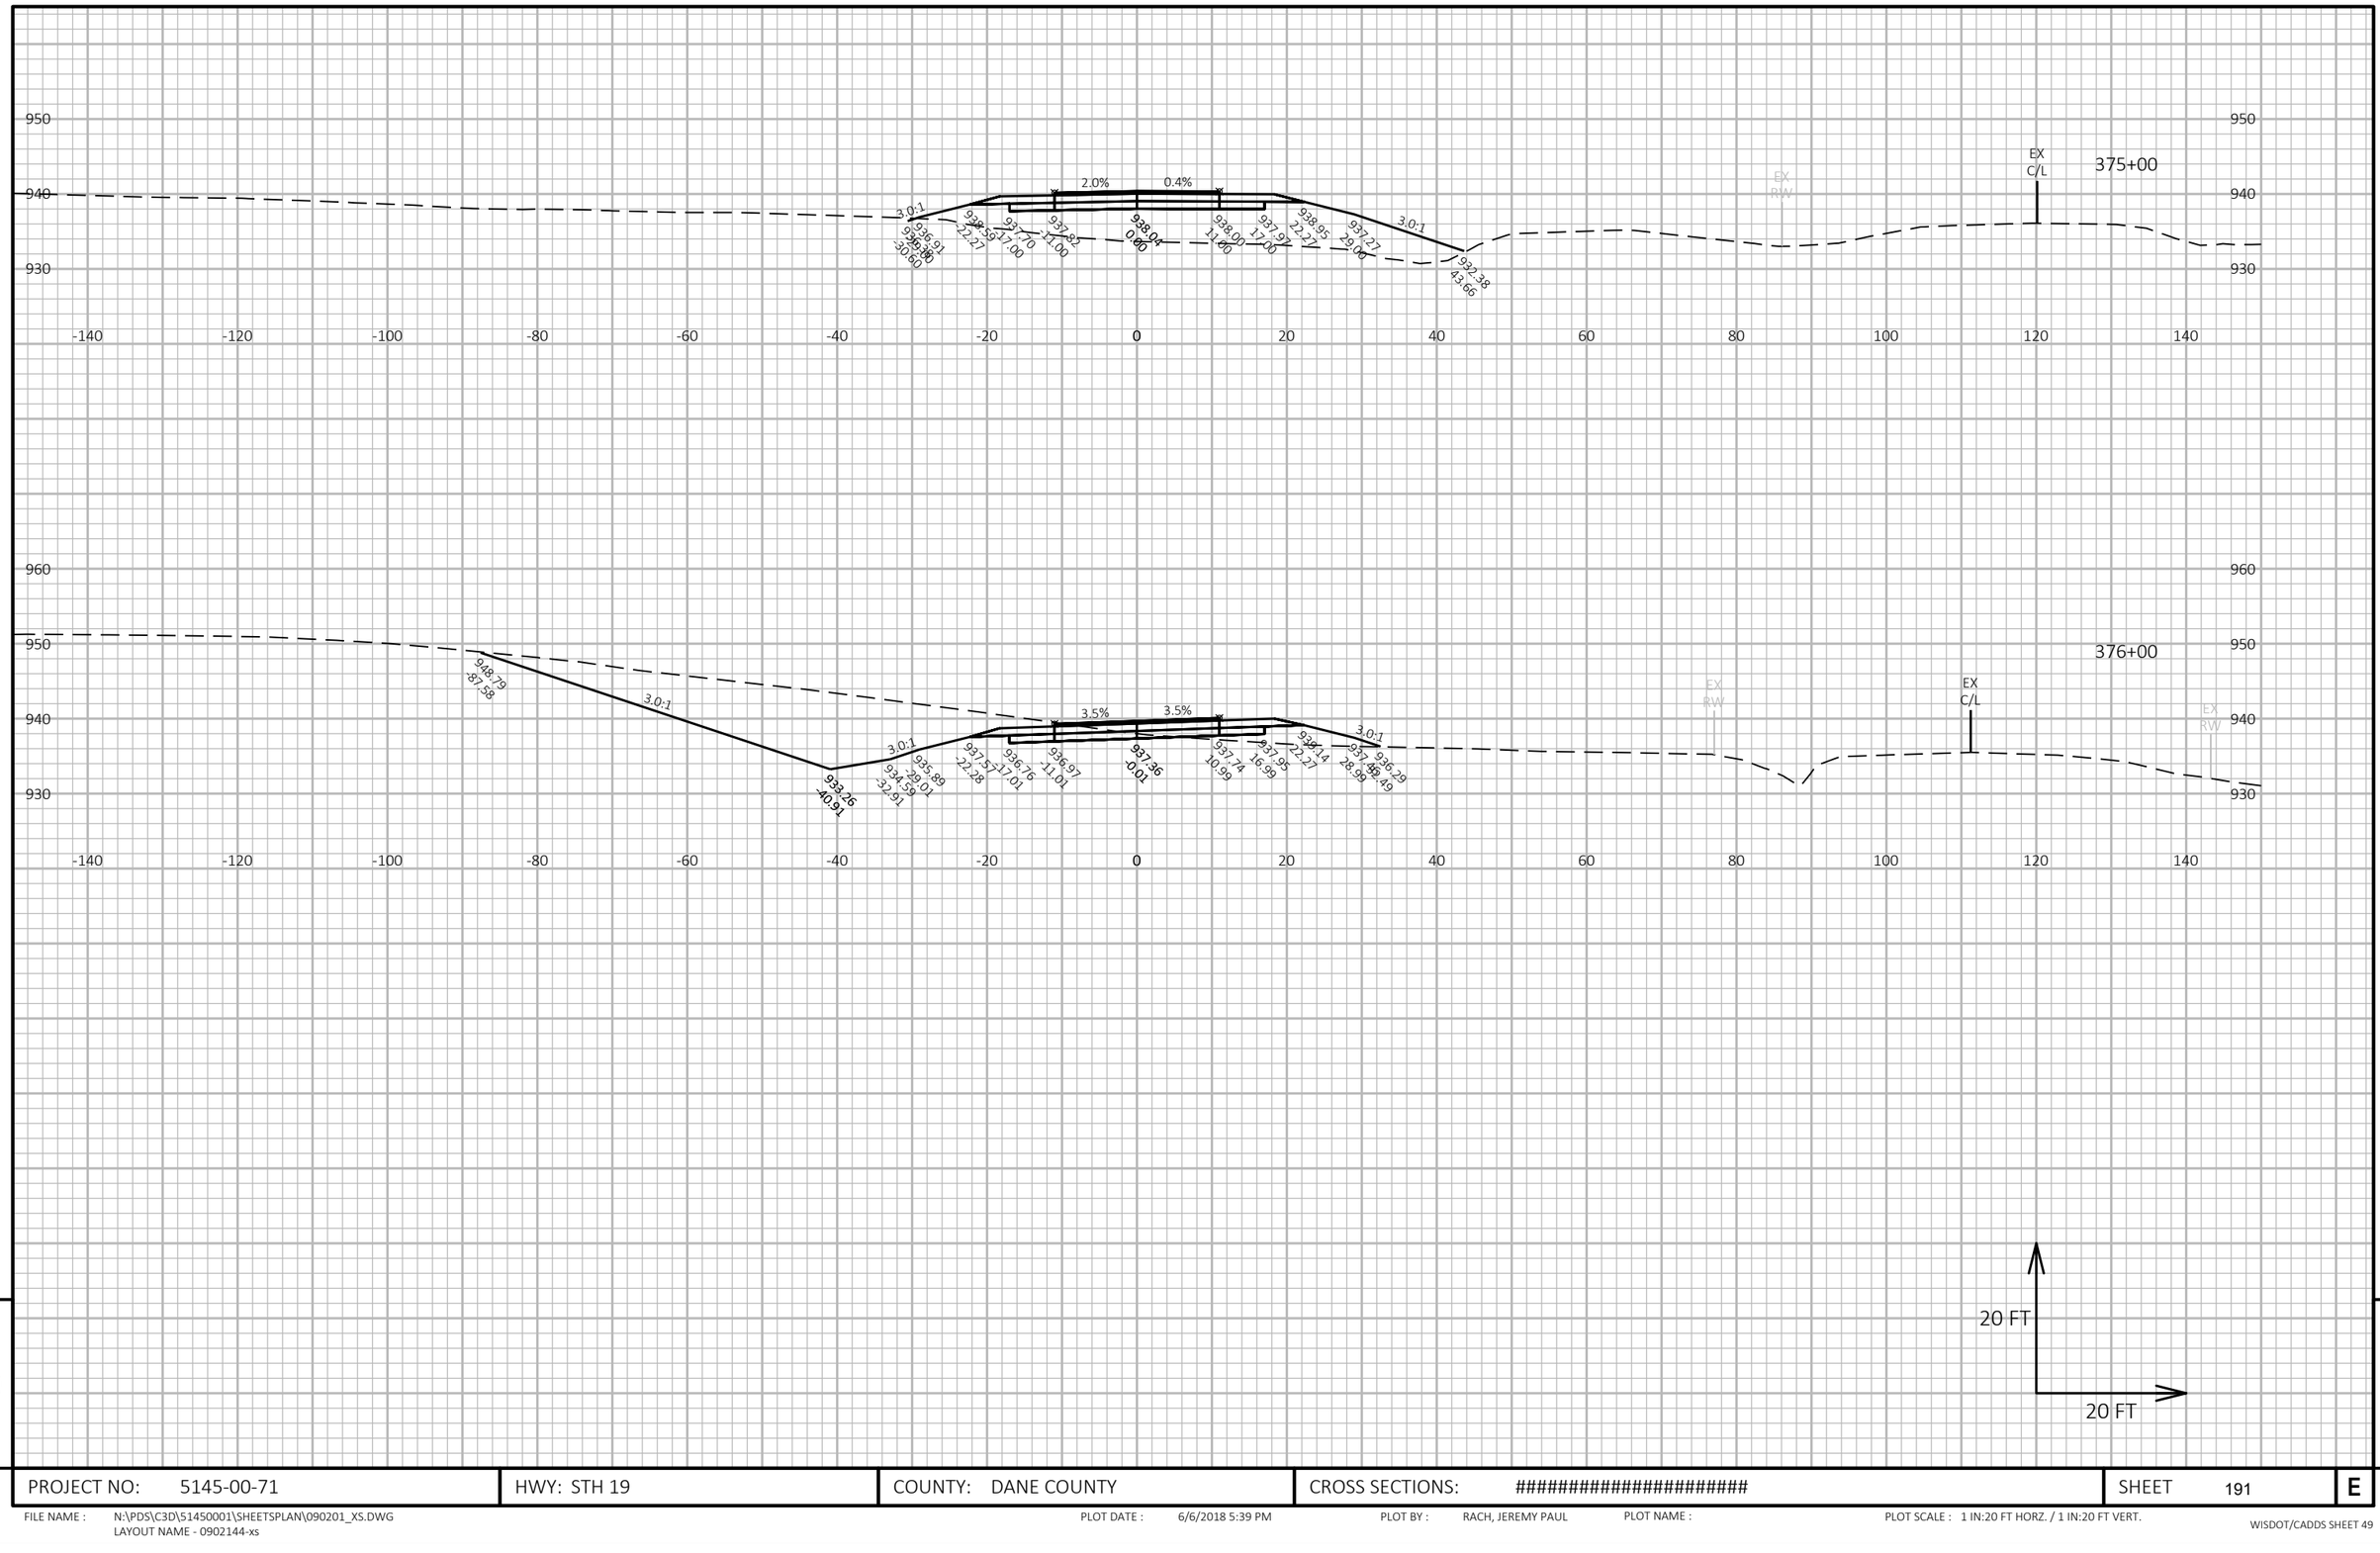

9

9

PROJECT NO: 5145-00-71	HWY: STH 19	COUNTY: DANE COUNTY	CROSS SECTIONS: ##########################	SHEET 191	E

FILE NAME : N:\PDS\C3D\51450001\SHEETSPLAN\090201_XS.DWG
LAYOUT NAME - 0902144-xs

PLOT DATE : 6/6/2018 5:39 PM PLOT BY : RACH, JEREMY PAUL PLOT NAME : PLOT SCALE : 1 IN:20 FT HORZ. / 1 IN:20 FT VERT.

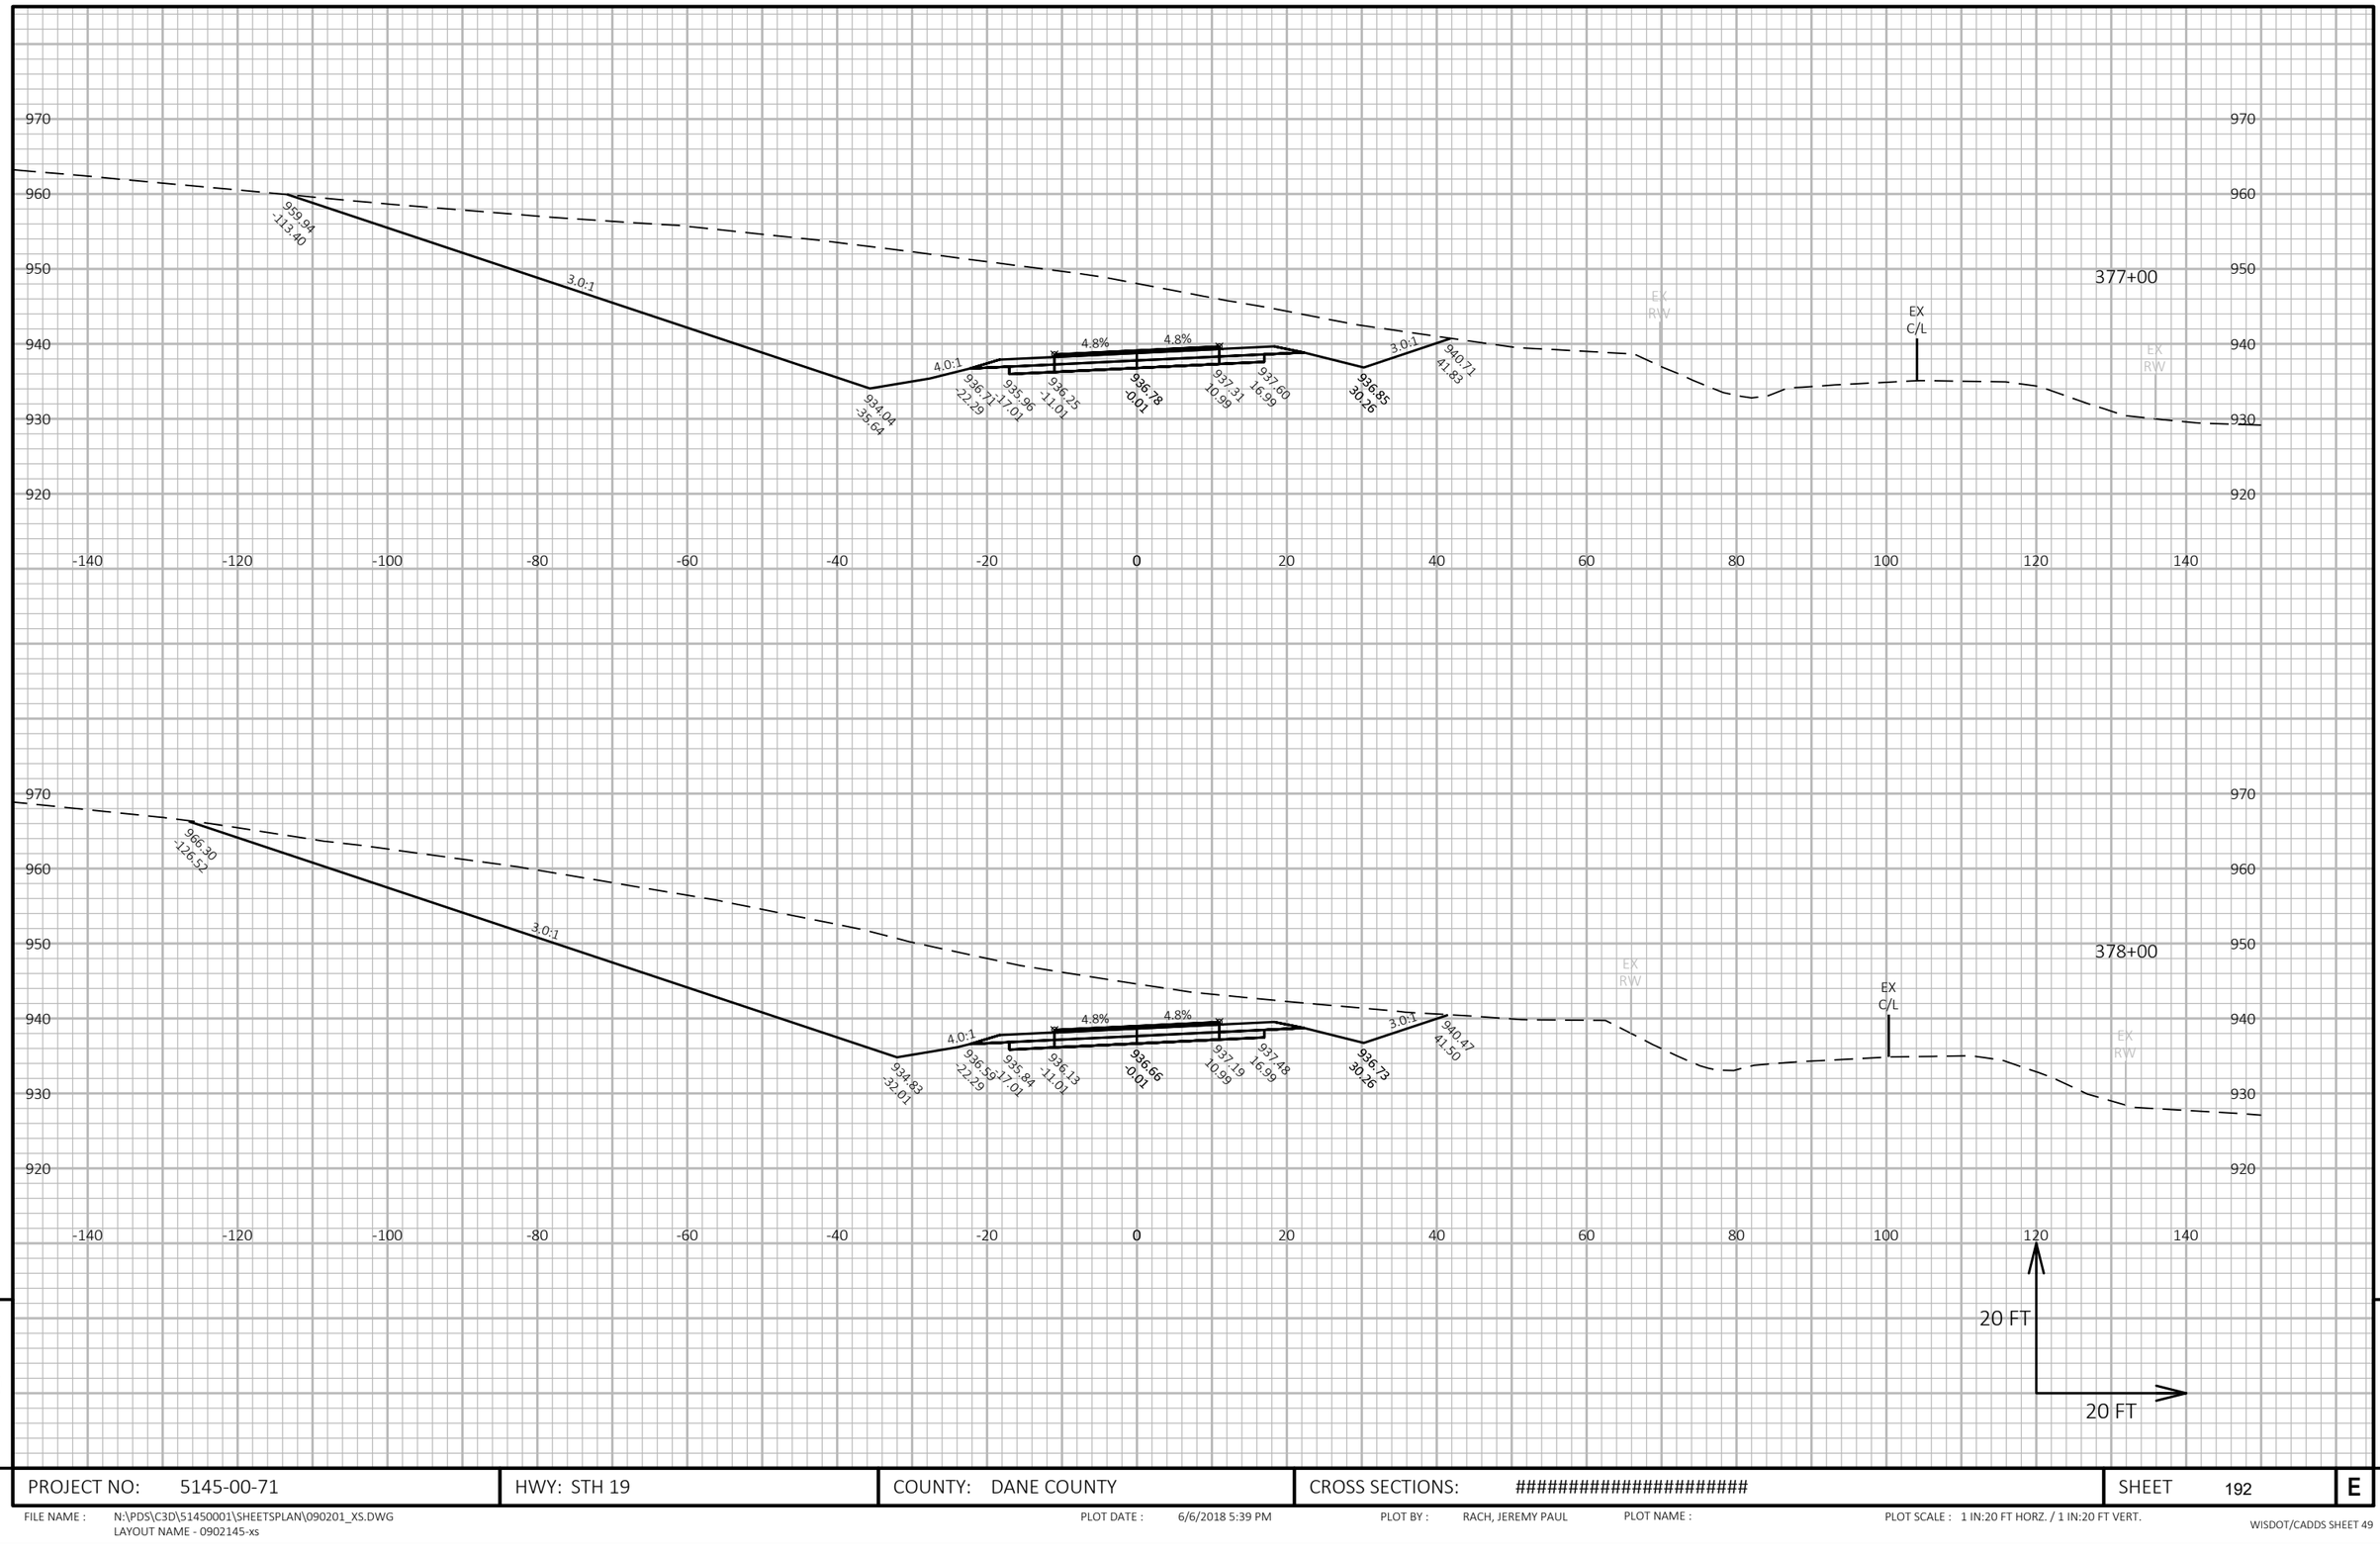

9

9

PROJECT NO: 5145-00-71	HWY: STH 19	COUNTY: DANE COUNTY	CROSS SECTIONS: ##########################	SHEET 192	E

FILE NAME : N:\PDS\C3D\51450001\SHEETSPLAN\090201_XS.DWG
LAYOUT NAME - 0902145-xs

PLOT DATE : 6/6/2018 5:39 PM

PLOT BY : RACH, JEREMY PAUL

PLOT NAME :

PLOT SCALE : 1 IN:20 FT HORZ. / 1 IN:20 FT VERT.

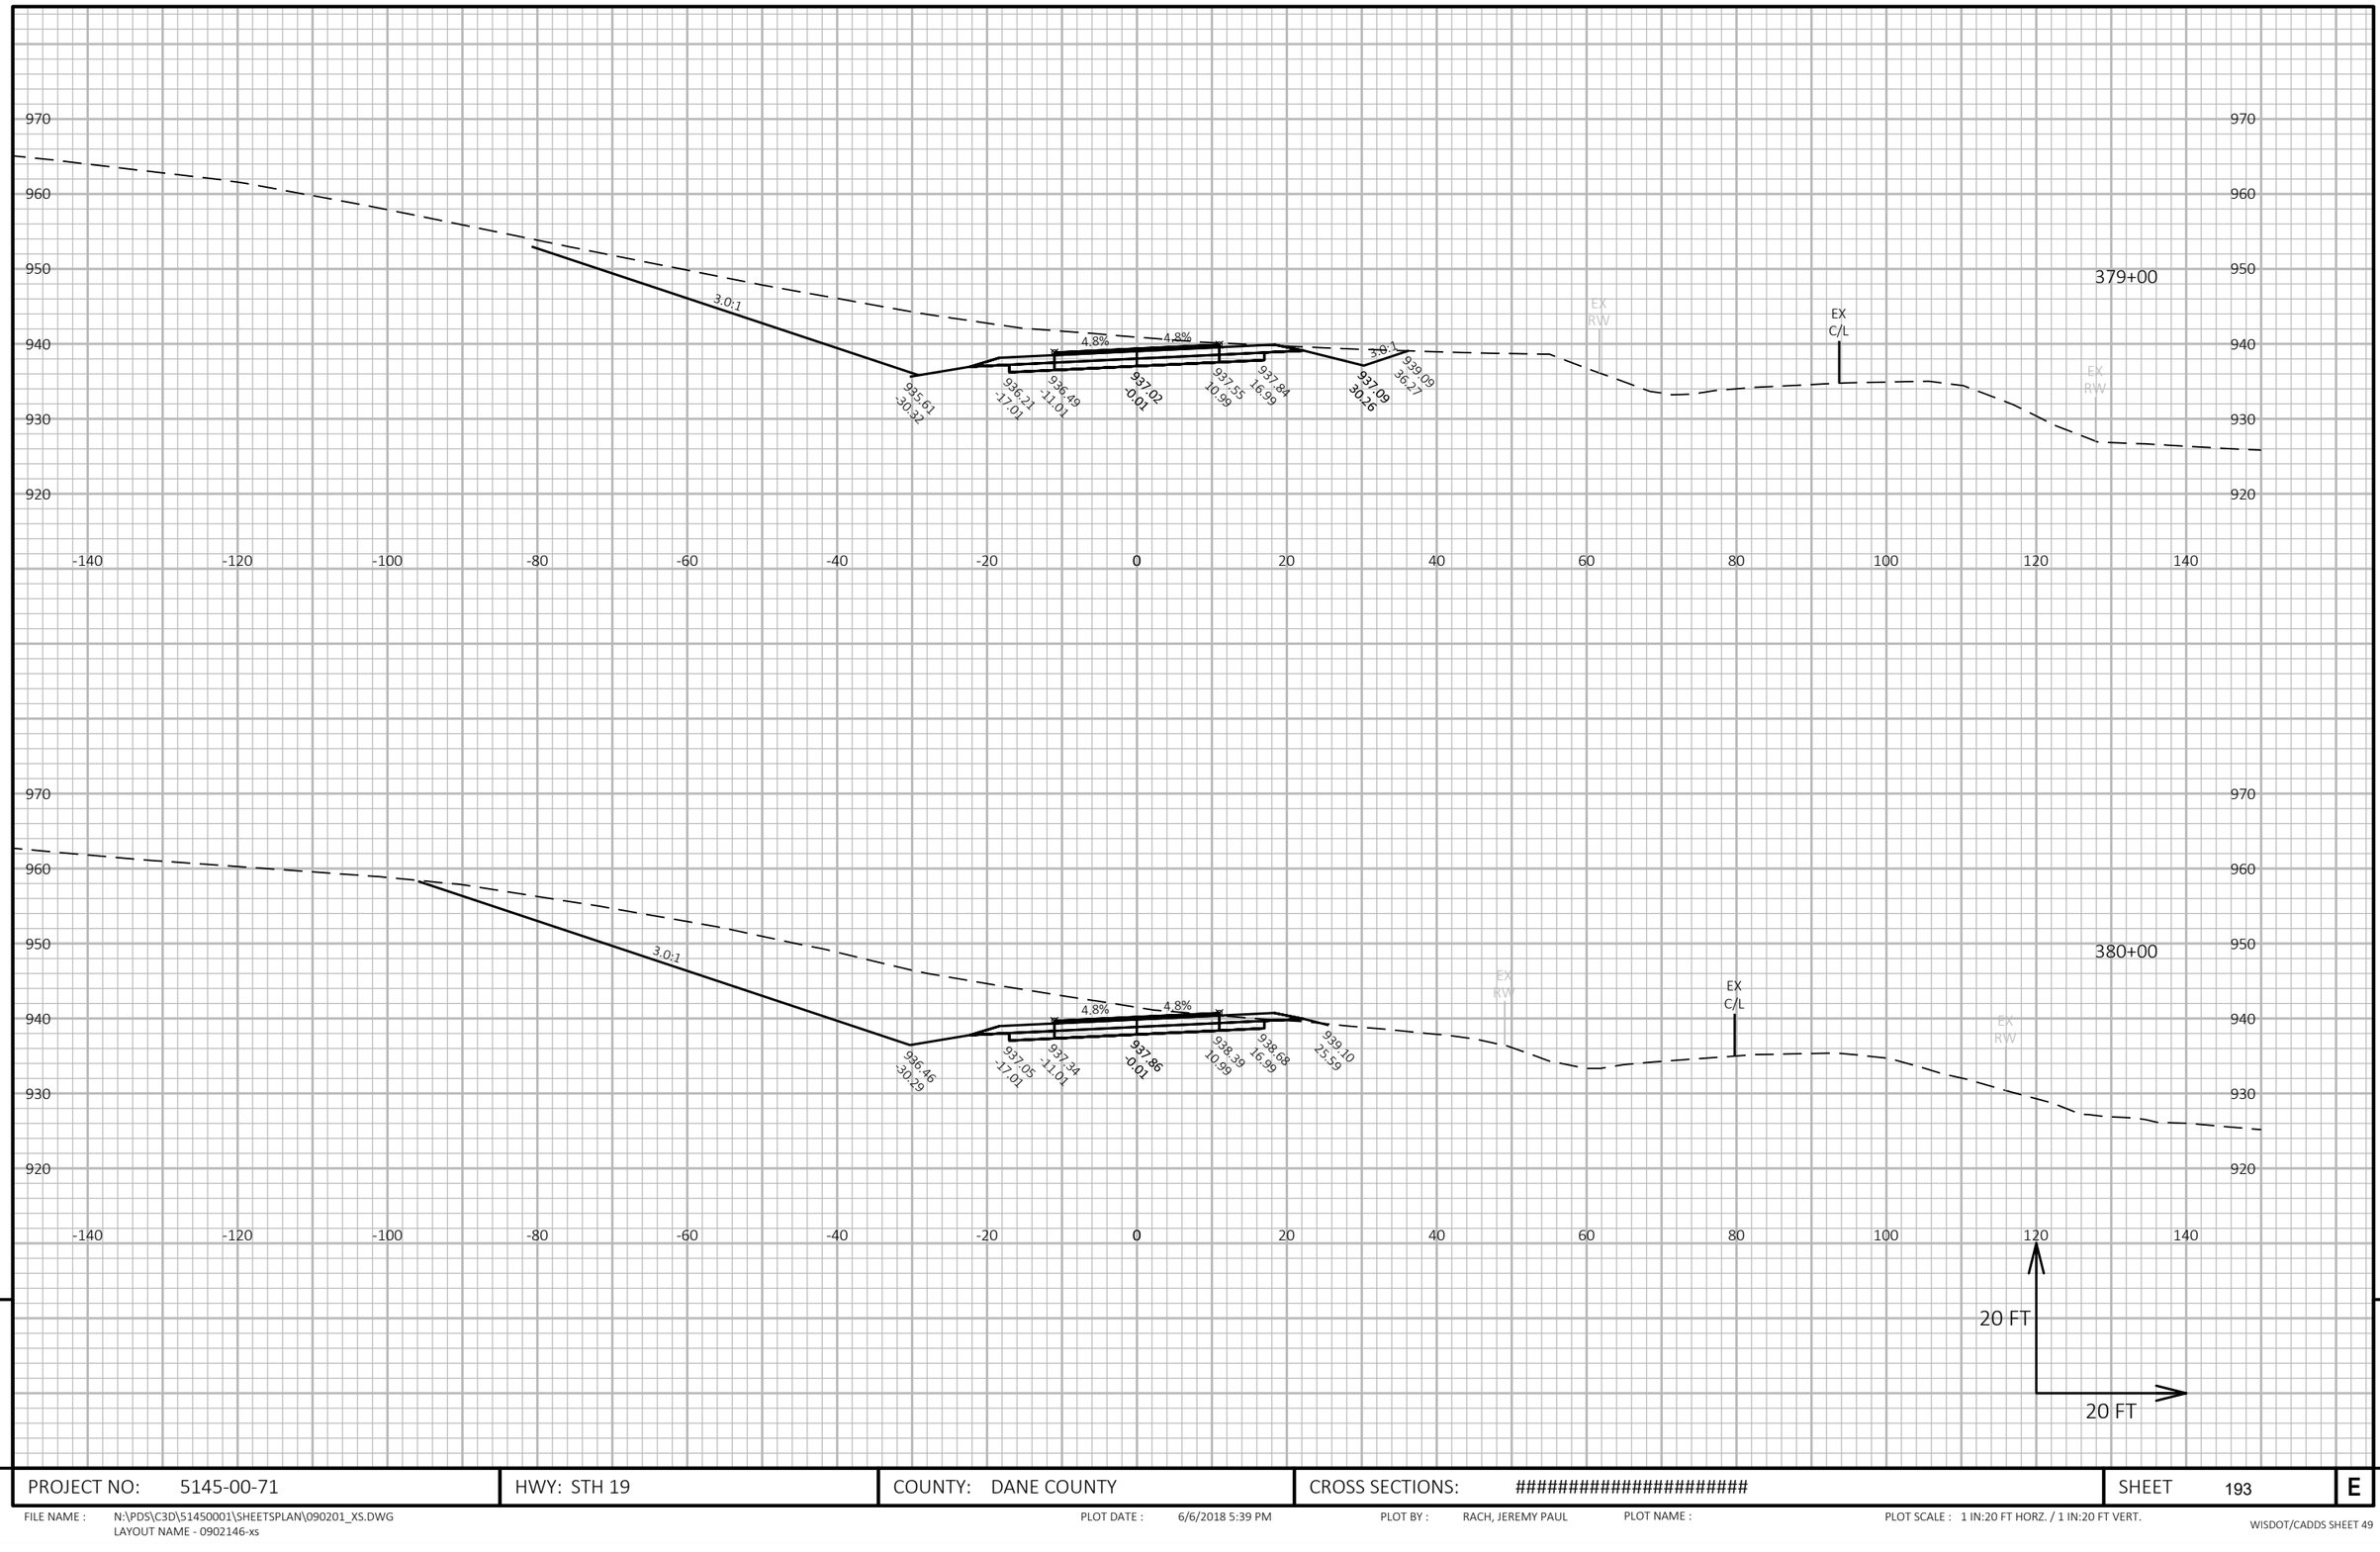

9

9

PROJECT NO: 5145-00-71	HWY: STH 19	COUNTY: DANE COUNTY	CROSS SECTIONS: ##########################	SHEET 193	E

FILE NAME : N:\PDS\C3D\51450001\SHEETSPLAN\090201_XS.DWG
LAYOUT NAME - 0902146-xs

PLOT DATE : 6/6/2018 5:39 PM

PLOT BY : RACH, JEREMY PAUL

PLOT NAME :

PLOT SCALE : 1 IN:20 FT HORZ. / 1 IN:20 FT VERT.

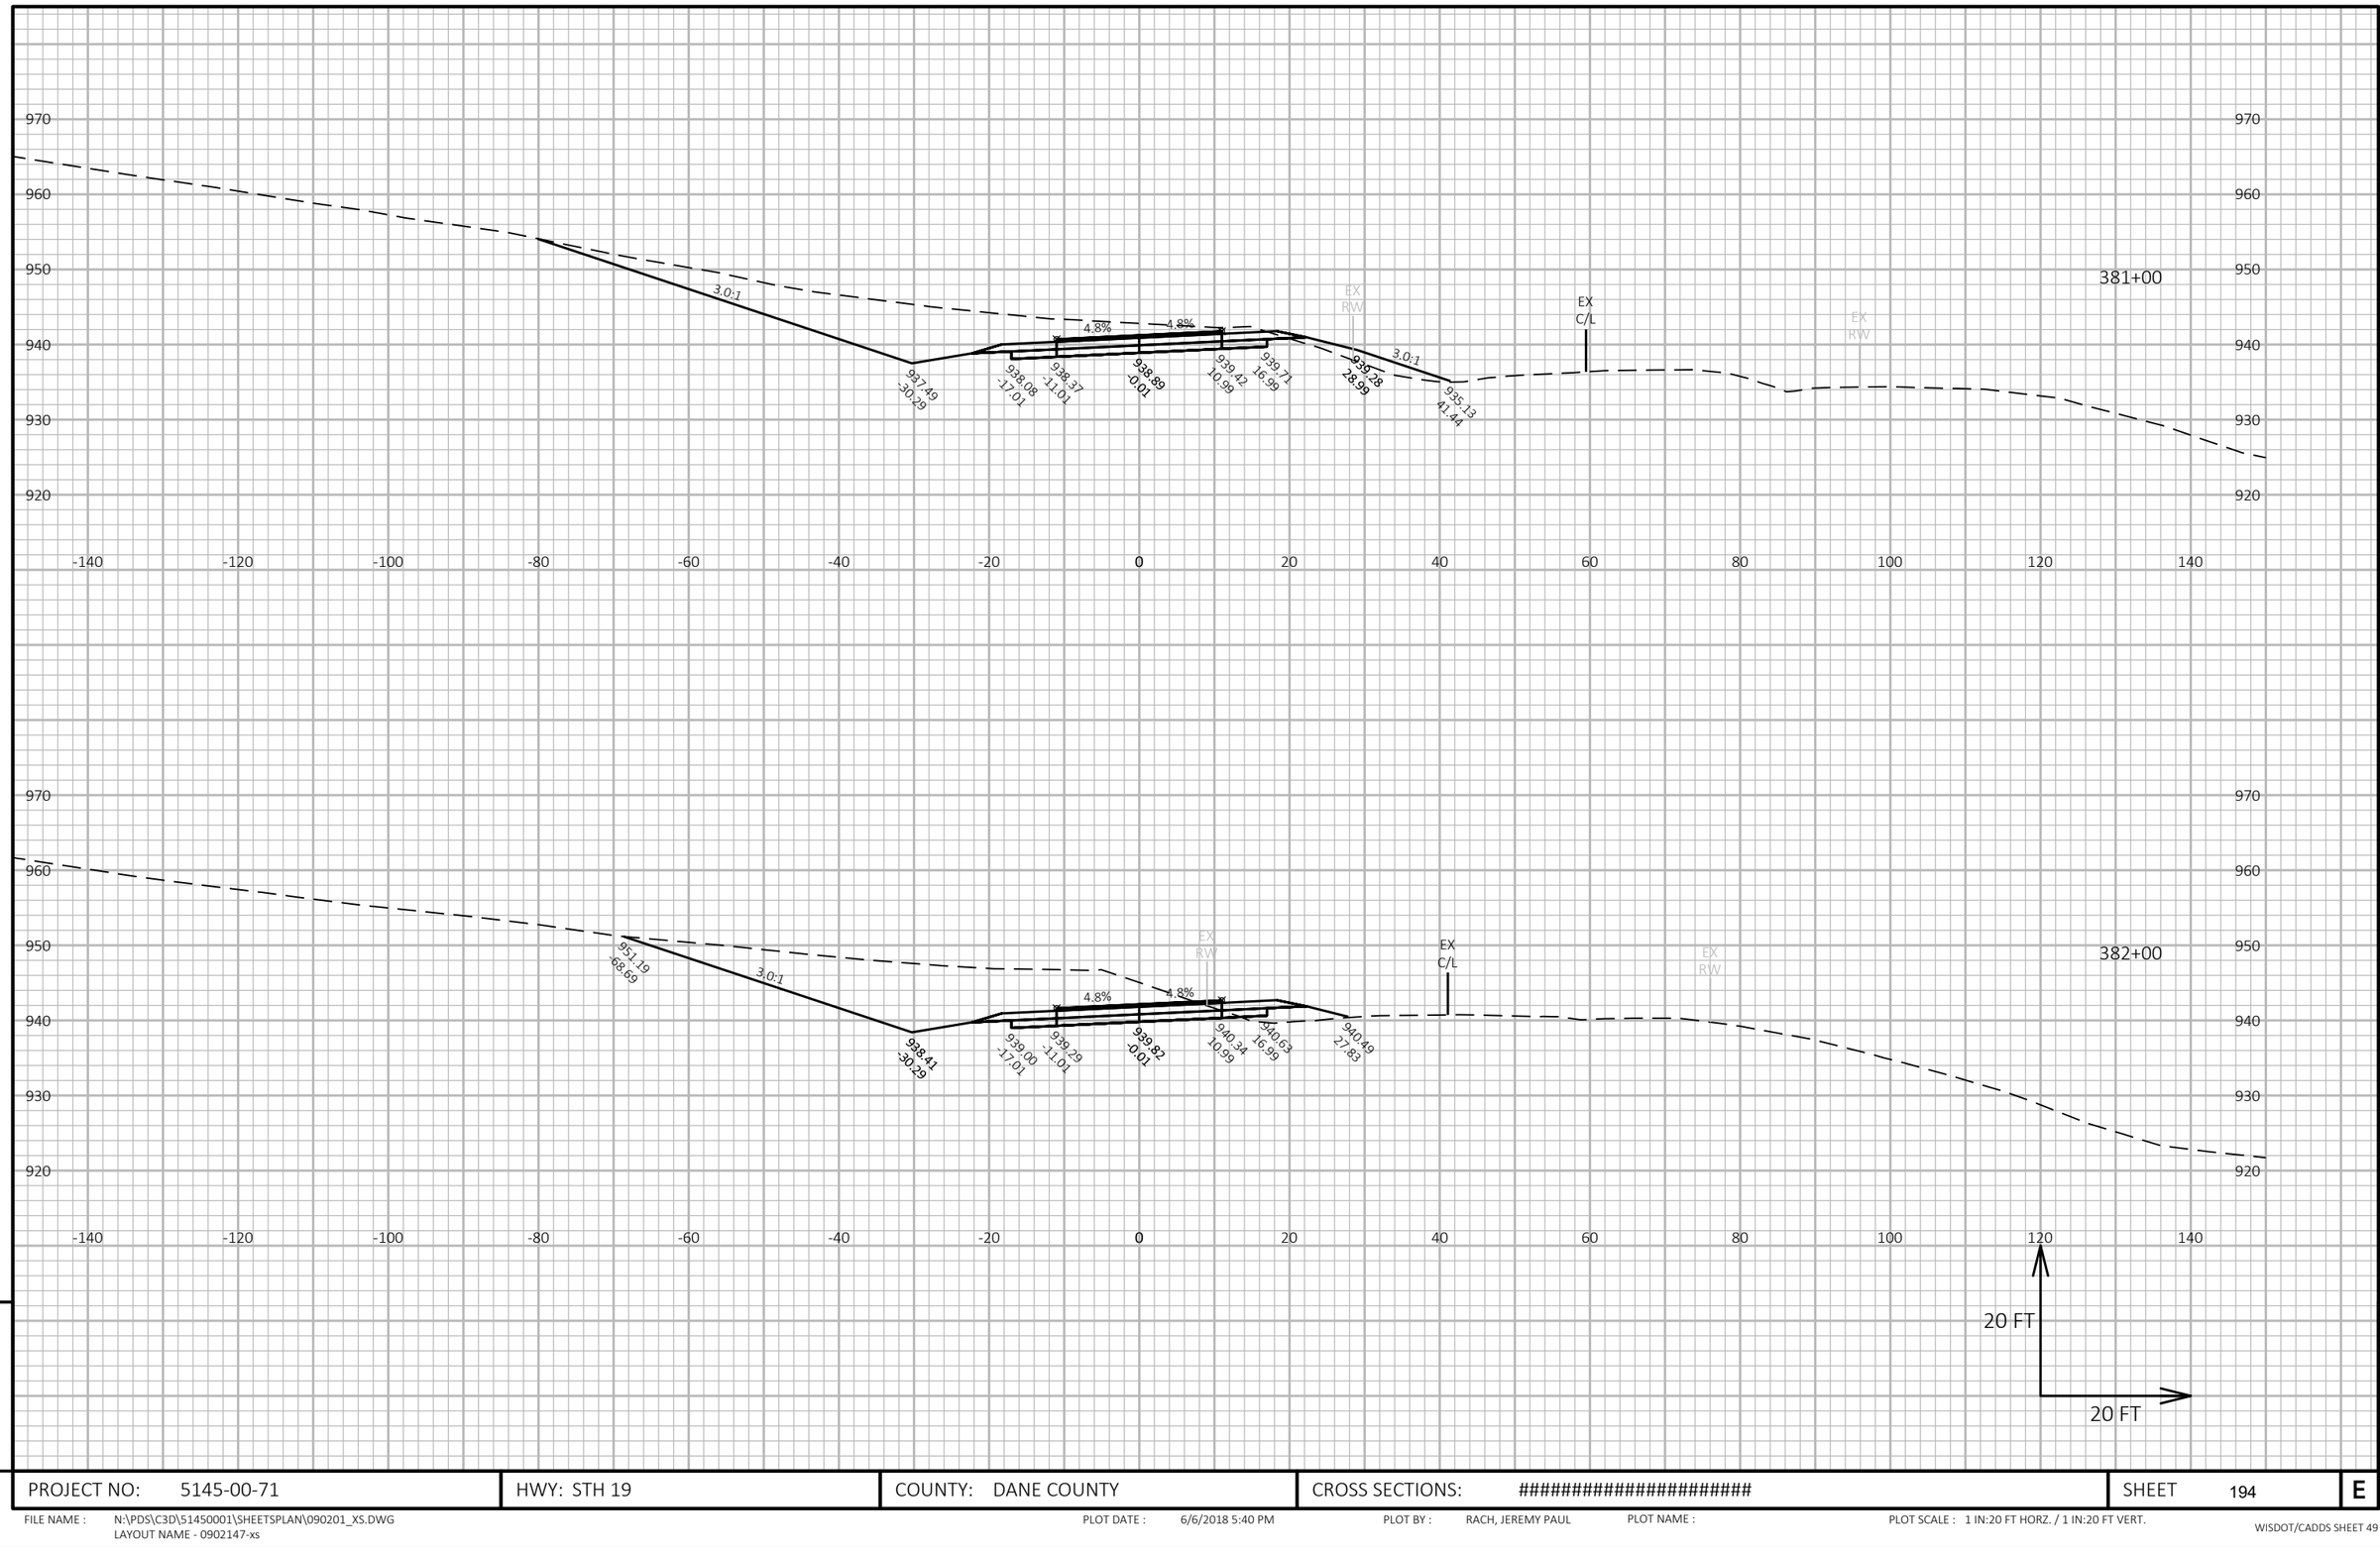

9

9

PROJECT NO: 5145-00-71	HWY: STH 19	COUNTY: DANE COUNTY	CROSS SECTIONS: ##########################	SHEET 194	E

FILE NAME : N:\PDS\C3D\51450001\SHEETSPLAN\090201_XS.DWG
LAYOUT NAME - 0902147-xs

PLOT DATE : 6/6/2018 5:40 PM PLOT BY : RACH, JEREMY PAUL PLOT NAME : PLOT SCALE : 1 IN:20 FT HORZ. / 1 IN:20 FT VERT.

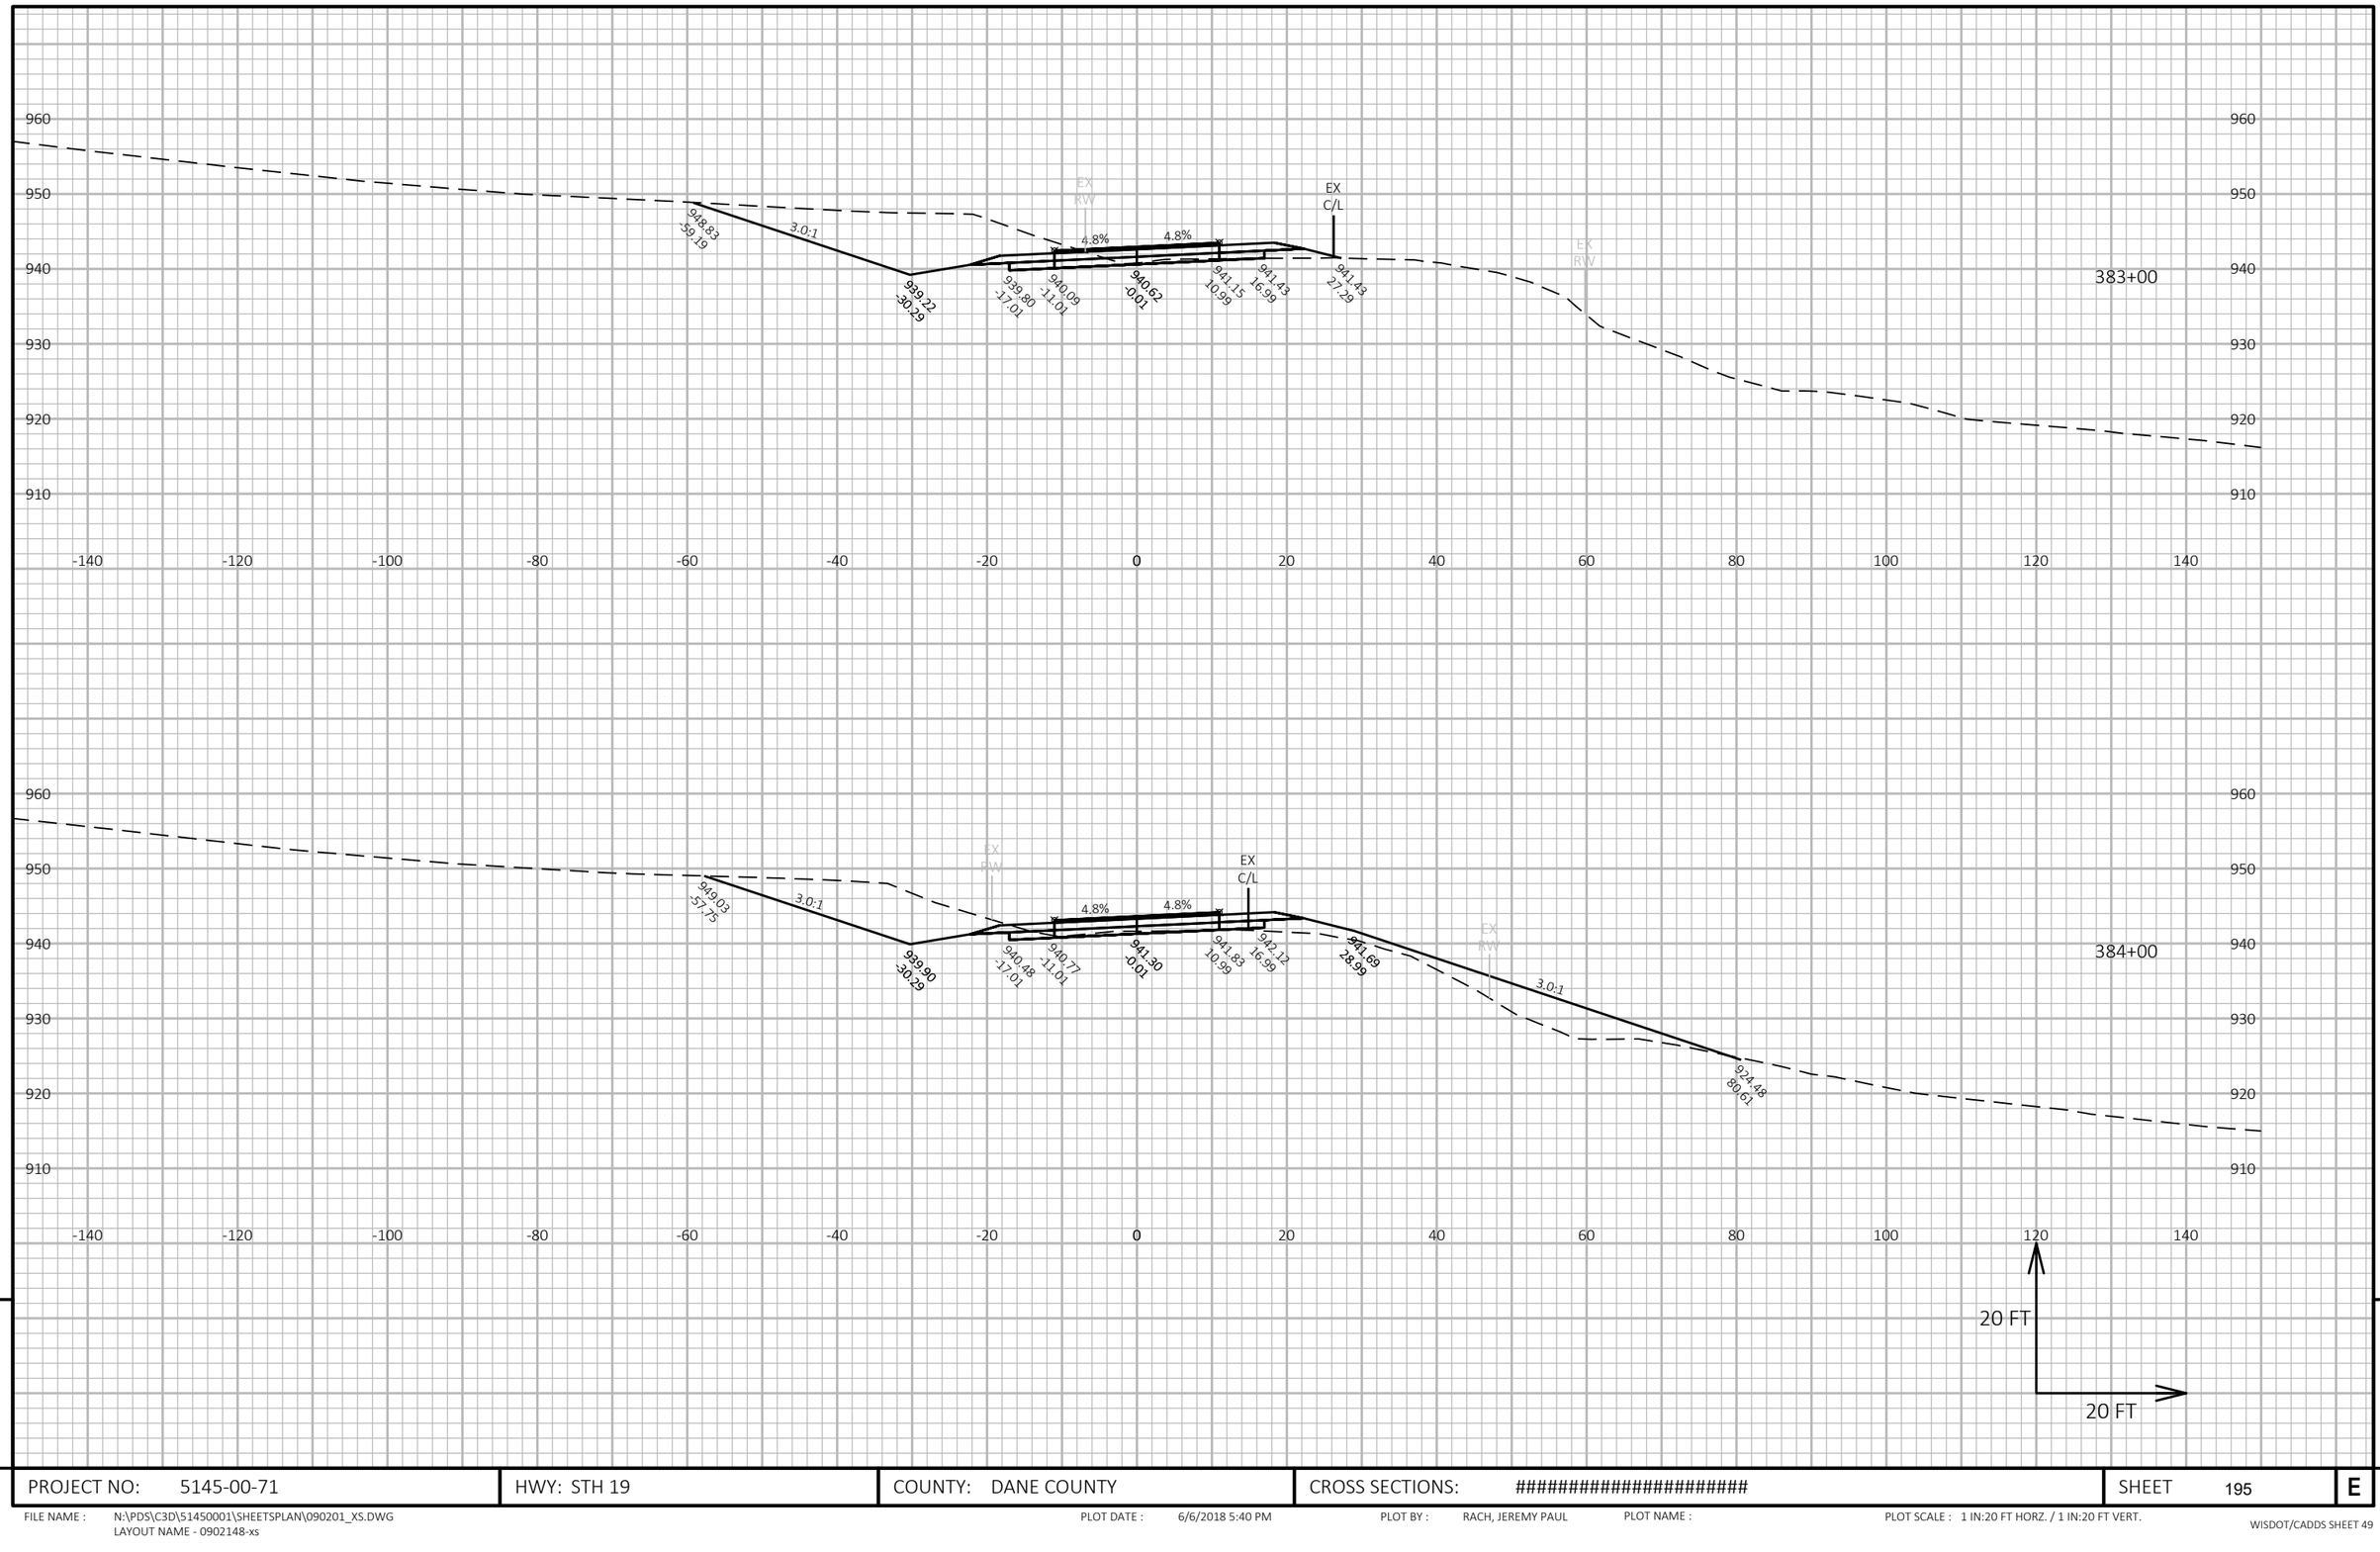

PROJECT NO: 5145-00-71	HWY: STH 19	COUNTY: DANE COUNTY	CROSS SECTIONS: ##########################	SHEET 195	E

FILE NAME : N:\PDS\C3D\51450001\SHEETSPLAN\090201_XS.DWG
LAYOUT NAME - 0902148-xs

PLOT DATE : 6/6/2018 5:40 PM PLOT BY : RACH, JEREMY PAUL PLOT NAME : PLOT SCALE : 1 IN:20 FT HORZ. / 1 IN:20 FT VERT.

WISDOT/CADDS SHEET 49

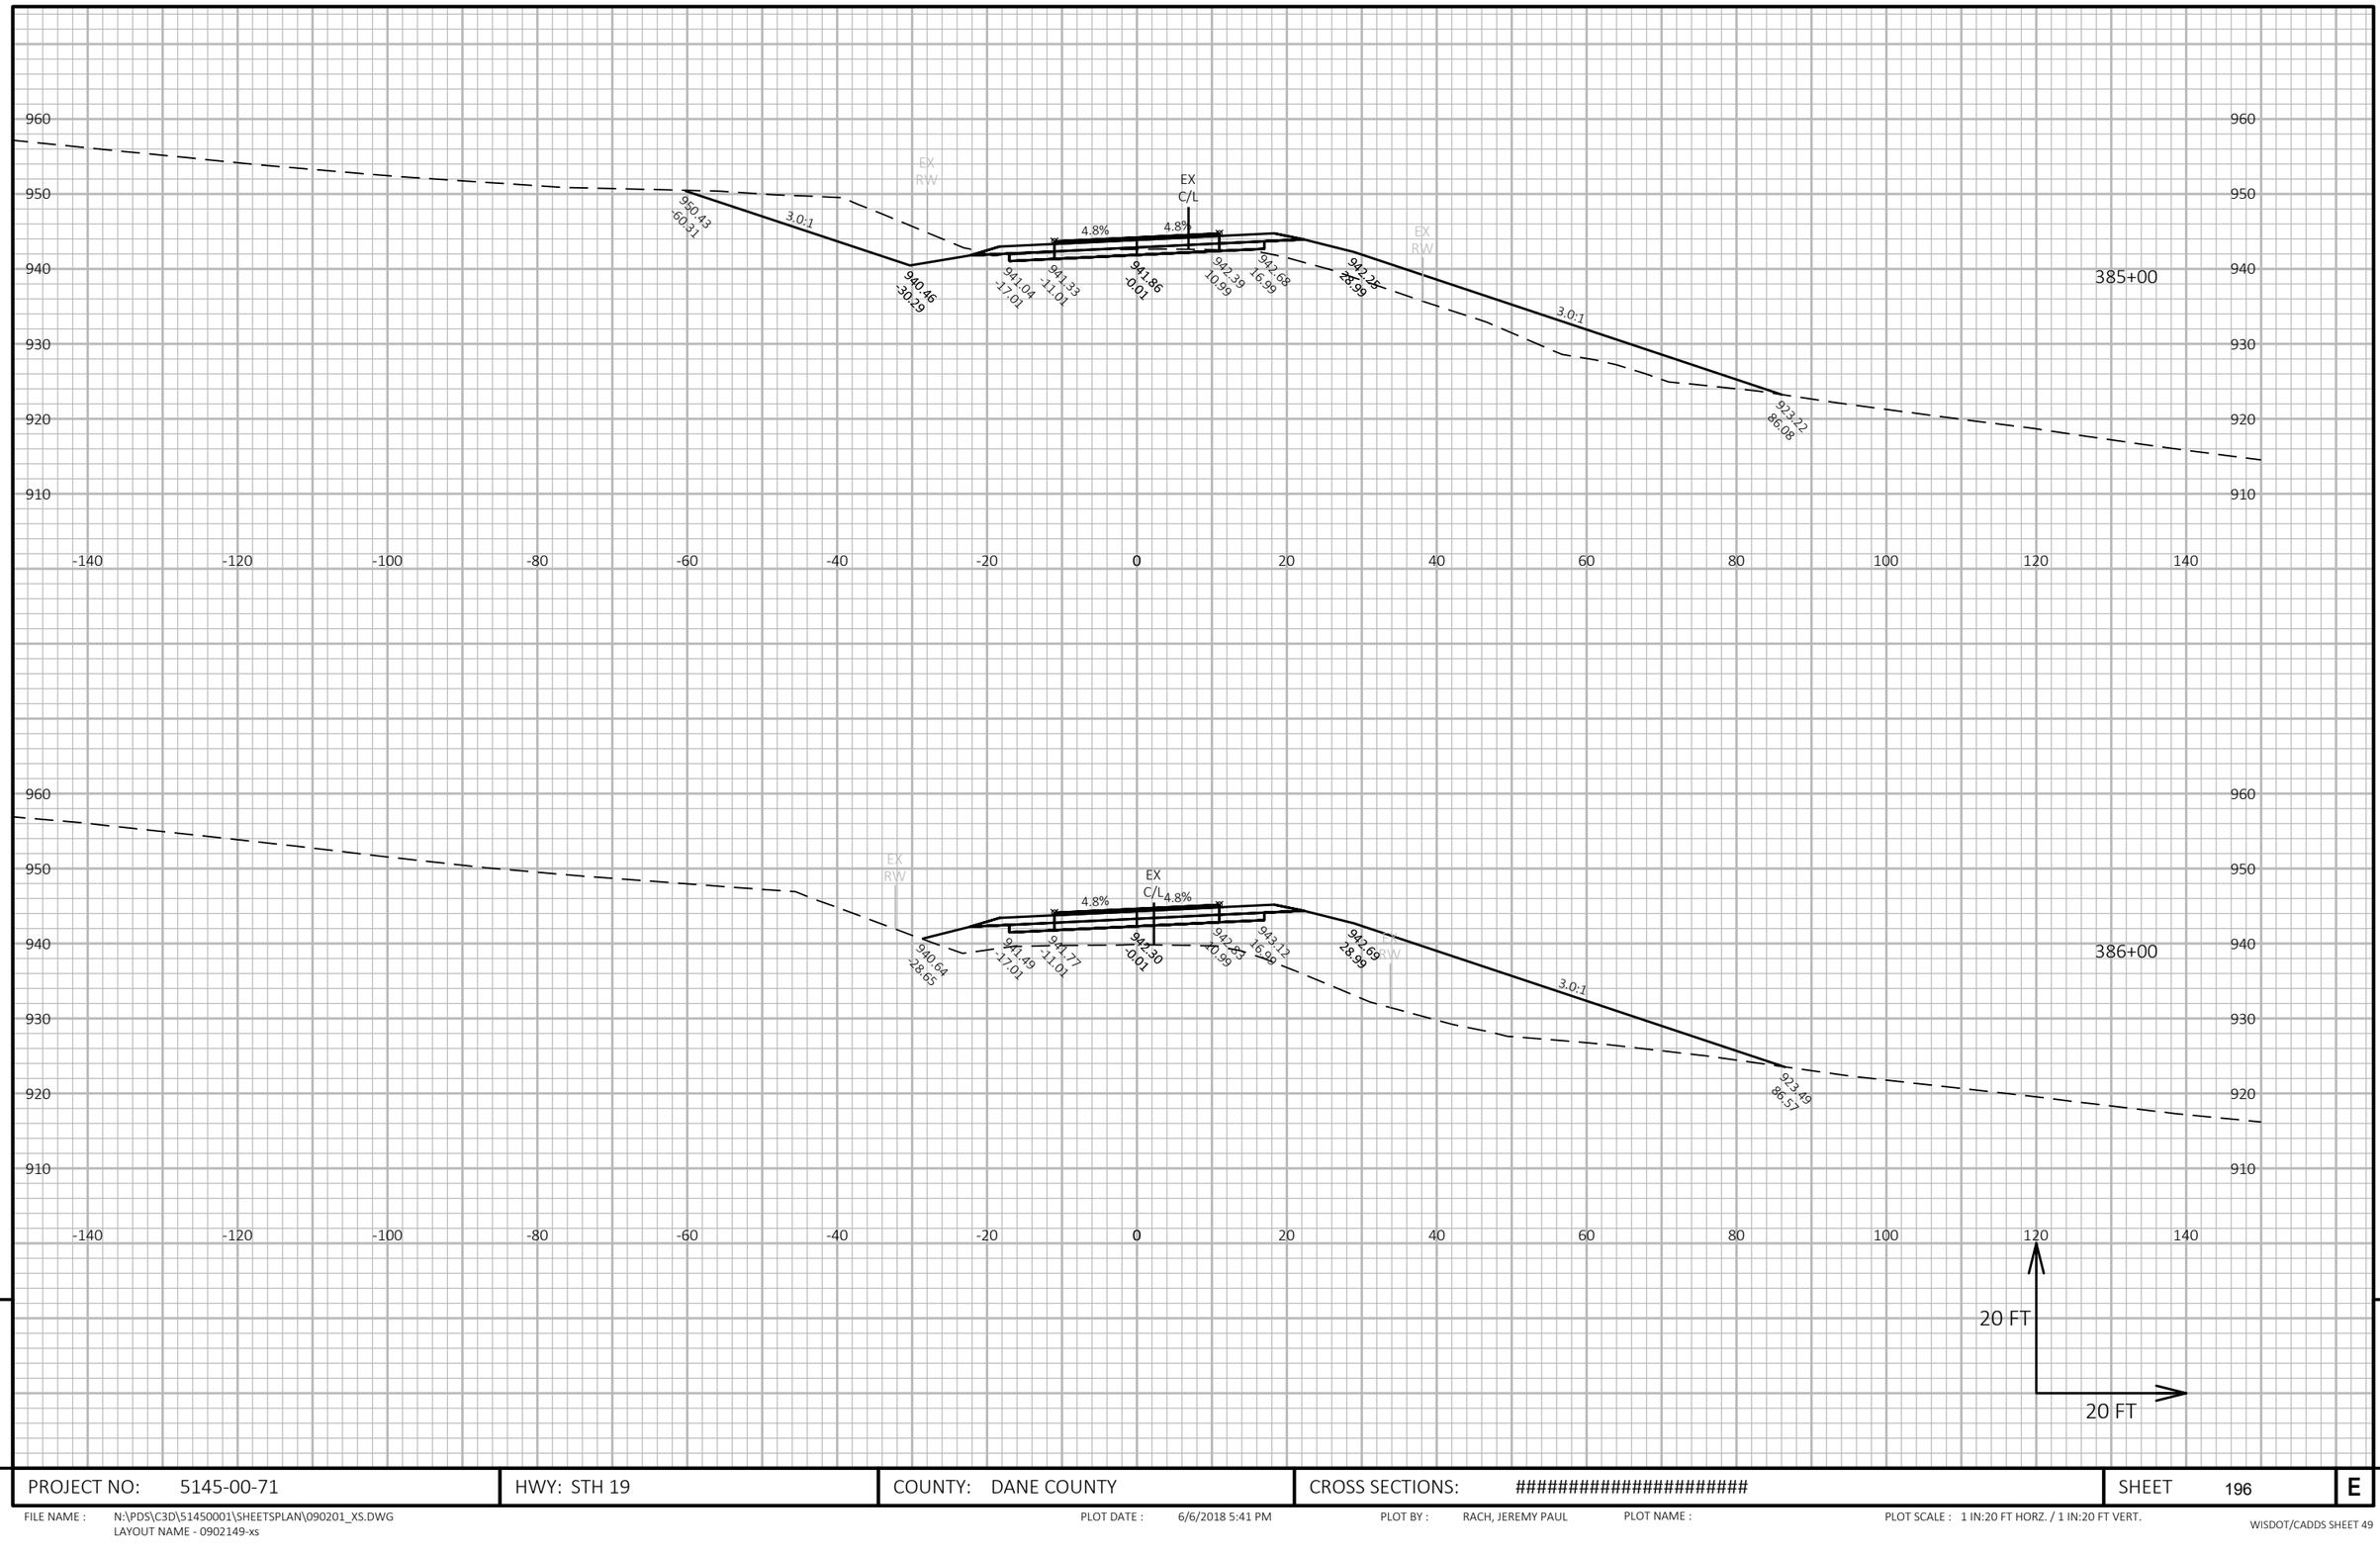

9

9

PROJECT NO: 5145-00-71	HWY: STH 19	COUNTY: DANE COUNTY	CROSS SECTIONS: ##########################	SHEET 196	E

FILE NAME : N:\PDS\C3D\51450001\SHEETSPLAN\090201_XS.DWG
LAYOUT NAME - 0902149-xs

PLOT DATE : 6/6/2018 5:41 PM PLOT BY : RACH, JEREMY PAUL PLOT NAME : PLOT SCALE : 1 IN:20 FT HORZ. / 1 IN:20 FT VERT.

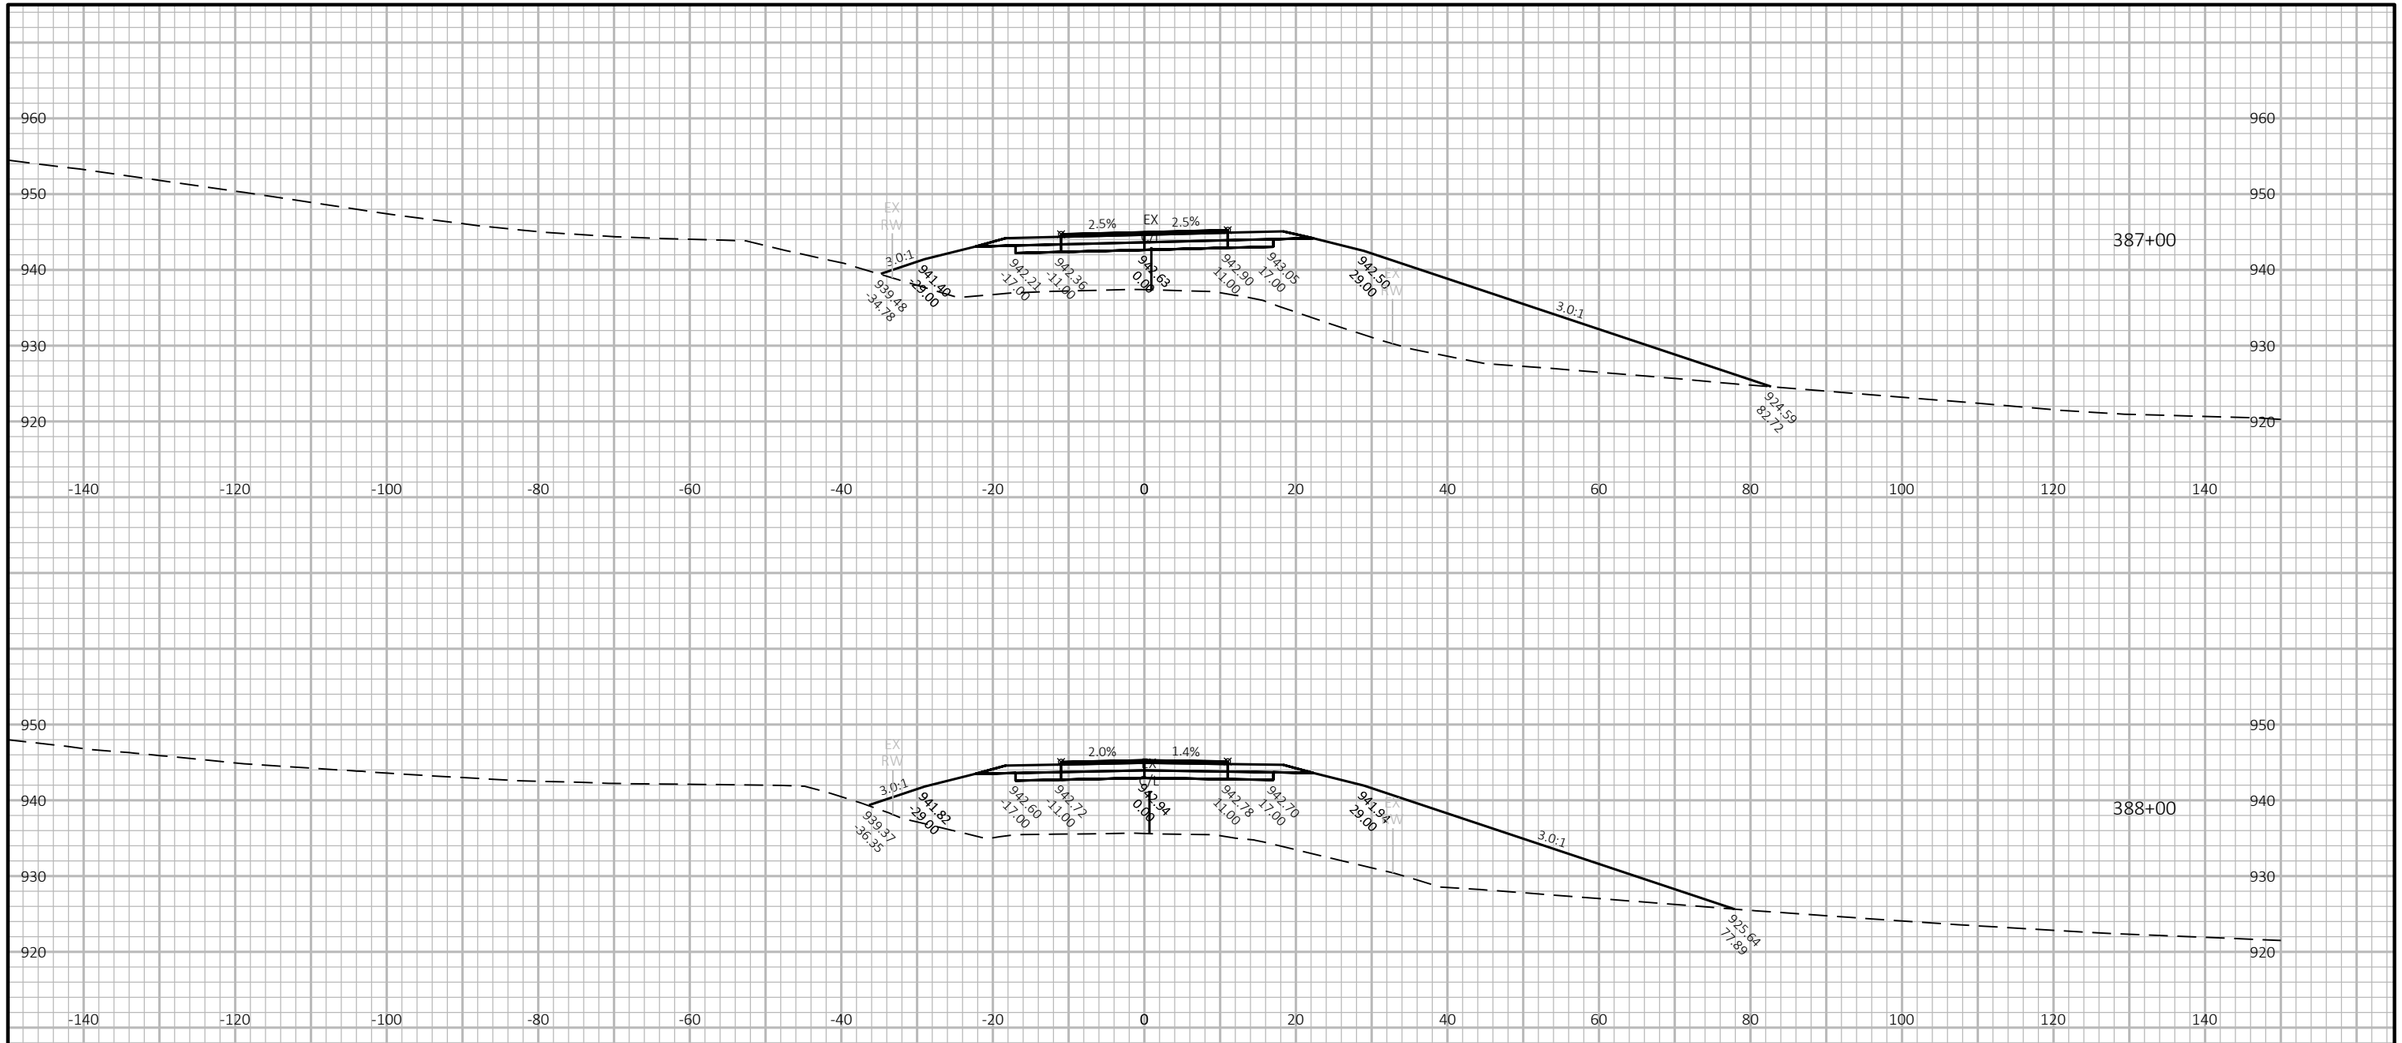

9

9

PROJECT NO: 5145-00-71	HWY: STH 19	COUNTY: DANE COUNTY	CROSS SECTIONS: ##########################	SHEET 197	E

FILE NAME : N:\PDS\C3D\51450001\SHEETSPLAN\090201_XS.DWG
LAYOUT NAME - 0902150-xs

PLOT DATE : 6/6/2018 5:41 PM

PLOT BY : RACH, JEREMY PAUL

PLOT NAME :

PLOT SCALE : 1 IN:20 FT HORZ. / 1 IN:20 FT VERT.

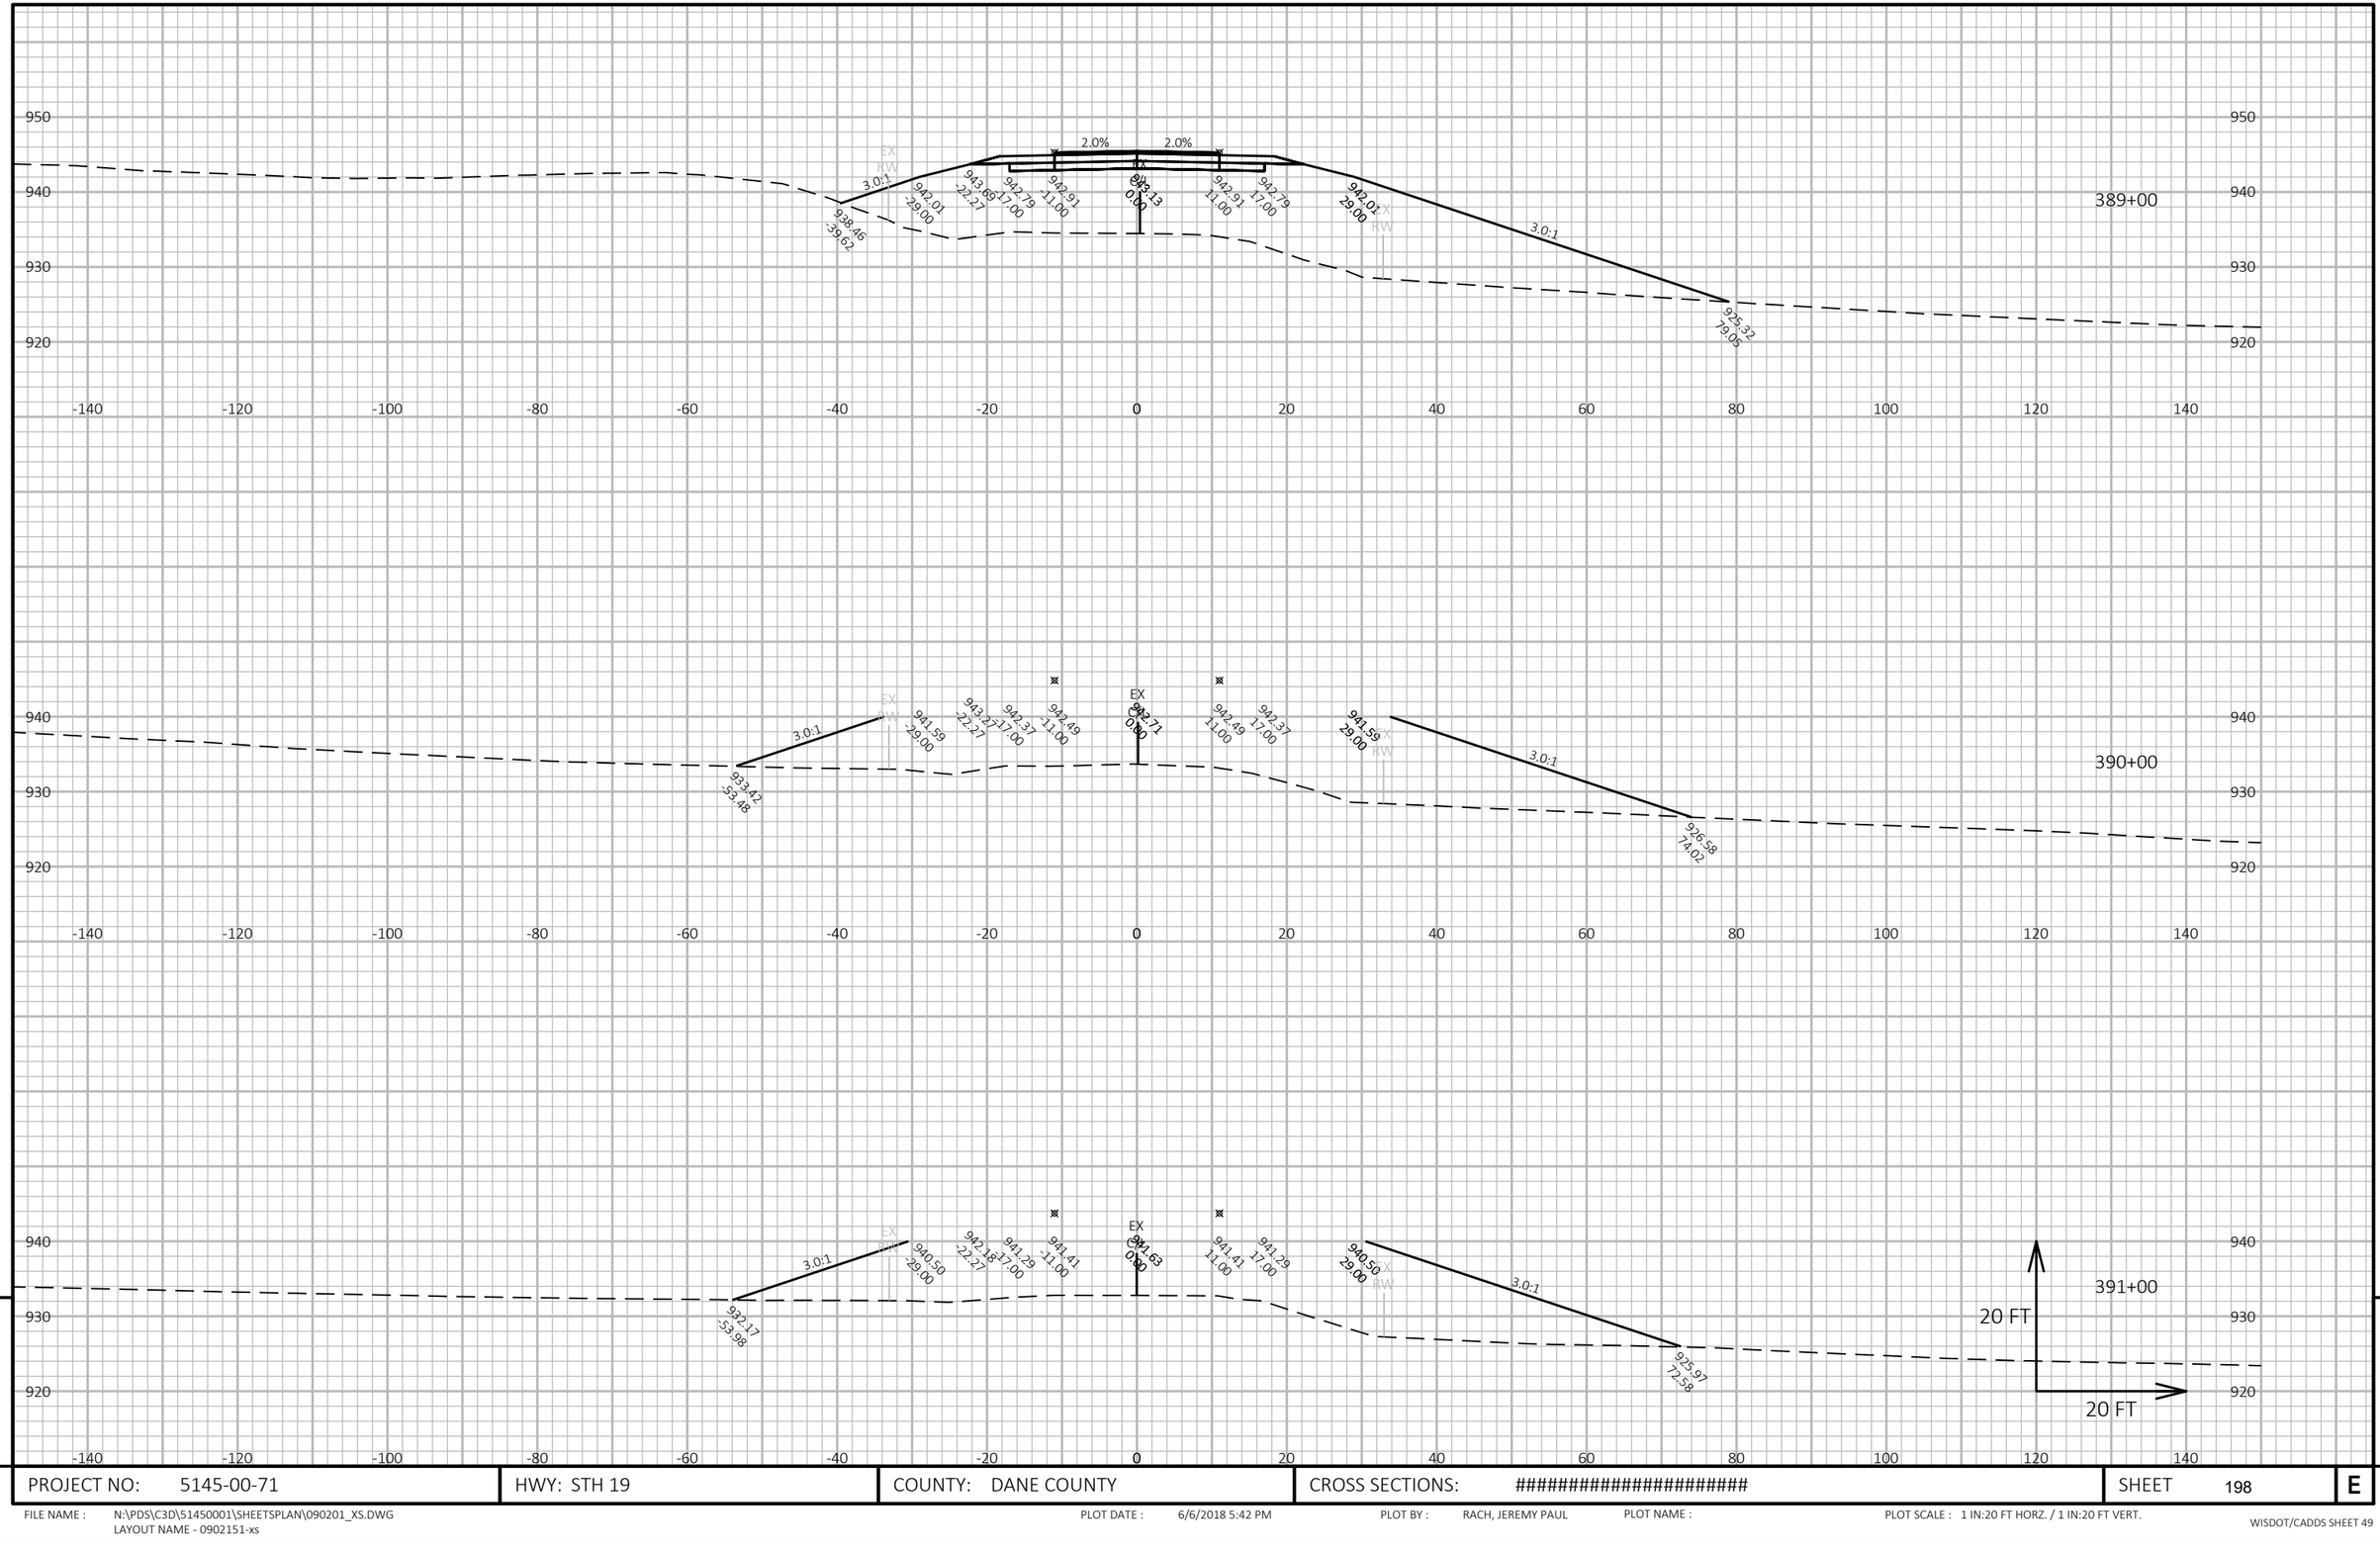

9

9

PROJECT NO: 5145-00-71	HWY: STH 19	COUNTY: DANE COUNTY	CROSS SECTIONS: ##########################	SHEET 198	E

FILE NAME : N:\PDS\C3D\51450001\SHEETSPLAN\090201_XS.DWG
LAYOUT NAME - 0902151-xs

PLOT DATE : 6/6/2018 5:42 PM PLOT BY : RACH, JEREMY PAUL PLOT NAME : PLOT SCALE : 1 IN:20 FT HORZ. / 1 IN:20 FT VERT.

WISDOT/CADDS SHEET 49

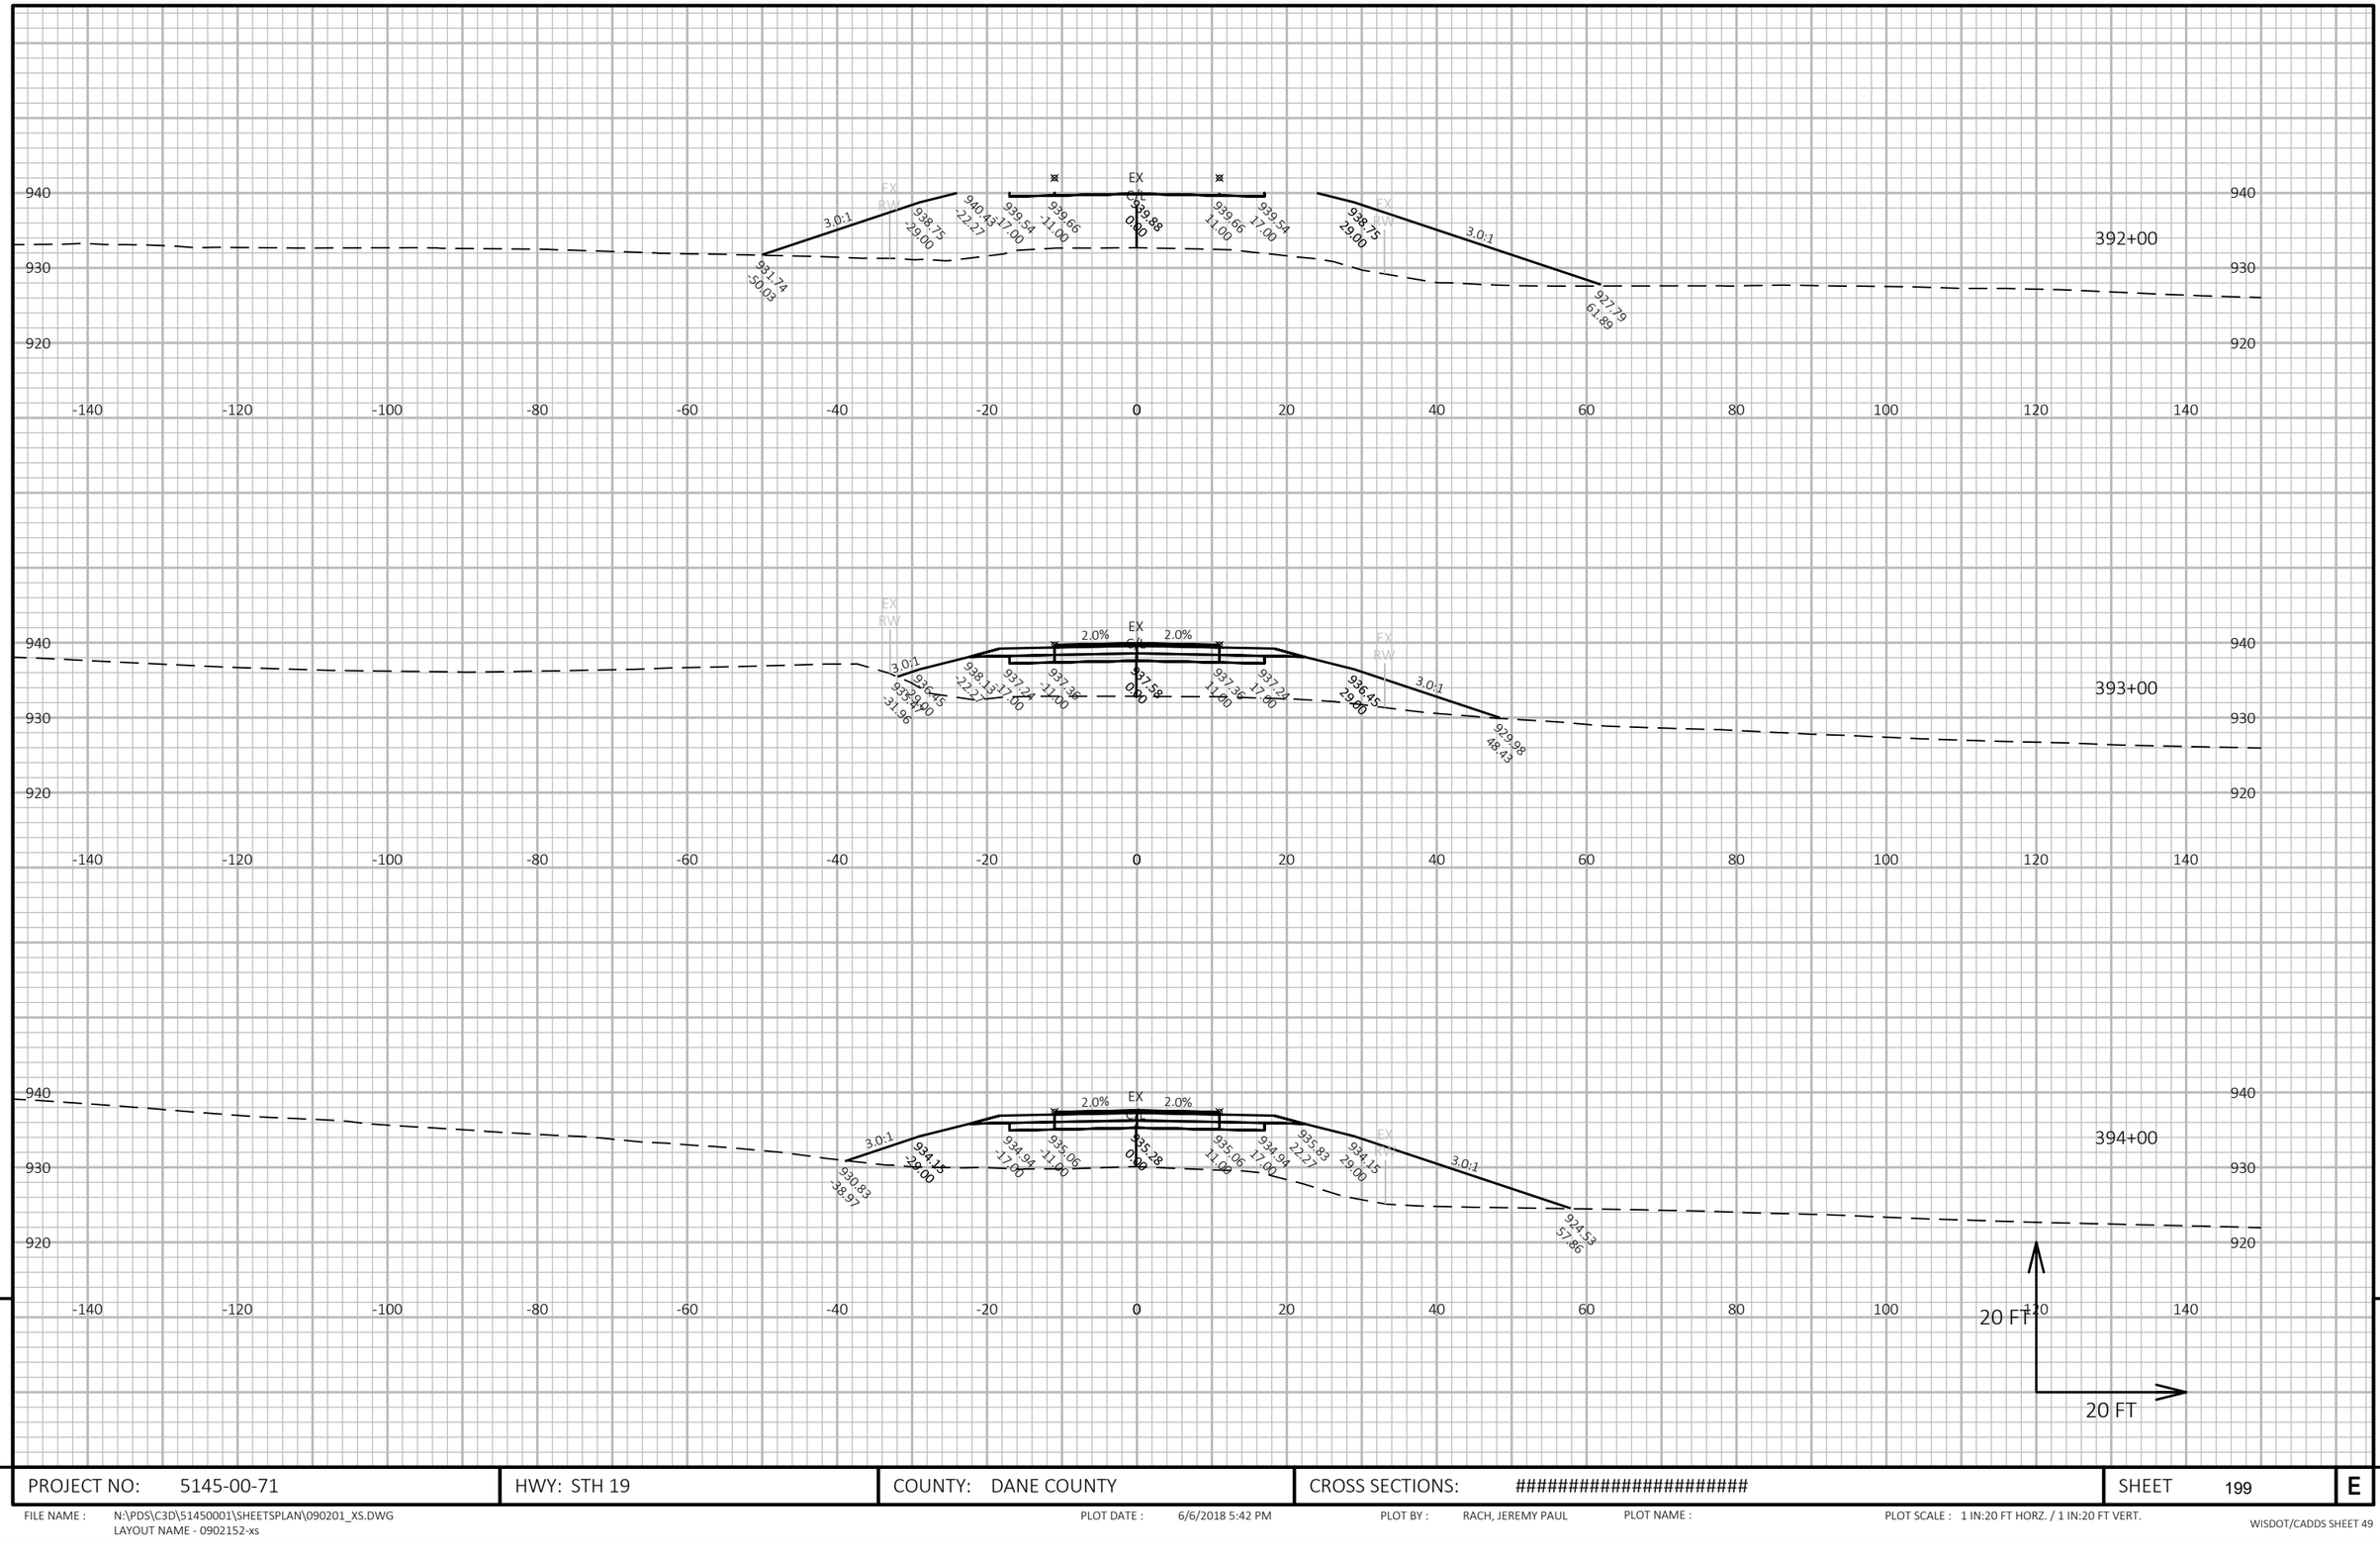

PROJECT NO: 5145-00-71	HWY: STH 19	COUNTY: DANE COUNTY	CROSS SECTIONS: ##########################	SHEET 199	E

FILE NAME : N:\PDS\C3D\51450001\SHEETSPLAN\090201_XS.DWG
LAYOUT NAME - 0902152-xs

PLOT DATE : 6/6/2018 5:42 PM PLOT BY : RACH, JEREMY PAUL PLOT NAME : PLOT SCALE : 1 IN:20 FT HORZ. / 1 IN:20 FT VERT.

WISDOT/CADDS SHEET 49

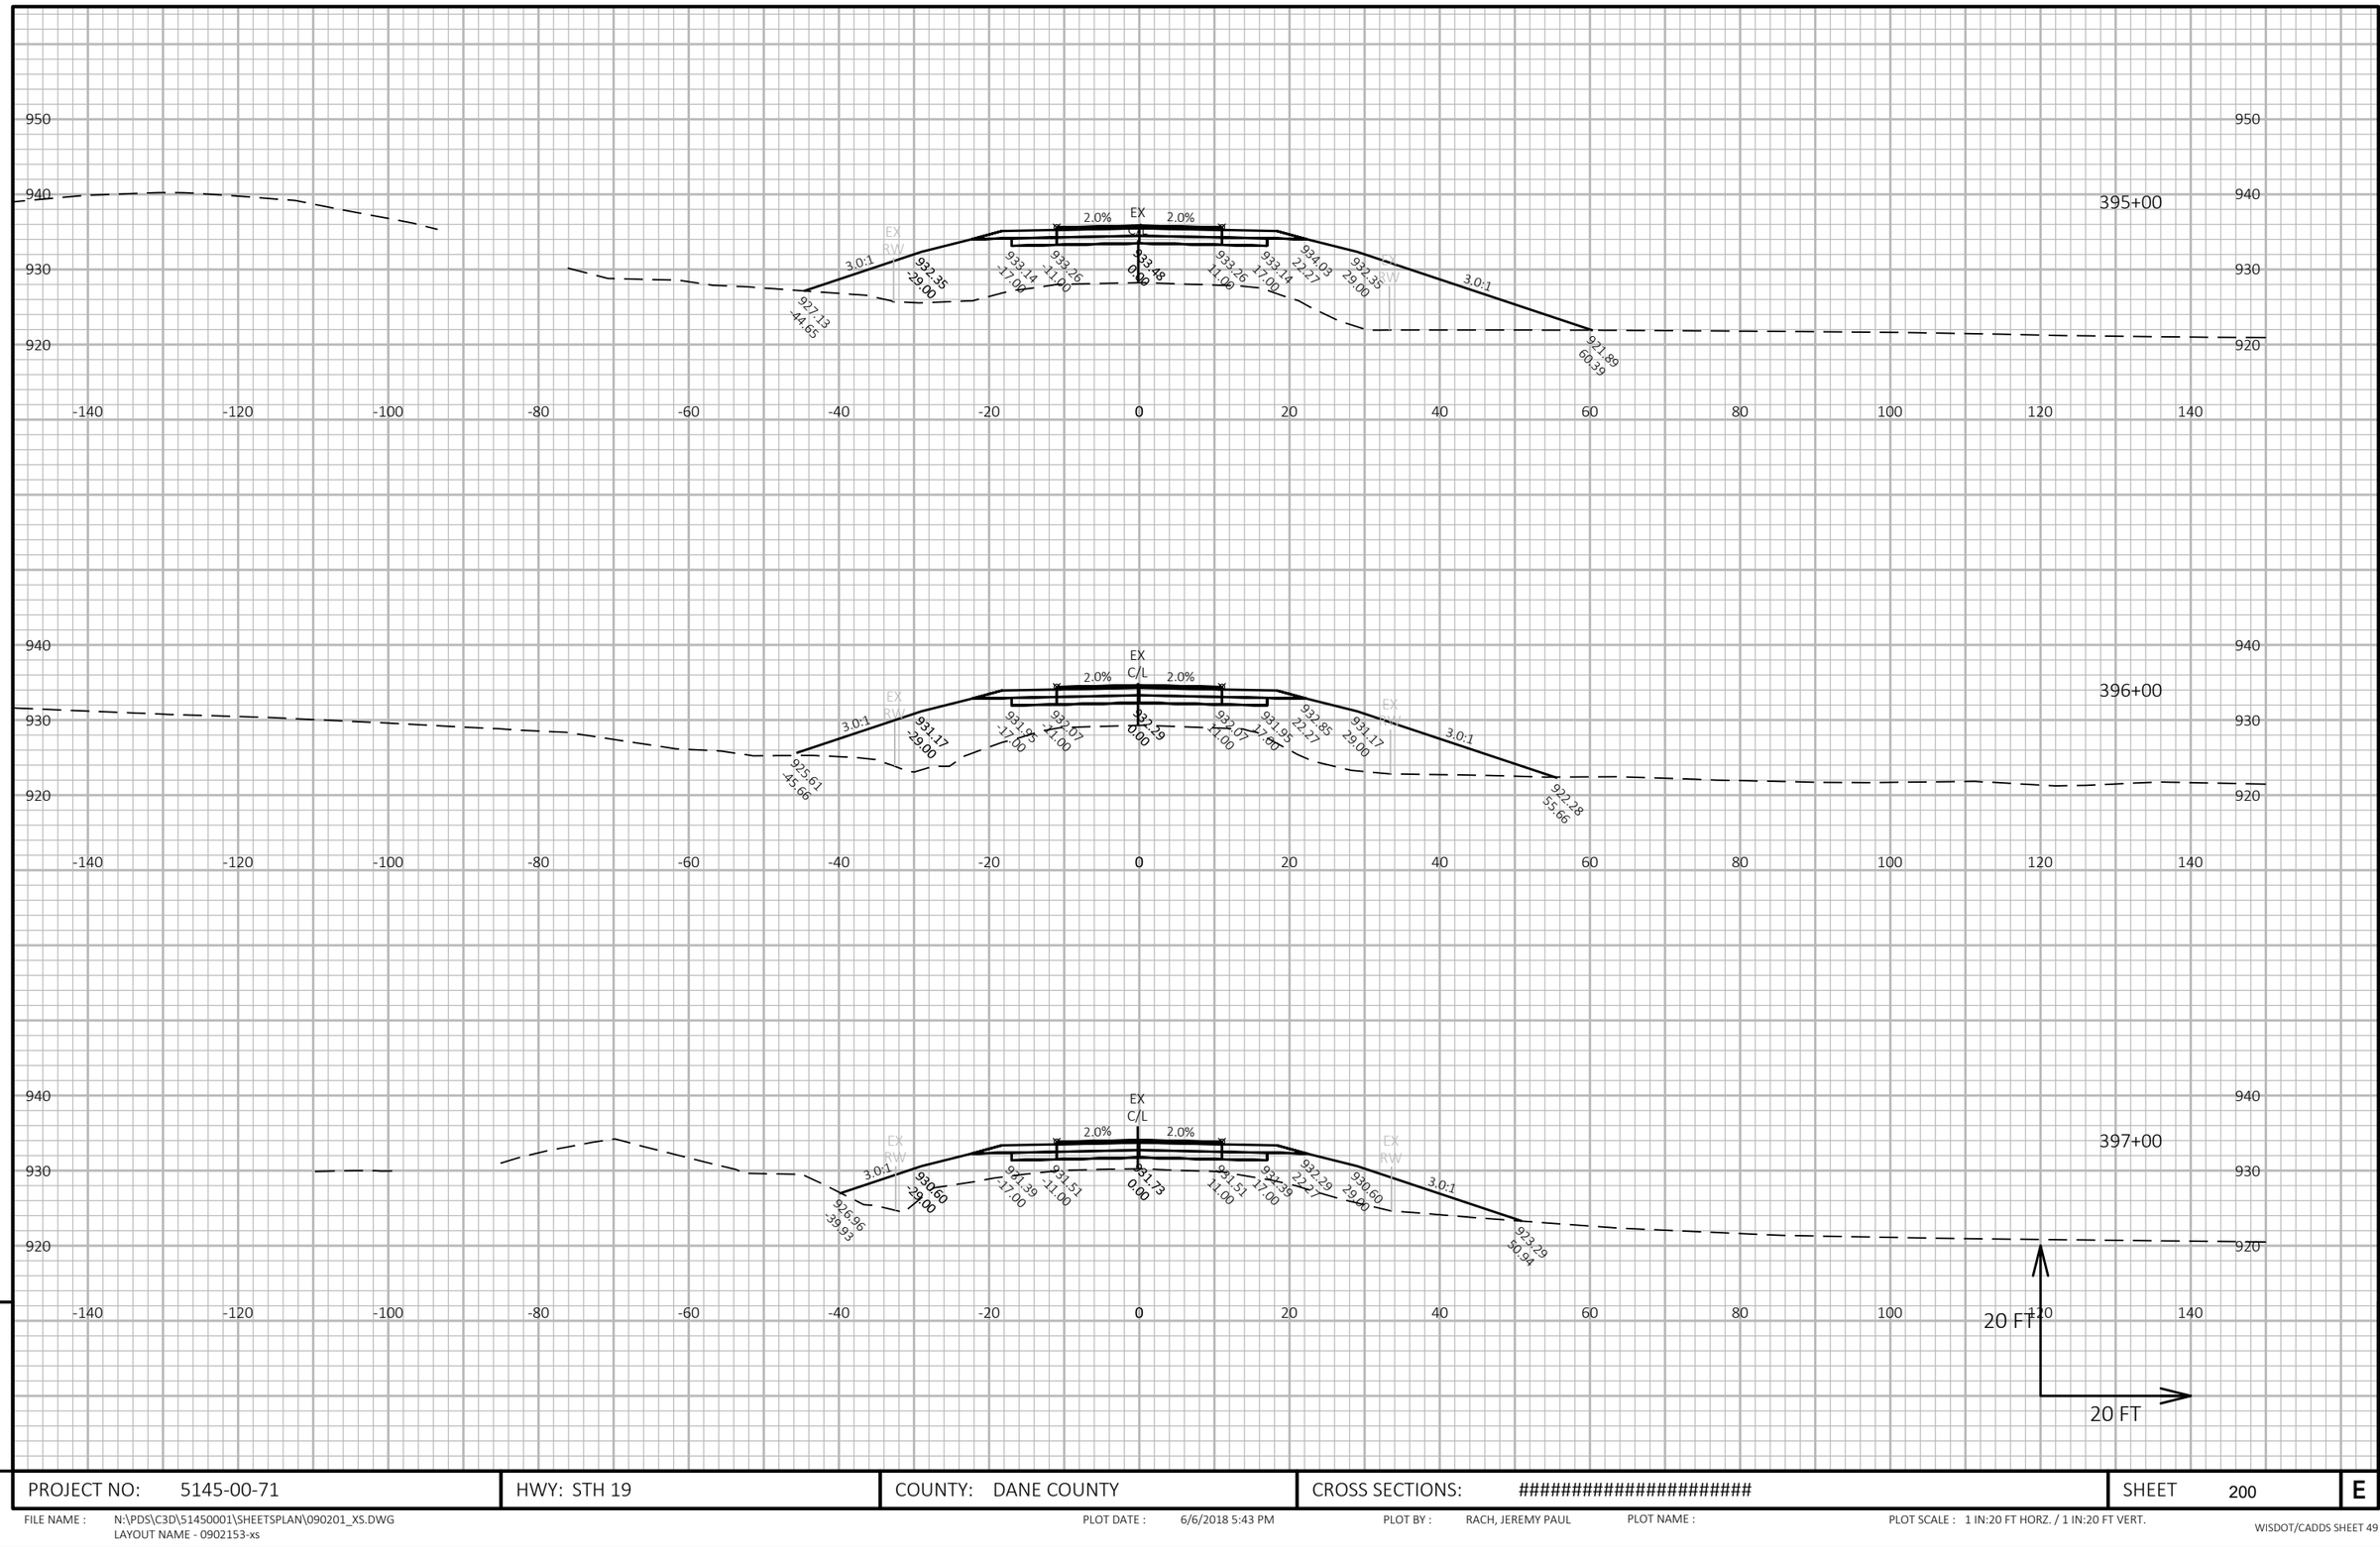

PROJECT NO: 5145-00-71	HWY: STH 19	COUNTY: DANE COUNTY	CROSS SECTIONS: ##########################	SHEET 200 E

FILE NAME : N:\PDS\C3D\51450001\SHEETSPLAN\090201_XS.DWG
LAYOUT NAME - 0902153-xs

PLOT DATE : 6/6/2018 5:43 PM PLOT BY : RACH, JEREMY PAUL PLOT NAME : PLOT SCALE : 1 IN:20 FT HORZ. / 1 IN:20 FT VERT.

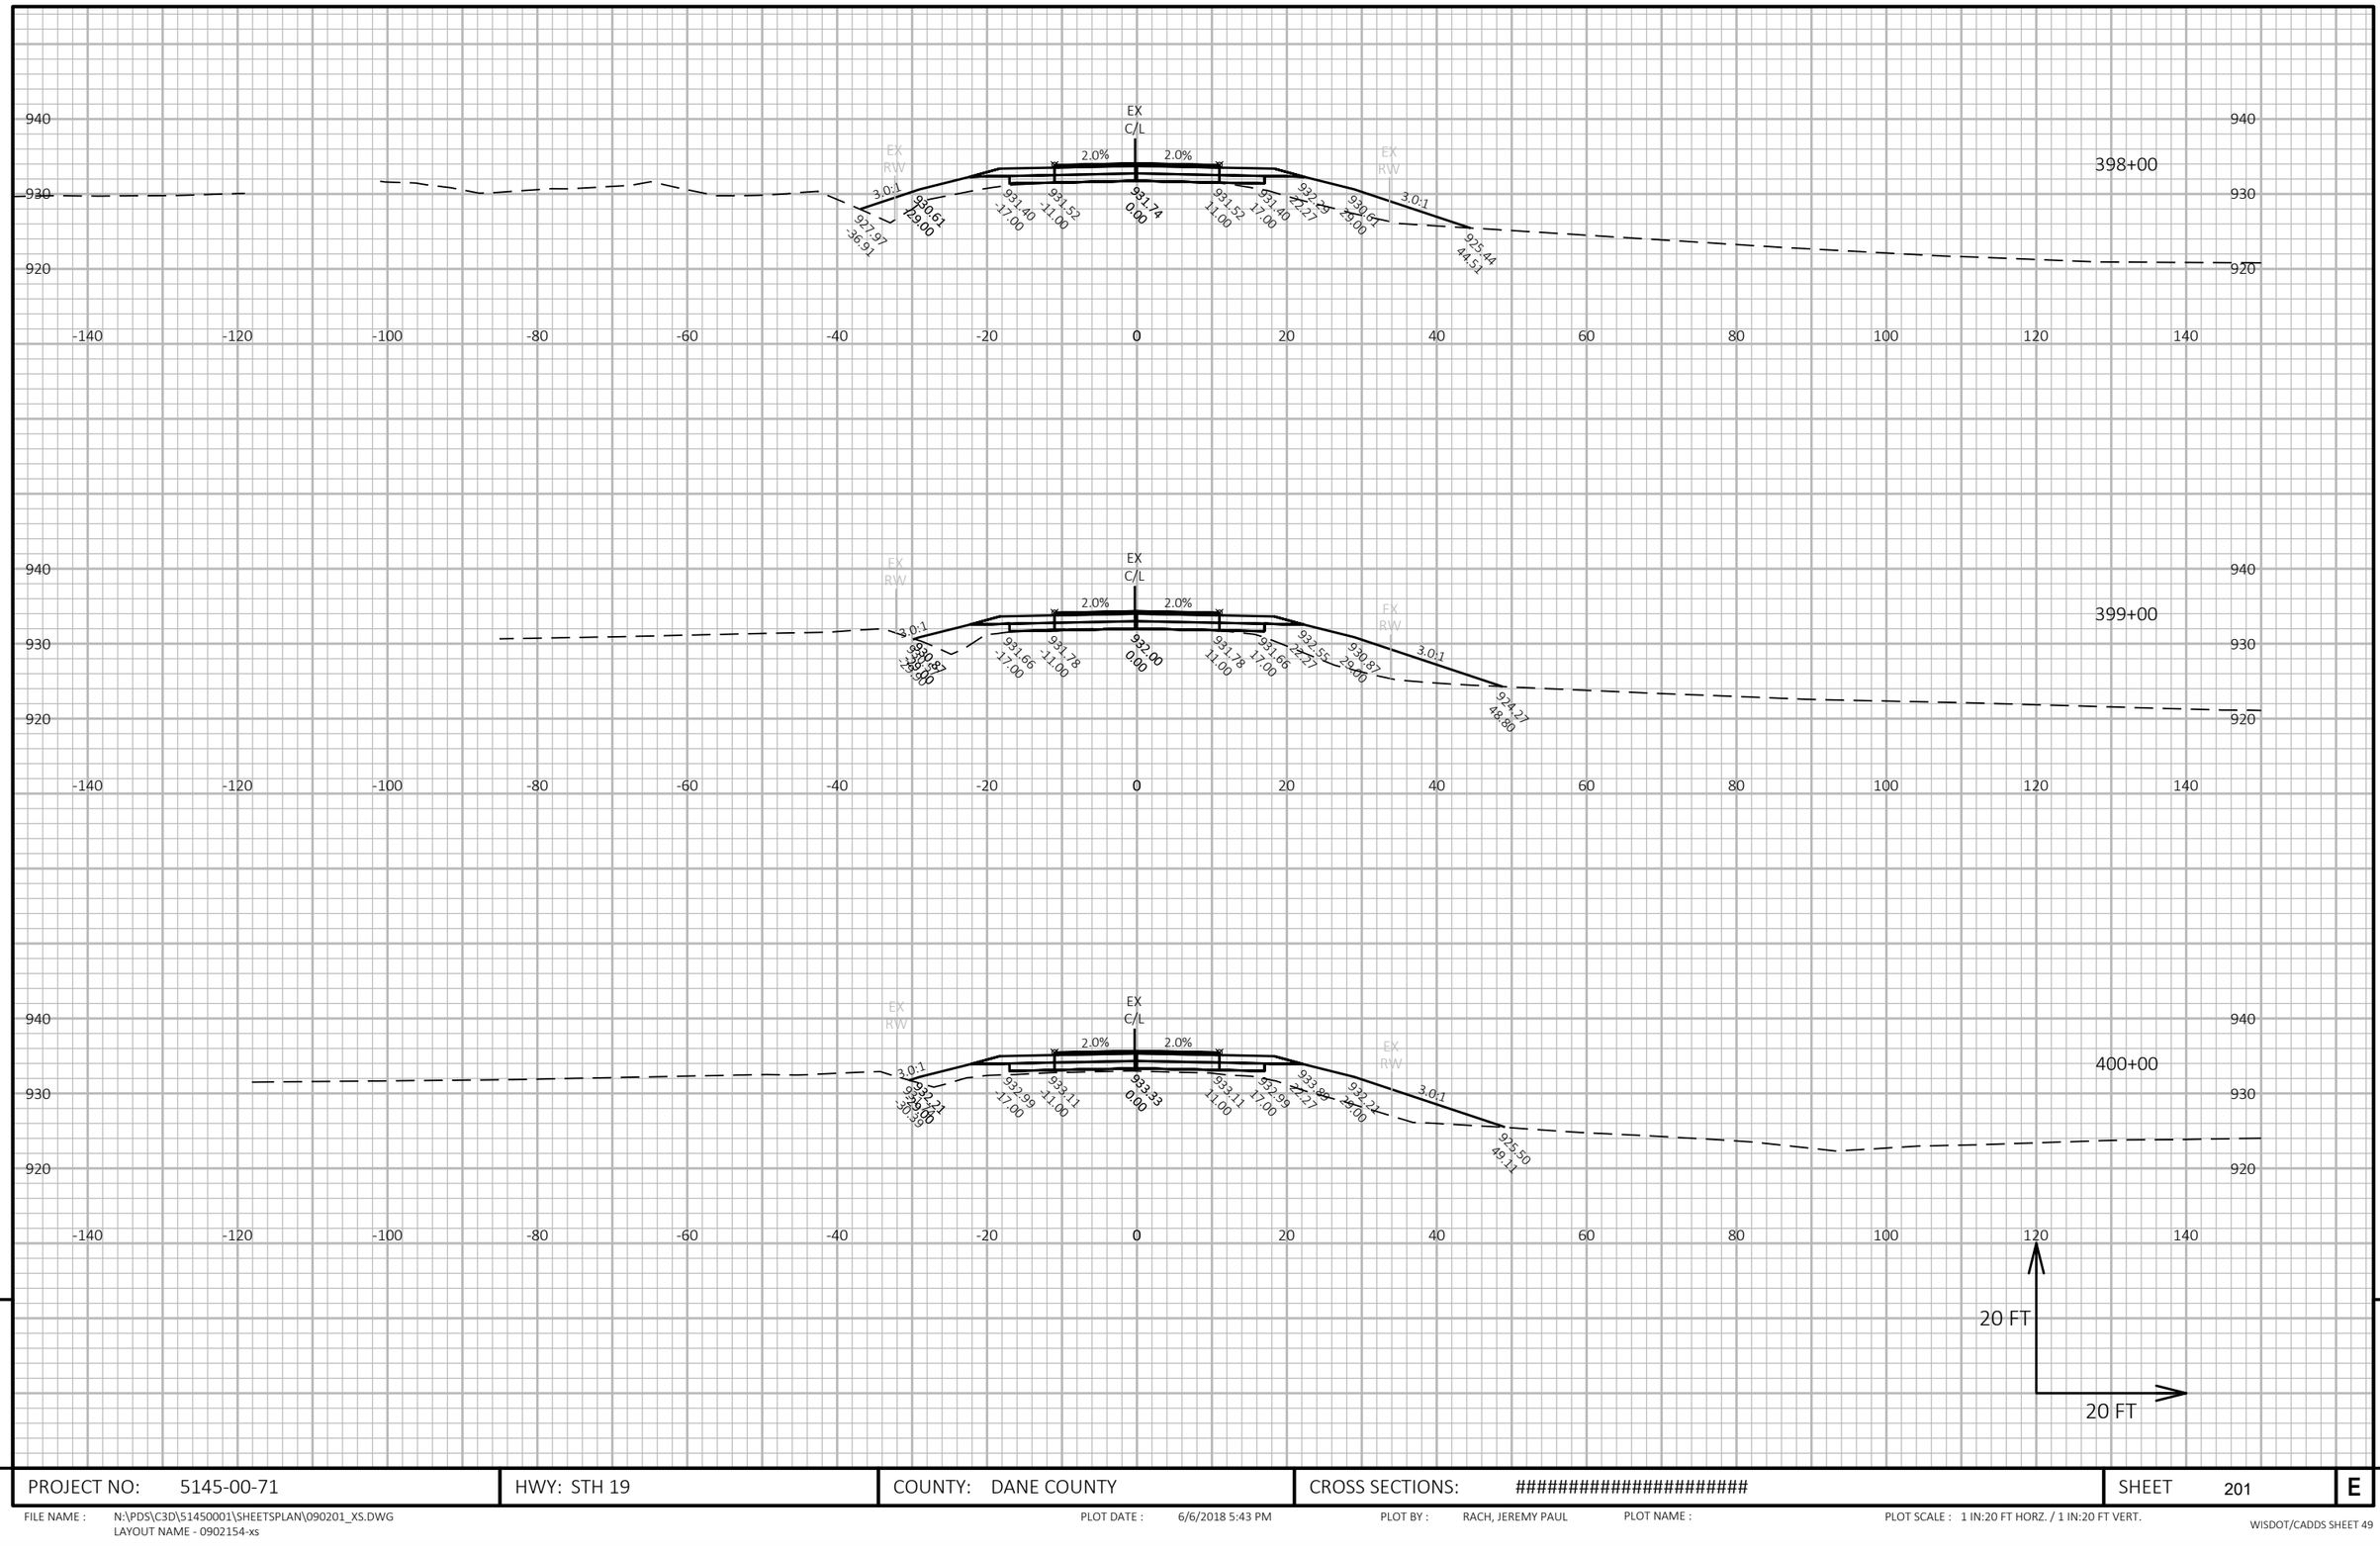

9

9

PROJECT NO: 5145-00-71	HWY: STH 19	COUNTY: DANE COUNTY	CROSS SECTIONS: ##########################	SHEET 201	E

FILE NAME : N:\PDS\C3D\51450001\SHEETSPLAN\090201_XS.DWG
LAYOUT NAME - 0902154-xs

PLOT DATE : 6/6/2018 5:43 PM PLOT BY : RACH, JEREMY PAUL PLOT NAME : PLOT SCALE : 1 IN:20 FT HORZ. / 1 IN:20 FT VERT.

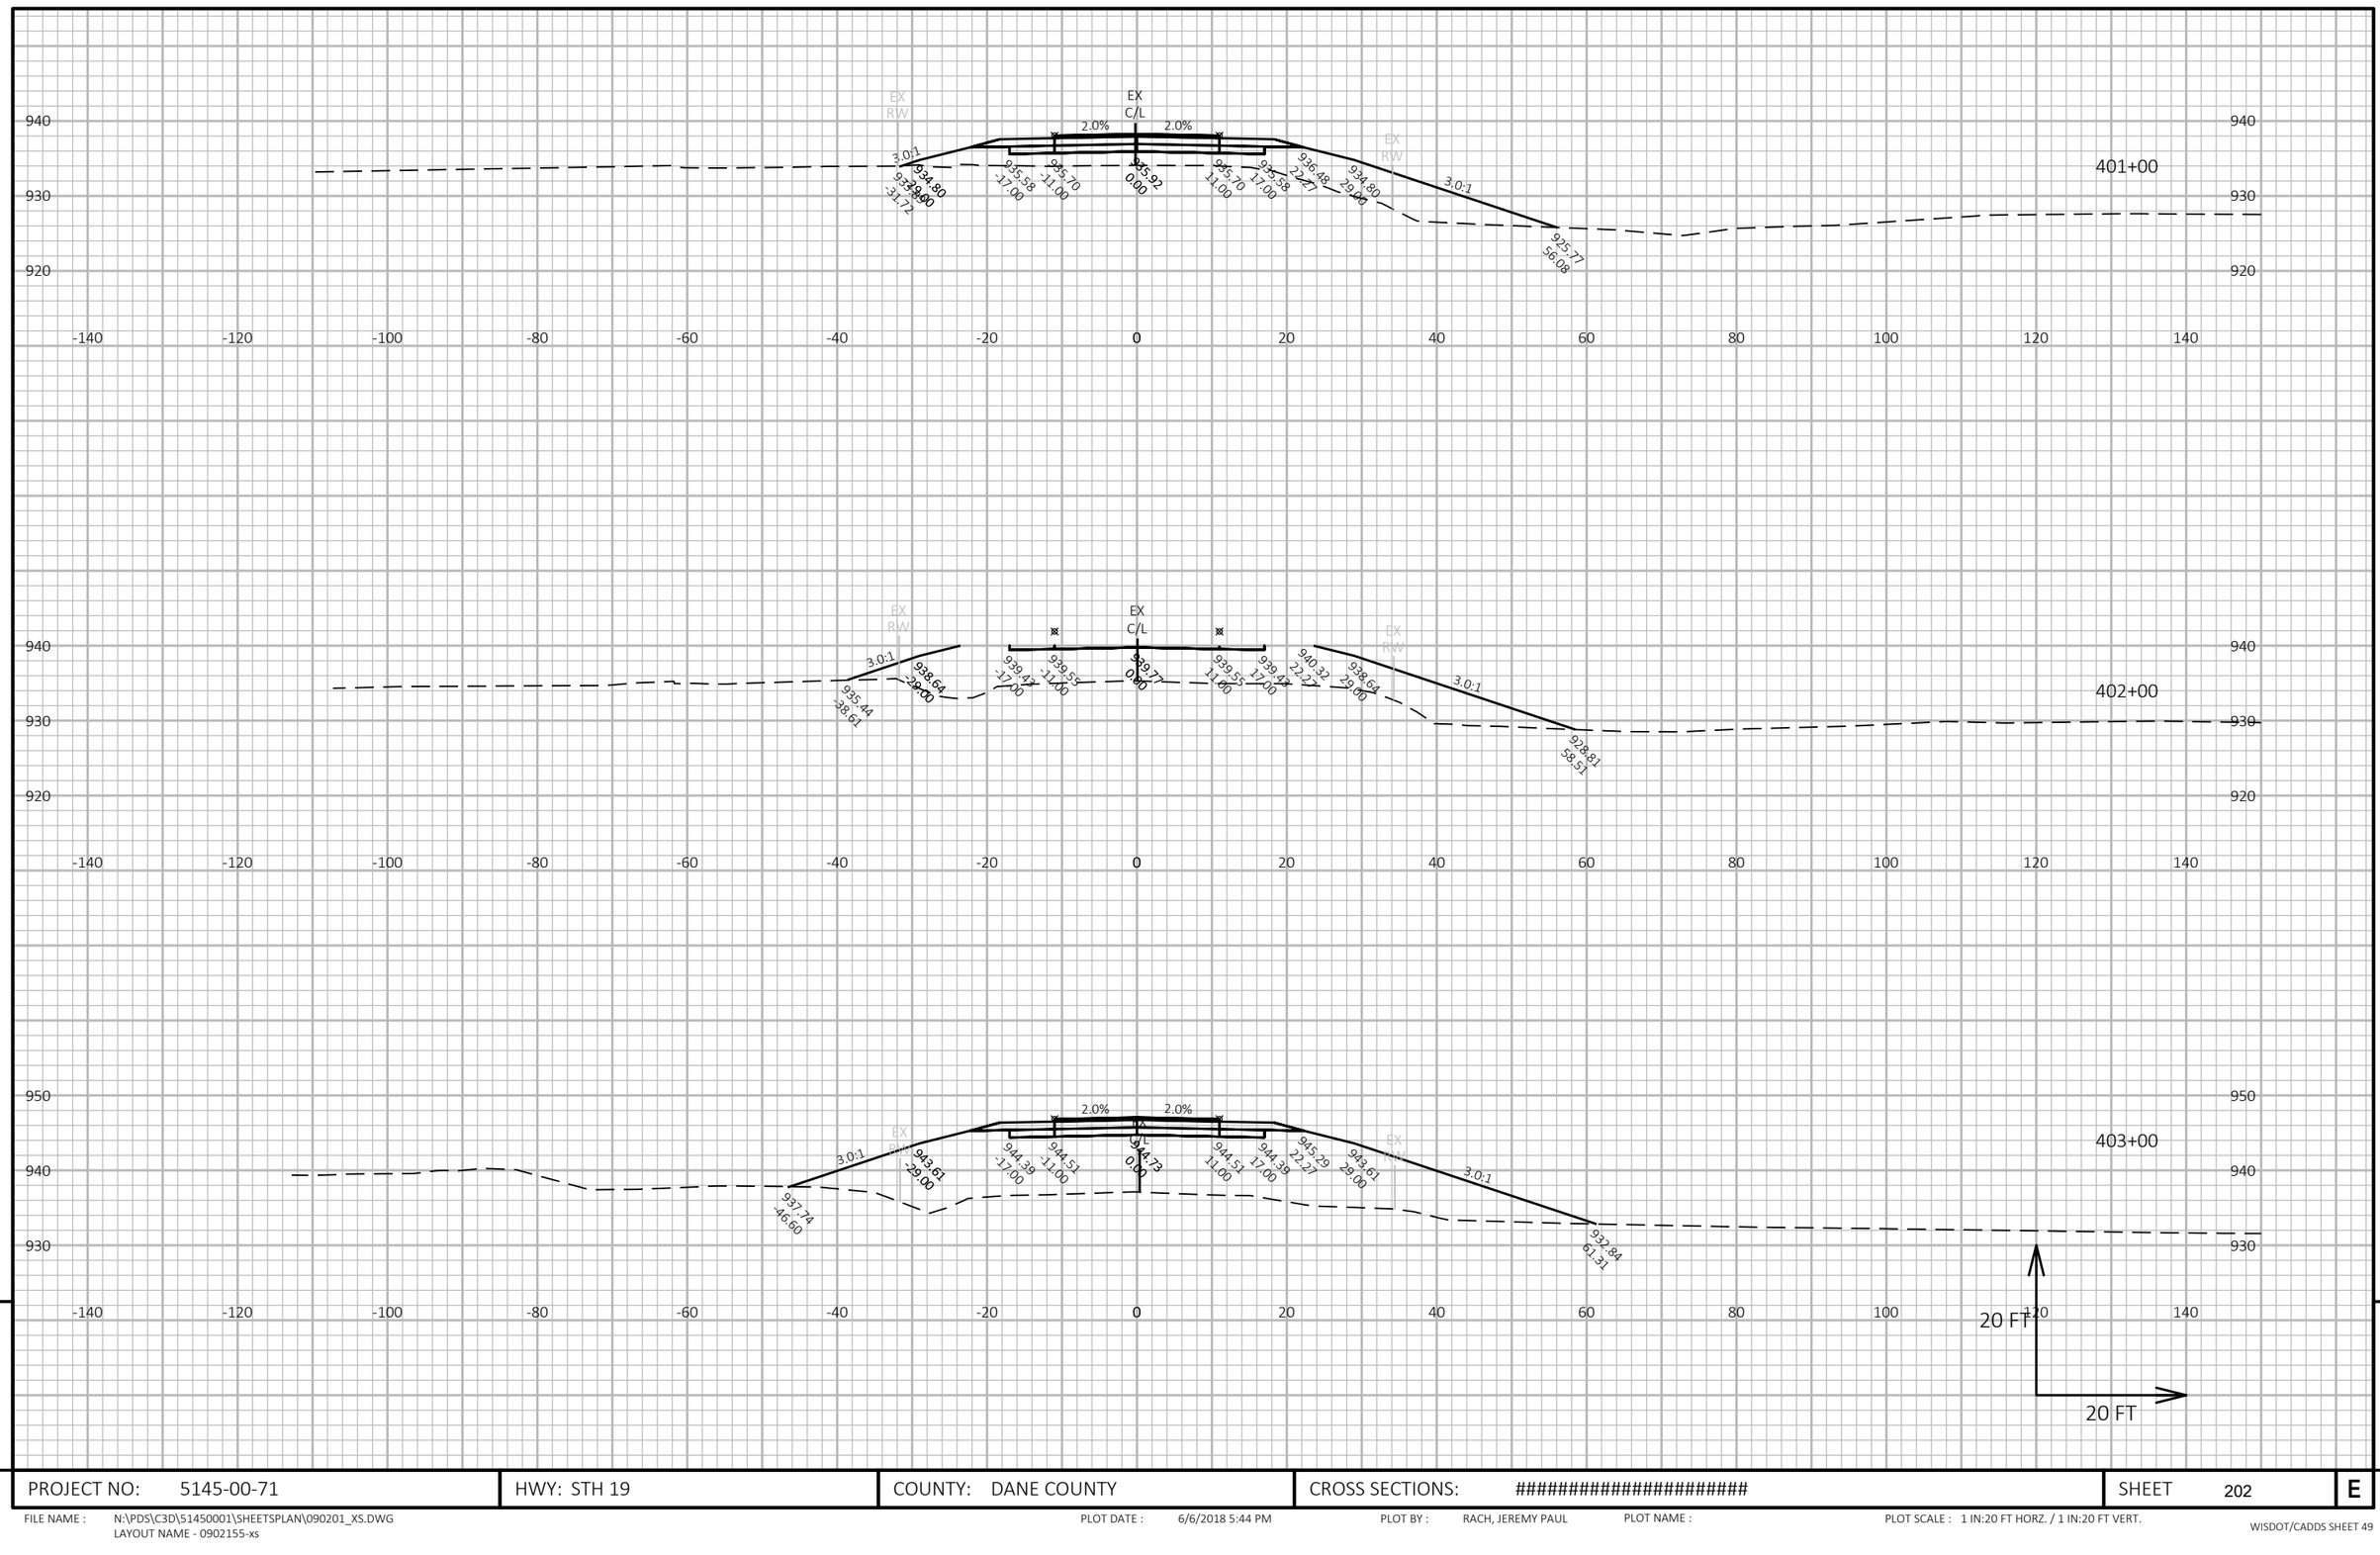

PROJECT NO: 5145-00-71	HWY: STH 19	COUNTY: DANE COUNTY	CROSS SECTIONS: ##########################	SHEET 202	E

FILE NAME : N:\PDS\C3D\51450001\SHEETSPLAN\090201_XS.DWG
LAYOUT NAME - 0902155-xs

PLOT DATE : 6/6/2018 5:44 PM PLOT BY : RACH, JEREMY PAUL PLOT NAME : PLOT SCALE : 1 IN:20 FT HORZ. / 1 IN:20 FT VERT.

WISDOT/CADDS SHEET 49

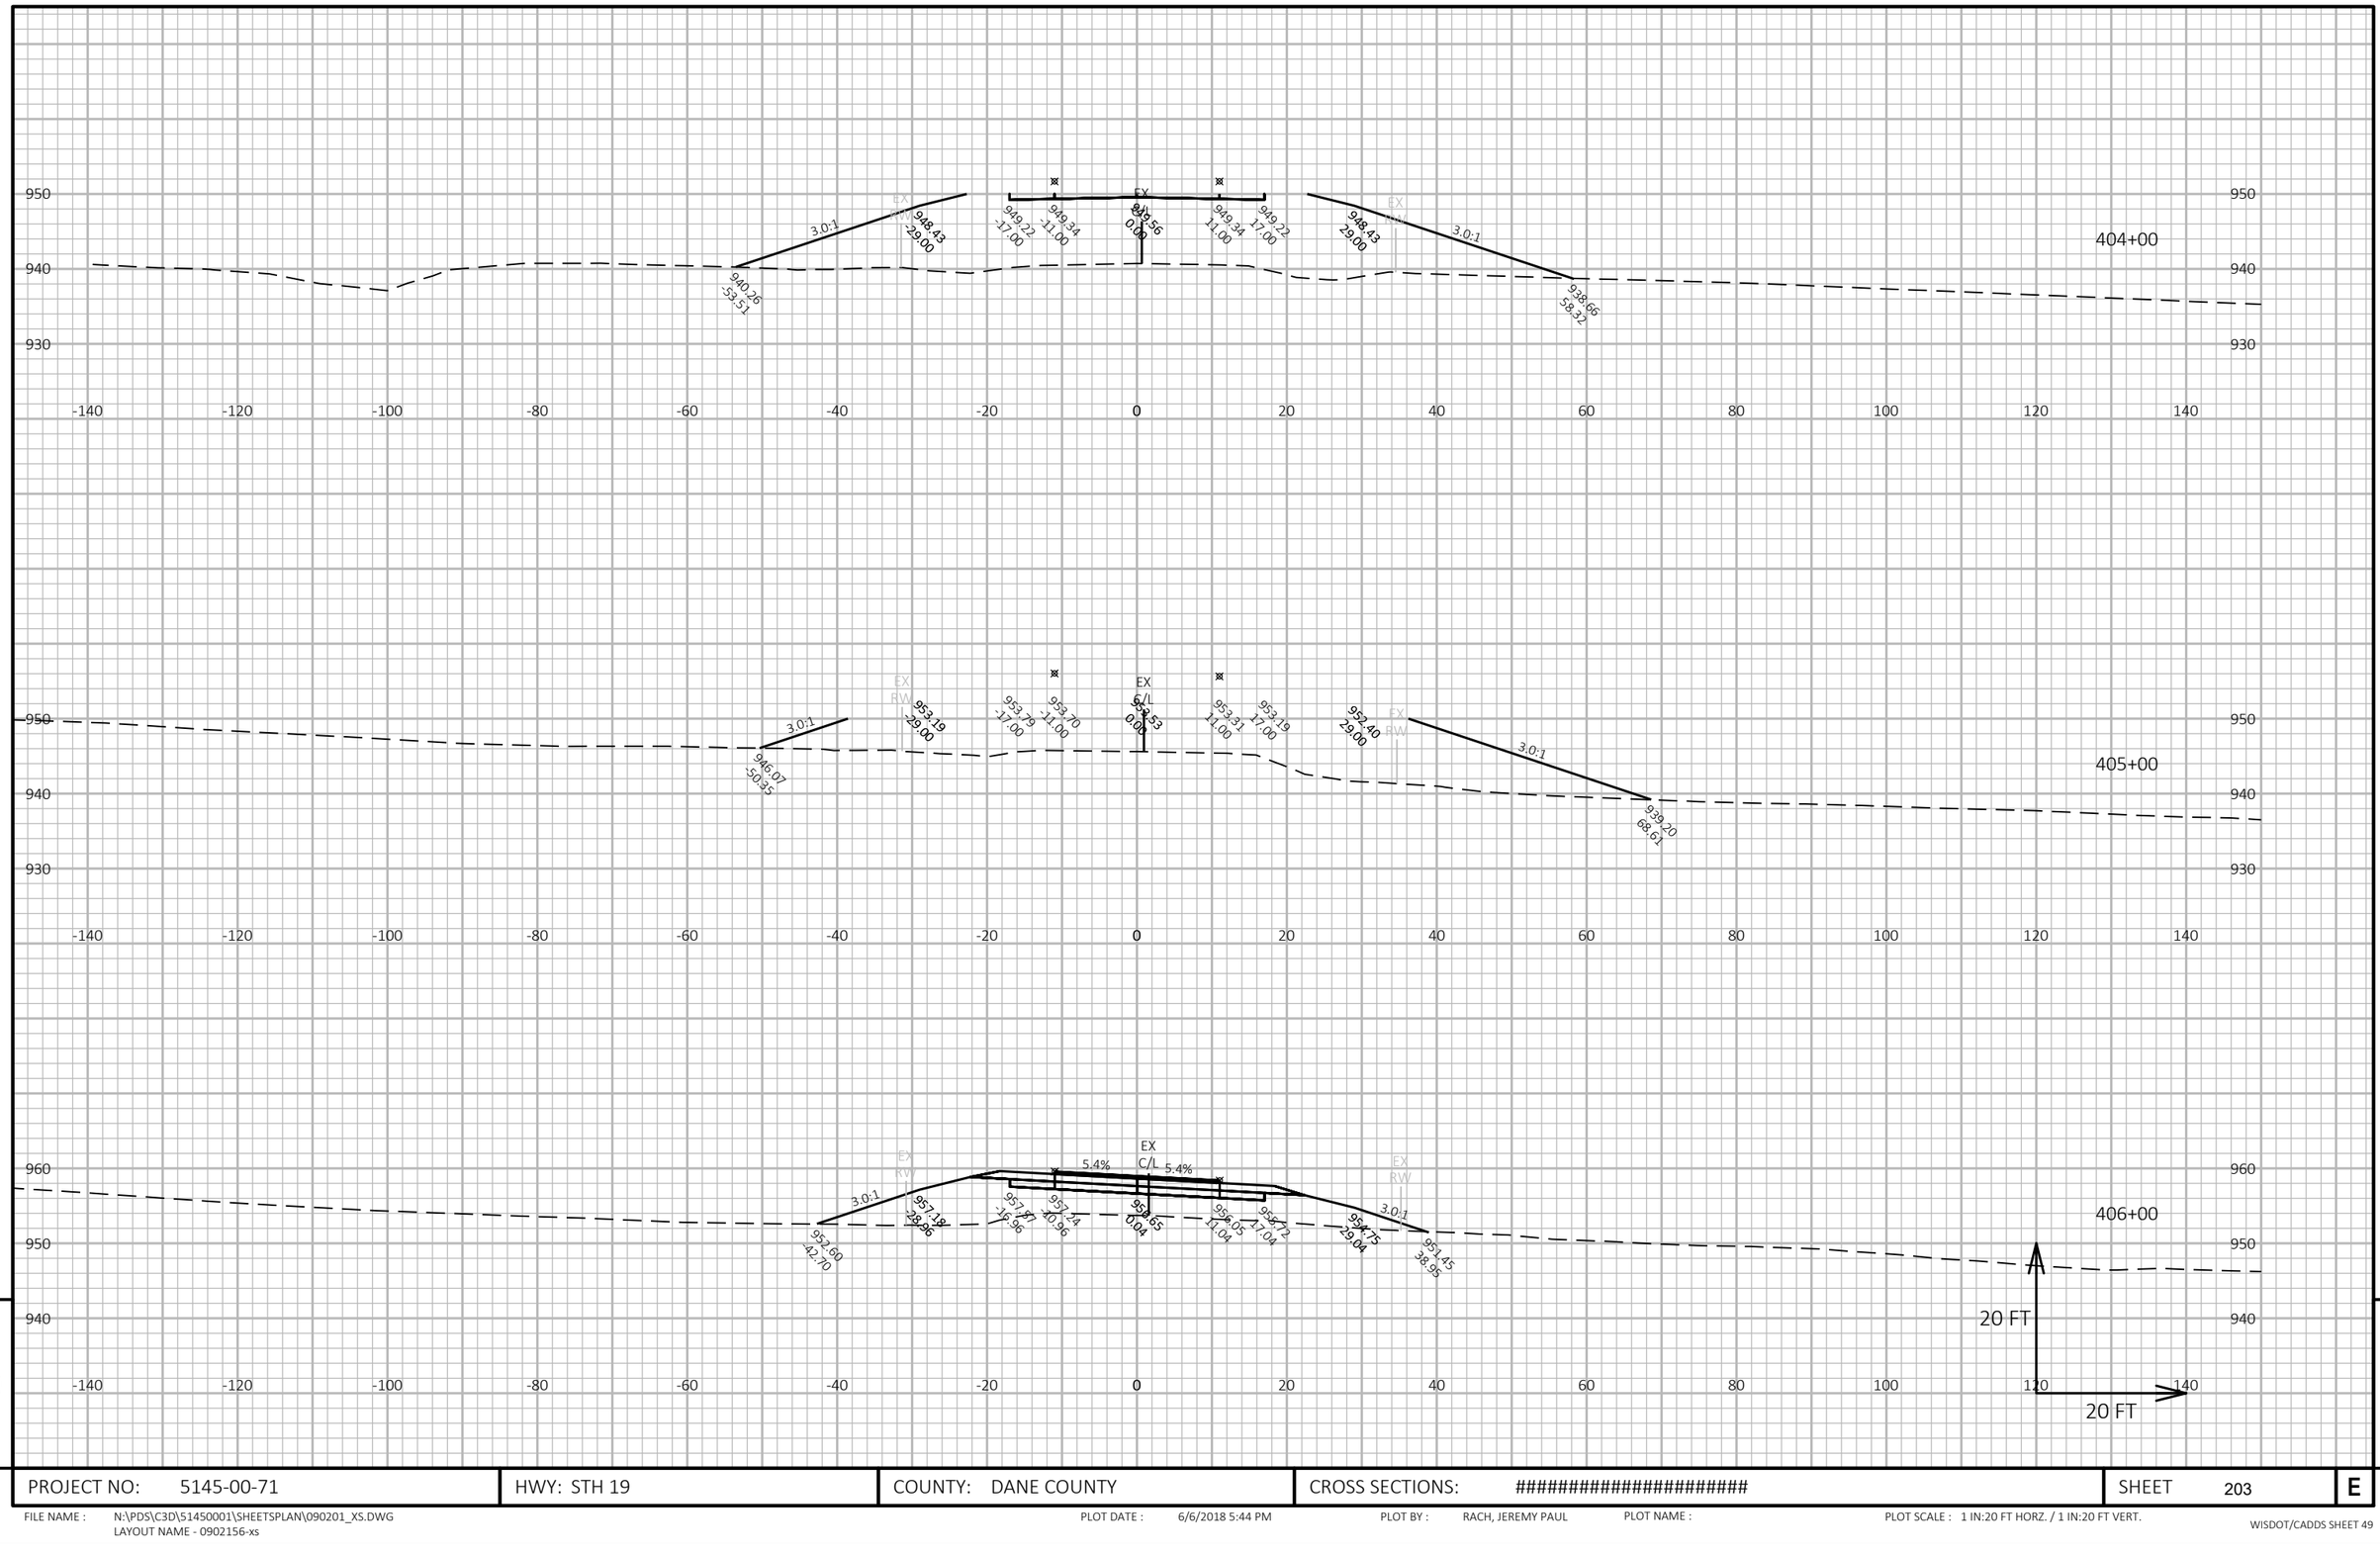

9

PROJECT NO: 5145-00-71	HWY: STH 19	COUNTY: DANE COUNTY	CROSS SECTIONS: ##########################	SHEET 203	E

9

FILE NAME : N:\PDS\C3D\51450001\SHEETSPLAN\090201_XS.DWG
LAYOUT NAME - 0902156-xs

PLOT DATE : 6/6/2018 5:44 PM PLOT BY : RACH, JEREMY PAUL PLOT NAME : PLOT SCALE : 1 IN:20 FT HORZ. / 1 IN:20 FT VERT.

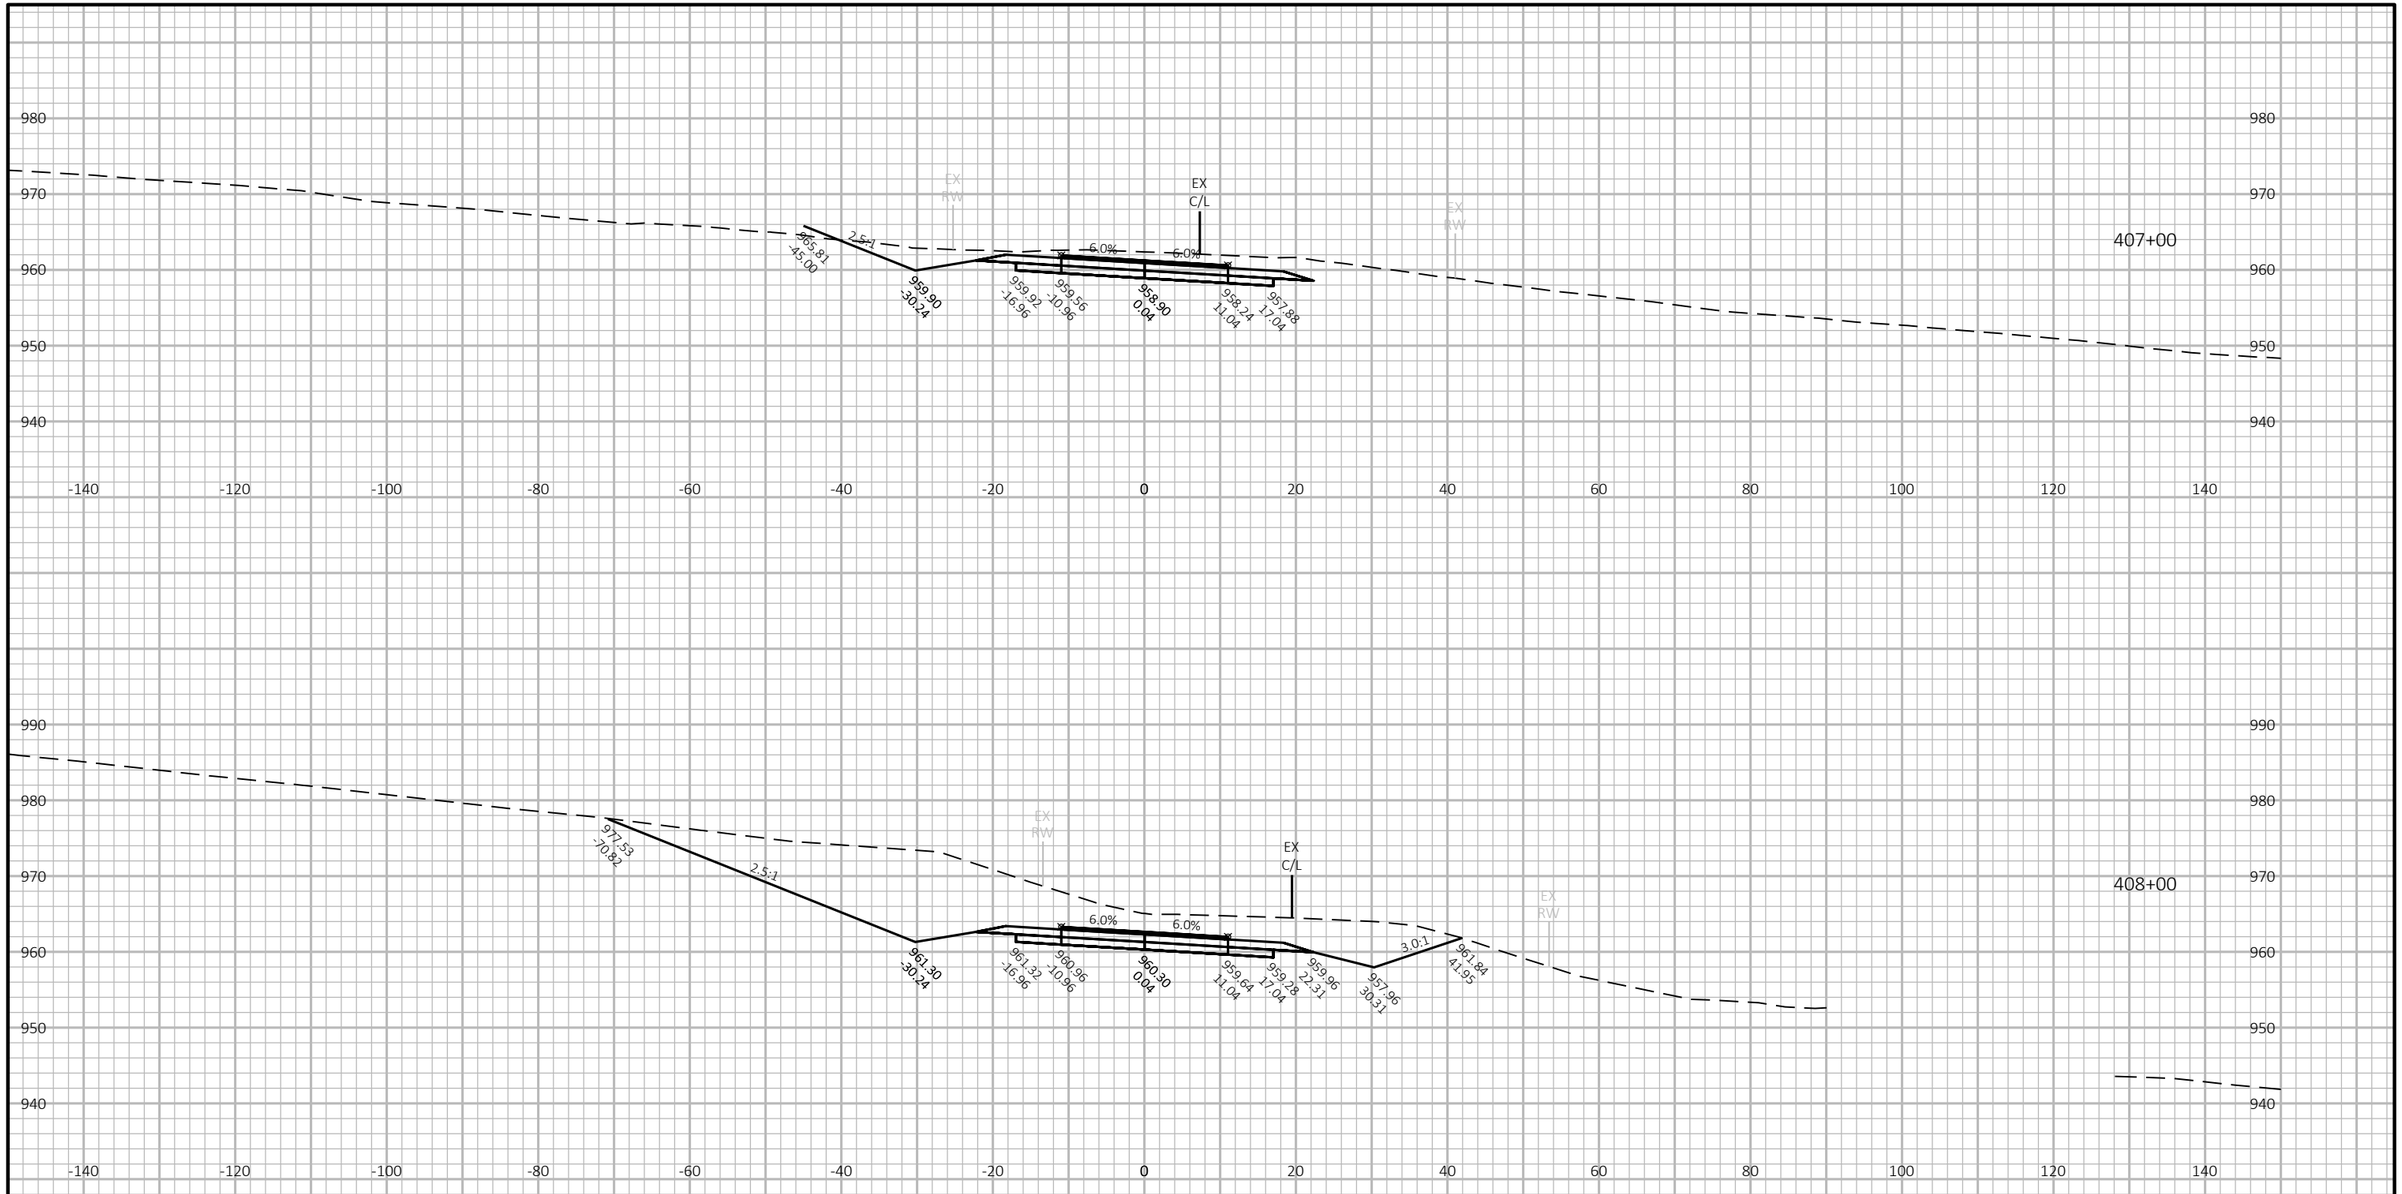

PROJECT NO: 5145-00-71	HWY: STH 19	COUNTY: DANE COUNTY	CROSS SECTIONS: ##########################	SHEET 204 E

FILE NAME : N:\PDS\C3D\51450001\SHEETSPLAN\090201_XS.DWG
LAYOUT NAME - 0902157-xs

PLOT DATE : 6/6/2018 5:45 PM

PLOT BY : RACH, JEREMY PAUL

PLOT NAME :

PLOT SCALE : 1 IN:20 FT HORZ. / 1 IN:20 FT VERT.

WISDOT/CADDS SHEET 49

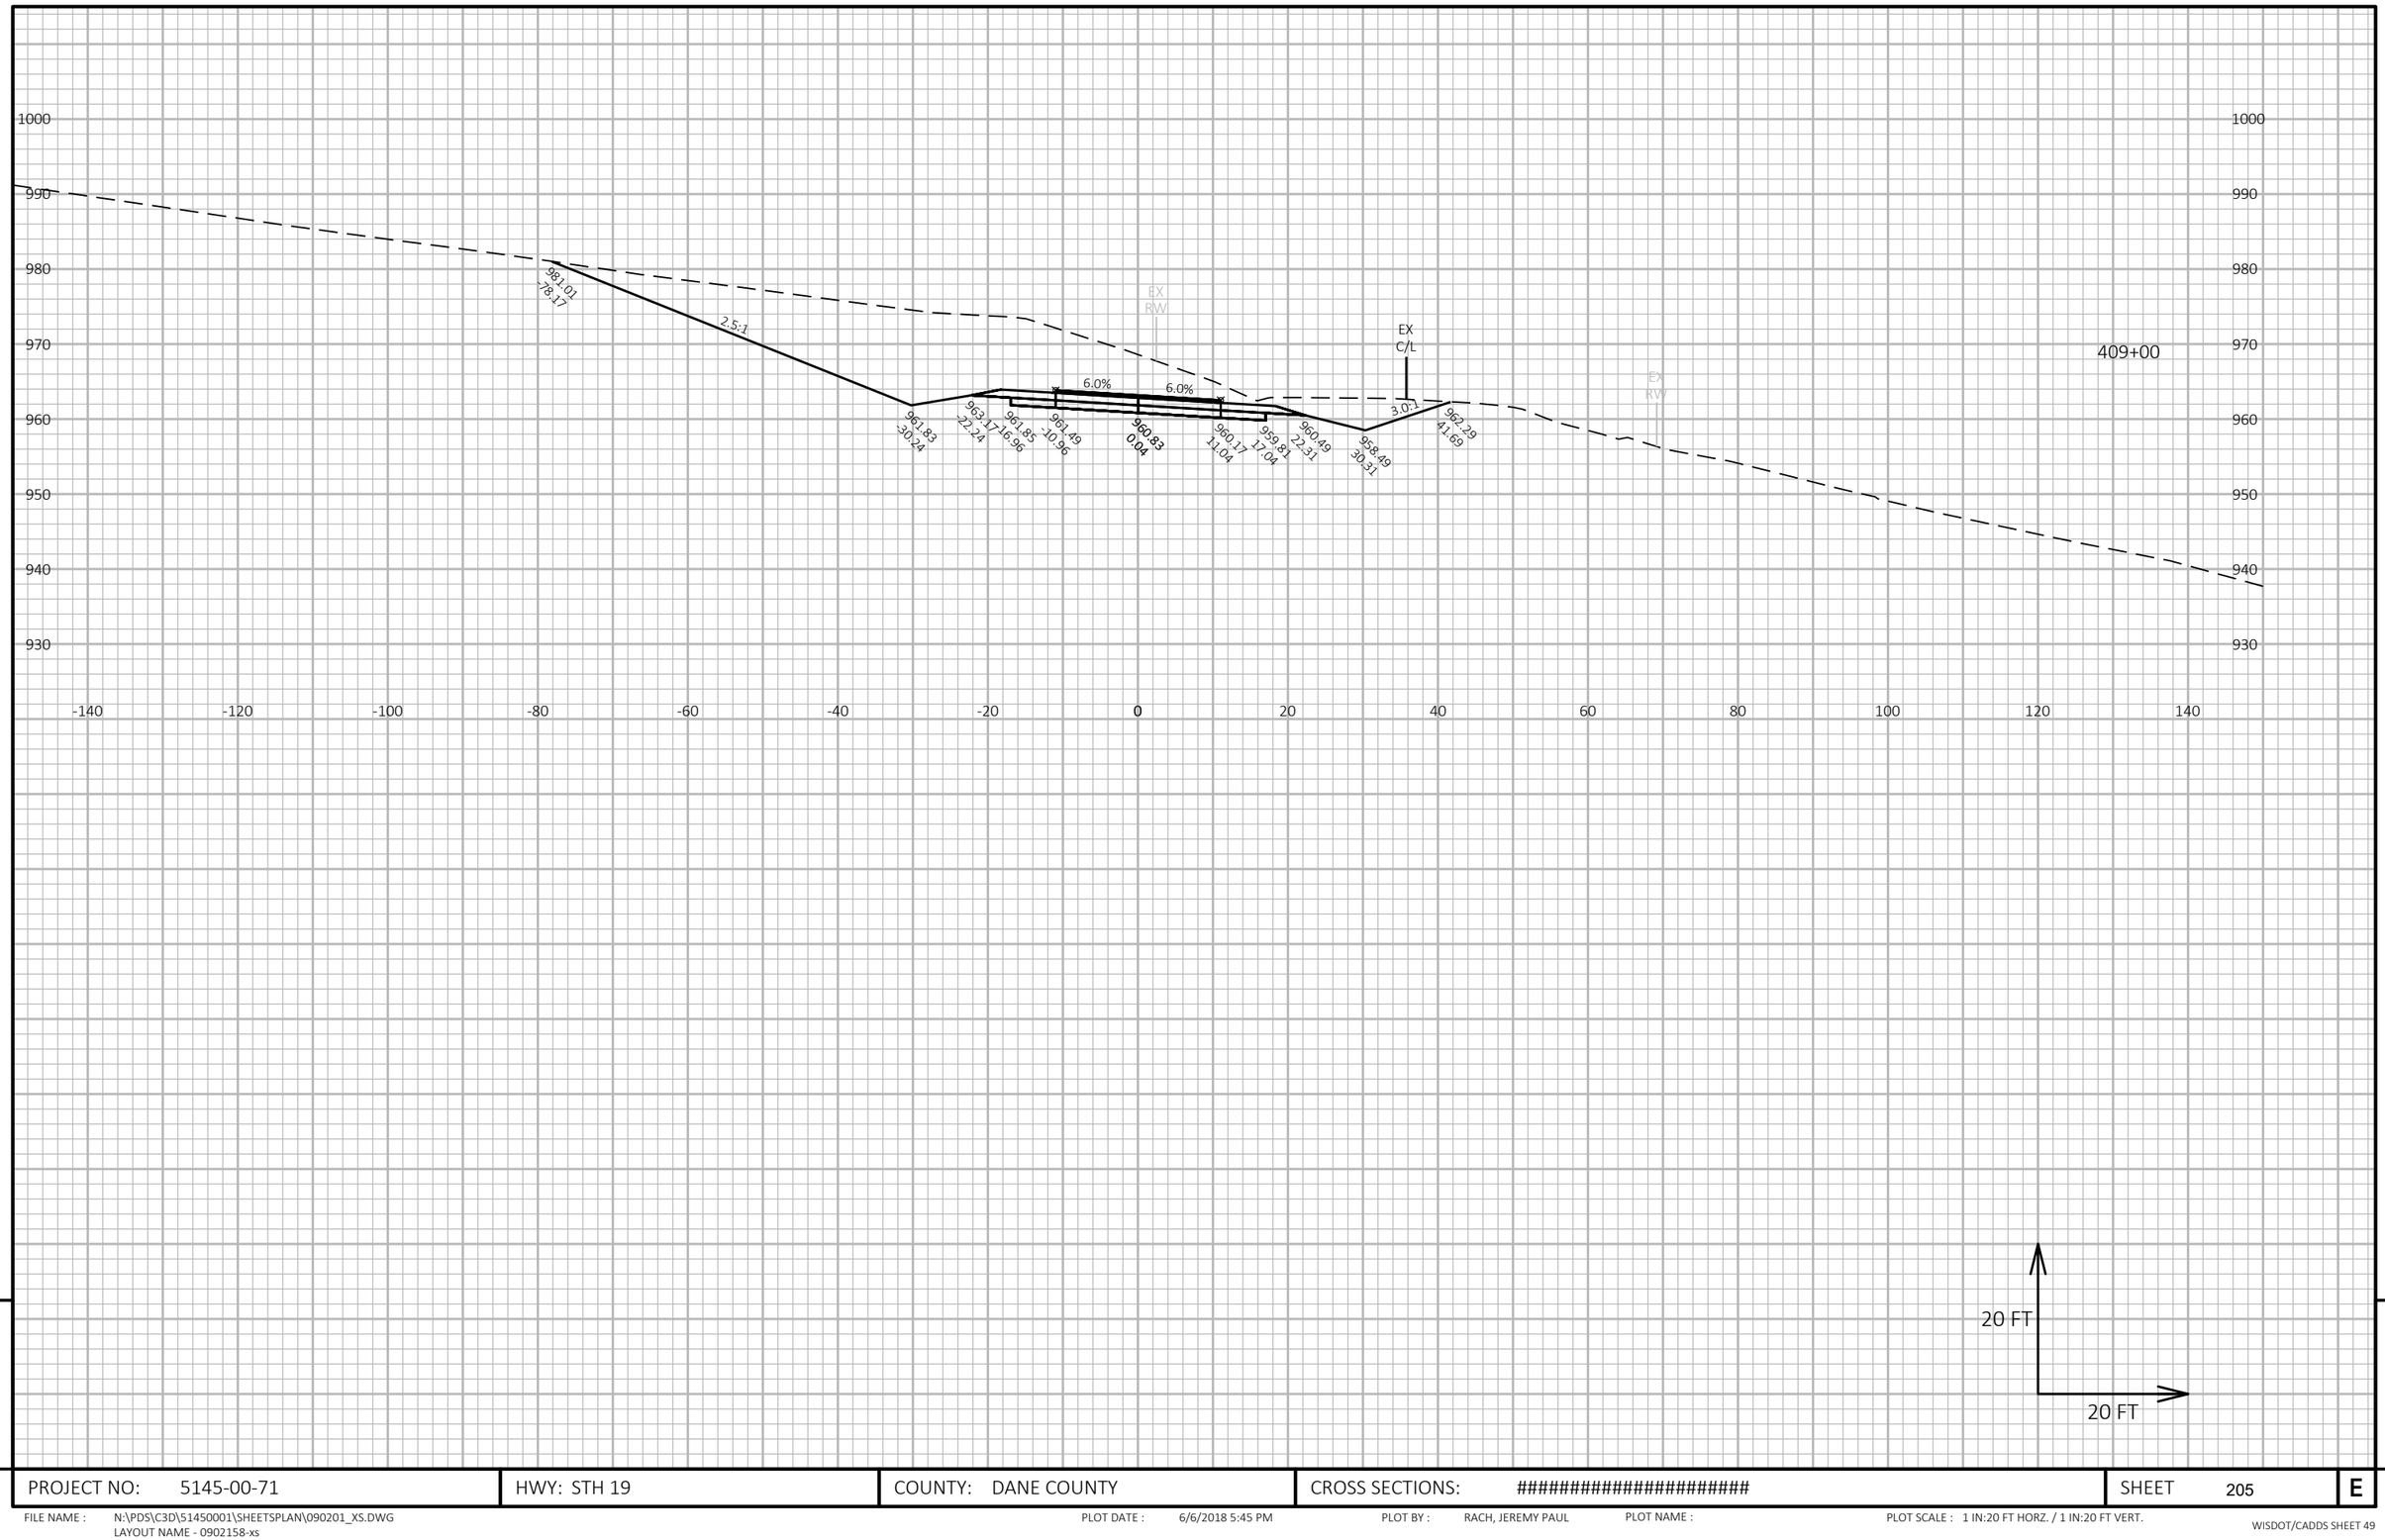

9

PROJECT NO: 5145-00-71	HWY: STH 19	COUNTY: DANE COUNTY	CROSS SECTIONS: ##########################	SHEET 205	E

9

FILE NAME : N:\PDS\C3D\51450001\SHEETSPLAN\090201_XS.DWG
LAYOUT NAME - 0902158-xs

PLOT DATE : 6/6/2018 5:45 PM PLOT BY : RACH, JEREMY PAUL PLOT NAME : PLOT SCALE : 1 IN:20 FT HORZ. / 1 IN:20 FT VERT.

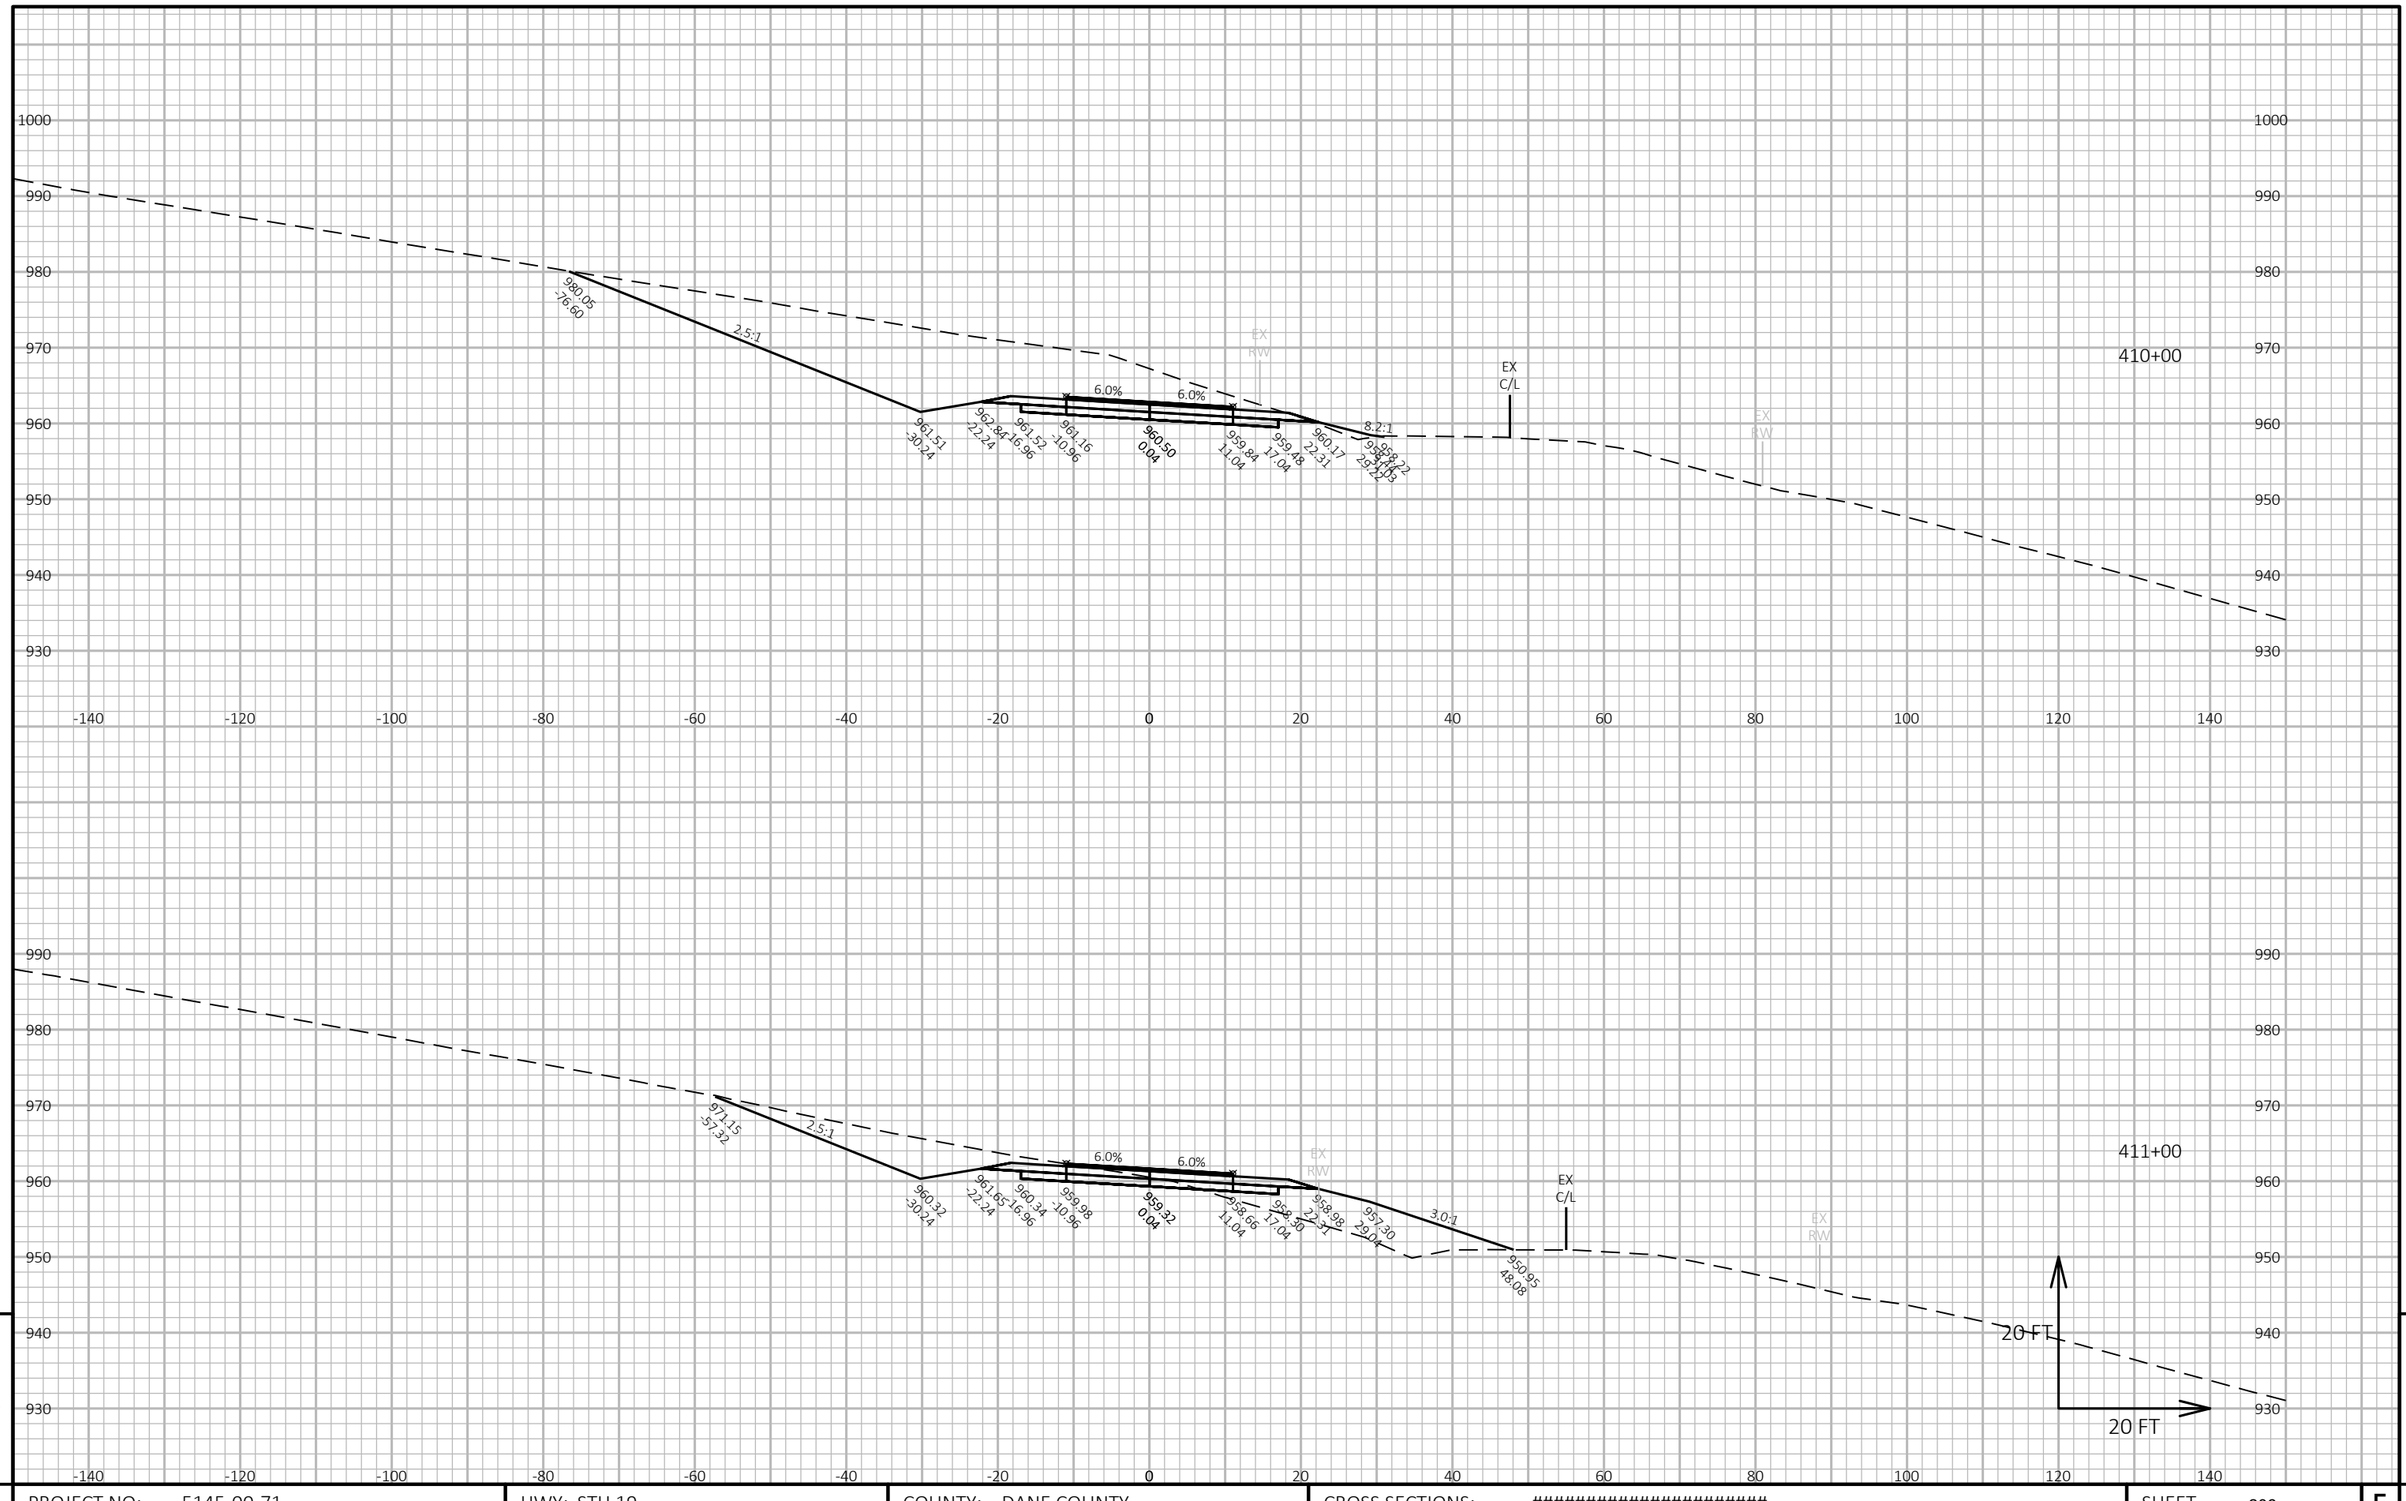

PROJECT NO: 5145-00-71	HWY: STH 19	COUNTY: DANE COUNTY	CROSS SECTIONS: ##########################	SHEET 206 E

FILE NAME : N:\PDS\C3D\51450001\SHEETSPLAN\090201_XS.DWG
LAYOUT NAME - 0902159-xs

PLOT DATE : 6/6/2018 5:46 PM PLOT BY : RACH, JEREMY PAUL PLOT NAME : PLOT SCALE : 1 IN:20 FT HORZ. / 1 IN:20 FT VERT.

WISDOT/CADDS SHEET 49

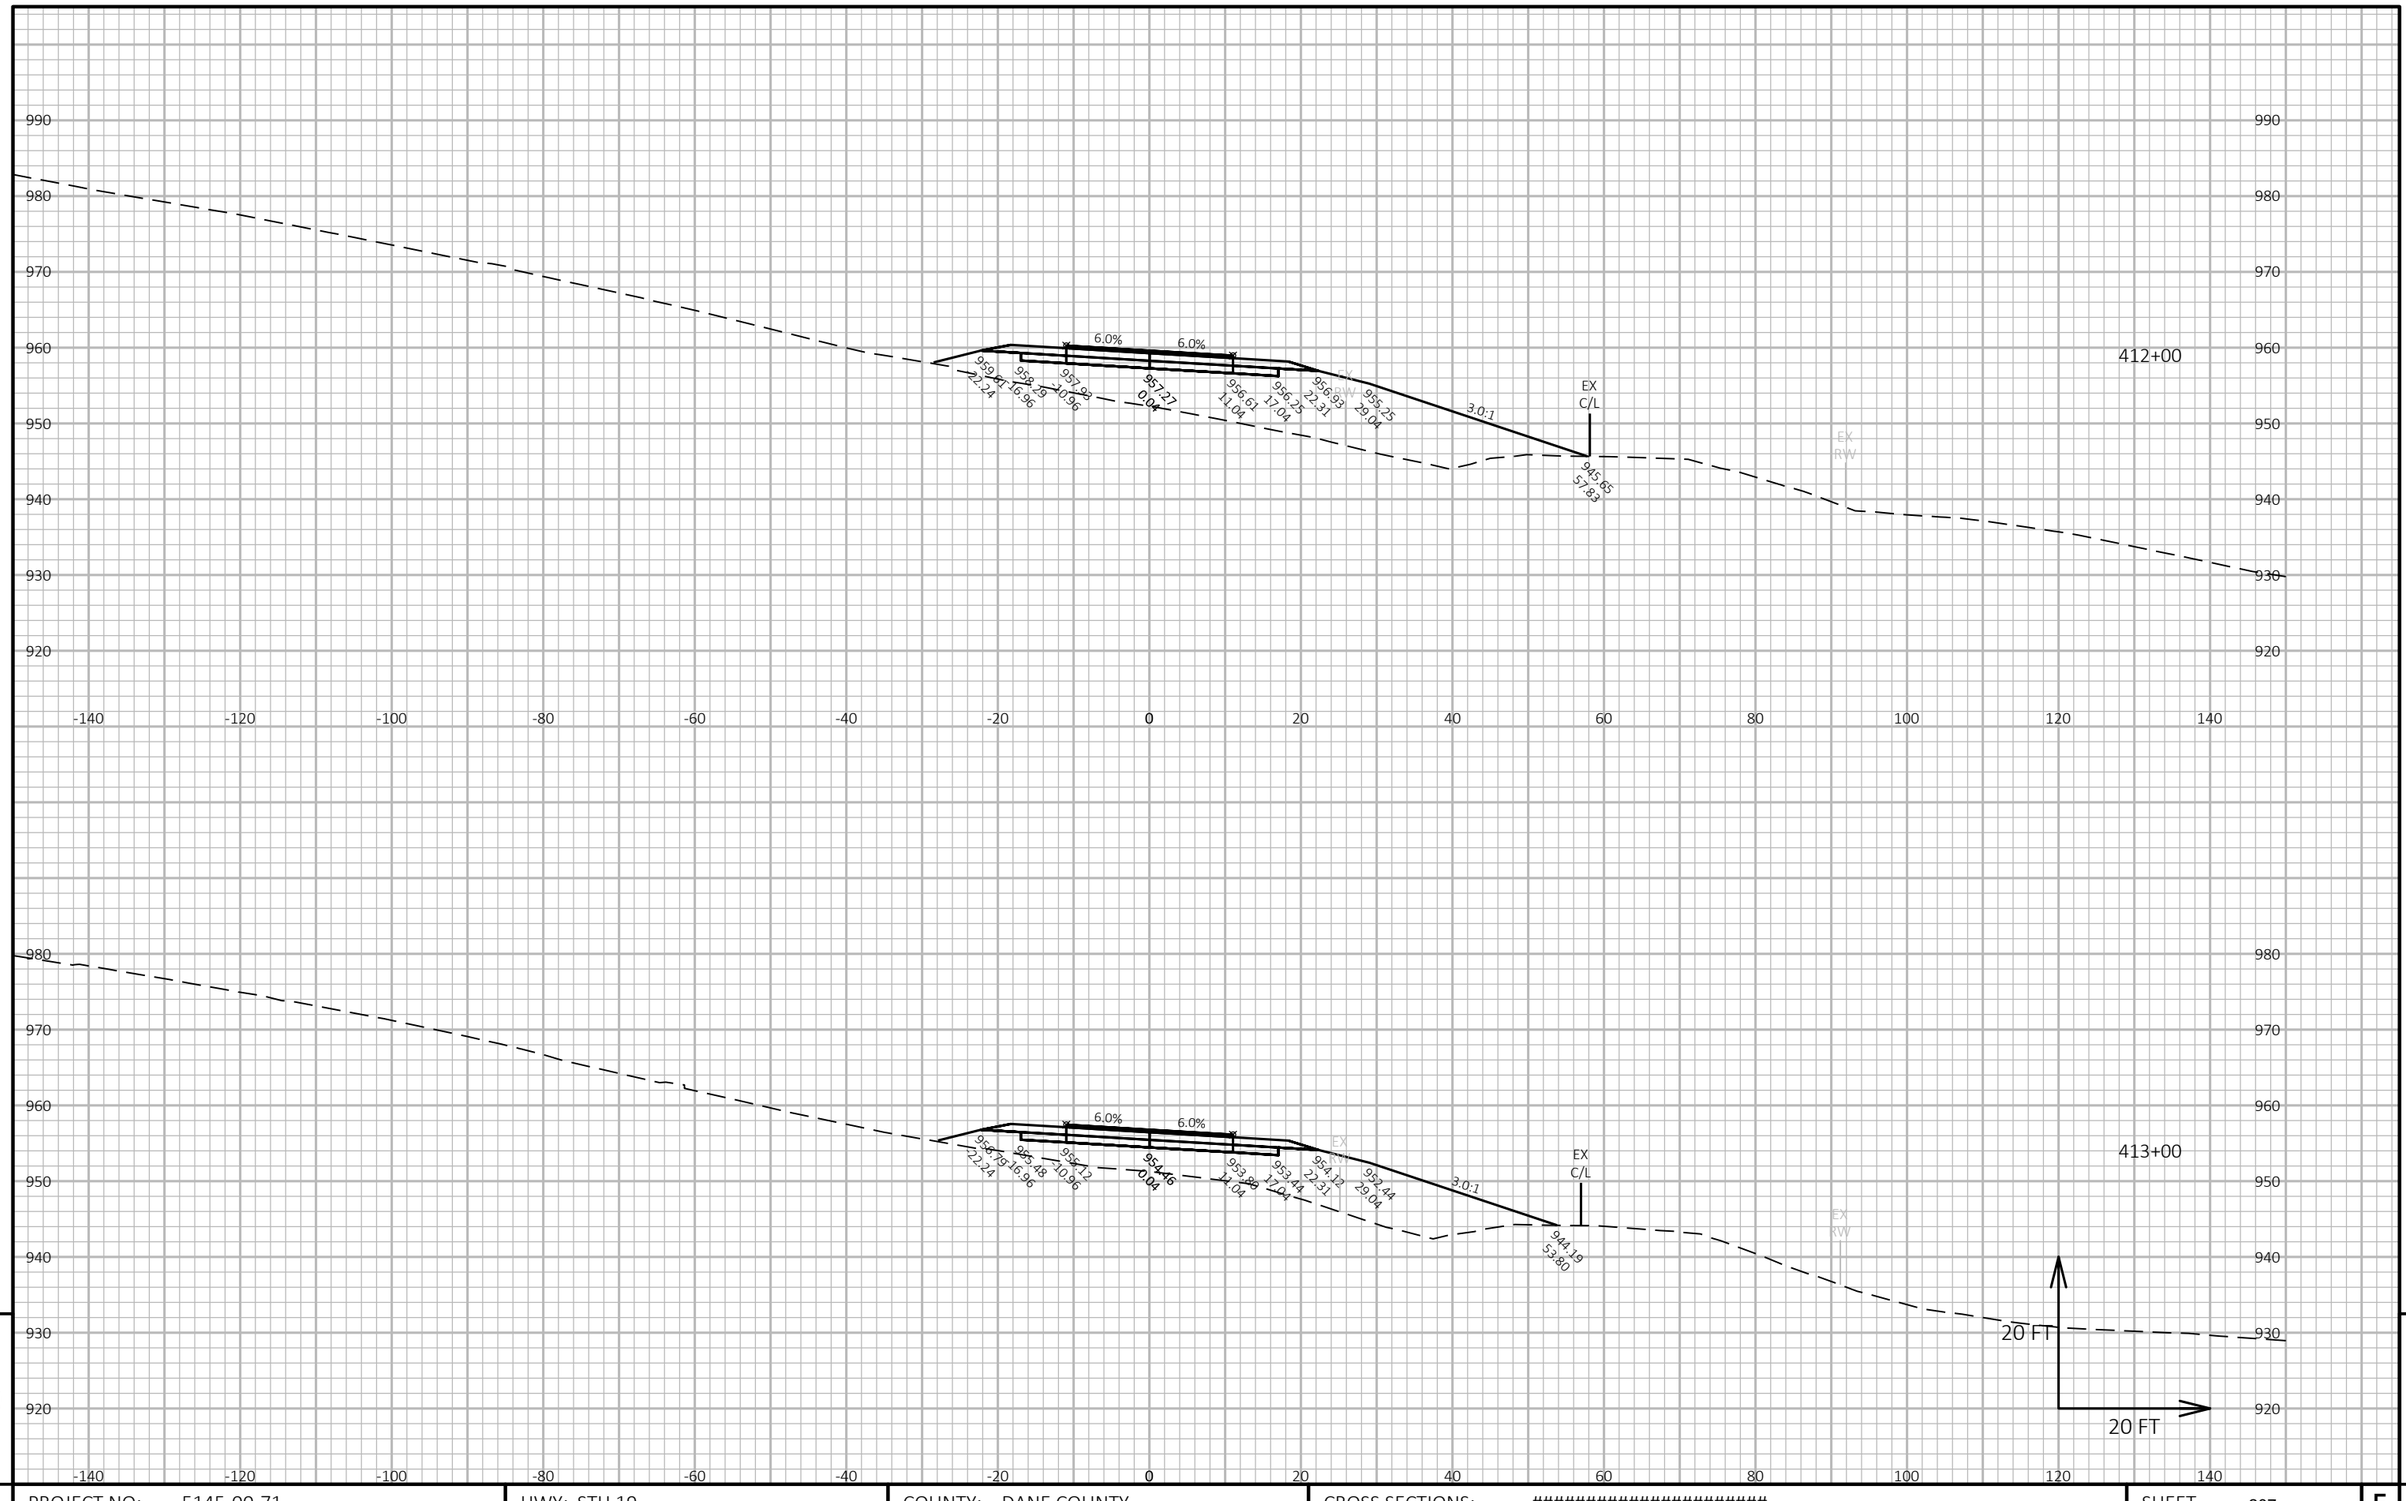

9

9

PROJECT NO: 5145-00-71	HWY: STH 19	COUNTY: DANE COUNTY	CROSS SECTIONS: ##########################	SHEET 207	E

FILE NAME : N:\PDS\C3D\51450001\SHEETSPLAN\090201_XS.DWG
LAYOUT NAME - 0902160-xs

PLOT DATE : 6/6/2018 5:46 PM PLOT BY : RACH, JEREMY PAUL PLOT NAME : PLOT SCALE : 1 IN:20 FT HORZ. / 1 IN:20 FT VERT.

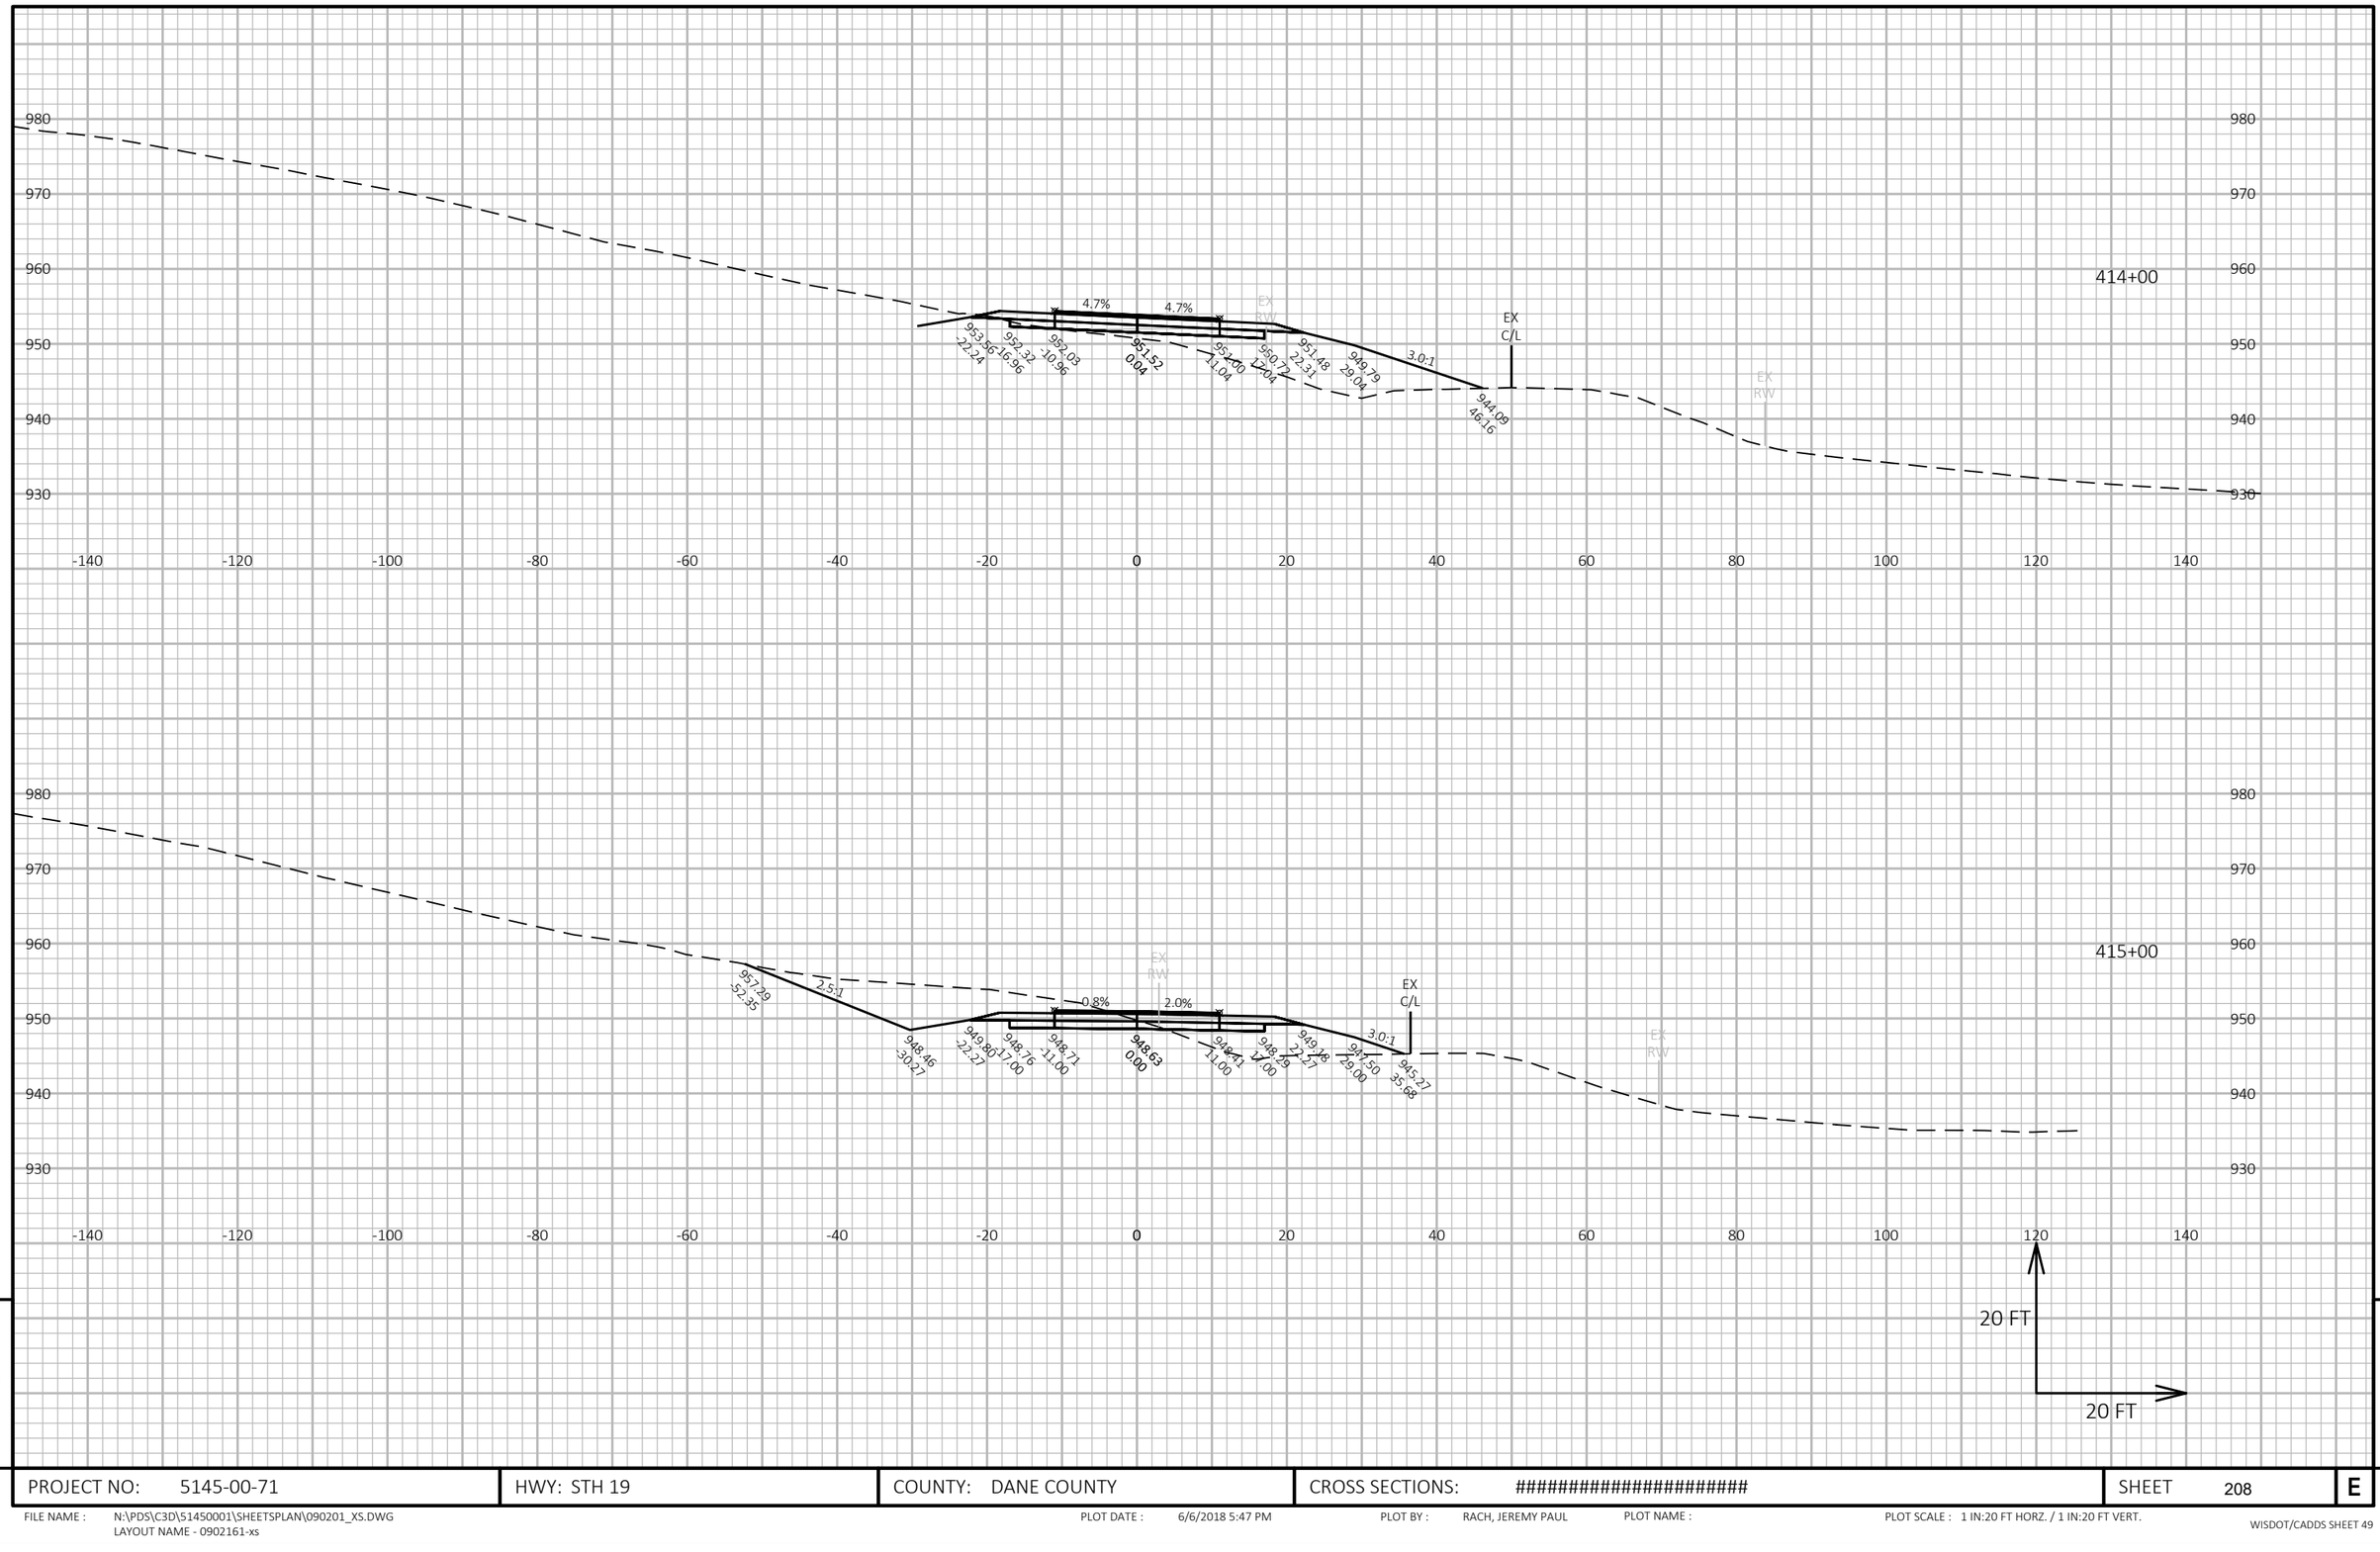

PROJECT NO: 5145-00-71	HWY: STH 19	COUNTY: DANE COUNTY	CROSS SECTIONS: ##########################	SHEET 208	E

FILE NAME : N:\PDS\C3D\51450001\SHEETSPLAN\090201_XS.DWG
LAYOUT NAME - 0902161-xs

PLOT DATE : 6/6/2018 5:47 PM PLOT BY : RACH, JEREMY PAUL PLOT NAME : PLOT SCALE : 1 IN:20 FT HORZ. / 1 IN:20 FT VERT.

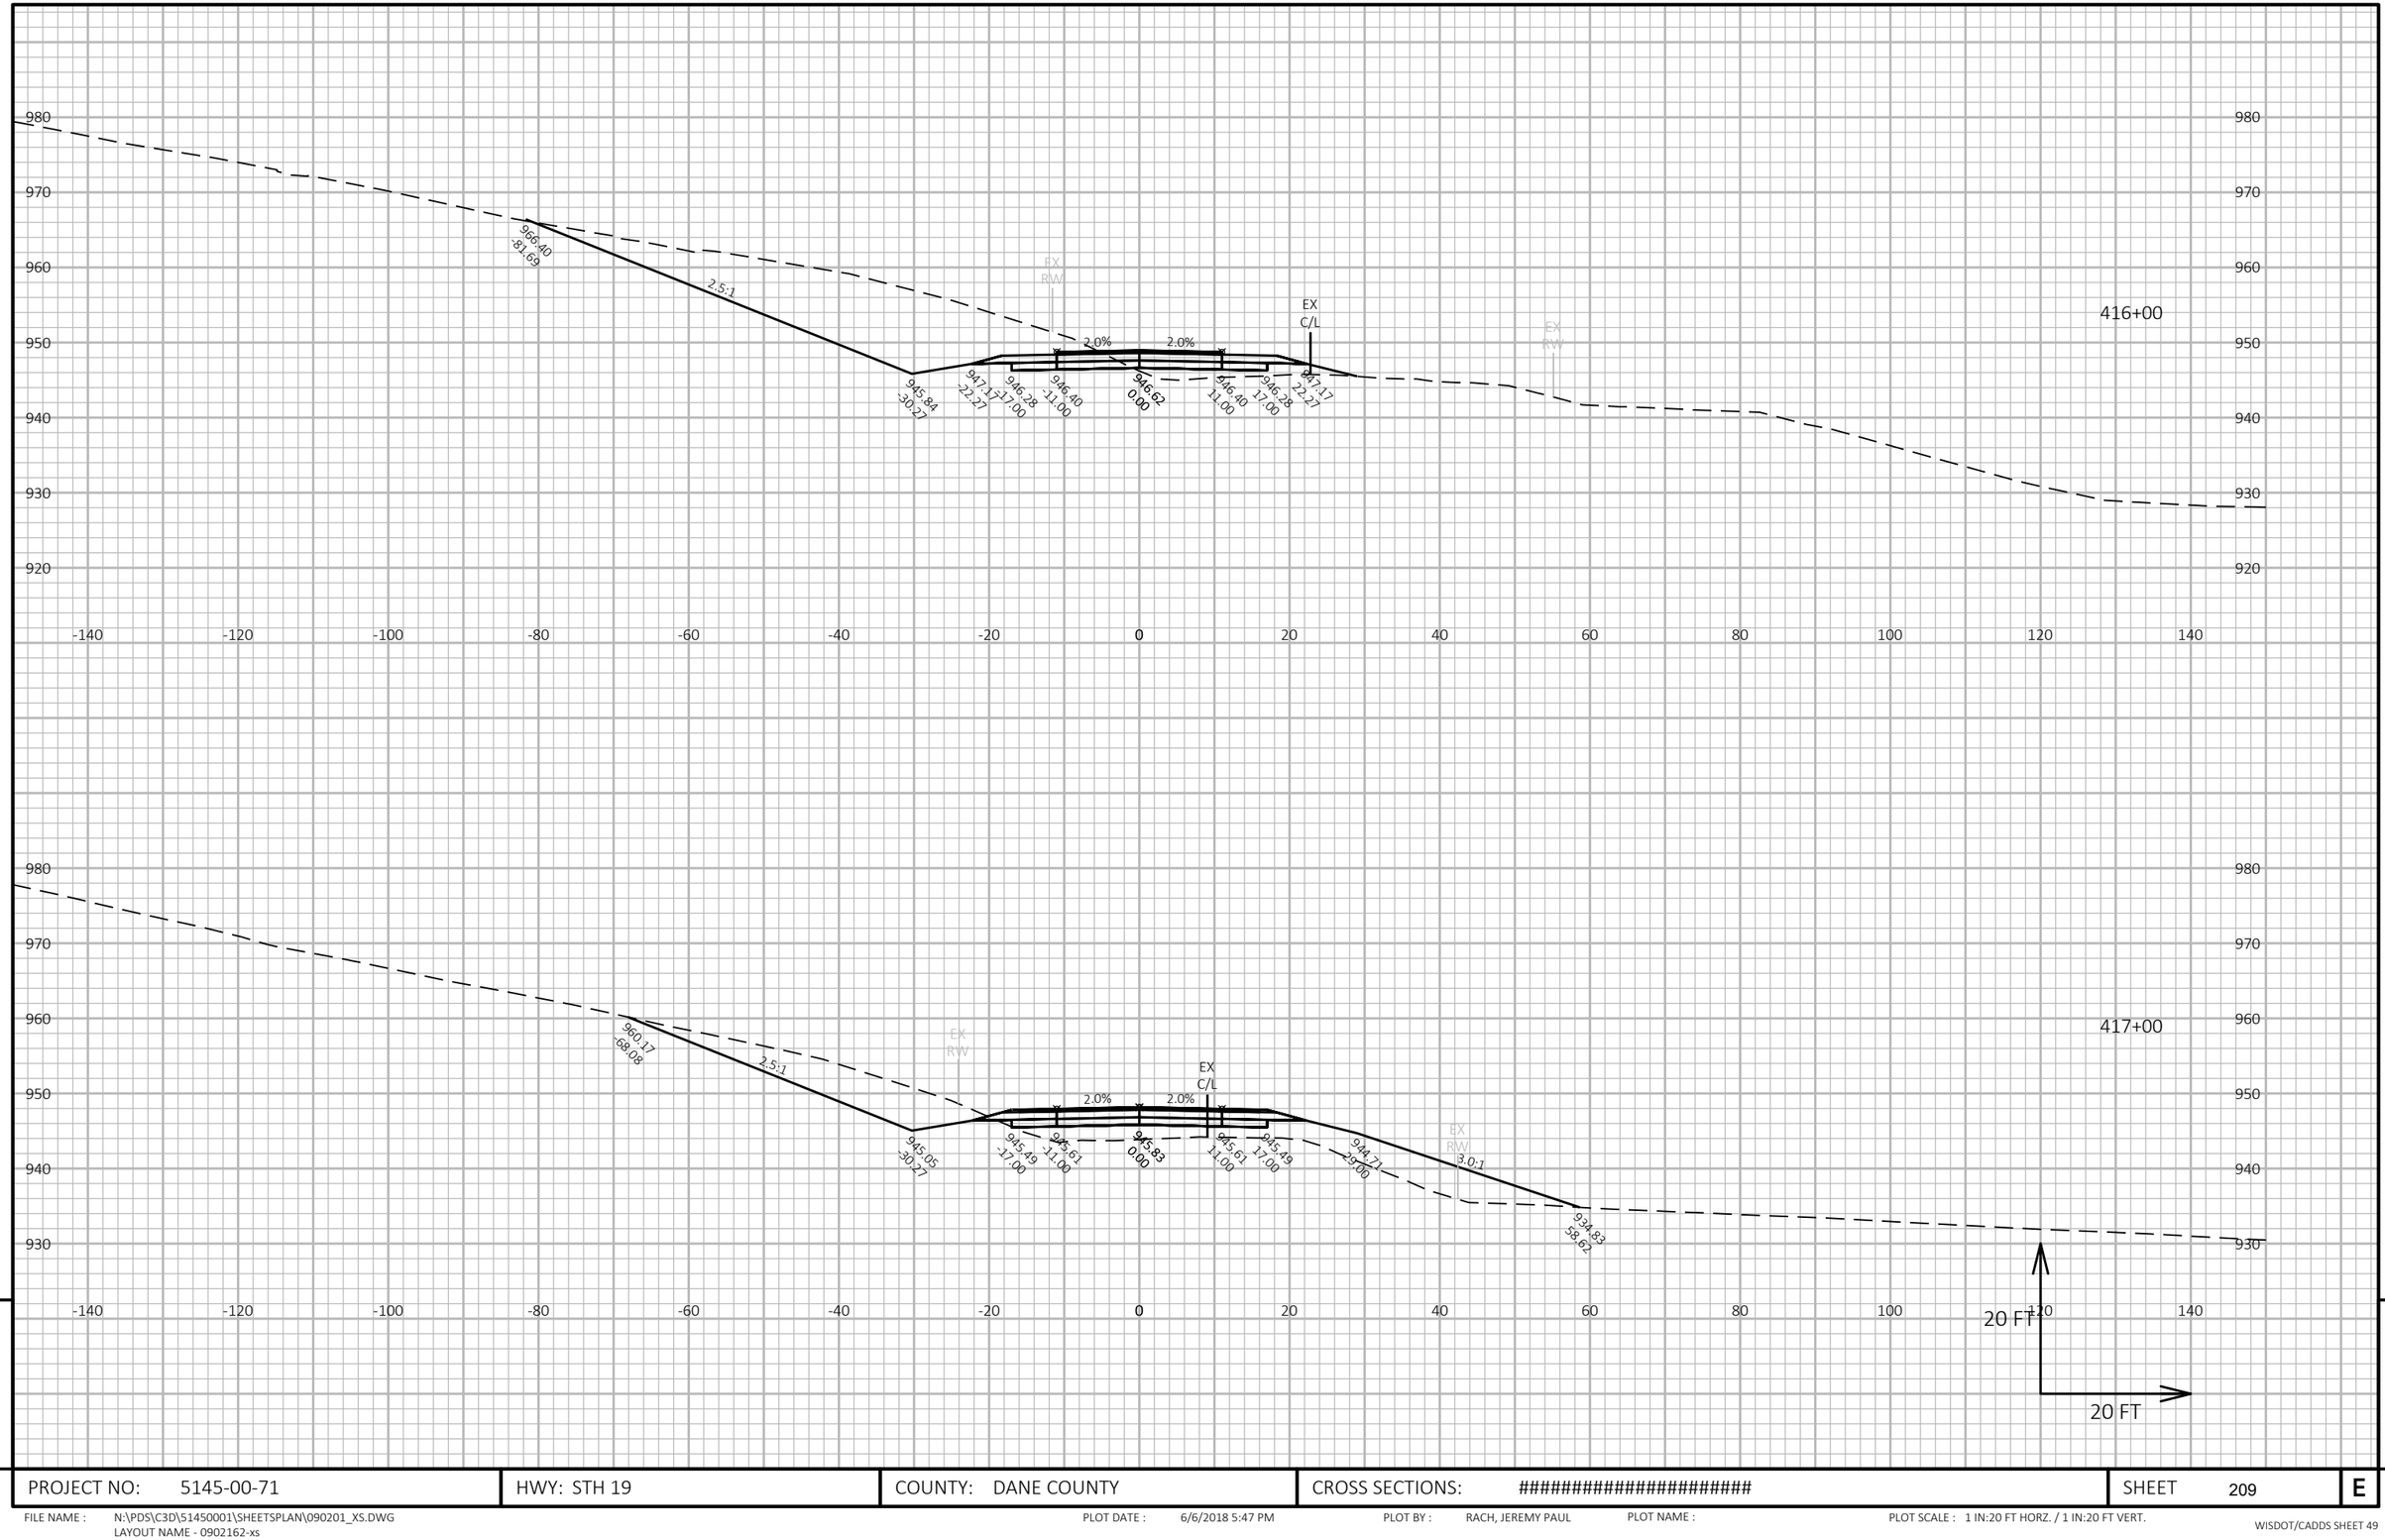

PROJECT NO: 5145-00-71	HWY: STH 19	COUNTY: DANE COUNTY	CROSS SECTIONS: ##########################	SHEET 209	E

FILE NAME : N:\PDS\C3D\51450001\SHEETSPLAN\090201_XS.DWG
LAYOUT NAME - 0902162-xs

PLOT DATE : 6/6/2018 5:47 PM PLOT BY : RACH, JEREMY PAUL PLOT NAME : PLOT SCALE : 1 IN:20 FT HORZ. / 1 IN:20 FT VERT.

WISDOT/CADDS SHEET 49

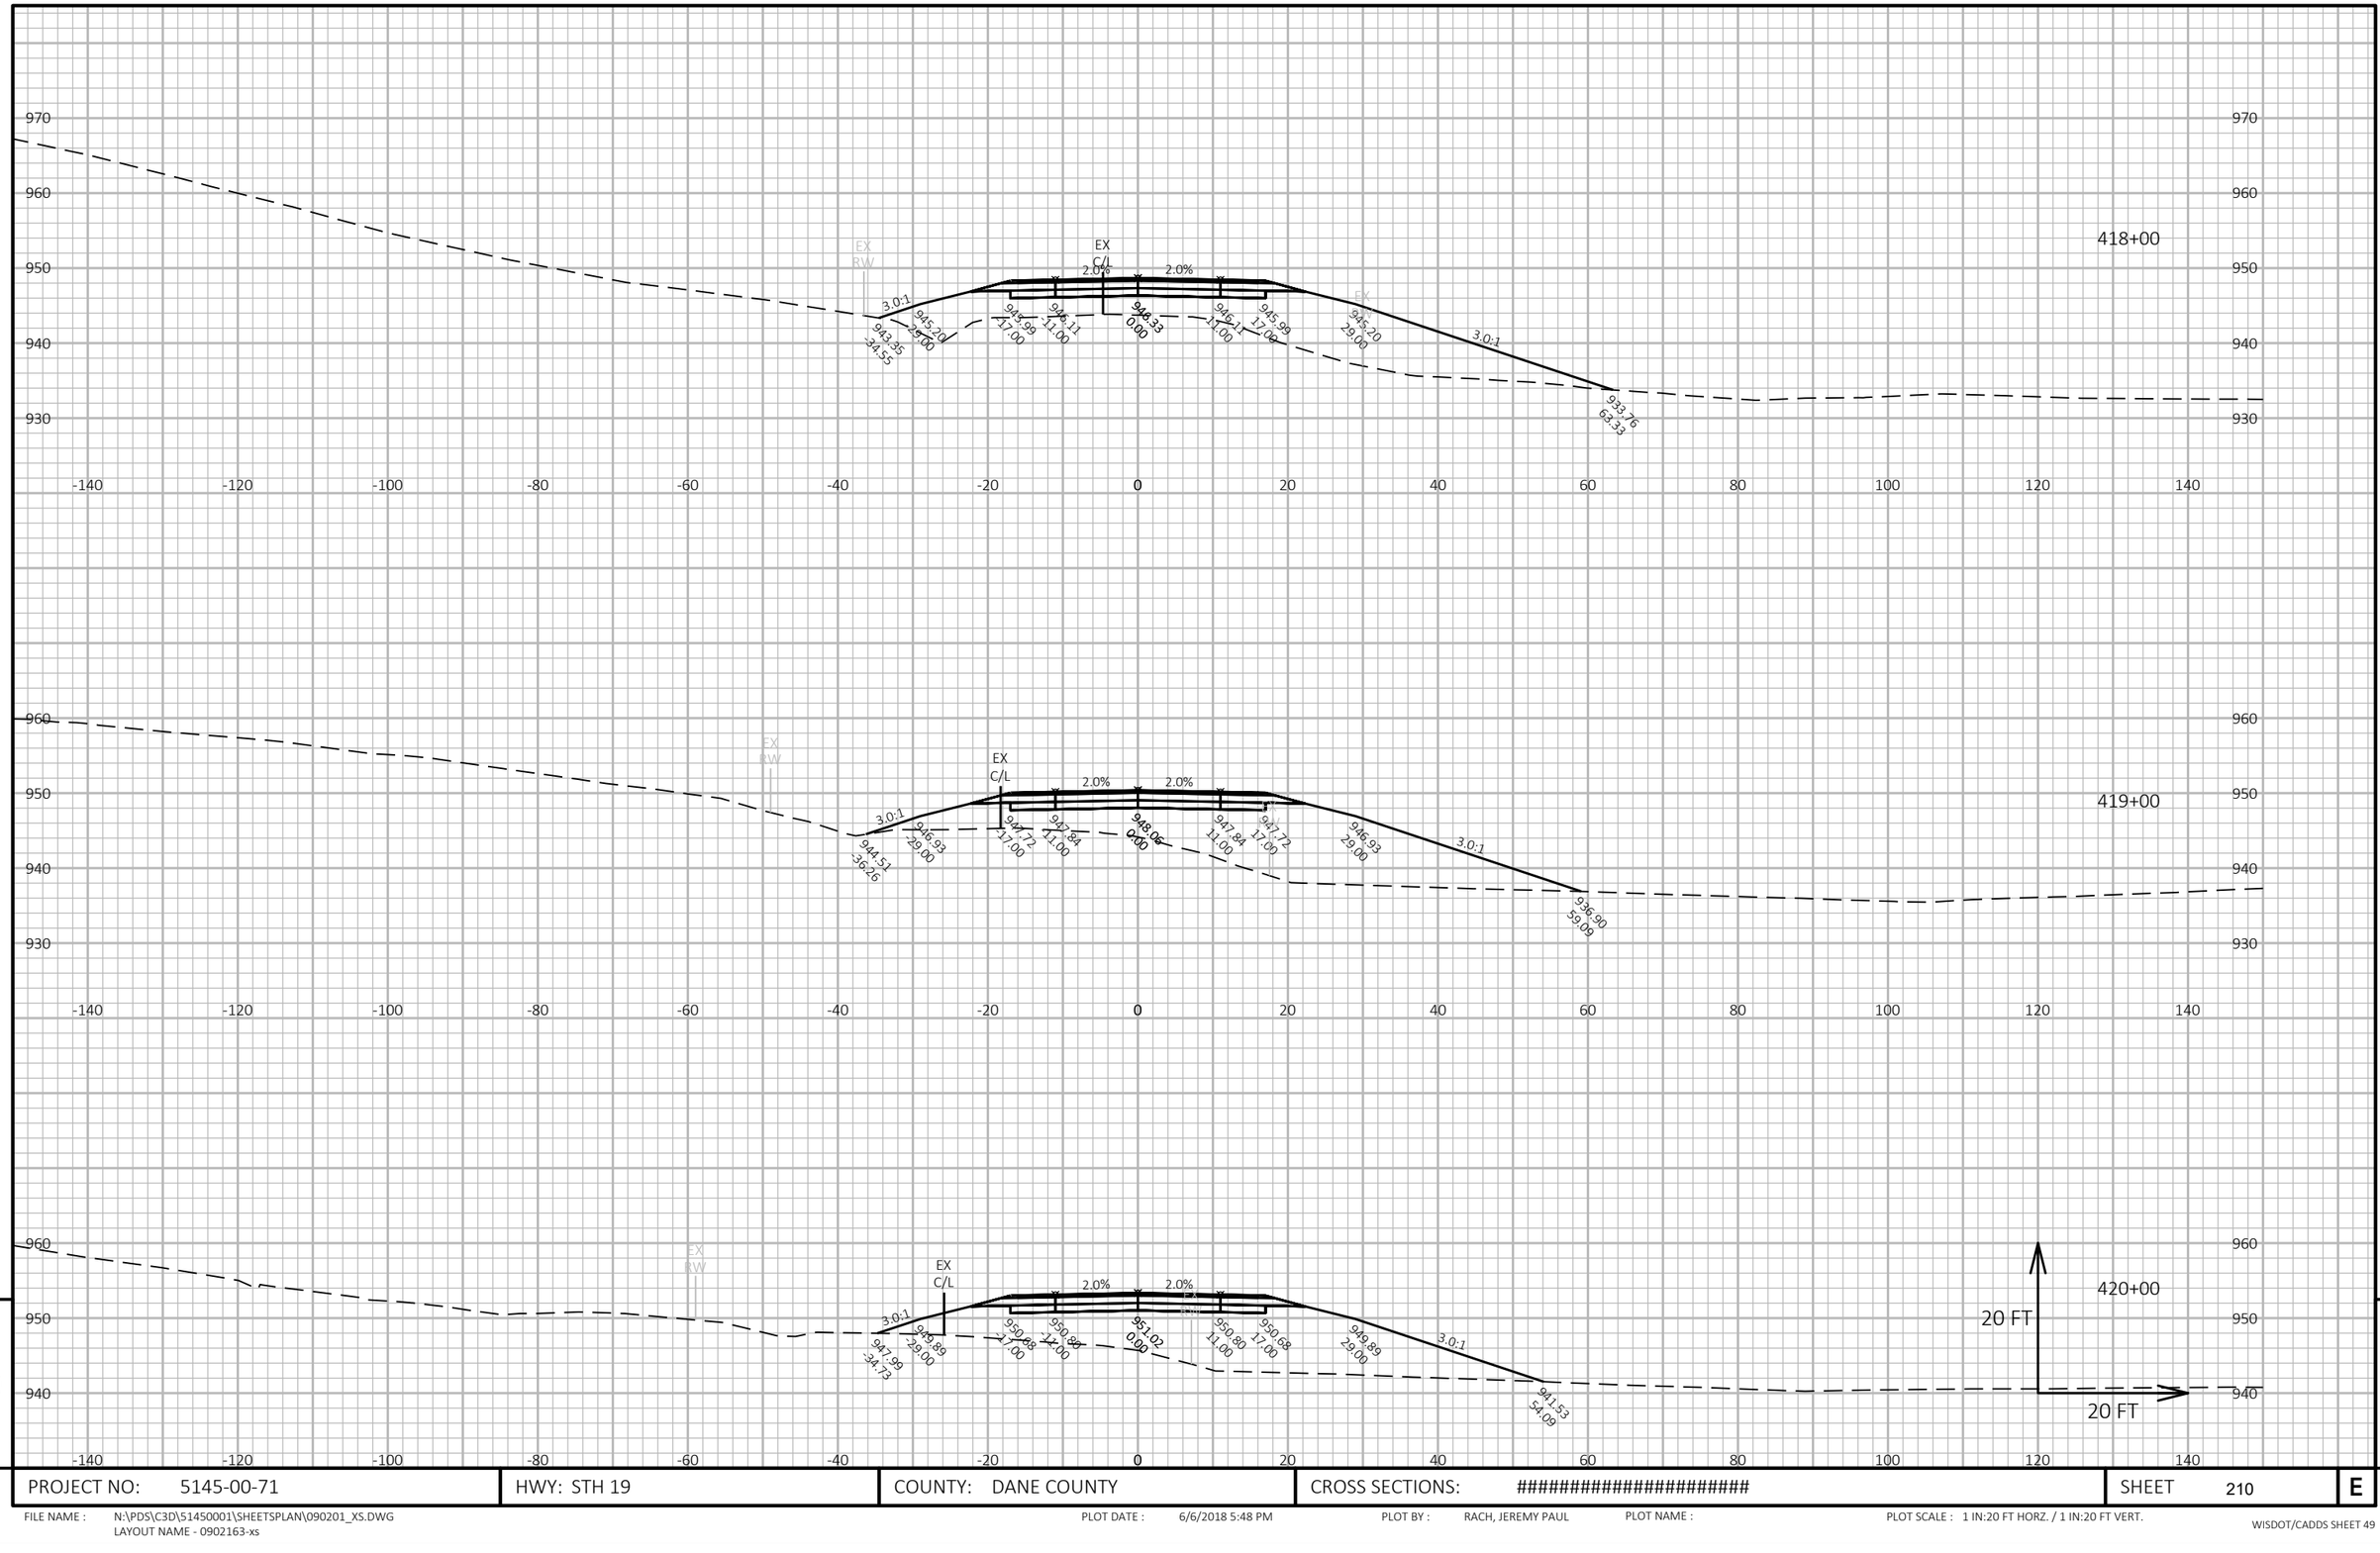

PROJECT NO: 5145-00-71	HWY: STH 19	COUNTY: DANE COUNTY	CROSS SECTIONS: ##########################	SHEET 210	E

FILE NAME : N:\PDS\C3D\51450001\SHEETSPLAN\090201_XS.DWG
LAYOUT NAME - 0902163-xs

PLOT DATE : 6/6/2018 5:48 PM PLOT BY : RACH, JEREMY PAUL PLOT NAME : PLOT SCALE : 1 IN:20 FT HORZ. / 1 IN:20 FT VERT.

WISDOT/CADDS SHEET 49

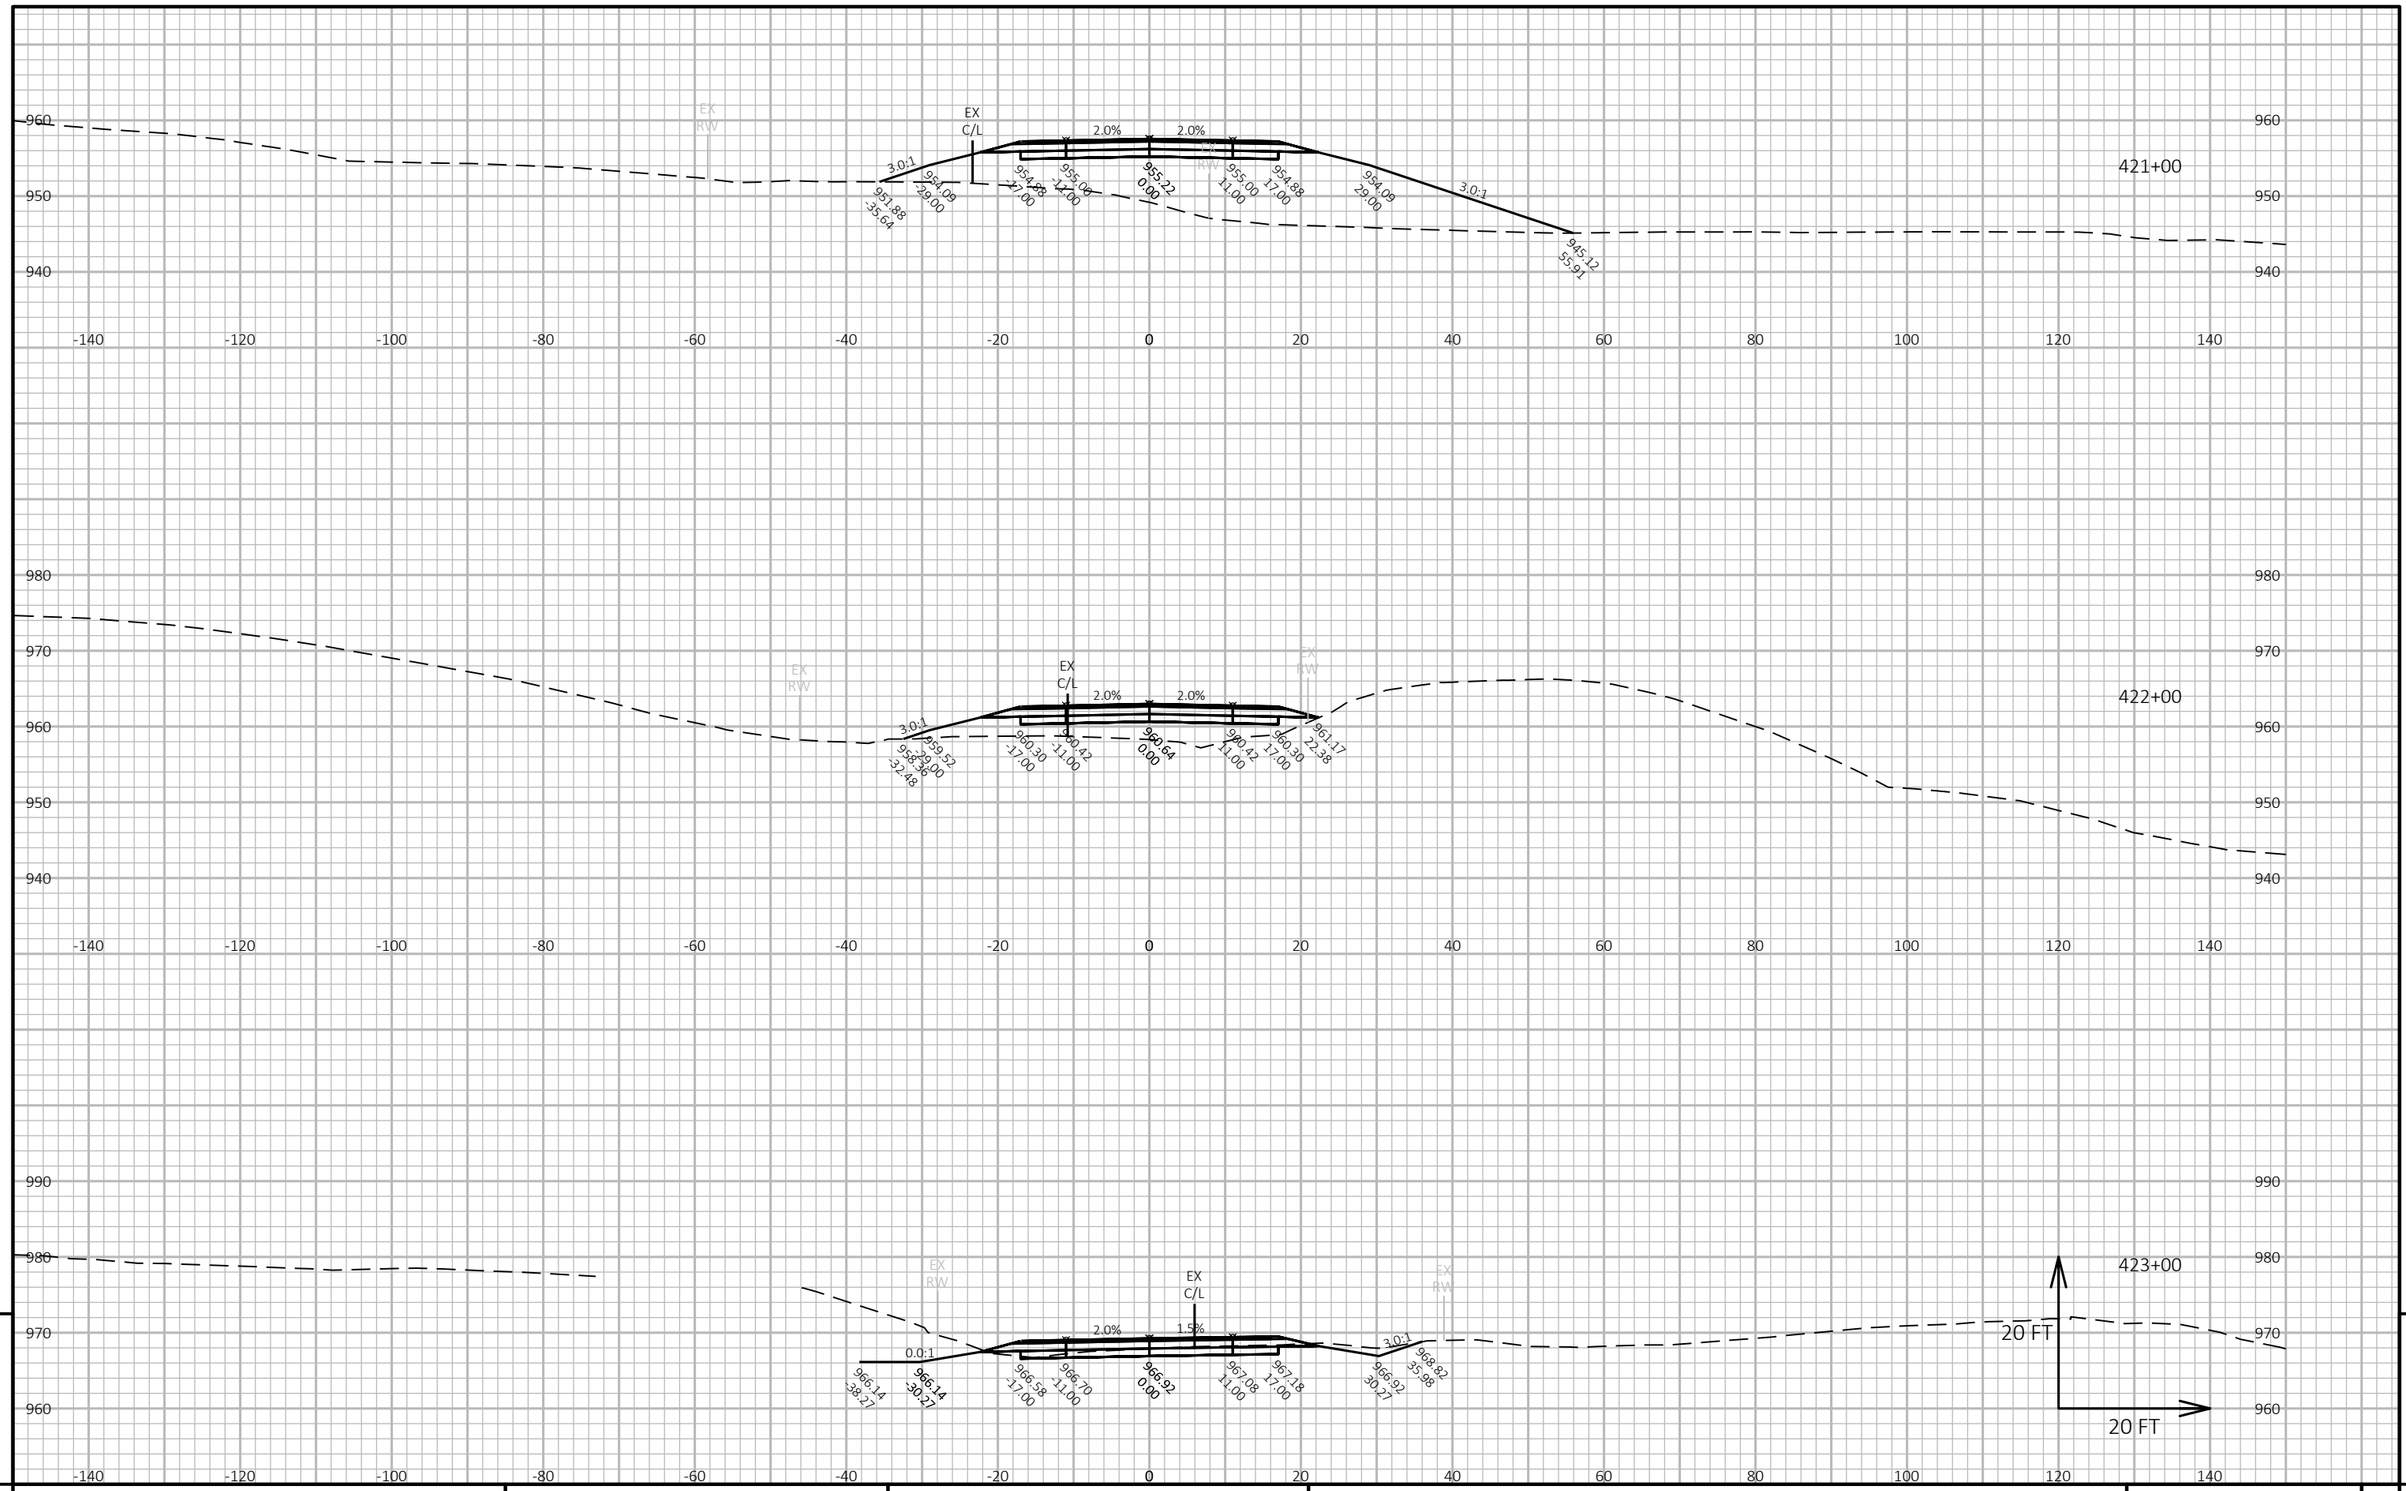

PROJECT NO: 5145-00-71	HWY: STH 19	COUNTY: DANE COUNTY	CROSS SECTIONS: ##########################	SHEET 211	E

FILE NAME : N:\PDS\C3D\51450001\SHEETSPLAN\090201_XS.DWG
LAYOUT NAME - 0902164-xs

PLOT DATE : 6/6/2018 5:48 PM PLOT BY : RACH, JEREMY PAUL PLOT NAME : PLOT SCALE : 1 IN:20 FT HORZ. / 1 IN:20 FT VERT.

WISDOT/CADDS SHEET 49

9

9

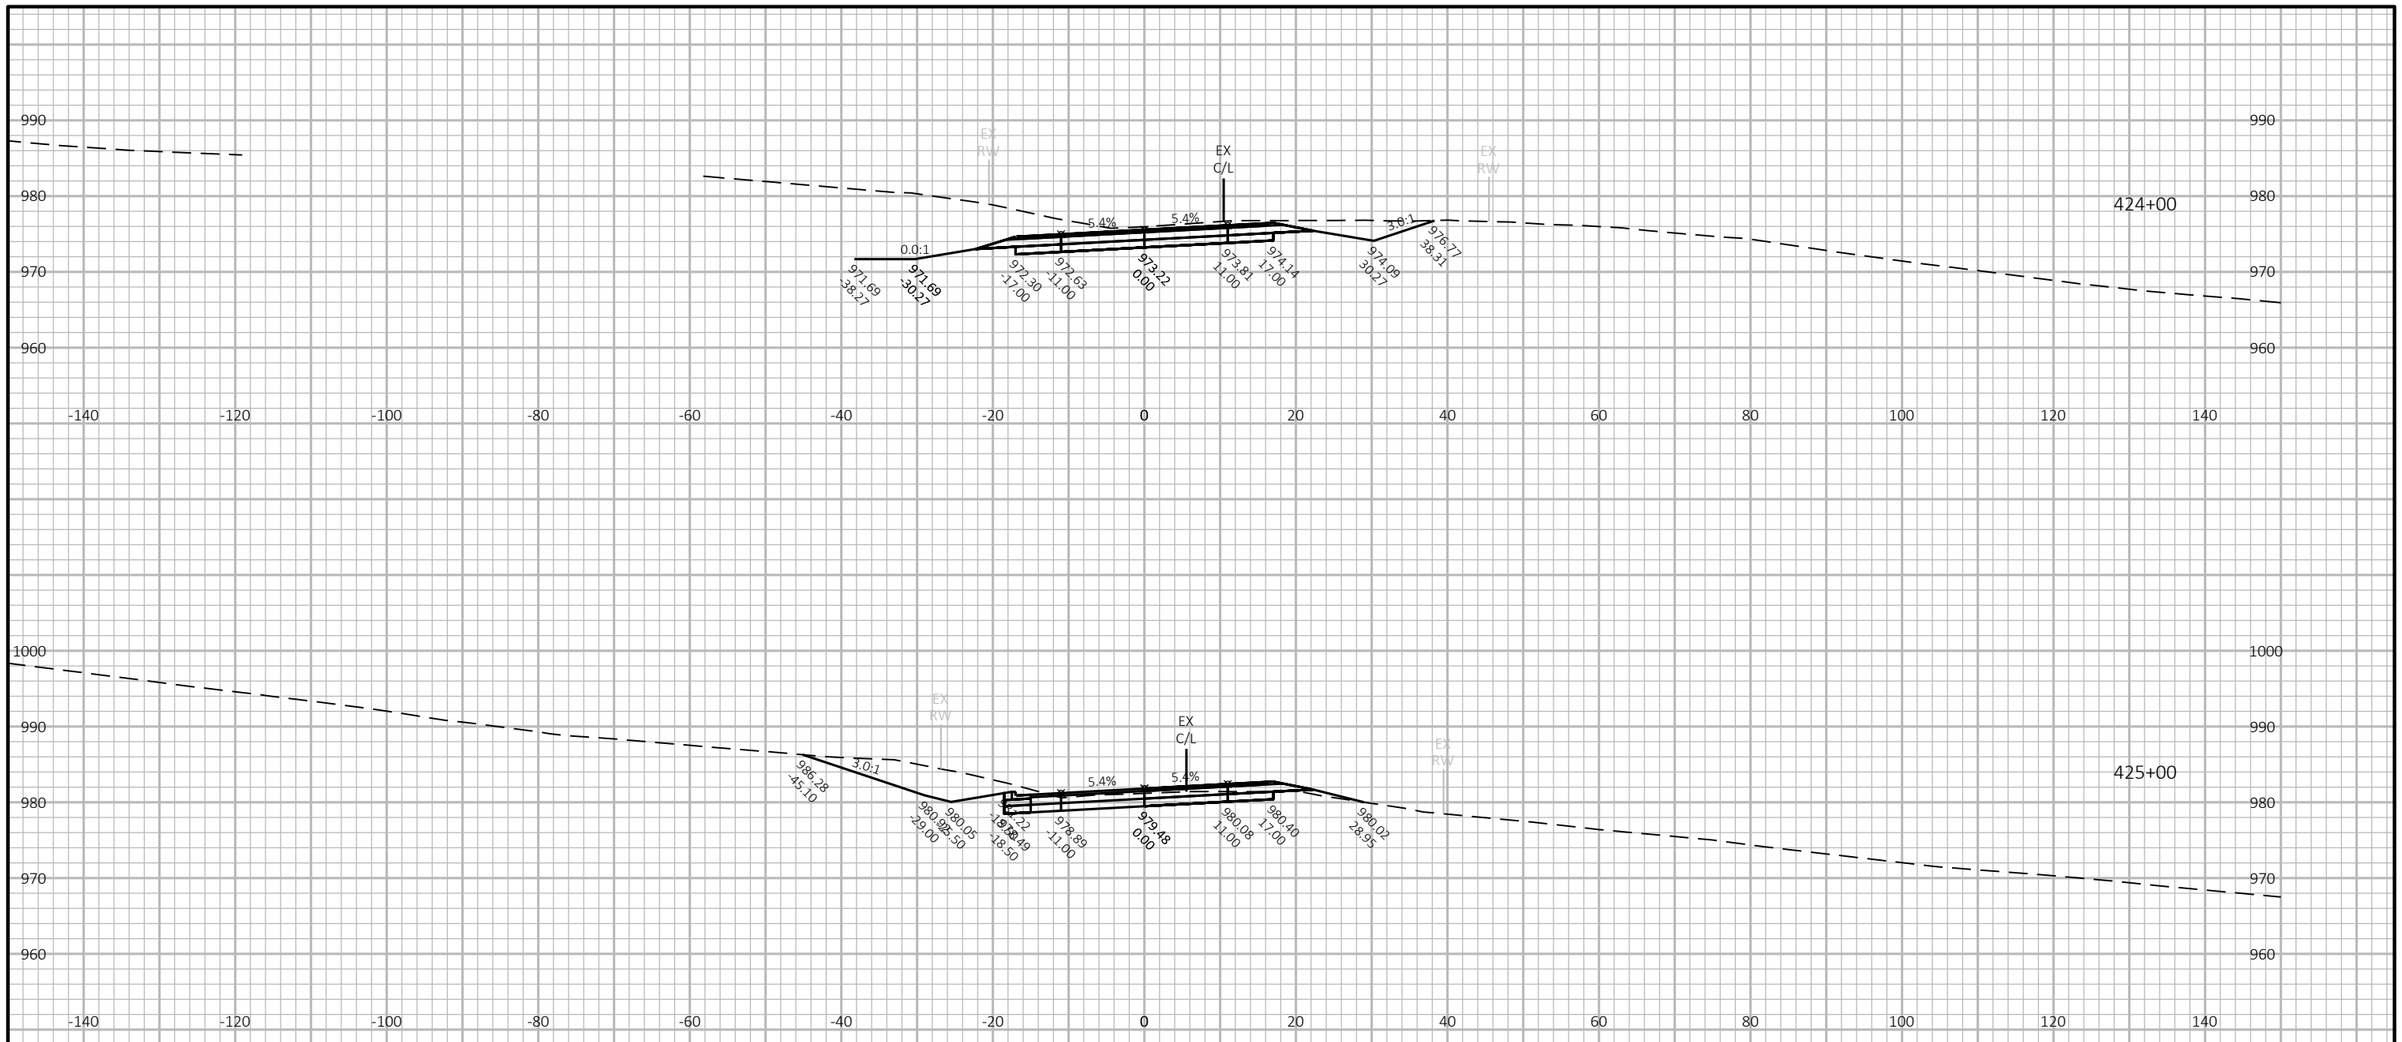

9

9

PROJECT NO: 5145-00-71	HWY: STH 19	COUNTY: DANE COUNTY	CROSS SECTIONS: ##########################	SHEET 212	E

FILE NAME : N:\PDS\C3D\51450001\SHEETSPLAN\090201_XS.DWG
LAYOUT NAME - 0902165-xs
PLOT DATE : 6/6/2018 5:48 PM
PLOT BY : RACH, JEREMY PAUL
PLOT NAME :
PLOT SCALE : 1 IN:20 FT HORZ. / 1 IN:20 FT VERT.
WISDOT/CADDS SHEET 49

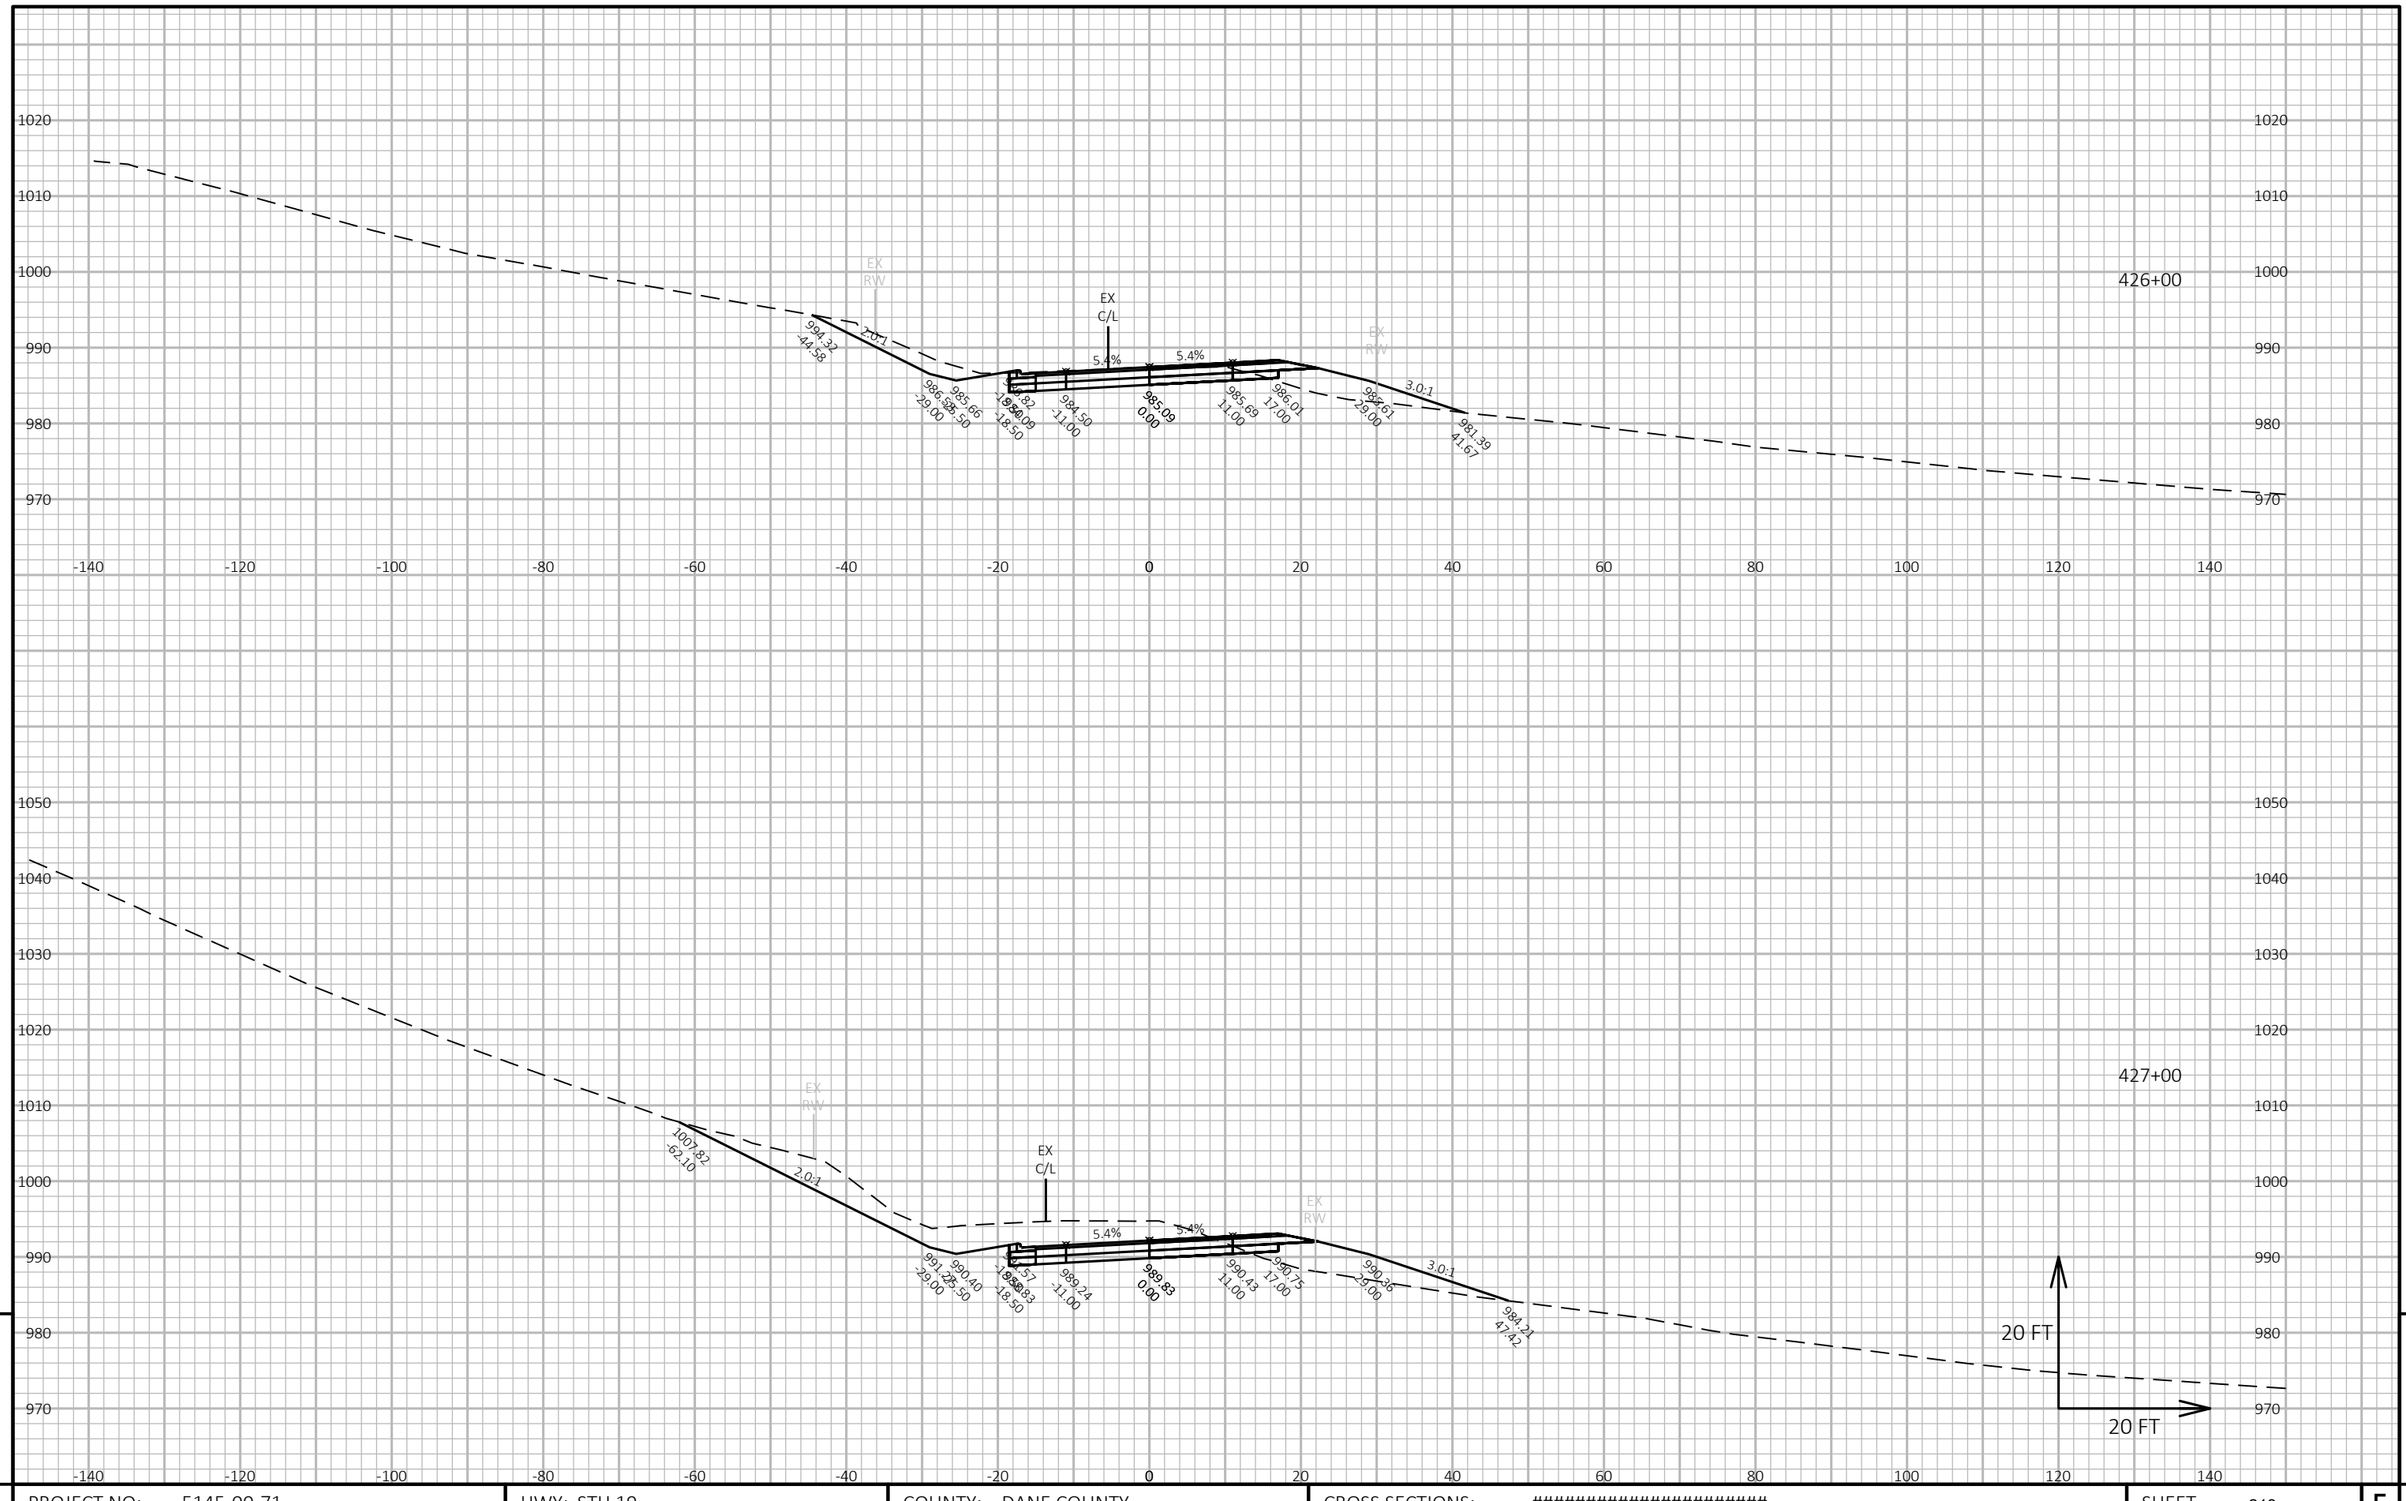

PROJECT NO: 5145-00-71	HWY: STH 19	COUNTY: DANE COUNTY	CROSS SECTIONS: ##########################	SHEET 213

FILE NAME : N:\PDS\C3D\51450001\SHEETSPLAN\090201_XS.DWG
LAYOUT NAME - 0902166-xs

PLOT DATE : 6/6/2018 5:49 PM PLOT BY : RACH, JEREMY PAUL PLOT NAME : PLOT SCALE : 1 IN:20 FT HORZ. / 1 IN:20 FT VERT.

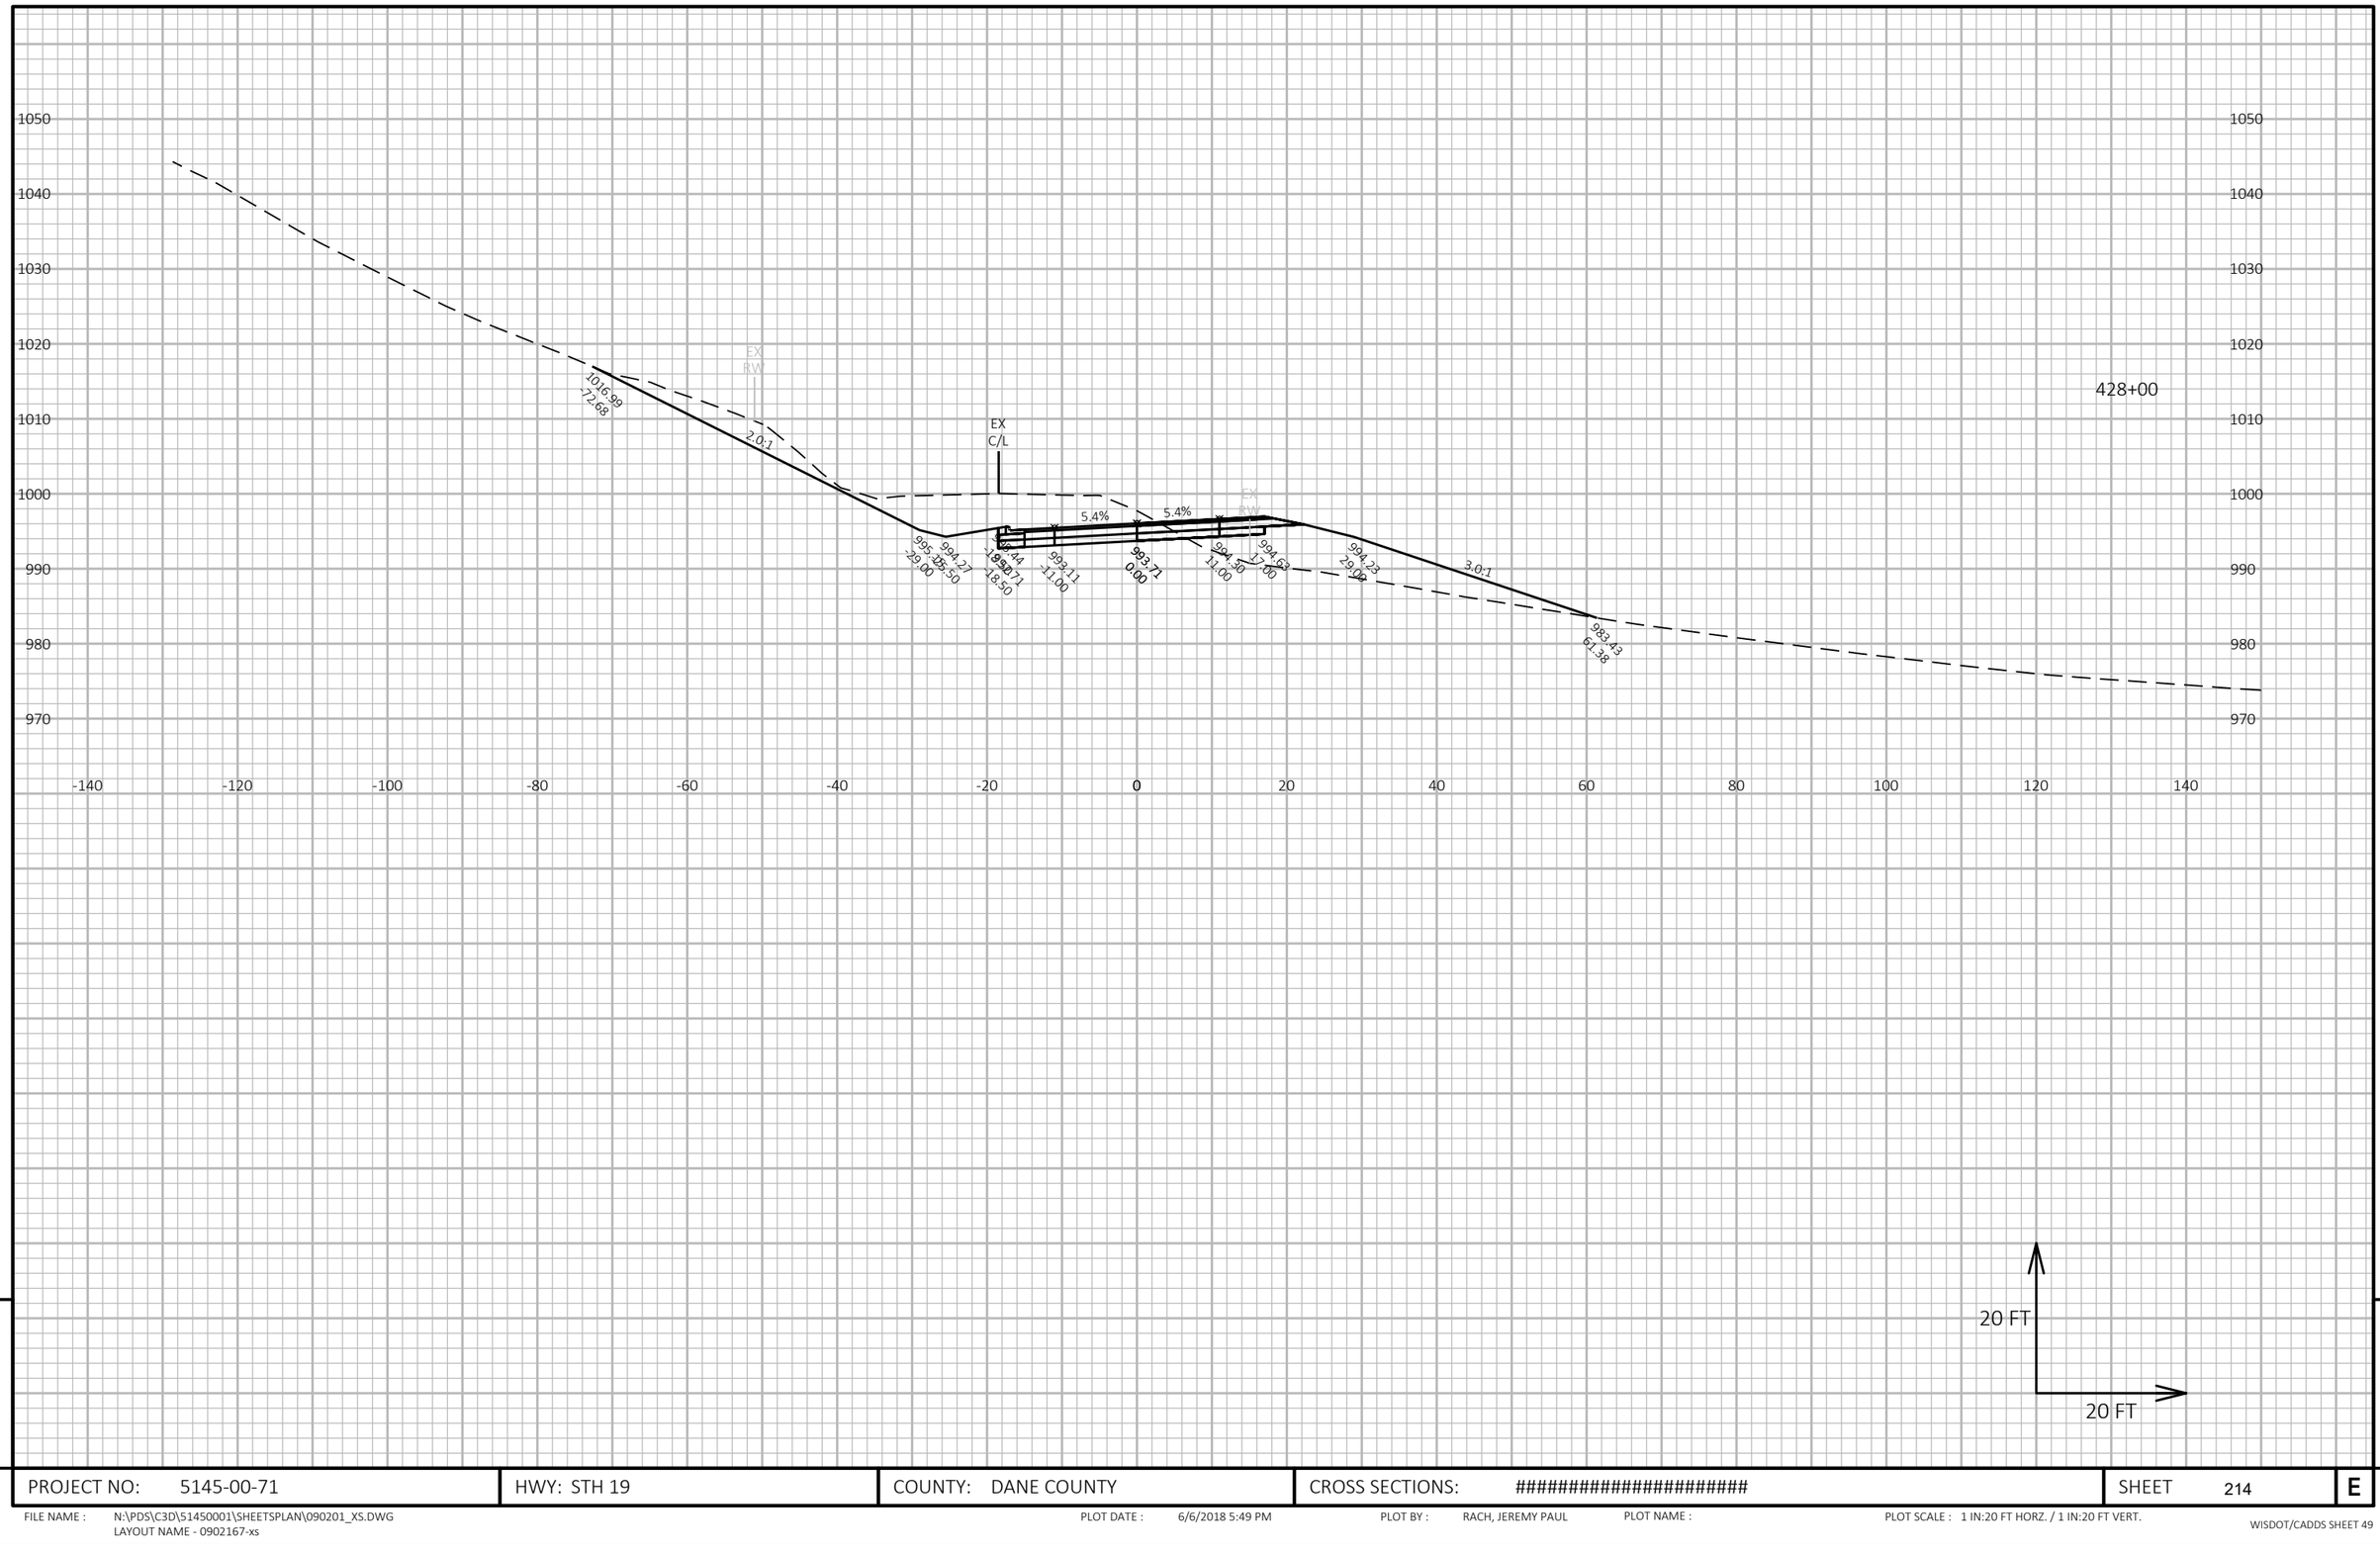

9

9

PROJECT NO: 5145-00-71	HWY: STH 19	COUNTY: DANE COUNTY	CROSS SECTIONS: ##########################	SHEET 214	E

FILE NAME : N:\PDS\C3D\51450001\SHEETSPLAN\090201_XS.DWG
LAYOUT NAME - 0902167-xs

PLOT DATE : 6/6/2018 5:49 PM

PLOT BY : RACH, JEREMY PAUL

PLOT NAME :

PLOT SCALE : 1 IN:20 FT HORZ. / 1 IN:20 FT VERT.

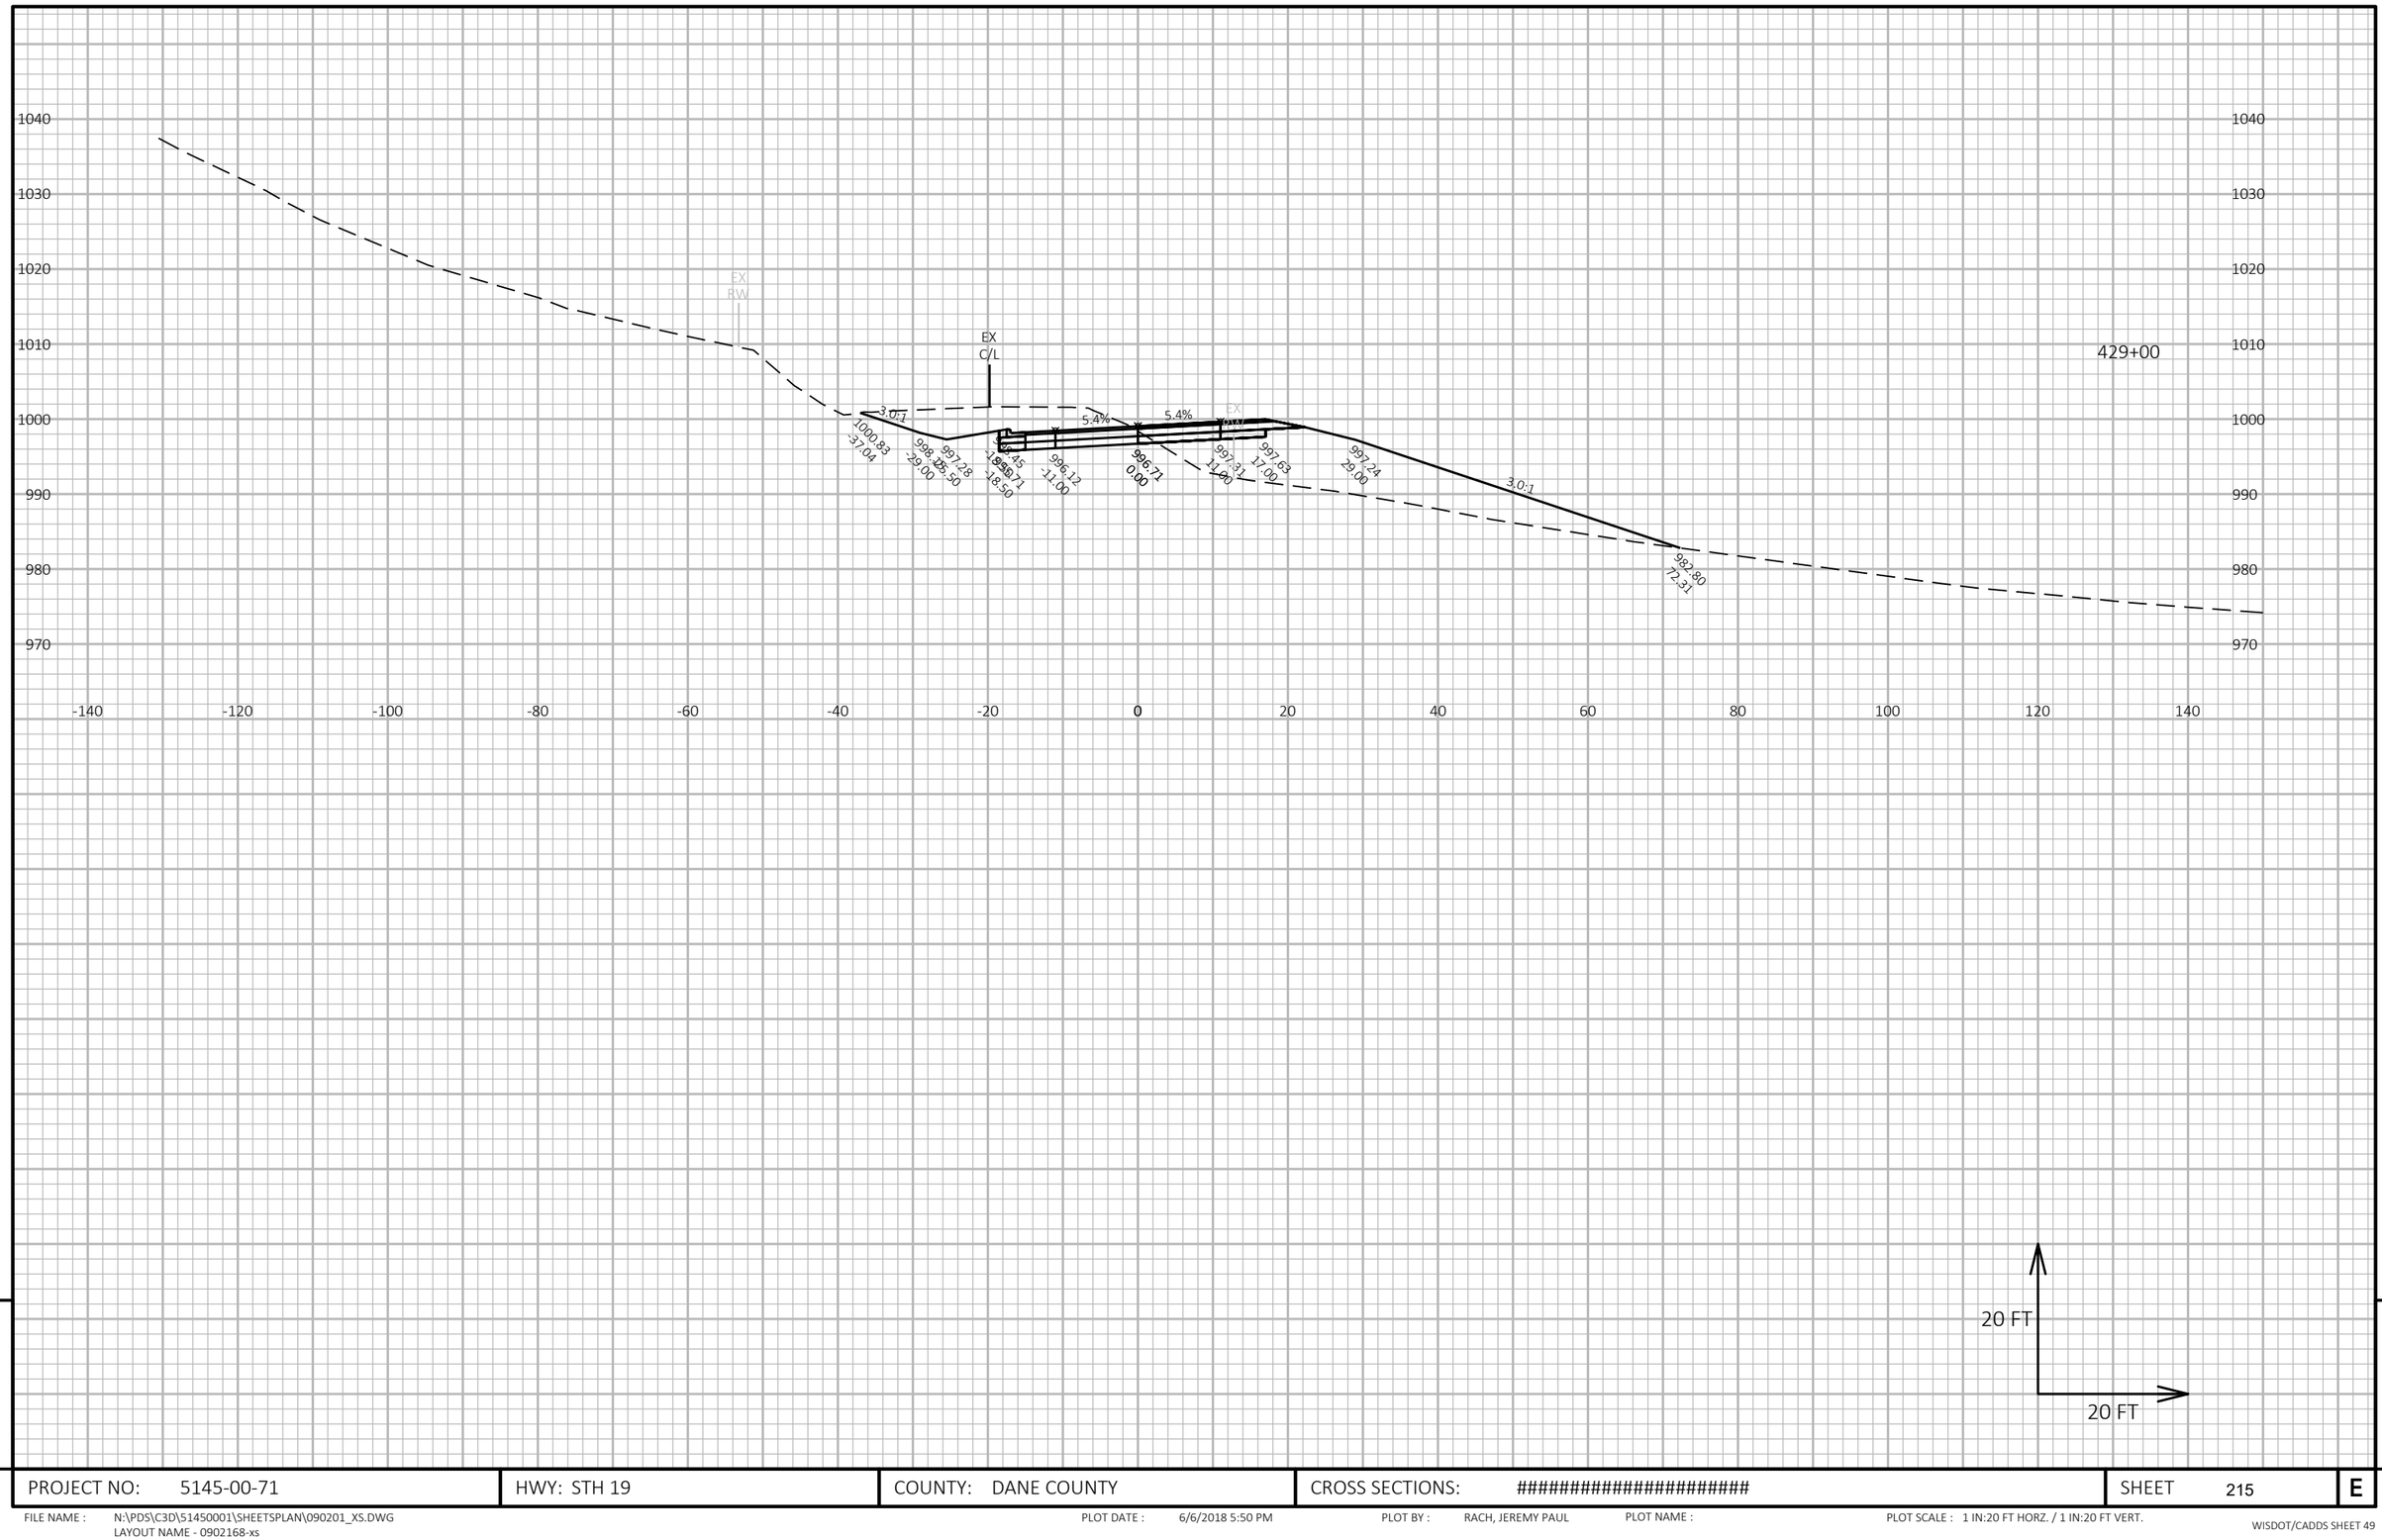

9

9

PROJECT NO: 5145-00-71	HWY: STH 19	COUNTY: DANE COUNTY	CROSS SECTIONS: ##########################	SHEET 215	E

FILE NAME : N:\PDS\C3D\51450001\SHEETSPLAN\090201_XS.DWG
LAYOUT NAME - 0902168-xs

PLOT DATE : 6/6/2018 5:50 PM PLOT BY : RACH, JEREMY PAUL PLOT NAME : PLOT SCALE : 1 IN:20 FT HORZ. / 1 IN:20 FT VERT.

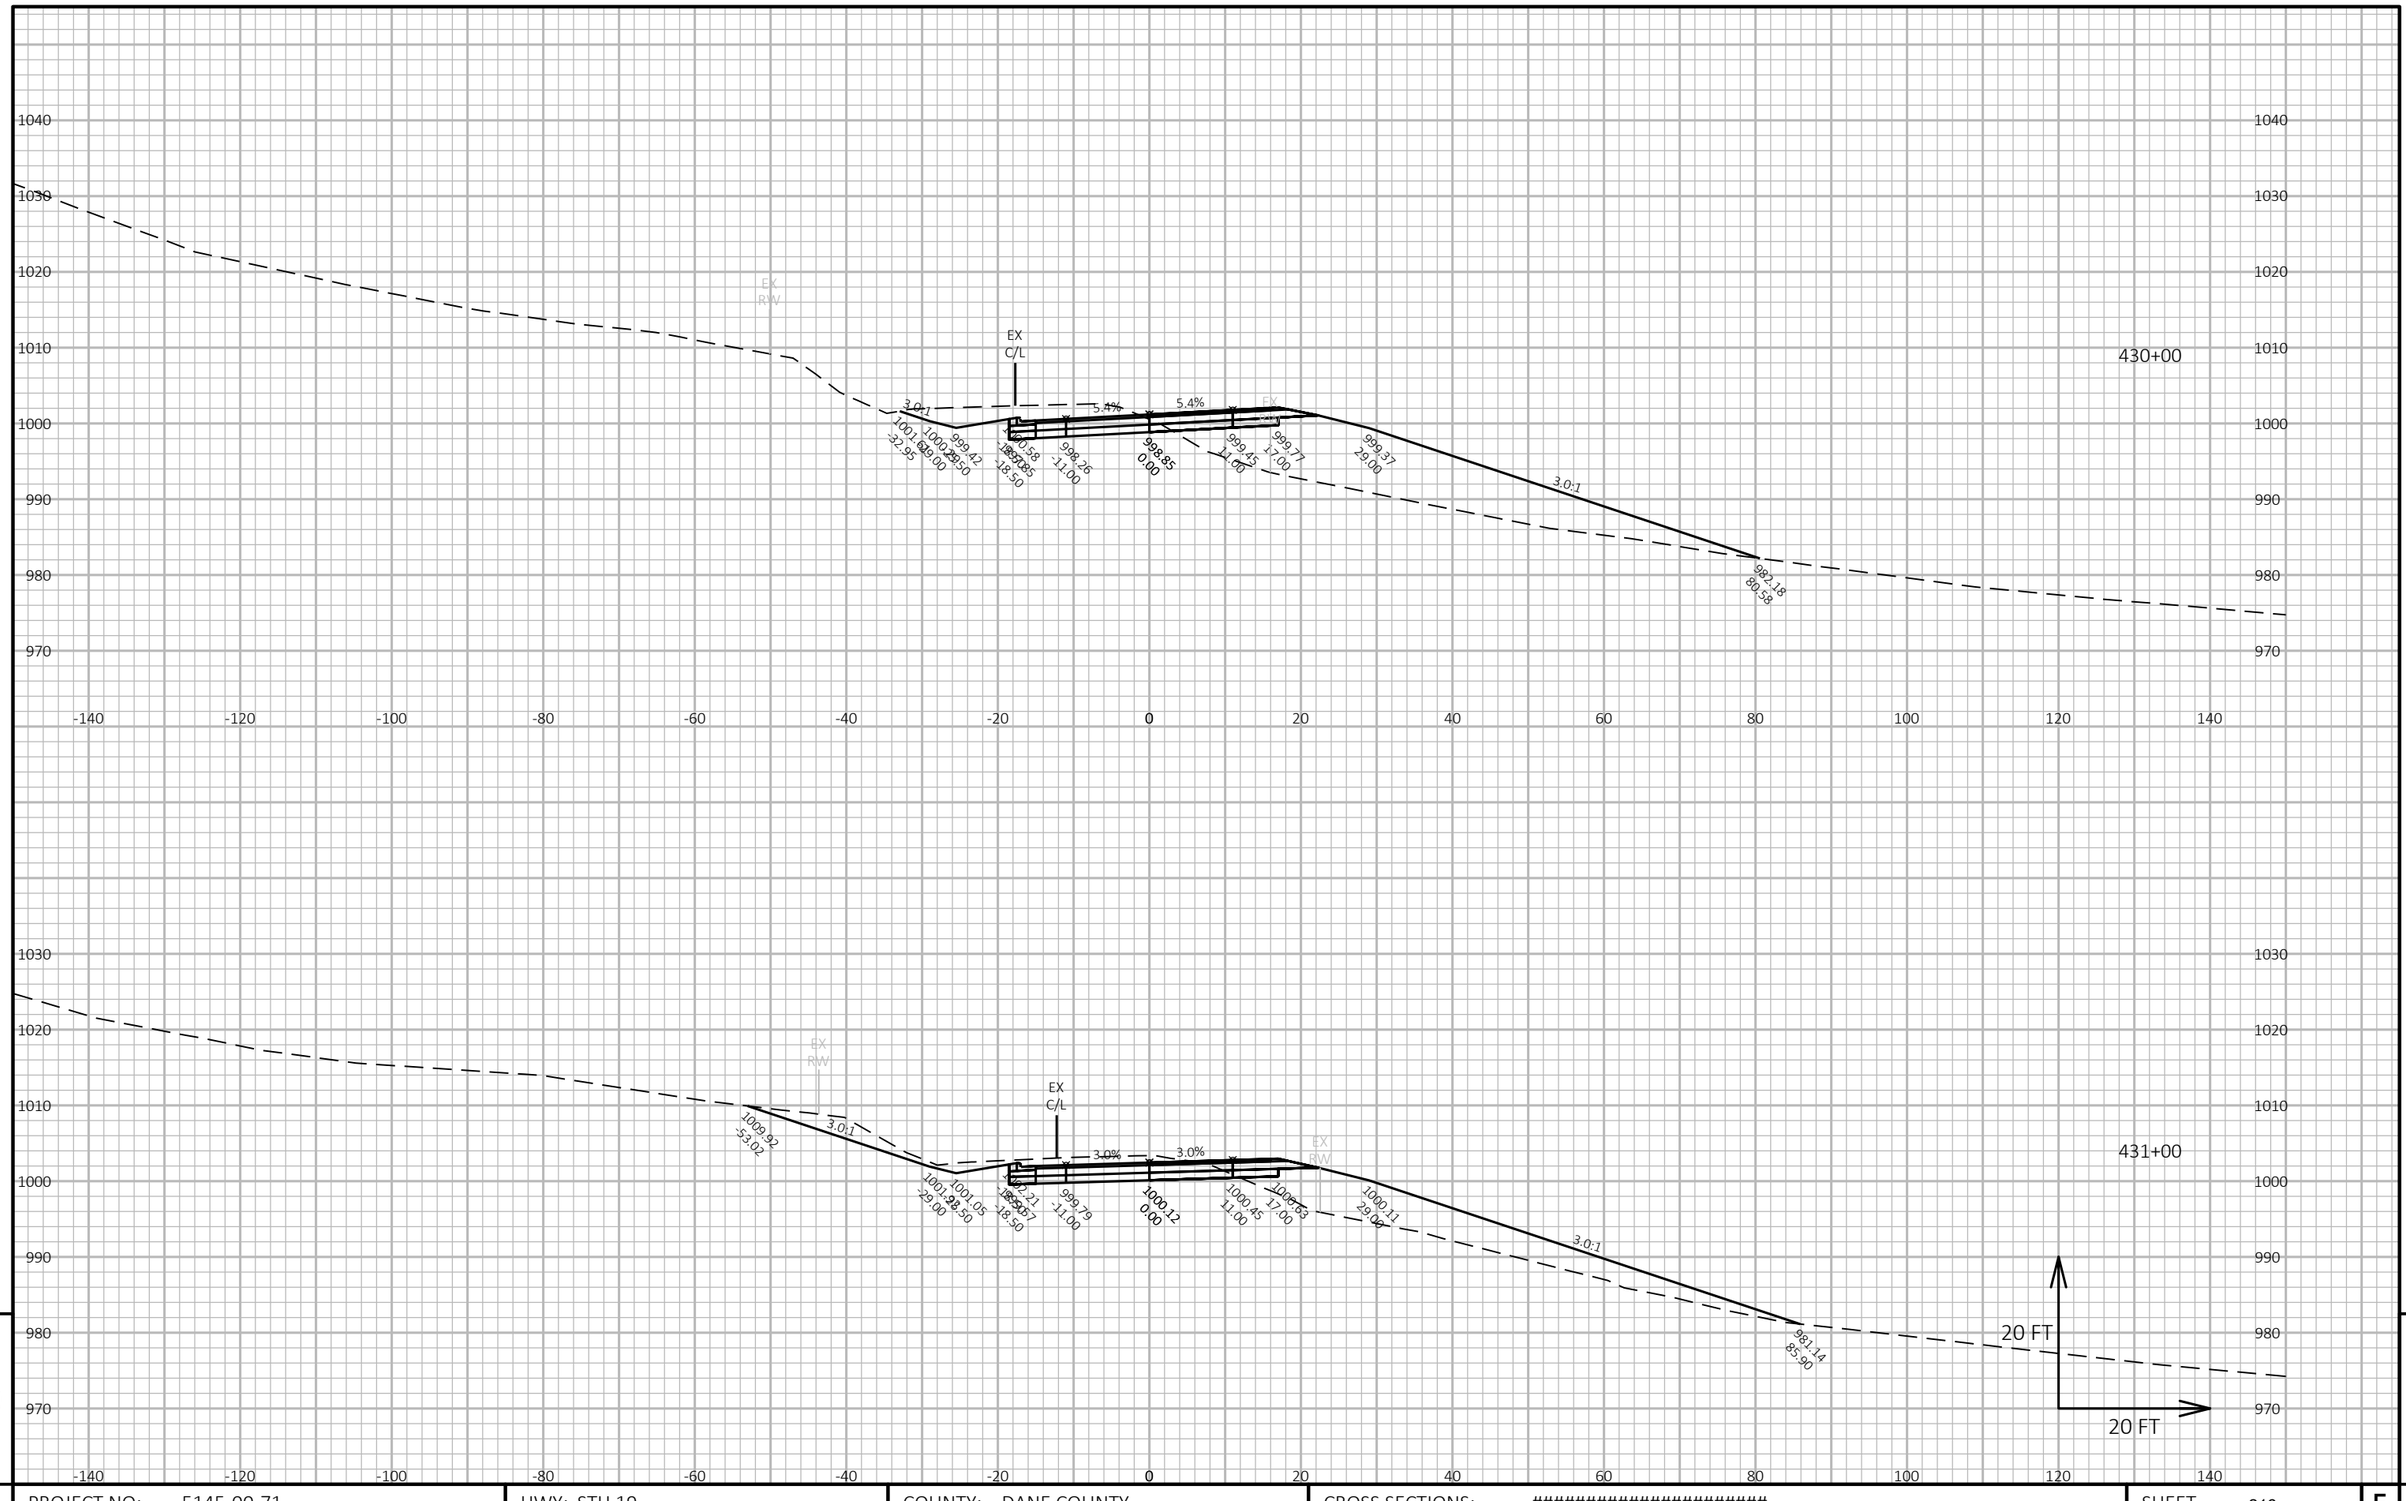

PROJECT NO: 5145-00-71	HWY: STH 19	COUNTY: DANE COUNTY	CROSS SECTIONS: ##########################	SHEET 216

FILE NAME : N:\PDS\C3D\51450001\SHEETSPLAN\090201_XS.DWG
LAYOUT NAME - 0902169-xs

PLOT DATE : 6/6/2018 5:50 PM PLOT BY : RACH, JEREMY PAUL PLOT NAME : PLOT SCALE : 1 IN:20 FT HORZ. / 1 IN:20 FT VERT.

WISDOT/CADDS SHEET 49

9 9

E

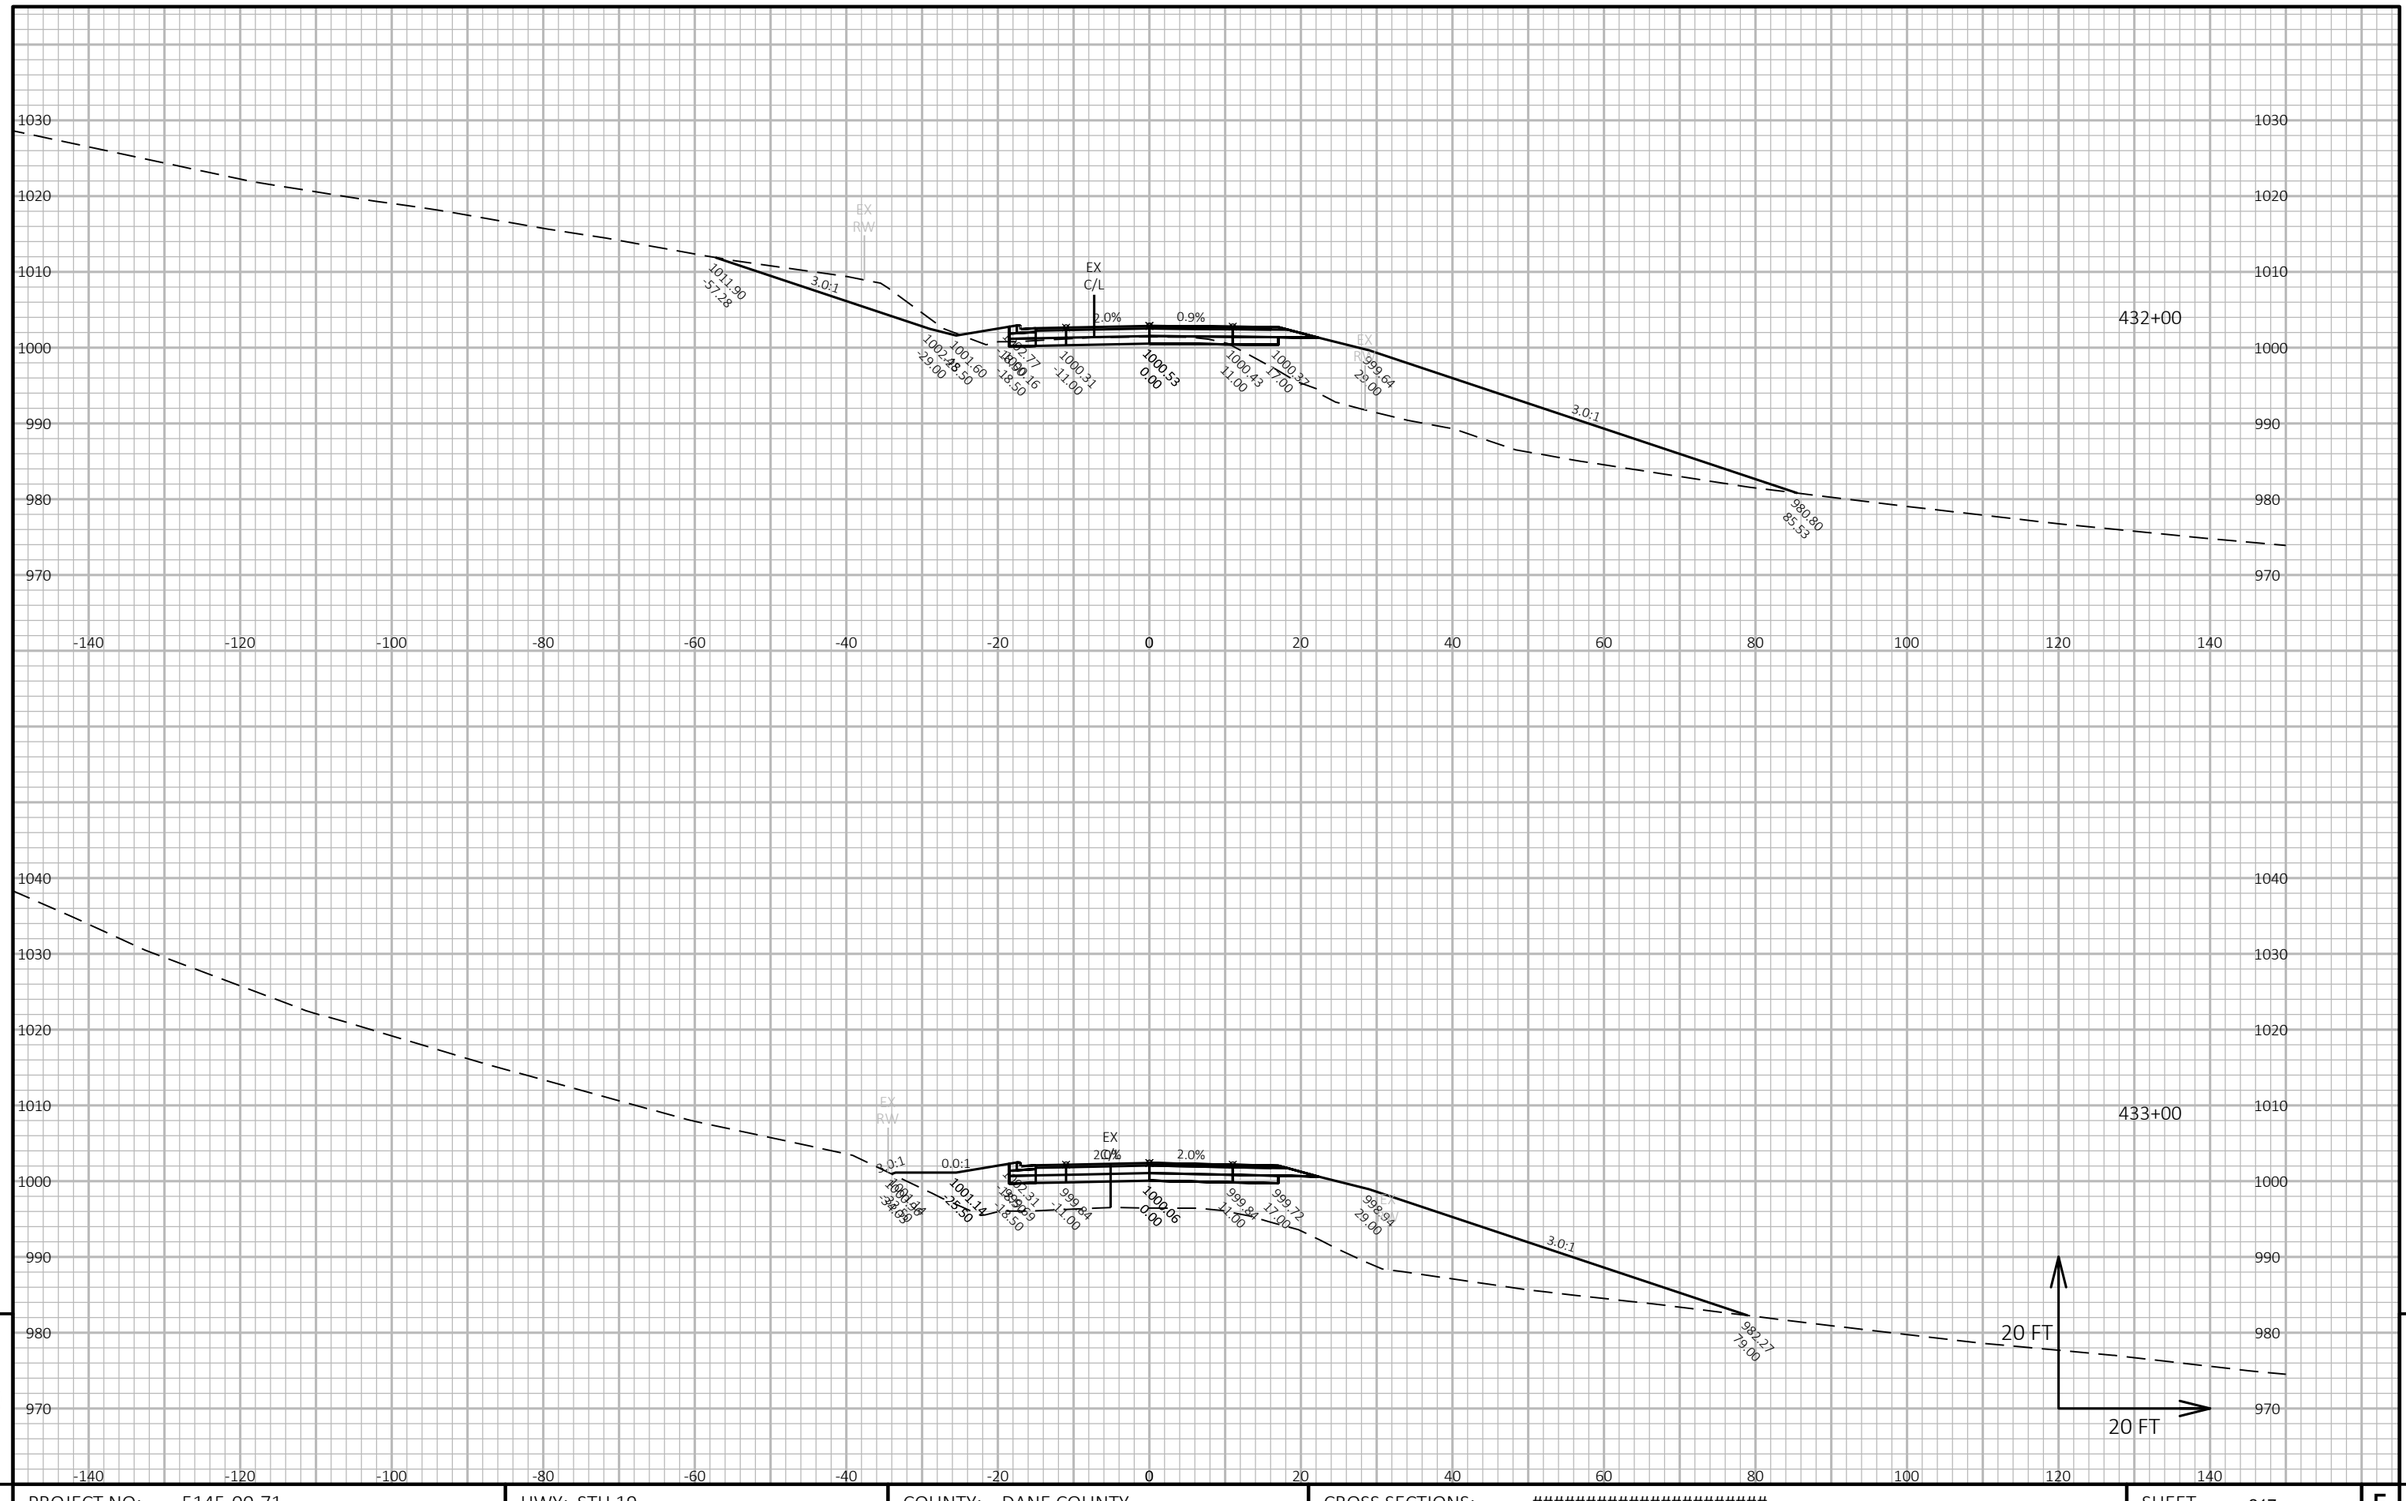

PROJECT NO: 5145-00-71	HWY: STH 19	COUNTY: DANE COUNTY	CROSS SECTIONS: ##########################	SHEET 217

FILE NAME : N:\PDS\C3D\51450001\SHEETSPLAN\090201_XS.DWG
LAYOUT NAME - 0902170-xs

PLOT DATE : 6/6/2018 5:51 PM PLOT BY : RACH, JEREMY PAUL PLOT NAME : PLOT SCALE : 1 IN:20 FT HORZ. / 1 IN:20 FT VERT.

WISDOT/CADDS SHEET 49

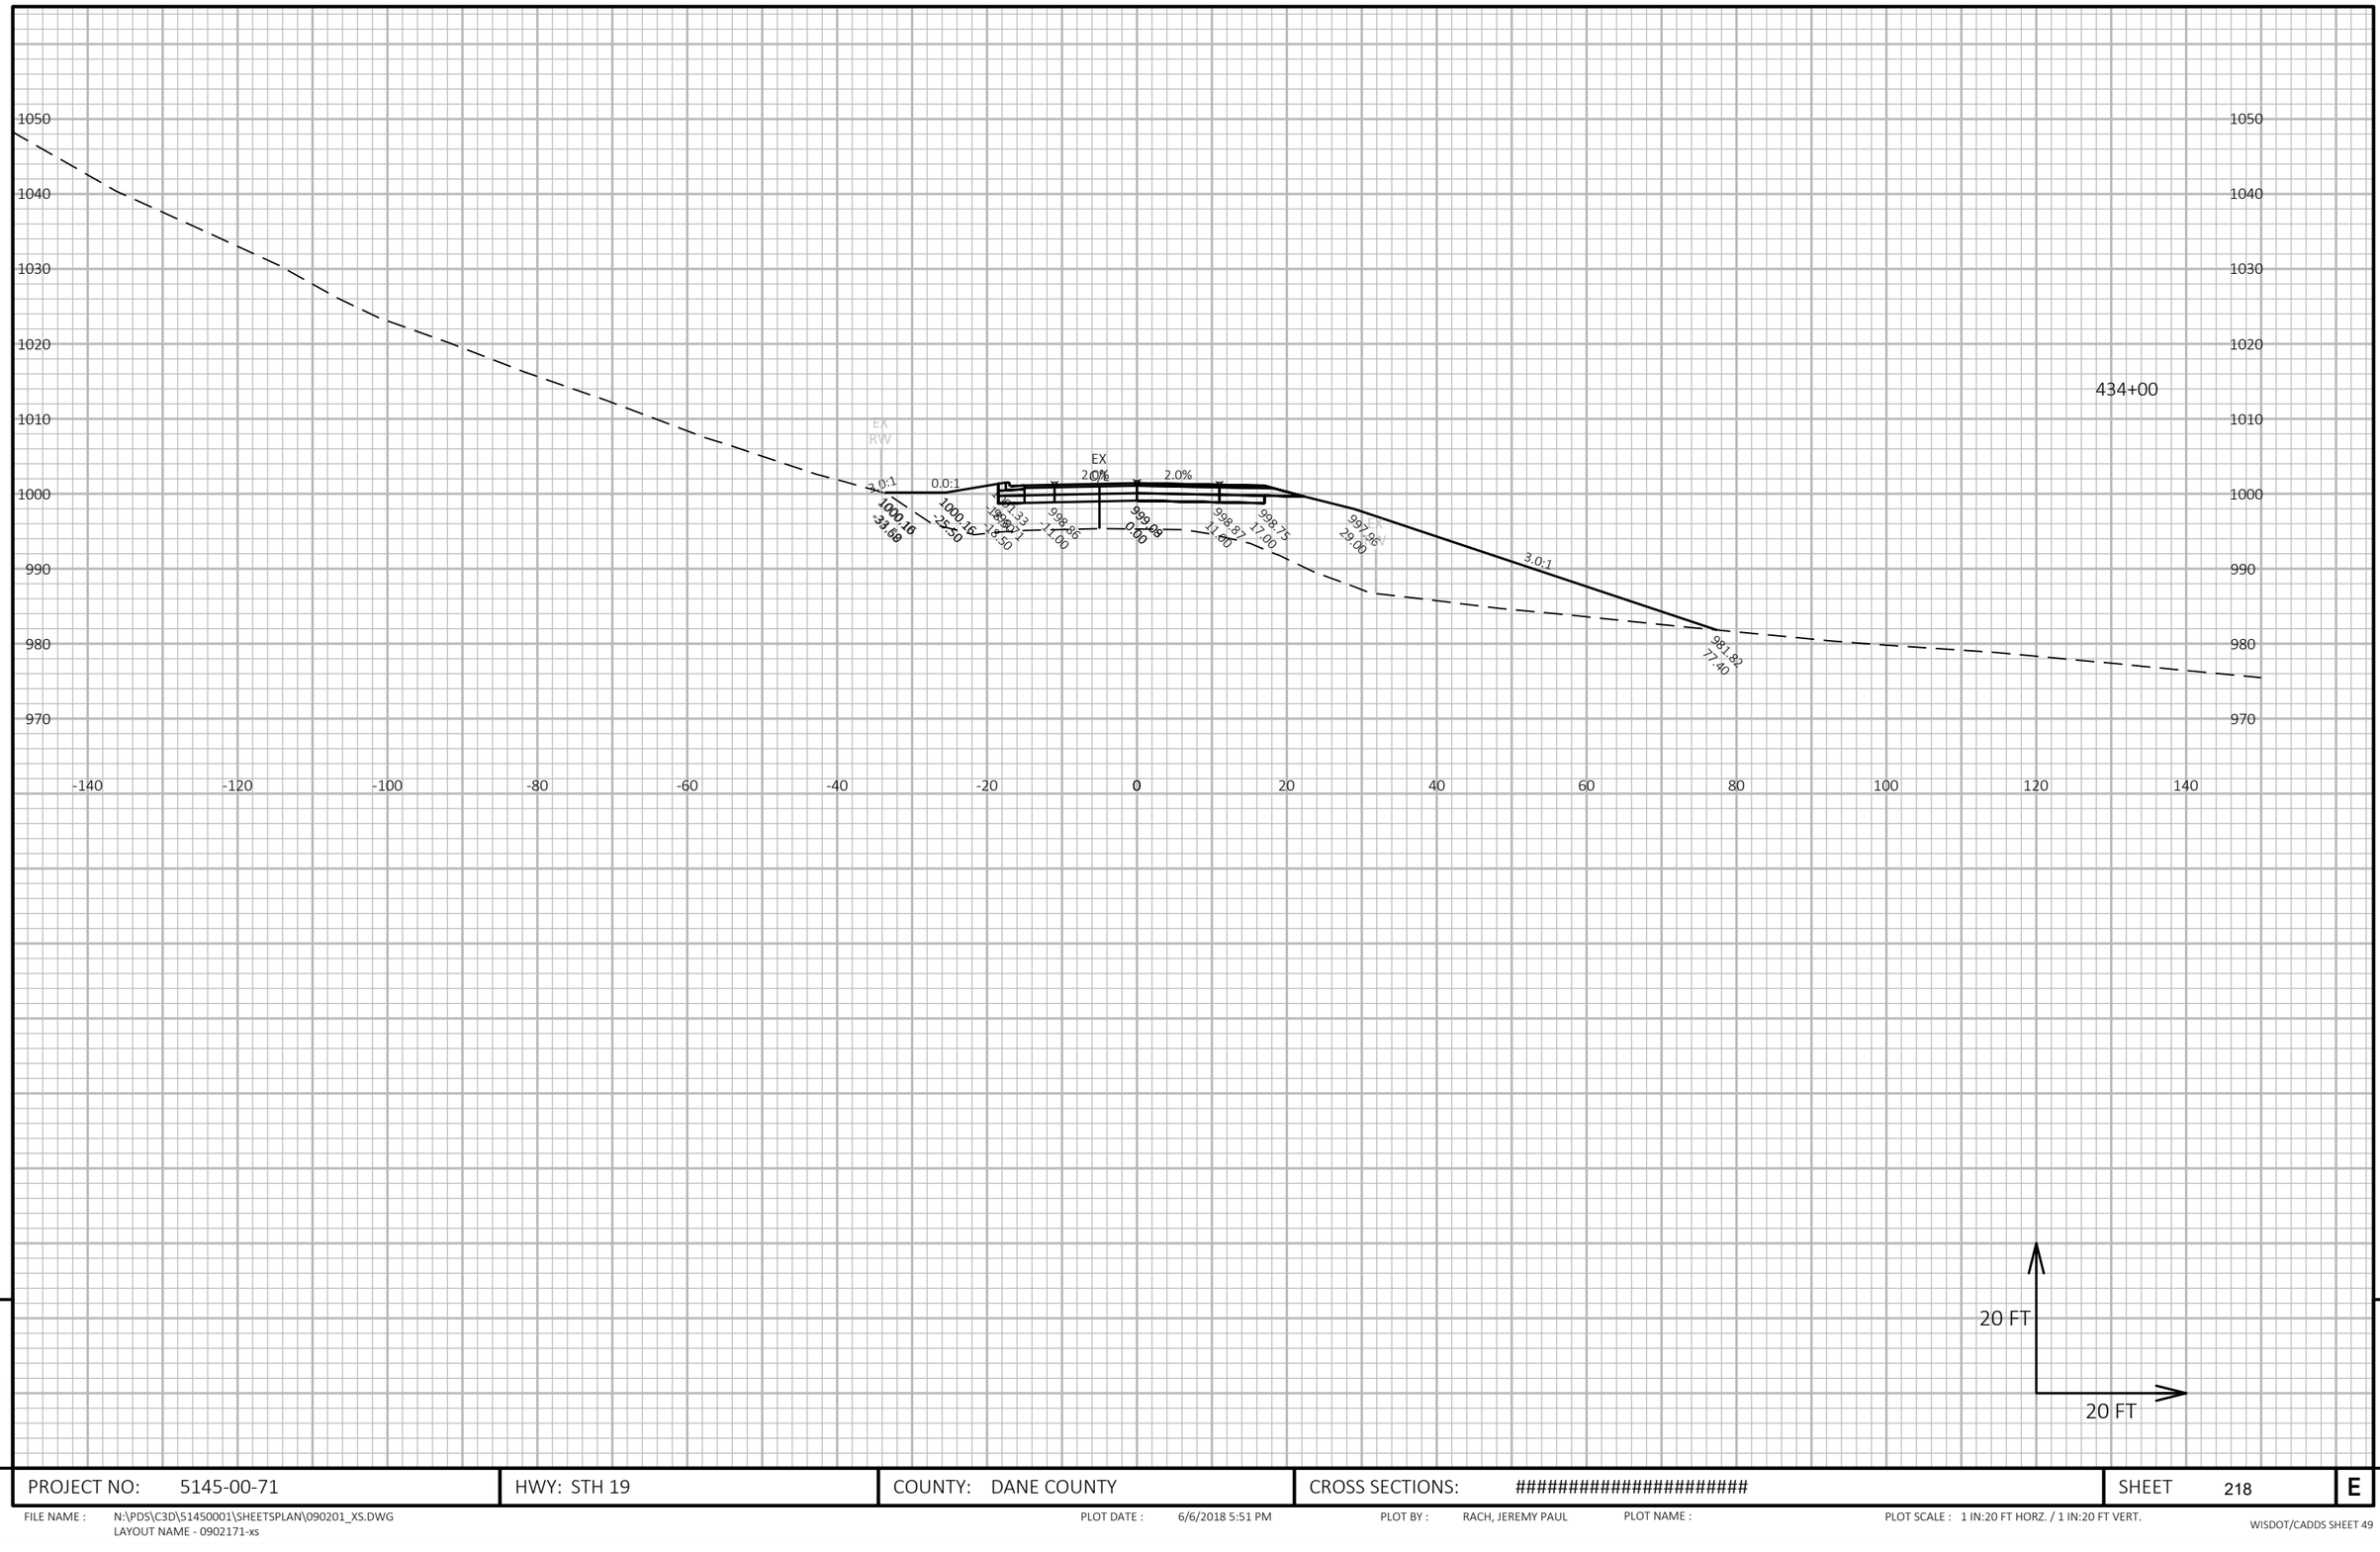

9

PROJECT NO: 5145-00-71	HWY: STH 19	COUNTY: DANE COUNTY	CROSS SECTIONS: ##########################	SHEET 218	E

9

FILE NAME : N:\PDS\C3D\51450001\SHEETSPLAN\090201_XS.DWG
LAYOUT NAME - 0902171-xs

PLOT DATE : 6/6/2018 5:51 PM PLOT BY : RACH, JEREMY PAUL PLOT NAME : PLOT SCALE : 1 IN:20 FT HORZ. / 1 IN:20 FT VERT.

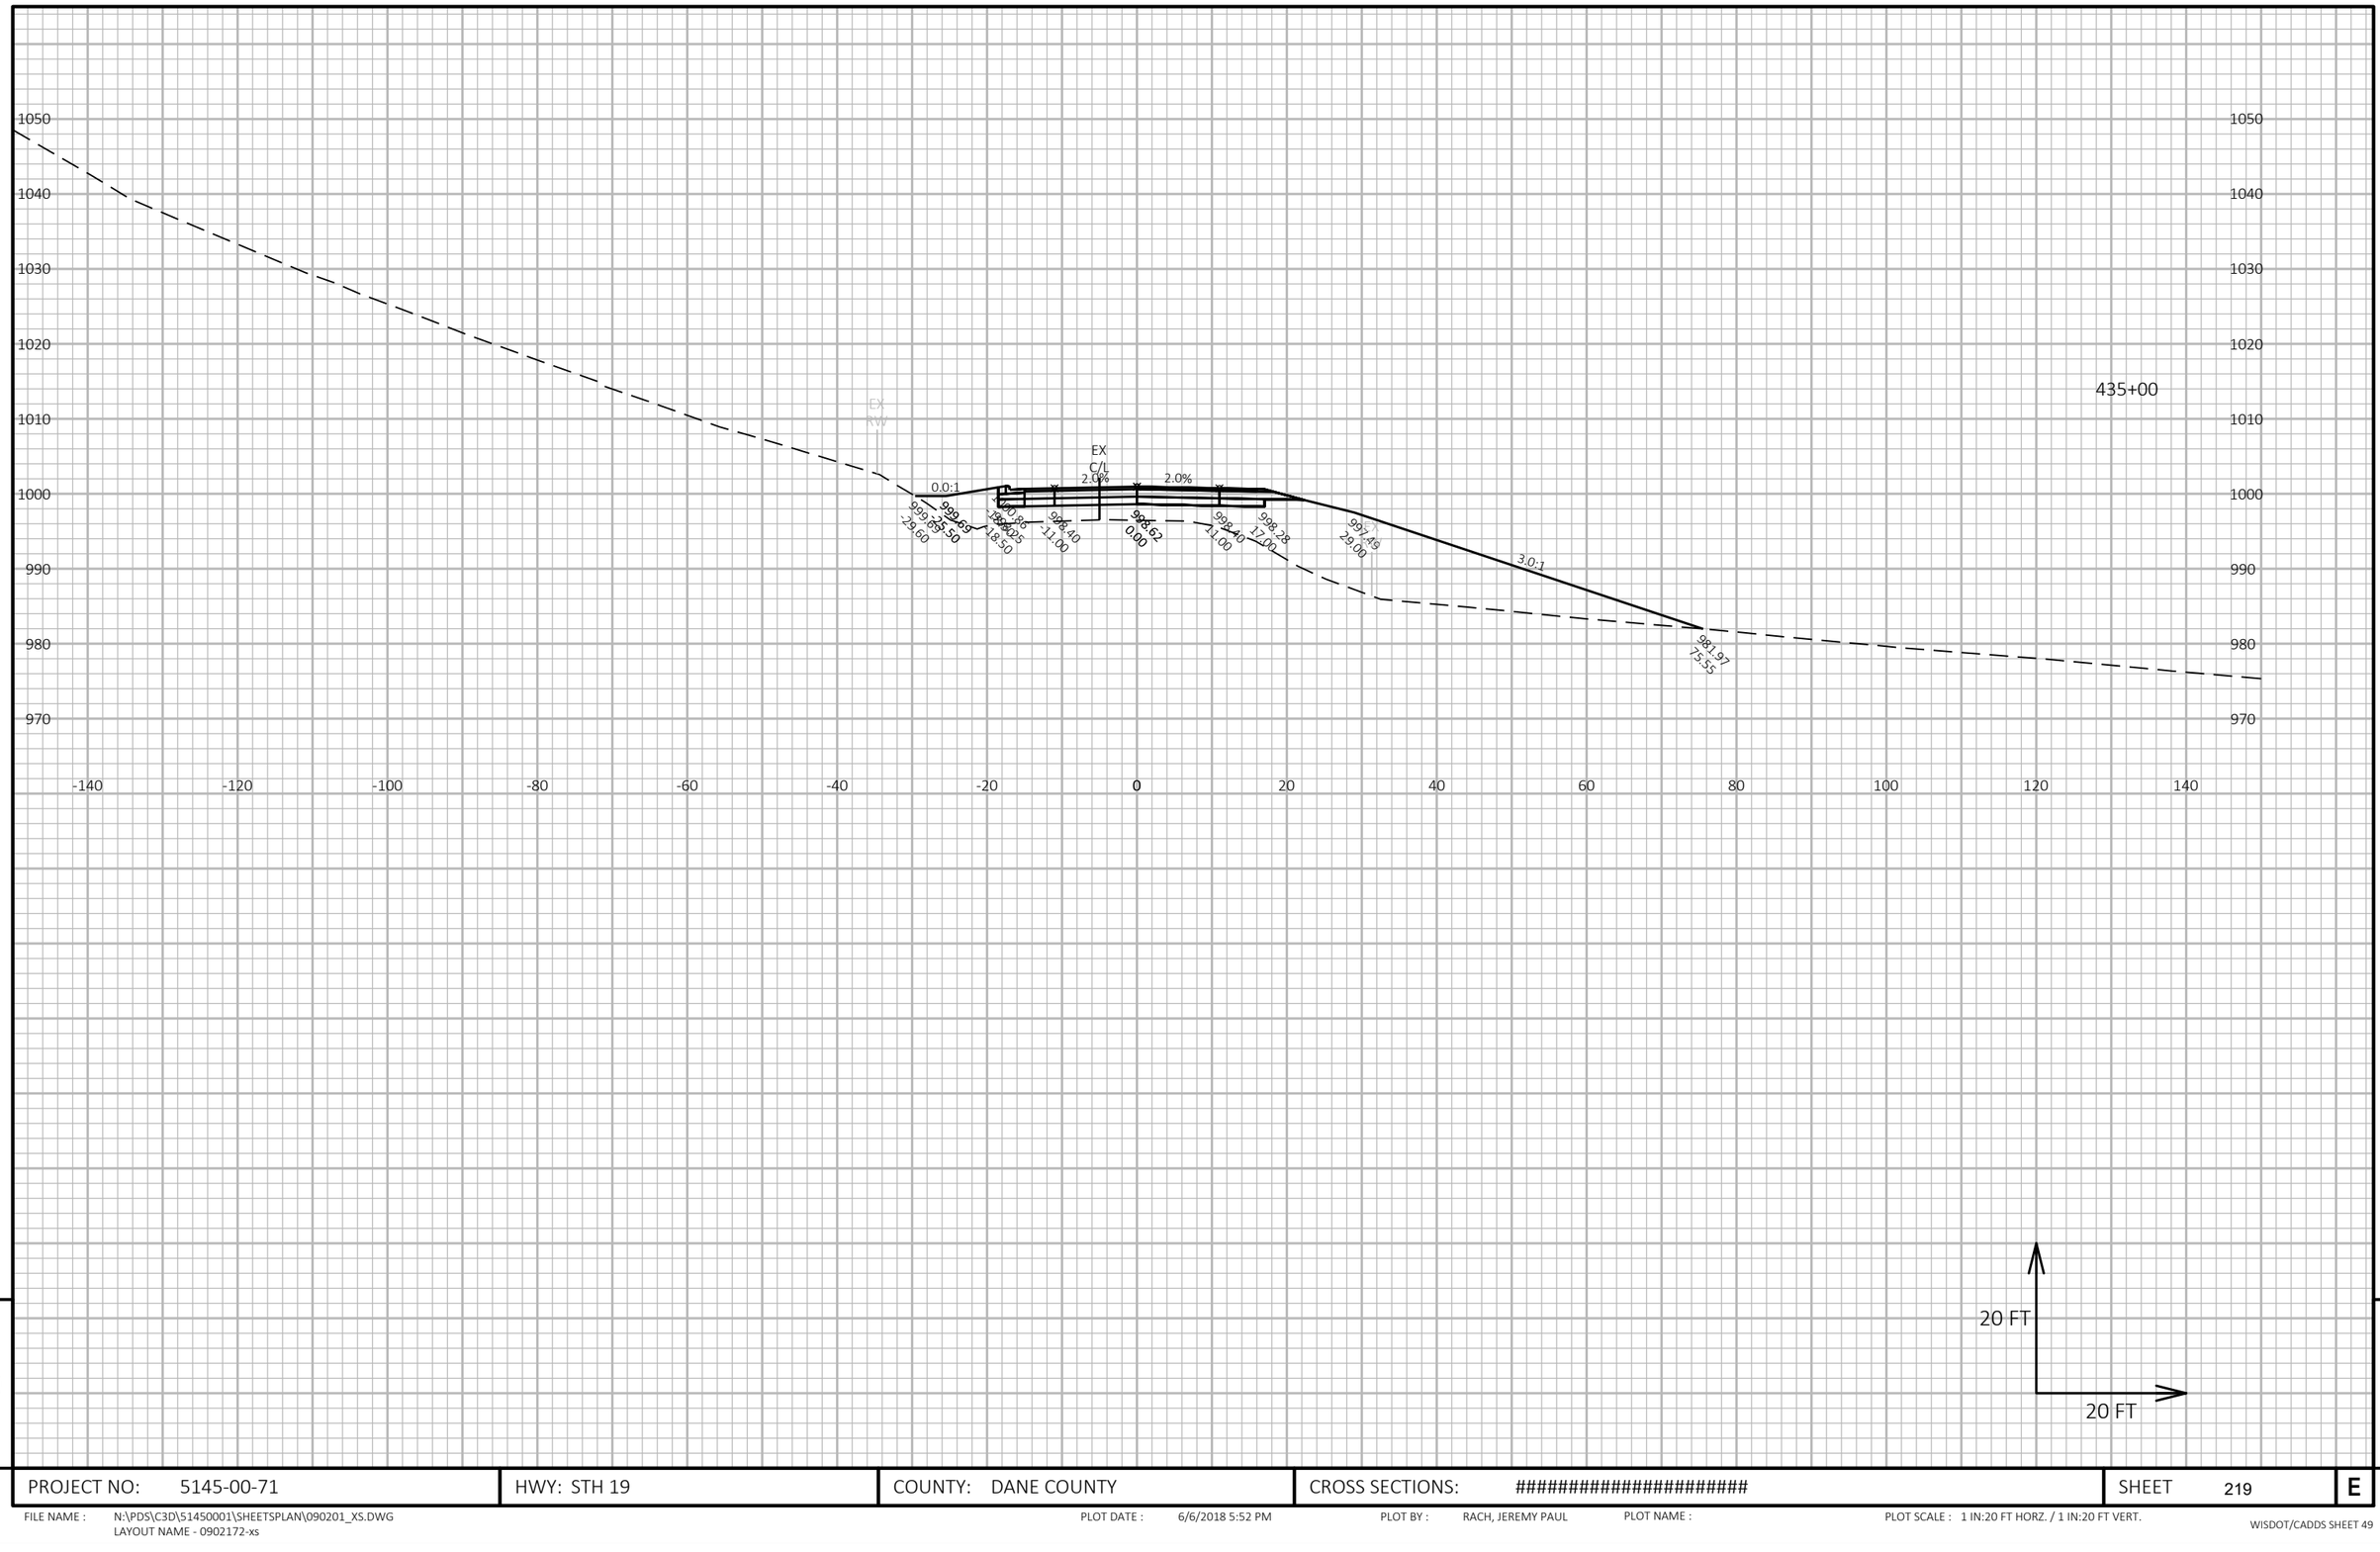

9

9

PROJECT NO: 5145-00-71	HWY: STH 19	COUNTY: DANE COUNTY	CROSS SECTIONS: ##########################	SHEET 219	E

FILE NAME : N:\PDS\C3D\51450001\SHEETSPLAN\090201_XS.DWG
LAYOUT NAME - 0902172-xs

PLOT DATE : 6/6/2018 5:52 PM PLOT BY : RACH, JEREMY PAUL PLOT NAME : PLOT SCALE : 1 IN:20 FT HORZ. / 1 IN:20 FT VERT.

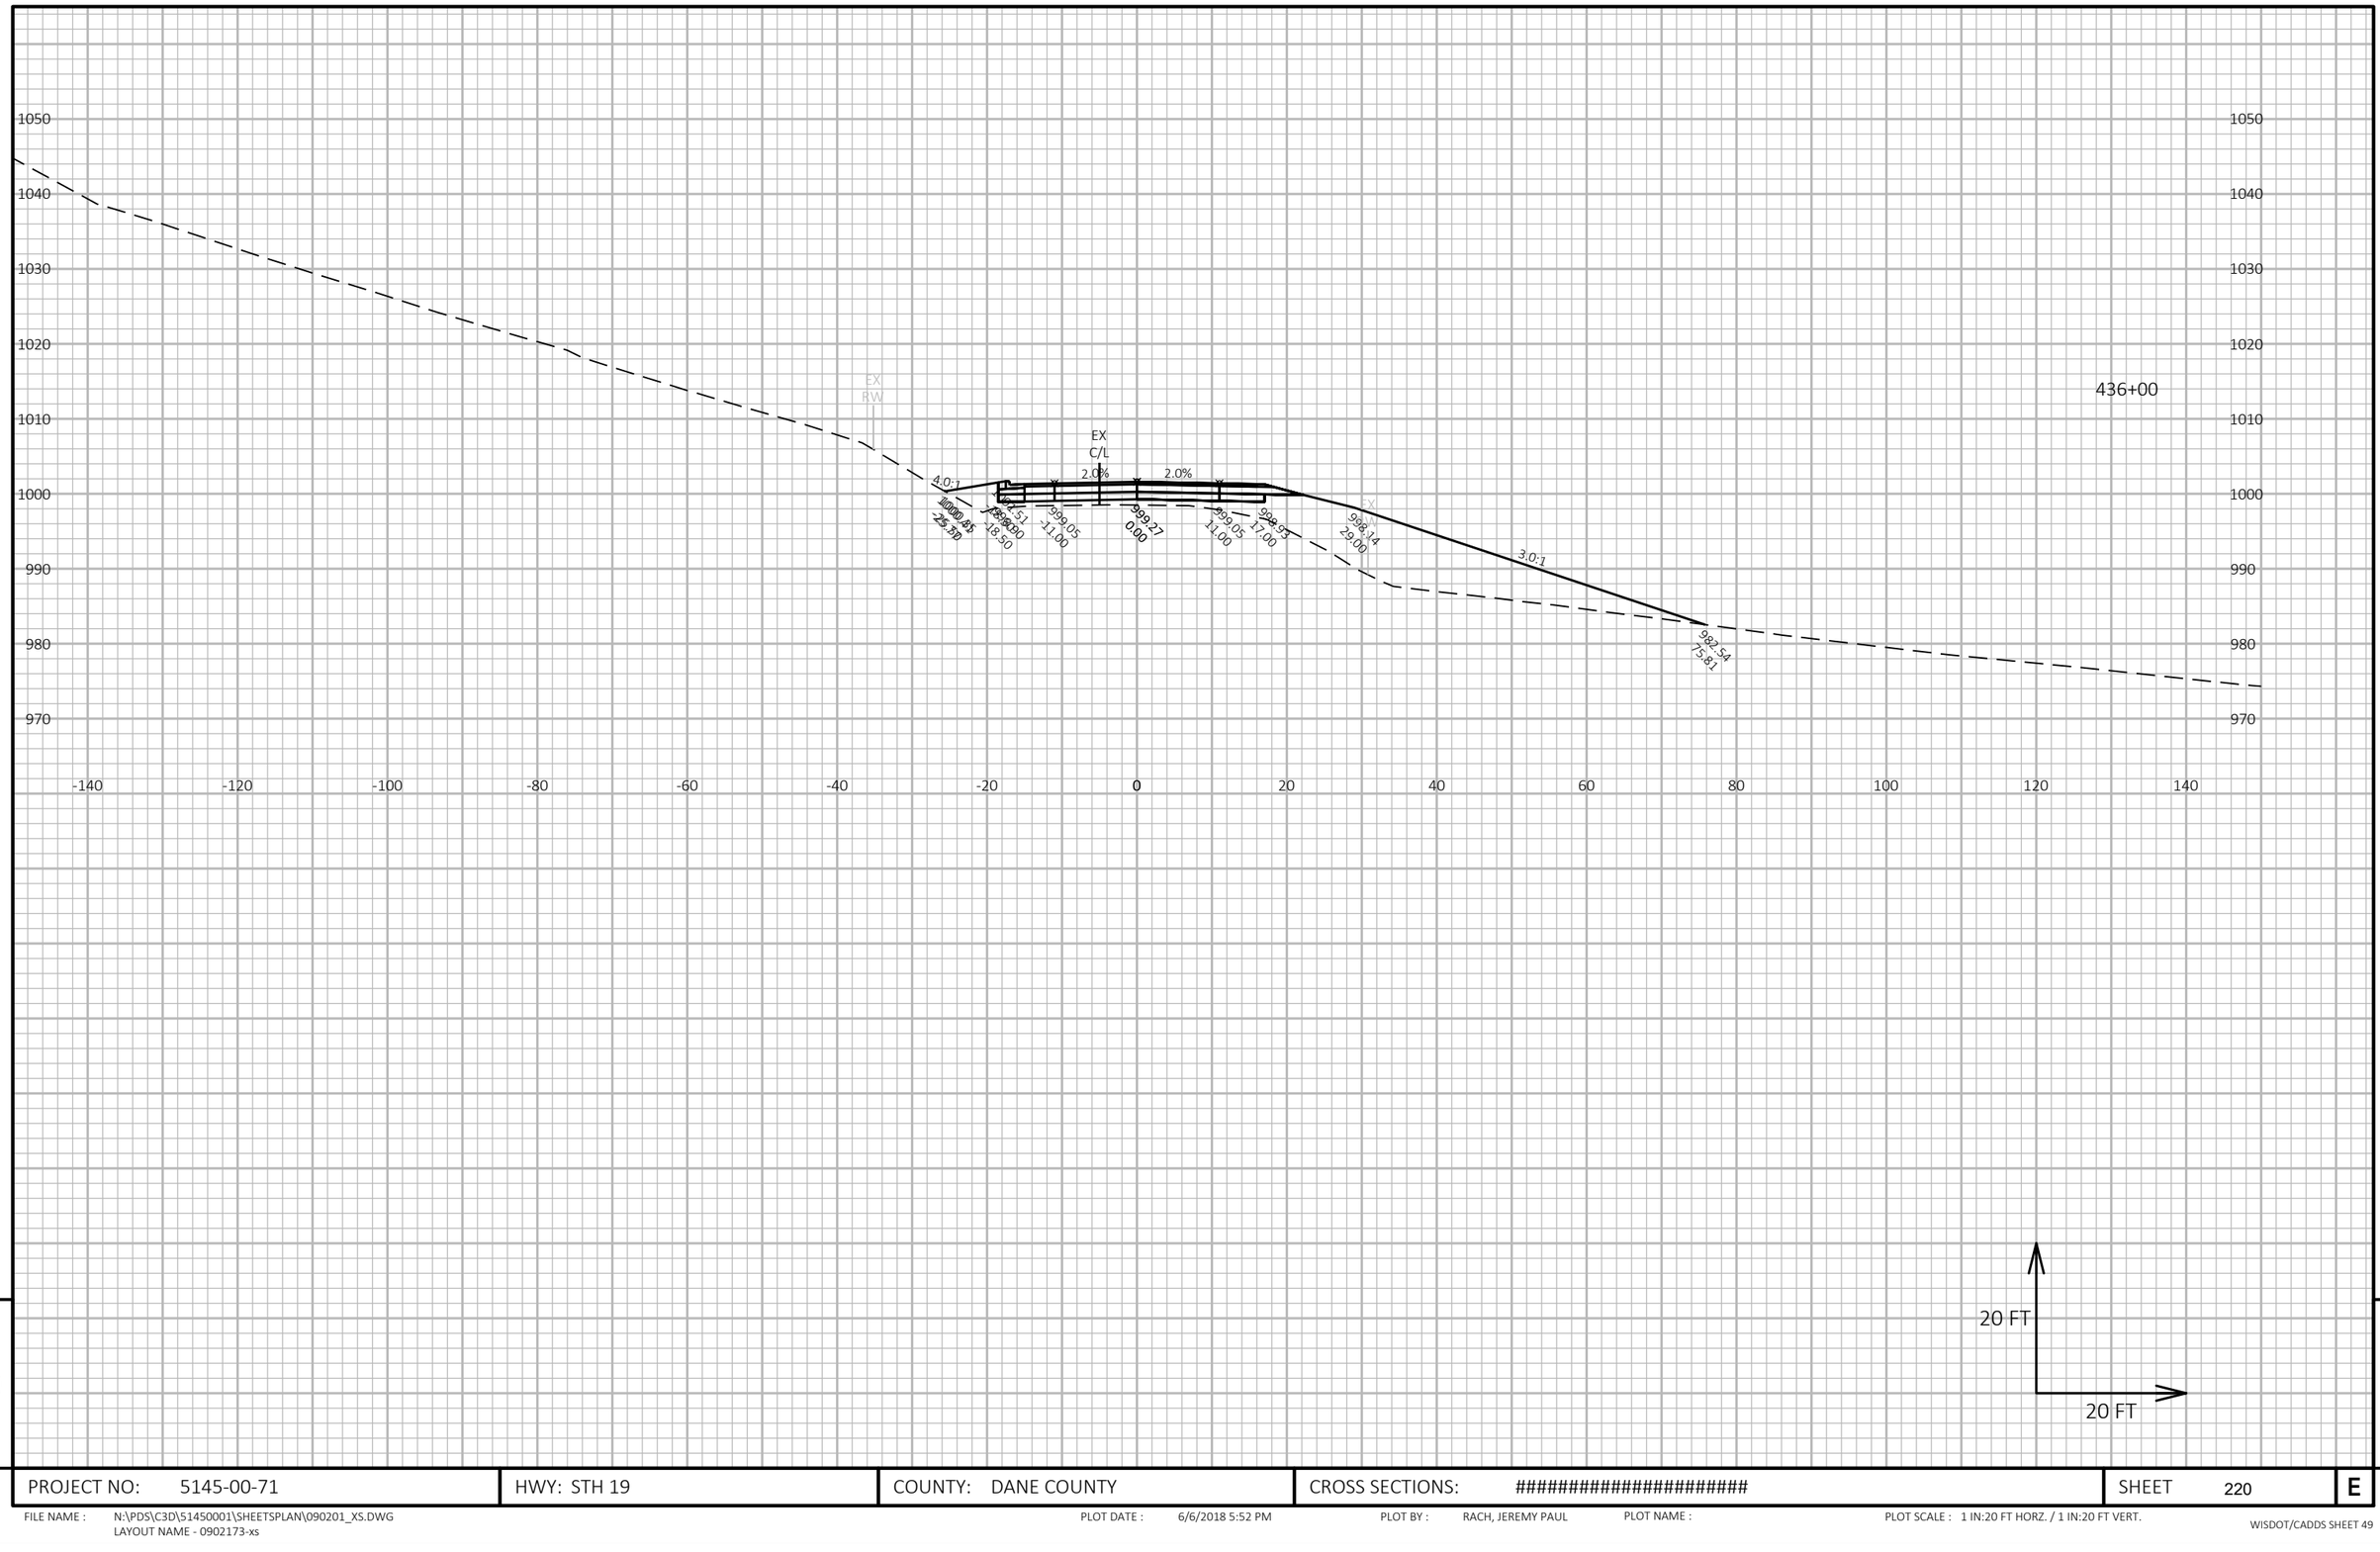

PROJECT NO: 5145-00-71	HWY: STH 19	COUNTY: DANE COUNTY	CROSS SECTIONS: ##########################	SHEET 220	E

FILE NAME : N:\PDS\C3D\51450001\SHEETSPLAN\090201_XS.DWG
LAYOUT NAME - 0902173-xs

PLOT DATE : 6/6/2018 5:52 PM PLOT BY : RACH, JEREMY PAUL PLOT NAME : PLOT SCALE : 1 IN:20 FT HORZ. / 1 IN:20 FT VERT.

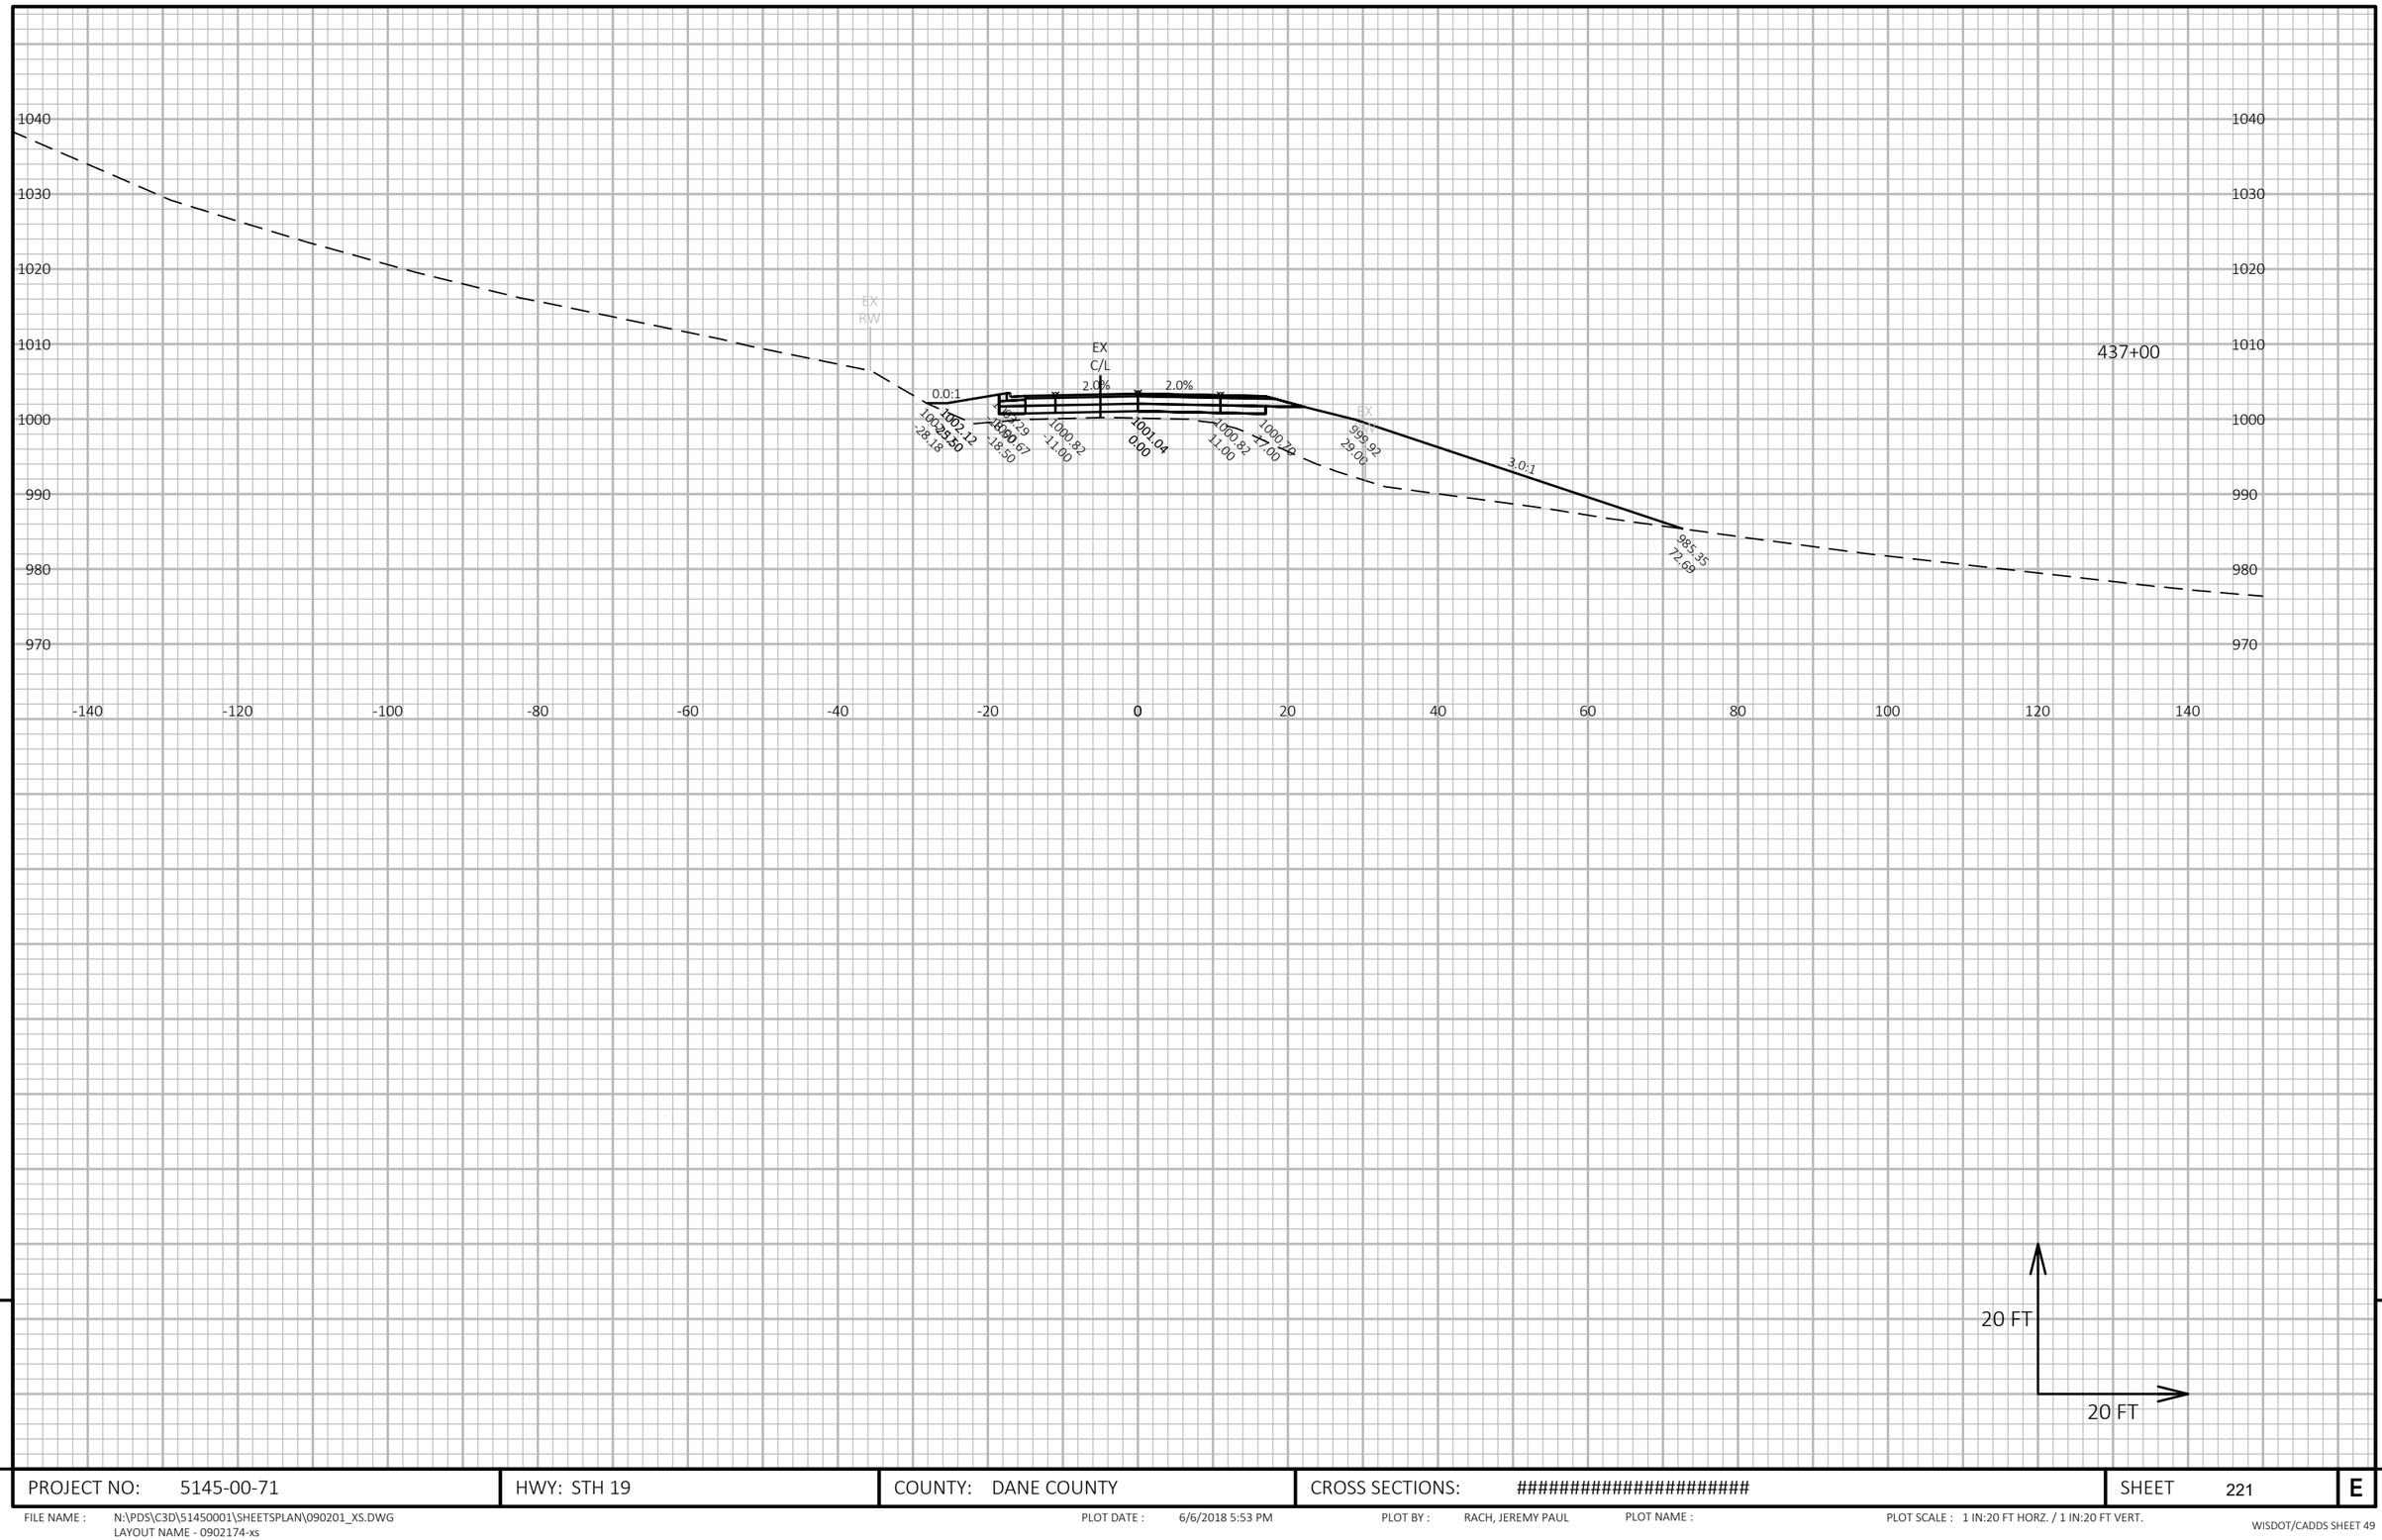

9

9

PROJECT NO: 5145-00-71	HWY: STH 19	COUNTY: DANE COUNTY	CROSS SECTIONS: ##########################	SHEET 221	E

FILE NAME : N:\PDS\C3D\51450001\SHEETSPLAN\090201_XS.DWG
LAYOUT NAME - 0902174-xs

PLOT DATE : 6/6/2018 5:53 PM PLOT BY : RACH, JEREMY PAUL PLOT NAME : PLOT SCALE : 1 IN:20 FT HORZ. / 1 IN:20 FT VERT.

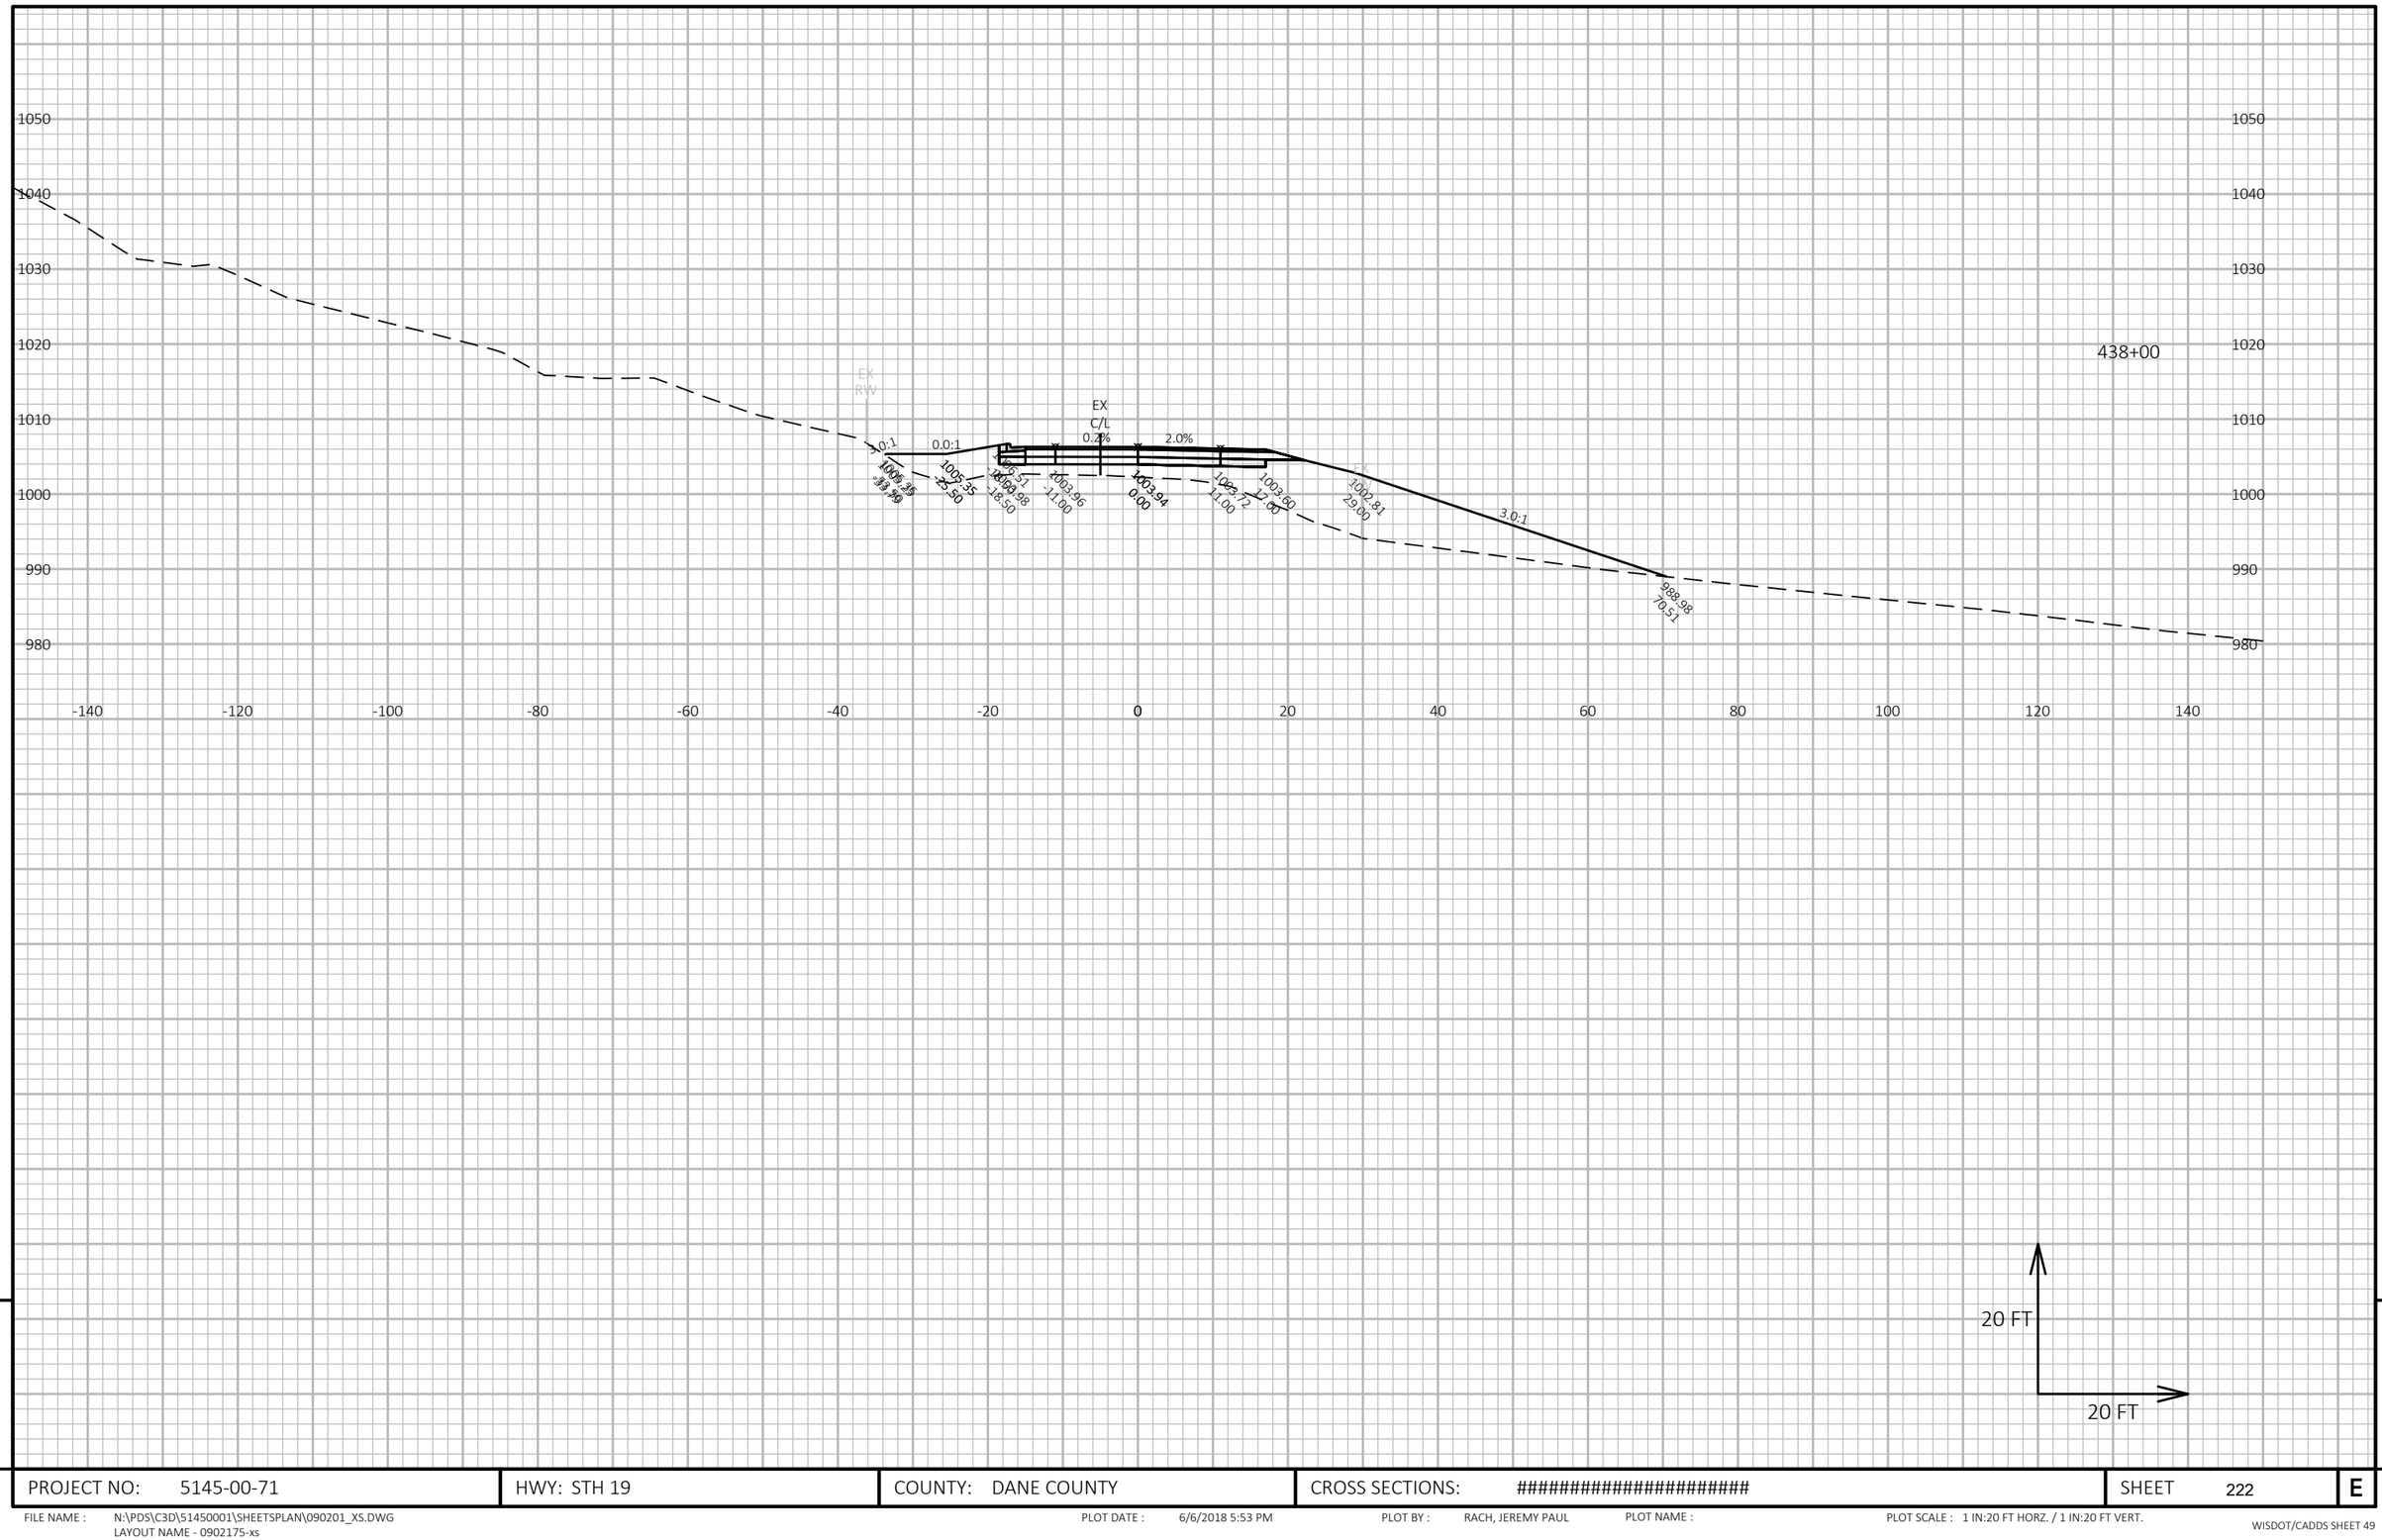

9

9

PROJECT NO: 5145-00-71	HWY: STH 19	COUNTY: DANE COUNTY	CROSS SECTIONS: ##########################	SHEET 222	E

FILE NAME : N:\PDS\C3D\51450001\SHEETSPLAN\090201_XS.DWG
LAYOUT NAME - 0902175-xs

PLOT DATE : 6/6/2018 5:53 PM PLOT BY : RACH, JEREMY PAUL PLOT NAME : PLOT SCALE : 1 IN:20 FT HORZ. / 1 IN:20 FT VERT.

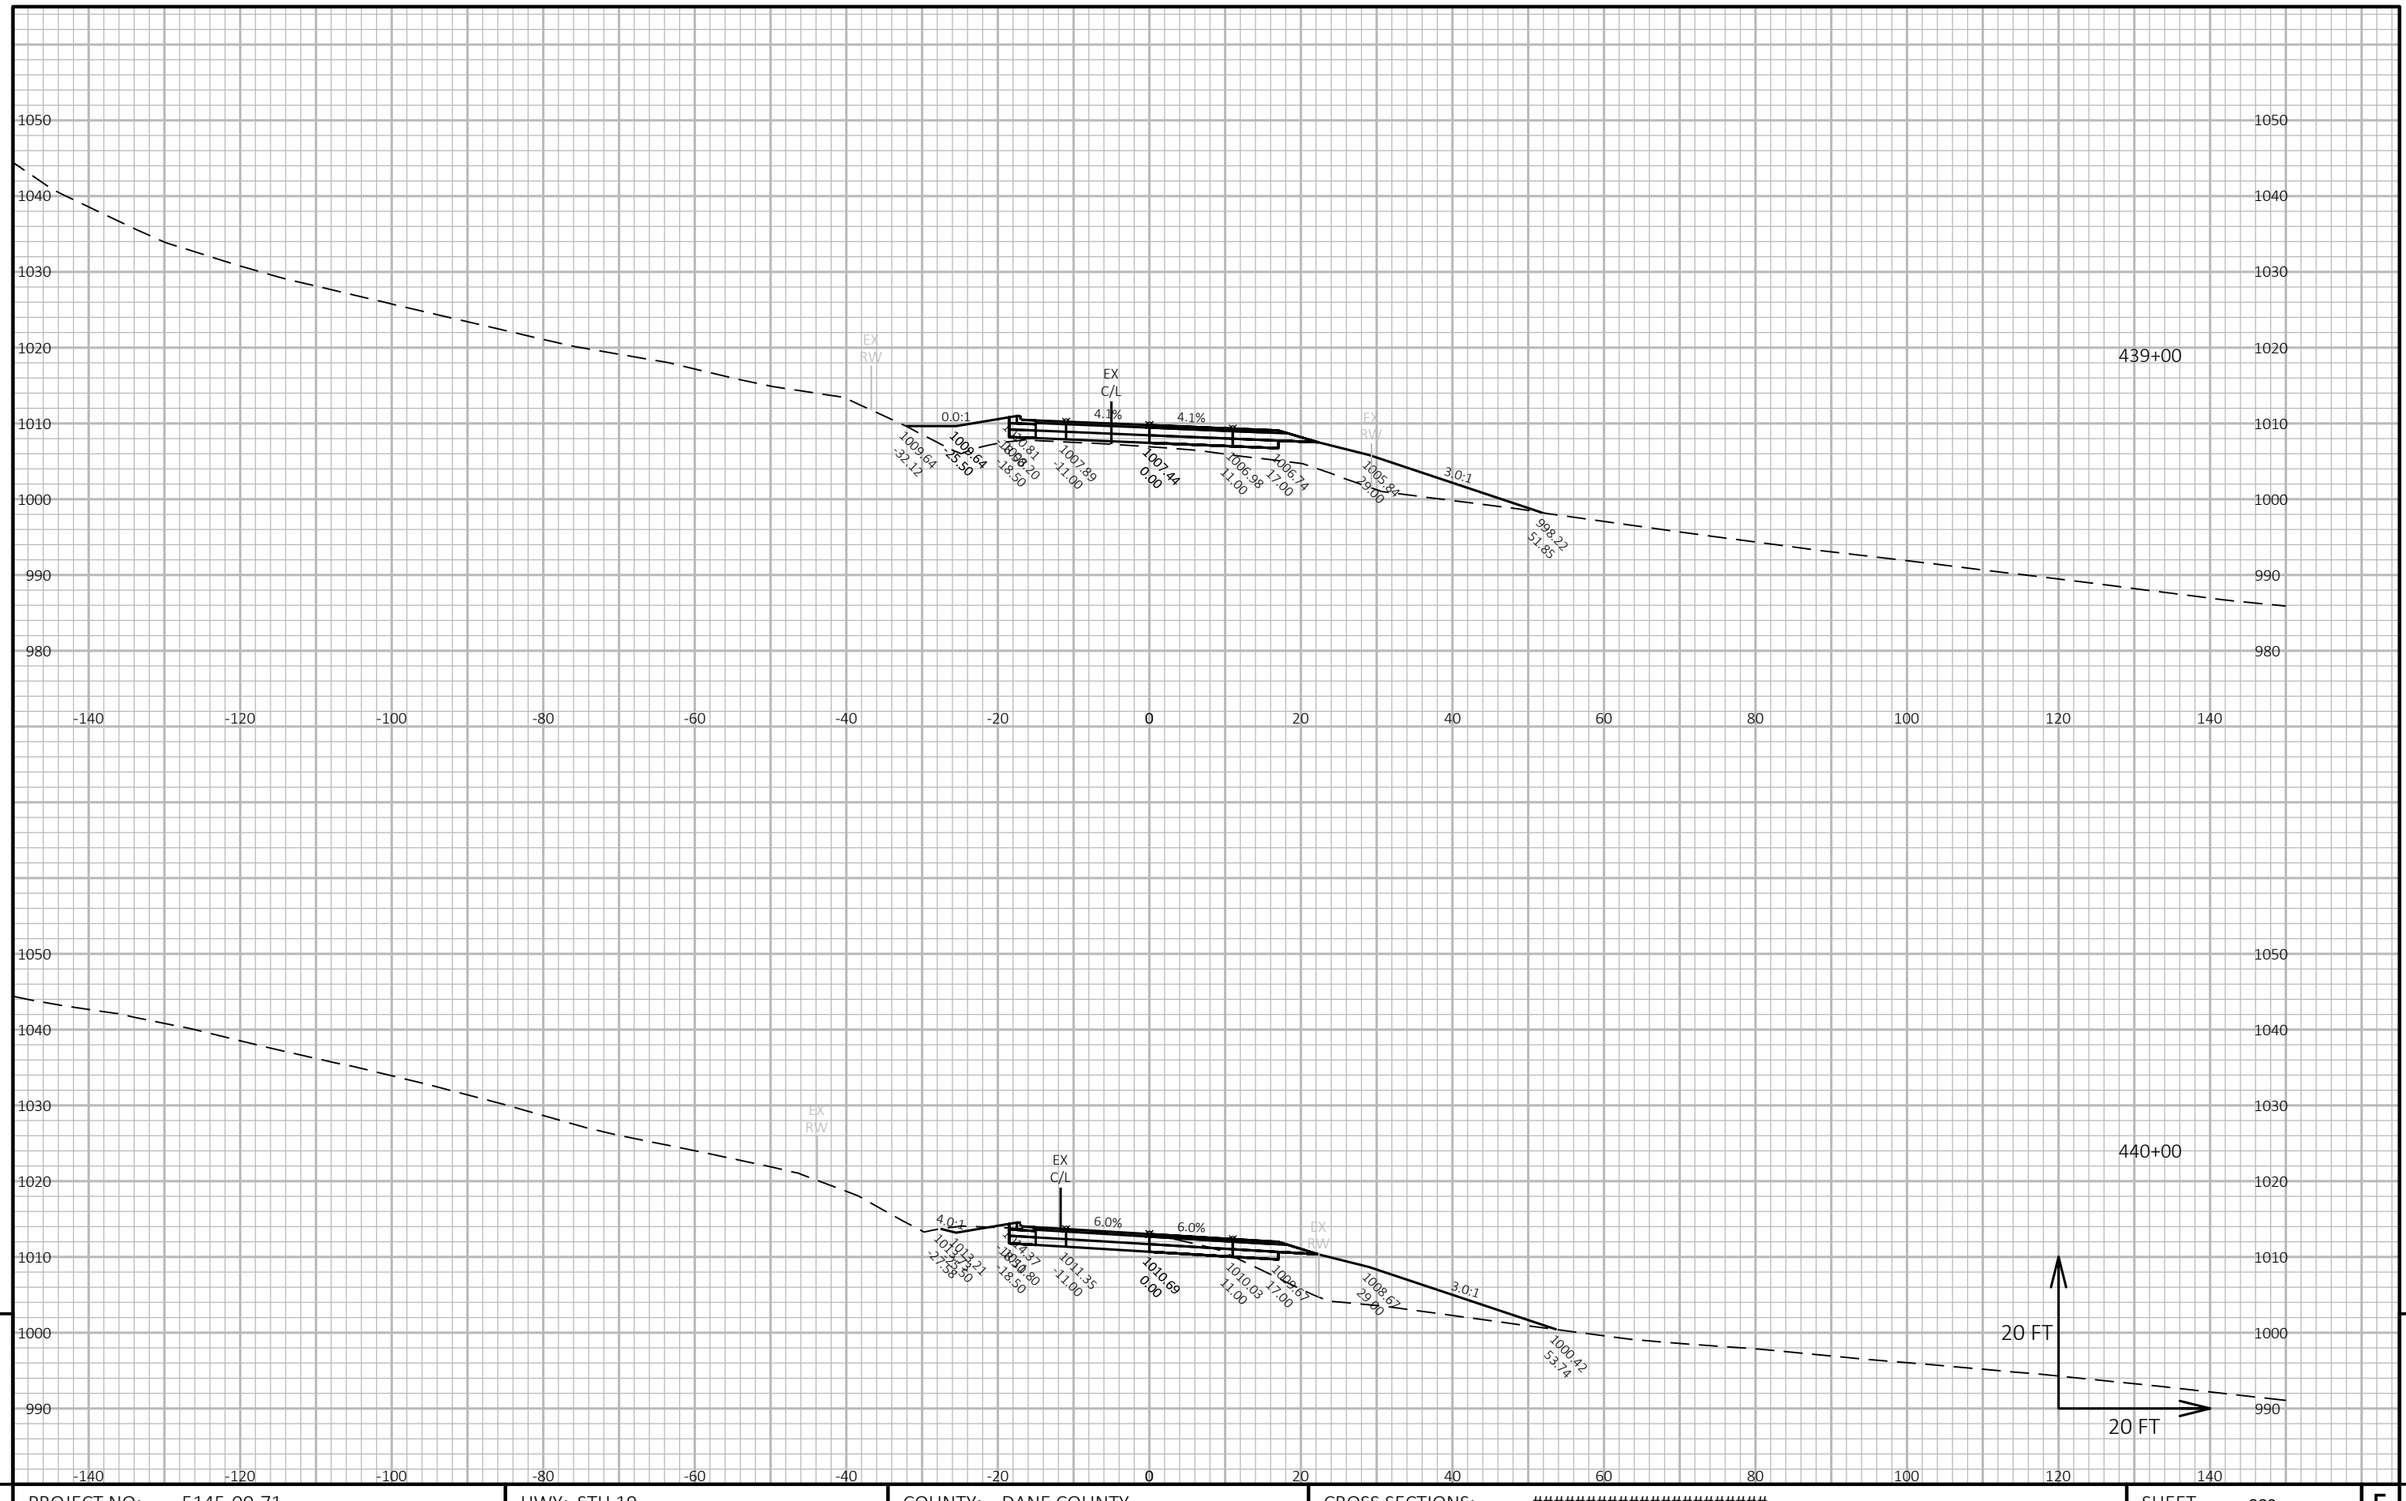

9

9

PROJECT NO: 5145-00-71	HWY: STH 19	COUNTY: DANE COUNTY	CROSS SECTIONS: ##########################	SHEET 223	E

FILE NAME : N:\PDS\C3D\51450001\SHEETSPLAN\090201_XS.DWG
LAYOUT NAME - 0902176-xs

PLOT DATE : 6/6/2018 5:54 PM PLOT BY : RACH, JEREMY PAUL PLOT NAME : PLOT SCALE : 1 IN:20 FT HORZ. / 1 IN:20 FT VERT.

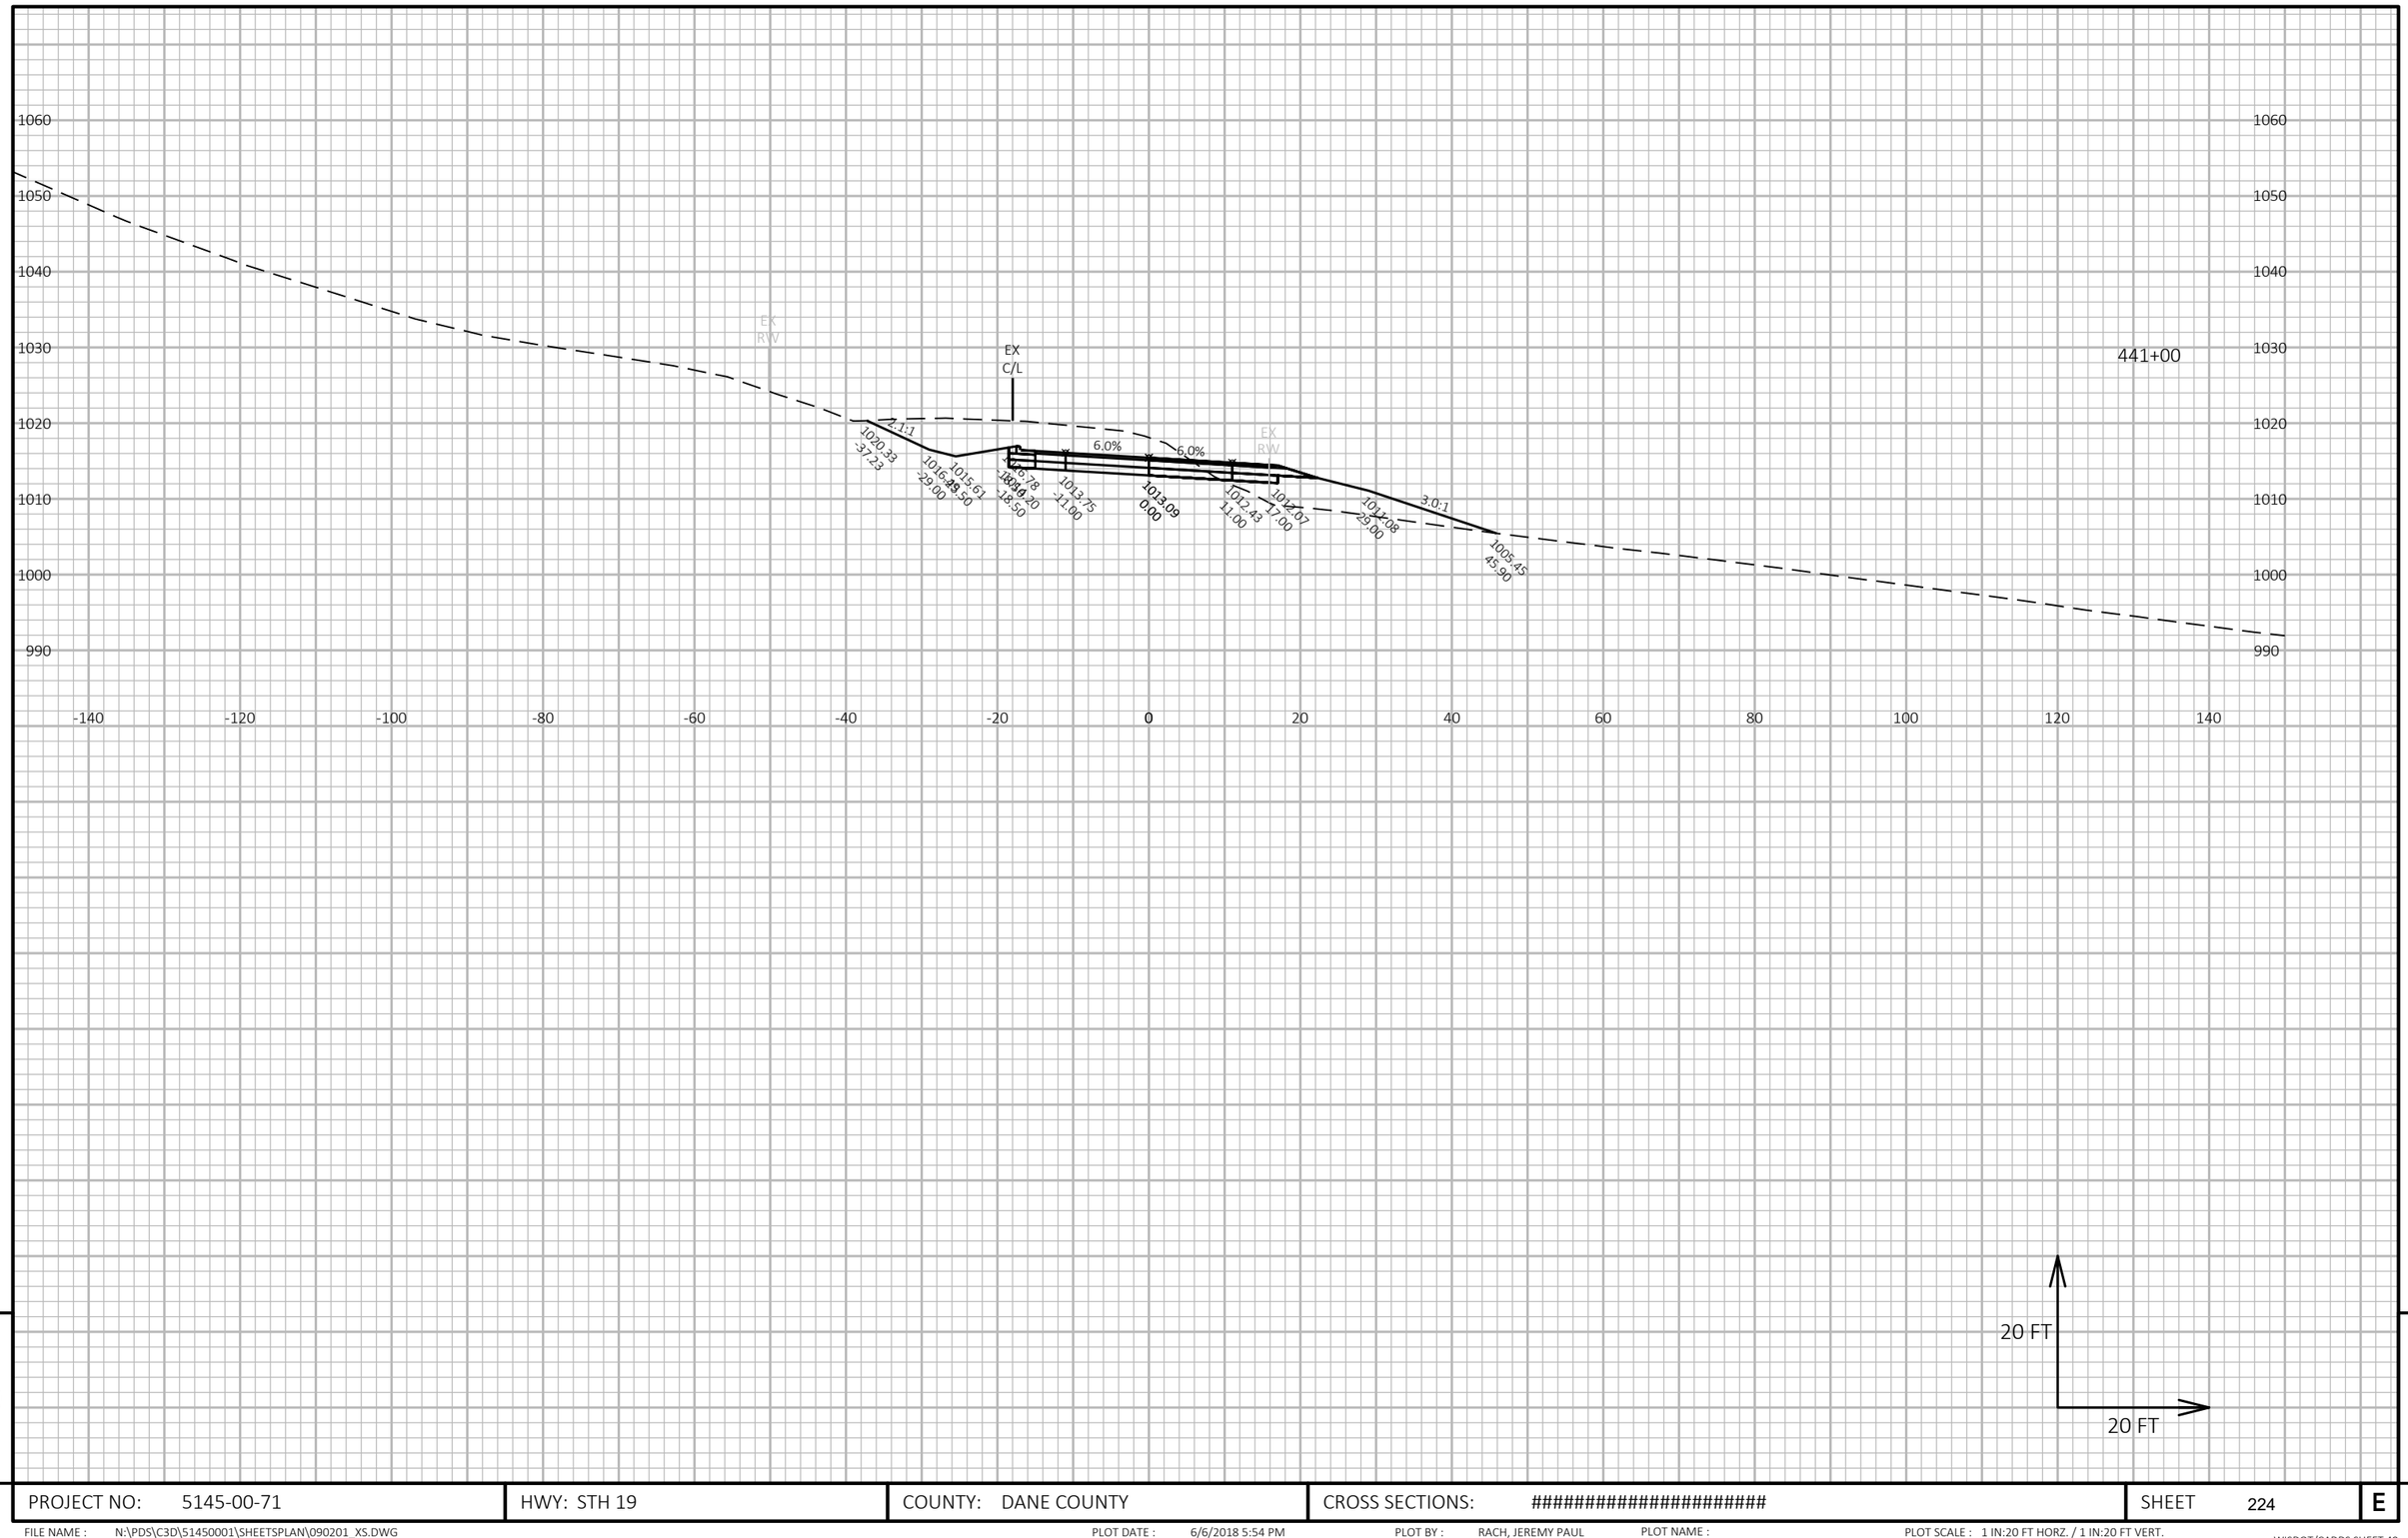

9

PROJECT NO: 5145-00-71	HWY: STH 19	COUNTY: DANE COUNTY	CROSS SECTIONS: ##########################	SHEET 224	E

9

FILE NAME : N:\PDS\C3D\51450001\SHEETSPLAN\090201_XS.DWG
LAYOUT NAME - 0902177-xs

PLOT DATE : 6/6/2018 5:54 PM

PLOT BY : RACH, JEREMY PAUL

PLOT NAME :

PLOT SCALE : 1 IN:20 FT HORZ. / 1 IN:20 FT VERT.

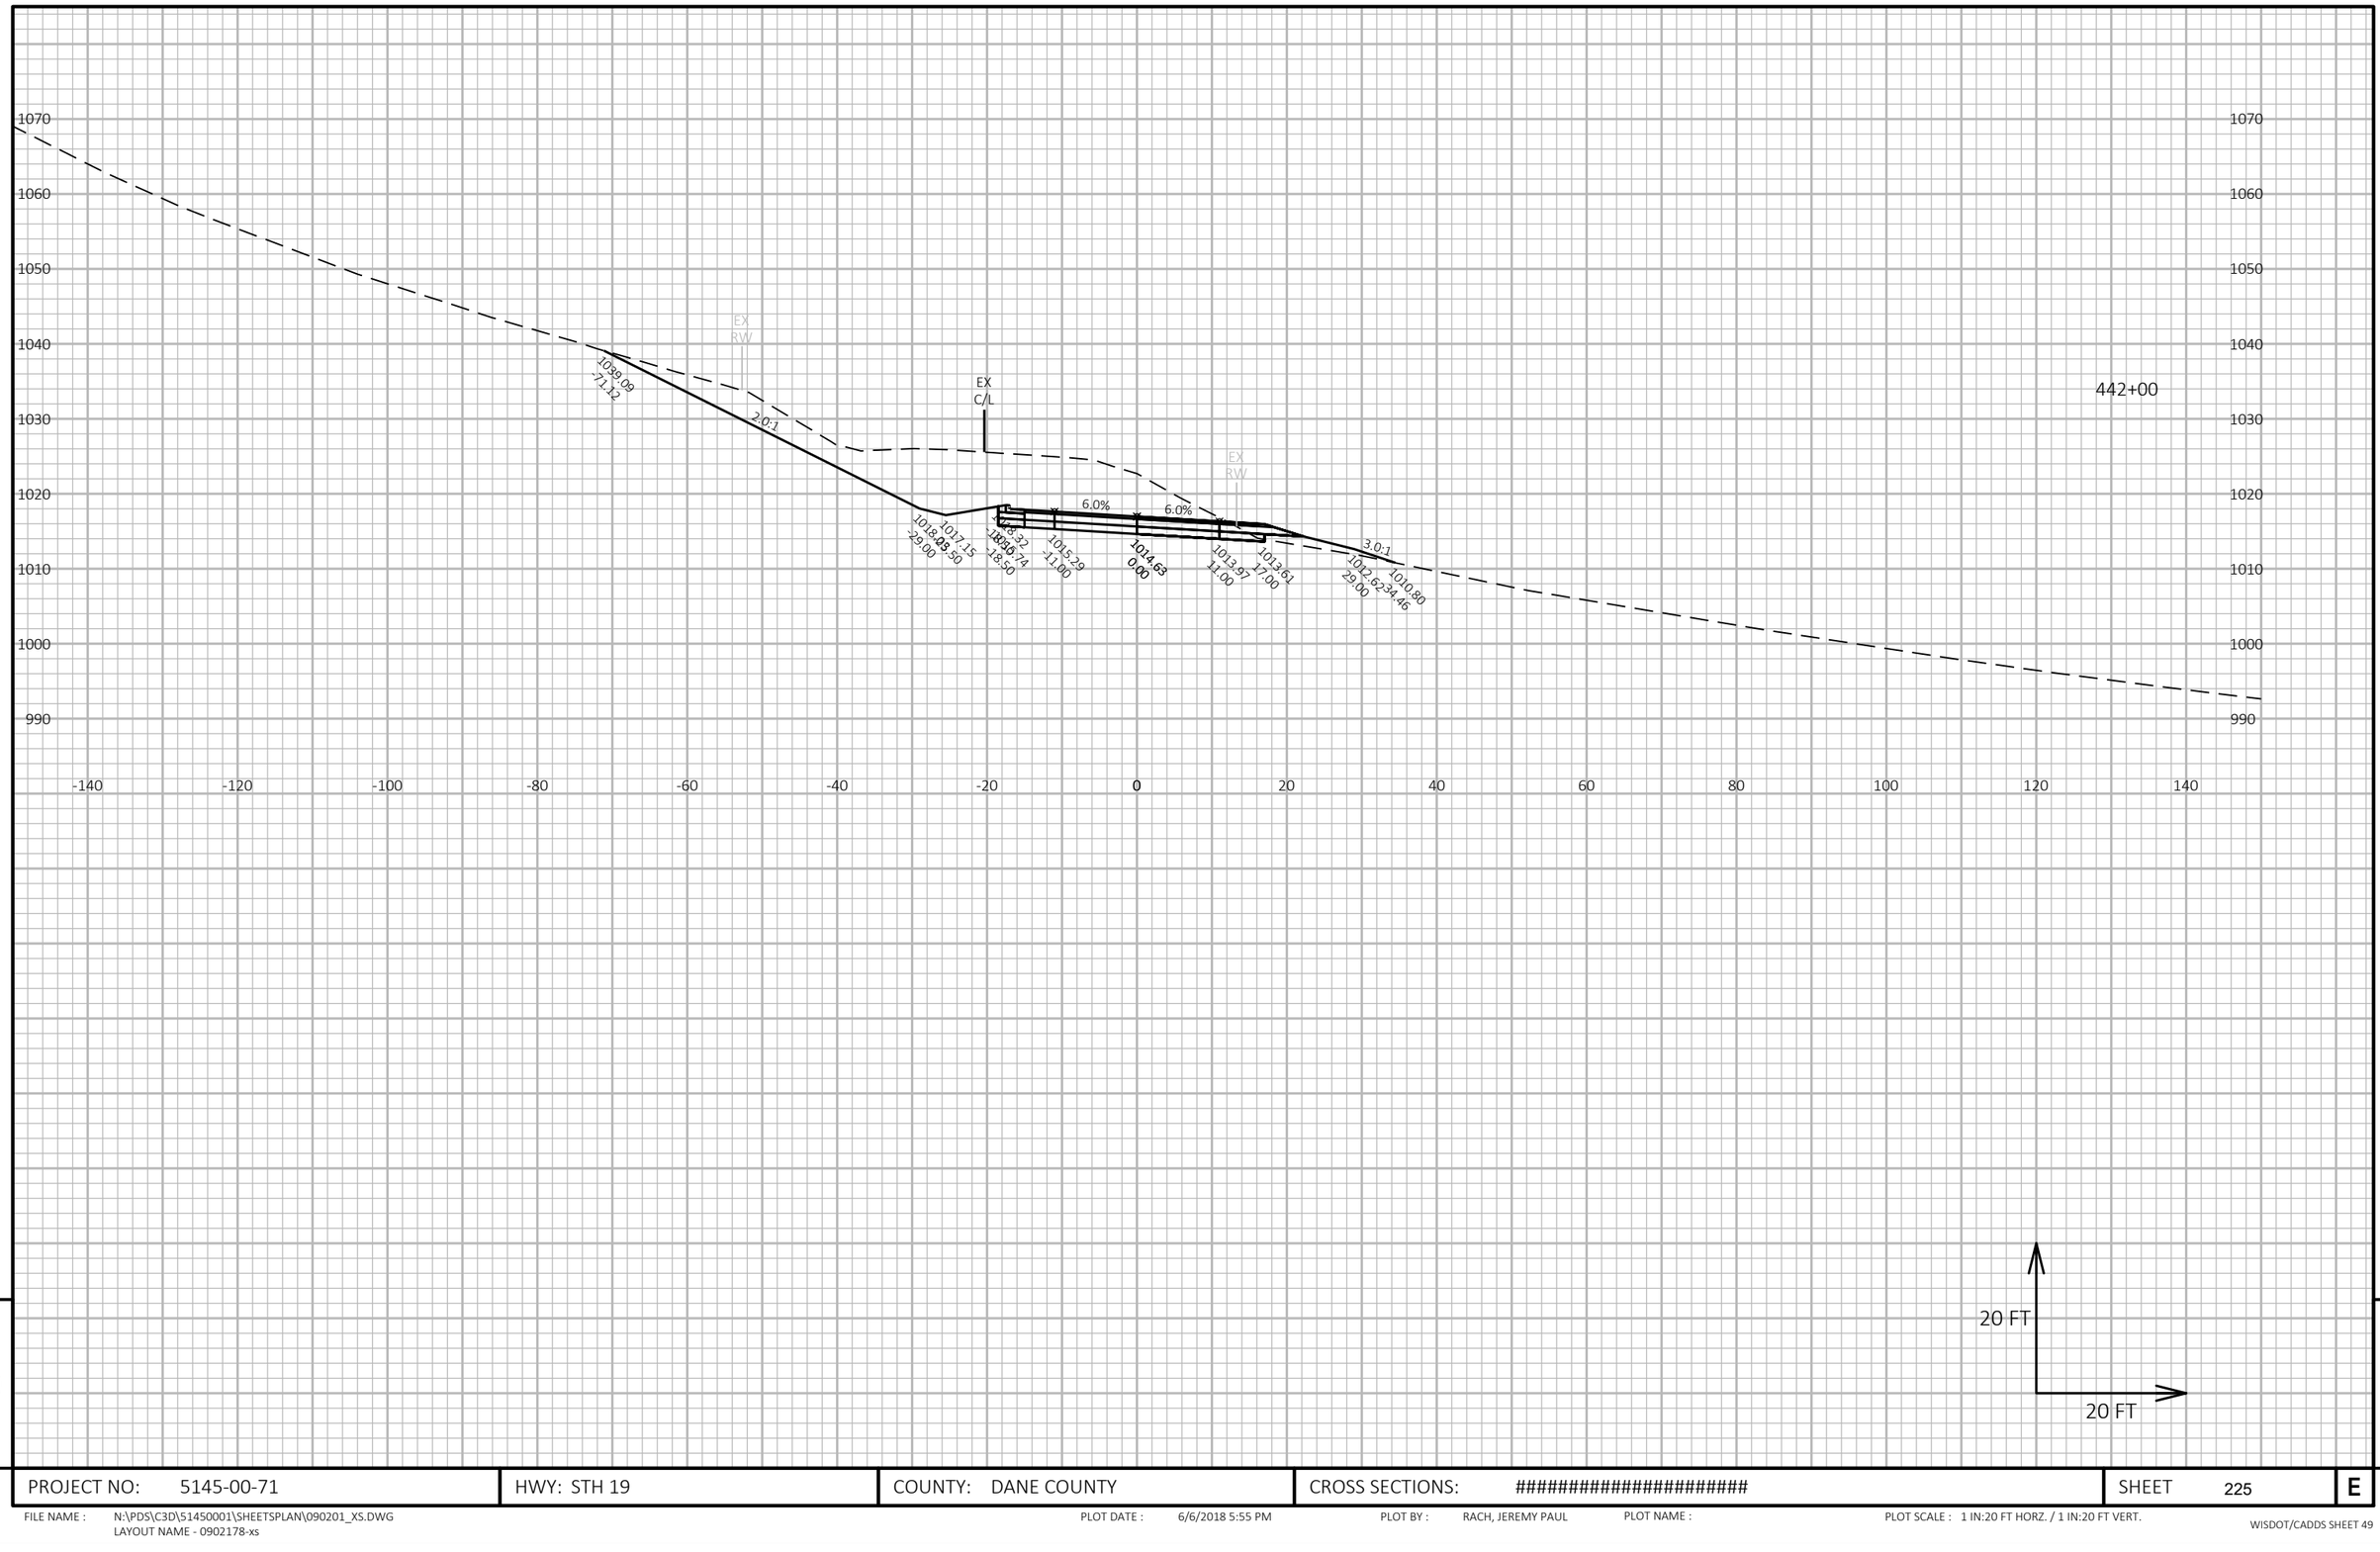

9

9

PROJECT NO: 5145-00-71	HWY: STH 19	COUNTY: DANE COUNTY	CROSS SECTIONS: ##########################	SHEET 225	E

FILE NAME : N:\PDS\C3D\51450001\SHEETSPLAN\090201_XS.DWG
LAYOUT NAME - 0902178-xs

PLOT DATE : 6/6/2018 5:55 PM

PLOT BY : RACH, JEREMY PAUL

PLOT NAME :

PLOT SCALE : 1 IN:20 FT HORZ. / 1 IN:20 FT VERT.

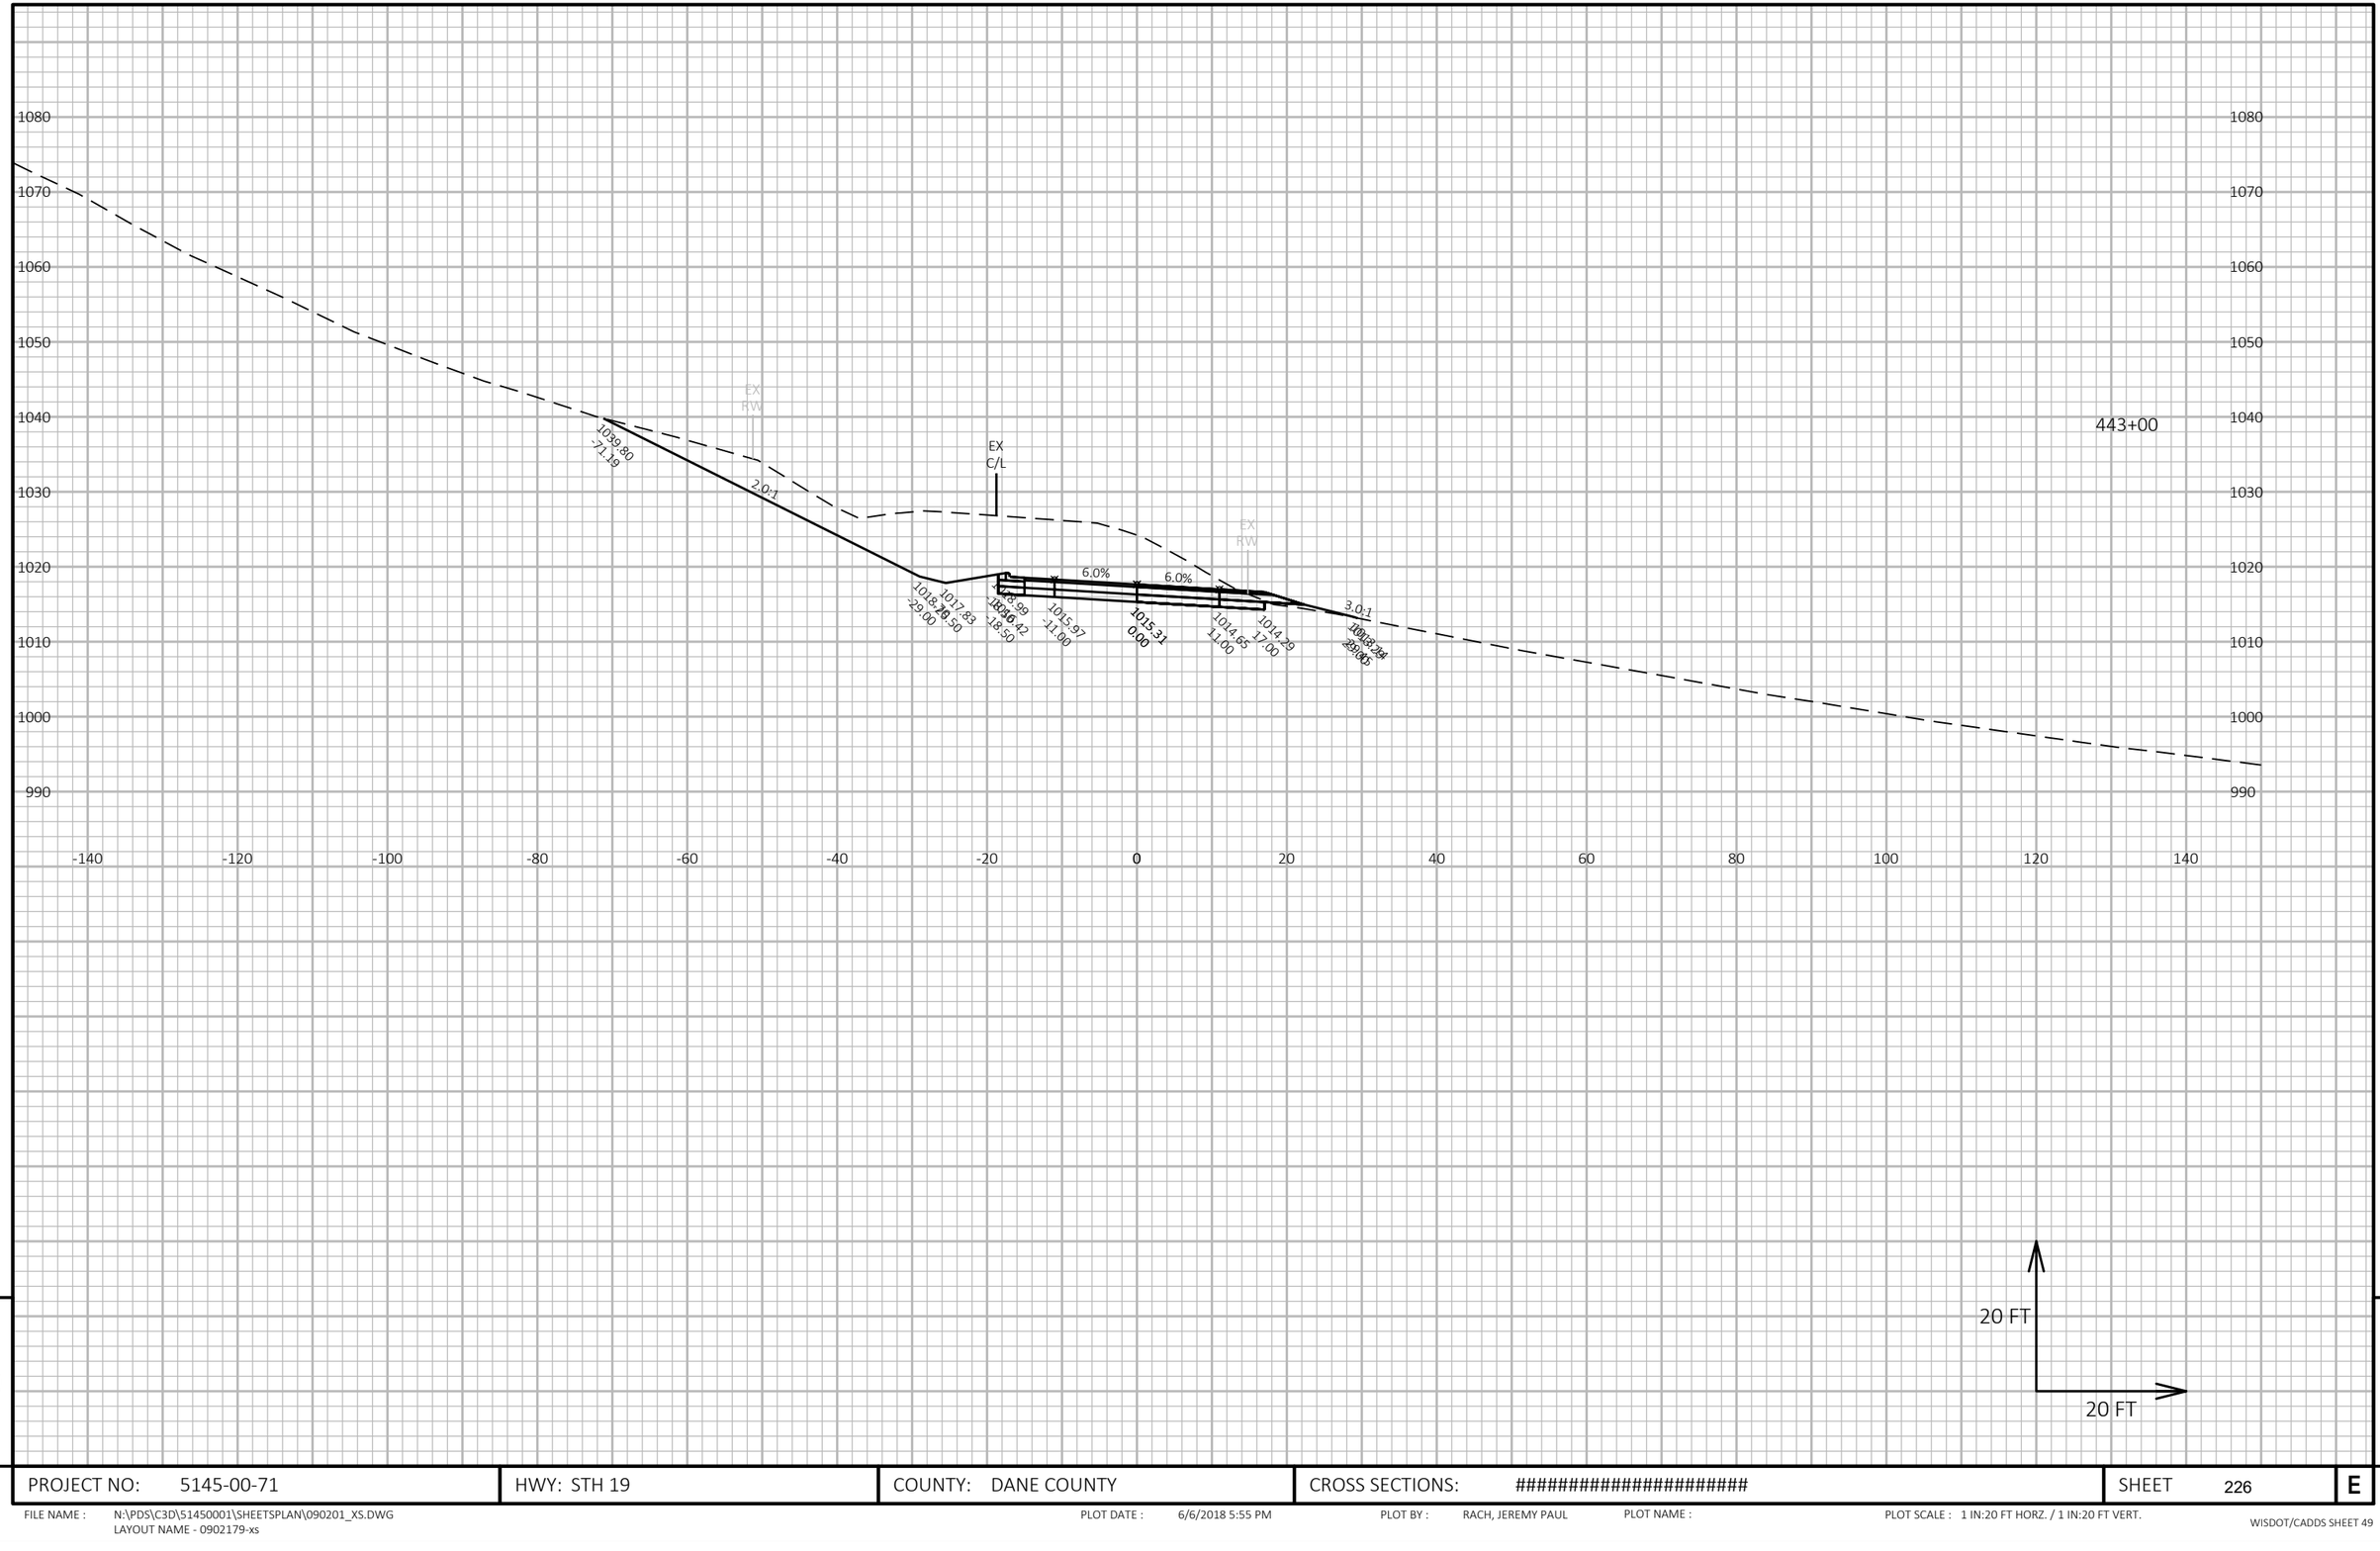

9

9

PROJECT NO: 5145-00-71	HWY: STH 19	COUNTY: DANE COUNTY	CROSS SECTIONS: ##########################	SHEET 226	E

FILE NAME : N:\PDS\C3D\51450001\SHEETSPLAN\090201_XS.DWG
LAYOUT NAME - 0902179-xs

PLOT DATE : 6/6/2018 5:55 PM PLOT BY : RACH, JEREMY PAUL PLOT NAME : PLOT SCALE : 1 IN:20 FT HORZ. / 1 IN:20 FT VERT.

WISDOT/CADDS SHEET 49

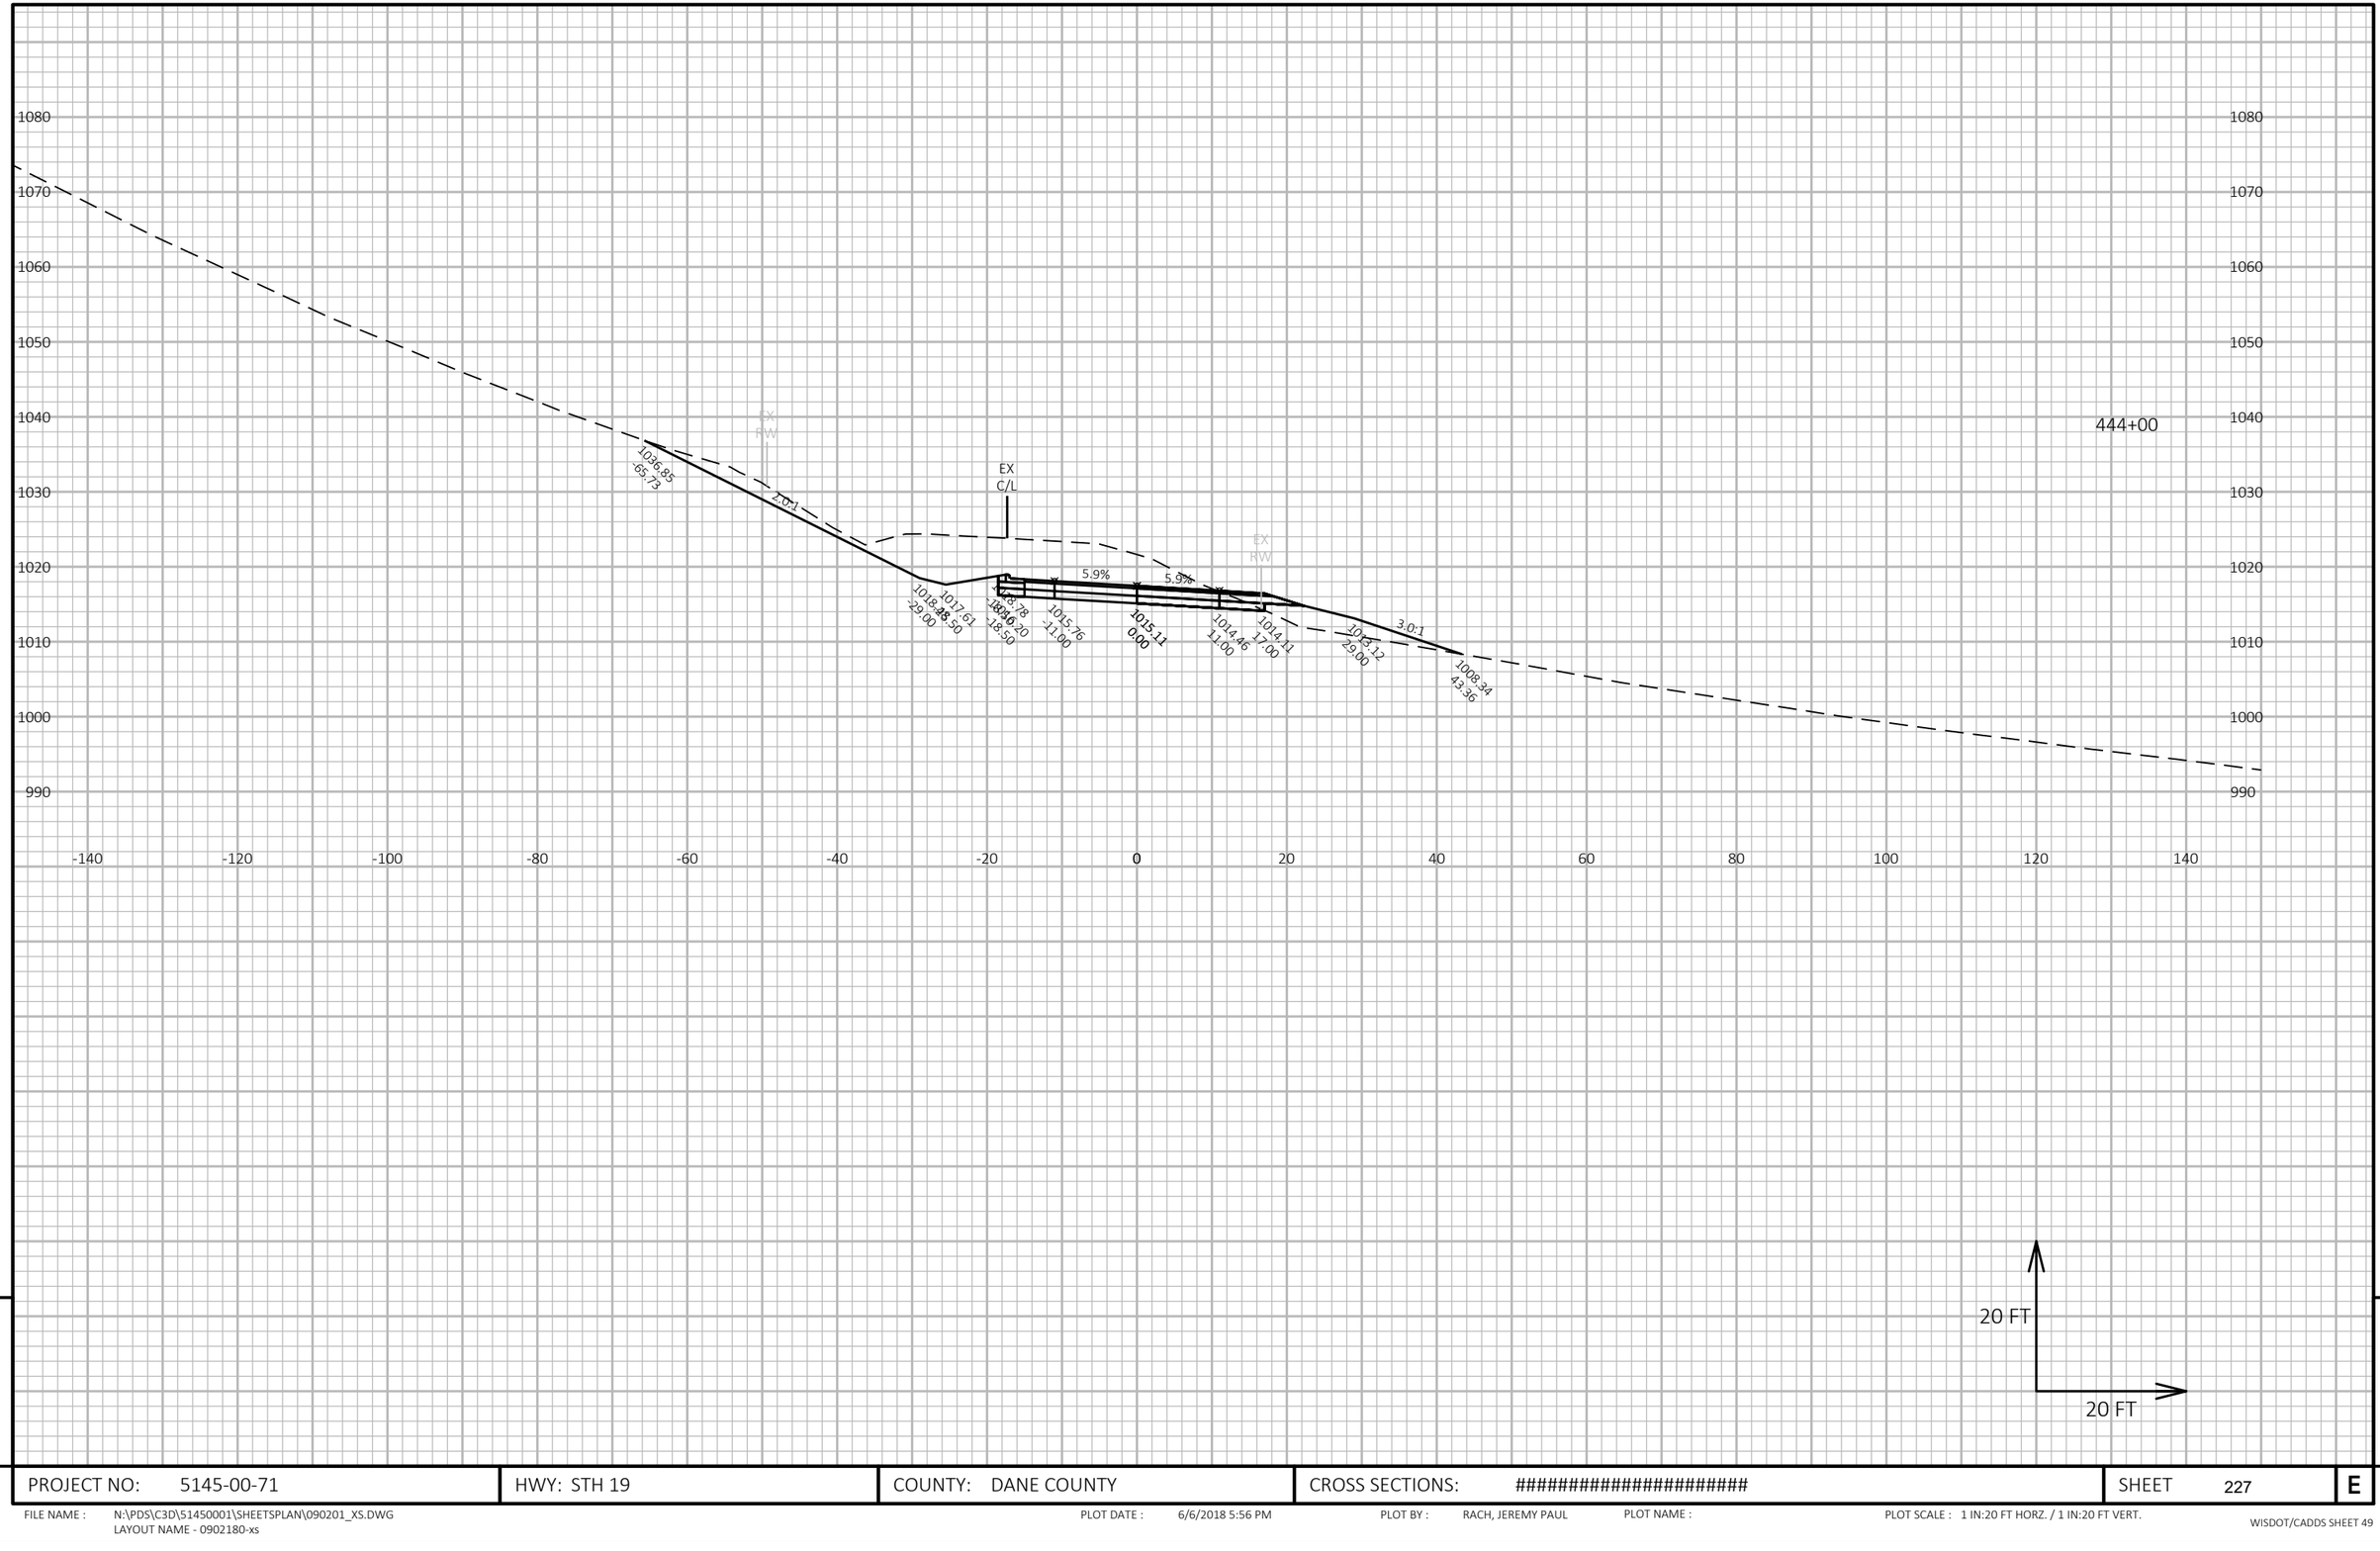

9

9

PROJECT NO: 5145-00-71	HWY: STH 19	COUNTY: DANE COUNTY	CROSS SECTIONS: ##########################	SHEET 227	E

FILE NAME : N:\PDS\C3D\51450001\SHEETSPLAN\090201_XS.DWG
LAYOUT NAME - 0902180-xs

PLOT DATE : 6/6/2018 5:56 PM PLOT BY : RACH, JEREMY PAUL PLOT NAME : PLOT SCALE : 1 IN:20 FT HORZ. / 1 IN:20 FT VERT.

WISDOT/CADDS SHEET 49

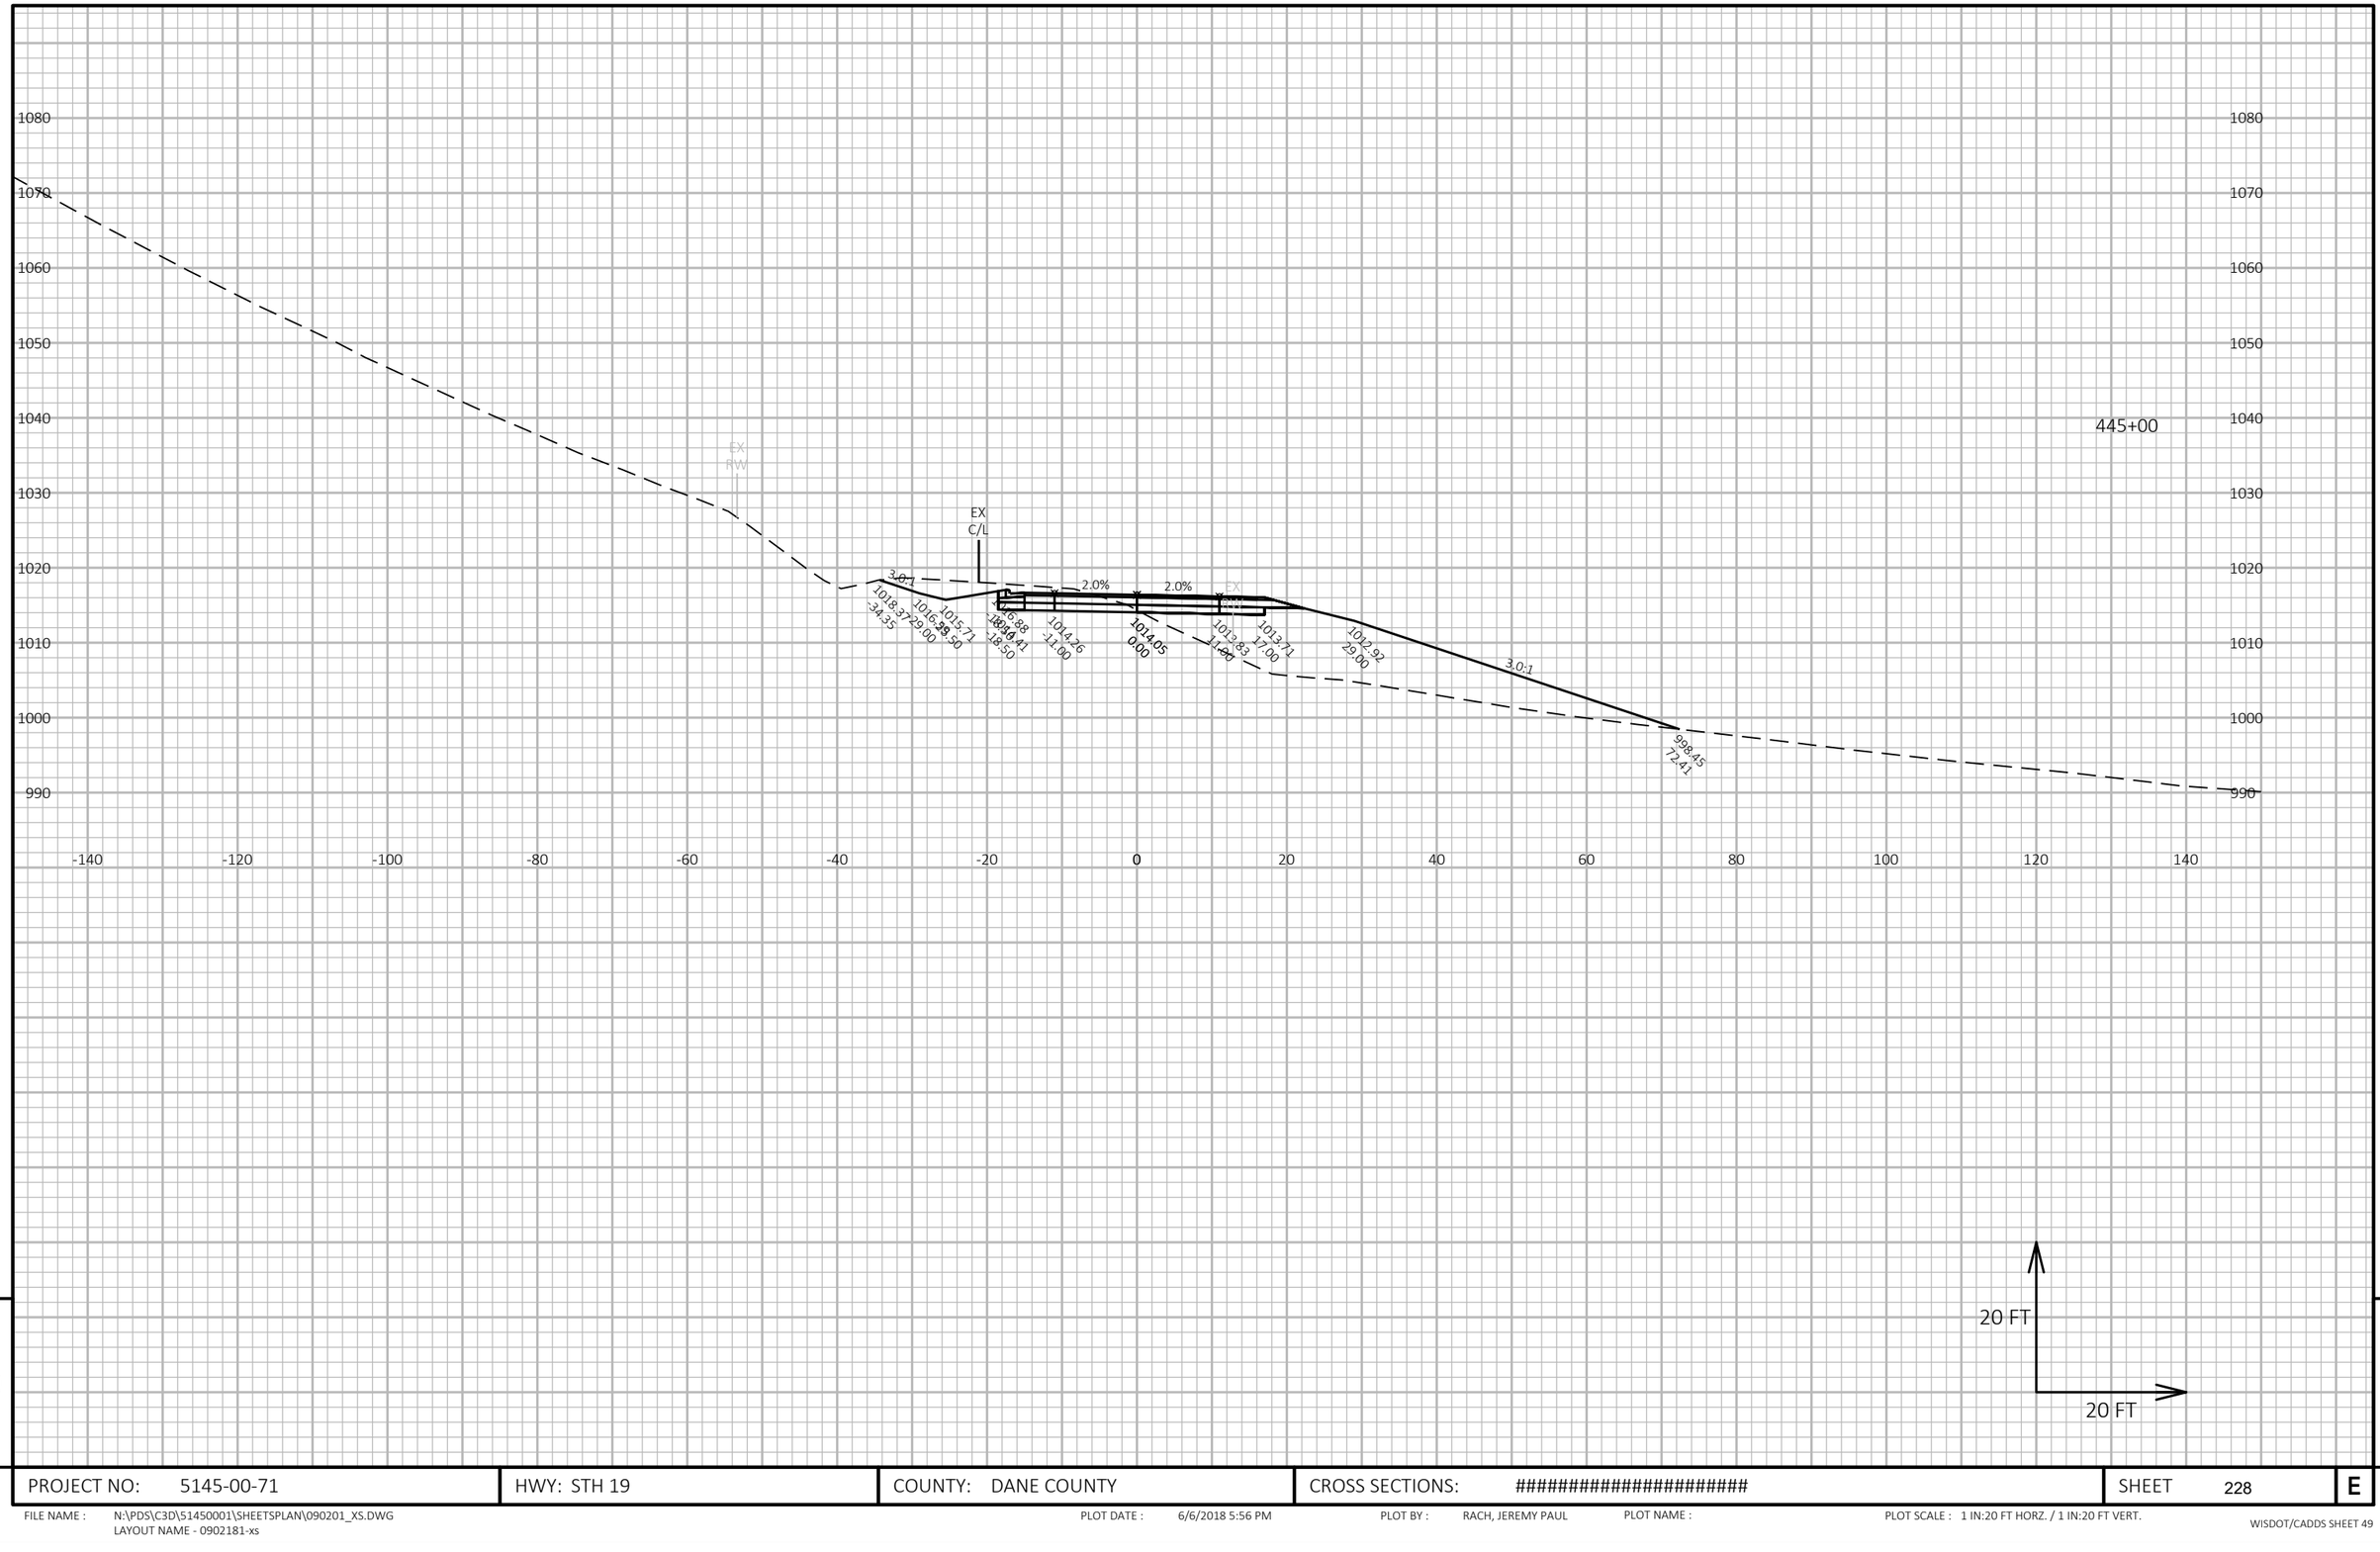

9

9

PROJECT NO: 5145-00-71	HWY: STH 19	COUNTY: DANE COUNTY	CROSS SECTIONS: ##########################	SHEET 228	E

FILE NAME : N:\PDS\C3D\51450001\SHEETSPLAN\090201_XS.DWG
LAYOUT NAME - 0902181-xs

PLOT DATE : 6/6/2018 5:56 PM PLOT BY : RACH, JEREMY PAUL PLOT NAME : PLOT SCALE : 1 IN:20 FT HORZ. / 1 IN:20 FT VERT.

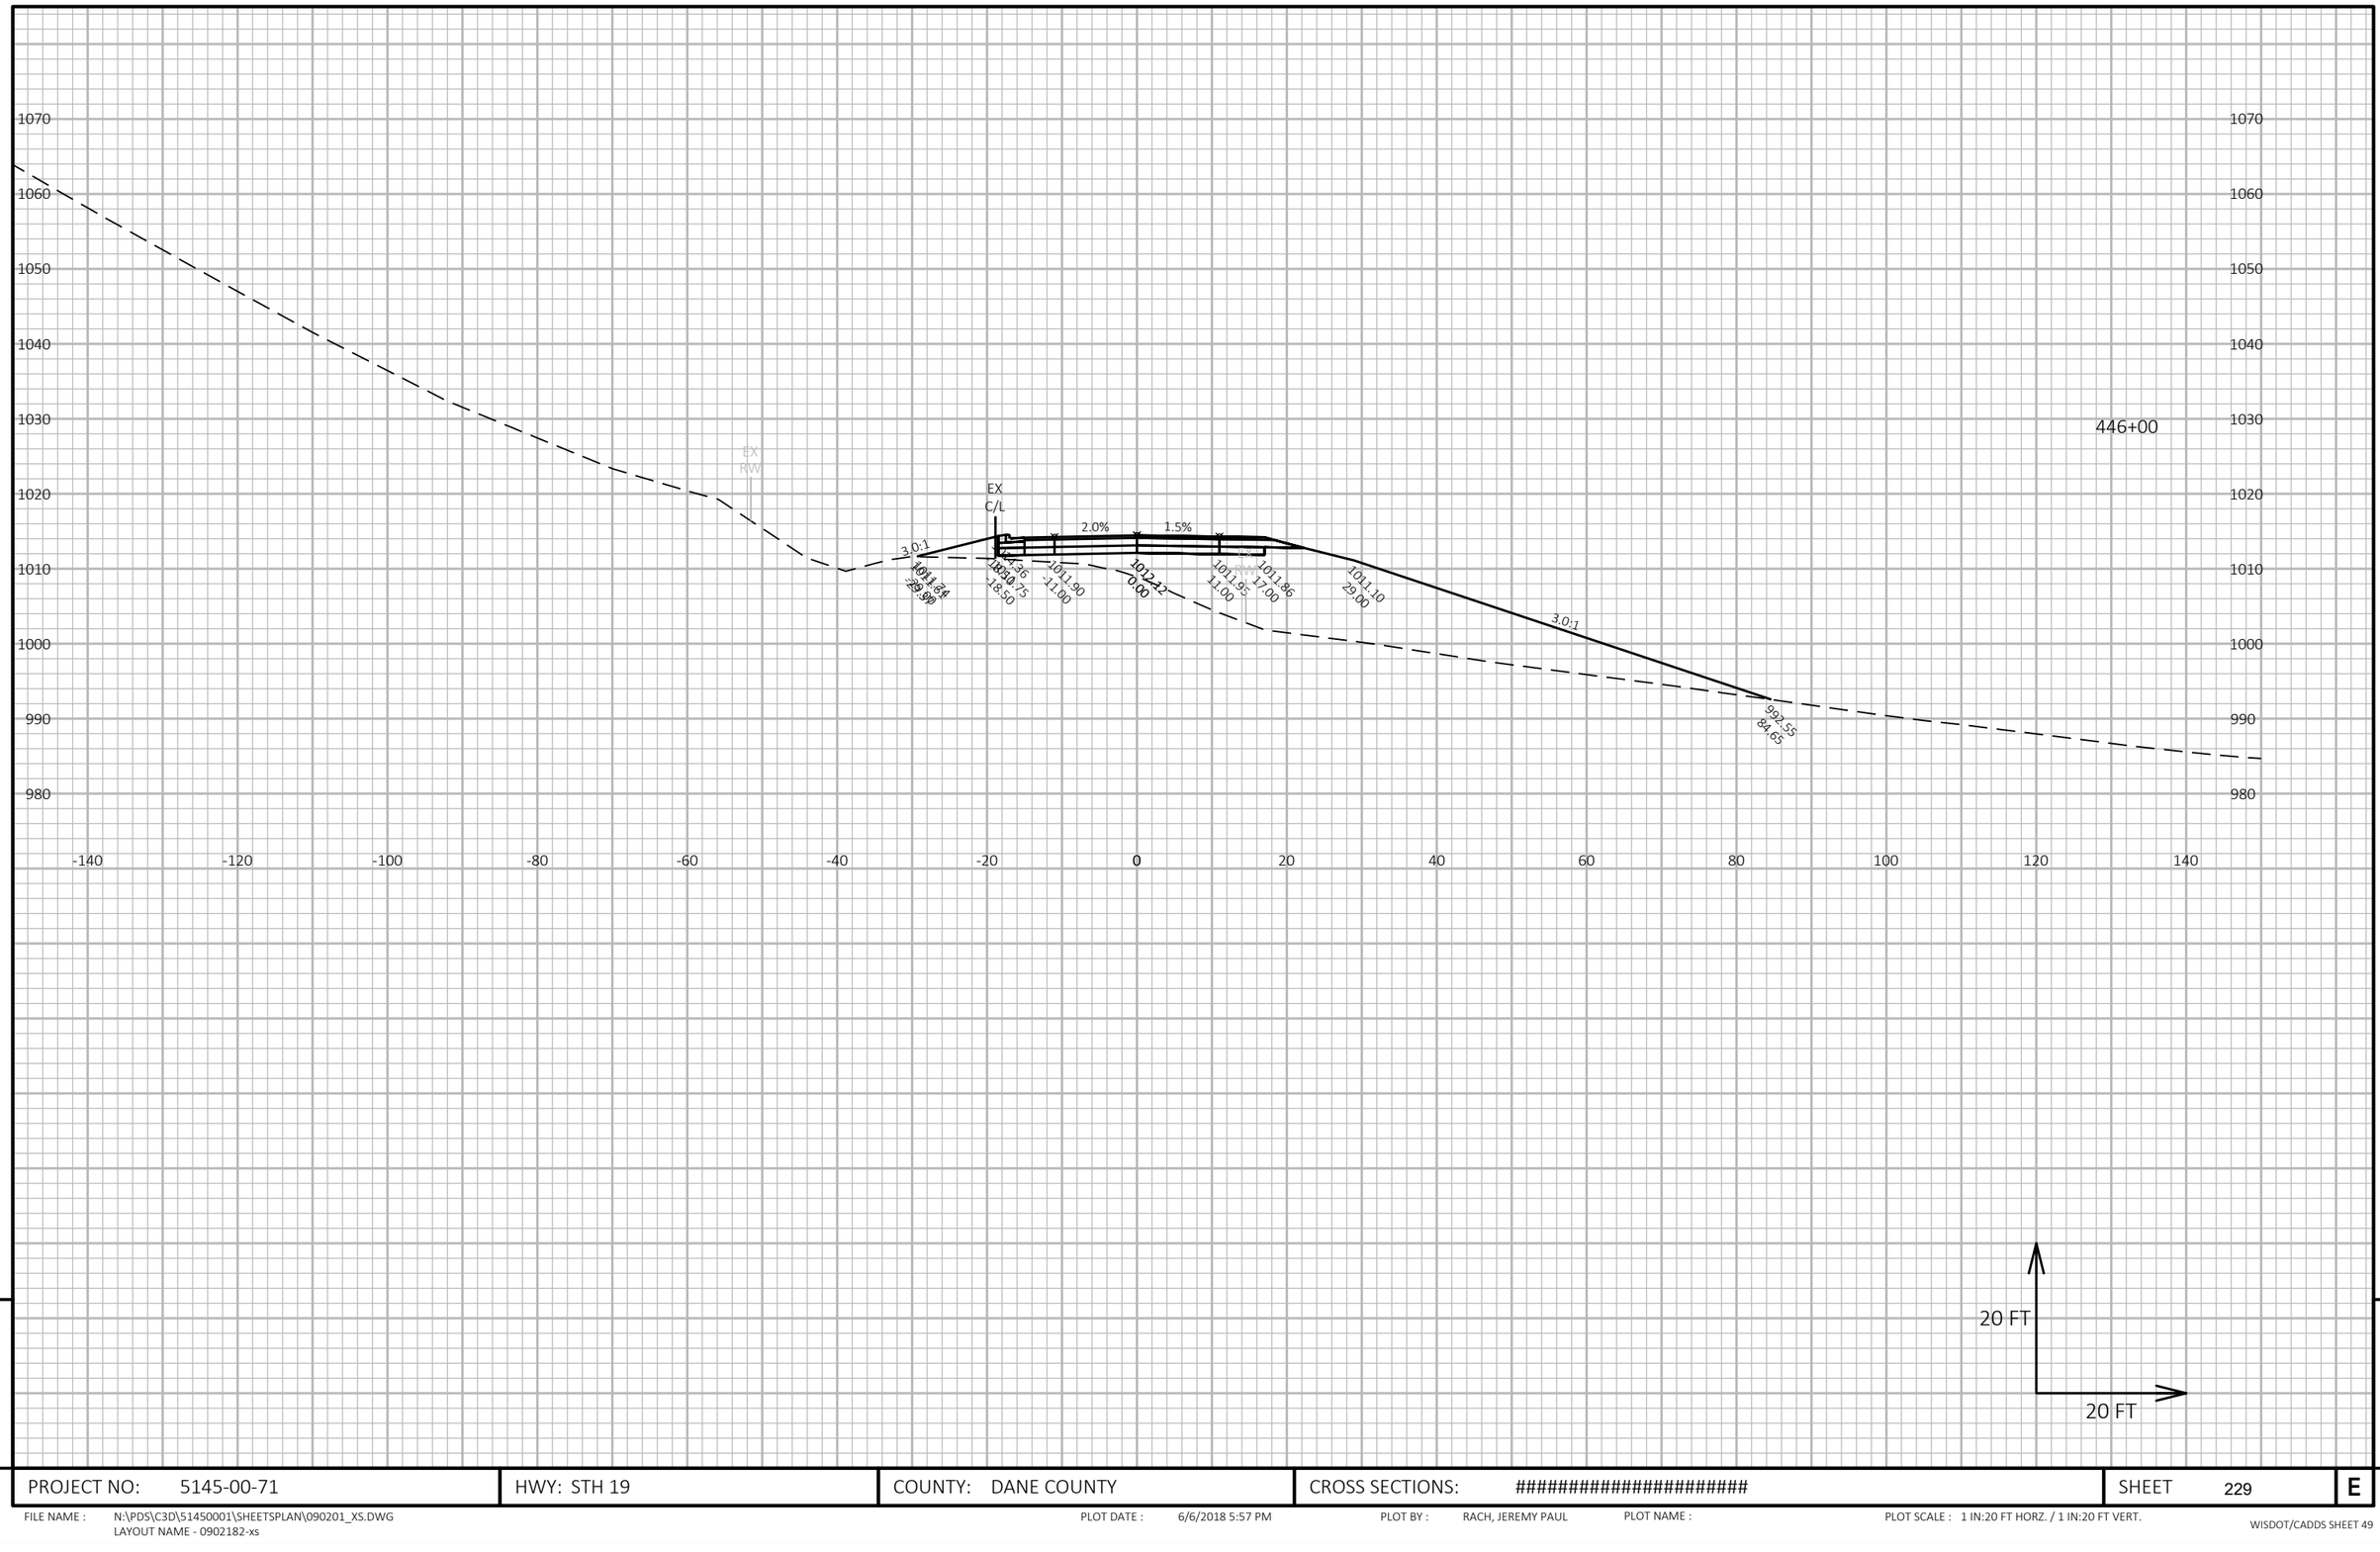

9

9

PROJECT NO: 5145-00-71	HWY: STH 19	COUNTY: DANE COUNTY	CROSS SECTIONS: ##########################	SHEET 229	E

FILE NAME : N:\PDS\C3D\51450001\SHEETSPLAN\090201_XS.DWG
LAYOUT NAME - 0902182-xs

PLOT DATE : 6/6/2018 5:57 PM PLOT BY : RACH, JEREMY PAUL PLOT NAME : PLOT SCALE : 1 IN:20 FT HORZ. / 1 IN:20 FT VERT.

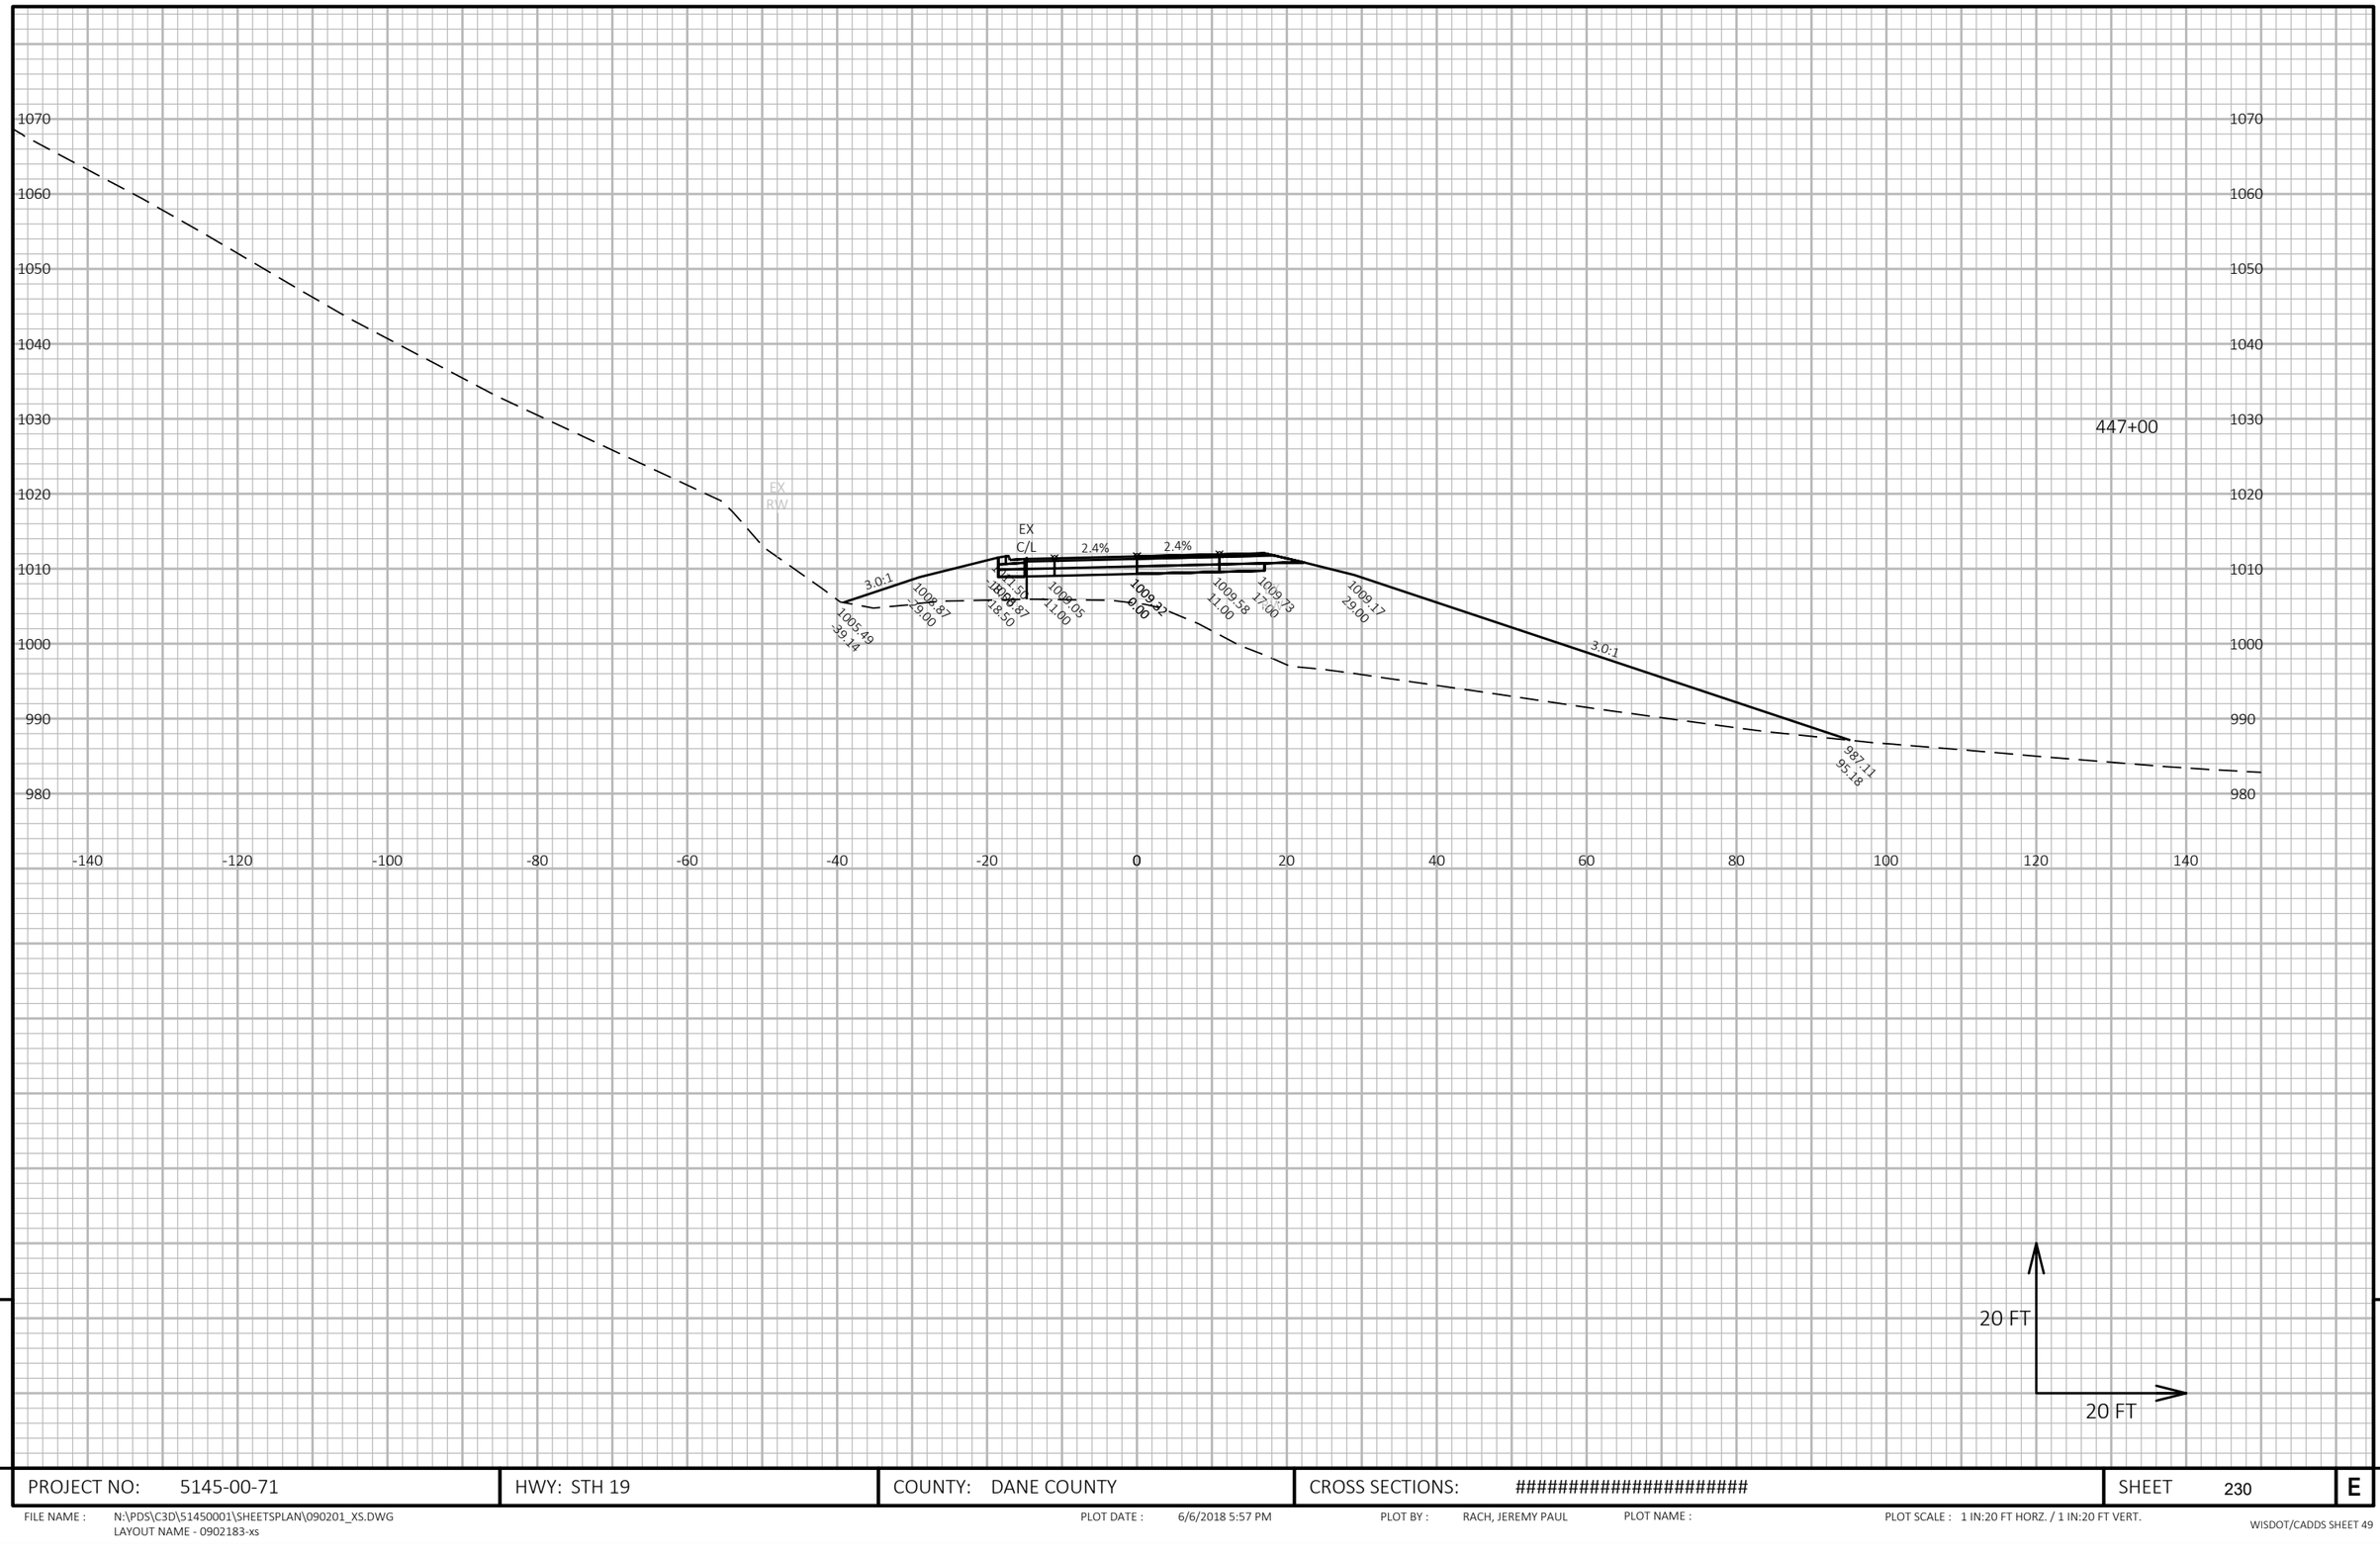

9

9

PROJECT NO: 5145-00-71	HWY: STH 19	COUNTY: DANE COUNTY	CROSS SECTIONS: ##########################	SHEET 230	E

FILE NAME : N:\PDS\C3D\51450001\SHEETSPLAN\090201_XS.DWG
LAYOUT NAME - 0902183-xs

PLOT DATE : 6/6/2018 5:57 PM PLOT BY : RACH, JEREMY PAUL PLOT NAME : PLOT SCALE : 1 IN:20 FT HORZ. / 1 IN:20 FT VERT.

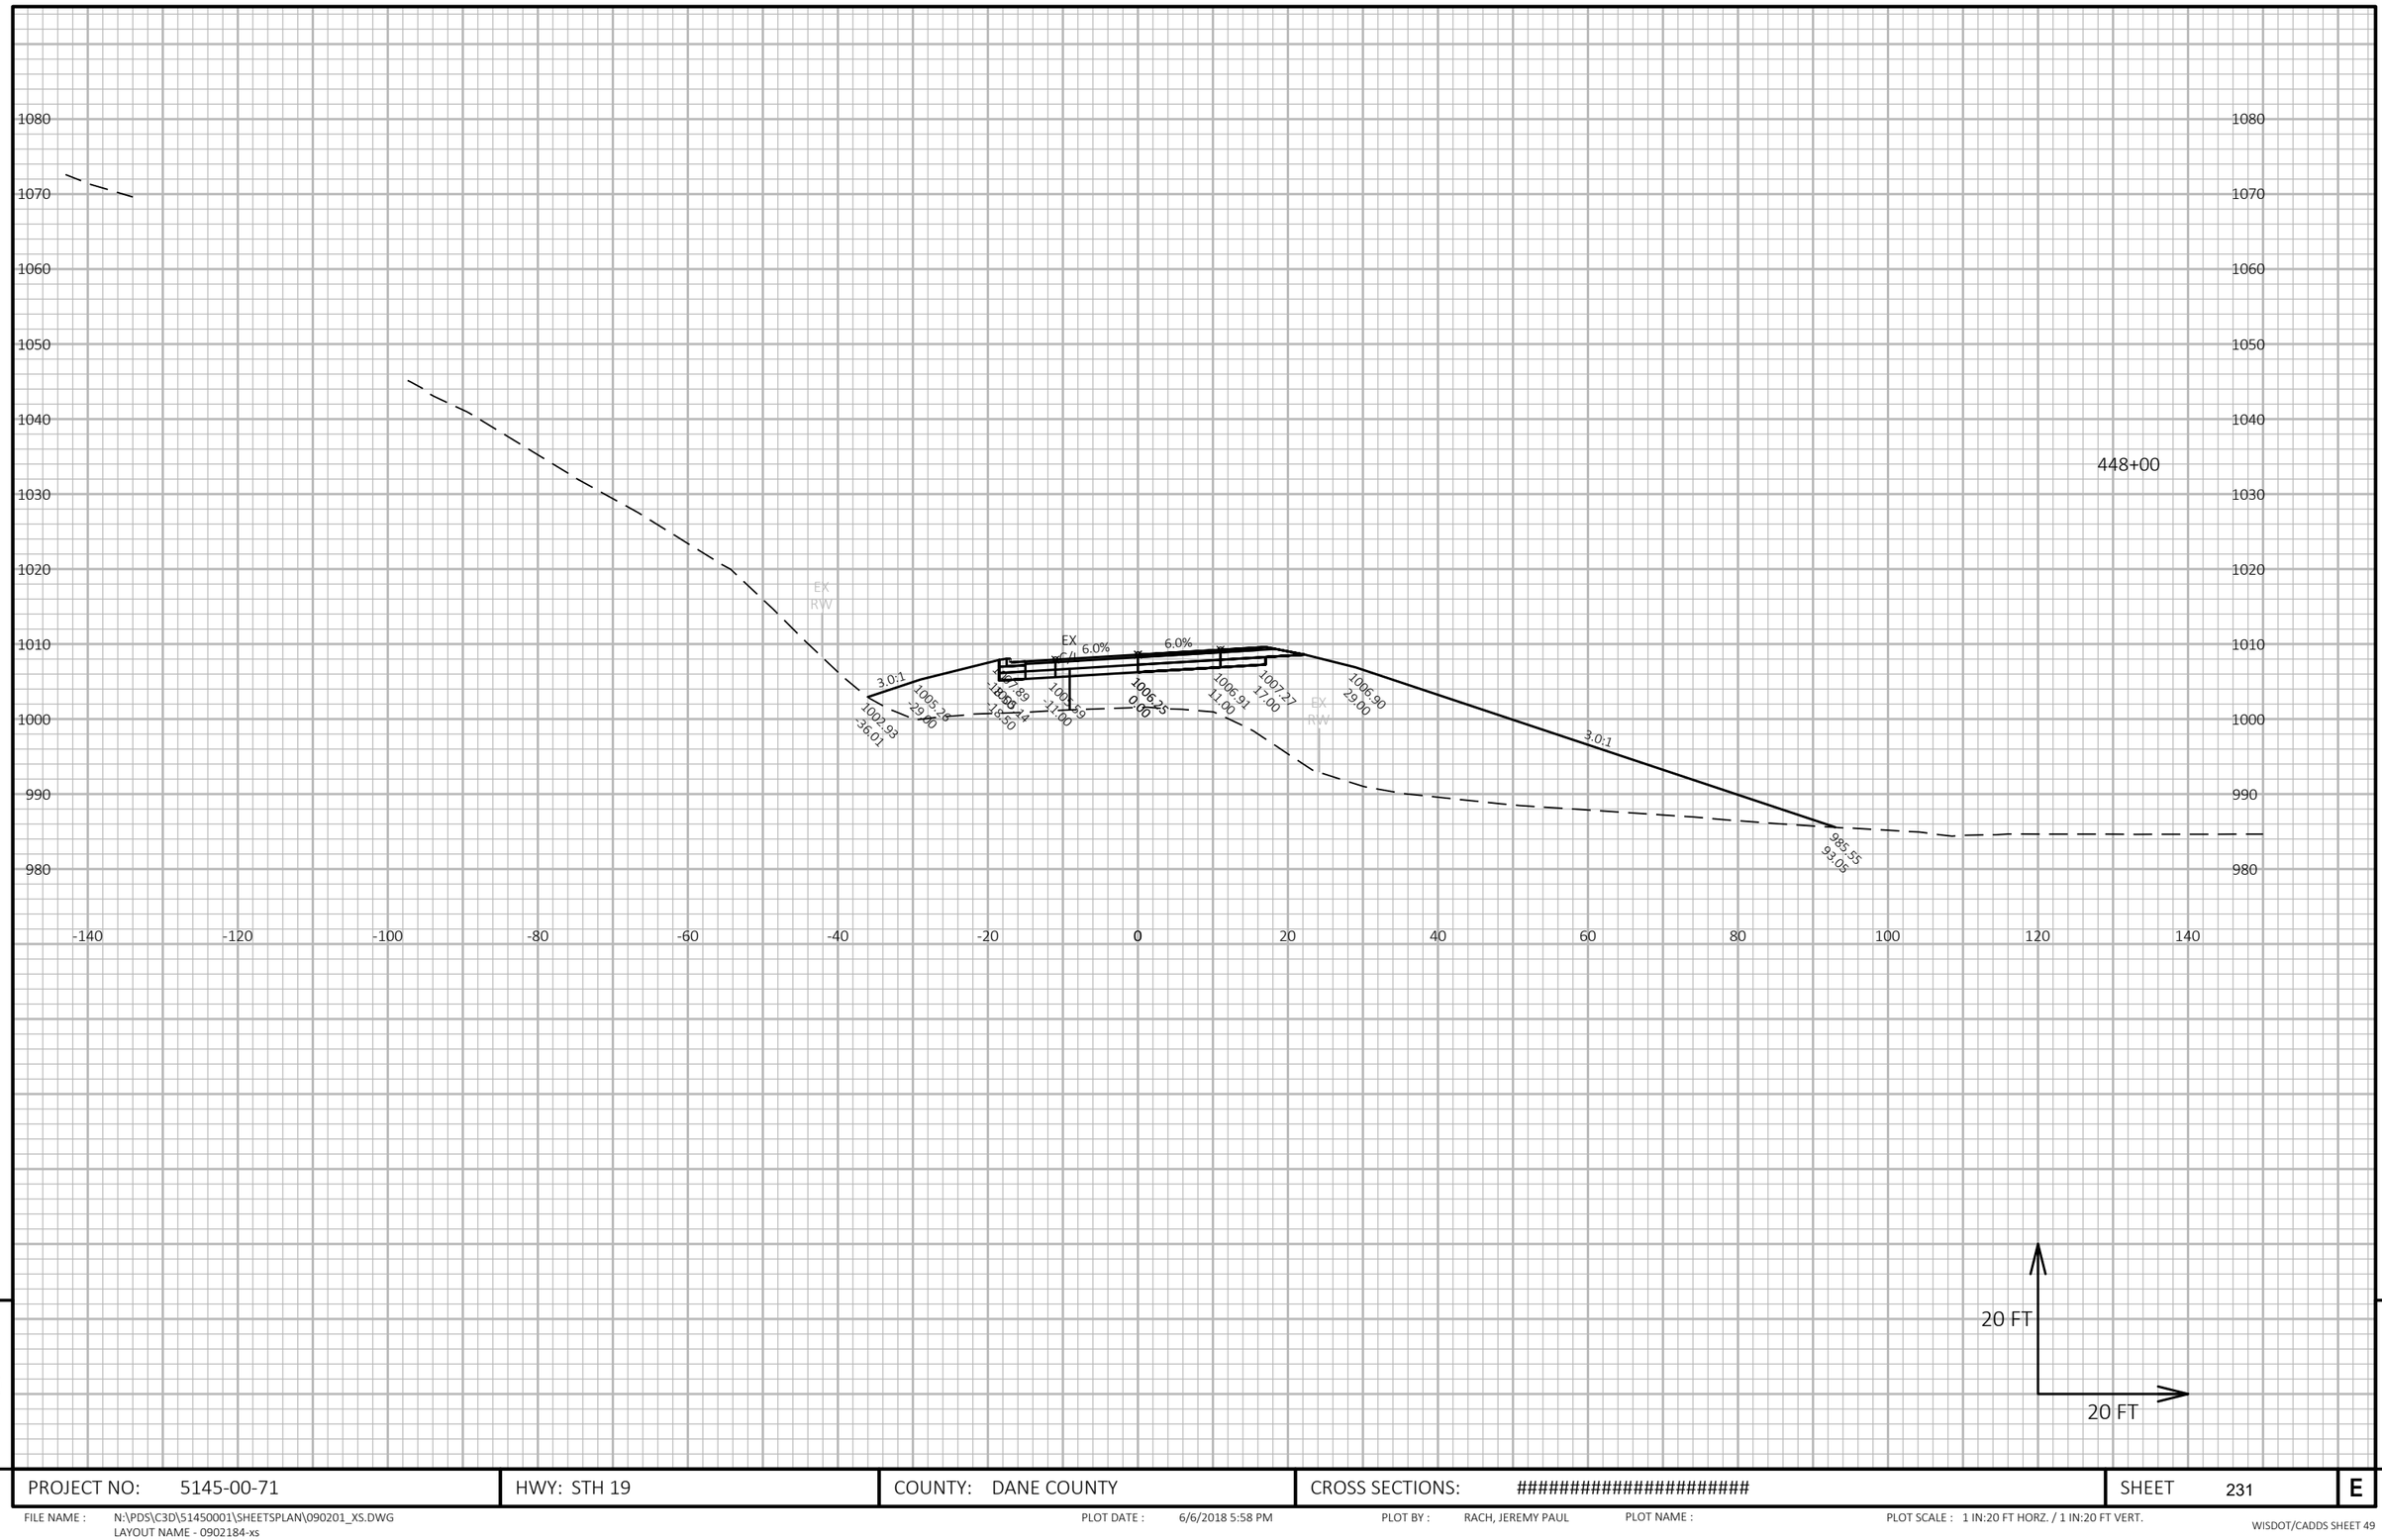

9

9

PROJECT NO: 5145-00-71	HWY: STH 19	COUNTY: DANE COUNTY	CROSS SECTIONS: ##########################	SHEET 231	E

FILE NAME : N:\PDS\C3D\51450001\SHEETSPLAN\090201_XS.DWG
LAYOUT NAME - 0902184-xs

PLOT DATE : 6/6/2018 5:58 PM PLOT BY : RACH, JEREMY PAUL PLOT NAME : PLOT SCALE : 1 IN:20 FT HORZ. / 1 IN:20 FT VERT.

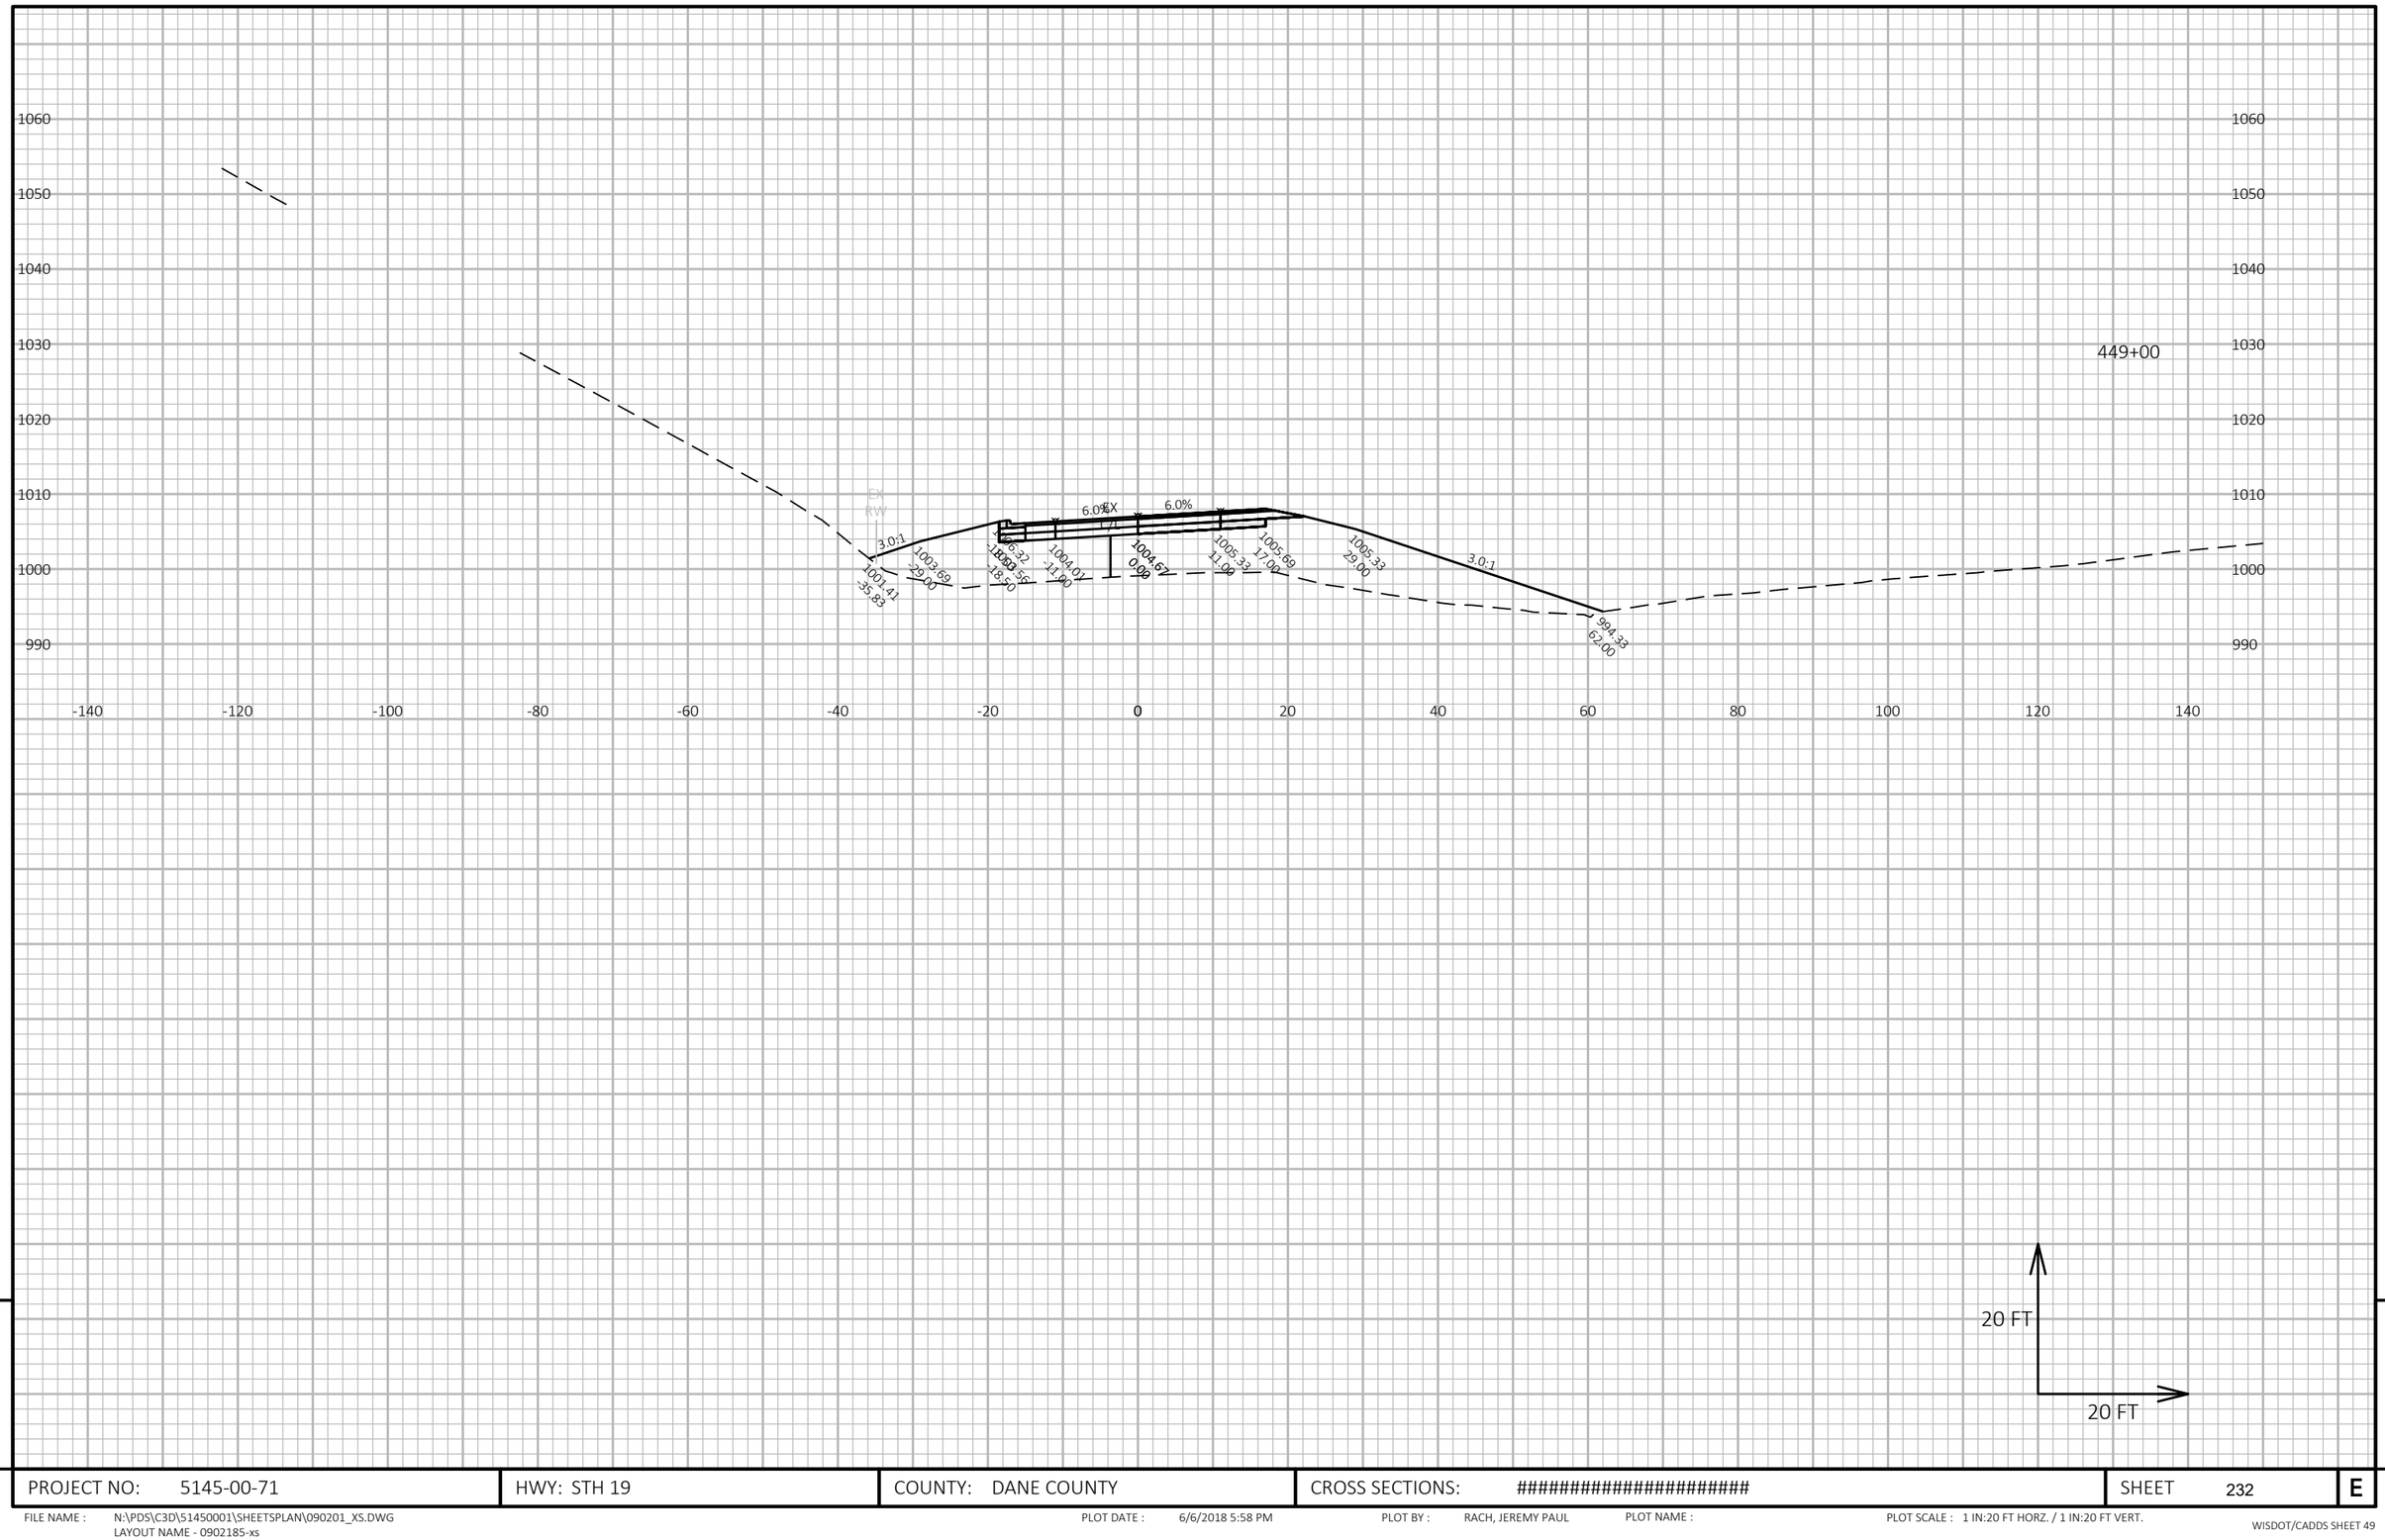

9

PROJECT NO: 5145-00-71	HWY: STH 19	COUNTY: DANE COUNTY	CROSS SECTIONS: ##########################	SHEET 232	E

9

FILE NAME : N:\PDS\C3D\51450001\SHEETSPLAN\090201_XS.DWG
LAYOUT NAME - 0902185-xs

PLOT DATE : 6/6/2018 5:58 PM PLOT BY : RACH, JEREMY PAUL PLOT NAME : PLOT SCALE : 1 IN:20 FT HORZ. / 1 IN:20 FT VERT.

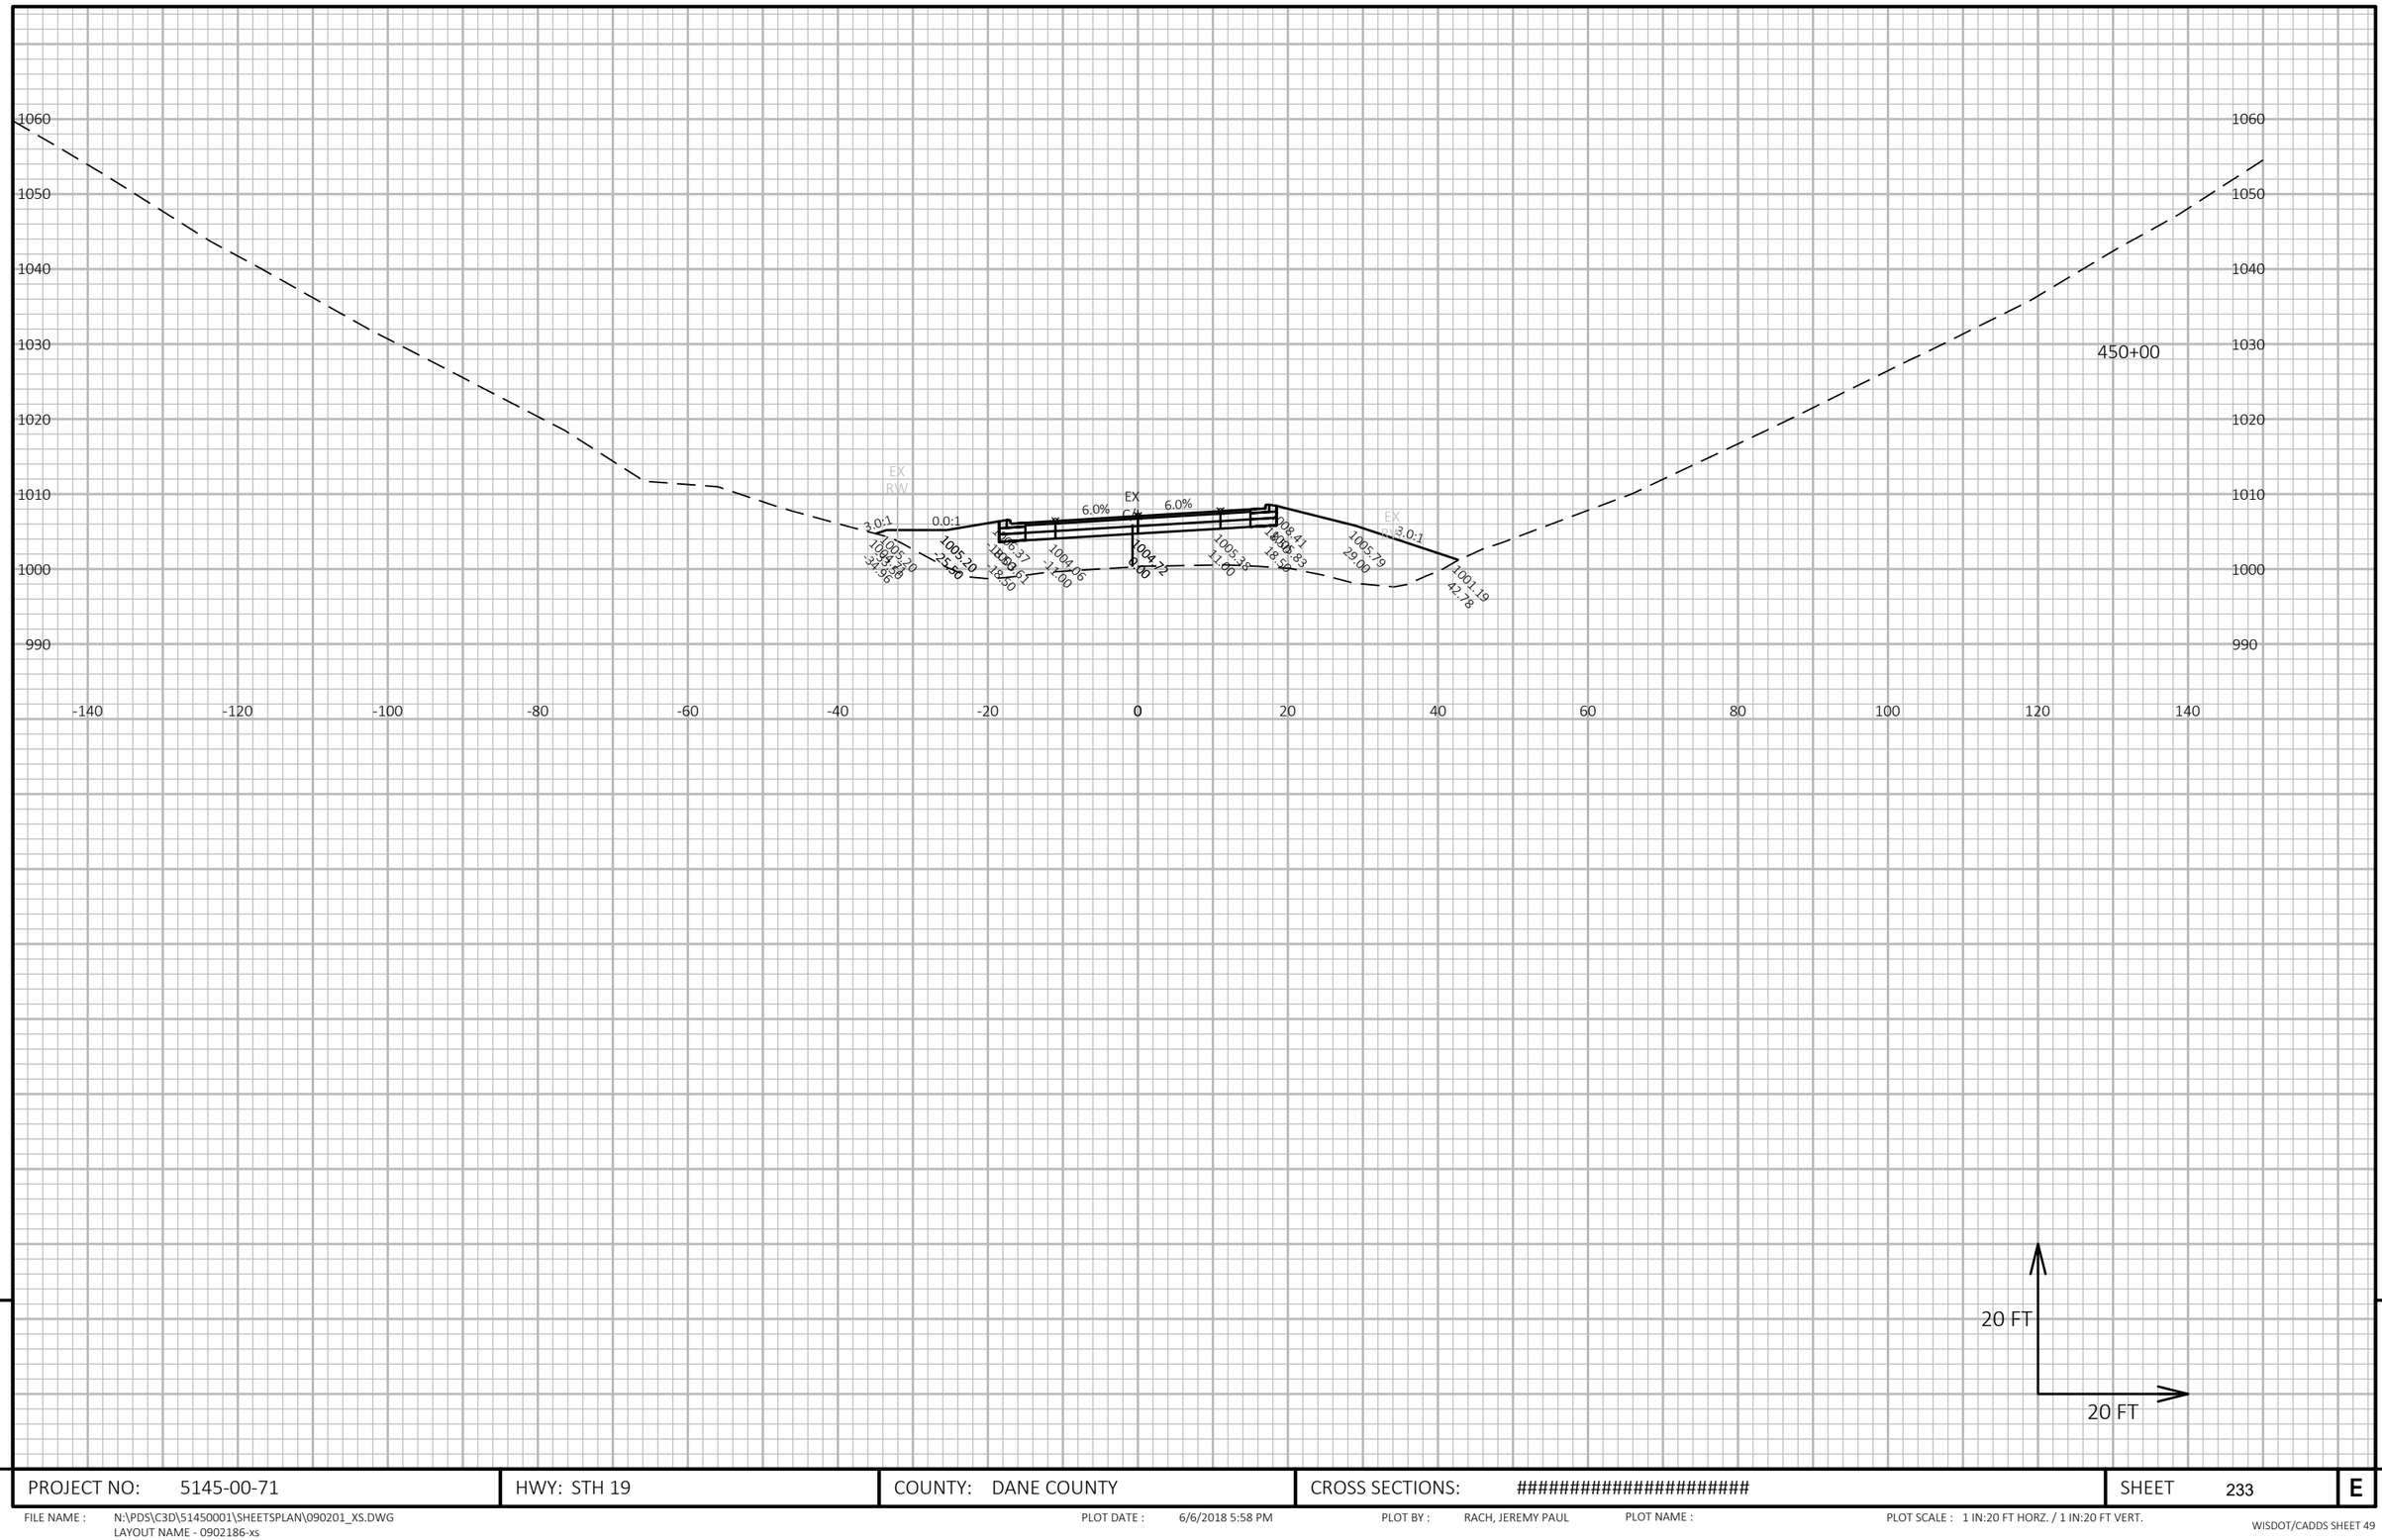

9

9

PROJECT NO: 5145-00-71	HWY: STH 19	COUNTY: DANE COUNTY	CROSS SECTIONS: ##########################	SHEET 233	E

FILE NAME : N:\PDS\C3D\51450001\SHEETSPLAN\090201_XS.DWG
LAYOUT NAME - 0902186-xs

PLOT DATE : 6/6/2018 5:58 PM PLOT BY : RACH, JEREMY PAUL PLOT NAME : PLOT SCALE : 1 IN:20 FT HORZ. / 1 IN:20 FT VERT.

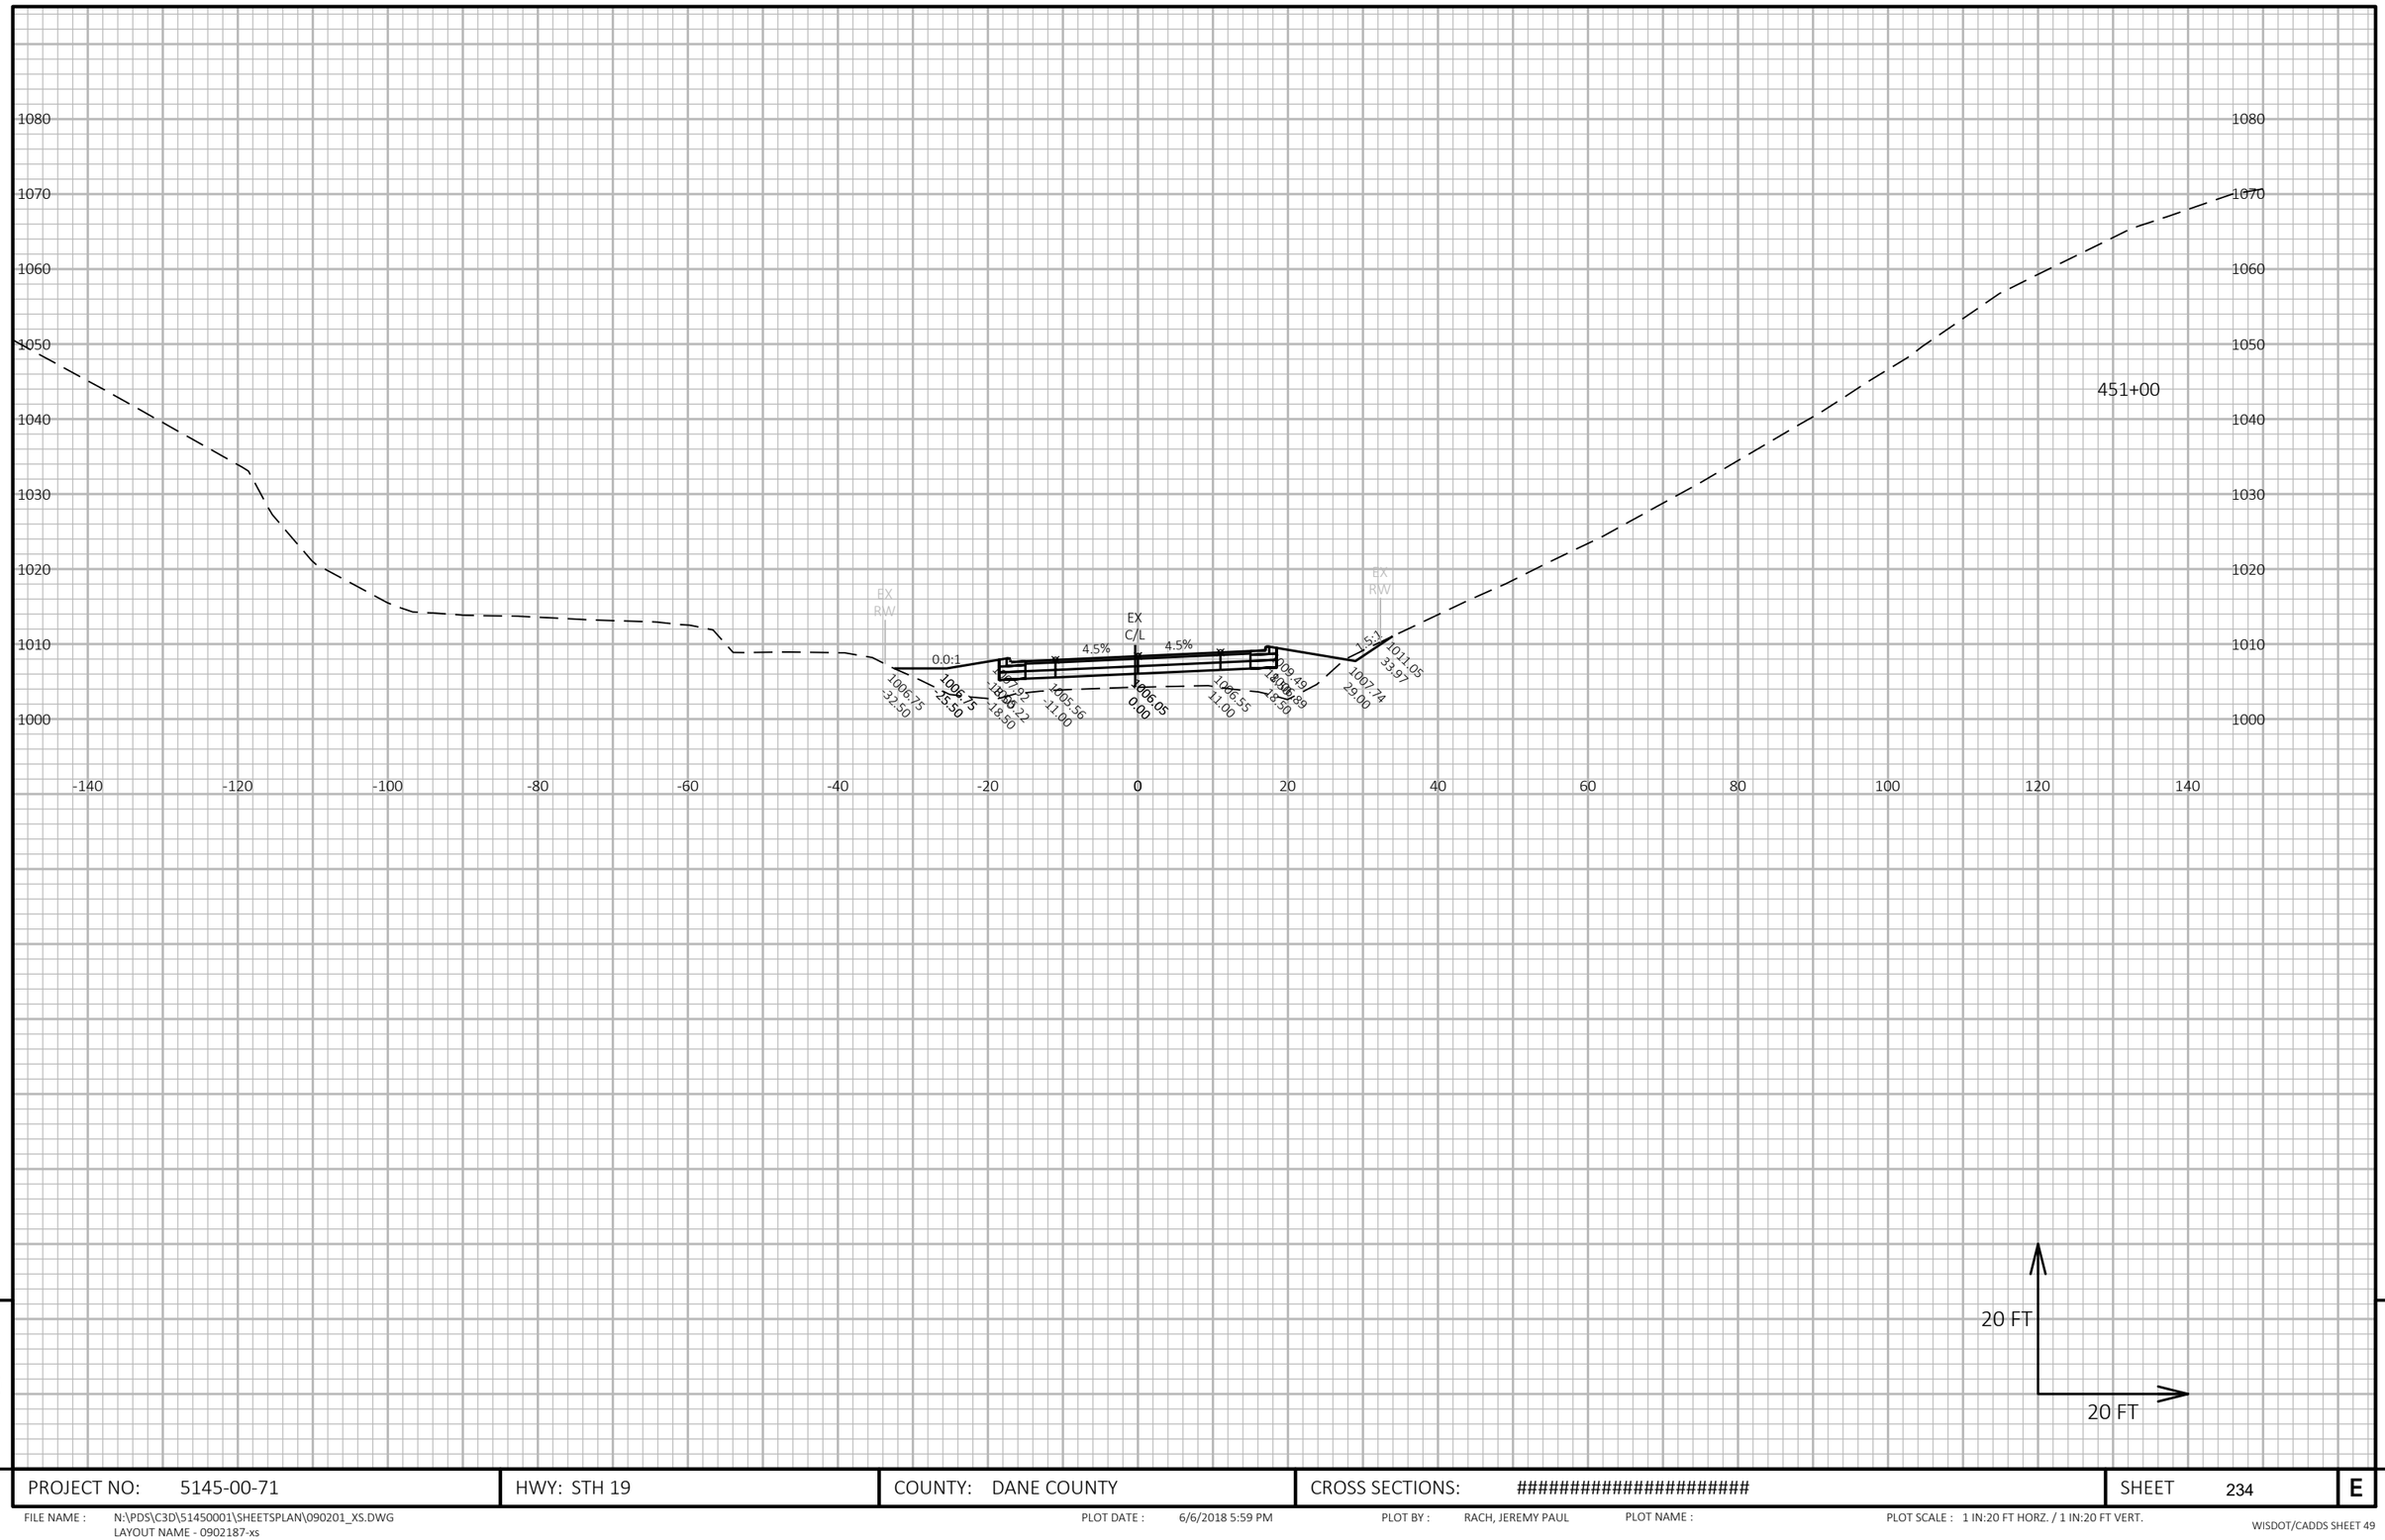

9

9

PROJECT NO: 5145-00-71	HWY: STH 19	COUNTY: DANE COUNTY	CROSS SECTIONS: ##########################	SHEET 234	E

FILE NAME : N:\PDS\C3D\51450001\SHEETSPLAN\090201_XS.DWG
LAYOUT NAME - 0902187-xs

PLOT DATE : 6/6/2018 5:59 PM PLOT BY : RACH, JEREMY PAUL PLOT NAME : PLOT SCALE : 1 IN:20 FT HORZ. / 1 IN:20 FT VERT.

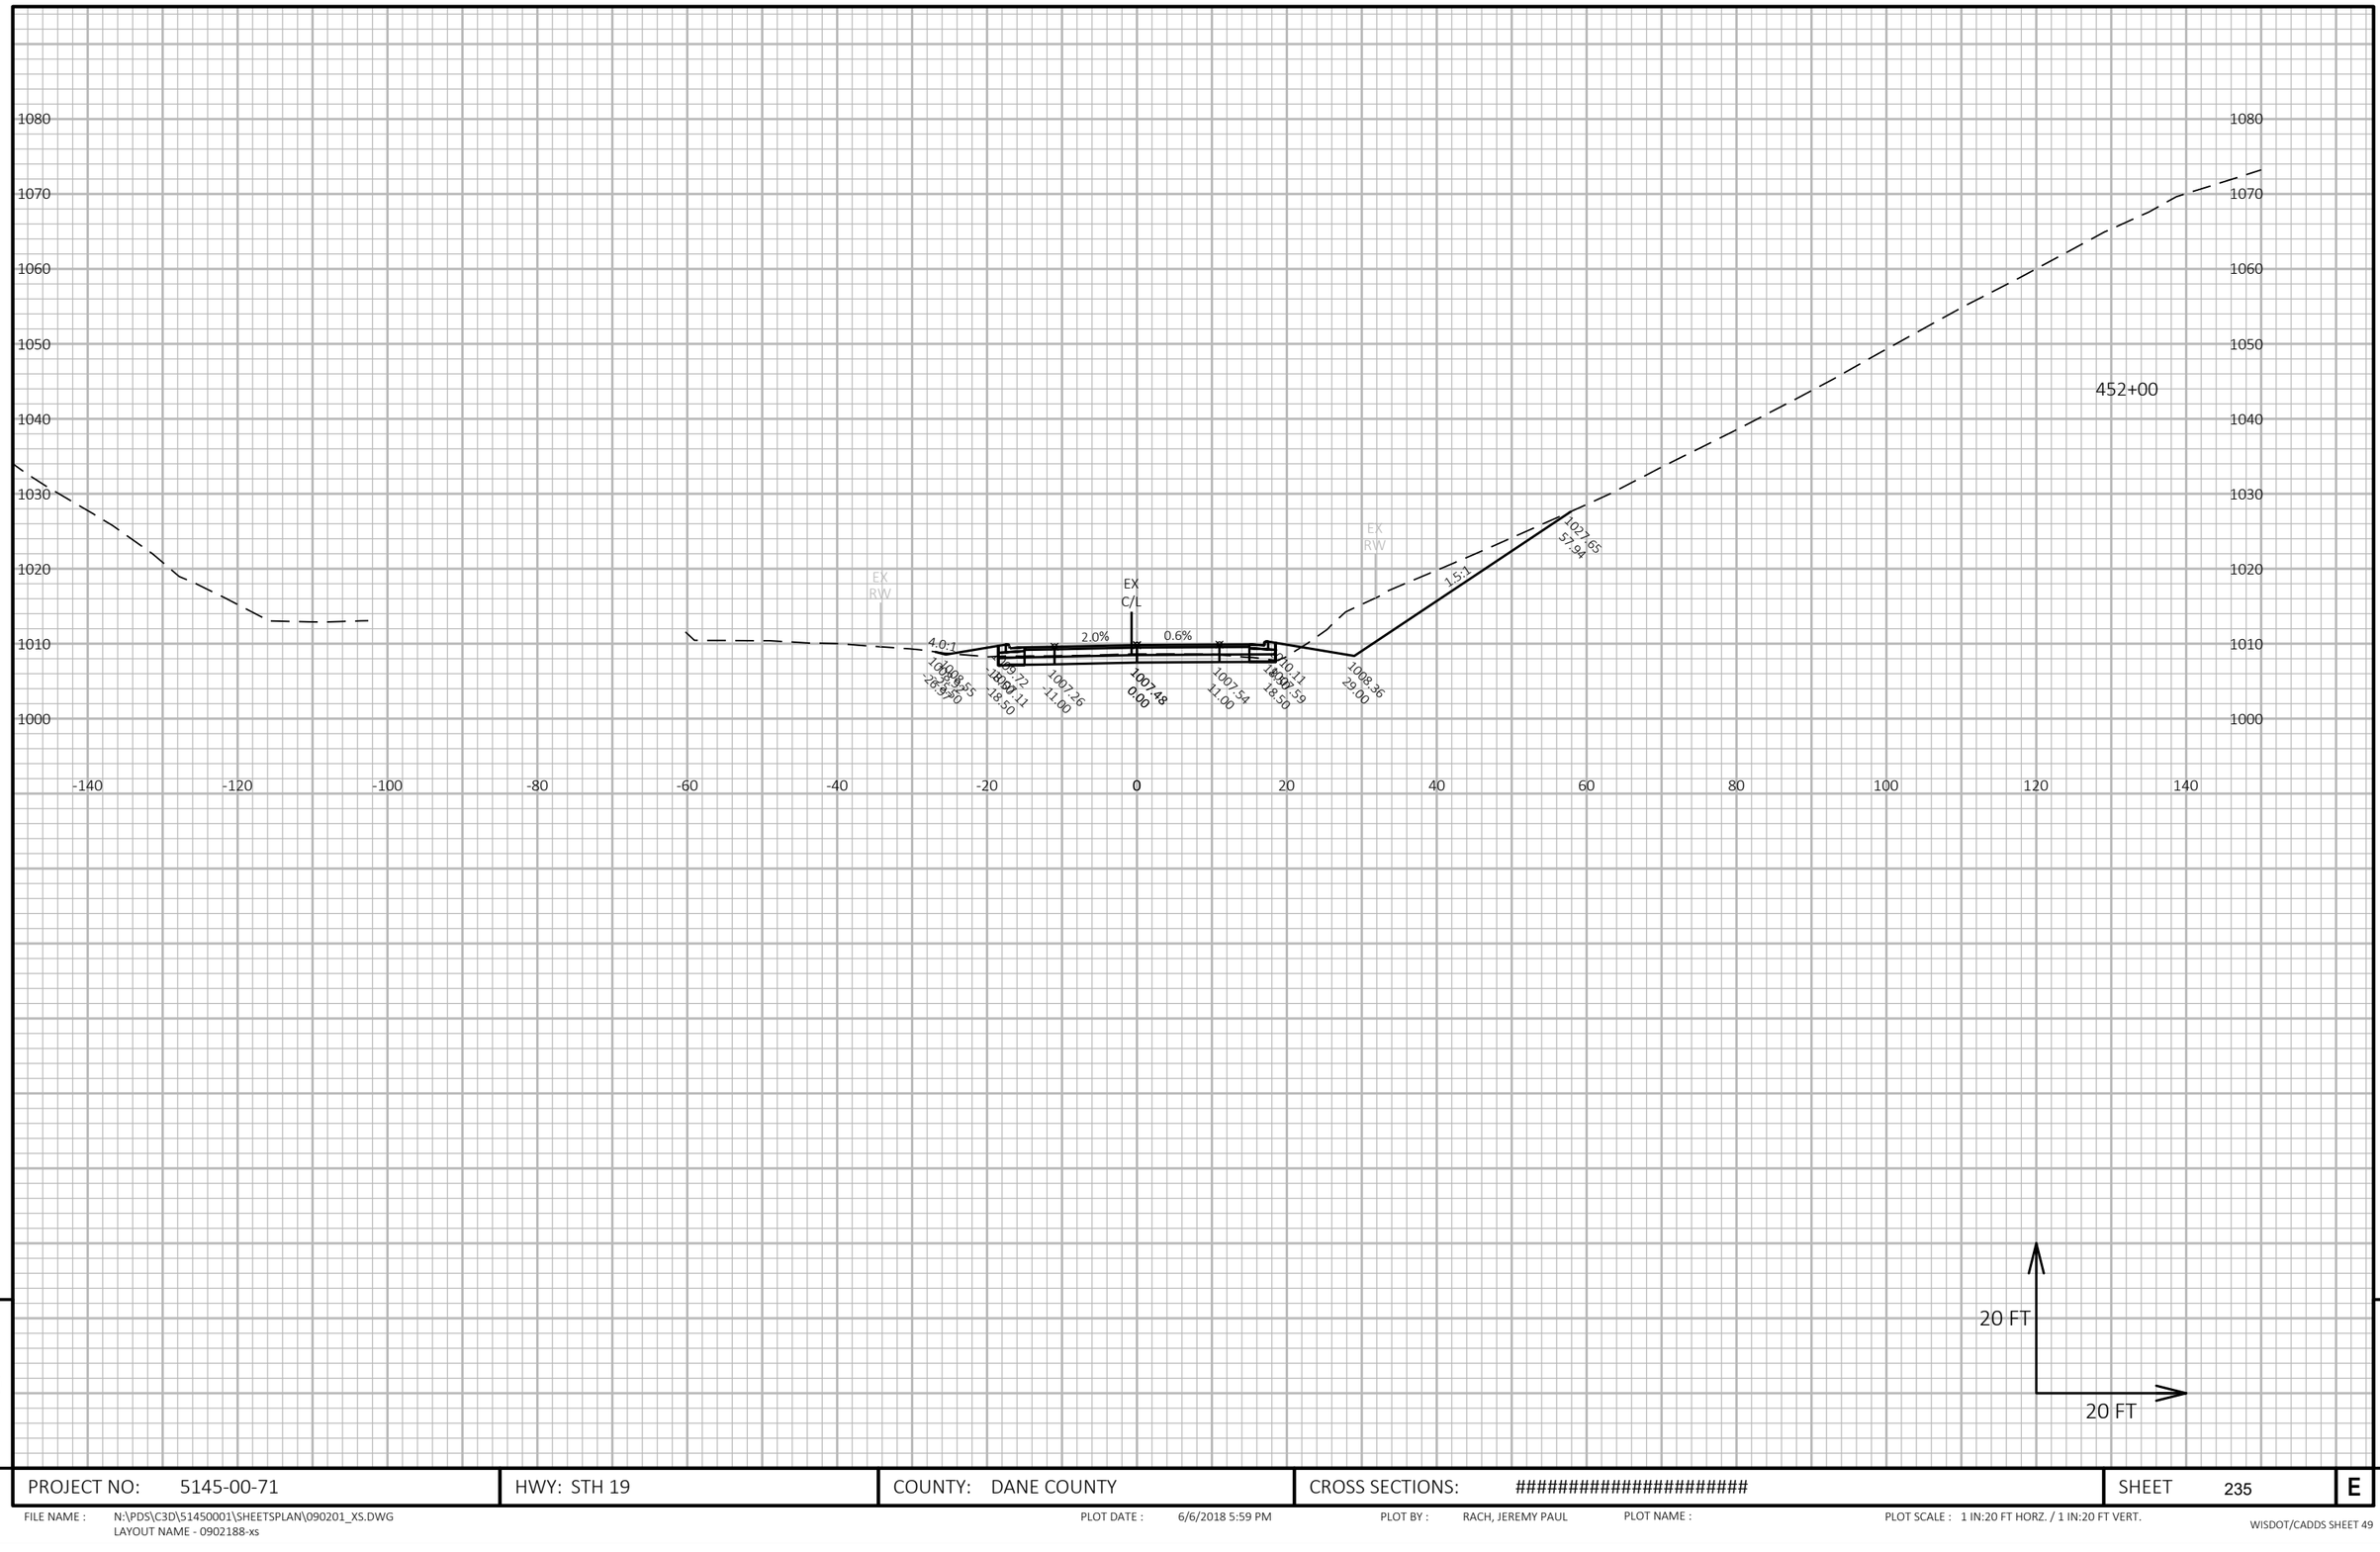

9

9

PROJECT NO: 5145-00-71	HWY: STH 19	COUNTY: DANE COUNTY	CROSS SECTIONS: ##########################	SHEET 235	E

FILE NAME : N:\PDS\C3D\51450001\SHEETSPLAN\090201_XS.DWG
LAYOUT NAME - 0902188-xs

PLOT DATE : 6/6/2018 5:59 PM PLOT BY : RACH, JEREMY PAUL PLOT NAME : PLOT SCALE : 1 IN:20 FT HORZ. / 1 IN:20 FT VERT.

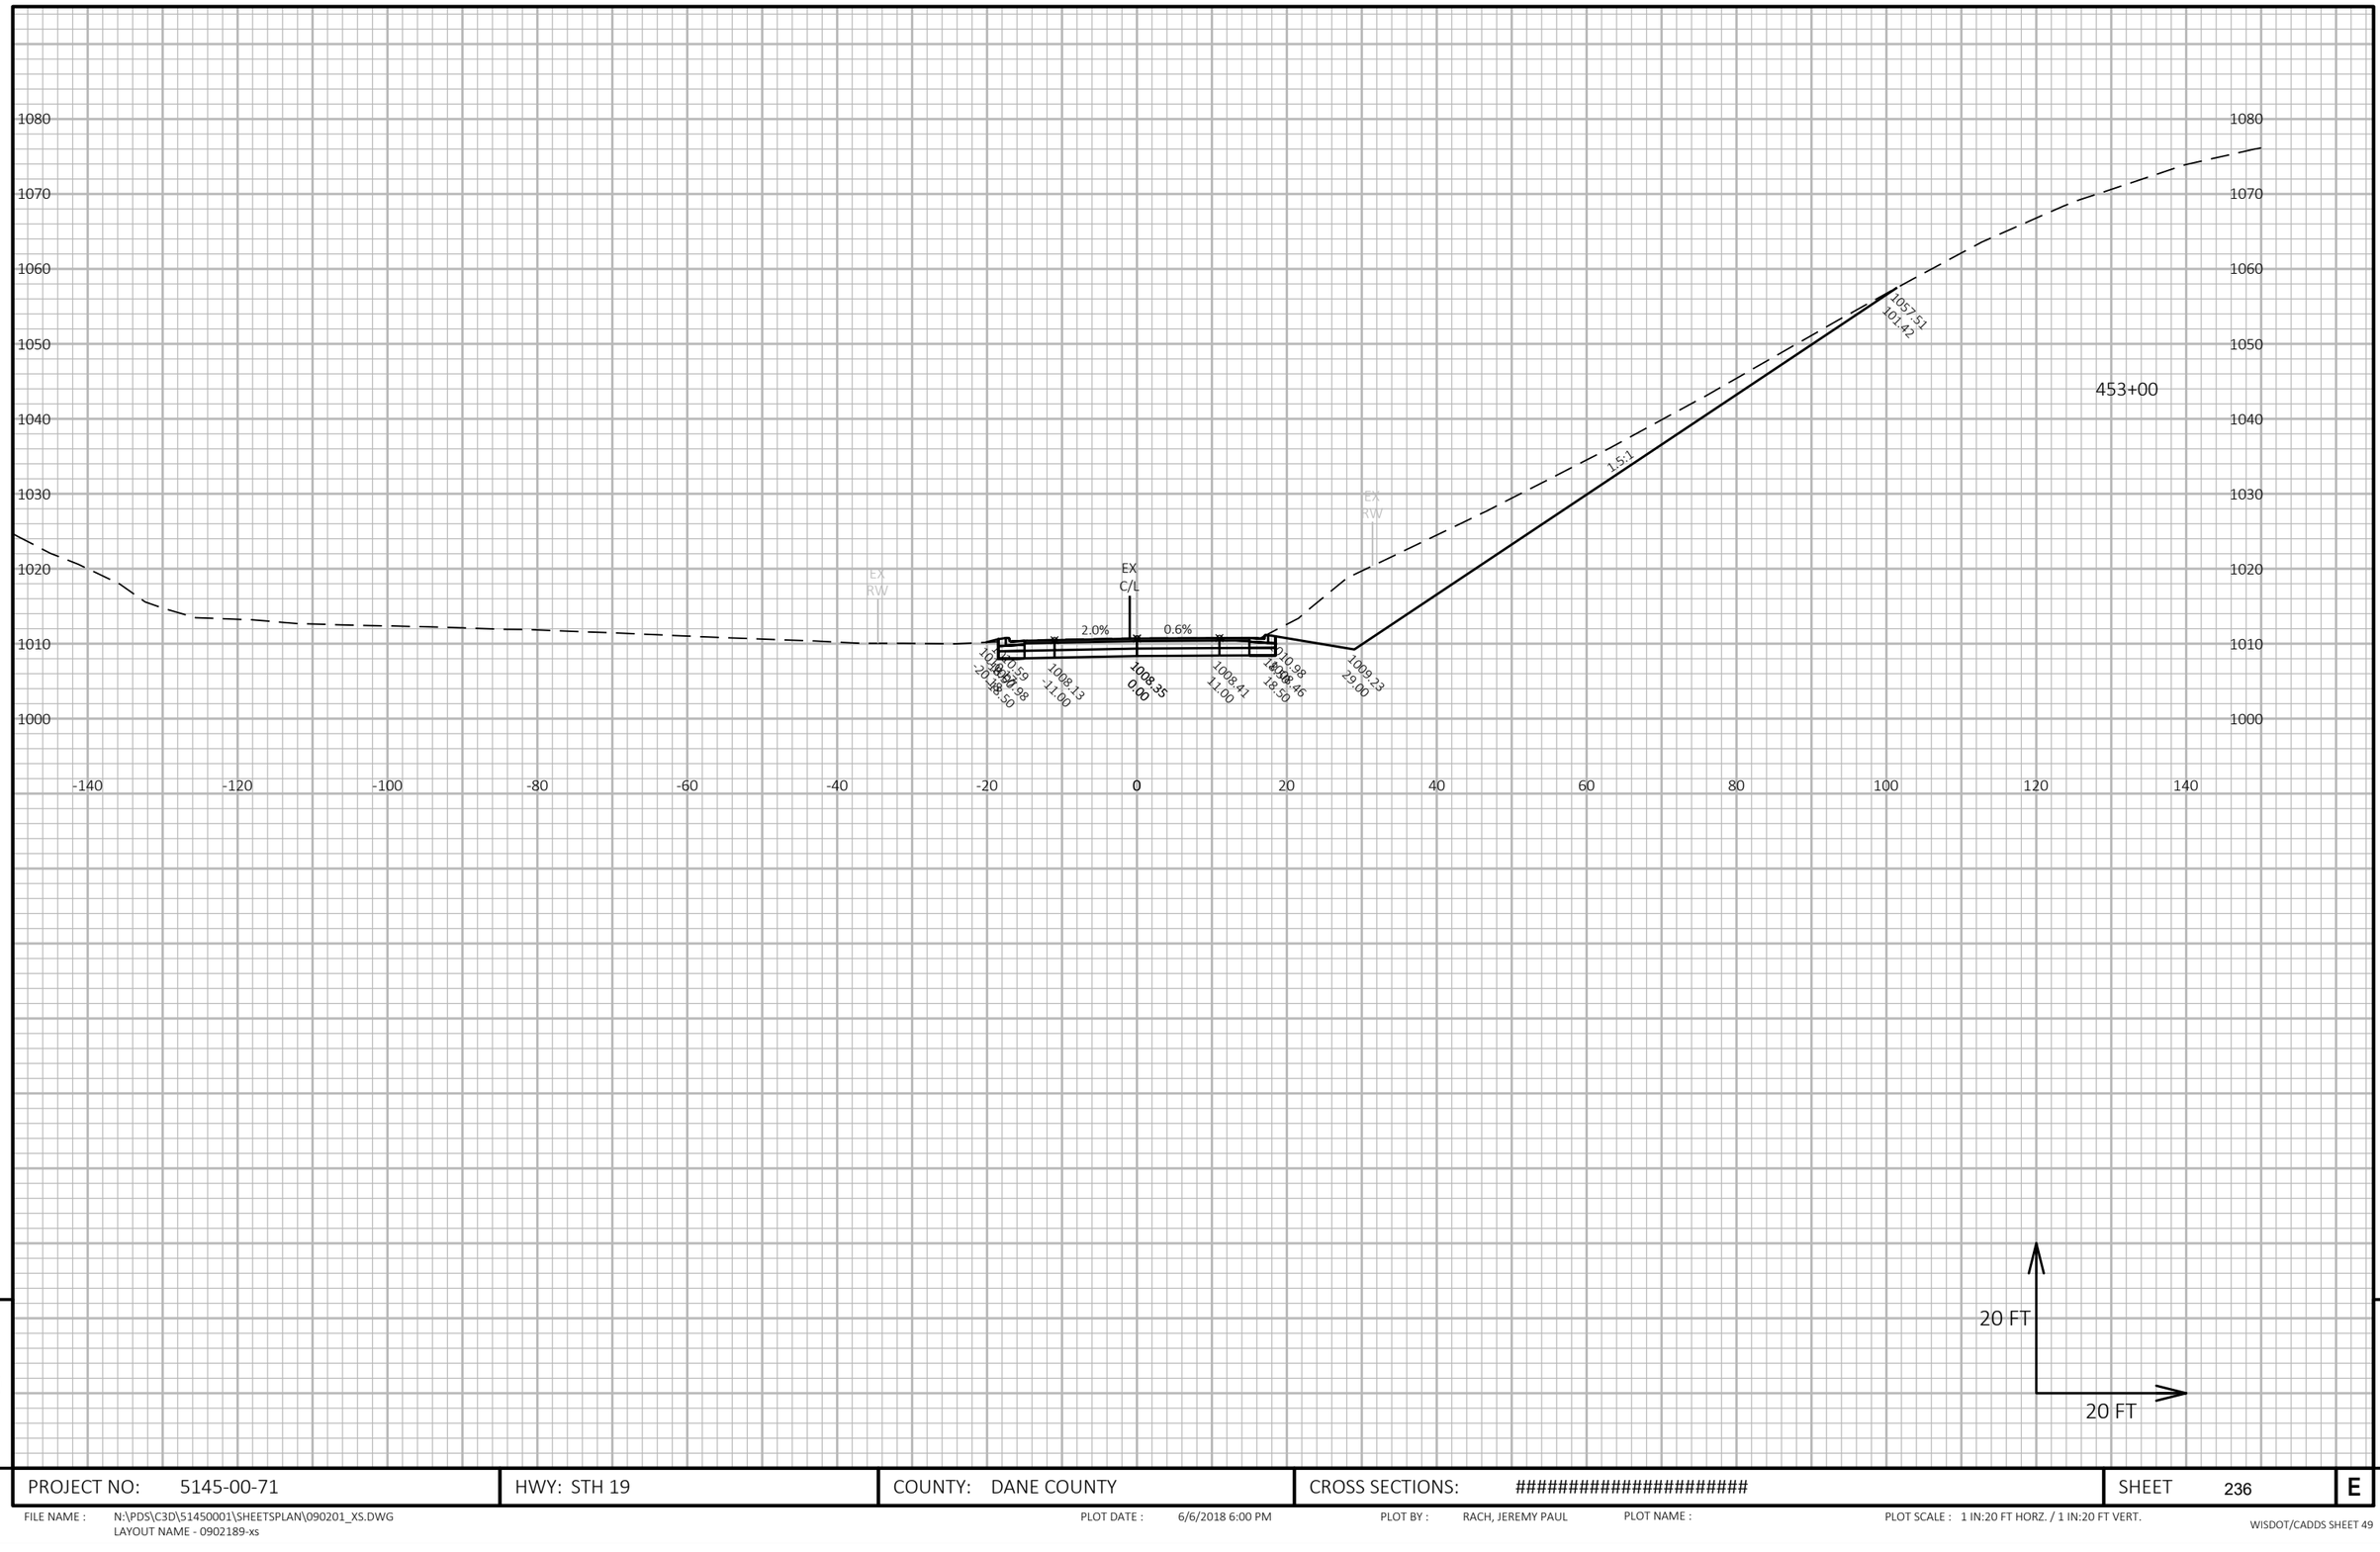

9

9

PROJECT NO: 5145-00-71	HWY: STH 19	COUNTY: DANE COUNTY	CROSS SECTIONS: ##########################	SHEET 236	E

FILE NAME : N:\PDS\C3D\51450001\SHEETSPLAN\090201_XS.DWG
LAYOUT NAME - 0902189-xs

PLOT DATE : 6/6/2018 6:00 PM PLOT BY : RACH, JEREMY PAUL PLOT NAME : PLOT SCALE : 1 IN:20 FT HORZ. / 1 IN:20 FT VERT.

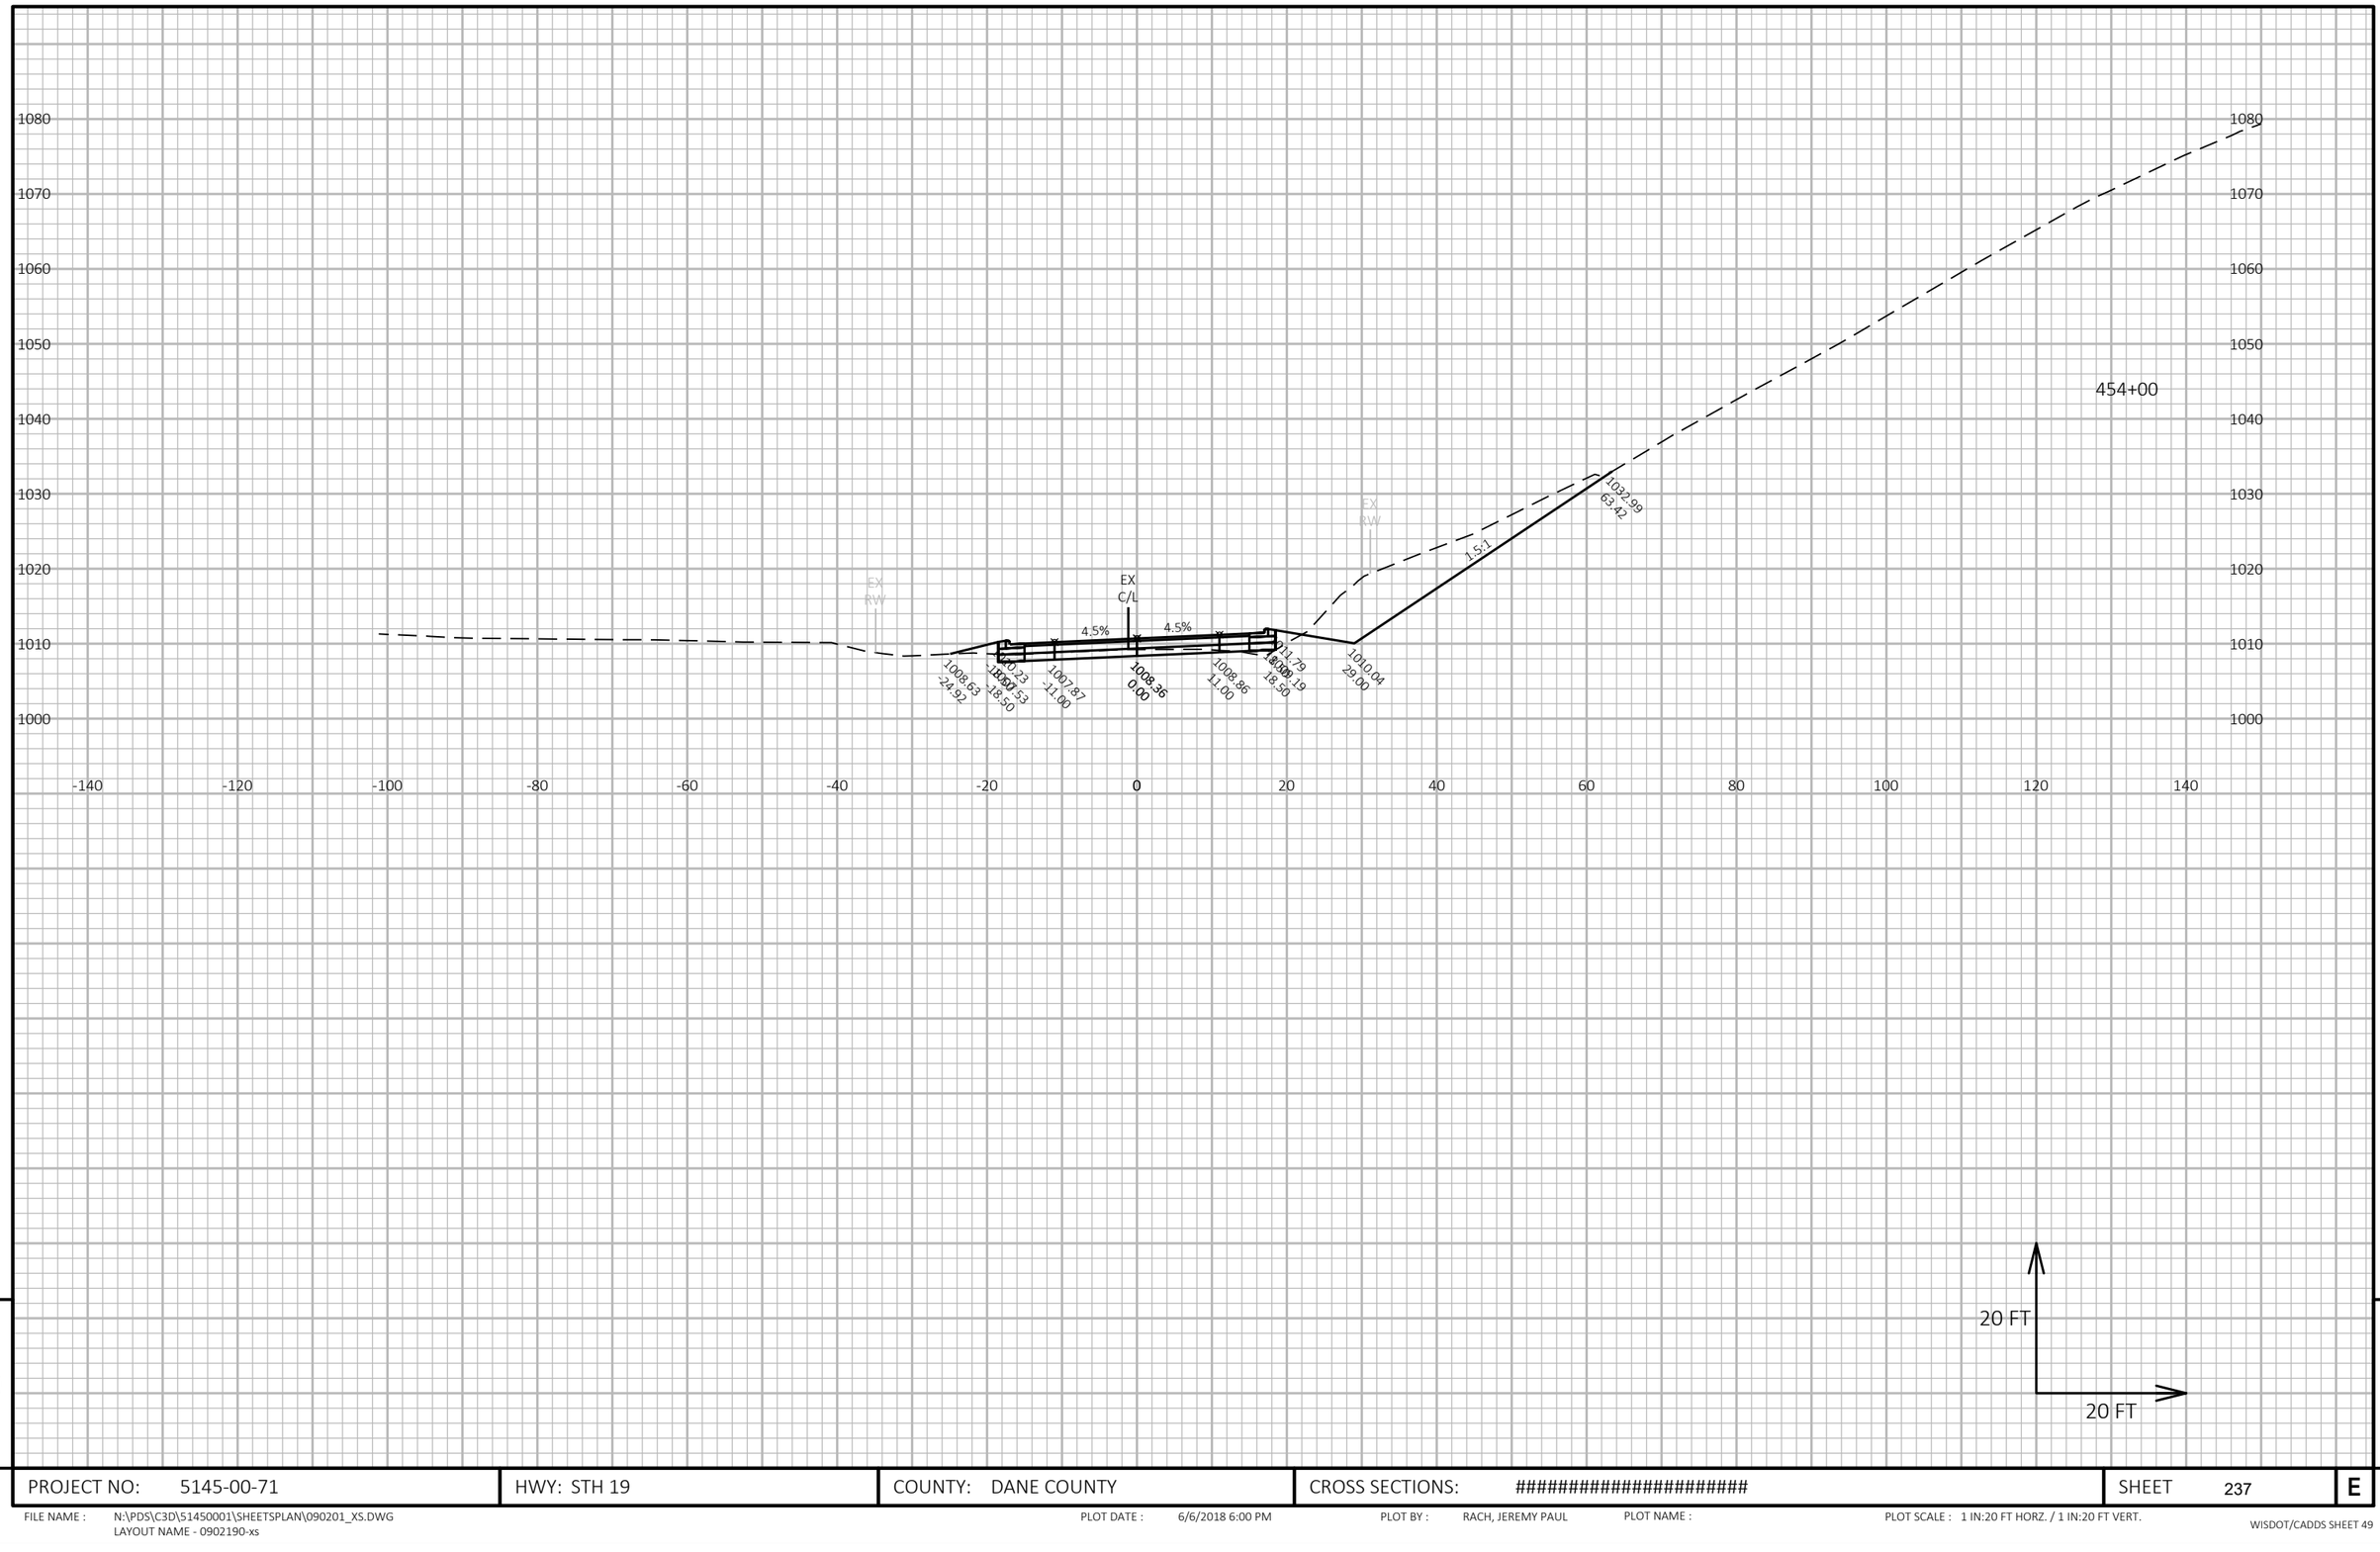

9

9

PROJECT NO: 5145-00-71	HWY: STH 19	COUNTY: DANE COUNTY	CROSS SECTIONS: ##########################	SHEET 237	E

FILE NAME : N:\PDS\C3D\51450001\SHEETSPLAN\090201_XS.DWG
LAYOUT NAME - 0902190-xs

PLOT DATE : 6/6/2018 6:00 PM PLOT BY : RACH, JEREMY PAUL PLOT NAME : PLOT SCALE : 1 IN:20 FT HORZ. / 1 IN:20 FT VERT.

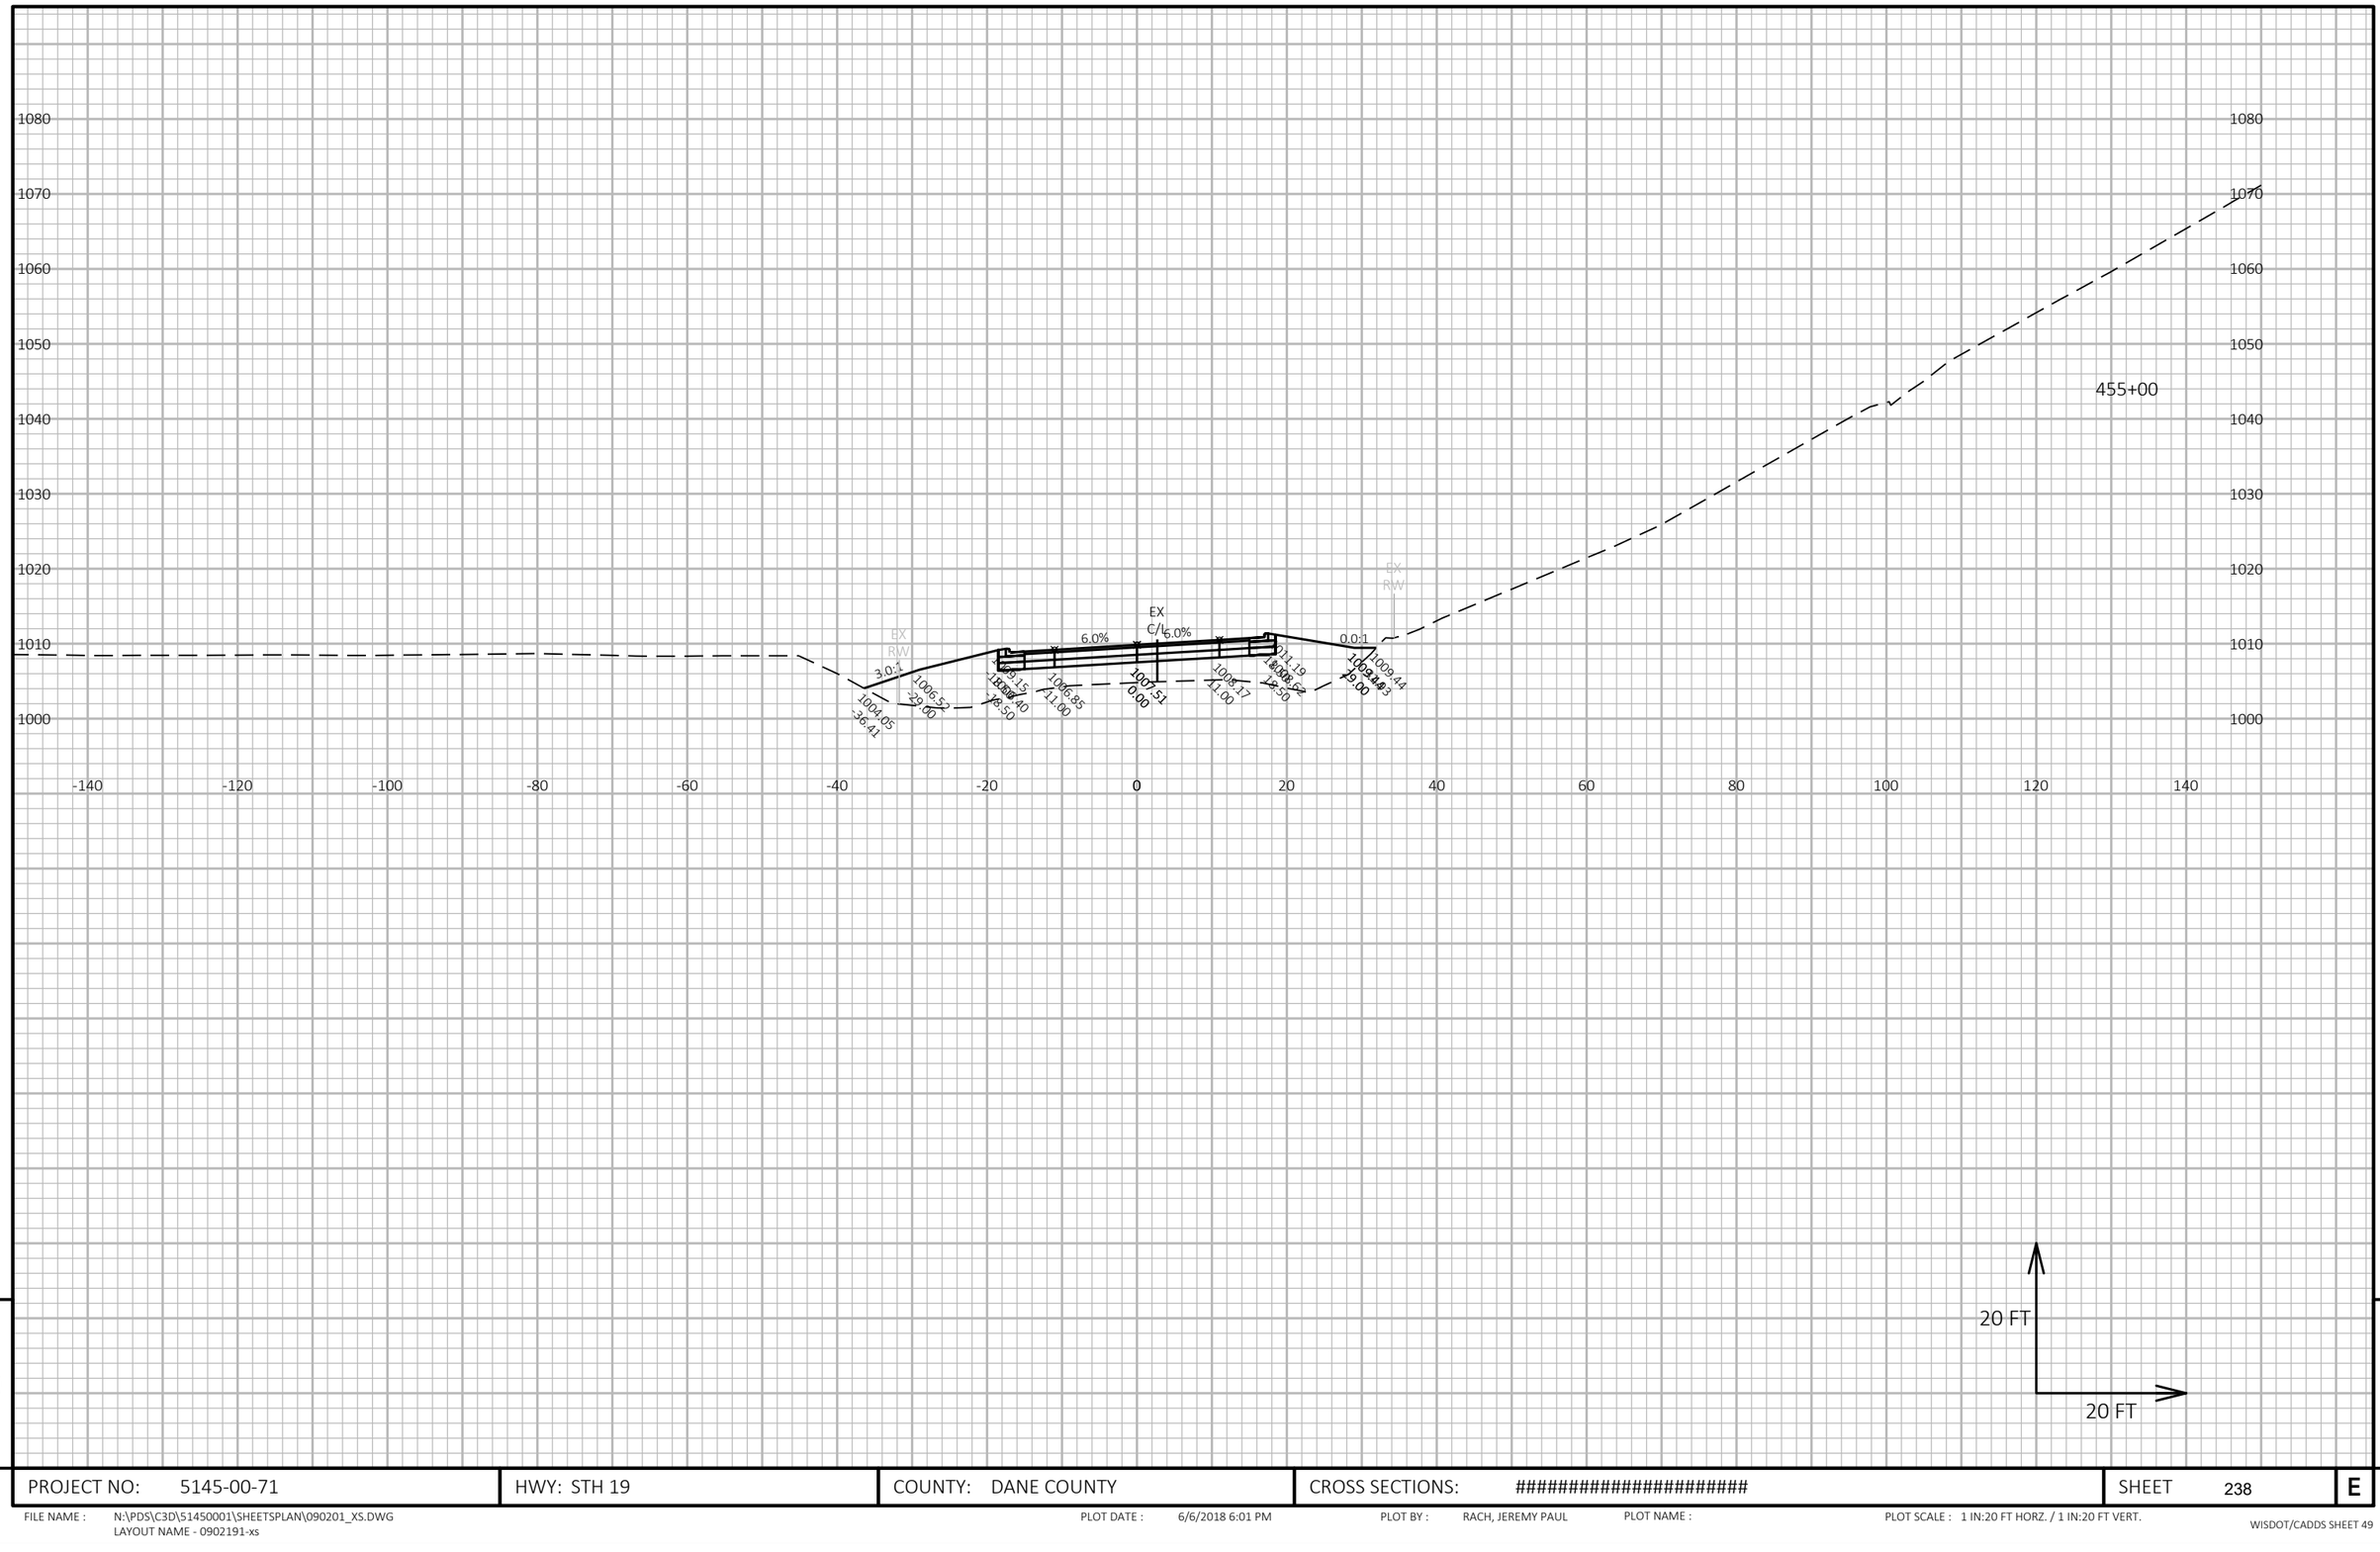

9

PROJECT NO: 5145-00-71	HWY: STH 19	COUNTY: DANE COUNTY	CROSS SECTIONS: ##########################	SHEET 238	E

9

FILE NAME : N:\PDS\C3D\51450001\SHEETSPLAN\090201_XS.DWG
LAYOUT NAME - 0902191-xs

PLOT DATE : 6/6/2018 6:01 PM PLOT BY : RACH, JEREMY PAUL PLOT NAME : PLOT SCALE : 1 IN:20 FT HORZ. / 1 IN:20 FT VERT.

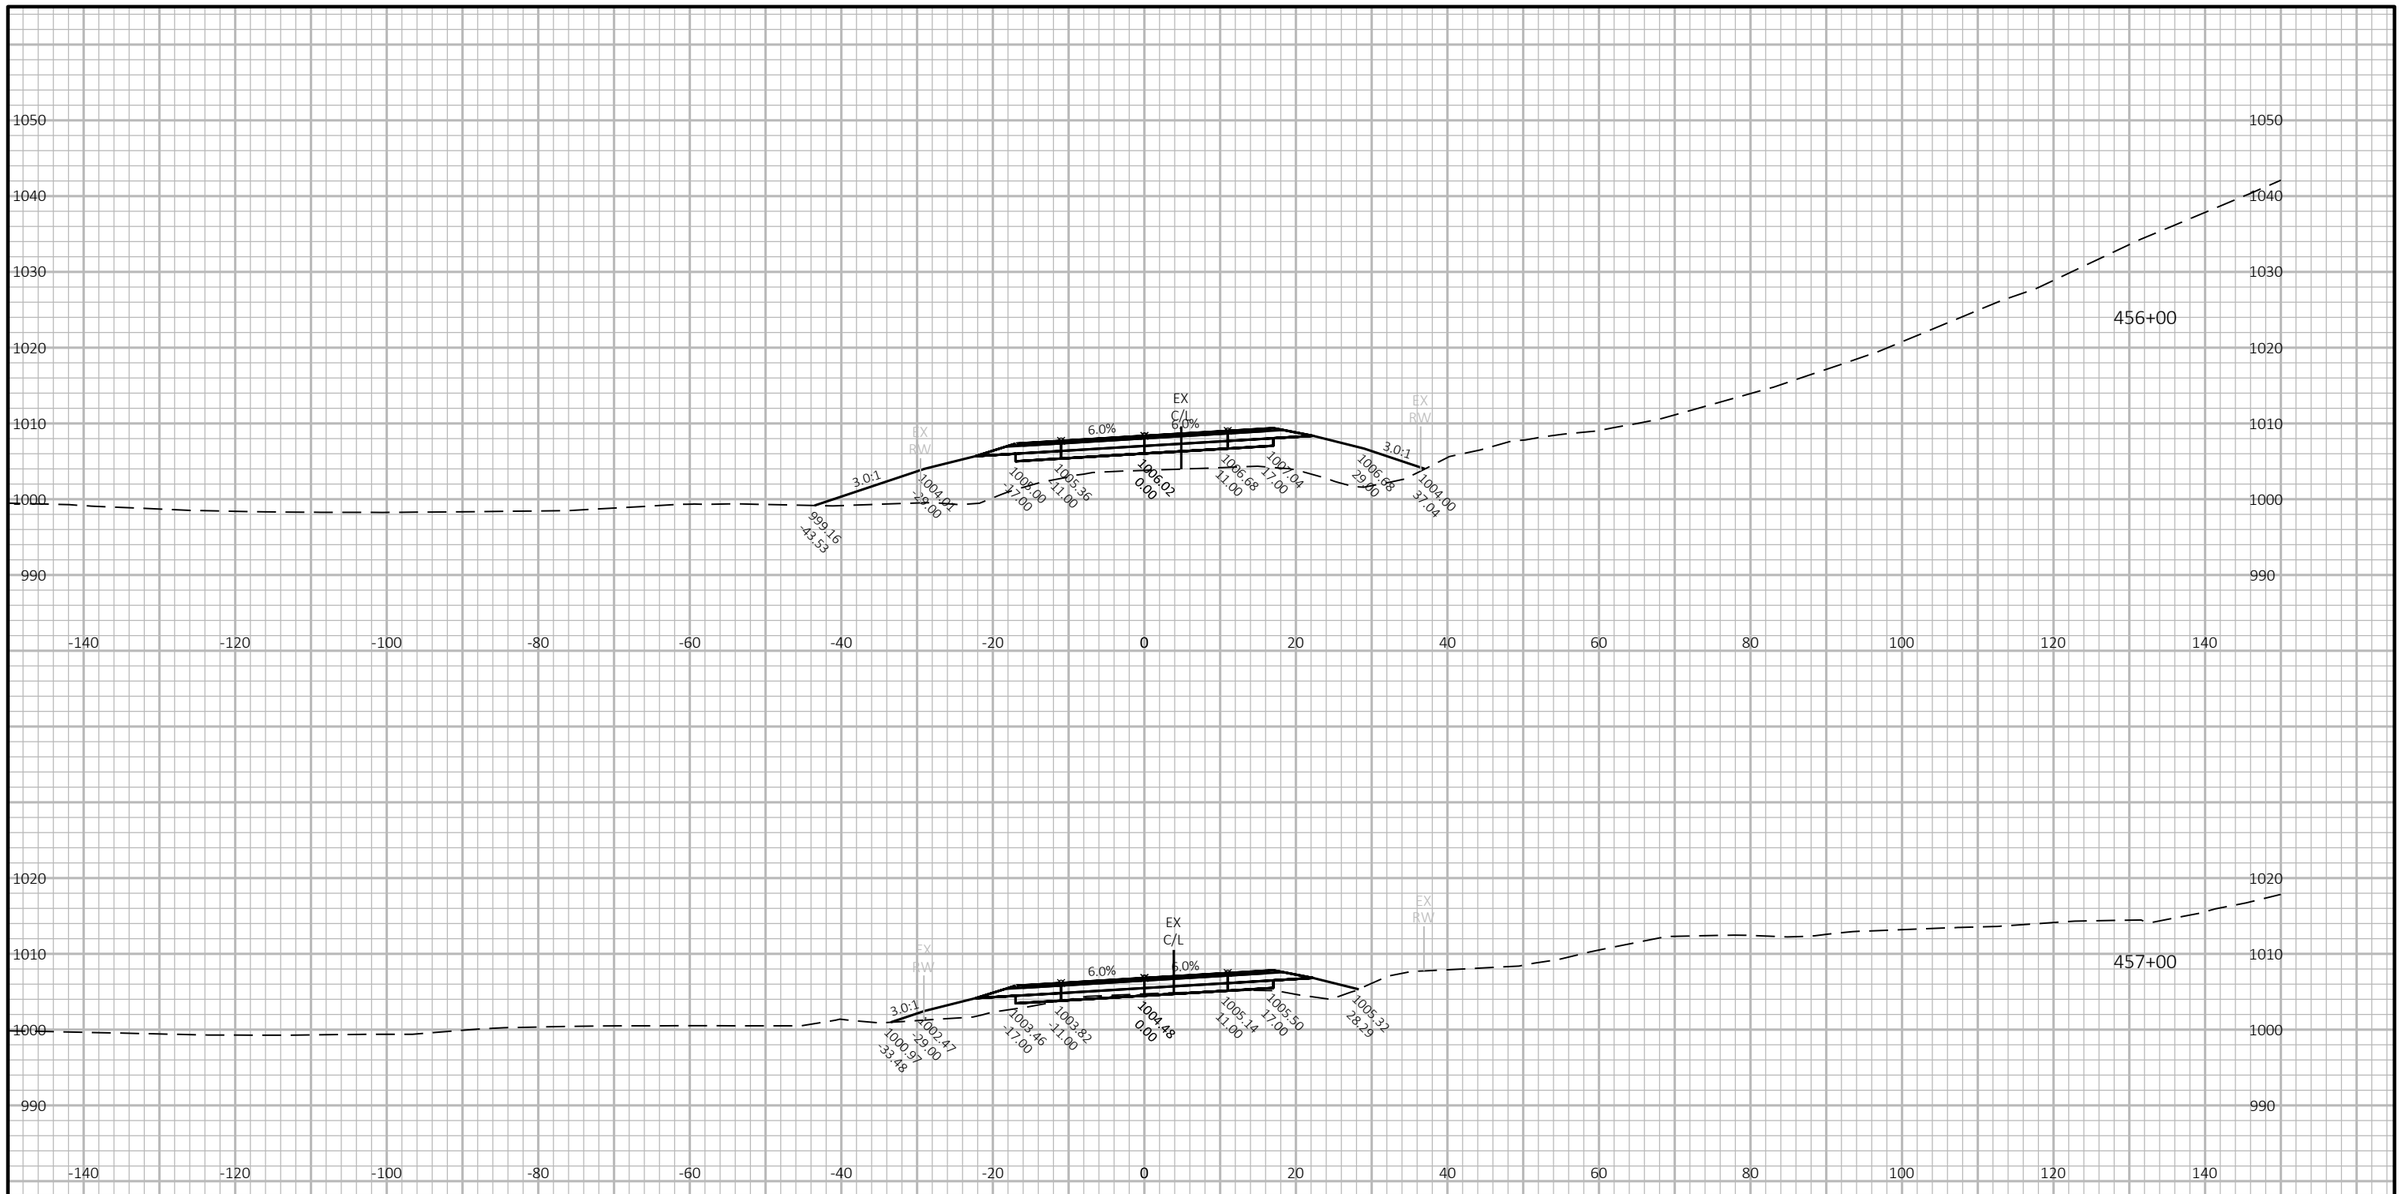

9

9

PROJECT NO: 5145-00-71	HWY: STH 19	COUNTY: DANE COUNTY	CROSS SECTIONS: ##########################	SHEET 239	E

FILE NAME : N:\PDS\C3D\51450001\SHEETSPLAN\090201_XS.DWG
LAYOUT NAME - 0902192-xs

PLOT DATE : 6/6/2018 6:01 PM PLOT BY : RACH, JEREMY PAUL PLOT NAME : PLOT SCALE : 1 IN:20 FT HORZ. / 1 IN:20 FT VERT.

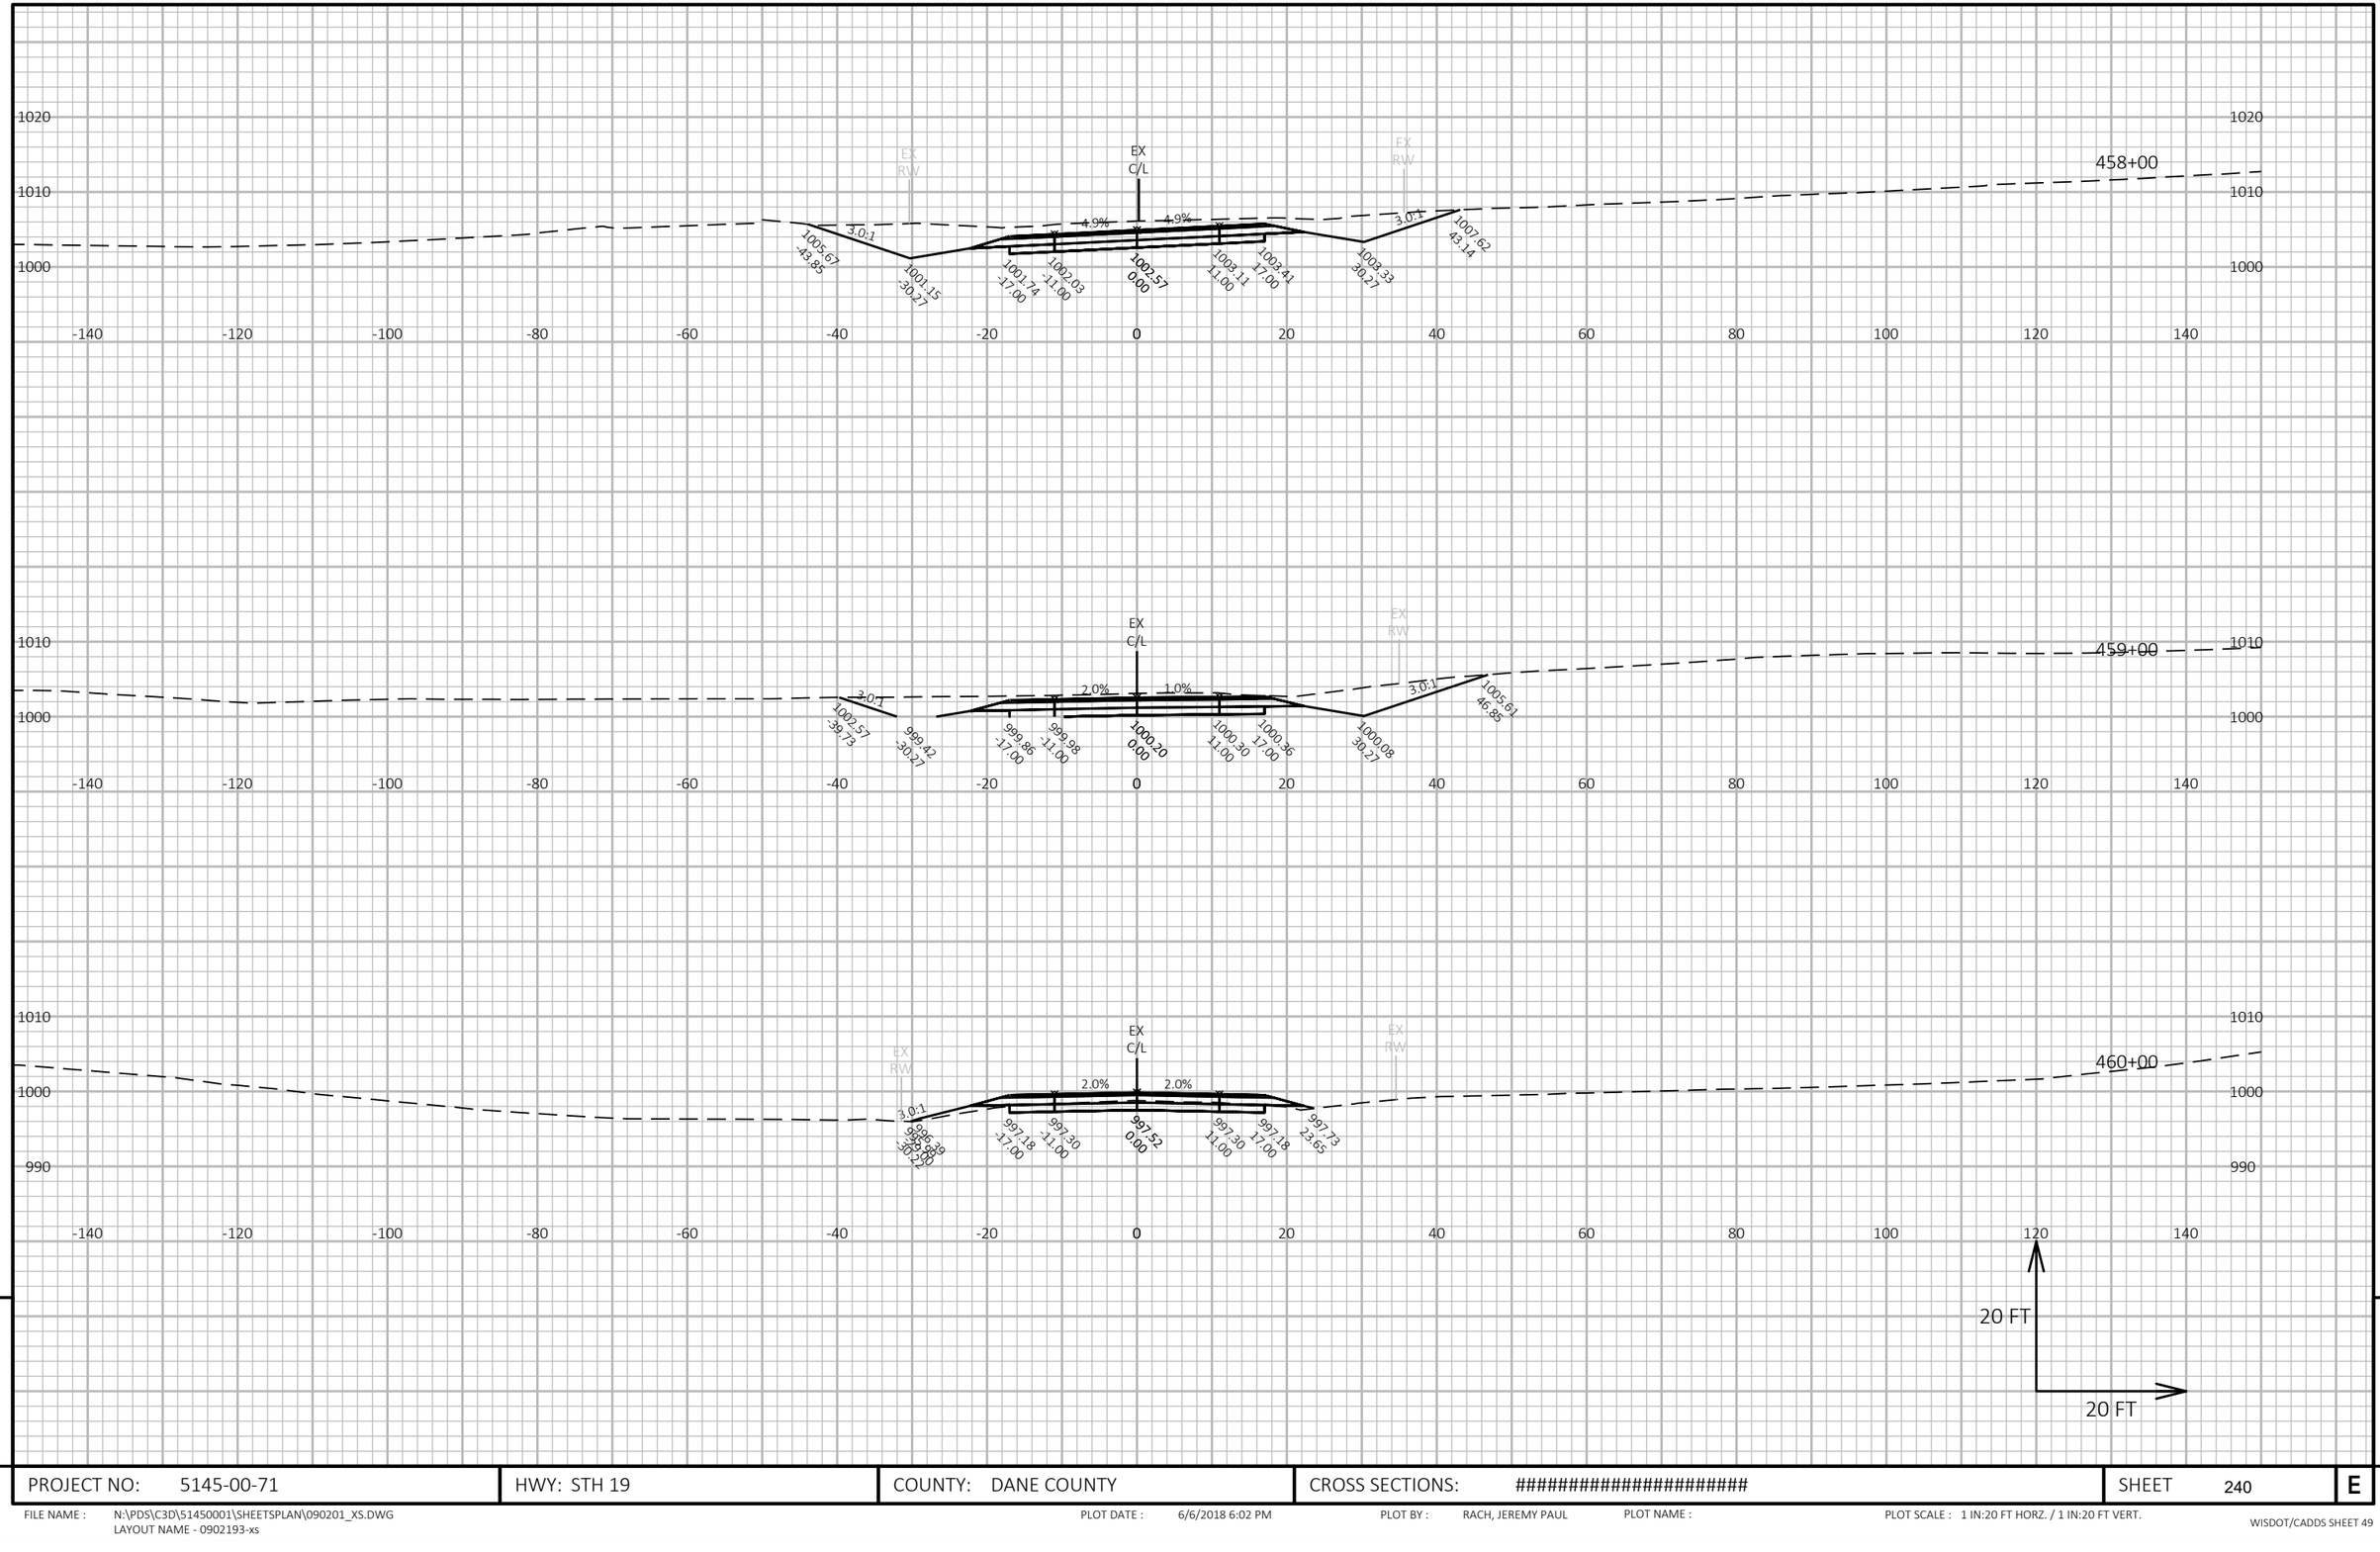

9

9

PROJECT NO: 5145-00-71	HWY: STH 19	COUNTY: DANE COUNTY	CROSS SECTIONS: ##########################	SHEET 240	E

FILE NAME : N:\PDS\C3D\51450001\SHEETSPLAN\090201_XS.DWG
LAYOUT NAME - 0902193-xs

PLOT DATE : 6/6/2018 6:02 PM PLOT BY : RACH, JEREMY PAUL PLOT NAME : PLOT SCALE : 1 IN:20 FT HORZ. / 1 IN:20 FT VERT.

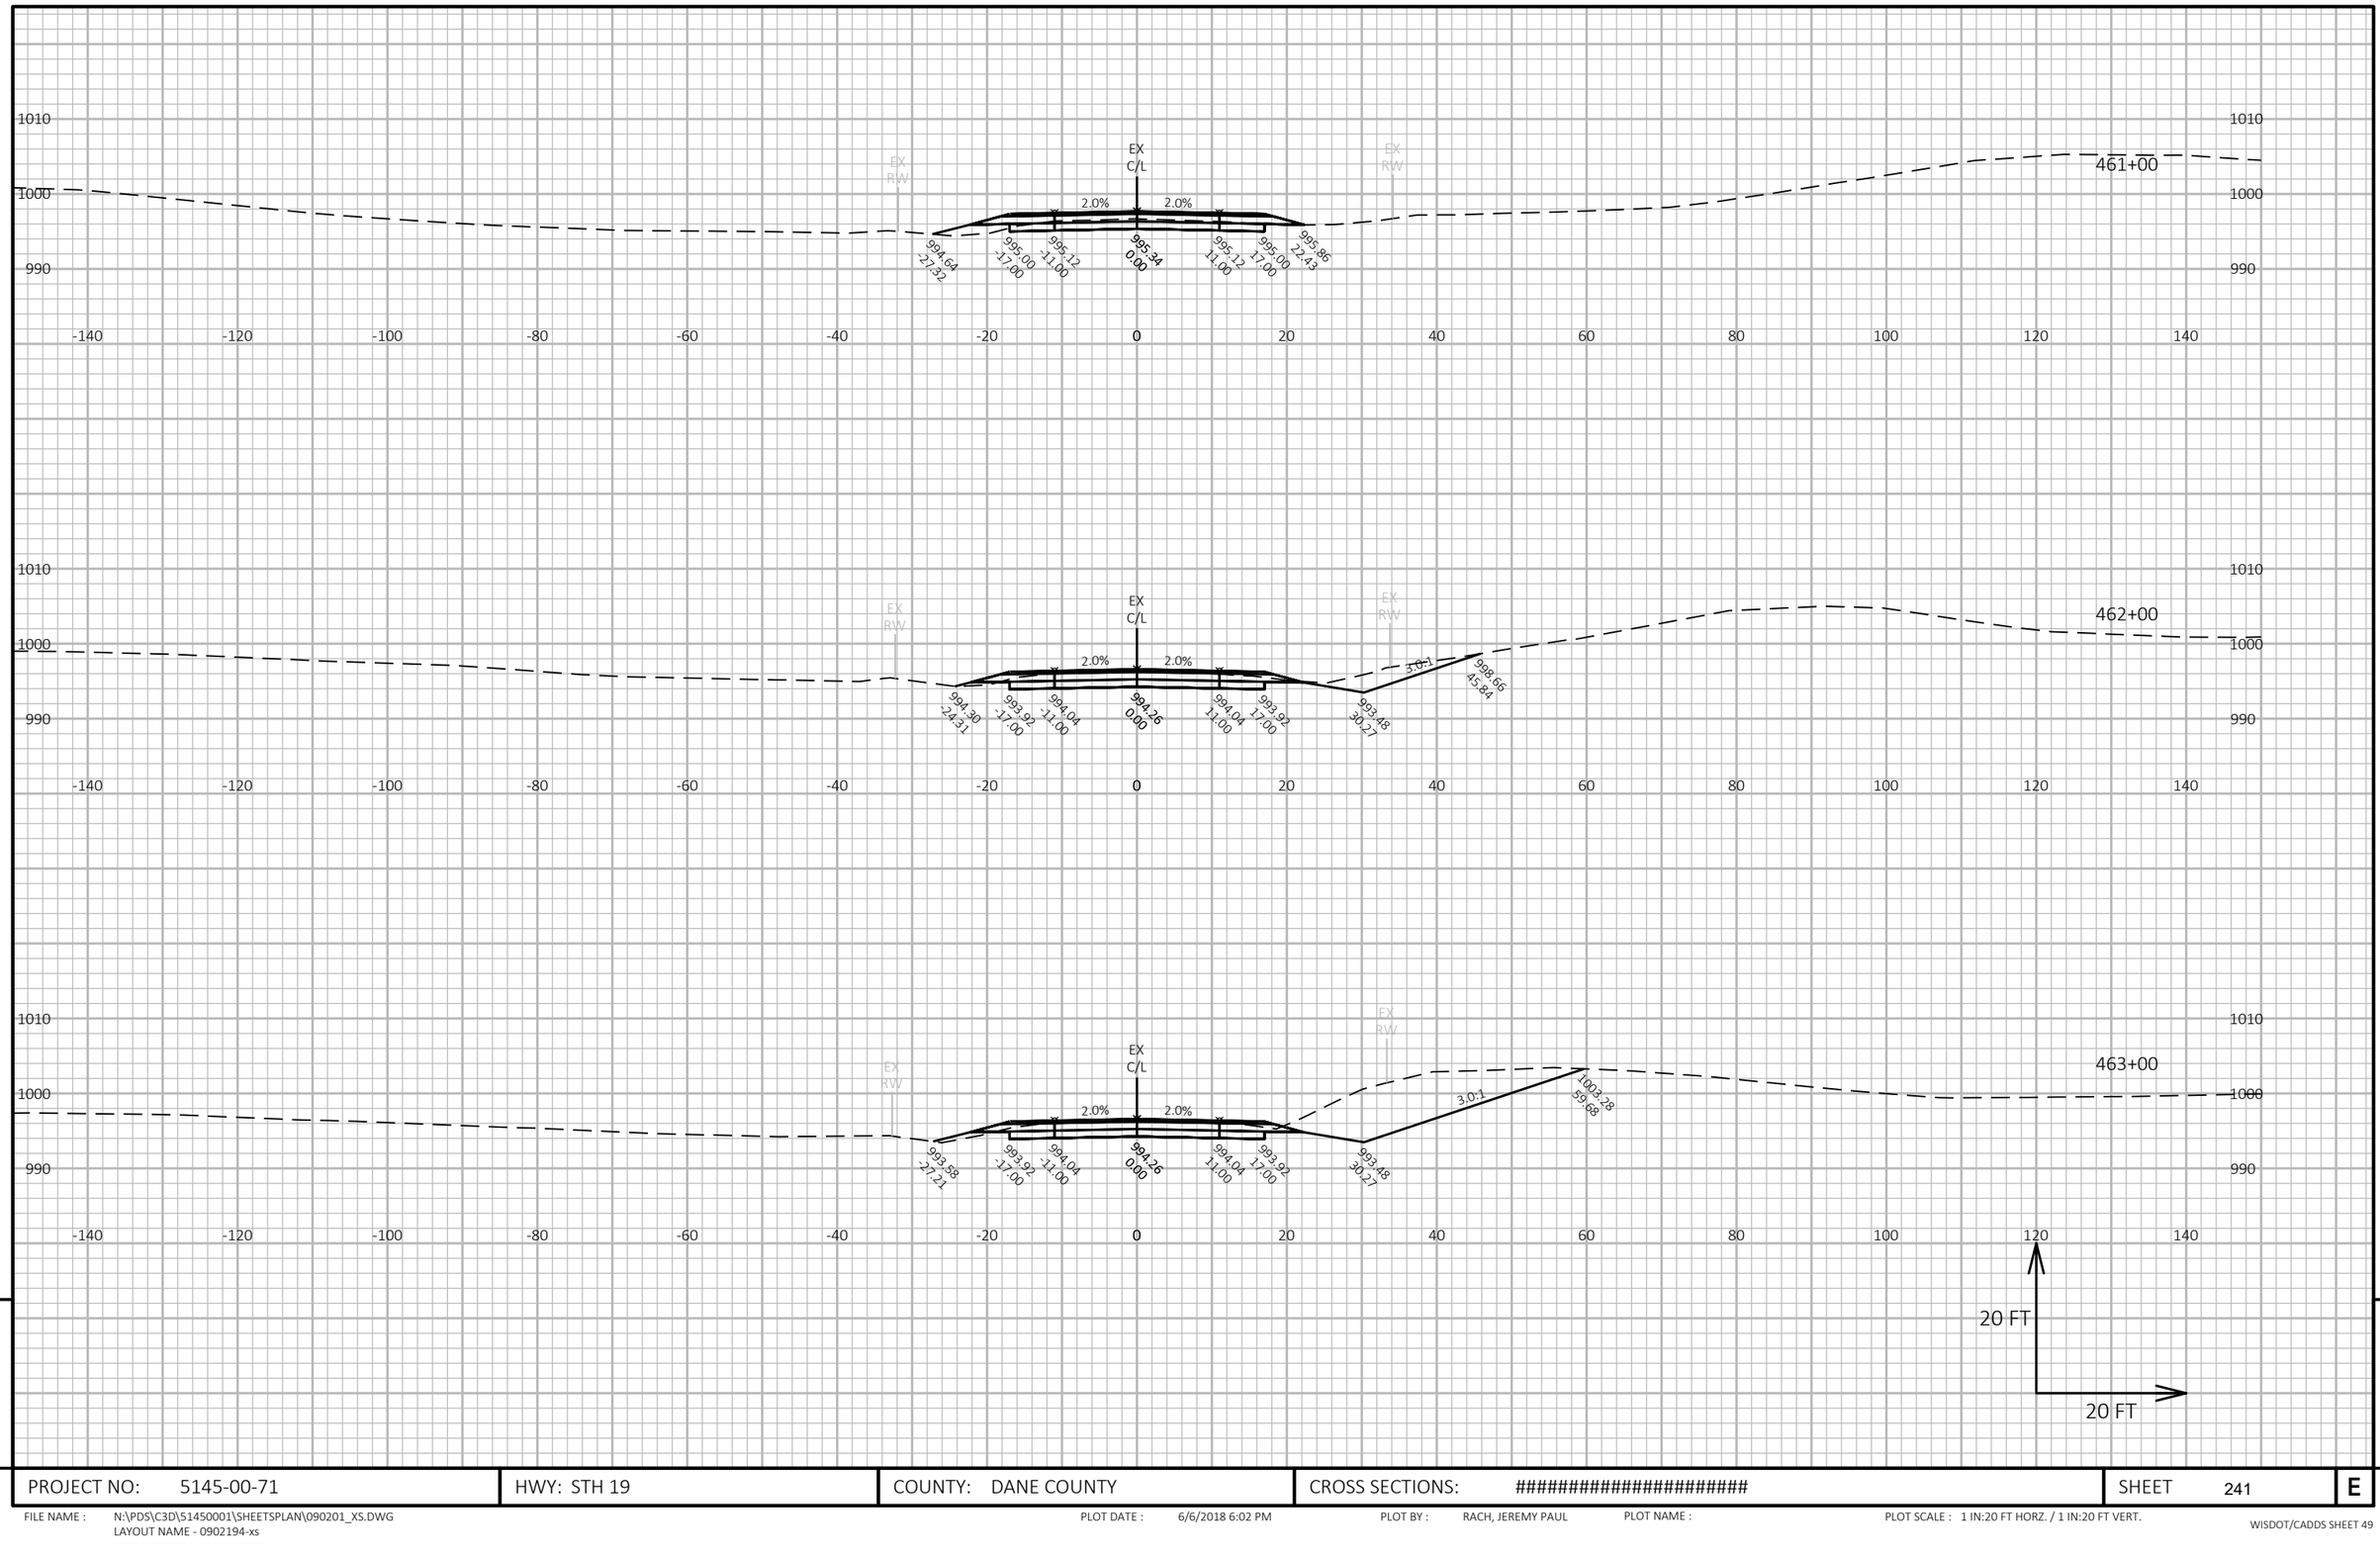

9

9

PROJECT NO: 5145-00-71	HWY: STH 19	COUNTY: DANE COUNTY	CROSS SECTIONS: ##########################	SHEET 241	E

FILE NAME : N:\PDS\C3D\51450001\SHEETSPLAN\090201_XS.DWG
LAYOUT NAME - 0902194-xs

PLOT DATE : 6/6/2018 6:02 PM PLOT BY : RACH, JEREMY PAUL PLOT NAME : PLOT SCALE : 1 IN:20 FT HORZ. / 1 IN:20 FT VERT.

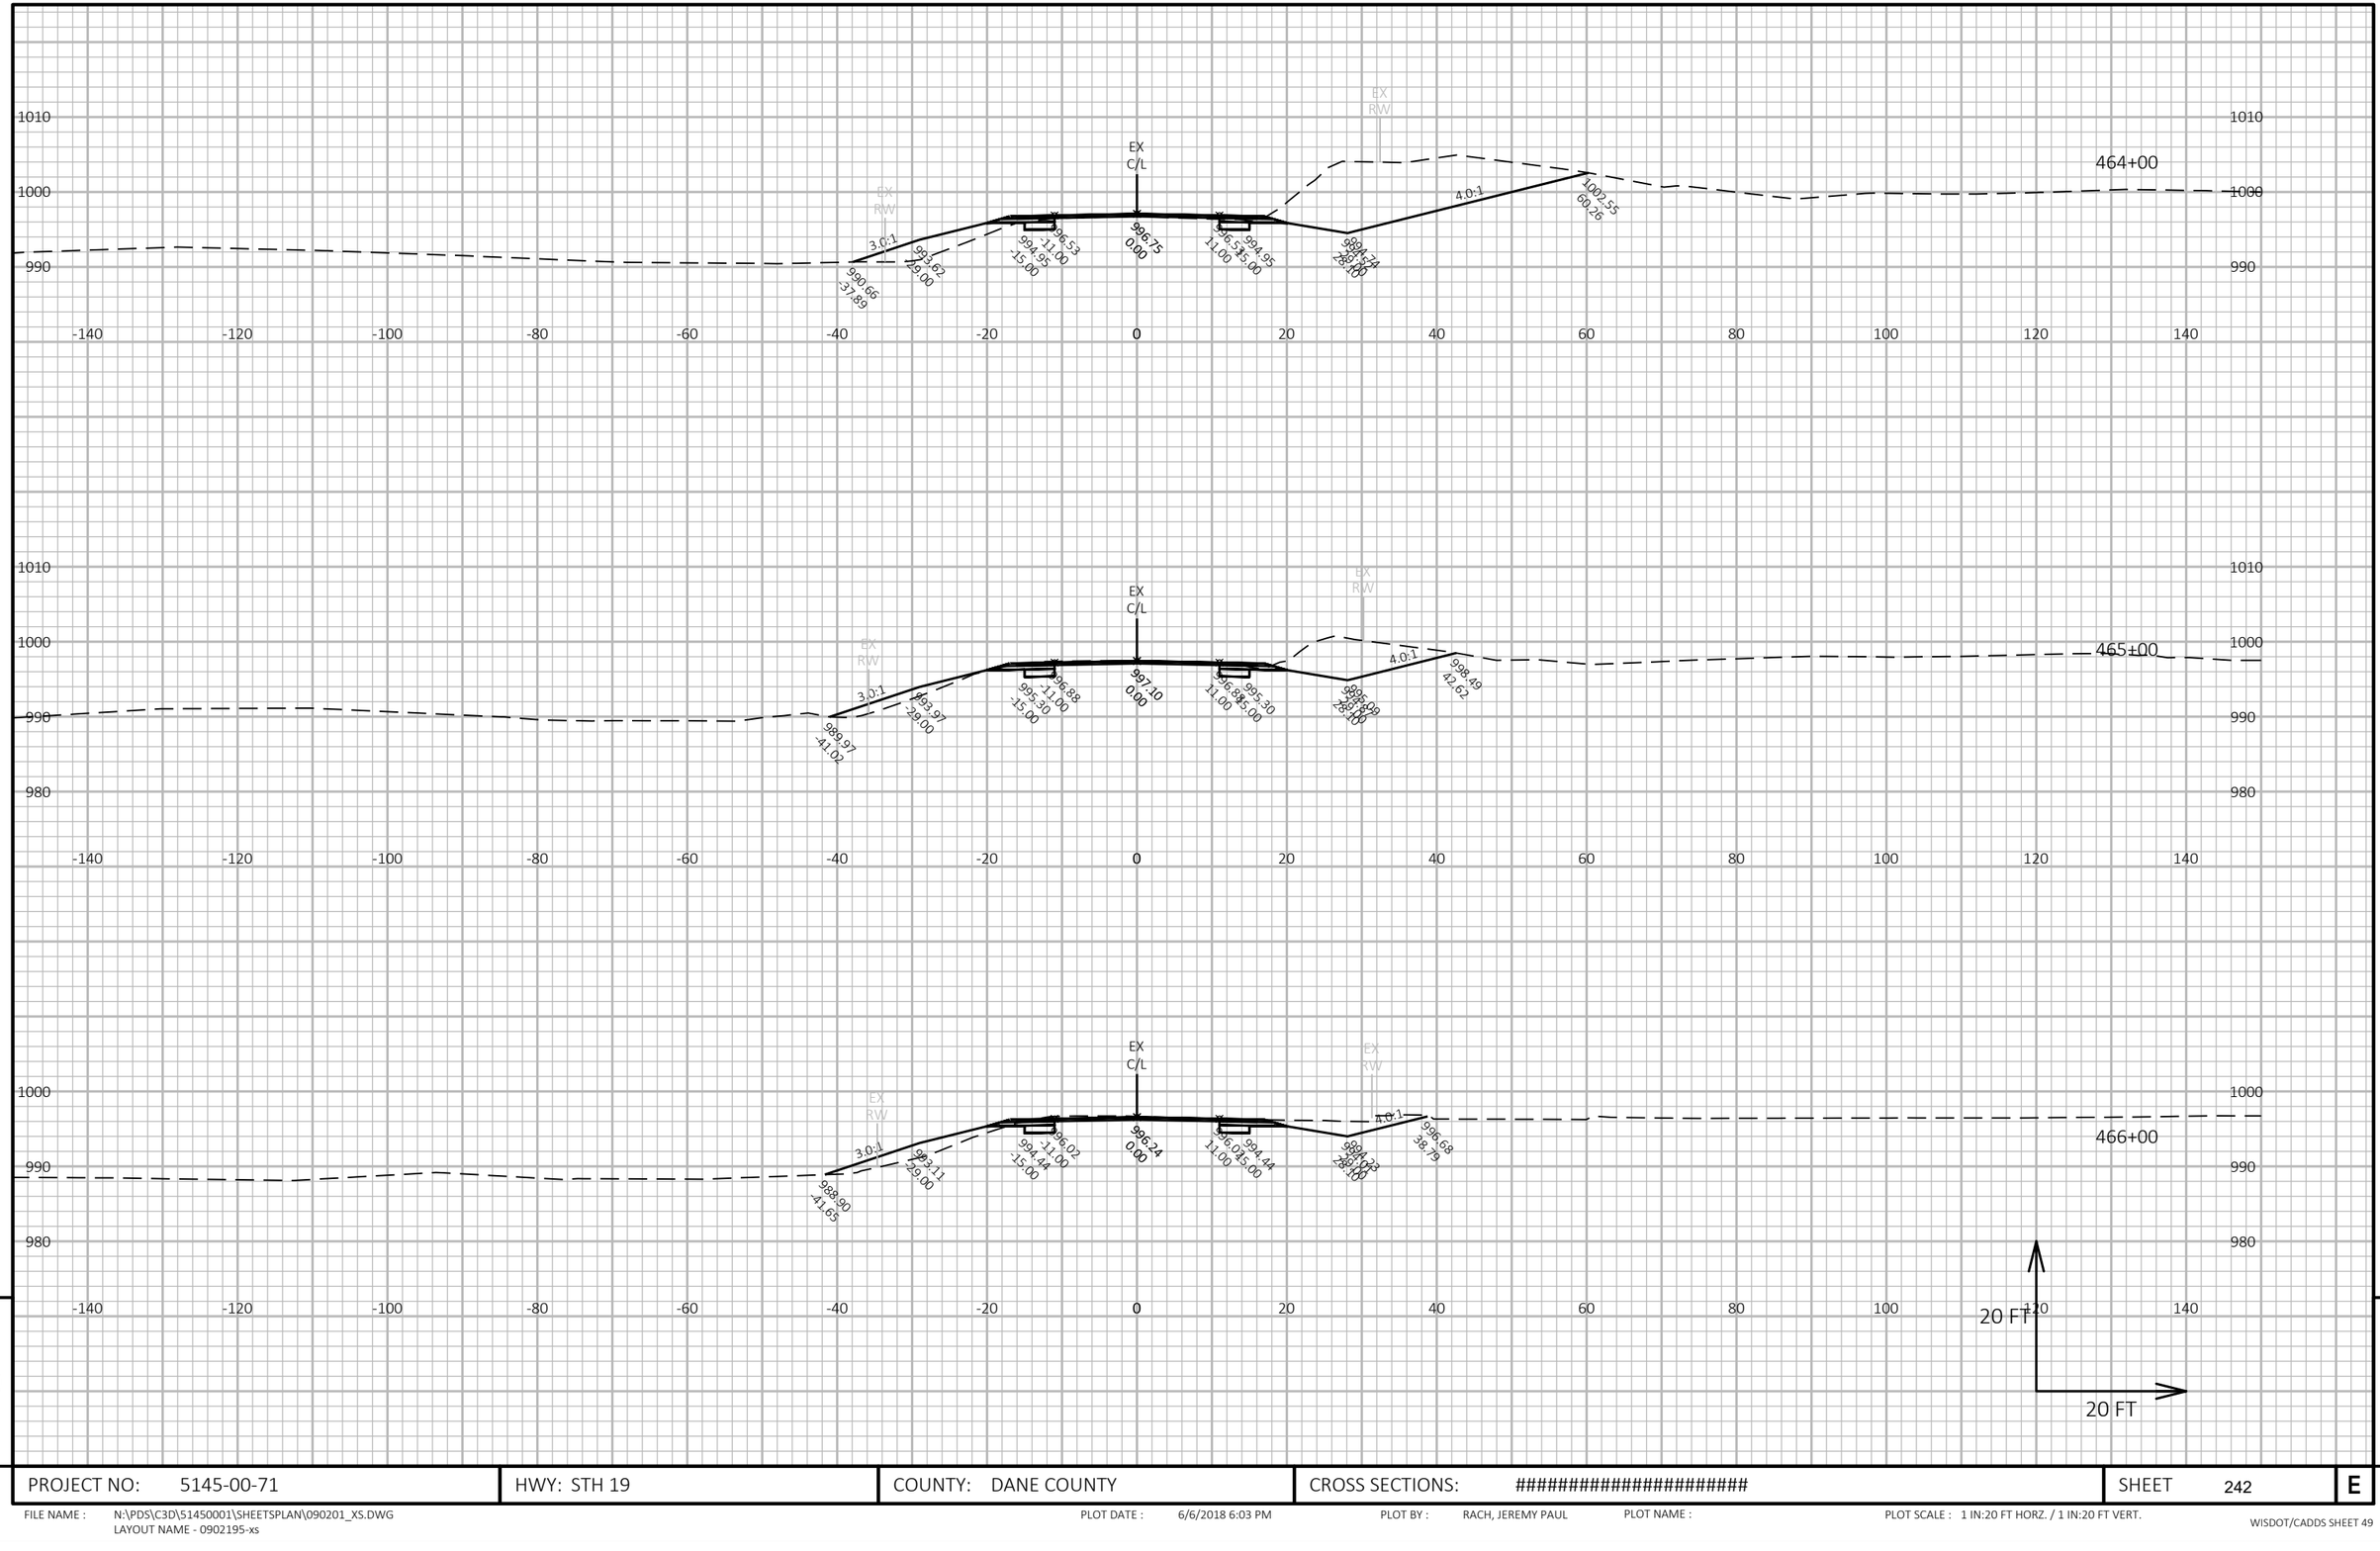

PROJECT NO: 5145-00-71	HWY: STH 19	COUNTY: DANE COUNTY	CROSS SECTIONS: ##########################	SHEET 242	E

FILE NAME : N:\PDS\C3D\51450001\SHEETSPLAN\090201_XS.DWG
LAYOUT NAME - 0902195-xs

PLOT DATE : 6/6/2018 6:03 PM PLOT BY : RACH, JEREMY PAUL PLOT NAME : PLOT SCALE : 1 IN:20 FT HORZ. / 1 IN:20 FT VERT.

WISDOT/CADDS SHEET 49

9

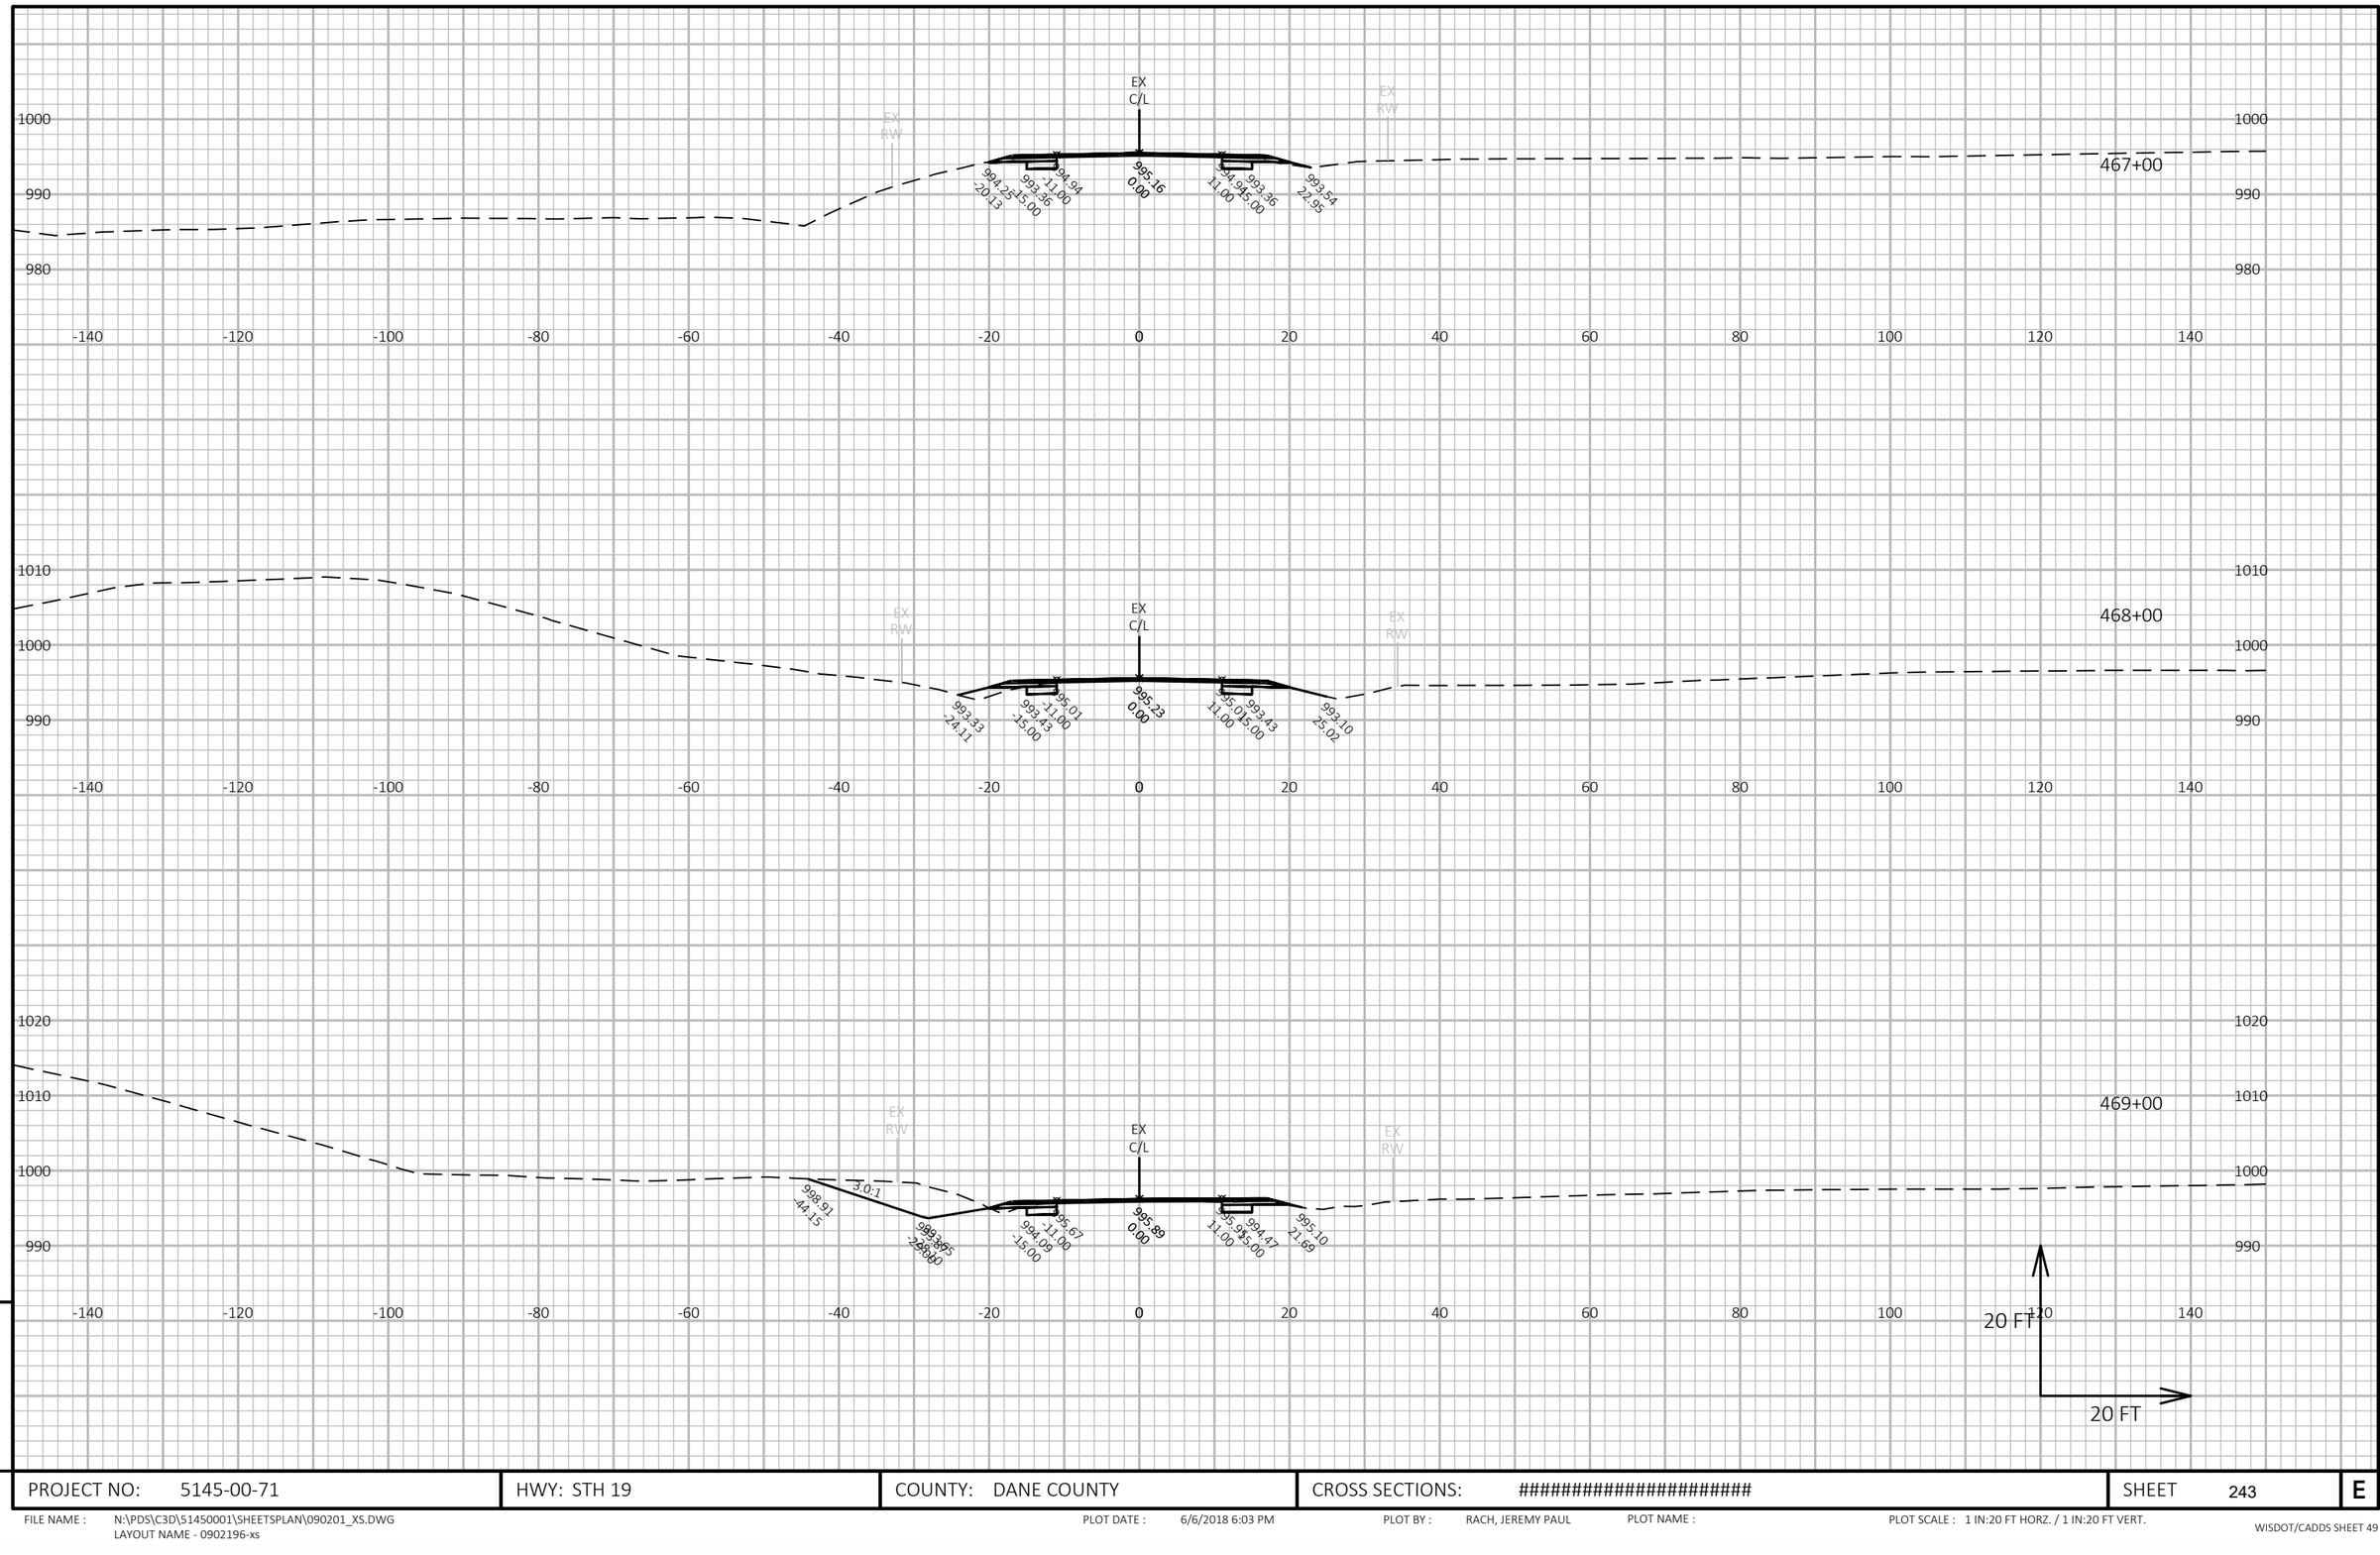

PROJECT NO: 5145-00-71	HWY: STH 19	COUNTY: DANE COUNTY	CROSS SECTIONS: ##########################	SHEET 243	E

FILE NAME : N:\PDS\C3D\51450001\SHEETSPLAN\090201_XS.DWG
LAYOUT NAME - 0902196-xs

PLOT DATE : 6/6/2018 6:03 PM PLOT BY : RACH, JEREMY PAUL PLOT NAME : PLOT SCALE : 1 IN:20 FT HORZ. / 1 IN:20 FT VERT.

WISDOT/CADDS SHEET 49

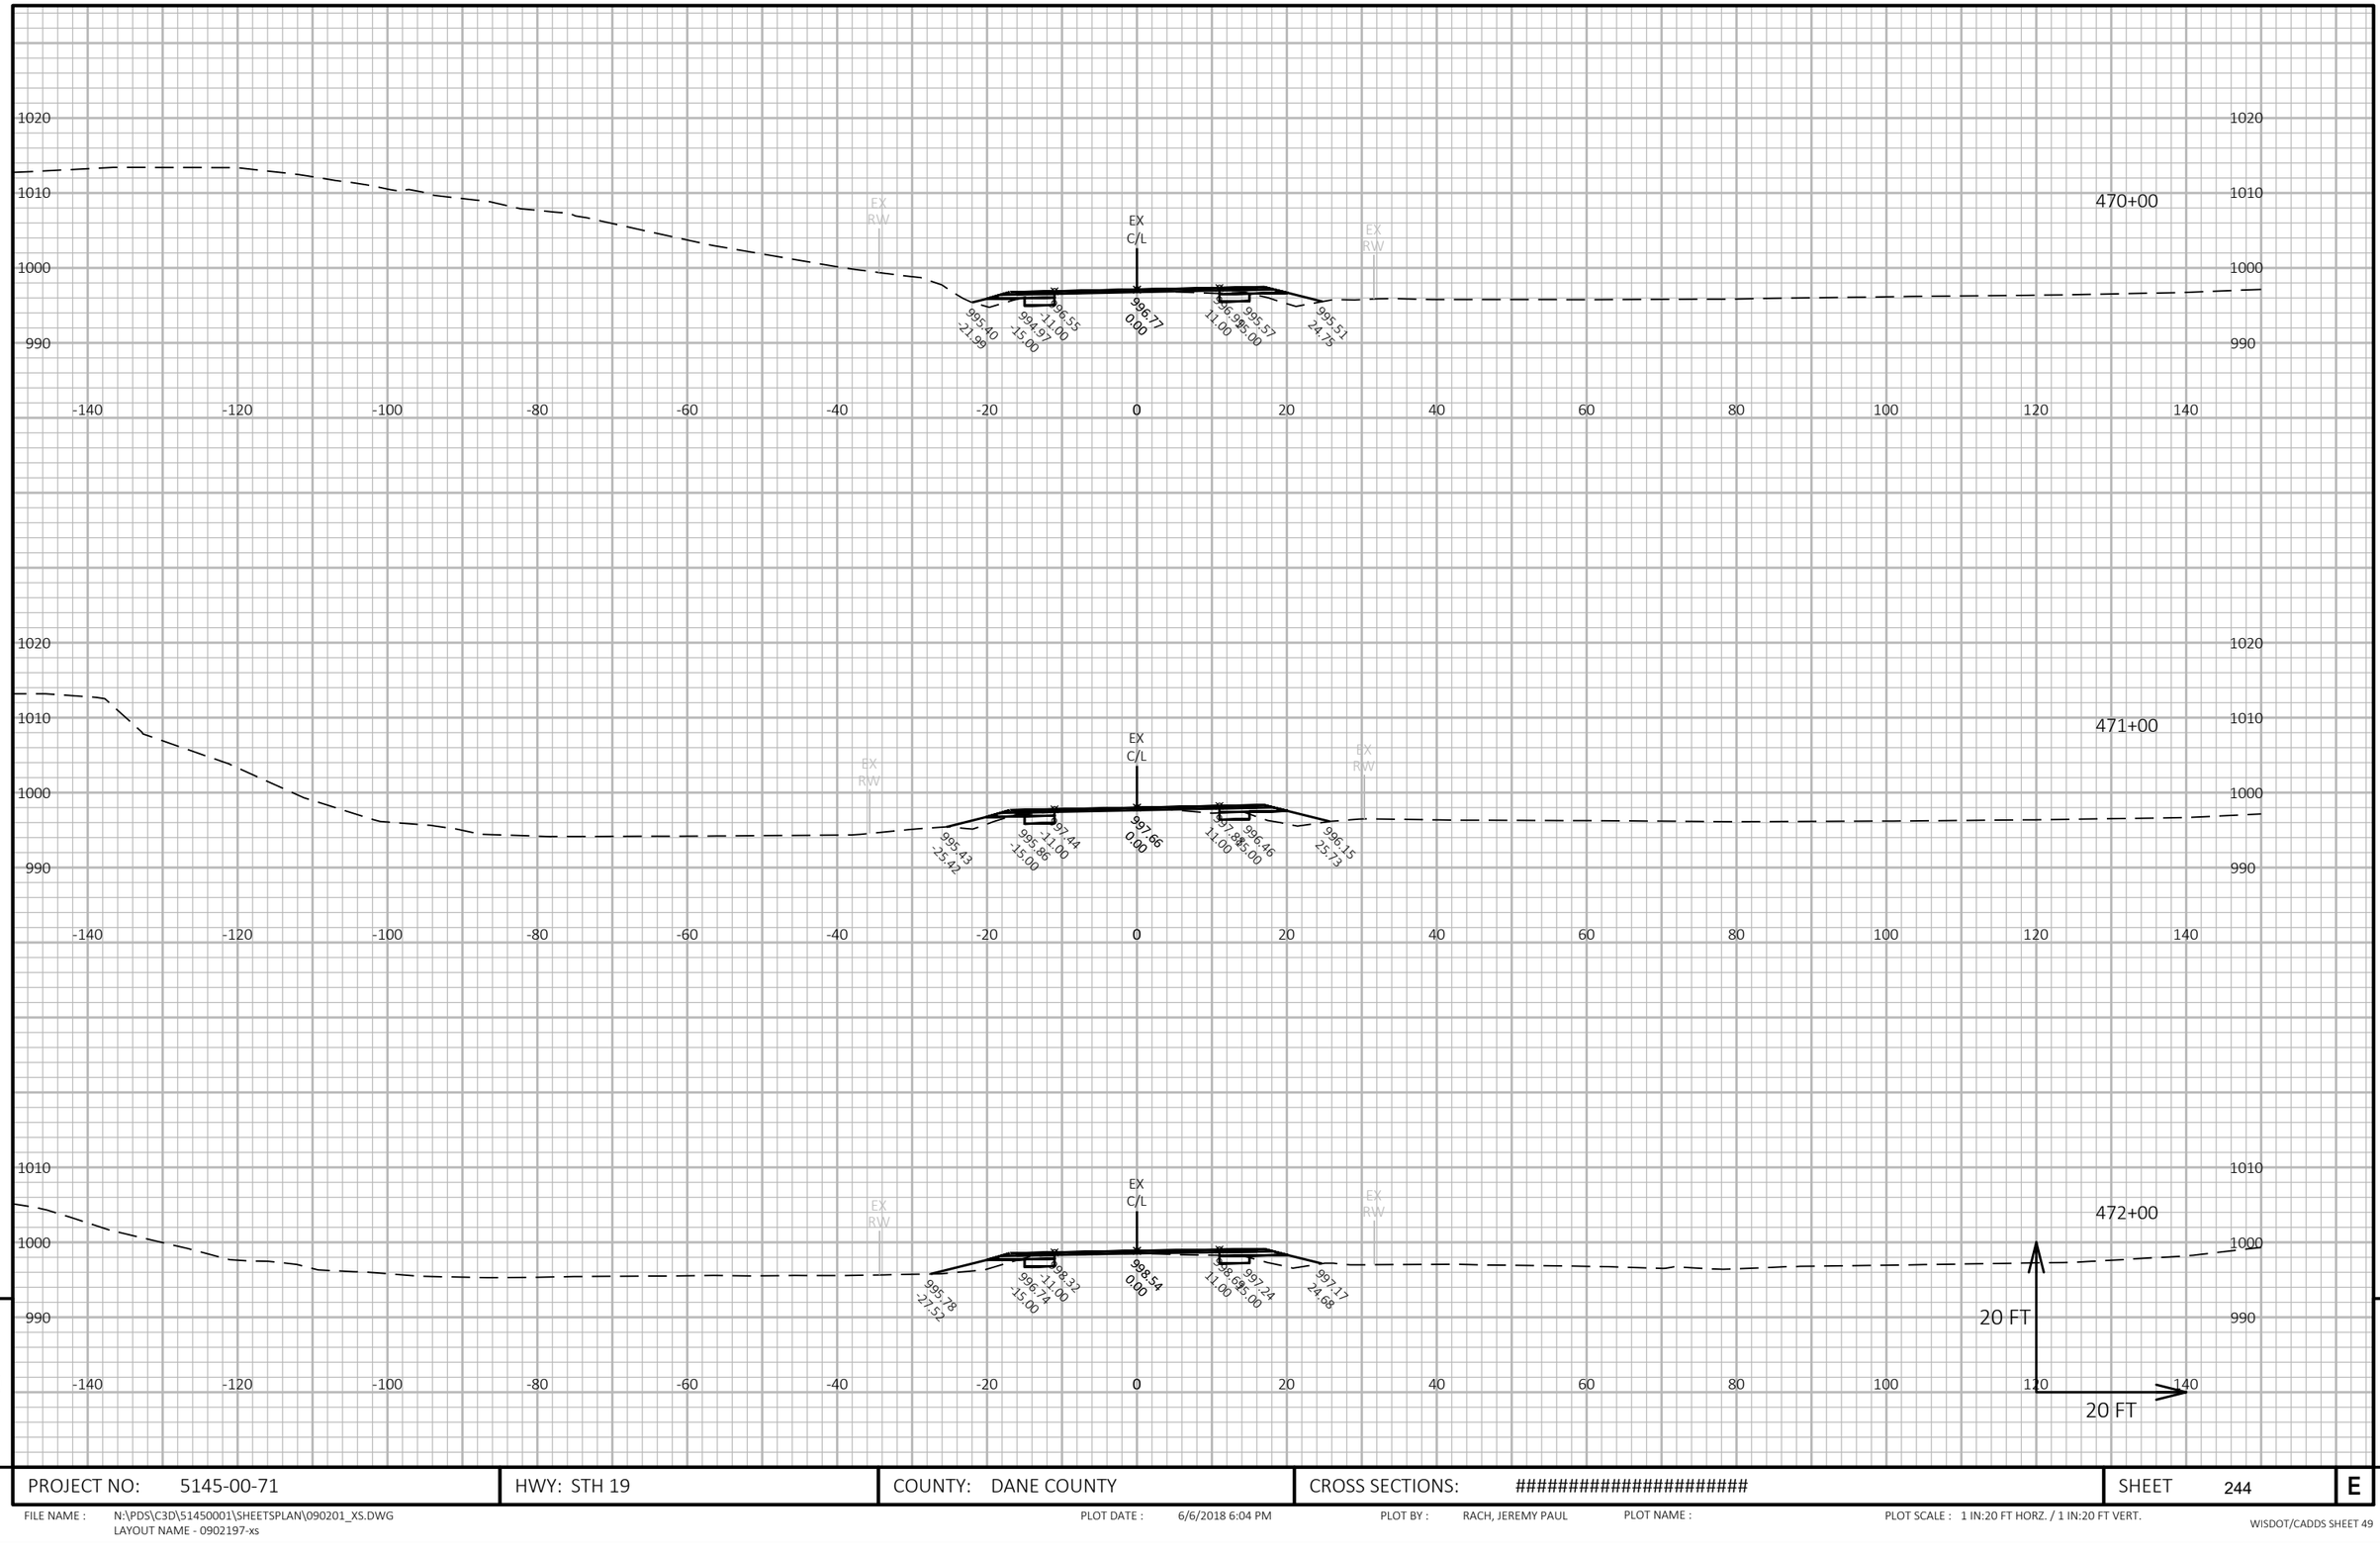

9

9

PROJECT NO: 5145-00-71	HWY: STH 19	COUNTY: DANE COUNTY	CROSS SECTIONS: ##########################	SHEET 244	E

FILE NAME : N:\PDS\C3D\51450001\SHEETSPLAN\090201_XS.DWG
LAYOUT NAME - 0902197-xs

PLOT DATE : 6/6/2018 6:04 PM

PLOT BY : RACH, JEREMY PAUL

PLOT NAME :

PLOT SCALE : 1 IN:20 FT HORZ. / 1 IN:20 FT VERT.

WISDOT/CADDS SHEET 49

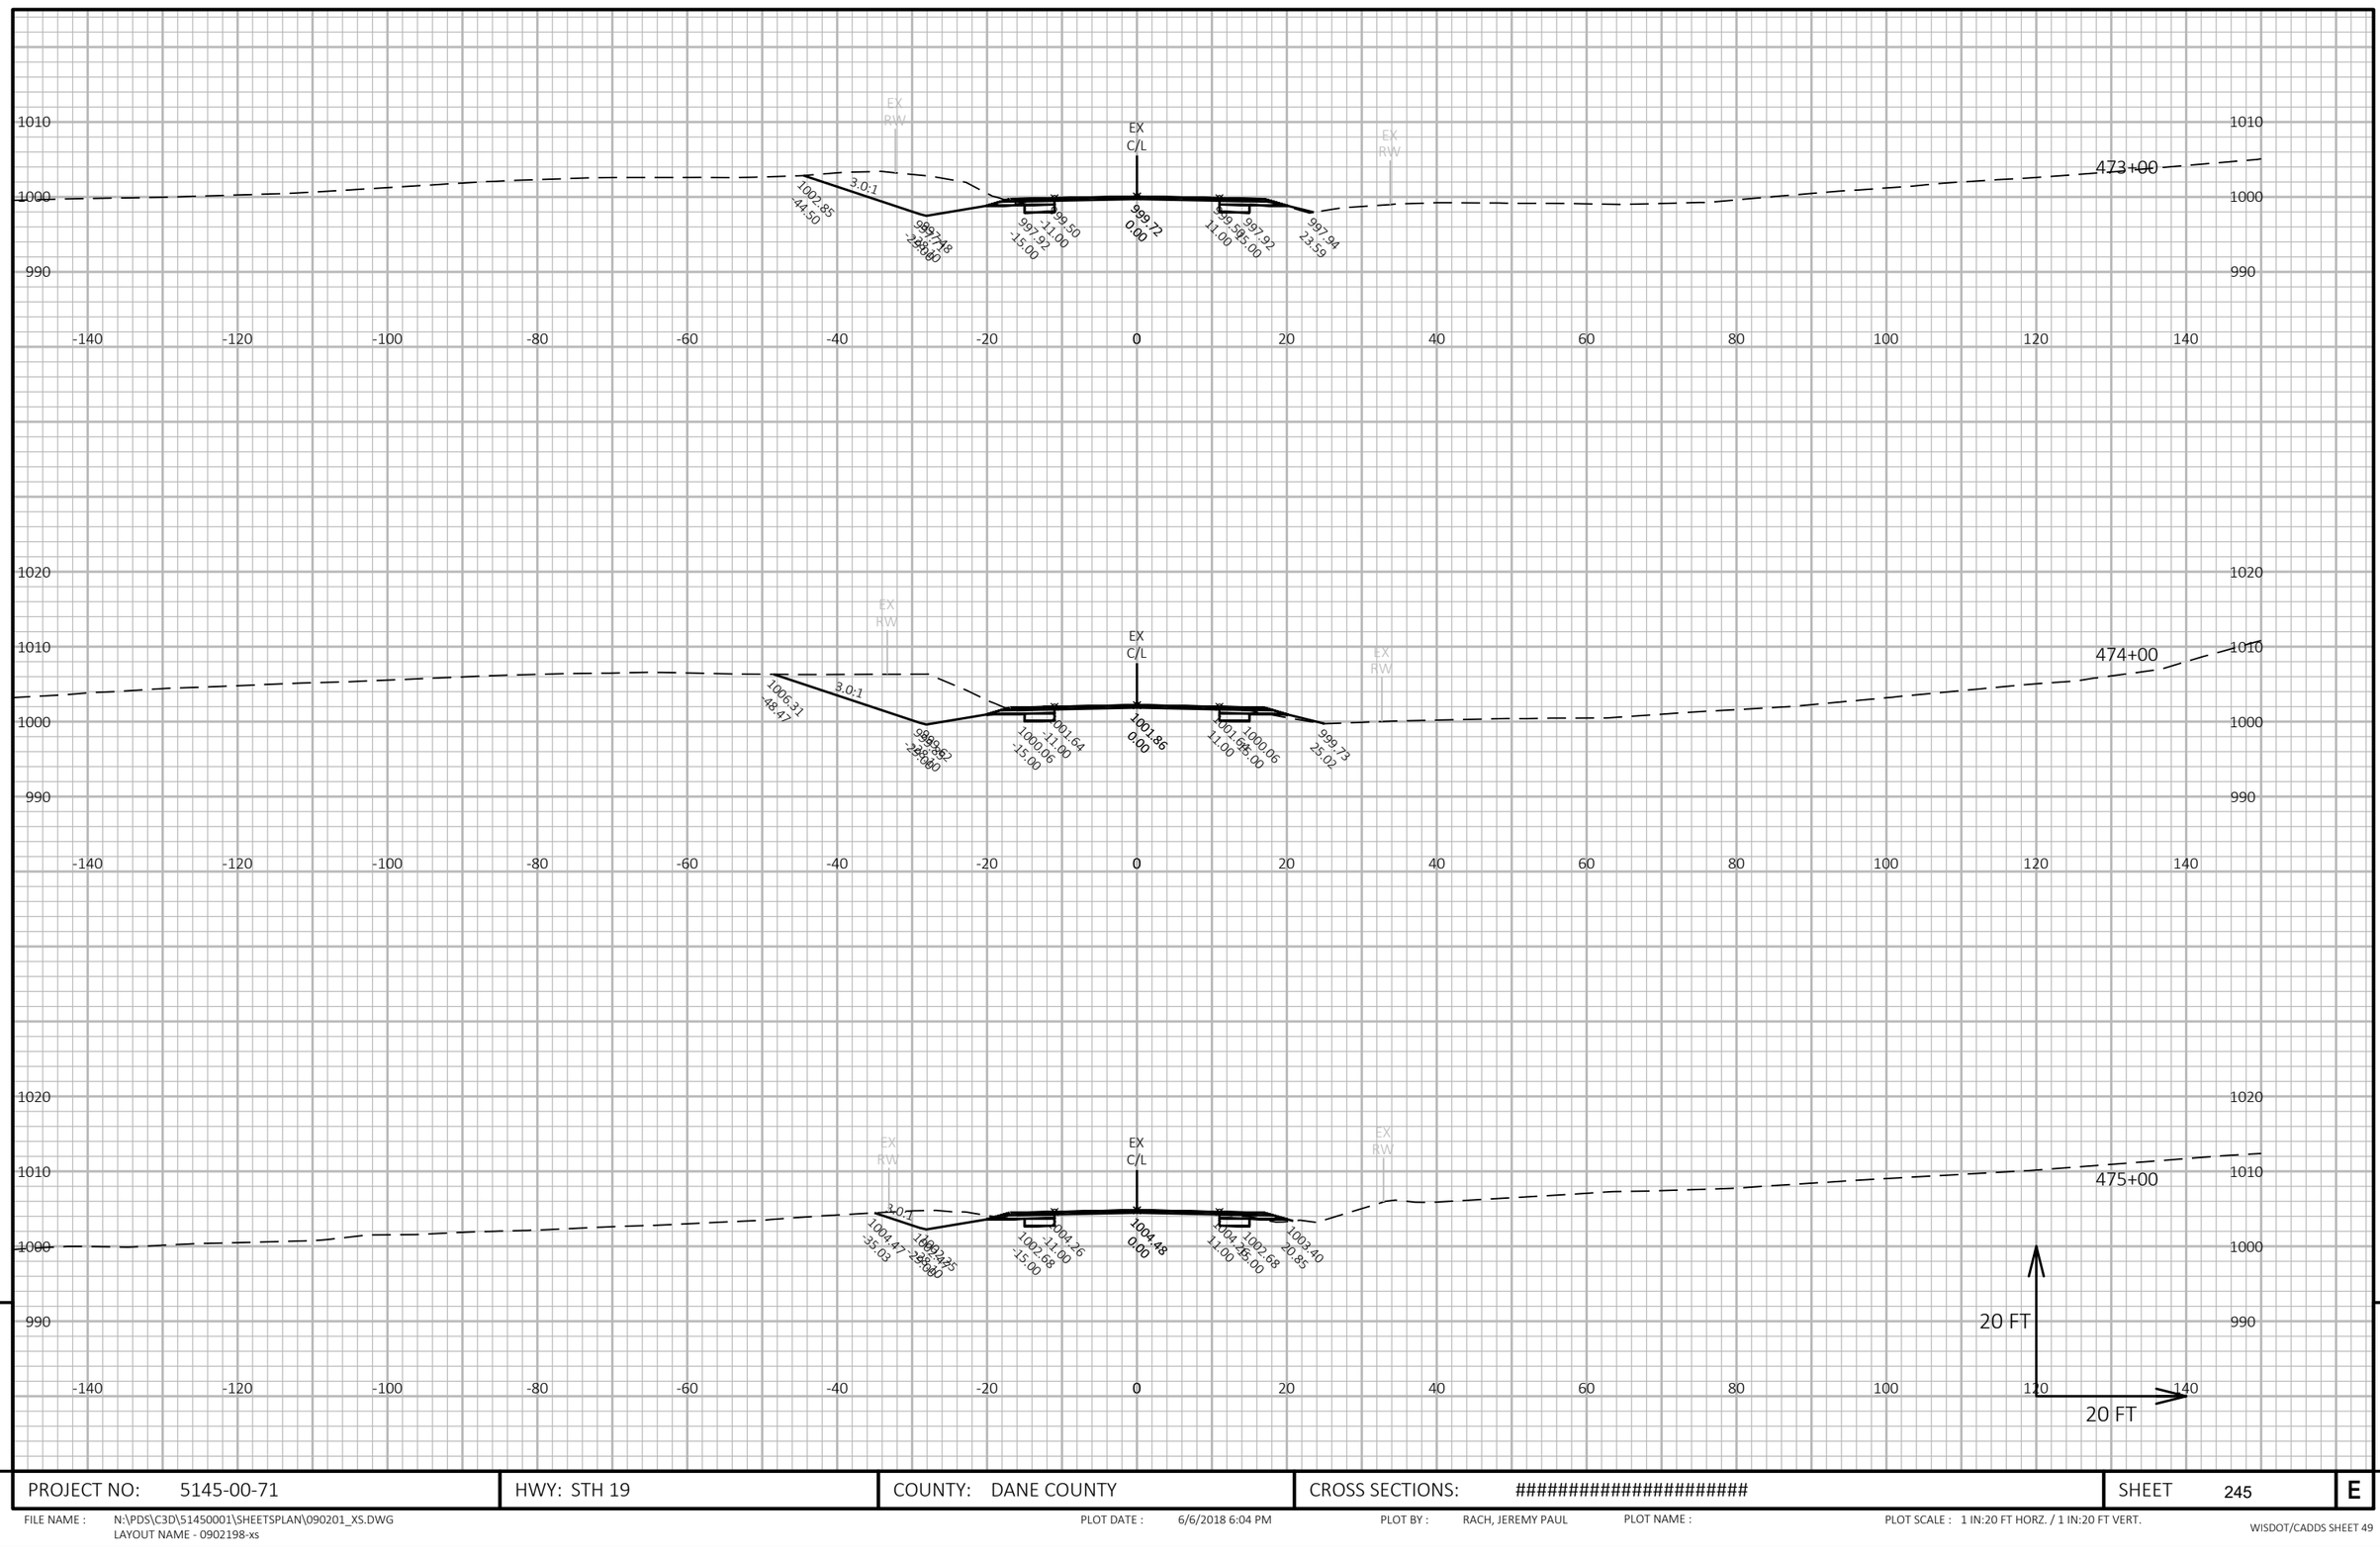

9

9

PROJECT NO: 5145-00-71	HWY: STH 19	COUNTY: DANE COUNTY	CROSS SECTIONS: ##########################	SHEET 245	E

FILE NAME : N:\PDS\C3D\51450001\SHEETSPLAN\090201_XS.DWG
LAYOUT NAME - 0902198-xs

PLOT DATE : 6/6/2018 6:04 PM PLOT BY : RACH, JEREMY PAUL PLOT NAME : PLOT SCALE : 1 IN:20 FT HORZ. / 1 IN:20 FT VERT.

WISDOT/CADDS SHEET 49

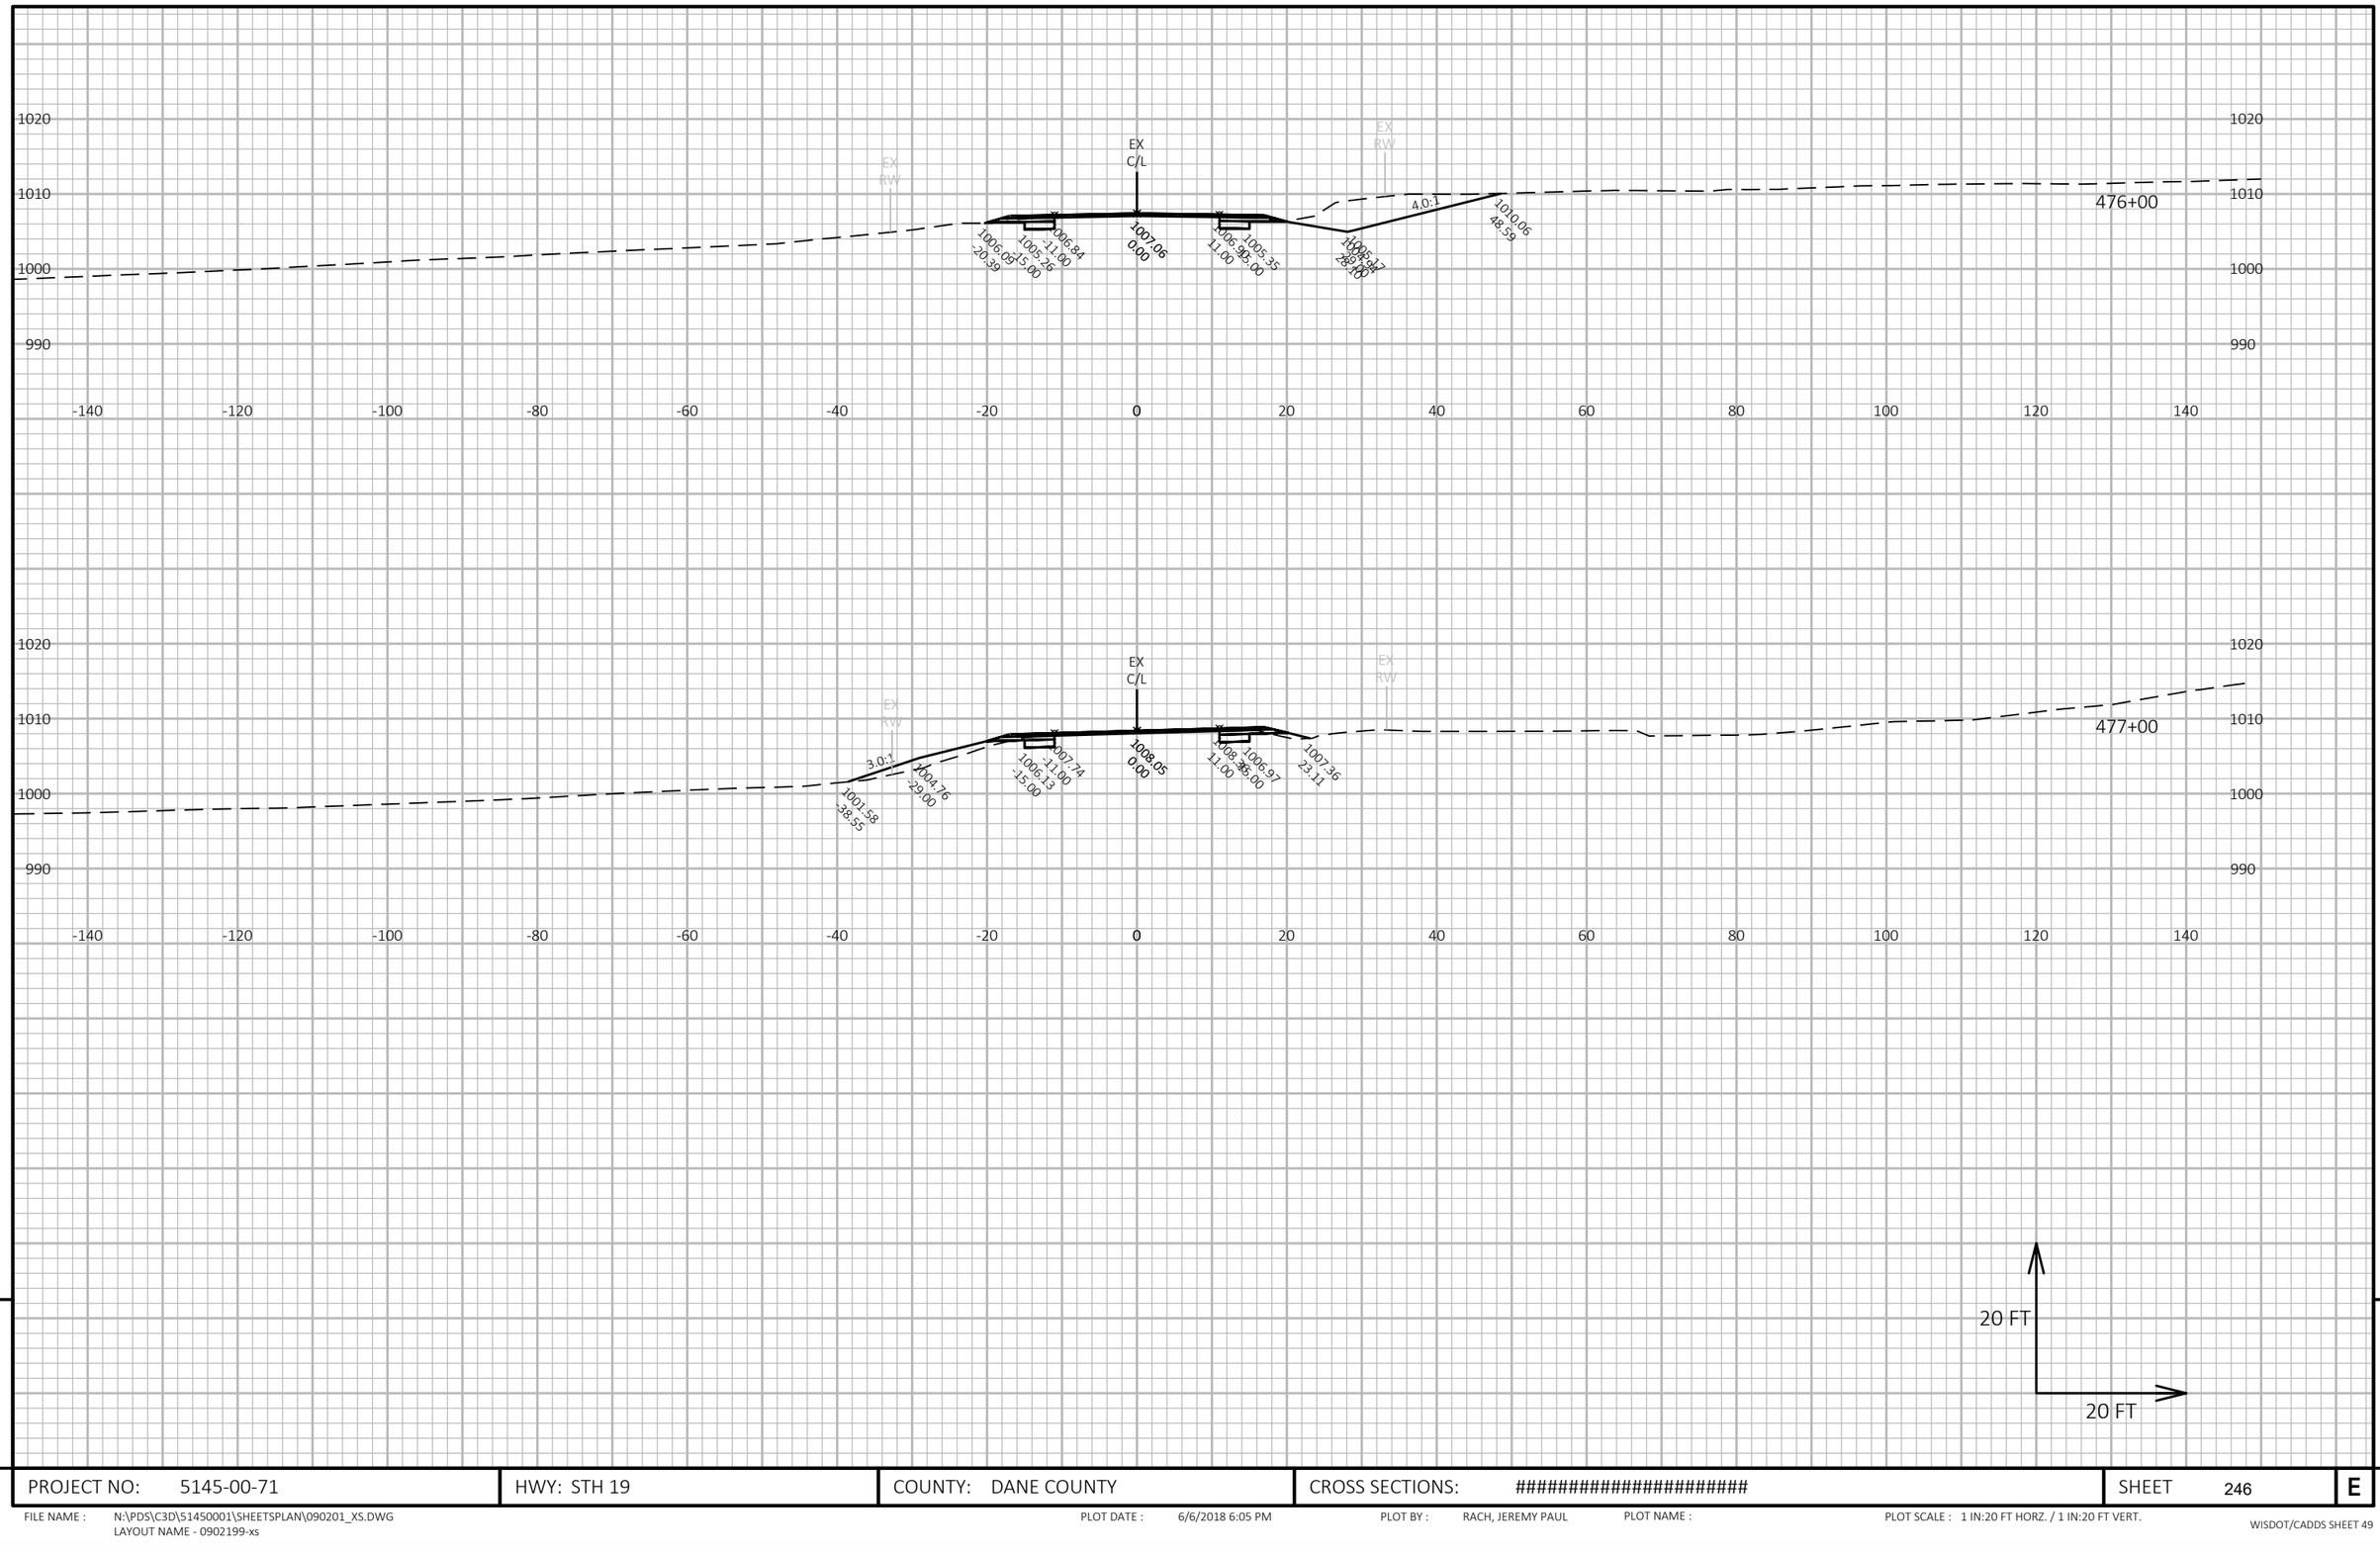

9

9

PROJECT NO: 5145-00-71	HWY: STH 19	COUNTY: DANE COUNTY	CROSS SECTIONS: ##########################	SHEET 246	E

FILE NAME : N:\PDS\C3D\51450001\SHEETSPLAN\090201_XS.DWG
LAYOUT NAME - 0902199-xs

PLOT DATE : 6/6/2018 6:05 PM PLOT BY : RACH, JEREMY PAUL PLOT NAME : PLOT SCALE : 1 IN:20 FT HORZ. / 1 IN:20 FT VERT.

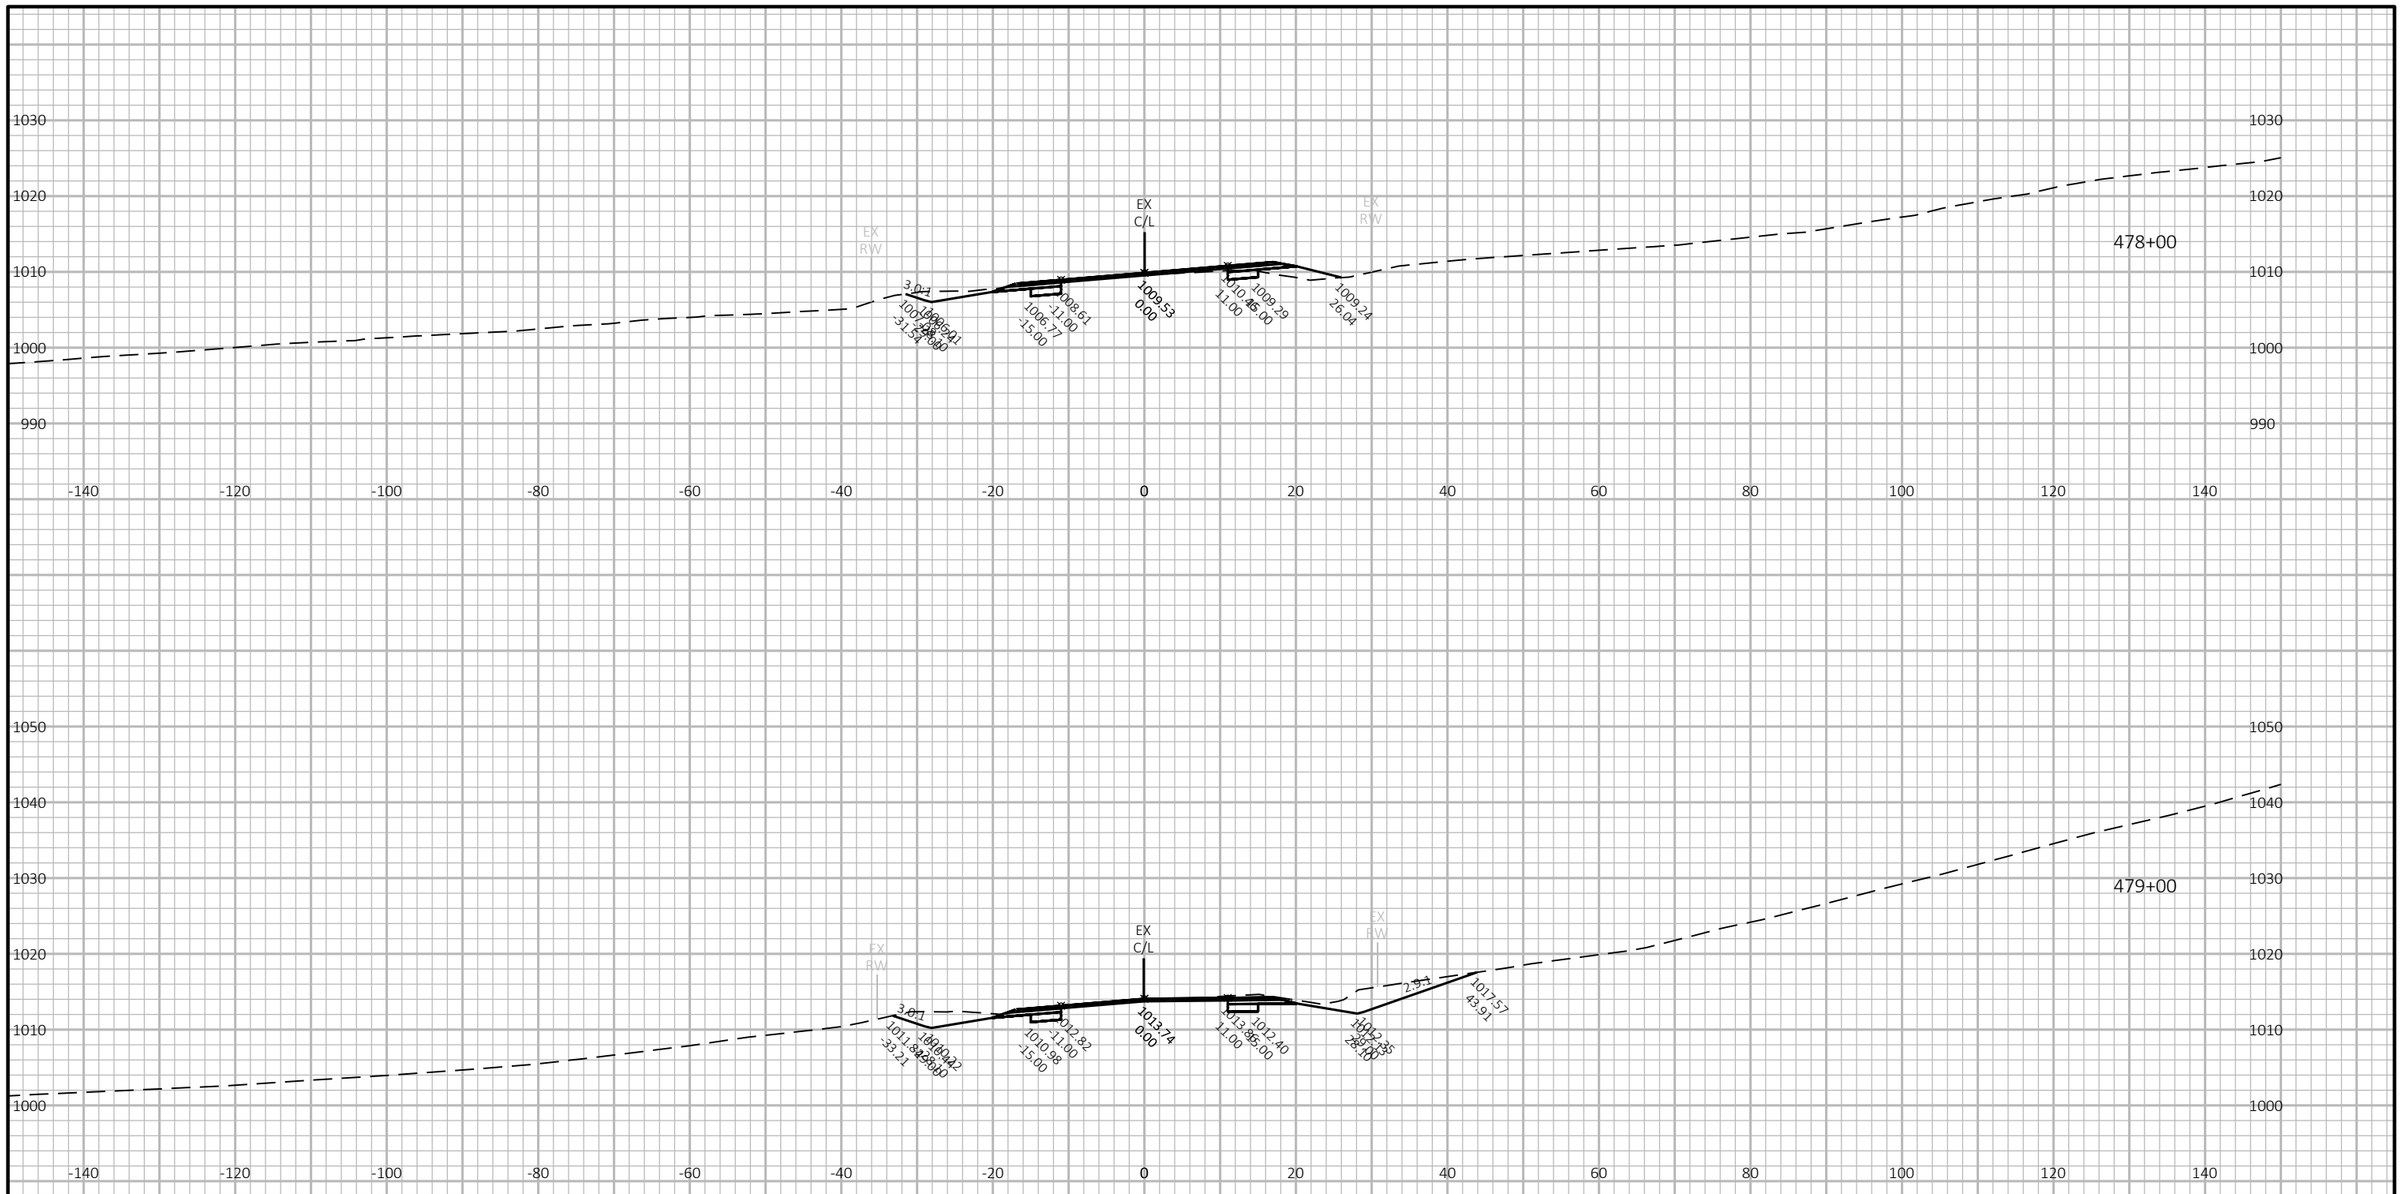

9

9

PROJECT NO: 5145-00-71	HWY: STH 19	COUNTY: DANE COUNTY	CROSS SECTIONS: ##########################	SHEET 247	E

FILE NAME : N:\PDS\C3D\51450001\SHEETSPLAN\090201_XS.DWG
LAYOUT NAME - 0902200-xs

PLOT DATE : 6/6/2018 6:05 PM PLOT BY : RACH, JEREMY PAUL PLOT NAME : PLOT SCALE : 1 IN:20 FT HORZ. / 1 IN:20 FT VERT.

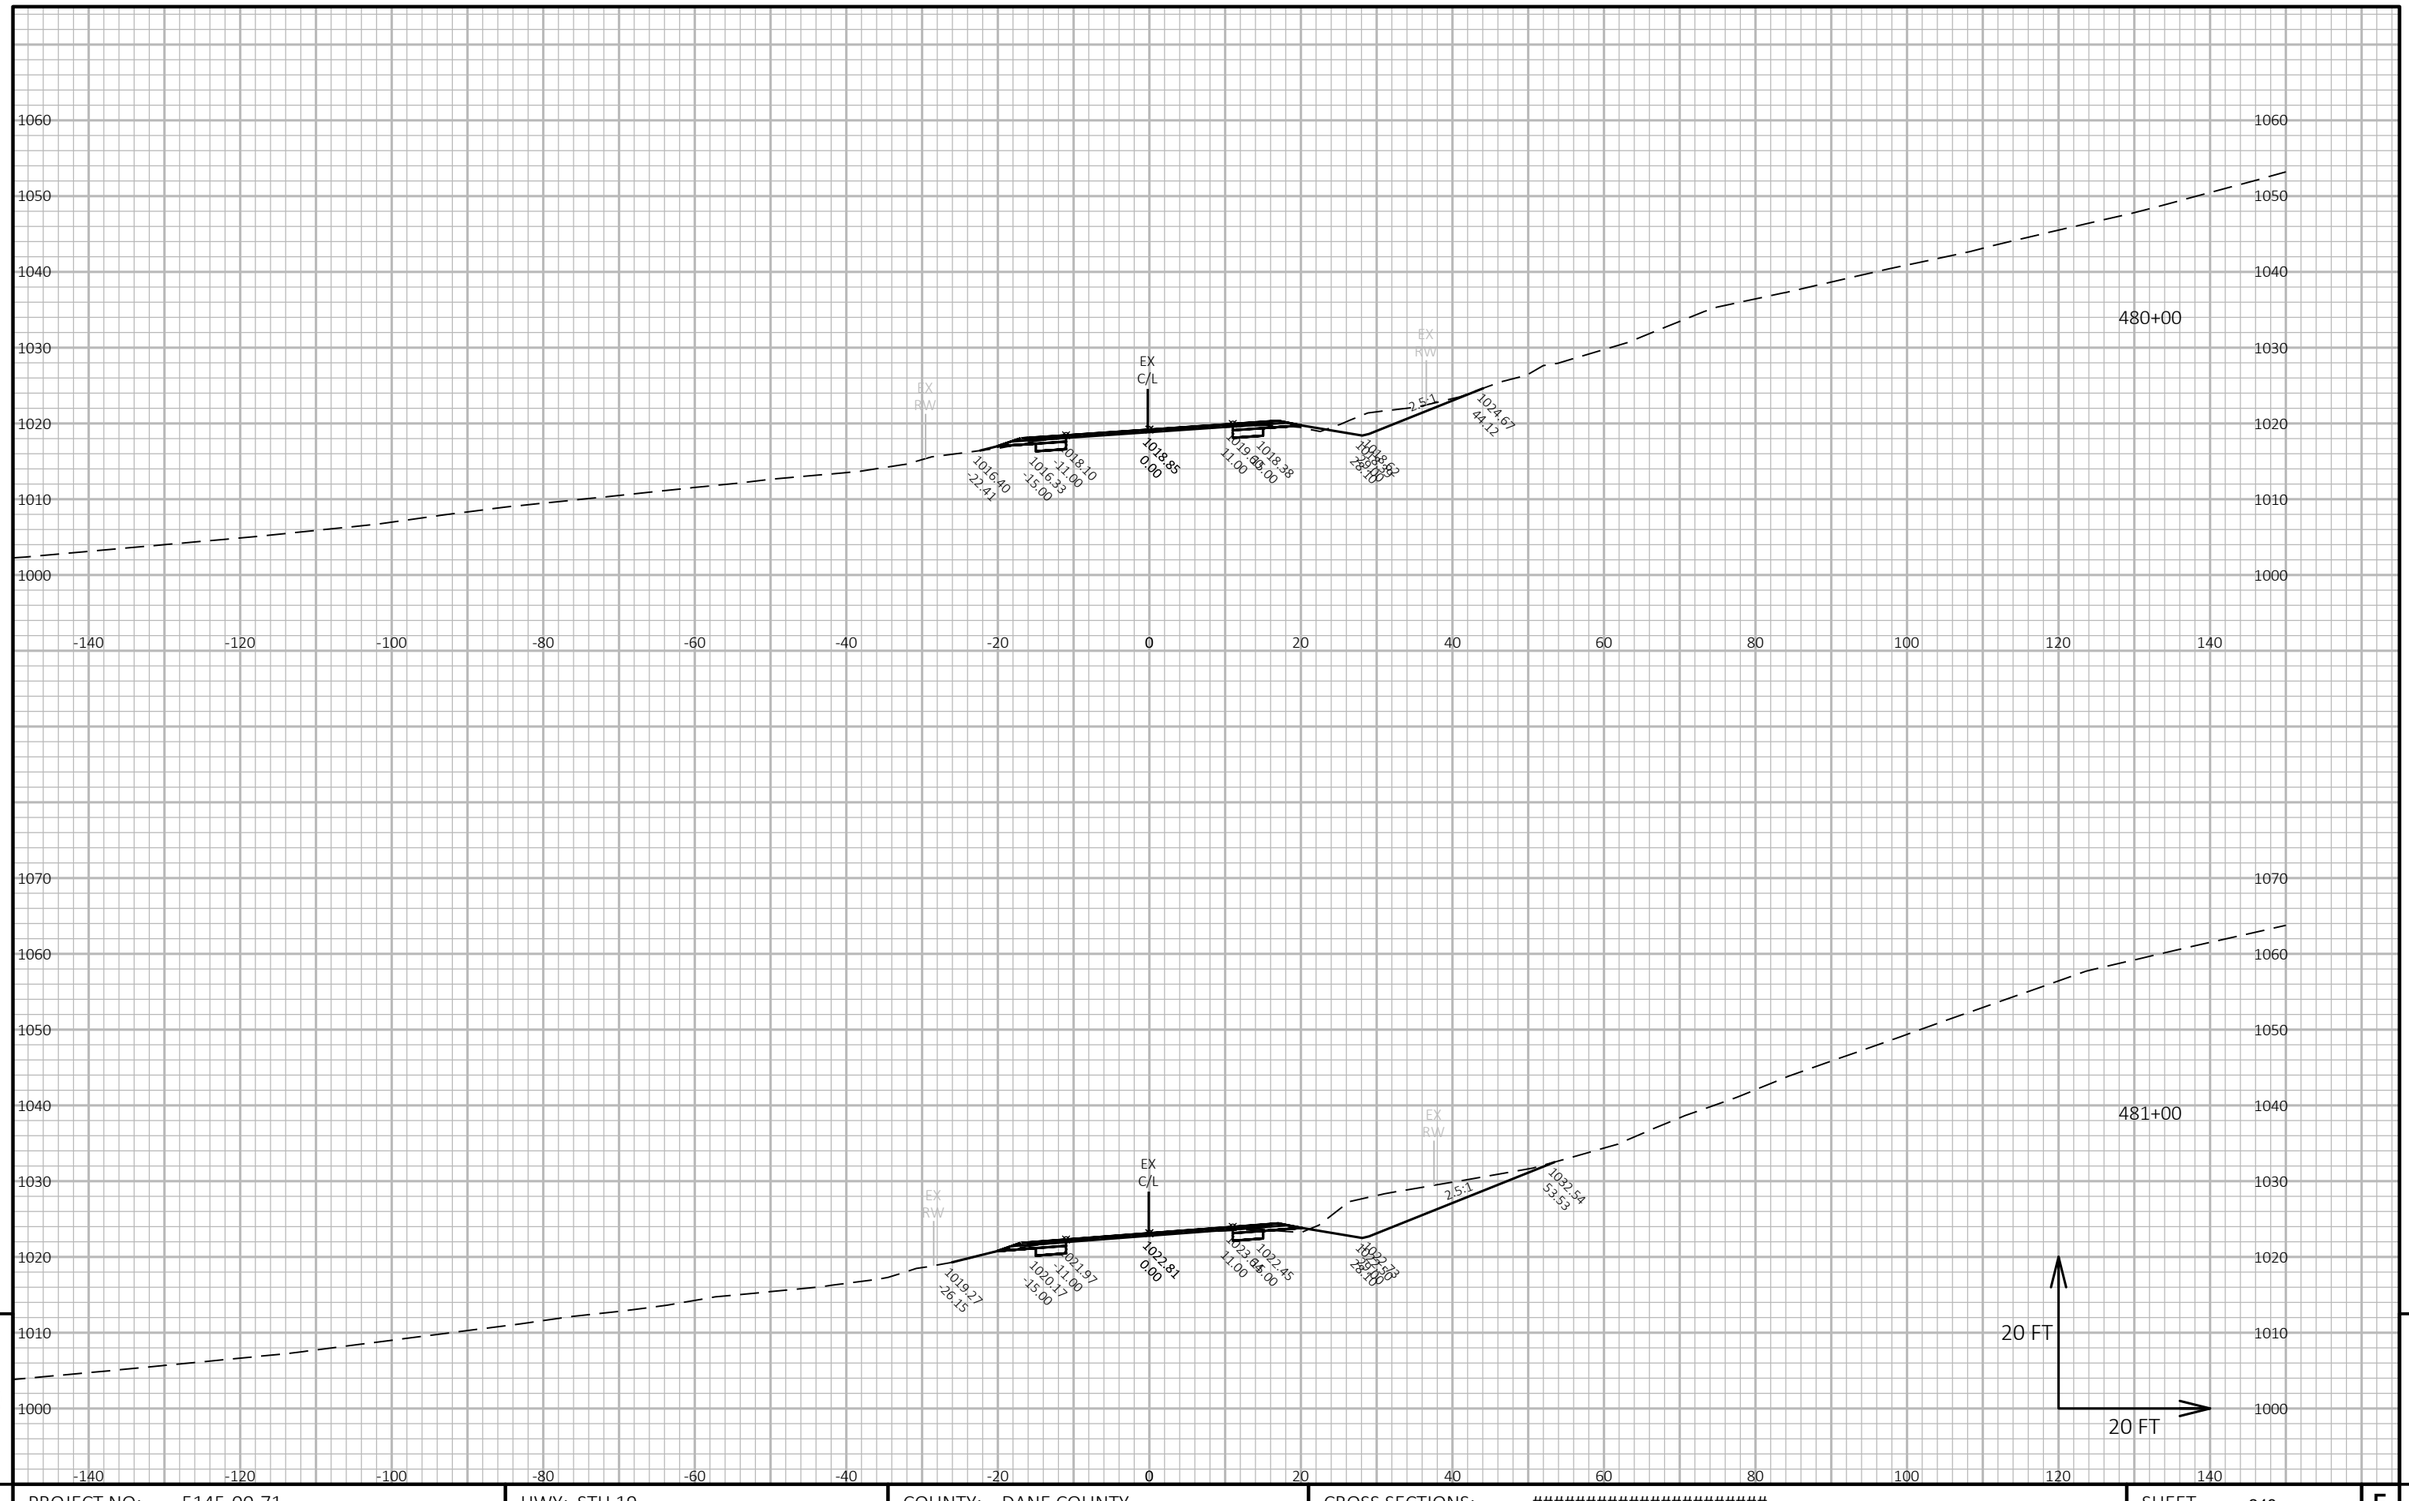

9

9

PROJECT NO: 5145-00-71	HWY: STH 19	COUNTY: DANE COUNTY	CROSS SECTIONS: ##########################	SHEET 248	E

FILE NAME : N:\PDS\C3D\51450001\SHEETSPLAN\090201_XS.DWG
LAYOUT NAME - 0902201-xs

PLOT DATE : 6/6/2018 6:06 PM PLOT BY : RACH, JEREMY PAUL PLOT NAME : PLOT SCALE : 1 IN:20 FT HORZ. / 1 IN:20 FT VERT.

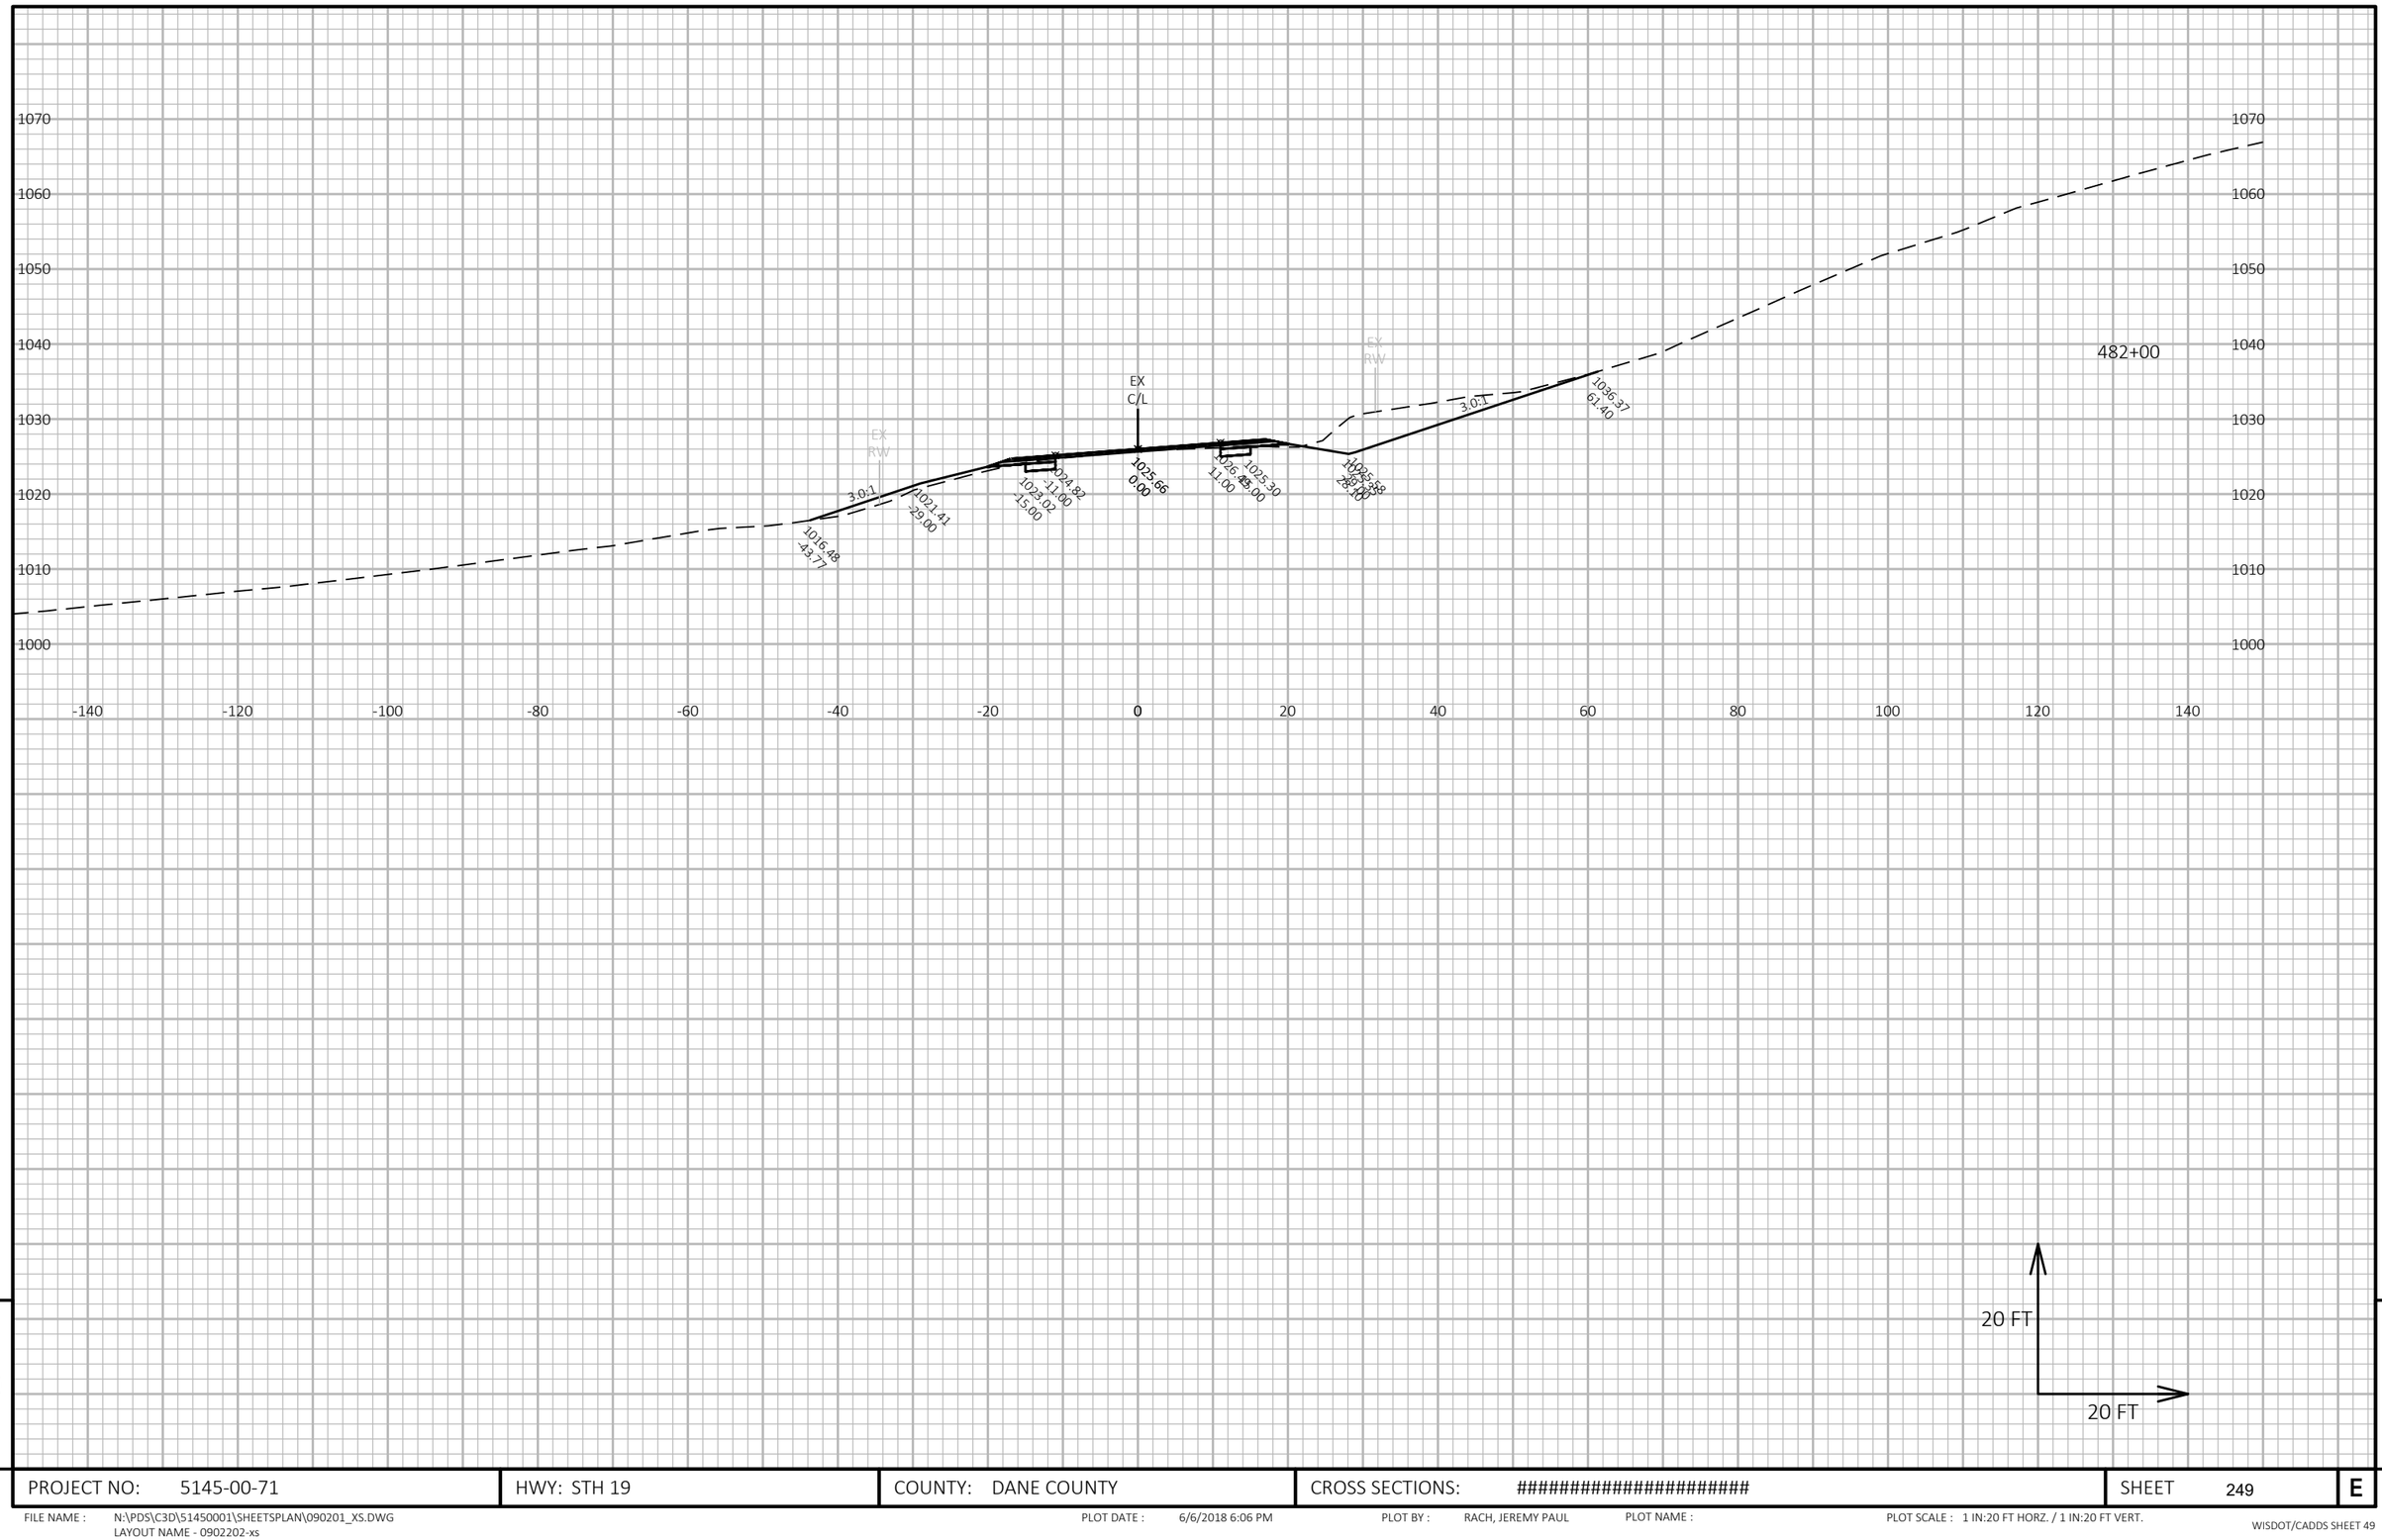

9

9

PROJECT NO: 5145-00-71	HWY: STH 19	COUNTY: DANE COUNTY	CROSS SECTIONS: ##########################	SHEET 249	E

FILE NAME : N:\PDS\C3D\51450001\SHEETSPLAN\090201_XS.DWG
LAYOUT NAME - 0902202-xs

PLOT DATE : 6/6/2018 6:06 PM

PLOT BY : RACH, JEREMY PAUL

PLOT NAME :

PLOT SCALE : 1 IN:20 FT HORZ. / 1 IN:20 FT VERT.

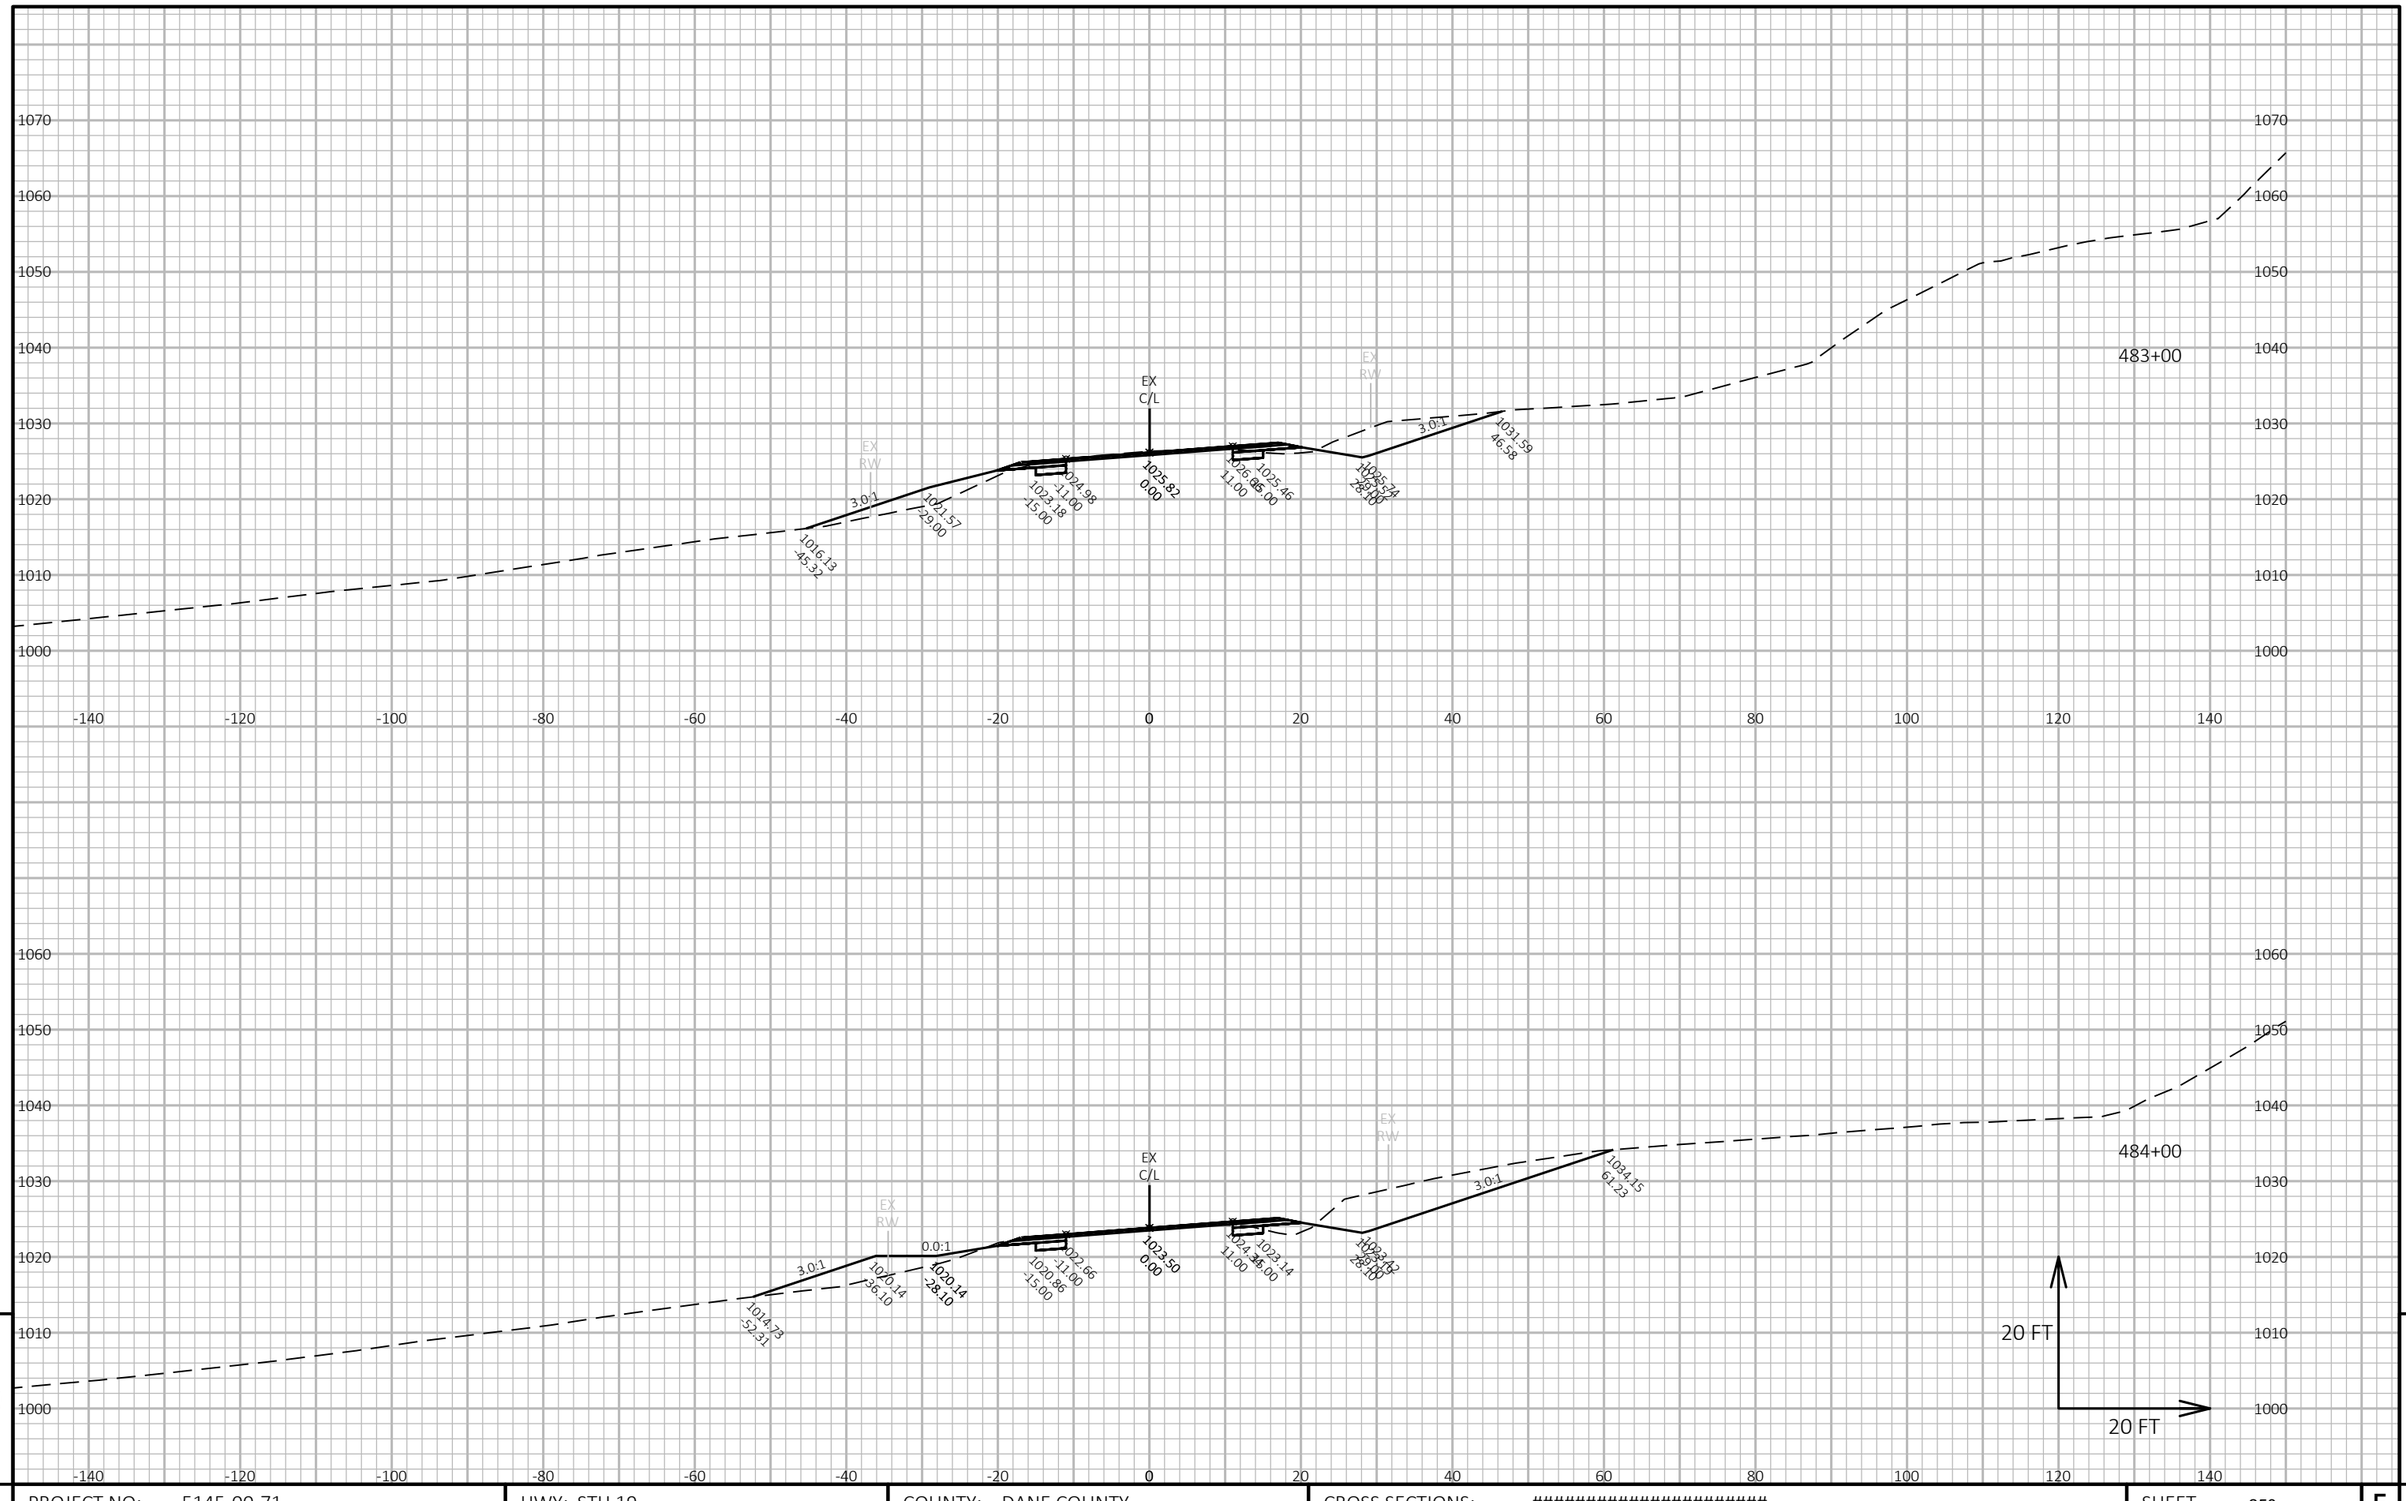

9

9

PROJECT NO: 5145-00-71	HWY: STH 19	COUNTY: DANE COUNTY	CROSS SECTIONS: ##########################	SHEET 250	E

FILE NAME : N:\PDS\C3D\51450001\SHEETSPLAN\090201_XS.DWG
LAYOUT NAME - 0902203-xs

PLOT DATE : 6/6/2018 6:07 PM PLOT BY : RACH, JEREMY PAUL PLOT NAME : PLOT SCALE : 1 IN:20 FT HORZ. / 1 IN:20 FT VERT.

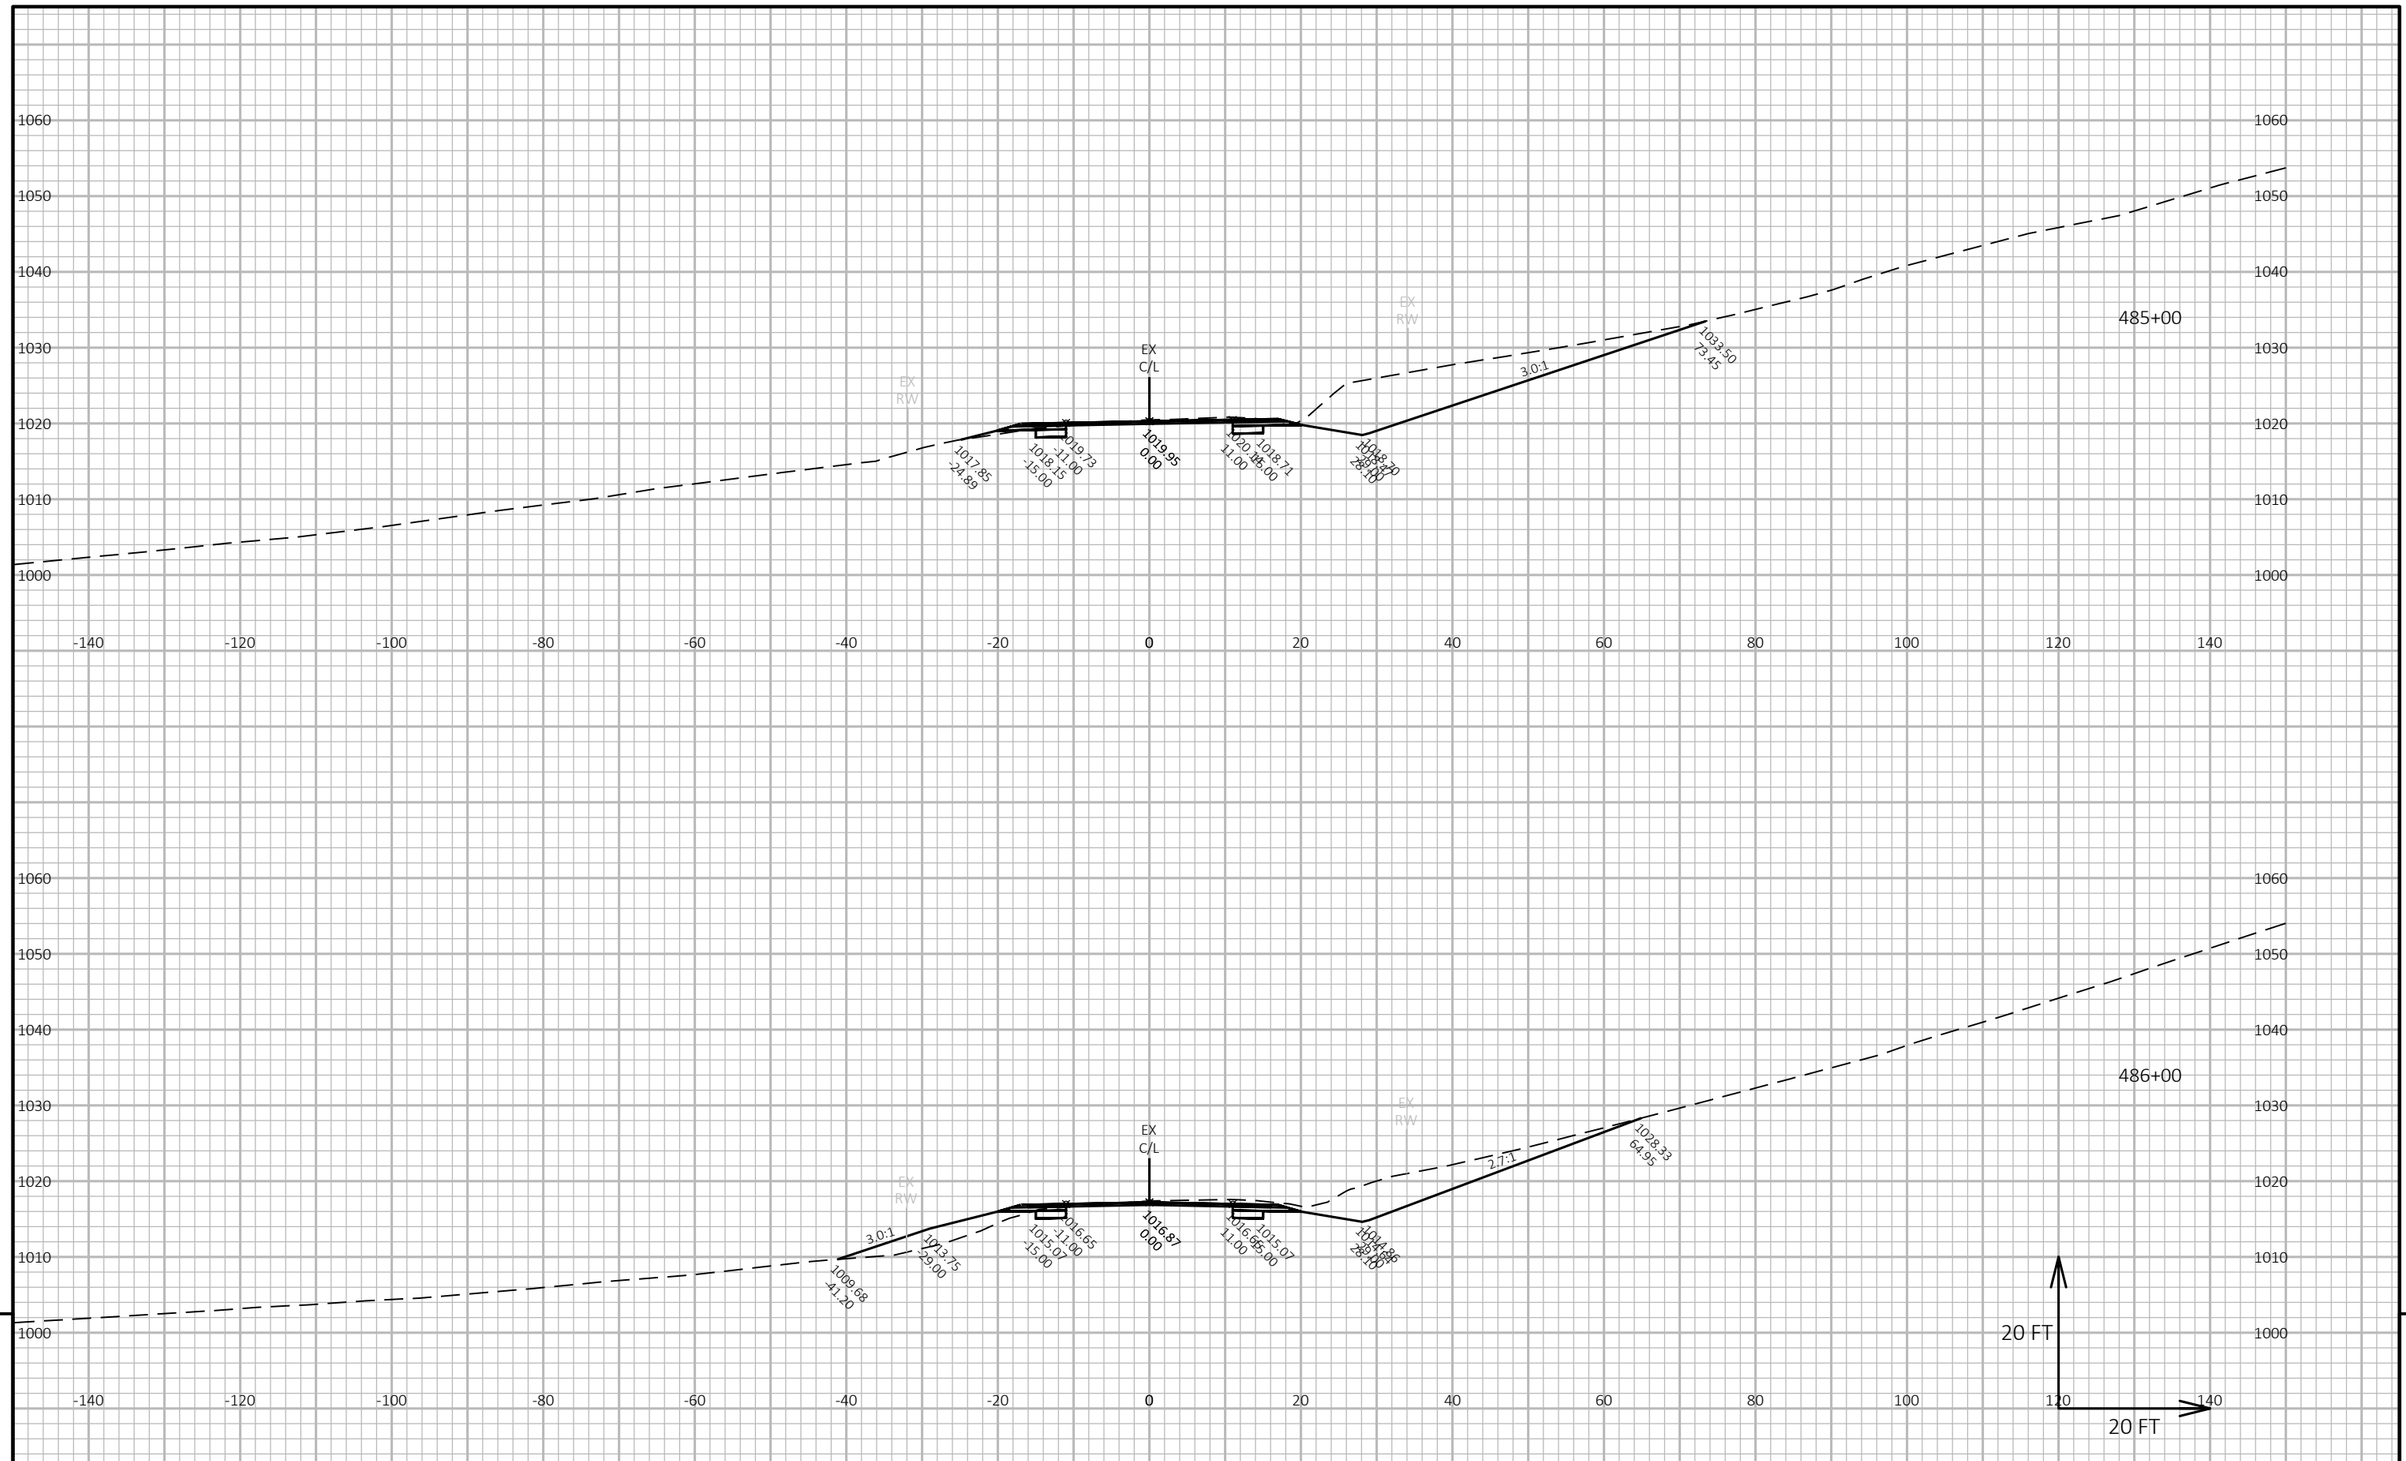

PROJECT NO: 5145-00-71	HWY: STH 19	COUNTY: DANE COUNTY	CROSS SECTIONS: ##########################	SHEET 251	E

FILE NAME : N:\PDS\C3D\51450001\SHEETSPLAN\090201_XS.DWG
LAYOUT NAME - 0902204-xs

PLOT DATE : 6/6/2018 6:07 PM PLOT BY : RACH, JEREMY PAUL PLOT NAME : PLOT SCALE : 1 IN:20 FT HORZ. / 1 IN:20 FT VERT.

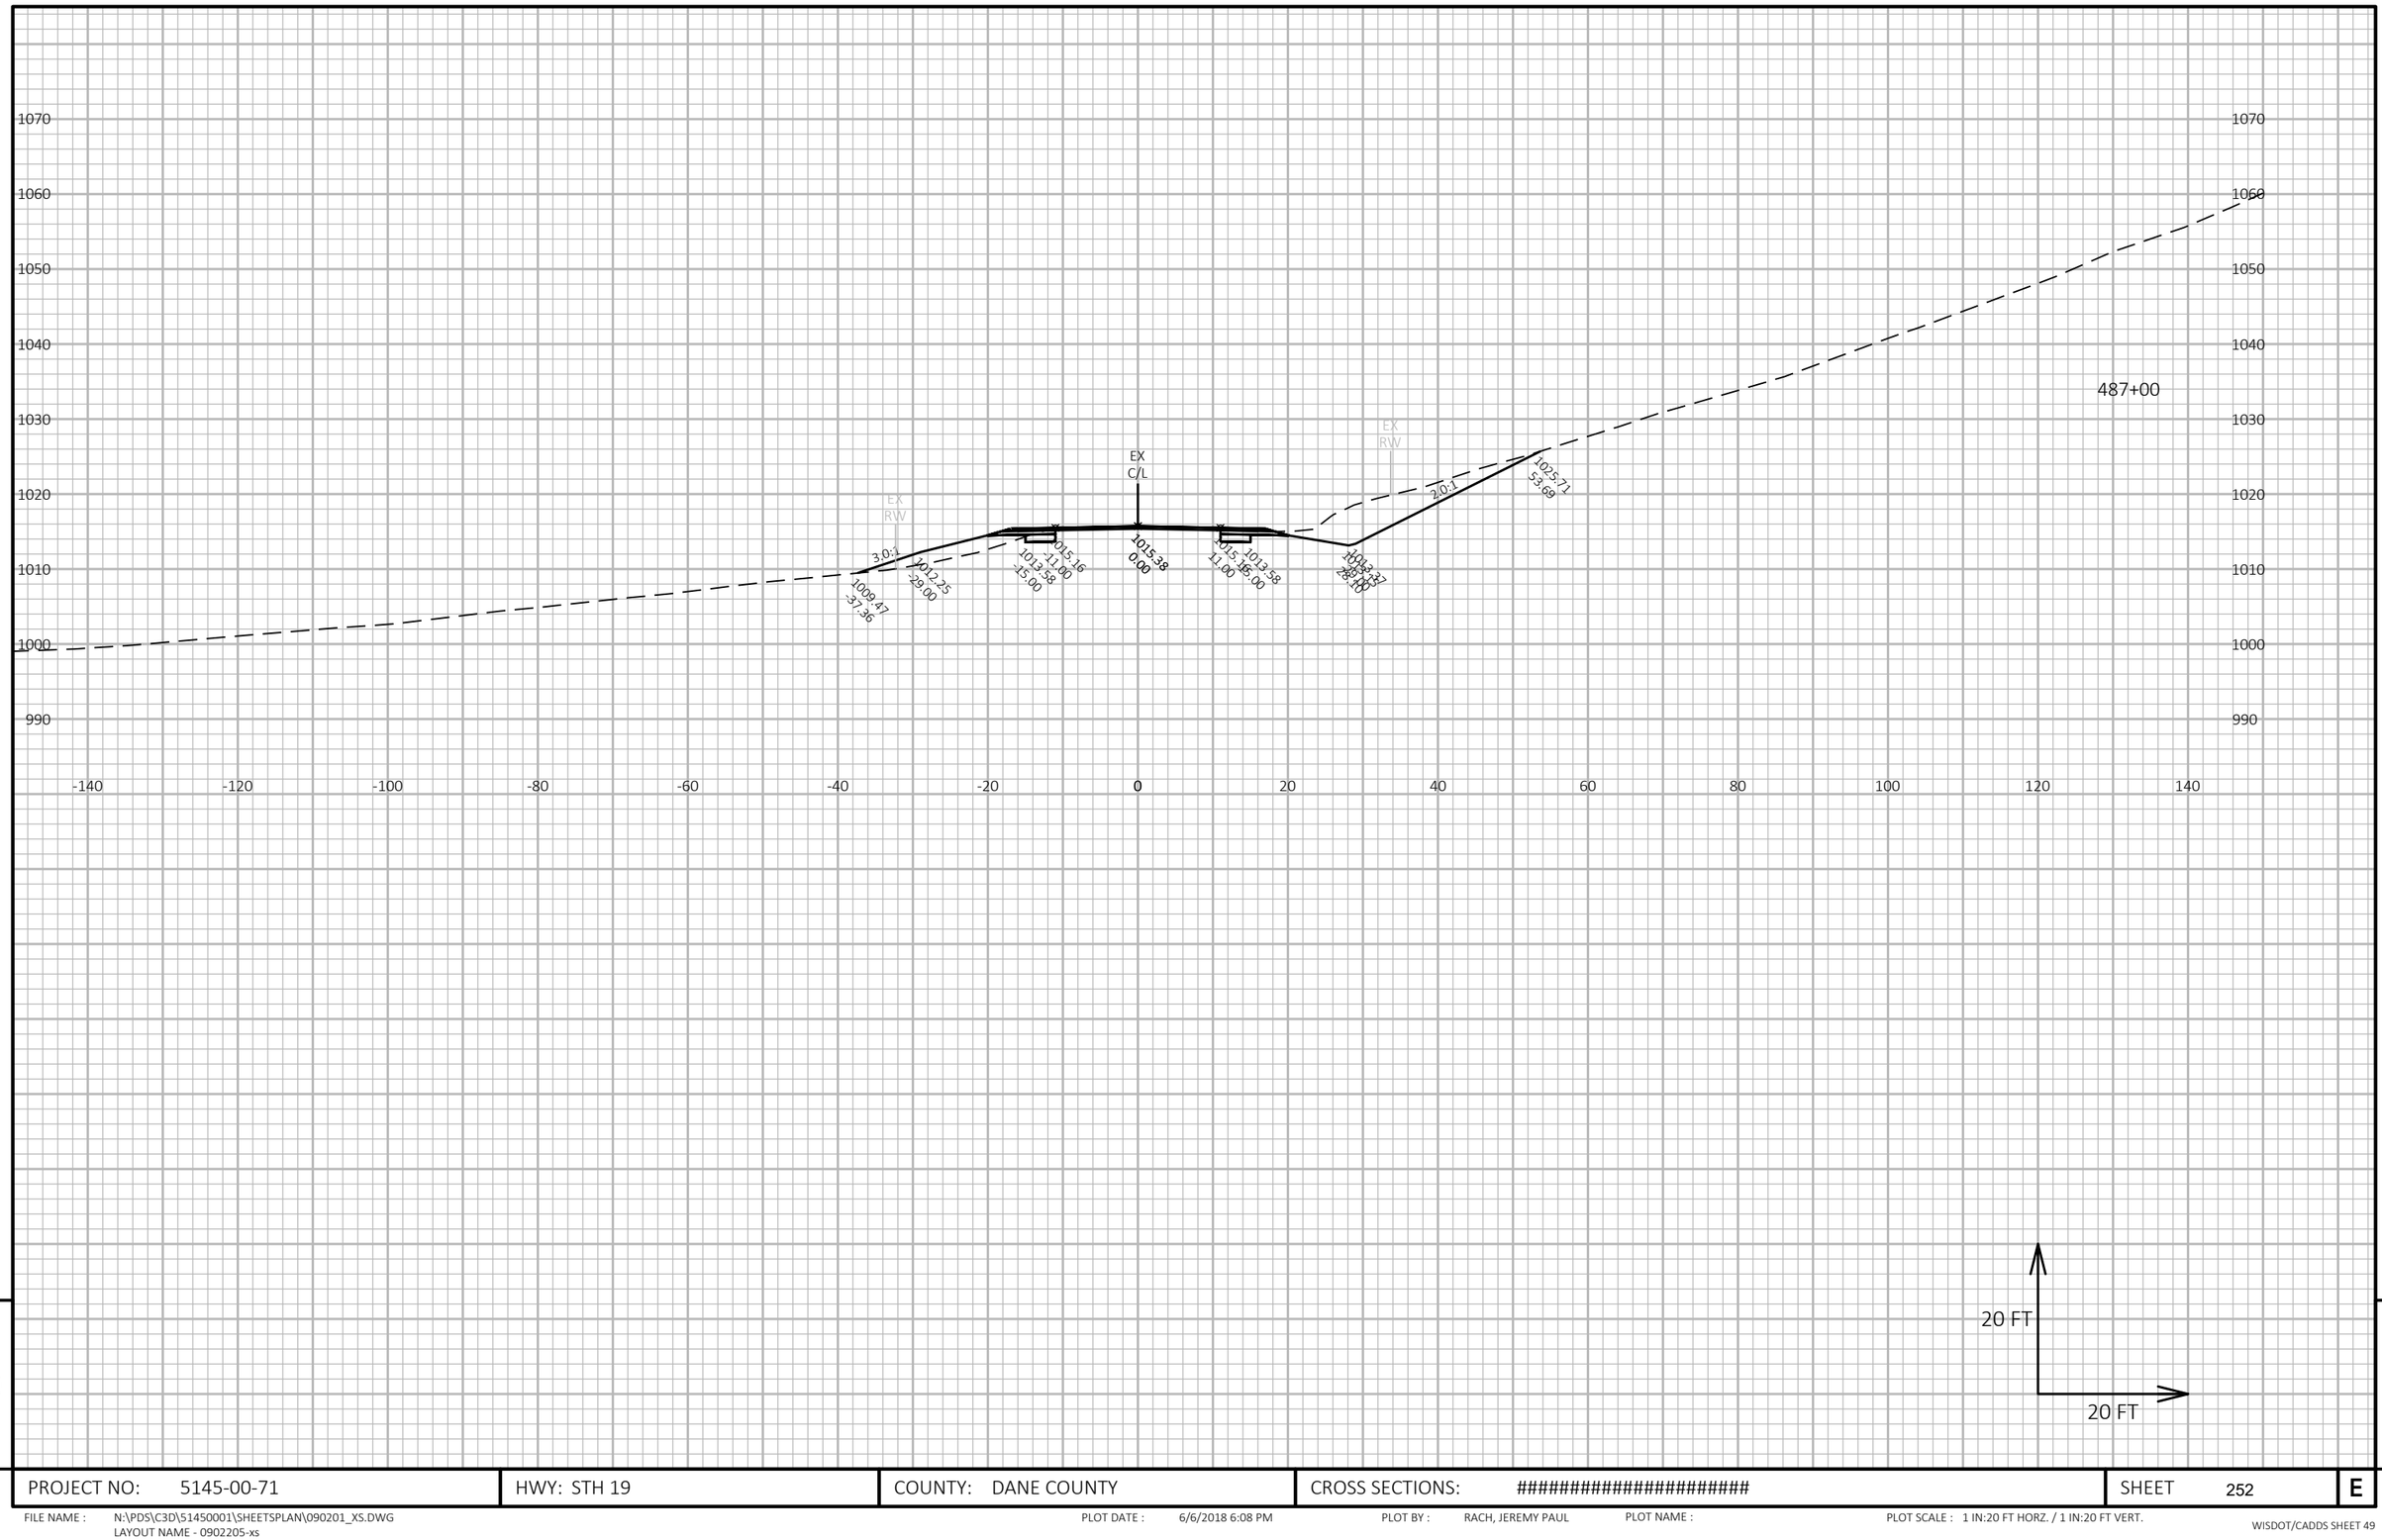

9

PROJECT NO: 5145-00-71	HWY: STH 19	COUNTY: DANE COUNTY	CROSS SECTIONS: ##########################	SHEET 252	E

9

FILE NAME : N:\PDS\C3D\51450001\SHEETSPLAN\090201_XS.DWG
LAYOUT NAME - 0902205-xs

PLOT DATE : 6/6/2018 6:08 PM

PLOT BY : RACH, JEREMY PAUL

PLOT NAME :

PLOT SCALE : 1 IN:20 FT HORZ. / 1 IN:20 FT VERT.

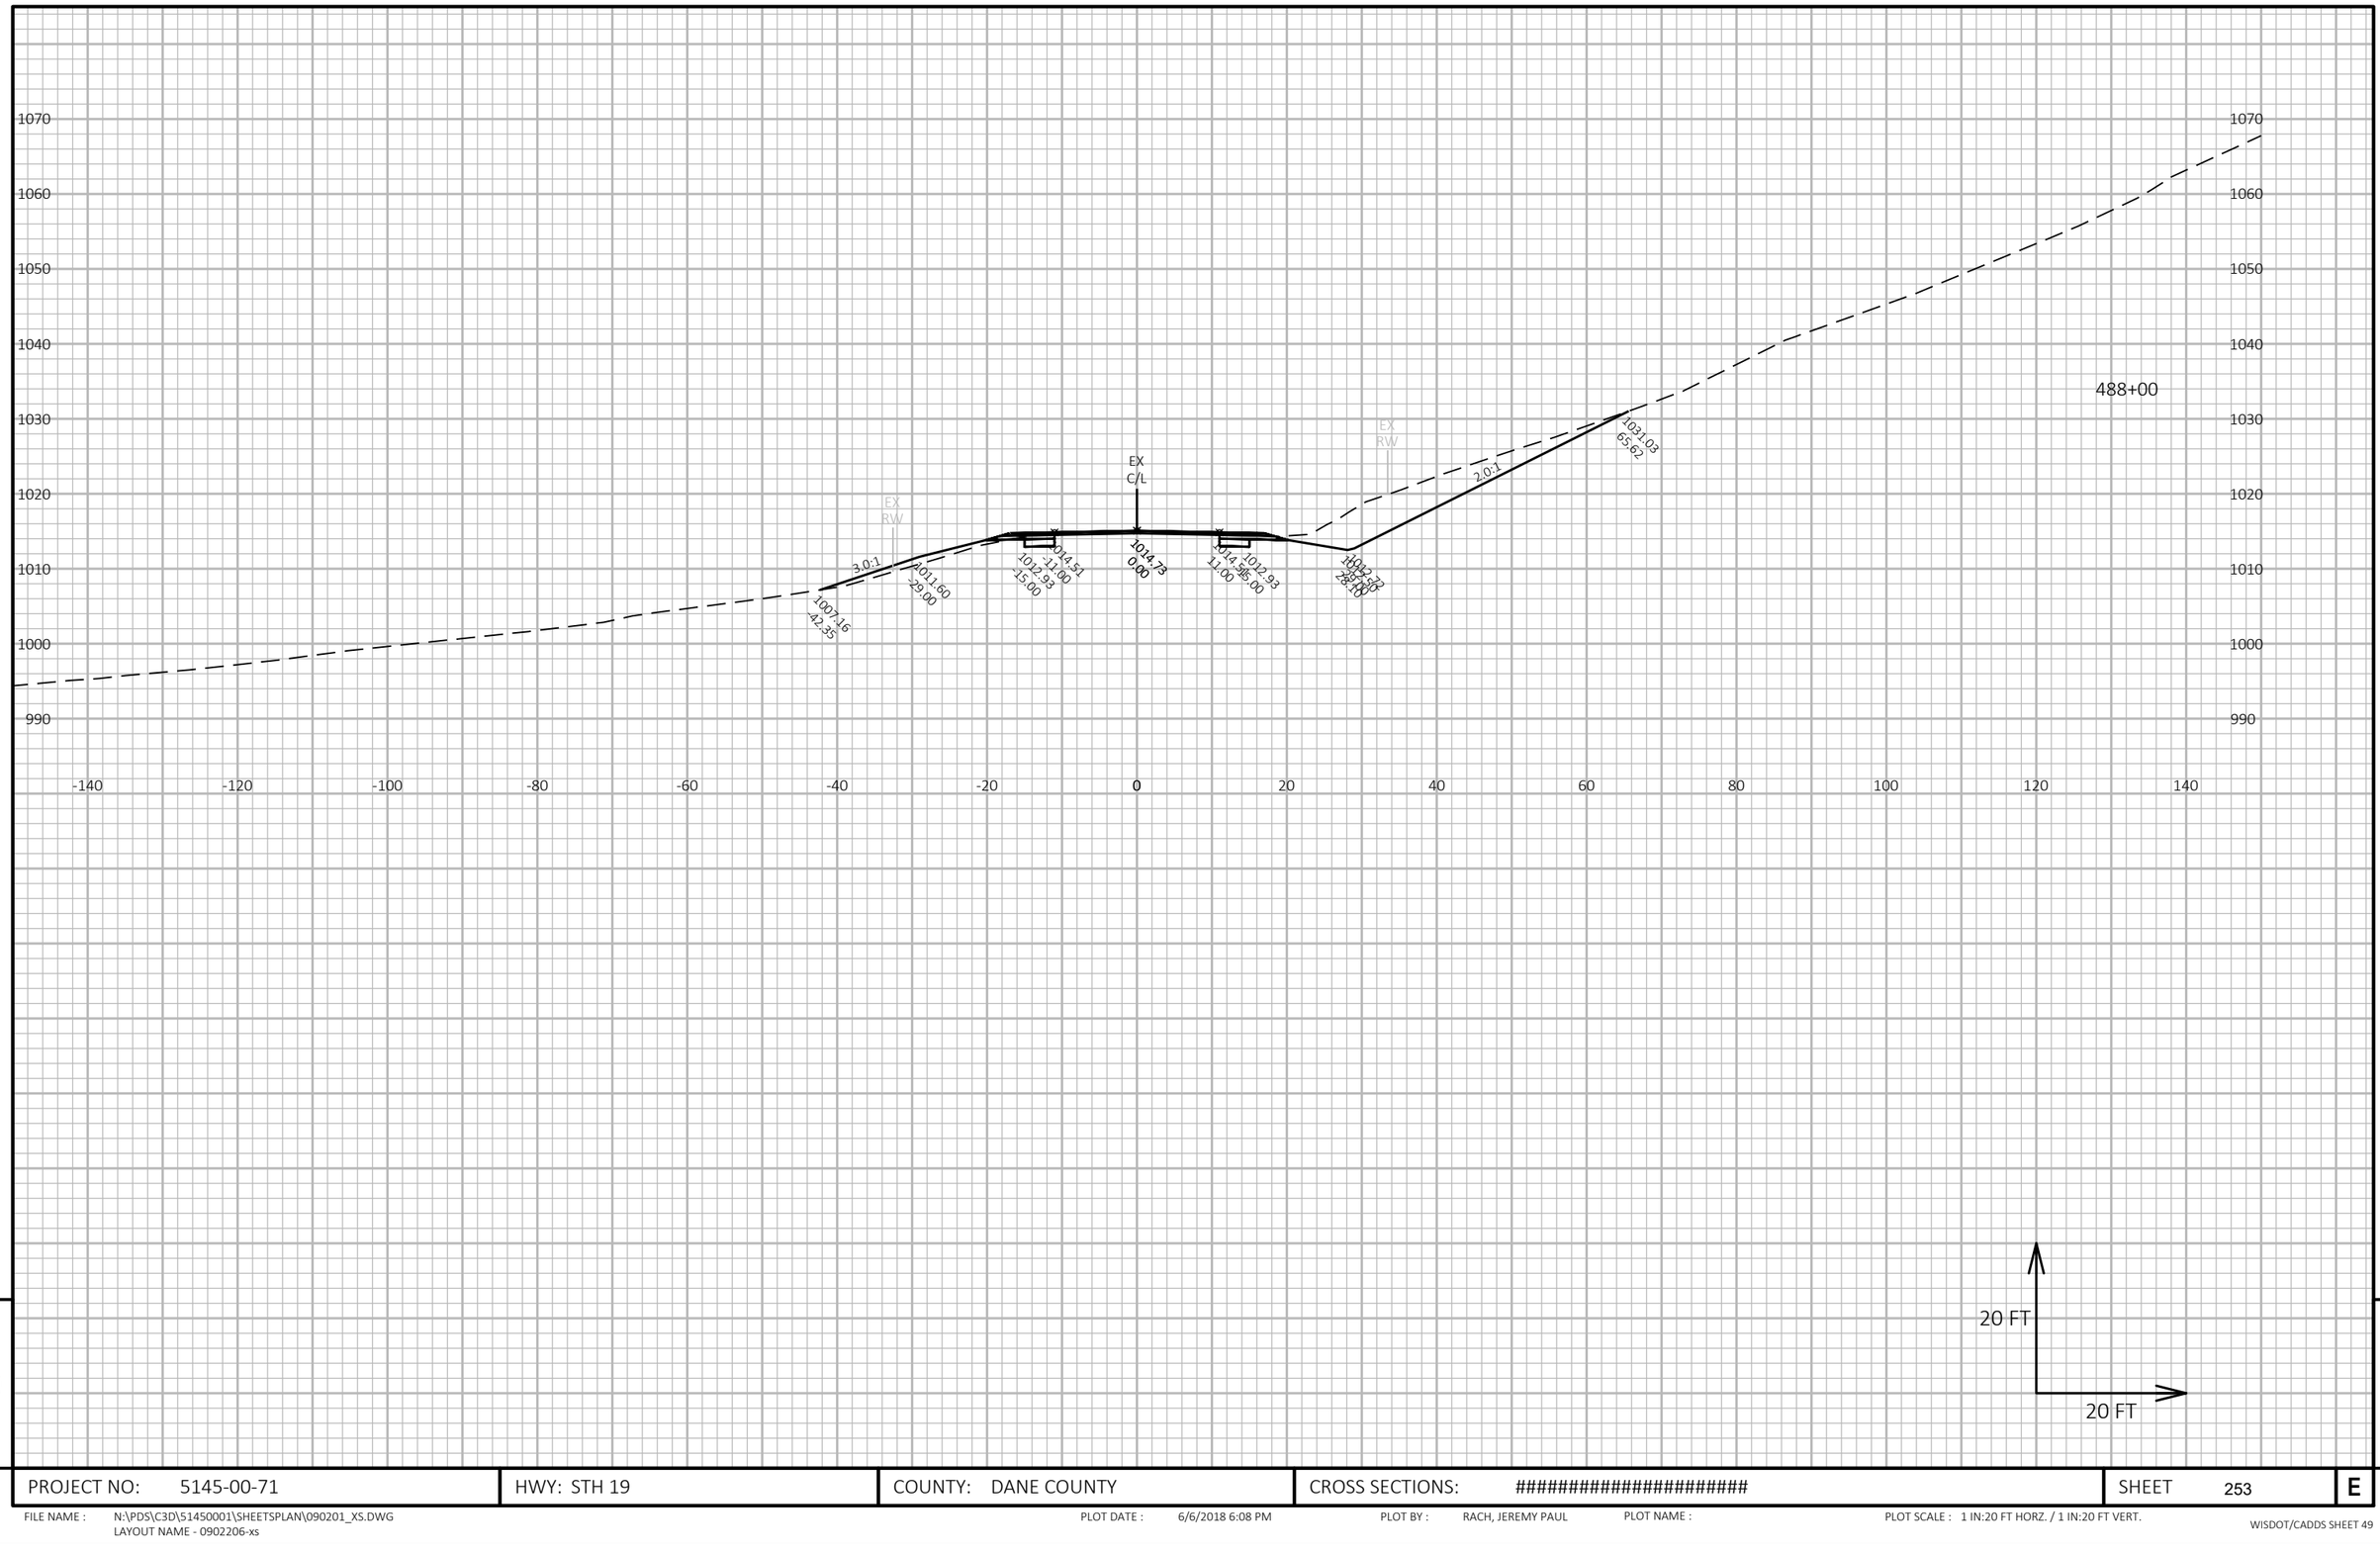

9

9

PROJECT NO: 5145-00-71	HWY: STH 19	COUNTY: DANE COUNTY	CROSS SECTIONS: ##########################	SHEET 253	E

FILE NAME : N:\PDS\C3D\51450001\SHEETSPLAN\090201_XS.DWG
LAYOUT NAME - 0902206-xs

PLOT DATE : 6/6/2018 6:08 PM PLOT BY : RACH, JEREMY PAUL PLOT NAME : PLOT SCALE : 1 IN:20 FT HORZ. / 1 IN:20 FT VERT.

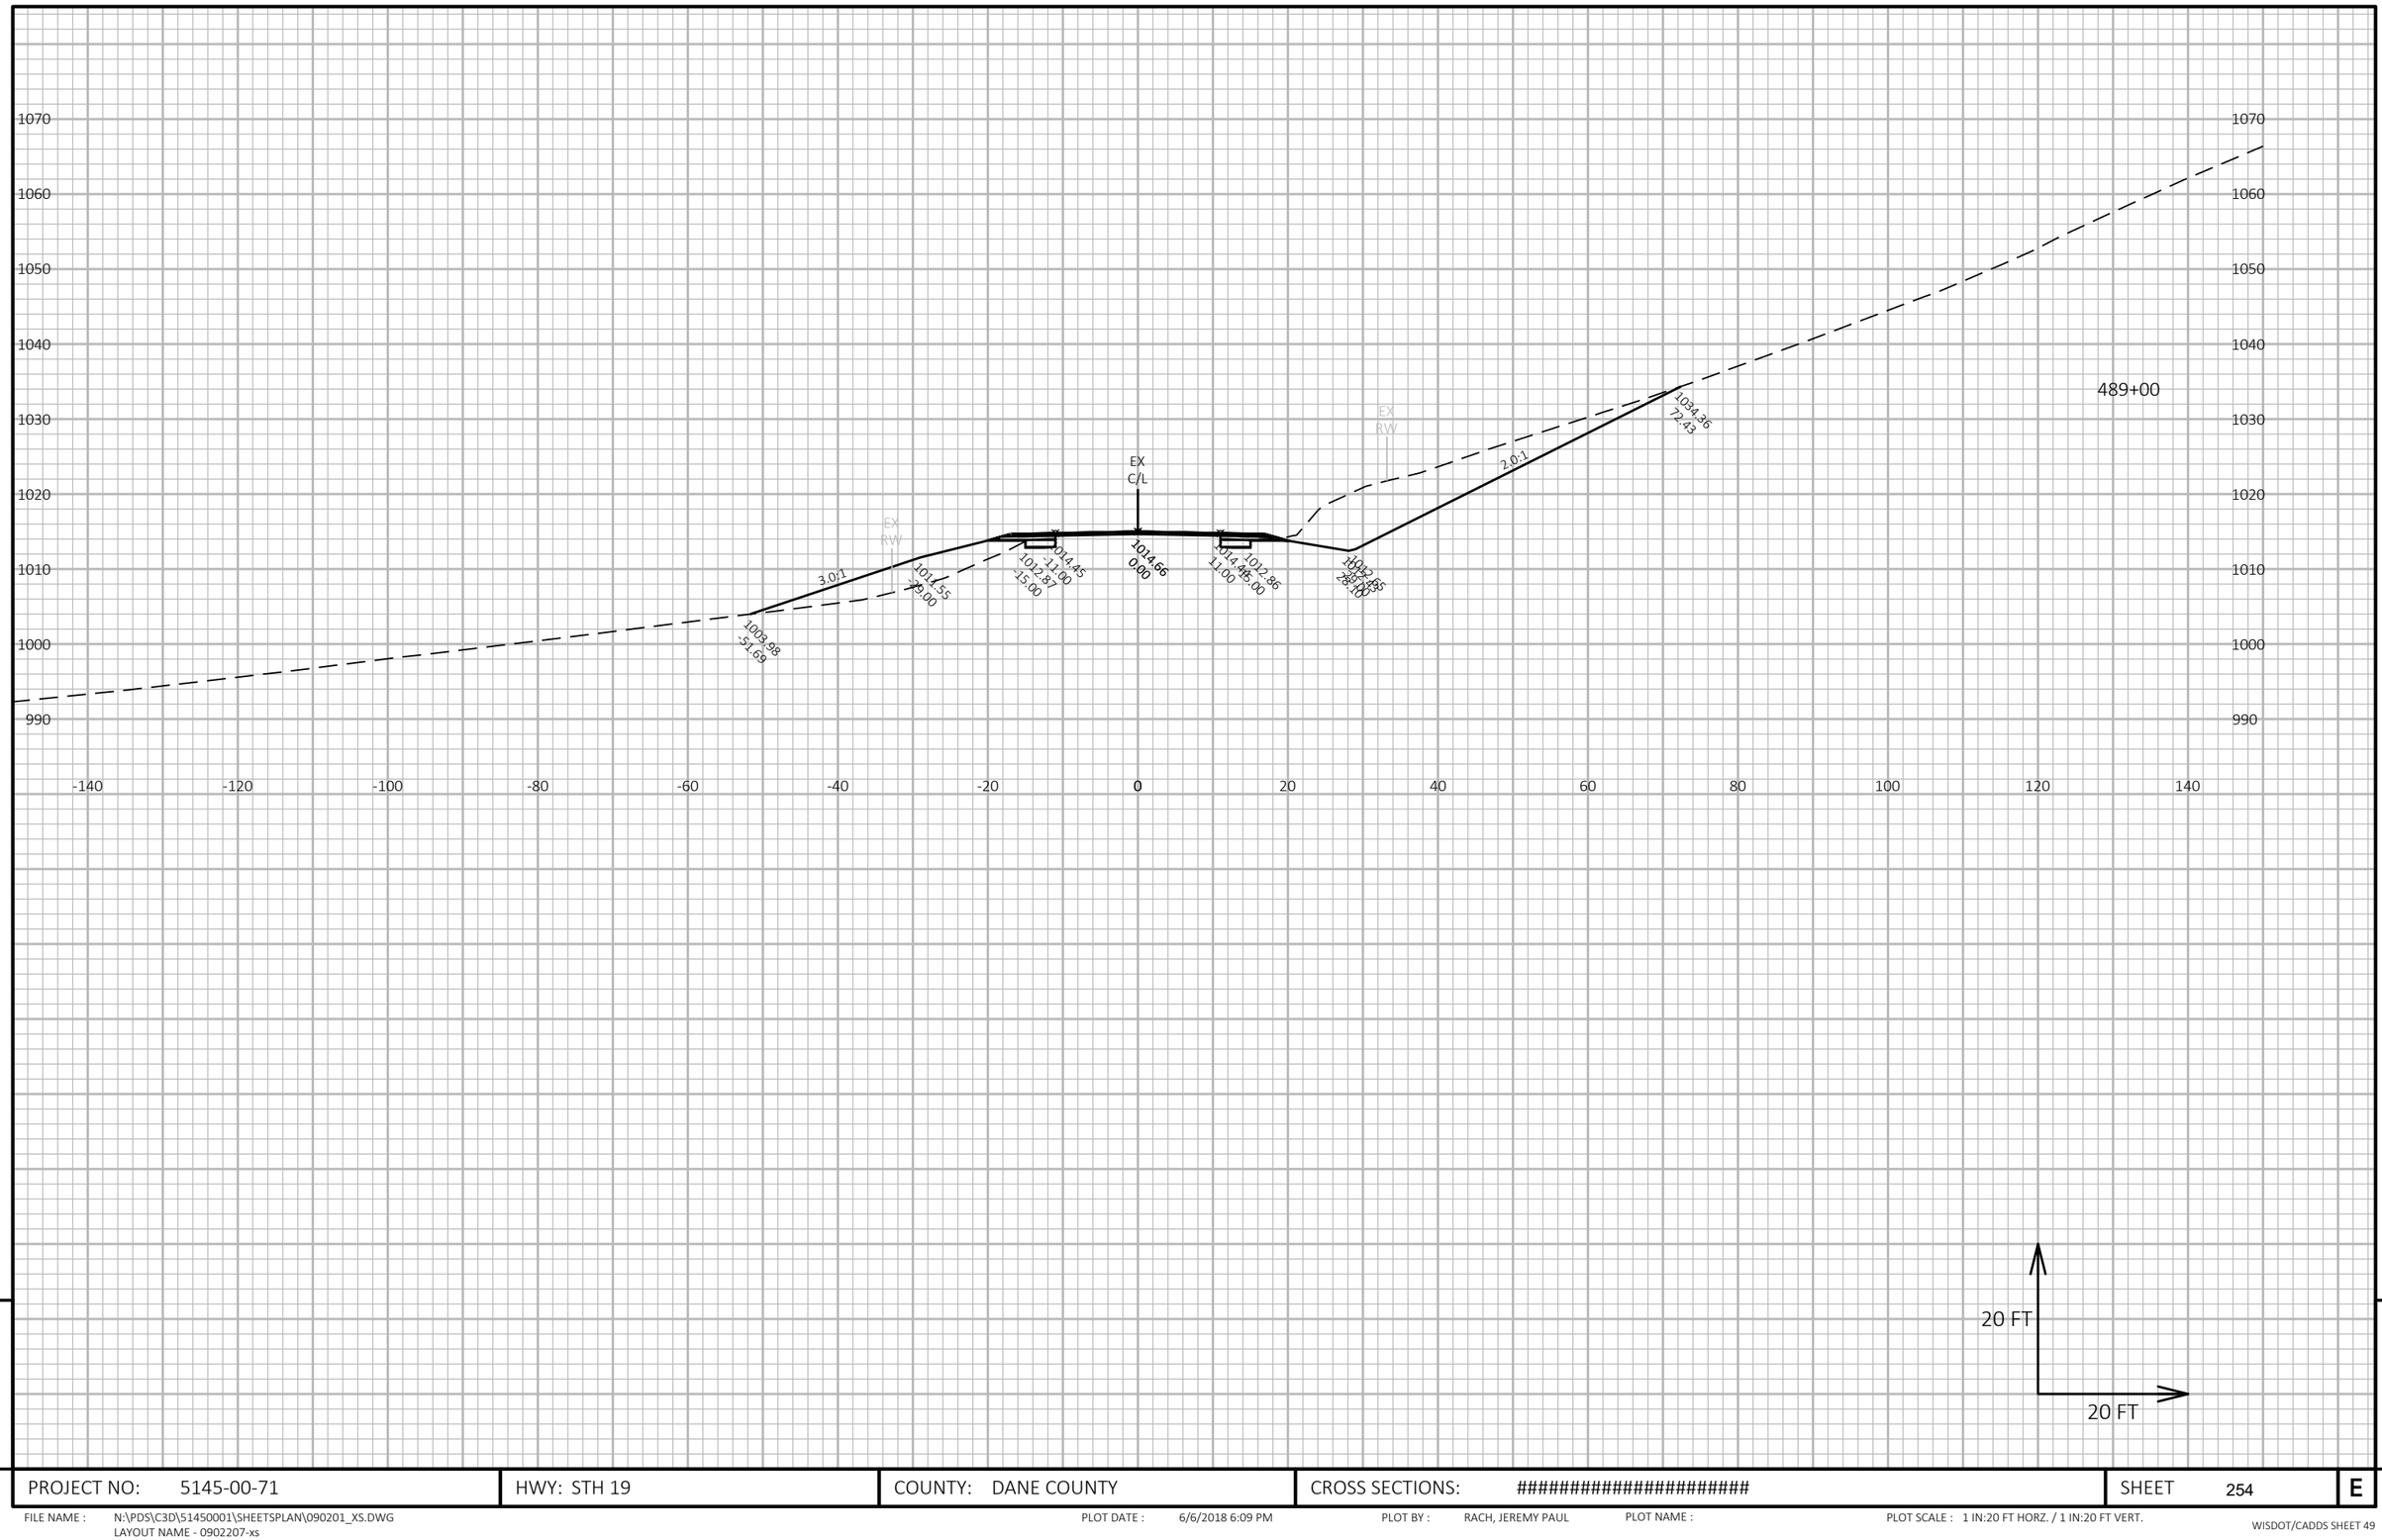

9

9

PROJECT NO: 5145-00-71	HWY: STH 19	COUNTY: DANE COUNTY	CROSS SECTIONS: ##########################	SHEET 254	E

FILE NAME : N:\PDS\C3D\51450001\SHEETSPLAN\090201_XS.DWG
LAYOUT NAME - 0902207-xs

PLOT DATE : 6/6/2018 6:09 PM PLOT BY : RACH, JEREMY PAUL PLOT NAME : PLOT SCALE : 1 IN:20 FT HORZ. / 1 IN:20 FT VERT.

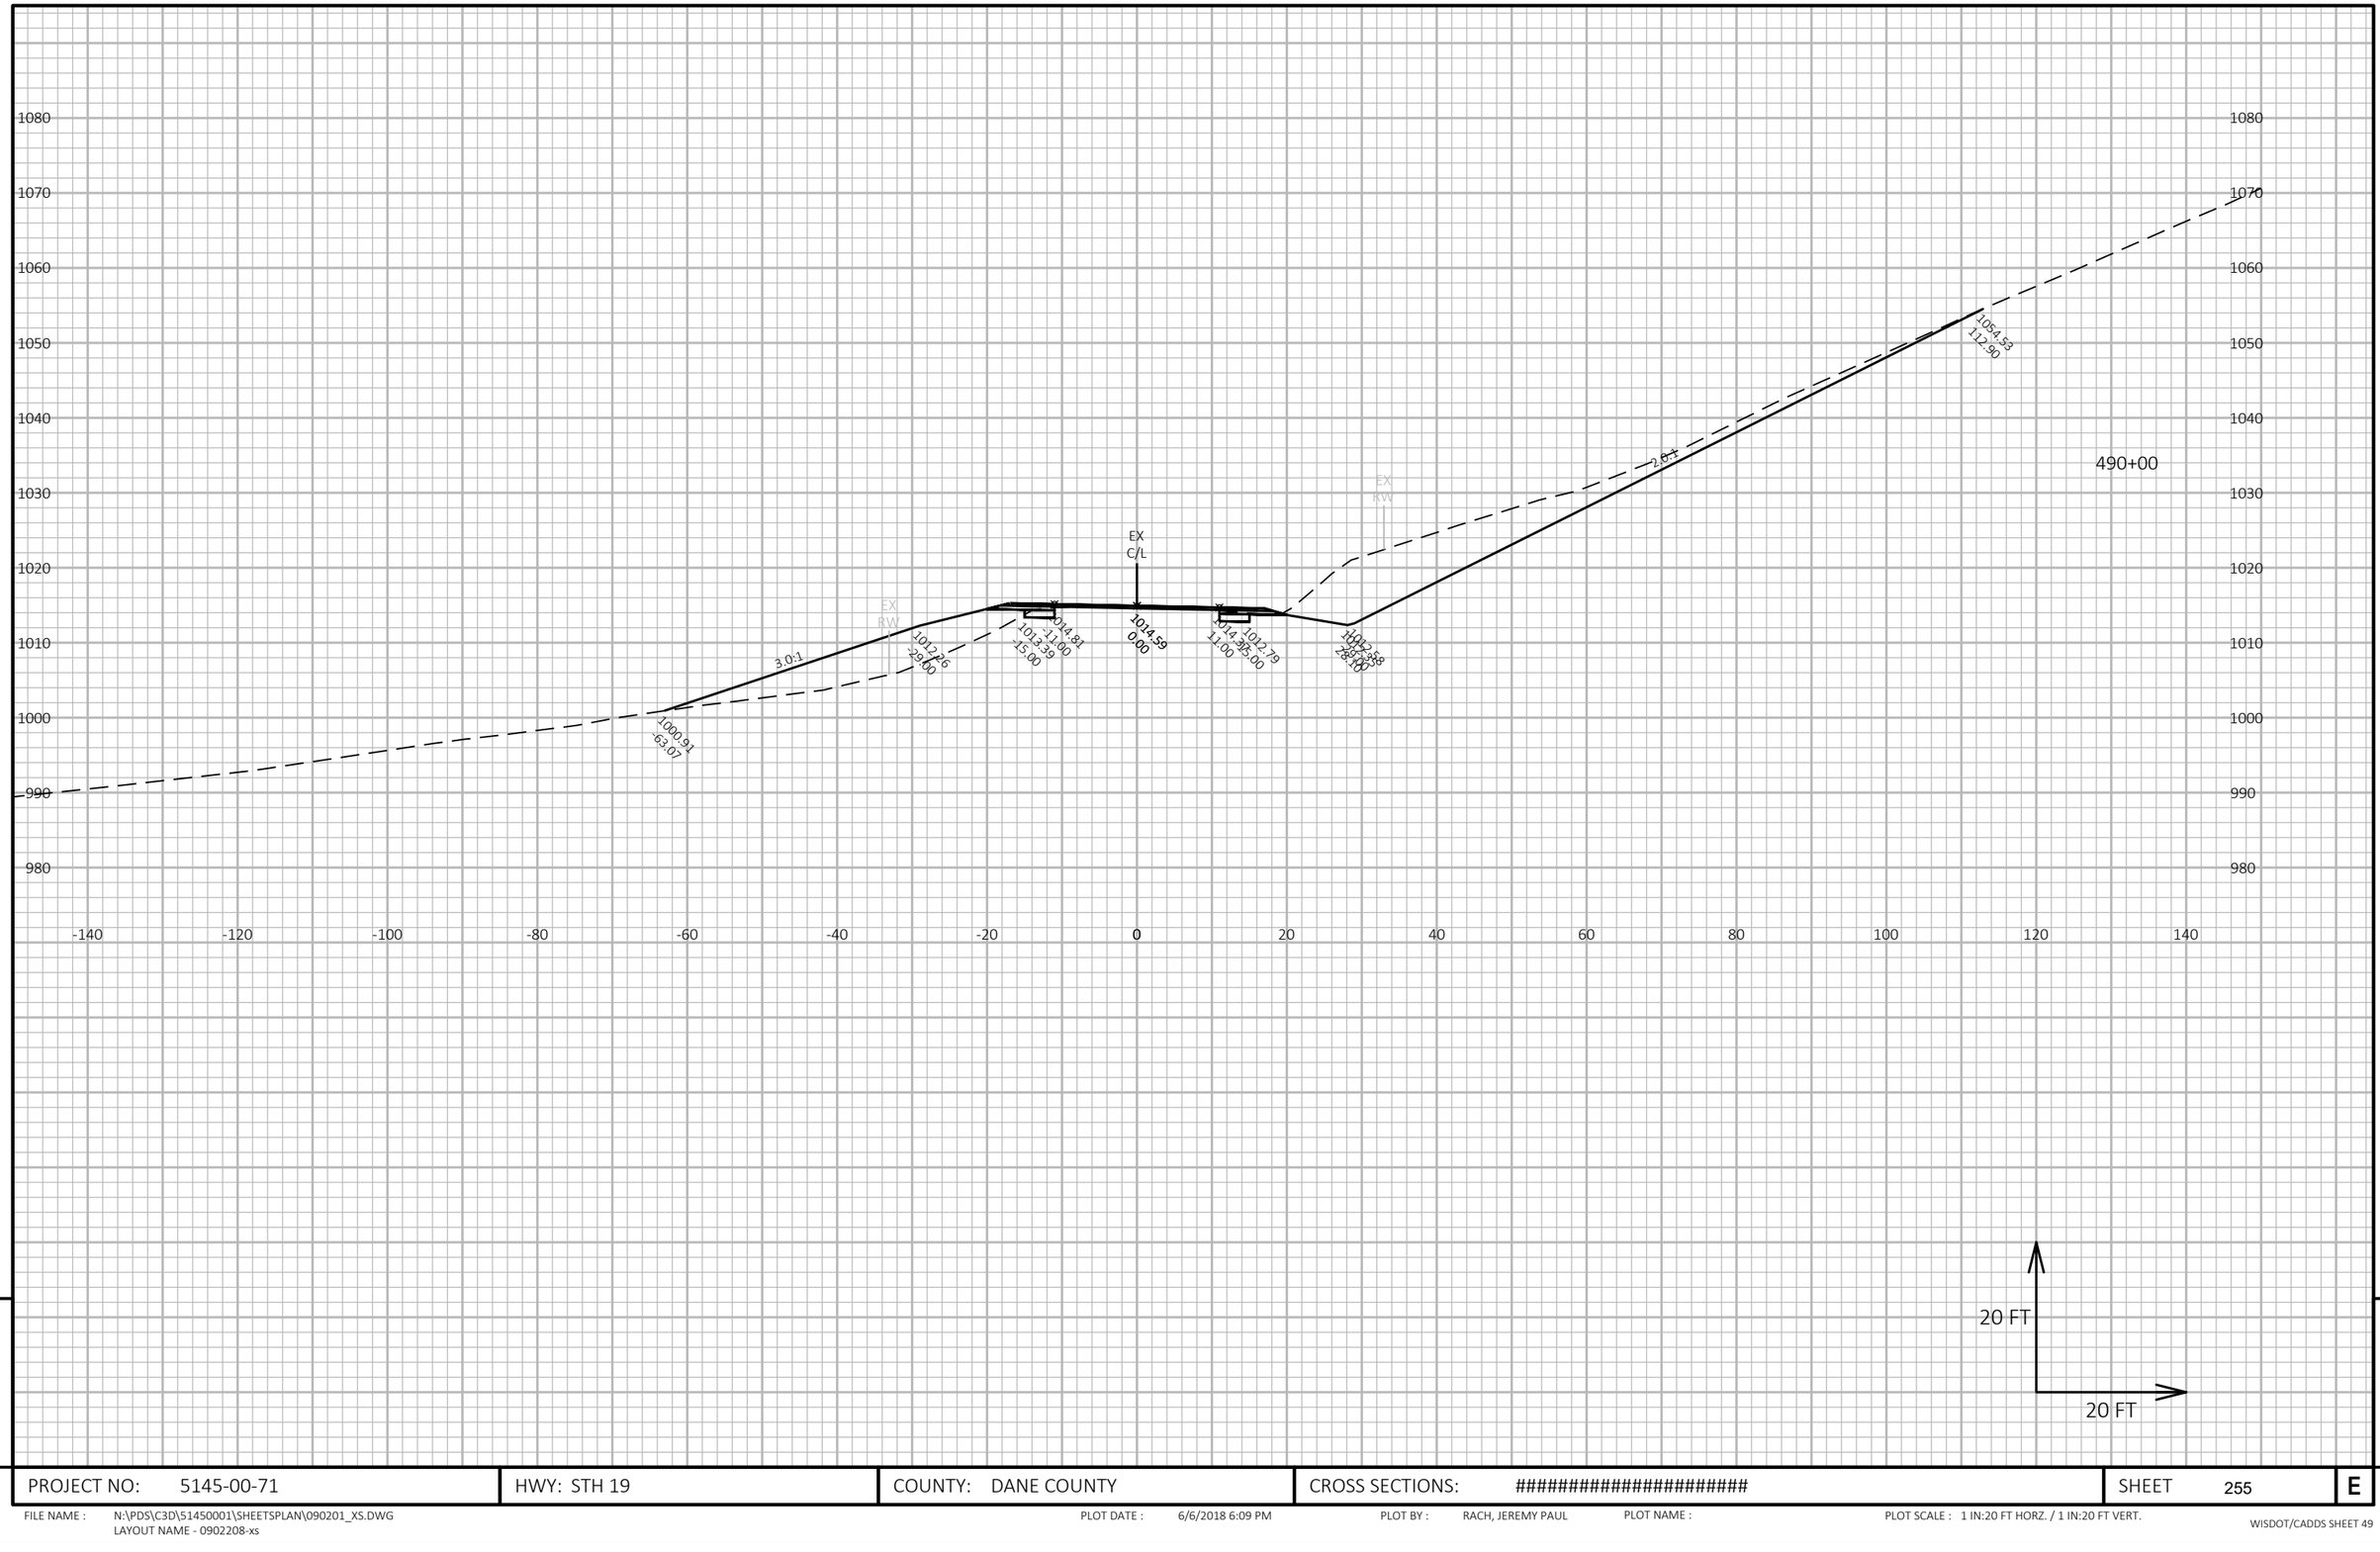

9

PROJECT NO: 5145-00-71	HWY: STH 19	COUNTY: DANE COUNTY	CROSS SECTIONS: ##########################	SHEET 255	E

9

FILE NAME : N:\PDS\C3D\51450001\SHEETSPLAN\090201_XS.DWG
LAYOUT NAME - 0902208-xs

PLOT DATE : 6/6/2018 6:09 PM PLOT BY : RACH, JEREMY PAUL PLOT NAME : PLOT SCALE : 1 IN:20 FT HORZ. / 1 IN:20 FT VERT.

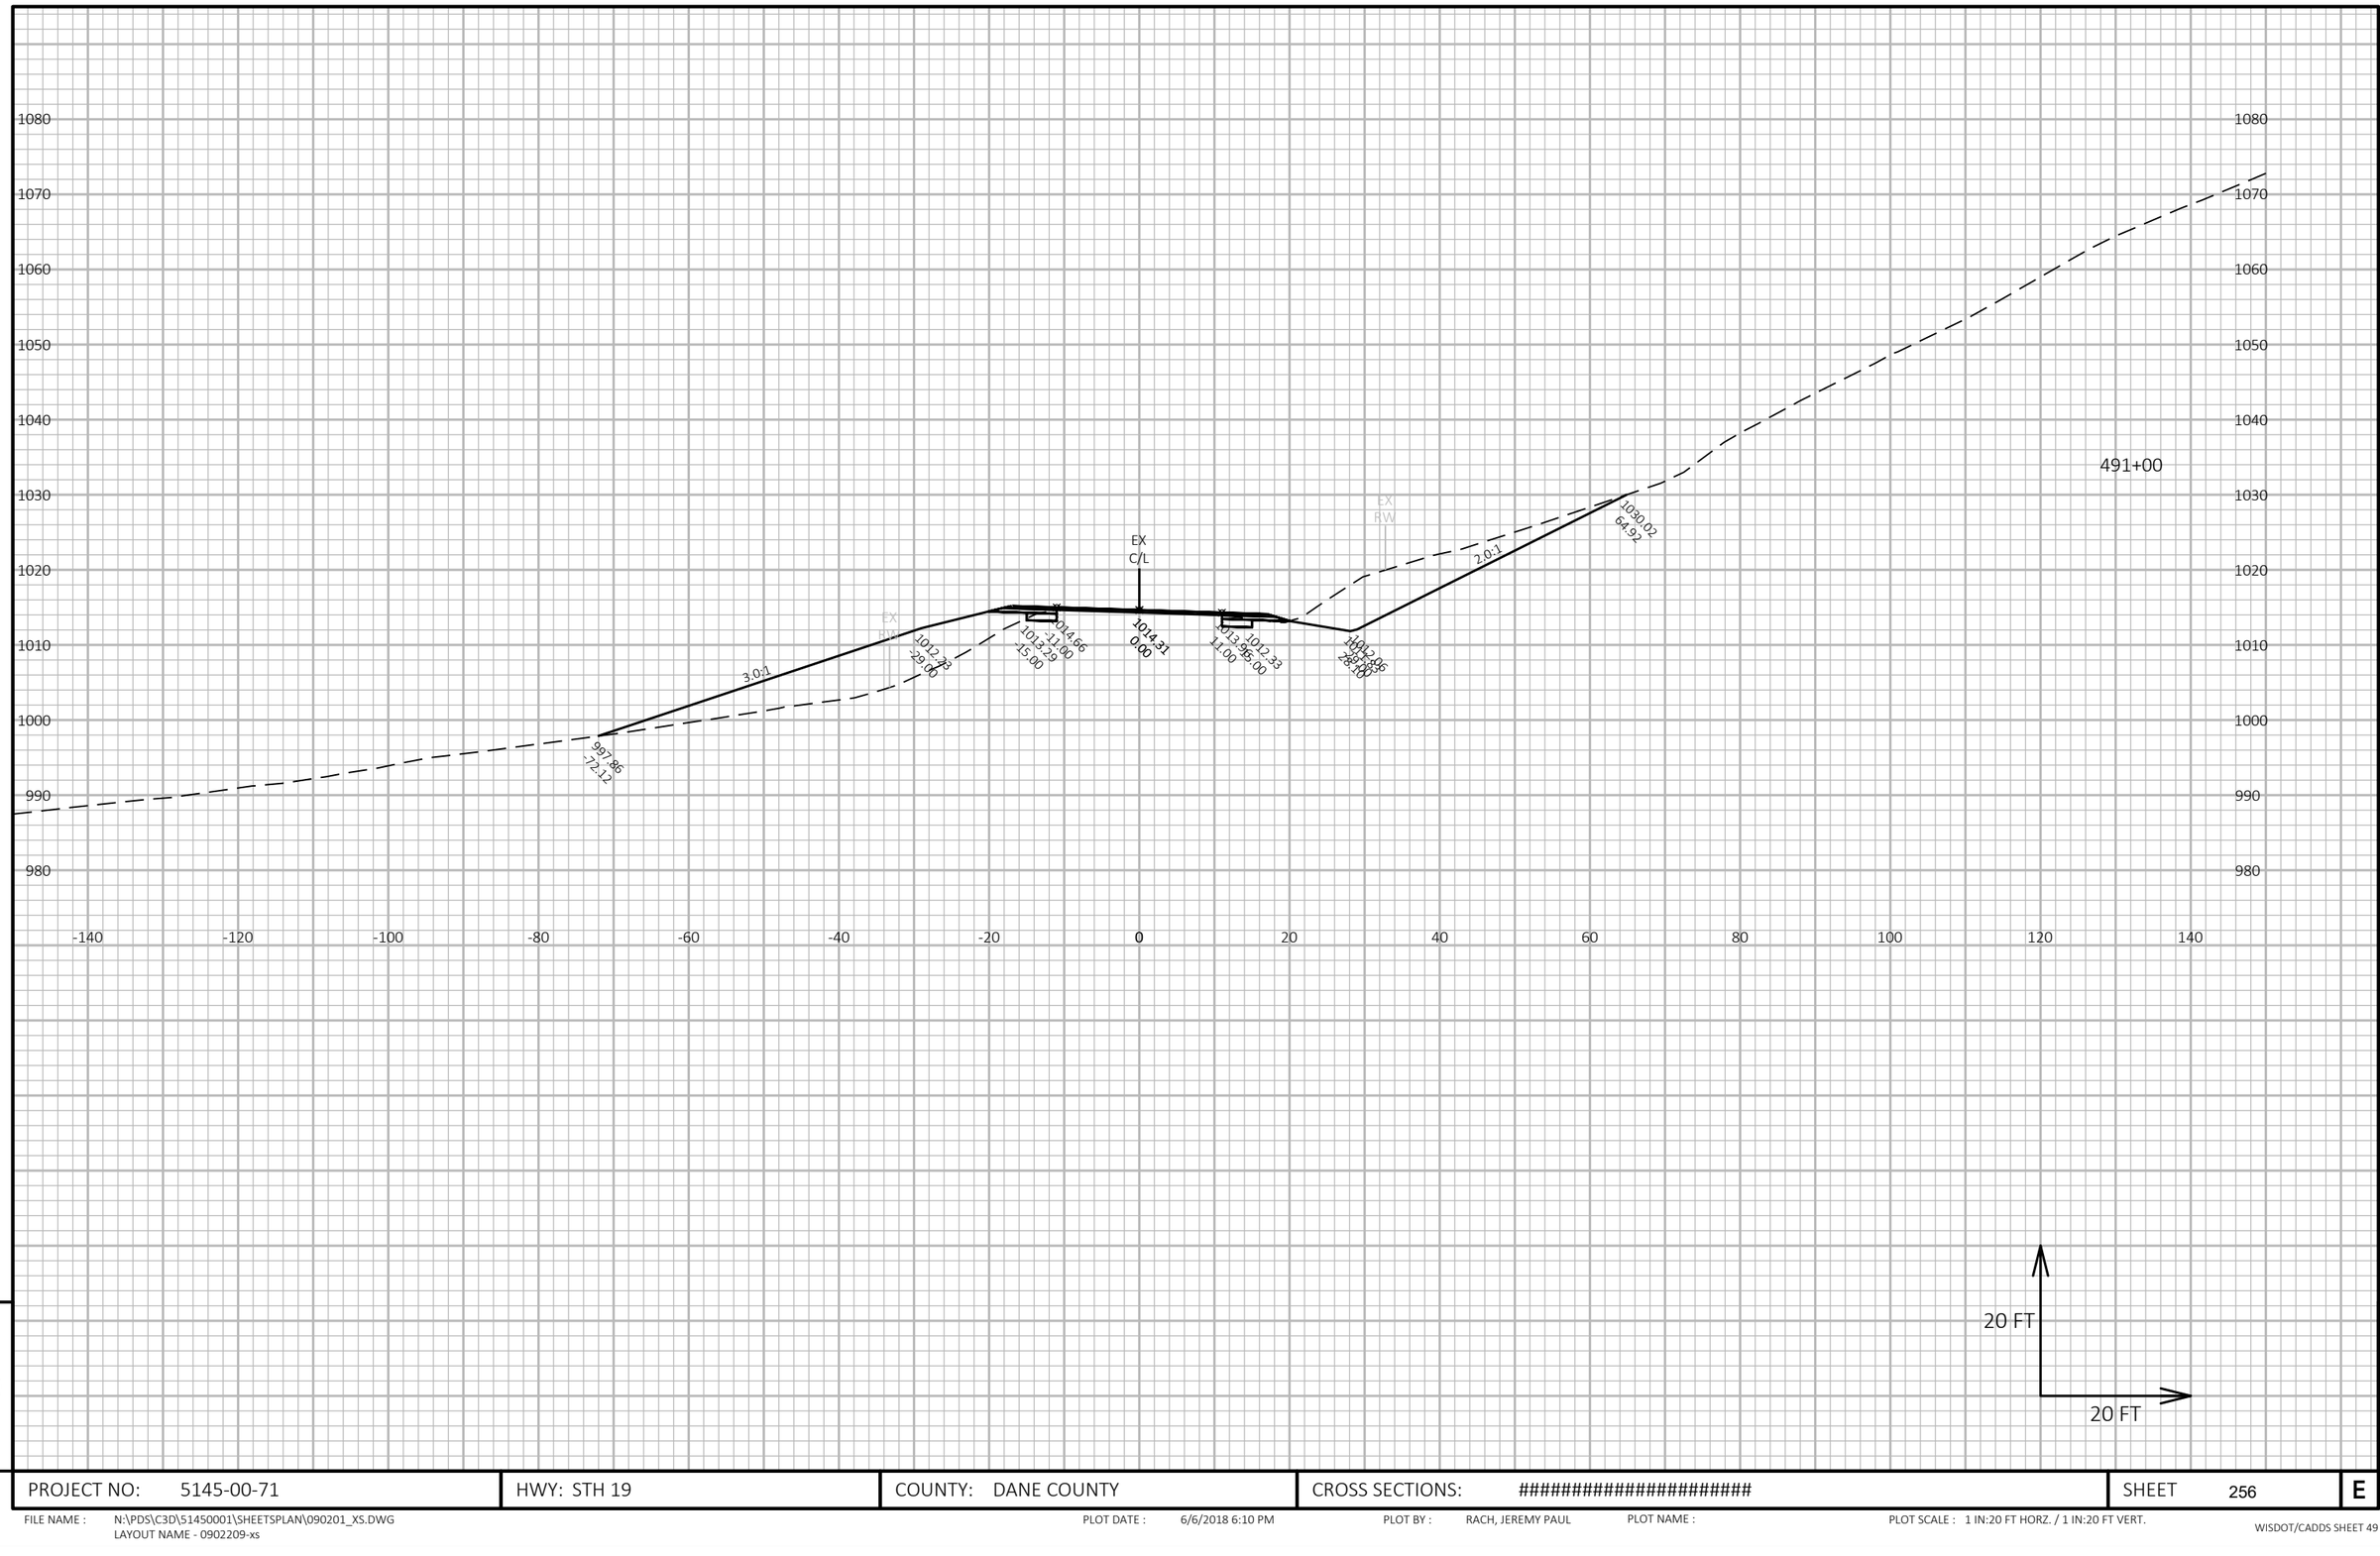

9

PROJECT NO: 5145-00-71	HWY: STH 19	COUNTY: DANE COUNTY	CROSS SECTIONS: ##########################	SHEET 256	E

9

FILE NAME : N:\PDS\C3D\51450001\SHEETSPLAN\090201_XS.DWG
LAYOUT NAME - 0902209-xs

PLOT DATE : 6/6/2018 6:10 PM PLOT BY : RACH, JEREMY PAUL PLOT NAME : PLOT SCALE : 1 IN:20 FT HORZ. / 1 IN:20 FT VERT.

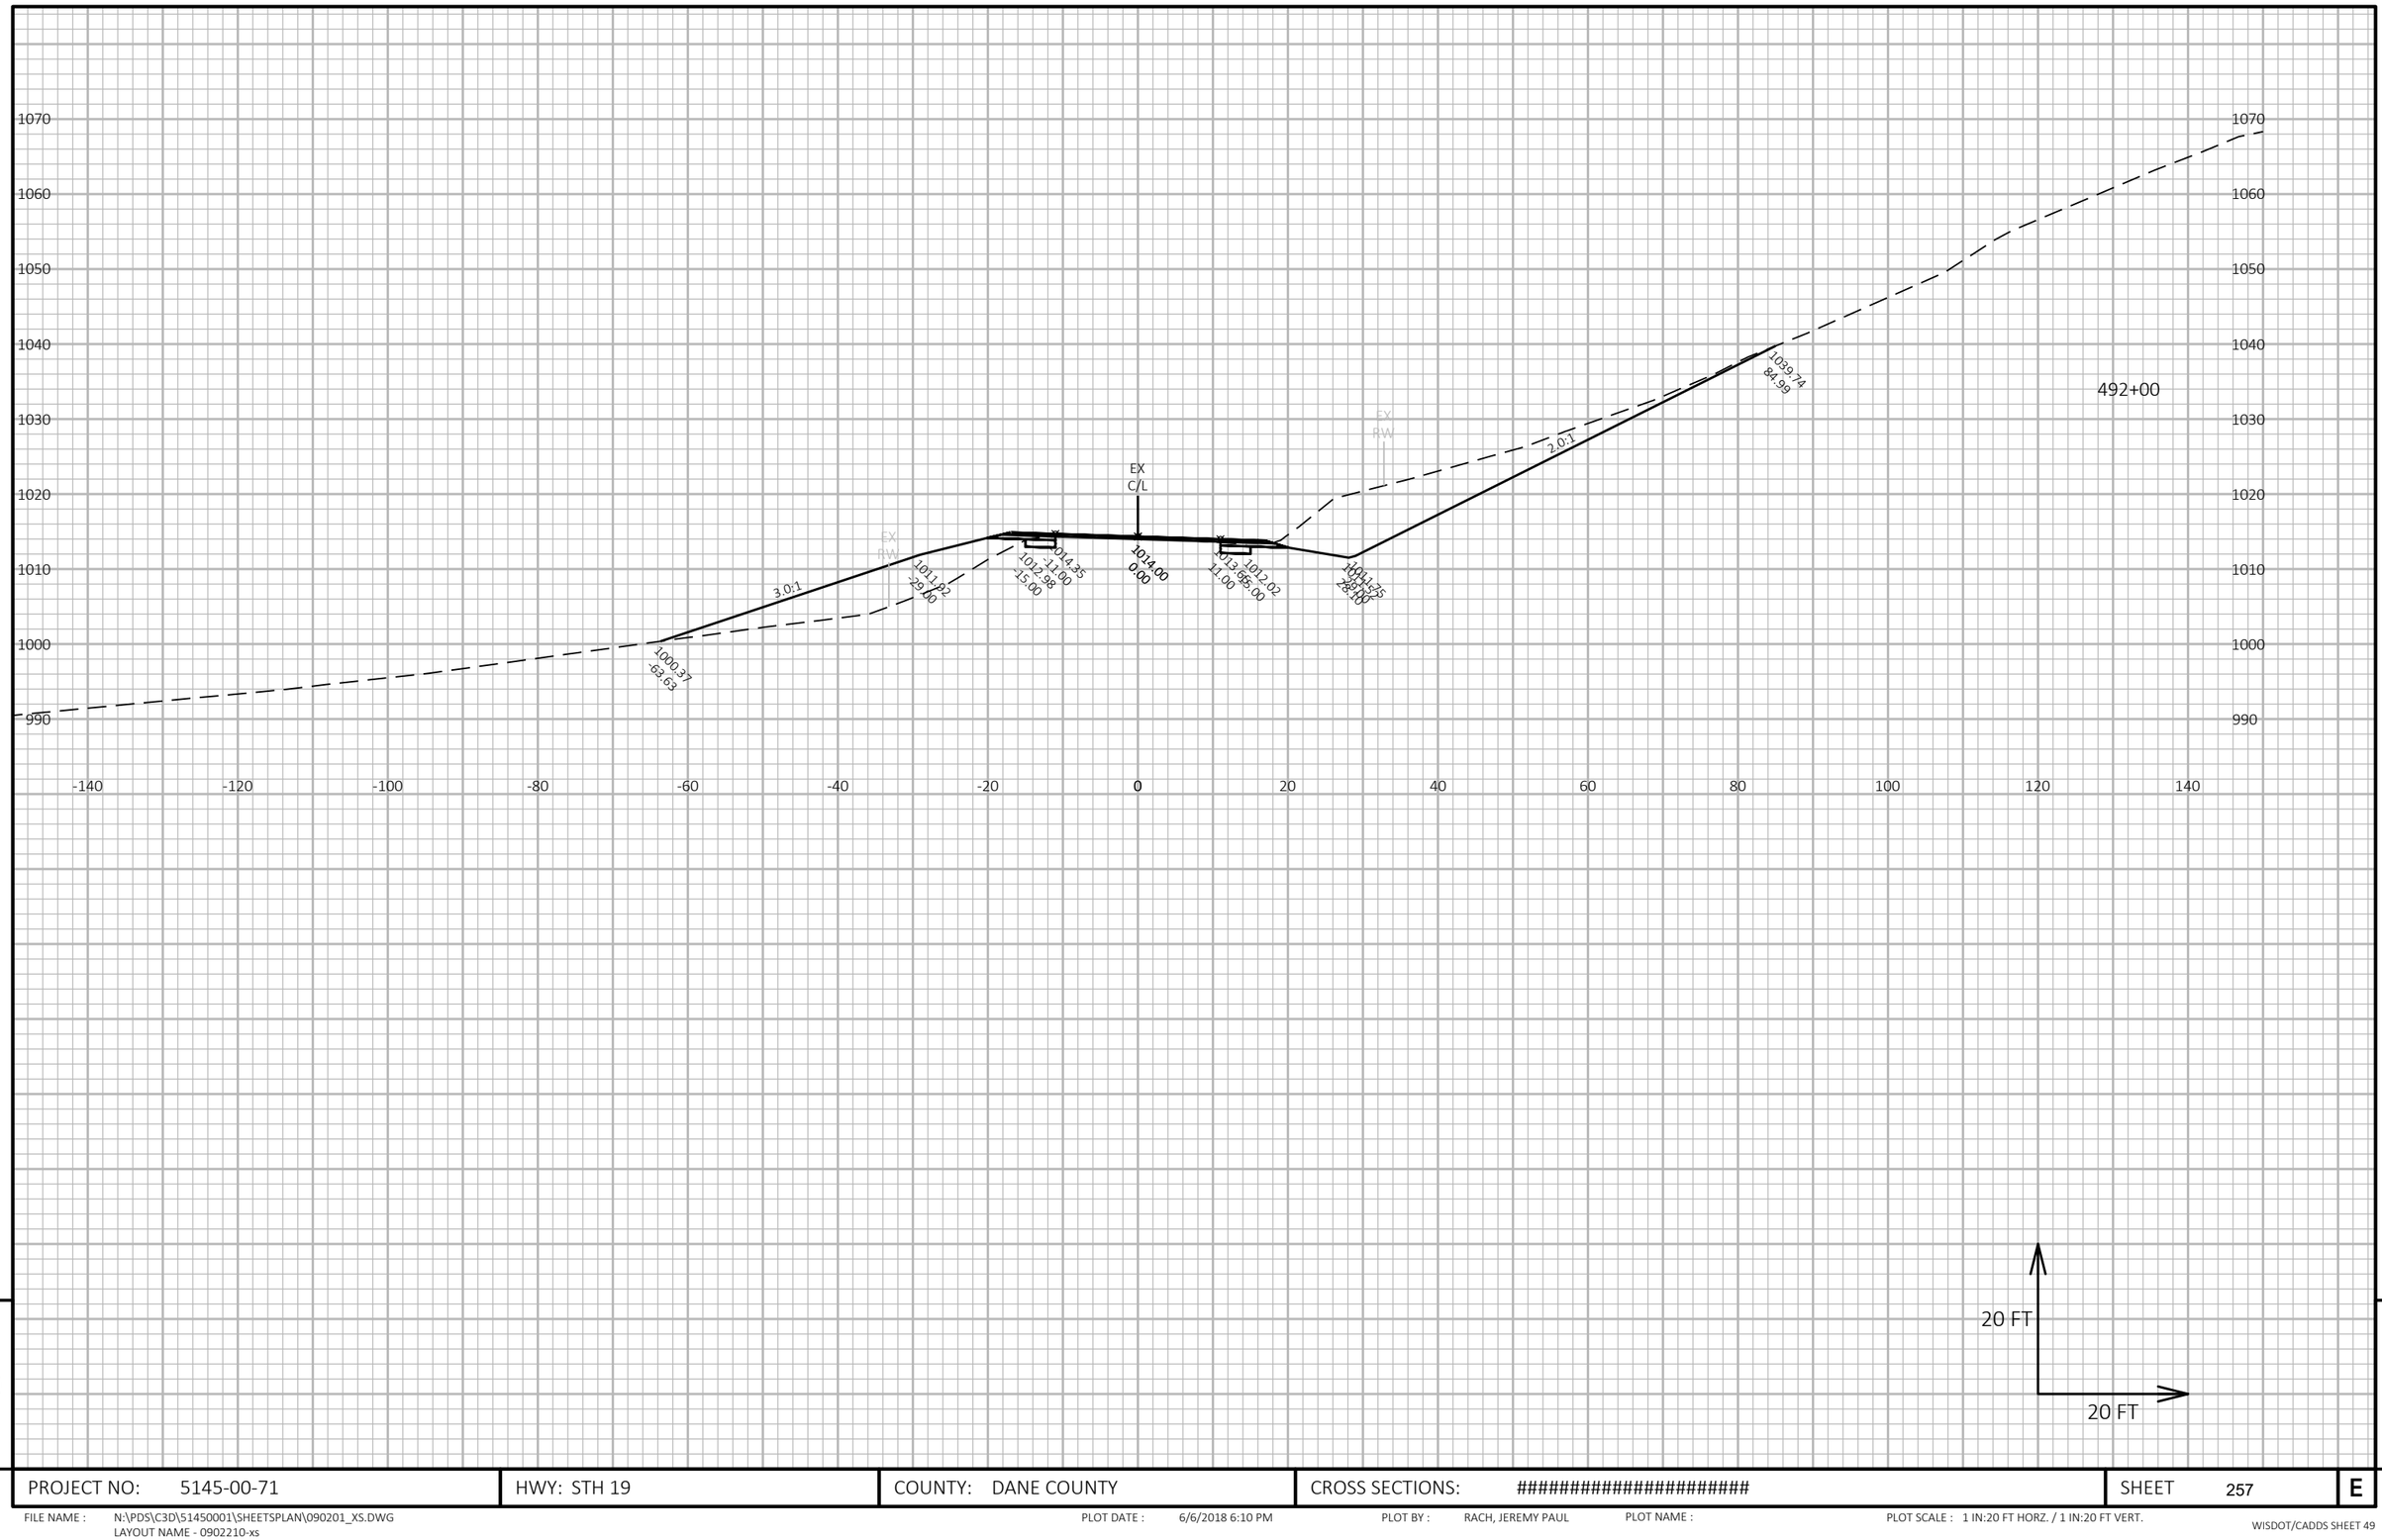

9

9

PROJECT NO: 5145-00-71	HWY: STH 19	COUNTY: DANE COUNTY	CROSS SECTIONS: ##########################	SHEET 257	E

FILE NAME : N:\PDS\C3D\51450001\SHEETSPLAN\090201_XS.DWG
LAYOUT NAME - 0902210-xs

PLOT DATE : 6/6/2018 6:10 PM PLOT BY : RACH, JEREMY PAUL PLOT NAME : PLOT SCALE : 1 IN:20 FT HORZ. / 1 IN:20 FT VERT.

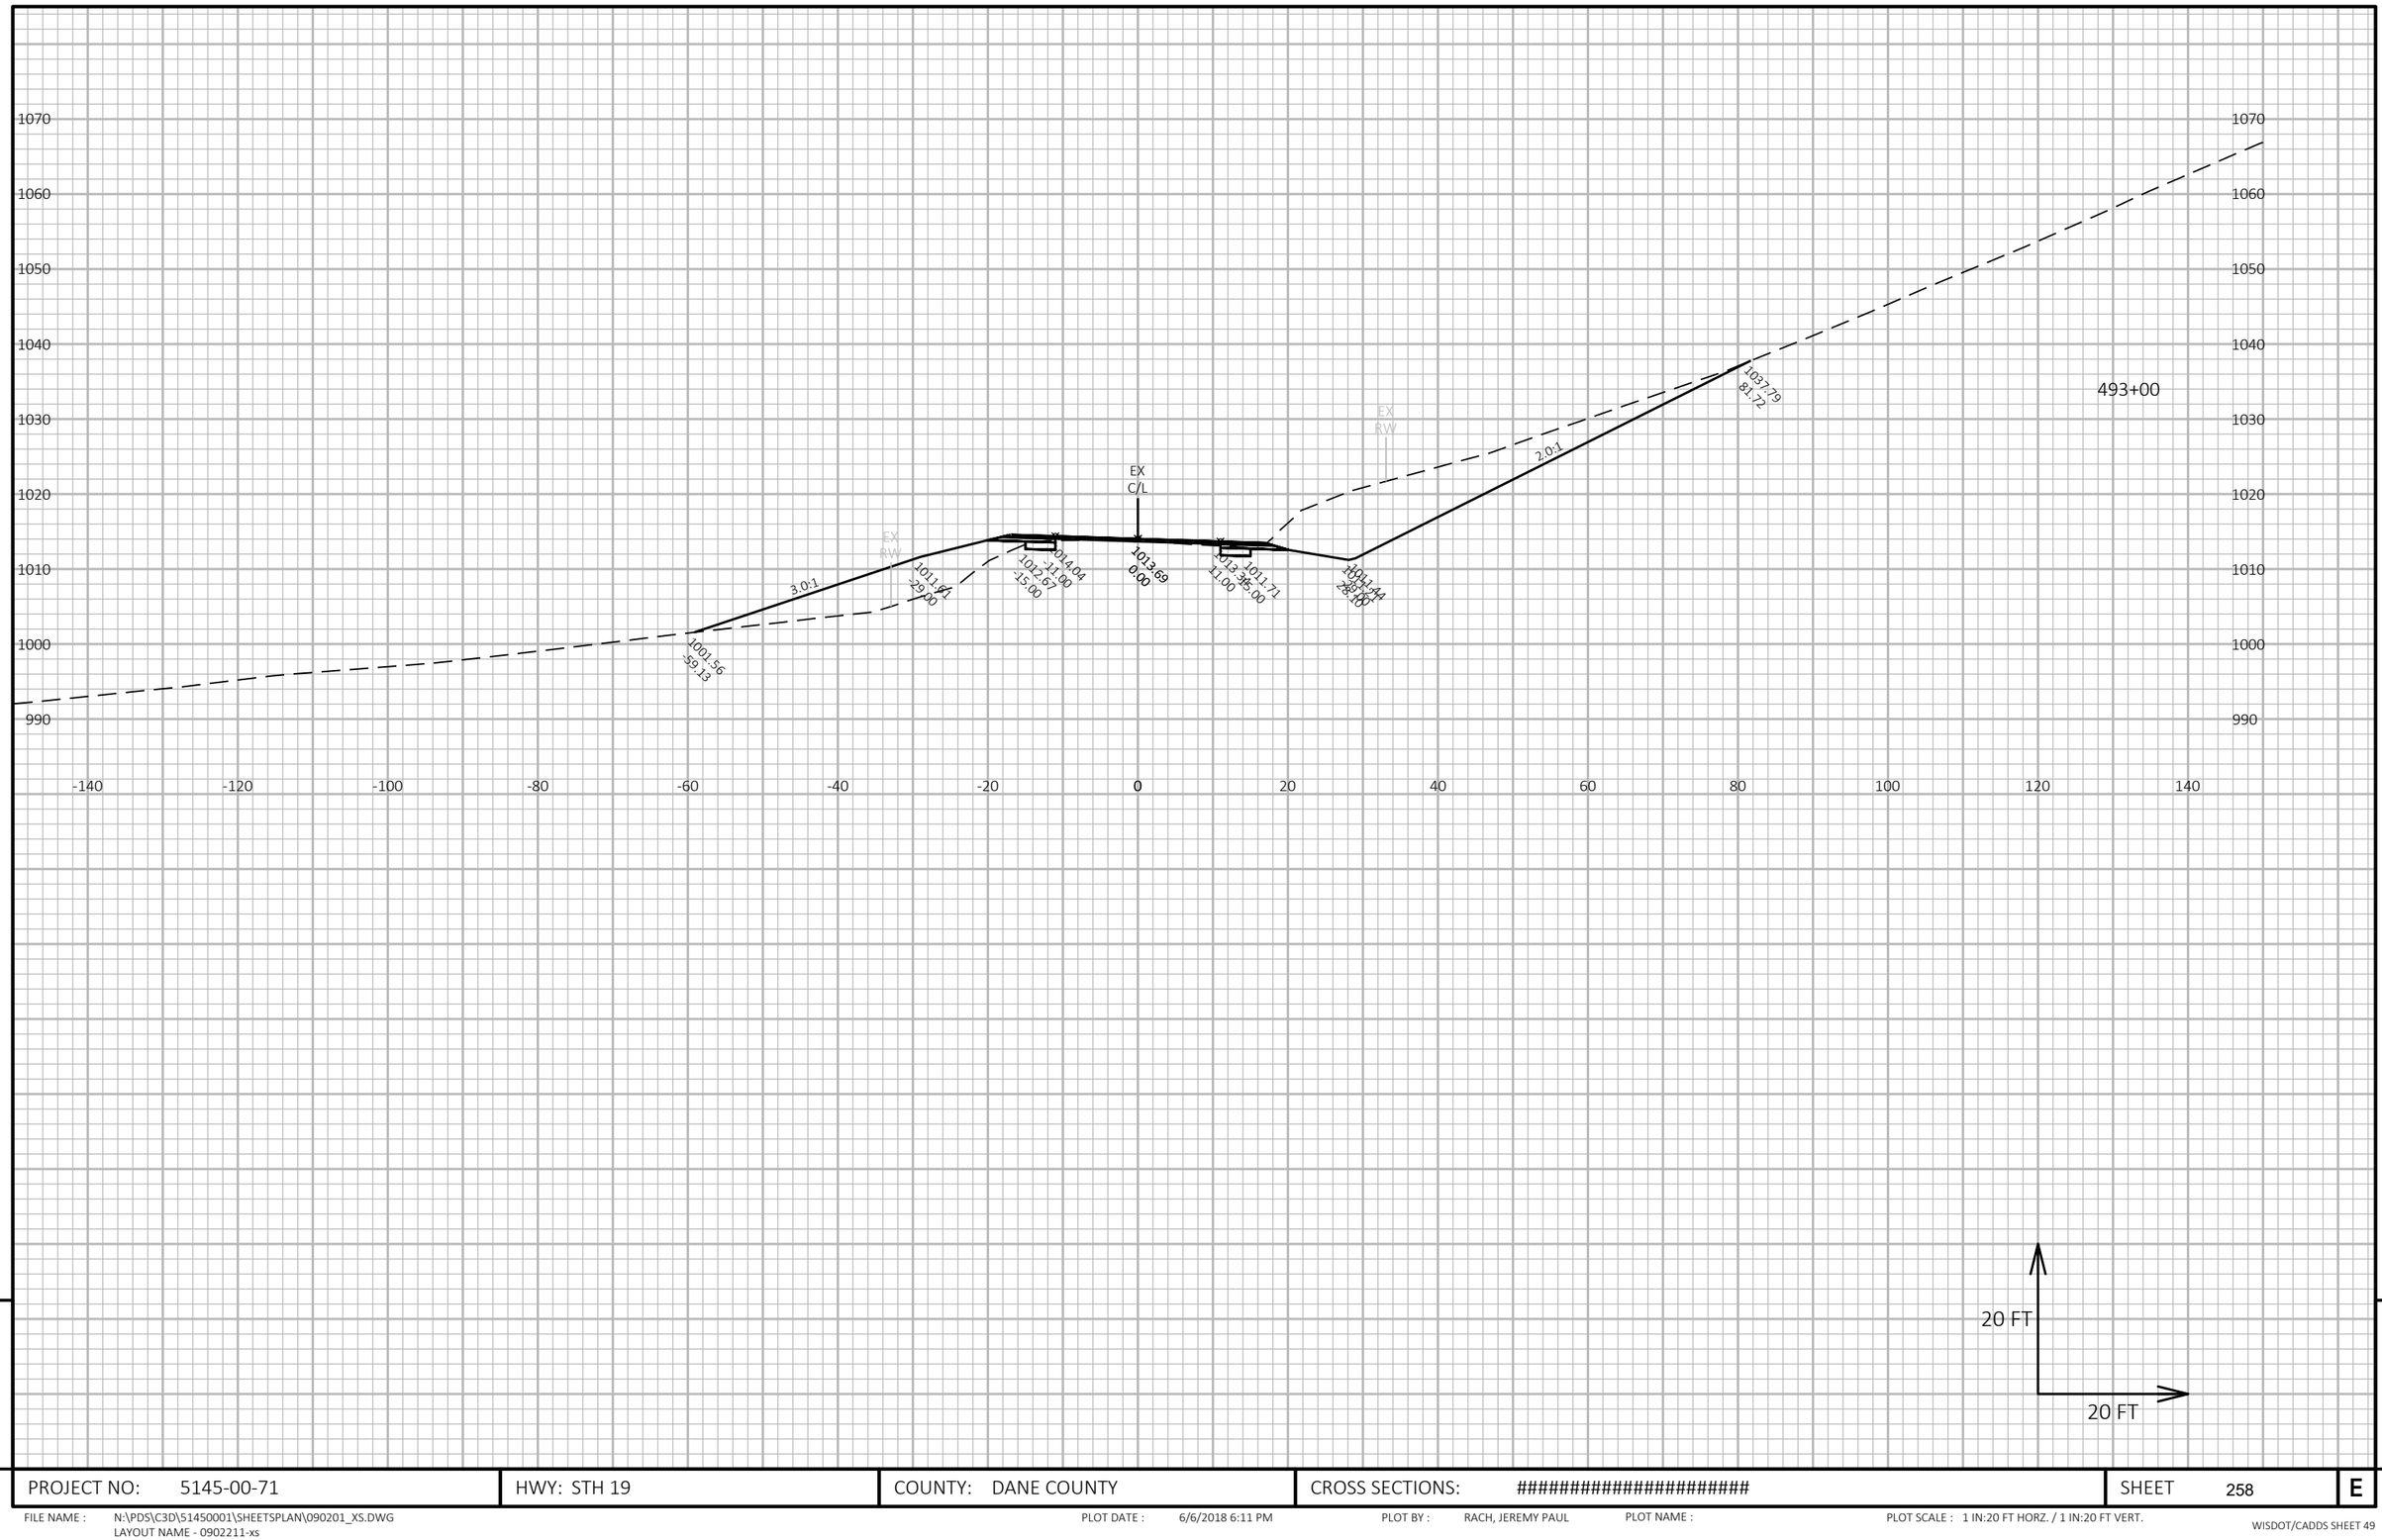

9

9

PROJECT NO: 5145-00-71	HWY: STH 19	COUNTY: DANE COUNTY	CROSS SECTIONS: ##########################	SHEET 258	E

FILE NAME : N:\PDS\C3D\51450001\SHEETSPLAN\090201_XS.DWG
LAYOUT NAME - 0902211-xs

PLOT DATE : 6/6/2018 6:11 PM

PLOT BY : RACH, JEREMY PAUL

PLOT NAME :

PLOT SCALE : 1 IN:20 FT HORZ. / 1 IN:20 FT VERT.

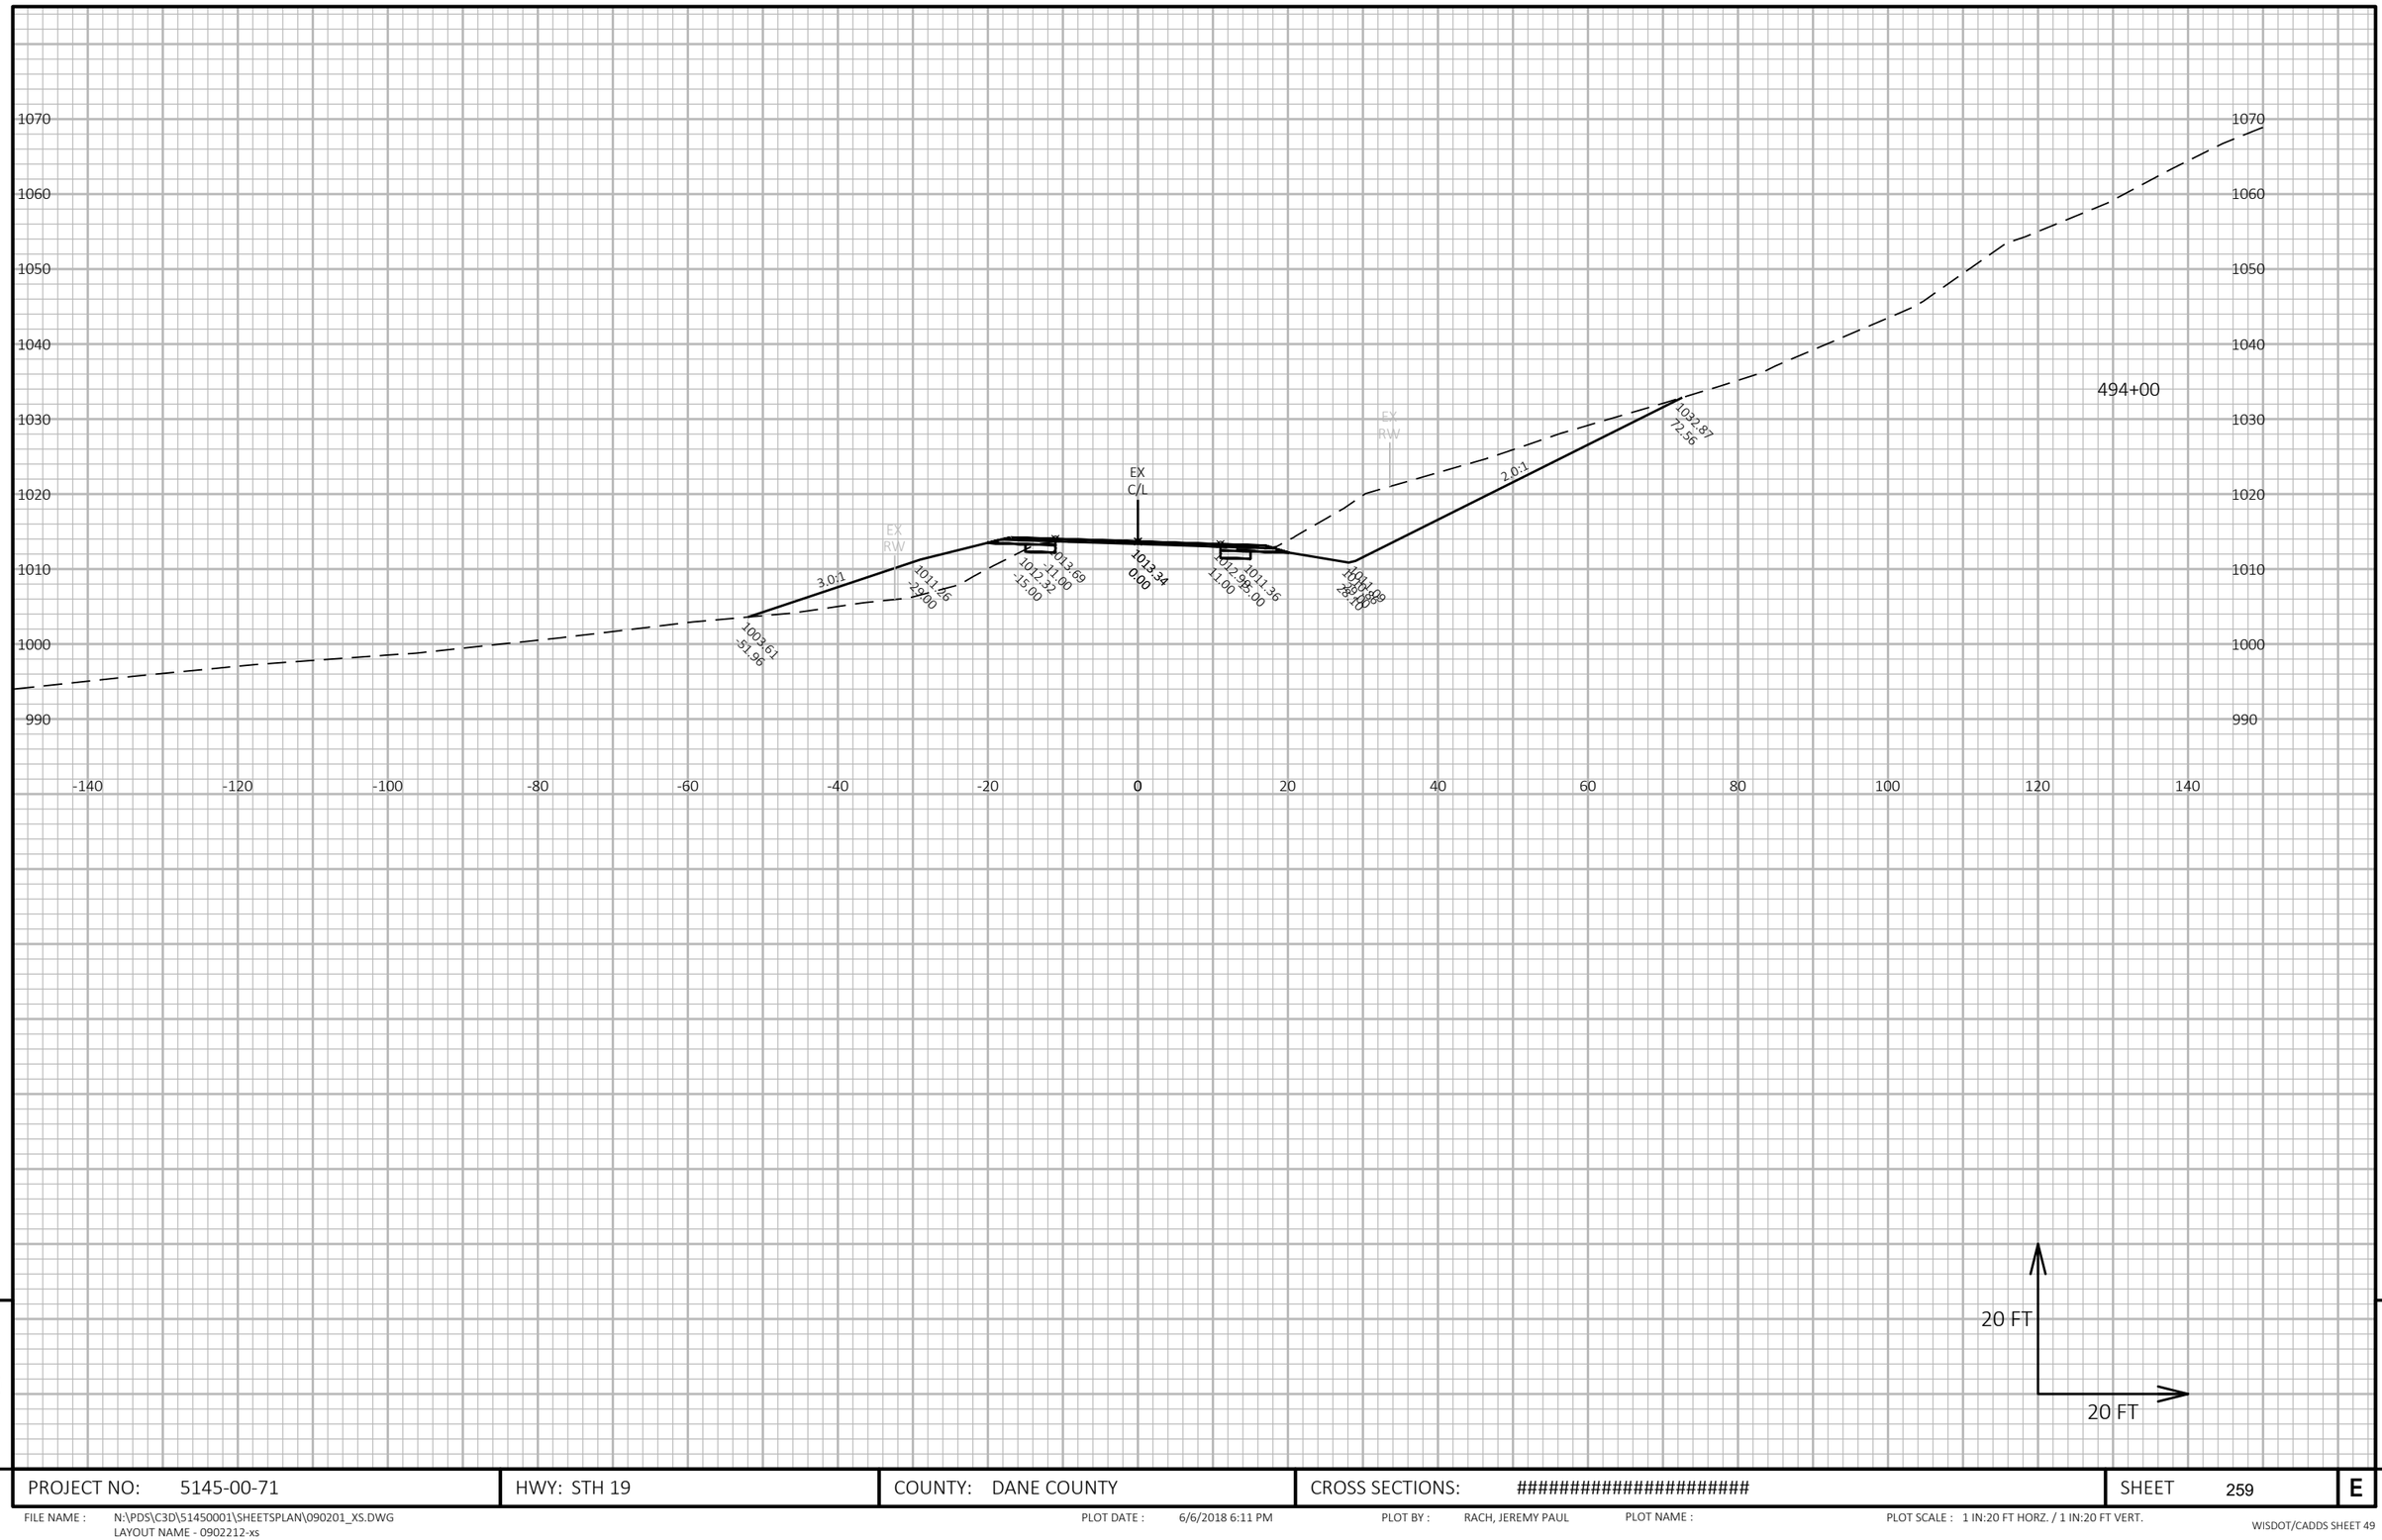

9

9

PROJECT NO: 5145-00-71	HWY: STH 19	COUNTY: DANE COUNTY	CROSS SECTIONS: ##########################	SHEET 259	E

FILE NAME : N:\PDS\C3D\51450001\SHEETSPLAN\090201_XS.DWG
LAYOUT NAME - 0902212-xs

PLOT DATE : 6/6/2018 6:11 PM PLOT BY : RACH, JEREMY PAUL PLOT NAME : PLOT SCALE : 1 IN:20 FT HORZ. / 1 IN:20 FT VERT.

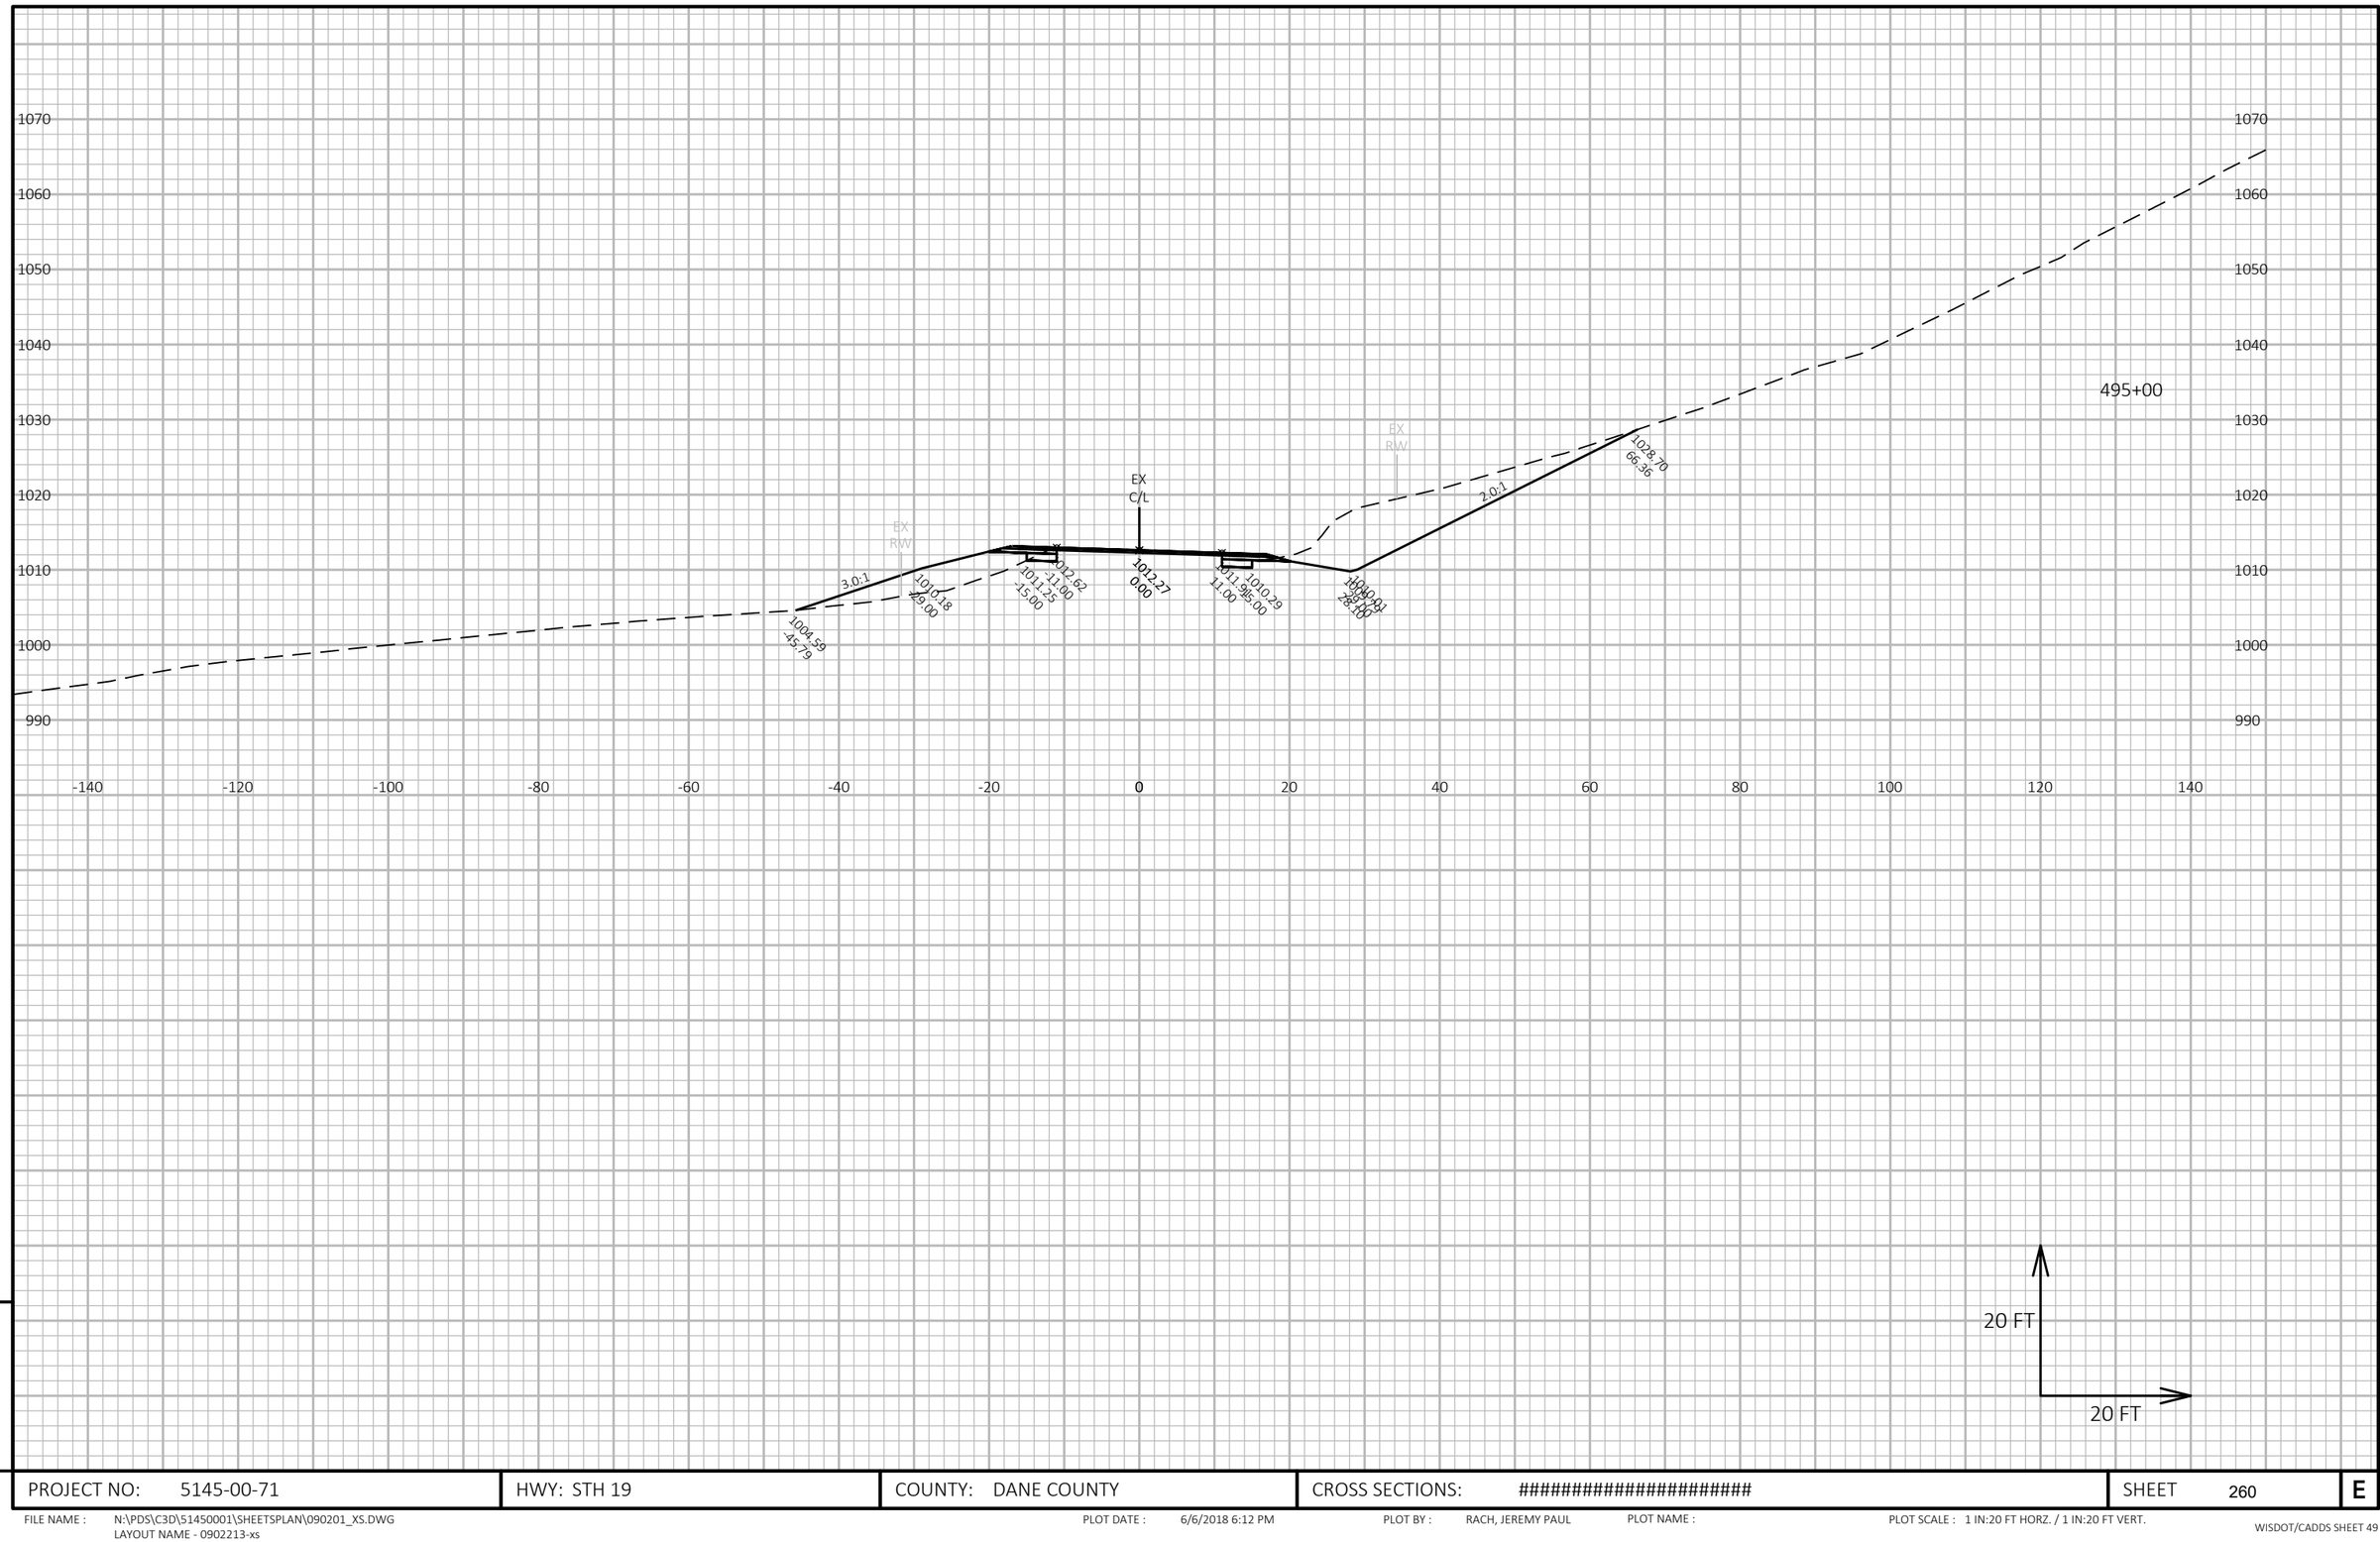

9

9

PROJECT NO: 5145-00-71	HWY: STH 19	COUNTY: DANE COUNTY	CROSS SECTIONS: ##########################	SHEET 260	E

FILE NAME : N:\PDS\C3D\51450001\SHEETSPLAN\090201_XS.DWG
LAYOUT NAME - 0902213-xs

PLOT DATE : 6/6/2018 6:12 PM PLOT BY : RACH, JEREMY PAUL PLOT NAME : PLOT SCALE : 1 IN:20 FT HORZ. / 1 IN:20 FT VERT.

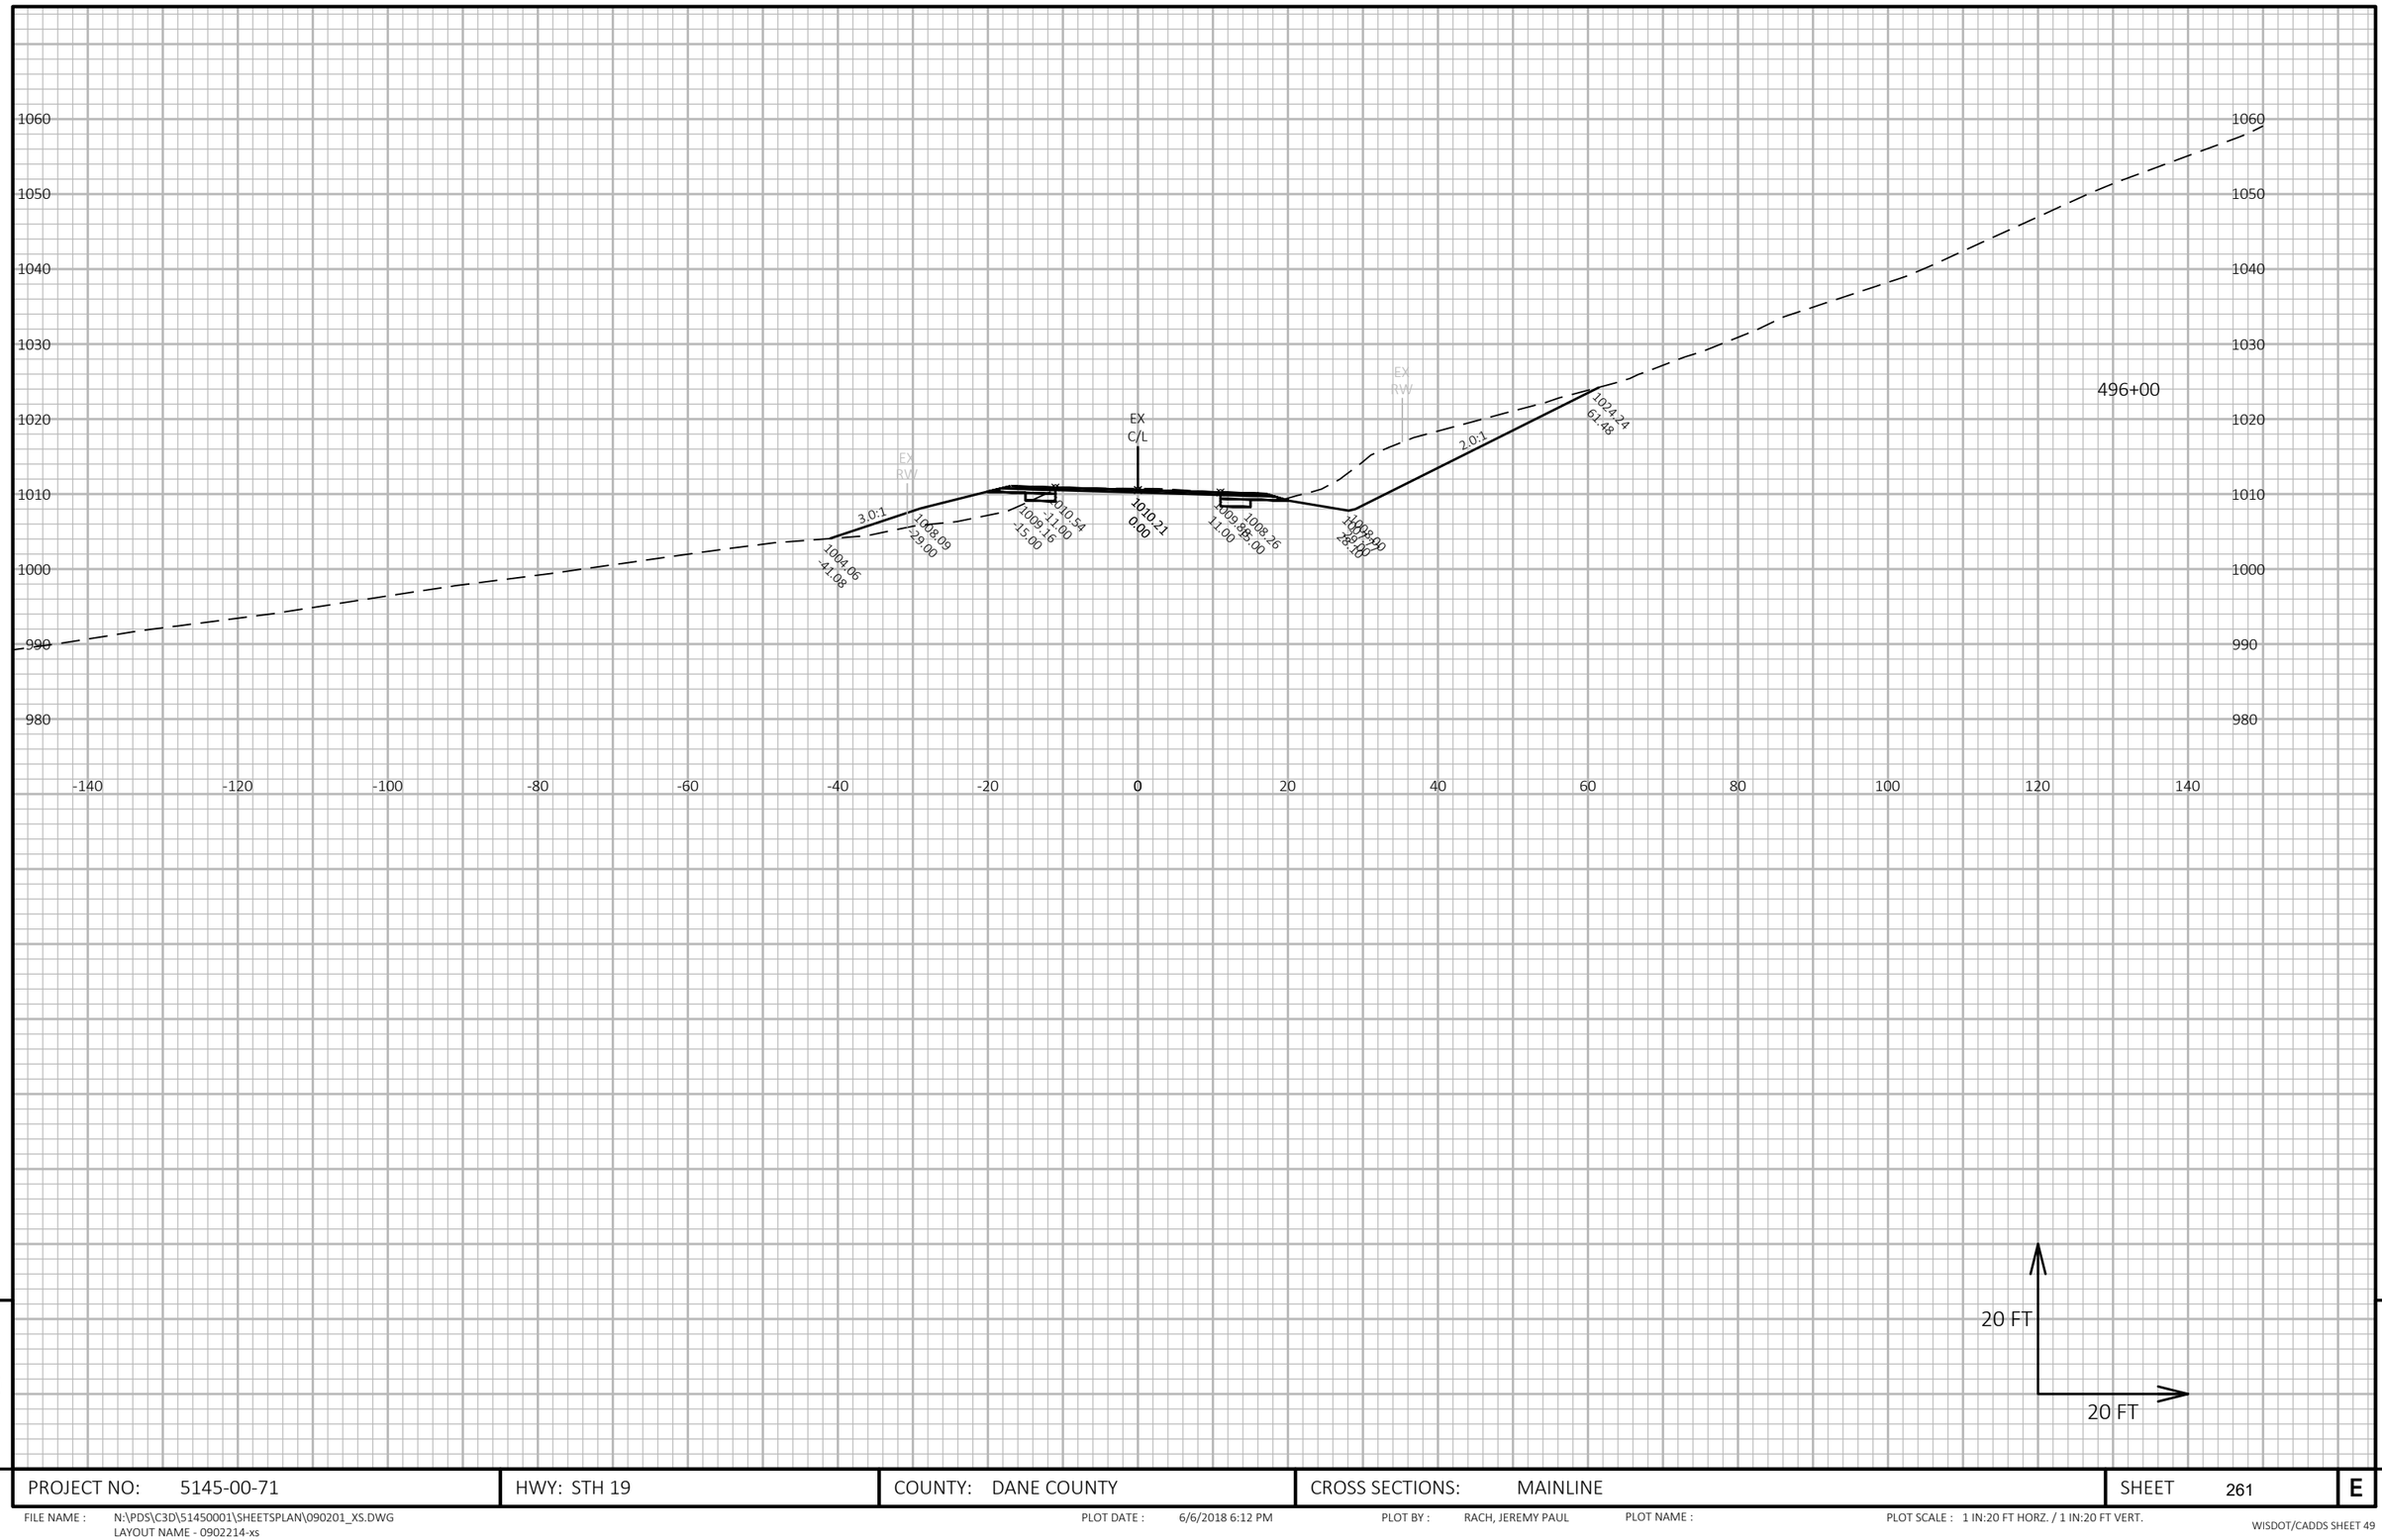

9

9

PROJECT NO: 5145-00-71	HWY: STH 19	COUNTY: DANE COUNTY	CROSS SECTIONS: MAINLINE	SHEET 261	E

FILE NAME : N:\PDS\C3D\51450001\SHEETSPLAN\090201_XS.DWG
LAYOUT NAME - 0902214-xs

PLOT DATE : 6/6/2018 6:12 PM

PLOT BY : RACH, JEREMY PAUL

PLOT NAME :

PLOT SCALE : 1 IN:20 FT HORZ. / 1 IN:20 FT VERT.

WISDOT/CADDS SHEET 49

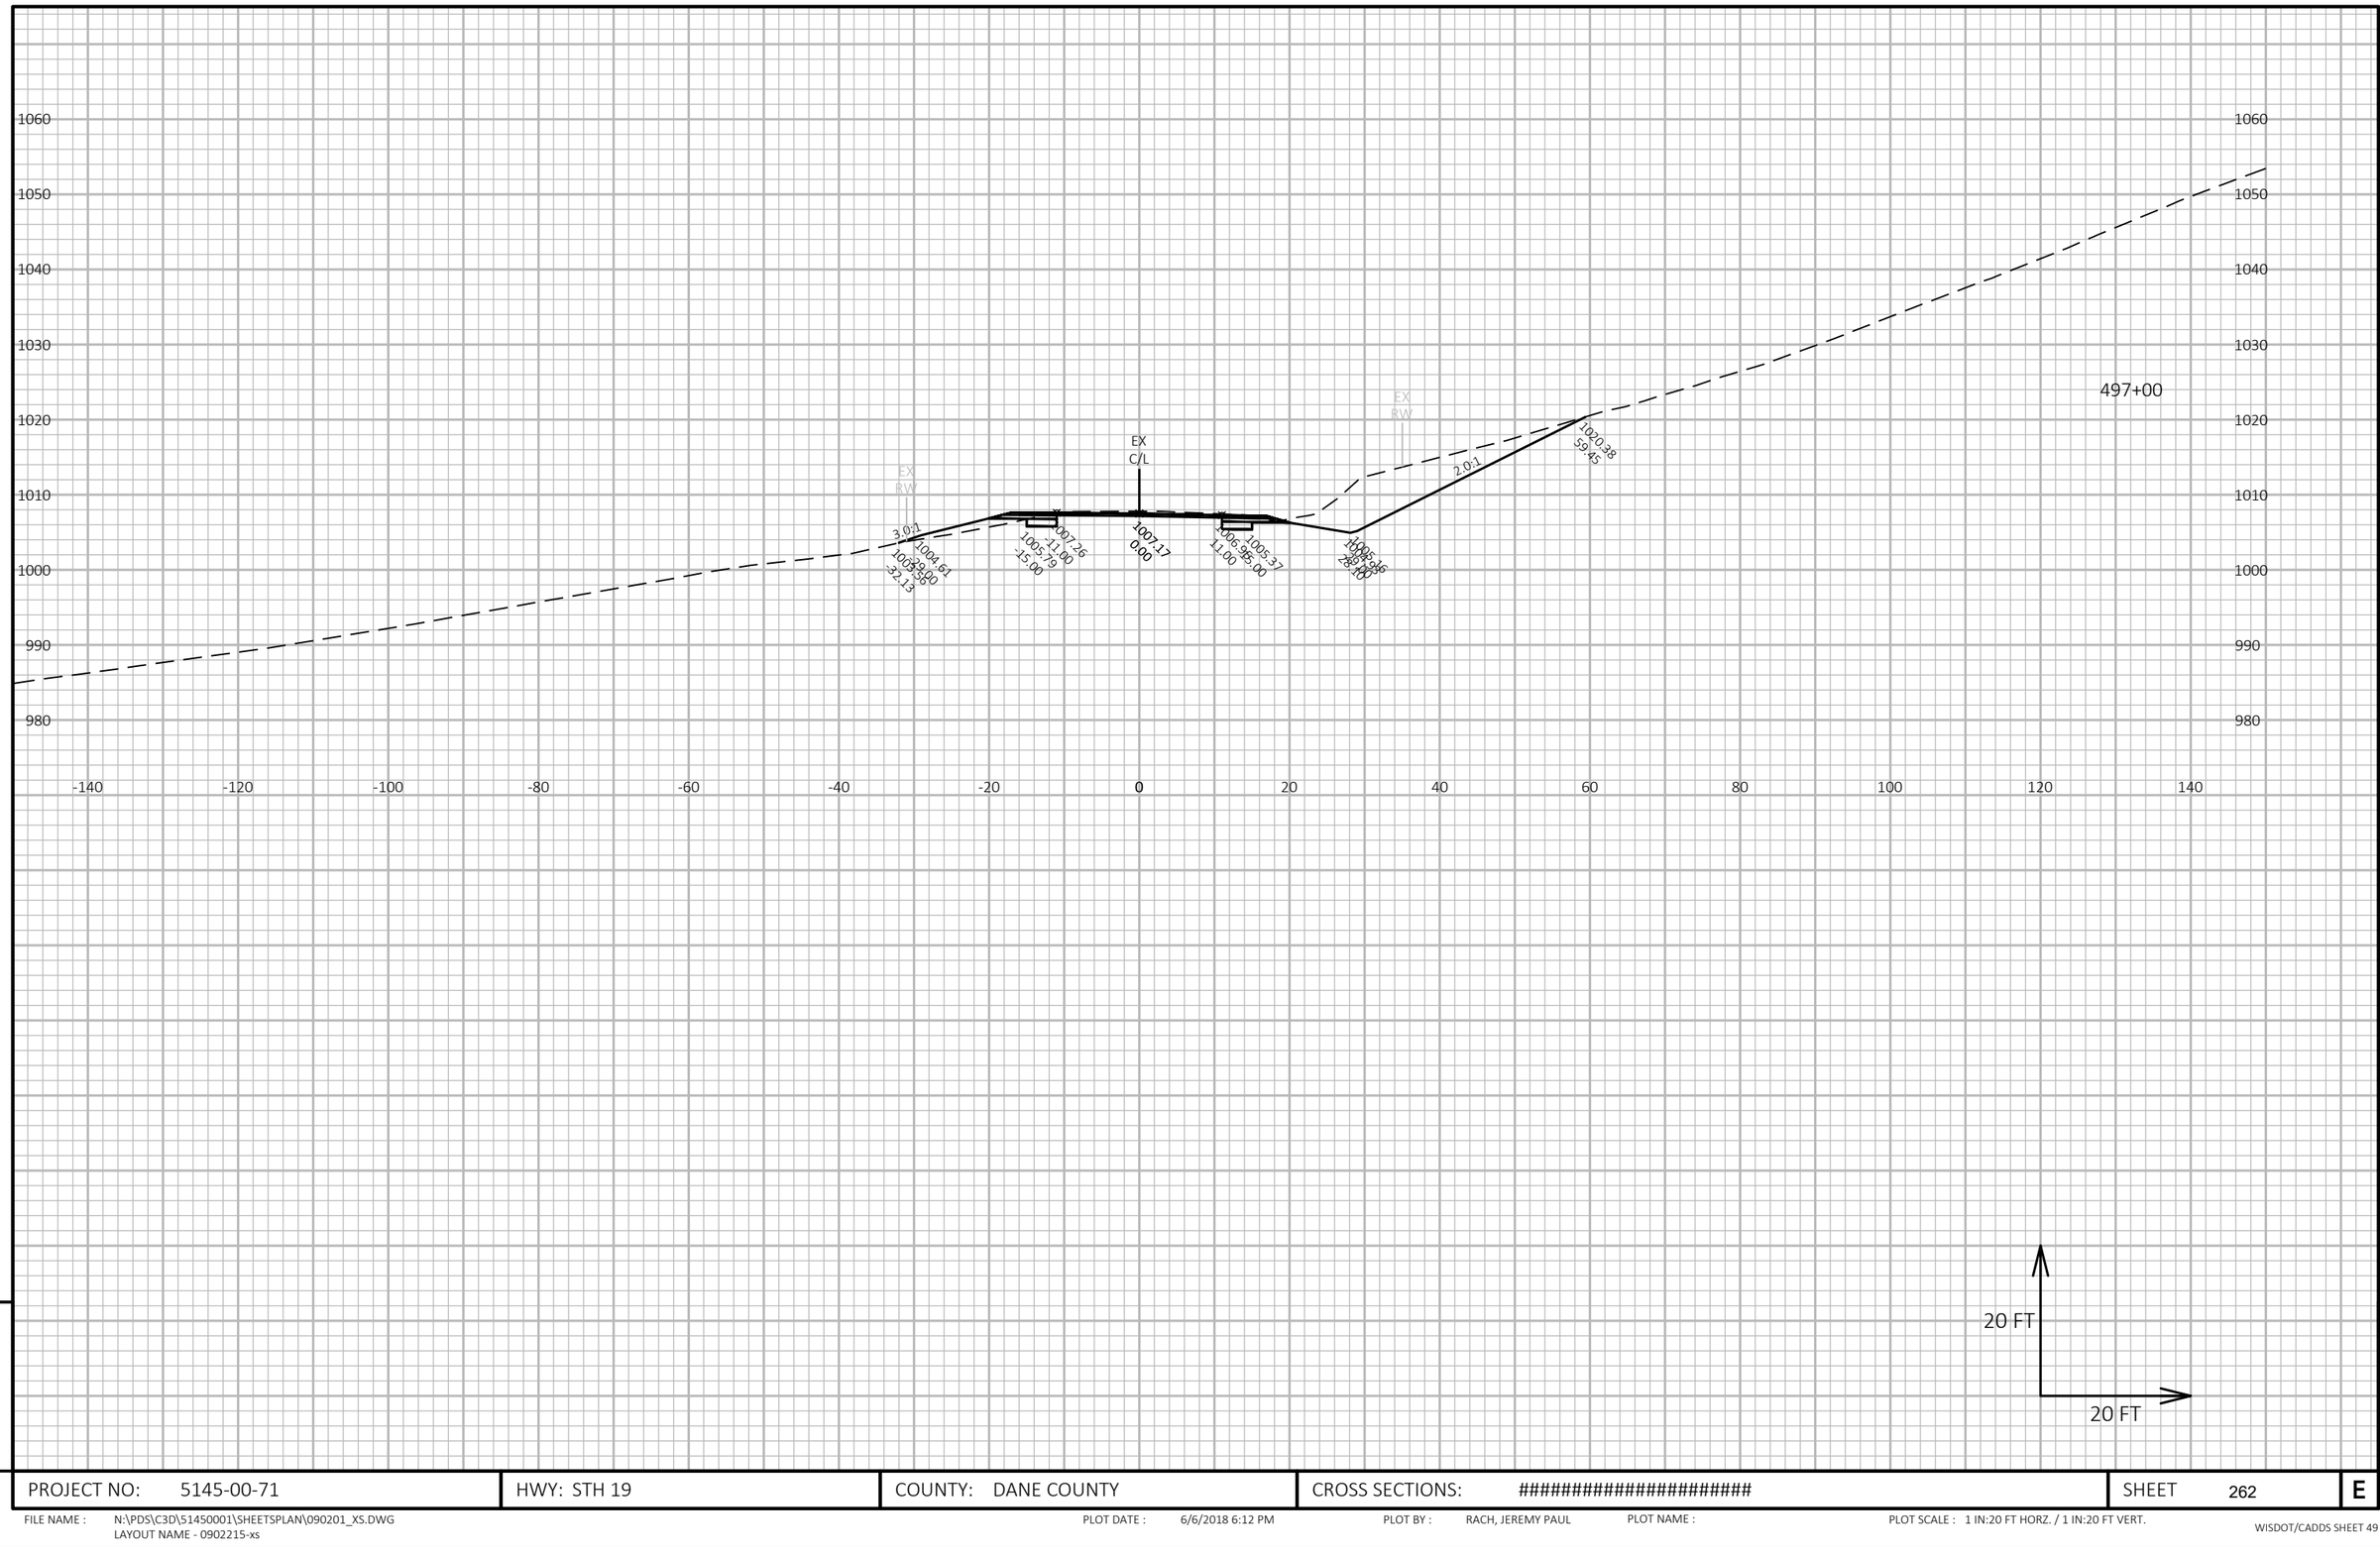

9

9

PROJECT NO: 5145-00-71	HWY: STH 19	COUNTY: DANE COUNTY	CROSS SECTIONS: ##########################	SHEET 262	E

FILE NAME : N:\PDS\C3D\51450001\SHEETSPLAN\090201_XS.DWG
LAYOUT NAME - 0902215-xs

PLOT DATE : 6/6/2018 6:12 PM PLOT BY : RACH, JEREMY PAUL PLOT NAME : PLOT SCALE : 1 IN:20 FT HORZ. / 1 IN:20 FT VERT.

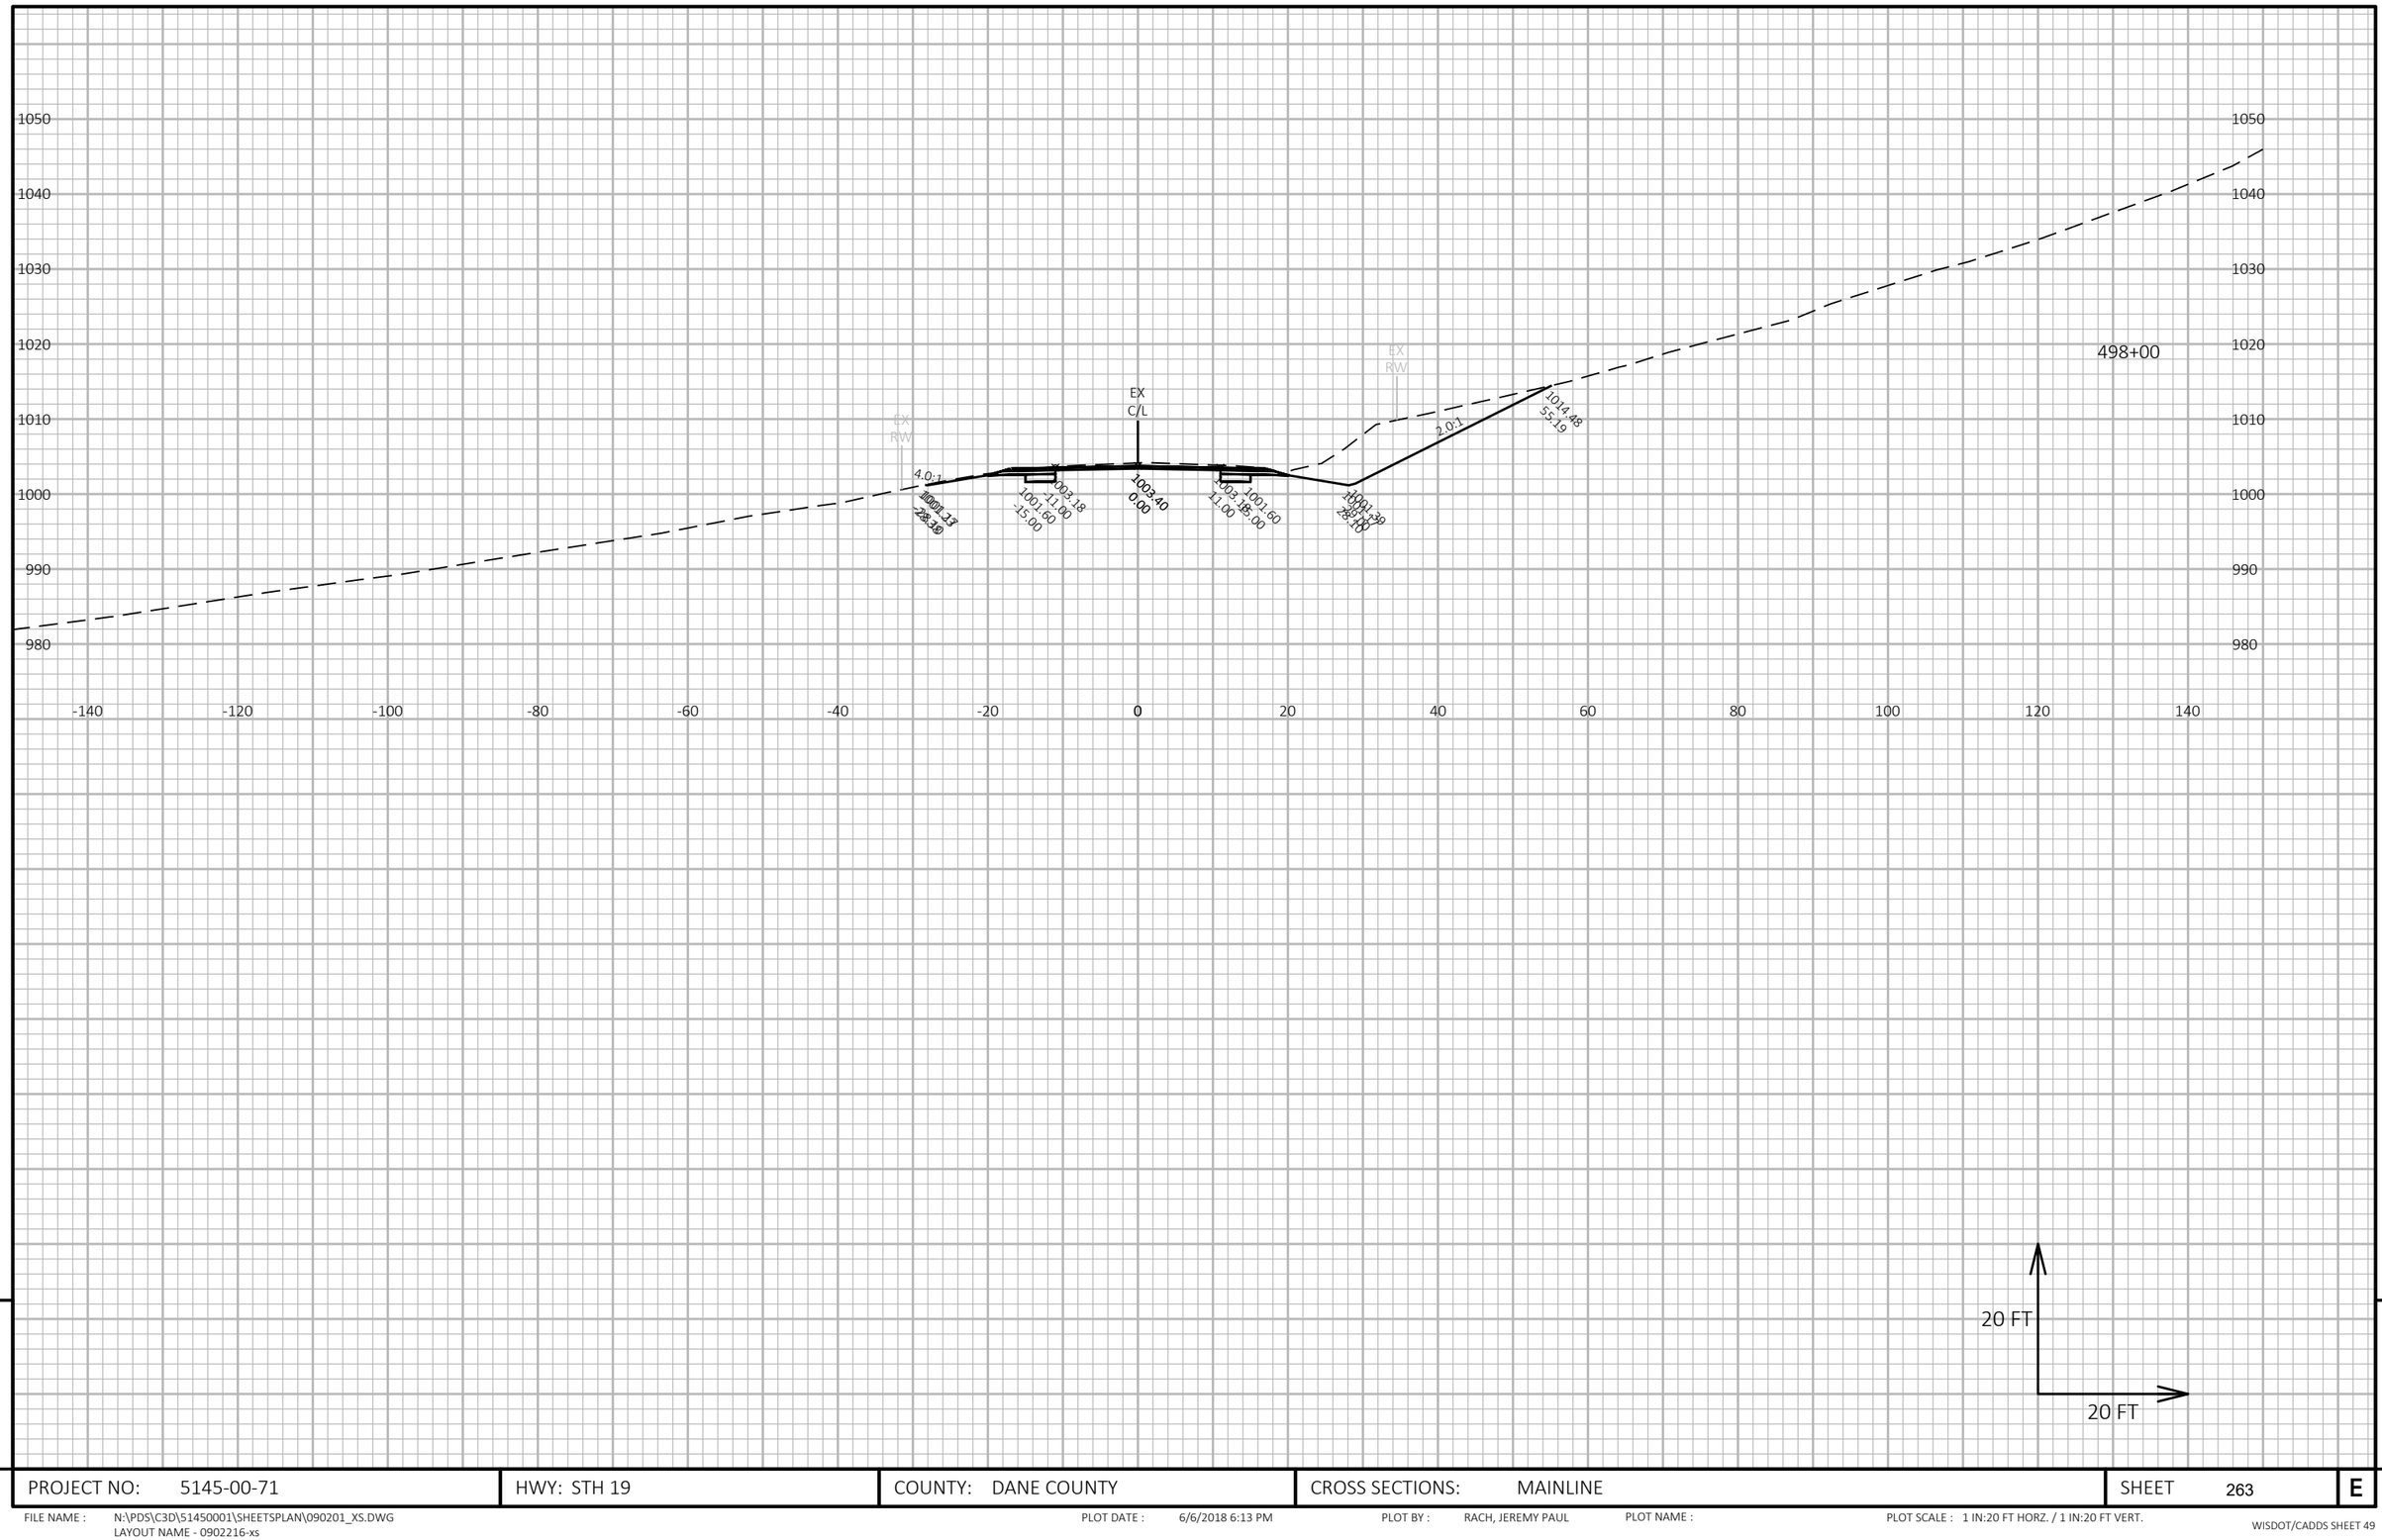

20 FT

20 FT

9

9

PROJECT NO: 5145-00-71	HWY: STH 19	COUNTY: DANE COUNTY	CROSS SECTIONS: MAINLINE	SHEET 263	E

FILE NAME : N:\PDS\C3D\51450001\SHEETSPLAN\090201_XS.DWG
LAYOUT NAME - 0902216-xs

PLOT DATE : 6/6/2018 6:13 PM

PLOT BY : RACH, JEREMY PAUL

PLOT NAME :

PLOT SCALE : 1 IN:20 FT HORZ. / 1 IN:20 FT VERT.

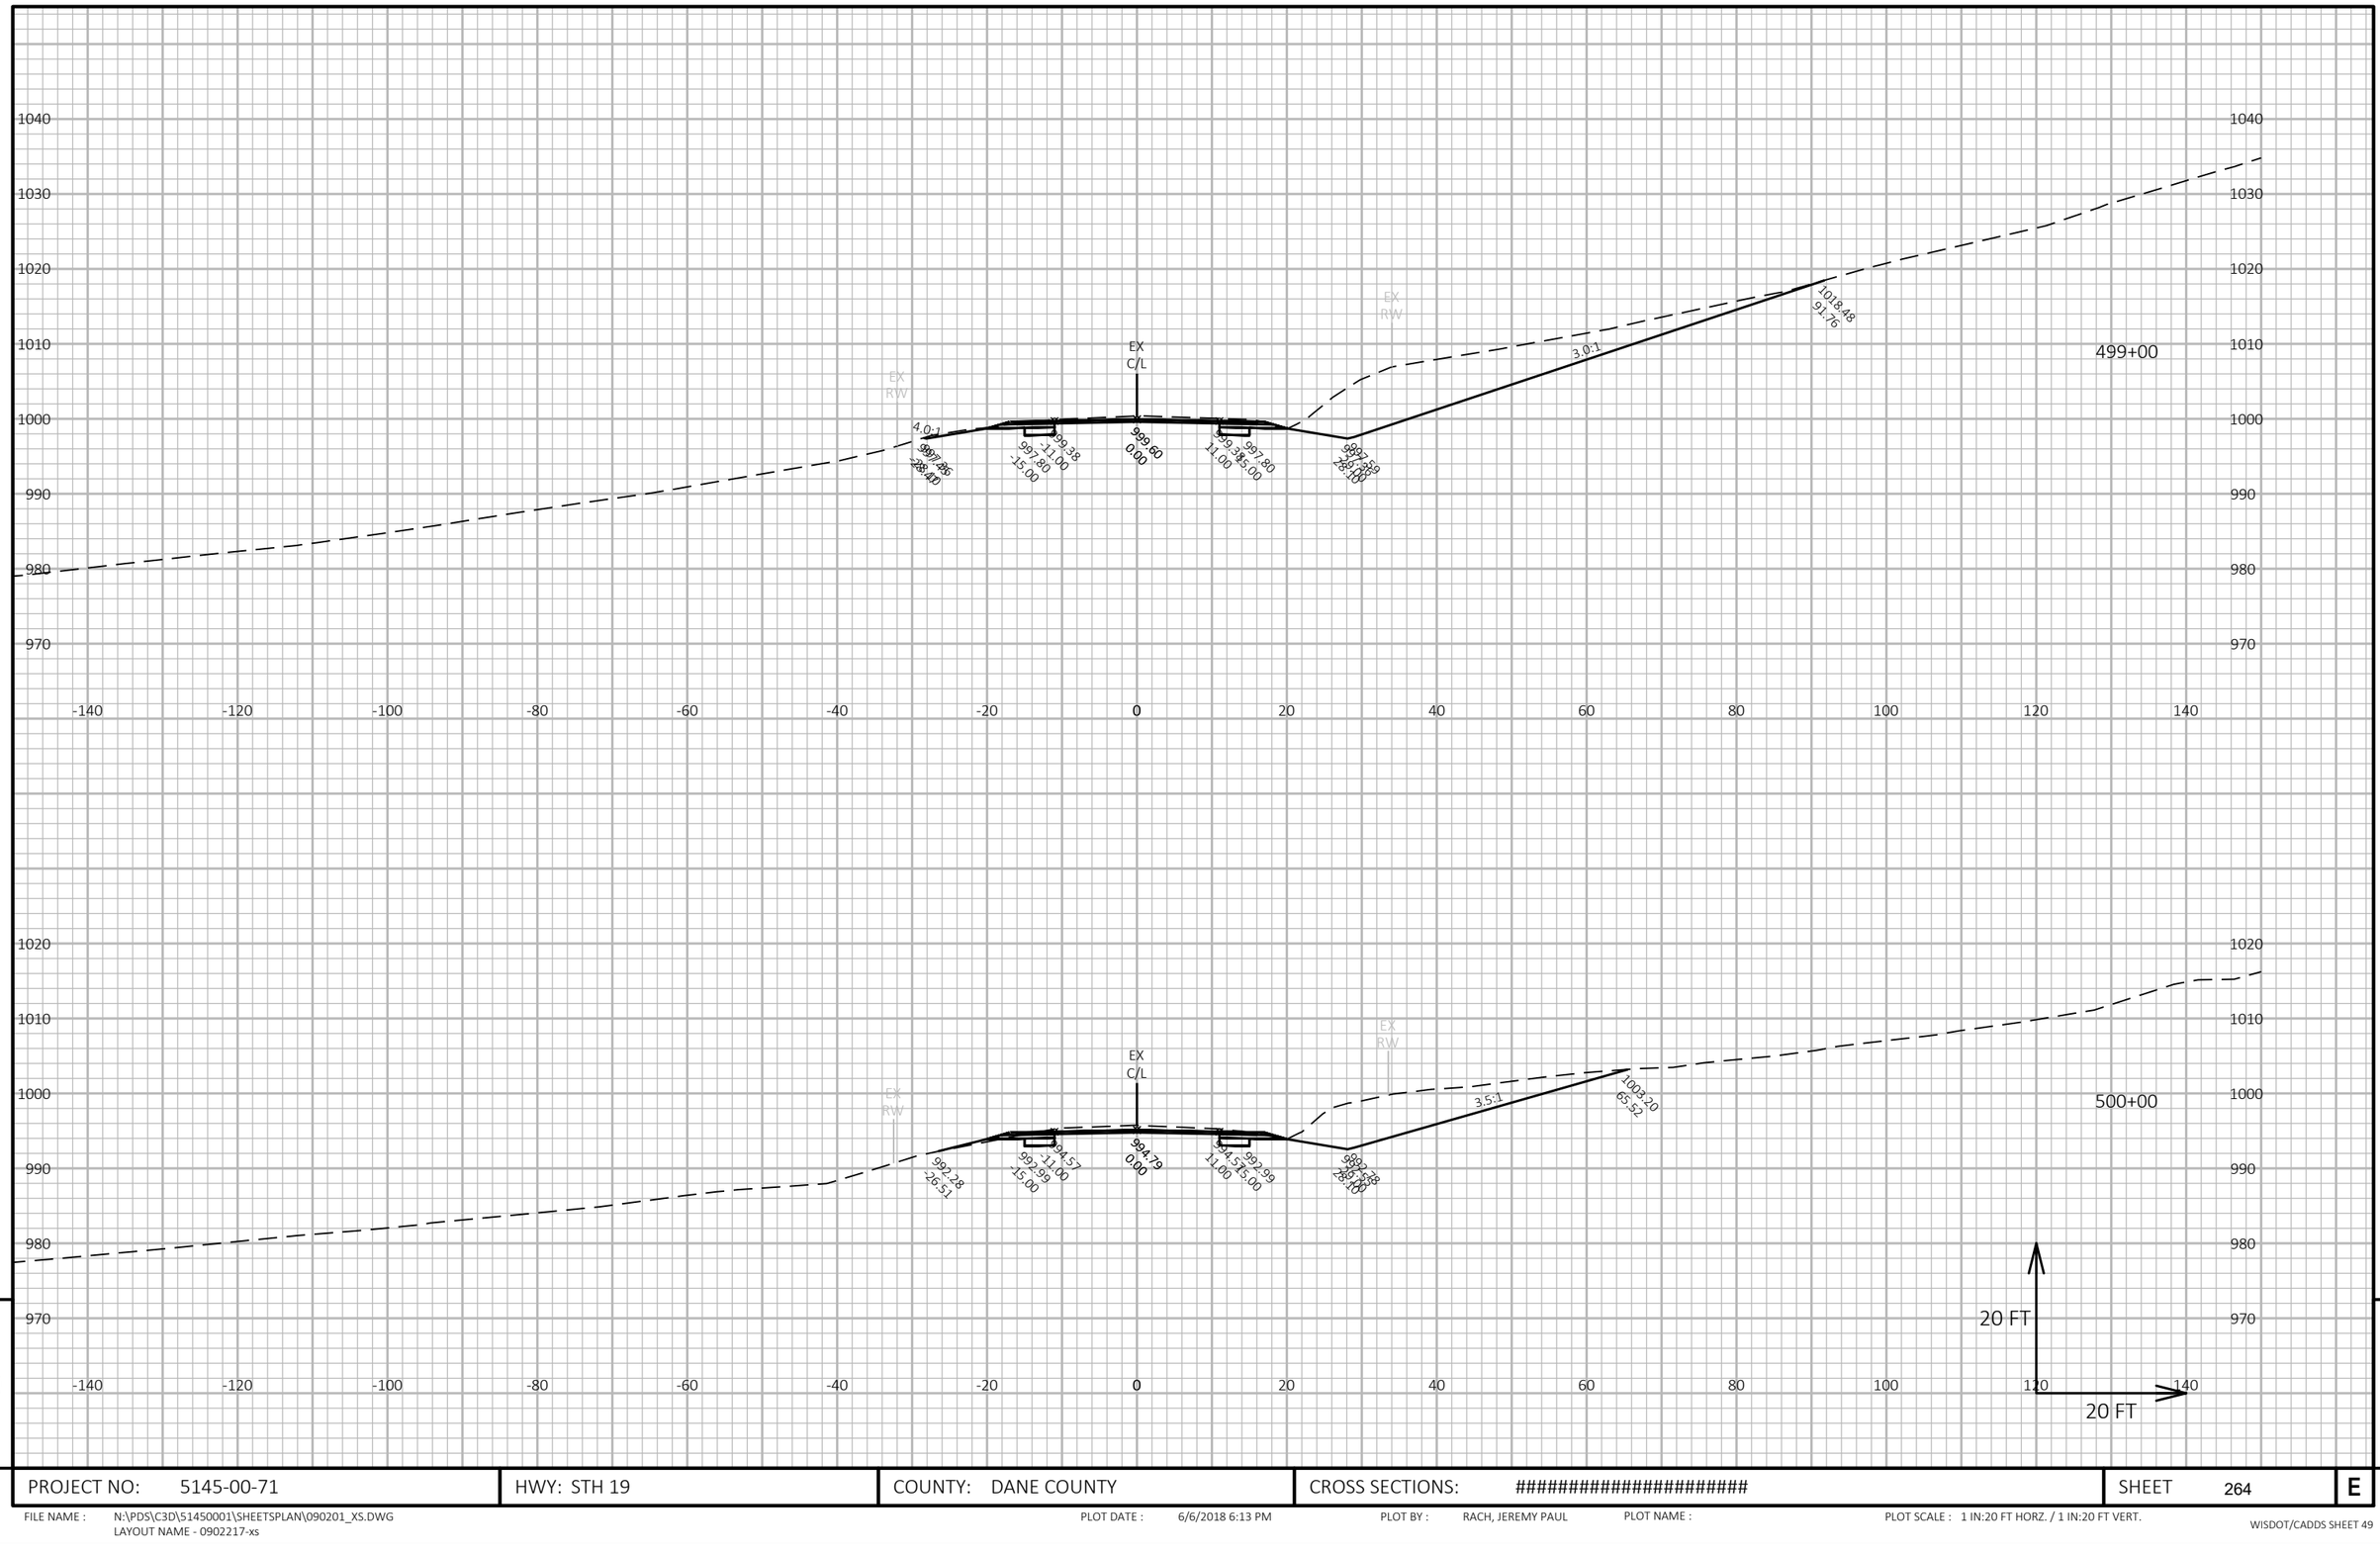

9

9

PROJECT NO: 5145-00-71	HWY: STH 19	COUNTY: DANE COUNTY	CROSS SECTIONS: ##########################	SHEET 264	E

FILE NAME : N:\PDS\C3D\51450001\SHEETSPLAN\090201_XS.DWG
LAYOUT NAME - 0902217-xs

PLOT DATE : 6/6/2018 6:13 PM PLOT BY : RACH, JEREMY PAUL PLOT NAME : PLOT SCALE : 1 IN:20 FT HORZ. / 1 IN:20 FT VERT.

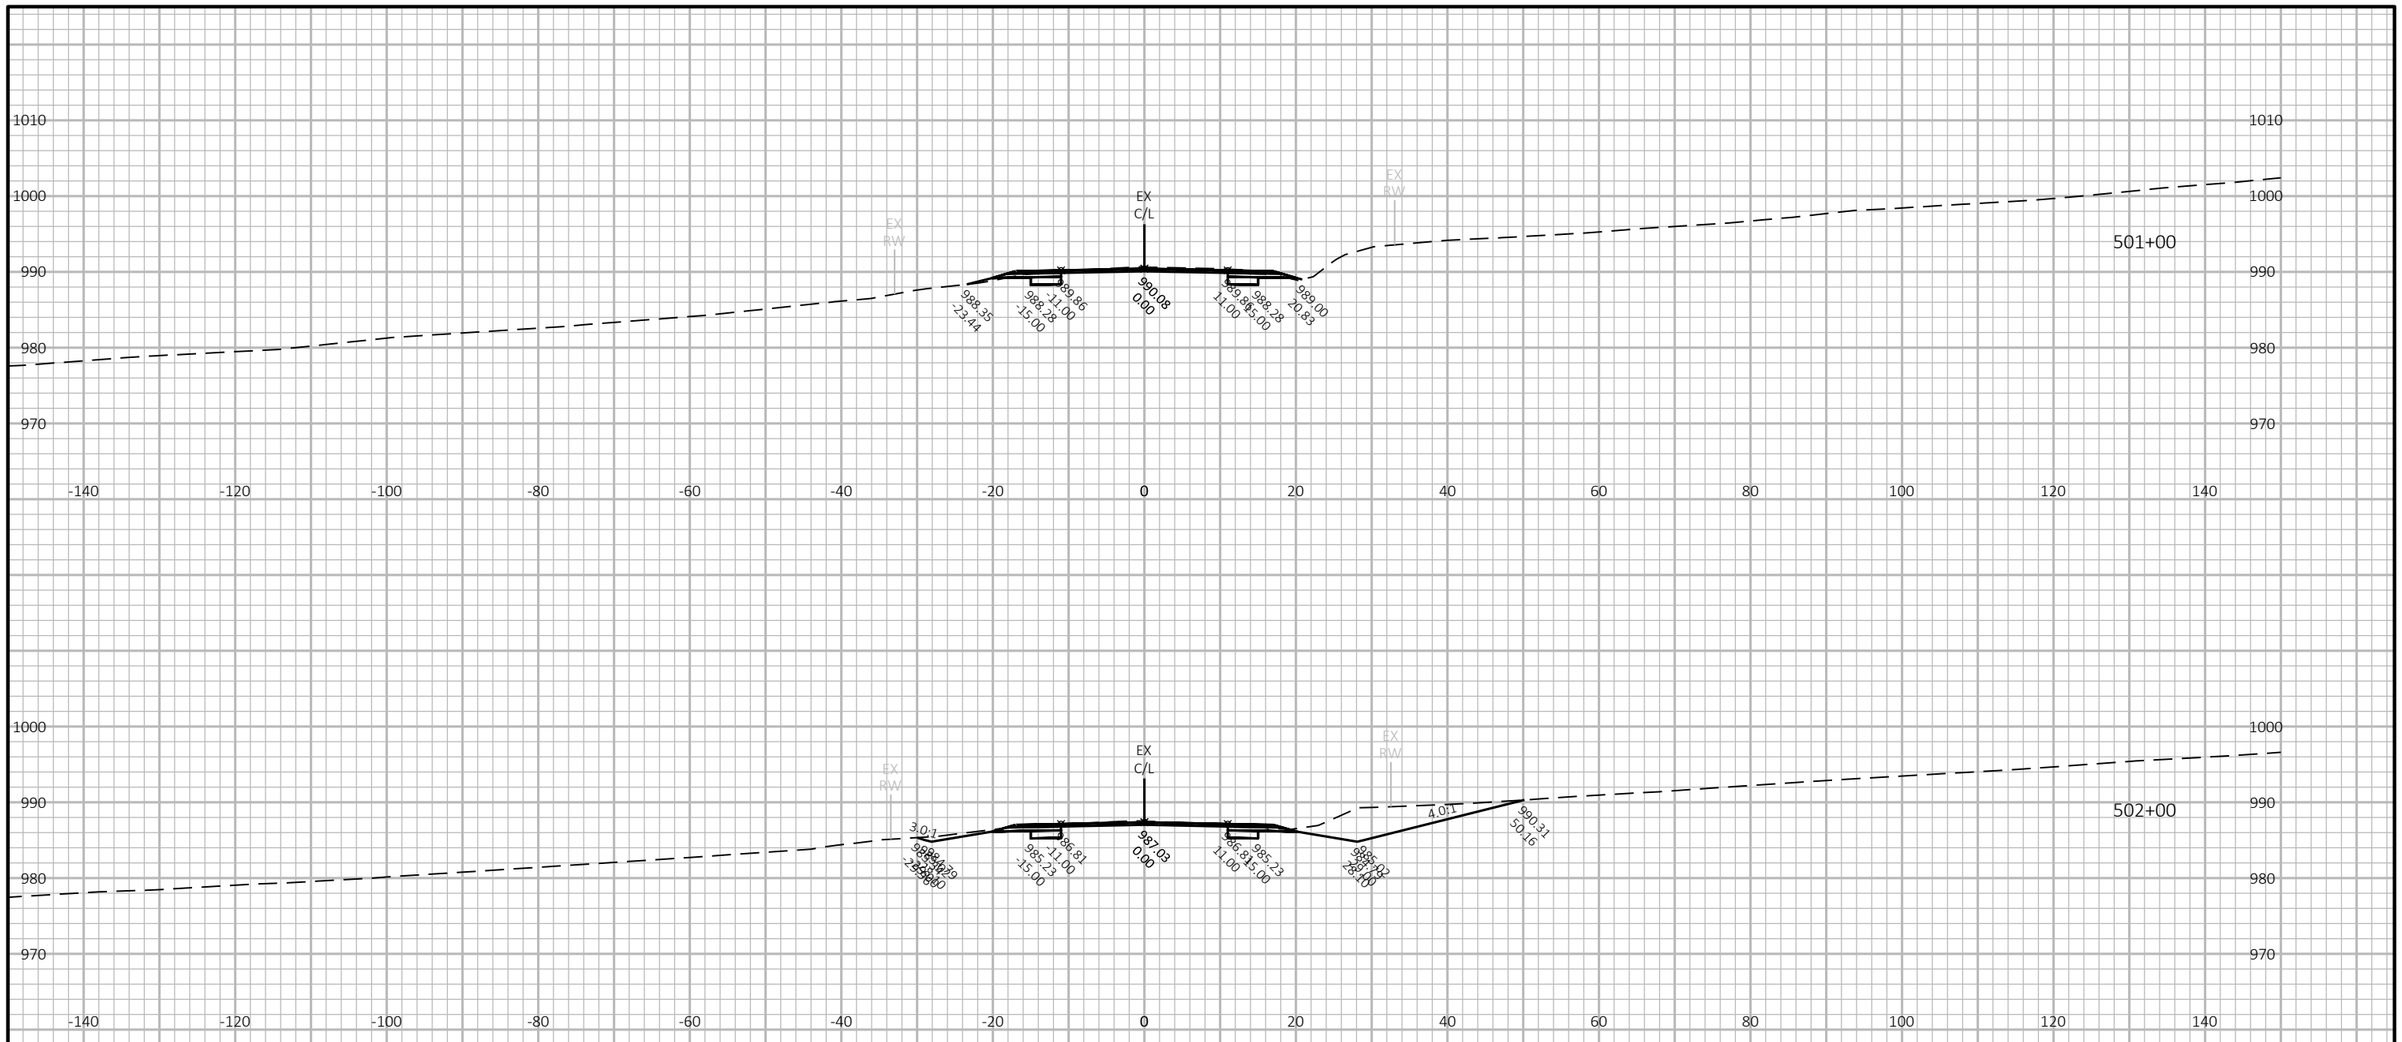

20 FT

20 FT

9

9

PROJECT NO: 5145-00-71	HWY: STH 19	COUNTY: DANE COUNTY	CROSS SECTIONS: ##########################	SHEET 265	E

FILE NAME : N:\PDS\C3D\51450001\SHEETSPLAN\090201_XS.DWG
LAYOUT NAME - 0902218-xs

PLOT DATE : 6/6/2018 6:14 PM

PLOT BY : RACH, JEREMY PAUL

PLOT NAME :

PLOT SCALE : 1 IN:20 FT HORZ. / 1 IN:20 FT VERT.

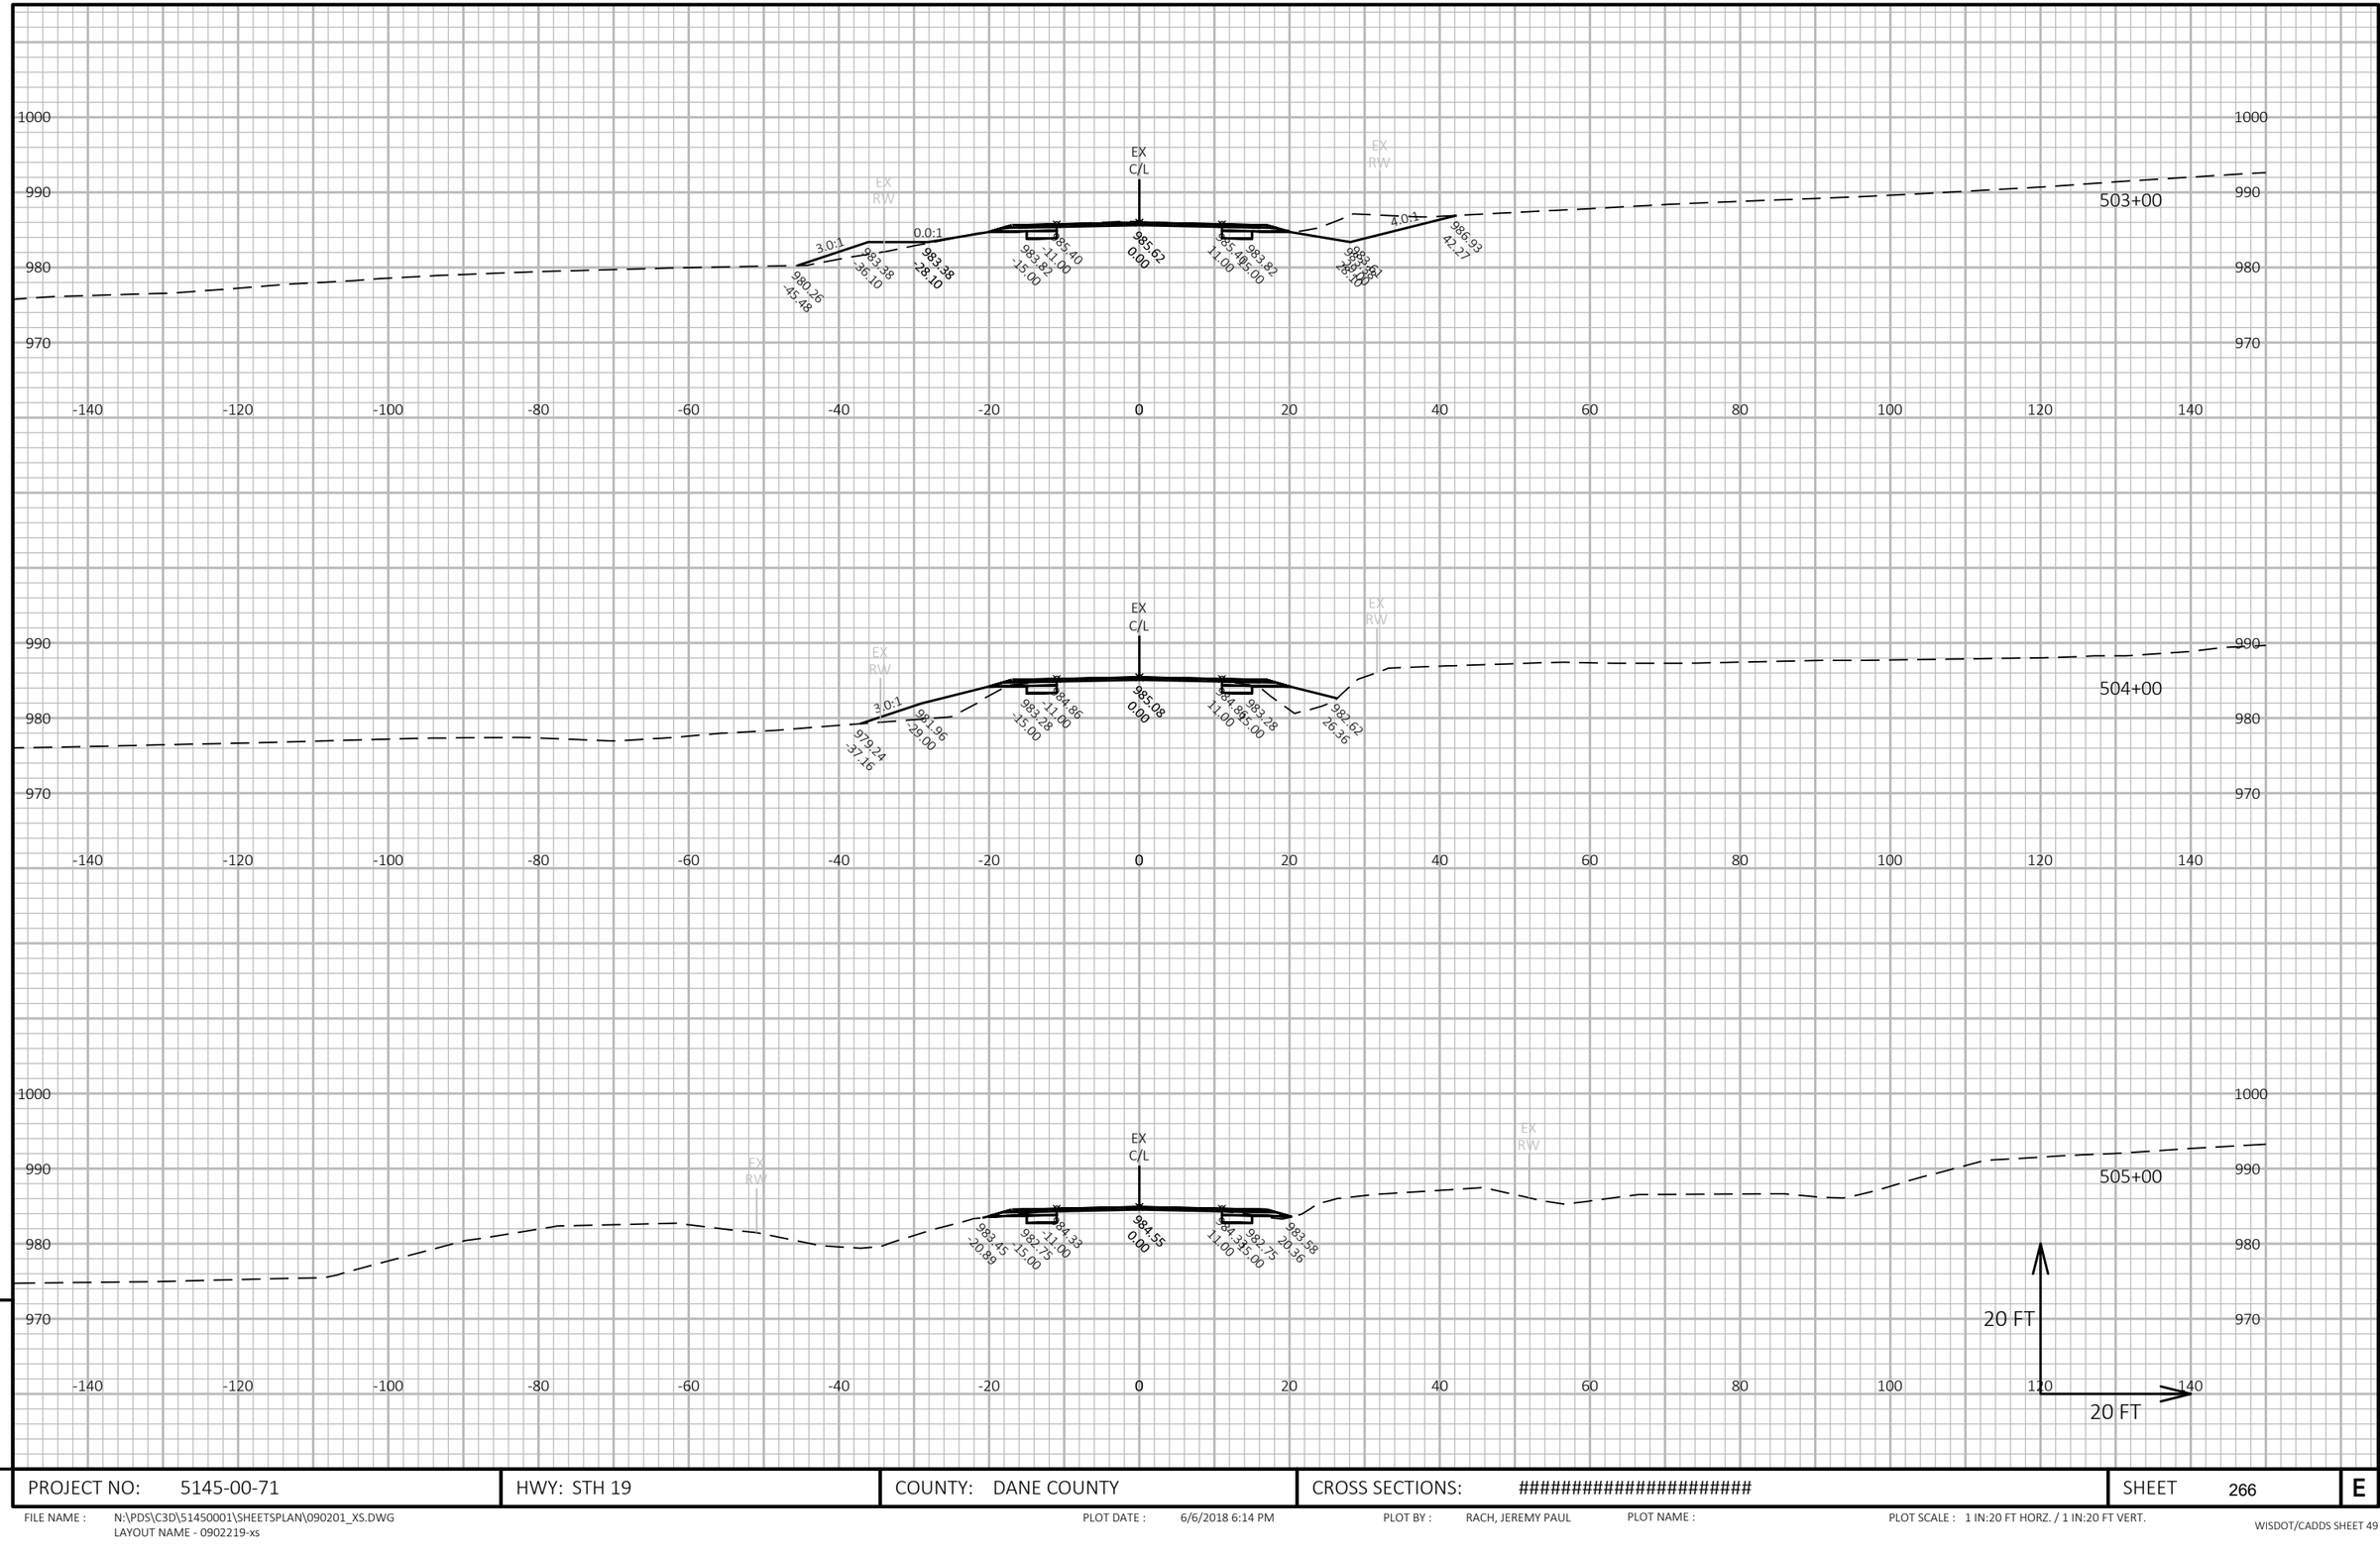

PROJECT NO: 5145-00-71	HWY: STH 19	COUNTY: DANE COUNTY	CROSS SECTIONS: ##########################	SHEET 266	E

FILE NAME : N:\PDS\C3D\51450001\SHEETSPLAN\090201_XS.DWG
LAYOUT NAME - 0902219-xs

PLOT DATE : 6/6/2018 6:14 PM PLOT BY : RACH, JEREMY PAUL PLOT NAME : PLOT SCALE : 1 IN:20 FT HORZ. / 1 IN:20 FT VERT.

WISDOT/CADDS SHEET 49

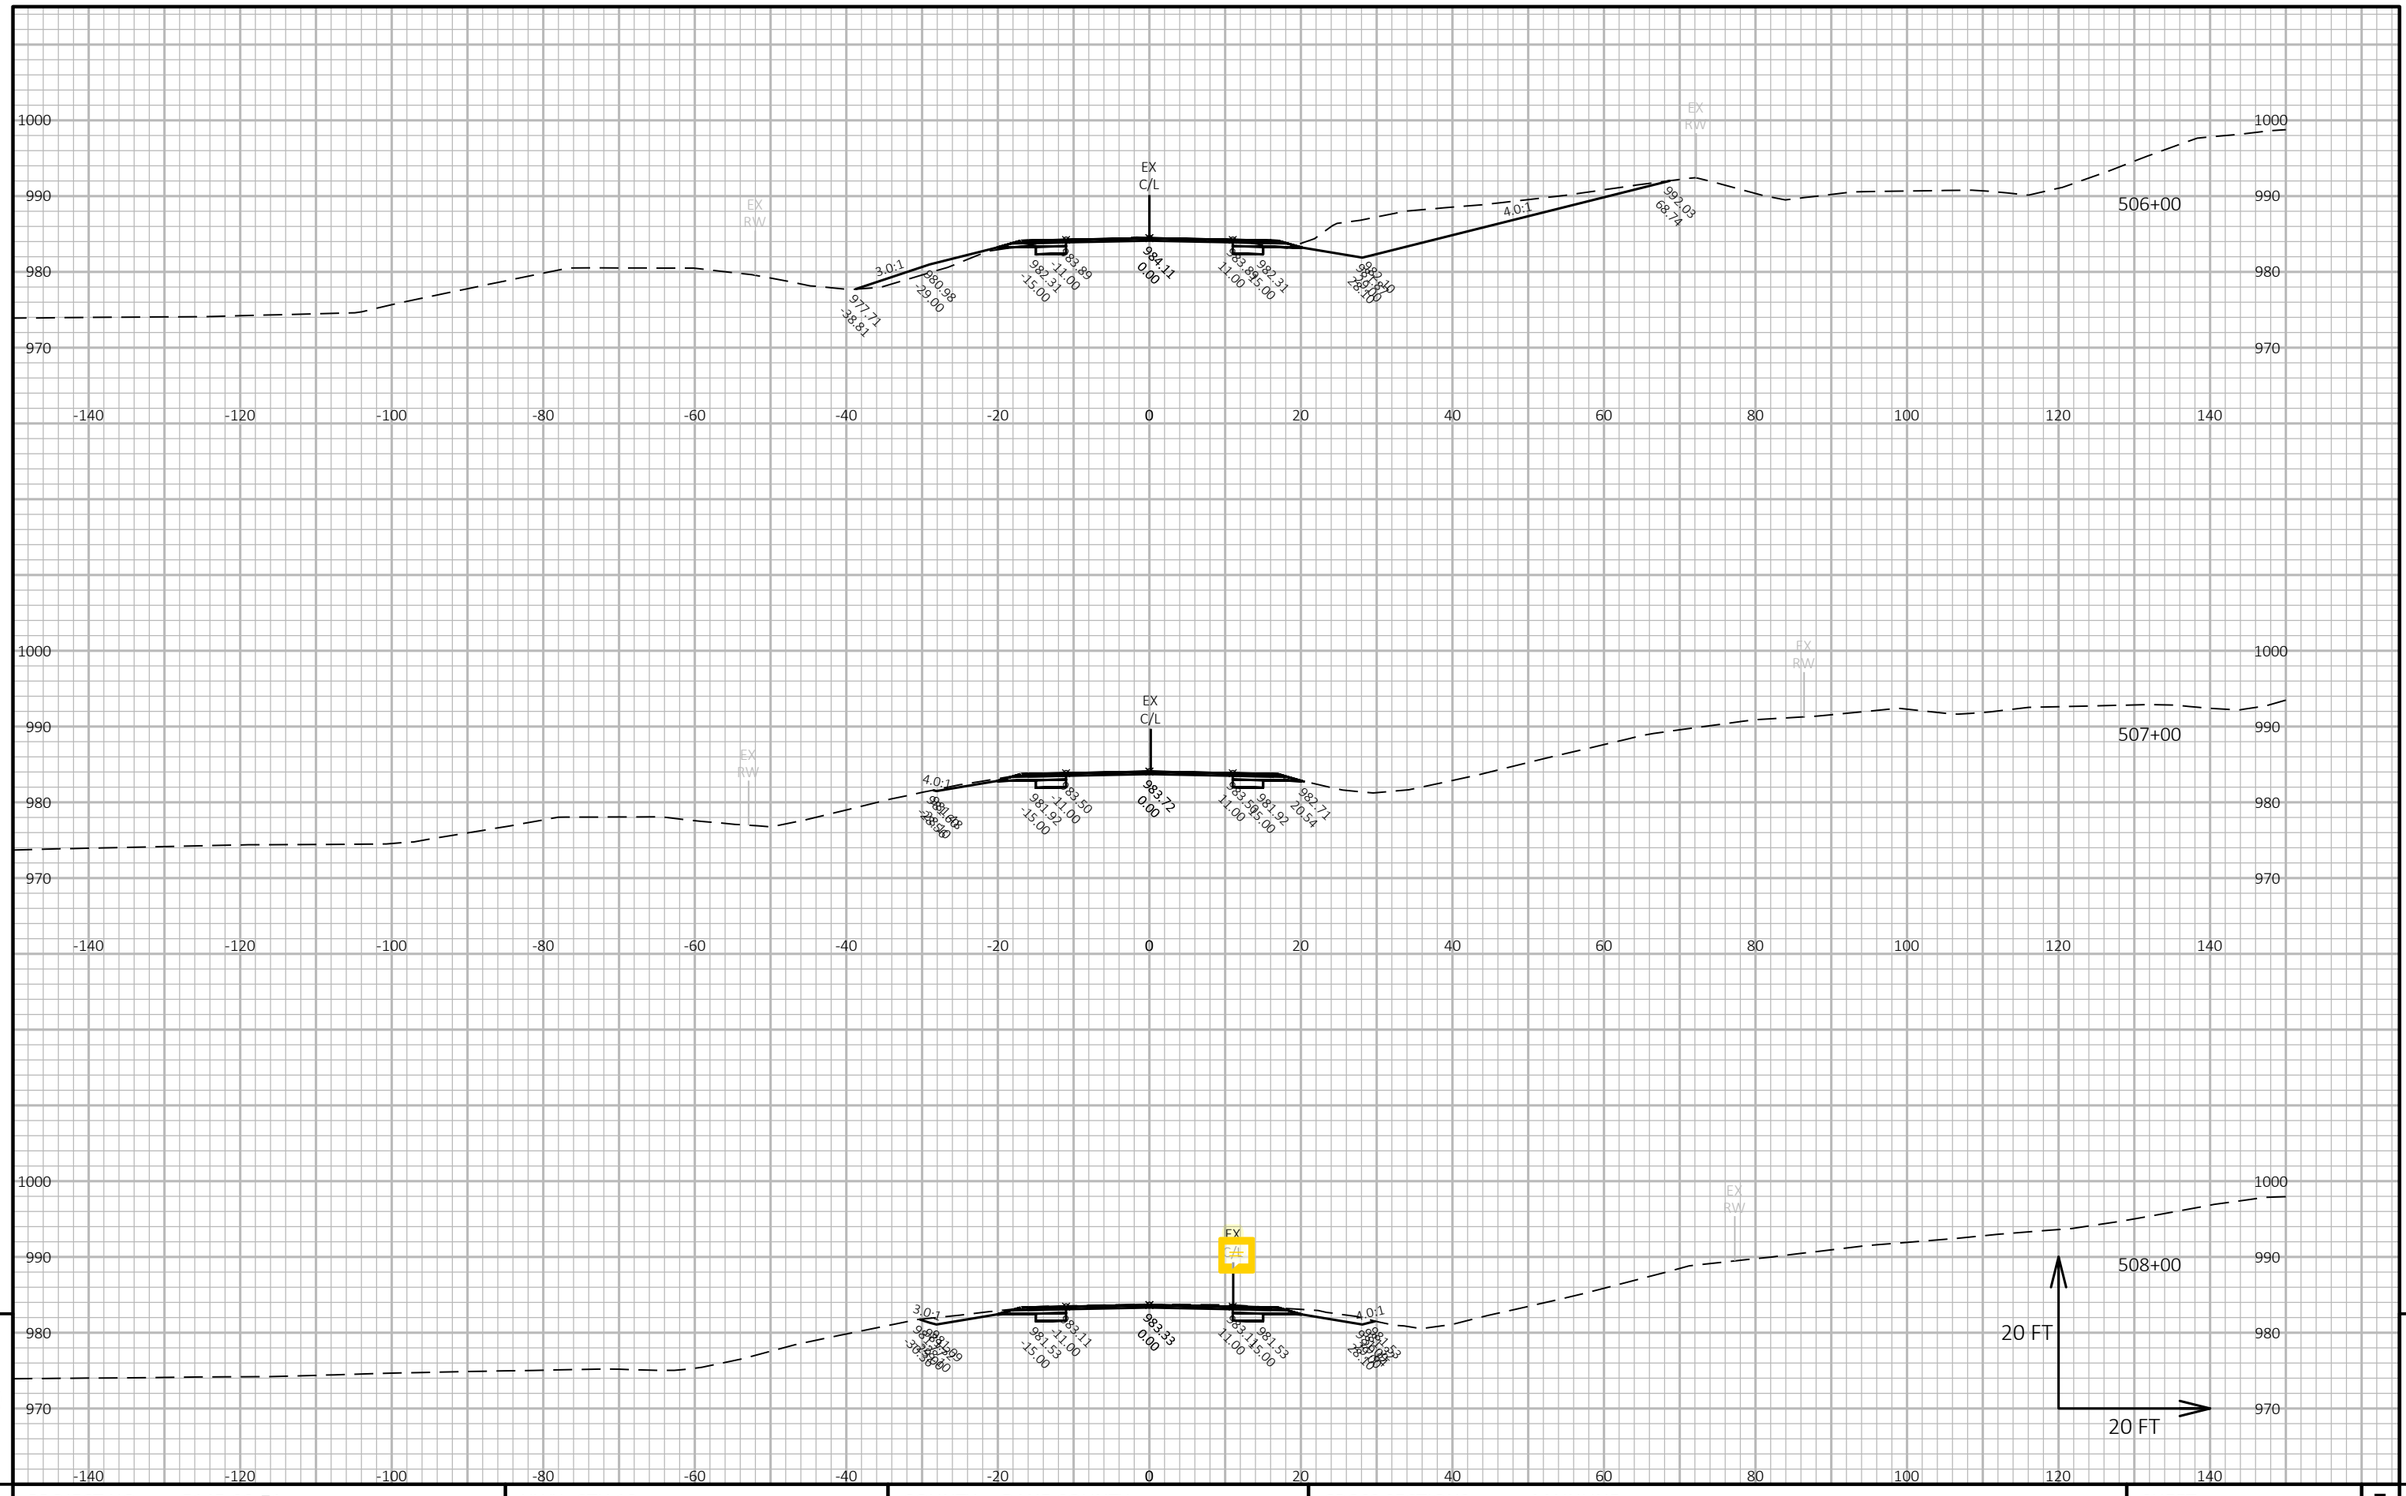

PROJECT NO: 5145-00-71	HWY: STH 19	COUNTY: DANE COUNTY	CROSS SECTIONS: MAINLINE	SHEET 267	E

FILE NAME : N:\PDS\C3D\51450001\SHEETSPLAN\090201_XS.DWG
LAYOUT NAME - 0902220-xs

PLOT DATE : 6/6/2018 6:15 PM

PLOT BY : RACH, JEREMY PAUL

PLOT NAME :

PLOT SCALE : 1 IN:20 FT HORZ. / 1 IN:20 FT VERT.

WISDOT/CADDS SHEET 49

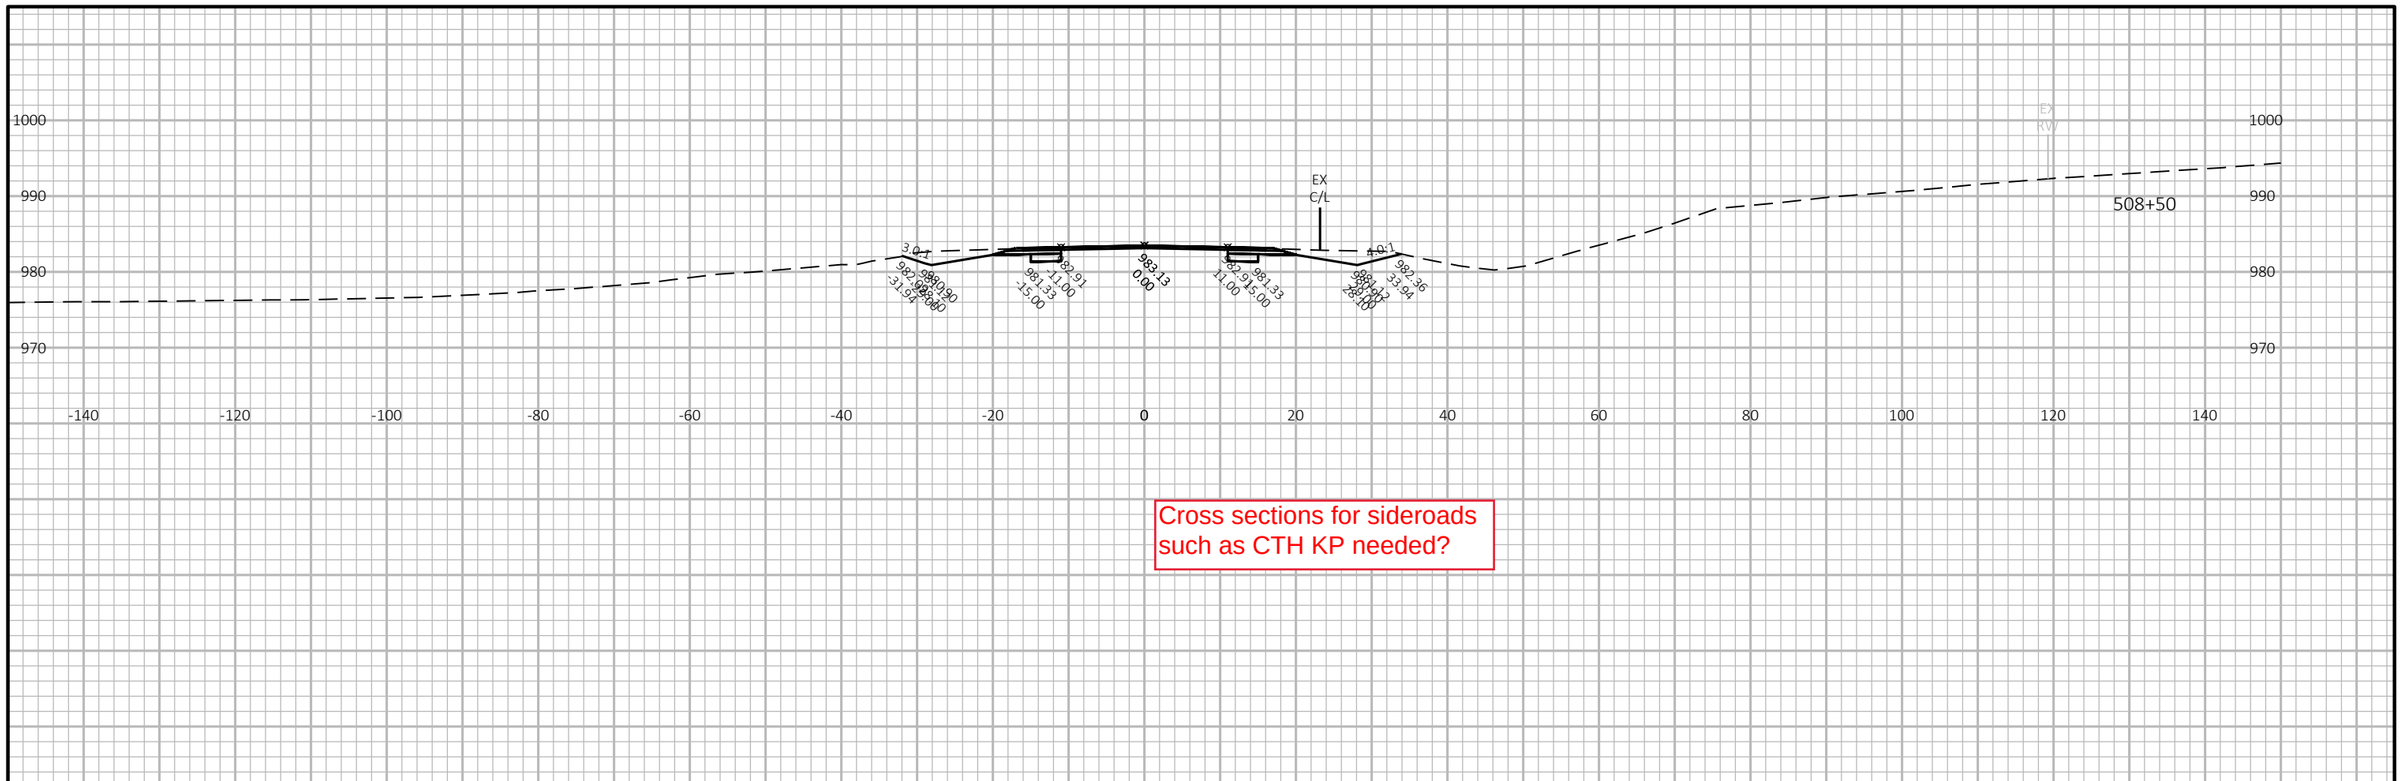

Cross sections for sideroads such as CTH KP needed?

20 FT

20 FT

9

9

PROJECT NO: 5145-00-71	HWY: STH 19	COUNTY: DANE COUNTY	CROSS SECTIONS: ##########################	SHEET 268	E

FILE NAME : N:\PDS\C3D\51450001\SHEETSPLAN\090201_XS.DWG
LAYOUT NAME - 0902221-xs

PLOT DATE : 6/6/2018 6:15 PM PLOT BY : RACH, JEREMY PAUL PLOT NAME : PLOT SCALE : 1 IN:20 FT HORZ. / 1 IN:20 FT VERT.